


FOR INFORMATION ONLY

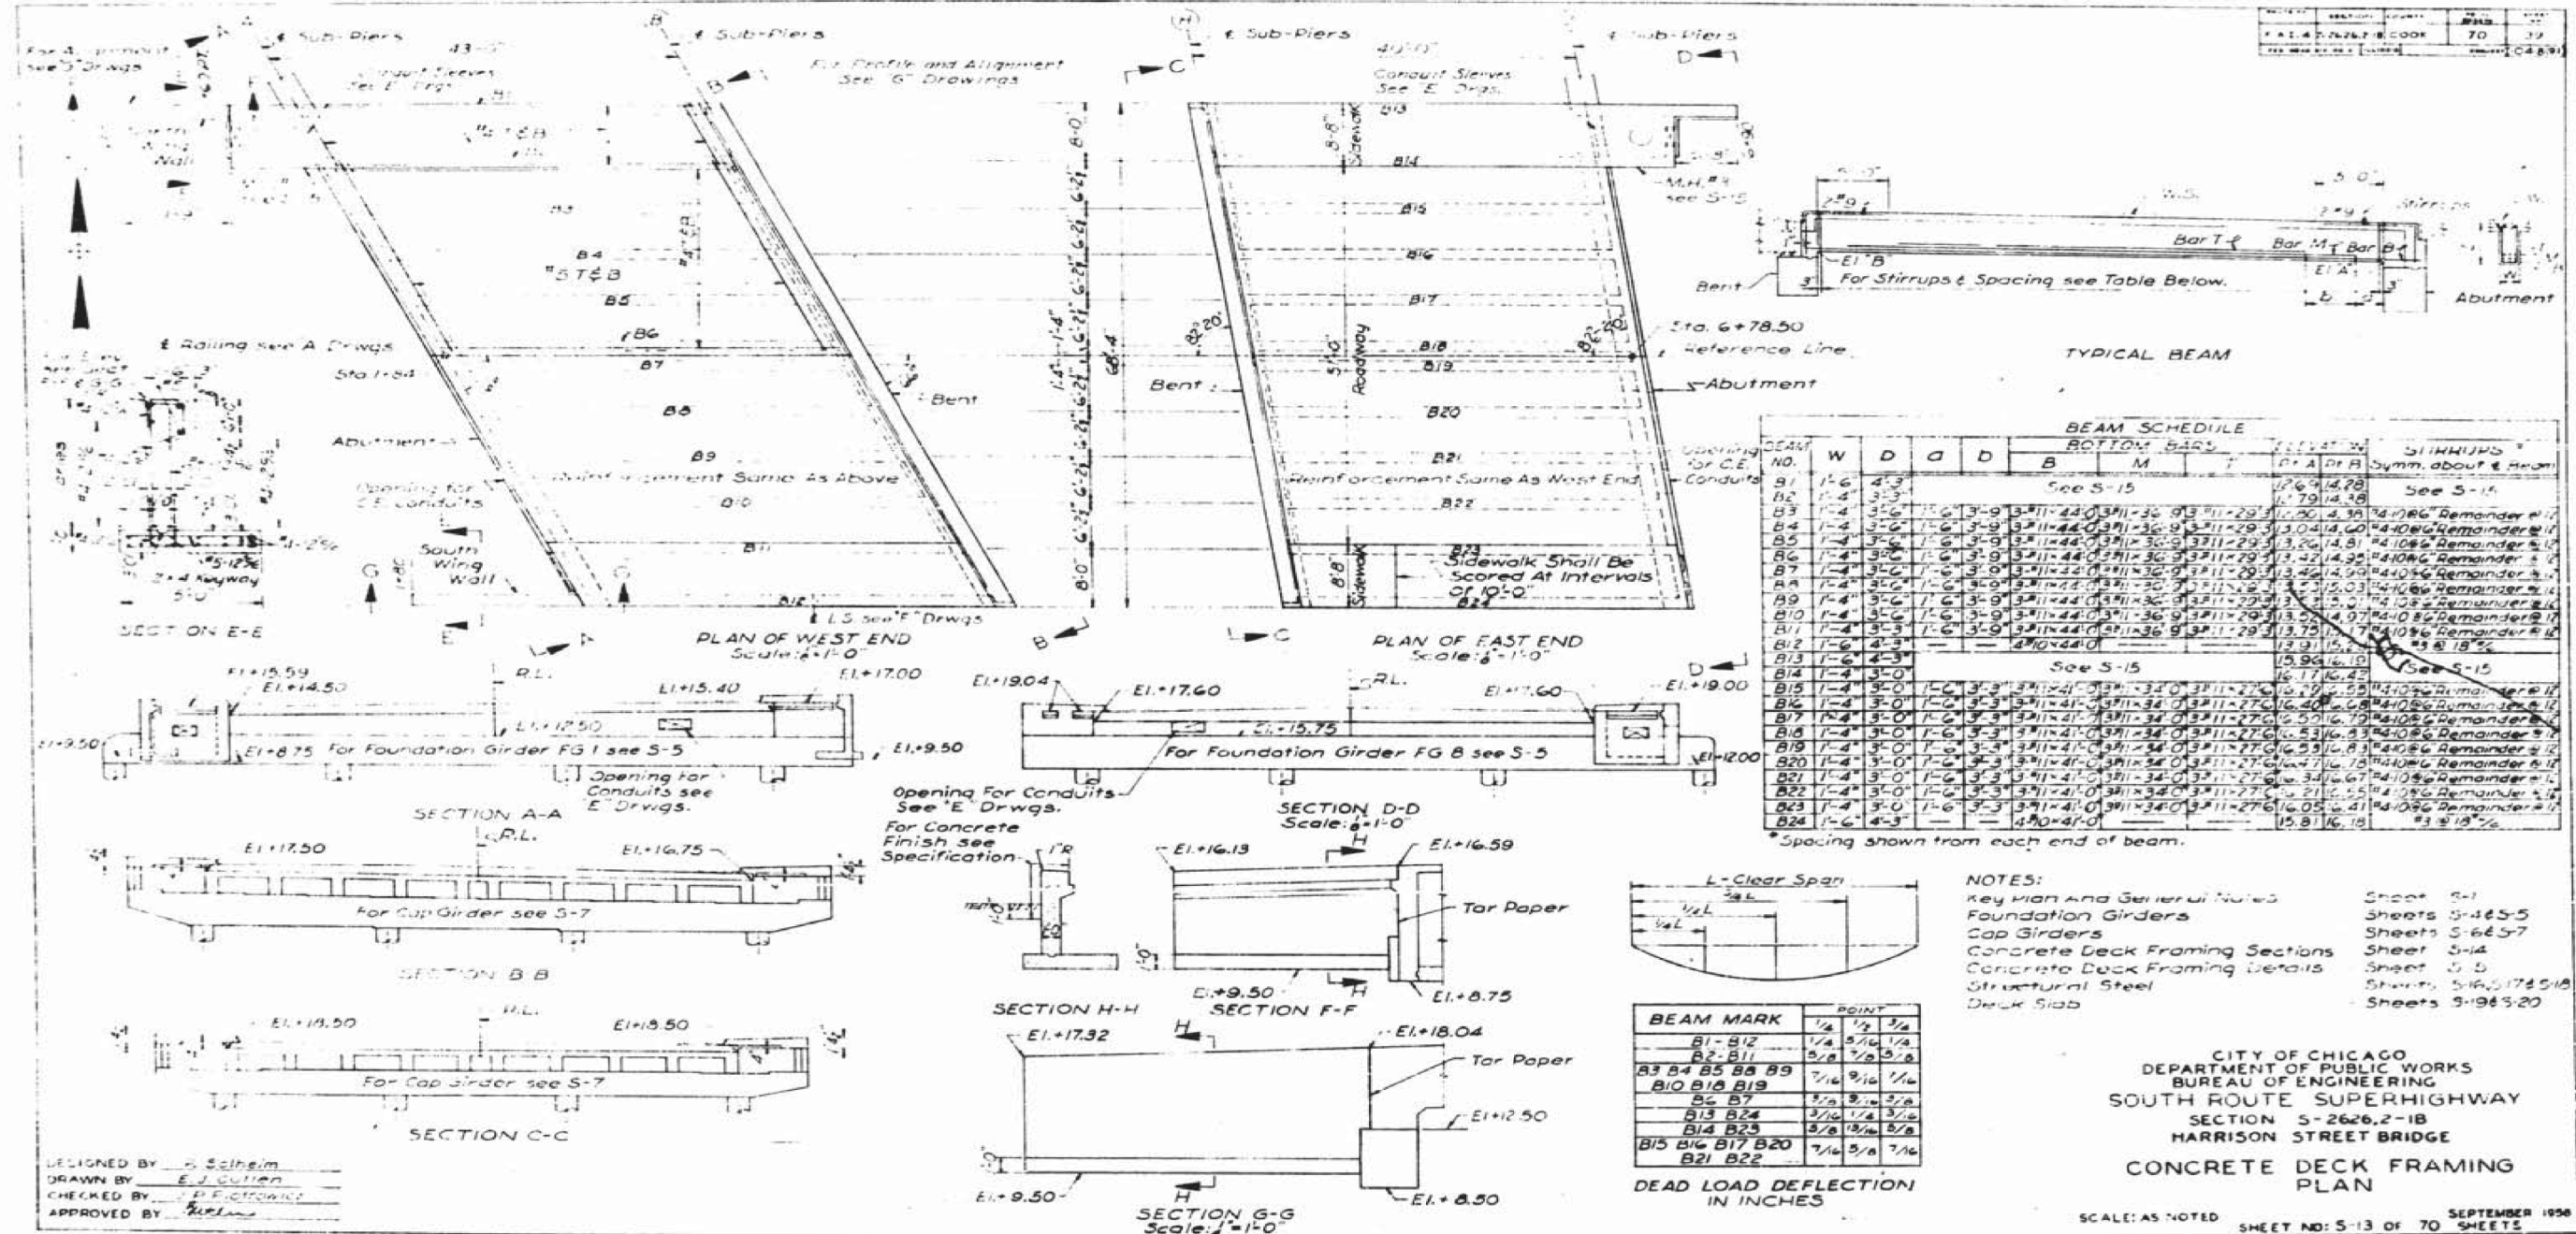

D:\6071-sht-AS-BUILT-43.dgn

DESIGNED BY: S. Scheim
 DRAWN BY: E. J. Gullen
 CHECKED BY: P. F. FORTIN
 APPROVED BY: [Signature]

USER NAME = dunkerleyb	DESIGNED -	REVISED
	CHECKED -	REVISED
PLOT SCALE = N.T.S.	DRAWN -	REVISED
PLOT DATE = 11/26/2013	CHECKED -	REVISED

STATE OF ILLINOIS
 DEPARTMENT OF TRANSPORTATION

EXISTING AS-BUILTS SN 016-1088

SHEET NO. AS-43 OF AS-72 SHEETS

F.A.I. R.T.E. 90/94/290	SECTION 2013-036R	COUNTY COOK	TOTAL SHEETS 256	SHEET NO. 185
CONTRACT NO. 60W71			ILLINOIS FED. AID PROJECT -NUMBER-	

SCALE: AS NOTED SHEET NO: 5-13 OF 70 SHEETS SEPTEMBER 1998