


FOR INFORMATION ONLY

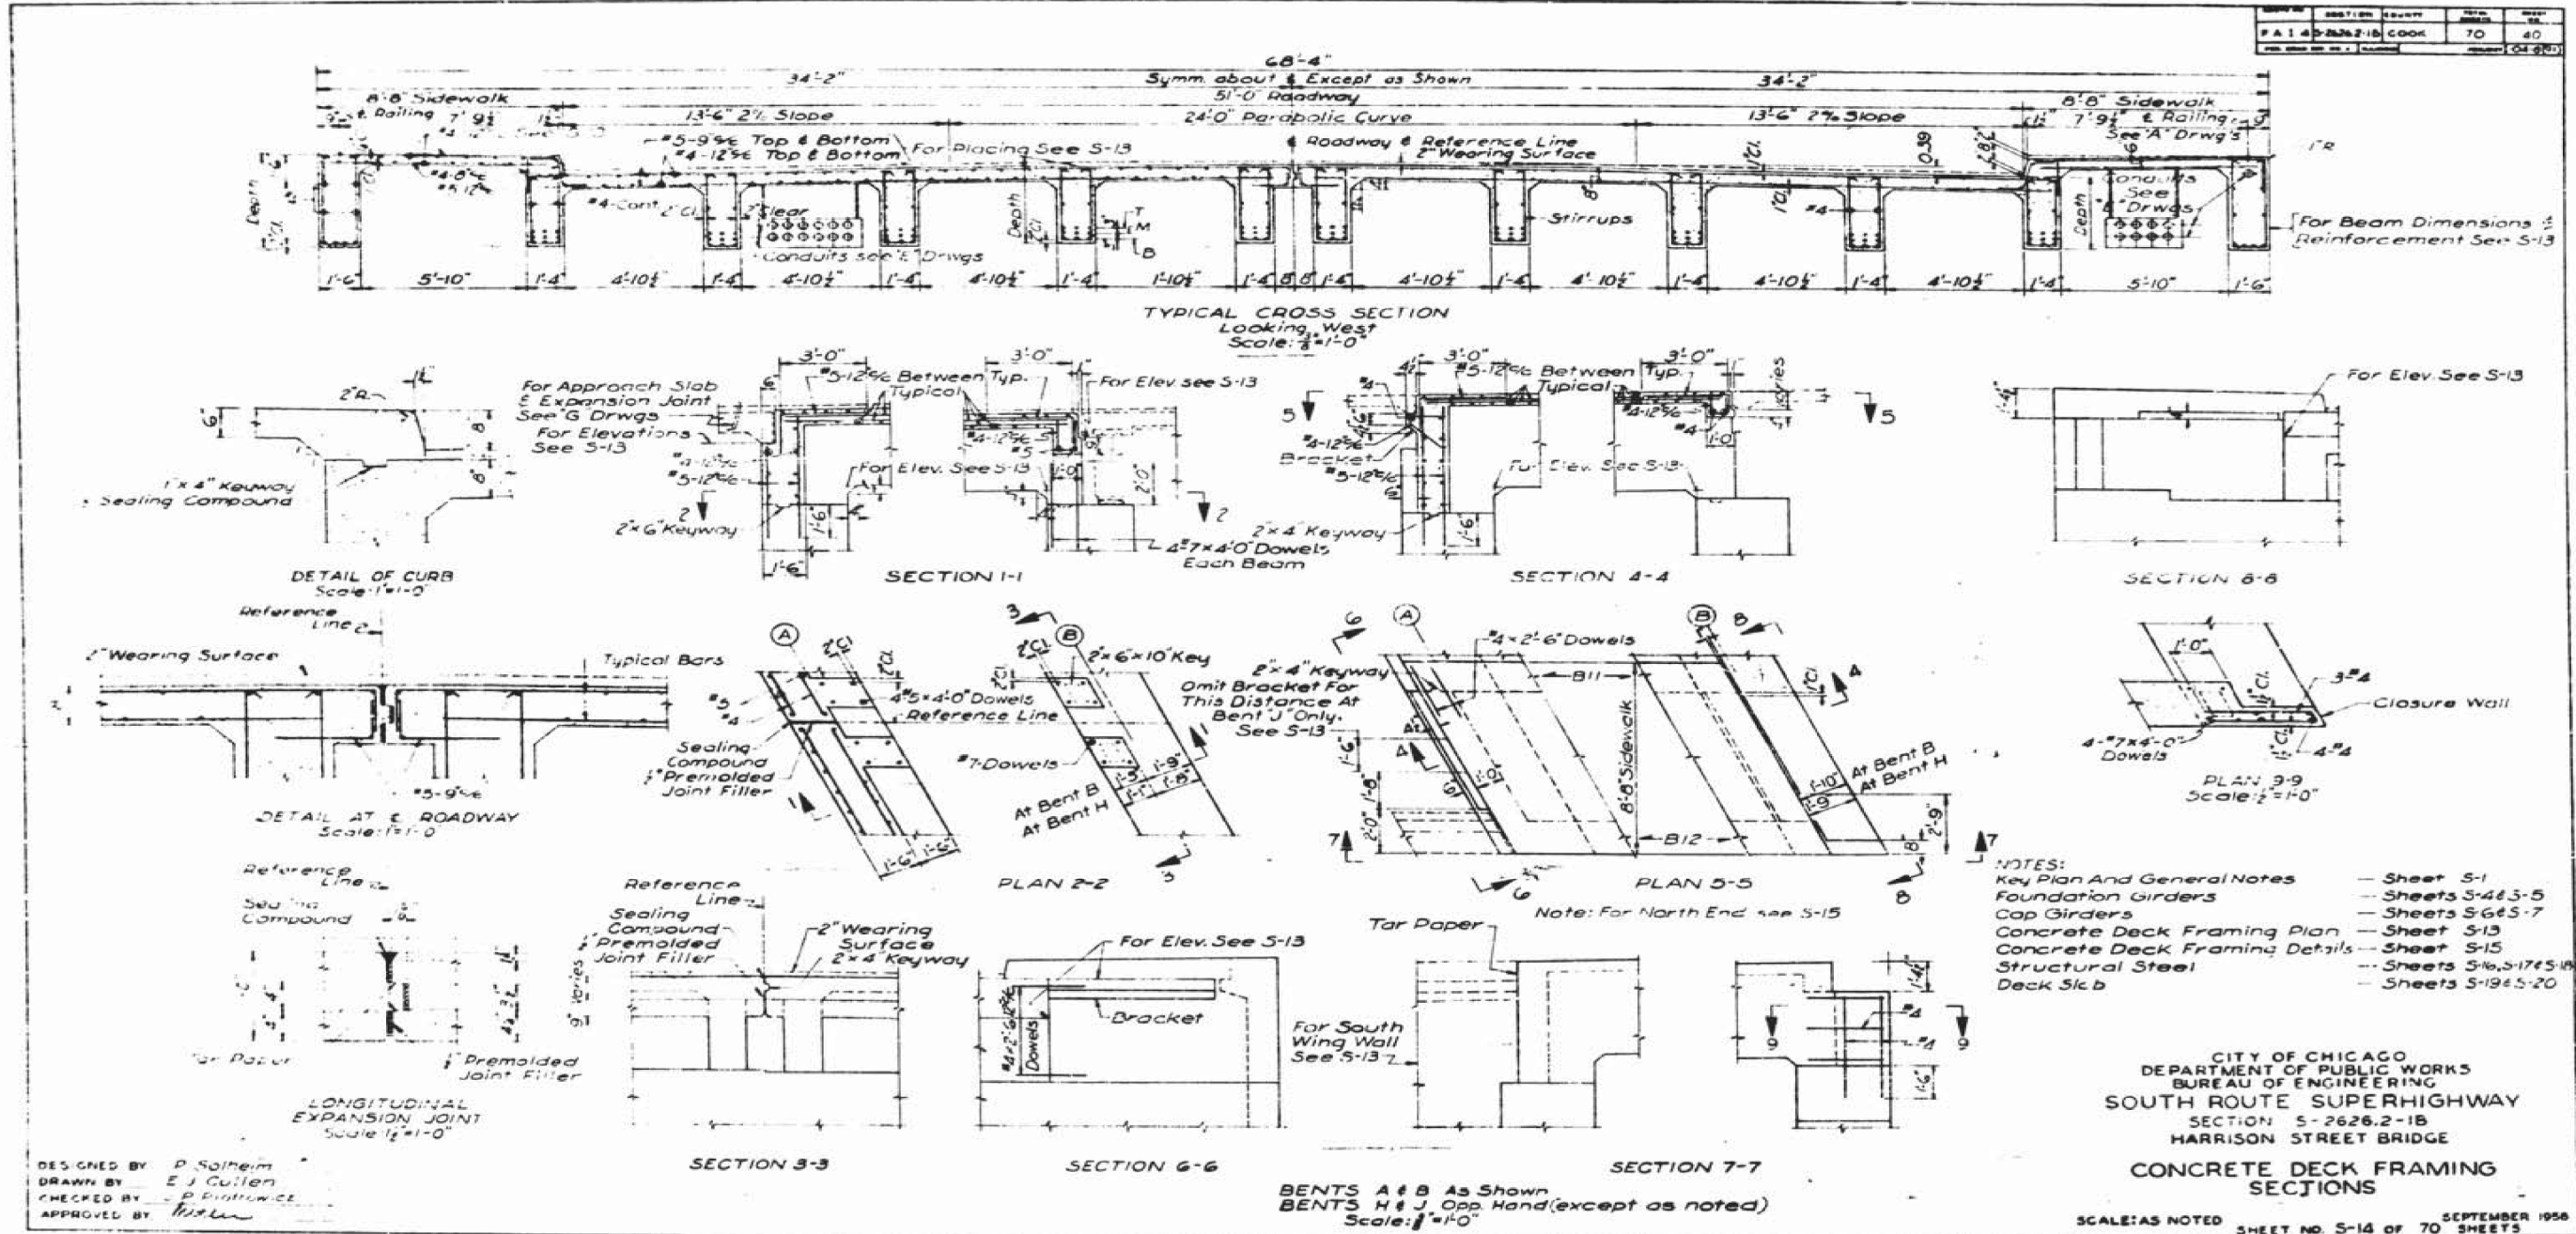

DESIGNED BY P. Solheim
 DRAWN BY E. J. Cullen
 CHECKED BY P. Piotrowski
 APPROVED BY [Signature]

- NOTES:
 Key Plan and General Notes — Sheet S-1
 Foundation Girders — Sheets S-4&5-5
 Cap Girders — Sheets S-6&5-7
 Concrete Deck Framing Plan — Sheet S-13
 Concrete Deck Framing Details — Sheet S-15
 Structural Steel — Sheets S-16, S-17&5-18
 Deck Slab — Sheets S-19&5-20

CITY OF CHICAGO
 DEPARTMENT OF PUBLIC WORKS
 BUREAU OF ENGINEERING
 SOUTH ROUTE SUPERHIGHWAY
 SECTION 5-2626.2-1B
 HARRISON STREET BRIDGE
 CONCRETE DECK FRAMING
 SECTIONS

SCALE: AS NOTED
 SHEET NO. S-14 OF 70 SHEETS
 SEPTEMBER 1958

D160W71-sht-AS-BUILT-44.dgn

USER NAME = dunkerleyb	DESIGNED -	REVISED
	CHECKED -	REVISED
PLOT SCALE = N.T.S.	DRAWN -	REVISED
PLOT DATE = 11/26/2013	CHECKED -	REVISED

STATE OF ILLINOIS
 DEPARTMENT OF TRANSPORTATION

EXISTING AS-BUILTS SN 016-1088

SHEET NO. AS-44 OF AS-72 SHEETS

F.A.I. R.T.E.	SECTION	COUNTY	TOTAL SHEETS	SHEET NO.
90/94/290	2013-036R	COOK	256	186
				CONTRACT NO. 60W71
ILLINOIS FED. AID PROJECT -NUMBER-				