


FOR INFORMATION ONLY

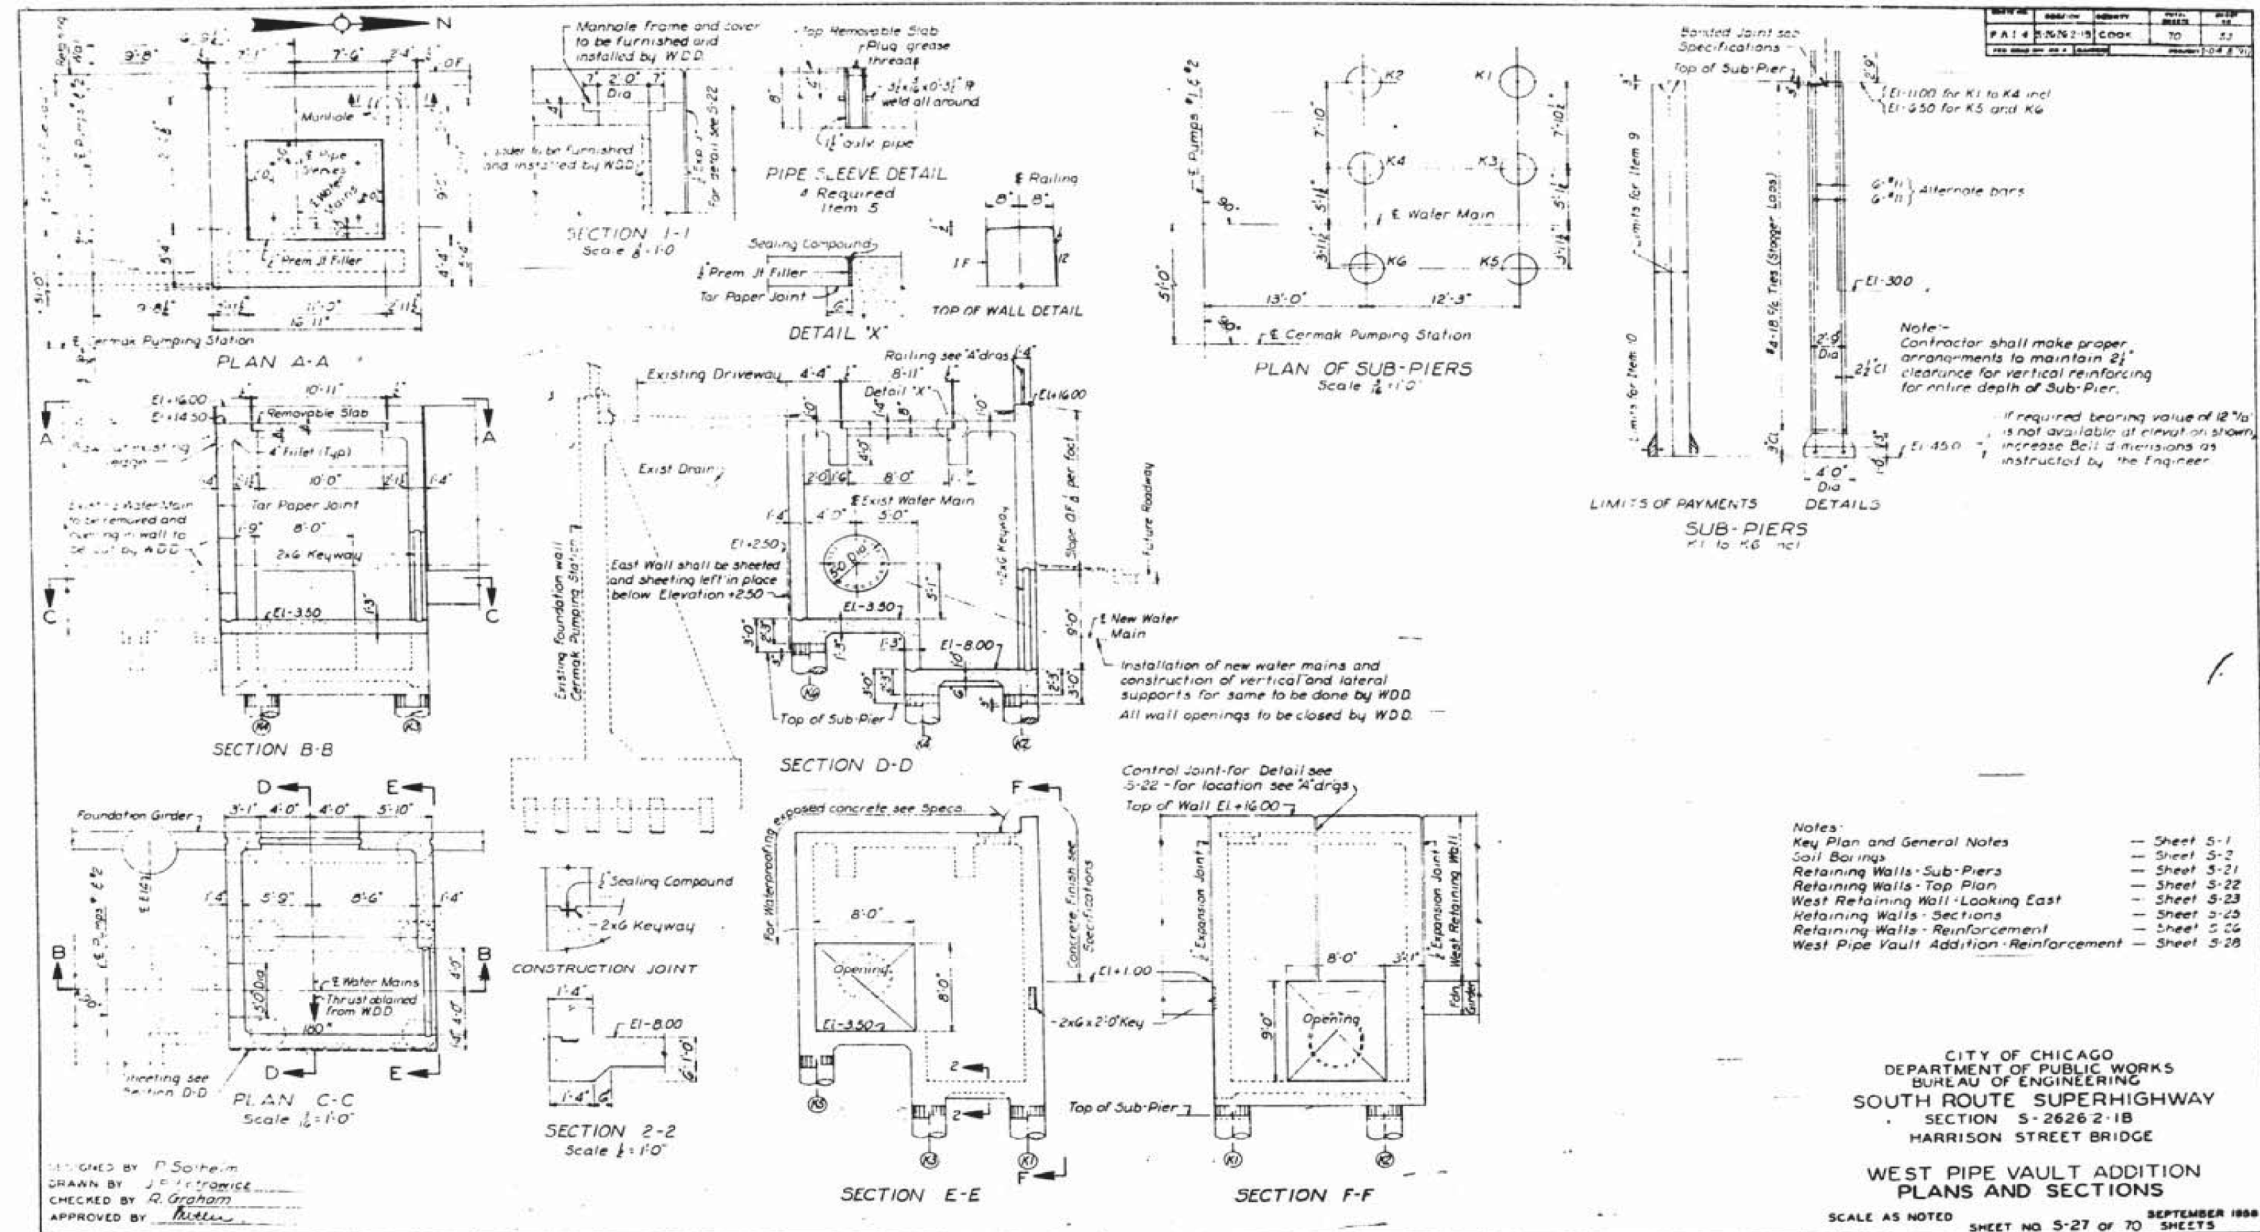

DESIGNED BY P. Seifert
 DRAWN BY J. C. Strickland
 CHECKED BY R. Graham
 APPROVED BY [Signature]

- Notes:
- Key Plan and General Notes — Sheet 5-1
 - Soil Borings — Sheet 5-2
 - Retaining Walls - Sub-Piers — Sheet 5-21
 - Retaining Walls - Top Plan — Sheet 5-22
 - West Retaining Wall - Looking East — Sheet 5-23
 - Retaining Walls - Sections — Sheet 5-25
 - Retaining Walls - Reinforcement — Sheet 5-26
 - West Pipe Vault Addition - Reinforcement — Sheet 5-28

CITY OF CHICAGO
 DEPARTMENT OF PUBLIC WORKS
 BUREAU OF ENGINEERING
 SOUTH ROUTE SUPERHIGHWAY
 SECTION S-2626 2-1B
 HARRISON STREET BRIDGE
 WEST PIPE VAULT ADDITION
 PLANS AND SECTIONS
 SCALE AS NOTED SHEET NO. 5-27 OF 70 SHEETS
 SEPTEMBER 1988

D:\GOW71-sht-AS-BUILT-58.dgn

USER NAME = dunkerleyb	DESIGNED -	REVISED -
	CHECKED -	REVISED -
PLOT SCALE = N.T.S.	DRAWN -	REVISED -
PLOT DATE = 11/26/2013	CHECKED -	REVISED -

STATE OF ILLINOIS
 DEPARTMENT OF TRANSPORTATION

EXISTING AS-BUILTS SN 016-1088

SHEET NO. AS-58 OF AS-72 SHEETS

F.A.I. R.T.E.	SECTION	COUNTY	TOTAL SHEETS	SHEET NO.
90/94/290	2013-036R	COOK	256	200
				CONTRACT NO. 60W71
ILLINOIS FED. AID PROJECT -NUMBER-				