


FOR INFORMATION ONLY

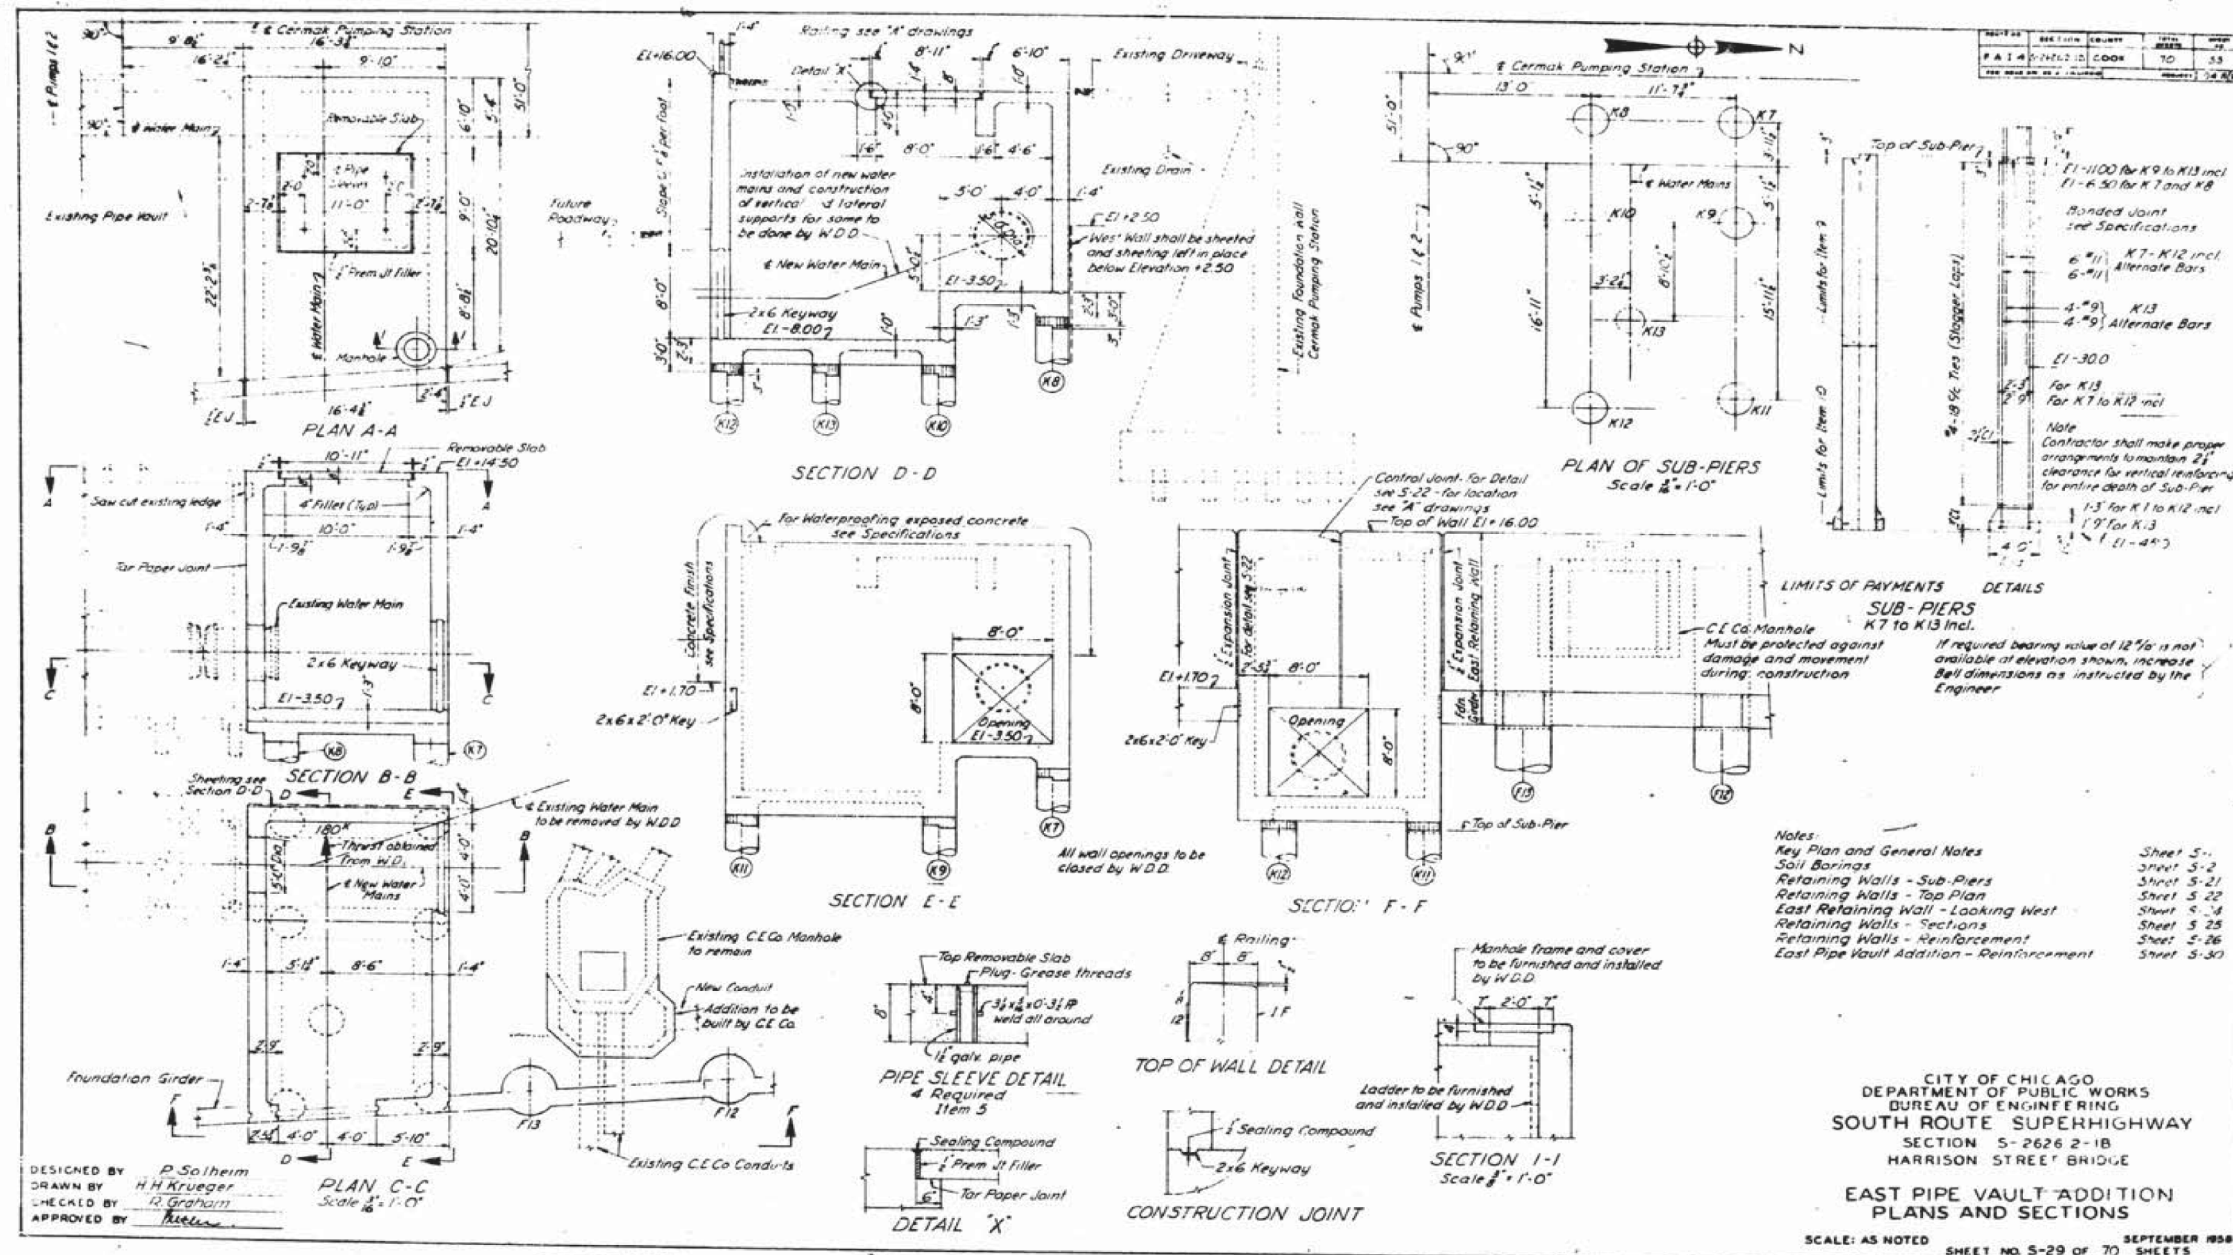

CITY OF CHICAGO
 DEPARTMENT OF PUBLIC WORKS
 BUREAU OF ENGINEERING
 SOUTH ROUTE SUPERHIGHWAY
 SECTION 5-2626 2-1B
 HARRISON STREET BRIDGE
**EAST PIPE VAULT ADDITION
 PLANS AND SECTIONS**
 SCALE: AS NOTED SHEET NO. 5-29 OF 70 SHEETS SEPTEMBER 1958

D:\6071-shr-AS-BUILT-60.dgn

USER NAME = dunkerleyb	DESIGNED -	REVISED	STATE OF ILLINOIS DEPARTMENT OF TRANSPORTATION	EXISTING AS-BUILTS SN 016-1088	F.A.I. R.E.	SECTION	COUNTY	TOTAL SHEETS	SHEET NO.	
	CHECKED -	REVISED			90/94/290	2013-036R	COOK	256	202	
PLOT SCALE = N.T.S.	DRAWN -	REVISED			CONTRACT NO. 60W71					
PLOT DATE = 11/26/2013	CHECKED -	REVISED			ILLINOIS FED. AID PROJECT -NUMBER-					