

0161711-60W71-S09-TopSlab

BEAM 1

Location	Station	Offset	Theoretical Grade Elevations	Theoretical Grade Elevations Adjusted For Dead Load Deflection
Bk. W. Abut.	7811+74.00	-31.625	598.19	598.19
⌚ Brg. W. Abut.	7811+77.00	-31.625	598.27	598.27
A	7811+87.00	-31.625	598.53	598.59
B	7811+97.00	-31.625	598.78	598.90
C	7812+07.00	-31.625	599.04	599.19
D	7812+17.00	-31.625	599.30	599.47
E	7812+27.00	-31.625	599.55	599.71
F	7812+37.00	-31.625	599.75	599.89
G	7812+47.00	-31.625	599.90	600.00
H	7812+57.00	-31.625	599.99	600.05
I	7812+67.00	-31.625	600.04	600.05
⌚ Pier	7812+73.25	-31.625	600.05	600.05
J	7812+83.25	-31.625	600.02	600.01
K	7812+93.25	-31.625	599.93	599.92
L	7813+03.25	-31.625	599.80	599.80
M	7813+13.25	-31.625	599.62	599.62
N	7813+23.25	-31.625	599.39	599.40
O	7813+33.25	-31.625	599.11	599.11
⌚ Brg. E. Abut.	7813+41.25	-31.625	598.84	598.84
Bk. E. Abut.	7813+44.25	-31.625	598.74	598.74

BEAM 2

Location	Station	Offset	Theoretical Grade Elevations	Theoretical Grade Elevations Adjusted For Dead Load Deflection
Bk. W. Abut.	7811+74.00	-25.875	598.04	598.04
⌚ Brg. W. Abut.	7811+77.00	-25.875	598.12	598.12
A	7811+87.00	-25.875	598.38	598.44
B	7811+97.00	-25.875	598.63	598.75
C	7812+07.00	-25.875	598.89	599.04
D	7812+17.00	-25.875	599.15	599.32
E	7812+27.00	-25.875	599.40	599.56
F	7812+37.00	-25.875	599.60	599.74
G	7812+47.00	-25.875	599.75	599.85
H	7812+57.00	-25.875	599.84	599.90
I	7812+67.00	-25.875	599.89	599.91
⌚ Pier	7812+73.25	-25.875	599.90	599.90
J	7812+83.25	-25.875	599.87	599.86
K	7812+93.25	-25.875	599.78	599.77
L	7813+03.25	-25.875	599.65	599.65
M	7813+13.25	-25.875	599.47	599.47
N	7813+23.25	-25.875	599.24	599.25
O	7813+33.25	-25.875	598.96	598.96
⌚ Brg. E. Abut.	7813+41.25	-25.875	598.69	598.69
Bk. E. Abut.	7813+44.25	-25.875	598.59	598.59

BEAM 3

Location	Station	Offset	Theoretical Grade Elevations	Theoretical Grade Elevations Adjusted For Dead Load Deflection
Bk. W. Abut.	7811+74.00	-20.125	597.97	597.97
⌚ Brg. W. Abut.	7811+77.00	-20.125	598.05	598.05
A	7811+87.00	-20.125	598.30	598.37
B	7811+97.00	-20.125	598.56	598.68
C	7812+07.00	-20.125	598.82	598.97
D	7812+17.00	-20.125	599.08	599.24
E	7812+27.00	-20.125	599.33	599.49
F	7812+37.00	-20.125	599.53	599.67
G	7812+47.00	-20.125	599.68	599.78
H	7812+57.00	-20.125	599.77	599.82
I	7812+67.00	-20.125	599.82	599.83
⌚ Pier	7812+73.25	-20.125	599.83	599.83
J	7812+83.25	-20.125	599.80	599.78
K	7812+93.25	-20.125	599.71	599.70
L	7813+03.25	-20.125	599.58	599.58
M	7813+13.25	-20.125	599.40	599.40
N	7813+23.25	-20.125	599.17	599.17
O	7813+33.25	-20.125	598.89	598.89
⌚ Brg. E. Abut.	7813+41.25	-20.125	598.62	598.62
Bk. E. Abut.	7813+44.25	-20.125	598.52	598.52



USER NAME =	dunkerleyb
PLOT SCALE =	N.T.S.
PLOT DATE =	12/17/2013

DESIGNED -	MK
CHECKED -	DD
DRAWN -	BRD
CHECKED -	DD

REVISED
REVISED
REVISED
REVISED

STATE OF ILLINOIS
DEPARTMENT OF TRANSPORTATION

TOP OF SLAB ELEVATIONS - I
STRUCTURE NO. 016-1711

SHEET NO. S-09 OF S-47 SHEETS

F.A.I. RTE.	SECTION	COUNTY	TOTAL SHEETS	SHEET NO.
90/94/290	2013-036R	COOK	256	101
		CONTRACT NO. 60W71		
ILLINOIS FED. AID PROJECT -NUMBER-				

0161711-60W71-S10-TopSlab.dwg

BEAM 4

Location	Station	Offset	Theoretical Grade Elevations	Theoretical Grade Elevations Adjusted For Dead Load Deflection
Bk. W. Abut.	7811+74.00	-14.375	598.06	598.06
⌒ Brg. W. Abut.	7811+77.00	-14.375	598.14	598.14
A	7811+87.00	-14.375	598.39	598.46
B	7811+97.00	-14.375	598.65	598.77
C	7812+07.00	-14.375	598.91	599.06
D	7812+17.00	-14.375	599.17	599.33
E	7812+27.00	-14.375	599.42	599.58
F	7812+37.00	-14.375	599.62	599.76
G	7812+47.00	-14.375	599.77	599.87
H	7812+57.00	-14.375	599.86	599.91
I	7812+67.00	-14.375	599.91	599.92
⌒ Pier	7812+73.25	-14.375	599.92	599.92
J	7812+83.25	-14.375	599.89	599.87
K	7812+93.25	-14.375	599.80	599.79
L	7813+03.25	-14.375	599.67	599.67
M	7813+13.25	-14.375	599.49	599.49
N	7813+23.25	-14.375	599.26	599.26
O	7813+33.25	-14.375	598.98	598.98
⌒ Brg. E. Abut.	7813+41.25	-14.375	598.71	598.71
Bk. E. Abut.	7813+44.25	-14.375	598.61	598.61

BEAM 5

Location	Station	Offset	Theoretical Grade Elevations	Theoretical Grade Elevations Adjusted For Dead Load Deflection
Bk. W. Abut.	7811+74.00	-8.625	598.15	598.15
⌒ Brg. W. Abut.	7811+77.00	-8.625	598.23	598.23
A	7811+87.00	-8.625	598.48	598.55
B	7811+97.00	-8.625	598.74	598.86
C	7812+07.00	-8.625	599.00	599.15
D	7812+17.00	-8.625	599.26	599.42
E	7812+27.00	-8.625	599.51	599.67
F	7812+37.00	-8.625	599.71	599.85
G	7812+47.00	-8.625	599.86	599.96
H	7812+57.00	-8.625	599.95	600.00
I	7812+67.00	-8.625	600.00	600.01
⌒ Pier	7812+73.25	-8.625	600.01	600.01
J	7812+83.25	-8.625	599.98	599.96
K	7812+93.25	-8.625	599.89	599.88
L	7813+03.25	-8.625	599.76	599.76
M	7813+13.25	-8.625	599.58	599.58
N	7813+23.25	-8.625	599.35	599.35
O	7813+33.25	-8.625	599.07	599.07
⌒ Brg. E. Abut.	7813+41.25	-8.625	598.80	598.80
Bk. E. Abut.	7813+44.25	-8.625	598.70	598.70

BEAM 6

Location	Station	Offset	Theoretical Grade Elevations	Theoretical Grade Elevations Adjusted For Dead Load Deflection
Bk. W. Abut.	7811+74.00	-2.875	598.24	598.24
⌒ Brg. W. Abut.	7811+77.00	-2.875	598.32	598.32
A	7811+87.00	-2.875	598.57	598.64
B	7811+97.00	-2.875	598.83	598.95
C	7812+07.00	-2.875	599.09	599.24
D	7812+17.00	-2.875	599.35	599.51
E	7812+27.00	-2.875	599.60	599.76
F	7812+37.00	-2.875	599.80	599.93
G	7812+47.00	-2.875	599.95	600.05
H	7812+57.00	-2.875	600.04	600.09
I	7812+67.00	-2.875	600.09	600.10
⌒ Pier	7812+73.25	-2.875	600.10	600.10
J	7812+83.25	-2.875	600.07	600.05
K	7812+93.25	-2.875	599.98	599.97
L	7813+03.25	-2.875	599.85	599.85
M	7813+13.25	-2.875	599.67	599.67
N	7813+23.25	-2.875	599.44	599.44
O	7813+33.25	-2.875	599.16	599.16
⌒ Brg. E. Abut.	7813+41.25	-2.875	598.89	598.89
Bk. E. Abut.	7813+44.25	-2.875	598.79	598.79



USER NAME = dunkerleyb	DESIGNED - MK
	CHECKED - DD
PLOT SCALE = N.T.S.	DRAWN - BRD
PLOT DATE = 12/17/2013	CHECKED - DD

REVISED
REVISED
REVISED
REVISED

STATE OF ILLINOIS
DEPARTMENT OF TRANSPORTATION

TOP OF SLAB ELEVATIONS - II
STRUCTURE NO. 016-1711

SHEET NO. S-10 OF S-47 SHEETS

F.A.I. RTE.	SECTION	COUNTY	TOTAL SHEETS	SHEET NO.
90/94/290	2013-036R	COOK	256	102
		CONTRACT NO. 60W71		
ILLINOIS FED. AID PROJECT -NUMBER-				

PROFILE GRADE LINE
CENTERLINE OF ROADWAY

Location	Station	Offset	Theoretical Grade Elevations	Theoretical Grade Elevations Adjusted For Dead Load Deflection
Bk. W. Abut.	7811+74.00	0	598.28	598.28
⌒ Brg. W. Abut.	7811+77.00	0	598.36	598.36
A	7811+87.00	0	598.62	598.68
B	7811+97.00	0	598.88	598.99
C	7812+07.00	0	599.13	599.28
D	7812+17.00	0	599.39	599.56
E	7812+27.00	0	599.64	599.80
F	7812+37.00	0	599.84	599.98
G	7812+47.00	0	599.99	600.09
H	7812+57.00	0	600.08	600.14
I	7812+67.00	0	600.13	600.15
⌒ Pier	7812+73.25	0	600.14	600.14
J	7812+83.25	0	600.11	600.10
K	7812+93.25	0	600.02	600.01
L	7813+03.25	0	599.89	599.89
M	7813+13.25	0	599.71	599.72
N	7813+23.25	0	599.48	599.49
O	7813+33.25	0	599.20	599.21
⌒ Brg. E. Abut.	7813+41.25	0	598.94	598.94
Bk. E. Abut.	7813+44.25	0	598.84	598.84

BEAM 7

Location	Station	Offset	Theoretical Grade Elevations	Theoretical Grade Elevations Adjusted For Dead Load Deflection
Bk. W. Abut.	7811+74.00	2.875	598.24	598.24
⌒ Brg. W. Abut.	7811+77.00	2.875	598.32	598.32
A	7811+87.00	2.875	598.57	598.64
B	7811+97.00	2.875	598.83	598.95
C	7812+07.00	2.875	599.09	599.24
D	7812+17.00	2.875	599.35	599.51
E	7812+27.00	2.875	599.60	599.76
F	7812+37.00	2.875	599.80	599.93
G	7812+47.00	2.875	599.95	600.05
H	7812+57.00	2.875	600.04	600.09
I	7812+67.00	2.875	600.09	600.10
⌒ Pier	7812+73.25	2.875	600.10	600.10
J	7812+83.25	2.875	600.07	600.05
K	7812+93.25	2.875	599.98	599.97
L	7813+03.25	2.875	599.85	599.85
M	7813+13.25	2.875	599.67	599.67
N	7813+23.25	2.875	599.44	599.44
O	7813+33.25	2.875	599.16	599.16
⌒ Brg. E. Abut.	7813+41.25	2.875	598.89	598.89
Bk. E. Abut.	7813+44.25	2.875	598.79	598.79

BEAM 8

Location	Station	Offset	Theoretical Grade Elevations	Theoretical Grade Elevations Adjusted For Dead Load Deflection
Bk. W. Abut.	7811+74.00	8.625	598.15	598.15
⌒ Brg. W. Abut.	7811+77.00	8.625	598.23	598.23
A	7811+87.00	8.625	598.48	598.55
B	7811+97.00	8.625	598.74	598.86
C	7812+07.00	8.625	599.00	599.15
D	7812+17.00	8.625	599.26	599.42
E	7812+27.00	8.625	599.51	599.67
F	7812+37.00	8.625	599.71	599.85
G	7812+47.00	8.625	599.86	599.96
H	7812+57.00	8.625	599.95	600.00
I	7812+67.00	8.625	600.00	600.01
⌒ Pier	7812+73.25	8.625	600.01	600.01
J	7812+83.25	8.625	599.98	599.96
K	7812+93.25	8.625	599.89	599.88
L	7813+03.25	8.625	599.76	599.76
M	7813+13.25	8.625	599.58	599.58
N	7813+23.25	8.625	599.35	599.35
O	7813+33.25	8.625	599.07	599.07
⌒ Brg. E. Abut.	7813+41.25	8.625	598.80	598.80
Bk. E. Abut.	7813+44.25	8.625	598.70	598.70

0161711-60W71-S11-TopSlab



USER NAME = dunkerleyb	DESIGNED - MK
	CHECKED - DD
PLOT SCALE = N.T.S.	DRAWN - BRD
PLOT DATE = 12/17/2013	CHECKED - DD

REVISED
REVISED
REVISED
REVISED

STATE OF ILLINOIS
DEPARTMENT OF TRANSPORTATION

TOP OF SLAB ELEVATIONS - III
STRUCTURE NO. 016-1711

SHEET NO. S-11 OF S-47 SHEETS

F.A.I. RTE.	SECTION	COUNTY	TOTAL SHEETS	SHEET NO.
90/94/290	2013-036R	COOK	256	103
		CONTRACT NO.	60W71	
		ILLINOIS FED. AID PROJECT -NUMBER-		

BEAM 9

Location	Station	Offset	Theoretical Grade Elevations	Theoretical Grade Elevations Adjusted For Dead Load Deflection
Bk. W. Abut.	7811+74.00	14.375	598.06	598.06
⌒ Brg. W. Abut.	7811+77.00	14.375	598.14	598.14
A	7811+87.00	14.375	598.39	598.46
B	7811+97.00	14.375	598.65	598.77
C	7812+07.00	14.375	598.91	599.06
D	7812+17.00	14.375	599.17	599.33
E	7812+27.00	14.375	599.42	599.58
F	7812+37.00	14.375	599.62	599.76
G	7812+47.00	14.375	599.77	599.87
H	7812+57.00	14.375	599.86	599.91
I	7812+67.00	14.375	599.91	599.92
⌒ Pier	7812+73.25	14.375	599.92	599.92
J	7812+83.25	14.375	599.89	599.87
K	7812+93.25	14.375	599.80	599.79
L	7813+03.25	14.375	599.67	599.67
M	7813+13.25	14.375	599.49	599.49
N	7813+23.25	14.375	599.26	599.26
O	7813+33.25	14.375	598.98	598.98
⌒ Brg. E. Abut.	7813+41.25	14.375	598.71	598.71
Bk. E. Abut.	7813+44.25	14.375	598.61	598.61

BEAM 10

Location	Station	Offset	Theoretical Grade Elevations	Theoretical Grade Elevations Adjusted For Dead Load Deflection
Bk. W. Abut.	7811+74.00	20.125	597.97	597.97
⌒ Brg. W. Abut.	7811+77.00	20.125	598.05	598.05
A	7811+87.00	20.125	598.30	598.37
B	7811+97.00	20.125	598.56	598.68
C	7812+07.00	20.125	598.82	598.97
D	7812+17.00	20.125	599.08	599.24
E	7812+27.00	20.125	599.33	599.49
F	7812+37.00	20.125	599.53	599.67
G	7812+47.00	20.125	599.68	599.78
H	7812+57.00	20.125	599.77	599.82
I	7812+67.00	20.125	599.82	599.83
⌒ Pier	7812+73.25	20.125	599.83	599.83
J	7812+83.25	20.125	599.80	599.78
K	7812+93.25	20.125	599.71	599.70
L	7813+03.25	20.125	599.58	599.58
M	7813+13.25	20.125	599.40	599.40
N	7813+23.25	20.125	599.17	599.17
O	7813+33.25	20.125	598.89	598.89
⌒ Brg. E. Abut.	7813+41.25	20.125	598.62	598.62
Bk. E. Abut.	7813+44.25	20.125	598.52	598.52

BEAM 11

Location	Station	Offset	Theoretical Grade Elevations	Theoretical Grade Elevations Adjusted For Dead Load Deflection
*Bk. W. Abut.	7811+74.00	25.875	597.88	597.88
*⌒ Brg. W. Abut.	7811+77.00	25.875	597.96	597.96
*A	7811+87.00	25.875	598.31	598.37
B	7811+97.00	25.875	598.63	598.75
C	7812+07.00	25.875	598.89	599.04
D	7812+17.00	25.875	599.15	599.32
E	7812+27.00	25.875	599.40	599.56
F	7812+37.00	25.875	599.60	599.74
G	7812+47.00	25.875	599.75	599.85
H	7812+57.00	25.875	599.84	599.90
I	7812+67.00	25.875	599.89	599.91
⌒ Pier	7812+73.25	25.875	599.90	599.90
J	7812+83.25	25.875	599.87	599.86
K	7812+93.25	25.875	599.78	599.77
L	7813+03.25	25.875	599.65	599.65
M	7813+13.25	25.875	599.47	599.47
N	7813+23.25	25.875	599.24	599.25
O	7813+33.25	25.875	598.96	598.96
⌒ Brg. E. Abut.	7813+41.25	25.875	598.69	598.69
Bk. E. Abut.	7813+44.25	25.875	598.59	598.59

*Adjusted for sidewalk
ramp slopes.

0161711-60W71-S12-TopSlab



USER NAME = dunkerleyb	DESIGNED - MK	REVISED
	CHECKED - DD	REVISED
PLOT SCALE = N.T.S.	DRAWN - BRD	REVISED
PLOT DATE = 12/17/2013	CHECKED - DD	REVISED

STATE OF ILLINOIS
DEPARTMENT OF TRANSPORTATION

TOP OF SLAB ELEVATIONS – IV
STRUCTURE NO. 016–1711

SHEET NO. S-12 OF S-47 SHEETS

F.A.I. RTE.	SECTION	COUNTY	TOTAL SHEETS	SHEET NO.
90/94/290	2013-036R	COOK	256	104
		CONTRACT NO. 60W71		
ILLINOIS FED. AID PROJECT -NUMBER-				

BEAM 12

Location	Station	Offset	Theoretical Grade Elevations	Theoretical Grade Elevations Adjusted For Dead Load Deflection
*Bk. W. Abut.	7811+74.00	31.625	597.79	597.79
*℄ Brg. W. Abut.	7811+77.00	31.625	597.88	597.88
*A	7811+87.00	31.625	598.35	598.41
B	7811+97.00	31.625	598.78	598.90
C	7812+07.00	31.625	599.04	599.19
D	7812+17.00	31.625	599.30	599.47
E	7812+27.00	31.625	599.55	599.71
F	7812+37.00	31.625	599.75	599.89
G	7812+47.00	31.625	599.90	600.00
H	7812+57.00	31.625	599.99	600.05
I	7812+67.00	31.625	600.04	600.05
℄ Pier	7812+73.25	31.625	600.05	600.05
J	7812+83.25	31.625	600.02	600.01
K	7812+93.25	31.625	599.93	599.92
L	7813+03.25	31.625	599.80	599.80
M	7813+13.25	31.625	599.62	599.62
N	7813+23.25	31.625	599.39	599.40
O	7813+33.25	31.625	599.11	599.11
℄ Brg. E. Abut.	7813+41.25	31.625	598.84	598.84
Bk. E. Abut.	7813+44.25	31.625	598.74	598.74


*Adjusted for sidewalk
ramp slopes.

0161711-60W71-S13-TopSlab

NORTH EDGE OF PAVEMENT			
Location	Station	Offset	Theoretical Grade Elevations
West End of Appr. Slab A B	7811+44.50	- 32.667'	597.64
	7811+54.50	- 32.667'	597.78
	7811+64.50	- 32.667'	597.98
East End of Appr. Slab	7811+74.50	- 32.667'	598.23


NORTH CURB LINE			
Location	Station	Offset	Theoretical Grade Elevations
West End of Appr. Slab A B	7811+44.50	- 22.000'	597.37
	7811+54.50	- 22.000'	597.51
	7811+64.50	- 22.000'	597.71
East End of Appr. Slab	7811+74.50	- 22.000'	597.96

CL HARRISON ST. & PGL			
Location	Station	Offset	Theoretical Grade Elevations
West End of Appr. Slab A B	7811+44.50	0.000'	597.71
	7811+54.50	0.000'	597.85
	7811+64.50	0.000'	598.05
East End of Appr. Slab	7811+74.50	0.000'	598.30

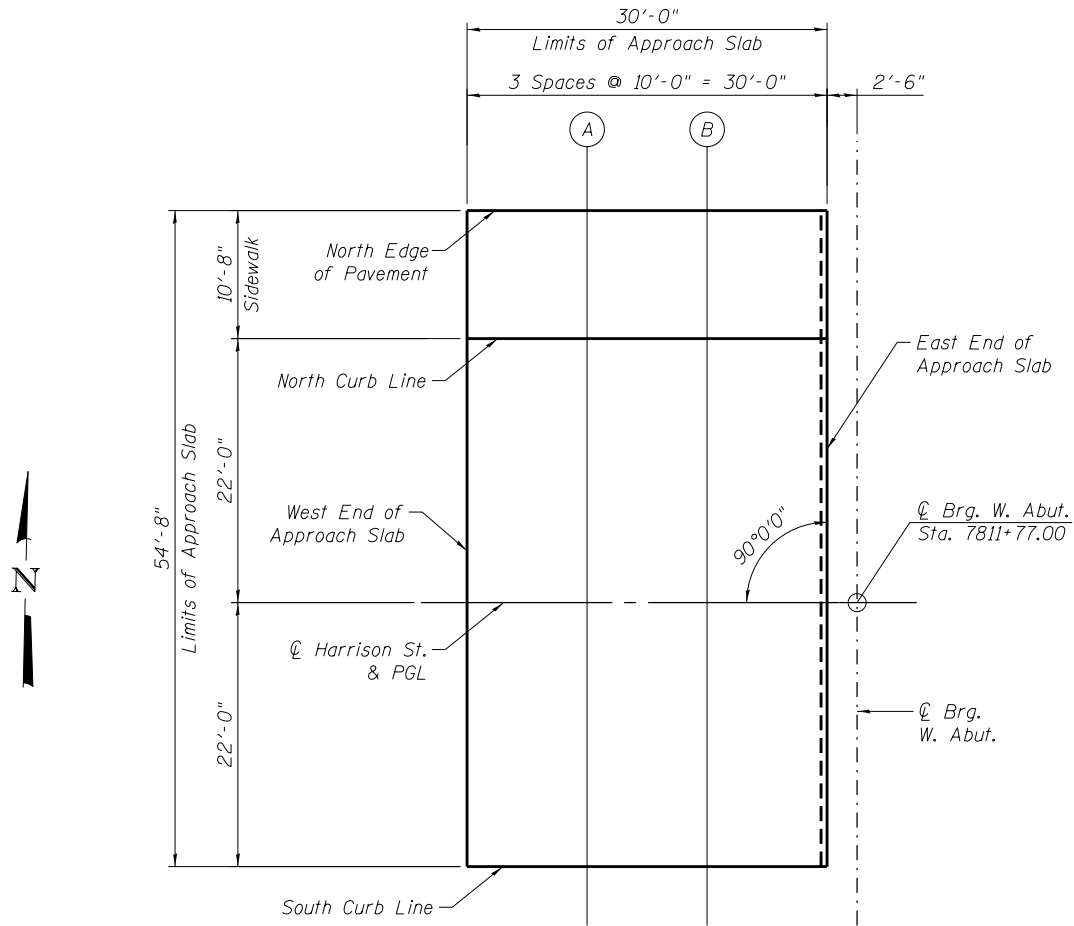

PLAN

SOUTH CURB LINE			
Location	Station	Offset	Theoretical Grade Elevations
West End of Appr. Slab A B	7811+44.50	22.000'	597.37
	7811+54.50	22.000'	597.51
	7811+64.50	22.000'	571.71
East End of Appr. Slab	7811+74.50	22.000'	597.96

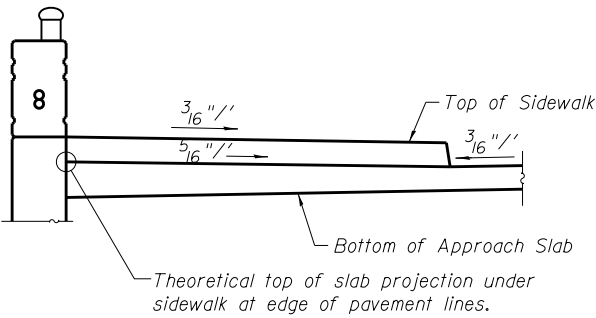



PROJECTION UNDER SIDEWALK
(North Sidewalk)

0161711-60W71-S14-Appr Slab

NORTH EDGE OF PAVEMENT			
Location	Station	Offset	Theoretical Grade Elevations
West End of Aprpr. Slab A B	7813+43.75	- 32.667'	598.79
	7813+53.75	- 32.667'	598.45
	7813+63.75	- 32.667'	598.11
East End of Aprpr. Slab	7813+73.75	- 32.667'	597.77

NORTH CURB LINE			
Location	Station	Offset	Theoretical Grade Elevations
West End of Aprpr. Slab A B	7813+43.75	- 22.000'	598.51
	7813+53.75	- 22.000'	598.17
	7813+63.75	- 22.000'	597.83
East End of Aprpr. Slab	7813+73.75	- 22.000'	597.49

CL HARRISON ST. & PGL			
Location	Station	Offset	Theoretical Grade Elevations
West End of Aprpr. Slab A B	7813+43.75	0.000'	598.85
	7813+53.75	0.000'	598.51
	7813+63.75	0.000'	598.17
East End of Aprpr. Slab	7813+73.75	0.000'	597.83

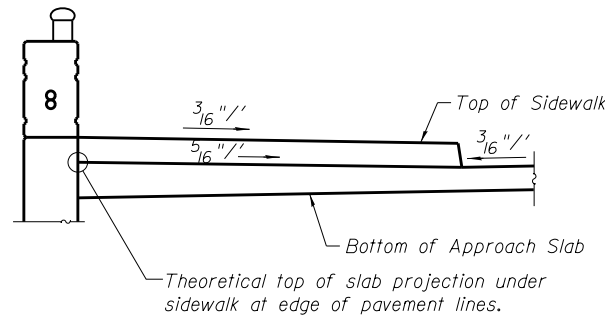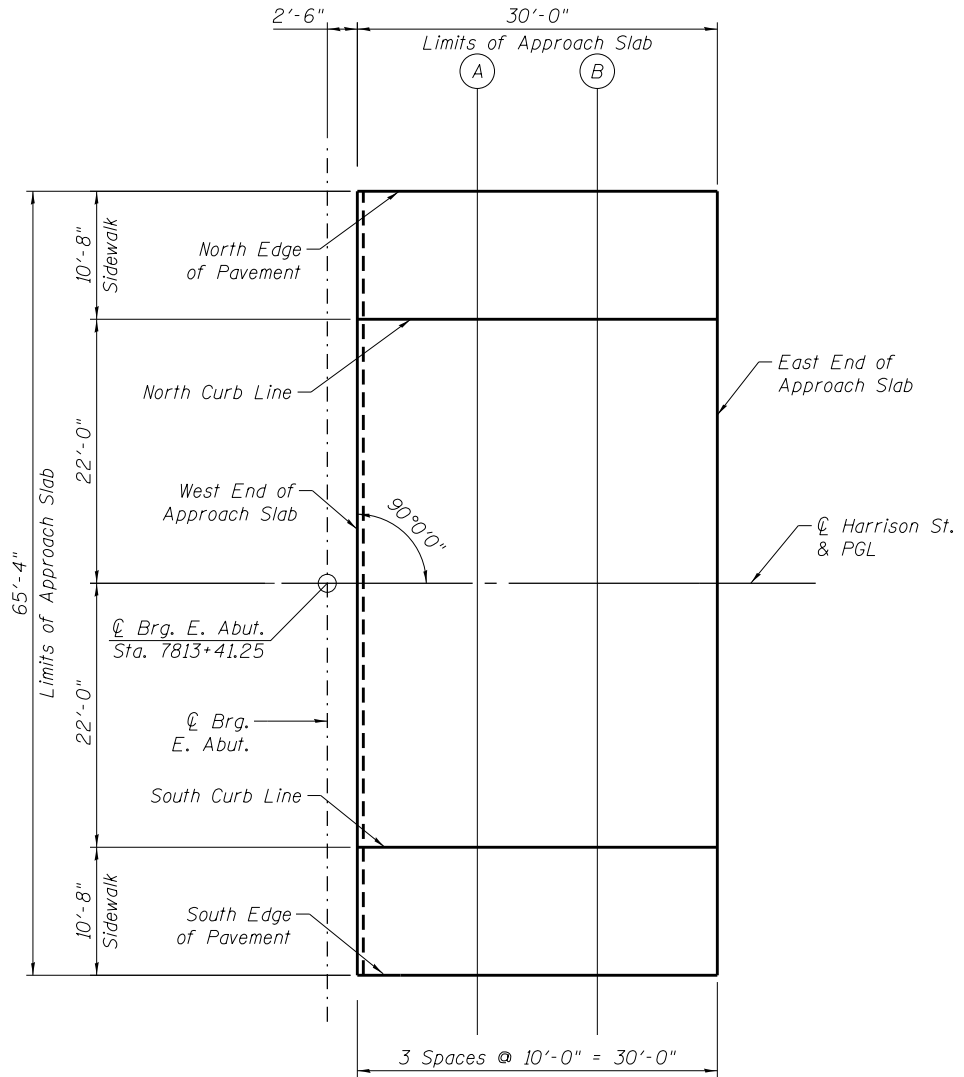

PROJECTION UNDER SIDEWALK

SOUTH CURB LINE			
Location	Station	Offset	Theoretical Grade Elevations
West End of Aprpr. Slab A B	7813+43.75	22.000'	598.51
	7813+53.75	22.000'	598.17
	7813+63.75	22.000'	597.83
East End of Aprpr. Slab	7813+73.75	22.000'	597.49

SOUTH EDGE OF PAVEMENT			
Location	Station	Offset	Theoretical Grade Elevations
West End of Aprpr. Slab A B	7813+43.75	32.667'	598.79
	7813+53.75	32.667'	598.45
	7813+63.75	32.667'	598.11
East End of Aprpr. Slab	7813+73.75	32.667'	597.77

PLAN

0161711-60W71-S15-ApprSlab



USER NAME = dunkerleyb	DESIGNED - MK	REVISED
	CHECKED - DD	REVISED
PLOT SCALE = N.T.S.	DRAWN - BRD	REVISED
PLOT DATE = 12/17/2013	CHECKED - DD	REVISED


STATE OF ILLINOIS
DEPARTMENT OF TRANSPORTATION

TOP OF EAST APPROACH SLAB ELEVATION
STRUCTURE NO. 016-1711
SHEET NO. S-15 OF S-47 SHEETS


F.A.I. RTE.	SECTION	COUNTY	TOTAL SHEETS	SHEET NO.
90/94/290	2013-036R	COOK	256	107
CONTRACT NO.				60W71
ILLINOIS FED. AID PROJECT -NUMBER-				




1. For approach slab details, see sheets S-22 thru S-25.
2. For reinforcement details at light poles, see sheet S-19.
3. Bars indicated thus:
68x10- #5 etc. indicates 68 lines of bars with 10 lengths per line.
4. See Sheet S-20 for Section A-A.
5. Parapet reinforcement not shown for clarity. See sheet S-19 for details.
6. Dimensions are based on a Rolled Rail Strip Seal Joint. If the Contractor elects to use the Welded Rail Strip Seal Joint, deck dimensions may require adjustments to satisfy the details on sheet S-26.
7. See sheet S-20 for Superstructure Bill of Material.
8. See Section Thru Sidewalk for bar arrangement on Sheet S-20.

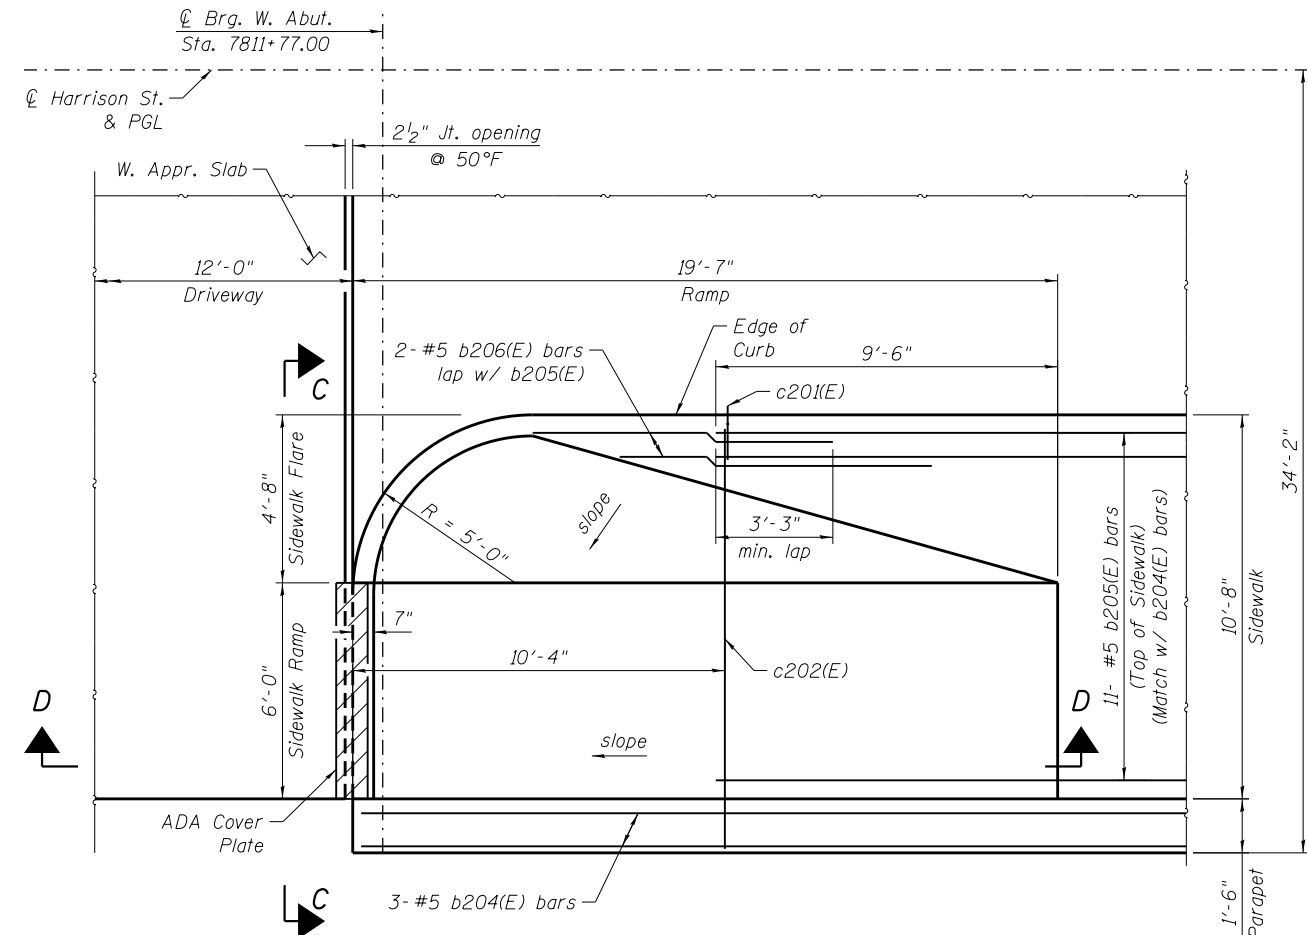

SIDEWALK RAMP PLAN

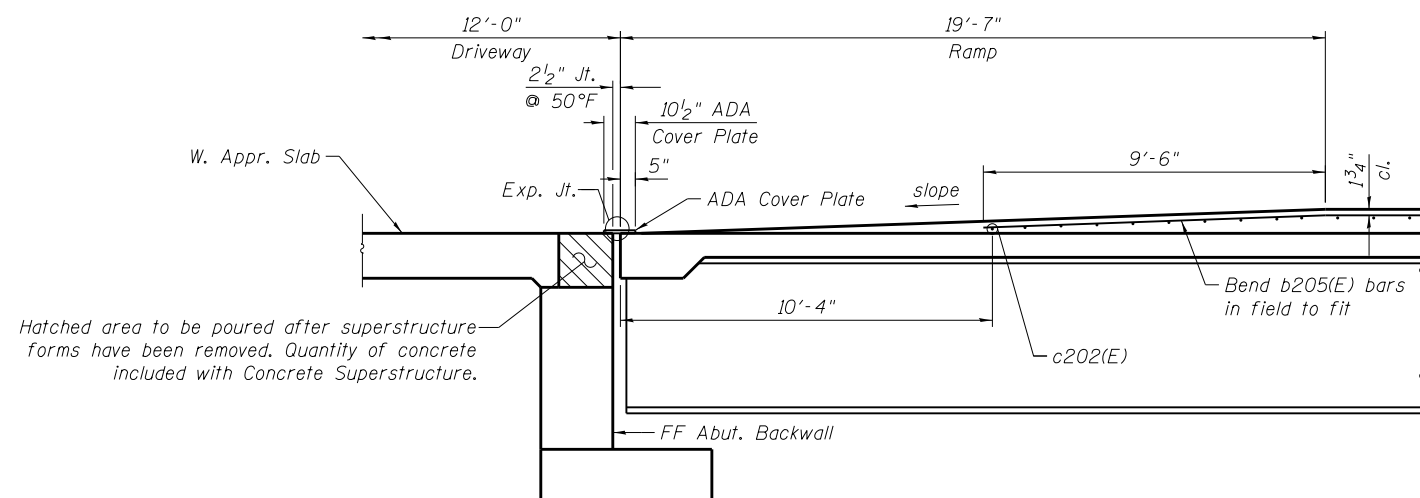


SECTION D-D: SIDEWALK RAMP ELEVATION
(Facing North)

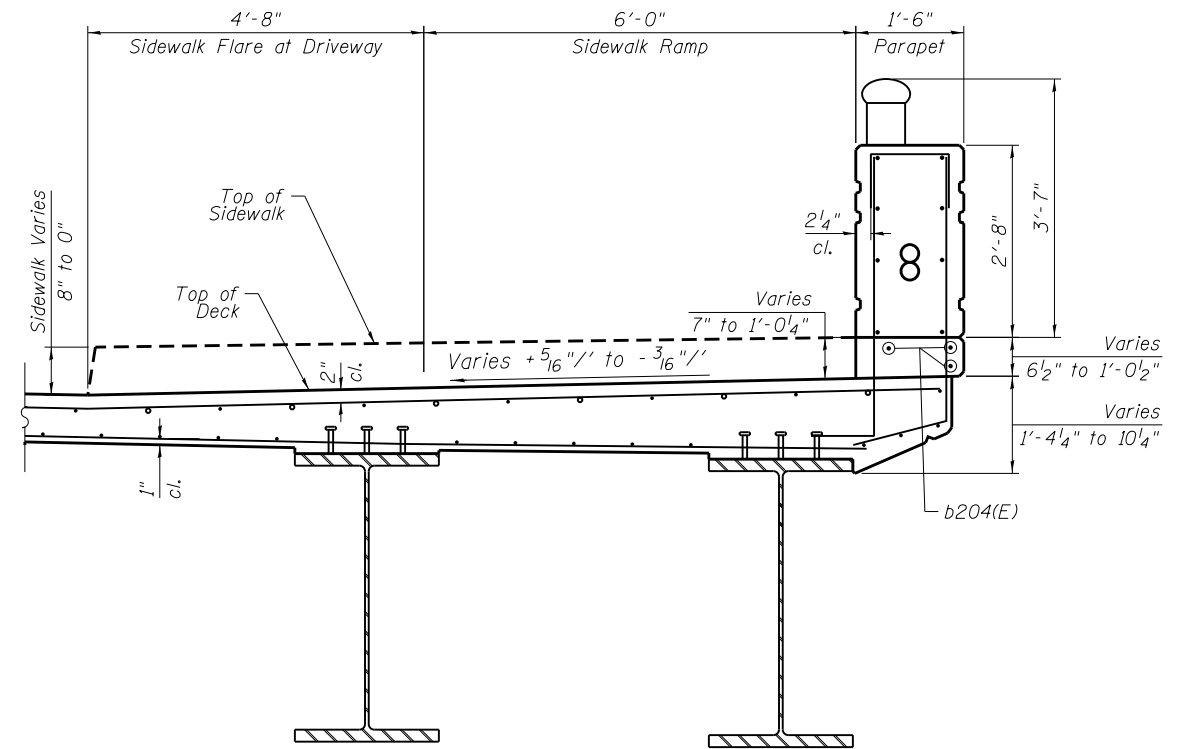


SECTION C-C THRU SOUTH SIDEWALK RAMP
(Facing East)

NOTES:

1. Work this sheet with S-16.
2. See Civil plans for driveway flare details.
3. See sheet S-26 for Expansion Joint details and ADA cover plate details.
4. Sign Panel, channels, bolts, and fasteners are included in Civil pay item Sign Panel - Type 3 (Special). See Civil Plans for details.

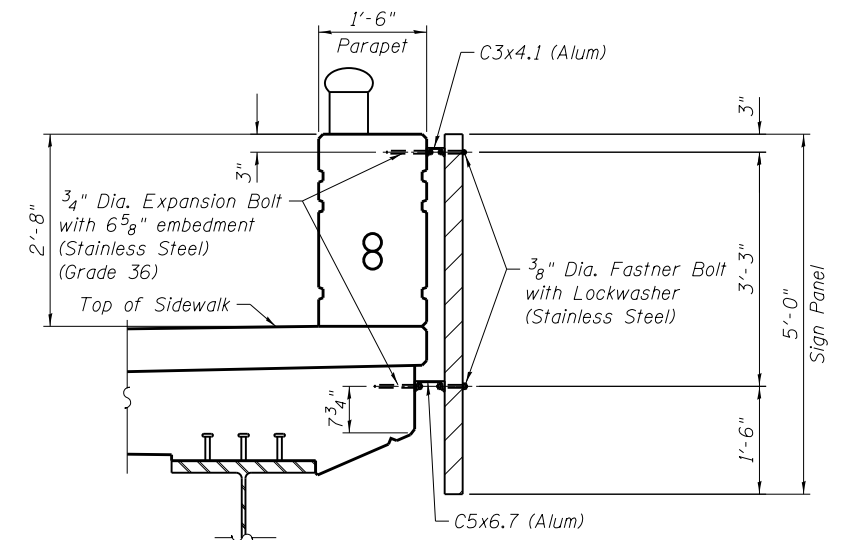

SECTION AT SIGN PANEL
(See Note 4)

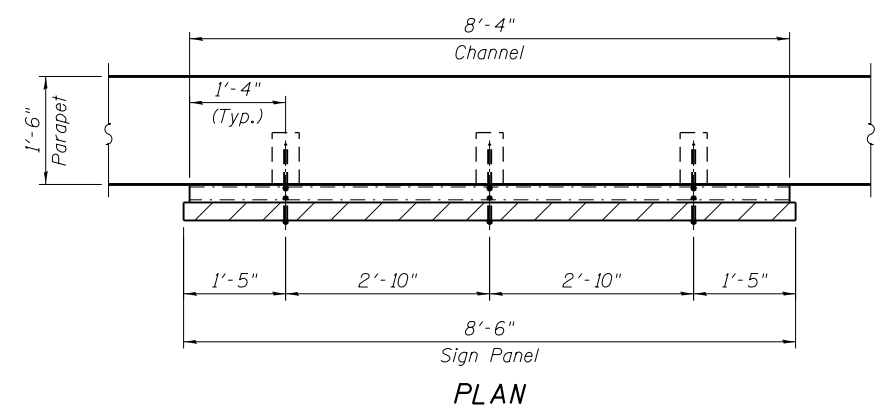

AECOM

USER NAME = dunkerleyb	DESIGNED - DEV	REVISED
	CHECKED - DD	REVISED
PLOT SCALE = N.T.S.	DRAWN - DEV	REVISED
PLOT DATE = 12/17/2013	CHECKED - DD	REVISED


STATE OF ILLINOIS
DEPARTMENT OF TRANSPORTATION

DECK PLAN - II
STRUCTURE NO. 016-1711

SHEET NO. S-17 OF S-47 SHEETS

F.A.I. RTE. 90/94/290	SECTION 2013-036R	COUNTY COOK	TOTAL SHEETS 256	SHEET NO. 109
CONTRACT NO. 60W71				ILLINOIS FED. AID PROJECT -NUMBER-


0161711-60W71-S17-Deck

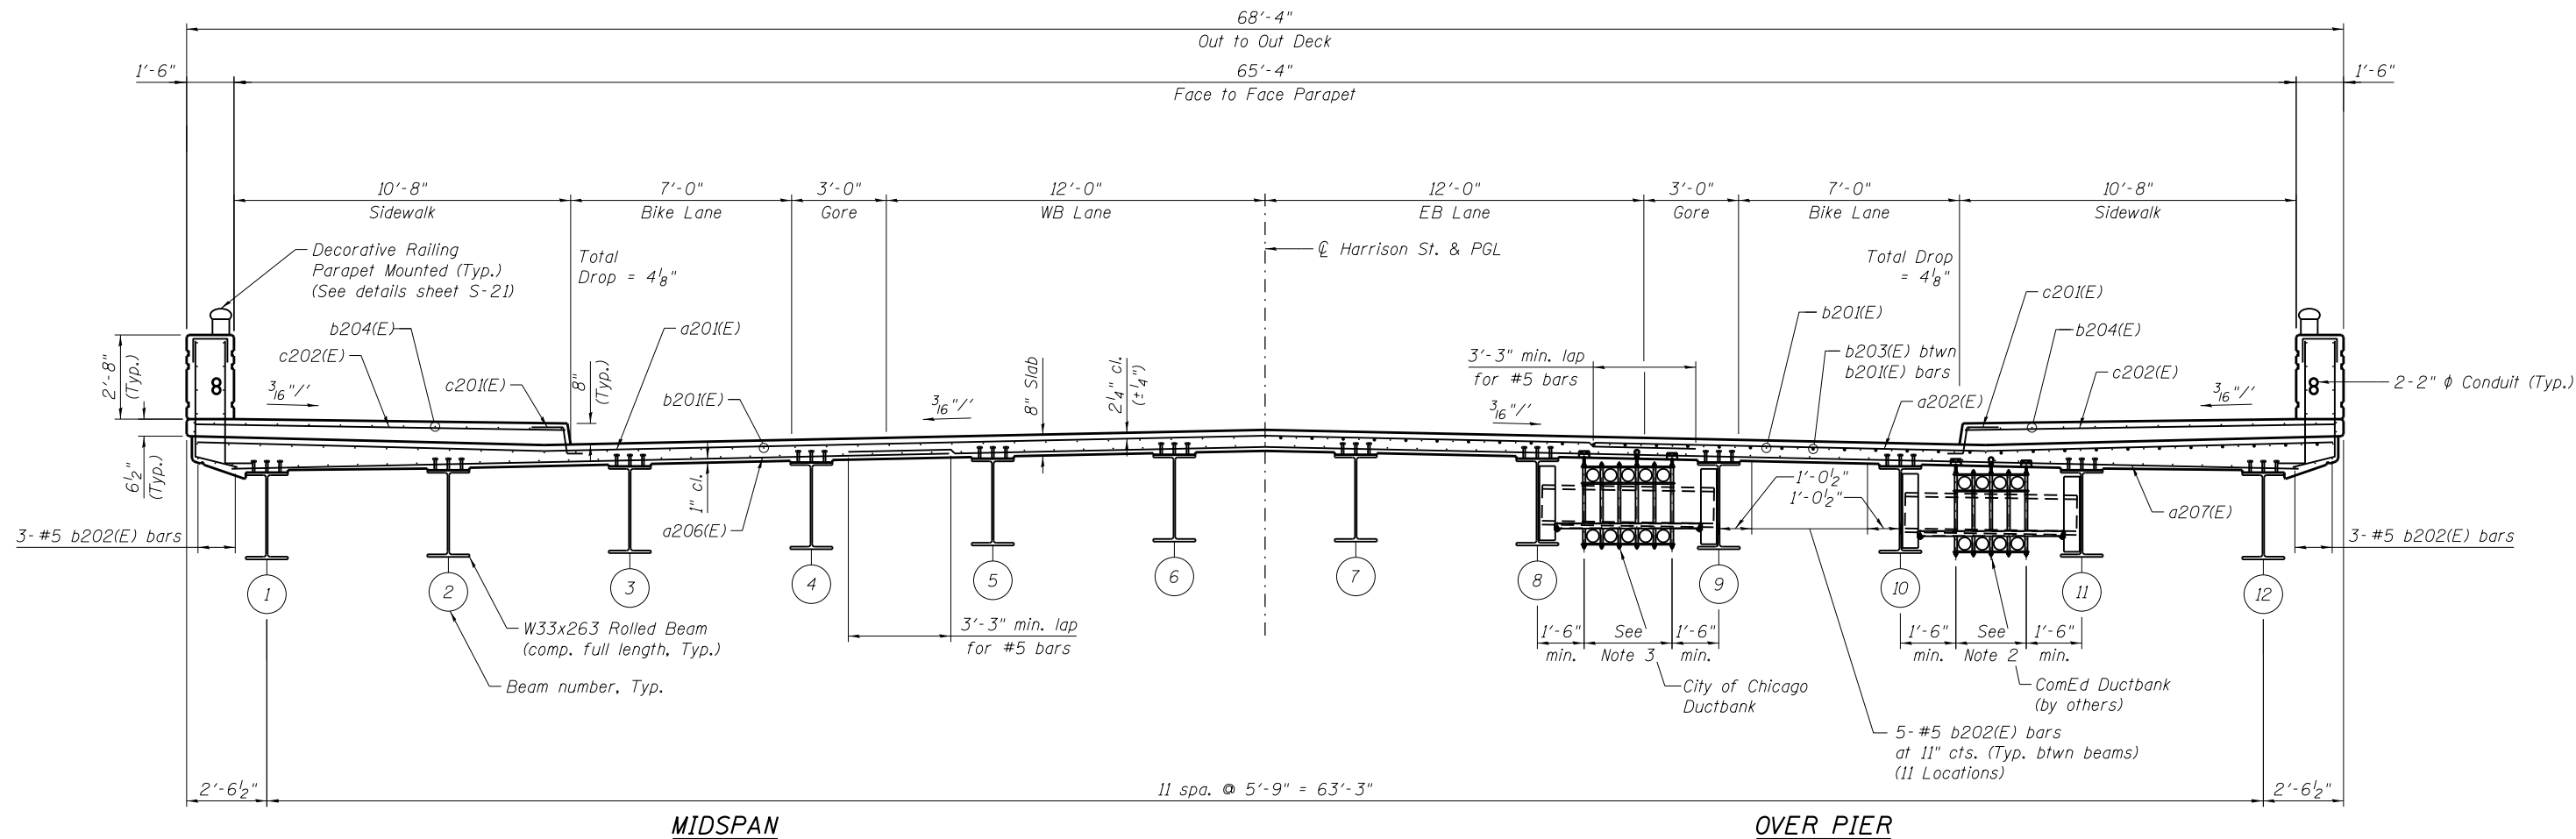

DECK CROSS SECTION
(Facing East)

NOTES:

1. Work this sheet with sheet S-16.
2. Proposed conduit support system is shown for information only on sheets 135A thru 135C. The concrete inserts will be provided to the Contractor by ComEd. The Contractor is responsible for placing inserts per layout details and ComEd direction. ComEd may elect to provide support to Contractor for final insert placement in advance of pouring concrete. There is no separate payment for the placement of inserts. The work involved in placing inserts is included within Concrete Superstructure.
3. Space inserts at 10'-0" cts max longitudinally, full length of bridge (see framing plans). Cost of inserts included in Concrete Superstructure. See electrical plans for conduit support and insert details.

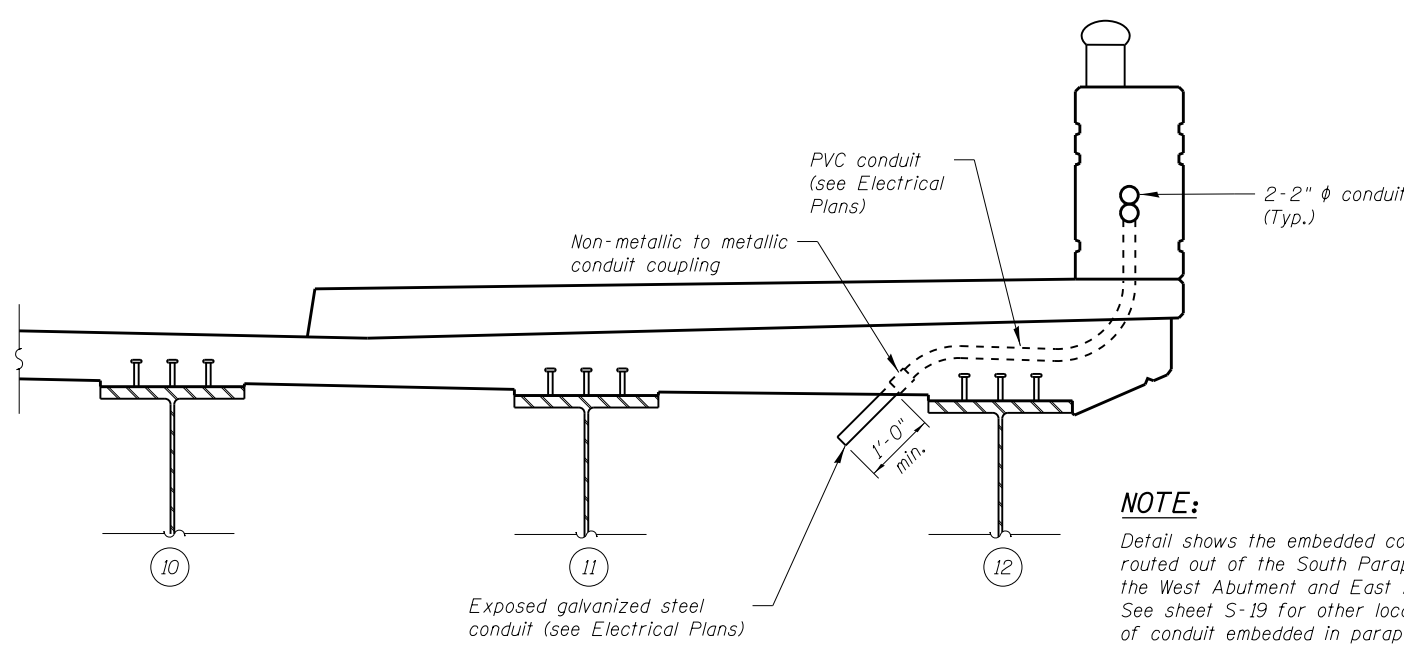

NOTE:

Detail shows the embedded conduits routed out of the South Parapet into the West Abutment and East Abutment. See sheet S-19 for other locations of conduit embedded in parapet.

CONDUIT EMBEDDED IN DECK DETAIL



USER NAME = dunkerleyb	DESIGNED - DEV	REVISED
	CHECKED - DD	REVISED
PLOT SCALE = N.T.S.	DRAWN - DEV	REVISED
PLOT DATE = 12/17/2013	CHECKED - DD	REVISED


STATE OF ILLINOIS
DEPARTMENT OF TRANSPORTATION

DECK CROSS SECTION
STRUCTURE NO. 016-1711

SHEET NO. S-18 OF S-47 SHEETS

F.A.I. RTE.	SECTION	COUNTY	TOTAL SHEETS	SHEET NO.
90/94/290	2013-036R	COOK	256	110
		CONTRACT NO.		60W7
ILLINOIS		FED. AID PROJECT -NUMBER-		


0161711-60W71-S18-Deck

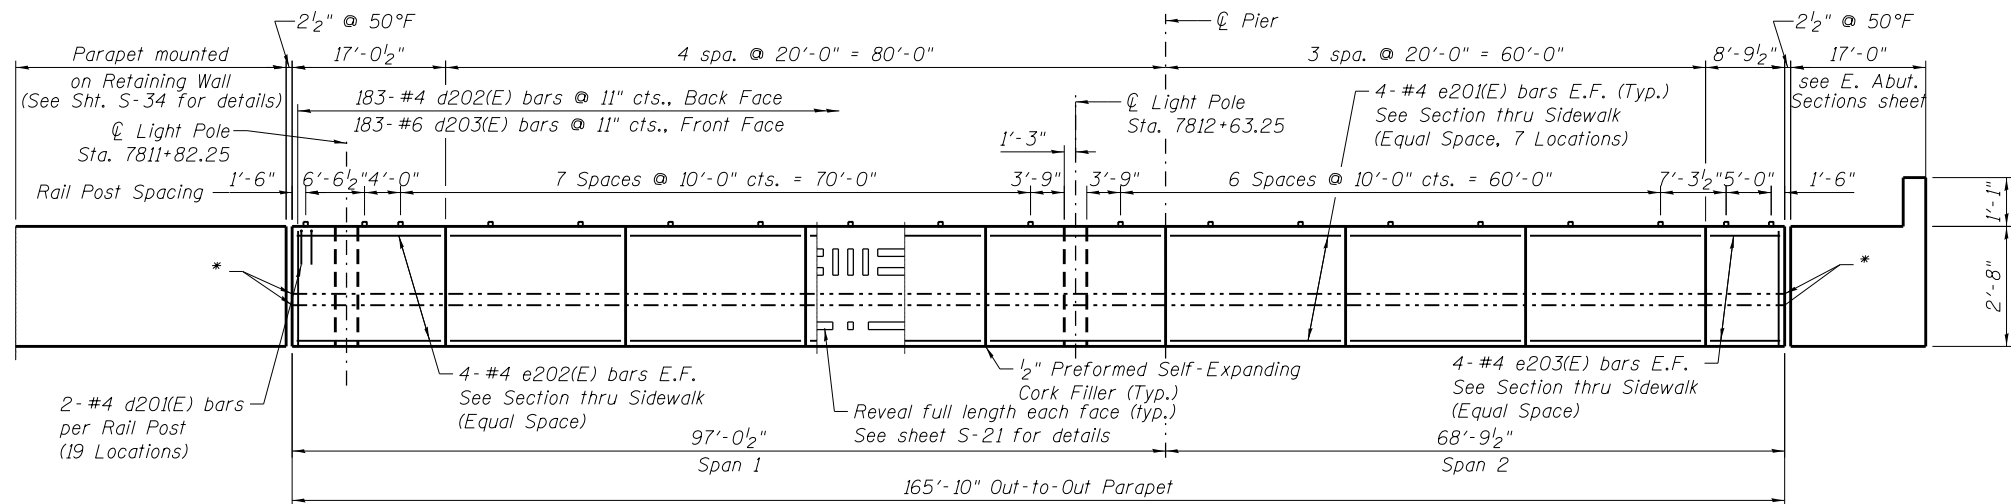

INSIDE ELEVATION OF NORTH PARAPET


(Facing North)

*Provide conduit expansion/deflection fitting at all expansion joints.

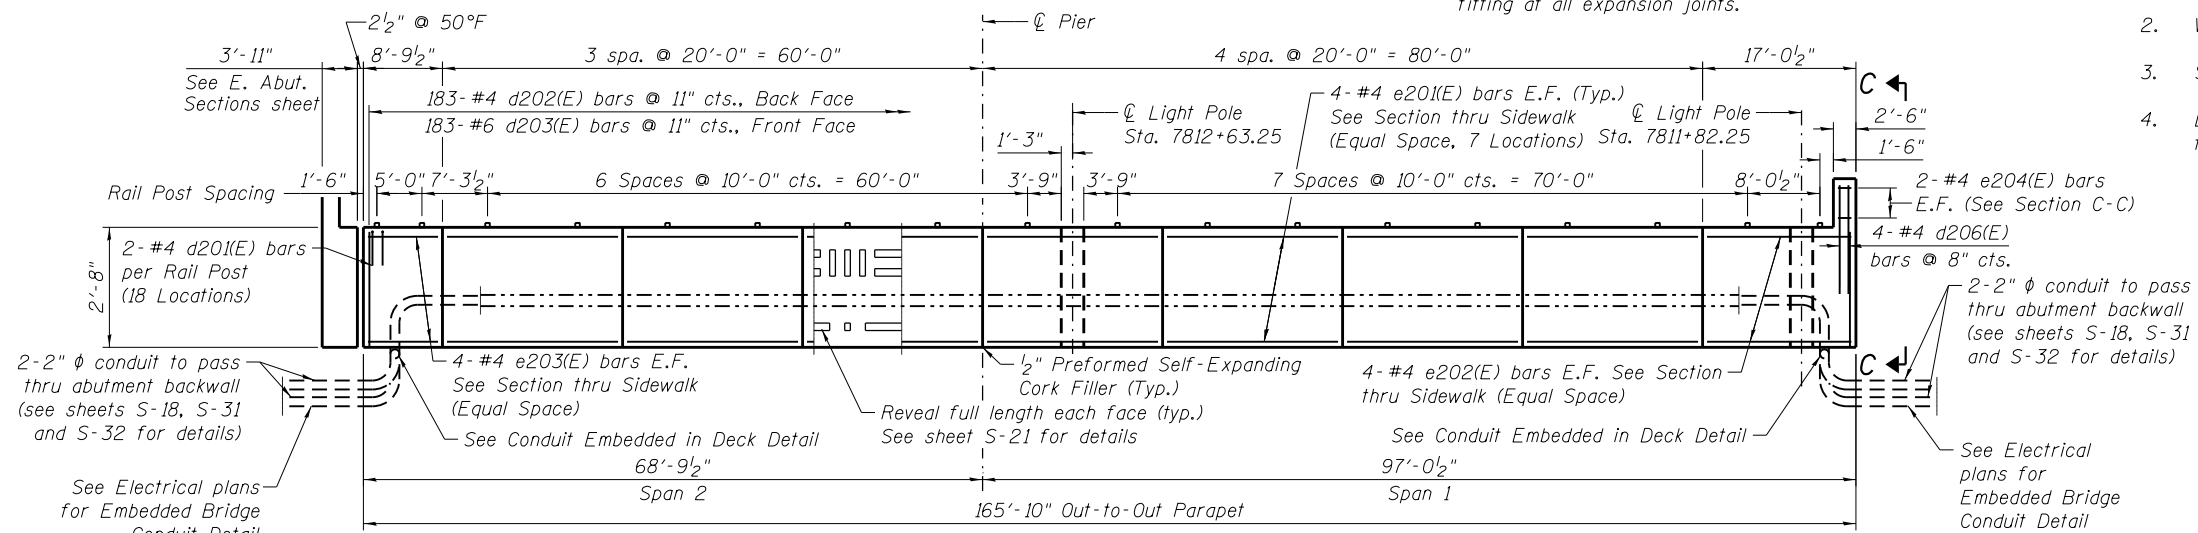

INSIDE ELEVATION OF SOUTH PARAPET


(Facing South)

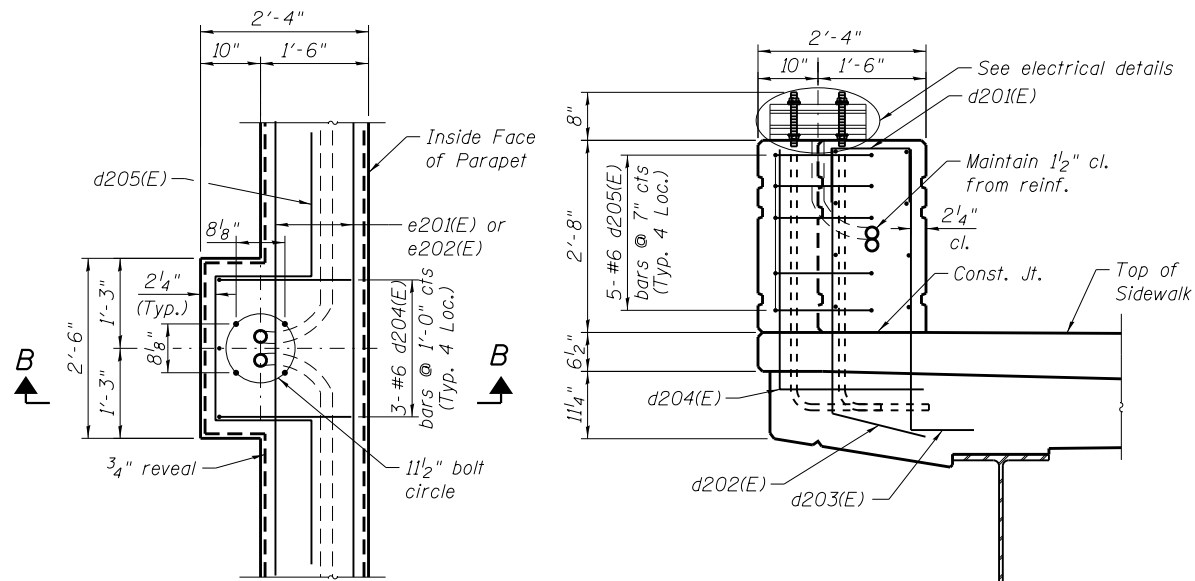

PLAN


SECTION B-B

PARAPET DETAIL AT LIGHTPOLE

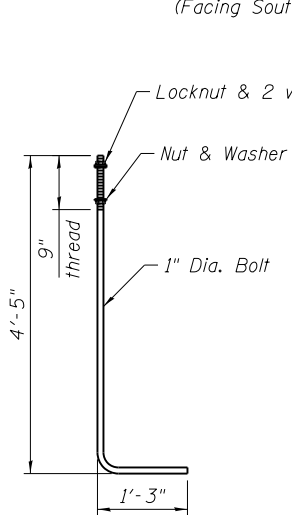


ANCHOR ROD

Cost of anchor rods is included with Concrete Superstructure. (ASTM F 1554 Grade 105) Full length hot dipped galvanized

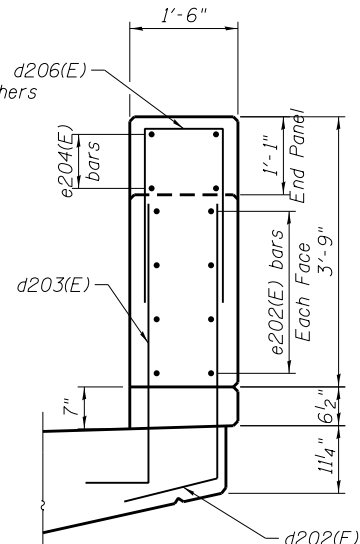

SECTION C-C

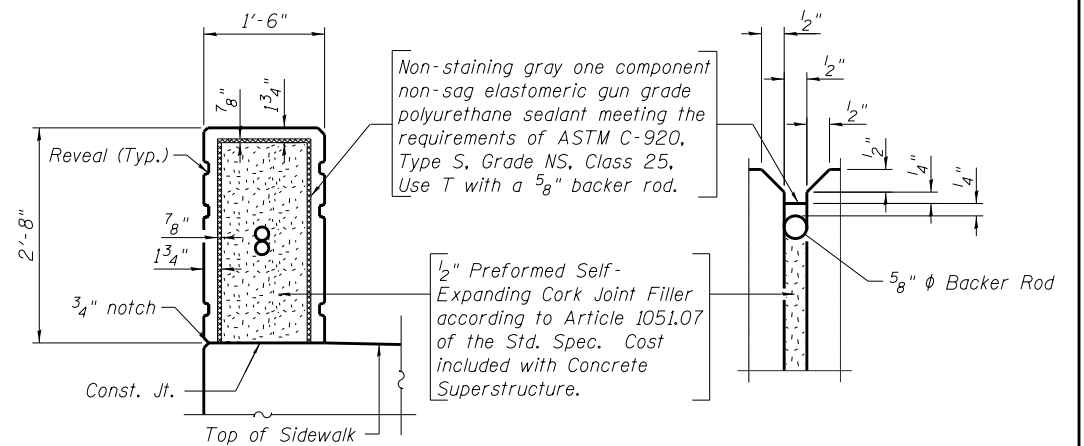


PARAPET JOINT DETAILS

NOTES:


1. Contractor to provide expansion/deflection conduit fittings at all structural expansion joints. See lighting plans for expansion/deflection fitting installation details.
2. Work this sheet with S-18 and S-20.
3. See sheet S-21 for additional rail details.
4. Decorative Rail Parapet Mounted is continuous in front of light poles.

USER NAME = dunkerleyb	DESIGNED - DEV	REVISED
PLOT SCALE = N.T.S.	CHECKED - DD	REVISED
PLOT DATE = 12/17/2013	DRAWN - DEV	REVISED
	CHECKED - DD	REVISED


F.A.I. RTE. 90/94/290	SECTION 2013-036R	COUNTY COOK	TOTAL SHEETS 256	SHEET NO. 111
CONTRACT NO. 60W71				ILLINOIS FED. AID PROJECT -NUMBER-

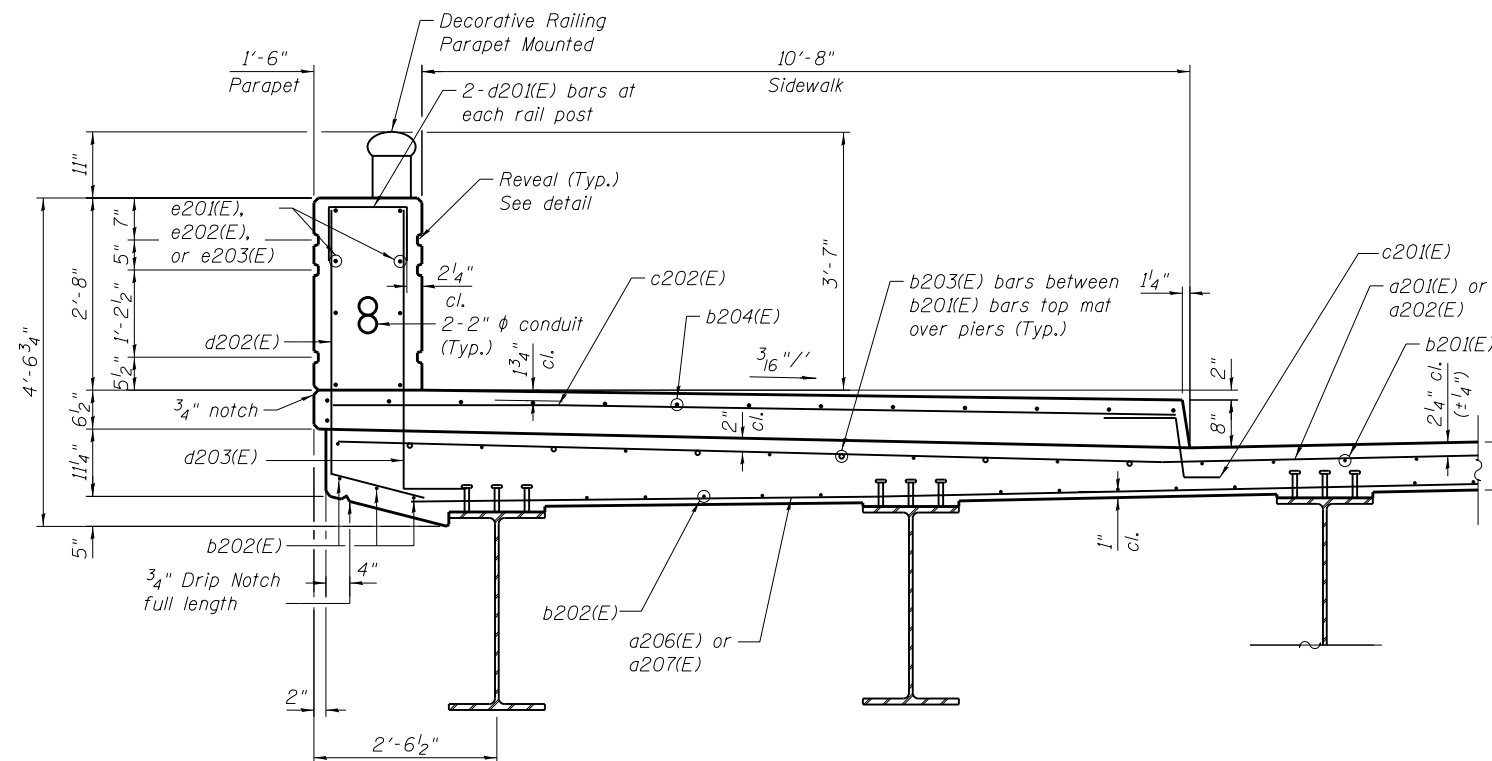


SECTION THRU SIDEWALK
(Typ. both sidewalks)

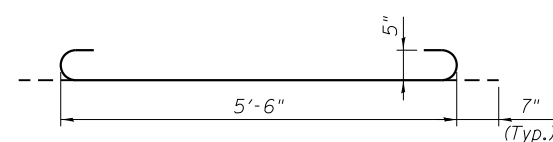

BAR a203(E)

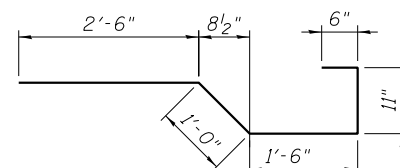


BAR x201(E)

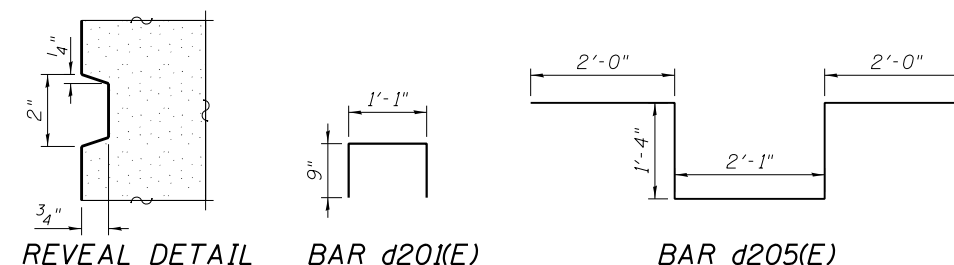

REVEAL DETAIL

BAR d201(E)


BAR d205(E)

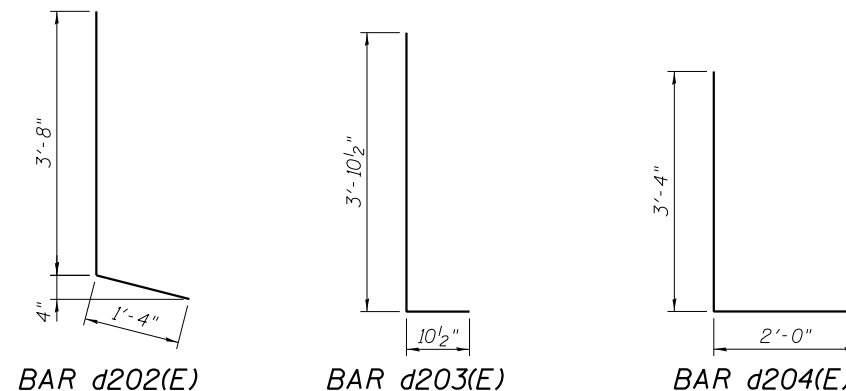


BAR d202(E)

BAR d203(E)


BAR d204(E)

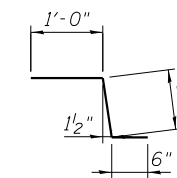

BAR c201(E)

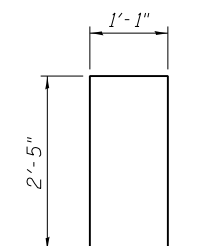

BAR d206(E)

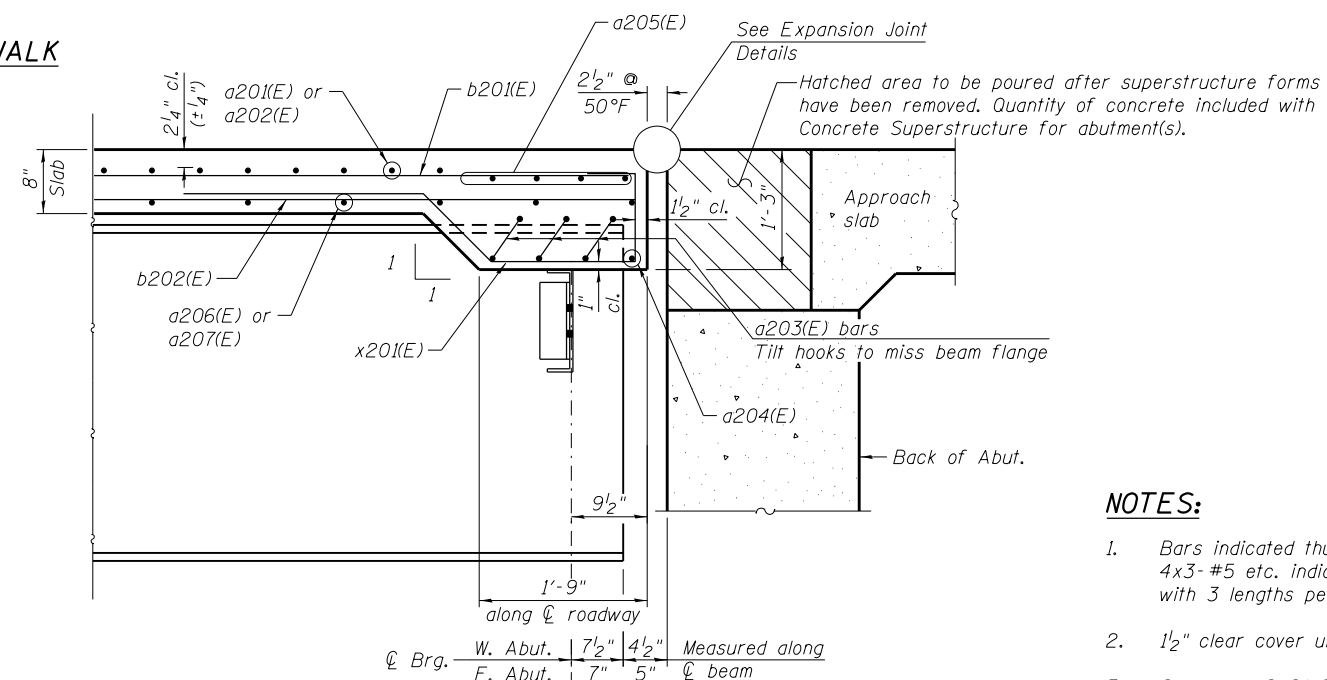

SECTION A-A AT EXPANSION JOINT
(Typ. both ends of deck)


NOTES:

1. Bars indicated thus:
4x3-#5 etc. indicates 4 lines of bars
with 3 lengths per line.
2. 1½" clear cover unless noted otherwise.
3. See sheet S-21 for Decorative Railing Details.
4. See sheet S-26 for Expansion Joint Details.


Bar	No.	Size	Length	Shape
a201(E)	277	#5	47'-4"	—
a202(E)	277	#5	23'-7"	—
a203(E)	66	#5	6'-8"	U
a204(E)	6	#5	23'-2"	—
a205(E)	24	#5	24'-9"	—
a206(E)	200	#5	22'-5"	—
a207(E)	200	#5	46'-1"	—
b201(E)	414	#5	30'-4"	—
b202(E)	427	#5	26'-6"	—
b203(E)	136	#6	25'-10"	—
b204(E)	157	#5	30'-4"	—
b205(E)	11	#5	20'-5"	—
b206(E)	2	#5	8'-8"	—
c201(E)	322	#5	2'-4"	L
c202(E)	322	#5	11'-8"	—
d201(E)	74	#4	2'-7"	U
d202(E)	366	#4	5'-0"	—
d203(E)	366	#6	4'-9"	U
d204(E)	12	#6	5'-4"	U
d205(E)	20	#6	8'-9"	U
d206(E)	4	#4	5'-11"	U
e201(E)	112	#4	19'-8"	—
e202(E)	16	#4	16'-8"	—
e203(E)	16	#4	8'-5"	—
e204(E)	4	#4	2'-2"	—
x201(E)	110	#5	6'-5"	U
Reinforcement Bars, Epoxy Coated			Pound	82,920
Concrete Superstructure			Cu. Yd.	490
Bridge Deck Grooving			Sq. Yd.	788
Protective Coat			Sa. Yd.	1,383

** Preformed Flexible Foam Expansion Joint Filler according to Article 1051.09 of Standard Specifications. Full depth of slab, full length of slab.

*** Cost included with Concrete Superstructure.

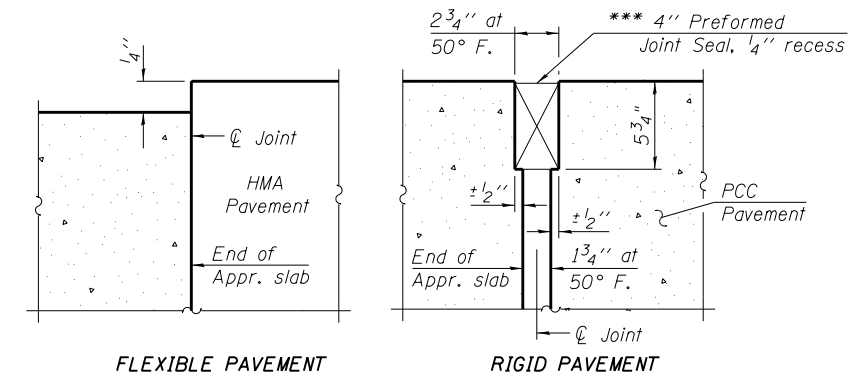


DETAIL A

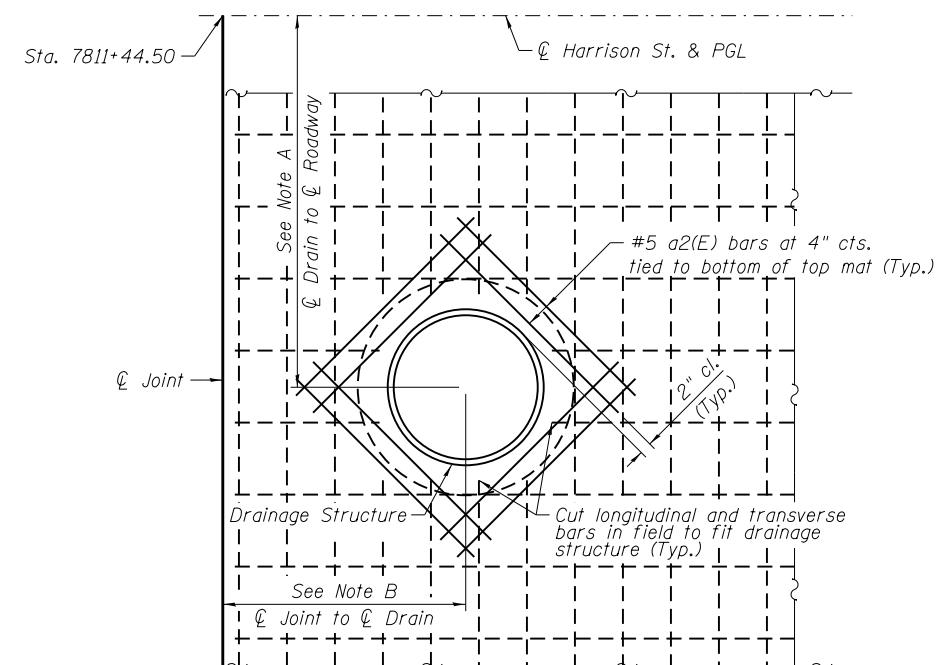

DETAIL B (TYP)

Cost of cutting bars included in Reinforcement Bars, Epoxy Coated

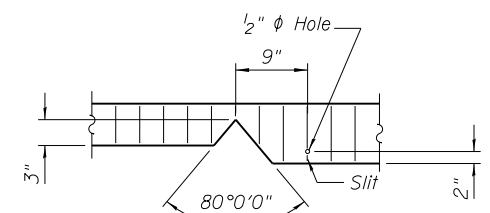

SEAL CUT-OUT AT CURB

NOTE A:


For Drainage Structure S-02 = 1'-0 3/4" (South)
For Drainage Structure S-03 = 5'-0" (South)
For Exist. Drainage Structure = 27'-3 1/2" (North)

NOTE B:

For Drainage Structure S-02 = 16'-2 3/8"
For Drainage Structure S-03 = 10'-6"
For Existing Drainage Structure = 2'-4 3/8"

NOTES:

- See sheet S-23 of S-47 for Sections C-C & D-D.
- See Civil plans for drainage structure details.

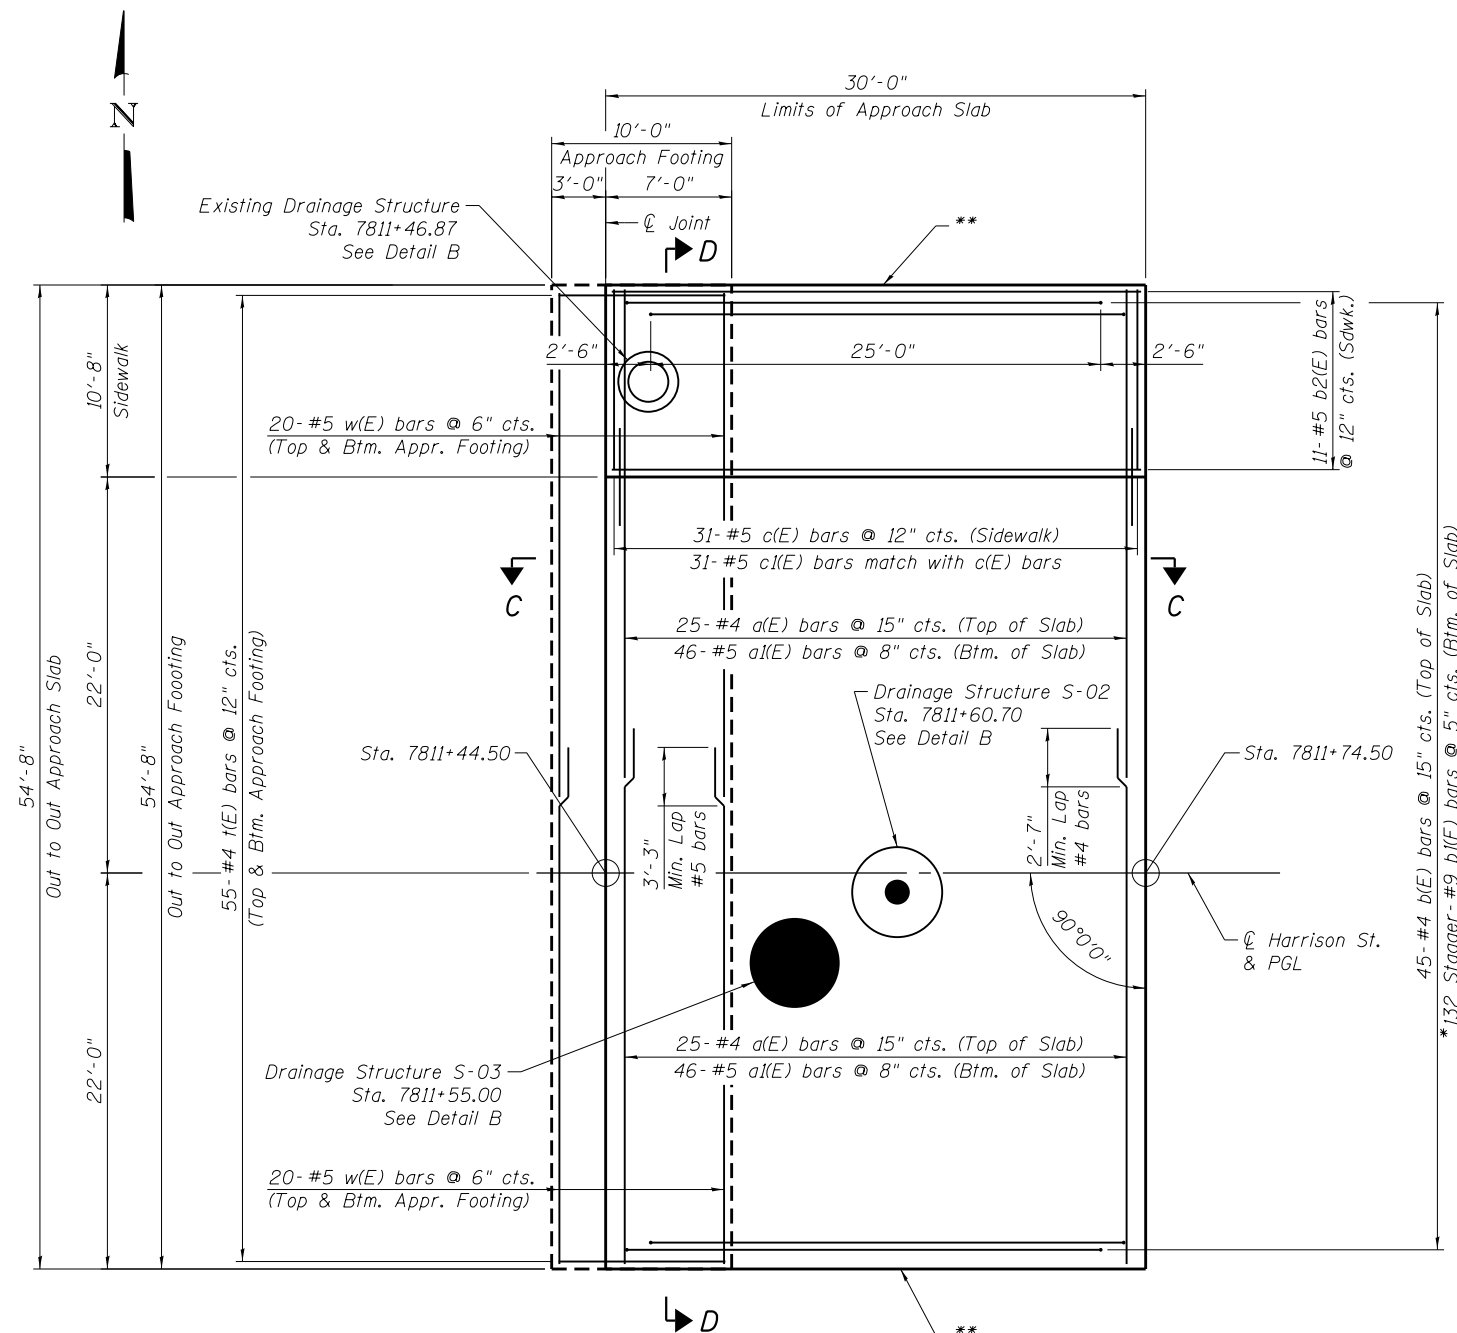

PLAN

*Tilt #9 b(E) bars as required to maintain clearances.

AECOM

USER NAME = dunkerleyb	DESIGNED - EJO	REVISED
	CHECKED - DD	REVISED
PLOT SCALE = N.T.S.	DRAWN - BRD	REVISED
PLOT DATE = 12/17/2013	CHECKED - DD	REVISED




STATE OF ILLINOIS
DEPARTMENT OF TRANSPORTATION

WEST APPROACH SLAB PLAN
STRUCTURE NO. 016-1711

SHEET NO. S-22 OF S-47 SHEETS


F.A.I. RTE.	SECTION	COUNTY	TOTAL SHEETS	SHEET NO.
90/94/290	2013-036R	COOK	256	114
		CONTRACT NO. 60W71		
		ILLINOIS FED. AID PROJECT -NUMBER-		

0161711-60W71-S22-Appr Slab

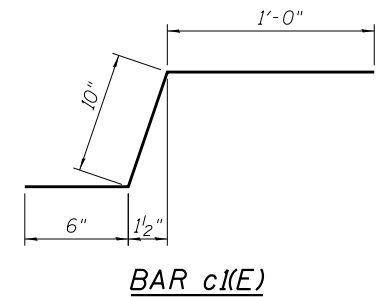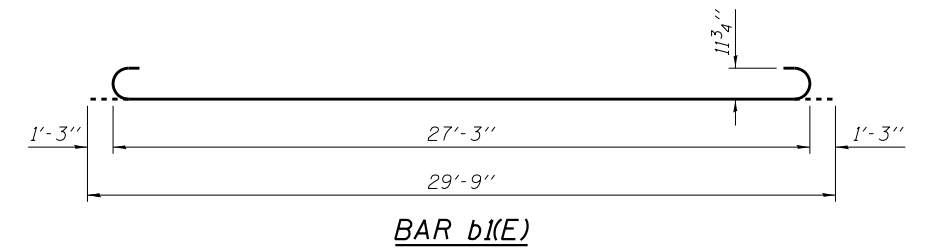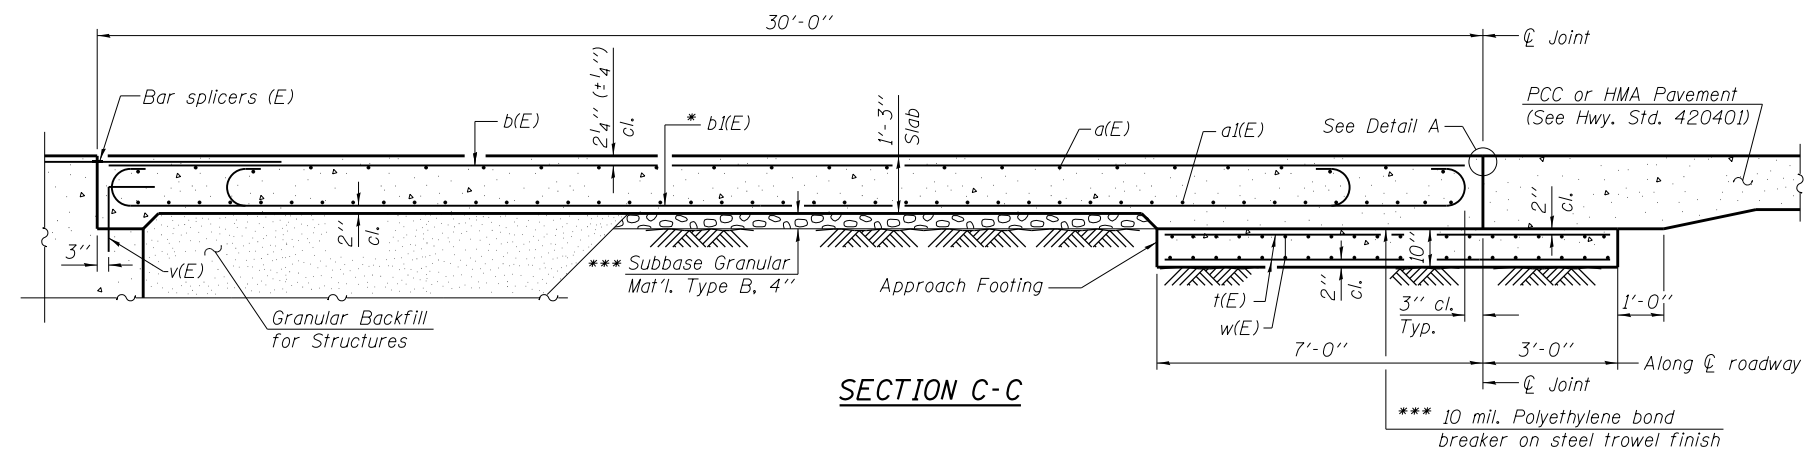


* Tilt #9 b1(E) bars as required to maintain clearance.

*** Cost included with Concrete Superstructure.



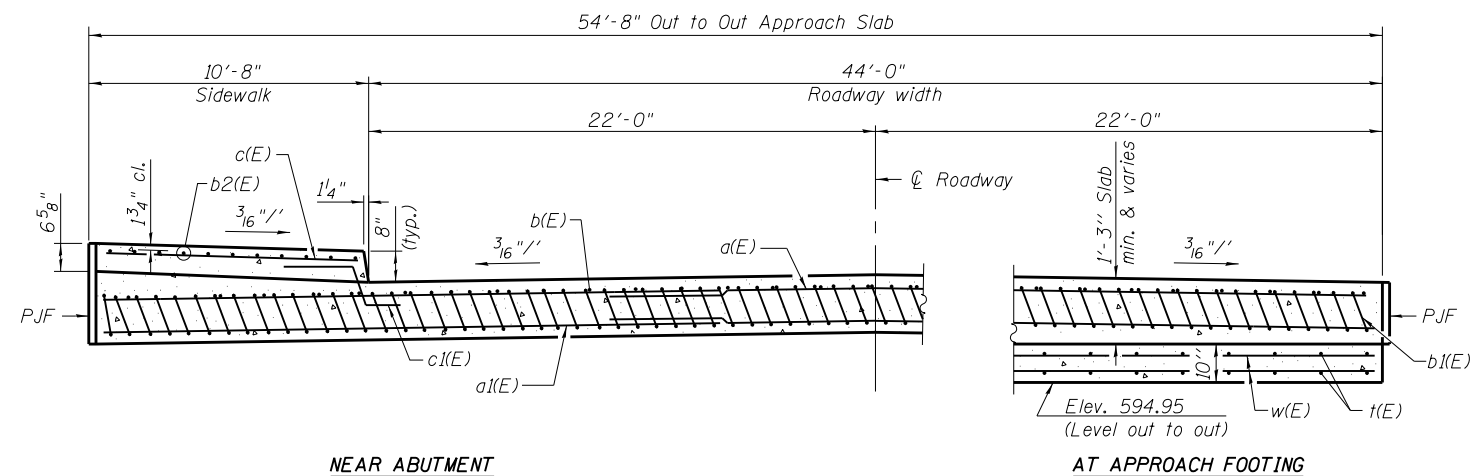


BILL OF MATERIAL

Bar	No.	Size	Length	Shape
a(E)	50	#4	28'-6"	————
a1(E)	92	#5	28'-10"	————
a2(E)	24	#5	3'-6"	————
b(E)	45	#4	29'-8"	————
b1(E)	132	#9	29'-9"	————
b2(E)	11	#5	29'-8"	————
c(E)	31	#5	10'-4"	————
c1(E)	31	#5	2'-4"	————
t(E)	110	#4	9'-8"	————
w(E)	80	#5	28'-10"	————
Concrete Superstructure			Cu. Yd.	92
Concrete Structures			Cu. Yd.	17
Reinforcement Bars, Epoxy Coated			Pound	21,920
Protective Coat			Sq. Yd.	194
Bridge Deck Grooving			Sq. Yd.	140

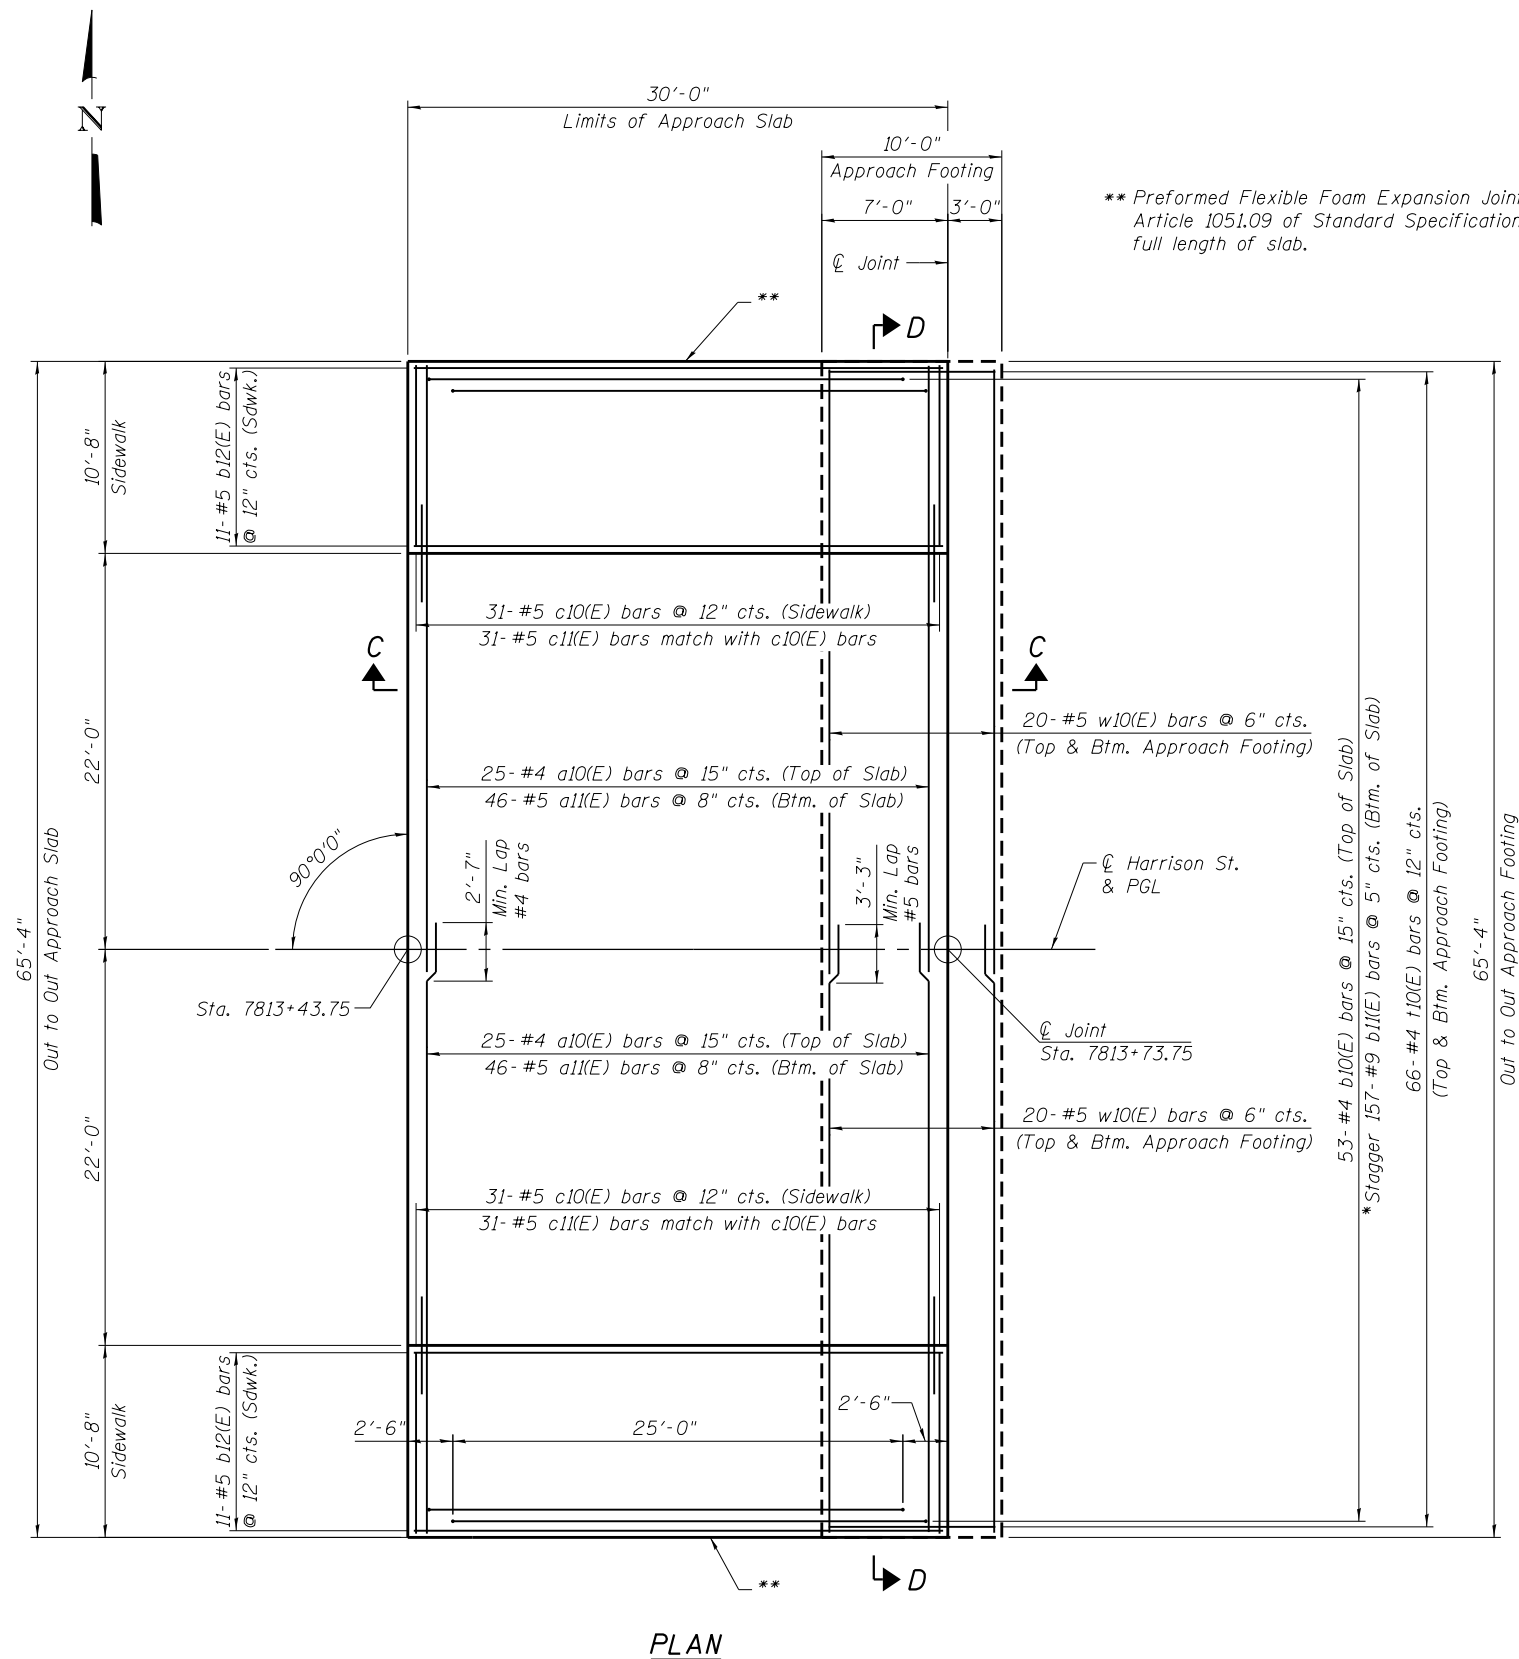

* Tilt #9 b11(E) bars as required to maintain clearance.

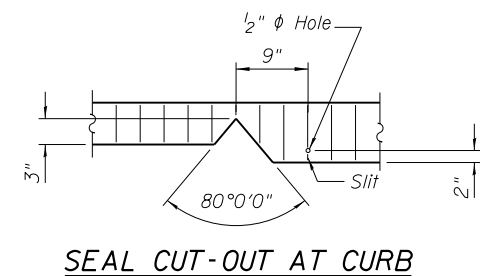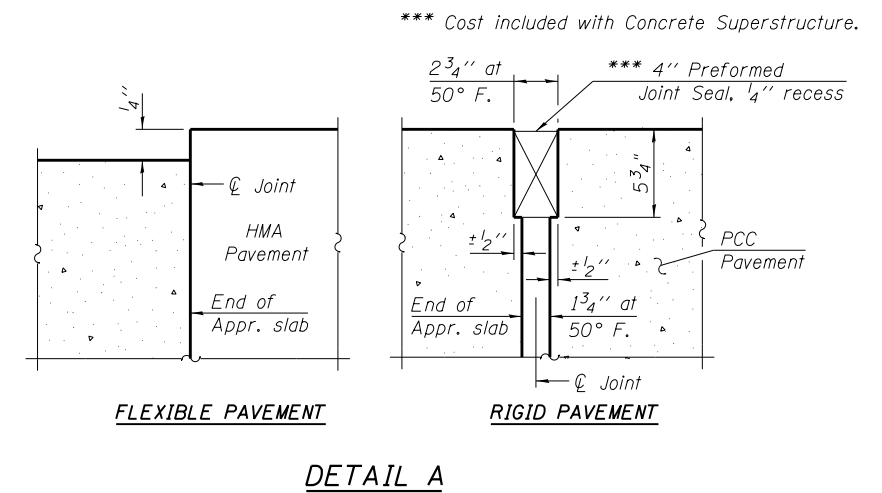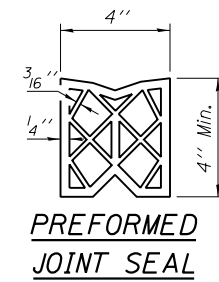

NOTES:
See sheet S-25 of S-47 for Sections C-C & D-D.

0161711-60W71-S24-Appr Slab

AECOM




USER NAME = dunkerleyb	DESIGNED - EJO	REVISED
	CHECKED - DD	REVISED
PLOT SCALE = N.T.S.	DRAWN - BRD	REVISED
PLOT DATE = 12/17/2013	CHECKED - DD	REVISED

**STATE OF ILLINOIS
DEPARTMENT OF TRANSPORTATION**

**EAST APPROACH SLAB PLAN
STRUCTURE NO. 016-1711**


SHEET NO. S-24 OF S-47 SHEETS

F.A.I. RTE.	SECTION	COUNTY	TOTAL SHEETS	SHEET NO.
90/94/290	2013-036R	COOK	256	116
		CONTRACT NO. 60W71		
ILLINOIS		FED. AID PROJECT -NUMBER-		

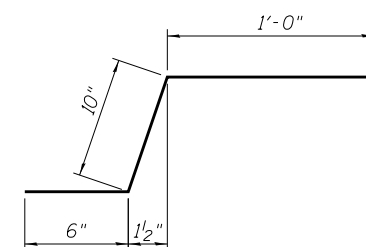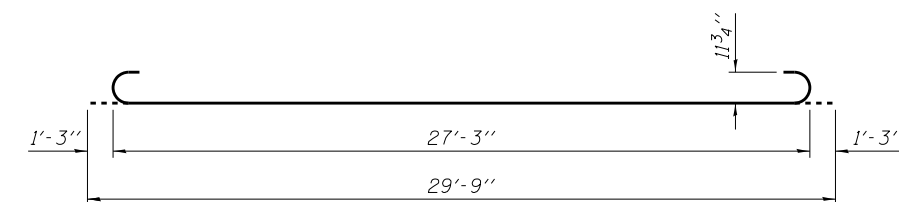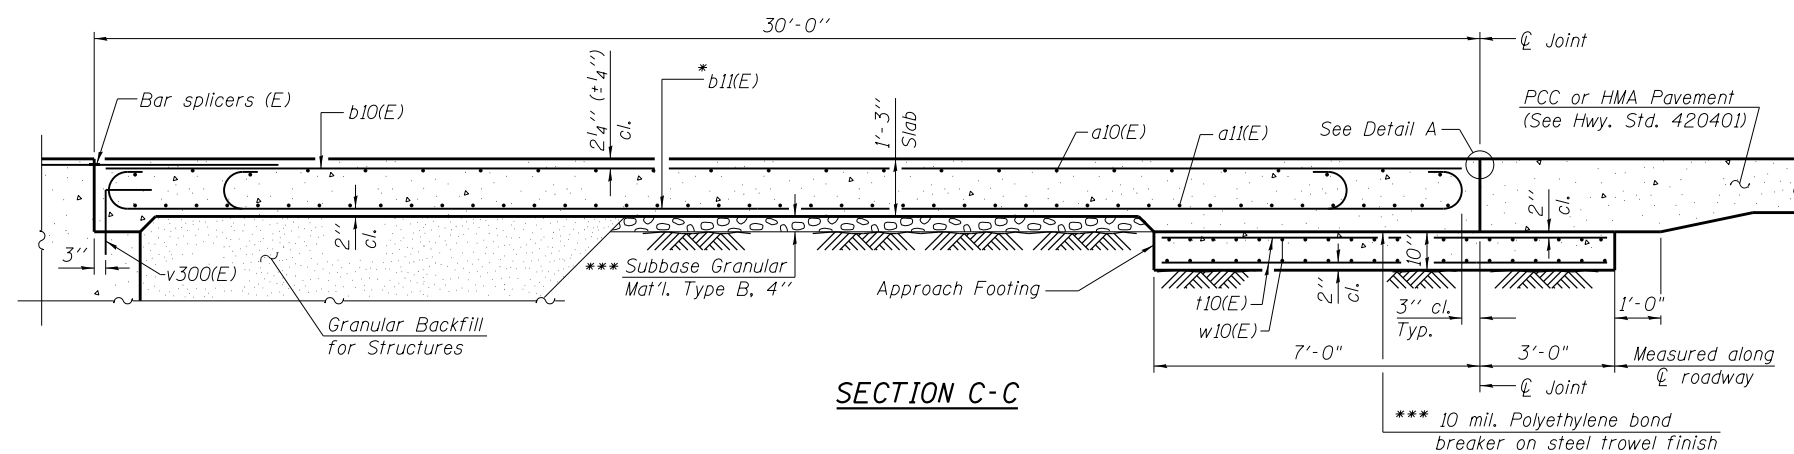


* Tilt #9 b11(E) bars as required to maintain clearance.

*** Cost included with Concrete Superstructure.

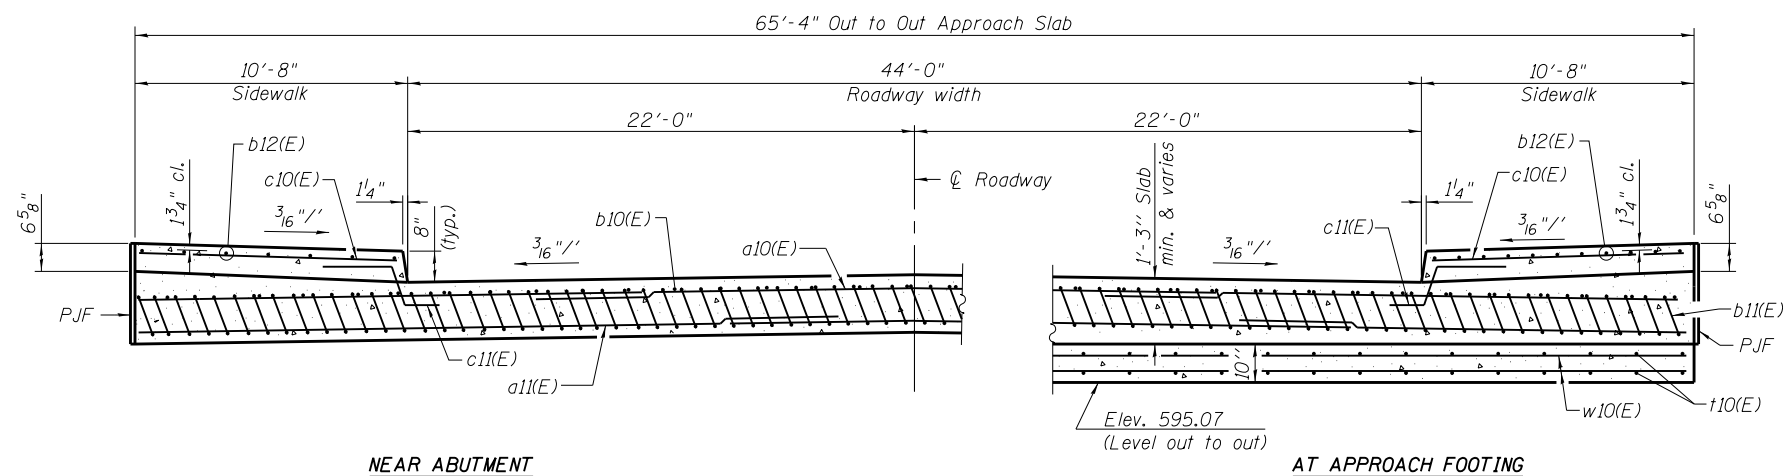


BILL OF MATERIAL

Bar	No.	Size	Length	Shape
a10(E)	50	#4	33'-10"	_____
a11(E)	92	#5	34'-2"	_____
b10(E)	53	#4	29'-8"	_____
b11(E)	157	#9	29'-9"	_____
b12(E)	22	#5	29'-8"	_____
c10(E)	62	#5	10'-4"	_____
c11(E)	62	#5	2'-4"	_____
t10(E)	132	#4	9'-8"	_____
w10(E)	80	#5	34'-2"	_____
Concrete Superstructure			Cu. Yd.	117
Concrete Structures			Cu. Yd.	21
Reinforcement Bars, Epoxy Coated			Pound	26,550
Protective Coat			Sq. Yd.	234
Bridge Deck Grooving			Sq. Yd.	140

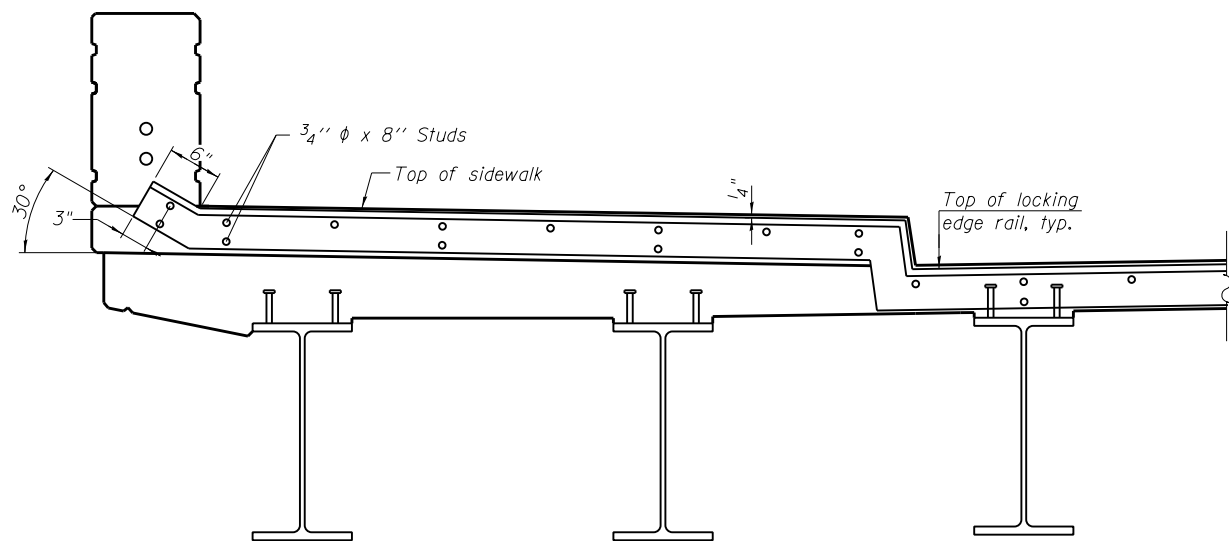


TYPICAL END TREATMENT AT SIDEWALK

Shorter plates with a single row of studs at 12" cts. may be necessary on sidewalks which are shallower than 9". See manufacturer's recommendation.

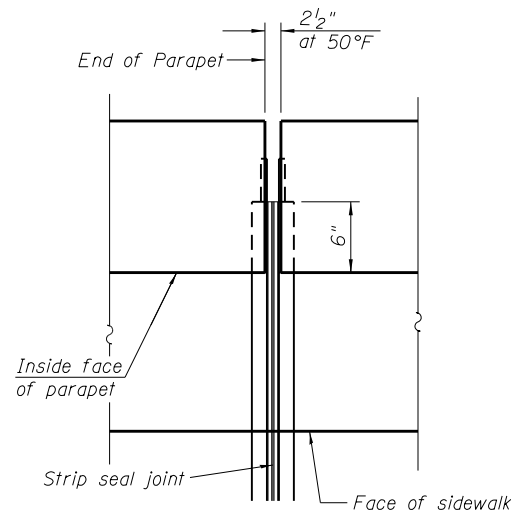


PLAN

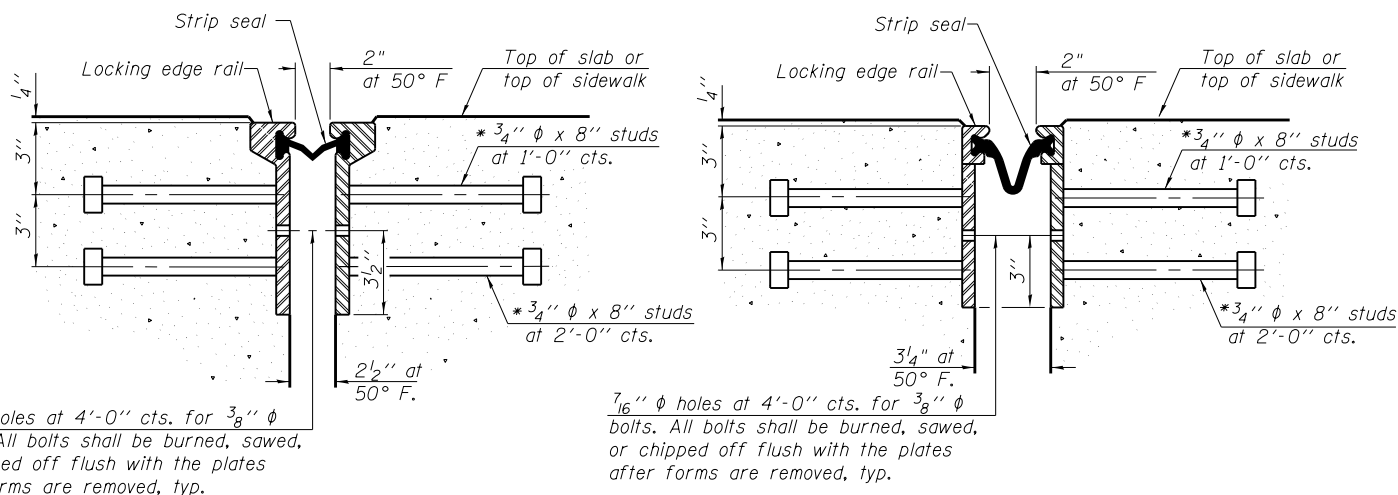

SECTION THRU
ROLLED RAIL JOINT

* Granular or solid flux filled headed studs conforming to Article 1006.32 of the Std. Specs., automatically end welded.

SECTION THRU
WELDED RAIL JOINT

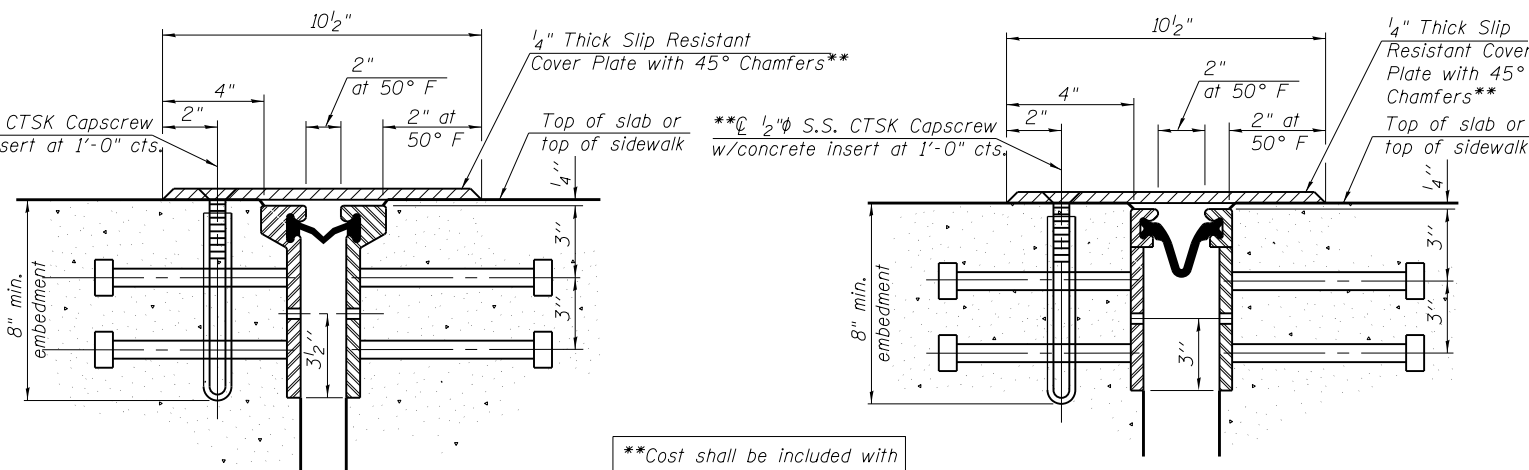

SECTION THRU
ROLLED RAIL JOINT
AT SIDEWALK


SECTION THRU
WELDED RAIL JOINT
AT ADA RAMP

Note:
At East Abut. and West Abut. attach cover plate to the Ramp Pavement with 1/2" S.S. CTSK capscrew with concrete insert at 1'-0" cts.

**Cost shall be included with
Preformed Joint Strip Seal

NOTES:

- The strip seal shall be made continuous and shall have a minimum thickness of 1/4". The configuration of the strip seal shall match the configuration of the Locking Edge Rails. Open or "webbed" strip seal gland configurations are not permitted. The gland shall be sized for a maximum rated movement of 4 inches.
- The Locking Edge Rails depicted are conceptual only, except for the minimum dimensions shown. The actual configuration of the Locking Edge Rails and matching strip seal may vary from manufacturer to manufacturer. Flanged edge rails will not be allowed. Locking Edge Rails may be spliced at slope discontinuities.
- The manufacturer's recommended installation methods shall be followed.
- The joint opening and deck dimensions detailed on the superstructure are based on a rolled rail expansion joint. If the Contractor elects to use the welded rail expansion joint, the opening and deck dimensions shall be modified according to the dimensions detailed on this sheet. Required modifications shall be made at no additional cost to the State.
- All steel components except expansion joint plates and attached bars shall be galvanized after fabrication according to Article 520.03 of the Standard Specifications.
- Maximum space between rail segments shall be 3/16", sealed with a suitable sealant. Joints in rails within 10 ft. of curbs shall be welded.

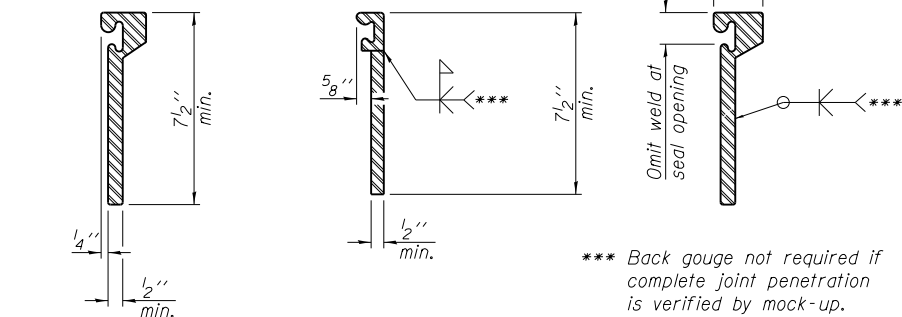

ROLLED
EXTRUDED RAIL WELDED RAIL
LOCKING EDGE RAILS

*** Back gouge not required if complete joint penetration is verified by mock-up.

LOCKING EDGE
RAIL SPLICE

The inside of the locking edge rail groove shall be free of weld residue.
Rolled rail shown, welded rail similar.

BILL OF MATERIAL

Item	Unit	Total
Preformed Joint Strip Seal	Foot	135

AECOM

USER NAME = dunkerleyb	DESIGNED - DEV	REVISED
	CHECKED - DD	REVISED
PLOT SCALE = N.T.S.	DRAWN - DEV	REVISED
PLOT DATE = 12/17/2013	CHECKED - DD	REVISED


STATE OF ILLINOIS
DEPARTMENT OF TRANSPORTATION

EXPANSION JOINT DETAILS
STRUCTURE NO. 016-1711


SHEET NO. S-26 OF S-47 SHEETS

F.A.I. RTE. 90/94/290	SECTION 2013-036R	COUNTY COOK	TOTAL SHEETS 256	SHEET NO. 118
CONTRACT NO. 60W71			ILLINOIS FED. AID PROJECT -NUMBER-	


0161711-60W71-S26-ExpJoint

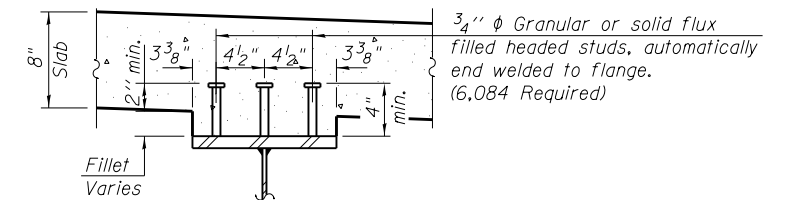

Do not place studs on splice plates.

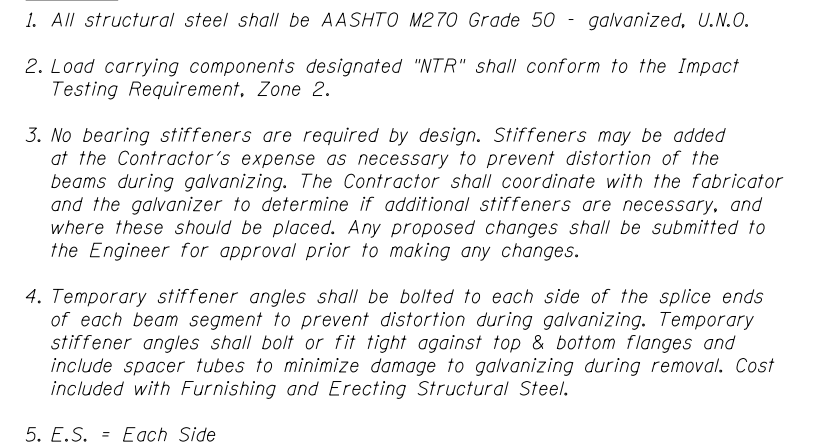


	USER NAME = dunkerleyb	DESIGNED - DD	REVISED	STATE OF ILLINOIS DEPARTMENT OF TRANSPORTATION	BEAM FRAMING PLAN STRUCTURE NO. 016-1711	F.A.I. RTE.	SECTION	COUNTY	TOTAL SHEETS	SHEET NO.
		CHECKED - EJO	REVISED			90/94/290	2013-036R	COOK	256	119
	PLOT SCALE = N.T.S.	DRAWN - DD	REVISED				CONTRACT NO.		60W71	
	PLOT DATE = 12/17/2013	CHECKED - EJO	REVISED		SHEET NO. S-27 OF S-47 SHEETS		ILLINOIS FED. AID PROJECT -NUMBER-			

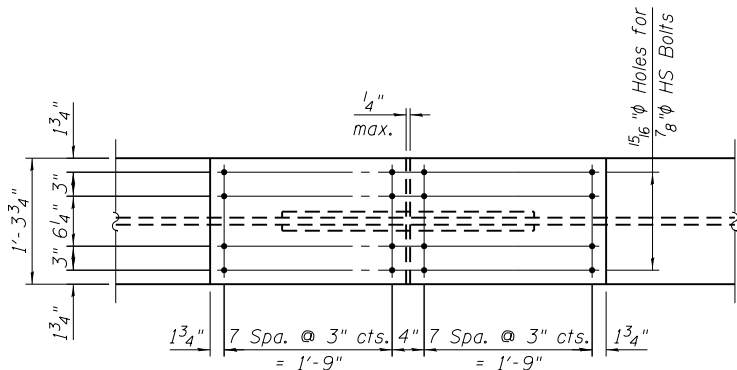

TOP FLANGE PLAN

(Bottom Flange Similar)

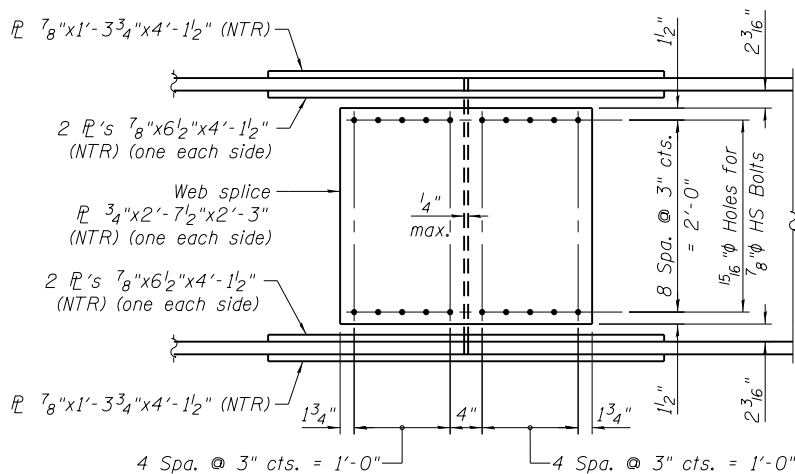

ELEVATION


SPLICE DETAIL

(36 Required)


TOP OF BEAM ELEVATIONS**						
Girder	℄ Brg. W. Abut.	℄ Splice 1	℄ Splice 2	℄ Pier	℄ Splice 3	℄ Brg. E. Abut.
1	597.12	597.69	598.76	598.90	598.66	597.70
2	597.21	597.78	598.85	598.99	598.75	597.79
3	597.30	597.87	598.94	599.08	598.84	597.88
4	597.39	597.96	599.03	599.17	598.93	597.97
5	597.48	598.05	599.12	599.26	599.02	598.06
6	597.57	598.14	599.21	599.35	599.11	598.15
7	597.57	598.14	599.21	599.35	599.11	598.15
8	597.48	598.05	599.12	599.26	599.02	598.06
9	597.39	597.96	599.03	599.17	598.93	597.97
10	597.30	597.87	598.94	599.08	598.84	597.88
11	597.21	597.78	598.85	598.99	598.75	597.79
12	597.12	597.69	598.76	598.90	598.66	597.70

**For fabrication use only.

***For Beams 10 and 11, the load due to ComEd ductbank is 43 pounds per linear foot per beam.
For Beams 8 and 9, the load due to City of Chicago ductbank is 53 pounds per linear foot per beam.

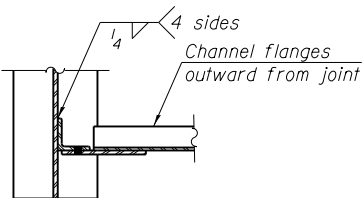

SECTION A-A

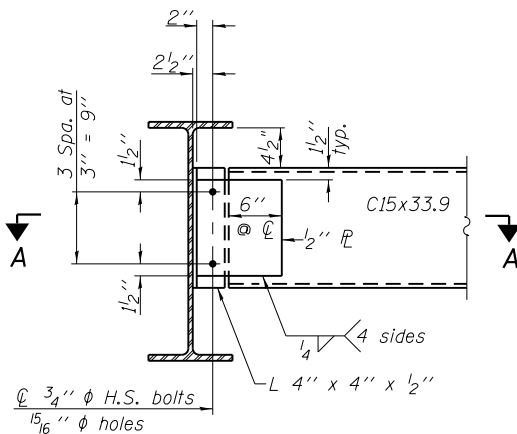


END DIAPHRAGM - D-1


(22 Required)

INTERIOR BEAM MOMENT TABLE			
	0.4 Sp. 1	Pier	0.6 Sp. 2
I_s	(in ⁴) 15,900	15,900	15,900
$I_c(n)$	(in ⁴) 33,166	-	33,166
$I_c(3n)$	(in ⁴) 24,097	-	24,097
$I_c(cr)$	(in ⁴) -	18,338	-
S_s	(in ³) 919	919	919
$S_c(n)$	(in ³) 1,219	-	1,219
$S_c(3n)$	(in ³) 1,095	-	1,095
$S_c(cr)$	(in ³) -	1,157	-
DC1	(k/')	1.08	1.08
M _{DC1}	(k)	806	979
DC2	(k/')	0.62	0.62
M _{DC2}	(k)	465	117
DW	(k/')	0.27	0.27
M _{DW}	(k)	203	51
M _{℄ + IM}	(k)	1,233	1,176
M _u (Strength I)	(k)	4,051	4,373
℄ _F M _n	(k)	5,444	-
f_s DC1	(ksi)	10.52	12.78
f_s DC2	(ksi)	5.10	5.94
f_s DW	(ksi)	2.22	2.59
f_s (℄ + IM)	(ksi)	12.14	12.20
f_s (Service II)	(ksi)	33.62	37.18
0.95R _n F _{yr}	(ksi)	47.50	47.50
f_s (Total)(Strength I)	(ksi)	-	48.64
℄ _F F _n	(ksi)	-	50.00
V _r	(k)	46.20	51.40

INTERIOR BEAM REACTION TABLE			
	W. Abut.	Pier	E. Abut.
R _{DC1}	(k) 42	113	23
R _{DC2}	(k) 24	66	13
R _{DW}	(k) 11	29	6
R _{℄ + IM}	(k) 83	149	73
R _{Total}	(k) 160	357	115

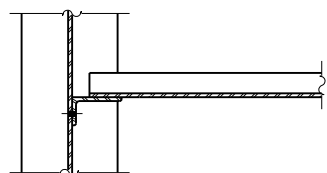

SECTION B-B

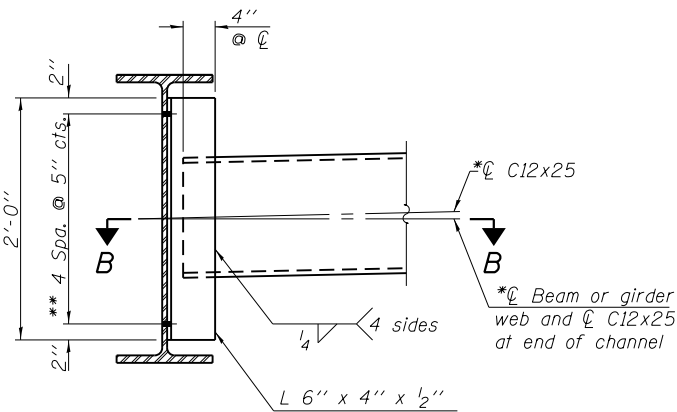

INTERIOR DIAPHRAGM - D-2

(110 Required)


Note:

*Alternate channels are permitted to facilitate material acquisition. Calculated weight of structural steel is based on the lighter section.
The alternate, if utilized, shall be provided at no additional cost to the Department.
**3/4" ϕ HS bolts, 15/16" ϕ holes


- I_s , S_s : Non-composite moment of inertia and section modulus of the steel section used for computing f_s (Total-Strength I, and Service II) due to non-composite dead loads (in⁴ and in³).
- $I_c(n)$, $S_c(n)$: Composite moment of inertia and section modulus of the steel and deck based upon the modular ratio, "n", used for computing f_s (Total-Strength I, and Service II) in uncracked sections due to short-term composite live loads (in⁴ and in³).
- $I_c(3n)$, $S_c(3n)$: Composite moment of inertia and section modulus of the steel and deck based upon 3 times the modular ratio, "3n", used for computing f_s (Total-Strength I, and Service II) in uncracked sections, due to long-term composite (superimposed) dead loads (in⁴ and in³).
- $I_c(cr)$, $S_c(cr)$: Composite moment of inertia and section modulus of the steel and longitudinal deck reinforcement, used for computing f_s (Total-Strength I and Service II) in cracked sections, due to both short-term composite live loads and long-term composite (superimposed) dead loads (in⁴ and in³).
- DC1: Un-factored non-composite dead load (kips/ft.).
- M_{DC1}: Un-factored moment due to non-composite dead load (kip-ft.).
- DC2: Un-factored long-term composite (superimposed excluding future wearing surface) dead load (kips/ft.).
- M_{DC2}: Un-factored moment due to long-term composite (superimposed excluding future wearing surface) dead load (kip-ft.).
- DW: Un-factored long-term composite (superimposed future wearing surface only) dead load (kips/ft.).
- M_{DW}: Un-factored moment due to long-term composite (superimposed future wearing surface only) dead load (kip-ft.).
- M_{℄ + IM}: Un-factored live load moment plus dynamic load allowance (impact) (kip-ft.).
- M_u (Strength I): Factored design moment (kip-ft.).
1.25 (M_{DC1} + M_{DC2}) + 1.5 M_{DW} + 1.75 M_{℄ + IM}
- ℄_F M_n: Compact composite positive moment capacity computed according to Article 6.10.7.1 or non-slender negative moment capacity according to Article A6.1.1 or A6.1.2 (kip-ft.).
- f_s DC1: Un-factored stress at edge of flange for controlling steel flange due to vertical non-composite dead loads as calculated below (ksi).
M_{DC1} / S_s
- f_s DC2: Un-factored stress at edge of flange for controlling steel flange due to vertical composite dead loads as calculated below (ksi).
M_{DC2} / $S_c(3n)$ or M_{DC2} / $S_c(cr)$ as applicable.
- f_s DW: Un-factored stress at edge of flange for controlling steel flange due to vertical composite future wearing surface loads as calculated below (ksi).
M_{DW} / $S_c(3n)$ or M_{DW} / $S_c(cr)$ as applicable.
- f_s (℄ + IM): Un-factored stress at edge of flange for controlling steel flange due to vertical composite live load plus impact loads as calculated below (ksi).
M_{℄ + IM} / $S_c(n)$ or M_{℄ + IM} / $S_c(cr)$ as applicable.
- f_s (Service II): Sum of stresses as computed below (ksi).
 f_s DC1 + f_s DC2 + f_s DW + 1.3 f_s (℄ + IM)
- 0.95R_nF_{yr}: Composite stress capacity for Service II loading according to Article 6.10.4.2 (ksi).
- f_s (Total)(Strength I): Sum of stresses as computed below on non-compact section (ksi).
1.25 (f_s DC1 + f_s DC2) + 1.5 f_s DW + 1.75 f_s (℄ + IM)
- ℄_F F_n: Non-Compact composite positive or negative stress capacity for Strength I loading according to Article 6.10.7 or 6.10.8 (ksi).
- V_r: Maximum factored shear range in span computed according to Article 6.10.10.

NOTES:


- Structural steel for flange and splice plates shall be AASHTO M270 Grade 50 - galvanized. Structural steel for diaphragms, connection plates and angles may be AASHTO M270 Grade 36 - galvanized.
- Load carrying components designated "NTR" shall conform to the Impact Testing Requirement, Zone 2.
- All diaphragms shall be installed as steel is erected and secured with erection pins and bolts except as otherwise noted. Individual diaphragms at supports may be temporarily disconnected to install bearing anchor rods.
- Two hardened washers required for each set of oversized holes.
- E.S. = Each Side

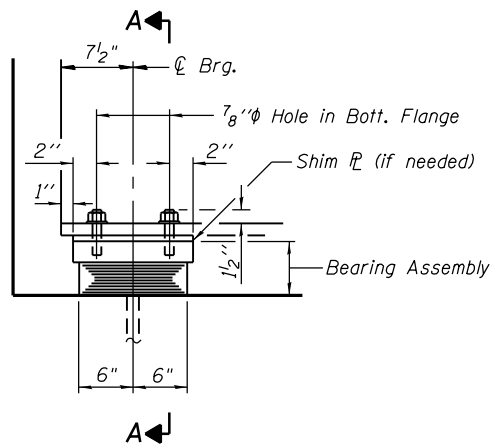


ELEVATION AT W. ABUT.

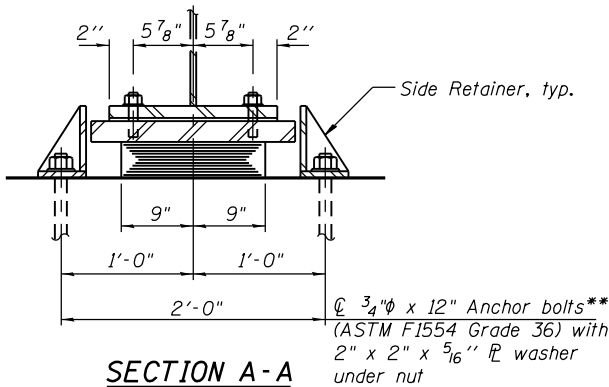

SECTION A-A

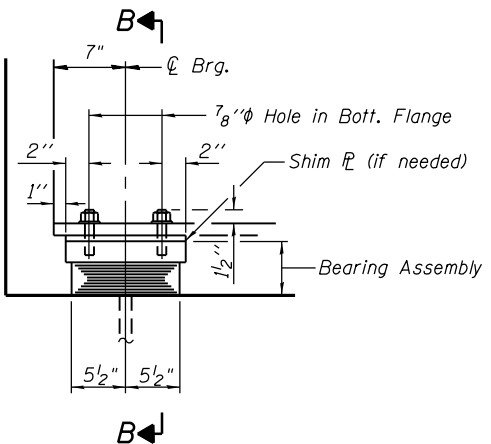

ELEVATION AT E. ABUT.

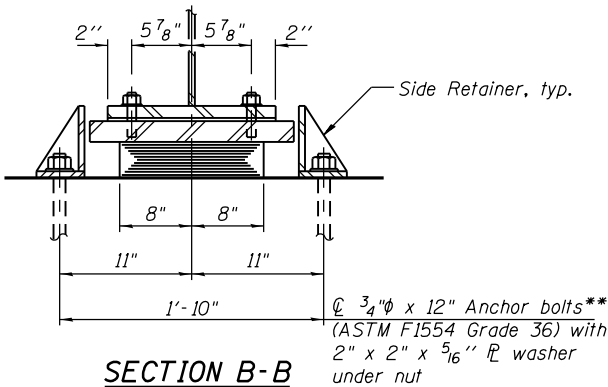


SECTION B-B

TYPE I ELASTOMERIC EXP. BRG.
WEST ABUTMENT

TYPE I ELASTOMERIC EXP. BRG.
EAST ABUTMENT


** Length shown is minimum required embedment length.

** Length shown is minimum required embedment length.

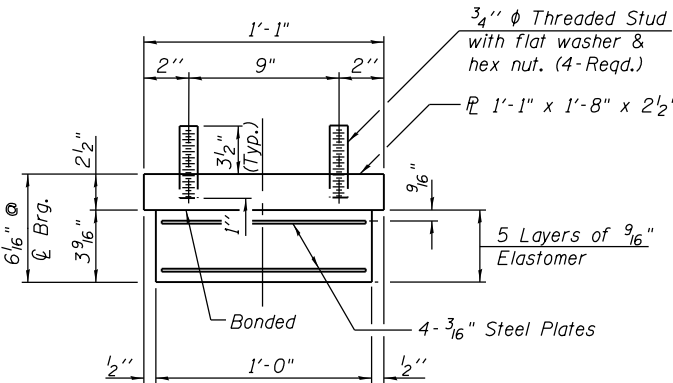


BEARING ASSEMBLY

Note:
Shim plates shall not be placed under Bearing Assembly.

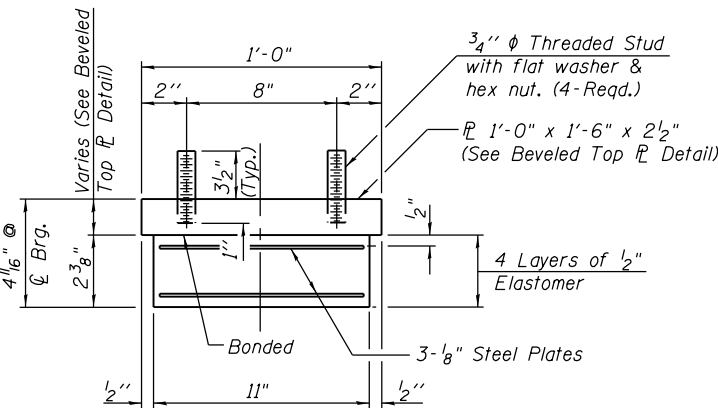


BEARING ASSEMBLY

Note:
Shim plates shall not be placed under Bearing Assembly.

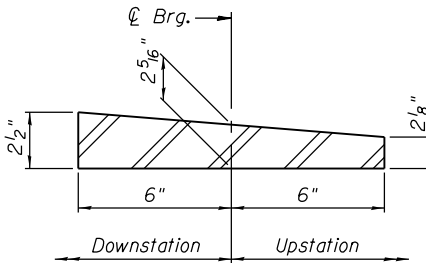


BEVELED TOP DETAIL
EAST ABUTMENT

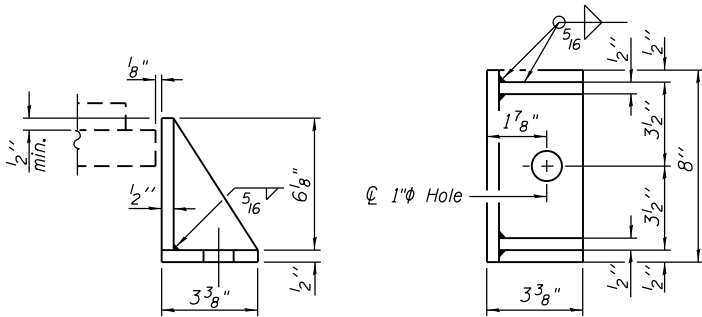

SIDE RETAINER

Equivalent rolled angle with stiffeners will be allowed in lieu of welded plates.

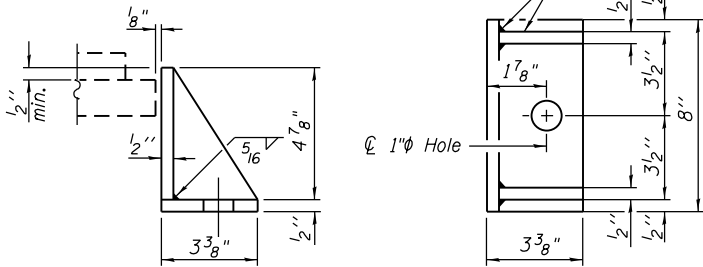

SIDE RETAINER

Equivalent rolled angle with stiffeners will be allowed in lieu of welded plates.

NOTES:


- Anchor bolts shall be ASTM F1554 all-thread (or an Engineer-approved alternate material) of the grade(s) and diameter(s) specified. The corresponding specified grade of AASHTO M314 anchor bolts may be used in lieu of ASTM F1554.
- Anchor bolts for side retainers may be cast in place or installed in holes drilled before or after members are in place.
- Drilled and set anchor bolts shall be installed according to Article 521.06 of the Standard Specifications.
- Side retainers and other steel members required for the elastomeric bearing assembly shall be included in the cost of Elastomeric Bearing Assembly, Type I.
- Two 1/8 in. adjusting shims shall be provided for each bearing in addition to all other plates or shims and placed as shown on bearing details.
- All (embedded and separate) bearing plates, side retainers, anchor bolts, nuts, washers and pintles shall be galvanized according to AASHTO M111 or M232 as applicable.

BILL OF MATERIAL


Item	Unit	Total
Elastomeric Bearing Assembly Type I	Each	24
Anchor Bolts, 3/4"	Each	48

USER NAME = dabezicd	DESIGNED - EJO	REVISED
	CHECKED - DD	REVISED
PLOT SCALE = N.T.S.	DRAWN - BRD	REVISED
PLOT DATE = 2/19/2014	CHECKED - DD	REVISED

F.A.I. RTE.	SECTION	COUNTY	TOTAL SHEETS	SHEET NO.
90/94/290	2013-036R	COOK	256	121
		CONTRACT NO. 60W71		
ILLINOIS FED. AID PROJECT -NUMBER-				

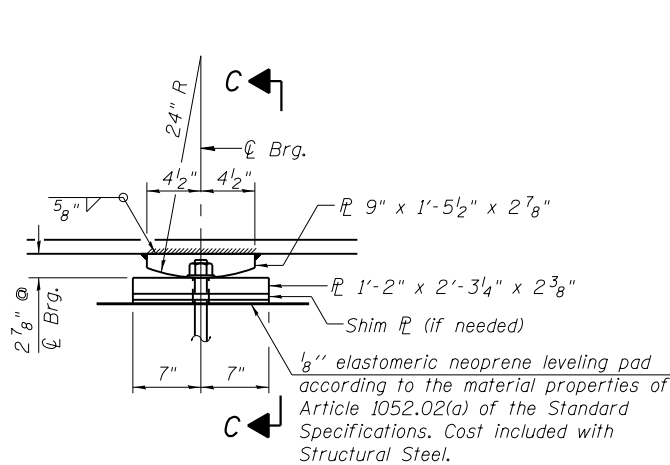


ELEVATION AT PIER

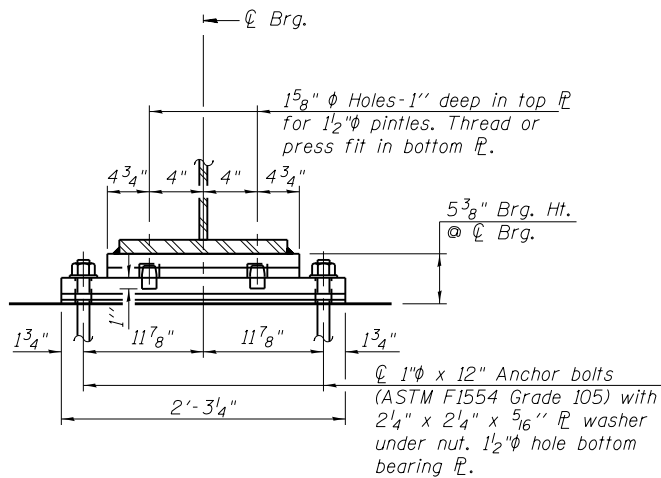

SECTION C-C

FIXED BEARING - PIER

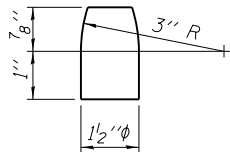

PINTLE

NOTES:

- Anchor bolts at fixed bearings may be either cast in place or installed in holes drilled after the supported member is in place.
- Fixed Bearing Assembly included in "Furnishing and Erecting Structural Steel."
- Anchor bolts shall be ASTM F1554 all-thread (or an Engineer-approved alternate material) of the grade(s) and diameter(s) specified. The corresponding specified grade of AASHTO M314 anchor bolts may be used in lieu of ASTM F1554.
- Drilled and set anchor bolts shall be installed according to Article 521.06 of the Standard Specifications.
- Two 1/8 in. adjusting shims shall be provided for each bearing in addition to all other plates or shims and placed as shown on bearing details.
- All (embedded and separate) bearing plates, side retainers, anchor bolts, nuts, washers and pintles shall be galvanized according to AASHTO M111 or M232 as applicable.

BILL OF MATERIAL

Item	Unit	Total
Anchor Bolts, 1"	Each	24

0161711-60W71-S30-Bearing

AECOM


USER NAME = dunkerleyb	DESIGNED - EJO	REVISED
	CHECKED - DD	REVISED
PLOT SCALE = N.T.S.	DRAWN - BRD	REVISED
PLOT DATE = 12/17/2013	CHECKED - DD	REVISED

STATE OF ILLINOIS
DEPARTMENT OF TRANSPORTATION

FIXED BEARING DETAILS
STRUCTURE NO. 016-1711

SHEET NO. S-30 OF S-47 SHEETS

F.A.I. RTE.	SECTION	COUNTY	TOTAL SHEETS	SHEET NO.
90/94/290	2013-036R	COOK	256	122
		CONTRACT NO. 60W71		
ILLINOIS		FED. AID PROJECT -NUMBER-		

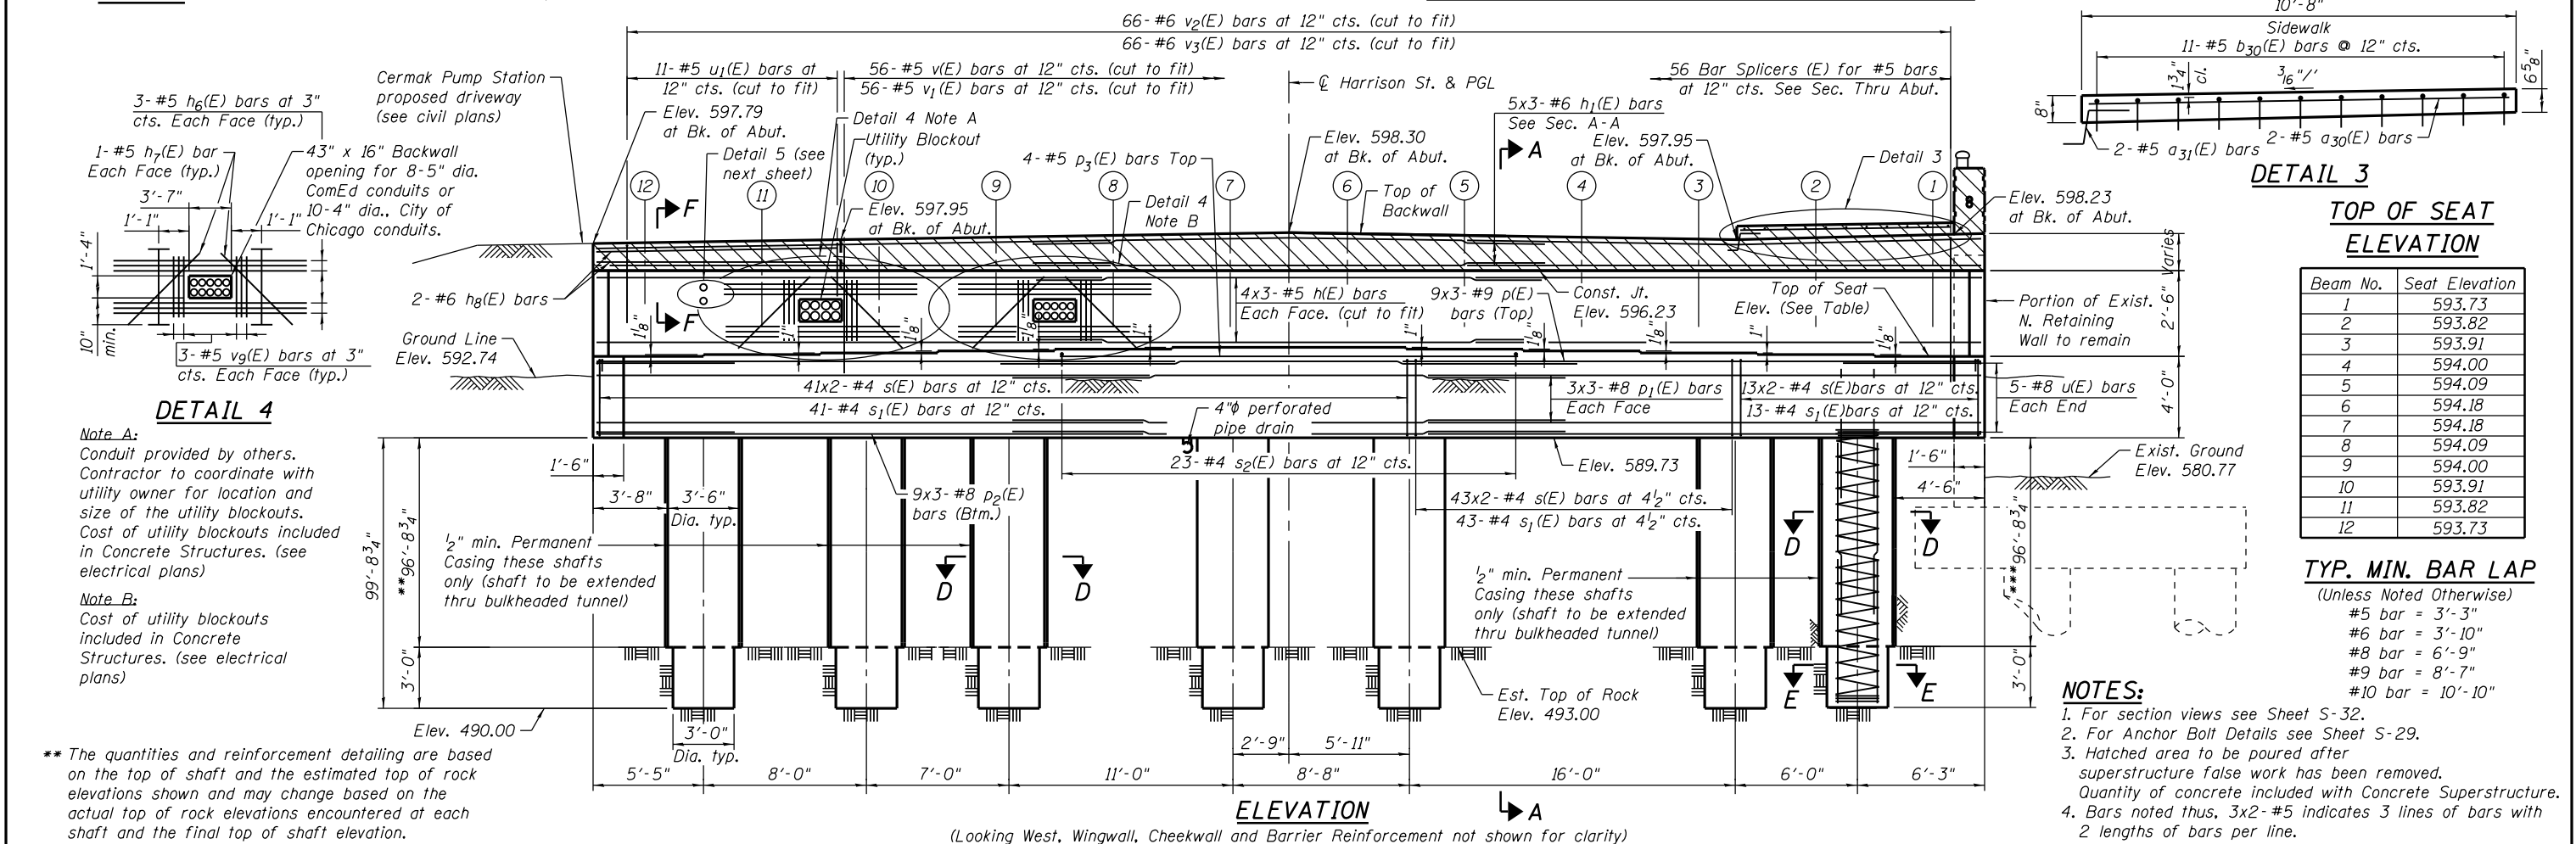

<i>Beam No.</i>	<i>Seat Elevation</i>
1	593.73
2	593.82
3	593.91
4	594.00
5	594.09
6	594.18
7	594.18
8	594.09
9	594.00
10	593.91
11	593.82
12	593.73

TYP. MIN. BAR LAF
(Unless Noted Otherwise)
#5 bar = 3'-3"
#6 bar = 3'-10"
#8 bar = 6'-9"
#9 bar = 8'-7"
#10 bar = 10'-10"

NOTES: #10 bar = 10' - 10"

1. For section views see Sheet S-32.
2. For Anchor Bolt Details see Sheet S-29.
3. Hatched area to be poured after superstructure false work has been removed. Quantity of concrete included with Concrete Superstructure.
4. Bars noted thus, 3x2-#5 indicates 3 lines of bars with 2 lengths of bars per line.

1. *Hatched area to be poured after superstructure false work has been removed. Quantity of concrete included with Concrete Superstructure.*
2. *Concrete Sealer shall be applied to abutment backwall, bearing seats and exposed faces of abutment cap, cheekwalls and wingwalls.*
3. *When splicing spiral reinforcement is necessary, the spiral shall be provided with 1½ extra turns at the ends to be spliced. These additional turns shall either be welded together according to AWS D1.4 or shall both terminate with a 135° standard hook.*
4. *E.F. = Each Face*
5. *Drill and grout of v6(E) bars in accordance with Article 584 of the Standard Specifications. Cost included with Reinforcement Bars, Epoxy Coated pay item.*
6. *For Pipe Underdrain detail see sheet S-03.*
7. *Bars noted thus, 3x2-#5 indicates 3 lines of bars with 2 lengths of bars per line.*




For details of Bar Splicers, see sheet S-44.
* Length is height of spiral



For details of Bar Splicers, see sheet S-44.
* Length is height of spiral

Epoxy Bonding Compound


Horizontal and vertical cracks shall have one way injection points installed in accordance with Section 590 of Standard Specifications.

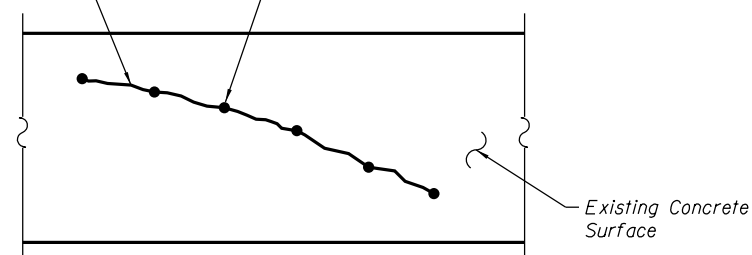


EPOXY CRACK INJECTION

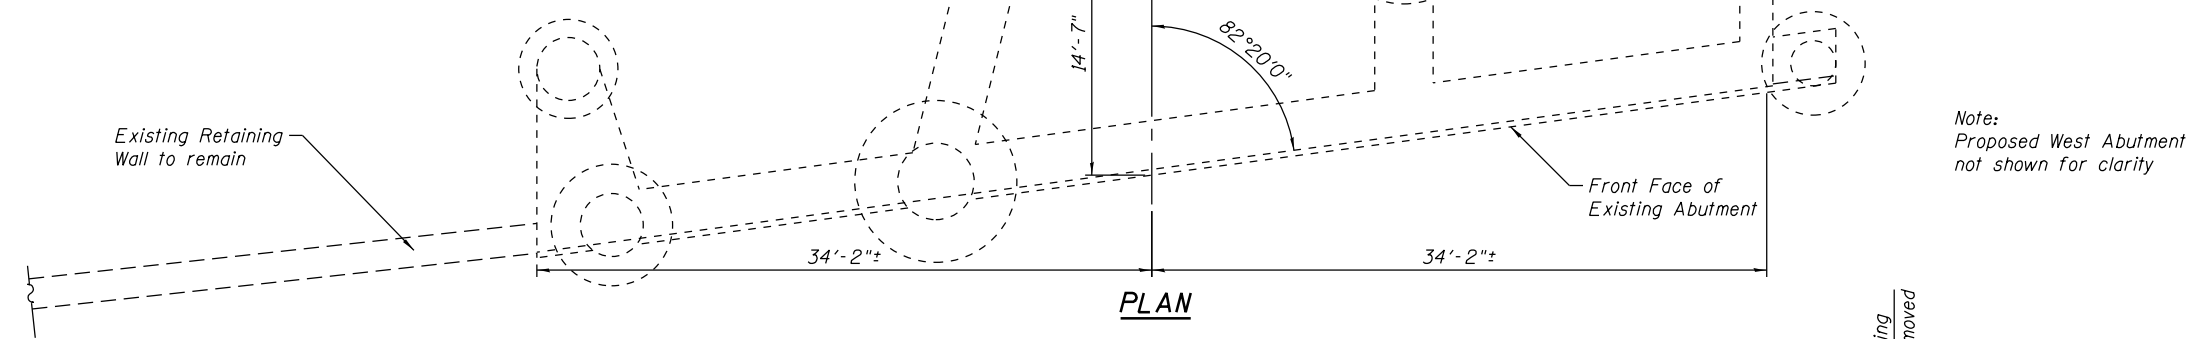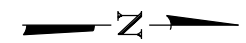

PLAN

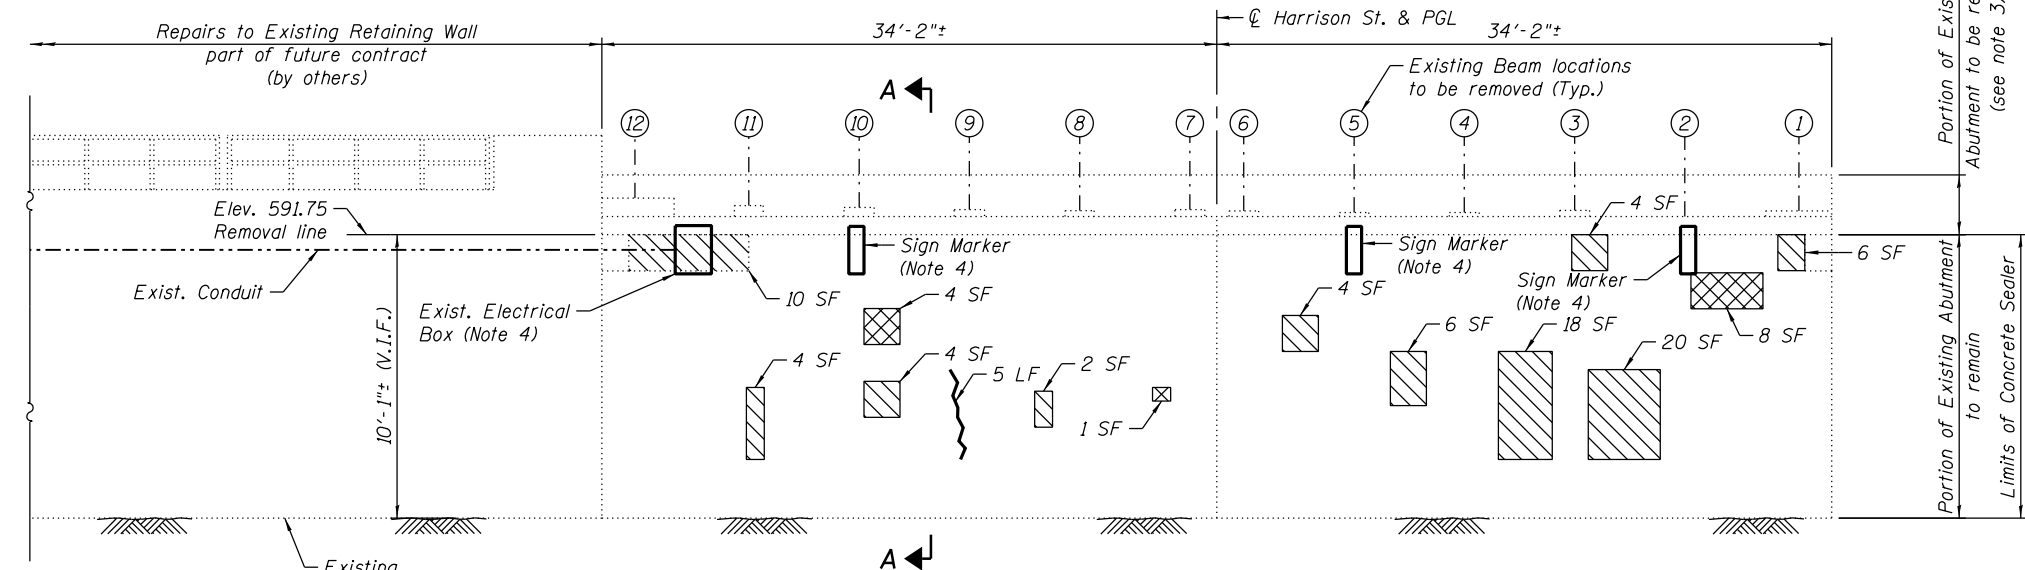

ELEVATION (Looking West)

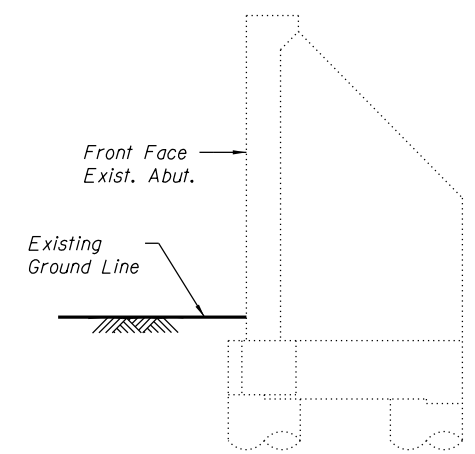

SECTION A-A

LEGEND

- Epoxy Crack Injection
- Area of Structural Repair of Concrete (depth equal to or less than 5")
- Area of Structural Repair of Concrete (depth greater than 5")

NOTES:

- Deck and superstructure not shown for clarity.
- Concrete sealer shall be applied to front face of existing abutment.
- For Removal Details see sheets S-04 thru S-06.
- Sign Markers, Conduit, and Electrical Boxes attached to face of abutment are to be removed prior to repair work.

BILL OF MATERIAL

Item	Unit	Quantity
Concrete Sealer	Sq. Ft.	690
Epoxy Crack Injection	Foot	5
Structural Repair of Concrete (depth equal to or less than 5")	Sq. Ft.	78
Structural Repair of Concrete (depth greater than 5")	Sq. Ft.	13



USER NAME = dabezlcd	DESIGNED - EJO	REVISED
	CHECKED - DEV	REVISED
PLOT SCALE = N.T.S.	DRAWN - BRD	REVISED
PLOT DATE = 2/19/2014	CHECKED - DEV	REVISED


STATE OF ILLINOIS
DEPARTMENT OF TRANSPORTATION

WEST ABUTMENT REPAIR DETAILS (1 OF 2)
STRUCTURE NO. 016-1711


SHEET NO. S-33 OF S-47 SHEETS

F.A.I. RTE. 90/94/290	SECTION 2013-036R	COUNTY COOK	TOTAL SHEETS 256	SHEET NO. 125
CONTRACT NO. 60W71			ILLINOIS FED. AID PROJECT -NUMBER-	


0161711-60W71-S33-Abutment

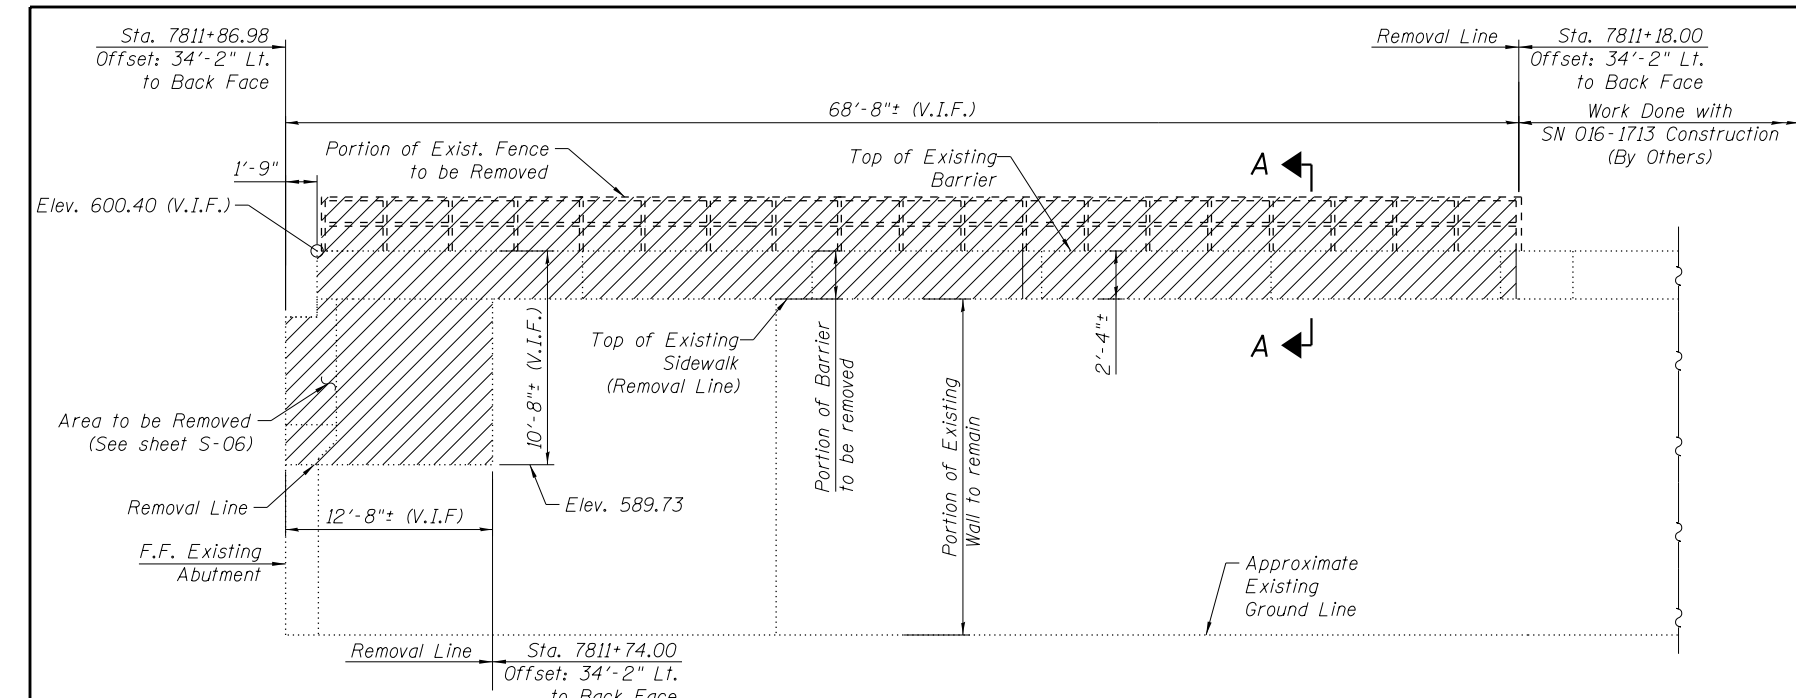


EXISTING ELEVATION
(Looking South)

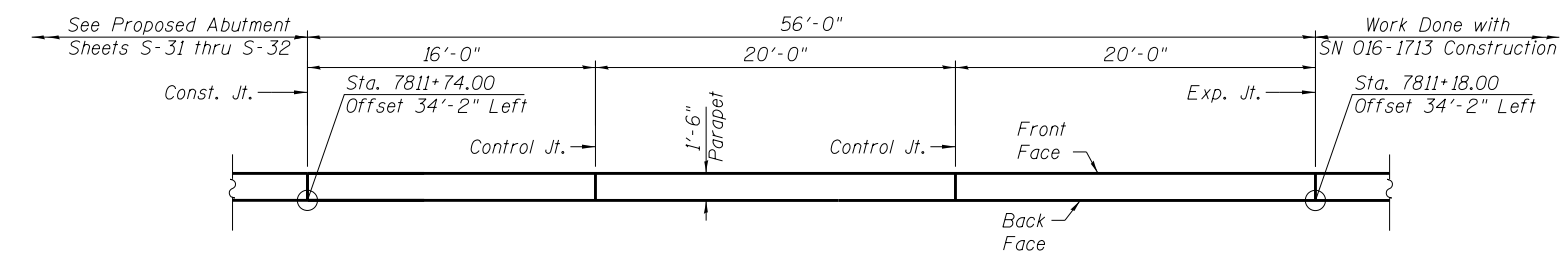


PLAN

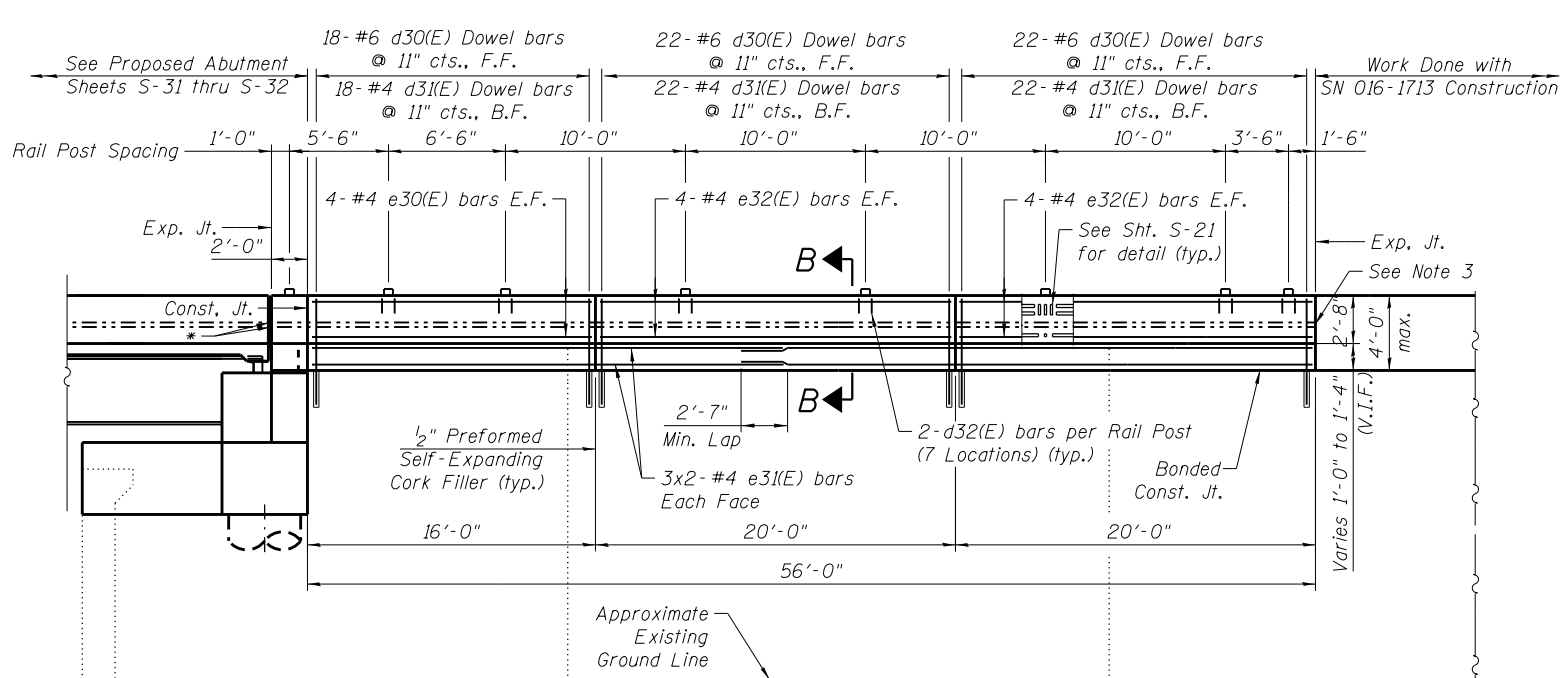

PROPOSED ELEVATION
(Looking South)

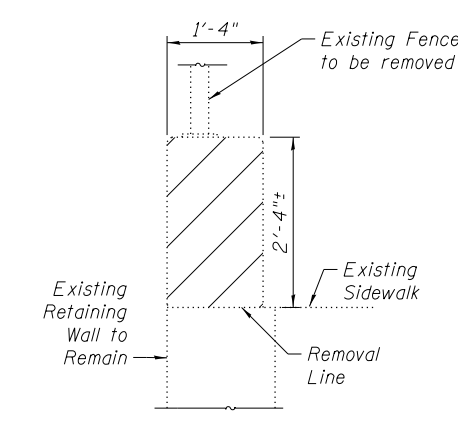

SECTION A-A

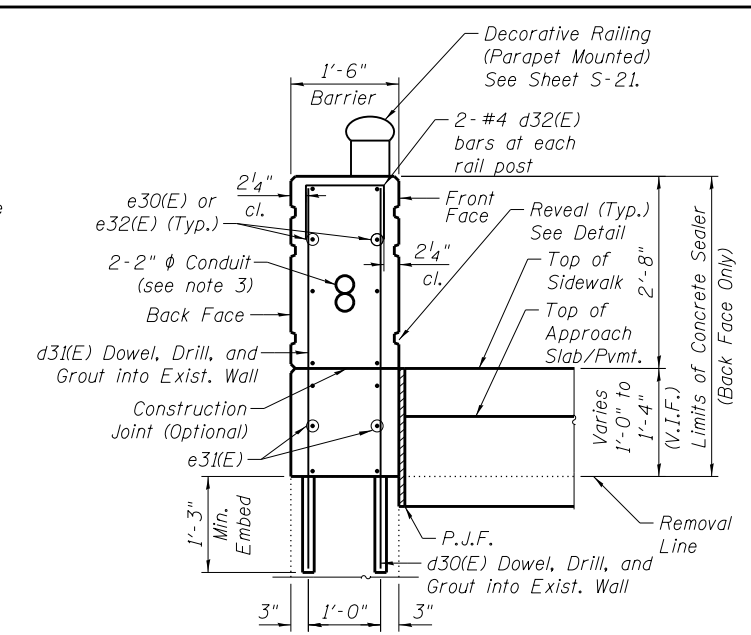

SECTION B-B


LEGEND:




NOTES:

1. Work this sheet with sheet S-33.
2. Drill and Grout d30(E) and d31(E) into the Concrete to 1/4" larger in dia. than the diameter of the bar used with a Minimum Depth of 15 Inches in accordance with Section 584 of the Standard Specifications. Cost included with Reinforcement Bars, Epoxy Coated pay item.
3. Embedded conduit shall be routed to the end of the new parapet wall and connected to SN. 016-1713 conduit in wall. See Lighting Plans details.
4. Apply Protective Coat to front face and top of Barrier. Concrete Sealer to be applied to back face only.
5. E.F. = Each Face
F.F. = Front Face
B.F. = Back Face
V.I.F. = Verify In Field

*Provide all conduit expansion/deflection fittings at expansion joints.

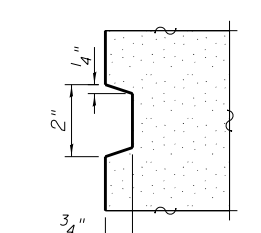

REVEAL DETAIL

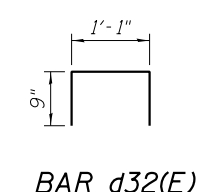

BAR d32(E)

BILL OF MATERIAL

Bar	No.	Size	Length	Shape
d30(E) Dowel	62	#6	5'-1"	—
d31(E) Dowel	62	#4	5'-1"	—
d32(E)	14	#4	2'-7"	□
e30(E)	8	#4	15'-8"	—
e31(E)	12	#4	29'-2"	—
e32(E)	16	#4	19'-8"	—
Concrete Superstructure		Cu. Yd.	12	
Protective Coat		Sq. Yd.	26	
Reinforcement Bars, Epoxy Coated		Pound	1,240	
Concrete Sealer		Sq. Ft.	215	

0161711-60W71-S34-Abutment





USER NAME = dunkerleyb	DESIGNED - EJO	REVISED
PLOT SCALE = N.T.S.	CHECKED - DEV	REVISED
PLOT DATE = 12/17/2013	DRAWN - BRD	REVISED
	CHECKED - DEV	REVISED

STATE OF ILLINOIS
DEPARTMENT OF TRANSPORTATION

WEST ABUTMENT REPAIR DETAILS (2 OF 2)
STRUCTURE NO. 016-1711

SHEET NO. S-34 OF S-47 SHEETS

F.A.I. RTE.	SECTION	COUNTY	TOTAL SHEETS	SHEET NO.
90/94/290	2013-036R	COOK	256	126
CONTRACT NO. 60W71			ILLINOIS FED. AID PROJECT -NUMBER-	

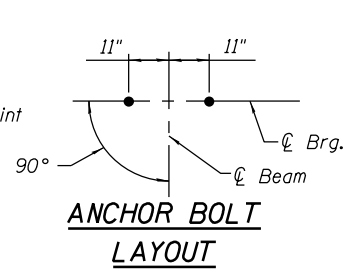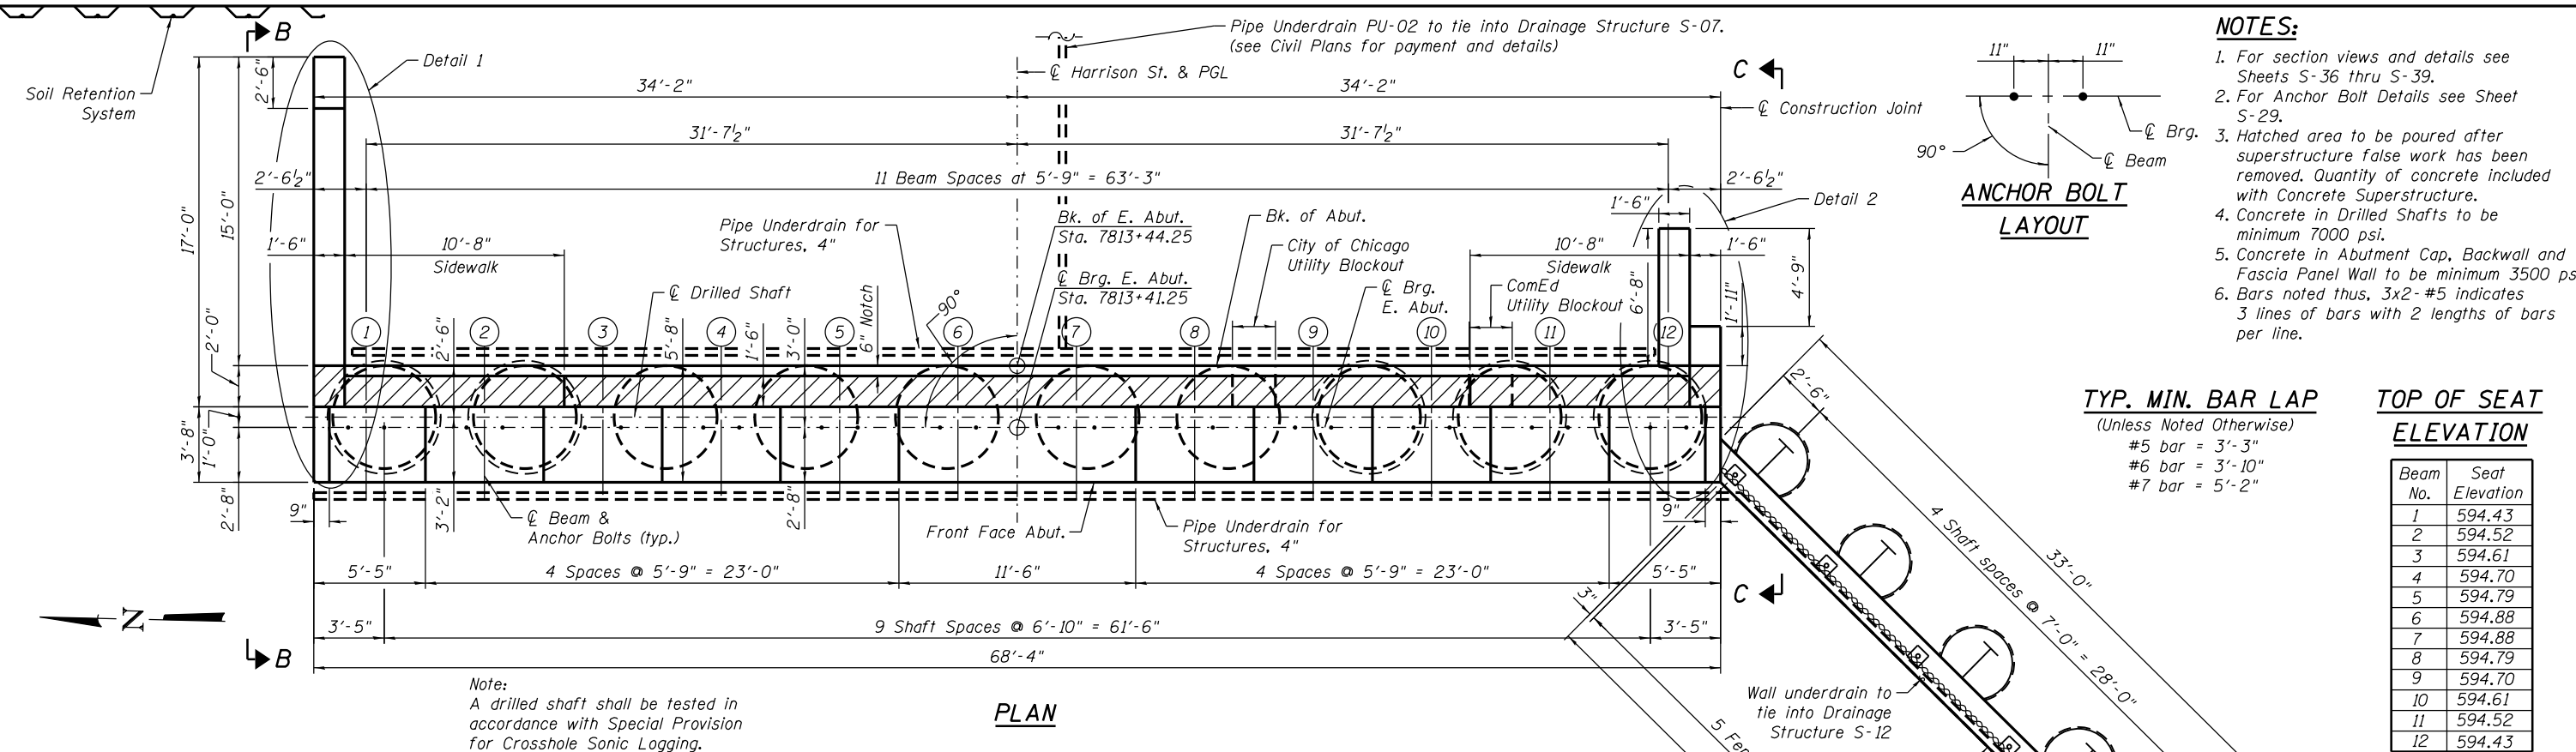


- NOTES:**
1. For section views and details see Sheets S-36 thru S-39.
 2. For Anchor Bolt Details see Sheet S-29.
 3. Hatched area to be poured after superstructure false work has been removed. Quantity of concrete included with Concrete Superstructure.
 4. Concrete in Drilled Shafts to be minimum 7000 psi.
 5. Concrete in Abutment Cap, Backwall and Fascia Panel Wall to be minimum 3500 psi.
 6. Bars noted thus, 3x2-#5 indicates 3 lines of bars with 2 lengths of bars per line.

TYP. MIN. BAR LAP
(Unless Noted Otherwise)
#5 bar = 3'-3"
#6 bar = 3'-10"
#7 bar = 5'-2"


TOP OF SEAT ELEVATION

Beam No.	Seat Elevation
1	594.43
2	594.52
3	594.61
4	594.70
5	594.79
6	594.88
7	594.88
8	594.79
9	594.70
10	594.61
11	594.52
12	594.43

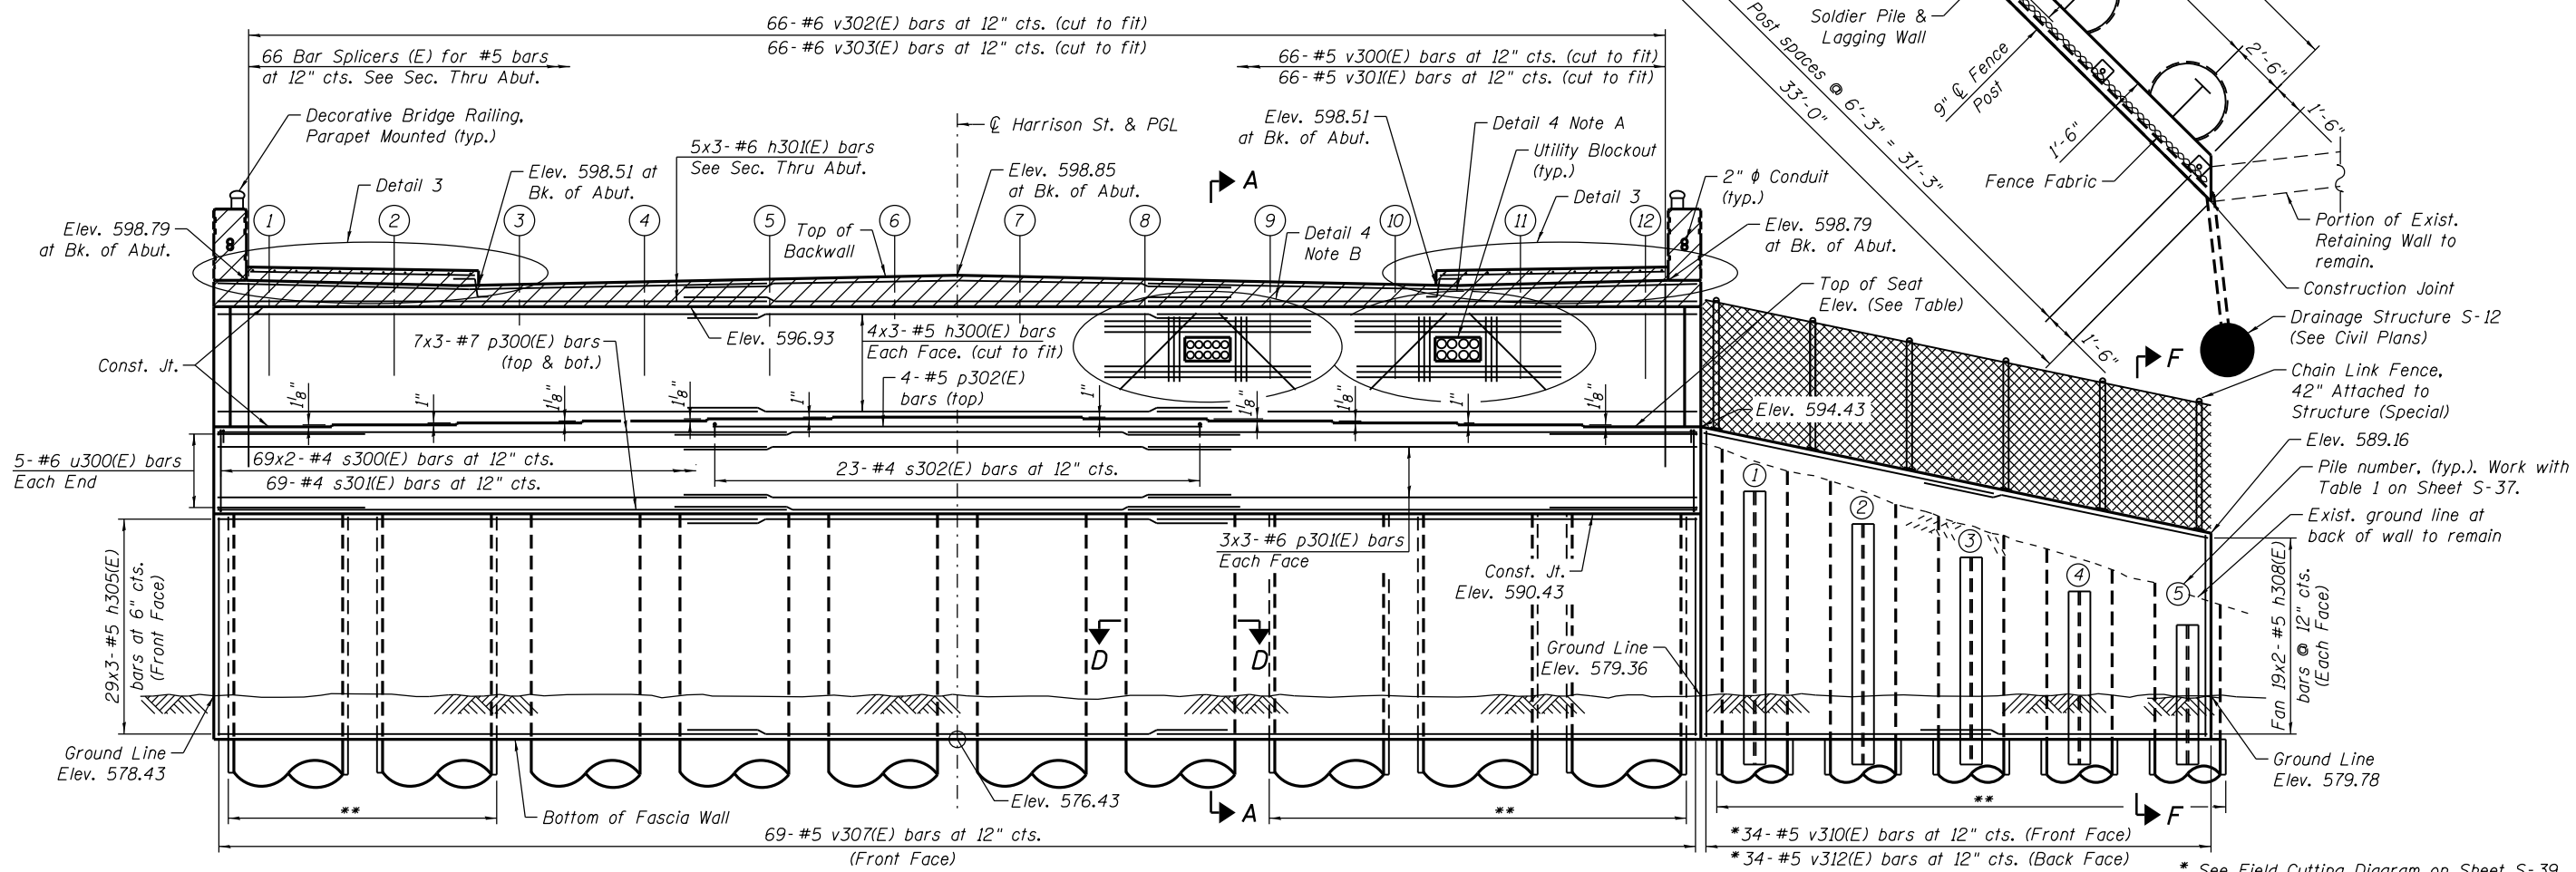


* See Field Cutting Diagram on Sheet S-39.
** 1/2" min. Permanent Casing these shafts only (shafts to extend thru bulkheaded tunnel)

0161711-60W71-S35-Abutment

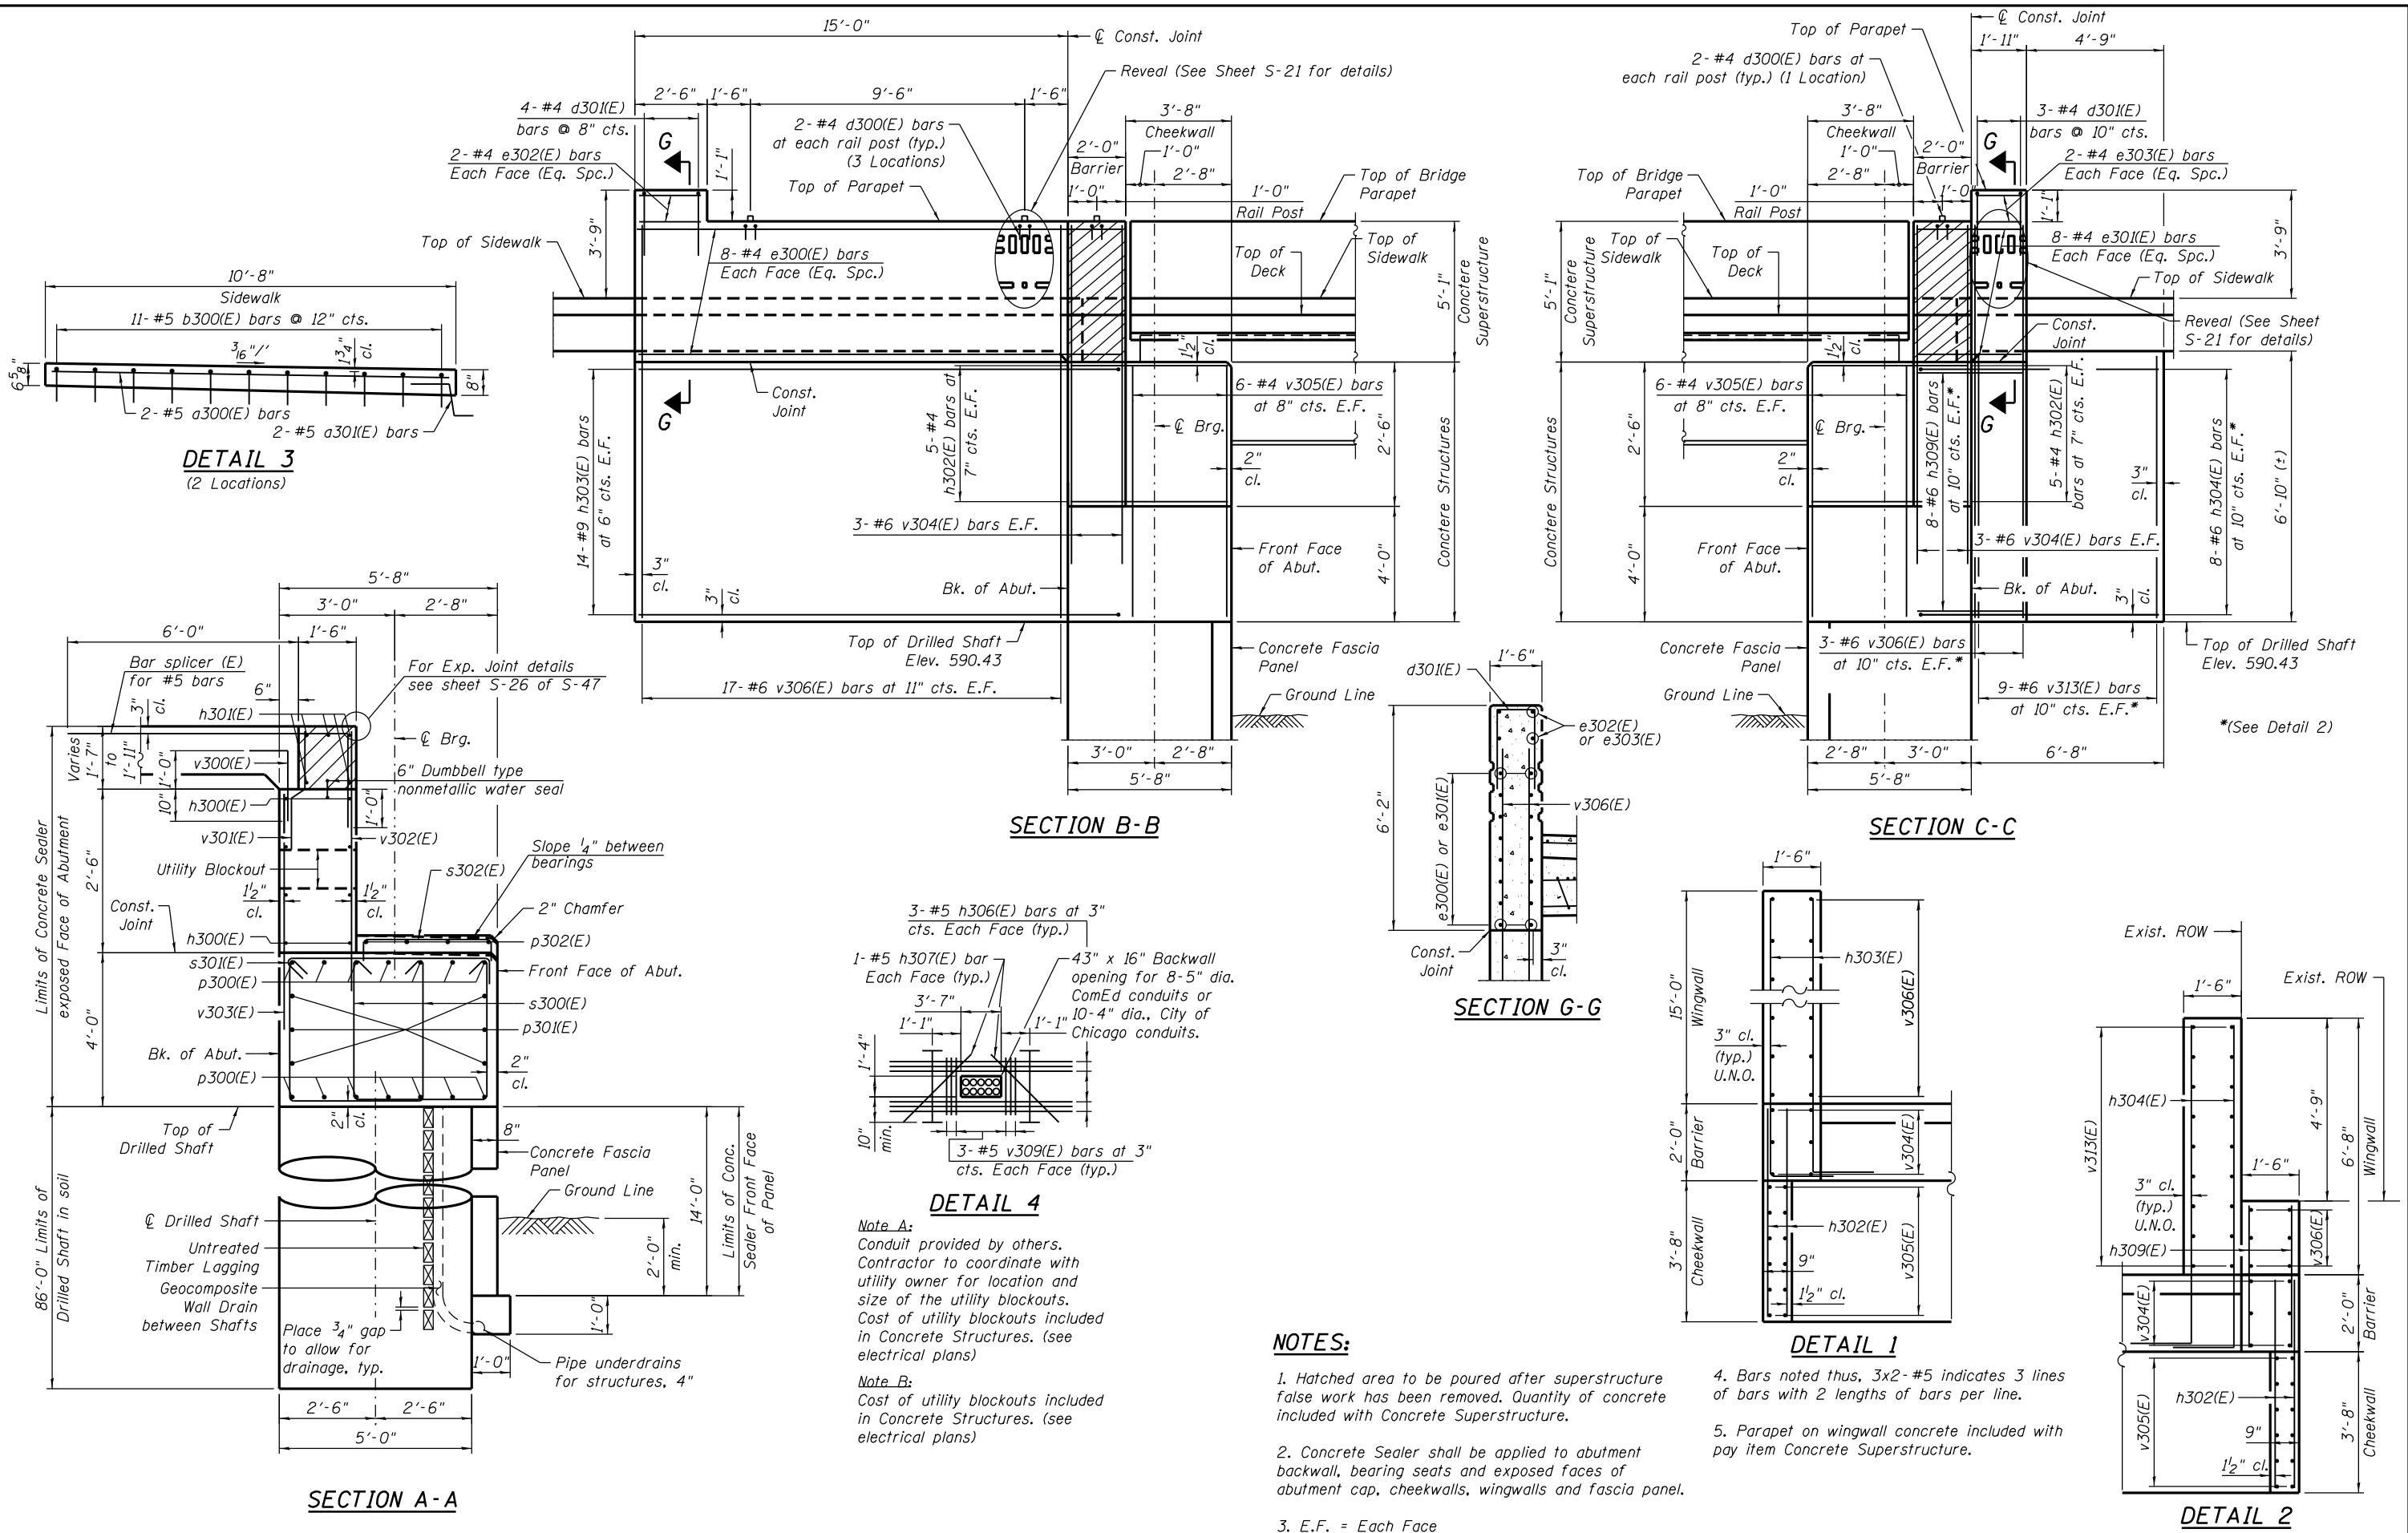


- NOTES:**
- 1. Hatched area to be poured after superstructure false work has been removed. Quantity of concrete included with Concrete Superstructure.
 - 2. Concrete Sealer shall be applied to abutment backwall, bearing seats and exposed faces of abutment cap, cheekwalls, wingwalls and fascia panel.
 - 3. E.F. = Each Face
 - 4. Bars noted thus, 3x2-#5 indicates 3 lines of bars with 2 lengths of bars per line.
 - 5. Parapet on wingwall concrete included with pay item Concrete Superstructure.

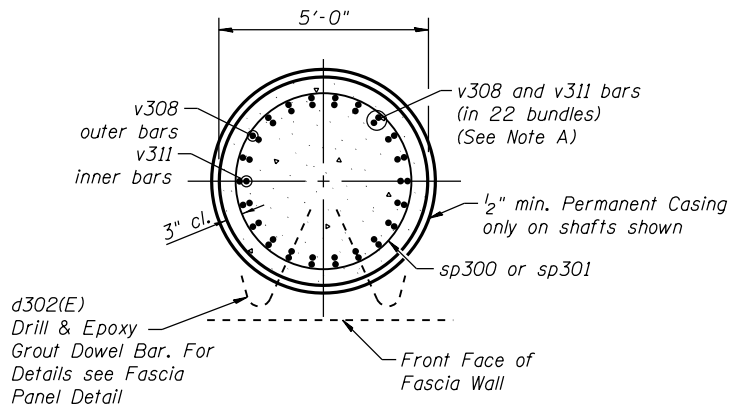

SECTION D-D


NOTES:

- When splicing spiral reinforcement is necessary, the spiral shall be provided with 1/2 extra turns at the ends to be spliced. These additional turns shall either be welded together according to AWS D1.4 or shall both terminate with a 135° standard hook.
- Drilling and grouting of d302(E) bars included with Class SI Concrete Miscellaneous pay item.
- Bars noted thus, 3x2-#5 indicates 3 lines of bars with 2 lengths of bars per line.
- For details of Bar Splicers see sheet S-44.
- Contractor to use Mechanical Splicers in drilled shafts that will fit between spirals.

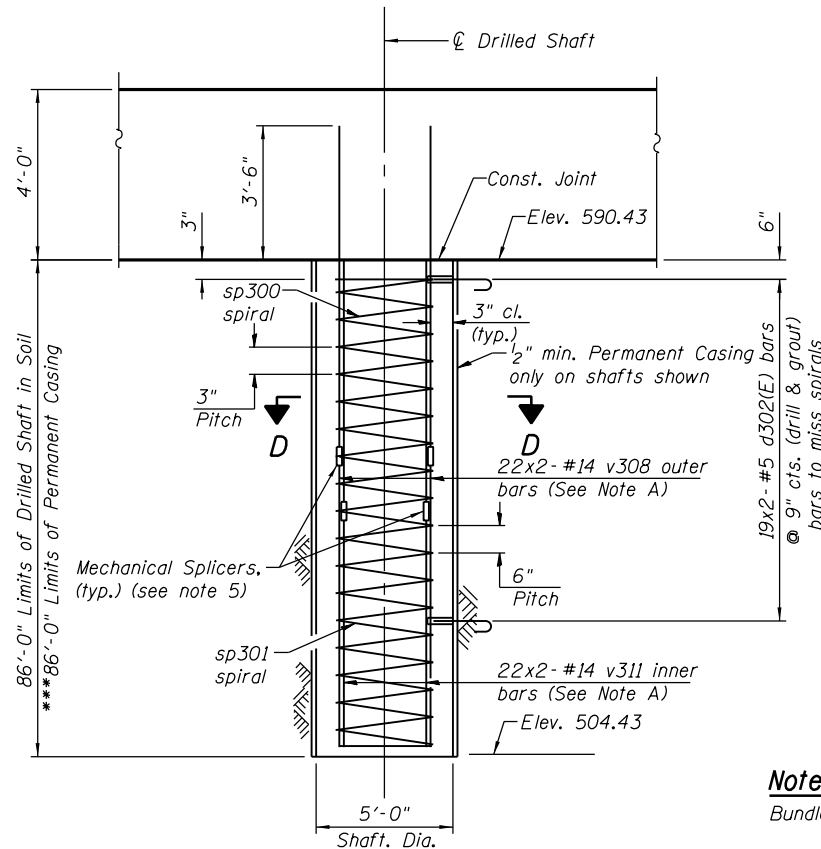

ABUTMENT SHAFT ELEVATION


Note B:
The Contractor is responsible for the design and performance of the lagging system, using no less than a 3 in. nominal rough-sawn thickness and timber with a minimum allowable bending stress of 1,000 psi, until the concrete facing is installed. The Contractor shall submit design calculations and details prepared by an Illinois Licensed Structural Engineer for the attachment of the lagging to the shaft for approval by the Engineer. Cost Included with Class SI Concrete Miscellaneous.

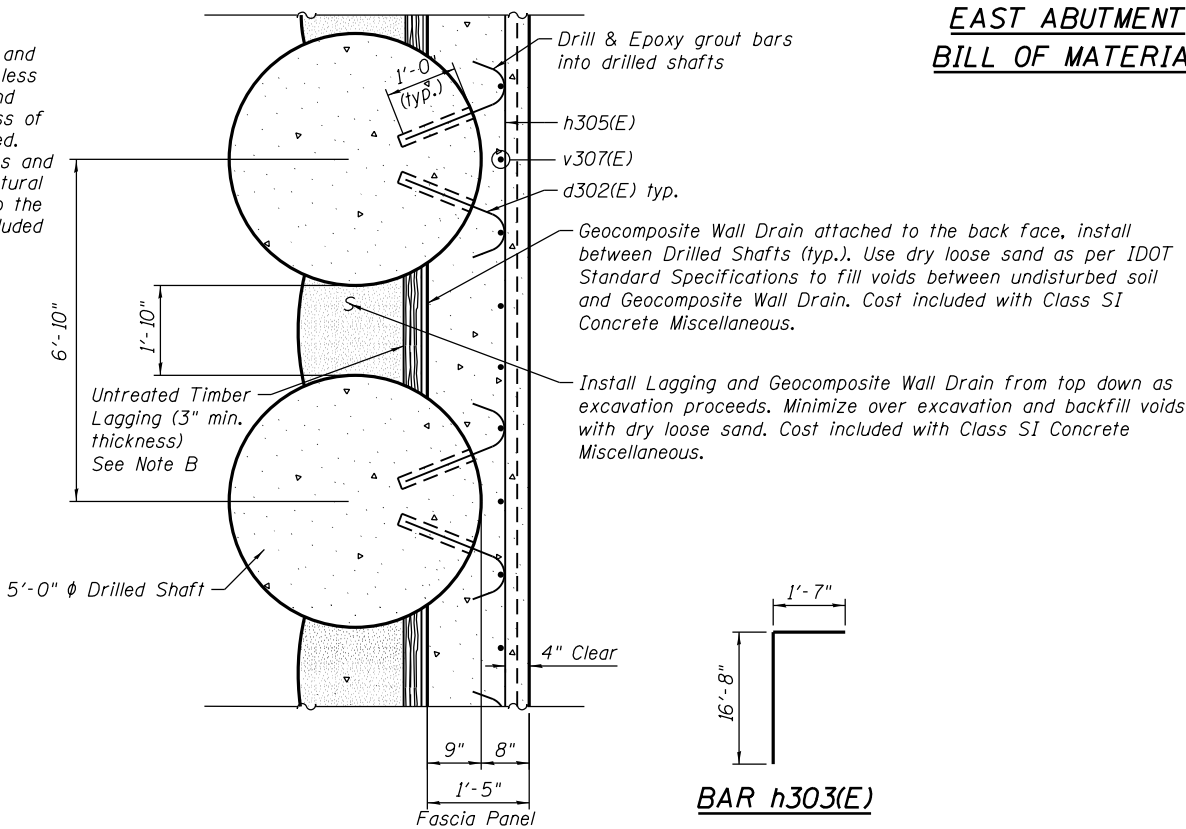

FASCIA PANEL DETAIL

EAST ABUTMENT
BILL OF MATERIAL

Bar	No.	Size	Length	Shape
a300(E)	4	#5	10'-4"	
a301(E)	4	#5	2'-4"	
b300(E)	22	#5	3'-10"	
d300(E)	8	#4	2'-7"	
d301(E)	7	#4	4'-5"	
d302(E)	380	#5	1'-11"	
e300(E)	16	#4	16'-8"	
e301(E)	16	#4	3'-7"	
e302(E)	4	#4	2'-2"	
e303(E)	4	#4	1'-7"	
h300(E)	24	#5	24'-10"	
h301(E)	15	#6	25'-3"	
h302(E)	20	#4	5'-4"	
h303(E)	28	#9	18'-3"	
h304(E)	16	#6	9'-4"	
h305(E)	87	#5	24'-10"	
h306(E)	24	#5	9'-6"	
h307(E)	8	#5	5'-0"	
h308(E)	76	#5	18'-2"	
h309(E)	16	#6	3'-7"	
p300(E)	42	#7	26'-2"	
p301(E)	18	#6	25'-3"	
p302(E)	4	#5	22'-8"	
s300(E)	138	#4	11'-9"	
s301(E)	69	#4	6'-4 1/2"	
s302(E)	23	#4	4'-8"	
sp300	10	#6	20'-0"	
sp301	10	#6	65'-9"	
u300(E)	10	#6	15'-8"	
v300(E)	66	#5	2'-10"	
v301(E)	66	#5	3'-7"	
v302(E)	66	#6	6'-6"	
v303(E)	66	#6	5'-1"	
v304(E)	12	#6	10'-0"	
v305(E)	24	#4	6'-0"	
v306(E)	40	#6	11'-3"	
v307(E)	69	#5	13'-8"	
v308	440	#14	44'-9"	
v309(E)	24	#5	2'-2"	
v310(E)	17	#5	30'-0"	
v311	440	#14	43'-0"	
v312(E)	17	#5	30'-0"	
v313(E)	18	#6	6'-6"	
Granular Backfill for Structures			Cu. Yd.	113
Structure Excavation			Cu. Yd.	491
Concrete Structures			Cu. Yd.	82
Concrete Superstructure			Cu. Yd.	14
Protective Coat			Sq. Yd.	11
Reinforcement Bars			Pound	340,200
Reinforcement Bars, Epoxy Coated			Pound	11,480
Permanent Casing			Foot	698
Drilled Shaft In Soil			Cu. Yd.	626
Concrete Sealer			Sq. Ft.	2,147
Geocomposite Wall Drain			Sq. Yd.	97
Pipe Underdrain for Structures 4"			Foot	166
Class SI Concrete Miscellaneous			Cu. Yd.	69
Crosshole Sonic Logging			Each	1
Stud Shear Connectors			Each	82
Untreated Timber Lagging			Sq. Ft.	458
Drilling and Setting Soldier Piles (In Soil)			Cu. Ft.	3,101
Furnishing Soldier Piles (W Section)			Foot	323
Chain Link Fence, 42" Attached to Structure (Special)			Foot	33

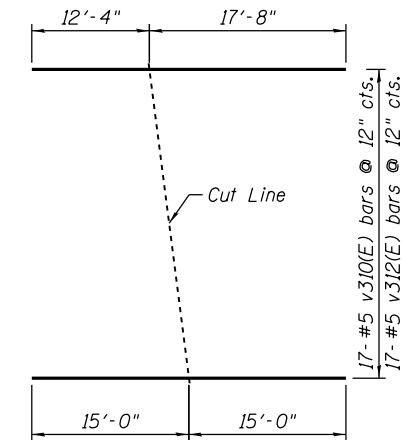

FIELD CUTTING DIAGRAM

Order v310(E) & v312(E) bars full length. Cut as shown and use remainder of bars at opposite end.

Note A:

Bundle v308 outer bars with v311 inner bars.

*** Contractor may need to increase the casing thickness to withstand the installation process. See Article 516.06(d) of the Standard Specifications.

**** Quantity shown is for Geocomposite Wall Drain behind E. Abut and Soldier Pile and Lagging wall. Geocomposite Wall Drain between shafts shall be included with Class SI Concrete Miscellaneous. Estimated Quantity = 29 Sq. Yd.

* Length is height of spiral
** Shown for information only. Cost included with Class SI Concrete Miscellaneous

AECOM


USER NAME =	dabezlcd	DESIGNED =	BMR	REVISED
PLOT SCALE =	N.T.S.	CHECKED =	DEV	REVISED
PLOT DATE =	3/19/2014	DRAWN =	BRD	REVISED
		CHECKED =	DEV	REVISED

STATE OF ILLINOIS
DEPARTMENT OF TRANSPORTATION


EAST ABUTMENT DETAILS
STRUCTURE NO. 016-1711

SHEET NO. S-39 OF S-47 SHEETS


F.A.I. RTE.	SECTION	COUNTY	TOTAL SHEETS	SHEET NO.
90/94/290	2013-036R	COOK	256	131
		CONTRACT NO. 60W71		
		ILLINOIS FED. AID PROJECT -NUMBER-		

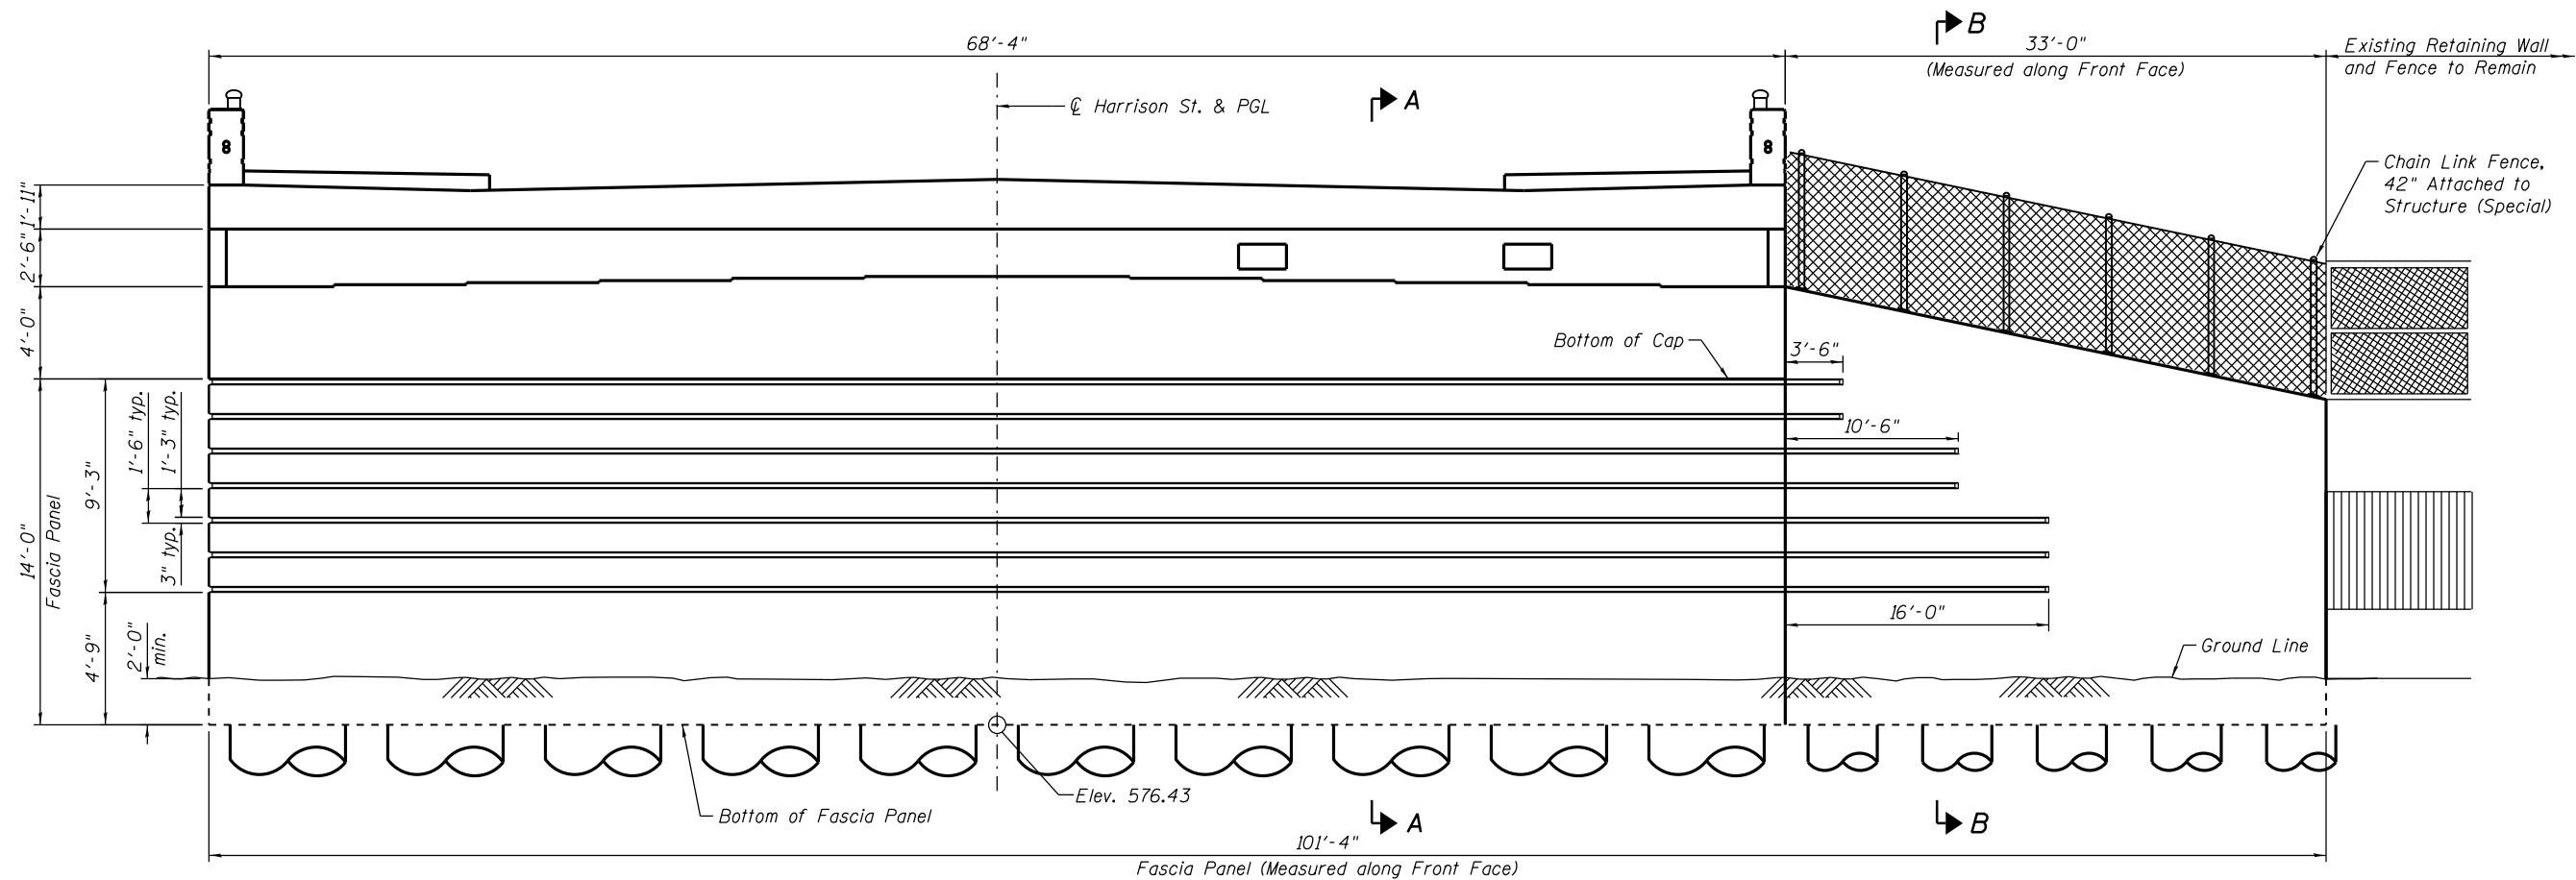


EAST ABUTMENT ELEVATION
(Looking East)

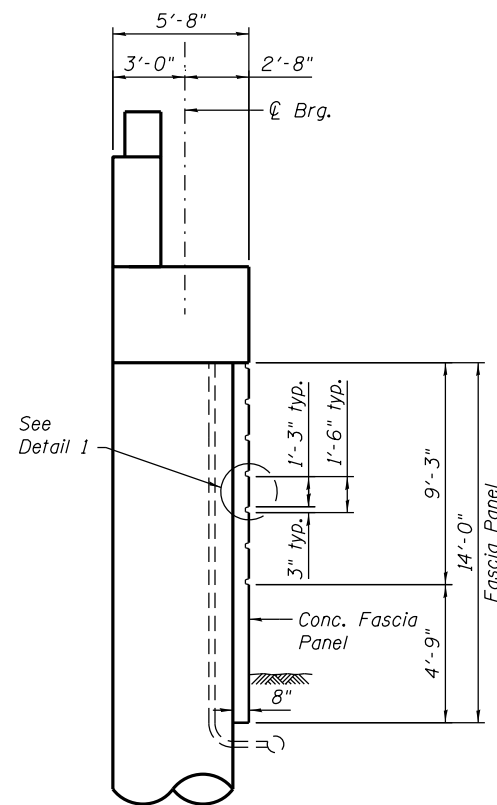

SECTION A-A

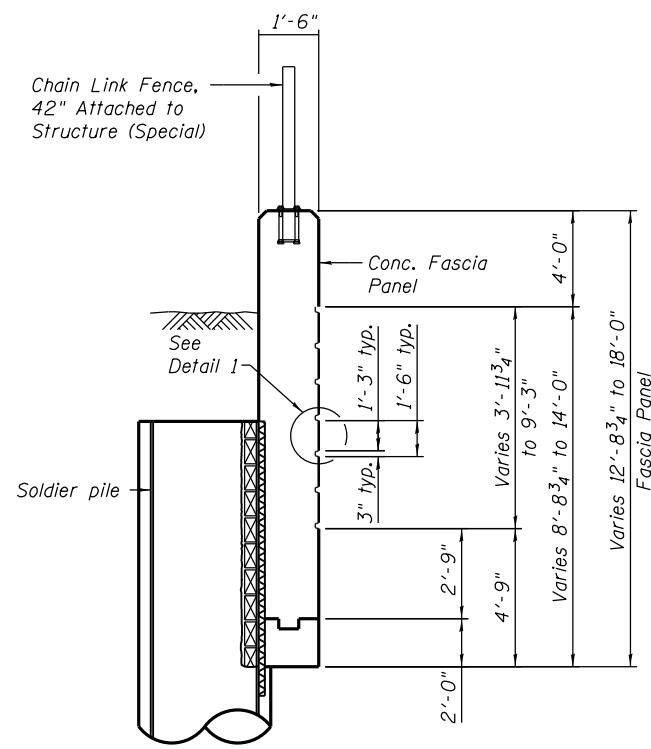

SECTION B-B

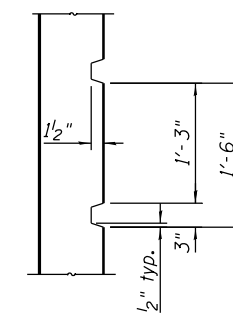

DETAIL 1

NOTES:

1. The 3" x 1 1/2" reveal in the fascia panel will not be paid separately and shall be included in the cost of the pay item Class SI Concrete Miscellaneous.

0161711-60W71-S40-Abutment

AECOM



USER NAME = dabezicd	DESIGNED - EJO	REVISED
PLOT SCALE = N.T.S.	CHECKED - DEV	REVISED
PLOT DATE = 2/19/2014	DRAWN - BRD	REVISED
	CHECKED - DEV	REVISED


STATE OF ILLINOIS
DEPARTMENT OF TRANSPORTATION

EAST ABUTMENT ARCHITECTURAL DETAILS
STRUCTURE NO. 016-1711


SHEET NO. S-40 OF S-47 SHEETS

F.A.I. RTE.	SECTION	COUNTY	TOTAL SHEETS	SHEET NO.
90/94/290	2013-036R	COOK	256	132
		CONTRACT NO. 60W71		
ILLINOIS		FED. AID PROJECT -NUMBER-		

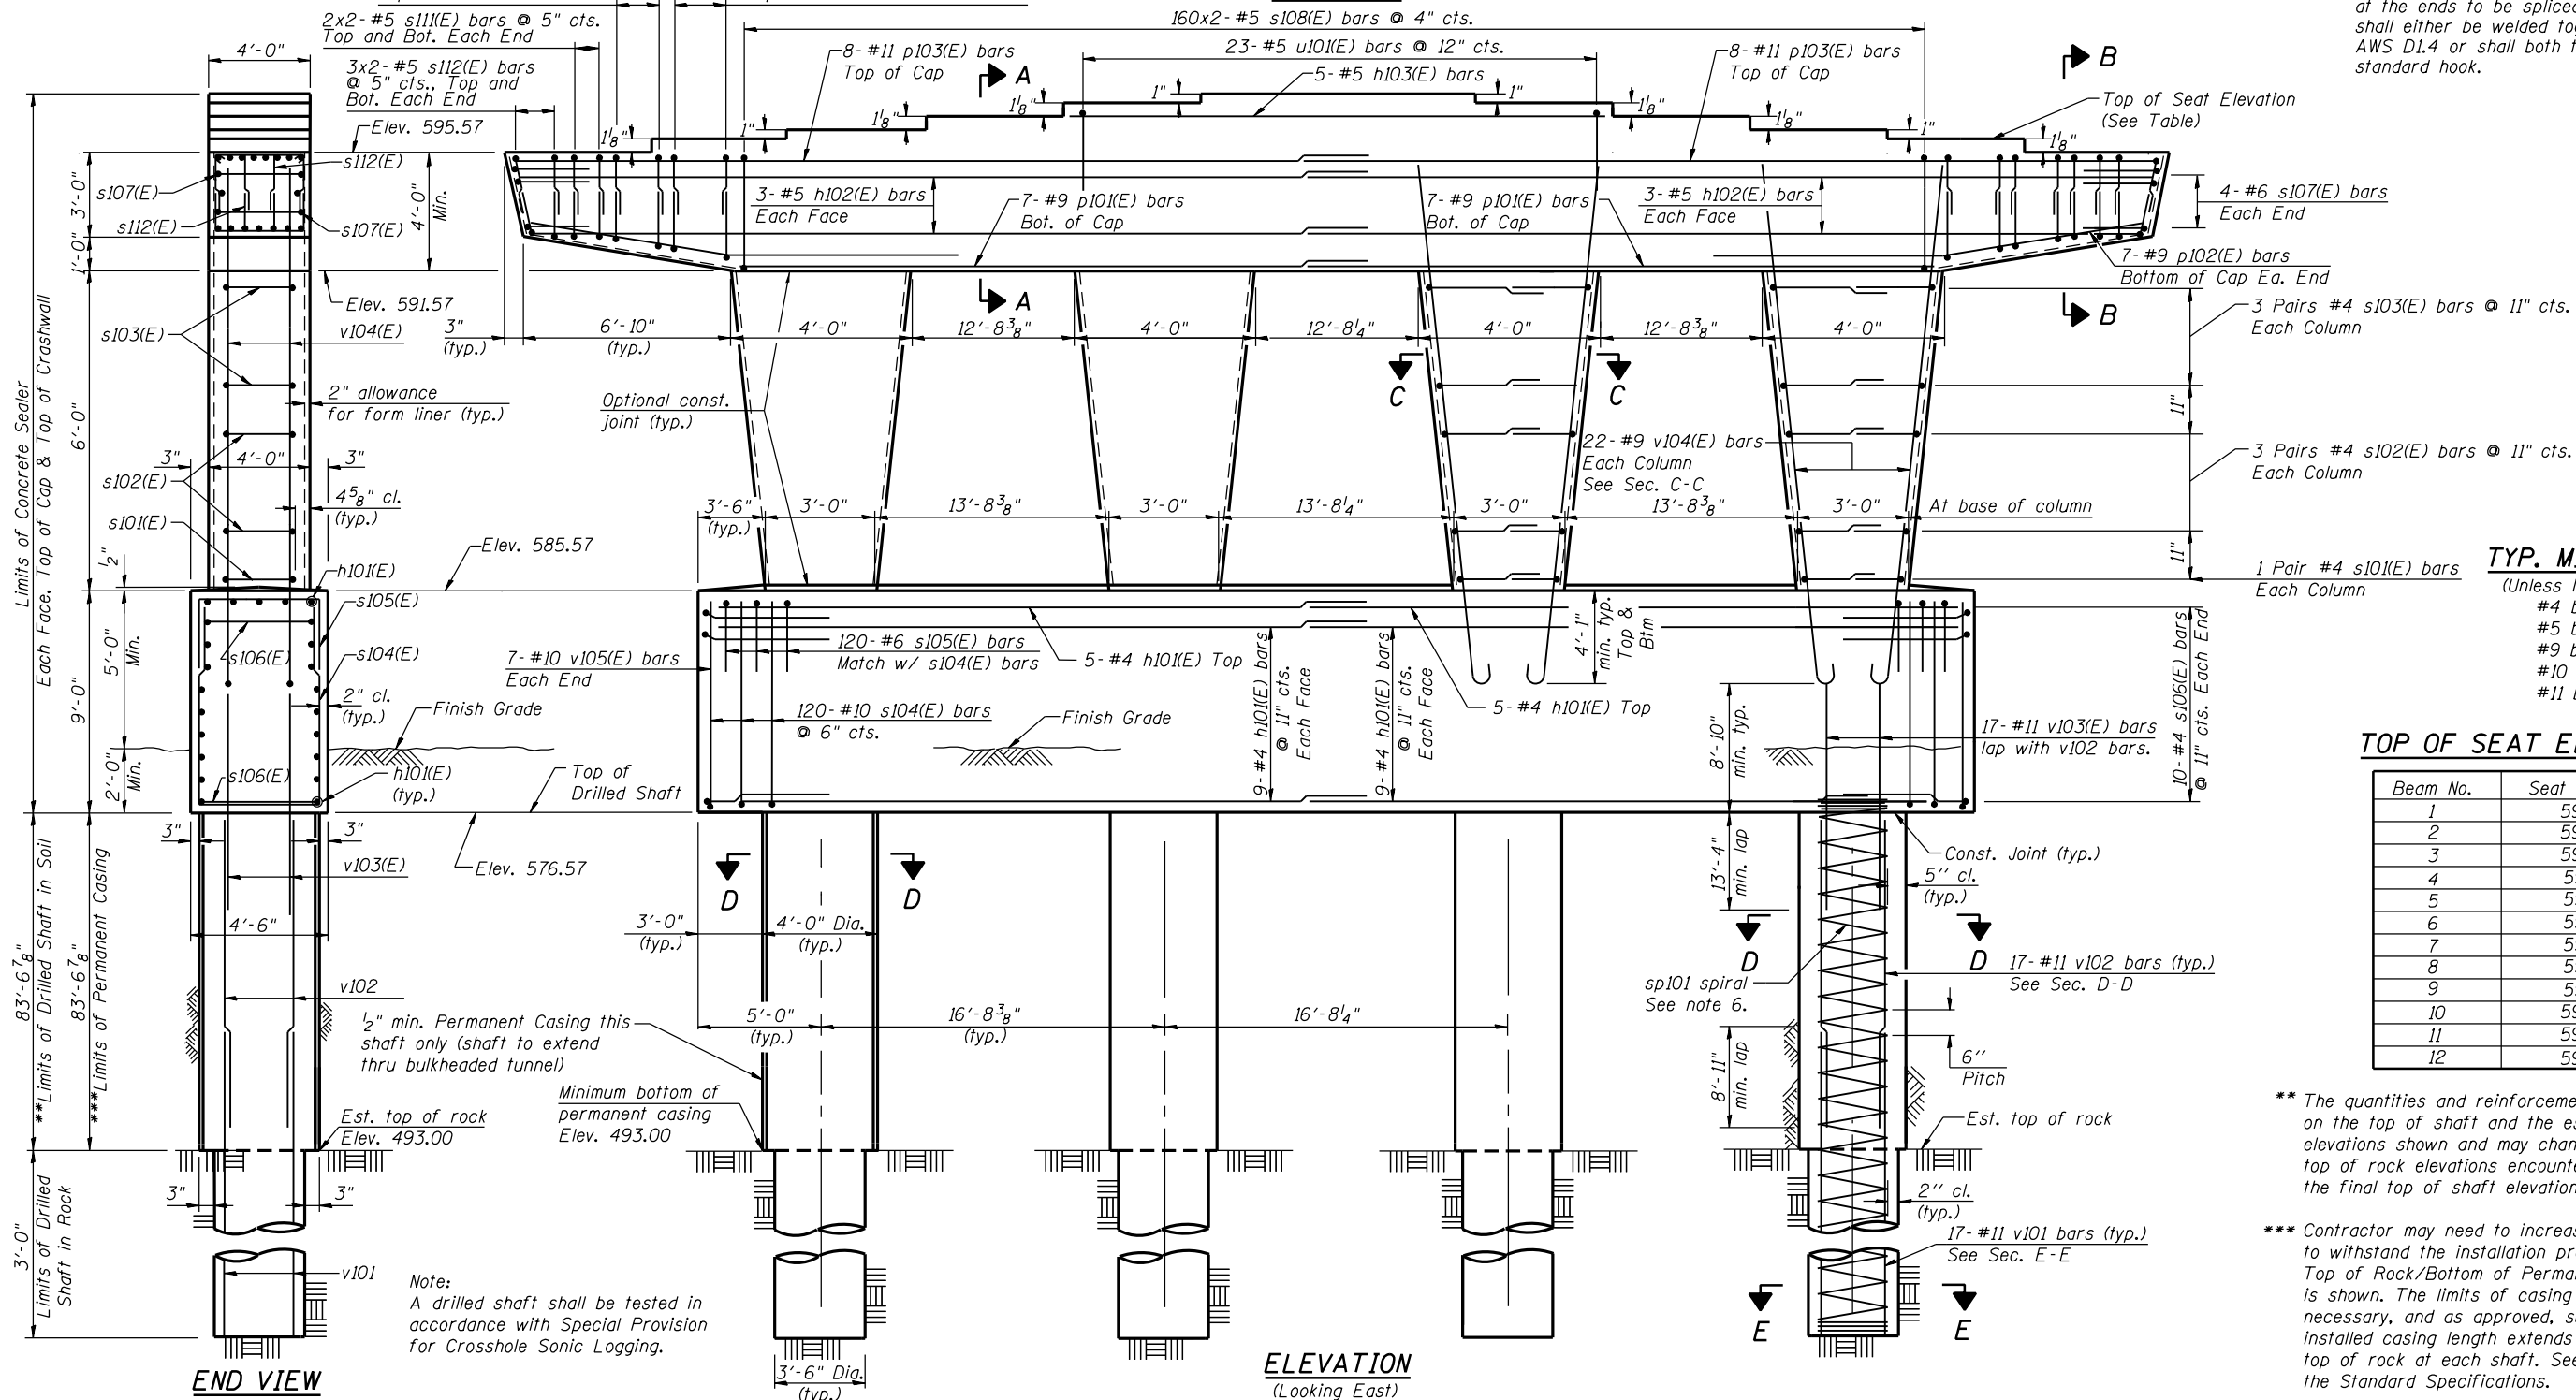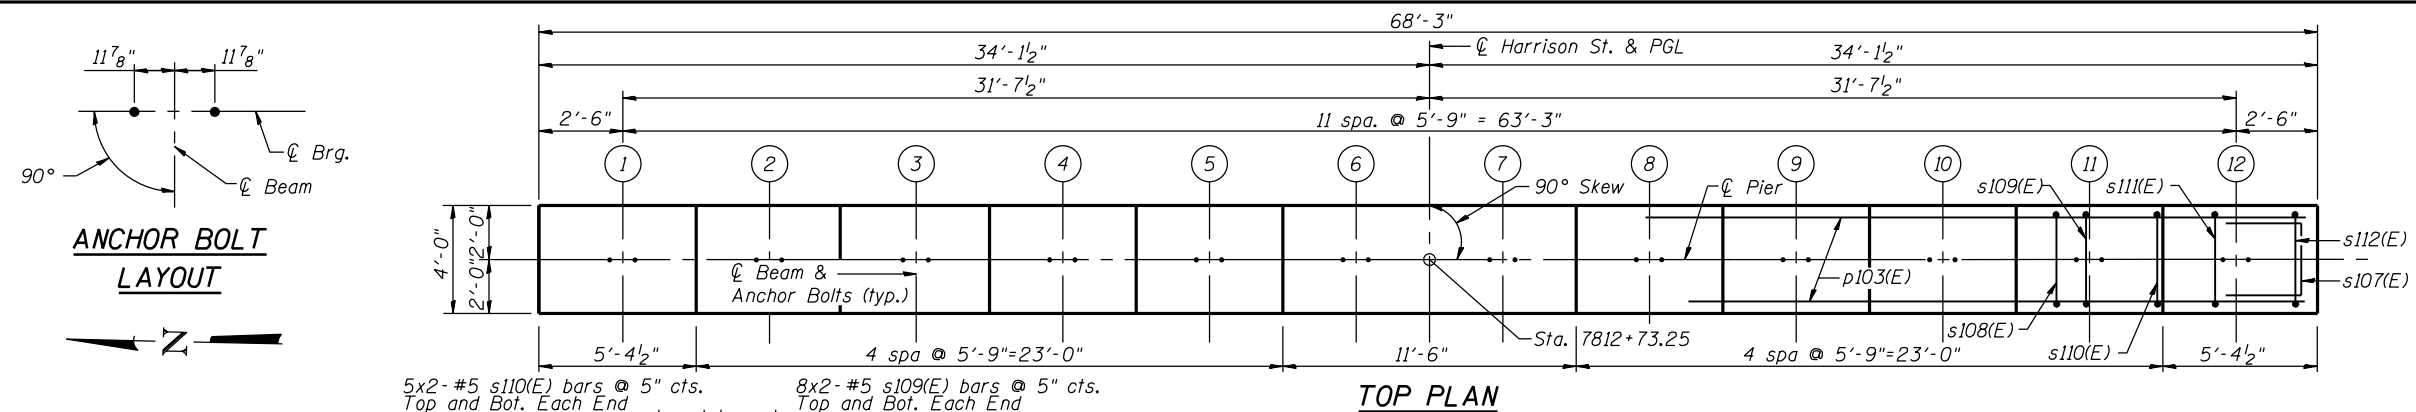


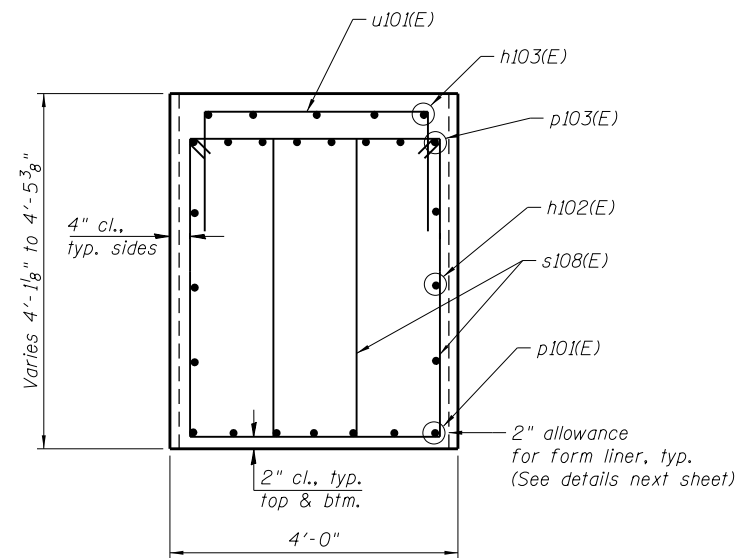


SECTION A-A

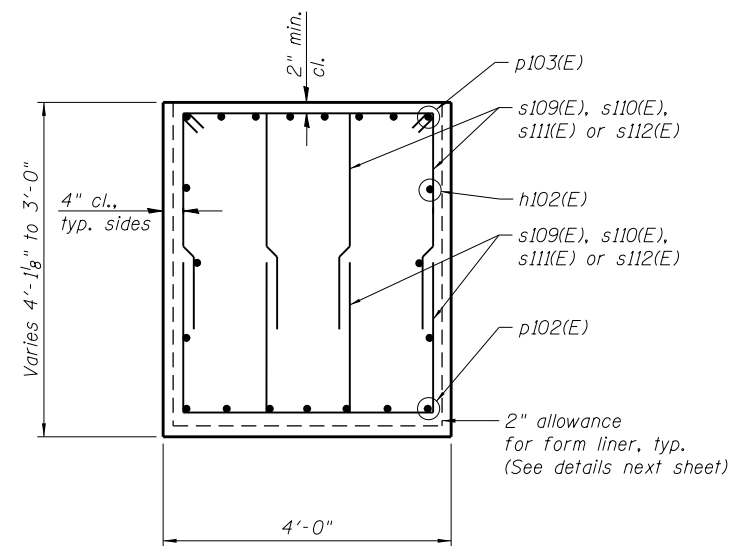


SECTION B-B

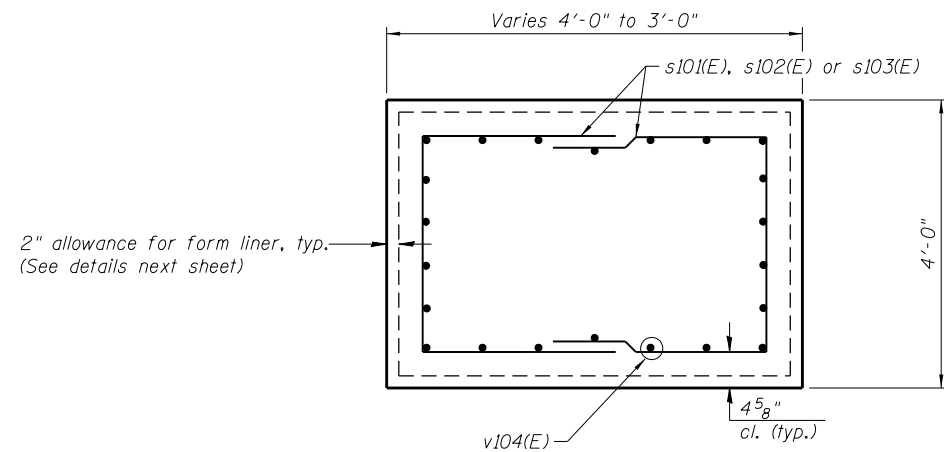


SECTION C-C

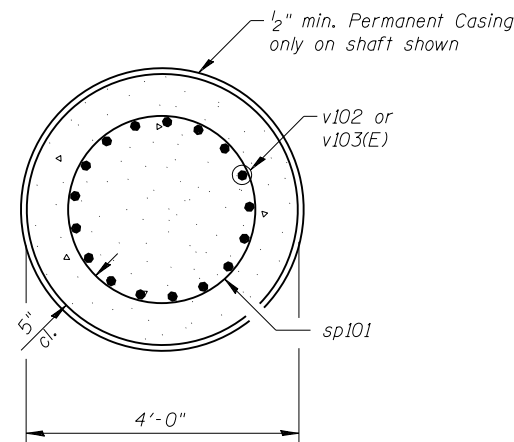


SECTION D-D

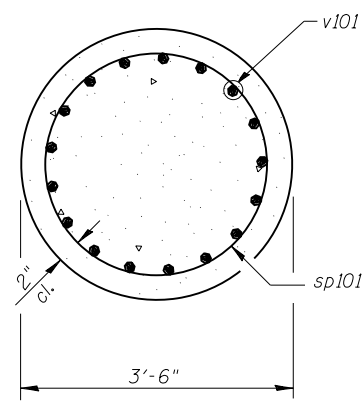


SECTION E-E

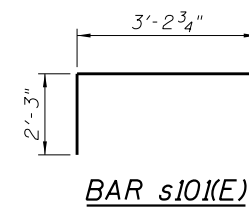


BAR s101(E)

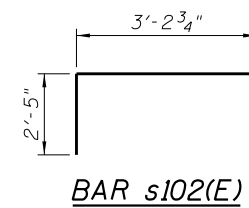


BAR s102(E)

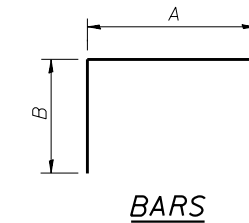


BARS

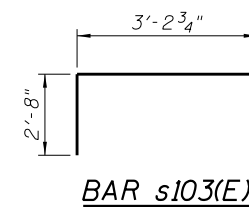


BAR s103(E)

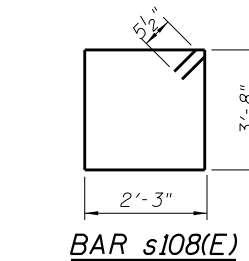

BAR s108(E)

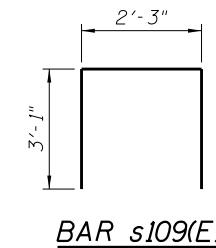


BAR s109(E)

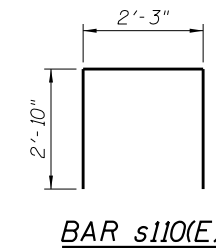


BAR s110(E)

A & B DIMENSIONS


Bar	A	B
s104(E)	4'-2"	8'-8"
s105(E)	4'-2"	3'-1"
s106(E)	4'-2"	3'-1"
s107(E)	3'-4"	1'-5"

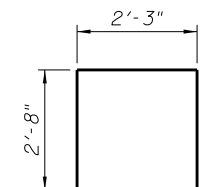


BAR s111(E)

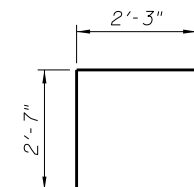

BAR s112(E)

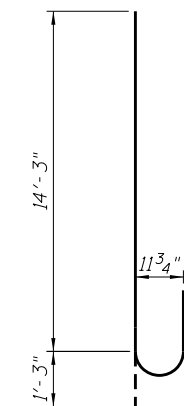

BAR v104(E)

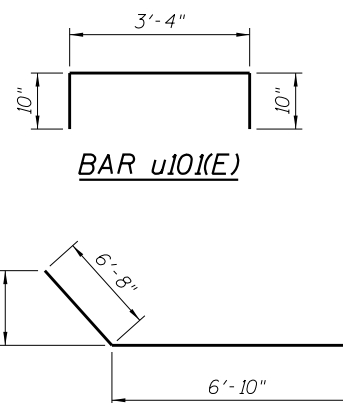


BAR p102(E)


BILL OF MATERIAL

Bar	No.	Size	Length	Shape
h101(E)	46	#4	31'-2"	
h102(E)	12	#5	35'-7"	
h103(E)	5	#5	22'-8"	
p101(E)	14	#9	31'-2"	
p102(E)	14	#9	13'-6"	
p103(E)	16	#11	40'-8"	
s101(E)	8	#4	7'-8 3/4"	
s102(E)	24	#4	8'-0 3/4"	
s103(E)	24	#4	8'-6 3/4"	
s104(E)	120	#10	21'-6"	
s105(E)	120	#6	10'-4"	
s106(E)	20	#4	10'-4"	
s107(E)	8	#6	6'-2"	
s108(E)	320	#5	12'-9"	
s109(E)	64	#5	8'-5"	
s110(E)	40	#5	7'-11"	
s111(E)	16	#5	7'-7"	
s112(E)	24	#5	7'-5"	
** sp101	4	#5	86'-9"	
u101(E)	23	#5	5'-0"	
v101	68	#11	60'-0"	
v102	68	#11	35'-6"	
v103(E)	68	#11	22'-2"	
v104(E)	88	#9	15'-6"	
v105(E)	14	#10	8'-8"	
Structure Excavation		Cu. Yd.	124	
Concrete Structures		Cu. Yd.	145	
Reinforcement Bars		Pound	41,710	
Reinforcement Bars Epoxy Coated		Pound	39,340	
Permanent Casing		Foot	84	
Drilled Shaft in Soil		Cu. Yd.	156	
Drilled Shaft in Rock		Cu. Yd.	5	
Concrete Sealer		Sq. Ft.	2,815	
Crosshole Sonic Logging		Each	1	


** Length is height of spiral.

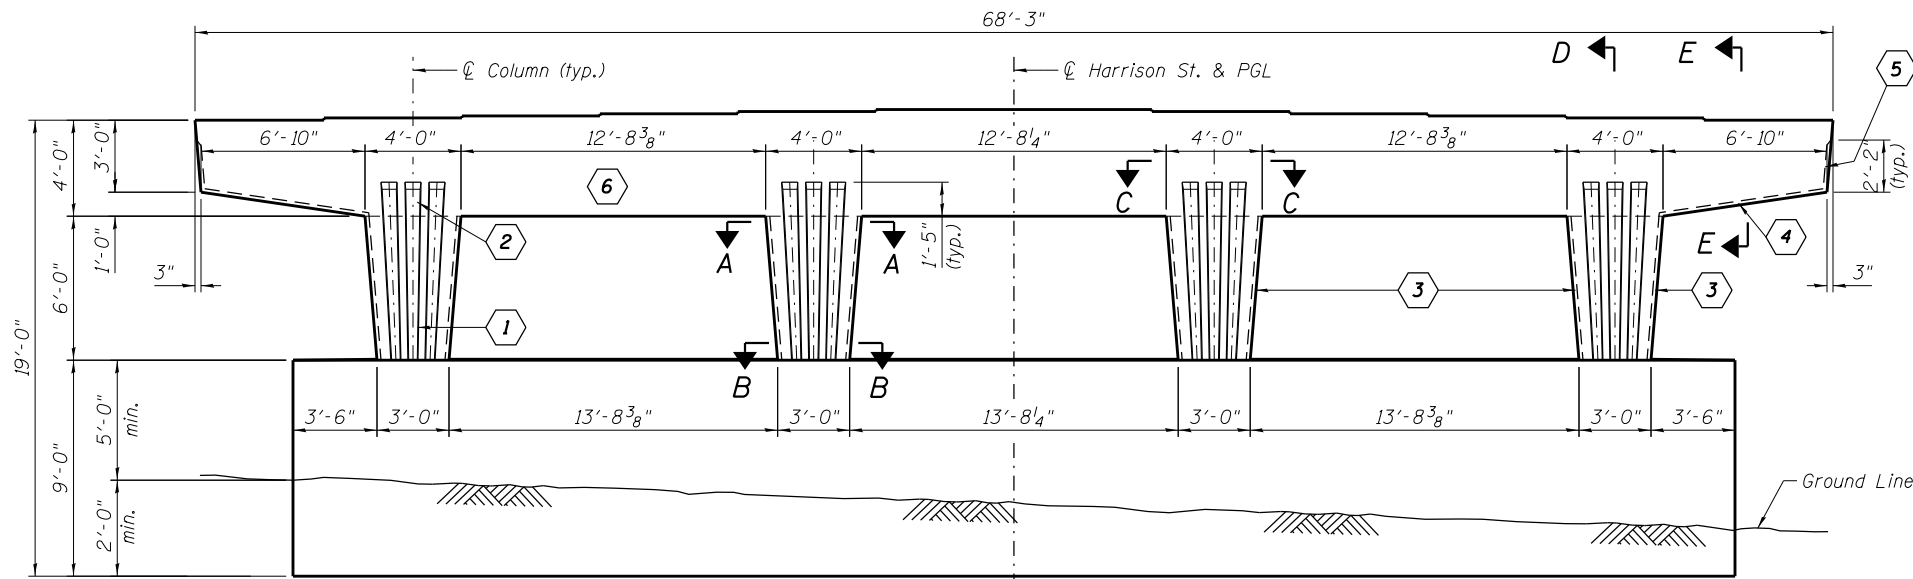


PIER ELEVATION
(Looking West)

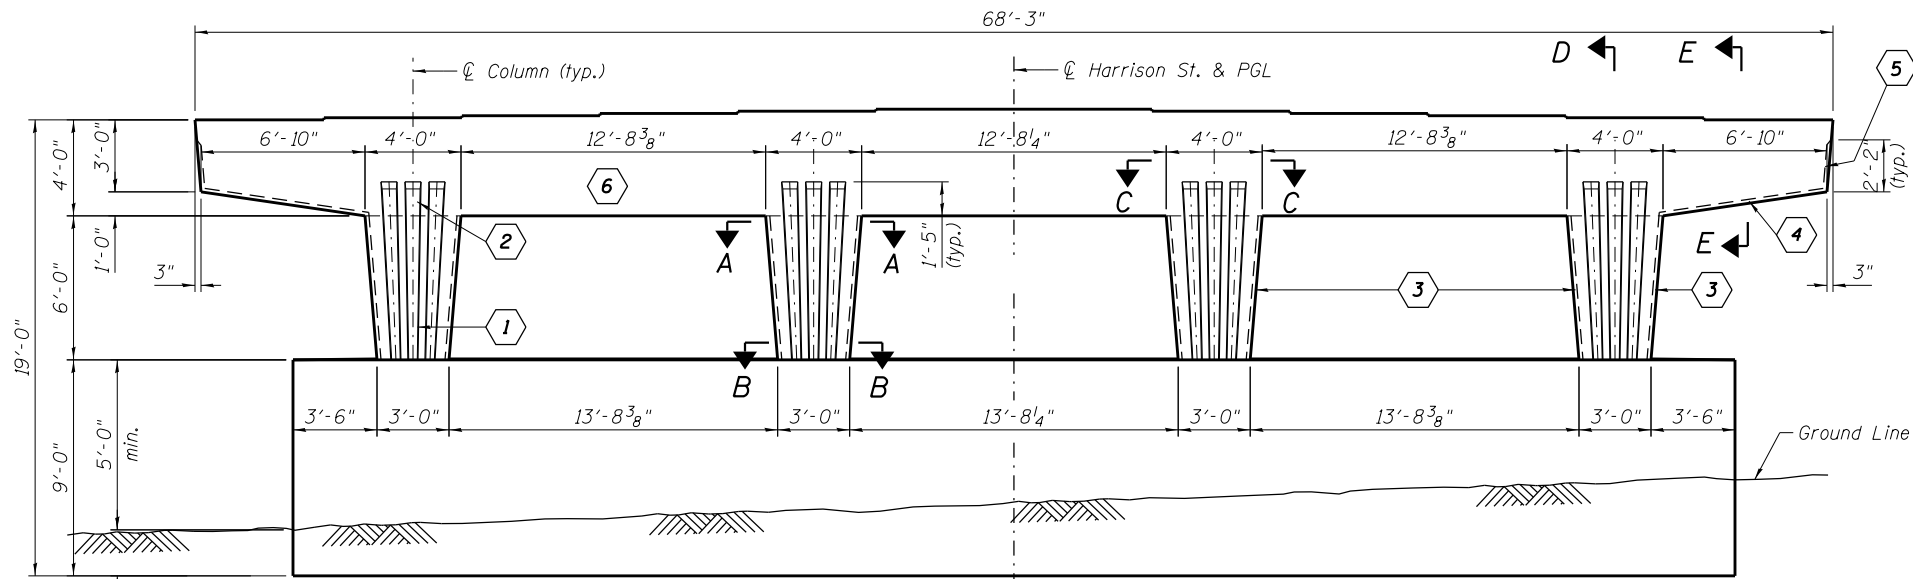


PIER ELEVATION
(Looking East)

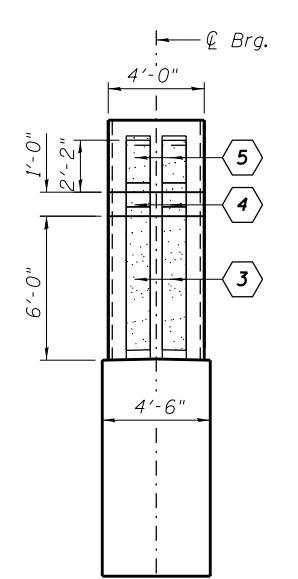


PIER END VIEW
(Looking South)
(Looking North - Sim.)

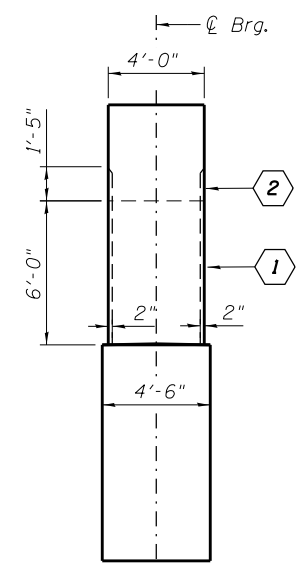

SECTION D-D

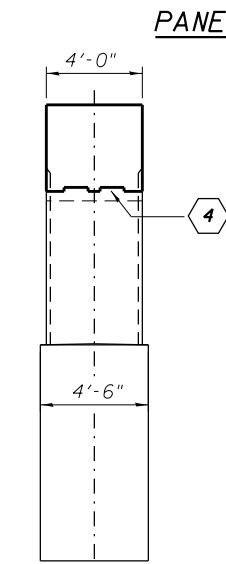


SECTION E-E

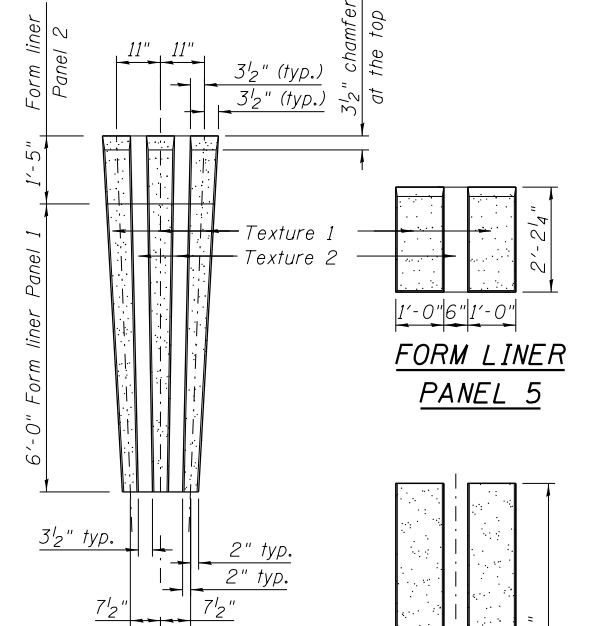


FORM LINER
PANEL 5


FORM LINER
PANEL 1 & 2

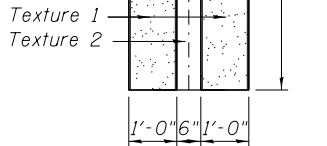


FORM LINER
PANEL 4

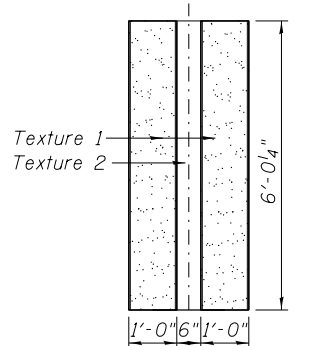


FORM LINER
PANEL 3

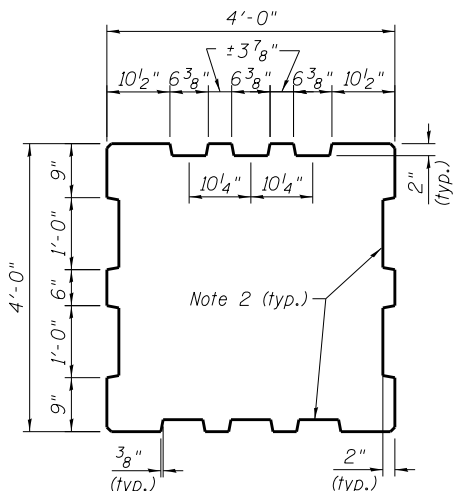

SECTION A-A
At Top of Column

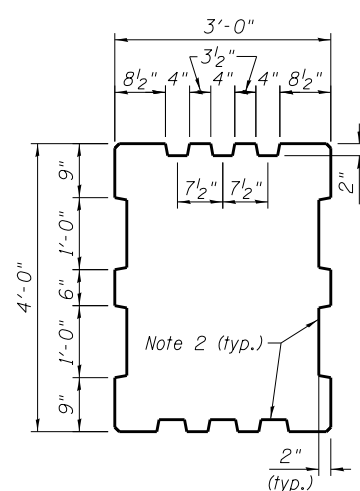

SECTION B-B
At Bottom of Column

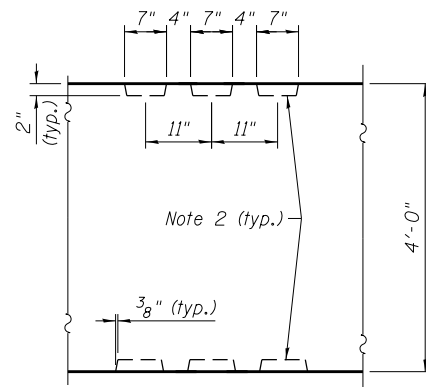


SECTION C-C
In Cap

NOTES:

1. Alternate: Surface indicated as Textured Form Liner Panel (6) shall be smooth. Contractor can choose to build large protrusion of panel (2) directly into forms of panel (6) if a smooth uniform surface can be provided.
2. Tapered fluting - dimensions vary, see elevation profile.
3. Form liner panel (2) is continuation of panel (1). Keep adjacent form liners aligned.
4. Hand clean and smooth the surface of the construction joint between the pier and cap.
5. Texture 1: Light Sandblast as selected from manufacturer's standard pattern selection. Texture 2: Smooth

LEGEND

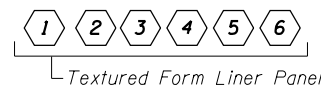

BILL OF MATERIAL

Item	Unit	Total
Form Liner Textured Surface	Sq. Ft.	1,002

AECOM

USER NAME = dunkerleyb
PLOT SCALE = N.T.S.
PLOT DATE = 12/17/2013

DESIGNED - EJO
CHECKED - BMR
DRAWN - BRD
CHECKED - DD


REVISED
REVISED
REVISED
REVISED

STATE OF ILLINOIS
DEPARTMENT OF TRANSPORTATION

PIER ARCHITECTURAL DETAILS
STRUCTURE NO. 016-1711

SHEET NO. S-43 OF S-47 SHEETS

F.A.I. RTE.	SECTION	COUNTY	TOTAL SHEETS	SHEET NO.
90/94/290	2013-036R	COOK	256	135
CONTRACT NO.			60W71	
ILLINOIS FED. AID PROJECT -NUMBER-				

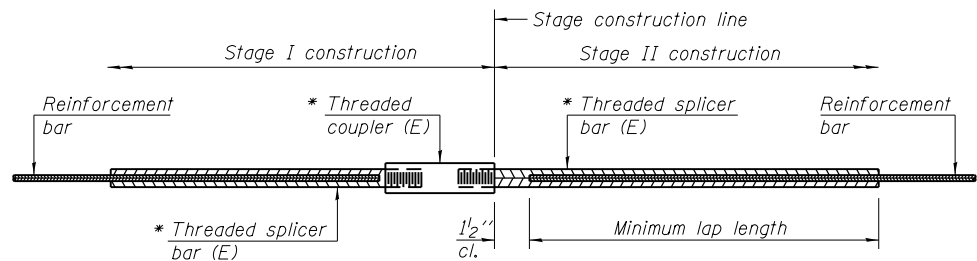

STANDARD BAR SPLICER ASSEMBLY


Minimum Lap Lengths						
Bar size to be spliced	Table 1	Table 2	Table 3	Table 4	Table 5	Table 6
3, 4	1'-5"	1'-11"	2'-1"	2'-4"	2'-7"	2'-11"
5	1'-9"	2'-5"	2'-7"	2'-11"	3'-3"	3'-8"
6	2'-1"	2'-11"	3'-1"	3'-6"	3'-10"	4'-5"
7	2'-9"	3'-10"	4'-2"	4'-8"	5'-2"	5'-10"
8	3'-8"	5'-1"	5'-5"	6'-2"	6'-9"	7'-8"
9	4'-7"	6'-5"	6'-10"	7'-9"	8'-7"	9'-8"

Table 1: Black bar, 0.8 Class C
Table 2: Black bar, Top bar lap, 0.8 Class C
Table 3: Epoxy bar, 0.8 Class C
Table 4: Epoxy bar, Top bar lap, 0.8 Class C
Table 5: Epoxy bar, Class C
Table 6: Epoxy bar, Top bar top, Class C

Threaded splicer bar length = min. lap length + 1 1/2" + thread length


* Epoxy not required on Bar Splicer Assembly components used in conjunction with black bars.

Location	Bar size	No. assemblies required	Table for minimum lap length

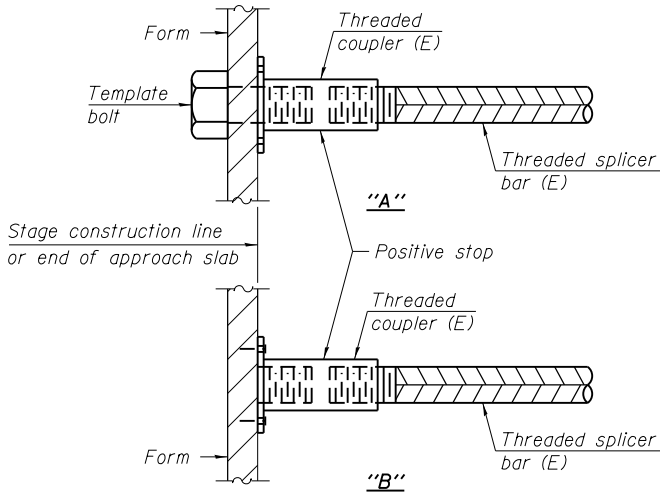


INSTALLATION AND SETTING METHODS

"A" : Set bar splicer assembly by means of a template bolt.
"B" : Set bar splicer assembly by nailing to wood forms or cementing to steel forms.
(E) : Indicates epoxy coating.

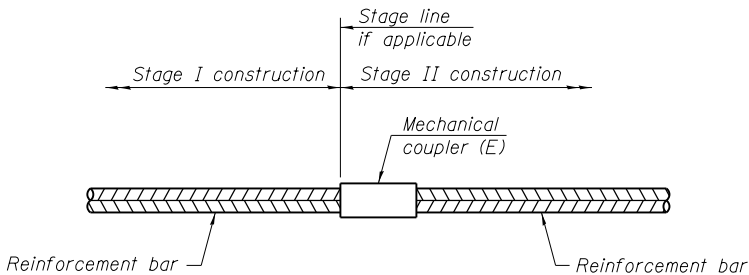


STANDARD MECHANICAL SPLICER

Location	Bar size	No. assemblies required
East Abutment	#14	440

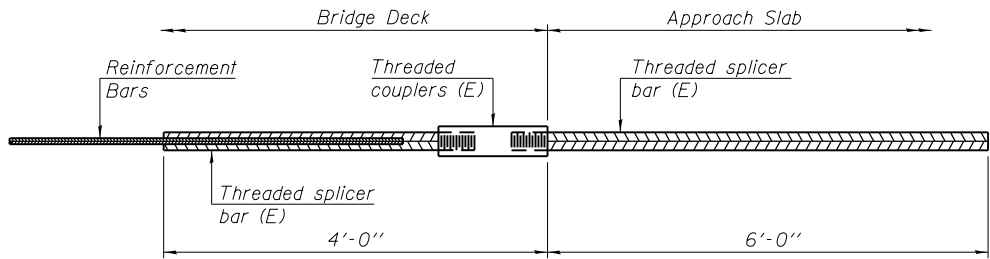

BAR SPLICER ASSEMBLY FOR #5 BAR ON INTEGRAL OR SEMI-INTEGRAL ABUTMENTS

No. required =

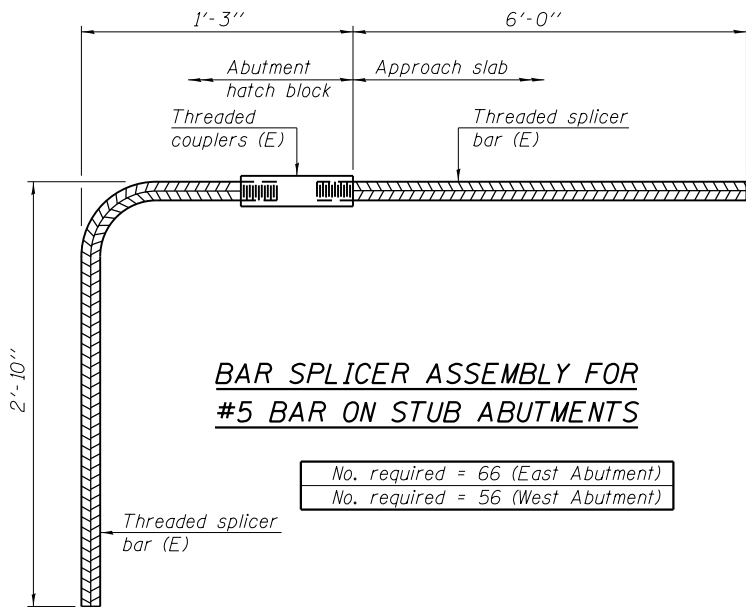

BAR SPLICER ASSEMBLY FOR #5 BAR ON STUB ABUTMENTS

No. required = 66 (East Abutment)
No. required = 56 (West Abutment)

NOTES

Splicer bars shall be deformed with threaded ends and have a minimum 60 ksi yield strength.
All reinforcement shall be lapped and tied to the splicer bars.
Bar splicer assemblies shall be epoxy coated according to the requirements for reinforcement bars. See Section 508 of the Standard Specifications.
See approved list of bar splicer assemblies and mechanical splicers for alternatives.

0161711-60W71-S44-Bar Splice

AECOM

USER NAME = dunkerleyb
PLOT SCALE = N.T.S.
PLOT DATE = 12/17/2013

DESIGNED - EJO
CHECKED - DD
DRAWN - BRD
CHECKED - EJO

REVISED
REVISED
REVISED
REVISED

STATE OF ILLINOIS
DEPARTMENT OF TRANSPORTATION

BAR SPLICER ASSEMBLY
STRUCTURE NO. 016-1711

SHEET NO. S-44 OF S-47 SHEETS

F.A.I. RTE.	SECTION	COUNTY	TOTAL SHEETS	SHEET NO.
90/94/290	2013-036R	COOK	256	136
		CONTRACT NO. 60W71		
ILLINOIS		FED. AID PROJECT -NUMBER-		

		BORING LOG 1088-B-01		Page 1 of 1	
wangeng@wangeng.com 1145 N Main Street Lombard, IL 60148 Telephone: 630 953-9928 Fax: 630 953-9938		WEI Job No.: 1100-04-01 AECOM Circle Interchange Reconstruction Sections 16 and 17, T39N, R14E of 3rd PM		Station: NAVD 88 Elevation: 597.11 ft North: 1897552.19 ft East: 1171668.11 ft Station: 7811+69.10 Offset: 02.09 LT	
Client Project Location					

[illegible]

GENERAL NOTES				WATER LEVEL DATA	
Begin Drilling	02-17-2013	Complete Drilling	02-17-2013	While Drilling	▽ DRY
Drilling Contractor	Wang Testing Services	Drill Rig	D-50 TMR	At Completion of Drilling	▽ DRY
Driller	R&N	Logger	D.Kolpacki	Time After Drilling	NA
Drilling Method	2.25" SSA to 5.5, boring backfilled upon completion				
				Depth to Water	▽ NA
The stratification lines represent the approximate boundary between soil layers. The actual transition may be irregular.					

 wangeng@wangeng.com 1145 N Main Street Lombard, IL 60148 Telephone: 630 953-9928 Fax: 630 953-9938	BORING LOG 1088-B-02 WEI Job No.: 1100-04-01 <table style="width: 100%; border: none;"> <tr> <td style="width: 33%; border: none;">Client</td> <td style="width: 33%; border: none;">AECOM</td> <td style="width: 33%; border: none;"></td> </tr> <tr> <td style="border: none;">Project</td> <td style="border: none;">Circle Interchange Reconstruction</td> <td style="border: none;"></td> </tr> <tr> <td style="border: none;">Location</td> <td style="border: none;">Sections 16 and 17, T39N, R14E of 3rd PM</td> <td style="border: none;"></td> </tr> </table>	Client	AECOM		Project	Circle Interchange Reconstruction		Location	Sections 16 and 17, T39N, R14E of 3rd PM		Datum: NAVD 88 Elevation: 582.09 ft North: 1897500.54 ft East: 1171752.80 ft Station: 7812+52.80 Offset: 51.02 ft
Client	AECOM										
Project	Circle Interchange Reconstruction										
Location	Sections 16 and 17, T39N, R14E of 3rd PM										

[illegible]

GENERAL NOTES				WATER LEVEL DATA	
Begin Drilling	03-06-2013	Complete Drilling	03-07-2013	While Drilling	∇ DRY
Drilling Contractor	Wang Testing Services	Drill Rig	D-50 TMR	At Completion of Drilling	∇ MUD (10')
Driller	R&N Logger	A. Happel	Checked by C. Marin	Time After Drilling	NA
Drilling Method	2.25" SSA to 10', Mud Rotary 10' thereafter, boring				
backfilled upon completion					
The stratification lines represent the approximate boundary between soil types. The actual transition may be different.					

 wangeng@wangeng.com 1145 N Main Street Lombard, IL 60148 Telephone: 630 953-9928 Fax: 630 953-9938	BORING LOG 1088-B-02		Page 2 of 2
	WEI Job No.: 1100-04-01		Datum: NAVD 88 Elevation: 582.09 ft North: 1897500.54 ft East: 1171752.80 ft Station: 7812+52.80 Offset: 51.02 RT
	Client	AECOM	
	Project	Circle Interchange Reconstruction	
Location	Sections 16 and 17, T39N, R14E of 3rd PM		

Profile Elevation (ft)	SOIL AND ROCK DESCRIPTION	Depth (ft)	Sample Type recovery	Sample No.	SPT Values (blw/6 in)	Qu (tsf)	Moisture Content (%)	Profile Elevation (ft)	SOIL AND ROCK DESCRIPTION	Depth (ft)	Sample Type recovery	Sample No.	SPT Values (blw/6 in)	Qu (tsf)	Moisture Content (%)
525.1	Medium stiff, gray SILTY CLAY LOAM	55		17	6 12 19	4.02 B	21	525.1	Run#2 : 77 to 86 feet --RECOVERY=14% --ROD=5%	80		2			
519.1	Dense, gray SILTY LOAM, trace gravel	60		18	7 6 7	0.98 B	28	519.1	--AUGER REFUSAL--	85					
515.1	Gray DOLOSTONE fragments with some SILTY CLAY Run#1 : 67 to 77 feet --RECOVERY=10% --ROD=0%	65		19	8 13 23	NP	23	515.1	Strong, excellent rock quality, light gray, fresh, slightly fractured, joint breaks with little to no infill, slightly vuggy DOLOSTONE Run#3 : 89.5 to 99.5 feet --RECOVERY=100% --ROD=95%	90		3			
		70							ROCK MASS RATING: Strength of rock material = 12 Drill core quality ROD = 20 Spacing of joints = 20 Condition of joints = 20 Groundwater condition = 10	95					
		75						482.6	Boring terminated at 99.50 ft	100					

GENERAL NOTES				WATER LEVEL DATA	
Begin Drilling	03-06-2013	Complete Drilling	03-07-2013	While Drilling	∇ DRY
Drilling Contractor	Wang Testing Services	Drill Rig	D-50 TMR	At Completion of Drilling	∇ MUD (10')
Driller	R&N	Logger	A. Happel	Time After Drilling	NA
Drilling Method	2.25" SSA to 10', Mud Rotary 10' thereafter,	Checked by	C. Marin	Depth to Water	∇ NA
backfilled upon completion				The stratification lines represent the approximate boundary between soil layers. The actual variation may be greater.	

**STATE OF ILLINOIS
DEPARTMENT OF TRANSPORTATION**

F.A.I. RTE.	SECTION	COUNTY	TOTAL SHEETS	SHEET NO.
90/94/290	2013-036R	COOK	256	139
		CONTRACT NO. 60W71		
ILLINOIS FED. AID PROJECT -NUMBER-				



Wang Engineering
wangeng@wangeng.com
1145 N Main Street
Lombard, IL 60148
Telephone: 630 953-9928
Fax: 630 953-9938

BORING LOG 1087-B-03

WEI Job No.: 1100-04-01

Page 2 of 2

Datum: NAVD 88
Elevation: 596.41 ft
North: 1897526.93 ft
East: 1171579.56 ft
Station: 78114+18.84
Offset: 5.33 RT

Client: AECOM




Project: Circle Interchange Reconstruction

Location: Sections 16 and 17, T39N, R14E of 3rd PM

Profile	Elevation (ft)	SOIL AND ROCK DESCRIPTION	Depth (ft)	Sample Type	Sample No.	SPT Values (blows/ft)	Qu (tsf)	Moisture Content (%)	Profile	Elevation (ft)	SOIL AND ROCK DESCRIPTION	Depth (ft)	Sample Type	Sample No.	SPT Values (blows/ft)	Qu (tsf)	Moisture Content (%)
DI	539.7	Very stiff to hard, gray SILTY LOAM to SILTY CLAY LOAM, trace gravel and sand seams	55	X	18	0 2 4	0.33 B	24	DI	514.7	Very dense, gray SANDY LOAM, some gravel	80	X	23	3 4 6	0.66 B	39
			60	X	19	7 10 11	3.69 S	14				24	16 50/3	NP	17		
			65	X	20	9 11 18	5.58 B	17				25	33 46 50/4	8.61 S	12		
DI	529.7	Medium stiff to hard, gray CLAY to SILTY CLAY, trace gravel and seams of sand	70	X	21	8 12 17	4.67 B	21	DI	509.7	Hard, gray SILTY LOAM, trace gravel	90	X	25	19 20 50/3	7.38 S	15
			75	X	22	3 5 6	1.56 B	25				27	50/4	4.50 P	13		
			100	X	27	50/4	4.50 P	13									
GENERAL NOTES										Boring terminated at 100.00 ft							
03-21-2013 Complete Drilling 03-22-2013 Drilling Contractor Wang Testing Services Drill Rig D-50 TMR Driller R&T Logger D. Kolpacki Checked by C. Marin Drilling Method 1.0" IDA Geoprobe to 11', 2.25" SSA 11' to 20', Mud Rotary 20' thereafter										WATER LEVEL DATA While Drilling ☒ DRY At Completion of Drilling ☒ DRY Time After Drilling NA Depth to Water ☒ NA							
The stratification lines represent the approximate boundary between soil layers; the actual transition is gradual.																	

WANGENG.DWG 11/03/00 (P2) 4/9/13

REVISIONS				
ZONE	REV	DESCRIPTION	DATE	APPROVED

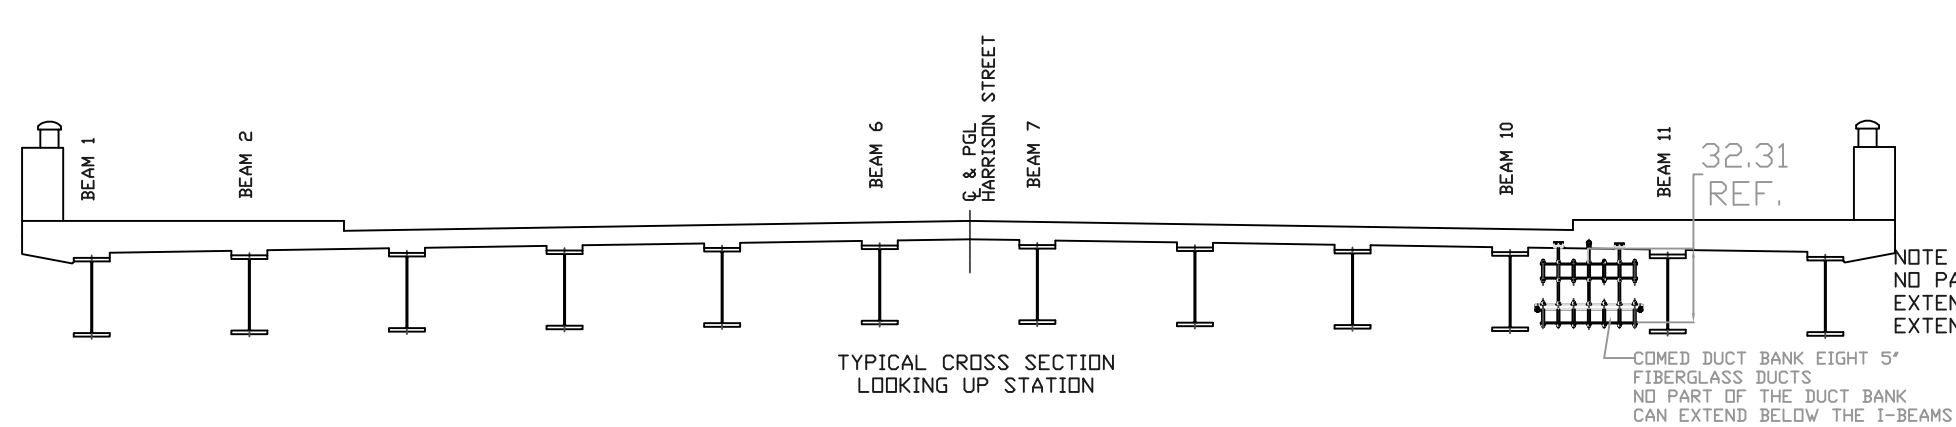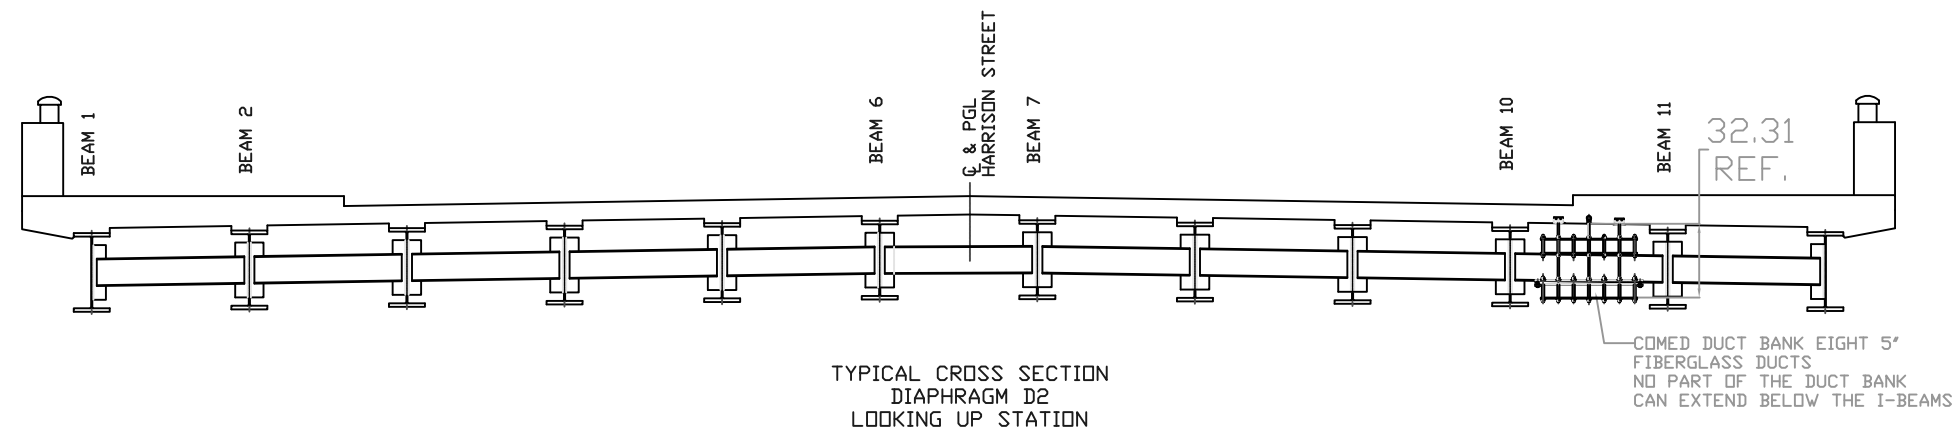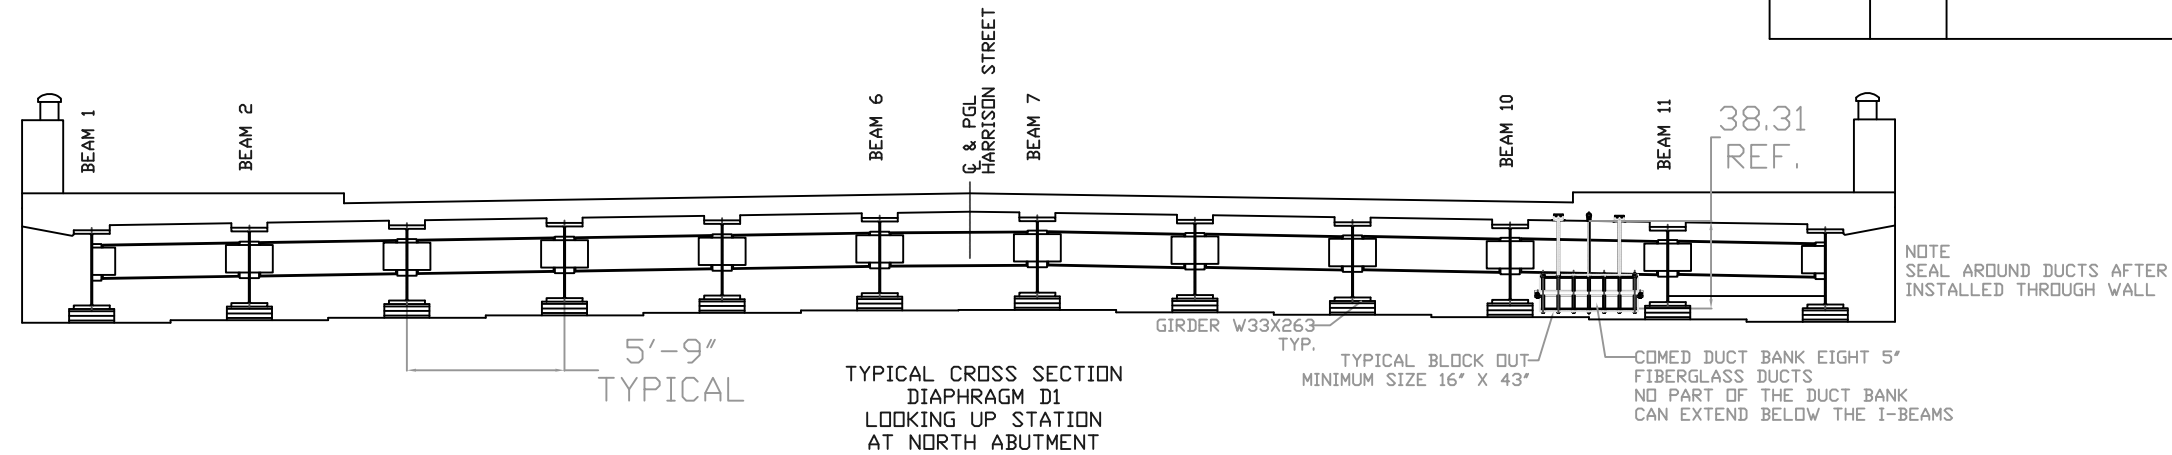

FOR INFORMATION ONLY
WORK TO BE PERFORMED BY OTHERS
WITH THE EXCEPTION OF PLACEMENT
OF INSERTS INTO SUPERSTRUCTURE

NOTE
NO PART OF THE CONDUIT SUPPORT HANGER CAN
EXTEND BELOW THE BRIDGE DECK GIRDER
EXTENDED RODS MAY NEED TO BE ALTERED



Bridge Deck Cross Section	CONDUX INTERNATIONAL, INC. MANKATO MN PH. 800-533-2077			
	Project: Com Ed Harrison Street East Bridge over F.A.I. RTE NB 90-94 Dan Ryan Expressway, Cook County Illinois			
WEIGHT: 0.0 LBS EA	SIZE	FSCM NO.	DWG NO. TBA	REV 0.0
QUOTE NO. 3985218599	SCALE 1/2	DATE: 12-09-2013	SHEET: CONDUX 1 OF 3 SHEET 140 OF 256	

Note:
ALL MEASUREMENTS ARE IN INCHES UNLESS
NOTED OTHERWISE

DRAWING APPROVAL
I APPROVE THIS DRAWING FOR MANUFACTURING
DATE: _____


This drawing is the property
of Condux International, Inc.
and the information thereon is
to be treated as confidential.
It is not to be used, copied
or disclosed to outside
parties without our written
consent

REVISIONS				
ZONE	REV	DESCRIPTION	DATE	APPROVED

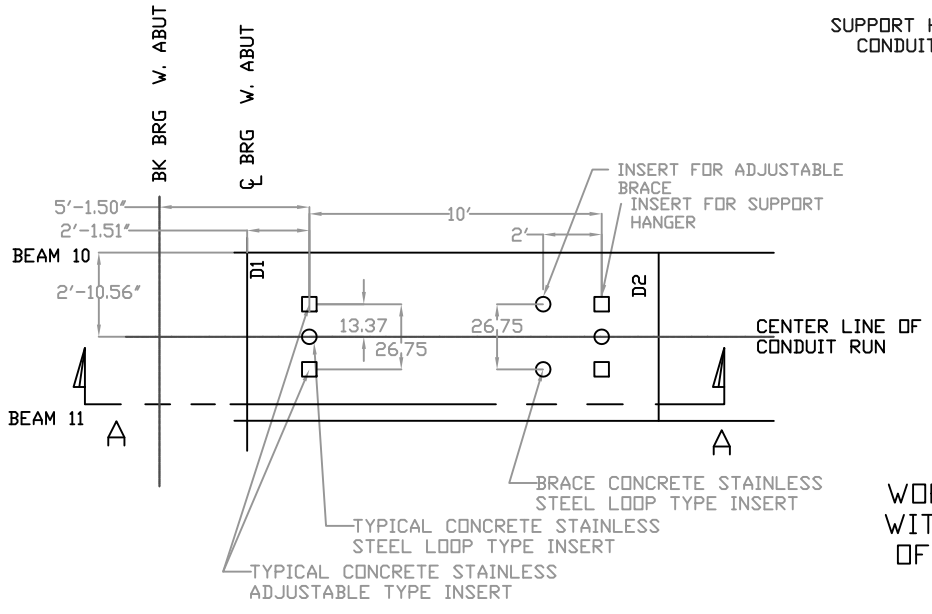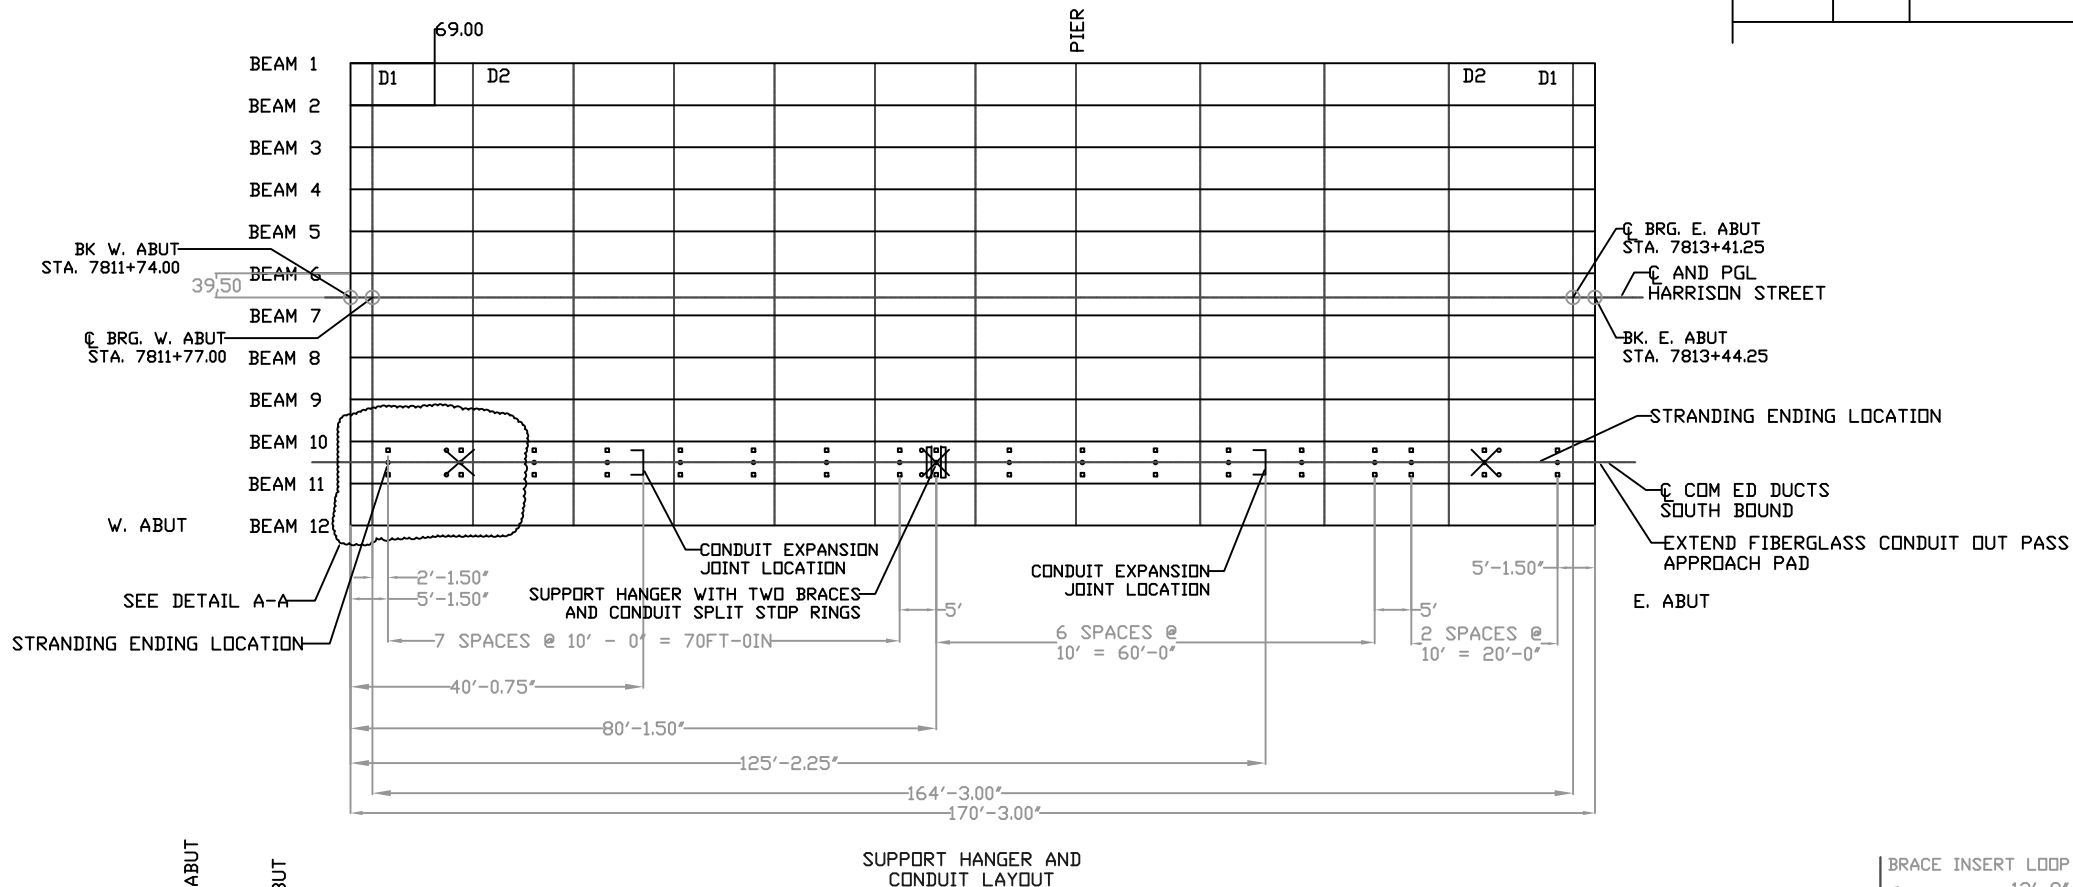

DETAIL A-A
CONCRETE INSERT LAYOUT DETAIL
SCALE 4:1

FOR INFORMATION ONLY
WORK TO BE PERFORMED BY OTHERS
WITH THE EXCEPTION OF PLACEMENT
OF INSERTS INTO SUPERSTRUCTURE

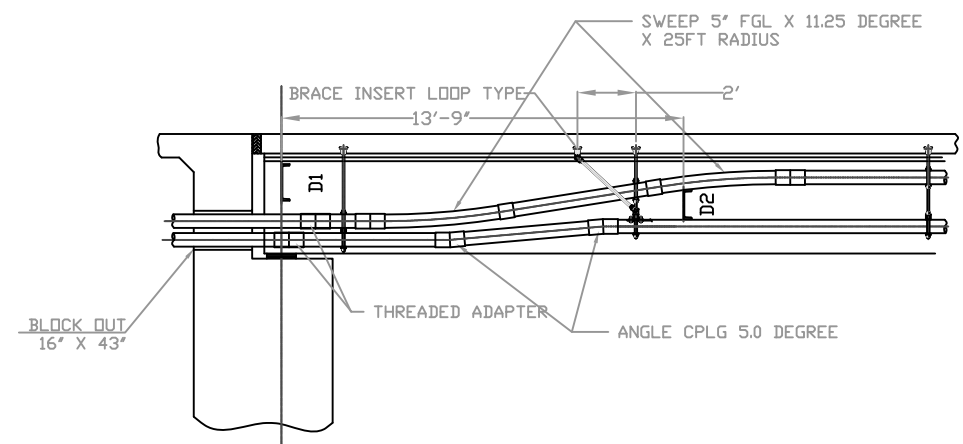

SECTION A-A


This drawing is the property of Condux International, Inc. and the information thereon is to be treated as confidential. It is not to be used, copied or disclosed to outside parties without our written consent.

Note:
ALL MEASUREMENTS ARE IN INCHES UNLESS NOTED OTHERWISE

DRAWING APPROVAL
I _____
APPROVE THIS DRAWING FOR MANUFACTURING
DATE: _____

CONDUIT SUPPORT AND CONDUIT LAYOUT	CONDUX INTERNATIONAL, INC. MANKATO MN PH. 800-533-2077			
	Project: ComEd Harrison Street East Bridge over F.A.I. RTE NB 90/94 Dan Ryan Expressway, Cook County Illinois			
WEIGHT: 0.0 LBS EA	SIZE	FSCM NO.	DWG NO. TBA	REV 0.0
QUOTE NO. 3985218599	SCALE 1/2	DATE: 12-09-2013	SHEET: CONDUX 2 OF 3 SHEET 141 OF 256	

This drawing is the property of Condux International, Inc. and the information thereon is to be treated as confidential. It is not to be used, copied or disclosed to outside parties without our written consent

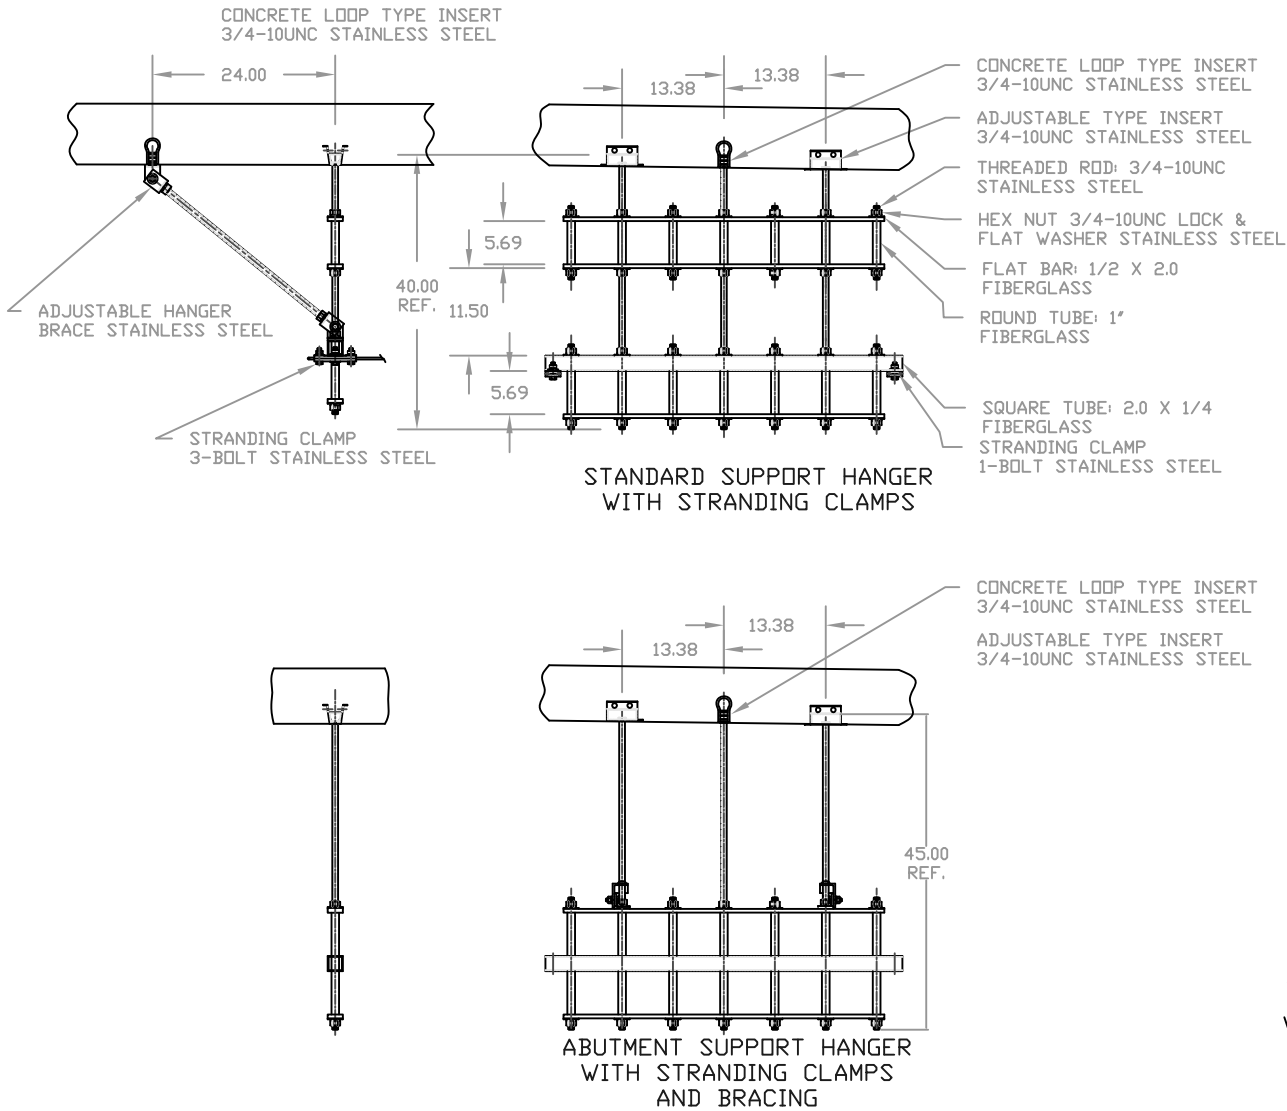

FOR INFORMATION ONLY
WORK TO BE PERFORMED BY OTHERS
WITH THE EXCEPTION OF PLACEMENT
OF INSERTS INTO SUPERSTRUCTURE

NOTE
NO PART OF THE CONDUIT SUPPORT HANGER
CAN EXTEND BELOW THE BRIDGE DECK
GIRDER
EXTENDED RODS MAY NEED TO BE ALTERED

REVISIONS				
ZONE	REV	DESCRIPTION	DATE	APPROVED

CURRENT BILL OF MATERIAL

ITEM NO.	PART NO.	DESCRIPTION	QTY	UNIT
1	26125F3S24	ABUTMENT CONDUIT SUPPORT HANGER: 2 HIGH X 6 WIDE FIBERGLASS AND STAINLESS STEEL, OPENING FOR EIGHT 5' FGL DUCTS THREADED RODS THREE @ 3/4-10UNC X 45.00 LONG	2	EA.
2	TBA	STANDARD CONDUIT SUPPORT HANGER: 2 HIGH X 6 WIDE FIBERGLASS AND STAINLESS STEEL, OPENING FOR EIGHT 5' FGL DUCTS THREADED RODS THREE @ 3/4-10UNC X 40.00 LONG	16	EA.
3	08610236	HANGER BRACE ADJUSTABLE: 3/6 INCH STAINLESS STEEL	6	EA.
4	08409990	CONCRETE INSERT: 3/4-10 LOOP TYPE, STAINLESS STEEL	24	EA.
5	08558300	CONCRETE INSERT SETTING PLUG: 3/4-10	24	EA.
6	TBA	CONCRETE INSERT ADJUSTABLE: 3/4-10 STAINLESS STEEL	36	EA.
7	08408950	STRANDING WIRE: 1/4 X 500 FT., STAINLESS STEEL	2	EA.
8	08409404	GUY STRAND CLAMP: 3-BOLT, STAINLESS STEEL	6	EA.
9	08409504	GUY STRAND CLAMP: 1-BOLT, STAINLESS STEEL	26	EA.
10	08460053	CONDUIT FIBERGLASS: 5' IPS, MW (5.57 O.D. X .096 WALL) MEETING NEMA TC-14A	1440	FT.
11	08460153	CONDUIT STOP COUPLING: 5' IPS MW	40	EA.
12	08460453	CONDUIT EXPANSION JOINT O-RING TYPE: 5' IPS MW	16	EA.
13	08460953	CONDUIT SPLIT STOP RING: 5' IPS MW	16	EA.
14	08461553	CONDUIT ADAPTER: 5' IPS MW TO 5' GRC	16	EA.
15	TBA	CONDUIT SWEEP: 5' IPS MW 11.25 DEGREE X 25FT RADIUS	16	EA.
16	08460253	CONDUIT 5 DEG. ANGLE COUPLING: 5' IPS MW	16	EA.
17	08463402	CONDUIT EPOXY ADHESIVE CARTRIDGE	20	EA.
18	02288990	CONDUIT EPOXY ADHESIVE GUN	1	EA.

General Construction, Hanger and Conduit Notes
1.0 Recommended spacing between Support is 10 foot.
2.0 Support Hanger Material shall be manufactured using 316 stainless steel and fiberglass components.
3.0 Conduit is 5 inch Fiberglass with minimum wall thickness of .096 inch meeting NEMA TC-14A Specs.
4.0 Conduit joints shall be positive locking adhesive bonded bell and spigot.
5.0 Conduit expansion joints shall be sliding sleeve with provision for 8 inch of travel.
6.0 Bridge abutments must have a block out or be sleeved to allow the fiberglass conduit to pass through. After conduit is placed through abutment seal up opening with state approved sealant.
7.0 Place concrete inserts for future support system. Hangers will be installed at a later date.
8.0 Conduit support hangers weight 870.00 LBS total
Fiberglass conduit weight 1915.00 LBS total
cable weight weight 11,710.00 LBS total

Grand total being placed on the bridge is 14,495 LBS.

Condux International, Inc. Support hanger meet the following specifications
Fiberglass Items
Flat Bar: 1/2 x 2.0
Round Tube: 1.0" O.D. .105 wall
Square Tube: 2 x 2 x 1/4
Fiberglass reinforced with polyester resin with surface veil for better weathering, resin shall contains u.v. inhibitor. Fiberglass is made with continuous strand mat and uni-directional roving.
gray in color
Tensile Strength (ASTM D 638) 30,000 PSI
Tensile Modules (ASTM D 638) 2.3E6 PSI
Flexural Strength (ASTM D 790) 30,000 PSI
Flexural Modules (ASTM D 790) 2.3E6 PSI
Compressive Strength (ASTM D 695) 20,000 PSI
Compressive Modules 1.4E6 PSI
Yield shear strength 2000 PSI
Barcol hardness 50
Dielectric strength (ASTM D 149) 200 VPM Min.

Stainless steel Hardware Items
Threaded Rod
Threaded rod meets (ASTM/ASME B1.1) (ASTM A307 Grade A) (Tensile Strength 60,000 PSI)
Hexnut
Hexnut meets (ANSI/ASME B18.2.2) Material: 316 Stainless steel (ASTM F594)
Flatwasher
Flatwasher meets (ANSI/ASME B18.22.1) Material: 316 stainless steel (ASTM F436)
Lockwasher
Lockwasher meets (ANSI/ASME B18.21.1) Material: 316 Stainless steel (ASTM F436)
Stranding Items
Stranding Clamps (1-Bolt & 3-Bolt) Material: 1/4 x 1.5 (316 Stainless Steel)
Stranding Wire
Cable: 1/4" Dia (7 X 19 Steel Aircraft) 304 Stainless Steel
Bracing
Adjustable hanger attachment brackets Material: angle 2.5 x 2.5 x .25 (316 Stainless steel)

DRAWING APPROVAL
I _____
APPROVE THIS DRAWING FOR MANUFACTURING
DATE: _____

Note:
ALL MEASUREMENTS ARE IN INCHES UNLESS NOTED OTHERWISE

CONDUIT SUPPORT HANGER DETAIL AND BILL OF MATERIALS	CONDUX INTERNATIONAL, INC. MANKATO MN PH. 800-533-2077			
	Project: Com Ed Harrison Street East Bridge over F.A.I. RTE NB 90/94 Dan Ryan Expressway, Cook County Illinois			
	WEIGHT: 0.0 LBS EA	SIZE	FSCM NO.	DWG NO. TBA
QUOTE NO. 3985218599	SCALE 1/2	DATE: 12-09-2013	SHEET: CONDUX 3 OF 3	REV 0.0
SHEET 142 OF 256				

STATE OF ILLINOIS
DEPARTMENT OF TRANSPORTATION
DIVISION OF HIGHWAYS
PLANS FOR PROPOSED
FEDERAL AID INTERSTATE HIGHWAY

INDEX OF VOLUMES		
VOL. NO.	DESCRIPTION	NO. OF SHEETS
1.	ROADWAY PLANS & GENERAL SHEETS	151
2.	MAINTENANCE OF TRAFFIC & ROADWAY CROSS SECTIONS	81
3.	BRIDGES & ASSOCIATED STRUCTURES	79
4.	RETAINING WALLS	38
5.	ROADWAY LIGHTING & SURVEILLANCE	36
TOTAL		385

NOTE: FOR INDEX OF SHEETS SEE SHEET NO. 2

PLAN 1 INCH = 50 FEET
PROFILE VERT. 1 INCH = 5 FEET
CROSS SECTIONS 1 INCH = 10 FEET HORIZONTAL
1 INCH = 5 FEET VERTICAL


VOLUME NO. 1

F.A.I. ROUTE 90/94 (DAN RYAN EXPRESSWAY)
SECTION 1985 - 080 R
PROJECT IDR-94-3 (268) 52
COOK COUNTY
C-91-433-85

ROADWAY GRADING AND PAVING
MAXWELL STREET TO I-290

DESIGN DESIGNATION


DAN RYAN EXPRESSWAY (MAINLINE S.B. & N.B.) } 153,700 (2000) TRUNK 118.41 (15" CRPCC - 20) 1/2
COLLECTOR-DISTRIBUTOR (S.B. & N.B.) }
N.B. ROOSEVELT RD./RUBLE ST. } 19,300 (2000) AREA SERVICE 16.08 (12" PCC - 20)
S.B. ROOSEVELT RD./UNION AVE. }
N.B. TAYLOR ST. ENTRANCE RAMP }
TAYLOR ST. MAINLINE EXIT } 7,700 (2000) AREA SERVICE 4.67 (10" PCC - 20)
AND RAMP W-S }

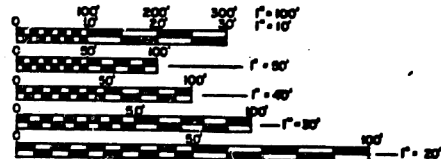

FULL SIZE PLANS HAVE BEEN PREPARED USING STANDARD ENGINEERING SCALES. REDUCED SIZED PLANS WILL NOT CONFORM TO STANDARD SCALES. IN MAKING MEASUREMENTS ON REDUCED PLANS, THE ABOVE SCALES MAY BE USED.

CONTRACT NO. 80063


REVISED 11-25-97

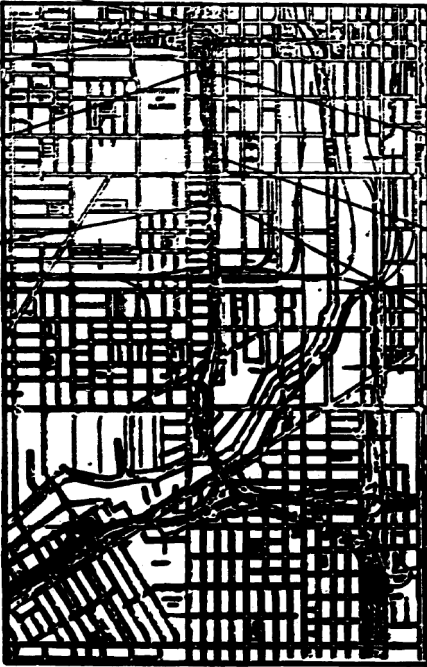

STA. EQ. NB. DAN RYAN EXPRESSWAY STA. 16+37.06 BK + STA. 16+37.67 AND
STA. EQ. SB. DAN RYAN EXPRESSWAY STA. 209+89.95 BK + STA. 3+06.94 AND
STA. EQ. NB. DAN RYAN EXPRESSWAY STA. 183+87.10 BK + STA. 183+15.36 AND
STA. EQ. SB. DAN RYAN EXPRESSWAY STA. 183+87.10 BK + STA. 183+15.36 AND



Thomas Allan Smith
8-15-87

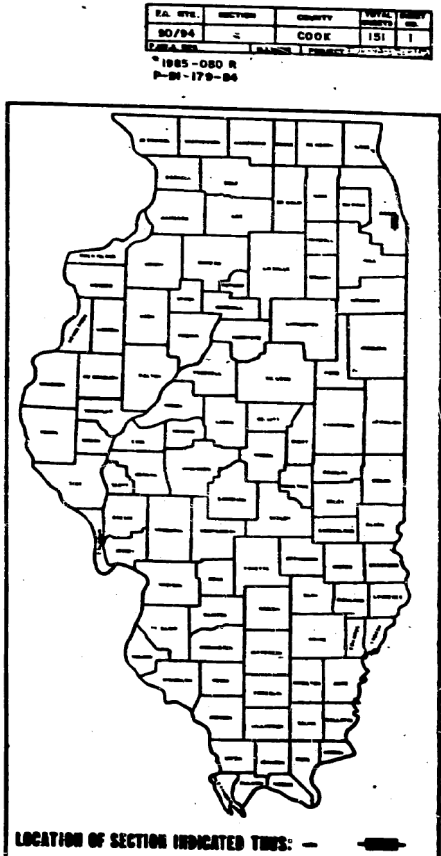

STATE OF ILLINOIS
DEPARTMENT OF TRANSPORTATION
DIVISION OF HIGHWAYS

DESIGNED BY: August 12, 1987
CHECKED BY: Ralph C. Williams
DRAWN BY: 11-26-87
PLOTTED BY: 10/20/87
APPROVED BY: 8-20-87
DATE: 8-20-87

DEPARTMENT OF TRANSPORTATION
FEDERAL HIGHWAY ADMINISTRATION

DIVISION ADMINISTRATOR DATE

NET LENGTH = 4,122.32 LIN. FT. (0.78 MILES)
GROSS LENGTH = 4,122.32 LIN. FT. (0.78 MILES)

USER NAME = dunkerleyb	DESIGNED -	REVISED
PLOT SCALE = N.T.S.	CHECKED -	REVISED
PLOT DATE = 11/26/2013	DRAWN -	REVISED
	CHECKED -	REVISED

STATE OF ILLINOIS
DEPARTMENT OF TRANSPORTATION

EXISTING AS-BUILTS SN 016-1088

SHEET NO. AS-01 OF AS-72 SHEETS

F.A.I. RTE.	SECTION	COUNTY	TOTAL SHEETS	SHEET NO.
90/94/290	2013-036R	COOK	256	143
CONTRACT NO. 60W71				
ILLINOIS FED. AID PROJECT -NUMBER-				

STATE OF ILLINOIS
DEPARTMENT OF TRANSPORTATION
DIVISION OF HIGHWAYS
PLANS FOR PROPOSED
FEDERAL AID INTERSTATE HIGHWAY

INDEX OF VOLUMES		
VOL. NO.	DESCRIPTION	NO. OF SHEETS
1.	ROADWAY PLANS & GENERAL SHEETS	151
2.	MAINTENANCE OF TRAFFIC & ROADWAY CROSS SECTIONS	81
3.	BRIDGES & ASSOCIATED STRUCTURES	79
4.	RETAINING WALLS AND MISC. STRUCTURES	38
5.	ROADWAY LIGHTING & SURVEILLANCE	36
TOTAL		386

PLAN 1 INCH = 50 FEET
PROFILE HORIZ. 1 INCH = 50 FEET
PROFILE VERT. 1 INCH = 5 FEET
CROSS SECTION 1 INCH = 10 FEET HORIZONTAL
1 INCH = 5 FEET VERTICAL


VOLUME NO. 3
F.A.I. ROUTE 90/94 (DAN RYAN EXPRESSWAY)
SECTION 1985 - 080 R
PROJECT

COOK COUNTY
C-91-433-85

ROADWAY GRADING AND PAVING
MAXWELL STREET TO I-290

DESIGN DESIGNATION

DAN RYAN EXPRESSWAY (MAINLINE S.B. & N.B.) 163,700 (2000) TRUNK 118.41 (13" CRPCC - 20)
COLLECTOR-DISTRIBUTOR (S.B. & N.B.) 28,100 (2000) COLLECTOR 21.63 (13" CRPCC - 20)
N.B. ROOSEVELT RD./RUBLE ST 19,300 (2000) AREA SERVICE 16.08 (12" PCC - 20)
S.B. ROOSEVELT RD./UNION AVE. N.B. TAYLOR ST. ENTRANCE RAMP
TAYLOR ST. MAINLINE EXIT AND RAMP W-5 7,700 (2000) AREA SERVICE 4.67 (10" PCC - 20)

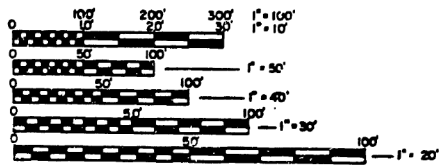

FULL SIZE PLANS HAVE BEEN PREPARED USING STANDARD
ENGINEERING SCALES. REDUCED SIZED PLANS WILL NOT
CONFORM TO STANDARD SCALES. IN MAKING MEASUREMENTS
ON REDUCED PLANS, THE ABOVE SCALES MAY BE USED.


CONTRACT NO. 80063

PROJECT ENDS
STA. 174+50 (S.B.)
STA. 14+75 (N.B.)
DAN RYAN EXPRESSWAY

STA. EQ. SE. DAN
RYAN EXPRESSWAY
STA. 16+37.86 BK +
STA. 16+37.67 AHD

STA. EQ. SB. DAN
RYAN EXPRESSWAY
STA. 209+97.18 BK +
STA. 3+11.69 AHD

PROJECT BEGINS
STA. 183+13.36
DAN RYAN EXPRESSWAY

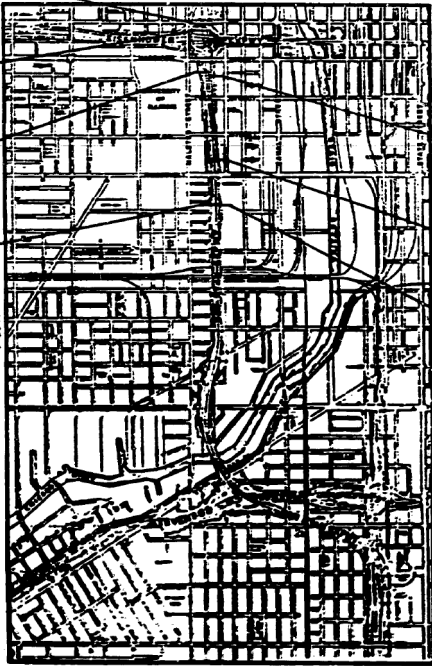

STA. EQ. NB. DAN
RYAN EXPRESSWAY
STA. 209+85.95 BK +
STA. 3+06.94 AHD

STA. EQ. NB. DAN
RYAN EXPRESSWAY
STA. 196+40.07 BK +
STA. 196+39.94 AHD

STA. EQ. SB. & NB.
DAN RYAN EXPRESSWAY
STA. 183+87.10 BK +
STA. 183+13.36 AHD

NET LENGTH = 4,122.32 LIN. FT. (0.78 MILES)
GROSS LENGTH = 4,122.52 LIN. FT. (0.78 MILES)

F.A. RTE.	SECTION	COUNTY	TOTAL SHEETS
90/94	1985-080 R	COOK	79
P-91-179-84			



LOCATION OF SECTION INDICATED TRUS: --

STATE OF ILLINOIS
DEPARTMENT OF TRANSPORTATION
DIVISION OF HIGHWAYS

SUBMITTED: _____
EXAMINED: _____
PREPARED: _____
APPROVED: _____

DEPARTMENT OF TRANSPORTATION
FEDERAL HIGHWAY ADMINISTRATION

DIVISION ENGINEER _____
DATE _____

SHEET G1 OF 2

Revision - Nov 23, 1987

USER NAME = dunkerleyb	DESIGNED -	REVISED
	CHECKED -	REVISED
PLOT SCALE = N.T.S.	DRAWN -	REVISED
PLOT DATE = 11/26/2013	CHECKED -	REVISED

STATE OF ILLINOIS
DEPARTMENT OF TRANSPORTATION

EXISTING AS-BUILTS SN 016-1088


SHEET NO. AS-02 OF AS-72 SHEETS

F.A.I. RTE.	SECTION	COUNTY	TOTAL SHEETS	SHEET NO.
90/94/290	2013-036R	COOK	256	144
CONTRACT NO. 60W71				
ILLINOIS FED. AID PROJECT -NUMBER-				


FOR INFORMATION ONLY

BENCH MARK

Mark cut in ledge of brick building on Union Avenue and Roosevelt Road, City of Chicago Bench Mark No. 4617 El. 17.55

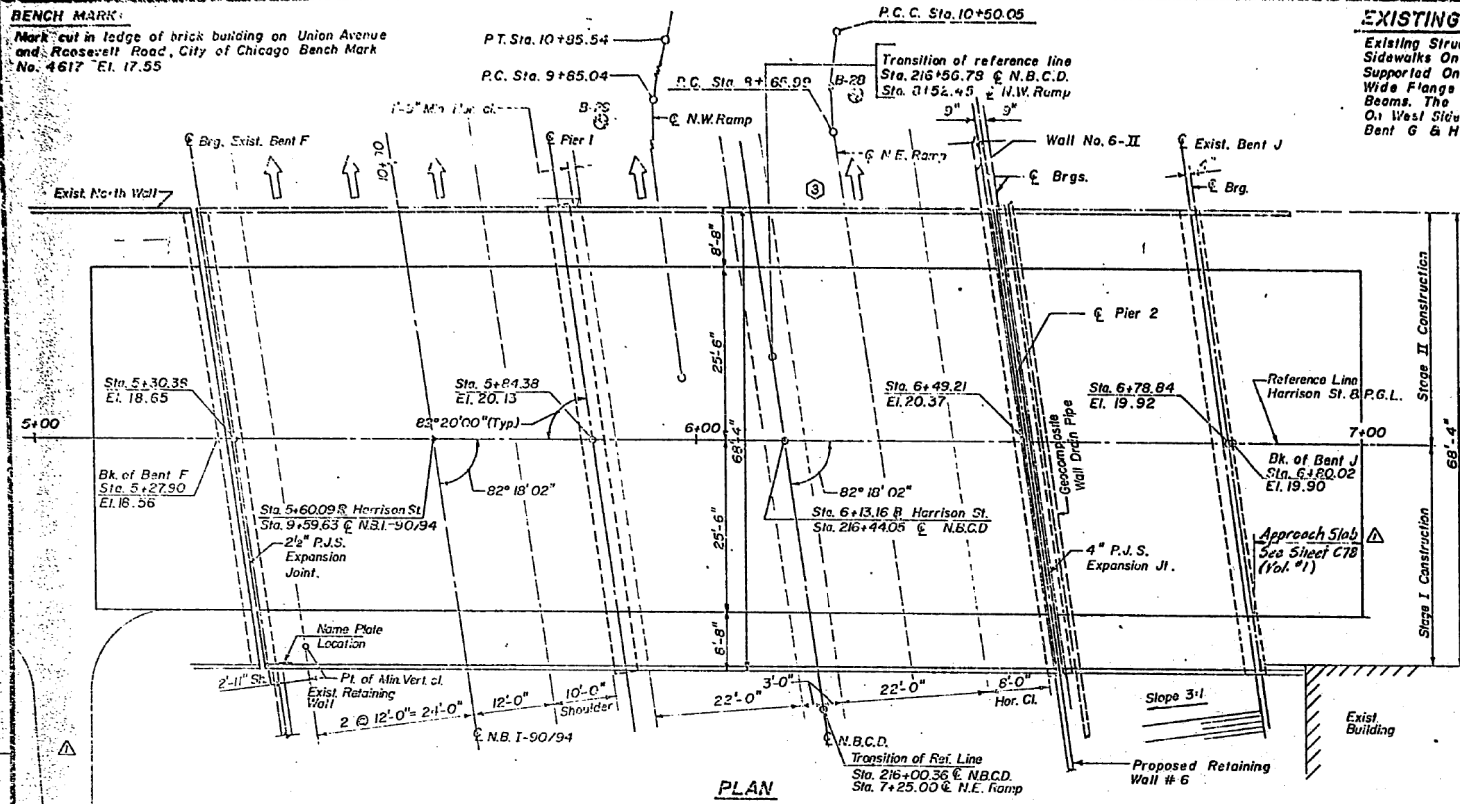

PLAN

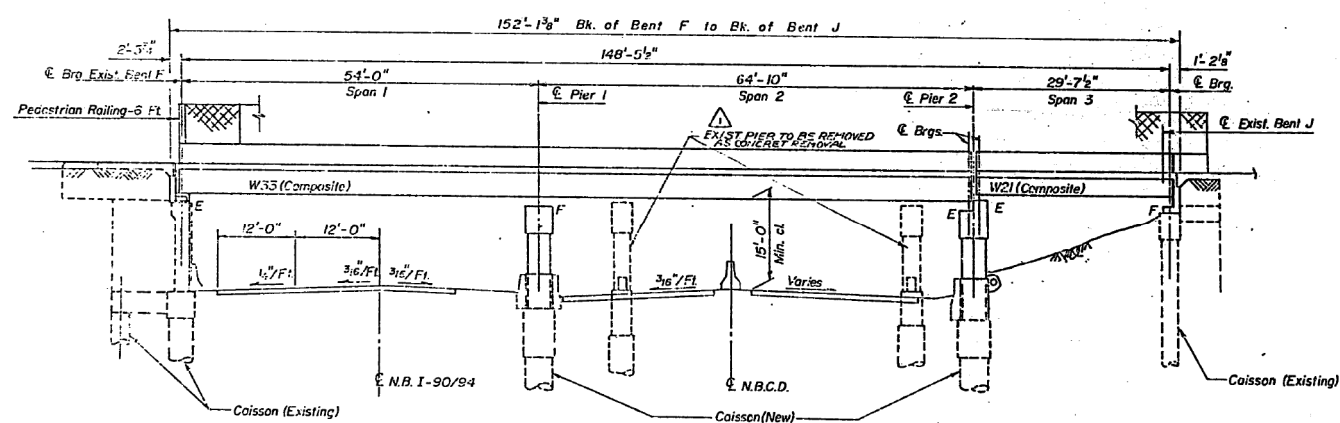

ELEVATION

EXISTING STRUCTURE

Existing Structure No. 016-1088 is 68'-4" Wide With 6'-0" Sidewalks On Each Side. The Deck is A Concrete Slab Supported On Two Span 66'-10" & 40'-9" Continuous Steel Wide Flange Beams And A 4'-0" Single Span Concrete Beam. The Substructure Consists Of A Closed Abutment On West Side, Span F, Two Multiple C. Innn G. Center Bent G & H And A Copped Abutment On East Side, Bent J.


MAJOR WORK ITEMS:

Remove and replace existing Superstructure and Piers. Rehabilitate Bent F & Bent J. No salvage value. Traffic is to be maintained during construction.

STATION 5+60.09
REBUILT 198 BY
STATE OF ILLINOIS
HARRISON STREET SEC.
F.A. PROJ. 102-94-3(268)
LOADING HS 20
STR. NO. 016-1088

NAME PLATE

(See Std. 2113)

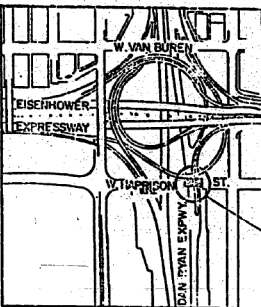

LOCATION PLAN

TOTAL BILL OF MATERIAL

ITEMS	UNIT	SUPER	SUB(C)	TOTAL
Removal of Existing Superstructure	L. Sum	6.8	—	6.8
Concrete Removal	Cu. Yd.	—	113.5	113.5
Expansion Bolts (1/2" x 4")	Each	—	222	222
Structure Excavation	Cu. Yd.	—	364	364
Protective Coat	Sq. Yd.	1217	25	1242
Class X Concrete	Cu. Yd.	—	341.4	341.4
Furnishing and Erecting Structural Steel	L. Sum	15	—	15
Stud Shear Connectors	Each	5,520	—	5,520
Reinforcement Bars	Pound	—	82,280	82,280
Reinforcement Bars (Epoxy Coated)	Pound	67,510	—	67,510
Elastomeric Bearing Assembly Type I	Each	36	—	36
Pedestrian Railing - 6 Ft.	Ln. Ft.	34	—	34
Formed Concrete Repair (Depth 4 in.)	Sq. Ft.	—	150	150
Epoxy Crack Sealing	Ln. Ft.	—	20	20
Name Plates	Each	1	—	1
Preformed Joint Seal, 2 1/2"	Ln. Ft.	71	—	71
Preformed Joint Seal, 4"	Ln. Ft.	71	—	71
Coisson Shafts, 36" x 6"	Cu. Ft.	—	2,150	2,150
Coisson Balls	Cu. Ft.	—	882	882
Protective Shield	Sq. Yd.	2,140	—	2,140
Geocomposite Wall Drain	Sq. Yd.	—	05	05
Class X Concrete Superstructure	Cu. Yd.	364	—	364
Pipe Underdrain - Perf. Corrugated - 6"	Ln. Ft.	—	115	115

Substructure quantities also include Retaining Wall #11.

DESIGN CRITERIA

DESIGN SPECIFICATIONS:

A.A.S.H.T.O. 1983 Standard Specifications For Highway Bridges & 1984 & 1985 Interims.

DESIGN CRITERIA:

Live Load: HS 20-44 & Alternate
Sidewalk Live Load: 60 Lbs./S.F.
Soil Pressure: 40 #/C.F. Equivalent Fluid Pressure
Allowable Bearing Pressure For Coisson = 12 Kips/S.F.
Allow 25 /Sq Ft For Future Wearing Surface.

DESIGN STRESSES:

Concrete	f'c	3,500	PSI	Proposed Structure
Reinforcing Steel (Grade 60)	Fy	60,000	PSI	
Structural Steel (M 223)	Fy	50,000	PSI	Existing Structure
(M 183)	Fy	36,000	PSI	
Concrete	f'c	1,400	PSI	Existing Structure
Reinforcing Steel	Fy	20,000	PSI	

LEGEND

Proposed Soil Boring
Existing Structure

SHEET S-1 OF S-17

STATE OF ILLINOIS
DEPARTMENT OF TRANSPORTATION
F.A.I. ROUTE 90/94 (DAN RYAN EXPRESSWAY)
SECTION 1985-080 R - COOK COUNTY
HARRISON STREET OVER DAN RYAN EXPRESSWAY
GENERAL PLAN & ELEVATION
S.N. 016-1088
Scale: None
Date: AUGUST 14, 1997
Checked By: S.D.D.
DRAWN BY: S.D.D.
CHICAGO, ILLINOIS

REVISIONS	Name	Date
1	Revision	3-11-85

APPROVED
James J. Roylance
P.G. ENGINEERING ASSOCIATES, INC.
603 WEST JACKSON BLVD.
CHICAGO, ILLINOIS 60606

USER NAME = dunkerleyb	DESIGNED -	REVISED -
PLOT SCALE = N.T.S.	CHECKED -	REVISED -
PLOT DATE = 11/26/2013	DRAWN -	REVISED -
	CHECKED -	REVISED -


STATE OF ILLINOIS
DEPARTMENT OF TRANSPORTATION

EXISTING AS-BUILTS SN 016-1088

SHEET NO. AS-04 OF AS-72 SHEETS

F.A.I. RTE.	SECTION	COUNTY	TOTAL SHEETS	SHEET NO.
90/94/290	2013-036R	COOK	256	146
CONTRACT NO. 60W71				
ILLINOIS FED. AID PROJECT -NUMBER-				

FOR INFORMATION ONLY

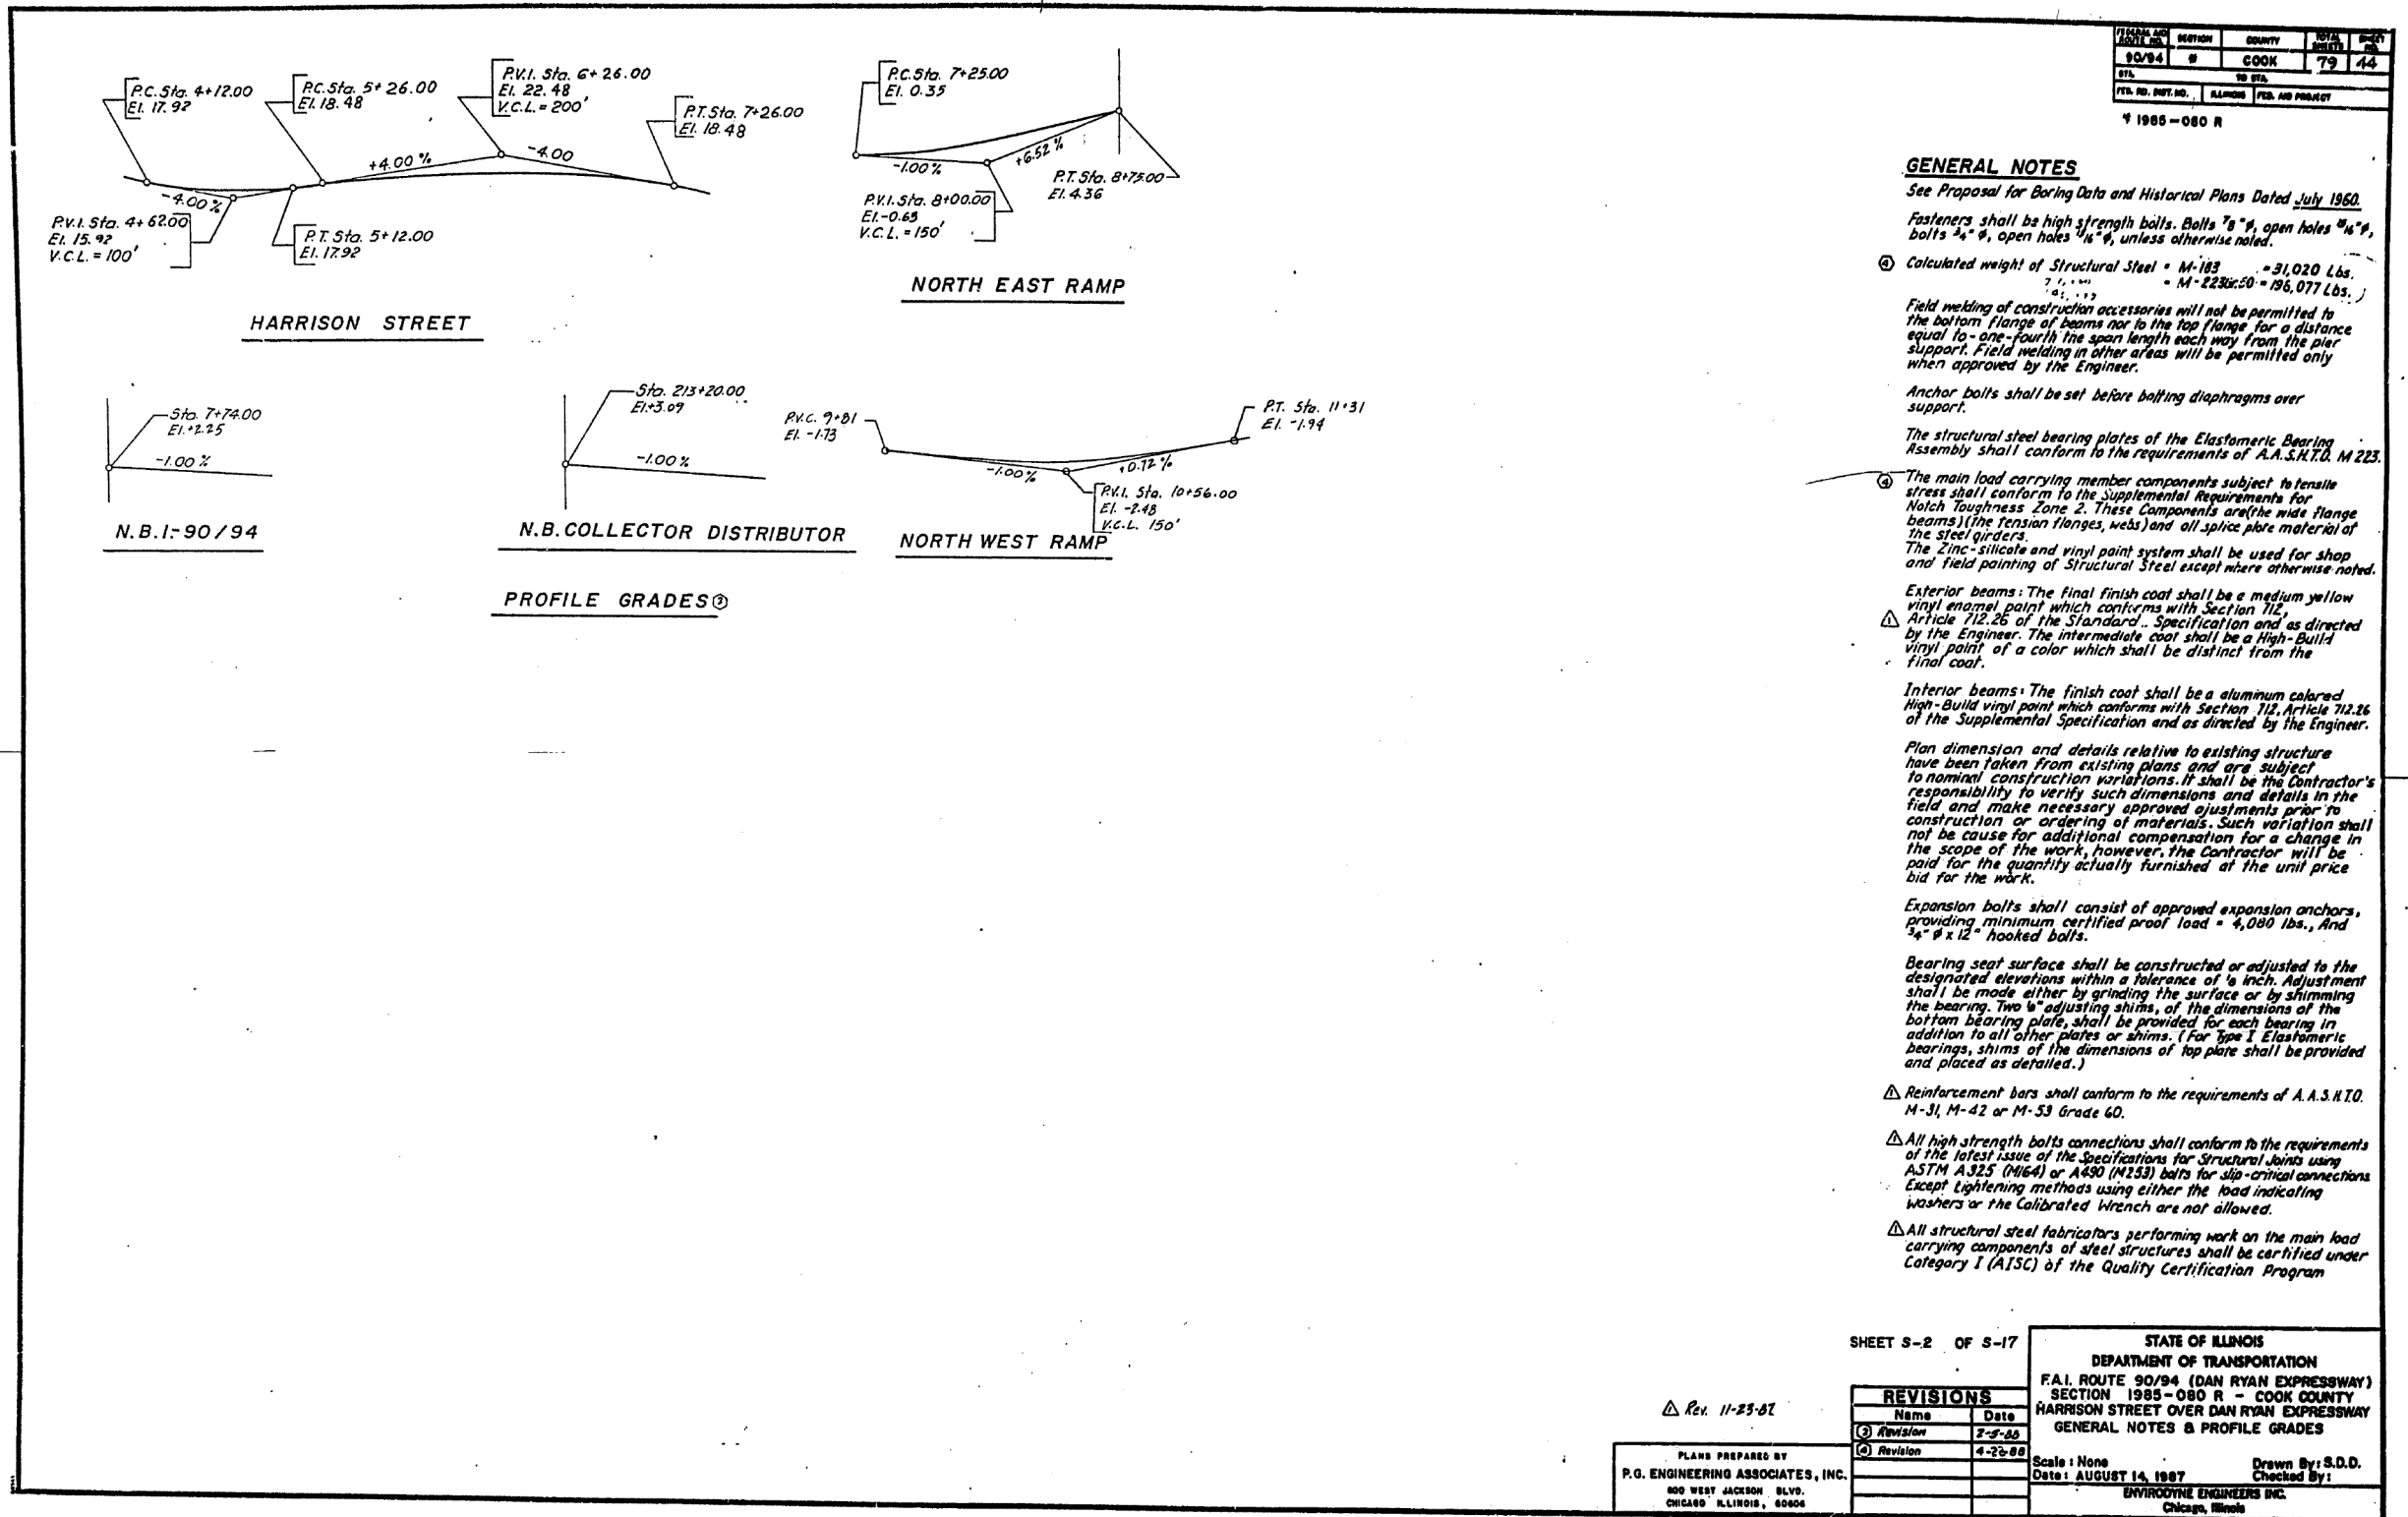

USER NAME = dunkerleyb	DESIGNED -	REVISED	STATE OF ILLINOIS DEPARTMENT OF TRANSPORTATION	EXISTING AS-BUILTS SN 016-1088	SHEET NO. AS-05 OF AS-72 SHEETS	F.A.I. RTE.	SECTION	COUNTY	TOTAL SHEETS	SHEET NO.
	CHECKED -	REVISED				90/94/290	2013-036R	COOK	256	147
PLOT SCALE = N.T.S.	DRAWN -	REVISED				CONTRACT NO. 60W71				
PLOT DATE = 11/26/2013	CHECKED -	REVISED				ILLINOIS FED. AID PROJECT -NUMBER-				

D:\60W71-shr-AS-BUILT-05.dgn

STATE OF ILLINOIS
DEPARTMENT OF TRANSPORTATION

* 1985-082 R Removal of Existing Superstructure

REVISIONS	
NAME	DATE


STATE OF ILLINOIS
DEPARTMENT OF TRANSPORTATION
F.A.I. ROUTE 90/84 (DAN RYAN EXPRESSWAY)
SECTION 1955-080 R - COOK COUNTY
HARRISON STREET OVER DAN RYAN EXPRESSWAY
STAGE CONSTRUCTION DETAILS

Scale : None
Date : AUGUST 14, 1987
Drawn By: S.D.D.
Checked By:

ENVIRODYNE ENGINEERS INC.

F.A.I. RTE.	SECTION	COUNTY	TOTAL SHEETS	SHEET NO.
90/94/290	2013-036R	COOK	256	148
		CONTRACT NO. 60W71		
		ILLINOIS FED. AID PROJECT -NUMBER-		

FOR INFORMATION ONLY

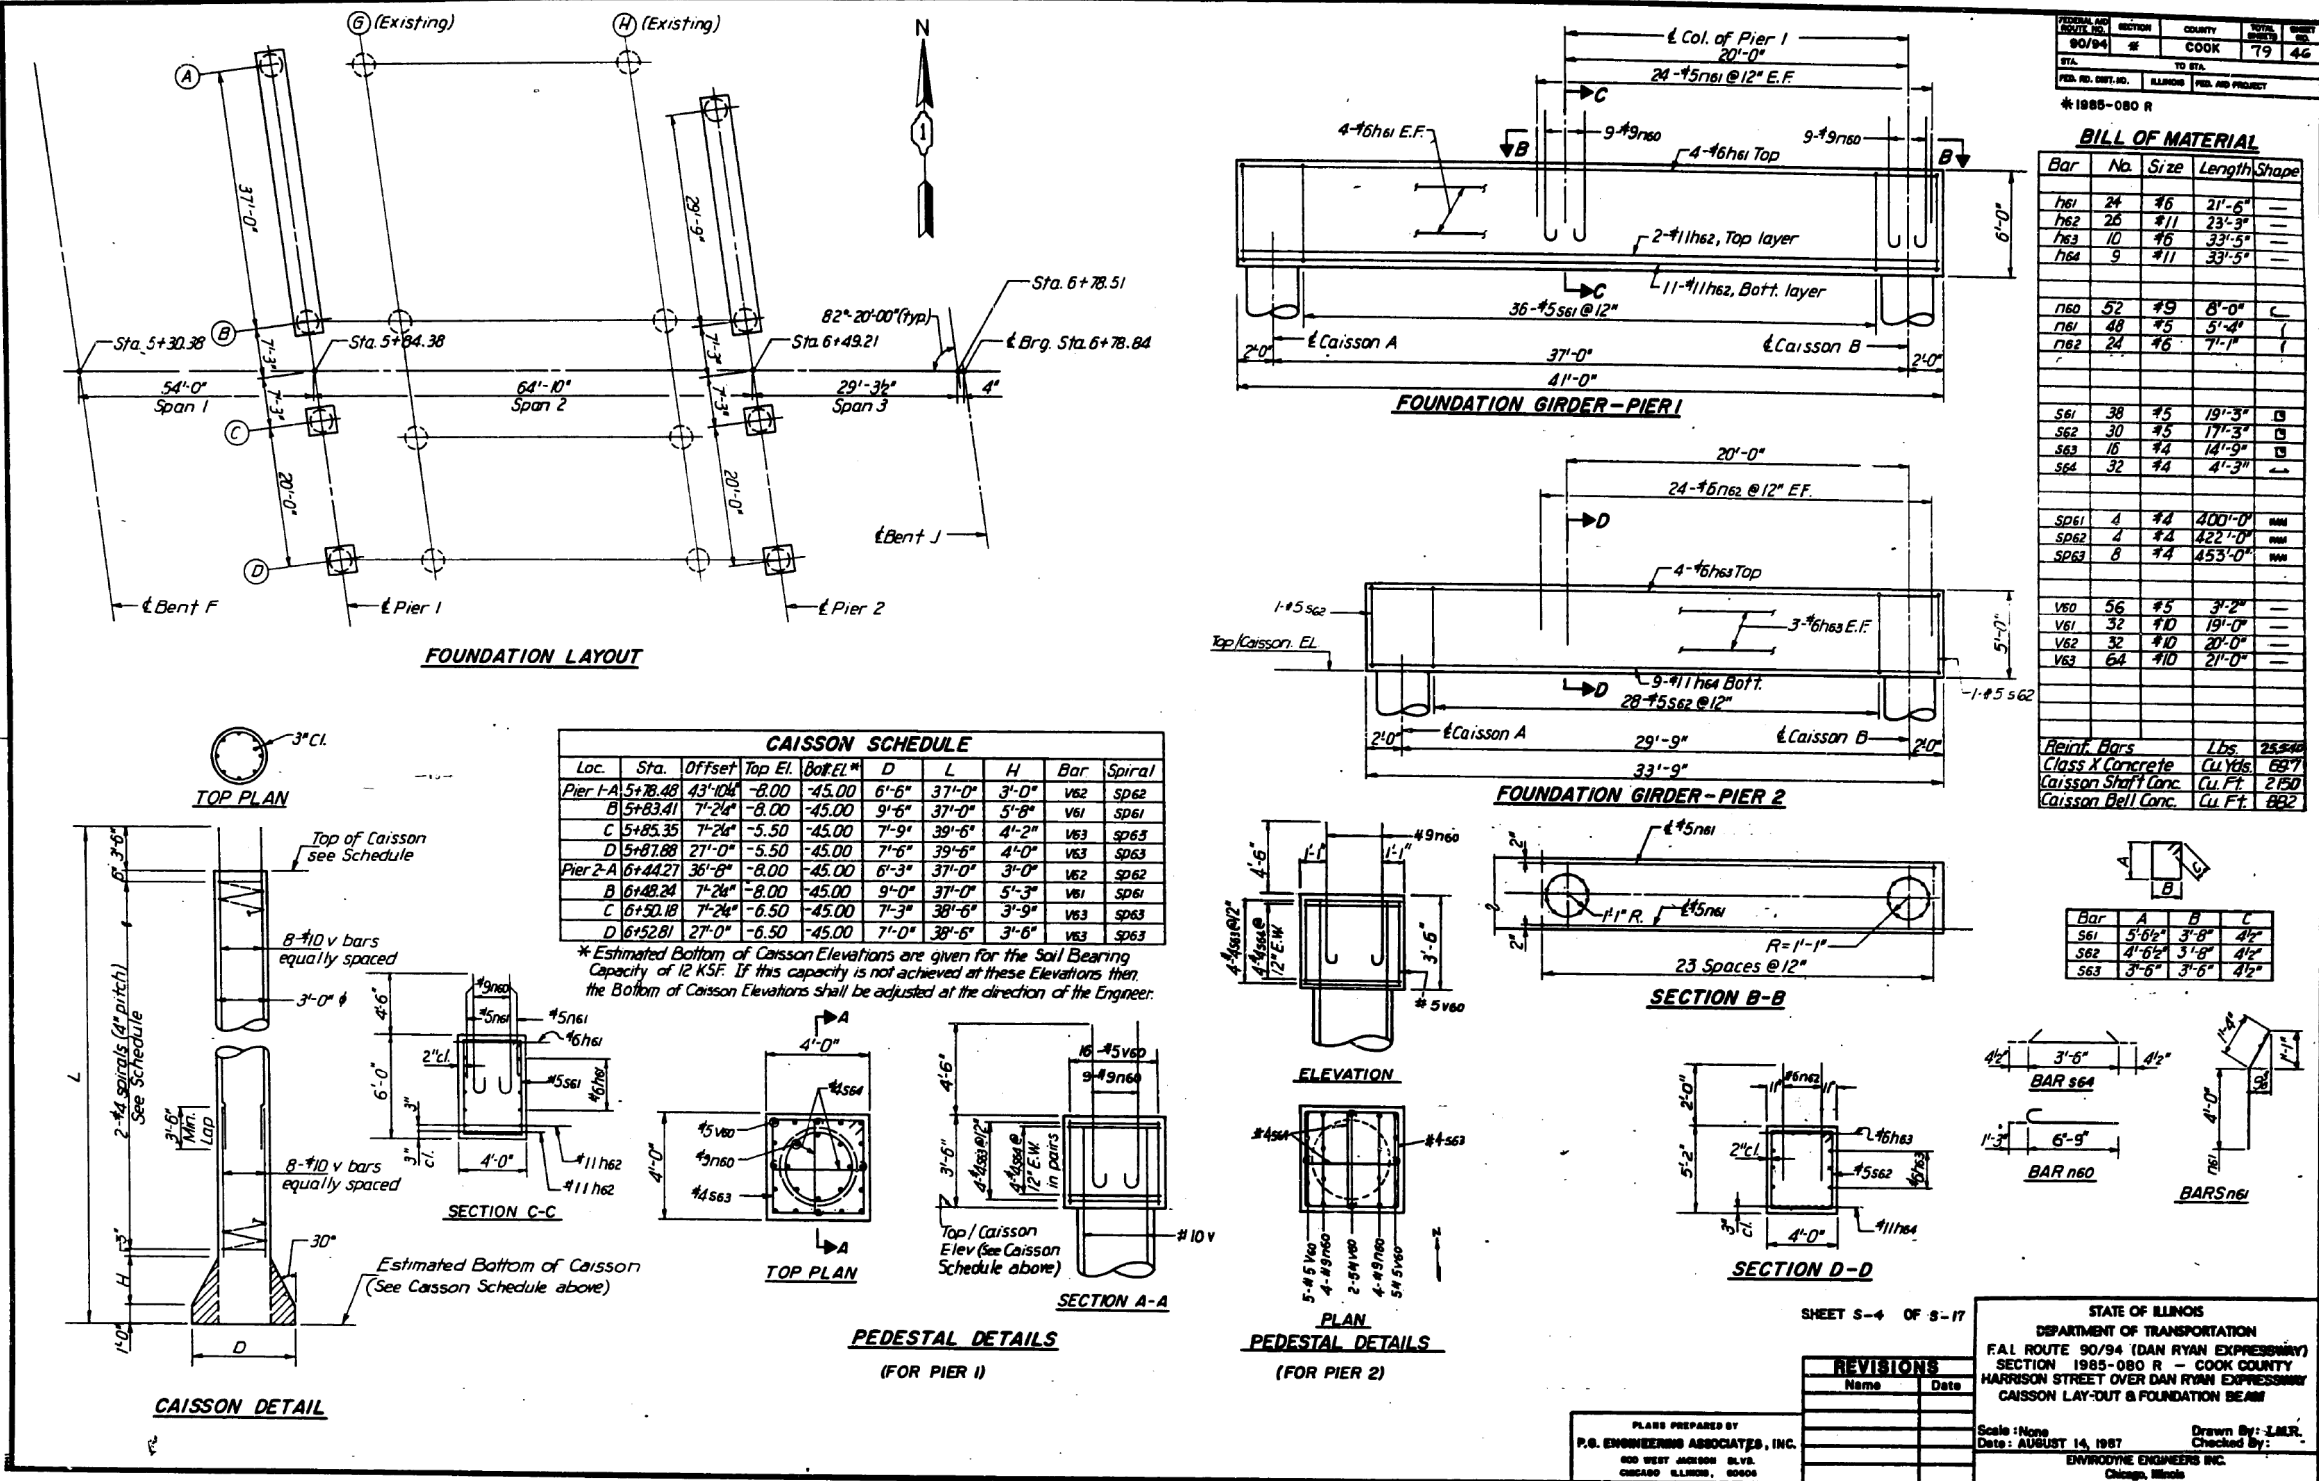

USER NAME = dunkerleyb	DESIGNED -	REVISED
	CHECKED -	REVISED
PLOT SCALE = N.T.S.	DRAWN -	REVISED
PLOT DATE = 11/26/2013	CHECKED -	REVISED


STATE OF ILLINOIS
DEPARTMENT OF TRANSPORTATION

EXISTING AS-BUILTS SN 016-1088

SHEET NO. AS-07 OF AS-72 SHEETS

F.A.I. RTE.	SECTION	COUNTY	TOTAL SHEETS	SHEET NO.
90/94/290	2013-036R	COOK	256	149
CONTRACT NO. 60W71				
ILLINOIS FED. AID PROJECT -NUMBER-				

FOR INFORMATION ONLY

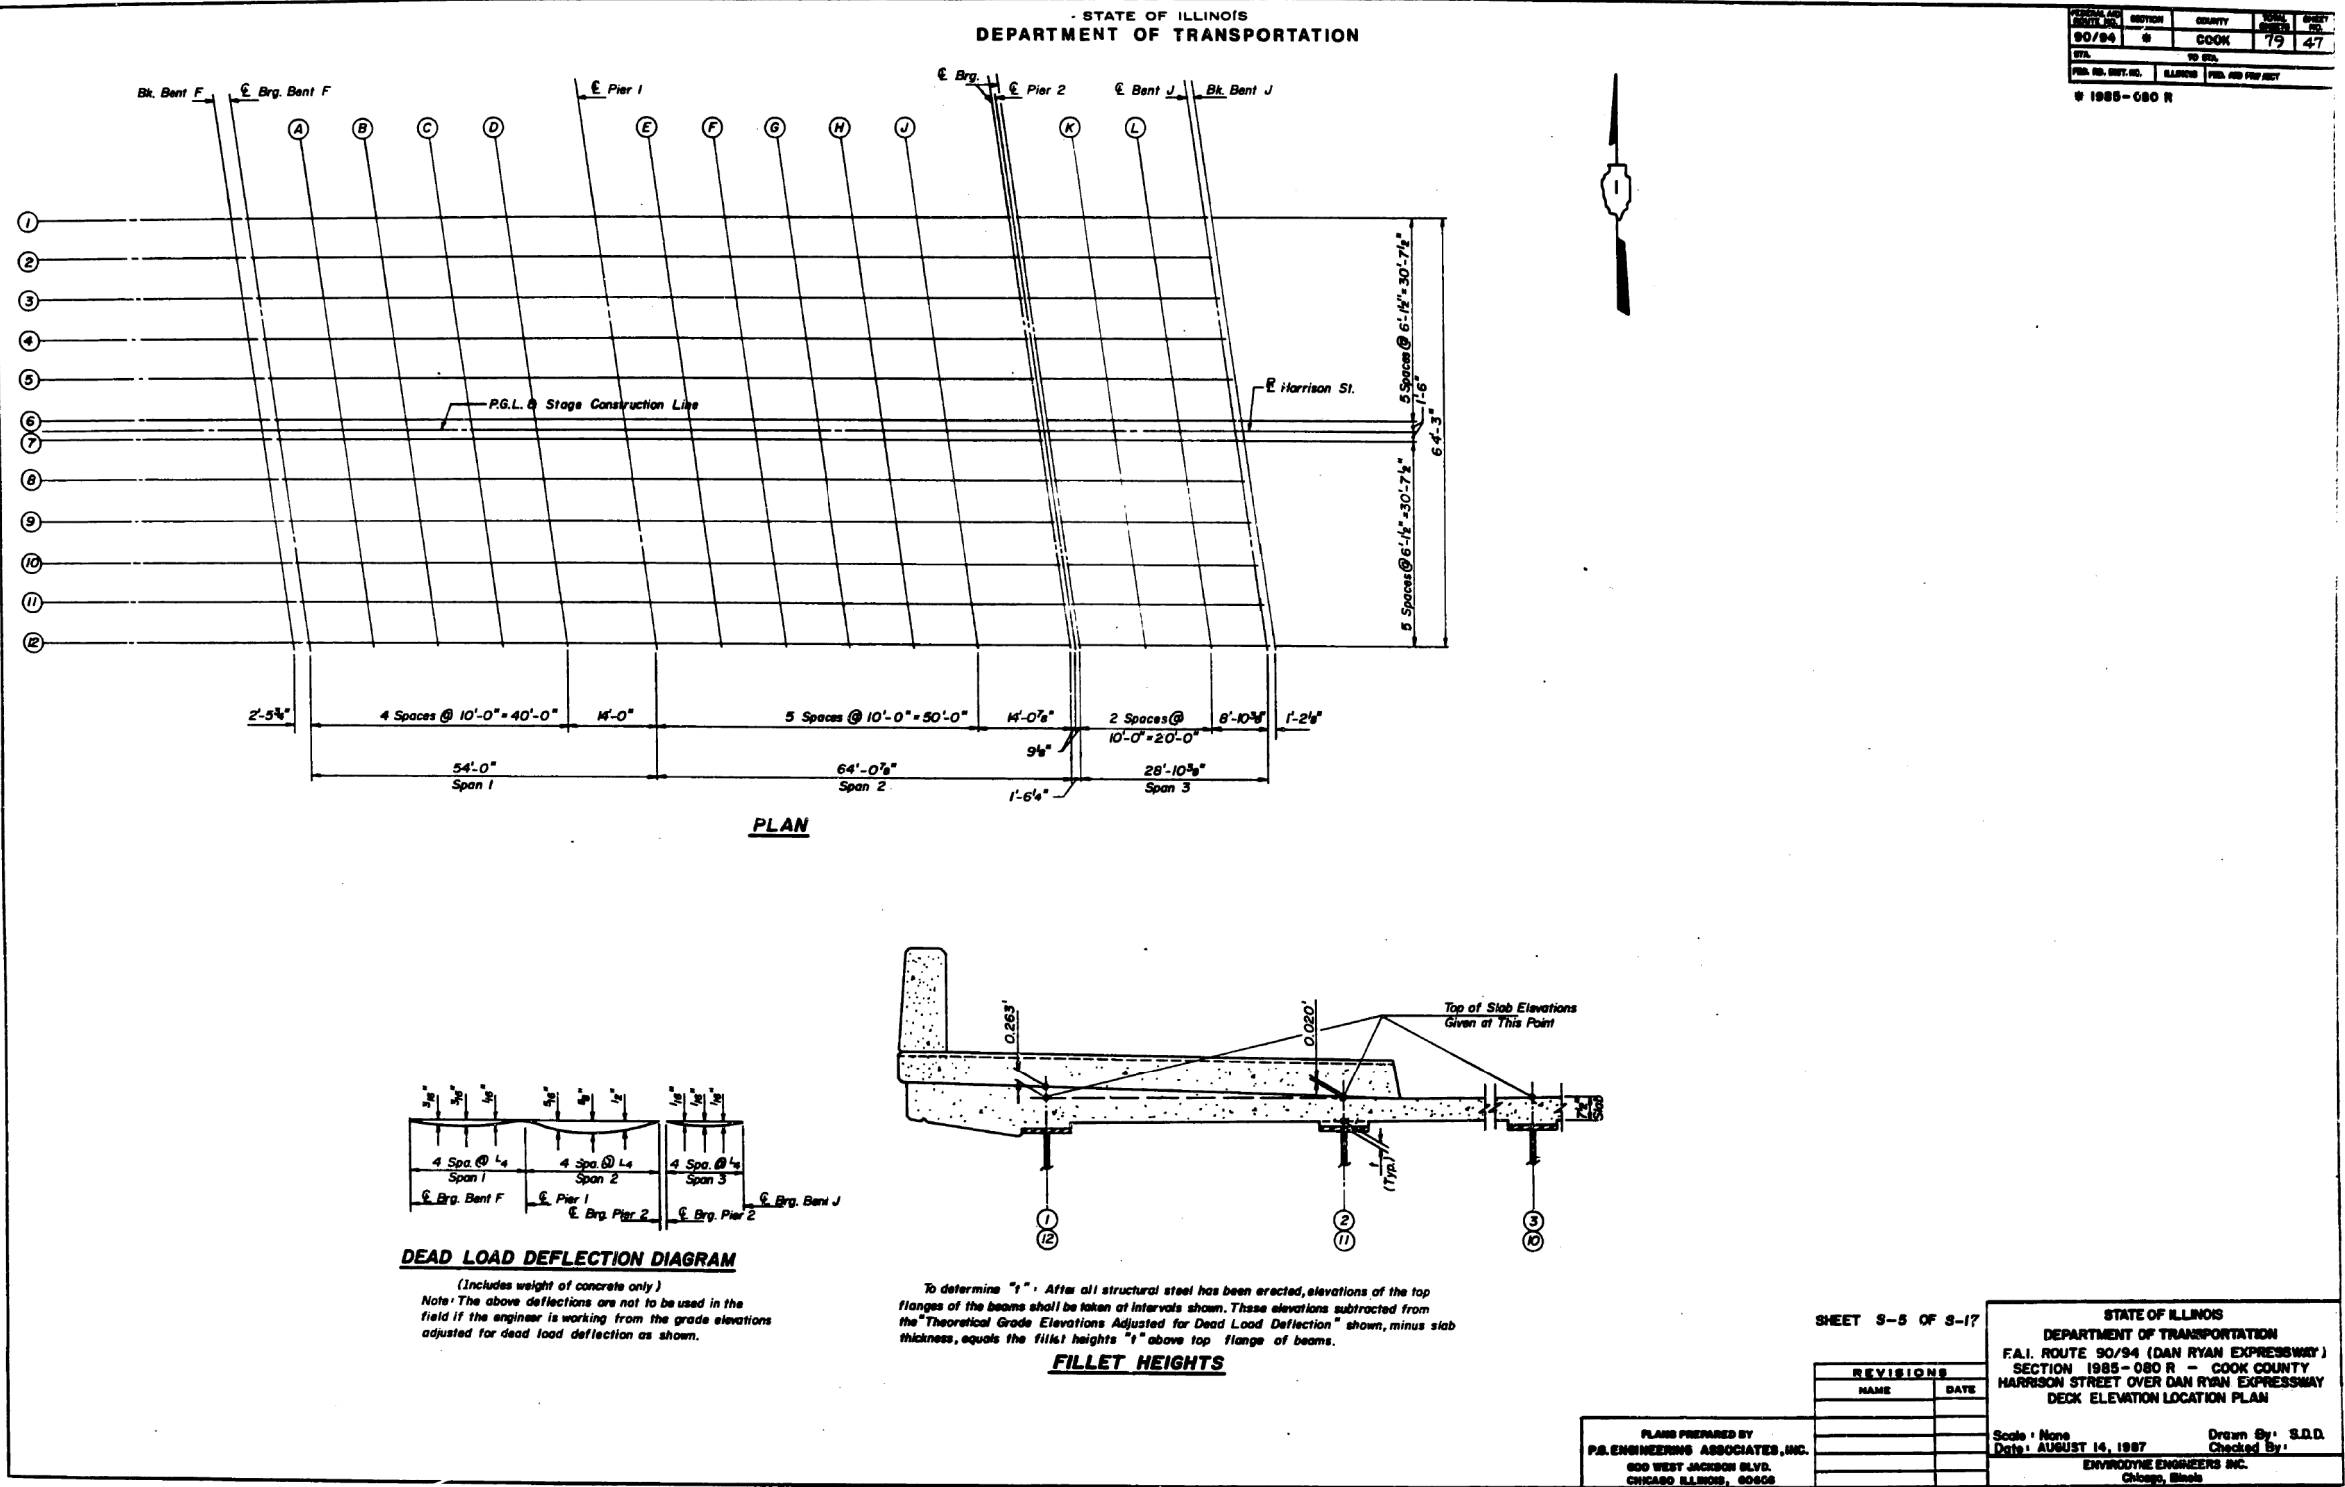

USER NAME = dunkerleyb	DESIGNED -	REVISED
	CHECKED -	REVISED
PLOT SCALE = N.T.S.	DRAWN -	REVISED
PLOT DATE = 11/26/2013	CHECKED -	REVISED

STATE OF ILLINOIS
DEPARTMENT OF TRANSPORTATION

EXISTING AS-BUILTS SN 016-1088

SHEET NO. AS-08 OF AS-72 SHEETS

F.A.I. RTE. 90/94/290	SECTION 2013-036R	COUNTY COOK	TOTAL SHEETS 256	SHEET NO. 150
CONTRACT NO. 60W71				

D:\60W71-shr-AS-BUILT-08.dgn

FOR INFORMATION ONLY

BEAM - I				
Location	Station	Offset	Theoretical Grade Elevations	Theoretical Grade Elevations Adjusted For Dead Load Deflection
BN. BENT F	523.576	32.125	17.081	17.881
E. BWA BENT F	516.055	32.125	17.080	17.880
A	536.055	32.12*	16.360	16.369
B	586.055	32.125	16.700	16.715
C	556.055	32.125	19.080	19.018
D	566.055	32.125	19.259	19.266
E. PIEN 1	580.055	32.125	19.556	19.556
E	590.055	32.125	19.720	19.735
F	600.055	32.125	19.883	19.879
G	610.055	32.125	19.927	19.977
H	620.055	32.125	19.971	20.022
I	630.055	32.125	19.975	20.012
E. BWA. P2	644.128	32.125	19.912	19.912
E. PIEN 2	644.889	32.125	19.907	19.907
E. E. BWA. P2	655.689	32.125	19.901	19.902
K	655.889	32.125	19.902	19.920
L	665.689	32.125	19.658	19.660
E. BENT J	674.514	32.125	19.507	19.507
BN. BENT J	675.685	32.170	19.884	19.888

BEAM-2				
Location	Station	Offset	Theoretical Grade Elevations	Theoretical Grade Elevations Adjusted For Dead Load Deflection
BK BENT F	524.401	36.000	18.010	18.010
EL BNS BENT F	526.080	26.000	18.109	18.109
A	536.080	26.000	18.485	18.489
B	566.080	26.000	18.822	18.837
C	556.080	26.000	19.118	19.132
D	566.080	26.000	19.375	19.381
EL PIER 1	580.080	26.000	19.667	19.667
E	590.080	26.000	19.827	19.842
F	600.080	26.000	19.948	19.963
G	610.080	26.000	20.028	20.077
H	620.080	26.000	20.069	20.119
J	630.080	26.000	20.069	20.108
EL BNS P2	644.953	26.000	20.002	20.002
EL PIER 2	645.713	26.000	19.996	19.996
EL BNS P2	646.473	26.000	19.990	19.991
K	656.473	26.000	19.888	19.906
L	666.473	26.000	19.786	19.751
EL BENT J	675.338	26.000	19.587	19.587
BK BENT J	676.515	26.000	19.563	19.563

Location	Station	Offset	Theoretical Grade Elevations	Theoretical Grade Elevations Adjusted For Dead Load Deflection
IK BENT F	525.225	19.875	10.130	10.130
IK BENT F	527.705	19.875	10.237	10.237
A	537.705	19.875	10.510	10.519
B	547.705	19.875	10.843	10.959
C	547.705	19.875	10.237	10.251
D	567.705	19.875	10.400	10.496
E PIER I	581.705	19.875	10.777	10.777
F	591.705	19.875	10.934	10.949
G	601.705	19.875	20.051	20.087
H	611.705	19.875	20.129	20.178
I	621.705	19.875	20.166	20.217
J	631.705	19.875	20.163	20.200
K W. BRG. P2	645.777	19.875	20.081	20.081
L PIER 2	646.538	19.875	20.085	20.080
M E. BRG. P2	647.298	19.875	20.079	20.080
N	657.298	19.875	19.974	19.991
O	667.298	19.875	19.928	19.933
P L	667.298	19.875	19.974	19.991
Q BENT J	676.163	19.875	19.666	19.666
R BENT J	577.960	19.875	19.644	19.642

BEAM-4				TO STA.	
		FEEL, OR. SURF. IN.	SLABED	FEEL AND FIN.	
# 1985-080 R					
Location	Station	Offset	Theoretical Grade Elevations	Theoretical Grd Elevations Adjust For Dero Load Deflection	
BN. BENT F	526.050'	13.750	18.267	18.267	
E. BN. BENT F	528.529	13.750	18.365	18.365	
A	538.529	13.750	18.735	18.746	
B	548.529	13.750	19.085	19.080	
C	558.529	13.750	19.355	19.349	
D	568.529	13.750	19.605	19.611	
E PIER I	582.529	13.750	19.887	19.887	
E	592.529	13.750	20.081	20.056	
F	602.529	13.750	20.155	20.190	
G	612.529	13.750	20.229	20.278	
H	622.529	13.750	20.283	20.318	
I	632.529	13.750	20.257	20.298	
J	646.062	13.750	20.180	20.180	
E. W. B. RD.	667.362	13.750	20.128	20.178	
E. PIER 22	684.122	13.750	20.167	20.168	
E. W. B. RD.	688.122	13.750	20.180	20.076	
K	658.122	13.750	20.059	19.915	
L	668.122	13.750	19.810	19.745	
E. BENT J	676.987	13.750	19.785	19.725	
BN. BENT J	678.164	13.750	19.721	19.721	

BEAM -5				
Location	Station	Offset	Theoretical Grade Elevations	Theoretical Grade Elevations Adjusted For Dead Load Deflection
BK. BENT F	526.874	7.625	18.396	18.396
E. BKG. BENT F	529.354	7.625	18.493	18.493
A	535.354	7.625	18.859	18.868
B	544.354	7.625	19.186	19.201
C	555.354	7.625	19.473	19.488
D	569.354	7.625	19.719	19.726
E. PIER I	583.354	7.625	19.997	19.997
E	592.354	7.625	20.148	20.162
F	603.354	7.625	20.258	20.269
G	615.354	7.625	20.329	20.378
H	623.354	7.625	20.359	20.404
J	633.354	7.625	20.350	20.387
E. B. BKG. PZ	647.926	7.625	20.269	20.269
E. PIER 2	648.187	7.625	20.262	20.262
E. BKG. PZ	648.097	7.625	20.256	20.257
K	655.987	7.625	20.144	20.161
L	666.987	7.625	19.992	19.999
E. BENT J	677.987	7.625	19.824	19.824
BK. BENT J	678.989	7.625	19.799	19.799

BEAM - 6			
Location	Station	Offset	Theoretical Grade Elevations Adjusted For Dead Load Deflection
BK. BENT F	527.499	1.500	18.526
E. BENT F	536.178	1.500	18.620
A	540.178	1.500	18.683
B	550.178	1.500	19.307
C	560.178	1.500	19.509
D	570.178	1.500	19.833
E. PIER I	588.178	1.500	20.107
E	596.178	1.500	20.258
F	604.178	1.500	20.361
G	614.178	1.500	20.429
H	626.178	1.500	20.456
I	634.178	1.500	20.693
E. W. BRG. PZ	648.251	1.500	20.358
E. PIER J	660.011	1.500	20.358
E. E. BRG. PZ	649.771	1.500	20.351
K	659.771	1.500	20.345
L	669.771	1.500	20.228
E. BENT J	677.436	1.500	20.073
BK. BENT J	679.813	1.500	19.902
			18.877

Location	Station	Offset	Theoretical Grade Elevations	Theoretical Grade Elevations Adjusted For Dead Load Deflection
BK. BENT F	527.901	0.000	18.555	18.955
1. BK'S BENT F	530.380	0.000	18.651	19.051
A	580.389	0.000	19.014	19.414
B	550.380	0.000	19.336	19.732
C	560.380	0.000	18.619	18.933
D	570.380	0.000	19.081	19.481
2. PIER 1	584.380	0.000	20.136	20.136
E	594.380	0.000	20.280	20.295
F	604.380	0.000	20.387	20.422
G	614.380	0.000	20.453	20.502
H	624.380	0.000	20.479	20.530
I	634.380	0.000	20.466	20.503
3. BRG. P2	648.553	0.000	20.379	20.379
4. PIER 2	658.553	0.000	20.372	20.372
5. BRG. P2	668.573	0.000	20.365	20.365
K	658.573	0.000	20.249	20.247
L	668.573	0.000	20.093	20.098
6. BENT 1	678.838	0.000	19.932	19.932
BK. BENT 1	680.015	0.000	19.896	19.896

SHEET 5-6 OF 5-17

INC.

REVISIONS

Name	Date

STATE OF ILLINOIS
DEPARTMENT OF TRANSPORTATION

F&I ROUTE 90/94 (DAN RYAN EXPRESSWAY)

SECTION 18-5-C&D R. COOK COUNTY

HARRISON STREET OVER DAN RYAN EXPRESSWAY

TOP OF SLAB ELEVATIONS - I

Scale: None

Date: AUGUST 14, 1987

Drawn By: S.D.E.

Checked By:

ENGINEERING DESIGNERS INC.

CHICAGO, ILLINOIS

FOR INFORMATION ONLY

FEDERAL AND STATE NO.	SECTION	COUNTY	TOTAL SHEETS	SHEET NO.
90/94	8	COOK	79	49
STA.		TO STA.		
FILE NO. DIST. NO.	ILLINOIS	FILE AND PROJECT		
* 1985-080 R				

BEAM-7

Location	Station	Offset	Theoretical Grade Elevations	Theoretical Grade Elevations Adjusted For Dead Load Deflection
BK. BENT F	528.103	-1.500	18.540	18.540
E. BKG. BENT F	530.582	-1.500	18.636	18.636
A	540.582	-1.500	18.997	19.006
B	550.582	-1.500	19.319	19.334
C	560.582	-1.500	19.601	19.615
D	570.582	-1.500	19.842	19.849
E. PIER I	584.582	-1.500	20.113	20.113
E	594.582	-1.500	20.259	20.274
F	604.582	-1.500	20.365	20.400
G	614.582	-1.500	20.430	20.480
H	624.582	-1.500	20.456	20.507
J	634.582	-1.500	20.442	20.479
E. W. BRG. P2	648.655	-1.500	20.354	20.354
E. PIER 2	649.415	-1.500	20.347	20.347
E. E. BRG. P2	650.175	-1.500	20.340	20.341
K	660.175	-1.500	20.223	20.241
L	670.175	-1.500	20.066	20.081
E. BENT J	679.040	-1.500	19.894	19.894
BK. BENT J	680.217	-1.500	19.869	19.869

BEAM-8

Location	Station	Offset	Theoretical Grade Elevations	Theoretical Grade Elevations Adjusted For Dead Load Deflection
BK. BENT F	528.927	-7.625	18.476	18.476
E. BKG. BENT F	531.406	-7.625	18.571	18.571
A	541.406	-7.625	18.930	18.930
B	551.406	-7.625	19.248	19.263
C	561.406	-7.625	19.526	19.540
D	571.406	-7.625	19.765	19.771
E. PIER I	585.406	-7.625	20.031	20.031
E	595.406	-7.625	20.174	20.189
F	605.406	-7.625	20.276	20.311
G	615.406	-7.625	20.338	20.388
H	625.406	-7.625	20.361	20.412
J	635.406	-7.625	20.343	20.380
E. W. BRG. P2	649.479	-7.625	20.251	20.251
E. PIER 2	650.240	-7.625	20.243	20.243
E. E. BRG. P2	651.000	-7.625	20.236	20.237
K	661.000	-7.625	20.116	20.133
L	671.000	-7.625	19.954	19.971
E. BENT J	679.864	-7.625	19.789	19.781
BK. BENT J	681.042	-7.625	19.755	19.755

BEAM-9

Location	Station	Offset	Theoretical Grade Elevations	Theoretical Grade Elevations Adjusted For Dead Load Deflection
BK. BENT F	529.752	-13.750	18.412	18.412
E. BKG. BENT F	532.231	-13.750	18.507	18.507
A	542.231	-13.750	18.862	18.870
B	552.231	-13.750	19.177	19.192
C	562.231	-13.750	19.452	19.466
D	572.231	-13.750	19.693	19.697
E. PIER I	586.231	-13.750	19.949	19.949
E	596.231	-13.750	20.188	20.193
F	606.231	-13.750	20.187	20.222
G	616.231	-13.750	20.246	20.296
H	626.231	-13.750	20.265	20.316
J	636.231	-13.750	20.244	20.282
E. W. BRG. P2	650.304	-13.750	20.147	20.147
E. PIER 2	651.064	-13.750	20.140	20.140
E. E. BRG. P2	651.824	-13.750	20.132	20.133
K	661.824	-13.750	20.008	20.026
L	671.824	-13.750	19.885	19.885
E. BENT J	680.689	-13.750	19.667	19.667
BK. BENT J	681.866	-13.750	19.641	19.641

BEAM-10

Location	Station	Offset	Theoretical Grade Elevations	Theoretical Grade Elevations Adjusted For Dead Load Deflection
BK. BENT F	530.576	-19.875	18.348	18.348
E. BKG. BENT F	533.055	-19.875	18.442	18.442
A	543.055	-19.875	18.793	18.802
B	553.055	-19.875	19.105	19.121
C	563.055	-19.875	19.377	19.391
D	573.055	-19.875	19.609	19.619
E. PIER I	587.055	-19.875	19.866	19.866
E	597.055	-19.875	20.002	20.017
F	607.055	-19.875	20.098	20.133
G	617.055	-19.875	20.153	20.203
H	627.055	-19.875	20.169	20.220
J	637.055	-19.875	20.145	20.182
E. W. BRG. P2	651.128	-19.875	20.043	20.043
E. PIER 2	651.889	-19.875	20.035	20.035
E. E. BRG. P2	652.649	-19.875	20.027	20.029
K	662.649	-19.875	19.901	19.918
L	672.649	-19.875	19.734	19.749
E. BENT J	681.513	-19.875	19.553	19.553
BK. BENT J	682.694	-19.875	19.526	19.526

BEAM-11

Location	Station	Offset	Theoretical Grade Elevations	Theoretical Grade Elevations Adjusted For Dead Load Deflection
BK. BENT F	531.401	-26.000	18.284	18.284
E. BKG. BENT F	533.880	-26.000	18.377	18.377
A	543.880	-26.000	18.725	18.734
B	553.880	-26.000	19.033	19.049
C	563.880	-26.000	19.302	19.316
D	573.880	-26.000	19.530	19.532
E. PIER I	587.880	-26.000	19.783	19.783
E	597.880	-26.000	19.916	19.931
F	607.880	-26.000	20.008	20.044
G	617.880	-26.000	20.061	20.110
H	627.880	-26.000	20.073	20.124
J	637.880	-26.000	20.046	20.083
E. W. BRG. P2	651.953	-26.000	19.939	19.939
E. PIER 2	652.713	-26.000	19.931	19.931
E. E. BRG. P2	653.473	-26.000	19.923	19.924
K	663.473	-26.000	19.793	19.811
L	673.473	-26.000	19.623	19.638
E. BENT J	682.338	-26.000	19.439	19.439
BK. BENT J	683.515	-26.000	19.412	19.412

BEAM-12

Location	Station	Offset	Theoretical Grade Elevations	Theoretical Grade Elevations Adjusted For Dead Load Deflection
BK. BENT F	532.225	-32.125	18.219	18.219
E. BKG. BENT F	534.704	-32.125	18.311	18.311
A	544.704	-32.125	18.656	18.665
B	554.704	-32.125	18.961	18.977
C	564.704	-32.125	19.227	19.241
D	574.704	-32.125	19.452	19.454
E. PIER I	588.704	-32.125	19.700	19.700
E	598.704	-32.125	19.829	19.844
F	608.704	-32.125	19.910	19.954
G	618.704	-32.125	19.947	20.017
H	628.704	-32.125	19.977	20.027
J	638.704	-32.125	19.946	19.983
E. W. BRG. P2	652.777	-32.125	19.835	19.835
E. PIER 2	653.538	-32.125	19.826	19.826
E. E. BRG. P2	654.298	-32.125	19.818	19.819
K	664.298	-32.125	19.685	19.702
L	674.298	-32.125	19.512	19.527
E. BENT J	683.162	-32.125	19.325	19.325
BK. BENT J	684.344	-32.125	19.297	19.297

SHEET 5-7 OF 5-17

STATE OF ILLINOIS DEPARTMENT OF TRANSPORTATION F.A.I. ROUTE 90/94 (DAN RYAN EXPRESSWAY) SECTION 1985-080 R - COOK COUNTY HARRISON STREET OVER DAN RYAN EXPRESSWAY TOP OF SLAB ELEVATIONS - II	
Scale: None Date: AUGUST 14, 1987	Drawn By: S.D.D. Checked By:
ENVIRONMENTAL ENGINEERS INC. Chicago, Illinois	

REVISIONS

Name	Date

PLANS PREPARED BY
P.O. ENGINEERS ASSOCIATES, INC.
600 WEST JACKSON BLVD.
CHICAGO ILLINOIS, 60601

USER NAME = dunkerleyb	DESIGNED -	REVISED
	CHECKED -	REVISED
PLOT SCALE = N.T.S.	DRAWN -	REVISED
PLOT DATE = 11/26/2013	CHECKED -	REVISED


STATE OF ILLINOIS
DEPARTMENT OF TRANSPORTATION

EXISTING AS-BUILTS SN 016-1088


SHEET NO. AS-10 OF AS-72 SHEETS

F.A.I. RTE.	SECTION	COUNTY	TOTAL SHEETS	SHEET NO.
90/94/290	2013-036R	COOK	256	152
CONTRACT NO. 60W71				
ILLINOIS FED. AID PROJECT -NUMBER-				

FOR INFORMATION ONLY

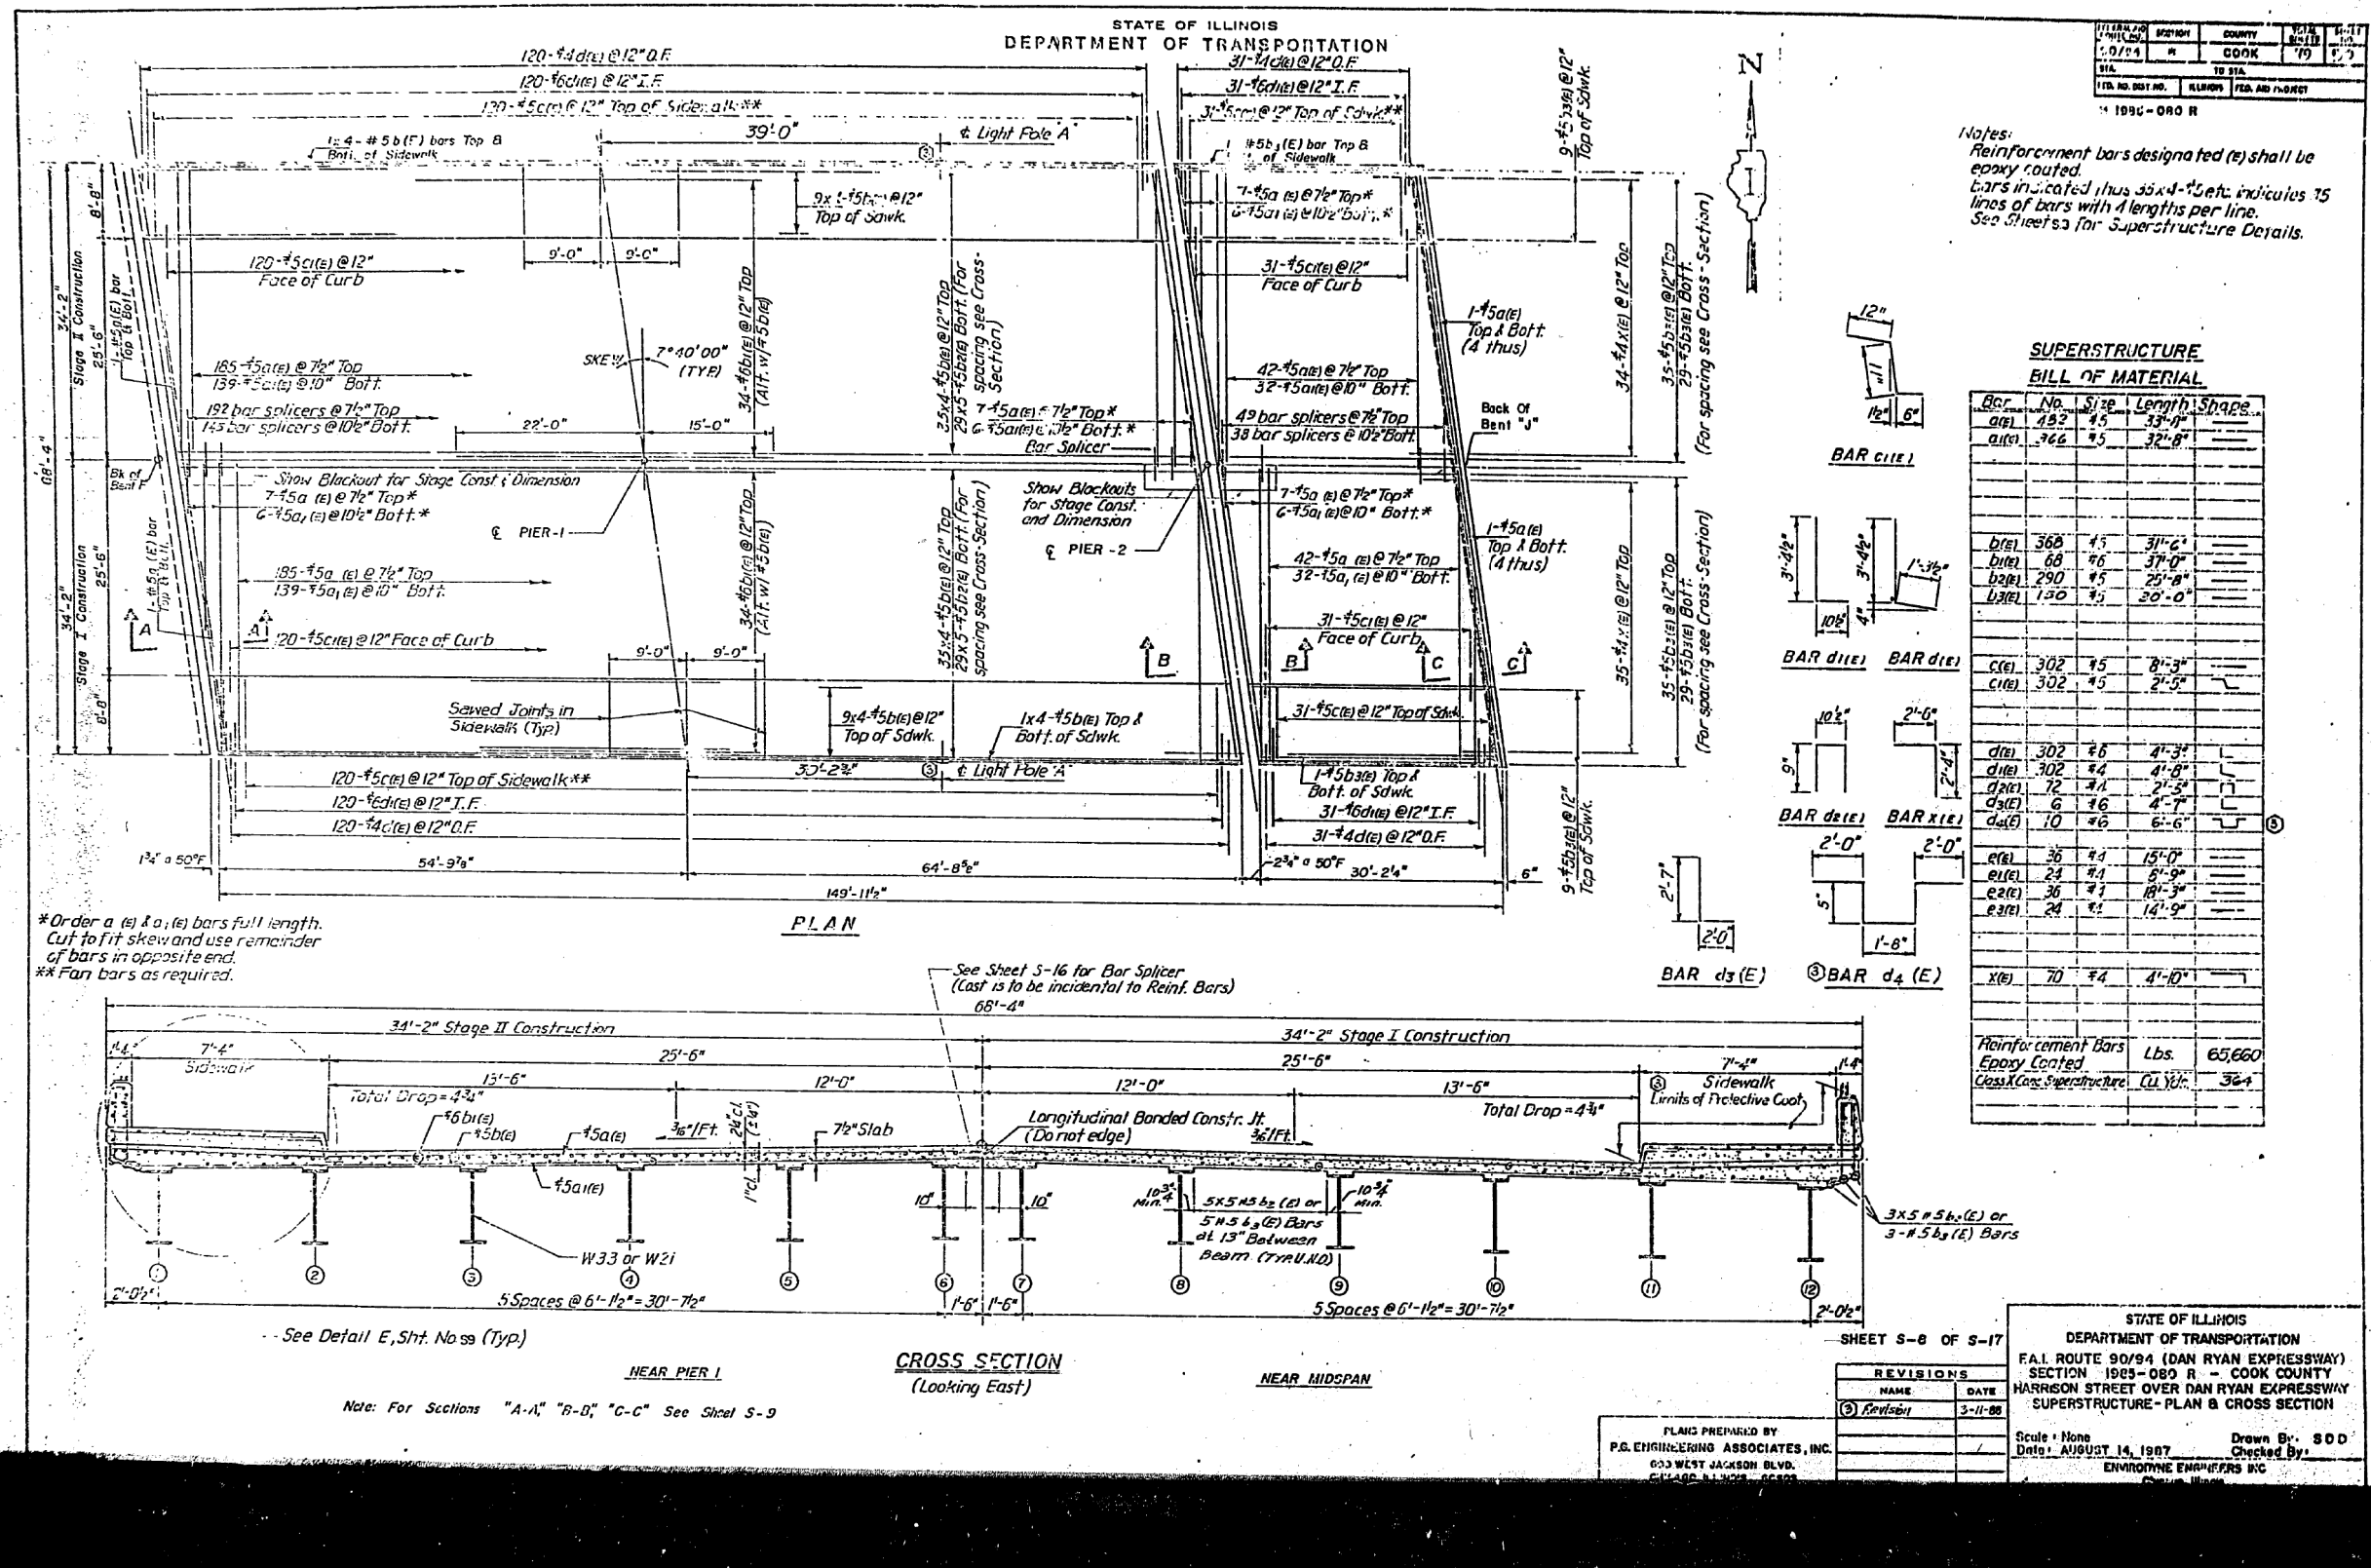

FOR INFORMATION ONLY

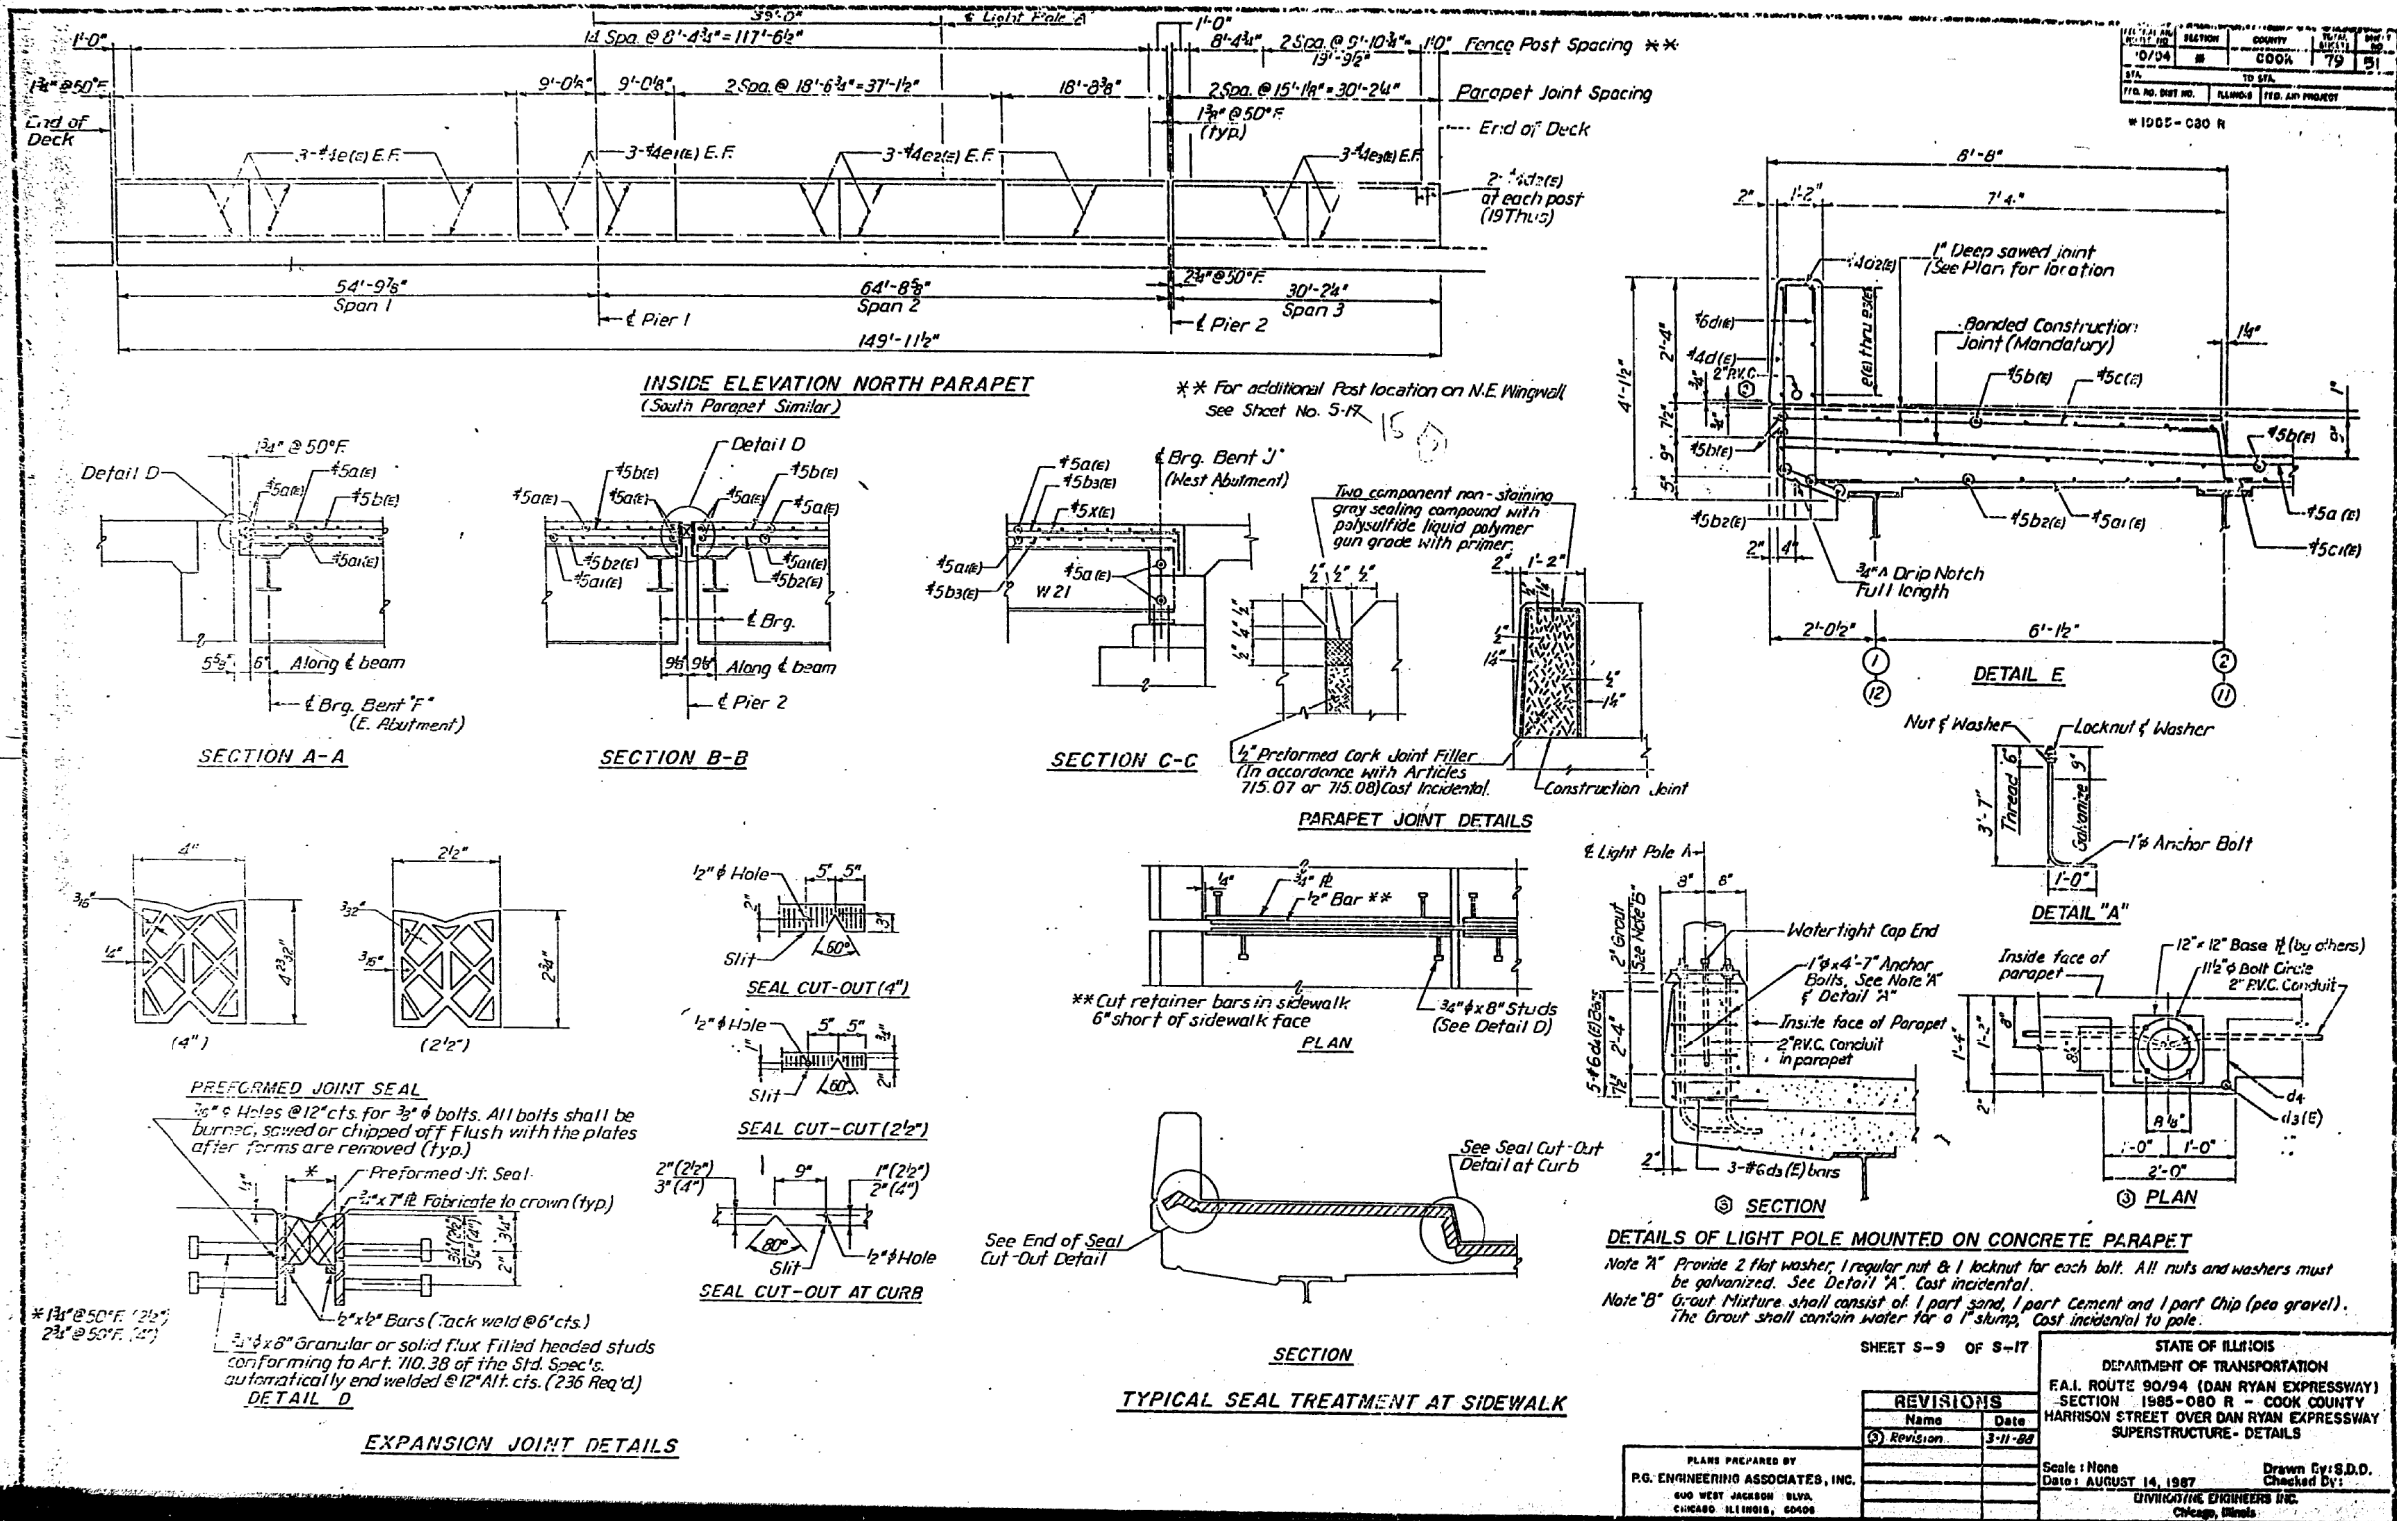

USER NAME = dunkerleyb	DESIGNED -	REVISED -
PLOT SCALE = N.T.S.	CHECKED -	REVISED -
PLOT DATE = 11/26/2013	DRAWN -	REVISED -
	CHECKED -	REVISED -

STATE OF ILLINOIS
DEPARTMENT OF TRANSPORTATION


EXISTING AS-BUILTS SN 016-1088

SHEET NO. AS-12 OF AS-72 SHEETS

F.A.I. RTE. 90/94/290	SECTION 2013-036R	COUNTY COOK	TOTAL SHEETS 256	SHEET NO. 154
CONTRACT NO. 60W71				ILLINOIS FED. AID PROJECT -NUMBER-

STATE OF ILLINOIS
DEPARTMENT OF TRANSPORTATION

FILE NO. AND SECTION NO.	SECTION	COUNTY	TOTAL SHEET(S)	NO. OF PAGES
90/94	#	COOK	79	52
STA.		TO STA.		
FED. RD. DIST. NO.	ILLINOIS	FED. AID PROJECT		

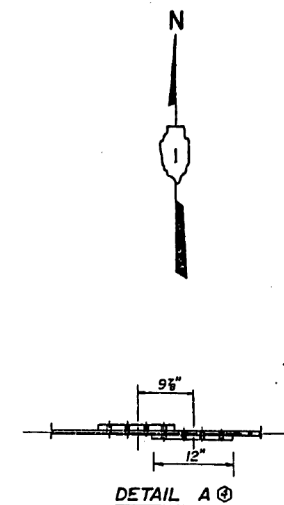

	0.4 SPAN 1	PIER 1	0.6 SPAN 2	0.5 SPAN 2
I_s (in. 4)	5,900	5,900	5,900	1530
I_c (in. 4)	15,668	-	15,668	4474
S_c (in. 3)	359	359	359	127
S_o (in. 3)	528	-	528	208
Z (in. 3)	-	-	-	-
ϕ (K /)	0.71	1.25	0.71	0.66
M/E (K /)	123	556	225	68
s/E (K /)	0.54	-	0.94	0.54
M_s/E (K /)	93	-	169	58
M_c/E (K /)	317	273	385	166
M_{imp}/E (K /)	89	74	102	50
$s_2(M/E \cdot I)$ (K /)	676	578	812	360
M_o (K /)	1160	434	1,568	629
M_u (K /)	-	-	-	-
f_s/E non-comp (k.s.i.)	4.11	18.58	7.52	6.43
f_s/E (comp) (k.s.i.)	2.11	-	3.65	3.23
$f_s/P_s(k \cdot l)$ (k.s.i.)	15.37	19.33	18.45	20.77
$f_s/Overload(k \cdot l)$ (k.s.i.)	21.59	37.91	29.62	30.43
$f_s/Tot(k \cdot l)$ (k.s.i.)	28.07	49.28	38.77	39.56
VR (K)	40.9	-	41.5	36.0

	BENT F	PIER 1	PIER 2 (SPAN 2)	PIER 2 (SPAN 3)	BENT
R ₀ (K)	23.5	92.7	31.4	17.2	172
R ₁ (K)	35.8	44.2	36.9	27.1	27.1
Imp. (K)	10.0	12.0	9.8	8.1	8.1
R _{total} (K)	69.3	148.9	18.1	32.4	52.4

I and S_x are the moment of inertia and section modulus of the steel section used in computing f_s (Total and Overload).
 I_c and S_{xc} are the moment of inertia and section modulus of the composite section used in computing f_s (Total and Overload).
 V is the maximum V_u imposed shear range in span.
 Z is the plastic section modulus used to determine the Fully Plastic Moments in non-composite areas.
The Fully Plastic Moment capacity (M_u) is computed according to AASHTO 10.48.1 & 10.50.1.1, f_s (Total is the sum of stresses due to $1.3 [M_{DL} + M_{SD} + 0.5 (M_{LL} + I)]$ & f_s (Overload) is the sum of the stresses due to $M_{DL} + M_{SD} + 0.75 (M_{LL} + I)$.
 M_{DL} - Moment due to dead loads on non-composite section.
 M_{SD} - Moment due to dead loads on composite section.
 I_{LL} - Moment due to live load on non-composite or composite section.
 I - Live load impact.
 $M_u = 1.3 [M_{DL} + M_{SD} + 0.5 (M_{LL} + I)]$
 M_u Values given in Reaction Table are based upon Service Loads.

TOP OF BEAM ELEVATIONS (For Fabrication Only)

Location	£ Brg.	£-Splice	£-Pie #1	£ Brg.	£ Brg.	£ Brg.
Beam No.	Cent. F.			Span # 2	Span # 3	Cent. J.
1	17.313	18.439	18.602	19.245	19.234	18.840
2	17.442	18.556	18.714	19.335	19.323	18.920
3	17.570	18.671	18.823	19.424	19.412	18.999
4	17.698	18.787	18.934	19.513	19.500	19.078
5	17.826	18.902	19.044	19.602	19.587	19.157
6	17.953	19.017	19.153	19.691	19.677	19.235
7	17.969	19.027	19.160	19.687	19.673	19.227
8	17.904	18.950	19.078	19.584	19.569	19.114
9	17.840	18.872	18.995	19.480	19.465	19.000
10	17.775	18.795	18.913	19.376	19.360	18.886
11	17.710	18.718	18.830	19.272	19.256	18.772
12	17.644	18.640	18.747	19.168	19.151	18.658

SHEAR STUDS
(Spans 1 & 2)

SHEAR STUDS
(Spec. 3)

SHEET S-10 OF S-17

STATE OF ILLINOIS
DEPARTMENT OF TRANSPORTATION
F.A.I. ROUTE 90/94 (DAN RYAN EXPRESSWAY)
SECTION 1985-080 R - COOK COUNTY
HARRISON STREET OVER DAN RYAN EXPRESSWAY
STRUCTURAL STEEL FRAMING PLAN

Scale: None
Date: AUGUST 14, 1987
Drawn By: S.D.D.
Checked By:
ENVIRODYNE ENGINEERS INC
Chicago, Illinois


PLANS PREPARED BY
P.G. ENGINEERING ASSOCIATES, INC.
900 WEST JACKSON BLVD.
CHICAGO 11, ILL. 60604

REVISIONS	
NAME	
① <i>Revisions</i>	4


Scale: None
Date: AUGUST 14, 1987
Drawn By: S.D.D.
Checked By:
ENVIRODYNE ENGINEERS INC
Chicago, Illinois

NOTE: Diaphragm D1, D3; D5 & D7 Shall be installed During Stage II Construction
All structural steel shall be M183 unless noted

FRAMING PLAN

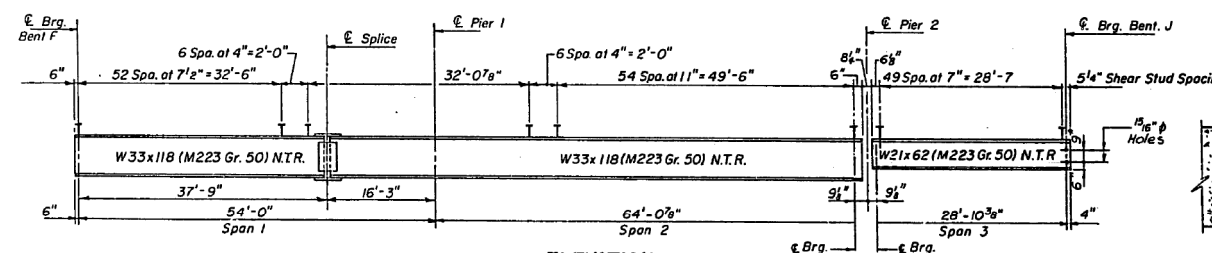ELEVATION

N.T.R. Indicates Notch Toughness Requirement

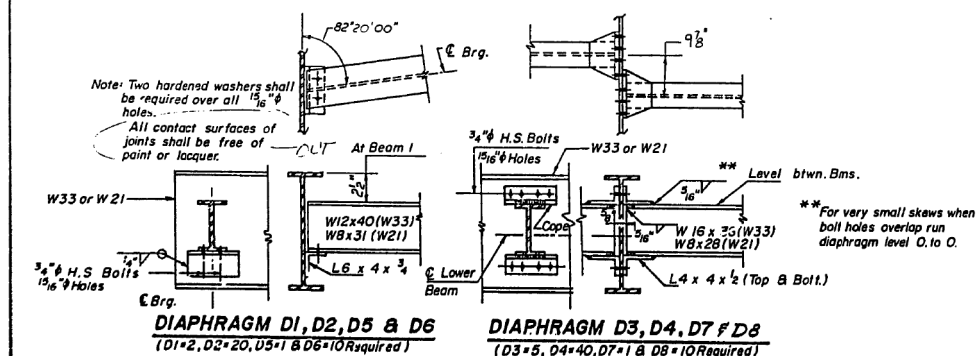

DIAPHRAGM D1, D2, D5 & D6
(D1=2, D2=20, D5=1 & D6=10 Required)

DIAPHRAGM D3, D4, D7 & D8
(D3=5, D4=40, D7=1 & D8=10 Required)

DETAIL OF SPLICE

Flange Splice Plate
 $\frac{1}{2}$ " x $1\frac{1}{2}$ " x $5'-0"$
 (M223) N.T.R.

$7/8$ " ϕ H.S. Bolts

$1\frac{1}{2}$ "

$1\frac{1}{2}$ " max.

9 sp. $\frac{3}{4}$ " 9 sp. $\frac{3}{4}$ "

at $3'$ cts. at $3'$ cts.

$3/4$ " ϕ H.S. Bolts

W33

Web Splice Plate
 $3/8$ " x $1'-6"$ x $2'-5"$
 (M223) N.T.R.

$3/4$ " ϕ S.I. Bars

0160W71-sht-AS-BUILT-13.dgn

USER NAME = dunkerleyb	DESIGNED -	REVISED
	CHECKED -	REVISED
PLOT SCALE = N.T.S.	DRAWN -	REVISED
PLOT DATE = 11/26/2013	CHECKED -	REVISED


STATE OF ILLINOIS
DEPARTMENT OF TRANSPORTATION

EXISTING AS-BUILTS SN 016-1088

SHEET NO. AS-13 OF AS-72 SHEETS

F.A.I. RTE.	SECTION	COUNTY	TOTAL SHEETS	SHEET NO.
90/94/290	2013-036R	COOK	256	155
		CONTRACT NO. 60W71		
ILLINOIS FED. AID PROJECT		-NUMBER-		

FOR INFORMATION ONLY

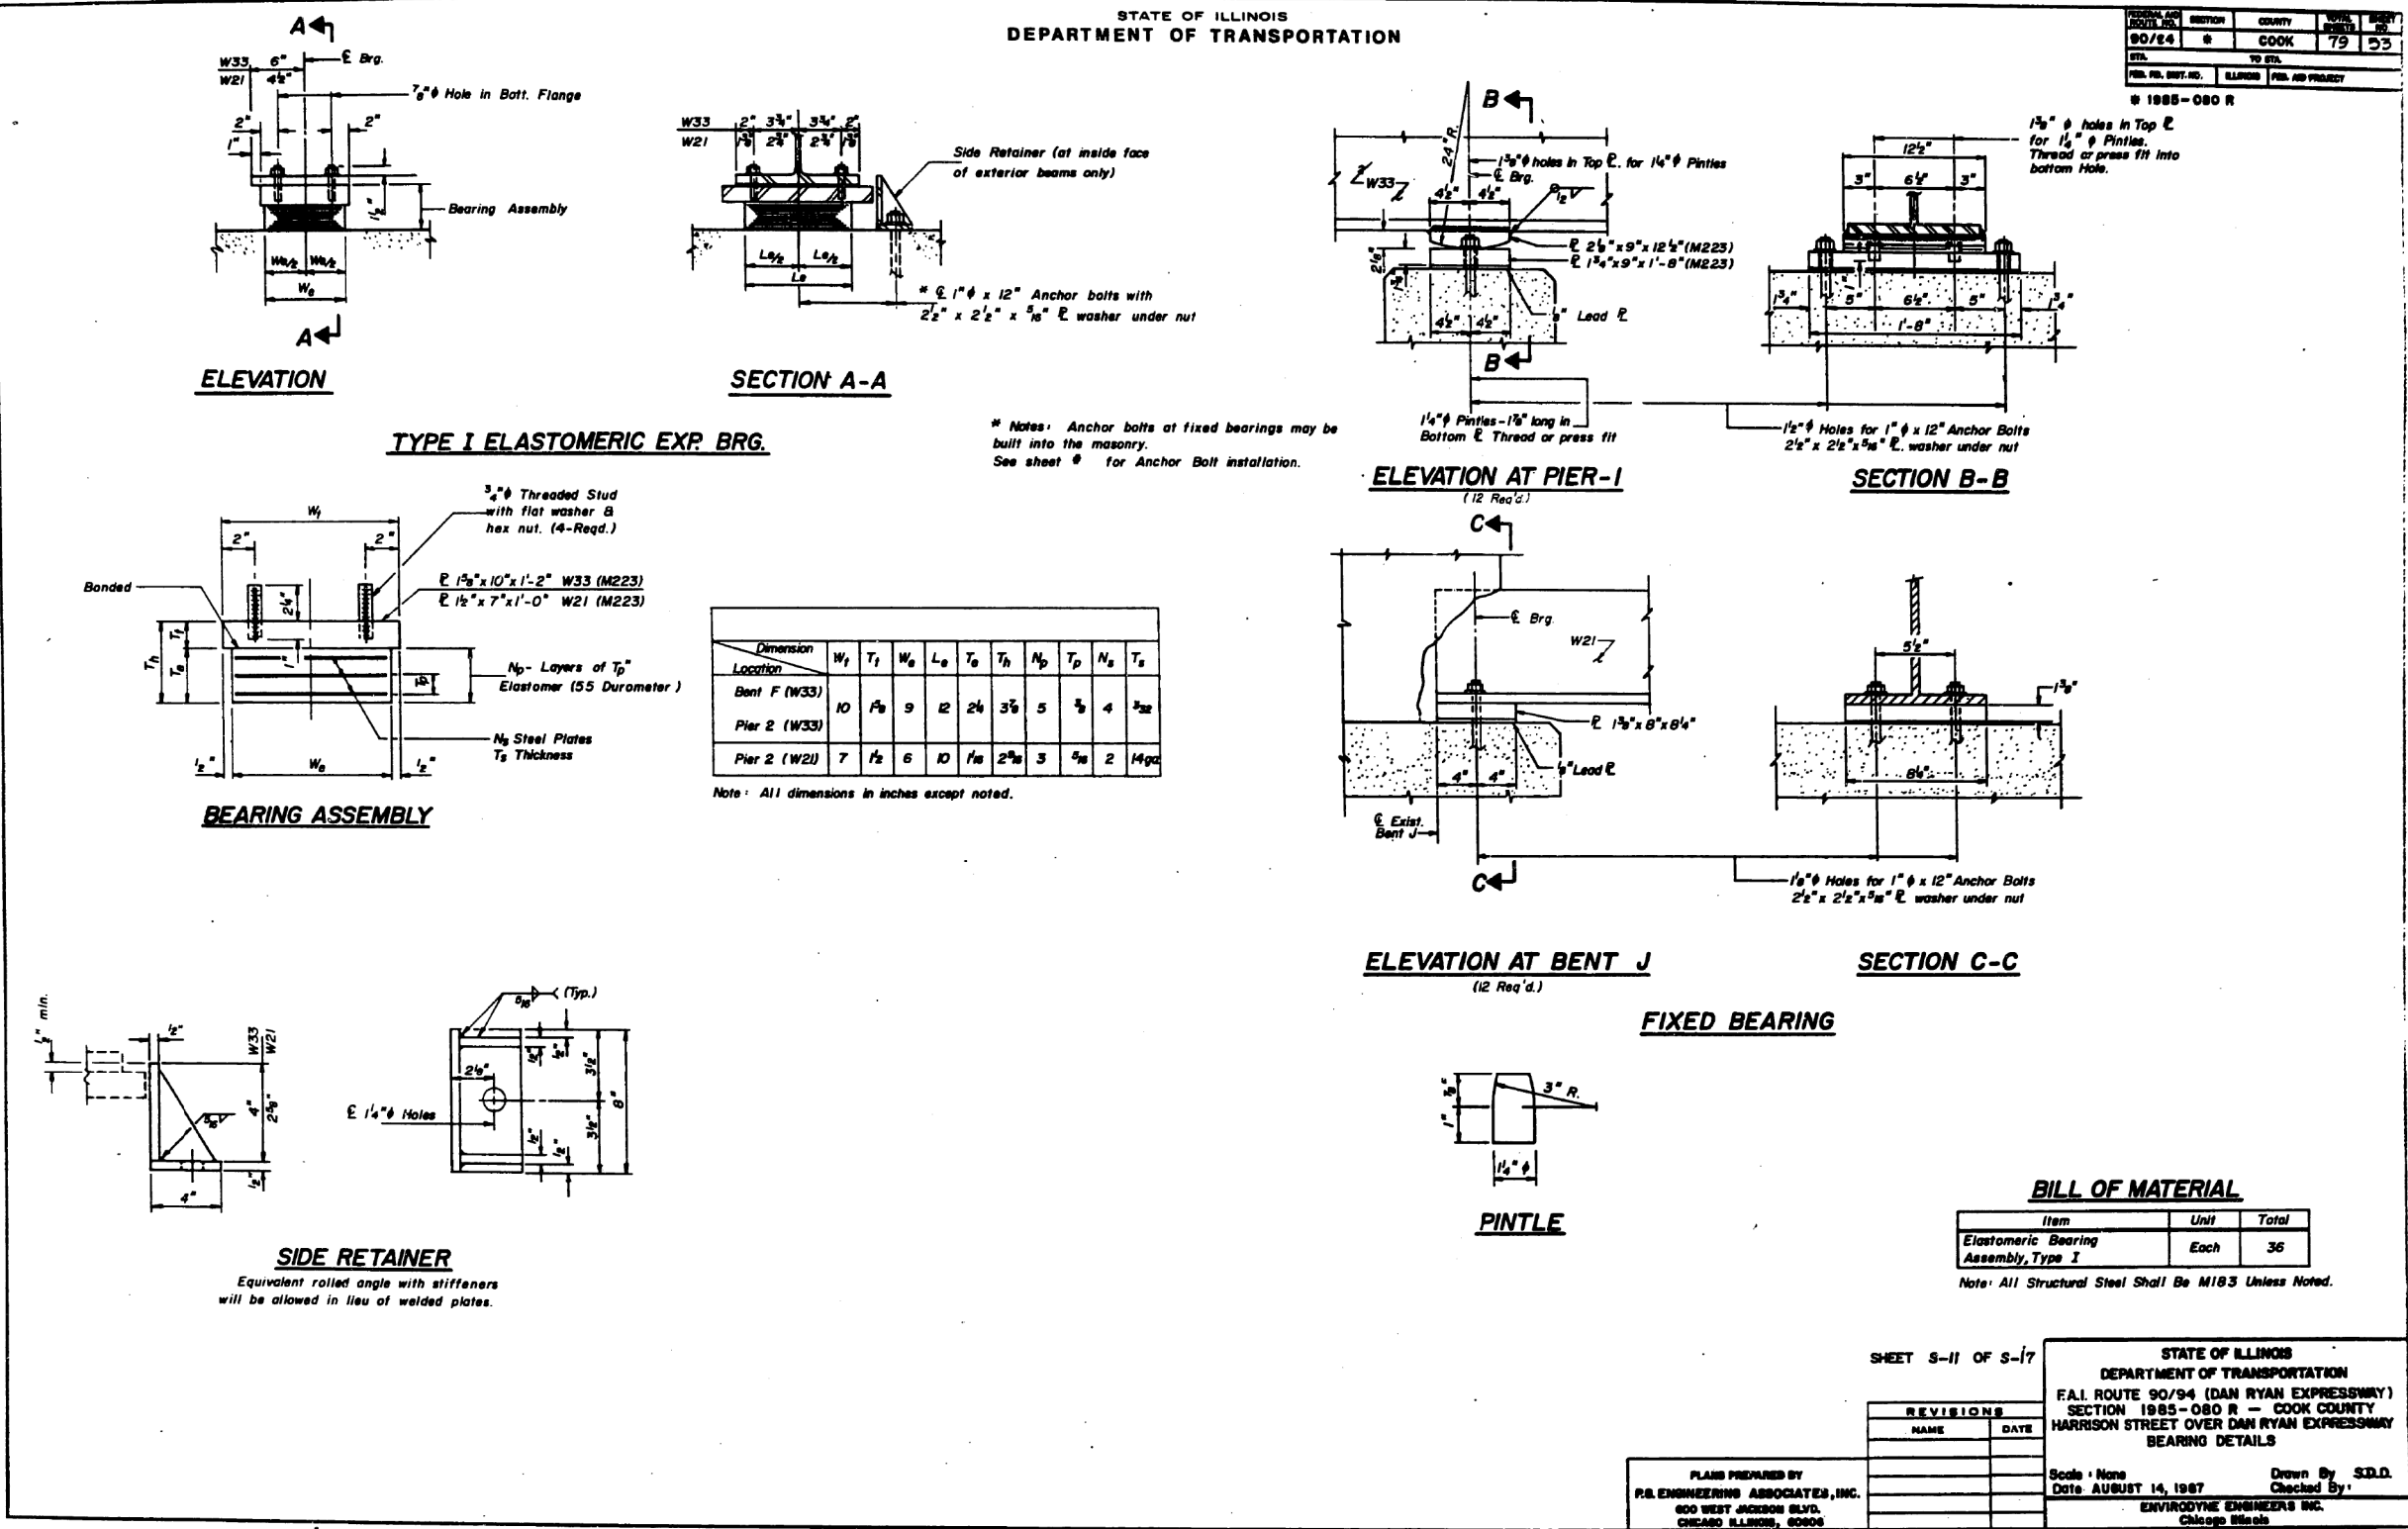

USER NAME = dunkerleyb	DESIGNED -	REVISED
PLOT SCALE = N.T.S.	CHECKED -	REVISED
PLOT DATE = 11/26/2013	DRAWN -	REVISED
	CHECKED -	REVISED


STATE OF ILLINOIS
DEPARTMENT OF TRANSPORTATION

EXISTING AS-BUILTS SN 016-1088

SHEET NO. AS-14 OF AS-72 SHEETS

F.A.I. RTE.	SECTION	COUNTY	TOTAL SHEETS	SHEET NO.
90/94/290	2013-036R	COOK	256	156
CONTRACT NO. 60W71				
ILLINOIS FED. AID PROJECT -NUMBER-				

FOR INFORMATION ONLY

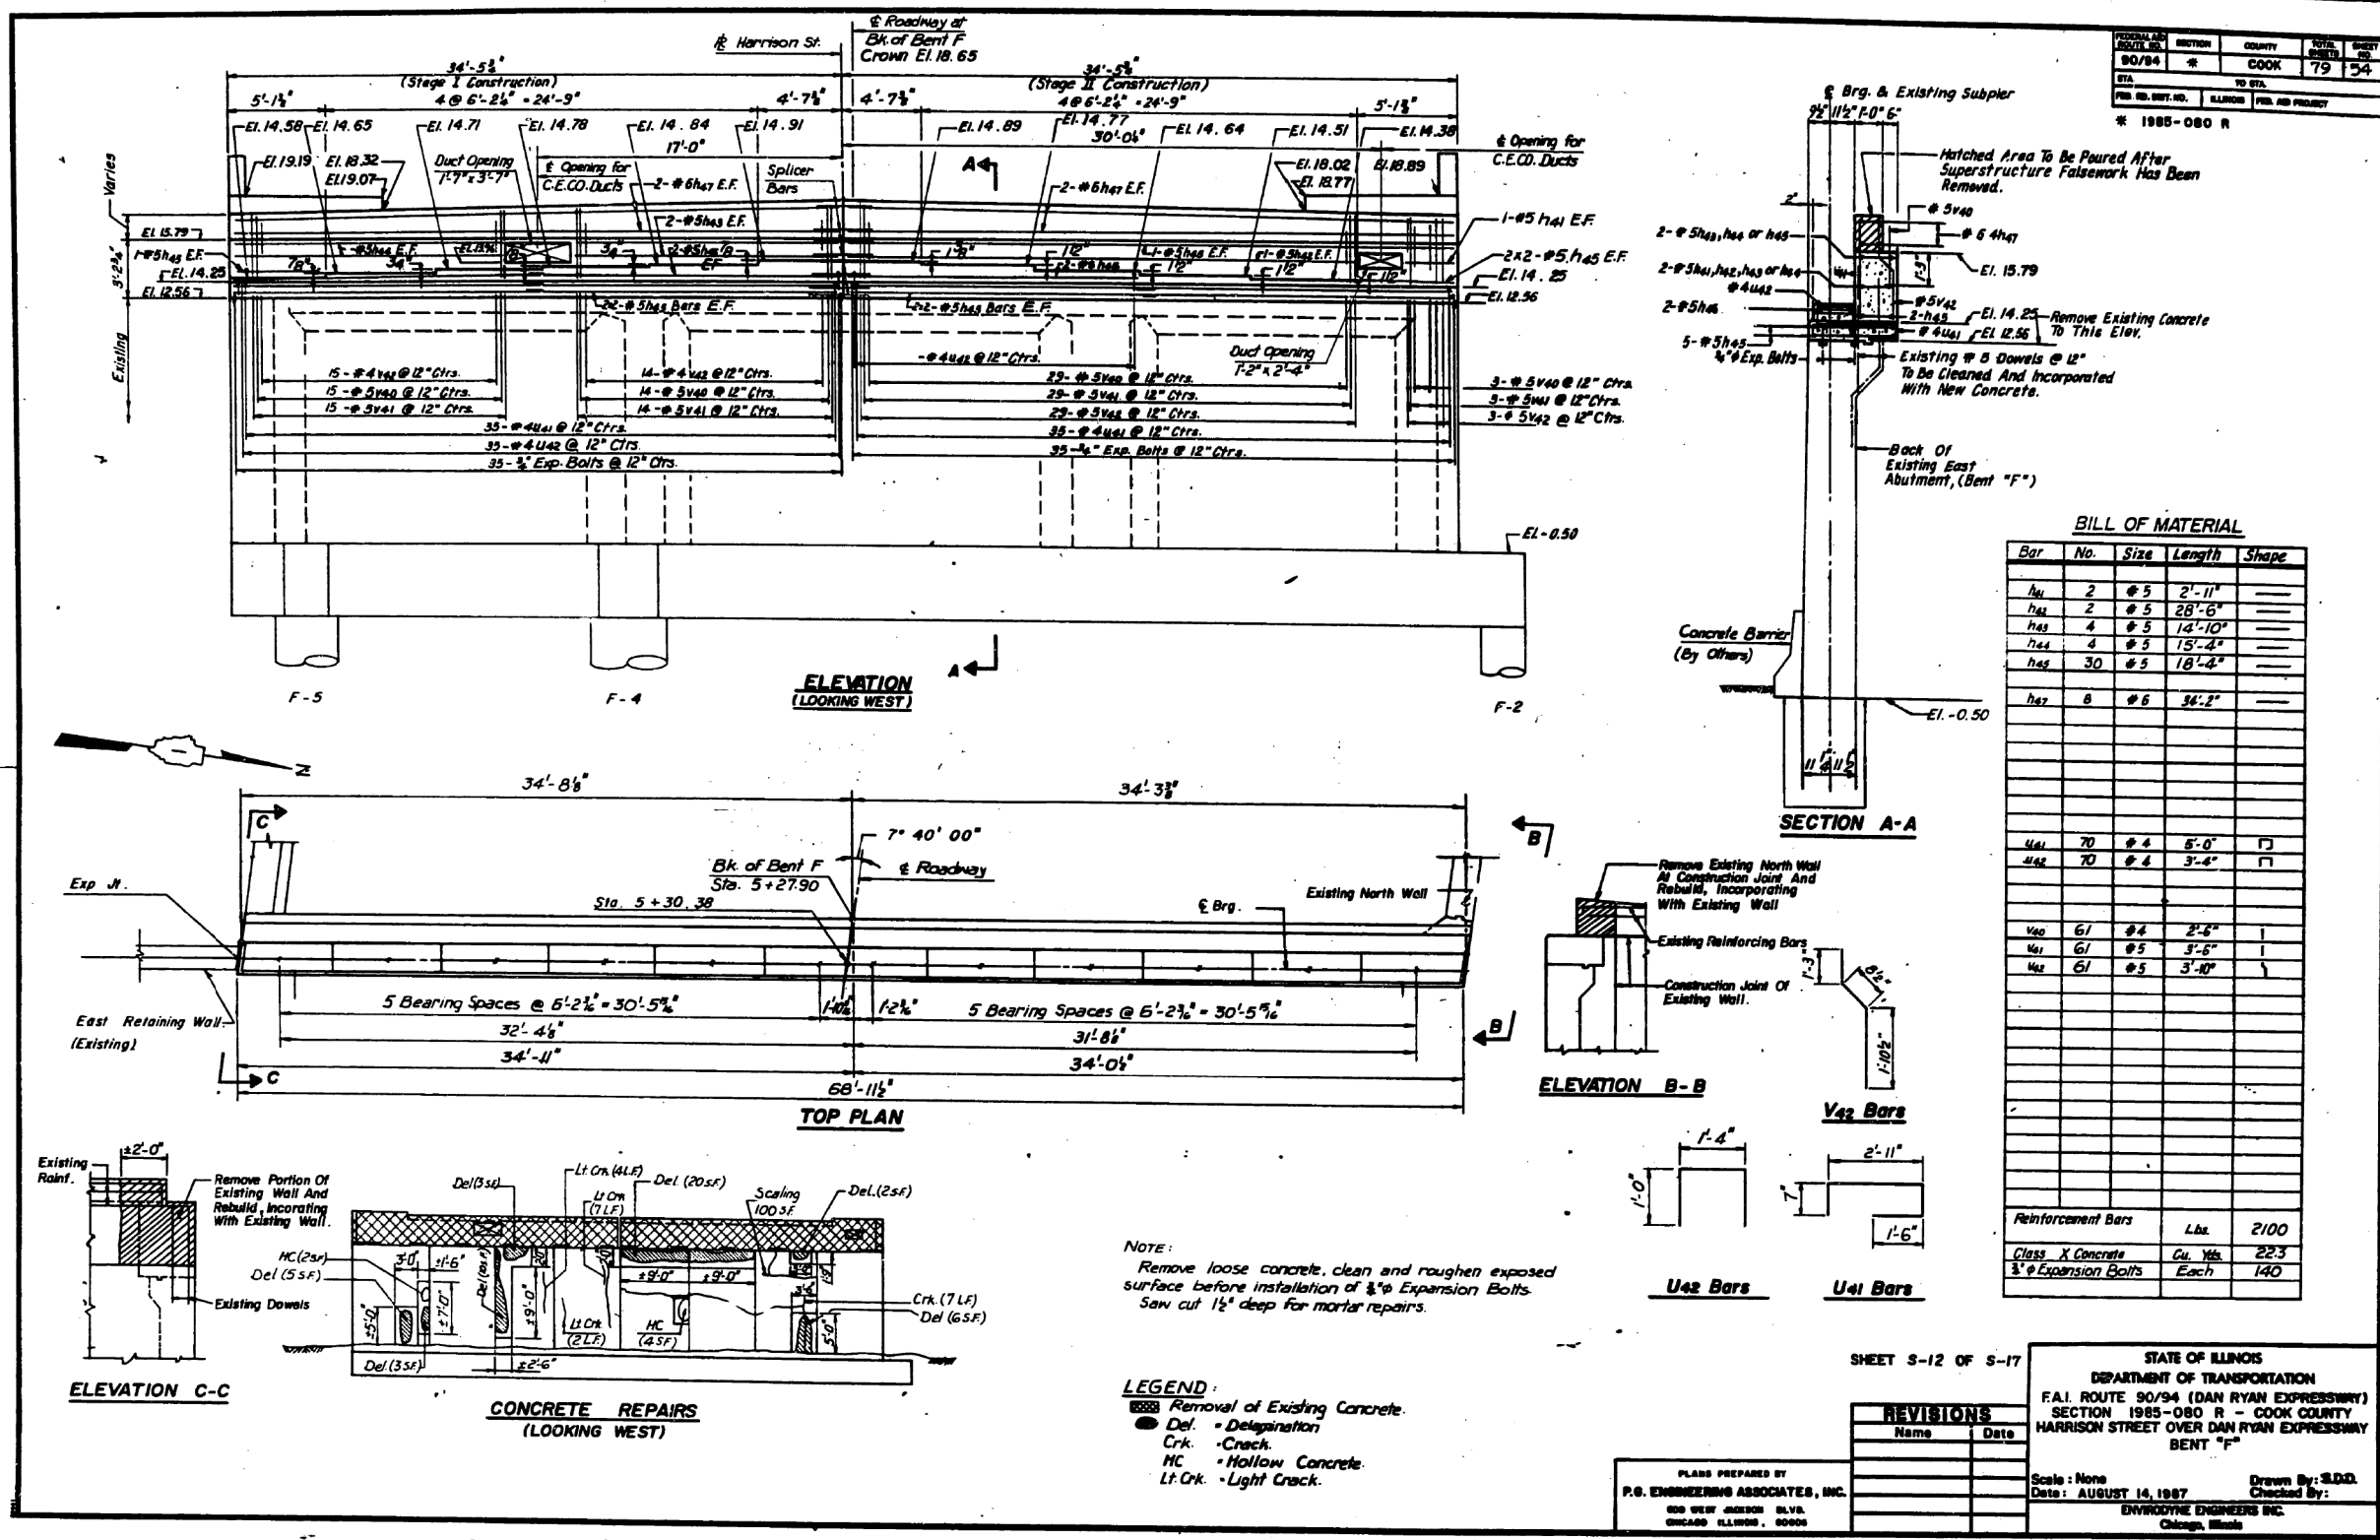

USER NAME = dunkerleyb	DESIGNED -	REVISED
	CHECKED -	REVISED
PLOT SCALE = N.T.S.	DRAWN -	REVISED
PLOT DATE = 11/26/2013	CHECKED -	REVISED

STATE OF ILLINOIS
DEPARTMENT OF TRANSPORTATION

EXISTING AS-BUILTS SN 016-1088

SHEET NO. AS-15 OF AS-72 SHEETS

F.A.I. RTE. 90/94/290	SECTION 2013-036R	COUNTY COOK	TOTAL SHEETS 256	SHEET NO. 157
ILLINOIS FED. AID PROJECT -NUMBER-				CONTRACT NO. 60W71

**STATE OF ILLINOIS
DEPARTMENT OF TRANSPORTATION**



F.A.I. RTE.	SECTION	COUNTY	TOTAL SHEETS	SHEET NO.
90/94/290	2013-036R	COOK	256	158
		CONTRACT NO. 60W71		
ILLINOIS		FED. AID PROJECT -NUMBER-		

REVISIONS	
Name	Date

STATE OF ILLINOIS
DEPARTMENT OF TRANSPORTATION
F.A.I. ROUTE 90/94 (DAN RYAN EXPRESSWAY)
SECTION 1985-080 R - COOK COUNTY
HARRISON STREET OVER DAN RYAN EXPRESSWAY
PIER 1

Scale: None
Date: AUGUST 14, 1987

Drawn By: S.J.D.
Checked By:

ENVIRONMENTAL ENGINEERS INC.
Chicago, Illinois

PLANS PREPARED BY
P.G. ENGINEERING ASSOCIATES, INC.
800 WEST JACKSON BLVD.
CHICAGO ILLINOIS, 60606

SHEET S-13 OF S-17

Scale : None
Date : AUGUST 14, 1967
Drawn By: S.D.D.
Checked By:


ENVIRODYNE ENGINEERS INC.
Chicago, Illinois

SHEET NO. AS-16 OF AS-72 SHEETS

ILLINOIS		FED. AID PROJECT	-NUMBER-
----------	--	------------------	----------

0160W71-sh+AS-BUILT-16.dgn

FOR INFORMATION ONLY

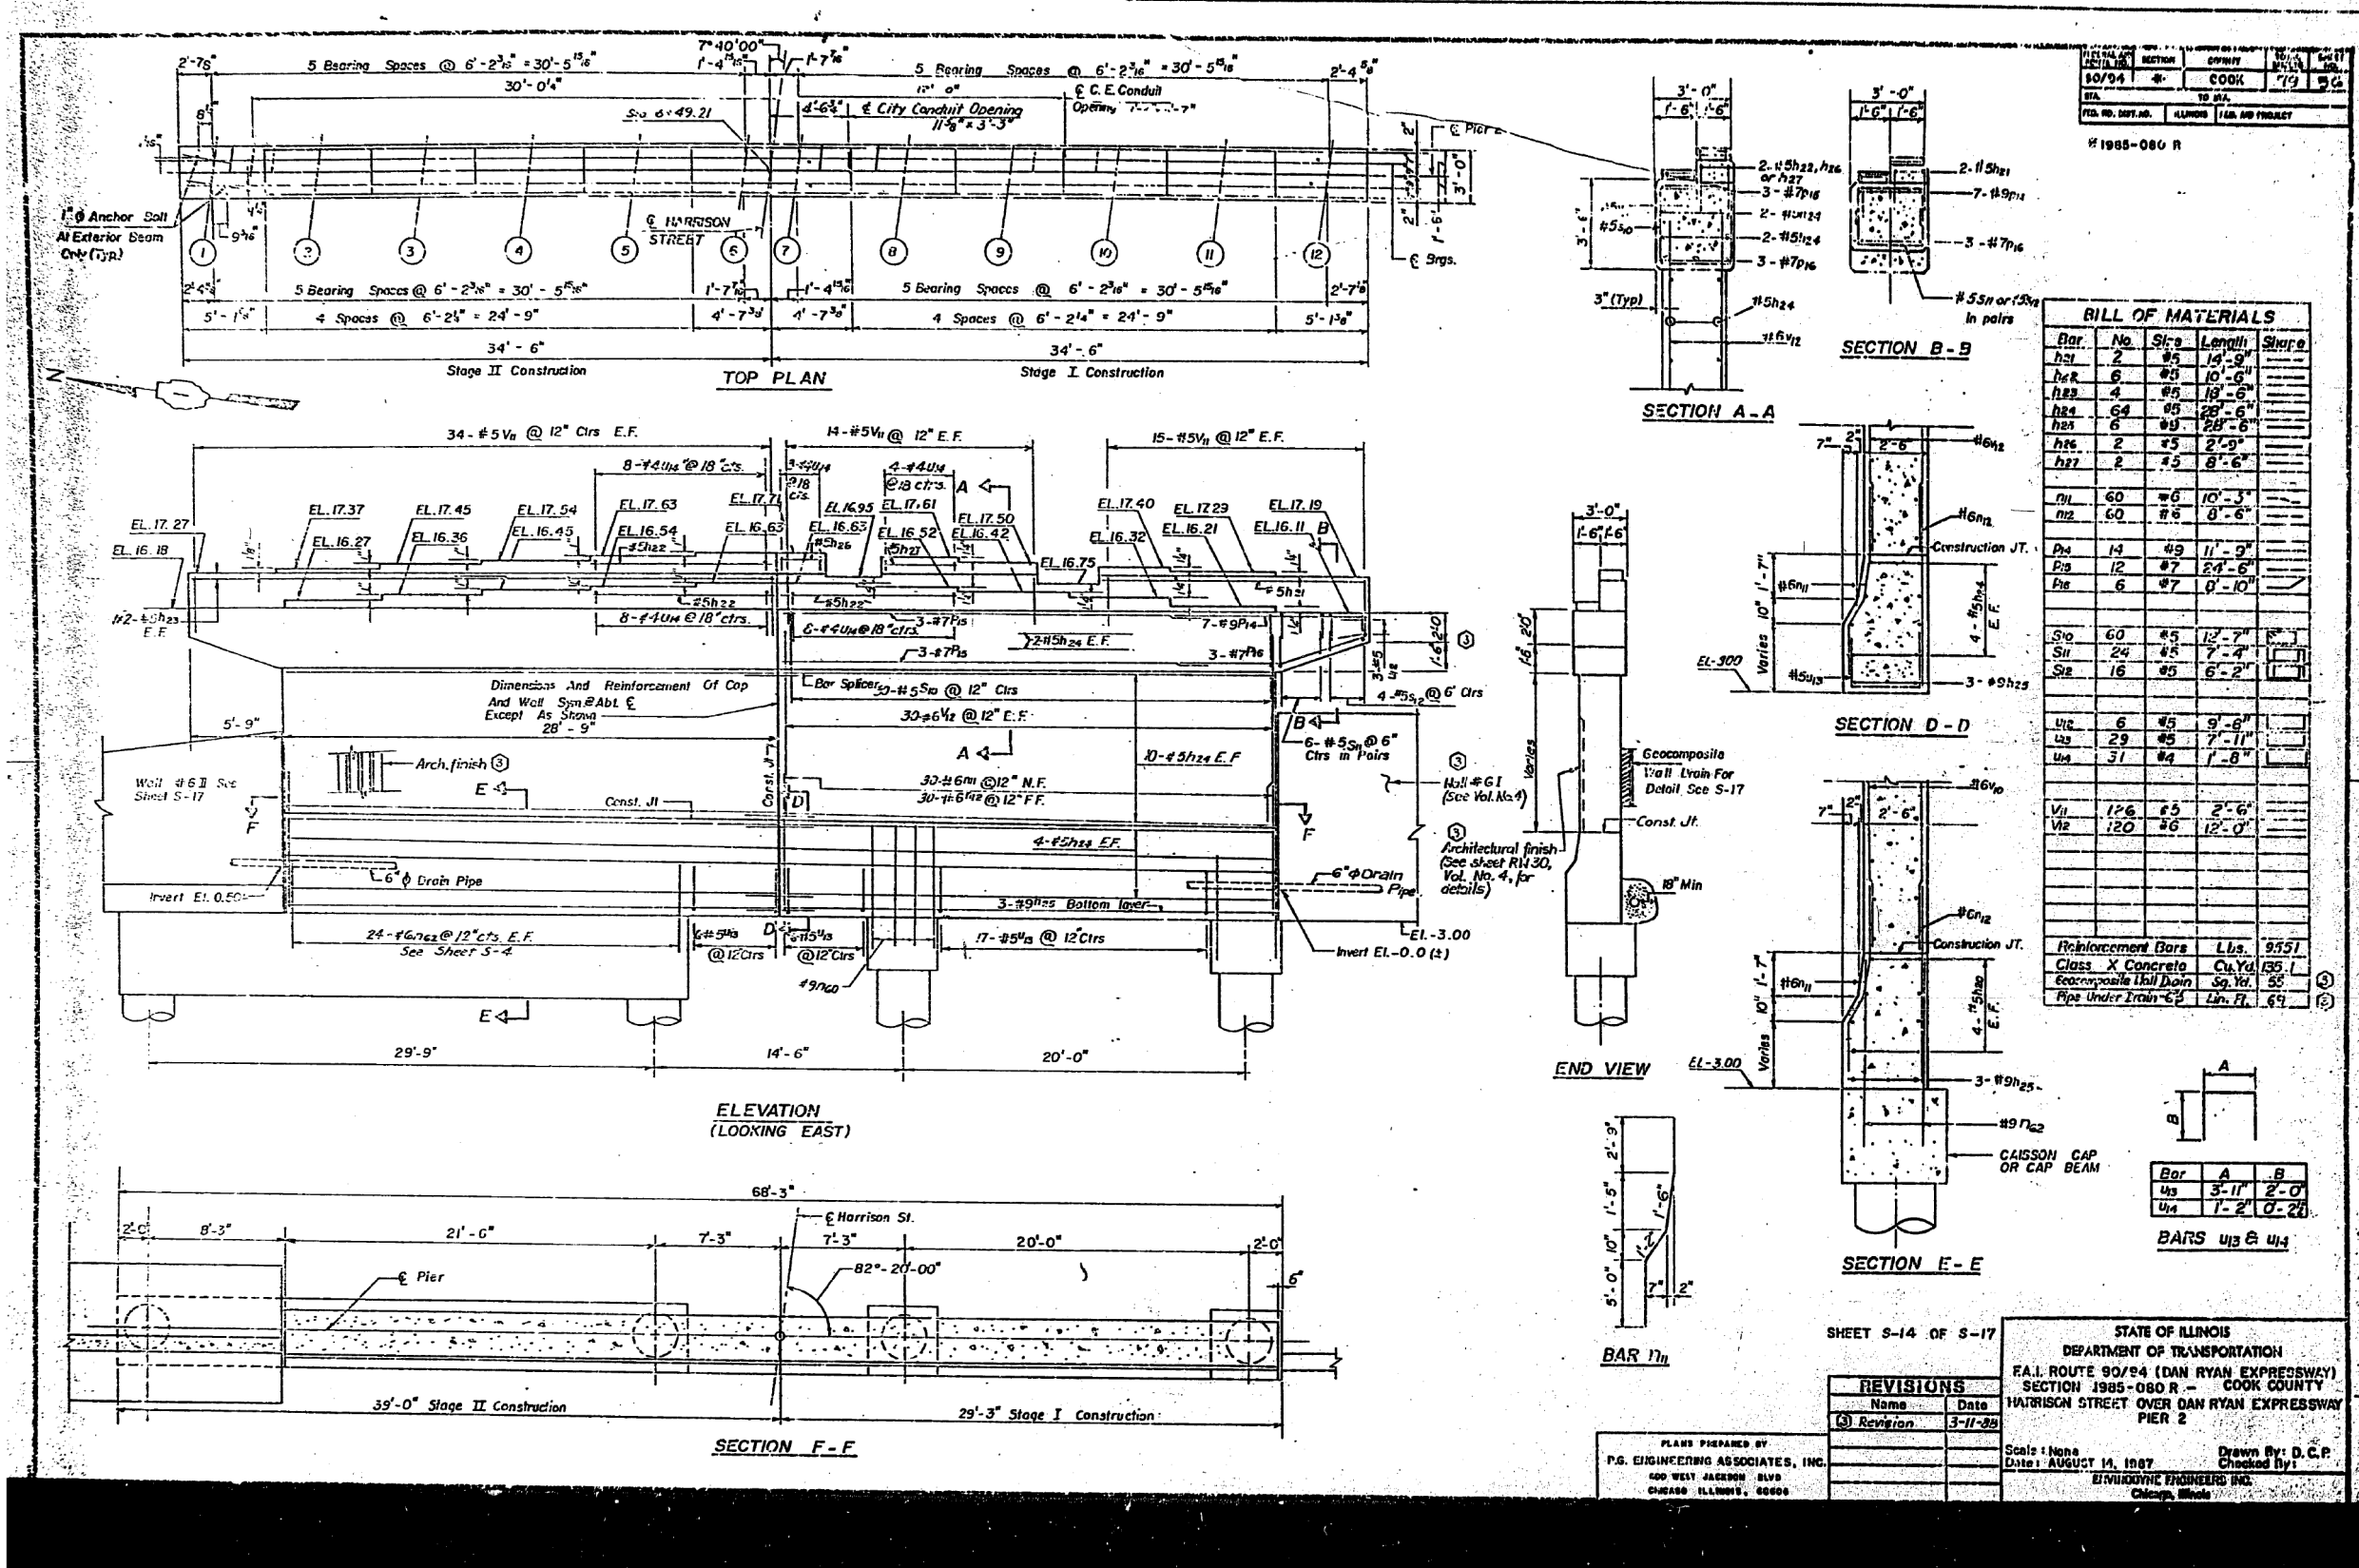

USER NAME = dunkerleyb	DESIGNED -	REVISED
	CHECKED -	REVISED
PLOT SCALE = N.T.S.	DRAWN -	REVISED
PLOT DATE = 11/26/2013	CHECKED -	REVISED


STATE OF ILLINOIS
DEPARTMENT OF TRANSPORTATION

EXISTING AS-BUILTS SN 016-1088

SHEET NO. AS-17 OF AS-72 SHEETS

F.A.I. RTE. 90/94/290	SECTION 2013-036R	COUNTY COOK	TOTAL SHEETS 256	SHEET NO. 159
CONTRACT NO. 60W71				ILLINOIS FED. AID PROJECT -NUMBER-

FOR INFORMATION ONLY

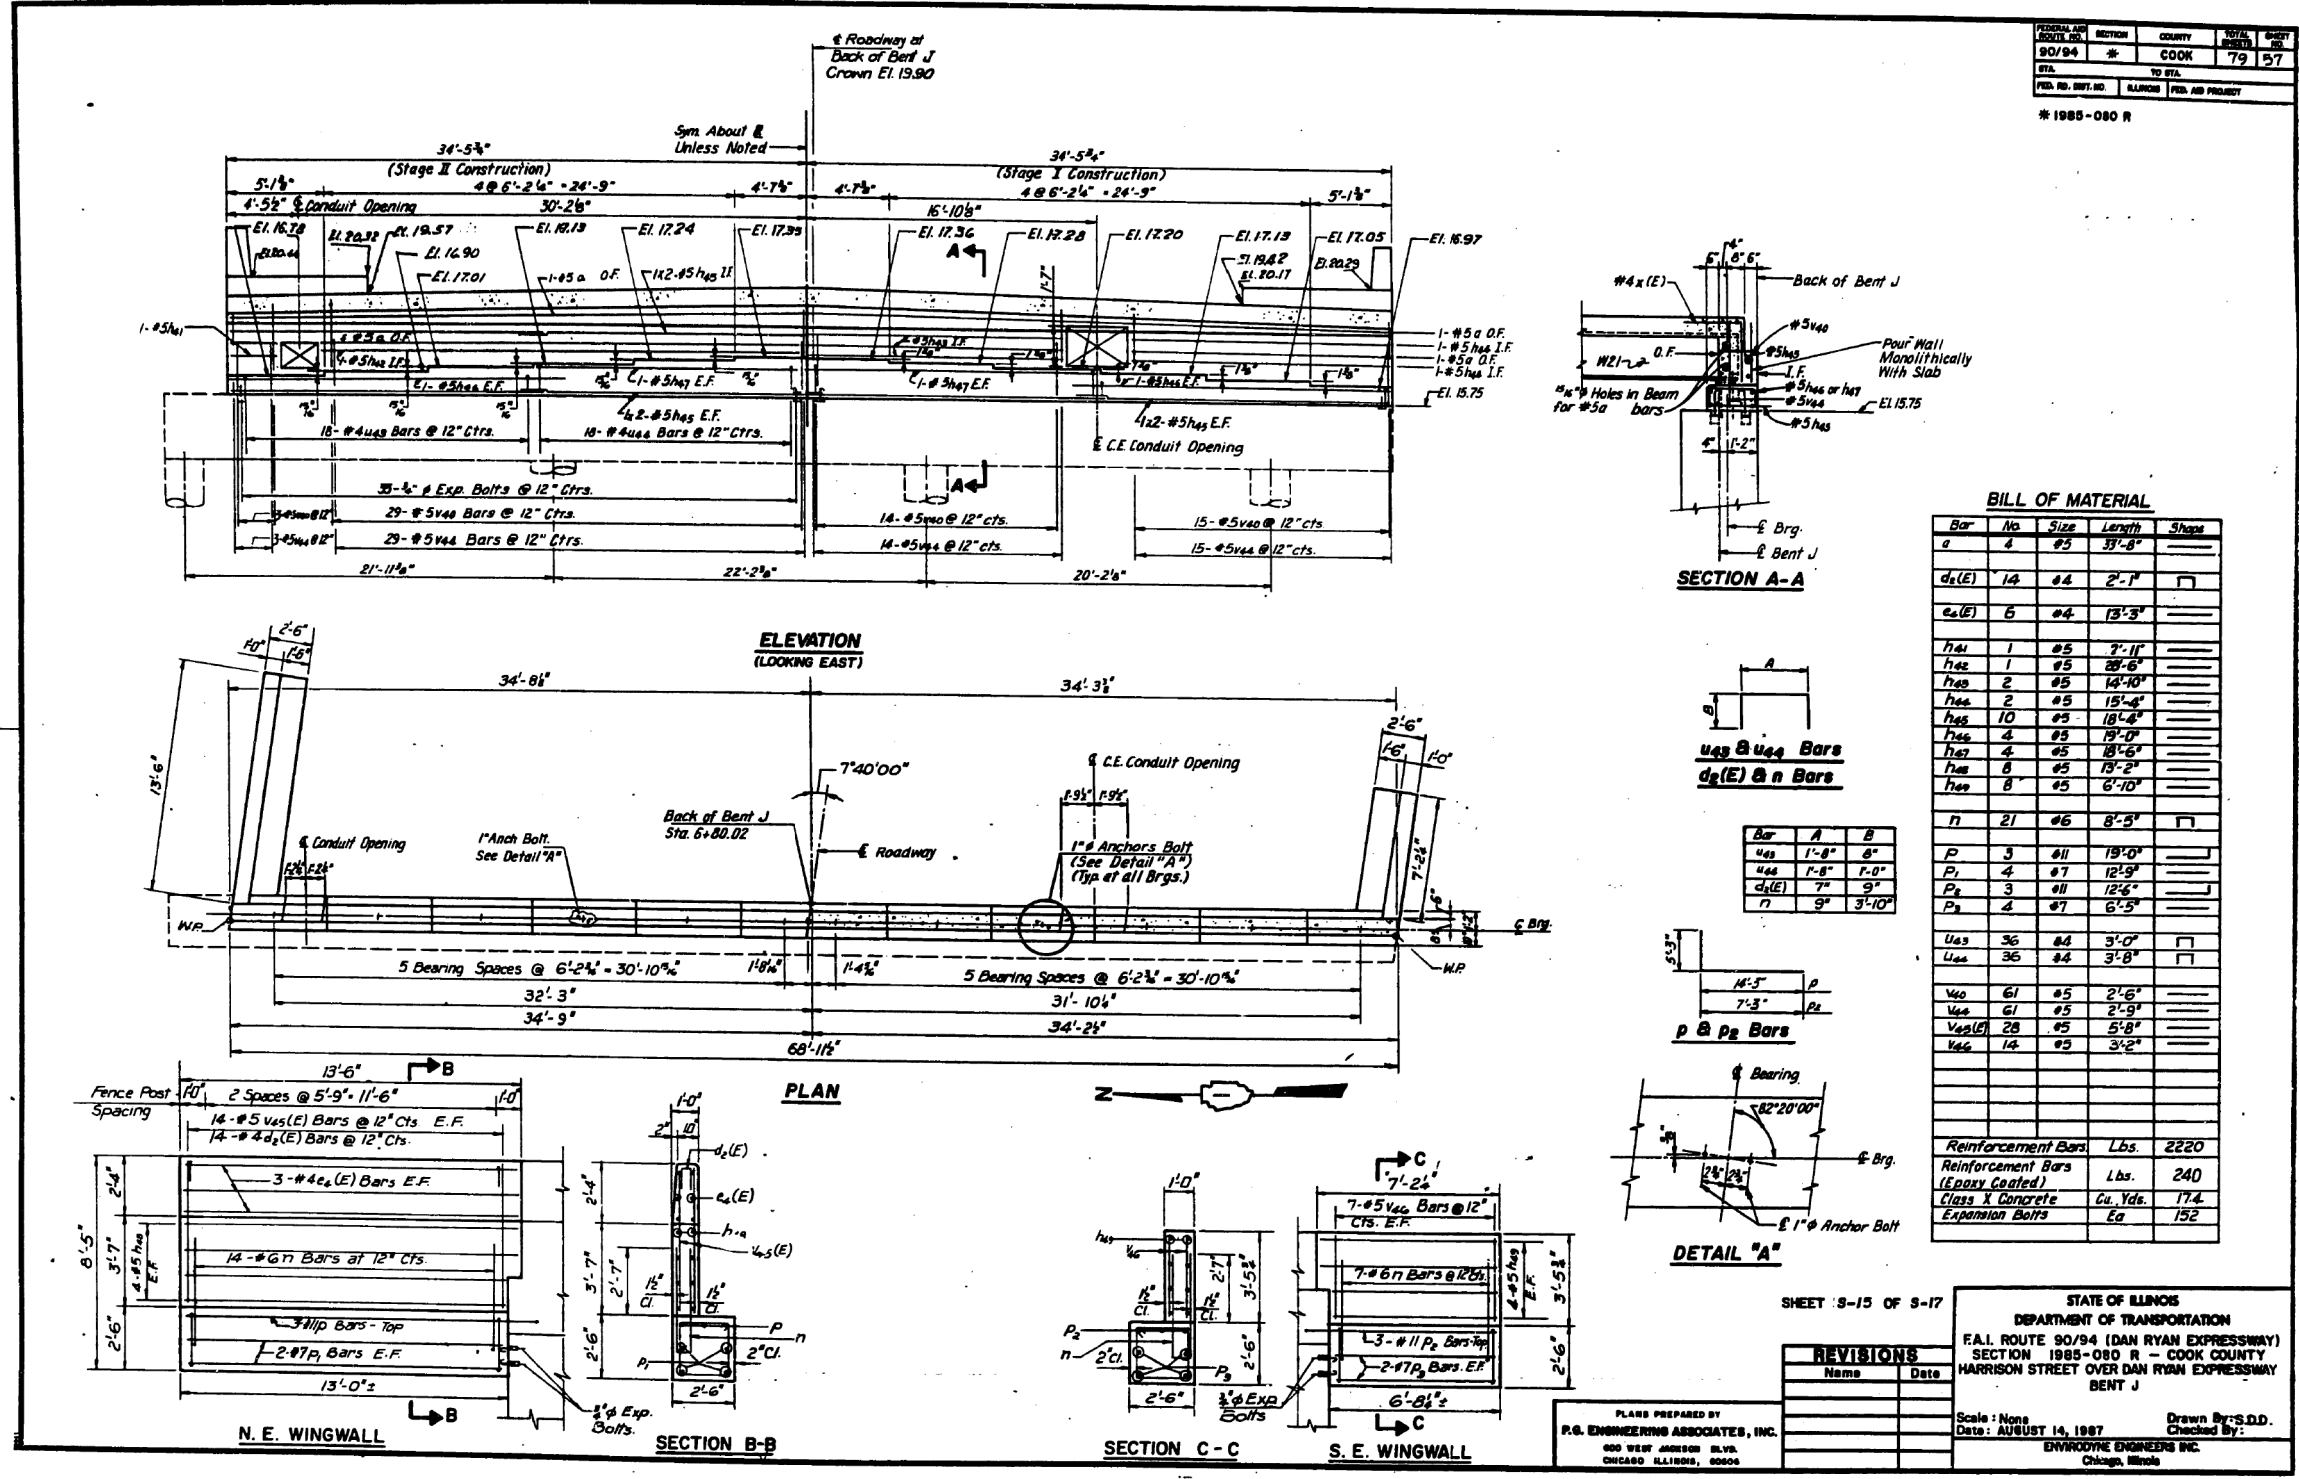

USER NAME = dunkerleyb	DESIGNED -	REVISED -
PLOT SCALE = N.T.S.	CHECKED -	REVISED -
PLOT DATE = 11/26/2013	DRAWN -	REVISED -
	CHECKED -	REVISED -


STATE OF ILLINOIS
DEPARTMENT OF TRANSPORTATION

EXISTING AS-BUILTS SN 016-1088

SHEET NO. AS-18 OF AS-72 SHEETS

F.A.I. RTE.	SECTION	COUNTY	TOTAL SHEETS	SHEET NO.
90/94/290	2013-036R	COOK	256	160
CONTRACT NO. 60W71				
ILLINOIS FED. AID PROJECT -NUMBER-				

FOR INFORMATION ONLY

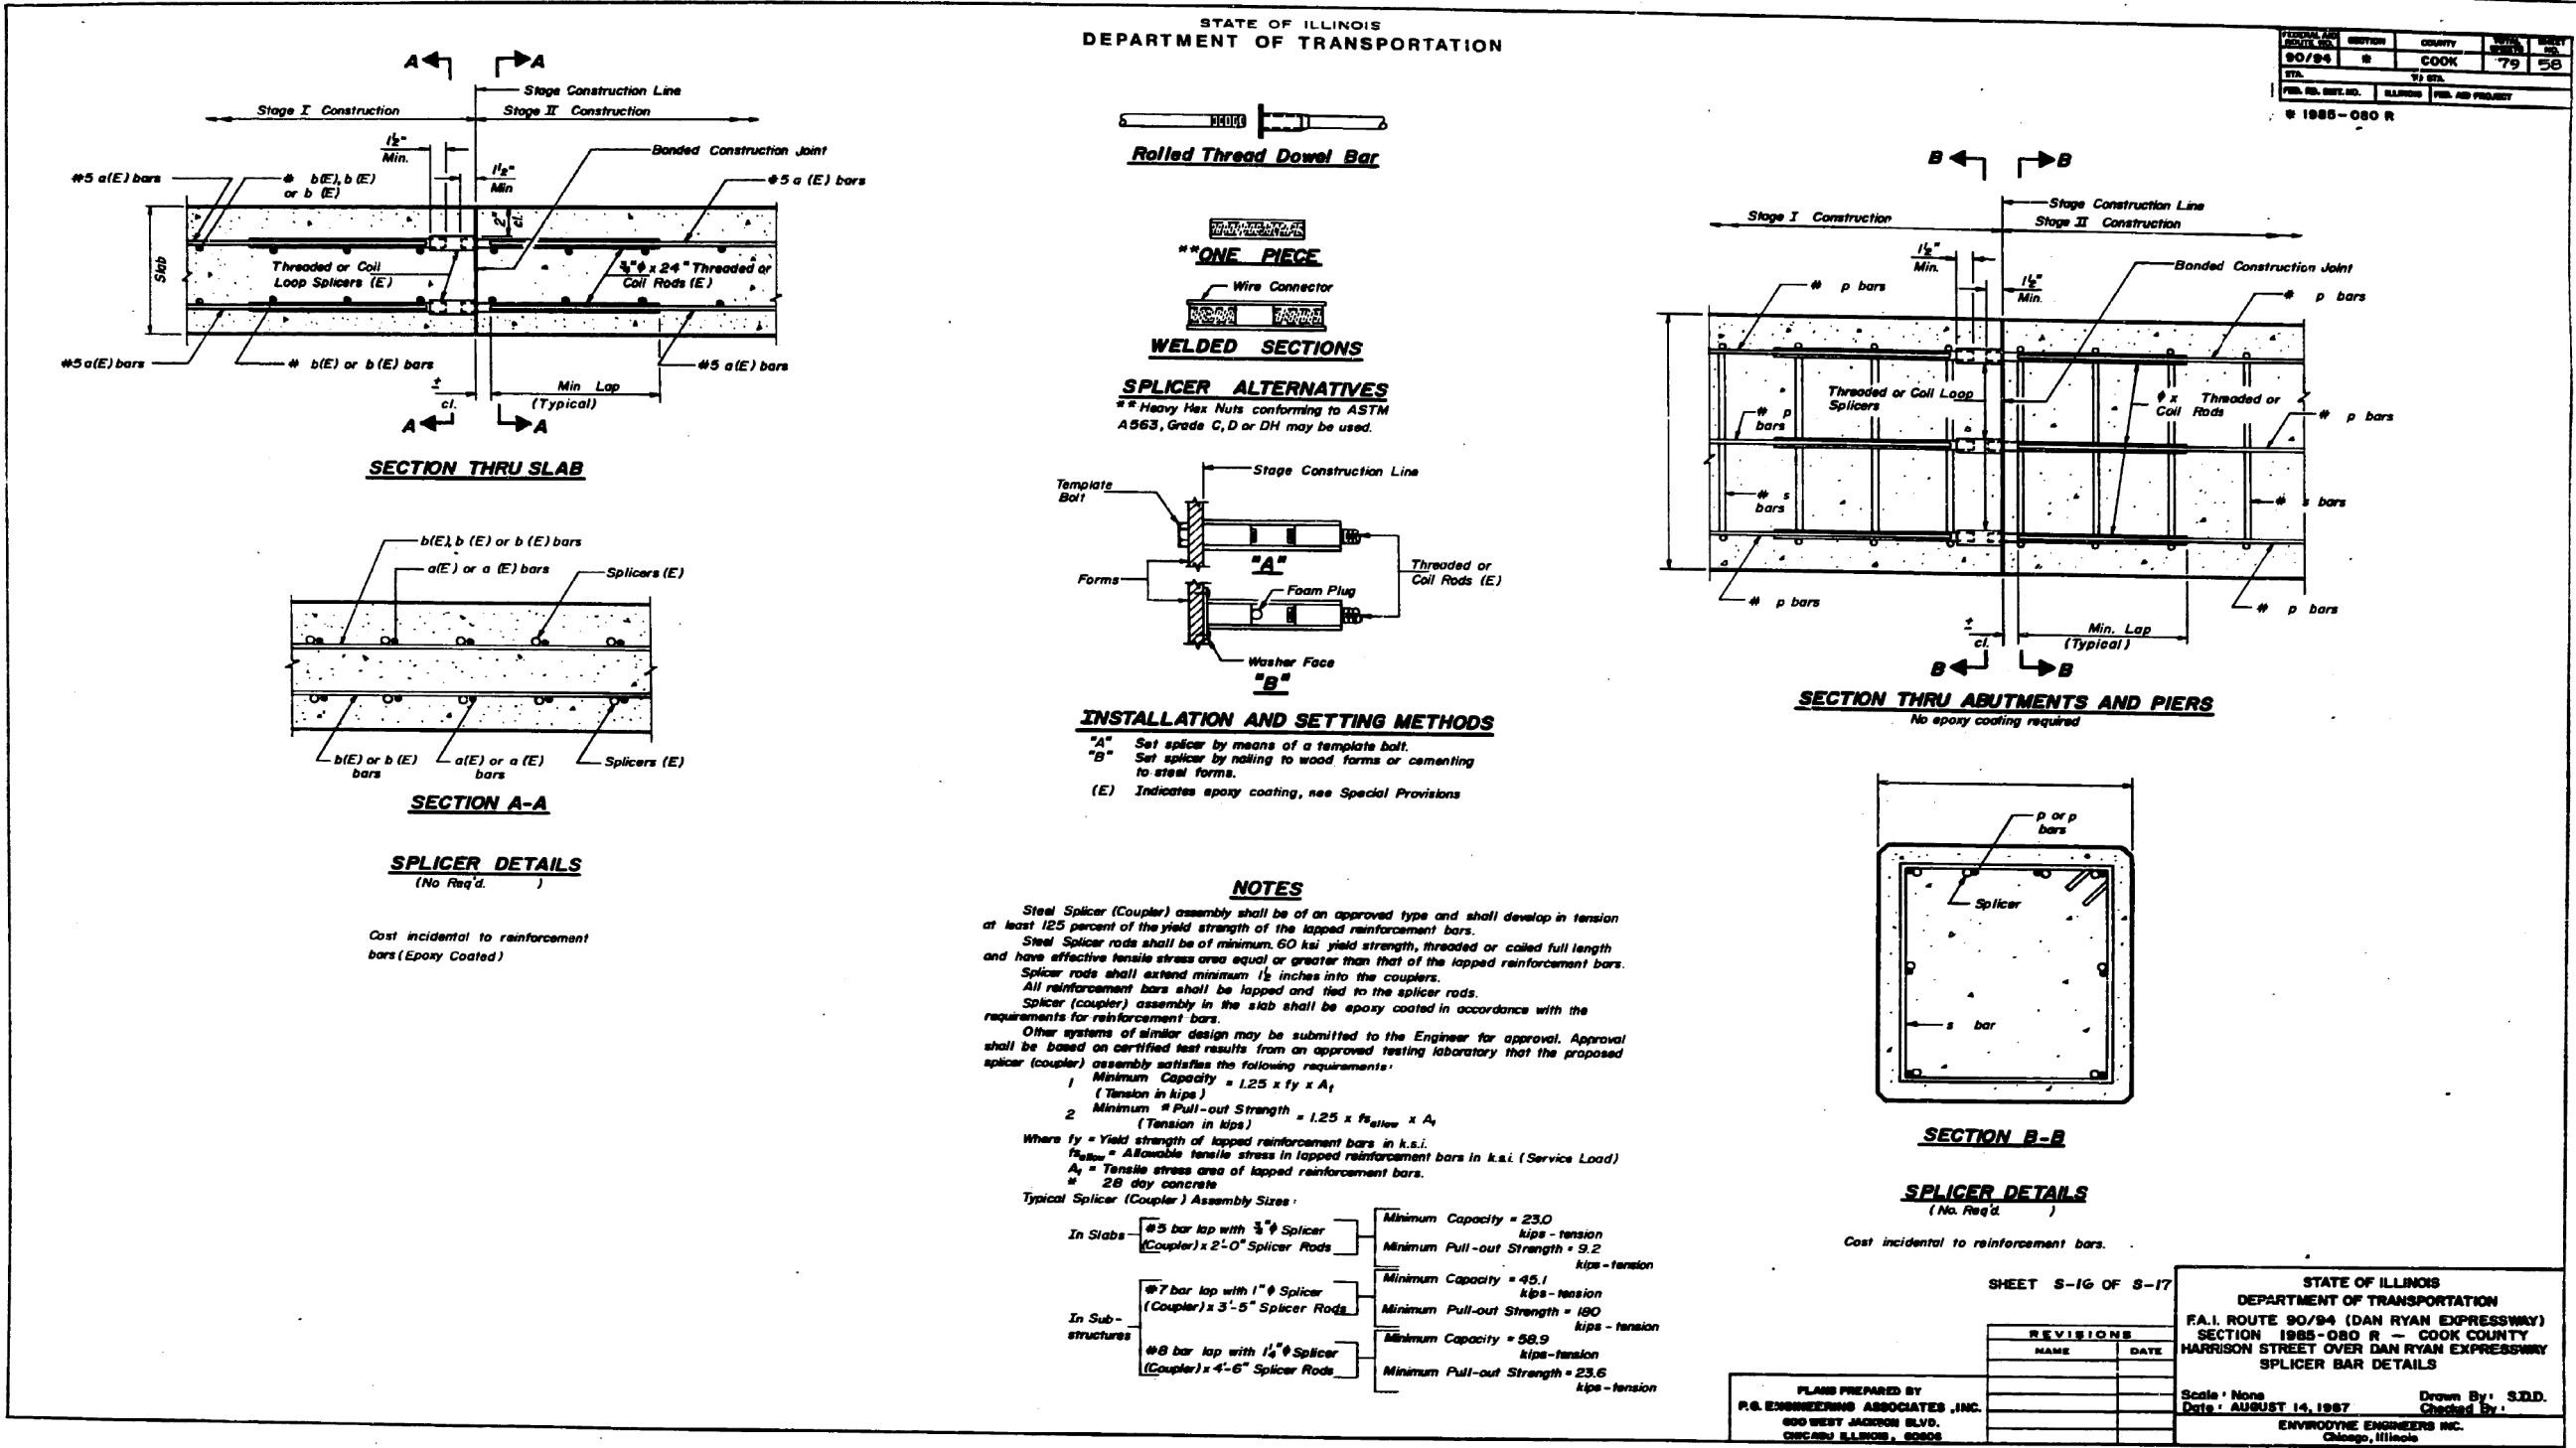

USER NAME = dunkerleyb	DESIGNED -	REVISED
	CHECKED -	REVISED
PLOT SCALE = N.T.S.	DRAWN -	REVISED
PLOT DATE = 11/26/2013	CHECKED -	REVISED

STATE OF ILLINOIS
DEPARTMENT OF TRANSPORTATION


EXISTING AS-BUILTS SN 016-1088

SHEET NO. AS-19 OF AS-72 SHEETS


F.A.I. RTE.	SECTION	COUNTY	TOTAL SHEETS	SHEET NO.
90/94/290	2013-036R	COOK	256	161
CONTRACT NO. 60W71				ILLINOIS FED. AID PROJECT -NUMBER-

FOR INFORMATION ONLY


ROUTE NO.	SECTION	COUNTY	TOTAL SHEETS	SHEET NO.
90/94	8	COOK	79	59
FILE NO. DES. NO.	ILLINOIS	FED. AID PROJECT	* 1985-080 R	

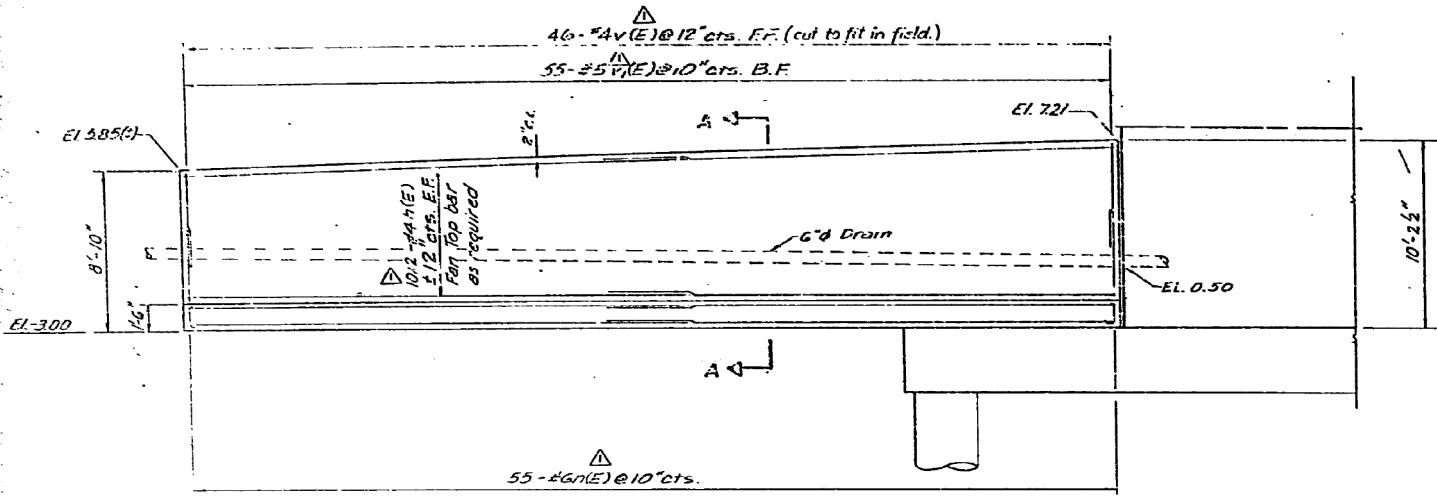


ELEVATION (Looking East)

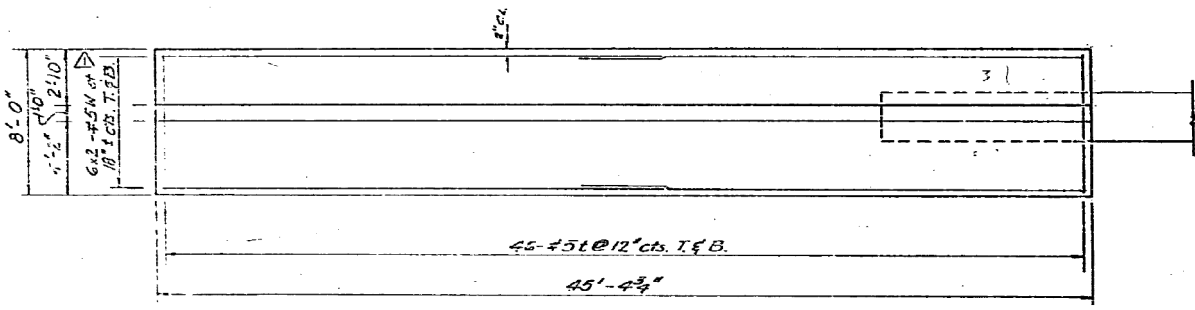


PLAN

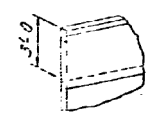

TYP. TOP COURSE

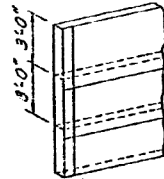


TYP. VERT. CROSS SECTION

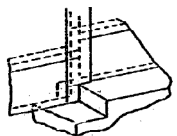

TYP. BUTT SPLICE

GEOCOMPOSITE DRAIN DETAIL

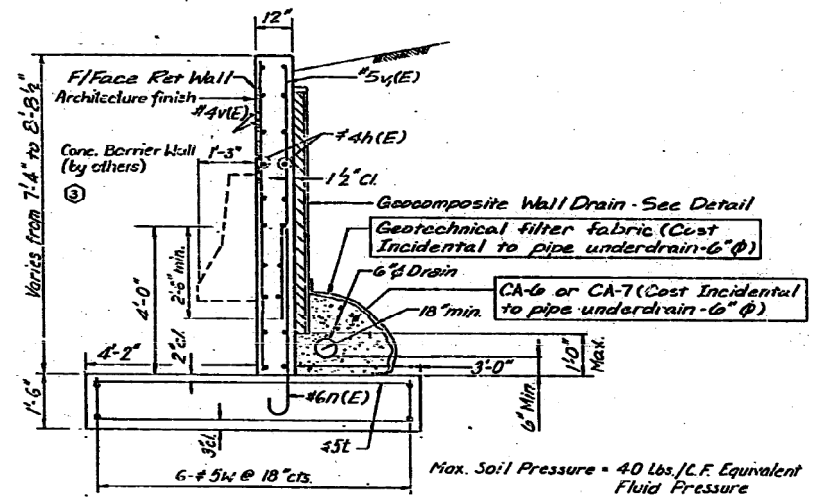


SECTION A-A

(Typical Detail for Wall Drain System) (3)

- Bars designated (E) shall be epoxy coated
- F.F. - Front Face of retaining wall
- B.B. - Back Face of retaining wall
- E.F. - Each Face of retaining wall
- See sheet RW30 (Vol. No. 4) for architectural finish details.

Revision: Nov. 23, 1987

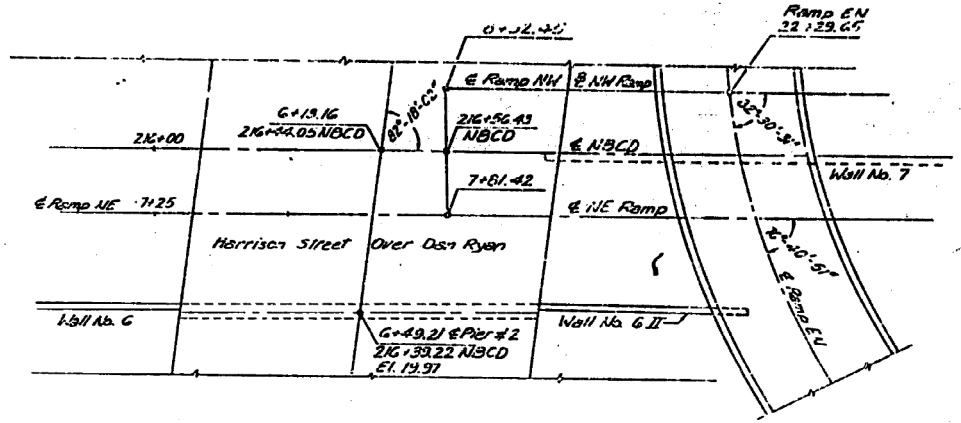

LOCATION PLAN

5'-4"	7'
BAR n (E)	

WALL 6 II - BILL OF MATERIAL

Bar	No.	Size	Length	Shape
H(E)	40	#4	24'-0"	
H(E)	55	#6	5'-11"	
E	92	#5	7'-6"	
V(E)	16	#4	8'-6"	
V(E)	55	#5	7'-11"	
W	24	#5	24'-0"	
Item		Unit	Quantity	
Reinforcement Bars		lbs.	1340	
Class A Concrete		cu. yd.	22.7	
Protective Coat		sq. yd.	25	
Geocomposite Wall Drain		sq. yd.	30	
Pipe Underdrain - 6"		lin. ft.	15	
Reinforcement Bars		lbs.	1780	
Epoxy Coated				
Structure Excavation		cu. yd.	120	

SHEET 517 OF 517

REVISIONS	
Name	Date
Revision	3-11-88

STATE OF ILLINOIS
DEPARTMENT OF TRANSPORTATION
F.A.I. ROUTE 90/94 (DAN RYAN EXPRESSWAY)
SECTION 1985-080 R - COOK COUNTY
HARRISON STREET OVER DAN RYAN EXPRESSWAY
WALL 6 II

Scale: None
Date: AUGUST 14, 1987
Drawn By: S.D.D.
Checked By: [Signature]
ENVIROTECH ENGINEERS INC.
CHICAGO, ILL.

USER NAME = dunkerleyb	DESIGNED -	REVISED
	CHECKED -	REVISED
PLOT SCALE = N.T.S.	DRAWN -	REVISED
PLOT DATE = 11/26/2013	CHECKED -	REVISED

STATE OF ILLINOIS
DEPARTMENT OF TRANSPORTATION


EXISTING AS-BUILTS SN 016-1088

SHEET NO. AS-20 OF AS-72 SHEETS

F.A.I. RTE.	SECTION	COUNTY	TOTAL SHEETS	SHEET NO.
90/94/290	2013-036R	COOK	256	162
				CONTRACT NO. 60W71
ILLINOIS FED. AID PROJECT -NUMBER-				

The Illinois Coil-Lock Anchor Bolt is a proprietary item which is the property of the Illinois Department of Transportation. Use, reproduction or disclosure without express written permission is prohibited and protected under Federal copyright laws. The production and the fabrication of this bolt for use on highway projects in the State of Illinois shall be permitted and there shall be no incurred charges or fees to the manufacturer or the fabricator for producing or fabricating this bolt.

D	E	H	K	"d"
1"	1 1/8"	0 5/8"	1 3/4"	1/4"
1 1/2"	1 5/8"	1 3/8"	2 1/8"	1/2"
2"	2 1/8"	1 7/8"	2 7/8"	1/2"
2 1/2"	2 5/8"	2 5/8"	3 3/8"	1"

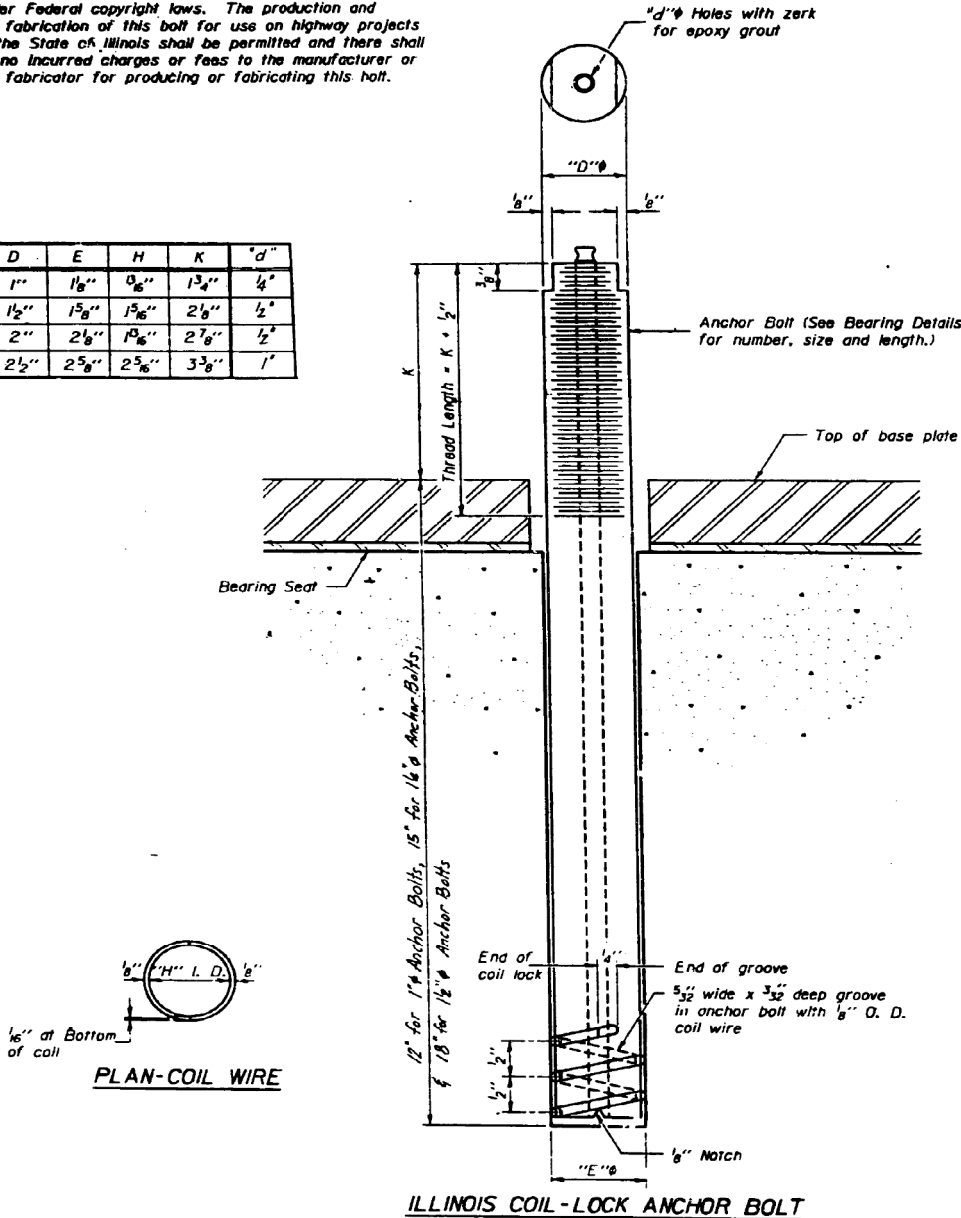

STATE OF ILLINOIS
DEPARTMENT OF TRANSPORTATION

MATERIALS FOR ILLINOIS COIL-LOCK
ANCHOR BOLT

The anchor bolt shall be fabricated from cold drawn or hot finished seamless carbon steel mechanical tubing conforming to ASTM A519, Grade 1025 and supplied with hexagonal nuts and cut washers.
The coil wire shall be made of any suitable soft steel wire.
The finished anchor bolt shall be cleaned of rust and other foreign materials and wrapped or packaged to prevent contamination until they are installed.
The epoxy grout shall be a two-component, epoxy resin bonding system conforming to ASTM C881, Type I, Grade I and of a Class suitable for the temperature at installation.

INSTALLATION PROCEDURE for the ILLINOIS
COIL-LOCK ANCHOR BOLT

- With the coil wire in place, the bolt shall be inserted into the hole and turned clockwise to a snug fit in the hole. Nut and washer shall be placed on the bolt. The nut shall be tensioned until the steel base plate is held securely to the concrete bearing seat.
- Epoxy grout shall be pumped through the zerk fitting with a pressure gun. Pumping shall continue until the epoxy overflows the hole around the bolt shank. After pumping is discontinued, excess epoxy shall be immediately wiped off.

ALTERNATE ANCHOR BOLTS

The Contractor may use, at his option, the capsule or the adhesive cartridge type anchor rods that have been previously tested and given a prior approval by the Department. The Contractor shall install these anchor rods in pre-drilled holes in accordance with the manufacturer's recommendations and procedures.
The capsule or the adhesive cartridge type anchor rods shall be a two part system composed of:
1. A threaded rod with nut and washer conforming to ASTM A307. (Unless Noted)
2. A sealed glass capsule or a sealed glass adhesive cartridge containing premeasured amounts of the adhesive chemical.

FED. AID PROJ. NO.	SECTION	COUNTY	TOTAL SHEETS	SHEET NO.
90/94	2	COOK	79	74
DATE	TO	BY		
90/94/290	10/30/94	WPK		

GENERAL NOTES

Holes in the masonry for anchor bolts shall be drilled through the base plates to the diameter and depth shown or in accordance with the manufacturer's recommendation after beams or girders have been erected and adjusted.
Prior to setting the bolts, the holes shall be dry and all dust and loose particles shall be removed by the use of compressed air or vacuuming.
The anchor bolts, furnished and installed and including the epoxy grout or capsules shall not be paid for separately but shall be included in the unit bid price each for "Expansion and Fixed Bearings".
Anchor bolt as shown on this drawing to be used at all locations, unless shown otherwise.

Anchor bolts, nuts and washers shall be completely coated by either the hot-dipped process conforming with AASHTO M232 or the mechanical plating method conforming to ASTM B495, Class 50. Zinc Coated nuts shall be topped oversize in accordance with the requirements of AASHTO M291 and shall meet the supplementary requirements S1.1 thru S1.21 of the same specification for lubricant and testing.

SHEET MD1 OF 6

REVISIONS
Name
Date

STATE OF ILLINOIS
DEPARTMENT OF TRANSPORTATION
F.A.I. ROUTE 90/94 (DAN RYAN EXPRESSWAY)
SECTION 1985-080 R - COOK COUNTY
ROADWAY GRADING AND PAVING
MISCELLANEOUS DETAILS - ALL STRUCTURES
ANCHOR BOLT DETAILS
Scale: NONE
Date: AUGUST 14, 1987
Drawn By: REP
Checked By: WPK
ENVIRONMENTAL ENGINEERS INC.
Chicago, Illinois

USER NAME = dunkerleyb	DESIGNED -	REVISED
	CHECKED -	REVISED
PLOT SCALE = N.T.S.	DRAWN -	REVISED
PLOT DATE = 11/26/2013	CHECKED -	REVISED

STATE OF ILLINOIS
DEPARTMENT OF TRANSPORTATION

EXISTING AS-BUILTS SN 016-1088

SHEET NO. AS-21 OF AS-72 SHEETS

F.A.I. RTE.	SECTION	COUNTY	TOTAL SHEETS	SHEET NO.
90/94/290	2013-036R	COOK	256	163
CONTRACT NO. 60W71				
ILLINOIS FED. AID PROJECT -NUMBER-				

FOR INFORMATION ONLY

JOINT SIZE	"C" AT 50°F	"D" AT 50°F
2"	2"	1 1/2" MIN.
2 1/2"	2 1/2"	1 3/4" MIN.
4"	3"	2 1/2" MIN.

INSTALLATION NOTES

USE ANCHOR BLOCKS AND CONTINUOUS SEAL AS ANCHOR BOLT LOCATION TEMPLATES.

1. INSTALL SPONGE MANDRELS INTO POSITIONS SHOWN TO FORM FLAP CONVOLUTION.
2. INSTALL PARAPET OR SIDEWALK PIECE (TRIM ROADWAY FLAP TO FIT BEFORE APPLYING EPOXY).
3. INSTALL CONTINUOUS SEAL IN ROADWAY.
4. INSTALL ANCHOR BLOCKS AS INDICATED.


NOTE A: MAXIMUM SPACING OF ANCHOR BOLTS SHALL BE 12" CENTERS.

SKREW LIMITATIONS


THE DETAILS OF THE ANCHOR BLOCKS AND THE ELASTOMERIC MEMBRANE IN THE PARAPET, AS SHOWN, ARE FOR UP TO 50° SKEWS.

FOR SKEWS GREATER THAN 50°, THE ANCHOR BLOCKS AND ELASTOMERIC MEMBRANE, INSTALLED IN ACCORDANCE WITH DIMENSION "D" MIGHT REQUIRE MODIFICATIONS TO INSURE A MINIMUM CLEARANCE OF 1 1/2" FROM CENTERLINE OF ANCHOR STUDS TO EDGE OF PARAPET OPENING.


THE ANCHOR BLOCKS AND THE ELASTOMERIC MEMBRANE SHALL ALSO BE INSTALLED TO THE TOP OF PARAPET WITH THE ANCHOR STUDS SPACED AT 12" CTS.

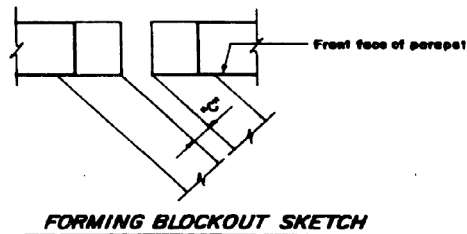


FORMING BLOCKOUT SKETCH

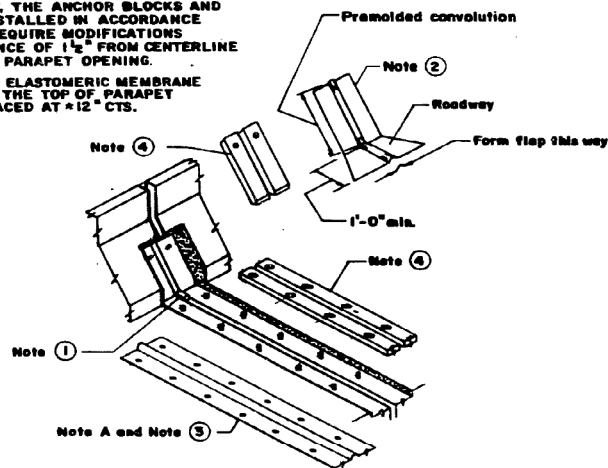


VIEW AT PARAPET FOR FORMING

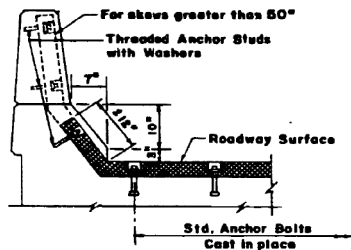

TYPICAL END TREATMENT

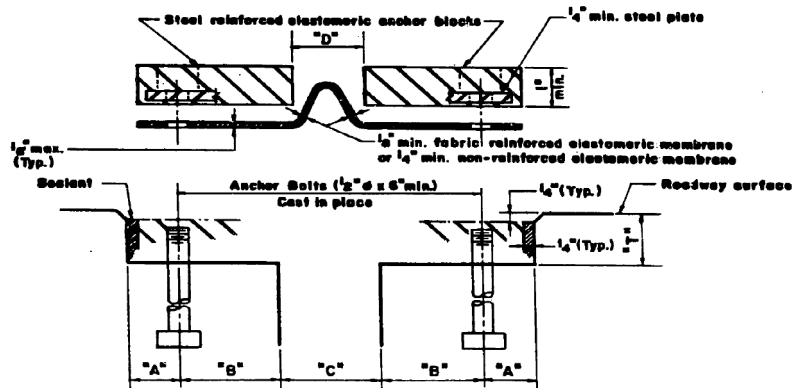

CROSS SECTION

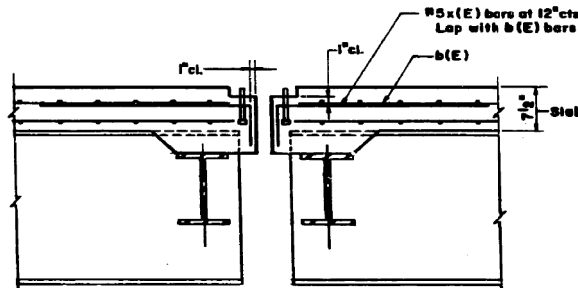

SECTION AT NEOPRENE EXPANSION JOINT

SECTION NO.	SECTION	COUNTY	TOTAL SHEETS	SHEET NO.
90/94	6	COOK	79	78
FED. AID PROJ. NO. 1985-080 R				

GENERAL NOTES

CONTINUOUS SEAL NEOPRENE EXPANSION JOINT SHALL CONSIST OF MOLDED ANCHOR BLOCKS OF ELASTOMER AND STEEL, WELD ASSEMBLED OVER CONTINUOUS LENGTHS OF ELASTOMERIC MEMBRANE. SEE SPECIAL PROVISIONS.

THE ELASTOMERIC MEMBRANE SHALL BE PREMOLDED WITH A SINGLE OR A DOUBLE UPWARD CONVOLUTION THAT WILL HAVE A "MEMORY" TO RETURN TO ITS MOLDED POSITION UPON JOINT CLOSURE.

THE STEEL REINFORCEMENT MUST EXTEND UP THE BACK FACE OF ANCHOR BLOCKS WHEN ASPHALT SURFACES ARE USED BUT IS OPTIONAL IN CONCRETE BLOCKOUT.

THE CONVOLUTION LENGTH SHALL BE SUCH THAT THE EXTENDED LENGTH WILL NOT BE GREATER THAN THE MANUFACTURED LENGTH WHEN THE JOINT IS FULLY EXPANDED IN ITS DESIGN RANGE AND WILL NOT PROTRUDE ABOVE THE ANCHOR BLOCKS WHEN THE JOINT IS FULLY COMPRESSED.

JOINT OPENINGS SHALL BE ADJUSTED IN ACCORDANCE WITH ARTICLE 802.07(g) OF THE STANDARD SPECIFICATIONS WHEN THE DECK IS POURED AT AN AMBIENT TEMPERATURE OTHER THAN 50°F.

THE PARAPET FLAPS MAY BE FURNISHED FACTORY VULCANIZED TO THE ROADWAY MEMBRANE PROVIDED THE CENTERLINE OF THE CONVOLUTION IS MAINTAINED AND THE PROCESS AND METHOD MEET THE APPROVAL OF THE ENGINEER.

ANCHOR BOLTS, WASHERS AND NUTS, TO BE PLACED AGAINST CORROSION IN ACCORDANCE WITH THE SPECIAL PROVISIONS, SHALL BE ZINC-COATED BY THE MECHANICAL PLATING METHOD CONFORMING TO ASTM B 695, CLASS 50. ZINC-COATED NUTS SHALL BE TAPPED OVERSIZE IN ACCORDANCE WITH THE REQUIREMENTS OF AASHTO M291 AND SHALL MEET THE SUPPLEMENTARY REQUIREMENTS S1.1 THRU S1.2.1 OF THE SAME SPECIFICATIONS FOR LUBRICANT AND TESTING.

SHEET MD 2 OF 6

REVISIONS	
Name	Date

STATE OF ILLINOIS DEPARTMENT OF TRANSPORTATION F.A.I. ROUTE 90/94 (DAN RYAN EXPRESSWAY) SECTION 1985-080 R - COOK COUNTY ROADWAY GRADING AND PAVING MISCELLANEOUS DETAILS - ALL STRUCTURES NEOPRENE EXPANSION JOINTS, 2", 2 1/2" & 4"	
Scale: NONE Date: AUGUST 14, 1987	Drawn By: J.R. Checked By: N.M. ENVIROTECH ENGINEERS INC. Chicago, Illinois

USER NAME = dunkerleyb	DESIGNED -	REVISED
PLOT SCALE = N.T.S.	CHECKED -	REVISED
PLOT DATE = 11/26/2013	DRAWN -	REVISED
	CHECKED -	REVISED


STATE OF ILLINOIS
DEPARTMENT OF TRANSPORTATION

EXISTING AS-BUILTS SN 016-1088


SHEET NO. AS-22 OF AS-72 SHEETS

F.A.I. RTE.	SECTION	COUNTY	TOTAL SHEETS	SHEET NO.
90/94/290	2013-036R	COOK	256	164
CONTRACT NO. 60W71				
ILLINOIS FED. AID PROJECT -NUMBER-				


ROUTE NO.	SECTION	COUNTY	SHEET NO.	SHEET TOTAL
80/94	8	COOK	79	78
F.A.I. TO STA.				
FED. RD. DIST. NO. ALIGNMENT FED. AID PROJECT				
* 1085-080 R				

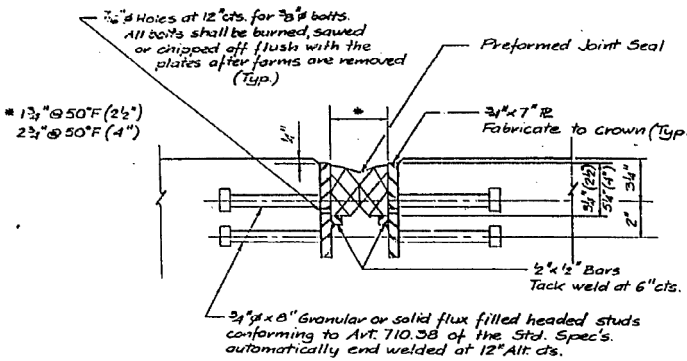


TYPICAL CROSS SECTION

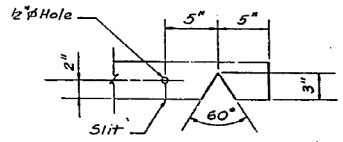


SEAL CUT-OUT (4")

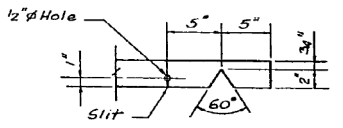

SEAL CUT-OUT (2 1/2")

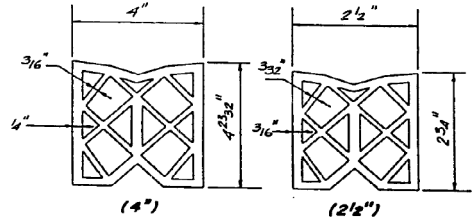


PREFORMED JOINT SEAL

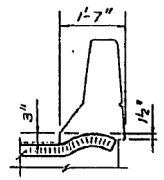

TYPICAL END OF SEAL TREATMENT

Note:
Joint openings shall be adjusted in accordance with Article 503.07(c) of the Standard Specifications when the deck is poured at an ambient temperature other than 50°F.

① Section Deleted

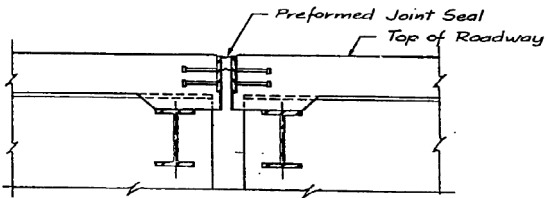

SECTION AT PREFORMED SEAL JOINT

SHEET NO 3 OF 8		STATE OF ILLINOIS DEPARTMENT OF TRANSPORTATION F.A.I. ROUTE 80/94 (DAN RYAN EXPRESSWAY) SECTION 1085-080 R - COOK COUNTY ROADWAY GRAU'GS AND PAVING MISCELLANEOUS DETAILS - ALL STRUCTURES PREFORMED JOINT SEAL 2 1/2" & 4"	
REVISIONS		Scale: NONE Date: AUGUST 14, 1987 Drawn By: J.R. Checked By: M.M. ENVIROTECH ENGINEERS INC. Chicago, Illinois	
Name	Date		
① Revision	1-22-88		

USER NAME = dunkerleyb	DESIGNED -	REVISED
	CHECKED -	REVISED
PLOT SCALE = N.T.S.	DRAWN -	REVISED
PLOT DATE = 11/26/2013	CHECKED -	REVISED

STATE OF ILLINOIS
DEPARTMENT OF TRANSPORTATION

EXISTING AS-BUILTS SN 016-1088


SHEET NO. AS-23 OF AS-72 SHEETS

F.A.I. RTE.	SECTION	COUNTY	TOTAL SHEETS	SHEET NO.
80/94/290	2013-036R	COOK	256	165
				CONTRACT NO. 60W71
ILLINOIS FED. AID PROJECT -NUMBER-				


REINFORCEMENT BAR SCHEDULE *

Bar	No.	Size	Length	Shape
Side	16	#5	2'-0"	
Set(E)	12	#5	1'-0"	


* For Scupper

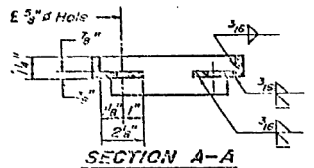


SECTION A-A

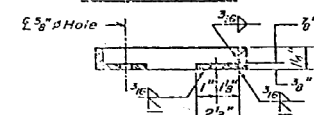

SECTION B-B

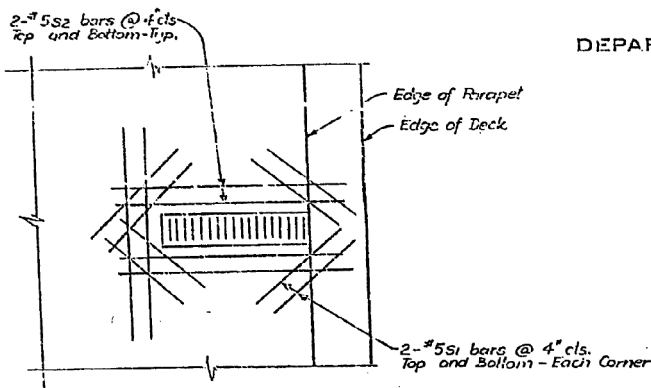


SCUPPER DECK REINFORCING DETAIL

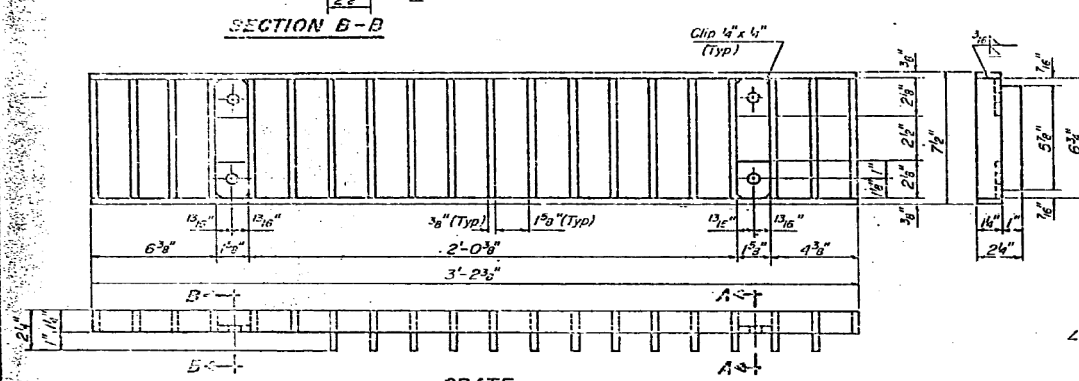


GRATE

Notes:


- Hollow structural steel tubing shall conform to the requirements of A.S.T.M. designation A-500 Grade B, or A-501 Structural Steel Tubing.
- All other shapes, plates and bars shall conform to the requirements of A.A.S.H.T.O. M 103.
- Bolts, studs, washers and nuts shall conform to the requirements of A.S.T.M. A-307.
- The Grate, Frame, and Downspout shall be galvanized after shop fabrication in accordance with A.A.S.H.T.O. M-111 & A.S.T.M. A-385.
- All bolts, washers and nuts shall be galvanized in accordance with A.A.S.H.T.O. M232.
- Cost of the Grate, Frame, Downspout, Bolts, Washers and Nuts including complete installation of Scupper shall be paid for at the unit bid price for "DRAINAGE SCUPPERS"

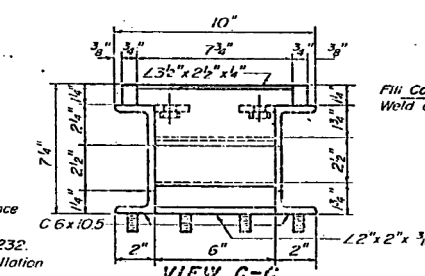


VIEW C-C

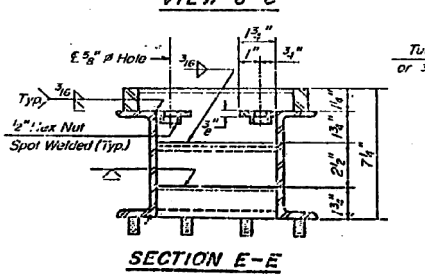

SECTION E-E

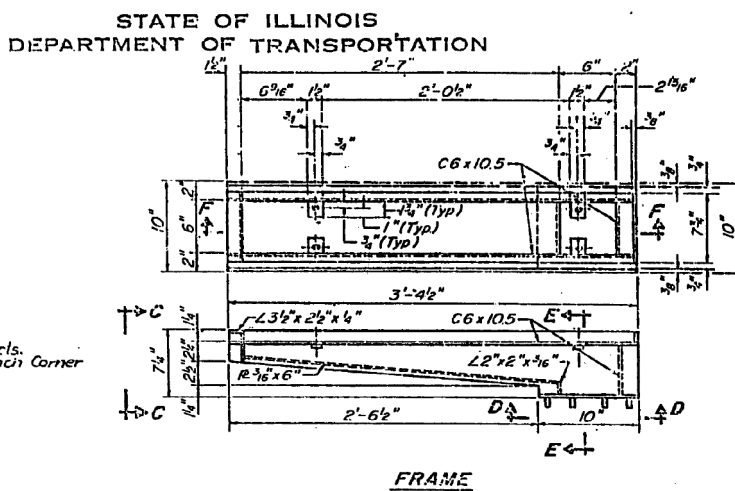


FRAME

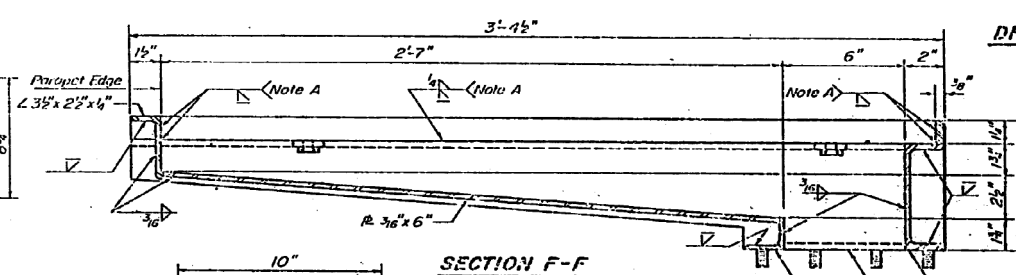


SECTION F-F


Note A: Surface of welds shall be recessed 1/16" Max. or placed flush with inside face of bars to provide clearance for Grate.

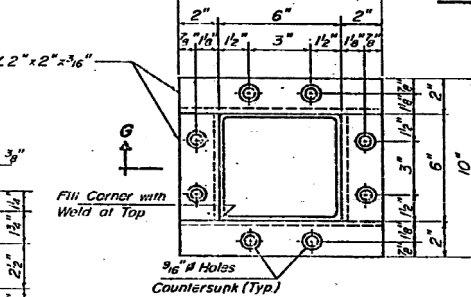


VIEW D-D

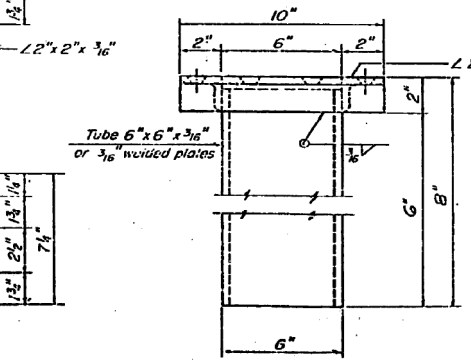

DOWNSPOUT

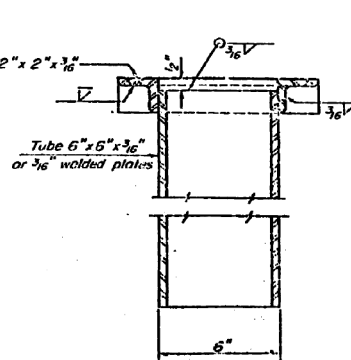


SECTION C-C

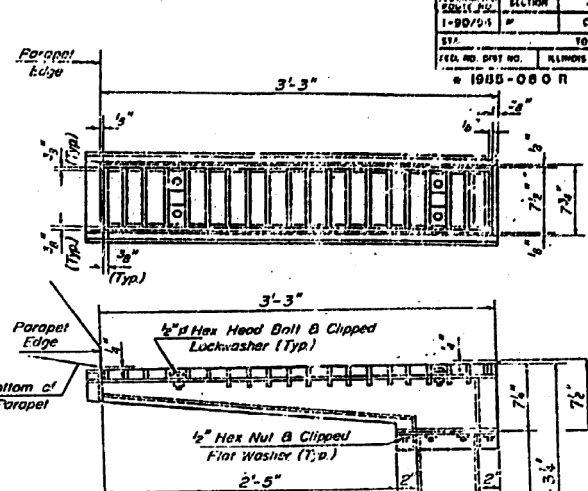

DRAINAGE SCUPPER

Seal Gap with
Mastic (Cost
incidental to
downspout)

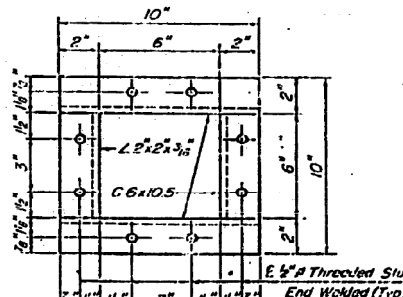

VIEW D-D

BILL OF MATERIAL

ITEM	UNIT	QUANTITY
Drainage Scupper	Each	1

SHEET MD 4 OF 8

REVISIONS	Name	Date
1	Revision	3-11-03

STATE OF ILLINOIS
DEPARTMENT OF TRANSPORTATION
F.A.I. ROUTE 90/94 (DAN RYAN EXPRESSWAY)
SECTION 1906-080R - COOK COUNTY
ROADWAY GRADING AND PAVING
MISCELLANEOUS DETAILS - ALL STRUCTURES
DRAINAGE SCUPPER, STEEL
Scale: NONE
Date: AUGUST 14, 1987
Checked By: J.M.K.
ENVIRODYNE ENGINEERS INC.

USER NAME = dunkerleyb	DESIGNED -	REVISED -
PLOT SCALE = N.T.S.	CHECKED -	REVISED -
PLOT DATE = 11/26/2013	DRAWN -	REVISED -
	CHECKED -	REVISED -



STATE OF ILLINOIS
DEPARTMENT OF TRANSPORTATION

EXISTING AS-BUILTS SN 016-1088











SHEET NO. AS-24 OF AS-72 SHEETS

F.A.I. RTE.	SECTION	COUNTY	TOTAL SHEETS	SHEET NO.
90/94/290	2013-036R	COOK	256	166
CONTRACT NO. 60W71				ILLINOIS FED. AID PROJECT -NUMBER-

STATE OF ILLINOIS
DEPARTMENT OF TRANSPORTATION

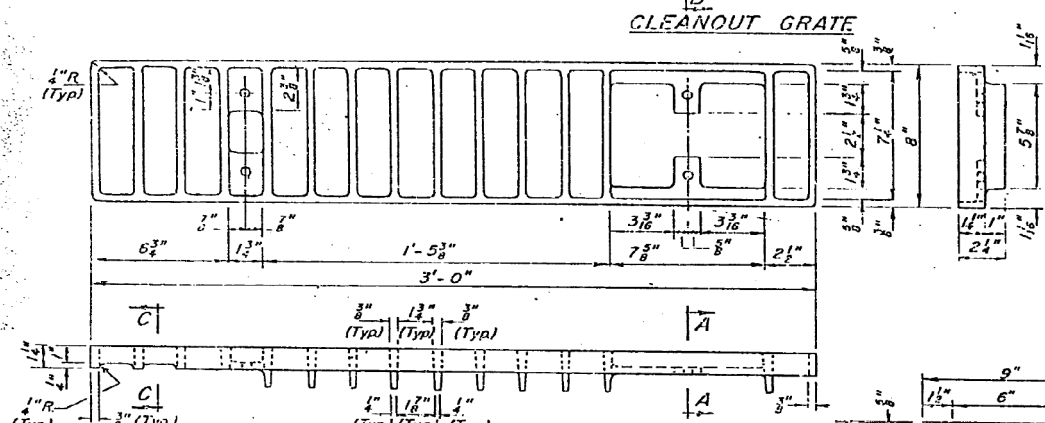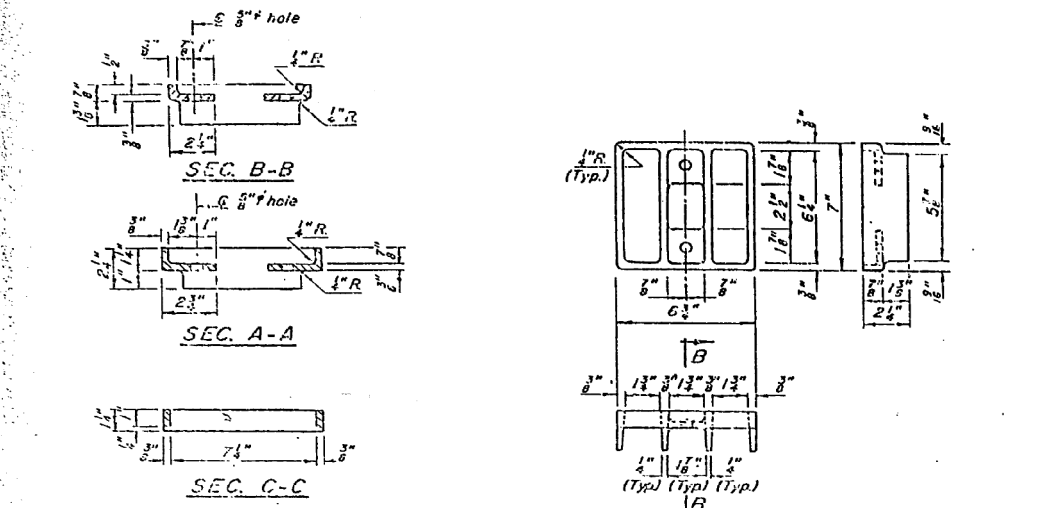

NOTES:
All cast iron parts shall be gray iron conforming to the requirements of AASHTO M103, Class 30.
Bolts, washers and nuts shall conform to the requirements of ASTM A-307.
All bolts, washers and nuts shall be galvanized in accordance with AASHTO M 232.
The waterproofing membrane system shall be installed such that the membrane covers the frame flanges and extends down into the frame with the grates placed on top of the membrane.
Cost of the Main Grate, Cleanout Grate, Frame, Downspout, Bolts, Washers and Nuts including complete installation of Scupper shall be paid for at the unit bid price for "DRAINAGE SCUPPERS".
The Contractor may use at his option steel frames and steel grates or cast frames and cast grates, but will not be allowed to use steel grates with cast frames nor cast grates with steel frames.

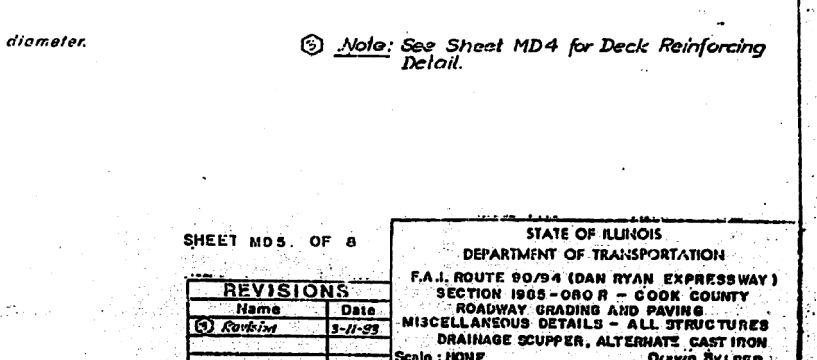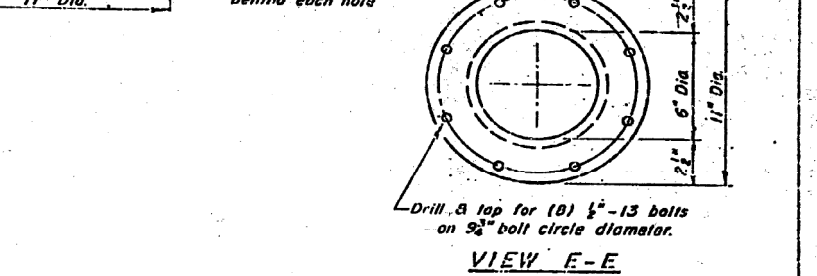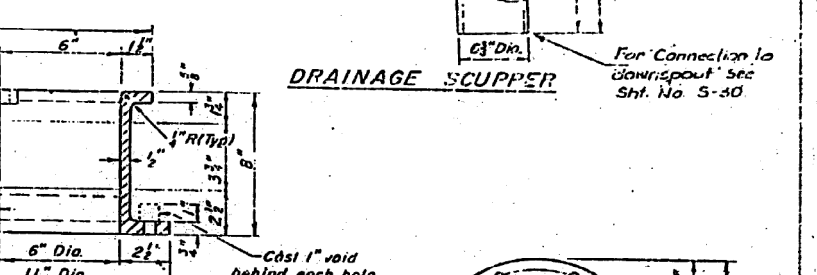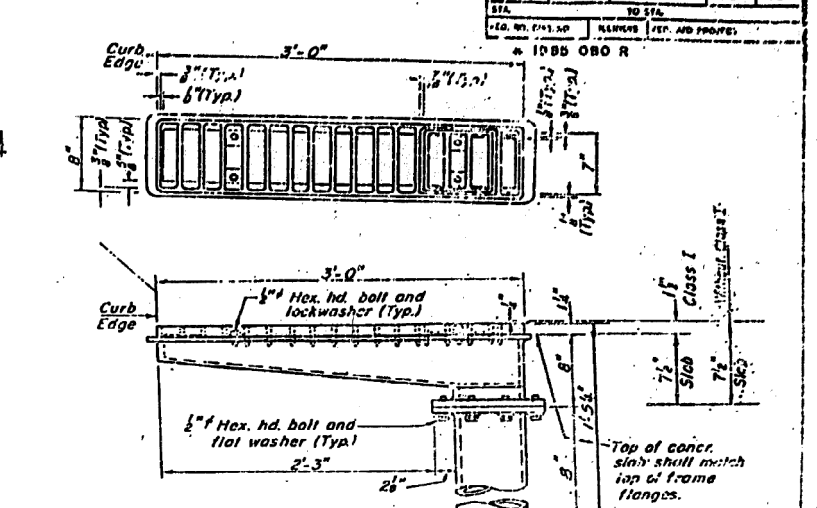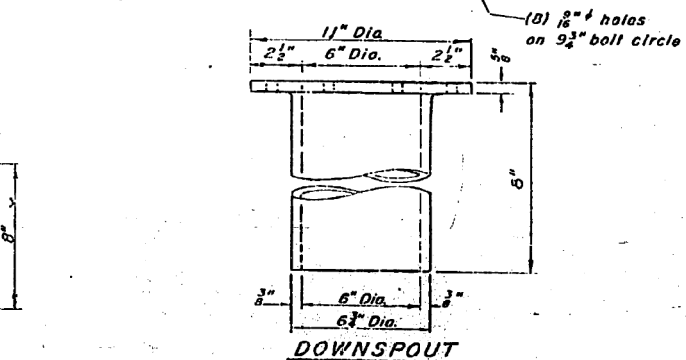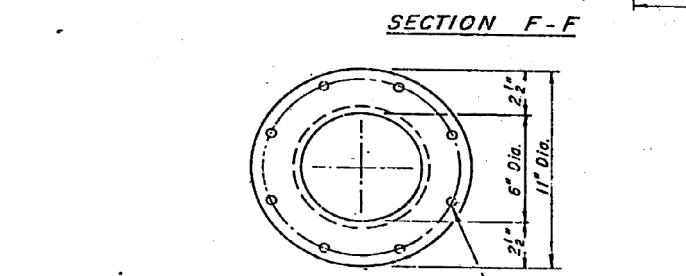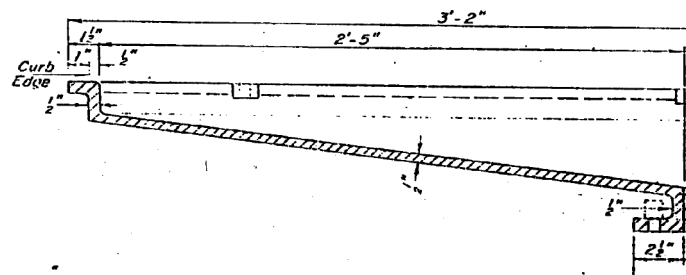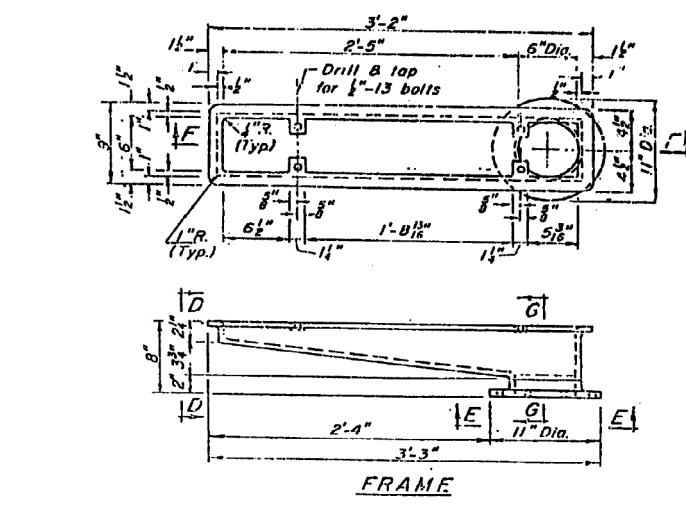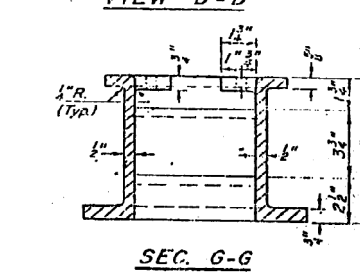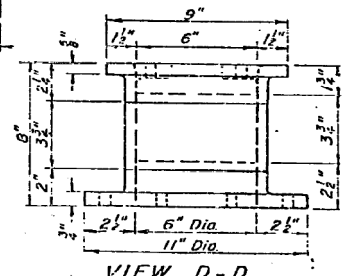

REVISIONS	
Name	Date
⑤ Rankin	3-11-99

STATE OF ILLINOIS DEPARTMENT OF TRANSPORTATION F.A.I. ROUTE 90/94 (DAN RYAN EXPRESSWAY) SECTION 1905-080 R - COOK COUNTY ROADWAY GRADING AND PAVING MISCELLANEOUS DETAILS - ALL STRUCTURES DRAINAGE SCUPPER, ALTERNATE CAST IRON Scale: NONE Date: AUGUST 14, 1997 Drawn By: REP Checked By: WPK ENVIRONMENTAL ENGINEERS INC. CHICAGO, ILLINOIS	SHEET MD5 OF 8
---	----------------

USER NAME = dunkerleyb	DESIGNED =	REVISED
PLOT SCALE = N.T.S.	CHECKED =	REVISED
PLOT DATE = 11/26/2013	DRAWN =	REVISED
	CHECKED =	REVISED

STATE OF ILLINOIS
DEPARTMENT OF TRANSPORTATION

EXISTING AS-BUILTS SN 016-1088

SHEET NO. AS-25 OF AS-72 SHEETS

F.A.I. RTE.	SECTION	COUNTY	TOTAL SHEETS	SHEET NO.
90/94/290	2013-036R	COOK	256	167
CONTRACT NO. 60W71				ILLINOIS FED. AID PROJECT -NUMBER-

FOR INFORMATION ONLY

STATE OF ILLINOIS
DEPARTMENT OF TRANSPORTATION

PROJECT NO.	SECTION	DATE	BY	CHKD	APP'D
90/04	1	COOK	79	79	
PER. NO. DATE	ILLINOIS	TYPE / NO. PROJECT			
1305-080 R					


NOTES

Railing shall be in accordance with Section 306 of the Standard Specifications, except as noted, and shall be paid for at the Contract Unit Price per linear foot for Pedestrian Railing. The 9 gauge fabric lies shall be in accordance with Article 710.33(1) of the Standard Specifications.


Installation of the chain link fabric shall be in accordance Section 629 of the Standard Specifications.

Hollow structural steel tubing shall conform to the requirements of ASTM designation A 500, Grade B, structural steel tubing.



All other steel shapes and plates shall conform to the requirements of AASHTO M183.

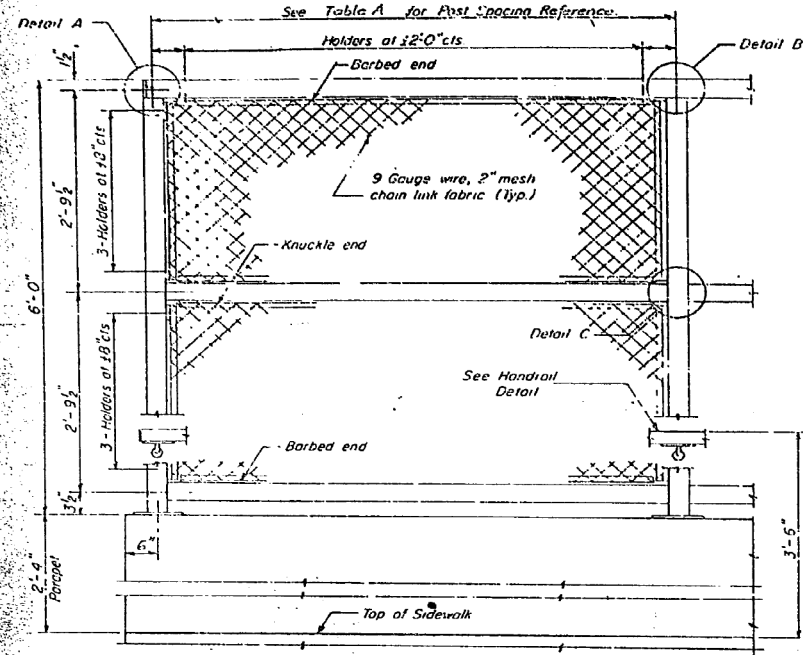


ELEVATION
(Inside Face)

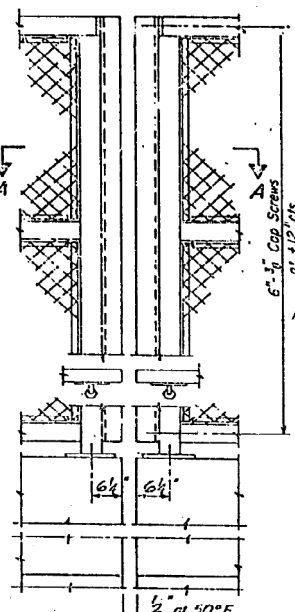


ELEVATION
(At Expansion Joint)

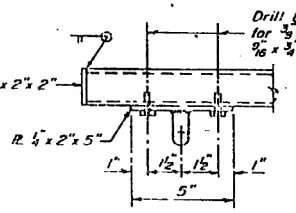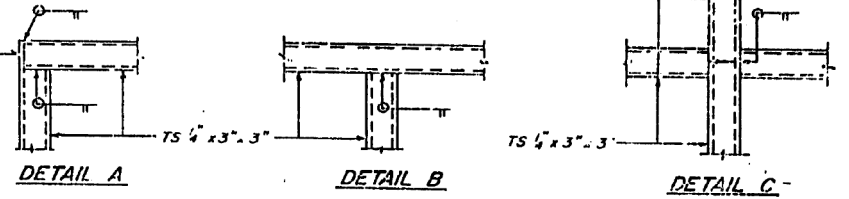


HANDRAIL DETAIL

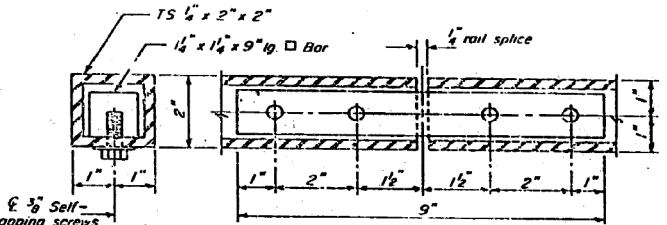


HANDRAIL SPLICE

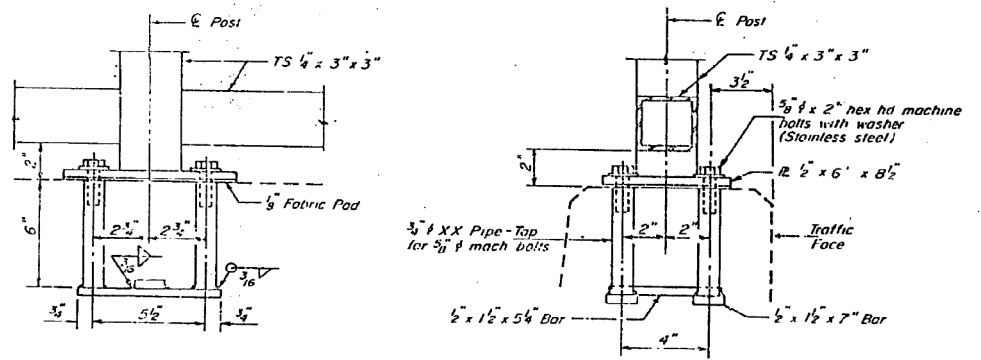


ANCHOR BOLT DETAILS

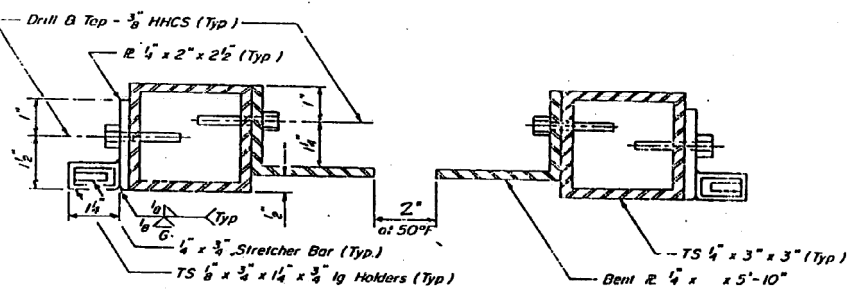

SECTION A-A

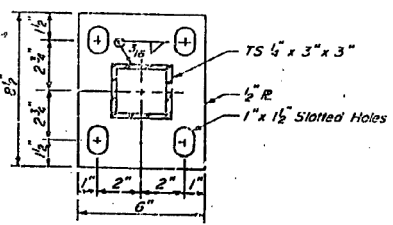

BASE PLATE

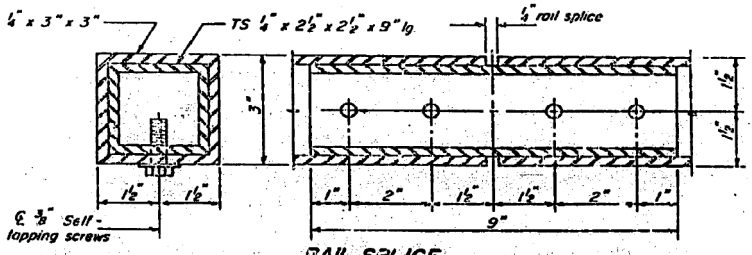

RAIL SPLICE

Notes

All posts, railing, splices, anchor devices and bent plates shall be galvanized after shop fabrication in accordance with AASHTO M-111 and ASTM A-363. All bolts, nuts and washers shall be provided in accordance with AASHTO M-230.

Vent holes for galvanizing shall be placed in the posts and rails at locations that will not allow the accumulation of moisture in the members.

The chain link fabric shall conform to the requirements of Article 710.33(1)(2)(3) of the Std. Specs.

BILL OF MATERIAL

ITEM	UNIT	QUANTITY
Pedestrian Railing	L.F.	879

TABLE A - POST SPACING REFERENCE

STRUCTURE	SEE SHEET No.
Taylor Street Entrance Ramp	ENT 13
Harrison Street over S.B. DAN RYAN EXP.	HAR-5B
Harrison Street over N.B. DAN RYAN EXP.	S-9 & S-15

SHEET NO. 6 OF 8

REVISIONS	
Name	Date
(3) Revision	3-11-83

STATE OF ILLINOIS
DEPARTMENT OF TRANSPORTATION
F.A.I. ROUTE 90/94 (DAN RYAN EXPRESSWAY)
SECTION 1985-080 R - COOK COUNTY
ROADWAY GRADING AND PAVING
MISCELLANEOUS DETAILS - ALL STRUCTURES
PEDESTRIAN RAILING - 6'

Scale: NONE
Date: AUGUST 14, 1987
Drawn By: REP
Checked By: WPK

ENVIRONMENTAL ENGINEERS INC.
Chicago, Illinois

USER NAME = dunkerleyb	DESIGNED -	REVISED
	CHECKED -	REVISED
PLOT SCALE = N.T.S.	DRAWN -	REVISED
PLOT DATE = 11/26/2013	CHECKED -	REVISED


STATE OF ILLINOIS
DEPARTMENT OF TRANSPORTATION

EXISTING AS-BUILTS SN 016-1088


SHEET NO. AS-26 OF AS-72 SHEETS

F.A.I. RTE.	SECTION	COUNTY	TOTAL SHEETS	SHEET NO.
90/94/290	2013-036R	COOK	256	168
				CONTRACT NO. 60W71
ILLINOIS FED. AID PROJECT -NUMBER-				




PROJECT NO.	SECTION	COUNTY	TOTAL SHEETS	SHEET NO.
90/94	B	COOK	79	78A
FED. AID PROJECT				
SECTION 1985-080 R				

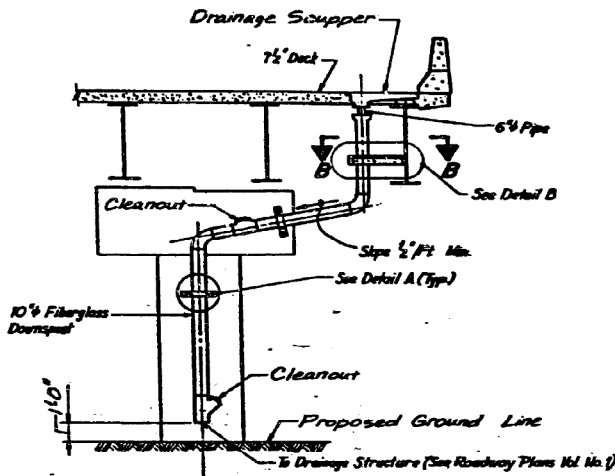

**TYPICAL SECTION OF SCUPPERS^②
AT PIER LOCATIONS**
Taylor St Exit Ramp Abutment No. 4
Taylor St Entrance Ramp Abutment No. 3

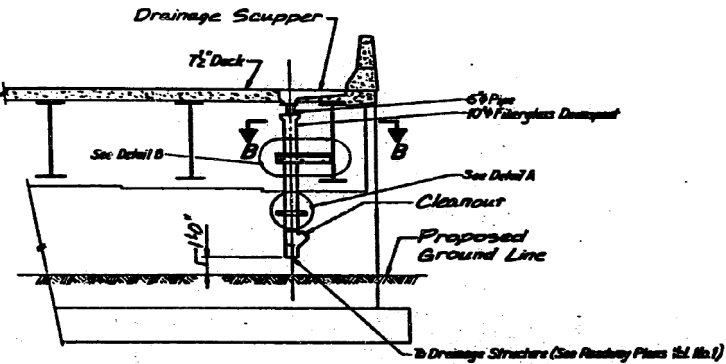

**TYPICAL SECTION OF SCUPPERS^②
AT ABUTMENT LOCATIONS**
Taylor St Exit Ramp Abutment No. 1
Taylor St Entrance Ramp Abutment No. 5

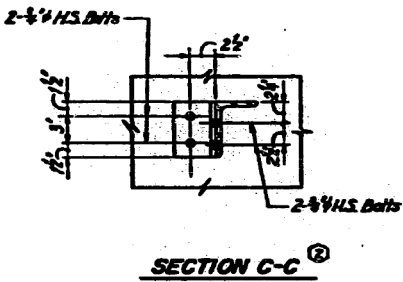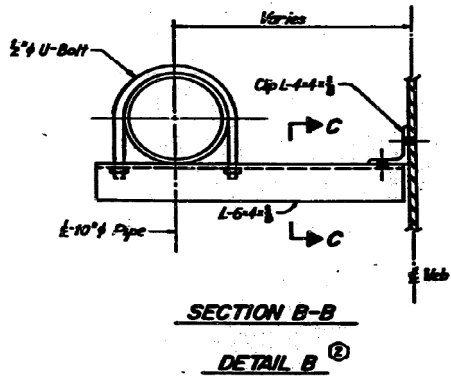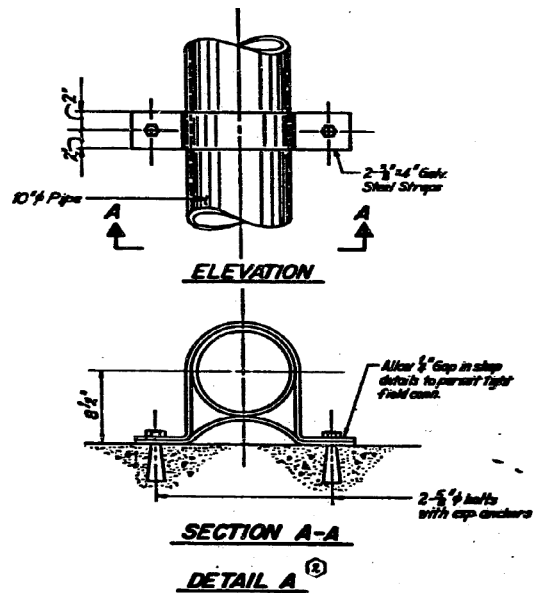

NOTES:
1. For Scupper Details, see Sigs MD 4 and MD 5 in this volume.
2. For Scupper Locations, see Sigs Exit 5 (Taylor St Exit Ramp) and Exit 4 (Taylor St Entrance Ramp).

BILL OF MATERIAL				
Item	Unit	Quantity	Total	
Downspout Drainage System	L.in. Ft.	34	35	67

SHEET MD7 OF 7		STATE OF ILLINOIS DEPARTMENT OF TRANSPORTATION F.A.I. ROUTE 90/94 (DAN RIVER EXPRESSWAY) SECTION 1985-080 R COOK COUNTY ROADWAY GRADING AND PAVING DECK DRAINAGE TYPICAL DETAILS AND SECTIONS Scale: NONE Date: AUG. 14, 1987 Checked By: W.P.K.	
REVISIONS		ENGINEERING CONSULTANTS CHICAGO, ILLINOIS	
Name	Date		
(1) Amend	2-3-88		

Δ New Sheet-Nov. 23, 1987



USER NAME = dunkerleyb	DESIGNED -	REVISED
	CHECKED -	REVISED
PLOT SCALE = N.T.S.	DRAWN -	REVISED
PLOT DATE = 11/26/2013	CHECKED -	REVISED

STATE OF ILLINOIS
DEPARTMENT OF TRANSPORTATION

EXISTING AS-BUILTS SN 016-1088

SHEET NO. AS-27 OF AS-72 SHEETS

F.A.I. RTE.	SECTION	COUNTY	TOTAL SHEETS	SHEET NO.
90/94/290	2013-036R	COOK	256	169
CONTRACT NO. 60W71				
ILLINOIS FED. AID PROJECT -NUMBER-				

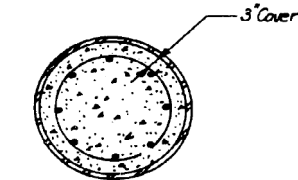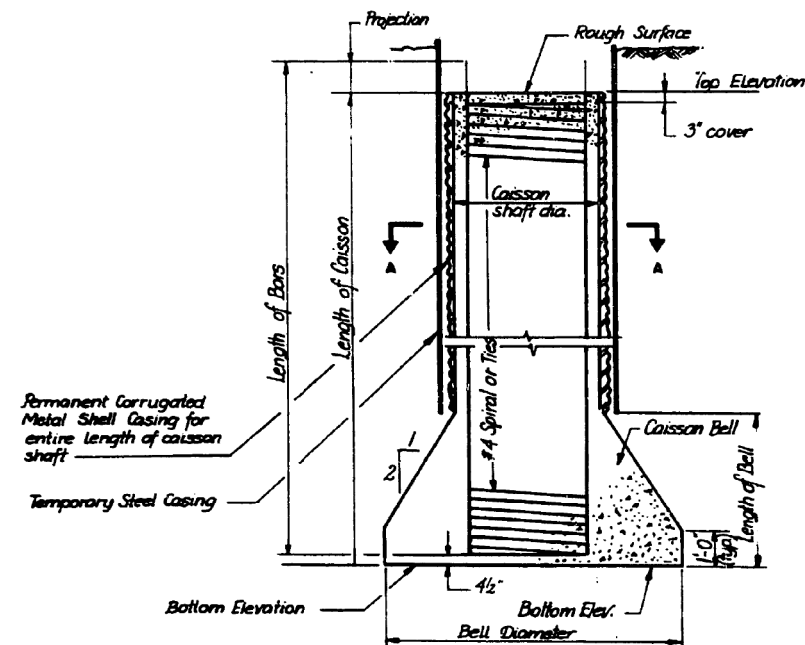

SECTION A-A
(Temporary Steel Casing
not shown in section A-A)

CAISSON SECTION

FEDERAL AID ROUTE NO.	SECTION	COUNTY	TOTAL SHEETS	SHEET NO.
90/94	#	COOK	79	798
ILLINOIS FED. AID PROJECT				

- Notes:**
- 1) Specific details for caissons as shown in the caisson section can be found on the following sheets:
Sheet Ent 12 for Taylor Street Exit Ramp Bent Nos. 3 & 4
Sheet ENT 12 for Taylor Street Entrance Ramp Bent Nos. 1 & 2
Sheet ENT 13 for Taylor Street Entrance Ramp Bent Nos. 3 & 4
Sheet S4 for Harrison Street Bridge Pier Nos. 1 & 2
Sheet EN2 for Ramp E-N Pier Nos. 27 & 28
 - 2) Annular space between the temporary casing and permanent metal shell shall be back filled with grout before removing the temporary casing.

SHEET MD 8 OF 8

REVISIONS	
Name	Date

STATE OF ILLINOIS
DEPARTMENT OF TRANSPORTATION
F.A.I. ROUTE 90/94 (DAN RYAN EXPRESSWAY)
SECTION 285-080 R - COOK COUNTY
ROADWAY GRADING AND PAVING
MISCELLANEOUS DETAILS - ALL STRUCTURES
TYPICAL CAISSON DETAILS
Scale: NONE
Date: AUG. 14, 1987
Drawn By: D.S.
Checked By: W.F.N.
ENVIRONMENTAL ENGINEERS INC.
Chicago, Illinois

△ New sheet 12-7-87


USER NAME = dunkerleyb	DESIGNED -	REVISED
	CHECKED -	REVISED
PLOT SCALE = N.T.S.	DRAWN -	REVISED
PLOT DATE = 11/26/2013	CHECKED -	REVISED

STATE OF ILLINOIS
DEPARTMENT OF TRANSPORTATION


EXISTING AS-BUILTS SN 016-1088


SHEET NO. AS-28 OF AS-72 SHEETS

F.A.I. RTE.	SECTION	COUNTY	TOTAL SHEETS	SHEET NO.
90/94/290	2013-036R	COOK	256	170
CONTRACT NO. 60W71				
ILLINOIS FED. AID PROJECT -NUMBER-				

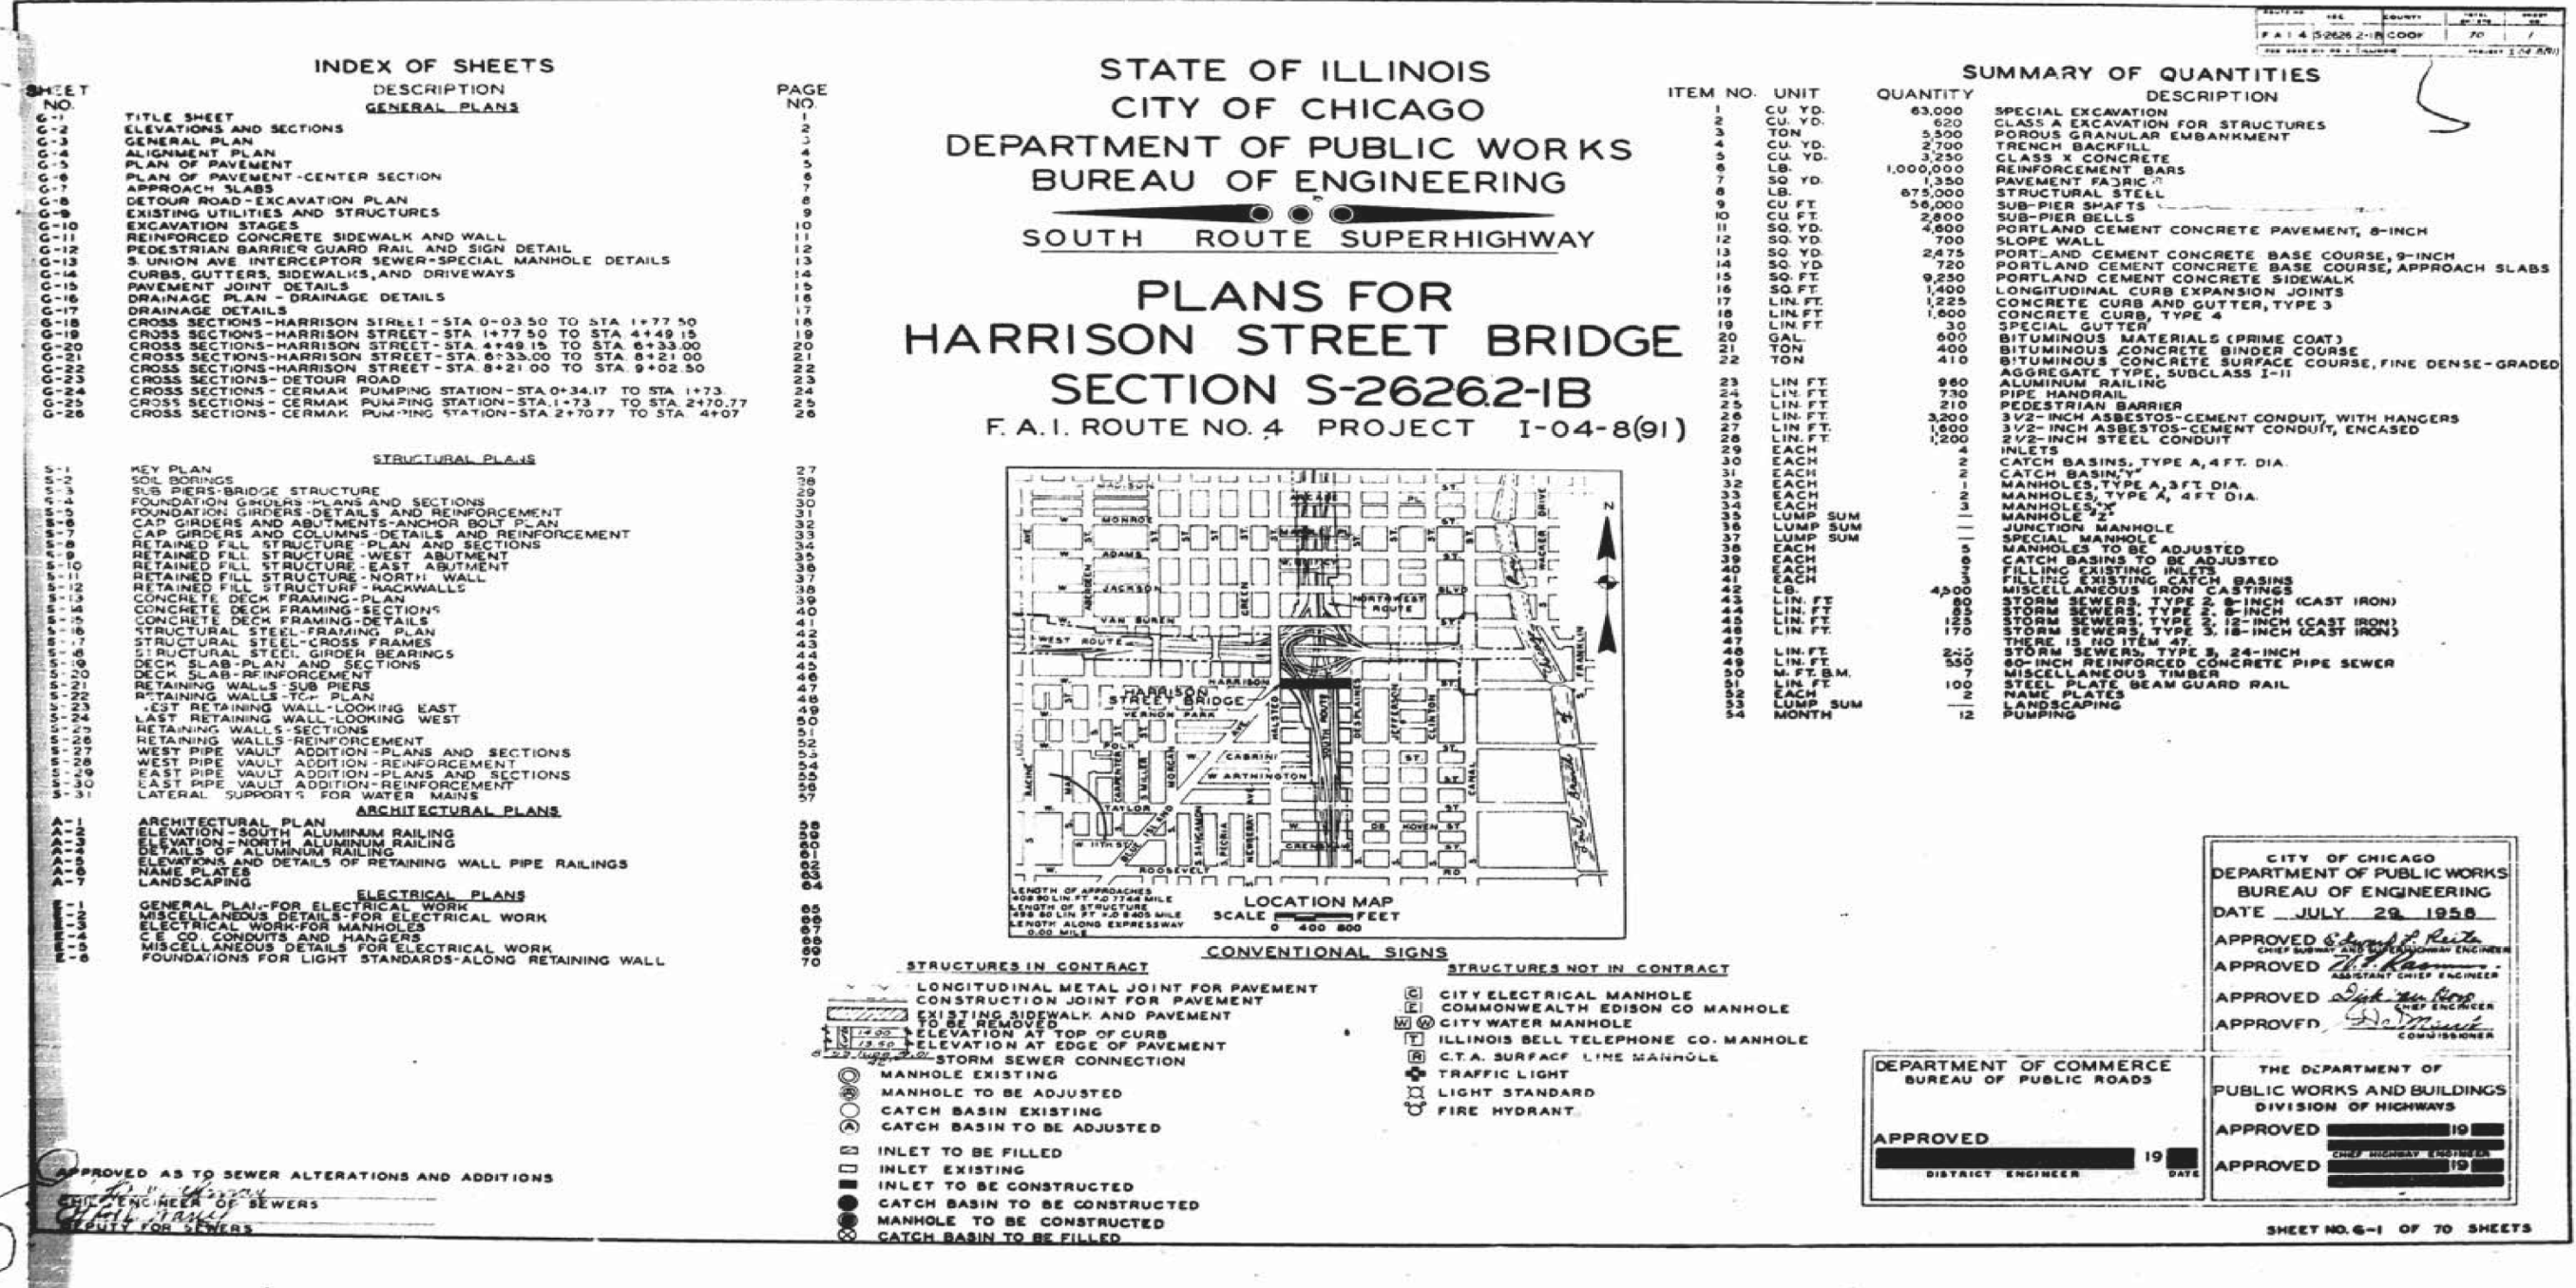

FOR INFORMATION ONLY

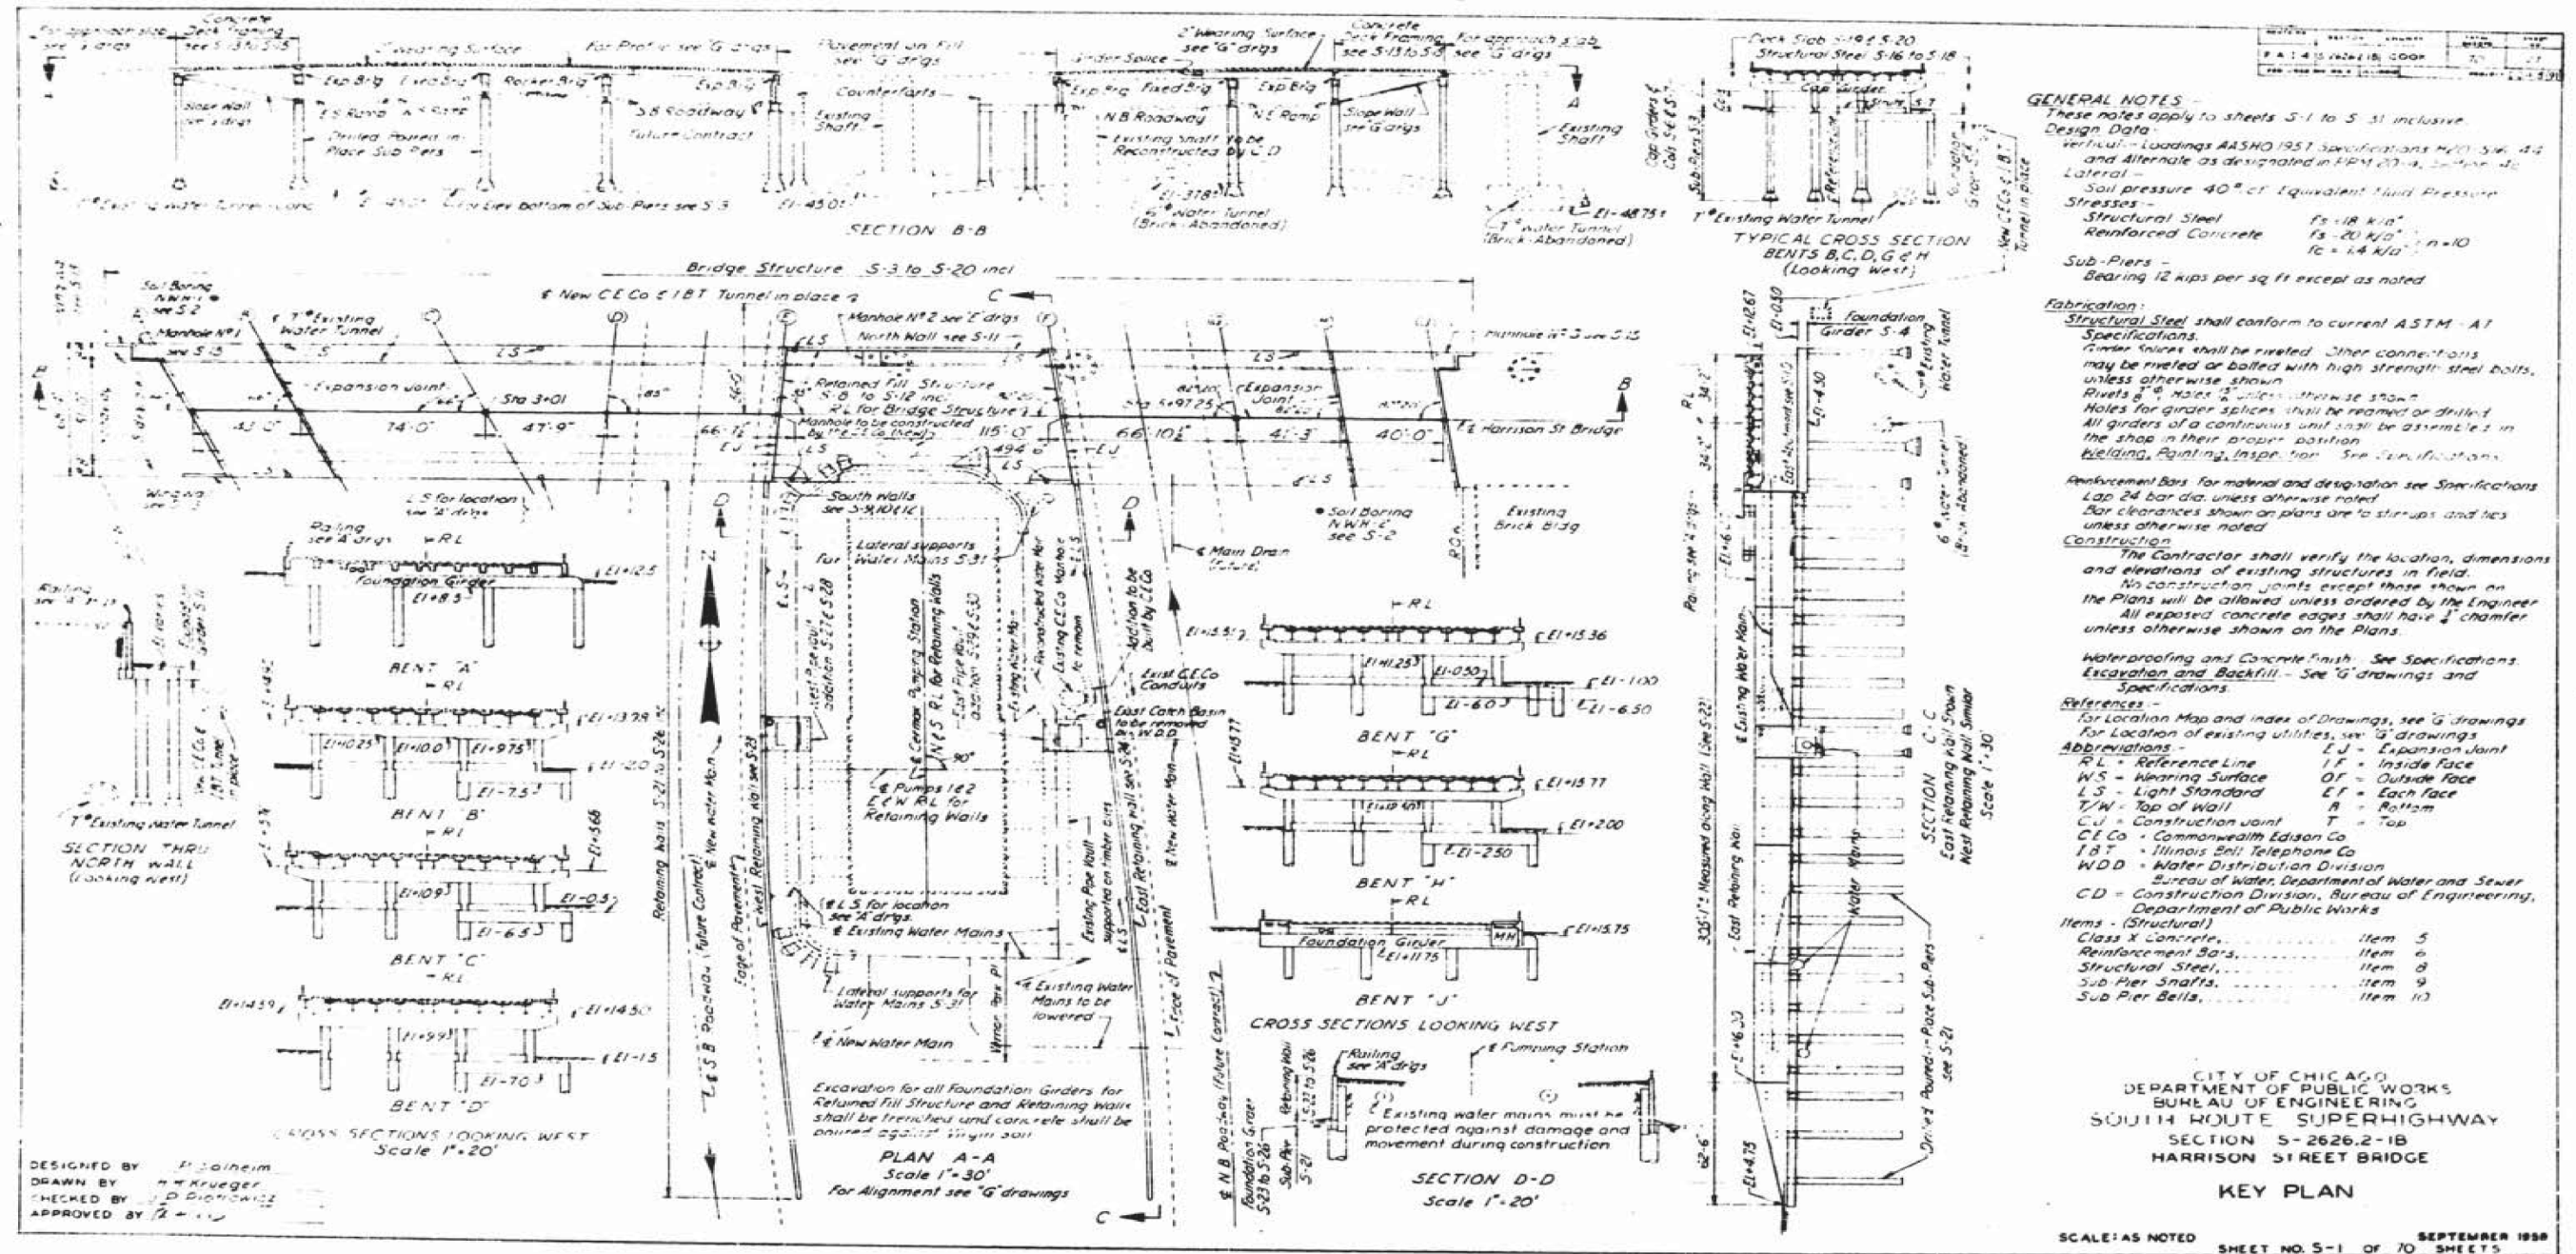

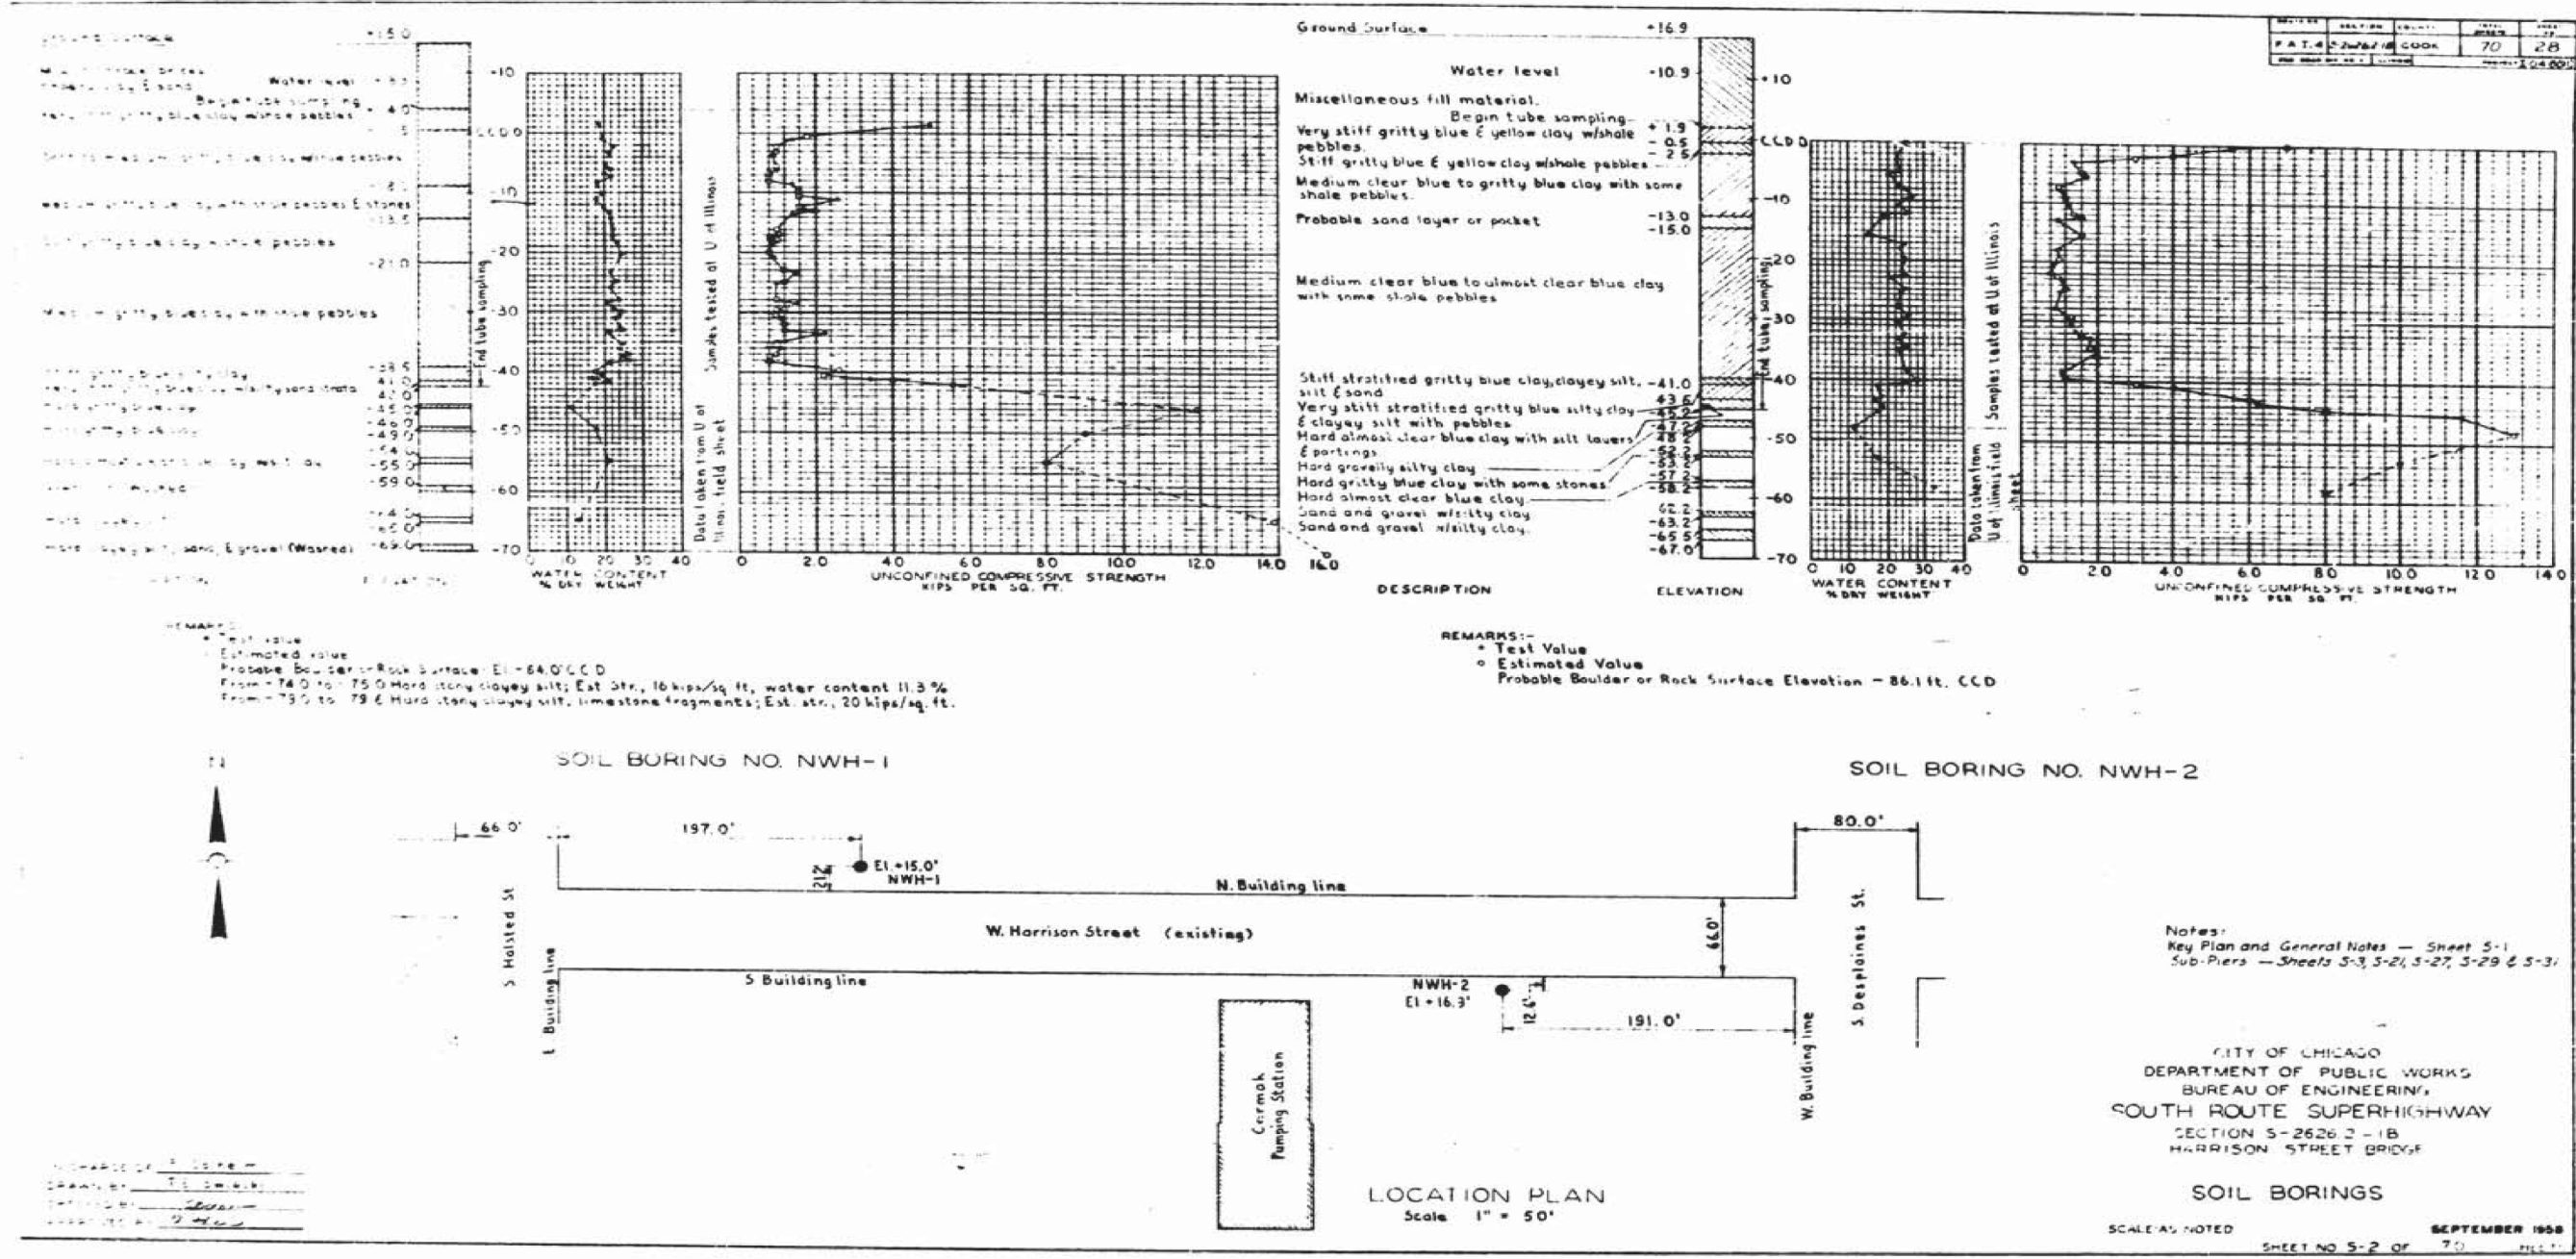


USER NAME = dunkerleyb	DESIGNED -	REVISED
	CHECKED -	REVISED
PLOT SCALE = N.T.S.	DRAWN -	REVISED
PLOT DATE = 11/26/2013	CHECKED -	REVISED

STATE OF ILLINOIS
DEPARTMENT OF TRANSPORTATION

EXISTING AS-BUILTS SN 016-1088

SHEET NO. AS-31 OF AS-72 SHEETS

F.A.I. RTE.	SECTION	COUNTY	TOTAL SHEETS	SHEET NO.
90/94/290	2013-036R	COOK	256	173
CONTRACT NO. 60W71				
ILLINOIS FED. AID PROJECT -NUMBER-				

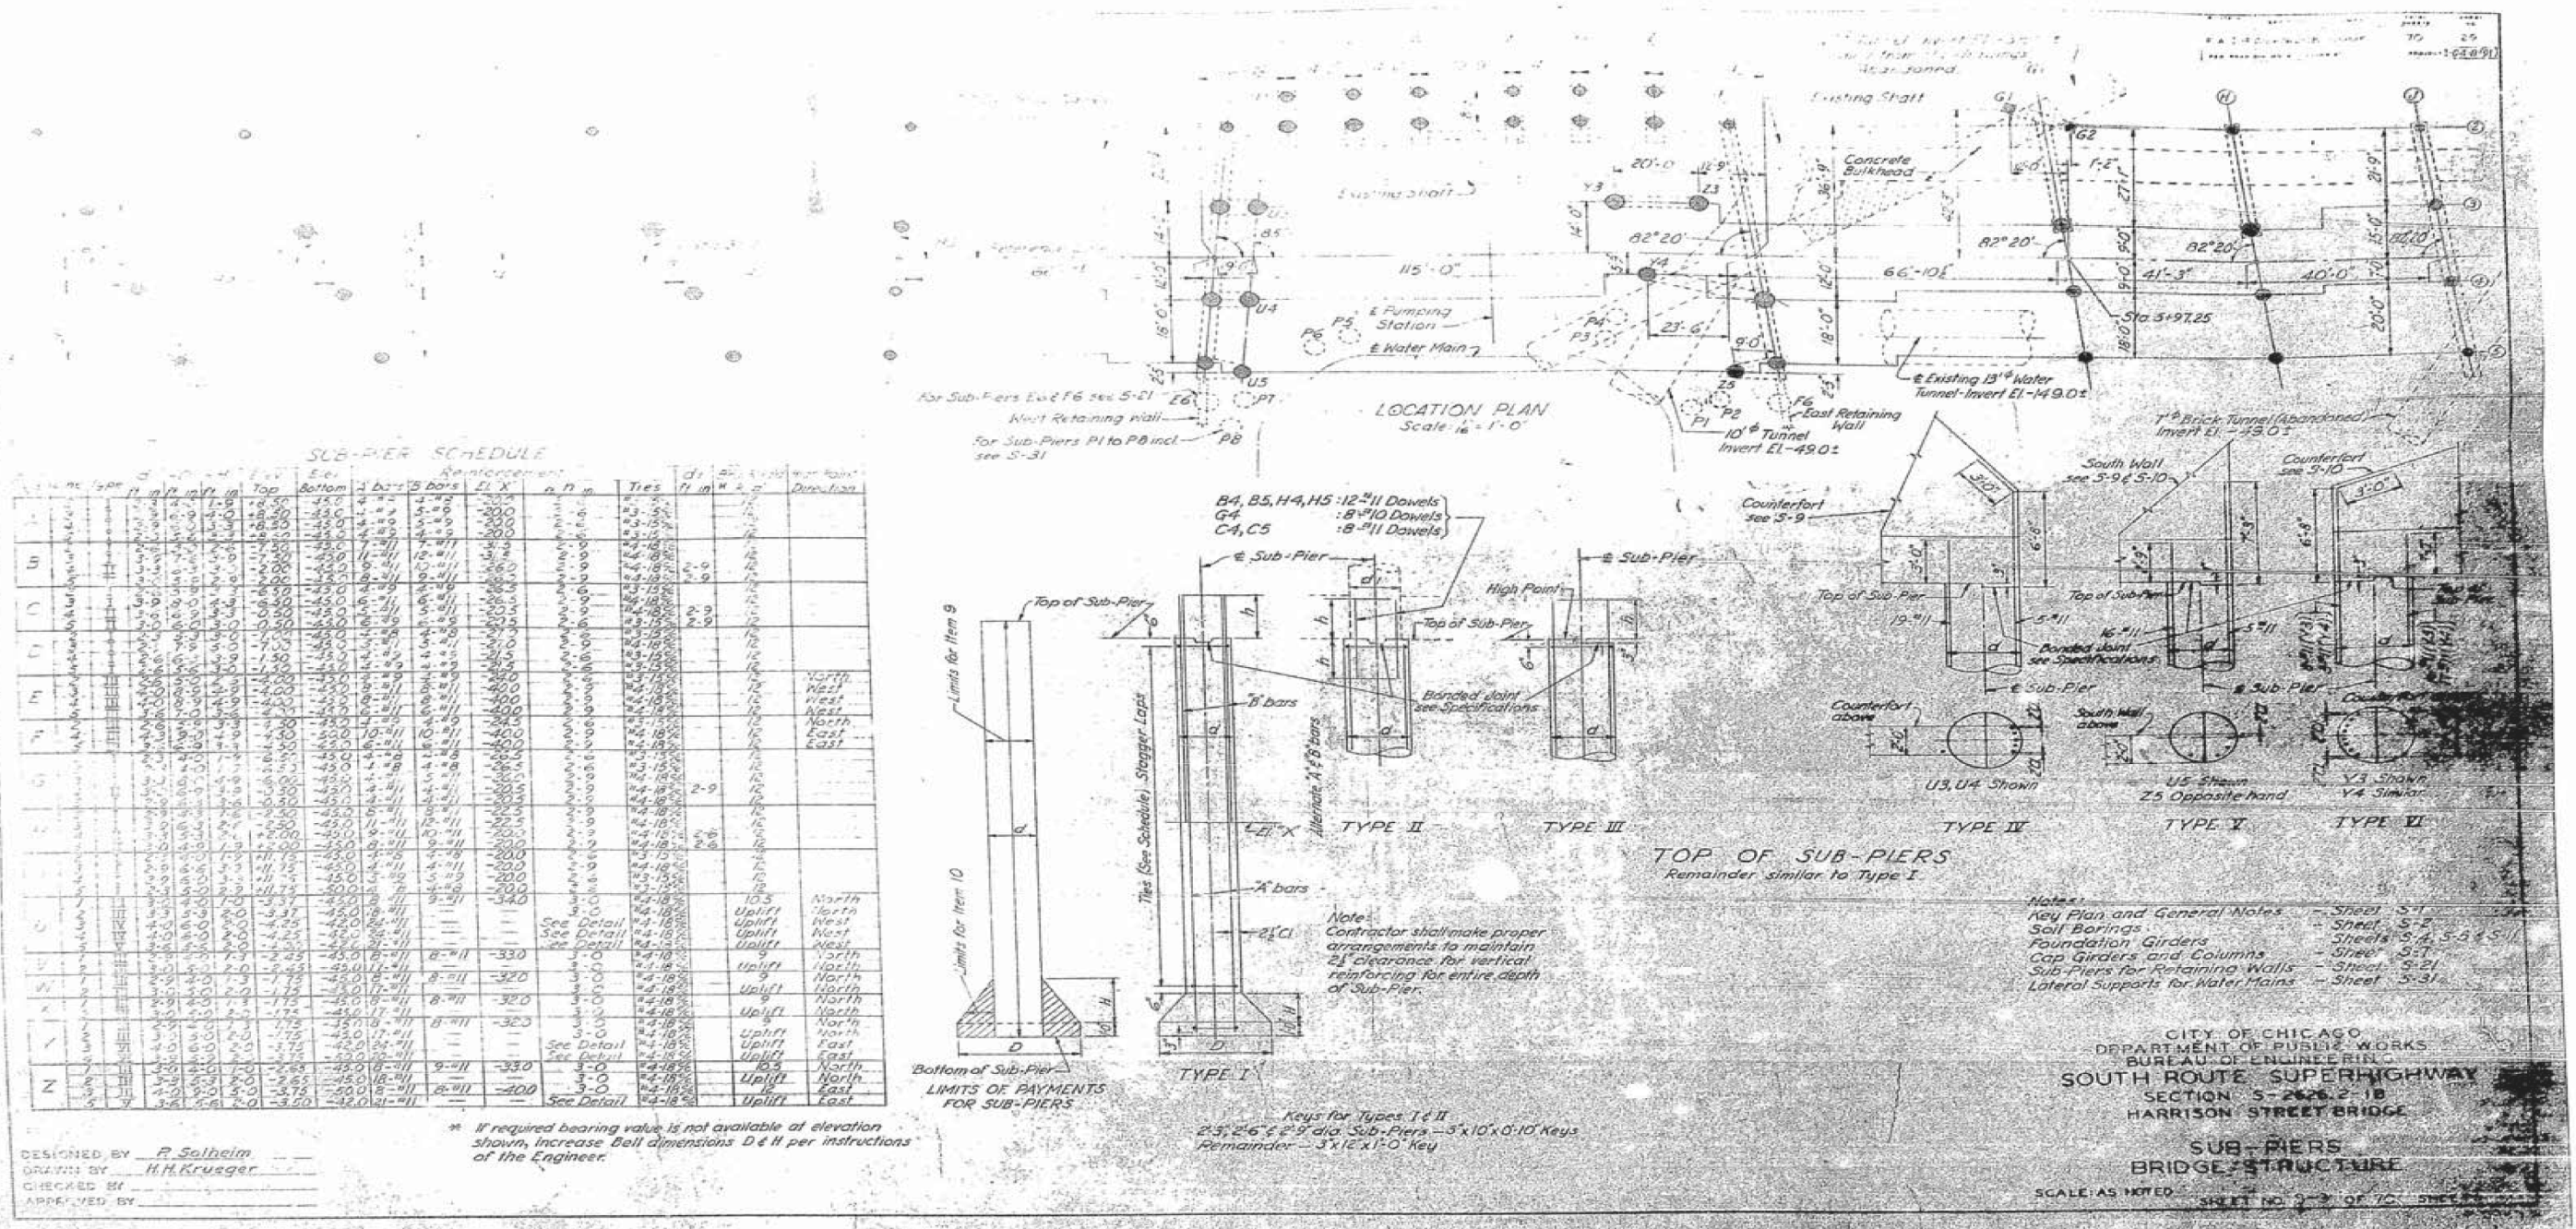

USER NAME = dunkerleyb	DESIGNED =	REVISED =
	CHECKED =	REVISED =
PLOT SCALE = N.T.S.	DRAWN =	REVISED =
PLOT DATE = 11/26/2013	CHECKED =	REVISED =


STATE OF ILLINOIS
DEPARTMENT OF TRANSPORTATION

EXISTING AS-BUILTS SN 016-1088

SHEET NO. AS-32 OF AS-72 SHEETS

F.A.I. RTE.	SECTION	COUNTY	TOTAL SHEETS	SHEET NO.
90/94/290	2013-036R	COOK	256	174
CONTRACT NO. 60W71				
ILLINOIS FED. AID PROJECT -NUMBER-				

FOR INFORMATION ONLY

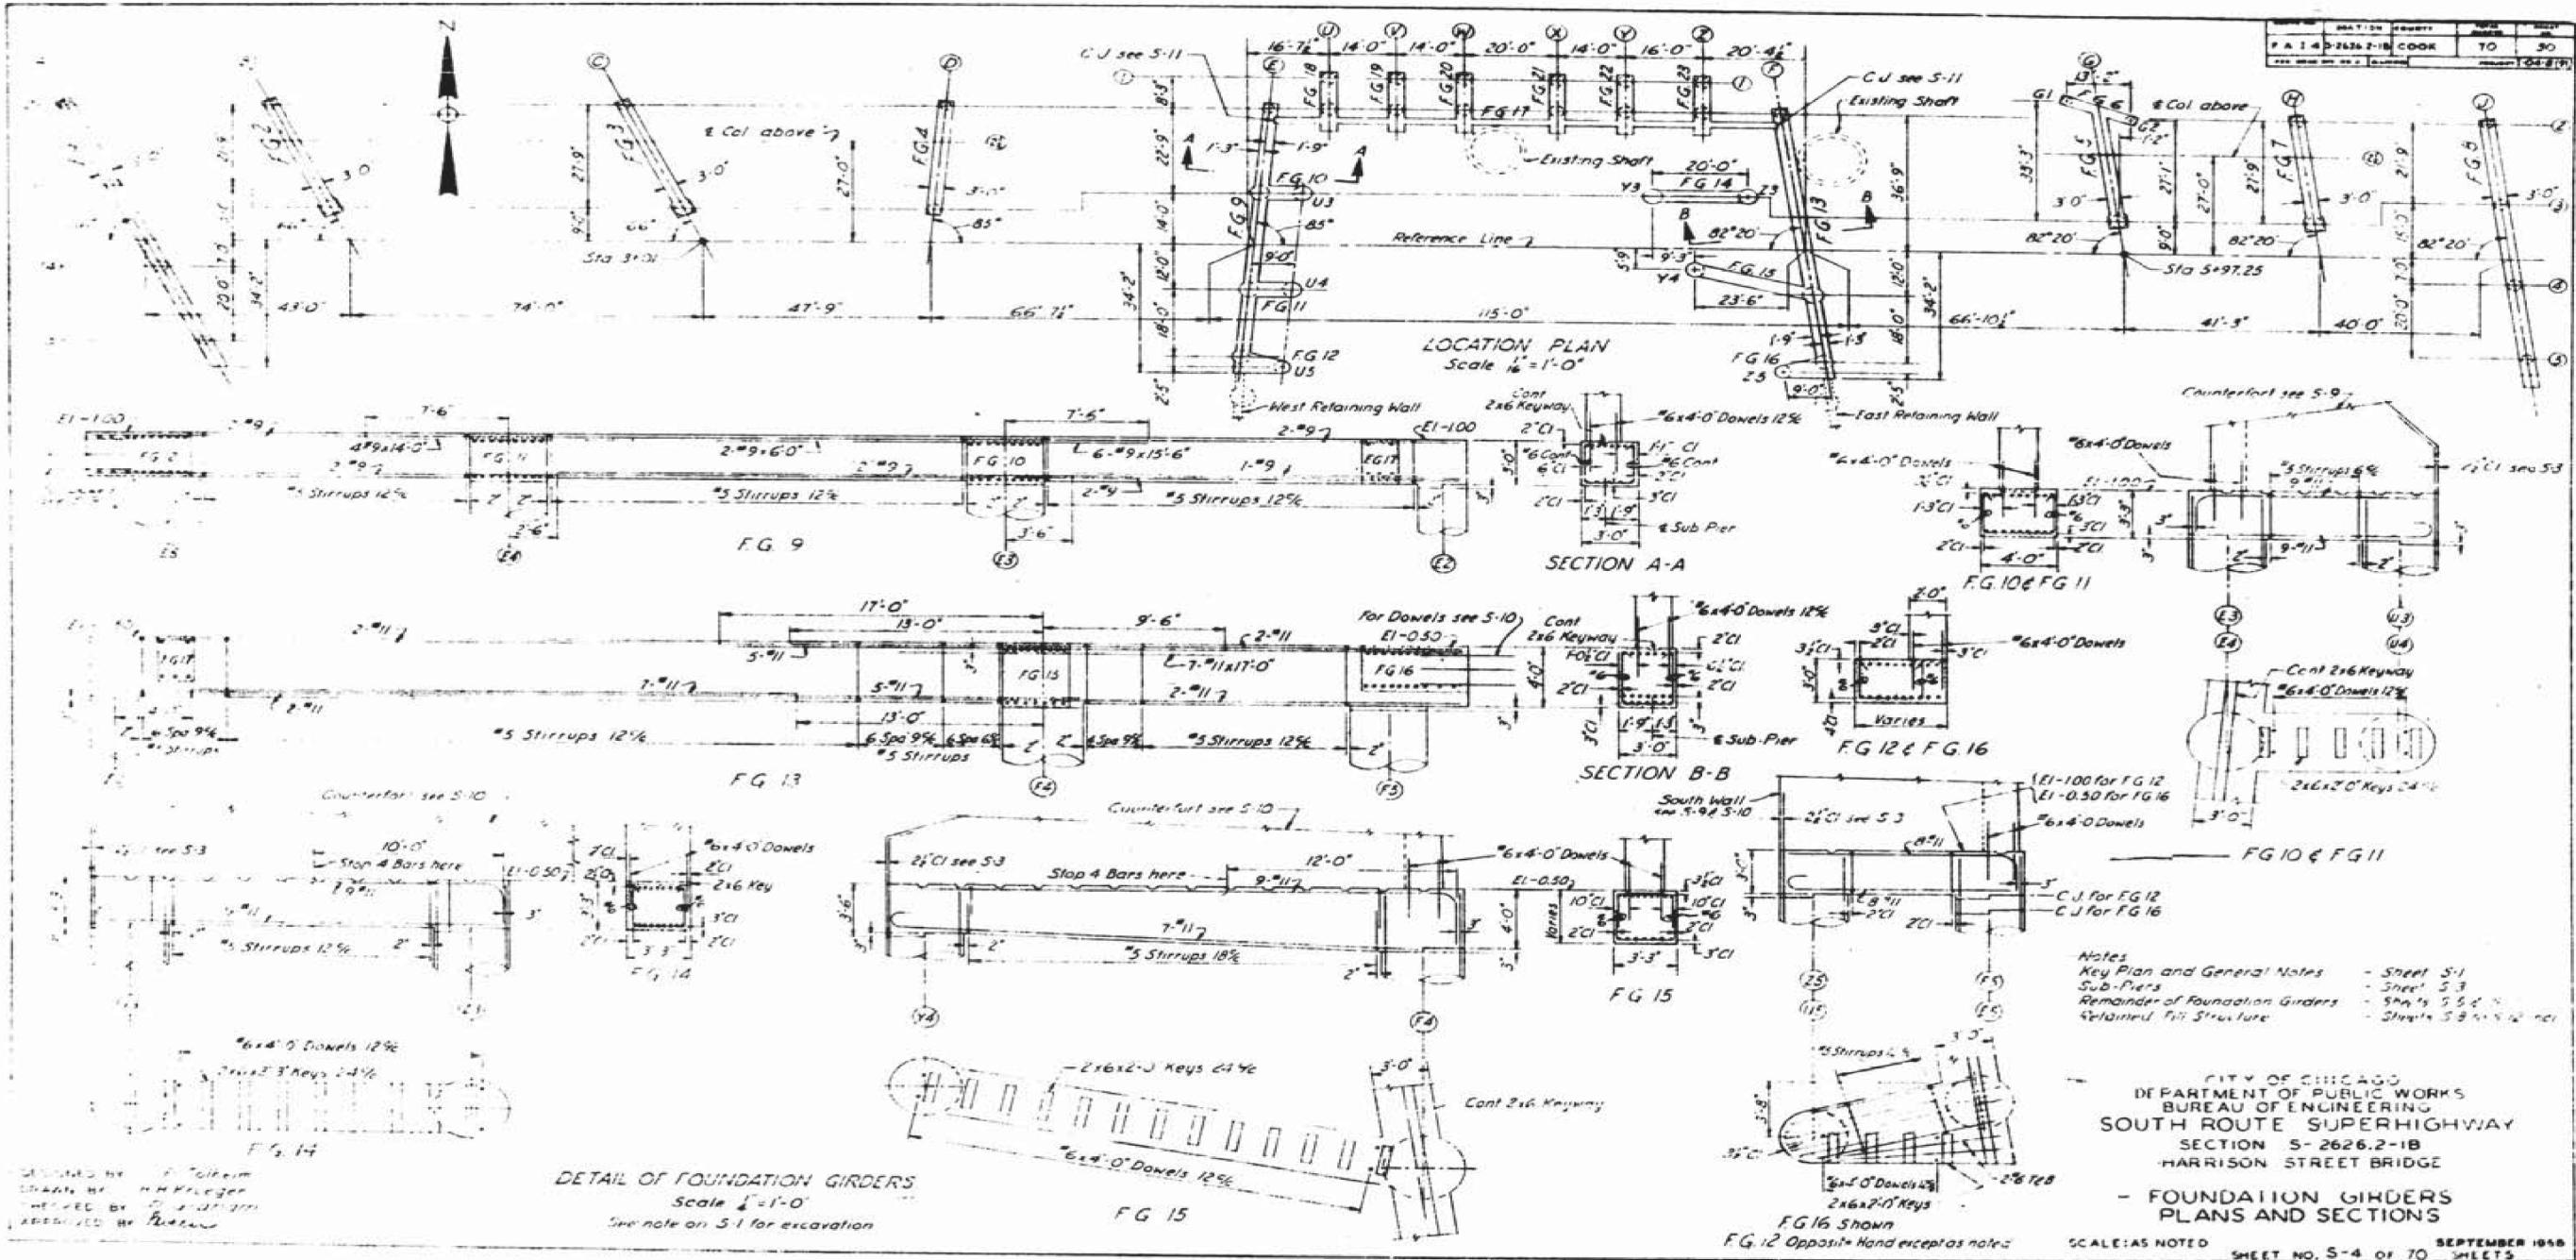

USER NAME = dunkerleyb	DESIGNED -	REVISED
	CHECKED -	REVISED
PLOT SCALE = N.T.S.	DRAWN -	REVISED
PLOT DATE = 11/26/2013	CHECKED -	REVISED

STATE OF ILLINOIS
DEPARTMENT OF TRANSPORTATION


EXISTING AS-BUILTS SN 016-1088

SHEET NO. AS-33 OF AS-72 SHEETS

F.A.I. RTE.	SECTION	COUNTY	TOTAL SHEETS	SHEET NO.
90/94/290	2013-036R	COOK	256	175
CONTRACT NO. 60W71				
ILLINOIS FED. AID PROJECT -NUMBER-				

D:\60W71-shr-AS-BUILT-33.dgn

FOR INFORMATION ONLY

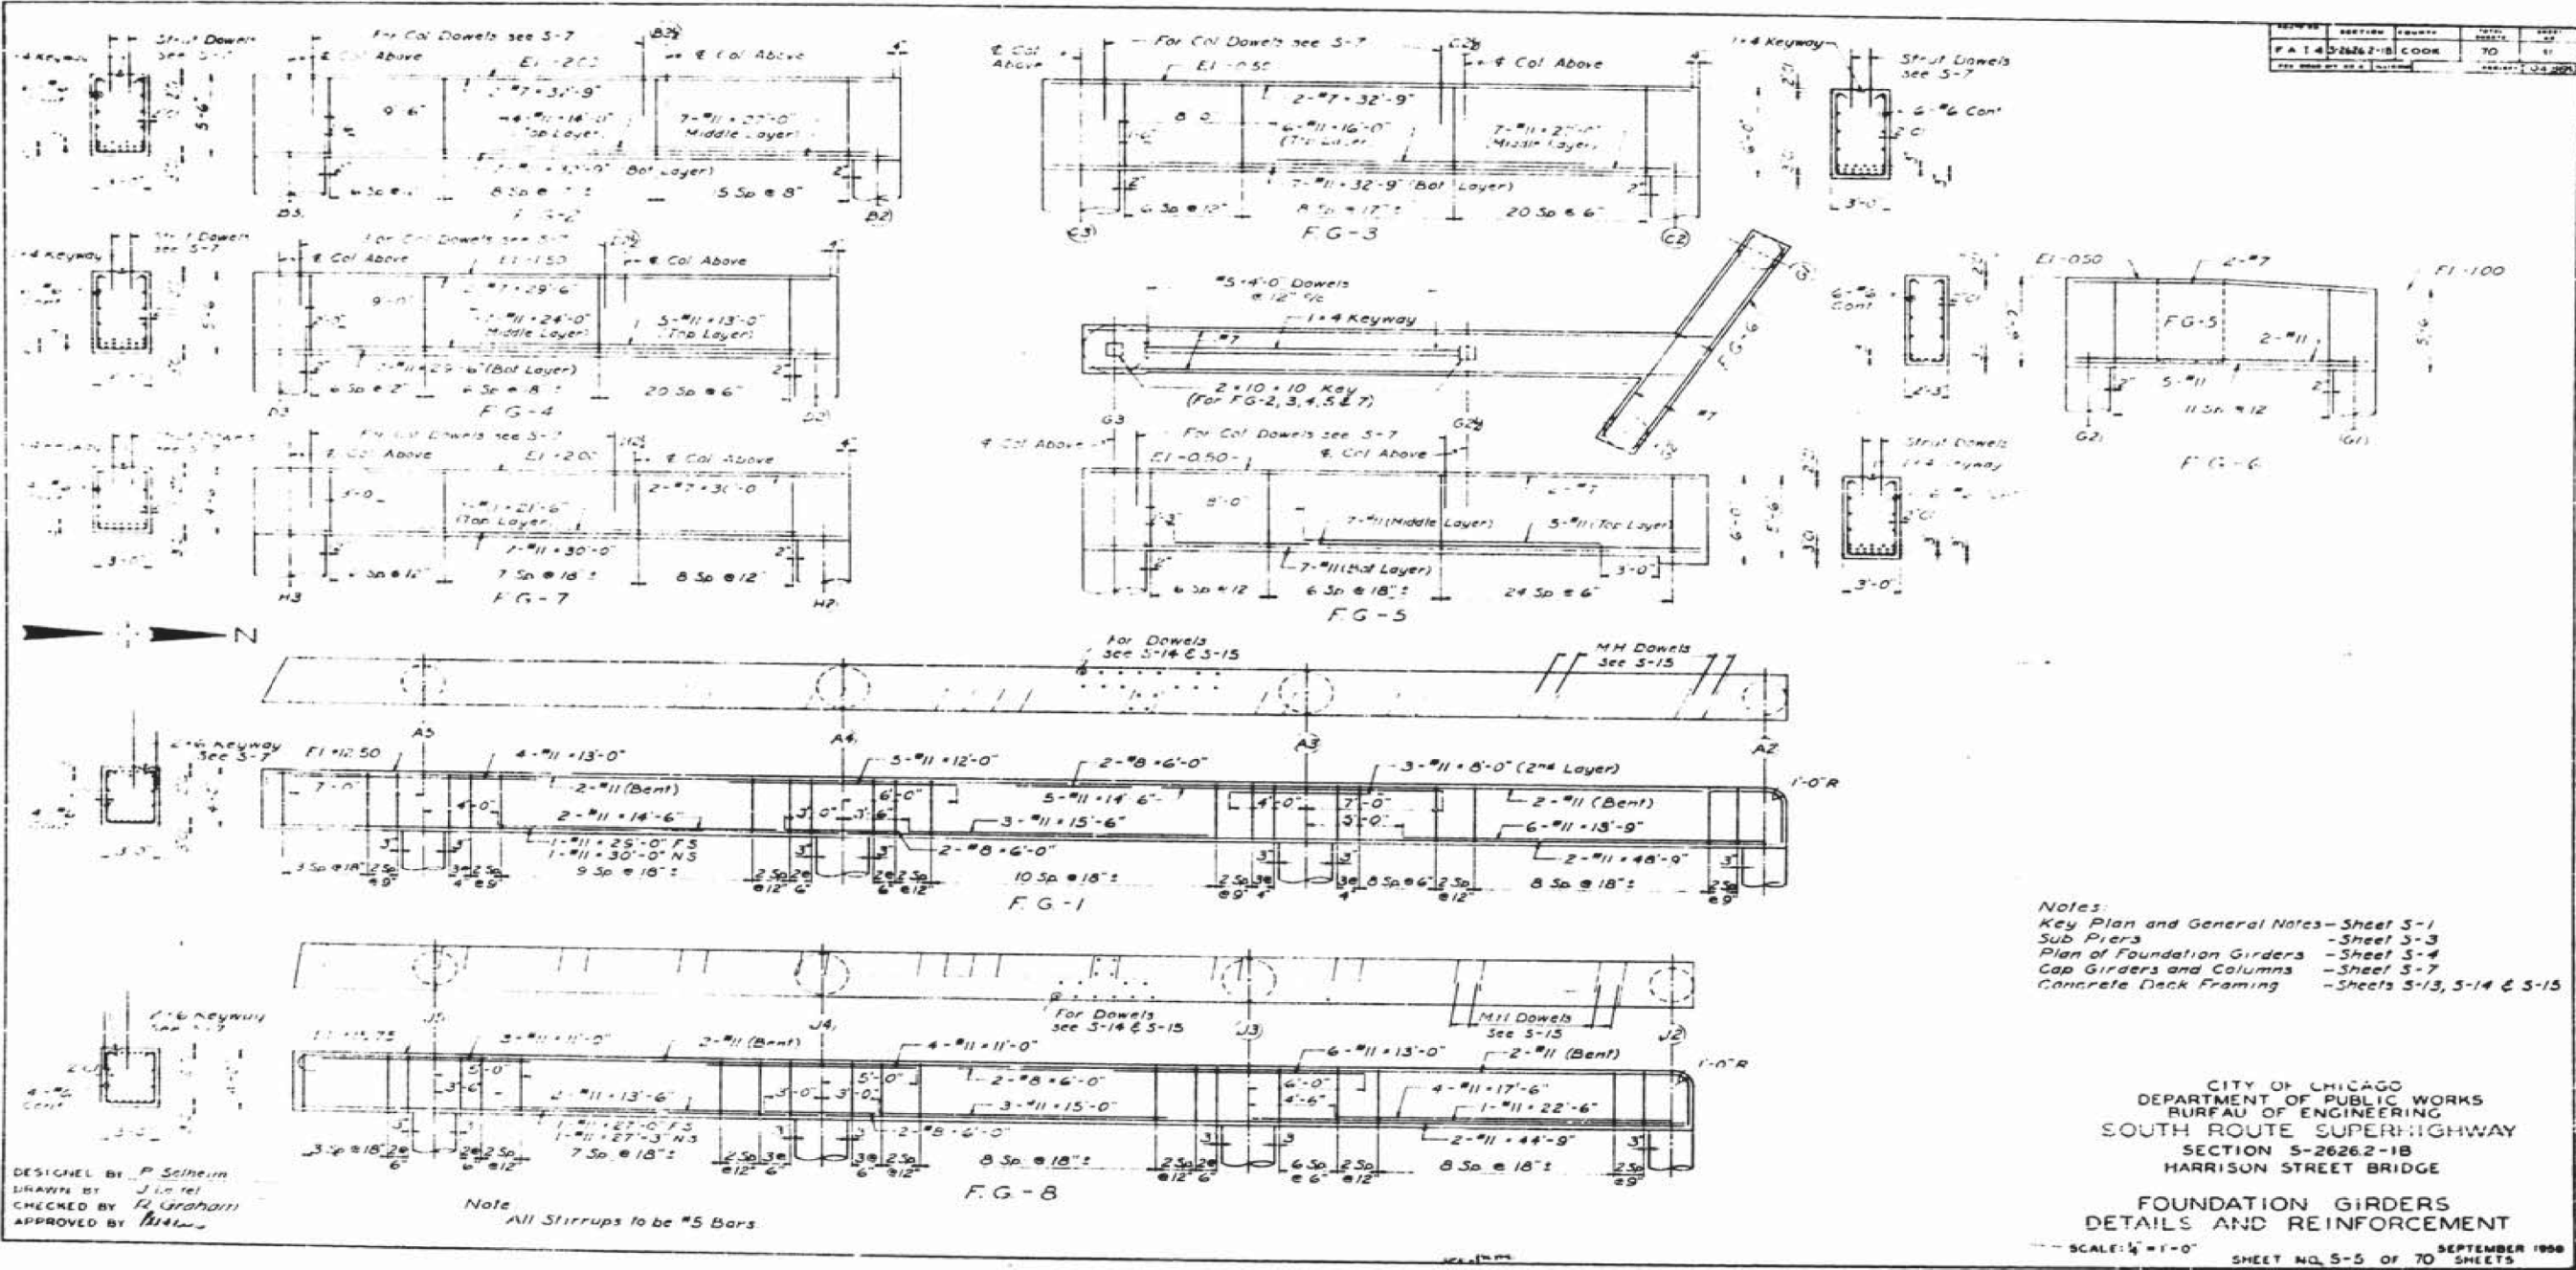

USER NAME = dunkerleyb	DESIGNED -	REVISED -
	CHECKED -	REVISED -
PLOT SCALE = N.T.S.	DRAWN -	REVISED -
PLOT DATE = 11/26/2013	CHECKED -	REVISED -

STATE OF ILLINOIS
DEPARTMENT OF TRANSPORTATION


EXISTING AS-BUILTS SN 016-1088

SHEET NO. AS-34 OF AS-72 SHEETS

F.A.I. RTE.	SECTION	COUNTY	TOTAL SHEETS	SHEET NO.
90/94/290	2013-036R	COOK	256	176
CONTRACT NO. 60W71				
ILLINOIS FED. AID PROJECT -NUMBER-				

D:\60W71-shr-AS-BUILT-34.dgn

FOR INFORMATION ONLY

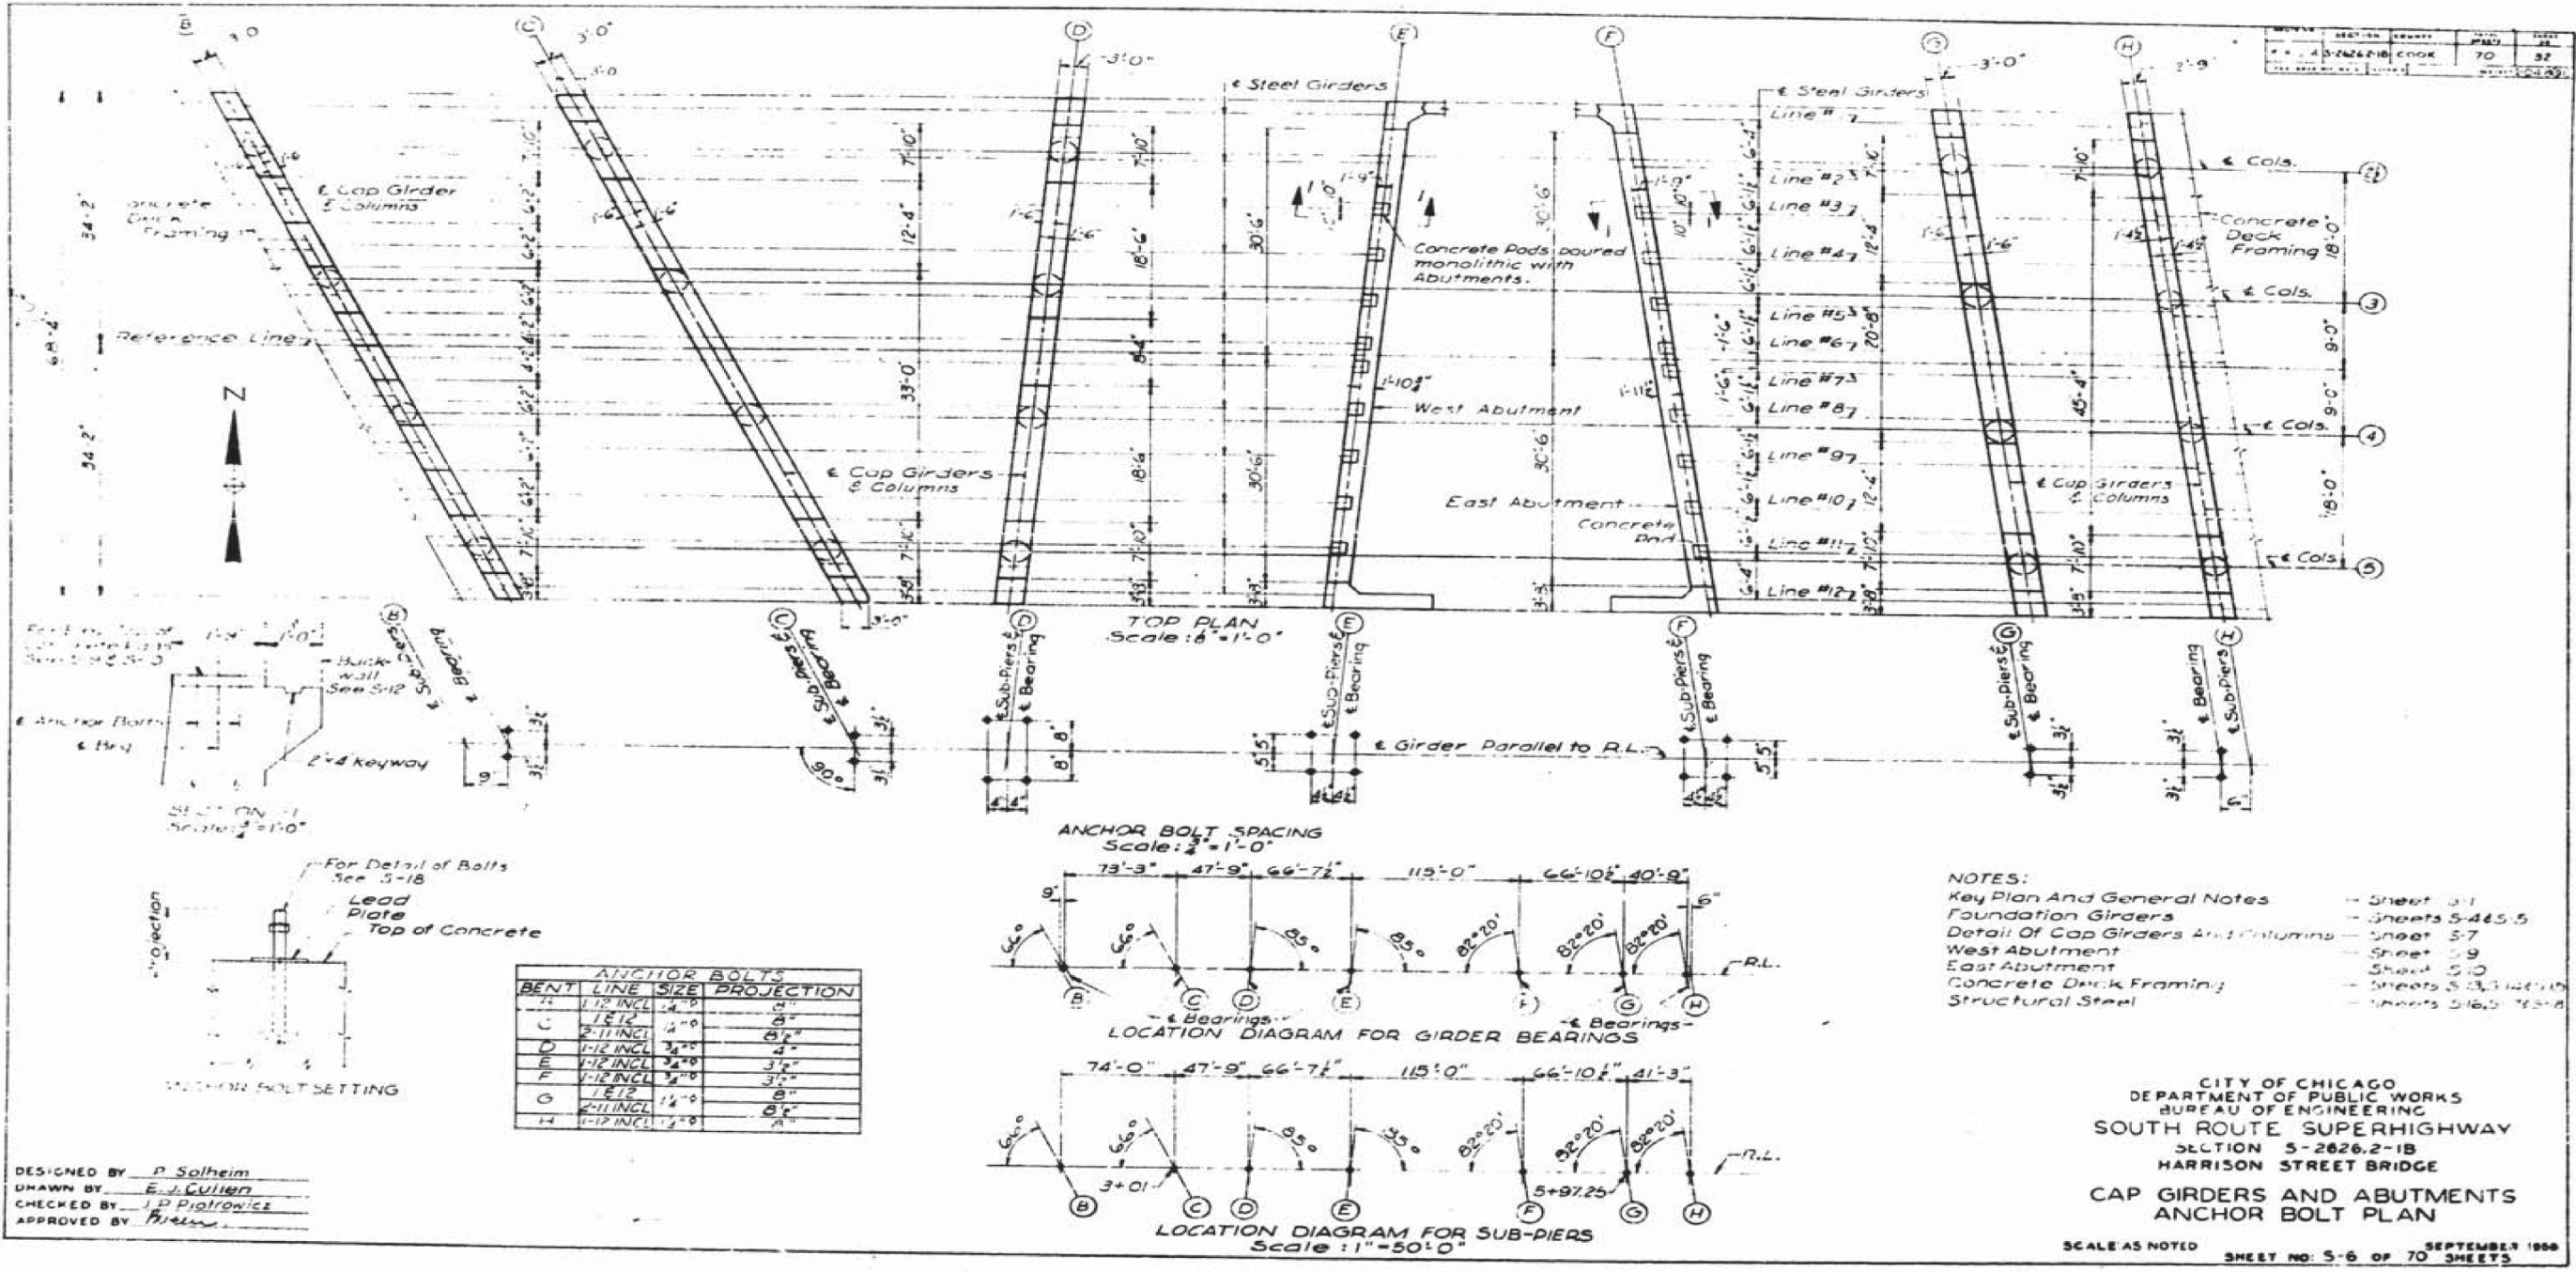

DESIGNED BY: P. Solheim
DRAWN BY: E. J. GILLEN
CHECKED BY: J. P. Piotrowicz
APPROVED BY: [Signature]


STATE OF ILLINOIS
DEPARTMENT OF TRANSPORTATION

EXISTING AS-BUILTS SN 016-1088

SHEET NO. AS-35 OF AS-72 SHEETS

F.A.I. RTE.	SECTION	COUNTY	TOTAL SHEETS	SHEET NO.
90/94/290	2013-036R	COOK	256	177
CONTRACT NO. 60W71				
ILLINOIS FED. AID PROJECT -NUMBER-				

D:\60W71-shr-AS-BUILT-35.dgn

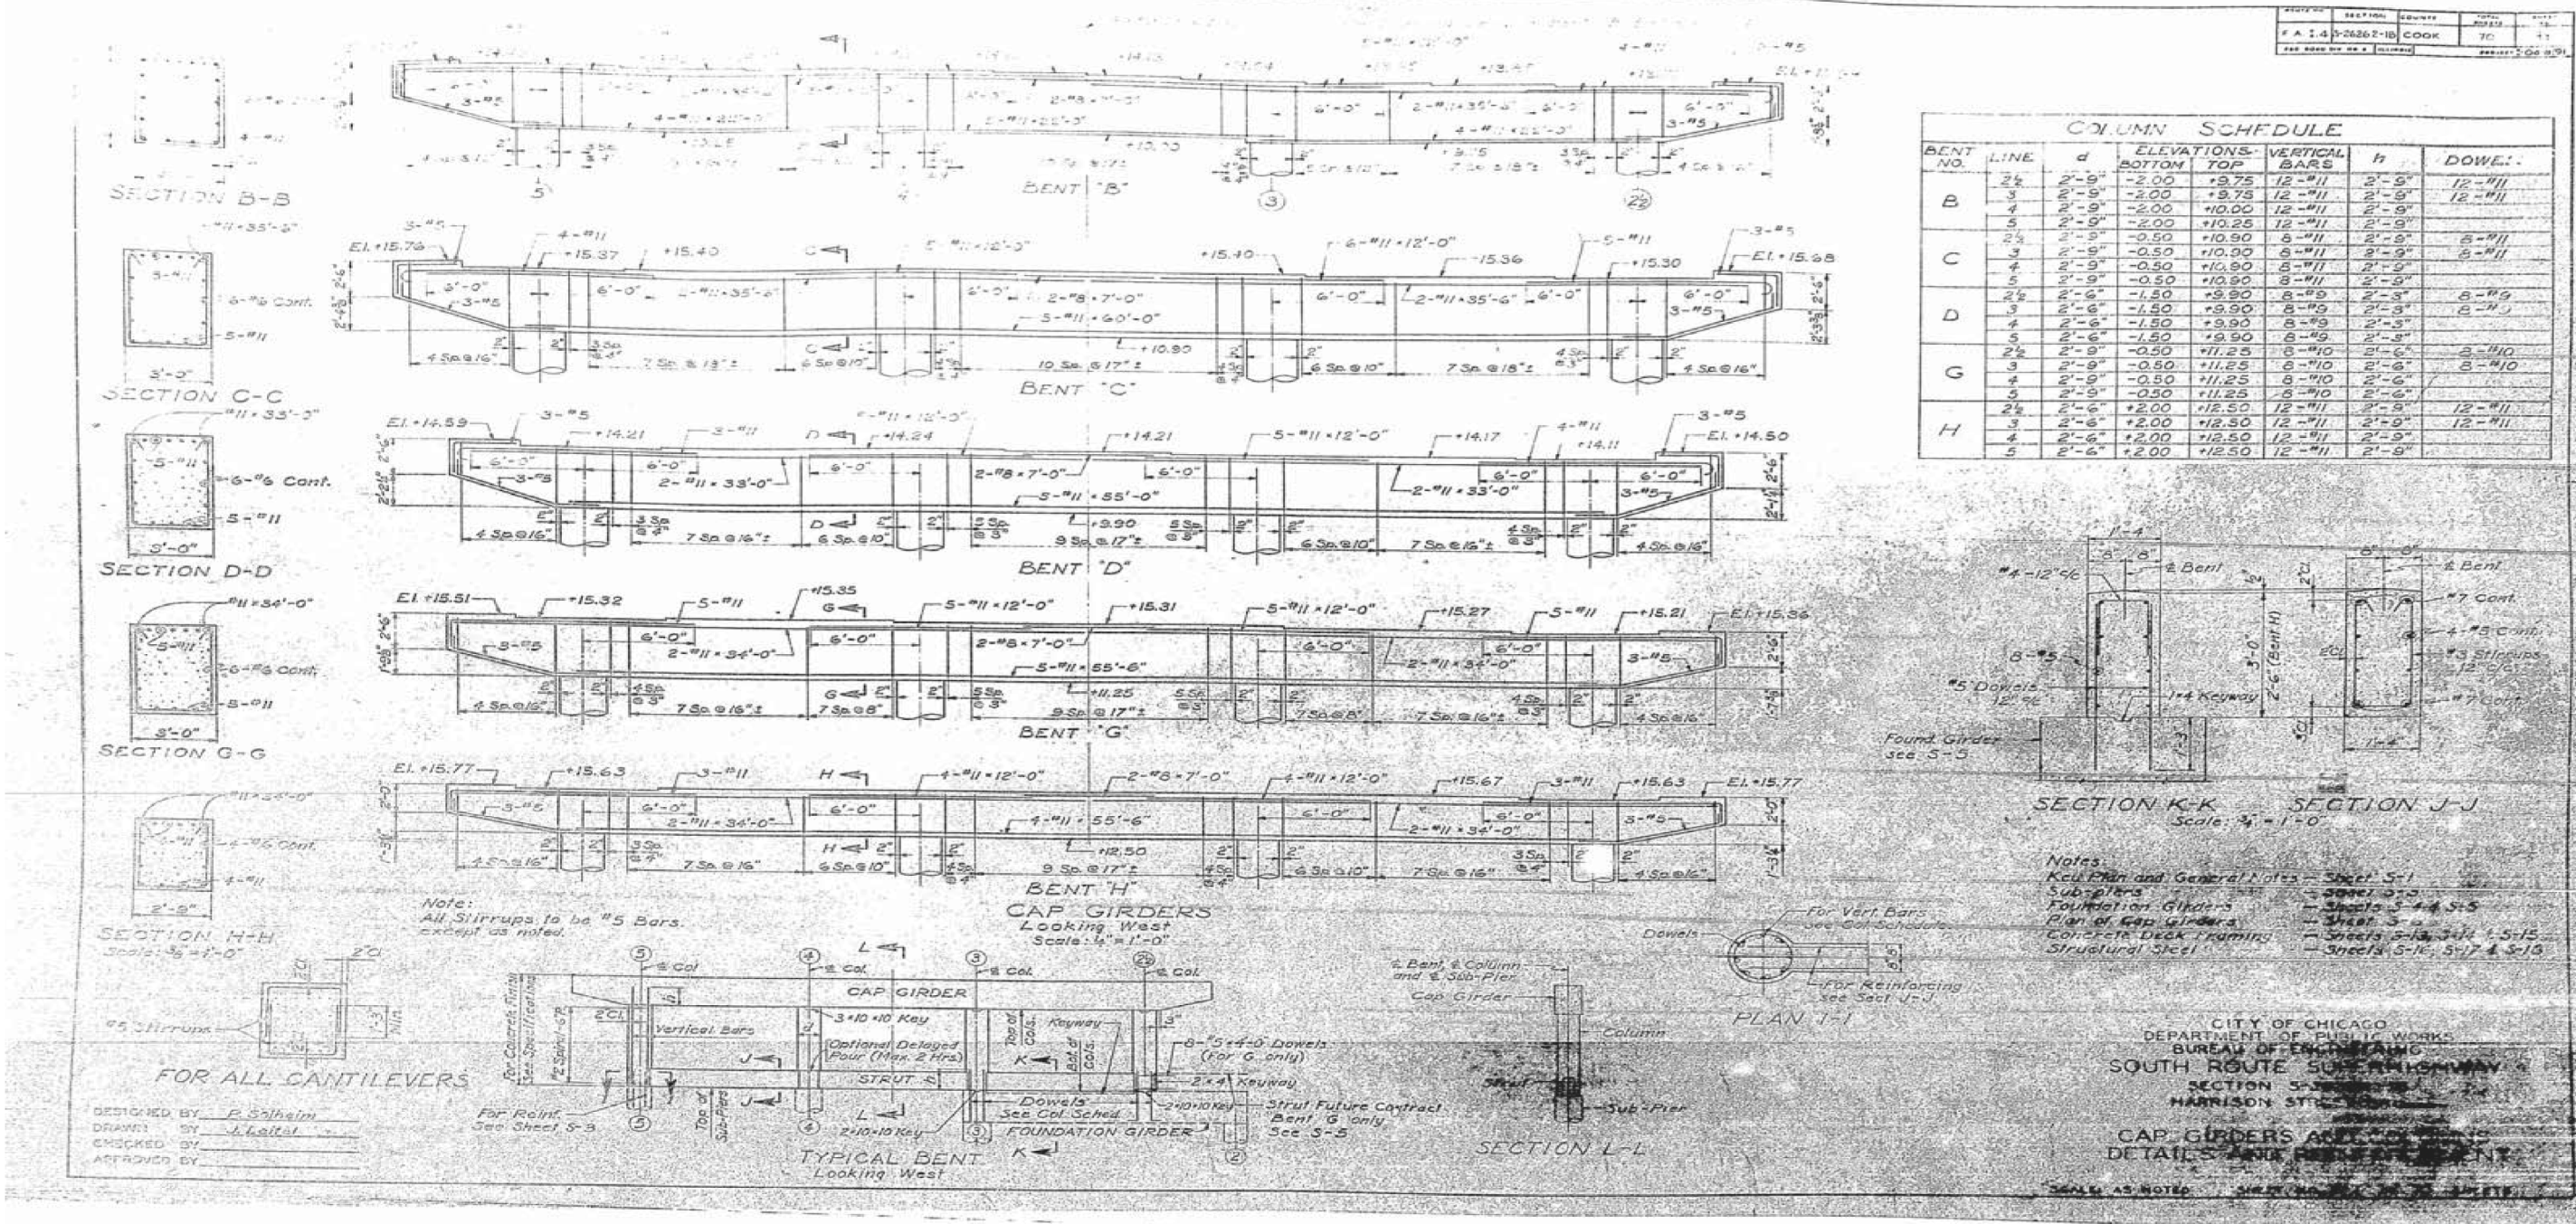

D:\60W71-shr-AS-BUILT-36.dgn


USER NAME = dunkerleyb	DESIGNED -	REVISED
	CHECKED -	REVISED
PLOT SCALE = N.T.S.	DRAWN -	REVISED
PLOT DATE = 11/26/2013	CHECKED -	REVISED

STATE OF ILLINOIS
DEPARTMENT OF TRANSPORTATION

EXISTING AS-BUILTS SN 016-1088

SHEET NO. AS-36 OF AS-72 SHEETS

F.A.I. RTE.	SECTION	COUNTY	TOTAL SHEETS	SHEET NO.
90/94/290	2013-036R	COOK	256	178
CONTRACT NO. 60W71				
ILLINOIS FED. AID PROJECT -NUMBER-				

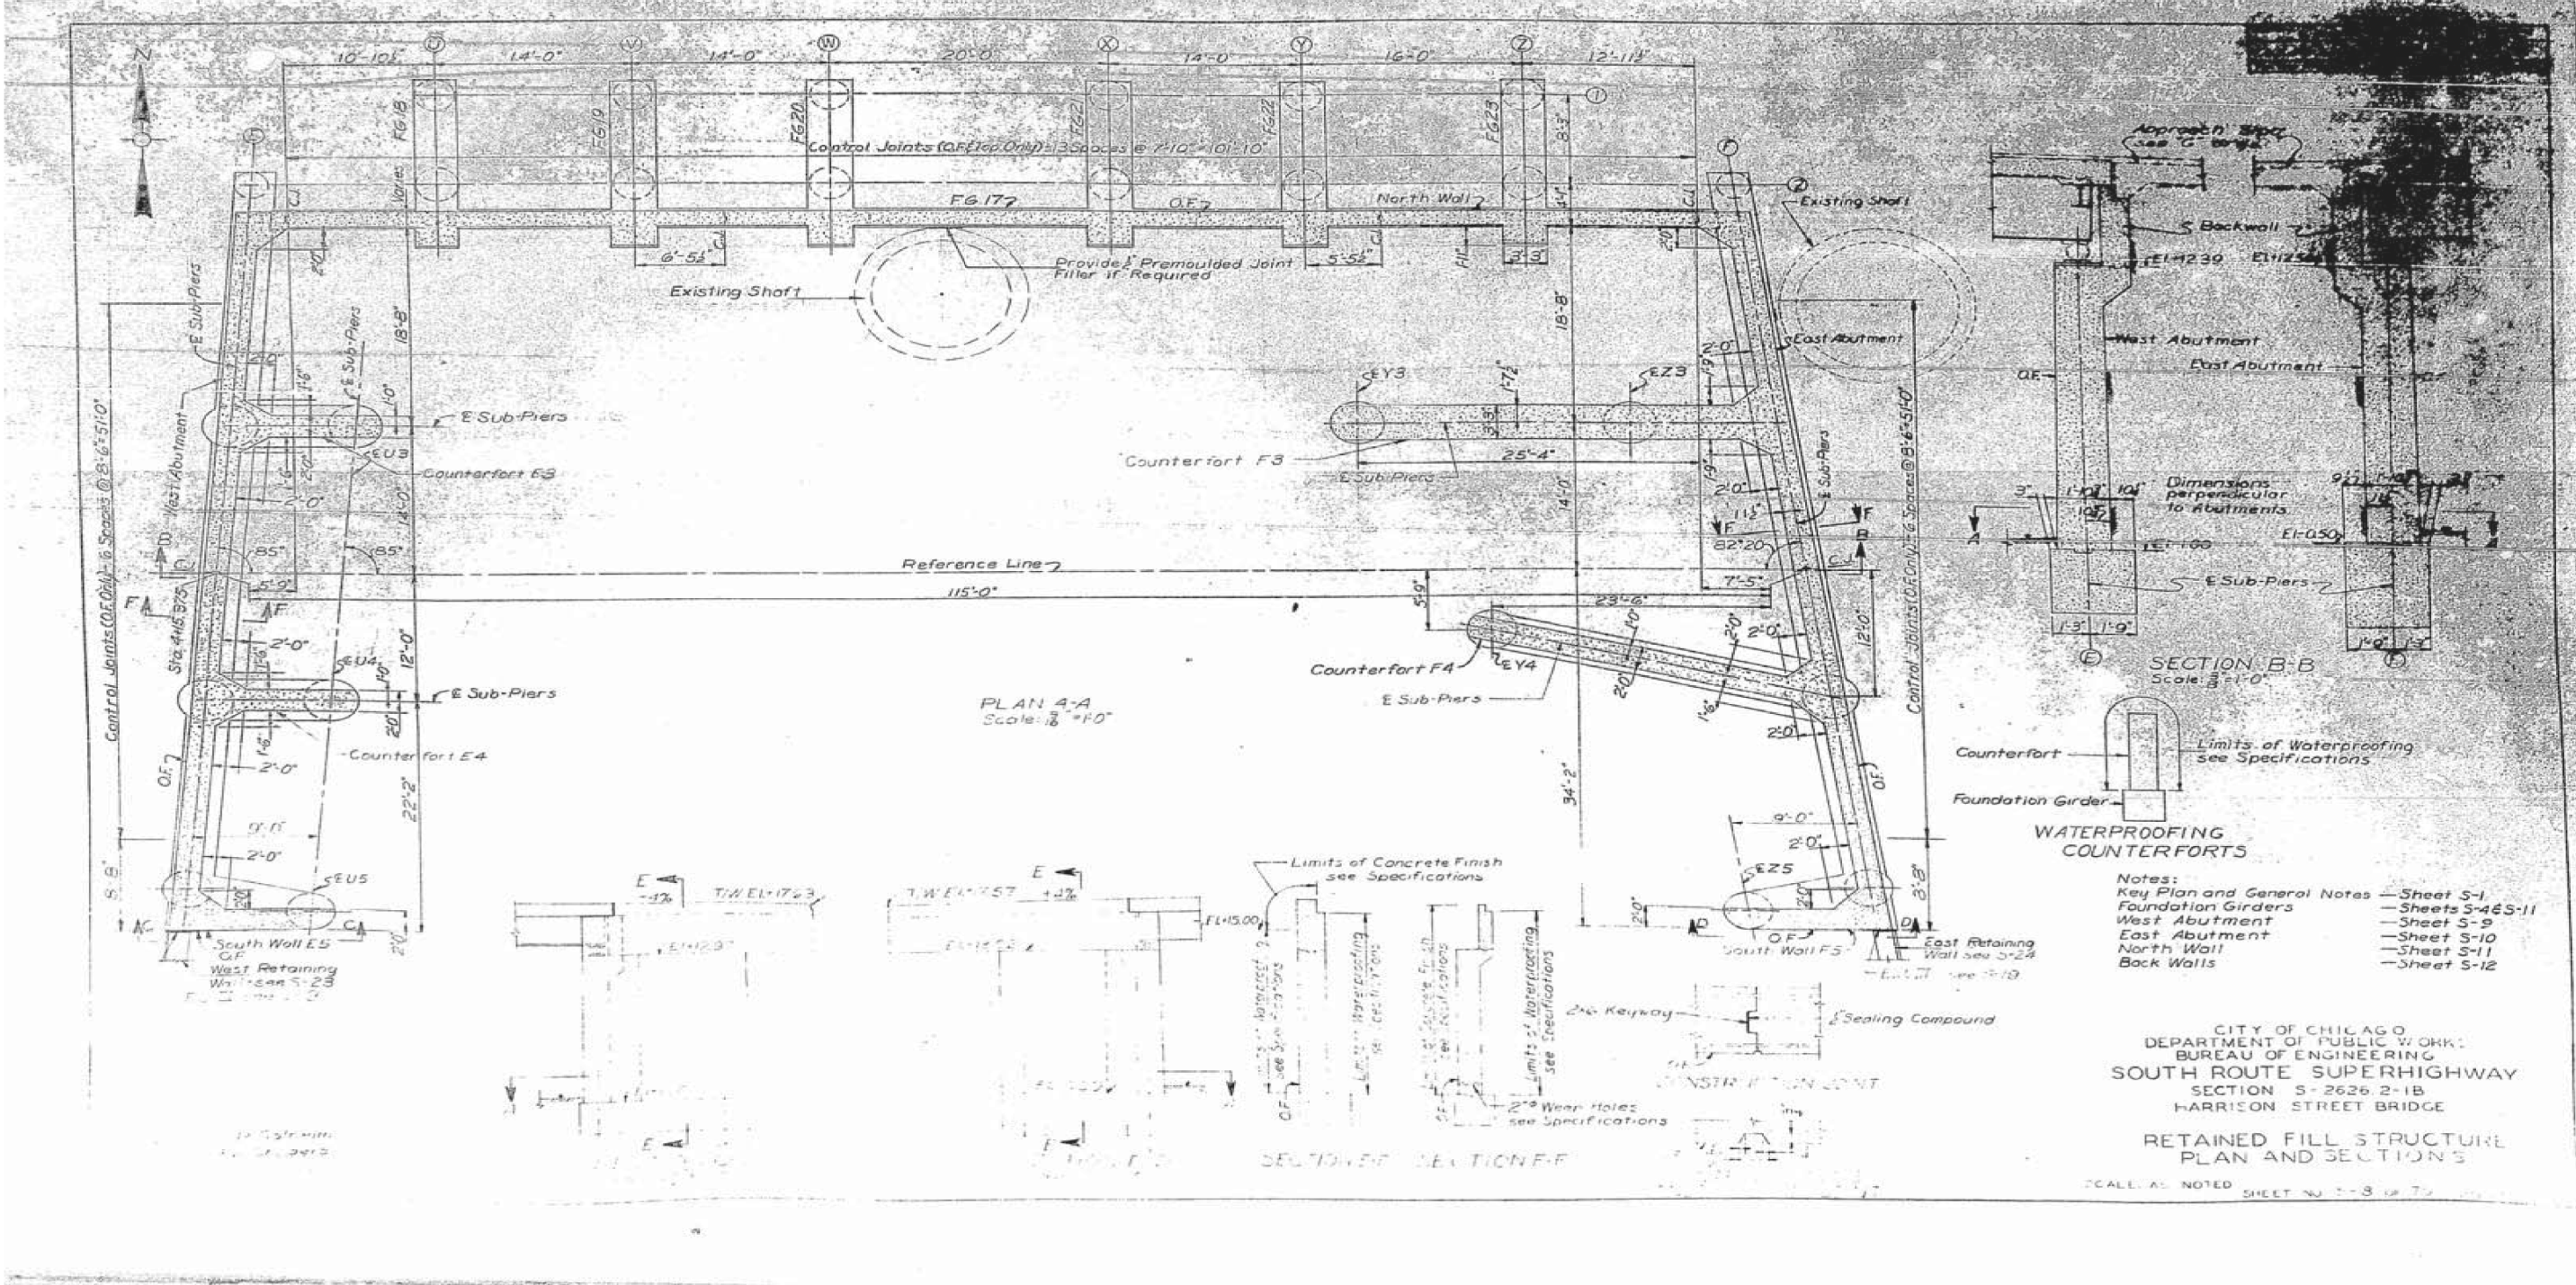

USER NAME = dunkerleyb	DESIGNED -	REVISED
	CHECKED -	REVISED
PLOT SCALE = N.T.S.	DRAWN -	REVISED
PLOT DATE = 11/26/2013	CHECKED -	REVISED

STATE OF ILLINOIS
DEPARTMENT OF TRANSPORTATION


EXISTING AS-BUILTS SN 016-1088

SHEET NO. AS-37 OF AS-72 SHEETS

F.A.I. RTE.	SECTION	COUNTY	TOTAL SHEETS	SHEET NO.
90/94/290	2013-036R	COOK	256	179
CONTRACT NO. 60W71				
ILLINOIS FED. AID PROJECT -NUMBER-				

D:\60W71-shr-AS-BUILT-37.dgn

FOR INFORMATION ONLY

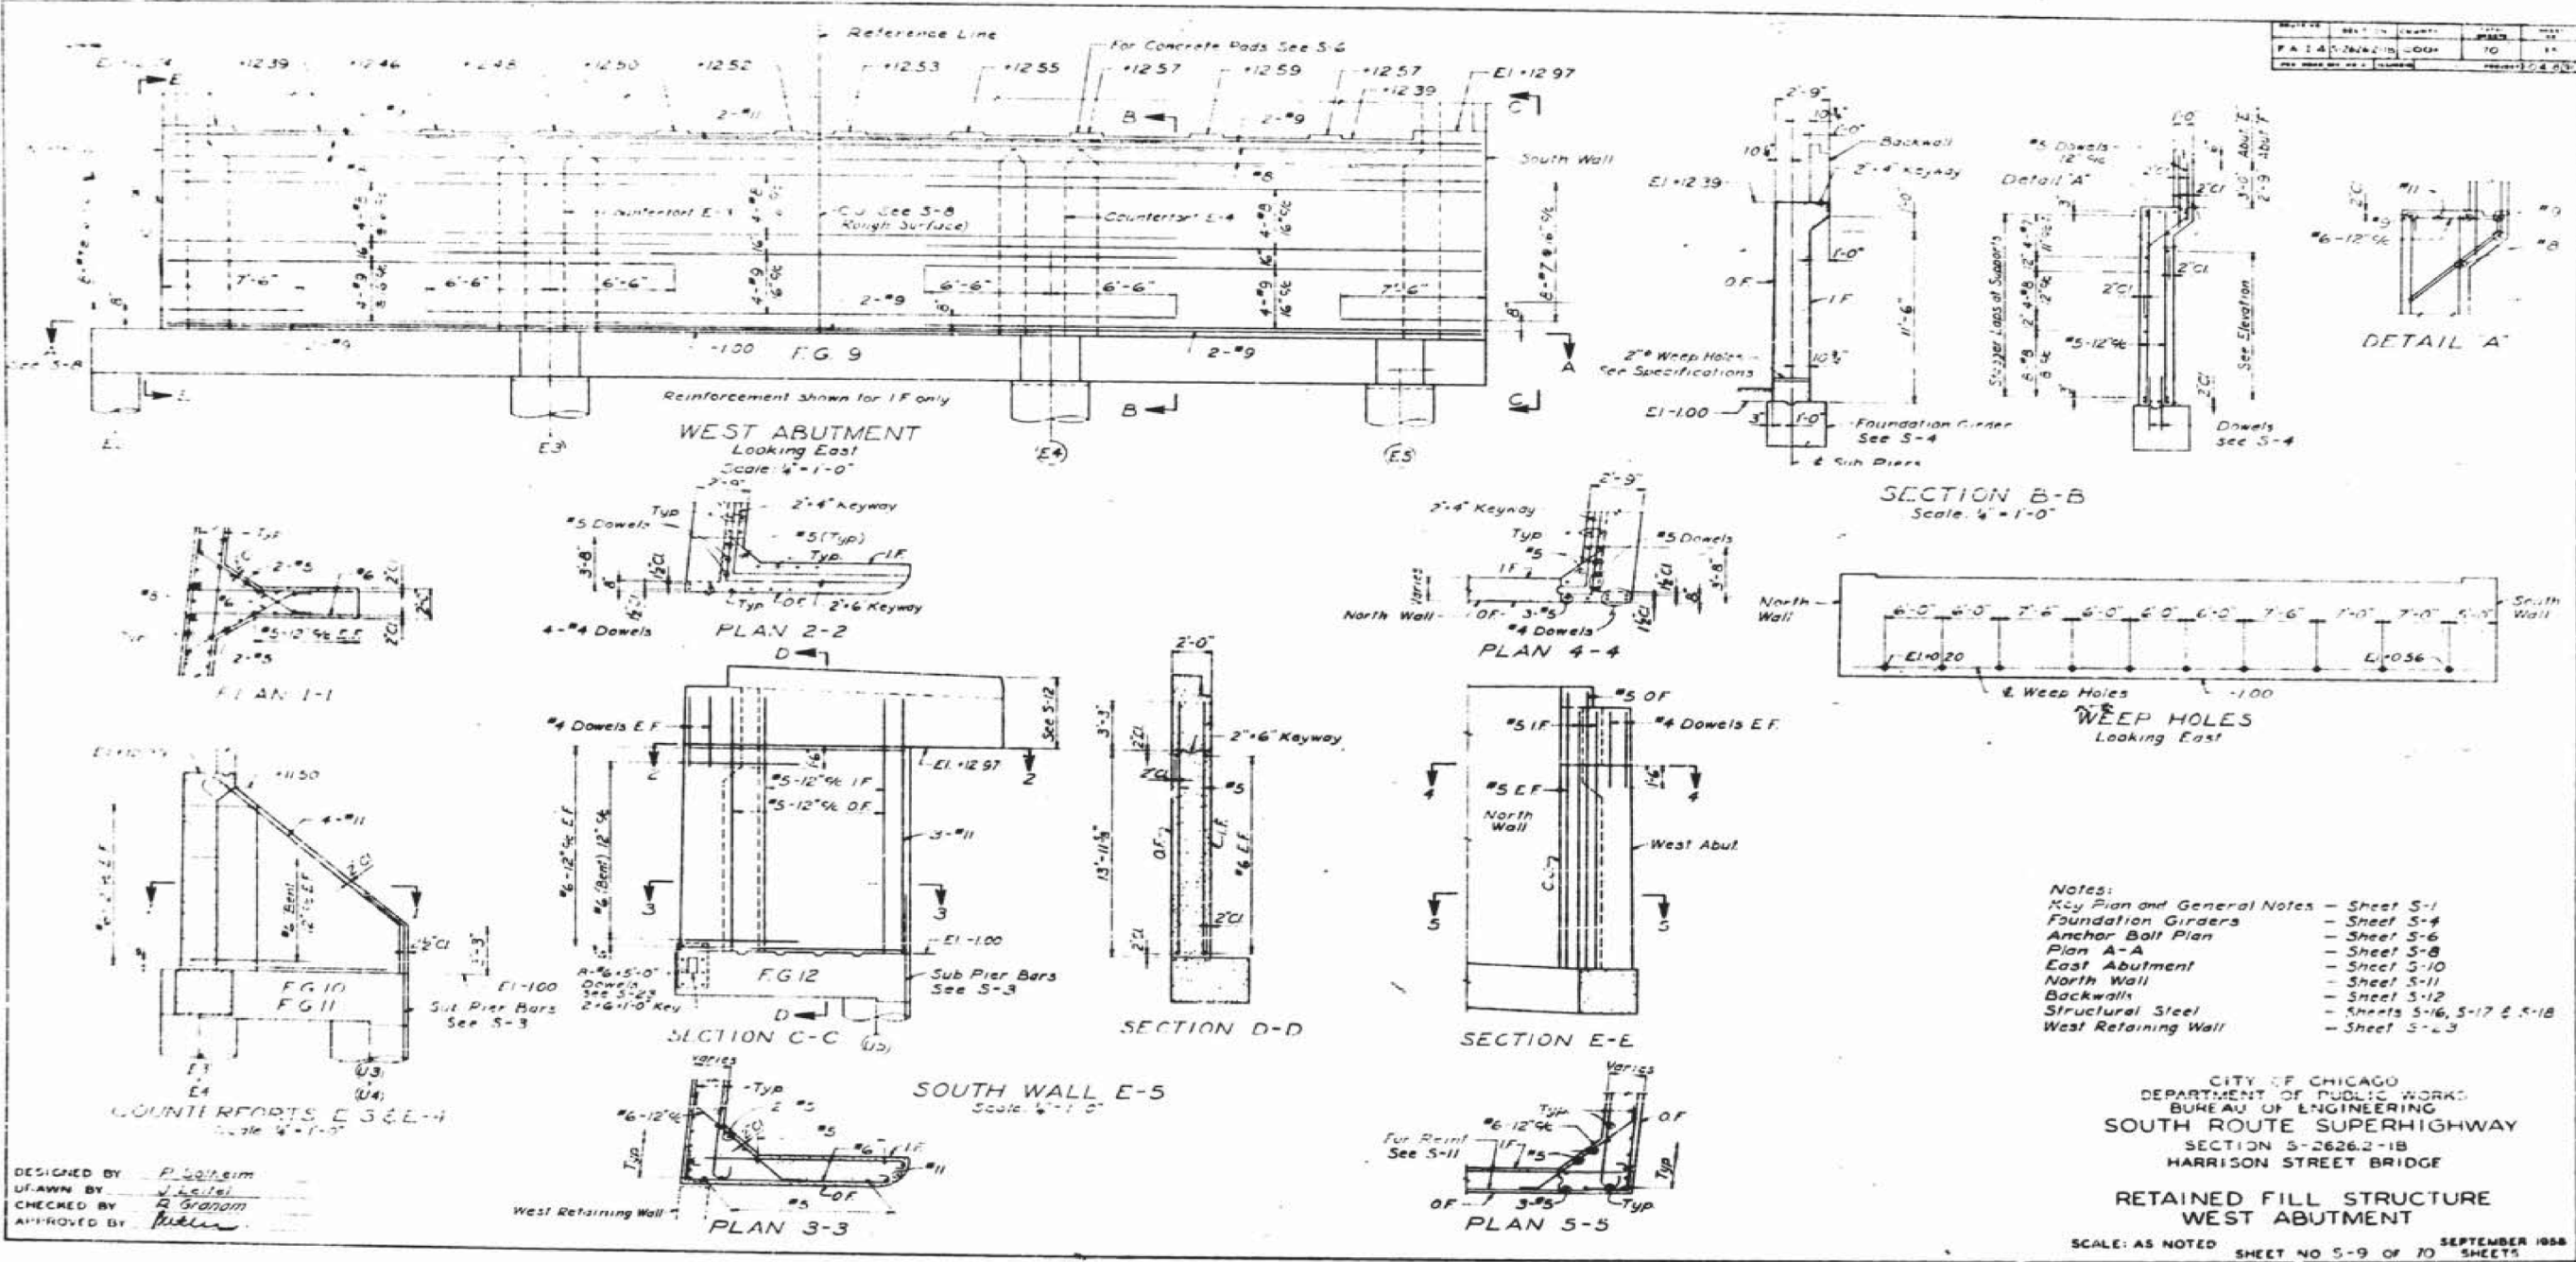

USER NAME = dunkerleyb	DESIGNED -	REVISED
	CHECKED -	REVISED
PLOT SCALE = N.T.S.	DRAWN -	REVISED
PLOT DATE = 11/26/2013	CHECKED -	REVISED

STATE OF ILLINOIS
DEPARTMENT OF TRANSPORTATION


EXISTING AS-BUILTS SN 016-1088

SHEET NO. AS-38 OF AS-72 SHEETS

F.A.I. RTE.	SECTION	COUNTY	TOTAL SHEETS	SHEET NO.
90/94/290	2013-036R	COOK	256	180
CONTRACT NO. 60W71				
ILLINOIS FED. AID PROJECT -NUMBER-				

D:\60W71-shr-AS-BUILT-38.dgn


D:\60W71-sh+ -AS-BUILT-39.dgn

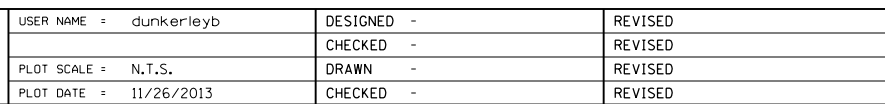

SHEET NO. AS-39 OF AS-72 SHEETS

CONTRACT NO.	60W71
--------------	-------

ILLINOIS	FED. AID PROJECT	-NUMBER-
----------	------------------	----------

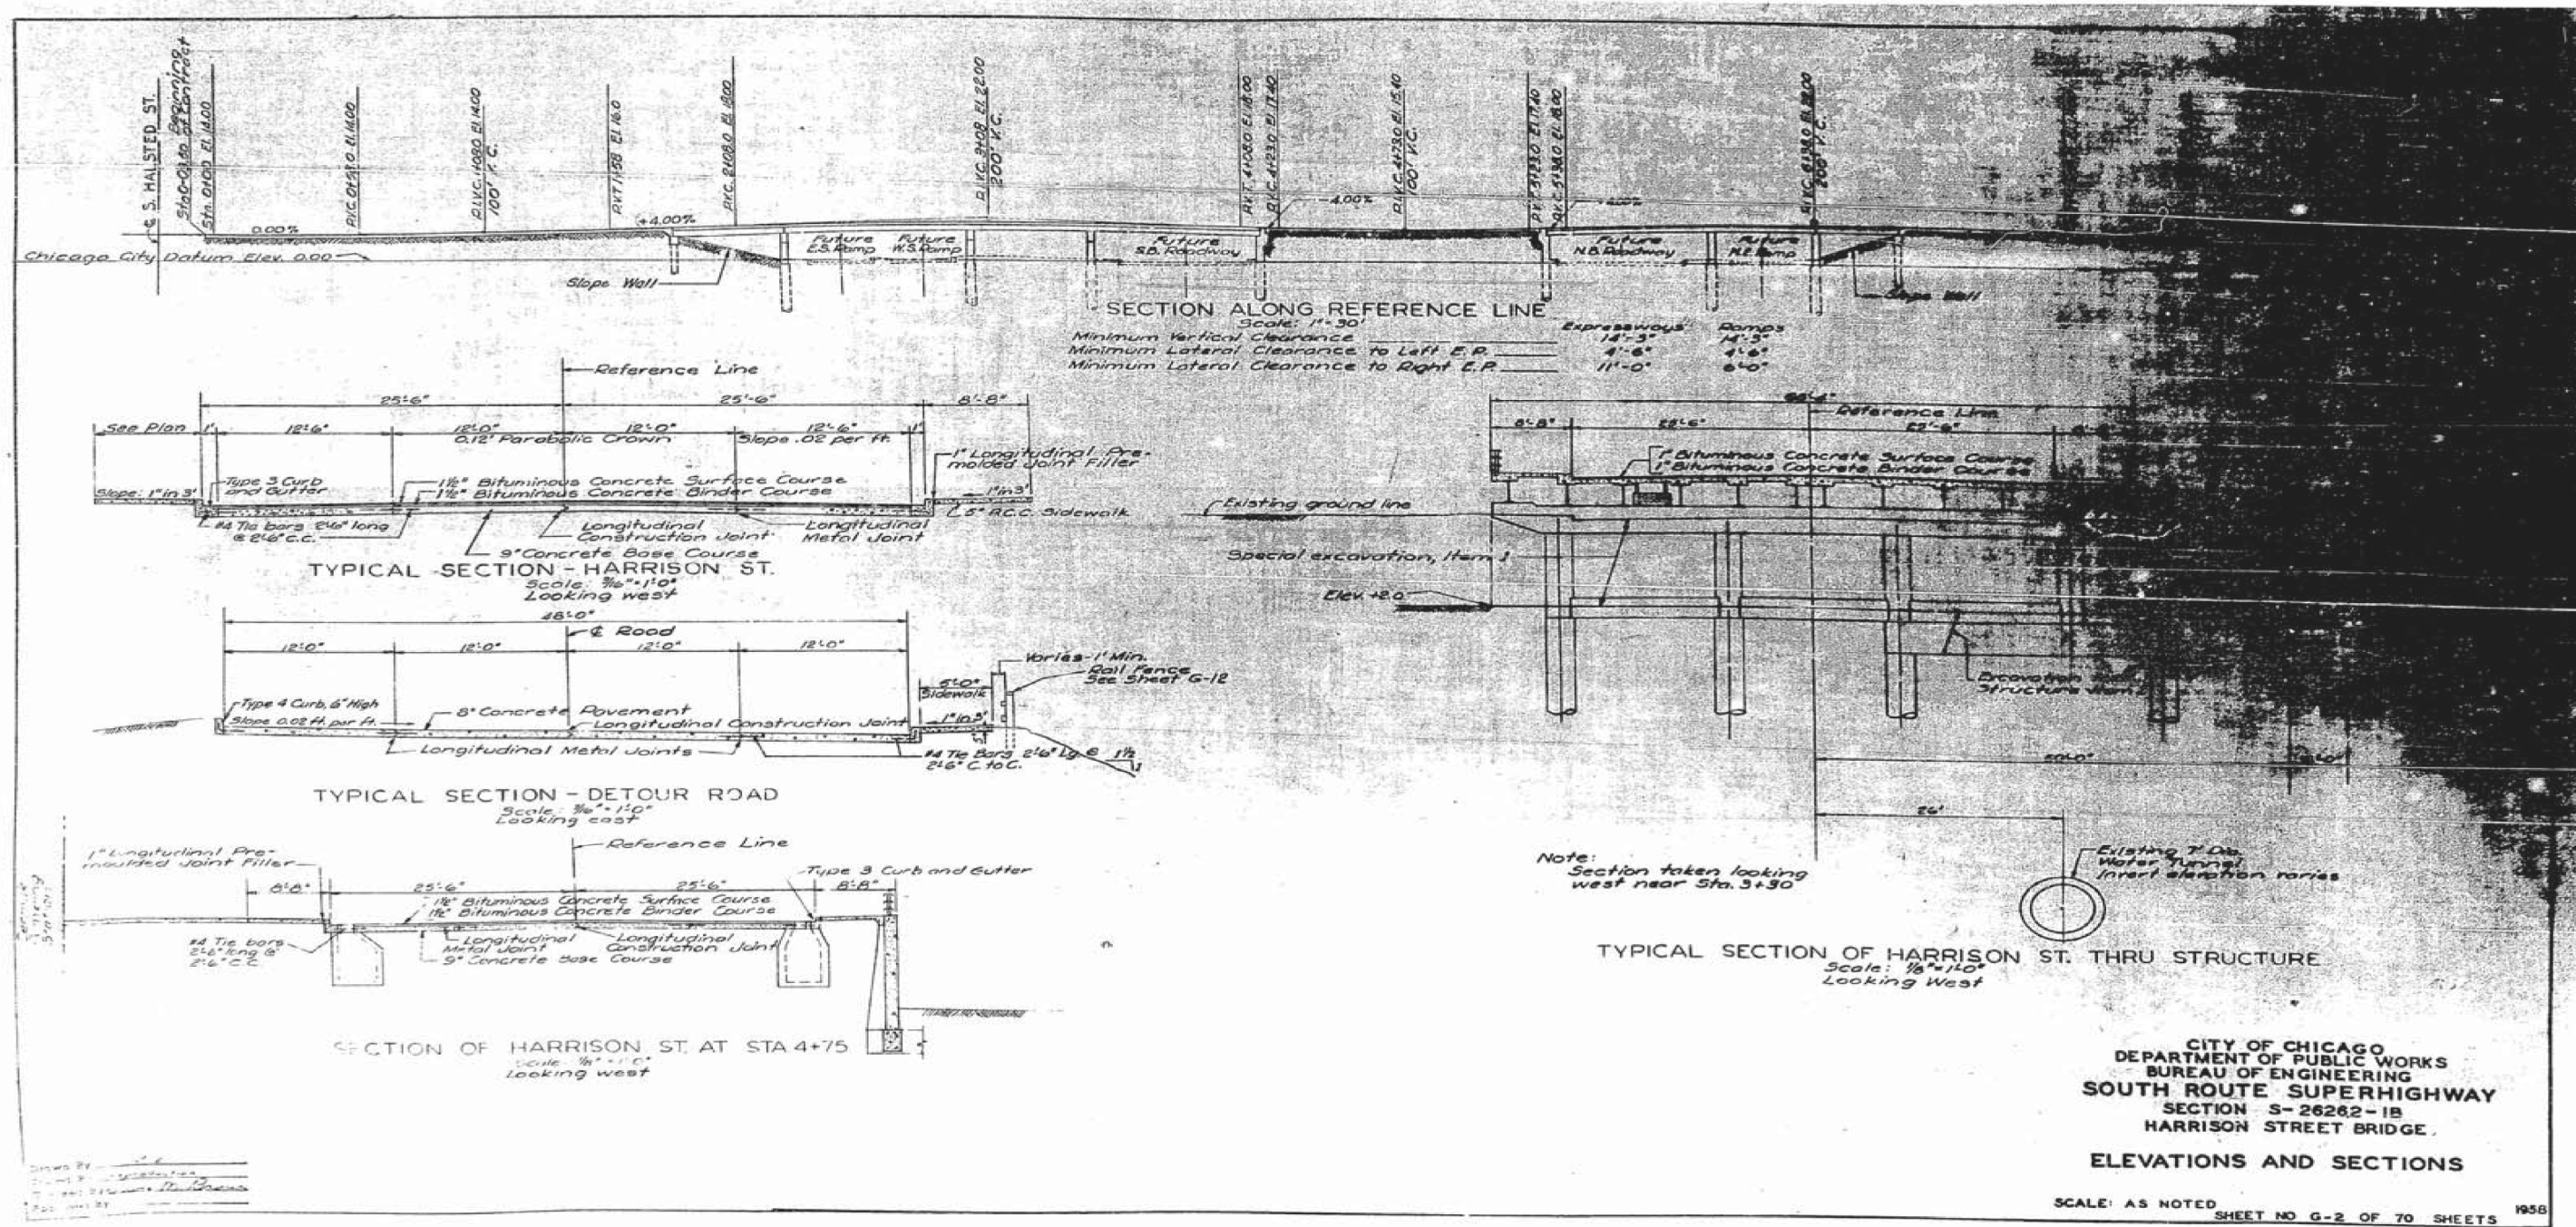

CITY OF CHICAGO
DEPARTMENT OF PUBLIC WORKS
BUREAU OF ENGINEERING
SOUTH ROUTE SUPERHIGHWAY
SECTION S-26262-1B
HARRISON STREET BRIDGE
ELEVATIONS AND SECTIONS
SCALE: AS NOTED
SHEET NO G-2 OF 70 SHEETS 1958

USER NAME = dunkerleyb	DESIGNED -	REVISED
	CHECKED -	REVISED
PLOT SCALE = N.T.S.	DRAWN -	REVISED
PLOT DATE = 11/26/2013	CHECKED -	REVISED

STATE OF ILLINOIS
DEPARTMENT OF TRANSPORTATION


EXISTING AS-BUILTS SN 016-1088

SHEET NO. AS-40 OF AS-72 SHEETS

F.A.I. RTE.	SECTION	COUNTY	TOTAL SHEETS	SHEET NO.
90/94/290	2013-036R	COOK	256	182
CONTRACT NO. 60W71				
ILLINOIS FED. AID PROJECT -NUMBER-				

D:\60W71-shr-AS-BUILT-40.dgn

FOR INFORMATION ONLY

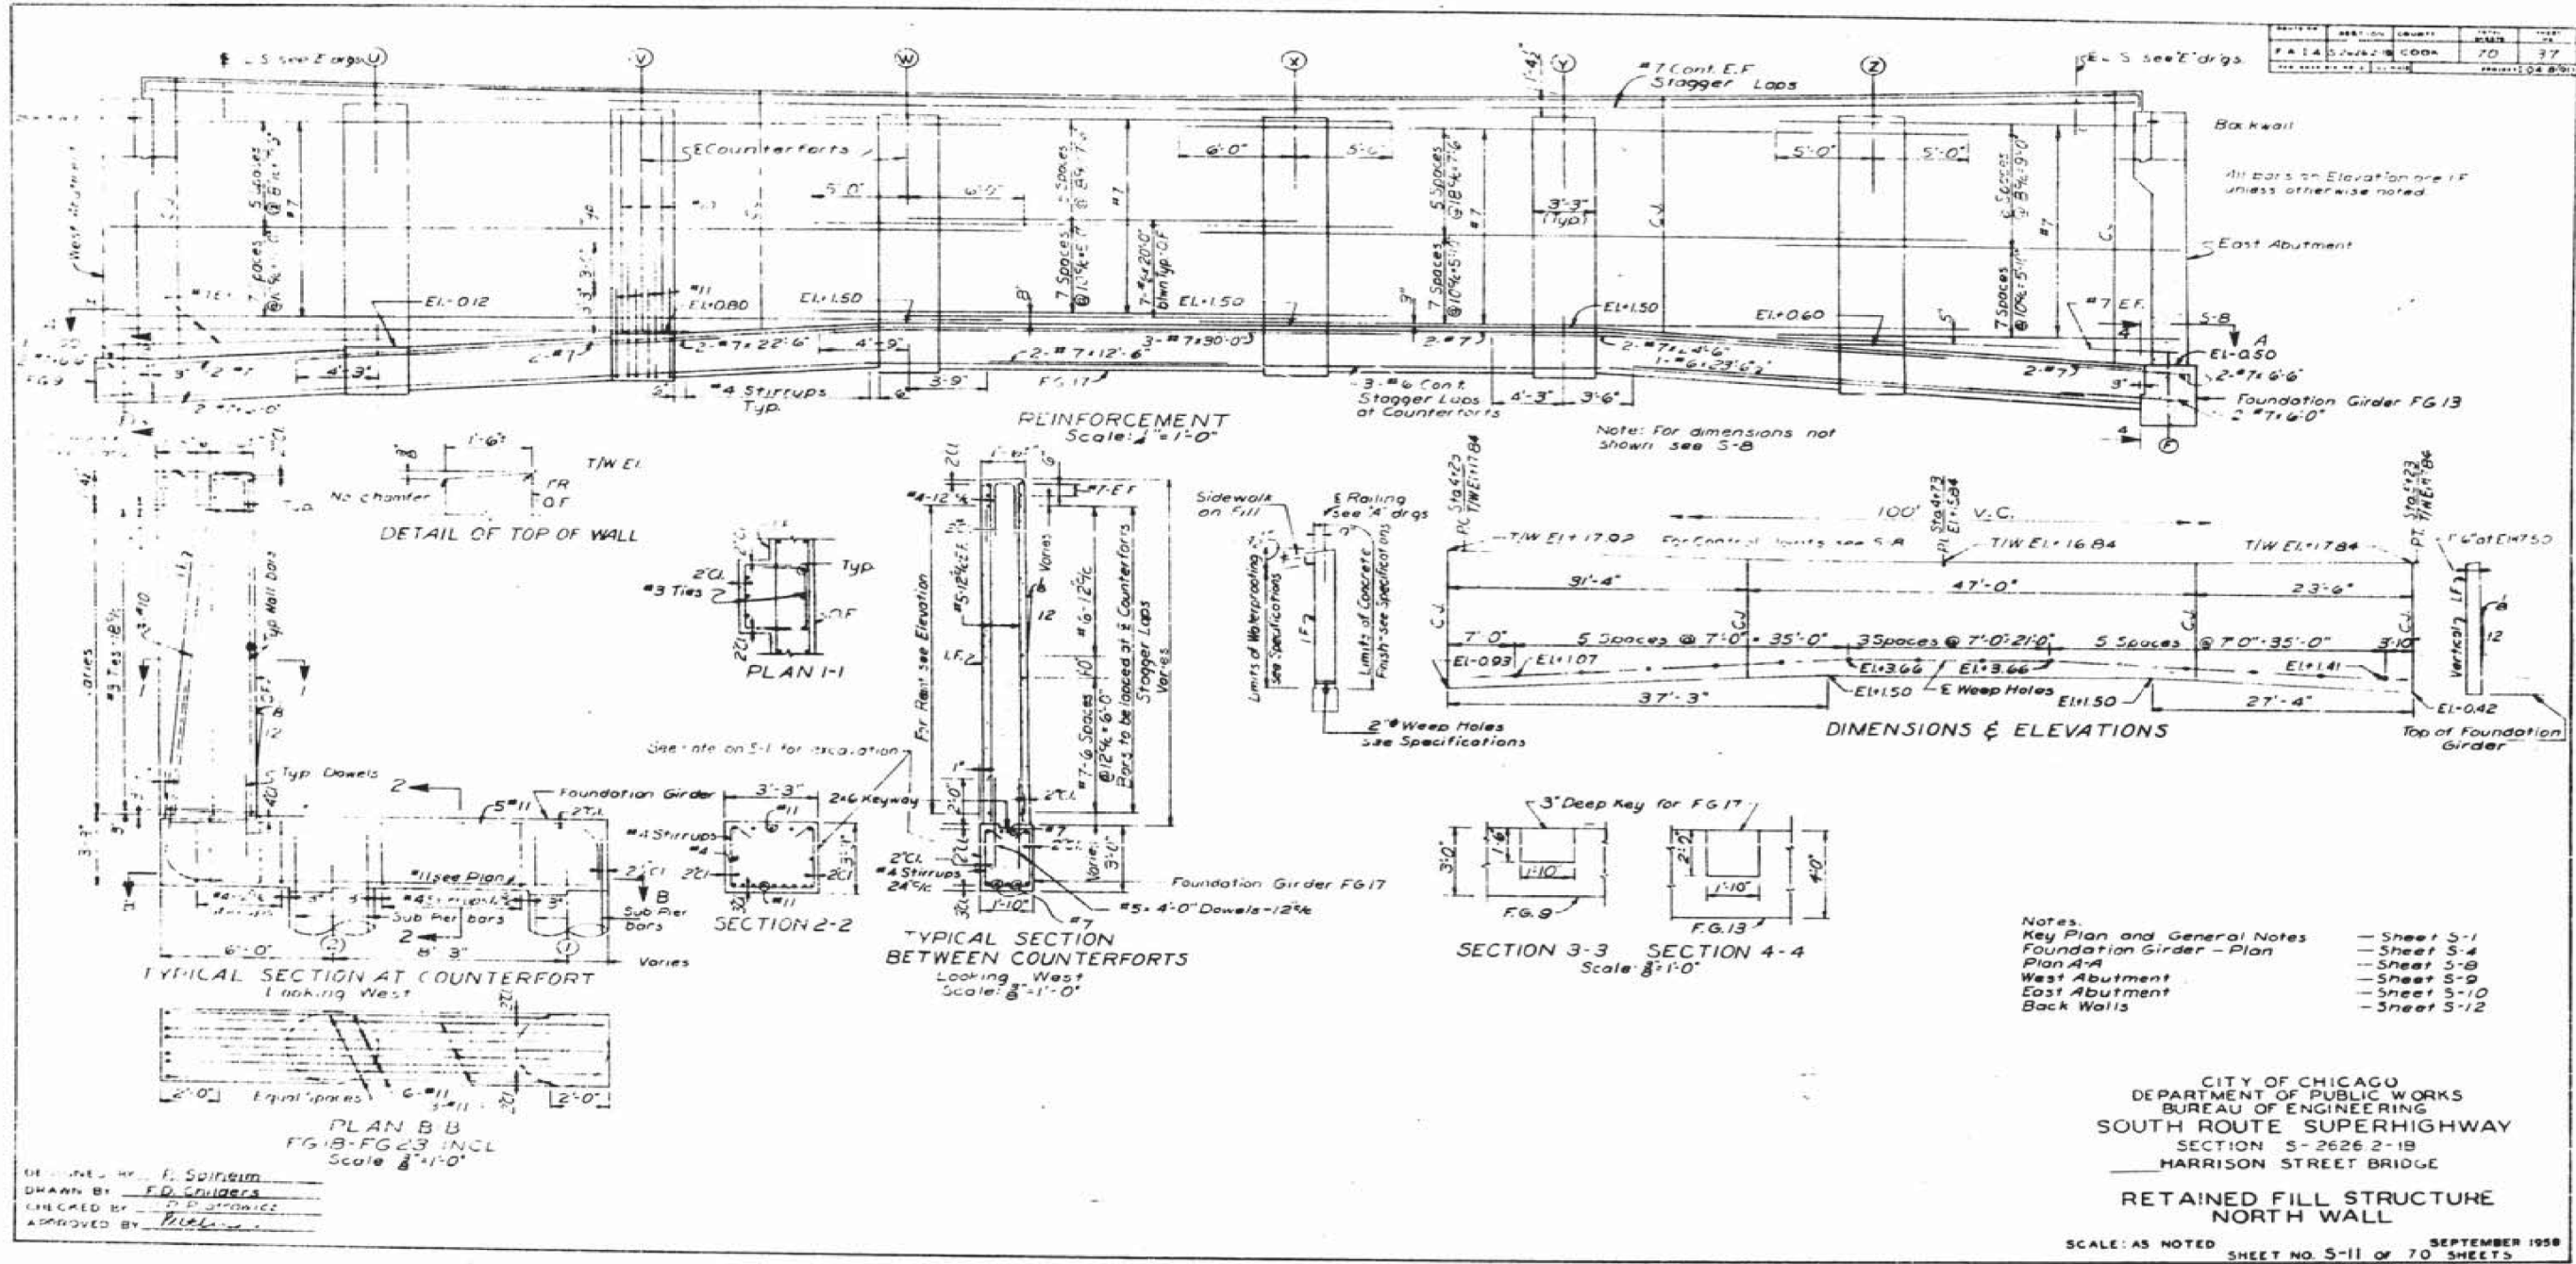


USER NAME = dunkerleyb	DESIGNED -	REVISED
	CHECKED -	REVISED
PLOT SCALE = N.T.S.	DRAWN -	REVISED
PLOT DATE = 11/26/2013	CHECKED -	REVISED

STATE OF ILLINOIS
DEPARTMENT OF TRANSPORTATION

EXISTING AS-BUILTS SN 016-1088

SHEET NO. AS-41 OF AS-72 SHEETS

F.A.I. RTE.	SECTION	COUNTY	TOTAL SHEETS	SHEET NO.
90/94/290	2013-036R	COOK	256	183
CONTRACT NO. 60W71				
ILLINOIS FED. AID PROJECT -NUMBER-				

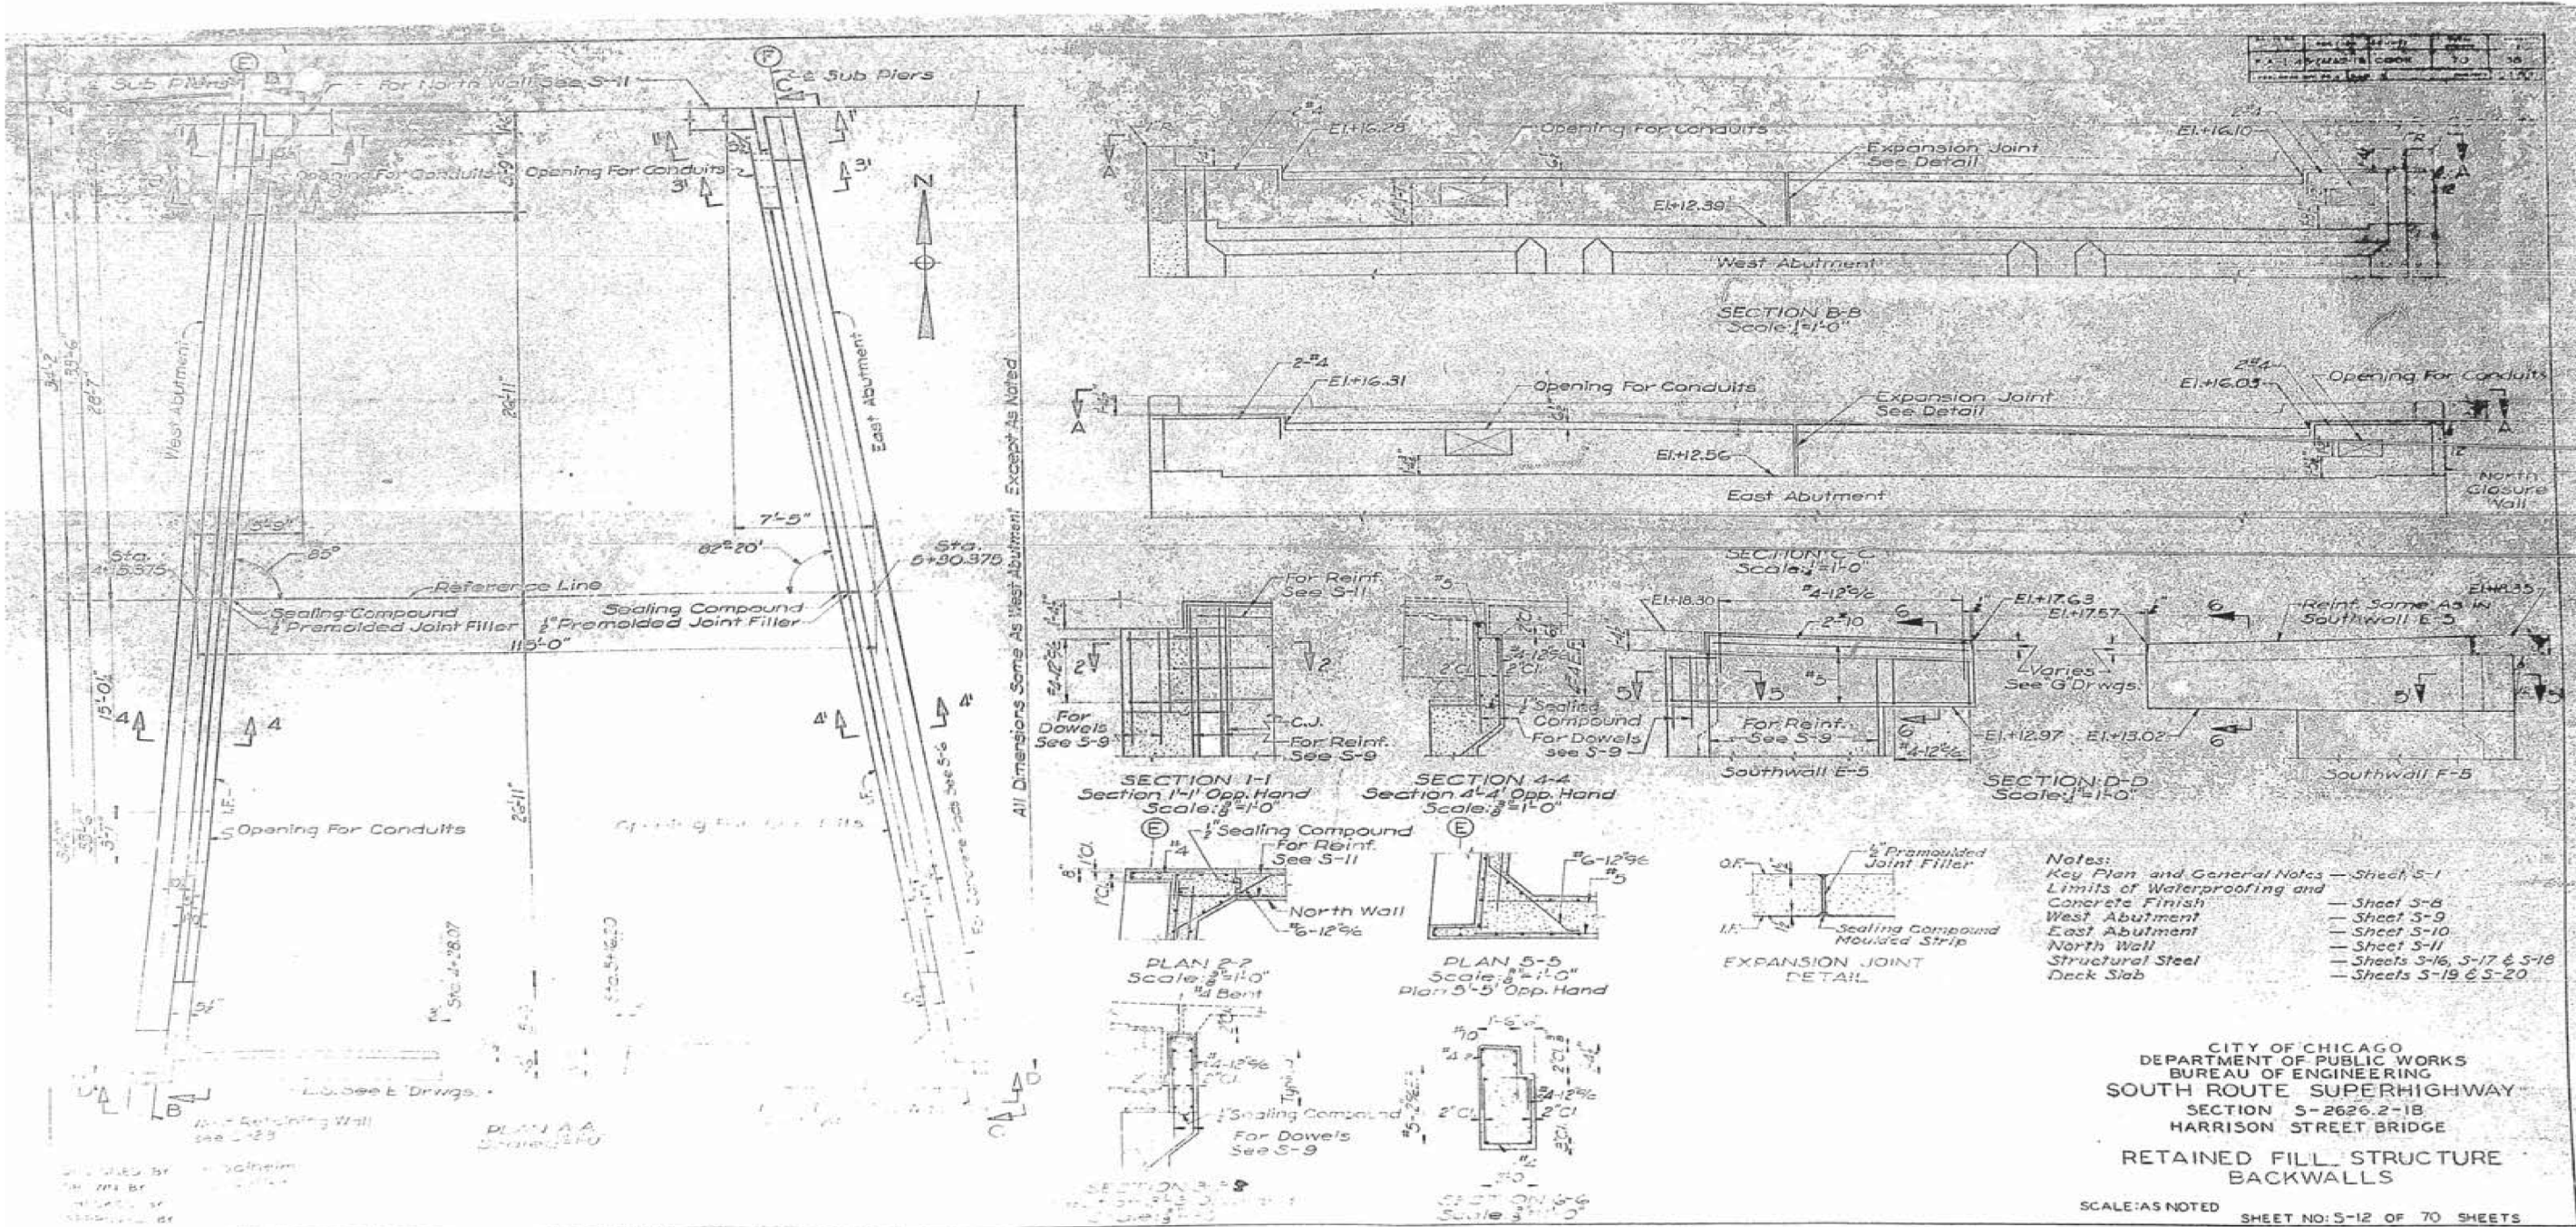

D:\60W71-shr-AS-BUILT-42.dgn

USER NAME = dunkerleyb	DESIGNED -	REVISED
	CHECKED -	REVISED
PLOT SCALE = N.T.S.	DRAWN -	REVISED
PLOT DATE = 11/26/2013	CHECKED -	REVISED


STATE OF ILLINOIS
DEPARTMENT OF TRANSPORTATION

EXISTING AS-BUILTS SN 016-1088

SHEET NO. AS-42 OF AS-72 SHEETS

F.A.I. RTE.	SECTION	COUNTY	TOTAL SHEETS	SHEET NO.
90/94/290	2013-036R	COOK	256	184
CONTRACT NO. 60W71				
ILLINOIS FED. AID PROJECT -NUMBER-				

FOR INFORMATION ONLY

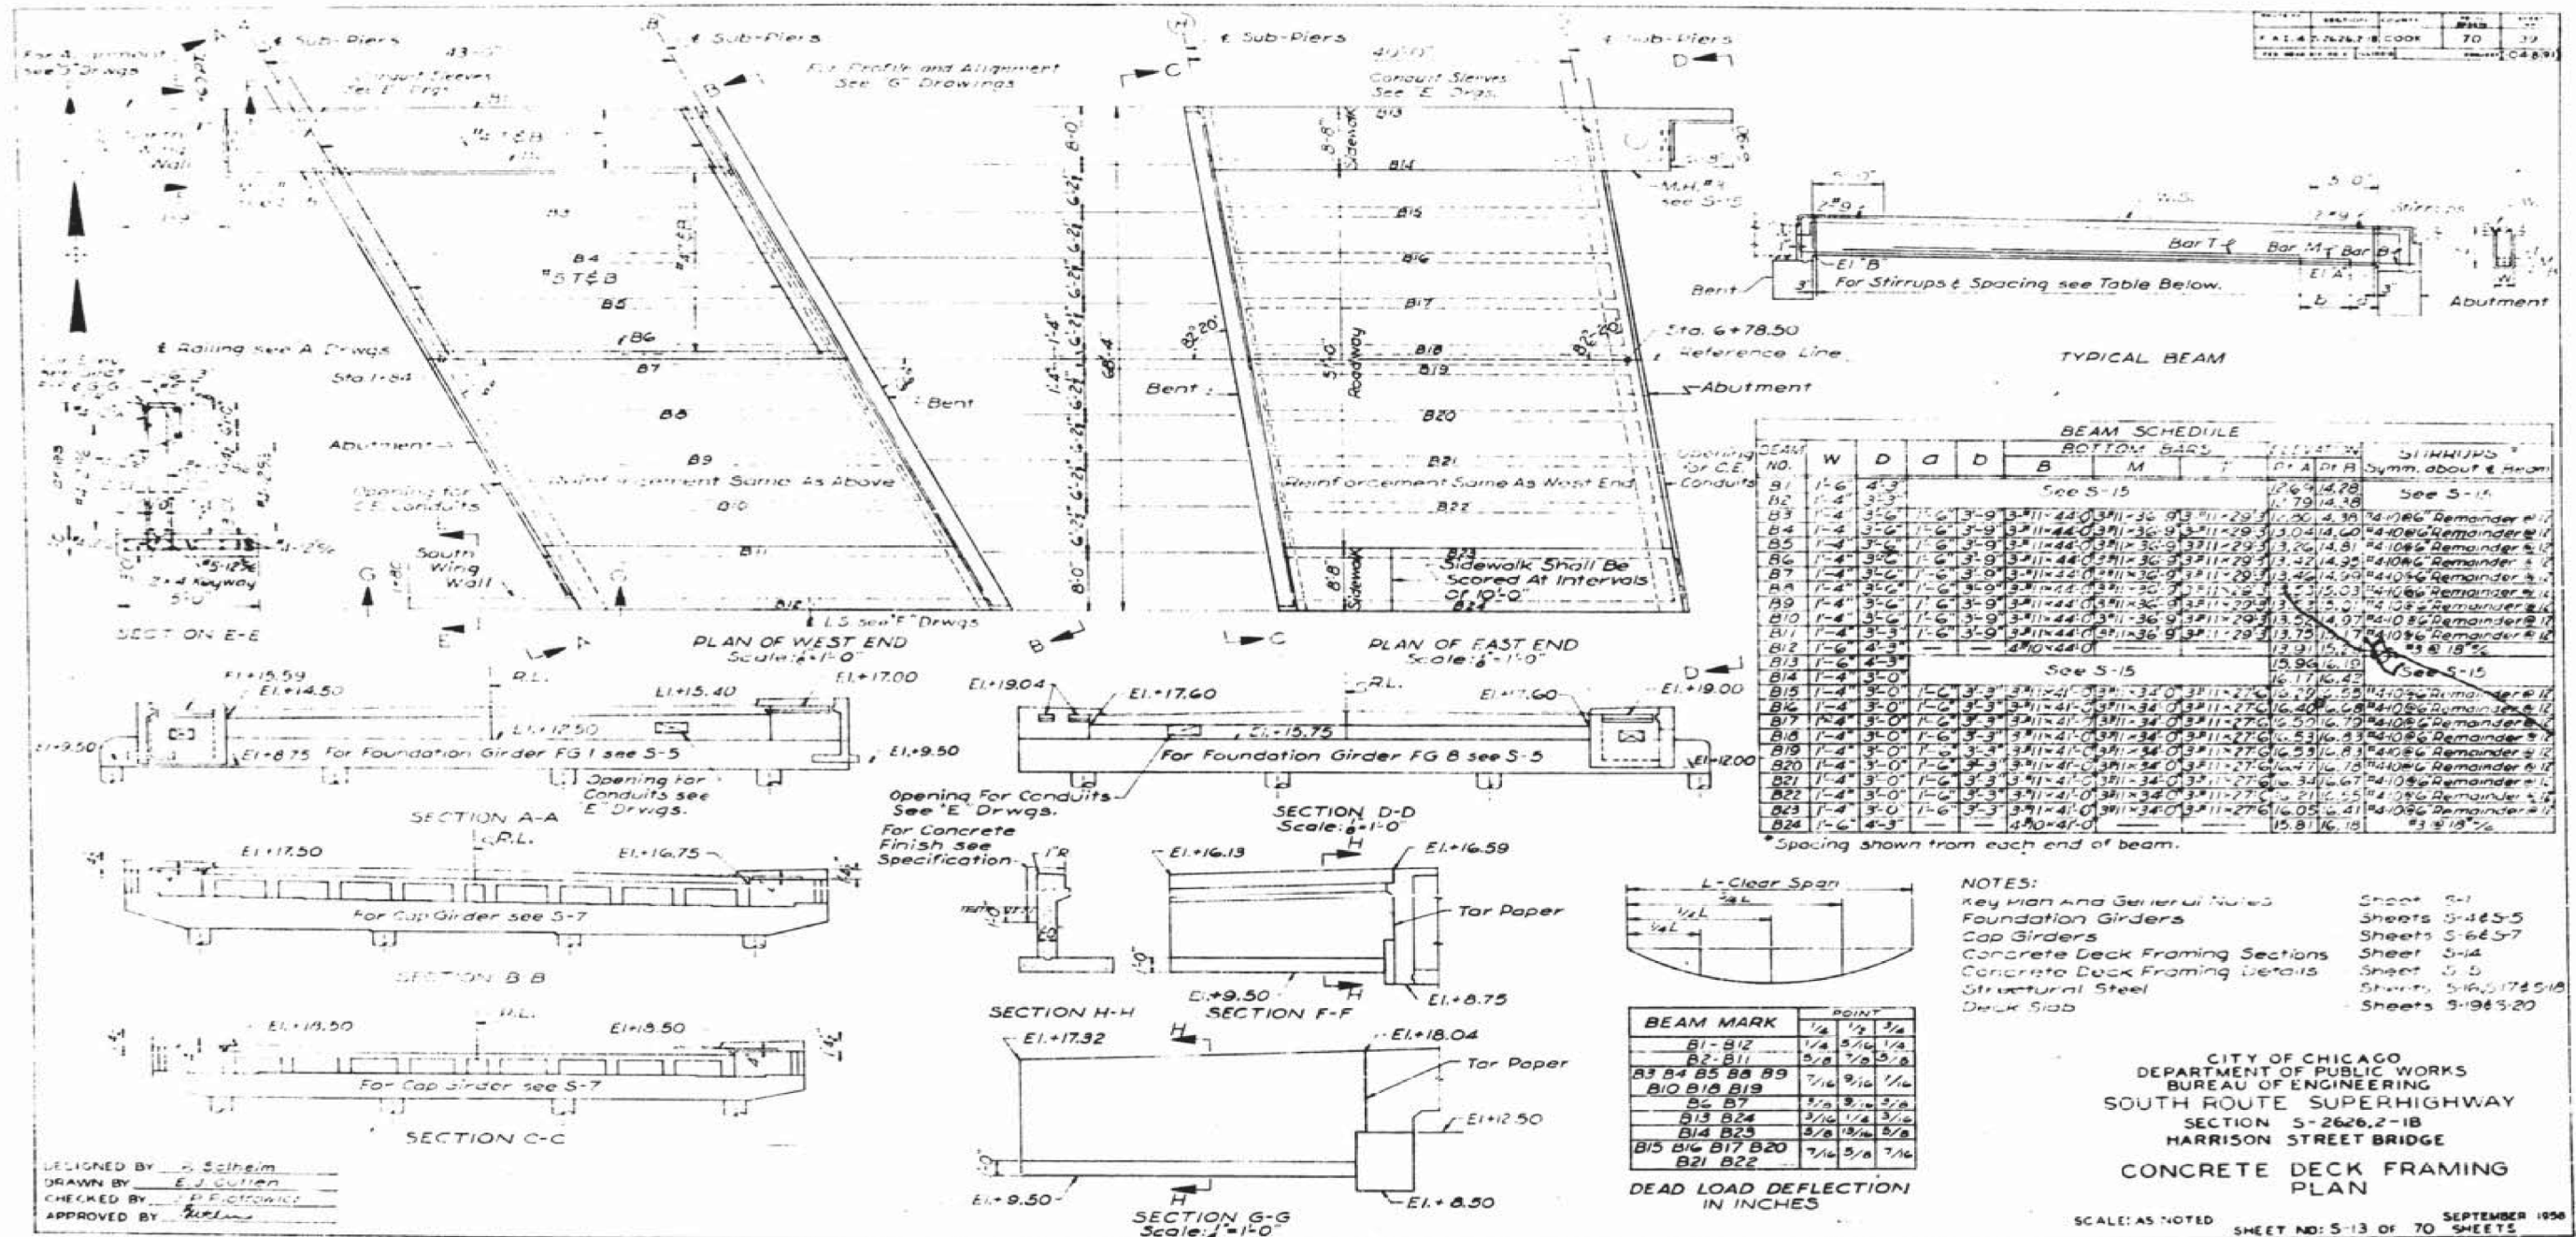

USER NAME = dunkerleyb	DESIGNED -	REVISED
	CHECKED -	REVISED
PLOT SCALE = N.T.S.	DRAWN -	REVISED
PLOT DATE = 11/26/2013	CHECKED -	REVISED


STATE OF ILLINOIS
DEPARTMENT OF TRANSPORTATION

EXISTING AS-BUILTS SN 016-1088


SHEET NO. AS-43 OF AS-72 SHEETS

F.A.I. RTE.	SECTION	COUNTY	TOTAL SHEETS	SHEET NO.
90/94/290	2013-036R	COOK	256	185
CONTRACT NO. 60W71				
ILLINOIS FED. AID PROJECT -NUMBER-				

FOR INFORMATION ONLY

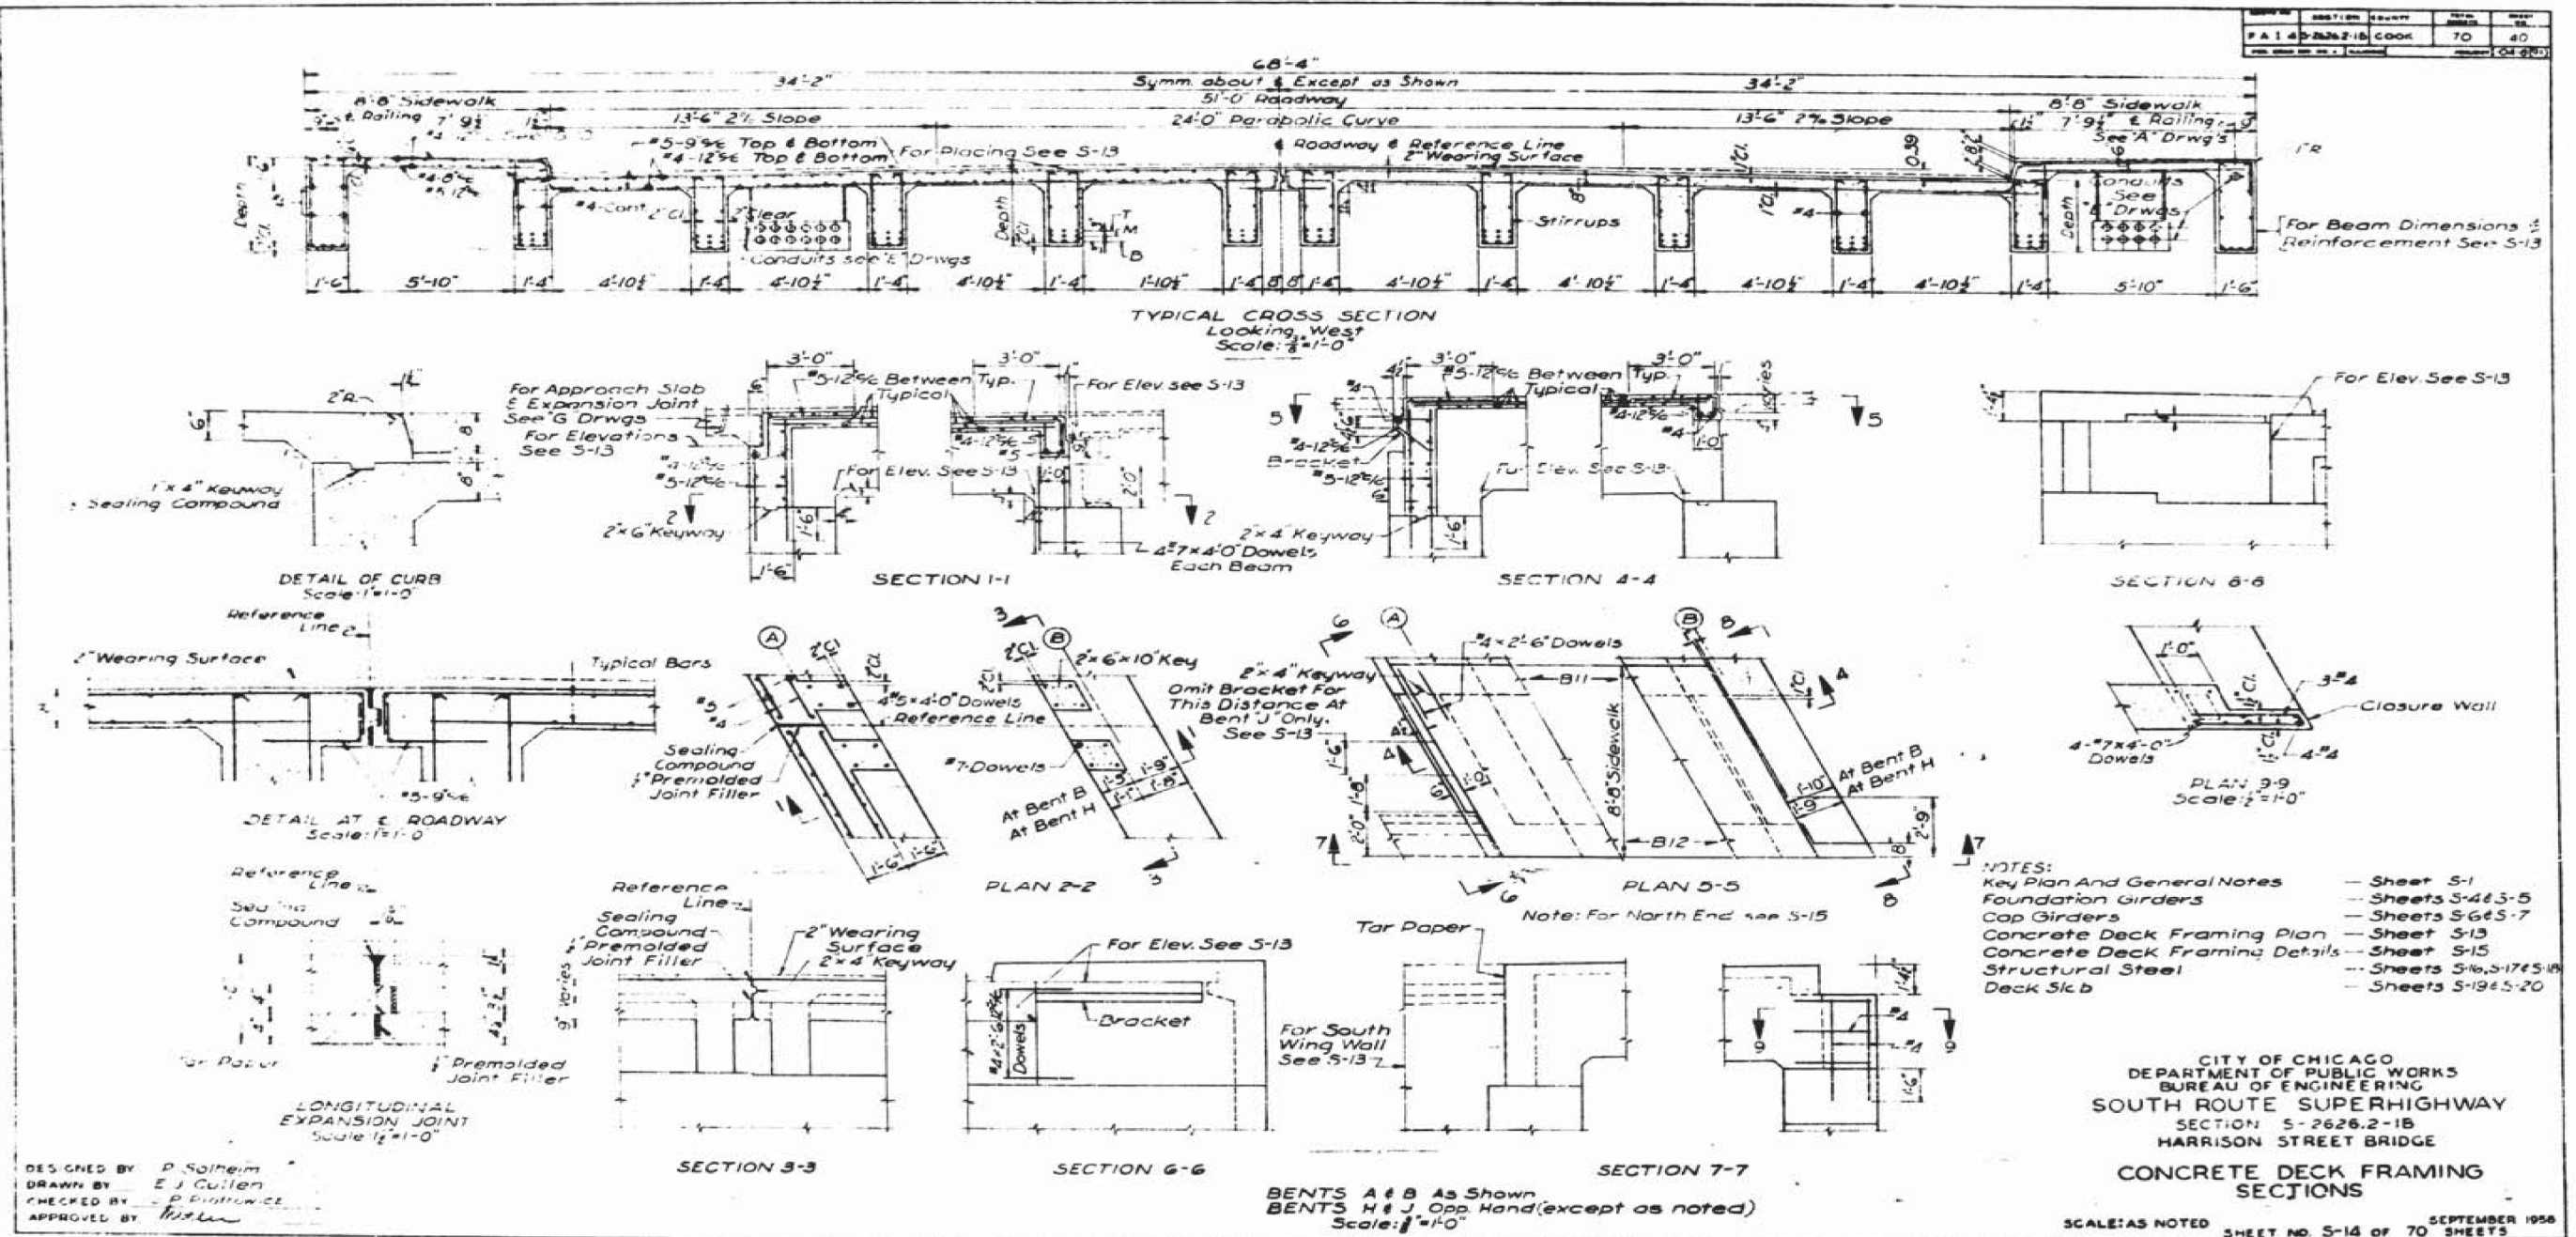

FOR INFORMATION ONLY

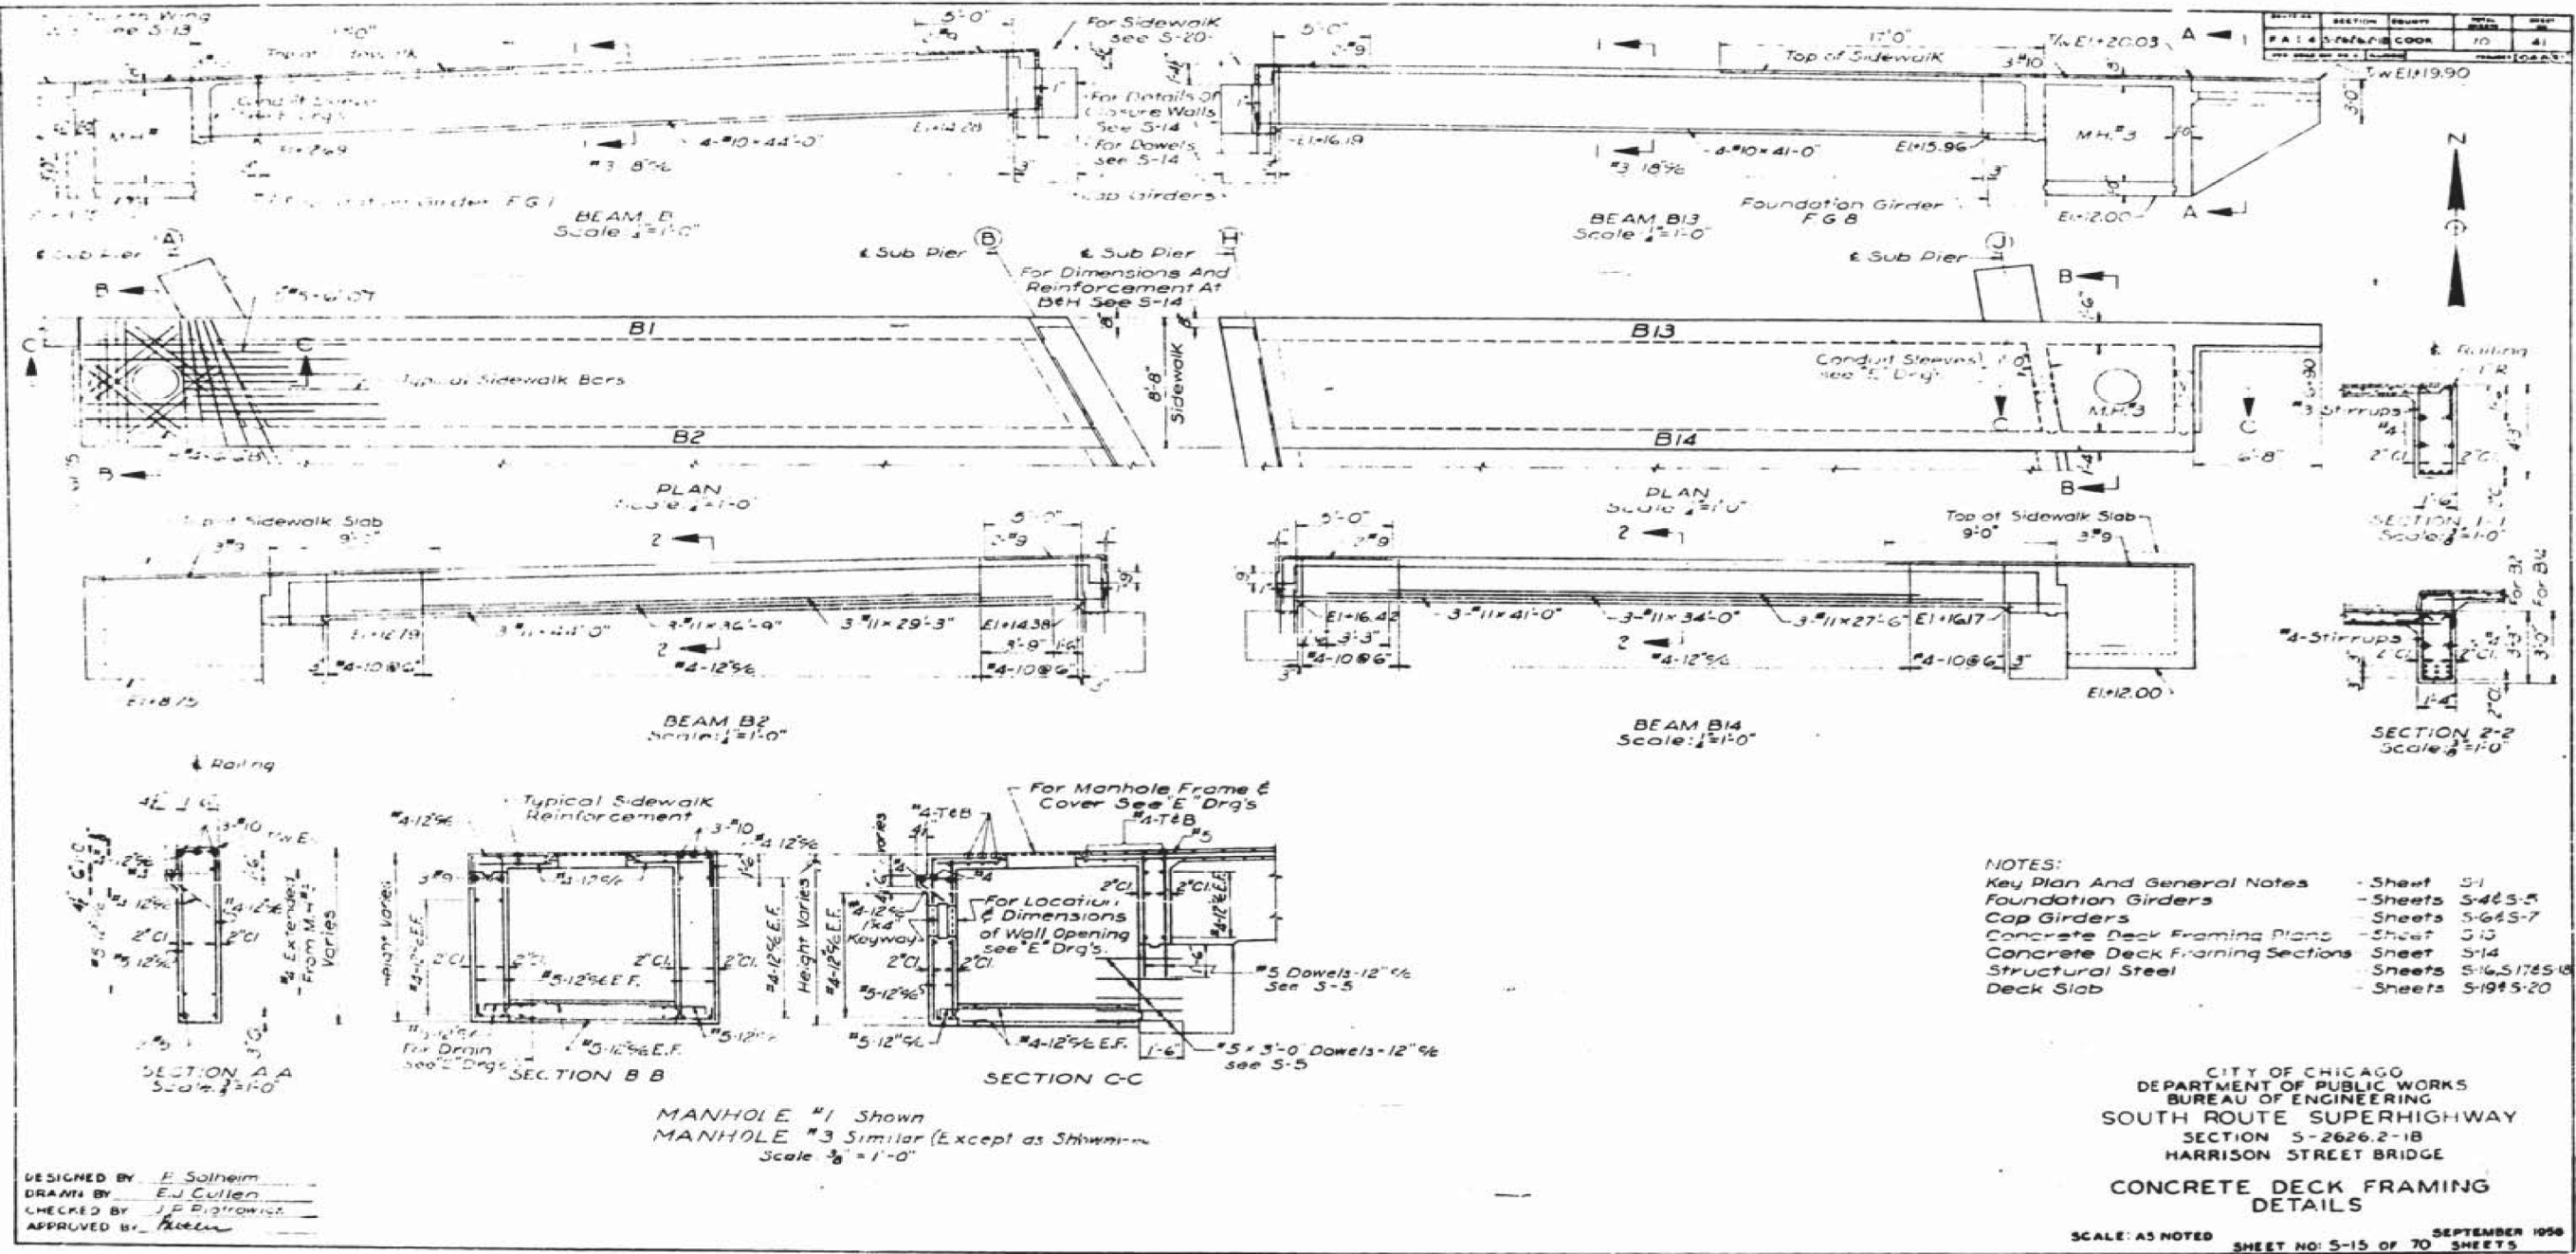

USER NAME = dunkerleyb	DESIGNED -	REVISED
	CHECKED -	REVISED
PLOT SCALE = N.T.S.	DRAWN -	REVISED
PLOT DATE = 11/26/2013	CHECKED -	REVISED

STATE OF ILLINOIS
DEPARTMENT OF TRANSPORTATION


EXISTING AS-BUILTS SN 016-1088

SHEET NO. AS-45 OF AS-72 SHEETS

F.A.I. RTE.	SECTION	COUNTY	TOTAL SHEETS	SHEET NO.
90/94/290	2013-036R	COOK	256	187
CONTRACT NO. 60W71				
ILLINOIS FED. AID PROJECT -NUMBER-				

D:\60W71-shr-AS-BUILT-45.dgn


D160W71-sh+AS-BUILT-46.dgn

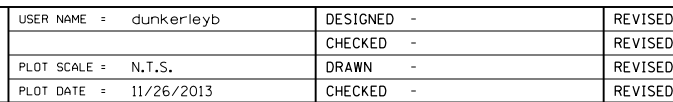

EXISTING AS-BUILTS SN 016-1088

SHEET NO. AS-46 OF AS-72 SHEETS

F.A.I. RTE.	SECTION	COUNTY	TOTAL SHEETS	SHEET NO.
90/94/290	2013-036R	COOK	256	188
		CONTRACT NO. 60W71		
ILLINOIS		FED. AID PROJECT -NUMBER-		

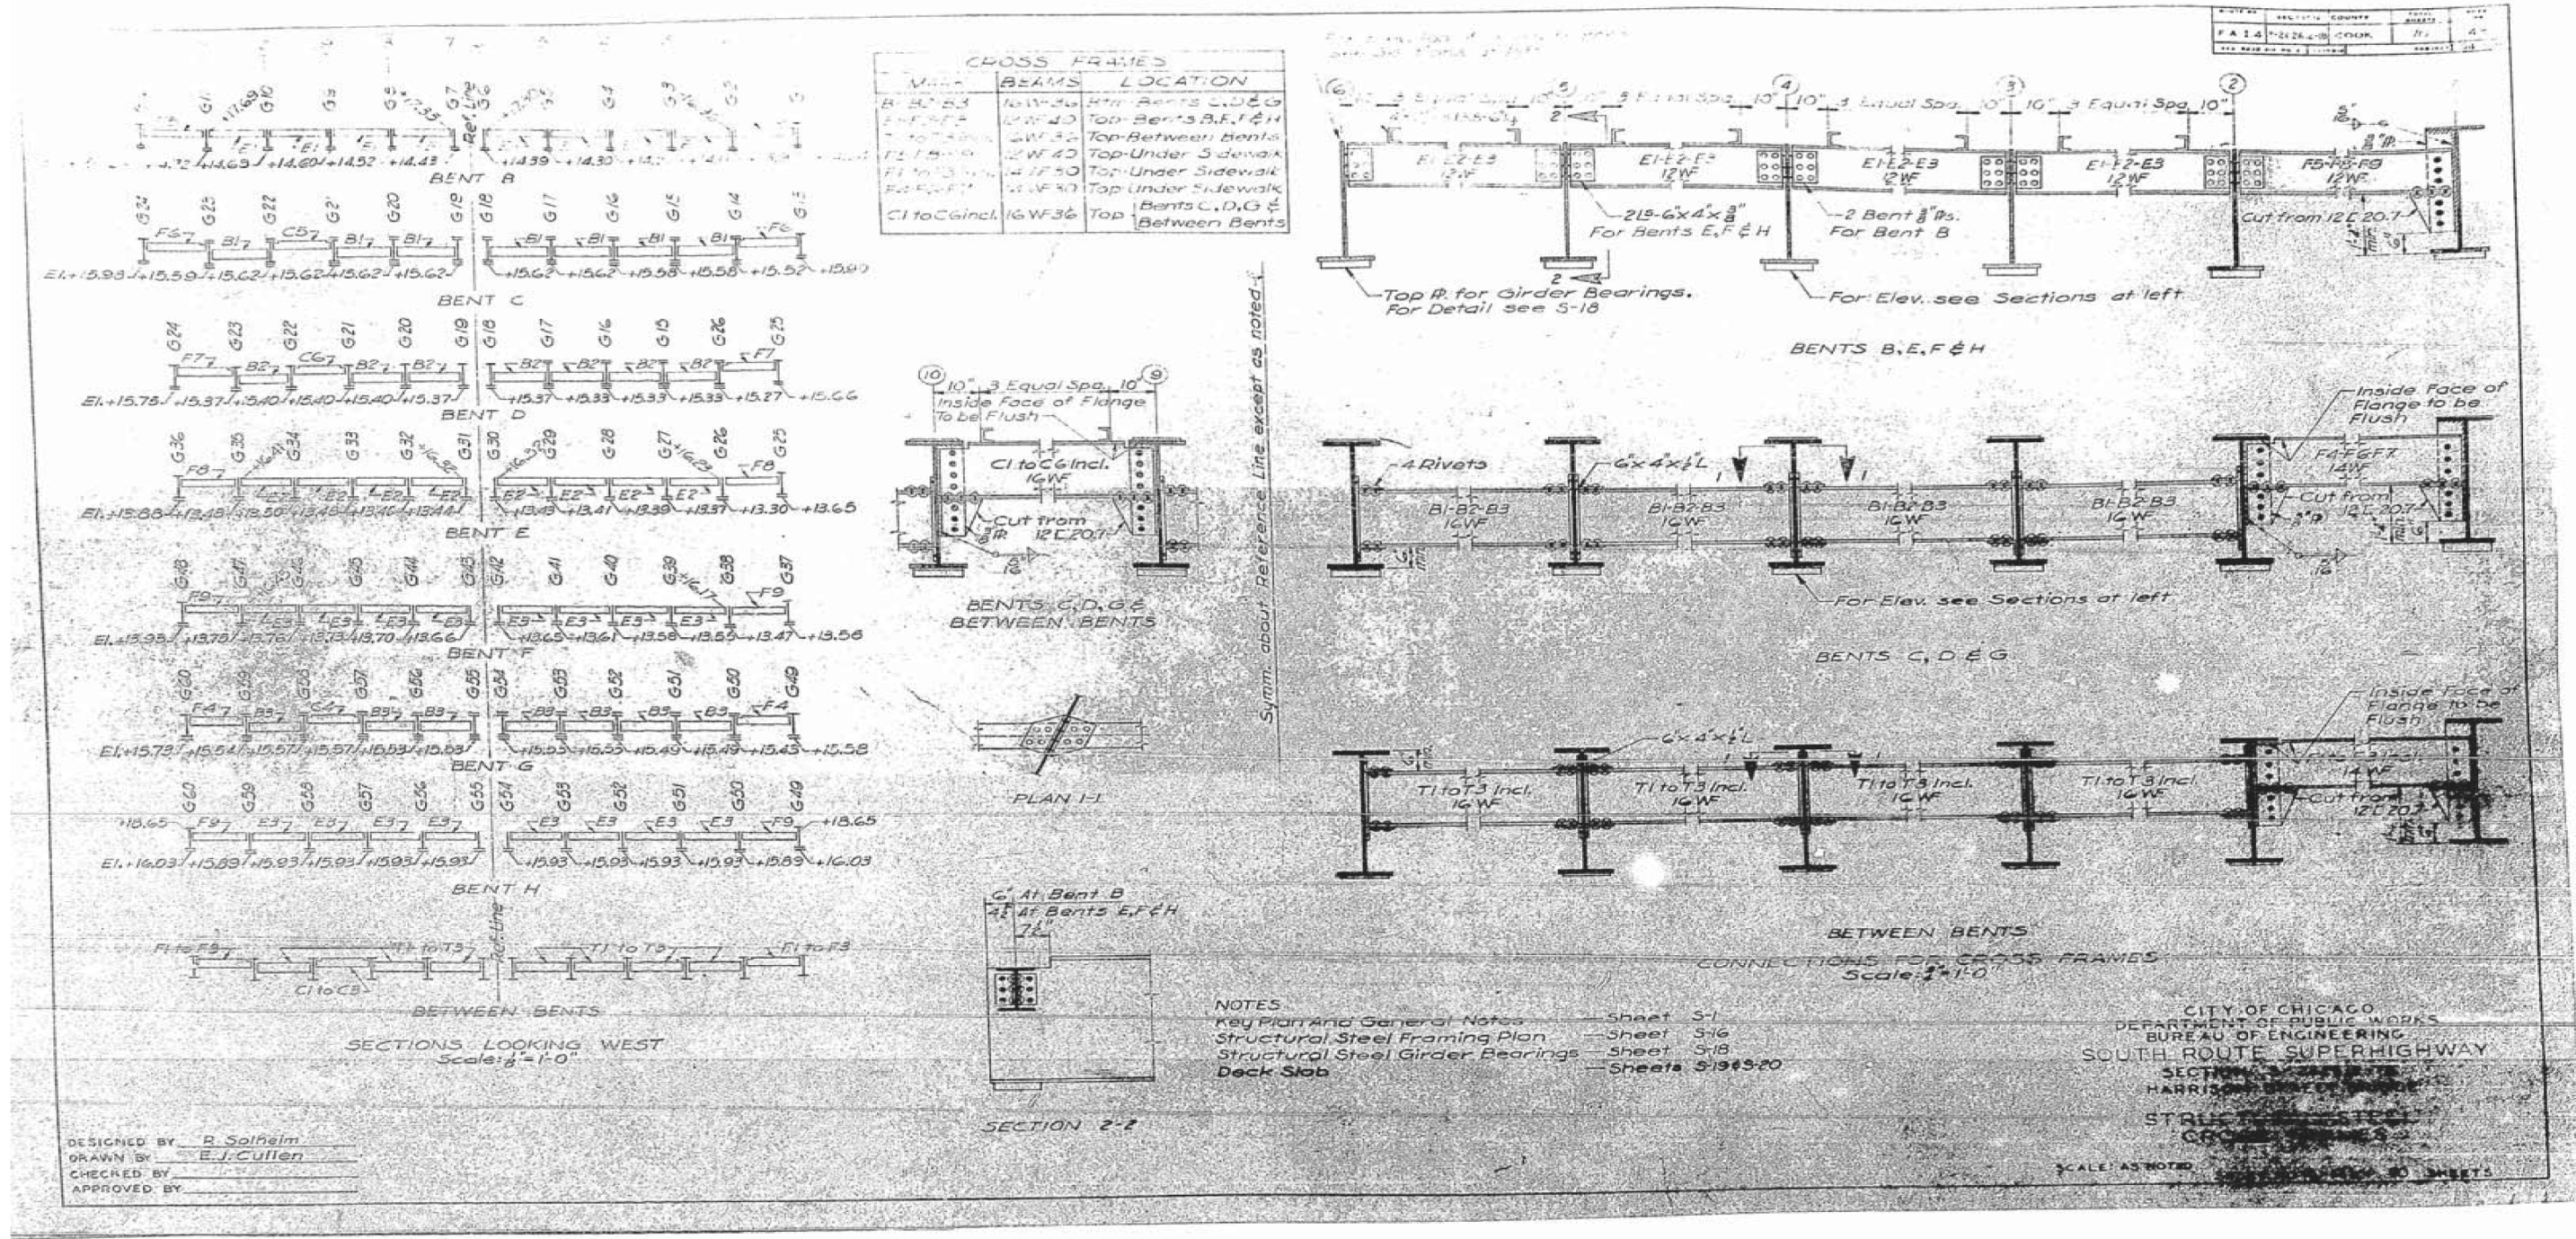

D:\60W71-shr-AS-BUILT-47.dgn


USER NAME - dunkerleyb	DESIGNED -	REVISED -
	CHECKED -	REVISED -
PLOT SCALE - N.T.S.	DRAWN -	REVISED -
PLOT DATE - 11/26/2013	CHECKED -	REVISED -

STATE OF ILLINOIS
DEPARTMENT OF TRANSPORTATION

EXISTING AS-BUILTS SN 016-1088

SHEET NO. AS-47 OF AS-72 SHEETS

F.A.I. RTE. 90/94/290	SECTION 2013-036R	COUNTY COOK	TOTAL SHEETS 256	SHEET NO. 189
CONTRACT NO. 60W71				ILLINOIS FED. AID PROJECT -NUMBER-

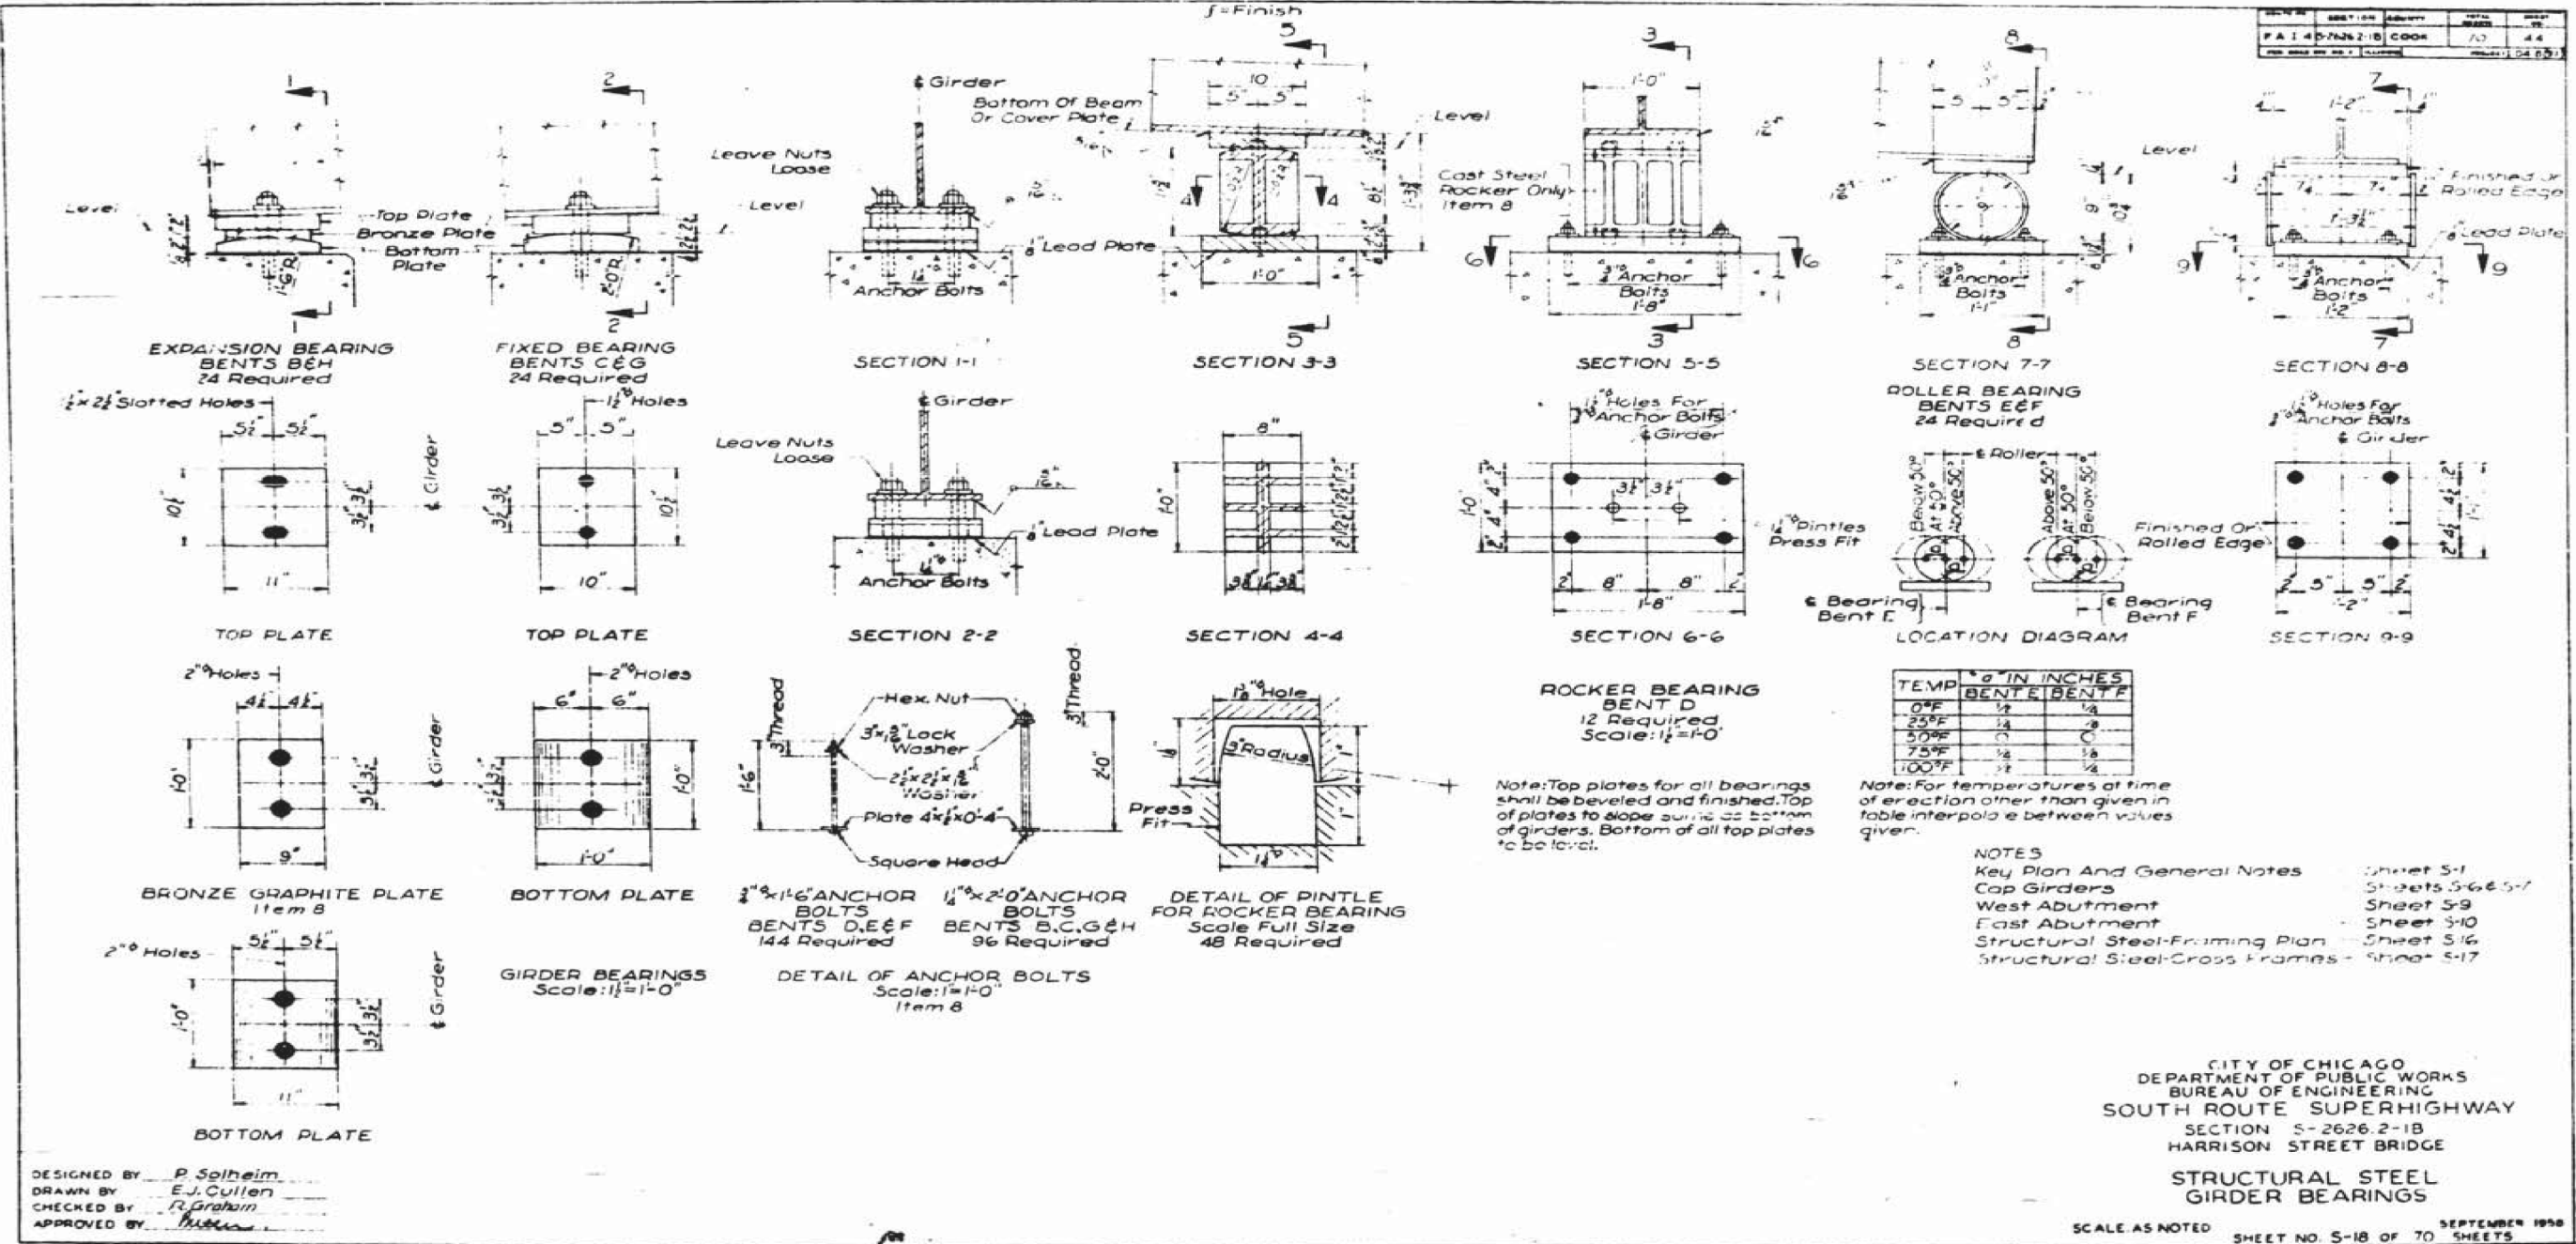


USER NAME = dunkerleyb	DESIGNED -	REVISED
	CHECKED -	REVISED
PLOT SCALE = N.T.S.	DRAWN -	REVISED
PLOT DATE = 11/26/2013	CHECKED -	REVISED

STATE OF ILLINOIS
DEPARTMENT OF TRANSPORTATION

EXISTING AS-BUILTS SN 016-1088

SHEET NO. AS-48 OF AS-72 SHEETS

F.A.I. RTE.	SECTION	COUNTY	TOTAL SHEETS	SHEET NO.
90/94/290	2013-036R	COOK	256	190
CONTRACT NO. 60W71				
ILLINOIS FED. AID PROJECT -NUMBER-				

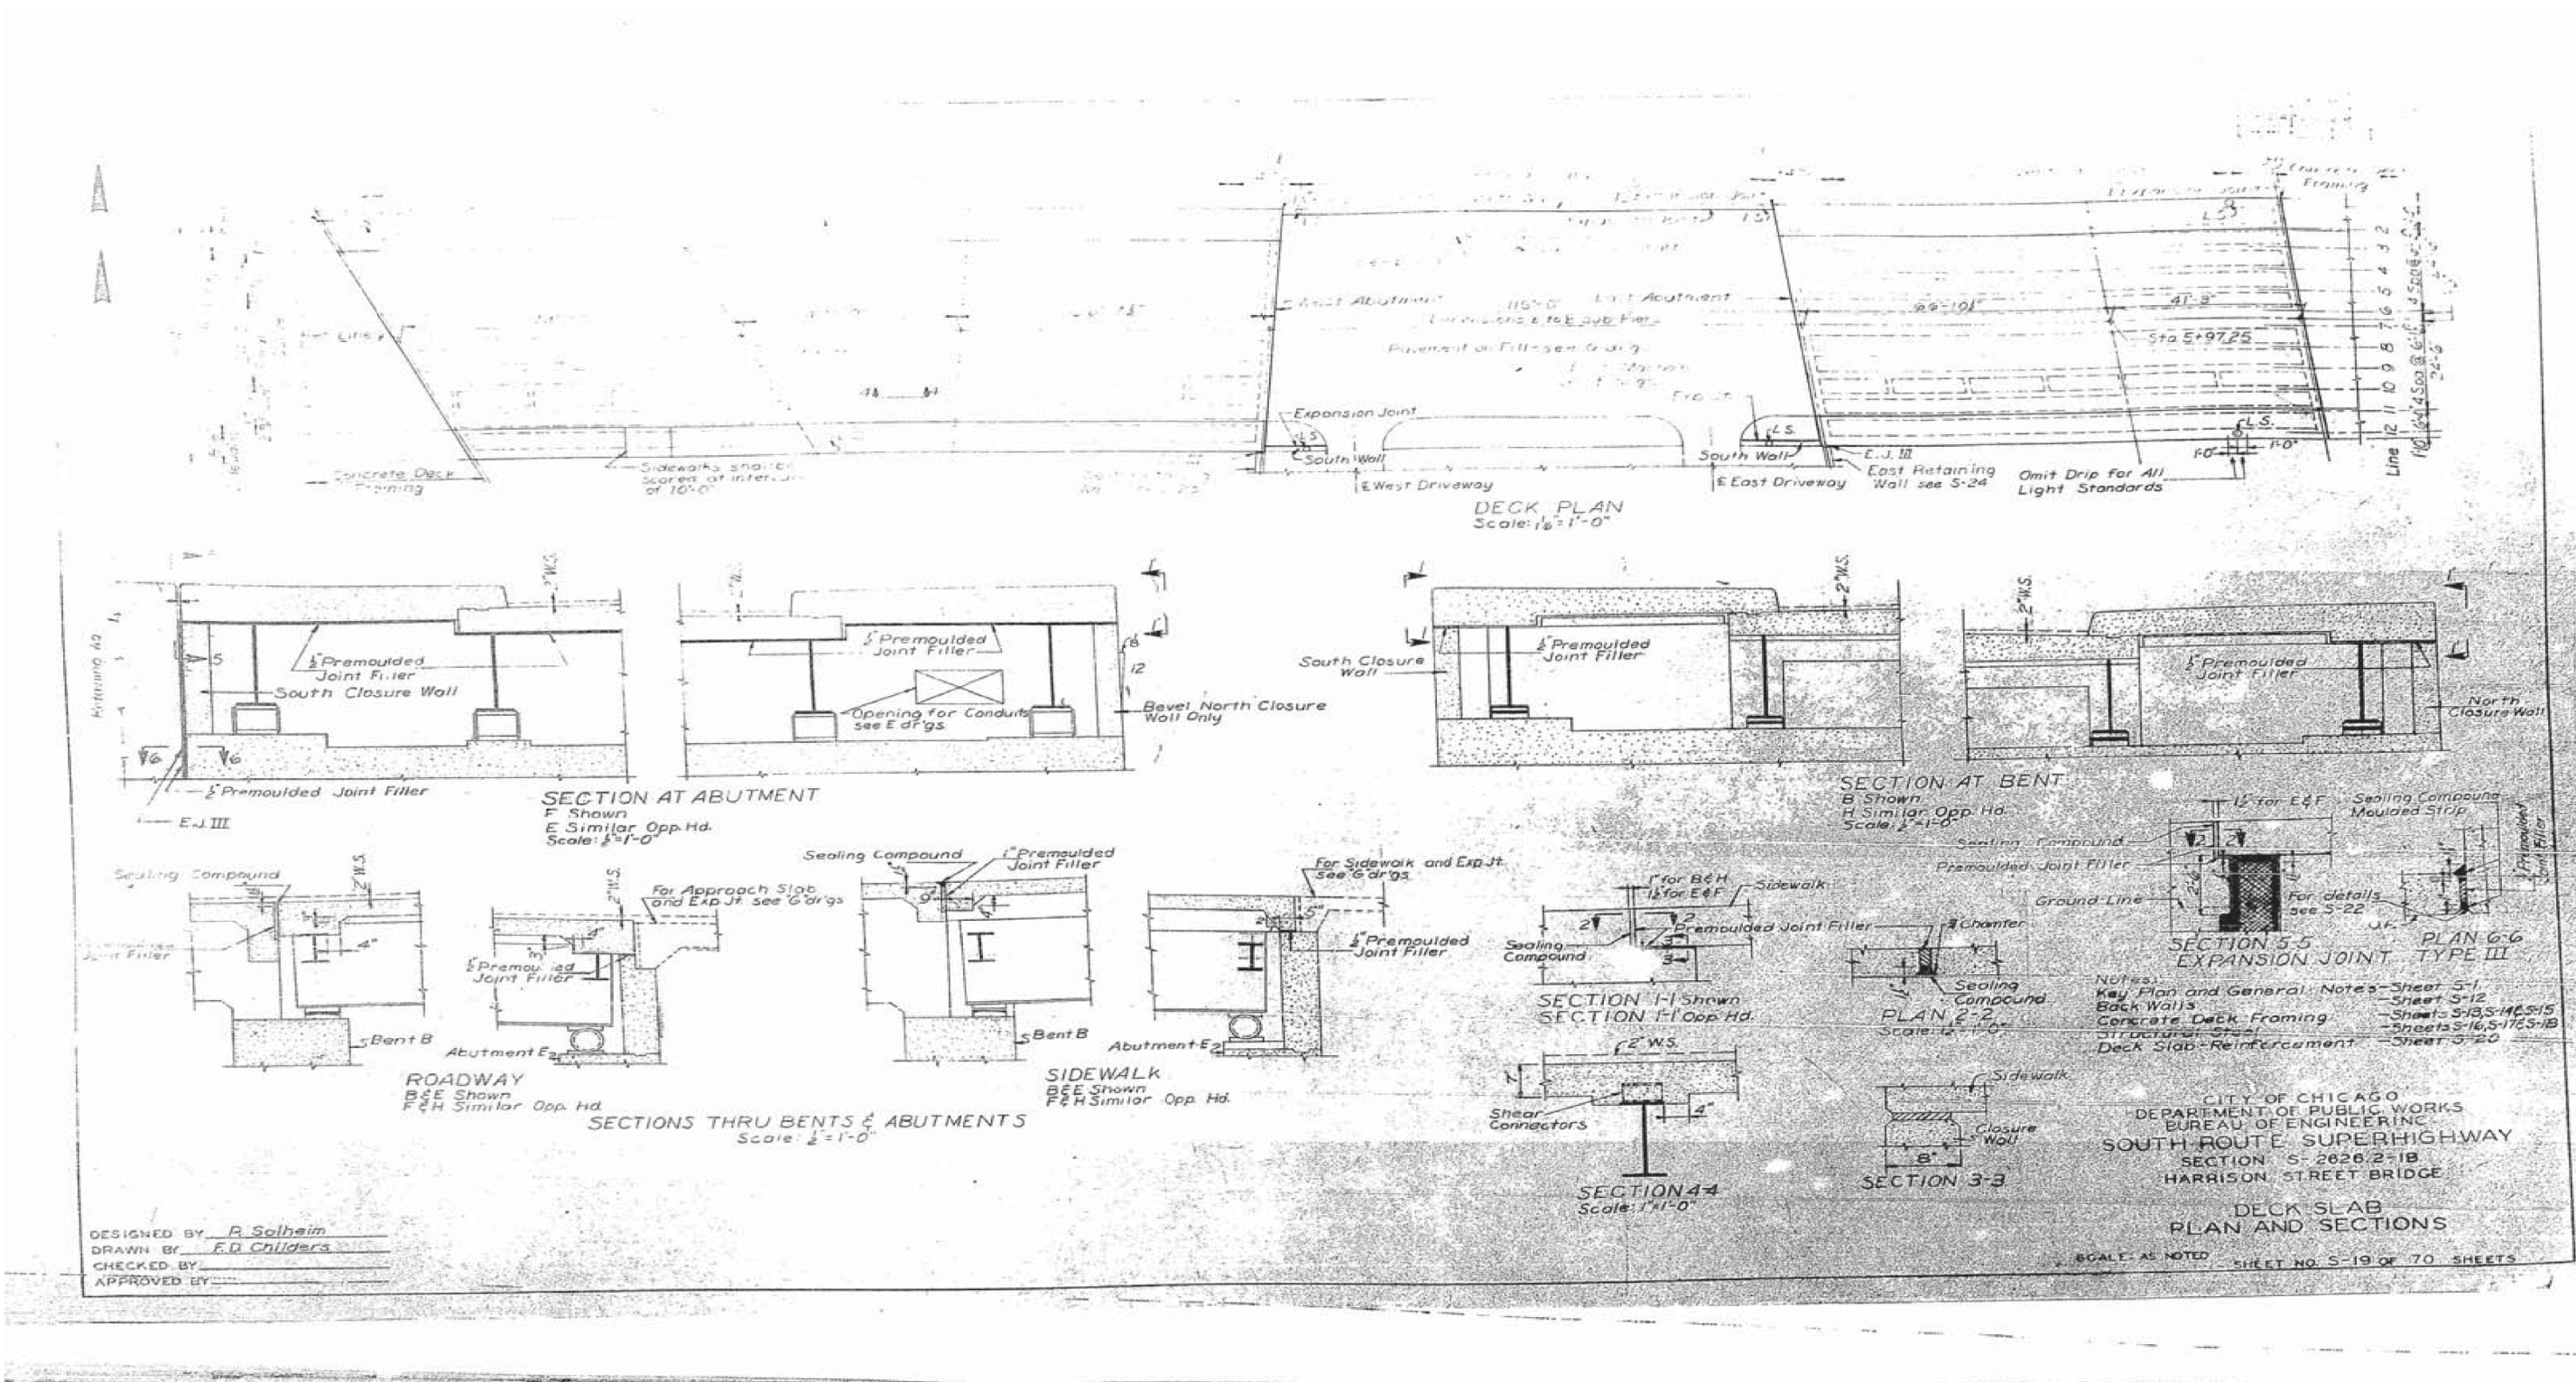

DESIGNED BY R. Solheim
DRAWN BY F.D. Childers
CHECKED BY _____
APPROVED BY _____

USER NAME = dunkerleyb	DESIGNED -	REVISED
	CHECKED -	REVISED
PLOT SCALE = N.T.S.	DRAWN -	REVISED
PLOT DATE = 11/26/2013	CHECKED -	REVISED


STATE OF ILLINOIS
DEPARTMENT OF TRANSPORTATION

EXISTING AS-BUILTS SN 016-1088

SHEET NO. AS-49 OF AS-72 SHEETS

F.A.I. RTE.	SECTION	COUNTY	TOTAL SHEETS	SHEET NO.
90/94/290	2013-036R	COOK	256	191
CONTRACT NO. 60W71				
ILLINOIS FED. AID PROJECT -NUMBER-				

FOR INFORMATION ONLY

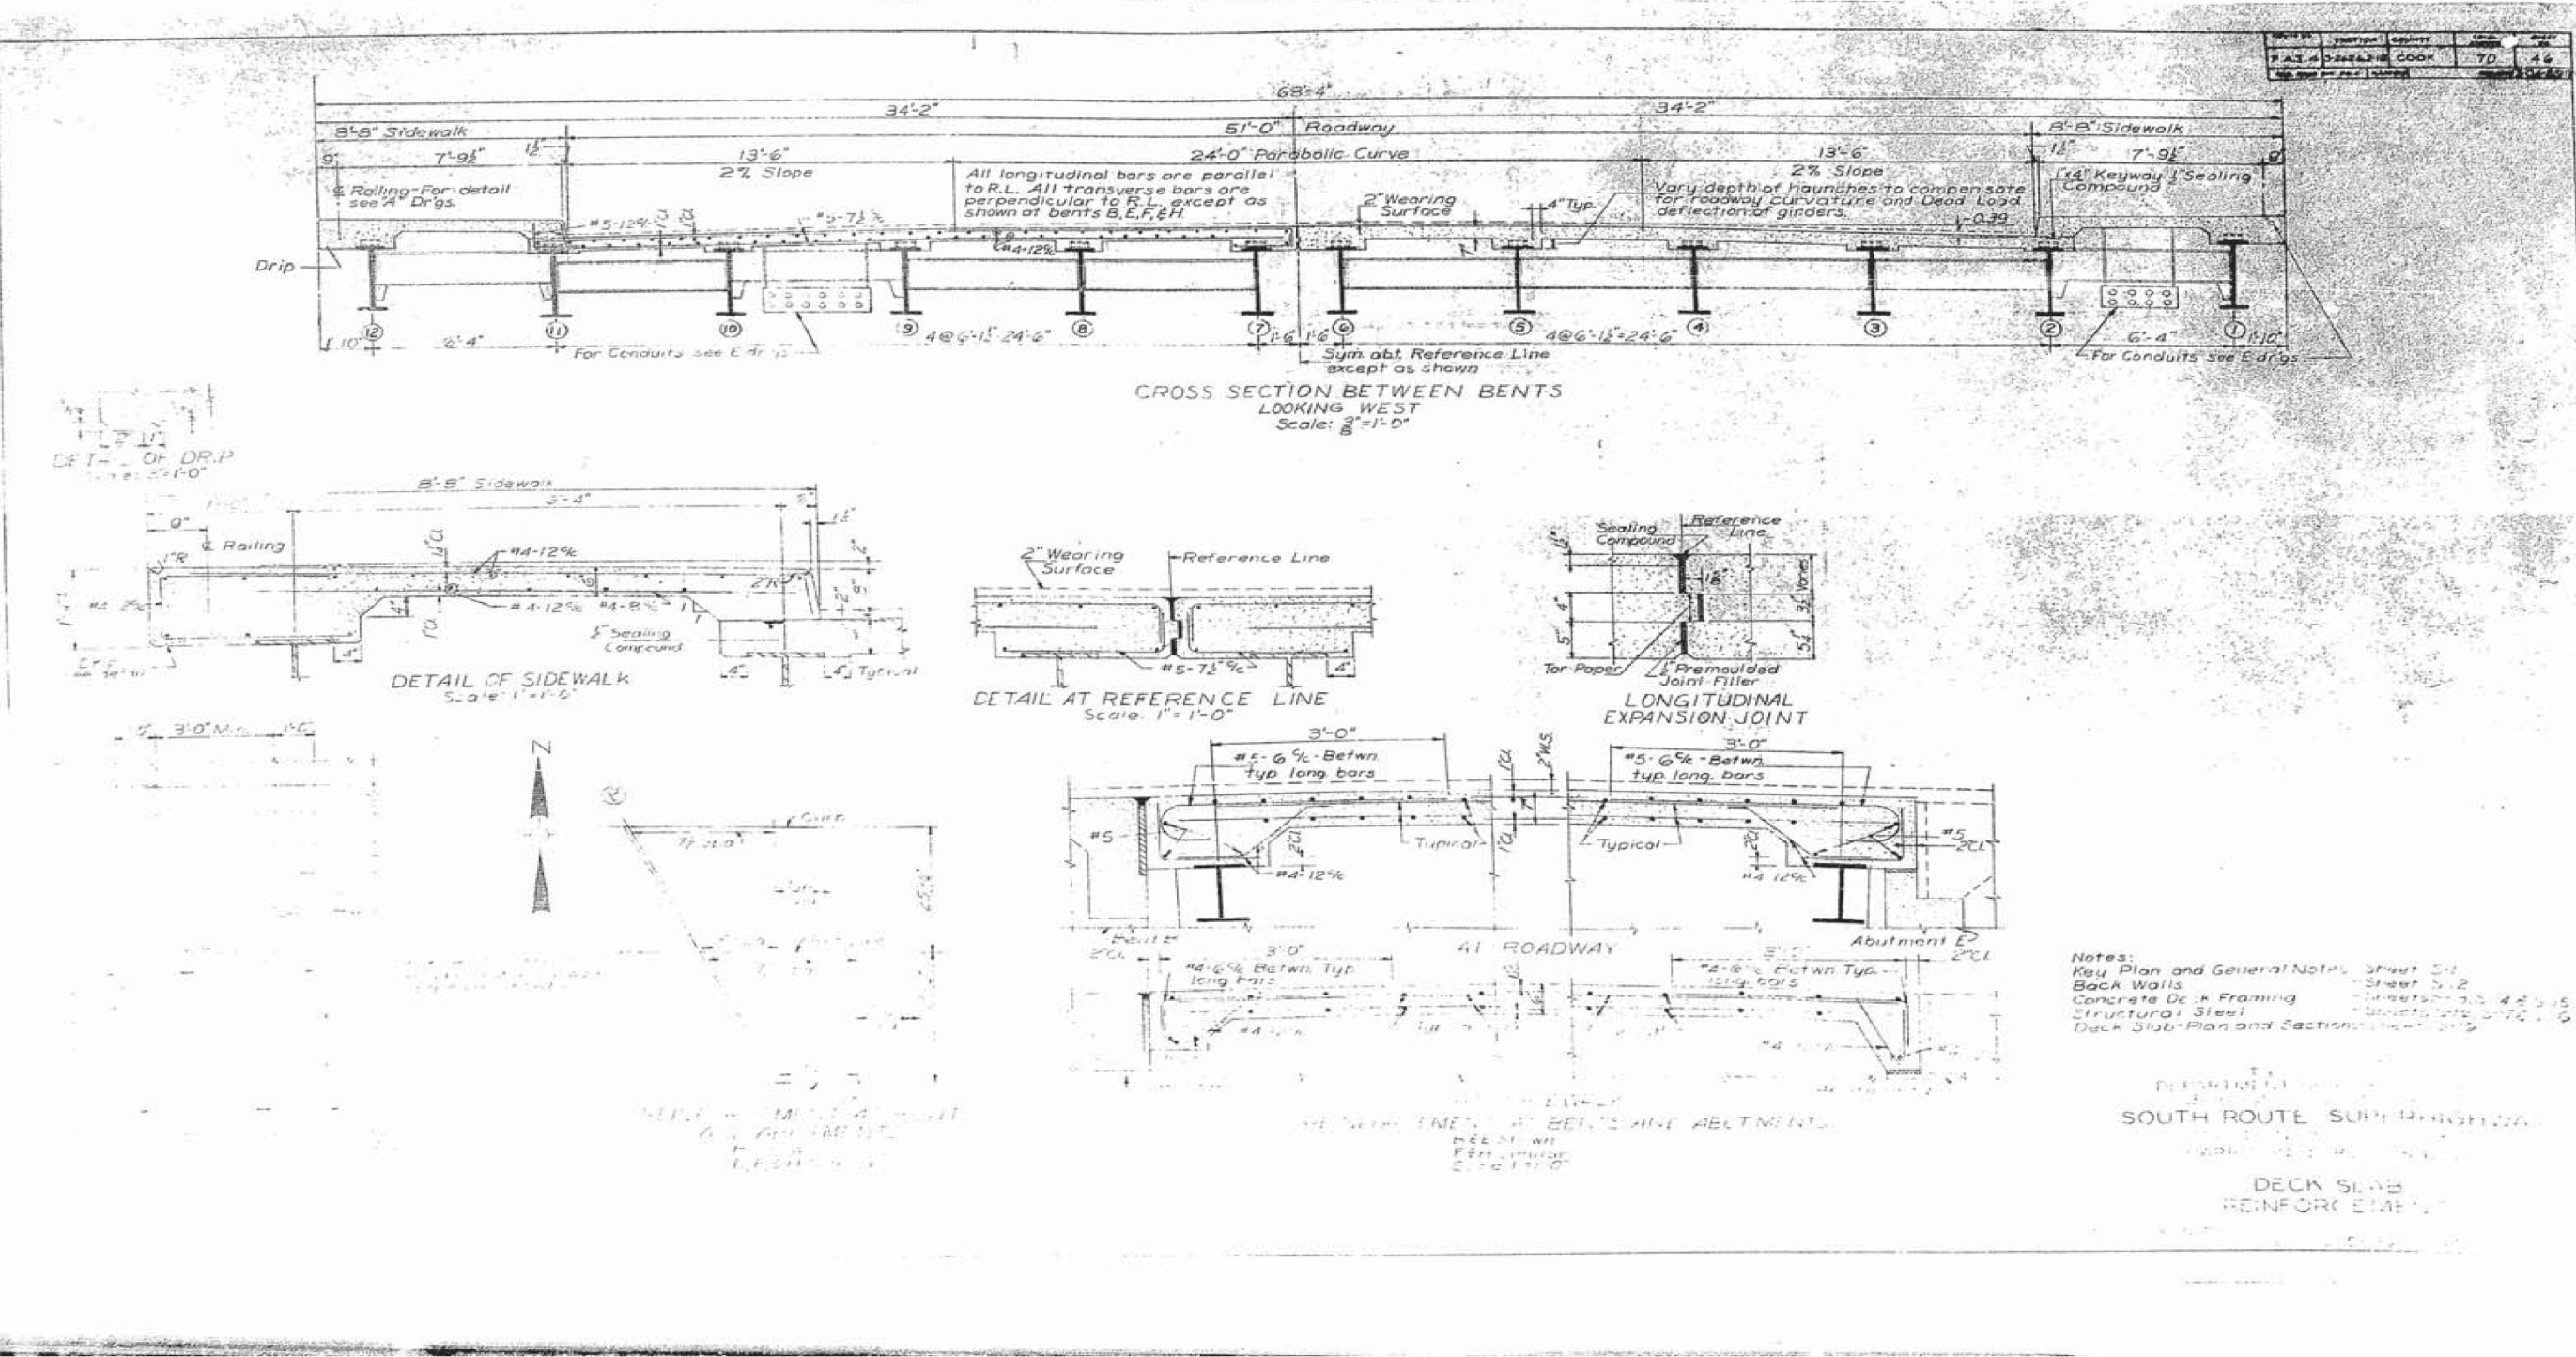

USER NAME = dunkerleyb	DESIGNED -	REVISED
	CHECKED -	REVISED
PLOT SCALE = N.T.S.	DRAWN -	REVISED
PLOT DATE = 11/26/2013	CHECKED -	REVISED


STATE OF ILLINOIS
DEPARTMENT OF TRANSPORTATION

EXISTING AS-BUILTS SN 016-1088

SHEET NO. AS-50 OF AS-72 SHEETS

F.A.I. RTE.	SECTION	COUNTY	TOTAL SHEETS	SHEET NO.
90/94/290	2013-036R	COOK	256	192
CONTRACT NO. 60W71				
ILLINOIS FED. AID PROJECT -NUMBER-				

FOR INFORMATION ONLY

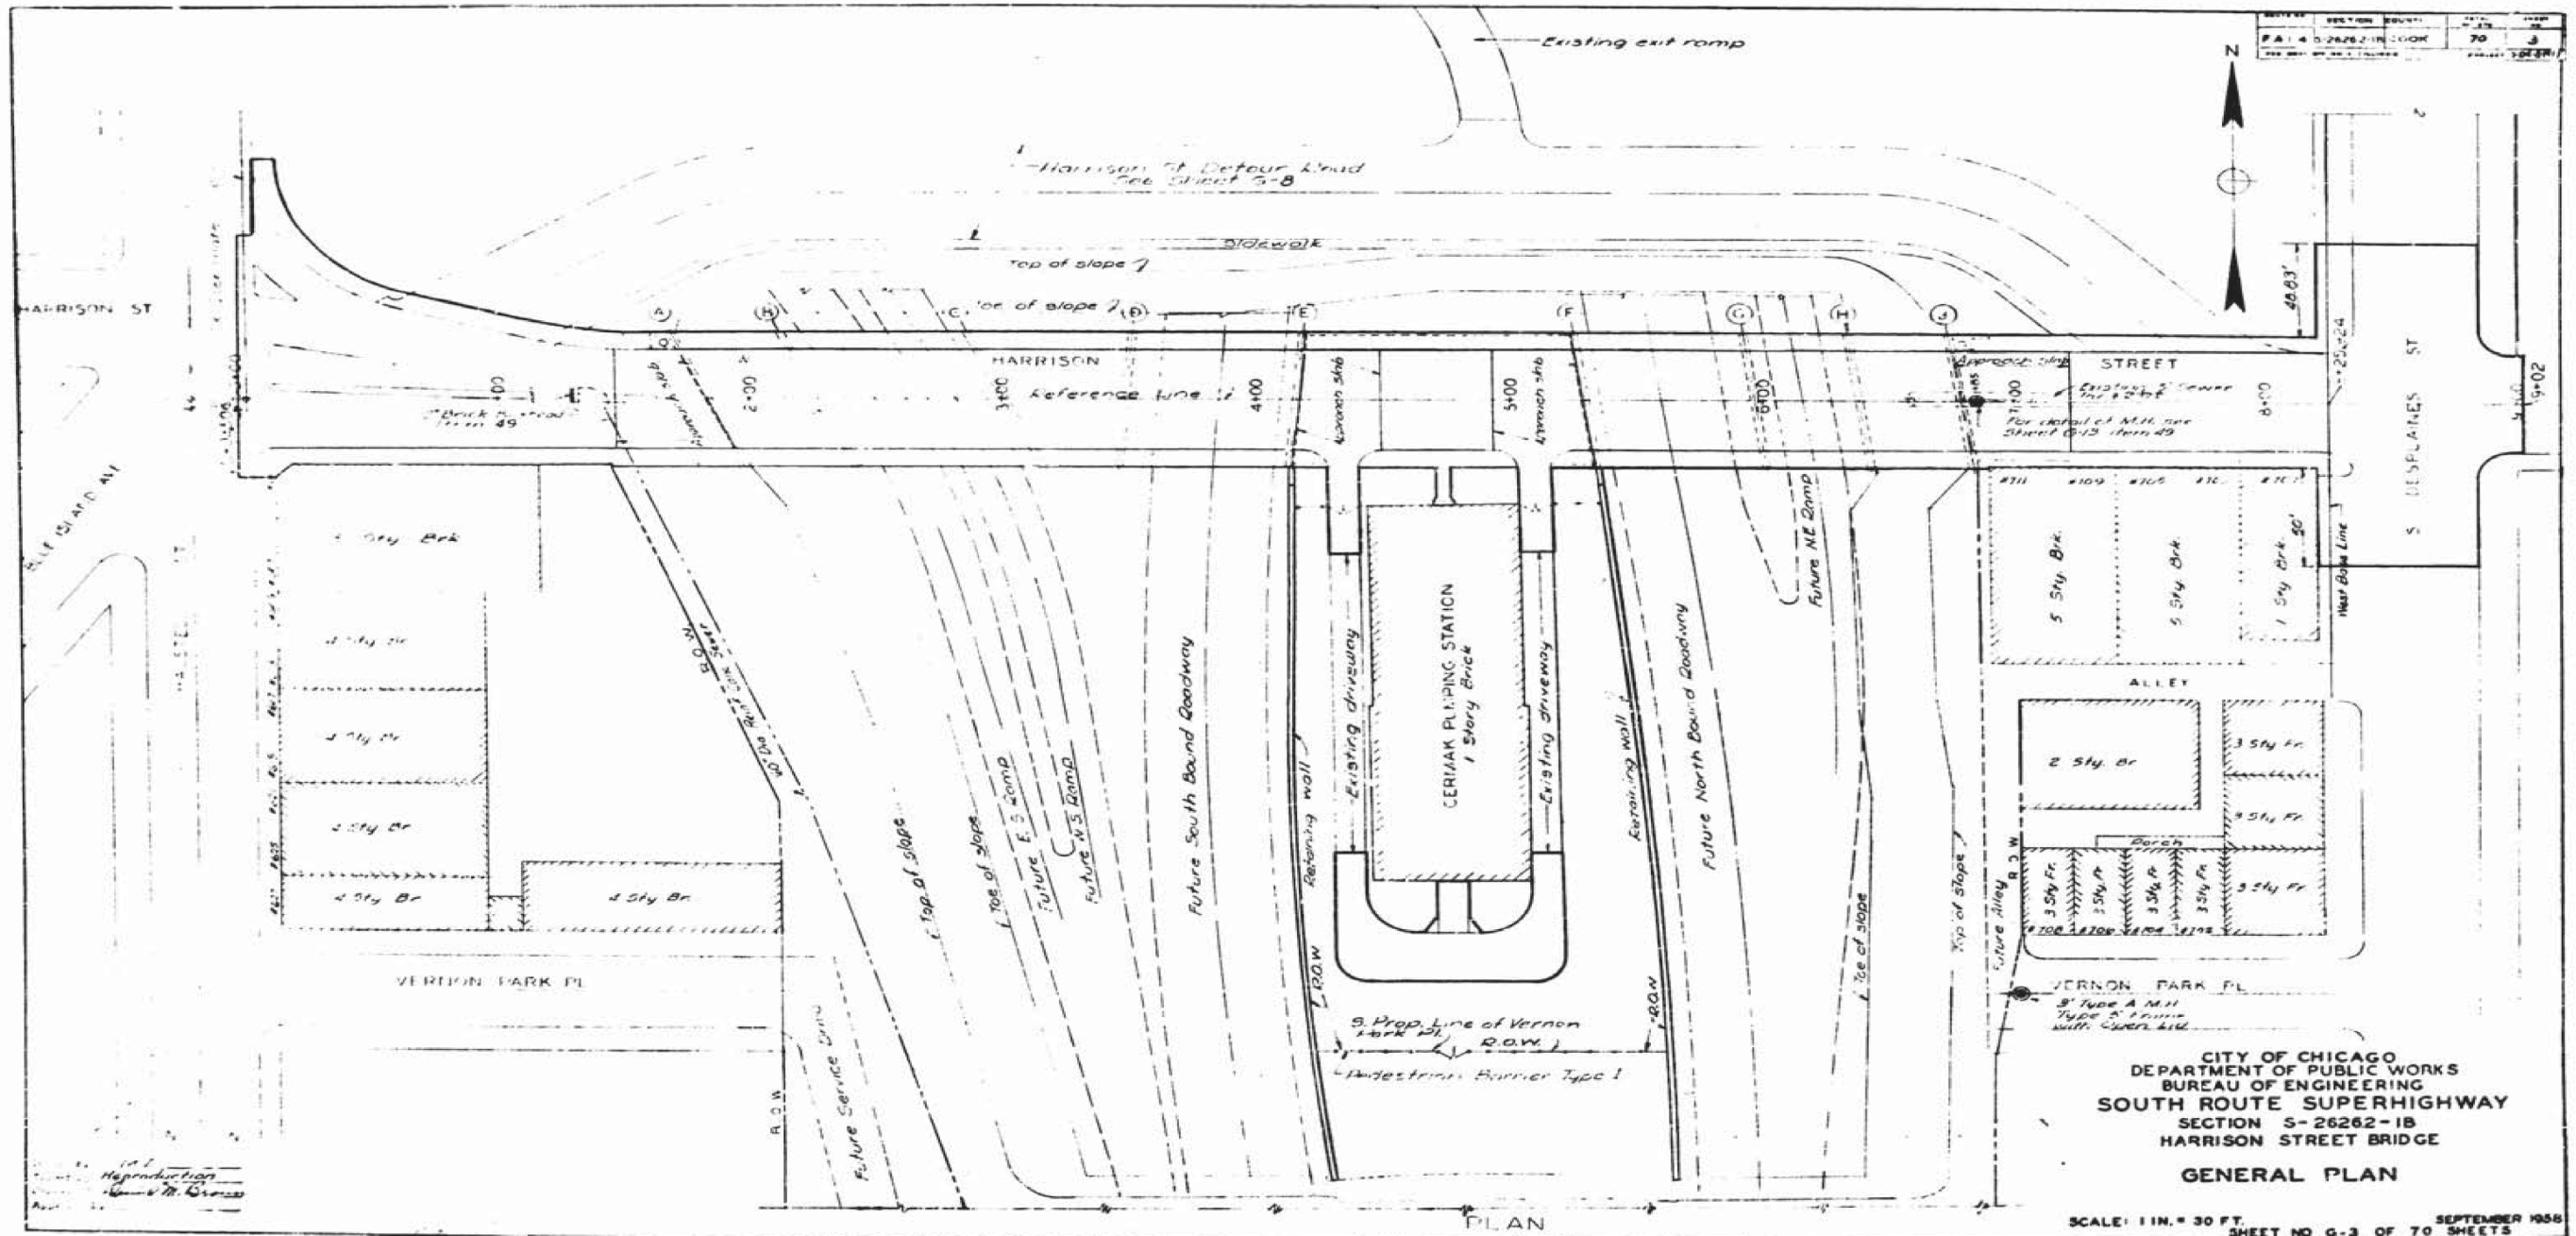

D:\160W71-sht-AS-BUILT-51.dgn

USER NAME = dunkerleyb	DESIGNED -	REVISED
	CHECKED -	REVISED
PLOT SCALE = N.T.S.	DRAWN -	REVISED
PLOT DATE = 11/26/2013	CHECKED -	REVISED


STATE OF ILLINOIS
DEPARTMENT OF TRANSPORTATION


EXISTING AS-BUILTS SN 016-1088

SHEET NO. AS-51 OF AS-72 SHEETS

F.A.I. RTE.	SECTION	COUNTY	TOTAL SHEETS	SHEET NO.
90/94/290	2013-036R	COOK	256	193
		CONTRACT NO. 60W71		
ILLINOIS FED. AID PROJECT -NUMBER-				

ILLINOIS		FED. AID PROJECT	-NUMBER-
----------	--	------------------	----------

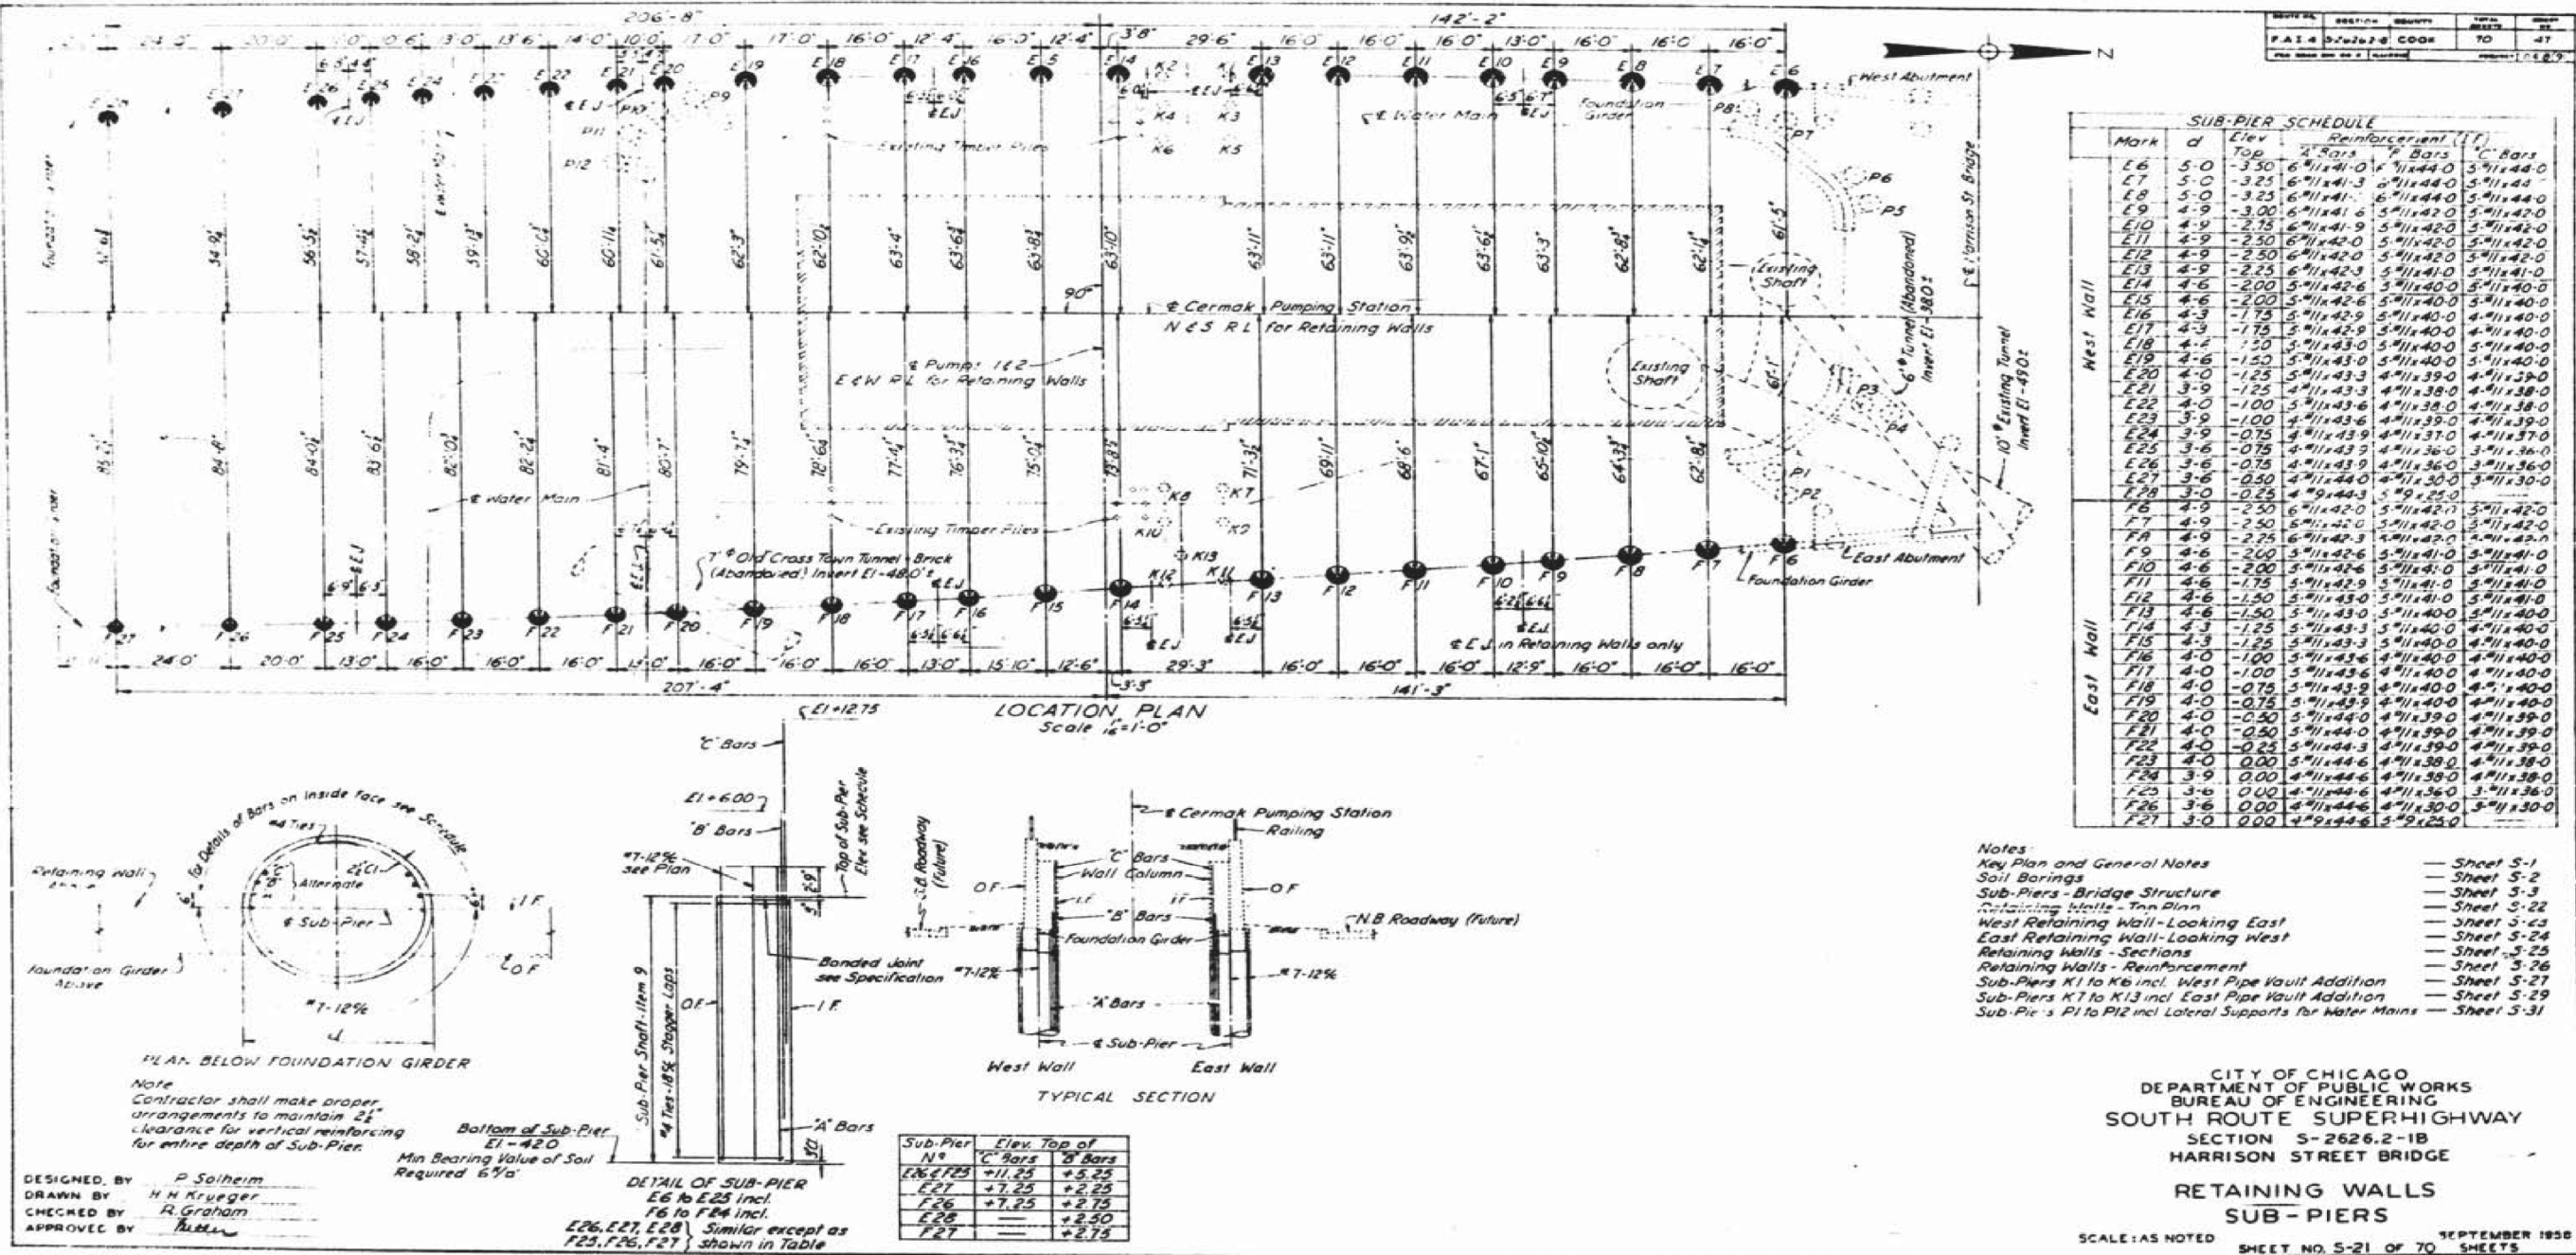

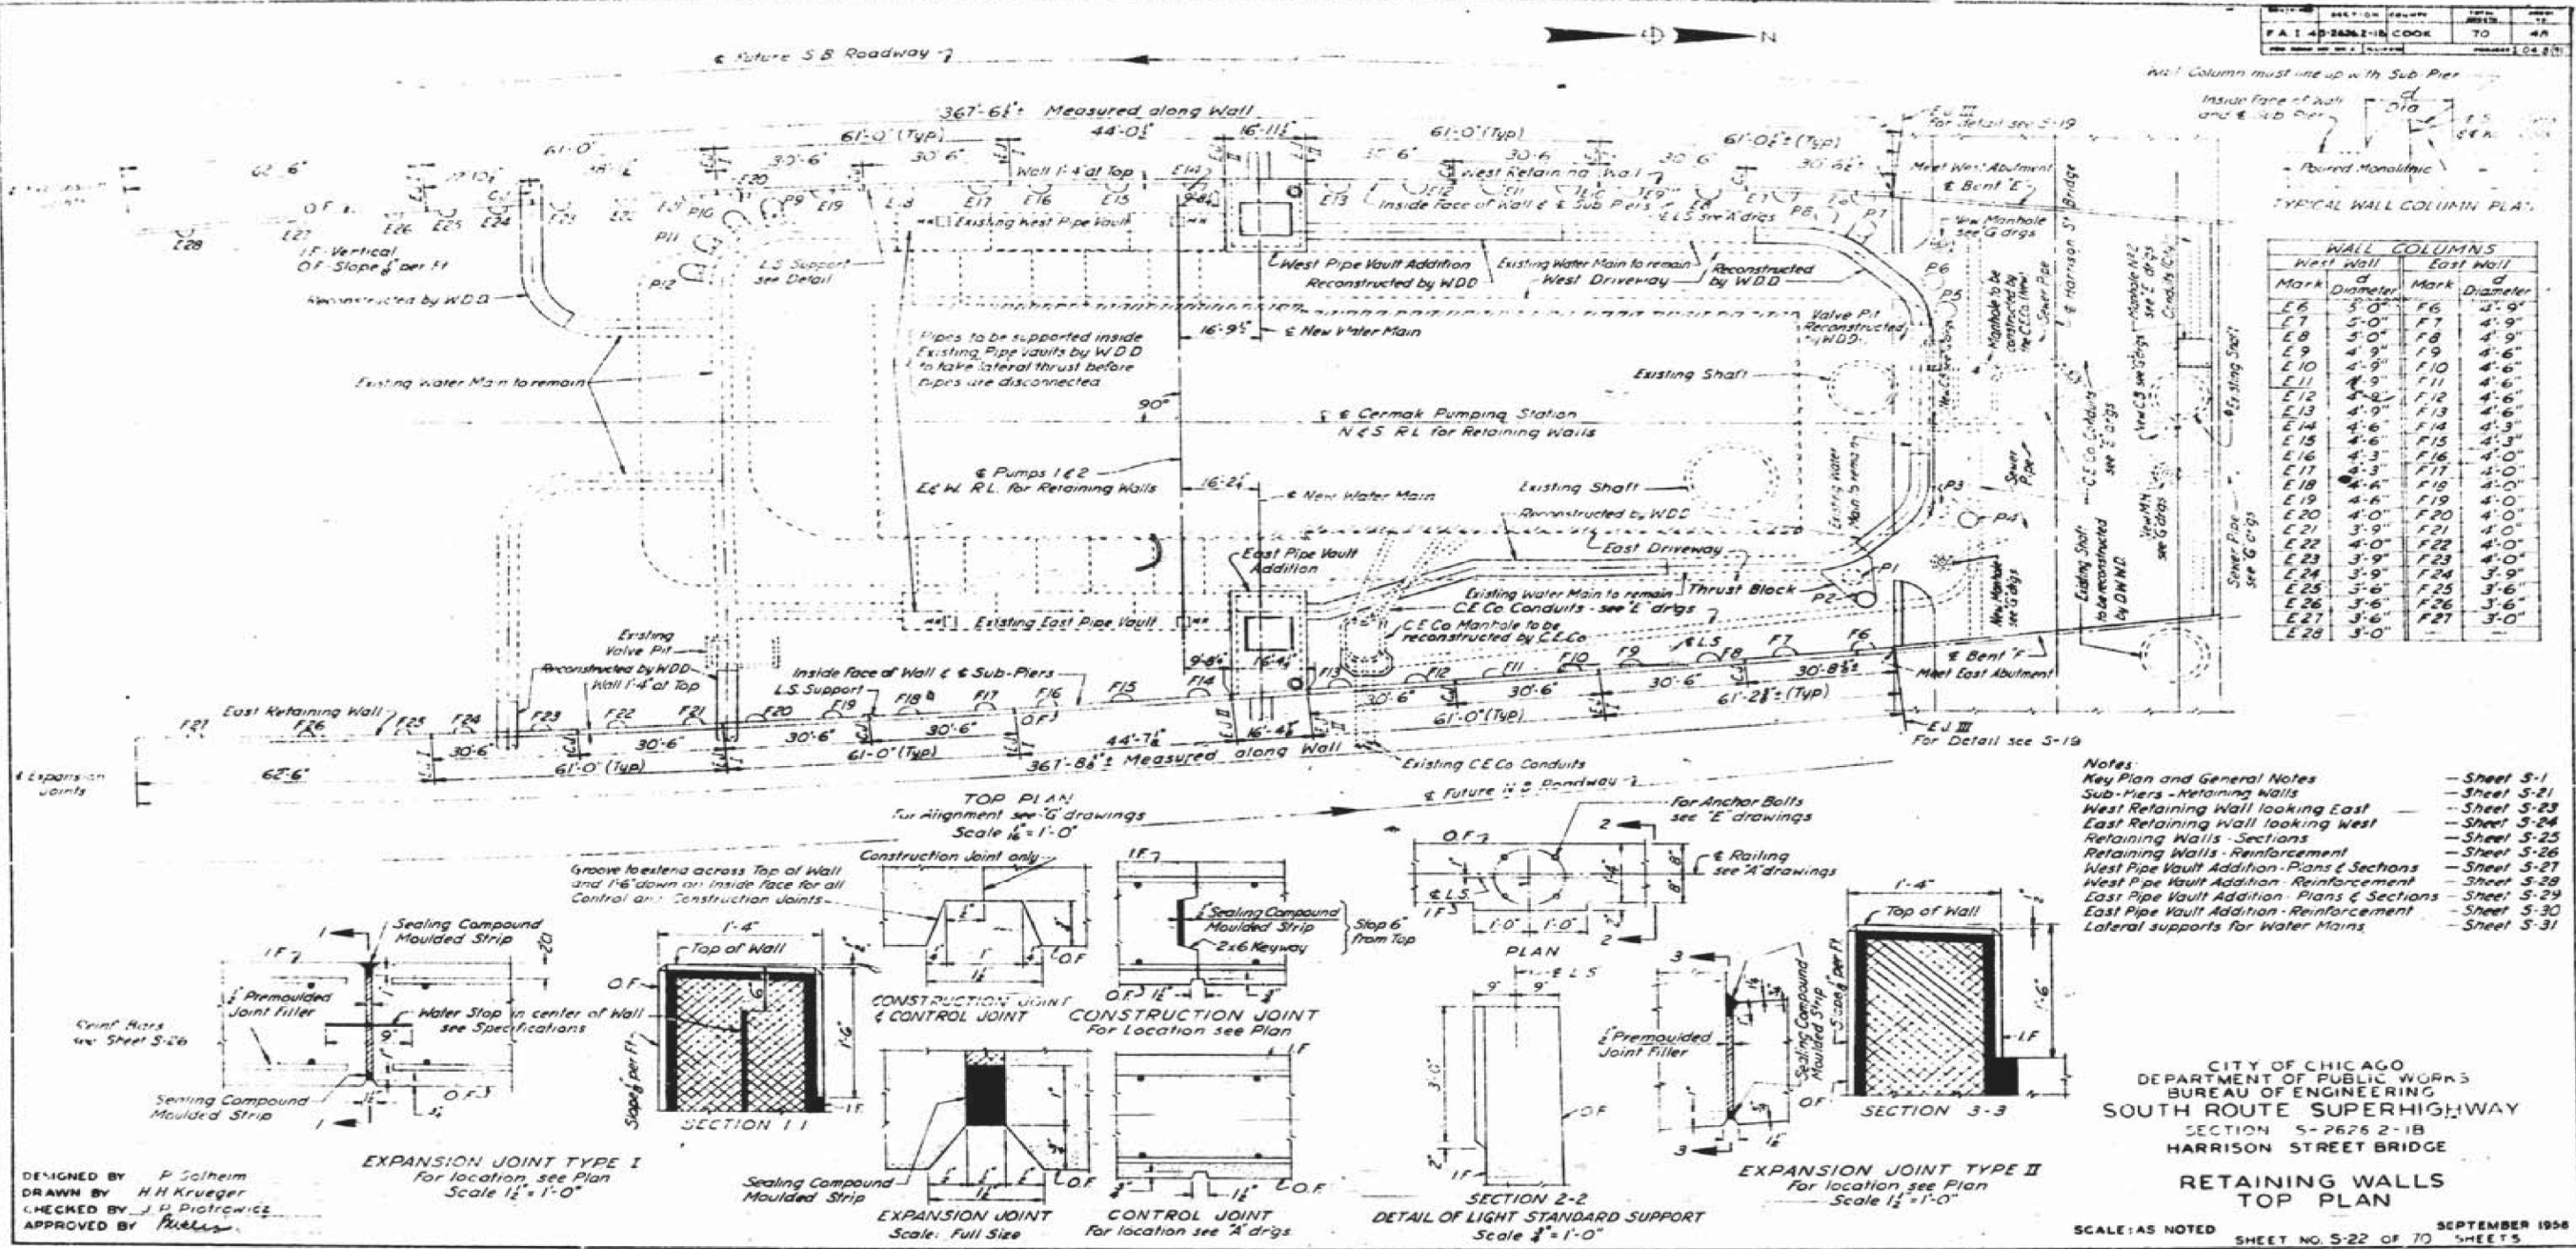


USER NAME = dunkerleyb	DESIGNED -	REVISED
	CHECKED -	REVISED
PLOT SCALE = N.T.S.	DRAWN -	REVISED
PLOT DATE = 11/26/2013	CHECKED -	REVISED

STATE OF ILLINOIS
DEPARTMENT OF TRANSPORTATION

EXISTING AS-BUILTS SN 016-1088

SHEET NO. AS-53 OF AS-72 SHEETS

F.A.I. RTE.	SECTION	COUNTY	TOTAL SHEETS	SHEET NO.
90/94/290	2013-036R	COOK	256	195
CONTRACT NO. 60W71				
ILLINOIS FED. AID PROJECT -NUMBER-				

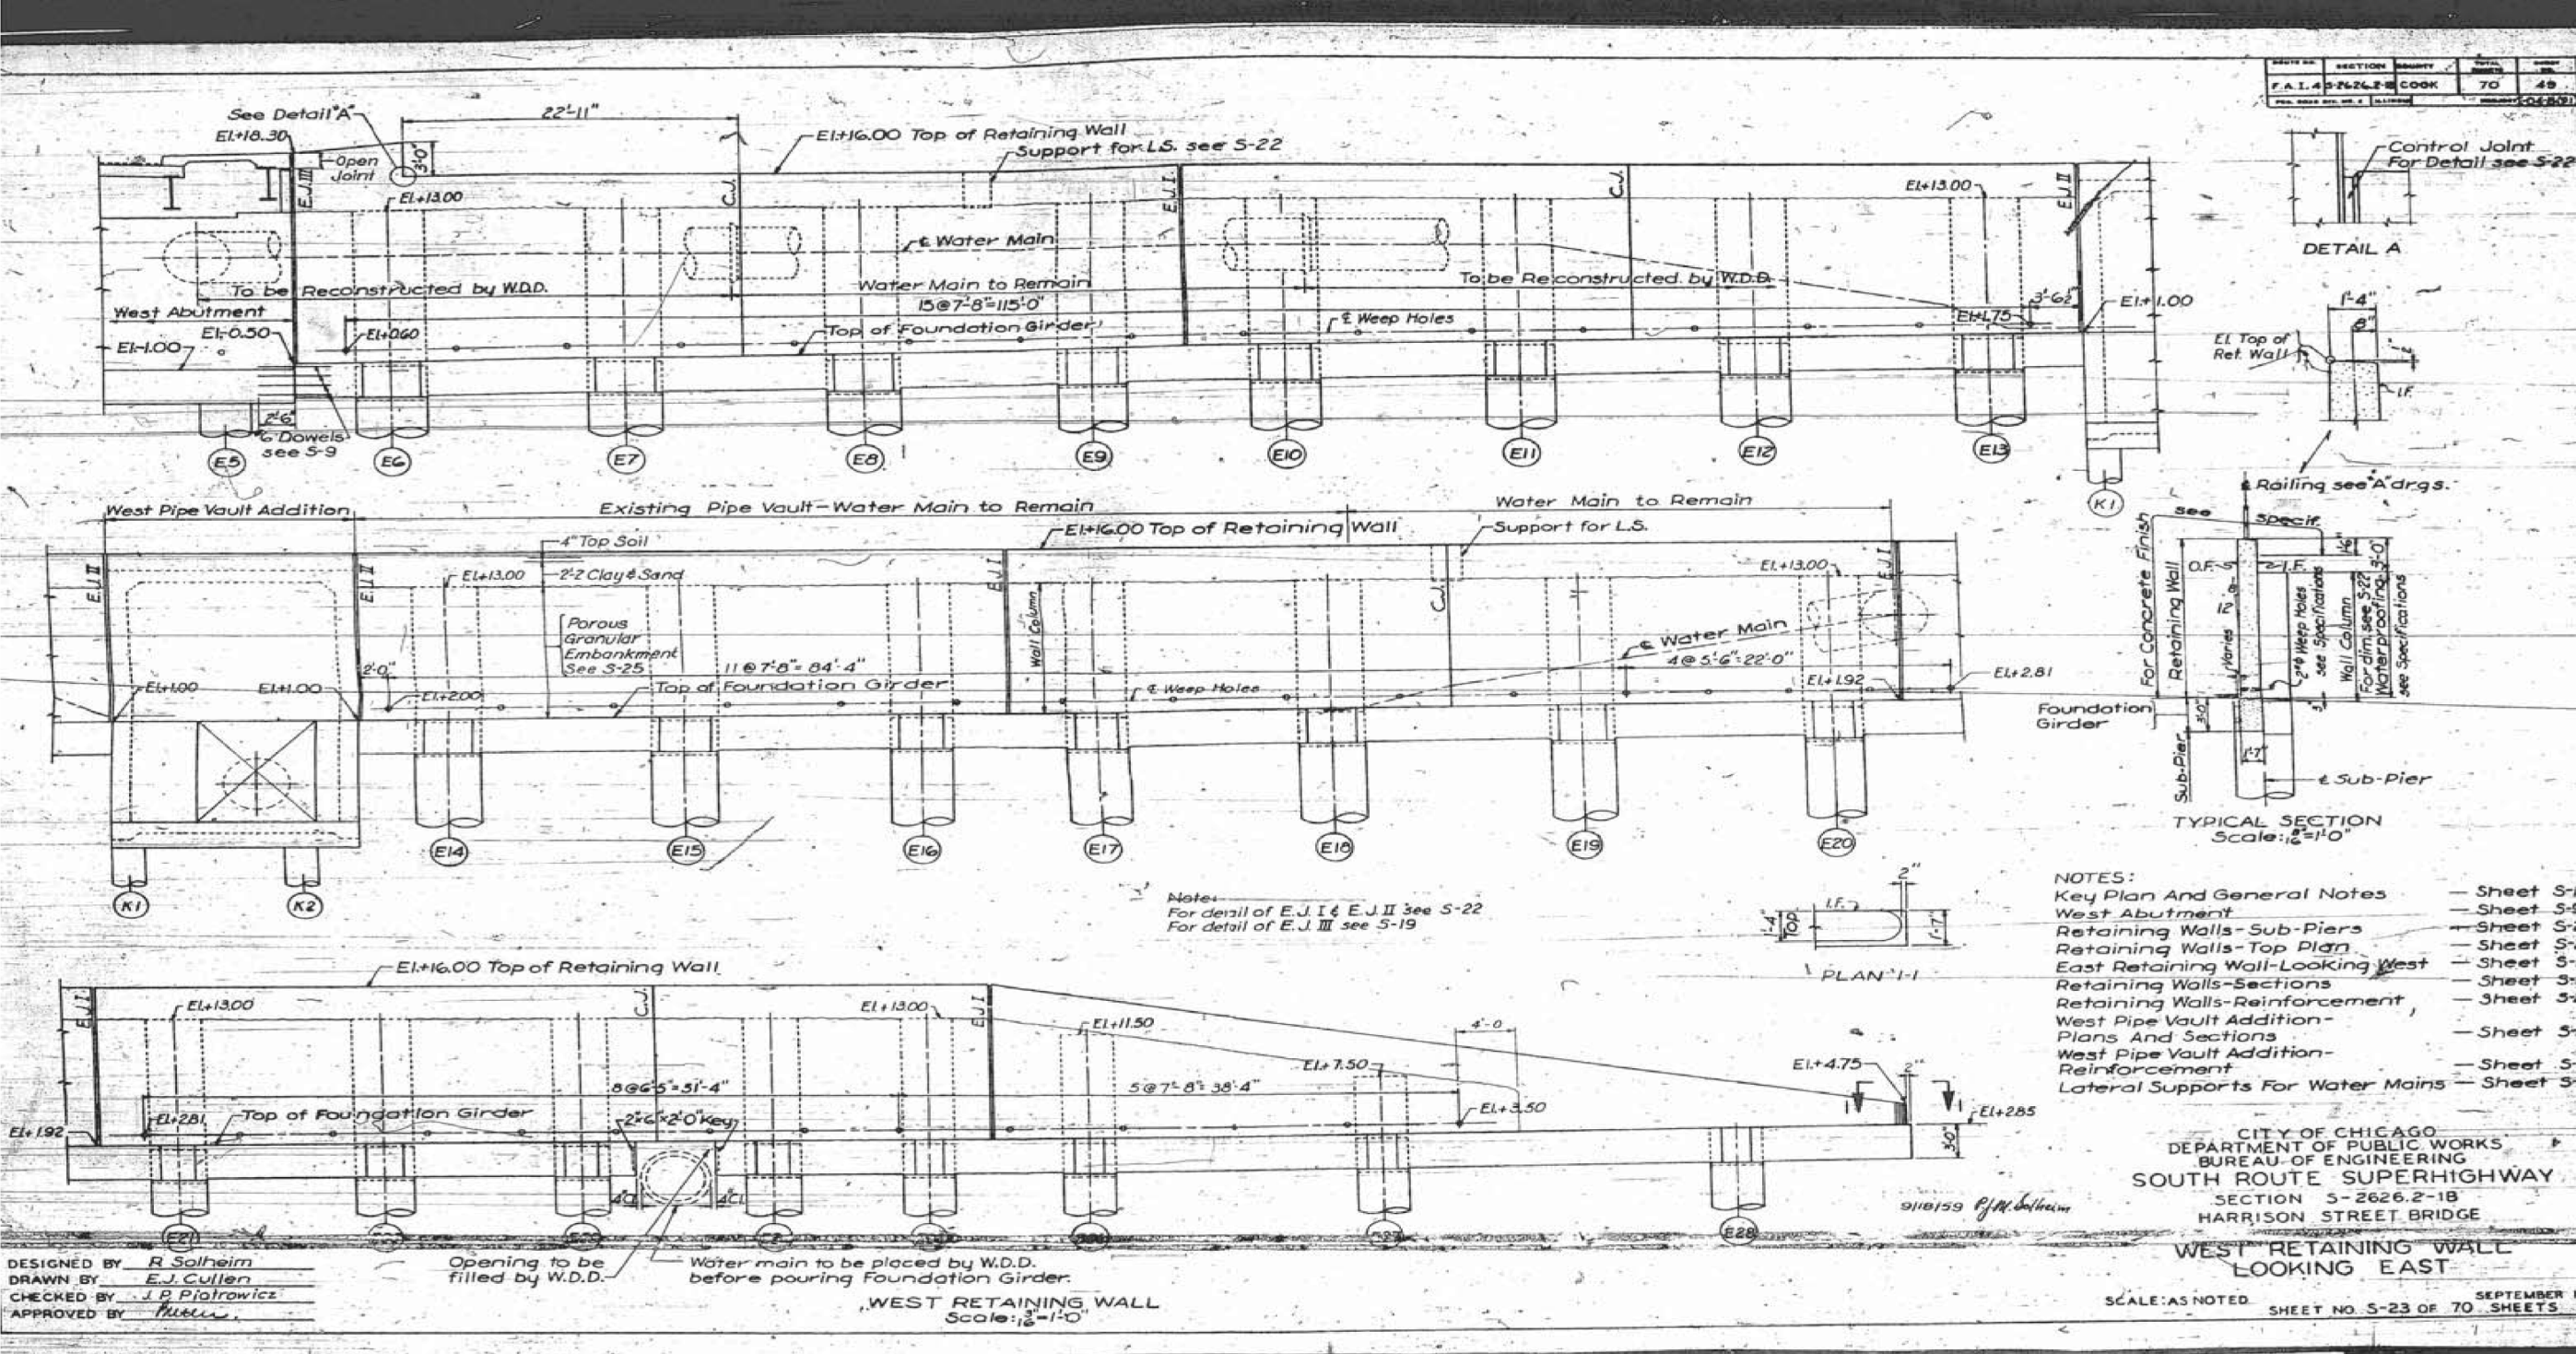

USER NAME = dunkerleyb	DESIGNED -	REVISED
	CHECKED -	REVISED
PLOT SCALE = N.T.S.	DRAWN -	REVISED
PLOT DATE = 11/26/2013	CHECKED -	REVISED


STATE OF ILLINOIS
DEPARTMENT OF TRANSPORTATION


EXISTING AS-BUILTS SN 016-1088

SHEET NO. AS-54 OF AS-72 SHEETS

F.A.I. RTE.	SECTION	COUNTY	TOTAL SHEETS	SHEET NO.
90/94/290	2013-036R	COOK	256	196
CONTRACT NO. 60W71				
ILLINOIS FED. AID PROJECT -NUMBER-				

 D:\160W71-sh+ -AS-BUILT-55.dgn



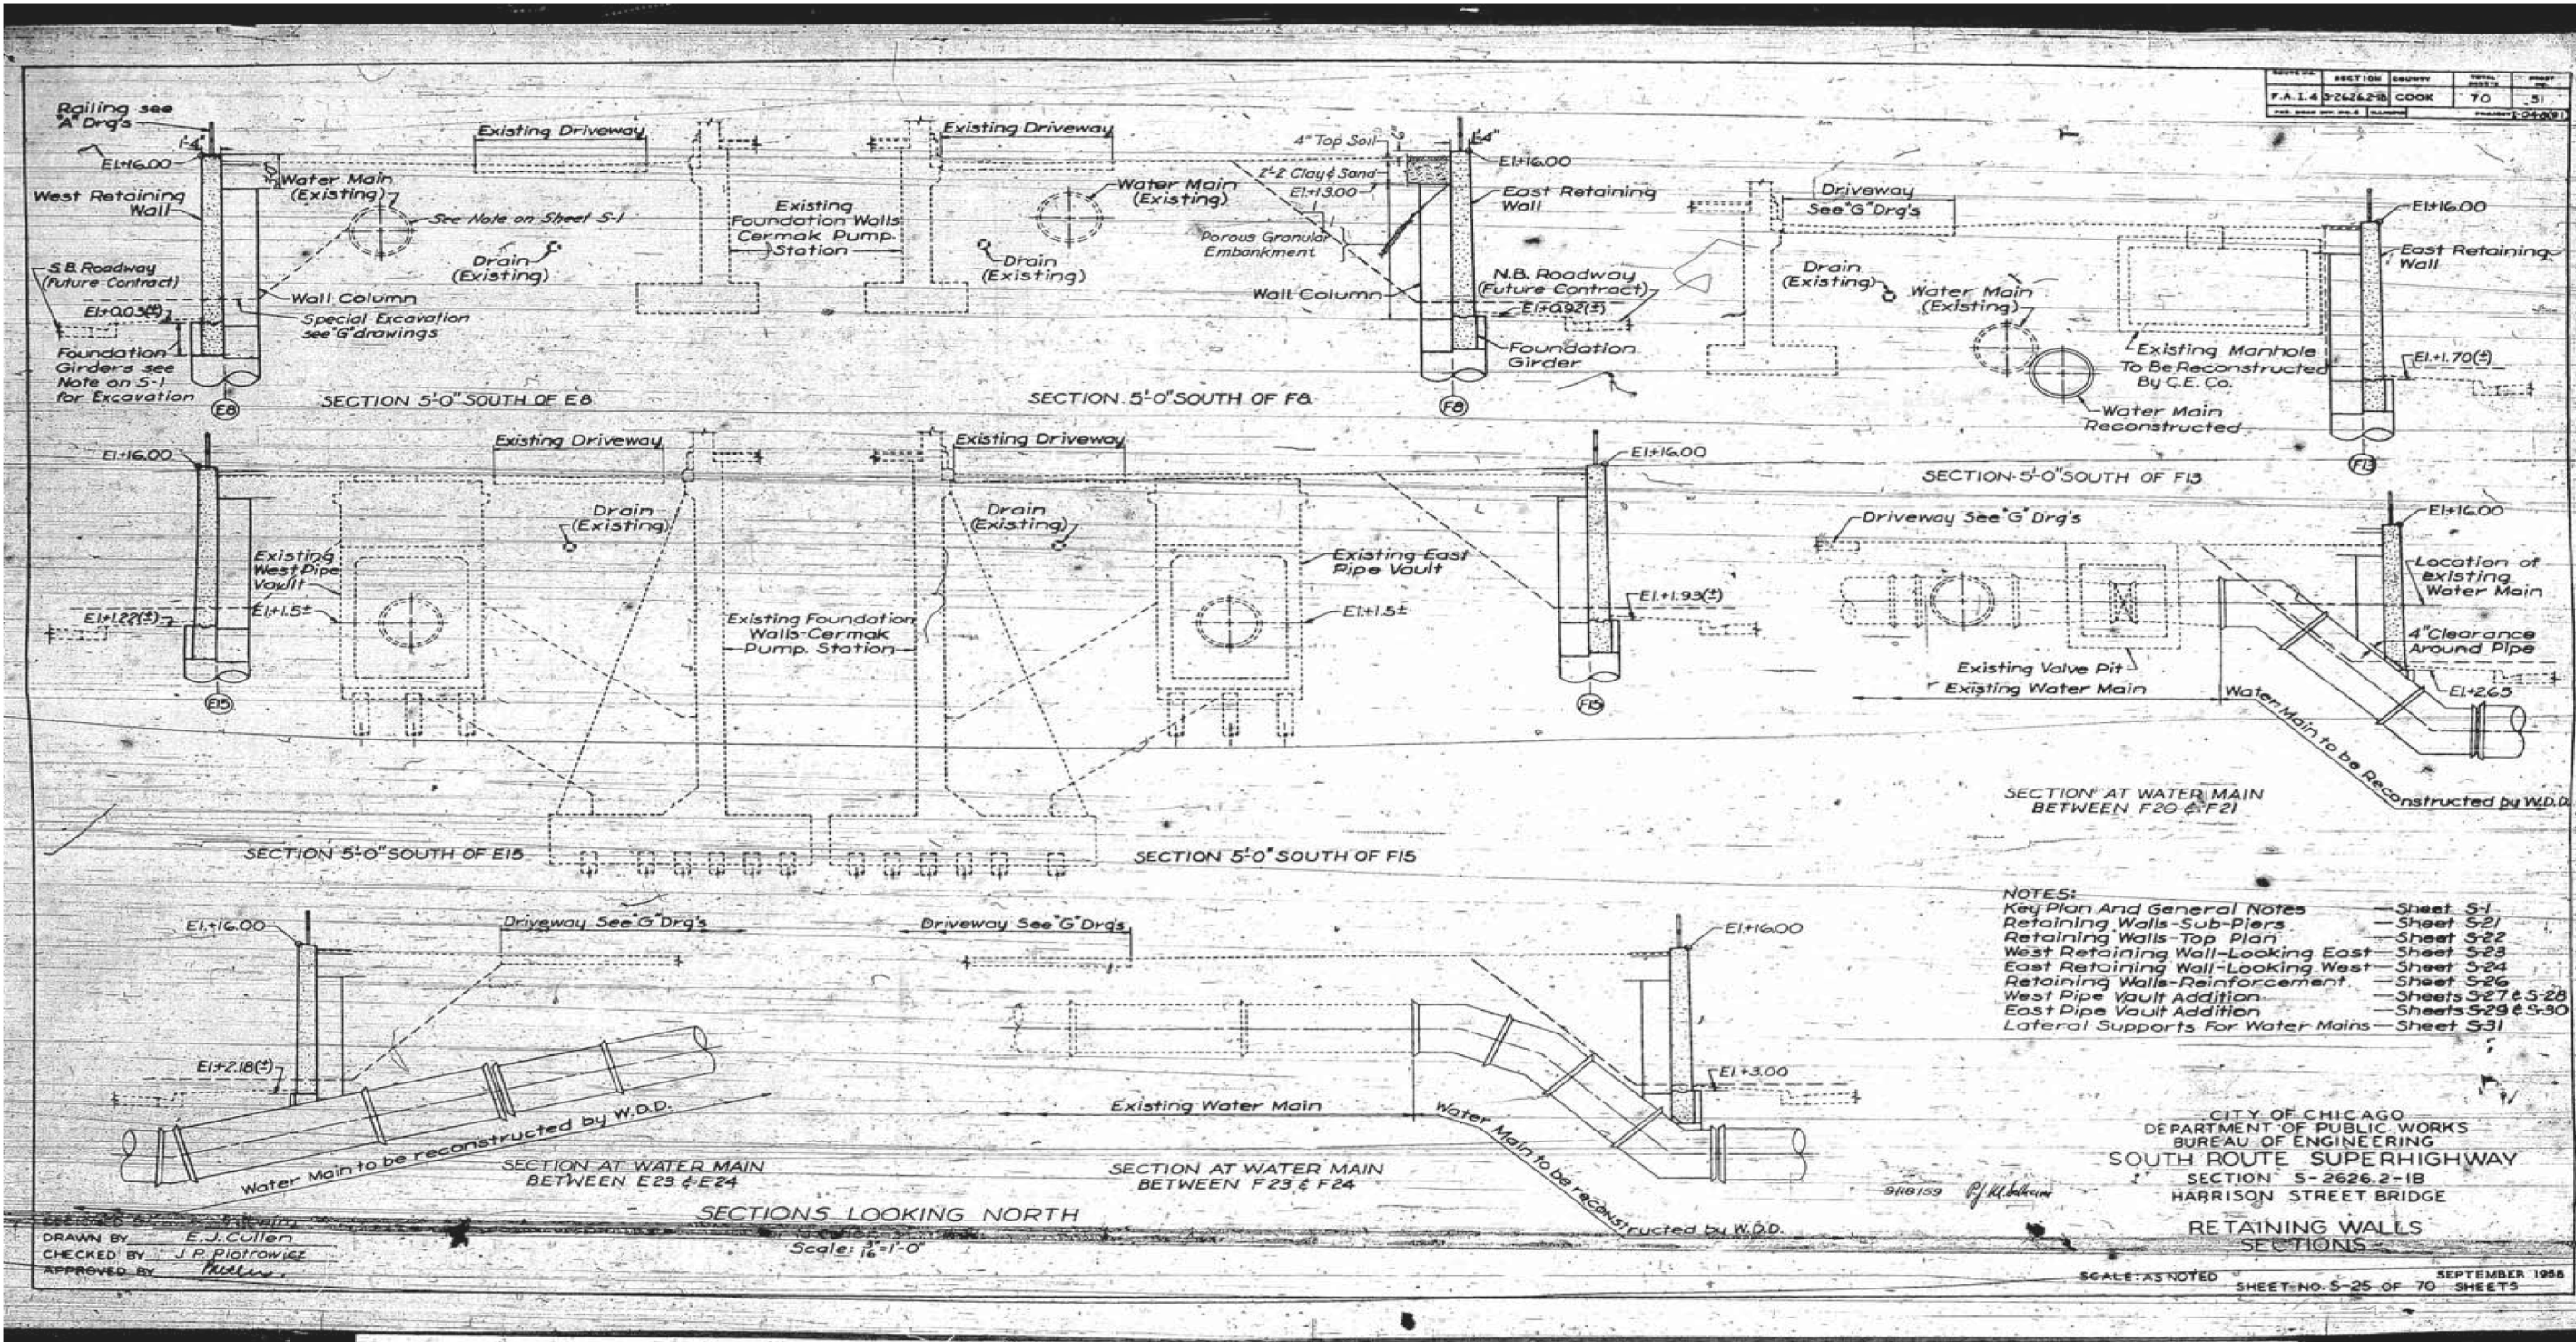

D:\60W71-shr-AS-BUILT-56.dgn


USER NAME = dunkerleyb	DESIGNED -	REVISED
	CHECKED -	REVISED
PLOT SCALE = N.T.S.	DRAWN -	REVISED
PLOT DATE = 11/26/2013	CHECKED -	REVISED

STATE OF ILLINOIS
DEPARTMENT OF TRANSPORTATION

EXISTING AS-BUILTS SN 016-1088

SHEET NO. AS-56 OF AS-72 SHEETS

F.A.I. RTE.	SECTION	COUNTY	TOTAL SHEETS	SHEET NO.
90/94/290	2013-036R	COOK	256	198
CONTRACT NO. 60W71				
ILLINOIS FED. AID PROJECT -NUMBER-				

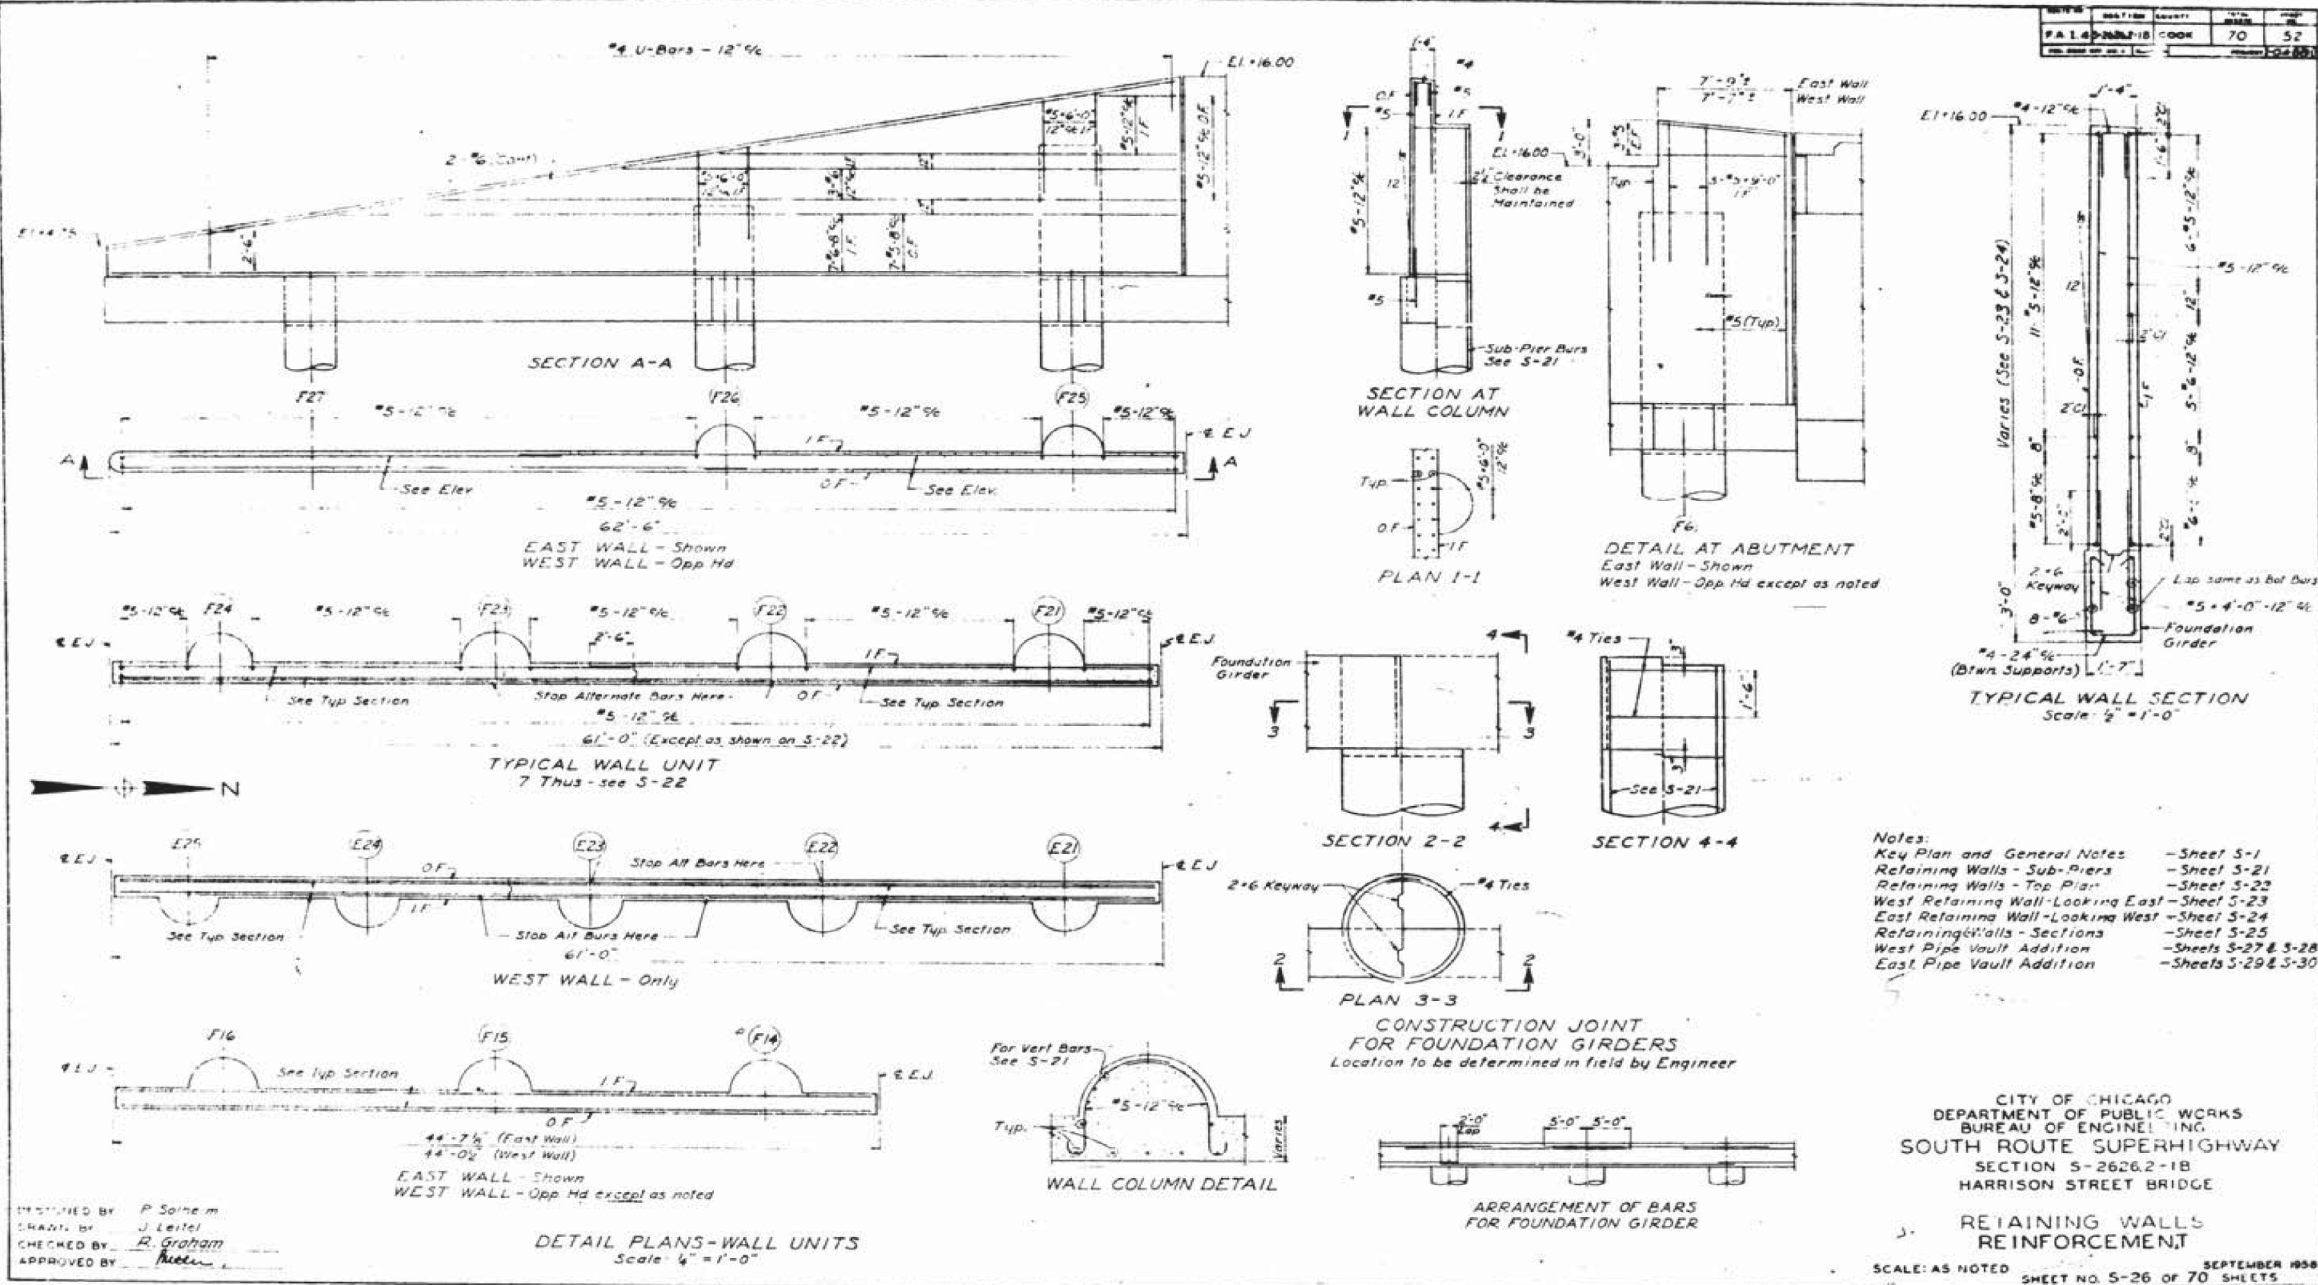

USER NAME = dunkerleyb	DESIGNED -	REVISED -
	CHECKED -	REVISED -
PLOT SCALE = N.T.S.	DRAWN -	REVISED -
PLOT DATE = 11/26/2013	CHECKED -	REVISED -

STATE OF ILLINOIS
DEPARTMENT OF TRANSPORTATION

EXISTING AS-BUILTS SN 016-1088

SHEET NO. AS-57 OF AS-72 SHEETS

F.A.I. RTE.	SECTION	COUNTY	TOTAL SHEETS	SHEET NO.
90/94/290	2013-036R	COOK	256	199
CONTRACT NO. 60W71				
ILLINOIS FED. AID PROJECT -NUMBER-				

FOR INFORMATION ONLY

