

PLAN	SURVEYED	BY	DATE
NO.	PLOTTED		
	ALIGNMENT CHECKED		
	AS BUILT		
	CADD FILE NAME		

© Copyright Hanson Professional Services Inc. 2025

**HANSON**
Hanson Professional Services Inc.


PROFILE	SURVEYED	BY	DATE
NO.	PLOTTED		
	GRADES CHECKED		
	STRUCTURE NOTATIONS CKD		

DESIGNED | BAB 6/24/2024 12:00:00 AM
DRAWN | RLA 6/24/2024 12:00:00 AM
REVIEWED | MGD 10/1/2024 12:00:00 AM

MODEL: sht-plnpr1.0
FILE NAME: h2010ba12010210CADRoadSheetshh-npr10.dgn



LEGEND

-  PORTLAND CEMENT CONCRETE
-  DRIVEWAY PAVEMENT, 8"
-  DETECTABLE WARNING

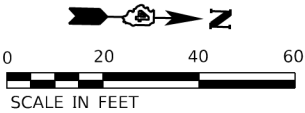

MATCHLINE STA. 125+00.00

MATCHLINE STA. 131+00.00

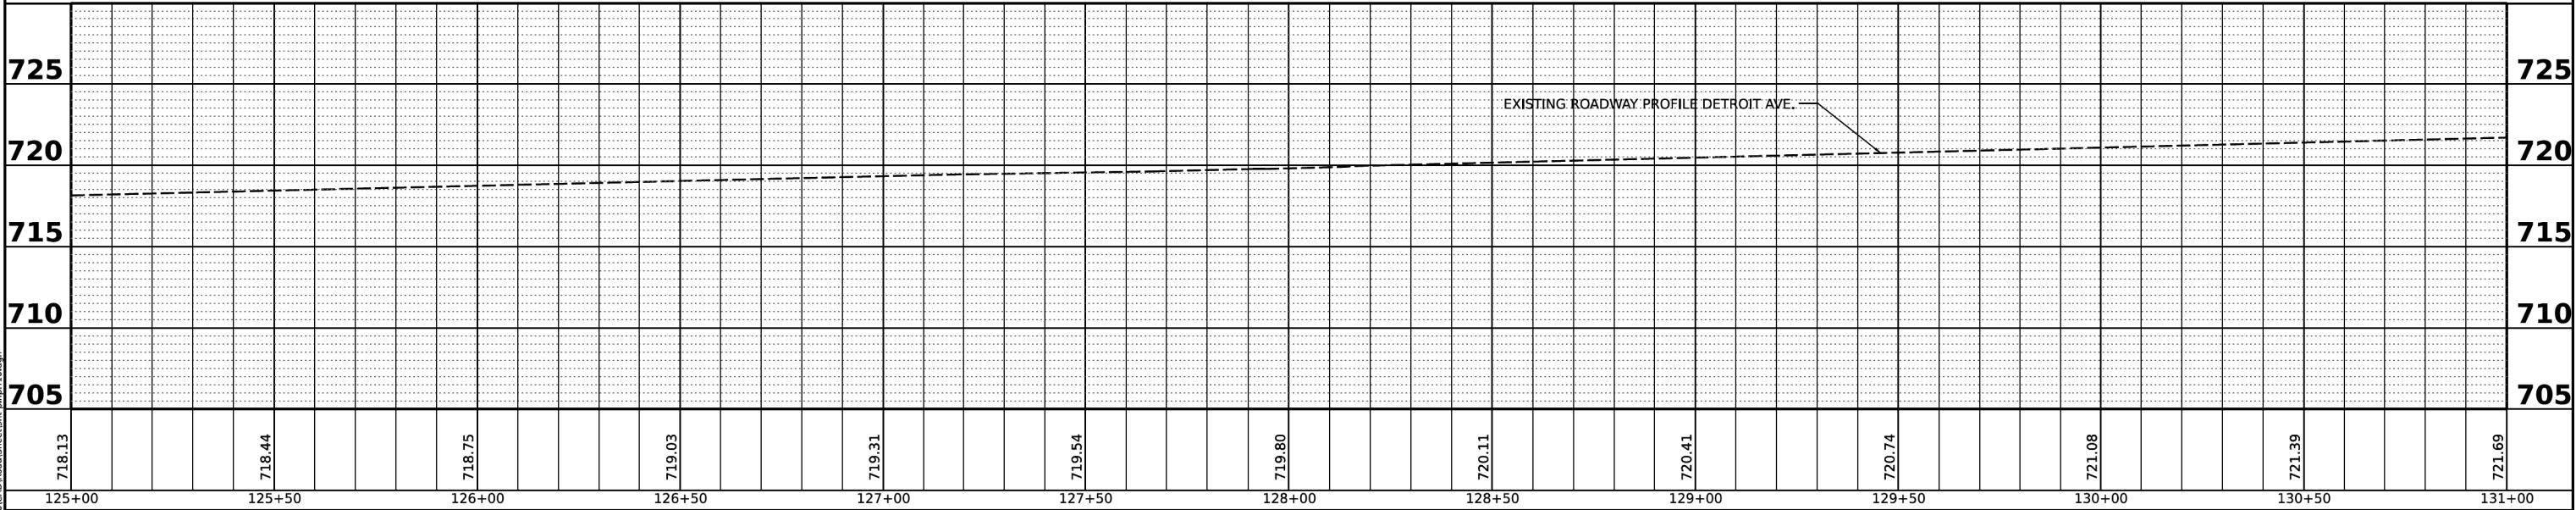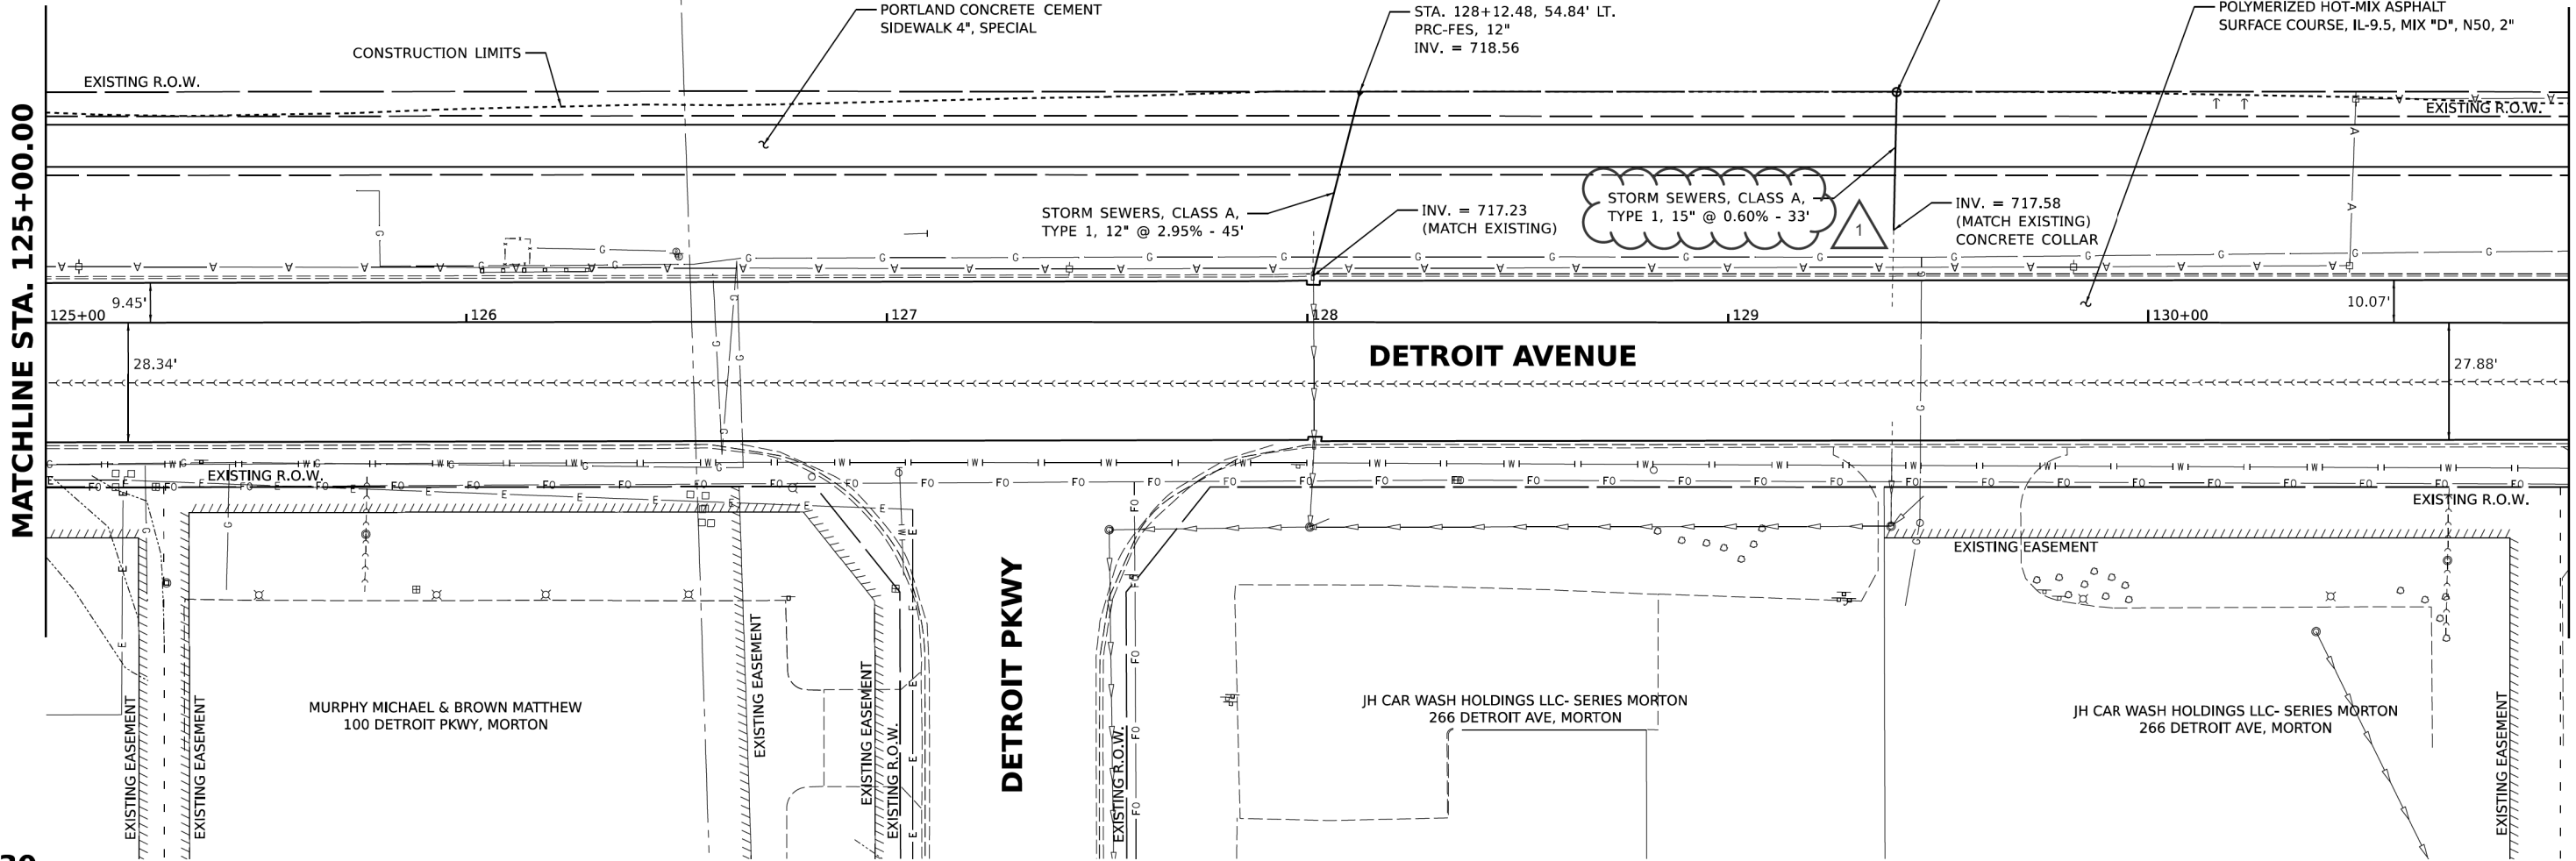

Final	USER NAME = Becks01673	DESIGNED - BAB	REVISED - 04/09/2025
	PLOT SCALE = 0.16666667' / in.	DRAWN - RLA	REVISED -
	PLOT DATE = 4/2/2025	CHECKED - MGD	REVISED -
		DATE - 10/1/2024 12:00:00	REVISED -

STATE OF ILLINOIS
DEPARTMENT OF TRANSPORTATION

DETROIT AVENUE
PLAN AND PROFILES

SCALE: 1" = 20' SHEET OF SHEETS STA. TO STA.

F.A.U. RTE.	SECTION	COUNTY	TOTAL SHEETS	SHEET NO.
6727	20-00130-00-RS	TAZEWELL	81	35
	20L0210			CONTRACT NO. 89802
		ILLINOIS	FED. AID PROJECT	