April 4, 2025

SUBJECT: Southern Illinois Airport

Murphysboro/Carbondale, Illinois

Jackson County

Illinois Project Number: MDH-5176 SBG Project Number: 3-17-SBGP-TBD

Contract No. SO086

Item No. 17A, April 25, 2025 Letting

Addendum A

NOTICE TO PROSPECTIVE BIDDERS

Attached is an addendum to the plans or proposal. This addendum involves revised and/or added material.

Reason for Addendum:

Revising the asphalt surface treatment specification item and associated pay items.

To All Plan Holders:

The asphalt surface treatment, including friction testing, shall be completed in accordance with **Item 608** of the Special Provisions and the Standard Specifications for Construction of Airports, Adopted March 22, 2023.

Plan Changes:

Plan Sheet 2, Summary of Quantities and Index to Sheets:

Revise Summary of Quantities to reflect Schedule of Prices Changes noted below.

Plan Sheet 5, Proposed Construction Plan:

Revise call-out note at top of page to reflect change in asphalt surface treatment item.

Special Provisions Changes:

Revise Page 2 (Index page) to reflect deletion of Item 629 and addition of Item 608.

Revise Page 10 to reflect deletion of Item 629 and addition of Item 608.

Schedule of Prices Changes:

Delete Item AR629520, Thermoplastic Sand Slurry Seal, 23,510 SQ YD. Add Item AR608510, Existing Asphalt Surface Treatment, 23,510 SQ YD. Add Item AR608530, Friction Testing, 1 L SUM.

Prime contractors must utilize the enclosed material when preparing their bid and must include any changes to the Schedule of Prices in their bid.

Questions on this addendum may be directed to Barry Stolz, P.E., of Hanson Professional Services at 314.942.5288.

GENERAL NOTES

- THE WORK FOR THIS PROJECT SHALL CONSIST OF PAVEMENT MAINTENANCE AND PAVEMENT MARKINGS FOR THE T-HANGAR TAXILANES ON THE WEST SIDE OF THE AIRFIELD. THIS PROJECT INCLUDES CRACK SEALING, ASPHALT SURFACE TREATMENT, PAVEMENT MARKING, AND ASSOCIATED ITEMS.
- THE CONTRACTOR SHALL FURNISH ALL LABOR, MATERIAL, EQUIPMENT, AND TRANSPORTATION NECESSARY TO CONSTRUCT ALL ELEMENTS OF THE PROJECT AS DESCRIBED IN THE CONSTRUCTION PLANS AND SPECIFICATIONS.
- THE RULES, REGULATIONS, AND SPECIFICATIONS ENUMERATED HEREIN SHALL BE CONSIDERED AS MINIMUM REQUIREMENTS. THEY SHALL NOT PROHIBIT THE CONTRACTOR FROM FURNISHING AND INSTALLING HIGHER GRADES OF MATERIAL THAN ARE SPECIFIED HEREIN.
- 4. IT SHALL BE THE RESPONSIBILITY OF THE CONTRACTOR TO PROTECT, PRESERVE, AND REPAIR THE EXISTING AIRFIELD AND ROADWAY PAVEMENTS AT ALL TIMES. THE CONTRACTOR SHALL REPAIR ANY DAMAGE TO EXISTING ELECTRICAL, DRAINAGE, AND PAVEMENT STRUCTURES AT NO ADDITIONAL COST TO THE CONTRACT.
- NO EQUIPMENT SHALL BE PERMITTED TO CROSS OR USE ANY EXISTING PAVEMENTS OUTSIDE THE CONSTRUCTION LIMITS, GENERAL PROJECT AREA, OR HAUL ROUTE.
- 6. CONTRACTOR IS REQUIRED TO PROVIDE THEIR OWN RESTROOM FACILITIES.
- UNLESS OTHERWISE NOTED, ALL DISTURBED AREAS OUTSIDE OF THE PROPOSED CONSTRUCTION LIMITS SHALL BE GRADED, SEEDED, AND/OR HYDROMULCH SEEDED IN ACCORDANCE WITH ITEM 901 AND 908 AT NO ADDITIONAL COST TO THE CONTRACT.
- ALL WASTE MATERIAL SHALL BE HAULED FROM THE AIRPORT AND PROPERLY DISPOSED OF UNLESS OTHERWISE SPECIFIED HEREIN.
- THE CONTRACTOR SHALL BE RESPONSIBLE FOR OBTAINING PERMITS FOR HAULING ON PUBLIC ROADS, AS APPLICABLE. THE CONTRACTOR SHALL BE RESPONSIBLE FOR CORRECTING ANY DAMAGES TO ANY PAVEMENTS (PUBLIC OR PRIVATE) CAUSED BY HIS/HER CONSTRUCTION FOILIPMENT OR PERSONNEI
- 10. THE OWNER SHALL HAVE THE RIGHT OF FIRST REFUSAL FOR ALL SALVAGEABLE MATERIAL REMOVED ON THE PROJECT
- 11. THE CONTRACTOR SHALL COORDINATE WITH THE RESIDENT ENGINEER/TECHNICIAN SO THEY MAY DEVELOP ONE SET OF REDLINED AS-BUILT RECORD DRAWINGS AT THE COMPLETION OF THE PROJECT
- 12. THE CONSTRUCTION LIMITS SHALL BE RESTRICTED TO AREAS THAT ARE ABSOLUTELY NECESSARY TO DISTURB TO COMPLETE THE REQUIRED WORK ITEMS. LIMITS SHALL BE COORDINATED WITH THE RESIDENT ENGINEER PRIOR TO BEGINNING ANY WORK.
- 13. CONTRACTOR SHALL RESTORE TO ORIGINAL CONDITION ALL GRASS, STONE, OR PAVEMENT DISTURBED BY CONTRACTOR'S CONSTRUCTION OPERATIONS, STAGING, AND CONSTRUCTION ACCESS/HAUL ROUTES. DISTURBED AREAS TO BE REPAIRED, GRADED, AND MULCHED SEEDED IN ACCORDANCE WITH ITEMS 901 AND 908, UNLESS OTHERWISE NOTED. STAGING AREA AND SITE ACCESS RESTORATION SHALL BE INCLUDED IN THE COST OF MOBILIZATION.
- 14. THE PROJECT PAY ITEMS ARE INTENDED TO BE INCLUSIVE OF ALL WORK TO BE PERFORMED AS SHOWN IN THESE PLANS. ALL INCIDENTAL WORK REQUIRED TO COMPLETE THE PROJECT TO SATISFACTION OF THE RESIDENT ENGINEER/TECHNICIAN IS TO BE INCLUDED IN THE COSTS OF PERFORMING THESE ITEMS.
- 15. ANY UTILITIES DAMAGED DURING CONSTRUCTION SHALL BE REPAIRED AT THE CONTRACTOR'S EXPENSE. CONTRACTOR SHALL COORDINATE WITH THE PROPER PERSONS FOR THE PURPOSE OF LOCATING AND PROTECTING EXISTING UNDERGROUND UTILITIES.
- 16. THE CONTRACTOR MUST AT ALL TIMES MAINTAIN PROPER DRAINAGE FOR ALL AREAS AFFECTED BY HIS/HER WORK.

	INDEX TO SHEETS		
SHEET NO.	SHEET TITLES		
1	COVER SHEET		
2	SUMMARY OF QUANTITIES AND INDEX TO SHEETS		
3	PROPOSED SAFETY PLAN		
4	CONSTRUCTION SAFETY NOTES		
5	PROPOSED CONSTRUCTION PLAN		
6	PROPOSED PAVEMENT MARKING PLAN		

ITEM NO.	DESCRIPTION	UNIT	TOTAL QUANTITY	AS-BUILT QUANTITY
AR150520	MOBILIZATION	L SUM	1	
AR201661	CLEAN & SEAL BITUMINOUS CRACKS	FOOT	9,000	
AR608510	EXISTING ASPHALT SURFACE TREATMENT	SQ YD	23,510	
AR608530	FRICTION TESTING	L SUM	1	
AR620520	PAVEMENT MARKING-WATERBORNE	SQ FT	4,256	
AR620900	PAVEMENT MARKING REMOVAL	SQ FT	620	

QUANTITIES

PAYMENT WILL BE MADE UNDER THE ITEM NUMBERS, DESCRIPTIONS AND UNITS NOTED IN THE ABOVE TABLE IN ACCORDANCE WITH THE BASIS OF PAYMENT FOR EACH RESPECTIVE WORK ITEM COMPLETED AND ACCEPTED BY THE ENGINEER.

CERTIFIED PAYROLLS

THE RESIDENT ENGINEER/TECHNICIAN CANNOT FORWARD CONSTRUCTION REPORTS TO THE ILLINOIS DIVISION OF AERONAUTICS FOR PROCESSING UNTIL ALL CERTIFIED PAYROLLS FOR THE PERIOD HAVE BEEN BECEIVED.

MATERIAL CERTIFICATIONS

MATERIALS TO BE INCORPORATED INTO THE PROJECT CANNOT BE USED WITHOUT PRIOR APPROVAL. ALL MATERIALS TO BE USED IN THE PROJECT MUST BE SUBMITTED TO THE RESIDENT ENGINEER/TECHNICIAN FOR APPROVAL. USE OF MATERIALS WITHOUT PRIOR APPROVAL AND ULTIMATELY DETERMINED TO BE UNACCEPTABLE BY THE ILLINOIS DIVISION OF AERONAUTICS ARE SUBJECT TO REMOVAL AND/OR NON-PAYMENT.

UTILITY NOTE

THE LOCATION, SIZE, AND TYPE OF MATERIAL OF EXISTING UNDERGROUND AND/OR ABOVEGROUND UTILITIES INDICATED ON THE PLANS ARE NOT REPRESENTED AS BEING ACCURATE, SUFFICIENT OR COMPLETE. NEITHER THE OWNER NOR THE ENGINEER ASSUMES ANY RESPONSIBILITY WHATSOEVER IN RESPECT TO THE ACCURACY, COMPLETENESS, OR SUFFICIENCY OF THE INFORMATION. THERE IS NO GUARANTEE, EITHER EXPRESSED OR IMPLIED, THAT THE LOCATIONS, SIZE AND TYPE OF MATERIAL OF EXISTING UNDERGROUND UTILITIES INDICATED ARE REPRESENTATIVE OF THOSE TO BE ENCOUNTERED IN THE CONSTRUCTION. IT SHALL BE THE CONTRACTOR'S RESPONSIBILITY TO DETERMINE THE ACTUAL LOCATION OF ALL SUCH FACILITIES, INCLUDING SERVICE CONNECTIONS TO UNDERGROUND UTILITIES.

PRIOR TO CONSTRUCTION, THE CONTRACTOR SHALL NOTIFY THE UTILITY COMPANIES OF ITS OPERATIONAL PLANS AND SHALL OBTAIN FROM THE RESPECTIVE UTILITY COMPANIES DETAILED INFORMATION AND ASSISTANCE RELATIVE TO THE LOCATION OF THEIR FACILITIES AND THE WORKING SCHEDULE OF THE COMPANIES FOR REMOVAL OR ADJUSTMENT WHERE REQUIRED. IN THE EVENT AN UNEXPECTED UTILITY INTERFERENCE IS ENCOUNTERED DURING CONSTRUCTION, THE CONTRACTOR SHALL IMMEDIATELY NOTIFY THE UTILITY COMPANY OF JURISDICTION. THE OWNER'S REPRESENTATIVE AND THE RESIDENT ENGINEER/TECHNICIAN SHALL ALSO BE IMMEDIATELY NOTIFIED. ANY DAMAGE TO SUCH MAINS AND SERVICES SHALL BE RESTORED TO SERVICE AT ONCE AND PAID FOR BY THE CONTRACTOR AT NO ADDITIONAL COST TO THE CONTRACT. ALL UTILITY CABLES AND LINES SHALL BE LOCATED BY THE RESPECTIVE UTILITY. CONTACT JULIE (JOINT UTILITY LOCATION INFORMATION FOR EXCAVATORS) FOR UTILITY INFORMATION, PHONE: 1-800-892-0123. CONTACT THE FAA (FEDERAL AVIATION ADMINISTRATION) FOR ASSISTANCE IN LOCATING FAA CABLES AND UTILITIES. LOCATION OF FAA POWER, CONTROL, AND COMMUNICATION CABLES SHALL BE COORDINATED WITH AND LOCATED BY THE FAA. ALSO CONTACT AIRPORT MANAGER AND AIRPORT PERSONNEL FOR ASSISTANCE IN LOCATING UNDERGROUND AIRPORT CABLES AND UTILITIES. ALSO COORDINATE WORK WITH ALL ABOVEGROUND UTILITIES.



Offices Nationwide

Hanson Professional Services Inc. 1525 S. 6th Street Springfield, IL 62703 phone: 217-788-2450 fax: 217-788-2503

Illinois Licensed
Professional Service Corporation
#184-001084



665 North Airport Road Murphysboro, II, 62966



DATE SIGNED: 3/10/2025 EXPIRES: 11/30/2025
T-HANGAR TAXILANES
PAVEMENT MAINTENANCE

IDA No: MDH-5176 SBG No. 3-17-SBGP-TBD Contract No. SO086


	Δ	4/4/25	REV. QUANTITIES			
			BSS	JRH	BSS	
	NO.	DATE	DES	CRIPT	ION	
	NO.	DATE	DES	DWN	REV	
i	ISSUE: MARCH 10, 2025					
PROJECT NO: 24A0092 CAD FILE: G-002-FLP.DWG						
i	DESIGN	RV∙ BS	S 12/	12/202	1	

SUMMARY OF QUANTITIES AND INDEX TO SHEETS

DRAWN BY: CWS 12/02/2024

SHEET TITLE

REVIEWED BY: BSS 12/12/2024

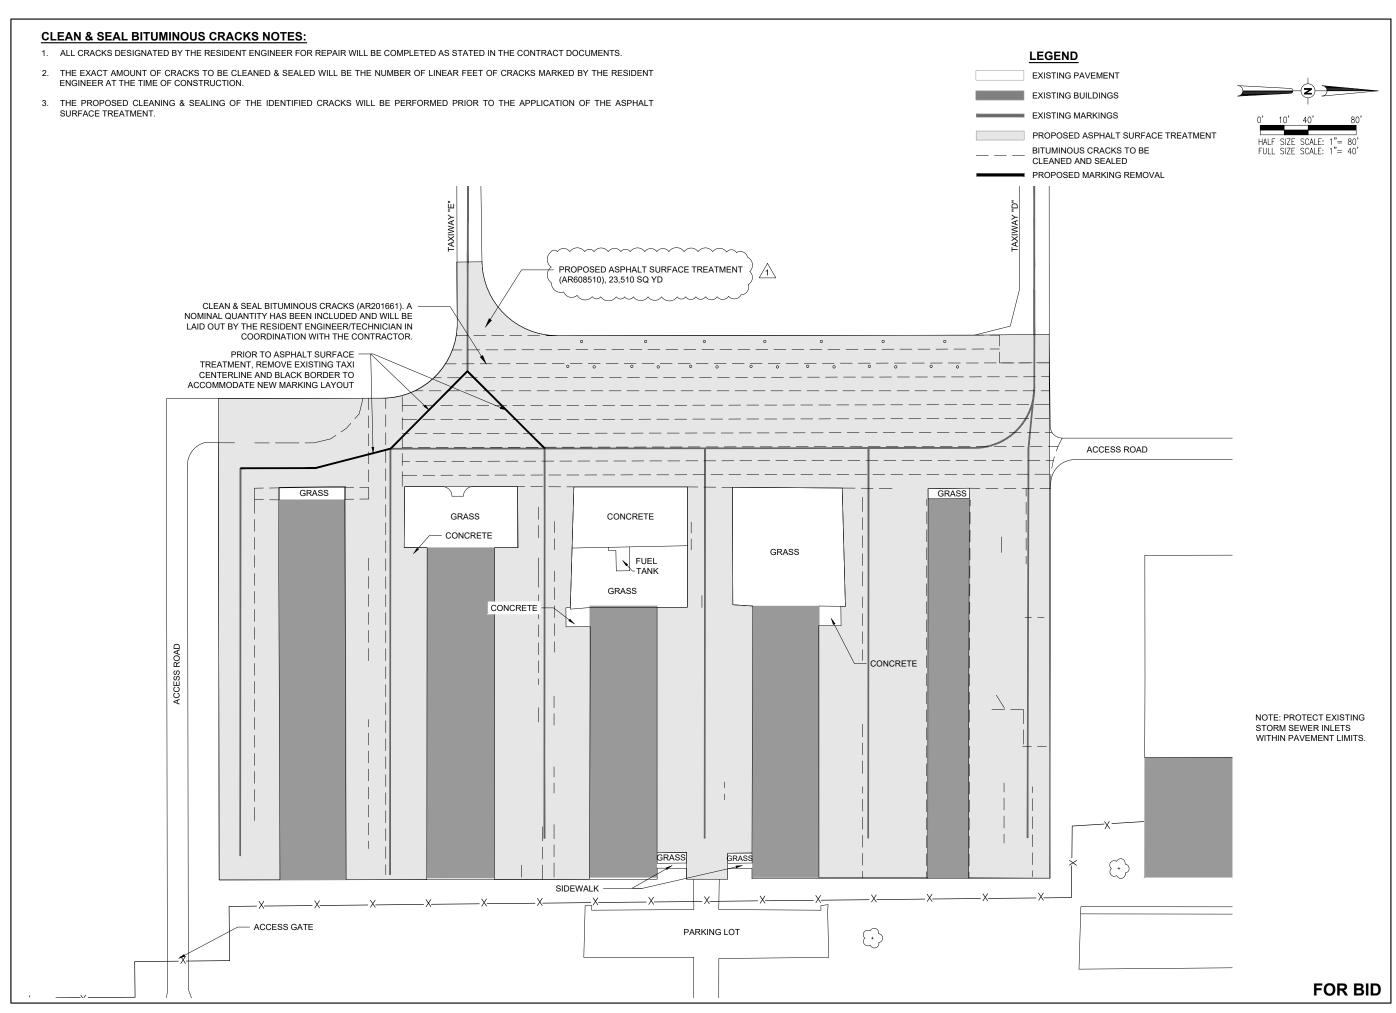




Offices Nationwide www.hanson-inc.com

Hanson Professional Services Inc. 1525 S. 6th Street Springfield, IL 62703 phone: 217-788-2450 fax: 217-788-2503

Illinois Licensed Professional Service Corporation #184-001084



665 North Airport Road

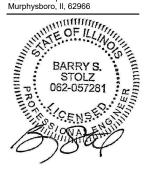

DATE SIGNED: 3/10/2025 LICENSE EXPIRES: 11/30/2025
T-HANGAR TAXILANES
PAVEMENT MAINTENANCE

IDA No: MDH-5176 SBG No. 3-17-SBGP-TBD Contract No. SO086

	1	4/4/25	REV. NOTE			
			BSS	JRH	BSS	
	NO.	DATE	DESCRIPTION			
	NO.		DES	DWN	REV	
i	ISSUE: MARCH 10, 2025					
i	PROJEC	CT NO: 2	4A009	12		
	CAD FIL	F: C-15	1-MRK	DWG		

DRAWN BY: CWS 12/02/2024 REVIEWED BY: BSS 12/12/2024

DESIGN BY: BSS 12/02/2024

SHEET TITLE

PROPOSED CONSTRUCTION PLAN

INDEX

Illinois Project No.: MDH-5176

Item No.	Description	Page No.
	Foreword	3
PART 1 – GENER 50 70 80	AL CONTRACT PROVISIONS Control of Work Legal Regulations and Responsibility to the Public Prosecution and Progress	5
PART 2 – GENER 105	AL CONSTRUCTION ITEMS Mobilization	8
PART 3 – SITEWO 101	ORK Preparation/Removal of Existing Pavements	9
PART 8 – SURFA 608	CE TREATMENTS Emulsified Asphalt Seat Coat	10
PART 9 – MISCEI 620	LANEOUS Runway and Taxiway Marking	11

PART 8 – SURFACE TREATMENTS

Illinois Project No.: MDH-5176

ITEM 608 EMULSIFIED ASPHALT SEAL COAT

COMPOSITION AND APPLICATION

608-3.1 Application Rate. Add the following to this section:

"A dilution rate of one (1) part emulsified asphalt to one (1) part water will be used."

BASIS OF PAYMENT

608-8.1 Add the following to this section:

"Payment will be made under:

Item AR608510 Existing Asphalt Surface Treatment - per square yard Item AR608530 Friction Testing - per lump sum."

END OF ITEM 608