

OIX

F.A.P. RTE.	SECTION	COUNTY	TOTAL SHEETS	SHEET NO.
317	15B;[(102-1),(14HB)]BR)BR	PEORIA-TAZEWELL	1363	1
ILLINOIS		CONTRACT NO. 68B46		

\* 1361 + 2 = 1363 TOTAL SHEETS

D-94-028-13

STATE OF ILLINOIS  
DEPARTMENT OF TRANSPORTATION

**PROPOSED  
HIGHWAY PLANS**

**VOLUME 1 OF 5**

FOR INDEX OF SHEETS, SEE SHEET NO. 3

FAP ROUTE 317 AND FAP ROUTE 673  
(EASTBOUND US 150 AND SOUTHBOUND IL 116)  
SECTION (15B;[(102-1),(14HB)]BR)BR  
PROJECT NHPP-YRP3(905)  
BRIDGE REPLACEMENT OVER ILLINOIS RIVER  
AND INTERCHANGE IMPROVEMENTS  
PEORIA & TAZEWELL COUNTY


C-94-052-13



LOCATION OF SECTION INDICATED THIS: -

WORK ON THIS PROJECT WILL CONSIST OF:  
ROADWAY WIDENING, RECONSTRUCTION AND RESURFACING,  
BRIDGE REPLACEMENT, SAFETY IMPROVEMENTS, DRAINAGE  
IMPROVEMENTS, BICYCLE AND PEDESTRIAN FACILITY  
IMPROVEMENTS, ROADWAY SIGNING, PAVEMENT MARKING,  
AND LANDSCAPING.


	US 150 (WEST SIDE)	UUS 150 (EAST SIDE)	IL 29	IL 116	RAMP A	RAMP B	RAMP E	RAMP SW
FUNCTIONAL CLASSIFICATION:	OTHER PRINCIPAL ARTERIAL	OTHER FREEWAY	OTHER PRINCIPAL ARTERIAL	OTHER PRINCIPAL ARTERIAL	RAMP	RAMP	RAMP	RAMP
DESIGN SPEED:	50	55	35	55	15	25	35	40
POSTED SPEED:	45	55	35	55	15	25	35	40
ADT:	41,500	41,500	22,800	28,500	3,300	1,600	4,450	5,780
SU:	1.9%	1.9%	2.7%	2.6%	1.8%	3.7%	2.5%	3.9%
MU:	0.7%	0.7%	2.1%	2.3%	2.1%	0.6%	0.8%	2.2%

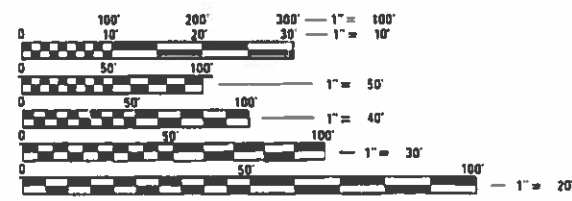

FULL SIZE PLANS HAVE BEEN PREPARED USING STANDARD ENGINEERING SCALES. REDUCED SIZED PLANS WILL NOT CONFORM TO STANDARD SCALES. IN MAKING MEASUREMENTS ON REDUCED PLANS, THE ABOVE SCALES MAY BE USED.

J.U.L.I.E.  
JOINT UTILITY LOCATION INFORMATION FOR EXCAVATION  
1-800-892-0123  
OR 811

PROJECT ENGINEER - CHRISTOPHER MAUSHARD  
PROJECT MANAGER - CHRISTOPHER MAUSHARD  
PHONE: (309)671-3453  
CONTRACT NO. 68B46  
CATALOG NO. 034923-00D

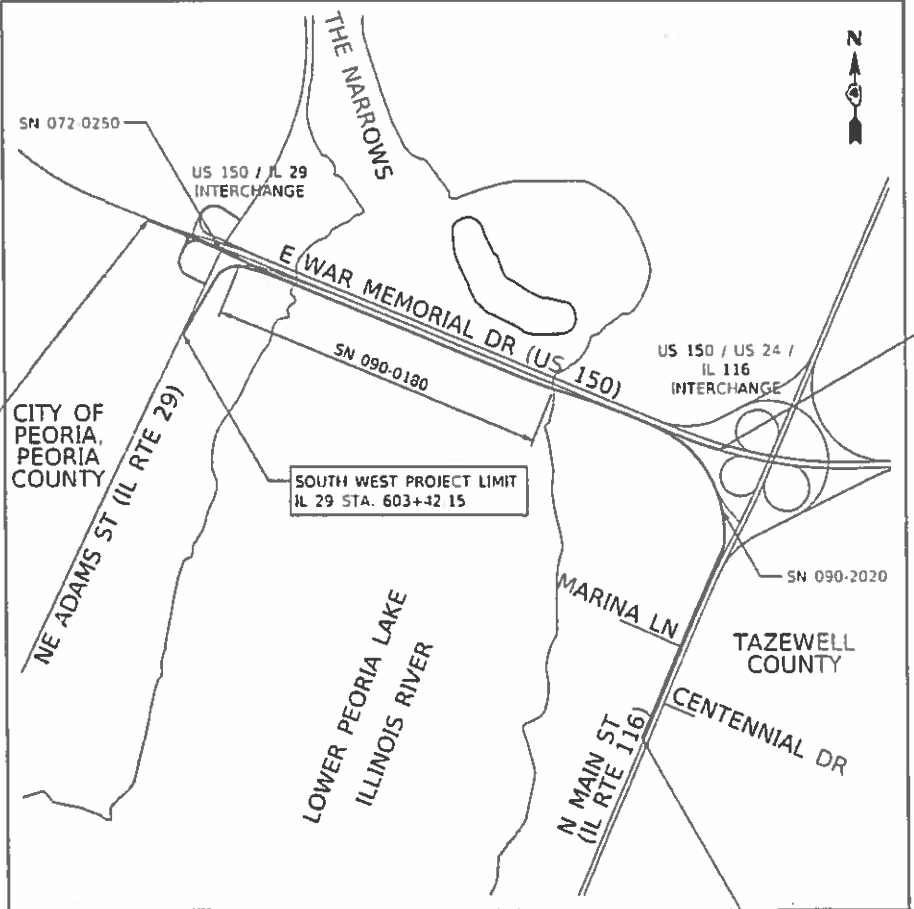

WEST PROJECT LIMIT  
US 150 STA. 2097+57.68

SOUTH WEST PROJECT LIMIT  
IL 29 STA. 603+42.15

EAST PROJECT LIMIT  
US 150 STA. 2179+38.36

SOUTH EAST PROJECT LIMIT  
IL 116 STA. 186+03.96

GROSS / NET LENGTH = 12,146.79 FT. = 2.301 MILE

STATE OF ILLINOIS  
DEPARTMENT OF TRANSPORTATION

SUBMITTED December 14, 2018

Paul A. James  
REGION THREE ENGINEER

Feb 1, 2019  
ENGINEER OF DESIGN AND ENVIRONMENT

Feb 7, 2019  
DIRECTOR OF HIGHWAYS PROJECT IMPLEMENTATION

**PRINTED BY THE AUTHORITY  
OF THE STATE OF ILLINOIS**



**GENERAL NOTES (CONTINUED):**

**CLEARING**

AT LOCATIONS WHERE CLEARING IS INDICATED ON THE PLANS BEYOND THE LIMITS OF THE PROPOSED EXCAVATION OR EMBANKMENT, THE CONTRACTOR SHALL RESTORE THE DISTURBED EARTH BY BLADING AND SHAPING TO BLEND WITH THE ADJACENT GROUND. THE CLEARING WILL NOT BE PAID FOR SEPARATELY BUT SHALL BE INCLUDED IN THE COST OF THE EXCAVATION PAY ITEMS IN THE PLANS. PAYMENT FOR RESEEDING OR RESODDING WILL BE AS PROVIDED IN THE PLANS.

**SEEDING - SIDESLOPE RIPPING**

ALL SLOPES STEEPER THAN 3 TO 1 AND OVER 15 FT. (4.5 M) IN HEIGHT SHALL BE RIPPED. THIS SHALL CONSIST OF RIPPING BETWEEN 18 INCHES TO 24 INCHES (450 MM TO 600 MM) DEEP NORMAL TO THE SLOPE. THE INTERVAL OF RIPPING ALONG THE SLOPE SHALL BE 12 FT. (3.6 M). THIS WORK SHALL BE DONE AFTER THE SEED BED HAS BEEN PREPARED BUT BEFORE ANY FERTILIZER OR SEED HAS BEEN APPLIED. THE FERTILIZER AND SEED SHALL BE APPLIED WITHIN A 24-HOUR PERIOD AFTER THE RIPPING HAS BEEN DONE. THIS WORK WILL NOT BE PAID FOR SEPARATELY BUT WILL BE INCLUDED IN THE COST OF THE VARIOUS ITEMS OF SEEDING INVOLVED.

**DRAINAGE**

PRIOR TO COMMENCEMENT OF ANY STORM SEWER WORK, THE CONTRACTOR SHALL FIELD VERIFY ALL LOCATIONS, DIMENSIONS, AND CONDITIONS OF EXISTING FACILITIES. IF A DISCREPANCY OCCURS BETWEEN ACTUAL FIELD CONDITIONS AND THE PLANS, STANDARD SPECIFICATIONS, AND/OR DETAILS, THE CONTRACTOR SHALL NOTIFY THE ENGINEER AND SECURE INSTRUCTION FROM THE ENGINEER PRIOR TO PROCEEDING WITH ANY PART OF THE AFFECTED WORK.

UTILITY NOTE: THE LOCATIONS OF EXISTING UTILITIES, AS SHOWN ON THE PLANS ARE BASED ON COORDINATION WITH THE UTILITY COMPANIES AND AVAILABLE EXISTING PLANS. THE LOCATION OF THESE FEATURES ARE SHOWN AS APPROXIMATE AND MAY NOT BE ALL INCLUSIVE. IT SHALL BE THE RESPONSIBILITY OF THE CONTRACTOR TO DETERMINE THEIR EXACT LOCATIONS FROM THE UTILITY COMPANIES. ALL EXISTING UTILITIES WHICH ARE TO REMAIN IN SERVICE SHALL BE FULLY PROTECTED BY THE CONTRACTOR AND ANY DAMAGE CAUSED BY THE CONSTRUCTION OPERATIONS SHALL BE IMMEDIATELY REPAIRED OR REPLACED UNDER THE UTILITY OWNER'S DIRECTION AT NO ADDITIONAL COST TO IDOT.

**CROSSING EXISTING STRUCTURES WITH EQUIPMENT**

THE FOLLOWING STRUCTURES HAVE BEEN DEEMED SUITABLE FOR USE WHILE TRANSPORTING AN EMPTIED MATERIAL TRANSFER DEVICE (MTD) WITHIN THE SPECIFIED CONSTRUCTION ZONE AS DESCRIBED IN THE BUREAU OF DESIGN & ENVIRONMENT MEMORANDUM AND THE SPECIAL PROVISION FOR MTD DATED APRIL 18, 2014.

- STRUCTURE NUMBER: 072-0167 EB US 150 OVER IL 29 (EXISTING)
- 072-0168 WB US 150 OVER IL 29
- 090-0069 US 150/IL 116 INTERCHANGE
- 090-0070 EB US 150 OVER RIVER (EXISTING)
- 090-0071 US 150/IL 116 INTERCHANGE
- 090-0072 US 150/IL 116 INTERCHANGE
- 090-0073 US 150/IL 116 INTERCHANGE
- 090-0074 US 150/IL 116 INTERCHANGE
- 090-0115 WB US 150 OVER RIVER
- 090-2006 US 150/IL 116 INTERCHANGE
- 090-2013 SW RAMP CULVERT (EXISTING)

STRUCTURES NOT LISTED ABOVE HAVE NOT BEEN DEEMED SUITABLE FOR USE BASED ON THE LOAD CARRYING CAPACITY OF THE STRUCTURE AND SHOULD NOT BE USED UNDER ANY CIRCUMSTANCES.

**ORDERING LENGTH CONFIRMATION - DRAINAGE ITEMS**

THE CONTRACTOR SHALL CONSULT WITH THE ENGINEER IN REGARD TO THE EXACT LENGTH OF THE BOX/PIPE CULVERTS, STORM SEWERS, AND/OR PIPE DRAINS REQUIRED PRIOR TO ORDERING THESE ITEMS.

**EXISTING DRAINAGE PIPES CONNECTED TO NEW STRUCTURES**

IN ACCORDANCE WITH SECTION 602 OF THE STANDARD SPECIFICATIONS, THE CONNECTING OF EXISTING DRAIN TILES, PIPE CULVERTS, OR STORM SEWERS TO THE PROPOSED DRAINAGE SYSTEM STRUCTURES WILL NOT BE PAID FOR SEPARATELY BUT SHALL BE CONSIDERED AS INCLUDED IN THE PAY ITEMS PROVIDED.

PRIOR TO ANY SUBSURFACE WORK IN THE VICINITY OF THE RAILROAD, CONTACT UPRR'S "CALL BEFORE YOU DIG"(CBYD) PHONE NUMBER: 1-800-336-9193.

**PROJECT COMMITMENTS:**

COMMITMENTS ARE NOT TO BE ALTERED WITHOUT THE WRITTEN APPROVAL OF ALL PARTIES TO WHICH THE COMMITMENT WAS MADE.

**PROCEDURES FOR AN UNANTICIPATED DISCOVERY OF HISTORIC PROPERTIES**

IN THE EVENT OF AN UNANTICIPATED DISCOVERY OF A) HISTORIC PROPERTIES, B) HUMAN REMAINS OR C) AN UNMARKED HUMAN BURIAL GROUND DURING CONSTRUCTION ACTIVITIES, THE CONSTRUCTION CONTRACTOR MUST IMMEDIATELY STOP ALL CONSTRUCTION ACTIVITY WITHIN A 150 FOOT RADIUS OF THE DISCOVERY, NOTIFY IDOT OF THE DISCOVERY, AND IMPLEMENT INTERIM MEASURES TO PROTECT THE DISCOVERY FROM LOOTING AND VANDALISM. THE CONTRACTOR WILL AWAIT FURTHER INSTRUCTION BEFORE RE-ENTERING THE AREA.

WHERE PRACTICABLE, REFUELING, STORAGE OF FUELS, OR MAINTENANCE OF CONSTRUCTION EQUIPMENT SHOULD NOT BE ALLOWED WITHIN 100 FEET OF WETLANDS OR WATER BODIES TO AVOID ACCIDENTAL SPILLS IMPACTING THESE RESOURCES.

**ILLINOIS AMERICAN WATER / SLUDGE MAINS:**

THE CONTRACTOR SHALL LIMIT/MINIMIZE THEIR CROSSINGS OF THE ILLINOIS AMERICAN WATER (ILWACS) WATER AND SLUDGE MAINS WITHIN THE MARKED AREAS. IN LOCATIONS WHERE CROSSINGS ARE NECESSARY, THE CONTRACTOR SHALL UTILIZE CRANE MATS TO ENSURE THAT CONSTRUCTION TRAFFIC DOES NOT RESULT IN PRESSURES THAT EXCEED THOSE OF THE CURRENT SOIL CONDITIONS. EMPLOYEES OF ILWACS OR THEIR DESIGNATED CONSULTANTS SHALL HAVE ACCESS AT ALL TIMES TO THEIR FACILITIES FOR INSPECTION PURPOSES. PLEASE CONTACT CHRISTIAN S. VOLZ AT (309)566-4114 PRIOR TO ANY CONSTRUCTION ACTIVITIES WITHIN THE MARKED RESTRICTED AREAS.

**TRI-COUNTY SEARCH AND RESCUE TEAM**

A COMMITMENT TO THE TRI-COUNTY SEARCH AND RESCUE TEAM WILL PROVIDE FOR RIVER ACCESS POINTS TO THE ILLINOIS RIVER ON BOTH THE PEORIA AND TAZEWELL COUNTIES RIVERBANKS AT THE CONSTRUCTION SITE AT ALL TIMES DURING CONSTRUCTION. IN ADDITION, ACCESS ROADWAYS TO THE RIVER LANDINGS SHALL BE PROVIDED AND OPEN TO ACCESS FOR THE TRI-COUNTY SEARCH AND RESCUE TEAM PERSONNEL, WATER CRAFTS AND EQUIPMENT AT ALL TIMES. RIVER ACCESS POINTS SHALL BE PROVIDED AS SHOWN ON THE PLANS OR MODIFIED AS REQUIRED. CONTACT MR. MIKE JOHNSON, CHIEF OF POLICE FON DU LAC PARK DISTRICT, AT 309-698-4700 OR POLICE@FONDULACPARK.COM FOR COORDINATION OF THE ACCESS SITES.

**IN ADDITION, THE EMERGENCY DISPATCH CENTER PHONE NUMBERS ARE AS FOLLOWS:**

- EAST PEORIA: 309-698-4700
- PEORIA: 309-673-4521

**THE PLEASURE DRIVEWAY AND PARK DISTRICT OF PEORIA**

THE STATE DEPARTMENT OF TRANSPORTATION AGREES TO THE FOLLOWING REGARDING PARCEL NO. 4ADH006-TE:

- THE 0.265 ACRE TEMPORARY EASEMENT TRACT OF LAND WILL BE RETURNED TO THE OWNER IN AS GOOD AS OR BETTER CONDITION UPON COMPLETION OF CONSTRUCTION.
- STATE OF ILLINOIS DEPARTMENT OF TRANSPORTATION AND/OR ITS CONTRACTORS USE OF THE PREMISES HEREIN DESCRIBED SHALL NOT INTERFERE WITH USE OF THE PREMISES BY THE PUBLIC INCLUDING, WITHOUT LIMITATION, THE PLEASURE DRIVEWAY AND PARK DISTRICT OF PEORIA AND ADJACENT LAND OWNERS.

**RAILROAD NOTES:**

- THE PROPOSED GRADE SEPARATION PROJECT SHALL NOT INCREASE THE QUANTITY AND/OR CHARACTERISTICS OF THE FLOW IN THE RAILROAD'S DITCHES AND/OR DRAINAGE STRUCTURES.
- THE ELEVATION OF THE EXISTING TOP-OF-RAIL PROFILE SHALL BE VERIFIED BEFORE BEGINNING CONSTRUCTION. ALL DISCREPANCIES SHALL BE BROUGHT TO THE ATTENTION OF THE RAILROAD PRIOR TO CONSTRUCTION.
- THE CONTRACTOR MUST SUBMIT A PROPOSED METHOD OF EROSION AND SEDIMENT CONTROL AND HAVE THE METHOD APPROVED BY THE RAILROAD.
- ALL DEMOLITIONS WITHIN THE RAILROAD'S RIGHT-OF-WAY AND/OR DEMOLITION THAT MAY IMPACT THE RAILROAD'S TRACKS OR OPERATIONS SHALL BE IN COMPLIANCE WITH THE RAILROAD'S DEMOLITION GUIDELINES.
- ERECTION OVER THE RAILROAD'S RIGHT-OF-WAY SHALL BE DESIGNED TO CAUSE NO INTERRUPTION TO THE RAILROAD'S OPERATION, ENABLING THE TRACK(S) TO REMAIN OPEN TO TRAFFIC PER THE RAILROAD'S REQUIREMENTS.
- ALL PERMANENT CLEARANCES SHALL BE VERIFIED BEFORE PROJECT CLOSING.

FINAL SUBMITTAL

MODEL: Default  
FILE: \\nas01\proj\2016\hanson\dom\hanson\project\13\06\phase-ii\cadd\road\sheet\dmcc\ce\p-c-gemot02-tyl.dgn

<b>TYLIN INTERNATIONAL</b> 200 S. WACKER DR. SUITE 1400 CHICAGO, IL 60606 TEL: 312-777-2900	USER NAME = mgormely	DESIGNED - MPG	REVISED - 4/16/2019
	PLOT SCALE = 2.00' / in.	CHECKED - DAJ	REVISED -
	PLOT DATE = 4/5/2019	DATE - 11/28/2018	REVISED -

STATE OF ILLINOIS  
DEPARTMENT OF TRANSPORTATION

US 150 EASTBOUND McCLUGAGE BRIDGE PROJECT  
GENERAL NOTES AND COMMITMENTS

SCALE: NONE SHEET 2 OF 2 SHEETS STA. N/A TO STA. N/A

F.A.P. RTE.	SECTION	COUNTY	TOTAL SHEETS	SHEET NO.
317	[15B:((102-1),(14HB))]BR BR	PEO TAZ	1361	5
ILLINOIS FED. AID PROJECT			CONTRACT NO. 68B46	
			NHPP:YRP3(905)	

GEN-02

FINAL SUBMITTAL

MODEL: Default  
 FILE: M:\MCP\_Plan\15012018\13001310\106Phase3\CD\Road\Sheet\DMCC\EP-50001-TY1.dgn

CODE NO.	ITEM	UNIT	TOTAL QUANTITY	CONSTRUCTION CODE																
				URBAN					80% FED / 20% STATE					100% STATE						
				PEORIA CO		TAZEVELL CO		TAZEVELL CO		PEORIA CO		TAZEVELL CO		PEORIA CO		TAZEVELL CO				
				FAP 317/318	FAP 317/673	FAP 317/673	SN 090-2020	SN 090-2020	SN 090-2020	SN 072-0250	SN 090-0180	SN 072-0250	SN 090-0180	LANDSCAPING & MOWING	LANDSCAPING & MOWING					
20100110	TREE REMOVAL (6 TO 15 UNITS DIAMETER)	UNIT	32	32																
20100500	TREE REMOVAL, ACRES	ACRE	4.25	2.25	2.00															
20101000	TEMPORARY FENCE	FOOT	3,352	3,352																
20200100	EARTH EXCAVATION	CU YD	24,465	10,975	13,490															
20400800	FURNISHED EXCAVATION	CU YD	41,705	1,715	39,990															
20700220	POROUS GRANULAR EMBANKMENT	CU YD	103			103														
20800150	TRENCH BACKFILL	CU YD	1,984	674	1,310															
21001000	GEOTECHNICAL FABRIC FOR GROUND STABILIZATION	SQ YD	59			59														
21101615	TOPSOIL FURNISH AND PLACE, 4"	SQ YD	62,904	22,486	40,418															
21400100	GRADING AND SHAPING DITCHES	FOOT	2,212		2,212															
* 25000210	SEEDING, CLASS 2A	ACRE	8.00	1.50	6.50															
* 25000300	SEEDING, CLASS 3	ACRE	2.25	2.25	0.50															
* 25000324	SEEDING, CLASS 5B	ACRE	1.75	1.00	0.75															
* 25000400	NITROGEN FERTILIZER NUTRIENT	POUND	1,171	419	752															

\* - SPECIALTY ITEM

**TYLIN INTERNATIONAL**  
 200 S. WACKER DR.  
 SUITE 1400  
 CHICAGO, IL 60606  
 TEL: 312-777-2900

USER NAME = kpeschel  
 PLOT SCALE = 2.00' / in.  
 PLOT DATE = 12/13/2018

DESIGNED - MPG  
 DRAWN - MPG  
 CHECKED - DAJ  
 DATE - 11/28/2018

REVISED -  
 REVISED -  
 REVISED -  
 REVISED -

STATE OF ILLINOIS  
 DEPARTMENT OF TRANSPORTATION

US 150 EASTBOUND McCLUGAGE BRIDGE PROJECT  
 SUMMARY OF QUANTITIES  
 SCALE: NONE SHEET 1 OF 35 SHEETS STA. N/A TO STA. N/A

F.A.P. RTE. 317 SECTION [15B;((102-1),(14HB))BR]BR COUNTY PEO/TAZ TOTAL SHEETS 1361 SHEET NO. 7 CONTRACT NO. 68B46  
 ILLINOIS FED. AID PROJECT NHPP-YRP3(905)

500-01



FINAL SUBMITTAL

MODEL: Default  
FILE: \\mhc\p\2016\hanson\cdm\hanson\Projects\Documents\13\0013\130106\Phase3\CD\Road\Sheet\DMHCEP-rs-S0002-TYLL.dgn

CODE NO.	ITEM	UNIT	TOTAL QUANTITY	CONSTRUCTION CODE																	
				80% FED / 20% STATE					80% FED / 20% STATE		100% STATE										
				URBAN					NHS BRIDGE PNLTY FUNDS		0031 - LANDSCAPING										
				PEORIA CO FAP 317/318	TAZEWELL CO FAP 317/673	TAZEWELL CO SN 090-2020	PEORIA CO	TAZEWELL CO	0010	0021 - SAFETY	0010 - BRIDGE REP.	0031 - LANDSCAPING	PEORIA CO	TAZEWELL CO							
US 150 IL 29	US 150 IL 116	CULVERT	PEORIA CO	TAZEWELL CO	US 150 OVER IL 29	US 150 OVER IL RIVER	LANDSCAPING & MOWING	LANDSCAPING & MOWING	PEORIA CO	TAZEWELL CO											
* 25000500	PHOSPHORUS FERTILIZER NUTRIENT	POUND	1,171	419	752																
* 25000600	POTASSIUM FERTILIZER NUTRIENT	POUND	1,171	419	752																
25000750	MOWING	ACRE	13.50												5.00						8.50
* 25003326	INTERSEEDING, CLASS 5C	ACRE	2.00	0.75	1.25																
* 25100115	MULCH, METHOD 2	ACRE	24.75	9.5	15.25																
* 25100635	HEAVY DUTY EROSION CONTROL BLANKET	SQ YD	8,815	2,118	6,697																
* 25100900	TURF REINFORCEMENT MAT	SQ YD	7,389		7,389																
* 28000250	TEMPORARY EROSION CONTROL SEEDING	POUND	2,090	591	1,499																
28000305	TEMPORARY DITCH CHECKS	FOOT	478	154	324																
28000400	PERIMETER EROSION BARRIER	FOOT	9,543	4,376	5,167																
28000500	INLET AND PIPE PROTECTION	EACH	45	8	27																
28000510	INLET FILTERS	EACH	96	69	27																
28001200	TEMPORARY HEAVY DUTY EROSION CONTROL BLANKET	SQ YD	32,406	4,235	28,171																

\* - SPECIALTY ITEM

**TYLIN INTERNATIONAL**  
200 S. WACKER DR.  
SUITE 1400  
CHICAGO, IL 60606  
TEL: 312-777-2900

USER NAME = kpeschel  
PLOT SCALE = 2.00' / in.  
PLOT DATE = 12/13/2018

DESIGNED - MPG  
DRAWN - MPG  
CHECKED - DAJ  
DATE - 11/28/2018

REVISED -  
REVISED -  
REVISED -  
REVISED -

STATE OF ILLINOIS  
DEPARTMENT OF TRANSPORTATION

US 150 EASTBOUND McCLUGAGE BRIDGE PROJECT  
SUMMARY OF QUANTITIES  
SCALE: NONE SHEET 2 OF 35 SHEETS STA. N/A TO STA. N/A

F.A.P. RTE. 317 SECTION [15B;((102-1),(14HB))BR]BR COUNTY PEO/TAZ TOTAL SHEETS 1361 SHEET NO. 8 CONTRACT NO. 68B46 ILLINOIS FED. AID PROJECT NHPP-YRP3(905)

SOQ-02

REV. 4/15/19 REV. 2/8/19 REV. 1/29/19



FINAL SUBMITTAL

MODEL: Default  
 FILE: MainC:\p\buslev\2016\hanson\cdm\hanson\Project\13\130106Phase3\CD\Road\Sheet\DMCC\EP-50004-TYLL.dgn

CODE NO.	ITEM	UNIT	TOTAL QUANTITY	CONSTRUCTION CODE							
				80% FED / 20% STATE			80% FED / 20% STATE		100% STATE		
				URBAN			NHS BRIDGE PNLTY FUNDS		0031 - LANDSCAPING		
				0003 - RDWY. RECON.	0010	0021 - SAFETY	0010 - BRIDGE REP.		0031 - LANDSCAPING		
PEORIA CO FAP 317/318	TAZEWELL CO FAP 317/673	TAZEWELL CO SN 090-2020	PEORIA CO	TAZEWELL CO	PEORIA CO SN 072-0250	TAZEWELL CO SN 090-0180	PEORIA CO	TAZEWELL CO			
	US 150 IL 29	US 150 IL 116	CULVERT			US 150 OVER IL 29	US 150 OVER IL RIVER	LANDSCAPING & MOWING	LANDSCAPING & MOWING		
40603208	POLYMERIZED HOT-MIX ASPHALT BINDER COURSE, 1L-9.5, N70	TON	1,951		1,951						
40603565	POLYMERIZED HOT-MIX ASPHALT SURFACE COURSE, MIX "E", N70	TON	3,836	529	3,307						
42000060	WELDED WIRE REINFORCEMENT	SQ YD	174	114	60						
42000080	PAVEMENT CONNECTOR (PCC) FOR BRIDGE APPROACH SLAB	SQ YD	352	229	123						
42000100	PORTLAND CEMENT CONCRETE PAVEMENT 6"	SQ YD	1,709	1,057	652						
42000411	PORTLAND CEMENT CONCRETE PAVEMENT 9 1/2" (JOINTED)	SQ YD	1,532	1,532							
42001300	PROTECTIVE COAT	SQ YD	15,526	10,080	5,446						
42300200	PORTLAND CEMENT CONCRETE DRIVEWAY PAVEMENT, 6 INCH	SQ YD	133	113	20						
42400200	PORTLAND CEMENT CONCRETE SIDEWALK 5 INCH	SQ FT	3,986	3,926	60						
42400300	PORTLAND CEMENT CONCRETE SIDEWALK 6 INCH	SQ FT	1,748	1,157	591						
* 42400800	DETECTABLE WARNINGS	SQ FT	188	188							
44000100	PAVEMENT REMOVAL	SQ YD	14,656	5,214	9,442						
44000157	HOT-MIX ASPHALT SURFACE REMOVAL, 2"	SQ YD	13,188		13,188						
44000159	HOT-MIX ASPHALT SURFACE REMOVAL, 2 1/2"	SQ YD	5,374	3,722	1,652						

\* - SPECIALTY ITEM

**TYLIN INTERNATIONAL**  
 200 S. WACKER DR.  
 SUITE 1400  
 CHICAGO, IL 60606  
 TEL: 312-777-2900

USER NAME = kpeschel  
 PLOT SCALE = 2.00' / in.  
 PLOT DATE = 12/13/2018

DESIGNED - MPG  
 DRAWN - MPG  
 CHECKED - DAJ  
 DATE - 11/28/2018

REVISED -  
 REVISED -  
 REVISED -  
 REVISED -

STATE OF ILLINOIS  
 DEPARTMENT OF TRANSPORTATION

US 150 EASTBOUND MCCLUGAGE BRIDGE PROJECT  
 SUMMARY OF QUANTITIES

SCALE: NONE SHEET 4 OF 35 SHEETS STA. N/A TO STA. N/A

F.A.P. RTE.	SECTION	COUNTY	TOTAL SHEETS	SHEET NO.
317	[15B;((102-1),(14HB))BR]BR	PEO/TAZ	1361	10
CONTRACT NO. 68B46			ILLINOIS FED. AID PROJECT NHPP-YRP3(905)	

SOQ-04

REV. 4/15/19 REV. 1/29/19





FINAL SUBMITTAL

MODEL: Default  
 FILE: N:\mhc\p\2016\hanson\cdm\hanson\project\cdm\document\13\0013\NO106Phase3\CD\RoadSheet\DMCC\EP-50011-TYLL.dgn

CODE NO.	ITEM	UNIT	TOTAL QUANTITY	CONSTRUCTION CODE							
				80% FED / 20% STATE			80% FED / 20% STATE		100% STATE		
				NHPP			NHS BRIDGE PNLTY FUNDS				
				0003 - RDWY. RECON.	0010	0021 - SAFETY	0010 - BRIDGE REP.		0031 - LANDSCAPING		
PEORIA CO FAP 317/318	TAZEWELL CO FAP 317/673	TAZEWELL CO SN 090-2020	PEORIA CO	TAZEWELL CO	PEORIA CO SN 072-0250	TAZEWELL CO SN 090-0180	PEORIA CO	TAZEWELL CO			
	US 150 IL 29	US 150 IL 116	CULVERT			US 150 OVER IL 29	US 150 OVER IL RIVER	LANDSCAPING & MOWING	LANDSCAPING & MOWING		
54213657	PRECAST REINFORCED CONCRETE FLARED END SECTIONS 12"	EACH	5	2	3						
54213660	PRECAST REINFORCED CONCRETE FLARED END SECTIONS 15"	EACH	1		1						
54213663	PRECAST REINFORCED CONCRETE FLARED END SECTIONS 18"	EACH	1		1						
54213669	PRECAST REINFORCED CONCRETE FLARED END SECTIONS 24"	EACH	5		5						
54244405	FLUSH INLET BOX FOR MEDIAN, STANDARD 542546	EACH	7	3	4						
54248510	CONCRETE COLLAR	CU YD	1.2	1.2							
550A0050	STORM SEWERS, CLASS A, TYPE 1 12"	FOOT	321		321						
550A0090	STORM SEWERS, CLASS A, TYPE 1 18"	FOOT	37		37						
550A0120	STORM SEWERS, CLASS A, TYPE 1 24"	FOOT	408		408						
550A0340	STORM SEWERS, CLASS A, TYPE 2 12"	FOOT	3,036	1,057	1,979						
550A0360	STORM SEWERS, CLASS A, TYPE 2 15"	FOOT	779	193	586						
550A0380	STORM SEWERS, CLASS A, TYPE 2 18"	FOOT	540	334	206						
550A0410	STORM SEWERS, CLASS A, TYPE 2 24"	FOOT	170		170						
550B0410	STORM SEWERS, CLASS B, TYPE 2 24"	FOOT	226	226							
55100500	STORM SEWER REMOVAL 12"	FOOT	1,176	1,176							
550B0450	STORM SEWERS, CLASS B, TYPE 2 36"	FOOT	305	305							

\* - SPECIALTY ITEM

**TYLIN INTERNATIONAL**  
 200 S. WACKER DR.  
 SUITE 1400  
 CHICAGO, IL 60606  
 TEL: 312-777-2900

USER NAME = kpeschel	DESIGNED - MPG	REVISED -
PLOT SCALE = 2.00' / in.	DRAWN - MPG	REVISED -
PLOT DATE = 12/13/2018	CHECKED - DAJ	REVISED -
	DATE - 11/28/2018	REVISED -

STATE OF ILLINOIS  
 DEPARTMENT OF TRANSPORTATION

US 150 EASTBOUND McCLUGAGE BRIDGE PROJECT  
 SUMMARY OF QUANTITIES

SCALE: NONE SHEET 11 OF 35 SHEETS STA. N/A TO STA. N/A

F.A.P. RTE.	SECTION	COUNTY	TOTAL SHEETS	SHEET NO.
317	[15B;((102-1),(14HB))BR]BR	PEO/TAZ	1361	17
CONTRACT NO. 68B46				
ILLINOIS		FED. AID PROJECT	NHPP-YRP3(905)	

50Q-11

REV. 4/15/19

FINAL SUBMITTAL

MODEL: Default  
 FILE: MainC:\projects\2016\hanson\cdm\hanson\project\document\13\0013\13\10\06\Phase\CD\Road\Sheet\DMCC\EP-50012-TYLL.dgn

CODE NO.	ITEM	UNIT	TOTAL QUANTITY	CONSTRUCTION CODE																	
				80% FED / 20% STATE					80% FED / 20% STATE		100% STATE										
				0003 - RDWY. RECON.		0010	0021 - SAFETY		0010 - BRIDGE REP.		0031 - LANDSCAPING										
				PEORIA CO FAP 317/318	TAZEWELL CO FAP 317/673	TAZEWELL CO SN 090-2020	PEORIA CO	TAZEWELL CO	PEORIA CO SN 072-0250	TAZEWELL CO SN 090-0180	PEORIA CO	TAZEWELL CO	LANDSCAPING & MOWING	LANDSCAPING & MOWING							
US 150 IL 29	US 150 IL 116	CULVERT			US 150 OVER IL 29	US 150 OVER IL RIVER															
55101200	STORM SEWER REMOVAL 24"	FOOT	20	20																	
55101300	STORM SEWER REMOVAL 27"	FOOT	16	16																	
55200600	STORM SEWERS JACKED IN PLACE, 18"	FOOT	47	47																	
58700300	CONCRETE SEALER	SQ FT	77,203.7							2,222.7	74,981.0										
59100100	GEOCOMPOSITE WALL DRAIN	SQ YD	360.6							137.0	223.6										
60100060	CONCRETE HEADWALLS FOR PIPE DRAINS	EACH	2	2																	
60100100	PIPE UNDERDRAINS 4" (SPECIAL)	FOOT	161	161																	
60200305	CATCH BASINS, TYPE A, 4' DIAMETER, TYPE 3 FRAME AND GRATE	EACH	1	1																	
60218400	MANHOLES, TYPE A, 4'-DIAMETER, TYPE 1 FRAME, CLOSED LID	EACH	9	5				4													
60219000	MANHOLES, TYPE A, 4'-DIAMETER, TYPE 8 GRATE	EACH	7	4				3													
60223800	MANHOLES, TYPE A, 6'-DIAMETER, TYPE 1 FRAME, CLOSED LID	EACH	2	2																	
60221100	MANHOLES, TYPE A, 5'-DIAMETER, TYPE 1 FRAME, CLOSED LID	EACH	1	1																	
60224446	MANHOLES, TYPE A, 7'-DIAMETER, TYPE 1 FRAME, CLOSED LID	EACH	1	1																	
60224448	MANHOLES, TYPE A, 7'-DIAMETER, TYPE 8 GRATE	EACH	1	1																	
60236800	INLETS, TYPE A, TYPE 11 FRAME AND GRATE	EACH	1					1													
60237420	INLETS, TYPE A, TYPE 20 FRAME AND GRATE	EACH	2	2																	

\* - SPECIALTY ITEM

**TYLIN INTERNATIONAL**  
 200 S. WACKER DR.  
 SUITE 1400  
 CHICAGO, IL 60606  
 TEL: 312-777-2900

USER NAME = kpeschel  
 PLOT SCALE = 2.00' / in.  
 PLOT DATE = 12/13/2018

DESIGNED - MPG  
 DRAWN - MPG  
 CHECKED - DAJ  
 DATE - 11/28/2018

REVISED -  
 REVISED -  
 REVISED -  
 REVISED -

STATE OF ILLINOIS  
 DEPARTMENT OF TRANSPORTATION

US 150 EASTBOUND MCCLUGAGE BRIDGE PROJECT  
 SUMMARY OF QUANTITIES  
 SCALE: NONE SHEET 12 OF 35 SHEETS STA. N/A TO STA. N/A

F.A.P. RTE. 317 SECTION [15B;((102-1),(14HB))BR]BR COUNTY PEO/TAZ TOTAL SHEETS 1361 SHEET NO. 18 CONTRACT NO. 68B46 ILLINOIS FED. AID PROJECT NHPP-YRP3(905)

SOQ-12

REV. 4/15/19

FINAL SUBMITTAL

MODEL: Default  
FILE: ModelC\_PlanSheet.dwg  
PROJECT: Documents\1306\1306Phase3\CD\RoadSheet\DMCC\EP-50013-TYLL.dgn

CODE NO.	ITEM	UNIT	TOTAL QUANTITY	CONSTRUCTION CODE																
				80% FED / 20% STATE					80% FED / 20% STATE		100% STATE									
				0003 - RDWY. RECON.		NHPP	0021 - SAFETY		NHS BRIDGE PNLTY FUNDS		0031 - LANDSCAPING									
				PEORIA CO FAP 317/318	TAZEWELL CO FAP 317/673	TAZEWELL CO SN 090-2020	PEORIA CO	TAZEWELL CO	PEORIA CO SN 072-0250	TAZEWELL CO SN 090-0180	PEORIA CO	TAZEWELL CO	LANDSCAPING & MOWING	LANDSCAPING & MOWING						
US 150 IL 29	US 150 IL 116	CULVERT			US 150 OVER IL 29	US 150 OVER IL RIVER														
60240210	INLETS, TYPE B, TYPE 1 FRAME, OPEN LID	EACH	1	1																
60240215	INLETS, TYPE B, TYPE 1 FRAME, CLOSED LID	EACH	2	2																
60240324	INLETS, TYPE B, TYPE 20 FRAME AND GRATE	EACH	2	2																
60255700	MANHOLES TO BE ADJUSTED WITH NEW TYPE 1 FRAME, OPEN LID	EACH	1	1																
60255800	MANHOLES TO BE ADJUSTED WITH NEW TYPE 1 FRAME, CLOSED LID	EACH	1	1																
60260100	INLETS TO BE ADJUSTED	EACH	1		1															
60270000	DRAINAGE STRUCTURES, TYPE 4 WITH ONE TYPE 20 FRAME AND GRATE	EACH	2	2																
60270005	DRAINAGE STRUCTURES, TYPE 5 WITH ONE TYPE 22 FRAME AND GRATE	EACH	4	4																
60270055	DRAINAGE STRUCTURES, TYPE 5 WITH TWO TYPE 22 FRAME AND GRATES	EACH	2	2																
60500040	REMOVING MANHOLES	EACH	4	4																
60500050	REMOVING CATCH BASINS	EACH	2		2															
60500060	REMOVING INLETS	EACH	16	16																
60500070	REMOVING MANHOLES TO MAINTAIN FLOW	EACH	1	1																
60600095	CLASS S1 CONCRETE (OUTLET)	CU YD	0.4		0.4															
60600605	CONCRETE CURB, TYPE B	FOOT	752.0	752.0																

\* - SPECIALTY ITEM

**TYLIN INTERNATIONAL**  
200 S. WACKER DR.  
SUITE 1400  
CHICAGO, IL 60606  
TEL: 312-777-2900

USER NAME = kpeschel  
PLOT SCALE = 2.00' / in.  
PLOT DATE = 12/13/2018

DESIGNED - MPG  
DRAWN - MPG  
CHECKED - DAJ  
DATE - 11/28/2018

REVISED -  
REVISED -  
REVISED -  
REVISED -

STATE OF ILLINOIS  
DEPARTMENT OF TRANSPORTATION

US 150 EASTBOUND McCLUGAGE BRIDGE PROJECT  
SUMMARY OF QUANTITIES  
SCALE: NONE SHEET 13 OF 35 SHEETS STA. N/A TO STA. N/A

F.A.P. RTE. 317 SECTION [15B;((102-1),(14HB))BR]BR COUNTY PEO/TAZ TOTAL SHEETS 1361 SHEET NO. 19 CONTRACT NO. 68B46 ILLINOIS FED. AID PROJECT NHPP-YRP3(905)

SOQ-13

REV. 4/15/19



FINAL SUBMITTAL

MODEL: Default  
 FILE: Model - Project\2016\hanson-donahanson - Project\313\130106Phase3\CAD\Road\Sheet\DMCC\EP-50016-TYLL.dgn

CODE NO.	ITEM	UNIT	TOTAL QUANTITY	CONSTRUCTION CODE										
				80% FED / 20% STATE						80% FED / 20% STATE		100% STATE		
				URBAN			NHPP			NHS BRIDGE PNLTY FUNDS				
				PEORIA CO	TAZEWELL CO	TAZEWELL CO	PEORIA CO	TAZEWELL CO	PEORIA CO	TAZEWELL CO	PEORIA CO	TAZEWELL CO		
FAP 317/318	FAP 317/673	SN 090-2020			SN 072-0250	SN 090-0180								
	US 150 IL 29	US 150 IL 116	CULVERT			US 150 OVER IL 29	US 150 OVER IL RIVER	LANDSCAPING & MOWING	LANDSCAPING & MOWING					
* 66901001	REGULATED SUBSTANCES PRE-CONSTRUCTION PLAN	L SUM	1	0.5	0.5									
* 66901002	ON-SITE MONITORING OF REGULATED SUBSTANCES	CAL DA	20	10	10									
* 66901003	REGULATED SUBSTANCES FINAL CONSTRUCTION REPORT	L SUM	1	0.5	0.5									
67100100	MOBILIZATION	L SUM	1	0.5	0.5									
70107025	CHANGEABLE MESSAGE SIGN	CAL DAY	1,053	936	117									
70300100	SHORT TERM PAVEMENT MARKING	FOOT	6,749	2,319	4,430									
70300150	SHORT TERM PAVEMENT MARKING REMOVAL	SQ FT	2,251	774	1,477									
70300900	PAVEMENT MARKING TAPE, TYPE IV - LETTERS AND SYMBOLS	SQ FT	224	224										
70300904	PAVEMENT MARKING TAPE, TYPE IV 4"	FOOT	92,099	45,229	46,870									
70300906	PAVEMENT MARKING TAPE, TYPE IV 6"	FOOT	3,910	454	3,456									
70300912	PAVEMENT MARKING TAPE, TYPE IV 12"	FOOT	287		287									
70300924	PAVEMENT MARKING TAPE, TYPE IV 24"	FOOT	134	134										
70400100	TEMPORARY CONCRETE BARRIER	FOOT	5,286	2,285	3,001									
70400200	RELOCATE TEMPORARY CONCRETE BARRIER	FOOT	5,213	950	4,236									

\* - SPECIALTY ITEM

**TYLIN INTERNATIONAL**  
 200 S. WACKER DR.  
 SUITE 1400  
 CHICAGO, IL 60606  
 TEL: 312-777-2900

USER NAME = kpeschel  
 PLOT SCALE = 2.00' / in.  
 PLOT DATE = 12/13/2018

DESIGNED - MPG  
 DRAWN - MPG  
 CHECKED - DAJ  
 DATE - 11/28/2018

REVISED -  
 REVISED -  
 REVISED -  
 REVISED -

STATE OF ILLINOIS  
 DEPARTMENT OF TRANSPORTATION

US 150 EASTBOUND MCCLUGAGE BRIDGE PROJECT  
 SUMMARY OF QUANTITIES

SCALE: NONE SHEET 16 OF 35 SHEETS STA. N/A TO STA. N/A

F.A.P. RTE.	SECTION	COUNTY	TOTAL SHEETS	SHEET NO.
317	[15B;((102-1),(14HB))BR]BR	PEO/TAZ	1361	22
CONTRACT NO. 68B46				

REV. 4/15/19 REV. 1/29/19

SOQ-16

FINAL SUBMITTAL

MODEL: Default  
 FILE: \\mhc\p\2016\hanson\cdm\hanson\project\317\317.dgn  
 PROJECT: 317\317.dgn

CODE NO.	ITEM	UNIT	TOTAL QUANTITY	CONSTRUCTION CODE									
				80% FED / 20% STATE					80% FED / 20% STATE		100% STATE		
				URBAN					NHS BRIDGE PNLTY FUNDS				
				0003 - RDWY. RECON.	0010	0021 - SAFETY		0010 - BRIDGE REP.	0031 - LANDSCAPING				
PEORIA CO FAP 317/318	TAZEWELL CO FAP 317/673	TAZEWELL CO SN 090-2020	PEORIA CO	TAZEWELL CO	PEORIA CO SN 072-0250	TAZEWELL CO SN 090-0180	PEORIA CO	TAZEWELL CO	LANDSCAPING & MOWING	LANDSCAPING & MOWING			
	US 150 IL 29	US 150 IL 116	CULVERT			US 150 OVER IL 29	US 150 OVER IL RIVER						
70600260	IMPACT ATTENUATORS, TEMPORARY (FULLY REDIRECTIVE, NARROW), TEST LEVEL 3	EACH	6	4	2								
70600332	IMPACT ATTENUATORS, RELOCATE (FULLY REDIRECTIVE, NARROW), TEST LEVEL 3	EACH	14	7	7								
* 72000100	SIGN PANEL - TYPE 1	SQ FT	150	33	117								
* 72000200	SIGN PANEL - TYPE 2	SQ FT	104	12	92								
* 72000300	SIGN PANEL - TYPE 3	SQ FT	1,261	105	1,156								
* 72400200	REMOVE SIGN PANEL ASSEMBLY - TYPE B	EACH	9	2	7								
* 72400310	REMOVE SIGN PANEL - TYPE 1	SQ FT	53	18	35								
* 72400320	REMOVE SIGN PANEL - TYPE 2	SQ FT	100	16	84								
* 72400330	REMOVE SIGN PANEL - TYPE 3	SQ FT	1,424	163	1,261								
* 72400600	RELOCATE SIGN PANEL ASSEMBLY - TYPE B	EACH	2		2								
* 72400710	RELOCATE SIGN PANEL - TYPE 1	SQ FT	2		2								
* 72501000	TERMINAL MARKER - DIRECT APPLIED	EACH	9	3	6								
72700100	STRUCTURAL STEEL SIGN SUPPORT - BREAKAWAY	POUND	4,279	1,116	3,163								
72800100	TELESCOPING STEEL SIGN SUPPORT	FOOT	147	15	132								

\* - SPECIALTY ITEM

**TYLIN INTERNATIONAL**  
 200 S. WACKER DR.  
 SUITE 1400  
 CHICAGO, IL 60606  
 TEL: 312-777-2900

USER NAME = kpeschel	DESIGNED - MPG	REVISED -
PLOT SCALE = 2.00' / in.	DRAWN - MPG	REVISED -
PLOT DATE = 12/13/2018	CHECKED - DAJ	REVISED -
	DATE - 11/28/2018	REVISED -

STATE OF ILLINOIS  
 DEPARTMENT OF TRANSPORTATION

US 150 EASTBOUND McCLUGAGE BRIDGE PROJECT  
 SUMMARY OF QUANTITIES

SCALE: NONE SHEET 17 OF 35 SHEETS STA. N/A TO STA. N/A

F.A.P. RTE.	SECTION	COUNTY	TOTAL SHEETS	SHEET NO.
317	[15B;((102-1),(14HB))BR]BR	PEO/TAZ	1361	23
CONTRACT NO. 68B46			SOQ-17	

ILLINOIS FED. AID PROJECT NHPP-YRP3(905)  
 REV. 4/15/19 REV. 1/29/19

MODEL: Default  
 FILE: \\mhc\p\users\levy206\hanson\cdm\hanson\Project\Documents\13\0013\NO106Phase3\CD\Road\Sheet\DMHCCEP-PC-S0018-TYLL.dgn

CODE NO.	ITEM	UNIT	TOTAL QUANTITY	CONSTRUCTION CODE									
				80% FED / 20% STATE			80% FED / 20% STATE		100% STATE				
				URBAN			NHP		NHS BRIDGE PNLTY FUNDS				
				PEORIA CO FAP 317/318	TAZEWELL CO FAP 317/673	TAZEWELL CO SN 090-2020	0021 - SAFETY		0010 - BRIDGE REP.		0031 - LANDSCAPING		
US 150 IL 29	US 150 IL 116	CULVERT	PEORIA CO	TAZEWELL CO	PEORIA CO SN 072-0250	TAZEWELL CO SN 090-0180	US 150 OVER IL 29	US 150 OVER IL RIVER	LANDSCAPING & MOWING	LANDSCAPING & MOWING			
73000100	WOOD SIGN SUPPORT	FOOT	51		51								
73300100	OVERHEAD SIGN STRUCTURE - SPAN, TYPE 1-A (4'-0" X 4'-6")	FOOT	170		170								
73304000	OVERHEAD SIGN STRUCTURE - BRIDGE MOUNTED	FOOT	11.5	11.5									
73400100	CONCRETE FOUNDATIONS	CU YD	42.3	2.4	39.9								
73600100	REMOVE OVERHEAD SIGN STRUCTURE - SPAN	EACH	1		1								
73602000	REMOVE OVERHEAD SIGN STRUCTURE - BRIDGE MOUNTED	EACH	2	1	1								
73700100	REMOVE GROUND MOUNTED SIGN SUPPORT	EACH	8	4	4								
73700200	REMOVE CONCRETE FOUNDATION - GROUND MOUNT	EACH	8	4	4								
73700300	REMOVE CONCRETE FOUNDATION - OVERHEAD	EACH	2		2								
* 78003110	PREFORMED PLASTIC PAVEMENT MARKING, TYPE B - LINE 4"	FOOT	8,910	737	8,173								
* 78003140	PREFORMED PLASTIC PAVEMENT MARKING, TYPE B - LINE 8"	FOOT	7,461	1,755	5,706								
* 78003150	PREFORMED PLASTIC PAVEMENT MARKING, TYPE B - LINE 12"	FOOT	1,019	191	828								
* 78009000	MODIFIED URETHANE PAVEMENT MARKING - LETTERS AND SYMBOLS	SQ FT	317	130	187								
* 78009004	MODIFIED URETHANE PAVEMENT MARKING - LINE 4"	FOOT	22,667	10,925	11,742								

\* - SPECIALTY ITEM

**TYLIN INTERNATIONAL**  
 200 S. WACKER DR.  
 SUITE 1400  
 CHICAGO, IL 60606  
 TEL: 312-777-2900

USER NAME = kpeschel	DESIGNED - MPG	REVISED -
PLOT SCALE = 2.00' / in.	DRAWN - MPG	REVISED -
PLOT DATE = 12/13/2018	CHECKED - DAJ	REVISED -
	DATE - 11/28/2018	REVISED -

STATE OF ILLINOIS  
 DEPARTMENT OF TRANSPORTATION

US 150 EASTBOUND MCCLUGAGE BRIDGE PROJECT  
 SUMMARY OF QUANTITIES

SCALE: NONE SHEET 18 OF 35 SHEETS STA. N/A TO STA. N/A

F.A.P. RTE.	SECTION	COUNTY	TOTAL SHEETS	SHEET NO.
317	[15B;{(102-1),(14HB)}]BR]BR	PEO/TAZ	1361	24
CONTRACT NO. 68B46			SOQ-18	



FINAL SUBMITTAL

MODEL: Default  
 FILE: \\mhc-pw\users\levy206\hanson\dwg\hanson\Project\313\130106Phase3\CD\Road\Sheet\DMCC\EP-50022-TYLD.dwg

CODE NO.	ITEM	UNIT	TOTAL QUANTITY	CONSTRUCTION CODE										
				80% FED / 20% STATE					80% FED / 20% STATE		100% STATE			
				URBAN					NHS BRIDGE PNLTY FUNDS					
				0003 - RDWY. RECON.	0010	0021 - SAFETY		0010 - BRIDGE REP.	0031 - LANDSCAPING					
PEORIA CO FAP 317/318	TAZEWELL CO FAP 317/673	TAZEWELL CO SN 090-2020	PEORIA CO	TAZEWELL CO	PEORIA CO SN 072-0250	TAZEWELL CO SN 090-0180	PEORIA CO	TAZEWELL CO	LANDSCAPING & MOWING	LANDSCAPING & MOWING				
	US 150 IL 29	US 150 IL 116	CULVERT			US 150 OVER IL 29	US 150 OVER IL RIVER							
* 83012100	LIGHT POLE, ALUMINUM, 30 FT. M.H., TENON MOUNT	EACH	15					10	5					
* 83060420	LIGHT POLE, GALVANIZED STEEL, 45 FT. M.H., 8 FT. MAST ARM	EACH	13						13					
* 83060450	LIGHT POLE, GALVANIZED STEEL, 45 FT. M.H., 15 FT. MAST ARM	EACH	9						9					
* 83060830	LIGHT POLE, GALVANIZED STEEL, 45 FT. M.H., TENON MOUNT	EACH	1					1						
* 83600200	LIGHT POLE FOUNDATION, 24" DIAMETER	FOOT	110.0					85.0	25.0					
* 83600300	LIGHT POLE FOUNDATION, 30" DIAMETER	FOOT	208.5					65.5	143.0					
83800650	BREAKAWAY DEVICE, COUPLING WITH STAINLESS STEEL SCREEN	EACH	52					24	28					
84200500	REMOVAL OF LIGHTING UNIT, SALVAGE	EACH	32					9	23					
84200804	REMOVAL OF POLE FOUNDATION	EACH	16					9	7					
84301200	REMOVAL OF NAVIGATION OBSTRUCTION WARNING LIGHTING SYSTEM	L SUM	1						1					
84500110	REMOVAL OF LIGHTING CONTROLLER	EACH	3					2	1					
84500120	REMOVAL OF ELECTRIC SERVICE INSTALLATION	EACH	3					2	1					
84500130	REMOVAL OF LIGHTING CONTROLLER FOUNDATION	EACH	3					2	1					
* 85000200	MAINTENANCE OF EXISTING TRAFFIC SIGNAL INSTALLATION	EACH	1						1					

\* - SPECIALTY ITEM

**TYLIN INTERNATIONAL**  
 200 S. WACKER DR.  
 SUITE 1400  
 CHICAGO, IL 60606  
 TEL: 312-777-2900

USER NAME = kpeschel  
 PLOT SCALE = 2.00' / in.  
 PLOT DATE = 12/13/2018

DESIGNED - MPG  
 DRAWN - MPG  
 CHECKED - DAJ  
 DATE - 11/28/2018

REVISED -  
 REVISED -  
 REVISED -  
 REVISED -

STATE OF ILLINOIS  
 DEPARTMENT OF TRANSPORTATION

US 150 EASTBOUND McCLUGAGE BRIDGE PROJECT  
 SUMMARY OF QUANTITIES

SCALE: NONE SHEET 22 OF 35 SHEETS STA. N/A TO STA. N/A

F.A.P. RTE.	SECTION	COUNTY	TOTAL SHEETS	SHEET NO.
317	[15B;((102-1),(14HB))BR]BR	PEO/TAZ	1361	28
CONTRACT NO. 68B46			SOQ-22	

REV. 4/18/19 REV. 4/15/19 REV. 1/29/19

FINAL SUBMITTAL

MODEL: Default  
 FILE: \\mhc\p\2016\hanson\cdm\hanson\Project\317\3170106\Phase\CD\Road\Sheet\DMCC\EP-50026-TYLL.dgn

CODE NO.	ITEM	UNIT	TOTAL QUANTITY	CONSTRUCTION CODE								
				80% FED / 20% STATE			80% FED / 20% STATE		100% STATE			
				NHPP			NHS BRIDGE PNLTY FUNDS					
				0003 - RDWY. RECON.	0010	0021 - SAFETY	0010 - BRIDGE REP.		0031 - LANDSCAPING			
PEORIA CO FAP 317/318	TAZEWELL CO FAP 317/673	TAZEWELL CO SN 090-2020	PEORIA CO	TAZEWELL CO	PEORIA CO SN 072-0250	TAZEWELL CO SN 090-0180	PEORIA CO	TAZEWELL CO				
	US 150 IL 29	US 150 IL 116	CULVERT		US 150 OVER IL 29	US 150 OVER IL RIVER	LANDSCAPING & MOWING	LANDSCAPING & MOWING				
X0301847	WATER TRANSPORTATION FOR ENGINEER	CAL MO	51		51							
X0320051	CROSSHOLE SONIC LOGGING ACCESS DUCTS	FOOT	41,396							41,396		
X0320052	CROSSHOLE SONIC LOGGING TESTING	EACH	9							9		
X0320586	FLEXIBLE DELINEATORS	EACH	29	29								
X0321158	PARK BENCHES	EACH	10	4	6							
X0321750	REMOVE TEMPORARY CONCRETE BARRIER, STATE OWNED	FOOT	823	823								
X0322792	BEDDING MATERIAL, SPECIAL	CU YD	98	98								
X0322916	PROPOSED STORM SEWER CONNECTION TO EXISTING STORM SEWER	EACH	1		1							
X0322917	PROPOSED STORM SEWER CONNECTION TO EXISTING MANHOLE	EACH	4	2	2							
X0322936	REMOVE EXISTING FLARED END SECTION	EACH	3		3							
X0323117	LANDSCAPING GRAVEL	SQ YD	43	43								
X0323388	TRAFFIC COUNTER	EACH	3			3						
* X0323898	CLOSED CIRCUIT TELEVISION DOME CAMERA	EACH	2			2						
* X0323906	CAMERA POLE, 45 FT	EACH	2			2						

\* - SPECIALTY ITEM

**TYLIN INTERNATIONAL**  
 200 S. WACKER DR.  
 SUITE 1400  
 CHICAGO, IL 60606  
 TEL: 312-777-2900

USER NAME = kpeschel  
 PLOT SCALE = 2.00' / in.  
 PLOT DATE = 12/13/2018

DESIGNED - MPG  
 DRAWN - MPG  
 CHECKED - DAJ  
 DATE - 11/28/2018

REVISED -  
 REVISED -  
 REVISED -  
 REVISED -

STATE OF ILLINOIS  
 DEPARTMENT OF TRANSPORTATION

US 150 EASTBOUND McCLUGAGE BRIDGE PROJECT  
 SUMMARY OF QUANTITIES

SCALE: NONE SHEET 26 OF 35 SHEETS STA. N/A TO STA. N/A

F.A.P. RTE.	SECTION	COUNTY	TOTAL SHEETS	SHEET NO.
317	[15B;((102-1),(14HB))BR]BR	PEO/TAZ	1361	32
CONTRACT NO. 68B46				

REV. 4/15/19 REV. 2/8/19 REV. 1/29/19

SOQ-26

MODEL: Default  
 FILE: \\na1pc-pw\pub\levy\2016\hanson\cdm\hanson-projects\document\13\job\13\NO106\Phase3\CAD\Road\Sheet\DMH\CEEP-CH-SOQ28-TYLD.dgn

CODE NO.	ITEM	UNIT	TOTAL QUANTITY	CONSTRUCTION CODE													
				URBAN					80% FED / 20% STATE					100% STATE			
				0003 - RDWY. RECON.		0010		0021 - SAFETY		0010 - BRIDGE REP.		0031 - LANDSCAPING					
				PEORIA CO FAP 317/318	TAZEWELL CO FAP 317/673	TAZEWELL CO SN 090-2020	PEORIA CO	TAZEWELL CO	PEORIA CO	TAZEWELL CO	PEORIA CO	TAZEWELL CO	PEORIA CO	TAZEWELL CO	LANDSCAPING & MOWING	LANDSCAPING & MOWING	
* X0326885	VIDEO DETECTION SYSTEM	EACH	3				3										
* X0326906	CLOSED CIRCUIT TELEVISION DOME CAMERA, IP BASED (MATERIAL ONLY)	EACH	2				2										
X0327000	TEMPORARY CONNECTION TO EXISTING STORM SEWER	EACH	4	4													
X0327131	DRAINAGE STRUCTURES, NO. 1	EACH	15		15												
X0327132	DRAINAGE STRUCTURES, NO. 2	EACH	1		1												
* X0327206	DATA SERVER	L SUM	1				1										
* X0327545	SOIL SAMPLING AND TESTING	EACH	1		1												
* X0327748	REMOVE AND REPLACE ITS EQUIPMENT	EACH	2				2										
X0327778	HANGER ASSEMBLIES FOR TIED ARCH SPAN	L SUM	1								1						
X0327880	WAYFINDING SIGN, SPECIAL	L SUM	1		1												
X0327978	CONCRETE PAVER PAVEMENT	SQ YD	1,757	1,757													
X0327980	PAVEMENT MARKING REMOVAL - WATER BLASTING	SQ FT	15,115	9,375	5,740												
X0350805	FOLD DOWN BOLLARDS	EACH	2	1	1												
X0900076	COFFERCELL (LOCATION - 12)	EACH	1								1						

\* - SPECIALTY ITEM

**TYLIN INTERNATIONAL**  
 200 S. WACKER DR.  
 SUITE 1400  
 CHICAGO, IL 60606  
 TEL: 312-777-2900

USER NAME = kpeschel  
 PLOT SCALE = 2.00' / in.  
 PLOT DATE = 12/13/2018

DESIGNED - MPG  
 DRAWN - MPG  
 CHECKED - DAJ  
 DATE - 11/28/2018

REVISED -  
 REVISED -  
 REVISED -  
 REVISED -

STATE OF ILLINOIS  
 DEPARTMENT OF TRANSPORTATION

US 150 EASTBOUND McCLUGAGE BRIDGE PROJECT  
 SUMMARY OF QUANTITIES

SCALE: NONE SHEET 28 OF 35 SHEETS STA. N/A TO STA. N/A

F.A.P. RTE.	SECTION	COUNTY	TOTAL SHEETS	SHEET NO.
317	[15B;((102-1),(14HB))BR]BR	PEO/TAZ	1361	34
CONTRACT NO. 68B46				

FINAL SUBMITTAL

MODEL: Default  
FILE: \\mhc\p\2016\hanson\cdm\hanson\Project\317\317010\Phase3\CD\Road\Sheet\DMCC\EP-50029-TYLL.dgn

CODE NO.	ITEM	UNIT	TOTAL QUANTITY	CONSTRUCTION CODE									
				URBAN			80% FED / 20% STATE NHPP		80% FED / 20% STATE NHS BRIDGE PNLTY FUNDS		100% STATE		
				0003 - RDWY. RECON.	0010	0021 - SAFETY	0010 - BRIDGE REP.		0031 - LANDSCAPING				
				PEORIA CO FAP 317/318 US 150 IL 29	TAZEWELL CO FAP 317/673 US 150 IL 116	TAZEWELL CO SN 090-2020 CULVERT	PEORIA CO	TAZEWELL CO	PEORIA CO SN 072-0250 US 150 OVER IL 29	TAZEWELL CO SN 090-0180 US 150 OVER IL RIVER	PEORIA CO LANDSCAPING & MOWING	TAZEWELL CO LANDSCAPING & MOWING	
X0900077	COFFERCELL (LOCATION - 13)	EACH	1								1		
X0900078	COFFERCELL (LOCATION - 14)	EACH	1								1		
X0900079	COFFERCELL (LOCATION - 15)	EACH	1								1		
X0900064	MEMBRANE WATERPROOFING SYSTEM FOR BURIED STRUCTURES	SQ YD	153			153							
X1200055	INFILTRATION AGGREGATE	CU YD	1,002	1,002									
X1200107	PIPE UNDERDRAINS 6" (MODIFIED)	FOOT	134	134									
* X1400007	FIBER OPTIC CABLE IN CONDUIT, 24 FIBERS, SINGLE MODE	FOOT	1,417				1,417						
* X1400014	CIRCUIT BREAKER IN STREET LIGHT CONTROLLER	EACH	1					1					
* X1400094	LUMINAIRE, LED, HORIZONTAL MOUNT, LOW WATTAGE	EACH	15				10	5					
* X1400095	LUMINAIRE, LED, HORIZONTAL MOUNT, HIGH WATTAGE	EACH	3					3					
* X1400113	LUMINAIRE, LED, HORIZONTAL MOUNT, MEDIUM WATTAGE	EACH	59				9	50					
* X1400179	CLOSED CIRCUIT TELEVISION DOME CAMERA, HD	EACH	11				10	1					
* X1400212	LUMINAIRE, LED, HORIZONTAL MOUNT, VERY LOW WATTAGE	EACH	7				7						
* X1400238	LUMINAIRE, LED, SPECIAL	EACH	28					28					

\* - SPECIALTY ITEM

**TYLIN INTERNATIONAL**  
200 S. WACKER DR.  
SUITE 1400  
CHICAGO, IL 60606  
TEL: 312-777-2900

USER NAME = kpeschel  
PLOT SCALE = 2.00' / in.  
PLOT DATE = 12/13/2018

DESIGNED - MPG  
DRAWN - MPG  
CHECKED - DAJ  
DATE - 11/28/2018

REVISED -  
REVISED -  
REVISED -  
REVISED -

STATE OF ILLINOIS  
DEPARTMENT OF TRANSPORTATION

US 150 EASTBOUND McCLUGAGE BRIDGE PROJECT  
SUMMARY OF QUANTITIES  
SCALE: NONE SHEET 29 OF 35 SHEETS STA. N/A TO STA. N/A

F.A.P. RTE. 317 SECTION [15B;((102-1),(14HB))BR]BR COUNTY PEO/TAZ TOTAL SHEETS 1361 SHEET NO. 35 CONTRACT NO. 68B46  
ILLINOIS FED. AID PROJECT NHPP-YRP3(905)

SOQ-29

REV. 4/16/19 REV. 1/29/19



MODEL: Default  
 FILE: \\mhc-pc\pub\lvs\2016\hanson\cdm\hanson\Project\CD\Drawings\Sheet\DMCC\EP-68-50030-TYLL.dgn

CODE NO.	ITEM	UNIT	TOTAL QUANTITY	CONSTRUCTION CODE																		
				80% FED / 20% STATE					80% FED / 20% STATE		100% STATE											
				URBAN					NHS BRIDGE PNLTY FUNDS		0031 - LANDSCAPING											
				0003 - RDWY. RECON.	0010	0021 - SAFETY		0010 - BRIDGE REP.		0031 - LANDSCAPING												
PEORIA CO FAP 317/318	TAZEWELL CO FAP 317/673	TAZEWELL CO SN 090-2020	PEORIA CO	TAZEWELL CO	PEORIA CO SN 072-0250	TAZEWELL CO SN 090-0180	PEORIA CO	TAZEWELL CO	PEORIA CO	TAZEWELL CO												
	US 150 IL 29	US 150 IL 116	CULVERT			US 150 OVER IL 29	US 150 OVER IL RIVER	LANDSCAPING & MOWING	LANDSCAPING & MOWING													
X1400268	REMOVAL OF LIGHTING LUMINAIRE, SALVAGE	EACH	10																			
* X1400326	RECTANGULAR RAPID FLASHING BEACON ASSEMBLY (COMPLETE)	EACH	1																			
* X1400339	LUMINAIRE, UNDERPASS, LED, LOW WATTAGE	EACH	4																			
<del>X3510407</del>	<del>AGGREGATE BASE COURSE, TYPE CA-7</del>	<del>TON</del>	<del>404</del>	<del>404</del>																		
X4200406	PORTLAND CEMENT CONCRETE PAVEMENT 6", SPECIAL	SQ YD	701	701																		
X4240430	PORTLAND CEMENT CONCRETE SIDEWALK 5 INCH, SPECIAL	SQ FT	39,440	39,440																		
X4240440	PORTLAND CEMENT CONCRETE SIDEWALK 6 INCH, SPECIAL	SQ FT	10,861	10,861																		
X4400110	TEMPORARY PAVEMENT REMOVAL	SQ YD	3,307	7000	2,607																	
X5010523	REMOVE CONCRETE END SECTION	EACH	1	1																		
X5030250	BRIDGE DECK GROOVING (LONGITUDINAL)	SQ YD	24,588								1,123	23,465										
X5051200	FURNISHING AND ERECTING STRUCTURAL STEEL, SPECIAL	L SUM	1	0.5	0.5																	
X5091730	BRIDGE FENCE RAILING (SPECIAL)	FOOT	4,646.0									4,646.0										
X5210100	HIGH LOAD MULTI-ROTATIONAL BEARINGS, GUIDED EXPANSION, 150K	EACH	14									14										
X5210180	HIGH LOAD MULTI-ROTATIONAL BEARINGS, GUIDED EXPANSION, 550K	EACH	7									7										
X5210190	HIGH LOAD MULTI-ROTATIONAL BEARINGS, GUIDED EXPANSION, 600K	EACH	12									12										

\* - SPECIALTY ITEM

**TYLIN INTERNATIONAL**  
 200 S. WACKER DR.  
 SUITE 1400  
 CHICAGO, IL 60606  
 TEL: 312-777-2900

USER NAME = kpeschel  
 PLOT SCALE = 2.00' / in.  
 PLOT DATE = 12/13/2018

DESIGNED - MPG  
 DRAWN - MPG  
 CHECKED - DAJ  
 DATE - 11/28/2018

REVISED -  
 REVISED -  
 REVISED -  
 REVISED -

STATE OF ILLINOIS  
 DEPARTMENT OF TRANSPORTATION

US 150 EASTBOUND McCLUGAGE BRIDGE PROJECT  
 SUMMARY OF QUANTITIES  
 SCALE: NONE SHEET 30 OF 35 SHEETS STA. N/A TO STA. N/A

F.A.P. RTE. 317 SECTION [15B;((102-1),(14HB))BR]BR COUNTY PEO/TAZ TOTAL SHEETS 1361 SHEET NO. 36 CONTRACT NO. 68B46  
 ILLINOIS FED. AID PROJECT NHPP-YRP3(905)

SOQ-30

CODE NO.	ITEM	UNIT	TOTAL QUANTITY	CONSTRUCTION CODE								
				80% FED / 20% STATE			80% FED / 20% STATE		100% STATE			
				URBAN			NHS BRIDGE PNLTY FUNDS					
				0003 - RDWY. RECON.	0010	0021 - SAFETY	0010 - BRIDGE REP.		0031 - LANDSCAPING			
PEORIA CO FAP 317/318	TAZEWELL CO FAP 317/673	TAZEWELL CO SN 090-2020	PEORIA CO	TAZEWELL CO	PEORIA CO SN 072-0250	TAZEWELL CO SN 090-0180	PEORIA CO	TAZEWELL CO				
	US 150 IL 29	US 150 IL 116	CULVERT		US 150 OVER IL 29	US 150 OVER IL RIVER	LANDSCAPING & MOWING	LANDSCAPING & MOWING				
X5210200	HIGH LOAD MULTI-ROTATIONAL BEARINGS, GUIDED EXPANSION, 650K	EACH	52							52		
X5210210	HIGH LOAD MULTI-ROTATIONAL BEARINGS, GUIDED EXPANSION, 700K	EACH	18							18		
X5210491	HIGH LOAD MULTI-ROTATIONAL BEARINGS, FIXED, 4650K	EACH	2							2		
X5210281	HIGH LOAD MULTI-ROTATIONAL BEARINGS, GUIDED EXPANSION, 4650K	EACH	2							2		
X5509900	ABANDON AND FILL EXISTING STORM SEWER	FOOT	66	66								
58600101	GRANULAR BACKFILL FOR STRUCTURES	CU YD	575						198	377		
<del>X6013600</del>	<del>PIPE UNDERDRAINS 4" (MODIFIED)</del>	<del>FOOT</del>	<del>944</del>	<del>944</del>								
X6020065	INLETS, TYPE G-1, DOUBLE (SPECIAL)	EACH	2	2								
X6020082	INLETS, TYPE G-1	EACH	7	7								
X6020092	MANHOLES, TYPE A, 6'-DIAMETER, WITH TYPE 3 FRAME AND GRATE, TYPE 1 FRAME, CLOSED LID	EACH	1	1								
X6021065	INLETS, TYPE G-1, SPECIAL	EACH	6	6								
X6024503	INLETS TO BE ADJUSTED WITH NEW FRAME AND GRATE (SPECIAL)	EACH	1	1								
X6060505	CONCRETE CURB (SPECIAL)	FOOT	340.0	340.0								
X6061100	CONCRETE MEDIAN, TYPE SB (SPECIAL)	SQ FT	3,931	3,931								
X6062700	CONCRETE GUTTER, TYPE A (SPECIAL)	FOOT	96.0	96.0								

\* - SPECIALTY ITEM

**TYLIN INTERNATIONAL**  
 200 S. WACKER DR.  
 SUITE 1400  
 CHICAGO, IL 60606  
 TEL: 312-777-2900

USER NAME = kpeschel  
 PLOT SCALE = 2.00' / in.  
 PLOT DATE = 12/13/2018

DESIGNED - MPG  
 DRAWN - MPG  
 CHECKED - DAJ  
 DATE - 11/28/2018

REVISED -  
 REVISED -  
 REVISED -  
 REVISED -

STATE OF ILLINOIS  
 DEPARTMENT OF TRANSPORTATION

US 150 EASTBOUND MCCLUGAGE BRIDGE PROJECT  
 SUMMARY OF QUANTITIES  
 SCALE: NONE SHEET 31 OF 35 SHEETS STA. N/A TO STA. N/A

F.A.P. RTE. 317 SECTION [15B;((102-1),(14HB))BR]BR COUNTY PEO/TAZ TOTAL SHEETS 1361 SHEET NO. 37 CONTRACT NO. 68B46  
 ILLINOIS FED. AID PROJECT NHPP-YRP3(905)

50Q-31

FINAL SUBMITTAL

MODEL: Default  
FILE: \\na1c2\proj\us150\2016\hanson\cdm\hanson\Project\Drawings\Sheet\DMCC\EP-68-S0032-TYLD.dgn

CODE NO.	ITEM	UNIT	TOTAL QUANTITY	CONSTRUCTION CODE							
				80% FED / 20% STATE			80% FED / 20% STATE		100% STATE		
				URBAN			NHS BRIDGE PNLTY FUNDS				
				0003 - RDWY. RECON.	0010	0021 - SAFETY	0010 - BRIDGE REP.		0031 - LANDSCAPING		
PEORIA CO FAP 317/318	TAZEWELL CO FAP 317/673	TAZEWELL CO SN 090-2020	PEORIA CO	TAZEWELL CO	PEORIA CO SN 072-0250	TAZEWELL CO SN 090-0180	PEORIA CO	TAZEWELL CO			
	US 150 IL 29	US 150 IL 116	CULVERT			US 150 OVER IL 29	US 150 OVER IL RIVER	LANDSCAPING & MOWING	LANDSCAPING & MOWING		
X6380204	MODULAR GLARE SCREEN SYSTEM (SPECIAL)	FOOT	5,076		5,076						
X6430120	REMOVE IMPACT ATTENUATORS, NO SALVAGE	EACH	1		1						
X6640298	CHAIN LINK FENCE (SPECIAL)	FOOT	224	224							
X6640302	CHAIN LINK FENCE REMOVAL (SPECIAL)	FOOT	153	153							
X6700410	ENGINEER'S FIELD OFFICE, TYPE A (SPECIAL)	CAL MO	51	26	25						
X6700600	ENGINEER'S FIELD LABORATORY (SPECIAL)	CAL MO	51	26	25						
X7010216	TRAFFIC CONTROL AND PROTECTION, (SPECIAL)	L SUM	1	0.5	0.5						
X7030005	TEMPORARY PAVEMENT MARKING REMOVAL	SQ FT	33,433	15,795	17,638						
X7040125	PINNING TEMPORARY CONCRETE BARRIER	EACH	4,932	1,553	3,379						
X7240500	RELOCATE EXISTING SIGNS	EACH	1		1						
* X7830076	GROOVING FOR RECESSED PAVEMENT MARKING 9"	FOOT	2,682		2,682						
* X8110454	CONDUIT ATTACHED TO STRUCTURE, 1" DIA., STAINLESS STEEL	FOOT	160			160					
* X8110551	CONDUIT, FLEXIBLE NON-METALLIC, WEATHERPROOF, 1.0" DIAMETER	FOOT	155				155				
* X8300001	LIGHT POLE, SPECIAL	EACH	26				26				

\* - SPECIALTY ITEM

**TYLIN INTERNATIONAL**  
200 S. WACKER DR.  
SUITE 1400  
CHICAGO, IL 60606  
TEL: 312-777-2900

USER NAME = kpeschel  
PLOT SCALE = 2.00' / in.  
PLOT DATE = 12/13/2018

DESIGNED - MPG  
DRAWN - MPG  
CHECKED - DAJ  
DATE - 11/28/2018

REVISED -  
REVISED -  
REVISED -  
REVISED -

STATE OF ILLINOIS  
DEPARTMENT OF TRANSPORTATION

US 150 EASTBOUND MCCLUGAGE BRIDGE PROJECT  
SUMMARY OF QUANTITIES  
SCALE: NONE SHEET 32 OF 35 SHEETS STA. N/A TO STA. N/A

F.A.P. RTE. 317 SECTION [15B;((102-1),(14HB))BR]BR COUNTY PEO/TAZ TOTAL SHEETS 1361 SHEET NO. 38 CONTRACT NO. 68B46 ILLINOIS FED. AID PROJECT NHPP-VRP3(905)

SOQ-32

REV. 4/16/19 REV. 1/29/19





REMOVAL SCHEDULE - TAZEWELL CO.

LOCATION						TREE REMOVAL, ACRES	HOT-MIX ASPHALT SURFACE REMOVAL BUTT JOINT SQ YD	PAVEMENT REMOVAL SQ YD	HOT-MIX ASPHALT SURFACE REMOVAL, 2 SQ YD	HOT-MIX ASPHALT SURFACE REMOVAL, 2 1/2" SQ YD	COMBINATION CURB AND GUTTER REMOVAL FOOT	SIDEWALK REMOVAL SQ FT	MEDIAN REMOVAL SQ FT	PAVED SHOULDER REMOVAL SQ YD	GUARDRAIL REMOVAL FOOT	REMOVE IMPACT ATTENUATORS, NO SALVAGE EACH	TEMPORARY RAMP SQ YD
FROM		TO				ACRES	SQ YD	SQ YD	SQ YD	SQ YD	FOOT	SQ FT	SQ FT	SQ YD	FOOT	EACH	SQ YD
STATION	OFFSET	LT/RT	STATION	OFFSET	LT/RT												
PR US 150																	
2157+05.85	12.83'	LT	2167+85.08	82.22'	RT	2.00											
2163+35.00	42'	RT													1		
2179+23.36			2179+38.36				39										22
2173+45.85			2179+38.36						1,652								
EX US 150																	
1106+49.30		RT	1119+43.96		RT								1,164				
1106+63.53	16.04'	RT	1109+94.43	22.34'	RT									331			
1106+68.27			1112+43.96					1,740									
1109+26.53		LT	1114+64.61		LT			1,458									
1112+43.96			1122+89.81					3,154									
1114+64.61		LT	1119+43.96		LT								153				
1119+05.00	27.13'	LT	1121+07.80	36.04'	LT									203			
1119+05.87	19.09'	RT	1121+07.47	18.66'	RT									202			
1119+43.96		LT	2179+38.36		LT								327				
1120+90.13	44.86'	LT	1123+36.74	41.85'	LT									274			
1122+80.26		RT	2179+38.36		RT								608				
RAMP SW																	
3+16.96			9+00.00					744									
3+16.96		RT	15+34.66		RT								1,064				
6+52.75		LT	15+35.97		LT								433				
9+00.00			15+34.83					984									
15+34.66		RT	20+83.02		RT								507				
15+34.83			20+19.53					779									
15+35.97		LT	20+56.44		LT								264				
20+19.53			20+61.89					105									
IL 116																	
186+03.96		LT	196+00.00		LT								935				
186+03.96			185+88.96				66										29
186+03.96			198+02.00						5,447								
191+18.09	54.8'	LT	192+81.98	59.4'	LT									164			
196+00.00		LT	197+85.21		LT								186				
197+85.21	44.5'	LT	198+42.25	106.1'	LT			51									
198+02.00		LT	209+00.00		LT				2,645								
198+51.70	52.0'	LT	198+76.22	84.6'	LT			16				332					
198+76.93	56.6'	LT	198+52.69	54.1'	LT					80							
199+72.51	136.0'	LT	200+59.94	142.0'	LT					113							
199+83.82		LT	208+07.32		LT								550				
200+09.02	45.5'	LT	204+16.26	44.5'	LT			411									
209+00.00		LT	213+40.00		LT				5,096								
213+39.73			213+54.73				48										21
208+07.32		LT	213+39.73		LT								515				
MARINA LANE INTERSECTION																	
198+05.68	195.74'	LT	198+20.68	198.56'	LT		54										25
200+53.63	174.76'	LT	200+68.63	170.00'	LT		46										21
EAST PARK																	
FAIR LANE DR										54	187						
TOTAL						2.00	253	9,442	13,188	1,652	247	187	332	6,707	1,174	1	119

2

FINAL SUBMITTAL

MODEL: Default  
FILE: Model - Plot.dwg  
PROJECT: I:\Projects\Documents\13\0013\130106\Phase-III\Road\Sheet\Drawings\Quantity\Removals\Removals.dwg

**TYLIN INTERNATIONAL**  
200 S. WACKER DR.  
SUITE 1400  
CHICAGO, IL 60606  
TEL: 312-777-2900

USER NAME = mgormely  
PLOT SCALE = 2.00' / in.  
PLOT DATE = 4/5/2019

DESIGNED - MPG  
DRAWN - KRP  
CHECKED - JDS  
DATE - 11/28/2018

REVISED - 4/16/2019  
REVISED -  
REVISED -  
REVISED -

STATE OF ILLINOIS  
DEPARTMENT OF TRANSPORTATION

US 150 EASTBOUND McCLUGAGE BRIDGE PROJECT  
SCHEDULE OF QUANTITIES - REMOVALS (TAZEWELL CO.)

SCALE: NONE SHEET 2 OF 8 SHEETS STA. N/A TO STA. N/A

F.A.P. RTE. SECTION COUNTY TOTAL SHEETS SHEET NO.  
317 [15B:((102-1),(14HB))]BRJBR TAZEWELL 1361 43  
CONTRACT NO. 68B46  
ILLINOIS FED. AID PROJECT NHPP-YRP3(905)

SCHED-02

PAVEMENT SCHEDULE - PEORIA CO.

LOCATION						SUBBASE GRANULAR MATERIAL, TYPE A	PORTLAND CEMENT CONCRETE BASE COURSE 8 1/2" SQ YD	PORTLAND CEMENT CONCRETE BASE COURSE WIDENING 9" SQ YD	POLYMERIZED BITUMINOUS MATERIALS (TACK COAT) POUND	POLYMERIZED LEVELING BINDER (MACHINE METHOD), N50 TON	HOT-MIX ASPHALT BINDER COURSE IL-19.0, N70 TON	POLYMERIZED HOT-MIX ASPHALT SURFACE COURSE MIX "E", N70 TON	WELDED WIRE REINFORCEMENT SQ YD	PAVEMENT CONNECTOR (PCC) FOR BRIDGE APPROACH SLAB SQ YD	PORTLAND CEMENT CONCRETE PAVEMENT 9 1/2" (JOINTED) SQ YD	PROTECTIVE COAT SQ YD	STRIP REFLECTIVE CRACK CONTROL TREATMENT FOOT	AGGREGATE SHOULDERS, TYPE B 6" SQ YD	HOT-MIX ASPHALT SHOULDERS, 8" SQ YD	PORTLAND CEMENT CONCRETE SHOULDERS 9 1/2" SQ YD	GUARDRAIL AGGREGATE EROSION CONTROL SQ YD	MATERIAL TRANSFER DEVICE TON	PORTLAND CEMENT CONCRETE PAVEMENT 6" SQ YD	PORTLAND CEMENT CONCRETE PAVEMENT 6" SPECIAL SQ YD
STATION	FROM OFFSET	LT/RT	STATION	TO OFFSET	LT/RT																			
US 150																								
2097+57.68			2098+30.00						314															
2097+57.68	12.00	RT	2098+30.00	12.00	LT												95							
2097+57.68			2106+60.48							159	159											318		
2098+30.00			2098+33.00								6											6		
2098+30.00			2106+60.48						1,814													62		
2098+30.00	12.00	LT	2106+60.48	12.00	LT				388	31	31													
2098+30.00			2106+75.48						1,683															
2098+33.00			2106+60.48																					
2098+60.00	21.50	LT	2102+24.06	21.50	LT																			
2102+24.06	21.50	LT	2102+80.93	21.50	LT																			
2102+80.65	29.52	LT	2106+75.48	20.00	LT				456															
2102+80.68	29.50	LT	2106+55.89	60.00	LT																			
2103+15.77	20.00	RT	2104+57.91	20.00	RT				27															
2105+40.62	78.41	LT	2105+60.38	80.36	LT																			
2106+59.54			2106+75.25																					
2108+80.93	21.50	LT	2106+77.52	23.50	LT							76	114			114								
RAMP A																								
1100+00.00			1106+96.01						647															
1100+00.00			1107+75.25																				154	
1100+13.75			1100+72.32																					
1100+82.50			1107+72.25																					
1106+96.01			1107+75.25						210															
1107+72.25			1107+75.25									4											4	
RAMP B																								
1206+12.98	16.00	RT	1206+15.98	16.00	RT																		3	
1206+12.98			1210+76.64																					
1206+12.98			1210+77.46						612	48	48													
1206+12.98	22.00	RT	1211+06.69	29.50	RT																			
1206+15.98			1210+77.46																					
1206+91.93			1210+92.33						548															
1209+47.25	26.00	RT	1211+06.65	26.92	RT																			
RAMP E																								
1500+00.00			1505+41.12																					
1502+62.98	16.00	LT	1505+41.13	16.00	LT																			
1503+05.62	20.00	LT	1505+63.27	25.60	LT																			
1504+11.65	20.00	LT	1505+63.27	23.40	LT																			
1505+41.12			1505+60.90																					
IL 29 / RAMP E																								
605+42.68	27.80	RT	1505+44.38	0.00	RT				8															
605+50.00	27.97	RT	607+45.27	31.69	RT																			
605+50.93	27.97	RT	605+90.93	28.73	RT																			
605+90.93	28.73	RT	607+45.27	31.69	RT																			
IL 29																								
603+42.14	23.40	RT	605+42.68	27.80	RT				377															
603+42.15	31.00	LT	603+86.02	66.80	LT				9															
603+42.15			608+92.53																					
604+00.00	38.70	LT																						
604+14.02	66.70	LT	604+33.17	23.60	LT				37															
606+20.49	41.63	RT	607+39.94	49.01	RT																			
608+17.20	33.00	RT	615+74.25	28.60	RT				1,089															
608+17.32	33.00	RT	615+07.66	28.00	RT																			
615+03.48	51.30	LT	615+46.88	50.00	LT																			
615+04.99	6.00	LT	616+16.10	6.00	LT				97															
615+34.06	5.50	LT	615+44.07	5.50	LT				644															
WEST PARK / PARKING LOT									909															
TOTAL						6,741	5,270	174	8,134	550	13	529	114	229	1,532	4,208	290	172	1,341	689	41	1,052	1,057	701

AGG. FOR TEMP. ACCESS SCHEDULE - PEORIA CO.

LOCATION						AGGREGATE FOR TEMPORARY ACCESS TON
FROM STATION	FROM OFFSET	LT/RT	TO STATION	TO OFFSET	LT/RT	
US 150						
2114+56.28	848.30	LT	2118+28.57	173.50	LT	852
TOTAL						852

PAVEMENT PATCH SCHEDULE - PEORIA CO.

LOCATION						CLASS B PATCHES, TYPE III, 10 INCH SQ YD	SAW CUTS FOOT
FROM STATION	FROM OFFSET	LT/RT	TO STATION	TO OFFSET	LT/RT		
IL 29							
615+06.98	15.60	RT	615+12.98	15.60	RT	17	50
615+06.99	33.00	LT	615+12.99	33.00	LT	25	73
615+36.11	15.70	RT	615+42.11	15.70	RT	17	50
615+36.84	32.50	LT	615+42.83	32.30	LT	24	72
TOTAL						83	245

FINAL SUBMITTAL

<b>TYLIN INTERNATIONAL</b> 200 S. WACKER DR. SUITE 1400 CHICAGO, IL 60606 TEL: 312-777-2900	USER NAME = mgormely	DESIGNED - MPG	REVISED - 4/16/2019	STATE OF ILLINOIS DEPARTMENT OF TRANSPORTATION	US 150 EASTBOUND McCLUGAGE BRIDGE PROJECT			F.A.P. RTE. 317	SECTION [15B;[(102-1),(14HB)]BR]BR	COUNTY TAZEWELL	TOTAL SHEETS 1361	SHEET NO. 44
	PLOT SCALE = 2.00' / in.	CHECKED - DAJ	REVISED -		SCALE: NONE	SHEET 3	OF 8	SHEETS	STA. N/A	TO STA. N/A	CONTRACT NO. 68B46	
PLOT DATE = 4/5/2019	DATE - 11/28/2018	REVISED -							ILLINOIS FED. AID PROJECT NHPY-RP3(905)			







ROADWAY						MULCH METHOD 2 (ACRE)	HD EROS CONTROL BLANKET (SQ YD)	TEMP HD EROS CONTR BL (SQ YD)	TEMP EROS CONTR SEED (POUND)	TEMPORARY DITCH CHECKS (FOOT)	PERIMETER EROSION BARRIER (FOOT)	INLET & PIPE PROTECTION (EACH)	INLET FILTERS (EACH)	STONE DUMP RIP CL A3 (SQ YD)
ROADWAY	STAGE	STATION	OFFSET	STATION	OFFSET									
US 150/ RAMP A	1&2	2097+57.68	18' RT	1107+75.25	25' RT	0.25		25		726		2		
RAMP B / US 150	1&2	1206+12.98	34' RT	2106+89.94	48' RT	0.51		51						
US 150	1&2	2106+70.00	100' RT	2107+31.85	45' RT		358	716	22	756				
IL 29	1&2	613+12.12	79' LT	615+21.69	61' LT	0.14			14					
IL 29	1&2	613+16.62	36' RT	615+24.65	41' RT	0.12			12					
US 150	1&2	2108+48.67	43' RT	2109+02.00	100' RT		118	235	7					
US 150	1&2	2109+02.00	94' RT	2109+45.47	39' RT	0.14			14					
US 150	1&2	2109+35.00	87' RT	2110+14.21	37' RT		196	392	12					
IL 29	1&2	613+17.47	39' RT	615+93.61	20.4' RT					443				
IL 29	1&2	615+13.46	66' LT	616+23.27	63' LT					118				
US 150	1&2	2090+00		2101+00								2		
US 150	1&2	2101+00		2115+00							1	17		
IL 29	1&2	603+00		614+01							2	9		
RAMP A	1&2	1109+33.6		1110+10.3					70					
US 150 (SEE NOTE 2)	1&2	2115+84.7		2118+63.9						1877				
IL 29	3	609+96.98	61' LT	610+21.10	71' LT	0.01			1					
IL 29	3	611+11.21	74' LT	611+36.32	67' LT	0.01			1					
IL 29	3	603+42.15	25' RT	606+82.12	157' RT	0.20			20					
IL 29	3	604+23.41	36' RT	605+38.95	76' RT	0.38			38					
IL 29 / RAMP E	3	605+38.80	30' RT	1504+54.70	18' RT	0.96			96					
IL 29 / RAMP E	3	606+82.26	162' RT	1505+11.83	32' RT	1.52			152					
IL 29	3	610+69.42	45' RT	612+17.21	56' RT	0.15			15					
IL 29	3	612+42.37	60' RT	613+67.86	84' RT	0.13			13					
IL 29	3	614+57.73	34' RT	615+24.70	43' RT	0.04			4					
IL 29	3	612+17.40	39' RT	614+65.00	41' RT		881	1762	54					
RAMP E	3	1505+11.83	32' RT	1506+35.91	31' RT		150	300	9					
RAMP E	3	1505+76.50	23' LT	1506+94.86	23' LT		415	830	25					
IL 29 / RAMP E	3	603+14.37	34' RT	1507+43.93	29' LT					1,291				
IL 29 / RAMP E	3	616+40.05	46' RT	1507+43.93	29' LT					469				
IL 29	3	609+92.25	58' LT	610+24.12	75' LT					44				
IL 29	3	611+10.23	76' LT	611+41.33	62' LT					38				
IL 29	3	604+24.73	36' RT	605+37.99	75' RT					191				
IL 29	3	604+29.16	38' RT	605+38.02	70' RT					180				
US 150	3	2101+00		2115+00								3		
IL 29	3	603+00		616+18.7								27		
RAMP E	3	1505+38.40	52.3' RT	1505+38.40	62.3' RT									5
IL 29	3	605+60.45	170' RT	605+60.45	180' RT									5
US 150	4	2105+37.58	82' LT	2105+62.37	117' LT	0.06			6	120				
US 150	4	2090+00		2101+00									2	
US 150	4	2101+00		2115+00									7	
TOTALS						4.6	2118	4235	591	154	4376	8	69	10

NOTE: THREE APPLICATIONS FOR TEMP EROS CONTROL SEEDING AND MULCH METHOD 2 AND TWO APPLICATIONS FOR TEMP HD EROS CONTROL BLANKET

NOTE 2: SEE SHEET 111 "RESTRICTED CONSTRUCTION AREAS - PEORIA CO." FOR LOCATION



4376  
6253



FINAL SUBMITTAL

MODEL: Default  
FILE: h:\m\c\2016\hanson\dom\hanson\Projects\13\06\Phase-III\CD\Road\Sheet\DMCC\EROS-Schedule01-ERF.dgn

**EFK Moen, LLC**  
Civil Engineering Design

USER NAME = MSjllers	DESIGNED - MYS	REVISED - 4/16/2019
PLOT SCALE = 2.00' / in.	DRAWN - MYS	REVISED -
PLOT DATE = 12/10/2018	CHECKED - SSB	REVISED -
	DATE - 11/28/2018	REVISED -



STATE OF ILLINOIS  
DEPARTMENT OF TRANSPORTATION

US 150 EASTBOUND McCLUGAGE BRIDGE PROJECT  
EROSION CONTROL - SCHEDULE OF QUANTITIES

SCALE: NONE SHEET 1 OF 2 SHEETS STA. N/A TO STA. N/A

F.A.P. RTE.	SECTION	COUNTY	TOTAL SHEETS	SHEET NO.
317	[15B;{(102-1),(14HB)}BR]BR	PEORIA	1361	51
CONTRACT NO. 68B46				
ILLINOIS FED. AID PROJECT NHPP-YRP3(905)				







MODEL: D:\default  
 FILE NAME: p:\us15e\svr2016\hanson\dom\hanson\_projects\Documents\13jobs\1340106Phase-III\CAD\Road\Street\DMCEEP-Sub-Drain-Schedule04.tbl.gmn



USER NAME = rwatson	DESIGNED - MJR	REVISED - 04/16/2019
DRAWN - RAW	CHECKED - RDC	REVISED -
PLOT SCALE = 2.00' / in.	DATE - 11/28/2018	REVISED -
PLOT DATE = 4/3/2019		

STATE OF ILLINOIS  
 DEPARTMENT OF TRANSPORTATION

US 150 EASTBOUND McCLUGAGE BRIDGE PROJECT  
 DRAINAGE - SCHEDULE OF QUANTITIES

SCALE: NONE SHEET 4 OF 6 SHEETS STA. N/A TO STA. N/A

F.A.P. RTE.	SECTION	COUNTY	TOTAL SHEETS	SHEET NO.
317	[15B;((102-1),(14HB))BR]BR	TAZEWELL	1361	57
CONTRACT NO. 68B46			ILLINOIS FED. AID PROJECT NHPP-YRP3(905)	

DRAINSCH-04

DRAINAGE REMOVAL SCHEDULE - TAZEWELL COUNTY												
STATION	OFFSET	LT/RT	STATION	OFFSET	LT/RT	PAVED DITCH REMOVAL	CONCRETE HEADWALL REMOVAL	PIPE CULVERT REMOVAL	REMOVING CATCH BASINS	PROPOSED STORM SEWER CONNECTION TO EXISTING STORM SEWER	PROPOSED STORM SEWER CONNECTION TO EXISTING MANHOLE	REMOVE EXISTING FLARED END SECTION
						FOOT	EACH	FOOT	EACH	EACH	EACH	EACH
US 150												
2160+22.28	58.0	LT										1
2160+22.28	58.0	LT	2160+74.38	55.1	LT			52				
2160+74.38	55.1	LT							1			
2160+74.38	55.1	LT	2163+68.17	38.6	LT			296				
2163+66.52	41.0	LT								1		
2163+68.17	38.6	LT							1			
2163+68.17	38.6	LT	2164+30.77	38.8	LT			63				
2164+30.77	38.8	LT										1
2176+75.38	30.1	LT	2179+38.36	31.0	LT	262						
RAMPS SW												
14+33.37	26.1	RT										1
14+33.37	26.1	RT	14+78.46	61.0	RT			57				
14+78.46	61.0	RT									1	
17+13.98	45.8	LT					1					
17+13.98	45.8	LT	17+12.12	9.7	RT			56				
17+12.12	9.7	RT					1					
IL ROUTE 116												
196+54.50	71.4	RT									1	
196+54.98	4.9	LT										
TOTAL						262	2	524	2	1	2	3

2

LANDSCAPE SCHEDULE - PEORIA

BEGIN STATION	END STATION		T-GINKGO BILOBA 2	S-RHUS AROMA GRO 18	MULCH	TEMPORARY FENCE	TOPSOIL FURNISH AND PLACE, 4"	SEEDING, CLASS 2A	SEEDING, CLASS 3	SEEDING, CLASS 5B	NITROGEN FERTILIZER NUTRIENT	PHOSPHORUS FERTILIZER NUTRIENT	POTASSIUM FERTILIZER NUTRIENT	INTERSEEDING, CLASS 5C	MULCH, METHOD 2
			EACH	EACH	SQ YD	FOOT	SQ YD	ACRE	ACRE	ACRE	POUND	POUND	POUND	ACRE	ACRE
US ROUTE 150															
2108+39.9	2118+24.8	LT/RT					8255								
2108+39.9	2110+15.7	LT							0.21		19	19	19		0.21
2108+55.0	2110+18.3	RT							0.07		6	6	6		0.07
2111+15.2	2111+48.4	LT							0.04		4	4	4		0.04
2111+49.1	2114+99.9	LT							0.64		58	58	58		0.64
2114+99.9	2118+63.9	LT								0.74	67	67	67		0.74
2115+97.1	2118+24.8	RT				1042									
RAMP A															
1100+00.0	1107+75.2	LT/RT					387								
1100+00.0	1107+75.2	RT						0.08			7	7	7		0.08
RAMP B															
1206+13.6	1211+52.0	LT/RT					1694								
1206+13.6	1210+16.6	RT						0.15			14	14	14		0.15
1210+16.6	1211+52.0	RT							0.20		18	18	18		0.20
IL RT 29															
603+50.1	615+23.5	LT/RT					<del>6050-5918</del>								
603+50.1	612+79.7	RT						0.38			34	34	34		0.38
604+23.9	605+56.8	RT						0.13			11	11	11		0.13
605+38.8	611+95.9	RT						0.34			31	31	31		0.34
606+08.0	606+82.1	RT		60	135						3	3	3		0.03
606+14.5		RT	1												
606+35.5		RT	1												
606+56.5		RT	1												
606+77.5		RT	4												
606+97.1	611+01.8	RT									28	28	28	0.31	0.31
613+12.0	615+23.5	LT						0.06			5	5	5		0.06
RAMP E															
1503+24.1	1515+43.7	LT/RT					<del>6100-7227</del>								
1503+24.1	1506+75.7	LT						0.19			17	17	17		0.19
1504+89.1	1506+75.5	LT									26	26	26	0.29	0.29
1505+61.8	1506+73.8	RT							0.05		5	5	5		0.05
1505+61.8	1507+55.4	LT							0.09		8	8	8		0.09
1506+28.9	1507+17.5	LT						0.13			12	12	12		0.13
1508+16.7	1508+57.8	RT							0.03	<del>0.27</del>	3	<del>24</del>	3	<del>24</del>	0.03
1508+72.2	1512+24.5	RT							0.29		26	26	26		0.29
1512+24.5	1515+43.7	RT								0.19	17	17	17		0.19
TOTAL			7	60	135	1042	<del>23482</del> 22486	1.50	<del>1.75</del> 2.00	1.00	419	<del>439</del>	419	<del>439</del>	0.75

2

2

FINAL SUBMITTAL

MODEL: Default  
FILE NAME: p:\projects\2016\hanson\dom\hanson\Projects\Documents\13\jobs\13\H0106PhaseII\CAD\Road\Street\DMCC\EP-st-l-landscaping\05-Schedule1-HLL.dgn



USER NAME = rwatson	DESIGNED -	REVISED - 04/16/2019
PLOT SCALE = 2.00' / in.	DRAWN -	REVISED -
PLOT DATE = 4/3/2019	CHECKED -	REVISED -
	DATE -	REVISED -

STATE OF ILLINOIS  
DEPARTMENT OF TRANSPORTATION

US 150 EASTBOUND McCLUGAGE BRIDGE PROJECT  
LANDSCAPE SCHEDULE

SCALE: N/A SHEET 1 OF 2 SHEETS STA. TO STA.

F.A.P RTE.	SECTION	COUNTY	TOTAL SHEETS	SHEET NO.
317	[15B:((102-1),(14HB))BR]BR	PEORIA	1361	60
CONTRACT NO. 68B46			ILLINOIS FED. AID PROJECT NHPP-YRP3(905)	

LSCSCH-01

FINAL SUBMITTAL

MODEL: D:\m\h\p\2016\hanson.dgn  
 FILE: I:\M\2016\hanson.dgn  
 PROJECT: I:\M\2016\hanson.dgn  
 SHEET: I:\M\2016\hanson.dgn

STAGING SCHEDULE - PAVEMENT MARKING										
LOCATION	BEGIN STATION	END STATION	SHORT TERM PAVT MKING	SHORT TRM PAVT MK REM	PAVT MARK TAPE T4 L&S	PAVT MARK TAPE T4 4	PAVT MARK TAPE T4 6	PAVT MARK TAPE T4 12	PAVT MARK TAPE T4 24	TEMP PAVT MKING REMOV
STAGE 1A										
US 150 (PEO)	2098+30.00	2109+56.00	LT							376
US 150 (PEO)	2098+30.00	2109+56.00	LT							94
US 150 (PEO)	2100+64.00	2103+05.80	RT							81
US 150 (PEO)	2100+64.00	2102+84.70	RT							74
US 150 (PEO)	2103+41.10		RT					38		75
US 150 (PEO)	2103+93.30	2109+57.50	LT							188
US 150 (TAZ)	2156+57.00	2175+00.00	LT							615
US 150 (TAZ)	2156+57.00	2171+11.00	RT							485
US 150 (TAZ)	2156+57.00	2175+00.00	RT							154
US 150 (TAZ)	2171+11.00	2172+65.40	RT							13
US 150 (TAZ)	2172+65.40	2175+00.00	RT							78
RAMP A (PEO)	1103+56.00				36					36
RAMP A (PEO)	1105+93.50	1112+42.00	LT							432
RAMP A (PEO)	1106+69.50	1109+53.30	RT							95
RAMP B (PEO)	1204+04.00	1208+30.70	LT							431
IL RTE 29 (PEO)	610+67.80	616+47.70	LT							583
IL RTE 29 (PEO)	611+77.00	616+32.80	RT							456
IL RTE 29 (PEO)	614+09.80	619+05.50	LT							496
RAMP SW (TAZ)	12+97.80	15+65.00	LT							268
RAMP SW (TAZ)	14+52.00	15+65.00	LT							114
STAGE 1B										
US 150 (PEO)	2088+00.00	2091+61.80	RT							362
US 150 (PEO)	2091+61.80	2092+13.40	RT							13
US 150 (PEO)	2091+61.80	2092+02.30	RT							42
US 150 (PEO)	2094+19.50	2102+40.50	LT							822
US 150 (PEO)	2094+46.30	2095+49.00	LT							205
US 150 (PEO)	2095+49.00	2107+45.00	LT							1196
US 150 (PEO)	2095+77.60	2105+48.00	LT							971
US 150 (PEO)	2102+40.50	2102+83.10	LT							11
US 150 (PEO)	2102+83.10	2106+82.80	LT							400
US 150 (PEO)	2106+82.80	2110+61.90	LT							95
RAMP A (PEO)	1104+82.60	1108+67.80	RT							387
RAMP A (PEO)	1105+24.10	1107+12.50	LT							189
RAMP B (PEO)	1201+01.20	1206+75.80	RT							1149
RAMP B (PEO)	1206+75.80	1211+14.70	LT							441
RAMP B (PEO)	1206+13.00	1211+63.00	LT							552
STAGE 1C										
US 150 (PEO)	2088+07.00	2093+47.40	RT							541
US 150 (PEO)	2092+43.80	2093+47.40	RT							103.60
US 150 (PEO)	2094+45.20	2106+96.30	LT							1252
US 150 (PEO)	2094+45.00	2098+29.60	RT							385
US 150 (PEO)	2098+29.60	2100+58.40	RT							57
US 150 (PEO)	2100+58.40	2106+96.30	LT							639
US 150 (PEO)	2106+96.30	2108+92.30	LT							51
RAMP A (PEO)	1100+71.90	1107+75.30	RT							704
RAMP A (PEO)	1105+05.30	1107+07.60	RT							202
RAMP A (PEO)	1107+07.60	1112+96.30	LT							1177
RAMP B (PEO)	1205+65.10	1206+79.90	RT							230
RAMP B (PEO)	1206+13.20	1211+17.00	LT							506
RAMP B (PEO)	1206+79.90	1211+15.60	LT							438
STAGE 2										
US 150 (PEO)	2097+57.00	2102+77.00	RT							130
US 150 (PEO)	2098+30.10	2108+92.30	LT							266
US 150 (PEO)	2098+30.10	2108+32.40	LT							1003
US 150 (PEO)	2102+77.70	2103+65.80	RT							88
US 150 (PEO)	2103+65.80	2104+27.60	RT							15
US 150 (PEO)	2104+27.60	2108+34.70	LT							408
US 150 (TAZ)	2165+57.20	2171+00.50	RT							545
US 150 (TAZ)	2165+57.20	2175+00.00	RT							236
US 150 (TAZ)	2165+57.20	2175+00.00	LT							944
US 150 (TAZ)	2171+00.50	2172+65.40	RT							41
US 150 (TAZ)	2172+65.40	2175+00.00	RT							59
RAMP A (PEO)	1105+20.00	1107+15.80	LT							196
RAMP A (PEO)	1107+15.80	1111+31.60	RT							832
RAMP B (PEO)	1206+13.00	1206+70.20	RT							115
RAMP B (PEO)	1206+70.20	1208+10.00	LT							150
RAMP B (PEO)	1206+70.20	1208+54.80	LT							190
RAMP SW (TAZ)	12+86.30	26+45.30	LT							1359
RAMP SW (TAZ)	14+51.60	26+40.70	LT							1189

STAGING SCHEDULE - PAVEMENT MARKING (CONTINUED)										
LOCATION	BEGIN STATION	END STATION	SHORT TERM PAVT MKING	SHORT TRM PAVT MK REM	PAVT MARK TAPE T4 L&S	PAVT MARK TAPE T4 4	PAVT MARK TAPE T4 6	PAVT MARK TAPE T4 12	PAVT MARK TAPE T4 24	TEMP PAVT MKING REMOV
STAGE 3										
US 150 (PEO)	2097+57.70	2099+77.70	RT							55
US 150 (PEO)	2097+57.70	2102+70.40	LT							128
US 150 (PEO)	2097+57.70	2112+33.90	LT							1477
US 150 (PEO)	2099+77.70	2108+93.20	LT							917
US 150 (PEO)	2106+90.50	2113+68.50	LT							679
US 150 (PEO)	2108+92.00	2112+34.60	LT							86
US 150 (TAZ)	2156+57.20	2181+64.60	LT							2509
US 150 (TAZ)	2156+57.20	2166+51.20	RT							997
US 150 (TAZ)	2156+57.20	2169+27.00	RT							1272
US 150 (TAZ)	2166+51.20	2181+64.60	RT							378
US 150 (TAZ)	2169+27.00	2171+00.00	RT							43
US 150 (TAZ)	2171+00.00	2181+64.60	RT							1065
IL RTE 29 (PEO)	601+00.00	616+41.70	RT							1542
IL RTE 29 (PEO)	603+41.00	609+08.00		851	284					
IL RTE 29 (PEO)	604+33.10	610+56.10	LT							1246
IL RTE 29 (PEO)	604+33.10	609+53.50	LT							130
IL RTE 29 (PEO)	604+33.10	607+05.10	RT							68
IL RTE 29 (PEO)	607+05.10	610+55.70	RT							350.60
IL RTE 29 (PEO)	607+34.70	610+35.60	RT					73		
IL RTE 29 (PEO)	610+56.90		RT							26
IL RTE 29 (PEO)	611+43.60		LT							14
IL RTE 29 (PEO)	611+43.80	615+03.60	LT							360
IL RTE 29 (PEO)	611+43.80	615+03.60	LT							360
IL RTE 29 (PEO)	611+64.20	615+44.60	LT					73		
IL RTE 116 (TAZ)	180+02.00	189+53.70	LT							238
IL RTE 116 (TAZ)	185+54.00	198+02.80	LT							1249
IL RTE 116 (TAZ)	186+04.00	197+83.80	LT							295
IL RTE 116 (TAZ)	186+05.00	213+40.00		2462	821					
IL RTE 116 (TAZ)	189+53.70	192+58.60	LT							305
IL RTE 116 (TAZ)	192+58.60	196+51.10	LT							98
IL RTE 116 (TAZ)	196+51.10	198+68.10	LT							218
IL RTE 116 (TAZ)	196+56.00	215+57.10	LT							1901
IL RTE 116 (TAZ)	199+99.60	215+57.50	LT							389
IL RTE 116 (TAZ)	200+18.00	215+57.90	LT							1540
RAMP A (PEO)	1102+66.00	1106+96.00	LT							430
RAMP A (PEO)	1106+95.90	1113+36.00	LT							1280
RAMP A (PEO)	1113+20.00							42		
RAMP A (PEO)	1113+34.50		RT							26
RAMP A (PEO)	1113+35.90		RT							348
RAMP A (PEO)	1113+36.00		RT							14
RAMP B (PEO)	1200+42.27		RT							120
RAMP B (PEO)	1200+50.50		RT							18
RAMP B (PEO)	1208+62.70	1211+08.40	LT							250
RAMP B (PEO)	1208+62.70	1210+74.20	LT							215
RAMP SW (TAZ)	11+16.10	24+06.10	LT							1290
RAMP SW (TAZ)	12+93.30	24+51.70	LT							1159
STAGE 4A										
US 150 (PEO)	2095+48.00	2110+05.50	RT							364
US 150 (PEO)	2095+48.00	2110+05.50	RT							1457
US 150 (PEO)	2095+48.00	2102+54.20	RT							706
US 150 (PEO)	2095+62.00	2108+04.40	LT							1244
US 150 (PEO)	2097+57.00	2106+75.00		1469	490					
US 150 (PEO)	2098+39.80	2101+38.40	LT							299



LANDSCAPE SCHEDULE - TAZEWell												
BEGIN STATION	END STATION		TOPSOIL FURNISH AND PLACE, 4" SQ YD	SEEDING, CLASS 2A ACRE	SEEDING, CLASS 3 ACRE	SEEDING, CLASS 5B ACRE	NITROGEN FERTILIZER NUTRIENT POUND	PHOSPHORUS FERTILIZER NUTRIENT POUND	POTASSIUM FERTILIZER NUTRIENT POUND	INTERSEEDING, CLASS 5C ACRE	MULCH, METHOD 2 ACRE	GUARDRAIL AGGREGATE EROSION CONTROL TON
US ROUTE 150												
2156+60.7	2179+38.4	LT/RT	13362									
<del>2156+60.7</del>	<del>2157+50.0</del>	<del>LT</del>			0.14		12	12	12		0.14	
2157+50.0	2161+11.1	LT		0.43			39	39	39		0.43	
2156+72.1	2160+99.9	RT			0.20		18	18	18		0.20	
<del>2156+72.1</del>	<del>2170+00.0</del>	<del>RT</del>		0.81			73	73	73		0.81	
2156+88.0	2166+70.9	RT				0.70	63	63	63		0.70	
2164+16.7	2179+38.5	LT		0.40			36	36	36		0.40	
2175+70.6	2179+38.4	RT		0.08			8	8	8		0.08	
Ramp SW												
11+93.7	30+89.1	LT/RT	19104									
11+93.7	25+39.3	RT		0.82			74	74	74		0.82	
15+49.1	16+10.0	LT										20
16+10.0	31+50.7	LT		0.84			75	75	75		0.84	
24+81.7	26+67.5	RT		0.28			25	25	25		0.28	
25+97.3	26+24.9	RT		0.02			2	2	2		0.02	
26+24.9	26+63.3	RT				0.02	2	2	2		0.02	
26+67.5	37+00.0	RT		0.95			86	86	86		0.95	
<del>27+06.2</del>	<del>30+89.1</del>	<del>RT LT</del>					91	91	91	1.01	1.01	
IL ROUTE 116												
186+04.1	208+06.5	LT/RT	7951									
186+04.1	198+05.0	LT		0.75			68	68	68		0.75	
193+55.6	196+68.7	LT		0.05			5	5	5		0.05	
193+55.0	196+68.7	RT		0.05			5	5	5		0.05	
199+41.7	208+06.5	LT		0.79			71	71	71		0.79	
TOTAL			40418	6.50	0.50	0.75	752	752	752	1.25	8.50	20

2

FINAL SUBMITTAL

MODEL: D:\default  
FILE: I:\AME: jax\user\svr2016.hanson.d\mshanson\_projects\Documents\13\jobs\13\H0106Phase-III\CAD\Road\Street\DMHCEEP-shc-landscaping\05-Schedule2-1111.dgn



USER NAME = rwatson	DESIGNED -	REVISED - 04/16/2019
	DRAWN -	REVISED -
PLOT SCALE = 2.00' / in.	CHECKED - 04/16/2019	REVISED -
PLOT DATE = 4/3/2019	DATE -	REVISED -

STATE OF ILLINOIS  
DEPARTMENT OF TRANSPORTATION

US 150 EASTBOUND McCLUGAGE BRIDGE PROJECT  
LANDSCAPE SCHEDULE

SCALE: N/A SHEET 2 OF 2 SHEETS STA. TO STA.

F.A.P. RTE.	SECTION	COUNTY	TOTAL SHEETS	SHEET NO.
317	[15B:((102-1),(14HB))BR]BR	TAZEWell	1361	61
CONTRACT NO. 68B46			ILLINOIS FED. AID PROJECT NHPP-YRP3(905)	

LSCSCH-02

STAGING SCHEDULE - PAVEMENT MARKING (CONTINUED)											
LOCATION	BEGIN STATION	END STATION	SHORT TERM PAVT MKING	SHORT TRM PAVT MK REM	PAVT MARK TAPE T4 L&S	PAVT MARK TAPE T4 4	PAVT MARK TAPE T4 6	PAVT MARK TAPE T4 12	PAVT MARK TAPE T4 24	TEMP PAVT MKING REMOV	
			FOOT	SQ FT	FOOT	FOOT	FOOT	FOOT	FOOT	SO FT	
STAGE 4A											
RAMP SW (TAZ)	10+00.00	20+75.60	RT							359	
RAMP SW (TAZ)	11+45.50	23+25.50	LT							393	
STAGE 4B											
US 150 (PEO)	2098+30.00	2101+50.70	RT		80					27	
US 150 (PEO)	2098+30.00	2110+05.20	LT		294					98	
US 150 (PEO)	2098+30.00	2110+05.20	LT		1175					392	
US 150 (PEO)	2101+50.70	2109+57.00	RT		806					269	
US 150 (PEO)	2104+75.20	2108+38.20	RT		363					121	
US 150 (PEO)	2109+57.00	2110+05.20	RT		12					4	
US 150 (TAZ)	2110+05.20	2112+28.00	LT		223					74	
US 150 (TAZ)	2110+05.20	2112+28.00	LT		56					19	
US 150 (TAZ)	2110+05.20	2112+28.00	RT		56					19	
US 150 (TAZ)	2110+05.20	2112+28.00	RT		223					74	
US 150 (TAZ)	2157+51.00	2177+00.00	RT		487					162	
US 150 (TAZ)	2157+51.00	2167+94.00	RT		261					87	
US 150 (TAZ)	2167+94.00	2177+01.60	RT		908					303	
US 150 (TAZ)	2165+39.00	2177+00.00	LT		1161					387	
US 150 (TAZ)	2165+39.00	2169+27.70	RT		389					130	
RAMP A (PEO)	1103+94.90	1112+94.50	RT		900					300	
RAMP A (PEO)	1107+75.30	1113+29.40	RT		555					185	
RAMP B (PEO)	1201+05.10	1213+15.50	LT		1210					403	
RAMP B (PEO)	1201+54.20	1208+88.60	RT		734					245	
RAMP SW (TAZ)	10+00.00	17+14.80	LT		715					238	
RAMP SW (TAZ)	11+16.70	17+47.50	RT		631					210	
TOTAL				6749	2251	224	92099	3910	287	134	33433

STAGING SCHEDULE																	
LOCATION	BEGIN STATION	END STATION	TEMP CONC BARRIER	REL TEMP CONC BARRIER	IMP ATTN TEMP FRN TL3	IMP ATTN REL FRN TL3	BARR WALL REF TYPE B	RAISED REF PVT MK REM	FLEXIBLE DELINEATORS	PVMT MRKG REM WTR BL	TEMP PAVT REMOVAL	MOD GLAR SCRNS SYS SPL	PIN TEMP CONC BARRIER	TEMP INFO SIGNING	TEMP PAVEMENT	TEMP PAVEMENT VAR DEPTH	
			FOOT	FOOT	EACH	EACH	EACH	EACH	EACH	SQ FT	SQ YD	FOOT	EACH	SQ FT	SQ YD	TON	
STAGE 1A																	
US 150 (PEO)	2098+30.00	2109+56.00						56		4513							
US 150 (PEO)	2102+00.00		RT											105			
US 150 (PEO)	2104+52.30		RT		1												
US 150 (PEO)	2104+52.30	2106+97.40	LT	245.5			10						118				
US 150 (PEO)	2105+54.10	2106+66.80									140					13	
US 150 (PEO)	2106+25.00		RT											63			
US 150 (TAZ)	2156+57.00	2175+00.00	LT		1												
US 150 (TAZ)	2157+43.00	2171+00.50	RT	1358.1			54						652				
US 150 (TAZ)	2156+57.00	2175+00.00						92		1991				201			
US 150 (TAZ)	2159+12.00		LT														
US 150 (TAZ)	2165+19.30	2175+00.00	LT								1093				1093		
US 150 (TAZ)	2169+25.00		RT											219			
US 150 (TAZ)	2175+20.00		RT											119			
IL RTE 29 (PEO)	614+71.30	615+79.10	RT	107.8			4						52				
IL RTE 29 (PEO)	614+72.00		RT											47			
IL RTE 29 (PEO)	614+83.00	616+37.50	LT	154.5			6						74				
IL RTE 29 (PEO)	616+37.50		RT		1												
RAMP A/B (PEO)	1105+00.00	1114+00.00								600							
RAMP A/B (PEO)	1105+58.50	1112+43.00									560				560		
RAMP A/B (PEO)	1105+95.00	1110+00.00	LT						20								
RAMP SW (TAZ)	10+79.00	35+40.00								794							
RAMP SW (TAZ)	11+50.00	14+50.00	LT								187				187		
RAMP SW (TAZ)	16+02.00	26+38.70	LT								1009				1009		
STAGE 1B																	
US 150 (PEO)	2094+46.00	2156+57.00						311									
US 150 (PEO)	2098+30.00	2102+40.00	LT	410			16						197				
US 150 (PEO)	2098+30.00		RT														
US 150 (PEO)	2102+83.10	2106+82.80	LT			1											
US 150 (PEO)	2103+20.00	2105+00.00	LT	180.1		1	7						86				
US 150 (PEO)	2106+29.40	2106+92.30	LT	63.7			3						31				
US 150 (PEO)	2106+29.40		RT				1										
RAMP A (PEO)	1104+82.30	1107+75.00	RT	293.5			12						142				
RAMP A/B (PEO)	1205+00.00	1206+75.80	RT						9								
STAGE 1C																	
US 150 (PEO)	2088+07.00	2094+56.00						32									
US 150 (PEO)	2094+45.00	2098+29.60	RT				1										
US 150 (PEO)	2097+80.00	2102+63.00	RT	483			19						232				
US 150 (PEO)	2098+00.00	2102+82.00	RT	484			19						232				
RAMP B (PEO)	1210+47.10	1211+09.50	LT	63			1	3					30				
STAGE 2																	
US 150 (PEO)	2106+27.80	2106+90.00	LT	62.4			1	2					30				
US 150 (TAZ)	2157+21.00	2171+00.50	RT	1380.1			1	55					662				
STAGE 3																	
US 150 (PEO)	2105+84.50		RT				1										
US 150 (PEO)	2105+84.50	2112+44.80	LT		663			27						318			
US 150 (TAZ)	2106+75.00	2157+51.00	RT									5076					
US 150 (TAZ)	2109+56.00	2112+45.00								14							
US 150 (TAZ)	2157+19.00	2162+20.80	RT		502.9			20					241				
US 150 (TAZ)	2157+19.40		LT				1										
US 150 (TAZ)	2160+00.00	2163+55.60	RT								319		0		319		
US 150 (TAZ)	2167+00.00		LT				1						0				
US 150 (TAZ)	2167+00.00	2173+45.40	RT		645.4			26					310				
US 150 (TAZ)	2175+00.00	2179+38.00															
IL RTE 116 (TAZ)	185+92.00	215+57.00								148			2955				
IL RTE 116 (TAZ)	186+04.00	198+02.80	LT		1198.8			48					575				
IL RTE 116 (TAZ)	198+02.80		LT				1										
IL RTE 116 (TAZ)	200+18.00	213+55.00	LT		1337			53					642				
IL RTE 116 (TAZ)	213+55.00		LT				1										
US 150 (PEO)	2106+52.00	2110+06.00	RT		354			14					170				
IL RTE 29 (PEO)	603+42.00	615+74.00								62			4262				
IL RTE 29 (PEO)	615+23.00	616+21.80	RT		98.8			4					47				
IL RTE 29 (PEO)	615+30.00	617+18.00	LT		188.1			8					90				
TOTAL				5286	4988	6	14	411	738	29	15115	3307	5076	4932	754	3167	13

STAGING SCHEDULE		CHANGE ABLE MESSAGE SN CAL DA
STAGE 1A		
US 150 (PEO)		39
NB IL RTE 29 (PEO)		117
SB IL RTE 29 (PEO)		117
STAGE 1B		
US 150 (PEO)		39
STAGE 1C		
US 150 (PEO)		39
STAGE 2		
US 150 (PEO)		117
STAGE 3		
US 150 (PEO)		117
IL RTE 116 (TAZ)		117
STAGE 4A		
US 150 (PEO)		58.5
IL RTE 29 (PEO)		117
SB IL RTE 29 (PEO)		117
STAGE 4B		
US 150 (PEO)		58.5
TOTAL		1053

FINAL SUBMITTAL

MODEL: Default  
FILE: I:\AEC\Projects\2016\hanson\dom\hanson\_projects\Documents\13\jobs\13\h0106\Phase4\CAD\Road\Sheet\DMCC\EP-4B-Stationing-Schedule02-ML.dgn



USER NAME = rwatson	DESIGNED - TN	REVISED - 04/16/2019
PLOT SCALE = 2.00' / in.	DRAWN - JP	REVISED -
PLOT DATE = 4/4/2019	CHECKED - RW	REVISED -
	DATE - 04/16/2019	REVISED -

STATE OF ILLINOIS  
DEPARTMENT OF TRANSPORTATION

US 150 EASTBOUND McCLUGAGE BRIDGE PROJECT  
MAINTENANCE OF TRAFFIC SCHEDULES


SCALE: SHEET OF SHEETS STA. TO STA.

F.A.P. RTE.	SECTION	COUNTY	TOTAL SHEETS	SHEET NO.
317	[15B:((102-1),(14HB))BR]BR	PEORIA/TAZ	1361	61B
			CONTRACT NO. 68B46	
			ILLINOIS FED. AID PROJECT NHPP-YRP3(905)	

PLAN	SURVEYED	BY	DATE
	PLOTTED		
	GRADES CHECKED		
	STRUCTURE NOTATIONS CHECKED		
	NOTE BOOK NO.		
	CADD FILE NAME		

PROFILE	SURVEYED	BY	DATE
	PLOTTED		
	GRADES CHECKED		
	STRUCTURE NOTATIONS CHECKED		
	NOTE BOOK NO.		
	CADD FILE NAME		

MODEL SHEET 01  
 FILE NAME: p:\cadd\svr\2016\hanson\gdm\hanson\Project\cadd\Documents\130813\40106\Phase3\CAD\Roadway\Sheet\DWG\CEE-EL-PROF01-HAN.dgn

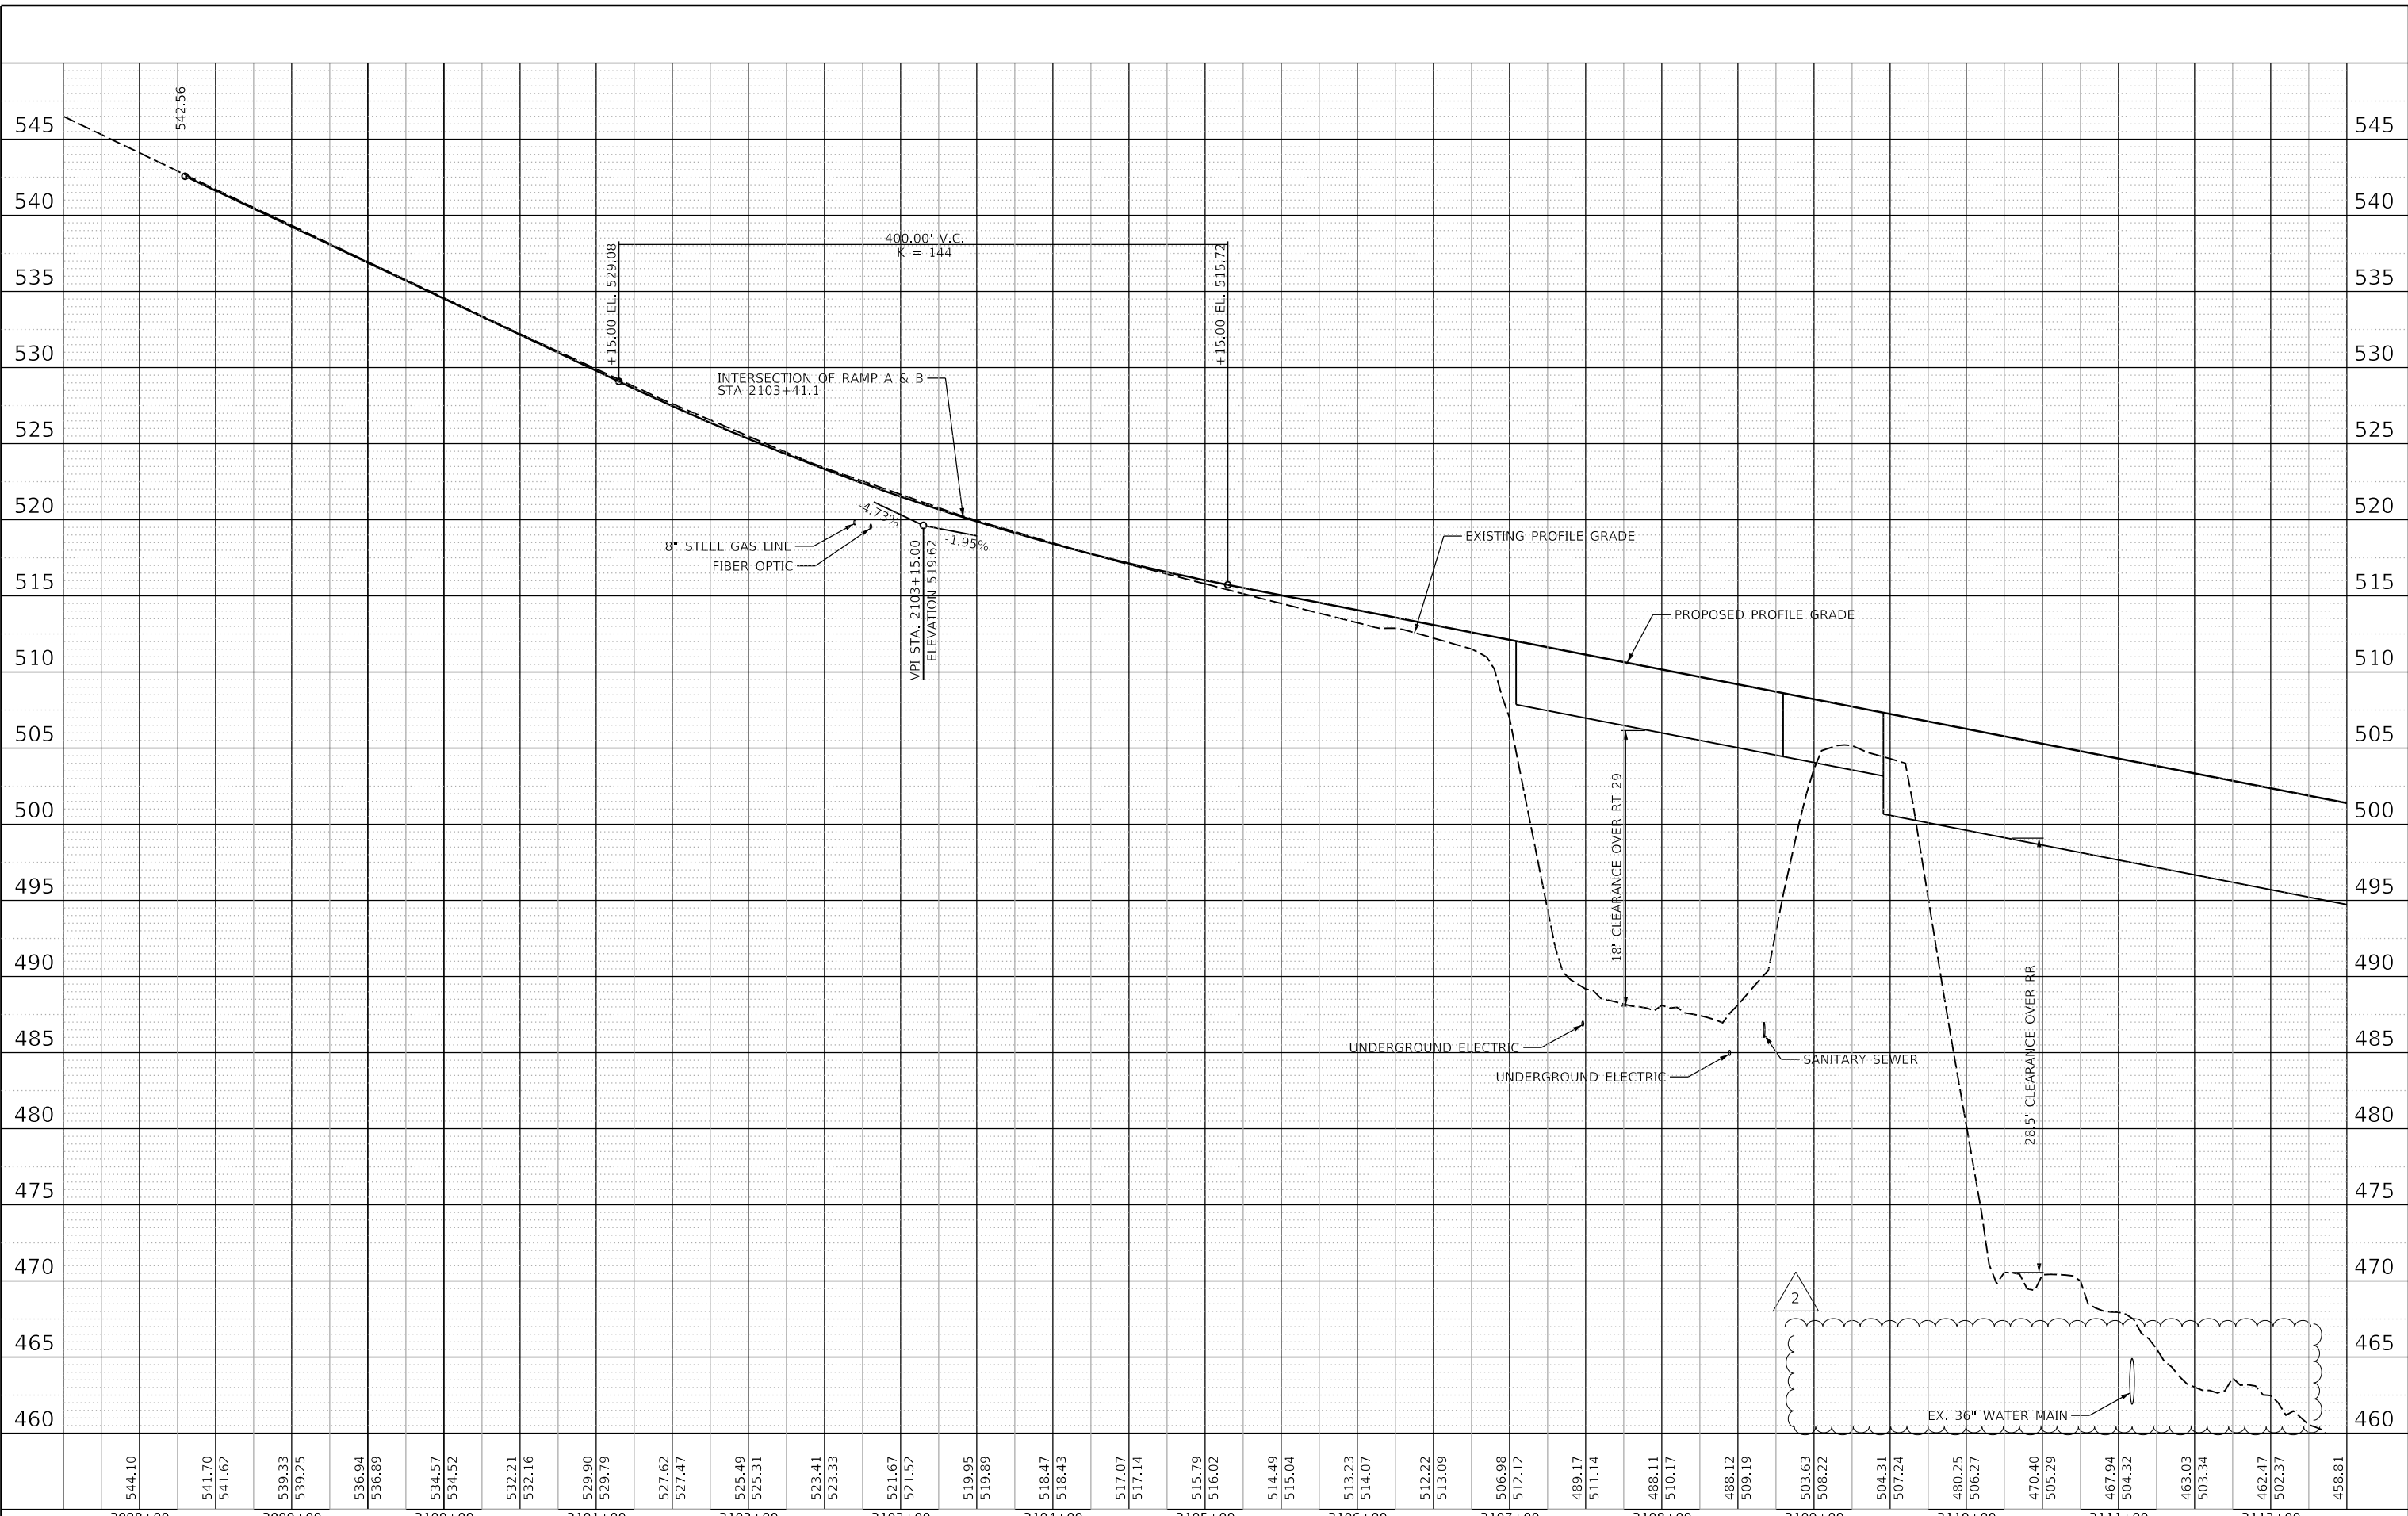

FINAL SUBMITTAL

2098+00	2099+00	2100+00	2101+00	2102+00	2103+00	2104+00	2105+00	2106+00	2107+00	2108+00	2109+00	2110+00	2111+00	2112+00															
544.10	541.70 541.62	539.33 539.25	536.94 536.89	534.57 534.52	532.21 532.16	529.90 529.79	527.62 527.47	525.49 525.31	523.41 523.33	521.67 521.52	519.95 519.89	518.47 518.43	517.07 517.14	515.79 516.02	514.49 515.04	513.23 514.07	512.22 513.09	506.98 512.12	489.17 511.14	488.11 510.17	488.12 509.19	503.63 508.22	504.31 507.24	480.25 506.27	470.40 505.29	467.94 504.32	463.03 503.34	462.47 502.37	458.81



USER NAME = Ship01364	DESIGNED - JDS	REVISED - 04/16/2019
PLOT SCALE = 100.00' / in.	DRAWN - JEO	REVISED - X
PLOT DATE = 4/3/2019	CHECKED - JDS	REVISED - X
	DATE - 11/28/2018	REVISED - X

STATE OF ILLINOIS  
 DEPARTMENT OF TRANSPORTATION

US 150 EASTBOUND McCLUGAGE BRIDGE PROJECT  
 ROADWAY PROFILE - PROPOSED RTE 150

F.A.P. RTE.	SECTION	COUNTY	TOTAL SHEETS	SHEET NO.
317	[15B;((102-1),(14HB))]BR/BR	PEORIA	1361	95
CONTRACT NO. 68B46				
ILLINOIS FED. AID PROJECT NHPP-YRP(905)				

SCALE: 1"=50'H 1"=5'V SHEET 1 OF 6 SHEETS STA. 2098+00 TO STA. 2112+00

**SUGGESTED MAINTENANCE OF TRAFFIC AND CONSTRUCTION STAGING**

**SUGGESTED STAGE CONSTRUCTION GENERAL NOTES**

**SUGGESTED MAINTENANCE OF TRAFFIC(MOT) AND SEQUENCE OF CONSTRUCTION(SOC)**

- THE SUGGESTED STAGES OF CONSTRUCTION AND TRAFFIC CONTROL PLANS SHALL SERVE AS A GUIDE FOR SAFE DIVERSION OF TRAFFIC DURING EXECUTION OF THIS CONTRACT. HOWEVER, THE CONTRACTOR MAY MODIFY THE TRAFFIC CONTROL PLANS TO MEET CONSTRUCTION NEEDS BUT NOT AT THE EXPENSE OF PUBLIC SAFETY OR CONVENIENCE. ANY CHANGES TO THE TRAFFIC CONTROL PLAN AND SEQUENCE OF CONSTRUCTION SHALL BE SUBMITTED TO THE ENGINEER FOR APPROVAL.
- EXISTING PAVEMENT MARKINGS THAT CONFLICT WITH TEMPORARY PAVEMENT MARKINGS SHALL BE REMOVED WITHIN 24 HOURS, AS DIRECTED BY THE ENGINEER. ON THE NEW PAVEMENT, WATER BLASTING SHALL BE UTILIZED FOR REMOVAL.
- THE CONTRACTOR IS RESPONSIBLE FOR COORDINATING AND PROVIDING ACCESS POINTS TO THE WORK ZONE. ACCESS POINTS MUST BE APPROVED BY THE ENGINEER PRIOR TO THE INSTALLATION. ANY SIGNING OR ADDITIONAL TRAFFIC CONTROL DEVICES REQUIRED TO PROVIDE CONTRACTOR ACCESS TO THE WORK ZONE SHALL BE INCLUDED IN THE CONTRACT FOR TRAFFIC CONTROL AND PROTECTION (SPECIAL).
- THE CONTRACTOR MUST COORDINATE ROAD CLOSURES WITH THE ENGINEER.
- THE CONTRACTOR SHALL PROVIDE AND INSTALL TWO WEIGHTED SAND BAGS ON EACH TYPE I AND TYPE II BARRICADE USED, ONE WEIGHTED SAND BAG ACROSS EACH BOTTOM RAIL.
- TRAFFIC SHALL ALWAYS BE MAINTAINED ON THE EXISTING EASTBOUND US 150 STRUCTURE UNTIL THE TRAFFIC CAN BE SHIFTED ONTO THE NEWLY CONSTRUCTED EASTBOUND US 150 STRUCTURE TO ALLOW THE CLOSURE OF THE EXISTING EASTBOUND US 150 STRUCTURE. ARTERIAL LANE CLOSURES NOT SHOWN IN THE STAGING PLANS WILL NOT BE PERMITTED.
- IN ADDITIONAL TO THE DROPOFF REQUIREMENTS STATED IN THE ARTICLE 701.07 OF THE STANDARD SPECIFICATION BOOK. BARRICADES THAT MUST BE PLACED IN EXCAVATED AREAS SHALL HAVE LEG EXTENSIONS INSTALLED SUCH THAT THE TOP OF THE BARRICADE IS IN COMPLIANCE WITH THE HEIGHT REQUIREMENTS OF STANDARD 701901.

2

- PLACE FALCON PROTECTION NETTING ON THE EXISTING BRIDGES AT THE LOCATIONS DESCRIBED IN THE CONTRACT SPECIAL PROVISIONS. UTILIZE IDOT HIGHWAY TRAFFIC CONTROL STANDARD. UTILIZE IDOT HIGHWAY TRAFFIC CONTROL STANDARD 701421 FOR INSTALLATION OF FALCON PROTECTION NETTING ON EASTBOUND US 150 BRIDGE. LANE CLOSURES SHALL OCCUR ONLY DURING WEEKDAY, DAYTIME, AND OFF-PEAK HOURS.

**TABLE 2. CONDITION II  
DROP-OFF NEAR THE EDGE OF TRAVELED WAY**

Existing Road Type	Normal Posted Speed Limit, NPSL (mph)	Drop-off Depth, D (in.)	TCB is Warranted(2)	Use of TCB may be warranted, based on traffic exposure.(2)	Maximum Allowable Total Traffic (Both Directions)Without TCB (3)
4L2W	Up to 35	12 ≤ D ≤ 18		Yes(1)	9.31
4L2W	Up to 35	18 < D ≤ 24		Yes(1)	7.3
4L2W	Up to 35	24 < D ≤ 36		Yes(1)	6.25
4L2W	Up to 35	>36	Yes(1)		
4L2W	35<NPSL≤45	24 < D ≤ 18		Yes(1)	3.43
4L2W	35<NPSL≤40	24 < D ≤ 24		Yes(1)	2.94
4L2W	> 45	D ≥ 12	Yes(1)		
4L2W	> 45	D ≥ 13	No (2)		
4L2W	> 45	D ≥ 14	Yes		

LOCATIONS WHERE THE DROP-OFF IS LOCATED WITHIN 8 FT. OF THE EDGE OF THE NEAREST OPEN TRAFFIC LANE. FOR DROP-OFF LOCATIONS BEYOND 8 FT. OF THE EDGE OF THE NEAREST OPEN TRAFFIC LANE, BUT WITHIN THE CONSTRUCTION CLEAR ZONE, BASE THE DECISION AND DESIGN UPON AN ENGINEERING STUDY.

CHANNELIZING DEVICES AND TEMPORARY BARRIER ARE TO BE PLACED AT SAME LEVEL AS TRAVELING LANE OR SHOULDER PROFILE.

- FOR URBAN/SUBURBAN LOCATIONS, THE DESIGNER SHOULD CONSIDER ACCESS NEEDS AND SIGHT DISTANCE IN MAKING A FINAL DECISION TO USE TCB.
- HOWEVER, SEE ABOVE SECTIONS FOR LONG DURATION STATIONARY OPERATIONS ON HIGH SPEED ROADS WITH WORKERS, AND FOR WORKER PROTECTION WHERE THERE IS NO MEANS OF ESCAPE.

**PRE-CONSTRUCTION – SOC**

- RELOCATE EXISTING UTILITIES (3-ELECTRICAL POLES AND 2-CONTROL CABINETS) LOCATED IN THE PROPOSED EASTBOUND U.S. RTE 150 BRIDGE OVER ILL RTE 29 EAST ABUTMENT AND THE PROPOSED EASTBOUND U.S. RTE 150 BRIDGE OVER THE ILLINOIS RIVER WEST ABUTMENT LANDING AREA.
- RELOCATE EXISTING UTILITY POLES, LIGHT POLES AND AERIAL LINES LOCATED ALONG THE SOUTH SIDE OF EASTBOUND U.S. RTE 150 AND THE SW RAMP EAST OF THE EXISTING U.S. RTE 150 BRIDGE OVER THE ILLINOIS RIVER.
- TEMPORARY PAVEMENT BETWEEN RAMP "A" AND "B" AND RAMP SW SHALL BE IN PLACE PRIOR TO STAGE I TRAFFIC. FROM RAMP B STATION 1205+50 TO INTERSECTION OF US RTE 150.

**STAGE 1A – MOT**

- SHIFT EASTBOUND U.S. RTE 150 TRAFFIC TO THE NORTH PROVIDING 2-11 FOOT THRU LANES STATION 2098+30 TO STATION 2109+00.
- INSTALL ATTENUATOR AND TEMPORARY CONCRETE BARRIER WALL ALONG THE SOUTH SIDE OF EXISTING EASTBOUND U.S. RTE 150 STATION 2104+50 TO STATION 2107+00.
- EASTBOUND U.S. RTE 150 SHALL MAINTAIN 2-11 FOOT LANES OF TRAFFIC AT ALL TIMES.
- INSTALL ATTENUATOR AND TEMPORARY CONCRETE BARRIER WALL ALONG THE SOUTH SIDE OF EXISTING EASTBOUND U.S. RTE 150 STATION 2157+21 TO STATION 2171+00.
- USE EXISTING RAMP "A" FOR BOTH RAMP "A" AND RAMP "B" TRAFFIC BY SHIFTING THE SINGLE LANE OF RAMP "B" TO THE EAST HALF OF RAMP A MAINTAINING 2-11 FOOT LANES. INSTALL TEMPORARY FLEXIBLE DELINEATORS AT 20 FEET C-C BETWEEN THE OPPOSING RAMP TRAFFIC.
- SHIFT SOUTHBOUND IL RTE 116 TRAFFIC TO THE EAST, MAINTAIN 2-11 FOOT THRU LANES AT ALL TIMES.
- MAINTAIN A SINGLE LANE OF TRAFFIC ON NORTHBOUND IL RTE 29 BY SHIFTING THE TRAFFIC TO THE EXISTING OUTSIDE LANE STA 614+00 TO STA 616+00. MAINTAIN A SINGLE LANE OF TRAFFIC ON SOUTHBOUND IL RTE 29 BY SHIFTING THE TRAFFIC TO THE EXISTING OUTSIDE LANE STA 614+00 TO STA 616+00.
- MAINTAIN EXISTING TRAFFIC PATTERNS ON WESTBOUND U.S. RTE 150 AND NB IL RTE 116.
- INSTALL LANE CLOSURE ADVANCED SIGNING ACCORDING TO THE PLANS.
- COVER OR REMOVE PERMANENT SIGNS AS NEEDED FOR STAGE 1A CONSTRUCTION.
- INSTALL LANE CLOSURE ADVANCED SIGNING ACCORDING TO THE PLANS.
- REMOVE ALL CONFLICTING RAISED PAVEMENT MARKERS WITHIN THE PROJECT LIMITS.

**STAGE 1A – SOC**

- REMOVE EXISTING PAVEMENT AND CURB & GUTTER RAMP "B" FROM STATION 1206+13 TO STATION 1210+92, REMOVE EXISTING RAISED CONCRETE MEDIAN AND RAISED ISLAND RAMP "B" STATION 1206+13 TO STATION 1208+50 AND INSTALL TEMPORARY PAVEMENT. REMOVE EXISTING RAISED CONCRETE MEDIAN RAMP "B" STATION 1201+00 TO 1206+13 AND INSTALL TEMPORARY PAVEMENT (NEEDED FOR STAGE (3) MAINTENANCE OF TRAFFIC).
- INSTALL WICK DRAINS AT LIMITS AND LOCATIONS SHOWN IN WICK DRAIN DETAIL SHEET. CONSTRUCT EMBANKMENT TO ELEVATION 460.00 FROM EAST ABUTMENT STATOIN 2157+50 TO STATION 2162+00. CONSTRUCT EMBANKMENT FOR US 150 EB AND SW RAMP FROM STA 2162+00 TO APPROX. STA 2172+00.
- REMOVE EXISTING RIGHT SHOULDER OF THE EXISTING SW RAMP FROM STATION 15+00 TO STATION 26+00.
- CONSTRUCT EMBANKMENT ALONG RIGHT SIDE OF THE EXISTING SW RAMP FROM STATION 15+00 TO STATION 33+00.
- GRADING AND CONSTRUCT EMBANKMENT ALONG IL RTE 116 TO MARINA LANE.
- CONSTRUCT PROPOSED RAMP "B" COMPOSITE PAVEMENT (PCC BASE COURSE ONLY), GORE AND SHOULDER. CONSTRUCT RAMP "B" PAVEMENT (PCC BASE COURSE ONLY) ALONG THE SOUTH SIDE OF U.S. RTE 150 TO THE U.S. RTE 150 BRIDGE OVER IL RTE 29 (RAMP B STATION 1206+13.0 TO STATION 2110+77).
- CONSTRUCT THE SOUTH HALF OF THE PROPOSED EASTBOUND U.S. ROUTE 150 BRIDGE OVER IL RTE 29 (SEE STRUCTURE PLANS).

- CONSTRUCT THE EASTBOUND U.S. ROUTE 150 BRIDGE OVER THE ILLINOIS RIVER FROM STATION 2115+95 (PIER #4) TO STATION 2157+51 (EAST ABUTMENT) AND THE WEST ABUTMENT (SEE STRUCTURE PLANS).
- REMOVE EXISTING RIGHT SHOULDER OF U.S. RTE 150 FROM STATION 2157+51 TO STATION 2175+65 NEAR THE GORE AREA OF THE SW RAMP.
- REMOVE THE EXISTING LEFT ASPHALT SHOULDER AND INSTALL TEMPORARY PAVEMENT PRIOR TO MOVING TRAFFIC TO THE LEFT SHOULDER OF THE SW RAMP STATION 15+00 TO STATION 26+25.
- REMOVE EXISTING OVERHEAD SIGN TRUSS RAMP SW STATION 13+39.
- CONSTRUCT BOX CULVERT SW RAMP STATION 26+80.

**STAGE 1B – MOT**

- RELOCATE AT 20 FEET C-C TEMPORARY FLEXIBLE DELINEATORS BETWEEN THE OPPOSING RAMP "A" AND "B" TRAFFIC.
- SHIFT RAMP "A" TRAFFIC TO NEWLY CONSTRUCTED RAMP "B" ALSO UTILIZING THE PREVIOUSLY INSTALLED TEMPORARY PAVEMENT BETWEEN EXISTING RAMP "A" AND "B". SHIFT RAMP "B" TRAFFIC TO THE NEWLY CONSTRUCTED RAMP "B" PAVEMENT AND RIGHT SHOULDER. MAINTAIN 1-11 FOOT RAMP LANE IN EACH DIRECTION.
- SHIFT TRAFFIC AS NEEDED TO CONSTRUCT RAMP "A" AND "B" PAVEMENT GAPS CREATED BY PREVIOUS MOT STAGING.
- SHIFT EASTBOUND U.S. RTE 150 TRAFFIC NORTH CREATING (1)-11 FOOT LANES STATION 2090+00 TO STATION 2107+45.
- REMOVE EXISTING TEMPORARY CONCRETE BARRIER WALL STATION 2098+50 TO STATION 2105+71. RELOCATE EXISTING ATTENUATOR FROM STATION 2098+50 TO STATION 2105+71.
- INSTALL TEMPORARY FLEXIBLE DELINEATORS AT 20 FEET C-C BETWEEN EASTBOUND AND WESTBOUND TRAFFIC STATION 2096+00 TO STATION 2105+50.
- SHIFT EASTBOUND U.S. RTE 150 TRAFFIC NORTH ONTO THE EXISTING MEDIAN SHOULDER CREATING (1)-12 FOOT LANE STATION 2088+00 TO STATION 2107+45.
- MAINTENANCE OF TRAFFIC ON U.S. RTE 150 OVER THE ILLINOIS RIVER AND EAST OF THE ILLINOIS RIVER WILL REMAIN IN STAGE 1A CONFIGURATION.
- INSTALL TEMPORARY PAVEMENT MARKING AND TEMPORARY TRAFFIC CONTROL DEVICES FOR STAGE 1B CONSTRUCTION.
- ADJUST ADVANCED SIGNING ACCORDING TO THE PLANS FOR STAGE 1B CONSTRUCTION.
- MAINTAIN TRAFFIC CONTROL DEVICES AND WORK ZONES ON EAST SIDE OF THE RIVER AS CONFIGURED IN STAGE 1A.

**STAGE 1B – SOC**

- REMOVE EXISTING PAVEMENT AND CURB & GUTTER RAMP "A" FROM STATION 1100+00 TO STATION 1106+75. REMOVE EXISTING RIGHT LANE OF U.S. RTE 150 FROM STATION 2098+30 TO 2105+30.
- CONSTRUCT PROPOSED RAMP "A" PAVEMENT (PCC BASE COURSE ONLY) AND SHOULDER. CONSTRUCT PROPOSED RIGHT LANE PAVEMENT (PCC BASE COURSE ) OF U.S. RTE 150 STATION 2098+30 TO 2105+30. SHIFT TRAFFIC AS NEEDED TO CONSTRUCT RAMP "A" AND "B" GAPS.
- CONTINUE WORK ON EMBANKMENT ON THE EAST SIDE, SW RAMP AND ALONG IL RTE 116 IN STAGES 1A, 1B AND 1C.

**STAGE 1C – MOT**

- RELOCATE AT 20 FEET C-C TEMPORARY FLEXIBLE DELINEATORS BETWEEN THE OPPOSING RAMP "A" AND "B" TRAFFIC.
- EASTBOUND U.S. RTE 150 TRAFFIC MERGE INSIDE LANE (LEFT) TO RIGHT LANE (OUTSIDE LANE) CREATING (1)-11 FOOT LANE STARTING AT EXISTING STATION 1037+55 TO STATION 2093+50 AND MAINTAIN ONE LANE THROUGH STATION 2107+00.
- RAMP "A" TRAFFIC WILL BE SHIFTED ONTO THE NEWLY CONSTRUCTED RAMP "A" PAVEMENT.
- THE WESTBOUND U.S. RTE 150 TRAFFIC WILL REMAIN IN THE STAGE 1B CONFIGURATION.

FINAL SUBMITTAL

MODEL: Default  
FILE NAME: m:\us150\2016\hanson\_domsthanon\_projects\Documents\13\bbbs13\h0106\phase1\CAD\Road\Sheet\14\CCCEP-eb-Staging-00-Notes01-1.mll.dgn



USER NAME = rwatson	DESIGNED - TVN	REVISED - 04/16/2019
PLOT SCALE = 2,0000 ' / in.	CHECKED - JM	REVISED -
PLOT DATE = 4/8/2019	DATE - 11/28/2018	REVISED -

STATE OF ILLINOIS  
DEPARTMENT OF TRANSPORTATION


US 150 EASTBOUND McCLUGAGE BRIDGE PROJECT	
MAINTENANCE OF TRAFFIC GENERAL NOTES & DESCRIPTIONS	
SCALE:	SHEET 1 OF 2 SHEETS STA. TO STA.

F.A.P. RTE.	SECTION	COUNTY	TOTAL SHEETS	SHEET NO.
317	[15B]:(102-1),(14HB)]BR]BR	PEORIA	1361	108
ILLINOIS / FED. AID PROJECT			CONTRACT NO. 68B46	
NHPY-RP3(905)				

STG1GN


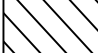


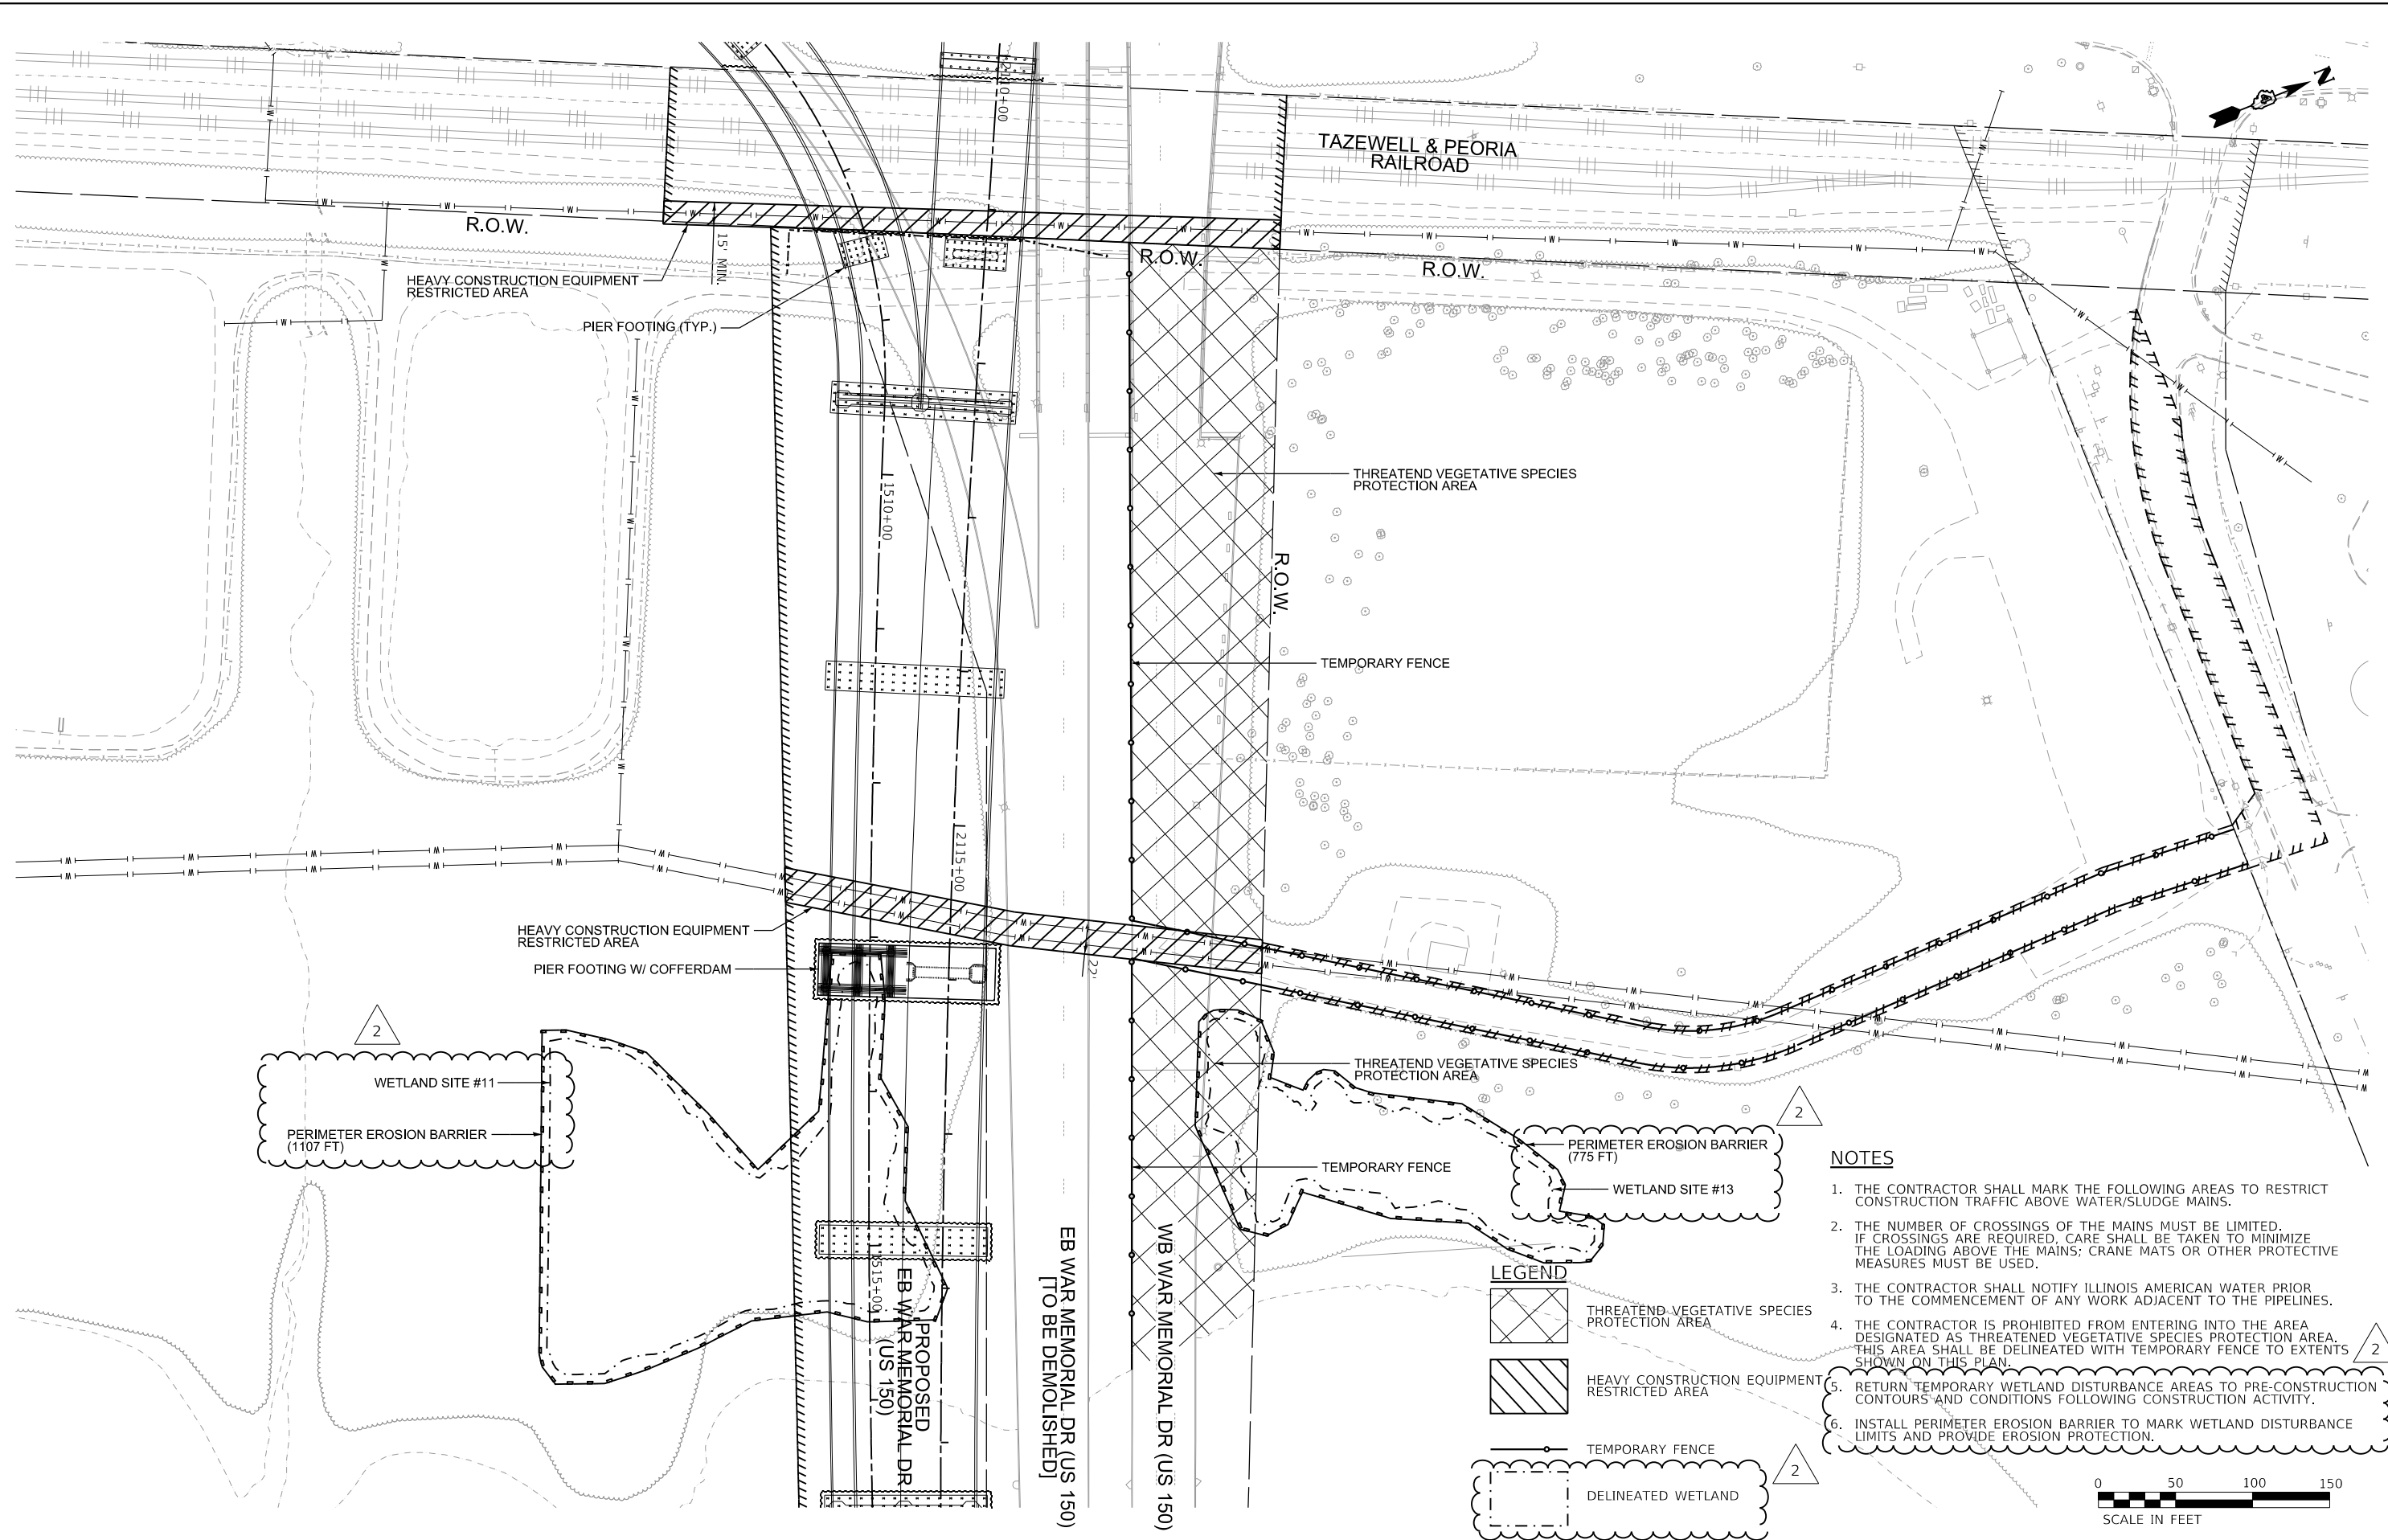

MODEL: Default  
 FILE: N:\mhc\_projects\us150\2016\hanson\dom\hanson\_projects\documents\13\0013\130106\phase-3\CAD\Road\Sheet\DRM\CEP\chicgo\_Constr\_Restr\_Areas\_TVL.dgn



- NOTES**
1. THE CONTRACTOR SHALL MARK THE FOLLOWING AREAS TO RESTRICT CONSTRUCTION TRAFFIC ABOVE WATER/SLUDGE MAINS.
  2. THE NUMBER OF CROSSINGS OF THE MAINS MUST BE LIMITED. IF CROSSINGS ARE REQUIRED, CARE SHALL BE TAKEN TO MINIMIZE THE LOADING ABOVE THE MAINS; CRANE MATS OR OTHER PROTECTIVE MEASURES MUST BE USED.
  3. THE CONTRACTOR SHALL NOTIFY ILLINOIS AMERICAN WATER PRIOR TO THE COMMENCEMENT OF ANY WORK ADJACENT TO THE PIPELINES.
  4. THE CONTRACTOR IS PROHIBITED FROM ENTERING INTO THE AREA DESIGNATED AS THREATENED VEGETATIVE SPECIES PROTECTION AREA. THIS AREA SHALL BE DELINEATED WITH TEMPORARY FENCE TO EXTENTS SHOWN ON THIS PLAN.
  5. RETURN TEMPORARY WETLAND DISTURBANCE AREAS TO PRE-CONSTRUCTION CONTOURS AND CONDITIONS FOLLOWING CONSTRUCTION ACTIVITY.
  6. INSTALL PERIMETER EROSION BARRIER TO MARK WETLAND DISTURBANCE LIMITS AND PROVIDE EROSION PROTECTION.

**LEGEND**

-  THREATEND VEGETATIVE SPECIES PROTECTION AREA
-  HEAVY CONSTRUCTION EQUIPMENT RESTRICTED AREA
-  TEMPORARY FENCE
-  DELINEATED WETLAND



**TYLIN INTERNATIONAL**  
 200 S. WACKER DR.  
 SUITE 1400  
 CHICAGO, IL 60606  
 TEL: 312-777-2900

USER NAME = mgormely	DESIGNED - MPG	REVISED - 04/16/2019
	DRAWN - MPG	REVISED -
PLOT SCALE = 100.00' / in.	CHECKED - DAJ	REVISED -
PLOT DATE = 4/8/2019	DATE - 11/28/2018	REVISED -

STATE OF ILLINOIS  
 DEPARTMENT OF TRANSPORTATION

US 150 EASTBOUND MCLUGAGE BRIDGE PROJECT  
 RESTRICTED CONSTRUCTION AREAS - PEORIA CO.

SCALE: 1"=50' SHEET 1 OF 1 SHEETS STA. N/A TO STA. N/A

F.A.P. RTE.	SECTION	COUNTY	TOTAL SHEETS	SHEET NO.
317	[15B;((102-1),(14H))BR]BR	PEORIA	1361	111
CONTRACT NO. 68B46				
ILLINOIS FED. AID PROJECT NHPP-YRP3(905)				










FINAL SURVEY NO.	SURVEYED	DATE
NOTE BOOK	PLOTTED	
	TEMPLATE	
	AREAS CHECKED	

ORIGINAL SURVEY NO.	SURVEYED	DATE
NOTE BOOK	PLOTTED	
	TEMPLATE	
	AREAS CHECKED	

FINAL SUBMITTAL  
 MODEL: D:\mfrt  
 FILE NAME: D:\projects\306\_hanson\cambrian\station\Project\Documents\1308513\3D\06\Phase3\CAD\Road\Sheet\DAI\CE\cass\cass1.mxd\29503-111.dgn

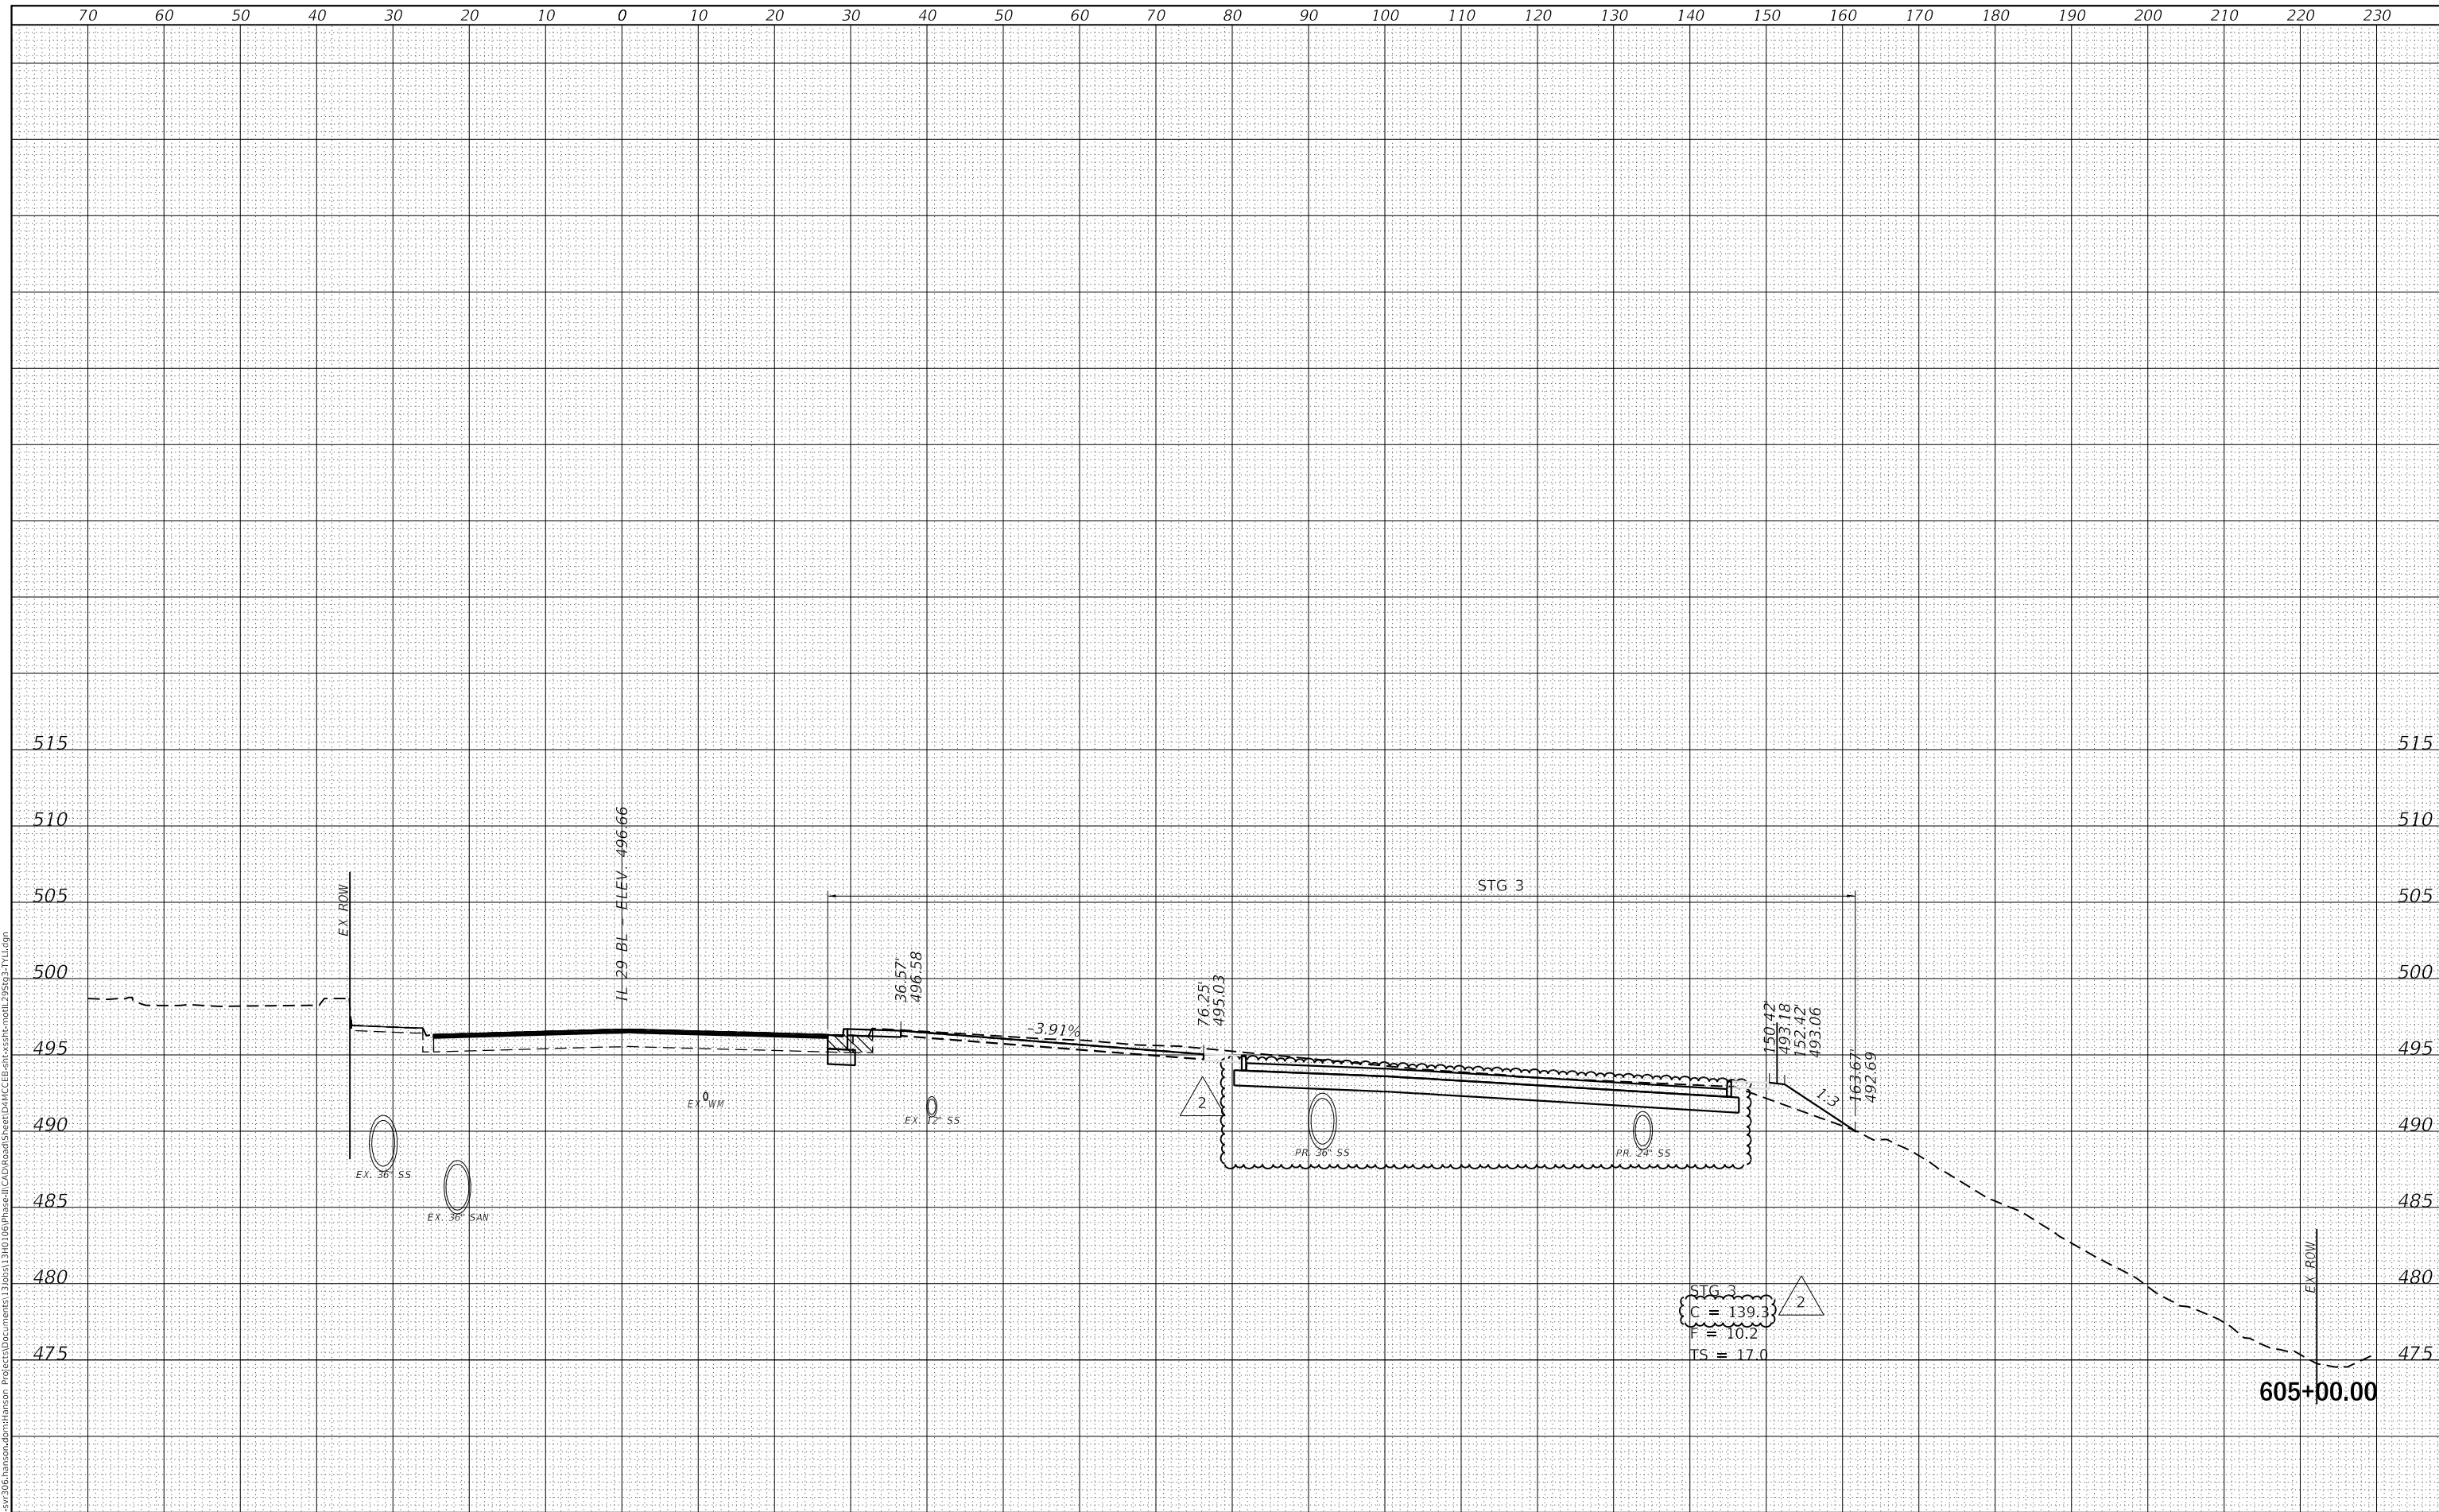

**TYLIN INTERNATIONAL**  
 200 S. WACKER DR.  
 SUITE 1400  
 CHICAGO, IL 60606  
 TEL: 312-777-2900

USER NAME = mgormely	DESIGNED - MPG	REVISD - 4/16/2019
	DRAWN - MPG	REVISD -
PLOT SCALE = 20.00' / in.	CHECKED - DAJ	REVISD -
PLOT DATE = 4/5/2019	DATE - 11/28/2018	REVISD -

STATE OF ILLINOIS  
 DEPARTMENT OF TRANSPORTATION


US 150 EASTBOUND MCLUGAGE BRIDGE PROJECT  
 STAGE 3: IL RTE 29  
 SCALE: 1"=10'H,5"V SHEET OF 13 SHEETS STA. 605+00.00 TO STA. 605+00.00

F.A.P. RTE.	SECTION	COUNTY	TOTAL SHEETS	SHEET NO.
317	[15B;((102-1),(14HB))BR]BR	PEORIA	1361	302
CONTRACT NO. 68B46				
ILLINOIS FED. AID PROJECT NHPY-RP3(905)				

FINAL SURVEY NO.	SURVEYED	DATE
NOTE BOOK	PLOTTED	
AREAS CHECKED	TEMPLATE	
	AREAS	
	CHECKED	

ORIGINAL SURVEY NO.	SURVEYED	DATE
NOTE BOOK	PLOTTED	
AREAS CHECKED	TEMPLATE	
	AREAS	
	CHECKED	

MODEL: D:\mifit  
 FILE NAME: D:\projects\306\_hanson\cambrian\station\Project\Documents\1308513\3D\106\Phase3\CAD\Road\Sheet\DAI\CC\CC-cc-ss11.mxd

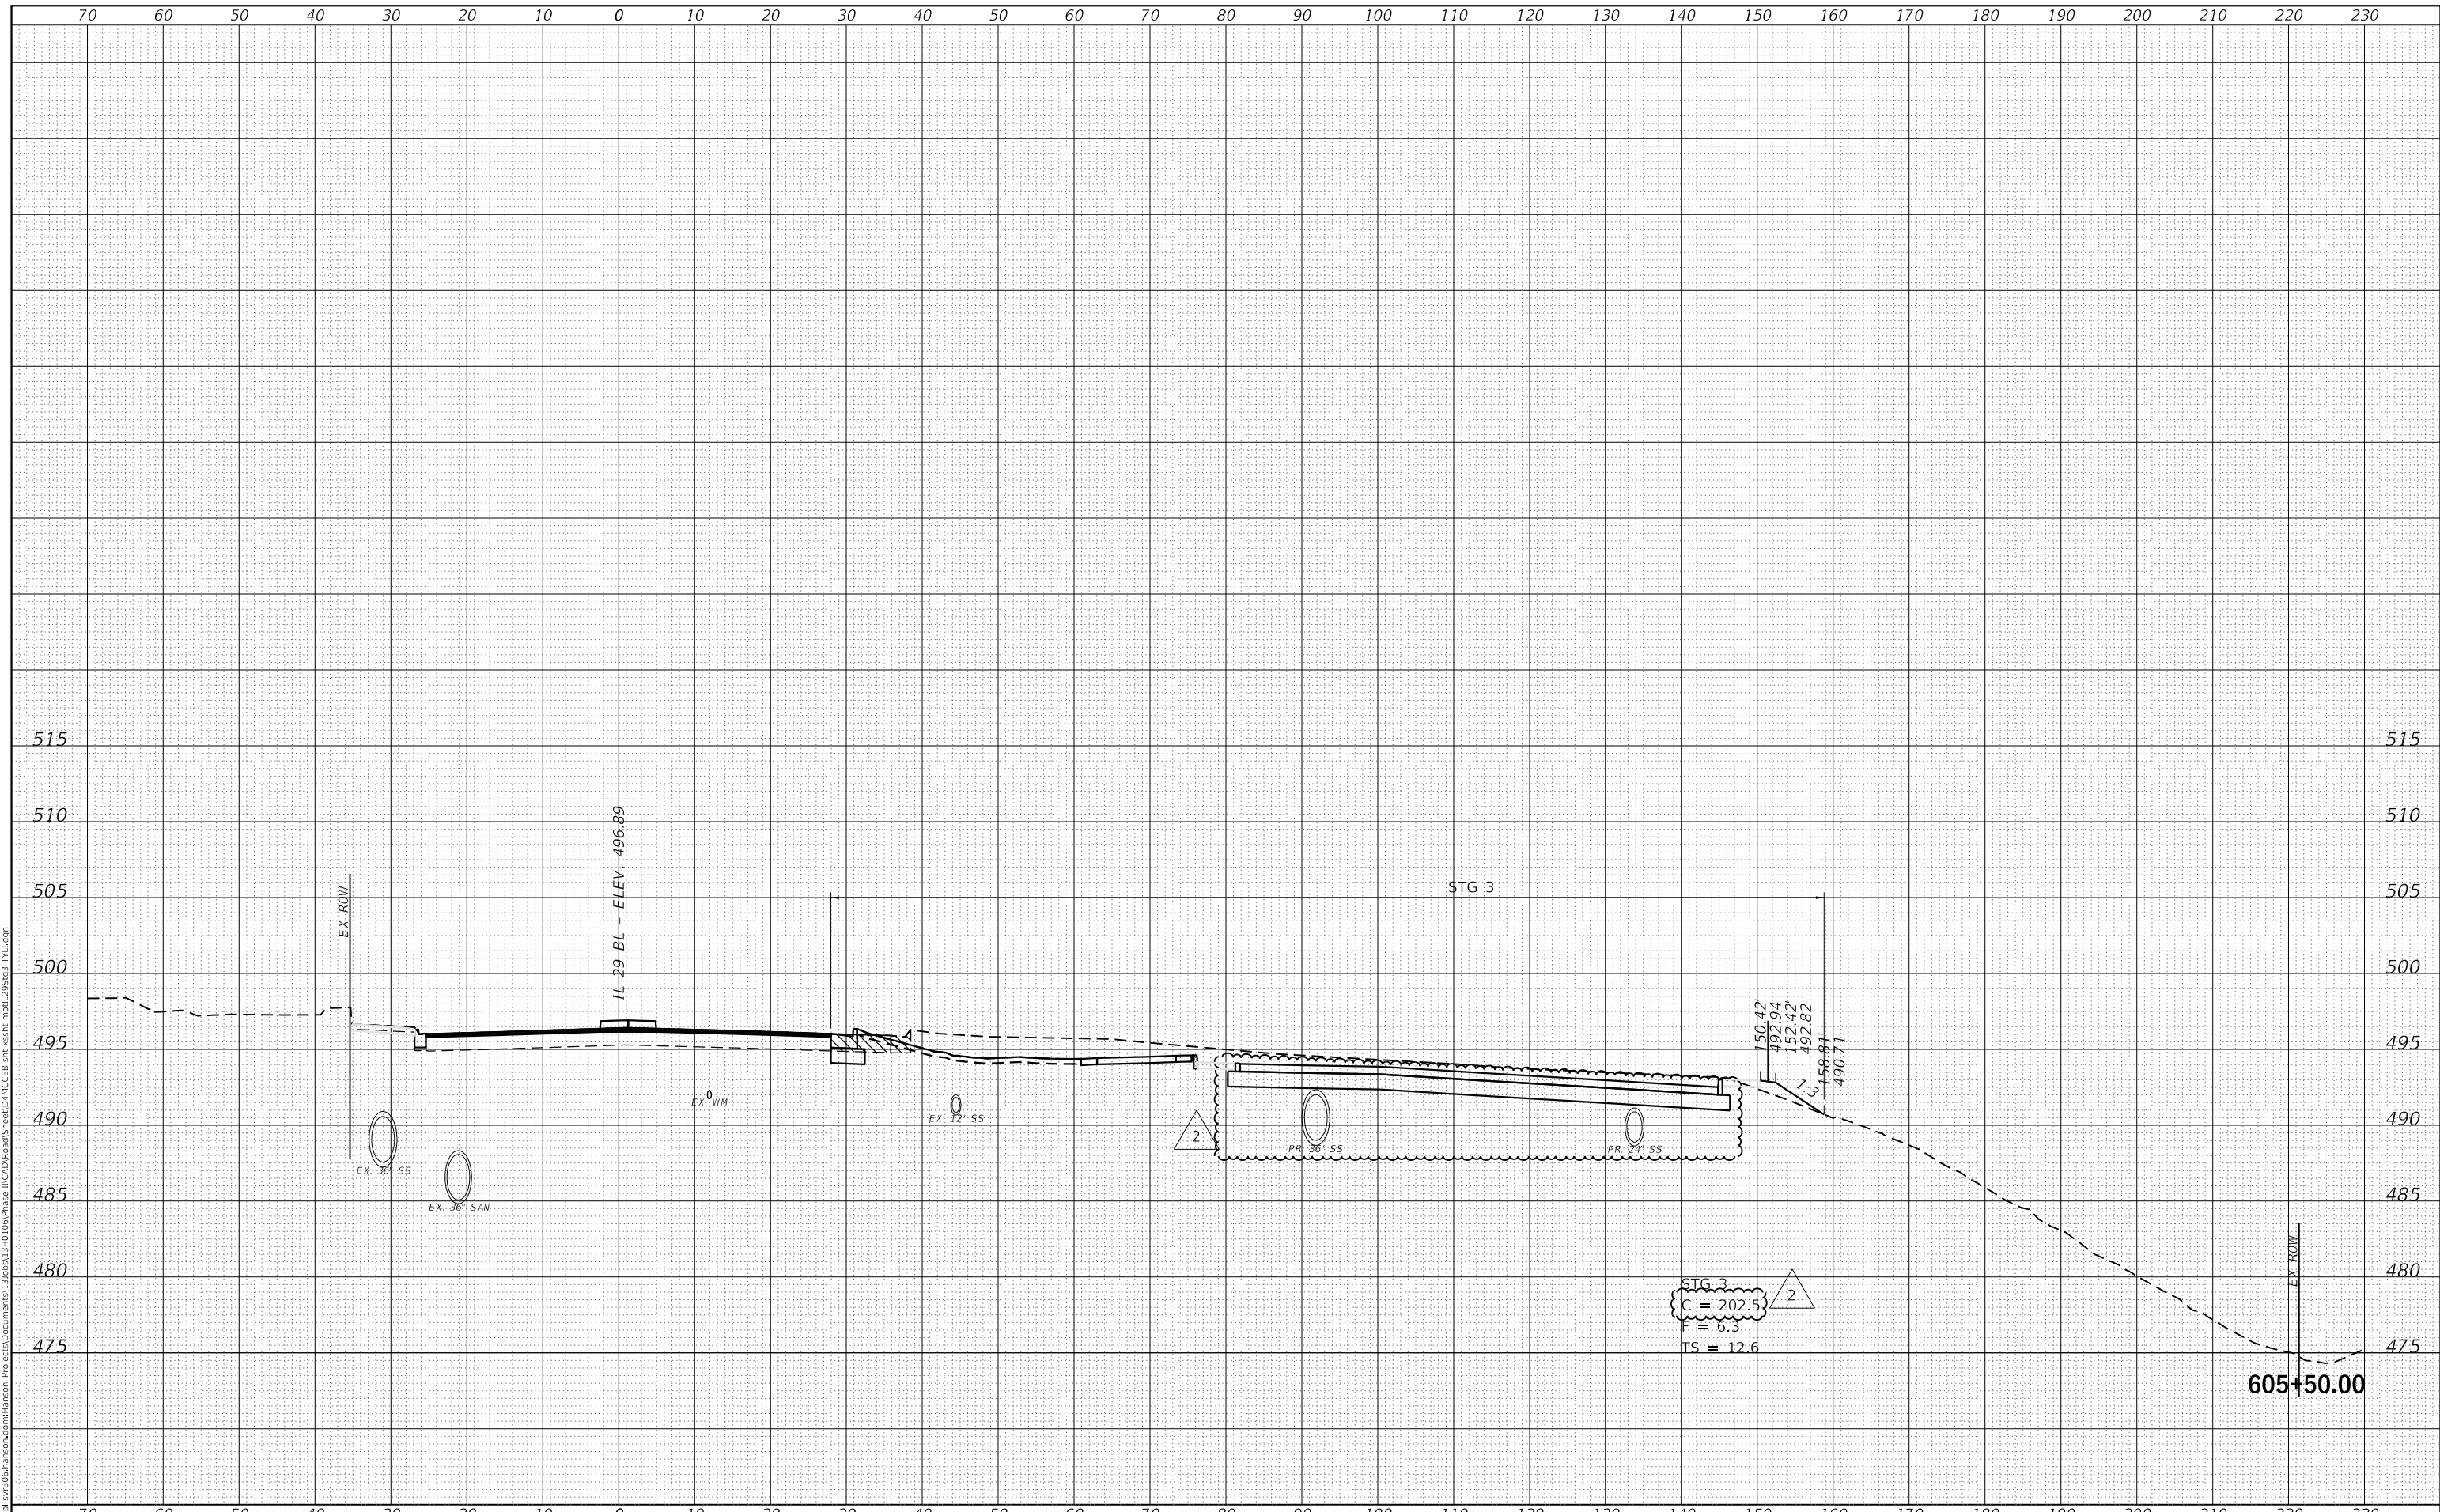

FINAL SUBMITTAL

**TYLIN INTERNATIONAL**  
 200 S. WACKER DR.  
 SUITE 1400  
 CHICAGO, IL 60606  
 TEL: 312-777-2900

USER NAME	= mgormely
DESIGNED	- MPG
DRAWN	- MPG
CHECKED	- DAI
DATE	- 11/28/2018
PLOT SCALE	= 20.00' / in.
PLOT DATE	= 4/5/2019

DESIGNED	- MPG	REVISED	- 4/16/2019
DRAWN	- MPG	REVISED	-
CHECKED	- DAI	REVISED	-
DATE	- 11/28/2018	REVISED	-

STATE OF ILLINOIS  
 DEPARTMENT OF TRANSPORTATION


US 150 EASTBOUND MCLUGAGE BRIDGE PROJECT  
 STAGE 3: IL RTE 29

SCALE: 1"=10'H,5"V SHEET OF 13 SHEETS STA. 605+50.00 TO STA. 605+50.00

F.A.P. RTE.	SECTION	COUNTY	TOTAL SHEETS	SHEET NO.
317	[15B;((102-1),(14HB))BR]BR	PEORIA	1361	303
CONTRACT NO. 68B46				
ILLINOIS FED. AID PROJECT NHPY-RP3(905)				

FINAL SURVEY NO.	SURVEYED	DATE
NOTE BOOK	PLOTTED	
AREAS CHECKED	TEMPLATE	
	AREAS CHECKED	

ORIGINAL SURVEY NO.	SURVEYED	DATE
NOTE BOOK	PLOTTED	
AREAS CHECKED	TEMPLATE	
	AREAS CHECKED	

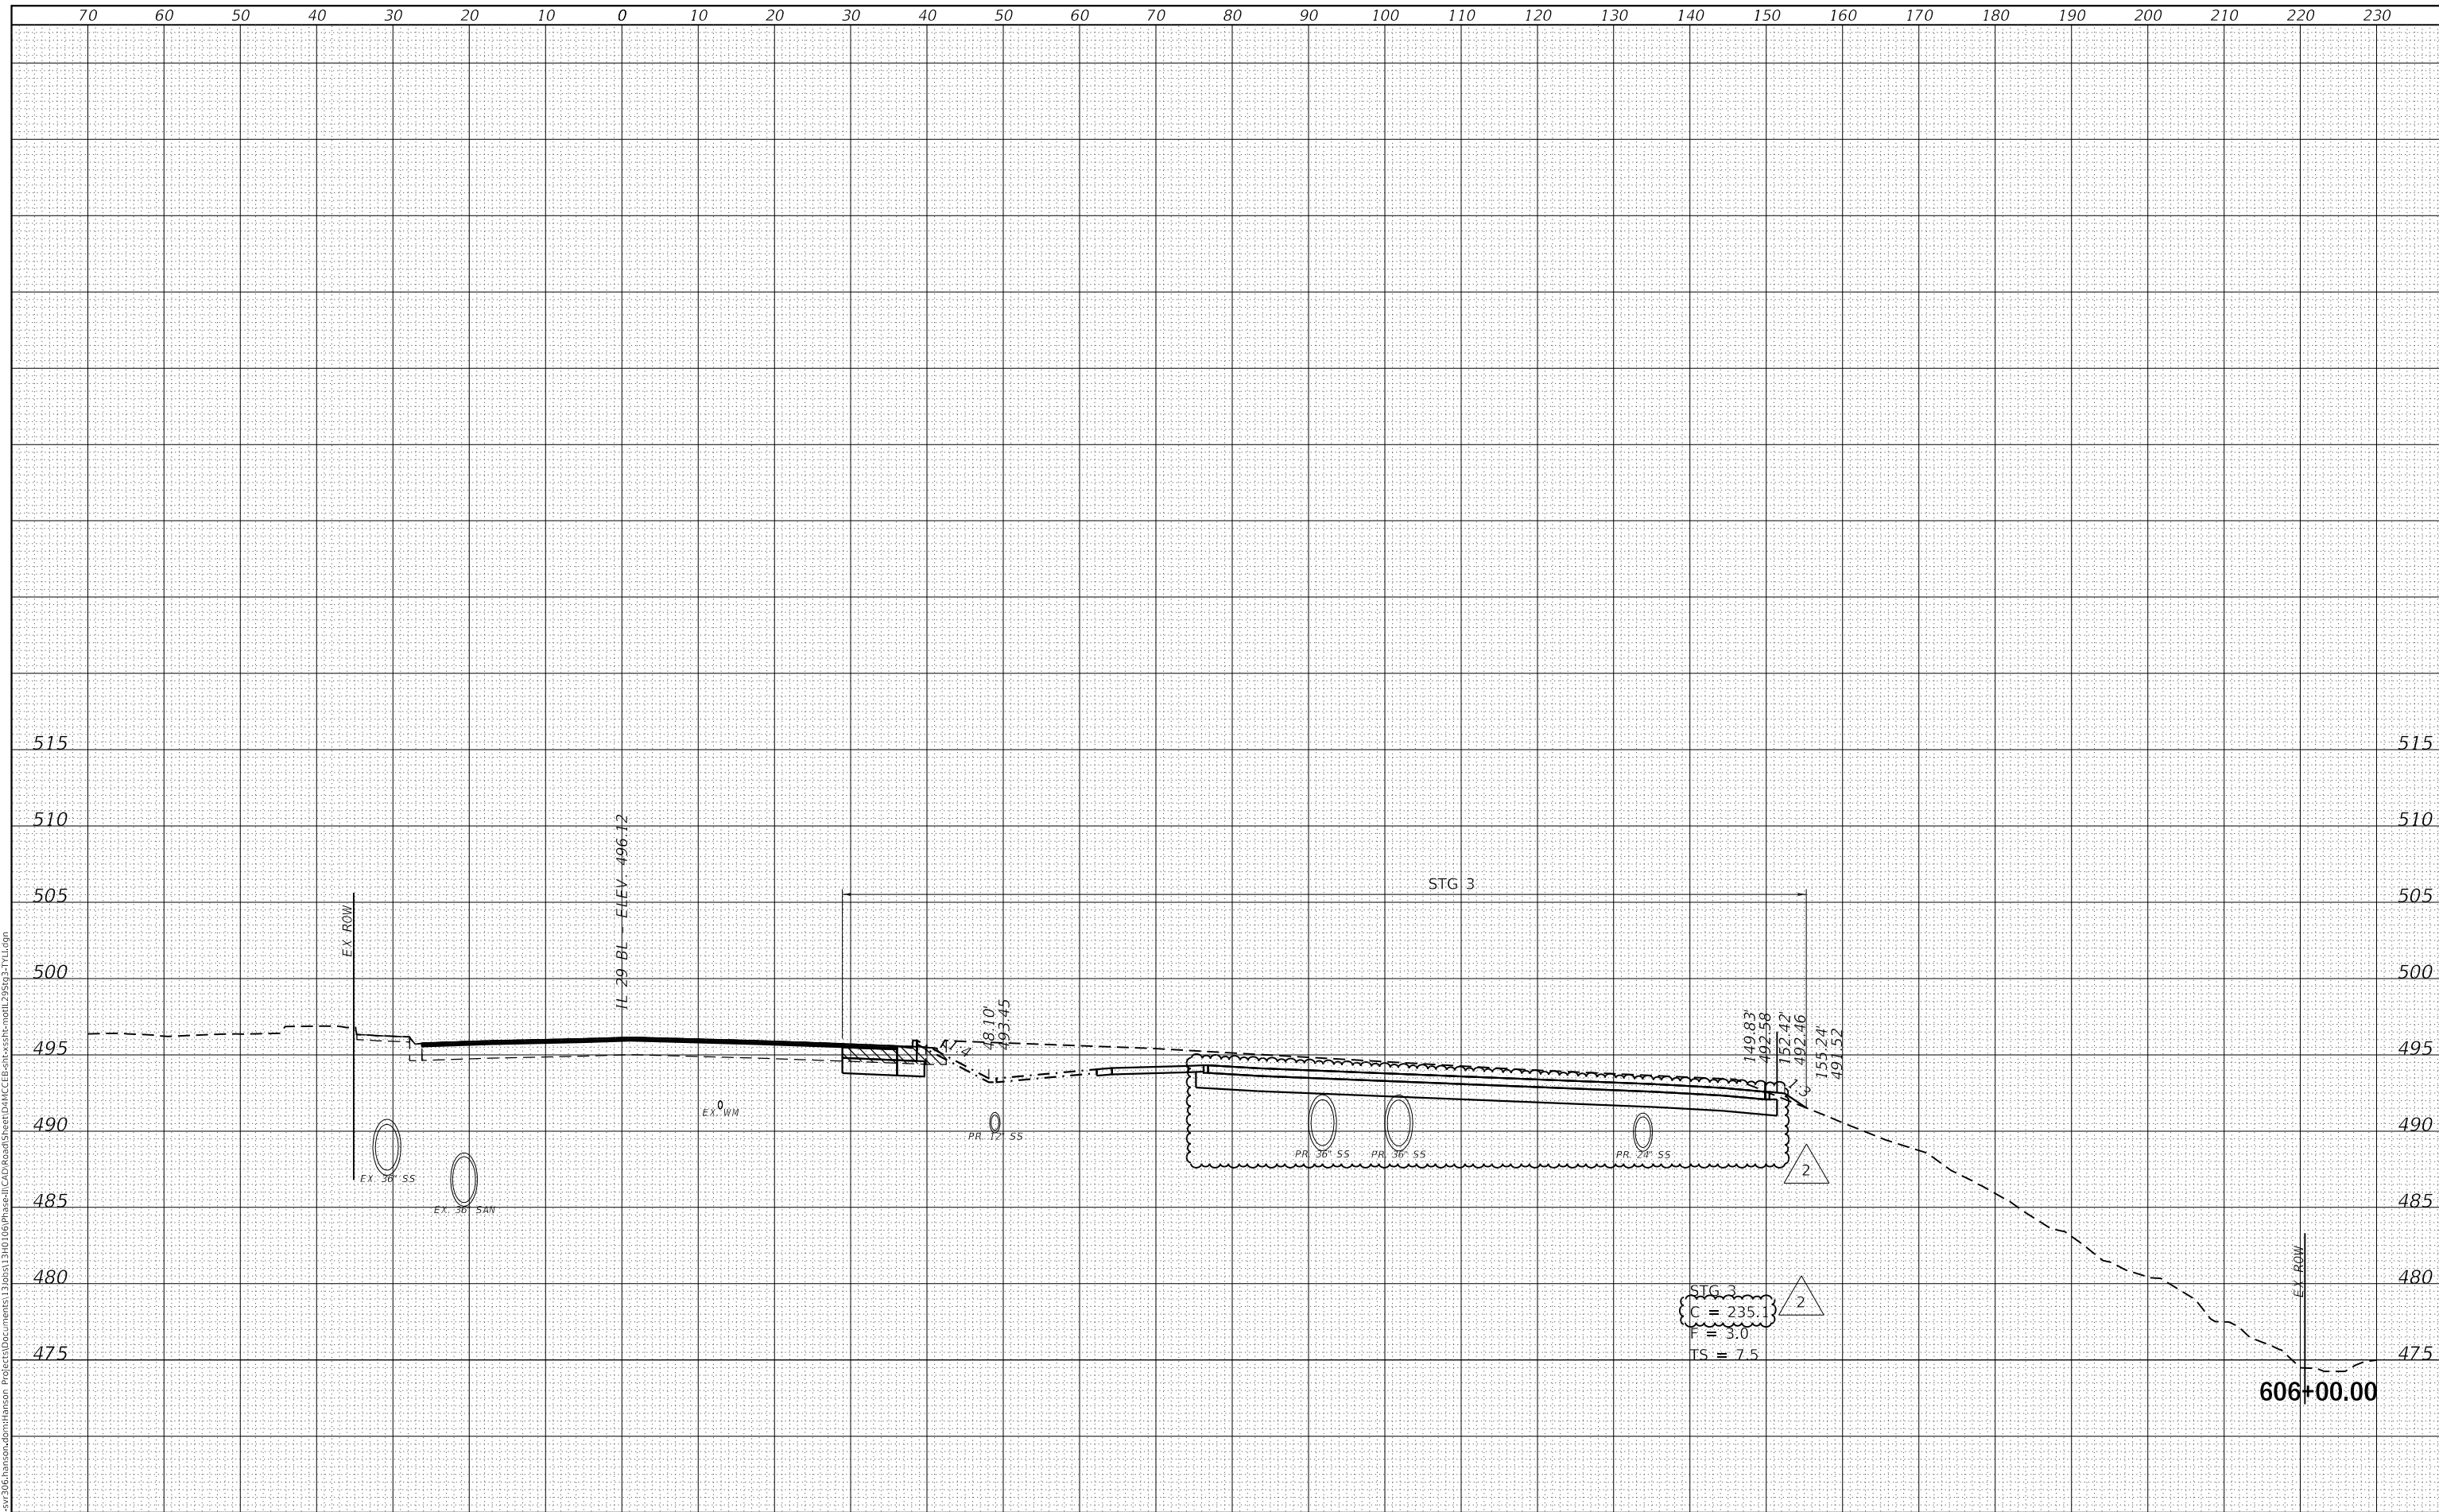

FINAL SUBMITTAL  
MODEL: D:\mfrt  
FILE NAME: D:\projects\306\_hanson\cambrian\hanson\cambrian\Project\Documents\1308513\3D\06\Phase3\CAD\Road\Sheet\DAI\CE\CE.ctb

**TYLIN INTERNATIONAL**  
200 S. WACKER DR.  
SUITE 1400  
CHICAGO, IL 60606  
TEL: 312-777-2900

USER NAME = mgormely
PLOT SCALE = 20.00' / in.
PLOT DATE = 4/5/2019

DESIGNED - MPG
DRAWN - MPG
CHECKED - DAI
DATE - 11/28/2018

REVISED - 4/16/2019
REVISED -
REVISED -
REVISED -

STATE OF ILLINOIS  
DEPARTMENT OF TRANSPORTATION

US 150 EASTBOUND MCLUGAGE BRIDGE PROJECT  
STAGE 3: IL RTE 29


SCALE: 1"=10'H,5'V SHEET OF 13 SHEETS STA. 606+00.00 TO STA. 606+00.00

F.A.P. RTE.	SECTION	COUNTY	TOTAL SHEETS	SHEET NO.
317	[15B;((102-1),(14HB))BR]BR	PEORIA	1361	304
CONTRACT NO. 68B46				
ILLINOIS FED. AID PROJECT NHPP-YRP3(905)				

FINAL SURVEY NO.	SURVEYED	DATE
NOTE BOOK	PLOTTED	
AREAS CHECKED	TEMPLATE	
	AREAS CHECKED	

ORIGINAL SURVEY NO.	SURVEYED	DATE
NOTE BOOK	PLOTTED	
AREAS CHECKED	TEMPLATE	
	AREAS CHECKED	

FINAL SUBMITTAL  
 MODEL: D:\mfrt  
 FILE NAME: D:\projects\306\_hanson\cambrian\station\Project\Documents\1308513\3D\106\Phase3\CAD\Road\Sheet\DAI\CE\c311.dgn

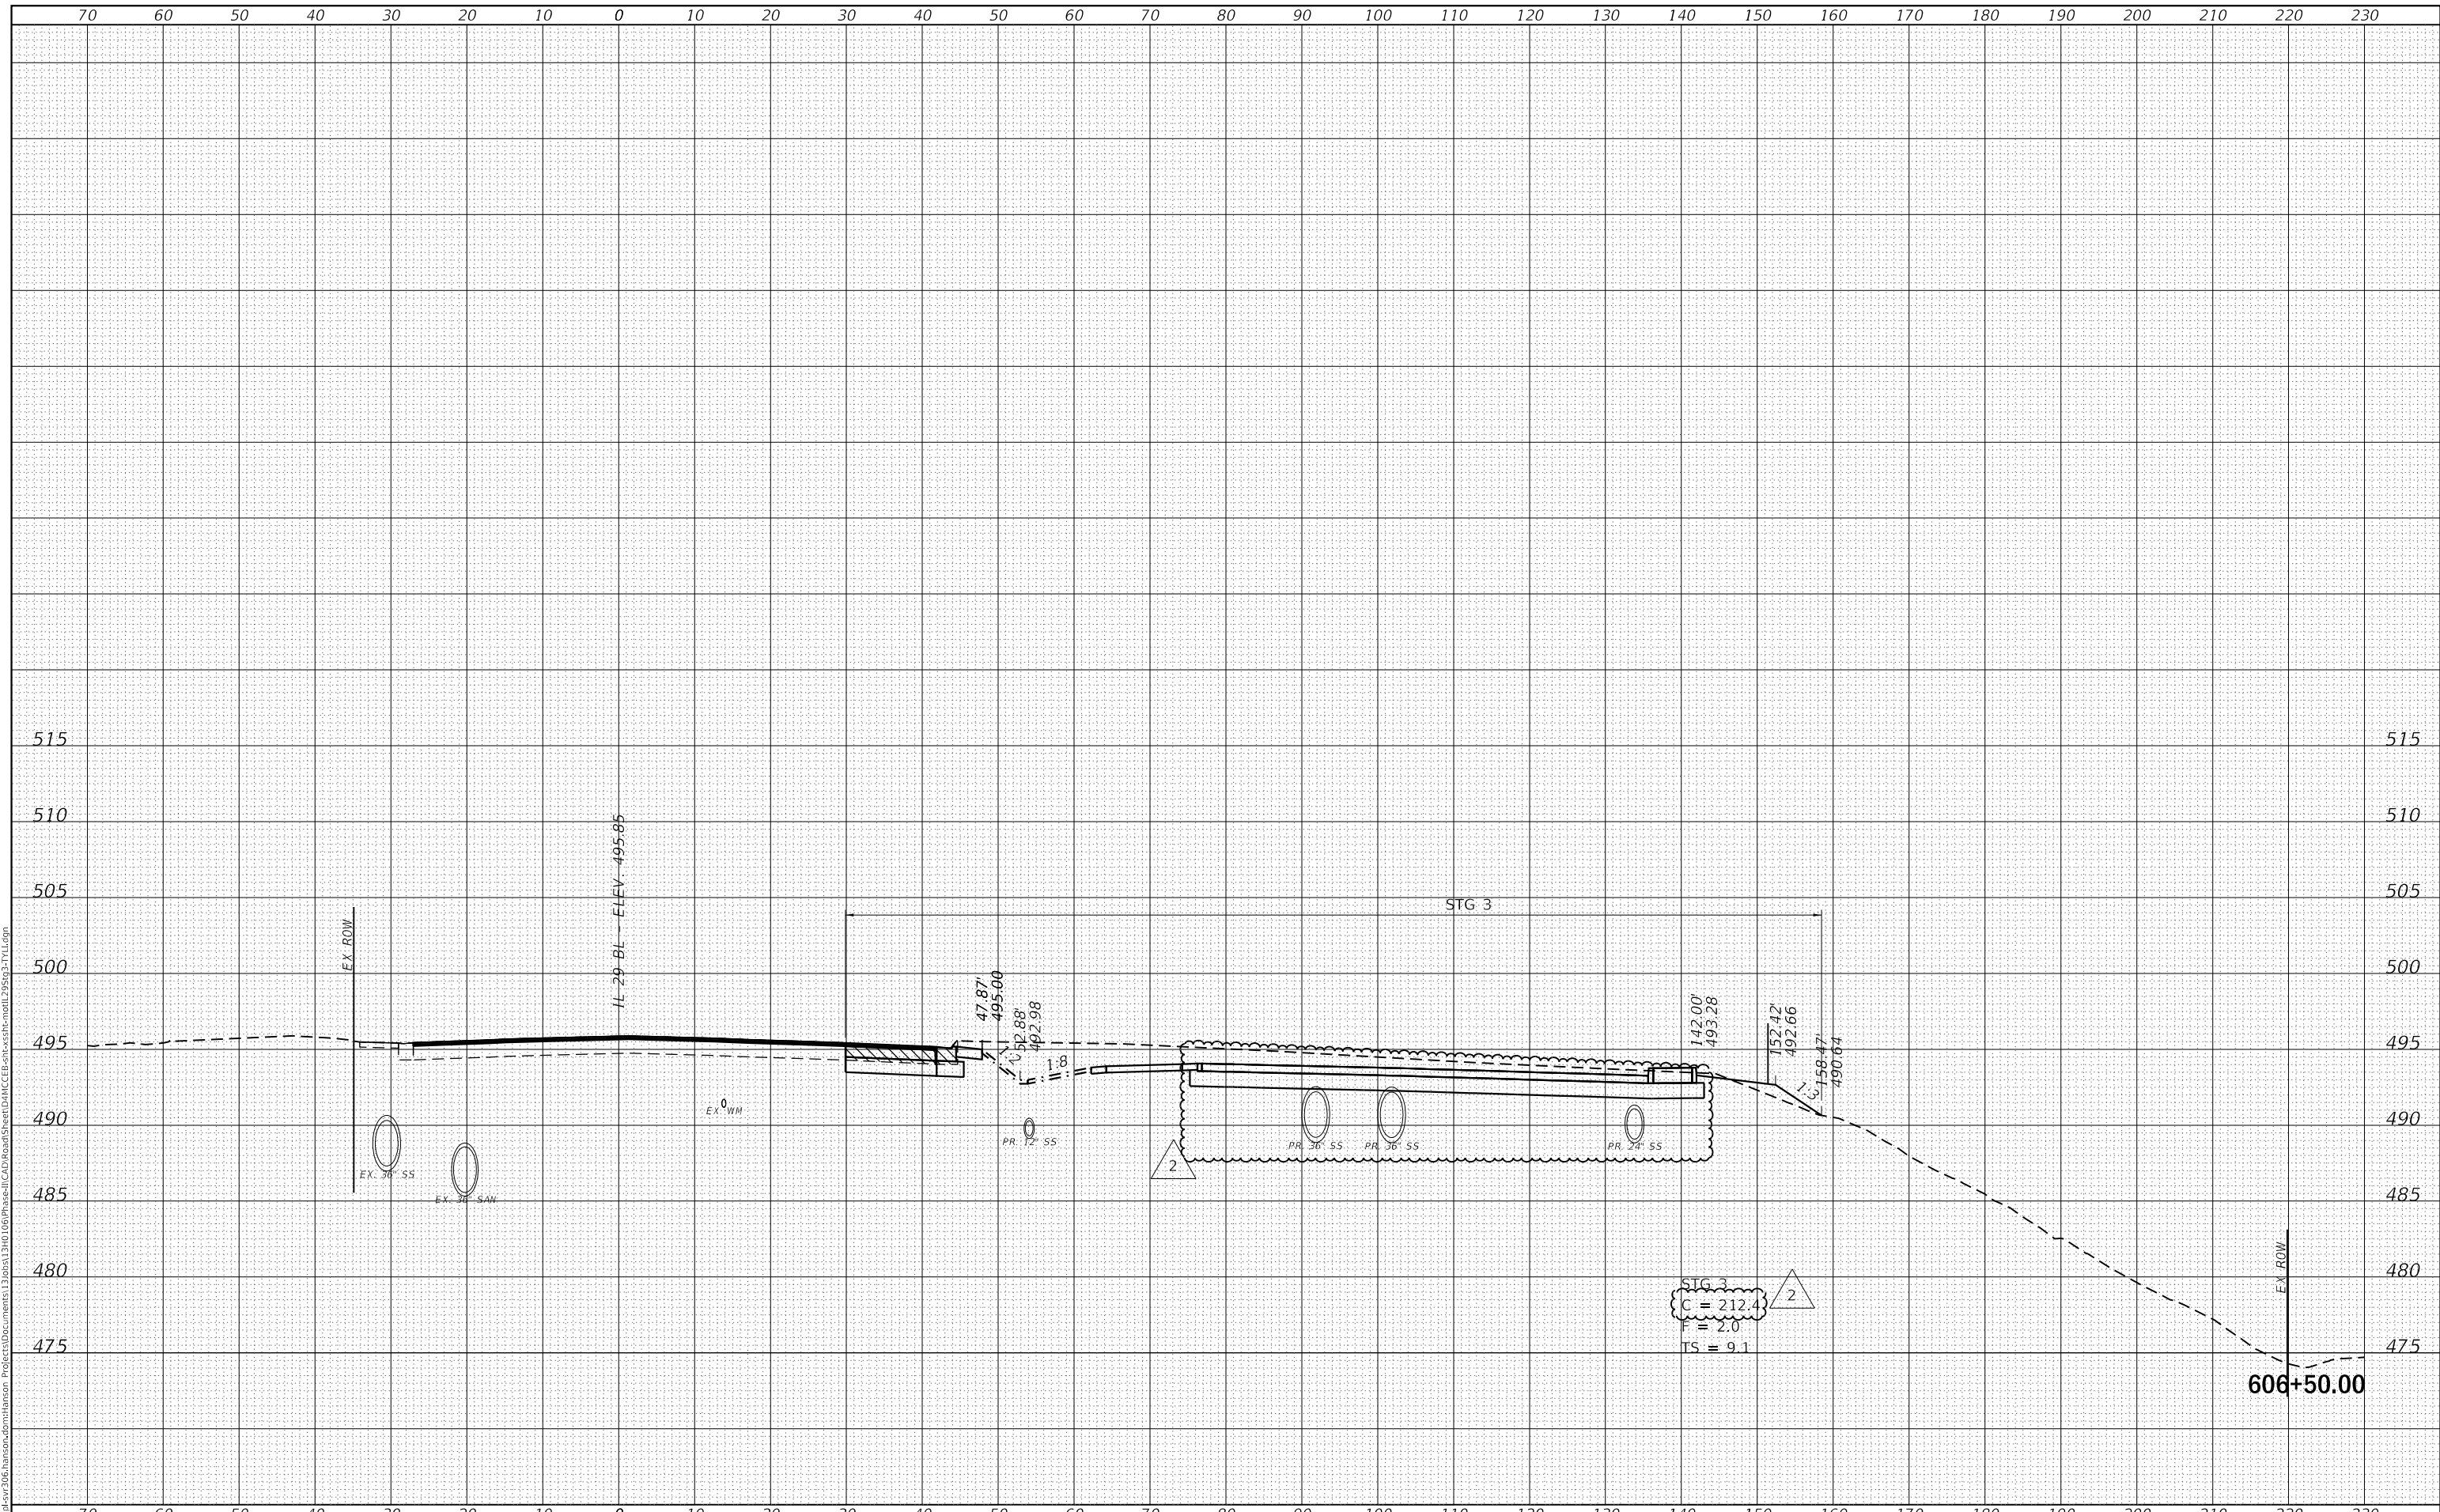

**TYLIN INTERNATIONAL**  
 200 S. WACKER DR.  
 SUITE 1400  
 CHICAGO, IL 60606  
 TEL: 312-777-2900

USER NAME = mgormely
PLOT SCALE = 20.00' / in.
PLOT DATE = 4/5/2019

DESIGNED - MPG
DRAWN - MPG
CHECKED - DAI
DATE - 11/28/2018

REVISED - 4/16/2019
REVISED -
REVISED -
REVISED -

STATE OF ILLINOIS  
 DEPARTMENT OF TRANSPORTATION

US 150 EASTBOUND MCCLUGAGE BRIDGE PROJECT  
 STAGE 3: IL RTE 29  
 SCALE: 1"=10'H,5"V SHEET OF 13 SHEETS STA. 606+50.00 TO STA. 606+50.00

F.A.P. RTE.	SECTION	COUNTY	TOTAL SHEETS	SHEET NO.
317	[15B;((102-1),(14HB))BR]BR	PEORIA	1361	305
CONTRACT NO. 68B46				
ILLINOIS FED. AID PROJECT NHPP-YRP3(905)				

FINAL SUBMITTAL



MODEL: Default  
 FILE NAME: p:\us150\erod\erod.dwg  
 PROJECT: Documents\13\jobs\1340\06Phase\Road\Sheet\EROD\EROD.dwg

**LEGEND:**

- TEMPORARY DITCH CHECK
- PERIMETER EROSION BARRIER
- INLET AND PIPE PROTECTION
- TEMPORARY FENCE
- EROSION CONTROL BLANKET
- TURF REINFORCEMENT MAT
- FLOWLINE FOR PROPOSED DITCH
- CONSTRUCTION LIMIT
- TREE PROTECTION (SEE DETAIL)
- MULCH, METHOD 2

NOTE: INLET FILTERS TO BE USED IN ALL INLETS

RETURN TEMPORARY WETLAND DISTURBANCE AREAS TO PRE-CONSTRUCTION CONTOURS AND CONDITIONS FOLLOWING CONSTRUCTION ACTIVITY.

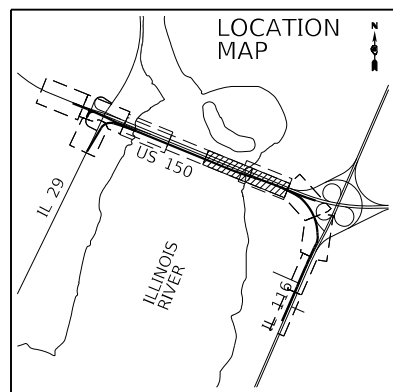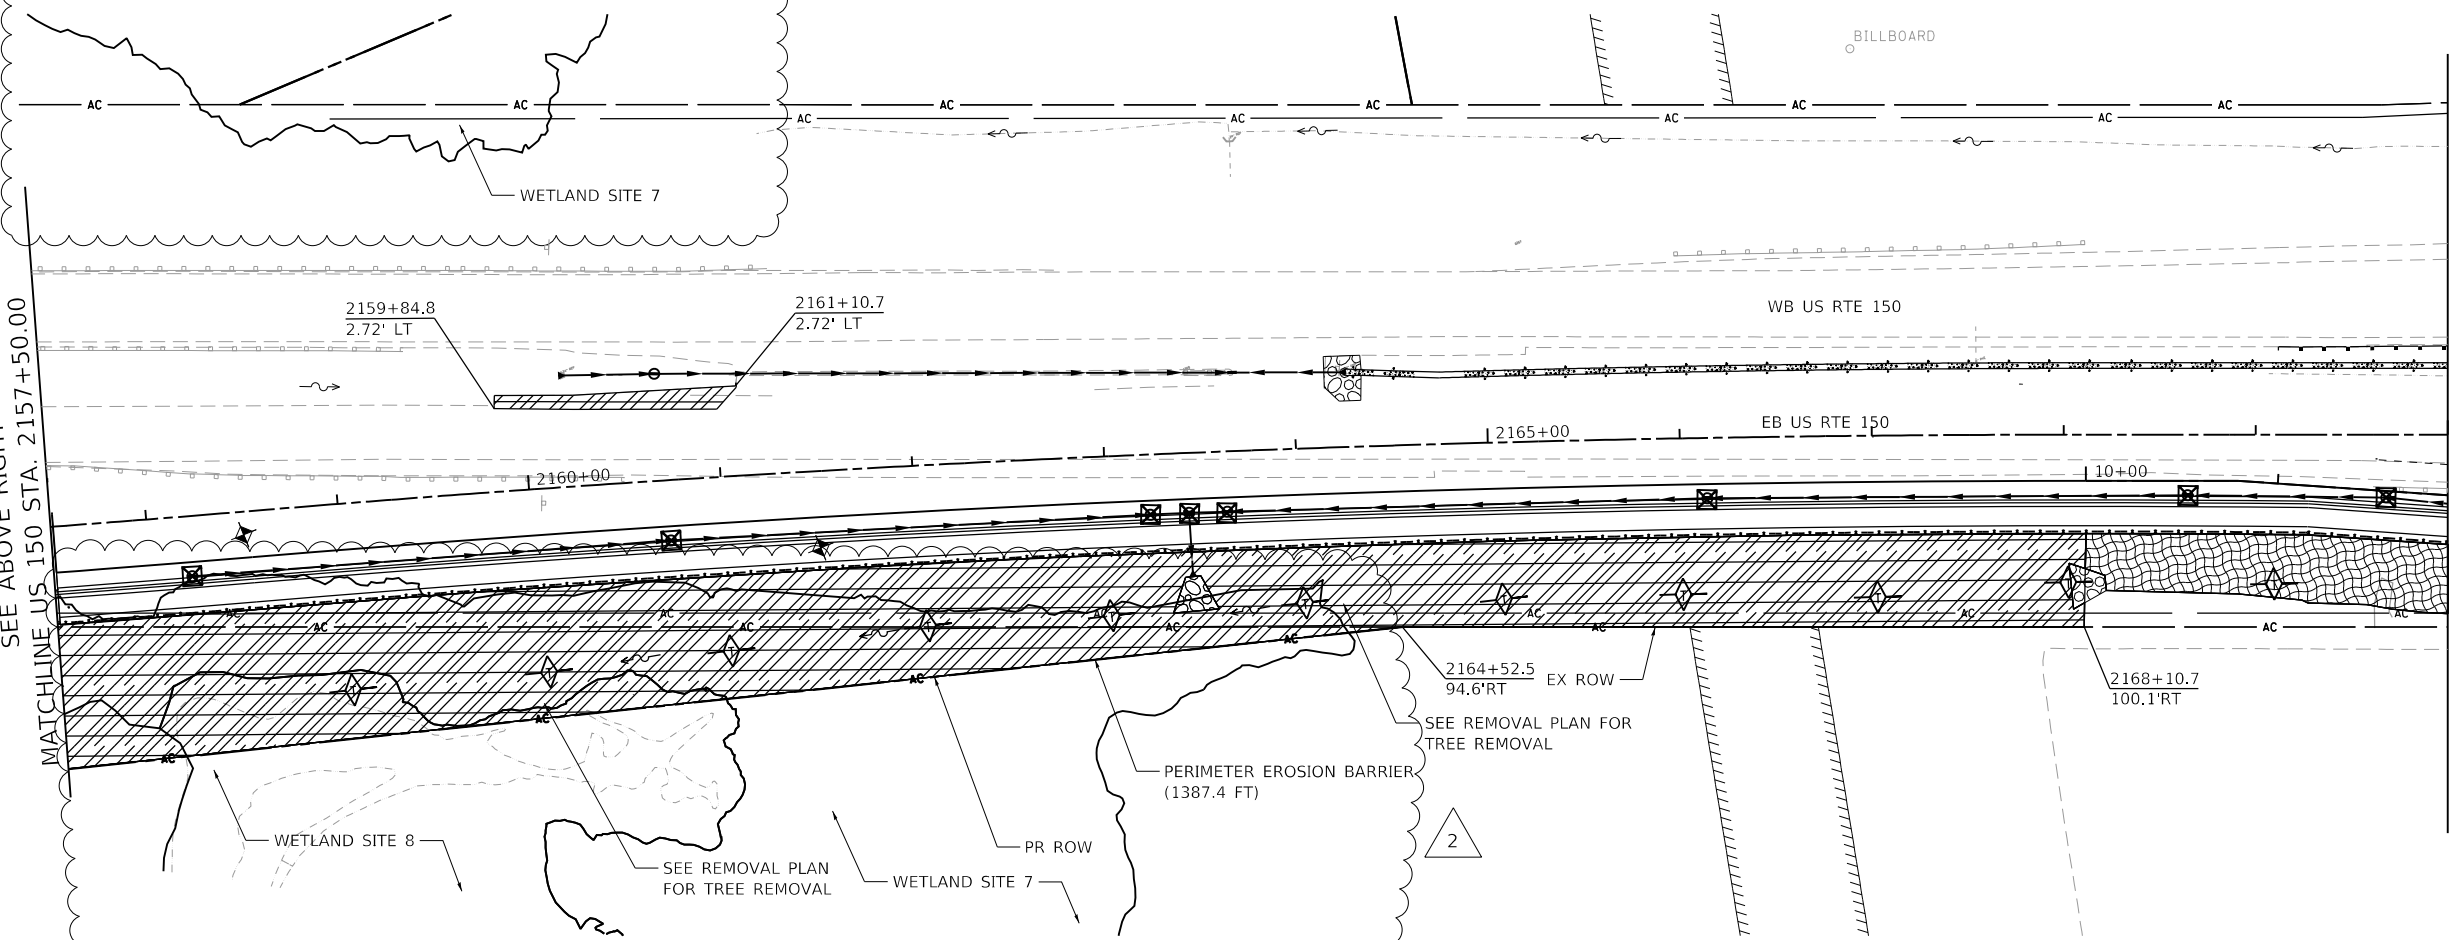

USER NAME = rwatson	DESIGNED - TN	REVISED - 2/04/16/2019
PLOT SCALE = 100.00' / in.	DRAWN - JP	REVISED -
PLOT DATE = 4/4/2019	CHECKED - TN	REVISED -
	DATE - 11/28/2018	REVISED -

STATE OF ILLINOIS  
 DEPARTMENT OF TRANSPORTATION



US 150 EASTBOUND McCLUGAGE BRIDGE PROJECT  
 EROSION CONTROL PLAN - STAGE 1 AND 2

SCALE: 1"=50' SHEET 4 OF 17 SHEETS STA. 2157+00.00 TO STA. 2170+00.00

F.A.P. RTE.	SECTION	COUNTY	TOTAL SHEETS	SHEET NO.
317	[15B;((102-1),(14HB))BR]BR	TAZEWELL	1361	476
CONTRACT NO. 68B46			ILLINOIS FED. AID PROJECT NHPP-YRP3(905)	

EC-04



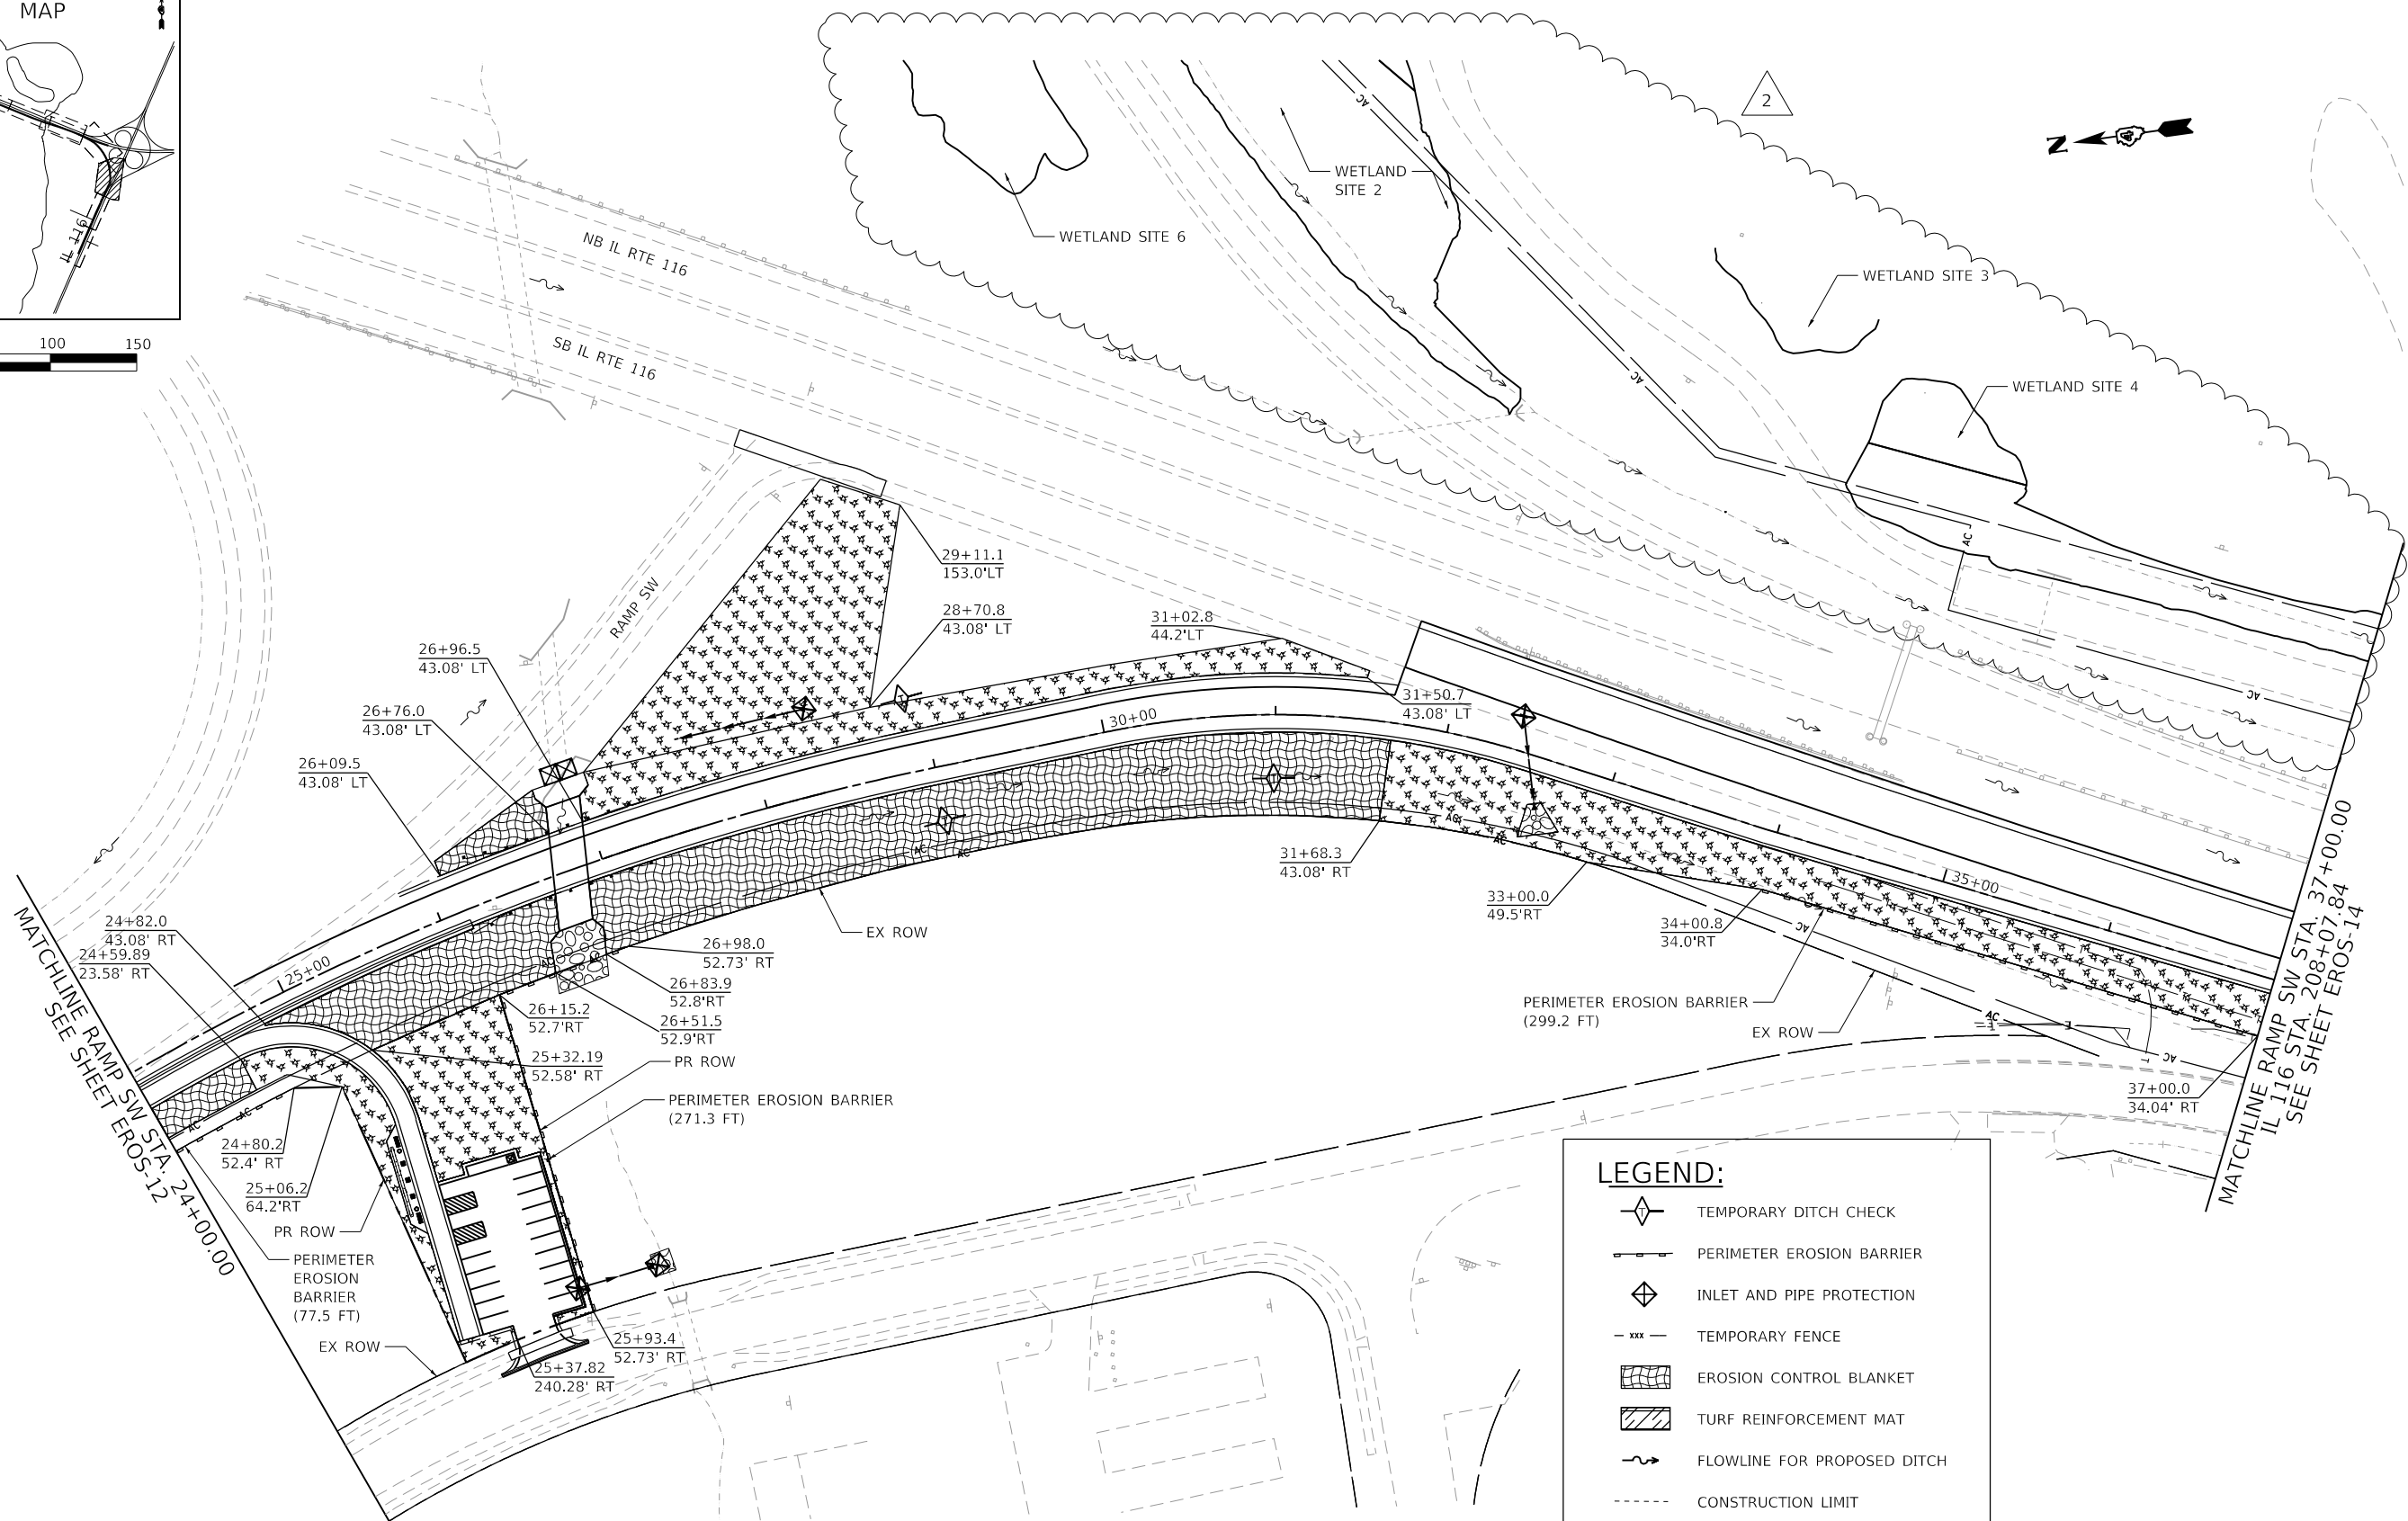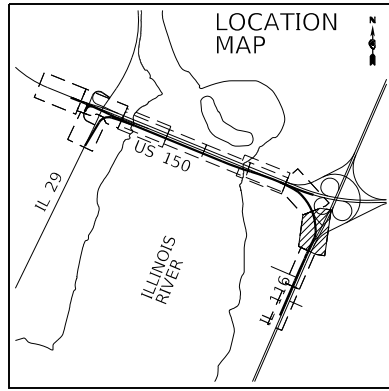

MATCHLINE RAMP SW STA. 24+00.00  
SEE SHEET EROS-12

MATCHLINE RAMP SW STA. 37+00.00  
IL 116 STA. 208+07.84  
SEE SHEET EROS-14

**LEGEND:**

- TEMPORARY DITCH CHECK
- PERIMETER EROSION BARRIER
- INLET AND PIPE PROTECTION
- TEMPORARY FENCE
- EROSION CONTROL BLANKET
- TURF REINFORCEMENT MAT
- FLOWLINE FOR PROPOSED DITCH
- CONSTRUCTION LIMIT
- TREE PROTECTION (SEE DETAIL)
- MULCH, METHOD 2

NOTE: INLET FILTERS TO BE USED IN ALL INLETS

RETURN TEMPORARY WETLAND DISTURBANCE AREAS TO PRE-CONSTRUCTION CONTOURS AND CONDITIONS FOLLOWING CONSTRUCTION ACTIVITY.

FINAL SUBMITTAL

MODEL: Default  
FILE NAME: p:\projects\2016\hanson\dom\hanson\_projects\1340106\Phase-1\CAD\Road\Sheet\DMCEP-14-EROS-13-MUL.dwg




USER NAME = rwatson	DESIGNED - TN	REVISED - 2 (04/2019)
DRAWN - JP	REVISIONS -	
PLOT SCALE = 100.00' / in.	CHECKED - TN	REVISIONS -
PLOT DATE = 4/4/2019	DATE - 11/28/2018	REVISIONS -

STATE OF ILLINOIS  
DEPARTMENT OF TRANSPORTATION




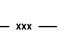

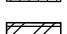
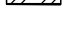



US 150 EASTBOUND McCLUGAGE BRIDGE PROJECT  
EROSION CONTROL PLAN - STAGE 1 AND 2  
SCALE: 1"=50' SHEET 6 OF 17 SHEETS STA. 24+00.00 TO STA. 37+00.00

F.A.P. RTE.	SECTION	COUNTY	TOTAL SHEETS	SHEET NO.
317	[15B:((102-1),(14HB))BR]BR	TAZEWELL	1361	478
ILLINOIS FED. AID PROJECT			CONTRACT NO. 68B46	
			NHPP-YRP3(905)	

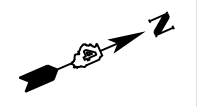
EC-06

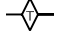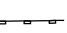

**LEGEND:**

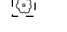-  TEMPORARY DITCH CHECK
-  PERIMETER EROSION BARRIER
-  INLET AND PIPE PROTECTION
-  TEMPORARY FENCE
-  EROSION CONTROL BLANKET
-  TURF REINFORCEMENT MAT
-  FLOWLINE FOR PROPOSED DITCH
-  CONSTRUCTION LIMIT
-  TREE PROTECTION (SEE DETAIL)
-  MULCH, METHOD 2



NOTE: INLET FILTERS TO BE USED IN ALL INLETS

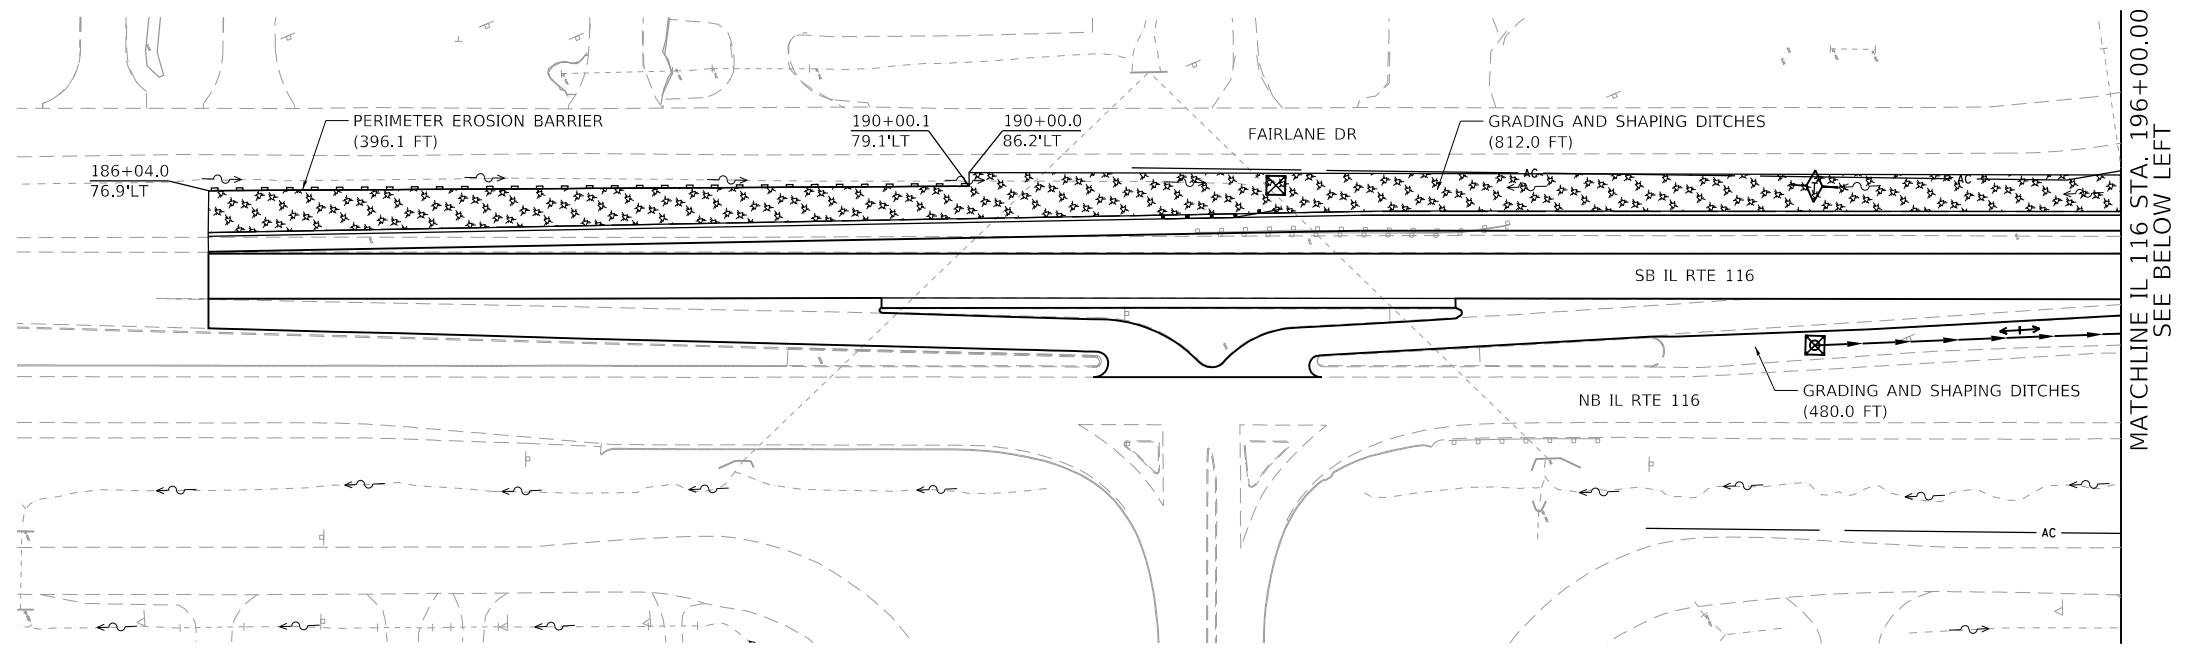

MATCHLINE IL 116 STA. 196+00.00  
SEE BELOW LEFT




RETURN TEMPORARY WETLAND DISTURBANCE AREAS TO PRE-CONSTRUCTION CONTOURS AND CONDITIONS FOLLOWING CONSTRUCTION ACTIVITY.

2

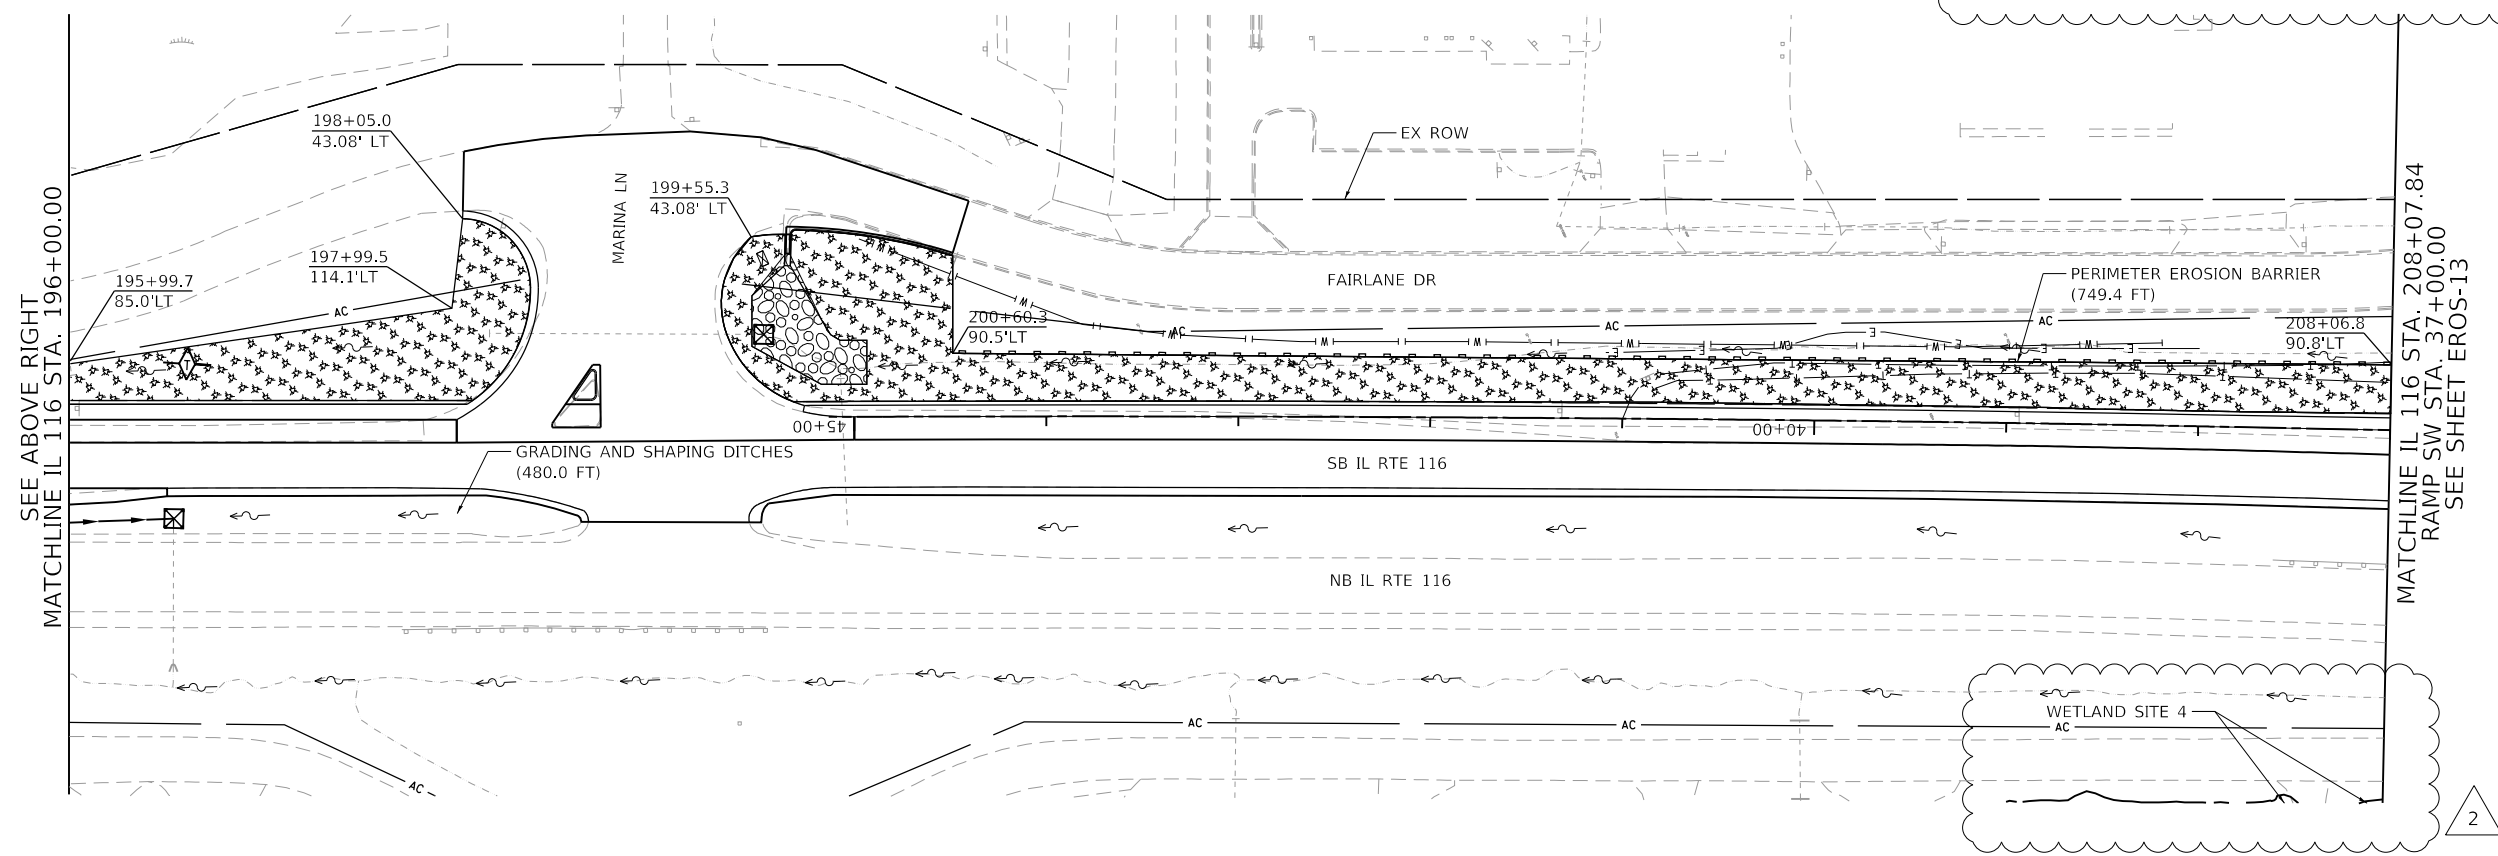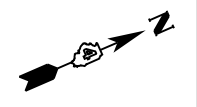

MATCHLINE IL 116 STA. 196+00.00  
SEE ABOVE RIGHT

MATCHLINE IL 116 STA. 208+07.84  
RAMP SW STA. 37+00.00  
SEE SHEET EROS-13

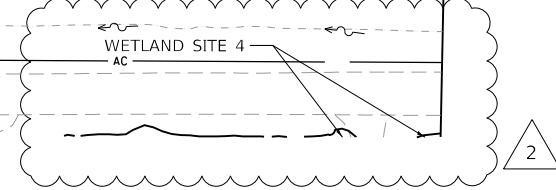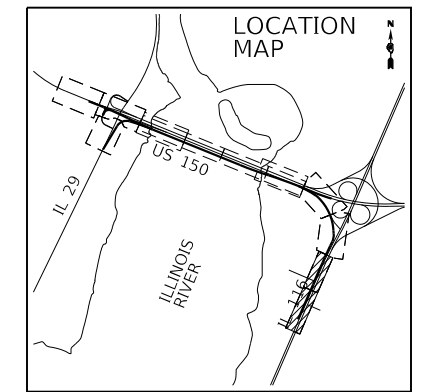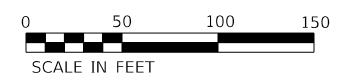

2

FINAL SUBMITTAL

MODEL: Default  
FILE: I:\A\ME: p\submittal\2016\hanson\dom\hanson\_projects\Documents\13\08\13\40\06\Phase-1\CD\Road\Street\DMCEP-sh-erosion-14.mxd



USER NAME = r.watson	DESIGNED - TN	REVISED - 04/16/2019
DRAWN - JP	REVISIONS -	
PLOT SCALE = 100.00' / in.	CHECKED - TN	REVISIONS -
PLOT DATE = 4/4/2019	DATE - 11/28/2018	REVISIONS -

STATE OF ILLINOIS  
DEPARTMENT OF TRANSPORTATION


US 150 EASTBOUND McCLUGAGE BRIDGE PROJECT  
EROSION CONTROL PLAN - STAGE 1 AND 2  
SCALE: 1"=50' SHEET 7 OF 17 SHEETS STA. 185+00.00 TO STA. 196+00.00

F.A.P. RTE.	SECTION	COUNTY	TOTAL SHEETS	SHEET NO.
317	[15B;((102-1),(14HB))BR]BR	TAZEWELL	1361	479
			CONTRACT NO. 68B46	
			ILLINOIS FED. AID PROJECT NHPP-YRP3(905)	


EC-07

STRUCTURE NUMBER	STATION	OFFSET	RIM ELEV.	INVERT ELEV.	STRUCTURE TYPE
119	613+34.59	68.93' LT.	490.07	480.35N; EX479.33S+/-	PRO SS CONN TO EX. MAN
120	613+39.50	33.36' RT.	490.13	486.03W	INLET, TYPE G-1, SPECIAL
121	605+65.09	31.01' RT.	495.87	490.92SW; 490.92SE	INLET, TYPE G-1, DBL SPECIAL
122	605+58.16	30.01' RT.	495.93	491.00NE	INLET, TYPE G-1
123	605+12.86	27.24' RT.	496.25	491.25SE	INLET, TYPE G-1
124	605+12.57	42.17' RT.	496.38	491.07NW; EX491.07SW; EX491.07NE	MANHOLE TA 4' DIA T1 CL SET OVER
125	605+63.06	45.07' RT.	493.80	490.80NW; EX490.80SW; 490.60NE	MANHOLE TA 4' DIA T8G
126	1500+63.05	21.04' RT.	491.66	488.83NW; 486.97 SW; 485.97NE	MANHOLE TA 4' DIA T8G
127	1501+50.00	23.74' RT.	491.00	488.21NW; 485.10SW; 485.10NE	MANHOLE TA 4' DIA T8G
128	1503+17.53	24.90' RT.	489.75	483.71NW; 483.42SE; 483.42NE	MANHOLE TA 4' DIA T8G
129	1503+84.02	21.41' RT.	491.88	482.75SW; 486.25NE; 471.20NW; 471.20SE	MANHOLE TA 7' DIA T8G, SET OVER
130	610+76.60	42.58' RT.	492.62	EX488.61W; 484.90N; 484.90SE	INLET, TYPE G-1, SPECIAL
131	611+26.55	40.33' RT.	492.24	485.40S	INLET, TYPE G-1, SPECIAL
132*	1505+40.87	14.50' RT	497.04	493.50SE	TYPE F INLET BOX 610001
133	1505+38.60	46.35' RT.	---	488.52	PRC FLARED END SECTION 12"
134	603+48.68	30.15' LT.	496.41	488.74SW; 488.74NE+/-	INLET, TYPE G-1
135	603+80.68	31.72' LT.	496.68	488.63W; 492.55NE	MANHOLE TA 5' DIA T1 CL
136	603+86.92	60.21' LT.	498.04	494.00N; 494.00E	INLET, TYPE G-1
137	604+13.09	60.14' LT.	498.31	494.30S	INLET, TYPE G-1
138	610+71.90	174.65' LT.	---	489.55NE	INLET ADJ. NEW F&G SPL.
139	611+26.13	32.28' RT.	---	---	MAN ADJ NEW T1F CL
140	1500+62.14	6.00' RT	493.97	488.97SE	DR STR T5 W/1 T22F&G
141	1501+50.00	6.00' RT	493.38	488.38SE	DR STR T5 W/1 T22F&G
142	1502+97.53	6.00' RT	492.45	487.54NE	DR STR T4 W/1 T20F&G
143	1503+07.53	6.00' RT	492.44	487.44SW; 487.44NE	DR STR T5 W/1 T22F&G
144	1503+17.53	6.00' RT	492.45	487.34SW; 484.51NW; 484.25SE	DR STR T4 W/1 T20F&G
145	1504+37.25	11.30' RT	493.87	488.86SW	DR STR T5 W/1 T22F&G
146**	605+60.45	144.83' RT	492.46	488.75	MH TA 6D T3FGT1CLR SEE DETAIL
147	605+60.45	163.76' RT	---	488.50	PRC FLARED END SECTION 12"


\*STATION, OFFSET, AND ELEVATION GIVEN FOR 132\* IS TO FACE OF BARRIER AT CENTERLINE OF PROPOSED GRATE.  
 \*\*STATION, OFFSET, AND ELEVATION GIVEN FOR 146 IS TO FACE OF CURB AT CENTERLINE OF PROPOSED GRATE.

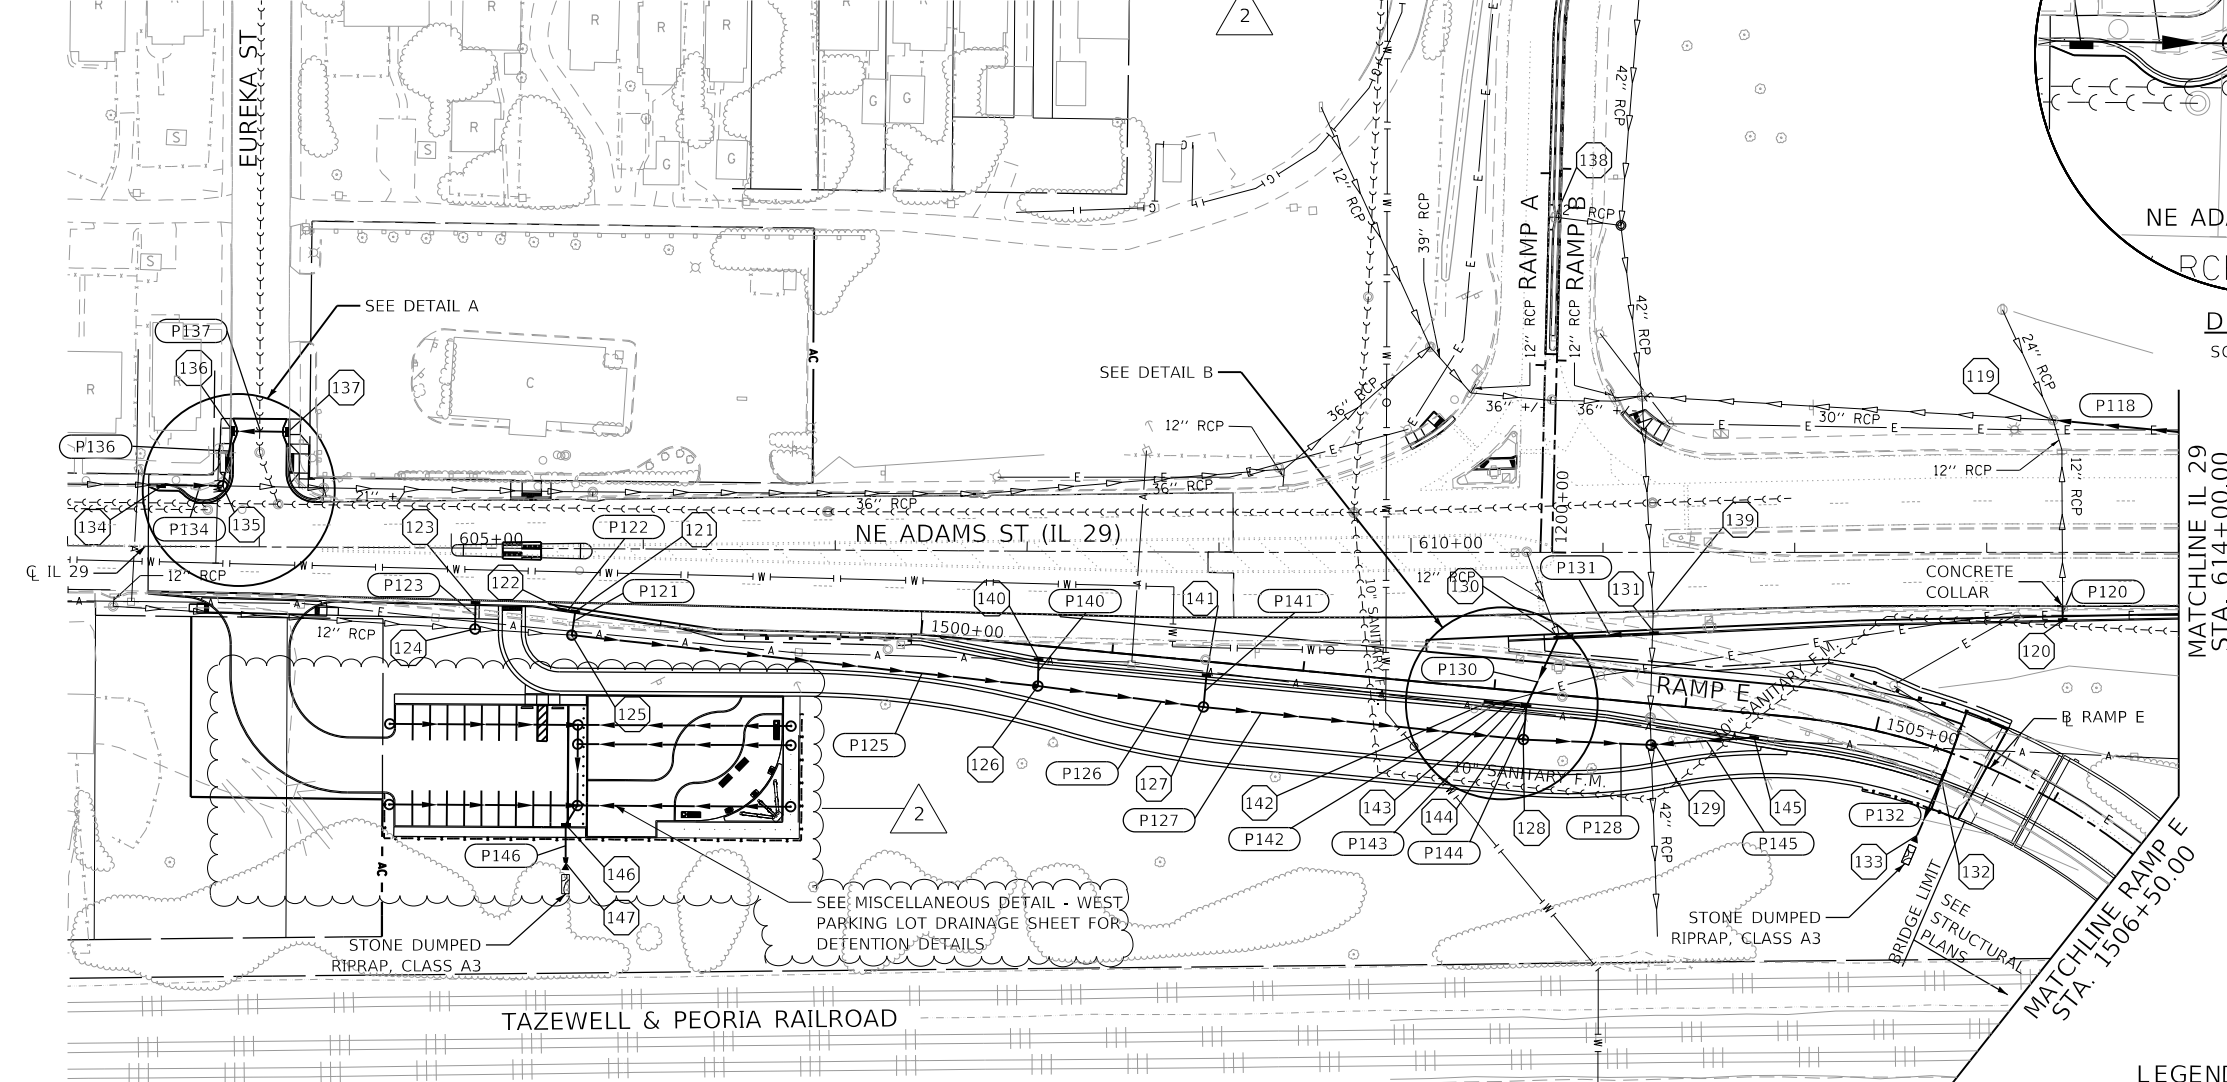



PIPE NUMBER	DESCRIPTION	LENGTH	TRENCH BACKFILL
P118	STORM SEWER, CLASS A, TYPE 2 - 12"	---	---
P120	STORM SEWER, CLASS A, TYPE 2 - 12"	5 FT	0.8 CU YD
P121	STORM SEWER, CLASS A, TYPE 2 - 12"	9 FT	0.5 CU YD
P122	STORM SEWER, CLASS A, TYPE 2 - 12"	4 FT	1.0 CU YD
P123	STORM SEWER, CLASS A, TYPE 2 - 12"	10 FT	0.5 CU YD
P125	STORM SEWER, CLASS A, TYPE 2 - 12"	240 FT	---
P126	STORM SEWER, CLASS A, TYPE 2 - 15"	83 FT	---
P127	STORM SEWER, TYPE 2, WAT MN - 15"	164 FT	---
P128	STORM SEWER, CLASS A, TYPE 2 - 15"	61 FT	---
P130	STORM SEWER, CLASS A, TYPE 2 - 12"	36 FT	29.6 CU YD
P131	STORM SEWER, CLASS A, TYPE 2 - 12"	47 FT	32.2 CU YD
P132	STORM SEWER, CLASS A, TYPE 2 - 12"	32 FT	4.3 CU YD
P134	STORM SEWER, TYPE 3 WAT MN - 27"	28 FT	25.6 CU YD
P136	STORM SEWER, TYPE 2, WAT MN - 12"	25 FT	3.8 CU YD
P137	STORM SEWER, CLASS A, TYPE 2 - 12"	26 FT	3.7 CU YD
P140	STORM SEWER, CLASS A, TYPE 2 - 12"	6 FT	0.5 CU YD
P141	STORM SEWER, CLASS A, TYPE 2 - 12"	9 FT	0.6 CU YD
P142	STORM SEWER, CLASS A, TYPE 2 - 12"	6 FT	1.5 CU YD
P143	STORM SEWER, CLASS A, TYPE 2 - 12"	6 FT	1.5 CU YD
P144	STORM SEWER, CLASS A, TYPE 2 - 15"	10 FT	1.9 CU YD
P145	STORM SEWER, CLASS A, TYPE 2 - 12"	48 FT	6.1 CU YD
P146	STORM SEWER, CLASS A, TYPE 2 - 12"	18 FT	0.4 CU YD

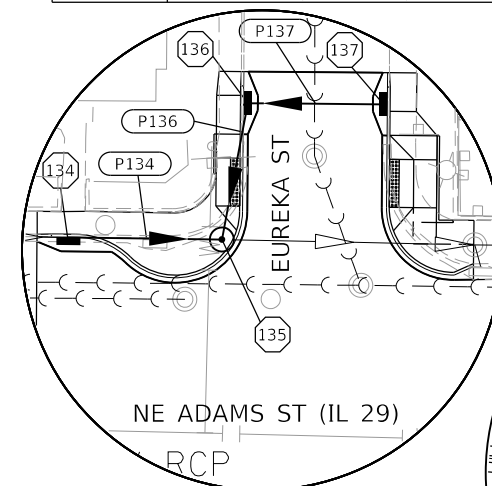

DETAIL A  
SCALE 1"=20'

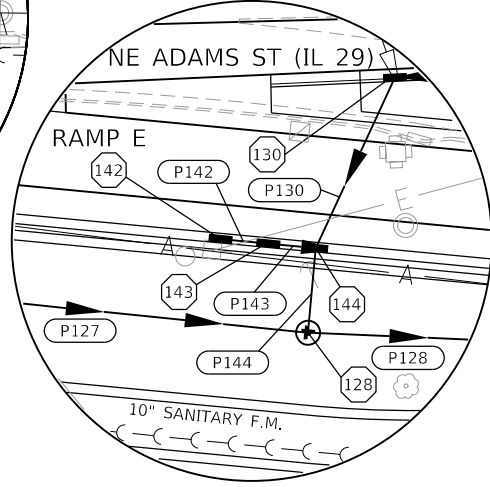

DETAIL B  
SCALE 1"=20'

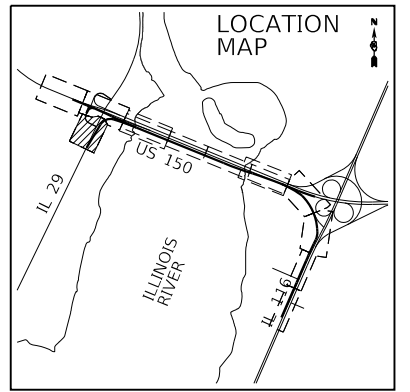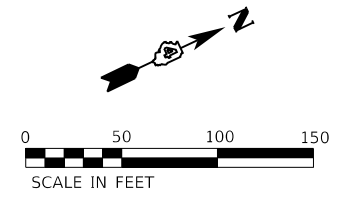

- LEGEND**
- (PXXX) DRAINAGE PIPE
  - (XXX) DRAINAGE STRUCTURE

FINAL SUBMITTAL

**EFK Moen, LLC**  
Civil Engineering Design

USER NAME = MSjllers	DESIGNED - MYS	REVISED - 4/16/2019
PLOT SCALE = 100.00' / in.	DRAWN - MYS	REVISED -
PLOT DATE = 4/3/2019	CHECKED - SLD	REVISED -
	DATE - 11/28/2018	REVISED -

STATE OF ILLINOIS  
DEPARTMENT OF TRANSPORTATION


US 150 EASTBOUND McCLUGAGE BRIDGE PROJECT  
DRAINAGE - PROPOSED PLANS

SCALE: 1"=50' SHEET 3 OF 8 SHEETS STA. 603+00 TO STA. 614+00


F.A.P. RTE.	SECTION	COUNTY	TOTAL SHEETS	SHEET NO.
317	[15B;[(102-1),(14H)]BR]BR	PEORIA	1361	500
ILLINOIS FED. AID PROJECT			CONTRACT NO. 68B46	
NHPY-RP3(905)			PRDRAIN-03	



PLAN	SURVEYED	DATE
	PLOTTED	
NOTE BOOK NO.	ALIGNED	
	CHECKED	
	FILE NAME	

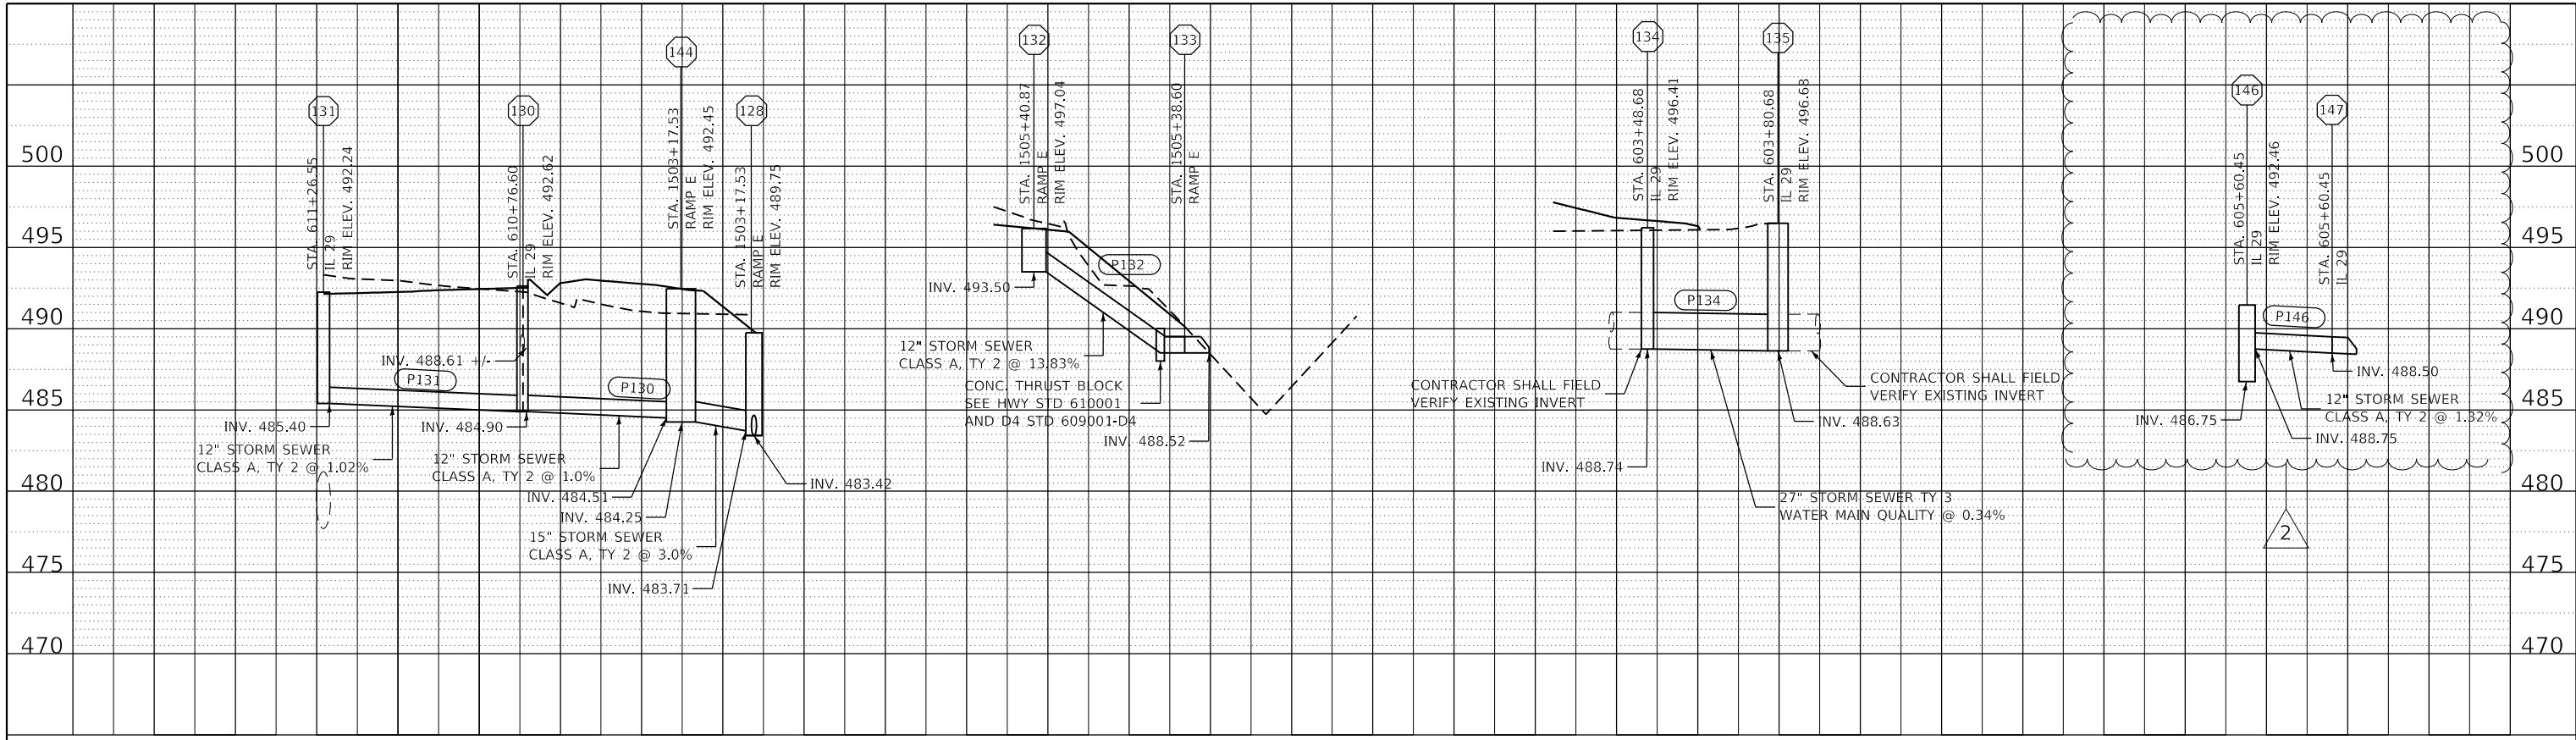

PROFILE	SURVEYED	DATE
	PLOTTED	
NOTE BOOK NO.	GRADES CHECKED	
	STRUCTURE NOTATIONS CHECKED	
	FILE NAME	

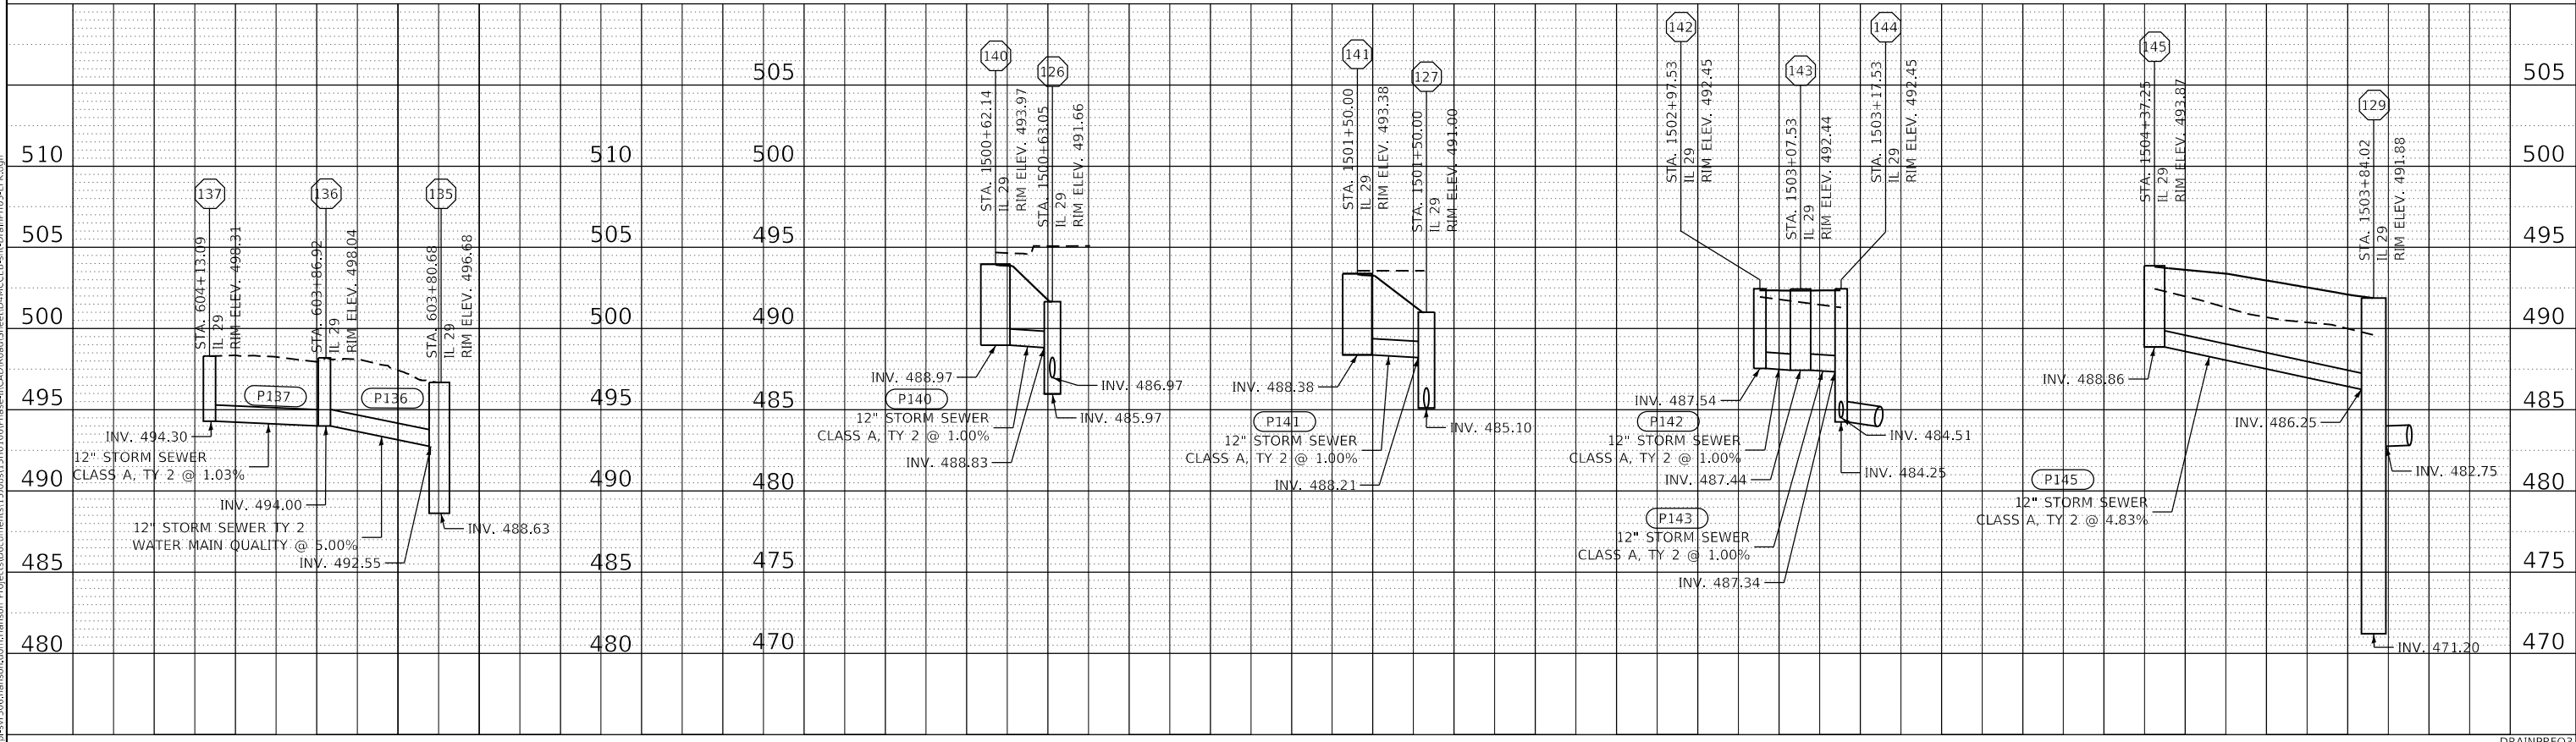

FINAL SUBMITTAL

MODEL: Default  
FILE NAME: p:\15b\15b306\hanson\cdm\hanson\Project\15b306\15b306.dwg

**EFK•Moen, LLC**  
Civil Engineering Design

USER NAME = MSollers  
PLOT SCALE = 40.00' / in.  
PLOT DATE = 4/3/2019

DESIGNED - MYS  
DRAWN - MSK  
CHECKED - SJF  
DATE - 11/28/2018

REVISED - 4/16/2019  
REVISED -  
REVISED -  
REVISED -

STATE OF ILLINOIS  
DEPARTMENT OF TRANSPORTATION

US 150 EASTBOUND MCCLUGAGE BRIDGE PROJECT  
DRAINAGE - PROPOSED PROFILES  
SCALE: 1=20H:1=5V SHEET 3 OF 5 SHEETS STA. N/A TO STA. N/A

F.A.P. RTE.	SECTION	COUNTY	TOTAL SHEETS	SHEET NO.
317	[15B:102-1],[14B:1BR/BR]	PEORIA	1361	508
ILLINOIS FED. AID PROJECT			CONTRACT NO. 68B46	
NHP:YR3(905)				

DRAINPRF03

PROPOSED SIGN SCHEDULE

MC CLUGAGE BRIDGE										SIGN PANELS			SIGN SUPPORTS				BREAKAWAY STEEL SIGN SUPPORT						OVERHEAD SIGN STRUCTURE											
ROUTE	STATION	LT/RT	MUTCD NO./ILSHS	SIGN NO.	LEGEND/ DESCRIPTION	"AA" (FT)	"BB" (FT)	WIDTH (IN)	HEIGHT (IN)	(SQ FT)	SIGN PANEL-TYPE 1 (SQ FT)	SIGN PANEL-TYPE 2 (SQ FT)	SIGN PANEL-TYPE 3 (SQ FT)	TELESCOPING STEEL SIGN SUPPORT (FT)	P1 (FT)	P2 (FT)	PAY LENGTH (FT)	POST SIZE	P1 (FT)	P2 (FT)	P3 (FT)	STRUCTURAL STEEL SIGN SUPPORT-BREAKAWAY (POUND)	(FT)	2.0 DIA (CU YD)	2.5 DIA (CU YD)	3.0 DIA (CU YD)	(CU YD)	OVERHEAD SIGN STRUCTURE - SPAN, TYPE I-A (4'-0" X 4'-6")						
EB US 150	2095+84	RT	M4-5	LP SGN-LP-101-P	TO	7.0	7.0	36.0	18.0	4.5	4.5																							
			M1-4		24			36.0	36.0	9.0	9.0																							
			M6-3		ARROW			30.0	21.0	4.4	4.4																							
EB US 150	2097+24	RT	W2-2	LP SGN-LP-102-P	SIDE ROAD	7.0	7.0	36.0	36.0	9.0	9.0																							
			W13-3		RAMP, 15 MPH			36.0	48.0	12.0	12.0																							
EB US 150	2096+52	RT		SGN-BS-103-P	IL29, ADAMS ST, CHILLICOTHE	9.4	14.9	126.0	120.0	105.0			105.0					W10X22	16.8	23.9		1116.0			2.4									
EB US 150	2108+30	LT		SGN-BR-104-P	150 WEST, NEXT LEFT			102.0	66.0	46.8			46.8																					
EB US 150	2109+29	RT		SGN-BS-105-P	150 EAST, TO 24, ARROW	7.6	7.0	108.0	84.0	63.0			63.0					W6X15	15.2	15.3		600.0		1.4										
EB US 150	2109+84	RT		W4-1	MERGE			48.0	48.0	16.0			16.0																					
NB IL 29 (RAMP E)	605+90	RT		SGN-BS-107-P	150 EAST, EAST PEORIA, ARROW	11.1	7.0	132	102	93.5			93.5					W6X15	15.3	15.4		603.0		1.4										
NB IL 29 (RAMP E)	606+87	RT	M3-2	SGN-LP-108-P	EAST	4.0	7.0	24	12	2.0	2.0																							
			M1-4		150			30	24	5.0	5.0																							
			M6-2		ARROW			21	15	2.2	2.2																							
			XM-11		RONALD REAGAN TRAIL			24	30	5.0	5.0																							
			M6-3		ARROW			21	15	2.2	2.2																							
RAMP E	1503+82	RT	W13-3	SGN-LP-109-P	RAMP, 30 MPH	8.0	7.0	36.0	48.0	12.0			12.0																					
	2119+43	RT	R2-1	SGN-TS-110-P	SPEED LIMIT 45			36	48	12.0			12.0	7.5	7.5																			
EB US 150	2129+66	LT	R2-1	SGN-LP-111-P	SPEED LIMIT 55		7.0	36	48	12.0			12.0																					
EB US 150	2130+77	RT		SGN-TR-112-P	150 EAST, 24, ILLINOIS 116, EAST PEORIA, METAMORA, 1 MILE			246	144	246.0			246.0																85.0					
EB US 150	2134+06	LT	I1-I104	SGN-LP-113-P	TAZEWELL COUNTY		7.0	30	24	5.0	5.0																							
EB US 150	2158+24	LT	D13-I102	SGN-LP-114-P	LEAVING	7.0	7.0	30	9	1.9	1.9																							
			D13-I100		WATER SUPPLY PROTECTION AREA			30	42	8.8	8.8																							
EB US 150	2160+07	RT		SGN-BS-115-P	150 EAST, 24, ILLINOIS 116 WEST, EAST PEORIA, 1 1/4 MILE	6.0	7.0	210	138	201.3			201.3					W10X22	21.3	24.5	27.5	1943.0			3.5									
EB US 150	2165+00	LT	R2-1	SGN-TS-116-P	SPEED LIMIT 55	7.0	7.0	36	48	12.0			12.0	7.5	7.5																			
			M3-4		WEST			36	18	4.5	4.5																							
			M1-4		24			36	36	9.0	9.0			9.8	9.8																			
EB US 150 (RAMP SW)	010+50	RT	M6-2	SGN-TS-117-P	ARROW	7.0	7.0	30	21	4.4	4.4																							
					24 EAST, WASHINGTON, ARROW			174	114	137.8				137.8																				
					ILLINOIS 116 EAST, METAMORA, 1/4 MILE			150	114	118.75				118.8																				
EB US 150 (RAMP SW)	2169+00	RT/LT		SGN-TR-118C-P	150 EAST, 24, ILLINOIS 116 WEST, EAST PEORIA, ARROW	7.0	7.0	210	150	218.8			218.8																33.6	85.0				
					24 EAST, WASHINGTON, ARROW			174	114	137.8				137.8																				
					ILLINOIS 116 EAST, METAMORA, 1/4 MILE			150	114	118.75				118.8																				
RAMP SW	013+39	RT	W13-3	SGN-WP-119-P	RAMP, 35 MPH	27.0	7.0	36	48	12.0			12.0																					
EB US 150 RAMP SW	2174+20	RT	E5-1	SGN-WP-120-P	EXIT, ARROW	22.0	7.0	66	66	30.3			30.3						17.5	17.5	35.0													
FAIRLANE DR (RAMP SW)	25+25	RT	R7-8	SGN-TS-121A-P	RESERVED PARKING	7.0	7.0	12	18	1.5	1.5			14.0	14.0																			
			R-I101P		\$350 FINE			12	6	0.5	0.5																							
FAIRLANE DR (RAMP SW)	25+25	RT	R7-8	SGN-TS-121B-P	RESERVED PARKING	7.0	7.0	12	18	1.5	1.5			14.0	14.0																			
			R-I101P		\$350 FINE			12	6	0.5	0.5																							
FAIRLANE DR (RAMP SW)	25+25	RT	R1-1	SGN-TS-122-P	STOP	7.0	7.0	30	30	6.3	6.3			14.5	14.5																			
IL RTE 29	605+41	RT	R7-8	SGN-TS-123A-P	RESERVED PARKING	7.0	7.0	12	18	1.5	1.5			14.0	14.0																			
			R-I101P		\$350 FINE			12	6	0.5	0.5																							
IL RTE 29	605+91	RT	R7-8	SGN-TS-123B-P	RESERVED PARKING	7.0	7.0	12	18	1.5	1.5			14.0	14.0																			
			R-I101P		\$350 FINE			12	6	0.5	0.5																							
IL RTE 29	604+21	RT	R1-1	SGN-TS-124-P	STOP	7.0	7.0	30	30	6.3	6.3			14.5	14.5																			
EB US 150	2116+46	LT		SGN-LP-125-P	MCCLUGAGE BRIDGE	7.0	7.0	54.0	24.0	9.0	9.0																							
					ILLINOIS RIVER			36.0	24.0	6.0	6.0																							
EB US 150	2159+00	RT	W9-7	SGN-TS-126-P	RIGHT LANE EXIT ONLY AHEAD			48	48	16.0			16.0	7.5	7.5																			
RAMP A	1112+00	RT	R5-1a	SGN-TS-127-P	WRONG WAY			36	24	6.0	6.0			15.0	15.0																			
RAMP SW	31+00	RT	R5-1a	SGN-TS-128-P	WRONG WAY			36	24	6.0	6.0			15.0	15.0																			
<b>TOTAL</b>											124	104	1261		147			51				4279	534	2.8	5.9	4.0	6.3	33.6	170					

FINAL SUBMITTAL

MODEL: Default  
FILE NAME: p:\projects\2016\hanson\_dom\hanson\_projects\Documents\13\jobs\13\h0106Phase3\CAD\Road\Sheet\DMCEP-EB-SIG-CHKP055.dgn; S:\h03\411.dgn



USER NAME = r.watson  
DESIGNED -  
DRAWN -  
PLOT SCALE = 100.00' / in.  
CHECKED -  
DATE = 4/3/2019

REVISIONS  
REVISED - 04/16/2019  
REVISED -  
REVISED -  
REVISED -

STATE OF ILLINOIS  
DEPARTMENT OF TRANSPORTATION

US 150 EASTBOUND MCCLUGAGE BRIDGE PROJECT  
PROPOSED SIGN SCHEDULE  
SCALE: N/A SHEET 3 OF 3 SHEETS STA. TO STA.

F.A.P. RTE.	SECTION	COUNTY	TOTAL SHEETS	SHEET NO.
317	[15B;[(102-1),(14HB)]BR]BR	PEORIA	1361	532
CONTRACT NO. 68B46			ILLINOIS FED. AID PROJECT NHPP-YRP3(905)	

MODEL: D:\default  
 FILE NAME: p:\us150\us150-2016.hanson.dms\hanson\_projects\Documents\13jobs\1340106PhaseII\CADD\Road\Street\DMCEEP-shc-2MKP05-Sign\_Sch04-411.dgn



USER NAME = rwatson	DESIGNED - TN	REVISED - 2/04/16/2019
DRAWN - JP	CHECKED -	REVISED -
PLOT SCALE = 100.00' / in.	DATE - 11/28/18	REVISED -
PLOT DATE = 4/3/2019		

STATE OF ILLINOIS  
 DEPARTMENT OF TRANSPORTATION

US 150 EASTBOUND McCLUGAGE BRIDGE PROJECT  
 PROPOSED PAVEMENT MARKING SCHEDULE

SCALE: N/A SHEET 1 OF 1 SHEETS STA. TO STA.

F.A.P. RTE.	SECTION	COUNTY	TOTAL SHEETS	SHEET NO.
317	[15B;((102-1),(14HB))BR]BR	PEORIA	1361	533
CONTRACT NO. 68B46			ILLINOIS FED. AID PROJECT NHPP-YRP3(905)	

PAVEMENT MARKING SCHEDULE - PEORIA AND TAZEWELL COUNTIES																
LOCATION (PEORIA & TAZEWELL)	STATION		DELINEATORS	PREFORMED PLASTIC PAVEMENT MARKING, TYPE B - LINE 4"	PREFORMED PLASTIC PAVEMENT MARKING, TYPE B - LINE 8"	PREFORMED PLASTIC PAVEMENT MARKING, TYPE B - LINE 12"	MODIFIED URETHANE PAVEMENT MARKING - LETTERS AND SYMBOLS	MODIFIED URETHANE PAVEMENT MARKING - LINE 4"	MODIFIED URETHANE PAVEMENT MARKING - LINE 6"	MODIFIED URETHANE PAVEMENT MARKING - LINE 8"	MODIFIED URETHANE PAVEMENT MARKING - LINE 12"	MODIFIED URETHANE PAVEMENT MARKING - LINE 24"	RAISED REFLECTIVE PAVEMENT MARKER	CURB REFLECTORS	GROOVING FOR RECESSED PAVEMENT MARKING 9"	
	TO	FROM														EACH
US 150 (PEO)	2090+60.7	2106+75.2					130	4831	813	1452	780		160			
US 150 (TAZ)	2106+75.2	2157+51.0		6173	5706	828		3918	547	1198	342		50		2682	
US 150 (TAZ)	2157+51.0	2179+38.4														
RAMPS A/B (PEO)	1105+00.0	1114+00.0	30					1844	169	378	140	47		75		
IL RTE 29 (PEO)	604+30.0	615+74.0						3852	729	854	881	62	91			
RAMP E (PEO)	1503+60.0	1505+59.0						398		554						
RAMP E (PEO)	1505+59.0	1509+27.4		737	1755	191										
RAMP SW (TAZ)	10+79.3	35+40.0						3269		827						
IL RTE 116 (TAZ)	185+91.7	213+37.5					125	4106	687	2780	134	40	86			
MARINA PARK RD (TAZ)							62	449	51	276	58	53				
<b>TOTAL</b>			30	8810	7461	1019	270	22667	2896	8319	1454	190	387	75	2682	
				8910			317		2996		2335	202				







S.P.	PAY ITEM	DESCRIPTION	UNIT	QUANTITY
81028350	UNDERGROUND CONDUIT, PVC, 2" DIA.		FOOT	529
81028370	UNDERGROUND CONDUIT, PVC, 3" DIA.		FOOT	47
* 81400700	HANDHOLE, PORTLAND CEMENT CONCRETE		EACH	2
87021430	ELECTRIC CABLE IN CONDUIT, 600V (XMP-TYPE USE) 1/C NO. 6		FOOT	1734
* 85000200	MAINTENANCE OF EXISTING TRAFFIC SIGNAL INSTALLATION		EACH	1
87301245	ELECTRIC CABLE IN CONDUIT, SIGNAL NO. 14 5C		FOOT	1568
87301245	ELECTRIC CABLE IN CONDUIT, LEAD IN, NO. 18 3 PAIR		FOOT	715
* 87301900	ELECTRIC CABLE IN CONDUIT, EQUIPMENT GROUNDING CONDUCTOR, NO. 6 1C		FOOT	744
* 87502500	TRAFFIC SIGNAL POST, GALVANIZED STEEL 16 FT.		EACH	2
* 87703040	STEEL COMBINATION MAST ARM ASSEMBLY AND POLE 62 FT.		EACH	1
* 87800100	CONCRETE FOUNDATION, TYPE A		FOOT	6
* 87800420	CONCRETE FOUNDATION, TYPE E 42-INCH DIAMETER		FOOT	21
87900200	DRILL EXISTING HANDHOLE		EACH	4
* 88030020	SIGNAL HEAD, LED, 1-FACE, 3-SECTION, MAST-ARM MOUNTED		EACH	3
* 88030050	SIGNAL HEAD, LED, 1-FACE, 3-SECTION, BRACKET MOUNTED		EACH	2
* 88200510	TRAFFIC SIGNAL BACKPLATE, RETROREFLECTIVE		EACH	5
88600100	DETECTOR LOOP, TYPE I		FOOT	511
89502375	REMOVE EXISTING TRAFFIC SIGNAL EQUIPMENT		EACH	1
89502385	REMOVE EXISTING CONCRETE FOUNDATION		EACH	2
X1400095	LUMINAIRE, LED, HORIZONTAL MOUNT, HIGH WATTAGE		EACH	3
* X7240500	RELOCATE EXISTING SIGNS		EACH	1

The Contractor shall remove the following items and dispose of them off of the right-of-way. The Contractor shall reflect the salvage value of the equipment in the bid price.

- Traffic Signal Post - Qty. 1
- Steel Combination Mast Arm Assembly and Pole with Luminaire - Qty. 1
- Traffic Signal Head, 3-Section, Mast Arm Mounted - Qty. 2
- Traffic Signal Head, 3-Section, Bracket Mounted - Qty. 2
- Traffic Signal Post Foundation - Qty. 1
- Mast Arm Foundation - Qty. 1

The cost of this work shall be included in the pay item "Remove Existing Traffic Signal Equipment"

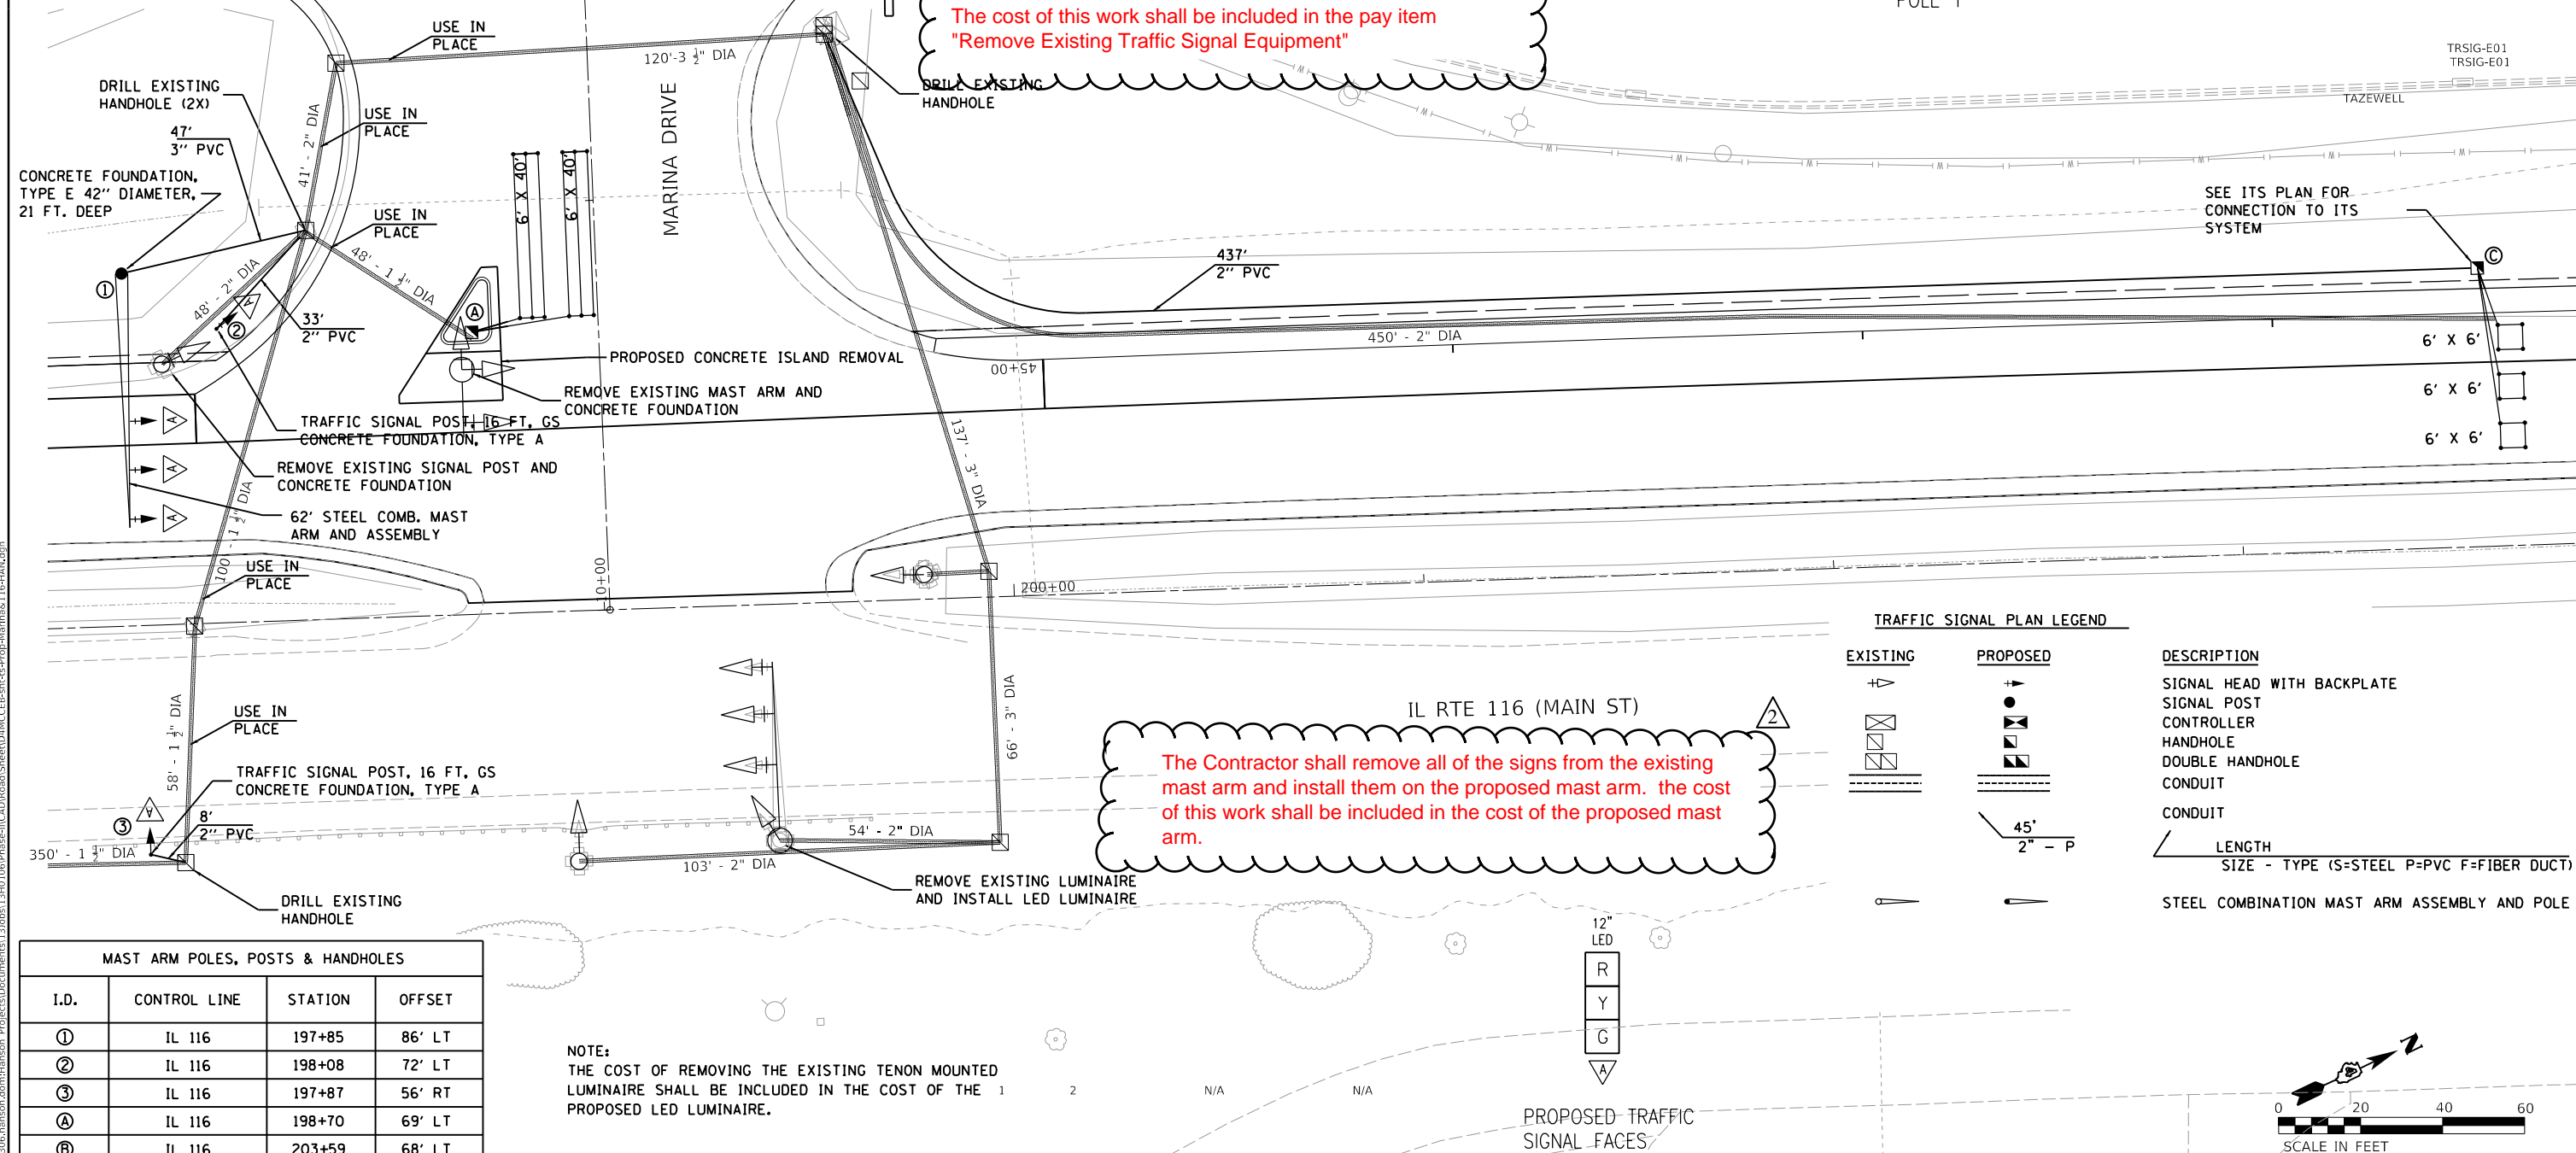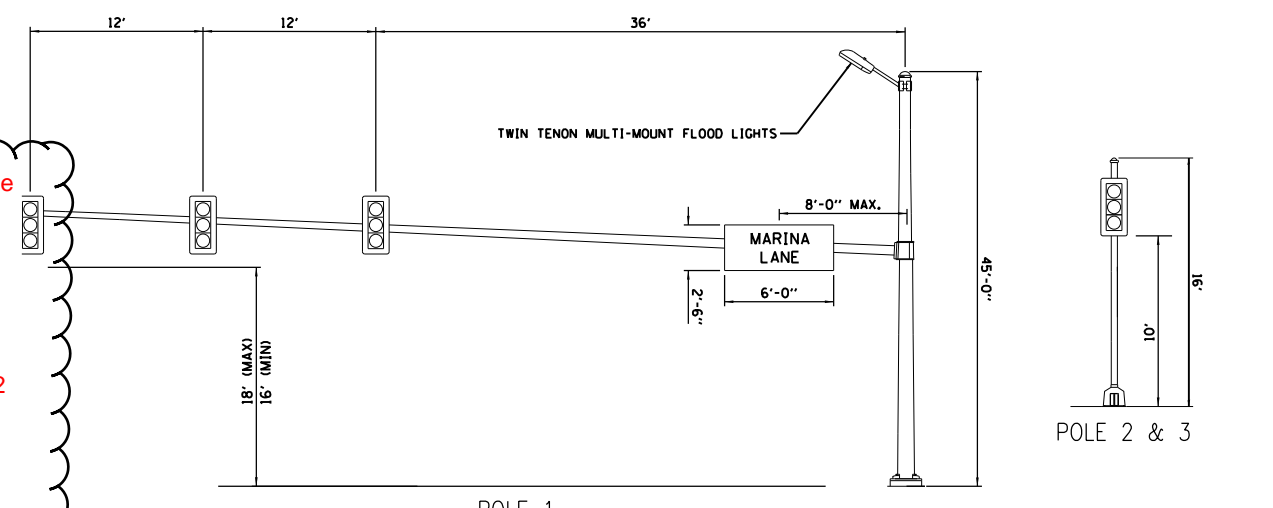

EXISTING		PROPOSED		DESCRIPTION
[Symbol]	[Symbol]	[Symbol]	[Symbol]	SIGNAL HEAD WITH BACKPLATE
[Symbol]	[Symbol]	[Symbol]	[Symbol]	SIGNAL POST
[Symbol]	[Symbol]	[Symbol]	[Symbol]	CONTROLLER
[Symbol]	[Symbol]	[Symbol]	[Symbol]	HANDHOLE
[Symbol]	[Symbol]	[Symbol]	[Symbol]	DOUBLE HANDHOLE
[Symbol]	[Symbol]	[Symbol]	[Symbol]	CONDUIT
[Symbol]	[Symbol]	[Symbol]	[Symbol]	CONDUIT
[Symbol]	[Symbol]	[Symbol]	[Symbol]	LENGTH
[Symbol]	[Symbol]	[Symbol]	[Symbol]	SIZE - TYPE (S=STEEL P=PVC F=FIBER DUCT)
[Symbol]	[Symbol]	[Symbol]	[Symbol]	STEEL COMBINATION MAST ARM ASSEMBLY AND POLE

MAST ARM POLES, POSTS & HANDHOLES			
I.D.	CONTROL LINE	STATION	OFFSET
①	IL 116	197+85	86' LT
②	IL 116	198+08	72' LT
③	IL 116	197+87	56' RT
A	IL 116	198+70	69' LT
B	IL 116	203+59	68' LT

NOTE: THE COST OF REMOVING THE EXISTING TENON MOUNTED LUMINAIRE SHALL BE INCLUDED IN THE COST OF THE PROPOSED LED LUMINAIRE.

STATE OF ILLINOIS DEPARTMENT OF TRANSPORTATION

US 150 EASTBOUND McCLUGAGE BRIDGE PROJECT  
PROPOSED TRAFFIC SIGNALS (IL. RTE. 116 & MARINA DR.)

SCALE: 1"=20'

F.A.P. RTE.	SECTION	COUNTY	TOTAL SHEETS	SHEET NO.
317	[15B:((102-1),(14HB))BR]BR	TAZEWELL	1361	606
CONTRACT NO. 68B46				
ILLINOIS FED. AID PROJECT NHPP-YRP3(905)				

SCALE IN FEET

FINAL SUBMITTAL



**GENERAL NOTES:**

- THE ELECTRICAL WORK SHALL BE PERFORMED IN ACCORDANCE WITH THE IDOT STANDARD SPECIFICATIONS FOR ROAD AND BRIDGE CONSTRUCTION, LATEST EDITION.
- CONTRACTOR SHALL BE RESPONSIBLE TO COORDINATE ELECTRICAL WORK WITH OTHER TRADES.
- THE LOCATION OF BURIED AND ABOVE GROUND UTILITIES SHOWN ARE APPROXIMATE AND ARE SHOWN FOR INFORMATION ONLY. REROUTING, DISCONNECTION, RELOCATION, PROTECTION ETC., OF ANY UTILITIES MUST BE COORDINATED BETWEEN THE CONTRACTOR, UTILITY COMPANY, AND OWNER. THE CONTRACTOR SHALL VERIFY THE EXACT LOCATION OF ALL UNDERGROUND UTILITIES PRIOR TO CONSTRUCTION.
- THE LOCATIONS OF EXISTING LIGHTING FACILITIES SHOWN ON THE PLANS ARE APPROXIMATE. THE CONTRACTOR SHALL FIELD VERIFY EXACT LOCATIONS.
- WHEREVER TEMPORARY AERIAL CABLE IS REQUIRED TO CROSS AN EXISTING OR PROPOSED ROADWAY, THE CONTRACTOR SHALL MAINTAIN A MINIMUM OF 20 FEET OF VERTICAL CLEARANCE OVER THE ROADWAY AT ALL TIMES.
- THE CONTRACTOR SHALL FURNISH AND INSTALL A CONCRETE WORK PAD IN FRONT OF THE LIGHTING CONTROLLER PER SECTION 825 OF THE STANDARD SPECIFICATIONS.
- NO LIGHT POLE SHALL BE ERECTED UNTIL THE FOUNDATION HAS CURED PER ARTICLE 1020.13 OF THE STANDARD SPECIFICATIONS.
- FOUNDATIONS FOR RELOCATED LIGHT POLES SHALL BE 30" DIAMETER. THE CONTRACTOR SHALL VERIFY THE ANCHOR BOLT DIAMETER, BOLT CIRCLE, BOLT PROJECTION OF THE EXISTING FOUNDATIONS BEFORE CONSTRUCTION OF THE NEW FOUNDATIONS.
- THE CONTRACTOR SHALL MAKE SPECIAL NOTE OF THE REQUIREMENTS FOR GROUNDING. GROUNDING CONNECTIONS AT FOUNDATIONS SHALL BE EXOTHERMIC, AS APPLICABLE.
- CONTRACTOR SHALL INSTALL LIGHT POLES AT THE LOCATIONS INDICATED ON THE PLANS, MAINTAINING ADEQUATE CLEARANCE FROM UTILITY LINES. CONTRACTOR SHALL BE RESPONSIBLE TO VERIFY CLEARANCES PER THE NATIONAL ELECTRICAL SAFETY CODE AND/OR THE REQUIREMENTS OF THE UTILITY COMPANIES. THE CONTRACTOR SHALL NOTIFY THE ENGINEER OF ALL CONFLICTS BETWEEN PROPOSED LIGHTING POLE LOCATIONS AND UTILITY LINES.
- POLE SETBACK SHALL BE 5 FT UNLESS NOTED OTHERWISE. NO POLE SHALL BE INSTALLED IN THE FLOW LINE OF DITCH. POLE SETBACK TO BE ADJUSTED IF NECESSARY AS DIRECTED BY THE ENGINEER.
- BREAKAWAY COUPLINGS SHALL BE INSTALLED ON ALL LIGHT POLES, EXCEPT LIGHT POLES THAT ARE MOUNTED ON THE BRIDGE PARAPET WALL, ARE LOCATED BEHIND GUARDRAIL, OR ARE IN A PEDESTRIAN CONFLICT AREA ACCORDING TO ARTICLE 838.
- STAINLESS STEEL SCREEN INSTALLED AROUND BREAKAWAY COUPLINGS OR ANCHOR RODS AND NUTS SHALL BE ACCORDING TO ARTICLE 1070.
- THE CONTRACTOR SHALL INSTALL LUMINAIRES WITH OPTICS SET PERPENDICULAR TO THE CENTERLINE OF THE ROADWAY OR PEDESTRIAN/BICYCLE PATHWAY.
- ALL PROPOSED LIGHTING UNITS SHALL BE LABELED ACCORDING TO THE STANDARD SPECIFICATIONS, WITH POLE NUMBERS ATTACHED WITH STAINLESS STEEL BANDING. LIGHTING UNIT NUMBER SHALL BE AS DIRECTED BY THE ENGINEER.
- FURNISH AND INSTALL STAINLESS STEEL CONDUIT WHEREVER CONDUIT ATTACHED TO STRUCTURE IS SUSCEPTIBLE TO DROPPING FROM THE BRIDGE OR SALT SPRAY. THE COST OF THIS WORK SHALL BE INCLUDED IN THE APPLICABLE CONDUIT ATTACHED TO STRUCTURE PAY ITEM.
- NO LIGHTING CIRCUIT OR PORTION THEREOF SHALL BE REMOVED FROM NIGHTTIME OPERATION WITHOUT THE APPROVAL OF THE ENGINEER.
- ALL LIGHT POLES, LUMINAIRES, AND LIGHTING EQUIPMENT SCHEDULED FOR REMOVAL IN PEORIA COUNTY SHALL BE DELIVERED TO THE CITY OF PEORIA DRIES LANE FACILITY LOCATED AT 3505 N. DRIES LANE, PEORIA, IL.
- ALL LIGHT POLES, LUMINAIRES, AND LIGHTING EQUIPMENT SCHEDULED TO BE REMOVED ON THE BRIDGE AND IN HAZARD COUNTY SHALL BE DELIVERED TO THE IDOT MAINTENANCE FACILITY LOCATED AT 6500 W US ROUTE 150 EDWARDS, IL.

- The Contractor shall furnish and install expansion/deflection couplings for all bridge joints as required and directed by the Engineer. The cost of this work shall be included in the cost of the proposed conduit.
- All non-metallic conduit shall be equipped with integral stainless steel kellum grips at the ends for increased strength and durability. The cost of this work shall be included in the cost of the proposed conduits attached to structure.
- The Contractor shall install thread locker on all attached conduit bracket threaded connections to prevent loosening through vibration. The cost of this work shall be included in the cost of the attached conduit.
- The Contractor shall ground all exposed steel conduits in accordance with NEC requirements. The Contractor shall maintain the continuity of the ground system when using non-metallic conduit by installing a #6 grounding conductor inside the non-metallic conduit and bonding this wire to the stainless steel conduits at each end. The cost of this work shall be included in the cost of the stainless steel conduit pay items.
- The cost of the 3/4" diameter waterproof non-metallic flexible conduit shall be included in the cost of the pay item for "Conduit Attached to Structure, 3/4 Dia., Galvanized Steel".
- The cost of the 2" waterproof flexible conduit shall be included in the cost of the pay item for "Conduit Attached to Structure, 2 Dia., Galvanized Steel".
- The Contractor shall furnish and install all items required to attach the conduits including but not limited to uni-strut, brackets, lbs, fittings, hardware and other miscellaneous items. These items will not be paid for separately, but shall be included in the cost of the attached conduit.

**LEGEND:**

- EXISTING ELECTRIC UTILITY POLE
- EXISTING LIGHTING CONTROLLER
- EXISTING LIGHTING UNIT NO.
- EXISTING ROADWAY LIGHTING UNIT
- EXISTING UNDERPASS LUMINAIRE
- EXISTING WATERWAY OBSTRUCTION WARNING LUMINAIRE, GREEN CHANNEL CENTER
- EXISTING WATERWAY OBSTRUCTION WARNING LUMINAIRE, RED CHANNEL MARGIN
- EXISTING JUNCTION BOX (JB)
- EXISTING UNIT DUCT
- PROPOSED LIGHTING CONTROLLER, SIZE AND TYPE AS NOTED
- PROPOSED LIGHTING UNIT NO.
- PROPOSED PATHWAY LIGHTING UNIT, LED LUMINAIRE, HORIZONTAL MOUNT, VERY LOW WATTAGE
- PROPOSED PARK LIGHTING UNIT, LED LUMINAIRE, HORIZONTAL MOUNT, LOW WATTAGE
- PROPOSED ROADWAY LIGHTING UNIT, LED LUMINAIRE, HORIZONTAL MOUNT, MEDIUM WATTAGE
- PROPOSED UNDERPASS LIGHTING UNIT, LED LUMINAIRE, WALL MOUNT
- PROPOSED WATERWAY OBSTRUCTION WARNING LUMINAIRE, GREEN CHANNEL CENTER, 25W, LED
- PROPOSED WATERWAY OBSTRUCTION WARNING LUMINAIRE, RED CHANNEL MARGIN, 25W, LED
- PROPOSED JUNCTION BOX, STAINLESS STEEL, ATTACHED TO STRUCTURE, SIZE AS NOTED
- PROPOSED UNDERGROUND CONDUIT, SIZE AND TYPE AS NOTED
- PROPOSED UNIT DUCT, SIZE AND TYPE AS NOTED
- PROPOSED AERIAL CABLE
- PROPOSED UNDERGROUND CONDUIT, COILABLE NONMETALLIC CONDUIT, 3" DIA. SCHEDULE 80

The existing lighting system shall remain in operation during the installation of the proposed lighting system. Any maintenance of existing lighting facilities will be considered extra work in accordance with Article 109.04 of the standard specifications.

**SCHEDULE OF QUANTITIES**

DESCRIPTION	UNITS	TOTAL QUANTITY
ELECTRIC SERVICE INSTALLATION	EACH	4
UNDERGROUND CONDUIT, GALVANIZED STEEL, 2" DIA.	FOOT	70
UNDERGROUND CONDUIT, COILABLE NONMETALLIC CONDUIT, 3" DIA.	FOOT	435
CONDUIT ATTACHED TO STRUCTURE, 3/4" DIA., GALVANIZED STEEL	FOOT	112
CONDUIT ATTACHED TO STRUCTURE, 1" DIA., GALVANIZED STEEL	FOOT	115
CONDUIT ATTACHED TO STRUCTURE, 2" DIA., GALVANIZED STEEL	FOOT	1,756
CONDUIT EMBEDDED IN STRUCTURE, 2" DIA., PVC	FOOT	20,265
JUNCTION BOX, STAINLESS STEEL, ATTACHED TO STRUCTURE, 6" X 6" X 4"	EACH	10
JUNCTION BOX, STAINLESS STEEL, ATTACHED TO STRUCTURE, 16" X 12" X 4"	EACH	28
JUNCTION BOX, STAINLESS STEEL, ATTACHED TO STRUCTURE, 16" X 12" X 8"	EACH	8
UNIT DUCT, 600V, 2-1C NO.8, 1/C NO.8 GROUND, (XLP-TYPE USE), 3/4" DIA. POLYETHYLENE	FOOT	3,850
UNIT DUCT, 600V, 2-1C NO.10, 1/C NO.10 GROUND, (XLP-TYPE USE), 3/4" DIA. POLYETHYLENE	FOOT	2,495
UNIT DUCT, 600V, 2-1C NO.6, 1/C NO.6 GROUND, (XLP-TYPE USE), 1" DIA. POLYETHYLENE	FOOT	6,086
ELECTRIC CABLE IN CONDUIT, 600V (XLP-TYPE USE) 1/C NO. 10	FOOT	462
ELECTRIC CABLE IN CONDUIT, 600V (XLP-TYPE USE) 1/C NO. 8	FOOT	31,414
ELECTRIC CABLE IN CONDUIT, 600V (XLP-TYPE USE) 1/C NO. 6	FOOT	17,156
ELECTRIC CABLE IN CONDUIT, 600V (XLP-TYPE USE) 1/C NO. 4	FOOT	7,520
ELECTRIC CABLE IN CONDUIT, 600V (XLP-TYPE USE) 1/C NO. 2	FOOT	19,505
WATERWAY OBSTRUCTION WARNING LUMINAIRE, LED	EACH	6
LIGHTING CONTROLLER, BASE MOUNTED, 240VOLT, 100AMP	EACH	1
LIGHTING CONTROLLER, BASE MOUNTED, 480VOLT, 100AMP (DUAL)	EACH	3
LIGHT POLE, ALUMINUM, 45 FT. M.H., 8 FT. DAVIT ARM	EACH	9
LIGHT POLE, ALUMINUM, 30 FT. M.H., TENON MOUNT	EACH	15
LIGHT POLE, GALVANIZED STEEL, 45 FT. M.H., 8 FT. MAST ARM	EACH	13
LIGHT POLE, GALVANIZED STEEL, 45 FT. M.H., 15 FT. MAST ARM	EACH	9
LIGHT POLE FOUNDATION, 24" DIAMETER	FOOT	110
LIGHT POLE FOUNDATION, 30" DIAMETER	FOOT	202
BREAKAWAY DEVICE, COUPLING WITH STAINLESS STEEL SCREEN	EACH	13
REMOVAL OF LIGHTING UNIT, SALVAGE	EACH	32
REMOVAL OF POLE FOUNDATION	EACH	16
REMOVAL OF NAVIGATION OBSTRUCTION WARNING LIGHTING SYSTEM	L SUM	1
REMOVAL OF LIGHTING CONTROLLER	EACH	3
REMOVAL OF ELECTRIC SERVICE INSTALLATION	EACH	3
REMOVAL OF LIGHTING CONTROLLER FOUNDATION	EACH	3
GFCI 20 AMP DUPLEX RECEPTACLE	EACH	28
CIRCUIT BREAKER IN STREET LIGHT CONTROLLER	EACH	1
LUMINAIRE, LED, HORIZONTAL MOUNT, LOW WATTAGE	EACH	15
LUMINAIRE, LED, HORIZONTAL MOUNT, MEDIUM WATTAGE	EACH	57
LUMINAIRE, LED, HORIZONTAL MOUNT, VERY LOW WATTAGE	EACH	7
LUMINAIRE, LED, SPECIAL	EACH	28
REMOVAL OF LIGHTING LUMINAIRE, SALVAGE	EACH	10
UNDERPASS LUMINAIRE, LED, LOW WATTAGE	EACH	4
CONDUIT, FLEXIBLE NON-METALLIC, WEATHERPROOF, 1.0" DAMETER	FOOT	155
LIGHT POLE, SPECIAL	EACH	26
LIGHT POLE, ALUMINUM, 18 FT. M.H., TENON MOUNT (SPECIAL)	EACH	7
REMOVAL OF UNDERPASS LIGHTING UNIT, NO SALVAGE	EACH	2

DESCRIPTION	UNITS	TOTAL QUANTITY
A UNIT DUCT, 600V, 2-1/C NO.10, 1/C NO.10 GROUND, (XLP-TYPE USE), 3/4" DIA. POLYETHYLENE		
B UNIT DUCT, 600V, 2-1/C NO. 8, 1/C NO. 8 GROUND, (XLP-TYPE USE), 3/4" DIA. POLYETHYLENE		
C UNIT DUCT, 600V, 2-1/C NO. 6, 1/C NO. 6 GROUND, (XLP-TYPE USE), 1" DIA. POLYETHYLENE		
D ELECTRIC CABLE, 600V (XLP-TYPE USE) 6-1/C NO. 2, 2-1/C NO. 4 GROUND AND 3-1/C NO.8, 1/C NO.8 GROUND IN UNDERGROUND CONDUIT, GALV STEEL, 2" DIA.		
E ELECTRIC CABLE, 600V (XLP-TYPE USE) 2-1/C NO. 8, 1/C NO. 8 GROUND IN CONDUIT EMBEDDED IN STRUCTURE, 2" DIA. PVC		
F ELECTRIC CABLE, 600V (XLP-TYPE USE) 2-1/C NO. 6, 1/C NO. 6 GROUND IN CONDUIT EMBEDDED IN STRUCTURE, 2" DIA. PVC		
G ELECTRIC CABLE, 600V (XLP-TYPE USE) 3-1/C NO. 2, 1/C NO. 4 GROUND, AND 3-1/C NO. 8, 1/C NO. 8 GROUND IN CONDUIT EMBEDDED IN STRUCTURE, 2" DIA. PVC		
H ELECTRIC CABLE, 600V (XLP-TYPE USE) 2-1/C NO. 10, 1/C NO. 10 GROUND, IN CONDUIT ATTACHED TO STRUCTURE, 3/4" DIA. GALV STEEL		
I ELECTRIC CABLE, 600V (XLP-TYPE USE) 2-1/C NO. 8, 1/C NO. 8 GROUND, IN CONDUIT ATTACHED TO STRUCTURE, 1" DIA. GALV STEEL		
J ELECTRIC CABLE, 600V (XLP-TYPE USE) 4-1/C NO. 2, 2-1/C NO. 4 GROUND, AND 4-1/C NO. 8, 2-1/C NO. 8 GROUND, IN CONDUIT ATTACHED TO STRUCTURE, 2" DIA. GALV STEEL		
K ELECTRIC CABLE, 600V (XLP-TYPE USE) 4-1/C NO. 6, 2-1/C NO. 6 GROUND IN CONDUIT ATTACHED TO STRUCTURE, 2" DIA. GALV STEEL		
L ELECTRIC CABLE, 600V (XLP-TYPE USE) 3-1/C NO. 2, 1/C NO. 4 GROUND, AND 3-1/C NO. 8, 1/C NO. 8 GROUND IN CONDUIT ATTACHED TO STRUCTURE, 2" DIA. GALV STEEL		
M ELECTRIC CABLE, 600V (XLP-TYPE USE) 2-1/C NO. 8, 1/C NO. 8 GROUND, IN CONDUIT, FLEXIBLE, LIQUID TIGHT, NON-METALLIC, 1" DIA.		

FINAL SUBMITTAL

MODEL: D:\proj\150E\150E.dwg  
FILE NAME: 150E.dwg  
PROJECT: US 150 EASTBOUND BRIDGE PROJECT  
SHEET: 613 OF 613  
DATE: 11/28/2018

**TYLON INTERNATIONAL**  
280 S. WACKER DR.  
SUITE 1400  
CHICAGO, IL 60606  
TEL: 312-777-2900

USER NAME = SFicker  
PLOT SCALE = 2.00' / in.  
PLOT DATE = 11/28/2018

DESIGNED - SF  
DRAWN - SF  
CHECKED -  
DATE - 11/28/2018

REVISED -  
REVISED -  
REVISED -  
REVISED -



STATE OF ILLINOIS  
DEPARTMENT OF TRANSPORTATION

US 150 EASTBOUND McCLUGAGE BRIDGE PROJECT  
LIGHTING GENERAL NOTES, SYMBOLS, LEGENDS

SCALE: NONE SHEET 1 OF 1 SHEETS STA. N/A TO STA. N/A

F.A.P. RTE. 317 SECTION [15B;((102-1),(14HB))]BR]BR COUNTY PEQ/TAZ TOTAL SHEETS 1361 SHEET NO. 613 CONTRACT NO. 68B46 ILLINOIS FED. AID PROJECT NHPP-YRP3(905)

LTG-01

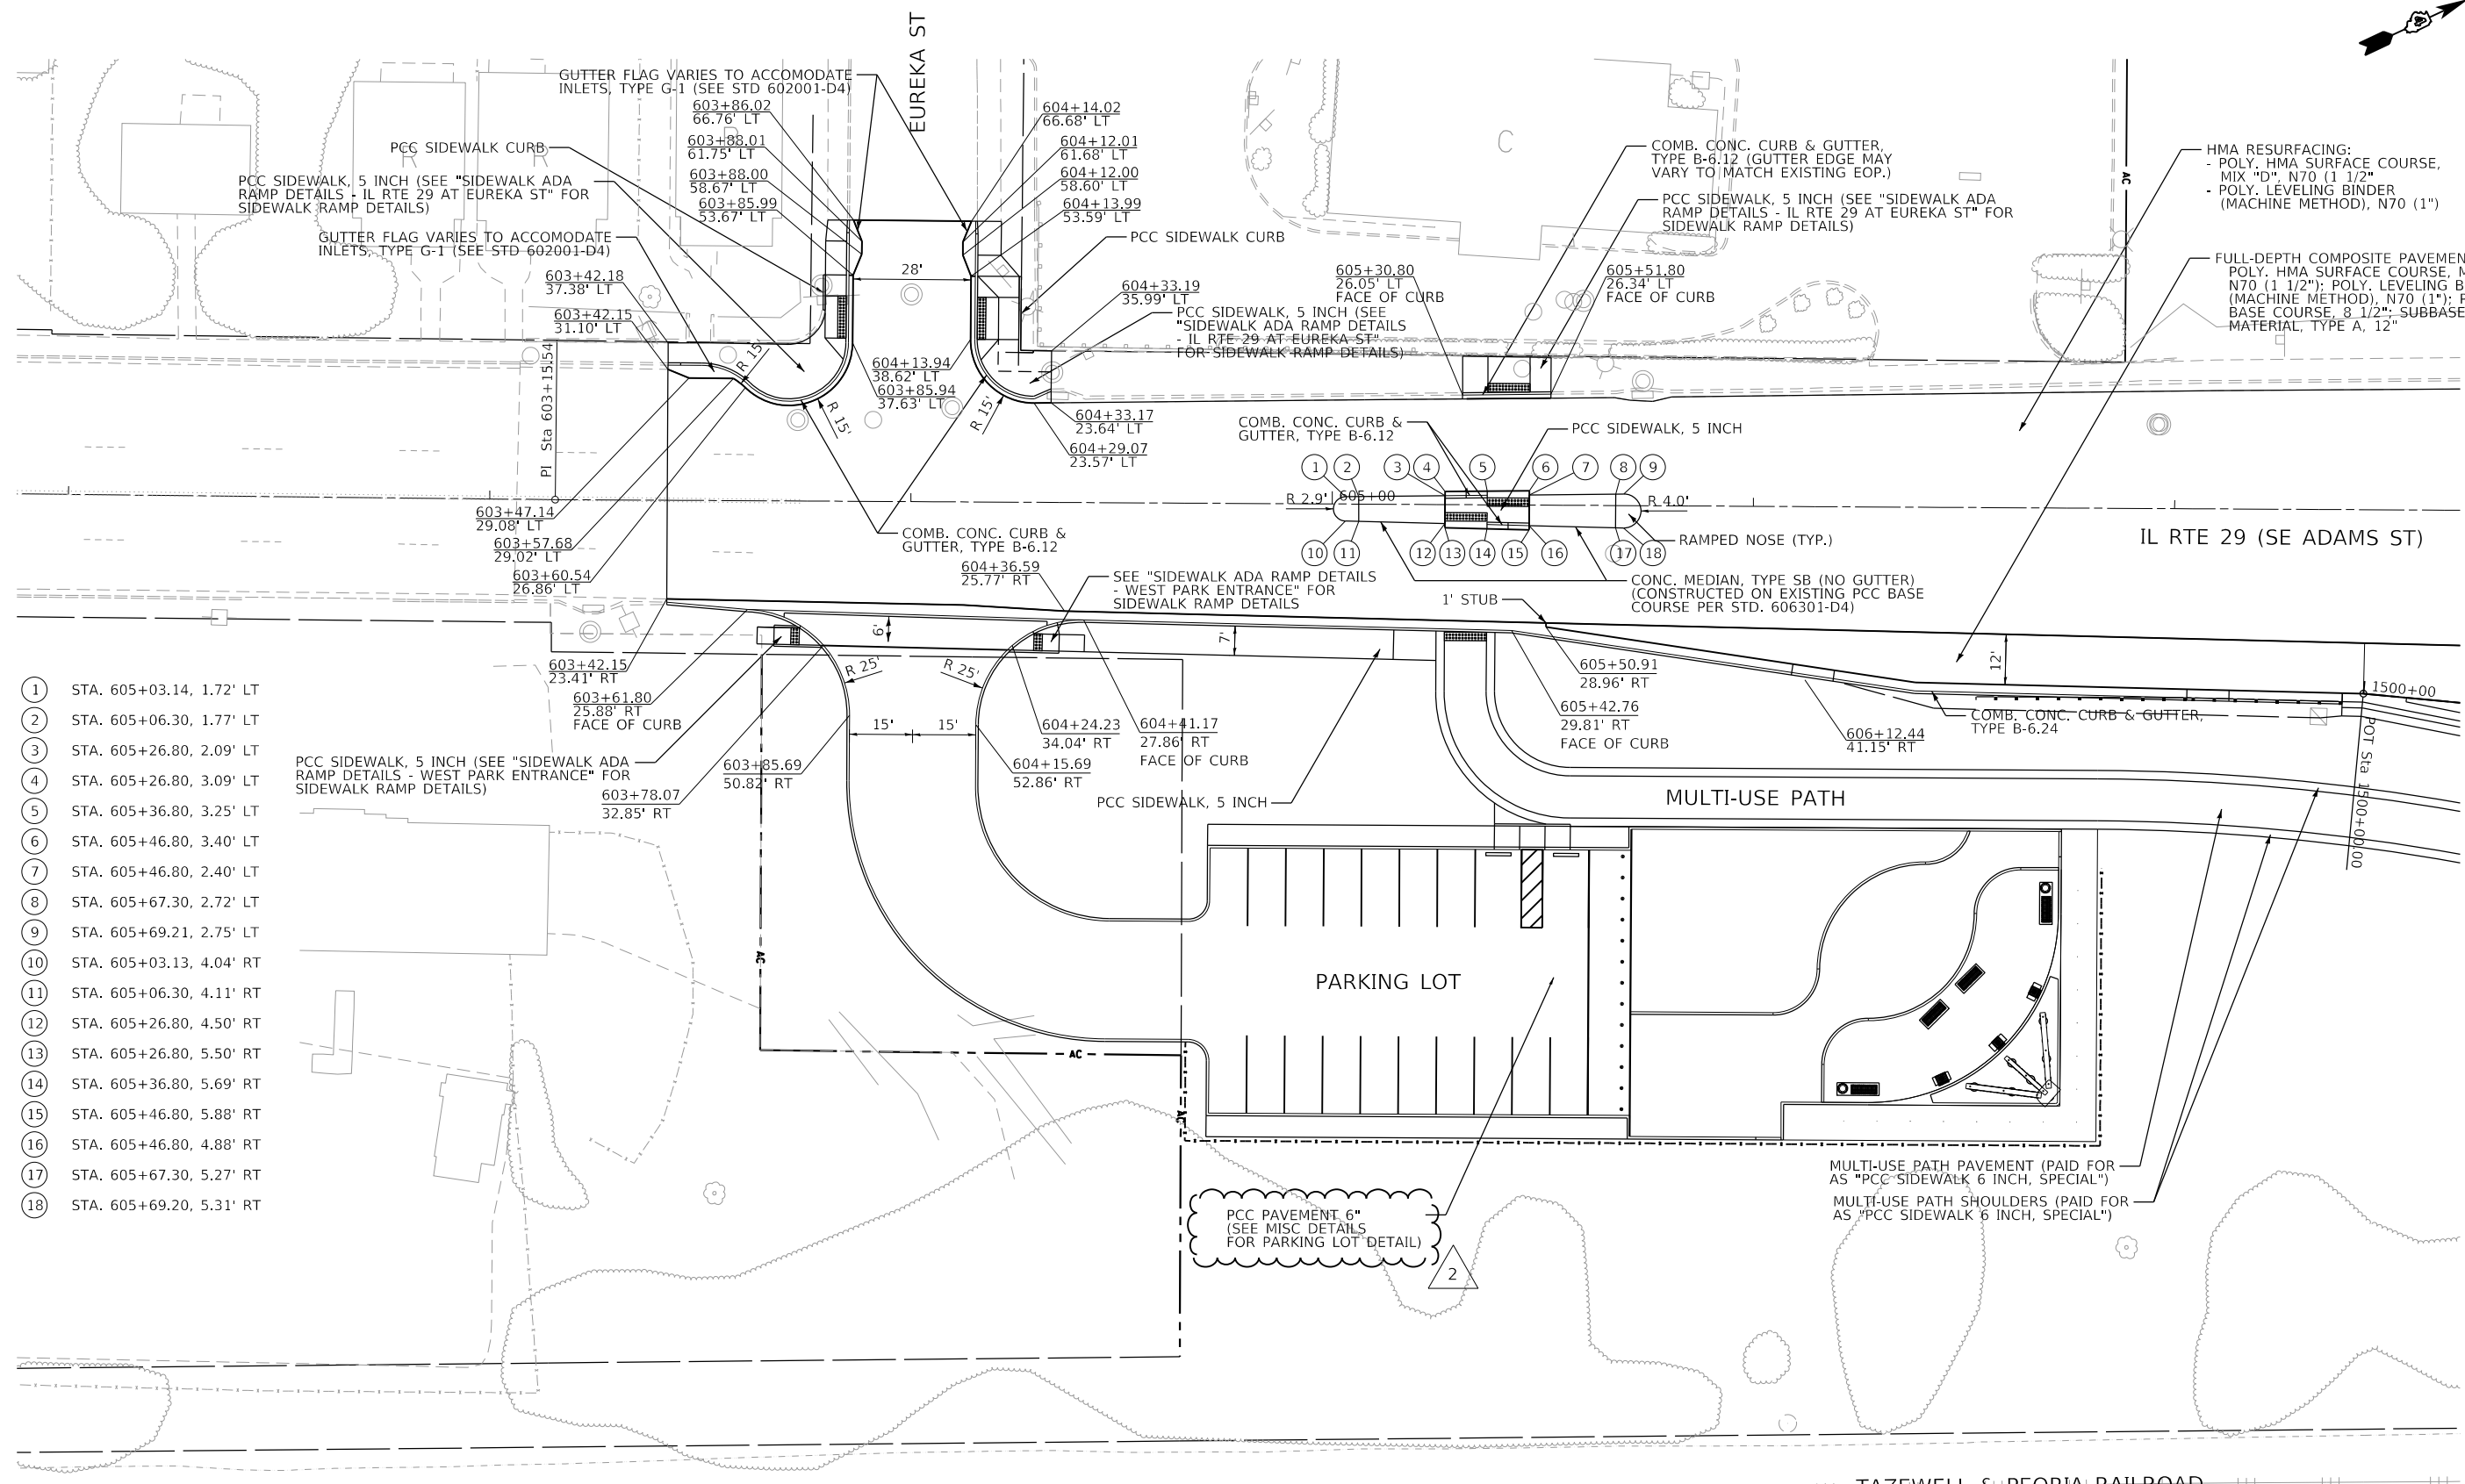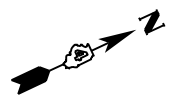

- ① STA. 605+03.14, 1.72' LT
- ② STA. 605+06.30, 1.77' LT
- ③ STA. 605+26.80, 2.09' LT
- ④ STA. 605+26.80, 3.09' LT
- ⑤ STA. 605+36.80, 3.25' LT
- ⑥ STA. 605+46.80, 3.40' LT
- ⑦ STA. 605+46.80, 2.40' LT
- ⑧ STA. 605+67.30, 2.72' LT
- ⑨ STA. 605+69.21, 2.75' LT
- ⑩ STA. 605+03.13, 4.04' RT
- ⑪ STA. 605+06.30, 4.11' RT
- ⑫ STA. 605+26.80, 4.50' RT
- ⑬ STA. 605+26.80, 5.50' RT
- ⑭ STA. 605+36.80, 5.69' RT
- ⑮ STA. 605+46.80, 5.88' RT
- ⑯ STA. 605+46.80, 4.88' RT
- ⑰ STA. 605+67.30, 5.27' RT
- ⑱ STA. 605+69.20, 5.31' RT



FINAL SUBMITTAL

MODEL: Default  
FILE: \\mhc\p\2016\hanson\dom\hanson\Projects\Illinois\2016\Phase3\CD\Road\Sheet\DMCC\EB-sh-drawn-29-TL.dgn

**TYLIN INTERNATIONAL**  
200 S. WACKER DR.  
SUITE 1400  
CHICAGO, IL 60606  
TEL: 312-777-2900

USER NAME = mgormely  
PLOT SCALE = 40.00' / in.  
PLOT DATE = 4/8/2019

DESIGNED - MPG  
DRAWN - MPG  
CHECKED - DAJ  
DATE - 11/28/2018

REVISED - 4/16/2019  
REVISED -  
REVISED -  
REVISED -

STATE OF ILLINOIS  
DEPARTMENT OF TRANSPORTATION

US 150 EASTBOUND McCLUGAGE BRIDGE PROJECT  
INTERSECTION DETAILS - IL RTE 29 AT EUREKA ST

SCALE: 1"=20' SHEET 3 OF 4 SHEETS STA. N/A TO STA. N/A

F.A.P. RTE.	SECTION	COUNTY	TOTAL SHEETS	SHEET NO.
317	[15B;((102-1),(14HB))]BR BR	PEORIA	1361	674
CONTRACT NO. 68B46				
ILLINOIS FED. AID PROJECT NHPP-YRP3(905)				

INTDET-W03














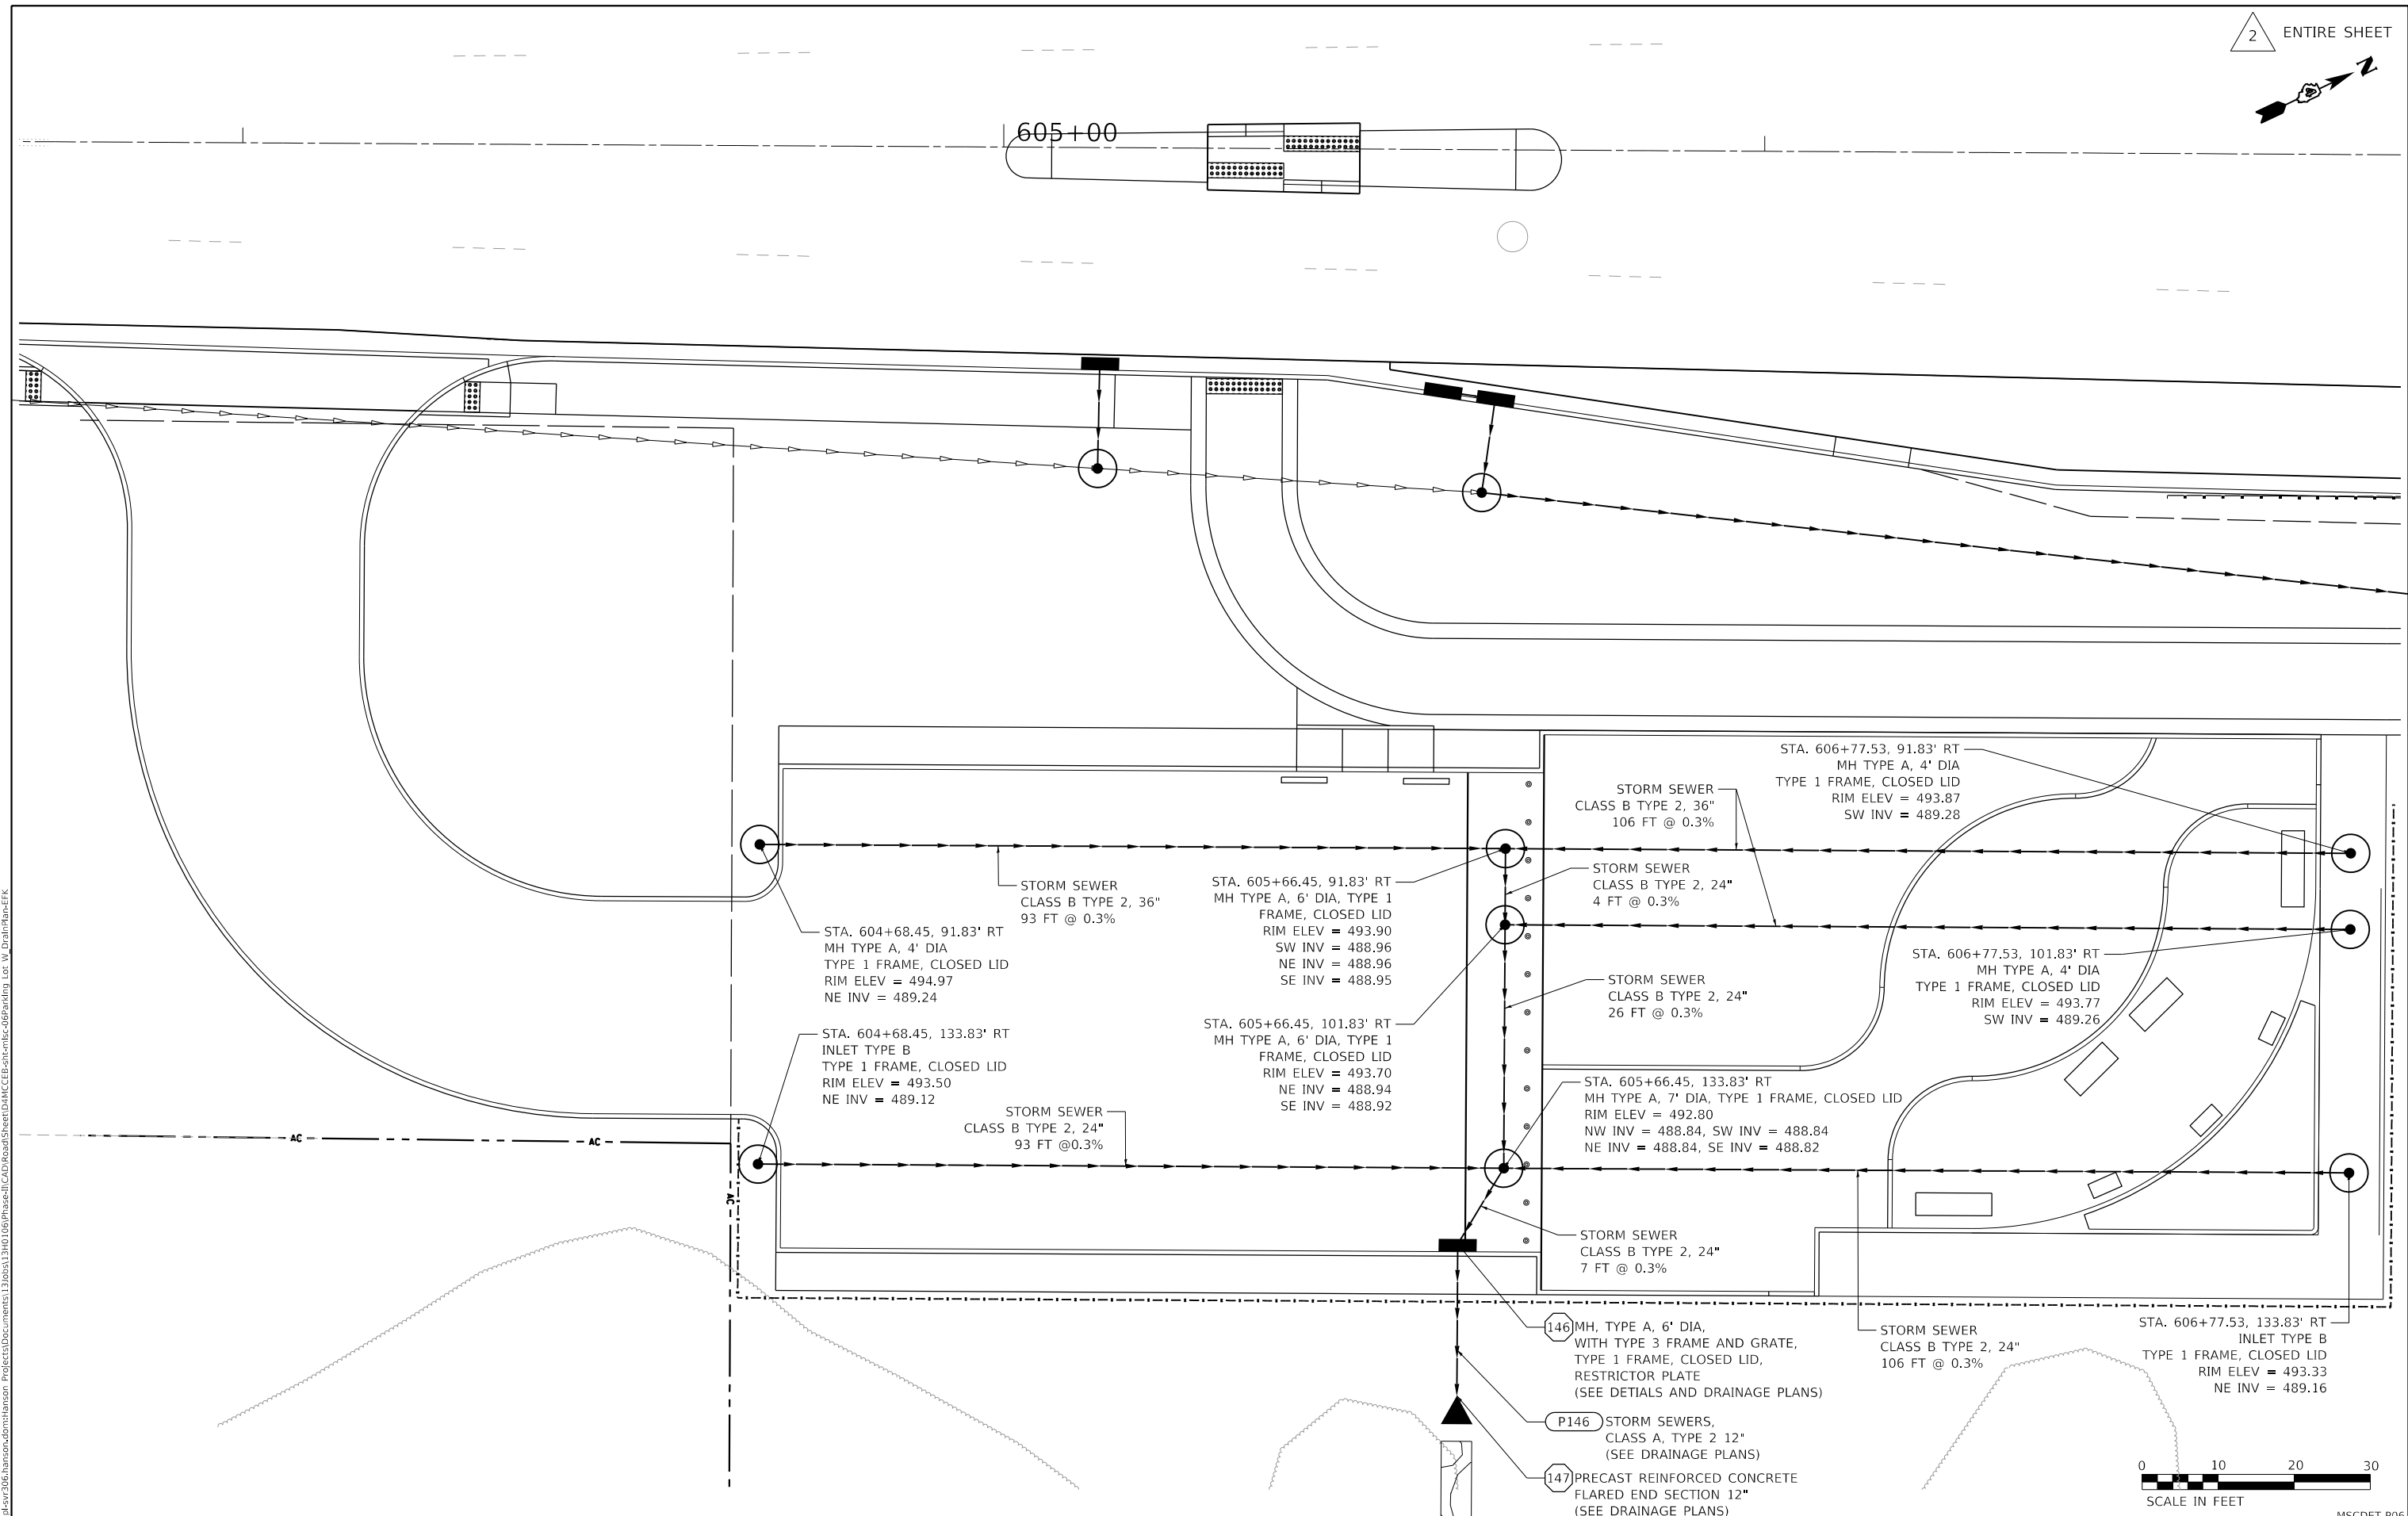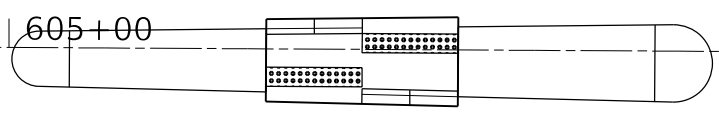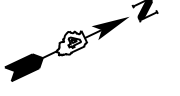

FINAL SUBMITTAL

MODEL: Default  
FILE: I:\Projects\2016\hanson\cdm\hanson\Projects\Documents\13\06\Phase-III\CD\RoadSheet\DWG\CEP\chc\chc\_06\parking\_lot\_w\_drain\map-efk

**EFK Moen, LLC**  
Civil Engineering Design

USER NAME = MSillers	DESIGNED - MYS	REVISED -  4/16/2019
PLOT SCALE = 20.00' / in.	DRAWN - MYS	REVISED -
PLOT DATE = 4/3/2019	CHECKED - SLD	REVISED -
	DATE - 11/28/2018	REVISED -


STATE OF ILLINOIS  
DEPARTMENT OF TRANSPORTATION

US 150 EASTBOUND McCLUGAGE BRIDGE PROJECT  
MISCELLANEOUS DETAIL - WEST PARK DRAINAGE







SCALE: 1"=10' SHEET 6 OF 14 SHEETS STA. N/A TO STA. N/A

F.A.P. RTE. 317	SECTION [15B;((102-1),(14HB))BR]BR	COUNTY PEORIA	TOTAL SHEETS 1361	SHEET NO. 685
ILLINOIS FED. AID PROJECT			CONTRACT NO. 68B46	
MSCDT-P06				

MODEL: Default  
 FILE: Miscel\_PlanView.dwg  
 PROJECT: US 150 Eastbound McClugage Bridge Project  
 SHEET: 317  
 DATE: 4/5/2019

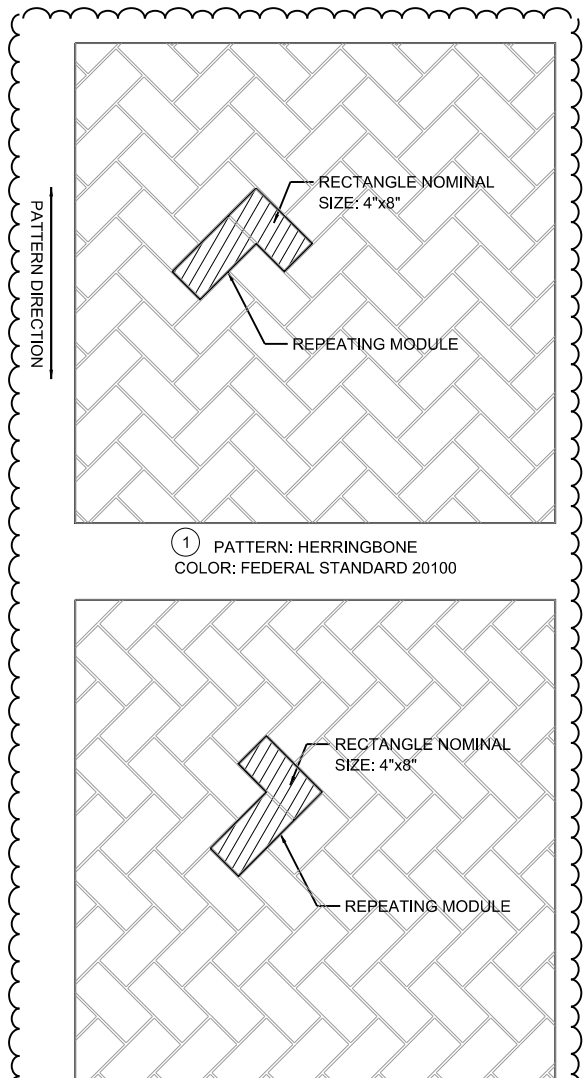

**PORTLAND CEMENT CONCRETE PAVEMENT 6", SPECIAL STAMP PATTERN**  
 SCALE: NONE

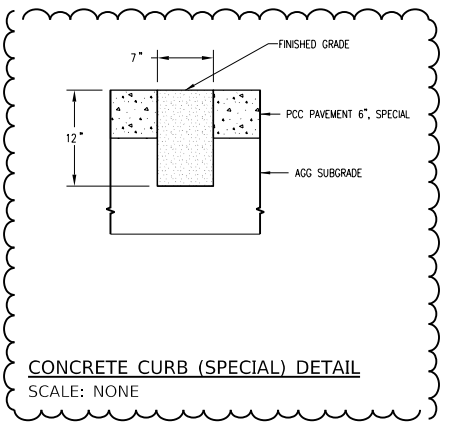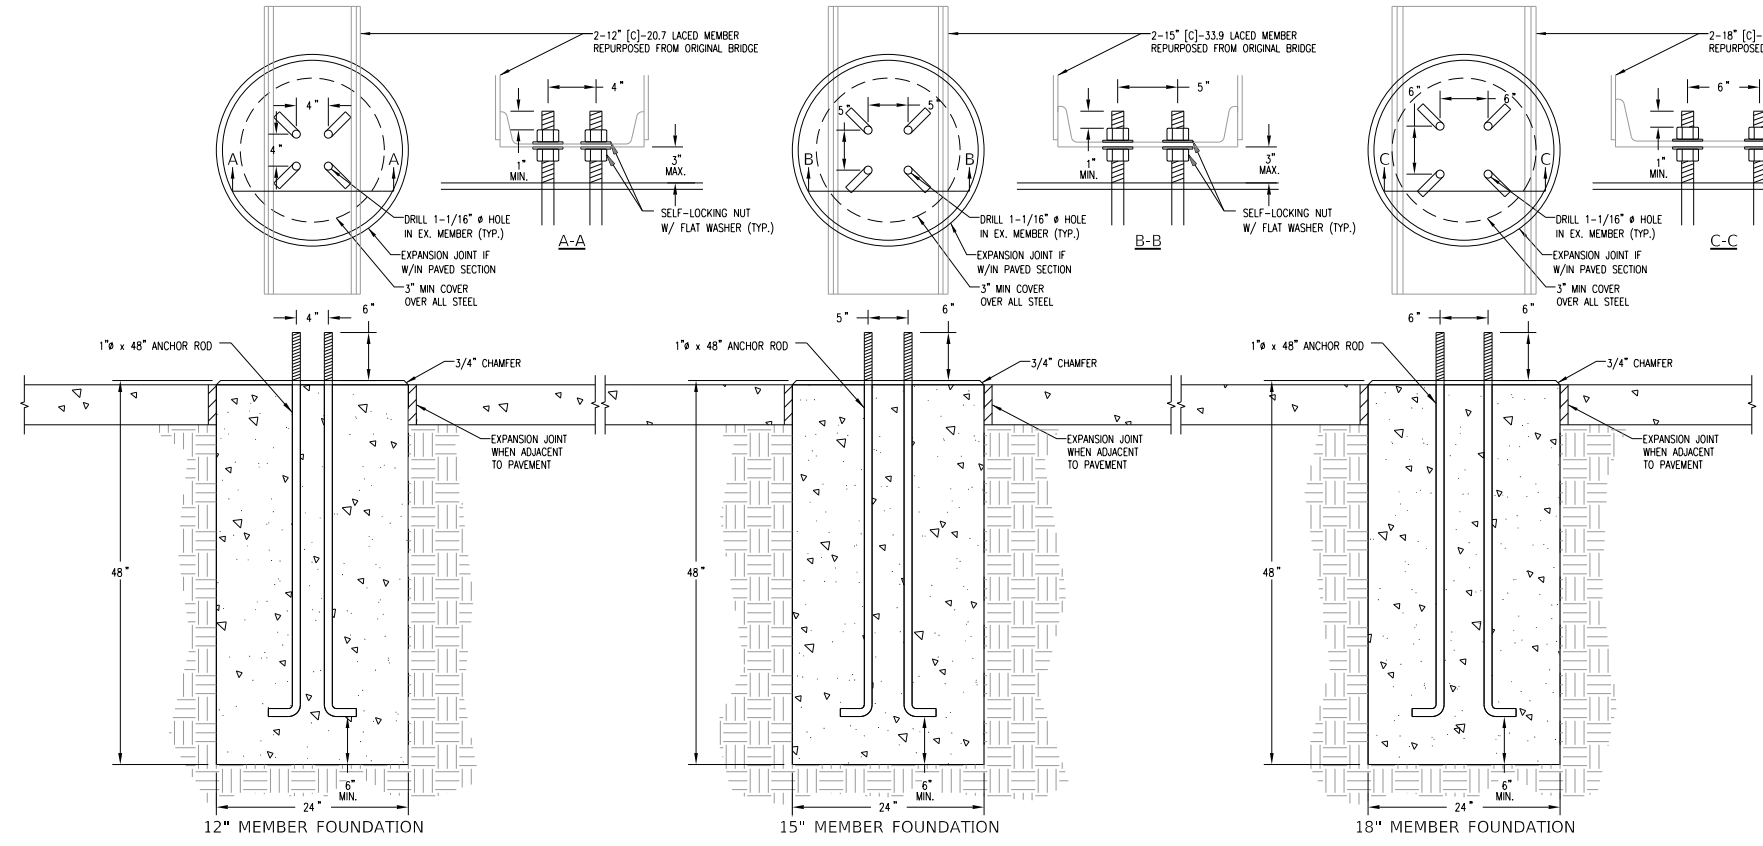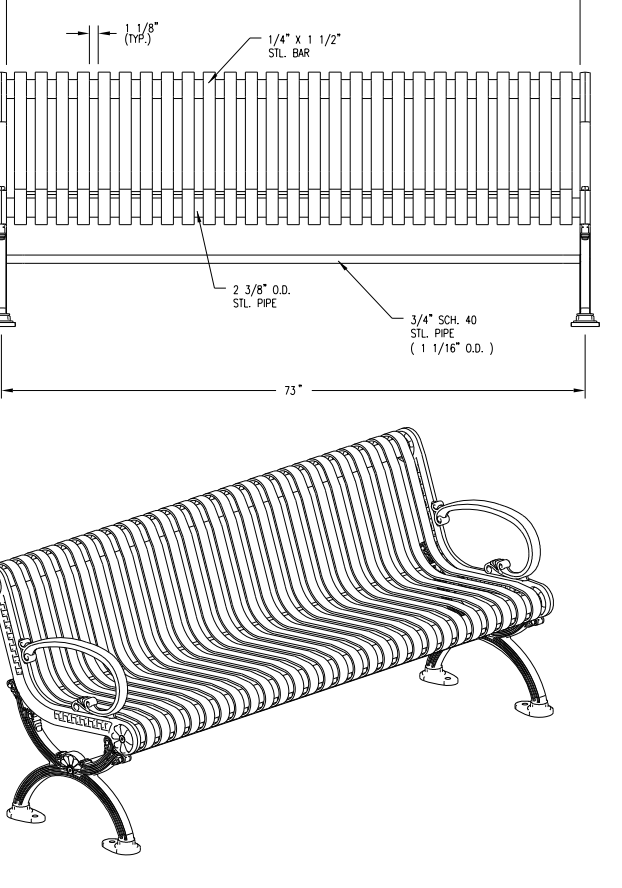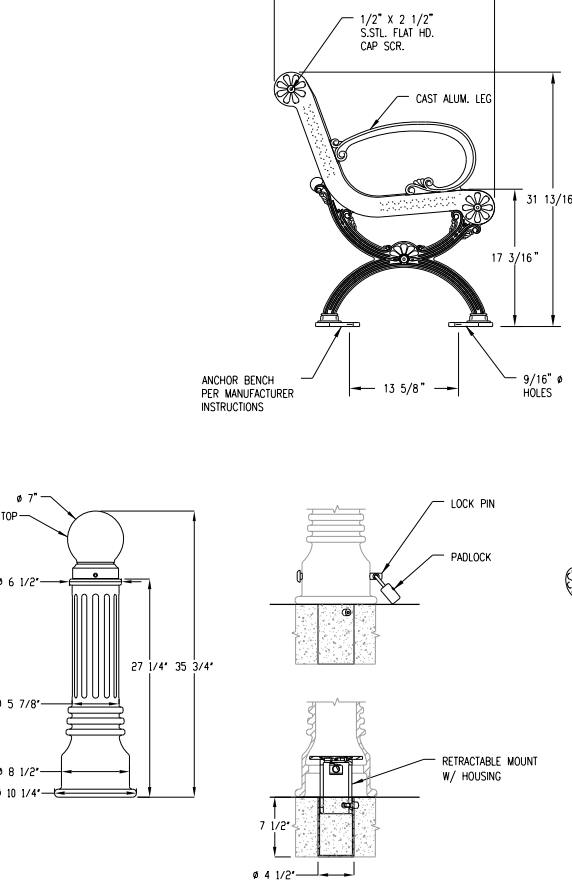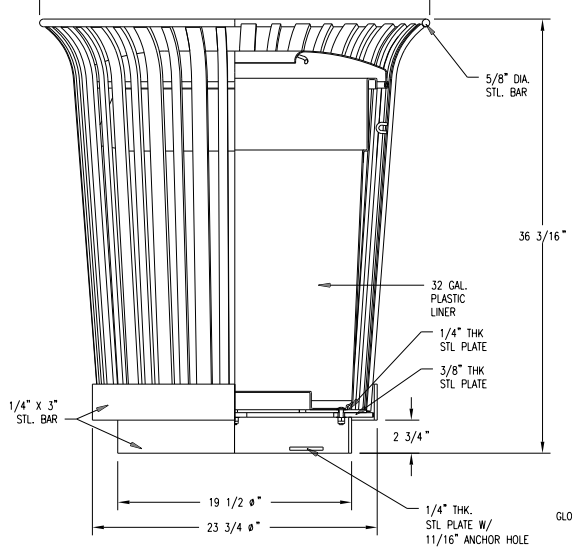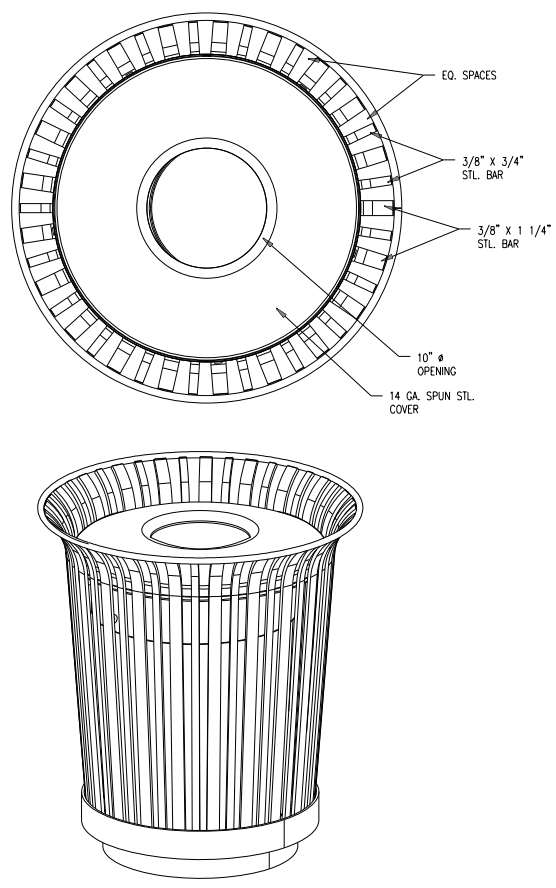


USER NAME = mgormely	DESIGNED - MPG	REVISED - 4/16/2019
DRAWN - KRP	REVISIONS -	
PLOT SCALE = 2.00' / in.	CHECKED - DAJ	REVISIONS -
PLOT DATE = 4/5/2019	DATE - 11/28/2018	REVISIONS -

STATE OF ILLINOIS  
 DEPARTMENT OF TRANSPORTATION

US 150 EASTBOUND McCLUGAGE BRIDGE PROJECT  
 MISCELLANEOUS DETAIL - SITE FURNISHING DETAILS


F.A.P. RTE.	SECTION	COUNTY	TOTAL SHEETS	SHEET NO.
317	[15B;((102-1),(14HB))BR]BR	PEORIA	1361	688
CONTRACT NO. 68B46				
ILLINOIS   FED. AID PROJECT   NHPY-RP3(905)				

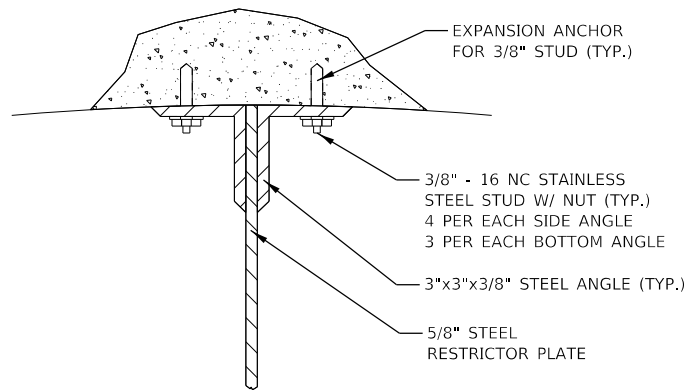


**SIDE AND BOTTOM RESTRICTOR PLATE FASTENER DETAIL**

NOTES:


1. SIDE STEEL ANGLES SHALL EXTEND FROM THE BOTTOM OF RESTRICTOR PLATE TO THE TOP OF THE RESTRICTOR PLATE ON BOTH SIDES OF THE PLATE ALONG EACH WALL OF THE MANHOLE.
2. BOTTOM ANGLE SHALL EXTEND FROM SIDE ANGLE TO SIDE ANGLE ALONG THE BOTTOM OF THE MANHOLE.
3. ALL STEEL ANGLES AND PLATES SHALL BE GALVANIZED AFTER FABRICATION.
4. ALL RESTRICTOR PLATES, STEEL ANGLES AND HARDWARE SHALL BE INCLUDED IN THE COST OF THE MANHOLE.

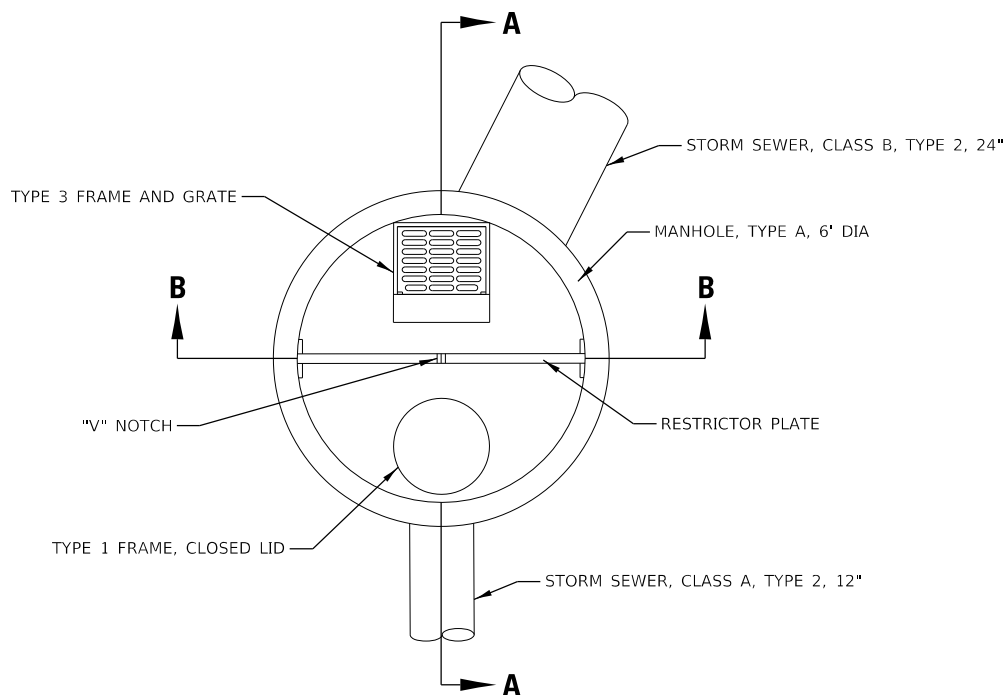

**DRAINAGE STRUCTURE 146 DETAIL  
PLAN VIEW**

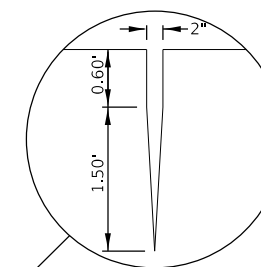


**NOTCH DETAIL**

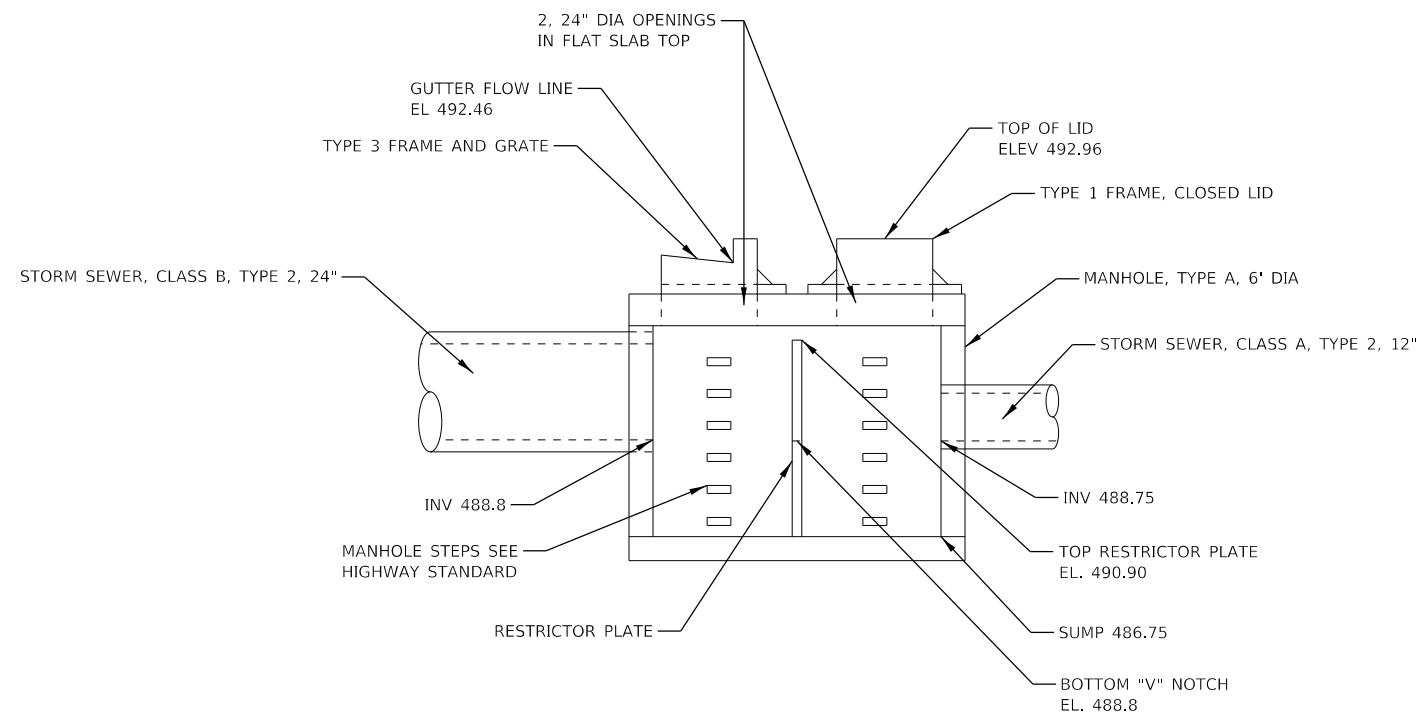

**DRAINAGE STRUCTURE 146 DETAIL  
VIEW A-A**

NOTES:

1. MANHOLE STEPS REQUIRED ON BOTH SIDES OF RESTRICTOR PLATE TO ALLOW ACCESS TO BOTH CHAMBERS.

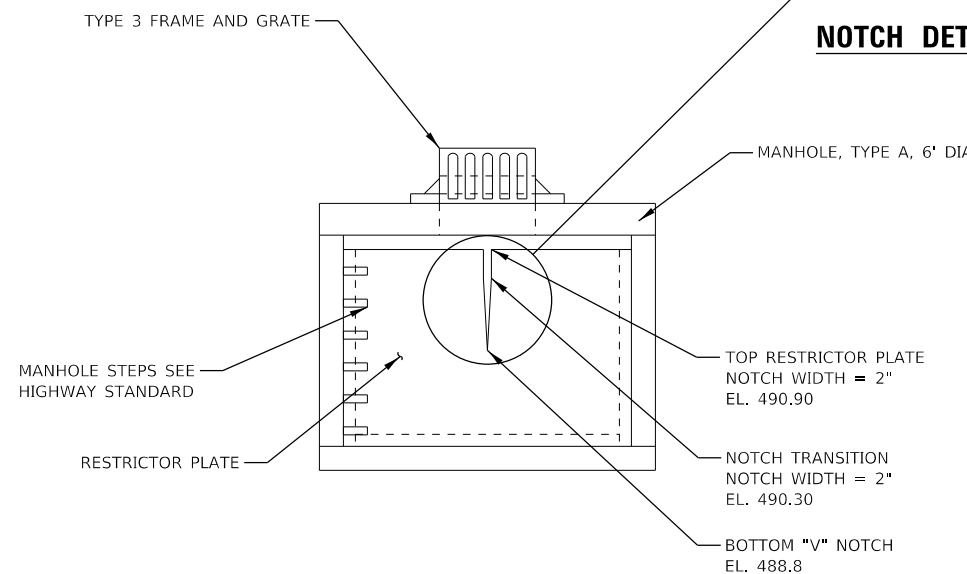

**DRAINAGE STRUCTURE 146 DETAIL  
VIEW B-B**

NOTES:

1. MANHOLE STEPS REQUIRED ON BOTH SIDES OF RESTRICTOR PLATE TO ALLOW ACCESS TO BOTH CHAMBERS.
2. STORM SEWERS NOT SHOWN ON THIS VIEW.

FINAL SUBMITTAL

MODEL: Default  
FILE: h:\mfc\317\3170106\Phase3\CD\RoadSheet\DWG\MSCEP\chm\kcs11\parking\_lot\_w\_drain\2-efk.dgn

**EFK Moen, LLC**  
Civil Engineering Design

USER NAME = MSpillers	DESIGNED - MYS	REVISD - 4/16/2019
PLOT SCALE = 20.00' / in.	CHECKED - SLD	REVISD -
PLOT DATE = 4/3/2019	DATE - 11/28/2018	REVISD -

DESIGNED - MYS	REVISD - 4/16/2019
CHECKED - SLD	REVISD -
DATE - 11/28/2018	REVISD -

DESIGNED - MYS	REVISD - 4/16/2019
CHECKED - SLD	REVISD -
DATE - 11/28/2018	REVISD -

STATE OF ILLINOIS  
DEPARTMENT OF TRANSPORTATION

US 150 EASTBOUND McCLUGAGE BRIDGE PROJECT  
MISCELLANEOUS DETAIL - WEST PARK DRAINAGE DETAILS

SCALE: NONE SHEET 11 OF 14 SHEETS STA. N/A TO STA. N/A


F.A.P. RTE. 317	SECTION [15B;((102-1),(14HB))BR]BR	COUNTY PEORIA	TOTAL SHEETS 1361	SHEET NO. 690
CONTRACT NO. 68B46			ILLINOIS FED. AID PROJECT NHPP-YRP3(905)	

MSCDET-P11

FINAL SURVEY NO.	SURVEYED	DATE
NOTE BOOK	PLOTTED	
	TEMPLATE	
	AREAS CHECKED	
	AREAS CHECKED	

ORIGINAL SURVEY NO.	SURVEYED	DATE
NOTE BOOK	PLOTTED	
	TEMPLATE	
	AREAS CHECKED	
	AREAS CHECKED	

MODEL: D:\mfr\...  
 FILE NAME: D:\mfr\...  
 PROJECT: D:\mfr\...

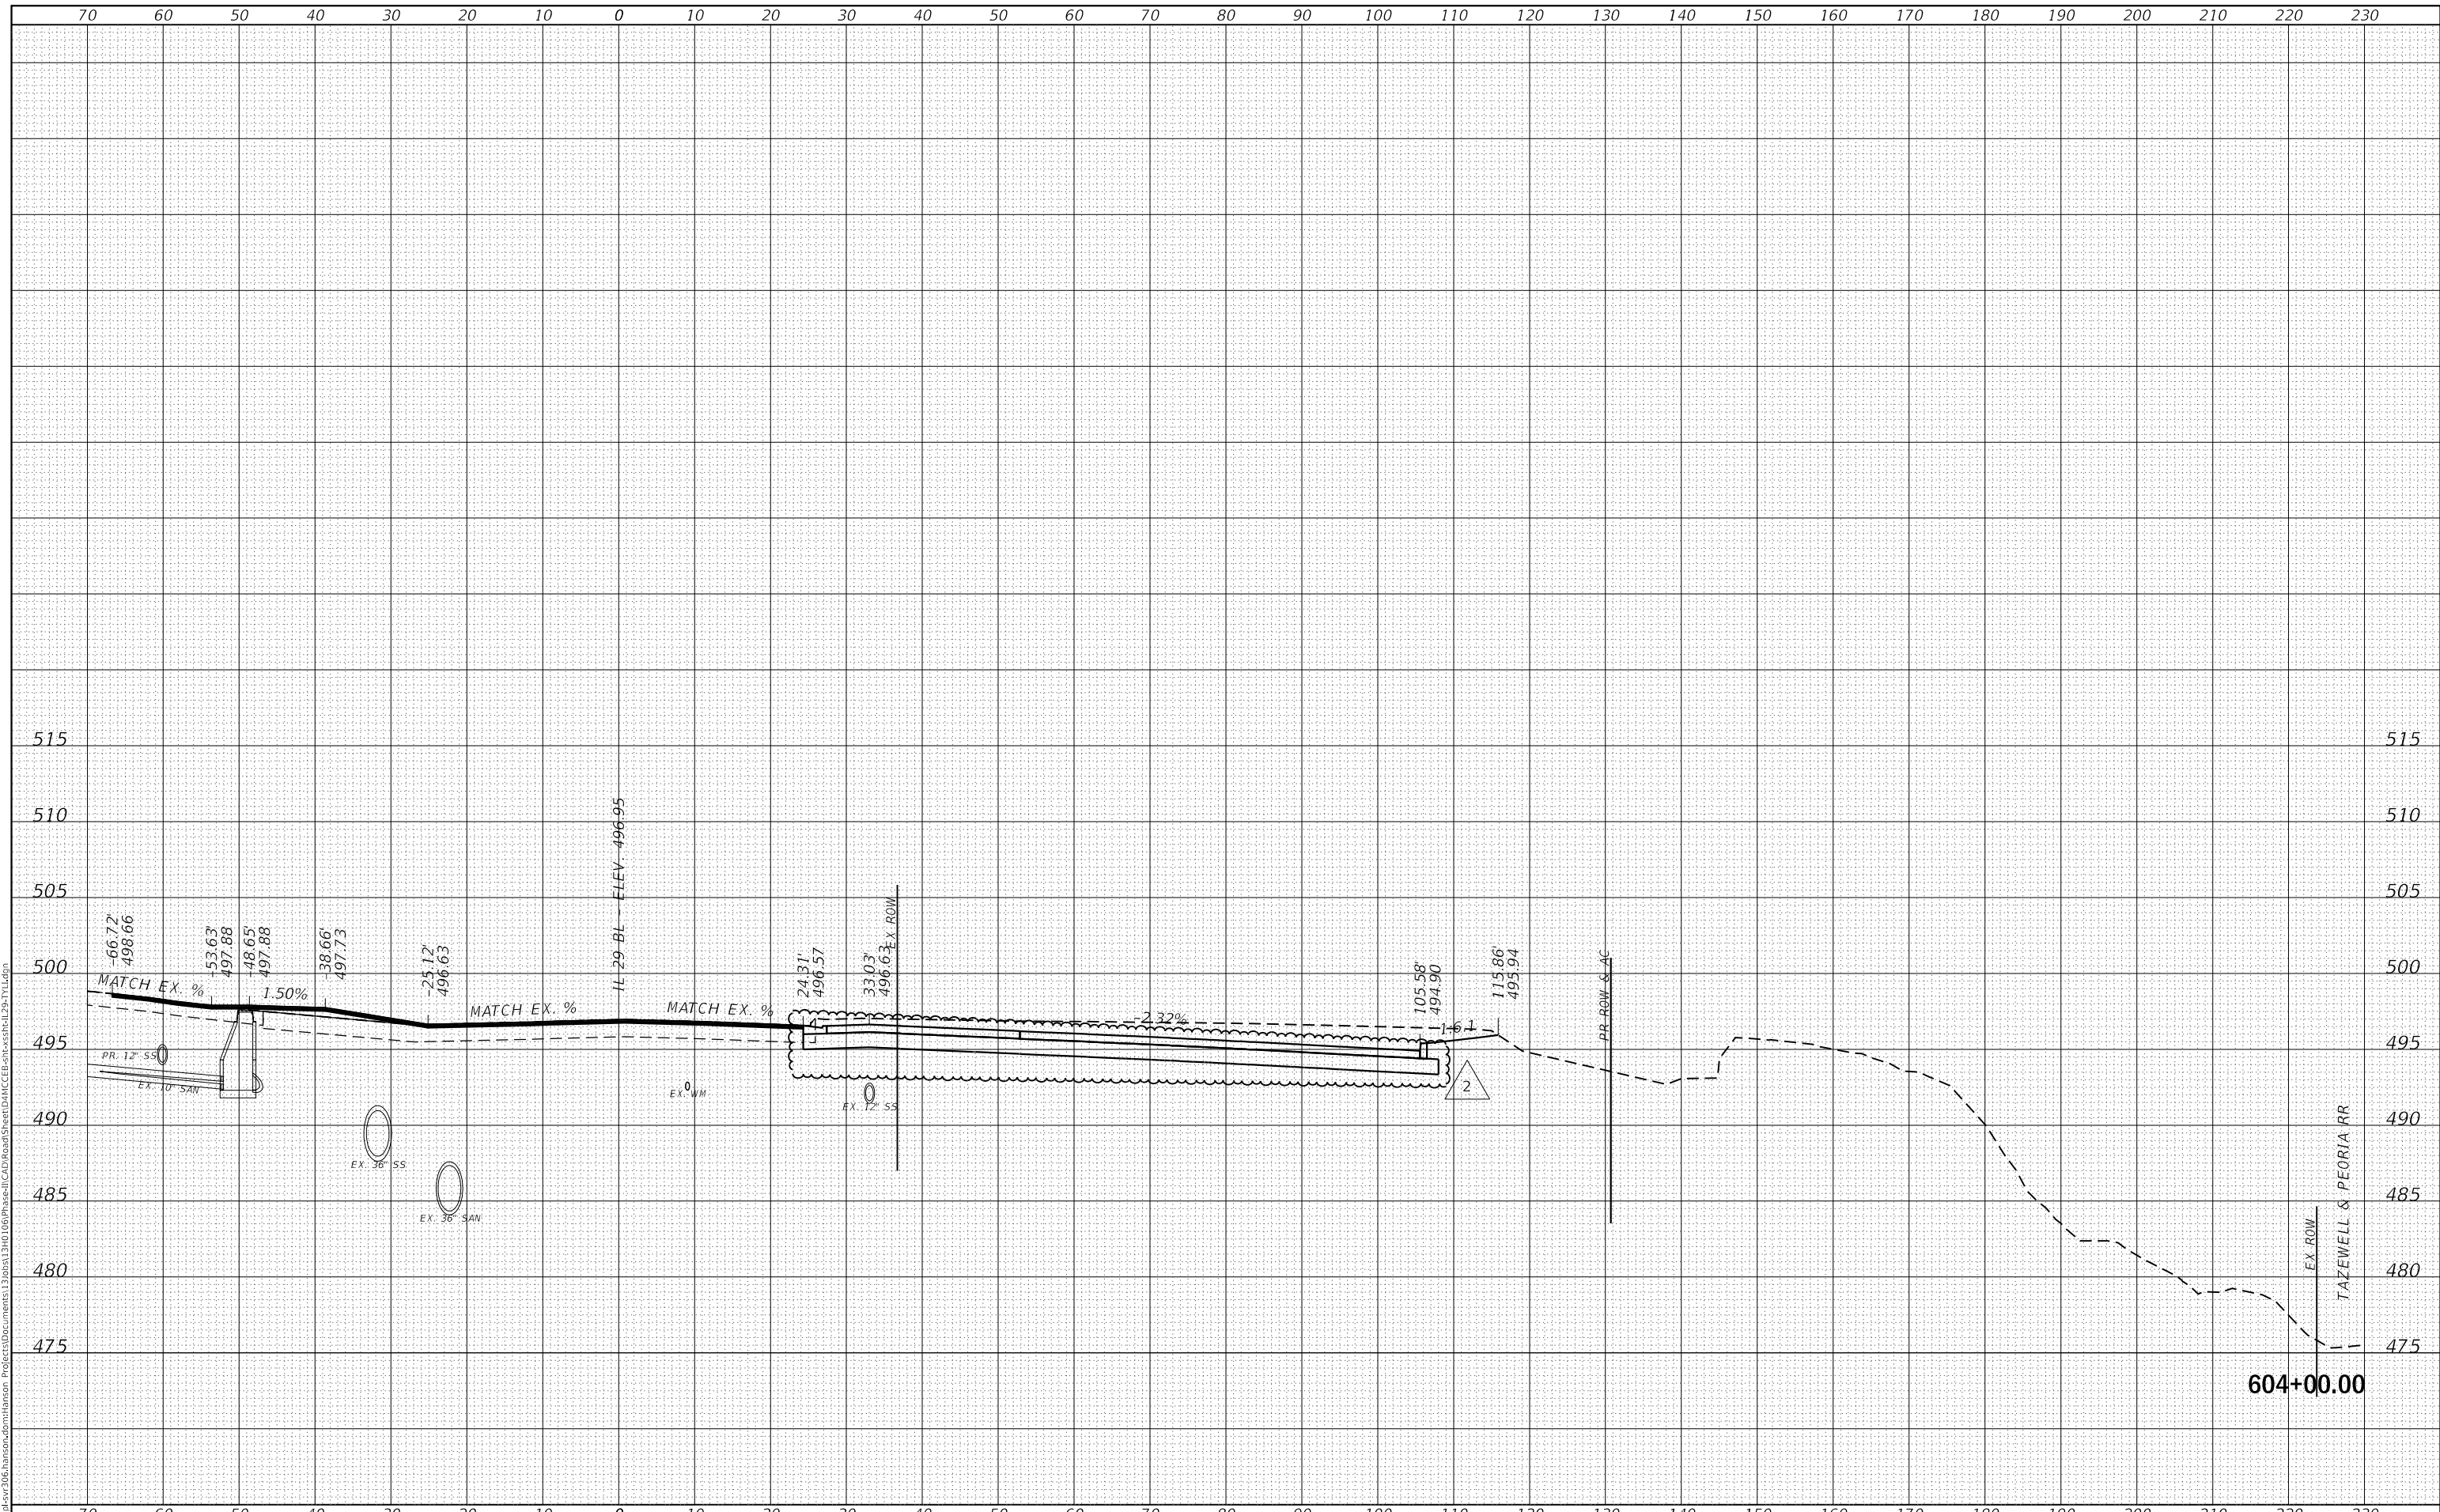

FINAL SUBMITTAL

**TYLIN INTERNATIONAL**  
 200 S. WACKER DR.  
 SUITE 1400  
 CHICAGO, IL 60606  
 TEL: 312-777-2900

USER NAME = mgormely  
 PLOT SCALE = 20.00' / in.  
 PLOT DATE = 4/5/2019

DESIGNED - MPG  
 DRAWN - MPG  
 CHECKED - DAJ  
 DATE - 11/28/2018

REVISED - 4/16/2019  
 REVISED -  
 REVISED -  
 REVISED -

STATE OF ILLINOIS  
 DEPARTMENT OF TRANSPORTATION

US 150 EASTBOUND MCLUGAGE BRIDGE PROJECT  
 CROSS-SECTIONS: IL RTE 29

SCALE: 1"=10'H,5'V SHEET OF 13 SHEETS STA. 604+00.00 TO STA. 604+00.00

F.A.P. RTE.	SECTION	COUNTY	TOTAL SHEETS	SHEET NO.
317	[15B;((102-1),(14HB))BR]BR	PEORIA	1361	739
CONTRACT NO. 68B46				
ILLINOIS FED. AID PROJECT NHPP-YRP3(905)				








FINAL SURVEY NO.	SURVEYED	DATE
NOTE BOOK	PLOTTED	
AREAS CHECKED	TEMPLATE	
AREAS CHECKED	AREAS CHECKED	

ORIGINAL SURVEY NO.	SURVEYED	DATE
NOTE BOOK	PLOTTED	
AREAS CHECKED	TEMPLATE	
AREAS CHECKED	AREAS CHECKED	

FINAL SUBMITTAL  
 MODEL: D:\mfrt  
 FILE NAME: D:\projects\306\_hanson\cambrian\hanson\cambrian\Project\Documents\306\317\317.dwg

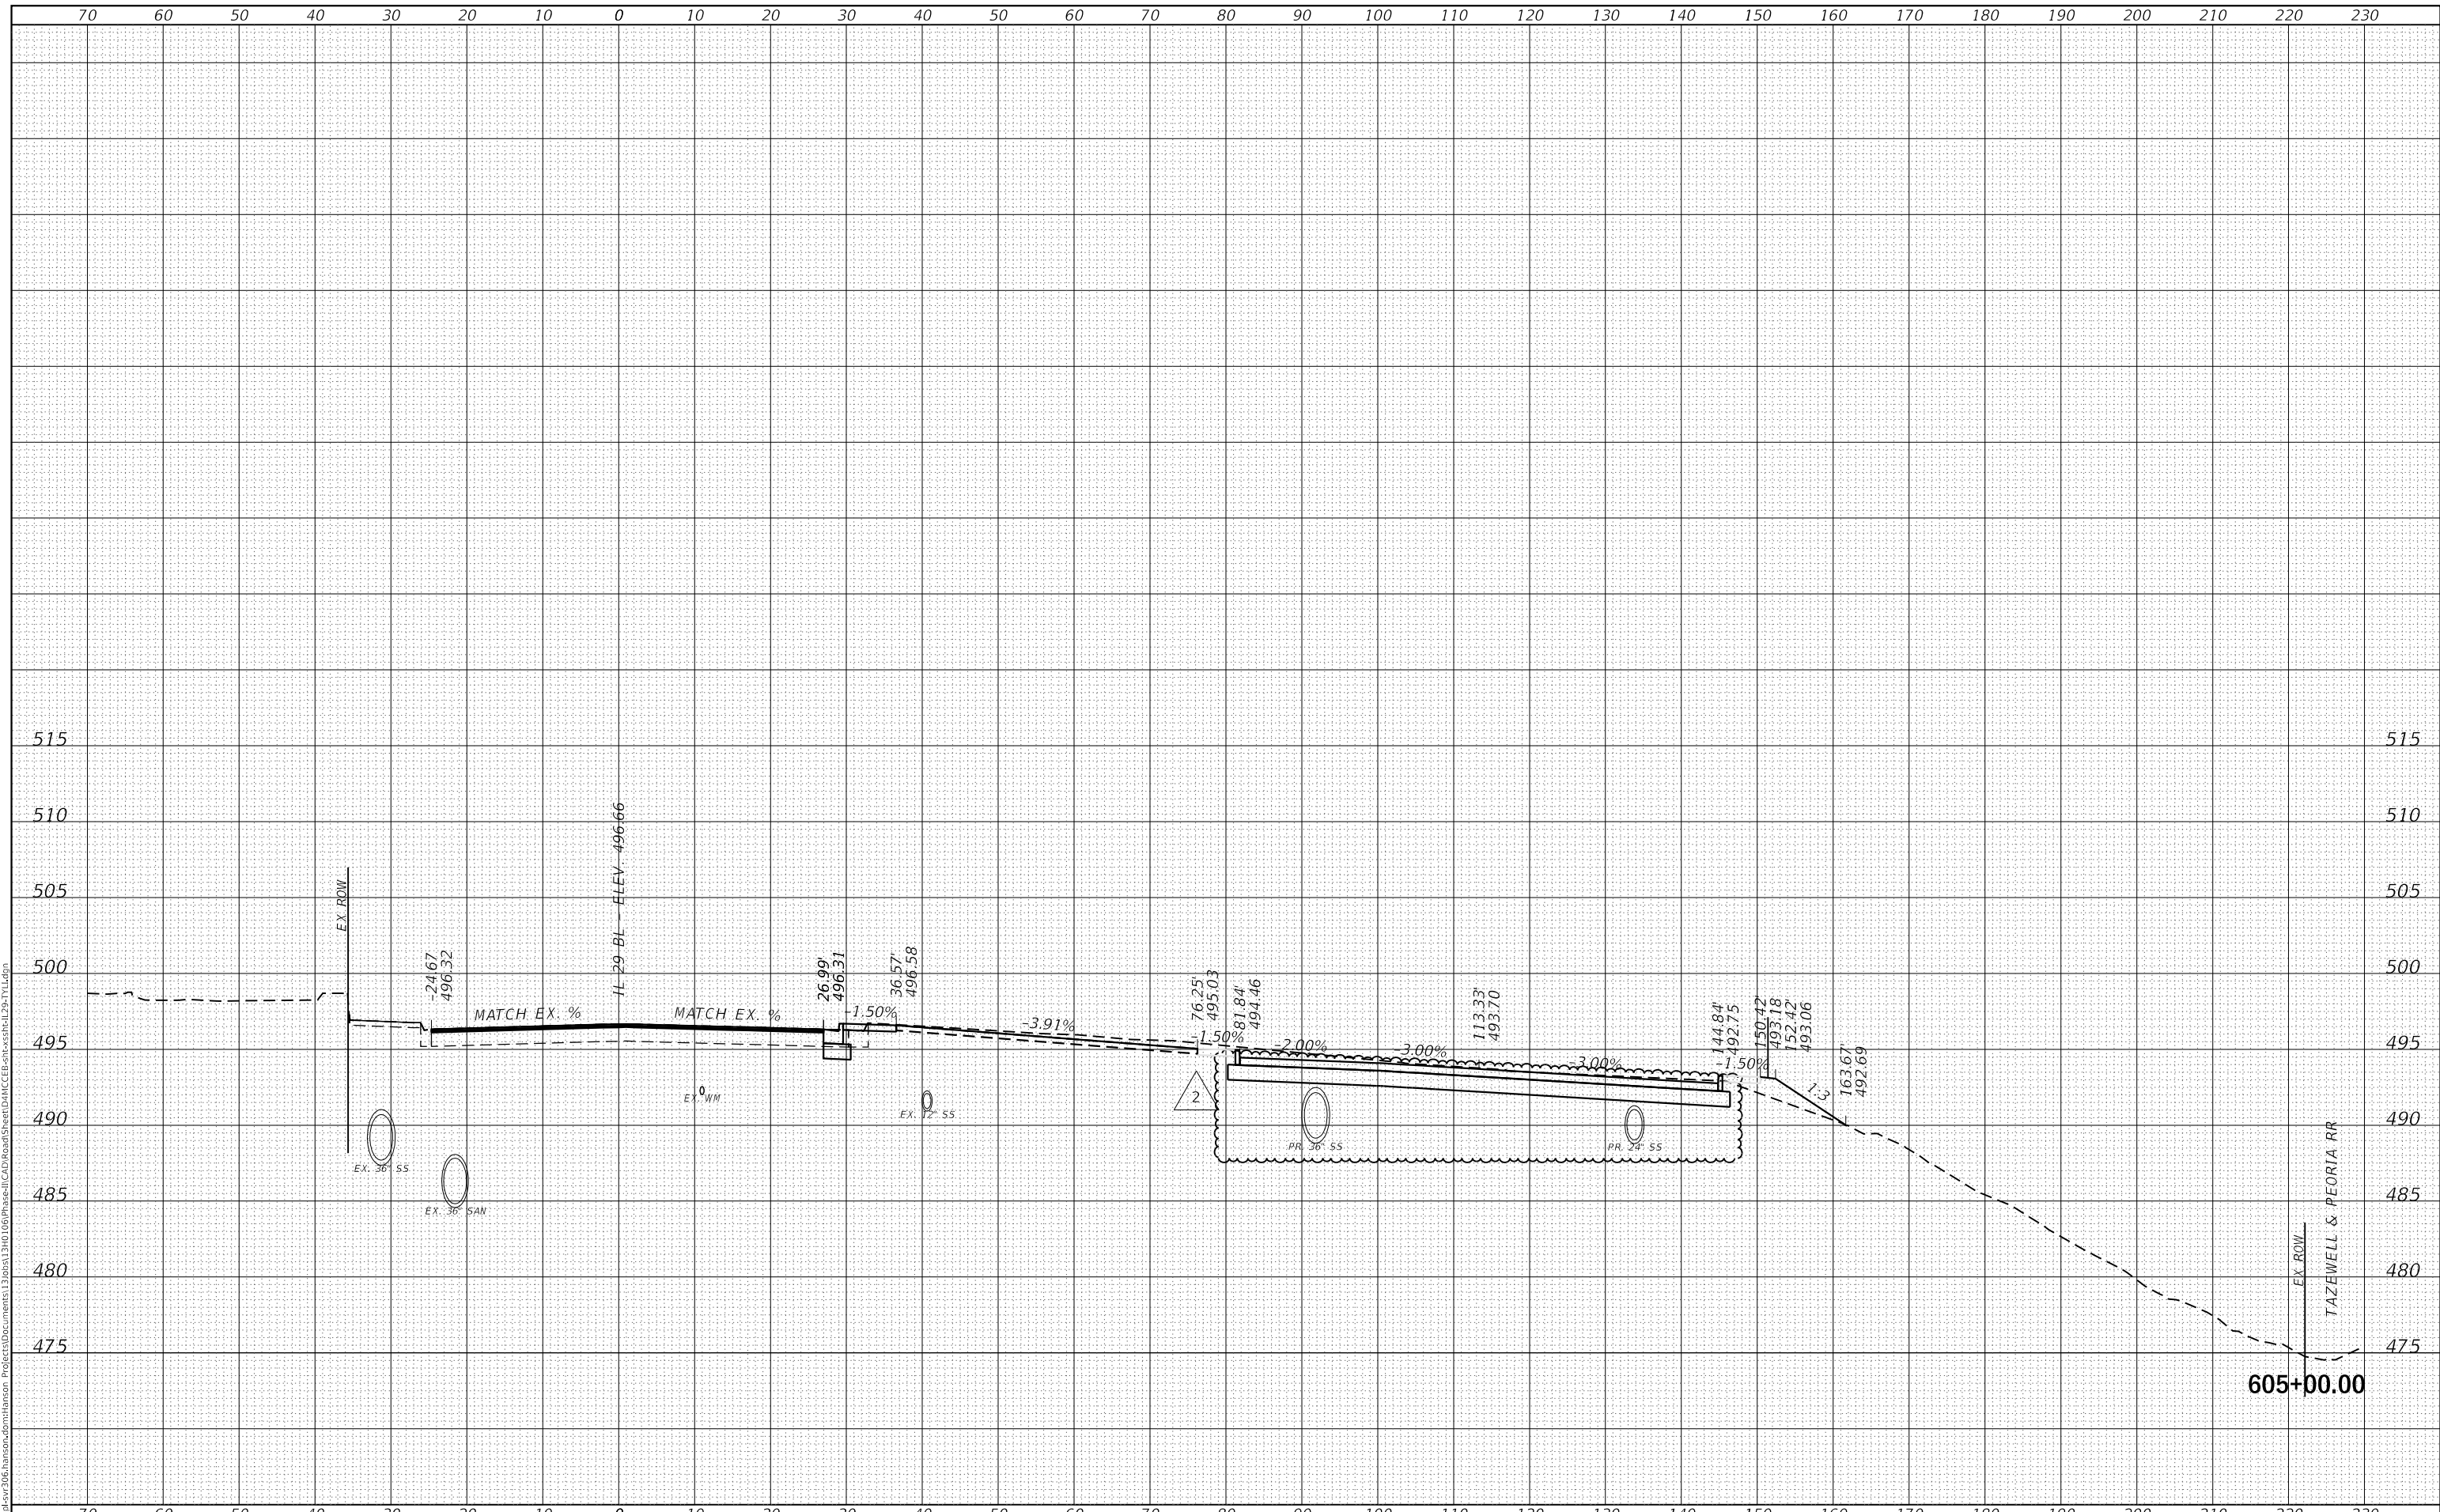

**TYLIN INTERNATIONAL**  
 200 S. WACKER DR.  
 SUITE 1400  
 CHICAGO, IL 60606  
 TEL: 312-777-2900

USER NAME = mgormely	DESIGNED - MPG	REVISD - 4/16/2019
	DRAWN - MPG	REVISD -
PLOT SCALE = 20.00' / in.	CHECKED - DAJ	REVISD -
PLOT DATE = 4/5/2019	DATE - 11/28/2018	REVISD -

STATE OF ILLINOIS  
 DEPARTMENT OF TRANSPORTATION


US 150 EASTBOUND MCLUGAGE BRIDGE PROJECT  
 CROSS-SECTIONS: IL RTE 29  
 SCALE: 1"=10'H,5"V SHEET OF 13 SHEETS STA. 605+00.00 TO STA. 605+00.00

F.A.P. RTE.	SECTION	COUNTY	TOTAL SHEETS	SHEET NO.
317	[15B;((102-1),(14HB))BR]BR	PEORIA	1361	741
CONTRACT NO. 68B46				
ILLINOIS FED. AID PROJECT NHPY-RP3(905)				



FINAL SURVEY NO.	SURVEYED	DATE
NOTE BOOK	PLOTTED	
AREAS CHECKED	TEMPLATE	
	AREAS CHECKED	

ORIGINAL SURVEY NO.	SURVEYED	DATE
NOTE BOOK	PLOTTED	
AREAS CHECKED	TEMPLATE	
	AREAS CHECKED	

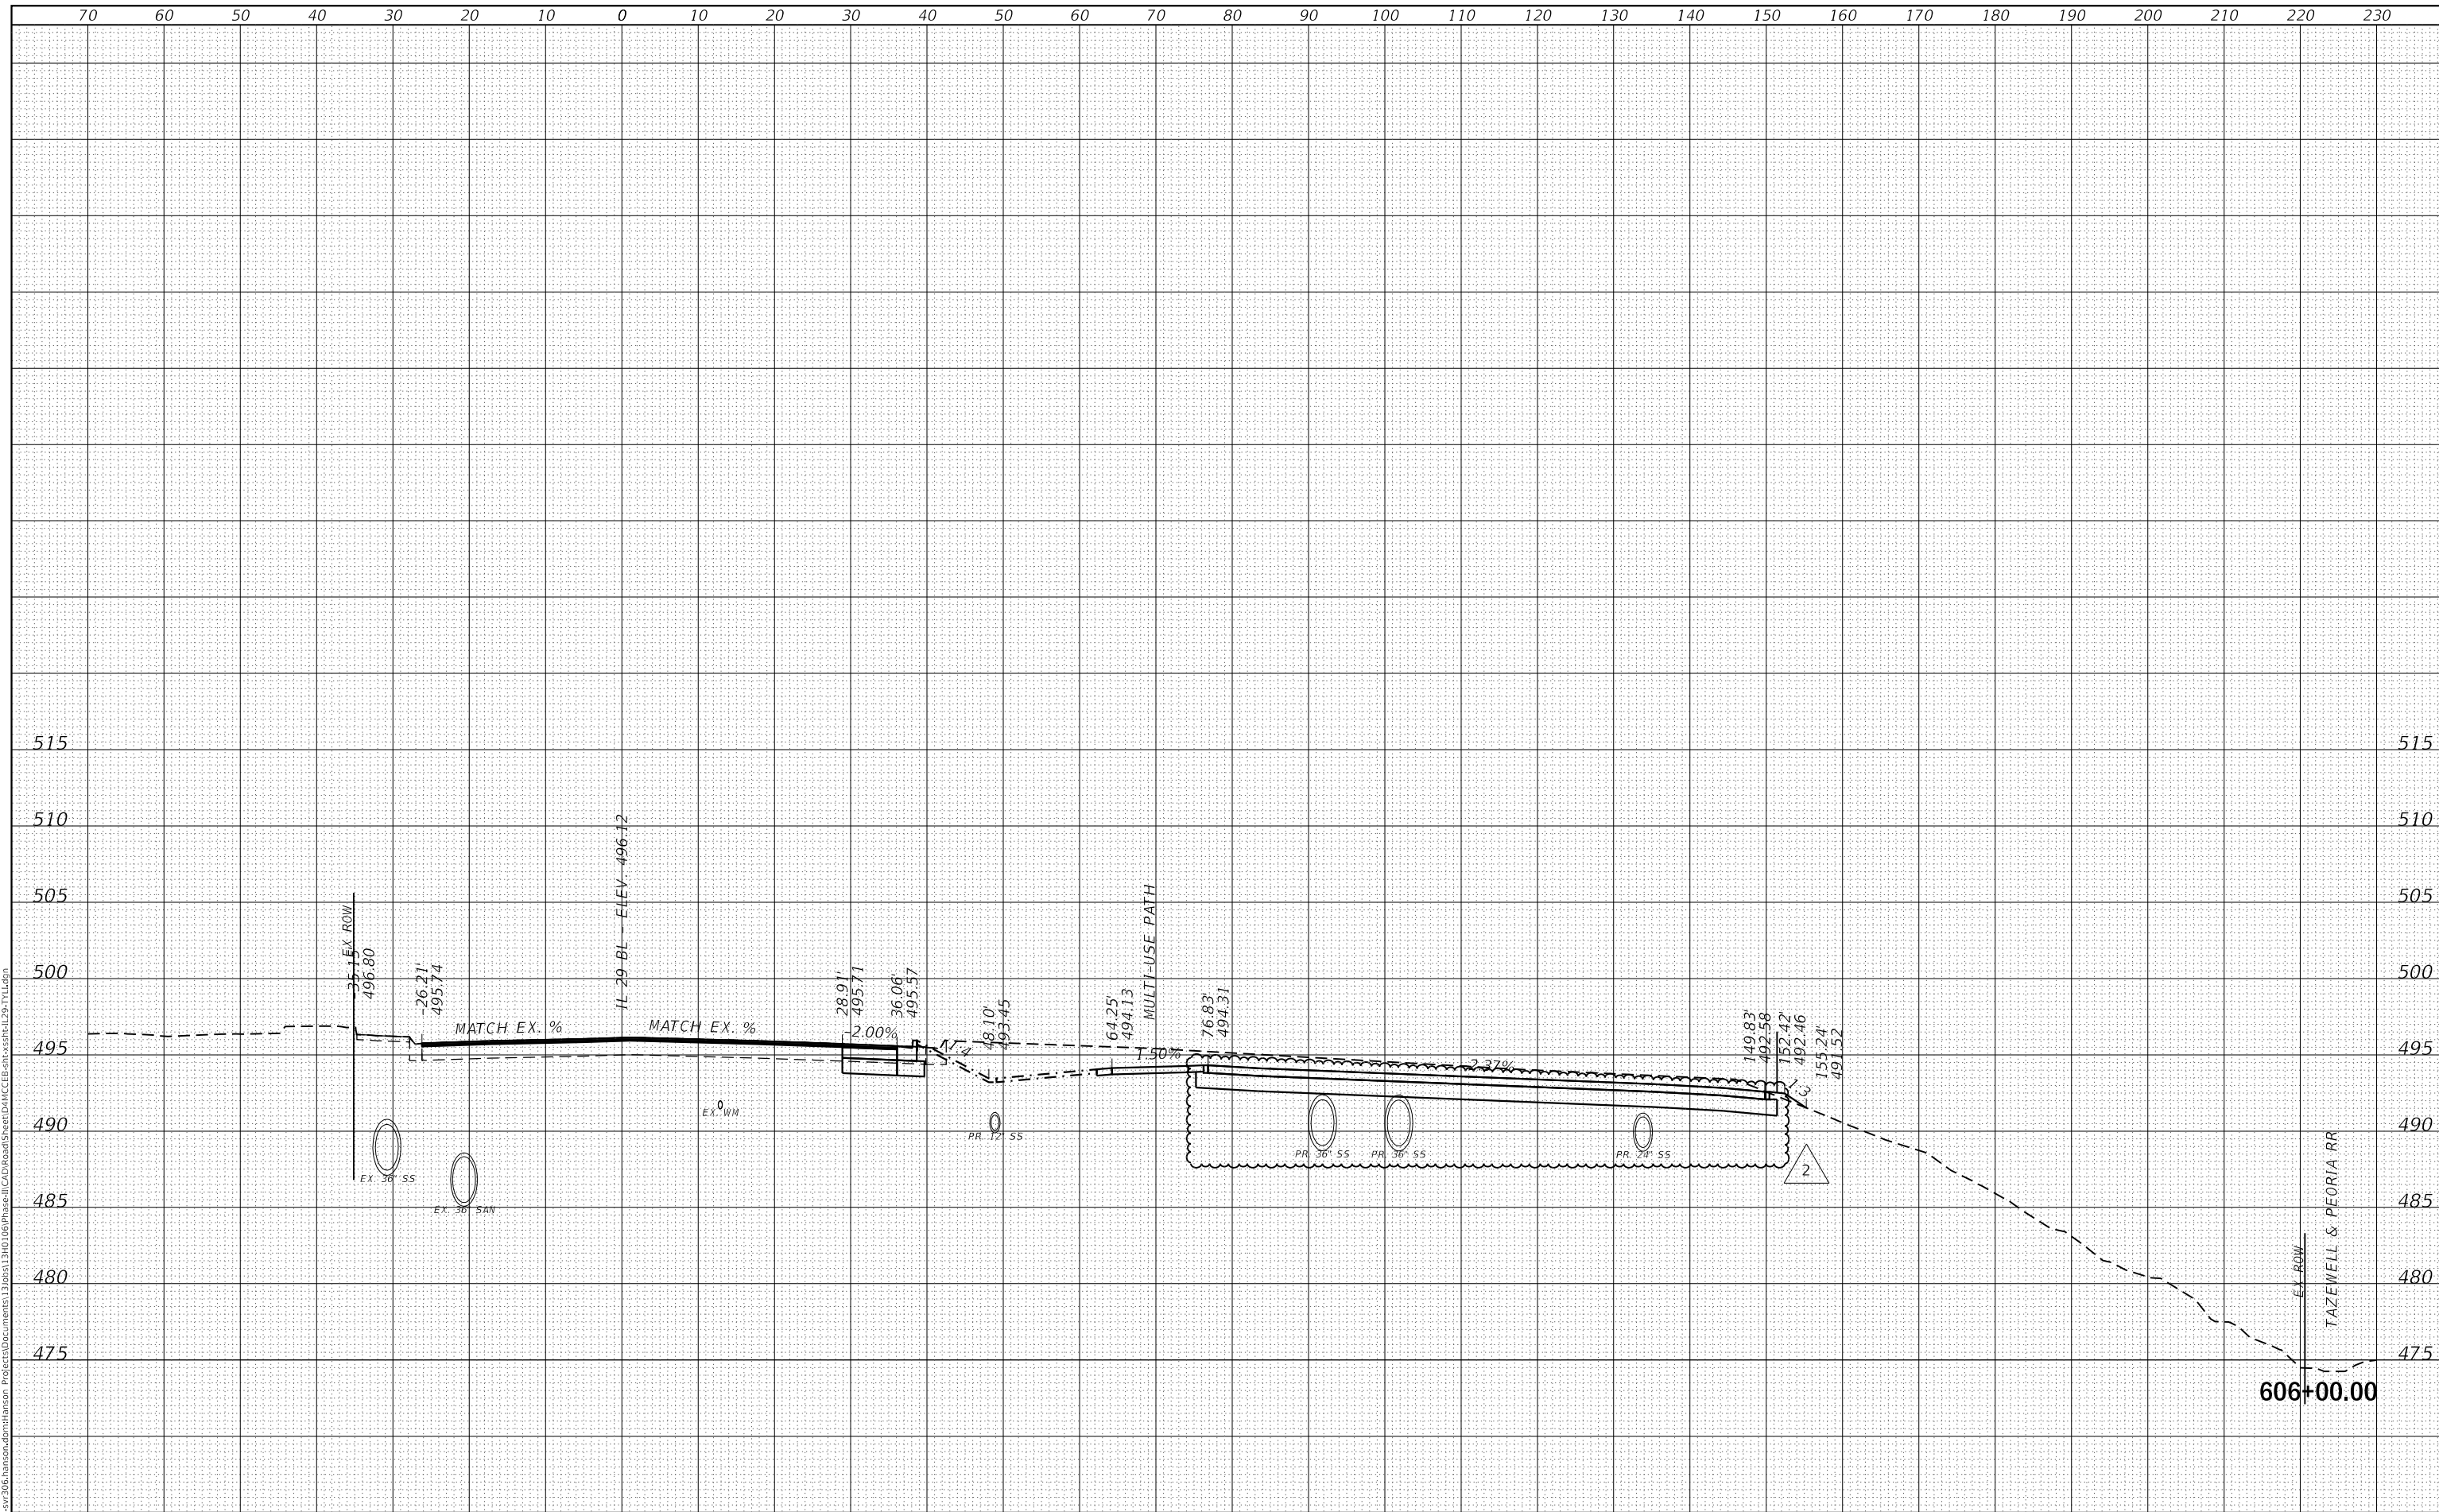

FINAL SUBMITTAL  
MODEL: D:\mfrt  
FILE NAME: D:\mfrt\sv\06\_hanson\camb\hanson\Project\Documents\1308513\RD\06\Phase3\CAD\Road\Sheet\DAI\CE\camb\camb\129-11.dwg

**TYLIN INTERNATIONAL**  
200 S. WACKER DR.  
SUITE 1400  
CHICAGO, IL 60606  
TEL: 312-777-2900

USER NAME = mgormely
PLOT SCALE = 20.00' / in.
PLOT DATE = 4/5/2019

DESIGNED - MPG
DRAWN - MPG
CHECKED - DAI
DATE - 11/28/2018

REVISED - 4/16/2019
REVISED -
REVISED -
REVISED -

STATE OF ILLINOIS  
DEPARTMENT OF TRANSPORTATION


US 150 EASTBOUND MCCLUGAGE BRIDGE PROJECT  
CROSS-SECTIONS: IL RTE 29  
SCALE: 1"=10'H,5"V SHEET OF 13 SHEETS STA. 606+00.00 TO STA. 606+00.00

F.A.P. RTE.	SECTION	COUNTY	TOTAL SHEETS	SHEET NO.
317	[15B;((102-1),(14HB))BR]BR	PEORIA	1361	743
CONTRACT NO. 68B46				
ILLINOIS FED. AID PROJECT NHPP-YRP3(905)				

FINAL SURVEY NO.	SURVEYED	DATE
NOTE BOOK	PLOTTED	
AREAS CHECKED	TEMPLATE	
AREAS CHECKED	AREAS	

ORIGINAL SURVEY NO.	SURVEYED	DATE
NOTE BOOK	PLOTTED	
AREAS CHECKED	TEMPLATE	
AREAS CHECKED	AREAS	


FINAL SUBMITTAL  
 MODEL: Definit  
 FILE NAME: D:\projects\306\_hanson\cambrian\station\306sta13\rd\06\Phase1\CAD\RoadSheet\DAI\CE\cambrian\306sta13\11.dgn

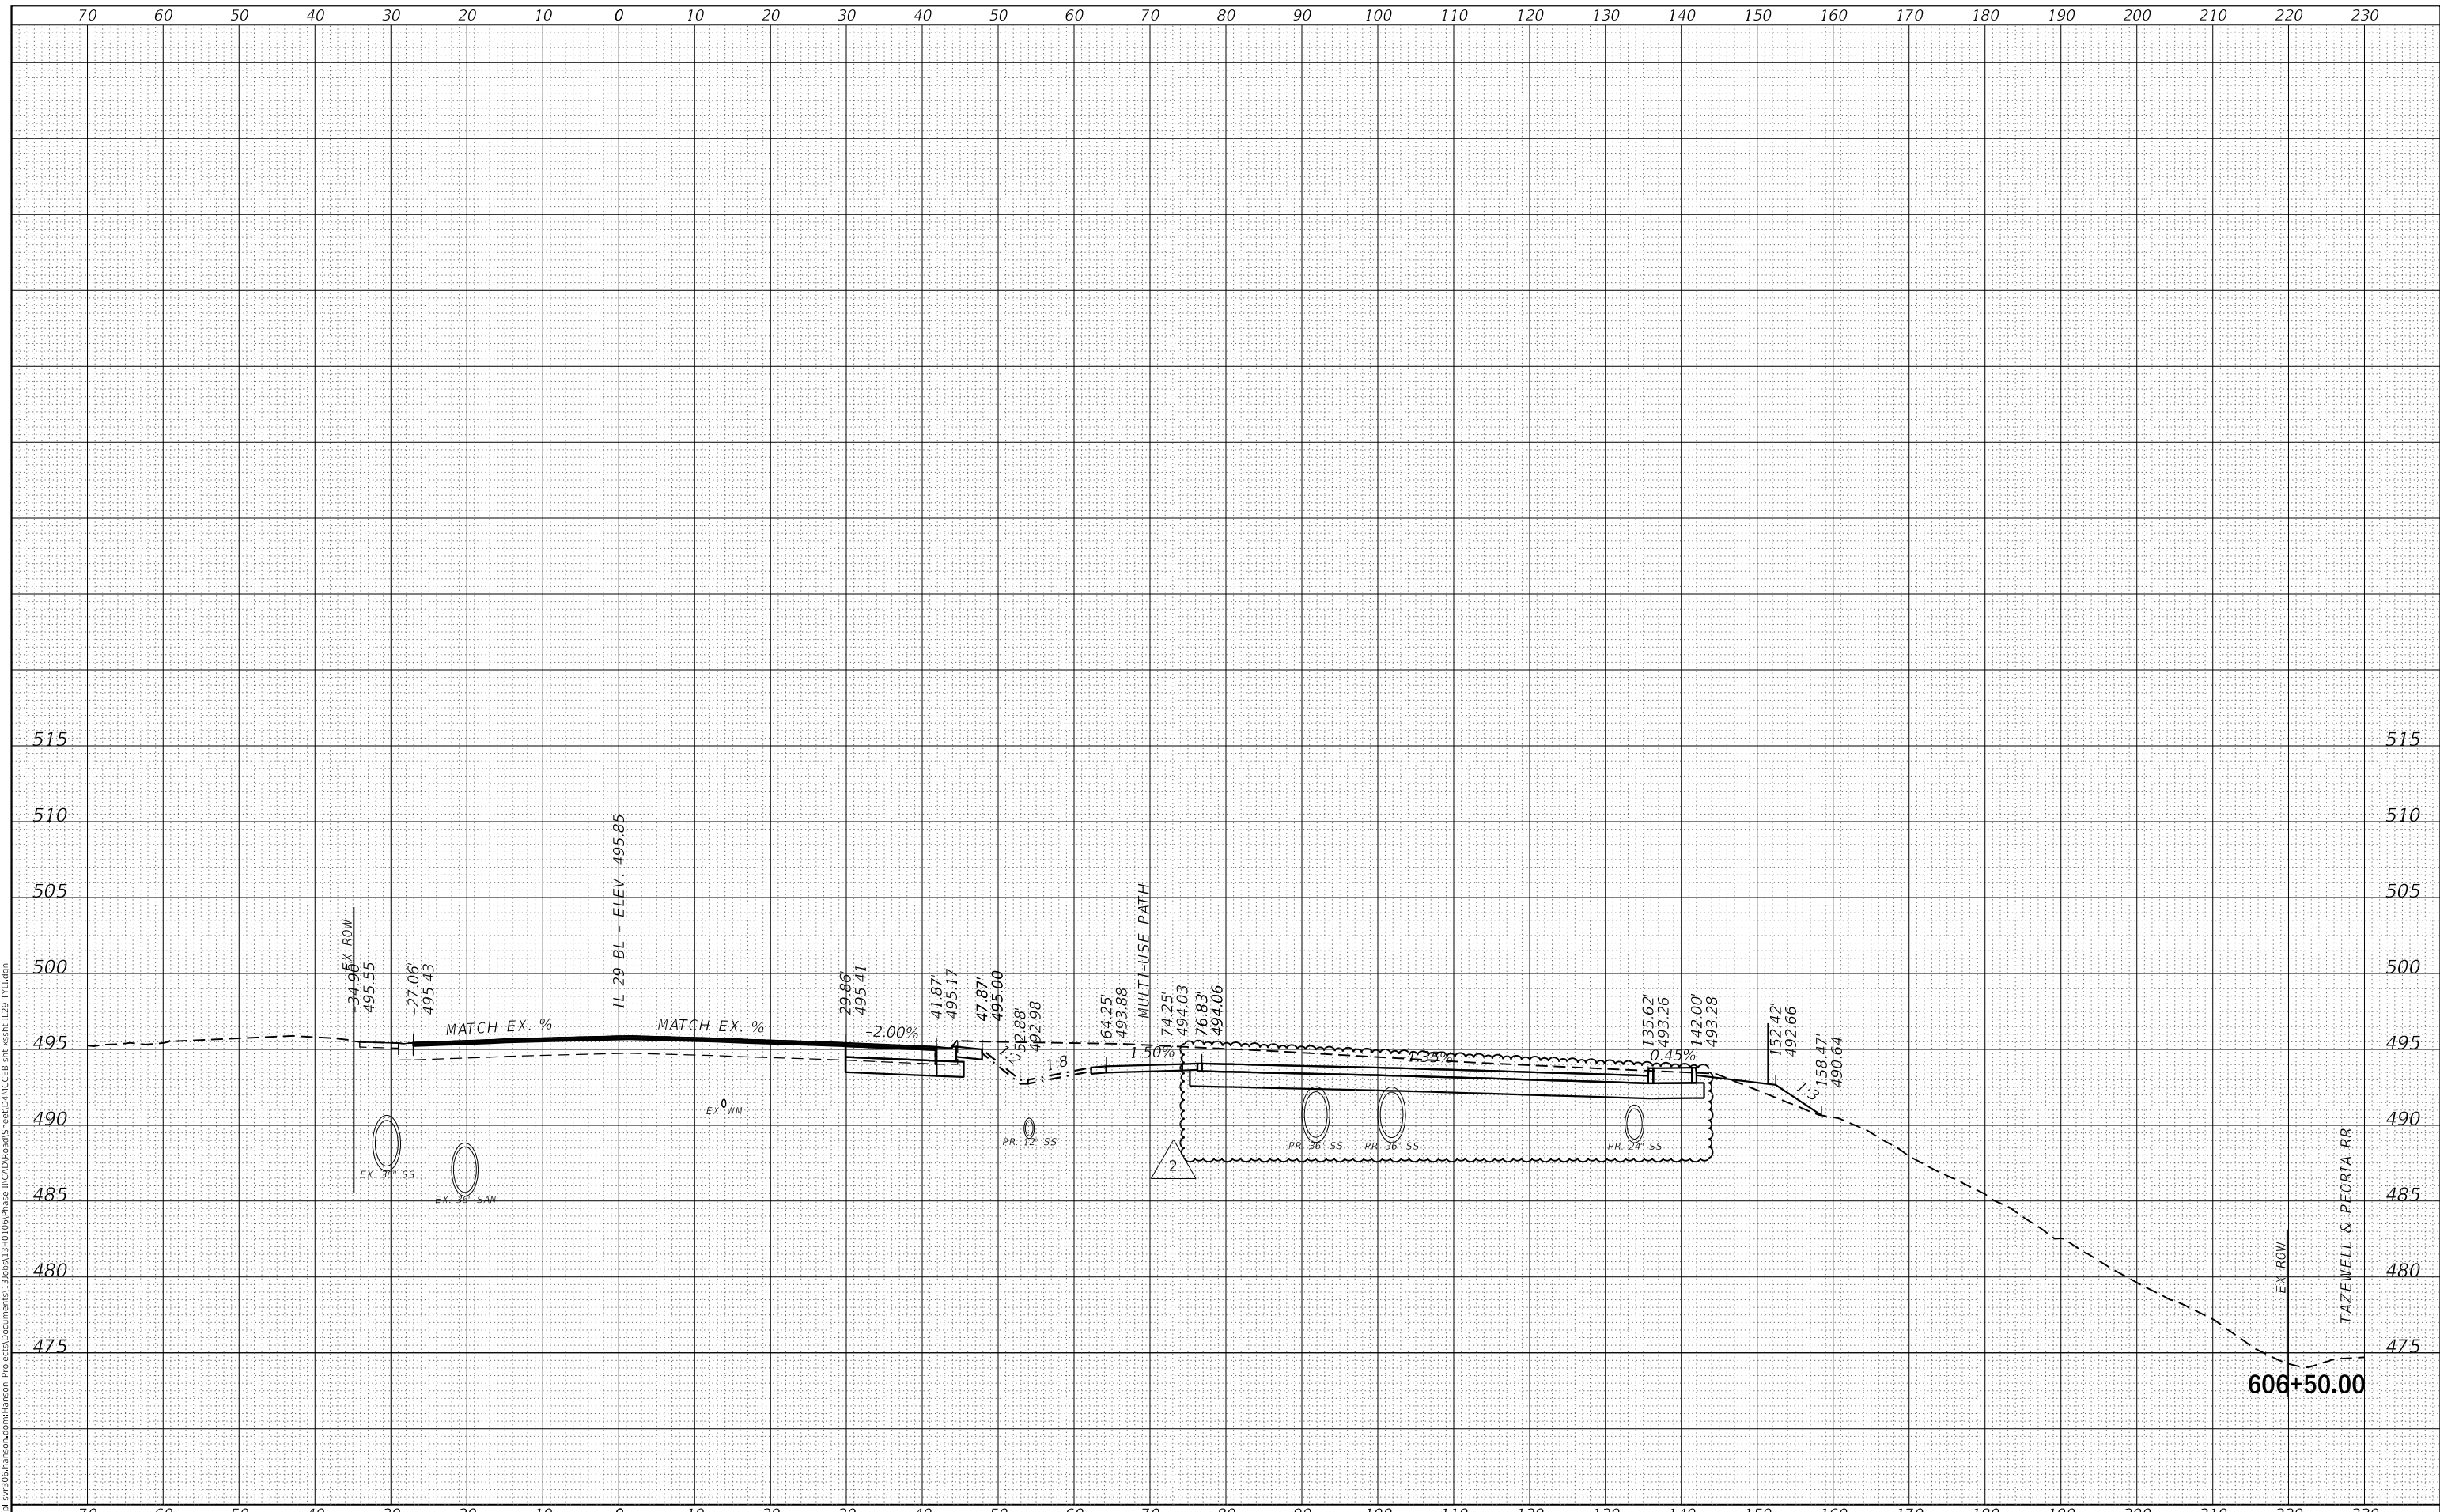

<b>TYLIN INTERNATIONAL</b> 200 S. WACKER DR. SUITE 1400 CHICAGO, IL 60606 TEL: 312-777-2900	USER NAME = mgormely	DESIGNED - MPG	REVISED - 4/16/2019	STATE OF ILLINOIS DEPARTMENT OF TRANSPORTATION	US 150 EASTBOUND MCLUGAGE BRIDGE PROJECT			F.A.P. RTE. 317	SECTION [15B;((102-1),(14HB))BR]BR	COUNTY PEORIA	TOTAL SHEETS 1361	SHEET NO. 744
	PLOT SCALE = 20.00' / in.	CHECKED - DAI	REVISED -		SCALE: 1"=10'H,5'V	SHEET OF 13 SHEETS	STA. 606+50.00 TO STA. 606+50.00	CONTRACT NO. 68B46		ILLINOIS FED. AID PROJECT	NHPP-YRP3(905)	


**GENERAL NOTES**

All dimensions shall remain the same as shown on superstructure details, except dimension A which is to be revised as shown. Additional concrete needed to revise dimension A = 0.00348 cu. yds./ft. for 39" and 44" parapets.  
 Place full depth aluminum sheets as shown on superstructure details.  
 Replace all cork joint filler locations with a full thickness saw cut.  
 Steel superstructure shown. Other superstructure types similar.

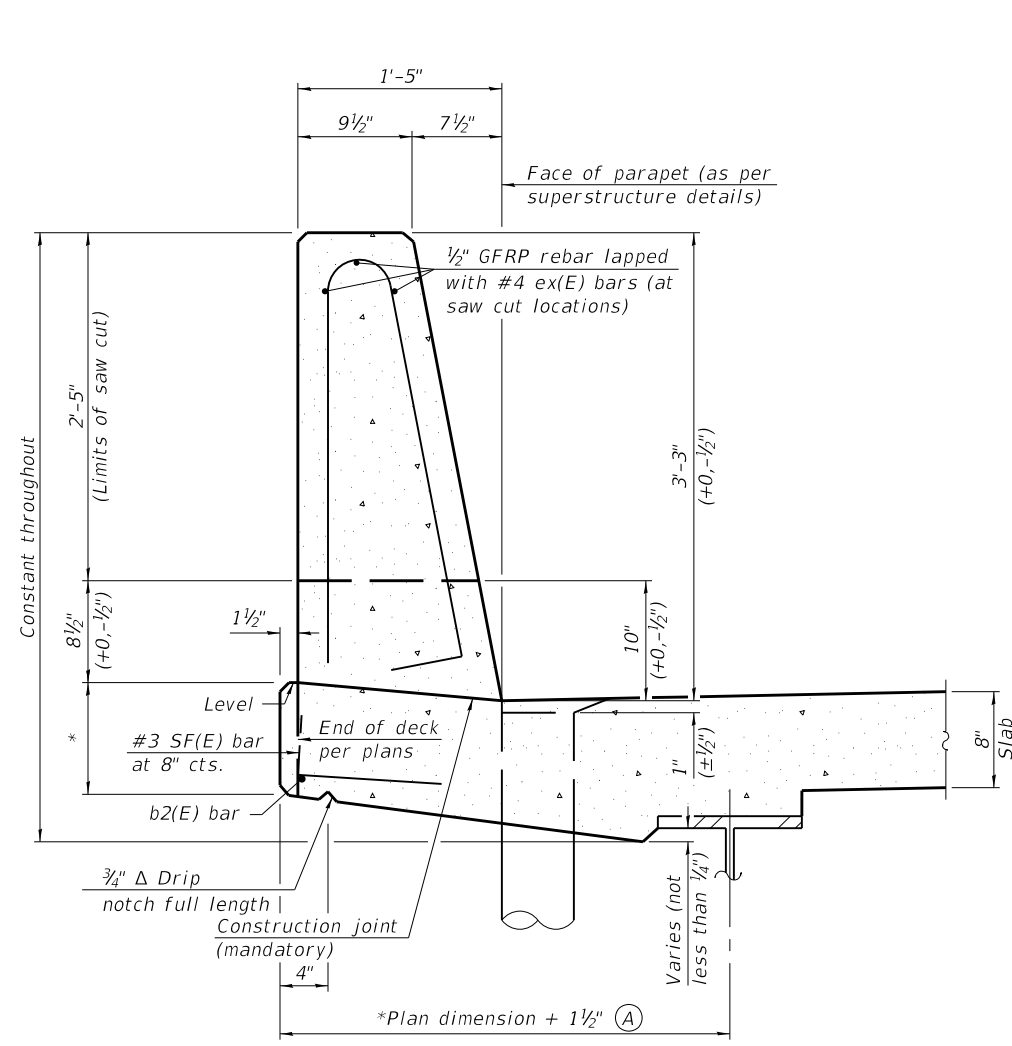

**39" CONSTANT-SLOPE  
PARAPET SECTION**


(Showing dimensions, d(E), and 1/2" Ø GFRP rebar)

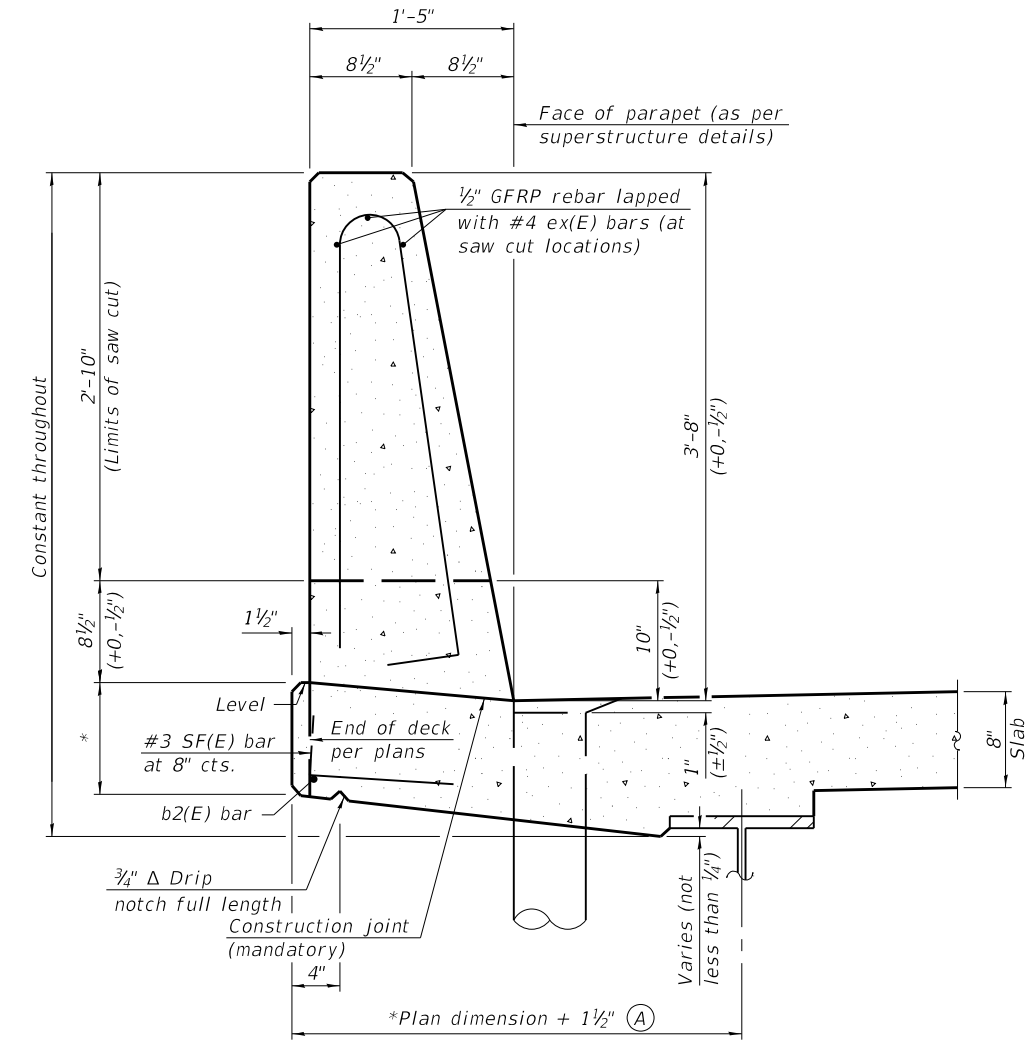


**44" CONSTANT-SLOPE  
PARAPET SECTION**

(Showing dimensions, d(E), and 1/2" Ø GFRP rebar)

\*See Superstructure Details.

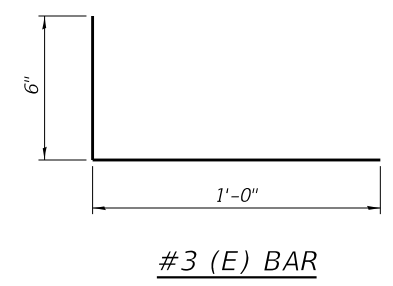

**#3 (E) BAR**

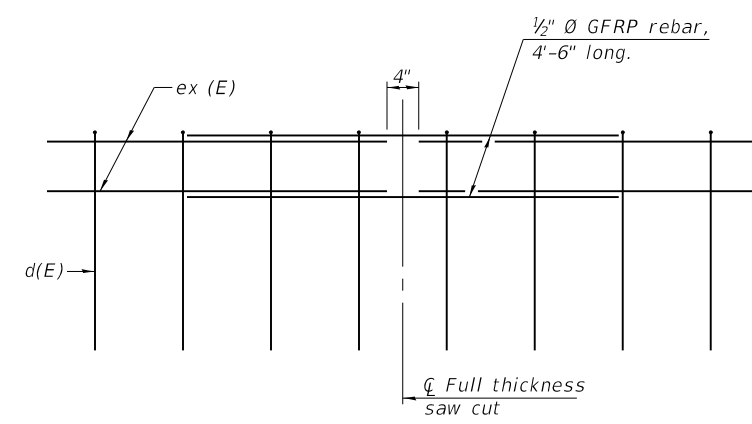

**GFRP REBAR STIFFENING DETAIL**

(Place as shown in parapet section at each parapet joint location.)

MODEL: Default  
 FILE NAME: \\SERVER18\Projects\54115009 IDOT McCluggage Bridge\DCN\Bridg\Final\Plotsheets\15009-032 Concrete Parapet Slipforming Option.dgn

SFP 39-44

1-14-2019

Entire Sheet Revised


<b>EFK Moen</b> Civil Engineering Design	USER NAME = cdl	DESIGNED - JSR	REVISED - 4/16/2019 CDL
	PLOT SCALE = 0.1667' / in.	CHECKED - ACB	REVISED -
	PLOT DATE = 4/2/2019	DRAWN - KAB	REVISED -
		CHECKED - ACB	REVISED -

**STATE OF ILLINOIS  
DEPARTMENT OF TRANSPORTATION**

**CONCRETE PARAPET SLIPFORMING OPTION  
STRUCTURE NO. 072-0250**

F.A.P. RTE.	SECTION	COUNTY	TOTAL SHEETS	SHEET NO.
317	(15B:(102-1),(14HB))BR	PEORIA	1361	902
CONTRACT NO. 68B46				
SHEET 32 OF 34 SHEETS				
ILLINOIS FED. AID PROJECT				




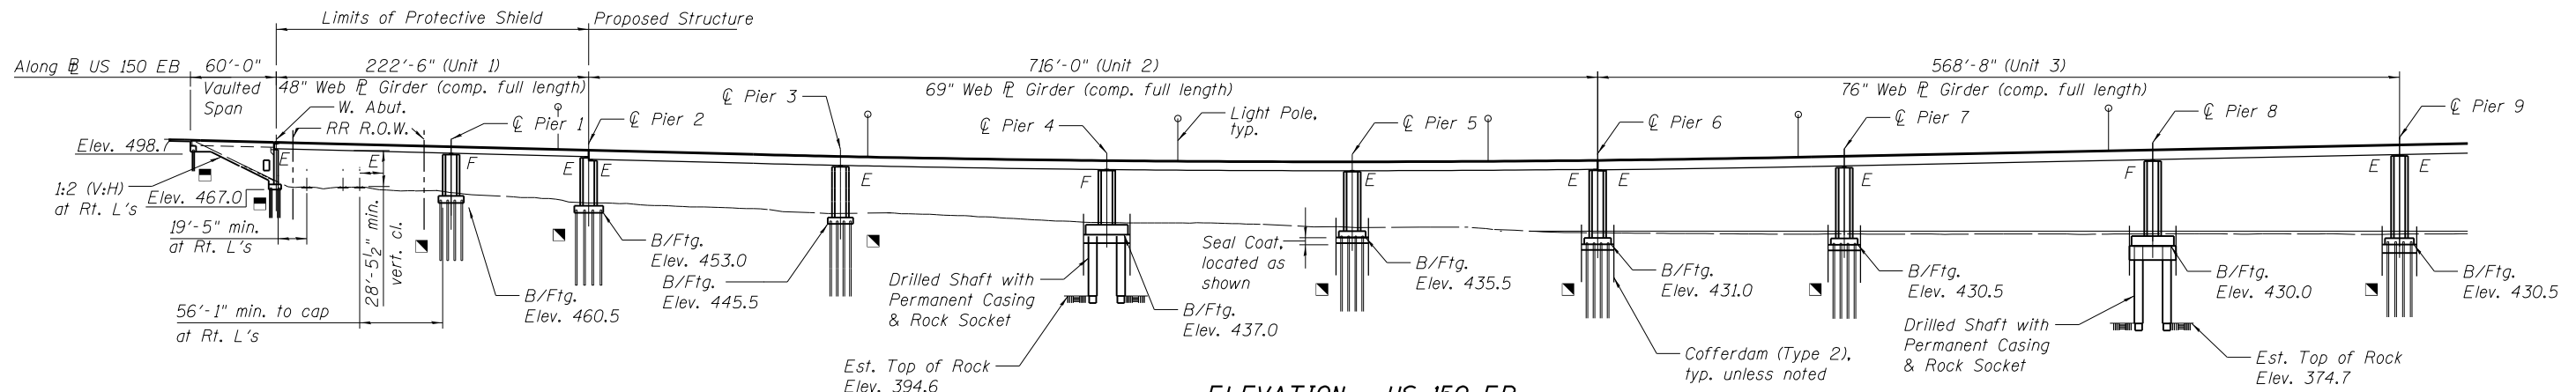

Note:  
No freefall deck drains will be permitted in the span over the tracks or within 10 ft. of cross arms of a railroad pole line.

**Foundation Support Legend**

- Denotes Steel HP Piles
  - Denotes Metal Shell Piles
- B/Cap Stepped Elev. 488.56 to Elev. 489.730  
Stone Dumped Riprap, Class A3

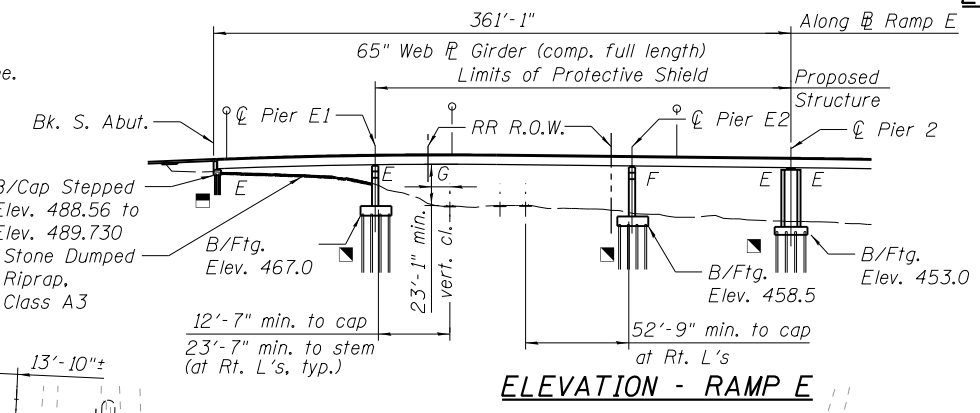

**ELEVATION - US 150 EB**


**DRAINAGE LOCATIONS-RAMP E**

Drainage Type	Span	Station	Offset
DS-12	1	1506+10.00	14.50' Rt.
DS-12	2	1508+39.00	14.50' Rt.
DS-12	3	1509+02.00	14.50' Rt.
DS-12	3	1509+20.00	14.50' Rt.

Provide DS-11 scuppers along shared-use path matching locations of scuppers placed along adjacent traffic barrier.

**DRAINAGE LOCATIONS-US 150 EB**

Drainage Type	Span	Station	Offset	Drainage Type	Span	Station	Offset
DS-11	2	2111+43.00	22.24' Lt. & 34.45' Rt.	DS-12	6	2118+85.00	22' Lt. & 55.45' Rt.
DS-11	2	2111+75.00	22.22' Lt. & 34.17' Rt.	DS-12	6	2119+01.00	22' Lt. & 55.13' Rt.
DS-11	2	2111+87.00	22.19' Lt. & 34.09' Rt.	DS-12	6	2119+11.00	22' Lt. & 54.93' Rt.
DS-11	2	2112+00.00	22.15' Lt. & 34.01' Rt.	DS-12	6	2119+21.00	22' Lt. & 54.73' Rt.
DS-11	2	2112+12.00	22.09' Lt. & 34.00' Rt.	DS-11	7	2119+63.00	22' Lt. & 53.89' Rt.
DS-12	3	2112+60.00	22' Lt.	DS-11	7	2119+89.00	22' Lt. & 53.37' Rt.
DS-12	3	2113+06.00	68.59' Rt.	DS-11	7	2119+15.00	22' Lt. & 52.85' Rt.
DS-12	3	2113+53.00	22' Lt.	DS-11	7	2120+41.00	22' Lt. & 52.33' Rt.
DS-12	4	2114+70.00	22' Lt.	DS-11	7	2120+67.00	22' Lt. & 51.81' Rt.
DS-12	4	2114+85.00	63.47' Rt.	DS-11	8	2121+75.00	22' Lt. & 49.65' Rt.
DS-12	4	2115+15.00	62.87' Rt.	DS-11	8	2122+12.00	22' Lt. & 48.91' Rt.
DS-12	4	2115+45.00	22' Lt. & 62.27' Rt.	DS-11	8	2122+47.00	22' Lt. & 48.21' Rt.
DS-12	5	2116+47.00	22' Lt. & 60.22' Rt.	DS-11	8	2122+82.00	22' Lt. & 47.51' Rt.
DS-12	5	2116+57.00	60.02' Rt.	DS-11	9	2123+90.00	22' Lt. & 45.35' Rt.
DS-12	5	2117+08.00	22' Lt.	DS-11	9	2124+38.00	22' Lt. & 44.39' Rt.
DS-12	6	2118+22.00	22' Lt. & 56.72' Rt.	DS-11	9	2124+88.00	22' Lt. & 43.39' Rt.
DS-12	6	2118+45.00	22' Lt. & 56.25' Rt.				
DS-12	6	2118+60.00	22' Lt. & 55.95' Rt.				
DS-12	6	2118+68.00	22' Lt. & 55.79' Rt.				

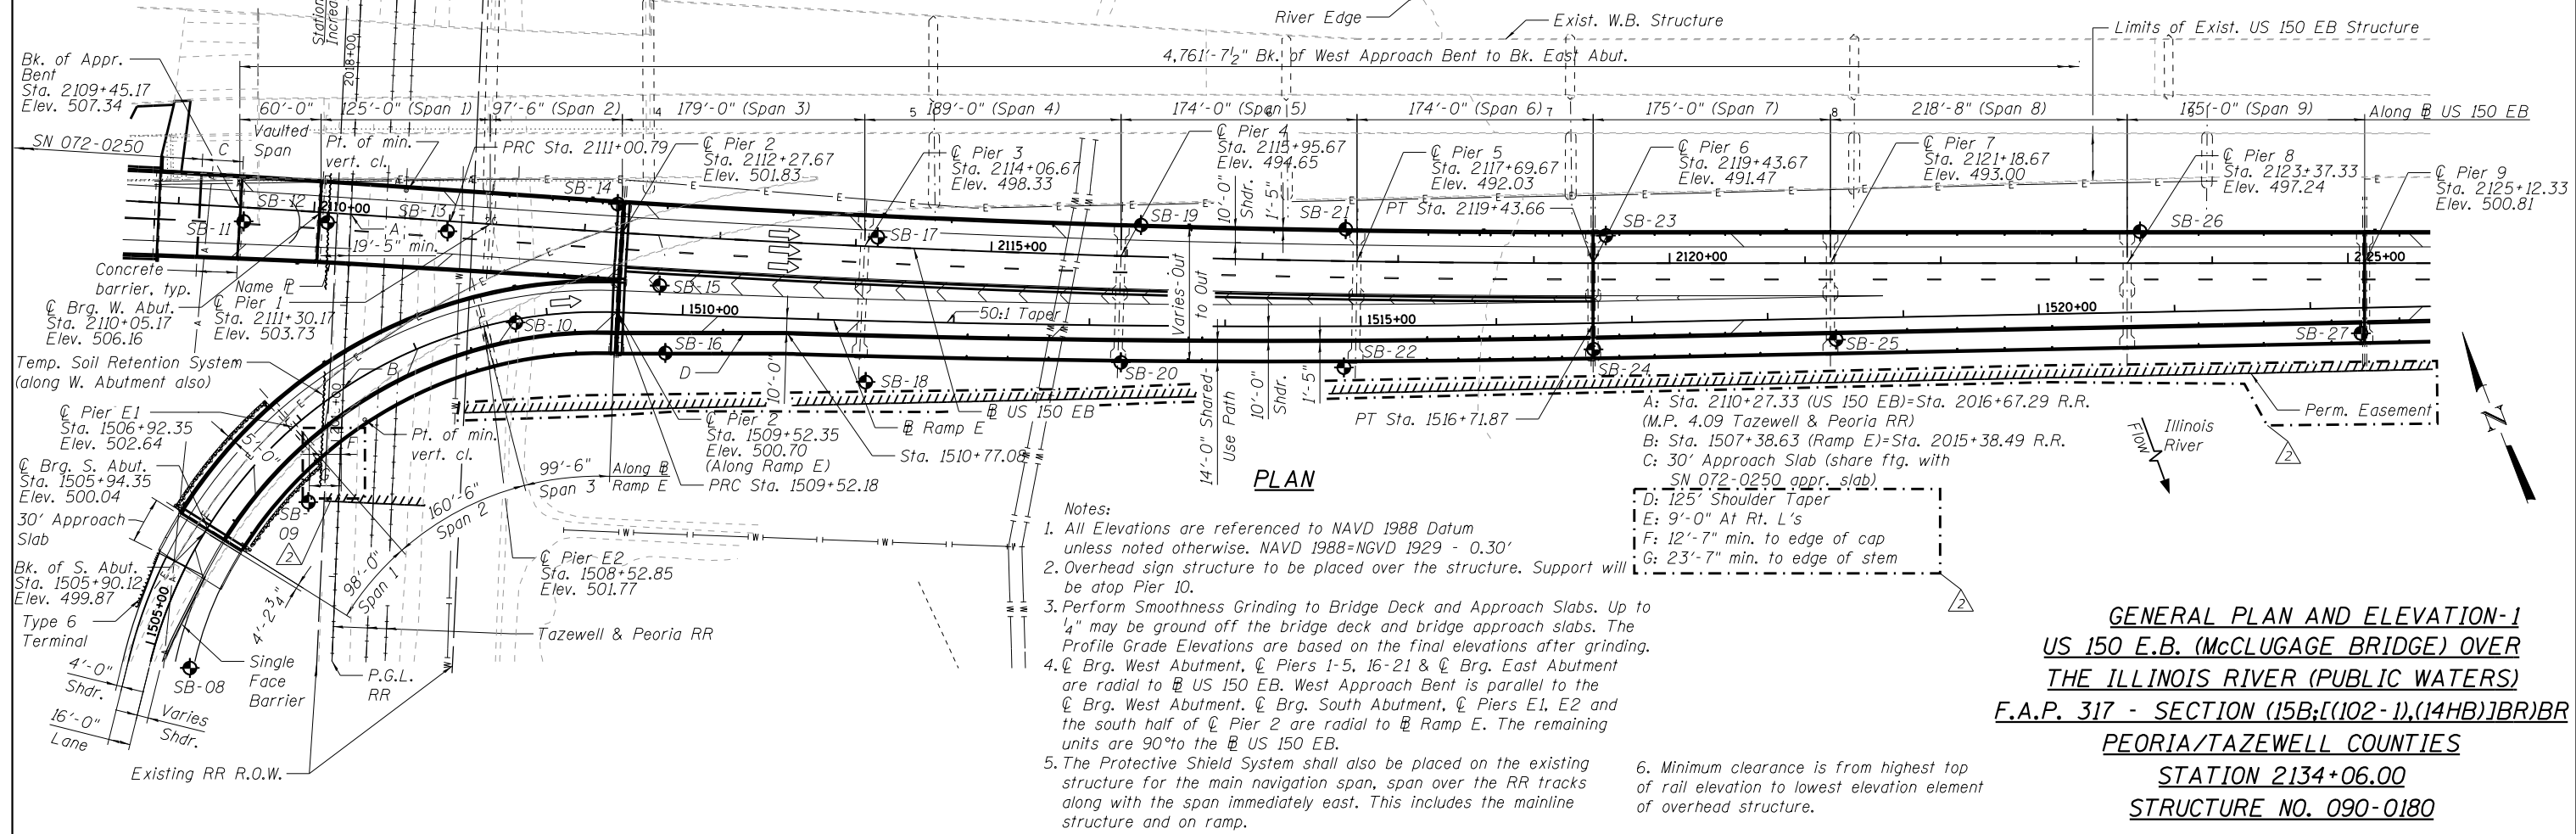

- Notes:
- All Elevations are referenced to NAVD 1988 Datum unless noted otherwise. NAVD 1988=NGVD 1929 - 0.30'
  - Overhead sign structure to be placed over the structure. Support will be atop Pier 10.
  - Perform Smoothness Grinding to Bridge Deck and Approach Slabs. Up to 1/4" may be ground off the bridge deck and bridge approach slabs. The Profile Grade Elevations are based on the final elevations after grinding.
  - Brg. West Abutment, Piers 1-5, 16-21 & Brg. East Abutment are radial to US 150 EB. West Approach Bent is parallel to the Brg. West Abutment. Brg. South Abutment, Piers E1, E2 and the south half of Pier 2 are radial to Ramp E. The remaining units are 90° to the US 150 EB.
  - The Protective Shield System shall also be placed on the existing structure for the main navigation span, span over the RR tracks along with the span immediately east. This includes the mainline structure and on ramp.
  - Minimum clearance is from highest top of rail elevation to lowest elevation element of overhead structure.

**GENERAL PLAN AND ELEVATION-1  
US 150 E.B. (McCLUGAGE BRIDGE) OVER  
THE ILLINOIS RIVER (PUBLIC WATERS)  
F.A.P. 317 - SECTION (15B;[(102-1),(14HB)]BR)BR  
PEORIA/TAZEWELL COUNTIES  
STATION 2134+06.00  
STRUCTURE NO. 090-0180**







**INDEX OF SHEETS**

S-1 OVERALL SITE PLAN  
 S-2 GENERAL PLAN 1  
 S-3 GENERAL PLAN 2  
 S-4 GENERAL PLAN 3  
 S-5 INDEX OF SHEETS 1  
 S-6 INDEX OF SHEETS 2  
 S-7 GENERAL NOTES  
 S-8 TOTAL BILL OF MATERIAL AND MISCELLANEOUS DETAILS  
 S-9 OFFSET SKETCH AND PROFILES  
 S-10 FOUNDATION LAYOUT - RAMP E  
 S-11 GRADING-SOUTH AND WEST ABUTMENT  
 S-12 STAGE CONSTRUCTION LAYOUT  
 S-13 EXCAVATION SUPPORT DETAILS  
 S-14 REMOVAL LIMITS  
 S-15 TOP OF DECK ELEVATIONS-VAULETED SPAN  
 S-16 TOP OF SLAB ELEVATIONS - LAYOUT UNIT 1  
 S-17 TOP OF SLAB ELEVATIONS - UNIT 1, 1 OF 2  
 S-18 TOP OF SLAB ELEVATIONS - UNIT 1, 2 OF 2  
 S-19 TOP OF SLAB ELEVATIONS - LAYOUT RAMP E  
 S-20 TOP OF SLAB ELEVATIONS - RAMP E, 1 OF 2  
 S-21 TOP OF SLAB ELEVATIONS - RAMP E, 2 OF 2  
 S-22 TOP OF SLAB ELEVATIONS - LAYOUT UNIT 2  
 S-23 TOP OF SLAB ELEVATIONS - UNIT 2, 1 OF 6  
 S-24 TOP OF SLAB ELEVATIONS - UNIT 2, 2 OF 6  
 S-25 TOP OF SLAB ELEVATIONS - UNIT 2, 3 OF 6  
 S-26 TOP OF SLAB ELEVATIONS - UNIT 2, 4 OF 6  
 S-27 TOP OF SLAB ELEVATIONS - UNIT 2, 5 OF 6  
 S-28 TOP OF SLAB ELEVATIONS - UNIT 2, 6 OF 6  
 S-29 TOP OF SLAB ELEVATIONS - LAYOUT UNIT 3  
 S-30 TOP OF SLAB ELEVATIONS - UNIT 3, 1 OF 4  
 S-31 TOP OF SLAB ELEVATIONS - UNIT 3, 2 OF 4  
 S-32 TOP OF SLAB ELEVATIONS - UNIT 3, 3 OF 4  
 S-33 TOP OF SLAB ELEVATIONS - UNIT 3, 4 OF 4  
 S-34 TOP OF SLAB ELEVATIONS - LAYOUT UNIT 4  
 S-35 TOP OF SLAB ELEVATIONS - UNIT 4, 1 OF 4  
 S-36 TOP OF SLAB ELEVATIONS - UNIT 4, 2 OF 4  
 S-37 TOP OF SLAB ELEVATIONS - UNIT 4, 3 OF 4  
 S-38 TOP OF SLAB ELEVATIONS - UNIT 4, 4 OF 4  
 S-39 TOP OF SLAB ELEVATIONS - LAYOUT UNIT 5  
 S-40 TOP OF SLAB ELEVATIONS - UNIT 5, 1 OF 3  
 S-41 TOP OF SLAB ELEVATIONS - UNIT 5, 2 OF 3  
 S-42 TOP OF SLAB ELEVATIONS - UNIT 5, 3 OF 3  
 S-43 TOP OF SLAB ELEVATIONS - LAYOUT UNIT 6  
 S-44 TOP OF SLAB ELEVATIONS - UNIT 6, 1 OF 4  
 S-45 TOP OF SLAB ELEVATIONS - UNIT 6, 2 OF 4  
 S-46 TOP OF SLAB ELEVATIONS - UNIT 6, 3 OF 4  
 S-47 TOP OF SLAB ELEVATIONS - UNIT 6, 4 OF 4  
 S-48 TOP OF SLAB ELEVATIONS - LAYOUT UNIT 7  
 S-49 TOP OF SLAB ELEVATIONS - UNIT 7, 1 OF 4  
 S-50 TOP OF SLAB ELEVATIONS - UNIT 7, 2 OF 4  
 S-51 TOP OF SLAB ELEVATIONS - UNIT 7, 3 OF 4  
 S-52 TOP OF SLAB ELEVATIONS - UNIT 7, 4 OF 4  
 S-53 TOP OF SLAB ELEVATIONS - LAYOUT UNIT 8  
 S-54 TOP OF SLAB ELEVATIONS - UNIT 8, 1 OF 6  
 S-55 TOP OF SLAB ELEVATIONS - UNIT 8, 2 OF 6  
 S-56 TOP OF SLAB ELEVATIONS - UNIT 8, 3 OF 6  
 S-57 TOP OF SLAB ELEVATIONS - UNIT 8, 4 OF 6  
 S-58 TOP OF SLAB ELEVATIONS - UNIT 8, 5 OF 6  
 S-59 TOP OF SLAB ELEVATIONS - UNIT 8, 6 OF 6  
 S-60 TOP OF APPROACH SLAB ELEVATIONS - WEST END  
 S-61 TOP OF APPROACH SLAB ELEVATIONS - EAST END  
 S-62 TOP OF APPROACH SLAB ELEVATIONS - RAMP E  
 S-63 VAULETED ABUTMENT APPROACH SPAN  
 S-64 VAULETED ABUTMENT APPROACH SPAN DETAILS  
 S-65 DECK PLAN - UNIT 1  
 S-66 DECK CROSS SECTION, UNIT 1  
 S-67 DECK PLAN - RAMP E, 1 OF 2  
 S-68 DECK PLAN - RAMP E, 2 OF 2  
 S-69 DECK CROSS SECTION, RAMP E  
 S-70 DECK PLAN - UNIT 2, 1 OF 3  
 S-71 DECK PLAN - UNIT 2, 2 OF 3  
 S-72 DECK PLAN - UNIT 2, 3 OF 3  
 S-73 DECK CROSS SECTION, UNIT 2  
 S-74 DECK PLAN - UNIT 3, 1 OF 2



S-75 DECK PLAN - UNIT 3, 2 OF 2  
 S-76 DECK CROSS SECTION, UNIT 3  
 S-77 DECK PLAN - UNIT 4, 1 OF 2  
 S-78 DECK PLAN - UNIT 4, 2 OF 2  
 S-79 DECK CROSS SECTION, UNIT 4  
 S-80 DECK PLAN - UNIT 5, 1 OF 4  
 S-81 DECK PLAN - UNIT 5, 2 OF 4  
 S-82 DECK PLAN - UNIT 5, 3 OF 4  
 S-83 DECK PLAN - UNIT 5, 4 OF 4  
 S-84 DECK CROSS SECTION, UNIT 5, 1 OF 2  
 S-85 DECK CROSS SECTION, UNIT 5, 2 OF 2  
 S-86 DECK PLAN - UNIT 6, 1 OF 3  
 S-87 DECK PLAN - UNIT 6, 2 OF 3  
 S-88 DECK PLAN - UNIT 6, 3 OF 3  
 S-89 DECK CROSS SECTION, UNIT 6  
 S-90 DECK PLAN - UNIT 7, 1 OF 3  
 S-91 DECK PLAN - UNIT 7, 2 OF 3  
 S-92 DECK PLAN - UNIT 7, 3 OF 3  
 S-93 DECK CROSS SECTION, UNIT 7  
 S-94 DECK PLAN - UNIT 8, 1 OF 4  
 S-95 DECK PLAN - UNIT 8, 2 OF 4  
 S-96 DECK PLAN - UNIT 8, 3 OF 4  
 S-97 DECK PLAN - UNIT 8, 4 OF 4  
 S-98 DECK CROSS SECTION, UNIT 8  
 S-99 VAULETED SPAN PARAPET ELEVATIONS  
 S-100 PARAPET ELEVATIONS - UNIT 1  
 S-101 SUPERSTRUCTURE DETAILS, UNIT 1  
 S-102 NORTH PARAPET ELEVATION - RAMP E  
 S-103 SOUTH PARAPET ELEVATION - RAMP E  
 S-104 SHARED-USE PATH CURB ELEVATION - RAMP E  
 S-105 SUPERSTRUCTURE DETAILS - RAMP E, 1 OF 2  
 S-106 SUPERSTRUCTURE DETAILS - RAMP E, 2 OF 2  
 S-107 NORTH PARAPET ELEVATION - UNIT 2  
 S-108 SOUTH PARAPET ELEVATION - UNIT 2  
 S-109 SHARED-USE PATH CURB ELEVATION - UNIT 2  
 S-110 SUPERSTRUCTURE DETAILS - UNIT 2, 1 OF 3  
 S-111 SUPERSTRUCTURE DETAILS - UNIT 2, 2 OF 3  
 S-112 SUPERSTRUCTURE DETAILS - UNIT 2, 3 OF 3  
 S-113 NORTH PARAPET ELEVATION - UNIT 3  
 S-114 SOUTH PARAPET ELEVATION - UNIT 3  
 S-115 SHARED-USE PATH CURB ELEVATION - UNIT 3  
 S-116 SUPERSTRUCTURE DETAILS, UNIT 3, 1 OF 2  
 S-117 SUPERSTRUCTURE DETAILS - UNIT 3, 2 OF 2  
 S-118 NORTH PARAPET ELEVATION - UNIT 4  
 S-119 SOUTH PARAPET ELEVATION - UNIT 4  
 S-120 SHARED-USE PATH CURB ELEVATION - UNIT 4  
 S-121 SUPERSTRUCTURE DETAILS - UNIT 4, 1 OF 2  
 S-122 SUPERSTRUCTURE DETAILS - UNIT 4, 2 OF 2  
 S-123 UNIT 5 - NORTH PARAPET ELEVATION  
 S-124 UNIT 5 - SOUTH PARAPET ELEVATION  
 S-125 UNIT 5 - SHARED-USE PATH CURB ELEVATION  
 S-126 UNIT 5 - SUPERSTRUCTURE DETAILS, 1 OF 4  
 S-127 UNIT 5 - SUPERSTRUCTURE DETAILS, 2 OF 4  
 S-128 UNIT 5 - SUPERSTRUCTURE DETAILS, 3 OF 4  
 S-129 UNIT 5 - SUPERSTRUCTURE DETAILS, 4 OF 4  
 S-130 NORTH PARAPET ELEVATION - UNIT 6  
 S-131 SOUTH PARAPET ELEVATION - UNIT 6  
 S-132 SHARED-USE PATH CURB ELEVATION - UNIT 6  
 S-133 SUPERSTRUCTURE DETAILS - UNIT 6, 1 OF 2  
 S-134 SUPERSTRUCTURE DETAILS - UNIT 6, 2 OF 2  
 S-135 NORTH PARAPET ELEVATION - UNIT 7  
 S-136 SOUTH PARAPET ELEVATION - UNIT 7  
 S-137 SHARED-USE PATH CURB ELEVATION - UNIT 7  
 S-138 SUPERSTRUCTURE DETAILS - UNIT 7, 1 OF 2  
 S-139 SUPERSTRUCTURE DETAILS - UNIT 7, 2 OF 2  
 S-140 NORTH PARAPET ELEVATION - UNIT 8  
 S-141 SOUTH PARAPET ELEVATION - UNIT 8  
 S-142 SHARED-USE PATH CURB ELEVATION - UNIT 8  
 S-143 SUPERSTRUCTURE DETAILS - UNIT 8, 1 OF 2  
 S-144 SUPERSTRUCTURE DETAILS - UNIT 8, 2 OF 2  
 S-145 WEST APPROACH SLAB  
 S-146 WEST APPROACH SLAB DETAILS  
 S-147 EAST APPROACH SLAB  
 S-148 EAST APPROACH SLAB DETAILS, 1 OF 3  
 S-149 EAST APPROACH SLAB DETAILS, 2 OF 3  
 S-150 EAST APPROACH SLAB DETAILS, 3 OF 3  
 S-151 RAMP E APPROACH SLAB  
 S-152 RAMP E APPROACH SLAB DETAILS, 1 OF 2  
 S-153 RAMP E APPROACH SLAB DETAILS, 2 OF 2  
 S-154 PARAPET RAILING AND BRIDGE FENCE (SPECIAL), 1 OF 2

S-155 PARAPET RAILING AND BRIDGE FENCE (SPECIAL), 2 OF 2  
 S-155A BRIDGE FENCE RAILING, PARAPET MOUNTED - LT. BARRIER  
 S-155B BRIDGE FENCE RAILING, PARAPET RAILING - RT. CURB  
 S-156 DRAINAGE SCUPPER, DS-11  
 S-157 DRAINAGE SCUPPER, DS-12  
 S-158 DRAINAGE SYSTEM (SPECIAL)  
 S-159 MODULAR EXPANSION JOINT - SOUTH ABUTMENT  
 S-160 MODULAR EXPANSION JOINT - PIER 2, 1 OF 2  
 S-161 MODULAR EXPANSION JOINT - PIER 2, 2 OF 2  
 S-162 FINGER PLATE EXPANSION JOINT PLAN - PIER 6  
 S-163 FINGER PLATE EXP. JOINT ELEVATION - PIER 6, 1 OF 2  
 S-164 FINGER PLATE EXP. JOINT ELEVATION - PIER 6, 2 OF 2  
 S-165 FINGER PLATE EXP. JOINT DETAILS - PIER 6, 1 OF 2  
 S-166 FINGER PLATE EXP. JOINT DETAILS - PIER 6, 2 OF 2  
 S-167 FINGER PLATE EXPANSION JOINT PLAN - PIER 9  
 S-168 FINGER PLATE EXP. JOINT ELEVATION - PIER 9, 1 OF 2  
 S-169 FINGER PLATE EXP. JOINT ELEVATION - PIER 9, 2 OF 2  
 S-170 FINGER PLATE EXP. JOINT DETAILS - PIER 9, 1 OF 2  
 S-171 FINGER PLATE EXP. JOINT DETAILS - PIER 9, 2 OF 2  
 S-172 FINGER PLATE EXPANSION JOINT PLAN - PIER 12  
 S-173 FINGER PLATE EXP. JOINT ELEVATION - PIER 12, 1 OF 2  
 S-174 FINGER PLATE EXP. JOINT ELEVATION - PIER 12, 2 OF 2  
 S-189 FINGER PLATE EXPANSION JOINT DETAILS - E. ABUT, 2 OF 2  
 S-190 MODIFIED PREFORMED JOINT STRIP SEAL, 1 OF 2  
 S-191 MODIFIED PREFORMED JOINT STRIP SEAL, 2 OF 2  
 S-192 FRAMING PLAN - UNIT 1  
 S-193 GIRDER DETAILS - UNIT 1, 1 OF 2  
 S-194 GIRDER DETAILS - UNIT 1, 2 OF 2  
 S-195 FRAMING PLAN - RAMP E  
 S-196 GIRDER LAYOUT - RAMP E  
 S-197 GIRDER DETAILS - RAMP E, 1 OF 3  
 S-198 GIRDER DETAILS - RAMP E, 2 OF 3  
 S-199 GIRDER DETAILS - RAMP E, 3 OF 3  
 S-200 FRAMING PLAN - UNIT 2  
 S-201 GIRDER ELEVATIONS - UNIT 2  
 S-202 GIRDER LAYOUT - UNIT 2  
 S-203 GIRDER DETAILS - UNIT 2, 1 OF 5  
 S-204 GIRDER DETAILS - UNIT 2, 2 OF 5  
 S-205 GIRDER DETAILS - UNIT 2, 3 OF 5  
 S-206 GIRDER DETAILS - UNIT 2, 4 OF 5  
 S-207 GIRDER DETAILS - UNIT 2, 5 OF 5  
 S-208 FRAMING PLAN - UNIT 3  
 S-209 GIRDER ELEVATIONS - UNIT 3  
 S-210 GIRDER DETAILS - UNIT 3, 1 OF 2  
 S-211 GIRDER DETAILS - UNIT 3, 2 OF 2  
 S-212 FRAMING PLAN - UNIT 4  
 S-213 GIRDER ELEVATIONS - UNIT 4  
 S-214 GIRDER DETAILS - UNIT 4, 1 OF 2  
 S-215 GIRDER DETAILS - UNIT 4, 2 OF 2  
 S-216 KEY PLAN - UNIT 5  
 S-217 WORK POINT GEOMETRY - UNIT 5  
 S-218 ARCH FORCES - UNIT 5  
 S-219 ELEVATION - UNIT 5  
 S-220 ARCH SPAN CONSTRUCTION SEQUENCE - UNIT 5  
 S-221 ARCH SPAN CAMBER DIAGRAM  
 S-222 TIE GIRDER ELEVATION - UNIT 5, 1 OF 4  
 S-223 TIE GIRDER ELEVATION - UNIT 5, 2 OF 4  
 S-224 TIE GIRDER ELEVATION - UNIT 5, 3 OF 4  
 S-225 TIE GIRDER ELEVATION - UNIT 5, 4 OF 4  
 S-226 TIE GIRDER DETAILS - UNIT 5, 1 OF 5  
 S-227 TIE GIRDER DETAILS - UNIT 5, 2 OF 5  
 S-228 TIE GIRDER DETAILS - UNIT 5, 3 OF 5  
 S-229 TIE GIRDER DETAILS - UNIT 5, 4 OF 5  
 S-230 TIE GIRDER DETAILS - UNIT 5, 5 OF 5  
 S-231 ARCH RIB ELEVATION - UNIT 5, 1 OF 5  
 S-232 ARCH RIB ELEVATION - UNIT 5, 2 OF 5

S-233 ARCH RIB ELEVATION - UNIT 5, 3 OF 5  
 S-234 ARCH RIB ELEVATION - UNIT 5, 4 OF 5  
 S-235 ARCH RIB ELEVATION - UNIT 5, 5 OF 5  
 S-236 ARCH RIB DETAILS - UNIT 5, 1 OF 4  
 S-237 ARCH RIB DETAILS - UNIT 5, 2 OF 4  
 S-238 ARCH RIB DETAILS - UNIT 5, 3 OF 4  
 S-239 ARCH RIB DETAILS - UNIT 5, 4 OF 4  
 S-240 KNUCKLE DETAILS - UNIT 5, 1 OF 5  
 S-241 KNUCKLE DETAILS - UNIT 5, 2 OF 5  
 S-242 KNUCKLE DETAILS - UNIT 5, 3 OF 3  
 S-243 KNUCKLE DETAILS - UNIT 5, 4 OF 5  
 S-244 KNUCKLE DETAILS - UNIT 5, 5 OF 5  
 S-245 ARCH RIB BRACING DETAILS - UNIT 5, 1 OF 3  
 S-246 ARCH RIB BRACING DETAILS - UNIT 5, 2 OF 3  
 S-247 ARCH RIB BRACING DETAILS - UNIT 5, 3 OF 3  
 S-248 HANGER DETAILS - UNIT 5  
 S-249 ARCH SPAN FLOOR FRAMING PLAN - UNIT 5  
 S-250 FLOOR BEAM DETAILS - UNIT 5, 1 OF 3  
 S-251 FLOOR BEAM DETAILS - UNIT 5, 2 OF 3  
 S-252 FLOOR BEAM DETAILS - UNIT 5, 3 OF 3  
 S-253 END FLOOR BEAM DETAILS - UNIT 5, 1 OF 2  
 S-254 END FLOOR BEAM DETAILS - UNIT 5, 2 OF 2  
 S-255 STRINGER ELEVATION - UNIT 5  
 S-256 STRINGER DETAILS - UNIT 5, 1 OF 2  
 S-257 STRINGER DETAILS - UNIT 5, 2 OF 2  
 S-258 FLOOR SYSTEM FORCES - UNIT 5  
 S-259 LOWER LATERAL BRACING DETAILS - UNIT 5, 1 OF 2  
 S-260 LOWER LATERAL BRACING DETAILS - UNIT 5, 2 OF 2  
 S-261 BELVEDERE DETAILS - UNIT 5, 1 OF 3  
 S-262 BELVEDERE DETAILS - UNIT 5, 2 OF 3  
 S-263 BELVEDERE DETAILS - UNIT 5, 3 OF 3  
 S-264 BEARING DETAILS - UNIT 5, 1 OF 3  
 S-265 BEARING DETAILS - UNIT 5, 2 OF 3  
 S-266 BEARING DETAILS - UNIT 5, 3 OF 3  
 S-267 FRAMING PLAN - UNIT 6  
 S-268 GIRDER DETAILS - UNIT 6, 1 OF 3  
 S-269 GIRDER DETAILS - UNIT 6, 2 OF 3  
 S-270 GIRDER DETAILS - UNIT 6, 3 OF 3  
 S-271 FRAMING PLAN - UNIT 7  
 S-272 GIRDER DETAILS - UNIT 7, 1 OF 3  
 S-273 GIRDER DETAILS - UNIT 7, 2 OF 3  
 S-274 GIRDER DETAILS - UNIT 7, 3 OF 3  
 S-275 FRAMING PLAN - UNIT 8  
 S-276 GIRDER ELEVATIONS - UNIT 8  
 S-277 GIRDER DETAILS - UNIT 8, 1 OF 4  
 S-278 GIRDER DETAILS - UNIT 8, 2 OF 4  
 S-279 GIRDER DETAILS - UNIT 8, 3 OF 4  
 S-280 GIRDER DETAILS - UNIT 8, 4 OF 4  
 S-281 HLMR EXPANSION BEARINGS, 1 OF 2  
 S-282 HLMR EXPANSION BEARINGS, 2 OF 2  
 S-283 BEARINGS, TYPE I AND LOW PROFILE FIXED  
 S-284 BEARINGS, TYPE II  
 S-285 FRAMING PLAN - VAULETED SPAN  
 S-286 42\_PPC I-BEAM  
 S-287 42\_PPC I-BEAM DETAILS  
 S-288 WEST ABUTMENT  
 S-289 WEST ABUTMENT DETAILS, 1 OF 2  
 S-290 WEST ABUTMENT DETAILS, 2 OF 2  
 S-291 SOUTH ABUTMENT  
 S-292 SOUTH ABUTMENT DETAILS, 1 OF 2  
 S-293 SOUTH ABUTMENT DETAILS, 2 OF 2  
 S-294 EAST ABUTMENT  
 S-295 EAST ABUTMENT DETAILS, 1 OF 2  
 S-296 EAST ABUTMENT DETAILS, 2 OF 2  
 S-297 PIER 1 PLAN AND ELEVATION  
 S-298 PIER 1 REINFORCEMENT  
 S-299 PIER 2 PLAN AND ELEVATION  
 S-300 PIER 2 FOOTING PLAN  
 S-301 PIER 2 REINFORCEMENT, 1 OF 4  
 S-302 PIER 2 REINFORCEMENT, 2 OF 4  
 S-303 PIER 2 REINFORCEMENT, 3 OF 4  
 S-303A PIER 2 REINFORCEMENT, 4 OF 4  
 S-304 PIER 3 PLAN AND ELEVATION  
 S-305 PIER 3 FOOTING PLAN  
 S-306 PIER 3 REINFORCEMENT, 1 OF 4  
 S-307 PIER 3 REINFORCEMENT, 2 OF 4  
 S-308 PIER 3 REINFORCEMENT, 3 OF 4  
 S-309 PIER 3 REINFORCEMENT, 4 OF 4  
 S-310 PIER 4 PLAN AND ELEVATION  
 S-311 PIER 4 FOOTING PLAN

MODEL: Default  
 FILE NAME: pw:\3\sp\sv\306\hanson.d\hanson\Projects\Documents\13\obs\13\H0106\Phase-III\CAD\Struct\Sheet\0900180-XXXX-TYLI-0140-SheetIndex-1

**TYLIN INTERNATIONAL**  
 200 S. WACKER DR.  
 SUITE 1400  
 CHICAGO, IL 60606  
 TEL: 312-777-2900

USER NAME = CHORBACZ	DESIGNED - KA	REVISED - 4/16/2019 S.P.
PLOT SCALE = 0:2.0000" = 1" / in.	CHECKED - MM	REVISED -
PLOT DATE = 4/8/2019	DRAWN - JR	REVISED -
	CHECKED - NS	REVISED -

**STATE OF ILLINOIS  
 DEPARTMENT OF TRANSPORTATION**

**INDEX OF SHEETS - 1 OF 2  
 STRUCTURE NO. 090-0180**

SHEET S-5 OF 445 SHEETS

F.A.P. RTE.	SECTION	COUNTY	TOTAL SHEETS	SHEET NO.
317	(15B;(102-1),(14HB)BR)BR	PEO/TAZ	1361	909
CONTRACT NO. 68B46				
ILLINOIS FED. AID PROJECT NHP:YRP3(905)				

**GENERAL NOTES**

- Fasteners shall be ASTM A325 Type 1, mechanically galvanized bolts in painted areas and ASTM A325 Type 3 in unpainted areas. Bolts 7/8" Ø, holes 1 1/16", unless otherwise noted. All bolt connections in Unit 5 shall have Class B faying surfaces and threads excluded from the shear plane, unless otherwise noted.
- Calculated weight of Grade 50W Structural Steel:  
West of Arch Span = 9,172,800 lbs.  
Arch Span = 5,740,000 lbs.  
East of Arch Span = 6,541,100 lbs.  
Grade 50W Total = 21,453,900 lbs.  
HSS Structural Tubing (Arch Span) = 324,000 lbs.  
Calculated Weight of Structural Steel = 21,777,900 lbs.
- All structural steel shall be AASHTO M 270 Grade 50W unless otherwise noted. All HSS structural tubing shall be ASTM A1085, with supplemental heat treatment S1, unless otherwise noted. For unit 5, all structural steel and tubing shall satisfy the Charpy-V-notch impact energy requirements for temperature zone 2.
- Materials, fabrication, welding, and non-destructive testing for the members identified as Fracture Critical Members (FCM) in the contract plans shall conform to the requirements of Section 12 of the AWS D1.5 Bridge Welding Code.
- No field welding is permitted except as specified in the contract documents.
- Reinforcement bars designated (E) shall be epoxy coated.
- For Ramp E, Units 1-4 and 6-8, if the Contractor elects to use cantilever forming brackets on the exterior beams or girders, the brackets shall be placed at the same locations as required for the hardwood blocks in Article 503.06(b) of the Standard Specifications. If additional cantilever forming brackets are required, hardwood blocking shall be wedged between the exterior and first interior beam at each of these additional bracket locations.
- Bearing seat surfaces shall be constructed or adjusted to the designated elevations within a tolerance of 1/8 inch (0.01 ft.). Adjustment shall be made either by grinding the surface or by shimming the bearings.
- Concrete Sealer shall be applied to the designated areas of each abutment and Piers 2, 6, 9, 12, 13, 16 and 19.
- The Organic Zinc Rich Primer / Epoxy / Urethane Paint System shall be used for painting of new structural steel except where otherwise noted. The entire system shall be shop applied, with the exception of the exterior surface and the bottom flange of the fascia beams, masked off connection surfaces, field installed fasteners and damaged areas shall be touched up in the field. The color scheme shall be as follows:

All Units except Unit 5:

Exterior and bottom flanges of exterior (fascia) girders shall be painted Blue, Munsell No. 10B 3/6. All interior surfaces shall not be painted, except all structural steel and exposed surfaces of bearings within a distance of 10 ft. from the deck joints and top flanges in contact with the finger plates shall be painted Brown (Fed Color Std. 595a 20045) as specified in Section 506 of the Standard Specifications.


Unit 5 (Arch Span):

All surfaces of the Tie Girders and End Floor Beams; all exterior surfaces of the Arch Ribs and Knuckle; and all exposed surfaces of the last 6 ft. of each Floor Beam end, including connection plates and Lower Lateral Bracing within the 6 ft. zone, at the tie girder connection shall be Blue, Munsell No. 10B 3/6. Interior structural steel such as stringers, remaining floorbeam surface and lower lateral bracing shall not be painted, except for all interior structural steel and exposed surfaces of bearings within a distance of 10 ft. from the deck joints shall be painted Brown (Fed Color Std. 595a 20045) as specified in Section 506 of the Standard Specifications.

The inside surfaces of the arch rib and knuckles shall be painted with a white prime coat. A non-skid coating shall be provided on the inside bottom flange surface of the arch ribs and knuckles for traction.

All structural tubing shall be galvanized and painted in accordance with Special Provision, "Hot Dip Galvanizing for Structural Steel". The color shall be Blue, Munsell No. 10B 3/6. See Sht. S-245 of 445 for additional details regarding the Arch Rib Bracing structural tubing.

- All structural steel connections that are below and within 10 feet of the expansion joints along with connections within the splash zone (within 15 feet above the top of deck) shall be caulked. Joints of all lapping members, not sealed by welding, shall be caulked after application of the intermediate epoxy coating. The exception are for connection members that are bolted together in the field. In this instance, the caulking shall be applied so as to not trap moisture, i.e. vertical and diagonal members shall be caulked along the top and sides. The bottom shall remain open for drainage. The caulk shall be appropriate for exterior conditions and compatible with the paint system. The cost shall be included with Furnishing and Erecting Structural Steel.
- Layout of the slope protection system may be varied to suit ground conditions in the field as directed by the Engineer.
- The embankment configuration shown shall be the minimum that must be placed and compacted prior to construction of the abutments.
- The Contractor shall obtain a construction permit from the Illinois Department of Natural Resources (IDNR), Office of Water Resources for any temporary construction activity placed in the water except cofferdams. This shall include the placement of material for run-arounds, causeways, etc. Any permit application by the Contractor shall refer to the IDNR 3704 Floodway Construction permit number allowing permanent construction as shown in the contract plans.
- Seal coat thickness design is based on the Cofferdam Design Water Elevation (CDWE). Cofferdam design details and proposed changes in seal coat thickness shall be submitted to the Engineer for approval with the cofferdam design.
- The erection of the structural steel shall be accomplished by a steel erection contractor or sub-contractor certified as a Certified Structural Steel Erector (CSE) with Bridge Erection Endorsement by AISC. See special provisions for "Erection of Curved Steel Structures" and "Fabrication and Erection of Complex Steel Structures".
- Construction and demolition activities shall be coordinated and approved in writing by the United States Coast Guard (USCG) and the United States Army Corps of Engineers (USACE). No additional compensation or time will be allowed for USCG or USACE restrictions.
- Slipforming of the parapets is allowed with the exception of the parapets on Ramp E.
- Plan dimensions and details relative to existing plans are subject to nominal construction variations. The Contractor shall field verify existing dimensions and details affecting new construction and make necessary approved adjustments prior to construction or ordering of materials. Such variations shall not be cause for additional compensation for a change in scope of the work, however, the Contractor will be paid for the quantity actually furnished at the unit price bid for the work.
- Diamond Grinding and Bridge Deck Grooving shall not be performed within the 14'-0" shared-use path.

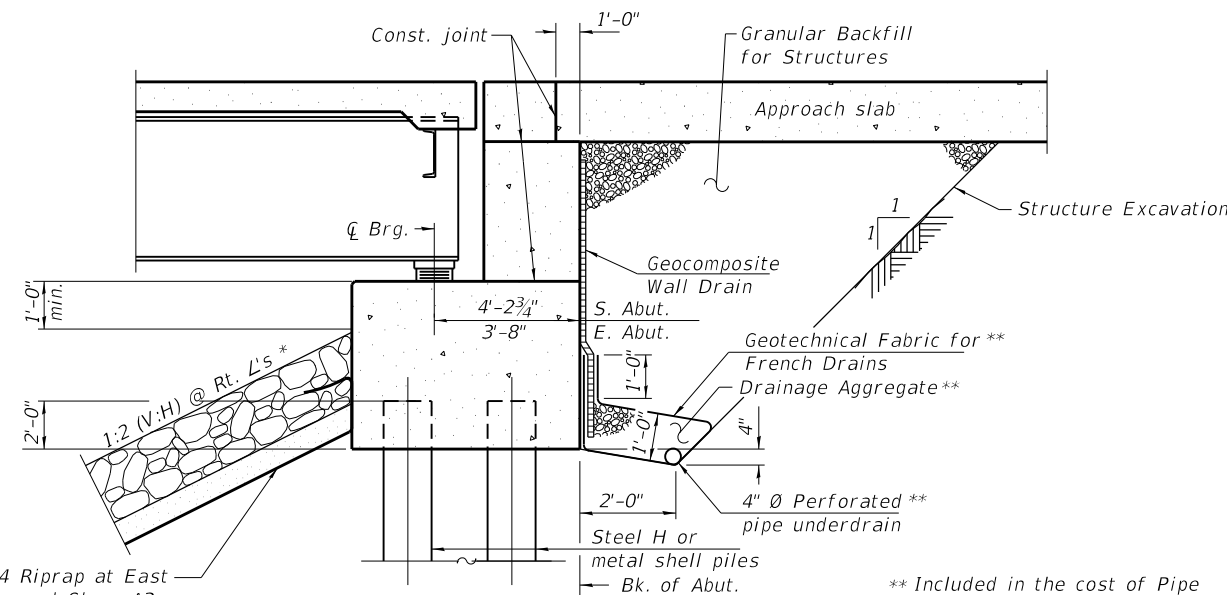

Class A4 Riprap at East Abut. Dumped Class A3 riprap at South Abut. (Min. thickness of Class A3 riprap is 8". No bedding material for Class A3 riprap)

\* At East Abutment. At South Abutment, slope follows existing contours and varies.

\*\* Included in the cost of Pipe Underdrains for Structures.

**SECTION THRU STUB ABUTMENTS  
SOUTH ABUTMENT-LOOKING SOUTHEAST;  
EAST ABUTMENT-LOOKING NORTH**

All drainage system components shall extend 2'-0" from the end of each wingwall except an outlet pipe shall extend until intersecting with the side slopes. The pipes shall drain into concrete headwalls. (See Article 601.05 of the Standard Specifications and Highway Standard 601101)

- The existing structural steel contains lead. The Contractor shall take appropriate precautions to deal with the presence of lead on this project.
- In Unit 5, the finishing machine rails shall be placed on the top of the top flange of the exterior beams within the deck pour. Beam blocks shall be placed between beams at all tie locations in each bay for the full width of the deck pour.
- The shared-use path portion of the bridge deck shall have a broomed finish.
- Removal of Existing Structures No. 1 and 3 cover the removal of existing structure 090-0070. See Special Provisions for removal limits for each.

**STRUCTURAL ASSESSMENT REPORT (SAR) NOTES**

- If the Contractor proposes to utilize the existing structure from which to perform any erection of steel girders, including staging and material deliveries, the Contractor shall submit Structural Assessment Report(s) for approval prior to beginning the work, see Special Provisions.
- The Contractor shall retain services of an engineering firm, prequalified in IDOT consultant selection category of "Highway Bridges-Complex", for preparation of the Structural Assessment Report. Contractor's pre-approval shall not be applicable for this project. See Special Provision.
- Current Ratings on file for existing structure:  
Inventory: HS-14.4  
Operating: HS-23.8  
Live Load Restrictions: No
- Inventory and Operating Ratings and Live Load Restrictions are provided for information only. Inventory and Operating Ratings are based on HS loading and configuration. Live Load Restrictions are based on Illinois legal loads and configurations. The Ratings and Live Load Restrictions are not necessarily representative of capacities to support the Contractor's equipment.
- The Contractor is advised that the existing structure contains members that are in a deteriorated condition with reduced load carrying capacity. It is the Contractor's responsibility to account for the condition of the existing structure when developing construction procedures for the complete or partial removal, or replacement of the structure. An Existing Structure Information Package is available upon request as noted in the Special Provisions.

STATION 2134+06.00  
BUILT 20 BY  
STATE OF ILLINOIS  
F.A.P. 317 SECTION  
(15B;((102-1),(14HB))BR)BR  
LOADING HL-93  
STRUCTURE NO. 090-0180

**NAME PLATE**  
See Std. 515001

MODEL: Default  
FILE NAME: pw:\vsp\sv\306\hanson\_dom\hanson\_projects\Documents\13\jobs\13\H0106\Phase-III\CAD\Struct\Sheet\0900180-XXXX-TYLL-0142-GeneralNotes

<b>TYLIN INTERNATIONAL</b> 200 S. WACKER DR. SUITE 1400 CHICAGO, IL 60606 TEL: 312-777-2900	USER NAME = CHORBACZ	DESIGNED - SP	REVISED - 2/4/16/2019 S.P.
	PLOT SCALE = 0:2.0000 " = 1" / in.	CHECKED - KA, MM	REVISED -
	PLOT DATE = 4/8/2019	DRAWN -	REVISED -
		CHECKED -	REVISED -

**STATE OF ILLINOIS  
DEPARTMENT OF TRANSPORTATION**

**GENERAL NOTES  
STRUCTURE NO. 090-0180**

SHEET 5-7 OF 445 SHEETS


F.A.P. RTE.	SECTION	COUNTY	TOTAL SHEETS	SHEET NO.
317	(15B;((102-1),(14HB))BR)BR	PEO/TAZ	1361	911
CONTRACT NO. 68B46			ILLINOIS FED. AID PROJECT NHP:RP3(905)	

TOTAL BILL OF MATERIAL

ITEM	UNIT	SUPER	SUB	TOTAL
STONE DUMPED RIPRAP, CLASS A3	SQ YD		665	665
STONE RIPRAP, CLASS A4	SQ YD		1,380	1,380
FILTER FABRIC	SQ YD		1,315	1,315
REMOVAL OF EXISTING STRUCTURES NO. 1	EACH			1
REMOVAL OF EXISTING STRUCTURES NO. 3	EACH			1
PROTECTIVE SHIELD	SQ YD	7,096		7,096
STRUCTURE EXCAVATION	CU YD		3,653	3,653
COFFERDAM EXCAVATION	CU YD		22,092	22,092
FLOOR DRAINS	EACH	42		42
CONCRETE STRUCTURES	CU YD		36,416.3	36,416.3
CONCRETE SUPERSTRUCTURE	CU YD	12,286.5		12,286.5
SEAL COAT CONCRETE	CU YD		10,953.4	10,953.4
CONCRETE ENCASEMENT	CU YD		8.2	8.2
PROTECTIVE COAT	SQ YD	50,044		50,044
CONCRETE SUPERSTRUCTURE (APPROACH SLAB)	CU YD	272.8		272.8
FURNISHING AND ERECTING PRECAST PRESTRESSED CONCRETE I-BEAMS, 42 IN.	FOOT	405		405
FURNISHING AND ERECTING STRUCTURAL STEEL	L SUM	1		1
STUD SHEAR CONNECTORS	EACH	134,722		134,722
REINFORCEMENT BARS	POUND		1,637,650	1,637,650
REINFORCEMENT BARS, EPOXY COATED	POUND	3,902,690	6,859,050	10,761,740
BAR SPLICERS	EACH	3,004	56	3,060
MECHANICAL SPLICERS	EACH		23,654	23,654
PARAPET RAILING	FOOT	4,876.0		4,876.0
FURNISHING METAL SHELL PILES 12"X0.250"	FOOT		882	882
FURNISHING METAL SHELL PILES 14"X0.250"	FOOT		567	567
FURNISHING STEEL PILES HP 14X89	FOOT		24,996	24,996
FURNISHING STEEL PILES HP 14X117	FOOT		22,478	22,478
DRIVING PILES	FOOT		48,923	48,923
TEST PILE METAL SHELLS	EACH		3	3
TEST PILE STEEL HP 14X89	EACH		8	8
TEST PILE STEEL HP 14X117	EACH		8	8
NAME PLATES	EACH	1		1
PERMANENT CASING	FOOT		4,933	4,933
DRILLED SHAFT IN SOIL	CU YD		7,089.6	7,089.6
DRILLED SHAFT IN ROCK	CU YD		1,195.2	1,195.2
PREFORMED JOINT STRIP SEAL	FOOT	133.5		133.5
FINGER PLATE EXPANSION JOINT, 3"	FOOT	71.5		71.5
FINGER PLATE EXPANSION JOINT, 4"	FOOT	152.0		152.0
FINGER PLATE EXPANSION JOINT, 5"	FOOT	235.0		235.0
ELASTOMERIC BEARING ASSEMBLY, TYPE I	EACH	81		81
ELASTOMERIC BEARING ASSEMBLY, TYPE II	EACH	57		57
ANCHOR BOLTS, 3/4"	EACH		28	28
ANCHOR BOLTS, 1"	EACH		168	168
ANCHOR BOLTS, 1 1/4"	EACH		416	416
ANCHOR BOLTS, 1 1/2"	EACH		200	200
ANCHOR BOLTS, 2"	EACH		48	48
TEMPORARY SHEET PILING	SQ FT		2,573	2,573
TEMPORARY SOIL RETENTION SYSTEM	SQ FT		510	510
CONCRETE SEALER	SQ FT		74,981	74,981
GEOCOMPOSITE WALL DRAIN	SQ YD		223.6	223.6

TOTAL BILL OF MATERIAL CONT

ITEM	UNIT	SUPER	SUB	TOTAL
COFFERDAM (TYPE 2) (LOCATION - 4)	Each		1	1
COFFERDAM (TYPE 2) (LOCATION - 5)	Each		1	1
COFFERDAM (TYPE 2) (LOCATION - 6)	Each		1	1
COFFERDAM (TYPE 2) (LOCATION - 7)	Each		1	1
COFFERDAM (TYPE 2) (LOCATION - 8)	Each		1	1
COFFERDAM (TYPE 2) (LOCATION - 9)	Each		1	1
COFFERDAM (TYPE 2) (LOCATION - 10)	Each		1	1
COFFERDAM (TYPE 2) (LOCATION - 11)	Each		1	1
COFFERDAM (TYPE 2) (LOCATION - 16)	Each		1	1
COFFERDAM (TYPE 2) (LOCATION - 17)	Each		1	1
COFFERDAM (TYPE 2) (LOCATION - 18)	Each		1	1
COFFERDAM (TYPE 2) (LOCATION - 19)	Each		1	1
COFFERDAM (TYPE 2) (LOCATION - 20)	Each		1	1
COFFERDAM (TYPE 2) (LOCATION - 21)	Each		1	1
COFFERDAM (TYPE 2) (LOCATION - 22)	Each		1	1
CROSSHOLE SONIC LOGGING ACCESS DUCTS	Foot		41,396	41,396
CROSSHOLE SONIC LOGGING TESTING	Each		9	9
HANGER ASSEMBLIES FOR TIED ARCH SPAN	L SUM	1		1
COFFERCELL (LOCATION - 12)	Each		1	1
COFFERCELL (LOCATION - 13)	Each		1	1
COFFERCELL (LOCATION - 14)	Each		1	1
COFFERCELL (LOCATION - 15)	Each		1	1
BRIDGE DECK GROOVING (LONGITUDINAL)	Sq Yd	23,465		23,465
BRIDGE FENCE RAILING (SPECIAL)	Foot	4,646.0		4,646.0
HIGH LOAD MULTI-ROTATIONAL BEARINGS, GUIDED EXPANSION, 150K	Each	14		14
HIGH LOAD MULTI-ROTATIONAL BEARINGS, GUIDED EXPANSION, 550K	Each	7		7
HIGH LOAD MULTI-ROTATIONAL BEARINGS, GUIDED EXPANSION, 600K	Each	12		12
HIGH LOAD MULTI-ROTATIONAL BEARINGS, GUIDED EXPANSION, 650K	Each	52		52
HIGH LOAD MULTI-ROTATIONAL BEARINGS, GUIDED EXPANSION, 700K	Each	18		18
HIGH LOAD MULTI-ROTATIONAL BEARINGS, FIXED, 4650K	Each	2		2
HIGH LOAD MULTI-ROTATIONAL BEARINGS, GUIDED EXPANSION, 4650K	Each	2		2
GRANULAR BACKFILL FOR STRUCTURES	CU YD		377	377
VERTICAL CLEARANCE GAUGE	Each		2	2
DRAINAGE SCUPPERS, DS-11	Each	145		145
DRAINAGE SCUPPERS, DS-12	Each	44		44
DIAMOND GRINDING (BRIDGE SECTION)	Sq Yd	32,762		32,762
MODULAR EXPANSION JOINT-SWIVEL 6"	Foot	167.5		167.5
PIPE UNDERDRAINS FOR STRUCTURES 4"	Foot		221	221
DRAINAGE SYSTEM (SPECIAL)	L SUM			1
BRIDGE FENCE RAILING	FOOT	506.0		506.0

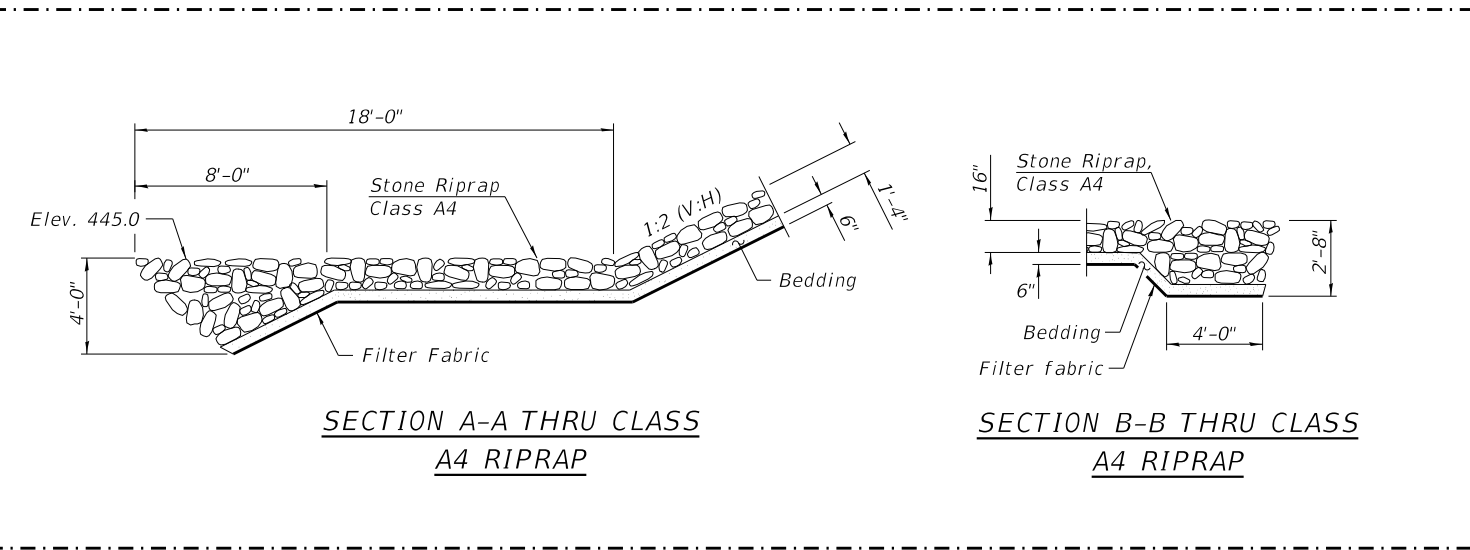

MODEL: Default  
 FILE NAME: p:\v\sp\sv\306\hanson\Projects\Documents\13\jobs\13\H0106\Phase-III\CAD\Struct\Sheet\0900180-XXXX-TYLI-0160-BOM.dgn  
 4/8/2019 11:19:23 AM

<b>TYLIN INTERNATIONAL</b> 200 S. WACKER DR. SUITE 1400 CHICAGO, IL 60606 TEL: 312-777-2900	USER NAME = CHORBACZ	DESIGNED -	REVISED - $\Delta$ 4/16/2019 S.P.
	PLOT SCALE = 0:2.0000 '"/in.	CHECKED -	REVISED -
	PLOT DATE = 4/8/2019	DRAWN -	REVISED -
		CHECKED -	REVISED -


STATE OF ILLINOIS  
DEPARTMENT OF TRANSPORTATION

TOTAL BILL OF MATERIAL AND MISCELLANEOUS DETAILS  
STRUCTURE NO. 090-0180

SHEET 5-8 OF 445 SHEETS

F.A.P. RTE. 317	SECTION [15B;(102-1),(14HB)]BR/BR	COUNTY PEO/TAZ	TOTAL SHEETS 1361	SHEET NO. 912
CONTRACT NO. 68B46			ILLINOIS FED. AID PROJECT NHPP-YRP3(905)	

MODEL: Default  
 FILE NAME: p:\v\sp\sv\306.hanson.dom\hanson\_projects\Documents\13\jobs\13\H0106\Phase-III\CAD\Struct\Sheet\0900180-XXXXX-TYLI-0200-FOUNDATION Layout Ramp E.dgn

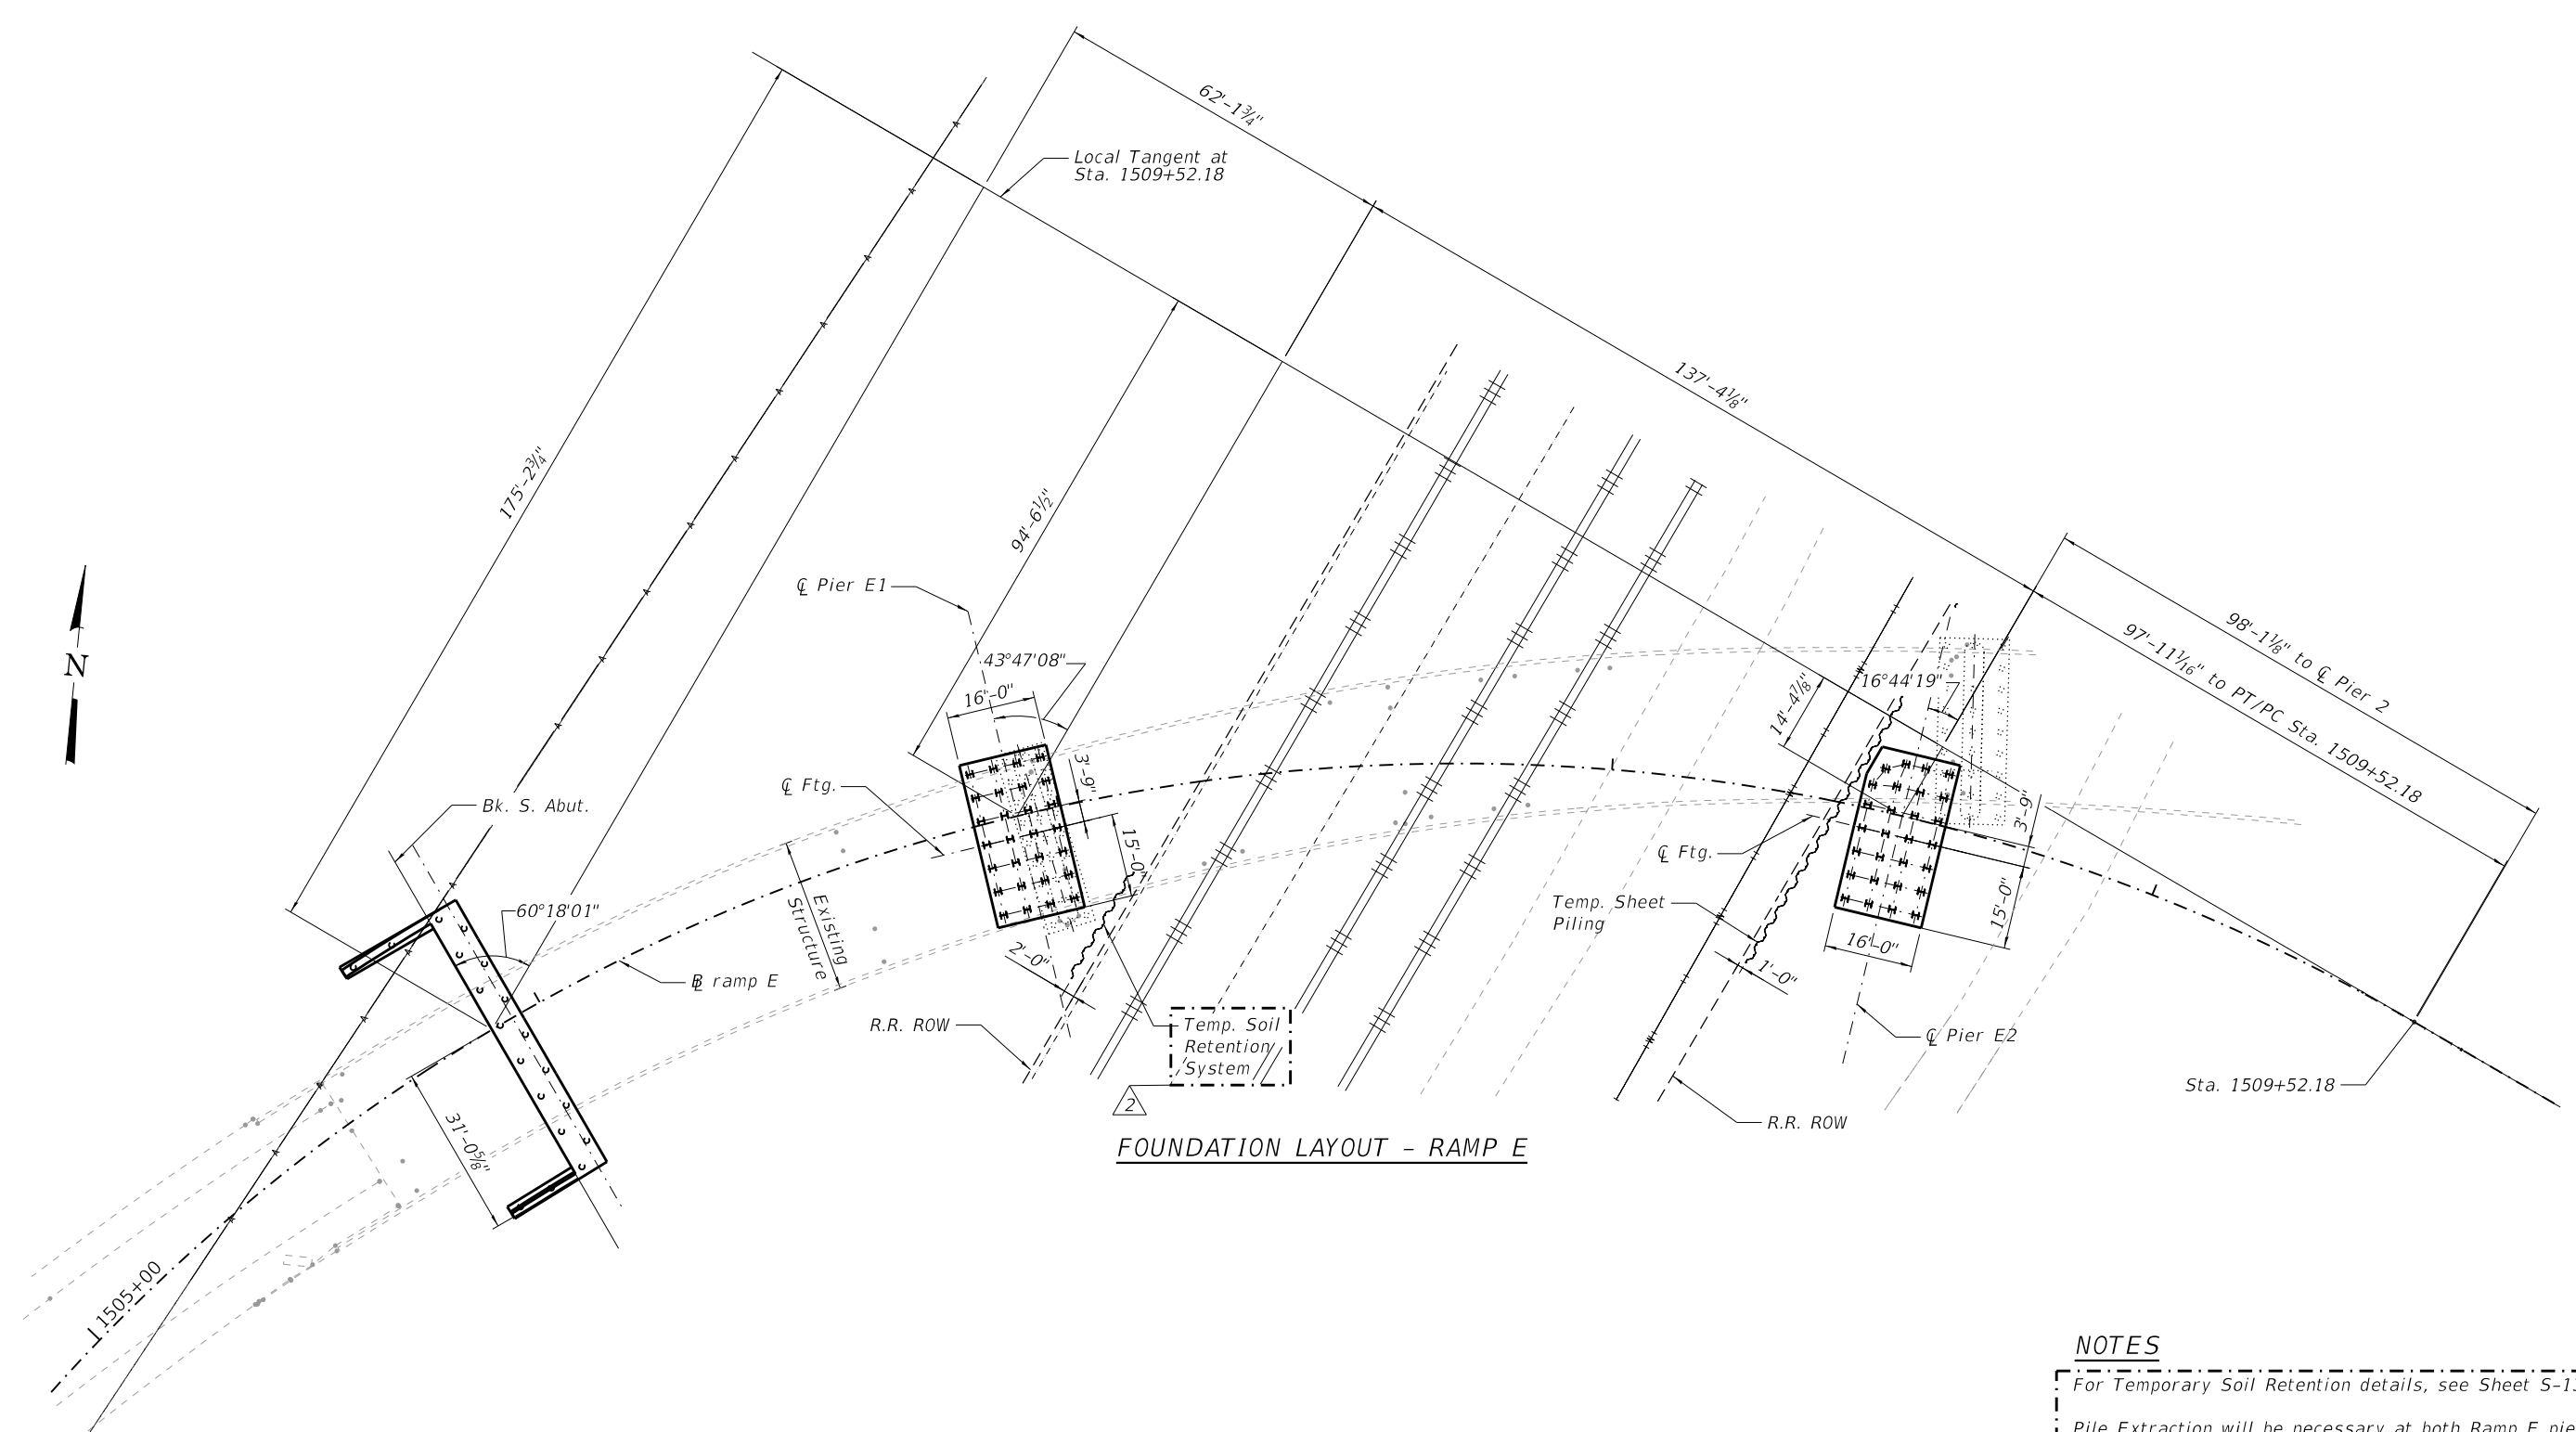

FOUNDATION LAYOUT - RAMP E

NOTES

- For Temporary Soil Retention details, see Sheet S-13 of 445.
- Pile Extraction will be necessary at both Ramp E piers. It is estimated 12 existing piles will require extraction at Pier E1 and 3 piles at Pier E2.
- Any voids remaining after removing existing piles shall be filled with dry loose sand prior to driving proposed piles. Cost shall be included in Removal of Existing Structures No. 1.
- The Temporary Soil Retention System design at Pier E1 and the West Abutment shall also be submitted to the Railroad for review and approval prior to the start of work. The design of the system shall be in accordance with the latest UPRR Guidelines for Temporary Shoring. The Contractor shall include track and ground monitoring plans as part of its submittal in accordance with Railroad criteria.

**TYLIN INTERNATIONAL**  
 200 S. WACKER DR.  
 SUITE 1400  
 CHICAGO, IL 60606  
 TEL: 312-777-2900

USER NAME = CHORBACZ	DESIGNED - S.P.	REVISED - 4/16/2019 S.P.
PLOT SCALE = 0:2,0000 '"/in.	CHECKED - P.D.F.	REVISED -
PLOT DATE = 4/8/2019	DRAWN -	REVISED -
	CHECKED -	REVISED -

**STATE OF ILLINOIS**  
**DEPARTMENT OF TRANSPORTATION**


FOUNDATION LAYOUT - RAMP E  
 STRUCTURE NO. 090-0180

SHEET 5-10 OF 445 SHEETS

F.A.P. RTE.	SECTION	COUNTY	TOTAL SHEETS	SHEET NO.
317	(15B;(102-1),(14HB)BR)BR	PEO/TAZ	1361	914
CONTRACT NO. 68B46				

ILLINOIS FED. AID PROJECT NHPP-YRP3(905)




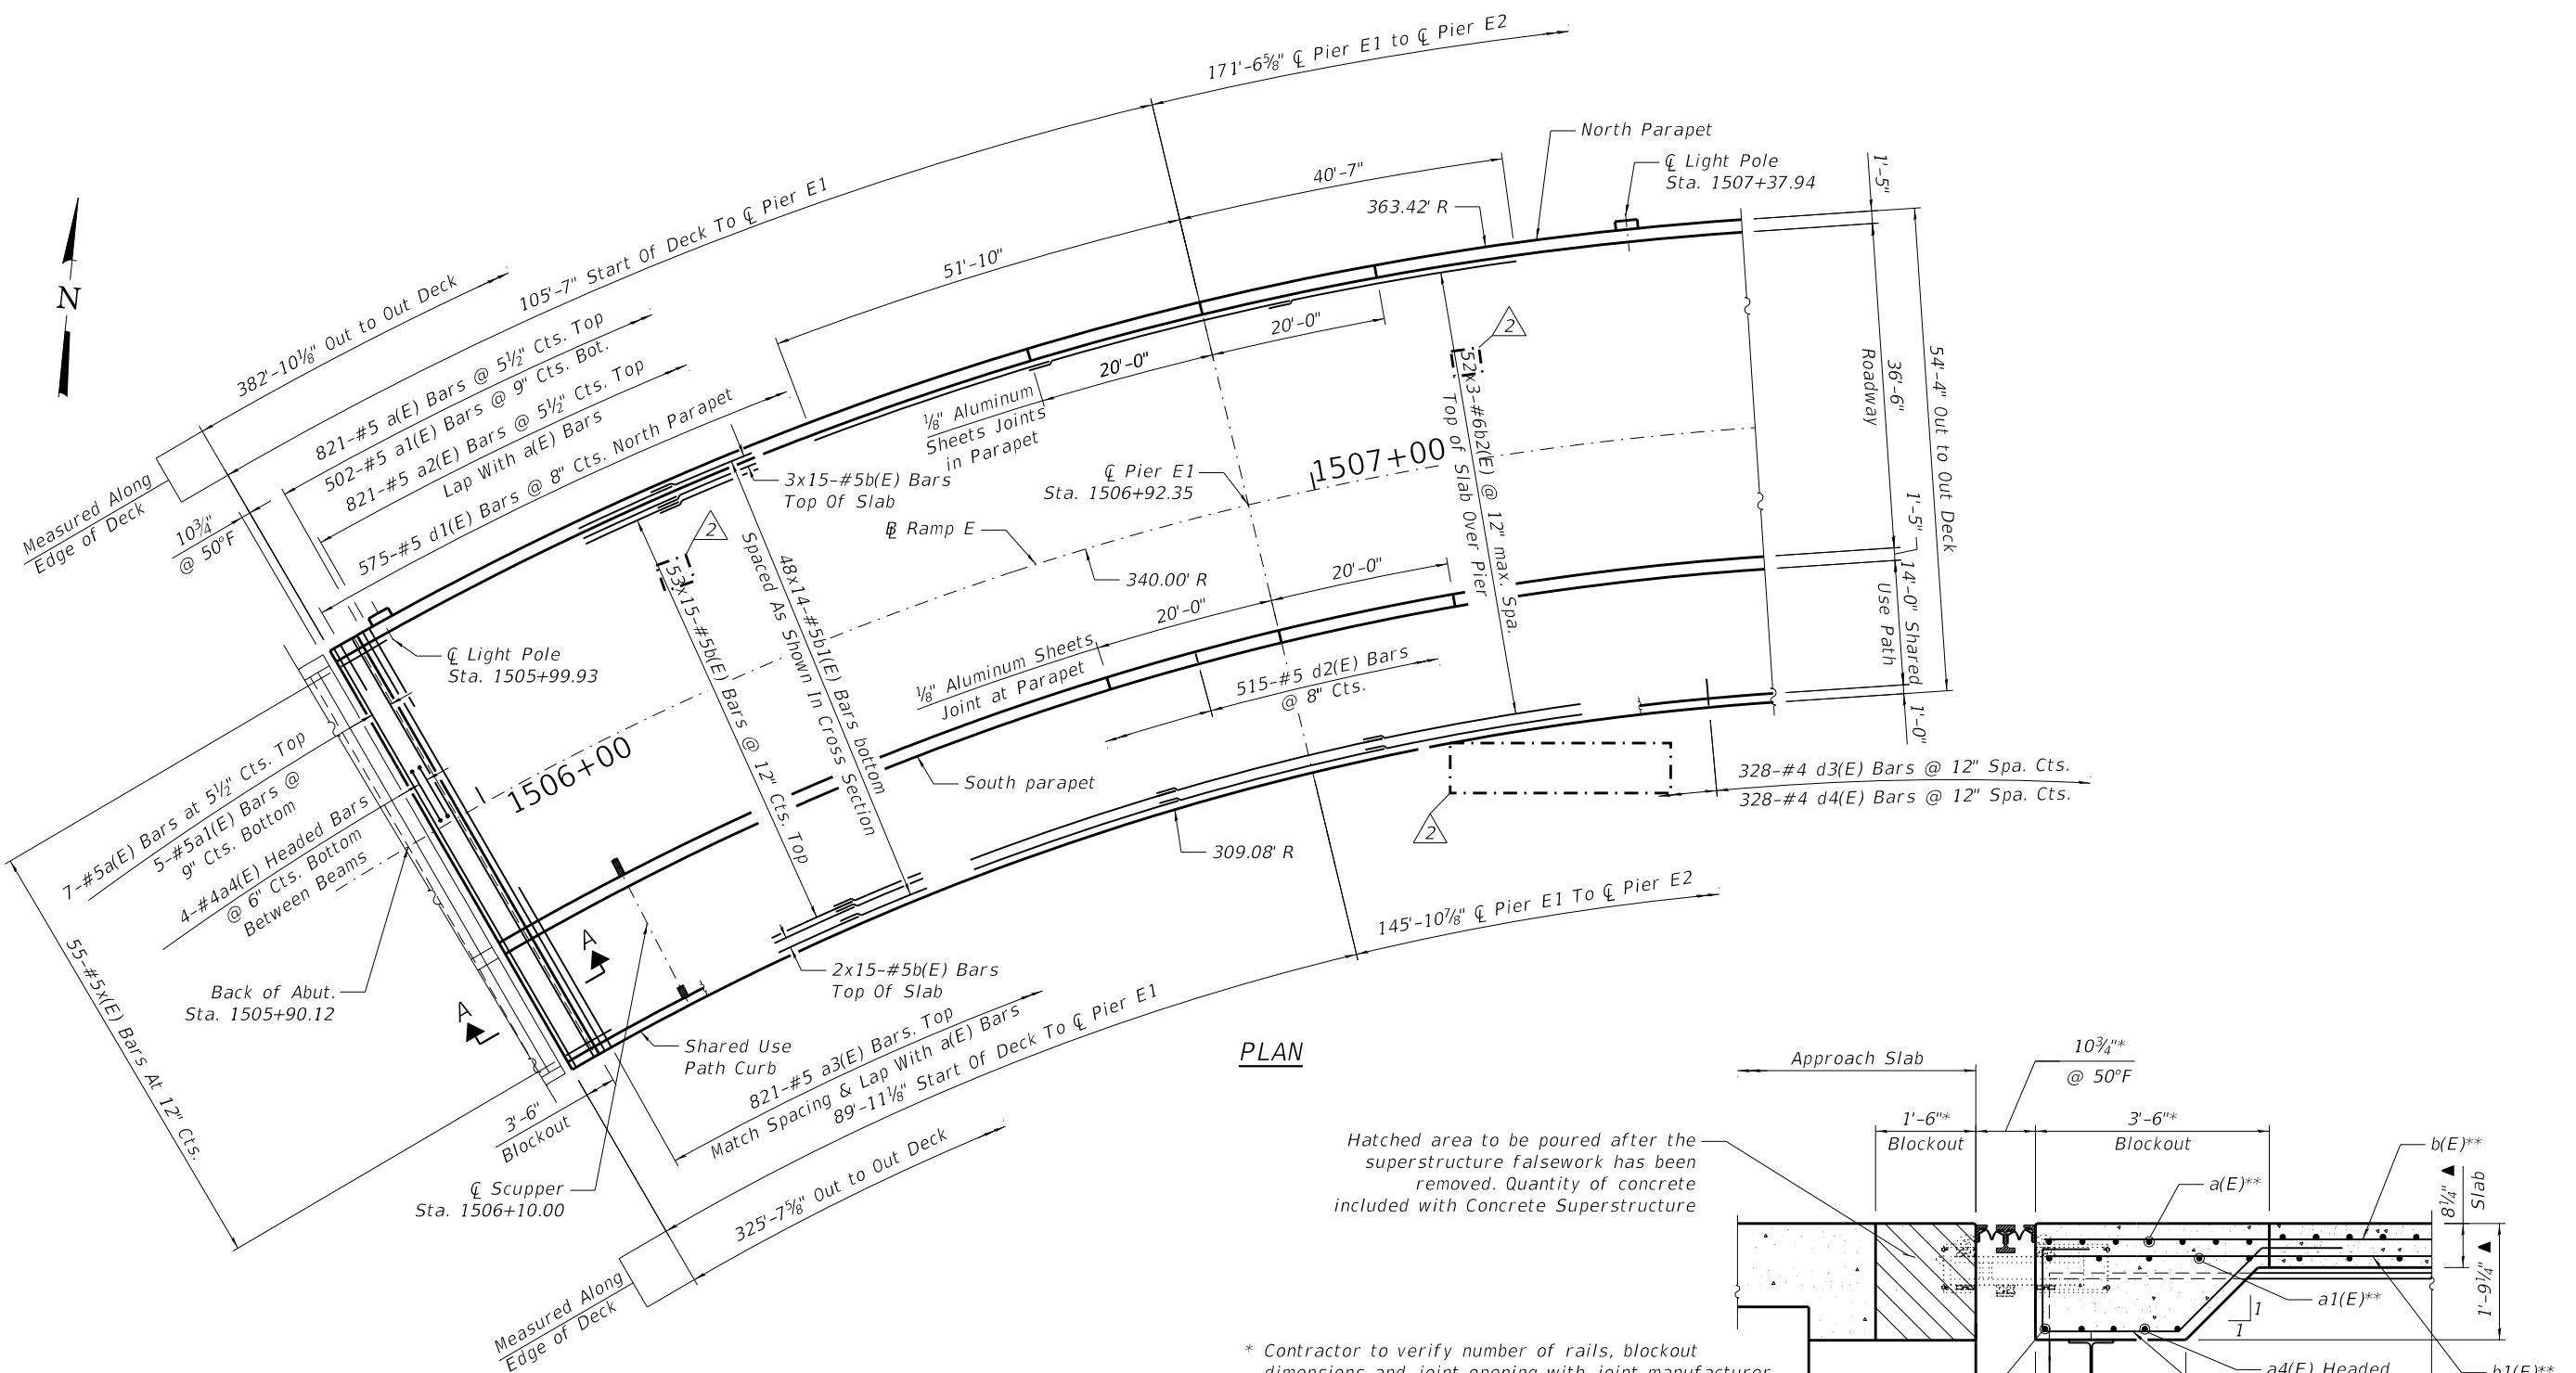

**PLAN**

Hatched area to be poured after the superstructure falsework has been removed. Quantity of concrete included with Concrete Superstructure

- \* Contractor to verify number of rails, blackout dimensions and joint opening with joint manufacturer.
- \*\* Bars to be adjusted and/or cut in field to miss support boxes and beam webs.

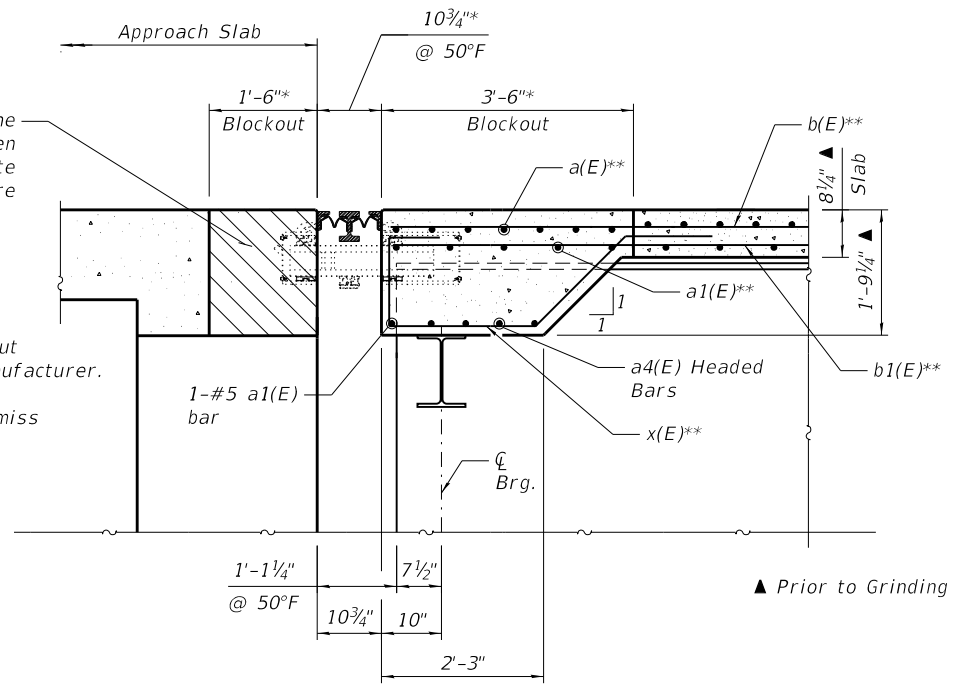

**SECTION A-A**

**MIN. LAP LENGTH**

- #5 = 3'-6"
- #6 = 3'-7"

**Notes:**

1. Bars indicated thus 20x3-#5, etc indicates 20 lines of bars with 3 lengths per line.
2. Longitudinal bars shall be sprung into place to be concentric at the spacing noted.
3. Transverse bars shall be placed radially at the spacing noted. The spacing is measured along the left edge of deck when looking upstation.
4. See sheet S-106 of 445 for superstructure details and Bill of Materials.

MODEL: Default  
FILE NAME: pw:\sp\svr\306.hanson.dom\hanson Projects\Documents\13\roba\13H0106\Phase-II\CAD\Struct\Sheet\0900180-XXXXX-TYLL-2140-Unit\_1a(RampE) Deck Plan-1.dgn  
4/4/2019 9:56:08 PM

<b>TYLIN INTERNATIONAL</b> 200 S. WACKER DR. SUITE 1400 CHICAGO, IL 60606 TEL: 312-777-2900	USER NAME = spantazis	DESIGNED - RH	REVISED - 4/16/2019 S.P.
	PLOT SCALE = 0:2.0000 " = 1 in.	CHECKED - SP	REVISED -
	PLOT DATE = 4/4/2019	DRAWN - RH	REVISED -
		CHECKED -	REVISED -



**STATE OF ILLINOIS  
DEPARTMENT OF TRANSPORTATION**

DECK PLAN - RAMP E, 1 OF 2  
STRUCTURE NO. 090-0180


SHEET S-67 OF 445 SHEETS

F.A.P. RTE. 317	SECTION [15B;(102-1),(14HB)BR]BR	COUNTY PEO/TAZ	TOTAL SHEETS 1361	SHEET NO. 971
CONTRACT NO. 68B46			ILLINOIS FED. AID PROJECT NHPP-YRP3(905)	

MODEL: Default  
 FILE NAME: p:\v\sp\sv\306\hanson\Projects\Documents\13\jobs\13\H0106\Phase-III\CAD\Struct\Sheet\0900180-XXXXX-TYLL-2141-Unit\_1a(RampE) Deck Plan-2.dgn

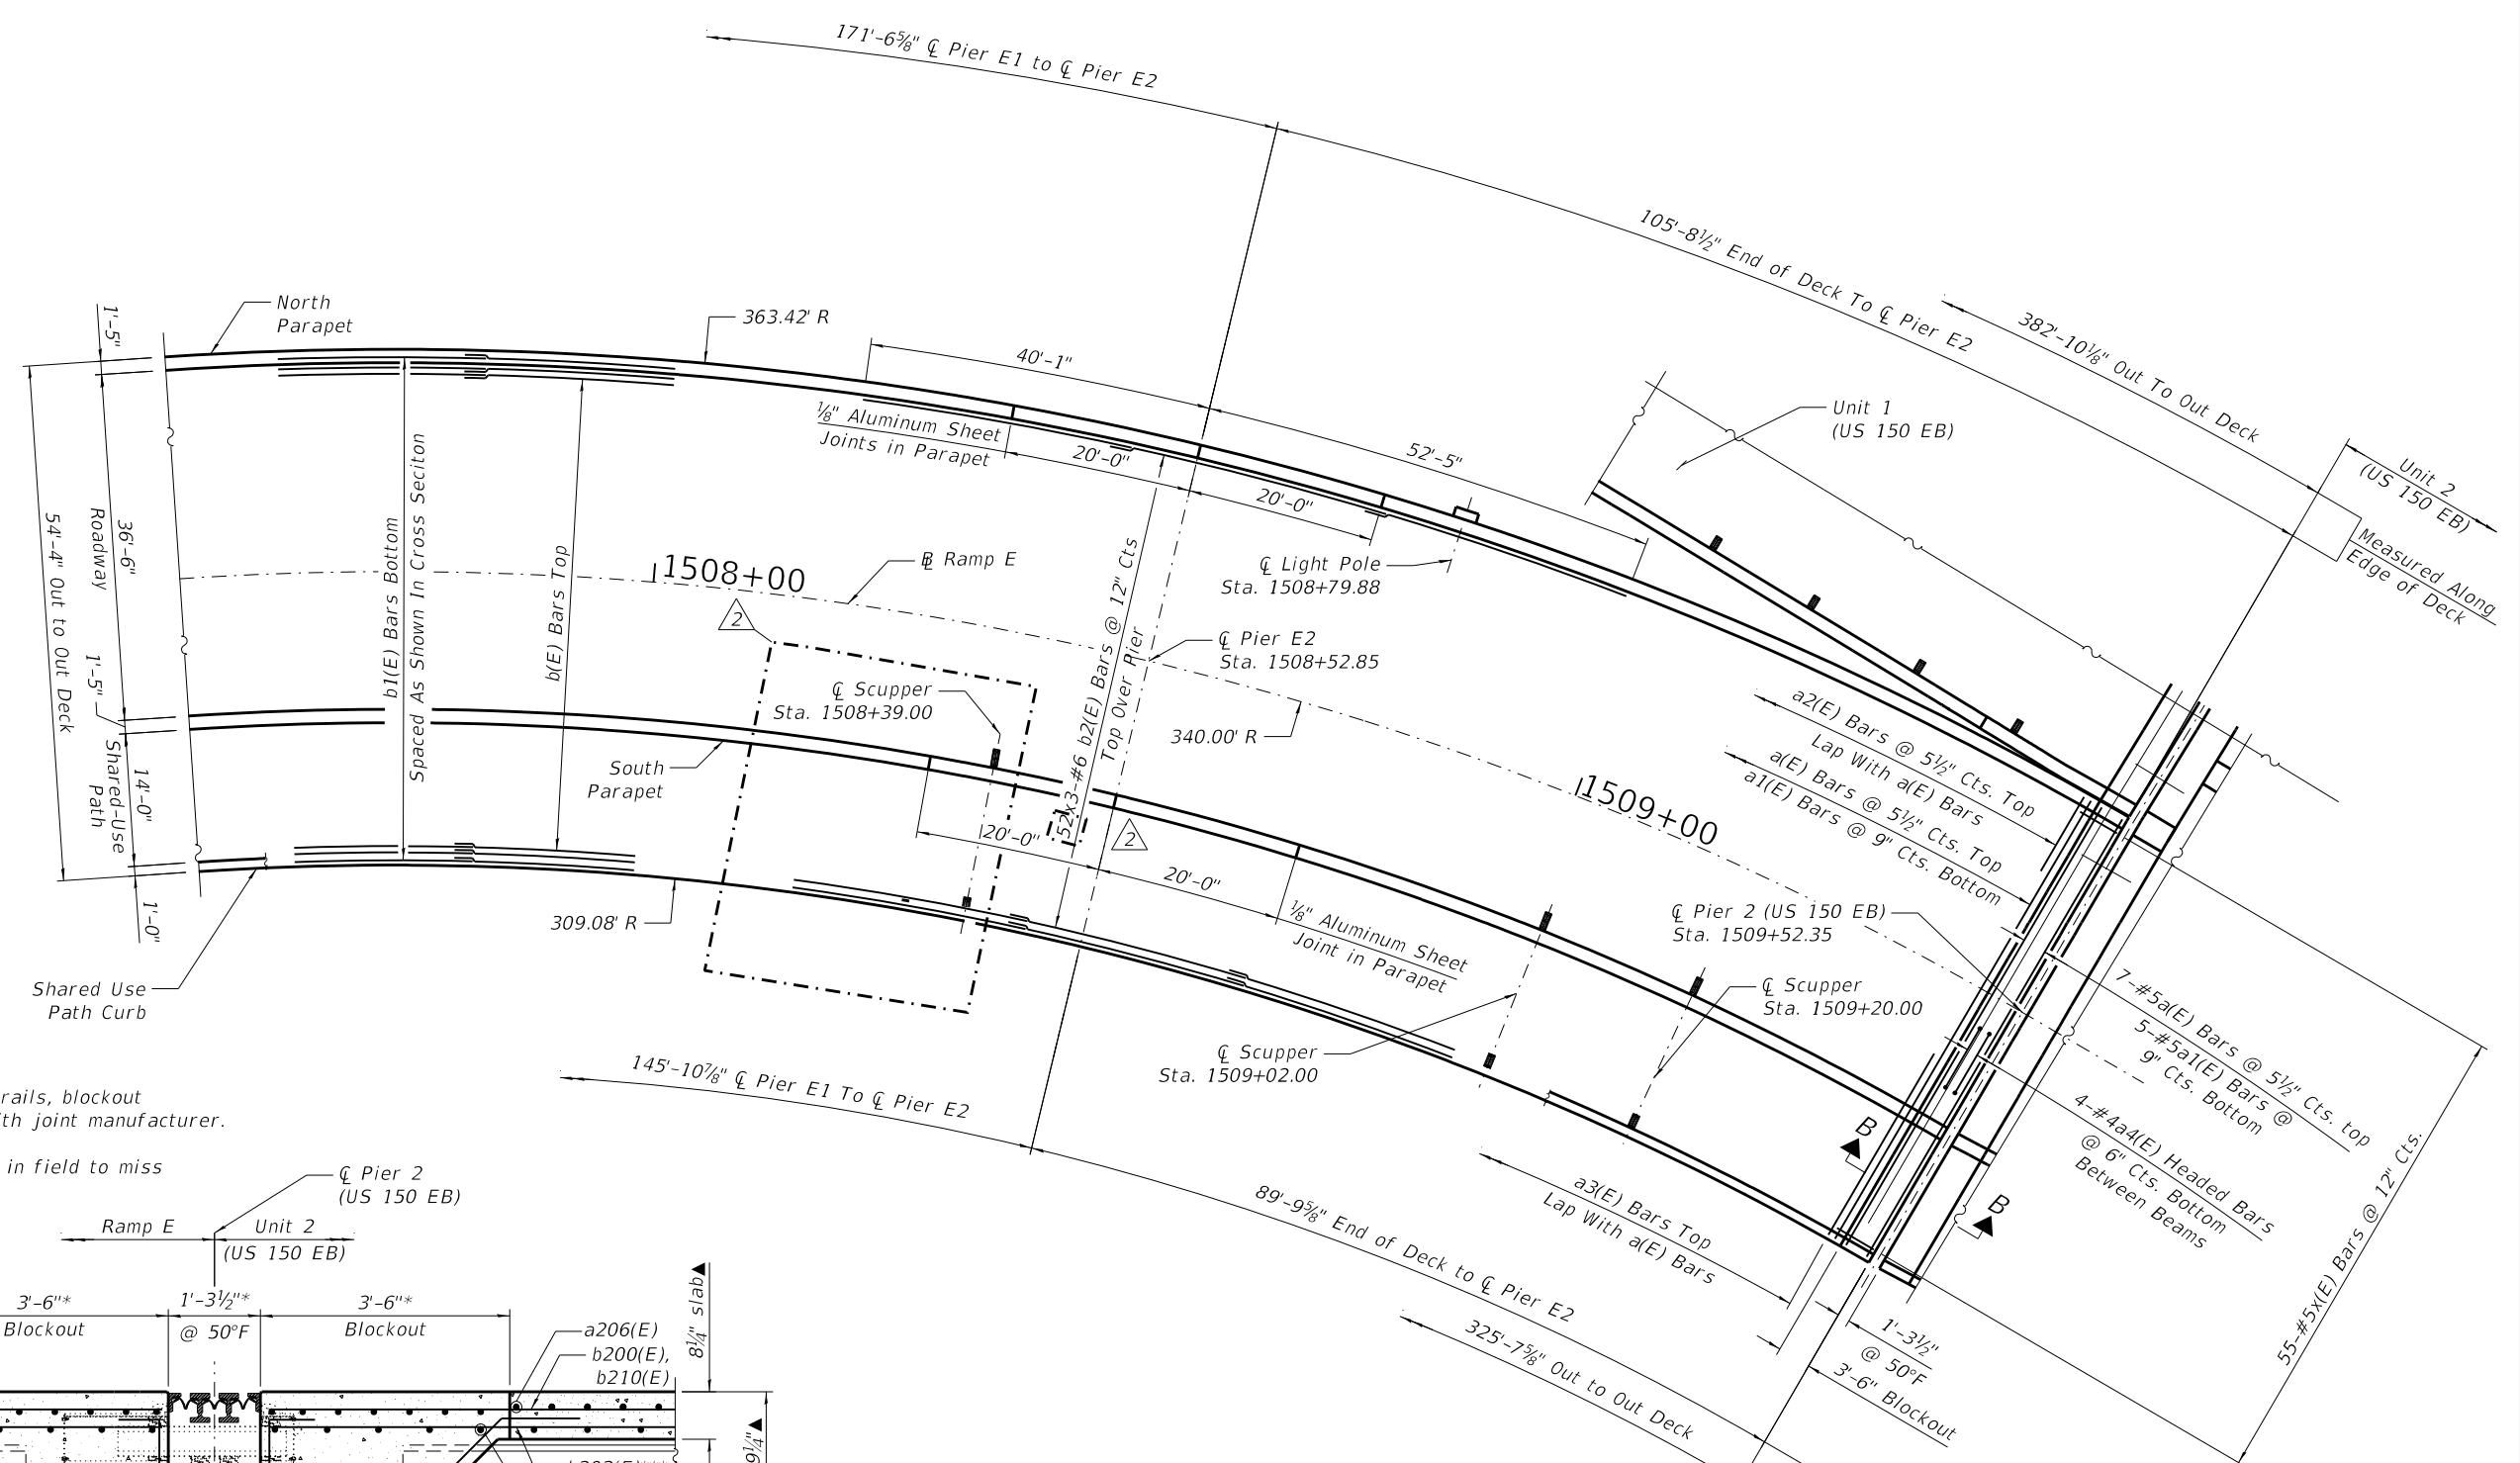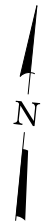

\* Contractor to verify number of rails, blackout dimensions and joint opening with joint manufacturer.  
 \*\* Bars to be adjusted and/or cut in field to miss support boxes and beam webs.

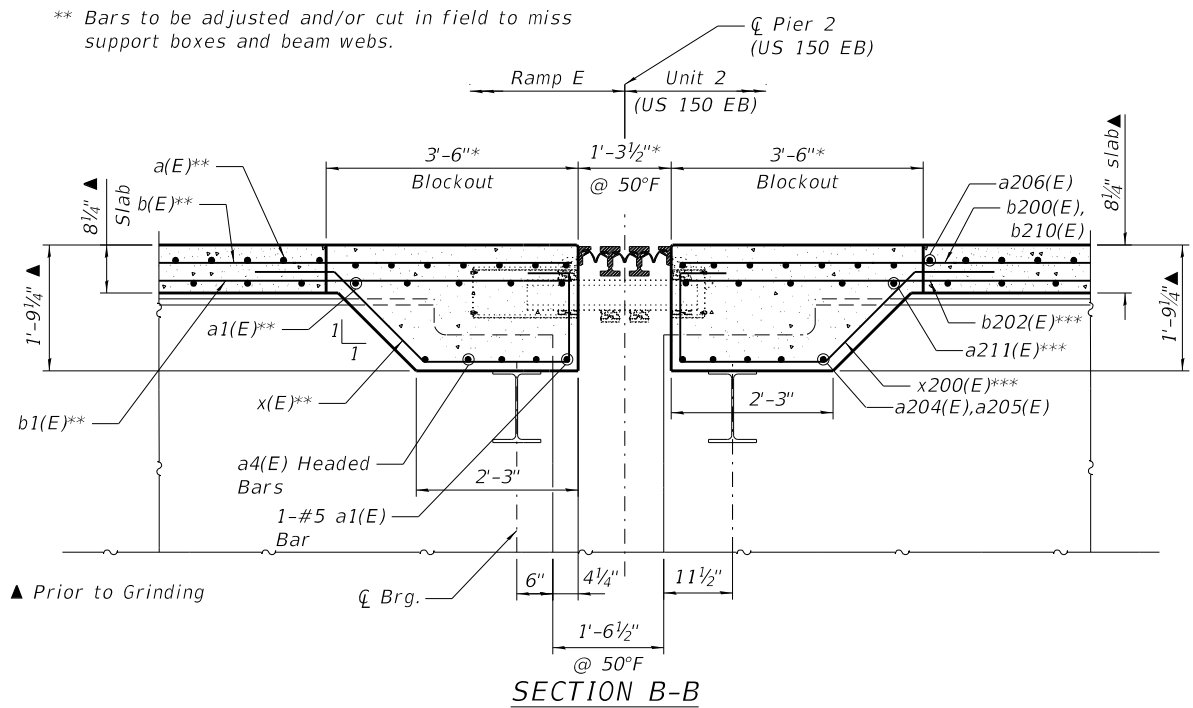

**MIN. LAP LENGTH**

- #5 = 3'-6"
- #6 = 3'-7"

Note:  
 1. Bars indicated thus 20x3-#5 etc. indicates 20 lines of bars with 3 lengths per line.

**TYLIN INTERNATIONAL**  
 200 S. WACKER DR.  
 SUITE 1400  
 CHICAGO, IL 60606  
 TEL: 312-777-2900

USER NAME = spantazis	DESIGNED - RH	REVISED - 4/16/2019 S.P.
PLOT SCALE = 0:2.0000 "/>		


**STATE OF ILLINOIS  
 DEPARTMENT OF TRANSPORTATION**

**DECK PLAN - RAMP E, 2 OF 2  
 STRUCTURE NO. 090-0180**

F.A.P. RTE.	SECTION	COUNTY	TOTAL SHEETS	SHEET NO.
317	[15B;(102-1),(14HB)]BR/BR	PEO/TAZ	1361	972
CONTRACT NO. 68B46				
ILLINOIS FED. AID PROJECT NHPY-RP3(905)				



MODEL: Default  
 FILE NAME: pw:\sps\sv306\hanson\_projects\Documents\13\130106\Phase-III\CAD\Struct\Sheet\0900180-XXXXX-TYU-2200-Unit 2 Deck Plan-1.dgn

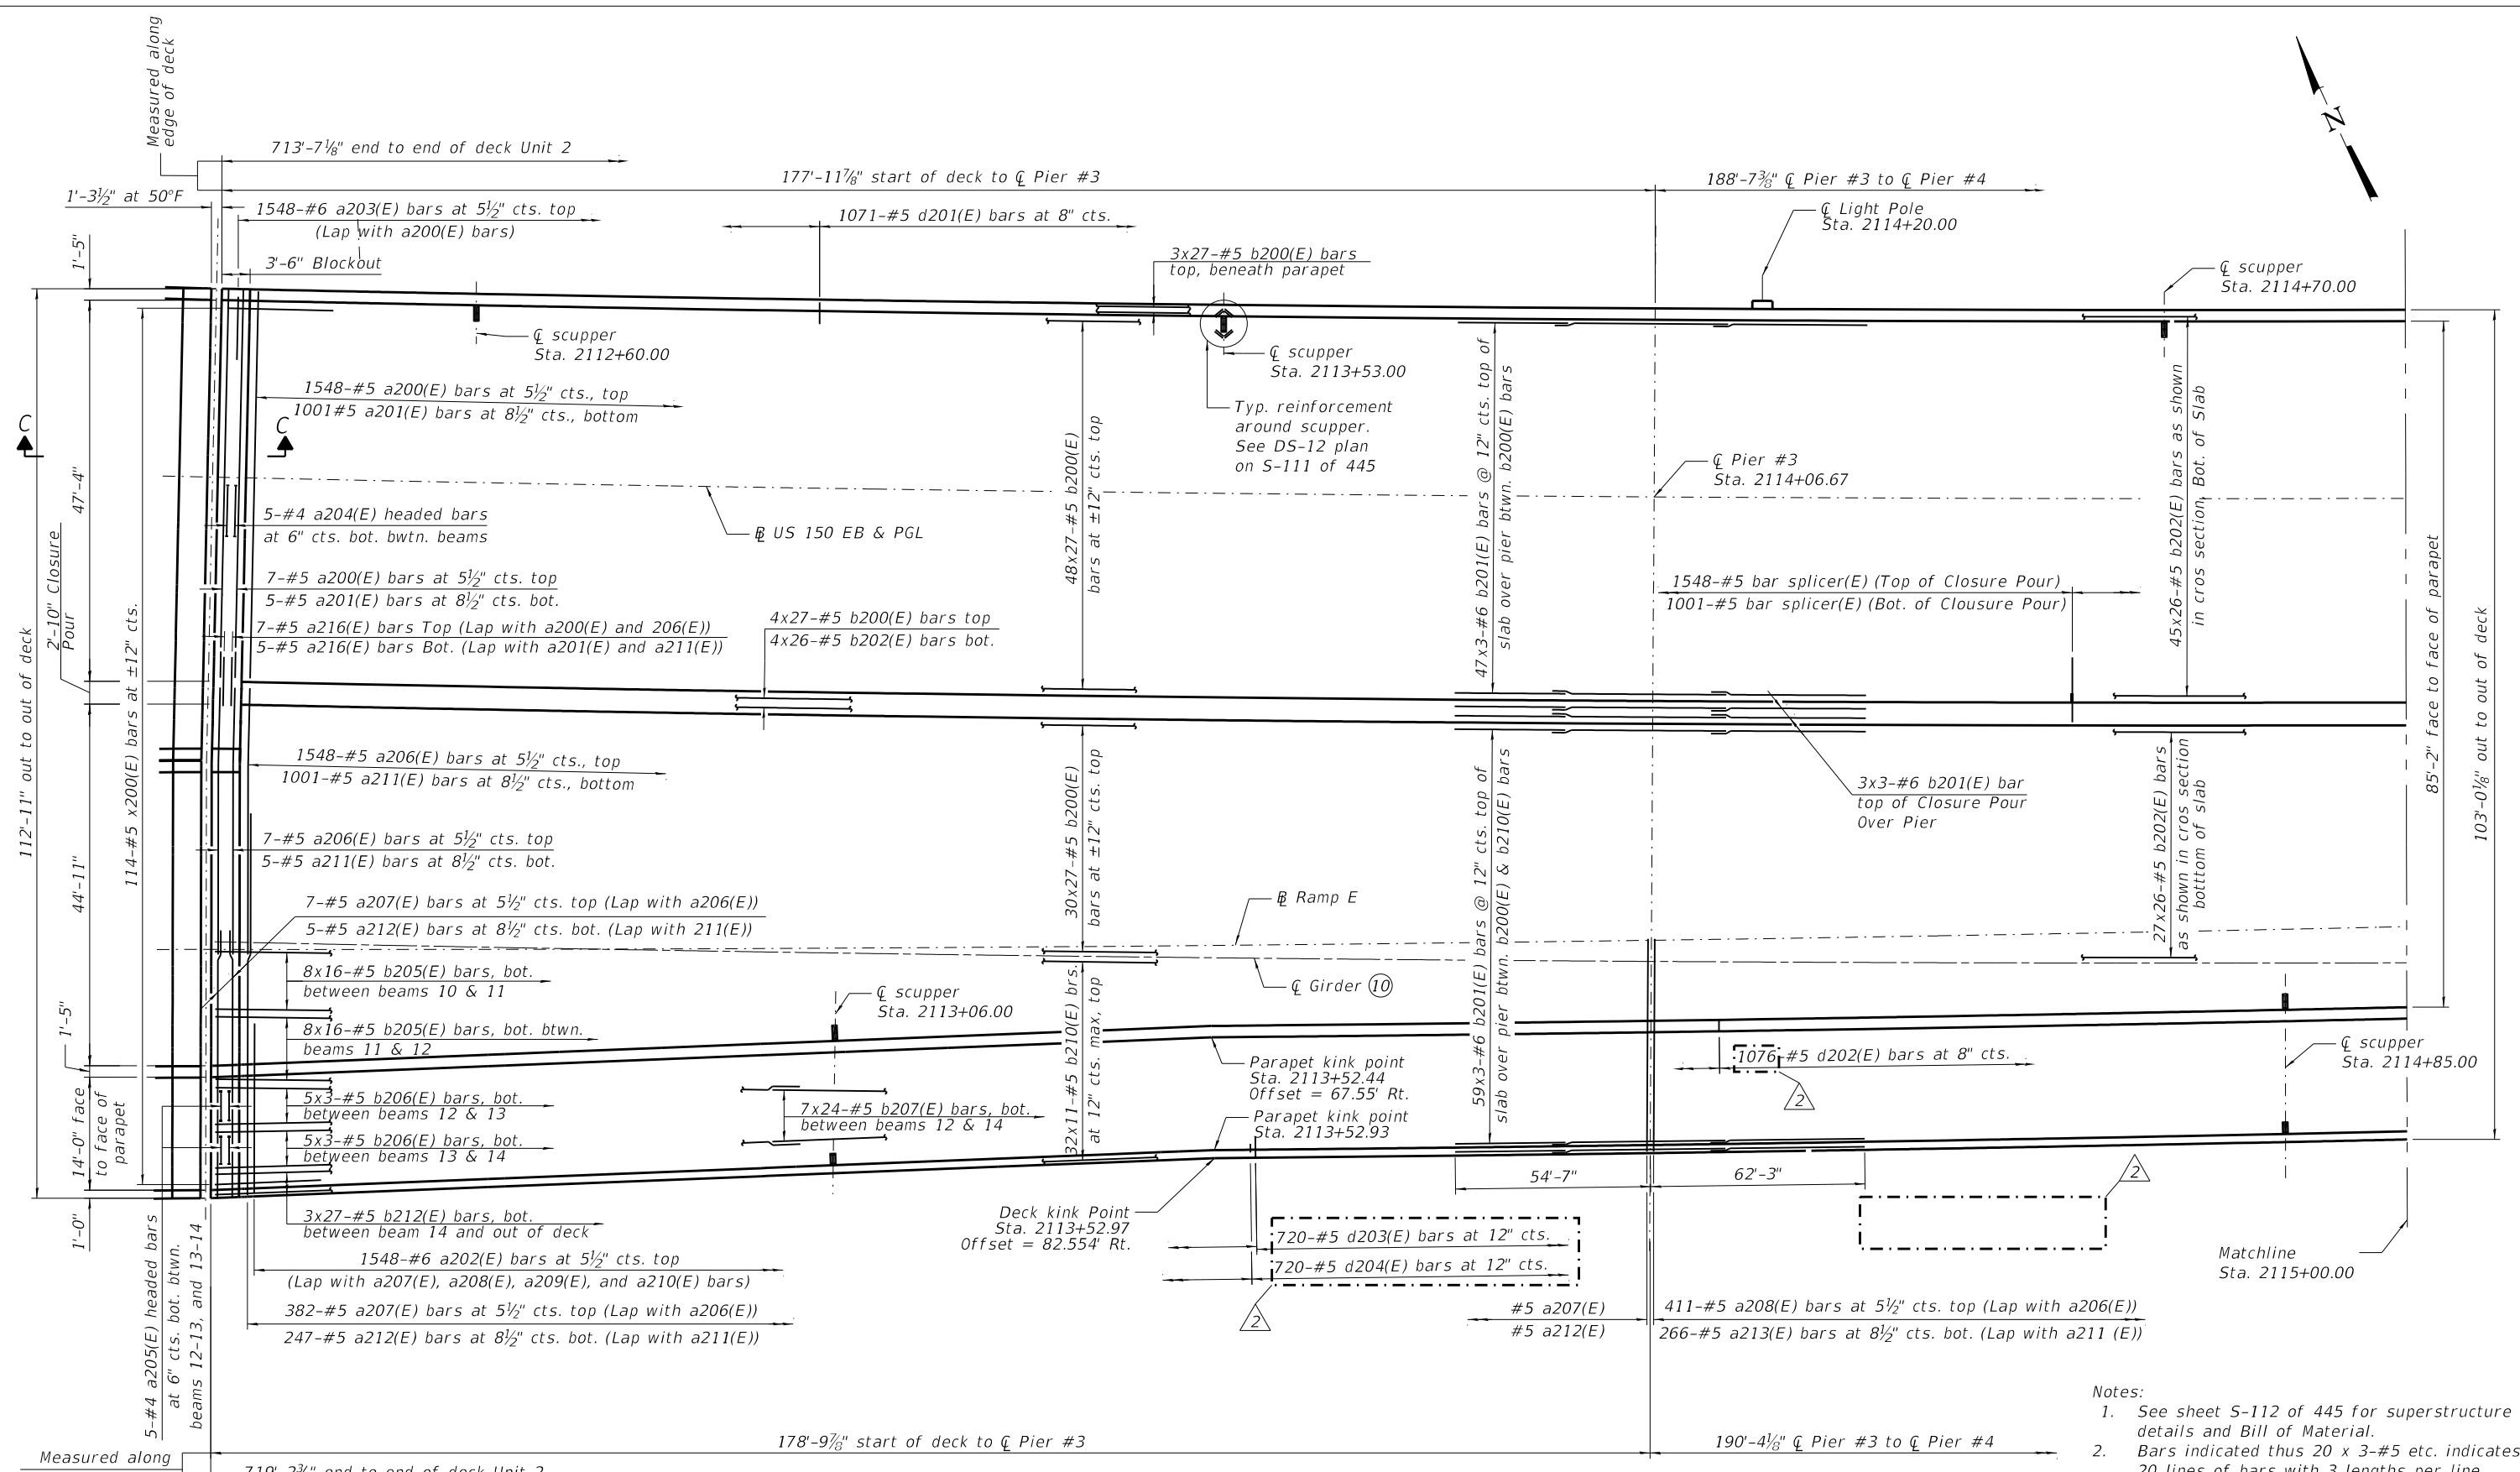

PLAN

MINIMUM BAR LAP

#5 bar = 3'-6"  
 #6 bar = 3'-7"

- Notes:
1. See sheet S-112 of 445 for superstructure details and Bill of Material.
  2. Bars indicated thus 20 x 3-#5 etc. indicates 20 lines of bars with 3 lengths per line.
  3. For Section C-C, see sheet S-65 of 445.

**TYLIN INTERNATIONAL**  
 200 S. WACKER DR.  
 SUITE 1400  
 CHICAGO, IL 60606  
 TEL: 312-777-2900

USER NAME = spantazis	DESIGNED -	REVISED - 4/16/2019 S.P.
PLOT SCALE = 20:0'"/in.	CHECKED -	REVISED -
PLOT DATE = 4/5/2019	DRAWN - CTH	REVISED -
	CHECKED -	REVISED -


**STATE OF ILLINOIS  
 DEPARTMENT OF TRANSPORTATION**

DECK PLAN - UNIT 2, 1 OF 3  
 STRUCTURE NO. 090-0180

SHEET 5-70 OF 445 SHEETS

F.A.P. RTE.	SECTION	COUNTY	TOTAL SHEETS	SHEET NO.
317	[15B;(102-1),(14HB)]BR/BR	PEO/TAZ	1361	974
CONTRACT NO. 68B46				
ILLINOIS		FED. AID PROJECT	NHPP-YRP3(905)	



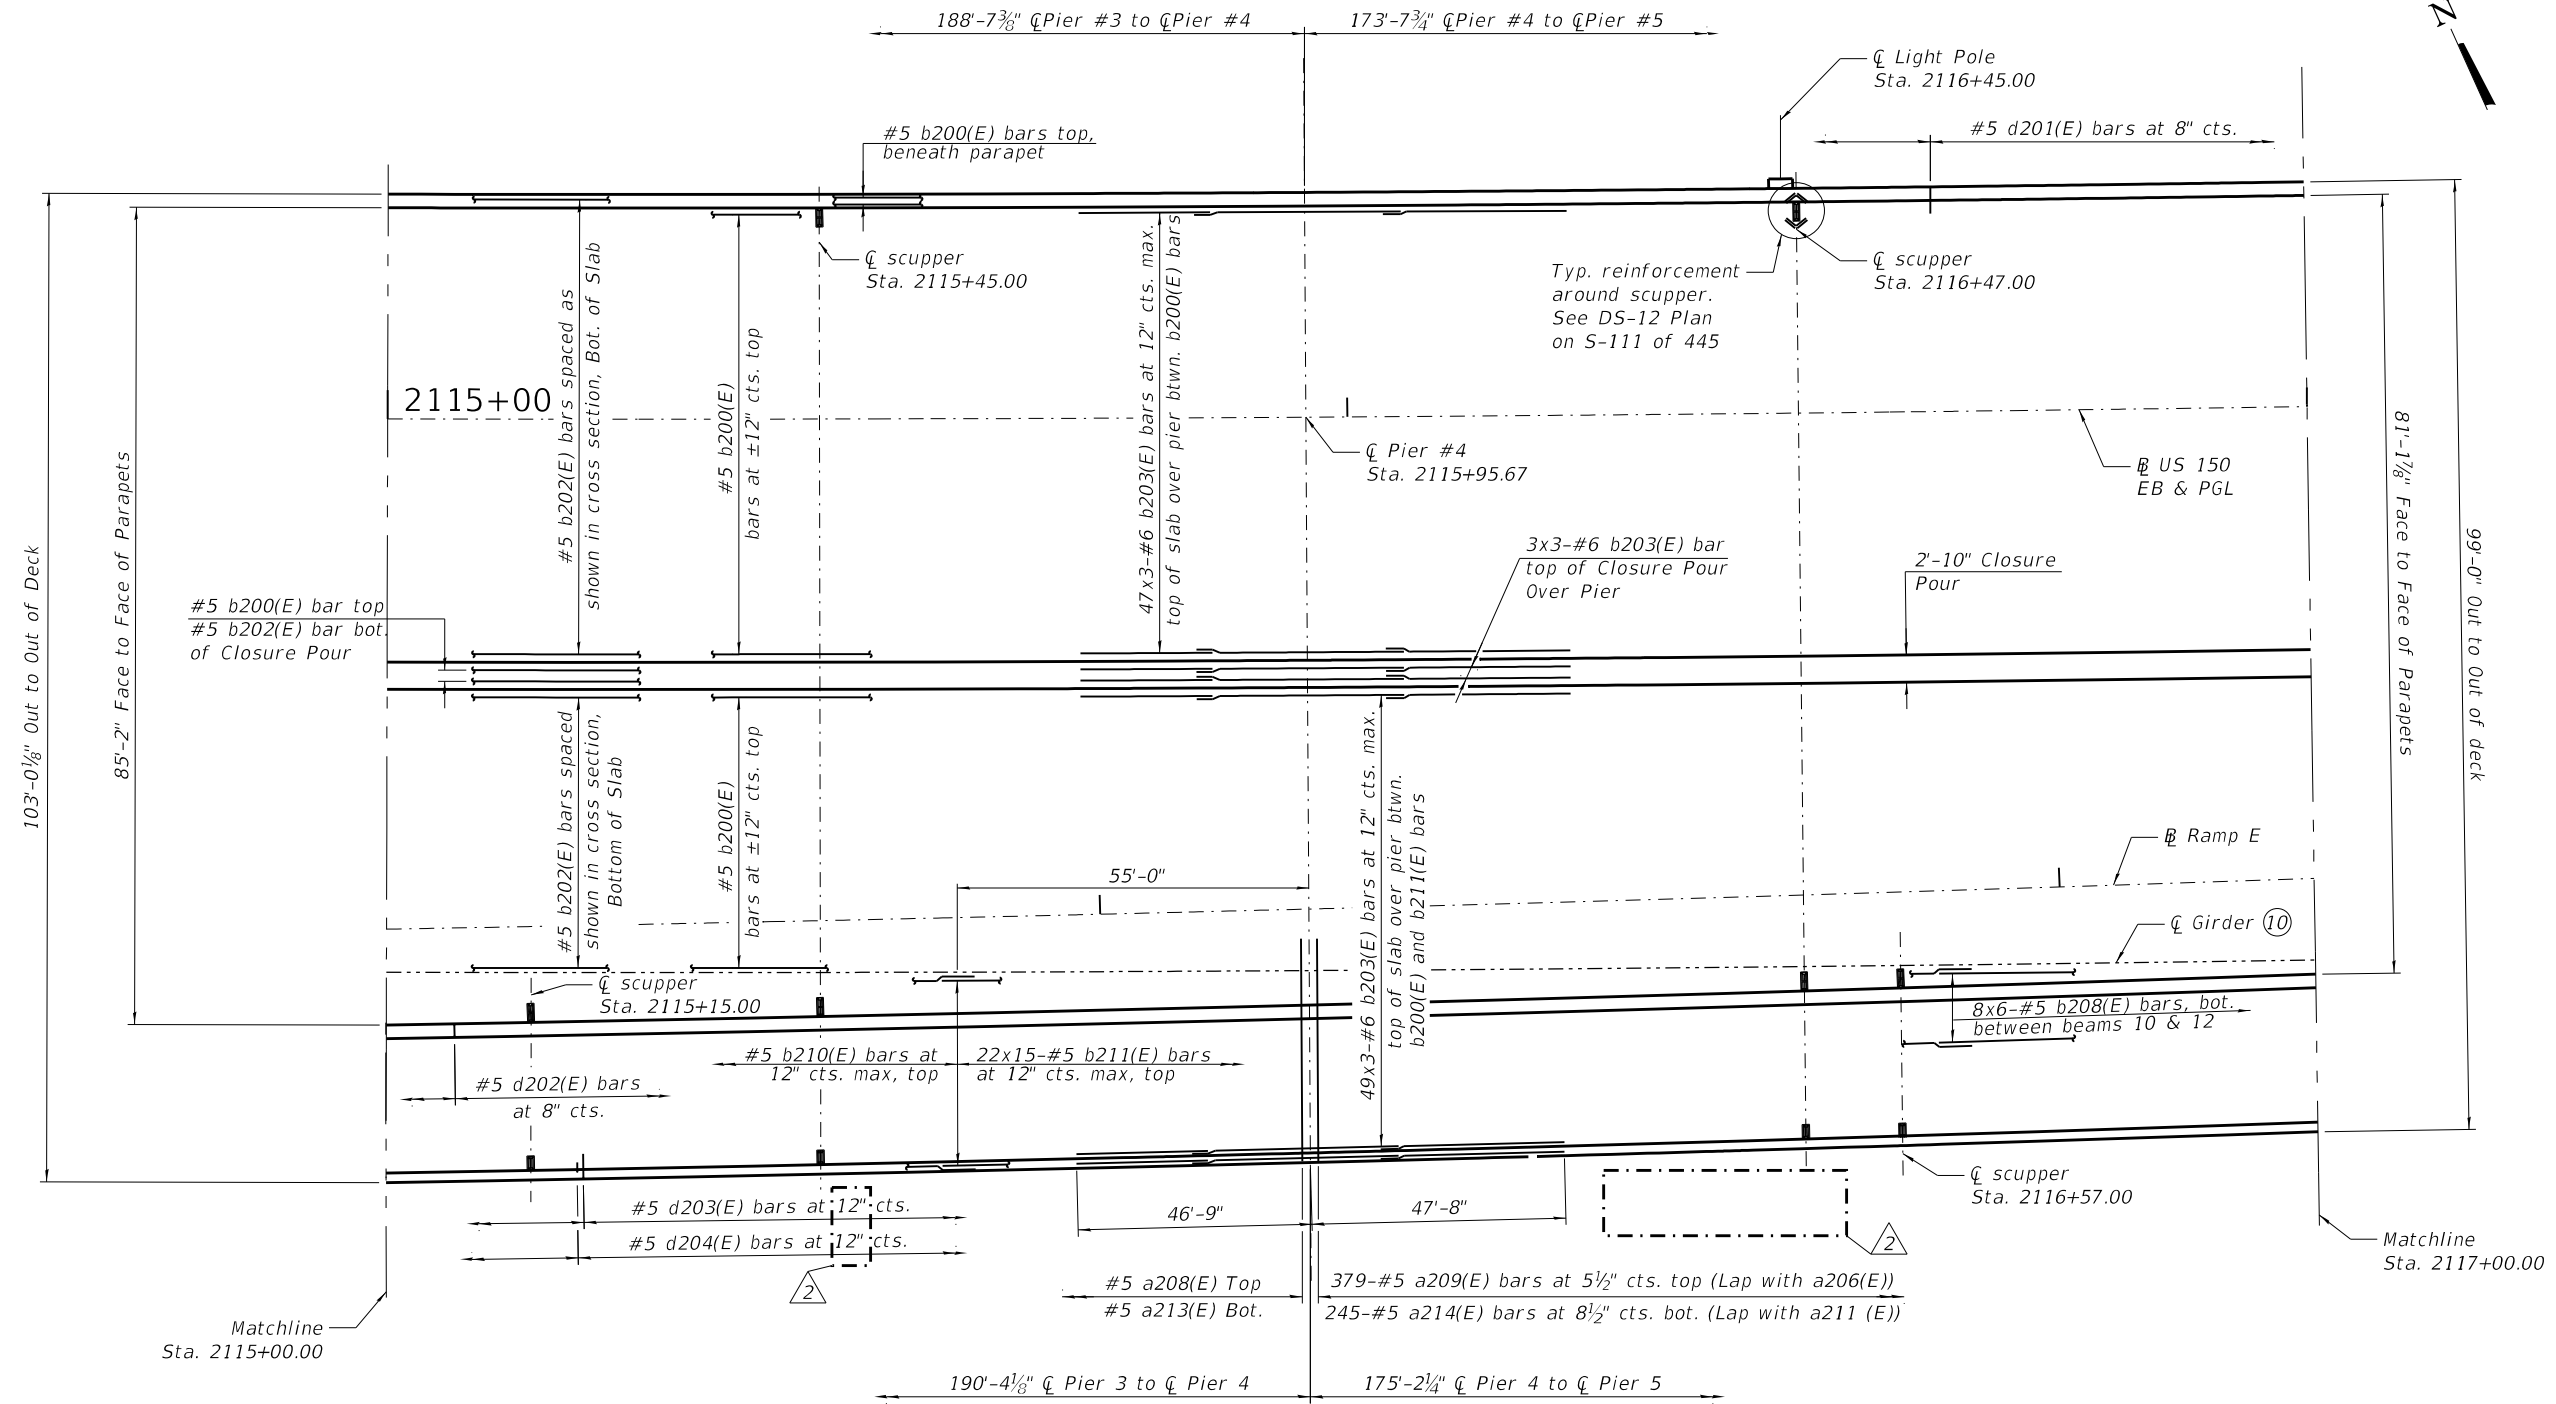

PLAN

**MINIMUM BAR LAP**

- #5 bar = 3'-6"
- #6 bar = 3'-7"

**Notes:**

1. See sheet S-112 of 445 for superstructure details and Bill of Material.
2. Bars indicated thus 20 x 3-#5 etc. indicates 20 lines of bars with 3 lengths per line.

MODEL: Default  
 FILE NAME: p:\1\sp\sv\306\hanson\Projects\Documents\13\130106\Phase-III\CAD\Struct\Sheet\0900180-XXXX-TYLI-2201-Unit 2 Deck Plan-2.dgn  
 4/5/2019 8:41:43 PM

**TYLIN INTERNATIONAL**  
 200 S. WACKER DR.  
 SUITE 1400  
 CHICAGO, IL 60606  
 TEL: 312-777-2900

USER NAME = spantazis	DESIGNED -	REVISED -
PLOT SCALE = 20:0.0000 " = 1" / in.	CHECKED -	REVISED -
PLOT DATE = 4/5/2019	DRAWN - CTH	REVISED -
	CHECKED -	REVISED -

4/16/2019	S.P.
-----------	------

**STATE OF ILLINOIS**  
**DEPARTMENT OF TRANSPORTATION**


DECK PLAN - UNIT 2, 2 OF 3  
 STRUCTURE NO. 090-0180

SHEET 5-71 OF 445 SHEETS

F.A.P. RTE.	SECTION	COUNTY	TOTAL SHEETS	SHEET NO.
317	[15B;(102-1),(14HB)]BR]BR	PEO/TAZ	1361	975
CONTRACT NO. 68B46				
ILLINOIS FED. AID PROJECT NHPP-YRP3(905)				

**SCUPPER LOCATIONS**

Location	Station
A	2117+08.00
B	2118+22.00
C	2118+45.00
D	2118+60.00
E	2118+68.00
F	2118+85.00
G	2119.01+00
H	2119+11.00
I	2119+21.00

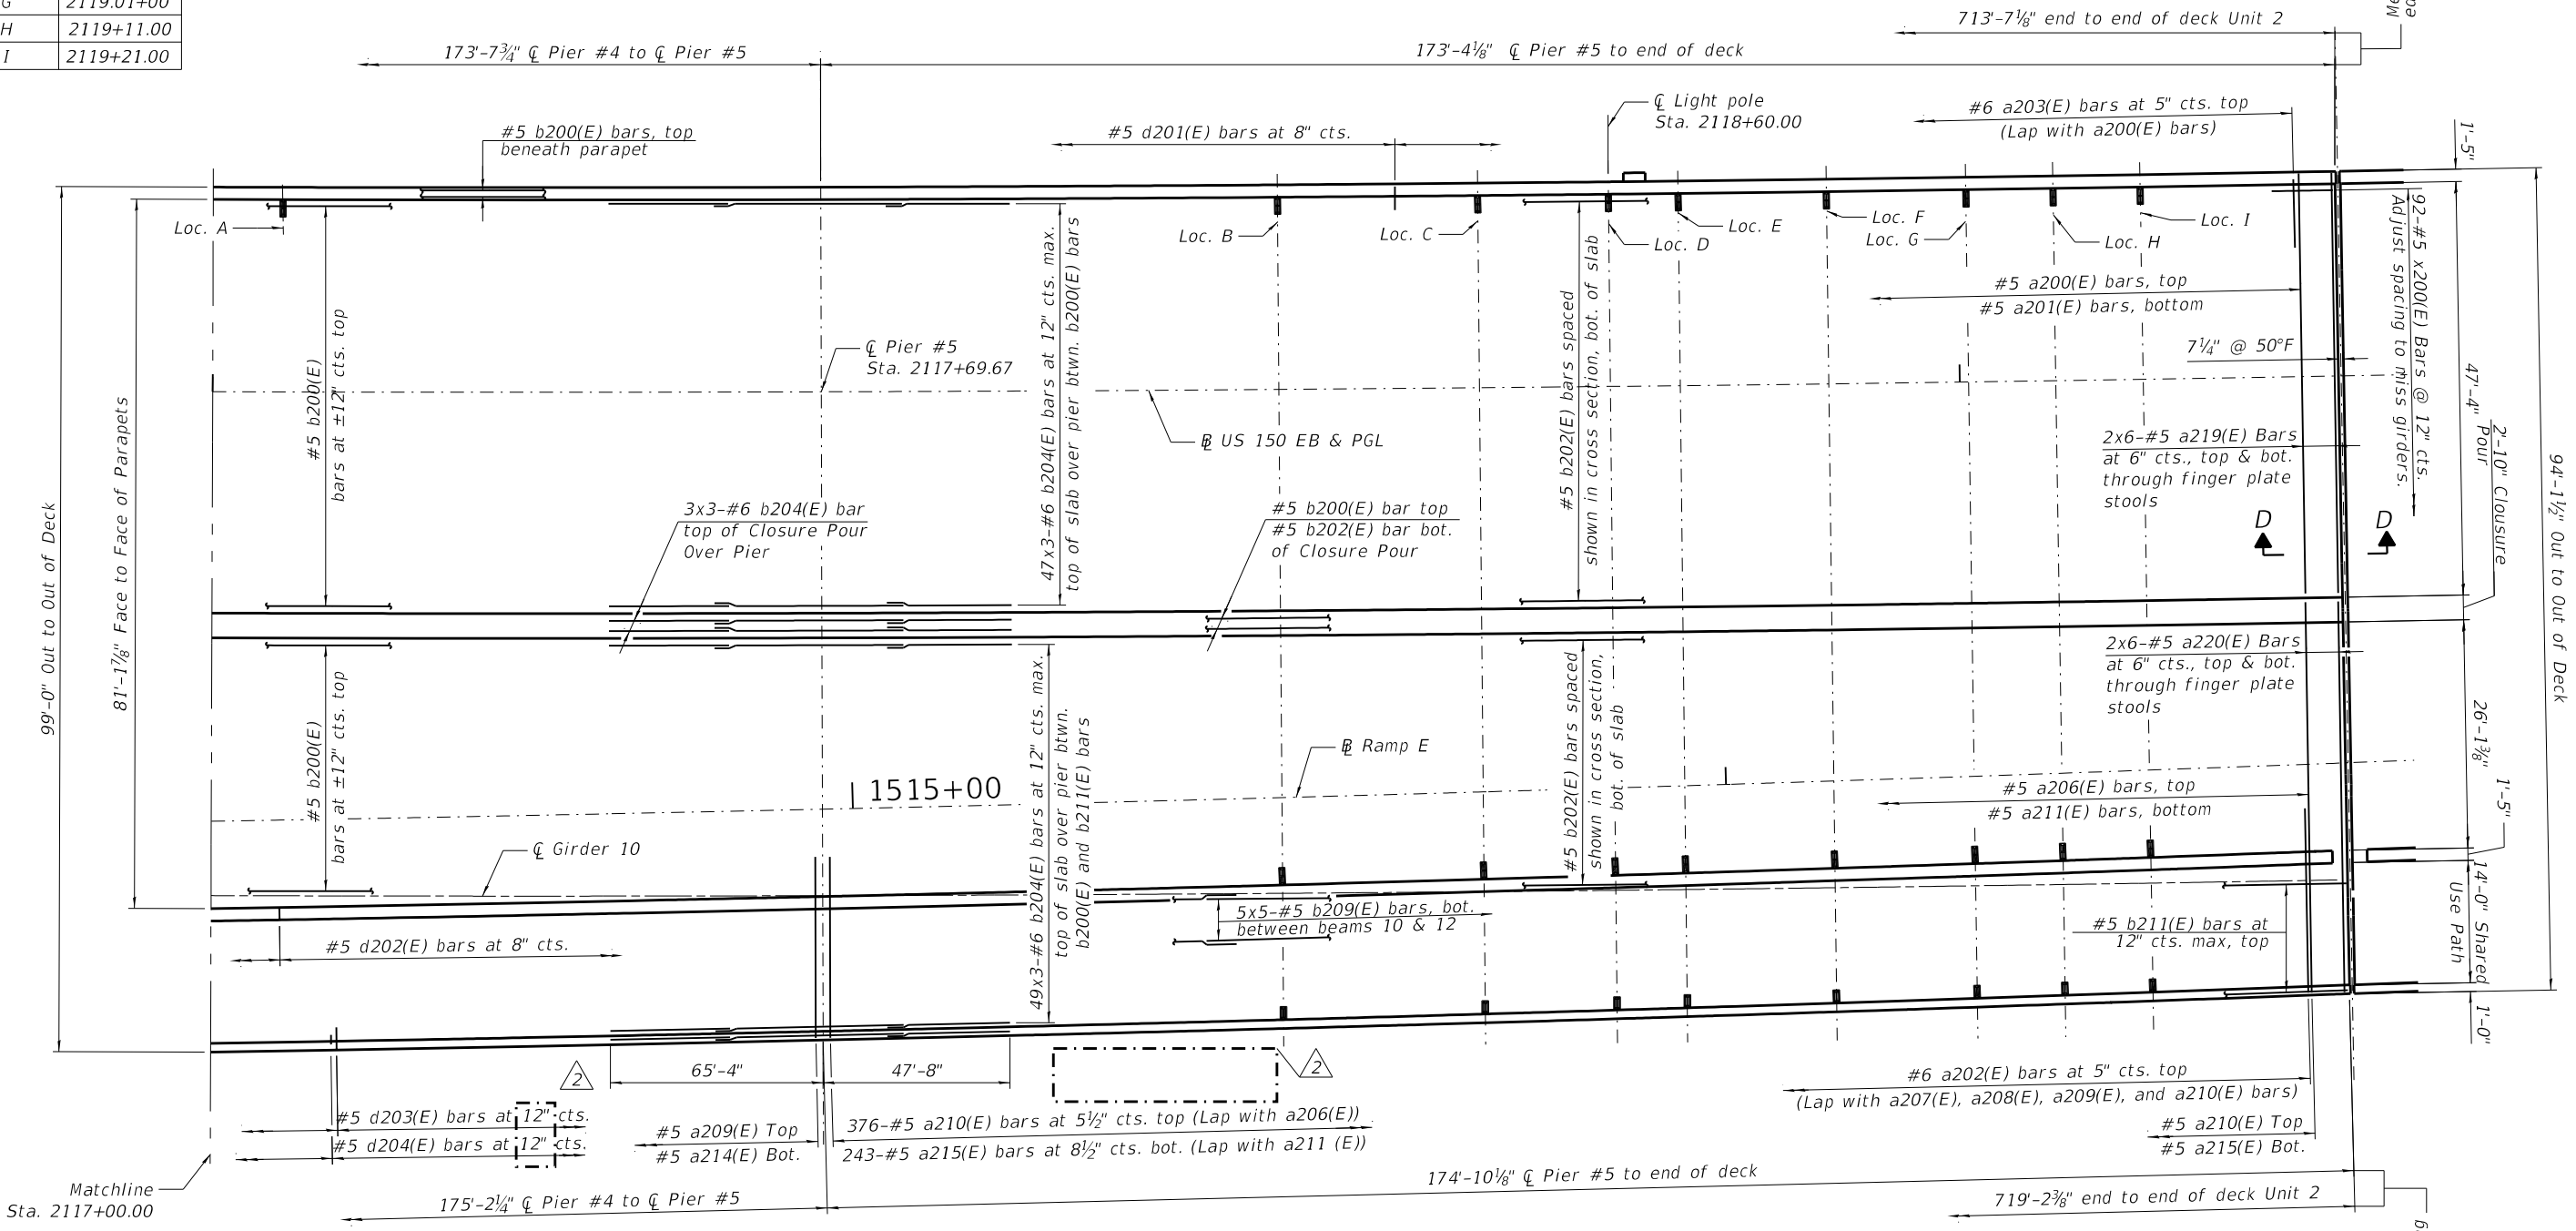

**MINIMUM BAR LAP**

- #5 bar = 3'-6"
- #6 bar = 3'-7"

- Notes:
- See sheet S-112 of 445 for superstructure details and Bill of Material.
  - Bars indicated thus 20 x 3-#5 etc. indicates 20 lines of bars with 3 lengths per line.
  - For section D-D, see sheet S-117 of 445.

MODEL: Default  
 FILE NAME: p:\1\sp\sv\306\hanson\Projects\Documents\13\1301106\Phase-III\CAD\Struct\Sheet\0900180-XXXX-TYLI-2202-Unit 2 Deck Plan-3.dgn  
 4/5/2019 8:46:19 PM

**TYLIN INTERNATIONAL**  
 200 S. WACKER DR.  
 SUITE 1400  
 CHICAGO, IL 60606  
 TEL: 312-777-2900

USER NAME = spantazis	DESIGNED -	REVISED -
PLOT SCALE = 20:0.0000' = 1" / in.	CHECKED -	REVISED -
PLOT DATE = 4/5/2019	DRAWN - CTH	REVISED -
	CHECKED -	REVISED -

**STATE OF ILLINOIS**  
**DEPARTMENT OF TRANSPORTATION**

DECK PLAN - UNIT 2, 3 OF 3  
 STRUCTURE NO. 090-0180

SHEET 5-72 OF 445 SHEETS

F.A.P. RTE.	SECTION	COUNTY	TOTAL SHEETS	SHEET NO.
317	[15B;(102-1),(14HB)]BR/BR	PEO/TAZ	1361	976
CONTRACT NO. 68B46				
ILLINOIS FED. AID PROJECT NHPY-RP3(905)				











**UNIT 1 - SUPERSTRUCTURE**  
**BILL OF MATERIAL**




Bar	No.	Size	Length	Shape
a100(E)	966	#5	32'-1"	—
a101(E)	891	#5	22'-7"	—
a102(E)	974	#6	8'-4"	—
a103(E)	35	#6	7'-9"	—
a104(E)	2	#6	32'-0"	—
a105(E)	8	#6	32'-1"	—
a106(E)	80	#5	1'-6"	—
a107(E)	8	#6	5'-5"	—
a108(E)	6	#6	6'-5"	—
b100(E)	455	#5	34'-10"	—
b101(E)	174	#6	28'-7"	—
b102(E)	408	#5	30'-11"	—
d100(E)	657	#5	6'-5"	—
d101(E)	670	#5	8'-7"	—
d102(E)	13	#5	6'-11"	—
d103(E)	3	#6	4'-10"	—
d104(E)	6	#6	8'-11"	—
e100(E)	6	#4	15'-7"	—
e101(E)	72	#4	17'-8"	—
e102(E)	58	#4	19'-8"	—
e103(E)	6	#4	16'-4"	—
e104(E)	6	#4	15'-3"	—
e105(E)	12	#4	11'-1"	—
e106(E)	8	#4	9'-7"	—
e107(E)	8	#4	8'-0"	—
e108(E)	40	#4	23'-2"	—
e109(E)	32	#4	21'-0"	—
x100(E)	62	#5	6'-6"	—
x101(E)	59	#5	6'-11"	—
Reinforcement Bars, Epoxy Coated		Pound	118,290	
Concrete Superstructure		Cu. Yds.	425.5	
Protective Coat		Sq. Yd.	1588	
Bridge Deck Grooving (Longitudinal)		Sq. Yd.	932	
Diamond Grinding (Bridge Section)		Sq. Yd.	1328	

2

2

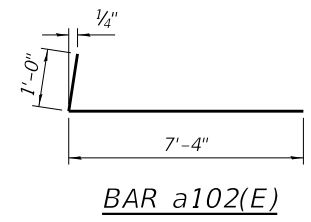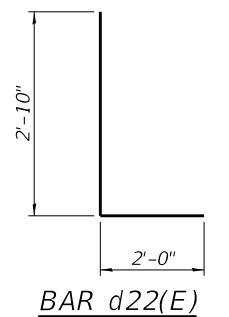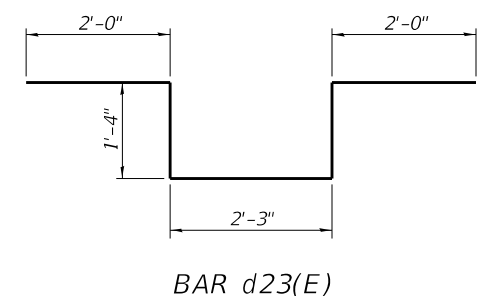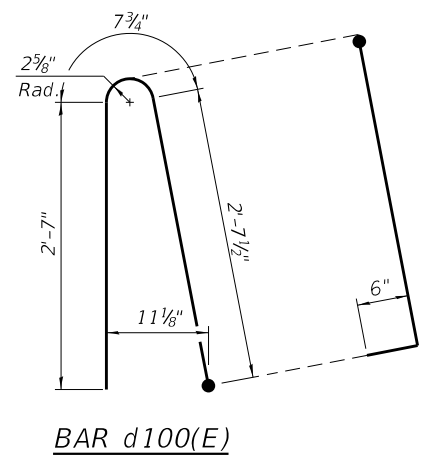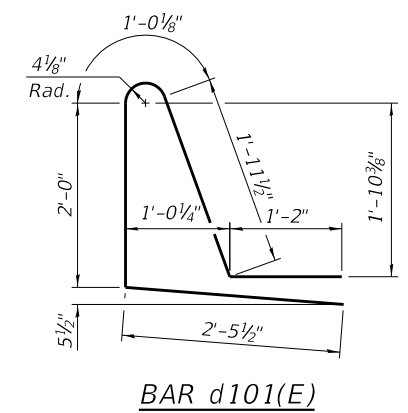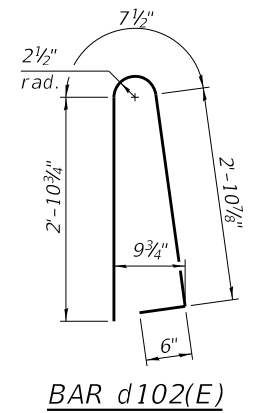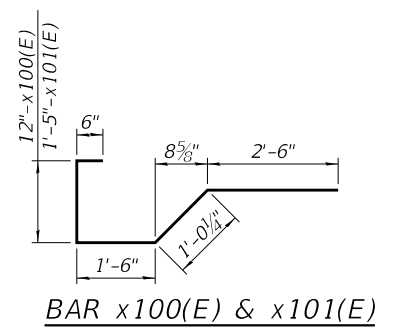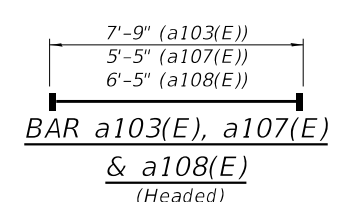

Notes:  
Headed bars shall conform to ASTM A970 with threaded attachment; Class HA; and reinforcement bars conforming to ASTM A706. Cost included with Reinforcement Bars, Epoxy Coated.

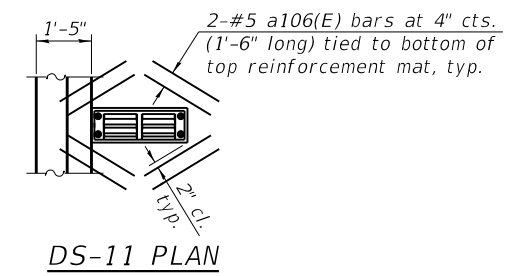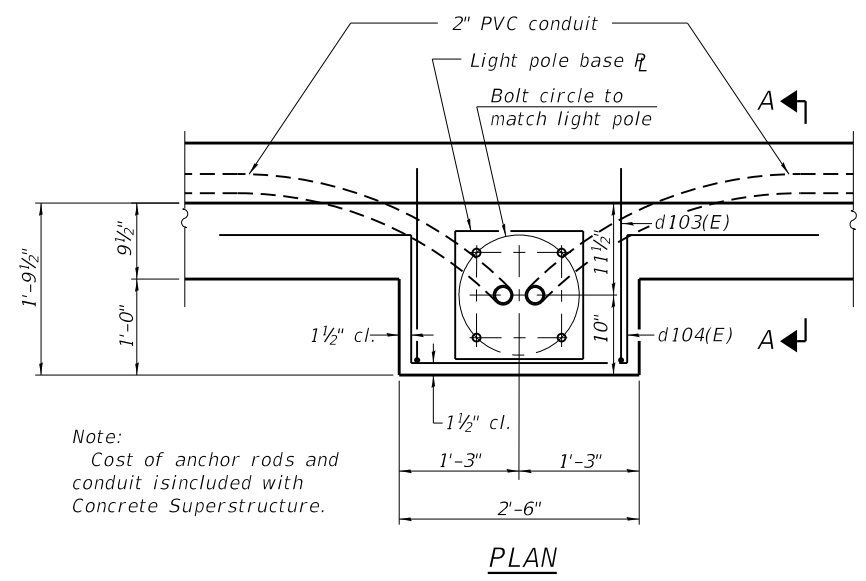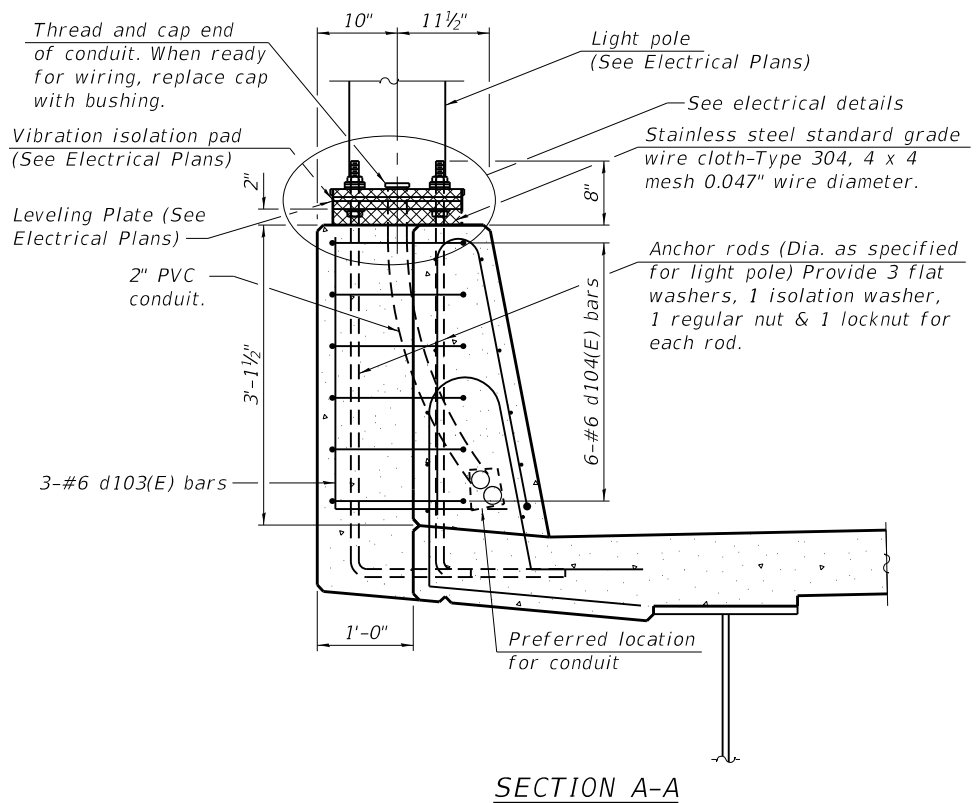

Note:  
Cut longitudinal reinforcement to clear drainage scuppers.

Note:  
Cost of anchor rods and conduit is included with Concrete Superstructure.

MODEL: Default  
FILE NAME: p:\v\sp\sv\306\hanson\Projects\Documents\13\jobs\13\H0106\Phase-III\CAD\Struct\Sheet\0900180-XXXX-TYLL-3101-Unit 1\_Super\_Details.dgn  
PROJECTS\Documents\13\jobs\13\H0106\Phase-III\CAD\Struct\Sheet\0900180-XXXX-TYLL-3101-Unit 1\_Super\_Details.dgn

<b>TYLIN INTERNATIONAL</b> 200 S. WACKER DR. SUITE 1400 CHICAGO, IL 60606 TEL: 312-777-2900	USER NAME = spantazis	DESIGNED -	REVISED - 2/4/16/2019 S.P.
	PLOT SCALE = 5/4 1/4" / in.	CHECKED - RH	REVISED -
	PLOT DATE = 4/8/2019	DRAWN - CTH	REVISED -
		CHECKED -	REVISED -

**STATE OF ILLINOIS**  
**DEPARTMENT OF TRANSPORTATION**

**SUPERSTRUCTURE DETAILS, UNIT 1**  
**STRUCTURE NO. 090-0180**


SHEET 5-101 OF 445 SHEETS

F.A.P. RTE.	SECTION	COUNTY	TOTAL SHEETS	SHEET NO.
317	[15B;(102-1),(14HB)]BR/BR	PEO/TAZ	1361	1005
CONTRACT NO. 68B46				
ILLINOIS		FED. AID PROJECT	NHPP-YRP3(905)	


RAMP E - SUPERSTRUCTURE

BILL OF MATERIAL


Bar	No.	Size	Length	Shape
a(E)	835	#5	54'-0"	—
a1(E)	514	#5	53'-10"	—
a2(E)	821	#5	8'-4"	—
a3(E)	821	#5	22'-2"	—
a4(E)	48	#4	7'-8"	—
a5(E)	32	#5	1'-6"	—
a6(E)	32	#5	2'-0"	—
b(E)	870	#5	28'-10"	—
b1(E)	672	#5	30'-8"	—
b2(E)	312	#6	33'-3"	—
d(E)	575	#5	6'-11"	—
d1(E)	575	#5	8'-4"	—
d2(E)	515	#5	5'-2"	—
d3(E)	328	#5	3'-0"	—
d4(E)	328	#5	4'-2"	—
d5(E)	9	#6	5'-3"	—
d6(E)	18	#6	8'-11"	—
d7(E)	515	#5	6'-5"	—
d8(E)	78	#5	2'-2"	—
e(E)	8	#4	16'-10"	—
e1(E)	64	#4	16'-8"	—
e2(E)	88	#4	19'-8"	—
e3(E)	24	#4	17'-7"	—
e4(E)	100	#4	18'-8"	—
e5(E)	8	#4	17'-0"	—
e6(E)	12	#4	17'-4"	—
e7(E)	12	#4	18'-6"	—
e8(E)	40	#4	17'-3"	—
e9(E)	16	#4	19'-6"	—
e10(E)	8	#4	18'-1"	—
e11(E)	24	#4	30'-0"	—
e12(E)	20	#4	28'-2"	—
e13(E)	24	#4	26'-5"	—
e14(E)	16	#4	30'-3"	—
x1(E)	110	#5	7'-10"	—
Reinforcement Bars, Epoxy Coated	Pound		191,060	
Concrete Superstructure	Cu. Yds.		590.2	
Parapet Railing	Foot		343	
Bridge Deck Grooving (Longitudinal)	Sq. Yd.		665	
Bridge Fence Railing (Special)	Foot		84.5	
Diamond Grinding (Bridge Section)	Sq. Yd.		1310	
Protective Coat	Sq. Yd.		2391	
Bridge Fence Railing	Foot		506	

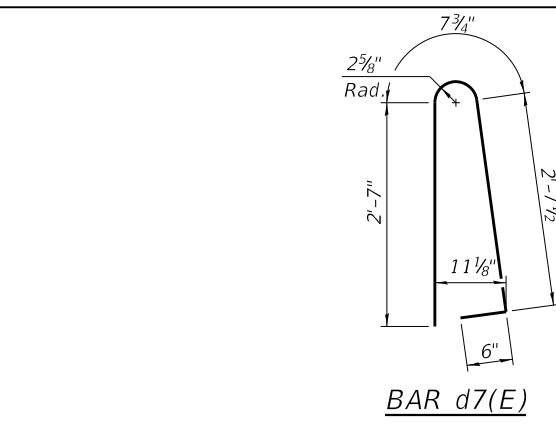


BAR d7(E)

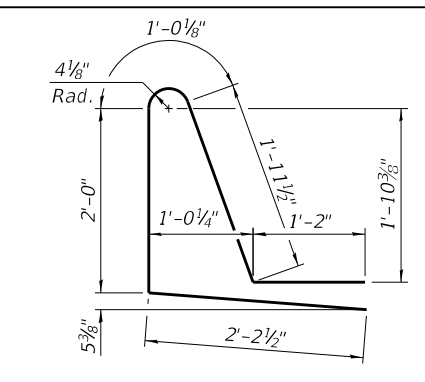


BAR d1(E)

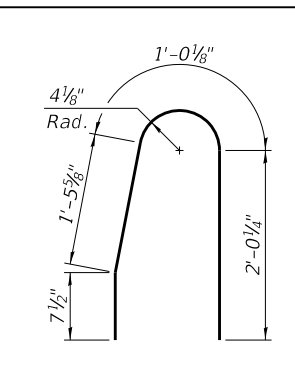


BAR d2(E)

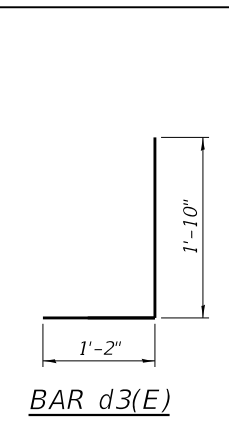


BAR d3(E)

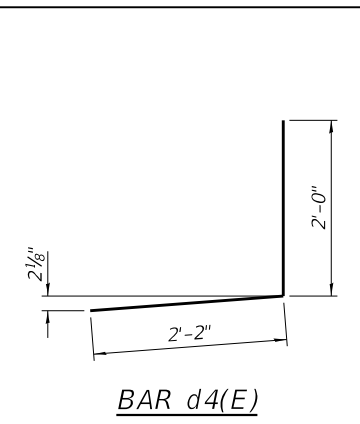


BAR d4(E)

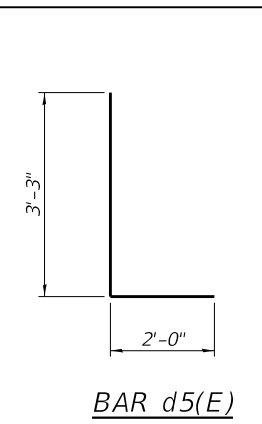


BAR d5(E)

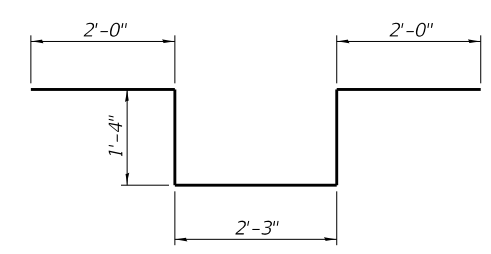


BAR d6(E)

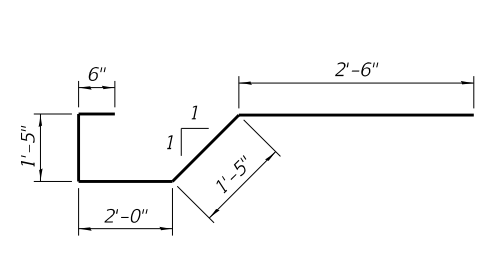


BAR x(E)  
Bend to fit in field

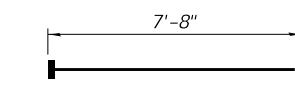

BAR a4(E)  
(Headed)

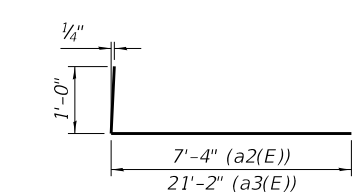


BAR a2(E) & a3(E)

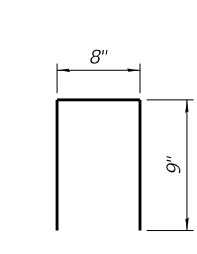


BAR d8(E)

Notes:  
Headed bars shall conform to ASTM A970 with threaded attachment; Class HA; and reinforcement bars conforming to ASTM A706. Cost included with Reinforcement Bars, Epoxy Coated.

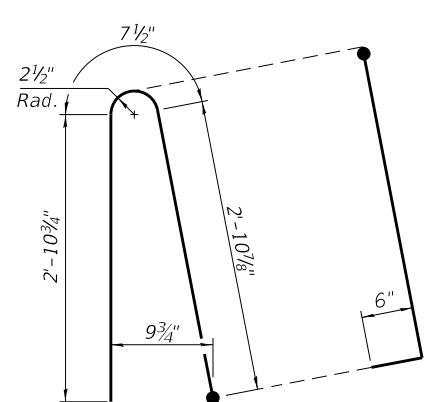

BAR d(E)

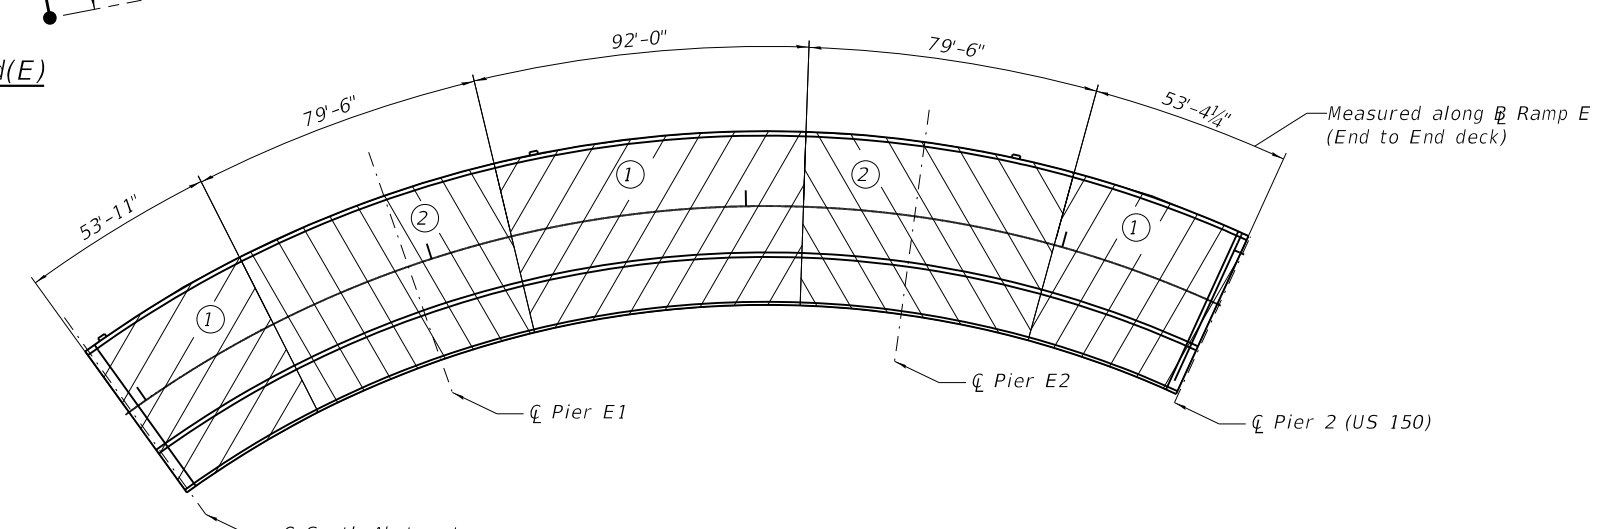

DECK POURING SEQUENCE - RAMP E  
(The pour can start from either end of the deck.)

Notes on Deck Pouring Sequence:  
When the deck pour is stopped for the day at one or more of the transverse bonded construction joints in the deck pouring sequence as shown, the next pour shall not be made until both of the following are met:  
1) At least 72 hours shall have elapsed from the end of the previous pour.  
2) The concrete strength shall have attained a minimum flexural strength of 650 psi or a minimum compressive strength of 3500 psi.

The Contractor is alerted that camber and dead load deflection values shown on the girder detail drawings were developed based on the deck pouring sequence shown. Any deviation from this pouring sequence will result in changes to camber and elevations that affect dead load deflections. If the Contractor wishes to change the sequence, then the proposed plan revisions and design calculations shall be submitted to the Engineer for review and approval. The calculations shall be prepared and sealed by a Licensed Structural Engineer in Illinois.

MODEL: Default  
FILE NAME: p:\w\sp\sv\306\hanson\_projects\documents\13\obs\13\H0106\Phase-III\CAD\Struct\Sheet\0900180-XXXXX-TYLL-3144-Unit\_1A\_(Rmap\_E)\_Super\_Details\_2.dgn  
4/8/2019 9:39:17 PM

TYLIN INTERNATIONAL  
200 S. WACKER DR.  
SUITE 1400  
CHICAGO, IL 60606  
TEL: 312-777-2900





USER NAME = spantazis  
DESIGNED - RH  
CHECKED - CH  
PLOT SCALE = 5/4 1/2" / in.  
PLOT DATE = 4/8/2019

REVISI  
4/16/2019 S.P.  
REVISI  
REVISI  
REVISI

STATE OF ILLINOIS  
DEPARTMENT OF TRANSPORTATION

SUPERSTRUCTURE DETAILS - RAMP E, 2 OF 2  
STRUCTURE NO. 090-0180  
SHEET 5-106 OF 445 SHEETS

F.A.P. RTE. 317  
SECTION [15B;(102-1),(14HB)BR]BR  
COUNTY PEO/TAZ  
TOTAL SHEETS 1361  
SHEET NO. 1010  
CONTRACT NO. 68B46  
ILLINOIS FED. AID PROJECT NHPV-RP3(905)

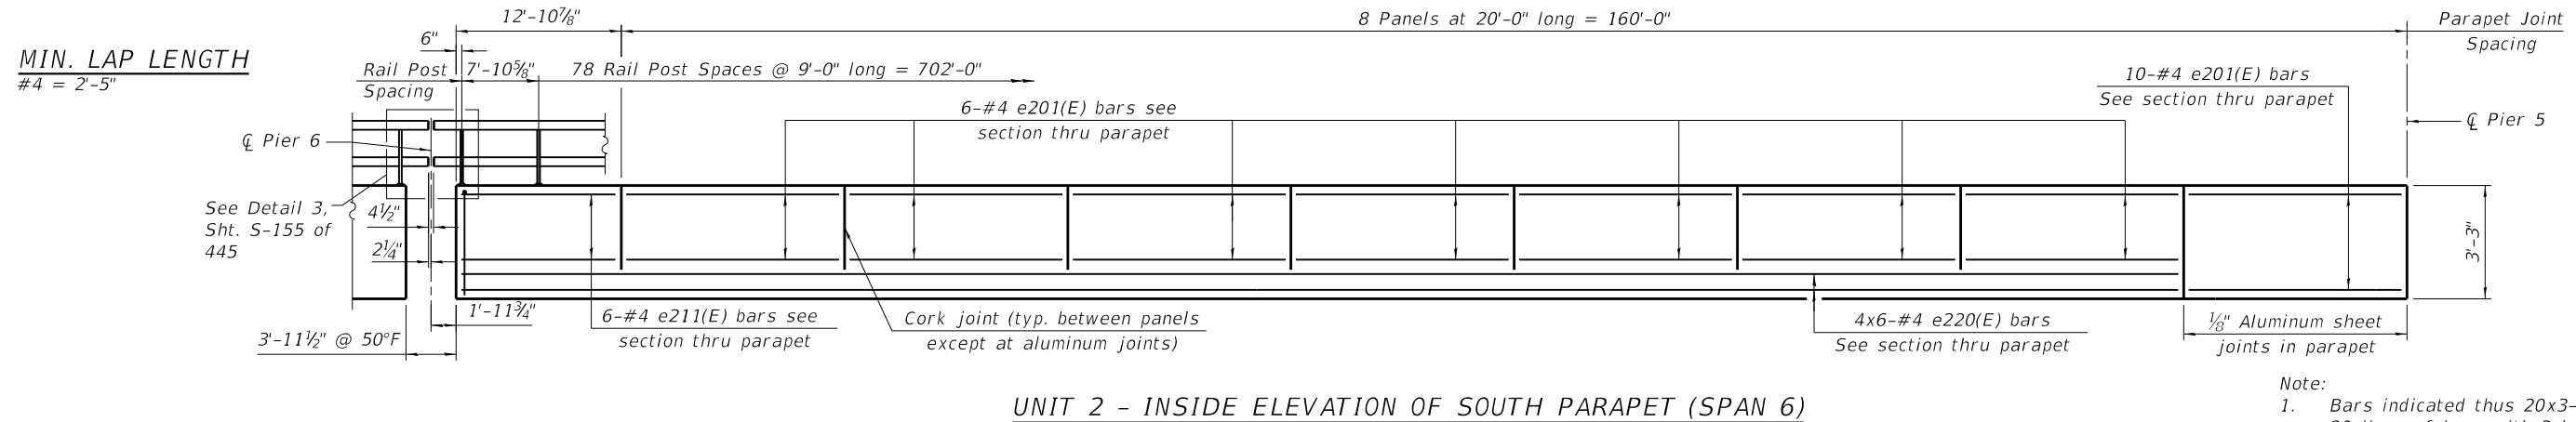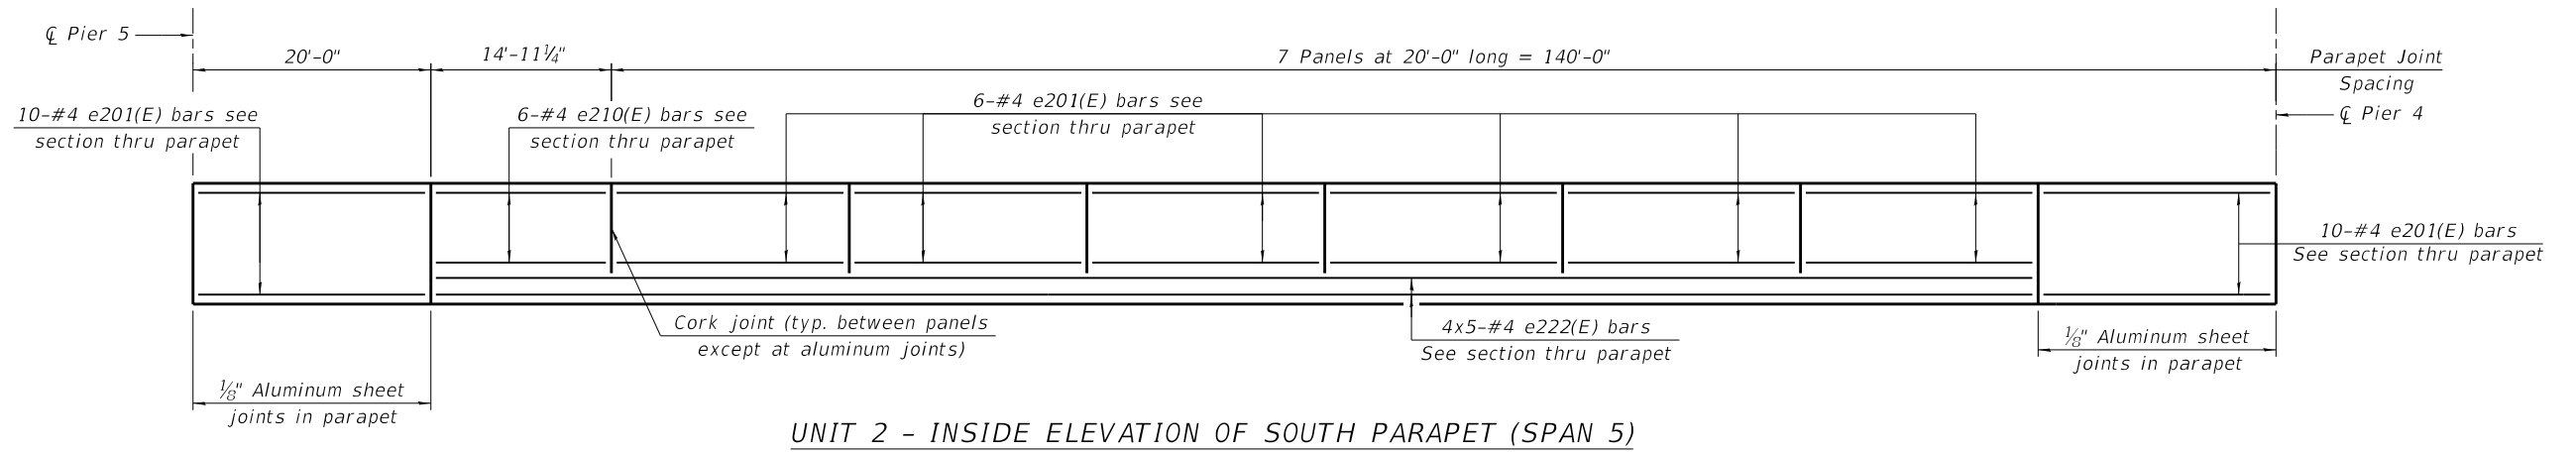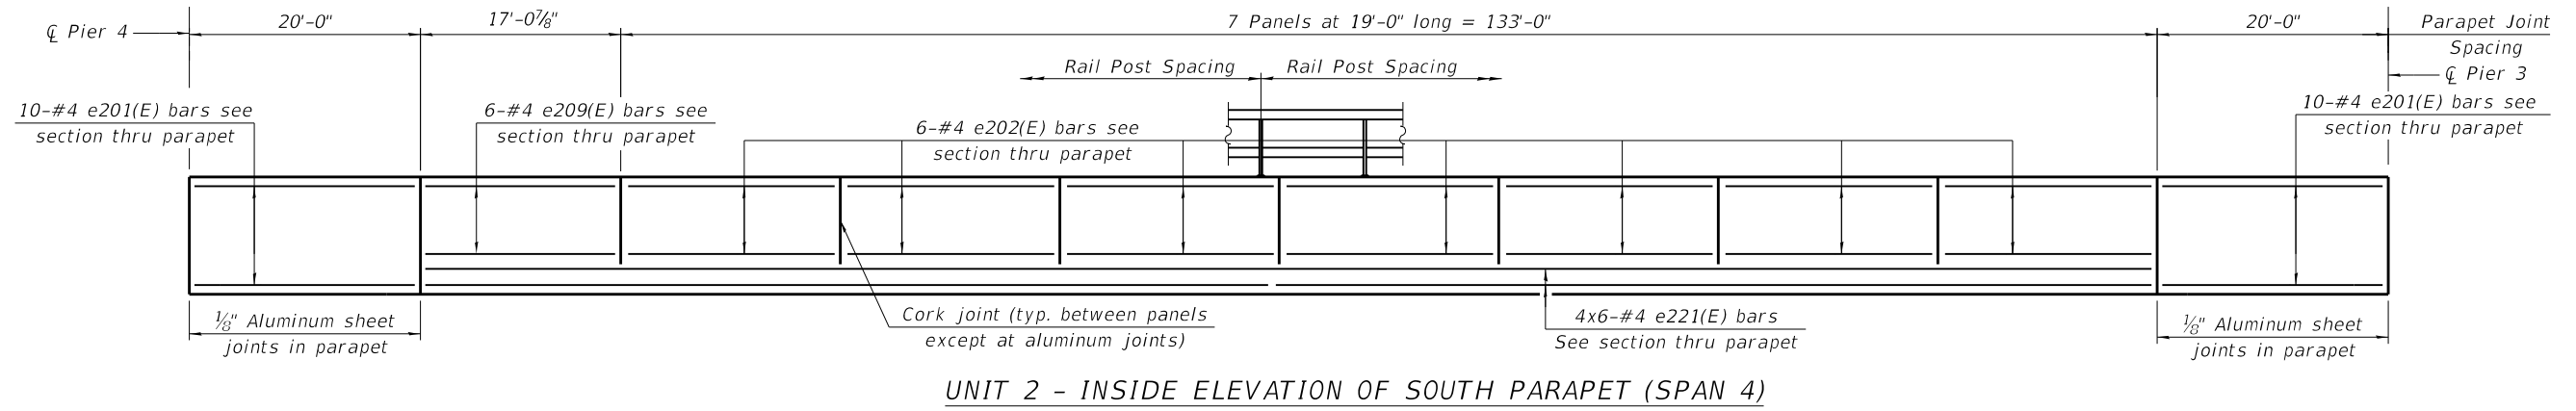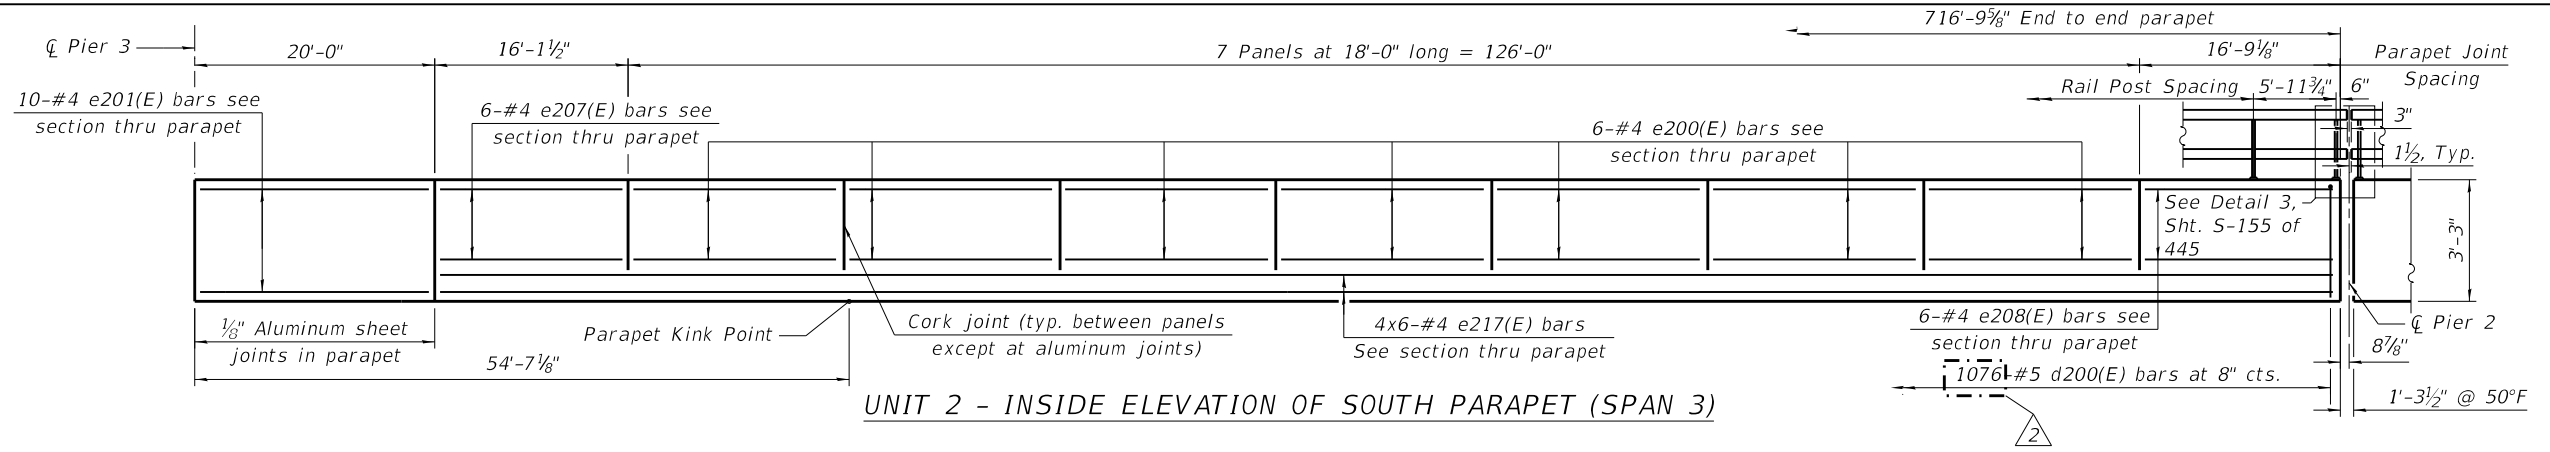

MIN. LAP LENGTH  
#4 = 2'-5"

Note:  
1. Bars indicated thus 20x3-#5 etc. indicates 20 lines of bars with 3 lengths per line.

MODEL: Default  
FILE NAME: p:\w\sp\sv\306\hanson\Projects\Documents\13\obs\13H0106\Phase-III\CAD\Struct\Sheet\0900180-XXXX-TYLI-3201-Unit 2\_South Parapet\_Elevation.dgn

**TYLIN INTERNATIONAL**  
200 S. WACKER DR.  
SUITE 1400  
CHICAGO, IL 60606  
TEL: 312-777-2900

USER NAME = CHORBACZ	DESIGNED -	REVISED -	4/16/2019 S.P.
PLOT SCALE = 16:0.0000 " = 1" / in.	CHECKED -	REVISED -	
PLOT DATE = 4/8/2019	DRAWN - CTH	REVISED -	
	CHECKED -	REVISED -	

**STATE OF ILLINOIS**  
**DEPARTMENT OF TRANSPORTATION**

**SOUTH PARAPET ELEVATION - UNIT 2**  
**STRUCTURE NO. 090-0180**

F.A.P. RTE.	SECTION	COUNTY	TOTAL SHEETS	SHEET NO.
317	(15B;(102-1),(14HB)BR)BR	PEO/TAZ	1361	1012
			CONTRACT NO. 68B46	
			ILLINOIS FED. AID PROJECT NHPP-VRP3(905)	



SHEET 5-108 OF 445 SHEETS

UNIT 2 - SUPERSTRUCTURE

BILL OF MATERIAL

Bar	No.	Size	Length	Shape
a200(E)	1555	#5	48'-5"	—
a201(E)	1006	#5	48'-2"	—
a202(E)	1548	#6	21'-6"	—
a203(E)	1548	#6	8'-4"	—
a204(E)	55	#4	22'-2"	—
a205(E)	10	#4	5'-2"	—
a206(E)	1555	#5	25'-10"	—
a207(E)	389	#5	41'-1"	—
a208(E)	411	#5	33'-1"	—
a209(E)	379	#5	29'-3"	—
a210(E)	376	#5	26'-1"	—
a211(E)	1006	#5	32'-11"	—
a212(E)	252	#5	34'-7"	—
a213(E)	266	#5	26'-7"	—
a214(E)	245	#5	22'-9"	—
a215(E)	243	#5	19'-4"	—
a216(E)	12	#5	7'-4"	—
a217(E)	224	#5	2'-0"	—
a218(E)	112	#5	1'-6"	—
a219(E)	24	#5	11'-0"	—
a220(E)	24	#5	10'-6"	—
b200(E)	2295	#5	30'-0"	—
b201(E)	327	#6	41'-5"	—
b202(E)	1976	#5	31'-0"	—
b203(E)	297	#6	33'-11"	—
b204(E)	297	#6	40'-1"	—
b205(E)	256	#5	30'-8"	—
b206(E)	30	#5	26'-11"	—
b207(E)	168	#5	30'-6"	—
b208(E)	48	#5	29'-8"	—
b209(E)	25	#5	28'-3"	—
b210(E)	352	#5	31'-11"	—
b211(E)	330	#5	30'-6"	—
b212(E)	81	#5	30'-0"	—
d200(E)	1076	#5	6'-5"	—
d201(E)	1071	#5	8'-5"	—
d202(E)	1088	#5	5'-2"	—
d203(E)	720	#5	3'-0"	—
d204(E)	720	#5	3'-9"	—
d205(E)	9	#6	4'-10"	—
d206(E)	18	#6	8'-11"	—
d207(E)	12	#5	5'-4"	—
d208(E)	168	#5	2'-2"	—
d209(E)	1071	#5	6'-5"	—

Bar	No.	Size	Length	Shape	
e200(E)	76	#4	17'-9"	—	
e201(E)	316	#4	19'-9"	—	
e202(E)	148	#4	18'-9"	—	
e203(E)	6	#4	15'-4"	—	
e204(E)	6	#4	19'-5"	—	
e205(E)	42	#4	19'-3"	—	
e206(E)	6	#4	16'-8"	—	
e207(E)	6	#4	15'-10"	—	
e208(E)	6	#4	16'-6"	—	
e209(E)	6	#4	16'-10"	—	
e210(E)	6	#4	14'-8"	—	
e211(E)	6	#4	12'-8"	—	
e212(E)	4	#4	16'-1"	—	
e213(E)	4	#4	16'-3"	—	
e214(E)	4	#4	17'-1"	—	
e215(E)	4	#4	14'-11"	—	
e216(E)	4	#4	14'-7"	—	
e217(E)	48	#4	28'-6"	—	
e218(E)	24	#4	26'-10"	—	
e219(E)	20	#4	28'-8"	—	
e220(E)	48	#4	27'-8"	—	
e221(E)	24	#4	27'-1"	—	
e222(E)	20	#4	29'-0"	—	
e250(E)	10	#4	3'-3"	—	
x200(E)	206	#5	5'-7"	—	
Reinforcement Bars, Epoxy Coated				Pound	635,470
Concrete Superstructure				Cu. Yds.	2177.8
Parapet Railing				Foot	717
Bridge Deck Grooving (Longitudinal)				Sq. Yd.	5081
Bridge Fence Railing (Special)				Foot	719.5
Diamond Grinding (Bridge Section)				Sq. Yd.	6352
Protective Coat				Sq. Yd.	8769

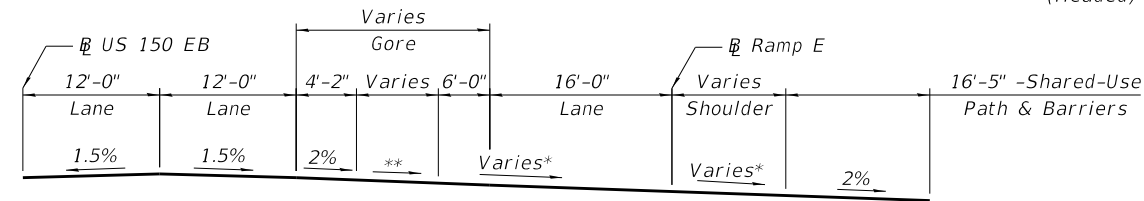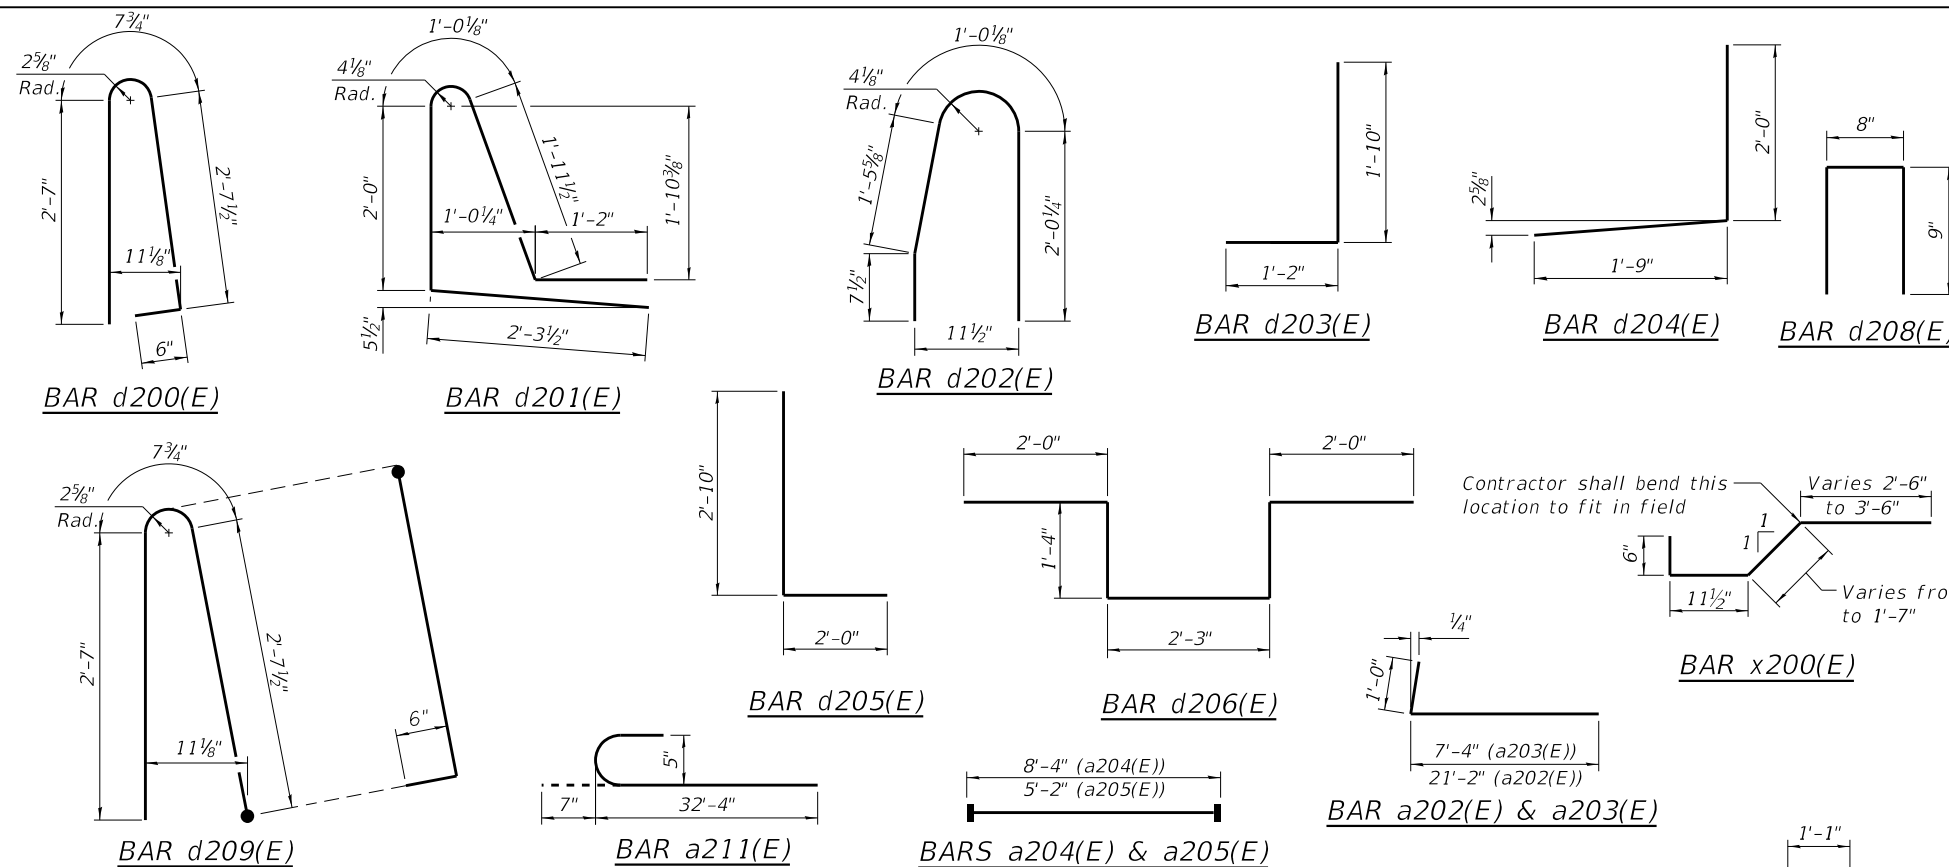


DECK CROSS SLOPE DETAIL

\* Varies 6% Sta. 1508+95.19 to 2% Sta. 1510+05.19  
 \*\* Varies, see Table A

TABLE A

Screed Point	Cross Slope %
CL E. Brg. Pier 2	2.00
CA	1.75
CB	1.96
CC	2.29
CD	2.74
CE	3.32
CF	2.98
CG	2.58
CH	2.27
CI	2.06
CJ	2.00

Note: For all points east of Screed Point CJ, gore cross slope is 2%.

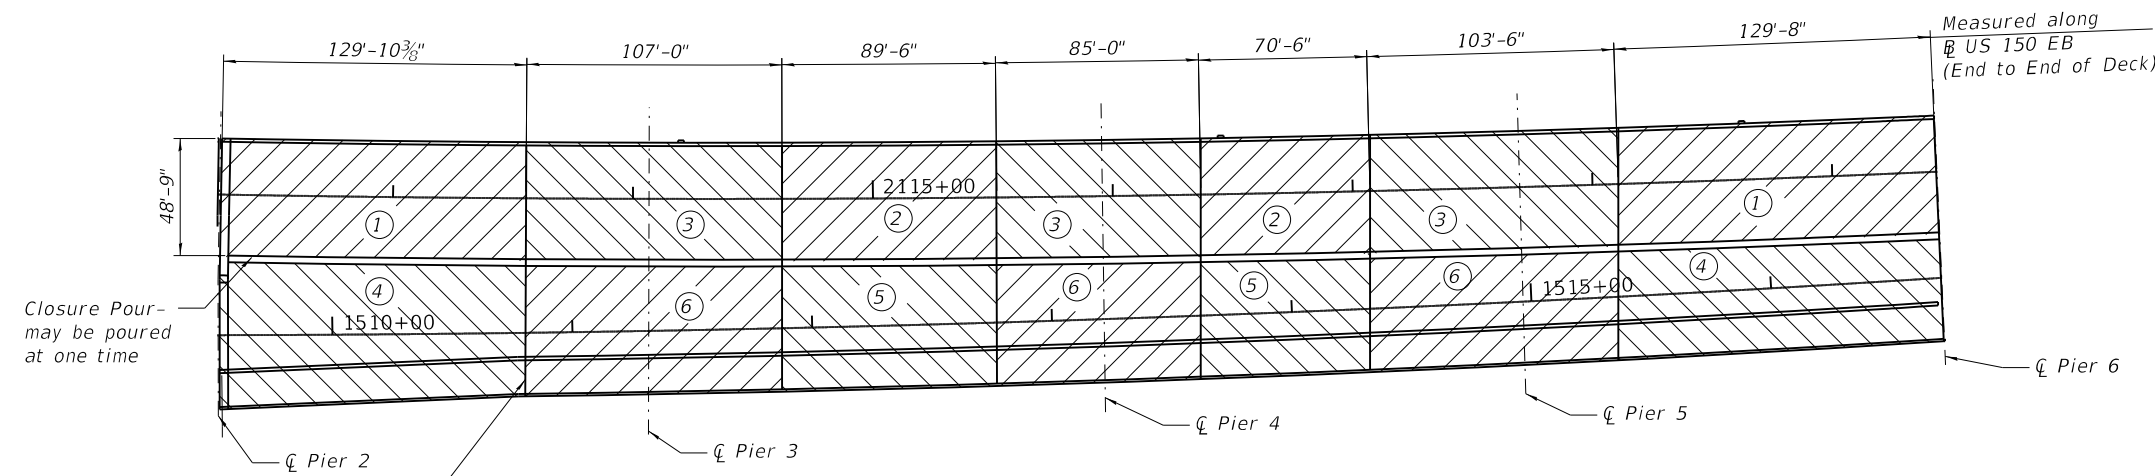

DECK POURING SEQUENCE - UNIT 2  
 (The pour can start from either end of the deck.)

Headed bars shall conform to ASTM A970 with threaded attachment; Class HA; and reinforcement bars conforming to ASTM A706. Cost included with Reinforcement Bars, Epoxy Coated.

Notes on Deck Pouring Sequence:  
 When the deck pour is stopped for the day at one or more of the transverse bonded construction joints in the deck pouring sequence as shown, the next pour shall not be made until both of the following are met:  
 1) At least 72 hours shall have elapsed from the end of the previous pour.  
 2) The concrete strength shall have attained a minimum flexural strength of 650 psi or a minimum compressive strength of 3500 psi.





The Contractor is alerted that camber and dead load deflection values shown on the girder detail drawings were developed based on the deck pouring sequence shown. Any deviation from this pouring sequence will result in changes to camber and elevations that affect dead load deflections. If the Contractor wishes to change the sequence, then the proposed plan revisions and design calculations shall be submitted to the Engineer for review and approval. The calculations shall be prepared and sealed by a Licensed Structural Engineer in Illinois.

MODEL: Default  
 FILE NAME: p:\v\sp\sv\306\hanson\dom\hanson\Projects\Documents\13\obs\13\H0106\Phase-III\CAD\Struct\Sheet\0900180-XXXX-TYLI-3205-Unit2\_Super\_Details\_3.dgn  
 4/8/2019 11:25:00 AM


UNIT 3 - SUPERSTRUCTURE

BILL OF MATERIAL

Bar	No.	Size	Length	Shape
a300(E)	4071	#5	33'-8"	—
a301(E)	3396	#5	26'-2"	—
a302(E)	1357	#6	22'-2"	—
a303(E)	1357	#6	8'-4"	—
a304(E)	288	#5	1'-6"	—
a305(E)	40	#5	12'-7"	—
a306(E)	40	#5	11'-6"	—
b300(E)	1960	#5	31'-9"	—
b301(E)	1558	#6	41'-4"	—
b302(E)	1634	#5	33'-3"	—
d300(E)	849	#5	6'-5"	⌋
d301(E)	853	#5	8'-2"	⌋
d302(E)	849	#5	5'-2"	⌋
d303(E)	569	#5	3'-0"	⌋
d304(E)	569	#5	4'-2"	⌋
d305(E)	6	#6	4'-10"	⌋
d306(E)	12	#6	8'-11"	⌋
d307(E)	116	#5	2'-2"	⌋
d308(E)	853	#5	6'-5"	⌋
e300(E)	20	#4	14'-6"	—
e301(E)	448	#4	19'-8"	—
e302(E)	16	#4	18'-5"	—
e303(E)	6	#4	12'-9"	—
e304(E)	6	#4	13'-1"	—
e305(E)	152	#4	27'-10"	—
x300(E)	92	#5	5'-7"	⌋
x301(E)	81	#5	5'-4"	⌋
Reinforcement Bars, Epoxy Coated	Pound		493,620	
Concrete Superstructure	Cu. Yds.		1524.2	
Parapet Railing	Foot		565	
Bridge Deck Grooving (Longitudinal)	Sq. Yd.		3194	
Bridge Fence Railing (Special)	Foot		568.5	
Diamond Grinding (Bridge Section)	Sq. Yd.		4204	
Protective Coat	Sq. Yd.		6140	

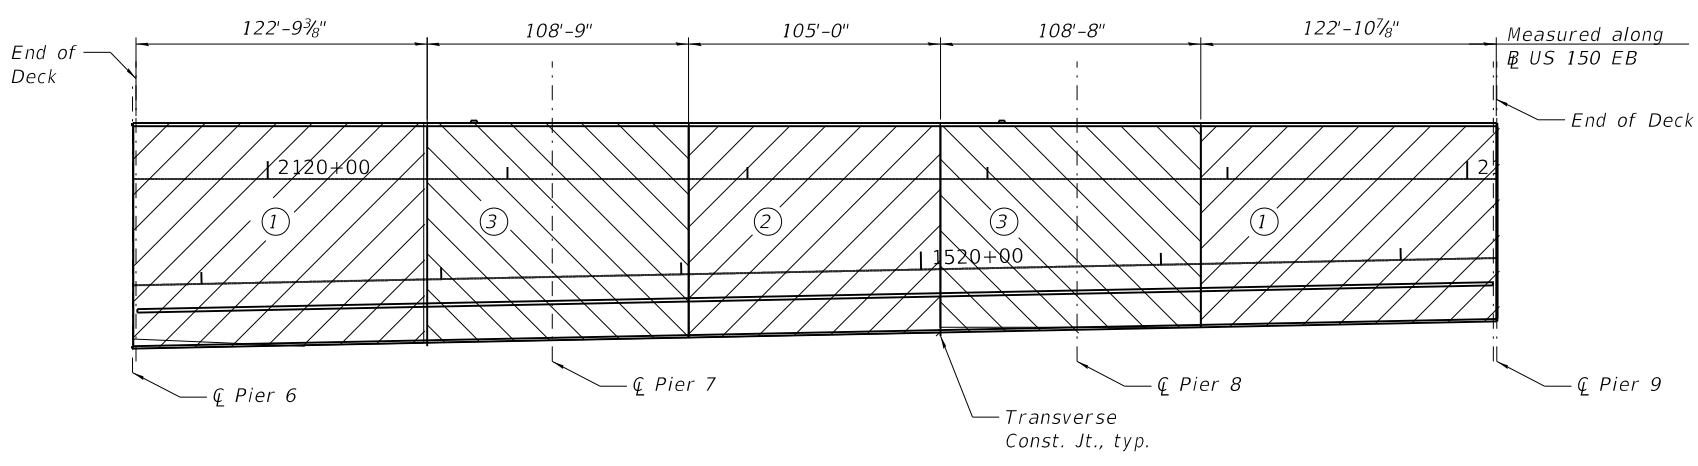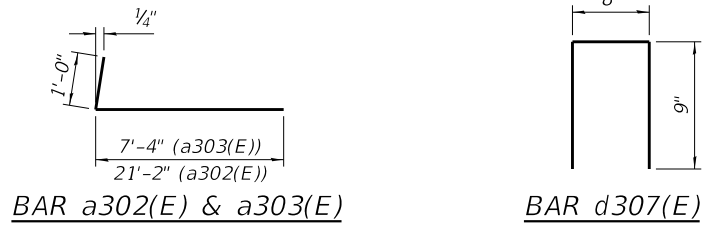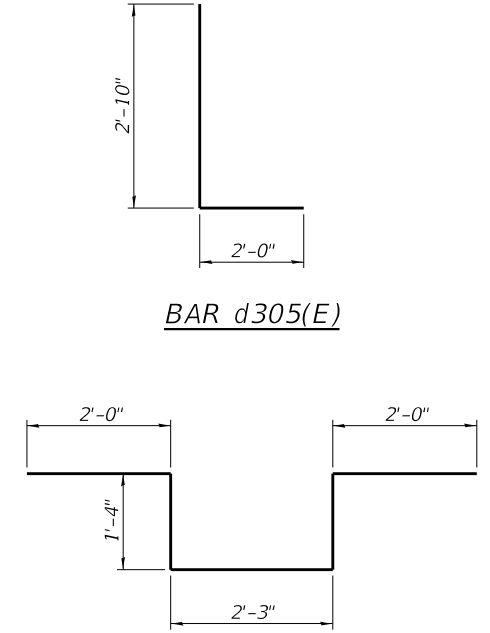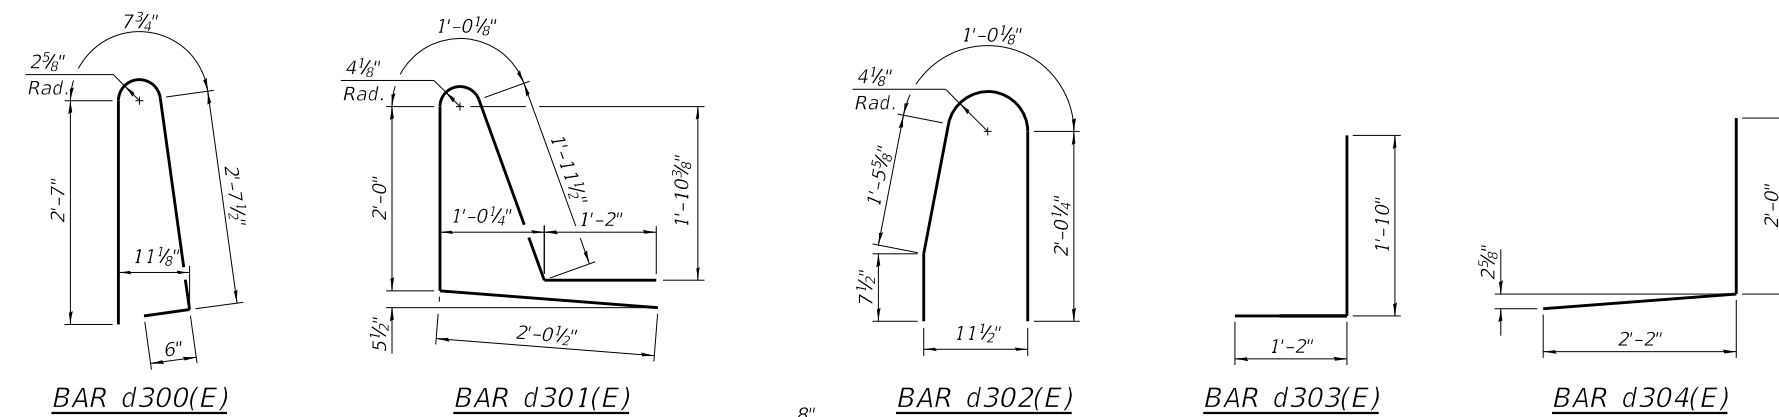


DECK POURING SEQUENCE - UNIT 3  
(The pour can start from either end of the deck.)

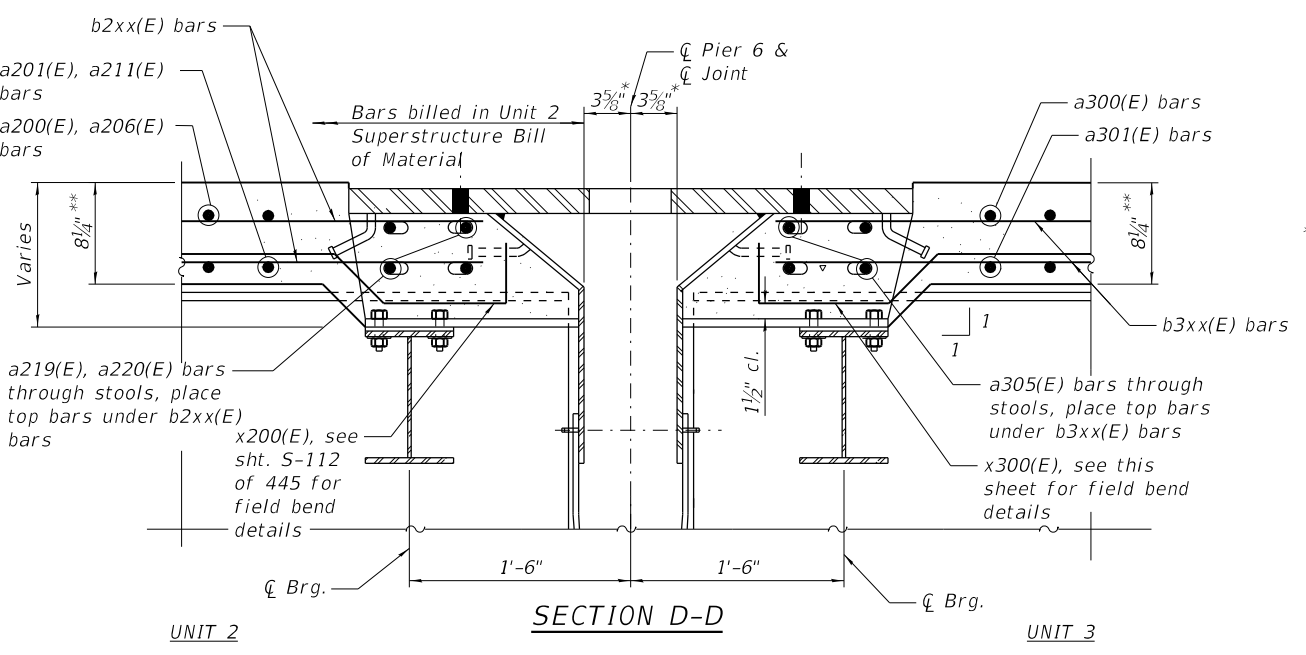


SECTION D-D


\* At 50° F  
\*\* Prior to grinding

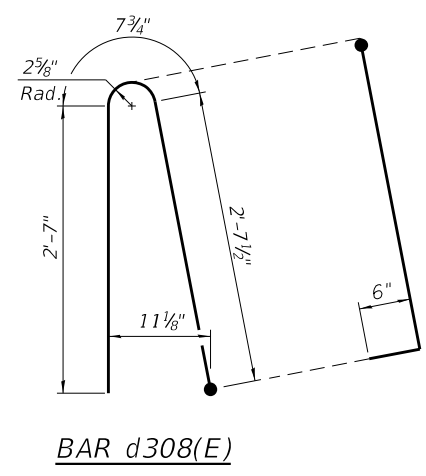

BAR d308(E)

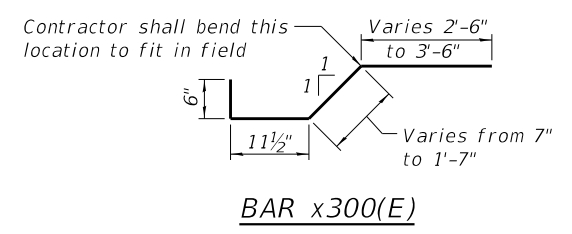

BAR x300(E)

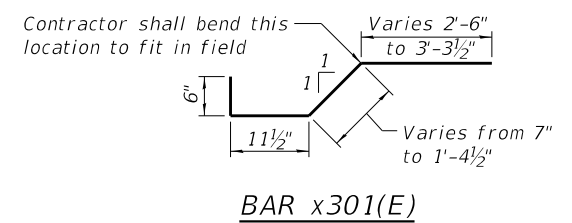

BAR x301(E)

Notes on Deck Pouring Sequence:

- When the deck pour is stopped for the day at one or more of the transverse bonded construction joints in the deck pouring sequence as shown, the next pour shall not be made until both of the following are met:
- 1) At least 72 hours shall have elapsed from the end of the previous pour.
  - 2) The concrete strength shall have attained a minimum flexural strength of 650 psi or a minimum compressive strength of 3500 psi.

The Contractor is alerted that camber and dead load deflection values shown on the girder detail drawings were developed based on the deck pouring sequence shown. Any deviation from this pouring sequence will result in changes to camber and elevations that affect dead load deflections. If the Contractor wishes to change the sequence, then the proposed plan revisions and design calculations shall be submitted to the Engineer for review and approval. The calculations shall be prepared and sealed by a Licensed Structural Engineer in Illinois.


MODEL: Default  
FILE NAME: p:\v\sp\sv\306\hanson\dom\hanson\Projects\Documents\13\Jobs\13\H0106\Phase-III\CAD\Struct\Sheet\0900180-XXXXX-TYLL-3304-Unit 3 Super Details 2.dgn  
4/5/2019 5:27:25 PM




UNIT 4 - SUPERSTRUCTURE

BILL OF MATERIAL


Bar	No.	Size	Length	Shape	
a400(E)	2458	#5	43'-0"	—	
a401(E)	2388	#5	29'-10"	—	
a402(E)	1229	#6	22'-2"	—	
a403(E)	1229	#6	8'-4"	—	
a404(E)	96	#5	2'-0"	—	
a405(E)	48	#5	1'-6"	—	
a406(E)	40	#5	11'-6"	—	
a407(E)	36	#5	11'-4"	—	
b400(E)	1978	#5	28'-0"	—	
b401(E)	1468.1	#6	42'-0"	—	
b402(E)	1716	#5	29'-2"	—	
d400(E)	846	#5	6'-5"	—	
d401(E)	850	#5	8'-4"	—	
d402(E)	846	#5	4'-10"	—	
d403(E)	567	#5	3'-0"	—	
d404(E)	567	#5	4'-3"	—	
d405(E)	9	#6	4'-10"	—	
d406(E)	18	#6	8'-11"	—	
d407(E)	118	#5	2'-2"	—	
d408(E)	850	#5	6'-5"	—	
e400(E)	701	#4	14'-6"	—	
e401(E)	336	#4	19'-8"	—	
e402(E)	16	#4	18'-5"	—	
e403(E)	112	#4	19'-3"	—	
e404(E)	10	#4	16'-0"	—	
e405(E)	6	#4	13'-1"	—	
e406(E)	6	#4	14'-1"	—	
e407(E)	152	#4	27'-10"	—	
x400(E)	81	#5	5'-4"	—	
x401(E)	72	#5	5'-2"	—	
Reinforcement Bars, Epoxy Coated				Pound	419,420
Concrete Superstructure				Cu. Yds.	1358.2
Parapet Railing				Foot	564
Bridge Deck Grooving (Longitudinal)				Sq. Yd.	2548
Bridge Fence Railing (Special)				Foot	567.5
Diamond Grinding (Bridge Section)				Sq. Yd.	3556
Protective Coat				Sq. Yd.	5489

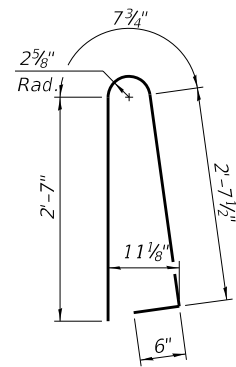


BAR d400(E)

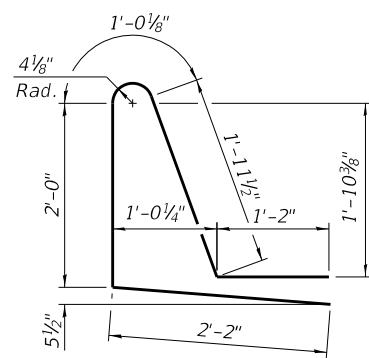


BAR d401(E)

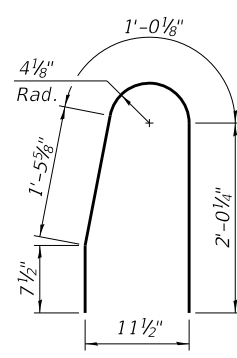

BAR d402(E)

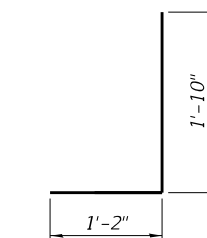


BAR d403(E)

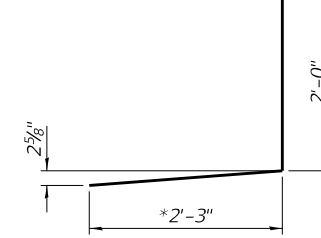


BAR d404(E)


\* Cut To Fit

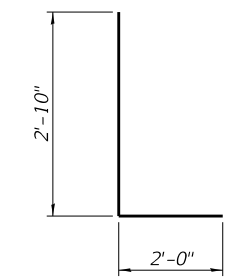


BAR d405(E)

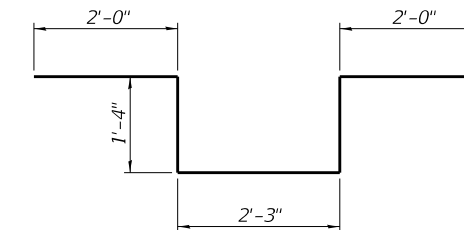


BAR d406(E)

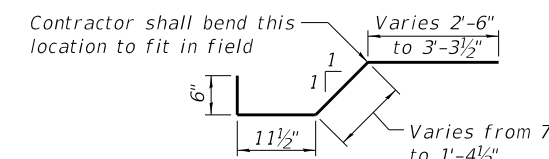

BAR x400(E)

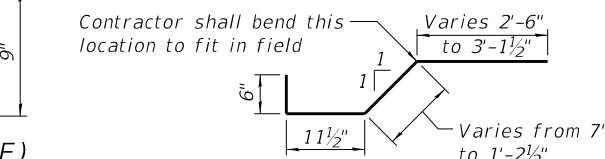


BAR x401(E)

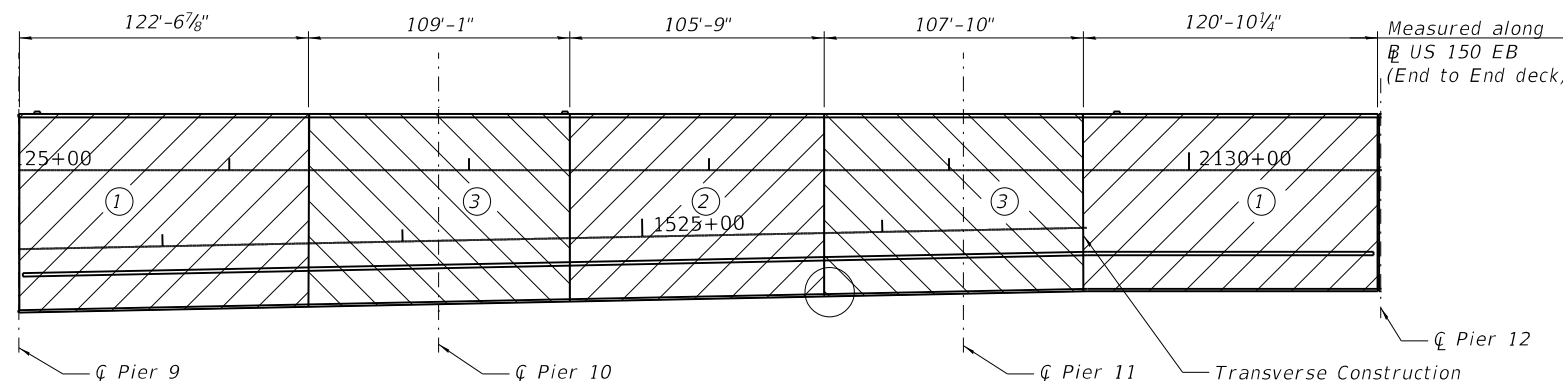


DECK POURING SEQUENCE - UNIT 4


(The pour can start from either end of the deck.)

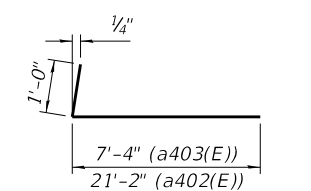

BAR a402(E) & a403(E)

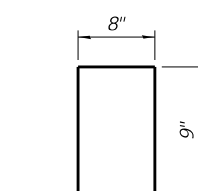

BAR d407(E)

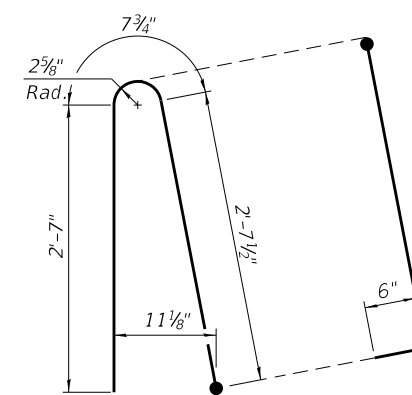


BAR d408(E)

Notes on Deck Pouring Sequence:

- When the deck pour is stopped for the day at one or more of the transverse bonded construction joints in the deck pouring sequence as shown, the next pour shall not be made until both of the following are met:
- 1) At least 72 hours shall have elapsed from the end of the previous pour.
  - 2) The concrete strength shall have attained a minimum flexural strength of 650 psi or a minimum compressive strength of 3500 psi.

The Contractor is alerted that camber and dead load deflection values shown on the girder detail drawings were developed based on the deck pouring sequence shown. Any deviation from this pouring sequence will result in changes to camber and elevations that affect dead load deflections. If the Contractor wishes to change the sequence, then the proposed plan revisions and design calculations shall be submitted to the Engineer for review and approval. The calculations shall be prepared and sealed by a Licensed Structural Engineer in Illinois.

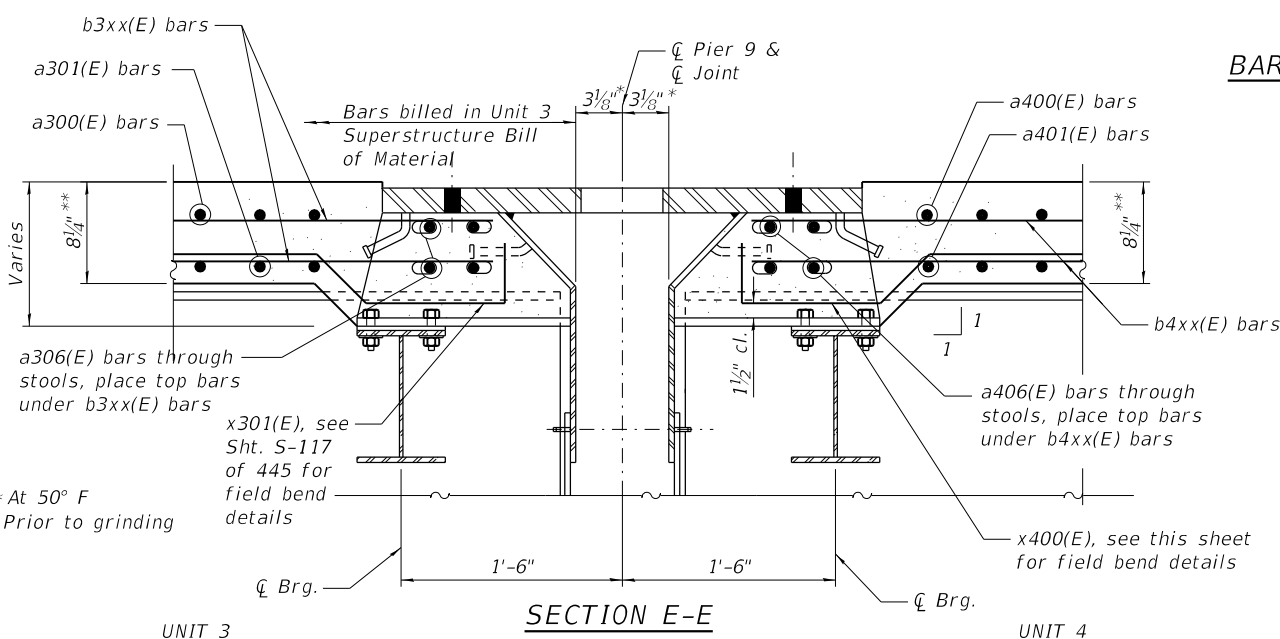

UNIT 3

SECTION E-E

UNIT 4

MODEL: Default  
FILE NAME: p:\v\sp\sv\306\hanson\_projects\Documents\13\jobs\13\H0106\Phase-III\CAD\Struct\Sheet\0900180-XXXX-TYLI-3404-Unit 4 Super Details 2.dgn  
4/4/2019 10:23:37 PM

TYLIN INTERNATIONAL  
200 S. WACKER DR.  
SUITE 1400  
CHICAGO, IL 60606  
TEL: 312-777-2900

USER NAME = spantazis  
DESIGNED - CTH  
CHECKED - RH  
PLOT SCALE = 5/4" = 1" / in.  
PLOT DATE = 4/4/2019

DESIGNED - CTH  
CHECKED - RH  
DRAWN -  
CHECKED -


REVISED - 2/4/16/2019 S.P.  
REVISED -  
REVISED -  
REVISED -

STATE OF ILLINOIS  
DEPARTMENT OF TRANSPORTATION

SUPERSTRUCTURE DETAILS - UNIT 4, 2 OF 2  
STRUCTURE NO. 090-0180

SHEET 5-122 OF 445 SHEETS


F.A.P. RTE.	SECTION	COUNTY	TOTAL SHEETS	SHEET NO.
317	(15B;(102-1),(14HB)BR)BR	PEO/TAZ	1361	1026
CONTRACT NO. 68B46				
ILLINOIS		FED. AID PROJECT	NHPP-YRP3(905)	

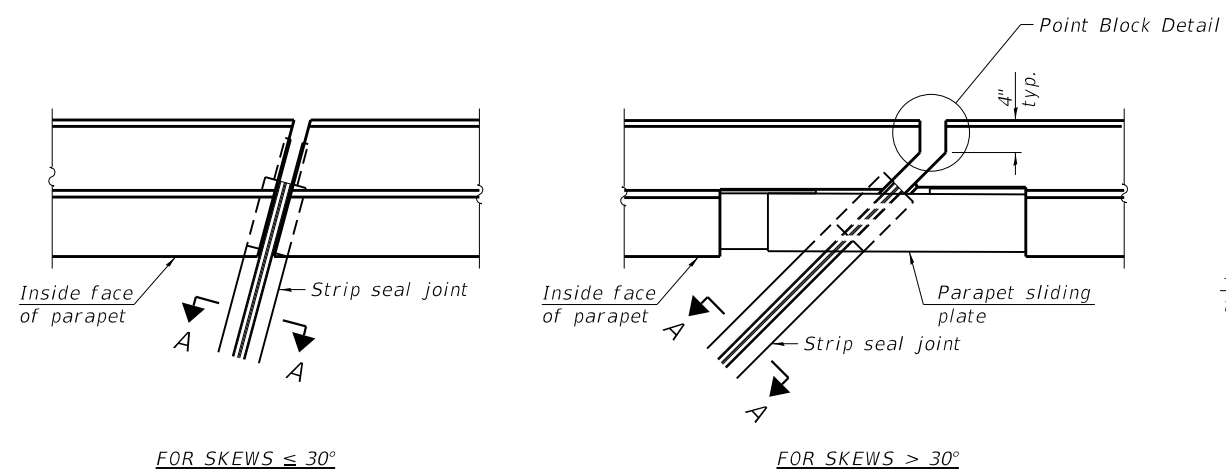

FOR SKEWS  $\leq 30^\circ$


FOR SKEWS  $> 30^\circ$

PLAN AT PARAPET

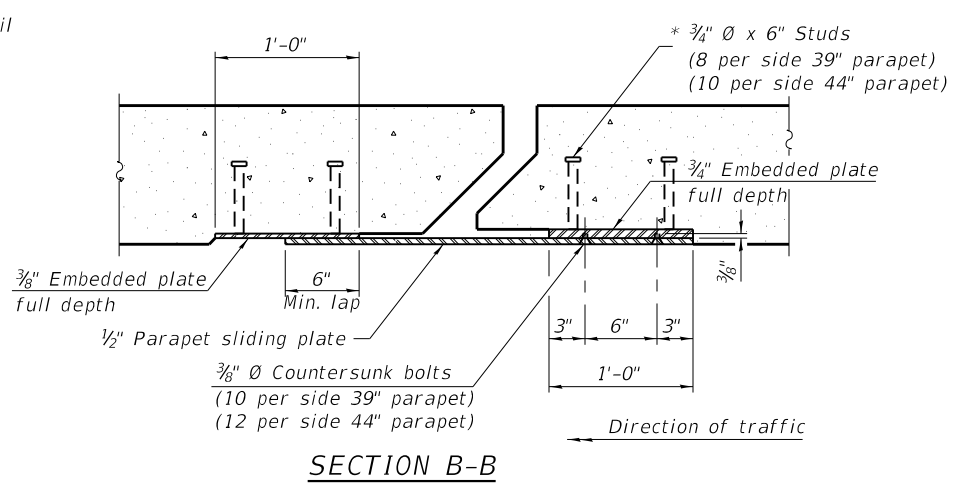


SECTION B-B

**Notes:**  
 The strip seal shall be made continuous and shall have a minimum thickness of 1/4". The configuration of the strip seal shall match the configuration of the locking edge rails. Open or "webbed" strip seal gland configurations are not permitted. The gland shall be sized for a maximum rated movement of 4 inches.  
 The locking edge rails depicted are configured for typical applications and are conceptual only. The actual configuration of the locking edge rails and matching strip seal may vary from manufacturer to manufacturer provided they fit the application and meet the minimum anchorage shown. Flanged edge rails, however, will not be allowed. Locking edge rails may exceed the 4 1/2" maximum depth provided the anchorage system is revised according to the manufacturer's recommendation.  
 The manufacturer's recommended installation methods shall be followed.  
 All steel components shall be galvanized after fabrication according to Article 520.03 of the Standard Specifications.  
 The Maximum space between locking edge rail segments shall be 3/16" and sealed with a suitable sealant; however, any rail joint within 10' measured perpendicular to the face of the curb or parapet shall be welded as shown in the locking edge rail splice detail.  
 The top surface of sidewalk sliding plates shall have a raised pattern according to ASTM A786.  
 Cost of parapet sliding plates, sidewalk sliding plates, embedded plates, anchorage studs, and expansion anchors included with Preformed Joint Strip Seal.  
 39" constant slope barrier shown, 44" constant slope barrier similar as noted.  
 The concrete opening below the strip seal will vary based on the locking edge rail chosen by the Contractor. Deck and parapet lengths shown elsewhere in the plans are dimensioned to the concrete opening, not the joint opening, and are based on the rolled locking edge rail. If the Contractor elects to use a different locking edge rail, dimensional adjustments may be required. One exception to this would be the strip seal joint at the end of the precast bridge approach slab. For these cases the pavement connector length shall be adjusted, not the length of the bridge approach slab.  
 Apply anti-seize compound to all countersunk bolts and anchors in sidewalk sliding plate and parapet embedded plate.

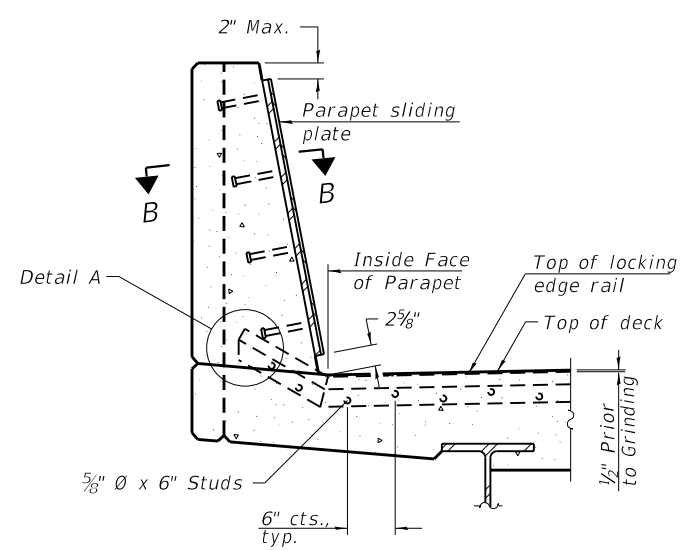


SECTION AT PARAPET


(Skews  $> 30^\circ$  shown. Skews  $\leq 30^\circ$  similar except as shown in plan view.)

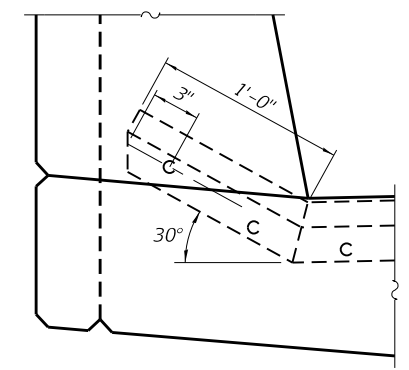

DETAIL A

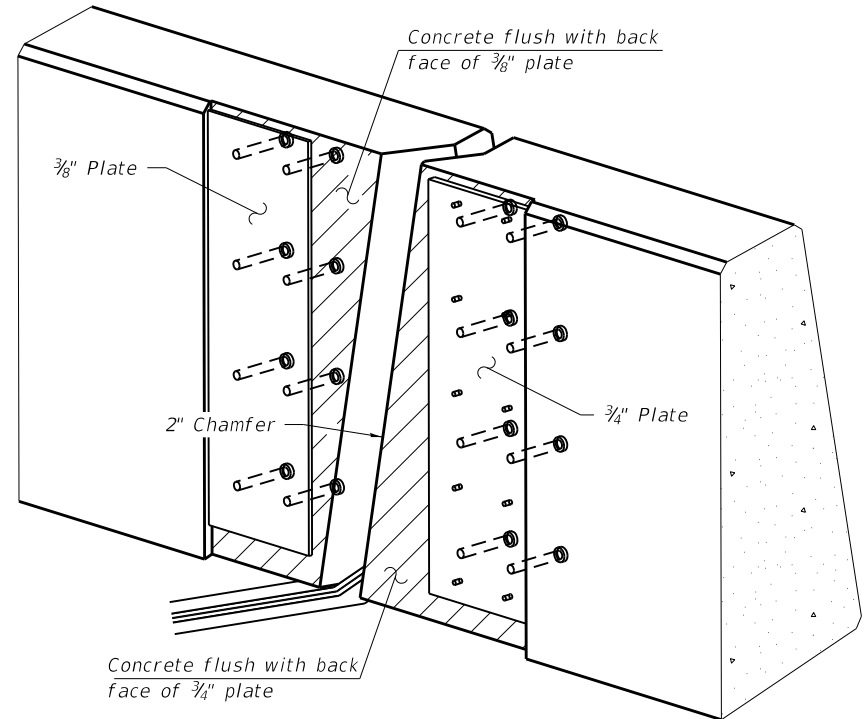

TRIMETRIC VIEW

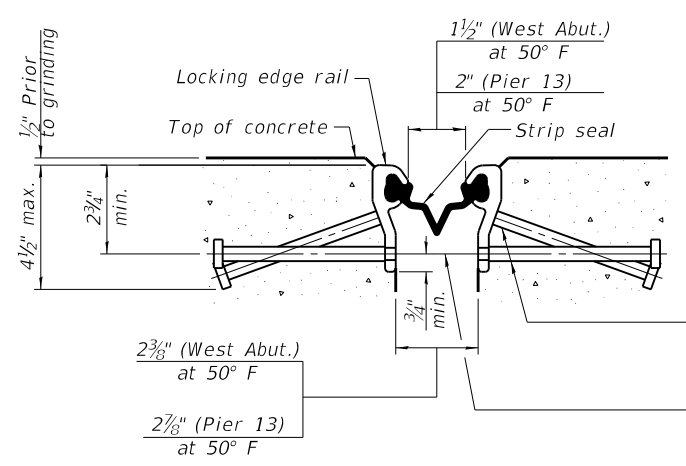


SHOWING ROLLED RAIL JOINT

\* 5/8"  $\phi$  x 6" studs @ 6" cts. (alternate angled/bent studs with horizontal studs)  
 3/8"  $\phi$  threaded rods in 7/16"  $\phi$  holes at  $\pm 4$ -0" cts. for holding the proper joint opening based on the temperature during the deck pour. Place to miss studs. All rods shall be burned, or sawed off flush with the plates after concrete is set.


SECTION A-A

\* Granular or solid flux filled headed studs conforming to Article 1006.32 of the Std. Specs., automatically end welded.


Entire Sheet Revised

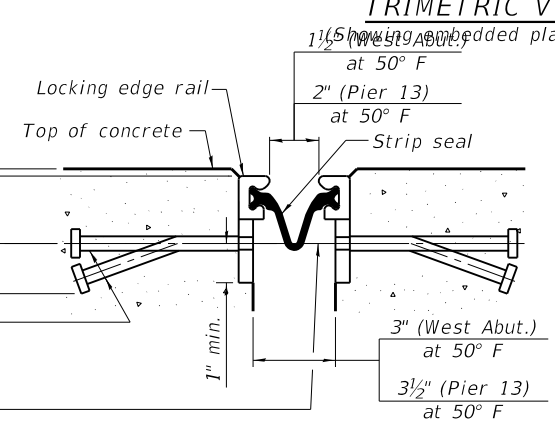

SHOWING WELDED RAIL JOINT

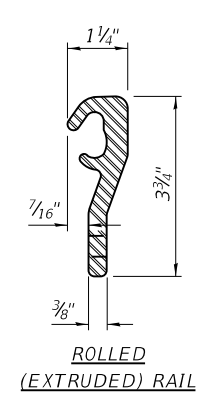


ROLLED (EXTRUDED) RAIL

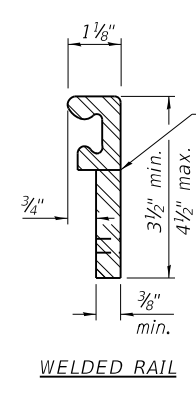

WELDED RAIL

LOCKING EDGE RAILS

\*\* Back gouge not required if complete joint penetration is verified by mock-up.

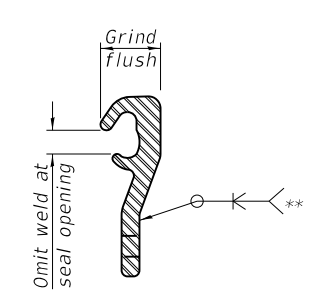

LOCKING EDGE RAIL SPLICE

The inside of the locking edge rail groove shall be free of weld residue. Rolled rail shown, welded rail similar.

BILL OF MATERIAL

Item	Unit	Total
Preformed Joint Strip Seal	Foot	133.5

60' at West Abutment  
 73.5' at Pier 13

MODEL: Default  
 FILE NAME: p:\v\sp\sv\306\hanson\_projects\documents\13\obs\13\H0106\Phase-III\CAD\Struct\Sheet\0900180-XXXX-TYL-4900-StripSeal\joint\_1.dgn  
 4/4/2019 5:09:09 PM

**TYLIN INTERNATIONAL**  
 200 S. WACKER DR.  
 SUITE 1400  
 CHICAGO, IL 60606  
 TEL: 312-777-2900

USER NAME = spantazis  
 DESIGNED - SP  
 CHECKED -  
 PLOT SCALE = 0:2.0000 " = 1"  
 PLOT DATE = 4/4/2019

DESIGNED - SP  
 CHECKED -  
 DRAWN -  
 CHECKED -


REVISED - 4/16/2019 S.P.  
 REVISED -  
 REVISED -  
 REVISED -

**STATE OF ILLINOIS**  
**DEPARTMENT OF TRANSPORTATION**

MODIFIED PREFORMED JOINT STRIP SEAL, 1 OF 2  
 STRUCTURE NO. 090-0180


SHEET 5-190 OF 445 SHEETS

F.A.P. RTE.	SECTION	COUNTY	TOTAL SHEETS	SHEET NO.
317	(15B;(102-1),(14HB)BR)BR	PEO/TAZ	1361	1096
CONTRACT NO. 68B46				
ILLINOIS		FED. AID PROJECT	NHPP-YRP3(905)	

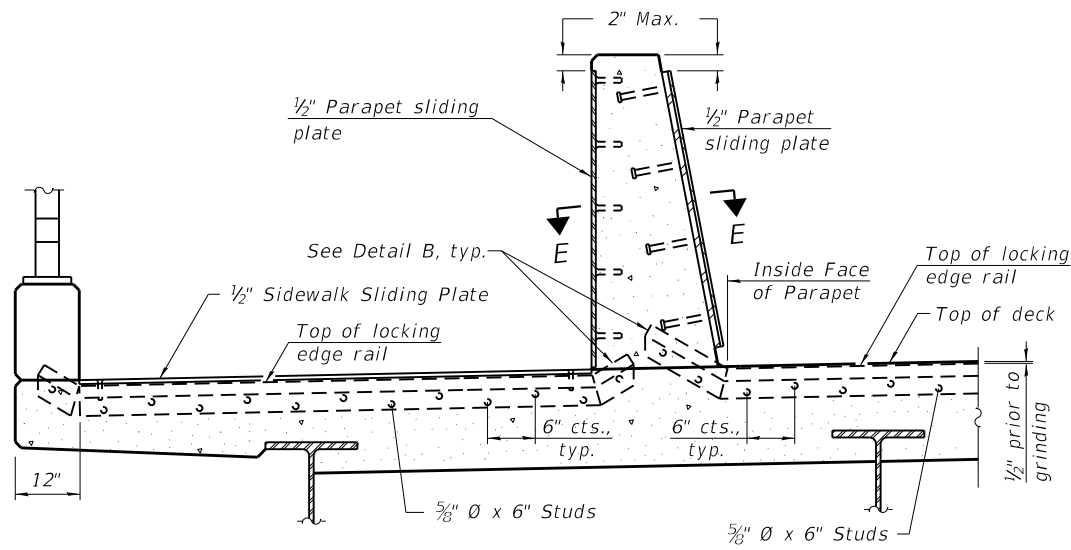


**ELEVATION AT DECK LEVEL SIDEWALK**


(Skews > 30° shown. Skews ≤ 30° similar except as shown in plan view.)

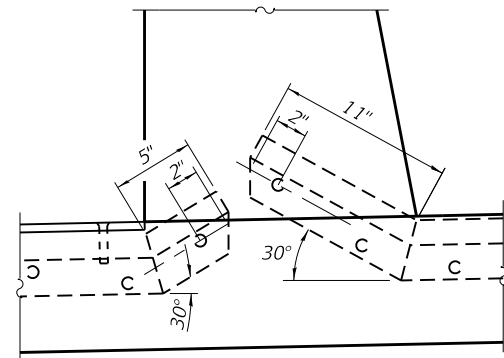

**DETAIL B**

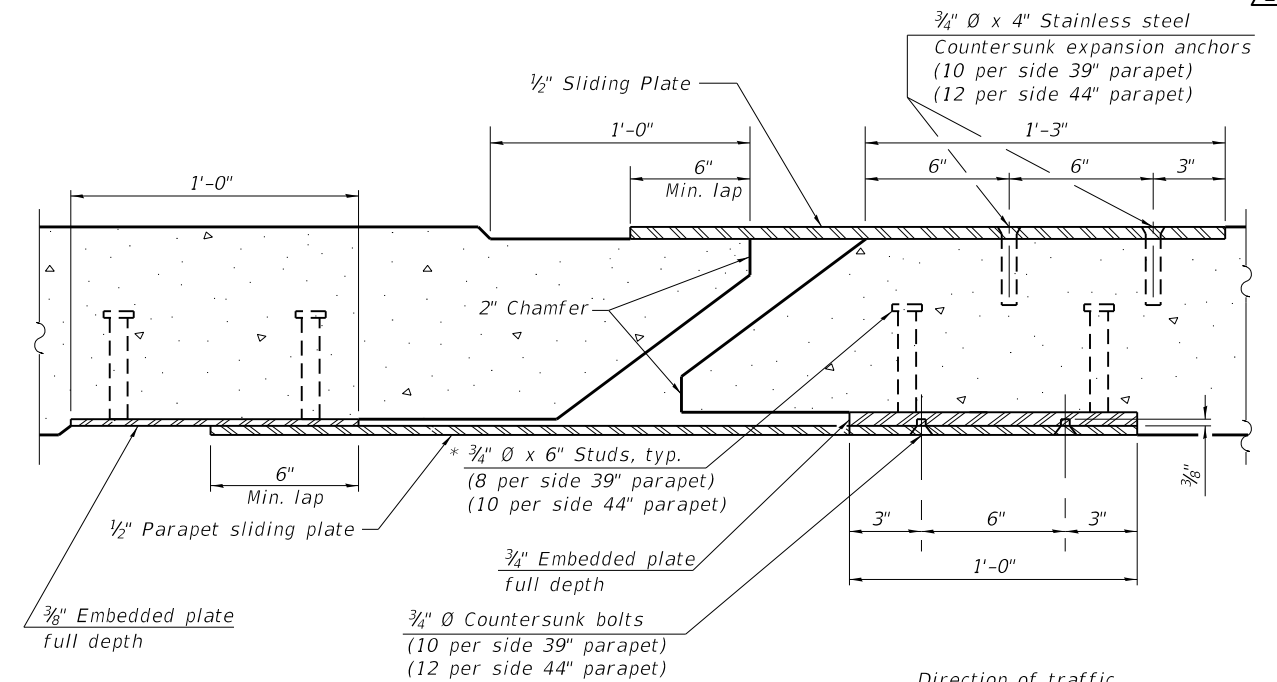


**SECTION E-E**

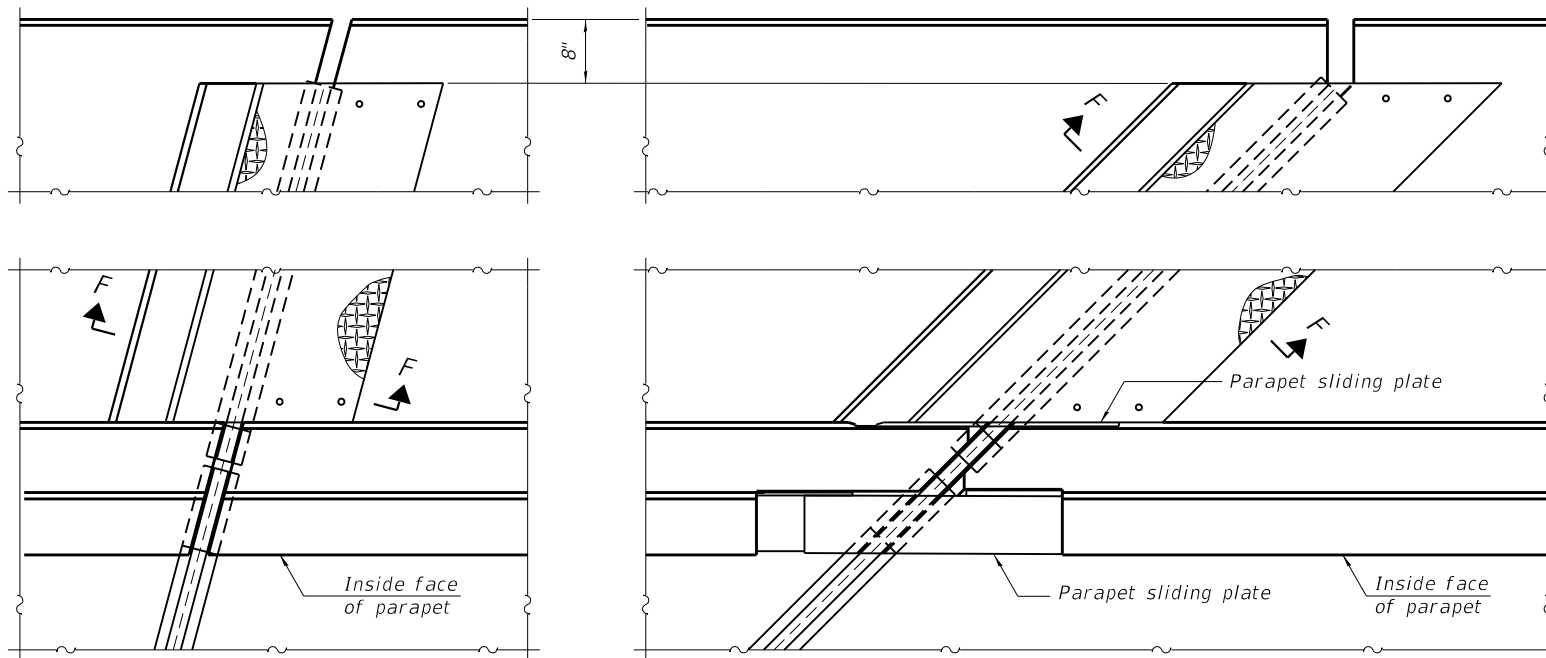

(FOR SKEWS ≤ 30°)

(FOR SKEWS > 30°)

**PLAN AT DECK LEVEL SIDEWALK**

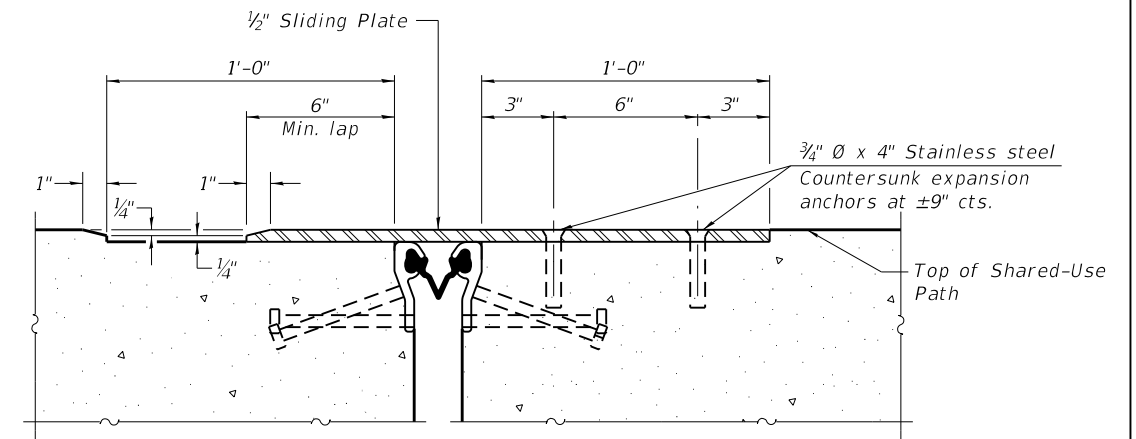

**SECTION F-F**

△ Entire Sheet Revised

MODEL: Default  
 FILE NAME: p:\v\sp\sv\306\hanson\Projects\Documents\13\jobs\13\H0106\Phase-III\CAD\Struct\Sheet\0900180-XXXX-TYL-4901-StripSeal\joint 2.dgn

**TYLIN INTERNATIONAL**  
 200 S. WACKER DR.  
 SUITE 1400  
 CHICAGO, IL 60606  
 TEL: 312-777-2900

USER NAME = spantazis  
 DESIGNED - SP  
 CHECKED -  
 PLOT SCALE = 0:2.0000 " = 1" / in.  
 DRAWN -  
 PLOT DATE = 4/4/2019  
 CHECKED -

REVISIONS  
 1 4/16/2019 S.P.  
 2 4/16/2019 S.P.  
 3 4/16/2019 S.P.  
 4 4/16/2019 S.P.

**STATE OF ILLINOIS  
 DEPARTMENT OF TRANSPORTATION**

MODIFIED PREFORMED JOINT STRIP SEAL, 2 OF 2  
 STRUCTURE NO. 090-0180

SHEET 5-191 OF 445 SHEETS

F.A.P. RTE.	SECTION	COUNTY	TOTAL SHEETS	SHEET NO.
317	[15B;(102-1),(14HB)]BR/BR	PEO/TAZ	1361	1097
CONTRACT NO. 68B46				
ILLINOIS		FED. AID PROJECT NHPP-YRP3(905)		

**PIER 1  
BILL OF MATERIAL**

Bar	No.	Size	Length	Shape
h100(E)	8	#7	58'-8"	—
h101(E)	7	#5	43'-5"	—
h102(E)	28	#7	30'-6"	—
h103(E)	58	#5	16'-6"	—
h104(E)	24	#5	24'-0"	—
n100(E)	63	#11	16'-10"	U
n101(E)	63	#11	17'-10"	U
p100(E)	24	#10	58'-8"	—
p101(E)	20	#7	33'-9"	—
s100(E)	44	#6	26'-0"	□
s101(E)	4	#6	25'-4"	□
s102(E)	4	#6	24'-9"	□
s103(E)	4	#6	24'-1"	□
s104(E)	4	#6	23'-6"	□
s105(E)	4	#6	22'-10"	□
s106(E)	4	#6	22'-3"	□
s107(E)	4	#6	21'-7"	□
s108(E)	4	#6	21'-0"	□
s109(E)	4	#6	20'-0"	□
s110(E)	4	#6	19'-1"	□
s111(E)	4	#6	18'-2"	□
s112(E)	4	#6	17'-2"	□
s113(E)	4	#6	16'-3"	□
s114(E)	4	#6	15'-4"	□
s115(E)	44	#5	10'-6"	□
s116(E)	474	#5	6'-0"	U
s117(E)	216	#5	5'-6"	U
t100(E)	41	#7	17'-8"	—
t101(E)	60	#9	17'-8"	—
u100(E)	58	#5	15'-4"	U
u101(E)	24	#5	17'-0"	U
v100(E)	63	#11	17'-4"	U
v101(E)	63	#11	16'-4"	U
w100(E)	19	#7	40'-0"	—
w101(E)	28	#9	40'-0"	—
Structure Excavation		Cu. Yd.	253	
Concrete Structures		Cu. Yd.	378.0	
Reinforcement Bars, Epoxy Coated		Pound	54,890	
Furnishing Steel Piles HP 14x89		Foot	2275	
Driving Piles		Foot	2275	
Test Pile, HP14x89		Each	1	



\*The bar length is to the center of the mechanical splicer. The Contractor shall adjust the length as required for the selected mechanical splicer.

**PILE DATA**  
 Type: HP 14x89  
 Nominal Required Bearing: 705 kips  
 Factored Resistance Available: 388 kips  
 Est. Length: 65'  
 No. Production Piles: 35  
 No. Test Piles: 1


**A DIMENSION**

Bar	A
s100(E)	8'-8"
s101(E)	8'-4 $\frac{1}{8}$ "
s102(E)	8'-0 $\frac{3}{8}$ "
s103(E)	7'-8 $\frac{1}{2}$ "
s104(E)	7'-4 $\frac{3}{4}$ "
s105(E)	7'-1"
s106(E)	6'-9 $\frac{1}{4}$ "
s107(E)	6'-5 $\frac{1}{2}$ "
s108(E)	6'-1 $\frac{3}{4}$ "
s109(E)	5'-8"
s110(E)	5'-2 $\frac{3}{8}$ "
s111(E)	4'-8 $\frac{3}{4}$ "
s112(E)	4'-3"
s113(E)	3'-9 $\frac{3}{8}$ "
s114(E)	3'-3 $\frac{3}{4}$ "


Note: Overall bar length in Bill of Material rounded where necessary

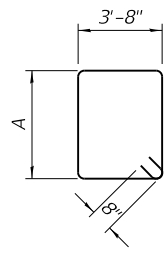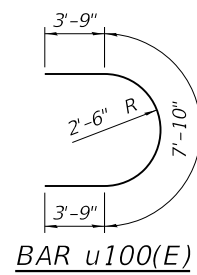


**BARS s100(E) - s114(E)**

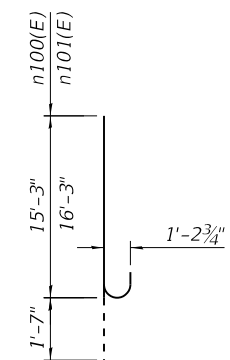


**BAR n100(E) & n101(E)**

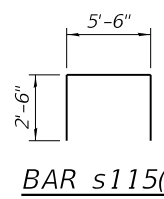


**BAR s115(E)**

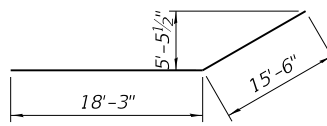


**BAR p101(E)**

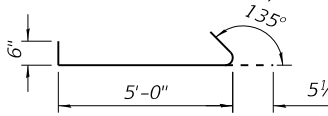


**BAR s116(E)**

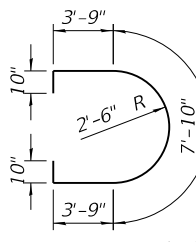


**BAR u101(E)**

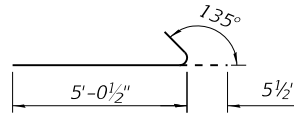

**BAR s117(E)**

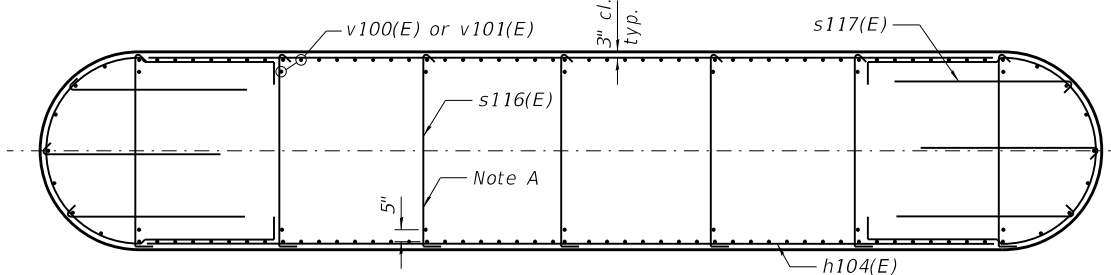


**SECTION B-B**

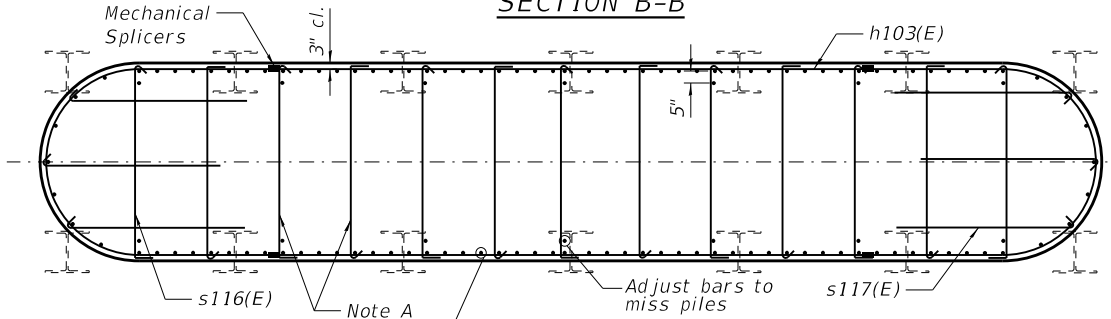


**SECTION C-C**

Note A:  
Alternate the position of 135° & 180° hooks at each vertical layer of ties.

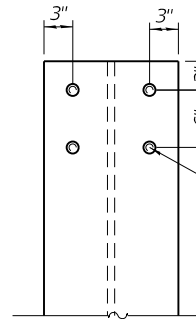


**END OF PILE DETAIL**

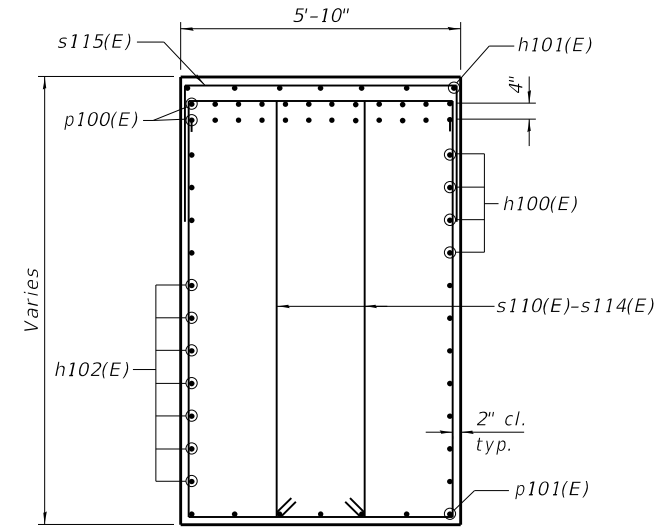

**SECTION A-A**



Piles Denoted such - see "End of pile Detail"

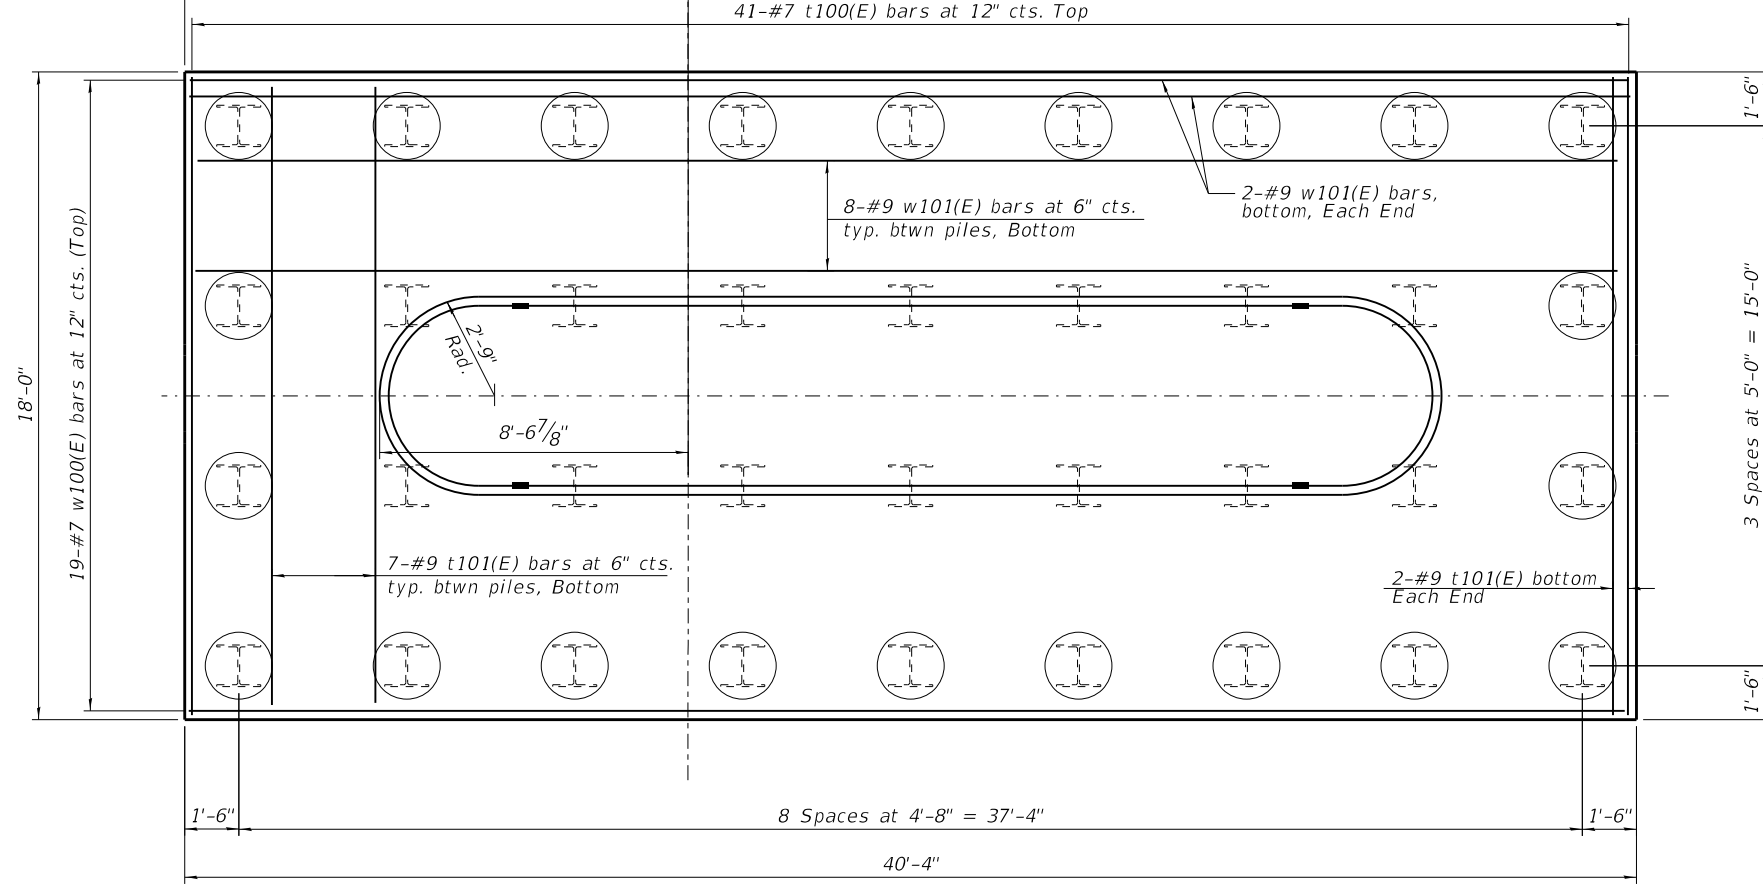

**FOOTING PLAN**

MODEL: Default  
 FILE NAME: p:\v\sp\sv\306\hanson\Projects\Documents\13\obj\13\H0106\Phase-III\CAD\Struct\Sheet\0900180-XXXX-TYLI-8111-Pier 1 details.dgn  
 4/5/2019 2:37:57 PM

**TYLIN INTERNATIONAL**  
 200 S. WACKER DR.  
 SUITE 1400  
 CHICAGO, IL 60606  
 TEL: 312-777-2900

USER NAME = spantazis	DESIGNED - SP	REVISED - 4/16/2019 S.P.
PLOT SCALE = 16:0,0000 '"/in.	CHECKED -	REVISED -
PLOT DATE = 4/5/2019	DRAWN - CH	REVISED -
	CHECKED -	REVISED -


**STATE OF ILLINOIS  
DEPARTMENT OF TRANSPORTATION**

**PIER 1 REINFORCEMENT  
STRUCTURE NO. 049-0180**

SHEET 5-298 OF 445 SHEETS

F.A.P. RTE.	SECTION	COUNTY	TOTAL SHEETS	SHEET NO.
317	(15B;(102-1),(14HB)BR)BR	PEO/TAZ	1361	1206
CONTRACT NO. 68B46				
ILLINOIS		FED. AID PROJECT	NHPP-YRP3(905)	


Mark A: 23 vertical lines of 6-#5 s214(E) bars in south crashwall and 25 vertical lines of 6-#5 s214(E) bars in north crashwall at 2'-0" cts. max. (Alternate ends each layer)

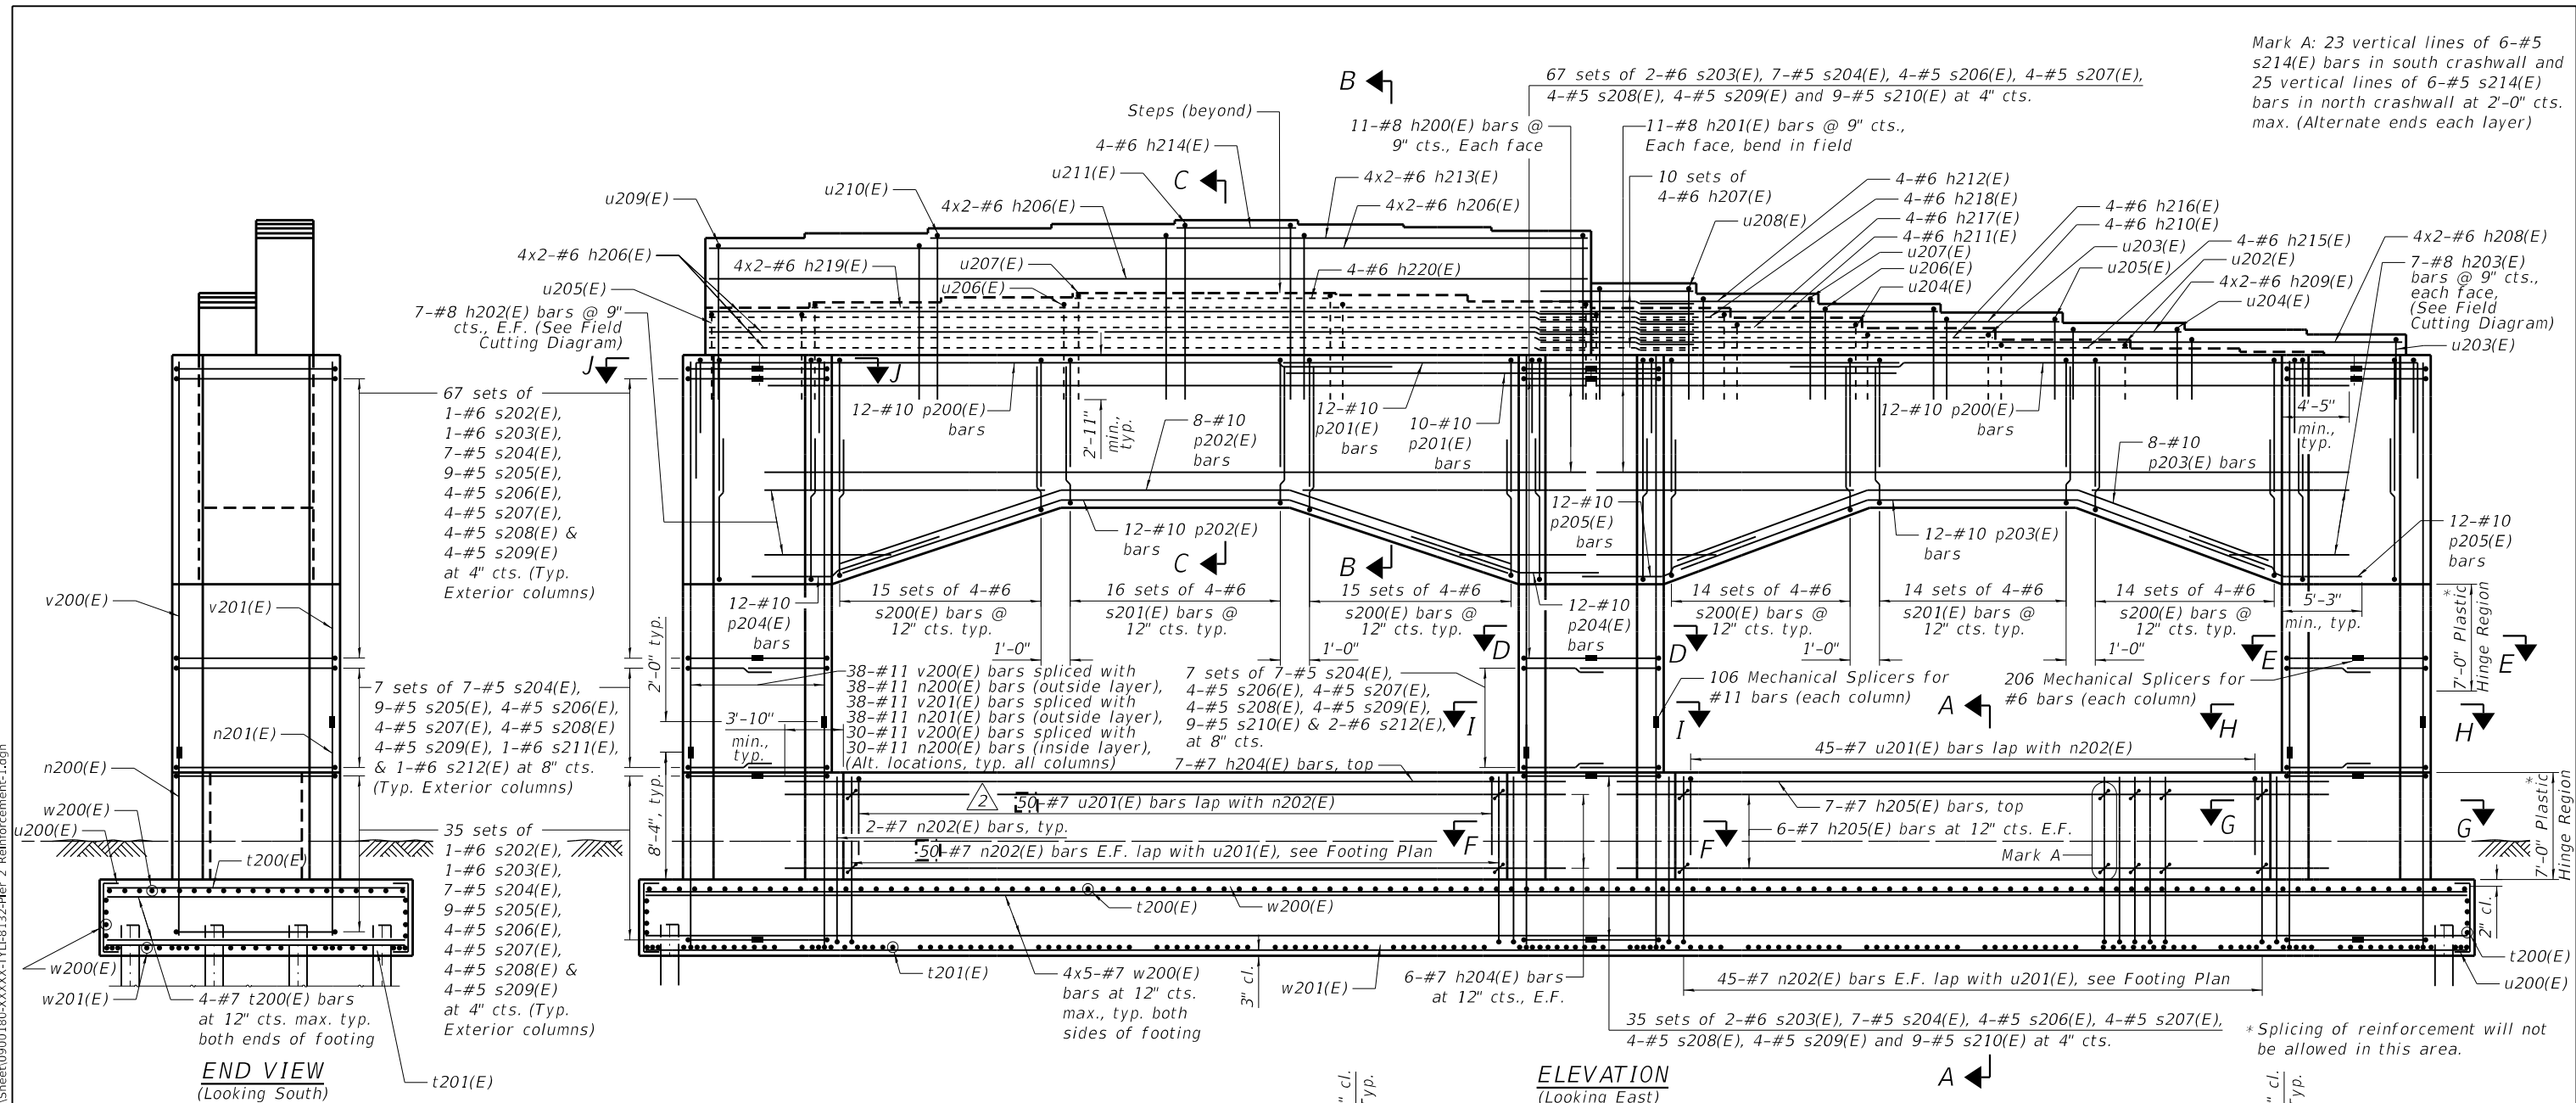


**MINIMUM BAR LAP**

- #5 bar = 3'-9"
- #6 bar = 4'-4"
- #7 bar = 5'-0"
- #10 bar (Top of cap) = 7'-8"
- #10 bar (Bot. of cap) = 6'-9"

- Notes:
1. Adjust bar spacing to miss anchor bolts.
  2. Cut bars according to cutting diagram on Sheet S-303A of 445 and use remainder of bars in opposite face.
  3. Bars indicated thus 8x2-#9 etc. indicates 8 lines of bars with 2 lengths per line.
  4. For bar list and Bill of Material, see Sheet S-303A of 445.
  5. Alternate ends of s204(E) thru s210(E) bars each layer.

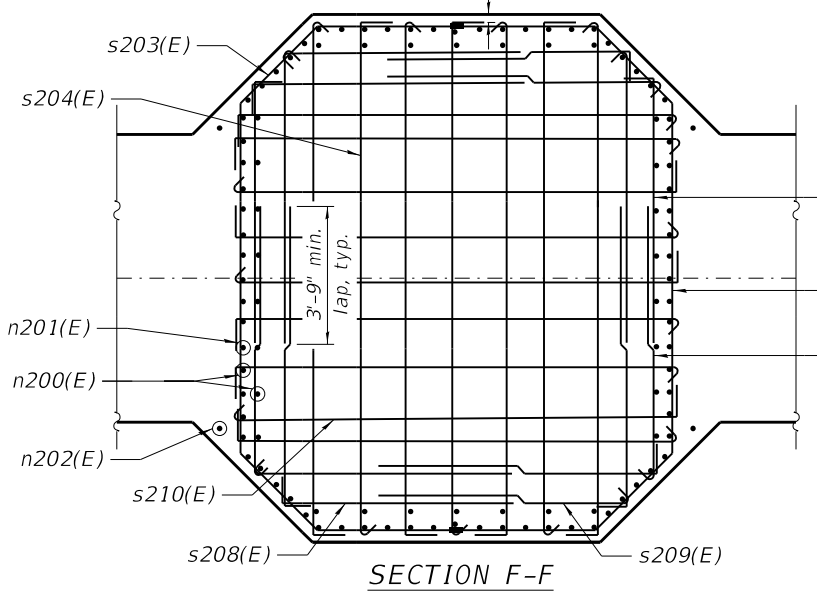

SECTION F-F

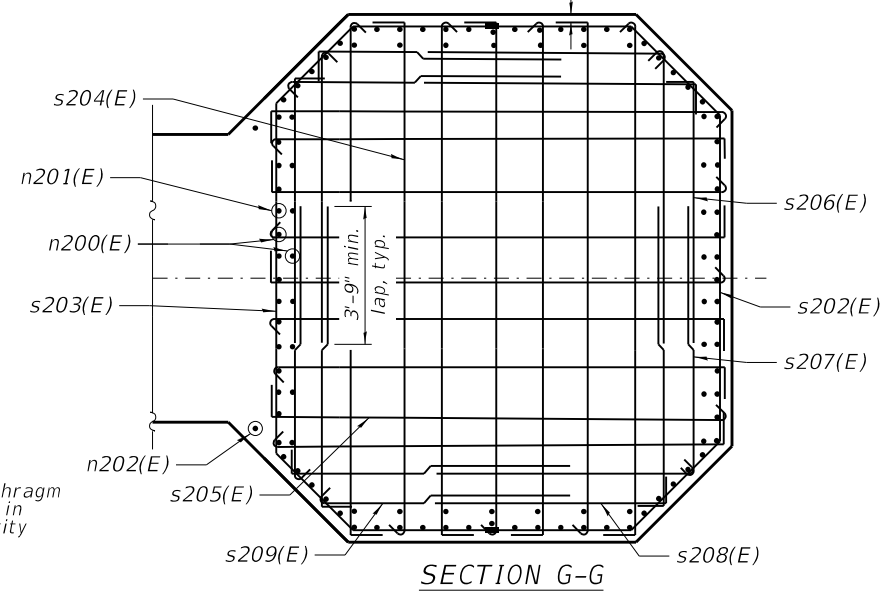

SECTION G-G

Note: Lower diaphragm rebar not shown in sections for clarity

MODEL: Default  
FILE NAME: p:\v\sp\sv\306.hanson.dom\hanson Projects\CAD\Struct\Sheet\0900180-XX-XX-TYL-8132-Pier 2 Reinforcement-1.dgn

**TYLIN INTERNATIONAL**  
200 S. WACKER DR.  
SUITE 1400  
CHICAGO, IL 60606  
TEL: 312-777-2900

USER NAME = spantazis  
DESIGNED - SP  
CHECKED -  
PLOT SCALE = 10:8,0000 " = 1" / in.  
DRAWN - CH  
PLOT DATE = 4/5/2019

DESIGNED - SP  
CHECKED -  
DRAWN - CH  
CHECKED -

REVISED - 4/16/2019 SP.  
REVISED -  
REVISED -  
REVISED -


**STATE OF ILLINOIS  
DEPARTMENT OF TRANSPORTATION**

**PIER 2 REINFORCEMENT, 1 OF 4  
STRUCTURE NO. 090-0180**

SHEET S-301 OF 445 SHEETS


F.A.P. RTE.	SECTION	COUNTY	TOTAL SHEETS	SHEET NO.
317	(15B;(102-1),(14HB)BR)BR	PEO/TAZ	1361	1209
CONTRACT NO. 68B46				
ILLINOIS FED. AID PROJECT NHPP-YRP3(905)				

MODEL: Default  
 FILE NAME: pw:\p\sp\sv\306\hanson\_projects\Documents\13\obs\13H0106\Phase-III\CAD\Struct\Sheet\0900180-XXXXXX-TYLI-8134-Pier 2 Reinforcement-3.dgn

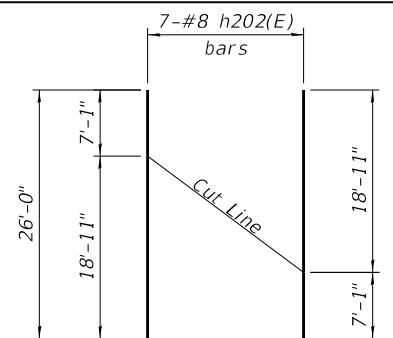


**FIELD CUTTING DIAGRAM**

Order full length. Cut as shown and use remainder of bars in opposite face.

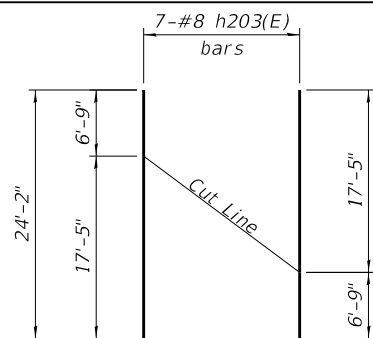

**FIELD CUTTING DIAGRAM**


Order full length. Cut as shown and use remainder of bars in opposite face.

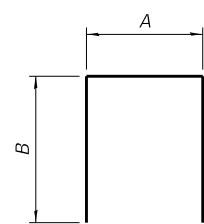


**BAR s200(E), s201(E), u200(E), u201(E), u202(E), u203(E), u204(E), u205(E), u206(E), u207(E), u208(E), u209(E), u210(E), u211(E)**

**A & B DIMENSIONS**


Bar	A	B
s200(E)	5'-2"	9'-6"
s201(E)	5'-2"	7'-0"
u200(E)	4'-6"	2'-11"
u201(E)	5'-8"	5'-0"
u202(E)	3'-5"	3'-1"
u203(E)	3'-5"	3'-5"
u204(E)	3'-5"	3'-9"
u205(E)	3'-5"	4'-1"
u206(E)	3'-5"	4'-5"
u207(E)	3'-5"	4'-9"
u208(E)	3'-5"	5'-1"
u209(E)	3'-5"	6'-5"
u210(E)	3'-5"	6'-9"
u211(E)	3'-5"	7'-1"

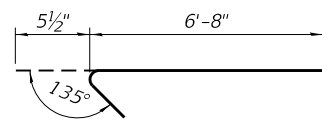

**BARS s207(E)**

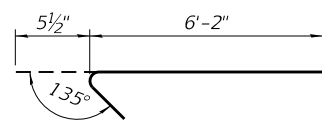


**BARS s209(E)**

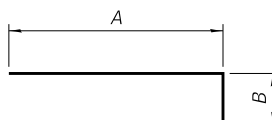


**BARS n200(E), n201(E), n202(E), p200(E), s206(E), s208(E) & s213(E)**

**A & B DIMENSIONS**


Bar	A	B
n200(E)	13'-0"	2'-0"
n201(E)	15'-0"	2'-0"
n202(E)	11'-6"	1'-2"
p200(E)	45'-8"	7'-7"
s206(E)	6'-8"	0'-6"
s208(E)	6'-2"	0'-6"
s213(E)	4'-8"	3'-7"

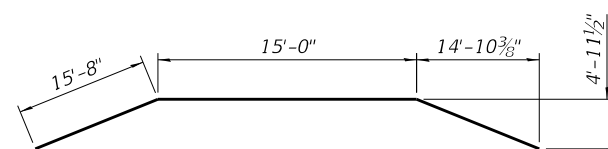

**BAR p202(E)**

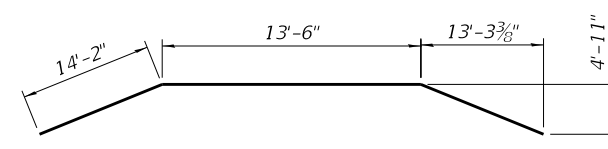

**BAR p203(E)**

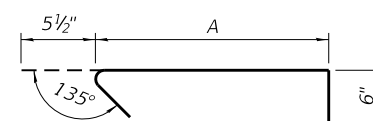


**BARS s204(E), s205(E), s210(E) & s214(E)**

**A DIMENSIONS**


Bar	A
s204(E)	10'-6"
s205(E)	9'-3"
s210(E)	9'-0"
s214(E)	5'-8"

**A, B & C DIMENSIONS**


Bar	A	B	C	D
h207(E)	3'-7"	6'-8"	6'-8"	0'-1 1/2"
p201(E)	31'-4"	3'-0"	3'-0"	3/4"
p204(E)	5'-3"	7'-2"	6'-9 1/2"	2'-3 1/4"
p205(E)	5'-3"	7'-3"	6'-9 3/4"	2'-5 3/4"

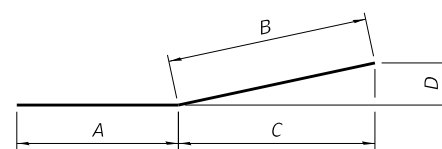

**BARS h207(E), p201(E), p204(E), p205(E), p206(E) & p207(E)**

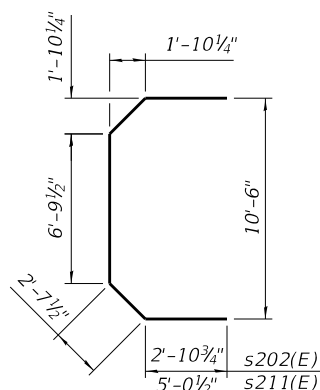

**BAR s202(E) and s211(E)**

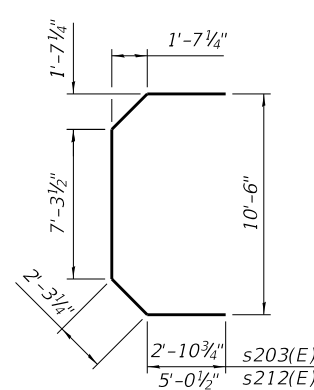

**BAR s203(E) and s212(E)**

**BILL OF MATERIAL**

Structure Excavation	Cu. Yd.	790
Concrete Structures	Cu. Yd.	1325.4
Reinforcement Bars, Epoxy Coated	Pound	282,640
Furnishing Steel Piles HP 14x89	Foot	4473
Driving Piles	Foot	4473
Test Pile, HP14x89	Each	1
Concrete Sealer	Sq. Ft.	8426

Bar	No.	Size	Length	Shape
h200(E)	22	#8	53'-10"	—
h201(E)	22	#8	49'-4"	—
h202(E)	14	#8	26'-0"	—
h203(E)	14	#8	24'-2"	—
h204(E)	19	#7	51'-2"	—
h205(E)	19	#7	46'-8"	—
h206(E)	64	#6	31'-0"	—
h207(E)	40	#6	10'-3"	—
h208(E)	8	#6	27'-8"	—
h209(E)	8	#6	20'-5"	—
h210(E)	4	#6	28'-5"	—
h211(E)	4	#6	20'-5"	—
h212(E)	4	#6	12'-5"	—
h213(E)	8	#6	23'-6"	—
h214(E)	4	#6	7'-9"	—
h215(E)	4	#6	32'-10"	—
h216(E)	4	#6	24'-2"	—
h217(E)	4	#6	15'-3"	—
h218(E)	4	#6	7'-0"	—
h219(E)	8	#6	27'-10"	—
h220(E)	4	#6	16'-11"	—
h221(E)	12	#6	9'-4"	—
n200(E)	204	#11	15'-0"	—
n201(E)	114	#11	17'-0"	—
n202(E)	198	#7	12'-8"	—
p200(E)	24	#10	53'-3"	—
p201(E)	22	#10	40'-0"	—
p202(E)	20	#10	35'-0"	—
p203(E)	20	#10	30'-8"	—
p204(E)	24	#10	12'-5"	—
p205(E)	24	#10	12'-6"	—
s200(E)	340	#6	24'-2"	—
s201(E)	120	#6	19'-2"	—
s202(E)	206	#6	17'-10"	—
s203(E)	412	#6	17'-8"	—
s204(E)	2289	#5	11'-6"	—
s205(E)	1962	#5	10'-3"	—
s206(E)	1308	#5	7'-2"	—
s207(E)	1308	#5	7'-2"	—
s208(E)	1308	#5	6'-8"	—
s209(E)	1308	#5	6'-8"	—
s210(E)	981	#5	10'-0"	—
s211(E)	14	#6	22'-2"	—
s212(E)	28	#6	21'-11"	—
s213(E)	60	#6	8'-3"	—
s214(E)	288	#5	6'-8"	—
t200(E)	129	#7	20'-0"	—
t201(E)	141	#8	20'-0"	—
u200(E)	284	#6	10'-4"	—
u201(E)	195	#7	15'-8"	—
u202(E)	9	#6	9'-9"	—
u203(E)	24	#6	10'-3"	—
u204(E)	17	#6	10'-11"	—
u205(E)	24	#6	11'-7"	—
u206(E)	42	#6	12'-3"	—
u207(E)	26	#6	12'-11"	—
u208(E)	7	#6	13'-7"	—
u209(E)	15	#6	16'-5"	—
u210(E)	35	#6	16'-11"	—
u211(E)	9	#6	17'-7"	—
v200(E)	204	#11	25'-10"	—
v201(E)	114	#11	23'-10"	—
w200(E)	150	#7	28'-0"	—
w201(E)	84	#8	33'-10"	—

\*The bar length is to the center of the mechanical splicer. The Contractor shall adjust the length as required for the selected mechanical splicer.

**TYLIN INTERNATIONAL**  
 200 S. WACKER DR.  
 SUITE 1400  
 CHICAGO, IL 60606  
 TEL: 312-777-2900

USER NAME = spantazis  
 DESIGNED - SP  
 CHECKED -  
 PLOT SCALE = 10:8,0000 '"/in.  
 DRAWN - CH  
 PLOT DATE = 4/5/2019

DESIGNED - SP  
 CHECKED -  
 DRAWN - CH  
 CHECKED -

REVISED - 4/16/2019 S.P.  
 REVISED -  
 REVISED -  
 REVISED -


**STATE OF ILLINOIS  
 DEPARTMENT OF TRANSPORTATION**

**PIER 2 REINFORCEMENT, 4 OF 4  
 STRUCTURE NO. 090-0180**

SHEET 5-303A OF 445 SHEETS


F.A.P. RTE.	SECTION	COUNTY	TOTAL SHEETS	SHEET NO.
317	(15B;(102-1),(14HB)BR)BR	PEO/TAZ	1361	1212
CONTRACT NO. 68B46				
ILLINOIS		FED. AID PROJECT	NHPP-YRP3(905)	

MODEL: Default  
 FILE NAME: p:\v\sp\sv\306\hanson\Projects\Documents\13\obs\13\H0106\Phase-III\CAD\Struct\Sheet\0900180-XXXX-TYLI-18162-Pier 3 Reinforcement-1.dgn

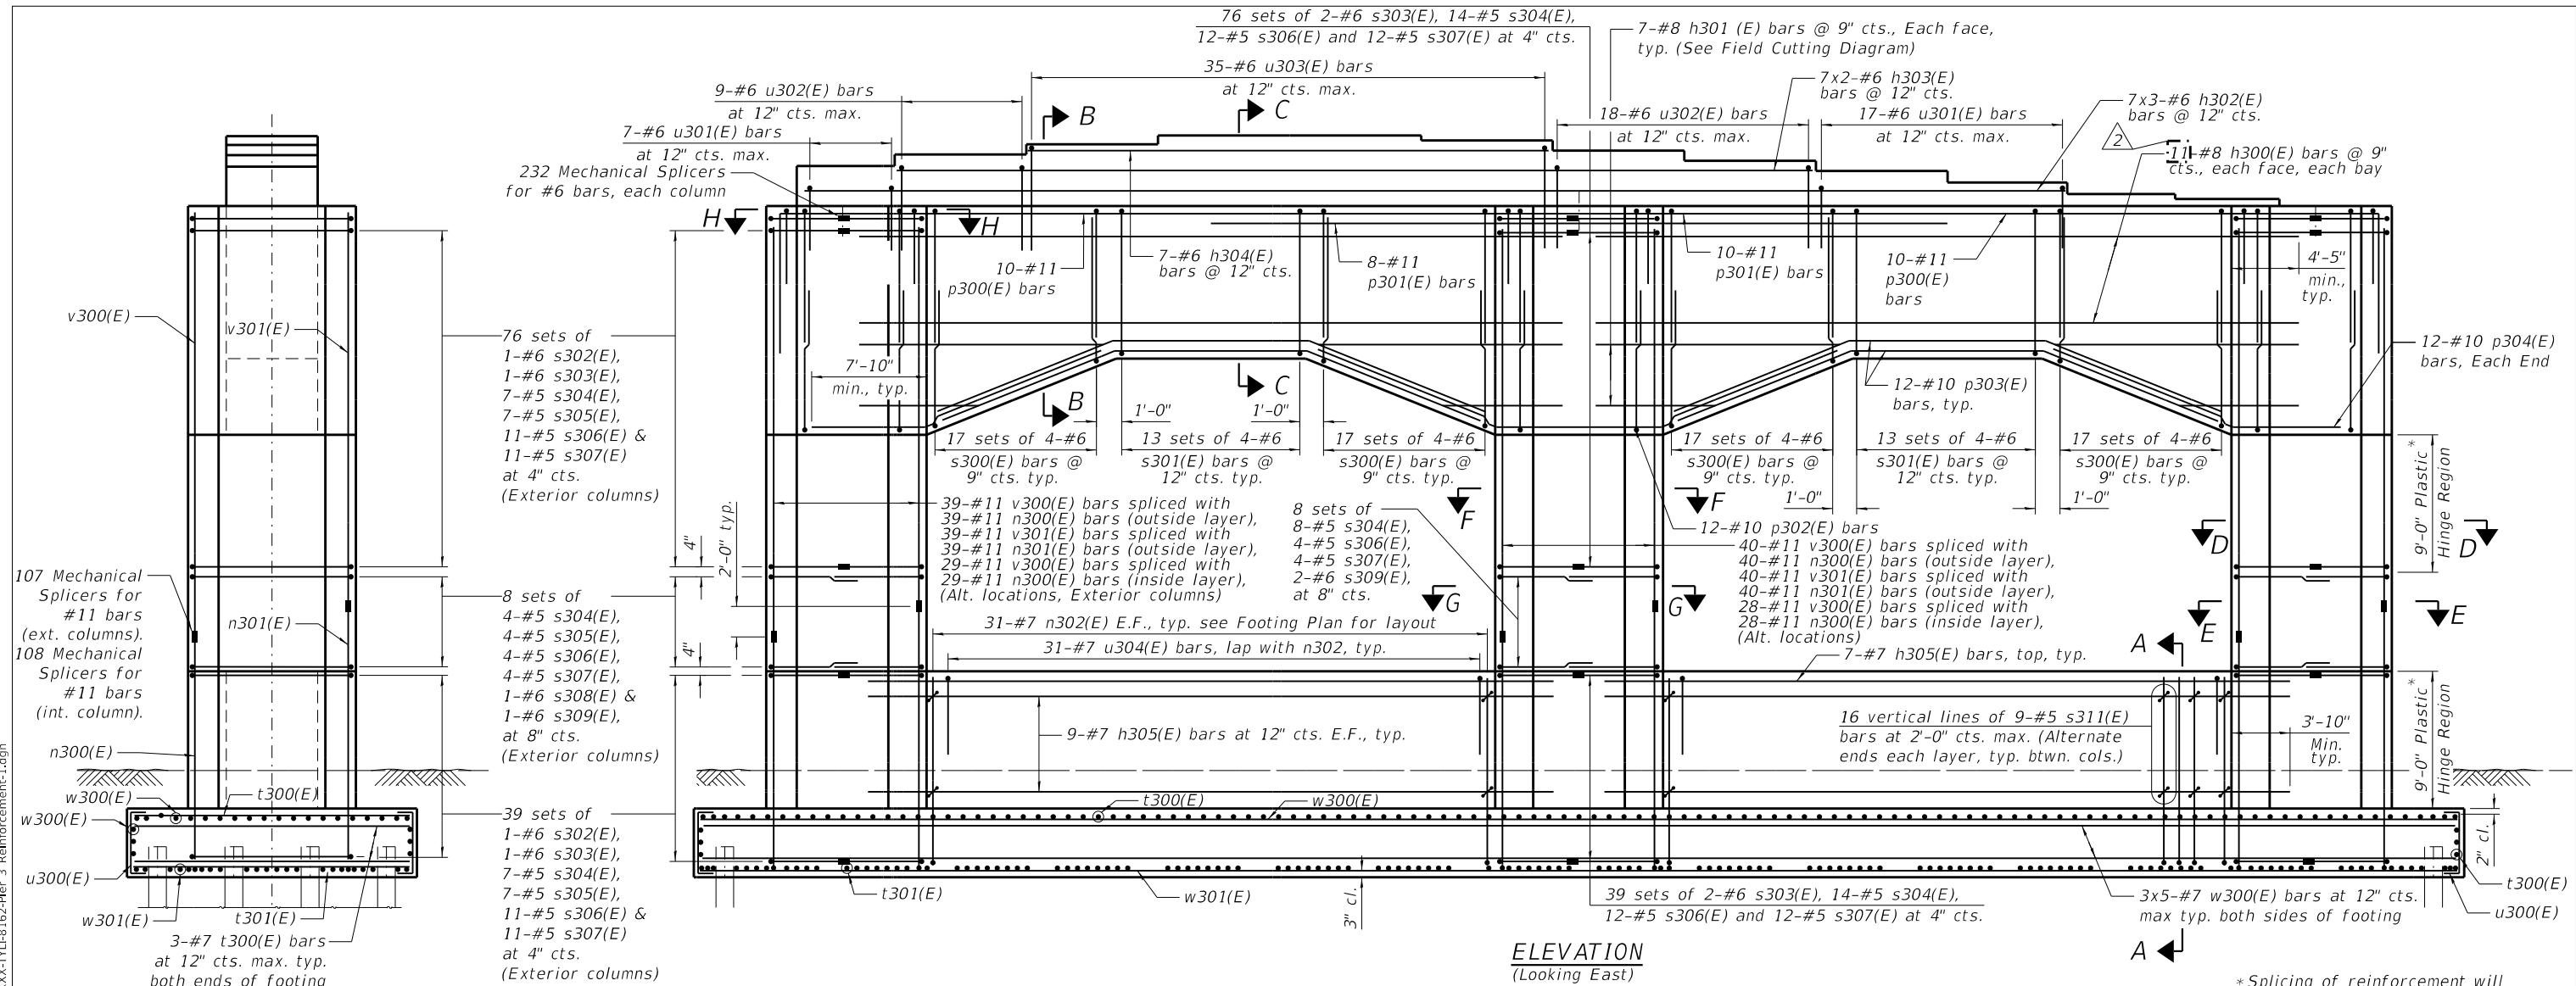

- MINIMUM BAR LAP**
- #5 bar = 3'-9"
  - #6 bar = 4'-4"
  - #7 bar = 5'-0"
  - #8 bar = 5'-1"
  - #10 bar = 10'-2"
  - #11 bar = 9'-5"


- Notes:**
1. Adjust bar spacing to miss anchor bolts.
  2. Cut bars according to cutting diagram on Sheet S-309 of 445 and use remainder of bars in opposite face.
  3. Bars indicated thus 8x2-#9 etc. indicates 8 lines of bars with 2 lengths per line.
  4. For bar list and Bill of Material, see Sheet S-309 of 445.
  5. Alternate ends of s304(E) thru s307(E) bars each layer.

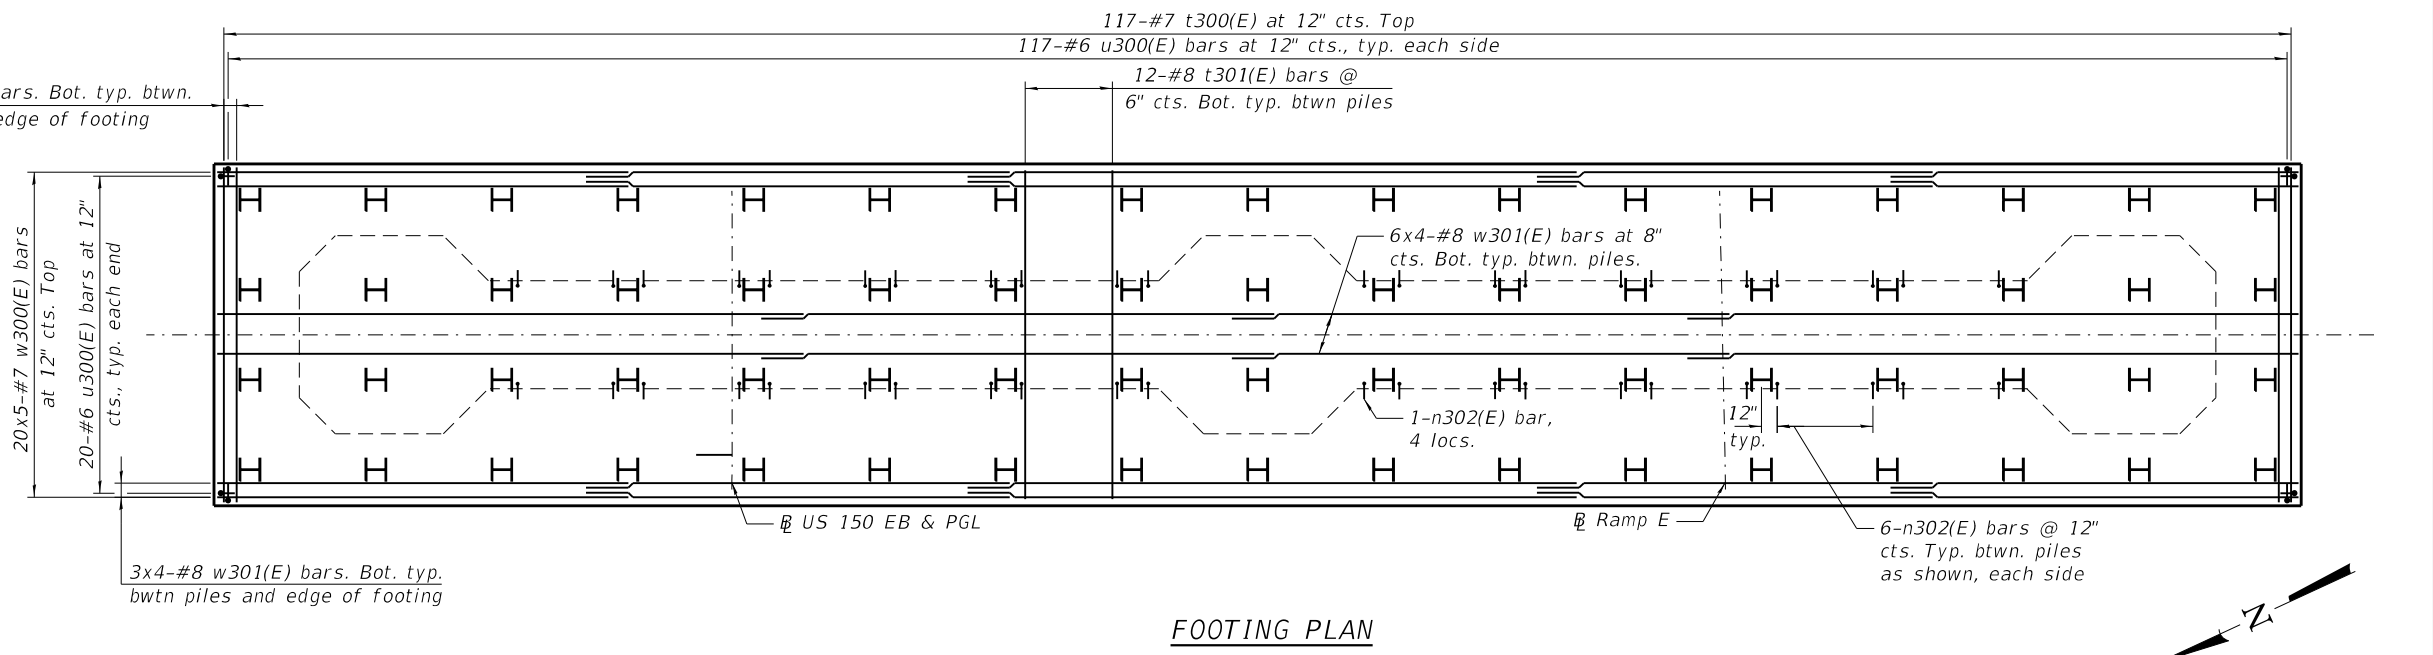

\*Splicing of reinforcement will not be allowed in this area.

<b>TYLIN INTERNATIONAL</b> 200 S. WACKER DR. SUITE 1400 CHICAGO, IL 60606 TEL: 312-777-2900	USER NAME = spantazis	DESIGNED - SP	REVISED - 4/16/2019 S.P.	<b>STATE OF ILLINOIS</b> <b>DEPARTMENT OF TRANSPORTATION</b>	PIER 3 REINFORCEMENT, 1 OF 4 STRUCTURE NO. 090-0180	F.A.P. RTE. 317	SECTION (15B;(102-1),(14HB)BR)BR	COUNTY PEO/TAZ	TOTAL SHEETS 1361	SHEET NO. 1215
	PLOT SCALE = 10:8,0000 "/>									

MODEL: Default  
 FILE NAME: p:\w\sp\sv\306\hanson\Projects\Documents\13\130106\Phase-III\CAD\Struct\Sheet\0900180-XXXX-TYLI-8282-Pier 7 Reinforcement-1.dgn

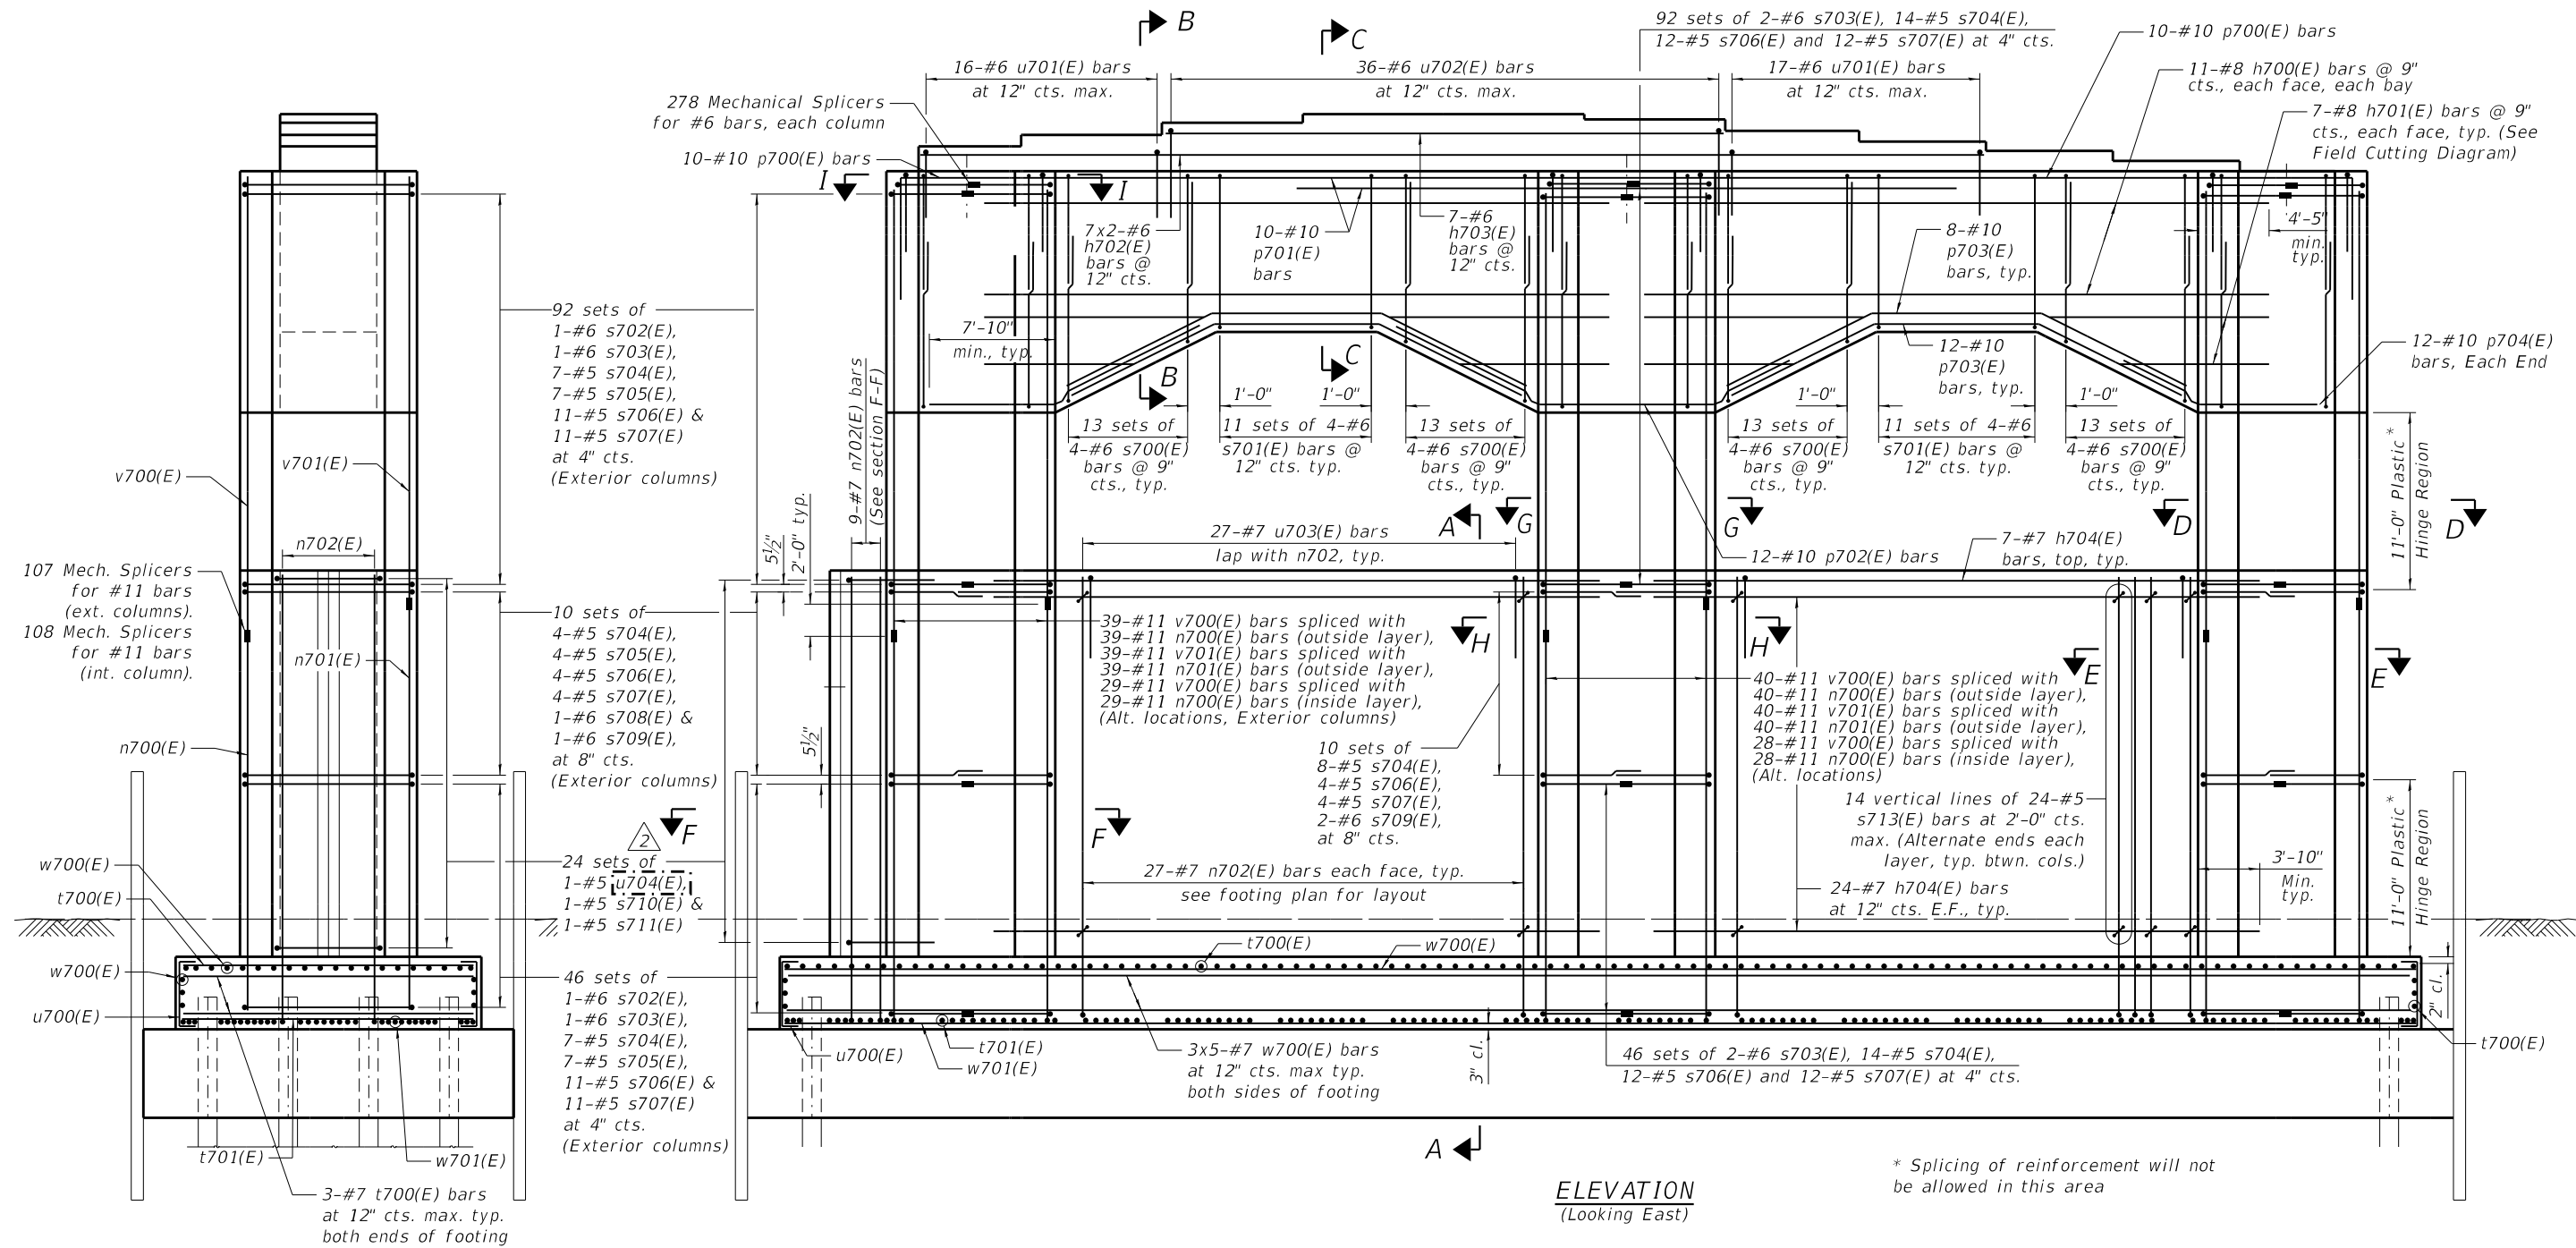

**TYLIN INTERNATIONAL**  
 200 S. WACKER DR.  
 SUITE 1400  
 CHICAGO, IL 60606  
 TEL: 312-777-2900

USER NAME = spantazis  
 DESIGNED -  
 CHECKED -  
 PLOT SCALE = 10:8,0000 " = 1" / in.  
 DRAWN -  
 PLOT DATE = 4/5/2019  
 CHECKED -

DESIGNED -  
 CHECKED -  
 DRAWN -  
 CHECKED -

REVISED - 4/16/2019 S.P.  
 REVISED -  
 REVISED -  
 REVISED -

**STATE OF ILLINOIS  
 DEPARTMENT OF TRANSPORTATION**

**PIER 7 REINFORCEMENT, 1 OF 4  
 STRUCTURE NO. 090-0180**

SHEET S-330 OF 445 SHEETS

F.A.P. RTE.	SECTION	COUNTY	TOTAL SHEETS	SHEET NO.
317	(15B;(102-1),(14HB)BR)BR	PEO/TAZ	1361	1239
CONTRACT NO. 68B46				
ILLINOIS FED. AID PROJECT NHPP-YRP3(905)				





**BILL OF MATERIAL**

Bar	No.	Size	Length	Shape
h1100(E)	44	#8	31'-5"	—
h1101(E)	14	#8	31'-10"	—
h1102(E)	14	#6	21'-11"	—
h1103(E)	7	#6	8'-0"	—
h1104(E)	98	#8	34'-4"	—
h1105(E)	8	#6	10'-7"	—
** n1100(E)	124	#11	38'-4"	┘┘
** n1101(E)	124	#11	40'-4"	┘┘
n1102(E)	121	#8	29'-4"	┘┘
p1100(E)	20	#11	52'-8"	┘┘
p1101(E)	16	#11	40'-2"	┘┘
p1102(E)	24	#11	49'-4"	┘┘
p1103(E)	24	#11	25'-3"	┘┘
p1104(E)	10	#11	41'-2"	┘┘
p1105(E)	24	#11	15'-7"	┘┘
s1100(E)	232	#6	22'-9"	┘┘
s1101(E)	144	#6	20'-3"	┘┘
s1102(E)	76	#6	19'-2"	┘┘
** s1103(E)	284	#6	19'-10"	┘┘
** s1104(E)	284	#6	20'-8"	┘┘
s1105(E)	4410	#5	12'-6"	┘┘
s1106(E)	978	#5	7'-1"	┘┘
s1107(E)	978	#5	7'-1"	┘┘
s1108(E)	1392	#5	7'-6"	┘┘
s1109(E)	1392	#5	7'-6"	┘┘
s1110(E)	66	#5	24'-2"	┘┘
s1111(E)	66	#5	25'-0"	┘┘
s1112(E)	21	#5	2'-4"	┘┘
s1113(E)	21	#5	5'-2"	┘┘
s1114	130	#6	16'-3"	○
s1115(E)	44	#6	8'-9"	┘┘
s1116(E)	588	#5	6'-8"	┘┘
* sp1100	10	#6	56'-6"	⋈
t1100(E)	105	#7	33'-6"	—
t1101(E)	196	#11	33'-6"	—
u1100(E)	32	#6	11'-10"	┘┘
u1101(E)	9	#6	12'-6"	┘┘
u1102(E)	55	#8	17'-2"	┘┘
u1103(E)	21	#5	15'-8"	┘┘
u1104(E)	252	#6	12'-10"	┘┘
** v1100(E)	124	#11	32'-11"	—
** v1101(E)	124	#11	30'-11"	—
** v1102	140	#11	36'-0"	—
** v1103	140	#11	34'-0"	—
** v1104	140	#11	25'-4"	—
** v1105	140	#11	27'-4"	—
w1100(E)	196	#7	26'-2"	—
w1101(E)	114	#9	33'-10"	—
Concrete Structures	Cu. Yd.		1875.9	
Permanent Casing	Foot		494	
Reinforcement Bars	Pound		124,440	
Reinforcement Bars, Epoxy Coated	Pound		348,440	
Drilled Shaft in Soil	Cu.Yd.		505.3	
Drilled Shaft in Rock	Cu.Yd.		105.6	
Cofferdam Excavation	Cu. Yd.		2250	
Cofferdam (Type 2) (Location-11)	Each		1	
Crosshole Sonic Logging Access Ducts	Foot		3,780	
Seal Coat Concrete	Cu. Yd.		1,323.0	
Crosshole Sonic Logging Testing	Each		1	

**A & B DIMENSIONS**

Bar	A	B
s1100(E)	3'-9"	9'-6"
s1101(E)	3'-9"	8'-2"
s1102(E)	3'-9"	7'-0"
u1100(E)	5'-8"	3'-1"
u1101(E)	5'-8"	3'-5"
u1102(E)	5'-8"	5'-9"
u1104(E)	7'-0"	2'-11"

**BAR s1100(E), s1101(E), s1102(E), u1100(E), u1101(E), u1102(E) & u1104(E)**

**A & B DIMENSIONS**


Bar	A	B
n1100(E)	36'-4"	2'-0"
n1101(E)	38'-4"	2'-0"
n1102(E)	28'-0"	1'-4"
s1106(E)	6'-7"	0'-6"
s1108(E)	7'-0"	0'-6"
s1115(E)	4'-8"	4'-1"
p1100(E)	43'-6"	9'-2"
p1101(E)	31'-0"	9'-2"

**BARS n1100(E), n1101(E), n1102(E), s1106(E), s1108(E) s1115(E), p1100(E) & p1101(E)**


**A DIMENSION**

Bar	A
s1105(E)	11'-6"
s1112(E)	1'-4"
s1113(E)	4'-2"
s1116(E)	5'-8"


**BARS s1105(E), s1112(E), s1113(E) & s1116(E)**

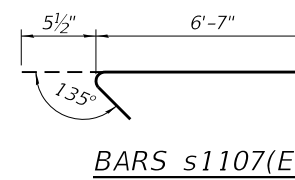


**BAR s1107(E)**

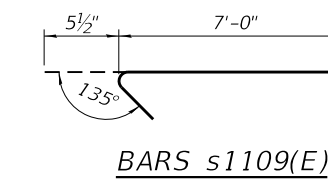


**BAR s1109(E)**

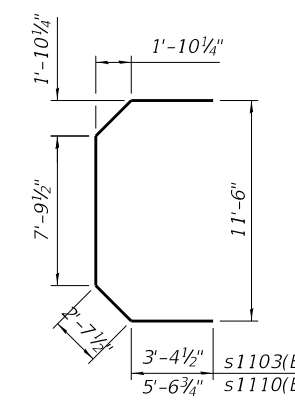

**BAR s1103(E) and s1110(E)**

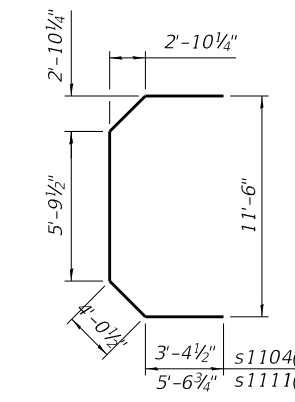


**BAR s1104(E) and s1111(E)**

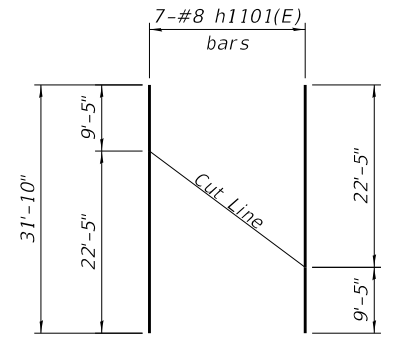


**FIELD CUTTING DIAGRAM**


Order full length. Cut as shown and use remainder of bars in opposite face.

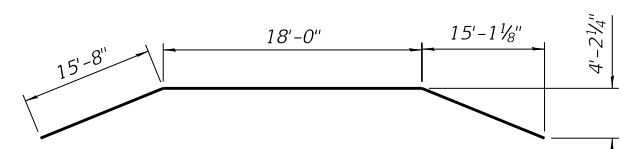


**BAR p1102(E)**

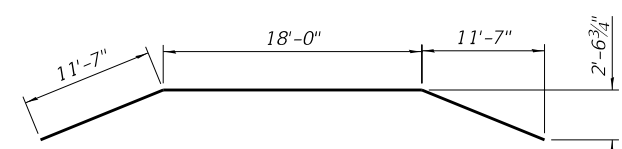


**BAR p1104(E)**

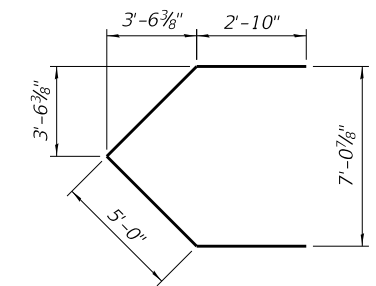


**BAR u1103(E)**

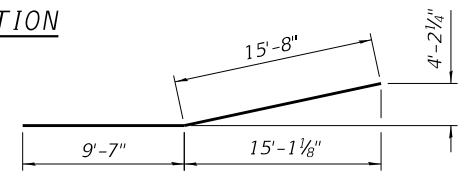

**BAR p1103(E)**

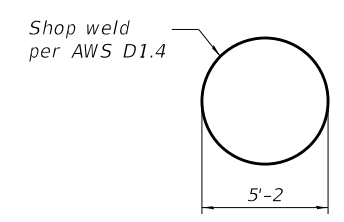


**BAR s1114**

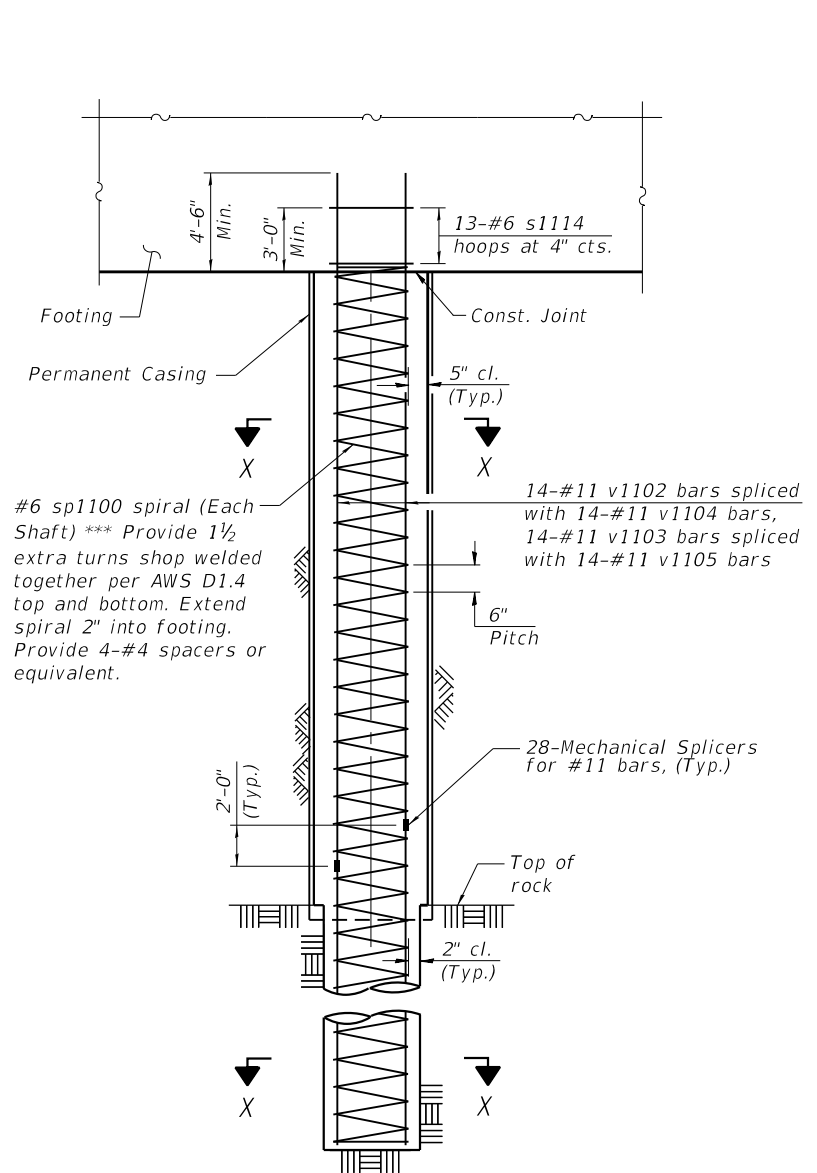


**ELEVATION**

\*\*\* Allowable substitution: Provide 1 1/2 extra turns top and bottom with 135 standard hook into core at ends of spiral.

Note A: 2" I.D. Steel pipe for crosshole sonic logging (6 each shaft) (typ.)

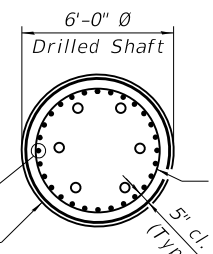

**SECTION X-X**

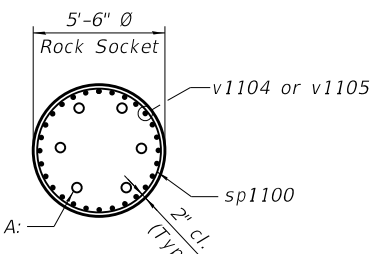


**SECTION X-X**

\* Length is height of spiral. Minimum lap for spirals = 2'-7"  
 \*\* The bar length is to the center of the mechanical splicer. The Contractor shall adjust the length as required for the selected mechanical splicer.

MODEL: Default; FILE NAME: p:\v\sp\306.hanson.donnhanson.Projects\Documents\13\obs\13\H0106\Phase-III\CAD\Struct\Sheet\0900180-XXXX-TYL-8404-Rfr 11 Reinforcement-3.dgn


**GENERAL NOTES**

All dimensions shall remain the same as shown on superstructure details, except dimension A which is to be revised as shown. Additional concrete needed to revise dimension A = 0.00348 cu. yds./ft. for 39" and 44" parapets.  
 Place full depth aluminum sheets as shown on superstructure details.  
 Replace all cork joint filler locations with a full thickness saw cut.  
 Steel superstructure shown. Other superstructure types similar.

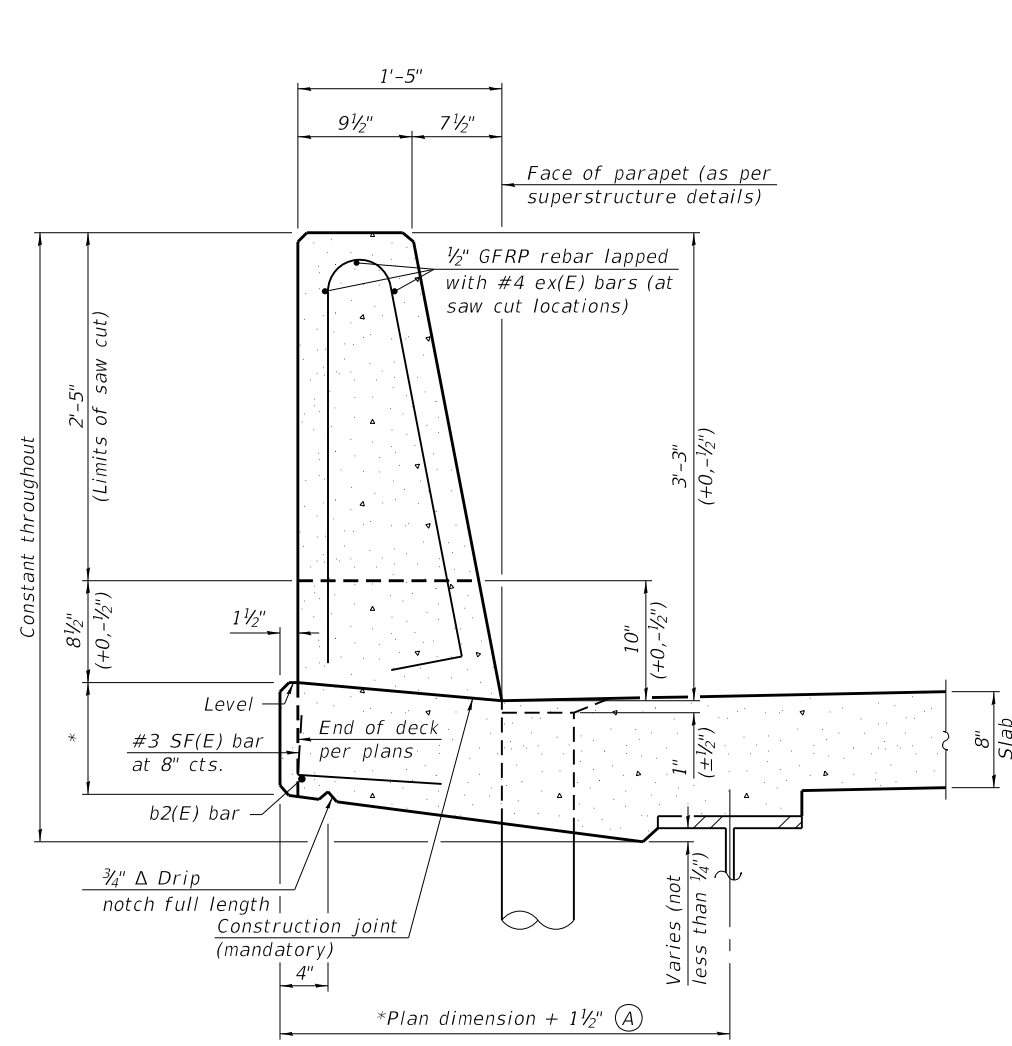

**39" CONSTANT-SLOPE  
PARAPET SECTION**


(Showing dimensions, d(E), and 1/2" Ø GFRP rebar)

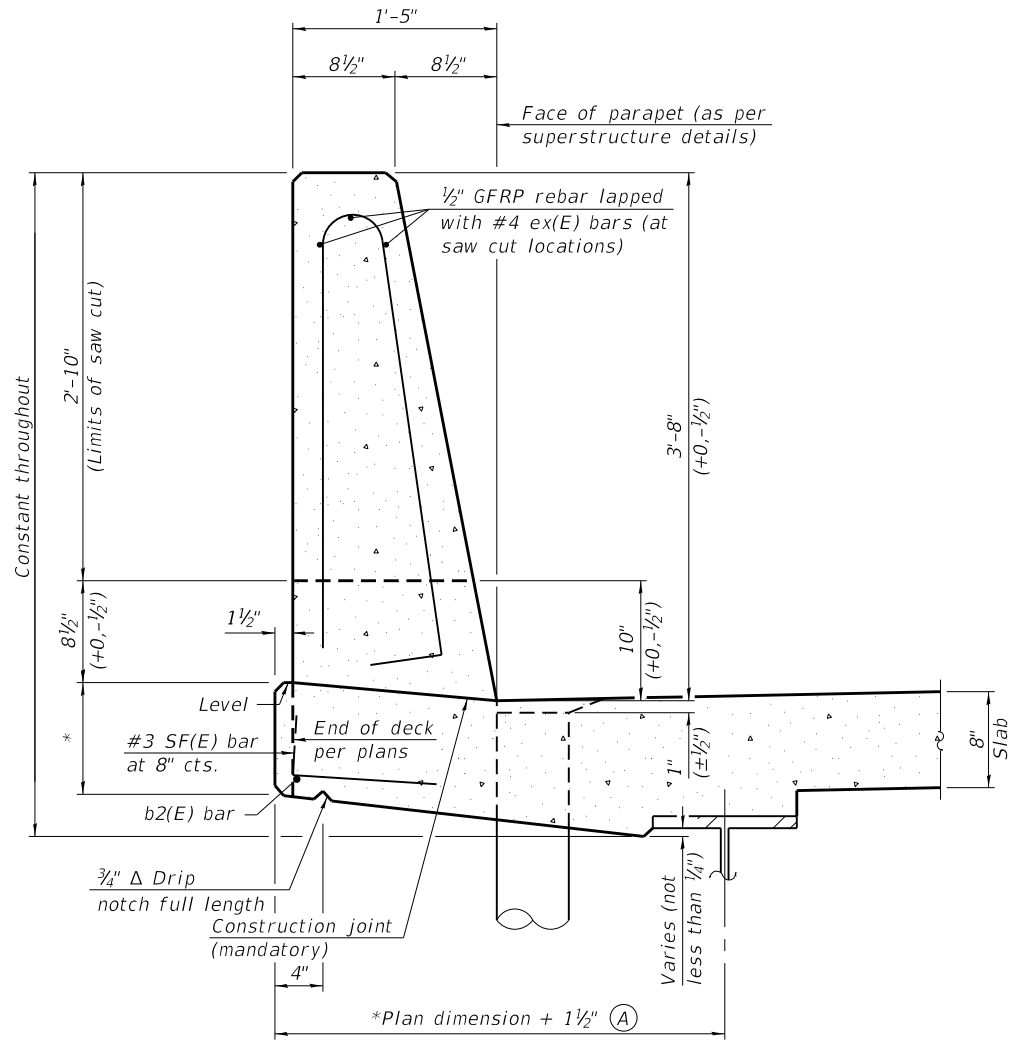


**44" CONSTANT-SLOPE  
PARAPET SECTION**

(Showing dimensions, d(E), and 1/2" Ø GFRP rebar)

\*See Superstructure Details.

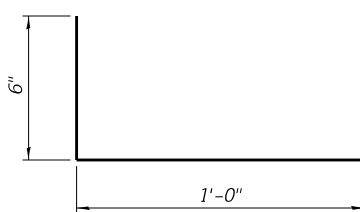

**#3 (E) BAR**

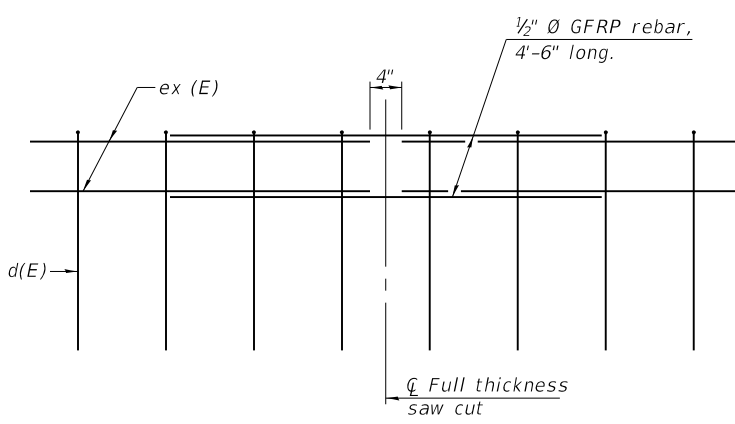

**GFRP REBAR STIFFENING DETAIL**

(Place as shown in parapet section at each parapet joint location.)

MODEL: Default  
 FILE NAME: p:\w\sp\sv\306\hanson\Projects\Documents\13\jobs\13\H0106\Phase-III\CAD\Struct\Sheet\0900180-XXXXX-TYL-9103-Parapet\_Slipforming.dgn

SFP 39-44

1-14-2019

Entire Sheet Revised

<b>TYLIN INTERNATIONAL</b> 200 S. WACKER DR. SUITE 1400 CHICAGO, IL 60606 TEL: 312-777-2900	USER NAME = spantazis	DESIGNED -	REVISED - 2/4/16/2019 S.P.
	PLOT SCALE = 0:2.0000 " = 1" / in.	CHECKED -	REVISED -
	PLOT DATE = 4/4/2019	DRAWN -	REVISED -
		CHECKED -	REVISED -

**STATE OF ILLINOIS  
DEPARTMENT OF TRANSPORTATION**

**CONCRETE PARAPET SLIPFORMING OPTION  
STRUCTURE NO. 090-0180**

SHEET 5-433 OF 445 SHEETS

F.A.P. RTE.	SECTION	COUNTY	TOTAL SHEETS	SHEET NO.
317	[15B;(102-1),(14HB)]BR/BR	PEO/TAZ	1361	1342
CONTRACT NO. 68B46				
ILLINOIS		FED. AID PROJECT	NHPP-YRP3(905)	