

76210 # 106 1-16-04 FAI 70 ST. CLAIR (82-3HVB-2R-1) JAR #106

106

CONTENTS


STRUCTURE	DESCRIPTION
Ramp O (SN. 082-0143)	Seismic Retrofit, Redundancy Retrofit, Deck rehabilitation and General Repair of Deteriorations of the Substructure and Superstructure for this Structure.
Ramp M (SN. 082-0145)	Seismic Retrofit, Redundancy Retrofit, Deck rehabilitation and General Repair of Deteriorations of the Substructure and Superstructure for this Structure.
Ramp O (SN. 082-0201)	Seismic Retrofit, Redundancy Retrofit, Deck rehabilitation and General Repair of Deteriorations of the Substructure and Superstructure for this Structure.
Ramp N (SN. 082-0202)	Seismic Retrofit, Redundancy Retrofit, Deck rehabilitation and General Repair of Deteriorations of the Substructure and Superstructure for this Structure.
Ramp P (SN. 082-0203)	Seismic Retrofit, Redundancy Retrofit, Deck rehabilitation and General Repair of Deteriorations of the Substructure and Superstructure for this Structure.
ROADWAY F (SN. 082-0204)	Seismic Retrofit, Redundancy Retrofit, Deck rehabilitation and General Repair of Deteriorations of the Substructure and Superstructure for this Structure.
ROADWAY E (SN. 082-0205)	Seismic Retrofit, Redundancy Retrofit, Deck rehabilitation and General Repair of Deteriorations of the Substructure and Superstructure for this Structure.

99.9%
9.24-2005

STATE OF ILLINOIS
DEPARTMENT OF TRANSPORTATION
DIVISION OF HIGHWAYS

**PLANS FOR PROPOSED
REHABILITATION**
PROJECT ACIM-ACBHI-070-1(178)001
FAI ROUTE 70 (I-55/70/64)
SECTION (82-3HVB-2R-1)-2
ILLINOIS ROUTE 3
TO AND FROM
POPLAR STREET BRIDGE COMPLEX
ST. CLAIR COUNTY
C-98-088-01


ROUTE NO.	DISTRICT	COUNTY	SECTION	SHEET NO.
FAI-70		St. Clair	388	1
PROJECT NO. ACIM-ACBHI-070-1(178)001				
SECTION NO. (82-3HVB-2R-1)-2				

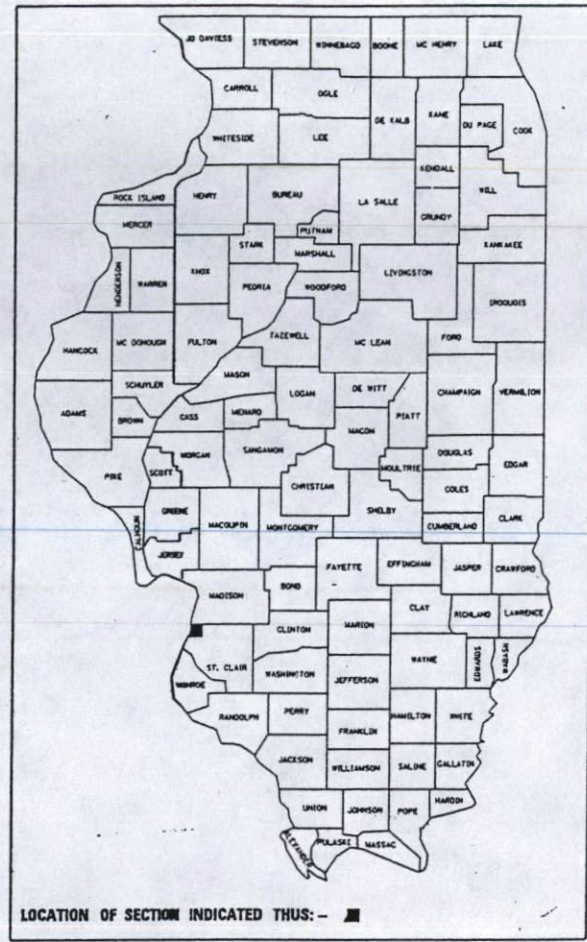

PROJECT LEADER: TOM MANNINO (618)346-3159
SQUAD LEADER: GREG HANCOCK (618)346-3195

RAMP O	RAMP M	RAMP N
2001 ADT = 6000 (actual)	2001 ADT = 9900 (actual)	2001 ADT = 8700 (actual)
2003 ADT = 6200 (estimated)	2003 ADT = 10200 (estimated)	2003 ADT = 9000 (estimated)
2003 DHV = 620 (estimated)	2003 DHV = 1020 (estimated)	2003 DHV = 900 (estimated)
2023 ADT = 8350 (estimated)	2023 ADT = 13700 (estimated)	2023 ADT = 12100 (estimated)
2023 DHV = 840 (estimated)	2023 DHV = 1370 (estimated)	2023 DHV = 1240 (estimated)
SU = 4.0%	SU = 4.0%	SU = 4.0%
MU = 8.0%	MU = 8.0%	MU = 8.0%

RAMP P	ROADWAY E	ROADWAY F
2001 ADT = 4300 (actual)	2001 ADT = 14200 (actual)	2001 ADT = 14600 (actual)
2003 ADT = 4400 (estimated)	2003 ADT = 14600 (estimated)	2003 ADT = 15000 (estimated)
2003 DHV = 440 (estimated)	2003 DHV = 1460 (estimated)	2003 DHV = 1500 (estimated)
2023 ADT = 5900 (estimated)	2023 ADT = 19600 (estimated)	2023 ADT = 20200 (estimated)
2023 DHV = 590 (estimated)	2023 DHV = 1960 (estimated)	2023 DHV = 2020 (estimated)
SU = 4.0%	SU = 4.0%	SU = 4.0%
MU = 8.0%	MU = 8.0%	MU = 8.0%

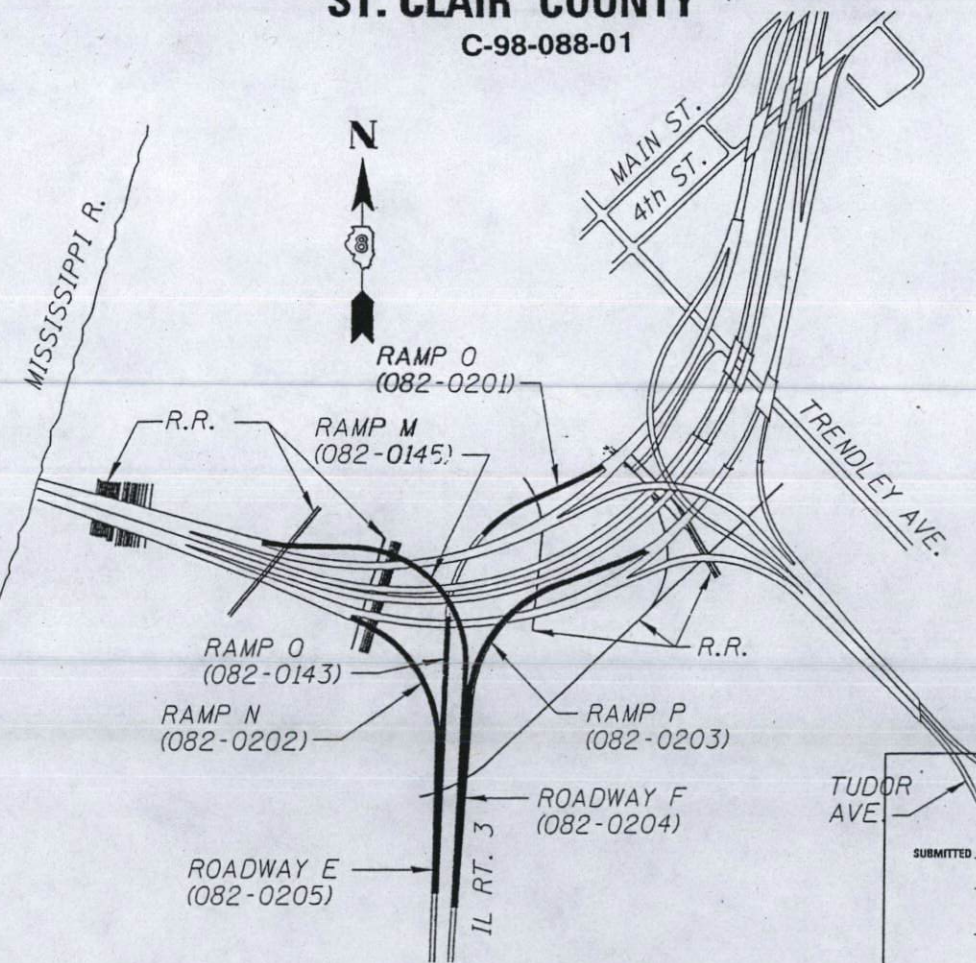

CONTRACT NO. 76210

DESIGNED	--
CHECKED	--
DRAWN	E. Bazzell
CHECKED	S. Koammerer

082-0205
PREPARED BY:
JACOBS CIVIL INC.
ST. LOUIS, MO

GROSS LENGTH OF PROJECT = 7403.3 FEET = 1.40 MILES
NET LENGTH OF PROJECT = 7403.3 FEET = 1.40 MILES

STATE OF ILLINOIS
DEPARTMENT OF TRANSPORTATION
DIVISION OF HIGHWAYS

SUBMITTED Oct 24, 2003
Ray Harris DISTRICT ENGINEER
December 5, 2003
Michael F. Klein ENGINEER OF DESIGN AND ENVIRONMENT
December 5, 2003
Victor A. Matus DIRECTOR, DIVISION OF HIGHWAYS



EXPIRES 11-30-2004
JOHN E. FINKE, S.E.
STRUCTURAL/SEISMIC RETROFIT



LANCE PETERMAN, S.E.
REDUNDANCY RETROFIT
LICENSE EXPIRES 11-30-04



ANDREW P. FREY, P.E.
TRAFFIC CONTROL

8-260

PRINTED BY THE AUTHORITY
OF THE STATE OF ILLINOIS

Structure Number 082-0205 (Rdwy E)
 Plan Quantity: Partial Depth 50.35y Full Depth 0.25y
 Final Quantity: Partial Depth 62.05y Full Depth 0
 Date Patching Completed 8-19-04

Please attach documentation showing patch size, type (PD or FD) and location.

Resident Steph E. Cook

CC: Bureau of Bridges & Structures
 District Bridge Maintenance Engineer


Rdwy E Right Side 082-0205

Patch #	Sq. Ft.	Loc.	Dis.	Full/Part.
1	36+33	Rt E 12'	11.3x16x12	42+T3 P
2.08 Ft ² / 9 = .23 yd ²				
TOTAL: .42 / 27 = 0.02 CY				

MEASURED BY GWA INITIAL(S) GWA DATE 7-10-04
 CALCULATED BY GWA INITIAL(S) GWA DATE 7-10-04
 CHECKED BY MDA INITIAL(S) MDA DATE 7-14-04

Point #	Sta.	Ln	D.M.	1 st R	2 nd R	3 rd R	4 th R	5 th R
2	28+14	1.7 R	1501.15	1.00	.21			
3	28+15	Ø R	381.845	3.00	.44			
4	28+19	Ø R	2441.72	4.50	.9			
5	28+22	12.8 2.5 R	3510.2	3.15				
	12.18 R ²	9 =	1.35 y ²					

0.08 cuyd

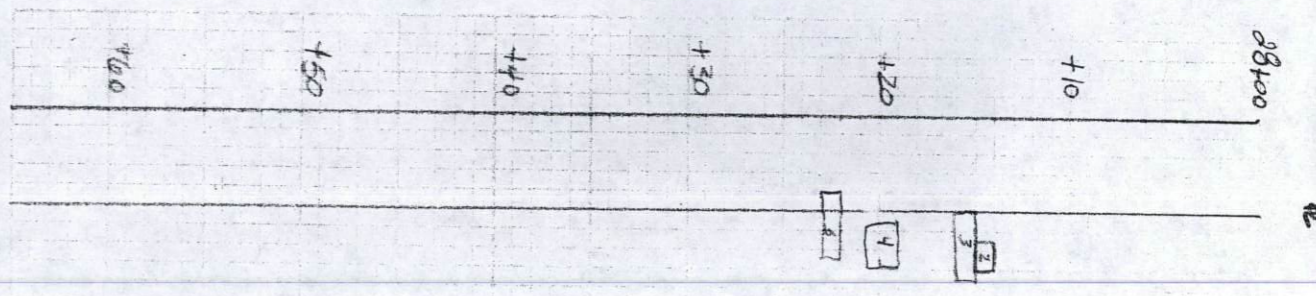


INITIAL(S) _____ DATE 7/10-04
 MEASURED BY GMM/DMS
 CALCULATED BY GMM
 CHECKED BY _____

Point #	Sta	Loc.	D.M.	1 st R	2 nd R	3 rd R	4 th R	5 th R
6	29+00	22.8-1/2 R	3021.04	3.00	.48			
7	29+36	52.8-10.8 R	1515.15	.75	.11			
	3.75 R ²	9 =	42 y ²					

0.02 cuyd


Left Road E Post Water Right

INITIAL(S) _____ DATE 7/10-04
 MEASURED BY GMM/DMS
 CALCULATED BY GMM
 CHECKED BY _____

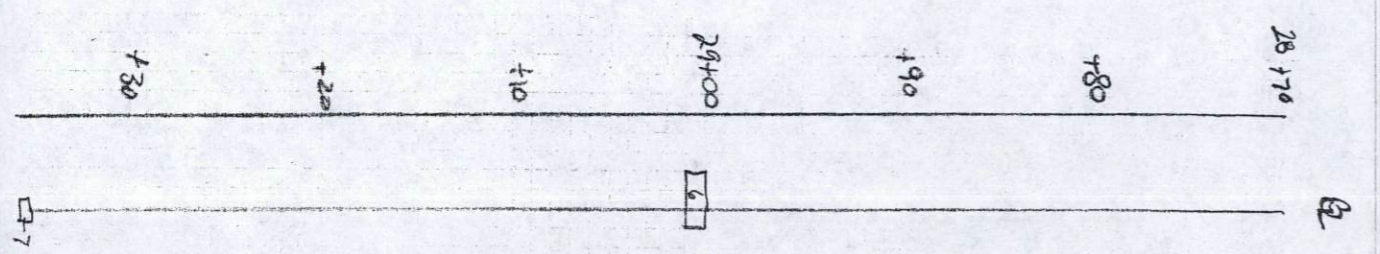

Plot #	Sta.	Loc.	Dist.	Notes
8	29+50	2'L.R. 2.5x2' R	1.15x4.8x.1	5.18' = .52V
9	29+53	4'R R	1.0x3.0x.2	3' = .60V
10	29+58	2'L.R. 1'R R	3.4x.15	3' = .45V
11	29+64	2'L R	1.5x.1x.15	1.5' = .23V
12	29+67	9.5 R R	1.5x.0.5x.15	.75' = .11V
13	29+77	1.5x.8x.8 R	2.5x.1x.12	2.5' = .3V
14	29+91	Ø L R	1.8x.7x.2	1.26' = .25V
15	29+94.5	Ø L R	.8x1.8x.15	1.44' = .22V
16	29+96.5	Ø L R	1.3x.8x.17	1.04' = .18V
19	29+97	FLZ	9 = 2.19' yd R	2.9V


MEASURED BY GMH/AMS INITIAL(S) DATE 7-10-04
 CALCULATED BY GMH
 CHECKED BY AMS

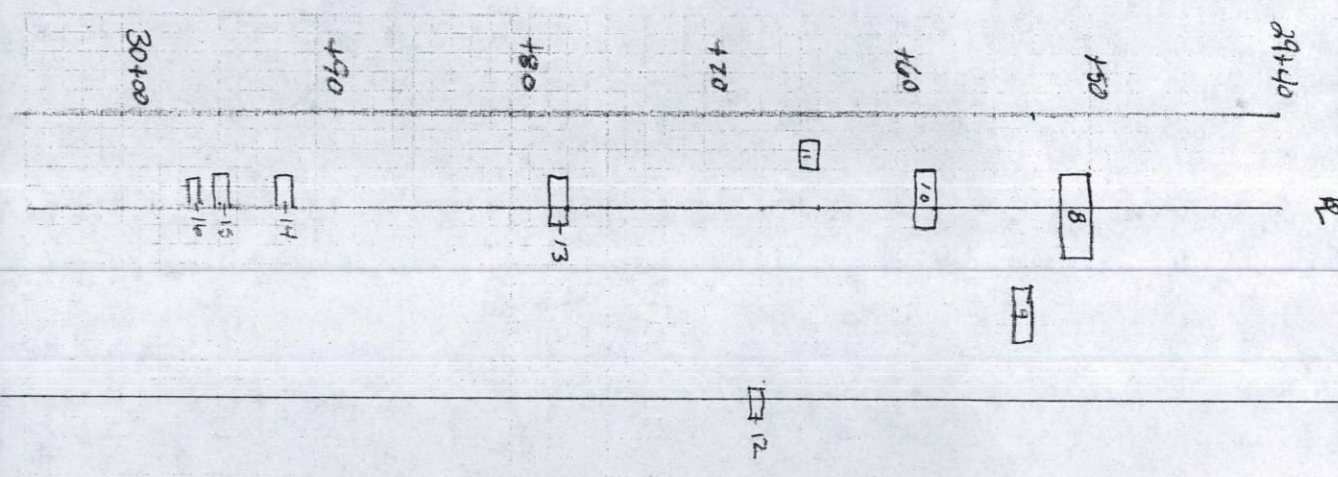

Plot #	Sta.	Loc.	Dist.	Notes
17	30+20	Ø L R	1.5x.7x.2	1.05' = .21V
18	30+43	15.2 R R	2.7x2.0x.27	5.4' = 1.5V
19	30+64	Ø L R	4.5x2.4x.25	10.8' = 2.7V
20	30+73	Ø L R	2x1.8x.10	3.2' = 3.2V

4925/19 = 247 yd
 5877 Flz / 9 = 652 yd
 0.29 amp

MEASURED BY GMH/AMS INITIAL(S) DATE 7-10-04
 CALCULATED BY GMH
 CHECKED BY AMS

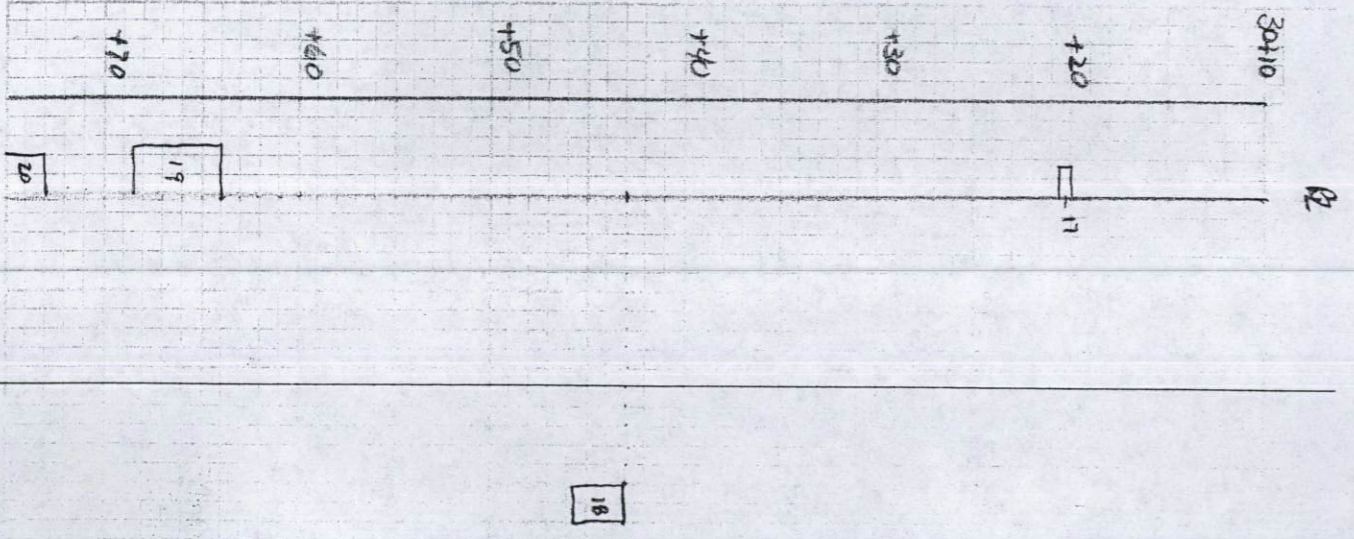

Roll #	Sta.	Loc.	Dist.	Dist. #	Dist. #	Dist. #
20	30173	0L B	See 19	#		
21	30121	1' L B	25110 x .15	2	=	38
22	31147	.5L B	40100 x .1	4.0	=	40
					$\frac{.40}{.78 \times .15}$	
					$\frac{.88}{y d^2}$	
					0.03 cup/yd	
					0.05 cup/yd	
					31100	
					+120	
					+30	
					+420	
					30180	


Roadway E BK 3A
Sub TOTAL - 0.52 cup/yd

MEASURED BY GMM/AB INITIAL(S) _____ DATE 7-10-04
 CALCULATED BY CAW _____ DATE 7-10-04
 CHECKED BY _____



Roll #	Sta.	Loc.	Dist.	Dist. #	Dist. #	Dist. #
23	33430	12L B 11R B	21126 x .11	5.72	=	.70
24	33460	3.2 B	12146			
18-58	#2 / 9		14081 x .13	12.91	=	1.71
					$\frac{2.41}{2.15}$	
					2.40	
					1842 #2 / 9 = 2.05 yd ²	
					Total 246 c.f. / 27 = 0.09 c.f.	

MEASURED BY DM INITIAL(S) _____ DATE 7/10/04
 CALCULATED BY DM _____ DATE 7/10/04
 CHECKED BY AB _____

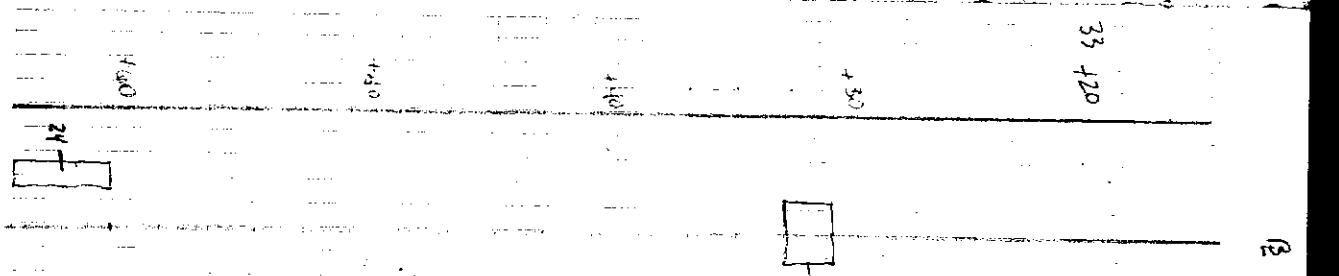

Post water Blast Zone East Side


Patch #	Sta.	Loc.	Dia.	
25	34+05	Ø 1.8	11.12 x .05	= .07 ✓

(20016200) Partial .07
Deck slab repair (partial)

$1.32 \text{ ft}^2 / 9 = .15 \text{ yd}^2$
 $1.32 \text{ ft}^2 / 9 = .15 \text{ yd}^2$

TOTAL = .07/27 = 0.003 CY


MEASURED BY DMW DATE 7/01/04
 CALCULATED BY DMW 7/01/04
 CHECKED BY WSP 7/20/04

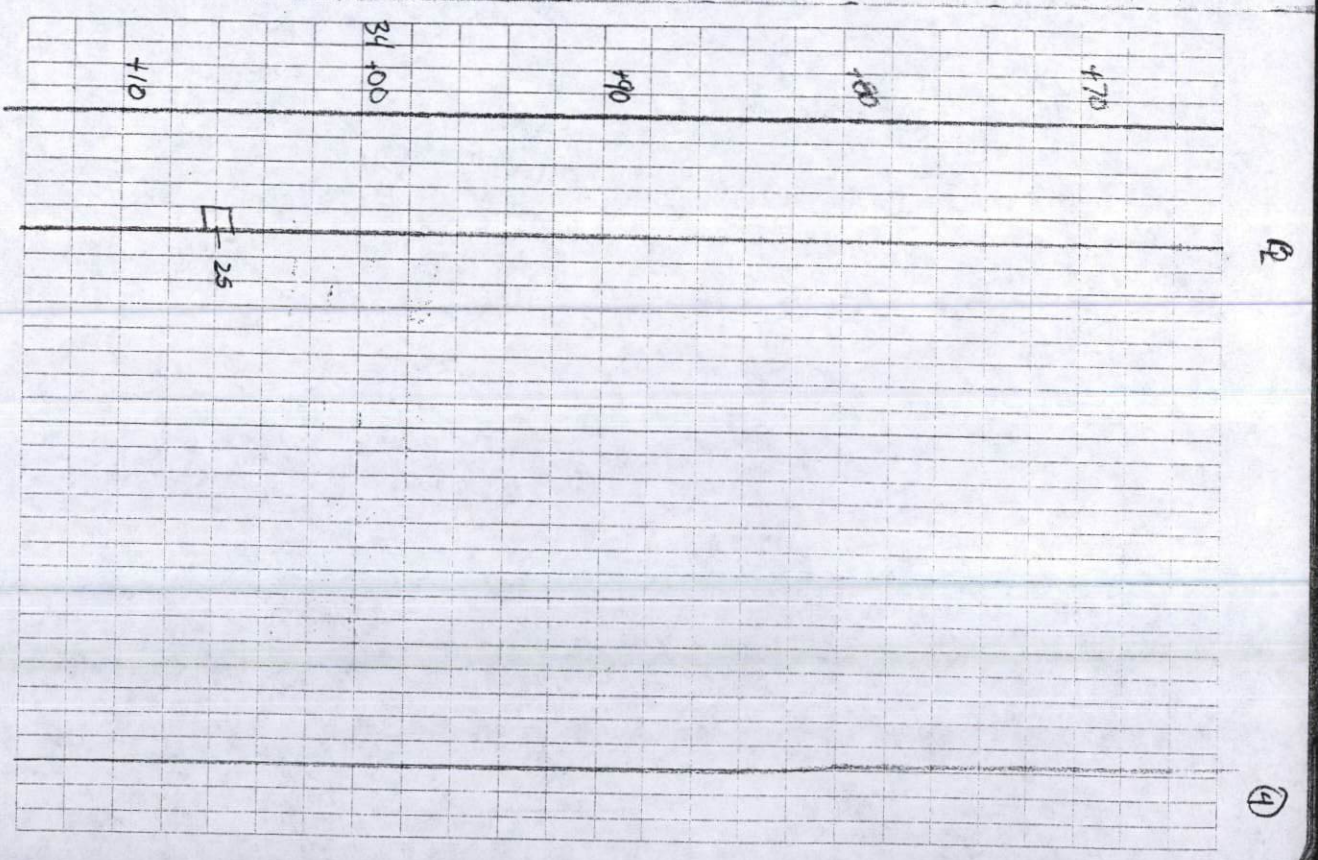

Patch # Sta. Post water Blast Zone East Side
 Loc. Dia. Left Side
 26 34+15 Ø 1.8 35.26 x .08 9.1 = .73 ✓
 27 34+00 1.11 Ø 05.11 x .07 5.75 = .40 ✓
 14.85 ft² / 9 = 1.65 yd² = 1.13 ✓

TOTAL = 1.13/27 = 0.04 CY

MEASURED BY DMW DATE 7/01/04
 CALCULATED BY DMW 7/01/04
 CHECKED BY WSP 7/20/04

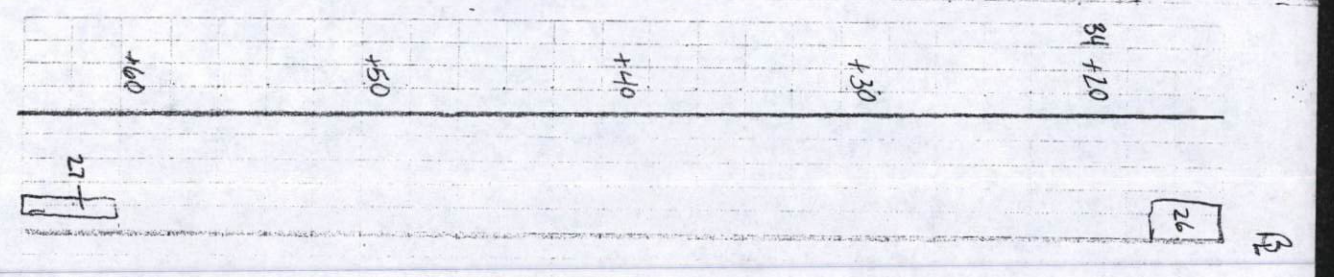


Patch #	Post Sta.	Water Loc.	Blast Dia.	Qty in Left Side
28	34+90	Ø 1 1/2	1.51 x .18	= .38 ✓

(20016200) Partial
Deck Slab Repair (partial)

2.1 Ft² / 9 = .23 Ft²

TOTAL: .38 / .01 = 38 ✓

MEASURED BY AMW 7/11/04
INITIALS) DATE
CALCULATED BY AMW 7/11/04
CHECKED BY ADD 7/20/04

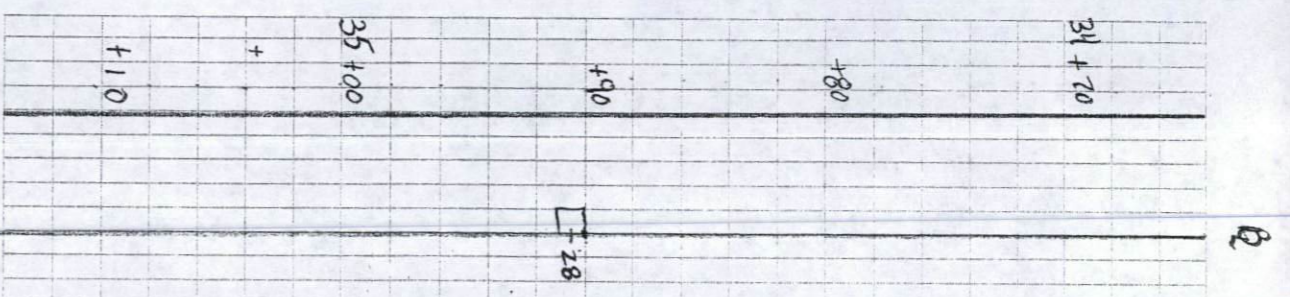


Patch #	Post Sta.	Water Loc.	Blast Dia.	Qty in Left Side
29	35+20	1 1/2	1.02 x .11	22.11 ✓ = 2.43 ✓
30	35+50.5	Ø 1 1/2	1.07 x 2.6 x .10	27.82 = 2.78 ✓
31	35+61.2	2.00 Ø 1.88	2.00 x .11	92.4 ✓ = 12.94 ✓

(20016200) Partial
Deck Slab Repair (partial)

142.32 Ft² / 9 = 15.81 Ft²

TOTAL: 18.15 / .27 = 67.22 ✓

MEASURED BY AMW 7/11/04
INITIALS) DATE
CALCULATED BY AMW 7/11/04
CHECKED BY ADD 7/20/04

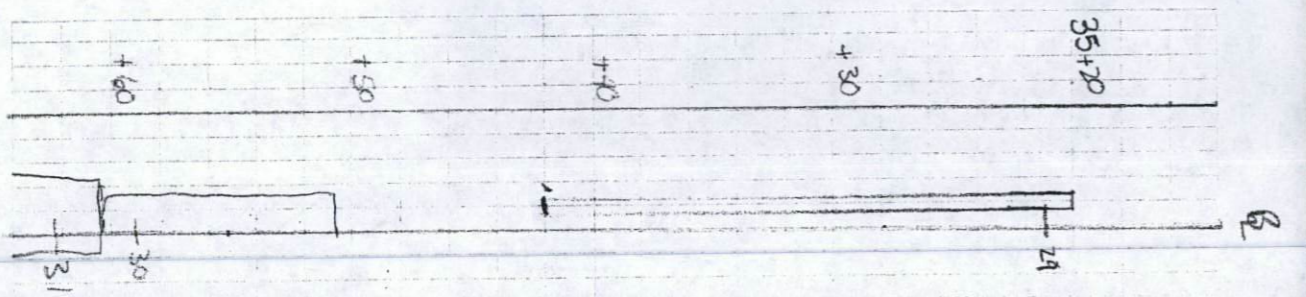


Batch #	Sta.	Post water	Loc.	Dist.	Right Side	Left Side
31	See pg 7					
32	35+82.2	ØL		3.6x16x.11	9.34	= 1.03 ✓
33	35+85.8	2.6x/2.2x		2.0x14x.10	28	= 2.80 ✓
34	35+92.8	4.5x/2.6x		2.2x18x.08	5.74	= .46 ✓
35	35+93.6	2.4x/1.9x		5.5x14x.09	24.75	= 2.23 ✓
36	35+99.1	4.5x/2.0x		7.1x13x.07	9.25	= .65 ✓
37	36+00	1.8x/2.6x		5.6x14x.08	24.64	= 2.0 ✓
38	36+06	3.9x/2.6x		3.2x15x.05	20.8	= 1.0 ✓
39	36+10.7	1.4x/2.6x		1.5x14x.10	6	= .60 ✓
40	36+14.5	3.9x/2.6x		6.5x16x.07	10.4	= .73 ✓

MEASURED BY MMW DATE 7/1/04
 CALCULATED BY MMW DATE 7/1/04
 CHECKED BY AWD DATE 7/20/04

INITIALS) DATE
 157194 / 9 = 1533 yd 2 15.44
 11.50

(Zodiac) Ractial 71.50 Total: 11.5/27
 Deck Slab repair (Ractial) Total: 0.43 C.Y.

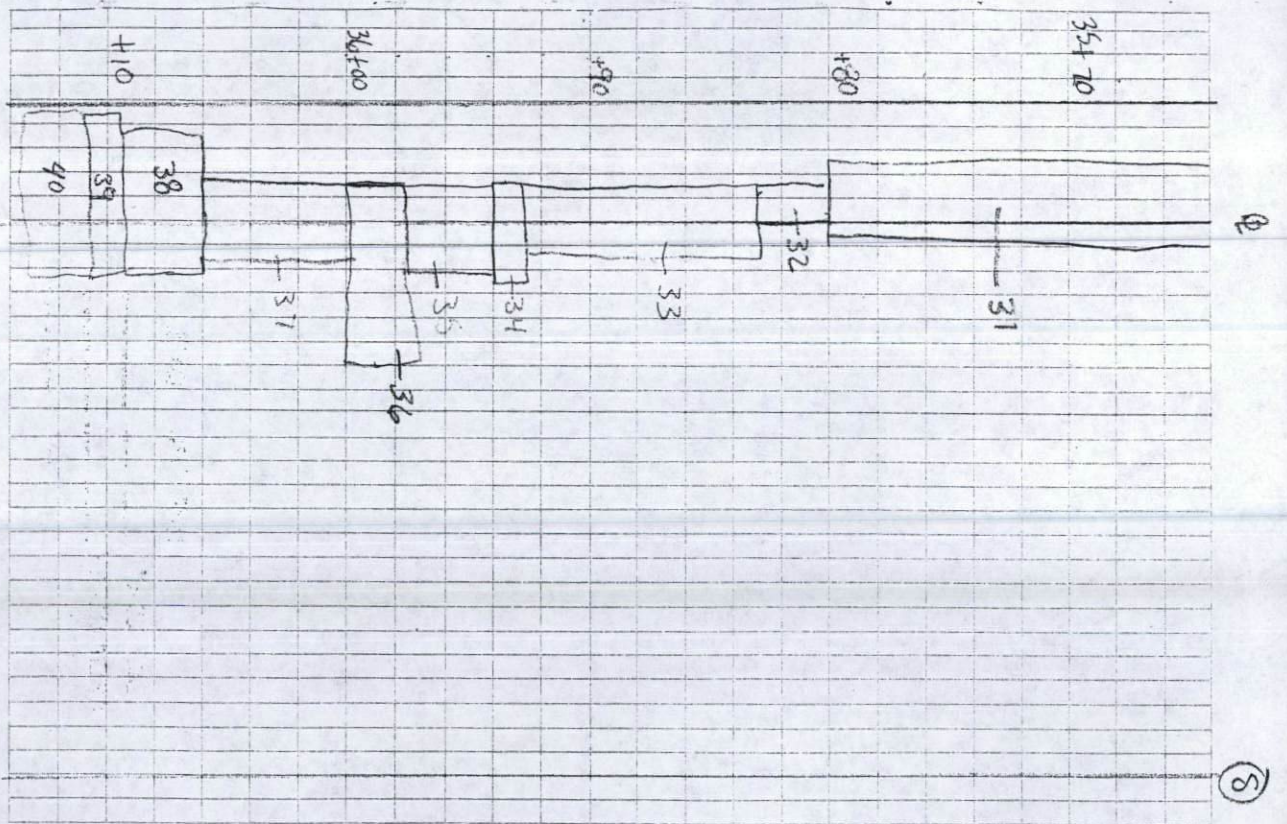


Batch #	Sta.	Post water	Loc.	Dist.	Right Side	Left Side
41	36+12.3	1.2x/2.6x		2.2x18x.1	9.34	= 5.9 ✓
42	36+14.5	6.1x/2.6x		9.2x17x.12	87.04	= 9.6 ✓
43	36+23.7	1.3x/2.6x		5.0x19x.08	11.7	= 9.4 ✓
44	36+26.7	1.0x		3.2x10x.19	3.5	= . ✓
45	36+29.9	9.1x/1.4x		4.1x10.5x.11	45.35	= 9.2 ✓

(Zodiac) Ractial 43.95
 Deck Slab repair (partially) Total: 43.95

146.35 yd 2 / 9 = 16.26 yd 2
 Total: 43.95/27 = 1.63 C.Y.

MEASURED BY MMW DATE 7/1/04
 CALCULATED BY MMW DATE 7/1/04
 CHECKED BY AWD DATE 7/20/04

INITIALS) DATE
 Total / pgs. 1-9 → 2.90 cu yd

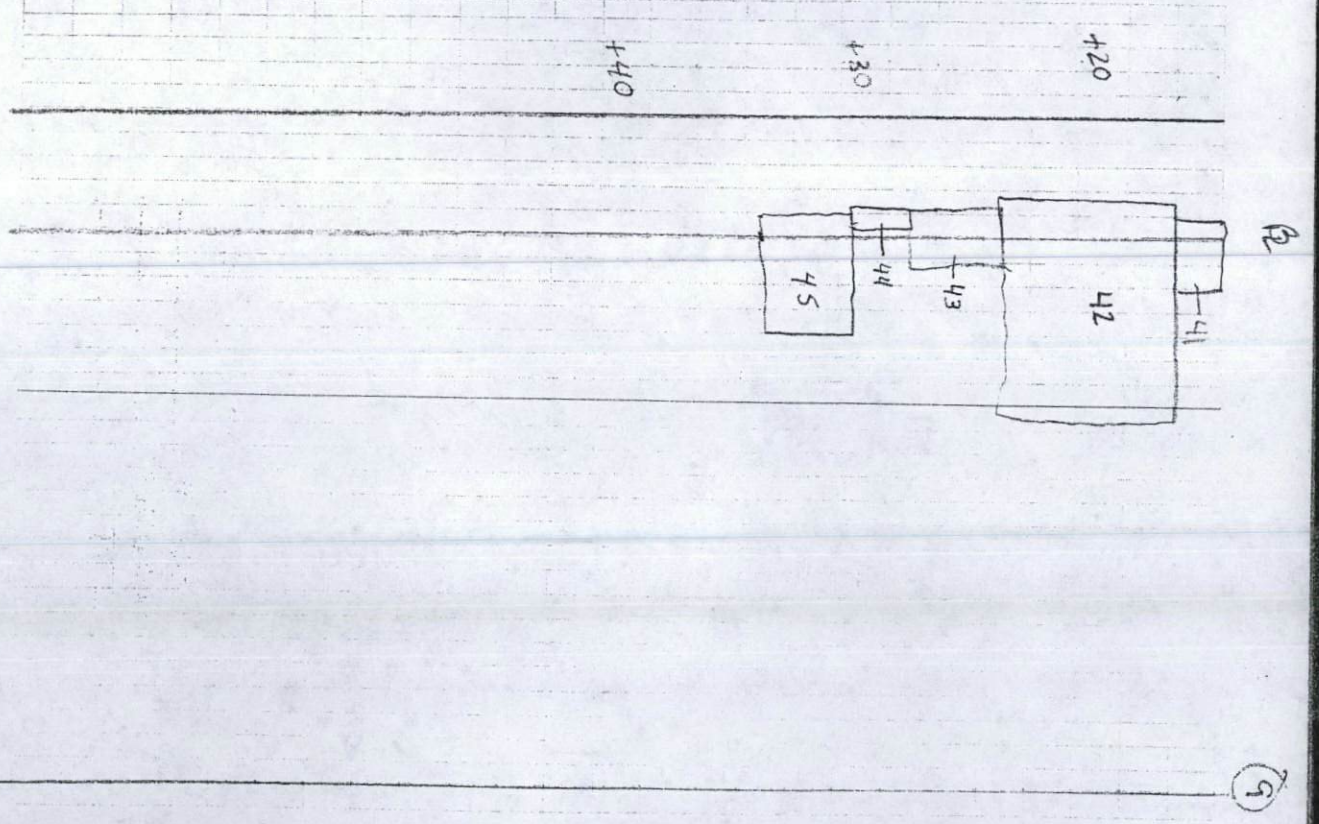

TOTALS:

RDWY E

Z0016200 - DECK SLAB REPAIR (PARTIAL)

= 61.97 S.Y. ~ 62.5 Y.
~ 3.44 C.Y.

See F.B. 3A PGS 72-73 : PGS 1-9 : 25-41 BK 3B

RDWY F

~~Z0016200 - DECK SLAB REPAIR (PARTIAL)~~

~~= 131.66 S.Y. ~ 131.7 S.Y.
~ 5.39 C.Y.~~

~~PGS 57-59, 72-75~~

RAMP N

~~Z0016200 - DECK SLAB REPAIR (PARTIAL)~~

~~= 510.99 S.Y. ~ 511 S.Y.
~ 17.3 C.Y.~~

~~See PGS 10-24~~

RAMP P

~~Z0016200 - DECK SLAB REPAIR (PARTIAL)~~

~~= 427.16 S.Y. ~ 427.2 S.Y. ~ 17.68 C.Y.
PGS 61-65 : 67-68~~

~~Z0016001 - DECK SLAB REPAIR (F.D. T.I.)~~

~~1 S.F. / 9 ~ 0.1 S.Y. PG 65~~

RAILWAY H

~~Z0016200 - DECK SLAB REPAIR (PARTIAL)~~

~~= 161.78 S.Y. ~ 164.8 S.Y.
~ 5.39 C.Y.~~

~~PG 66~~

RAMP N (FULL DEPTH)

~~Z0016001 - DECK SLAB REPAIR (FULL DEPTH T.I.)~~

~~= 9.46 ~ 9.5 S.F. / 9 ~ 1.05
~ 1.1 S.Y.~~

~~X9801200 - DECK SLAB REPAIR (FULL DEPTH T.I.)~~

~~= 217.75 S.F. / 9 ~ 24.13 ~ 24.2 S.Y.~~

~~PGS 10-11, 13-14, 17~~

MEAS BY GMM 11/10/04
CALC. BY SAG 9/16/04
✓ BY DAS

STATE OF ILLINOIS
DEPARTMENT OF TRANSPORTATION

ROUTE NO.	SECTION	COUNT	FEET	SHEET NO.
FAI-70	#	St. Clair	388	2
FED. ROAD DIST. NO. 7		CLASSIFICATION	FED. AID PROJECT	

(02-3H.3-2R-1)-2

SUMMARY OF QUANTITIES				URBAN										
CODE NUMBER	ITEM	UNIT	PROJECT TOTAL	ACIM		ACBHI				ACIM		ACBHI		100% STATE
				90% FED. 10% STATE	TRAFFIC CONTROL 0000-2A	RAMP O STRUCTURE NO. 082-0143 X531-2A	RAMP M STRUCTURE NO. 082-0145 X531-2A	RAMP D STRUCTURE NO. 082-0201 X131-2A	RAMP N STRUCTURE NO. 082-0202 X131-2A	RAMP P STRUCTURE NO. 082-0203 X531-2A	ROADWAY F STRUCTURE NO. 082-0204 X131-2A	ROADWAY E STRUCTURE NO. 082-0205 X131-2A	ROADWAY H STRUCTURE NO. 082-0206 SFTT-2A	
44000910	BITUMINOUS CONCRETE REMOVAL (DECK)	SO YD	21,594	--	--	1,479	3,845	2,499	1,927	3,462	4,801	3,443	138	
50102400	CONCRETE REMOVAL	CU YD	3,398.3	--	--	275.5	694.9	418.6	356.7	621.9	574.1	437.1	19.5	
50300150	NEOPRENE EXPANSION JOINT - 2"	FOOT	135	--	--	--	--	27	--	--	35	73	--	
50300155	NEOPRENE EXPANSION JOINT - 2.5"	FOOT	209	--	--	--	--	27	--	27	62	93	--	
50300160	NEOPRENE EXPANSION JOINT - 4"	FOOT	163	--	--	--	--	26	--	27	65	45	--	
50300225	CONCRETE STRUCTURES	CU YD	7.8	--	--	2.1	--	2.3	--	--	1.7	1.7	--	
50300255	CONCRETE SUPERSTRUCTURE	CU YD	2,670.0	--	--	215.3	561.7	342.8	286.5	493.9	427.6	327.2	15.0	
50300260	BRIDGE DECK GROOVING	SO YD	22,285	--	--	1,536	3,991	2,591	2,002	3,596	4,906	3,521	142	
50300300	PROTECTIVE COAT	SO YD	5,842	--	--	491	1,275	680	640	1,113	923	685	35	
50300310	ELASTOMERIC BEARING ASSEMBLY, TYPE I	EACH	14	--	--	--	6	--	--	2	6	--	--	
50300320	ELASTOMERIC BEARING ASSEMBLY, TYPE II	EACH	18	--	--	--	--	8	2	--	2	6	--	
50301245	FORMED CONCRETE REPAIR (DEPTH EQUAL TO OR LESS THAN 5")	SO FT	3,771	--	--	11	1,077	222	490	215	381	1,375	--	
50301250	FORMED CONCRETE REPAIR (DEPTH GREATER THAN 5")	SO FT	4	--	--	1	3	--	--	--	--	--	--	
50500105	FURNISHING AND ERECTING STRUCTURAL STEEL	L SUM	1	--	--	0.1	0.2	0.1	0.1	0.2	0.2	0.1	--	
50500715	JACK AND REMOVE EXISTING BEARINGS	EACH	32	--	--	--	6	8	2	2	8	6	--	
50800205	REINFORCEMENT BARS, EPOXY COATED	POUND	523,210	--	--	43,290	107,980	59,280	55,490	96,580	88,410	69,040	3,140	
54002500	EXPANSION BOLTS (SPECIAL)	EACH	1,752	--	--	92	502	154	164	390	218	232	--	
67000400	ENGINEER'S FIELD OFFICE, TYPE A	CAL MO	24	24	--	--	--	--	--	--	--	--	--	
67100100	MOBILIZATION	L SUM	1	1	--	--	--	--	--	--	--	--	--	
70100205	TRAFFIC CONTROL AND PROTECTION, STANDARD 701401	EACH	6	--	6	--	--	--	--	--	--	--	--	
70100207	TRAFFIC CONTROL AND PROTECTION, STANDARD 701402	EACH	2	--	2	--	--	--	--	--	--	--	--	
70101800	TRAFFIC CONTROL AND PROTECTION (SPECIAL)	L SUM	1	--	1	--	--	--	--	--	--	--	--	
70300220	TEMPORARY PAVEMENT MARKING LINE 4"	FOOT	15,759	--	15,759	--	--	--	--	--	--	--	--	
70300240	TEMPORARY PAVEMENT MARKING LINE 6"	FOOT	5,493	--	5,493	--	--	--	--	--	--	--	--	
70301000	WORK ZONE PAVEMENT MARKING REMOVAL	SO FT	4,061	--	4,061	--	--	--	--	--	--	--	--	
70400500	TEMPORARY CONCRETE BARRIER (STATE OWNED)	FOOT	1,451	--	1,451	--	--	--	--	--	--	--	--	
70400600	RELOCATE TEMPORARY CONCRETE BARRIER (STATE OWNED)	FOOT	4,042	--	4,042	--	--	--	--	--	--	--	--	
7800310	POLYUREA PAVEMENT MARKING TYPE II - LINE 4 INCH	FOOT	17,019	14,840	2,179	--	--	--	--	--	--	--	--	
7800340	POLYUREA PAVEMENT MARKING TYPE II - LINE 8 INCH	FOOT	2,380	2,380	--	--	--	--	--	--	--	--	--	
78100105	RAISED REFLECTIVE PAVEMENT MARKER (BRIDGE)	EACH	74	74	--	--	--	--	--	--	--	--	--	
78200100	MONODIRECTIONAL PRESMAIC BARRIER REFLECTOR	EACH	178	--	178	--	--	--	--	--	--	--	--	
78300100	PAVEMENT MARKING REMOVAL	SO FT	1,672	--	1,672	--	--	--	--	--	--	--	--	
X0321781	MECHANICAL SPLICE	EACH	618	--	--	50	150	50	50	50	179	89	--	
X0322050	RAISED REFLECTIVE PAVEMENT MARKER, REFLECTOR REMOVAL	EACH	9	--	9	--	--	--	--	--	--	--	--	
X0322549	COLUMN WRAP	SO FT	17,149	--	--	950	3,668	1,916	1,385	4,243	3,123	1,864	--	
X0322553	FOUNDATION WALL DOWEL MODIFICATION	EACH	18	--	--	6	2	--	1	3	2	4	--	
X0322556	STIFFENER INTERSECTION MODIFICATION	EACH	1,976	--	--	272	--	408	344	--	544	408	--	
X0322559	BOLT REPLACEMENT	EACH	514	--	--	10	109	6	30	2	273	84	--	
X0322560	CRACK EXTENSION MODIFICATION	EACH	28	--	--	4	4	4	4	4	4	4	--	
X0322563	VERTICAL WEB STIFFENER REMOVAL	EACH	3,668	--	--	316	801	482	360	691	628	390	--	
X0323082	DRAINAGE SCUPPERS, DS-33	EACH	64	--	--	2	10	8	14	7	8	15	--	
X0323558	BRIDGE JOINT SYSTEM (EXPANSION), 1-5/8"	FOOT	134	--	--	26	--	26	26	39	--	--	17	
X0343400	REMOVE AND REINSTALL BEARINGS	EACH	10	--	--	--	--	--	4	--	2	4	--	
X70151050	PORTABLE CHANGEABLE MESSAGE SIGN	CAL MO	126	--	126	--	--	--	--	--	--	--	--	
Z0076600	TRAINEES	HOOR	500	500	--	--	--	--	--	--	--	--	--	
XZ193500	BRIDGE DECK MICROSILICA CONCRETE OVERLAY - 2 1/4"	SO YD	23,879	--	--	1,670	4,340	2,777	2,177	3,896	5,159	3,709	151	
Z0012100	CONCRETE BRIDGE DECK SCARIFICATION (1/4 INCH)	SO YD	23,879	--	--	1,670	4,340	2,777	2,177	3,896	5,159	3,709	151	
Z0016001	DECK SLAB REPAIR (FULL DEPTH, TYPE I)	SO YD	5.1	--	--	0.4	0.7	0.4	0.4	0.3	0.7	0.2	--	
Z0016200	DECK SLAB REPAIR (PARTIAL)	SO YD	510.2	--	--	41.7	192.4	94.3	81.3	40.1	10.1	50.3	--	
Z0018800	DRAINAGE SYSTEM	L SUM	1	--	--	0.125	0.375	0.125	0.125	0.125	0.125	--	--	
Z0022400	FABRIC REINFORCED ELASTOMERIC TROUGH	FOOT	237	--	--	27	79	27	27	27	50	--	--	
Z0029999	IMPACT ATTENUATOR REMOVAL	EACH	1	1	--	--	--	--	--	--	--	--	--	
Z0030150	IMPACT ATTENUATOR (NON-REDIRECTIVE), TEST LEVEL 3	EACH	1	1	--	--	--	--	--	--	--	--	--	
Z0047300	PROTECTIVE SHIELD	SO YD	3,026	--	--	--	865	1,037	358	420	171	175	--	
Z0048665	RAILROAD PROTECTIVE LIABILITY INSURANCE	L SUM	1	1	--	--	--	--	--	--	--	--	--	
Z0049100	RAISED PAVEMENT MARKER REFLECTOR REPLACEMENT	EACH	9	--	9	--	--	--	--	--	--	--	--	
Z0030250	IMPACT ATTENUATORS, TEMPORARY (NON-REDIRECTIVE), TEST LEVEL 3	EACH	24	--	24	--	--	--	--	--	--	--	--	
Z0030350	IMPACT ATTENUATORS, RELOCATE (NON-REDIRECTIVE), TEST LEVEL 3	EACH	48	--	48	--	--	--	--	--	--	--	--	
Z0073200	TEMPORARY SHORING AND CRIBBING	EACH	32	--	--	--	6	8	2	2	8	6	--	
I REMOVE TIE BEAM (SPECIAL)	EACH	13	--	--	1	--	--	4	--	--	5	3	--	
I REPLACE TIE BEAM (SPECIAL)	EACH	6	--	--	--	--	--	1	--	--	3	2	--	
I REMOVE AND REPLACE COLUMN (SPECIAL)	EACH	6	--	--	--	--	--	3	--	--	1	2	--	

DESIGNED	R. Victor
CHECKED	D. James
DRAWN	E. Bazzell
CHECKED	R. Victor

- * SPECIALTY ITEM
- Ø Y080
- Δ SFTY 3N

PREPARED BY:
JACOBS CIVIL INC.
ST. LOUIS, MO

REHABILITATION FOR FAI 55/70 COMPLEX

SUMMARY OF QUANTITIES
(FAI-70) ST. CLAIR CO.

F.A.P. RTE.	SECTION	COUNTY	TOTAL SHEETS	SHEET NO.	SHEET NO. 2
FAI-70	482-3HV8-2R-11-2	ST. CLAIR	388	3	56 SHEETS
STA.	TO STA.				
FED. ROAD DIST. NO.	ILLINOIS FED. AID PROJECT				

INDEX OF SHEETS

- 1 NOT USED
- 2 STAGE CONSTRUCTION DETAILS
- 3 NOT USED
- 4-7 TYPICAL SECTIONS
- 8-9 SCHEDULE OF QUANTITIES (TRAFFIC CONTROL)
- 10-13 EXISTING SIGNS KEY
- 14-15 EXISTING SIGNS STAGE 1
- 16-22 TRAFFIC CONTROL PLAN STAGE 1
- 23-28 EXISTING SIGNS STAGE 2
- 27-34 TRAFFIC CONTROL PLAN STAGE 2
- 35-37 EXISTING SIGNS STAGE 3
- 38-44 TRAFFIC CONTROL PLAN STAGE 3
- 45 EXISTING SIGNS STAGE 4
- 46-54 TRAFFIC CONTROL PLAN STAGE 4
- 55 TRAFFIC CONTROL AND PROTECTION (SPECIAL 01)
- 56 SPECIAL SIGN DETAILS

STANDARDS


- 000001-04
- 635006-02
- 635011-01
- 701401
- 701402-03
- 701426-01
- 702001-03
- 704001-02
- 780001-01
- 781001-02

INDEX OF SHEETS - PROJECT


- 1 COVER SHEET
- 2 SUMMARY OF QUANTITIES
- 3-56 STAGE CONSTRUCTION AND TRAFFIC CONTROL
- 57-89 RAMP O - SN 082-0143
- 90-150 RAMP M - SN 082-0145
- 151-196 RAMP D - SN 082-0201
- 199-236 RAMP N - SN 082-0202
- 239-290 RAMP P - SN 082-0203
- 291-342 ROADWAY F - SN 082-0204
- 343-388 ROADWAY E - SN 082-0205

NOTES


1. ALL PAVEMENT MARKINGS FOR STAGE CONSTRUCTION SHALL BE PAINTED.
2. DELETED
3. PEAK HOURS IS DEFINED AS 6:00 AM TO 9:00 AM WESTBOUND AND 3:00 PM TO 6:00 PM EASTBOUND.
4. ANY ADDITIONAL SIGNAGE REQUIRED FOR ANY/ALL PHASES OF CONSTRUCTION THAT REQUIRE LANE CLOSURES SHALL BE INCLUDED IN THE LUMP SUM PAY ITEM FOR TRAFFIC CONTROL STANDARD 701401.
5. NO LANE CLOSURE BETWEEN NOVEMBER 30 AND MAY 1 UNLESS APPROVED BY THE ENGINEER.
6. AN ESTIMATED QUANTITY OF SEVEN (7) PORTABLE CHANGEABLE MESSAGE SIGNS HAS BEEN INCLUDED IN THE PLANS FOR ADVANCED NOTICE OF DETOURS AND RAMP CLOSURES. FOUR (4) OF THE CHANGEABLE MESSAGE SIGNS WILL BE LOCATED IN MISSOURI ON INTERSTATES 44,55,64, AND 70. TWO (2) CHANGEABLE MESSAGE SIGNS WILL BE LOCATED ON INTERSTATE 255 IN ILLINOIS. ONE (1) CHANGEABLE MESSAGE SIGN WILL BE PROVIDED FOR EACH STAGE OF CONSTRUCTION. THE EXACT LOCATIONS WILL BE DETERMINED BY THE ENGINEER.
7. STATE OWNED CONCRETE BARRIER IS LOCATED NEAR THE INTERSECTION OF IL ROUTE 111 AND FAI 55/70. THE CONTRACTOR IS RESPONSIBLE FOR PICK UP AND RETURN OF STATE OWNED BARRIER.
8. SIGNS SHALL BE MOUNTED ON EXISTING TRUSS MEMBERS. SIGN TRUSS STRUCTURAL MEMBERS ARE NOT TO BE DRILLED, CUT OR OTHERWISE MODIFIED IN MOUNTING DETOUR SIGNS.
9. TAPERED END SECTION NO LONGER ALLOWED.
10. PAINT REMOVAL SHALL BE BY THE WATER-BLAST METHOD.
11. ONE-WAY TRAFFIC IN AND OUT OF ACCESS OPENINGS.
12. WARNING SIGNS READING "TRUCKS ENTERING AND LEAVING HIGHWAY" SHALL BE PLACED IN ADVANCE OF ACCESS OPENINGS.
13. BRIDGE DECK MICROSILICA CONCRETE OVERLAY SHALL REQUIRE THE DIRECT BOND METHOD.
14. IF ANY SECTION OR SUB-SECTION MONUMENTS ARE ENCOUNTERED, THE ENGINEER SHALL BE NOTIFIED BEFORE SUCH MONUMENTS ARE REMOVED OR DISTURBED. THE CONTRACTOR SHALL PROTECT AND CAREFULLY PRESERVE ALL PROPERTY MARKERS AND MONUMENTS UNTIL THE OWNER, AND AUTHORIZED SURVEYOR, OR AGENT HAS WITNESSED OR OTHERWISE REFERENCED THEIR LOCATION.
15. ILLINOIS STATE LAW REQUIRES A 48-HOUR NOTICE BE GIVEN TO ALL UTILITIES BEFORE DIGGING. FIELD MARKING OF FACILITIES MAY BE OBTAINED BY CONTACTING J.U.L.I.E. AT (800)-892-0123, OR FOR NON-MEMBERS, THE UTILITY COMPANY DIRECTLY.
16. ALL TEMPORARY PAVEMENT MARKINGS WILL BE PLACED IN SUCH A MANNER SO AS NOT TO INTERFERE WITH THE PLACEMENT OF PERMANENT PAVEMENT MARKINGS.
17. ANY TEMPORARY CONCRETE BARRIER UNITS SHALL BE ANCHORED TO THE PAVEMENT TO PREVENT OVERTURNING AND LATERAL DEFLECTIONS GREATER THAN THOSE OBTAINED DURING THE NCHRP TESTS.
18. THE APPROACH ENDS OF TEMPORARY BARRIER SHALL BE PROTECTED WITH NCHRP TEST LEVEL 3 APPROACH DEVICE SUCH AS A MULTIPLE ARRAY OF SAND FILLED PLASTIC BARRELS OR A TYPE 3, SPECIAL TERMINAL.

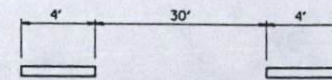

**REFLECTORIZED PAVEMENT MARKING
SKIP-DASH DETAIL**

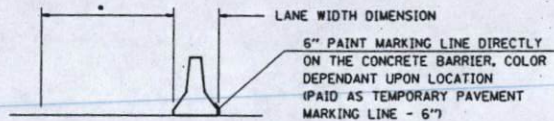

• DIMENSION FROM EDGE OF PAVEMENT OR BRIDGE PARAPET TO CONCRETE BARRIER

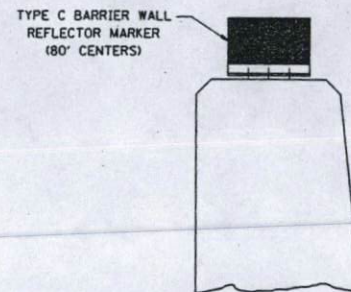

**TYPICAL MOUNTING DETAIL
FOR BARRIER WALL REFLECTOR**

P:\C111980\706cadd\702civil\stage00_special_standard.dwg

REVISIONS	
NAME	DATE

ILLINOIS DEPARTMENT OF TRANSPORTATION

STAGE CONSTRUCTION DETAILS

DATE 17-NOV-2003
DRAWN BY A. Ledbetter
CHECKED BY A. Frey

Benchmark: #26 Elev. 404.396 X-cut in N.W. corner of concrete abutment at center pier of Ill. Central R.R. Bridge over Ill. Rte. 3.


Existing Structure: SN 082-0205 was built as F.A.I. Route 70 Section (82-3HVB-2R-1)-2 in 1970. The roadway is striped for two 12-foot lanes. The Superstructure consists of three-3 span continuous units with two welded steel plate girders, plate girder floor beams, rolled stringers, and non-composite R.C. slab, and one simple span with composite slab on rolled girders. The Substructure is R.C. piers on R.C. piles and one spill through abutment. Existing structure shall be rehabilitated with seismic retrofit and redundancy retrofit. Traffic shall be maintained during the rehabilitation.

STATE OF ILLINOIS
DEPARTMENT OF TRANSPORTATION

ROUTE NO.	SECTION	QUANTITY	DATE	SHEET NO.
FAI-70	*	St. Clair	388	343
46 SHEETS				



(82-3HVB-2R-1)-2

Salvage: None

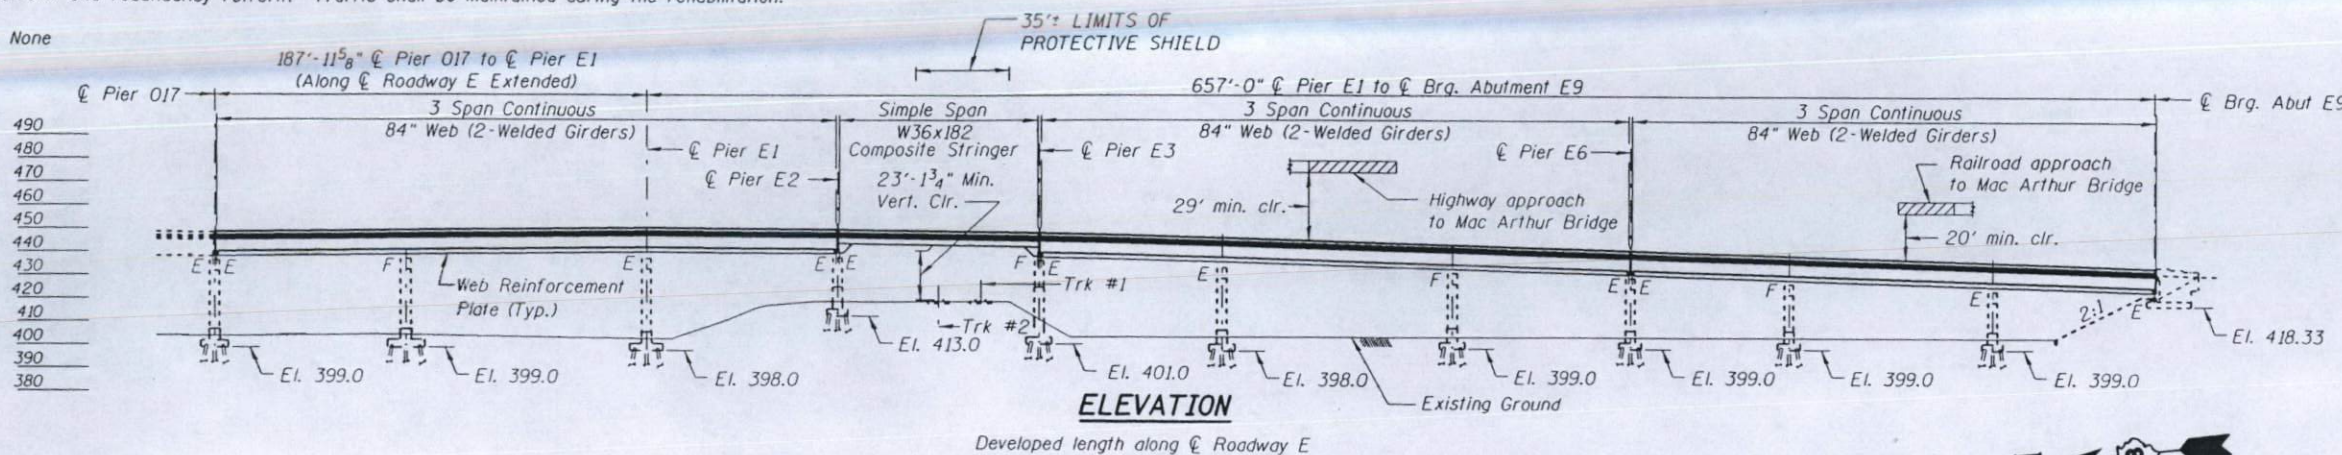

INDEX OF SHEETS

1	GENERAL PLAN AND ELEVATION SPANS 018 THRU E9	510
2	GENERAL NOTES AND TOTAL BILL OF MATERIAL	500
3	SCOPE OF WORK	490
4	NOT USED	490
5	SLAB SPANS 018 AND E1 THRU E3	480
6	SLAB SPANS E4 THRU E9	470
7	PARAPET DETAILS SPANS 018, E1 AND E2	460
8	PARAPET DETAILS SPANS E3 THRU E9	450
9	EXPANSION JOINT REPLACEMENT DETAILS	440
10	DEMOLITION DETAILS AND SUPERSTRUCTURE BILL OF MATERIAL	430
11	DRAINAGE DETAILS	420
12	DRAINAGE SCUPPER DS-33	410
13	NEOPRENE EXPANSION JOINT DETAILS PIERS 017, E2, E3, E6 AND ABUTMENT E9	400
14	RETROFIT AND SUBSTRUCTURE REPAIR PIER 017	390
15	RETROFIT AND SUBSTRUCTURE REPAIR PIER 017	380
16	RETROFIT AND SUBSTRUCTURE REPAIR PIER 018	
17	RETROFIT AND SUBSTRUCTURE REPAIR PIER 018	
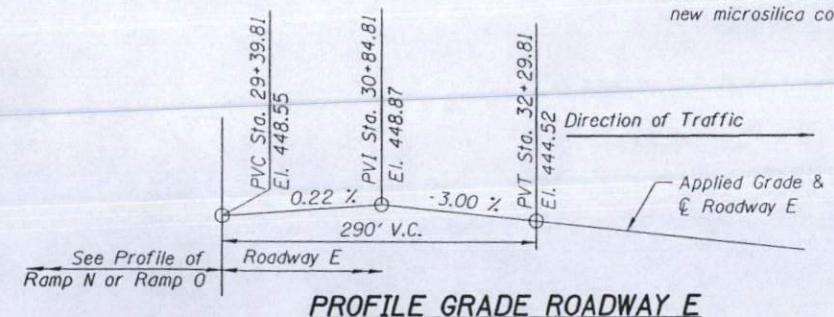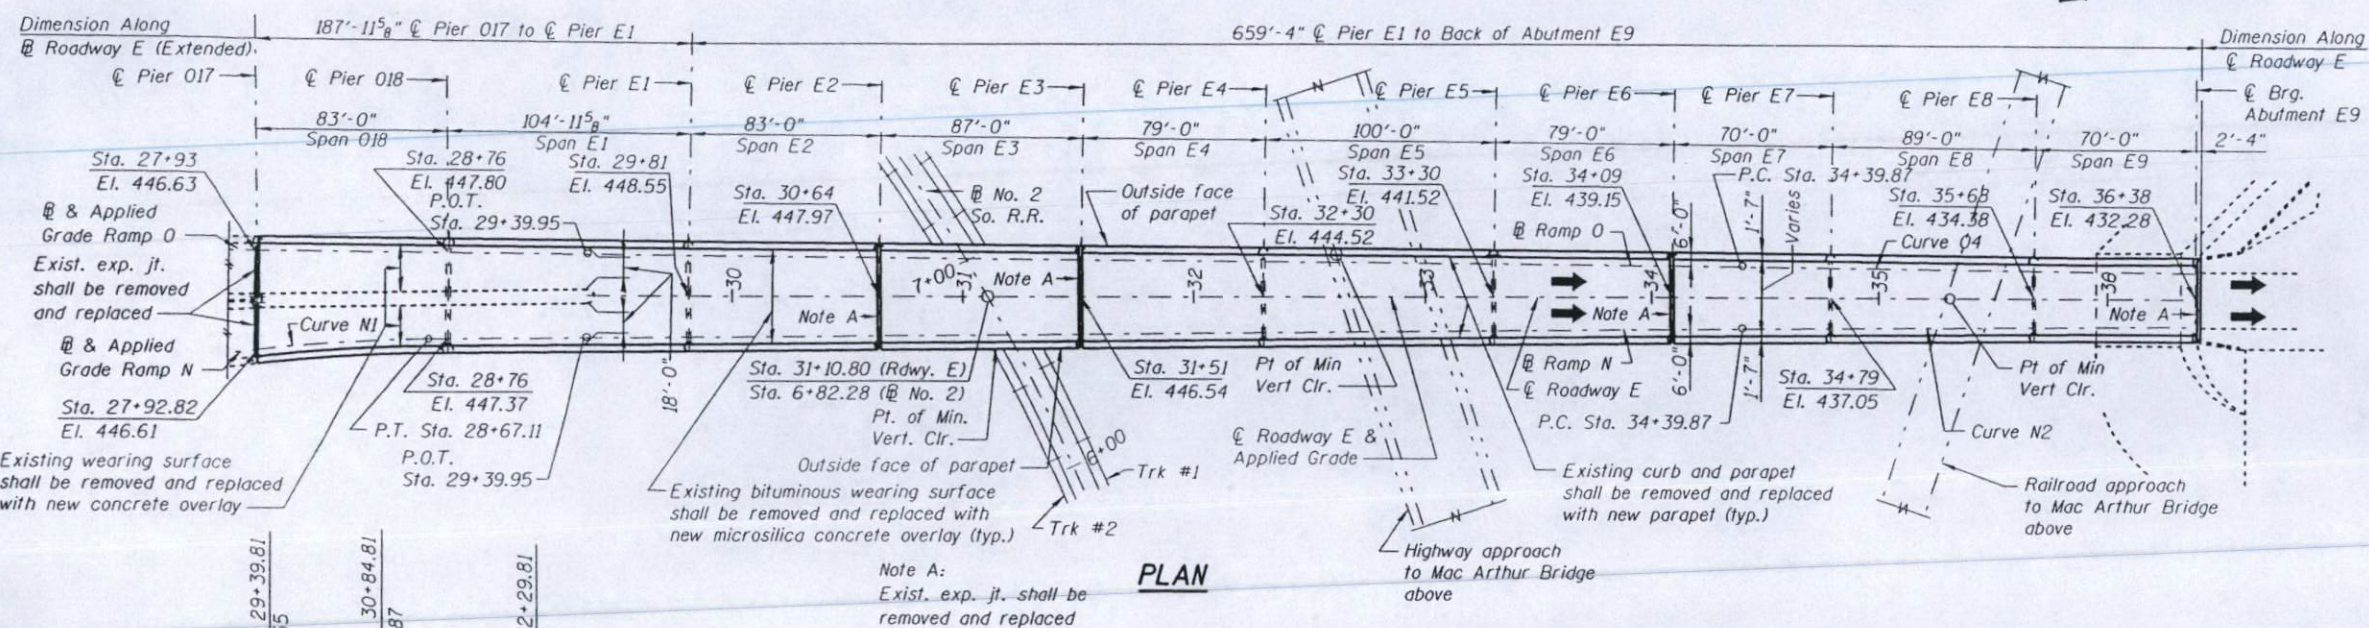

CURVE DATA

CURVE N1	CURVE N2	CURVE 04
P.I. = 25+09.37	P.I. = 35+89.88	P.I. = 35+89.88
Δ = 67°44'14"	Δ = 0°31'44"	Δ = 0°31'44"
D = 8°11'06"	D = 0°10'35"	D = 0°10'35"
R = 700.00'	R = 32,500.00'	R = 32,500.00'
L = 827.57'	L = 300.00'	L = 300.00'
T = 469.82'	T = 150.00'	T = 150.00'
E = 143.05'	E = 0.35'	E = 0.35'
S = 8.00%		

DESIGN SPECIFICATIONS:
1996 AASHTO with 1997 thru 2002 interims. FHWA-RD-94-052 "Seismic Retrofitting Manual for Highway Bridges", 1995


SEISMIC DATA:
Seismic Performance Category (SPC) = B
Bedrock Acceleration Coefficient (A) = 0.12
Site Coefficient (S) = 1.0

DESIGN STRESSES:
New Construction:
Reinforced concrete: f'c = 3,500 psi
Reinforcement bars: fy = 60,000 psi
Structural steel: fy = 70,000-psi (M270, Grade 70W) Web Reinforcement Plate fy = 50,000 psi (M270, Grade 50) All other locations

Existing Structure:
Reinforced concrete: f'c = 1,400 psi n = 10
Structural Steel: fs = 20,000 psi

NOTES

Profile grade elevations are to top of original slab and do not take into account wearing surface or overlay thickness.

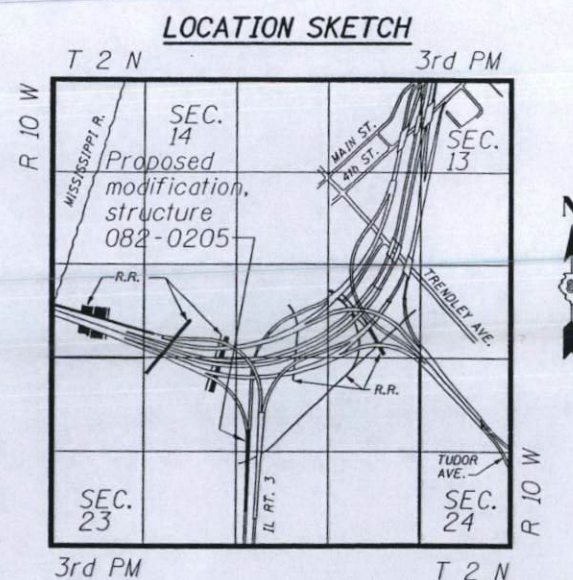

DESIGNED	M. Capron
CHECKED	A. Amidi
DRAWN	M. King
CHECKED	D. James

PREPARED BY:
JACOBS CIVIL INC.
ST. LOUIS, MO

JOHN E. FINKE, S.E.
STRUCTURAL/SEISMIC RETROFIT

LANCE PETERMAN, S.E.
REDUNDANCY RETROFIT

REHABILITATION FOR FAI 55/70 COMPLEX
ROADWAY E - STRUCTURE NO. 082-0205
GENERAL PLAN AND ELEVATION
SPANS 018 THRU E9
STA. 27+92.82 THRU 36+38 (FAI-70) ST. CLAIR CO.

STATE OF ILLINOIS
DEPARTMENT OF TRANSPORTATION

ROUTE NO.	SECTION	COUNTY	POST MILE	SHEET NO.	SHEET NO. 2
FAI-70	*	St. Clair	388	344	46 SHEETS
FED. ROAD DIST. NO. 7	S.L. NO.	FED. ROAD PROJECT			

*(82-3HVB-2R-1)-2

GENERAL NOTES

Plan dimensions and details relative to existing structure have been taken from existing plans and are subject to nominal construction variations. It shall be the Contractor's responsibility to verify such dimensions and details in the field and make necessary approved adjustments prior to construction or ordering of materials. Such variations shall not be cause for additional compensation for a change in the scope of the work, however, the Contractor shall be paid for the quantity actually furnished at the unit price for the work.

All transverse and longitudinal dimensions are measured horizontally. All dimensions are measured at a temperature of 50° F.

All existing operational electrical and I.T.S. equipment shall remain in operation during construction unless approved otherwise by the Engineer.

Reinforcement bars shall conform to the requirements of AASHTO M31, M42 or M53, Grade 60.

Unless noted otherwise, all new steel shall be AASHTO M270 Grade 50.

Calculated weight of Structural Steel (M270, Grade 70W) = 149,480 lbs.

Calculated weight of Structural Steel (M270, Grade 50) = 118,960 lbs.

Fasteners shall be high strength bolts.

All turnbuckles, clevises and pins shall be galvanized and capable of developing the ultimate strengths of the corresponding assemblies.

Field welding of construction accessories will not be permitted to beams or girders.

The inorganic zinc rich primer/acrylic/acrylic paint system shall be used for shop and field painting of new structural steel except where otherwise noted. The color of the final finish coat shall be Interstate Green, Munsell No. 7.5G/8. See Special Provision for "Cleaning and Painting New Metal Structures".

Existing structural steel that will be in contact with new structural steel shall be cleaned and painted prior to erection as required by the special provision "Cleaning And Painting Contact Surface Areas Of Existing Steel Structures".

All construction joints shall be bonded.

Prior to pouring the new concrete deck, all loose rust, loose mill scale, and other loose potentially detrimental foreign material shall be removed from the surfaces of the beams or girders in contact with concrete. The cost of this work will be included in the pay item covering removal of existing concrete. All heavy rust and other tightly adhered potentially detrimental foreign matter shall also be removed from the surfaces of the beams or girders in contact with concrete. Tightly adhered paint may remain unless otherwise noted. This removal shall be accomplished by methods that will not damage the steel. The cost of this work will be paid for according to Article 109.04.

All existing construction accessories welded to the top flange over the pier(s) between the quarter points of the beams or girders shall be removed. The remaining weld shall be ground smooth and inspected for cracks using magnetic particle testing. Any cracks that can not be removed by grinding approximately 1/4 inch deep shall be identified and reported to the Bureau of Bridges and Structures for further disposition. The cost of this work shall be paid for according to Article 109.04.

Expansion joint openings shall be adjusted according to Article 503.10(c) of the Standard Specifications when the deck is poured at an ambient temperature other than 50° F.

All web reinforcement plates and web splice plates shall conform to the Supplemental Requirements for Notch Toughness, Zone 2.

Existing reinforcement bars extending into the removal area shall be cleaned, straightened and incorporated into the new construction. Any reinforcement bars that are damaged during concrete removal shall be replaced with an approved bar splicer or anchorage system. Cost included with the applicable pay item for removal.

TOTAL BILL OF MATERIAL

ITEM	UNIT	SUPERSTRUCTURE	SUBSTRUCTURE	TOTAL
BITUMINOUS CONCRETE REMOVAL (DECK)	SQ YD	3,443	--	3,443
CONCRETE REMOVAL	CU YD	437.1	--	437.1
NEOPRENE EXPANSION JOINT - 2"	FOOT	73	--	73
NEOPRENE EXPANSION JOINT - 2.5"	FOOT	93	--	93
NEOPRENE EXPANSION JOINT - 4"	FOOT	45	--	45
CONCRETE STRUCTURES	CU YD	--	1.7	1.7
CONCRETE SUPERSTRUCTURE	CU YD	327.2	--	327.2
BRIDGE DECK GROOVING	SQ YD	3,521	--	3,521
PROTECTIVE COAT	SQ YD	685	--	685
ELASTOMERIC BEARING ASSEMBLY, TYPE II	EACH	6	--	6
FORMED CONCRETE REPAIR (DEPTH EQUAL TO OR LESS THAN 5")	SQ FT	--	1,375	1,375
FURNISHING AND ERECTING STRUCTURAL STEEL	L SUM	--	--	0.1
JACK AND REMOVE EXISTING BEARINGS	EACH	6	--	6
REINFORCEMENT BARS, EPOXY COATED	POUND	69,040	--	69,040
EXPANSION BOLTS (SPECIAL)	EACH	232	--	232
MECHANICAL SPLICE	EACH	89	--	89
COLUMN WRAP	SQ FT	--	1,864	1,864
FOUNDATION WALL DOWEL MODIFICATION	EACH	--	4	4
STIFFENER INTERSECTION MODIFICATION	EACH	408	--	408
BOLT REPLACEMENT	EACH	84	--	84
CRACK EXTENSION MODIFICATION	EACH	4	--	4
VERTICAL WEB STIFFENER REMOVAL	EACH	390	--	390
DRAINAGE SCUPPERS, DS-33	EACH	15	--	15 *
BRIDGE DECK MICROSILICA CONCRETE OVERLAY - 2 1/4"	SQ YD	3,709*	--	3,709
CONCRETE BRIDGE DECK SCARIFICATION (1/4 INCH)	SQ YD	3,709	--	3,709
DECK SLAB REPAIR (FULL DEPTH, TYPE I)	SQ YD	0.2	--	0.2
DECK SLAB REPAIR (PARTIAL)	SQ YD	50.3	--	50.3
PROTECTIVE SHIELD	SQ YD	175	--	175
TEMPORARY SHORING AND CRIBBING	EACH	6	--	6
REMOVE TIE BEAM (SPECIAL)	EACH	--	3	3
REPLACE TIE BEAM (SPECIAL)	EACH	--	2	2
REMOVE AND REPLACE COLUMN (SPECIAL)	EACH	--	2	2
REMOVE AND REINSTALL BEARINGS	EACH	--	4	4

* Includes Bearing Stiffener Modification (24 Total)

DESIGNED	R. Victor
CHECKED	D. James
DRAWN	S. Kaemmerer
CHECKED	R. Victor

PREPARED BY:
JACOBS CIVIL INC.
ST. LOUIS, MO

REHABILITATION FOR FAI 55/70 COMPLEX
ROADWAY E - STRUCTURE NO. 082-0205
GENERAL NOTES AND
TOTAL BILL OF MATERIAL

(FAI-70) ST. CLAIR CO.

STATE OF ILLINOIS
DEPARTMENT OF TRANSPORTATION

ROUTE NO.	DISTRICT	COUNTY	TOTAL SHEETS	SHEET NO.	SHEET NO.
FAI-70	*	St. Clair	388	345	46 SHEETS
FED. ROAD DIST. NO. 7	SUBDIVISION	FED. AID PROJECT			

*(82-3HVB-2R-1)-2

SCOPE OF WORK

GENERAL:

The detailed drawings presented herein are for Roadway E - Structure Number 082-0205 in St. Clair County, Illinois. Work relating to Piers 017, 018, E1 through E8 and Abutment E9 and Spans 018 and E1 through E9 are included within this Scope. Work to be performed is associated with a Seismic Retrofit, a Fatigue and Redundancy Retrofit and General Rehabilitation of the Deck and Substructure.

SEISMIC RETROFIT:

1. Install Column Wraps at the following Piers:
017, 018, E1, E2, E3, E4, E5, E6, E7, E8
2. Install Tie Beam Confinement Plates at the following Piers:
018, E1, E4, E5, E7, E8
3. Remove Tie Beam at Pier E6
4. Remove and Replace Tie Beams at Pier 017
5. Install Cross Frame Connection Plates at Pier 017
6. Remove and Replace Pier Columns at 017 East and 017 West
7. Remove and Reinstall Bearings at Pier Columns 017 East (Span 017/Girder 01 and Span 018/Girder E1) and 017 west (Span N7/Girder N2 and Span 018/Girder E2)
8. Install Cross Frame Assemblies (including Column Band Assemblies) at the following Piers: 017, 018, E1, E2, E3, E4, E5, E6, E7, E8
9. Install Bumper/Restrainer Assemblies at the following Piers:
017, 018, E1, E2, E3, E4, E5, E6, E7, E8
10. Install Bumper Plates at the following Piers:
017, 018, E1, E2, E3, E4, E5, E6, E7, E8
11. Install Slab-to-Floorbeam Connections at the following Piers/Abutments:
017, 018, E1, E2, E3, E4, E5, E6, E7, E8, E9
12. Remove Existing and Install New Bearings at the following Piers: E2, E8
13. Install Extensions to the following Abutments: E9
14. Perform Column Base Modifications (including Dowel Cutting and Fuse Bars) to the following Piers: E3, E6

1

FATIGUE AND REDUNDANCY RETROFIT:

1. Install Web Reinforcement Plates on the following Spans:
018E, E1, E2, E4 through E9
2. Perform Stiffener Intersection Modifications on the following Spans:
018E, E1, E2, E4 through E9

GENERAL REHABILITATION:

1. Perform Formed Concrete Repair on the following Piers/Abutments:
017, 018, E1, E2, E3, E4, E5, E6, E9
2. Perform a Type 2 Deck Rehabilitation (including Overlay Removal, Scarification and Installation of a Microsilica Concrete Overlay) on the following Spans:
018, E1 through E9
3. Remove and Replace Expansion Joints at the following Piers/Abutments:
017, E2, E3, E6, E9
4. Remove Existing Curbs and Barriers and Replace with New Parapets on the following Spans: 018E, E1, E2, E4 through E9
5. Perform Full or Partial Deck Repair on the following Spans:
018E, E1 through E4, E7, E8
6. Remove Existing Floor Drains on the following Spans:
018E, E1, E2, E4 through E9
7. Install New Scuppers or Drains on the following Spans:
018E, E1, E2, E3, E4, E6, E9


DESIGNED	R. Victor
CHECKED	S. Kaemmerer
DRAWN	M. King
CHECKED	S. Kaemmerer

PREPARED BY:
JACOBS CIVIL INC.
ST. LOUIS, MO

REHABILITATION FOR FAI 55/70 COMPLEX
ROADWAY E - STRUCTURE NO. 082-0205
SCOPE OF WORK
(FAI-70) ST. CLAIR CO.

STATE OF ILLINOIS
DEPARTMENT OF TRANSPORTATION


ROUTE NO.	SECTION	DATE	SHEET NO.	SHEETS
FAI-70	St. Clair	3/88	346	46 SHEETS

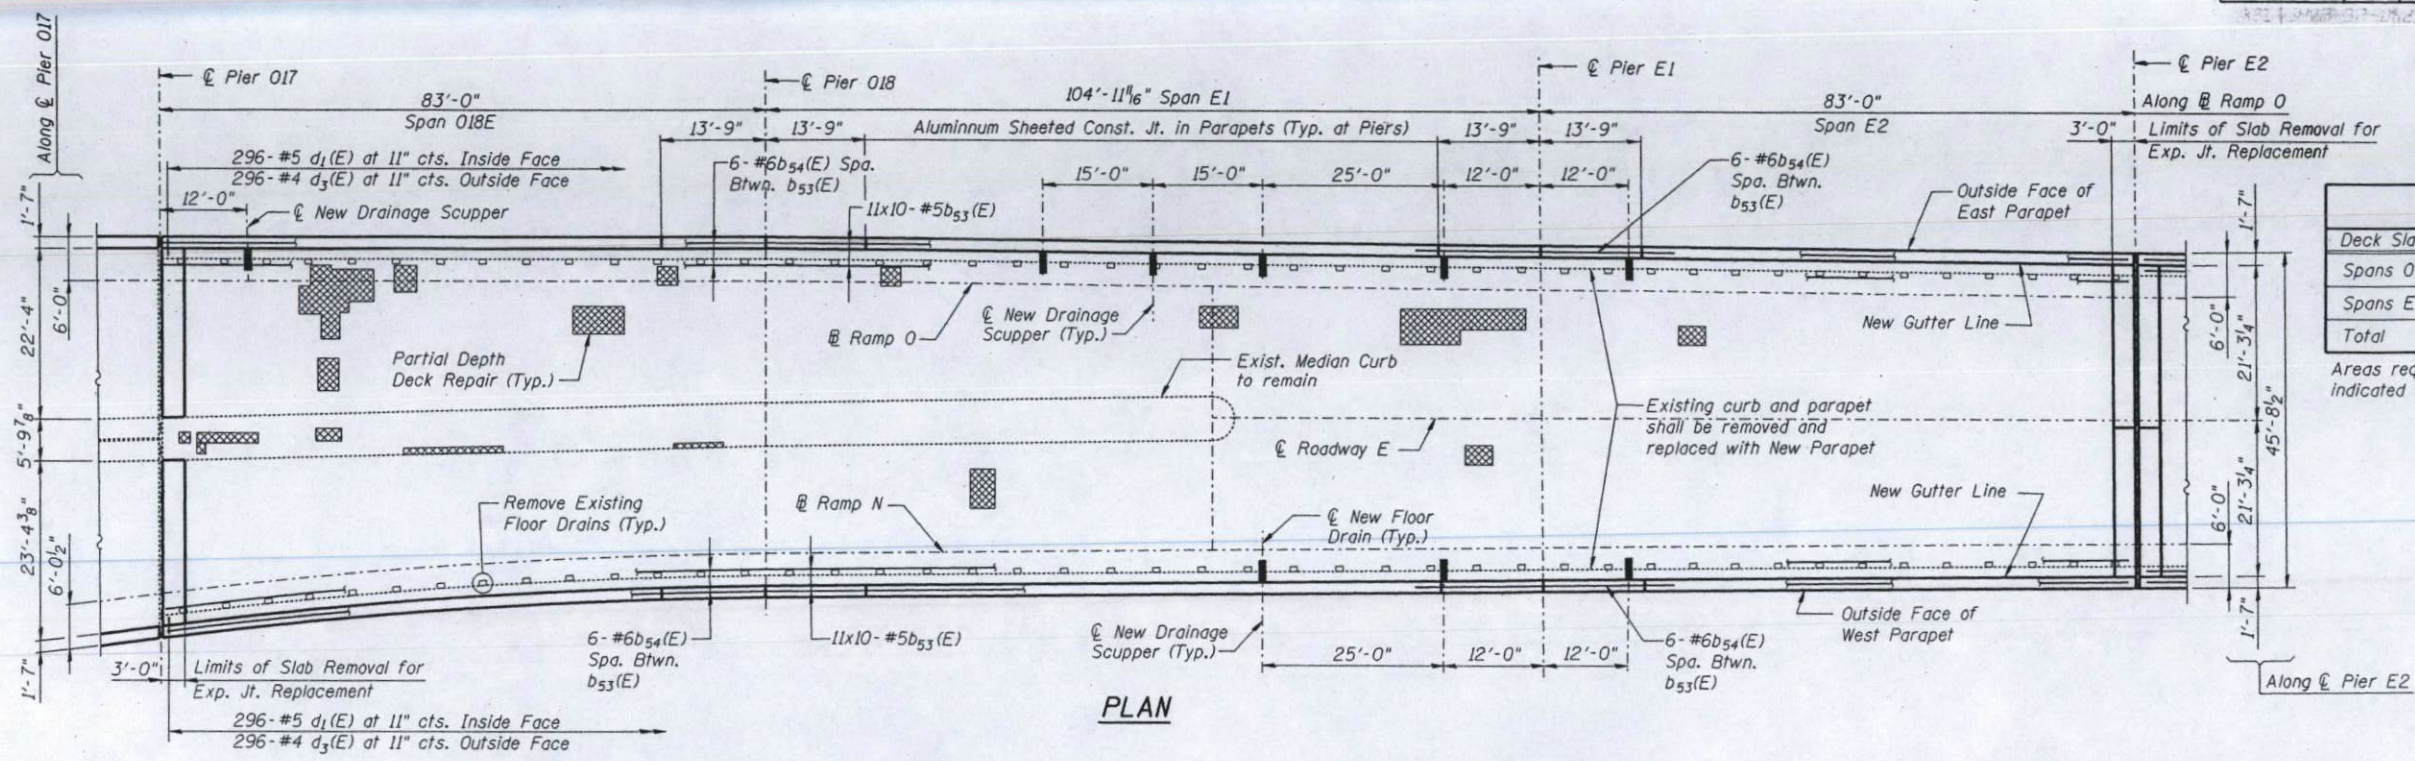

PLAN

DECK REPAIR	
Deck Slab Repair (Partial)	Sq. Yd.
Spans 018E-E2	32
Spans E3-E4	5
Total	37

Areas requiring partial depth slab repair indicated thus: See Special Provisions.

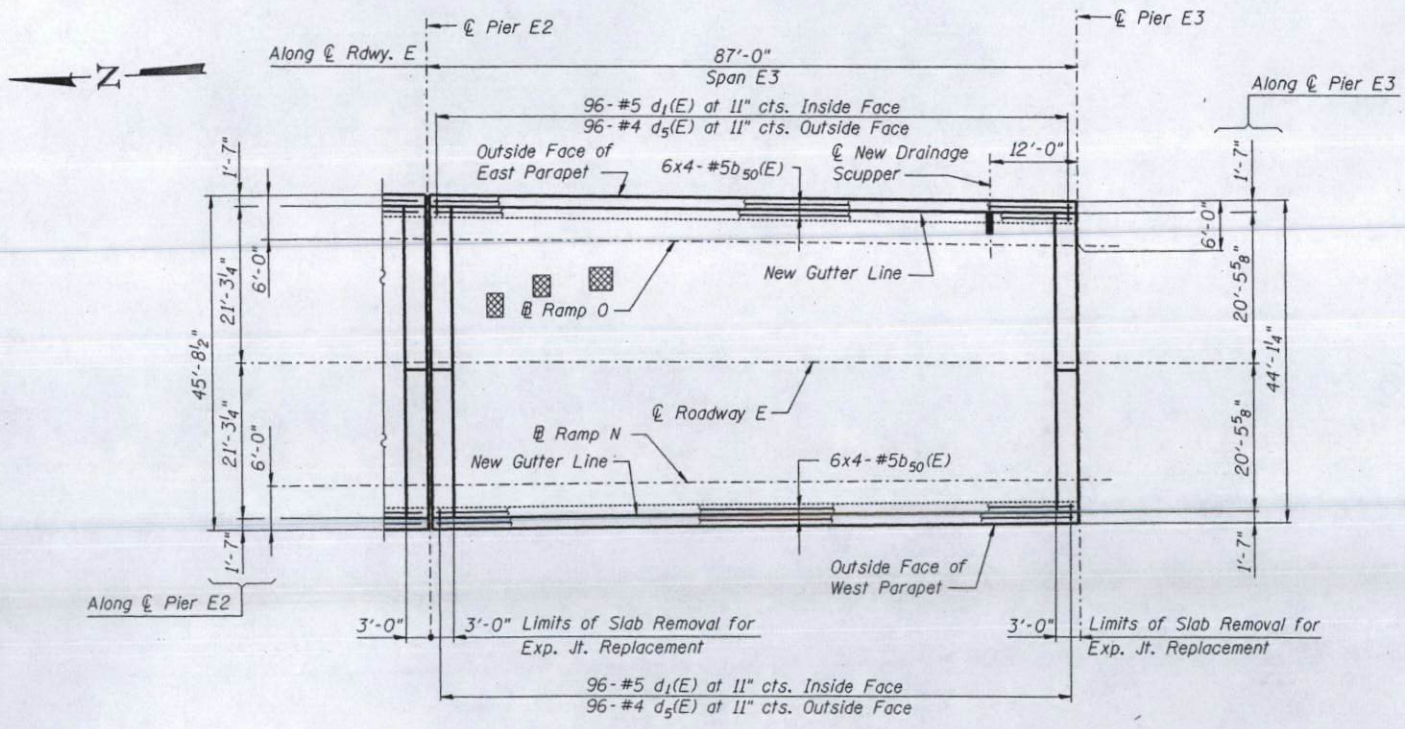

PLAN

Note:
Areas of deck repairs shown are estimated. The Engineer shall show actual locations of deck repairs on As-Built Plans.

Date of Deck Survey - August, 2000.

NOTES

- Lap splices:
#5 longitudinal bars 2'-7" min.
- For Superstructure Bill of Material see Sheet 10.
- For Parapet details, see Sheets 7 and 8.
- For Drainage details, see Sheet 11.
- For Expansion Joint details, see Sheet 13.
- Bars indicated thus 6 x 7-#5 etc. indicates 6 lines of bars with 7 lengths per line.
- Provide Full Depth Slab Repair at each Bridge Inspection Core Hole.
- For Concrete Removal Details, see Sheet 10.
- Additional #6 bars over piers shall be centered about centerline of pier.


DESIGNED	M. King
CHECKED	F. Camba
DRAWN	M. King
CHECKED	F. Camba

PREPARED BY:
JACOBS CIVIL INC.
ST. LOUIS, MO

REHABILITATION FOR FAI 55/70 COMPLEX
ROADWAY E - STRUCTURE NO. 082-0205
SLAB
SPANS 018 AND E1 THRU E3
(FAI-70) ST. CLAIR CO.


STATE OF ILLINOIS
DEPARTMENT OF TRANSPORTATION

PROJECT NO.	SECTION	DRAWN	DATE	SHEET NO.
FAI-70	•	St. Clair	388	347
PROJECT NAME				46 SHEETS
				*182-3HVB-2R-D-2

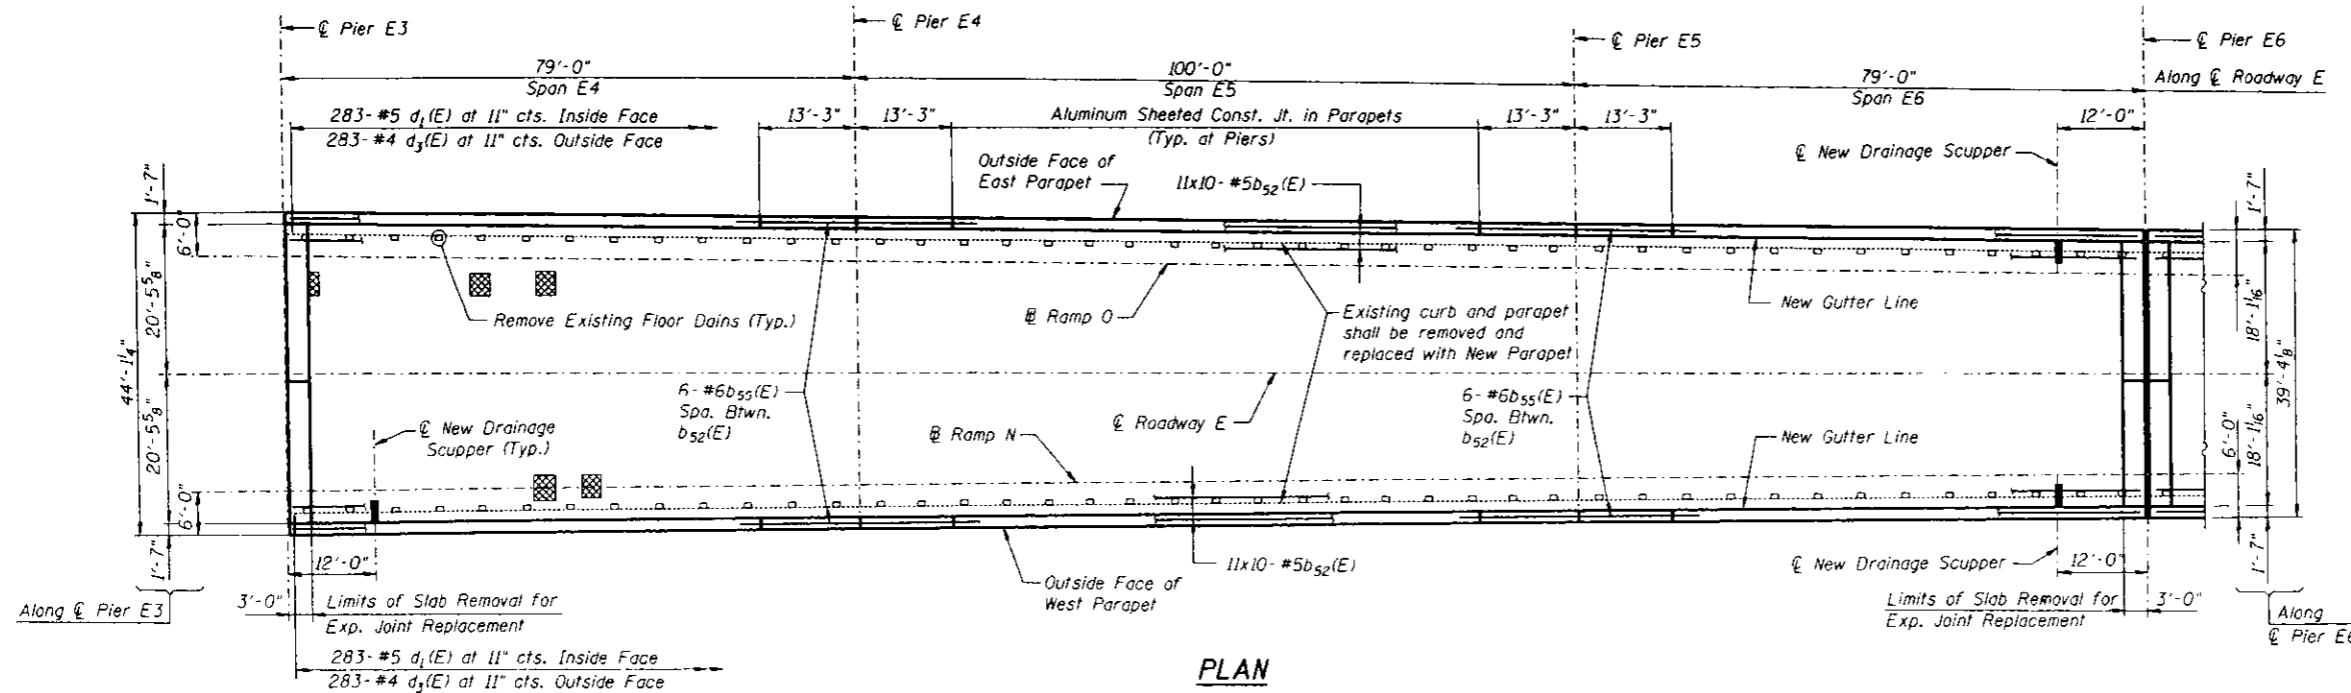

DECK REPAIR	
Depth Slab Repair (Partial)	Sq. Yd.
Spans E4-E6	5
Spans E7-E9	13
Total	18

Areas requiring partial depth slab repair indicated thus: [hatched box]. See Special Provisions.

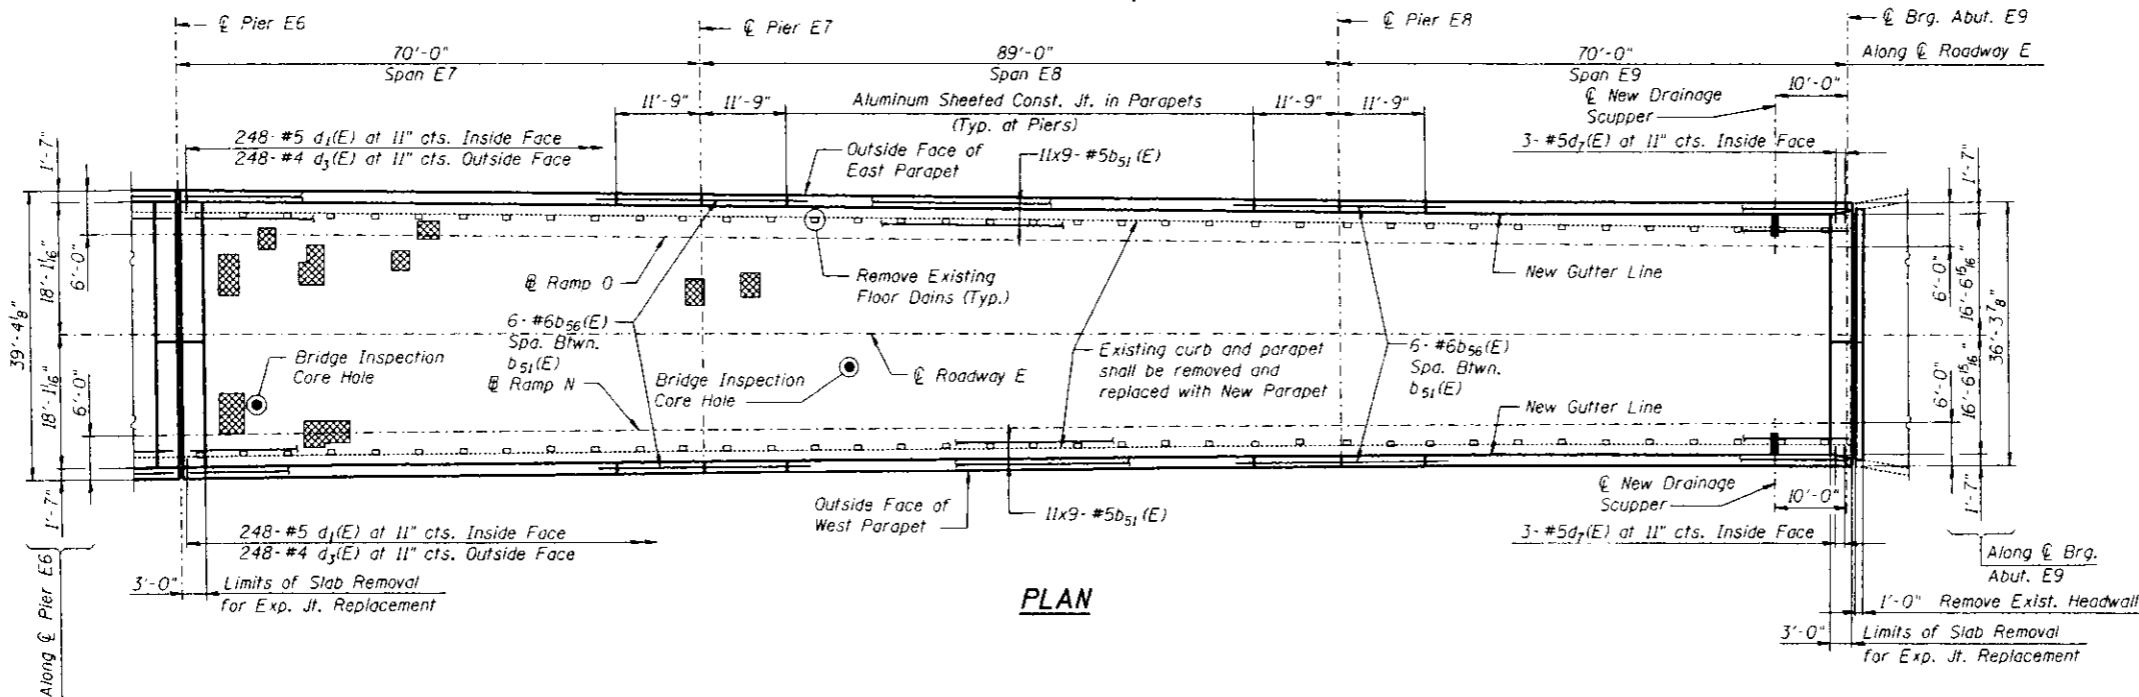

NOTES

Work this sheet with Sheet 5.






DESIGNED	M. King
CHECKED	F. Camba
DRAWN	M. King
CHECKED	F. Camba

PREPARED BY:
JACOBS CIVIL INC.
ST. LOUIS, MO

REHABILITATION FOR FAI 55/70 COMPLEX
ROADWAY E - STRUCTURE NO. 082-0205
SLAB
SPANS E4 THRU E9
(FAI-70) ST. CLAIR CO.

STATE OF ILLINOIS
DEPARTMENT OF TRANSPORTATION

ROUTE NO.	SECTION	COUNTY	SHEET	NO.	SHEET NO. 7
FAI-70	*	St. Clair	388	348	46 SHEETS
FED. ROAD DIST. NO. 7	ILLINOIS	FED. AID PROJECT			

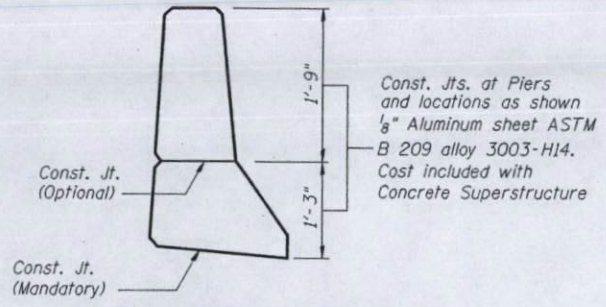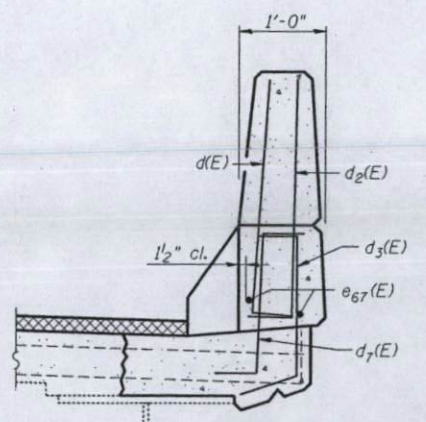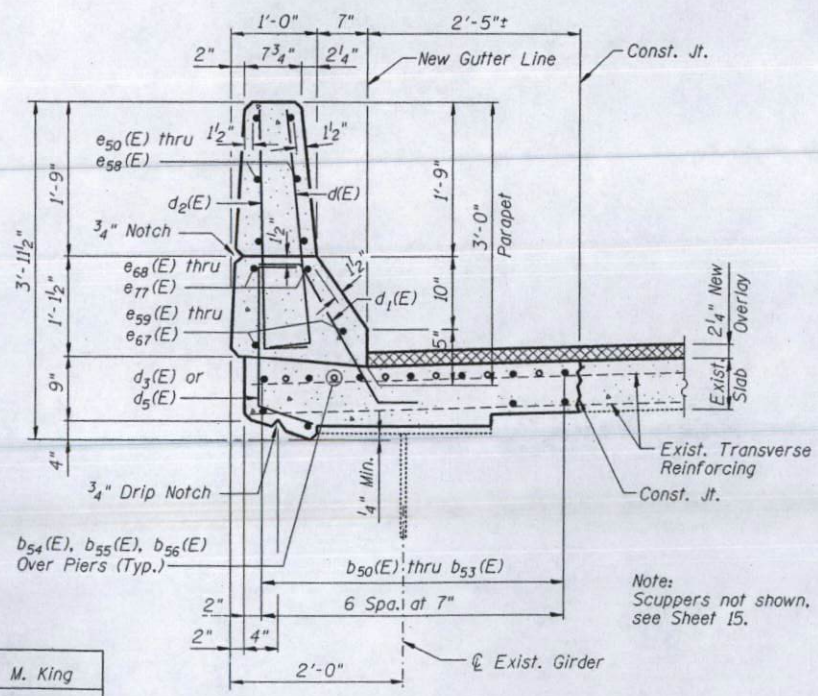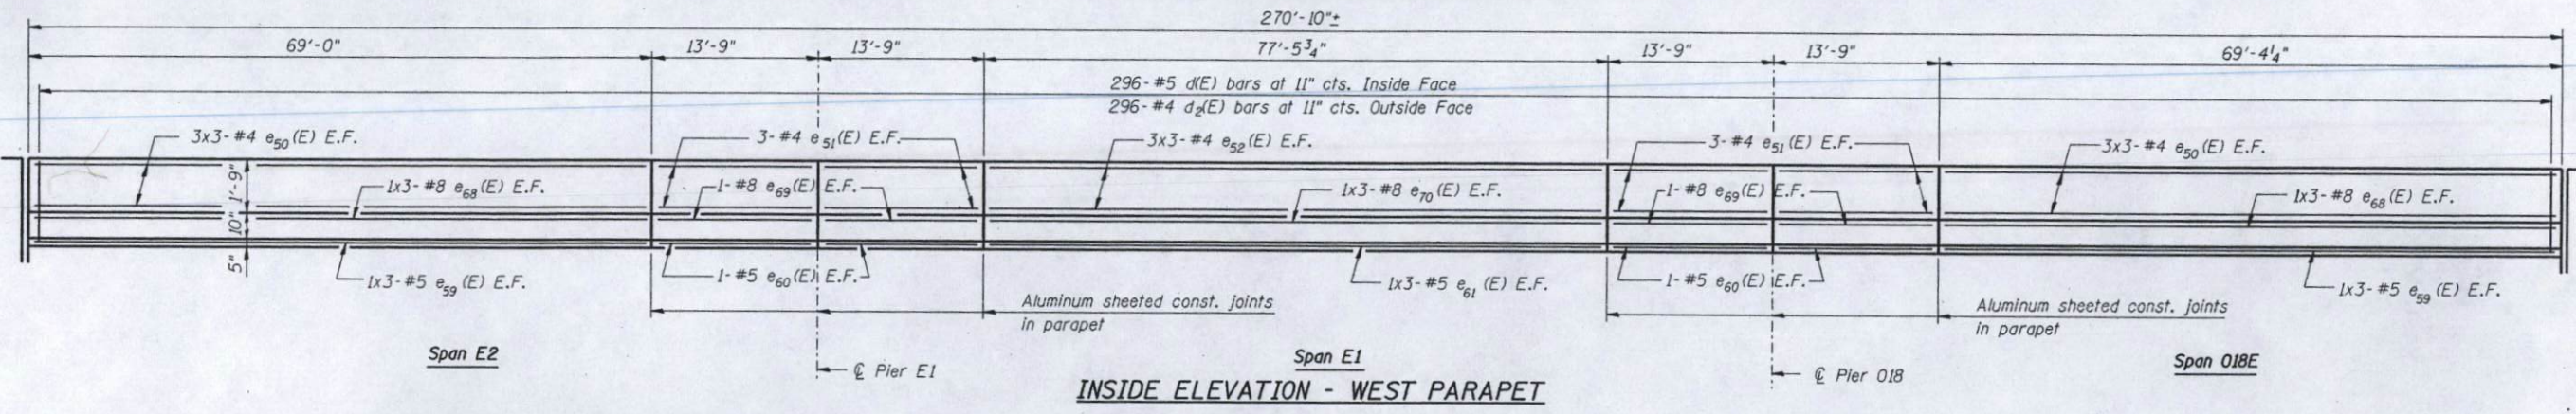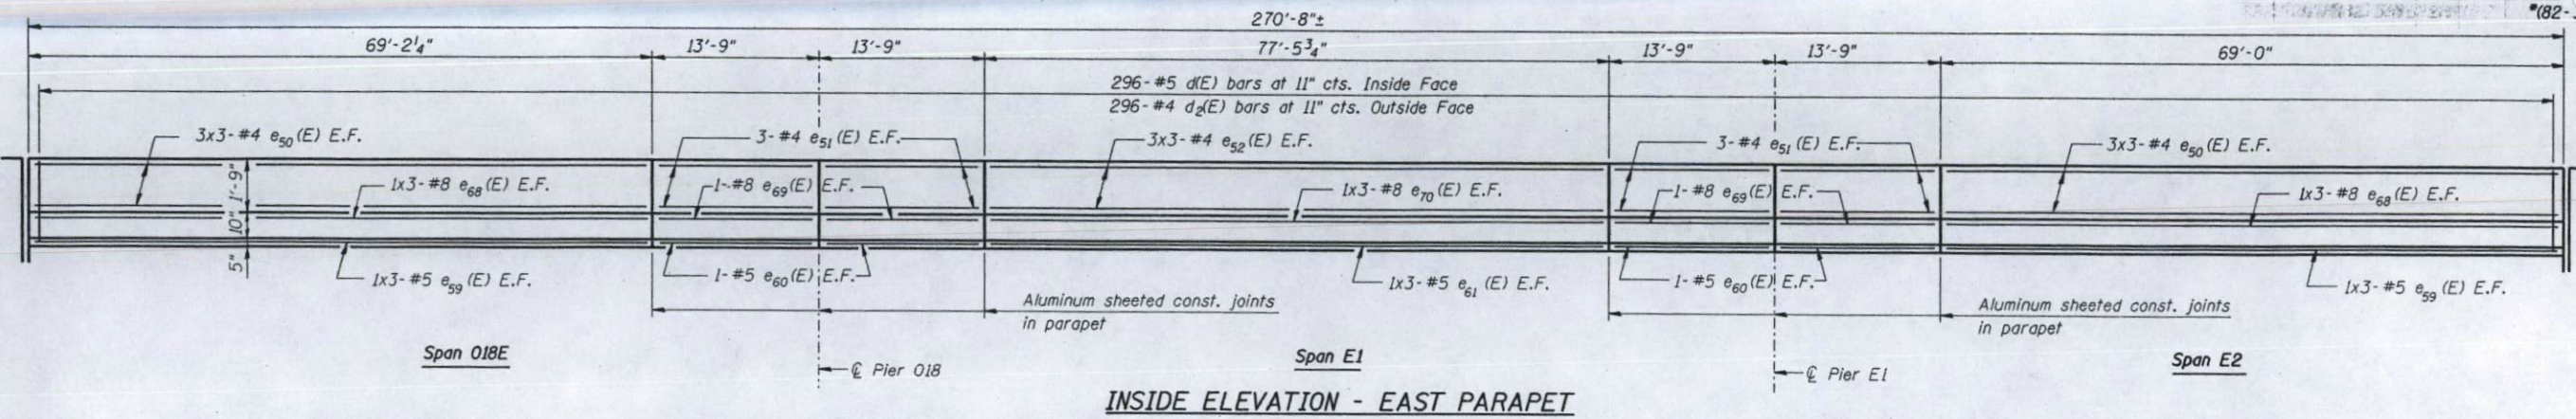

PARAPET NOTES

- Parapet lengths are taken from the plans prepared by H.W. Lochner for the original structure. Adjustment shall be made to accommodate new expansion device.
- Lap splices:
#4 longitudinal bars 1'-7" min.
#5 longitudinal bars 2'-7" min.
#8 longitudinal bars 5'-6" min.
- E.F. indicates each face.
- All edges shall have a 3/4" chamfer, unless otherwise noted.
- For Superstructure Bill of Material, see Sheet 10.
- Bars indicated thus 1x2 #5 etc. indicates 1 line of bars with 2 lengths per line.
- For expansion joint details, see Sheet 13.

REHABILITATION FOR FAI 55/70 COMPLEX
ROADWAY E - STRUCTURE NO. 082-0205
PARAPET DETAILS
SPANS O18E, E1 and E2
(FAI-55) ST. CLAIR CO.


DESIGNED	M. King
CHECKED	F. Camba
DRAWN	M. King
CHECKED	F. Camba

PREPARED BY:
JACOBS CIVIL INC.
ST. LOUIS, MO


STATE OF ILLINOIS
DEPARTMENT OF TRANSPORTATION

ROUTE NO.	SECTION	COUNTY	POST MILE	POST MILE	SHEET NO. 8
FAI-70	*	St. Clair	308	349	46 SHEETS
<small>FOR ROAD DIST. NO. 7</small>					<small>ALIGNED</small>


*(82-JHWB-2R-1)-2

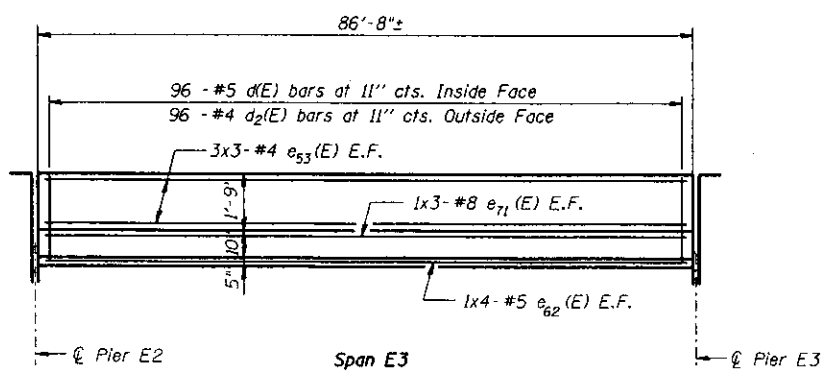

**INSIDE ELEVATION - EAST PARAPET
WEST PARAPET OPPOSITE HAND**

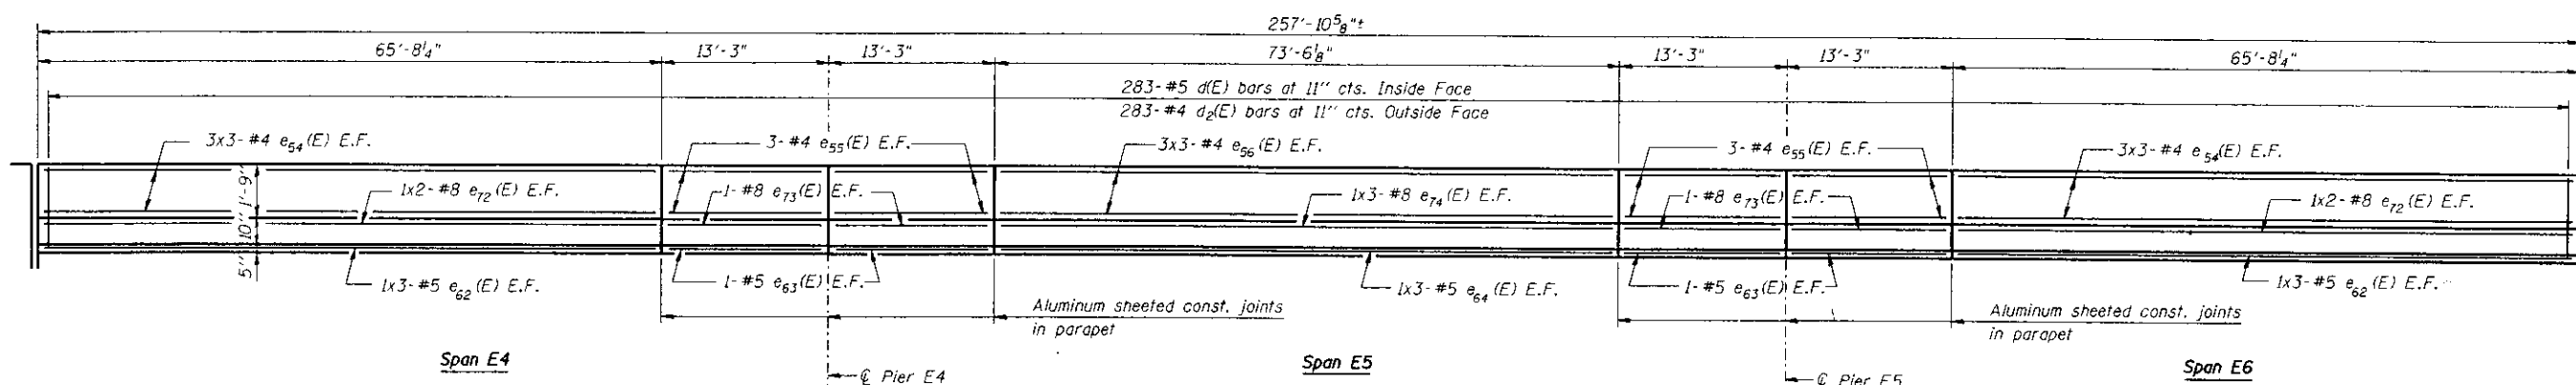

**INSIDE ELEVATION - EAST PARAPET
WEST PARAPET OPPOSITE HAND**

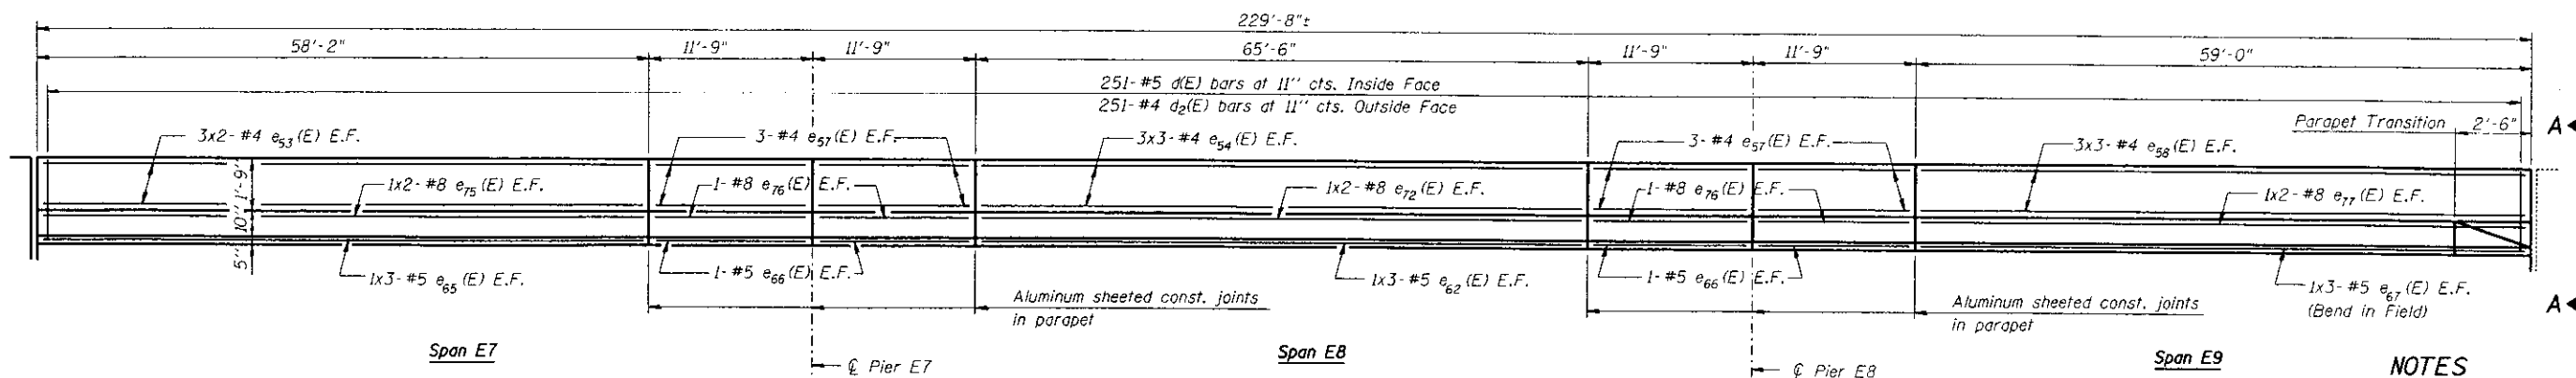

**INSIDE ELEVATION - EAST PARAPET
WEST PARAPET OPPOSITE HAND**

NOTES

For SECTION A-A, see Sheet 7.

DESIGNED	M. King
CHECKED	F. Camba
DRAWN	M. King
CHECKED	F. Camba



PREPARED BY:
JACOBS CIVIL INC.
ST. LOUIS, MO

REHABILITATION FOR FAI 55/70 COMPLEX
ROADWAY E - STRUCTURE NO. 082-0205
PARAPET DETAILS
SPANS E3 THRU E9
(FAI-70) ST. CLAIR CO.

STATE OF ILLINOIS
DEPARTMENT OF TRANSPORTATION

ROUTE NO.	SECTION	COUNTY	SHEET	SHEET NO. 9
FAI-70	*	St. Clair	388 350	46 SHEETS


PIER	"A" bars	"B" bars	"C" bars	Dim. D	Dim. E
E2	6-#5 _{a50} (E)	43-#5 _x (E)	6-#5 _{a56} (E)	21'-10 1/4"	23'-10 1/4"
E3	6-#5 _{a53} (E)	41-#5 _x (E)	6-#5 _{a57} (E)	21'-0 5/8"	23'-0 5/8"
E6	6-#5 _{a54} (E)	37-#5 _x (E)	6-#5 _{a58} (E)	18'-8"	20'-8"

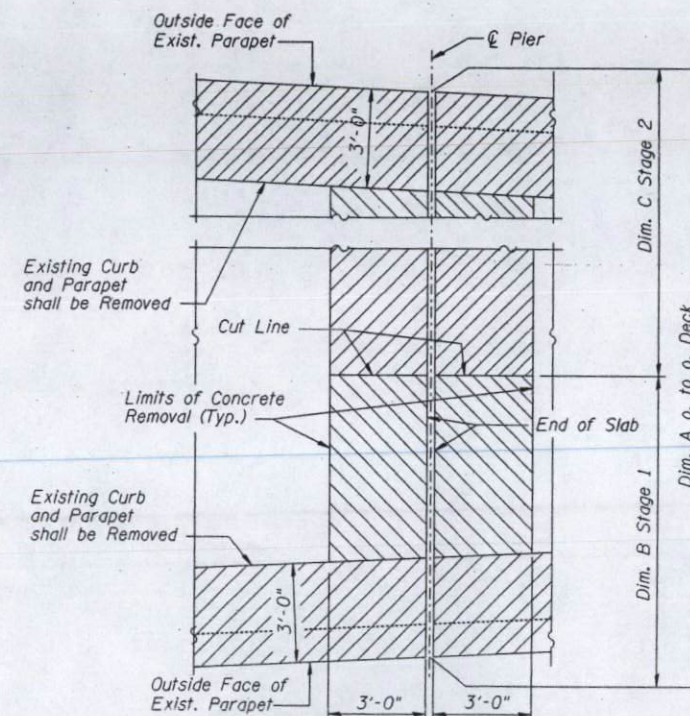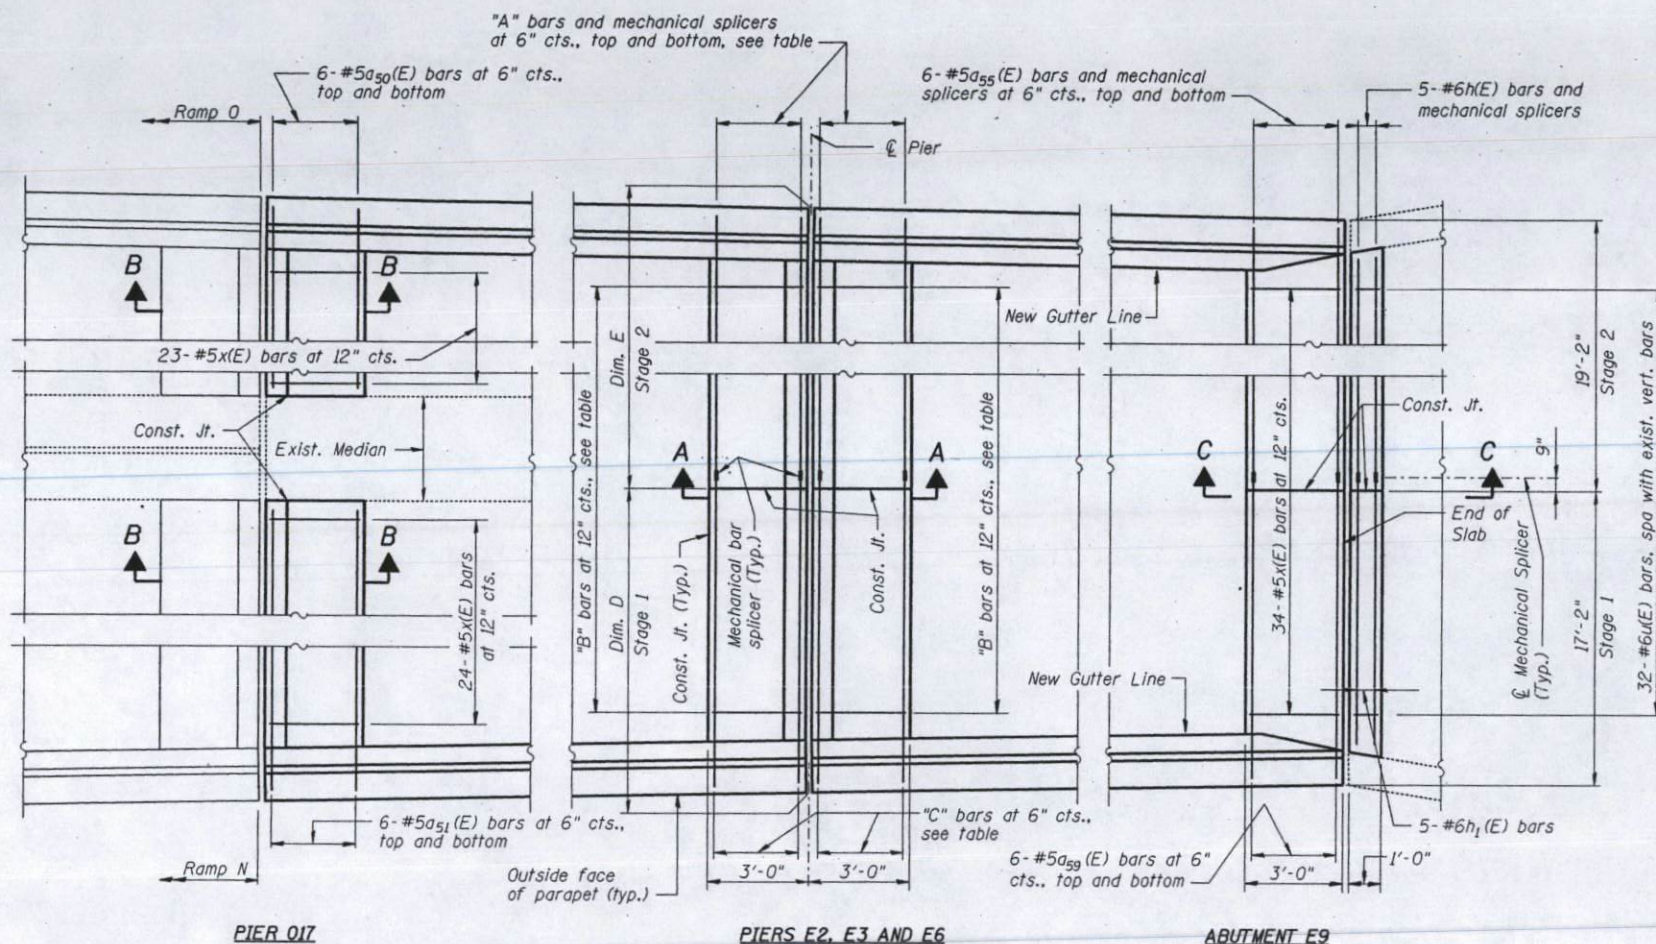

DEMOLITION PLAN AT PIERS E2, E3 AND E6


PIER	Dim. A	Dim. B	Dim. C
E2	45'-8 1/2"	22'-10 1/4"	22'-10 1/4"
E3	44'-1 1/4"	22'-0 5/8"	22'-0 5/8"
E6	39'-4"	19'-8"	19'-8"

Pier	Size
017	2 1/2"
E2	4"
E3	2 1/2"
E6	2"

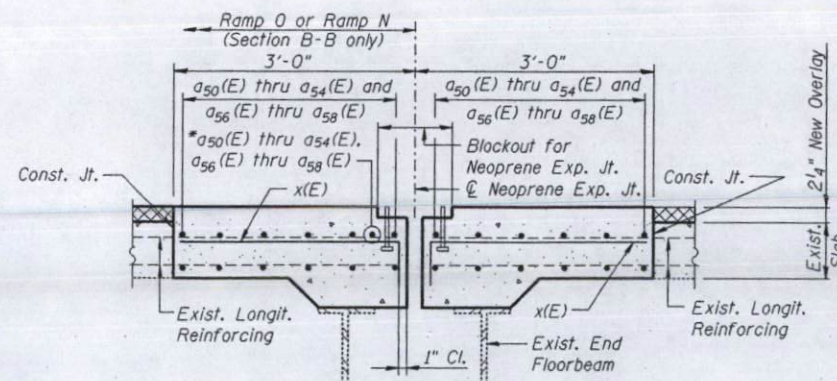

SECTION A-A
SECTION B-B

* Place a₅₀(E) thru a₅₄(E) and a₅₆(E) thru a₅₈(E) bars in back of Anchor Bolt as shown if required to maintain 1" cl. (+0 -1/8"). Anchor Bolts shall be tied to a₅₀(E) thru a₅₄(E) and a₅₆(E) thru a₅₈(E) bars.

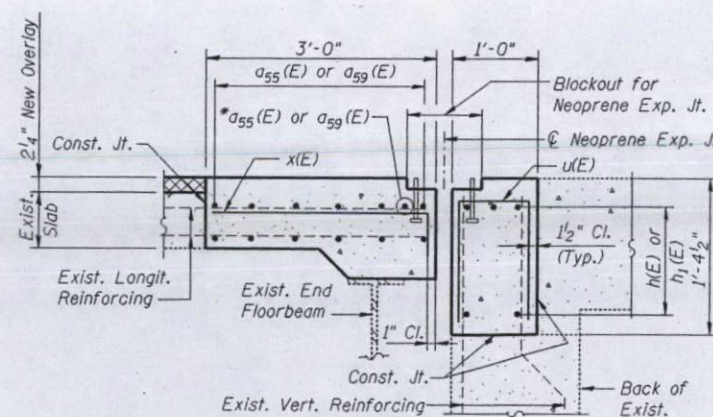

SECTION C-C

* Place a₅₅(E) and a₅₉(E) bars in back of Anchor Bolt as shown if required to maintain 1" cl. (+0 -1/8"). Anchor Bolts shall be tied to a₅₅(E) and a₅₉(E) bars.

DESIGNED	R. Victor
CHECKED	M. Supak
DRAWN	M. King
CHECKED	F. Camba


PREPARED BY:
JACOBS CIVIL INC.
ST. LOUIS, MO

REHABILITATION FOR FAI 55/70 COMPLEX
ROADWAY E- STRUCTURE NO. 082-0205
EXPANSION JOINT
REPLACEMENT DETAILS
(FAI-70) ST. CLAIR CO.



STATE OF ILLINOIS
DEPARTMENT OF TRANSPORTATION

ROUTE NO.	SECTION	COUNTY	SERIES	POST	SHEET NO. OF
FAI-70	*	St. Clair	388	352	46 SHEETS

082-3HB-2R-1-2

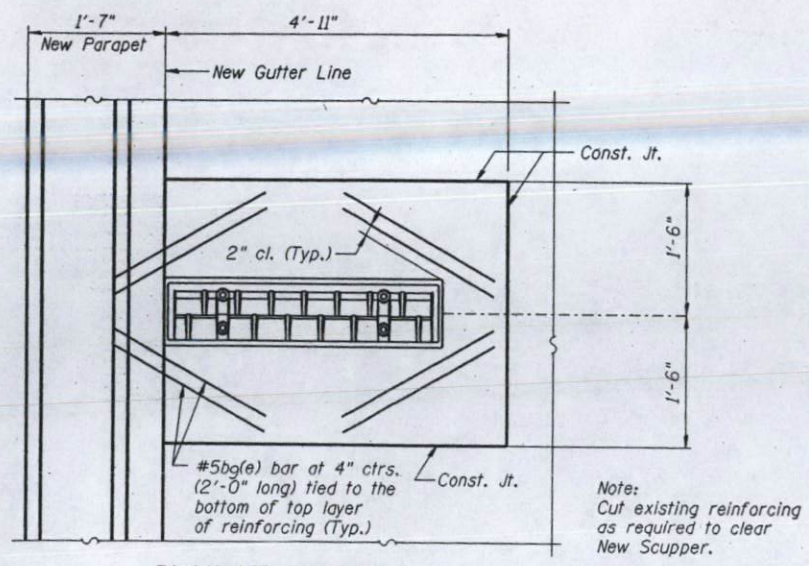


PLAN AT SCUPPER

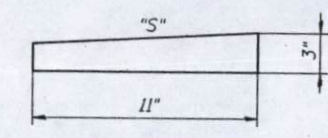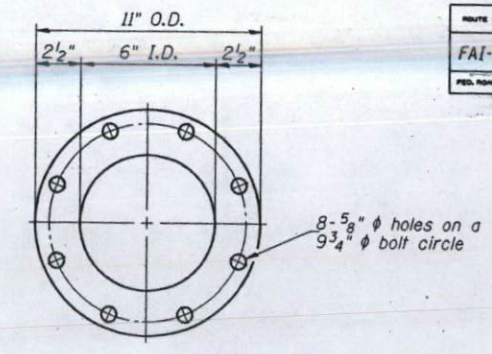

BEVELED SPACER RING DETAIL

1. "S" equals the slope of the superelevation at the individual scupper location.
2. The bevel shall be sufficient to allow vertical installation of the downspout.
3. Beveled spacer ring shall conform to the requirements of AASHTO M155, Class 35B.
4. Rings shall be galvanized according to AASHTO M111 and ASTM A385.

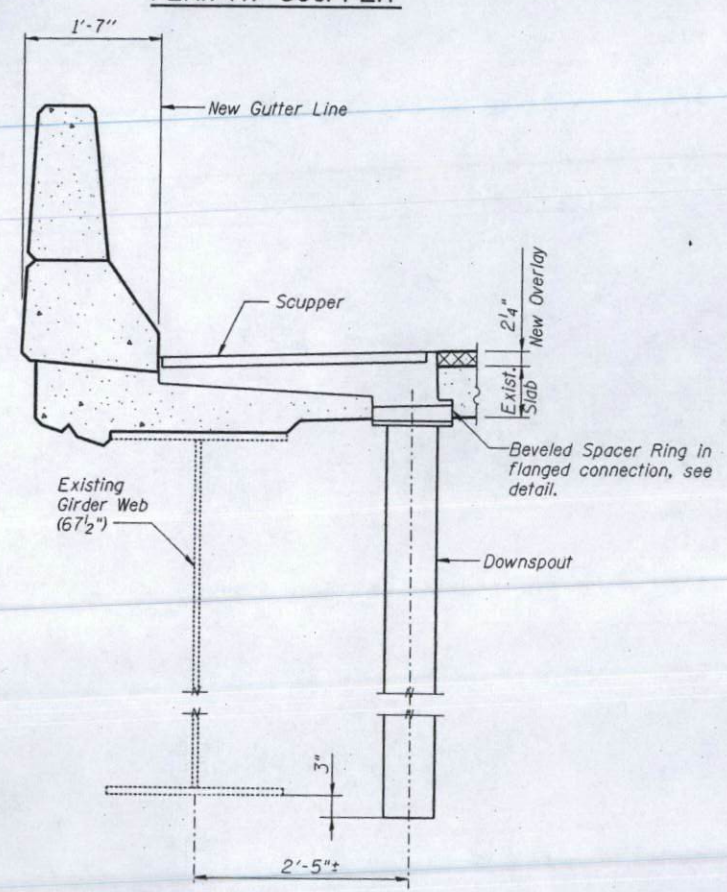

SECTION AT SCUPPER

NOTES

1. For DS-33 Scupper detail see Sheet 12.
2. Cost and installation of scuppers, spacer rings and downspouts shall be included in the unit price for Drainage Scuppers, DS-33.
3. The cost associated with concrete removal, reinforcing bars (epoxy coated) and concrete superstructure shall be included in their respective pay items. The quantities for these items are included in the "Superstructure Bill of Material".

DESIGNED	M. King
CHECKED	R. Victor
DRAWN	M. King
CHECKED	R. Victor

PREPARED BY:
JACOBS CIVIL INC.
ST. LOUIS, MO

REHABILITATION FOR FAI 55/70 COMPLEX
ROADWAY E - STRUCTURE NO. 082-0205
DRAINAGE DETAILS
(FAI-70) ST. CLAIR CO.

STATE OF ILLINOIS
DEPARTMENT OF TRANSPORTATION

ROUTE NO.	SECTION	COUNTY	LETS	PIES	SHEET NO. 13
FAI-70	*	St. Clair	388	354	46 SHEETS
FED. AID DIST. NO. 7					PROJECT NO.
BALANCE					PROJ. NO.


082-3HVB-2R-1-2

Joint Size	"C" at 50°F	"D" at 50°F	Dim "F"
2"	2"	1 1/2" Min.	2"
2 1/2"	2 1/2"	1 3/4" Min.	2 1/2"
4"	3"	2 1/2" Min.	3"


INSTALLATION NOTES

- Install continuous seal in roadway, parapet, curb, and sidewalk.
- Install anchor blocks as indicated.


NOTE A: Maximum spacing of anchor bolts shall be 12" centers.

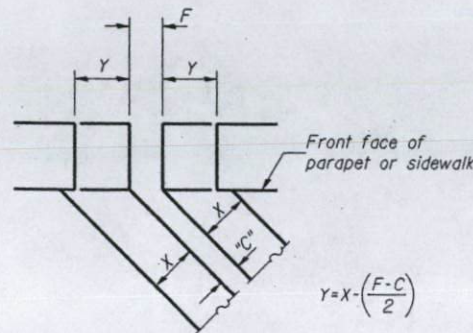

FORMING BLOCKOUT SKETCH

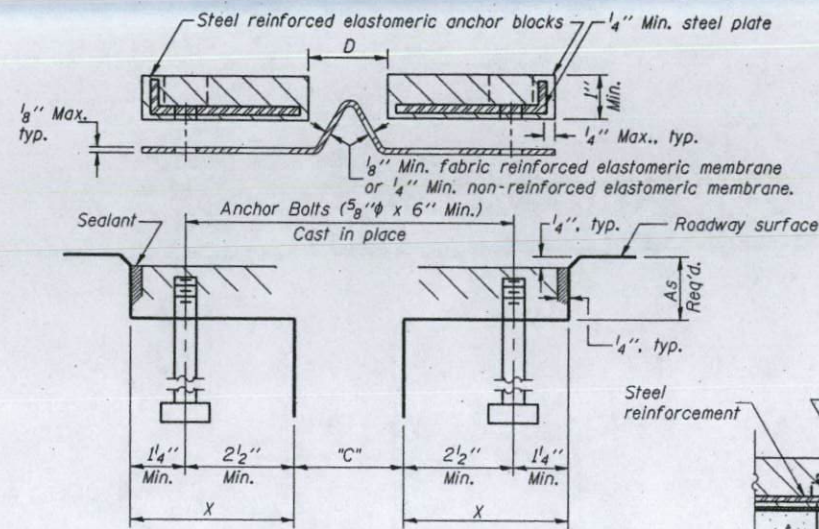

CROSS SECTION

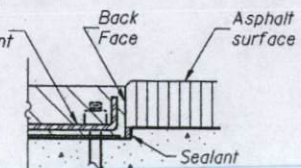

ANCHOR BLOCK WITH ASPHALT SURFACE

GENERAL NOTES

Continuous Seal Neoprene Expansion Joint shall consist of molded anchor blocks of elastomer and steel, field assembled over continuous lengths of elastomeric membrane.

The elastomeric membrane shall be premolded with a single or a double upward convolution that will have a "memory" to return to its molded position upon joint closure.

The convolution length shall be such that the extended length will not be greater than the manufactured length when the joint is fully expanded in its design range and will not protrude above the anchor blocks when the joint is fully compressed.


Joint openings shall be adjusted according to Article 503.10(c) of the Standard Specifications when the deck is poured at an ambient temperature other than 50° F.

The parapet and roadway membrane shall be made continuous by an approved vulcanizing process. Lapping will not be permitted.


SKREW LIMITATIONS

The details of the anchor blocks and the elastomeric membrane in the parapet, as shown, are for up to 50° skews.


For skews greater than 50°, the anchor blocks and the elastomeric membrane, installed according to dimension "D", might require modifications to insure a minimum clearance of 1 1/2" from centerline of anchor studs to edge of parapet opening. The anchor blocks and the elastomeric membrane shall also be installed to the top of the parapet with the anchor studs spaced at ±12" cts.

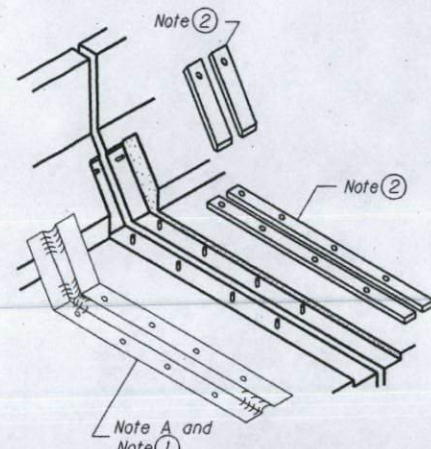


AT PARAPET

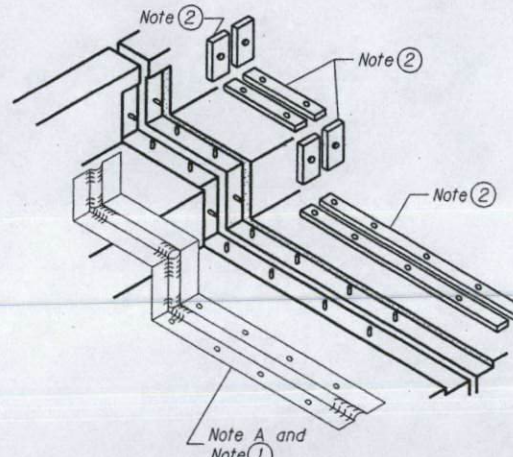

AT SIDEWALK OR MEDIAN

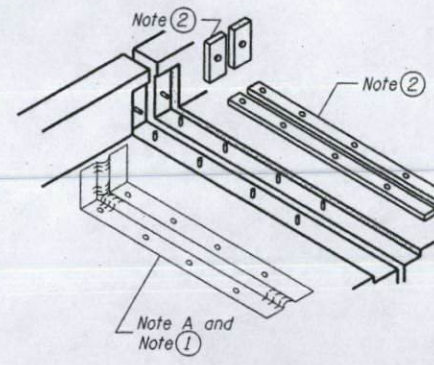


AT WALL

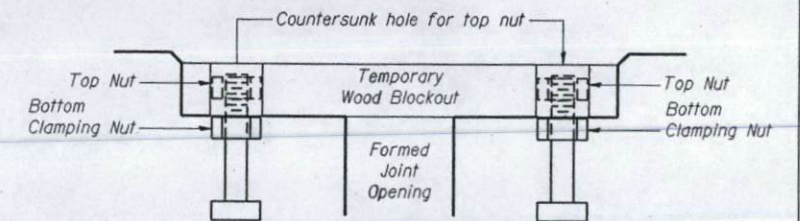


RECOMMENDED BLOCKOUT DETAIL

Note: Stud needs to be threaded lower to allow for use of clamping nut.


Anchor studs should be stainless

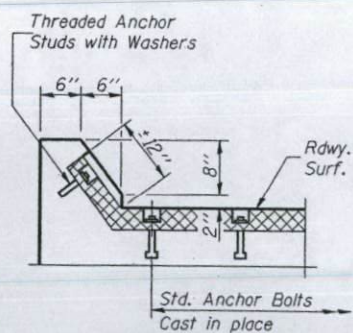


AT CURB

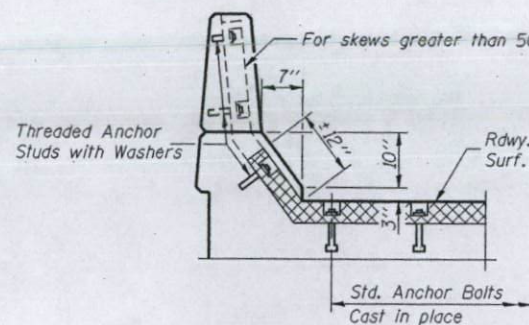

AT PARAPET

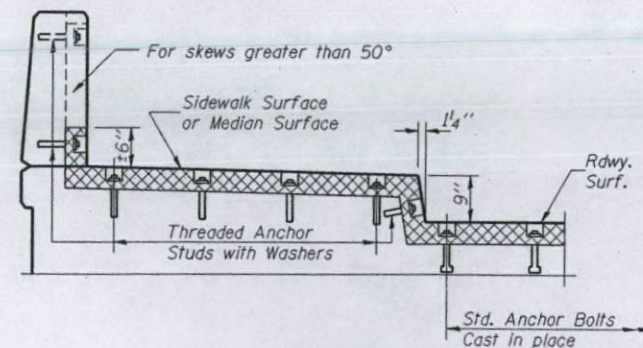

**AT SIDEWALK OR MEDIAN
TYPICAL END TREATMENTS**

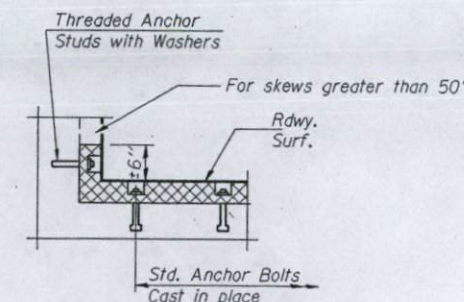

AT WALL

DESIGNED	R. Victor
CHECKED	M. Supak
DRAWN	E. Bazzell
CHECKED	S. Kaemmerer

EJ-CS 10-31-02

PREPARED BY:
JACOBS CIVIL INC.
ST. LOUIS, MO


REHABILITATION FOR FAI 55/70 COMPLEX
ROADWAY E - STRUCTURE NO. 082-0205
NEOPRENE EXPANSION JOINT DETAILS
PIERS 017, E2, E3, E6 AND ABUTMENT E9

(FAI-70) ST. CLAIR CO.


STATE OF ILLINOIS
DEPARTMENT OF TRANSPORTATION

ROUTE NO.	SECTION	COUNTY	TOTAL SHEETS	SHEET NO.	SHEET NO. 14
FAI-70	*	St. Clair	388	355	46 SHEETS
FED. ROAD DIST. NO. 7	S.L. NO.	FED. ROAD PROJECT			


*(82-3H/B-2R-1)-2

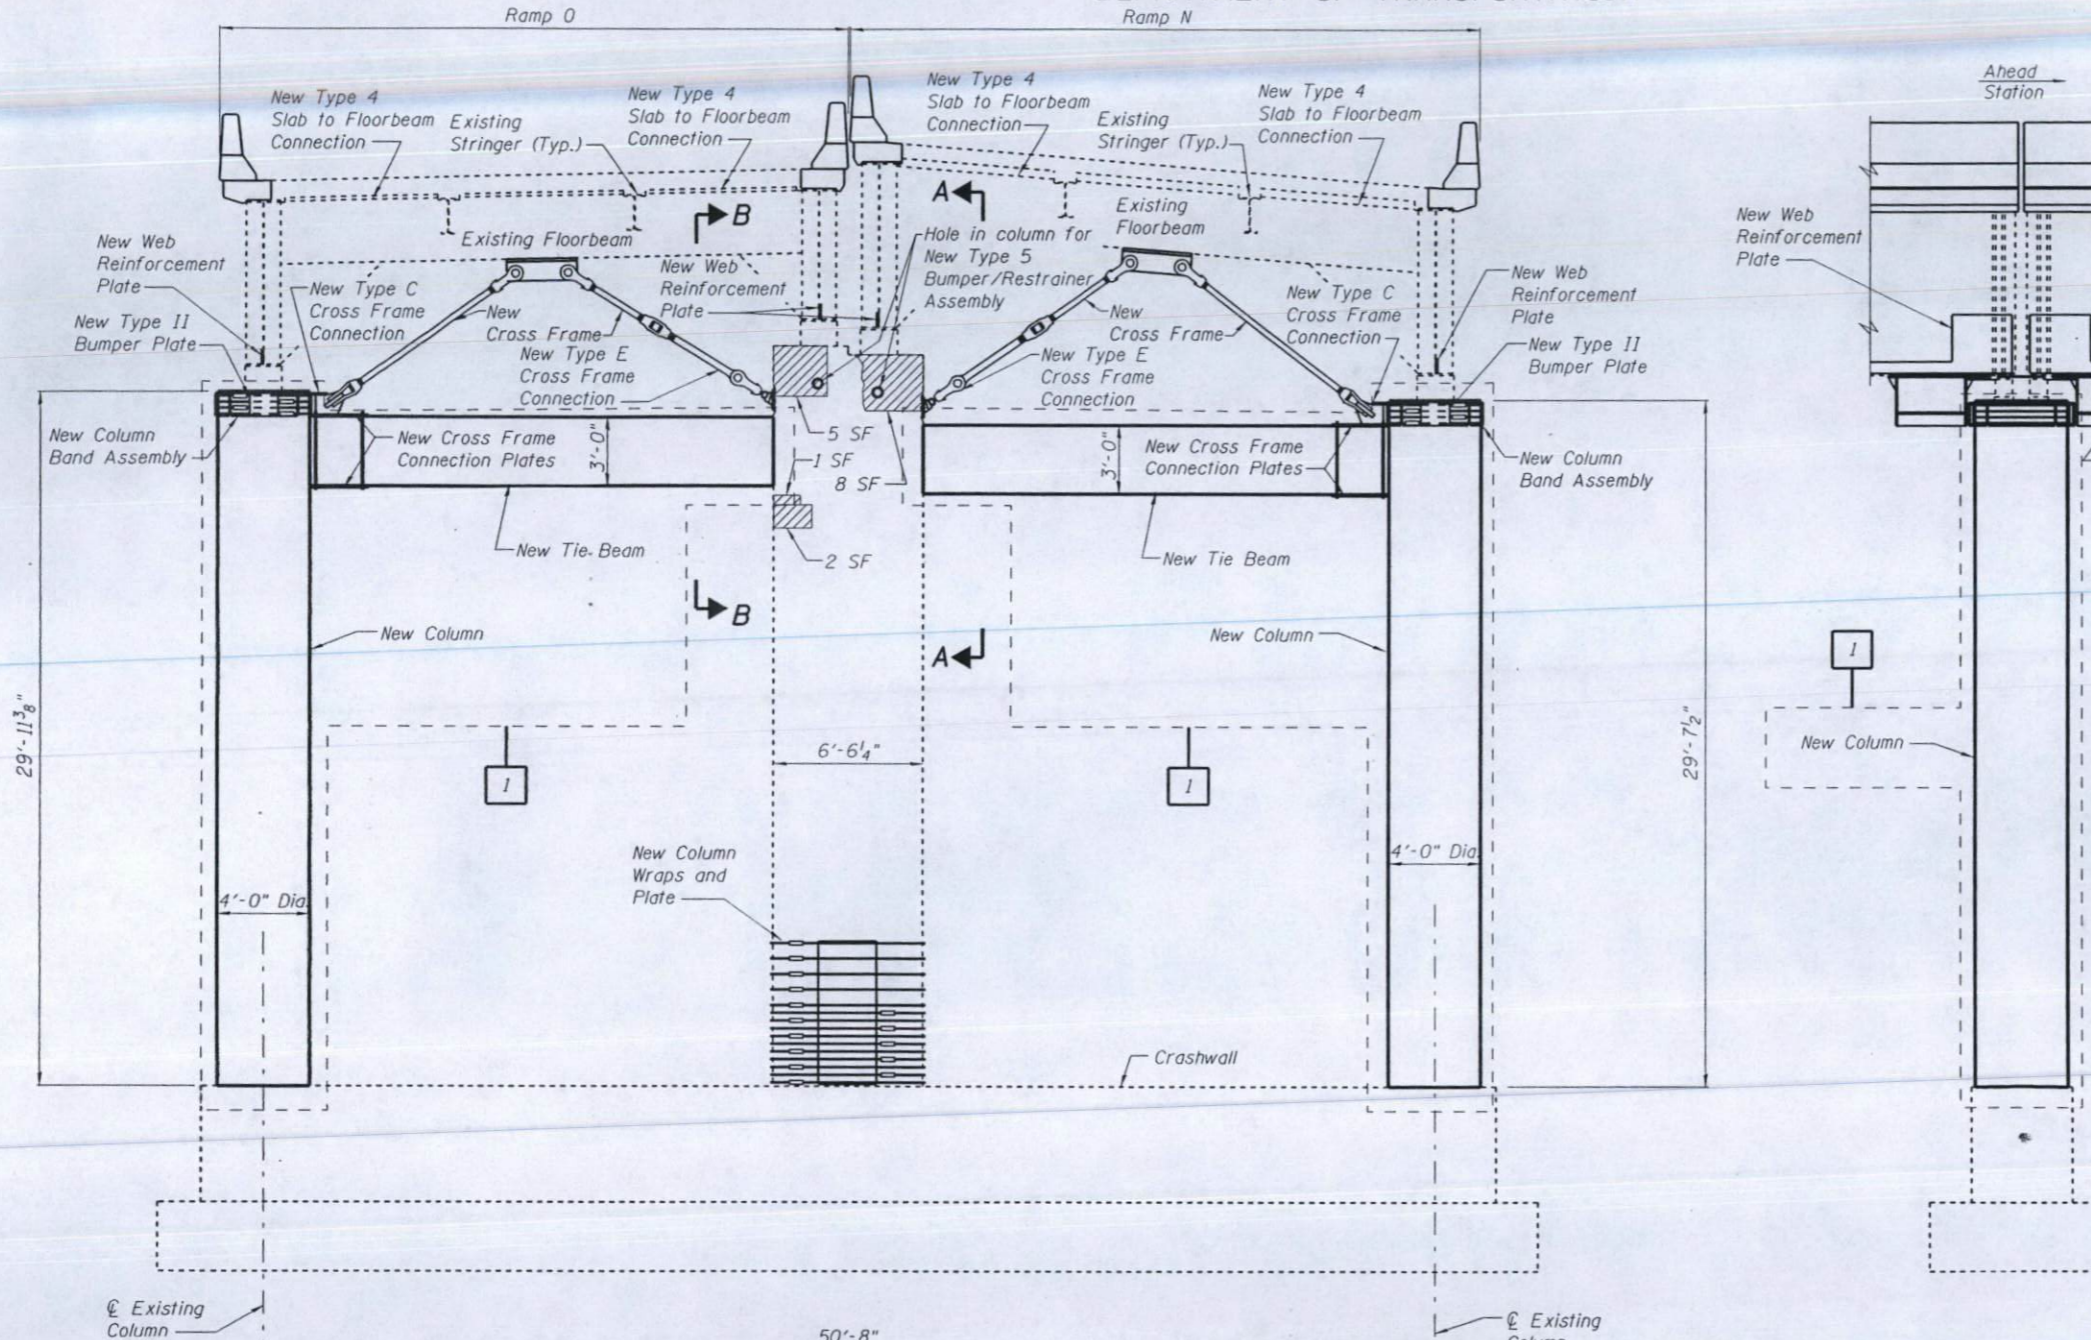

ELEVATION
(Looking Ahead Station)

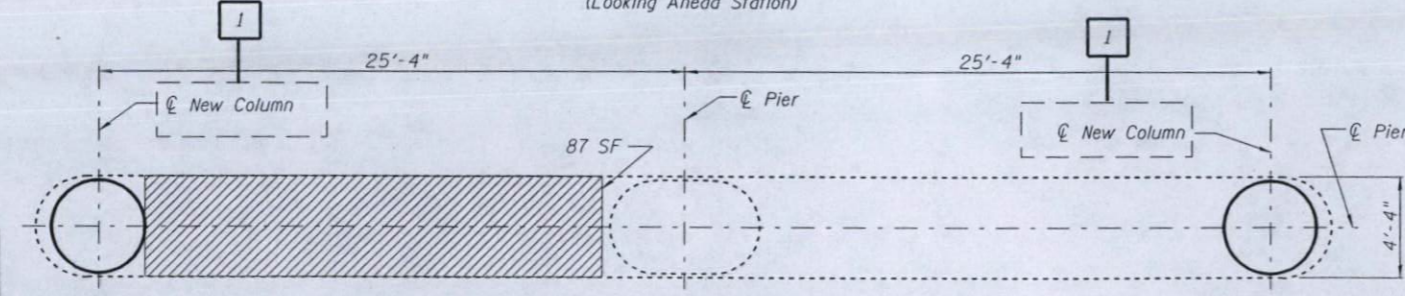

PLAN OF CRASHWALL

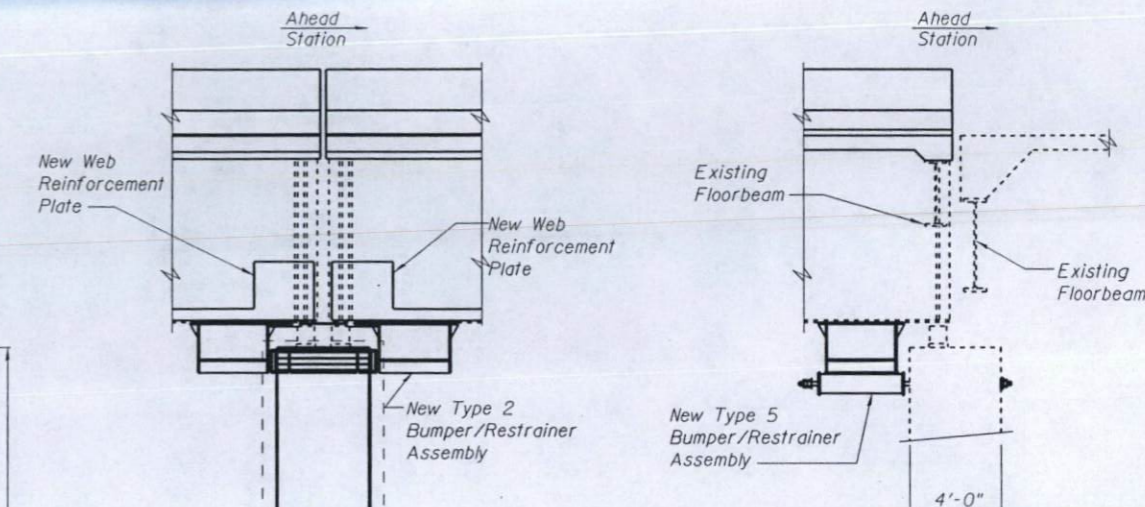

SECTION A-A

Note: "SECTION B-B", similar and opposite hand.

NOTES

1. For Formed Concrete Repairs, see Special Provisions.
2. For Cross Frame Details, see Sheets 39 and 40.
3. For Column Band Assembly Details, see Sheets 39 and 40.
4. For Slab to Floorbeam Connection Details, see Sheet 41.
5. For Bumper Plate Details, see Sheet 38.
6. For Bumper/Restrainer Assembly Details, see Sheets 34 thru 37.
7. For Column Wrap Details, see Sheet 43.
8. For Web Reinforcement Plate Details, see Sheet 30.
9. SF Indicates Square Foot.
10. For New Tie Beam Details, See Sheet 41.
11. For New Column Details, see Sheet 42.
12. For New Cross Frame Connection Plates Detail, see Sheet 43.
13. For Bearing Notes, see Sheet 15.
14. Only one Tie Beam and Column may be removed at any time. Second Tie Beam and Column may be removed after first Tie Beam and Column have been replaced.

LEGEND

= Formed Concrete Repair (Depth ≤ 5")

END VIEW

Pier	THEORETICAL COLUMN REACTION (kips)					
	O17					
	East			West		
Span	O17	O18	Total	N7	O18	Total
Dead Load	88	135	223	96	135	231
Live Load	47	75	122	49	75	124
Impact	11	18	29	11	18	28
Centrifugal Force	--	--	--	9	--	9

Note: Theoretical jacking loads listed above were taken from the design drawings for the original structure.
See Special Provisions "Remove and Reinstall Bearings" for requirements and limitations for jacking the structure.

BILL OF MATERIAL - PIER O17

ITEM	UNIT	QUANTITY
Column wrap	SQ. FT.	115
Expansion Bolts (Special)	EACH	32
Formed Concrete Repair (Depth ≤ 5")	SQ. FT.	128
Remove Tie Beam (Special)	EACH	2
Replace Tie Beam (Special)	EACH	2
Remove and Replace Column (Special)	EACH	2

**REHABILITATION FOR FAI 55/70 COMPLEX
ROADWAY E - STRUCTURE NO. 082-0205
RETROFIT AND SUBSTRUCTURE REPAIR
PIER O17**
(FAI-70) ST. CLAIR CO.


DESIGNED	A. Amidi
CHECKED	R. Victor/ M. Capron
DRAWN	S. Kaemmerer
CHECKED	R. Victor

PREPARED BY
JACOBS CIVIL INC.
ST. LOUIS, MO

STATE OF ILLINOIS
DEPARTMENT OF TRANSPORTATION

ROUTE NO.	SECTION	COUNTY	TOTAL SHEETS	SHEET NO.	SHEET NO.
FAI-70	*	St. Clair	388	356	46 SHEETS

*(82-3HV/B-2R-1)-2

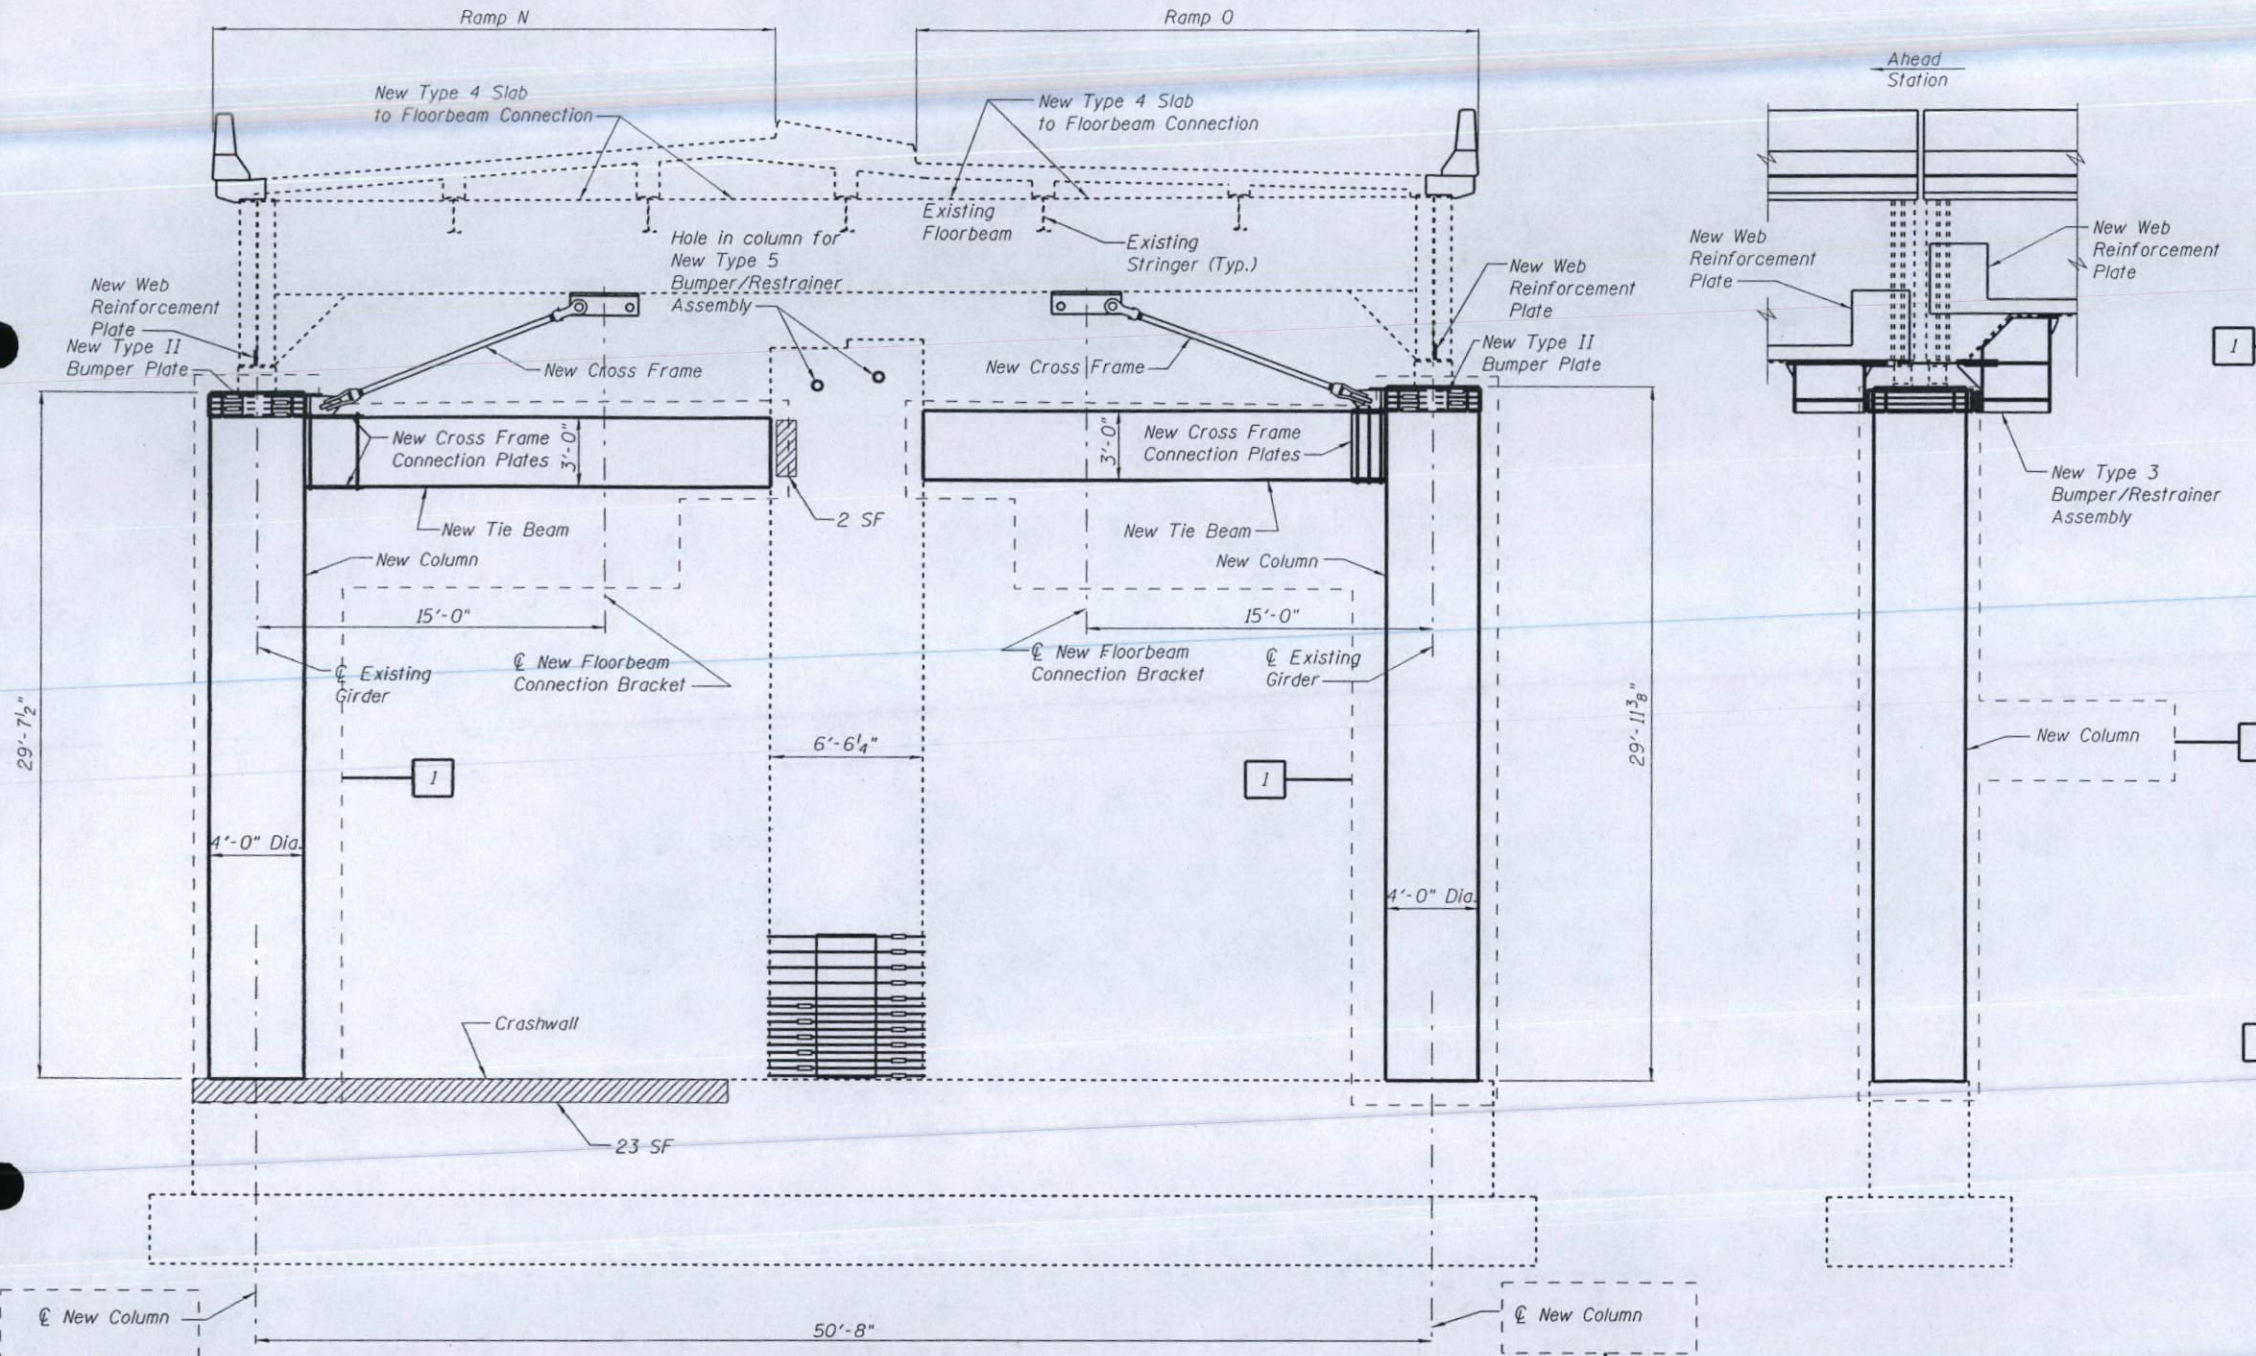

- ### BEARING NOTES
1. The capacity of the jacks used to lift the bridge shall be at least 50% to 100% greater than the theoretical jacking loads shown in the table.
 2. After jacking the structure off the bearing assembly, remove existing anchor bolt nuts and or any welded plate washers that secure the existing bearing assembly to the anchor bolt. Existing anchor bolts will not be re-used and may be cut-off just above the bearing plate to minimize the jacking height requirements.
 3. All portions of existing bearing assemblies including bolsters, masonry plates and shims shall be removed and stored in such a manner as to prevent damage to the assembly. The bearing assemblies shall be stored in an area where they will be protected from damage, dust and debris. The bearing assemblies will be reinstalled once the new column has cured a minimum of 7 days or as approved by the Engineer.
 4. If required, top of new column concrete shall be leveled using an epoxy grout prior to bearing installation.
 5. Use shims as required between top of leveled column and bottom of bearing assembly.
 6. Use a new 1/8" lead plate or 1/2" fabric pad between the masonry plate or shims and top of concrete.
 7. New anchor bolts shall be drilled and grouted into new concrete after bearings are in place.
 8. Area between restrainer bars and elastomeric bearing to be filled with an Elastomeric Polymer type sealer, 1" thick, sloped to drain.

- ### NOTES
1. For Formed Concrete Repairs, see Special Provisions.
 2. For Cross Frame Details, see Sheets 39 and 40.
 3. For Slab to Floorbeam Connection Details, see Sheet 41.
 4. For Bumper Plate Details, see Sheet 38.
 5. For Bumper/Restrainer Assembly Details, see Sheets 34 thru 37.
 6. For Web Reinforcement Plate Details, see Sheet 30.
 7. SF Indicates Square Foot.
 8. For New Tie Beam Details, see Sheet 41.
 9. For New Column Details, see Sheet 42.
 10. For New Cross Frame Connection Plates Detail, See Sheet 43.

LEGEND

= Formed Concrete Repair (Depth ≤ 5")

ELEVATION
(Looking Back Station)
Note: For seismic and redundancy information not shown, see "ELEVATION" on Sheet 14.


DESIGNED	A. Amidi
CHECKED	R. Victor/ M. Capron
DRAWN	S. Kaemmerer
CHECKED	R. Victor

PREPARED BY:
JACOBS CIVIL INC.
ST. LOUIS, MO


REHABILITATION FOR FAI 55/70 COMPLEX
ROADWAY E - STRUCTURE NO. 082-0205
RETROFIT AND SUBSTRUCTURE REPAIR
PIER 017
(FAI-70) ST. CLAIR CO.

STATE OF ILLINOIS
DEPARTMENT OF TRANSPORTATION


ROUTE NO.	DISTRICT	COUNTY	SHEET NO.	SHEET NO.
FAI-70	St. Clair	388	357	46 SHEETS

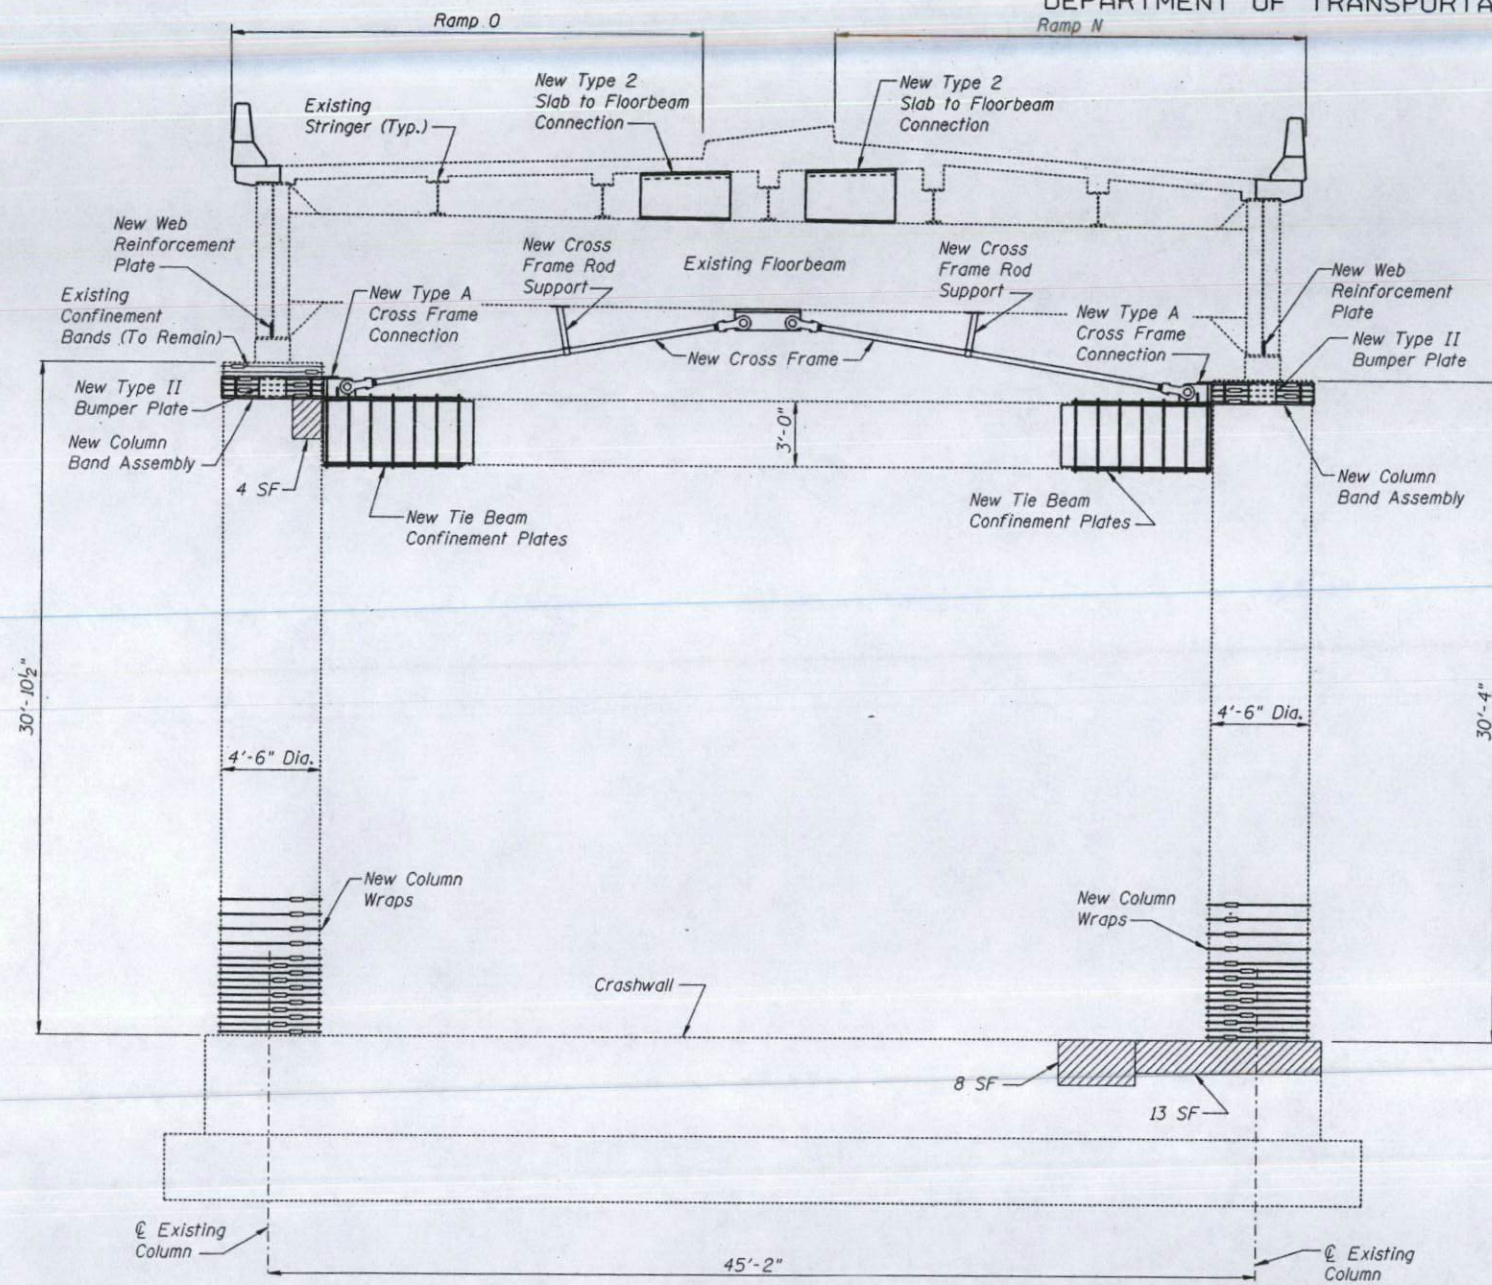

ELEVATION
(Looking Ahead Station)

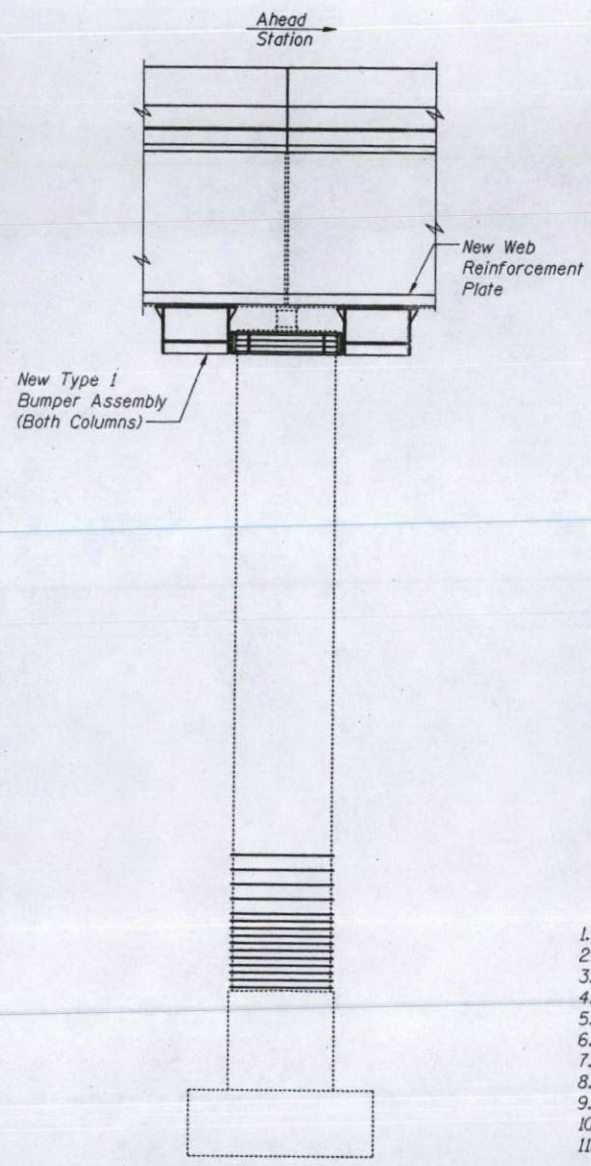

END VIEW

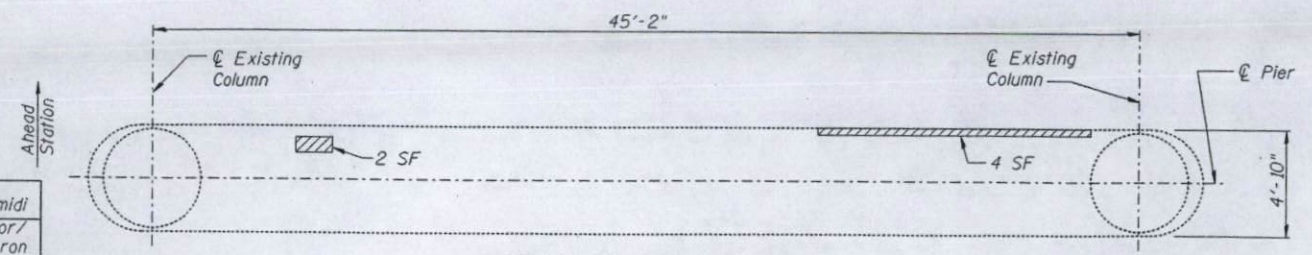

PLAN OF CRASHWALL

NOTES

1. For Formed Concrete Repairs, see Special Provisions.
2. For Cross Frame Details, see Sheets 39 and 40.
3. For Cross Frame Rod Support Details, see Sheet 38.
4. For Column Band Assembly Details, see Sheets 39 and 40.
5. For Slab to Floorbeam Connection Details, see Sheet 41.
6. For Bumper Plate Details, see Sheet 38.
7. For Bumper/Restrainer Assembly Details, see Sheets 34 thru 37.
8. For Column Wrap Details, see Sheet 43.
9. For Web Reinforcement Plate Details, see Sheet 30.
10. For Tie Beam Confinement Plates, see Sheet 43.
11. SF Indicates Square Foot.

LEGEND

= Formed Concrete Repair (Depth ≤ 5")

BILL OF MATERIAL - PIER 018		
ITEM	UNIT	QUANTITY
Column wrap	SQ. FT.	259
Expansion Bolts (Special)	EACH	16
Formed Concrete Repair (Depth ≤ 5")	SQ. FT.	75

REHABILITATION FOR FAI 55/70 COMPLEX
ROADWAY E - STRUCTURE NO. 082-0205
RETROFIT AND SUBSTRUCTURE REPAIR
PIER 018
(FAI-70) ST. CLAIR CO.


DESIGNED	A. Amidi
CHECKED	R. Victor/ M. Capron
DRAWN	S. Kaemmerer
CHECKED	R. Victor

PREPARED BY:
JACOBS CIVIL INC.
ST. LOUIS, MO

STATE OF ILLINOIS
DEPARTMENT OF TRANSPORTATION

ROUTE NO.	DISTRICT	COUNTY	SECTION	SHEET	SHEET NO.
FAI-70		St. Clair	388	358	46 SHEETS

*82-3HVB-2R-1-2

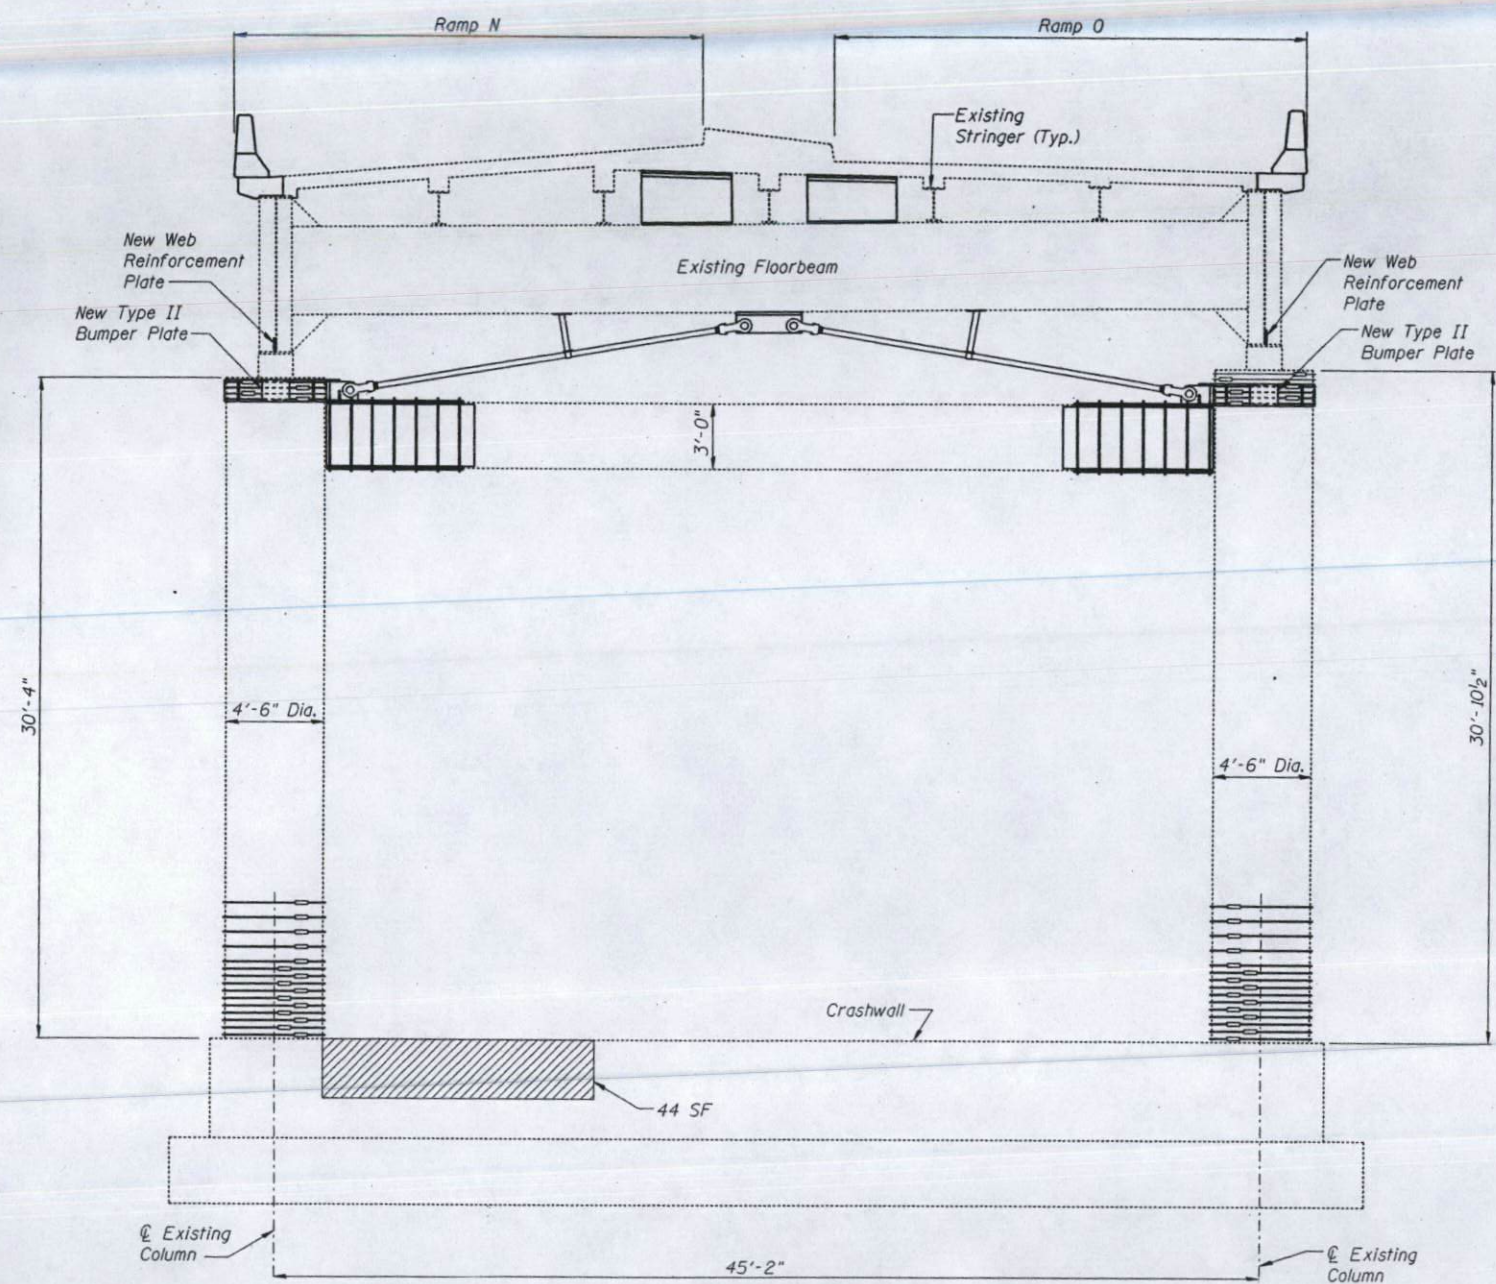

NOTES

1. For Formed Concrete Repairs, see Special Provisions.
2. For Bumper Plate Details, see Sheet 38.
3. For Web Reinforcement Plate Details, see Sheet 30.
4. SF Indicates Square Foot.

LEGEND

= Formed Concrete Repair (Depth ≤ 5")

ELEVATION

(Looking Back Station)

Note: For seismic and redundancy information not shown, see "ELEVATION" on Sheet 16.

DESIGNED	A. Amidi
	R. Victor/ M. Capron
CHECKED	
DRAWN	S. Kaemmerer
CHECKED	R. Victor


PREPARED BY:
JACOBS CIVIL INC.
ST. LOUIS, MO

REHABILITATION FOR FAI 55/70 COMPLEX
ROADWAY E - STRUCTURE NO. 082-0205
RETROFIT AND SUBSTRUCTURE REPAIR
PIER 018
(FAI-70) ST. CLAIR CO.


STATE OF ILLINOIS
DEPARTMENT OF TRANSPORTATION

ROUTE NO.	SECTION	COUNTY	JOB NO.	SHEET NO.
FAI-70		St. Clair	388	359
FED. ROAD DIST. NO. 7		ILLINOIS		FED. AID PROJECT NO.
		082-3HVB-2R-D-2		

46 SHEETS

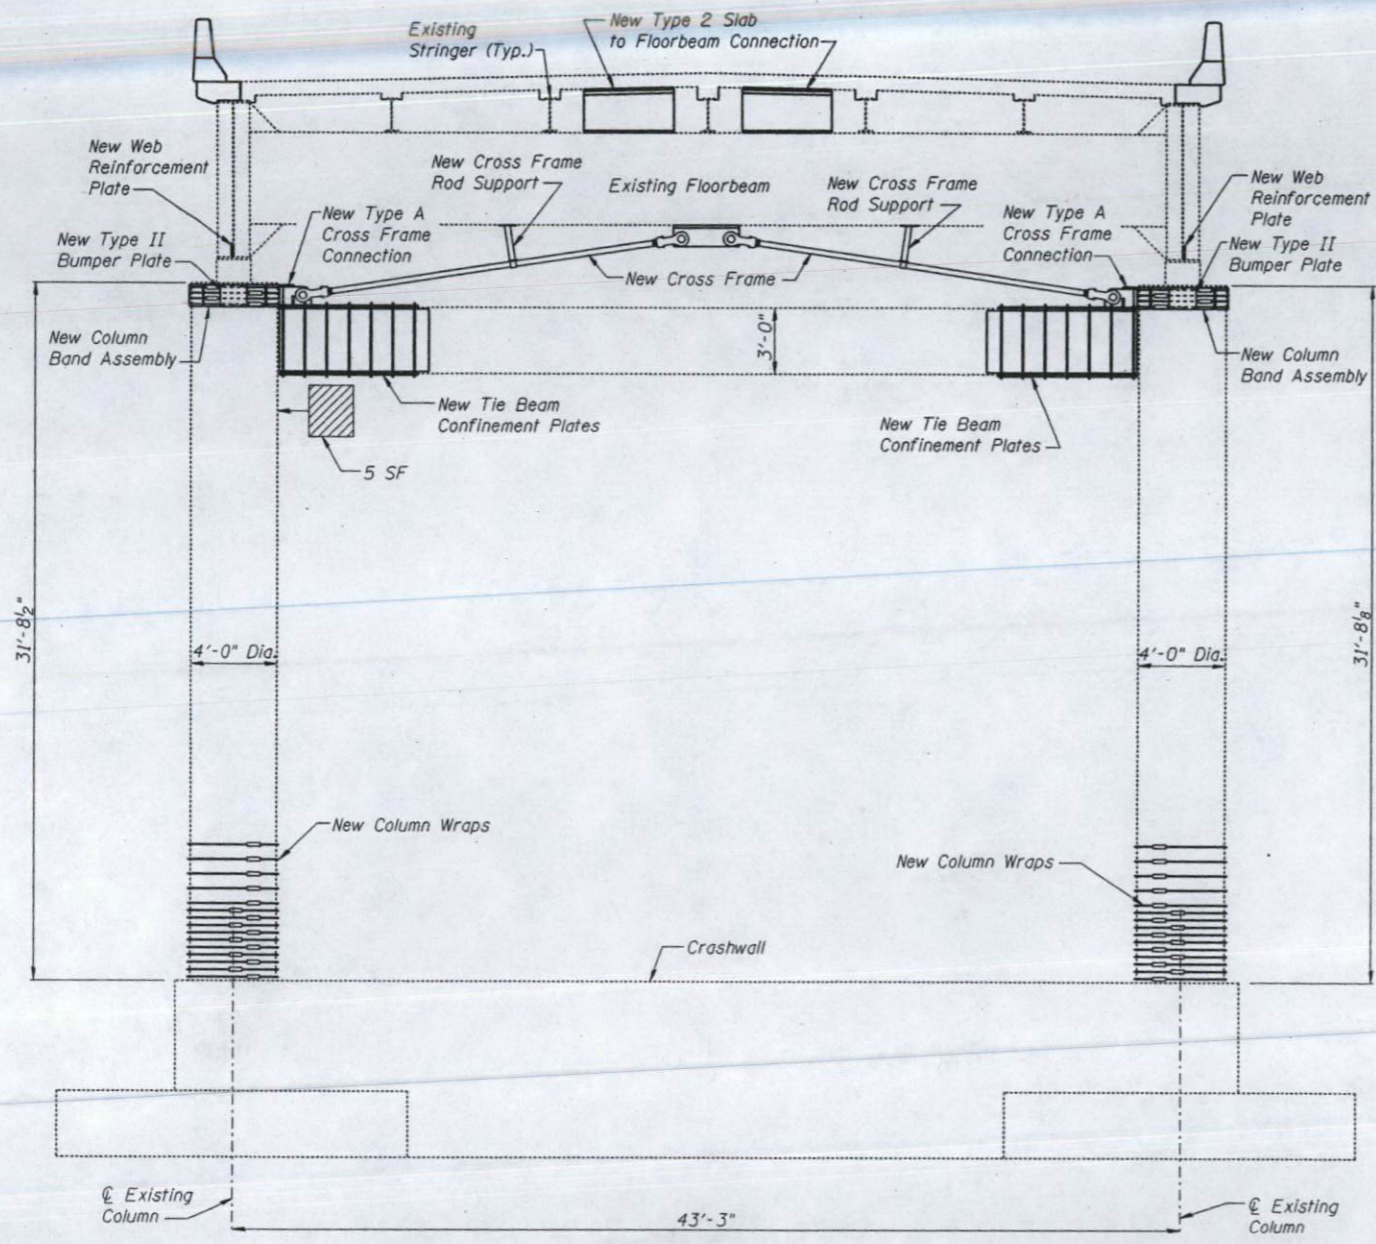

ELEVATION
(Looking Ahead Station)

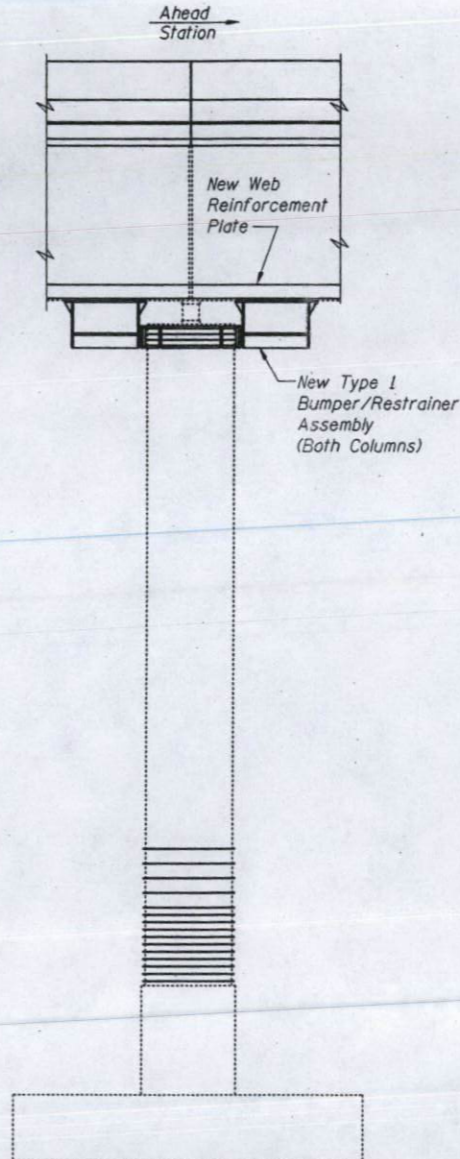

END VIEW

NOTES

1. For Formed Concrete Repairs, see Special Provisions.
2. For Cross Frame Details, see Sheets 39 and 40.
3. For Cross Frame Rod Support Details, see Sheet 38.
4. For Column Band Assembly Details, see Sheets 39 and 40.
5. For Slab to Floorbeam Connection Details, see Sheet 41.
6. For Bumper Plate Details, see Sheet 38.
7. For Bumper/Restrainer Assembly Details, see Sheets 34 thru 37.
8. For Column Wrap Details, see Sheet 43.
9. For Web Reinforcement Plate Details, see Sheet 30.
10. For Tie Beam Confinement Plates, see Sheet 43.
11. SF Indicates Square Foot.

LEGEND

= Formed Concrete Repair (Depth ≤ 5")

BILL OF MATERIAL - PIER E1		
ITEM	UNIT	QUANTITY
Column wrap	SQ. FT.	230
Expansion Bolts (Special)	EACH	16
Formed Concrete Repair (Depth ≤ 5")	SQ. FT.	6


DESIGNED	A. Amidi
CHECKED	R. Victor/ M. Capron
DRAWN	S. Koemmerer
CHECKED	R. Victor

PREPARED BY:
JACOBS CIVIL INC.
ST. LOUIS, MO

REHABILITATION FOR FAI 55/70 COMPLEX
ROADWAY E - STRUCTURE NO. 082-0205
RETROFIT AND SUBSTRUCTURE REPAIR
PIER E1
(FAI-70) ST. CLAIR CO.

STATE OF ILLINOIS
DEPARTMENT OF TRANSPORTATION

ROUTE NO.	SECTION	COUNTY	SHEET	POST	SHEET NO. 19
FAI-70	*	St. Clair	388	360	46 SHEETS

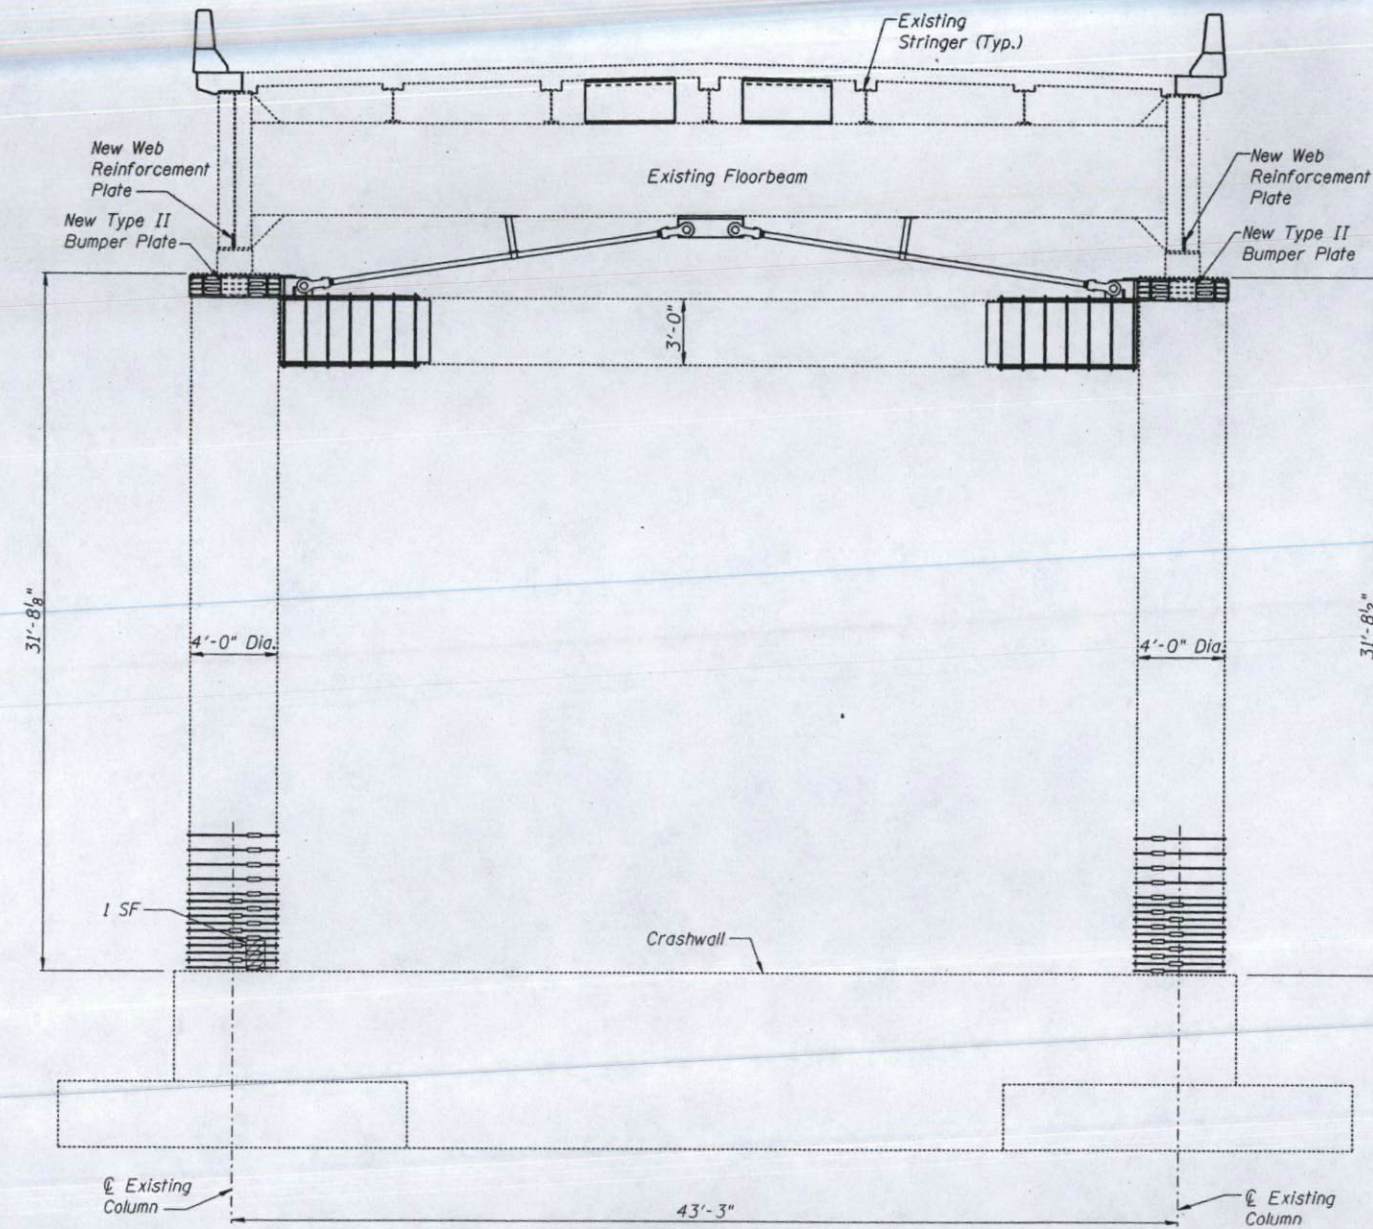

ELEVATION


(Looking Back Station)

Note: For seismic and redundancy information not shown, see "ELEVATION" on Sheet 18.

NOTES

1. For Formed Concrete Repairs, see Special Provisions.
2. For Bumper Plate Details, see Sheet 38.
3. For Web Reinforcement Plate Details, see Sheet 30.
4. SF Indicates Square Foot.

LEGEND

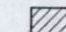 = Formed Concrete Repair (Depth ≤ 5")

DESIGNED	A. Amidi
CHECKED	R. Victor/ M. Capron
DRAWN	S. Kaemmerer
CHECKED	R. Victor


PREPARED BY:
JACOBS CIVIL INC.
ST. LOUIS, MO

REHABILITATION FOR FAI 55/70 COMPLEX
ROADWAY E - STRUCTURE NO. 082-0205
RETROFIT AND SUBSTRUCTURE REPAIR
PIER E1
(FAI-70) ST. CLAIR CO.

STATE OF ILLINOIS
DEPARTMENT OF TRANSPORTATION

ROUTE NO.	SECTION	COUNTY	MILE	POST	SHEET NO. 20
FAI-70	*	St. Clair	388	361	46 SHEETS
REL. ROAD DIST. NO. 7	BLANK	REL. ROAD PROJECT			

082-3HVB-2R-D-2

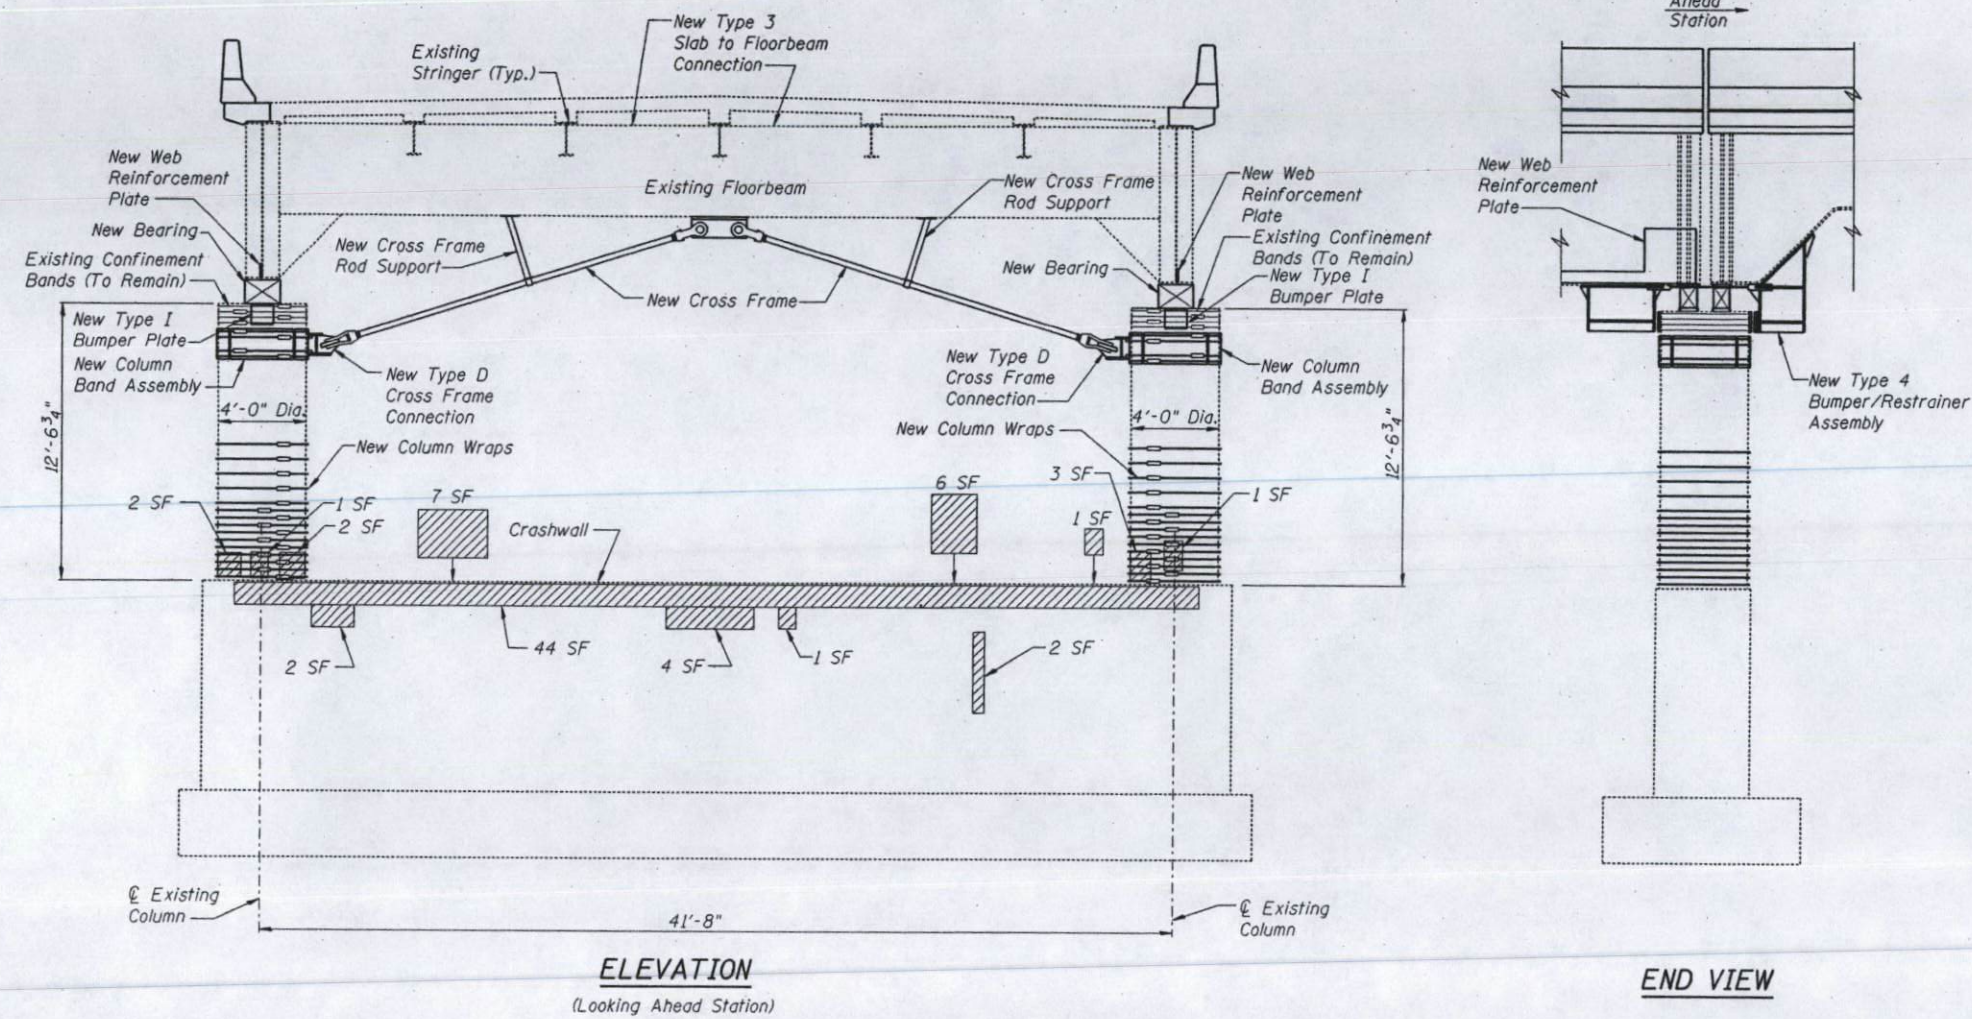

- NOTES**
1. For Formed Concrete Repairs, see Special Provisions.
 2. For Cross Frame Details, see Sheets 39 and 40.
 3. For Cross Frame Rod Support Detail, see Sheet 38.
 4. For Column Band Assembly Details, see Sheets 39 and 40.
 5. For Slab to Floorbeam Connection Details, see Sheet 41.
 6. For Bumper Plate Details, see Sheet 38.
 7. For Bumper/Restrainer Assembly Details, see Sheets 34 thru 37.
 8. For Column Wrap Details, see Sheet 43.
 9. For Web Reinforcement Plate Details, see Sheet 30.
 10. For Elastomeric Bearing Details, see Sheet 44.
 11. SF Indicates Square Foot.

LEGEND

= Formed Concrete Repair (Depth ≤ 5")

BILL OF MATERIAL - PIER E2

ITEM	UNIT	QUANTITY
Column wrap	SO. FT.	180
Expansion Bolts (Special)	EACH	24
Formed Concrete Repair (Depth ≤ 5")	SO. FT.	125
Elastomeric Bearing, Type II	EACH	4

REHABILITATION FOR FAI-55/70 COMPLEX
ROADWAY E - STRUCTURE NO. 082-0205
RETROFIT AND SUBSTRUCTURE REPAIR
PIER E2
(FAI-70) ST. CLAIR CO.


DESIGNED	A. Amidi
CHECKED	R. Victor/ M. Capron
DRAWN	S. Koemmerer
CHECKED	R. Victor

PREPARED BY:
JACOBS CIVIL INC.
ST. LOUIS, MO

STATE OF ILLINOIS
DEPARTMENT OF TRANSPORTATION

PROJECT NO.	SHEET	COUNTY	SECT	PIER	SHEET NO. 21
FAI-70	•	St. Clair	388	362	46 SHEETS
PIER NO. DIST. NO. 7					
BLVD. NO. PIER NO. PROJECT					


082-3HVB-2R-1)-2

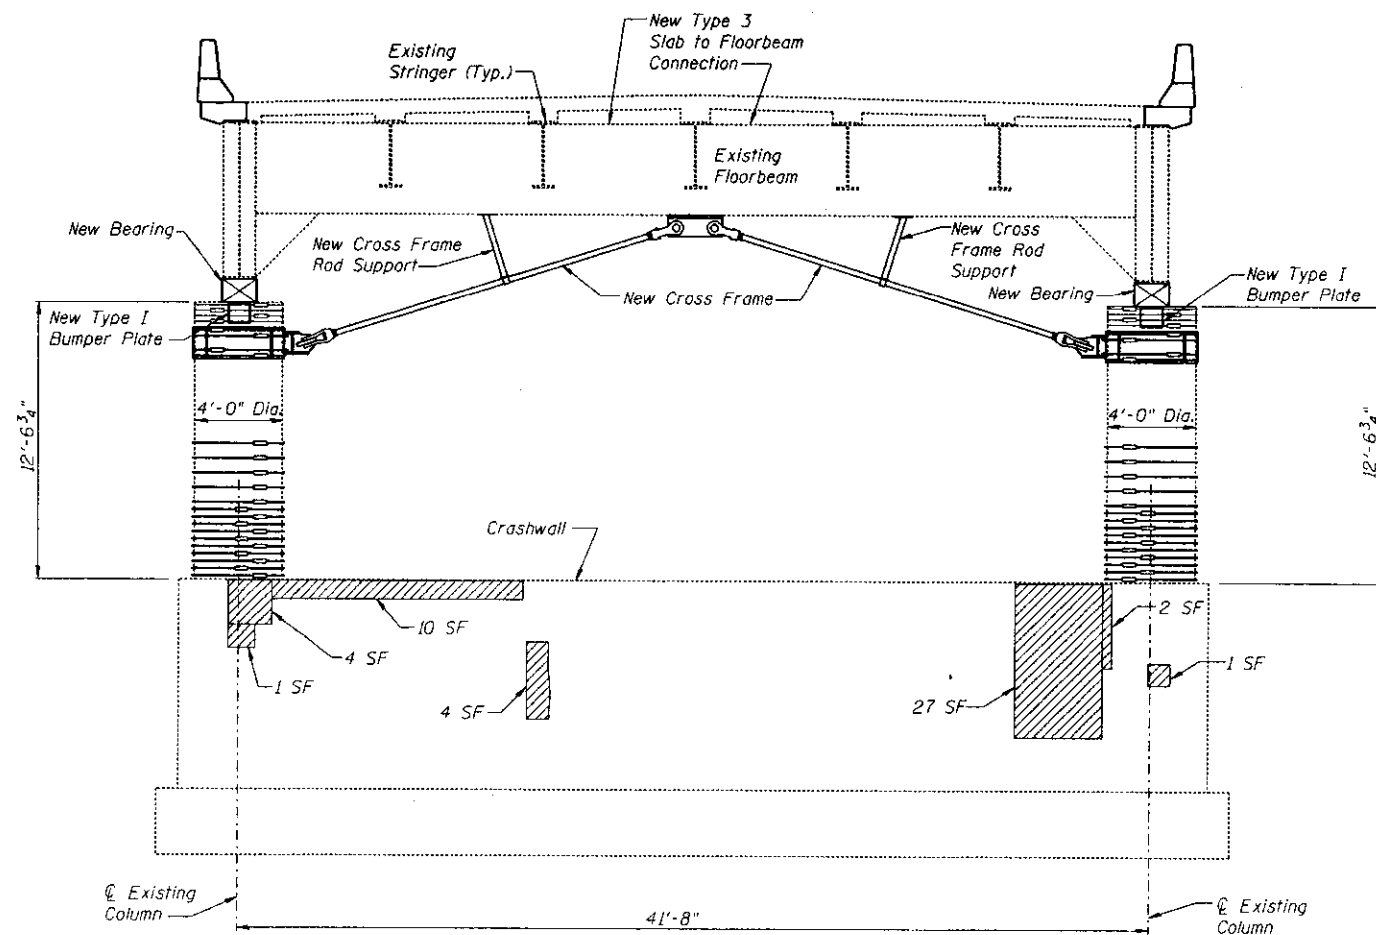

ELEVATION

(Looking Back Station)

Note: For seismic and redundancy information not shown, see "ELEVATION" on Sheet 20.

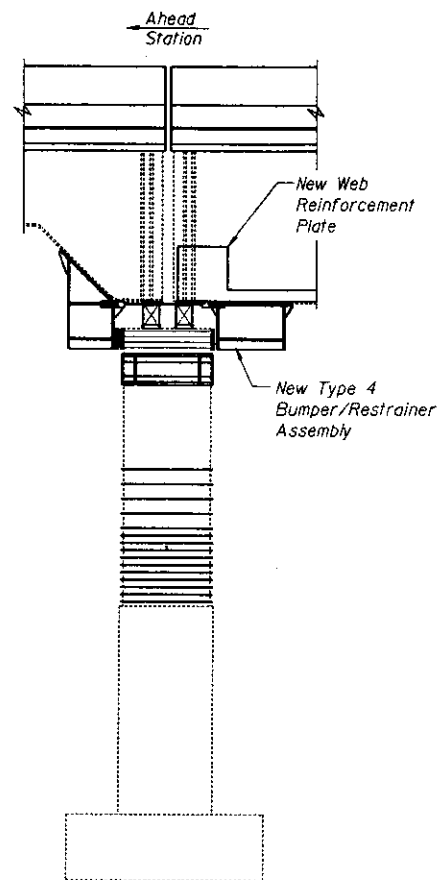

END VIEW

NOTES

1. For Formed Concrete Repairs, see Special Provisions.
2. For Cross Frame Details, see Sheets 39 and 40.
3. For Cross Frame Rod Support Detail, see Sheet 38.
4. For Slab to Floorbeam Connection Details, see Sheet 41.
5. For Bumper Plate Details, see Sheet 38.
6. For Bumper/Restrainer Assembly Details, see Sheets 34 thru 37.
7. For Web Reinforcement Plate Details, see Sheet 30.
8. For Elastomeric Bearing Details, see Sheet 44.
9. SF Indicates Square Foot.

LEGEND

= Formed Concrete Repair (Depth ≤ 5")

DESIGNED	A. Amidi
CHECKED	R. Victor / M. Capron
DRAWN	S. Kaemmerer
CHECKED	R. Victor


PREPARED BY:
JACOBS CIVIL INC.
ST. LOUIS, MO

REHABILITATION FOR FAI 55/70 COMPLEX
ROADWAY E - STRUCTURE NO. 082-0205
RETROFIT AND SUBSTRUCTURE REPAIR
PIER E2
(FAI-70) ST. CLAIR CO.


STATE OF ILLINOIS
DEPARTMENT OF TRANSPORTATION

PROJECT NO.	SECTION	COUNTY	SHEET NO.	TOTAL SHEETS
FAI-70		St. Clair	388	363
PROJECT DIST. NO.	ALIGNED	FEED. NO. PROJECT		

082-3HVB-2R-11-2

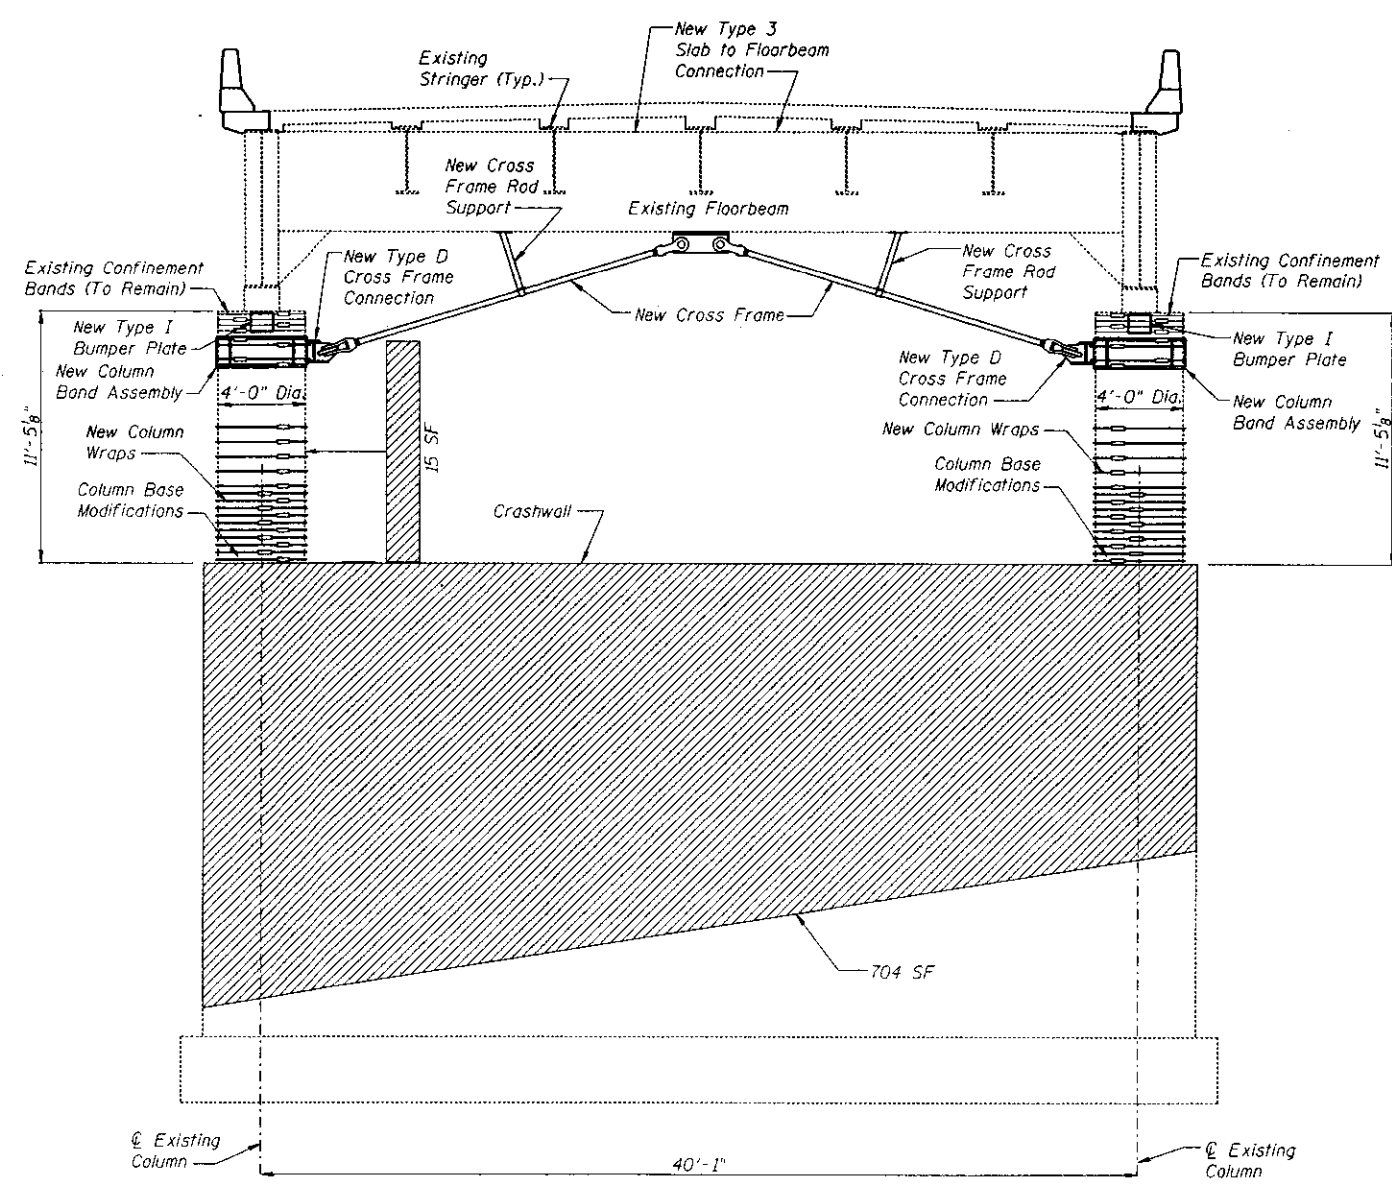

ELEVATION
(Looking Ahead Station)

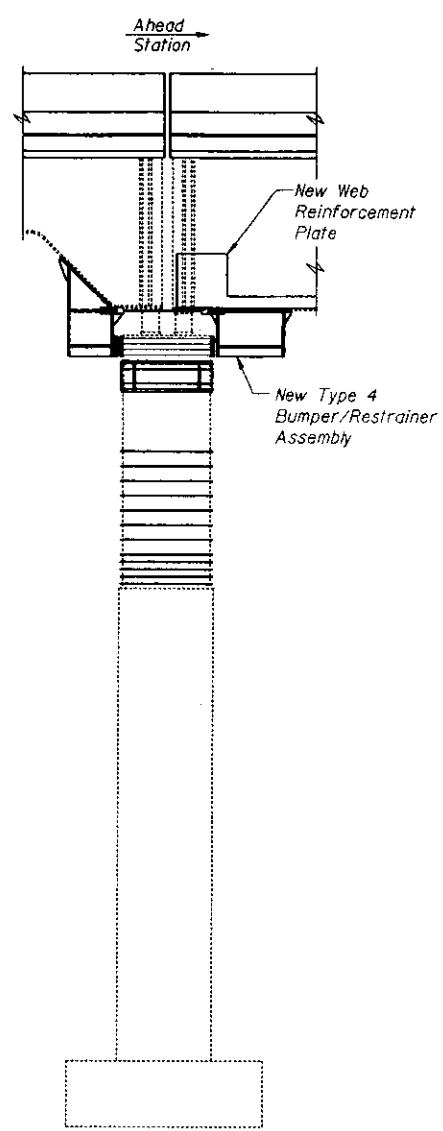

END VIEW

NOTES

1. For Formed Concrete Repairs, see Special Provisions.
2. For Cross Frame Details, see Sheets 39 and 40.
3. For Cross Frame Rod Support Details, see Sheet 38.
4. For Column Band Assembly Details, see Sheets 39 and 40.
5. For Slab to Floorbeam Connection Details, see Sheet 41.
6. For Bumper Plate Details, see Sheet 38.
7. For Bumper/Restrainer Assembly Details, see Sheets 34 thru 37.
8. For Column Wrap Details, see Sheet 43.
9. For Column Base Modification Details, see Sheet 42.
10. For Web Reinforcement Plate Details, see Sheet 30.
11. SF Indicates Square Foot.

LEGEND

= Formed Concrete Repair (Depth ≤ 5")

BILL OF MATERIAL - PIER E3		
ITEM	UNIT	QUANTITY
Column wrap	SQ. FT.	180
Expansion Bolts (Special)	EACH	24
Foundation Wall Dowel Modification	EACH	2
Formed Concrete Repair (Depth ≤ 5")	SQ. FT.	888

REHABILITATION FOR FAI 55/70 COMPLEX
ROADWAY E - STRUCTURE NO. 082-0205
RETROFIT AND SUBSTRUCTURE REPAIR
PIER E3
(FAI-70) ST. CLAIR CO.


DESIGNED	A. Amidi
CHECKED	R. Victor/ M. Capron
DRAWN	S. Kaemmerer
CHECKED	R. Victor

PREPARED BY:
JACOBS CIVIL INC.
ST. LOUIS, MO

STATE OF ILLINOIS
DEPARTMENT OF TRANSPORTATION

ROUTE NO.	SECTION	QUANTITY	DATE	NO.	SHEET NO. 23
FAI-70	*	St. Clair	388	364	46 SHEETS
FILE NO. OR FILE #		ALIAS	FILE NO. PROJECT		


082-3HVB-2R-11-2

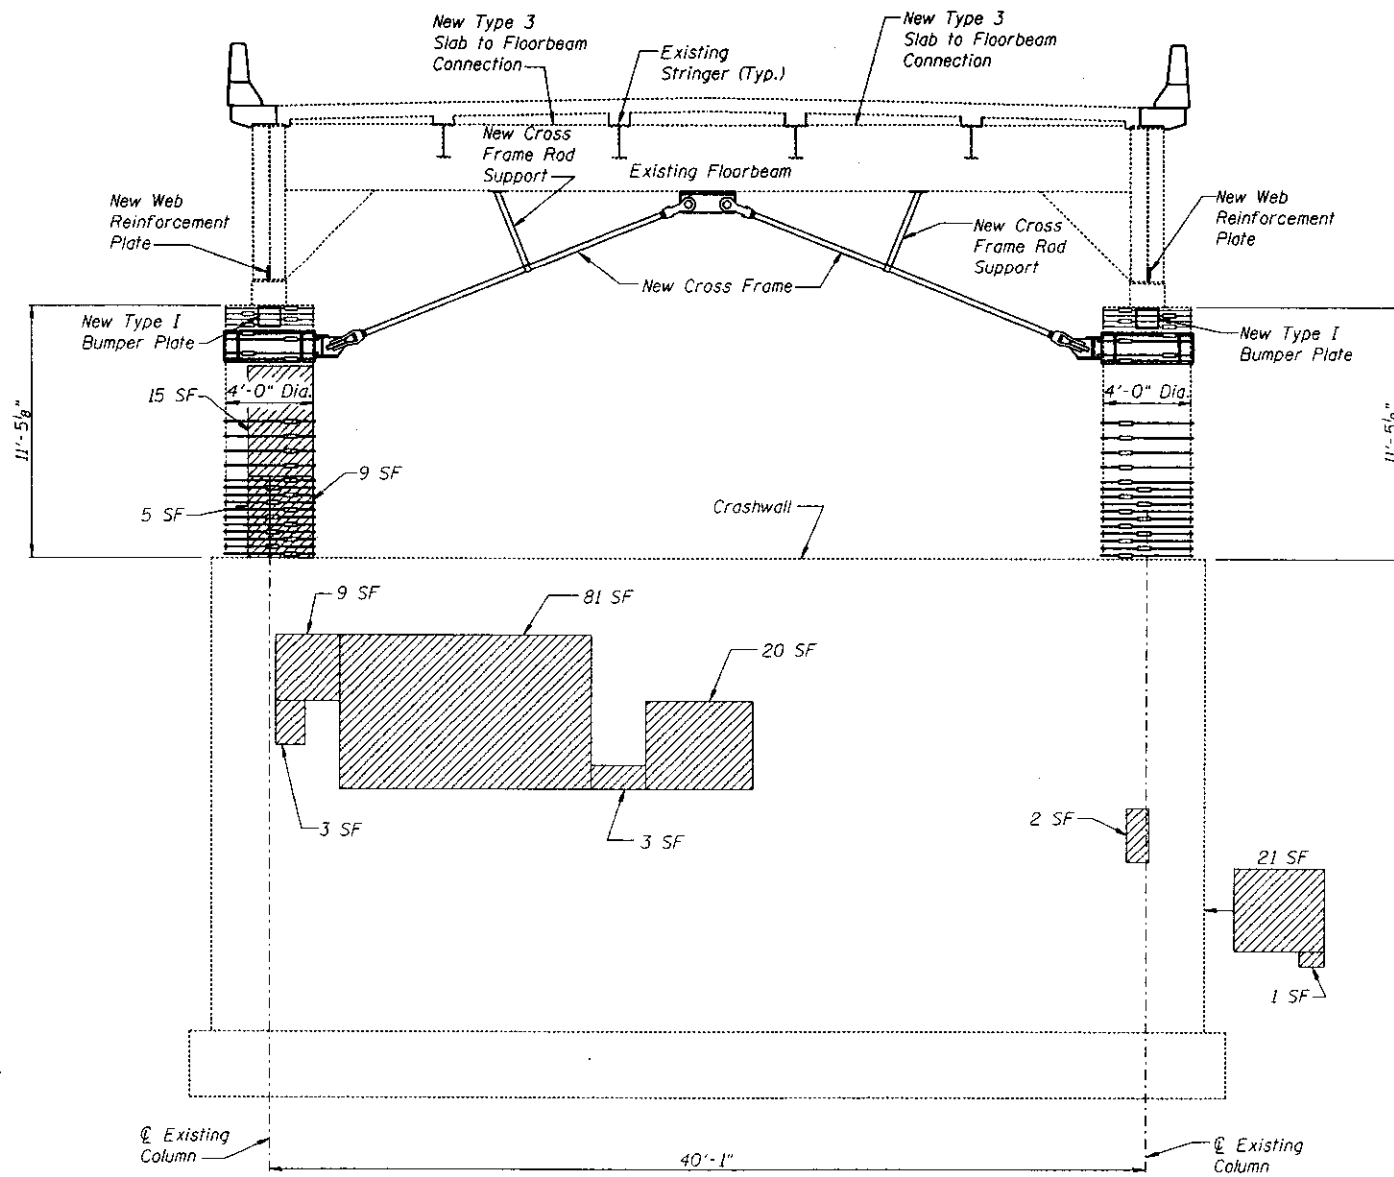

ELEVATION

(Looking Back Station)

Note: For seismic and redundancy information not shown, see "ELEVATION" on Sheet 22.

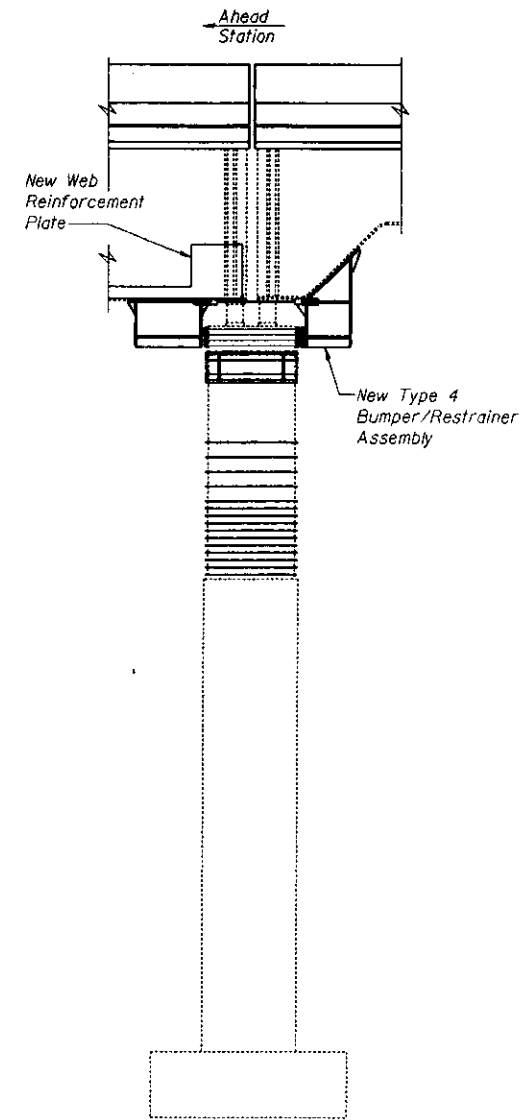

END VIEW

NOTES

1. For Formed Concrete Repairs, see Special Provisions.
2. For Cross Frame Details, see Sheets 39 and 40.
3. For Cross Frame Rod Support Detail, see Sheet 38.
4. For Slab to Floorbeam Connection Details, see Sheet 41.
5. For Bumper Plate Details, see Sheet 38.
6. For Bumper/Restrainer Assembly Details, see Sheets 34 thru 37.
7. For Web Reinforcement Plate Details, see Sheet 30.
8. SF Indicates Square Foot.

LEGEND

= Formed Concrete Repair (Depth ≤ 5")

DESIGNED	A. Amidi
	R. Victor
CHECKED	M. Capron
DRAWN	S. Kaemmerer
CHECKED	R. Victor


PREPARED BY:
JACOBS CIVIL INC.
ST. LOUIS, MO

REHABILITATION FOR FAI 55/70 COMPLEX
ROADWAY E - STRUCTURE NO. 082-0205
RETROFIT AND SUBSTRUCTURE REPAIR
PIER E3
(FAI-70) ST. CLAIR CO.

STATE OF ILLINOIS
DEPARTMENT OF TRANSPORTATION

PROJECT NO.	SECTION	CHART	SHEET NO.	TOTAL SHEETS
FAI-70	*	St. Clair	388	365
				46 SHEETS

082-3HVB-2R-D-2

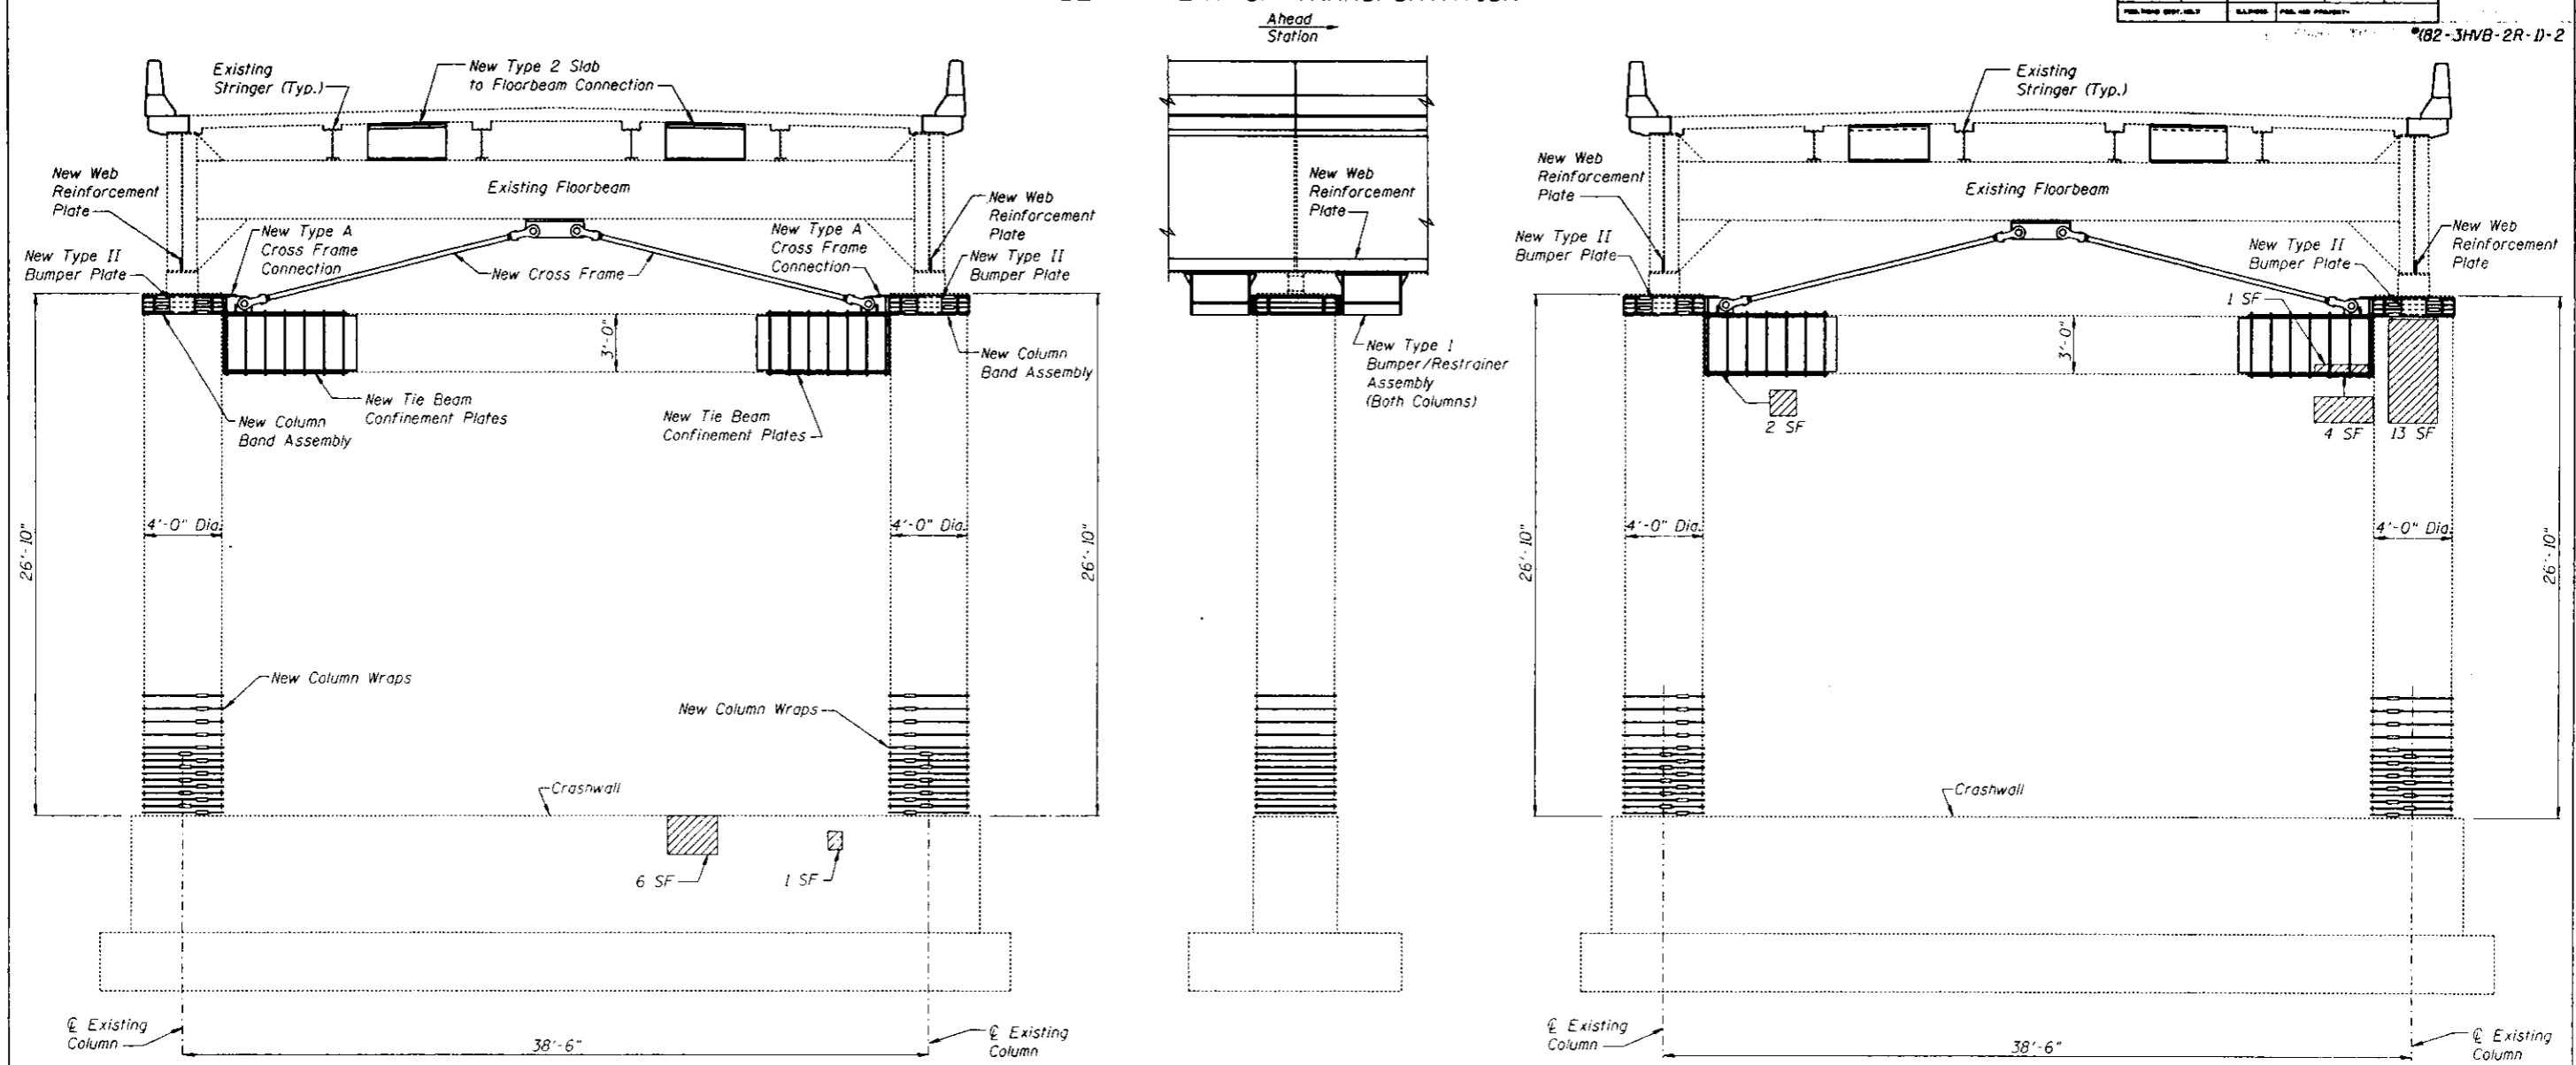

ELEVATION
(Looking Ahead Station)

END VIEW

ELEVATION
(Looking Back Station)

Note: For seismic and redundancy information not shown, see "ELEVATION (Looking Ahead Station)".

NOTES

1. For Formed Concrete Repairs, see Special Provisions.
2. For Cross Frame Details, see Sheets 39 and 40.
3. For Column Band Assembly Details, see Sheets 39 and 40.
4. For Slab to Floorbeam Connection Details, see Sheet 41.
5. For Bumper Plate Details, see Sheet 33.
6. For Bumper/Restrainer Assembly Details, see Sheets 34 thru 37.
7. For Column Wrap Details, see Sheet 43.
8. For Web Reinforcement Plate Details, see Sheet 30.
9. For Tie Beam Confinement Plates, see Sheet 43.
10. SF Indicates Square Foot.

LEGEND

= Formed Concrete Repair (Depth ≤ 5")

BILL OF MATERIAL - PIER E4		
ITEM	UNIT	QUANTITY
Column wrap	SQ. FT.	180
Expansion Bolts (Special)	EACH	16
Formed Concrete Repair (Depth ≤ 5")	SQ. FT.	27

DESIGNED	A. Amidi
	R. Victor / M. Capron
CHECKED	M. Capron
DRAWN	S. Kaemmerer
CHECKED	R. Victor


PREPARED BY:
JACOBS CIVIL INC.
ST. LOUIS, MO

REHABILITATION FOR FAI 55/70 COMPLEX
ROADWAY E - STRUCTURE NO. 082-0205
RETROFIT AND SUBSTRUCTURE REPAIR
PIER E4
(FAI-70) ST. CLAIR CO.

STATE OF ILLINOIS
DEPARTMENT OF TRANSPORTATION

ROUTE NO.	SECTION	COUNTY	JOB NO.	SHEET NO.
FAI-70	*	St. Clair	388 366	46 SHEETS

PROJECT: (82-3HVB-2R-1)-2

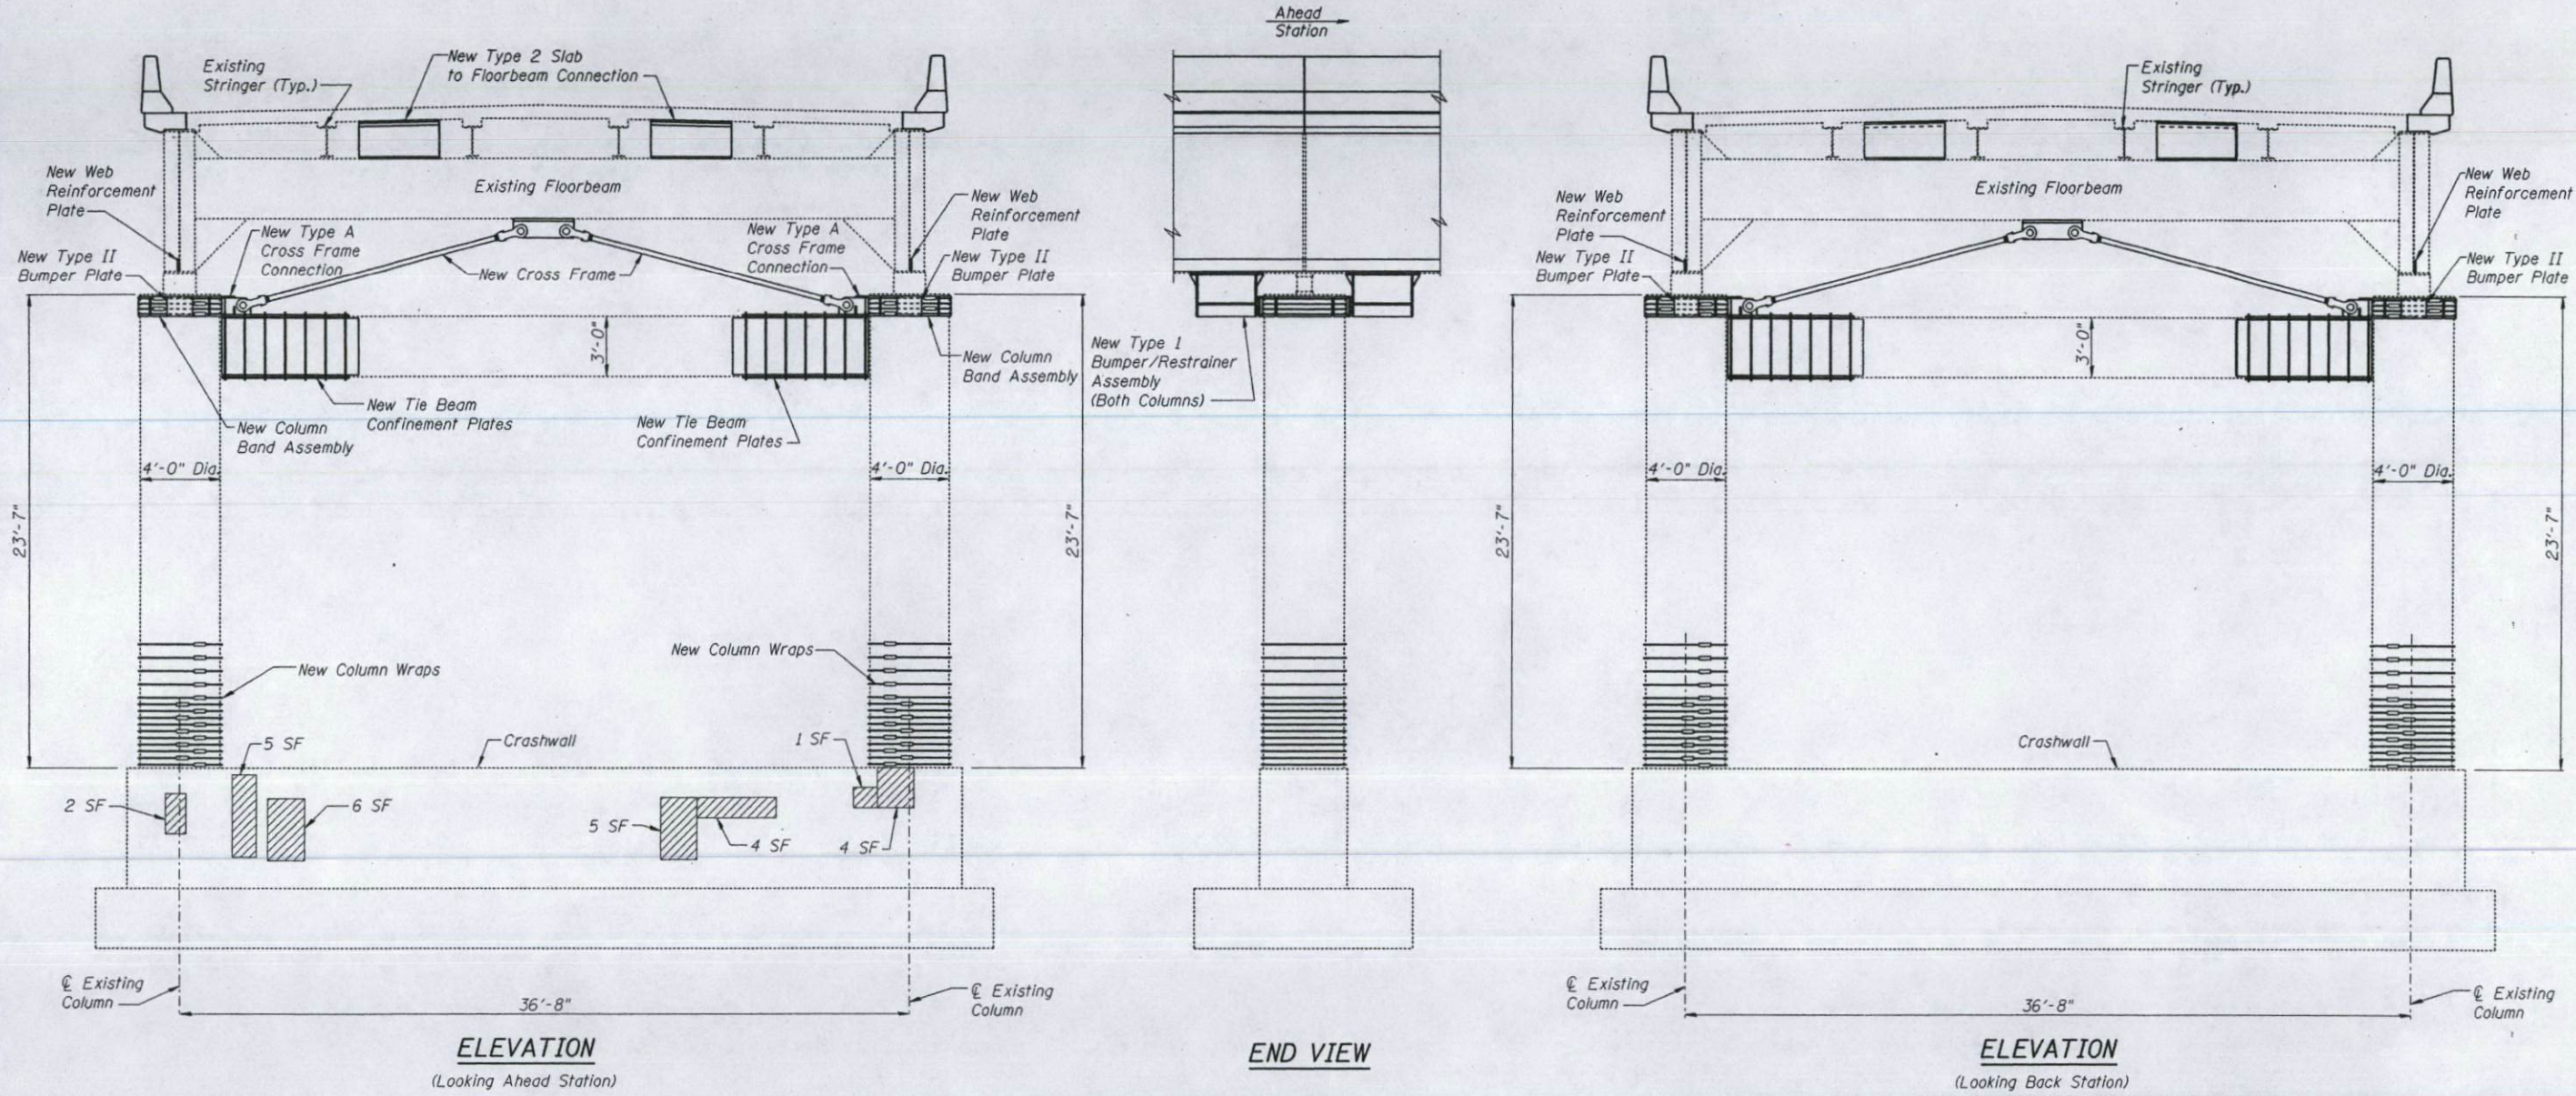

Note: For seismic and redundancy information not shown, see "ELEVATION (Looking Ahead Station)".

NOTES

1. For Formed Concrete Repairs, see Special Provisions.
2. For Cross Frame Details, see Sheets 39 and 40.
3. For Column Band Assembly Details, see Sheets 39 and 40.
4. For Slab to Floorbeam Connection Details, see Sheet 41.
5. For Bumper Plate Details, see Sheet 38.
6. For Bumper/Restrainer Assembly Details, see Sheets 34 thru 37.
7. For Column Wrap Details, see Sheet 43.
8. For Web Reinforcement Plate Details, see Sheet 30.
9. For Tie Beam Confinement Plates, see Sheet 43.
10. SF Indicates Square Foot.

LEGEND

= Formed Concrete Repair (Depth ≤ 5")

ITEM	UNIT	QUANTITY
Column wrap	SQ. FT.	180
Expansion Bolts (Special)	EACH	16
Formed Concrete Repair (Depth ≤ 5")	SQ. FT.	27

DESIGNED	A. Amidi
CHECKED	R. Victor/ M. Capron
DRAWN	S. Kaemmerer
CHECKED	R. Victor


PREPARED BY:
JACOBS CIVIL INC.
ST. LOUIS, MO

REHABILITATION FOR FAI 55/70 COMPLEX
ROADWAY E - STRUCTURE NO. 082-0205
RETROFIT AND SUBSTRUCTURE REPAIR
PIER E5
(FAI-70) ST. CLAIR CO.


STATE OF ILLINOIS
DEPARTMENT OF TRANSPORTATION

ROUTE NO.	SECTION	COUNTY	POST MILES	POST MILES	SHEET NO. 26
FAI-70	*	St. Clair	388	367	46 SHEETS
FED. ROAD DIST. NO. 7		ALIGNED	RELIEF PROJECT		


*(82-3HVB-2R-D)-2

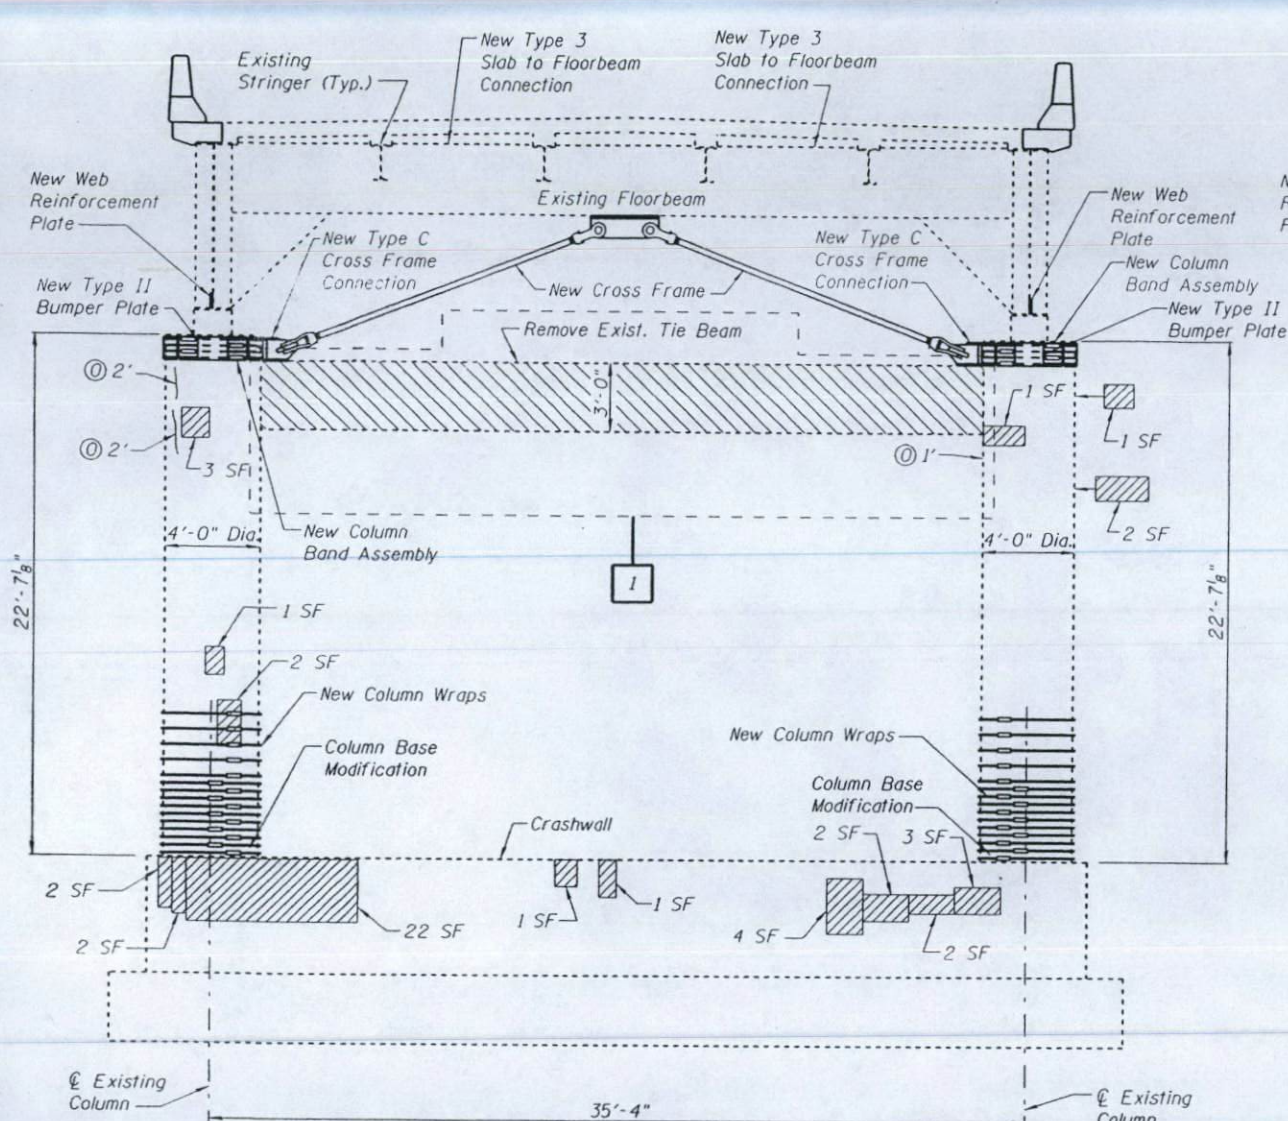

ELEVATION
(Looking Ahead Station)

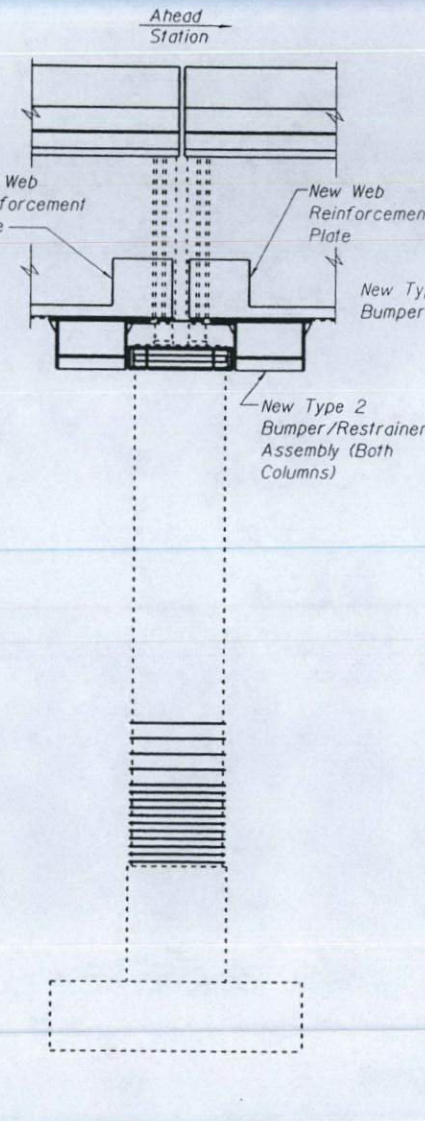


END VIEW

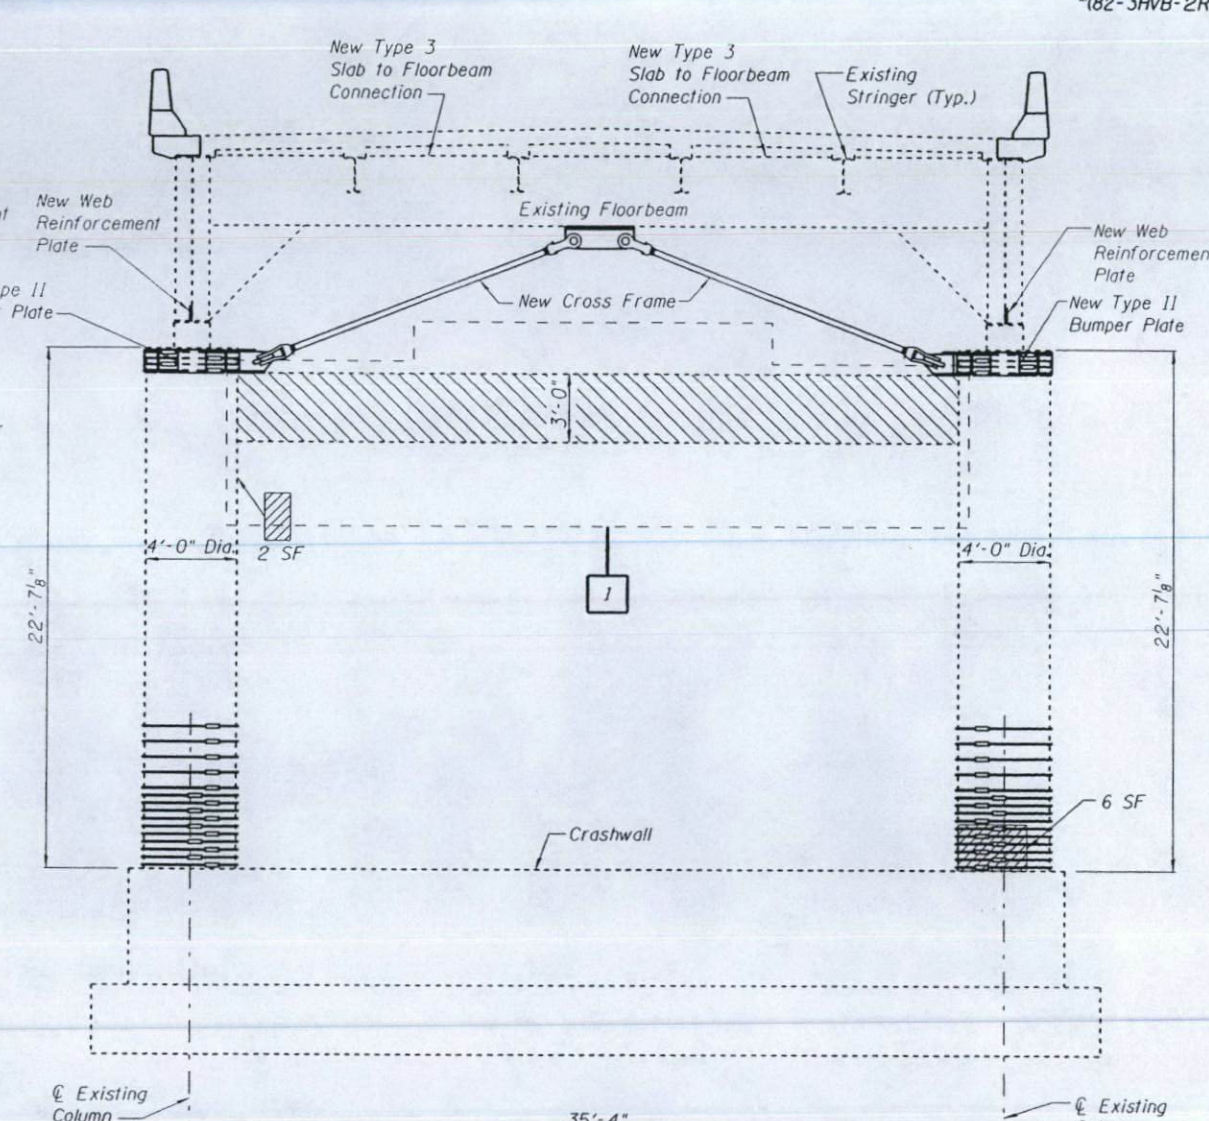

ELEVATION
(Looking Back Station)

Note: For seismic and redundancy information not shown, see "ELEVATION (Looking Ahead Station)".

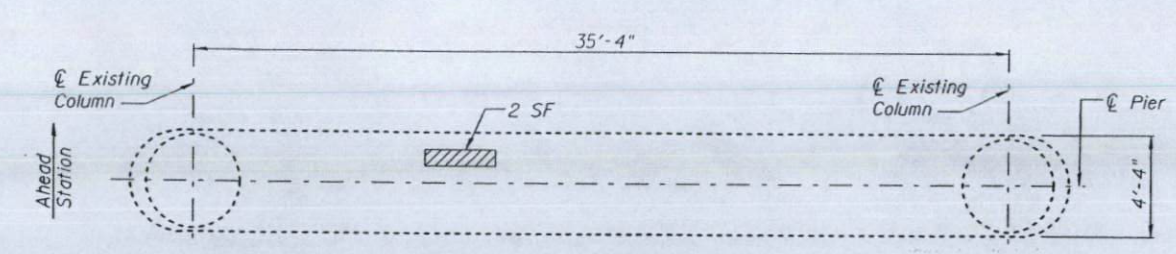

PLAN OF CRASHWALL

NOTES

1. For Formed Concrete Repairs, see Special Provisions.
2. For Cross Frame Details, see Sheets 39 and 40.
3. For Column Band Assembly Details, see Sheets 39 and 40.
4. For Slab to Floorbeam Connection Details, see Sheet 41.
5. For Bumper Plate Details, see Sheet 38.
6. For Bumper/Restrainer Assembly Details, see Sheets 34 thru 37.
7. For Column Wrap Details, see Sheet 43.
8. For Column Base Modification Details, see Sheet 42.
9. For Web Reinforcement Plate Details, see Sheet 30.
10. SF Indicates Square Foot.

LEGEND

- = Formed Concrete Repair (Depth ≤ 5")
- = Open Crack - Formed Concrete Repair (Depth ≤ 5")
- = Remove Tie Beam (Special)

DESIGNED	A. Amidi
CHECKED	R. Victor/ M. Capron
DRAWN	S. Kaemmerer
CHECKED	R. Victor

PREPARED BY:
JACOBS CIVIL INC.
ST. LOUIS, MO


ITEM	UNIT	QUANTITY
Column wrap	SQ. FT.	180
Expansion Bolts (Special)	EACH	24
Formed Concrete Repair (Depth ≤ 5")	SQ. FT.	1.67
Foundation Wall Dowel Modification	EACH	2
Remove Tie Beam (Special)	EACH	1

**REHABILITATION FOR FAI 55/70 COMPLEX
ROADWAY E - STRUCTURE NO. 082-0205
RETROFIT AND SUBSTRUCTURE REPAIR
PIER E6
(FAI-70) ST. CLAIR CO.**

STATE OF ILLINOIS
DEPARTMENT OF TRANSPORTATION

ROUTE NO.	DISTRICT	COUNTY	SHEET NO.	SHEET NO.
FAI-70	*	St. Clair	388	368
FED. ROAD DIST. NO.		ALPHABETIC PROJECT		082-3HVB-2R-D-2

082-3HVB-2R-D-2

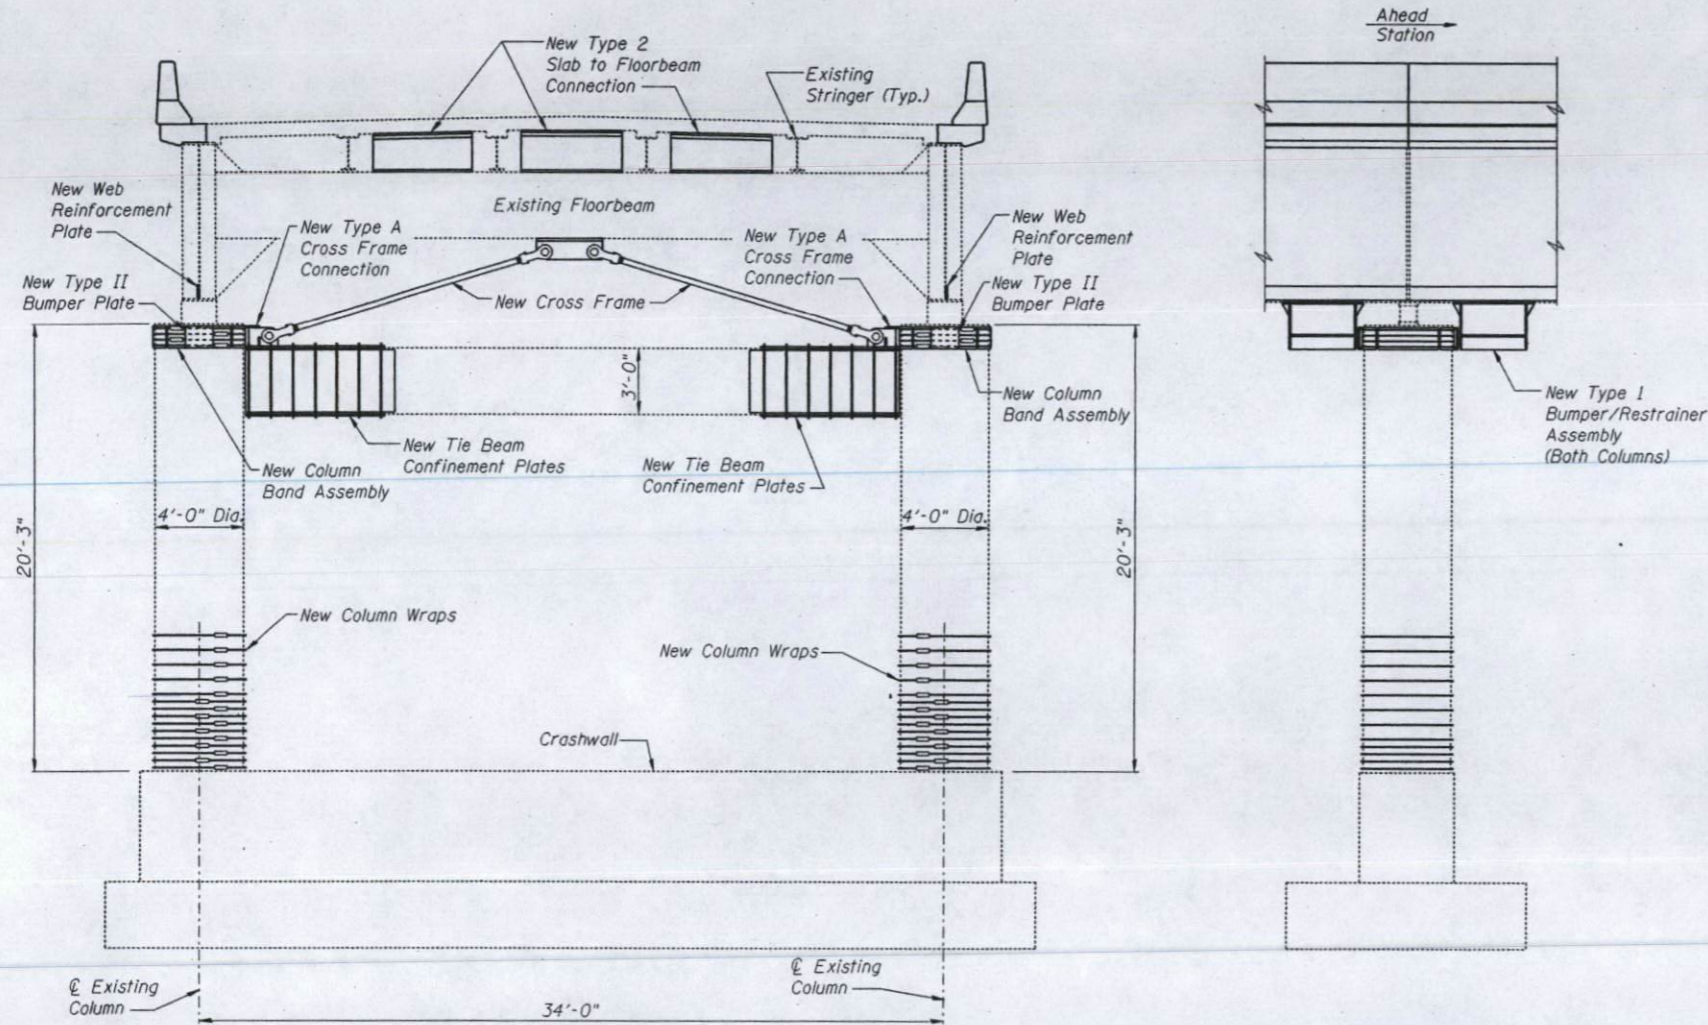

ELEVATION

(Looking Ahead Station)

Note: "ELEVATION (Looking Back Station)" similar and opposite hand.

END VIEW

NOTES

1. For Cross Frame Details, see Sheets 39 and 40.
2. For Column Band Assembly Details, see Sheets 39 and 40.
3. For Slab to Floorbeam Connection Details, see Sheet 41.
4. For Bumper Plate Details, see Sheet 38.
5. For Bumper/Restrainer Assembly Details, see Sheets 34 thru 37.
6. For Column Wrap Details, see Sheet 43.
7. For Web Reinforcement Plate Details, see Sheet 30.
8. For Tie Beam Confinement Plates, see Sheet 43.

DESIGNED	A. Amidi
CHECKED	R. Victor/ M. Capron
DRAWN	S. Kaemmerer
CHECKED	R. Victor

PREPARED BY:
JACOBS CIVIL INC.
ST. LOUIS, MO




BILL OF MATERIAL - PIER E7		
ITEM	UNIT	QUANTITY
Column wrap	SQ. FT.	180
Expansion Bolts (Special)	EACH	24

REHABILITATION FOR FAI 55/70 COMPLEX
ROADWAY E - STRUCTURE NO. 082-0205
RETROFIT AND SUBSTRUCTURE REPAIR
PIER E7
(FAI-70) ST. CLAIR CO.

STATE OF ILLINOIS
DEPARTMENT OF TRANSPORTATION

ROUTE NO.	SECTION	SUBJECT	DATE	NO.	SHEET NO. 28
FAI-70		St. Clair	388	369	46 SHEETS
PUBL. ROAD DIST. NO. 7	PLAN NO.	PUBL. PROJ. NO.			

082-3HVB-2R-1)-2

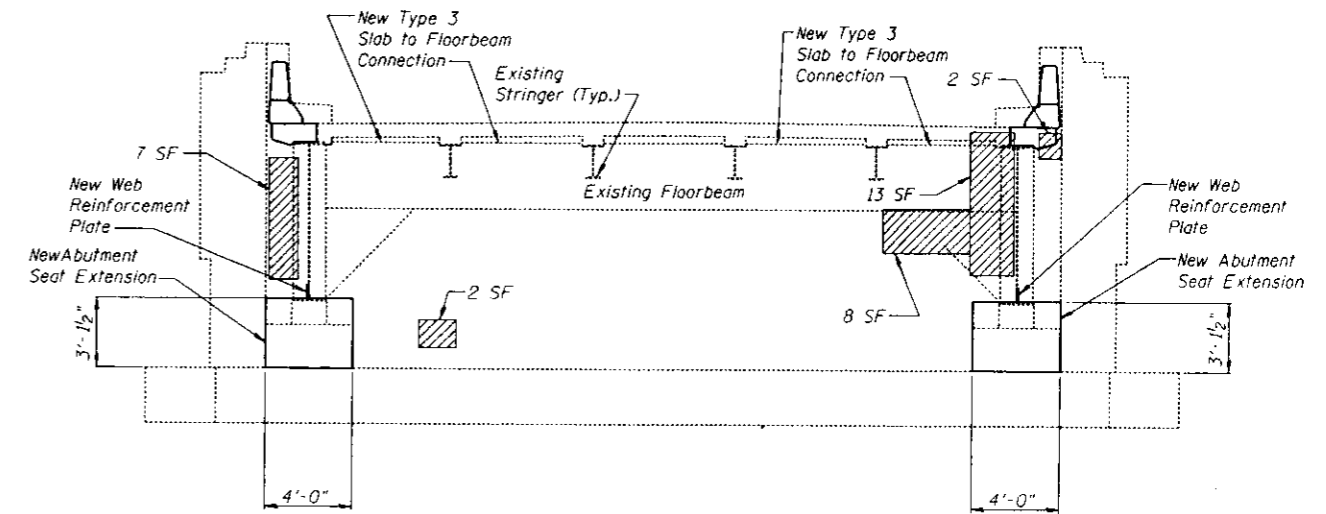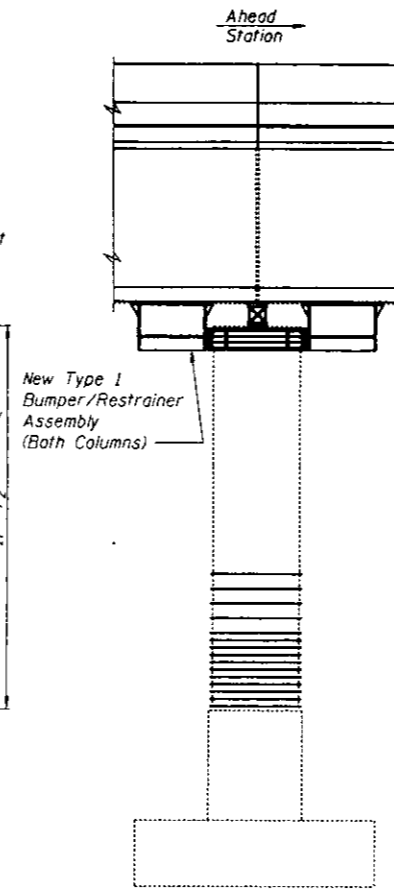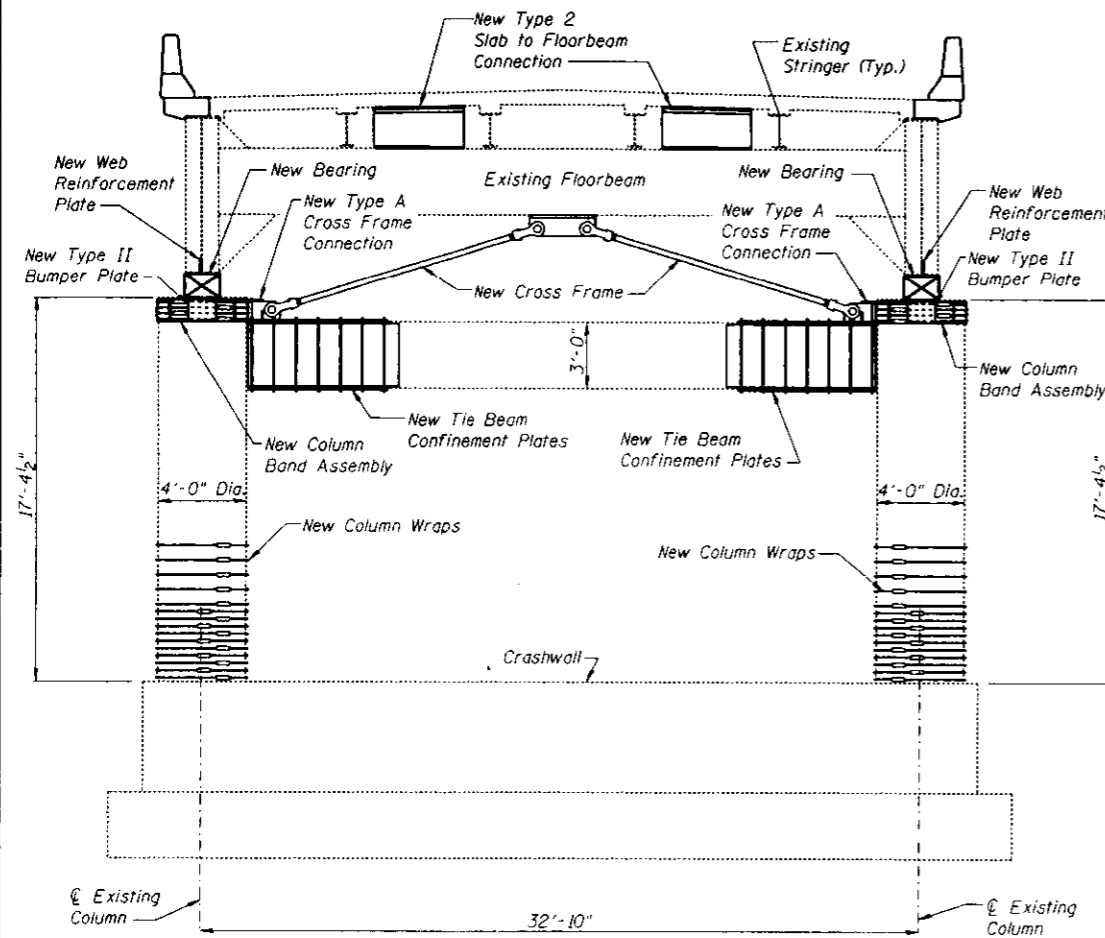

LEGEND
 = Formed Concrete Repair (Depth ≤ 5")

- NOTES**
1. For Formed Concrete Repairs, see Special Provisions.
 2. For Abutment Seat Extensions, see Sheet 33.
 3. For Cross Frame Details, see Sheets 39 and 40.
 4. For Column Band Assembly Details, see Sheets 39 and 40.
 5. For Slab to Floorbeam Connection Details, see Sheet 41.
 6. For Bumper Plate Details, see Sheet 38.
 7. For Bumper/Restrainer Assembly Details, see Sheets 34 thru 37.
 8. For Column Wrap Details, see Sheet 43.
 9. For Web Reinforcement Plate Details, see Sheet 30.
 10. For Tie Beam Confinement Plates, see Sheet 43.
 11. For Elastomeric Bearing Details, see Sheet 44A.
 12. SF Indicates Square Foot.

BILL OF MATERIAL - PIER E8

ITEM	UNIT	QUANTITY
Column wrap	SQ. FT.	180
Expansion Bolts (Special)	EACH	16
Elastomeric Bearing Assembly, Type II	EACH	2

BILL OF MATERIAL - ABUTMENT E9

ITEM	UNIT	QUANTITY
Expansion Bolts (Special)	EACH	24
Reinforcement Bars (Epoxy Coated)	LBS.	1,260
Concrete Structures	C.Y.	1.7
Formed Concrete Repair (Depth ≤ 5")	SQ. FT.	32

DESIGNED	A. Amidi
	R. Victor
CHECKED	M. Capron
DRAWN	S. Kaemmerer
CHECKED	R. Victor


PREPARED BY:
JACOBS CIVIL INC.
ST. LOUIS, MO

REHABILITATION FOR FAI 55/70 COMPLEX
ROADWAY E - STRUCTURE NO. 082-0205
RETROFIT AND SUBSTRUCTURE REPAIR
PIER E8 AND ABUTMENT E9
(FAI-70) ST. CLAIR CO.

STATE OF ILLINOIS
DEPARTMENT OF TRANSPORTATION


ROUTE NO.	SECTION	COUNTY	POST MILE	SHEET NO.
FAI-70		St. Clair	388 370	29
TOTAL SHEETS				46 SHEETS

182-3HVB-2R-D-2

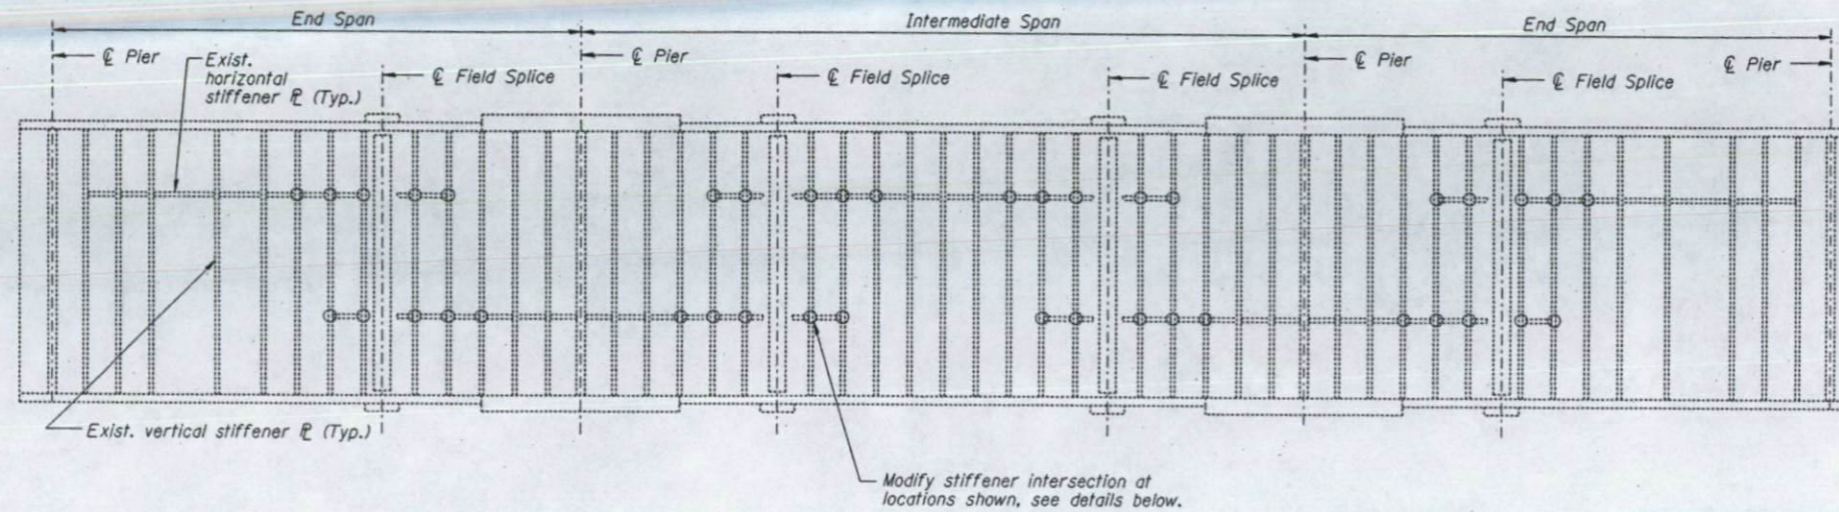

GIRDER ELEVATION - FRACTURE CONTROL MODIFICATION LOCATIONS

Exterior Face of Girder E1, shown. Exterior Face of Girder E2, Similar.

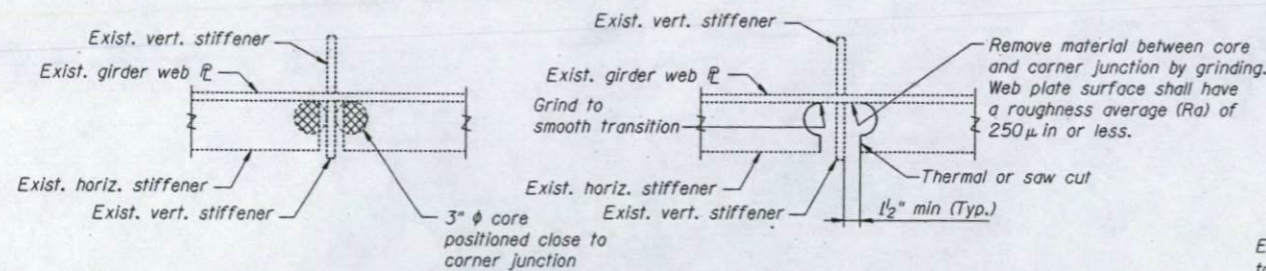


STIFFENER INTERSECTION MODIFICATION DETAILS

(Showing 2 locations)

Procedure:


1. Core 3" diameter hole positioned close to corner junction through $\frac{3}{8}$ " thick horizontal stiffener as shown in detail.
2. Remove material between core and intersection junction by grinding with carbide tool and a dye grinder as shown in details. Web plate surface shall have a roughness average (Ra) of 250 μ in or less.
3. Remove all burrs from cut edge and check for irregularities. Cored surface shall have an Ra equal to 500 μ in or less.
4. After burr removal the modification shall be inspected using liquid dye penetrant or magnetic particle (MT) inspection methods. Any cracks found shall be identified and reported to the Bureau of Bridges and Structures for further disposition.
5. The exposed steel surfaces shall be cleaned and painted using a aluminum epoxy mastic primer.
6. Obtain approval of Engineer before proceeding.
7. Paint area with top coat.

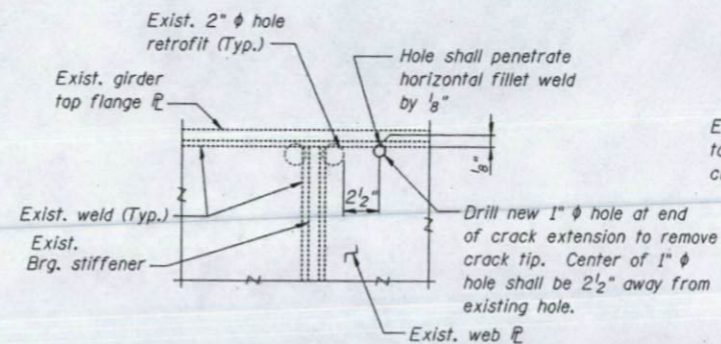

CRACK EXTENSION RETROFIT AT PIER

Procedure:

1. Inspect girder web plate in region of existing retrofits to determine location of crack extension and crack tip using liquid dye penetrant or magnetic particle (MT) inspection methods (Cost included with crack extension modifications).
2. Drill 1" diameter hole at end of crack extension to remove crack tip. Center of 1" diameter crack arrester hole shall be positioned in accordance with detail.
3. Cored surfaces shall have a roughness average (Ra) of 500 μ in or less.
4. Re-inspect area using liquid dye penetrant or magnetic particle (MT) methods to verify crack does not extend past the newly drilled holes (Cost included with crack extension modification).
5. Obtain approval of Engineer.
6. Clean exposed steel surfaces to remove contaminants and paint with aluminum epoxy mastic primer.

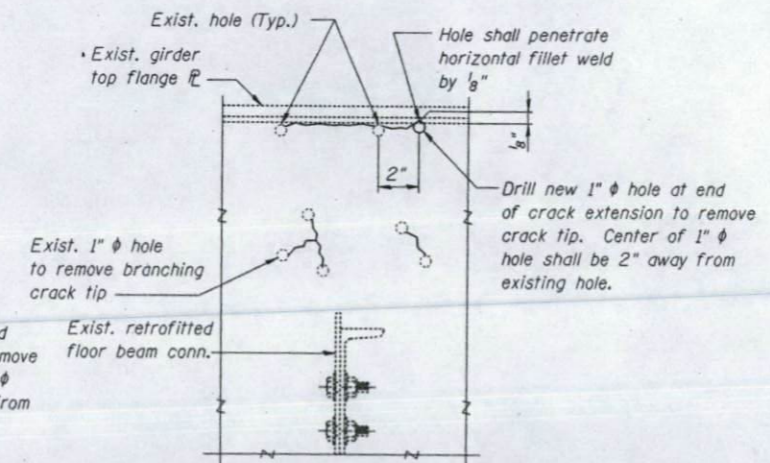

CRACK EXTENSION RETROFIT AT INTERIOR FLOOR BEAM


DESIGNED	L. Peterman
CHECKED	V. Van Santen
DRAWN	J. Corley
CHECKED	F. Camba

PREPARED BY
JACOBS CIVIL INC.
ST. LOUIS, MO

REHABILITATION FOR FAI 55/70 COMPLEX
ROADWAY E - STRUCTURE NO. 082-0205
STIFFENER INTERSECTION MODIFICATIONS
AND CRACK EXTENSION RETROFIT
(FAI-70) ST. CLAIR CO.

STATE OF ILLINOIS
DEPARTMENT OF TRANSPORTATION

ROUTE NO.	SECTION	COUNTY	SHEET	SHEET NO.
FAI-70		St. Clair	388	371
FED. ROAD DIST. NO. 7	ALIGNMENT	FED. AID PROJECT		

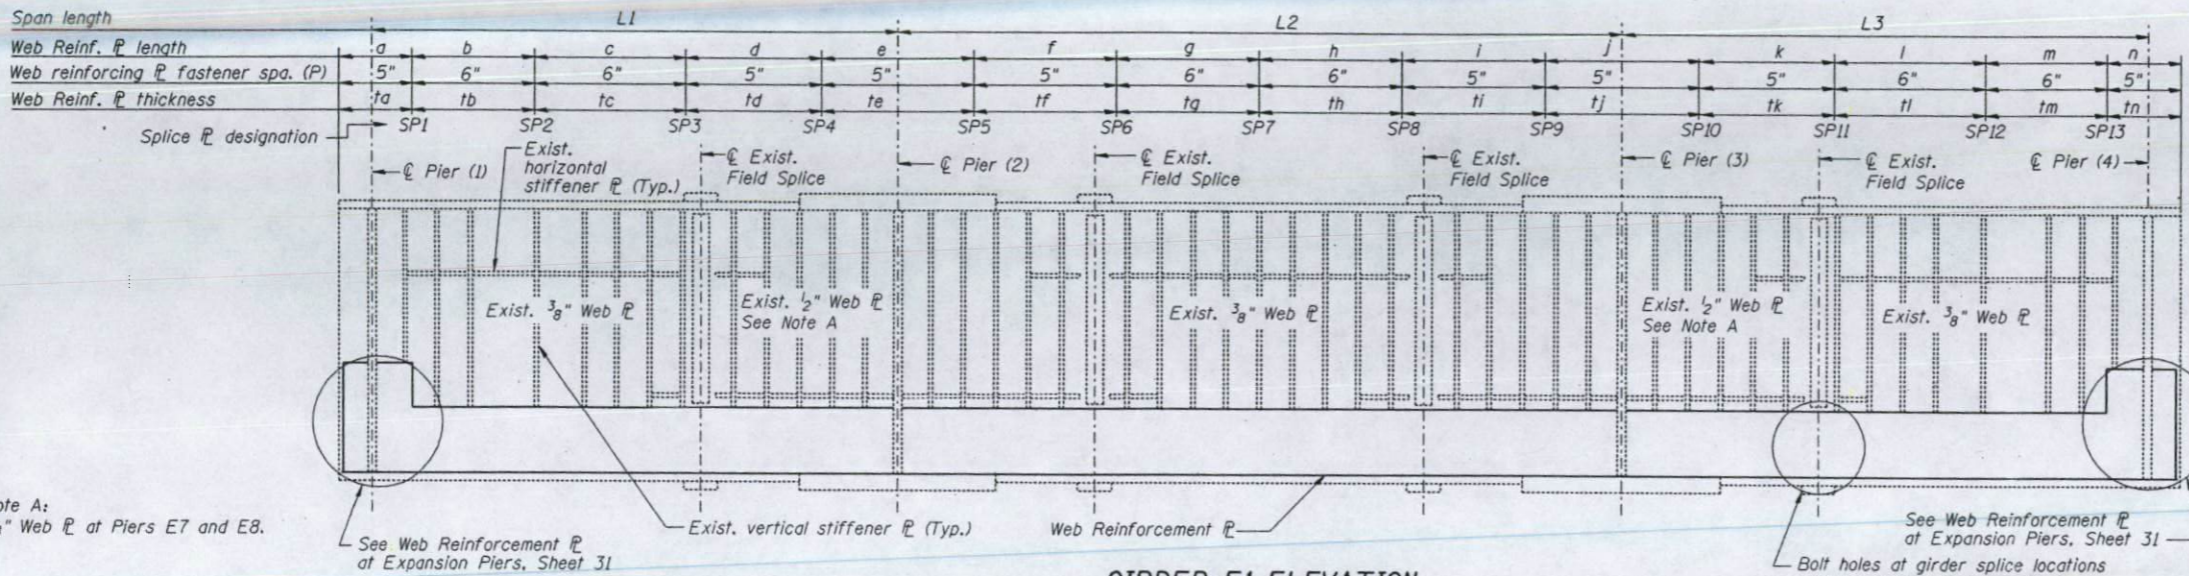


GIRDER E1 ELEVATION

Exterior Face of Girder E1, shown.
Exterior Face of Girder E2, similar and opposite hand.


Girder	Pier (1)	Span 1										Pier (2)	Span 2										Pier (3)	Span 3										Pier (4)	
		L1	a	ta	b	tb	c	tc	d	td	e		te	L2	f	tf	g	tg	h	th	i	ti		j	tj	L3	k	tk	l	tl	m	tm	n		tn
E1	E2	82'-3"	3'-5"	$\frac{3}{4}$ "	23'-6"	1"	23'-6"	1"	19'-3"	$1\frac{1}{2}$ "	26'-0"	$1\frac{1}{2}$ "	E1	104'-11 $\frac{11}{16}$ "	19'-3"	$1\frac{1}{2}$ "	20'-6"	1"	20'-0"	1"	19'-3"	$1\frac{1}{2}$ "	25'-11 $\frac{1}{2}$ "	$1\frac{1}{2}$ "	018	82'-3"	19'-3"	$1\frac{1}{2}$ "	23'-6"	1"	23'-6"	1"	3'-5"	$\frac{3}{4}$ "	017
E2	E2	82'-3"	3'-5"	$\frac{3}{4}$ "	23'-6"	1"	23'-6"	1"	19'-3"	$1\frac{1}{2}$ "	25'-11"	$1\frac{1}{2}$ "	E1	104'-11 $\frac{11}{16}$ "	19'-3"	$1\frac{1}{2}$ "	20'-6"	1"	20'-0"	1"	19'-3"	$1\frac{1}{2}$ "	25'-11"	$1\frac{1}{2}$ "	018	82'-5 $\frac{1}{16}$ "	19'-3"	$1\frac{1}{2}$ "	23'-5"	1"	23'-11"	1"	3'-5"	$\frac{3}{4}$ "	017
E1	E6	78'-3 $\frac{1}{16}$ "	3'-5"	$\frac{3}{4}$ "	23'-0 $\frac{1}{2}$ "	1"	23'-0 $\frac{1}{2}$ "	1"	17'-2"	$1\frac{1}{2}$ "	23'-10"	$1\frac{1}{2}$ "	E5	100'-0 $\frac{1}{16}$ "	17'-2"	$1\frac{1}{2}$ "	21'-0"	1"	21'-0"	1"	17'-2"	$1\frac{1}{2}$ "	23'-10"	$1\frac{1}{2}$ "	E4	78'-3 $\frac{1}{16}$ "	17'-2"	$1\frac{1}{2}$ "	23'-0 $\frac{1}{2}$ "	1"	23'-0 $\frac{1}{2}$ "	1"	3'-5"	$\frac{3}{4}$ "	E3
E2	E6	78'-3 $\frac{1}{16}$ "	3'-5"	$\frac{3}{4}$ "	23'-0 $\frac{1}{2}$ "	1"	23'-0 $\frac{1}{2}$ "	1"	17'-2"	$1\frac{1}{2}$ "	23'-10"	$1\frac{1}{2}$ "	E5	100'-0 $\frac{1}{16}$ "	17'-2"	$1\frac{1}{2}$ "	21'-0"	1"	21'-0"	1"	17'-2"	$1\frac{1}{2}$ "	23'-10"	$1\frac{1}{2}$ "	E4	78'-3 $\frac{1}{16}$ "	17'-2"	$1\frac{1}{2}$ "	23'-0 $\frac{1}{2}$ "	1"	23'-0 $\frac{1}{2}$ "	1"	3'-5"	$\frac{3}{4}$ "	E3
E1	E9*	70'-0"	3'-4 $\frac{1}{2}$ "	$\frac{3}{4}$ "	19'-11 $\frac{1}{2}$ "	1"	19'-11 $\frac{1}{2}$ "	1"	16'-4"	$1\frac{1}{2}$ "	21'-9"	$1\frac{1}{2}$ "	E8	89'-0"	16'-4"	$1\frac{1}{2}$ "	17'-6"	1"	17'-0"	1"	16'-4"	$1\frac{1}{2}$ "	21'-9"	$1\frac{1}{2}$ "	E7	69'-3 $\frac{1}{16}$ "	16'-4"	$1\frac{1}{2}$ "	19'-6 $\frac{1}{2}$ "	1"	19'-6 $\frac{1}{2}$ "	1"	3'-4 $\frac{1}{2}$ "	$\frac{3}{4}$ "	E6
E2	E9*	70'-0"	3'-4 $\frac{1}{2}$ "	$\frac{3}{4}$ "	20'-0"	1"	19'-11 $\frac{1}{2}$ "	1"	16'-4"	$1\frac{1}{2}$ "	21'-9"	$1\frac{1}{2}$ "	E8	89'-0"	16'-4"	$1\frac{1}{2}$ "	17'-6"	1"	17'-0"	1"	16'-4"	$1\frac{1}{2}$ "	21'-9"	$1\frac{1}{2}$ "	E7	69'-3 $\frac{1}{16}$ "	16'-4"	$1\frac{1}{2}$ "	19'-6 $\frac{1}{2}$ "	1"	19'-6"	1"	3'-4 $\frac{1}{2}$ "	$\frac{3}{4}$ "	E6

* Denotes Abutment

Piers	Web Reinforcement ϕ Splice Plate Lengths												
	SP1	SP2	SP3	SP4	SP5	SP6	SP7	SP8	SP9	SP10	SP11	SP12	SP13
E2-017	5'-7 $\frac{1}{2}$ "	5'-0"	4'-8"	6'-0 $\frac{1}{2}$ "	6'-0 $\frac{1}{2}$ "	4'-8"	5'-0"	4'-8"	6'-0 $\frac{1}{2}$ "	6'-0"	4'-8"	5'-0"	5'-7 $\frac{1}{2}$ "
E6-E3	5'-7 $\frac{1}{2}$ "	5'-1"	4'-8"	6'-0"	6'-0"	4'-8"	5'-0"	4'-8"	6'-0"	6'-0"	4'-8"	5'-1"	5'-7 $\frac{1}{2}$ "
E9*-E6	5'-6 $\frac{1}{2}$ "	5'-0"	4'-7 $\frac{1}{2}$ "	6'-0"	6'-0"	4'-8"	5'-0"	4'-8"	6'-0"	6'-0"	4'-8 $\frac{1}{2}$ "	5'-0"	5'-7 $\frac{1}{2}$ "
ϕ thk.	1"	1"	$1\frac{1}{2}$ "	$1\frac{1}{2}$ "	$1\frac{1}{2}$ "	$1\frac{1}{2}$ "	1"	$1\frac{1}{2}$ "	$1\frac{1}{2}$ "	$1\frac{1}{2}$ "	$1\frac{1}{2}$ "	1"	1"

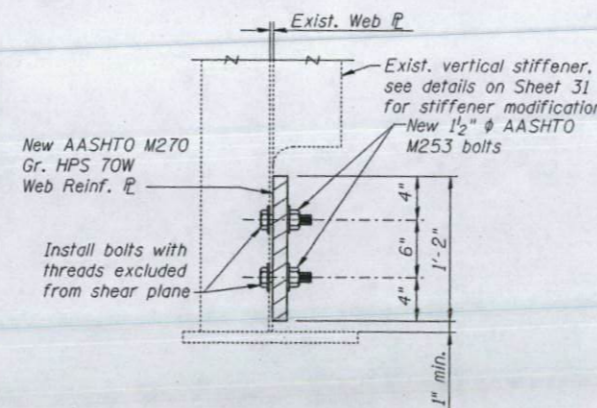

TYPICAL WEB REINFORCEMENT PLATE

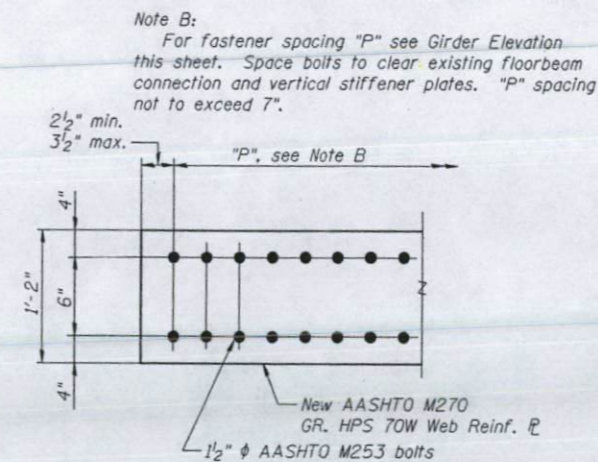

WEB REINFORCEMENT PLATE ELEVATION

NOTES
Remove paint from web of existing girder under new web reinforcement plates.
Existing pier and girder designations are taken from plans prepared by H.W. Lochner Inc. for the original structure.


DESIGNED	L. Peterman
CHECKED	V. Van Santen
DRAWN	M. King
CHECKED	F. Camba

PREPARED BY
JACOBS CIVIL INC.
ST. LOUIS, MO


REHABILITATION FOR FAI 55/70 COMPLEX
ROADWAY E - STRUCTURE NO. 082-0205
REDUNDANCY RETROFIT DETAILS
(FAI-70) ST. CLAIR CO.

STATE OF ILLINOIS
DEPARTMENT OF TRANSPORTATION

ROUTE NO.	SECTION	COUNTY	DATE	NO.	SHEET NO. 31
FAI-70		St. Clair	388	372	46 SHEETS
FED. ROAD DIST. NO.					82-3HVB-2R-D-2

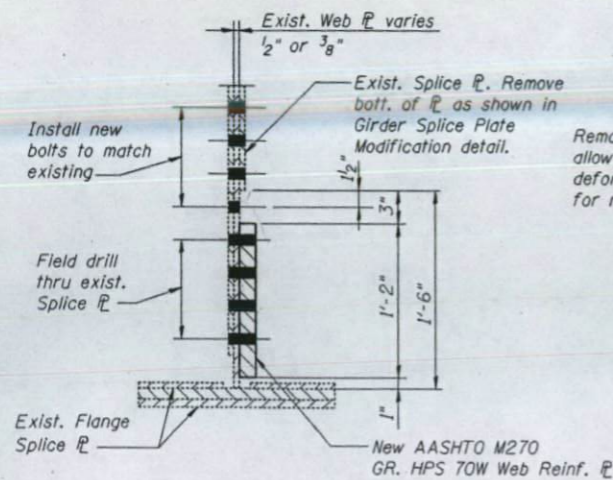


**WEB REINFORCEMENT PLATE
AT GIRDER WEB SPLICE**

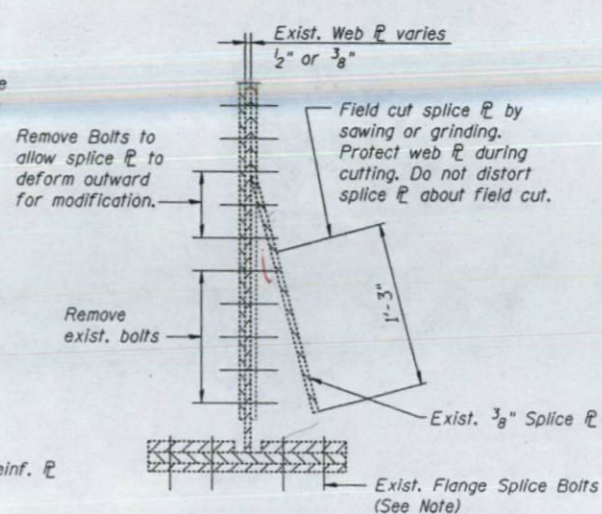


GIRDER SPLICE PLATE MODIFICATION


Note:
It is intended that the existing flange splice bolts remain in place during installation of the web reinforcement plate. Contractor shall notify the Engineer and obtain approved sequence and procedure prior to proceeding.

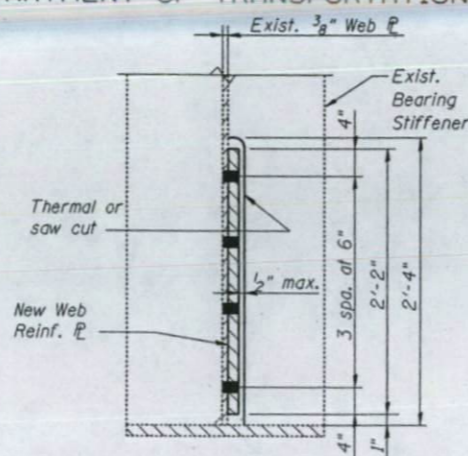

**TYPICAL SECTION THRU WEB
REINFORCEMENT PLATE AT
EXPANSION BEARING STIFFENER**

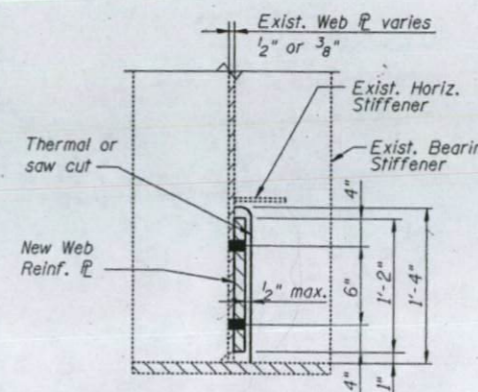


**TYPICAL SECTION THRU WEB
REINFORCEMENT PLATE AT
INTERIOR BEARING STIFFENER**

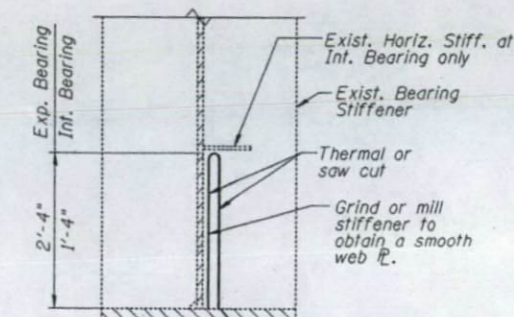


**BEARING STIFFENER
MODIFICATION**

Procedure:
1. Thermal or saw cut horizontal cut and vertical cut. Vertical cut shall be positioned at least 1/2" away from girder web. Do not notch or gouge web plate.
2. Remove all stiffener remnants and connecting welds by grinding or by milling. Web plate surface shall have Roughness average (Ra) of 250 or less.

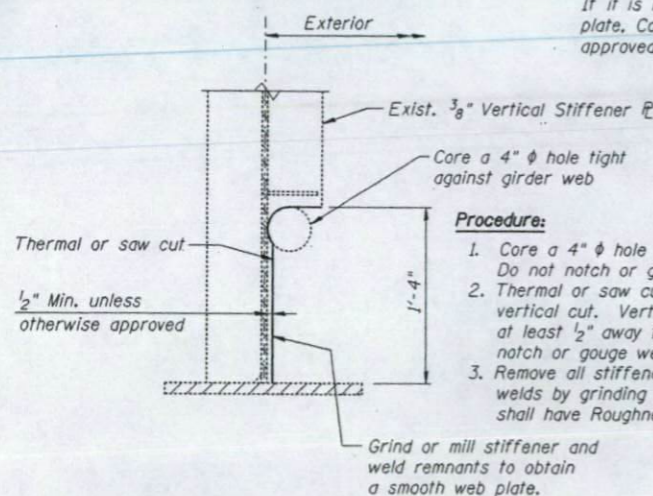


VERTICAL STIFFENER MODIFICATION


Procedure:
1. Core a 4" ϕ hole tight to girder web. Do not notch or gouge web plate.
2. Thermal or saw cut horizontal cut and vertical cut. Vertical cut shall be positioned at least 1/2" away from girder web. Do not notch or gouge web plate.
3. Remove all stiffener remnants and connecting welds by grinding or by milling. Web plate surface shall have Roughness average (Ra) of 250 or less.
Grind or mill stiffener and weld remnants to obtain a smooth web plate.

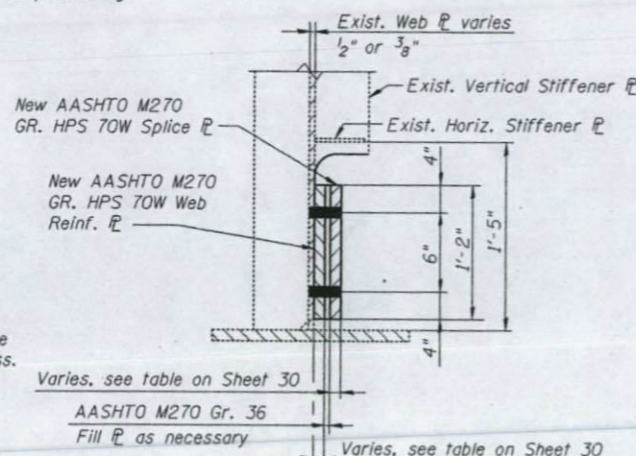


**TYPICAL SECTION THRU
WEB REINFORCEMENT SPLICE PLATE**

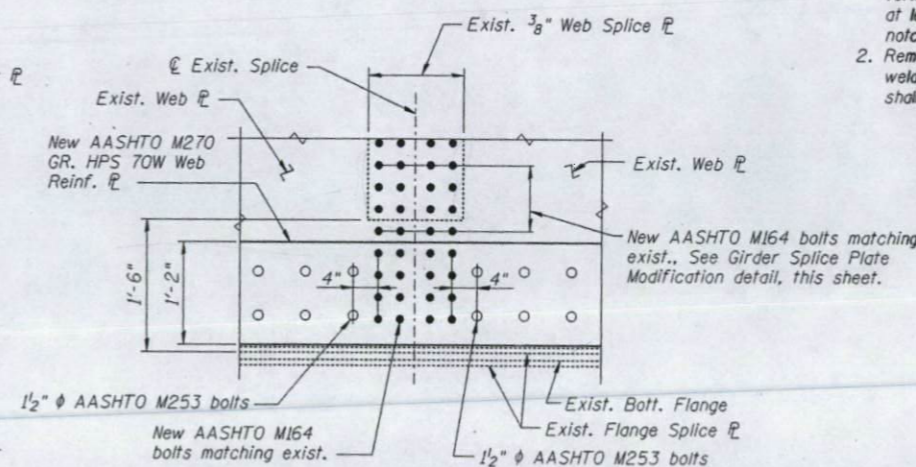

ELEVATION AT GIRDER WEB SPLICE

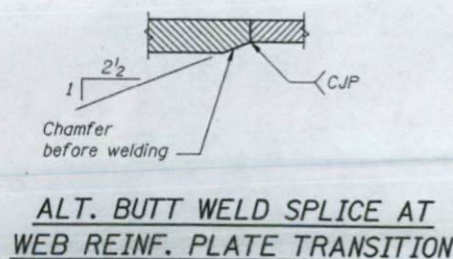


**ALT. BUTT WELD SPLICE AT
WEB REINF. PLATE TRANSITION**

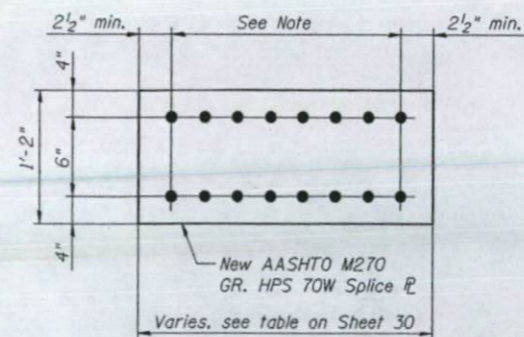

**TYPICAL WEB REINFORCEMENT
SPLICE PLATE**

Note:
Hole sizes and spacing to match web reinforcement R. For alternate butt weld splice see detail this sheet.

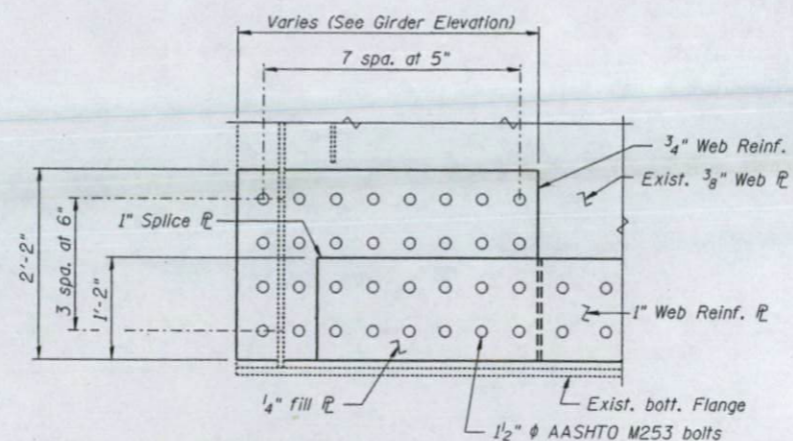


WEB REINFORCEMENT PLATE AT EXPANSION PIERS

DESIGNED	L. Peterman
CHECKED	V. Van Santen
DRAWN	M. King
CHECKED	F. Camba

PREPARED BY:
JACOBS CIVIL INC.
ST. LOUIS, MO

REHABILITATION FOR FAI 55/70 COMPLEX
ROADWAY E- STRUCTURE NO. 082-0205
TYPICAL REDUNDANCY RETROFIT DETAILS
(FAI-70) ST. CLAIR CO.

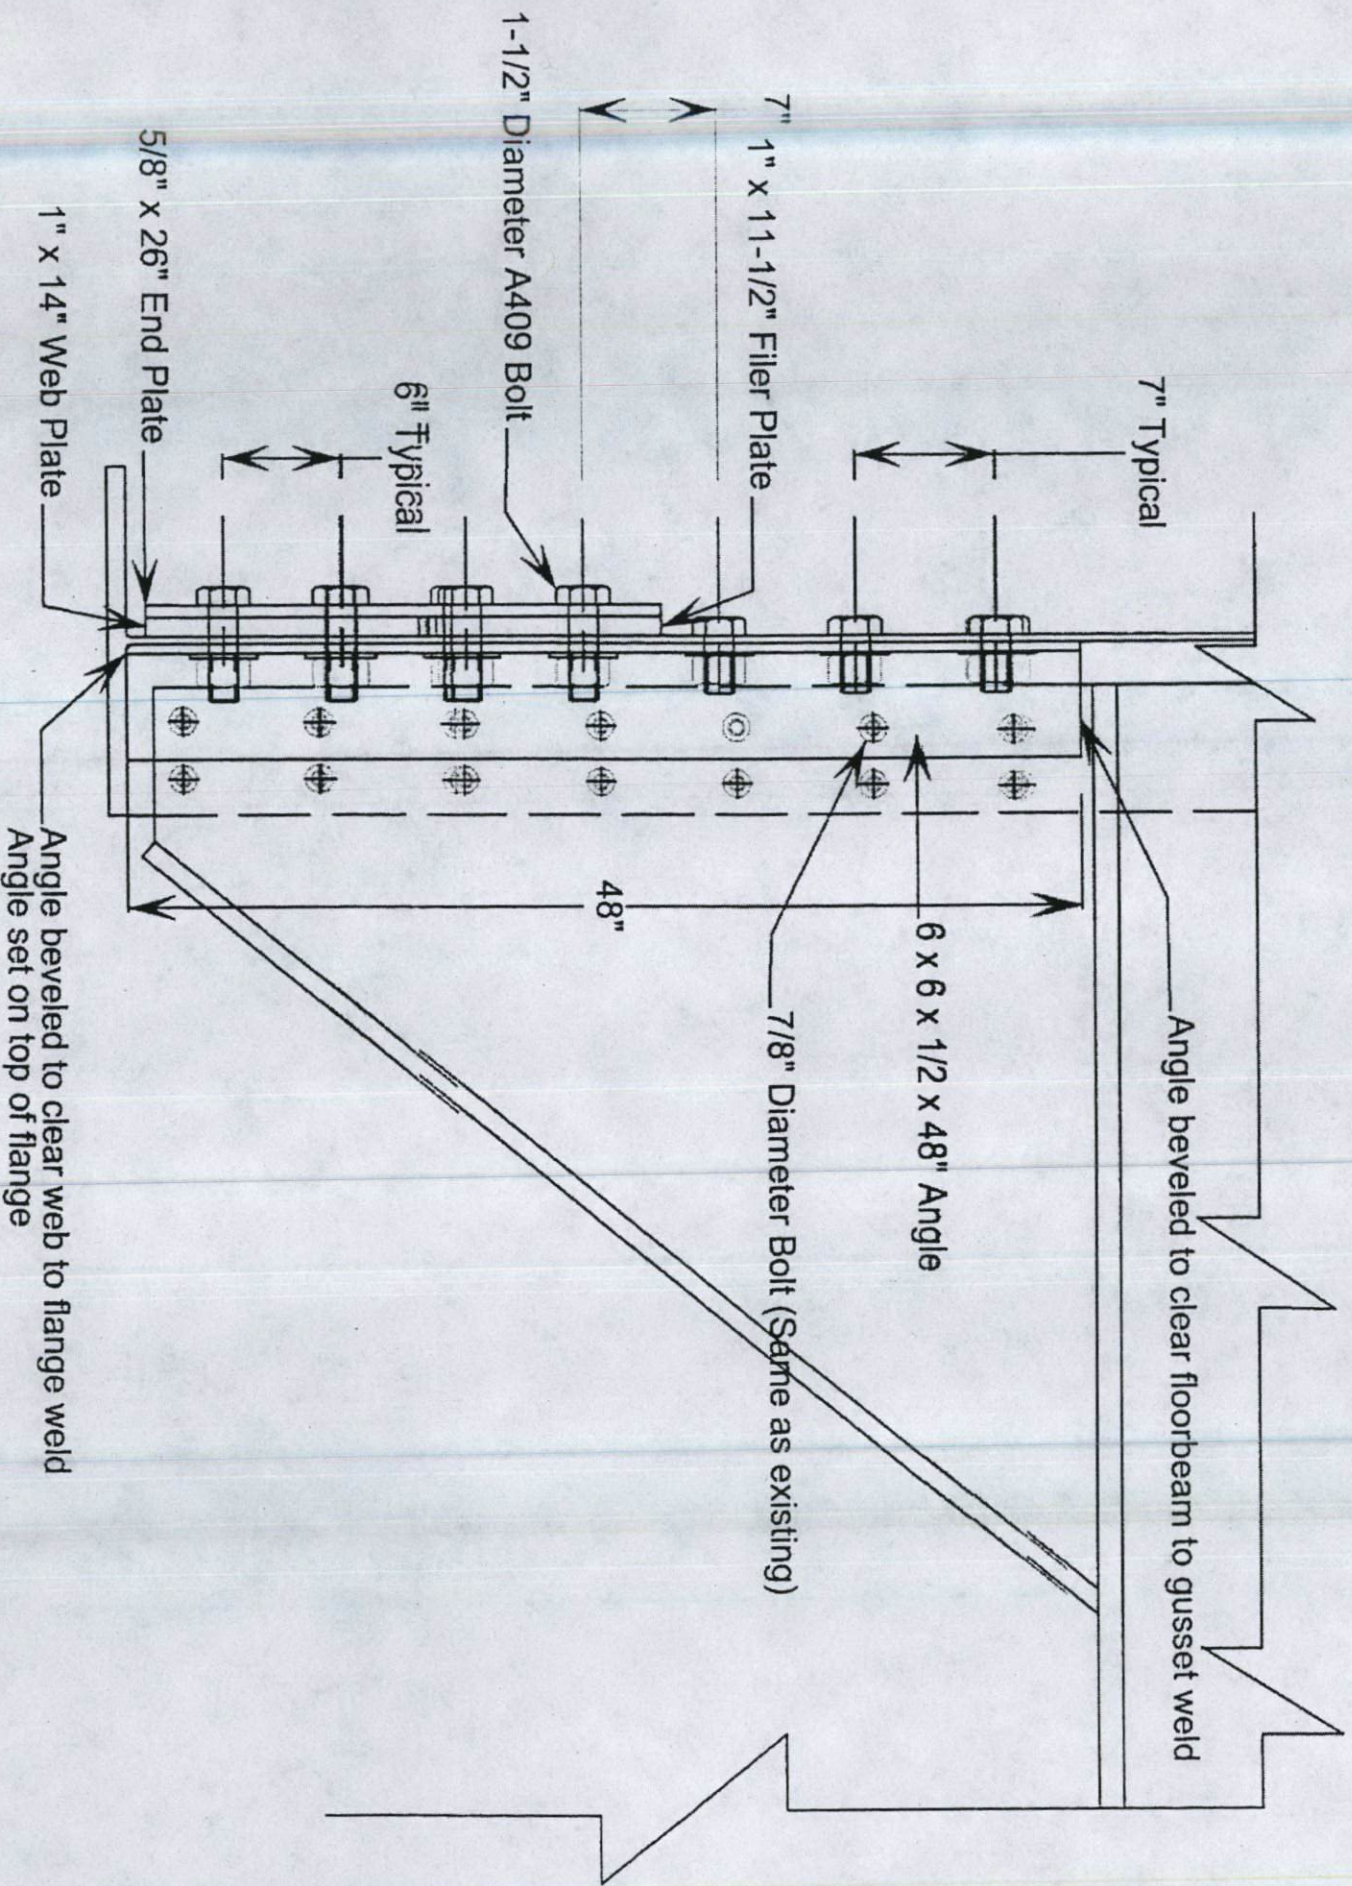

**GIRDER E-2 1ST FLOORBEAM SOUTH
OF PIER E-3 SN 082-0205**

STATE OF ILLINOIS
DEPARTMENT OF TRANSPORTATION

ROUTE NO.	MILEPOST	COUNTY	SECTION	SHEET	SHEET NO.
FAI-70	#	St. Clair	388	373	46 SHEETS
FED. ROAD DIST. NO. 1		BLANDED	FED. AID PROJECT		

(82-3HVB-2R-1)-2

SUPERSTRUCTURE REPAIR TABLE

Span	Floorbeam	Condition	Repair
E1	FB-6	Two bolts missing or damaged in bottom flange splice plate for Girder E1	Replace bolts
E1	FB-6	Four bolts missing or damaged in bottom flange splice plate for Girder E2	Replace bolts
E4	FB-20	Five bolts missing or damaged in bottom flange splice plate for Girder E1	Replace bolts
E4	FB-20	Four bolts missing or damaged in bottom flange splice plate for Girder E2	Replace bolts
E5	FB-22	Two bolts missing or damaged in bottom flange splice plate for Girder E1	Replace bolts
E5	FB-22	Five bolts missing or damaged in bottom flange splice plate for Girder E2	Replace bolts
E5	FB-25	Four bolts missing or damaged in bottom flange splice plate for Girder E1	Replace bolts
E5	FB-25	Eighteen bolts missing or damaged in bottom flange splice plate for Girder E2	Replace bolts
E6	FB-27	Two bolts missing or damaged in bottom flange splice plate for Girder E1	Replace bolts
E6	FB-27	Ten bolts missing or damaged in bottom flange splice plate for Girder E2	Replace bolts
E7	FB-34	Eight bolts missing or damaged in bottom flange splice plate for Girder E2	Replace bolts
E8	FB-39	Twelve bolts missing or damaged in bottom flange splice plate for Girder E2	Replace bolts
E9	FB-41	Eight bolts missing or damaged in bottom flange splice plate for Girder E2	Replace bolts

Notes:

- Contractor shall identify all loose, broken, severely corroded or missing bolts not identified in the above table. Contractor shall replace these bolts as approved by the Engineer.
- Girder E1 is on the left side of the structure looking ahead station.
- Floorbeams are numbered sequentially, looking ahead station, beginning with FB-1 at Pier 017.


DESIGNED	S. Kaemmerer
CHECKED	R. Victor
DRAWN	S. Kaemmerer
CHECKED	R. Victor

PREPARED BY:
JACOBS CIVIL INC.
ST. LOUIS, MO


REHABILITATION FOR FAI 55/70 COMPLEX
ROADWAY E - STRUCTURE NO. 082-0205
SUPERSTRUCTURE REPAIR TABLE
(FAI-70) ST. CLAIR CO.

STATE OF ILLINOIS
DEPARTMENT OF TRANSPORTATION


ROUTE NO.	SECTION	COUNTY	SHEET NO.	SHEET	SHEET NO. 33
FAI-70	*	St. Clair	388	374	46 SHEETS
FED. ROAD DIST. NO. 7	ALIGNMENT	FED. AID PROJECT	*082-3HVB-2R-1-2		

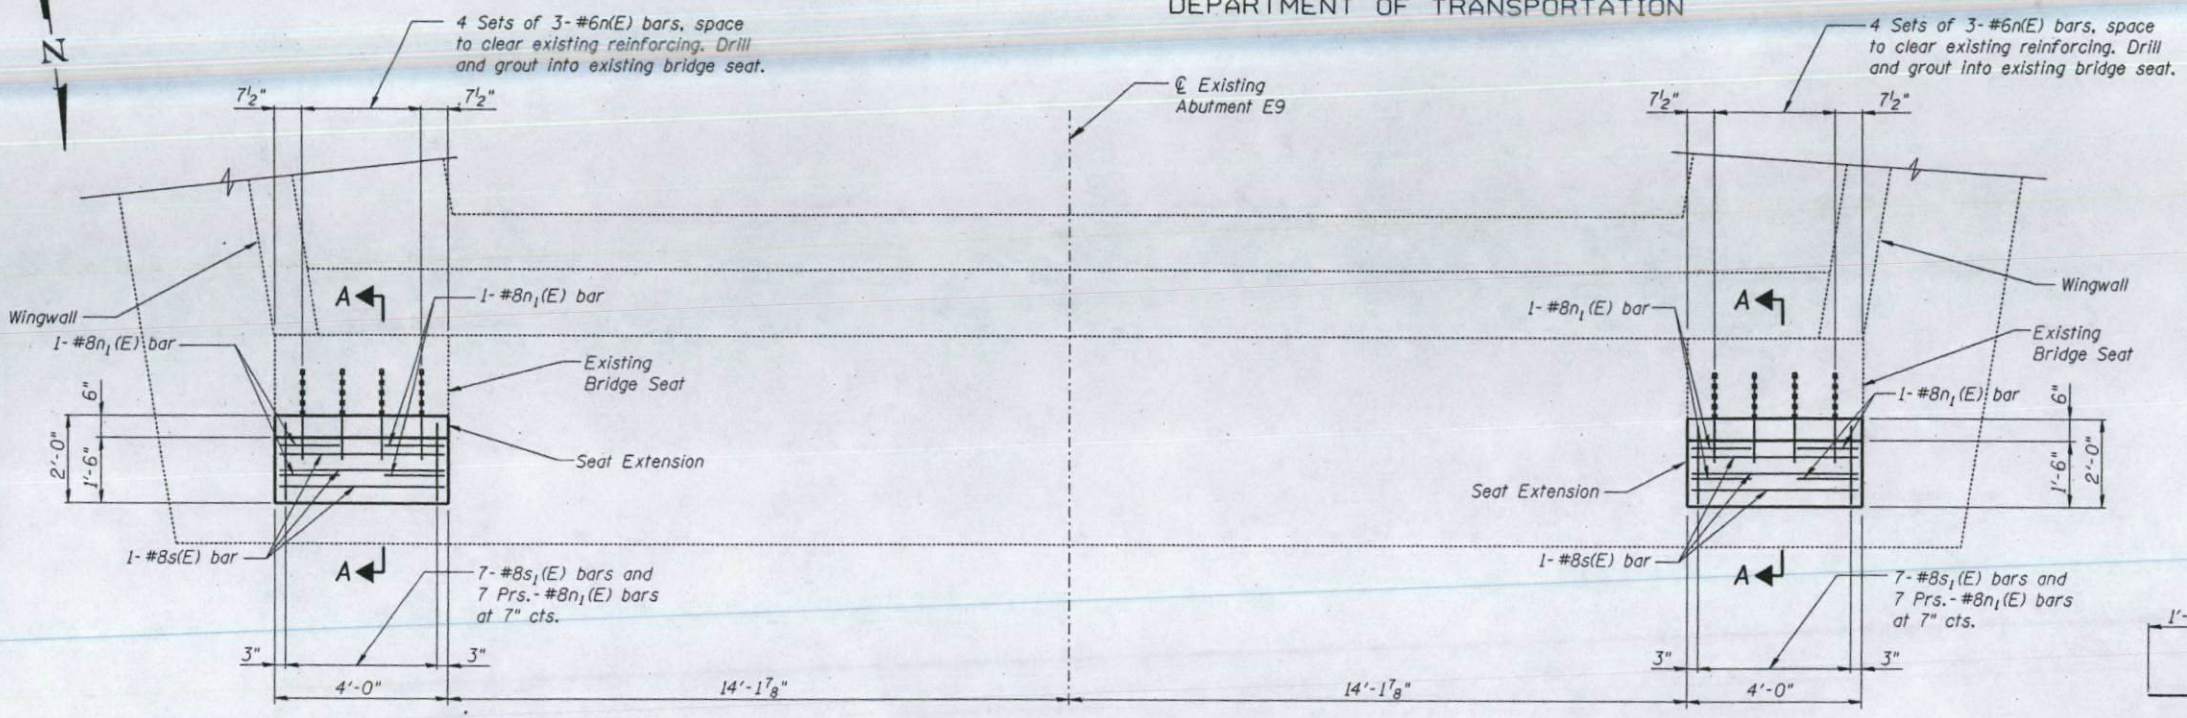


PLAN

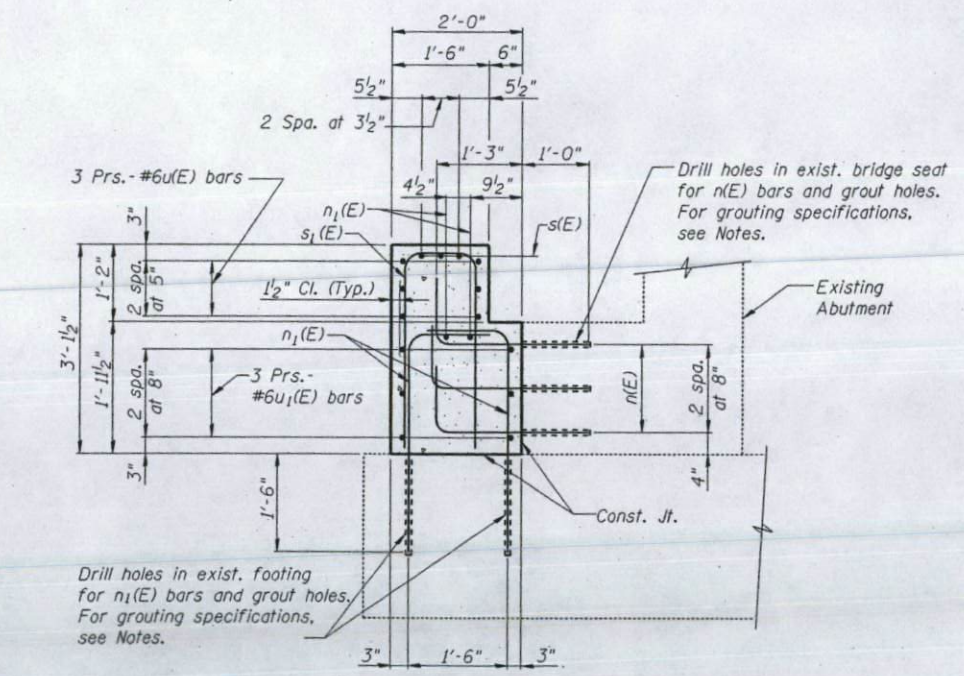


SECTION A-A

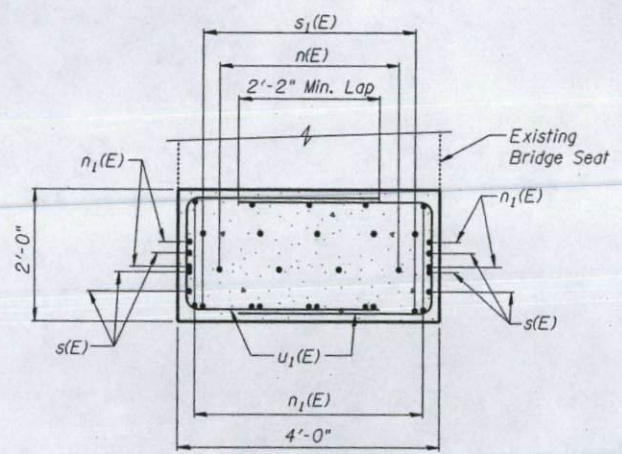

SECTION THRU SEAT EXTENSION

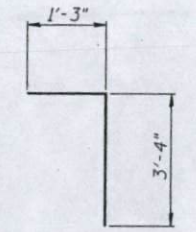


BAR - n₁(E)

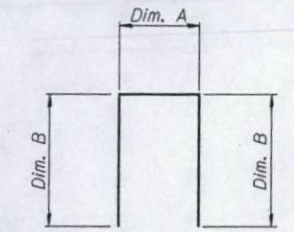

BARS - s(E), s₁(E), u(E) and u₁(E)

Bar	Dim. A	Dim. B
s(E)	3'-7 1/2"	3'-0"
s ₁ (E)	1'-1 1/2"	3'-0"
u(E)	1'-3"	3'-0"
u ₁ (E)	1'-9"	3'-0"

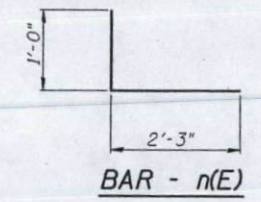

BAR - n(E)

NOTES

Drill and grout bars according to Article 584 of the Standard Specifications.

DESIGNED	A. Amidi
CHECKED	M. Capron
DRAWN	S. Kaemmerer
CHECKED	F. Camba


PREPARED BY:
JACOBS CIVIL INC.
ST. LOUIS, MO

REHABILITATION FOR FAI 55/70 COMPLEX
ROADWAY E - STRUCTURE NO. 082-0205
ABUTMENT SEAT EXTENSION
ABUTMENT E9
(FAI-70) ST. CLAIR CO.

STATE OF ILLINOIS
DEPARTMENT OF TRANSPORTATION

ROUTE NO.	SECTION	COUNTY	SHEETS	SHEET	SHEET NO. 34
FAI-70	*	St. Clair	388	375	46 SHEETS
FED. ROAD DIST. NO. 7	ILLINOIS	FED. AID PROJECT-			

*082-3HVB-2R-D-2

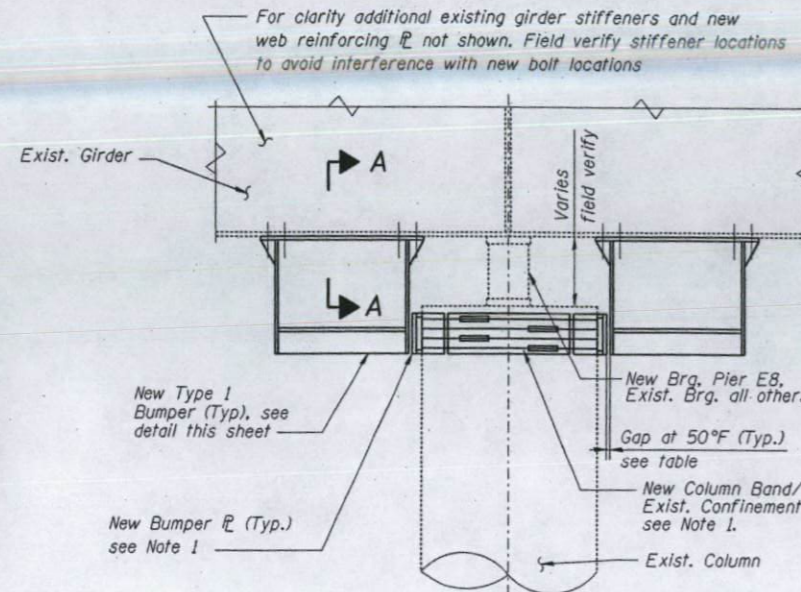


PIER	GAP (in)
017 Span N7 (Girder N2)	7/8"
017 Span 018 (Girder E2)	3/4"
018	1/4"
E1	7/8"
E4	7/8"
E5	1/4"
E6 Span E6	3/4"
E6 Span E7	1/16"
E7	1/4"
E8	5"

ELEVATION: TYPE 1 BUMPER/RESTRAINER ASSEMBLY

Piers 018, E1, E4, E5, E7 and E8

Note 1:
For new column band and bumper plate assembly details see sheets 38 thru 40.

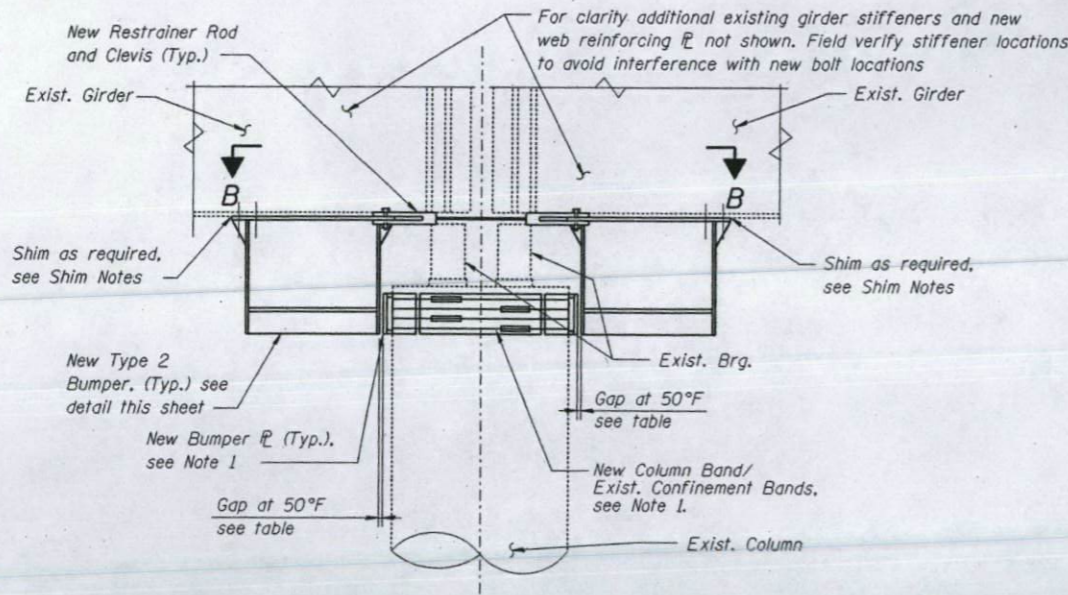


ELEVATION: TYPE 2 BUMPER/RESTRAINER ASSEMBLY

Pier E6 and 017 (Girders E2 and N2)


DESIGNED	A. Amidi
CHECKED	R. Victor
DRAWN	M. King
CHECKED	R. Victor

PREPARED BY:
JACOBS CIVIL INC.
ST. LOUIS, MO

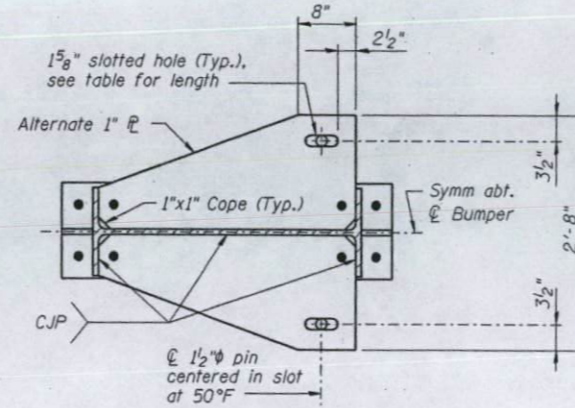


SECTION D-D

(When alternate connection \bar{r} is required)

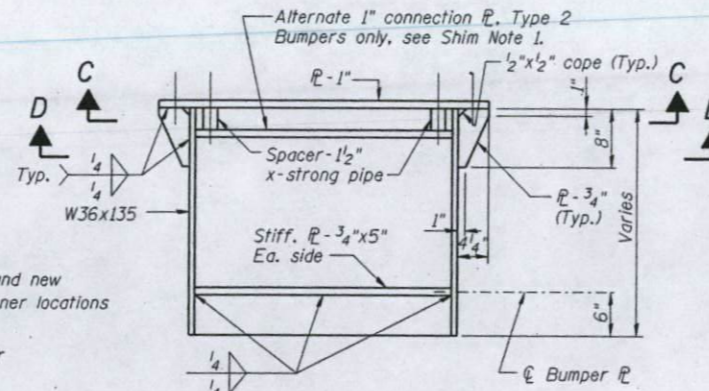


TYPE 1 OR TYPE 2 BUMPER

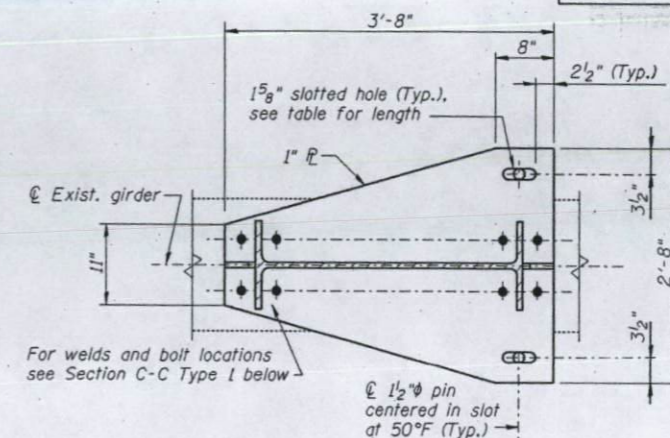

SECTION C-C - TYPE 2

Piers E2, E3, E6 and 017 (Girders E1, E2 and N2)

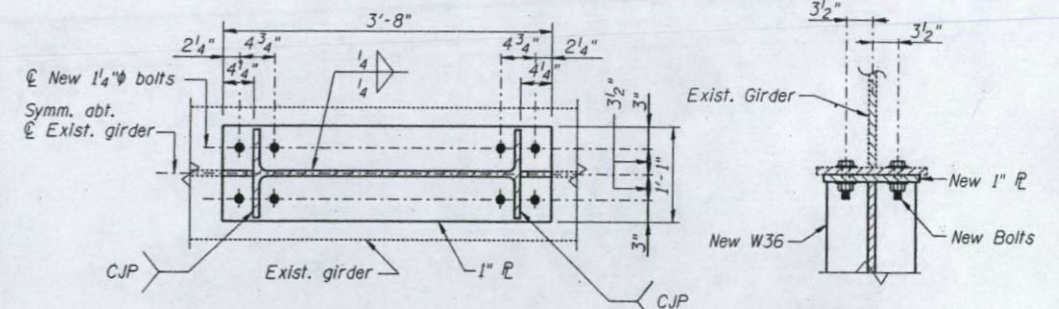

SECTION C-C - TYPE 1

Type 1: Piers 018, E1, E4, E5, E7, and E8
Type 2: With alternate connection \bar{r}
Type 5: Pier 017 (Girders N1 and N2)


SECTION A-A

SHIM NOTES

1. Shim (1/2" max.) higher flange so that elevation difference between ends of rod is no more than 1/2". Use alternate connection plate when shims are insufficient.
2. Shim Plate length shall match the smaller length of the plates being shimmed, and shim plate width shall match the smaller width of the plates being shimmed.
3. Field verify shim requirements.

BUMPER/RESTRAINER NOTES

1. All bolt holes shall be standard round holes ($\phi = 1/16$) Unless Noted Otherwise.
2. All bumpers and restrainer rod connection plates shall be centered on the existing girder.
3. The total length of the unthreaded portion of each restrainer rod assembly shall not be less than 1'-8".
4. Restrainer rods shall extend 0" min. to 3/4" max. into clevis openings Unless Noted Otherwise.
5. The cost of bumper/restrainer assemblies including shims shall be included in the Unit Price for "Furnishing and Erecting Structural Steel".

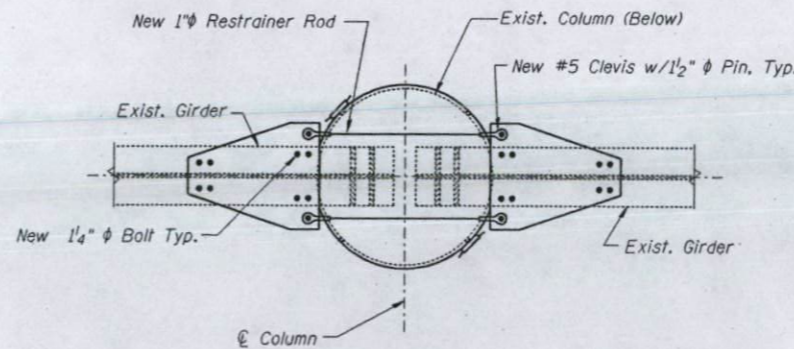


SECTION B-B

REHABILITATION FOR FAI 55/70 COMPLEX
ROADWAY E - STRUCTURE NO. 082-0205
BUMPER/RESTRAINER DETAILS
(FAI-70) ST. CLAIR CO.

STATE OF ILLINOIS
DEPARTMENT OF TRANSPORTATION


PROJECT NO.	SECTION	DATE	BY	CHKD	SHEET NO. 36
FAI-70	*	St. Clair	388	377	46 SHEETS
FILE NAME: 082-0205\205sm04.dgn	DATE PLOTTED:	SCALE:	PLT BY:	PLT DATE:	

*082-3HVB-2R-1)-2

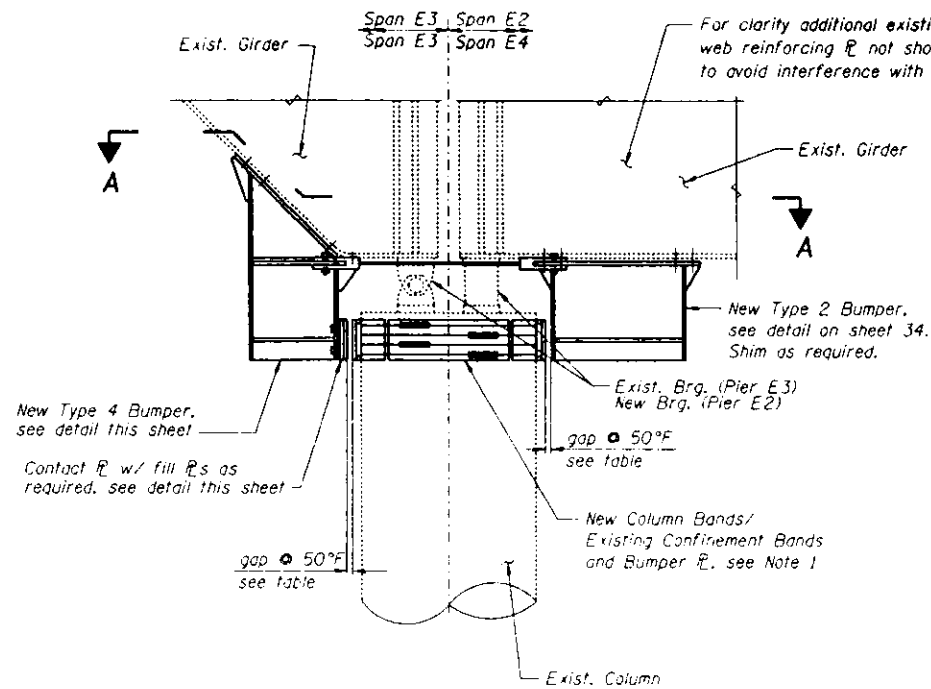


ELEVATION: TYPE 4 BUMPER/RESTRAINER ASSEMBLY
Piers E2 and E3


GAP TABLE	
PIER/SPAN	GAP (in)
E2 SPAN E2	5"
E2 SPAN E3	5"
E3 SPAN E3	1/4"
E3 SPAN E4	3/8"

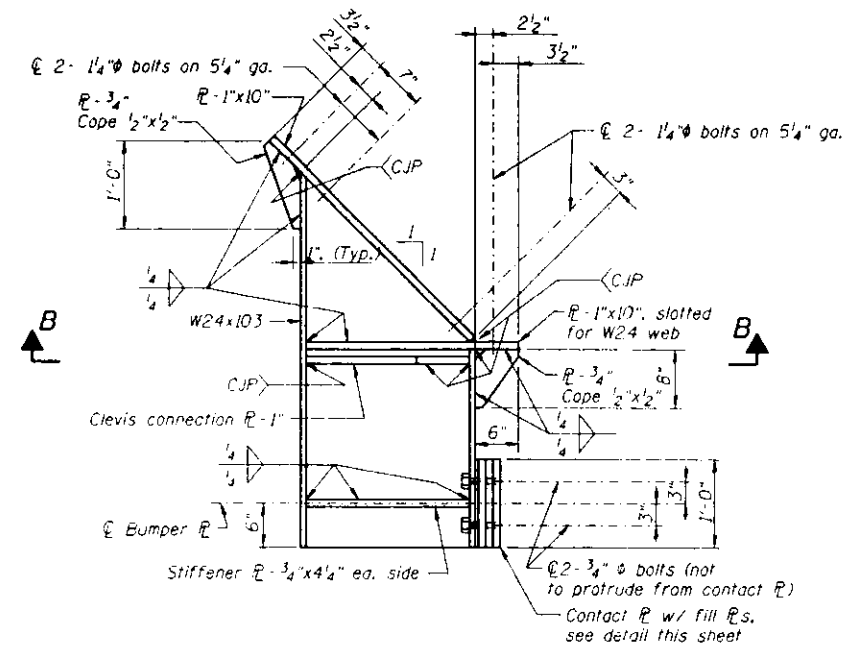


TYPE 4 BUMPER

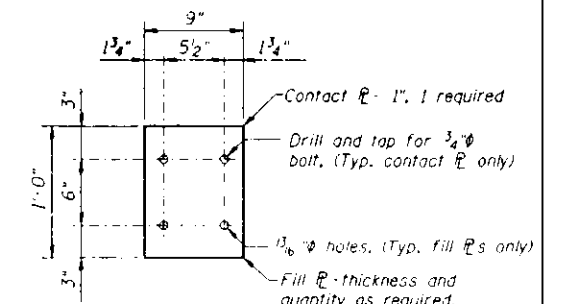

CONTACT AND FILL R DETAIL

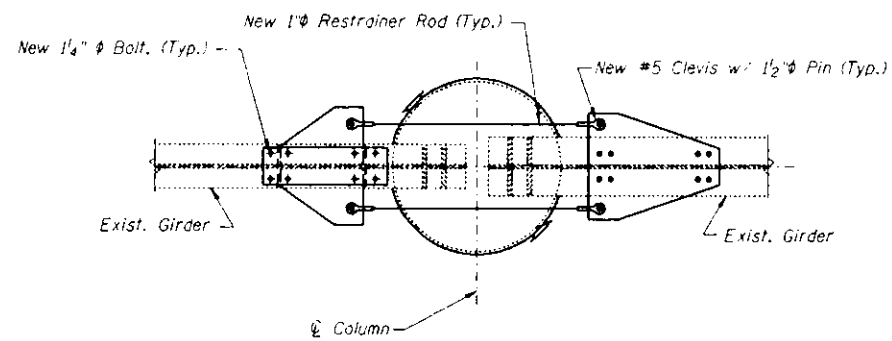

SECTION A-A

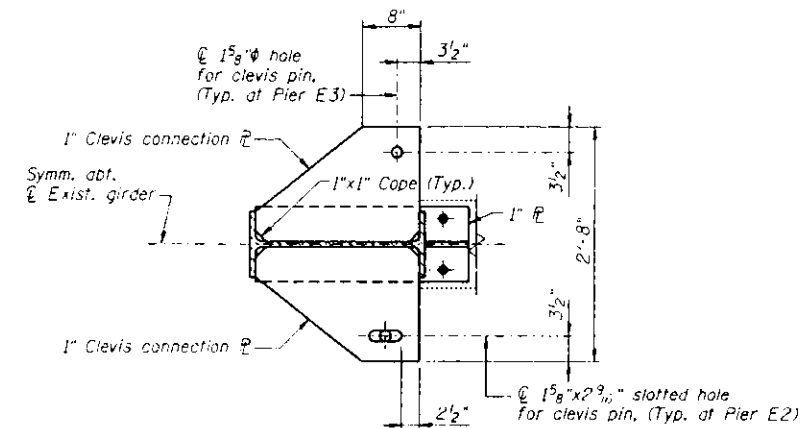

SECTION B-B

NOTES

1. For new column band and bumper plate assembly details see sheets 38 thru 40.
2. For shim and bumper/restrainer notes see sheet 34.
3. For bearing replacement details see sheet 44.

DESIGNED	A. Amidi
CHECKED	R. Victor
DRAWN	M. King
CHECKED	R. Victor


PREPARED BY:
JACOBS CIVIL INC.
ST. LOUIS, MO

REHABILITATION FOR FAI 55/70 COMPLEX
ROADWAY E - STRUCTURE NO. 082-0205
BUMPER/RESTRAINER DETAILS
(FAI-70) ST. CLAIR CO.


STATE OF ILLINOIS
DEPARTMENT OF TRANSPORTATION

ROUTE NO.	SECTION	COUNTY	SHEET	POST	SHEET NO. 37
FAI-70	*	St. Clair	388	378	46 SHEETS
FED. ROAD DIST. NO.		ILLINOIS		FED. AID PROJECT	


For clarity additional existing girder stiffeners and new web reinforcing \bar{r} not shown. Field verify stiffener locations to avoid interference with new bolt locations

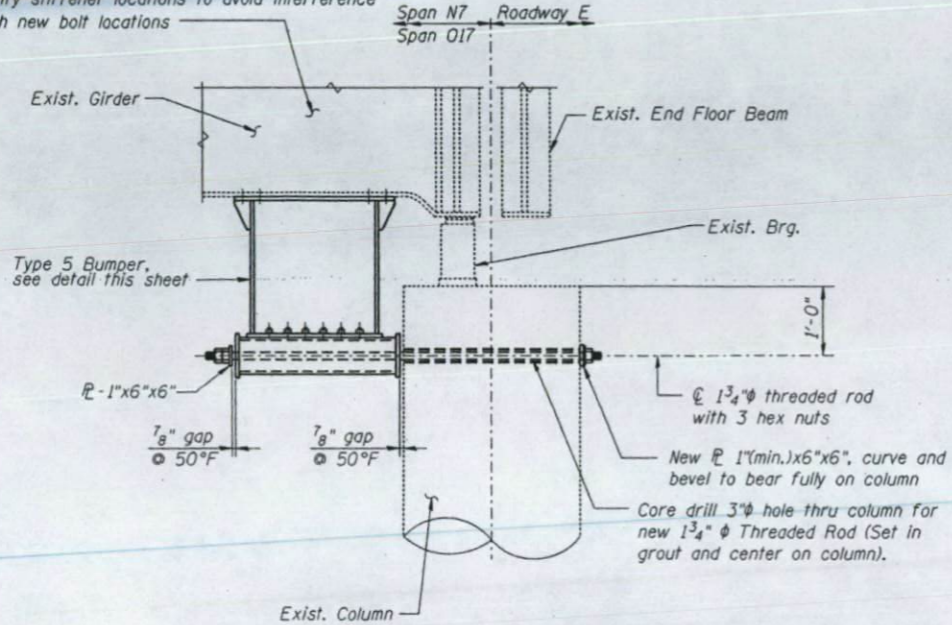


ELEVATION: TYPE 5 BUMPER/RESTRAINER ASSEMBLY
Pier O17 Girders N1 and O2

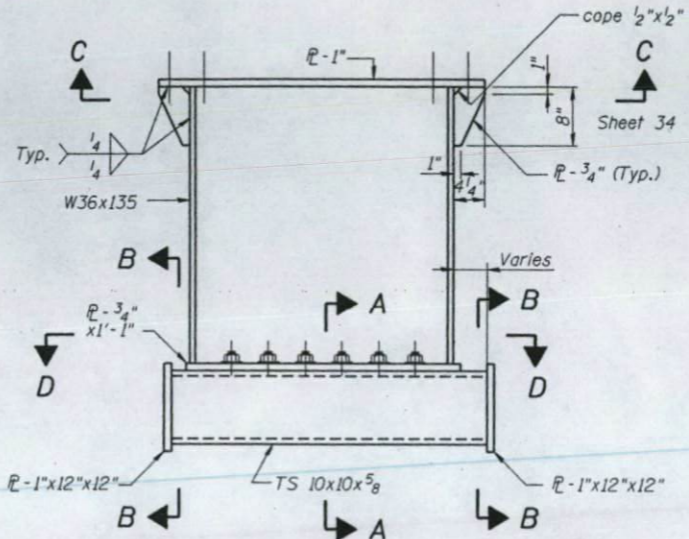


TYPE 5 BUMPER
Pier O17 Girders N1 and O2

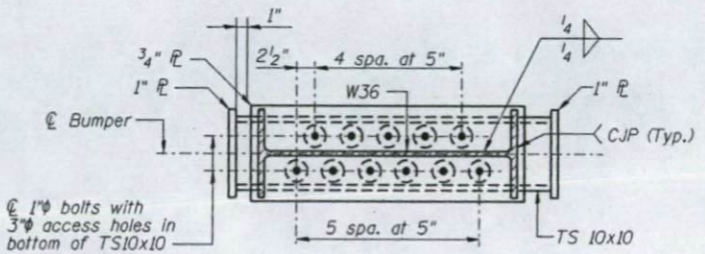

SECTION D-D

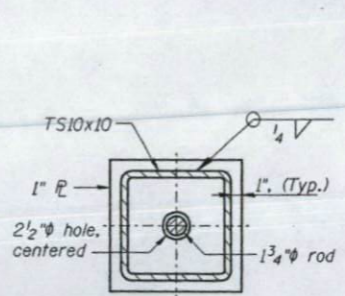

SECTION B-B

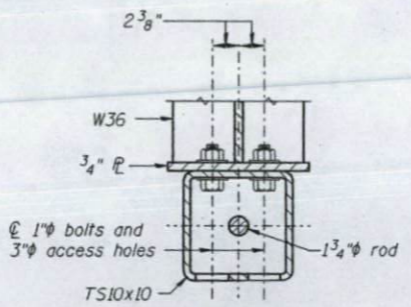

SECTION A-A

NOTES

1. For Bumper/Restrainer Notes see sheet 34.

DESIGNED	A. Amidi
CHECKED	R. Victor
DRAWN	M. King
CHECKED	R. Victor


PREPARED BY:
JACOBS CIVIL INC.
ST. LOUIS, MO

REHABILITATION FOR FAI 55/70 COMPLEX
ROADWAY E - STRUCTURE NO. 082-0205
BUMPER/RESTRAINER DETAILS
(FAI-70) ST. CLAIR CO.


STATE OF ILLINOIS
DEPARTMENT OF TRANSPORTATION

PROJECT NO.	SECTION	DATE	REV.	SHEET NO.
FAI-70		St. Clair	388 379	46 SHEETS
DESIGNED BY	CHECKED BY	DRAWN BY	CHECKED BY	

082-3HVB-2R-D-2

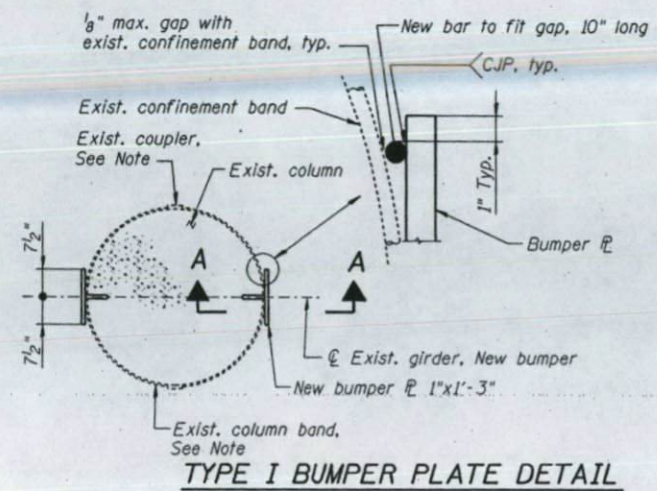


TYPE I BUMPER PLATE DETAIL

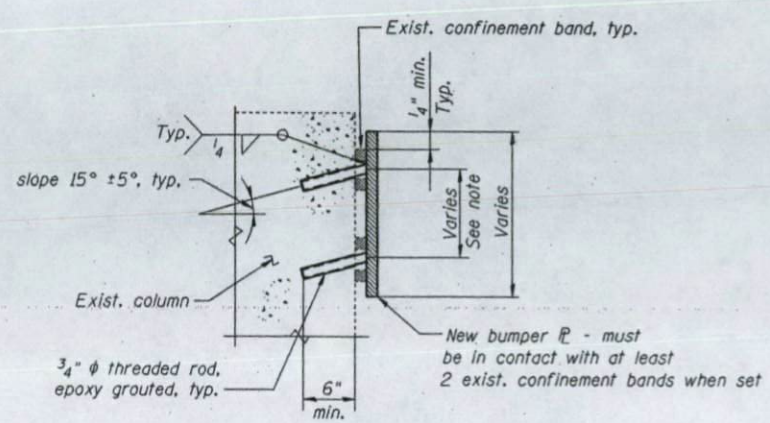


Note: Locate dowels between existing confinement bands as shown.

SECTION A-A


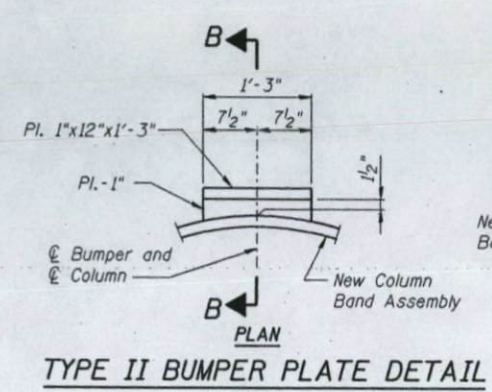


TYPE II BUMPER PLATE DETAIL

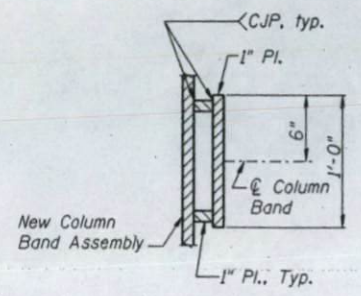


SECTION B-B

NOTE: If necessary, existing bands may be loosened and repositioned to eliminate interference between existing coupler and new bumper plate. Loosened bands shall be reinstalled from bottom up. The repositioned bands shall be evenly spaced as possible and all shall be located within a spacing of 10" vertically. The top of the top band shall not be closer than 3 1/4" nor farther than 4" from the top of column. The coupler bolts shall be tightened in 55 Ft.-Lbs increments in a clockwise direction to a final torque of 220 Ft.-Lbs. All nut threads shall be full engaged upon final tightening. Peen confinement band threads to prevent loosening.

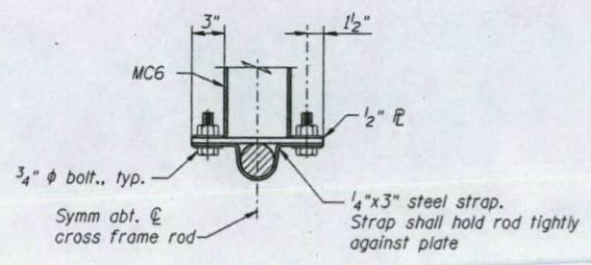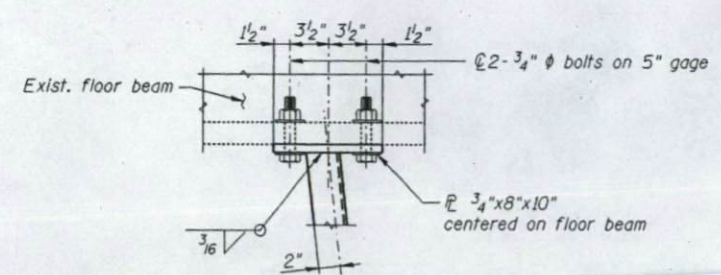

SECTION C-C

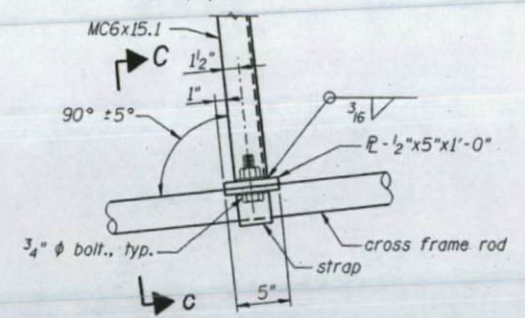

CROSS FRAME ROD SUPPORT DETAIL


NOTES

1. The cost of bumper plates shall be included in the Unit Price for "Furnishing and Erecting Structural Steel".
2. The cost of the Cross Frame Rod Support shall be included in the Unit Price for "Furnishing and Erecting Structural Steel".

DESIGNED	A. Amidi
CHECKED	R. Victor
DRAWN	J. Corley
CHECKED	R. Victor


PREPARED BY:
JACOBS CIVIL INC.
ST. LOUIS, MO

REHABILITATION FOR FAI 55/70 COMPLEX
ROADWAY E - STRUCTURE NO. 082-0205
MISCELLANEOUS SEISMIC
RETROFIT DETAILS
(FAI-70) ST. CLAIR CO.

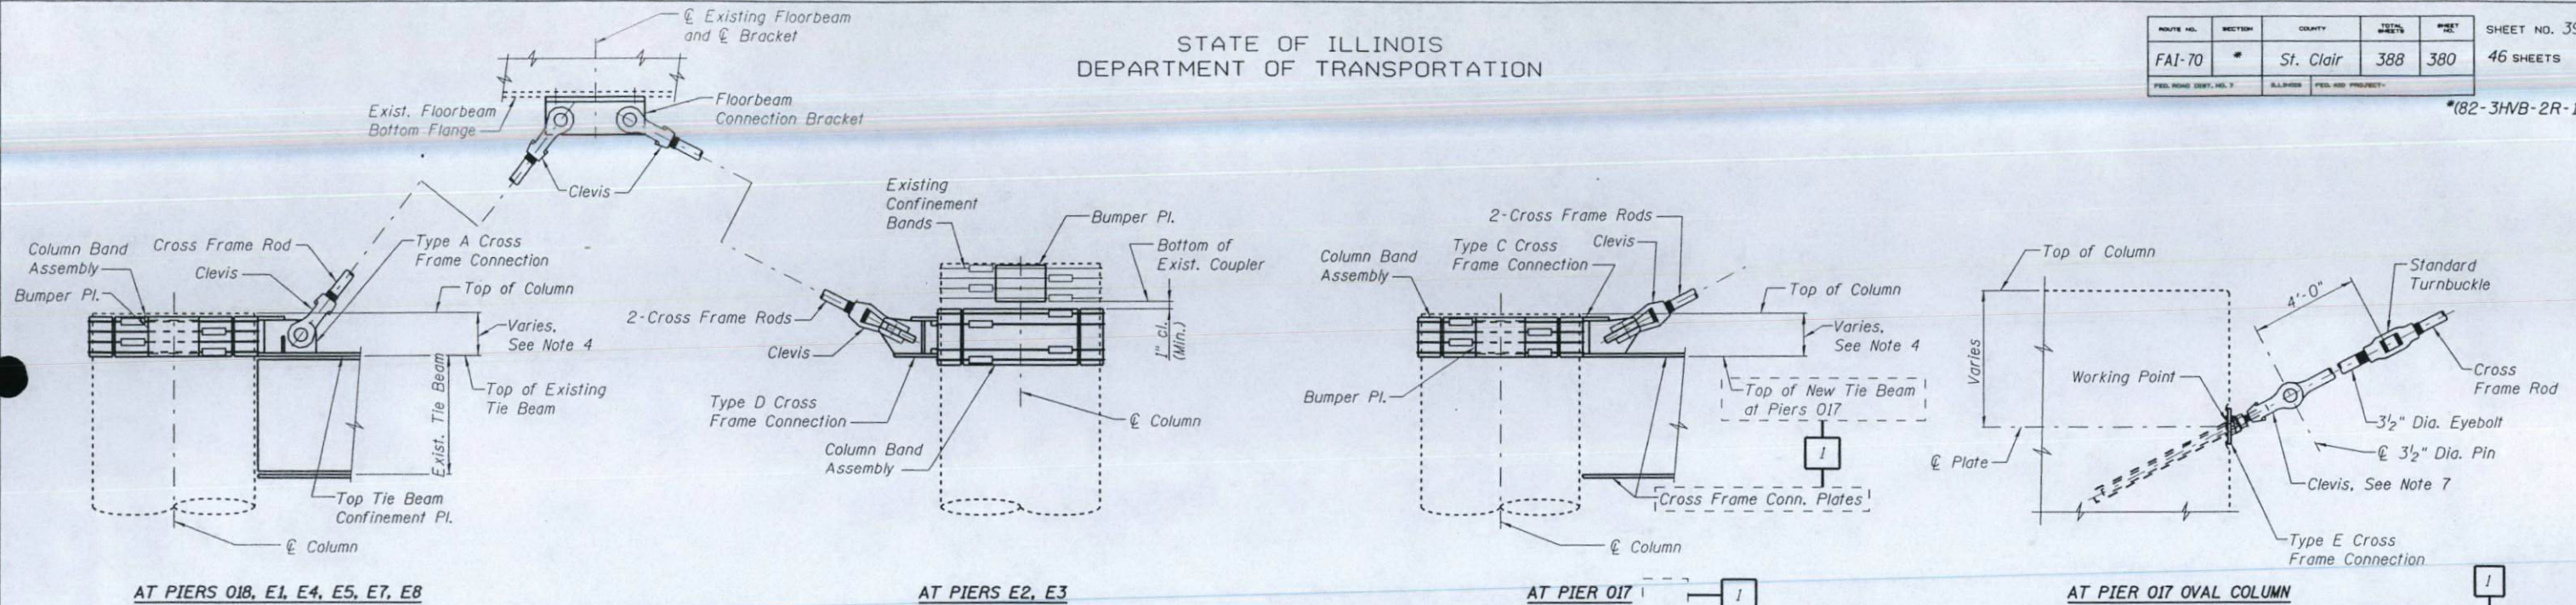


ELEVATION - NEW CROSS FRAME CONNECTIONS

Note: Threaded rods for Tie Beam Confinement Plates not shown for clarity.

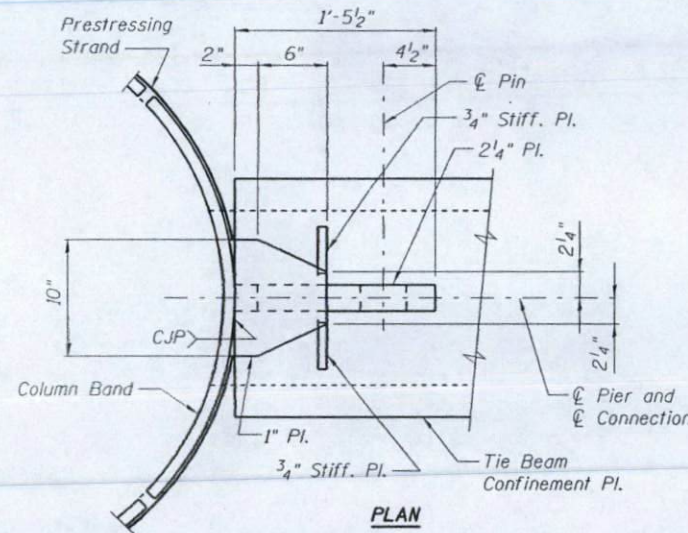

PLAN

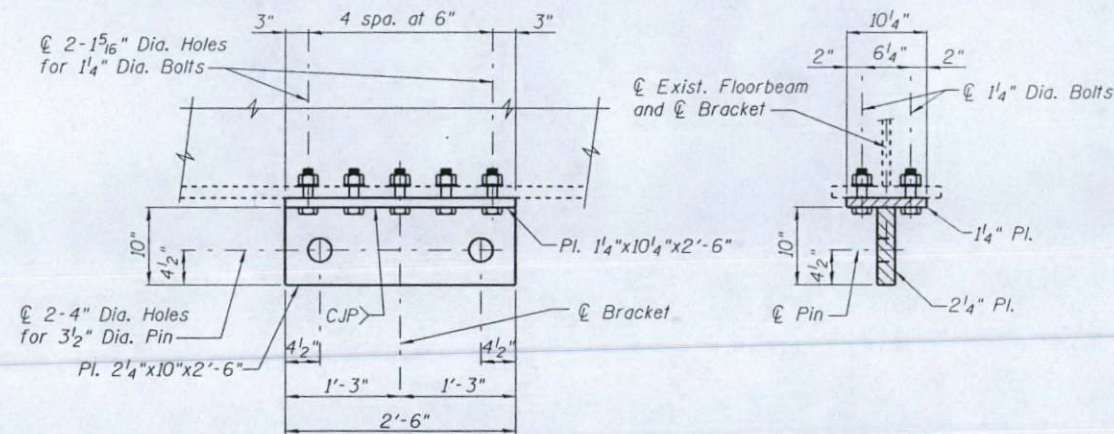


ELEVATION

SECTION

FLOORBEAM CONNECTION BRACKET

Note: Clevis' not shown for clarity.

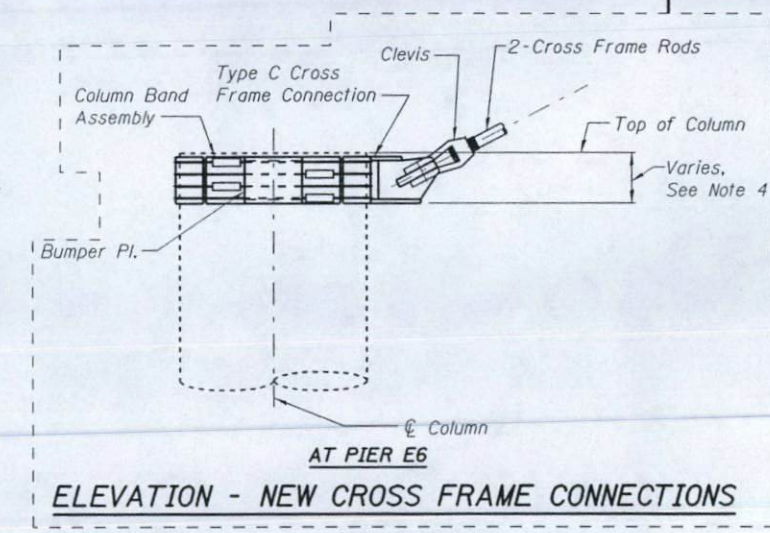


AT PIER E6

ELEVATION - NEW CROSS FRAME CONNECTIONS


NOTES

1. Cross Frame Rods shall be 3" Dia. solid steel with 3 1/2" Dia. Upset Ends.
2. Clevis shall be a #8 Clevis with an opening for a 3 1/2" Dia. Pin. Pins shall be Cotter Pins.
3. Floorbeam Connection brackets shall be located at the centerline of the Existing Floorbeam between Existing Girders, Unless Otherwise Noted on Pier Elevations.
4. Existing Confinement Bands shall be removed as necessary to allow installation of the New Column Band and to give a minimum clearance of 1" from the bottom of the lowest Existing Coupler to the top of the Column Band Plate.
5. Cross Frame Rods shall extend 0" Min. to 1" Max. into Clevis Openings.
6. Column Band Assembly consists of 4 Column Band Plates and 4 Low-relaxation strands with couplers.
7. Clevis for Type E Connection shall be machined to accept threads from 2" Dia. Anchor Bolt.
8. The cost of Cross Frame Rods, Column Band Assemblies, Clevises, and Connection Brackets shall be included in the Unit Price for "Furnishing And Erecting Structural Steel".

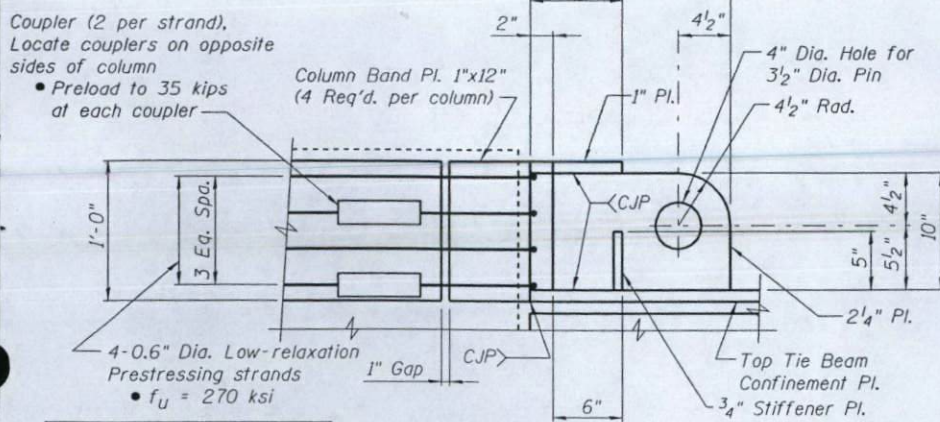

ELEVATION


TYPE A CONNECTION DETAIL

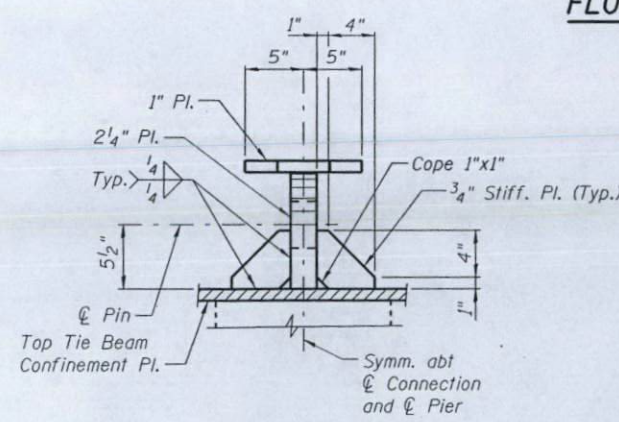

END VIEW

VARIABLES





PIER	"R"
017	2'-0"
018	2'-3"
E1	2'-0"
E2	2'-0"
E3	2'-0"
E4	2'-0"
E5	2'-0"
E6	2'-0"
E7	2'-0"
E8	2'-0"

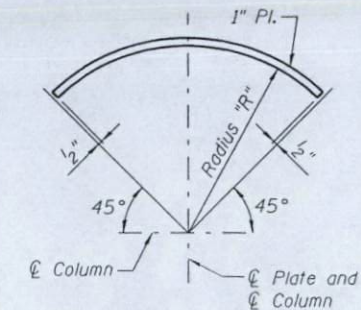


COLUMN BAND PLATE DETAIL

DESIGNED	A. Amidi
CHECKED	R. Victor
DRAWN	S. Kaemmerer
CHECKED	R. Victor


PREPARED BY:
JACOBS CIVIL INC.
ST. LOUIS, MO

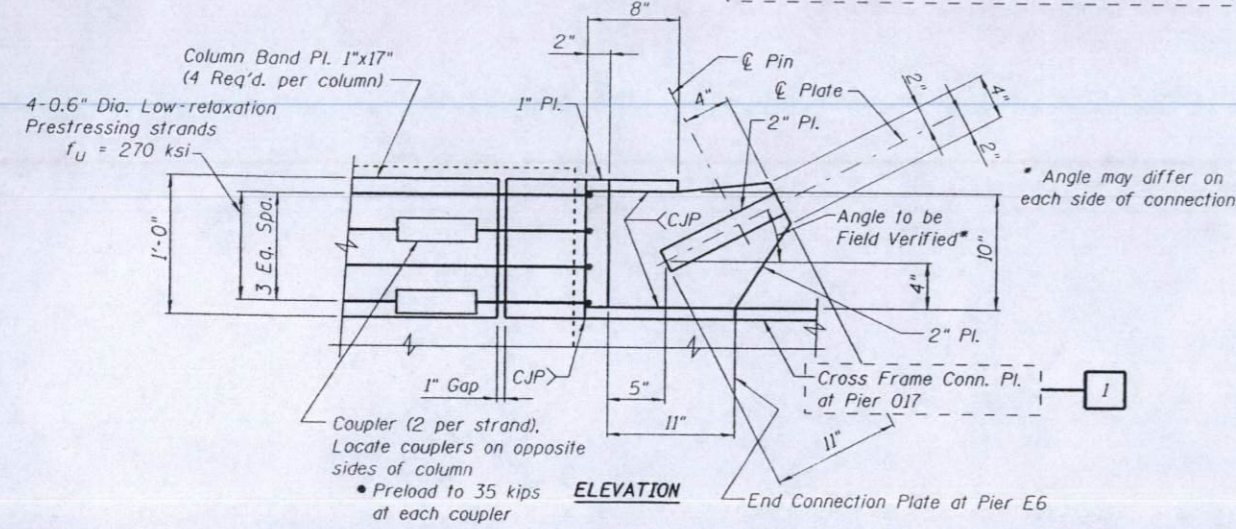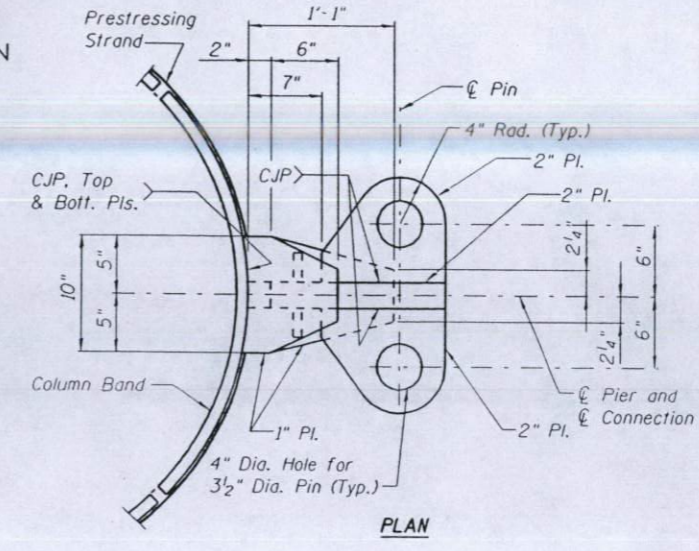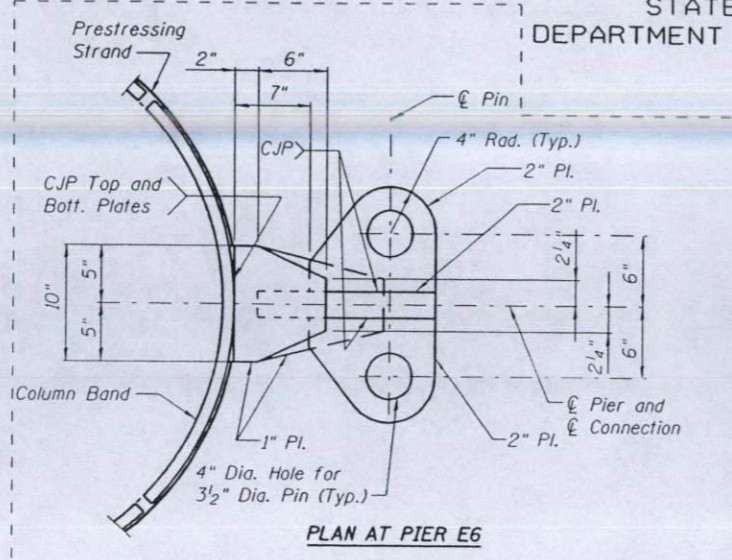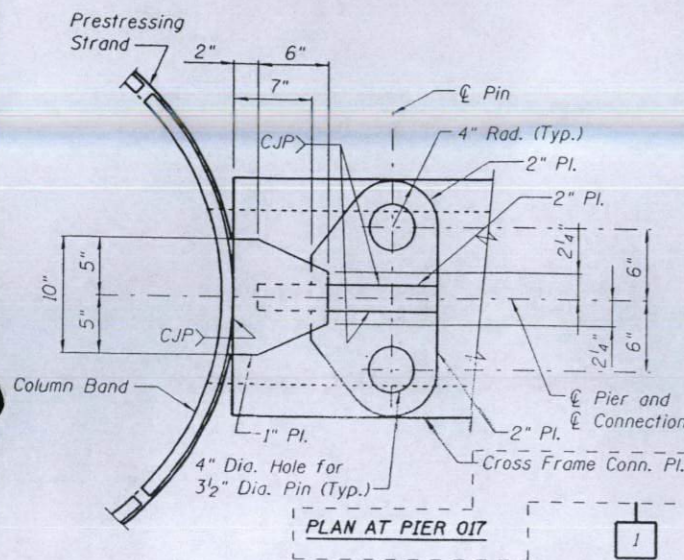


TYPE C CONNECTION DETAIL

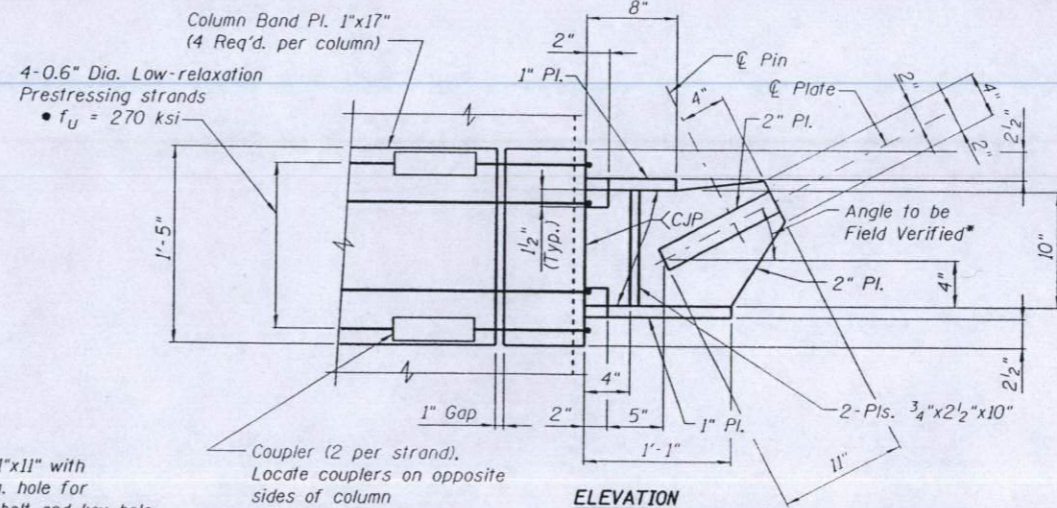

TYPE D CONNECTION DETAIL

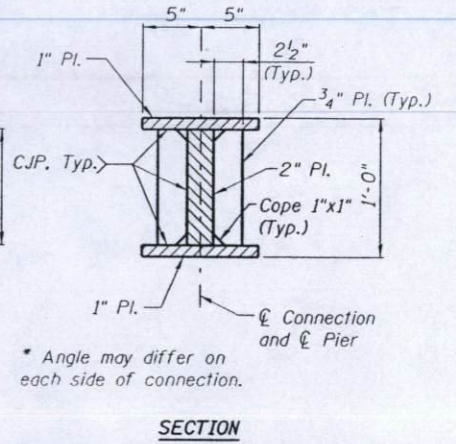

SECTION

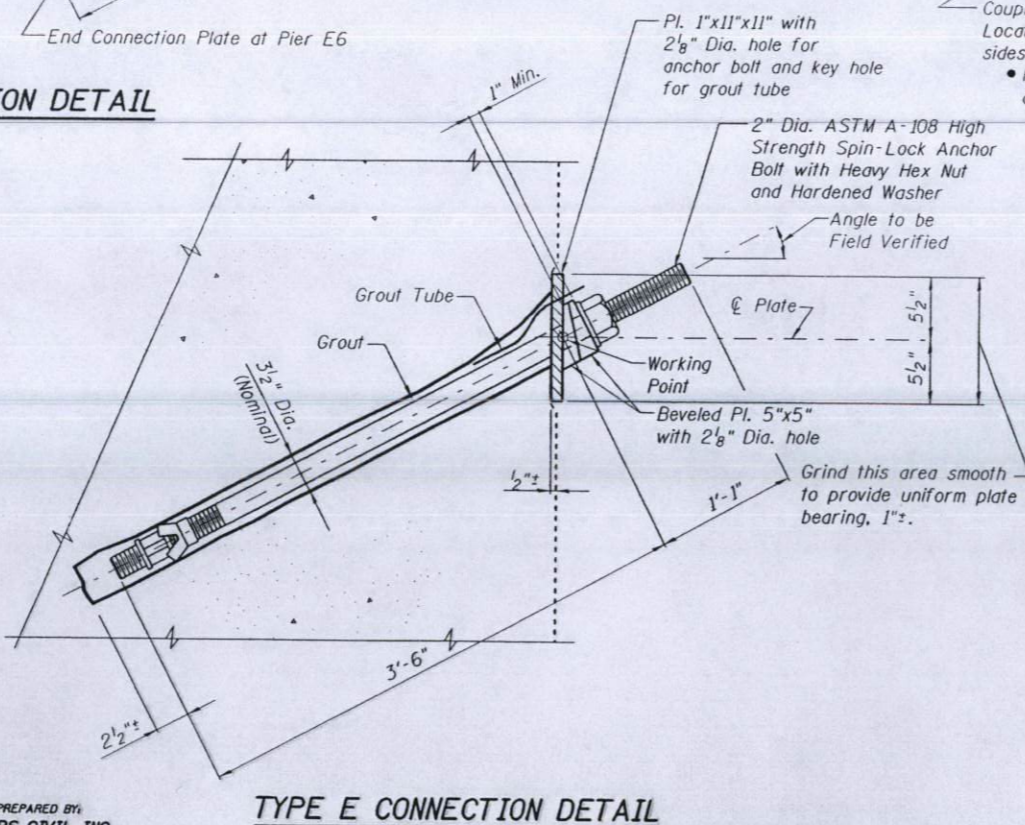

TYPE E CONNECTION DETAIL


NOTES

1. Grout shall be a 2-component, 100% solids, moisture insensitive, high-modulus, high-strength, structural epoxy conforming to the current ASTM C-881 and AASHTO M-235 specifications. Minimum bond strength for hardened concrete to steel shall be 2,600 psi.
2. For Additional Notes see Sheet 39.


REHABILITATION FOR FAI 55/70 COMPLEX
ROADWAY E - STRUCTURE NO. 082-0205
CROSS FRAME MODIFICATIONS
(FAI-70) ST. CLAIR CO.

DESIGNED	A. Amidi
CHECKED	R. Victor
DRAWN	S. Kaemmerer
CHECKED	R. Victor


PREPARED BY
JACOBS CIVIL INC.
ST. LOUIS, MO

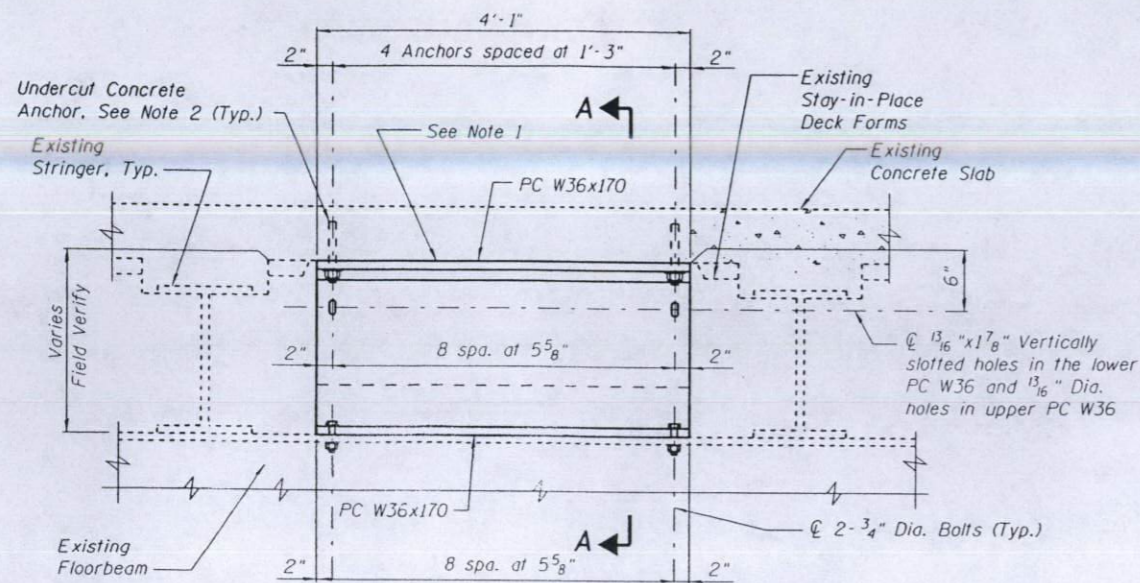

SLAB TO FLOORBEAM CONNECTION DETAIL - TYPE 2

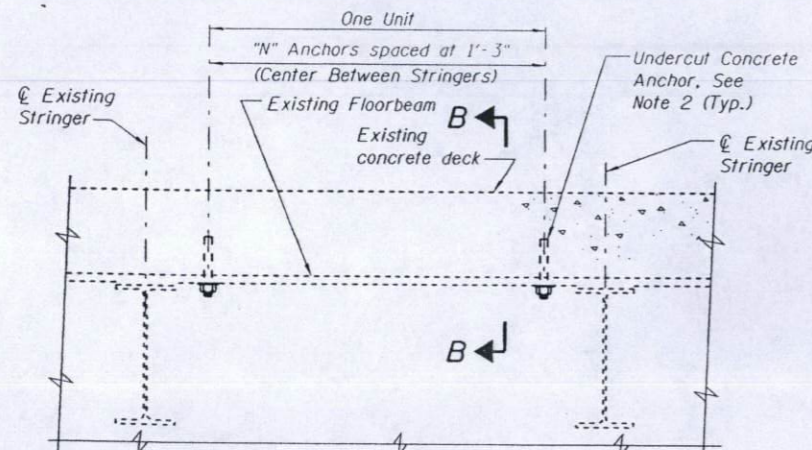


SLAB TO FLOORBEAM CONNECTION DETAIL - TYPES 3 & 4

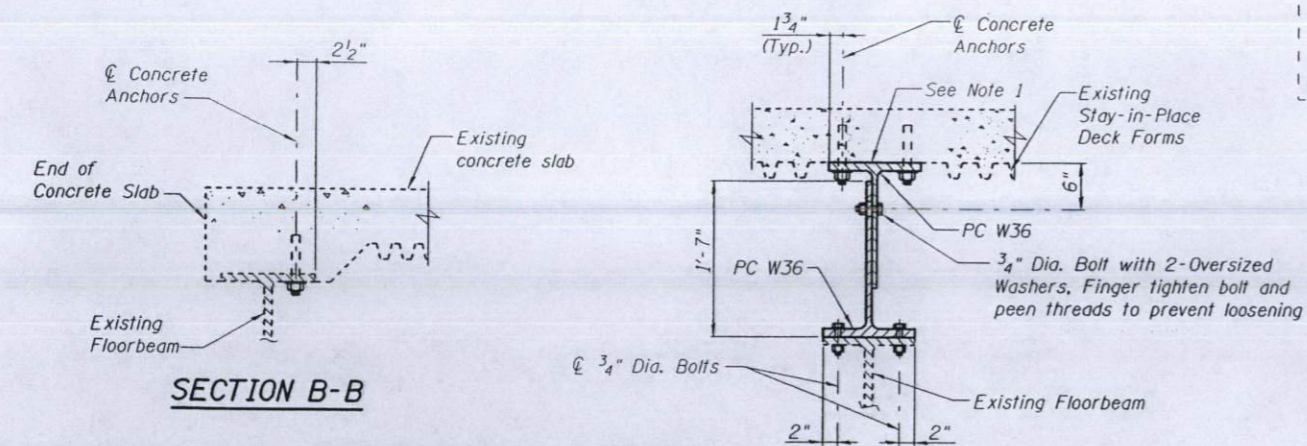


DESIGNED	M. Capron
CHECKED	M. Supak
DRAWN	S. Kaemmerer
CHECKED	R. Victor

TABLE OF VARIABLES				
TYPE NO.	DIM. A	"N"	"M"	DIM. B
3	---	6	---	---
4	---	4	---	---

PREPARED BY:
JACOBS CIVIL INC.
ST. LOUIS, MO

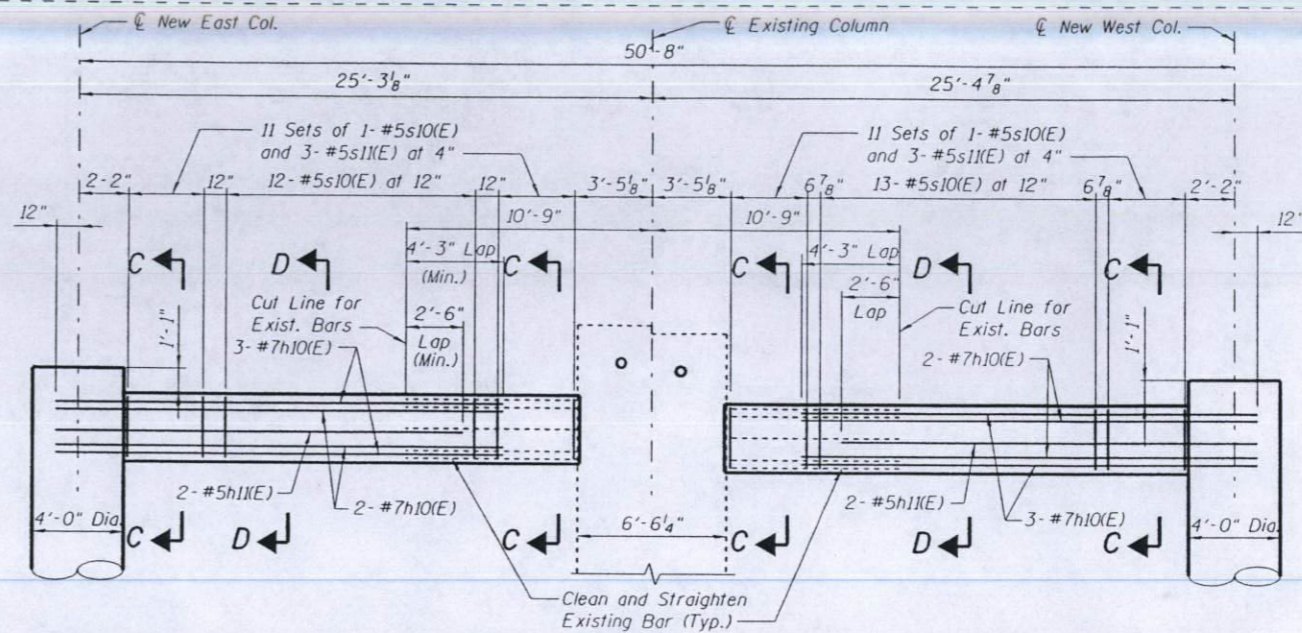


ELEVATION - PIER 017
(Looking Ahead Station)

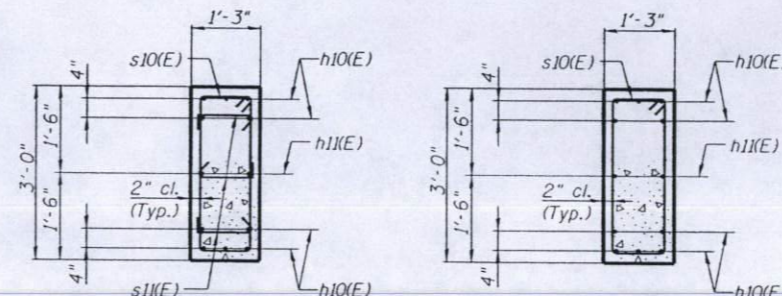

SECTION C-C

SECTION D-D

Note: The 90° hooks for two successive s11(E) bars engaging the same longitudinal bars shall be alternated end for end.

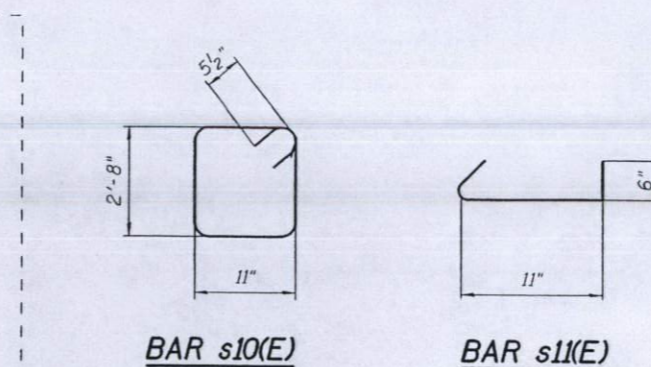

BAR s10(E)

BAR s11(E)

SUBSTRUCTURE BILL OF MATERIAL


Bar	No.	Size	Length	Shape
h10(E)	20	#7	19'-11"	—
h11(E)	4	#5	18'-2"	—
s10(E)	69	#5	8'-1"	□
s11(E)	132	#5	1'-11"	└┘
Reinforcement		Pound		1,735
Concrete		Cu. Yd.		5.6

Reinforcement Bars designated (E) shall be Epoxy Coated.

NOTES

- Remove existing stay-in-place deck form and grind concrete smooth to provide uniform bearing.
- Undercut Concrete Anchors shall have a bolt diameter of 0.827", Bolt Yield Stress of 93 ksi and Bolt Ultimate Stress of 116 ksi. Sleeve is to have a Cross Sectional Area of 0.346 sq. in. and an Ultimate Strength of 123 ksi and extend thru the connected steel item. Embedment is to be 5" into existing concrete slab. See Special Provisions for Expansion Bolts (Special).
- The cost of the Slab to Floorbeam connection shall be included in the Unit Price for "Furnishing And Erecting Structural Steel".
- The cost of Undercut Concrete Anchors shall be included in the Unit Price for Expansion Bolts (Special).
- The cost of reinforcement bars, concrete and all other labor, equipment and materials necessary to construct the new tie beam shall be included in the Unit Price for Replace Tie Beam (Special).

REHABILITATION FOR FAI 55/70 COMPLEX
ROADWAY E - STRUCTURE NO. 082-0205
PIER SEISMIC RETROFIT DETAILS
(FAI-70) ST. CLAIR CO.

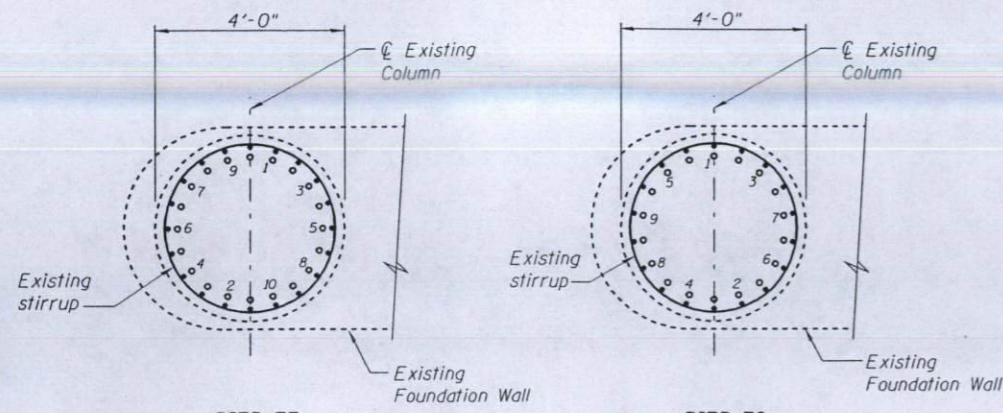


PIER E3
Note: Numbers indicate locations of foundation wall dowel bars to be cut (10 Total). See Detail 1.


PIER E6
Note: Numbers indicate locations of foundation wall dowel bars to be cut (9 Total). See Detail 1.

SECTIONS THRU COLUMNS


- Indicates Foundation Wall Dowel Bar
- Indicates Column Longitudinal Bar

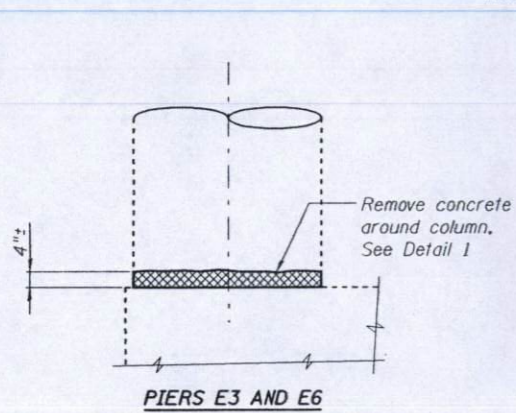


ELEVATION - DEMOLITION

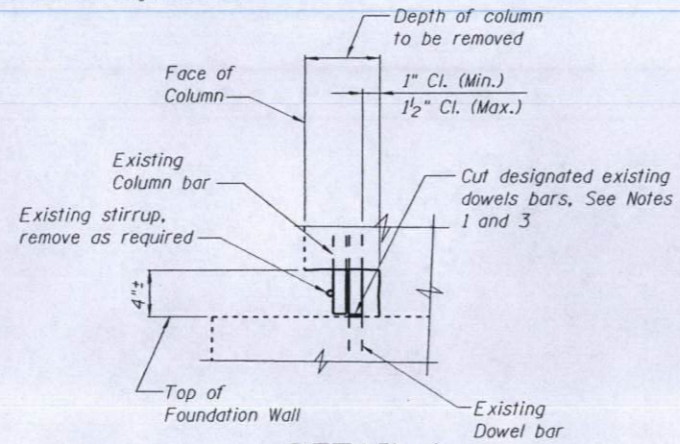

DETAIL 1

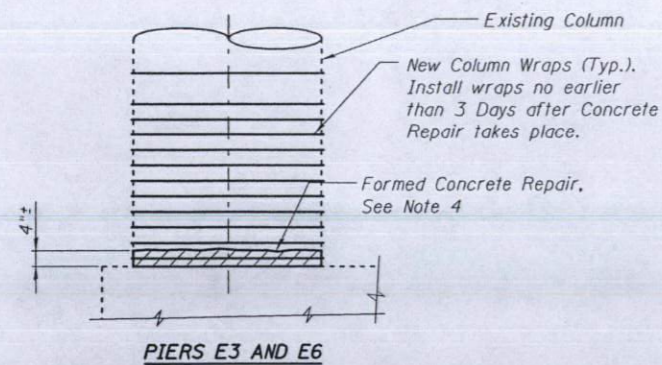

ELEVATION - FINAL CONDITION

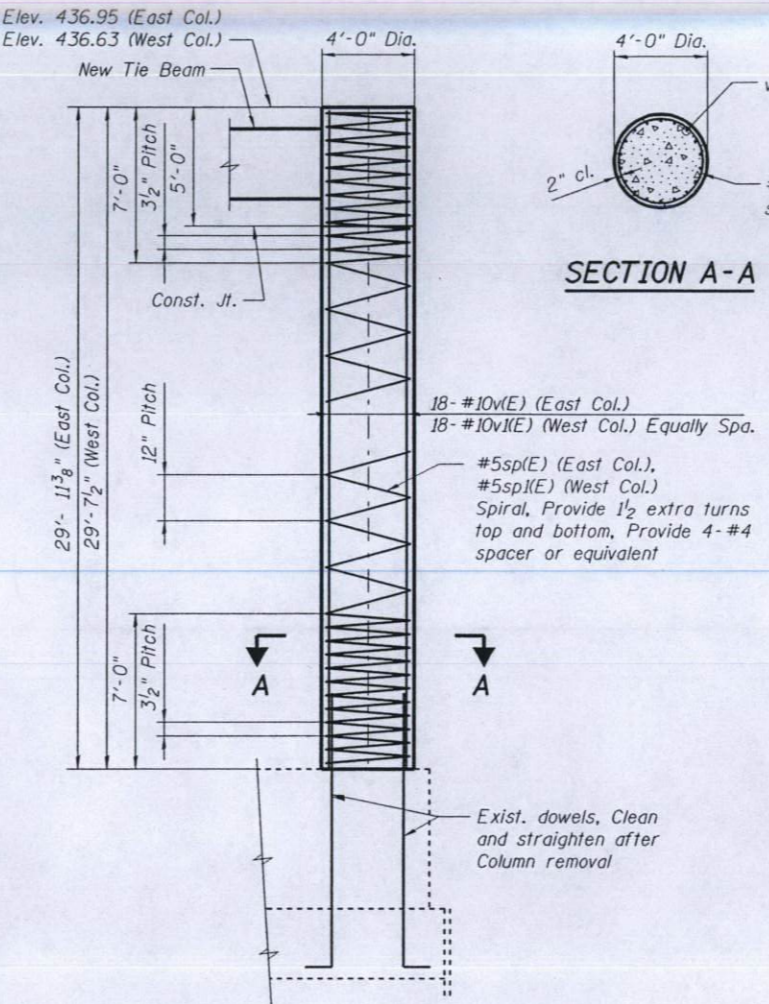


ELEVATION - PIER 017 COLUMN

SUBSTRUCTURE BILL OF MATERIAL


Bar	No.	Size	Length	Shape	
v(E)	18	#10	29'-9"	—	
v(E)	18	#10	29'-5"	—	
sp(E)		#5	29'-9"	WWW	
sp(E)		#5	29'-5"	WWW	
Reinforcement				Pound	6,295
Concrete				Cu. Yd.	27.7

Reinforcement Bars designated (E) shall be Epoxy Coated.

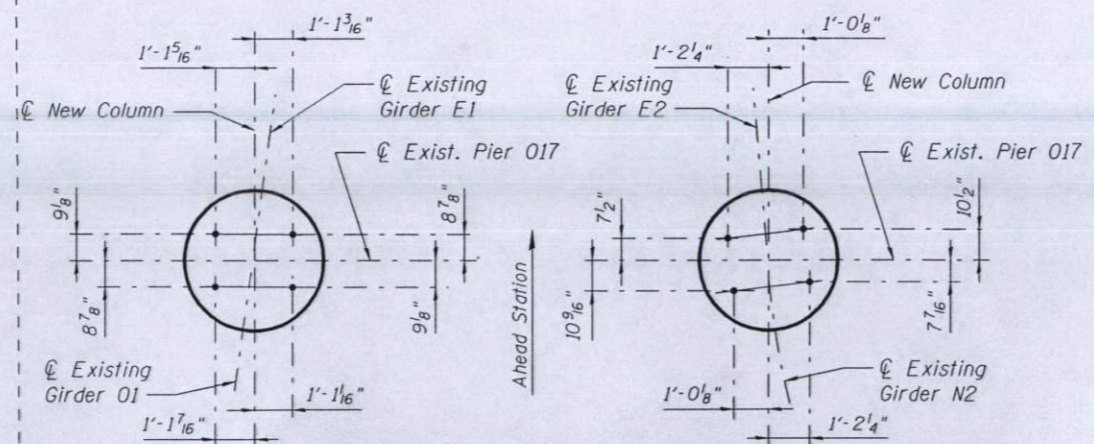

ANCHOR BOLT PLAN - PIER 017

Note: Anchor bolts shall be drilled and grouted into new concrete.

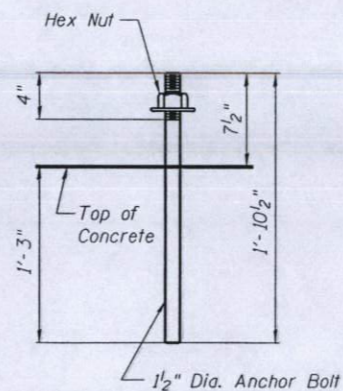

ANCHOR BOLT DETAIL

NOTES

- The contractor shall positively discern between column longitudinal reinforcing bars and foundation wall dowel bars prior to cutting any bars.
- Cut number of foundation wall dowel bars indicated. To determine which bars to cut, see "SECTION THRU COLUMN", and cut bars sequentially starting with the number one. Dowel bars shall be cut within 2" of the top of the foundation wall.
- Concrete repair shall be in accordance with the Special Provisions. Before repairing column, contractor shall replace all removed #4 stirrups with new #4 stirrups. All unsound concrete caused by modification shall be removed prior to concrete repair.
- Only one column per pier may be modified at a time. Work on a successive column shall not start until the previous column base modification is complete and its wrapping is in place.
- The cost of Concrete Removal and cutting existing dowel bars shall be paid at the Unit Price for "Foundation Wall Dowel Modification".
- For New Column Wrap Details, see Sheet 43.
- For New Tie Beam Details, see Sheet 41.
- The cost of reinforcement bars, concrete and all other labor, equipment and materials necessary to construct the new columns shall be included in the Unit Price for Remove and Replace Column (Special).

REHABILITATION FOR FAI 55/70 COMPLEX
ROADWAY E - STRUCTURE NO. 082-0205
PIER COLUMN BASE MODIFICATIONS PIERS E3 AND E6 AND COLUMN REPLACEMENT PIER 017
(FAI-70) ST. CLAIR CO.


DESIGNED	R. Victor
CHECKED	A. Amidl
DRAWN	S. Kaemmerer
CHECKED	R. Victor

PREPARED BY:
JACOBS CIVIL INC.
ST. LOUIS, MO


STATE OF ILLINOIS
DEPARTMENT OF TRANSPORTATION

ROUTE NO.	SECTION	COUNTY	SHEET NO.	TOTAL SHEETS
FAI-70	*	St. Clair	388	384
SHEET NO. 43				
46 SHEETS				

*82-3HVB-2R-1-2

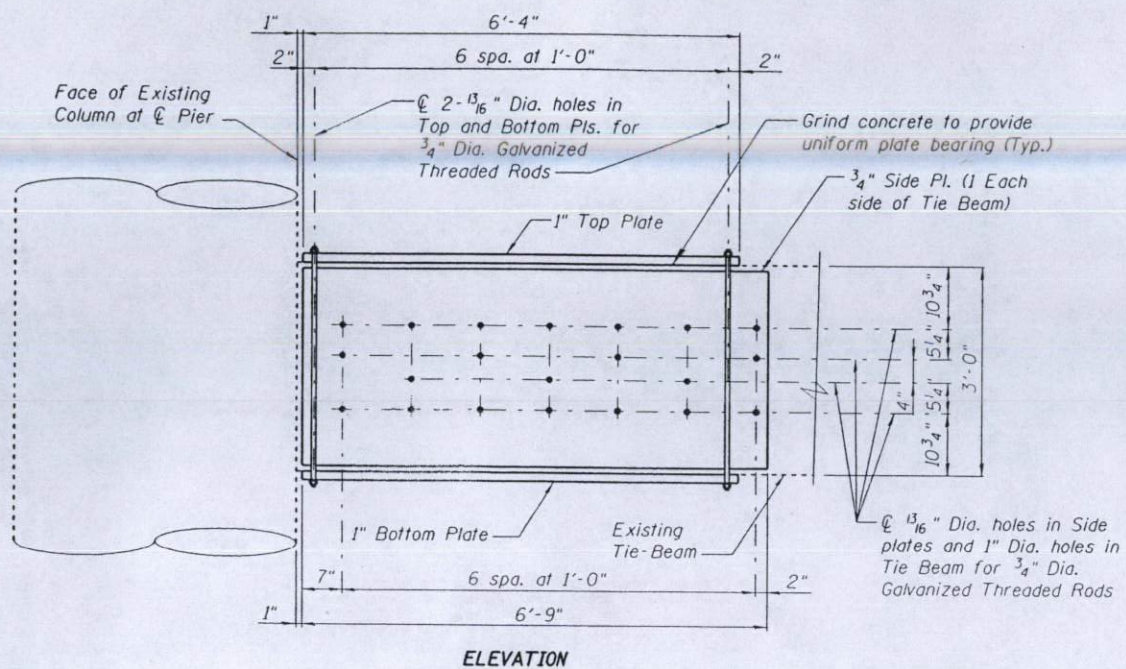

ELEVATION

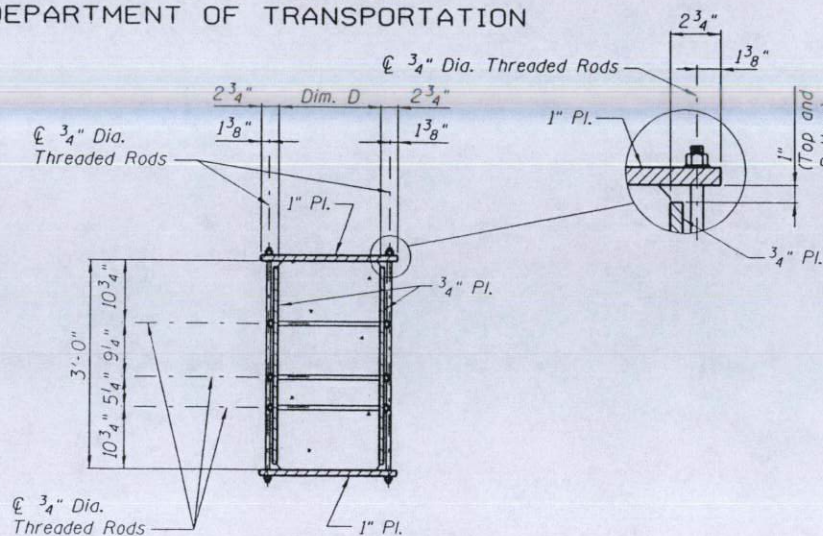

SECTION


TIE BEAM CONFINEMENT PLATES

Note: Wrap each end of Tie Beam as shown. Tension Threaded Rods to 12 kips each and peen threads to prevent loosening. Grout Tension Rod holes.

TABLE OF VARIABLES								
PIER	NO. COLS.	DIM. A	"B"	Dim. C	Dim. D	TOP/BOTTOM PLATES	SIDE PLATES	COMMENTS
O17	-	-	-	-	-	-	-	See Note A
O18	2	4'-6"	8"	8"	2'-0"	Pl. 1"x29 1/2"x6'-4"	Pl. 3/4"x34"x6'-9"	
E1	2	4'-0"	8"	8"	1'-9"	Pl. 1"x26 1/2"x6'-4"	Pl. 3/4"x34"x6'-9"	
E2	2	4'-0"	5"	8"	-	-	-	No Tie Beam
E3	2	4'-0"	5"	8"	-	-	-	No Tie Beam
E4	2	4'-0"	5"	8"	1'-6"	Pl. 1"x23 1/2"x6'-4"	Pl. 3/4"x34"x6'-9"	
E5	2	4'-0"	5"	8"	1'-6"	Pl. 1"x23 1/2"x6'-4"	Pl. 3/4"x34"x6'-9"	
E6	2	4'-0"	5"	8"	-	-	-	Tie Beam Removed
E7	2	4'-0"	5"	8"	1'-3"	Pl. 1"x20 1/2"x6'-4"	Pl. 3/4"x34"x6'-9"	
E8	2	4'-0"	5"	8"	1'-3"	Pl. 1"x20 1/2"x6'-4"	Pl. 3/4"x34"x6'-9"	

1
1


Note A: Circular Column and Tie Beam replaced. Column wraps not required on New Column.

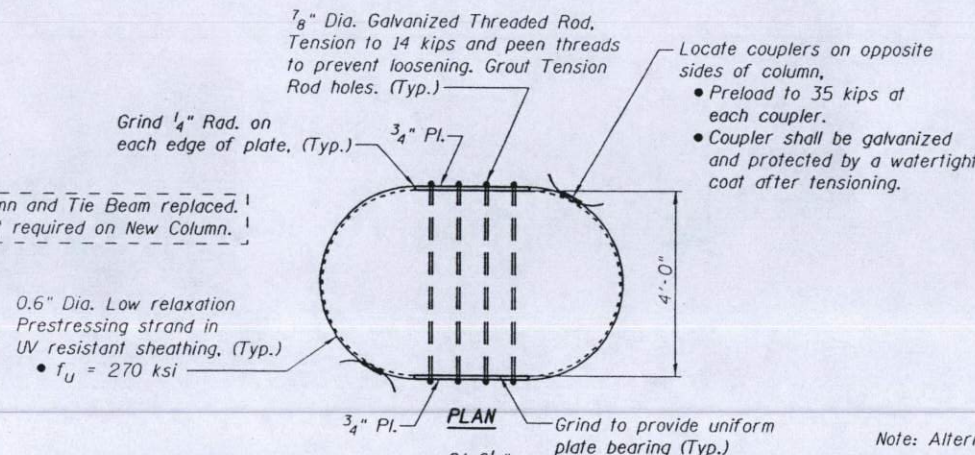

PLAN

Locate couplers on opposite sides of column.
• Preload to 35 kips at each coupler.
• Coupler shall be galvanized and protected by a watertight coat after tensioning.


PLAN

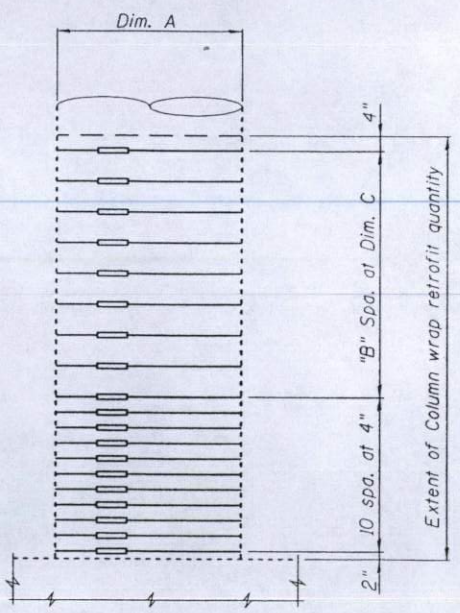

ELEVATION

CIRCULAR COLUMN WRAP

Note: Alternate column wraps may be used. See Special Provisions.

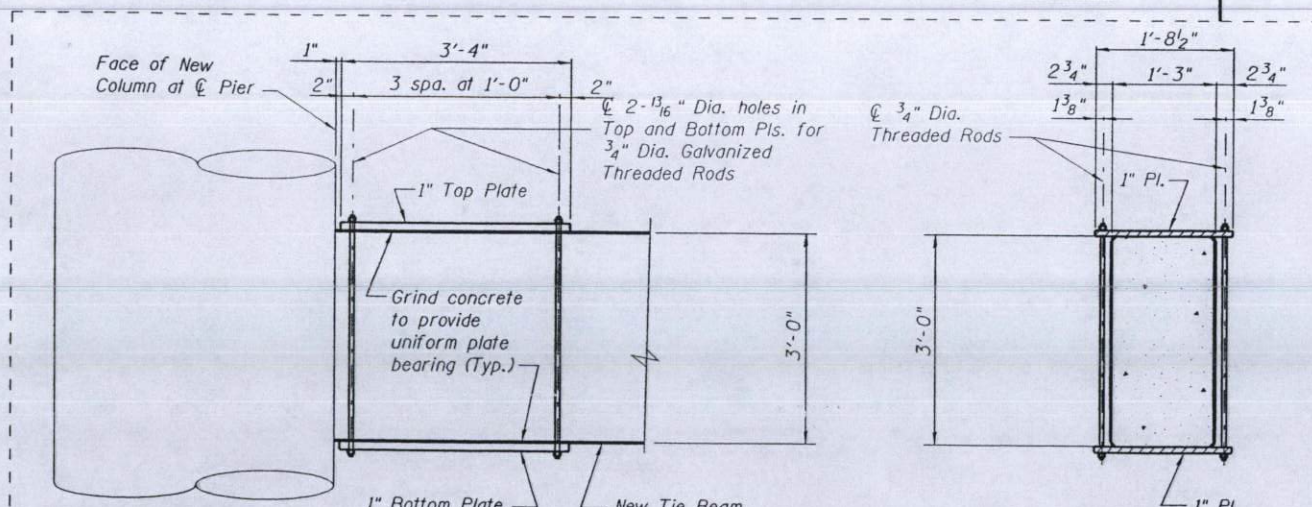


ELEVATION

SECTION

CROSS FRAME CONNECTION PLATES AT PIER O17

Note: Peen threads to prevent loosening.

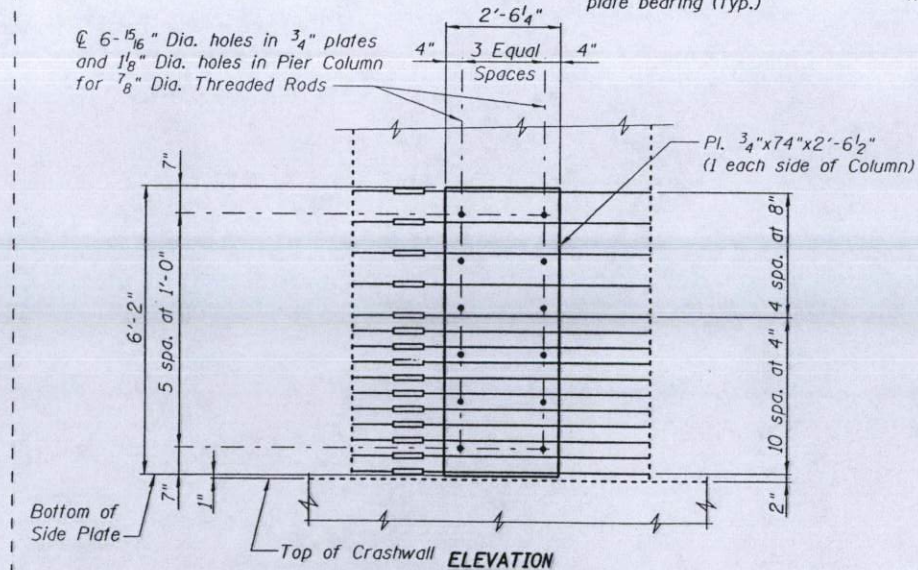

ELEVATION

PIER O17 OVAL COLUMN WRAP

Note: Alternate column wraps may be used. See Special Provisions.

NOTES

- The cost of Tie Beam Confinement Plates and Threaded Rods shall be included in the Unit Price for "Furnishing And Erecting Structural Steel".
- The cost of Side Plates and Threaded Rods for Pier O17 shall be included in the Unit Price for "Column Wrap".

REHABILITATION FOR FAI 55/70 COMPLEX
ROADWAY E - STRUCTURE NO. 082-0205
PIER SEISMIC MODIFICATIONS


(FAI-70) ST. CLAIR CO.

DESIGNED	A. Amidi
CHECKED	M. Capron
DRAWN	S. Kaemmerer
CHECKED	R. Victor


PREPARED BY:
JACOBS CIVIL INC.
ST. LOUIS, MO

STATE OF ILLINOIS
DEPARTMENT OF TRANSPORTATION


ROUTE NO.	SECTION	COUNTY	POST MILE	SHEET NO.	TOTAL SHEETS
FAI-70		St. Clair	388 385	44	46
FED. ROAD DIST. NO.	ILLINOIS	FED. AID PROJECT			

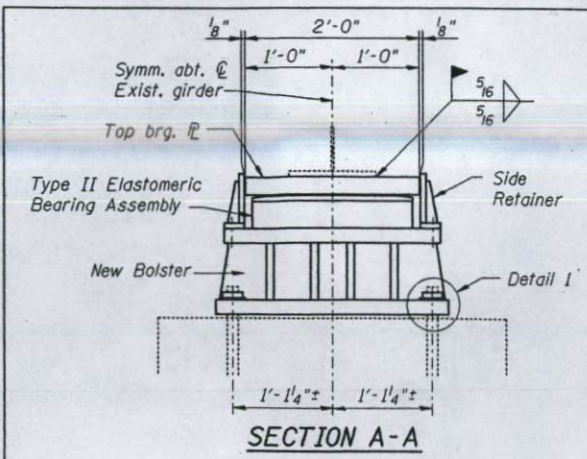


SECTION A-A

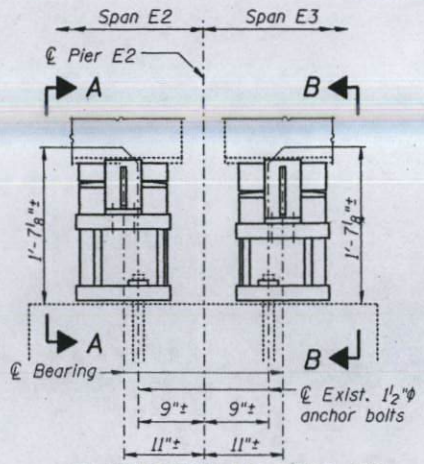


ELEVATION AT PIER E2

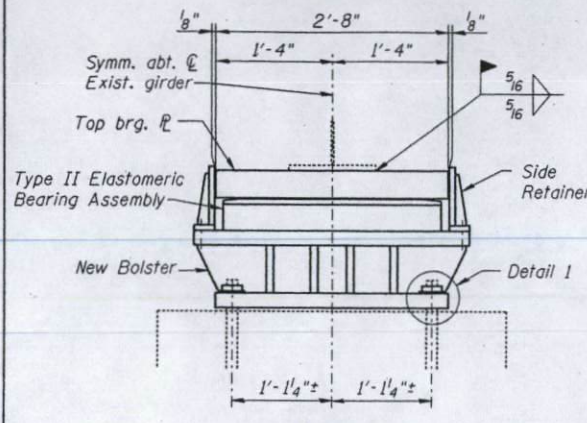


SECTION B-B

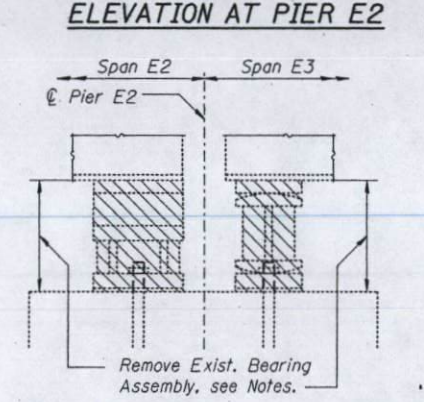


BEARING REMOVAL AT PIER E2

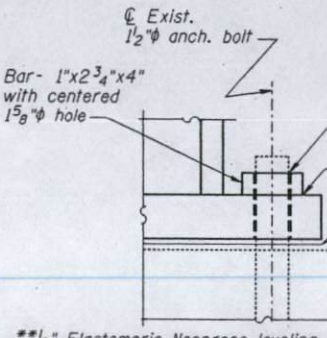


DETAIL 1

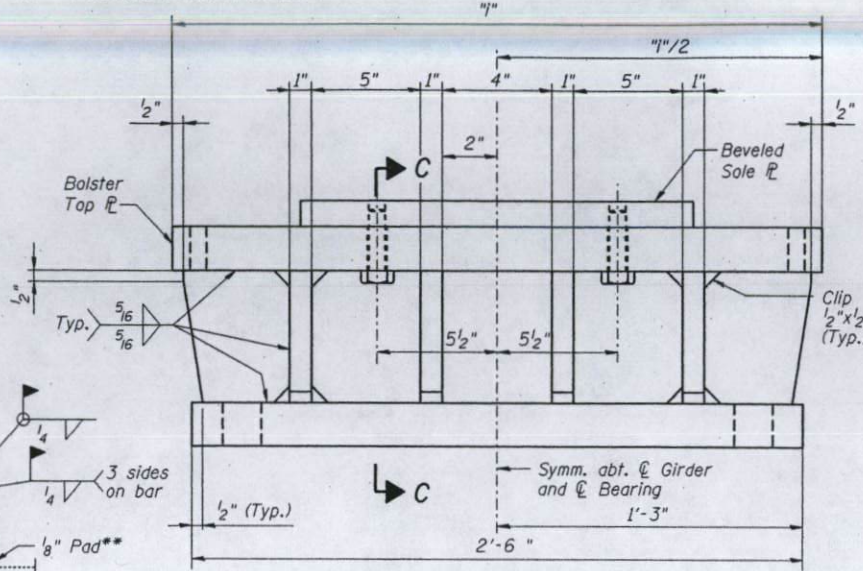


BOLSTER ELEVATION

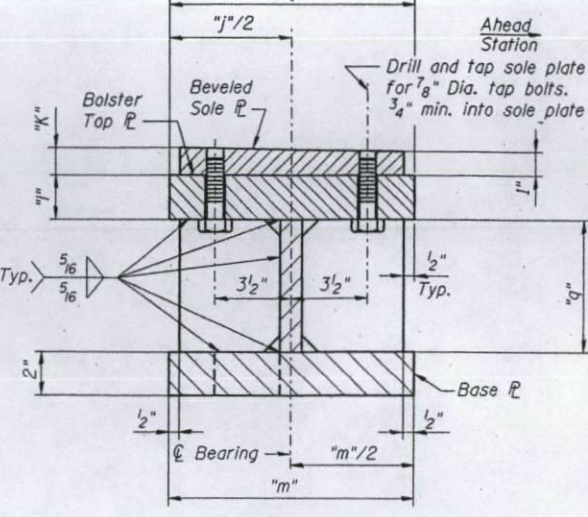


SECTION C-C

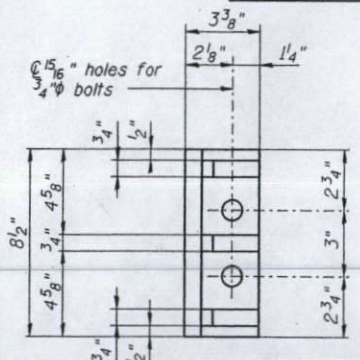


TOP BEARING ASSEMBLY

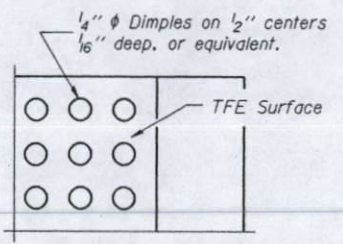


PLAN-TFE SURFACE

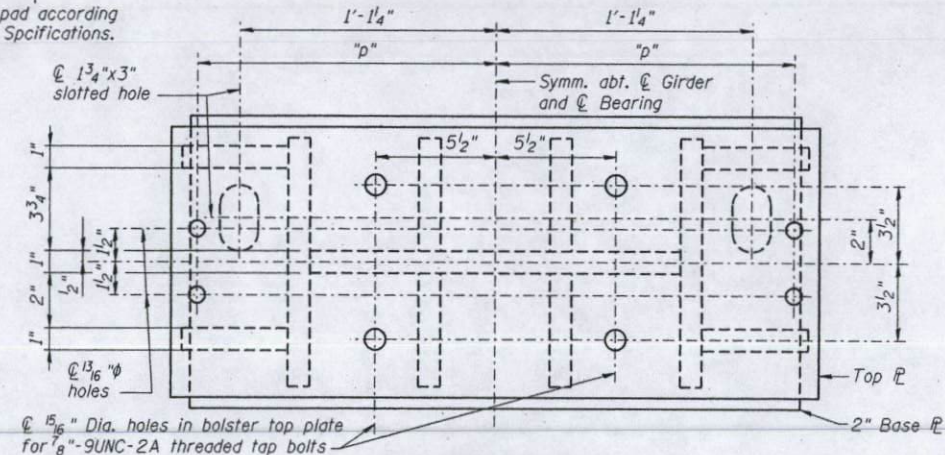


BOLSTER PLAN

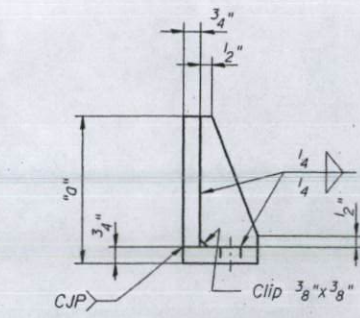

SIDE RETAINER

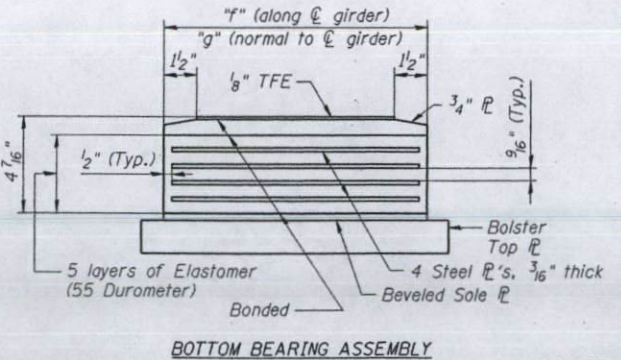

BOTTOM BEARING ASSEMBLY

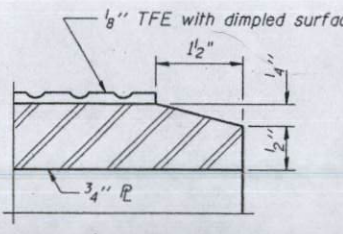

SECTION THRU TFE

Pier / Span	"a"	"b"	"c"	"d"	"f"	"g"	"i"
Pier E2 Span E2	8 3/4"	2 5/8"	1'-1 3/8"	2'-0"	1'-0"	1'-10"	2'-7"
Pier E2 Span E3	9 7/8"	3 3/4"	1'-1 1/8"	2'-8"	1'-1"	2'-6"	3'-3"
Pier / Span	"j"	"k"	"l"	"m"	"p"	"q"	
Pier E2 Span E2	1'-1 3/8"	1 1/8"	1 1/8"	1'-1 3/8"	1'-1 7/8"	7 7/8"±	
Pier E2 Span E3	1'-1 1/8"	1 3/16"	1"	1'-1 1/8"	1'-5 7/8"	6 3/4"±	

Span	Pier	Jacking Load per Bearing	
		Dead Load	Live Load + Impact
E2	E2	112 k	112 k
E3	E2	184 k	151 k

Note: The theoretical jacking loads listed above were taken from the design drawings for the original structure. See Special Provision "Jack and Remove Existing Bearings" for requirements and limitations for jacking the structure.

DESIGNED	D. James
CHECKED	R. Victor
DRAWN	M. King
CHECKED	R. Victor

PREPARED BY:
JACOBS CIVIL INC.
ST. LOUIS, MO

BILL OF MATERIAL

Item	Unit	Total
Elastomeric Bearing Assembly Type II	Each	4

NOTES

Minimum Jack Capacity:
1. The capacity of the jacks used to lift the bridge shall be at least 50% to 100% greater than the theoretical jacking loads shown in the table.


Bearing Demolition:
1. After jacking the structure off the bearing assembly, remove existing anchor bolt nuts and/or any welded plate washers that secure the existing bearing assembly to the anchor bolt. Existing anchor bolts are to remain intact to a minimum projection of 4" above top of concrete. Contractor shall verify soundness of existing anchor bolts prior to installation of new bearing assembly. Regrout in place if necessary.
2. All portions of existing bearing assemblies, including bolsters, sole plates and shims, shall be removed.

Bearing Installation:
1. Bearings to be replaced are for both girders at locations shown.
2. If the portion of the bottom flange above the new bearing is bent, the flange should be straightened using continuous pressure applied to both faces of the plate simultaneously before installation of the new bearing.
3. Top of column concrete shall be leveled using an epoxy grout prior to bearing installation.
4. Shim as required between top of leveled column and bottom of bolster.
5. Existing grounding wires to be re-attached after bearing replacement is complete.
6. Cost of Bolster and Side Retainers shall be included in the Lump Sum of "Furnishing and Erecting Structural Steel".


REHABILITATION FOR FAI 55/70 COMPLEX
ROADWAY E - STRUCTURE NO. 082-0205
BEARINGS
(FAI-70) ST. CLAIR CO.

STATE OF ILLINOIS
DEPARTMENT OF TRANSPORTATION


ROUTE NO.	SECTION	COUNTY	JEFF	386	SHEET NO. 44A
FAI-70	*	St. Clair	388	386	46 SHEETS
FED. ROAD DIST. NO. 7	ILLINOIS	FED. AID PROJECT	082-3HVB-2R-U-2		

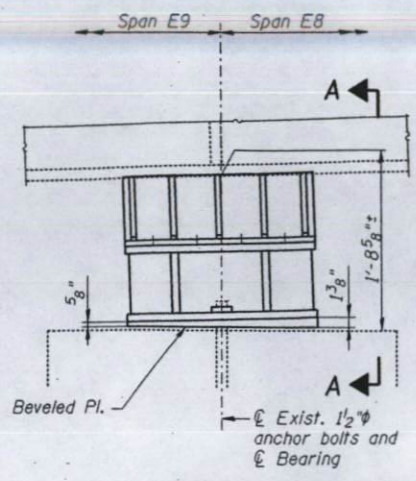


ELEVATION AT PIER E8

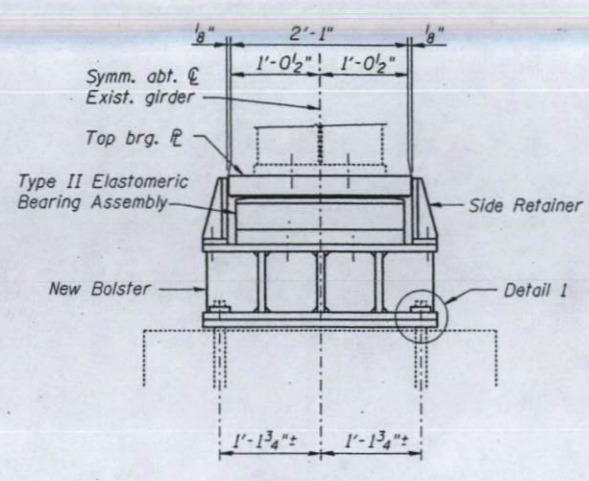


SECTION A-A

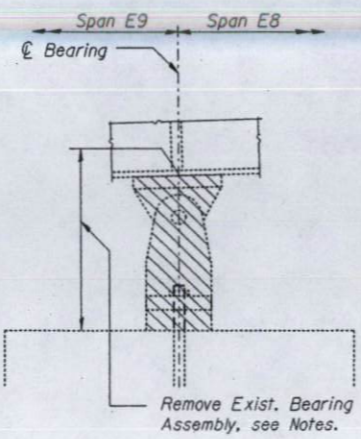

BEARING REMOVAL AT PIER E8

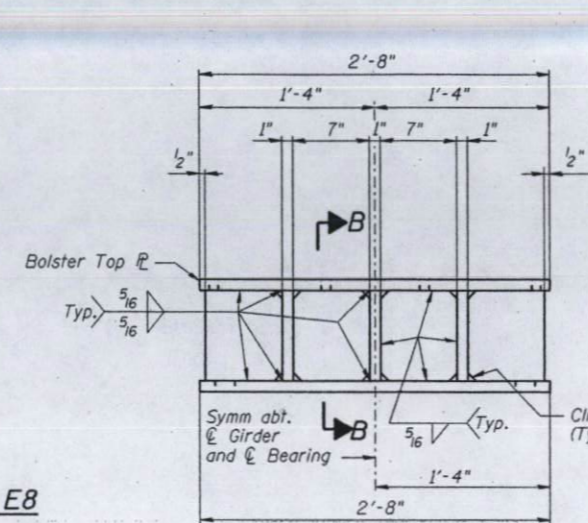


BOLSTER ELEVATION

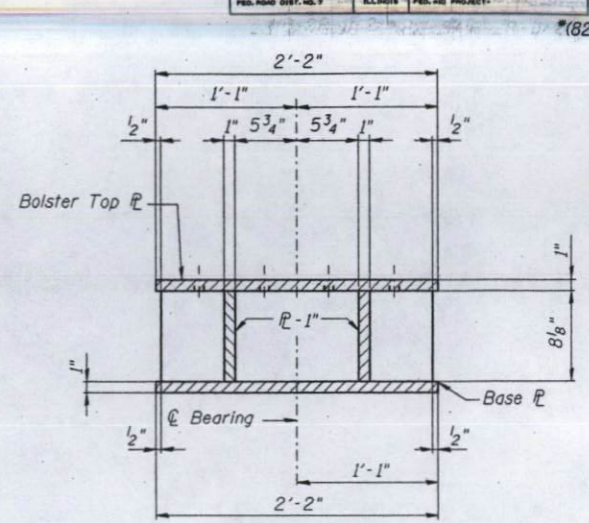


SECTION B-B



* Match existing bolt locations in flange of existing girder.

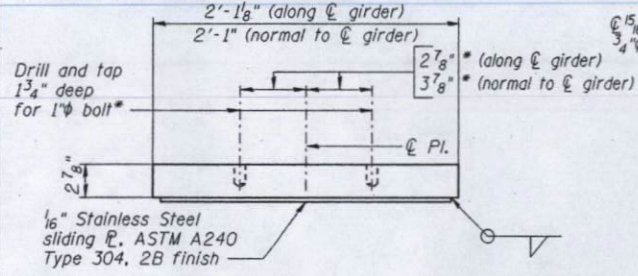

TOP BEARING ASSEMBLY

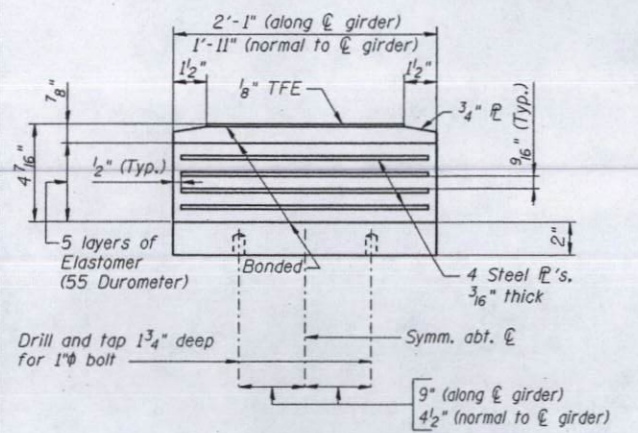


BOTTOM BEARING ASSEMBLY
TYPE II ELASTOMERIC BEARING ASSEMBLY

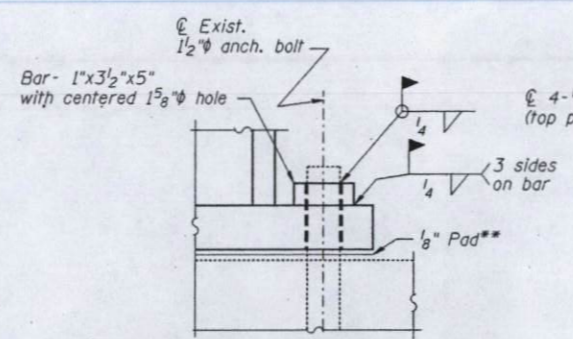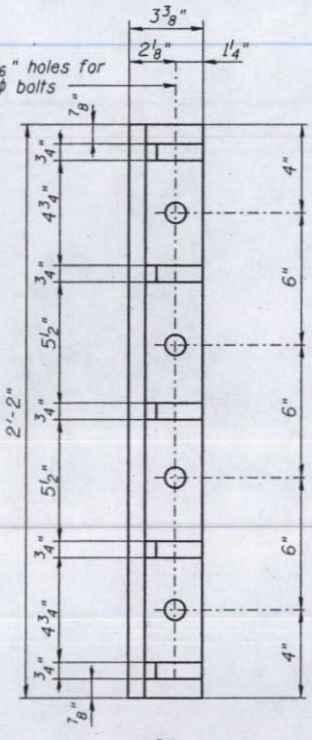


DETAIL 1


*** $\frac{1}{8}$ " Elastomeric Neoprene leveling pad according to Article 1052.02 of the Standard Specifications. Cost of mat included with bearing.

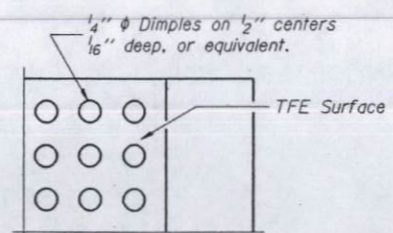

PLAN-TFE SURFACE

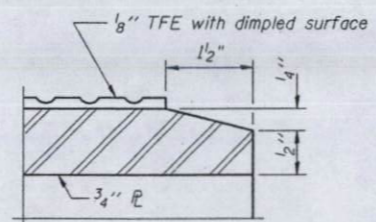

SECTION THRU TFE

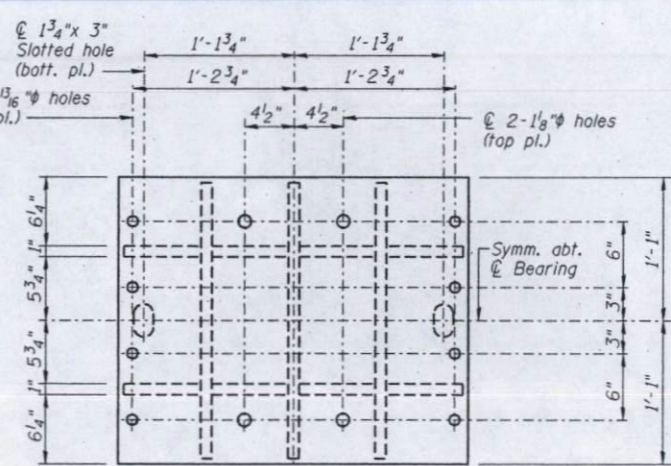

BOLSTER PLAN

Note: The $\frac{1}{8}$ " TFE sheet shall be bonded directly to the top steel plate with a two-component, medium viscosity epoxy resin, conforming to the requirements of the Federal Specification MMM-A-134, Type I. The bond agent shall be applied on the full area of the contact surfaces. Bonding of $\frac{1}{8}$ " TFE sheet during vulcanizing process will be permitted provided the process and method of adjusting assembly height is approved by the Engineer.

THEORETICAL JACKING LOADS

Pier	Jacking Load per Bearing	
	Dead Load	Live Load + Impact
E8	286 k	132 k

Note: The theoretical jacking loads listed above were taken from the design drawings for the original structure. See Special Provision "Jack and Remove Existing Bearings" for requirements and limitations for jacking the structure.

BILL OF MATERIAL

Item	Unit	Total
Elastomeric Bearing Assembly Type II	Each	2

NOTES

Minimum Jack Capacity:
1. The capacity of the jacks used to lift the bridge shall be at least 50% to 100% greater than the theoretical jacking loads shown in the table.

Bearing Demolition:
1. After jacking the structure off the bearing assembly, remove existing anchor bolt nuts and/or any welded plate washers that secure the existing bearing assembly to the anchor bolts. Existing anchor bolts are to remain intact to a minimum projection of 4" above top of concrete. Contractor shall verify soundness of existing anchor bolts prior to installation of new bearing assembly. Regrout in place if necessary.
2. All portions of existing bearing assemblies, including bolsters, sole plates and shims, shall be removed.

Bearing Installation:
1. Bearings to be replaced are for both girders at locations shown.
2. If the portion of the bottom flange above the new bearing is bent, the flange should be straightened using continuous pressure applied to both faces of the plate simultaneously before installation of the new bearing.
3. Top of column concrete shall be leveled using an epoxy grout prior to bearing installation.
4. Shim as required between top of leveled column and bottom of bolster.
5. Existing grounding wires to be re-attached after bearing replacement is complete.
6. Cost of Bolster, Beveled Plate, and Side Retainers shall be included in the Lump Sum of "Furnishing and Erecting Structural Steel".

REHABILITATION FOR FAI 55/70 COMPLEX
ROADWAY E - STRUCTURE NO. 082-0205
BEARINGS
(FAI-70) ST. CLAIR CO.


DESIGNED	D. James
CHECKED	M. Capron
DRAWN	M. King
CHECKED	M. Capron

PREPARED BY:
JACOBS CIVIL INC.
ST. LOUIS, MO


STATE OF ILLINOIS
DEPARTMENT OF TRANSPORTATION

ROUTE NO.	SECTION	COUNTY	JOB NO.	SHEET NO.
FAI-70		St. Clair	388 387	46 SHEETS
FED. ROAD DIST. NO. 7		ILLINOIS	FED. AID PROJECT	

082-3HVB-2R-D-2

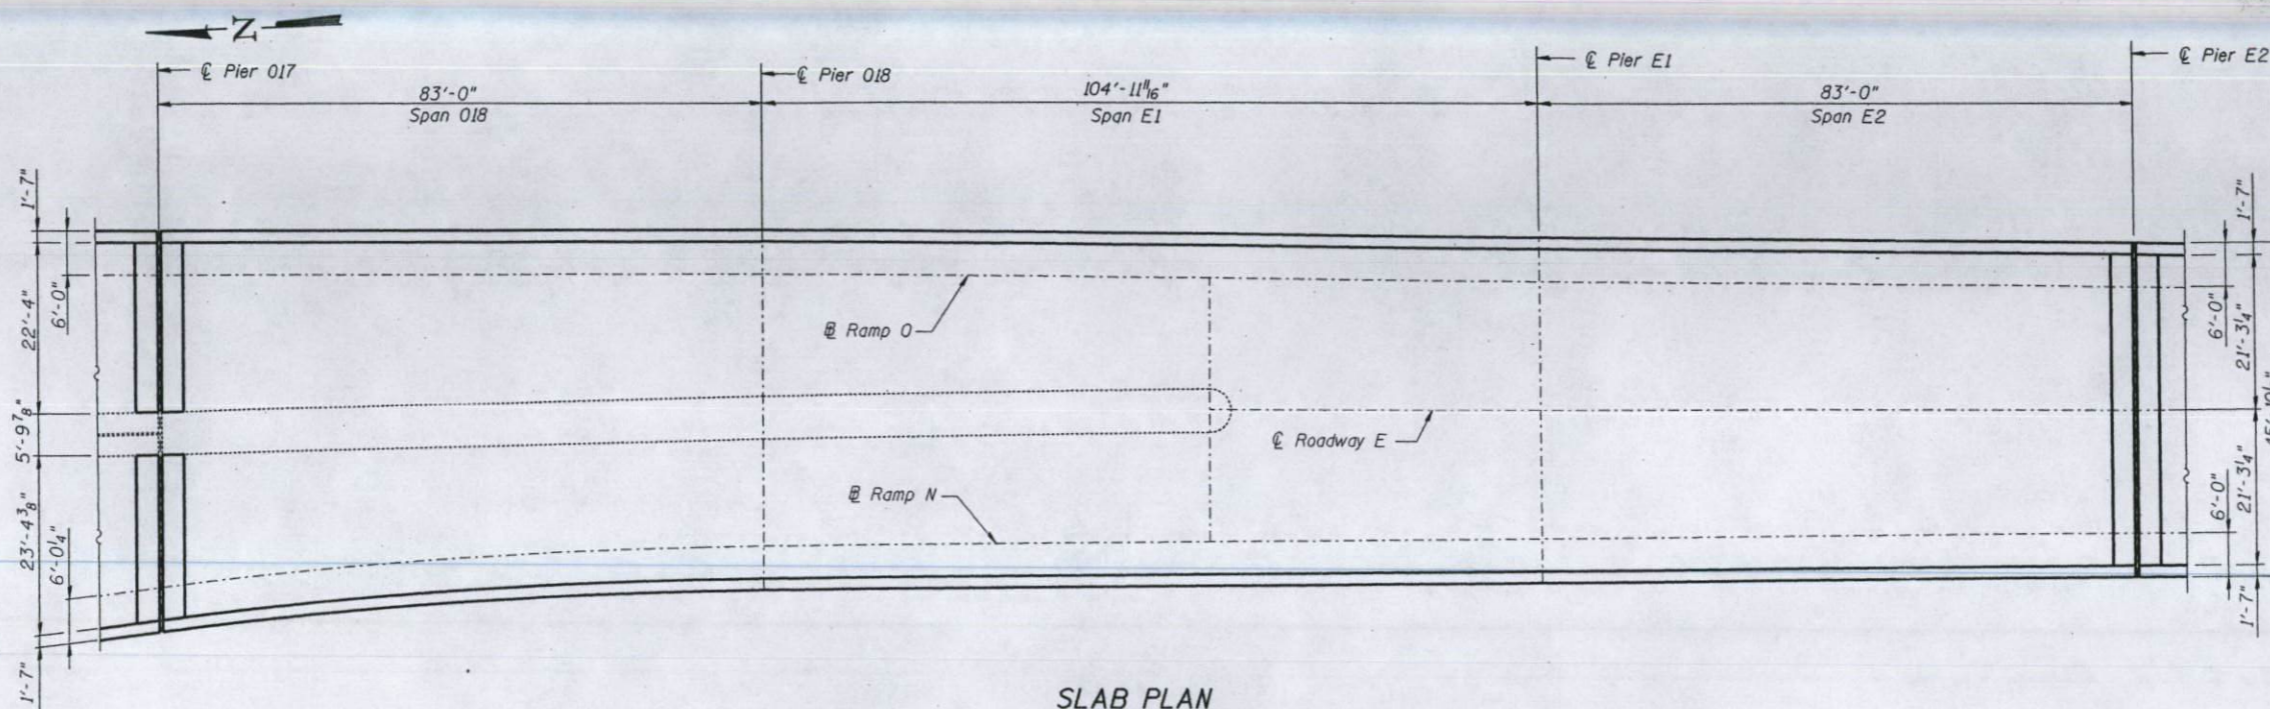

SLAB PLAN
SPANS 018E, E1 AND E2

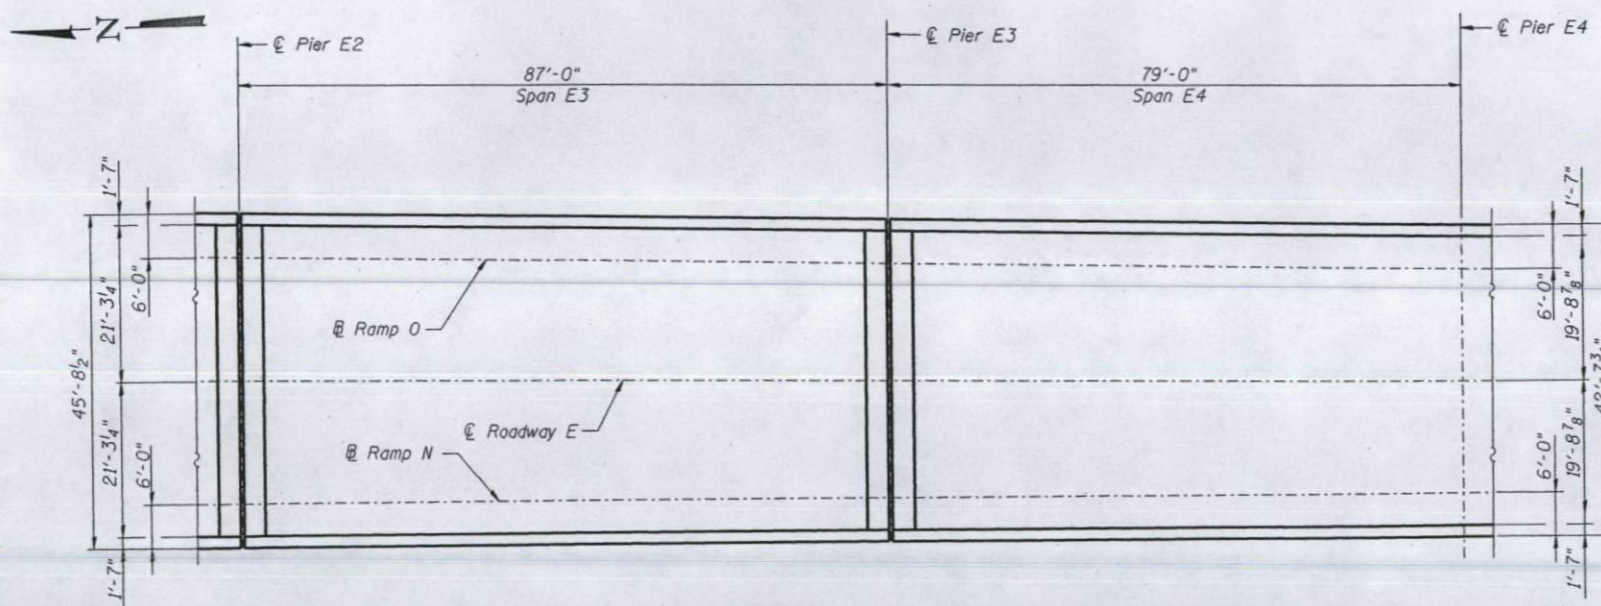

SLAB PLAN
SPANS E3 AND E4

DESIGNED
CHECKED
DRAWN
CHECKED

PREPARED BY:
JACOBS CIVIL INC.
ST. LOUIS, MO


REHABILITATION FOR FAI 55/70 COMPLEX
ROADWAY E - STRUCTURE NO. 082-0205
AS-BUILT DECK REPAIR LOCATIONS
SPANS 018 AND E1 THRU E4

(FAI-70) ST. CLAIR CO.


STATE OF ILLINOIS
DEPARTMENT OF TRANSPORTATION

ROUTE NO.	SECTION	COUNTY	POST MILE	POST MILE	SHEET NO. 46
FAI-70		St. Clair	388	388	46 SHEETS
FED. ROAD DIST. NO.	SLAB NO.	FED. PROJ. NO.			

082-3HVB-2R-1-2

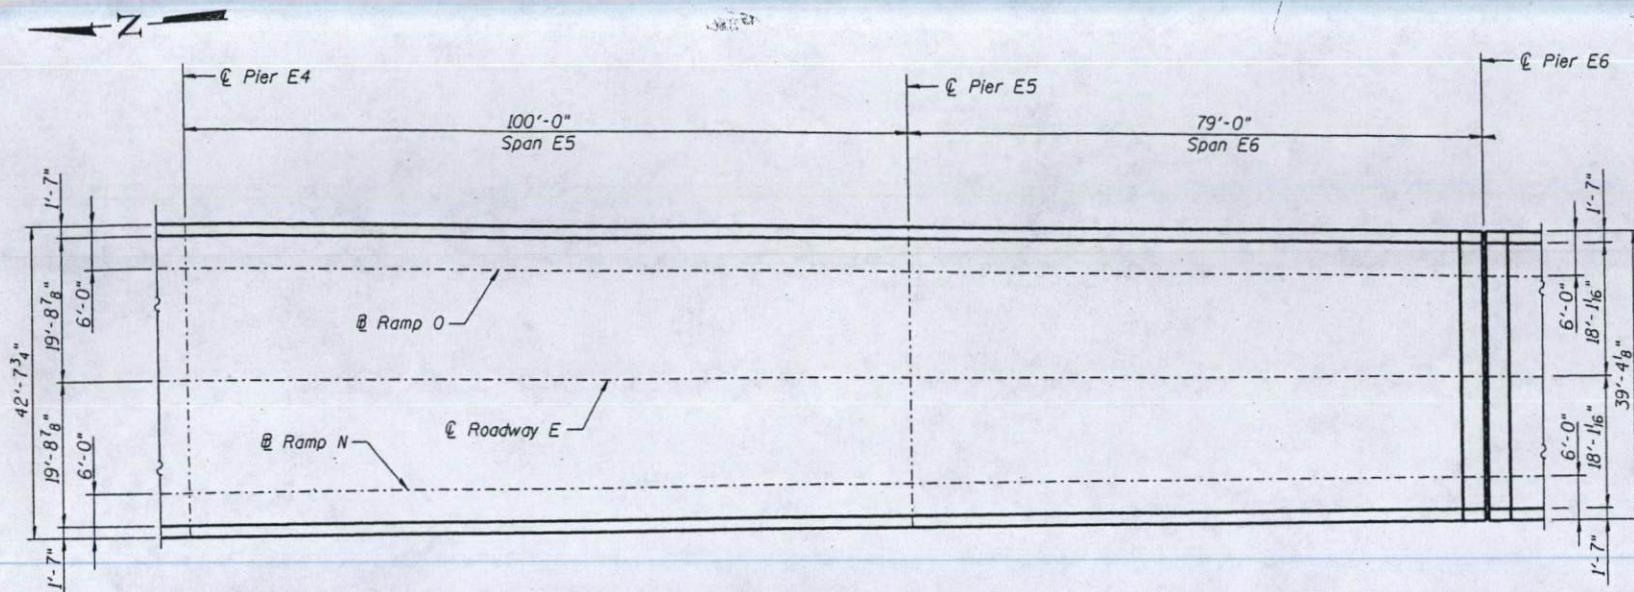

SLAB PLAN
SPANS E5 AND E6

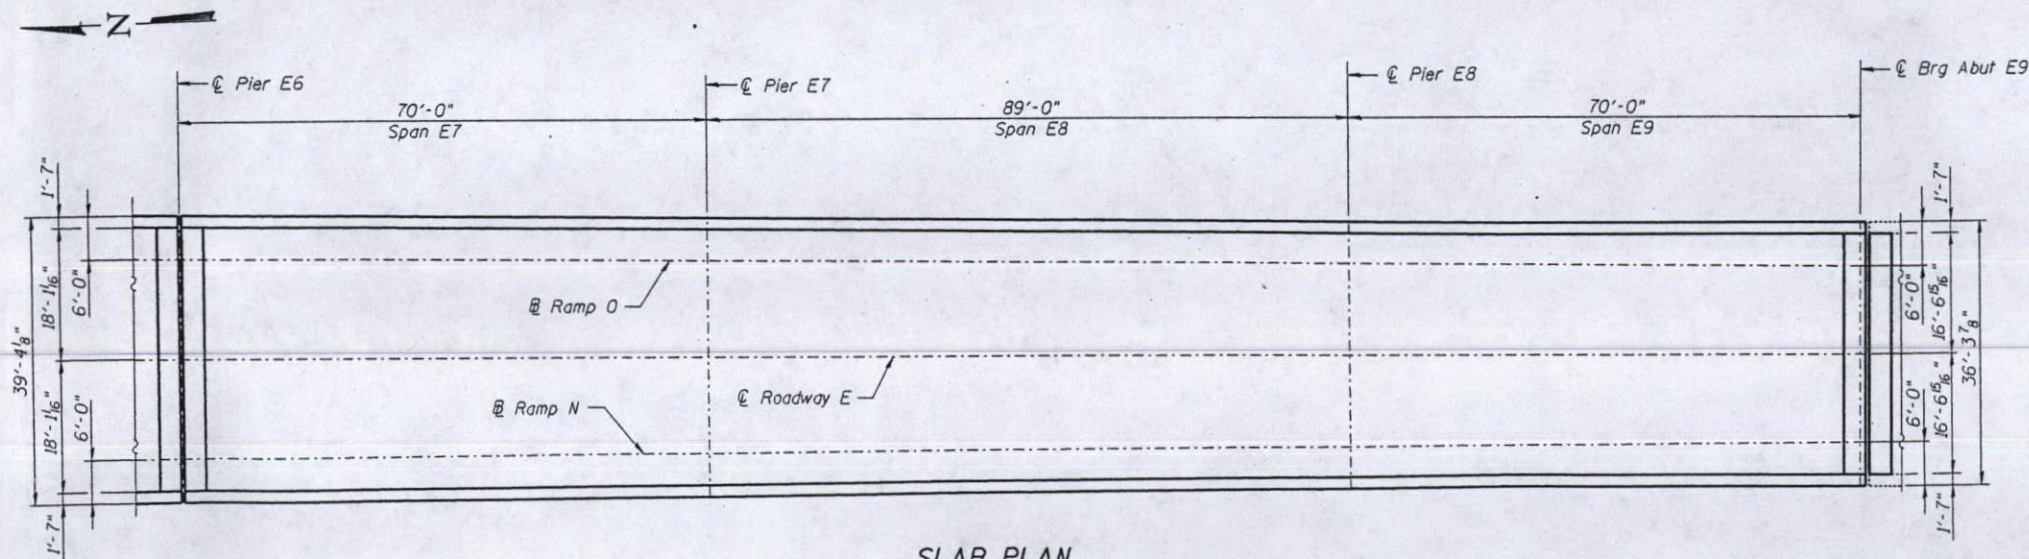

SLAB PLAN
SPANS E7 THRU E9

DESIGNED
CHECKED
DRAWN
CHECKED

PREPARED BY:
JACOBS CIVIL INC.
ST. LOUIS, MO

REHABILITATION FOR FAI 55/70 COMPLEX
ROADWAY E - STRUCTURE NO. 082-0205
AS-BUILT DECK REPAIR LOCATIONS
SPANS E5 THRU E9

(FAI-70) ST. CLAIR CO.

STATE OF ILLINOIS
DEPARTMENT OF TRANSPORTATION
DIVISION OF HIGHWAYS

PLANS FOR PROPOSED
FEDERAL AID HIGHWAY

FAI ROUTE 70

SECTION (82-3HVB-1, 2, 3) D, RS


ST CLAIR COUNTY

C-98-109-96

FAI ROUTE	SECTION	COUNTY	TOTAL SHEETS	SHEET NO.
70		ST CLAIR	11	1

FED. ROAD DIST. NO. D ILLINOIS FED. AID PROJECT
* (82-3HVB-1, 2, 3) D, RS

D-98-094-96

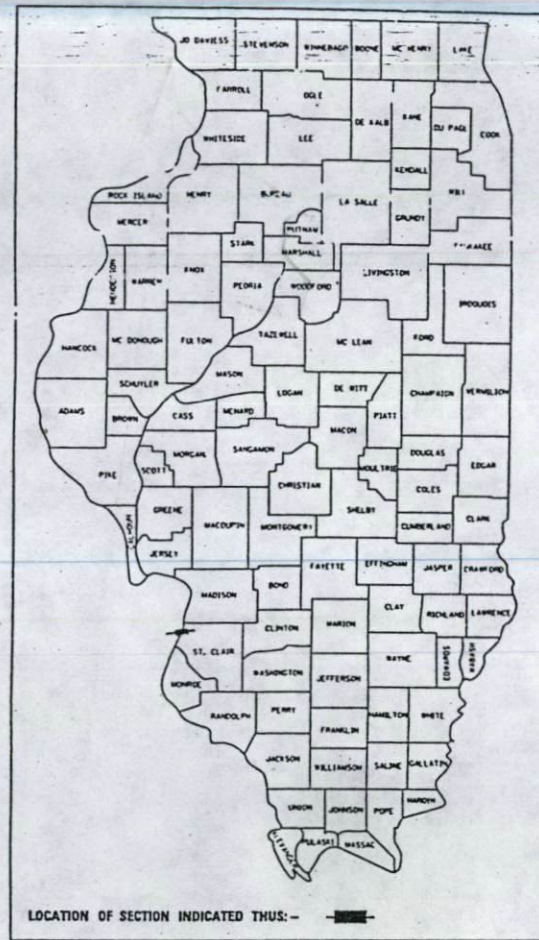

- INDEX OF SHEETS**
1. TITLE SHEET
 2. SUMMARY OF QUANTITIES
 - 3-4. SCHEDULE OF QUANTITIES
 5. TYPICAL SECTIONS
 - 6.-11. PLAN VIEW

STANDARDS


- 2298-12
- 2397-2
- 2316-16
- 2396-1

Sec. (82-3HVB-1, 2, 3) D, RS

- 82-3HVB-R-1
- 82-3HVB-1R
- 82-3HVB-R-5
- 82-3HVB-R-4
- 82-3HVB-R-3
- 82-3HVB-R-2'
- 82-3HVB-2

MICROFILMED _____
REEL NUMBER _____
AWARDED _____
RESIDENT ENGINEER _____
AS BUILT CHANGES WERE MADE
ON THE FOLLOWING SHEETS

*For Sec. 82-3HVB-1 see S.N. 0141
82-3HVB-2R-1 see S.N. 0201
82-3HVB-5-1 see S.N. 0144
82-(3,4) DRS see S.N. 0142*

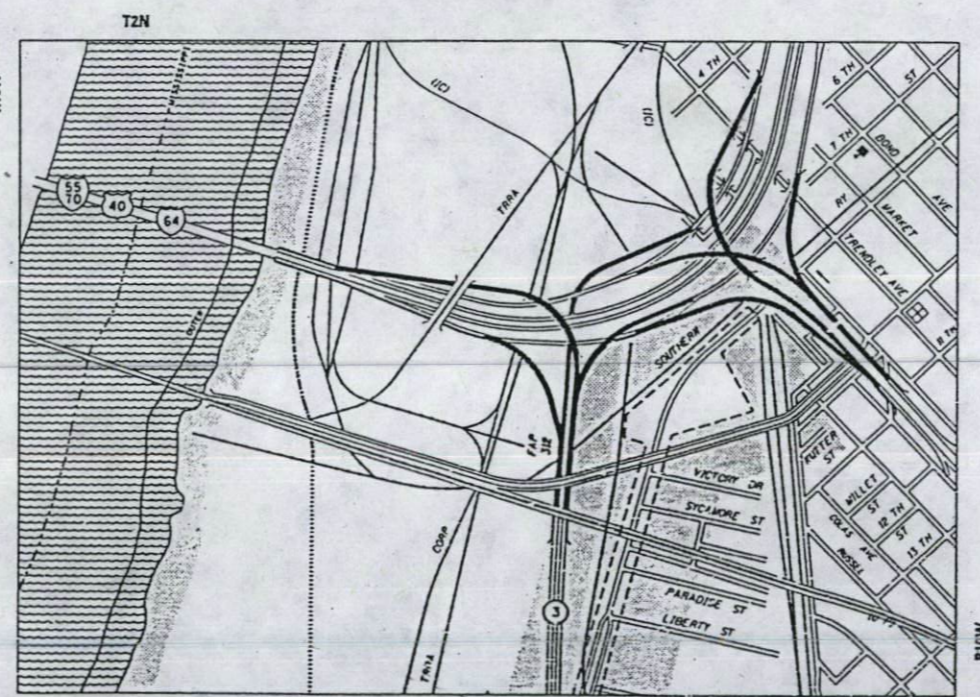

PROJECT LOCATION

Reels 8-224
180 M
8-159
8-151
8-147
8-136
8-76

STATE OF ILLINOIS
DEPARTMENT OF TRANSPORTATION
DIVISION OF HIGHWAYS

SUBMITTED 6/27 1996
John K... DISTRICT ENGINEER

PASSED August 2 1996
ENGINEER OF DESIGN AND ENVIRONMENT

APPROVED August 2 1996
DIRECTOR, DIVISION OF

SN 082-0205 REEL 8-224

J.U.L.E.
JOINT UTILITY LOCATION INFORMATION FOR EXCAVATION
1-800-892-0123

CONTRACT NO. 76003

PROJECT ENGINEER; WILLIAM ULIVI (618) 346-3180
SQUAD LEADER; STEVE JINES (618) 346-3194

082-0205

TYPICAL SECTION "A"

ROADWAY/RAMP	STR. NUMBER	PIER/ABUT.	STATION TO STATION	BIT. CONC. SURF. REM. SQ. METER	BIT. MATLS. PRIME CT. METRIC TON	BIT. CONC. SURF. CSE., MIX D. CL. 1, TY 1 METRIC TON
RAMP W/ RAMP F	082-0145.0204	M-7 TO F-1	1+90.29 TO 1+887.02	4488.50	1.57	375.78
RAMP E/ RAMP D	082-0205.0143	E-7 TO D-11	0+662.84 TO 0+729.57	3538.10	1.24	296.71
RAMP O	082-0201	O-9 TO O-10	0+282.25 TO 0+300.07	1353.50	0.55	132.59
RAMP P	082-0203	P-12 TO P-1	1+667.87 TO 2+004.06	2255.83	0.79	188.86
RAMP D	082-0144	D-33 TO D-46	2+488.08 TO 2+833.13	1577.57	0.55	132.07
RAMP A	082-0141	A-25 TO A-42	2+223.40 TO 2+760.88	3606.49	1.26	301.94
RAMP T	082-0146	T-35 TO T-6	0+190.18 TO 0+362.25	1154.59	0.40	96.66
RAMP S	082-0142.0144	S-1 TO D-39	0+122.22 TO 0+778.15	4401.29	1.54	368.48
RAMP N	082-0202	O-17 TO N-4	0+729.08 TO 0+651.31	820.16	0.29	68.66
TOTALS				23426.22	8.19	1961.25

PARTIAL DEPTH REPAIR SCHEDULE

SPAN	SIZE (IN METERS)	BITUMINOUS CONCRETE SURFACE REMOVAL (50MM) SQ. METER	BITUMINOUS MATERIALS PRIME COAT METRIC TON	LEVELING BINDER HAND METHOD TYPE I (50 MM) METRIC TON
D-11 TO N-1	12X6	72	0.03	0.50
N-1 TO N-2	3X3	18	0.01	2.00
	2X2	4	0.01	0.50
	2X6	12	0.01	1.50
N-2 TO N-3	2X2	4	0.01	0.50
	2X2	4	0.01	0.50
	2X2	4	0.01	0.50
N-3 TO N-4	2X23	46	0.02	5.50
	2X23	46	0.02	5.50
N-4 TO N-5	2X28	56	0.02	6.50
	2X28	56	0.02	6.50
P-14 TO P-15	5X26	130	0.05	15.50
TOTALS		452	0.22	53.50

TYPICAL SECTION "B"


ROADWAY/RAMP	STR. NUMBER	PIER/ABUT.	STATION TO STATION	BIT. SURF. REM. (COLD MILL) (CHECK SHEET #12) SQ. METER	SHEET WATERPROOF MEM. SYSTEM SQ. METER	BIT. CONC. SURF. CSE., MIX D. CL. 1, TY 1 METRIC TON
RAMP E	082-0205	E-2 TO E-9	0+993.91 TO 1+109.57	1178.68	1178.68	126.87
RAMP N	082-0202	D-11 TO N-4	0+608.99 TO 0+729.08	549.05	549.05	59.10
RAMP M	082-0145.0141	A-1 TO M-7	1+510.45 TO 1+887.02	2526.78	2526.78	271.98
RAMP P	082-0203	P-12 TO P-15	2+004.06 TO 2+095.96	616.65	616.65	66.38
RAMP S	082-0142	G-12 TO S-1	0+099.91 TO 0+122.22	149.70	149.70	16.11
RAMP A	082-0141	A-40 TO A-46	2+703.27 TO 2+859.73	1239.16	1239.16	133.38
RAMP D	082-0144	D-40 TO D-46	2+689.25 TO 2+833.13	657.80	657.80	70.80
TOTALS				6917.82	6917.82	744.62

The following quantities are not included on the schedules but are used for the removal and replacement of the 15.24 m bituminous tapers at abutments O-11, O-10, A-46, and D-46.

Bituminous Concrete Surface Course, Mix D, Class I, Type 1 - 40.08 Metric Tons
 Bituminous Materials Prime Coat - 0.18 Metric Tons
 Bituminous Concrete Surface Removal - 515.60 Sq. Meters

JOINT REPAIR SCHEDULE


JOINT	POLYMER CONCRETE CU. METER	SILICONE JOINT SEALER (40MM) METER
N-1	0.102	6.71
O-17	0.102	6.71
E-2	0.056	3.66
E-3	0.056	3.66
E-6	0.051	3.36
E-9	0.141	9.24
P-4	0.102	6.71
P-14	0.102	6.71
S-21	0.102	6.71
T-6	0.102	6.71
TOTALS	0.92	60.18

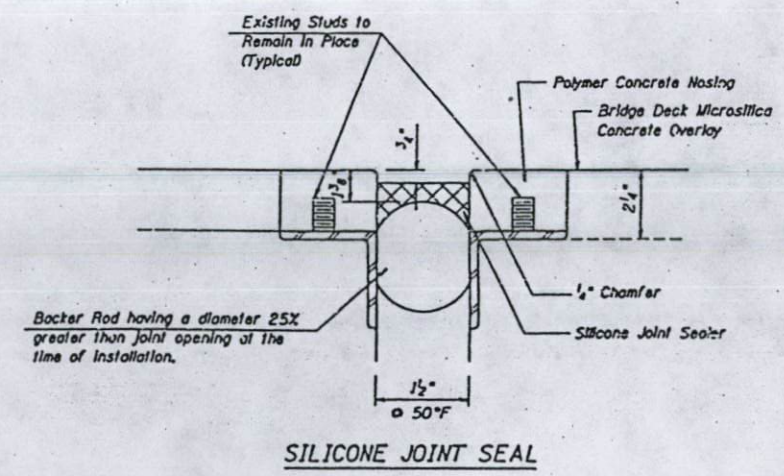

ILLINOIS DEPARTMENT OF TRANSPORTATION
TYPICAL SECTION, JOINT REPAIR AND PARTIAL DEPTH REPAIR SCHEDULES
 F.A.I. ROUTE TO SECTION (82-3HV-B-1, 2, 3) D.R.S ST. CLAIR COUNTY


PLAN
 SHEET NO. 1
 DATE: 11/15/00
 DRAWN BY: J. J. BROWN
 CHECKED BY: J. J. BROWN
 APPROVED BY: J. J. BROWN

F.A.I. DIST.	SECTION	COUNTY	HWY. NO.	SHEET NO.
70	*	ST. CLAIR	11	5
STA.	TO STA.			
EXISTING CONDITIONS:				
* (82-3HWB-1, 2, 3) D.R.S				

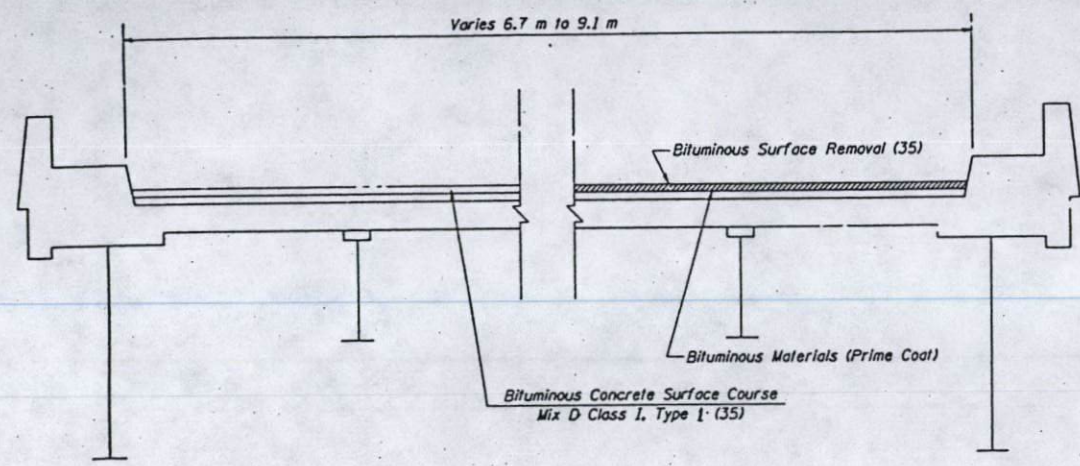


TYPICAL SECTION A

Area Shown on Plan View

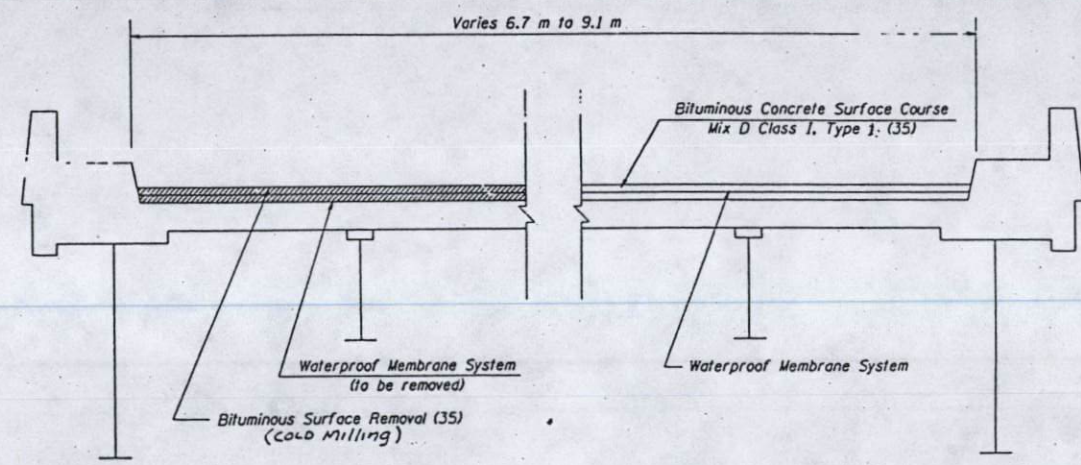

TYPICAL SECTION B

Area Shown on Plan View

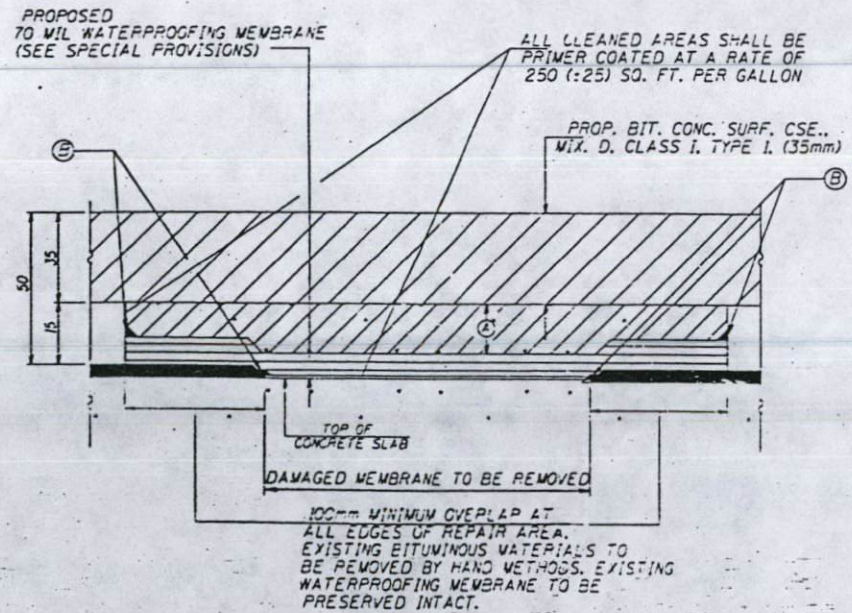

SECTION
WATERPROOFING MEMBRANE REPAIR

- (A) AFTER COLD MILLING, EXISTING BITUMINOUS MATERIAL TO BE REMOVED TO PERMIT REPAIR OF MEMBRANE. BITUMINOUS CONCRETE SURFACE COURSE, MIXTURE D, CLASS I SHALL BE PLACED PRIOR TO PLACEMENT OF NEW BITUMINOUS CONCRETE WEARING SURFACE. (COST TO BE INCLUDED IN THE CONTRACT UNIT PRICE FOR WATERPROOFING MEMBRANE REPAIR). SEE SPECIAL PROVISIONS FOR TEMPERATURE AND DENSITY REQUIREMENTS FOR INITIAL LIFT OF BITUMINOUS SURFACE COURSE OVER REPAIR AREAS.
- (B) ALL PERIMETER EDGES SHALL RECEIVE A MINIMUM 5mm BEAD OF 150 m MASTIC.

EXISTING WEARING SURFACE CONSISTS OF A 13mm ASPHALT SAND SEAL LAYER AND A 38mm BITUMINOUS SURFACE COURSE. PROPOSED COLDMILLING WILL REMOVE 35mm UNIFORMLY ON THE ENTIRE BRIDGE DECK.


ILLINOIS DEPARTMENT OF TRANS

TYPICAL SECTION


F.A.I. ROUTE 70
SECTION (82-3HWB-1, 2, 3) D.R.S
ST. CLAIR COUNTY

FBI	DISTRICT	COUNTY	SECTION
70	St. Clair		11

4 (52-3446-1, 2, 3) D, FS

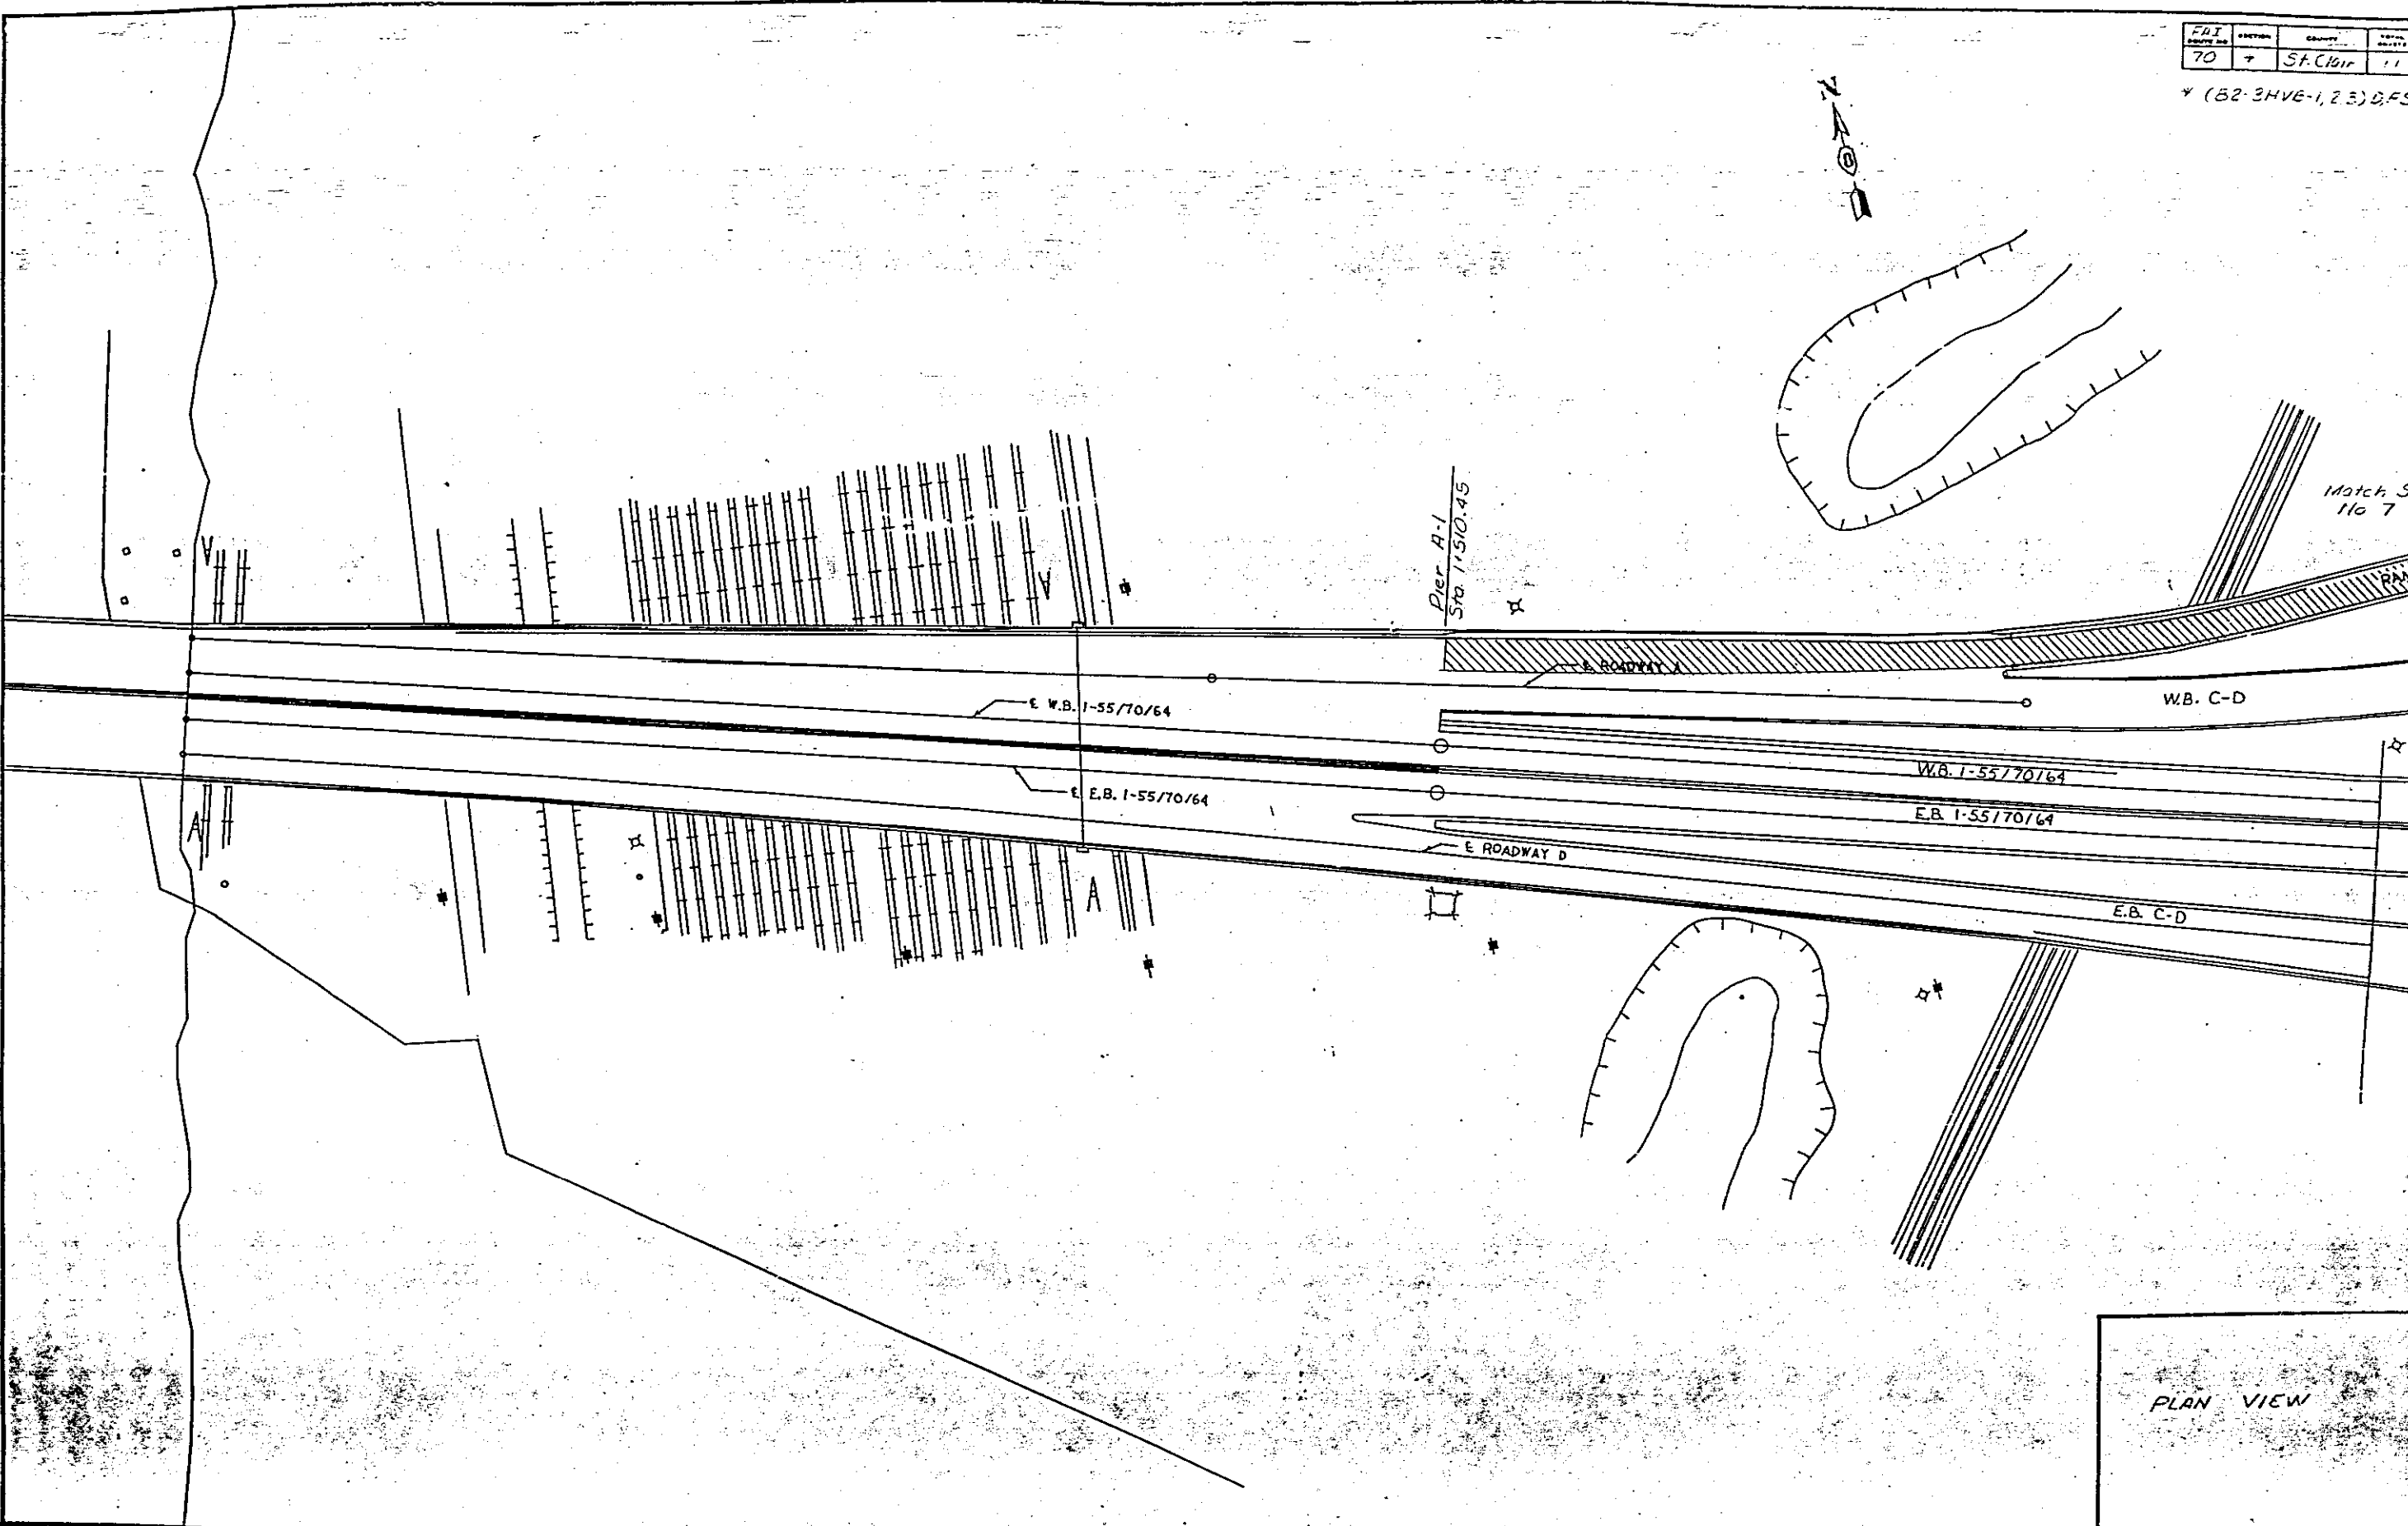


PLAN VIEW

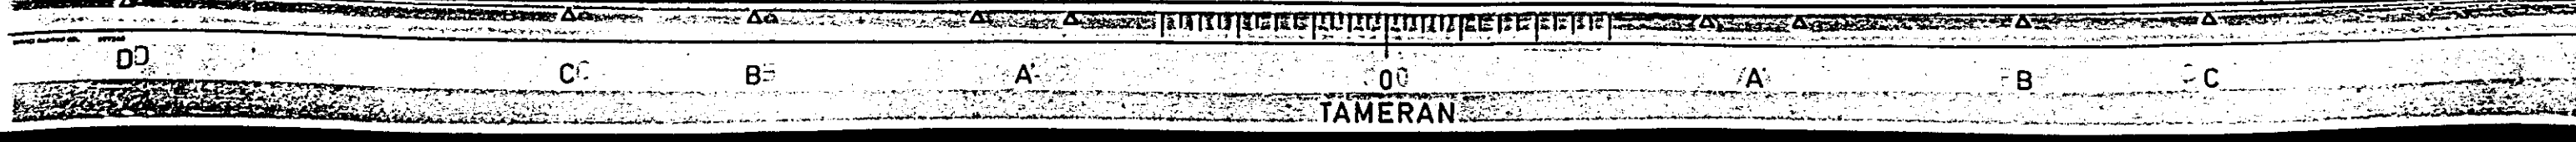

PAI	DATE	REVISION	BY	CHKD
70			ST. CLAR	11

(R2-3-10-123)ORS

MATCH SHEET NO. 11

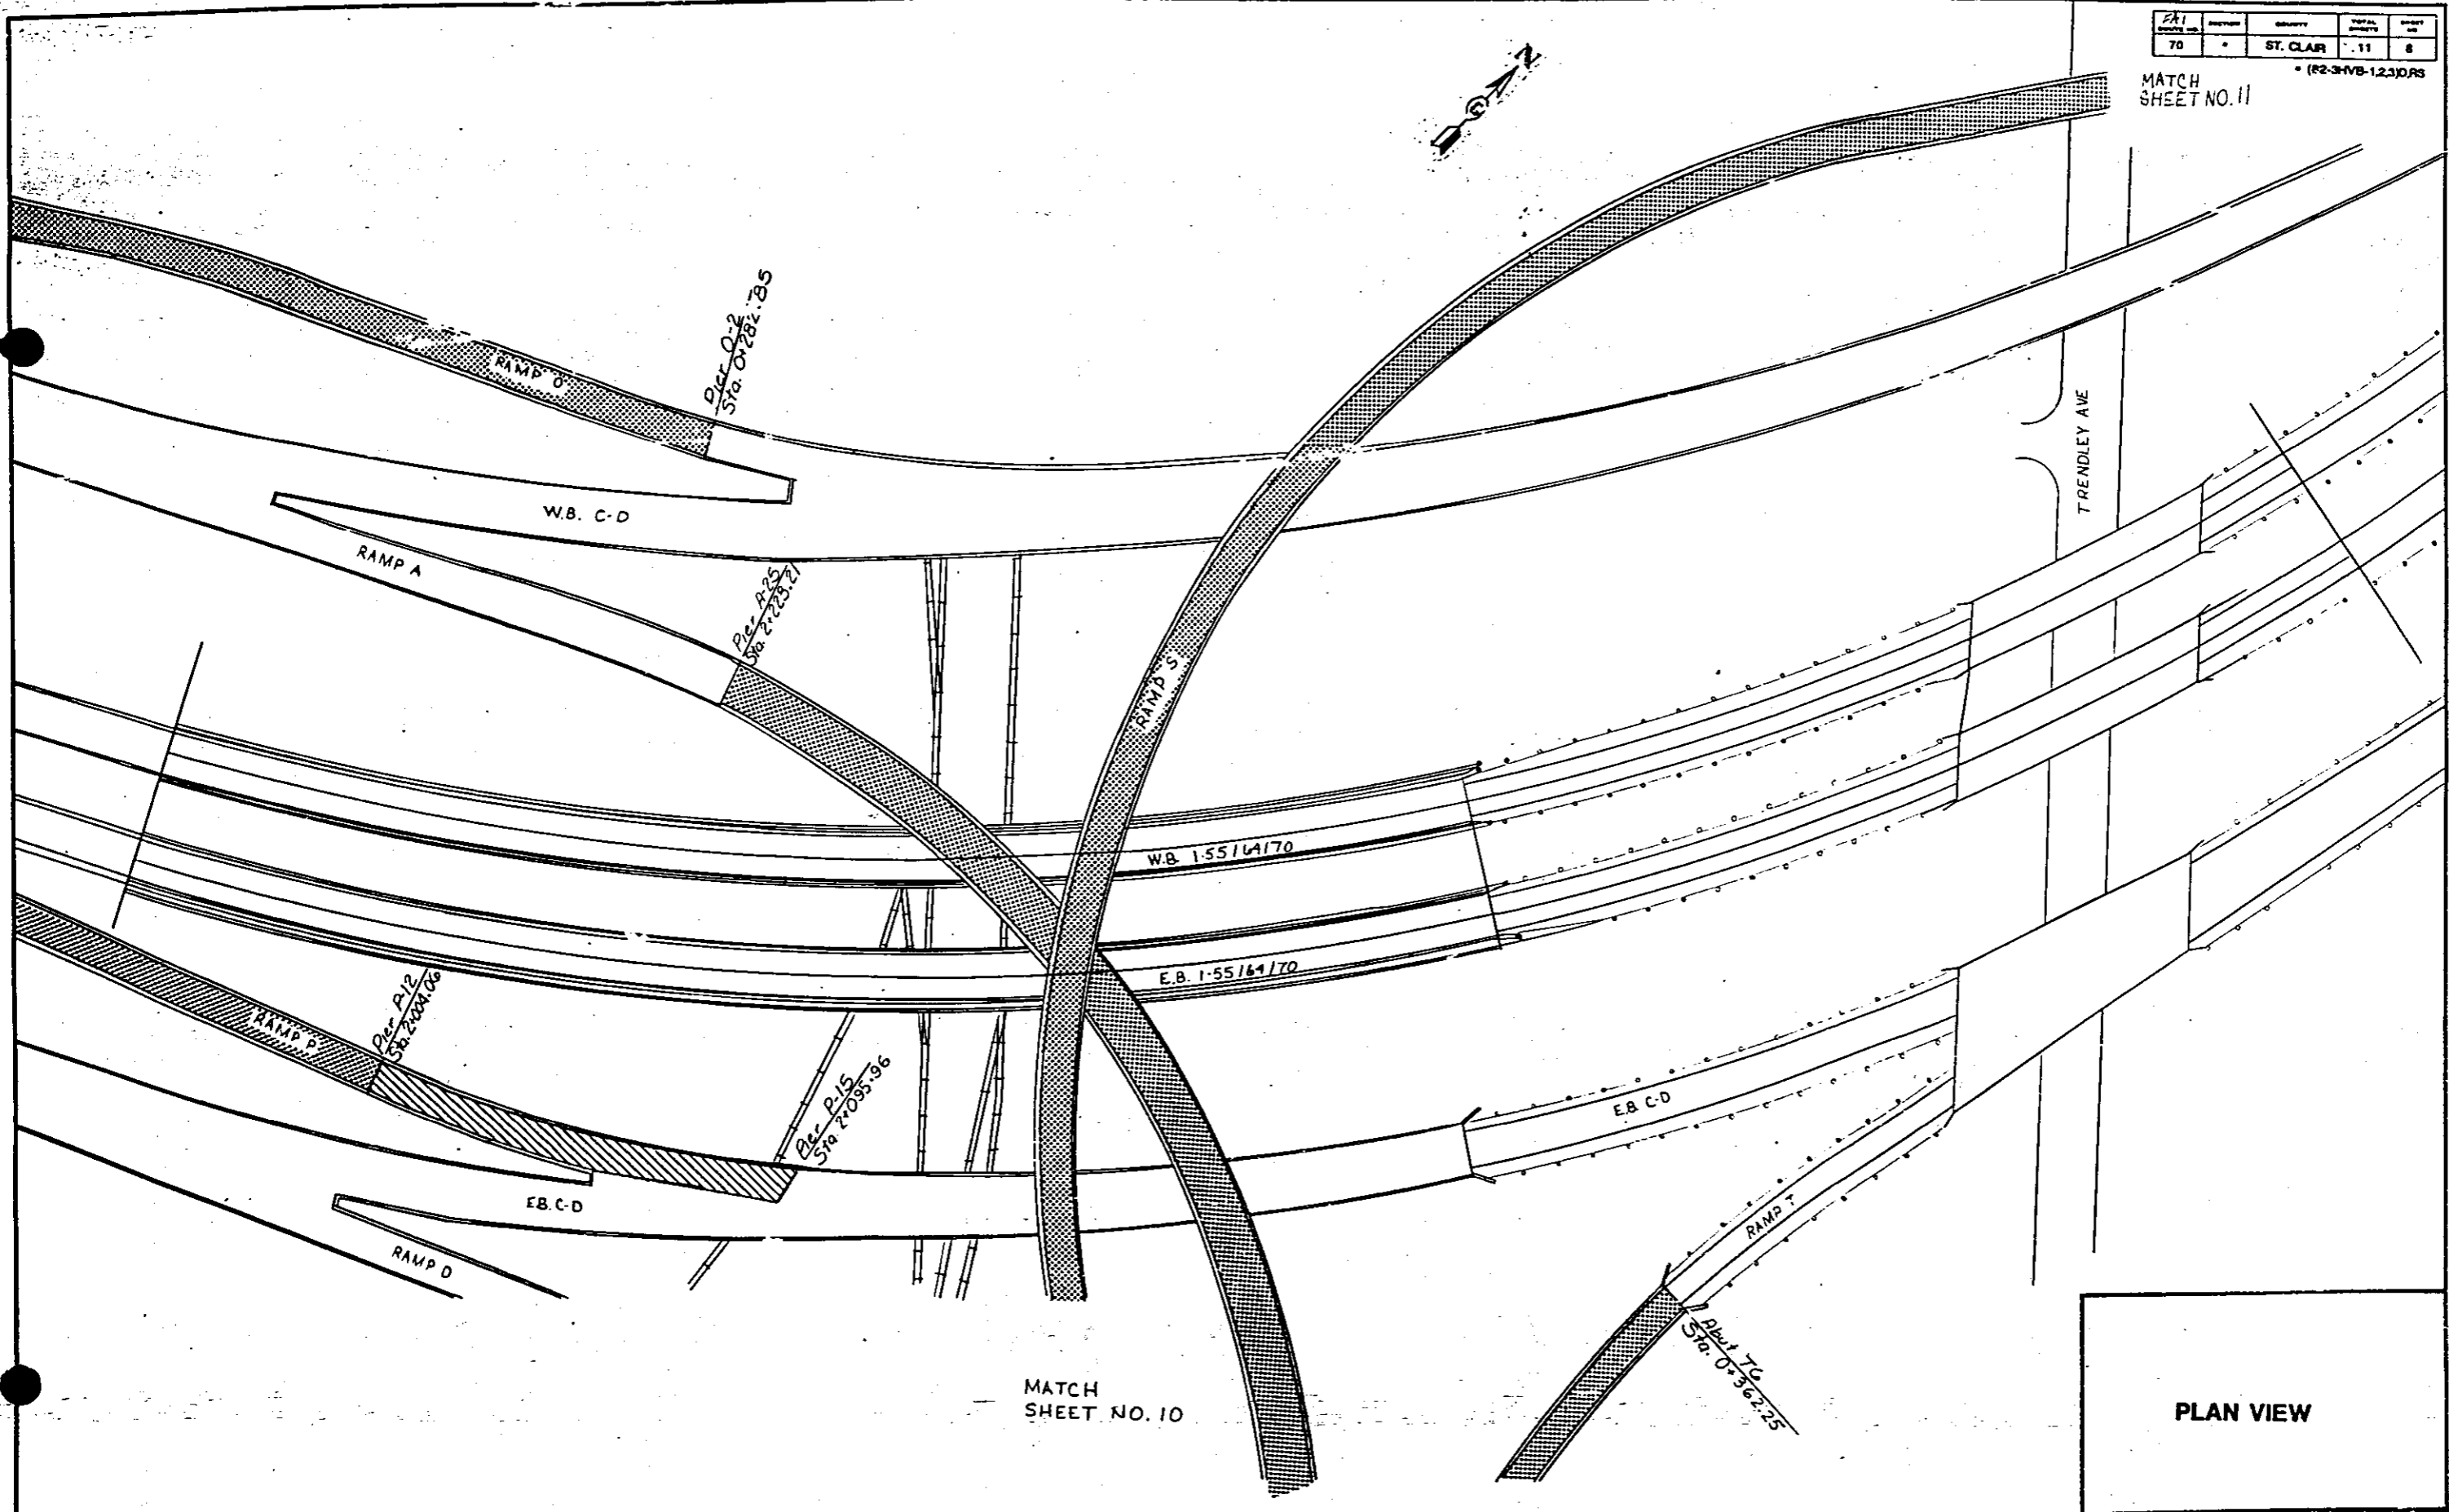

PLAN VIEW


00 CC BB AA 00 AAA BBB EC 00

FAI	DISTRICT	COUNTY	TOTAL SHEETS	SHEET NO.
70		ST. CLAR	11	9

(82-34VB-123)ORS



MATCH SHEET NO. 7

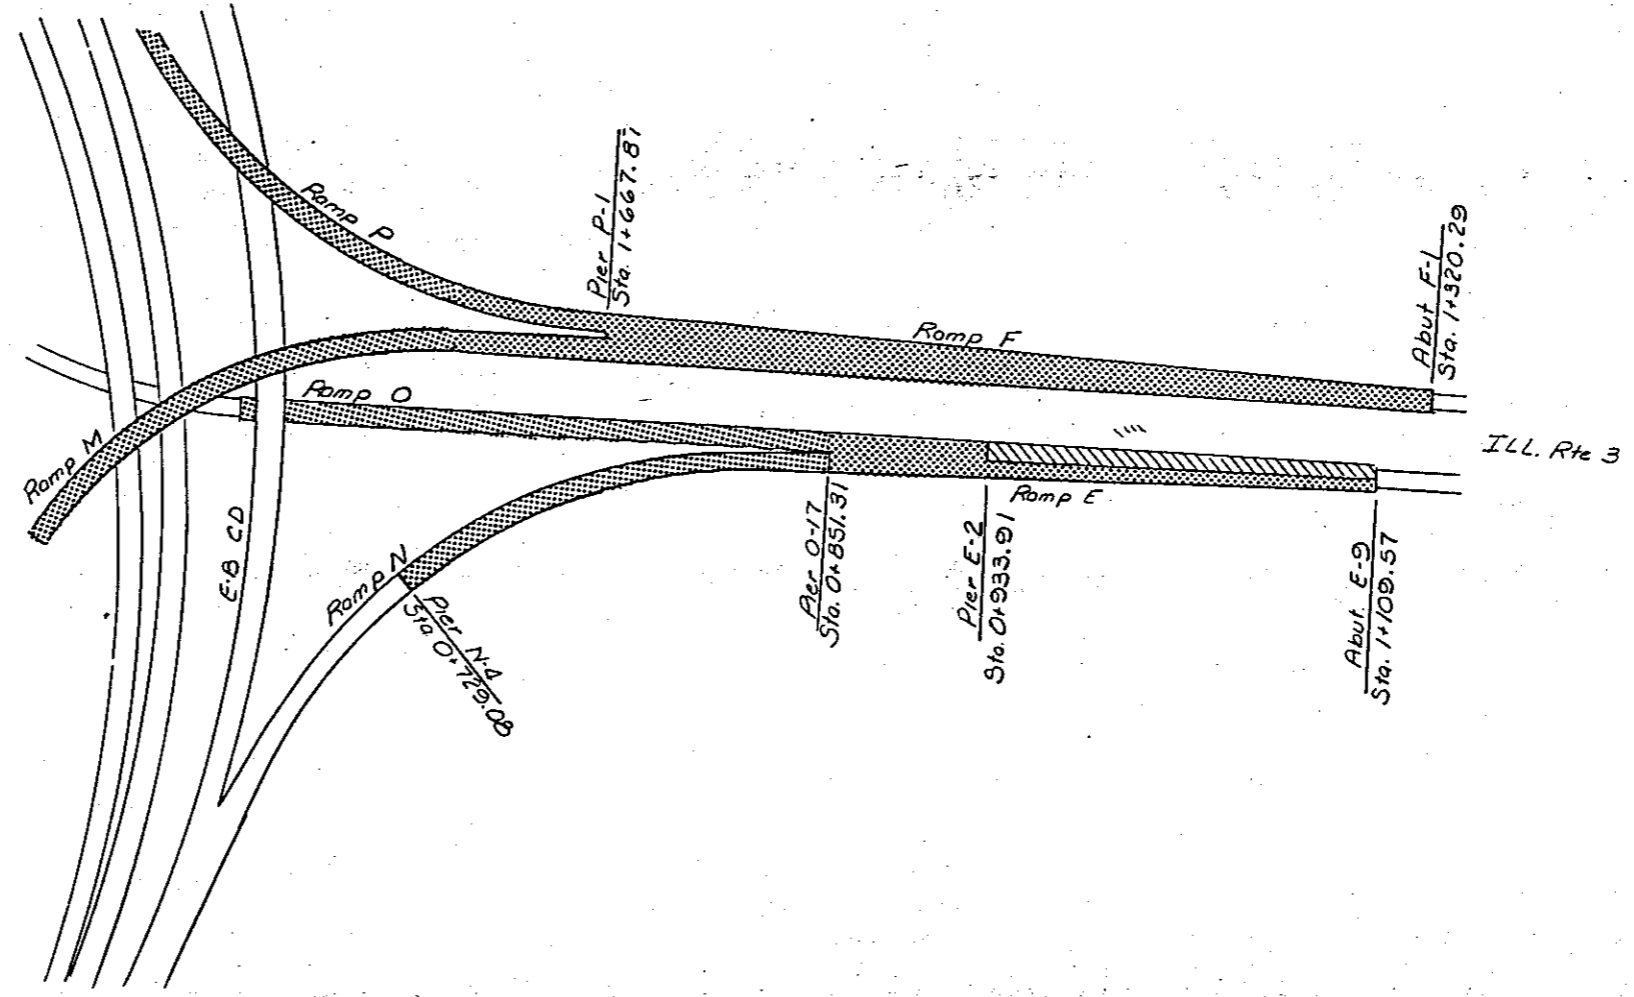


PLAN VIEW



FBI	SECTION	COUNTY	...
70	*	St. Clair	...
* (62-3HV6-1,2,3)			


Match Sheet No. 8

Match Sheet No. 6

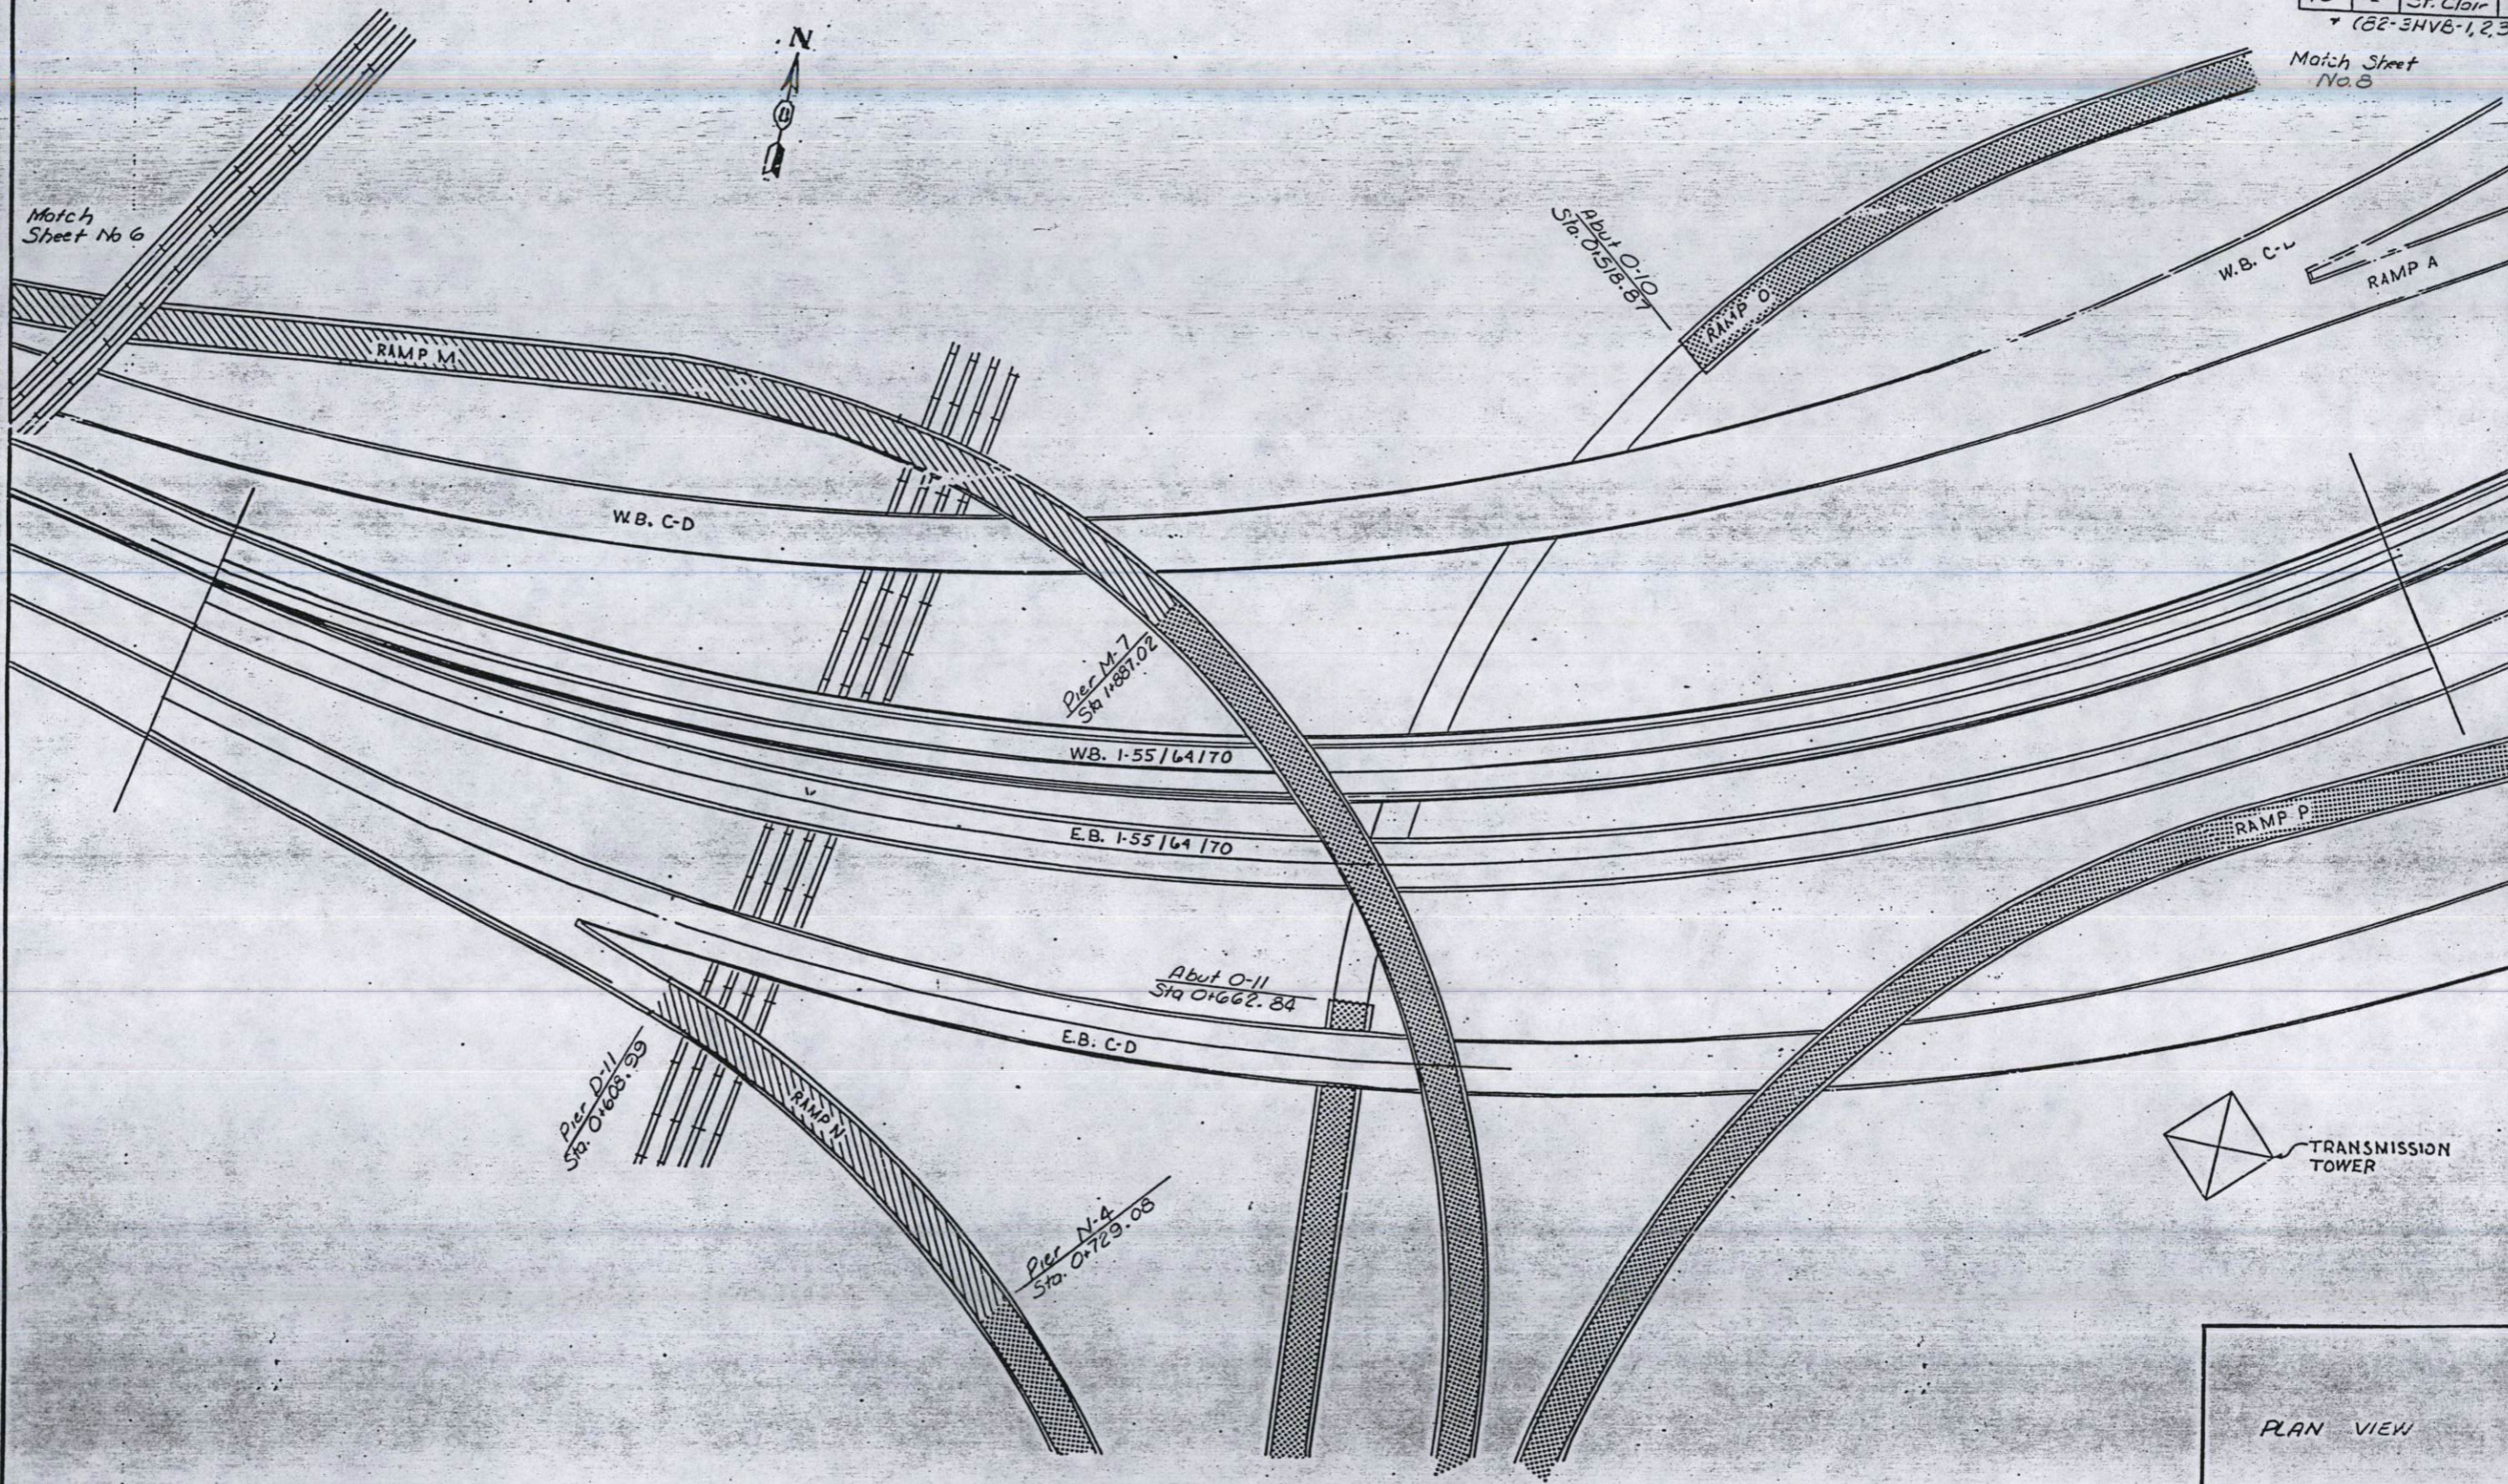

PLAN VIEW

Match Sheet No. 9

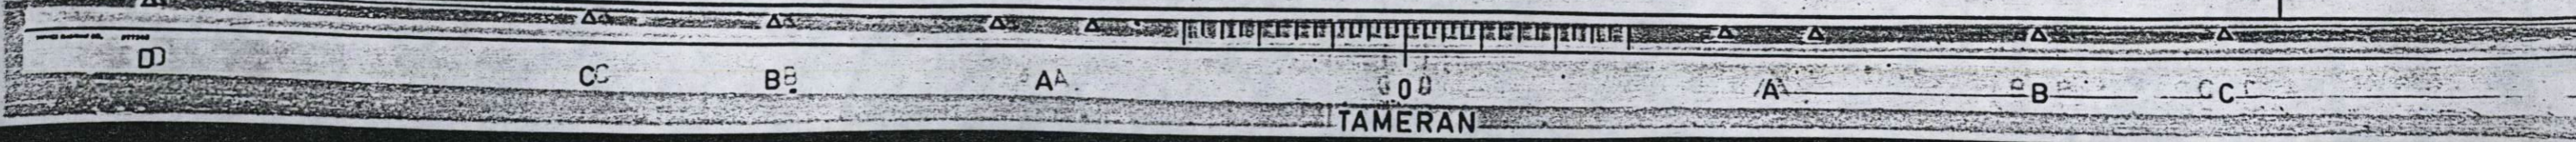


PROJECT NO.	DISTRICT	COUNTY	TOTAL SHEETS	SHEET NO.
70	*	ST. CLAIR	11	10


(82-31VB-123)D.RS



MATCH SHEET NO. 8

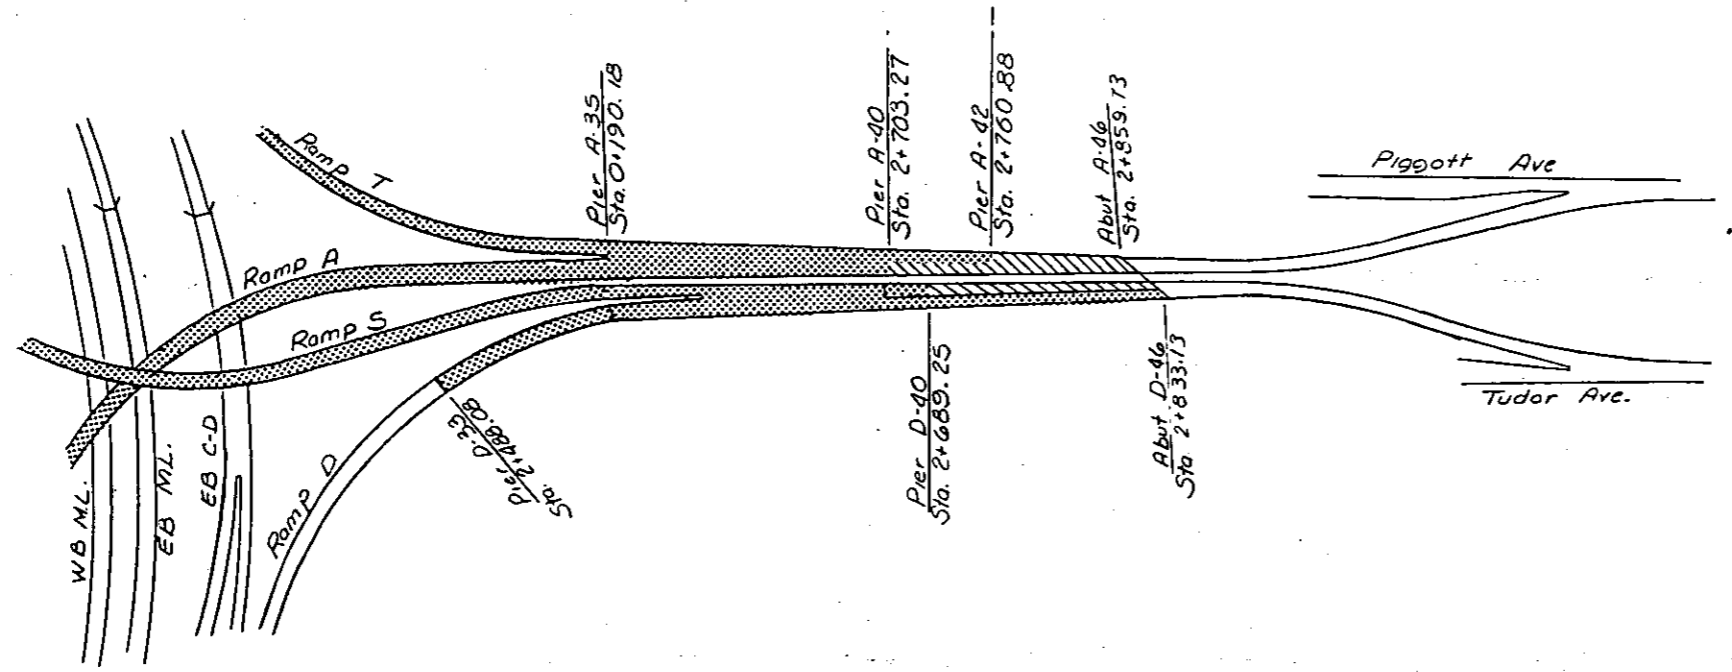



PLAN VIEW

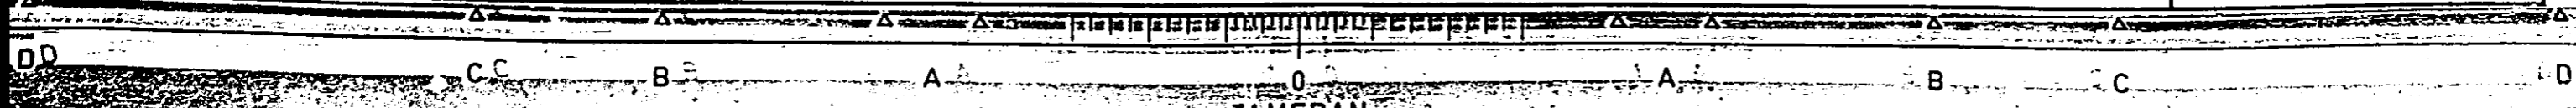


FAI	SECTION	COUNTY	TOTAL SHEETS	SHEET NO.
70	*	ST. CLAIR	11	11

* (82-3HVB-1,2,3)D,RS

MATCH SHEET NO. 8

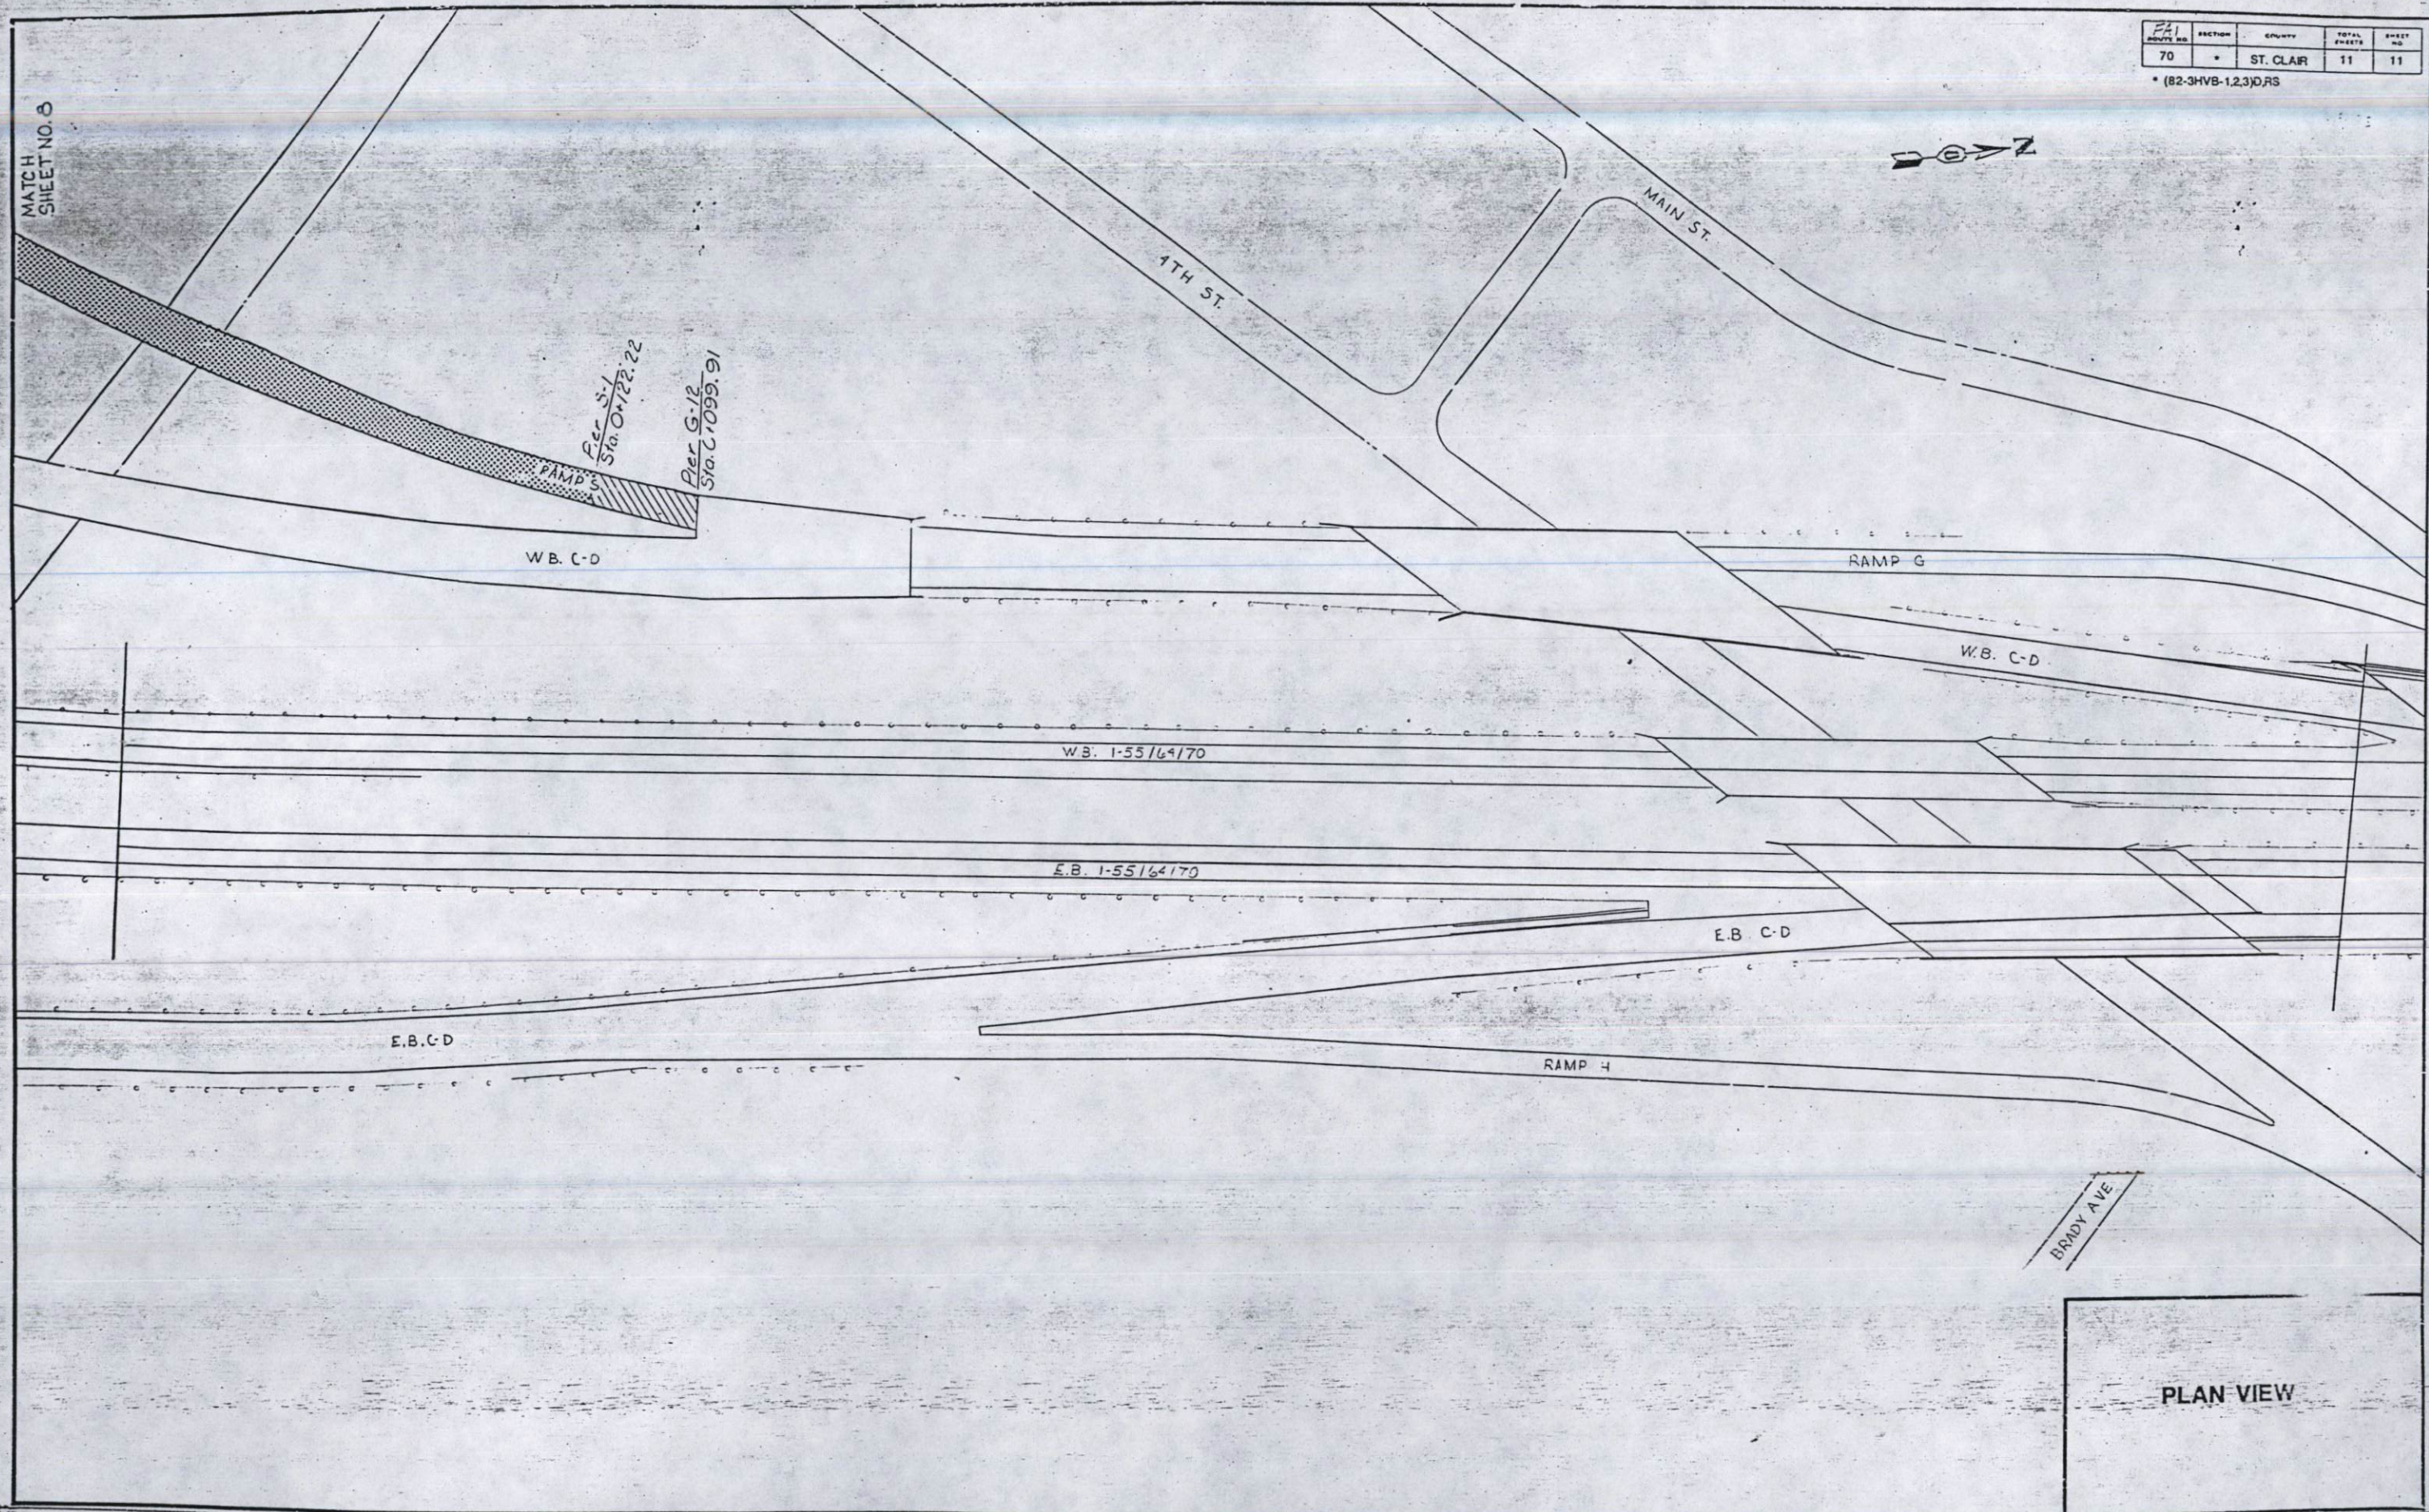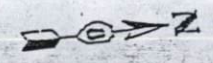


PLAN VIEW

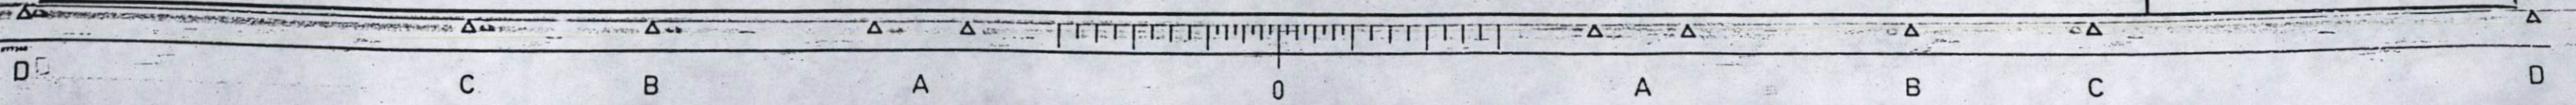

082-0205

STATE OF ILLINOIS
DEPARTMENT OF TRANSPORTATION


ROUTE NO.	SECTION	QUANTITY	DETAIL NUMBER	UNIT PRICE	SHEET NO. 1
					1 SHEETS

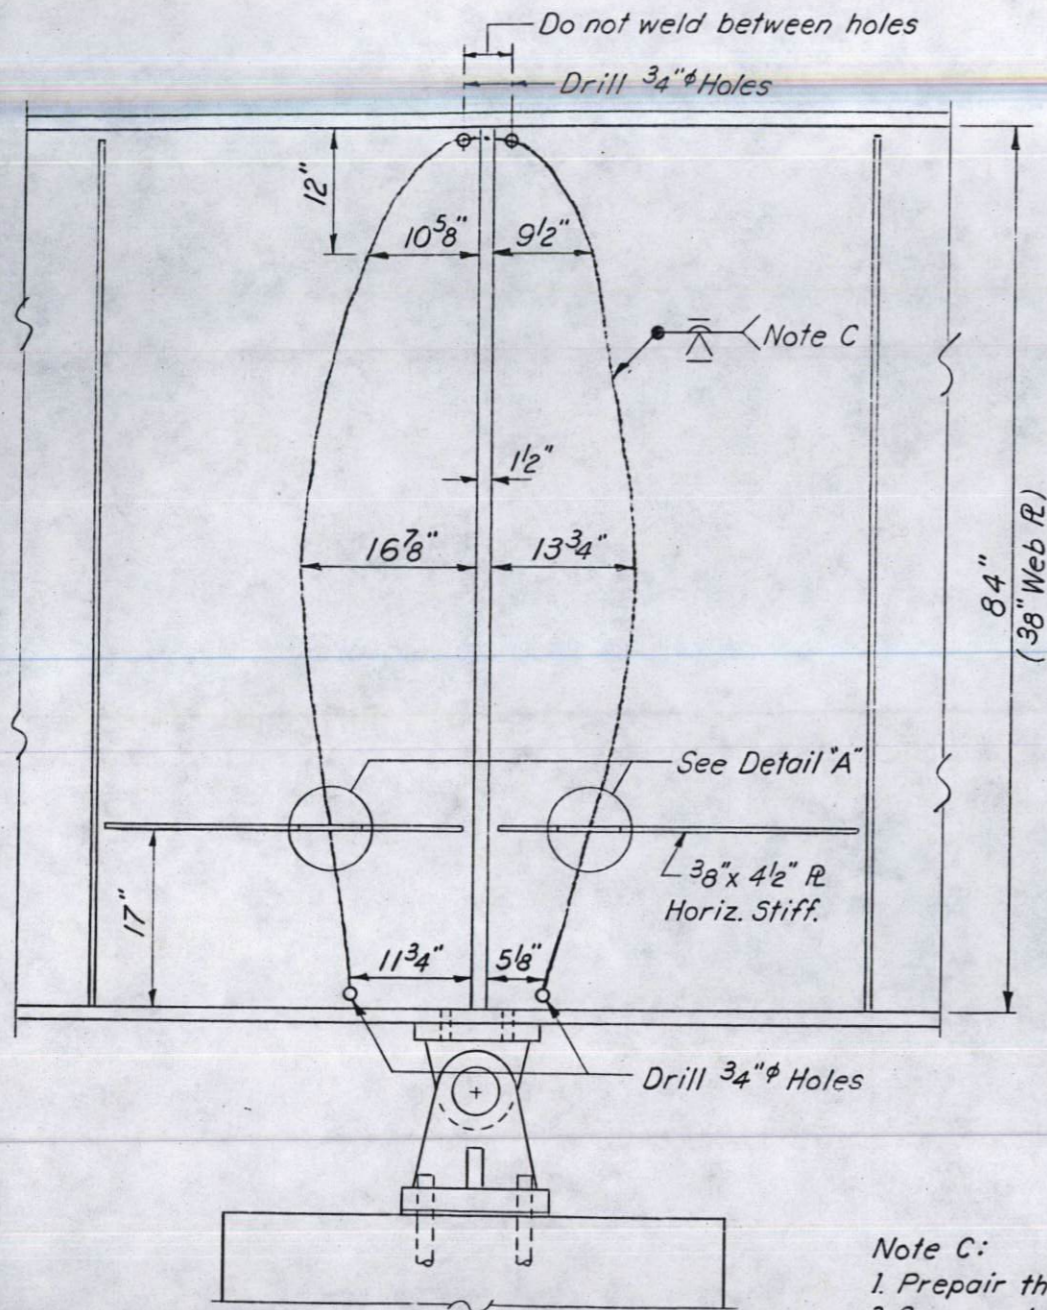

ELEVATION
WEST END PIER 7 - ROADWAY E

Provide temporary supports at each side of pier during repairs.


DESIGNED	WAH	EXAMINED	1978
CHECKED		PASSED	
DRAWN	P.A.	APPROVED	
CHECKED			

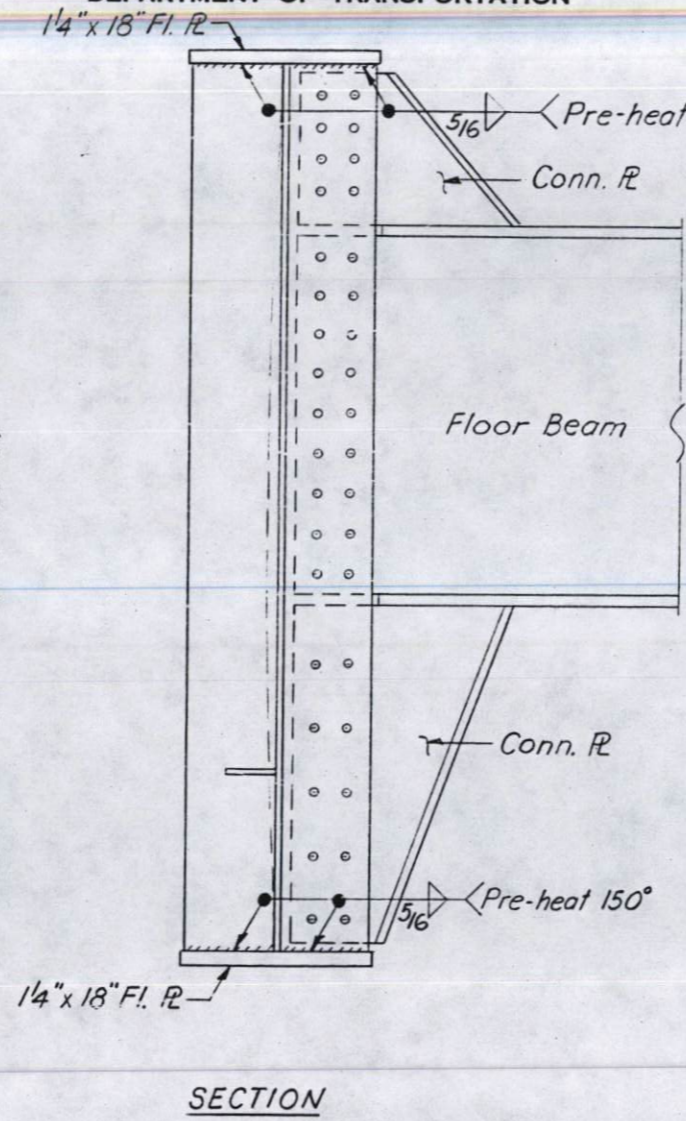

SECTION

Note C:

1. Prepare the cracked web for single V groove weld.
2. Care must be exercised to minimize the warping of the web plate while welding.
3. Preheat the web to 100°F.
4. Make sufficient 3"-4" intermittent welds to maintain the alignment of the web.
5. Weld the web together from one side, two passes minimum, starting from the bottom and alternating between the cracks on each side of bearing stiffener.
6. Back gouge the other side to sound metal and weld again.
7. Grind smooth both sides.

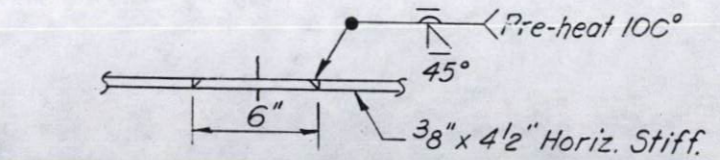

Remove 3/8" Horiz. Stiff. R in this area. Replace with new R after crack in web has been welded.

DETAIL A

REPAIR PROCEDURE:

- Drill 3/4" holes at bottom ends of crack. (Edge of hole may cut into web to flange weld 1/8" max.)
Remove 6" portion of horizontal stiff. at crack in web.
A - Loosen all bolts in bearing stiff. connection to a snug fit.
Push cracked portion of web into alignment with web.
Tighten bolts.
If cracked web can't be aligned as stated in A use procedure B.
B - Remove bolts in floor beam portion of connection only and replace with 5/8" H.S. bolts tightened to a snug fit.
Remove bolts in top and bottom connecting R's.
Push cracked portion of web into alignment with web.
Ream holes in top & bott. conn. R's if necessary and replace original bolts and tighten.
Remove 5/8" bolts from floor bm. conn., ream holes if necessary and replace original bolts and tighten.
Remove paint clean surfaces to be welded.
Weld bearing stiffener at top & bottom.
Weld crack in web. (See Note C)
Weld 6" plate in horizontal stiffeners.
Paint repaired areas to match.

TRAFFIC SHALL BE STOPPED WHILE WELDING






082-0205
WEB REPAIR
F.A.I. RT. TO SEC. 82-3HVB-R-1
ST. CLAIR COUNTY

Proposed but not completed



Reel 180M

Procedure 1978

1. Restrict to one lane traffic.
2. Crib on both sides of bearing.
3. No construction traffic past centerline of bearing (see span only).
4. No tack welded construction accessories. (Remove and grind smooth any existing accessories.)
5. Field drill 2 lines of $\frac{13}{16}$ " holes in girder web, 4" to the north and $3\frac{1}{2}$ " to the south of the face of exist. brg. stiff. (Remove paint and clean all contact surfaces for new steel and bolts.)
6. Remove bolt line (2) - See Section A-A - and install inside web splice \mathbb{R} 's and L's
7. Remove existing fascia bearing stiffener and horizontal stiffeners and grind web and flange areas smooth.
8. Using inside or outside web splice \mathbb{R} 's as templates, bolt the 4" web \mathbb{R} to the girder.
9. Bolt bottom $\frac{3}{4}$ " x 14" fill \mathbb{R} to bottom flange and bearing assembly.
10. Stop all traffic and weld new bearing stiffener to the top flange of the girder and to the $\frac{3}{4}$ " bottom fill \mathbb{R} and bottom flange of girder.

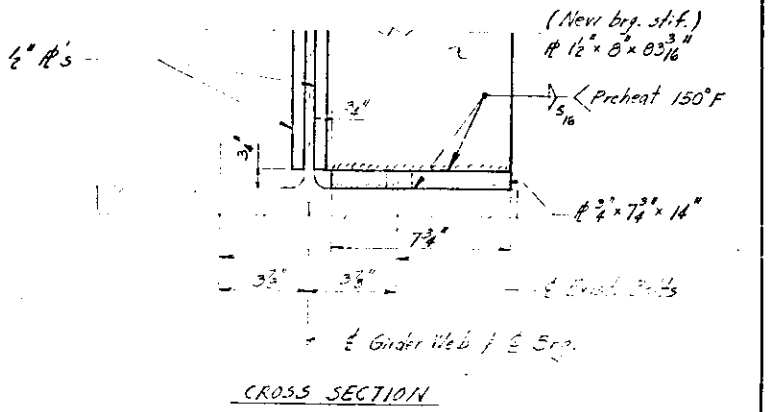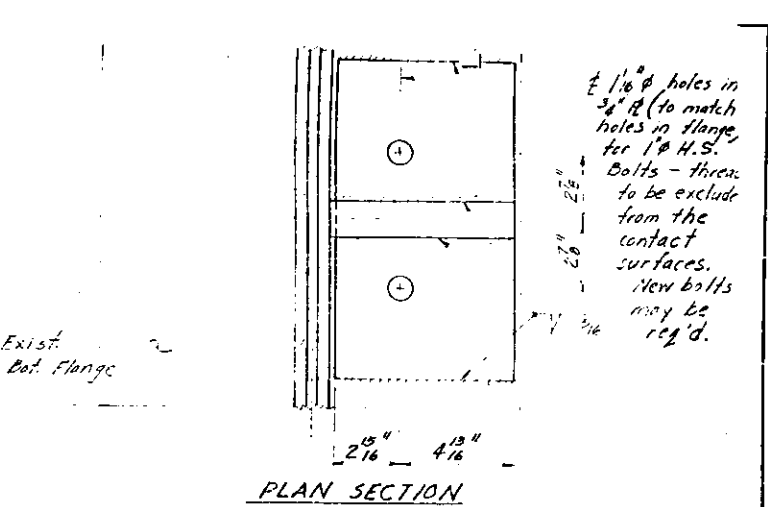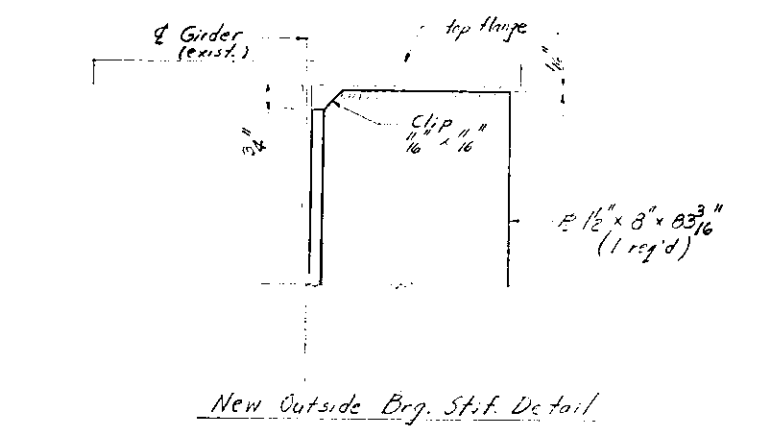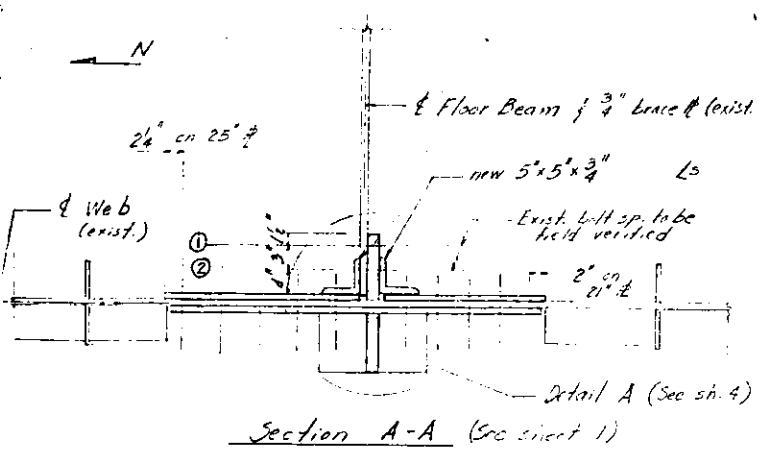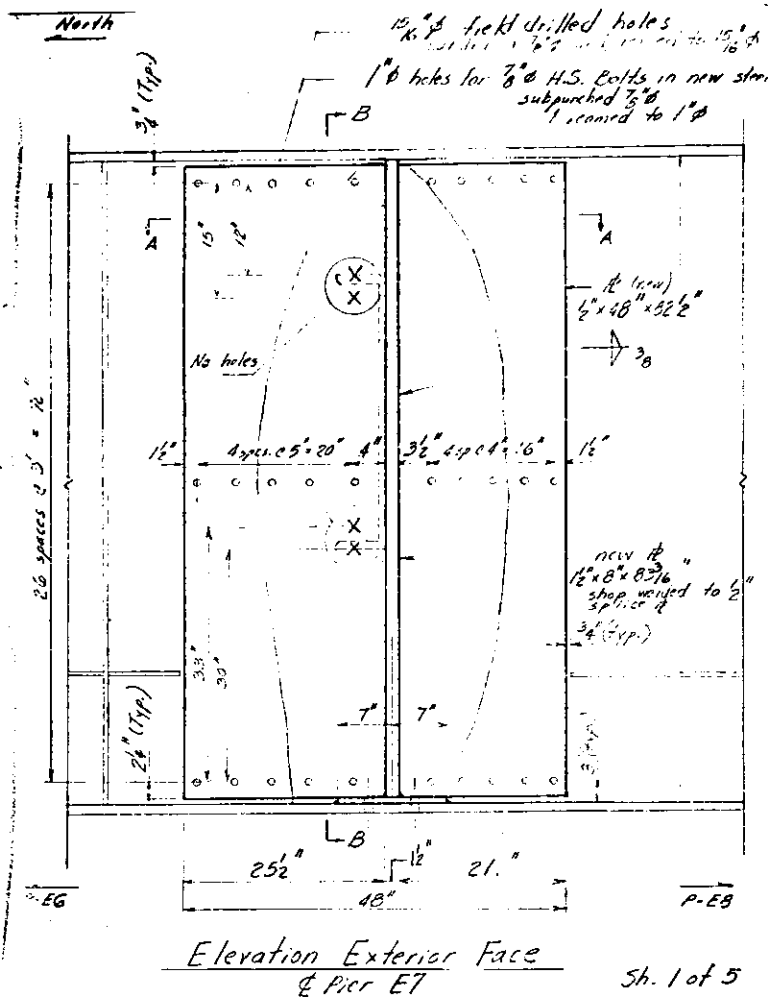

BEARING STIF. DETAILS AT BOT. FLANGE
Sh. 3 of 5

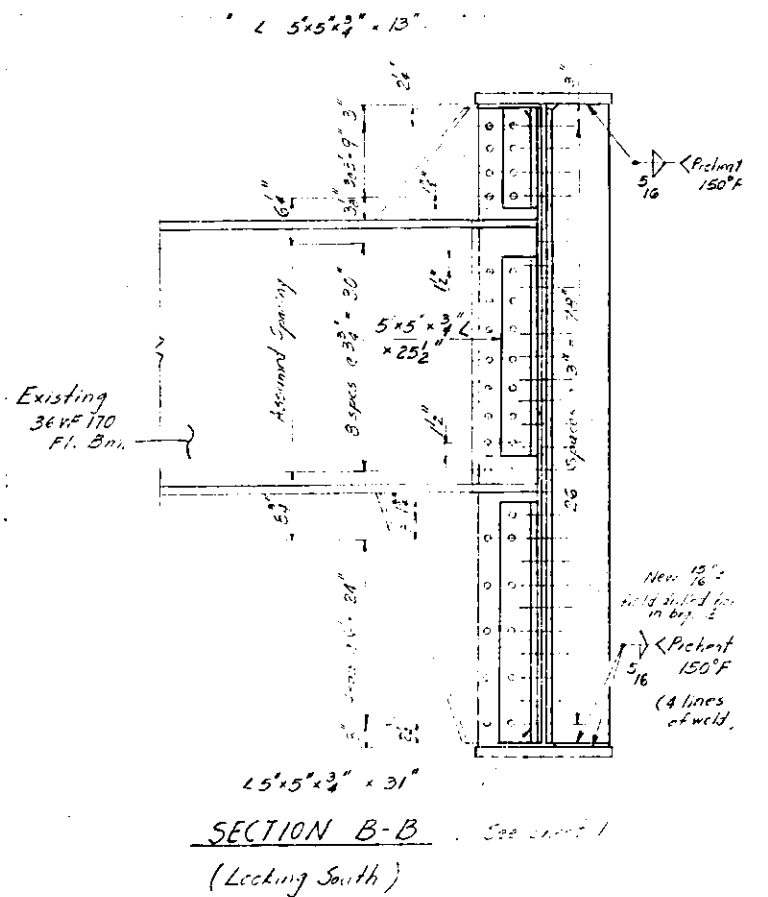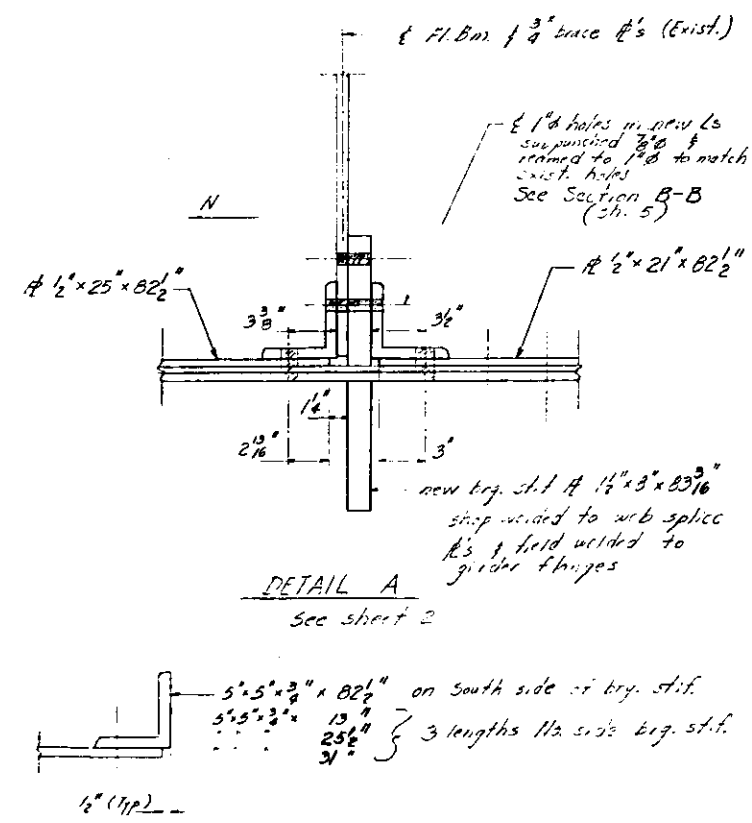


Sh. 4 of 5

STATE OF ILLINOIS
DEPARTMENT OF TRANSPORTATION

P.O. NO.	SEC.	COUNTY	SHEET NO.
FAL.70	82-3HVB-IR	ST. CLAIR	11

P-98-078-83

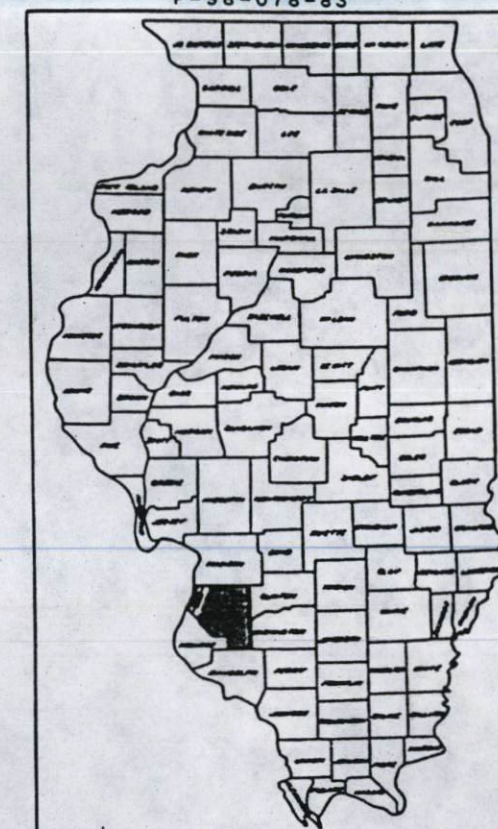

LOCATION OF SECTION INDICATED THUS:—

INDEX OF SHEETS	
SHEET NO.	DESCRIPTION
1	TITLE SHEET
2	PROJECT KEY PLAN
3	KEY PLAN FOR ROADWAYS A - H
4	KEY PLAN FOR RAMPS M - T
5	BEARING STIFFENER RETROFIT DETAILS
6	INTERIOR, NON BEARING STIFFENER RETROFIT DETAILS
7	REPAIR DETAIL LOCATIONS; ROADWAYS A,B,C
8	REPAIR DETAIL LOCATIONS; ROADWAYS D - H
9	REPAIR DETAIL LOCATIONS; RAMPS M - R
10	REPAIR DETAIL LOCATIONS; RAMPS S, T * MISCELLANEOUS DETAILS
11	TRAFFIC CONTROL AND PROTECTION
STANDARDS: 2298-7,2299-10,2300-3	

PLANS FOR PROPOSED SUPERSTRUCTURE REPAIRS


FAI ROUTE 70
SECTION 82-3HVB-IR

PROJ. ACIR-70-1(147)1

POPLAR STREET BRIDGE APPROACHES
ST. CLAIR COUNTY

C-98-115-85

MICROFILMED _____
REEL NUMBER _____
AWARDED _____
RESIDENT ENGINEER _____
AS BUILT CHANGES WERE MADE
ON THE FOLLOWING SHEETS

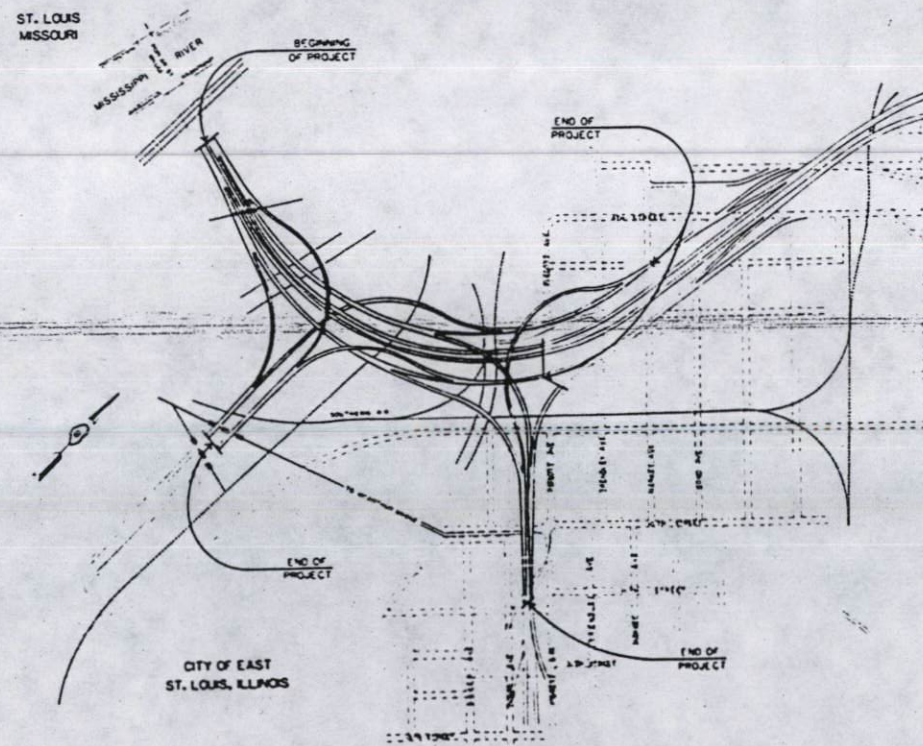

STATE OF ILLINOIS
DEPARTMENT OF TRANSPORTATION
APPROVED: *[Signature]*
March 27, 1986
March 27, 1986
March 27, 1986
DIRECTOR OF HIGHWAYS

DEPARTMENT OF TRANSPORTATION
FEDERAL HIGHWAY ADMINISTRATION
APPROVED: _____
DIVISION ADMINISTRATOR DATE




B-159

CONTRACT NO. 40769

NET LENGTH OF PROJECT - 166 MILES

ST. CLAIR COUNTY SECTION 82-3HVB-IR FAI ROUTE 70

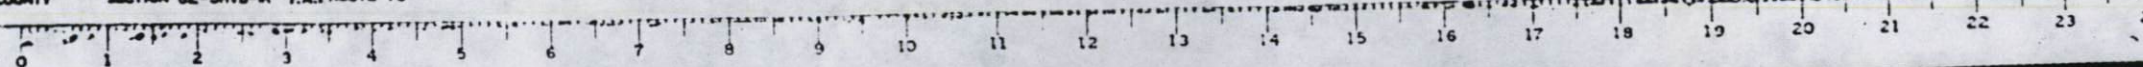

PROJECT NO.	70	SECTION	ST. CLAIR	DATE	11	2
DATE						
BY						
CHECKED BY						

SUMMARY OF QUANTITIES			SFTY-1-D
CODE No	ITEM	UNIT	QUANTITY
X09954	Structural Steel Repairs, Type 1	Each	355
X09955	Structural Steel Repairs, Type 2	Each	732
X09956	Removal and Replacement of Existing Traffic Signs	Each	8
X09957	Cleaning and Painting Previously Repaired Connections	Each	20
X09958	Traffic Control for Repair Locations Above Another Roadway	Each	36
Z10527	TRAINEES	HOURL	1000
650001	MOBILIZATION	L. SUM	1

GENERAL NOTES

- Design criteria - A.A.S.H.T.O. Standard Specifications for Highway Bridges, 1983 Edition.
- New fasteners shall be high-strength bolts, 7/8 inch ϕ , unless noted otherwise.
- Plan conditions, dimensions, and details relative to the existing structure have been taken from existing plans and are subject to normal construction variations. It shall be the Contractor's responsibility to verify such conditions, dimensions, and details in the field, and make necessary approved adjustments prior to construction. Such variations shall not be cause for additional compensation for a change in scope of work. However, the Contractor will be paid for the quantity actually furnished at the unit price bid for the work.

MAJOR WORK ITEMS

- Installation of structural steel repair Type 1 at bearing stiffener connections between floor beams above piers and main girders above piers at continuous supports.
- Installation of structural steel repair Type 2 at non-bearing stiffener connections between first interior floor beams and main girders.
- Removal and replacement of existing traffic signs and support brackets where they interfere with Type 1 repairs.
- Cleaning and painting of connections between floor beams and main girder which have been previously retrofitted with repairs.
- Provide traffic control and protection for repair locations which are located above another roadway.



PROJECT KEY PLAN

STATE OF ILLINOIS
DEPARTMENT OF TRANSPORTATION
SUPERSTRUCTURE REPAIRS



FAI ROUTE 70
POPLAR STREET BRIDGE APPROACHES
ST. CLAIR COUNTY

SCALE: NONE
DATE 2/26/86
CHECKED BY: TLR

KEY PLAN
POPLAR ST BRIDGE APPROACHES
FAI ROUTE 70
East St. Louis, St. Clair County, Illinois

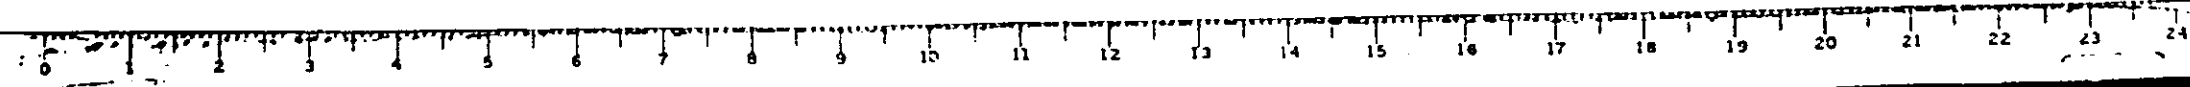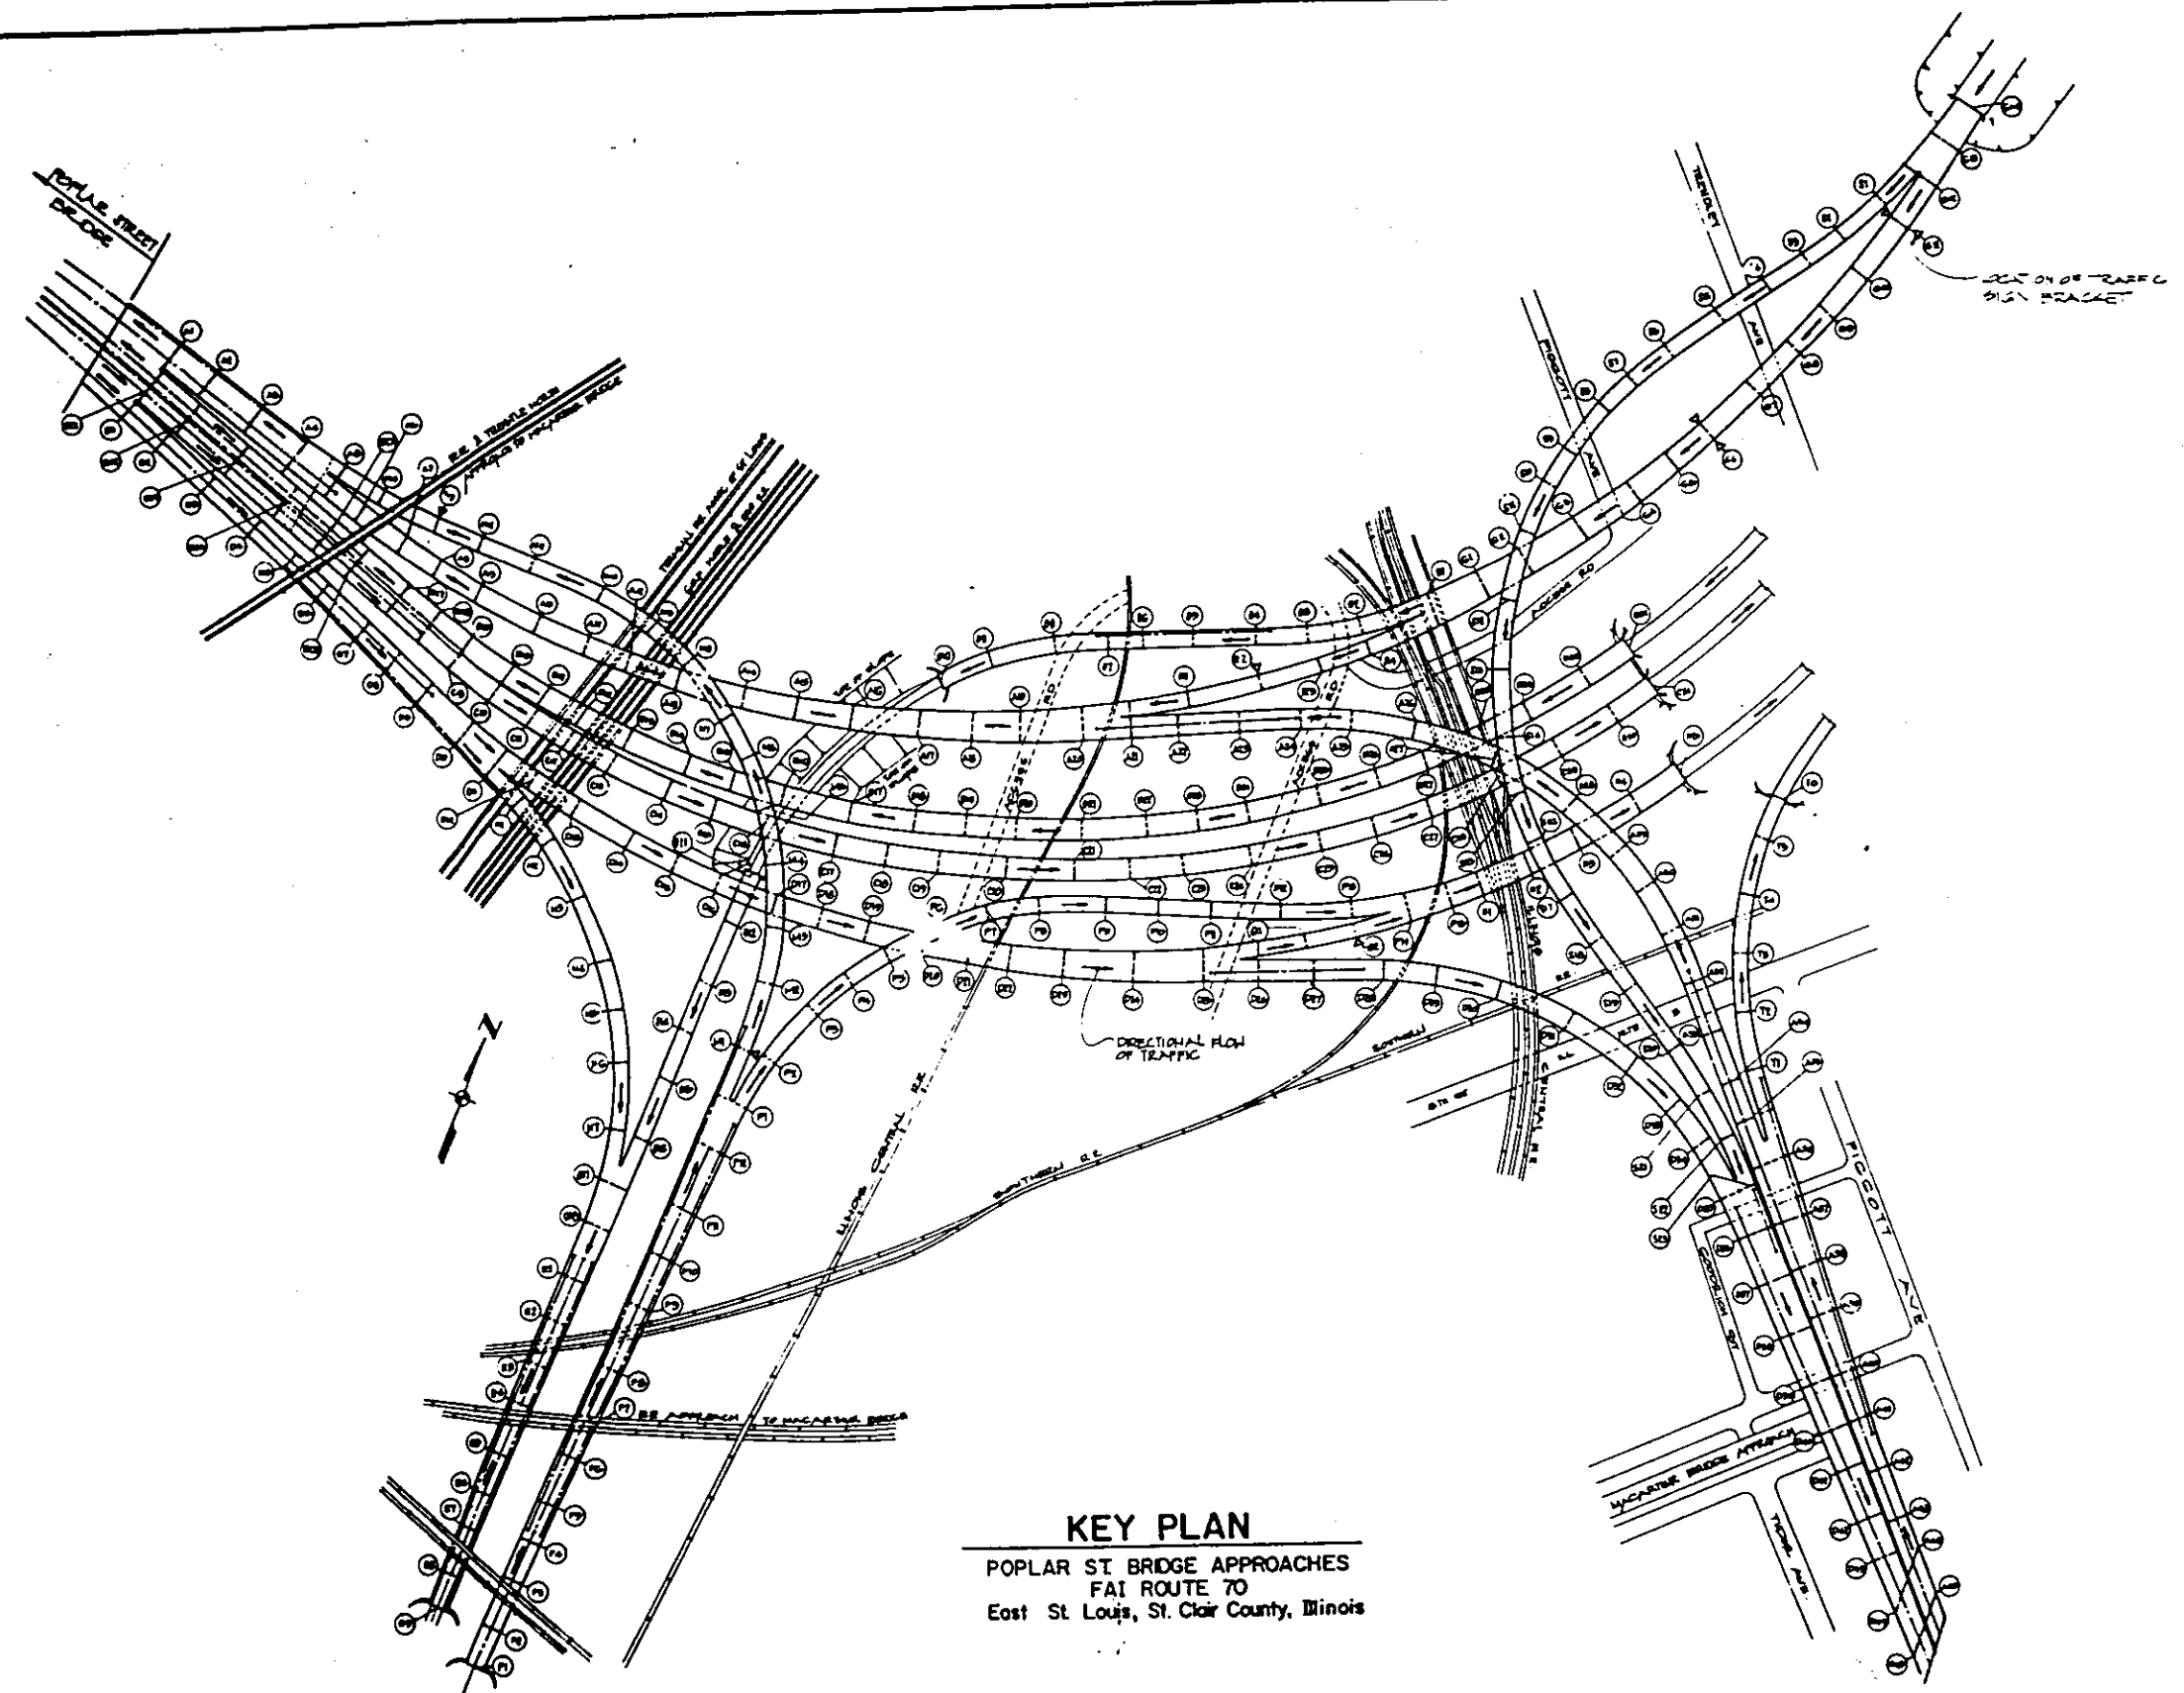


NO.	DATE	BY	CHKD.	APP'D.
70	2/26/66	GSA	TLR	
PROJECT		ST. CLAIR		
SHEET NO.		11		
SHEET TOTAL		3		
DRAWN BY: GSA				
CHECKED BY: TLR				

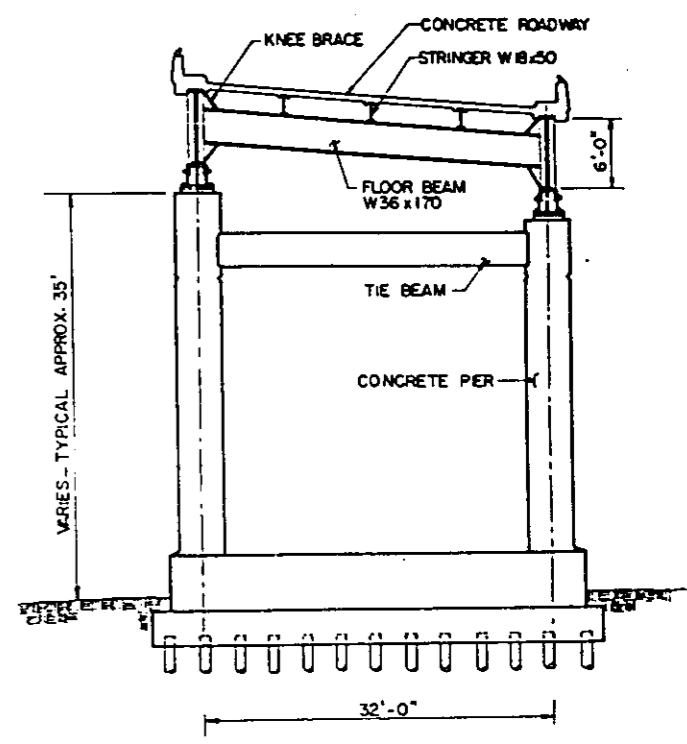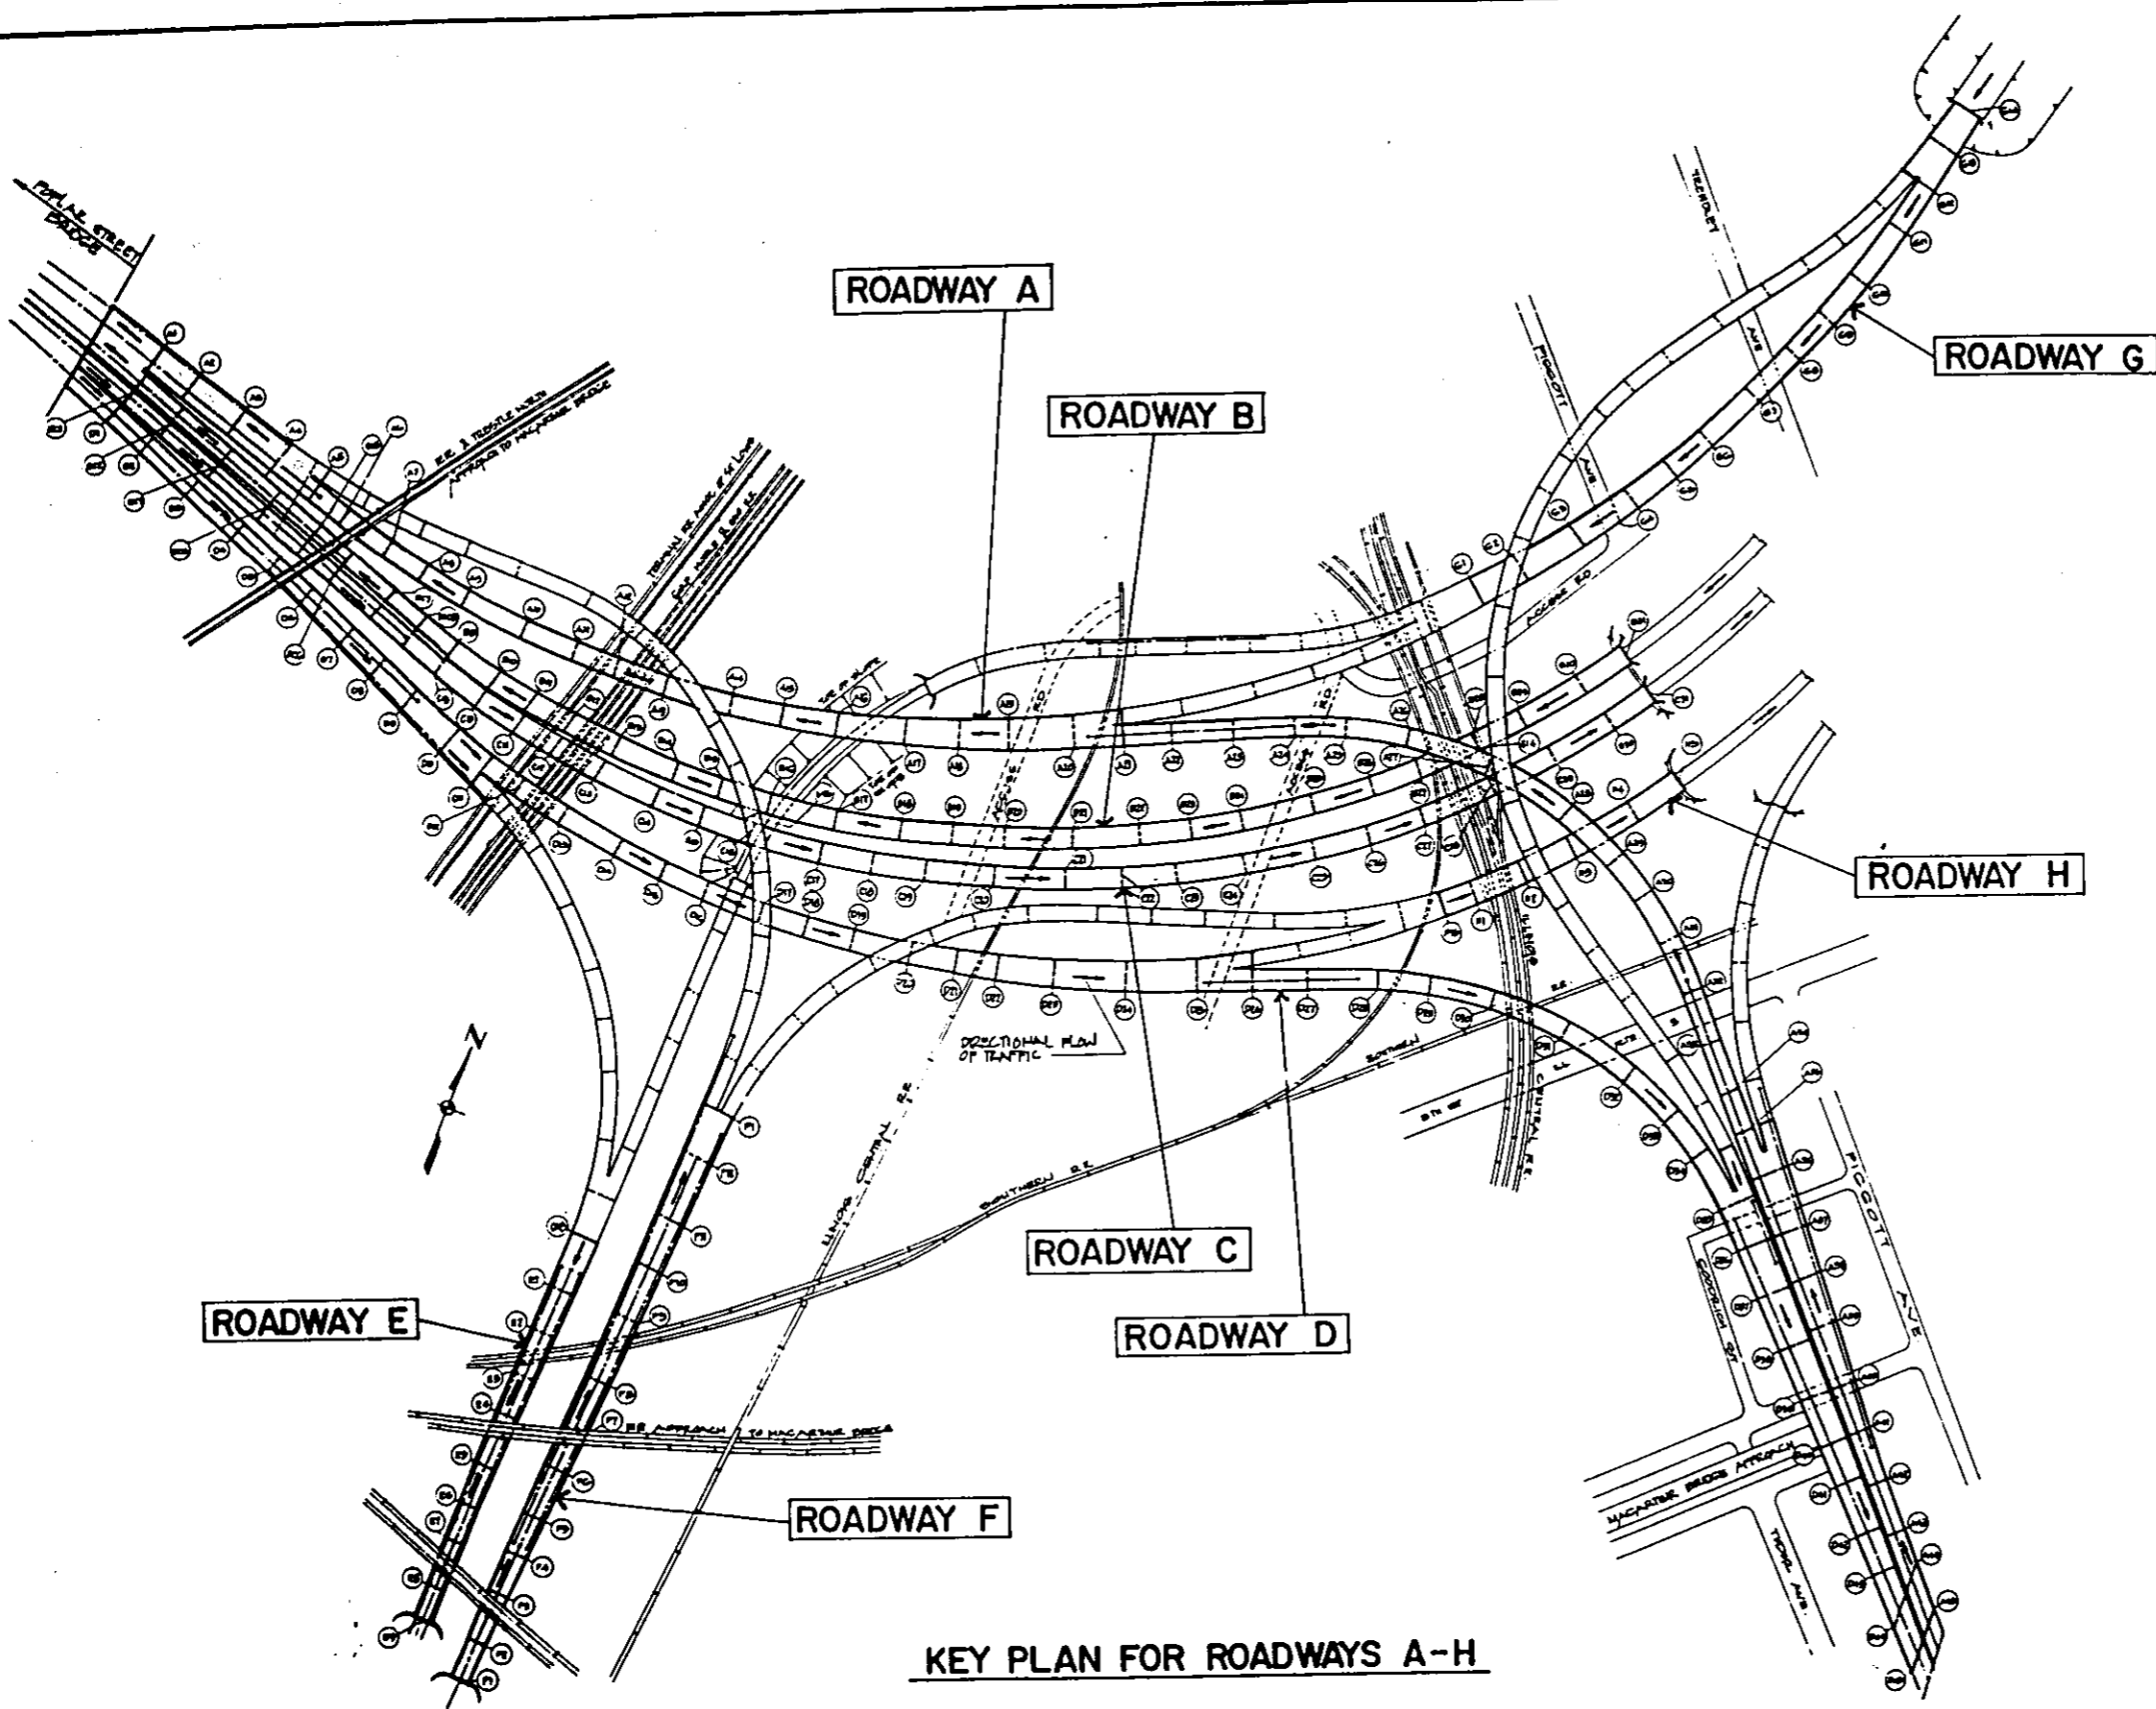




TYPICAL SECTION THROUGH ROADWAY
(Section through Ramp Similar)

KEY PLAN FOR ROADWAYS A-H

KEY PLAN FOR ROADWAYS A-H
STATE OF ILLINOIS
DEPARTMENT OF TRANSPORTATION
SUPERSTRUCTURE REPAIRS
FAI ROUTE 70
POPLAR STREET BRIDGE APPROACHES
ST. CLAIR COUNTY
SCALE: NONE
DATE 2/26/66
DRAWN BY: GSA
CHECKED BY: TLR

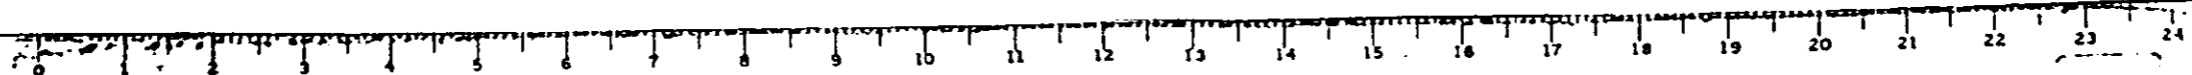

70	US-50/BR	ST. CLAIR	11	4
DATE	NO. SHEET	TOTAL SHEETS	DATE	NO. SHEET
2/26/86	11	11		

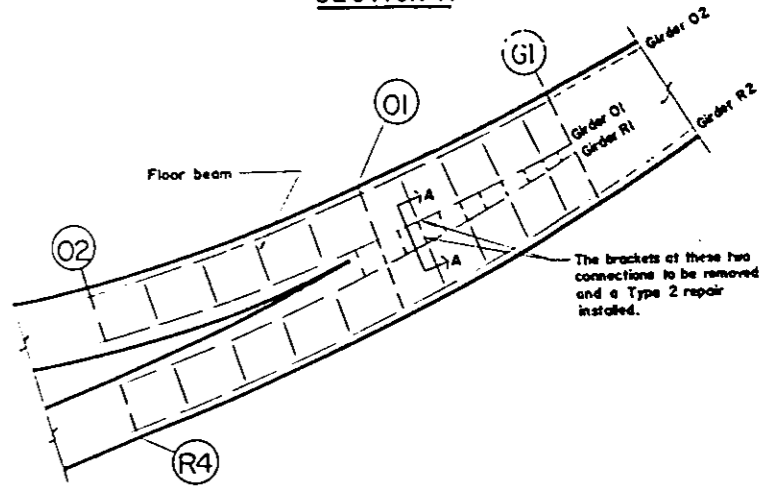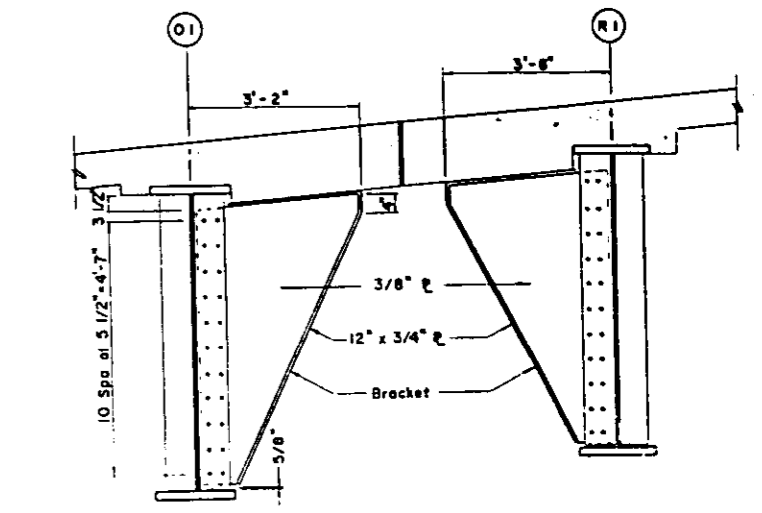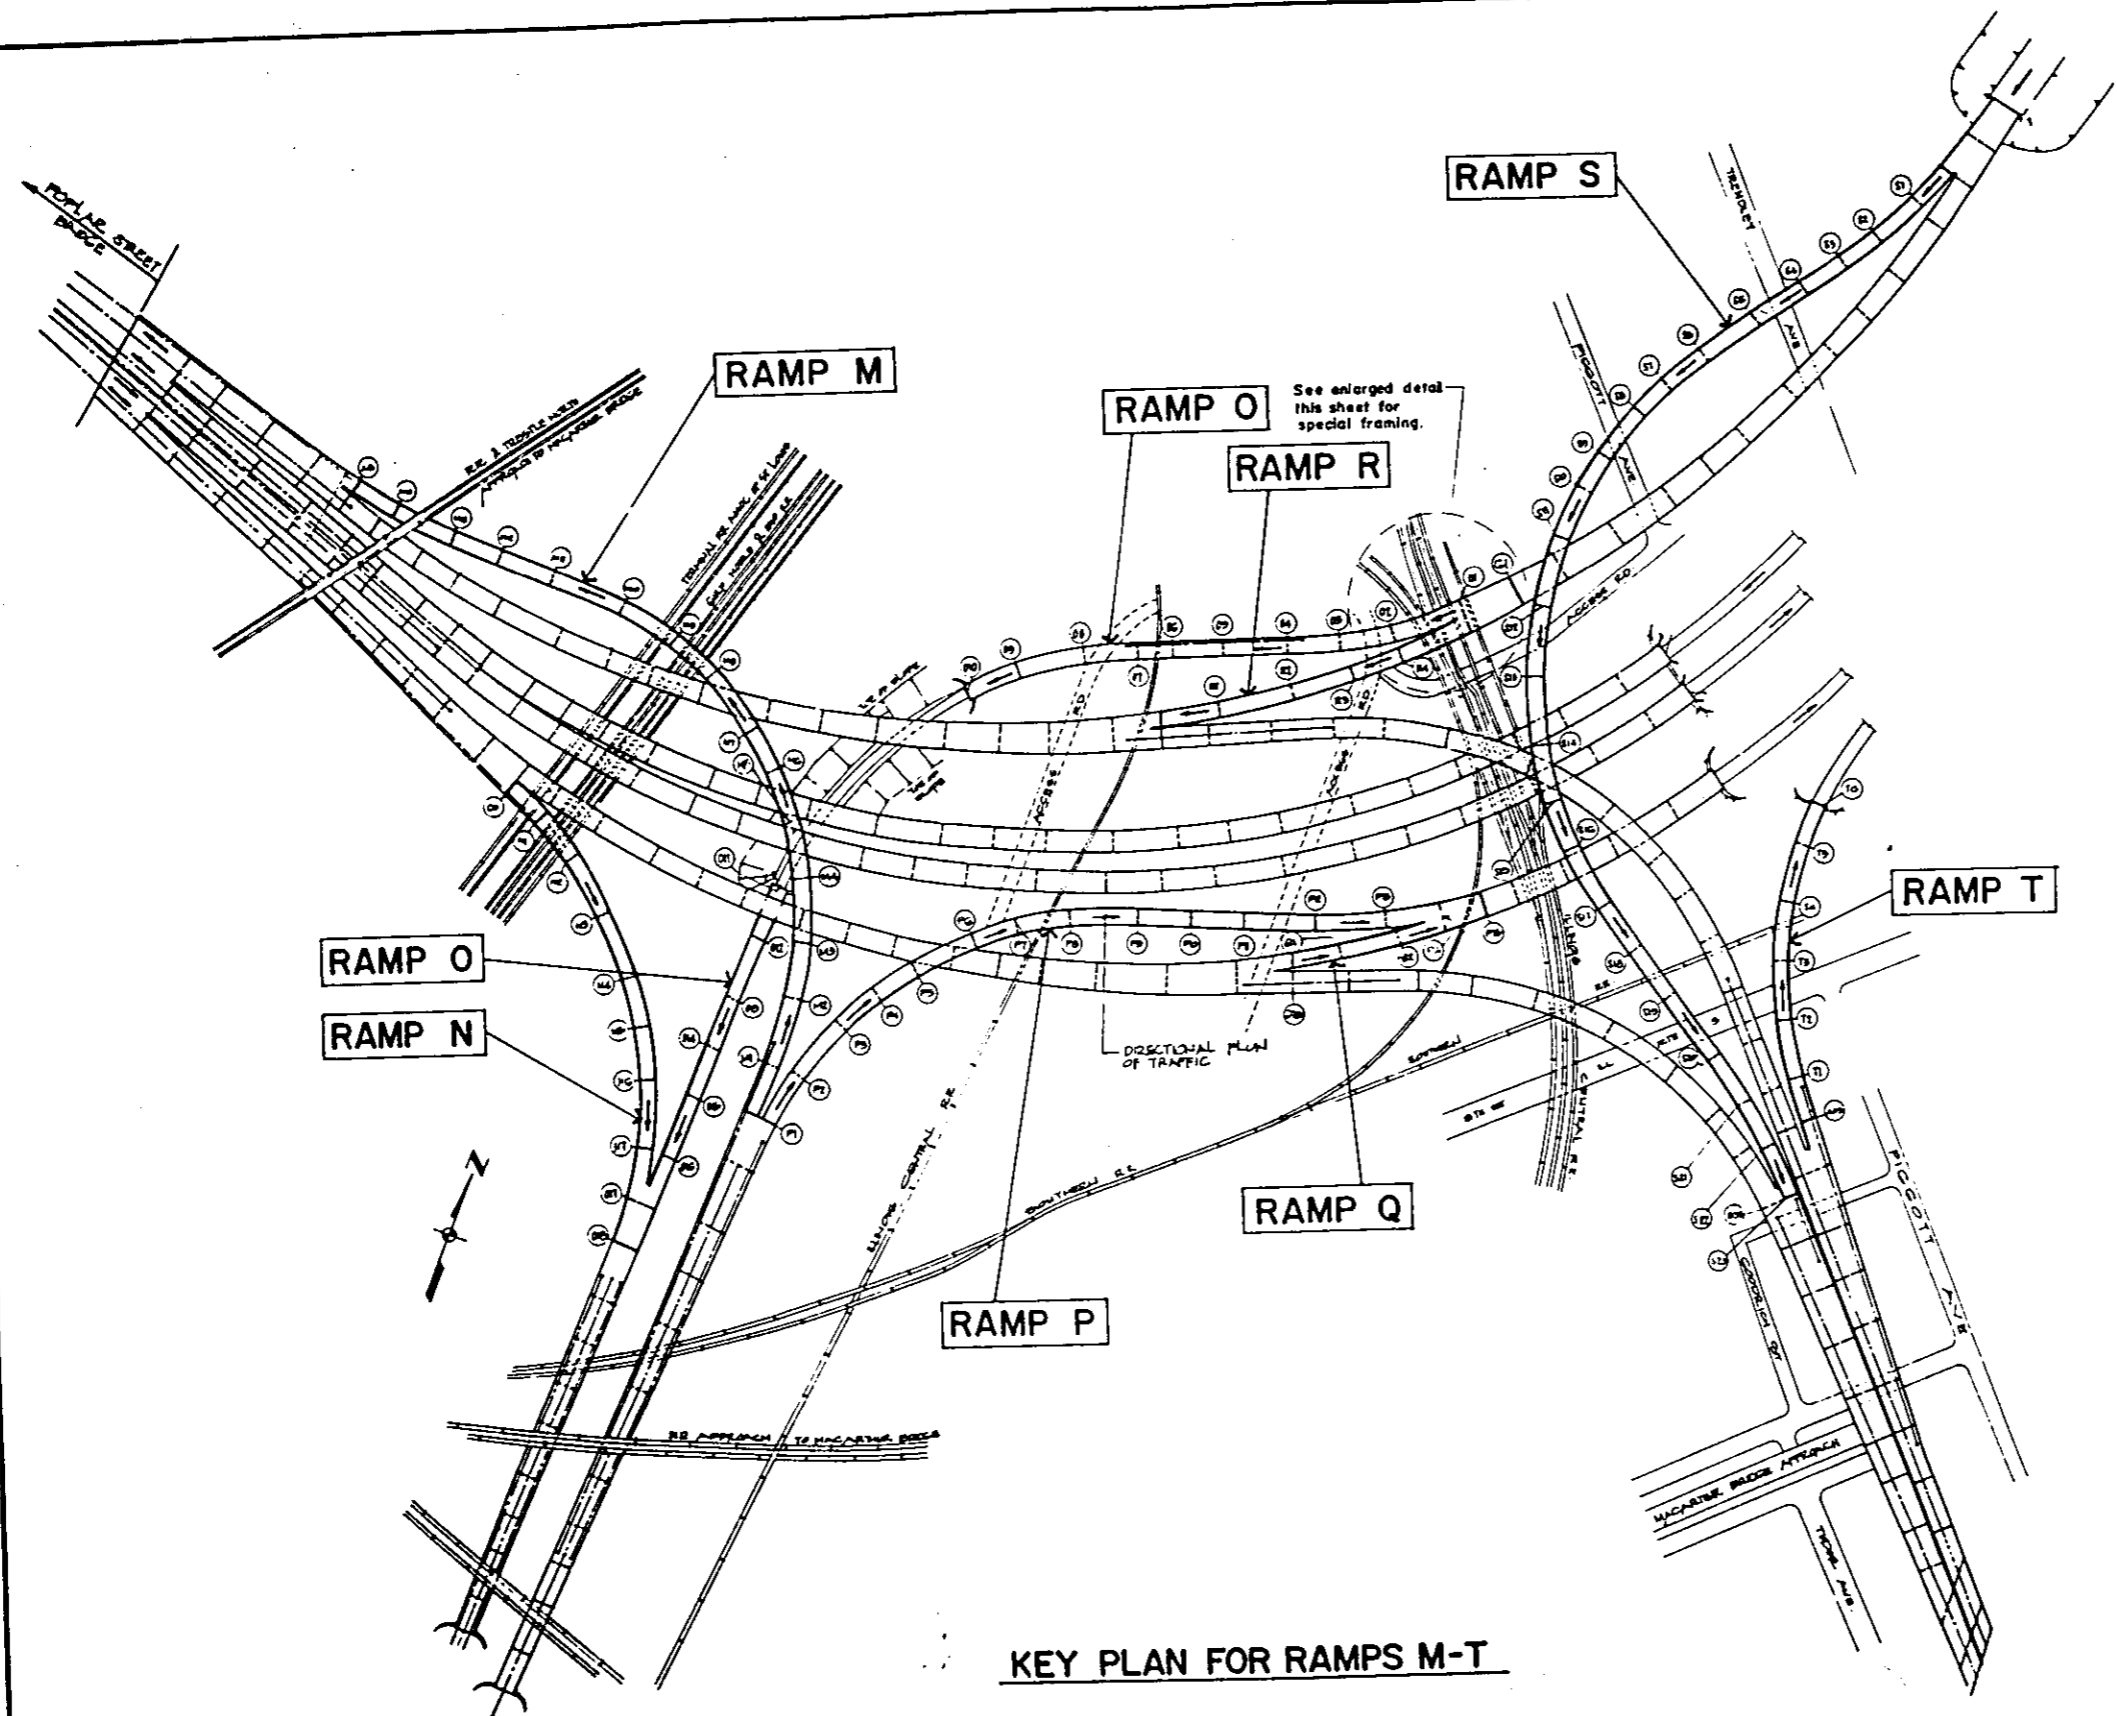

EXISTING BRACKETS AT RAMP O AND RAMP R INTERSECTION


- NOTE: Brackets are to be removed at two locations (ONint-IE and OISint-IE) and the Type 2 retrofit detail installed.
1. Remove all existing high strength bolts between the existing bracket and stiffener.
 2. Remove bracket.
 3. Install Type 2 retrofit detail.

KEY PLAN FOR RAMPS M-T
 STATE OF ILLINOIS
 DEPARTMENT OF TRANSPORTATION
 SUPERSTRUCTURE REPAIRS
 FAI ROUTE TO
 POPLAR STREET BRIDGE APPROACHES
 ST. CLAIR COUNTY
 SCALE: NONE
 DATE 2/26/86
 DRAWN BY: GSA
 CHECKED BY: TLR


6'-0" TYP.

EXISTING FILLET
 LOS

NOTE: EXISTING
 RAPET CONC
 SHOWN FOR
 CLARITY.

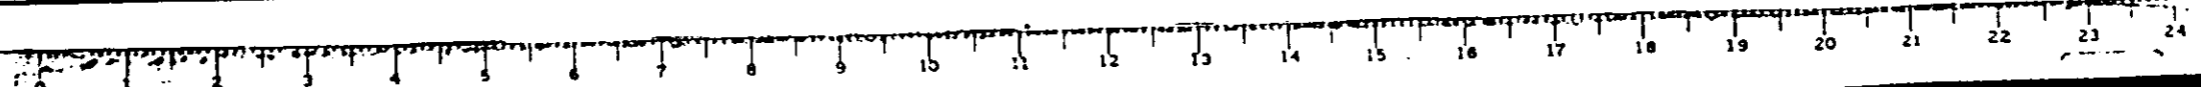

NO.	SECTION	EMPH.	DATE	BY
70	S2-31V8-B	ST. CLAIR	11	5
NO.	NO. OF SHEETS	NO. OF SHEETS	NO. OF SHEETS	NO. OF SHEETS
113	NO. OF SHEETS	NO. OF SHEETS	NO. OF SHEETS	NO. OF SHEETS

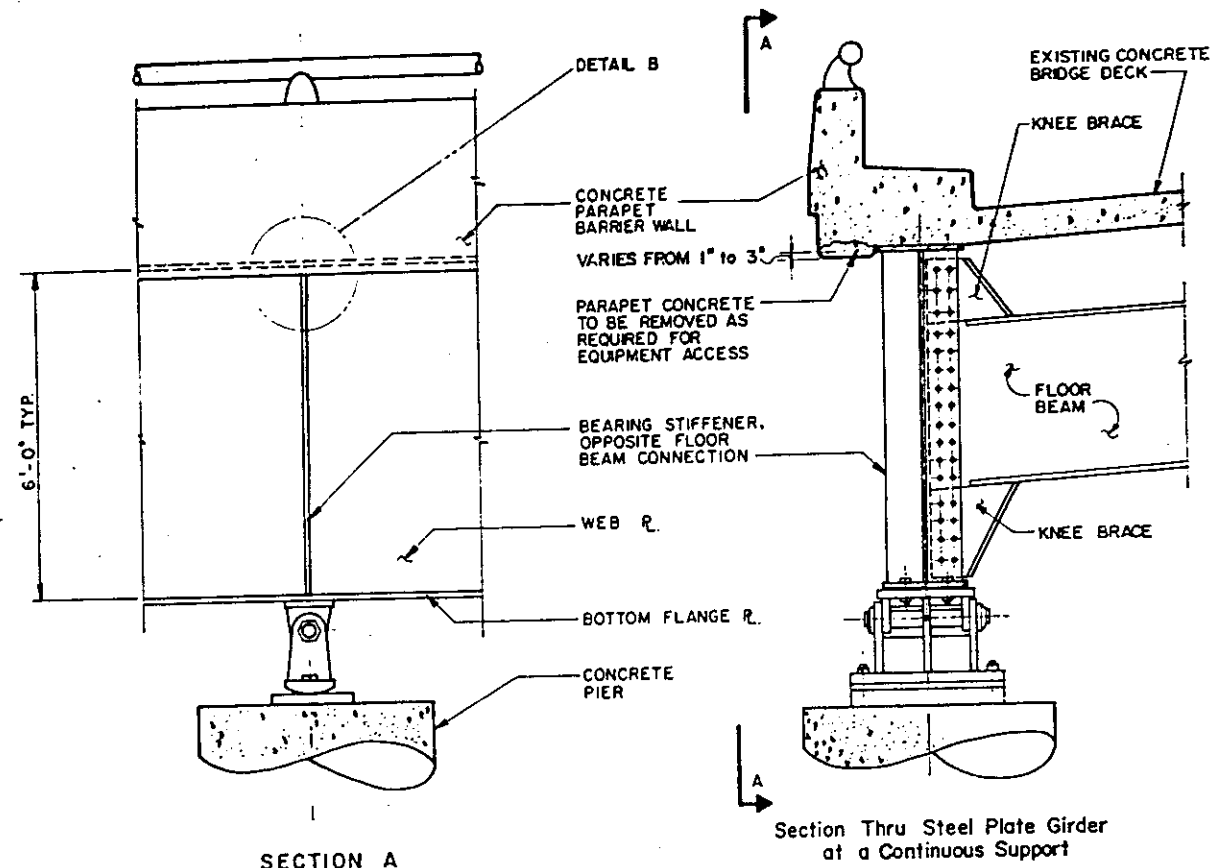

- REPAIR PROCEDURE FOR INSTALLATION OF BEARING STIFFENER RETROFIT**
1. Remove existing parapet concrete, as required, for equipment access.
 2. Core 2 in. diameter holes through web plate adjacent to the top flange as positioned in Detail B. Core hole shall penetrate horizontal and vertical fillet welds approximately 1/8 in. If core does not penetrate weld by 1/8 in., remove additional material by grinding. Remove all burrs from core surface and surface shall have a Roughness average (Ra) of 500 or less. Bevel edges of cored holes 1/16".
 3. Obtain approval of engineer before proceeding.
 4. Clean surface to remove any cutting oils or contaminants.
 5. Clean and paint all areas of existing structural steel affected by this repair process, in accordance with the Special Provisions.
 6. Patch parapet concrete at the direction of the Engineer, in accordance with the Special Provisions.


QUANTITIES

ITEM	UNIT	QUANTITY
Structural Steel Repairs, Type 1	Each	355
Removal and Replacement of Existing Traffic Signs	Each	8
Cleaning and Painting Previously Repaired Connections	Each	12
Traffic Control for Repair Locations Above Another Roadway	Each	8

DETAILS FOR REPAIR OF GIRDER WEB CRACKING AT A FLOOR BEAM-TO-BEARING STIFFENER GIRDER CONNECTION

TYPE 1 REPAIR

Note: Refer to Sheet Nos. 7 through 10 for repair detail locations.

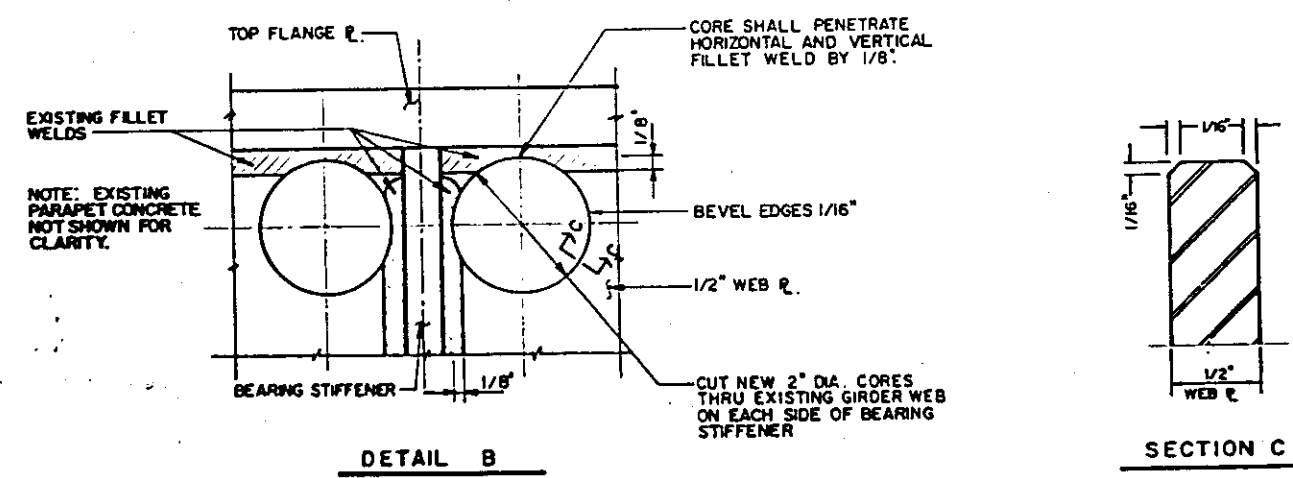


BEARING STIFFENER RETROFIT DETAILS

STATE OF ILLINOIS
DEPARTMENT OF TRANSPORTATION
SUPERSTRUCTURE REPAIRS


FAI ROUTE 70
POPLAR STREET BRIDGE APPROACHES
ST. CLAIR COUNTY

SCALE: NONE
DATE: 2/26/88

DESIGNED BY: GSA
CHECKED BY: TLR

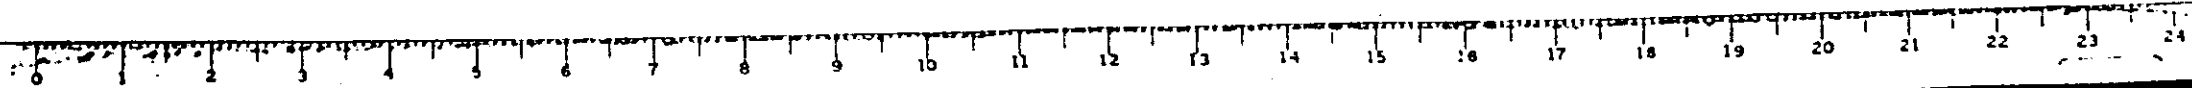

70	42-3046-3R	ST. CLAIR	11	6
DATE OF REV. 1				
REVISIONS				

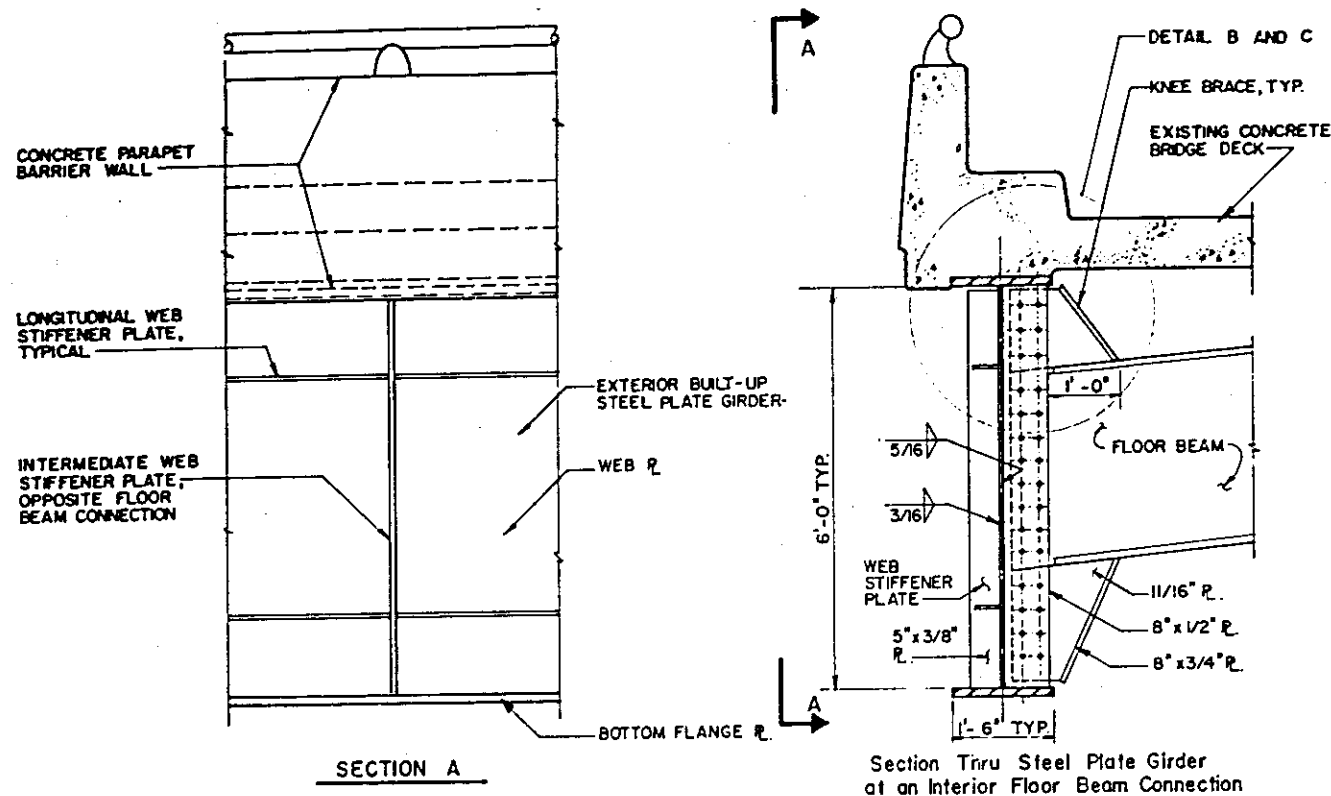

REPAIR PROCEDURE FOR INSTALLATION OF INTERIOR NON-BEARING STIFFENER RETROFIT:

1. Remove existing bolts between floor beam and connection plate that will interfere with coring operation. Core 4 in. diameter holes through the interior and exterior stiffeners as shown in Detail B.
2. Make horizontal flame cuts through knee brace and exterior stiffener as shown in Detail B. Refer to Special Provisions.
3. Make vertical flame cuts through the exterior stiffener and interior connection plate. These cuts shall be sufficiently away from the girder web to avoid gouging of the web plate. Also, utmost care shall be taken to not gouge the top flange plate during the cutting operation. Temperature of web plate shall not exceed 800° F. Refer to Special Provisions.
4. Grind surfaces immediately after flame cutting. Roughness of all flame cut surfaces shall be (R_a)1000 or less before leaving the location.
5. Remove remnants of vertical fillet welds and stiffener plates so that the web plate has a surface roughness of (R_a) 250 or less. The final grinding shall be done parallel to the flange. Refer to Special Provisions.
6. Inspect web plate in region of repairs. Drill 1" holes at ends of all cracks that do not terminate at an existing drilled hole.
7. Obtain approval of Engineer before proceeding.
8. Install 7/8" diameter high strength A325 bolts in crack retrofit holes as specified in the Special Provisions. Hardened washers shall be installed under both nut and bolt head. Tighten bolts to the minimum fastener tension, using the "turn-of-the-nut" method, as specified in the AISC "Specification for Structural Joints Using ASTM A325 or A490 Bolts".
9. Clean exposed steel surface to remove any contaminants or rust.
10. Clean and paint all areas of existing Structural Steel affected by this repair process, in accordance with the Special Provisions.


QUANTITIES

ITEM	UNIT	QUANTITY
Structural Steel Repairs, Type 2	Each	732
Cleaning and Painting Previously Repaired Connections	Each	8
Traffic Control for Repair Locations Above Another Roadway	Each	28


DETAILS FOR REPAIR OF GIRDER WEB CRACKING AT FIRST INTERIOR FLOOR BEAM - TO-GIRDER CONNECTION

TYPE 2 REPAIR


Note: Refer to Sheet Nos. 7 through 10 for repair detail locations.

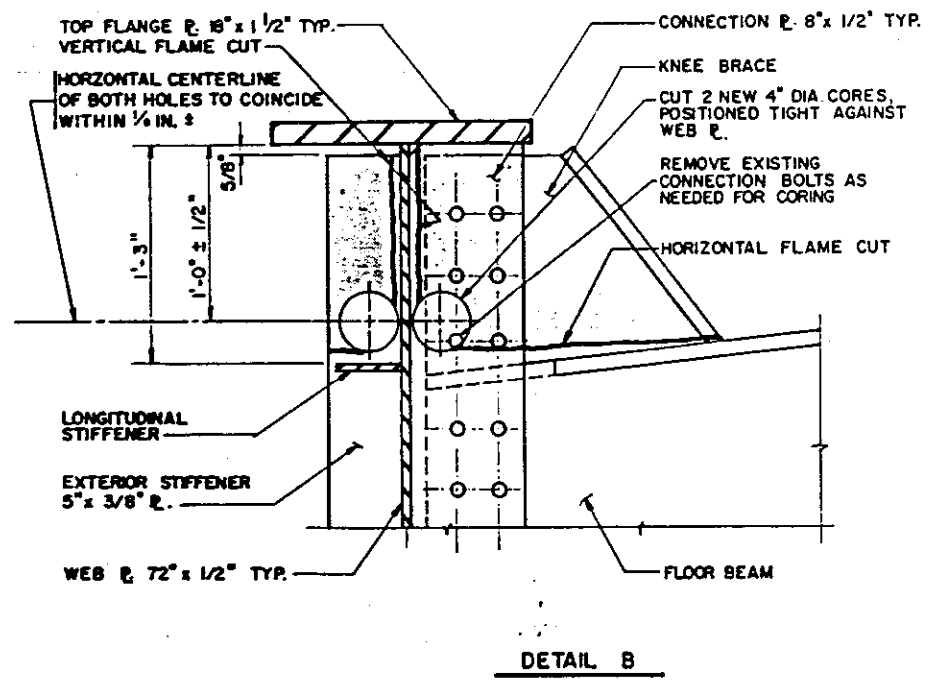


Illustrating Steps 1 thru 3 of the Repair Sequence

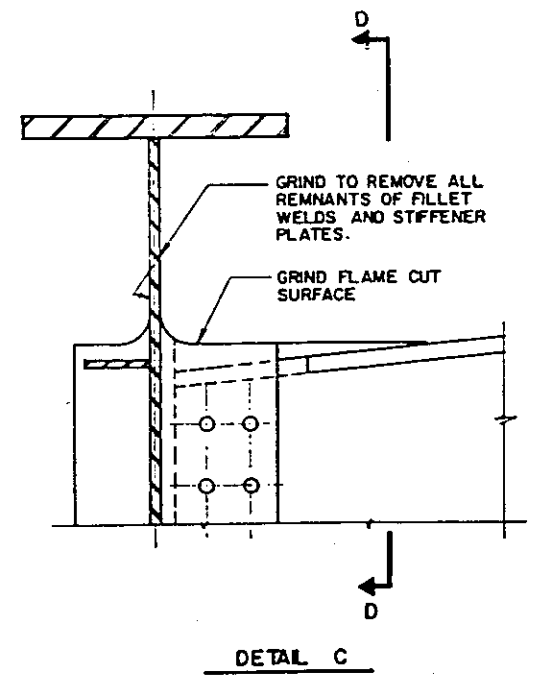


Illustrating Steps 4 and 5 of the Repair Sequence

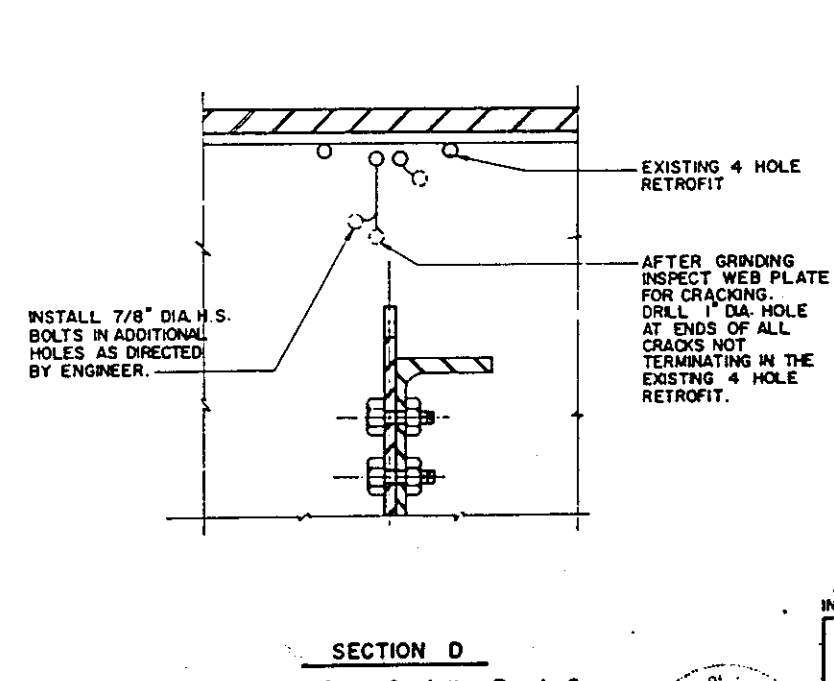

Illustrating Steps 6 thru 9 of the Repair Sequence

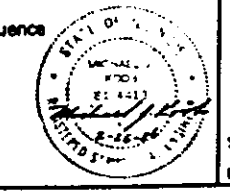

INTERIOR NON-BEARING STIFFENER RETROFIT DETAILS
 STATE OF ILLINOIS
 DEPARTMENT OF TRANSPORTATION
 SUPERSTRUCTURE REPAIRS
 FAI ROUTE 70
 POPLAR STREET BRIDGE APPROACHES
 ST. CLAIR COUNTY
 SCALE: NONE
 DATE 2/26/86
 DRAWN BY: GSA
 CHECKED BY: TLR

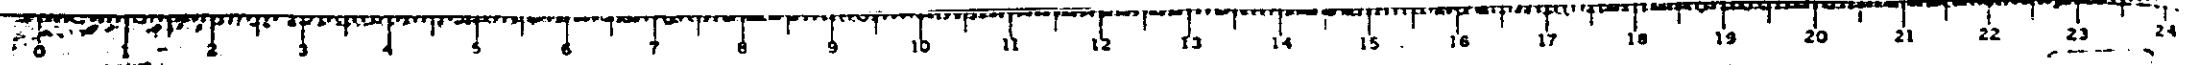

STATE OF ILLINOIS
DEPARTMENT OF TRANSPORTATION

PLANS FOR PROPOSED
FEDERAL AID HIGHWAY

F.A.I. ROUTE 70

SECTION 82-3HVB-R-5


PROJECT IR-70-1(145)0

ST. CLAIR COUNTY

C-98-050-84

ROUTE NO.	SEC.	COUNTY	TOTAL SHEETS	SHEET NO.
70	*	ST. CLAIR	4	1

* 82-3HVB-R-5
P-98-073-83

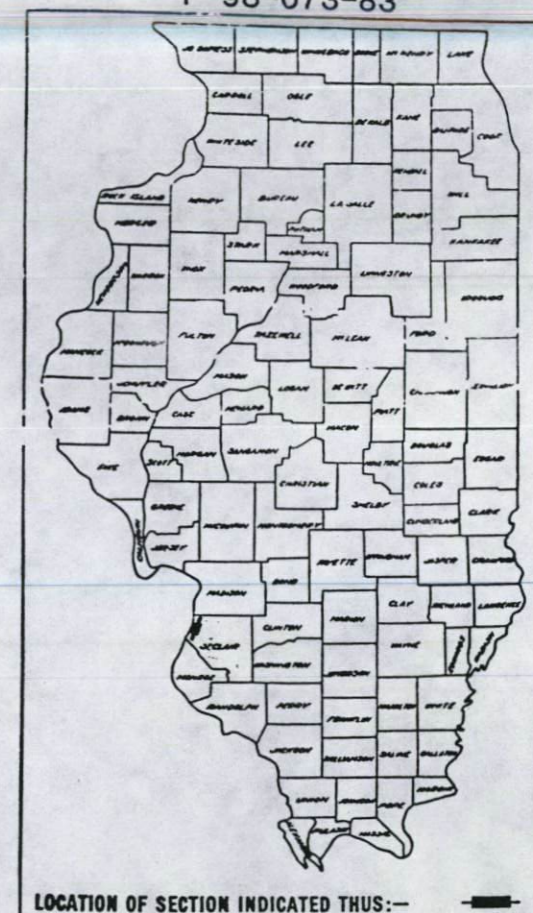

LOCATION OF SECTION INDICATED THIS:—

INDEX


1. TITLE SHEET & SUMMARY OF QUANTITIES
2. GENERAL PLAN
3. POST-TENSIONING SYSTEM & GENERAL NOTES
4. END CONNECTION BRACKET!

STANDARDS:

2298-7 2300-3
2299-10 2307-6

SUMMARY OF QUANTITIES

CODE NO.	PAY ITEM	UNIT	QUANTITY
* X04748	MOBILIZATION	L SUM	1
* X07723	PIER COLUMN REPAIR TYPE I	EACH	270
* X07724	PIER COLUMN REPAIR TYPE II	EACH	151
** Z10527	TRAINEES	HOURS	4,000
* CONSTRUCTION TYPE CODE Y007			
** CONSTRUCTION TYPE CODE Y080			

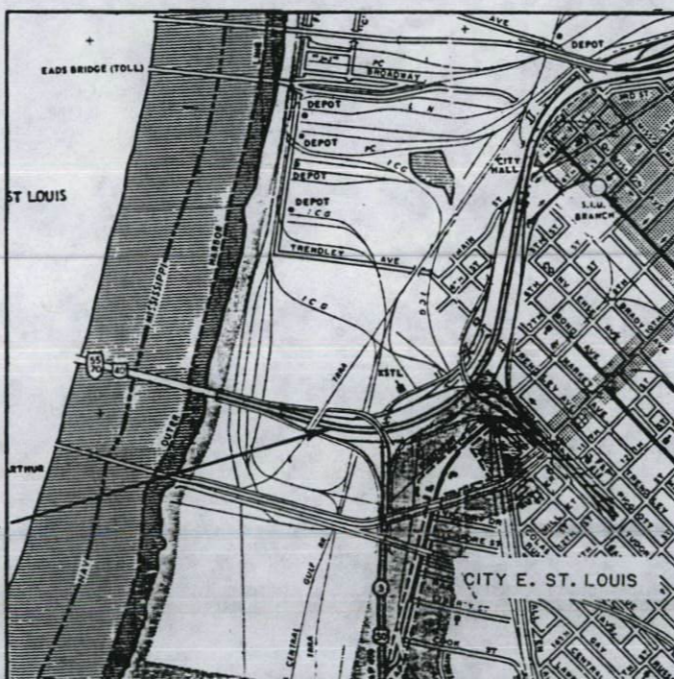

LOCATION MAP

0" 1200 2400
SCALE: 1"=1200FT.

THIS PROJECT CONSISTS OF
THE PIER CAP REPAIR AT VARIOUS
LOCATIONS IN THE POPLAR
STREET BRIDGE COMPLEX


MICROFILMED _____
REEL NUMBER _____
AWARDED _____
RESIDENT ENGINEER _____
AS BUILT CHANGES WERE MADE
ON THE FOLLOWING SHEETS

STATE OF ILLINOIS DEPARTMENT OF TRANSPORTATION	
SUBMITTED	11-27 <i>Det. [Signature]</i>
EXAMINED	12-20 <i>[Signature]</i>
PASSED	12-20 <i>[Signature]</i>
APPROVED	12-20 <i>[Signature]</i> DIRECTOR OF HIGHWAYS

REEL 8-151

CONTRACT NO. 38649


ST. CLAIR COUNTY SECTION 82-3HVB-R-5 F.A.I. ROUTE 70

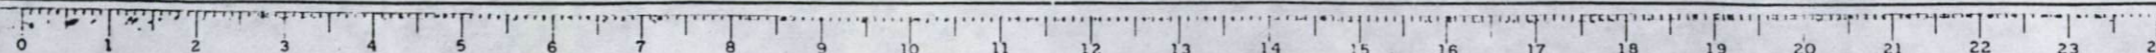

STATE OF ILLINOIS
DEPARTMENT OF TRANSPORTATION

ROUTE NO.	SECTION	COUNTY	SHEET NO.	TOTAL SHEETS
70	SEC. 82-34	ST. CLAIR	1	3

Sheet No. 1
3 Sheets

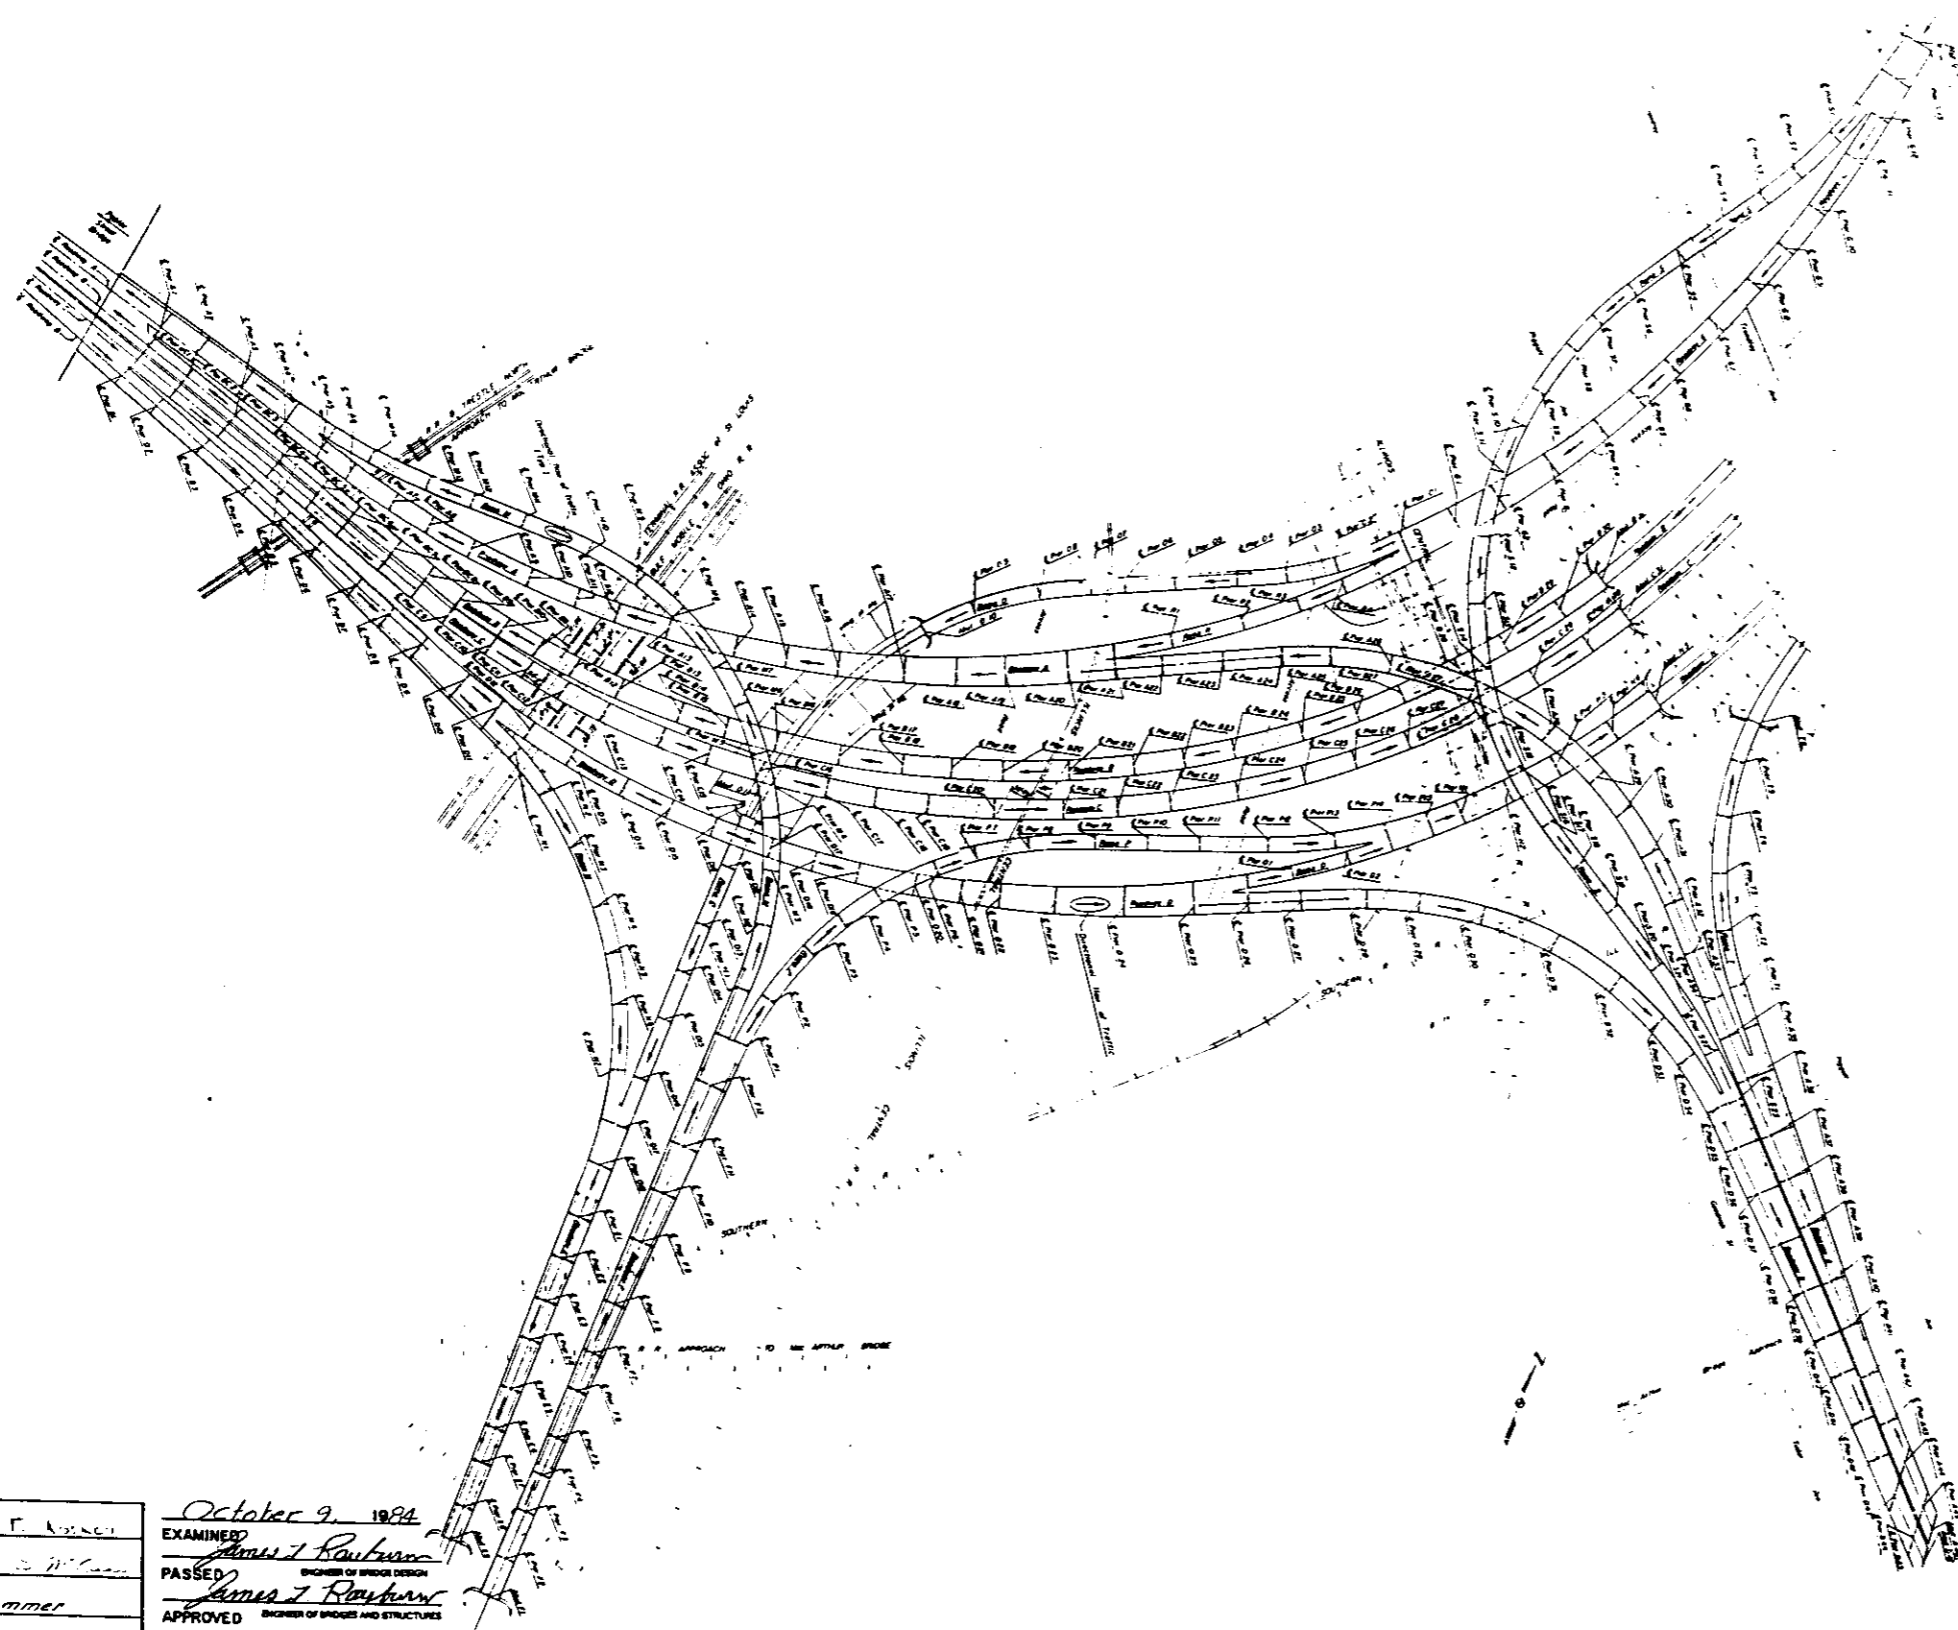

TOTAL BILL OF MATERIALS.


ITEM	UNIT	TOTAL
* Pier Column Repair - Type I	Each	270
* Pier Column Repair - Type II	Each	15

* For pier locations see special provisions

DESIGNED R. F. [Signature]
 CHECKED P. [Signature]
 DRAWN R. Sommer
 CHECKED [Signature] S.F.K.

October 9, 1984
 EXAMINED [Signature]
 PASSED [Signature]
 APPROVED [Signature]
 DIRECTOR OF HIGHWAYS


GENERAL PLAN
 FA.I. RT. 70 SEC. 82-34 -- 9-5
 ST. CLAIR COUNTY

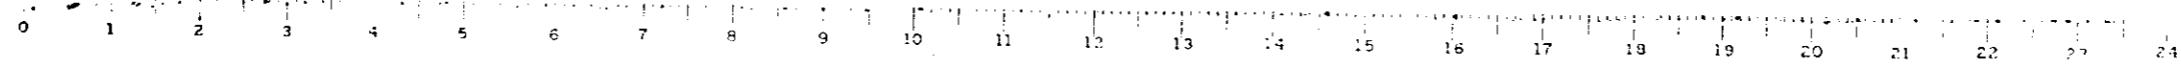



STATE OF ILLINOIS
DEPARTMENT OF TRANSPORTATION

ROUTE NO.	SECTION	COUNTY	TOTAL SHEETS	SHEET NO.
			4	2
FED. ROAD DIST. NO. 7		ILLINOIS	PER. AND PROJECT	

SHEET NO. 2
3 SHEETS

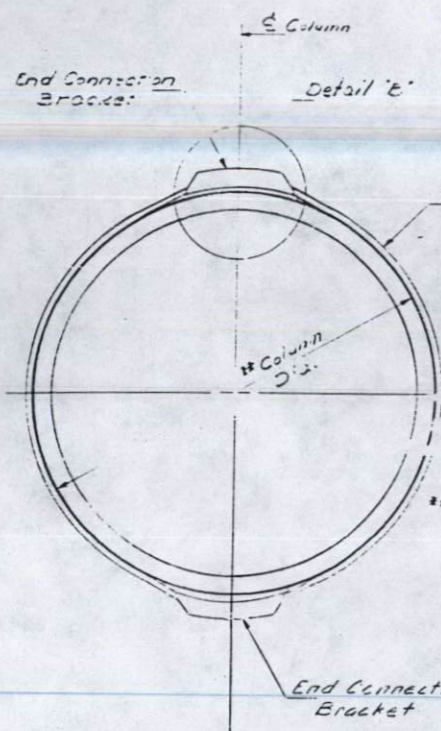

Template shall be made of the top of each column to be repaired. (See Special Provisions)

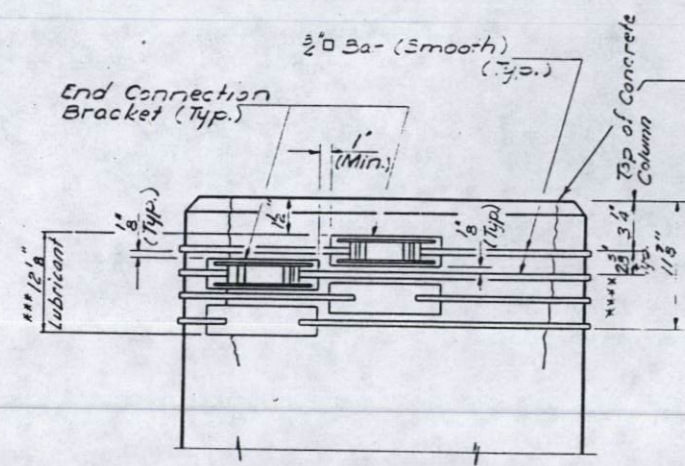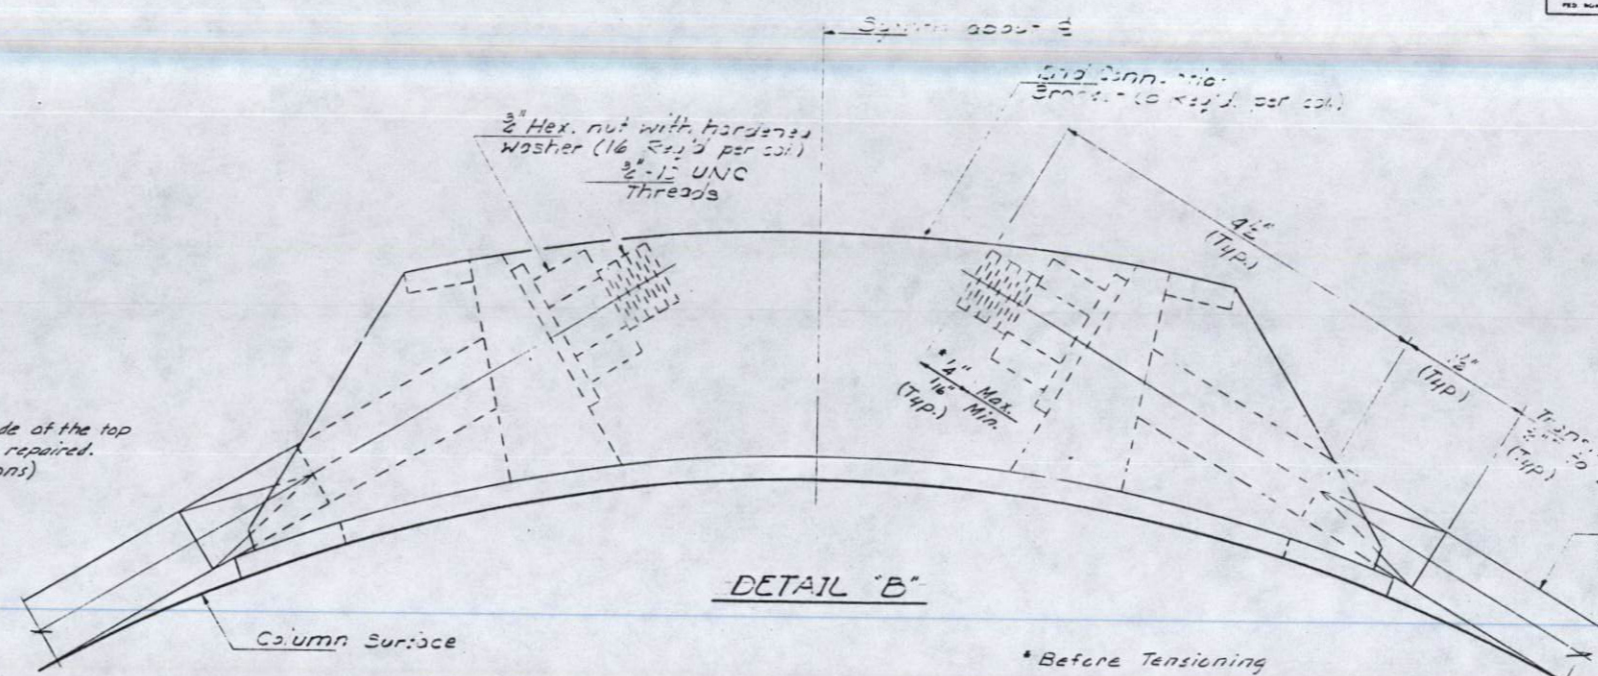


TOP OF PIER COLUMNS
For locations see Special Provisions

Clean and epoxy grout cracks before bar tensioning. See Special Provisions.

BAR TENSIONING PROCEDURE

The 3/4" bars shall be tensioned in sequence from the bottom bar to the top bar. Each bar shall be tensioned by tightening the nuts to the given torques according to the following sequence:

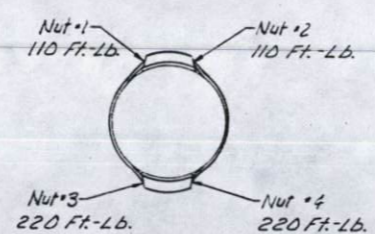

After tightening all four nuts on a bar they shall all be checked for 220 Ft.-Lb. Torque according to the same above sequence. The Engineer shall then verify the 220 Ft.-Lb. torque on all the nuts and the threads shall be set.

QUANTITY OF STRUCTURAL STEEL PER COLUMN IN LBS.

COL. DIA.	AASHTO M-223	AISI 4140	TOTAL
4'-0"	113	16	219
4'-6"	113	108	226
5'-0"	113	120	236
5'-6"	113	132	250
6'-0"	113	144	262
6'-6"	113	156	274
7'-0"	117	168	285

All Structural Steel is incidental to "Pier Column Repair - Type I" or "Pier Column Repair - Type II" as applicable.


GENERAL NOTES

- End Connection Bracket shall conform to the requirements of A.A.S.H.T.O. M 223 Grade 50.
- The 3/4" bar shall conform to the requirements of AISI 4140, quenched and tempered to a minimum yield strength of 120,000 psi. and a maximum yield strength of 120,000 psi.
- The hardened washer shall conform to the requirements of A.S.T.M. F-436.
- The end connection brackets, 3/4" bars, nuts and washers shall receive one shop coat of red lead paint and two shop coats of aluminum paint.
- The 3/4" hex. nut shall conform to the requirements of A.S.T.M. A-563, Grade DH.
- Plan dimensions and details relative to existing structure have been taken from existing plans and are subject to nominal construction variations. It shall be the Contractor's responsibility to verify such dimensions and details in the field and make necessary approved adjustments prior to construction or ordering of materials. Such variations shall not be cause for additional compensation for a change in the scope of the work.
- Concrete surfaces to receive Post-Tensioning System shall be smoothed by stoning or grinding as required to eliminate projections.

POST-TENSIONING SYSTEM
PIER COLUMNS - REPAIR
I.A.S. RT. 70 SEC. 82-34V3-R-5
ST. CLAIR COUNTY

DESIGNED R. F. COLLINS
CHECKED R. S. M. COLLINS
DRAWN J. SCHNEIDER
CHECKED P. M. R. F. COLLINS

October 9 1984
EXAMINED James J. Rauburn
PASSED James J. Rauburn
APPROVED James J. Rauburn
DIRECTOR OF HIGHWAYS

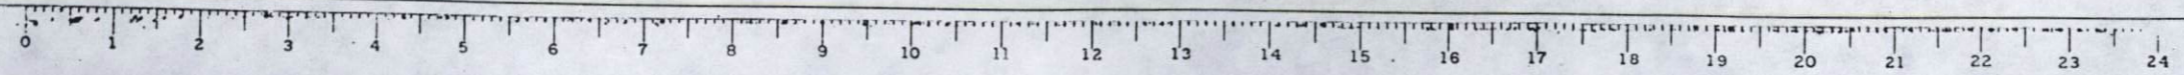

STATE OF ILLINOIS
DEPARTMENT OF TRANSPORTATION

ROUTE NO.	SECTION	LENGTH	TOTAL SHEETS	SHEET NO.
			3	3

SHEET NO. 3
3 SHEETS



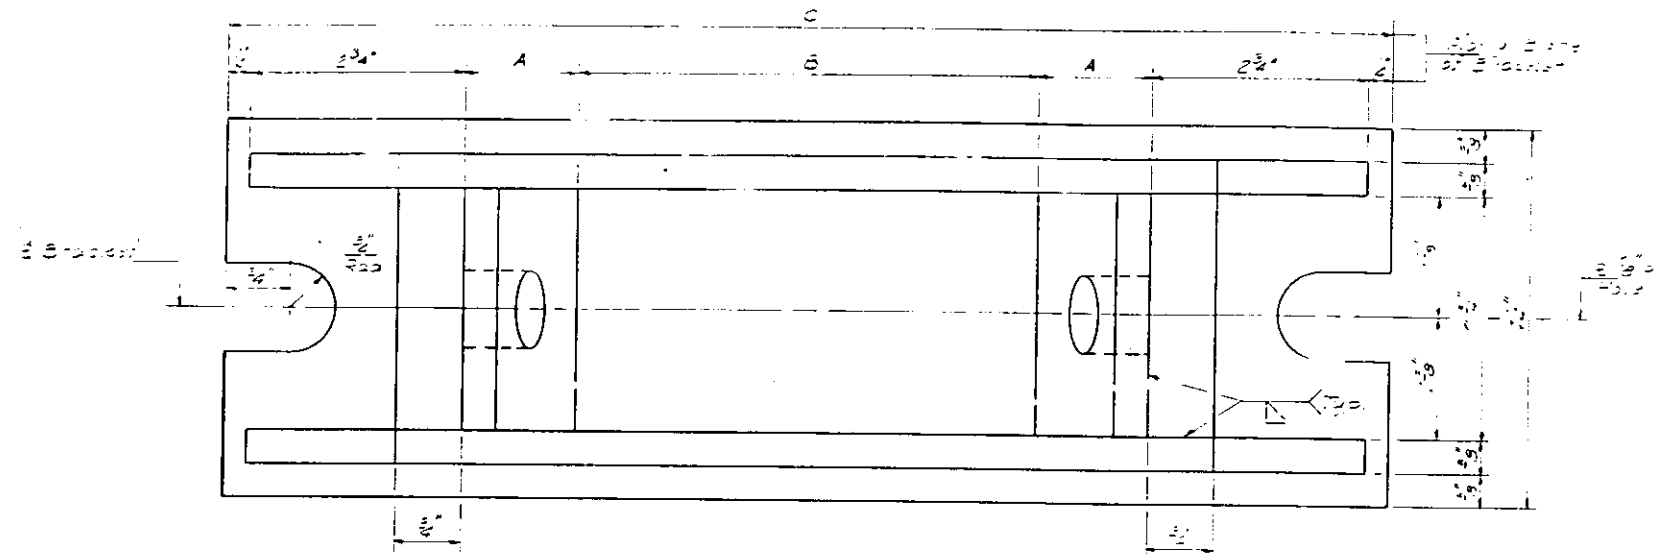


TABLE OF DIMENSIONS

COL. DIA.	A	B	C	D	E	F	G	H
4'-0"	1 3/4"	2 3/4"	13'5"	1 3/4"	1 1/2"	6'-20'30"	24"	26 3/4"
6'-6"	1 3/8"	5"	13'6"	1 3/8"	1 1/4"	10'-50'-23"	27"	29 3/4"
5'-0"	1 3/8"	5"	13'5"	1 3/8"	1"	15'-29'-01"	30"	32 3/4"
5'-6"	1 5/8"	5"	13'5"	1 1/4"	1"	14'-46'-31"	33"	35 3/4"
6'-0"	1 5/8"	5"	13'5"	1 1/4"	1"	4'-14'-15"	36"	38 3/4"
6'-6"	1 5/8"	5 3/8"	13'5"	1 5/8"	1 3/8"	13'-45'-10"	39"	41 3/4"
7'-0"	1 1/4"	5 1/2"	14"	1 5/8"	1 5/8"	13'-09'-07"	42"	44 3/4"

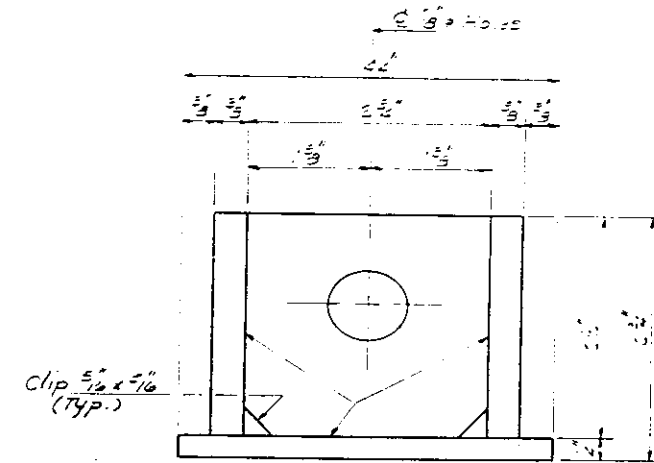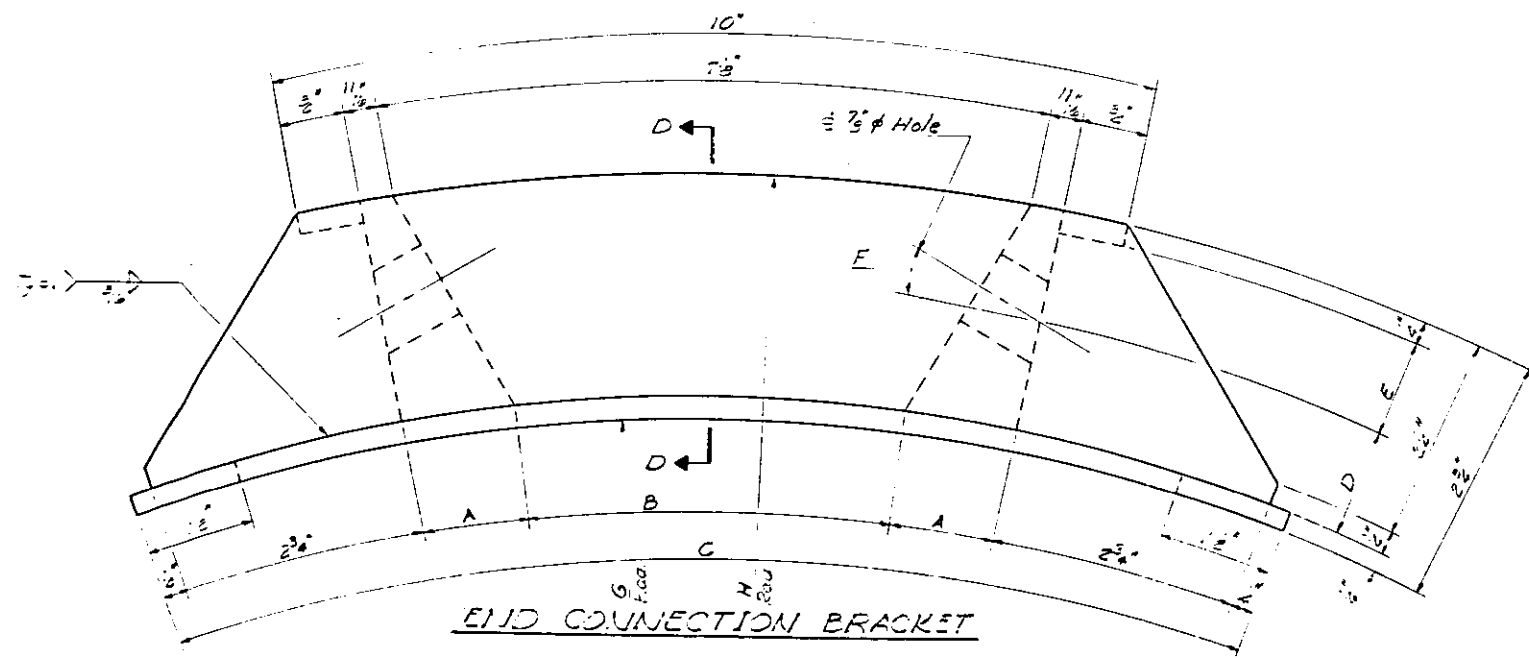


SECTION D-D

DESIGNED R. F. KELLE
CHECKED Paul S. McCombs
DRAWN J. SCHNELLER
CHECKED DSM LFA

October 9 1984
EXAMINED James T. Roeburn
APPROVED James T. Roeburn
DIRECTOR OF HIGHWAYS


END CONNECTION BRACKET
POST-TENSIONING SYSTEM
PIER COLUMNS REPAIR
S.A. RT. 70 SEC. 82-34VB-R-5
ST. CLAIR COUNTY

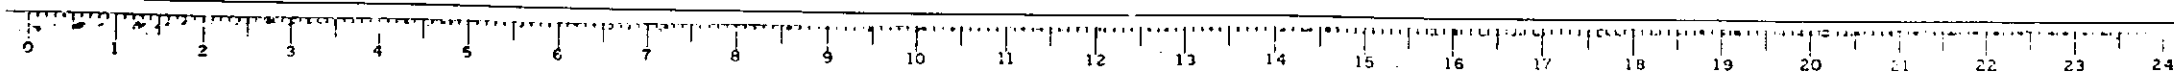

STATE OF ILLINOIS
DEPARTMENT OF TRANSPORTATION

F.A.I. ROUTE NO.	SEC.	COUNTY	TOTAL SHEETS	SHEET NO.
70	*	St. Clair	4	1
F.A.I. PROJ. NO.		RANGE	PROJECT	
			*82-3HVB-R-4	

P-98-066-82

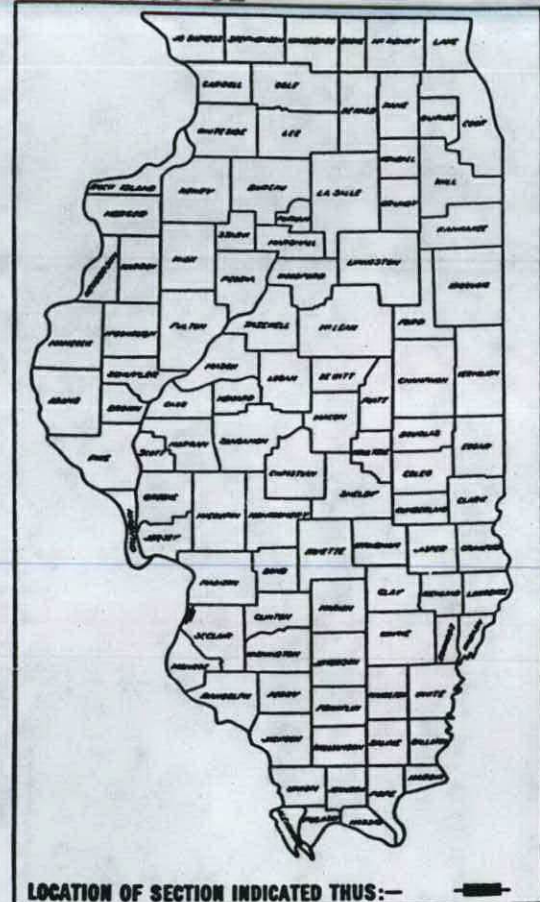

PLANS FOR PROPOSED
FEDERAL AID HIGHWAY

F.A.I. ROUTE 70
SECTION 82-3HVB-R-4
PROJECT IR-70-1(141)0
ST. CLAIR COUNTY

C-98-074-83

INDEX

1. TITLE SHEET and SUMMARY OF QUANTITIES
2. GENERAL PLAN
3. POST-TENSIONING SYSTEM and GENERAL NOTES
4. END CONNECTION BRACKET

STANDARDS:


- 2298-7
- 2299-10
- 2300-3
- 2307-6

SUMMARY OF QUANTITIES

CODE NO.	PAY ITEM	UNIT	QUANTITY *
X04748	MOBILIZATION	L SUM	1
X07723	PIER COLUMN REPAIR, TYPE I	EACH	80
X07724	PIER COLUMN REPAIR, TYPE II	EACH	28

* CONSTRUCTION TYPE CODE Y007

THIS PROJECT CONSISTS OF THE PIER
CAP REPAIR AT VARIOUS LOCATIONS
IN THE POPLAR STREET COMPLEX.

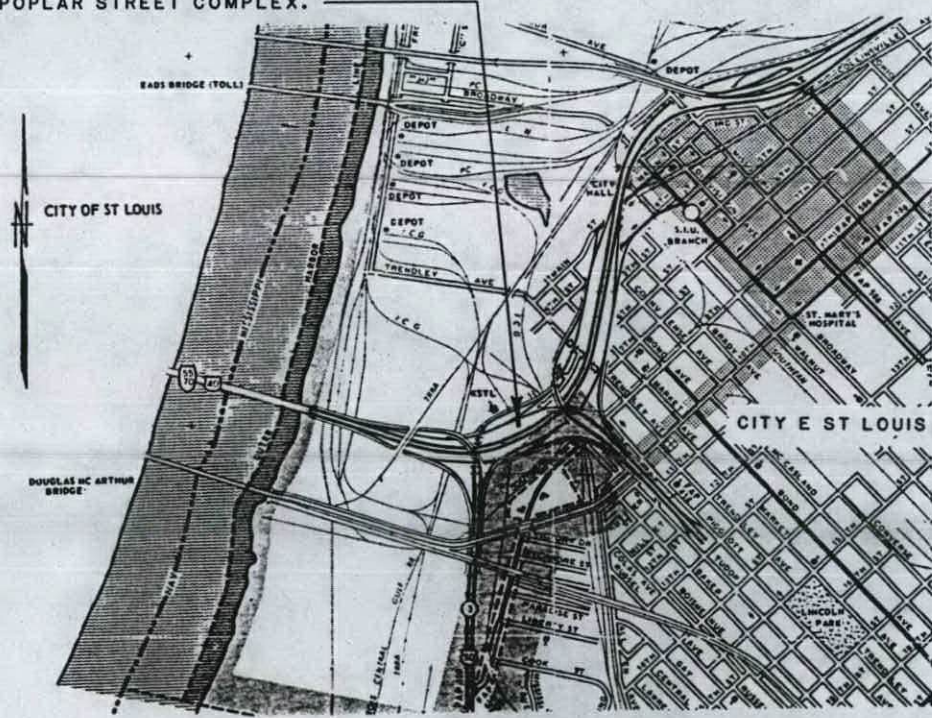

MICROFILMED _____
REEL NUMBER _____
AWARDED _____
RESIDENT ENGINEER _____
AS BUILT CHANGES WERE MADE
ON THE FOLLOWING SHEETS

STATE OF ILLINOIS
DEPARTMENT OF TRANSPORTATION

SUBMITTED: 1/29 1984
EXAMINED: 2-3 1984
PASSED: 2-3 1984
APPROVED: [Signature] DIRECTOR OF HIGHWAYS

DEPARTMENT OF TRANSPORTATION
FEDERAL HIGHWAY ADMINISTRATION

APPROVED: _____ DATE: _____
DIVISION ADMINISTRATOR




0 1200 2400
Scale 1" = 1200'

CONTRACT NO. 36877



STATE OF ILLINOIS
DEPARTMENT OF TRANSPORTATION


DATE	SECTION	PROJECT	TOTAL SHEETS	SHEET NO.
AUG 10	*	ST. CLAIR	4	3
SHEET NO. 2		3 SHEETS		
82-3HVB-R-4				

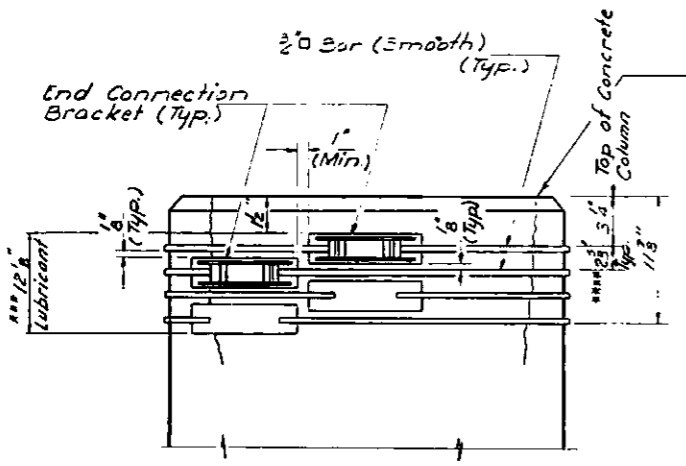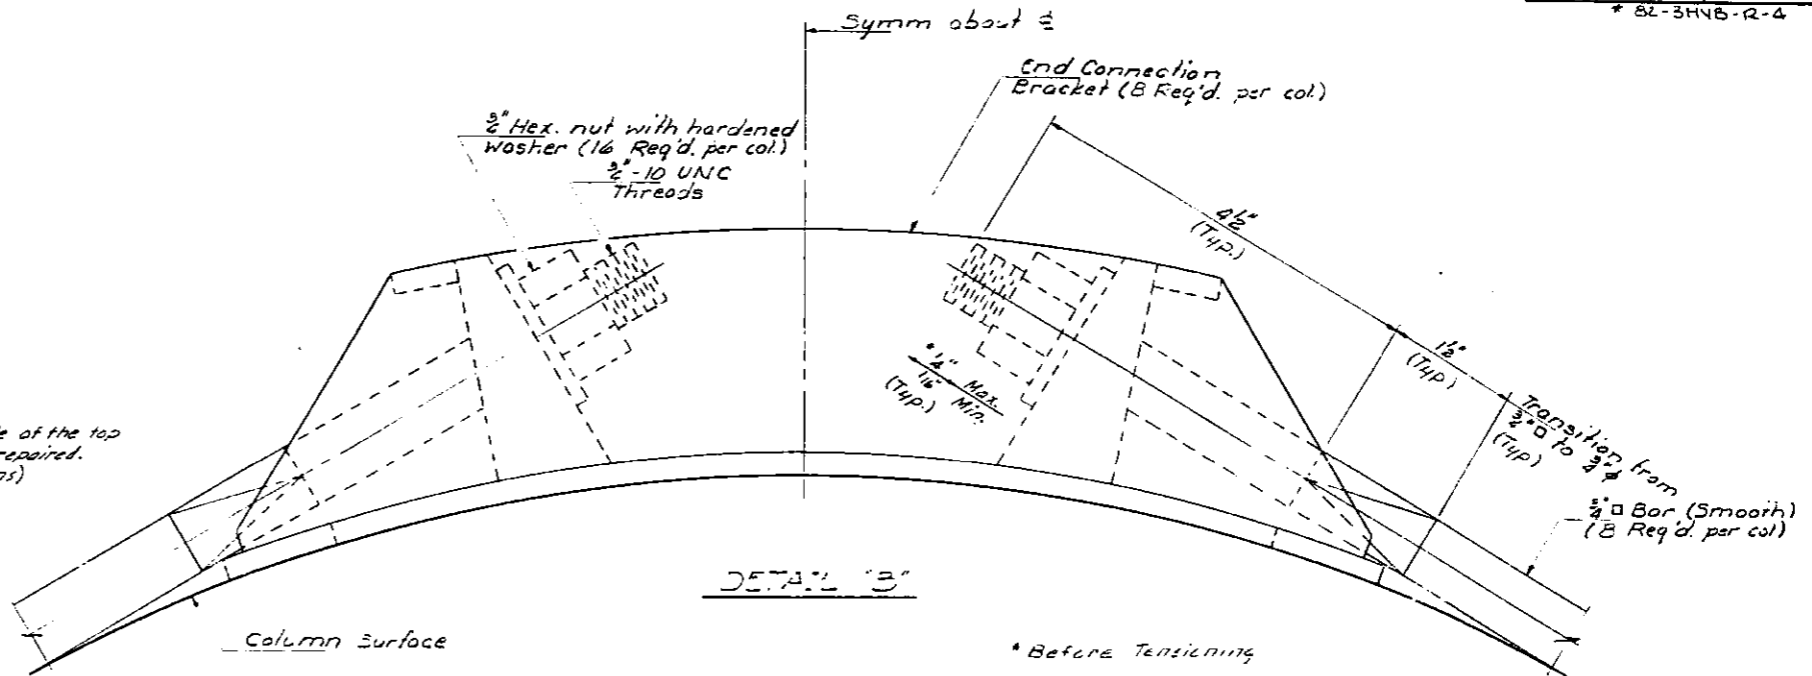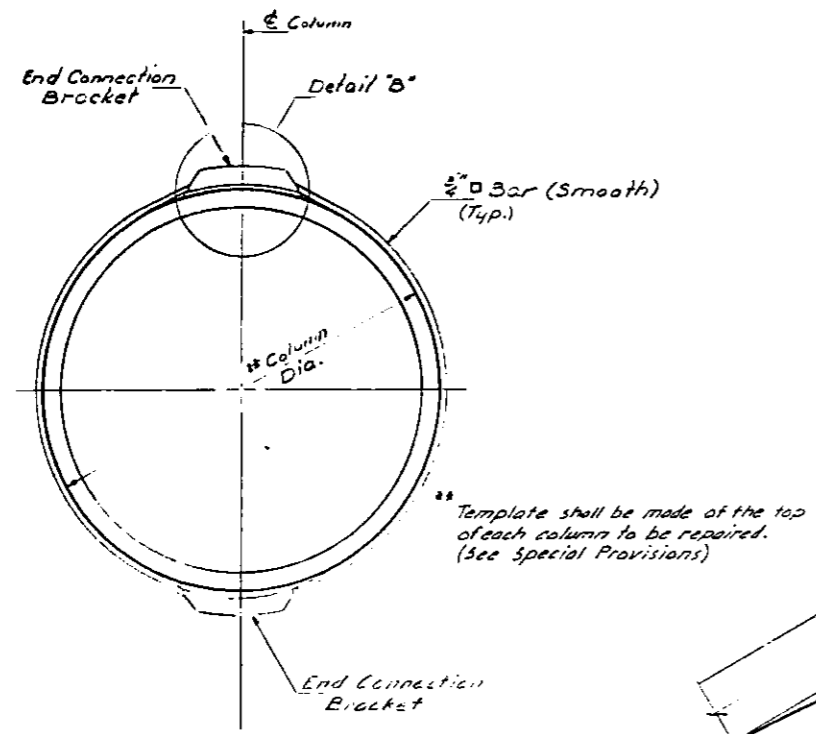

Clean and epoxy grout cracks before bar tensioning. See Special Provisions.

BAR TENSIONING PROCEDURE

The 3/4 inch bars shall be tensioned in sequence from the bottom bar to the top bar. Each bar shall be tensioned by tightening the nuts to the given torques according to the following sequence:

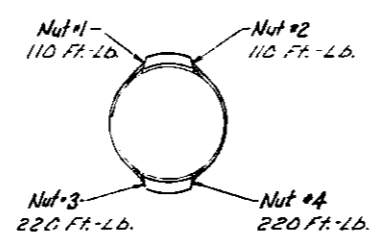

After tightening all four nuts on a bar they shall all be checked for 220 Ft.-Lb. Torque according to the same above sequence. The Engineer shall then verify the 220 Ft.-Lb. torque on all the nuts and the threads shall be set.

QUANTITY OF STRUCTURAL STEEL PER COLUMN IN LBS.

COL. DIA.	AASHTO M-223	AISI 4140	TOTAL
4'-0"	113	96	210
4'-6"	113	108	226
5'-0"	113	120	238
5'-6"	113	132	250
6'-0"	113	144	262
6'-6"	113	156	274
7'-0"	117	168	285

All Structural Steel is incidental to "Pier Column Repair - Type I" or "Pier Column Repair - Type II" as applicable.

TOP OF PIER COLUMNS
For locations see Special Provisions

*** A petroleum base lubricant approved by the Engineer shall cover the entire surface area between the 3/4 inch bars and the concrete surface. This shall be accomplished by placing lubricant on the concrete surface in the area shown around the entire circumference of the column.

**** The spacing of the Post-Tensioning bars shall be maintained throughout the perimeter of the Columns, as shown, by using templates.

GENERAL NOTES

Concrete surfaces to receive Post-Tensioning System shall be smoothed by sanding or grinding as required to eliminate projections.
End Connection Bracket shall conform to the requirements of A.A.S.H.T.O. M223 Grade 50.
The 3/4 inch bar shall conform to the requirements of AISI 4140, quenched and tempered to a minimum yield strength of 120,000 psi. and a maximum yield strength of 120,000 psi.
The hardened washer shall conform to the requirements of A.S.T.M. F-436.


The end connection brackets, 3/4 inch bars, nuts and washers shall receive one shop coat of red lead paint and two shop coats of aluminum paint.

The 3/4 inch hex. nut shall conform to the requirements of A.S.T.M. A-563, Grade D.H. Plan dimensions and details relative to existing structure have been taken from existing plans and are subject to nominal construction variations. It shall be the Contractor's responsibility to verify such dimensions and details in the field and make necessary approved adjustments prior to construction or ordering of materials. Such variations shall not be cause for additional compensation for a change in the scope of the work.

DESIGNED R. F. KOLLE
CHECKED R. S. M...
DRAWN J. SCHNEIDER
CHECKED P. S. ...

August 4, 1983
EXAMINED James J. Randolph
APPROVED [Signature]
DIRECTOR OF HIGHWAYS


**POST-TENSIONING SYSTEM
PIER COLUMNS REPAIR
I.A.T. RT. 70 SEC. 82-3HVB-R-4
ST. CLAIR COUNTY**

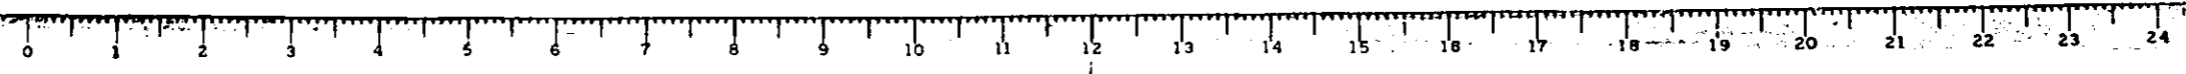

STATE OF ILLINOIS
DEPARTMENT OF TRANSPORTATION

F.A.I. ROUTE NO.	SECTION	COUNTY	TOTAL SHEETS	SHEET NO.
70	#	ST. CLAIR	4	2

Sheet No. 1
3 Sheets

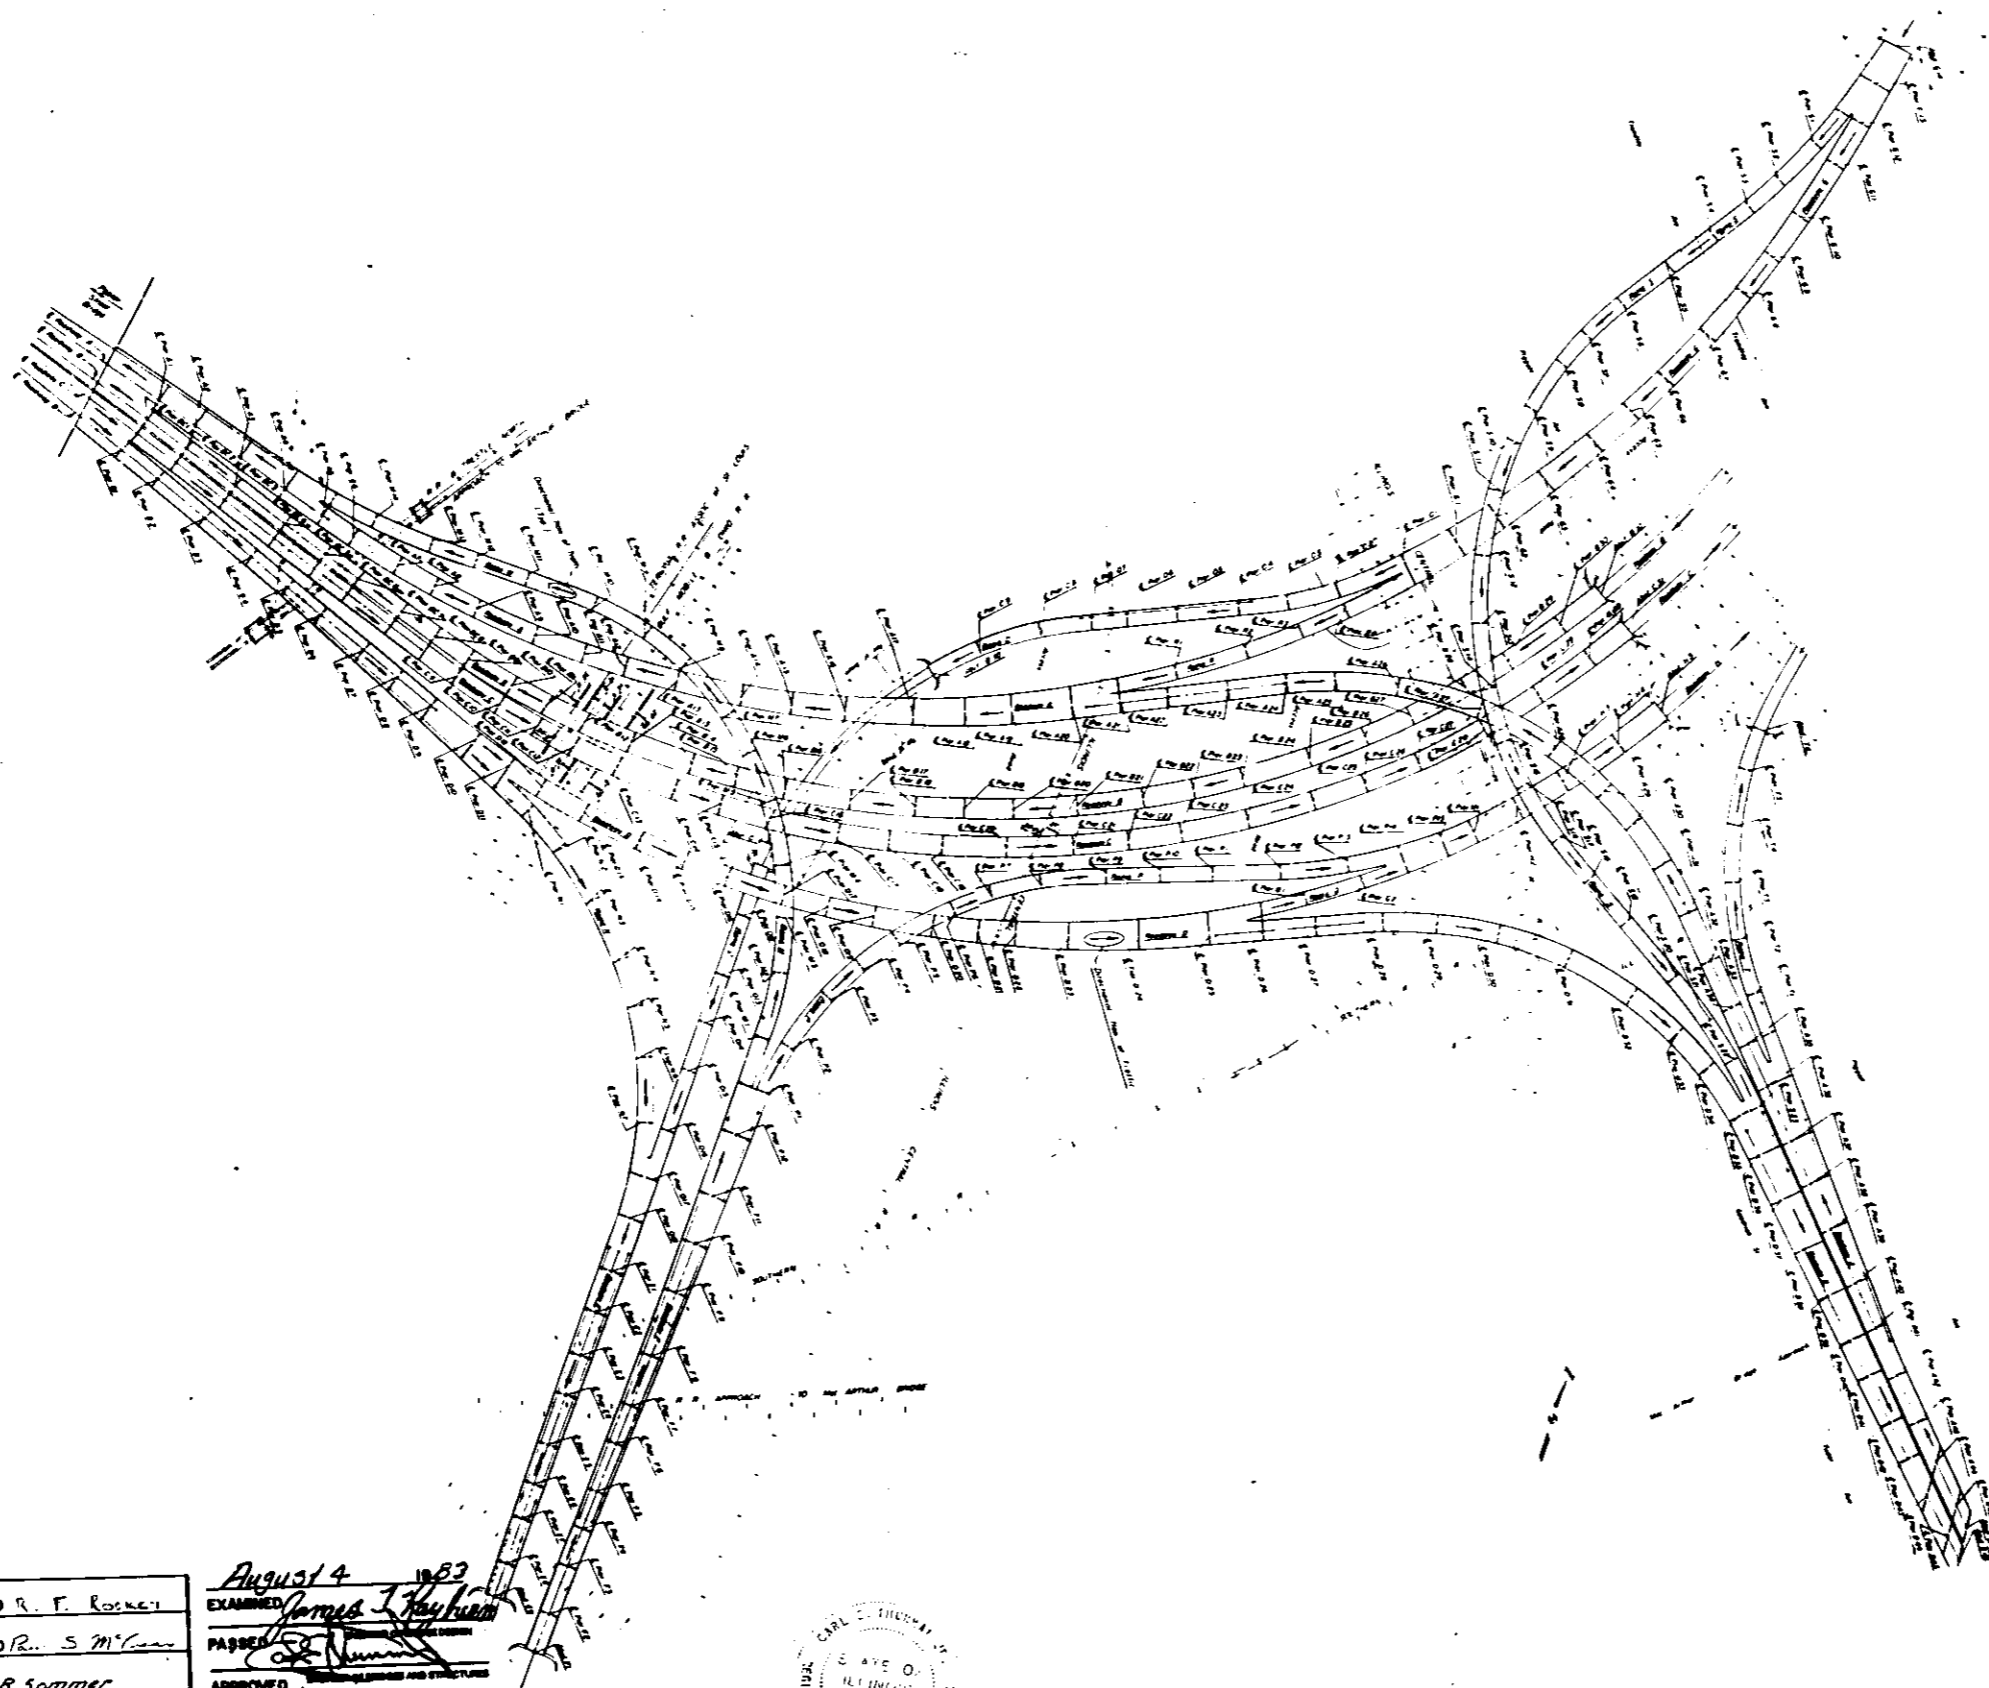

TOTAL BILL OF MATERIALS

ITEM	UNIT	TOTAL
Pier Column Repair - Type I	Each	80
Pier Column Repair - Type II	Each	25


*For pier locations see special provisions

DESIGNED R. F. ROCKEY
CHECKED R. S. McLENNAN
DRAWN R. Sommer
CHECKED R. F. ROCKEY

EXAMINED August 4 1932
PASSED
APPROVED



GENERAL PLAN
F.A.I. RT. 70 SEC. 82-3HVB-R-4
ST. CLAIR COUNTY

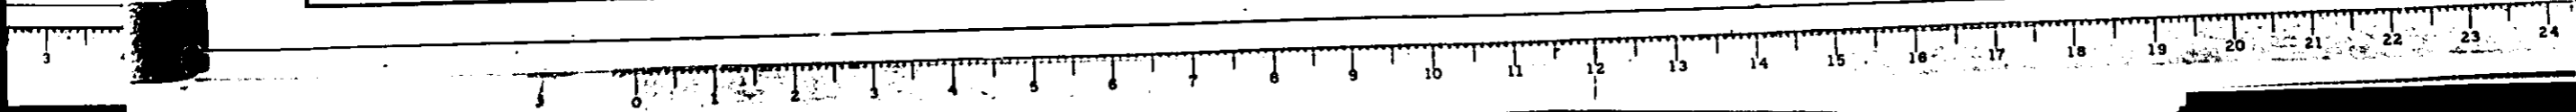



Roadway

082-0205

Illinois Department of Transportation Memorandum

JUN 2 1978

To: E. J. Kehl Attn: E. G. Wheatley

From: Thomas R. Bright By: Carl E. Thunman, Jr.

Subject: Poplar Street Repairs

Date: May 26, 1978

FAI Route 70
Section 82-3HVB-R-1
St. Clair County

FILE	
ADM. SERV.	
CONG.	
DESIGN	
EVAL. RDS.	
MAINT.	
MAT.	
PLAN.	
LAND USE	

Attached for your use are four (4) sets of seven (7) sheets of procedures and details for the repair of the girder web at Pier E7, Roadway E, Poplar Street Complex

Carl E. Thunman


RJL:baa
cc/Attach.- Dale Klohr Attn: H. Ruffner

Procedure

1. Restrict to one lane traffic.
2. Crib on both sides of bearing.
3. No construction traffic past centerline of bearing (one span only)
4. No tack welded construction accessories.
(Remove and grind smooth any existing accessories.)
5. Field drill 2 lines of $1\frac{5}{16}$ " ϕ holes in girder web, 4" to the north and $3\frac{1}{2}$ " to the south of the face of exist. brg. stiff.
(Remove paint and clean all contact surfaces for new steel and bolts.)
6. Remove bolt line (E) - See Section A-A - and install inside web splice PL's and Ls
7. Remove existing fascia bearing stiffener and horizontal stiffeners and grind web and flange areas smooth.
8. Using inside or outside web splice PL's as templates, bolt the 4' web PL to the girder.
9. Bolt bottom $3\frac{3}{4}$ " x 14" fill PL to bottom flange and L.
10. Stop all traffic and weld new bearing stiffener to the top flange of the girder and to the $3\frac{3}{4}$ " bottom fill PL and bottom flange of girder.


1 5/16" ϕ field drilled holes
 subdrilled 7/8" ϕ drilled
 1" ϕ holes for 7/8" ϕ H.S. bolts in new steel
 subpunched 7/8" ϕ reamed to 1" ϕ

3/4" (Typ.)

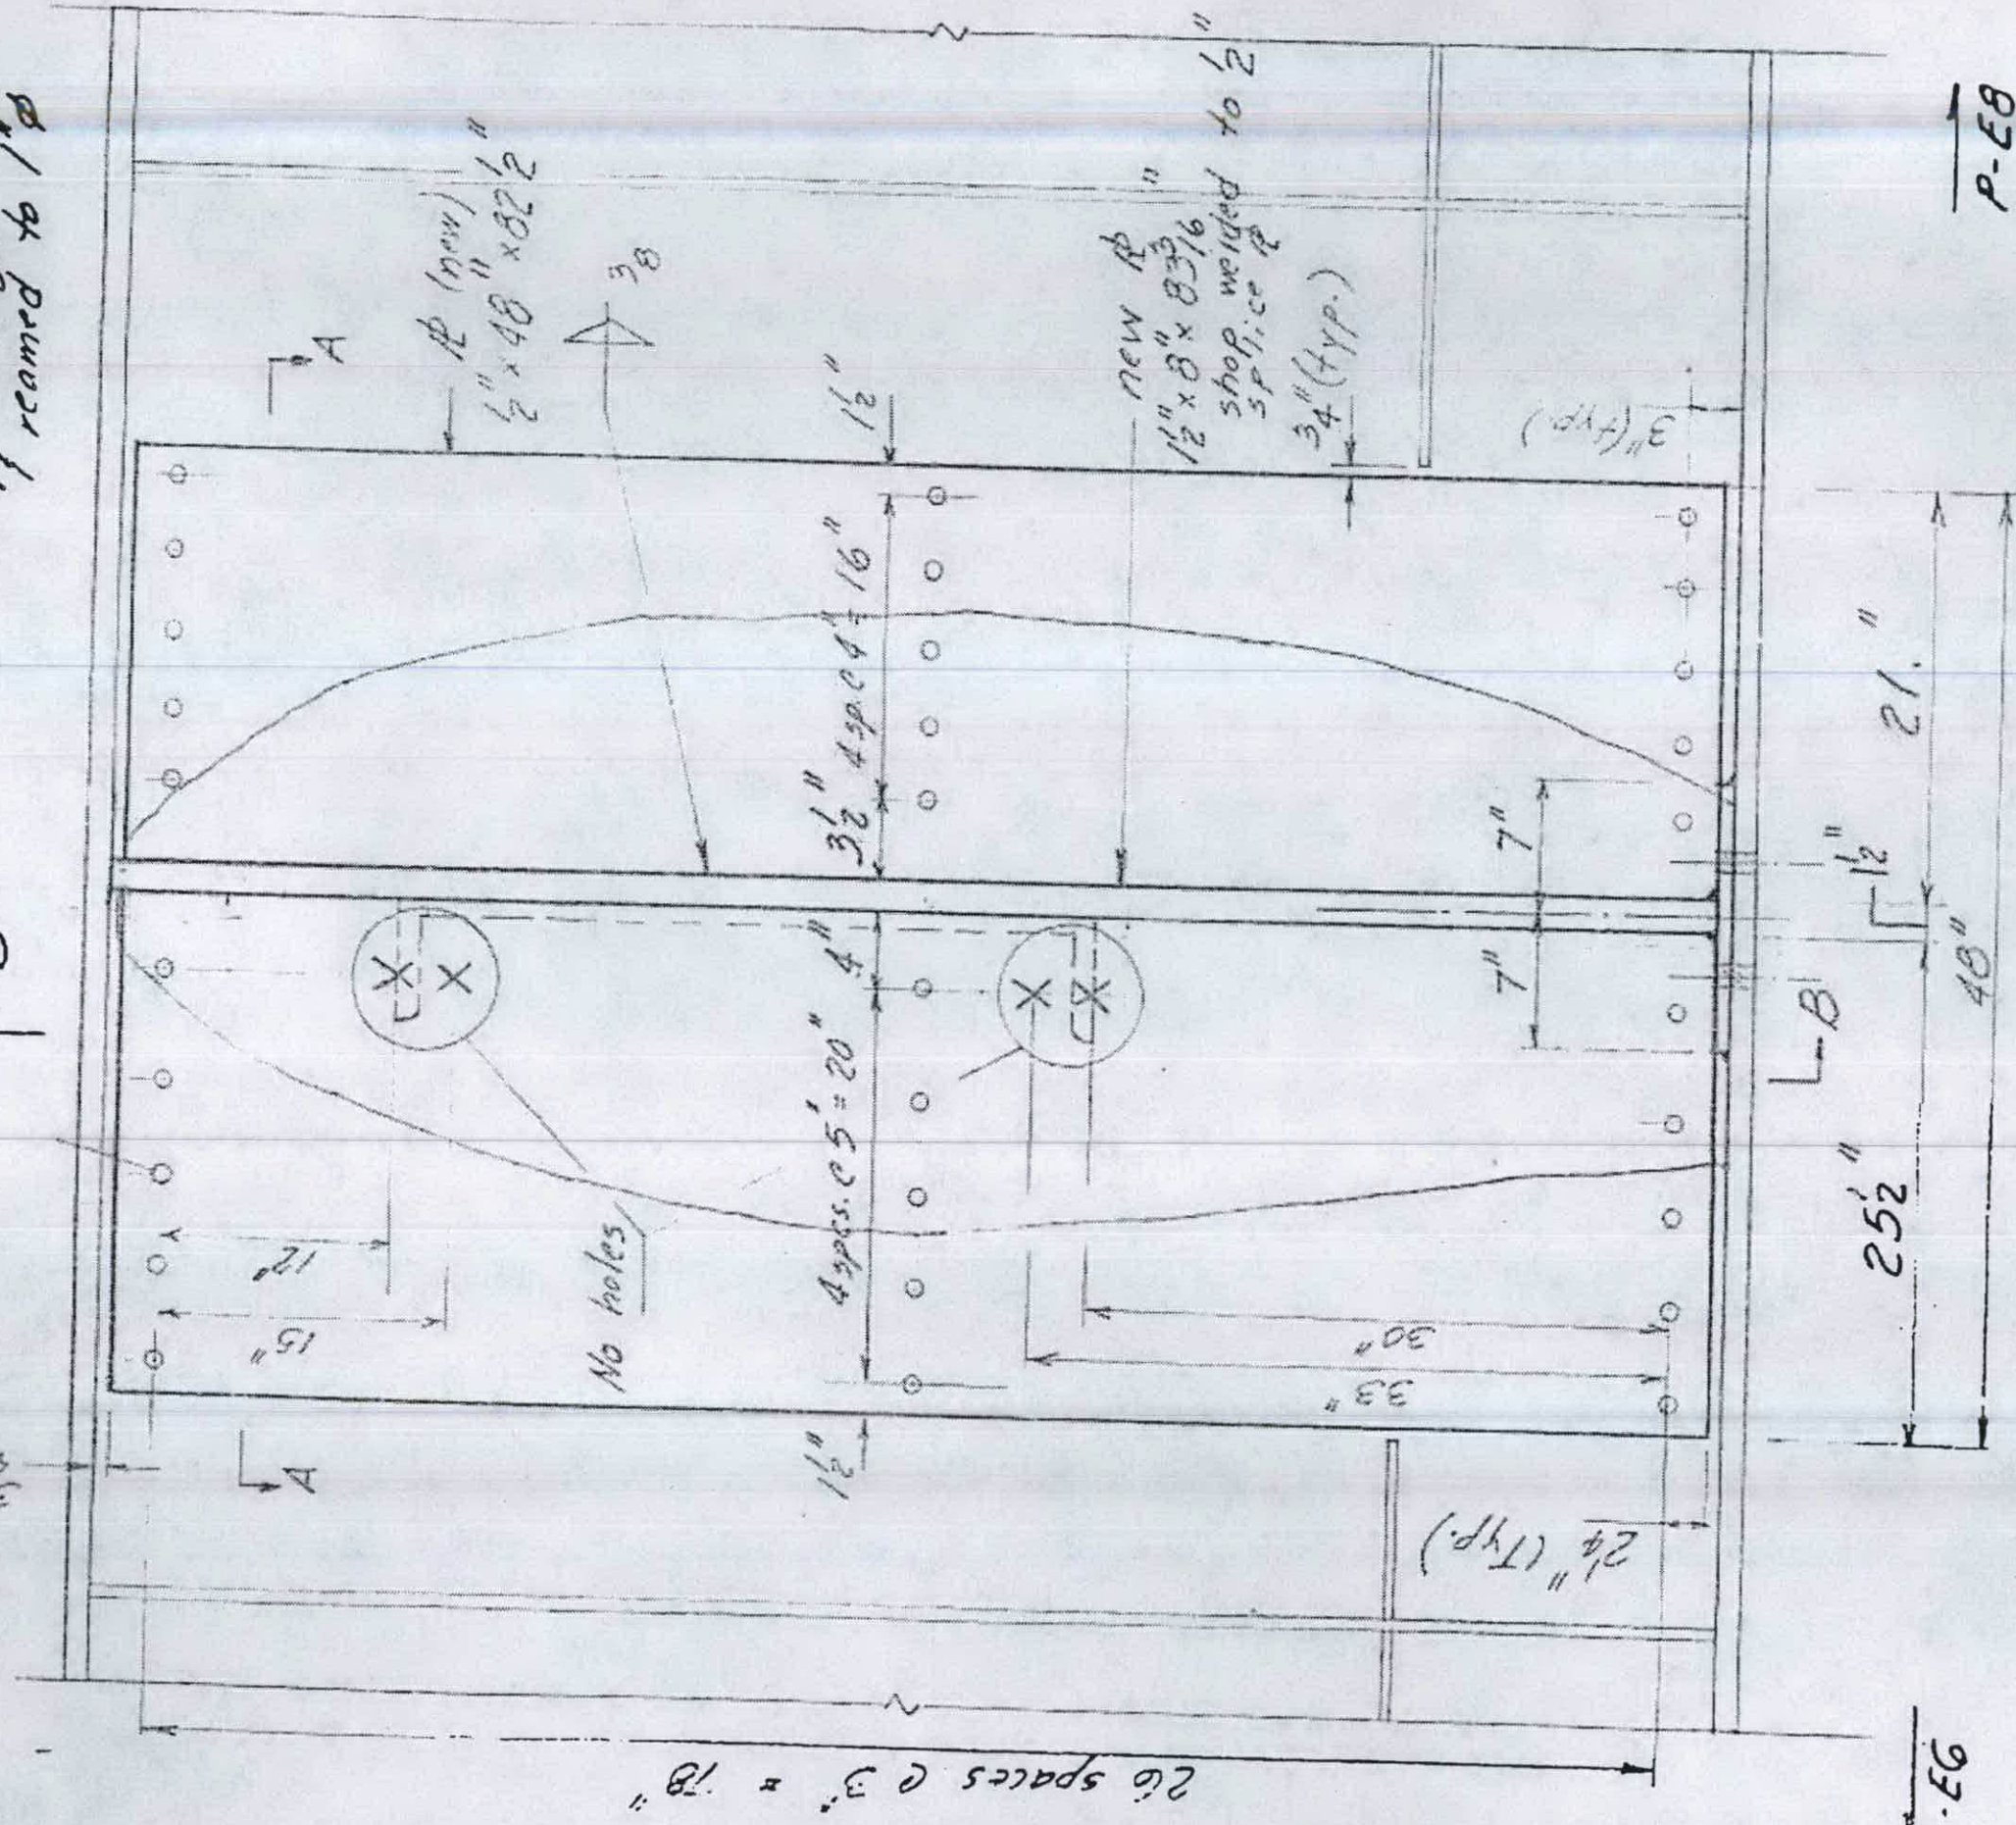


93-EG

83-D
P-EG

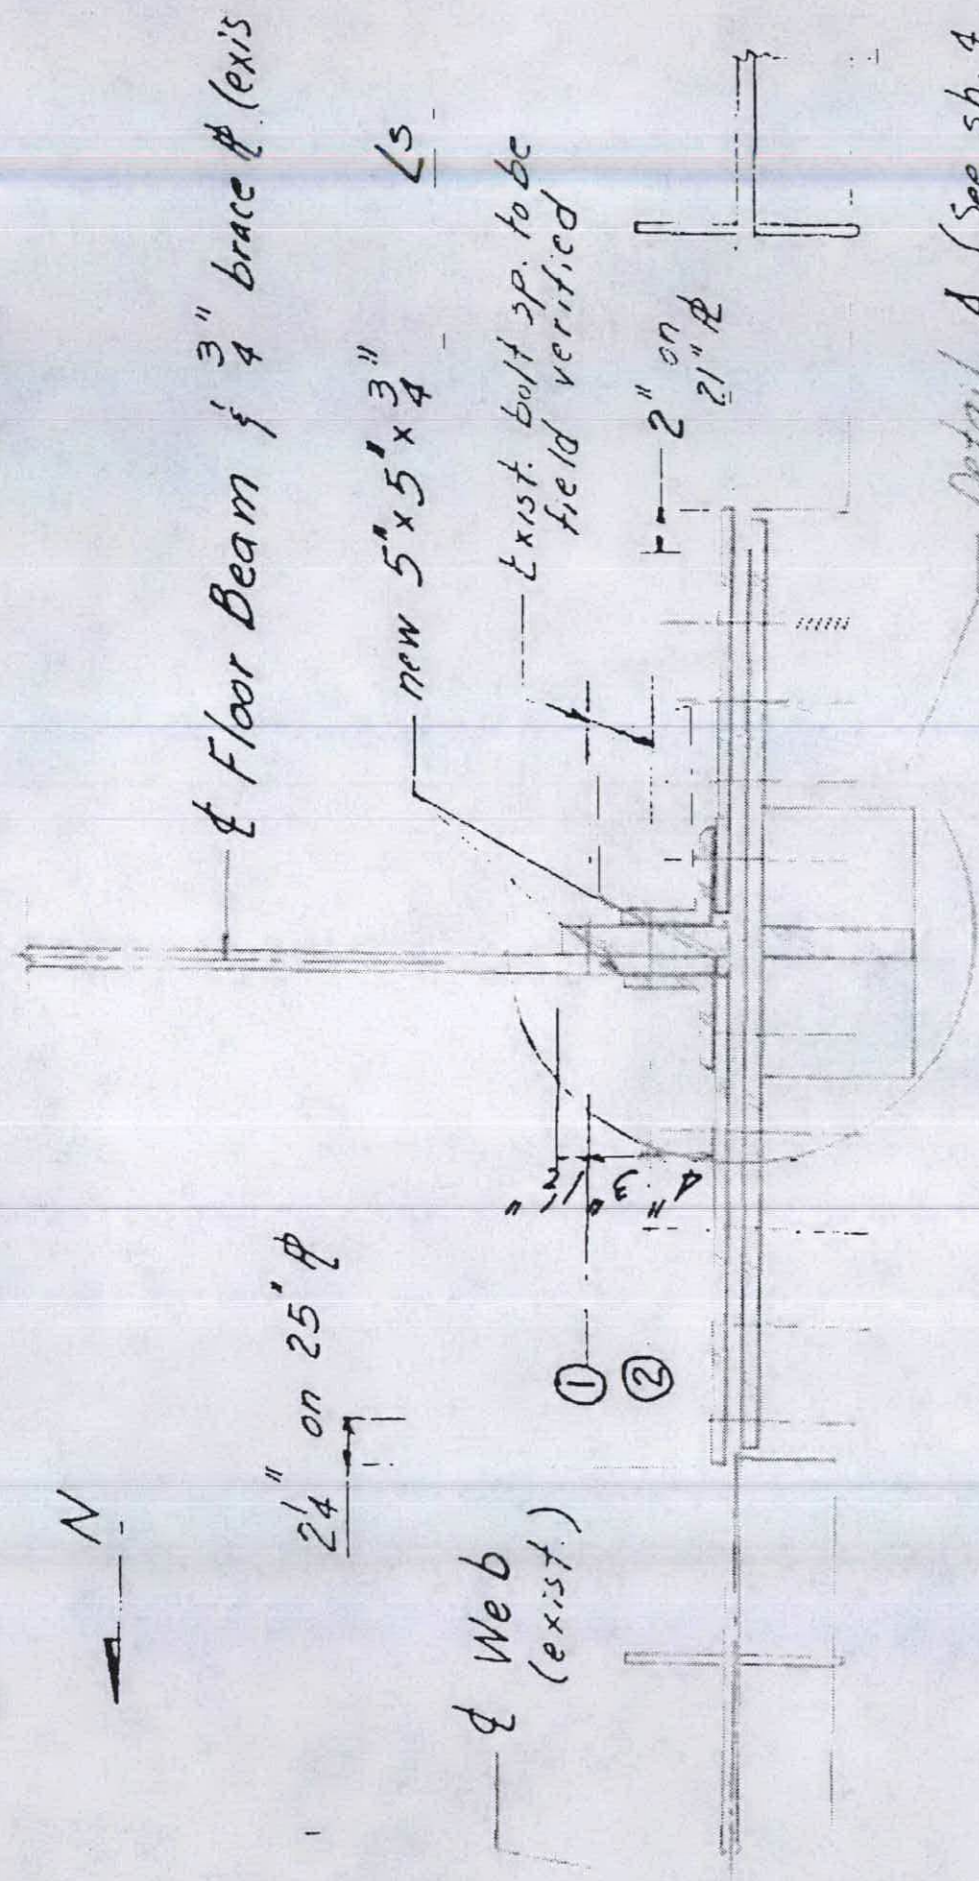


Detail A (See sh. 4,

Section A-A (See sheet 1)

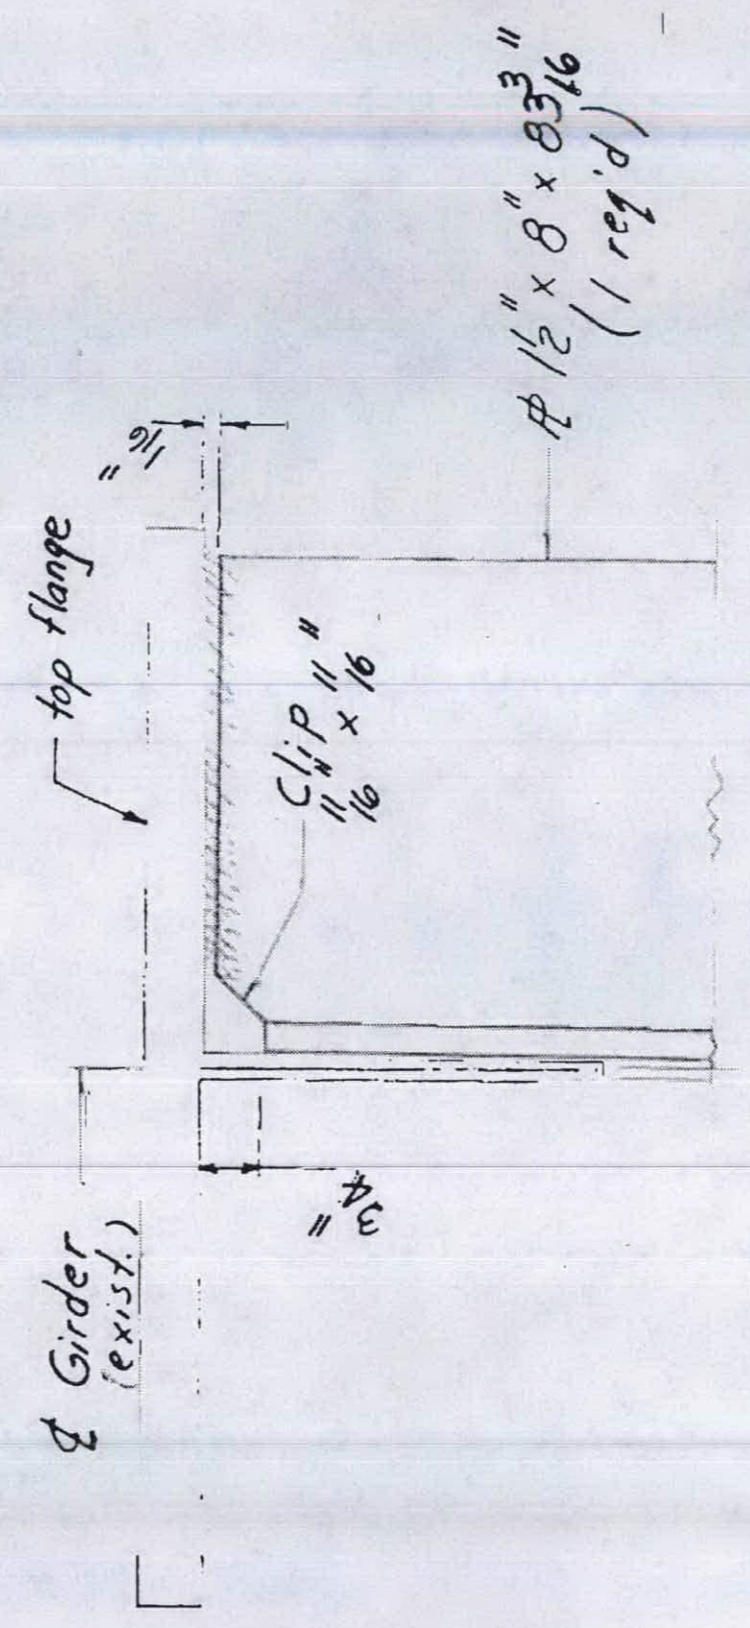

New Outside Brg. Stif. Detail

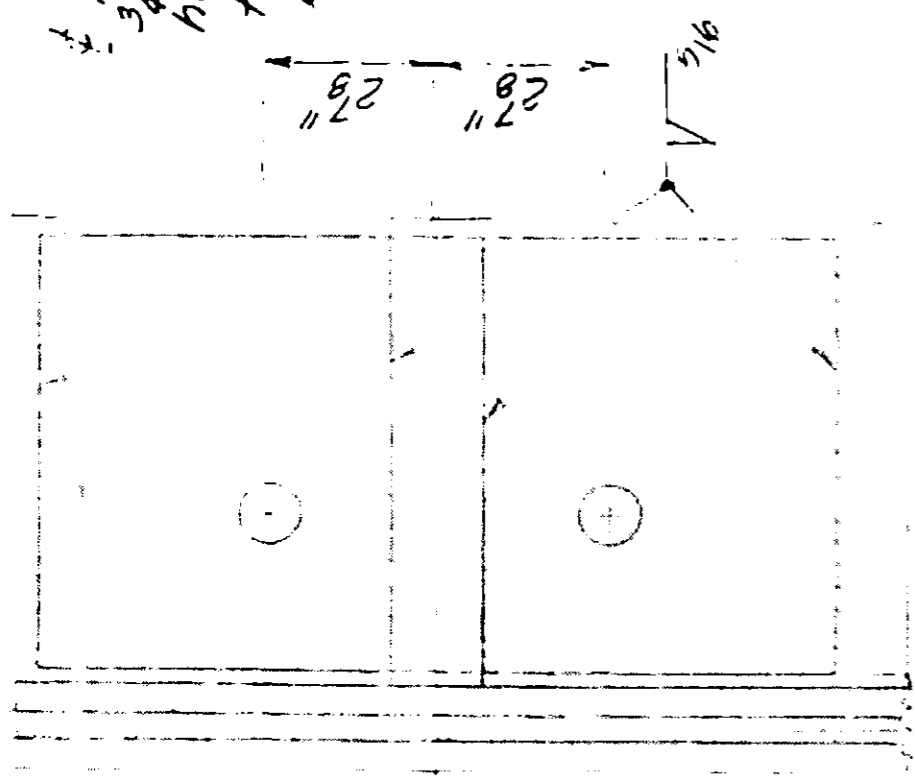


± 1/16" φ holes
 3/4" R (to match
 holes in flange
 for 1" φ H.S.)
 Bolts - three
 to be excluded
 from the
 contact
 surfaces.
 New bolts
 may be
 req'd.

Exist.
 Bot. Flange

2.15" 4.13" / 4.16"

PLAN SECTION

(New brg. stiff.)
 R 1/2" 8" x 8 3/16"
 15%
 150°F

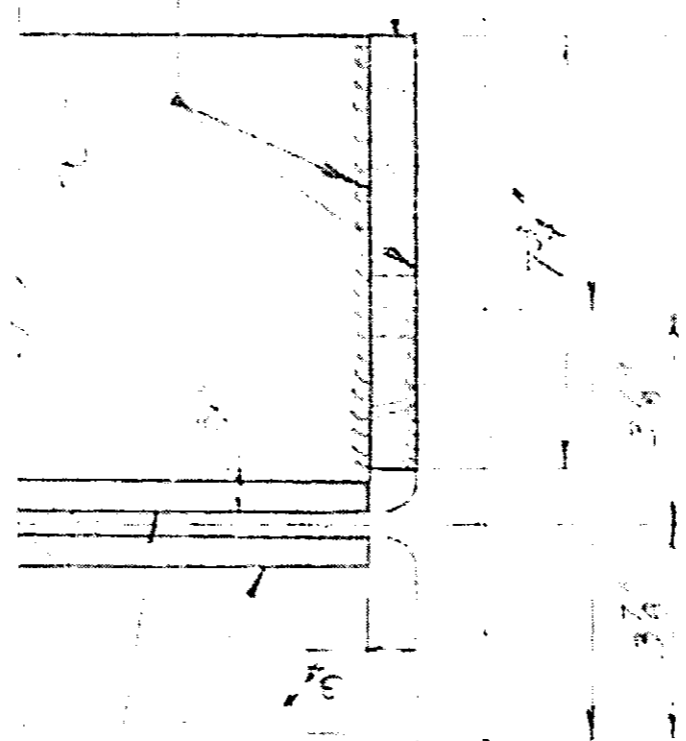


1/2" R's

- & Girder Web f & Brg.

CROSS SECTION

BEARING STIF. DETAILS AT BOT. FLANGE


Fl. brn. f 3" brace R's (Exist.)

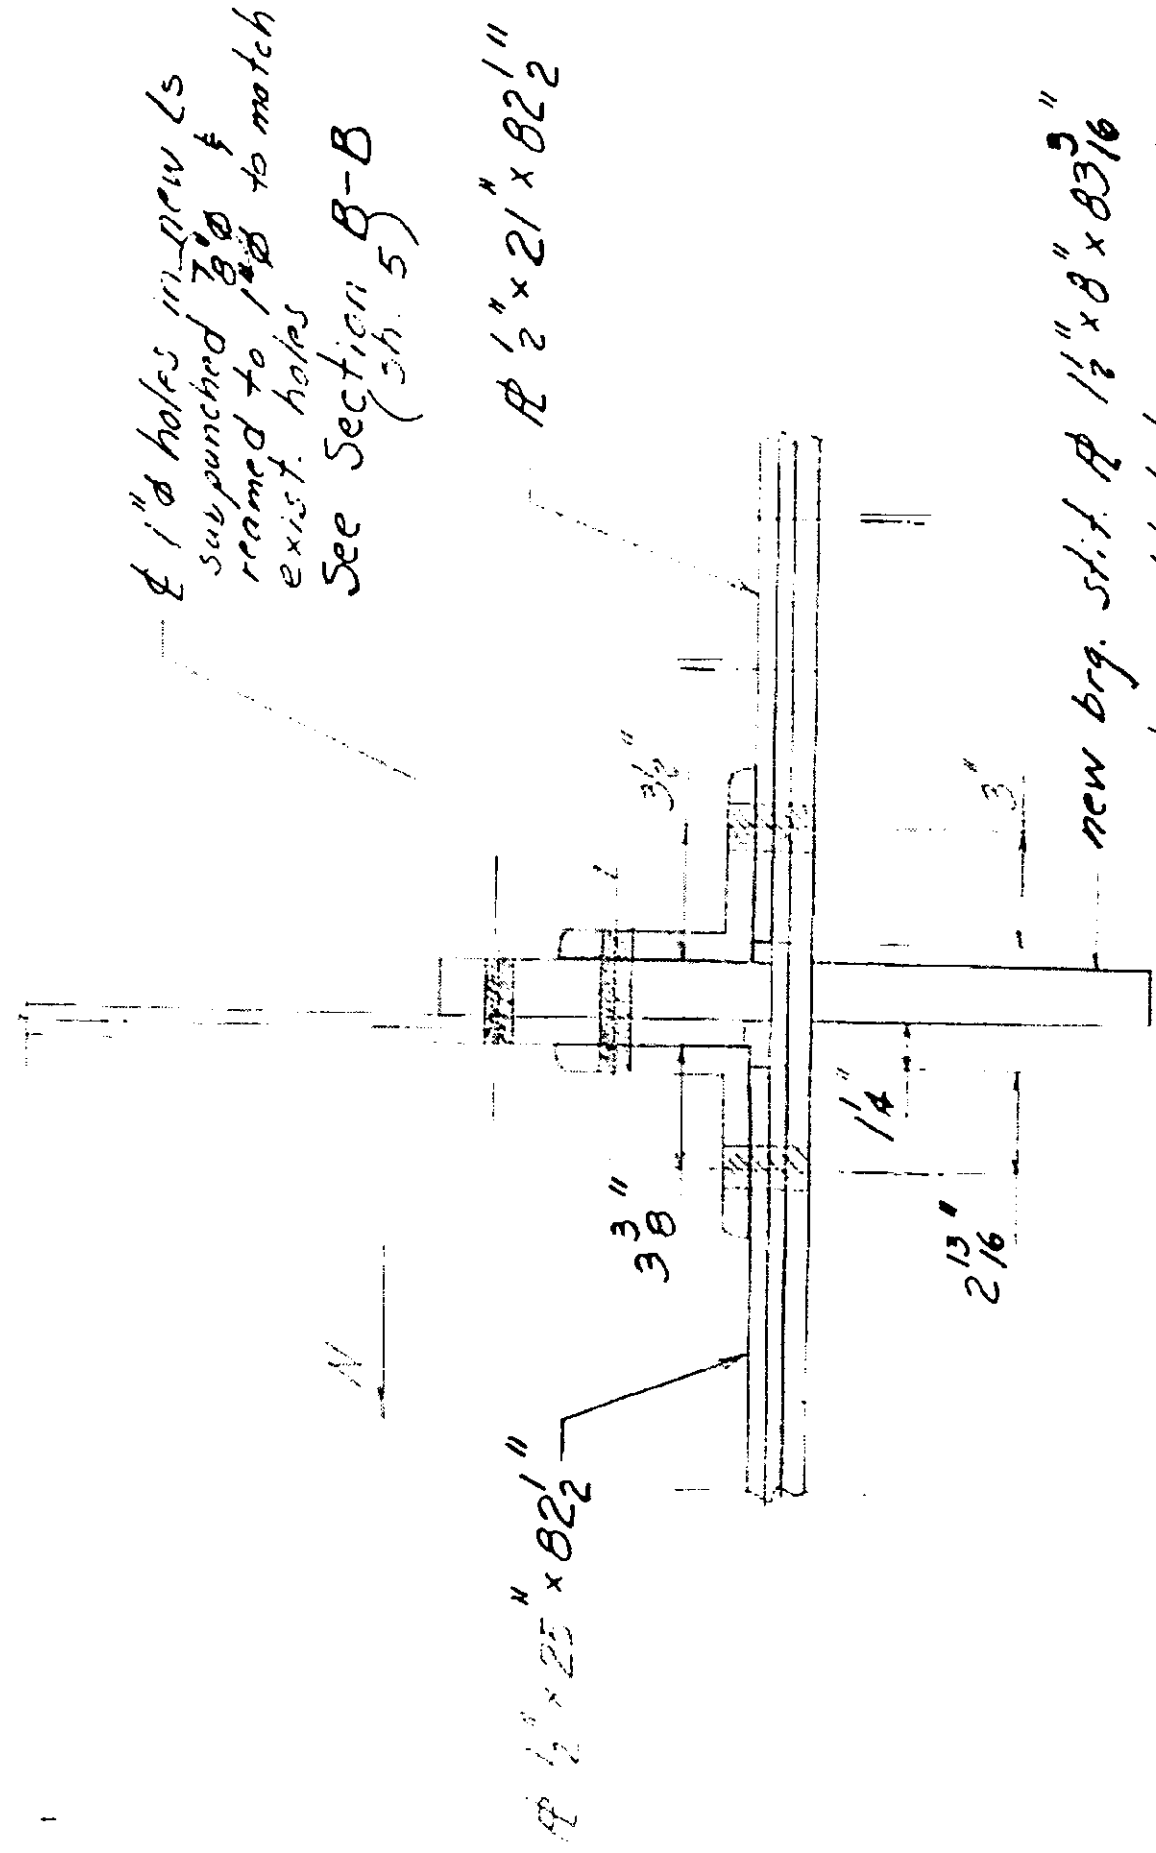

new brg. stiff. R 1 1/2" x 8" x 83 1/16"
shop welded to splice
R's f field welded to
girder flanges


DETAIL A

See sheet 2

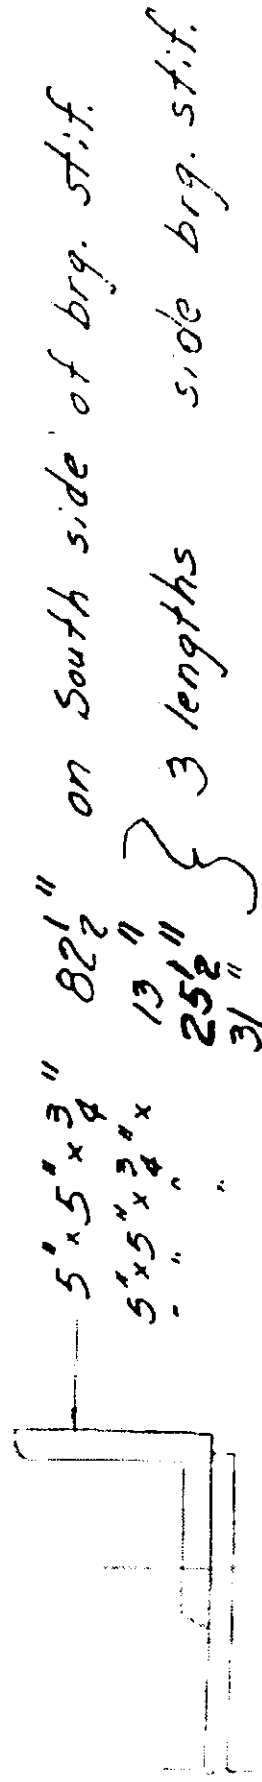

12" (Typ)

$\angle 5'5\frac{3}{4}" \times 13"$

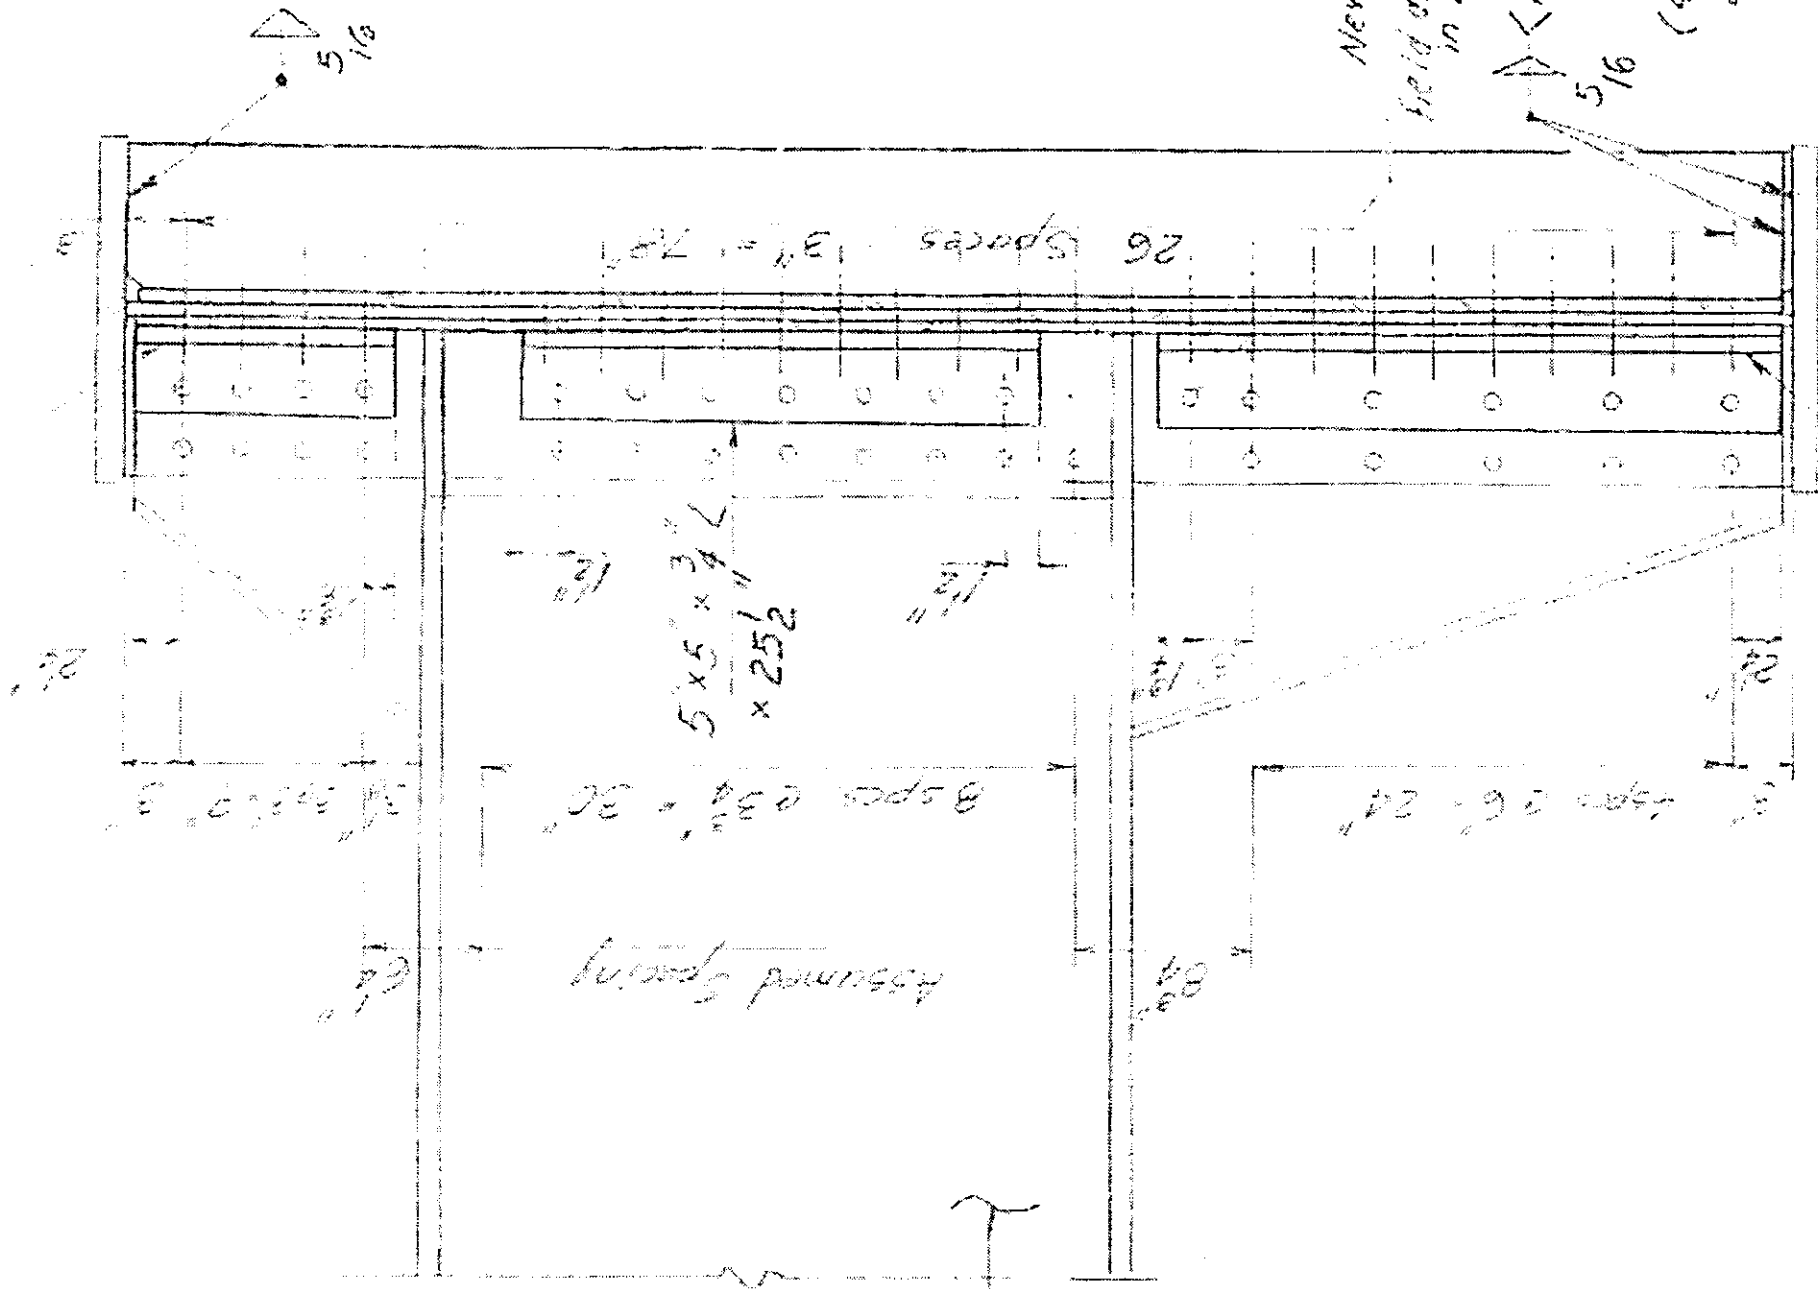

NEW $1\frac{5}{16}" \phi$
field drilled hole
in brg. R

\angle Pre-brg.
150°
5/16
(4 lines
of weld)

$5'5\frac{3}{4}" \times 25\frac{1}{2}" \angle$

Assumed Spacing
3 spcs @ 34" = 30"

3 spcs @ 6" = 24"

$\angle 5'5\frac{3}{4}" \times 31"$

SECTION B-B See sheet 1

(Looking South)


r t




Illinois Department of Transportation

Division of Highways / District 8
9300 St. Clair Avenue / Fairview Heights, Illinois / 62208

All Steel Grapes

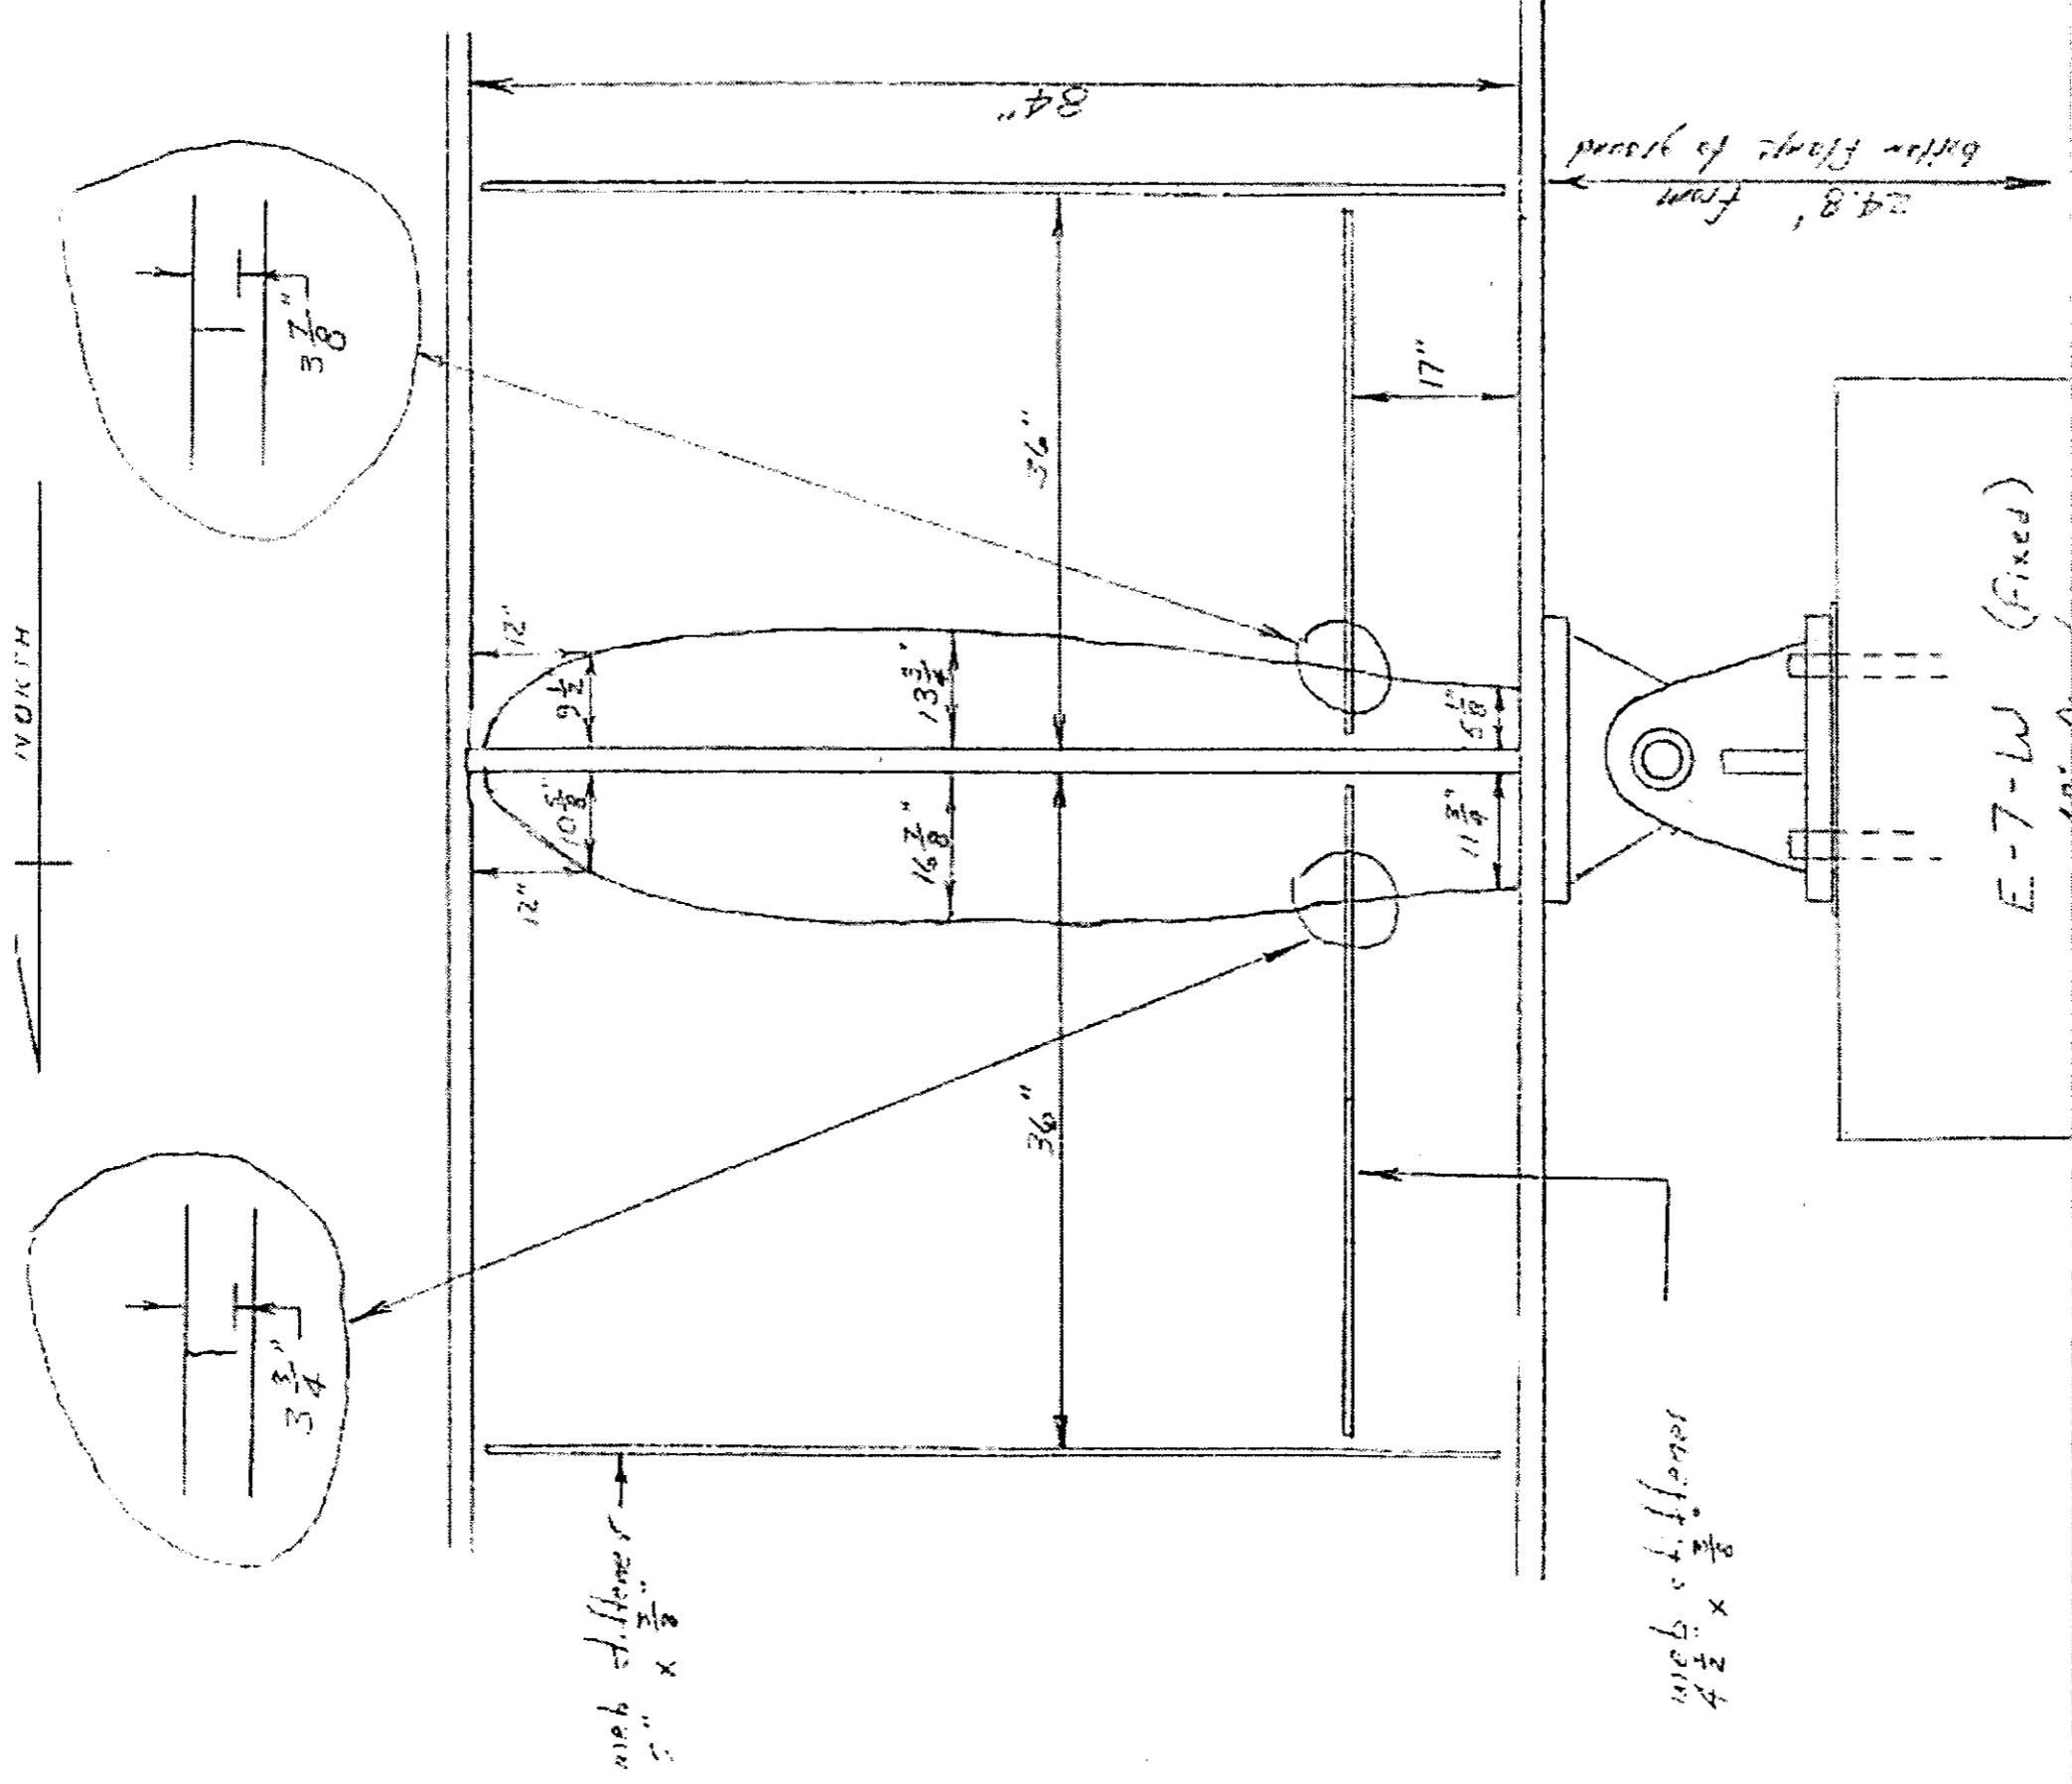

∟ 5' x 5' 3/4" x 13"

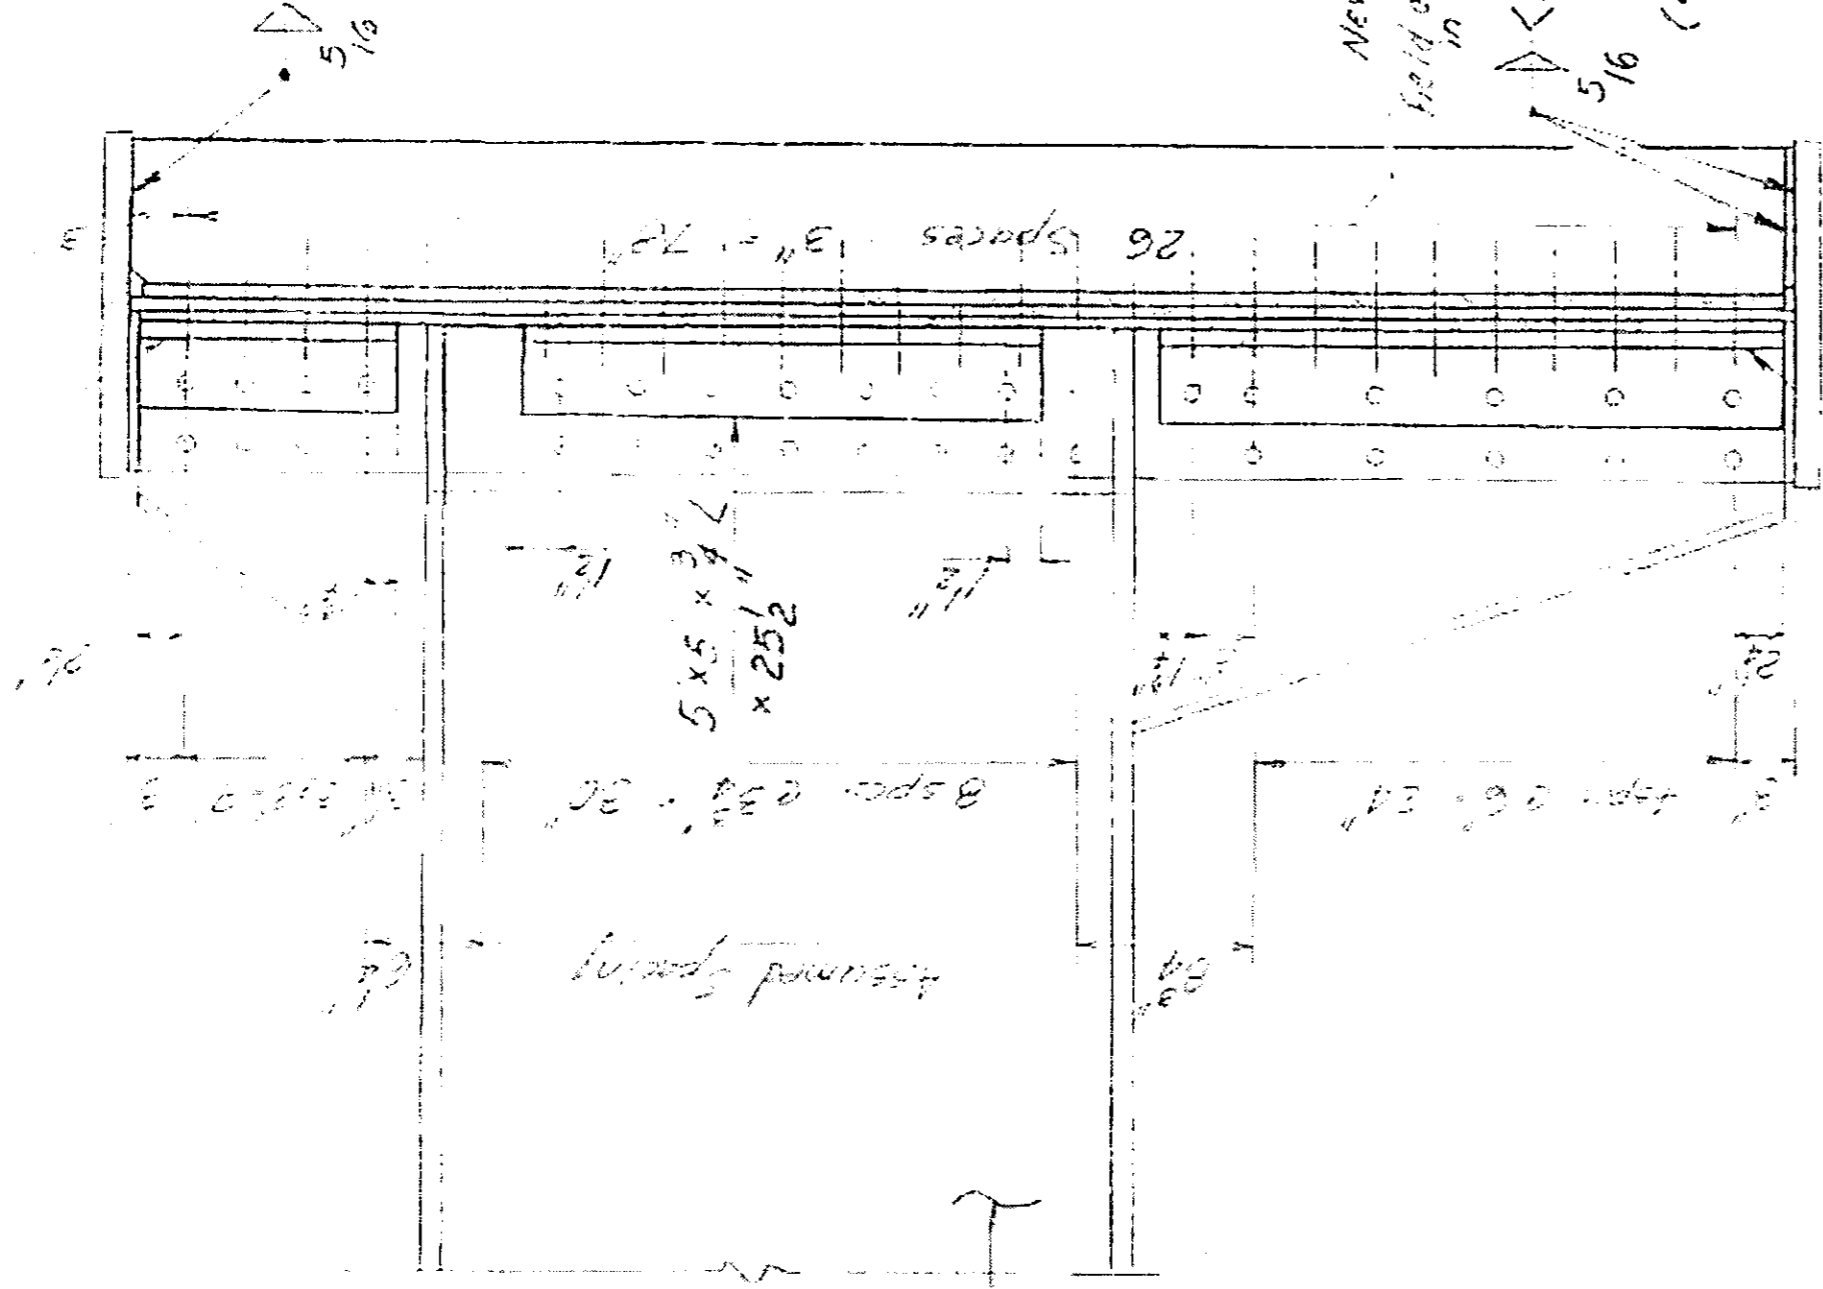

New 15" φ
field drilled hole
in brg. IR

∟ Preheat
150°F
(4 lines
of weld)

∟ 5' x 5' 3/4" x 31"

SECTION B-B
(Looking South)

See sheet 1

r r

**STATE OF ILLINOIS
DEPARTMENT OF PUBLIC WORKS AND BUILDINGS**

FEDERAL-AID ROUTE NO.	SECTION	COUNTY	TOTAL SHEETS	SHEET NO.
F.A.I. 70	82-3HVB-2	ST. CLAIR	252	1
FED. ROAD DIV. NO. 4		ILLINOIS	PROJECT I-IG-70-1(79)0	
P-98-087-00				

FOR INDEX OF SHEETS, SEE SHEET NO. 3

DESCRIPTION OF PROJECT:

SECTION 82-3HVB-2 INCLUDES THE FURNISHING AND FABRICATING OF STRUCTURAL STEEL AND THE COMPLETE CONSTRUCTION OF THE FOLLOWING:

ROADWAY E	ONE-3 SPAN CONTINUOUS UNIT SPANS: 82'-105'-82'	WELDED PLATE GIRDERS WITH PLATE GIRDER FLOORBEAMS AND ROLLED STRINGERS ON R.C. PIERS
	TWO-3 SPAN CONTINUOUS UNIT SPANS: 1 @ 78'-100'-78' 1 @ 70'-89'-69'	WELDED PLATE GIRDERS WITH ROLLED FLOORBEAMS AND STRINGERS ON R.C. PIERS AND SPILL THRU ABUTMENT
	ONE-SINGLE SPAN @ 85'	COMPOSITE WF ON R.C. PIERS
ROADWAY F	TWO-3 SPAN CONTINUOUS UNIT SPANS: 1 @ 76'-97'-75' 1 @ 75'-97'-75'	WELDED PLATE GIRDERS WITH ROLLED FLOORBEAMS AND STRINGERS ON R.C. PIERS AND SPILL THRU ABUTMENT
	TWO-3 SPAN CONTINUOUS UNIT SPANS: 1 @ 99'-128'-99' 1 @ 94'-122'-94'	CURVED WELDED PLATE GIRDERS WITH PLATE GIRDER FLOORBEAMS AND ROLLED STRINGERS ON R.C. PIERS
RAMP M	ONE-3 SPAN CONTINUOUS UNIT SPANS: 95'-125'-98'	CURVED WELDED PLATE GIRDERS WITH ROLLED FLOOR BEAMS AND STRINGERS ON R.C. PIERS
RAMP N	ONE-3 SPAN CONTINUOUS UNIT SPANS: 99'-125'-97'	CURVED WELDED PLATE GIRDERS WITH ROLLED FLOOR BEAMS AND STRINGER ON R.C. PIERS
RAMP O	ONE-3 SPAN CONTINUOUS UNIT SPANS: 93'-120'-93'	WELDED PLATE GIRDERS WITH ROLLED FLOORBEAMS AND STRINGERS ON R.C. PIERS
RAMP P	ONE-3 SPAN CONTINUOUS UNIT SPANS: 94'-119'-92'	CURVED WELDED PLATE GIRDERS WITH ROLLED FLOORBEAMS AND STRINGERS ON R.C. PIERS

**PLANS FOR PROPOSED
FEDERAL AID HIGHWAY
F.A.I. ROUTE 70**

SEC. 82-3HVB-2

**GRADING & PAVING
AND**

POPLAR STREET BRIDGE APPROACHES

PROJECT I-IG-70-1 (79)0
ST. CLAIR COUNTY


C-98-030-65

BEGIN CONSTRUCTION
RAMP 'O'
STA. 24+85

END CONSTRUCTION
ROADWAY 'EF'
STA. 60+12.48

THE POPLAR STREET BRIDGE APPROACHES FOR THIS SECTION CARRY THE FOLLOWING: ROADWAY E, ROADWAY F AND RAMPS M, N, O, P OVER THE TRACKS OF SOUTHERN R.R. AND UNDER THE RAILROAD AND HIGHWAY APPROACHES TO MAC ARTHUR BRIDGE.

THE WORK ALSO INCLUDES THE FURNISHING OF ALL MATERIALS AND LABOR NECESSARY TO COMPLETE THE GRADING, PAVING, CONSTRUCTING SEWERS AND DRAINAGE STRUCTURES, THE FURNISHING, INSTALLING AND TESTING OF COMPLETE HIGHWAY LIGHTING SYSTEMS AND TRAFFIC SIGNALS, THE FURNISHING AND ERECTING OF HIGHWAY SIGNS, THE RECONSTRUCTION OF EXISTING CITY STREETS, AND ALL APPURTENANT AND COLLATERAL WORK NECESSARY TO COMPLETE THE PROJECT AS SHOWN ON THE PLANS AND AS HEREIN SPECIFIED.

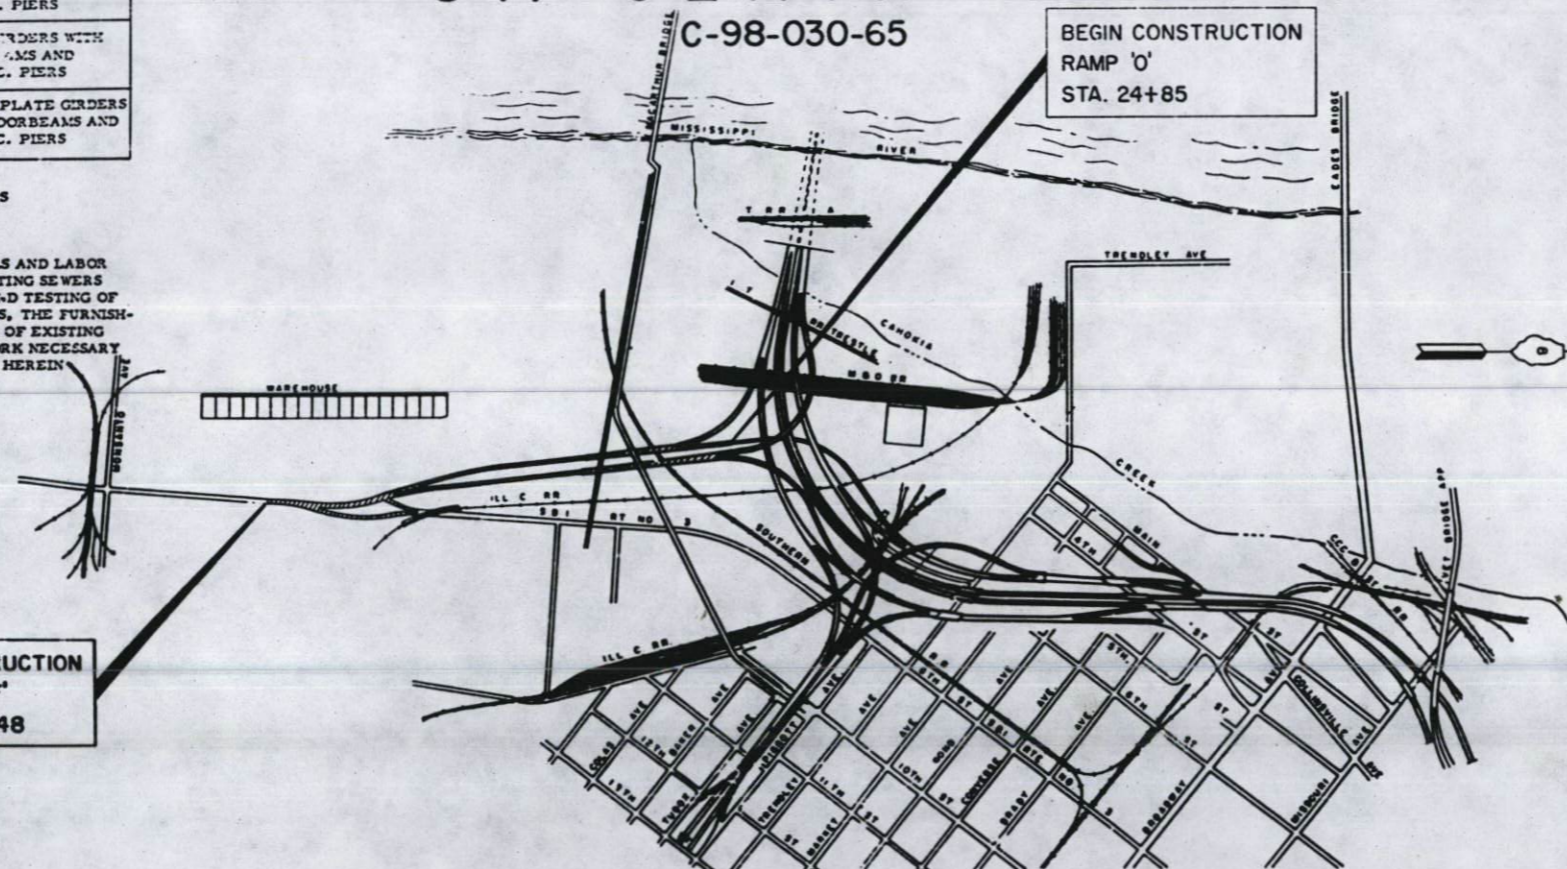

CITY OF EAST ST. LOUIS
LOCATION PLAN

NET LENGTH TO BE IMPROVED
3527.48 FT. (0.668 MILES)

TRACT NO. 25919

DESIGN DESIGNATION
4051(88)-A-1-13.3(PCC-20)(50MPH)

Kevin Cotton
10/19/68



LOCATION OF SECTION INDICATED THIS:

STATE OF ILLINOIS
DEPARTMENT OF PUBLIC WORKS AND BUILDINGS
DIVISION OF HIGHWAYS

APPROVED: *Robert E. Krost*
DATE: 2-6-69

APPROVED: *William J. Doherty*
DATE: 2-6-69

APPROVED: *John J. Brennan*
DATE: 2-6-69

APPROVED: *W. J. Collins*
DATE: 2-6-69

321 3941
4,567
321 3941

Rdwy E
SN. 082-0205

DEPARTMENT OF TRANSPORTATION
BUREAU OF PUBLIC ROADS

APPROVED _____

DIVISION ENGINEER DATE _____

H. W. LOCHNER, INC.
ENGINEERS
CHICAGO, ILLINOIS.

REEL 8-70

FEDERAL-AND ROUTE NO.	SECTION	COUNTY	TOTAL SHEETS	SHEET NO.
7.0 1-70	20-3000-7	ST. CLAIR	206	30
FED. ROAD DIV. NO. 6 ILLINOIS PROJECT				

SHEET NO.	DESCRIPTION	SHEET NO.
1	TITLE SHEET	43
2	TYPICAL PAVEMENT SECTIONS - ILL. ROUTE 3	44
3	INDEX OF PLANS, GENERAL NOTES	45
4	ALPHABETIC SUMMARY OF QUANTITIES	46
5	SUMMARY OF QUANTITIES	47
6	SUMMARY OF QUANTITIES, SCHEDULE OF QUANTITIES	48
7	PLAN - RDWY. 'C' STA. 14+00 TO STA. 14+25	49
8	PLAN - RDWY. 'C' STA. 14+25 TO RDWY. 'E' STA. 14+12.00	50
9	PROFILE - RDWY. 'C' STA. 14+00 TO STA. 14+12.00	51
10	PROFILE - RDWY. 'E' STA. 14+12.00 TO STA. 14+25	52
11	MANAGE PL. V - RDWY. 'C' STA. 14+25 TO STA. 14+12.00	53
12	MANAGE PL. V - RDWY. 'E' STA. 14+12.00 TO STA. 14+25	54
13	INTERSECTION DETAIL - P.WY. 'E' WITH RAMP 'C' AND 'D'	55
14	TRAFFIC CONTROL - SIGNAL PLAN	56
15	SECTION CONTROL SIGNAL DETAILS, WHOLE SPECIAL & LOOP DETECTION SYSTEM AND DETAILS	57
16	LIST OF BENCH MARKS, TIE TO TRAVERSE LINE AND GENERAL PLAN OF TRAVERSE LINE	58
17	ALIGNMENT PLAN - RDWY. 'C' STA. 14+00 TO STA. 14+25	59
18	ALIGNMENT PLAN - RDWY. 'E' STA. 14+00 TO RDWY. 'C' STA. 14+12.00	60
19-20	LIST OF COORDINATE POINTS AND DESCRIPTIONS	61-62
21	ELECTRICAL PLANS - RDWY. 'C' STA. 14+00 TO END OF CONTRACT	213, 215
22	ELECTRICAL PLANS - RDWY. 'E' STA. 14+00 TO STA. 14+25	216, 217
23	ELECTRICAL PLANS - ILL. ROUTE 3 TO STA. 14+00 RDWY. 'C'	218
24	ELECTRICAL DETAILS - LIGHT STANDARD ON EMBANKMENT AND CONDUIT ARRANGEMENTS	219
25	ELECTRICAL DETAILS - STEEL POLE DETAILS	220, 221
26	ELECTRICAL DETAILS - LIGHT STANDARDS ON BRIDGES	222
27	ELECTRICAL DETAILS - SCHEMATIC WIRING DIAGRAM FOR CONTROL CENTER NO. 3, SCHEDULE OF LIGHT STANDARDS	223
28	ELECTRICAL DETAILS - PANEL FOR CONTROL CENTER NO. 3	224
29	ELECTRICAL DETAILS - DETAILS FOR CONTROL CENTER NO. 3 SERVICE POLE AND PAD MOUNTED TRANSFORMER	225
30	ELECTRICAL DETAILS - CONTROL CENTER NO. 3 CABINET DETAILS FOR LIGHTING AND METERING CABINET	226
31	ELECTRICAL DETAILS - SCHEMATIC WIRING DIAGRAM FOR CONTROL CENTER NO. 1	227
32	ELECTRICAL DETAILS - TYPICAL GROUNDING DETAILS	228
33	ELECTRICAL DETAILS - GROUNDING AND ARRANGEMENT OF CONDUIT THROUGH ABUTMENT, TYPICAL DETAIL FOR FEEDER CONDUIT AT EXPANSION JOINTS	229
34	ELECTRICAL DETAILS - ATTACHING CONDUITS AND JUNCTION BOXES TO BRIDGES	230
35	ELECTRICAL DETAILS - FLOUORESCENT SIGN LIGHTING FIXTURES	231
36	ELECTRICAL DETAILS - SIGN TRUSSES	232
37	ELECTRICAL DETAILS - ATTACHING CONDUIT TO BRIDGES FOR SIGN TRUSSES	233
38	SIGNING PLAN - RAMP 'D' STA. 14+00 TO RDWY. 'C' STA. 14+25	234
39	SIGNING PLAN - RDWY. 'C' STA. 14+00 TO END OF PROJECT	235
40	SIGNING DETAILS - SPECIAL SIGNS (E-2, E-3, E-4, E-5, E-7, E-1A, E-4 AND E-9)	236
41	SIGNING DETAILS - LOCATION OF SIGNS ON TRUSS NO. 11, 12 AND 13	237
42	SIGNING DETAILS - SPECIAL SIGN QUANTITIES	238
43	SIGNING DETAILS - SIGN MOUNTING DETAILS	239

INDEX OF SHEETS	DESCRIPTION	SHEET NO.
240	SIGNING DETAILS - TYPICAL DETAIL OF ROUTE MARKER ASSEMBLY DELETED	240
241	SIGNING DETAILS - GENERAL PLAN AND ELEVATION OF ALUMINUM TRUSS AND STEEL SUPPORTS	241
242	SIGNING DETAILS - ALUMINUM TRUSS DETAILS	242
243	SIGNING DETAILS - SUPPORT FRAME FOR ALUMINUM TRUSS NO. 11	243
244	SIGNING DETAILS - SUPPORT FRAME FOR ALUMINUM TRUSS NO. 12	244
245	SIGNING DETAILS - ALUMINUM WALKWAY DETAILS	245
246	SIGNING DETAILS - ALUMINUM WALKWAY DETAILS	246
247	SIGNING DETAILS - FOUNDATION DETAILS FOR TRUSS NO. 12 & NO. 13	247
248	SIGNING DETAILS - GENERAL PLAN AND ELEVATION OF STEEL TRUSS AND STEEL SUPPORTS	248
249	SIGNING DETAILS - STEEL TRUSS DETAILS	249
250	SIGNING DETAILS - SUPPORT FRAME FOR STEEL TRUSS NO. 13	250
251	SIGNING DETAILS - SUPPORT FRAME FOR STEEL TRUSS NO. 11	251
252	SIGNING DETAILS - STEEL WALKWAY DETAILS	252
253	SIGNING DETAILS - STEEL WALKWAY DETAILS	253
254	CROSS SECTIONS - ILL. ROUTE 3	254
255	BRIDGE PLANS - F.A.I. ROUTE 70 RDWY. E AND F AND RAMP M, N, O AND P OVER SOUTHERN RAILROAD, UNDER MAC ARTHUR BRIDGE APPROACH AND RAILROAD APPROACH TO MAC ARTHUR BRIDGE (1 THRU 147 OF 147)	255
256	CULVERT DETAILS	256
257	DRAINAGE DETAILS - GRATED OUTLET AND INLET BOXES	257
258	DETAILS FOR JUNCTION BOX, DRAINAGE TREATMENT AT BRIDGE WINGWALLS, MEASUREMENT FOR TRENCH BACKFILL	258
259	DETAILS FOR GRAZING AT BRIDGE CONES	259
260	RIGHT-OF-WAY PLANS (FOR INFORMATION ONLY)	260
261	STANDARD DRAWINGS 2130-31683-2, 2179-4	261
262	STANDARD DRAWINGS 2219-2, 2220-2	262
263	STANDARD DRAWINGS 2220-3, 1706-6	263
264	STANDARD DRAWINGS 2244-2	264
265	STANDARD DRAWINGS 2237-4, 2122-4	265
266	STANDARD DRAWINGS 1684-3, 2115-3	266
267	STANDARD DRAWINGS 2225-1	267
268	STANDARD DRAWINGS 1909-10	268
269	STANDARD DRAWINGS 2224-8	269
270	STANDARD DRAWINGS 2232-1	270
271	STANDARD DRAWINGS 2300, 2153-7	271
272	STANDARD DRAWINGS 2230-3	272
273	STANDARD DRAWINGS 2231-3, 1976	273
274	STANDARD DRAWINGS 2253-2	274
275	STANDARD DRAWINGS 1973, 2100-8, 2113-1	275
276	STANDARD DRAWINGS 2239-1	276
277	STANDARD DRAWINGS 2167-4	277
278	STANDARD DRAWINGS 2162-4	278
279	STANDARD DRAWINGS 2087-8	279
280	STANDARD DRAWINGS 2470	280
281	STANDARD DRAWINGS 2300	281
282	STANDARD DRAWINGS 2167-2	282

INDEX OF SHEETS	DESCRIPTION	SHEET NO.
283	STANDARD DRAWINGS 2161-1	283
284	STANDARD DRAWINGS 2162-4	284
285	STANDARD DRAWINGS 2173-1	285
286	STANDARD DRAWINGS 2206	286
287	STANDARD DRAWINGS 2161-8	287
288	STANDARD DRAWINGS 2160-4	288
289	STANDARD DRAWINGS 2080-1	289
290	STANDARD DRAWINGS 2166-9	290
291	STANDARD DRAWINGS 2254-2, 2340-1, 2397-1 & 2398-1	291

SPECIAL NOTE

ALL ELEVATIONS REFER TO U.S.C.S. MEAN SEA LEVEL DATUM.
 REMOVE CROWN FOR SUPERELEVATED SECTIONS.
 THE PROFILE GRADE LINE REFERS TO THE GRADE ELEVATION AT THE POINT SHOWN ON THE TYPICAL SECTIONS AND PLANS.
 POSITIVE PROFILE GRADES ARE IN THE DIRECTION OF TRAFFIC AND HIGHER ELEVATIONS.
 NEGATIVE PROFILE GRADES ARE IN THE DIRECTION OF TRAFFIC AND LOWER ELEVATIONS.
 THE CONTRACTOR WILL BE REQUIRED TO REED THE AREA BETWEEN RIGHT OF WAY LIMITS EXCEPT THE PAVED OR SODDED AREAS AND ANY OTHER AREAS AS DIRECTED BY THE ENGINEER. THE MEDIAN, THE PORTION OF THE SHOULDER THAT IS NOT SURFACED AND ALL SLOPES 4:1 OR STEEPER WILL BE SOBBED.
 VARIABLE WIDTH CURBS, CURBS AND FLAGS ARE REQUIRED AS SHOWN ON THE PLANS. ANY ADDITIONAL COST SHALL BE INCLUDED IN THE CONTRACT UNIT PRICE PER LINEAL FOOT FOR THE TYPE OF CURB OR CURB AND GUTTER SPECIFIED. NO ADDITIONAL COMPENSATION SHALL BE ALLOWED.
 ALL EXPOSED EXISTING PAVEMENT SHALL BE REMOVED WITHIN THE LIMITS OF RIGHT OF WAY OR AS DIRECTED BY THE ENGINEER.
 BUILDINGS WITHIN R.O.W. LIMITS HAVE BEEN REMOVED OR ARE IN THE PROCESS OF BEING REMOVED DOWN TO EXISTING GROUND LEVEL AND BASEMENTS BACKFILLED WITH BRICK OR MASONRY RUBBLE AND SAND TO FILL THE VOID.
 TWO SIGNS (STANDARDS 2151-7, 2154-5) TO BE CONSTRUCTED AT LOCATIONS INDICATED ON THE PLANS OR AS DIRECTED BY THE ENGINEER. (SHEET NO. 8)
 ALL PAVEMENT DIMENSIONS ARE TO EDGE OF PAVEMENT UNLESS OTHERWISE NOTED.

* Includes Sheets 88A and 167A

** Includes sheet 80A

STATE OF ILLINOIS
 DEPARTMENT OF PUBLIC WORKS & BUILDINGS
 DIVISION OF HIGHWAYS

**INDEX OF PLANS
 GENERAL NOTES**

H. W. JOHNSON, INC.
 ENGINEERS
 CHICAGO, ILL.

Revised [] 10-13-70 J.M.J.

[] Revised 9-28-71 J.M.J.

FEDERAL-AID ROUTE NO.	SECTION	COUNTY	TOTAL SHEETS	SHEET NO.
P.A. 1-70	A2-3-4-5-6-7	ST. CLAIR	212	21
FED. ROAD DIV. NO. 4	ILLINOIS	PROJECT		

SHEET NO.	DESCRIPTION	SHEET NO.	DESCRIPTION
1	TITLE SHEET	43	SIGNING DETAILS - TYPICAL DETAIL OF ROUTE MARKER ASSEMBLY DELETED
2	TYPICAL PAVEMENT SECTIONS - ILL. ROUTE 3	44	SIGNING DETAILS - GENERAL PLAN AND ELEVATION OF ALUMINUM TRUSSES AND STEEL SUPPORTS
3	INDEX OF PLANS, GENERAL NOTES	45	SIGNING DETAILS - ALUMINUM TRUSS DETAILS
4	ILLINOIS ROUTE 3 SIGNING PLANS SUMMARY OF QUANTITIES	46	SIGNING DETAILS - SUPPORT FRAME FOR ALUMINUM TRUSS NO. 10
5	SUMMARY OF QUANTITIES	47	SIGNING DETAILS - SUPPORT FRAME FOR ALUMINUM TRUSS NO. 11
6	SUMMARY OF QUANTITIES, SCHEDULE OF QUANTITIES	48	SIGNING DETAILS - ALUMINUM WALKWAY DETAILS
7	PLAN - RDWY. 'E' STA. 34+00 TO STA. 49+25	49	SIGNING DETAILS - ALUMINUM WALKWAY DETAILS
8	PLAN - RDWY. 'E' STA. 49+25 TO RDWY. 'EF' STA. 60+12.48	50	SIGNING DETAILS - FOUNDATION DETAILS FOR TRUSS NO. 12 & NO. 13
9	PROFILE - RDWY. 'E' STA. 34+00 TO STA. 52+41.96 RDWY. 'EF' STA. 52+41.96 TO STA. 60+12.48	51	SIGNING DETAILS - GENERAL PLAN AND ELEVATION OF STEEL TRUSS AND STEEL SUPPORTS
10	PROFILE - RDWY. 'E' STA. 23+01.20 TO STA. 45+00 TEMP. ACCESS RD. STA. 18+00 TO STA. 17+50	52	SIGNING DETAILS - STEEL TRUSS DETAILS
11	DRAINAGE PLAN - RDWY. 'E' STA. 34+00 TO STA. 49+25	53	SIGNING DETAILS - SUPPORT FRAME FOR STEEL TRUSS NO. 13
12	DRAINAGE PLAN - RDWY. 'E' STA. 49+25 TO STA. 52+41.96 RDWY. 'EF' STA. 52+41.96 TO STA. 60+12.48	54	SIGNING DETAILS - SUPPORT FRAME FOR STEEL TRUSS NO. 11
13	INTERSECTION DETAIL - RDWY. 'EF' WITH RAMP 'X' AND 'W'	55	SIGNING DETAILS - STEEL WALKWAY DETAILS
14	TRAFFIC CONTROL - SIGNAL PLAN	55A	SIGNING DETAILS - STEEL WALKWAY DETAILS
14.1	DETECTOR CONDUIT INSTALL DETAILS, MINOR SPECIAL & LOOP DETECTION SYSTEM AND DETAILS	56-66	CROSS SECTIONS - ILL. ROUTE 3
15	LIST OF BENCH MARKS, TIES TO TRAVERSE LINE AND GENERAL PLAN OF TRAVERSE LINE	67-213	BRIDGE PLANS - F.A.I. ROUTE 76 RDWY. E AND F AND RAMP S, N, O AND P OVER SOUTHERN RAILROAD, UNDER MAC ARTHUR BRIDGE APPROACH AND RAILROAD APPROACH TO MAC ARTHUR BRIDGE (1 THRU 147 OF 147)
16	ALIGNMENT PLAN - RDWY. 'C' STA. 43+02 TO STA. 71+00	214, 215	CULVERT DETAILS
17	ALIGNMENT PLAN - RDWY. 'E' STA. 34+00 TO RDWY. 'EF' STA. 60+12.48	216, 217	DRAINAGE DETAILS - GRATED OUTLET AND INLET BOXES
18-20	LIST OF COORDINATE POINTS AND DESCRIPTIONS	218	DETAILS FOR JOINTS AND DRAINAGE TREATMENT AT BRIDGE WING WALLS, MEASUREMENT FOR TRENCH BACKFILL
21	ELECTRICAL PLANS - RDWY. 'E' STA. 49+00 TO END OF CONTRACT	219	DETAILS FOR GRADING AT BRIDGE CONES
22	ELECTRICAL PLANS - RDWY. 'E' STA. 34+00 TO STA. 49+00	220, 221	RIGHT-OF-WAY PLANS (FOR INFORMATION ONLY)
23	ELECTRICAL PLANS - ILL. ROUTE 3 TO STA. 34+00 RDWY. 'E'	222	STANDARD DRAWINGS 2150-31483-2, 2175-4
24	ELECTRICAL DETAILS - LIGHT STANDARD ON EMBANKMENT AND CONDUIT ARRANGEMENTS	223	STANDARD DRAWINGS 2219-2, 2220-2
24A	ELECTRICAL DETAILS - STEEL POLE DETAILS	224	STANDARD DRAWINGS 2220-1, 1746-6
25	ELECTRICAL DETAILS - LIGHT STANDARDS ON BRIDGES	225	STANDARD DRAWINGS 2244-2
26	ELECTRICAL DETAILS - SCHEMATIC WIRING DIAGRAM FOR CONTROL CENTER NO. 1, SCHEDULE OF LIGHT STANDARDS	226	STANDARD DRAWINGS 2217-4, 2122-4
27	ELECTRICAL DETAILS - PANEL FOR CONTROL CENTER NO. 1	227	STANDARD DRAWINGS 1484-3, 2115-0
28	ELECTRICAL DETAILS - DETAILS FOR CONTROL CENTER NO. 5 (METER POINT AND PAD MOUNTED TRANSFORMER)	228	STANDARD DRAWINGS 2225-1
29	ELECTRICAL DETAILS - CONTROL CENTER NO. 5 CABINET DETAILS FOR LIGHTING AND METERING CABINET	229	STANDARD DRAWINGS 1909-10
30	ELECTRICAL DETAILS - SCHEMATIC WIRING DIAGRAM FOR CONTROL CENTER NO. 1	230	STANDARD DRAWINGS 2224-8
31	ELECTRICAL DETAILS - TYPICAL GROUNDING DETAILS	231	STANDARD DRAWINGS 2225-1
32	ELECTRICAL DETAILS - GROUNDING AND ARRANGEMENT OF CONDUIT THROUGH ABUTMENT, TYPICAL DETAIL FOR FEEDER CONDUIT AT EXPANSION JOINTS	232	STANDARD DRAWINGS 2230-3
33	ELECTRICAL DETAILS - ATTACHING CONDUITS AND JUNCTION BOXES TO BRIDGES	234	STANDARD DRAWINGS 2231-2, 1976
34	ELECTRICAL DETAILS - FLUORESCENT SIGN LIGHTING FIXTURES	235	STANDARD DRAWINGS 2253-2
35	ELECTRICAL DETAILS - SIGN TRUSSES	236	STANDARD DRAWINGS 1973, 2150-5, 2113-1
36	ELECTRICAL DETAILS - ATTACHING CONDUIT TO BRIDGES FOR SIGN TRUSSES	237	STANDARD DRAWINGS 2229-1
37	SCHEMATIC PLAN - RAMP 'O' STA. 24+00 TO RDWY. 'E' STA. 46+00	438	STANDARD DRAWINGS 2147-4
38	SCHEMATIC PLAN - RDWY. 'E' STA. 46+00 TO END OF PROJECT	439	STANDARD DRAWINGS 2142-4
39	SIGNING DETAILS - SPECIAL SIGNS SE-2, SE-3, SE-4, SE-5, SE-7, SE-7A, SE-8 AND SE-9	440	STANDARD DRAWINGS 757-2
40	SIGNING DETAILS - LOCATION OF SIGNS ON TRUSS NO. 11, 12, AND 13	441	STANDARD DRAWINGS 4340
41	SIGNING DETAILS - SPECIAL SIGN QUANTITIES	442	STANDARD DRAWINGS 4350
42	SIGNING DETAILS - SIGN MOUNTING DETAILS	443	STANDARD DRAWINGS 2167-2

SHEET NO.	DESCRIPTION	SHEET NO.	DESCRIPTION
144	STANDARD DRAWINGS 2161-1	252, A, B, C	STANDARD DRAWINGS 2254-2, 2310-1, 2315-1 & 2318-1
245	STANDARD DRAWINGS 2162-4		
246	STANDARD DRAWINGS 2173-1		
247	STANDARD DRAWINGS 2206		
248	STANDARD DRAWINGS 2161-6		
249	STANDARD DRAWINGS 2160-4		
250	STANDARD DRAWINGS 2086-1		
251	STANDARD DRAWINGS 2164-9		
252, A, B, C	STANDARD DRAWINGS 2254-2, 2310-1, 2315-1 & 2318-1		

GENERAL NOTES

ALL ELEVATIONS REFER TO U.S.G.C. MEAN SEA LEVEL DATUM.

REMOVE CROWN FOR SUPERELEVATED SECTIONS.

THE PROFILE GRADE LINE REFERS TO THE GRADE ELEVATION AT THE POINT SHOWN ON THE TYPICAL SECTIONS AND PLANS.

POSITIVE PROFILE GRADES ARE IN THE DIRECTION OF TRAFFIC AND HIGHER ELEVATIONS.

NEGATIVE PROFILE GRADES ARE IN THE DIRECTION OF TRAFFIC AND LOWER ELEVATIONS.

THE CONTRACTOR WILL BE REQUIRED TO SEED THE AREA BETWEEN RIGHT OF WAY LIMITS EXCEPT THE PAVED OR SODDED AREAS AND ANY OTHER AREAS AS DIRECTED BY THE ENGINEER. THE MEDIAN, THE PORTION OF THE SHOULDERS THAT IS NOT SURFACED AND ALL SLOPES 6:1 OR STEEPER WILL BE SODDED.

VARIABLE WIDTH GUTTERS, CURBS AND FLAGS ARE REQUIRED AS SHOWN ON THE PLANS. ANY ADDITIONAL COST SHALL BE INCLUDED IN THE CONTRACT UNIT PRICE PER LINEAL FOOT FOR THE TYPE OF GUTTER OR CURB AND GUTTER SPECIFIED. NO ADDITIONAL COMPENSATION SHALL BE ALLOWED.

ALL EXPOSED EXISTING PAVEMENT SHALL BE REMOVED WITHIN THE LIMITS OF RIGHT OF WAY OR AS DIRECTED BY THE ENGINEER.

BUILDINGS WITHIN R.O.W. LIGHTS HAVE BEEN REMOVED OR ARE IN THE PROCESS OF BEING REMOVED DOWN TO EXISTING GROUND LEVEL AND BASEMENTS BACKFILLED WITH BRICK OR MASONRY RUBBLE AND SAND TO FILL THE VOID.

TWO SIGNS (STANDARD 2153-7, 2158-5) TO BE CONSTRUCTED AT LOCATIONS INDICATED ON THE PLANS OR AS DIRECTED BY THE ENGINEER. (SHEET NO. 8)

ALL PAVEMENT DIMENSIONS ARE TO EDGE OF PAVEMENT UNLESS OTHERWISE NOTED.

* Includes sheets 67A, 86A, 87A, 88B, 89A, 92A, 100A & 113A

* Includes Sheets 88A and 167A

* Includes Sheet 195A

STAT. OF ILLINOIS
DEPARTMENT OF PUBLIC WORKS & BUILDINGS
DIVISION OF HIGHWAYS

**INDEX OF PLANS
GENERAL NOTES**

H. W. LOCKER, INC.
ENGINEERS
CHICAGO, ILL.

Revised 10-13-70 J.M.J.

Revised 12-11-70 J.M.J.

Revised J.R.H. 3-4-71

FEDERAL-AID ROUTE NO.	SECTION	COUNTY	TOTAL SHEETS	SHEET NO.
F. A. 1-70	DE-3 MV8-2	ST. CLAIR	Z 02	3
FED. ROAD DIV. NO. 4		ILLINOIS	PROJECT	

SHEET NO.	DESCRIPTION	SHEET NO.
1	TITLE SHEET	43
2	TYPICAL PAVEMENT SECTIONS - ILL. ROUTE 3	44
3	INDEX OF PLANS, GENERAL NOTES	45
3A & 3B	ILLINOIS ROUTE 3 STAGING PLANS	
4	SUMMARY OF QUANTITIES	
5	SUMMARY OF QUANTITIES	
6	SUMMARY OF QUANTITIES, SCHEDULE OF QUANTITIES	
7	PLAN - RDWY. 'E' STA. 36+00 TO STA. 49+25	
8	PLAN - RDWY. 'E' STA. 49+25 TO RDWY. 'EF' STA. 60+12.48	
9	PROFILE - RDWY. 'E' STA. 35+00 TO STA. 52+41.96 RDWY. 'EF' STA. 52+41.96 TO STA. 60+12.48	
10	PROFILE - RDWY. 'F' STA. 28+03.20 TO STA. 45+00 TEMP. ACCESS RD. STA. 10+00 TO STA. 17+50	
11	DRAINAGE PLAN - RDWY. 'E' STA. 36+00 TO STA. 49+25	
12	DRAINAGE PLAN - RDWY. 'E' STA. 49+25 TO STA. 52+41.96 RDWY. 'EF' STA. 52+41.96 TO STA. 60+12.48	
13	INTERSECTION DETAIL - RDWY. 'EF' WITH RAMP 'X' AND 'W'	
14	TRAFFIC CONTROL - SIGNAL PLAN	
14A, B	DETECTOR CONDUIT INSTALL. DETAILS, HANDHOLE SPECIAL & LOOP DETECTION SYSTEM AND DETAILS	
15	ALIGNMENT PLAN - RDWY. 'C' STA. 43+42 TO STA. 71+00	
17	ALIGNMENT PLAN - RDWY. 'E' STA. 36+00 TO RDWY. 'EF' STA. 60+12.48	
18-20	LIST OF COORDINATE POINTS AND DESCRIPTIONS	
21	ELECTRICAL PLANS - RDWY. 'F' STA. 49+00 TO END OF CONTRACT	
22	ELECTRICAL PLANS - RDWY. 'F' STA. 34+00 TO STA. 49+00	
23	ELECTRICAL PLANS - ILL. ROUTE 3 TO STA. 34+00 RDWY. 'F'	
24	ELECTRICAL DETAILS - LIGHT STANDARD ON EMBANKMENT AND CONDUIT ARRANGEMENTS	
24A	ELECTRICAL DETAILS - STEEL POLE DETAILS	
25	ELECTRICAL DETAILS - LIGHT STANDARDS ON BRIDGES	
26	ELECTRICAL DETAILS - SCHEMATIC WIRING DIAGRAM FOR CONTROL CENTER NO. 5, SCHEDULE OF LIGHT STANDARDS	
27	ELECTRICAL DETAILS - PANEL FOR CONTROL CENTER NO. 5	
28	ELECTRICAL DETAILS - DETAILS FOR CONTROL CENTER NO. 5 SERVICE POLE AND PAD MOUNTED TRANSFORMER	
29	ELECTRICAL DETAILS - CONTROL CENTER NO. 5 CABINET DETAILS FOR LIGHTING AND METERING CABINET	
30	ELECTRICAL DETAILS - SCHEMATIC WIRING DIAGRAM FOR CONTROL CENTER NO. 1	
31	ELECTRICAL DETAILS - TYPICAL GROUNDING DETAILS	
32	ELECTRICAL DETAILS - GROUNDING AND ARRANGEMENT OF CONDUIT THRU ABUTMENT, TYPICAL DETAIL FOR FEEDER CONDUIT AT EXPANSION JOINTS	
33	ELECTRICAL DETAILS - ATTACHING CONDUITS AND JUNCTION BOXES TO BRIDGES	
34	ELECTRICAL DETAILS - FLUORESCENT SIGN LIGHTING FIXTURES	
35	ELECTRICAL DETAILS - SIGN TRUSSES	
36	ELECTRICAL DETAILS - ATTACHING CONDUIT TO BRIDGE FOR SIGN TRUSSES	
37	SIGNING PLAN - RAMP 'O' STA. 24+85 TO RDWY. 'F' STA. 46+00	
38	SIGNING PLAN - RDWY. 'F' STA. 46+00 TO END OF PROJECT	
39	SIGNING DETAILS - SPECIAL SIGNS SE-2, SE-3, SE-4, SE-5, SE-7, SE-7A, SE-8 AND SE-9	
40	SIGNING DETAILS - LOCATION OF SIGNS ON TRUSSES 11, 12, AND 13	
41	SIGNING DETAILS - SPECIAL SIGN QUANTITIES	
42	SIGNING DETAILS - SIGN MOUNTING DETAILS	

SHEET NO.	DESCRIPTION	SHEET NO.
	SIGNING DETAILS - TYPICAL DETAIL OF ROUTE MARKER ASSEMBLY DELETED	
	SIGNING DETAILS - GENERAL PLAN AND ELEVATION OF ALUMINUM TRUSS AND STEEL SUPPORTS	
	SIGNING DETAILS - ALUMINUM TRUSS DETAILS	
	SIGNING DETAILS - SUPPORT FRAME FOR ALUMINUM TRUSS NO. 13	
	SIGNING DETAILS - SUPPORT FRAME FOR ALUMINUM TRUSS NO. 11	
	SIGNING DETAILS - ALUMINUM WALKWAY DETAILS	
	SIGNING DETAILS - ALUMINUM WALKWAY DETAILS	
	SIGNING DETAILS - FOUNDATION DETAILS FOR TRUSS NO. 12 & NO. 13	
	SIGNING DETAILS - GENERAL PLAN AND ELEVATION OF STEEL TRUSS AND STEEL SUPPORTS	
	SIGNING DETAILS - STEEL TRUSS DETAILS	
	SIGNING DETAILS - SUPPORT FRAME FOR STEEL TRUSS NO. 13	
	SIGNING DETAILS - SUPPORT FRAME FOR STEEL TRUSS NO. 11	
	SIGNING DETAILS - STEEL WALKWAY DETAILS	
	SIGNING DETAILS - STEEL WALKWAY DETAILS	
	CROSS SECTIONS - ILL. ROUTE 3	
	BRIDGE PLANS - F.A.I. ROUTE TO RDWY. E AND F AND RAMPS M, N, O AND P OVER SOUTHERN RAILROAD, UNDER MAC ARTHUR BRIDGE APPROACH AND RAILROAD APPROACH TO MAC ARTHUR BRIDGE (1 THRU 147 OF 147)	
	CULVERT DETAILS	
	DRAINAGE DETAILS - GRATED OUTLET AND INLET BOXES	
	DETAILS FOR JUNCTION BOX, DRAINAGE TREATMENT AT BRIDGE WINGWALLS, MEASUREMENT FOR TRENCH BACKFILL	
	DETAILS FOR GRADING AT BRIDGE CONES	
	RIGHT-OF-WAY PLANS (FOR INFORMATION ONLY)	
	STANDARD DRAWINGS 2130-31683-2, 2179-4	
	STANDARD DRAWINGS 2219-2, 2220-2	
	STANDARD DRAWINGS 2228-1, 1766-8	
	STANDARD DRAWINGS 2244-2	
	STANDARD DRAWINGS 2237-4, 2122-4	
	STANDARD DRAWINGS 1686-3, 2115-2	
	STANDARD DRAWINGS 2225-3	
	STANDARD DRAWINGS 1909-10	
	STANDARD DRAWINGS 1224-8	
	STANDARD DRAWINGS 2125-1	
	STANDARD DRAWINGS 2300, 2153-7	
	STANDARD DRAWINGS 2230-3	
	STANDARD DRAWINGS 2231-3, 1976	
	STANDARD DRAWINGS 2253-2	
	STANDARD DRAWINGS 1973, 2158-5, 2113-1	
	STANDARD DRAWINGS 2239-1	
	STANDARD DRAWINGS 2147-4	
	STANDARD DRAWINGS 2167-4	
	STANDARD DRAWINGS 2157-2	
	STANDARD DRAWINGS 2319	
	STANDARD DRAWINGS 2320	
	STANDARD DRAWINGS 2167-2	

SHEET NO.	DESCRIPTION
244	STANDARD DRAWINGS 2161-1
245	STANDARD DRAWINGS 2142-4
246	STANDARD DRAWINGS 2173-1
247	STANDARD DRAWINGS 2206
248	STANDARD DRAWINGS 2141-3
249	STANDARD DRAWINGS 2140-4
250	STANDARD DRAWINGS 2080-1
251	STANDARD DRAWINGS 2146-9
252, A, B, C	STANDARD DRAWINGS 2256-2, 2310-1, 2315-1 & 2318-1
218A	REVISED SEWER PROTECTION DETAILS
66A	REVISED DIMENSION PLAN F10 THRU F12
67A	REVISED SLAB PLAN F10 THRU F12
68B	REVISED SLAB PLAN F10 THRU F12
69A	REVISED SLAB PLAN M-1 THRU M-3
92A	REVISED SLAB PLAN P-1 THRU P-3
100A	REVISED PAVEMENT AND HANDRAIL F10 THRU F12

GENERAL NOTES

- ALL ELEVATIONS REFER TO U.S.G.S. MEAN SEA LEVEL DATUM.
- REMOVE CROWN FOR SUPERELEVATED SECTIONS.
- THE PROFILE GRADE LINE REFERS TO THE GRADE ELEVATION AT THE POINT SHOWN ON THE TYPICAL SECTIONS AND PLANS.
- POSITIVE PROFILE GRADES ARE IN THE DIRECTION OF TRAFFIC AND HIGHER ELEVATIONS.
- NEGATIVE PROFILE GRADES ARE IN THE DIRECTION OF TRAFFIC AND LOWER ELEVATIONS.
- THE CONTRACTOR WILL BE REQUIRED TO SEED THE AREA BETWEEN RIGHT OF WAY LIMITS EXCEPT THE PAVED OR SODDED AREAS AND ANY OTHER AREAS AS DIRECTED BY THE ENGINEER. THE MEDIAN, THE PORTION OF THE SHOULDERS THAT IS NOT SURFACED AND ALL SLOPES 6:1 OR STEEPER WILL BE SODDED.
- VARIABLE WIDTH GUTTERS, CURBS AND FLAGS ARE REQUIRED AS SHOWN ON THE PLANS. ANY ADDITIONAL COST SHALL BE INCLUDED IN THE CONTRACT UNIT PRICE PER LINEAL FOOT FOR THE TYPE OF GUTTER OR CURB AND GUTTER SPECIFIED. NO ADDITIONAL COMPENSATION SHALL BE ALLOWED.
- ALL EXPOSED EXISTING PAVEMENT SHALL BE REMOVED WITHIN THE LIMITS OF RIGHT OF WAY OR AS DIRECTED BY THE ENGINEER.
- BUILDINGS WITHIN R.O.W. LIMITS HAVE BEEN REMOVED OR ARE IN THE PROCESS OF BEING REMOVED DOWN TO EXISTING GROUND LEVEL AND BASEMENTS BACKFILLED WITH BRICK OR MASONRY RUBBLE AND SAND TO FILL THE VOIDS.
- TWO SIGNS (STANDARD 2153-7, 2158-5) TO BE CONSTRUCTED AT LOCATIONS INDICATED ON THE PLANS OR AS DIRECTED BY THE ENGINEER. (SHEET NO. 8)
- ALL PAVEMENT DIMENSIONS ARE TO EDGE OF PAVEMENT UNLESS OTHERWISE NOTED.

STATE OF ILLINOIS
DEPARTMENT OF PUBLIC WORKS & BUILDINGS
DIVISION OF HIGHWAYS

**INDEX OF PLANS
GENERAL NOTES**

H. W. LOCHNER, INC.
ENGINEERS
CHICAGO, ILL.

Approved: 6-18-70
Checked: 6-18-70
Date: 6-18-70

FEDERAL-AID ROUTE No.	SECTION	COUNTY	TOTAL SHEETS	SHEET No.
F.A. 1-70	82-3HVB-2	ST. CLAIR	252	4
FED. ROAD DIV. No. 4 ILLINOIS PROJECT				

IG PORTION 49%
I PORTION 51%

SECTION 82-3HVB-2
PROJECT I-KG-70-1(79)O

SECTION 82-3HVB-2
PROJECT I-KG-70-1(79)O

SUMMARY OF QUANTITIES				FEDERAL PARTICIPATION				STATE WORK				SUMMARY OF QUANTITIES				FEDERAL PARTICIPATION				STATE WORK			
LOCATION OF WORK (See Legend) CONSTRUCTION TYPE CODE				X531	Y002	Y030	TOTAL QUANTITY	T223	Y002	Y030	Y031	LOCATION OF WORK (See Legend) CONSTRUCTION TYPE CODE				X531	Y002	Y030	TOTAL QUANTITY	T223	Y002	Y030	Y031
CODE NO.	ITEM	UNIT	TOTAL QUANTITY	QUANTITY	201001	TREE REMOVAL (6 TO 15 INCH DIAMETER) IN, DIA.		40	40																			
205001	SPECIAL EXCAVATION	CU. YD.	1,276				1,276																
207001	EMBANKMENT	CU. YD.	152,825				152,825																
210001	TRENCH BACKFILL	CU. YD.	144.4				144.4																
213002	SUB-BASE GRANULAR MATERIAL, TYPE A	CU. YD.	35				35																
213002	STABILIZED SUB-BASE 4"	SQ. YD.	16,440				16,440																
301002	AGGREGATE BASE COURSE, TYPE A	CU. YD.	841				841																
301016	STABILIZED BASE COURSE 7"	SQ. YD.	516				516																
402002	AGGREGATE SURFACE COURSE, TYPE A	CU. YD.	75				75																
215004	AGGREGATE SHOULDERS, TYPE B	TON	82				82																
405001	BITUMINOUS MATERIALS (PRIME COAT)	GALLON	851				851																
406017	BITUMINOUS CONCRETE BINDER COURSE	TON	170				170																
406006	BITUMINOUS CONCRETE SURFACE COURSE, CLASS 1	TON	203				203																
408005	PORTLAND CEMENT CONCRETE PAVEMENT 10"	SQ. YD.	9,894				9,894																
408006	PORTLAND CEMENT CONCRETE PAVEMENT 16 1/2 - 10 1/2 - 16 1/2	SQ. YD.	214				214																
408013	PAVEMENT FABRIC	SQ. YD.	9,894				9,894																
409003	CONTINUOUSLY REINFORCED PORTLAND CEMENT CONCRETE PAVEMENT 8"	SQ. YD.	4,988				4,988																
409013	PAVEMENT REINFORCEMENT (8")	SQ. YD.	4,988				4,988																
502001	CLASS A EXCAVATION FOR STRUCTURES	CU. YD.	4,637	4,637																			
504003	CLASS X CONCRETE	CU. YD.	2,522.6	2,596.5																			
503002	CLASS X CONCRETE HEADWALLS	CU. YD.	13.7				13.7																
408014	PROTECTIVE COAT	SQ. YD.	15,547				15,547																
507001	FURNISHING AND ERECTING STRUCTURAL STEEL	POUND	33,620	33,620																			
507050	FURNISHING AND ERECTING STRUCTURAL STEEL	LUM. SUM	1	1																			
511004	PIPE CULVERTS, TYPE 1A, 15"	LIN. FT.	66				66																
511026	PIPE CULVERT, TYPE 1 18"	LIN. FT.	68				68																
511784	METAL END SECTIONS 12"	EACH	2				2																
511129	PIPE CULVERTS, TYPE 2, RCCP 24"	LIN. FT.	88				88																
511131	PIPE CULVERTS, TYPE 2, RCCP 36"	LIN. FT.	342				342																
512001	REINFORCEMENT BARS	POUND	1,710,610	1,692,590																			
513004	FURNISHING CREOSOTED PILES UP TO 20 FEET	LIN. FT.	240		240																		
513005	FURNISHING CREOSOTED PILES 20.1 TO 38 FEET	LIN. FT.	674				674																
513022	DRIVING TIMBER PILES	LIN. FT.	864		240		624																
513027	DRIVING CONCRETE PILES	LIN. FT.	34,906	34,906																			
513021	FURNISHING CONCRETE PILES	LIN. FT.	34,906	34,906																			
513041	TEST PILE CONCRETE	EACH	32	32																			
503729	PILE SPLICES FOR CONCRETE PILES	EACH	190	190																			
514001	NAME PLATES	EACH	1	1																			
503846	BROUGHT IRON PIPE DRAIN SYSTEM	L. SUM	1	1																			
607020	PIPE DRAINS, CORRUGATED STEEL 12"	LIN. FT.	178				178																
603127	STORM SEWERS, TYPE 1, REINFORCED CONCRETE CULVERT, STORM DRAIN AND SEWER PIPE, CLASS III 15"	LIN. FT.	120				120																
612164	INLETS, TYPE A, TYPE 10 FRAME AND GRATE	EACH	2				2																
612165	INLETS, TYPE A, TYPE 11 FRAME AND GRATE	EACH	2				2																
615041	COMBINATION CONCRETE CURB AND GUTTER, TYPE B-6.24	LIN. FT.	72				72																
616065	COMBINATION CONCRETE CURB AND GUTTER, TYPE M-6.06	LIN. FT.	331				331																
616047	COMBINATION CONCRETE CURB AND GUTTER, TYPE B-2.12	LIN. FT.	2,024				2,024																

LEGEND FOR "LOCATION OF WORK"

R = ROADWAY	B = BRIDGE
Roadway 'E' Sta. 36+39.83 to Sta. 52+41.96	Roadway 'E' Sta. 29+38.81 to Sta. 36+39.83
Roadway 'F' Sta. 28+03.19 to Sta. 43+32.17	Roadway 'F' Sta. 43+32.17 to Sta. 54+00
Roadway 'EF' Sta. 52+41.96 to Sta. 60+12.48	Ramp 'N' Sta. 24+82 to Sta. 37+39.88
Ramp 'W' Sta. 0+17.02 to Sta. 1+13.22	Ramp 'O' Sta. 2+185 to Sta. 17+39.88
Ramp 'X' Sta. 0+00 to Sta. 6+61.78	Ramp 'M' Sta. 46+00.22 to Sta. 57+87
Temporary Access Road Sta. 10+00 to Sta. 17+50	Ramp 'H' Sta. 46+00.22 to Sta. 57+69
Temporary Access Road Connector Sta. 0+00 to Sta. 1+46.04	

* CONSTRUCTION TYPE CODE Y005
** CONSTRUCTION TYPE CODE CES8
*** SPECIALTY ITEMS

STATE OF ILLINOIS
DEPARTMENT OF PUBLIC WORKS & BUILDINGS
DIVISION OF HIGHWAYS

SUMMARY OF QUANTITIES

H. W. LOCHNER, INC.
ENGINEERS
CHICAGO, ILL.

BASED UPON 507001 EXCISES WHICH ARE
REV. 1-1-70
REVISED 5-20-70

SUMMARY OF QUANTITIES
LOCATION OF WORK (See Legend)
CONSTRUCTION TYPE CODE

SECTION 82-3HVB-2
PROJECT I-K-70-1(79)0

IG PORTION 49 %
I PORTION 51 %

FEDERAL-AID ROUTE NO.	SECTION	COUNTY	TOTAL SHEETS	SHEET NO.
F. A. 1-70	82-3HVB-2	ST. CLAIR	252	5
FED. ROAD DIV. No. 4 ILLINOIS PROJECT				

CODE NO.	ITEM	UNIT	TOTAL QUANTITY	FEDERAL PARTICIPATION			STATE WORK					
				X531	Y002	Y030	T223	Y002	Y030	Y031		
L02200	POLE FOUNDATION	EACH	22						22			
L02404	LUMINAIRE, MERCURY VAPOR, WITH BUILT-IN REGULATOR BALLAST 700 WATTS	EACH	15			15						
L02434	LUMINAIRE, MERCURY VAPOR, 700 WATTS	EACH	22						22			
L02499	CONTROL INSTALLATION (CONTROL CENTER NO. 5)	LUMPSUM	1						1			
L04300	TRENCH AND BACKFILL	LN. FT.	5,027						5,027			
106163	ELECTRIC CONDU. TOR IN TRENCH (BARE ANNEALED COPPER NO. 6)	LN. FT.	314						314			
105077	ELECTRIC CABLE, UNIT DUCT, 2-600 V THW #6 1" POLYETHYLENE	LN. FT.	1,723						885		838	
105078	ELECTRIC CABLE, UNIT DUCT, 3-600 V THW #6 1" POLYETHYLENE	LN. FT.	3,299			20			3,279			
L05294	ELECTRIC CABLE, UNIT DUCT, 3-600 V THW #2 1 1/4" POLYETHYLENE	LN. FT.	1,220						1,220			
L05066	SYSTEMS GROUNDING	LUMPSUM	1			1						
S27016	ELECTRIC CABLE IN CONDUIT NO. 8-2/C	LN. FT.	13						13			
S27018	ELECTRIC CABLE IN CONDUIT NO. 12-2/C	LN. FT.	876						876			
S27020	ELECTRIC CABLE IN CONDUIT NO. 12-5/C	LN. FT.	538						538			
S27022	ELECTRIC CABLE IN CONDUIT NO. 12-9/C	LN. FT.	471						471			
S25002	GALVANIZED STEEL CONDUIT IN TRENCH 1 1/4"	LN. FT.	1,355						1,356			
S25003	GALVANIZED STEEL CONDUIT IN TRENCH 1 1/2"	LN. FT.	118						118			
S25004	GALVANIZED STEEL CONDUIT IN TRENCH 2"	LN. FT.	90						90			
S25006	GALVANIZED STEEL CONDUIT IN TRENCH 3"	LN. FT.	60						60			
S10004	TRAFFIC CONTROL SIGNAL POST 10 FT.	EACH	6						6			
S11001	CONTROLLER PEDESTAL 3 - 1/2 FT.	EACH	1						1			
S06004	SIGNAL HEAD, TRAFFIC CONTROL, 1-FACE, 3-SECTION WITH 12 INCH RED LENS	EACH	3						3			
S06034	SIGNAL HEAD, TRAFFIC CONTROL, 2-FACE, 3-SECTION WITH 12 INCH RED LENSES	EACH	3						3			
S14005	WOOD POLE 25 FT., CLASS 4	EACH	1						1			
S33001	SERVICE INSTALLATION, TYPE A	EACH	3						3			
S34001	CONCRETE FOUNDATION TYPE A	EACH	6						6			
S35007	HANDHOLE, SPECIAL	EACH	1						1			
S37001	TRENCH AND BACKFILL	LN. FT.	2072						2072			
S34002	CONCRETE FOUNDATIONS, TYPE A (CONTROLLER)	EACH	1						1			
S16027	TRAFFIC ACTUATED CONTROLLER, FULL ACTUATED SPECIAL	EACH	1						1			
S23003	VEHICLE DETECTOR, INDUCTION LOOP TYPE WITH PRESENCE FEATURE	EACH	3						3			
S39001	DETECTOR LOOP	LN. FT.	324						324			
S08005	ALUMINUM RAILING	LN. FT.	6,405			6,405						
215010	STABILIZED SHOULDERS (8")	SQ. YD.	4,322						4,322			
215012	STABILIZED SHOULDERS (10")	SQ. YD.	4,320						4,320			
Z10029	BRIDGE SEAT SEALANT	LUMPSUM	1						1			

CODE NO.	ITEM	UNIT	TOTAL QUANTITY	FEDERAL PARTICIPATION			STATE WORK					
				X531	Y002	Y030	T223	Y002	Y030	Y031		
614057	GRATING	SQ. FT.	93						93			
646001	ENGINEER'S FIELD OFFICE, TYPE A**	EACH	1						1			
646003	ENGINEER'S FIELD LABORATORY **	EACH	1						1			
Z20199	SIGN PANEL, REFLECTORIZED	SQ. FT.	1,194.75			758						436.75
Z20208	CAPITAL LETTERS AND NUMERALS 16"	EACH	12			8						4
Z20211	CAPITAL LETTERS AND NUMERALS 12"	EACH	28			14						14
Z20213	CAPITAL LETTERS AND NUMERALS 10"	EACH	15									15
Z20214	CAPITAL LETTERS AND NUMERALS 8"	EACH	4			4						
Z20228	LOWER CASE LETTERS 12"	EACH	63			47						16
Z20231	LOWER CASE LETTERS 6"	EACH	17			17						
Z20253	BORDER 2"	LN. FT.	406.5			235.7						170.8
Z20254	BORDER 1/4"	LN. FT.	24.1			24.1						
Z20274	CONCRETE FOUNDATIONS	CU. YD.	63.5			61.2						2.3
Z20326	STANDARD SIGNS R2-1-4860	EACH	6			5						1
Z20355	STANDARD SIGNS R3-1-2430	EACH	1									1
Z20489	STANDARD SIGNS W3-3-36	EACH	4			2						2
Z20494	STANDARD SIGNS W4-1-48	EACH	1			1						
Z20589	STANDARD SIGNS M1-3-2424	EACH	4			2						2
Z20593	STANDARD SIGNS M1-30-2424	EACH	2									2
Z20594	STANDARD SIGNS M1-30(2)-3636	EACH	10			8						2
Z20612	STANDARD SIGNS M1-5-2424	EACH	3			2						1
Z20623	STANDARD SIGNS M3-1L-2115	EACH	1									1
Z20631	STANDARD SIGNS M3-1BR-2115	EACH	1									1
Z20643	STANDARD SIGNS M4-1-2115	EACH	1			1						
Z20646	STANDARD SIGNS M4-1B-2115	EACH	1									1
Z20707	STANDARD SIGNS M6-1-219	EACH	1									1
Z20712	STANDARD SIGNS M7-1-1812	EACH	2									2
L03117	BALLAST, MERCURY VAPOR, MULTIPLE REGULATOR TYPE FOR POLE BASE MOUNTING, 700 WATTS, 240/480 VOLTS	EACH	22									22
L04975	LAMP, MERCURY VAPOR 700 WATTS TYPE H35-18NA	EACH	37			15						22
XZ1016	TRAFFIC CONTROL AND PROTECTION, STANDARD 2310	EACH	1									1
XZ1008	TRAFFIC CONTROL AND PROTECTION, STANDARD 2315	CAL DAY	10									10
XZ1020	TRAFFIC CONTROL AND PROTECTION, STANDARD 2318	EACH	1									1

LEGEND FOR "LOCATION OF WORK"

R = ROADWAY	B = BRIDGE
Roadway 'E' Sta. 36+39.83 to Sta. 52+41.96	Roadway 'E' Sta. 29+38.81 to Sta. 36+39.83
Roadway 'F' Sta. 28+03.19 to Sta. 43+32.17	Roadway 'F' Sta. 43+32.17 to Sta. 54+00
Roadway 'EF' Sta. 52+41.96 to Sta. 60+12.48	Ramp 'N' Sta. 24+82 to Sta. 37+39.88
Ramp 'W' Sta. 0+17.02 to Sta. 3+13.22	Ramp 'O' Sta. 24+85 to Sta. 37+39.88
Ramp 'X' Sta. 0+00 to Sta. 6+61.78	Ramp 'M' Sta. 46+00.22 to Sta. 57+67
Temporary Access Road Sta. 10+00 to Sta. 17+50	Ramp 'P' Sta. 46+00.22 to Sta. 57+69
Temporary Access Road Connector Sta. 0+00 to Sta. 1+46.04	






** CONSTRUCTION TYPE CODE Y005
*** CONSTRUCTION TYPE CODE C*58
SPECIAL ITEM

STATE OF ILLINOIS
DEPARTMENT OF PUBLIC WORKS & BUILDINGS
DIVISION OF HIGHWAYS


SUMMARY OF QUANTITIES

H. W. LOCHNER, INC.
ENGINEERS
CHICAGO, ILL.

ROUTE NO.	SECTION	COUNTY	TOTAL SHEETS	SHEET NO.
F.A.I. - 70	82-3MV8-2	ST. CLAIR	25	69
FED. ROAD DIV. NO. 4	ILLINOIS PROJECT			

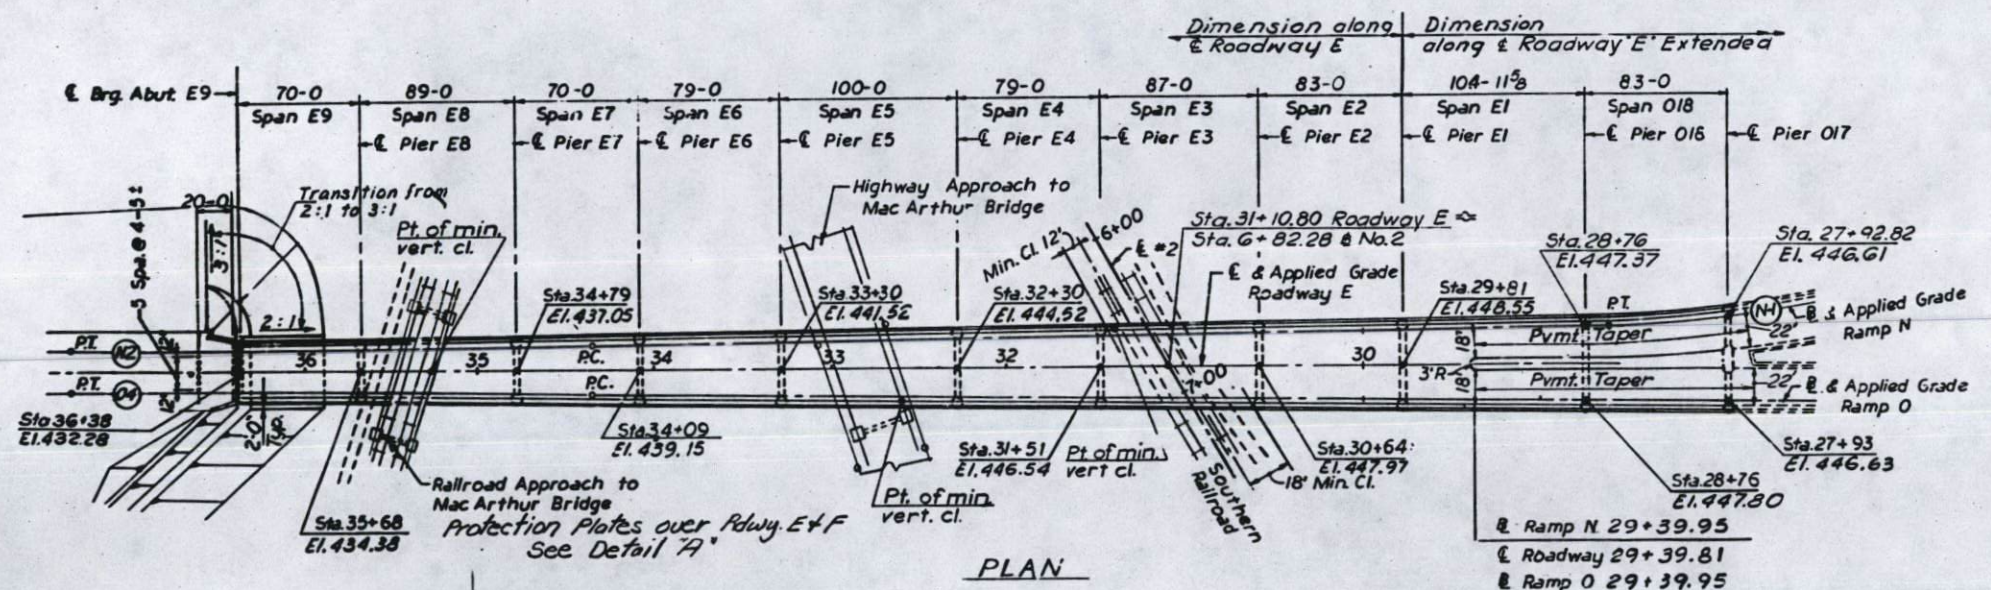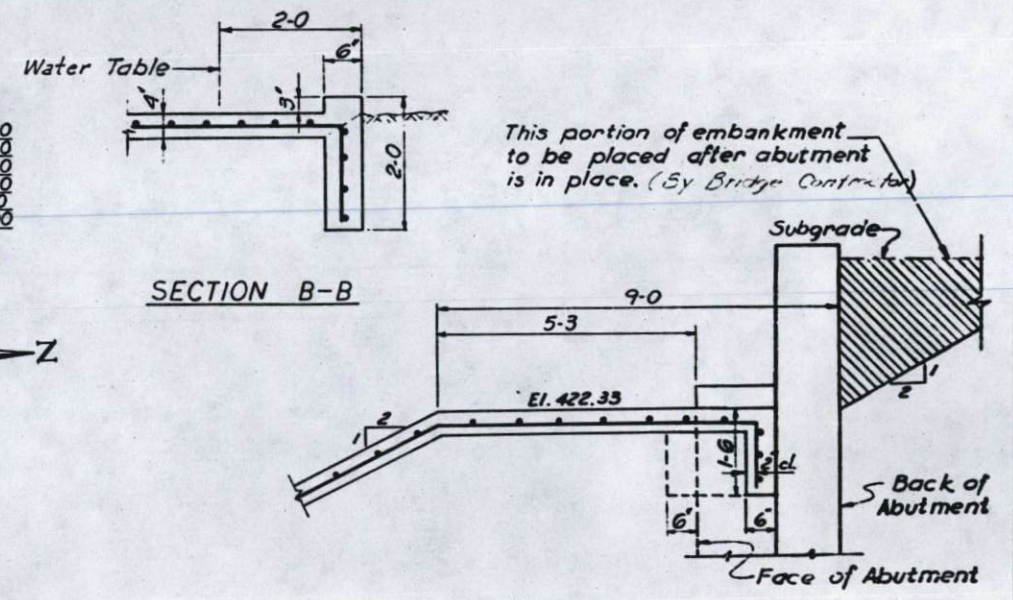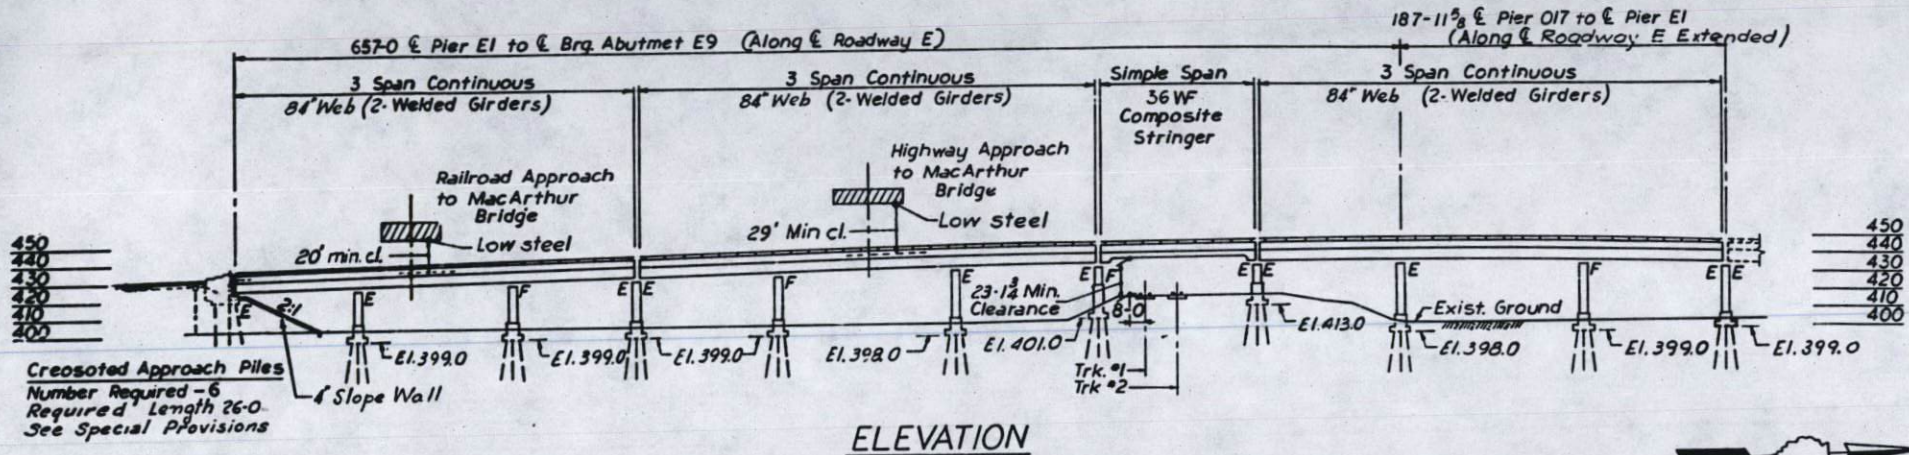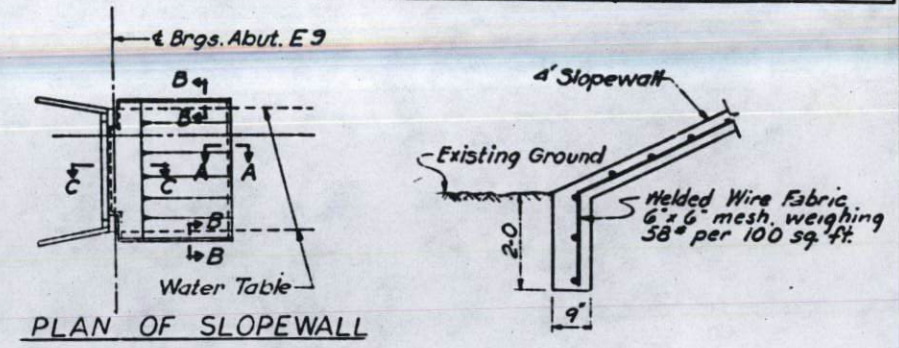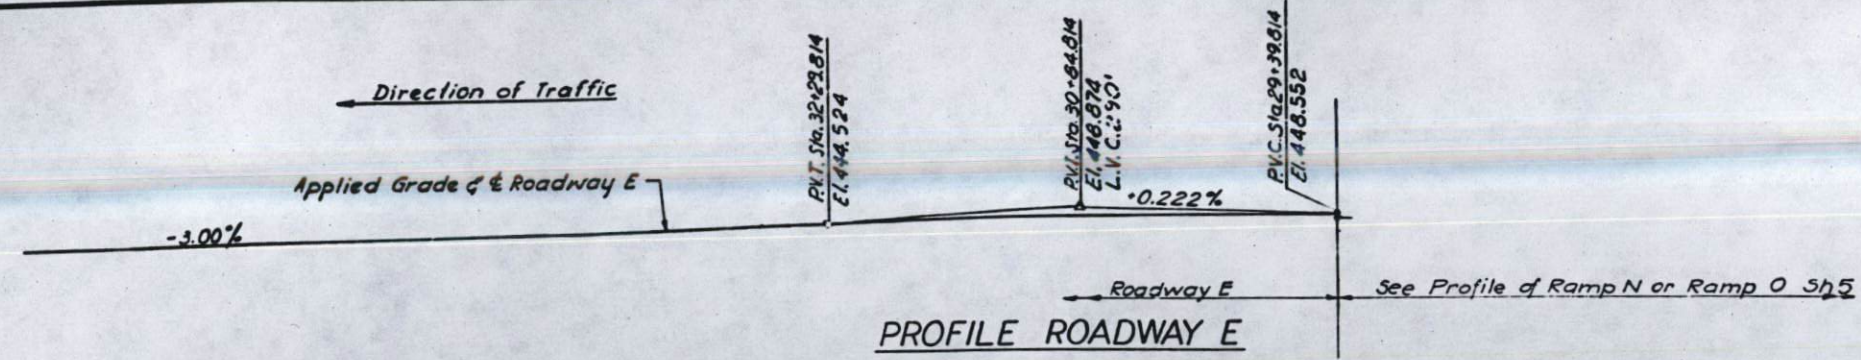

Item	Unit	Quantity
Slope Wall 4'	S.Y.	271

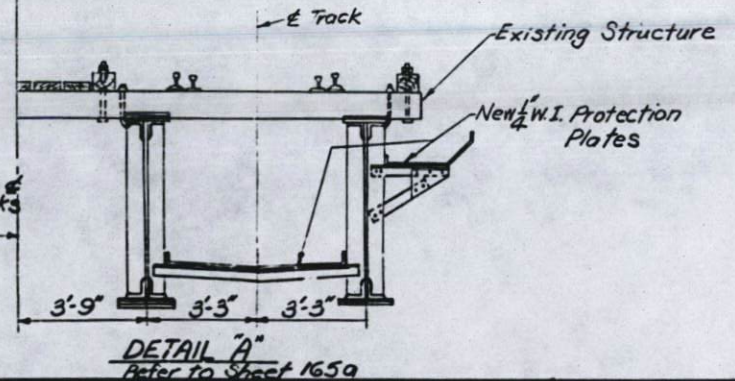


Notes:
 For Curve Data see Sh. No. 14
 For R.R. Profiles see Sh. No. 135.

STATE OF ILLINOIS
 DEPARTMENT OF PUBLIC WORKS & BLDGS.
 DIVISION OF HIGHWAYS
 PLAN AND ELEVATION
 SPANS E9 THRU O18
 POPLAR STREET BRIDGE APPROACHES
 ROADWAY "E" & RAMP "O"
 F.A.I. RT.-70 ST. CLAIR CO. SECTION 82-3MV8-2
 H. W. LOCHNER, INC.
 ENGINEERS
 CHICAGO, ILLINOIS
 SHEET 3 OF 147


DESIGNED BY J.E.M.
 DRAWN BY P.C.F.
 CHECKED BY A.T.A.J.G.

Rdwy E - 082-0205
 (Ramp O - 082-0143)


ROUTE NO.	SECTION	COUNTY	TOTAL SHEETS	SHEET NO.
F.A.I. - 70	82-3MV8-2	ST. CLAIR	252	77
FED. ROAD DIV. NO. 4	ILLINOIS	PROJECT		

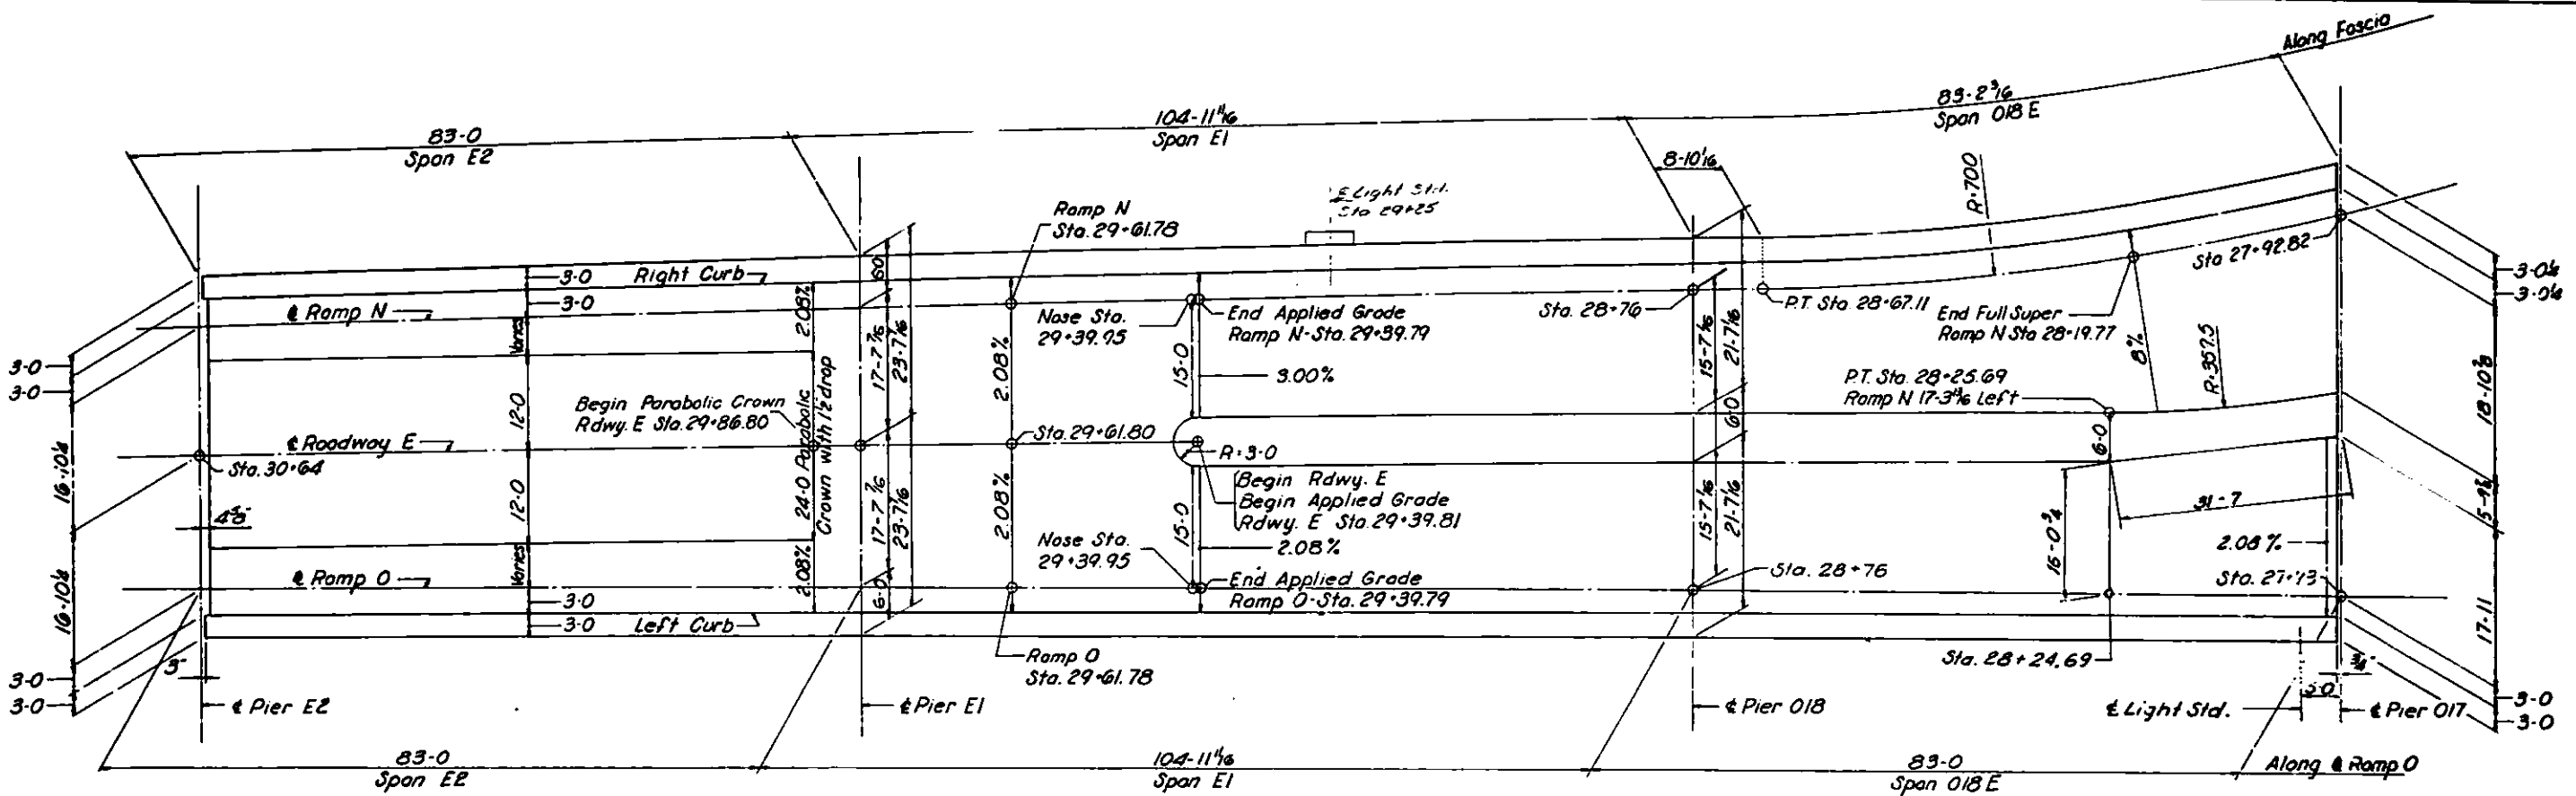


GEOMETRIC LAYOUT
Spans E2 thru O1B E

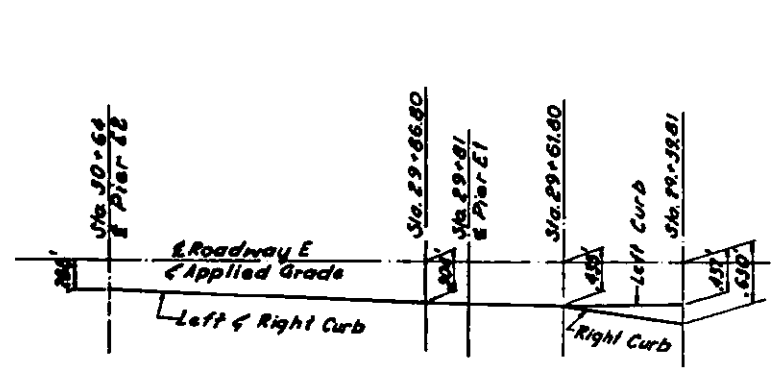

Roadway E Cross Slope Transition

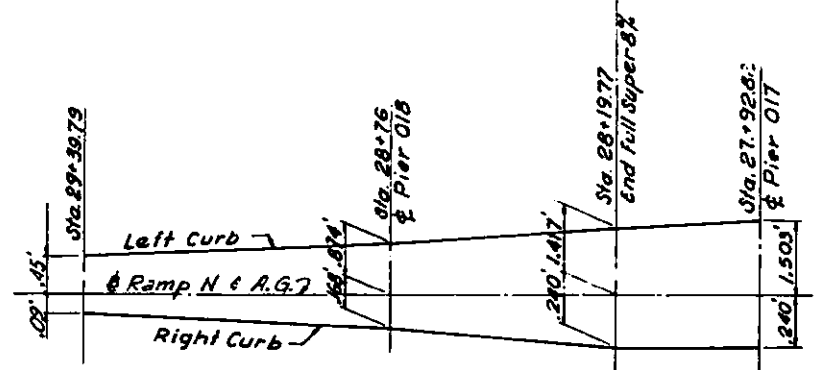

Ramp N Cross Slope Transition

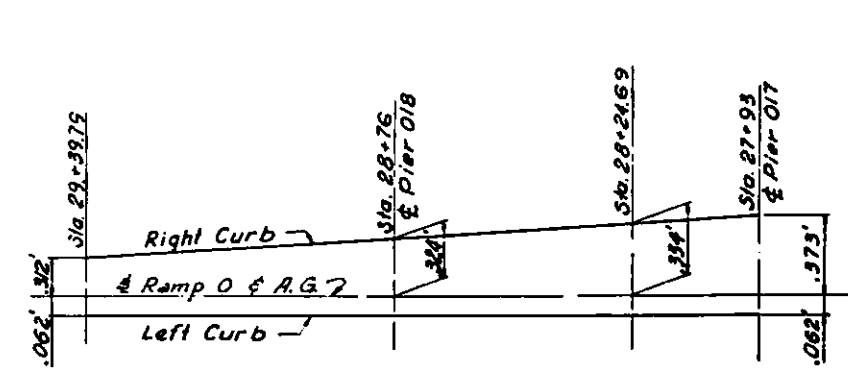

Ramp O Cross Slope


DESIGNED BY R.T.
 DRAWN BY Hamilton
 CHECKED BY K.L.F.

STATE OF ILLINOIS
 DEPARTMENT OF PUBLIC WORKS & BLDGS.
 DIVISION OF HIGHWAYS


DIMENSION PLAN
 SPANS E2 THRU O1B E
 POPLAR STREET BRIDGE APPROACHES
 ROADWAY "E"

F.A.I. RT. 70 ST. CLAIR CO. SECTION 82-3MV8-2
 SHEET
 H. W. LOCHNER, INC.
 ENGINEERS
 CHICAGO, ILLINOIS


SHEET
 8 OF 147

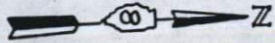

ROUTE NO.	SECTION	COUNTY	TOTAL SHEETS	SHEET NO.
F.A. 1-70	82-3HVB-2	ST. CLAIR	252	78
FED. ROAD DIV. NO. 4		ILLINOIS	PROJECT	

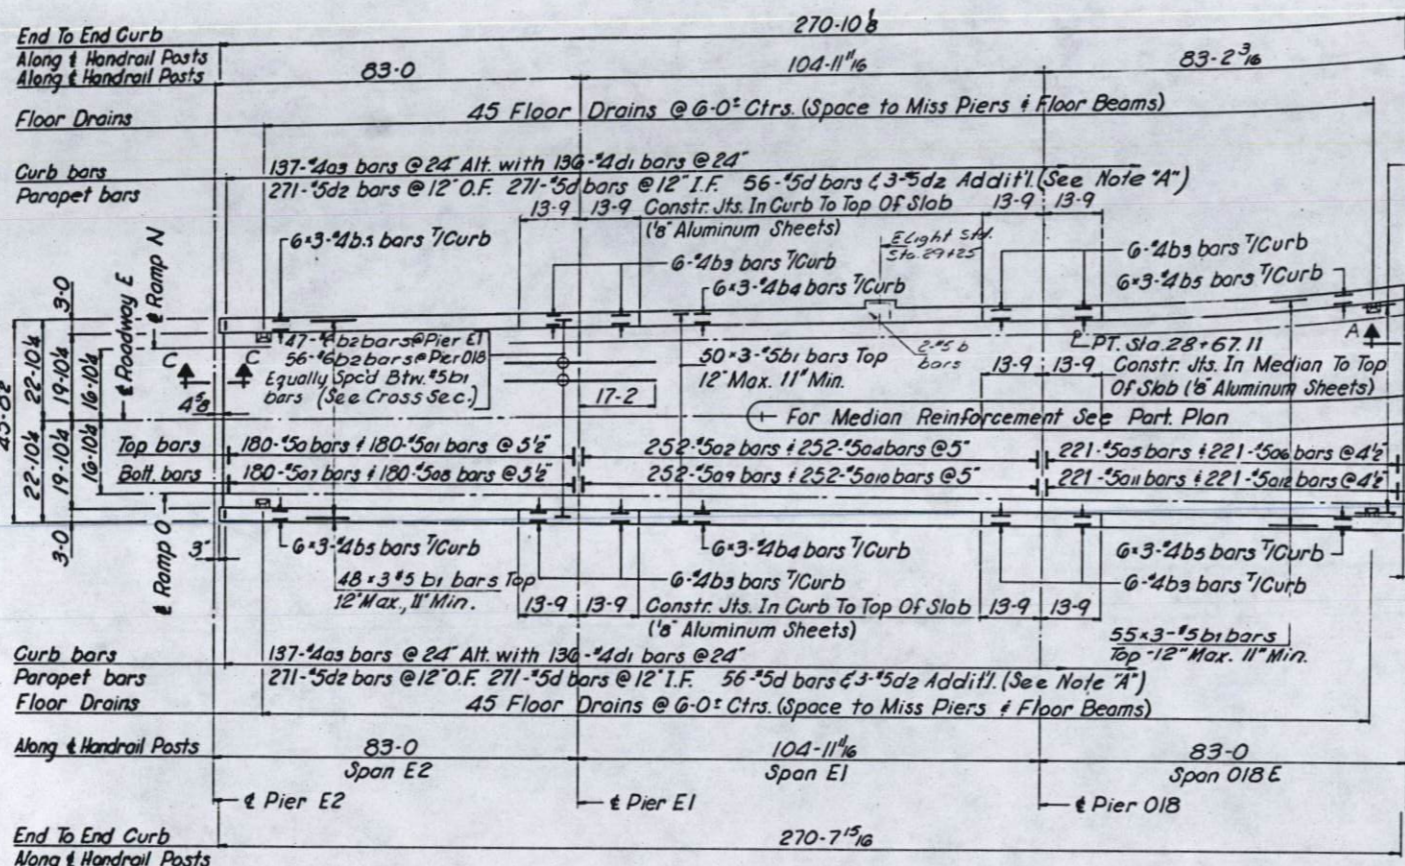

PLAN
Spans E2 thru O18E

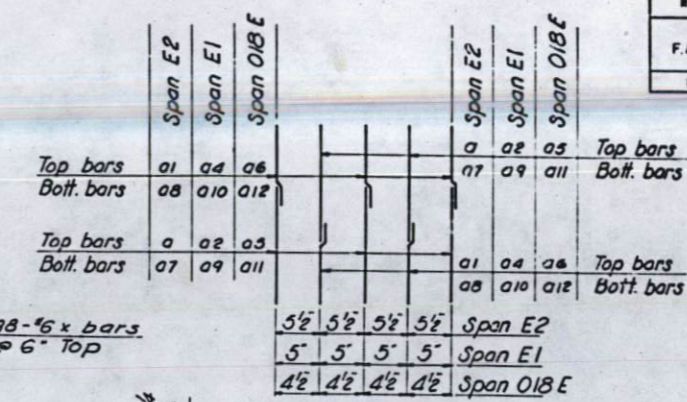


DETAIL "A"
Arrangement of Main Reinforcement (Normal to & Rdwy. E)

BILL OF MATERIAL






BAR NO	SIZE	LENGTH	SHAPE
12 a	180	*5	20-7
12 a1	180	*5	27-9
12 a2	252	*5	28-10
12 a3	283	*4	3-9
12 a4	252	*5	21-5
12 a5	281	*5	31-8
12 a6	221	*5	24-0
12 a7	180	*5	31-4
12 a8	180	*5	18-0
12 a9	252	*5	32-7
12 a10	252	*5	13-8
12 a11	221	*5	36-0
12 a12	221	*5	20-8
12 a13	68	*4	4-6
12 a14	115	-	7-7
12 b	4	*5	3-8
12 b1	1143	*5	31-0
12 b2	103	*6	34-4
12 b3	62	*4	19-6
12 b4	36	*4	26-7
12 b5	72	*4	23-8
12 b6	1	*4	10-6
12 b7	14	*4	25-6
12 b8	14	*4	35-0
12 b9	432	*4	4-1
12 b10	60	*4	28-0
12 b11	104	*4	5-3
12 b12	82	*4	6-7
12 b13	126	*4	4-7
12 b14	82	*4	5-7
12 b15	2	*4	22-0
12 d	654	*5	5-3
12 d1	272	*2	1-1
12 d2	548	*5	3-6
12 x	98	16	5-2

See Note X Sh. No. 14

ITEM	UNIT	TOTAL
Class X Concrete	Cu. Yds.	463.3
Reinforcement Bars	Lbs.	126,510
Protective Coat	Sq. Yds.	1654

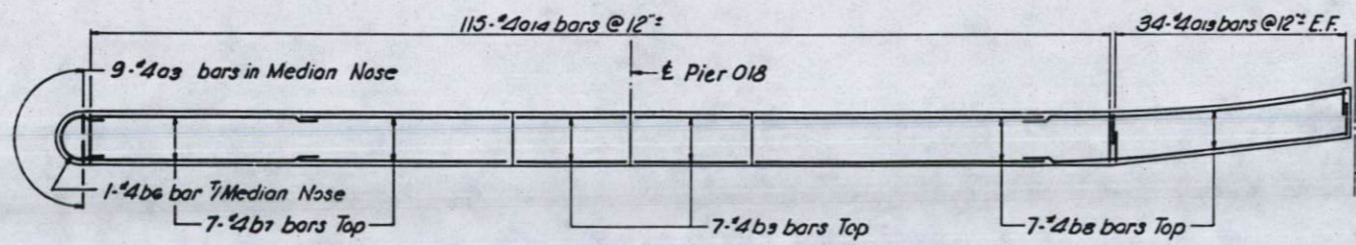

REINFORCEMENT PLAN - MEDIAN

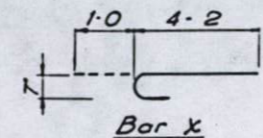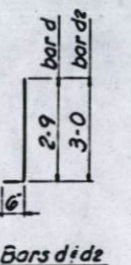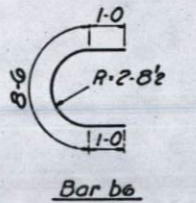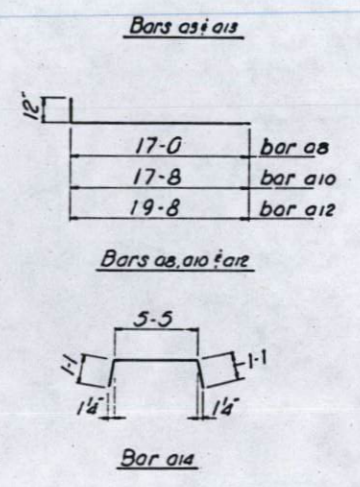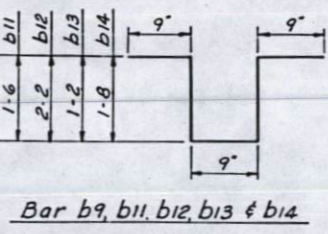

Notes:
 For Note "A" & Misc. Details See Sh. No. 14
 For Section A-A See Sh. No. 104
 For Section C-C See Sh. No. 103
 For Dimension Plan See Sh. No. 11
 For Cross Section See Sh. 13
 For Dead Load Deflection Diagram See Sh. No. 13

STATE OF ILLINOIS
 DEPARTMENT OF PUBLIC WORKS & BLDGS.
 DIVISION OF HIGHWAYS


SLAB
 SPANS E2 THRU O18E
 POPLAR STREET BRIDGE APPROACHES
 ROADWAY "E"

F.A. 1, RT. 70 ST. CLAIR CO. SECTION 82-3HVB-2 SHEET 12 OF 147
 H. W. LOCHNER, INC.
 ENGINEERS
 CHICAGO, ILLINOIS


DESIGNED BY A.T.
 DRAWN BY HAMILTON
 CHECKED BY W.J.F.

REV 1-21-70 Slab from 7' to 12', Class X from 352 B to 403.5 Cu. Yds. SM


ROUTE NO.	SECTION	COUNTY	TOTAL SHEETS	SHEET NO.
F.A. 1-70	82-SHVB-2	ST. CLAIR	252	79
FED. ROAD DIV. NO. 4		ILLINOIS	PROJECT	

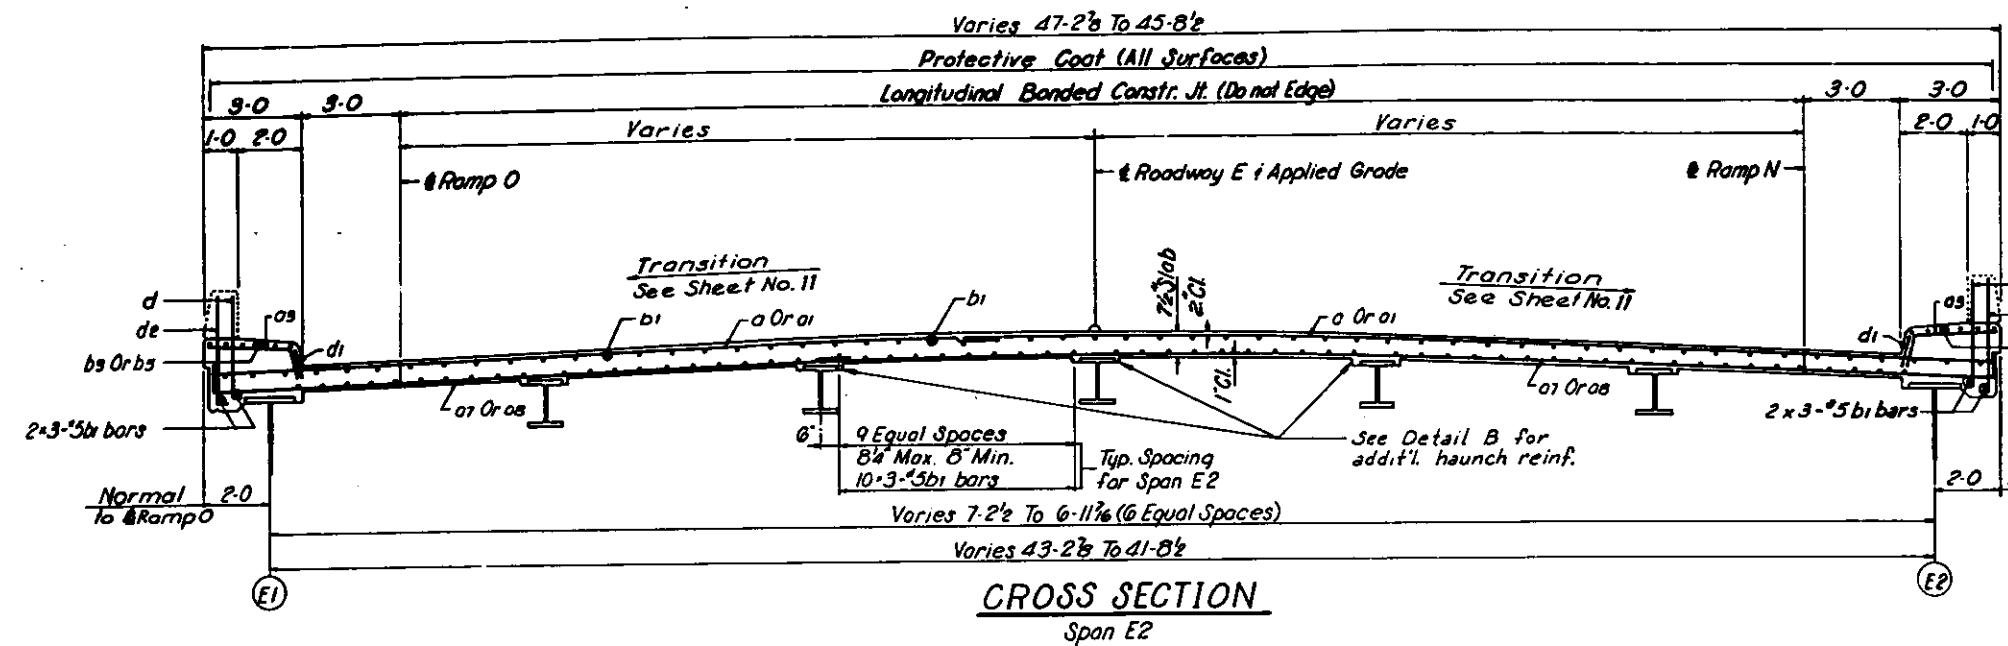


CROSS SECTION
Span E2

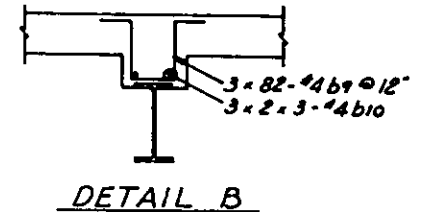


DETAIL B

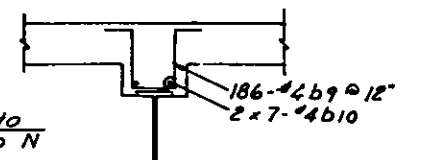


DETAIL C

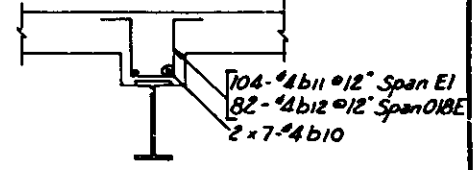

DETAIL D

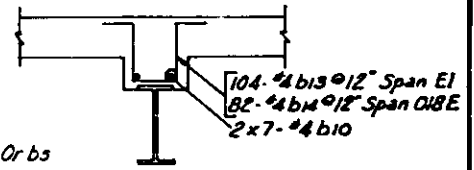


DETAIL E

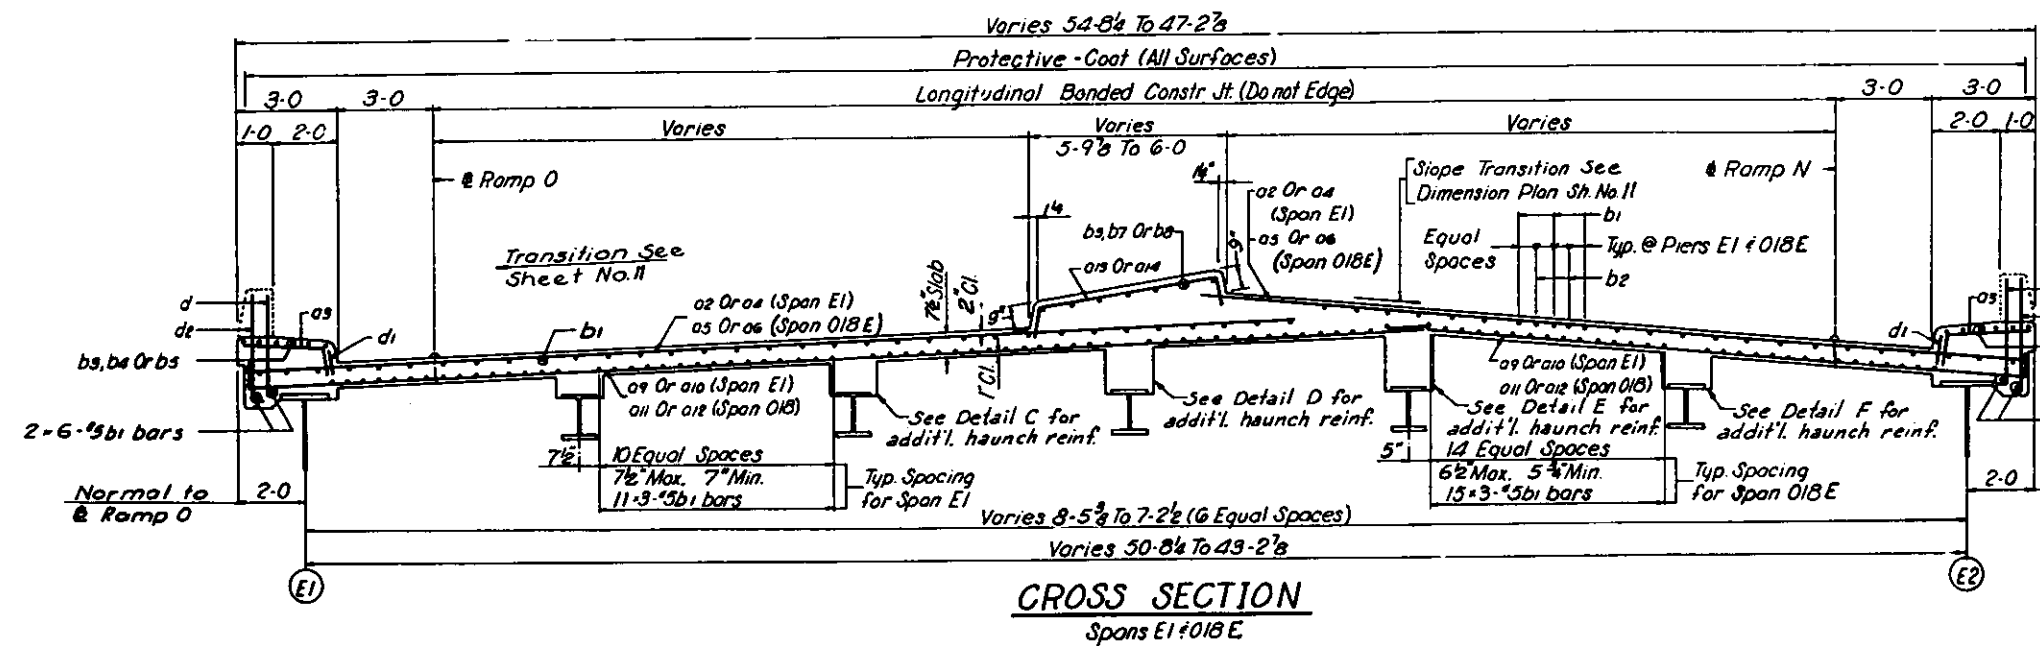

CROSS SECTION
Spans E1 + O1BE


Note:
For Bill of Material See Sheet No. 12

Note:
Details B, C, D, E & F show additional haunch reinforcement within limits shown and at stringers indicated in Cross Section. Stirrup bars may be placed on slant to provide 2" min. clearance on top of slab.

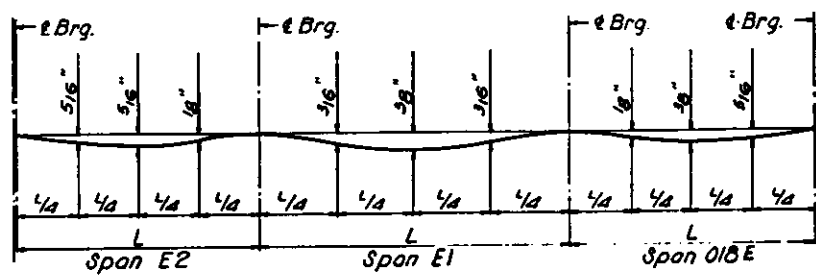

DEAD LOAD DEFLECTION DIAGRAM

FASCIA GIRDERS
(Wt. Of Concrete Only)

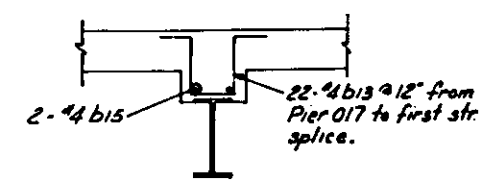

DETAIL F

DESIGNED BY AT
DRAWN BY HAMILTON
CHECKED BY W.J.P.




STATE OF ILLINOIS
DEPARTMENT OF PUBLIC WORKS & BLDGS.
DIVISION OF HIGHWAYS

SLAB
SPANS E2, E1 AND O1BE
POPLAR STREET BRIDGE APPROACHES
ROADWAY "E"

F.A. RT. 70 ST. CLAIR CO SECTION 82-SHVB-2
H. W. LOCHNER, INC.
ENGINEERS
CHICAGO, ILLINOIS

SHEET
13 OF 147

ROUTE NO.	SECTION	COUNTY	TOTAL SHEETS	SHEET NO.
F.A.I.-70	82-3HVB-2	ST. CLAIR	252	80
FED. ROAD DIV. NO. 4		ILLINOIS	PROJECT	

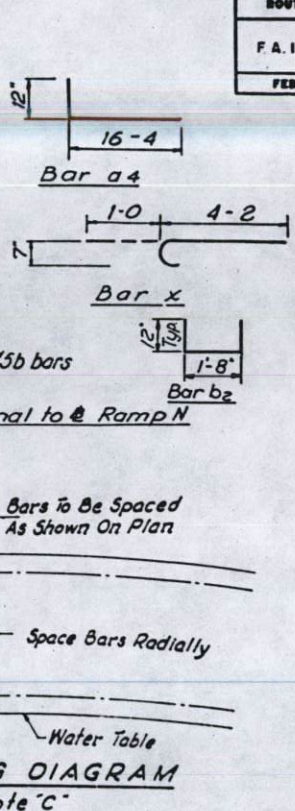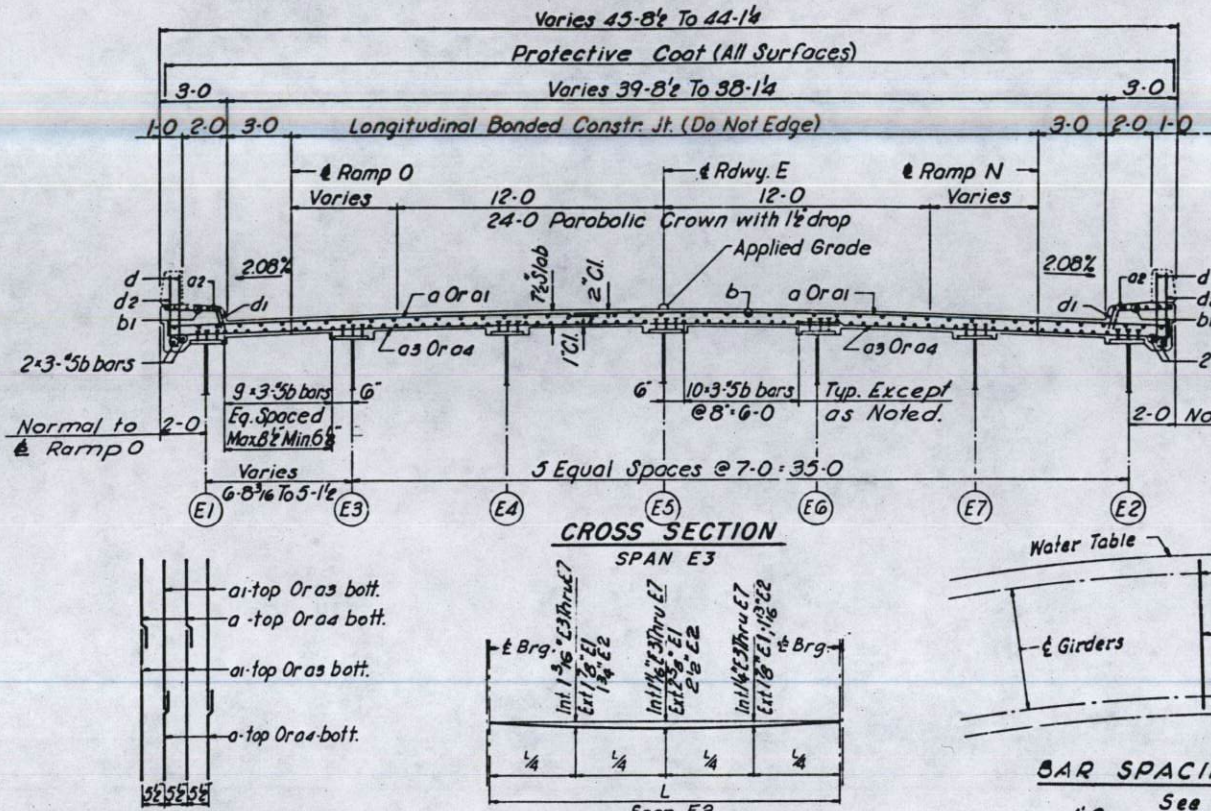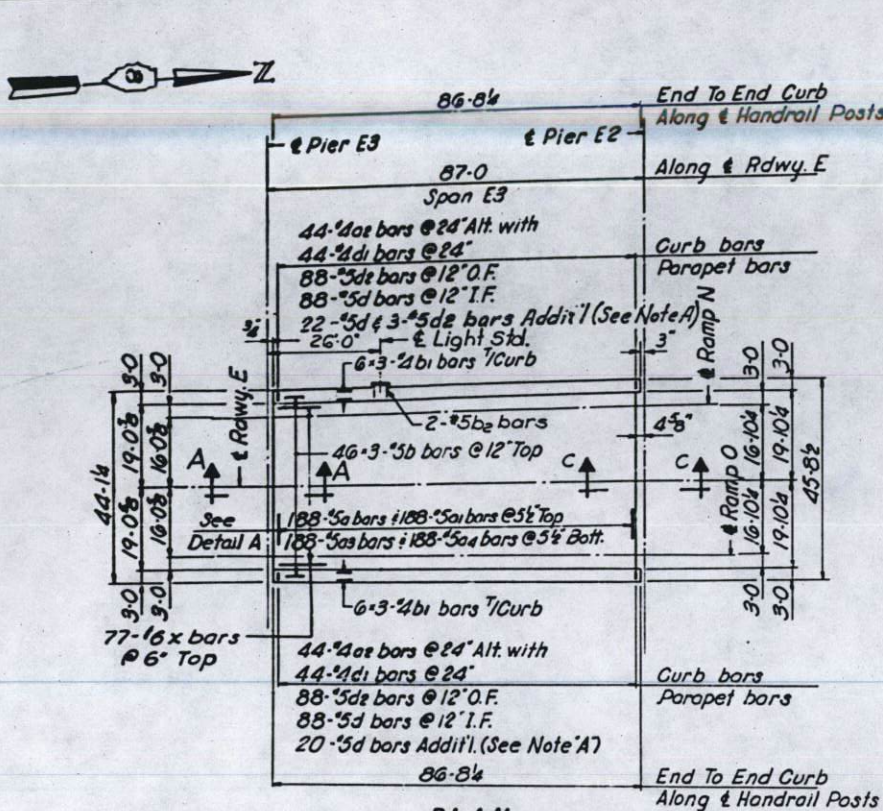

BILL OF MATERIAL

BAR NO.	NO.	SIZE	LENGTH	SHAPE
14 a	188	#5	19-10	—
14 a1	188	#5	27-0	—
14 a2	88	#5	3-9	—
14 a3	188	#5	30-6	—
14 a4	188	#5	17-4	—
14 b	327	#5	29-6	—
14 b1	36	#5	29-7	—
14 b2	2	#5	3-8	—
14 d	218	#5	3-3	J
14 di	88	#4	1-1	—
14 de	179	#5	3-6	J
14 x	77	#6	5-8	C

• See Note "X"

ITEM	UNIT	TOTAL
Class "X" Concrete	Cu. Yds.	111.7
Reinforcement Bars	Lbs.	31,590
Protective Coat	Sq. Yds.	457






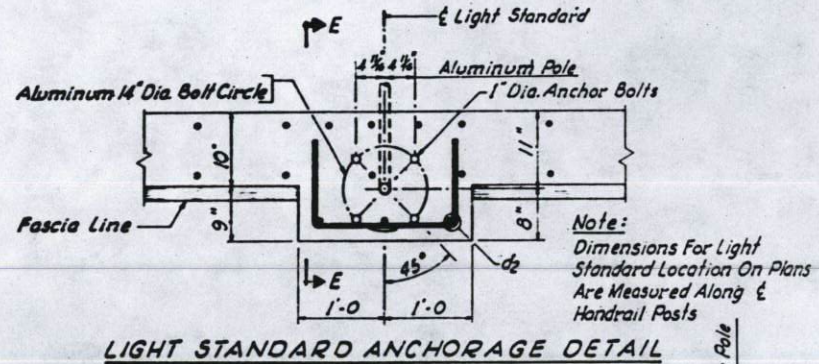


Table of Fascia Dimensions

Location	Span	Girder E1			Girder E2		
		A	Min	Max	A	Min	Max
Rdwy. "C"	E2 Thru O18	3-4	1/2	1-0 1/2	3-4	1/2	1-0 1/2
	E3	3-4 1/2	3/8	1-1	3-4 1/2	3/8	1-1
	E4 Thru E6	3-3 1/2	1/2	1-0	3-3 1/2	1/2	1-0
Rdwy. "F"	F1 Thru F3	3-3 1/2	1/2	1-0	3-3 1/2	1/2	1-0
	F4 Thru F6	3-3 1/2	3/8	1-0	3-3 1/2	3/8	1-0
	F7 Thru F9	3-3 1/2	1/4	1-0	3-3 1/2	1/4	1-0
Ramp "M"	M1 Thru M3	3-4 1/2	1	1-1	3-4 1/2	1	1-1
	M4 Thru M7	3-3 1/2	3/8	1-0	3-3 1/2	3/8	1-0
Ramp "N"	N1 Thru N3	3-4 1/2	1/2	1-1	3-4 1/2	1/2	1-1
	N4 Thru N7	3-4 1/2	1/2	1-1	3-4 1/2	1/2	1-1
Ramp "O"	O1 Thru O3	3-4 1/2	1/2	1-1	3-4 1/2	1/2	1-1
	O4 Thru O7	3-4 1/2	1/2	1-1	3-4 1/2	1/2	1-1
Ramp "P"	P1 Thru P3	3-4	5/8	1-0 1/2	3-4	5/8	1-0 1/2
	P4 Thru P7	3-4	5/8	1-0 1/2	3-4	5/8	1-0 1/2

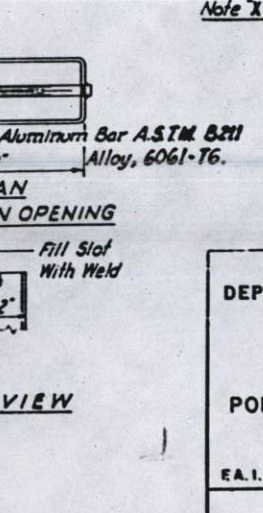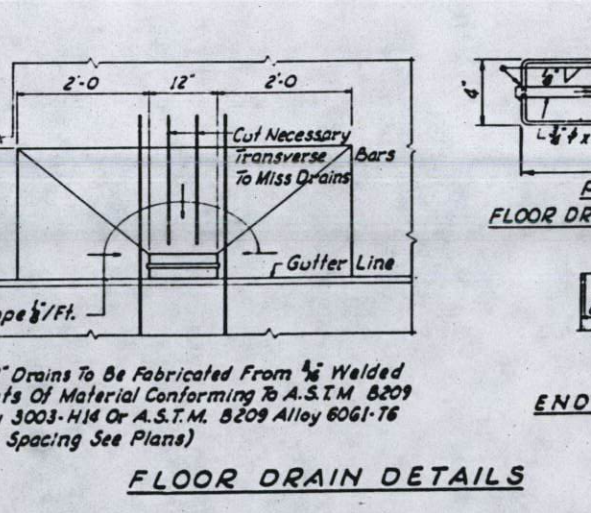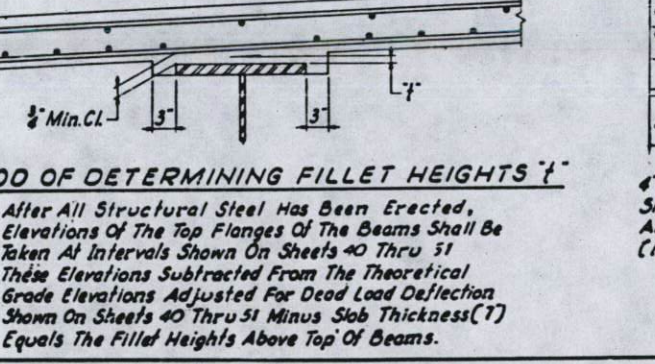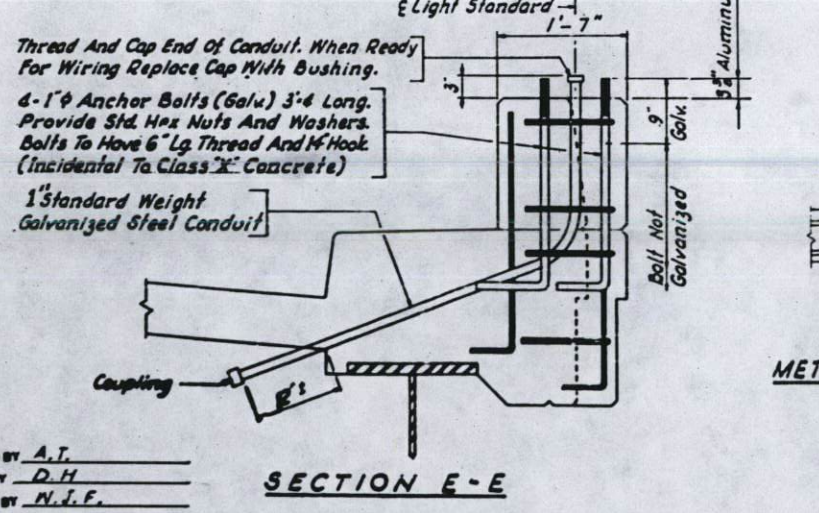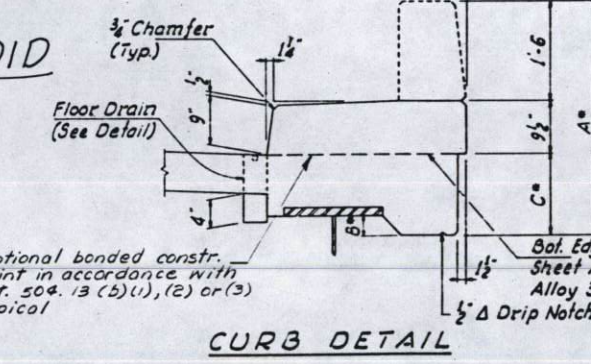

GENERAL SLAB NOTES

Note A 2-Additional #5d Bars Inside Face Of Parapet At Each Handrail Post And Light Standard. 3-Additional #5d Bars In Outside Face At Light Standard. Space Bars To Miss Parapet Joints.

Note B Bars Indicated Thus 5x6-#5 Etc. Indicates 5 Lines Of Bars With 4 Lengths Per Line Min. Bar Laps = 20 Dia. (Transverse Slab Bars Shall Have A Min. Lap Of 30 Dia.)

Note C Transverse Bars In Horizontally Curved Slab Shall Be Spaced Radially. See Bar Spacing Diagram.

Note X The First Two Or Three Digits Of The Bar Mark In The Bill Of Material Correspond To The Sheet No. These Digits Are Omitted On The Drawing.

NOTES:

For Section A-A See Sheet No. 104.

For Section C-C See Sheet No. 103.

STATE OF ILLINOIS
DEPARTMENT OF PUBLIC WORKS & BLDGS.
DIVISION OF HIGHWAYS

SLAB
SPAN E3
POPLAR STREET BRIDGE APPROACHES
ROADWAY "E"

E.A.I. RT.70 ST. CLAIR CO. SECTION 82-3HVB-2

H. W. LOCHNER, INC.
ENGINEERS
CHICAGO, ILLINOIS

SHEET
14 of 147

DESIGNED BY A.T.
DRAWN BY D.H.
CHECKED BY N.L.F.

Rev. 1-27-70 Slab from 1" to 7/8", Class X from 105.6 to 111.7 Cu. Yds. S.M.


ROUTE NO.	SECTION	COUNTY	TOTAL SHEETS	SHEET NO.
F.A. 1.-70	82-3HVB-2	ST. CLAIR	252	80 A
FED. ROAD DIV. NO. 4		ILLINOIS	PROJECT	

BILL OF MATERIAL


BAR NO.	NO.	SIZE	LENGTH	SHAPE
14 a	188	5	19-10	—
14 ai	188	5	27-0	—
14 a2	88	5	3-9	—
14 a3	188	5	30-6	—
14 a4	188	5	17-4	—
14 b	927	5	29-6	—
14 bi	36	5	29-7	—
14 b2	2	5	3-8	—
14 d	218	5	3-3	—
14 di	88	5	1-1	—
14 de	179	5	3-6	—
14 x	77	6	5-2	—

See Note "X"


ITEM	UNIT	TOTAL
Class "X" Concrete	Cu. Yds.	111.7
Reinforcement Bars	Lbs.	31,590
Protective Coat	Sq. Yds.	487

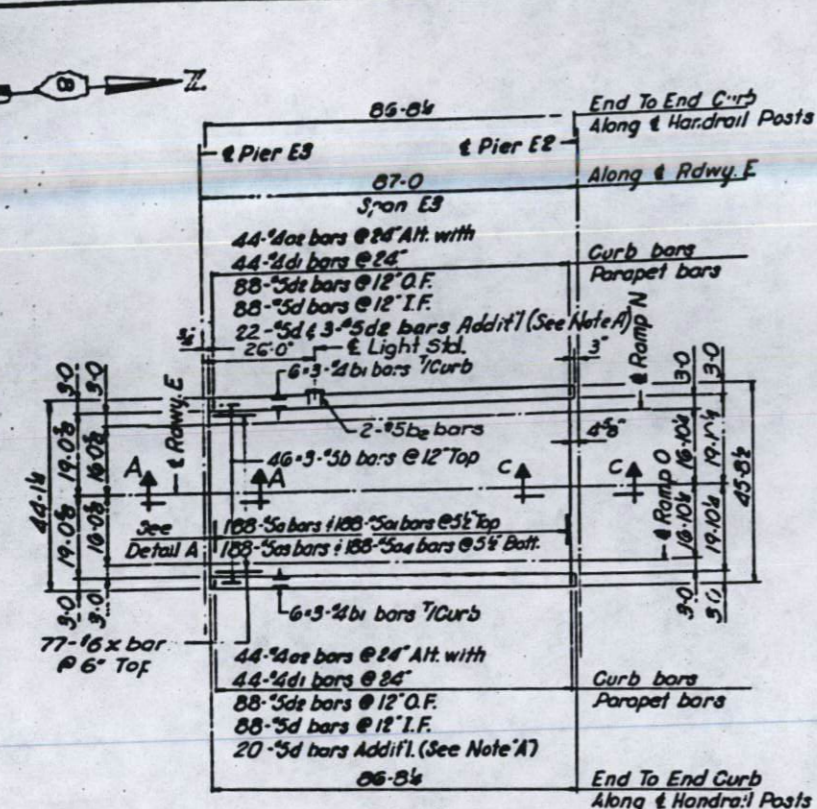

PLAN SPAN E3

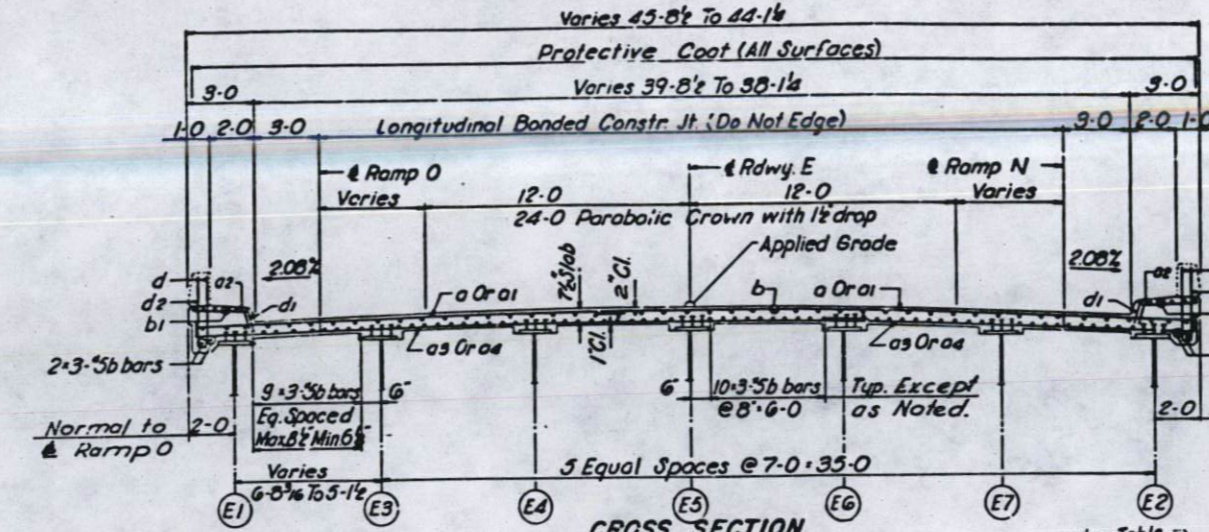


CROSS SECTION SPAN E3

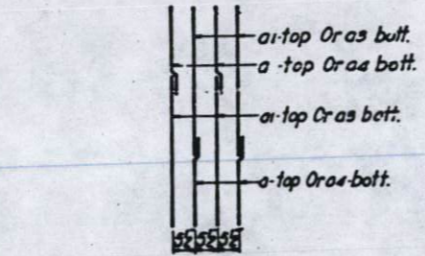

DETAIL A
Arrangement of Main Reinf.


DEAD LOAD DEFLECTION DIAGRAM
(Wt. C. Concrete Only)

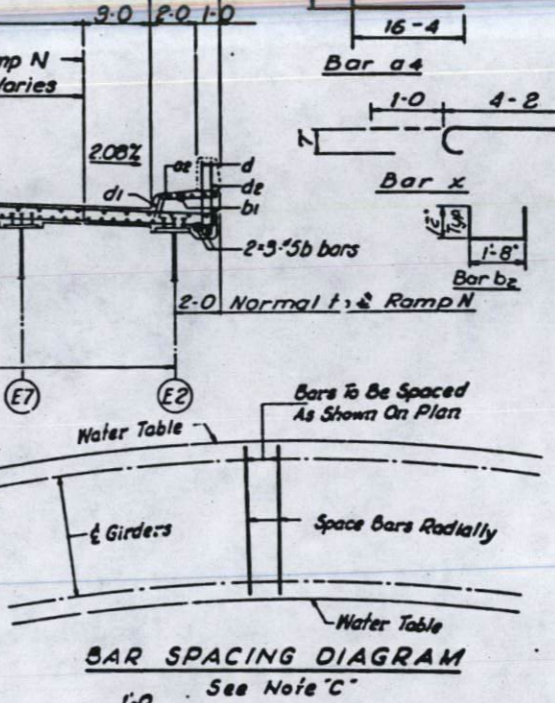


BAR SPACING DIAGRAM
See Note "C"

GENERAL SLAB NOTES

- 1-Additional #5d Bars Inside Face Of Parapet At Each Handrail Post And Light Standard. 3-Additional #5d Bars In Outside Face At Light Standard. Space Bars To Miss Parapet Joints.
- 2-Additional #5d Bars Inside Face Of Parapet At Each Handrail Post And Light Standard. 3-Additional #5d Bars In Outside Face At Light Standard. Space Bars To Miss Parapet Joints.
- Bars Indicated Thus 5x6-#5 Etc. Indicates 5 Lines Of Bars With 6 Lengths Per Line Min. Bar Lgs = 20 Dia. (Transverse Slab Bars Shall Have A Min. Lg Of 3C Dia.)
- Note "C" Transverse Bars In Horizontally Curved Slab Shall Be Spaced Radially. See Bar Spacing Diagram.
- Note "X" The First Two Or Three Digits Of The Bar Mark In The Bill Of Material Correspond To The Sheet No. These Digits Are Omitted On The Drawing.

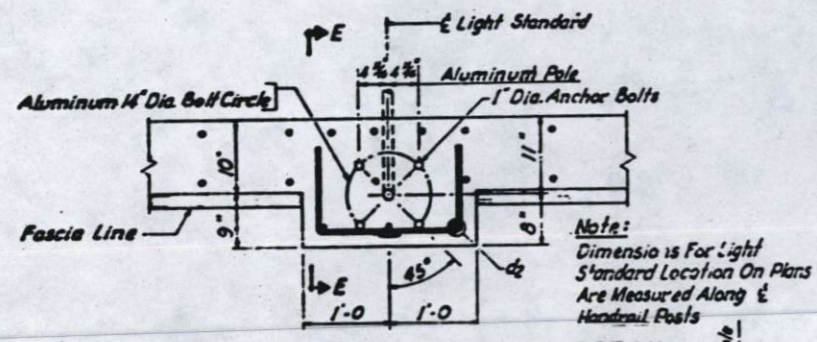

LIGHT STANDARD ANCHORAGE DETAIL

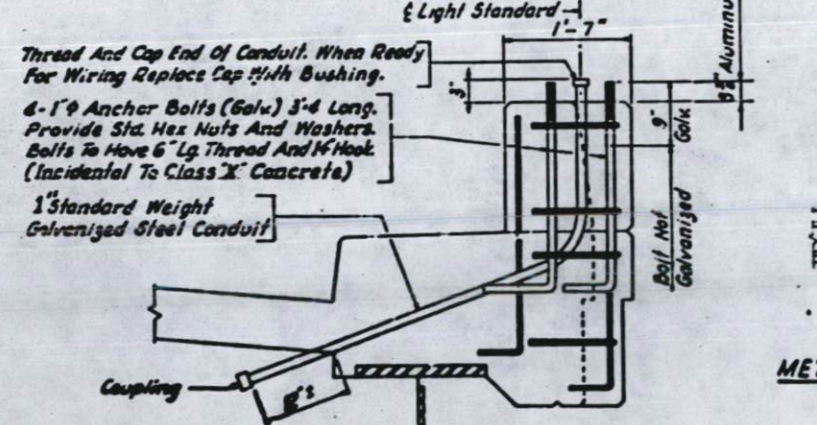


SECTION E-E


Location	Span	Girder E1			Girder E2		
		A	Min	Max	A	Min	Max
Rdr. J. "E"	E2 Thru E3	3-4	1/2	1-0 1/2	3-4	1/2	1-0 1/2
	E3	3-4 1/2	3/4	1-1	3-4 1/2	3/4	1-1
	E4 Thru E6	3-3 1/2	1/2	1-0	3-3 1/2	1/2	1-0
Rdwy. "F"	E7 Thru E9	3-3 1/2	3/4	1-0	3-3 1/2	3/4	1-0
	F1 Thru F3	3-3 1/2	1/2	1-0	3-3 1/2	1/2	1-0
	F4 Thru F6	3-3 1/2	3/4	1-0	3-3 1/2	3/4	1-0
Ramp "M"	F7 Thru F9	3-3 1/2	1/2	1-0	3-3 1/2	1/2	1-0
	F10 Thru F12	3-5	1/2	1-1 1/2	3-5	1/2	1-1 1/2
	M1 Thru M3	3-4 1/2	1	1-1	3-4 1/2	1	1-1
Ramp "N"	M4 Thru M6	3-3 1/2	3/4	1-0	3-3 1/2	3/4	1-0
	N5 Thru N7	3-3 1/2	3/4	1-0	3-3 1/2	3/4	1-0
Ramp "O"	O1 Thru O3	3-4 1/2	1/2	1-1	3-4 1/2	1/2	1-1
	O4 Thru O7	3-4 1/2	1/2	1-1	3-4 1/2	1/2	1-1
Ramp "P"	P1 Thru P3	3-4	5/8	1-0 1/2	3-4	5/8	1-0 1/2
	P4 Thru P6	3-4	5/8	1-0 1/2	3-4	5/8	1-0 1/2

METHOD OF DETERMINING FILLET HEIGHTS "T"


After All Structural Steel Has Been Erected, Elevations Of The Top Flanges Of The Beams Shall Be Taken At Intervals Shown On Sheets 40 Thru 51 These Elevations Subtracted From The Theoretical Grade Elevations Adjusted For Dead Load Deflection Shown On Sheets 40 Thru 51 Minus Slab Thickness (T) Equals The Fillet Heights Above Top Of Beams.

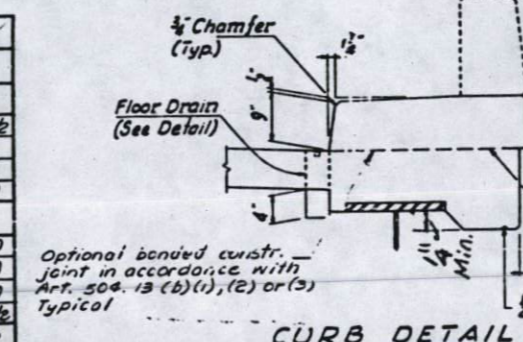

CURB DETAIL

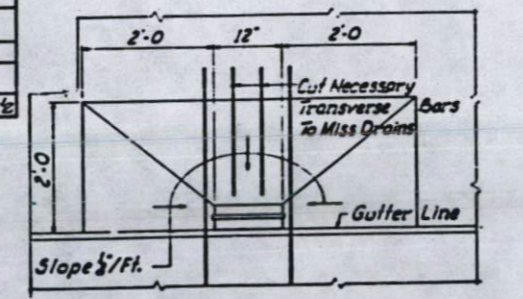

FLOOR DRAIN DETAILS

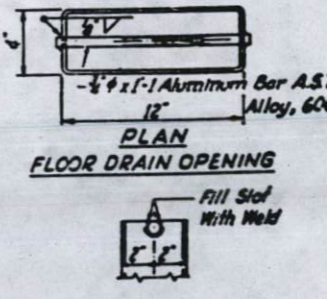

END VIEW

NOTES:
For Section A-A See Sheet No. 104.
For Section C-C See Sheet No. 103.

STATE OF ILLINOIS
DEPARTMENT OF PUBLIC WORKS & BLDGS.
DIVISION OF HIGHWAYS

SLAB
SPAN E3
POPLAR STREET BRIDGE APPROACHES
ROADWAY "E"

E.A. I. RT. 70 ST. CLAIR CO. SECTION 82-3HVB-2
H. W. LOCHNER, INC.
ENGINEERS
CHICAGO, ILLINOIS


SHEET
14 of 147

DESIGNED BY A.T.
DRAWN BY J.H.
CHECKED BY N.J.F.

REV. 9-28-71 J.M.J.

REV. 1-21-70 Slab from 1" to 7", Class X from 105.6 to 111.7 Cu Yds. SM

ROUTE NO.	SECTION	COUNTY	TOTAL SHEETS	SHEET NO.
F.A.I.-70	82-3HV8-2	ST. CLAIR	252	81
FED. ROAD DIV. NO. 4		ILLINOIS	PROJECT	

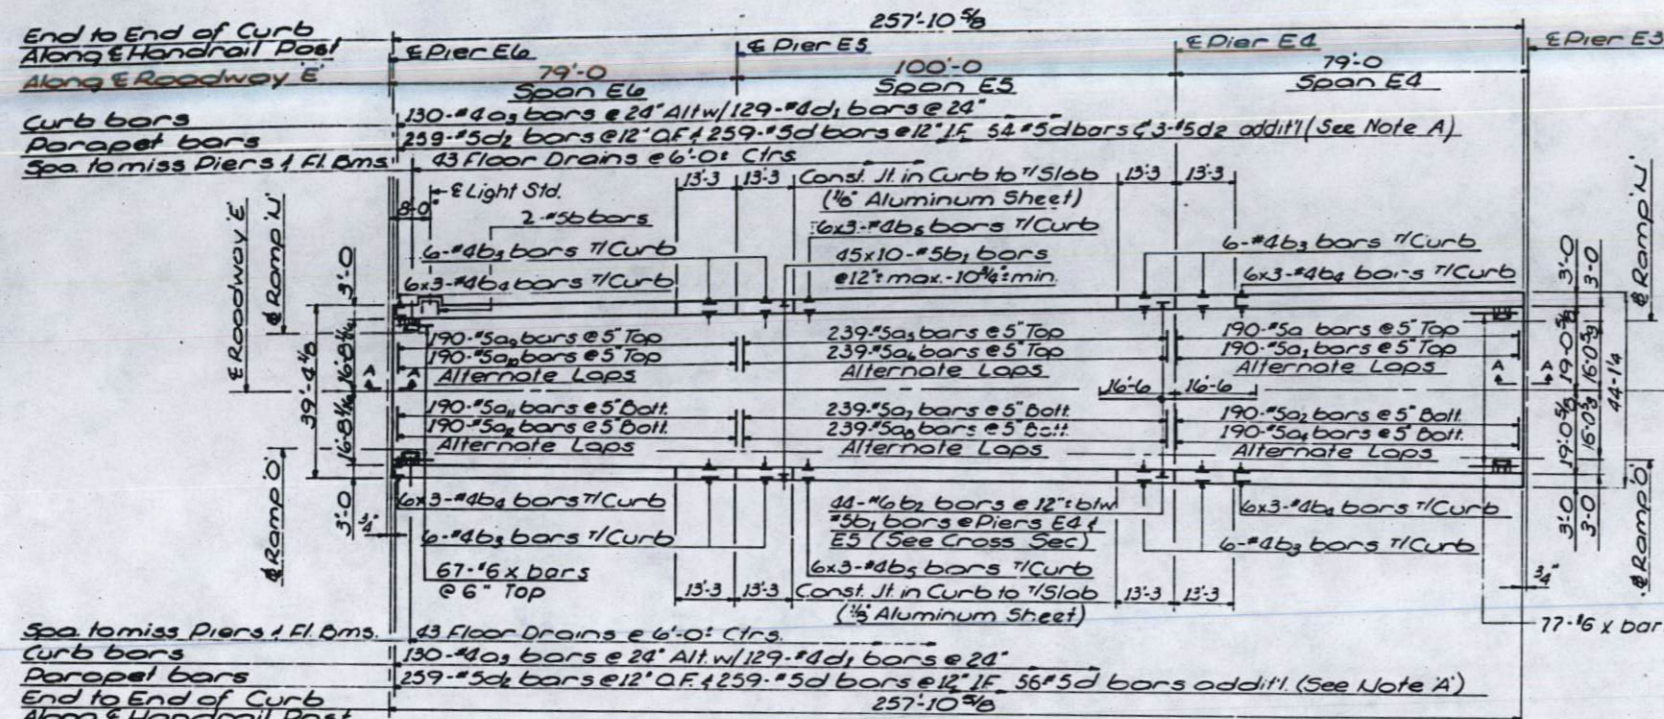


PLAN
Spans E4, E5, E6


BILL OF MATERIAL

Bar	N ^o	Size	Length	Shape
15a	190	#5	30.8	—
15a ₁	190	#5	14.6	—
15a ₂	190	#5	26.8	—
15a ₃	260	#4	3.9	—
15a ₄	190	#5	19.6	—
15a ₅	239	#5	29.7	—
15a ₆	239	#5	14.2	—
15a ₇	239	#5	25.8	—
15a ₈	239	#5	19.1	—
15a ₉	190	#5	26.2	—
15a ₁₀	190	#5	13.8	—
15a ₁₁	190	#5	24.6	—
15a ₁₂	190	#5	18.4	—
15b	2	#5	3.8	—
15b ₁	1055	#5	26.8	—
15b ₂	88	#6	33.0	—
15b ₃	48	#4	12.11	—
15b ₄	72	#4	22.6	—
15b ₅	36	#4	25.2	—
15c	628	#5	3.3	—
15c ₁	258	#4	1.1	—
15c ₂	521	#5	3.6	—
15x	144	#6	5.2	—
ITEM	UNIT	TOTAL		
Class X Concrete	Cu Yds.	313.4		
Reinforcement Bars	Lbs.	99,360		
Protective Coat	Sq Yds.	1315		


• See Note 'X' Sh. No. 14

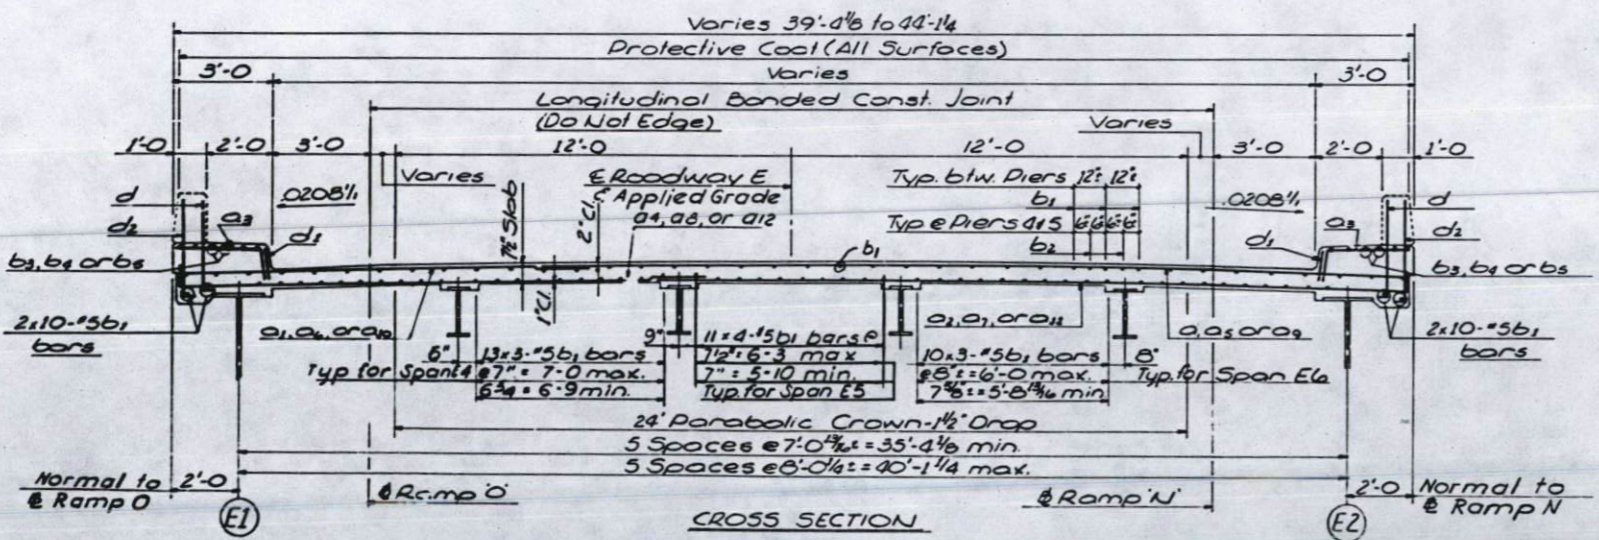


CROSS SECTION

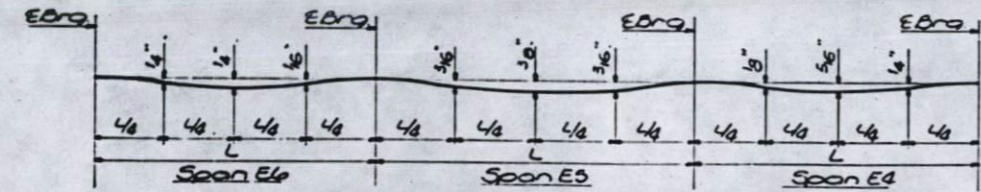


DEAD LOAD DEFLECTION DIAGRAM
Fascia Girders (Wt. of Conc. only)

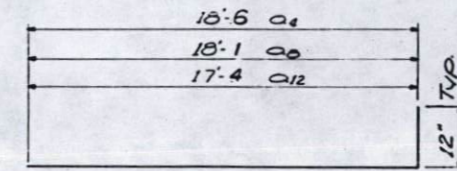


Bars o4, o6, o12

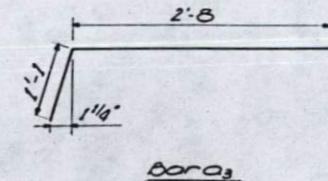

Bar a3

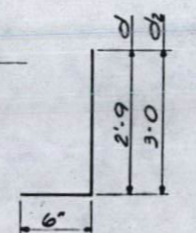

Bars d1, d2

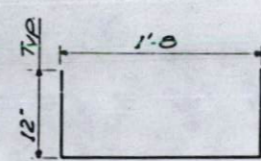

Bar b

NOTE:
For Section A-A See Sh. No. 104
For Note 'A' & Misc. Details See
Sh. No. 14

DESIGNED BY: RT
DRAWN BY: W.J.F.
CHECKED BY: W.J.F.


STATE OF ILLINOIS
DEPARTMENT OF PUBLIC WORKS & BLDGS.
DIVISION OF HIGHWAYS

SLAB
SPANS E4 THRU E6
POPLAR STREET BRIDGE APPROACHES
ROADWAY "E"

F.A.I.R.T. 70 ST. CLAIR CO SECTION 82-3HV8-2
H. W. LOCHNER, INC.
ENGINEERS
CHICAGO, ILLINOIS. SHEET
15 OF 147

Rev 1-27-70 Slab from 1" to 7/8", Class X from 296 G to 313 & Cu Yds SM

ROUTE NO.	SECTION	COUNTY	TOTAL SHEETS	SHEET NO.
F. A. I. - 70	82-3HVB-2	ST. CLAIR	252	93
FED. ROAD DIV. NO. 4		ILLINOIS	PROJECT	

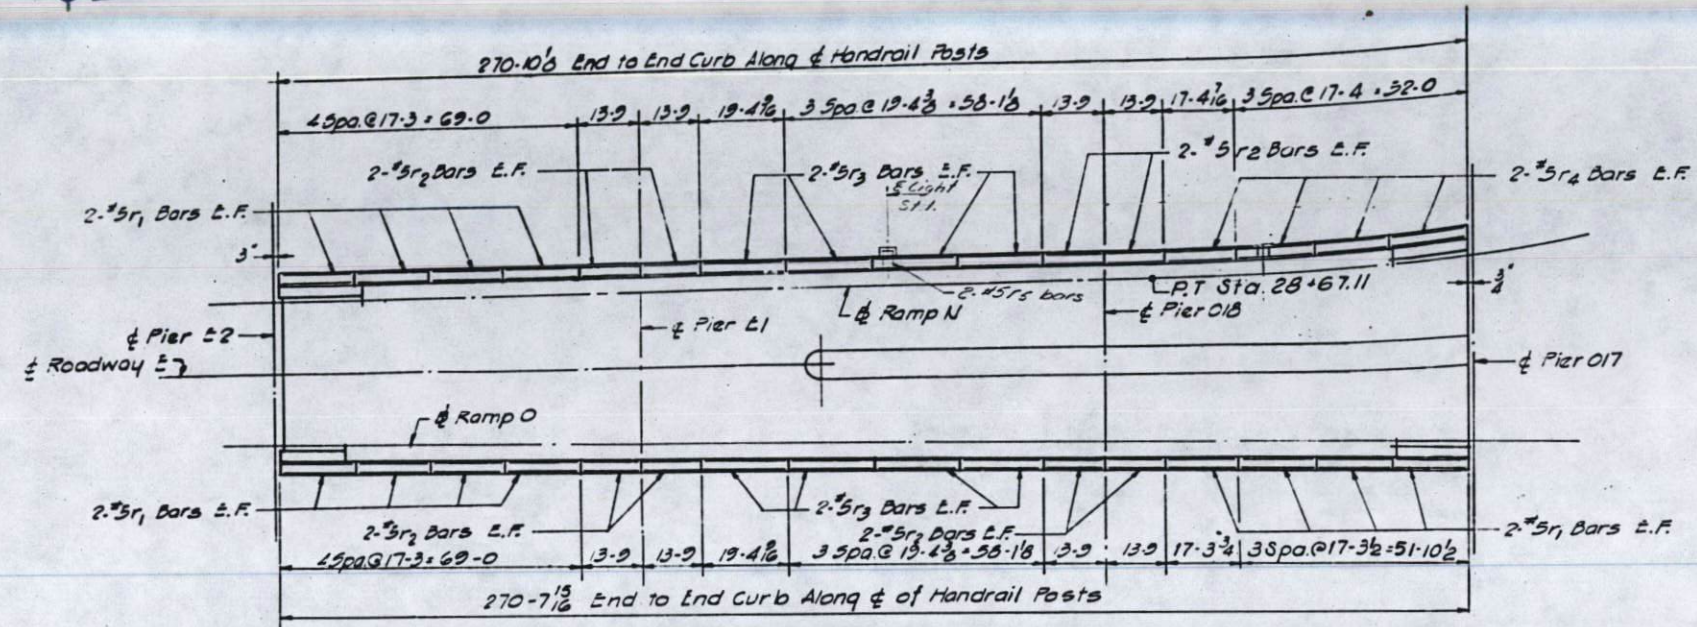


PLAN
Parapet Joint Spacing
Spans E2 thru O18E


NOTE:
All dimensions in plan
are along & of posts

BILL OF MATERIAL				
* BAR	NO	SIZE	LENGTH	SHAPE
27r1	48	#5	16-11	—
27r2	32	#5	13-5	—
27r3	32	#5	15-0	—
27r4	16	#5	17-0	—
27r5	4	#5	3-8	□
ITEM		UNIT	TOTAL	
Class X Concrete		Cu.Yd.	27.6	
Reinforcement Bars		Lbs.	2230	
Aluminum Railing		Lin. Ft.	542	

* See Note 'X' Sheet No. 14

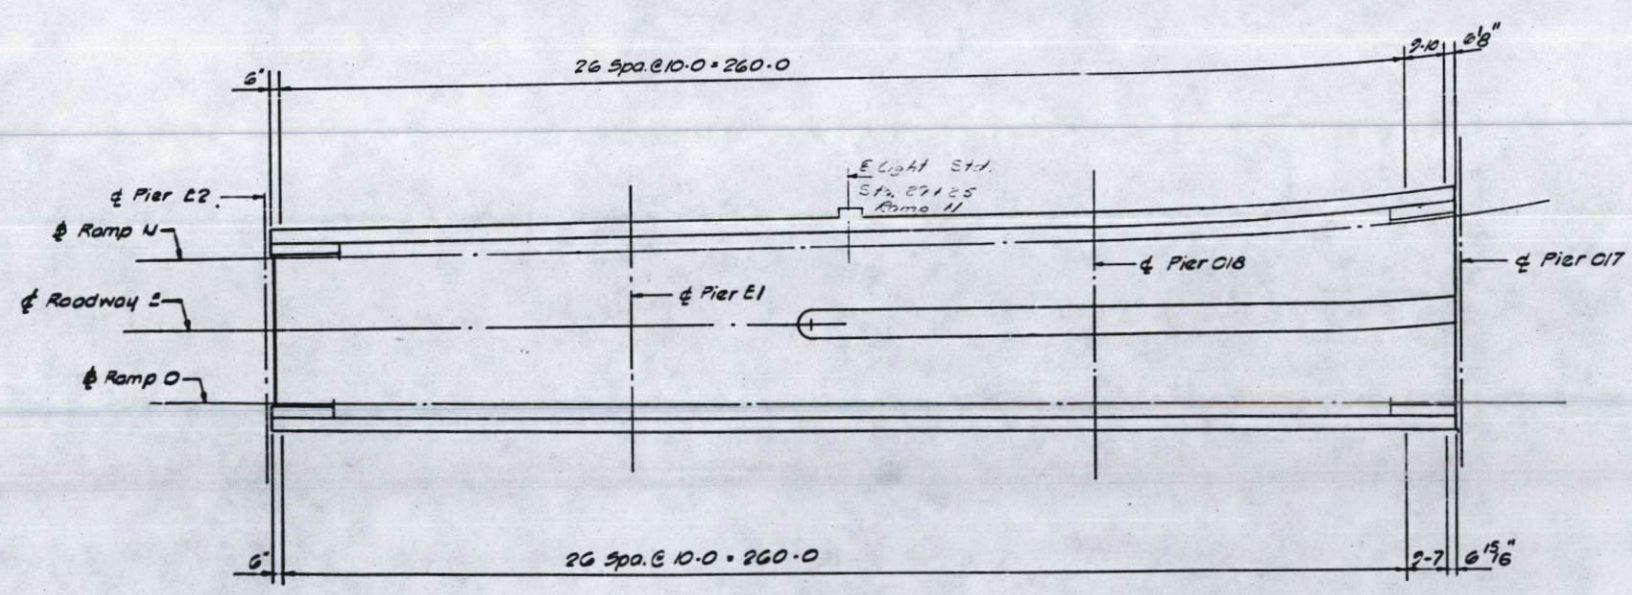

PLAN
Handrail Post Spacing
Spans E2 thru O18E

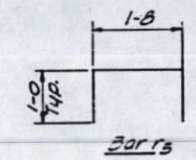

NOTES:
For Details at Light Str. see Sheet No. 14
For Handrail and Parapet Joint Details
see Sheet No. 39


DESIGNED BY: A.T.
DRAWN BY: V.E.
CHECKED BY: W.J.F.

STATE OF ILLINOIS
DEPARTMENT OF PUBLIC WORKS & BLDGS.
DIVISION OF HIGHWAYS
PARAPET AND HANDRAIL
SPANS E2 THRU O18E
POPLAR STREET BRIDGE APPROACHES
ROADWAY "E"


F. A. I. RT. 70 ST. CLAIR CO. SECTION 82-3HVB-2
H. W. LOCHNER, INC.
ENGINEERS
CHICAGO, ILLINOIS

SHEET
27 of 147

ROUTE NO.	SECTION	COUNTY	TOTAL SHEETS	SHEET NO.
F. A. I.-70	82-3HVB-2	ST. CLAIR	252	94
FED. ROAD DIV. NO. 4	ILLINOIS	PROJECT		

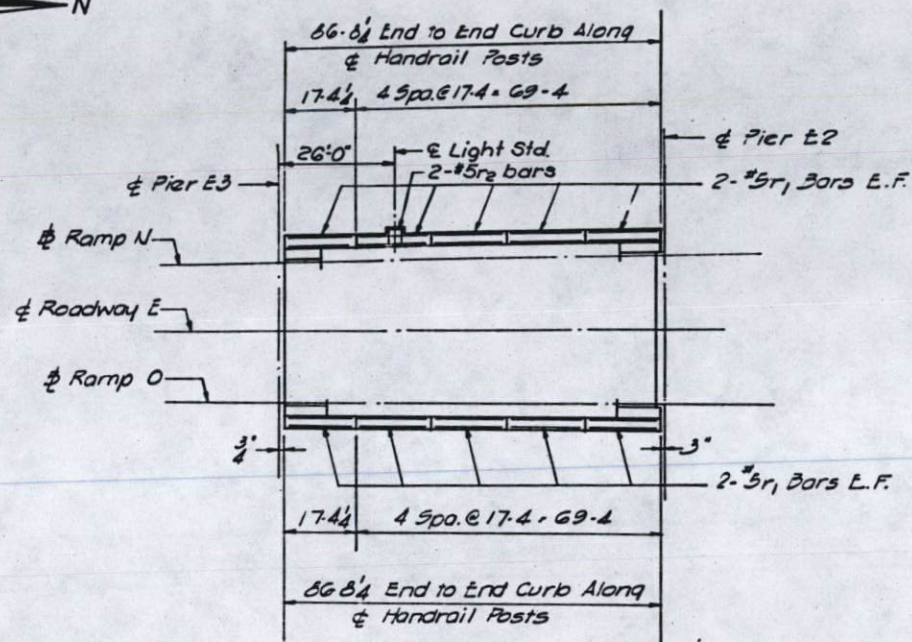


PLAN
Parapet Joint Spacing
Span E3

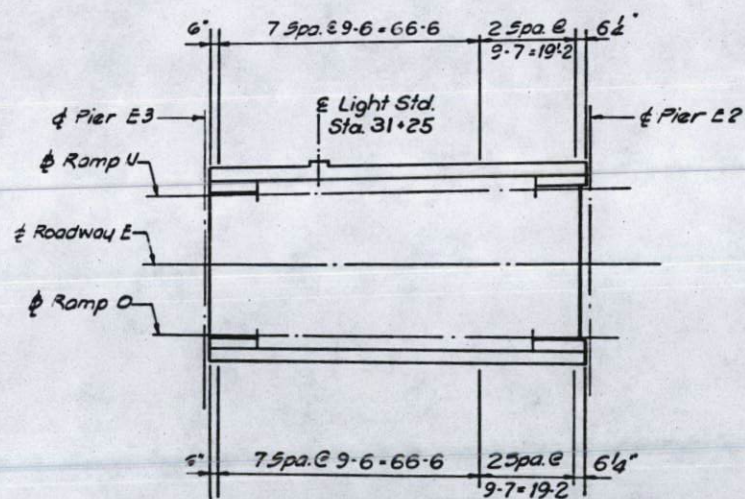

PLAN
Handrail Post Spacing
Span E3

NOTE: All dimensions in plan are along & of posts.

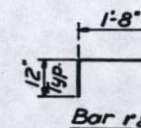

BILL OF MATERIAL				
*BAR	NO	SIZE	LENGTH	SHAPE
28 r1	40	#5	17'-0"	—
28 r2	2	#5	3'-8"	□
ITEM		UNIT	TOTAL	
Class X Concrete		Cu. Yd.	8.8	
Reinforcement Bars		Lbs.	710	
Aluminum Railing		Lin. Ft.	174	

*See Note 'x' Sheet No 14


NOTES:
For Handrail and Parapet Joint Details see Sheet No. 39

STATE OF ILLINOIS
DEPARTMENT OF PUBLIC WORKS & BLDGS.
DIVISION OF HIGHWAYS
PARAPET AND HANDRAIL
SPAN E3
POPLAR STREET BRIDGE APPROACHES
ROADWAY "E"
F. A. I. RT. 70 ST. CLAIR CO. SECTION 82-3HVB-2
H. W. LOCHNER, INC.
ENGINEERS
CHICAGO, ILLINOIS


DESIGNED BY R.T.
DRAWN BY [Signature]
CHECKED BY W.J.F.

SHEET
28 of 147

ROUTE NO.	SECTION	COUNTY	TOTAL SHEETS	SHEET NO.
E.A.I.-70	82-3HVB-2	ST. CLAIR	252	95
FED. ROAD DIV. NO. 4		ILLINOIS PROJECT		

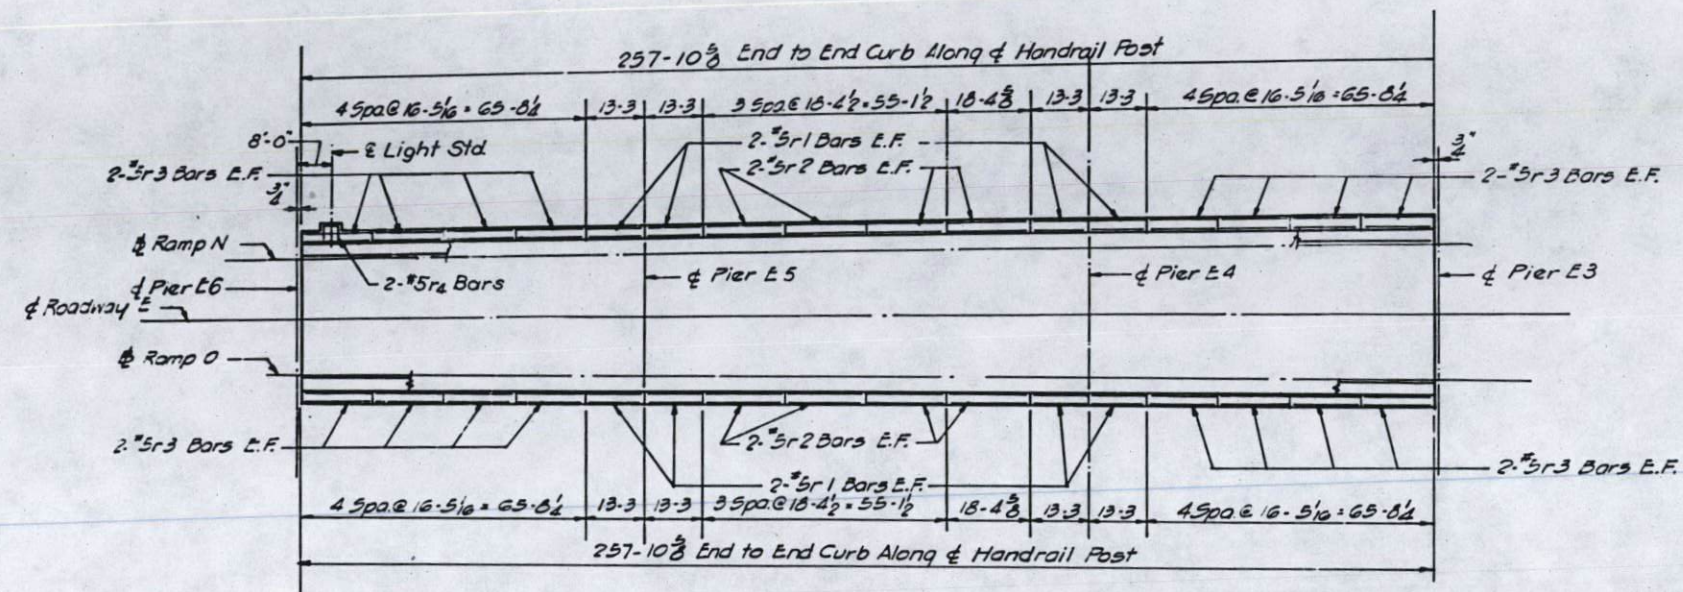

PLAN
Parapet Joint Spacing
Spans E4 thru E6

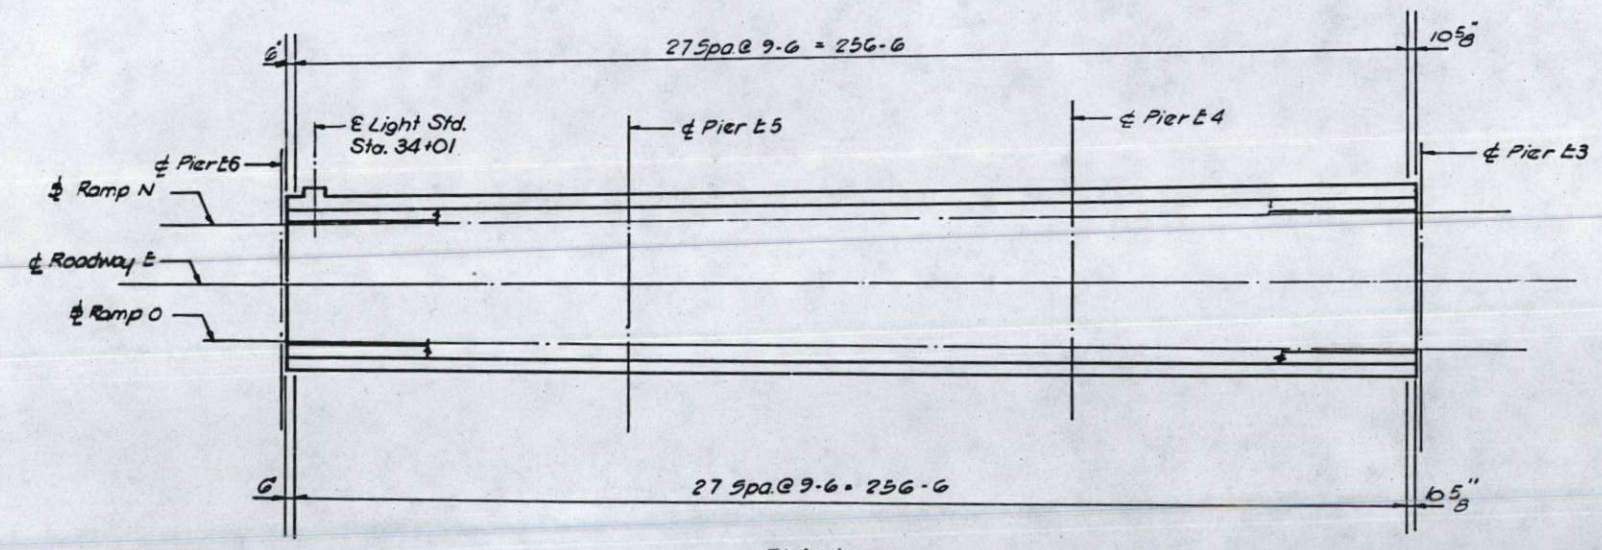


PLAN
Handrail Post Spacing

NOTE: All dimensions in plan are along ϕ of post

BILL OF MATERIAL				
#BAR	NO	SIZE	LENGTH	SHAPE
29r1	32	#5	12-11	—
29r2	32	#5	18-0	—
29r3	64	#5	16-1	—
29r4	2	#5	3-3	□
ITEM UNIT TOTAL				
Class X Concrete			Cu. Yds.	26.3
Reinforcement Bars			Lbs.	2120
Aluminum Railing			Lin. Ft.	516

* See Note x Sheet No. 14

NOTES:
For Detail at Light Std see Sheet No. 14
For Handrail and Parapet Joint Details see Sheet No. 39

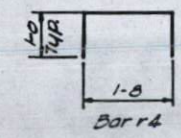


DESIGNED BY: T.G.
DRAWN BY: J.F.
CHECKED BY: W.J.P.

STATE OF ILLINOIS
DEPARTMENT OF PUBLIC WORKS & BLDGS.
DIVISION OF HIGHWAYS
PARAPET AND HANDRAIL
SPANS E4 THRU E6
POPLAR STREET BRIDGE APPROACHES
ROADWAY "E"

E.A.I.RT.70 ST. CLAIR CO. SECTION 82-3HVB-2
N. W. LOCHNER, INC.
ENGINEERS
CHICAGO, ILLINOIS

SHEET
29 OF 147

ROUTE NO.	SECTION	COUNTY	TOTAL SHEETS	SHEET NO.
F.A.I.-70	82-3HVB-2	ST. CLAIR	252	96
FED. ROAD DIV. NO. 4		ILLINOIS	PROJECT	

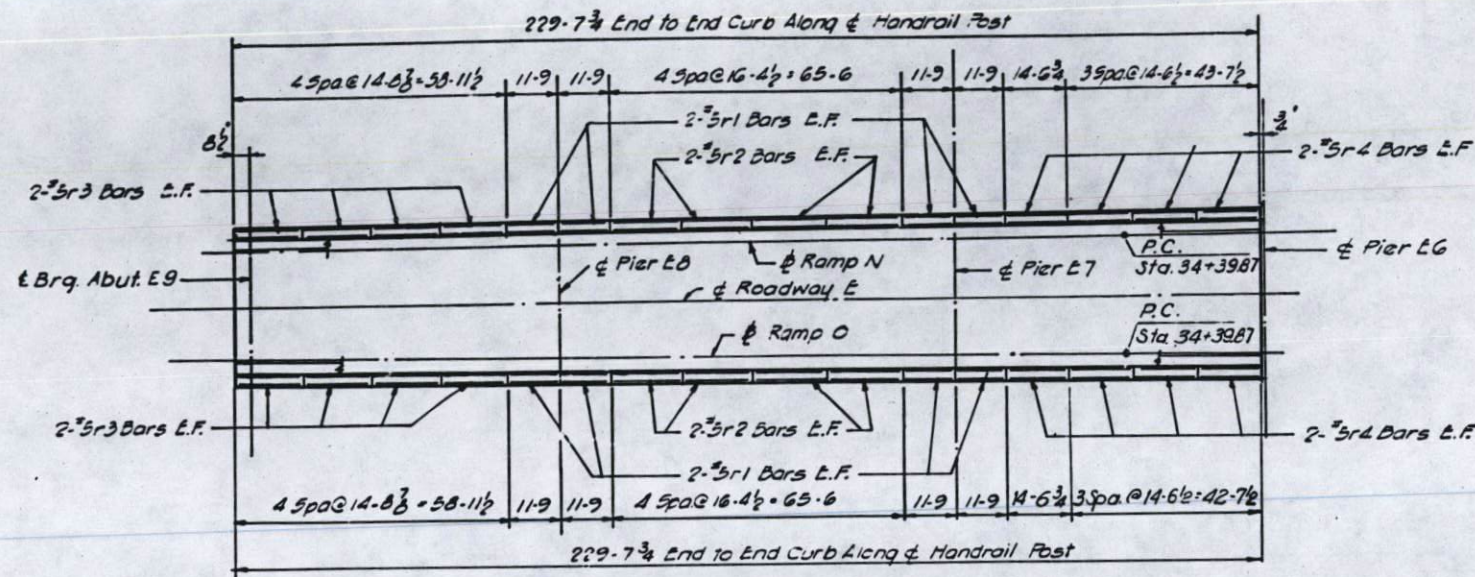


PLAN
Parapet Joint Spacing
Spans E7 thru E9

NOTE:
All dimensions in plan
are along ϕ of post.

BILL OF MATERIAL					
*BAR	NO	SIZE	LENGTH	SHAPE	
30r1	32	#5	11-5	—	
30r2	32	#5	16-0	—	
30r3	32	#5	14-5	—	
30r4	32	#5	14-2	—	
ITEM				UNIT	TOTAL
Class X Concrete				Cu Yds.	23.4
Reinforcement Bars				Lbs.	1880
Aluminum Railing				Lin. Ft.	459

* See Note K sheet No. 14

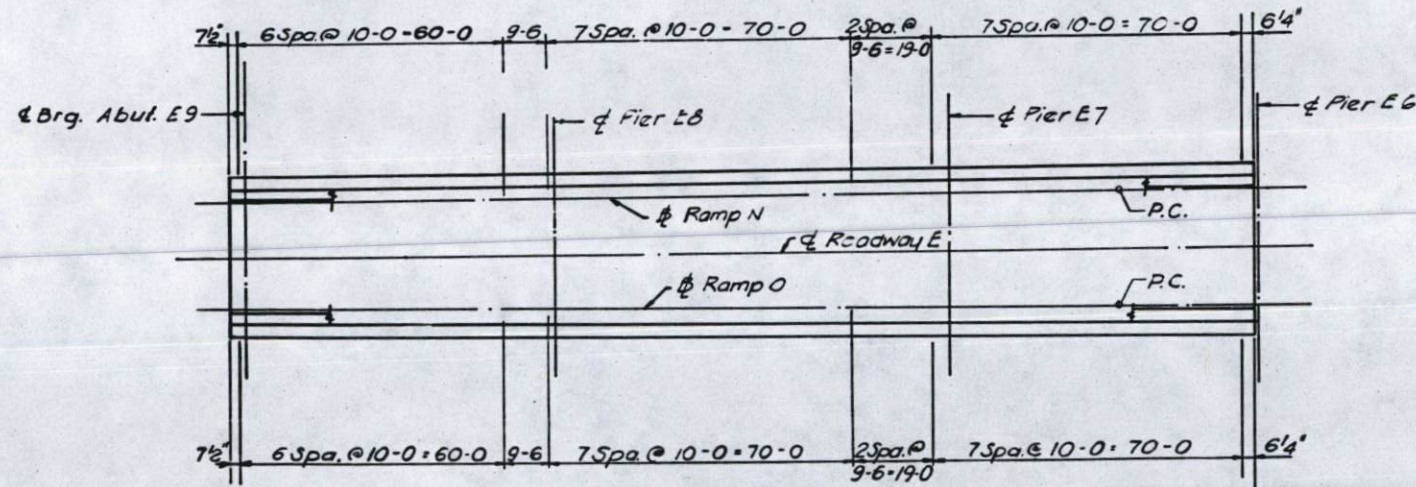

PLAN
Handrail Post Spacing

NOTES:
For Detail at Light Std. See Sheet No. 14
For Handrail and Parapet Joint Details
See Sheet No. 39


DESIGNED BY A.T.
DRAWN BY V.Z.
CHECKED BY W.J.E.

STATE OF ILLINOIS
DEPARTMENT OF PUBLIC WORKS & BLDGS.
DIVISION OF HIGHWAYS
PARAPET AND HANDRAIL
SPANS E7 THRU E9
POPLAR STREET BRIDGE APPROACHES
ROADWAY "E"

F.A.I. RT. 70 ST. CLAIR CO. SECTION 82-3HVB-2
N. W. LOCHNER, INC.
ENGINEERS
CHICAGO, ILLINOIS


SHEET
30 of 147

ROUTE NO.	SECTION	COUNTY	TOTAL SHEETS	SHEET NO.
F.A.I. 70	82-3HYB-2	ST. CLAIR	252	118
FED. ROAD DIV. NO. 4		ILLINOIS	PROJECT	

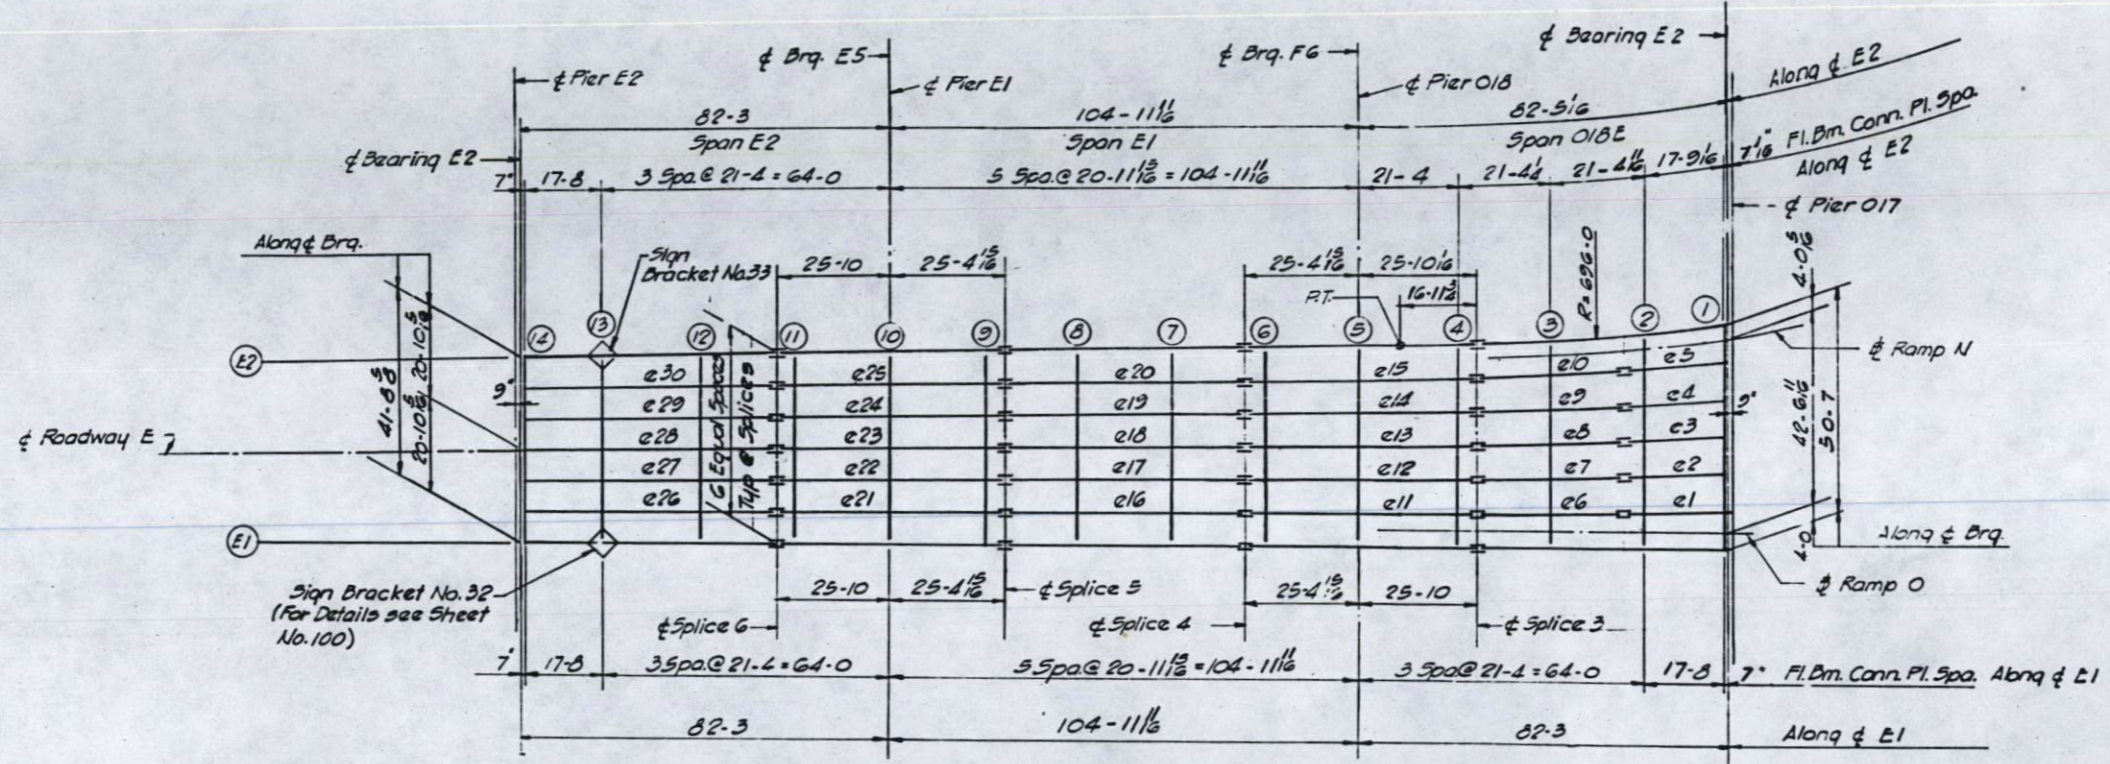

* ELEVATION TOP OF GIRDER WEB
 * Lower all elevations .042 ft

	GIR. E1	GIR. E2	DIFF.
CL. BRG.	445.647	445.375	.271
FLOOR BEAM 1	445.635	445.362	.274
FLOOR BEAM 2	445.929	445.555	.374
FLOOR BEAM 3	446.258	445.763	.495
SPLICE 3	446.518	445.927	.591
FLOOR BEAM 4	446.581	445.960	.581
FLOOR BEAM 5	446.763	446.229	.534
FLOOR BEAM 6	446.982	446.475	.487
SPLICE 4	447.004	446.388	.478
FLOOR BEAM 7	447.085	446.715	.390
FLOOR BEAM 8	447.141	446.935	.186
SPLICE 5	447.201	447.144	.057
FLOOR BEAM 9	447.202	447.150	.051
FLOOR BEAM 10	447.208	447.179	.028
FLOOR BEAM 11	447.213	447.208	.005
SPLICE 6	447.214	447.214	.000
FLOOR BEAM 12	447.677	447.677	.000
FLOOR BEAM 13	446.982	446.982	.000
FLOOR BEAM 14	446.738	446.738	.000
CL. BRG.	446.733	446.733	.000

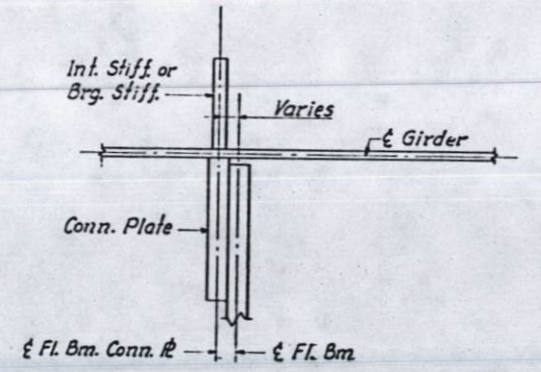

FLOOR BEAM LOCATION SKETCH

Weight of Bearing Assemblies with Lead Plates and Anchor Bolts are Included as Structural Steel Wt. 6430 Lbs.

DESIGNED BY AT
 DRAWN BY VE
 CHECKED BY SAD

STATE OF ILLINOIS
 DEPARTMENT OF PUBLIC WORKS & BLDGS.
 DIVISION OF HIGHWAYS

FRAMING PLAN
 SPANS E2 THRU O1B E
 POPLAR STREET BRIDGE APPROACHES
 ROADWAY "E"

F.A.I. RT. 70 ST. CLAIR CO. SECTION 82-3HYB-2

H. W. LOCHNER, INC.
 ENGINEERS
 CHICAGO, ILLINOIS




SHEET
 52 OF 147

STRINGER DIMENSIONS

STR	L	S1	S2	S3	S4	S1	S2
1	22'-8"	17'-8"	○	○	4'-6"	89.30.04	90.29.56
2	22'-2 1/16"	17'-8 1/16"	○	○	4'-6"	88.28.25	91.31.35
3	22'-2 1/4"	17'-8 3/16"	○	○	4'-6 1/16"	87.26.50	92.33.10
4	22'-2 1/2"	17'-8 3/8"	○	○	4'-6 1/8"	86.25.20	93.34.40
5	22'-2 7/8"	17'-8 11/16"	○	○	4'-6 3/16"	85.23.59	94.36.01
6	33'-8"	16'-10"	○	○	16'-10"	89.53.16	90.06.44
7	33'-8 1/16"	16'-10"	○	○	16'-10"	89.14.47	90.45.13
8	33'-8 1/8"	16'-10 1/16"	○	○	16'-10 1/16"	88.36.20	91.23.40
9	33'-8 1/4"	16'-10 1/8"	○	○	16'-10 1/8"	87.57.53	92.02.07
10	33'-8 7/16"	16'-10 1/4"	○	○	16'-10 1/4"	87.19.29	92.40.31
11	51'-2 15/16"	4'-6"	21'-4"	20'-11 15/16"	4'-5"	90.18.50	89.41.10
12	51'-2 15/16"	4'-6"	21'-4"	20'-11 15/16"	4'-5"	90.05.57	89.54.03
13	51'-2 15/16"	4'-6"	21'-4"	20'-11 15/16"	4'-5"	89.53.03	90.06.57
14	51'-2 15/16"	4'-6"	21'-4"	20'-11 15/16"	4'-5"	89.40.10	90.19.50
15	51'-2 15/16"	4'-6"	21'-4"	20'-11 15/16"	4'-5"	89.27.16	90.32.44
16	54'-1 13/16"	16'-6 15/16"	20'-11 15/16"	○	16'-6 15/16"	90.21.09	89.38.51
17	54'-1 13/16"	16'-6 15/16"	20'-11 15/16"	○	16'-6 15/16"	90.10.35	89.49.25
18	54'-1 3/4"	16'-6 15/16"	20'-11 15/16"	○	16'-6 15/16"	90.00.00	90.00.00
19	54'-1 13/16"	16'-6 15/16"	20'-11 15/16"	○	16'-6 15/16"	89.49.25	90.10.35
20	54'-1 13/16"	16'-6 15/16"	20'-11 15/16"	○	16'-6 15/16"	89.38.51	90.21.09
21	51'-2 15/16"	4'-5"	20'-11 15/16"	21'-4"	4'-6"	90.21.09	89.38.51
22	51'-2 15/16"	4'-5"	20'-11 15/16"	21'-4"	4'-6"	90.10.35	89.49.25
23	51'-2 15/16"	4'-5"	20'-11 15/16"	21'-4"	4'-6"	90.00.00	90.00.00
24	51'-2 15/16"	4'-5"	20'-11 15/16"	21'-4"	4'-6"	89.49.25	90.10.35
25	51'-2 15/16"	4'-5"	20'-11 15/16"	21'-4"	4'-6"	89.38.51	90.21.09
26	55'-10"	16'-10"	21'-4"	○	17'-8"	90.21.09	89.38.51
27	55'-10"	16'-10"	21'-4"	○	17'-8"	90.10.35	89.49.25
28	55'-10"	16'-10"	21'-4"	○	17'-8"	90.00.00	90.00.00
29	55'-10"	16'-10"	21'-4"	○	17'-8"	89.49.25	90.10.35
30	55'-10"	16'-10"	21'-4"	○	17'-8"	89.38.51	90.21.09

FLOOR BEAM DIMENSIONS

FL. BM.	L	F1	F2	F3	F4	F5	F6	A1	A2	A3	A4	A5	A6	A7	Plate A Top of Bm.	Plate B Top of Bm.
1	50'-6 1/8"	8'-5"	8'-5"	8'-5"	8'-5"	8'-5"	8'-5"	90.31.44	89.30.04	88.28.25	87.26.50	86.25.20	85.23.59	83.27.48	12 x 1 1/2	12 x 1
2	48'-6 5/8"	8'-1 3/16"	8'-1 3/16"	8'-1 3/16"	8'-1 3/16"	8'-1 3/16"	8'-1 3/16"	90.31.44	89.30.04	88.28.25	87.26.50	86.25.20	85.23.59	84.55.30	12 x 1 1/2	12 x 1 1/2
3	46'-9 1/2"	7'-10"	7'-10"	7'-10"	7'-10"	7'-10"	7'-10"	90.31.44	89.53.16	89.14.47	88.36.20	87.57.53	87.19.29	86.41.10	12 x 1 1/2	12 x 1 1/2
4	45'-8 1/4"	7'-7 1/2"	7'-7 1/2"	7'-7 1/2"	7'-7 1/2"	7'-7 1/2"	7'-6 5/8"	90.31.44	90.18.50	90.05.57	89.53.03	89.40.10	89.27.16	88.26.38	12 x 1 1/2	12 x 1 1/2
5	45'-2 1/8"	7'-6 9/16"	7'-6 9/16"	7'-6 9/16"	7'-6 9/16"	7'-6 9/16"	7'-5 5/16"	90.31.44	90.18.50	90.05.57	89.53.03	89.40.10	89.27.16	89.28.16	12 x 1 1/2	12 x 1 1/2
6	44'-9 1/2"	7'-5 5/8"	7'-5 5/8"	7'-5 5/8"	7'-5 5/8"	7'-5 5/8"	7'-5 3/8"	90.31.44	90.18.50	90.05.57	89.53.03	89.40.10	89.27.16	89.28.16	12 x 1 1/2	12 x 1 1/2
7	44'-4 7/8"	7'-4 13/16"	7'-4 13/16"	7'-4 13/16"	7'-4 13/16"	7'-4 13/16"	7'-4 13/16"	90.31.44	90.21.09	90.10.35	90.00.00	89.49.25	89.38.51	89.28.16	12 x 1 1/2	12 x 1 1/2
8	44'-3/16"	7'-4 1/16"	7'-4 1/16"	7'-4 1/16"	7'-4 1/16"	7'-4 1/16"	7'-4 1/16"	90.31.44	90.21.09	90.10.35	90.00.00	89.49.25	89.38.51	89.28.16	12 x 1 1/2	12 x 1 1/2
9	43'-7 9/16"	7'-3 1/4"	7'-3 1/4"	7'-3 1/4"	7'-3 1/4"	7'-3 1/4"	7'-3 1/4"	90.31.44	90.21.09	90.10.35	90.00.00	89.49.25	89.38.51	89.28.16	12 x 1 1/2	12 x 1 1/2
10	43'-2 7/8"	7'-2 1/2"	7'-2 1/2"	7'-2 1/2"	7'-2 1/2"	7'-2 1/2"	7'-2 1/2"	90.31.44	90.21.09	90.10.35	90.00.00	89.49.25	89.38.51	89.28.16	12 x 1 1/2	12 x 1 1/2
11	42'-10 3/16"	7'-1 11/16"	7'-1 11/16"	7'-1 11/16"	7'-1 11/16"	7'-1 11/16"	7'-1 11/16"	90.31.44	90.21.09	90.10.35	90.00.00	89.49.25	89.38.51	89.28.16	12 x 1 1/2	12 x 1 1/2
12	42'-5 7/16"	7'-15/16"	7'-15/16"	7'-15/16"	7'-15/16"	7'-15/16"	7'-15/16"	90.31.44	90.21.09	90.10.35	90.00.00	89.49.25	89.38.51	89.28.16	12 x 1 1/2	12 x 1
13	42'-3/4"	7'-1/8"	7'-1/8"	7'-1/8"	7'-1/8"	7'-1/8"	7'-1/8"	90.31.44	90.21.09	90.10.35	90.00.00	89.49.25	89.38.51	89.28.16	12 x 1 1/2	12 x 1
14	41'-8 13/16"	6'-11 7/16"	6'-11 7/16"	6'-11 7/16"	6'-11 7/16"	6'-11 7/16"	6'-11 7/16"	90.31.44	90.21.09	90.10.35	90.00.00	89.49.25	89.38.51	89.28.16	12 x 1 1/2	12 x 3/4

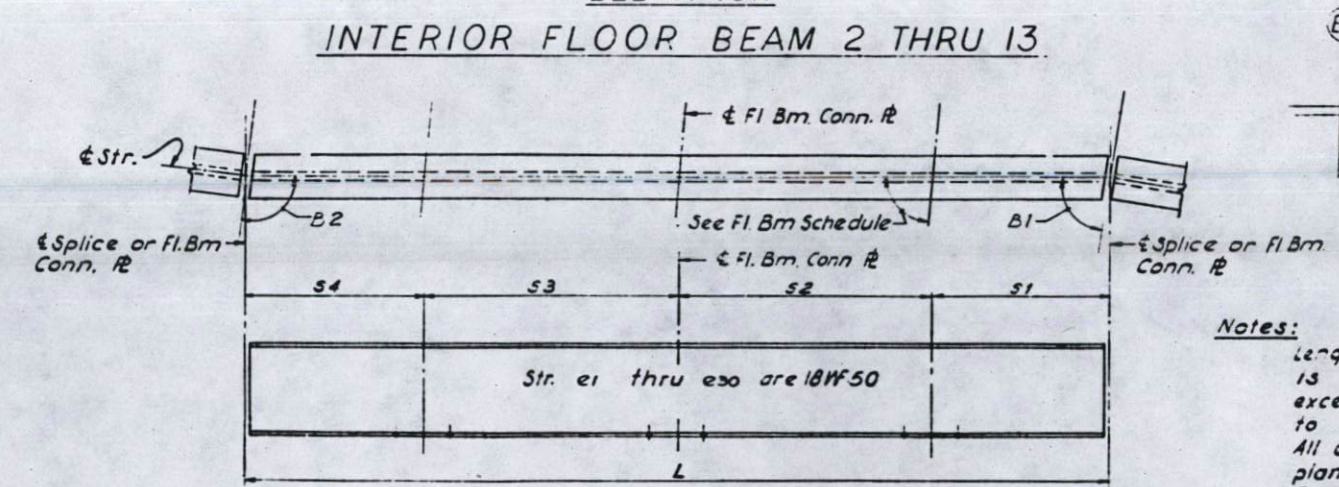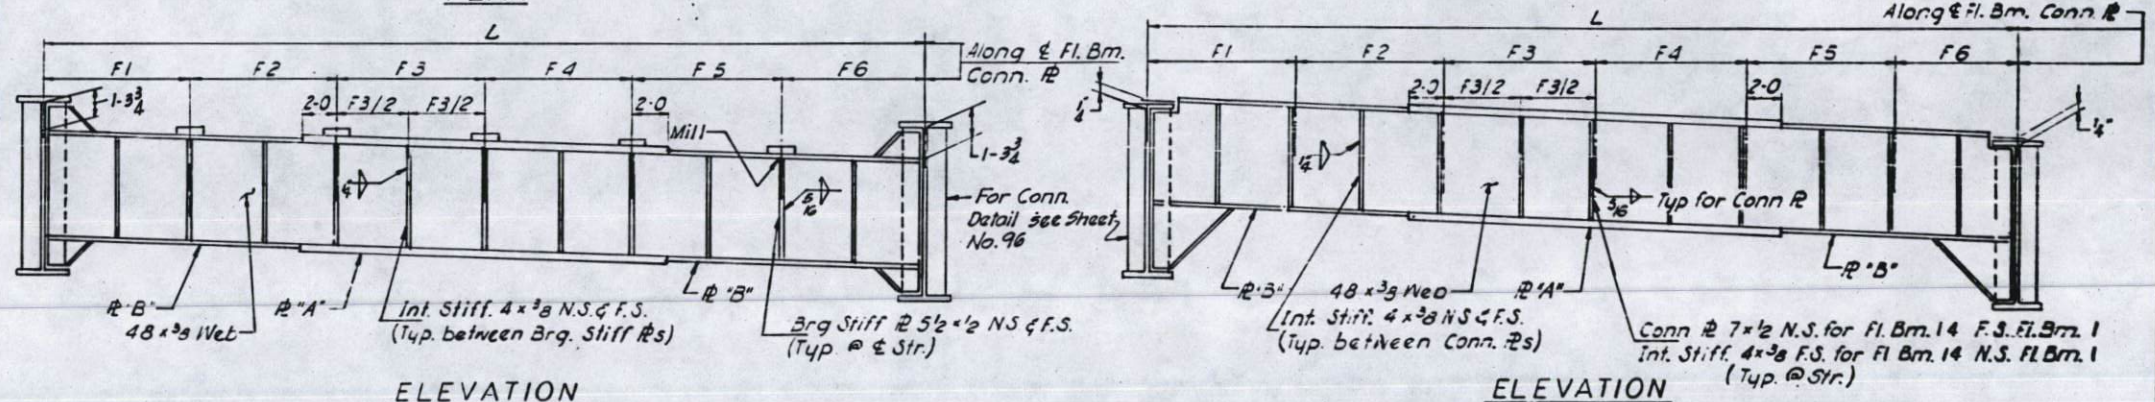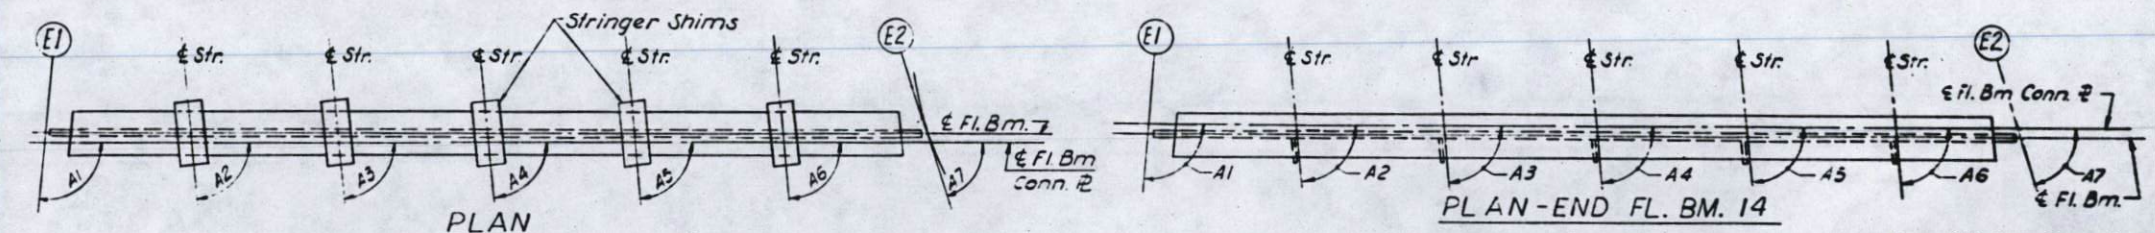

Notes:
 Length L of Stringers and Fl. Bms. is correct as given in the table except the increment lengths are given to the nearest 1/16".
 All dimensions are in the horizontal plane.
 For Intermediate Stiffener, End Stiffener and Connection Plate Details see Sh. No. 97

STATE OF ILLINOIS
 DEPARTMENT OF PUBLIC WORKS & BLDGS.
 DIVISION OF HIGHWAYS
STRINGER AND FLOOR BEAM SCHEDULE
 SPANS E2 THRU O18E
 POPLAR STREET BRIDGE APPROACHES
 ROADWAY "E"

F. A. I. RT.-70 ST. CLAIR CO. SECTION 82-3HVB-2
 N. W. LOCHNER, INC.
 ENGINEERS
 CHICAGO, ILLINOIS

SHEET 53 OF 147

DESIGNED BY A.T.
 DRAWN BY I.M.
 CHECKED BY S.A.B.

ROUTE NO.	SECTION	COUNTY	TOTAL SHEETS	SHEET NO.
F.A.I. - 70	82-3MVB-2	ST. CLAIR	252	120
FED. ROAD DIV. NO. 6		ILLINOIS	PROJECT	

FLOOR BEAM 2 AND 3	T1	T2	T3	T4
STR. 1 THRU 10	3/8	7/16	11/16	3/4


FLOOR BEAM 4 THRU 6	T1	T2	T3	T4
STR. 11 THRU 15	7/16	1/2	5/8	11/16

FLOOR BEAM 7	T1	T2	T3	T4
STR. 16	1/2	9/16	5/8	11/16
17	7/16	1/2	5/8	11/16
18	7/16	1/2	5/8	11/16
19	7/16	1/2	5/8	11/16
20	7/16	1/2	5/8	11/16

FLOOR BEAM 8	T1	T2	T3	T4
STR. 16	1/2	1/2	5/8	5/8
17	1/2	1/2	5/8	5/8
18	7/16	1/2	5/8	11/16
19	7/16	1/2	5/8	11/16
20	7/16	7/16	11/16	11/16


FLOOR BEAM 9 THRU 11	T1	T2	T3	T4
STR. 21 THRU 25	9/16	9/16	9/16	9/16

FLOOR BEAM 12 AND 13	T1	T2	T3	T4
STR. 26 THRU 30	5/8	5/8	1/2	1/2

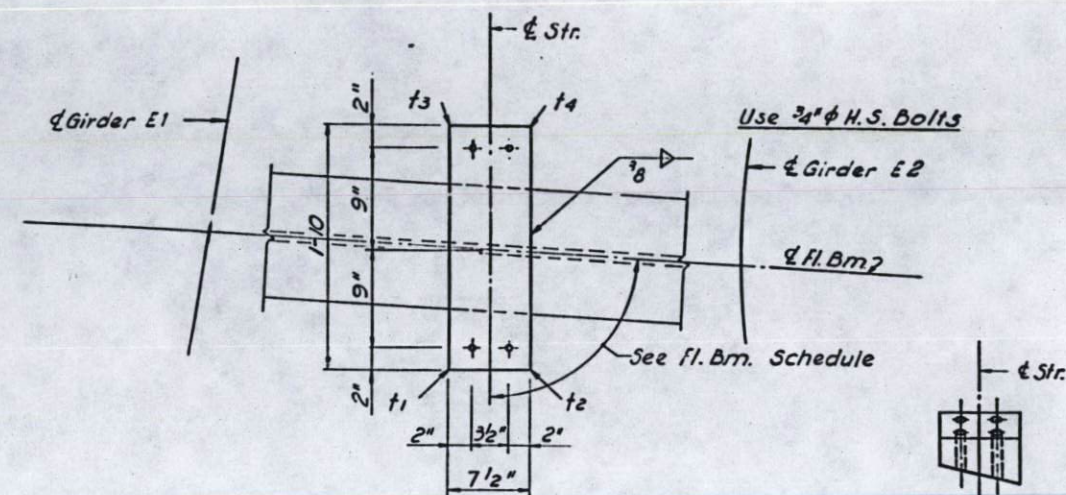


PLAN

END VIEW

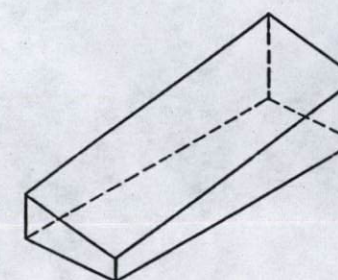

ISOMETRIC VIEW

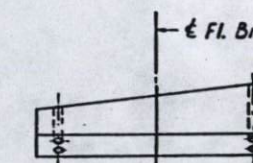

SIDE VIEW

SHIM DETAIL


Shim thickness t_1 , t_2 , t_3 & t_4 shown in the Table are orientated with the Plan View shown above.

DESIGNED BY: A.T.
 DRAWN BY: K.M.
 CHECKED BY: A.T.


STATE OF ILLINOIS
 DEPARTMENT OF PUBLIC WORKS & BLDGS.
 DIVISION OF HIGHWAYS
 STRINGER SHIMS
 SPANS E2 THRU O18 E
 POPLAR STREET BRIDGE APPROACHES
 ROADWAY "E"
 F.A.I. RT. 70. ST. CLAIR CO. SECTION 82-3MVB-2
 H. W. LOCHNER, INC.
 ENGINEERS
 CHICAGO, ILLINOIS

SHEET
 54 of 147

ROUTE NO.	SECTION	COUNTY	TOTAL SHEETS	SHEET NO.
F.A.I-70	82-3HVB-2	ST. CLAIR	252	121
FED. ROAD DIV. NO. 4		ILLINOIS	PROJECT	

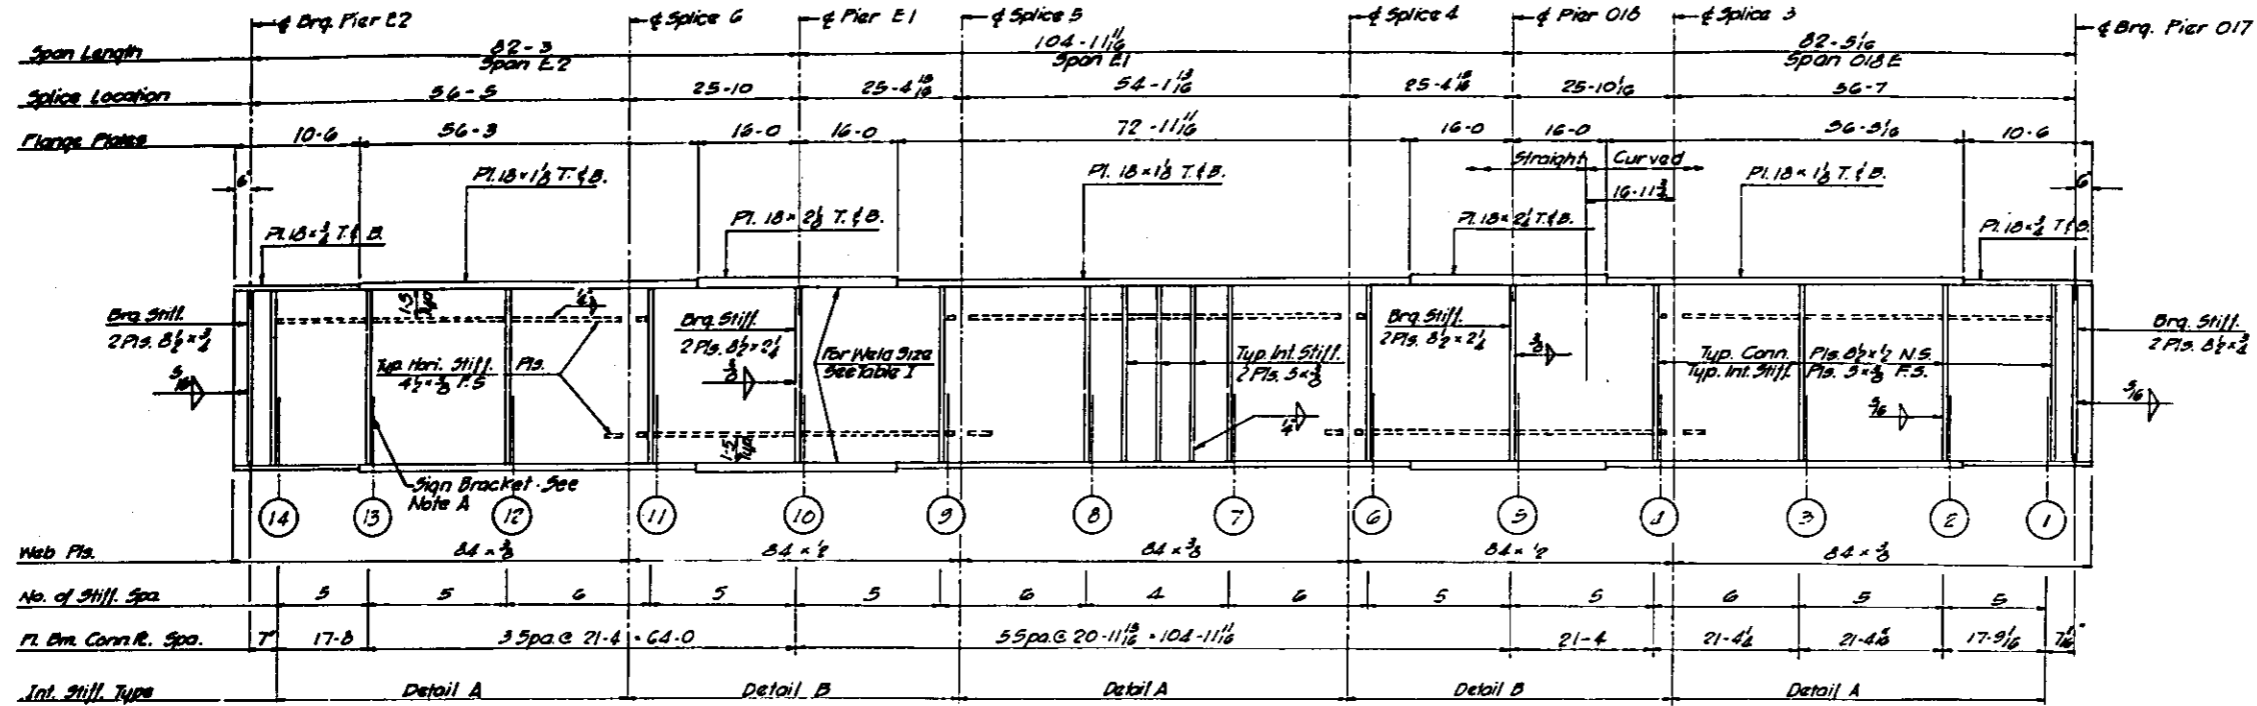

GIRDER E2
Spans E2 thru O18E

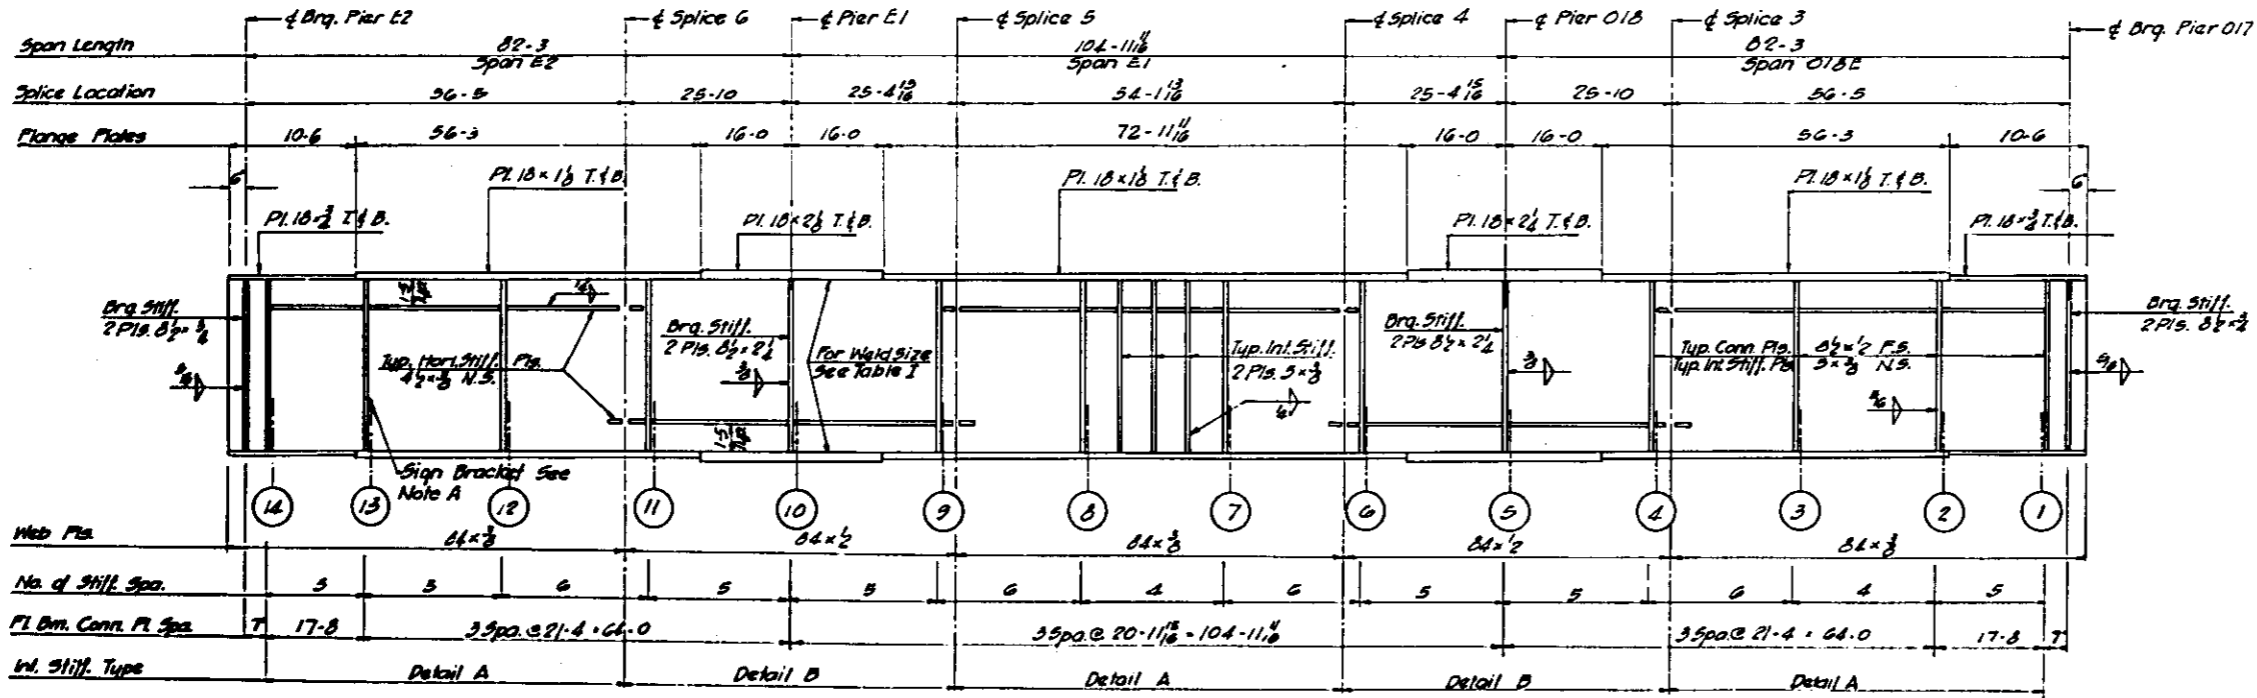

GIRDER E1
Spans E2 thru O18E

NOTES:
 All longitudinal dimensions shown are given along ϕ of web see Sheet No. 52
 All Bearing Stiffeners and Connection Plates to be vertical.
 For Splice, Stiffener, Connection Plate Details and Table I see Sheet No. 97 & 98

Note A
 Intermediate stiffeners should be moved if necessary to clear sign bracket connection plates.

DESIGNED BY: A.T.
 DRAWN BY: J.F.
 CHECKED BY: S.A.B.


STATE OF ILLINOIS
 DEPARTMENT OF PUBLIC WORKS & BLDGS.
 DIVISION OF HIGHWAYS

GIRDERS E1 AND E2
 SPANS E2 THRU O18E
 POPLAR STREET BRIDGE APPROACHES
 ROADWAY "E"

F.A.I RT. 70 ST. CLAIR CO. SECTION 82-3HVB-2
 H. W. LOCHNER, INC.
 ENGINEERS
 CHICAGO, ILLINOIS

SHEET
 55 of 147

ROUTE NO.	SECTION	COUNTY	TOTAL SHEETS	SHEET NO.
F.A.I.-70	82-3HV8-2	ST. CLAIR	252	122
FED. ROAD DIV. NO. 4		ILLINOIS	PROJECT	

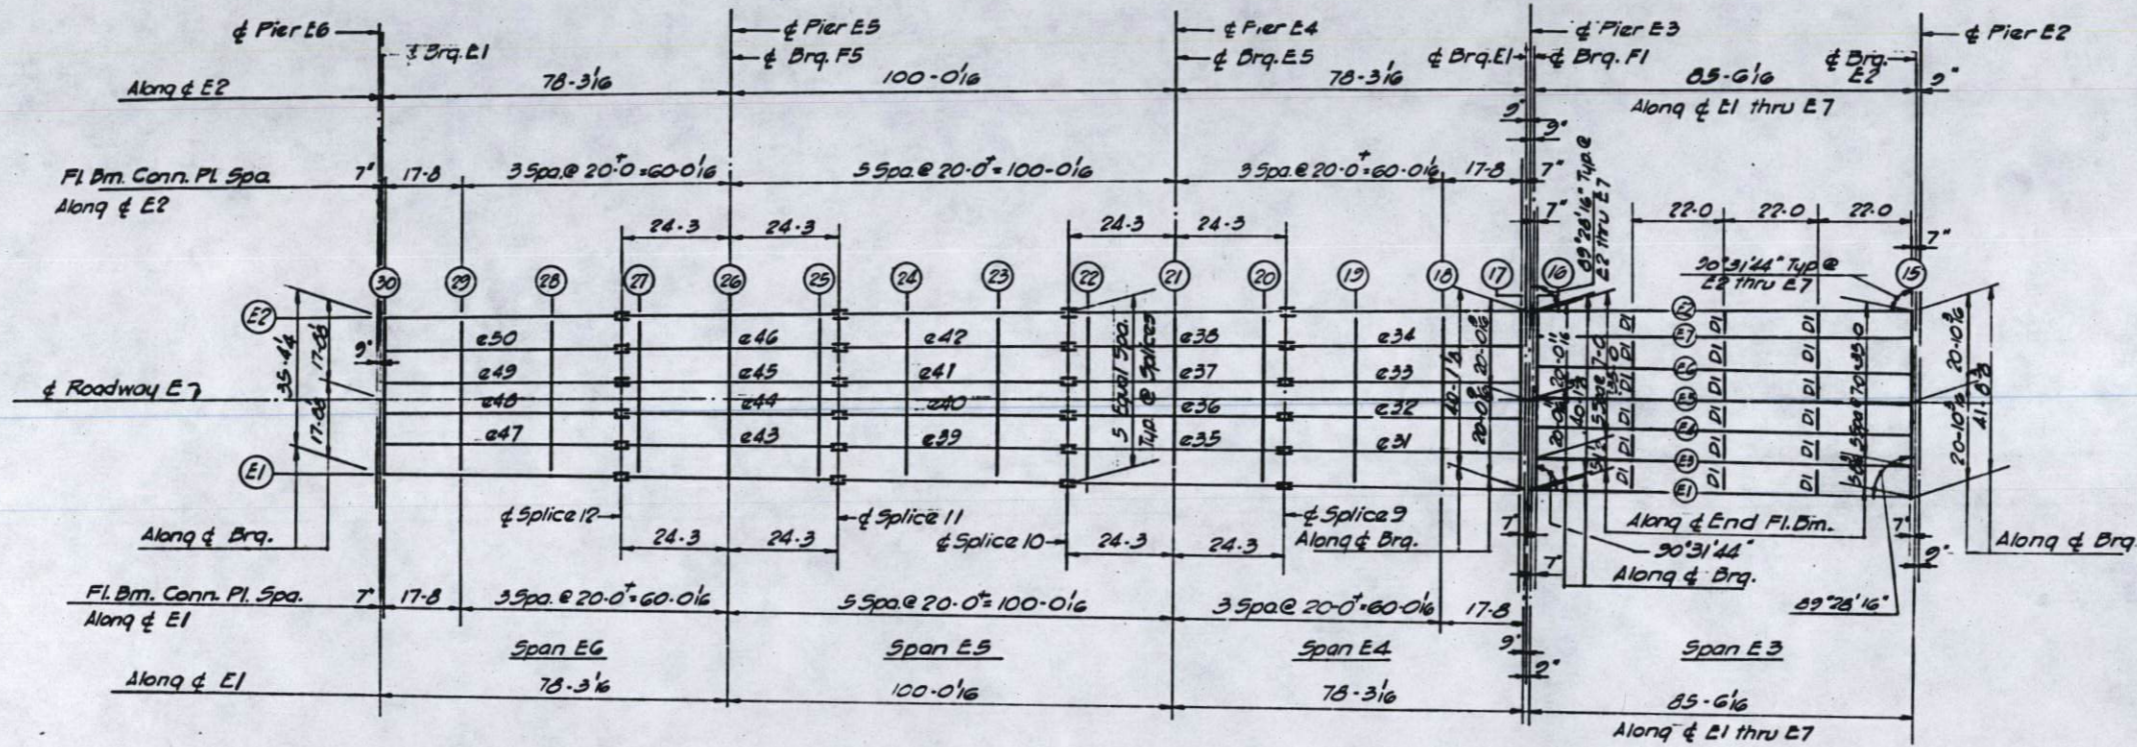

PLAN
Spans E3 thru E6

* ELEVATION TOP OF GIRDERS
Lower all elevations .042 ft.

* ELEVATION TOP OF FLANGE

	GIR. E1	GIR. E2	DIFF.
CL. BRG.	445.318	445.318	.000
FLOOR BEAM 17	445.304	445.304	.000
FLOOR BEAM 18	444.878	444.878	.000
FLOOR BEAM 19	444.885	444.885	.000
SPLICE 9	444.914	444.914	.000
FLOOR BEAM 20	443.888	443.888	.000
FLOOR BEAM 21	443.888	443.888	.000
FLOOR BEAM 22	442.725	442.725	.000
SPLICE 10	442.801	442.801	.000
FLOOR BEAM 23	442.132	442.132	.000
FLOOR BEAM 24	441.888	441.888	.000
SPLICE 11	441.888	441.888	.000
FLOOR BEAM 25	440.940	440.940	.000
FLOOR BEAM 26	440.940	440.940	.000
FLOOR BEAM 27	439.747	439.747	.000
SPLICE 12	439.888	439.888	.000
FLOOR BEAM 28	439.191	439.191	.000
FLOOR BEAM 29	439.884	439.884	.000
FLOOR BEAM 30	439.888	439.888	.000
CL. BRG.	439.890	439.890	.000

	GIR. E1	GIR. E2	DIFF.
CL. BRG.	446.945	446.945	.000
FLOOR BEAM 15	446.935	446.935	.000
FLOOR BEAM 16	445.587	445.587	.000
CL. BRG.	445.558	445.558	.000

Note
Dimensions locating Floor Beams are given to the Floor Beam Conn. Plate see Sketch Sheet No. 52

BILL OF MATERIAL		
*Structural Steel	L.S.	Lump Sum

Weight of Bearing Assemblies with Lead Plates and Anchor Bolts are Included as Structural Steel
Wt. 11,280 Lbs.

STATE OF ILLINOIS
DEPARTMENT OF PUBLIC WORKS & BLDGS.
DIVISION OF HIGHWAYS

FRAMING PLAN
SPANS E3 THRU E6
POPLAR STREET BRIDGE APPROACHES
ROADWAY "E"

F.A.I.R.T.-70 ST. CLAIR CO. SECTION 82-3HV8-2


H. W. LOCHNER, INC.
ENGINEERS
CHICAGO, ILLINOIS

SHEET
56 of 147


DESIGNED BY A.T.
DRAWN BY H.E.
CHECKED BY S.A.B.

Rev. Structural Steel from 503,660 to 503,700 lbs. 10-31-68 H.A.F.


ROUTE NO.	SECTION	COUNTY	TOTAL SHEETS	SHEET NO.
F. A. I.-70	82-3HVB-2	ST. CLAIR	252	123
FED. ROAD DIV. NO. 4	ILLINOIS	PROJECT		

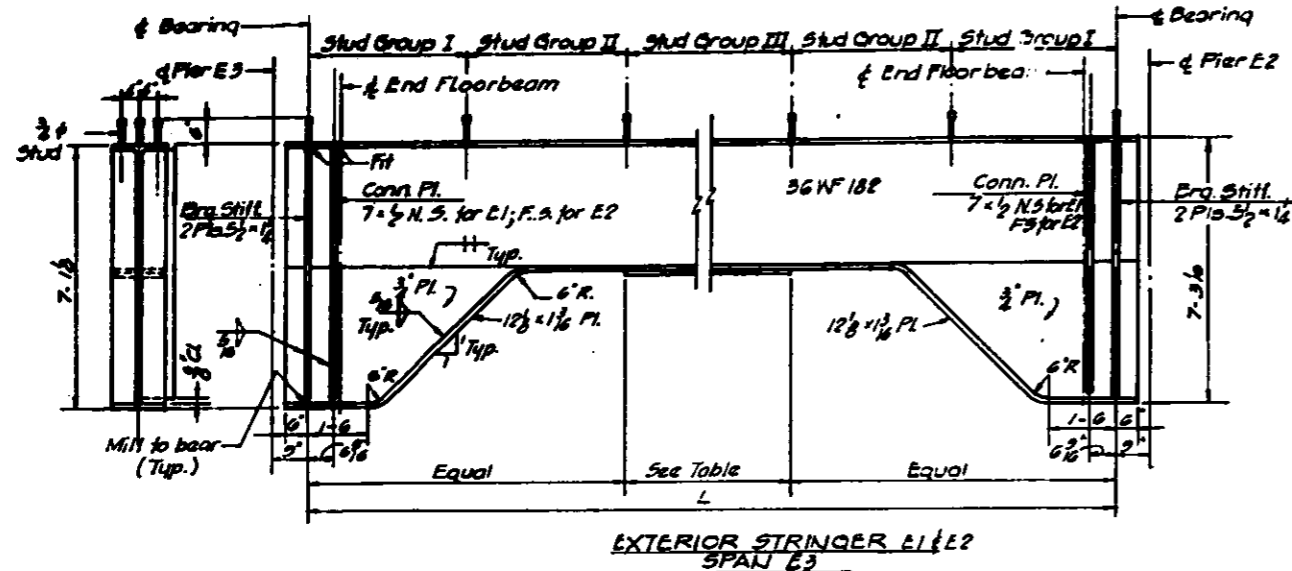


EXTERIOR STRINGER E1 & E2
SPAN E3

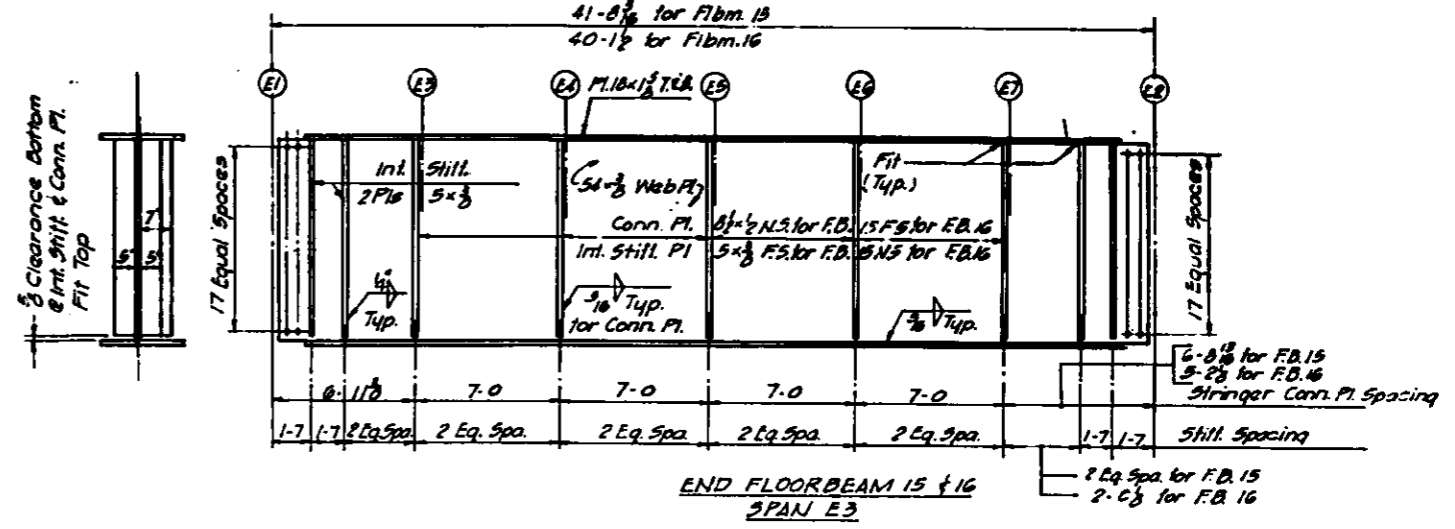


END FLOORBEAM E15 & E16
SPAN E3

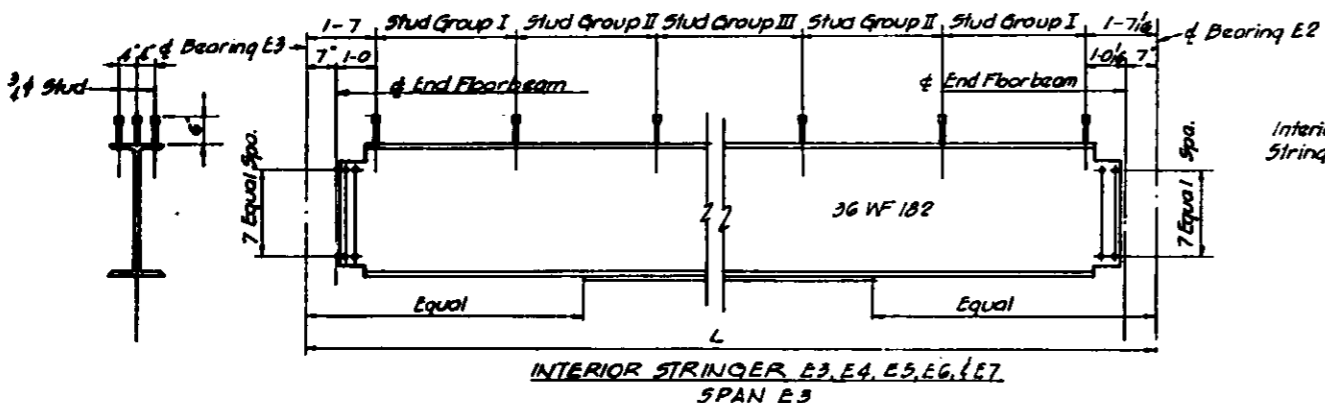


INTERIOR STRINGER E3, E4, E5, E6, & E7
SPAN E3

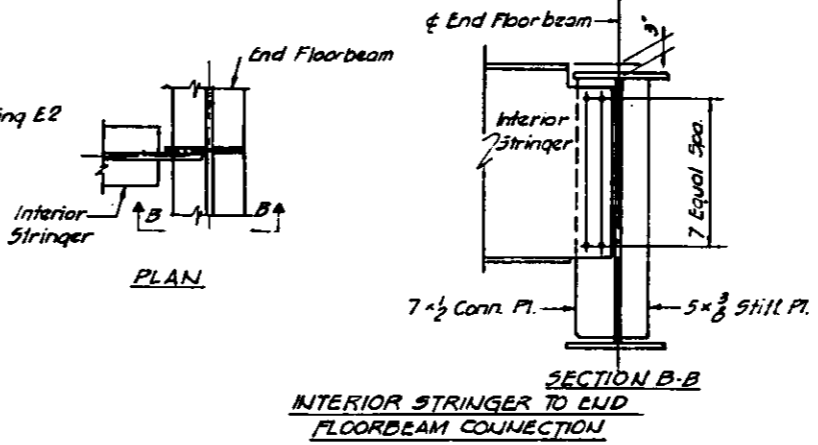


SECTION B-B
INTERIOR STRINGER TO END FLOORBEAM CONNECTION

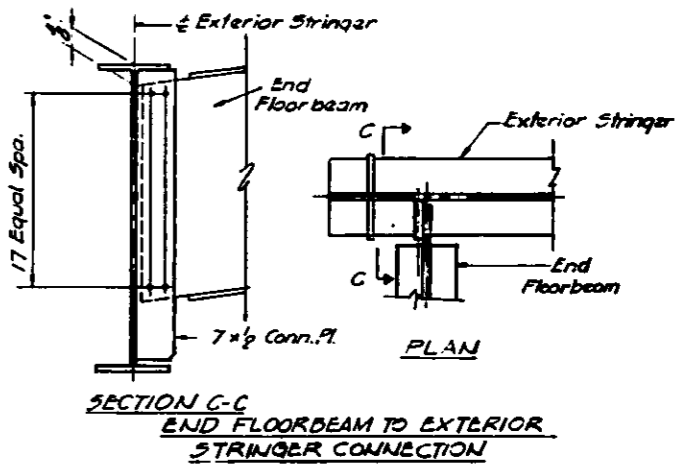


SECTION C-C
END FLOORBEAM TO EXTERIOR STRINGER CONNECTION

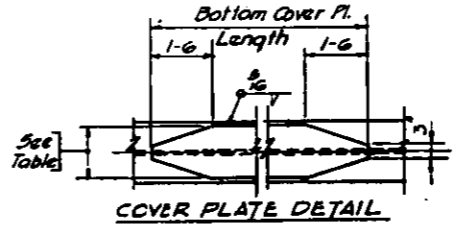

COVER PLATE DETAIL

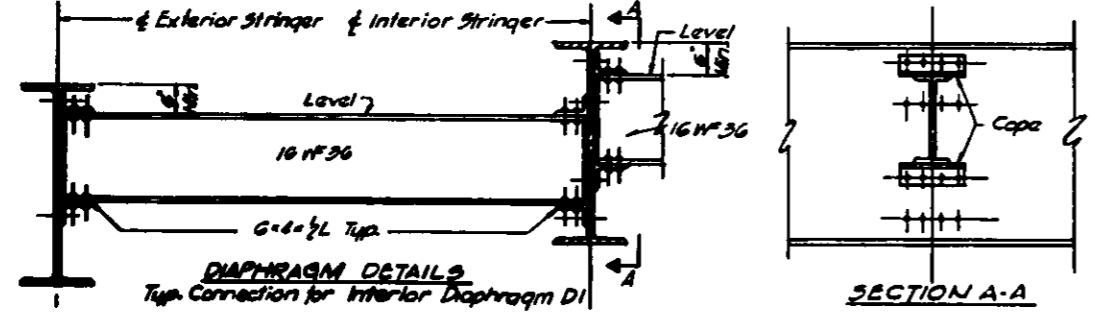

DIAPHRAGM DETAILS
Typ. Connection for Interior Diaphragm D1

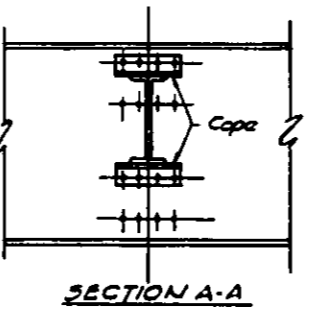

SECTION A-A

STRINGER	LENGTH (L)	BOTTOM COVER PL.	STUD GROUP I	STUD GROUP II	STUD GROUP III
E1	85'-6 1/2	11 x 1/2 x 1/2	25 Spa @ 10'	15 Spa @ 15'	15 Spa @ 15'
E2	85'-6 1/2	-	-	-	-
E3	85'-6 1/2	-	25 Spa @ 7'	15 Spa @ 11'	-
E4	85'-6 1/2	-	-	-	-
E5	85'-6 1/2	-	-	-	-
E6	85'-6 1/2	-	-	-	-
E7	85'-6 1/2	-	-	-	-









DESIGNED BY A.T.
CHECKED BY E.L.
APPROVED BY A.T.

STATE OF ILLINOIS
DEPARTMENT OF PUBLIC WORKS & BLDGS.
DIVISION OF HIGHWAYS
STEEL DETAILS
SPAN E3
POPLAR STREET BRIDGE APPROACHES
ROADWAY "E"
F.A.I. RT. 70 ST. CLAIR CO. SECTION 82-3HVB-2
H. W. LOCHNER, INC.
ENGINEERS
CHICAGO, ILLINOIS
SHEET
57 OF 147

ROUTE NO.	SECTION	COUNTY	TOTAL SHEETS	SHEET NO.
FA 1-70	B2-3HVB-2	ST. CLAIR	252	124
FED. ROAD DIV. NO. 4		ILLINOIS PROJECT		

STRINGER DIMENSIONS							
SPR	L	S1	S2	S3	S4	S5	S6
21	33'-5"	17'-0"		20'-0"	15'-9"	90'-19.02"	89'-40.58"
22	33'-5"	17'-0"		20	15'-9"	90.06.21	89.53.39
23	33'-5"	17'-0"		20	15'-9"	89.53.39	90.06.21
24	33'-5"	17'-0"		20	15'-9"	89.40.58	90.19.02
25	33'-5"	17'-0"		20	15'-9"	90.19.02	89.40.58
26	33'-5"	17'-0"		20	15'-9"	90.06.21	89.53.39
27	33'-5"	17'-0"		20	15'-9"	89.53.39	90.06.21
28	33'-5"	17'-0"		20	15'-9"	89.40.58	90.19.02
29	33'-5"	17'-0"		20	15'-9"	90.19.02	89.40.58
30	33'-5"	17'-0"		20	15'-9"	90.06.21	89.53.39
31	33'-5"	17'-0"		20	15'-9"	89.53.39	90.06.21
32	33'-5"	17'-0"		20	15'-9"	89.40.58	90.19.02
33	33'-5"	17'-0"		20	15'-9"	90.19.02	89.40.58
34	33'-5"	17'-0"		20	15'-9"	90.06.21	89.53.39
35	33'-5"	17'-0"		20	15'-9"	89.53.39	90.06.21
36	33'-5"	17'-0"		20	15'-9"	89.40.58	90.19.02
37	33'-5"	17'-0"		20	15'-9"	90.19.02	89.40.58
38	33'-5"	17'-0"		20	15'-9"	90.06.21	89.53.39
39	33'-5"	17'-0"		20	15'-9"	89.53.39	90.06.21
40	33'-5"	17'-0"		20	15'-9"	89.40.58	90.19.02
41	33'-5"	17'-0"		20	15'-9"	90.19.02	89.40.58
42	33'-5"	17'-0"		20	15'-9"	90.06.21	89.53.39
43	33'-5"	17'-0"		20	15'-9"	89.53.39	90.06.21
44	33'-5"	17'-0"		20	15'-9"	89.40.58	90.19.02
45	33'-5"	17'-0"		20	15'-9"	90.19.02	89.40.58
46	33'-5"	17'-0"		20	15'-9"	90.06.21	89.53.39
47	33'-5"	17'-0"		20	15'-9"	89.53.39	90.06.21
48	33'-5"	17'-0"		20	15'-9"	89.40.58	90.19.02
49	33'-5"	17'-0"		20	15'-9"	90.19.02	89.40.58
50	33'-5"	17'-0"		20	15'-9"	90.06.21	89.53.39

FLOOR BEAM DIMENSIONS													
FL. BM.	L	F1	F2	F3	F4	F5	A1	A2	A3	A4	A5	A6	
17	40'-0 15/16"	6'-0 3/16"	6'-0 3/16"	6'-0 3/16"	6'-0 3/16"	6'-0 3/16"	90'-31.44"	90'-19.02"	90'-06.21"	89'-53.39"	89'-40.58"	89'-28.16"	
18	38'-9"	7'-11 3/8"	7'-11 3/8"	7'-11 3/8"	7'-11 3/8"	7'-11 3/8"	90'-31.44"	90'-19.02"	90'-06.21"	89'-53.39"	89'-40.58"	89'-28.16"	
19	38'-4 5/8"	7'-10 1/2"	7'-10 1/2"	7'-10 1/2"	7'-10 1/2"	7'-10 1/2"	90'-31.44"	90'-19.02"	90'-06.21"	89'-53.39"	89'-40.58"	89'-28.16"	
20	38'-3 1/8"	7'-9 5/8"	7'-9 5/8"	7'-9 5/8"	7'-9 5/8"	7'-9 5/8"	90'-31.44"	90'-19.02"	90'-06.21"	89'-53.39"	89'-40.58"	89'-28.16"	
21	38'-7 3/4"	7'-8 3/4"	7'-8 3/4"	7'-8 3/4"	7'-8 3/4"	7'-8 3/4"	90'-31.44"	90'-19.02"	90'-06.21"	89'-53.39"	89'-40.58"	89'-28.16"	
22	38'-3 5/16"	7'-7 7/8"	7'-7 7/8"	7'-7 7/8"	7'-7 7/8"	7'-7 7/8"	90'-31.44"	90'-19.02"	90'-06.21"	89'-53.39"	89'-40.58"	89'-28.16"	
23	37'-10 7/8"	7'-7"	7'-7"	7'-7"	7'-7"	7'-7"	90'-31.44"	90'-19.02"	90'-06.21"	89'-53.39"	89'-40.58"	89'-28.16"	
24	37'-6 7/16"	7'-6 1/16"	7'-6 1/16"	7'-6 1/16"	7'-6 1/16"	7'-6 1/16"	90'-31.44"	90'-19.02"	90'-06.21"	89'-53.39"	89'-40.58"	89'-28.16"	
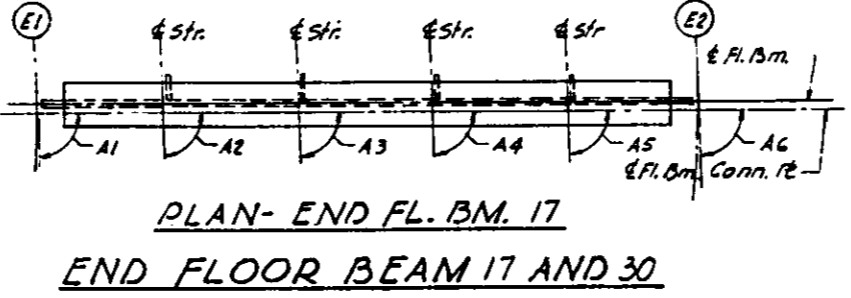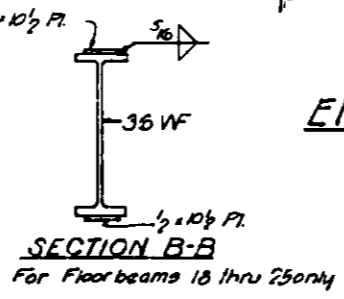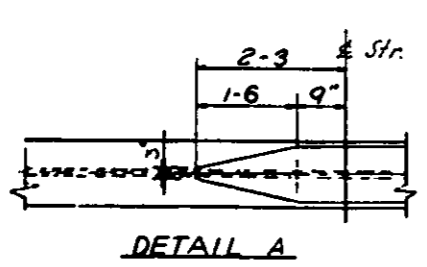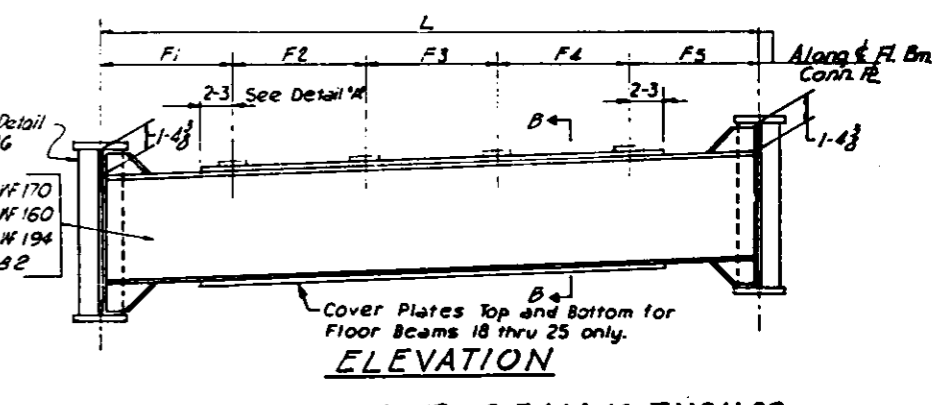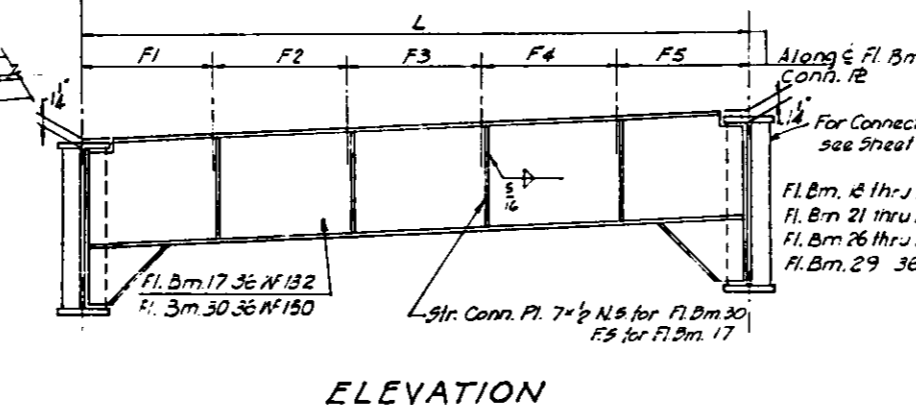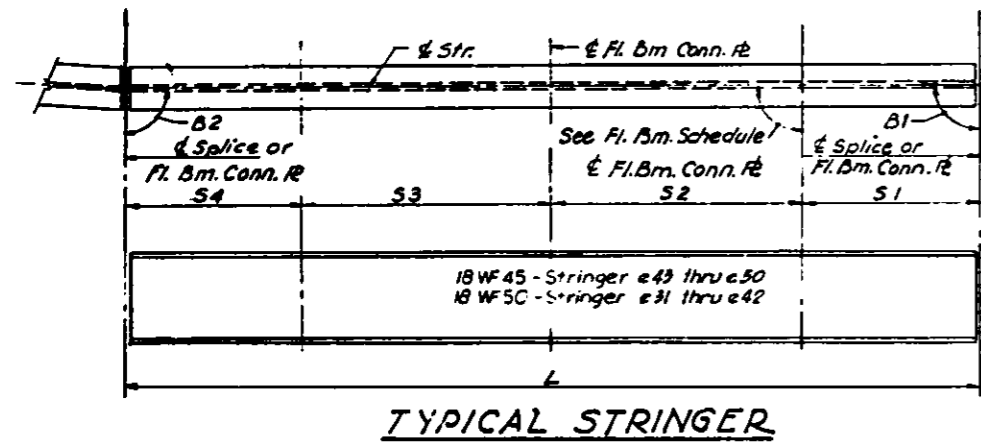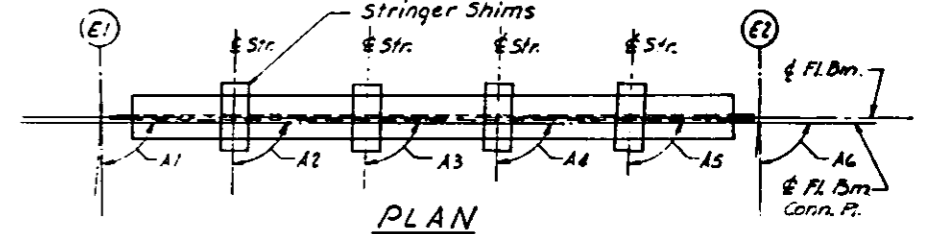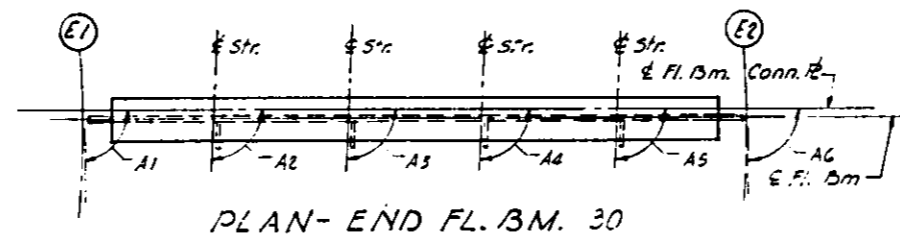

Notes:
Length L of Stringers and Fl. Bms. is correct as given in the Table, except the increment lengths are given to the nearest 1/8".
All dimensions are in the horizontal plane.
For Connection Plate Details see Sheet No. 97




DESIGNED BY A.T.
CHECKED BY S.A.P.

STATE OF ILLINOIS
DEPARTMENT OF PUBLIC WORKS & BLDGS.
DIVISION OF HIGHWAYS
STRINGER AND FLOOR BEAM
SCHEDULE
SPANS E4 THRU E6
POPLAR STREET BRIDGE APPROACHES
ROADWAY "E"
F.A.I. RT 70 ST. CLAIR CO. SECTION 82-3HVB-2
4. W. LOCHNER, INC.
ENGINEERS
CHICAGO, ILLINOIS

SHEET
58 OF 147

ROUTE NO.	SECTION	COUNTY	TOTAL SHEETS	SHEET NO.
F.A.I.-70	82-34VB-2	ST. CLAIR	252	125
FED. ROAD DIV. NO. 2		ILLINOIS	PROJECT	

FLOOR BEAM 18 & 19	T1	T2	T3	T4
STR. 31 THRU 34	15/16	15/16	7/16	7/16
FLOOR BEAM 20 THRU 22	T1	T2	T3	T4
STR. 35 THRU 38	1	1	3/8	3/8
FLOOR BEAM 23 THRU 24	T1	T2	T3	T4
STR. 39 THRU 42	1	1	3/8	3/8
FLOOR BEAM 25 THRU 27	T1	T2	T3	T4
STR. 43 THRU 46	1	1	3/8	3/8
FLOOR BEAM 28 & 29	T1	T2	T3	T4
STR. 47 THRU 50	1	1	3/8	3/8

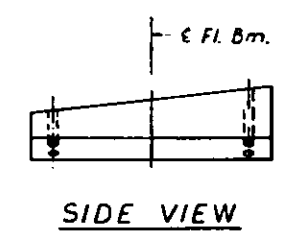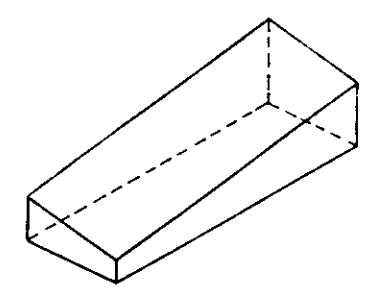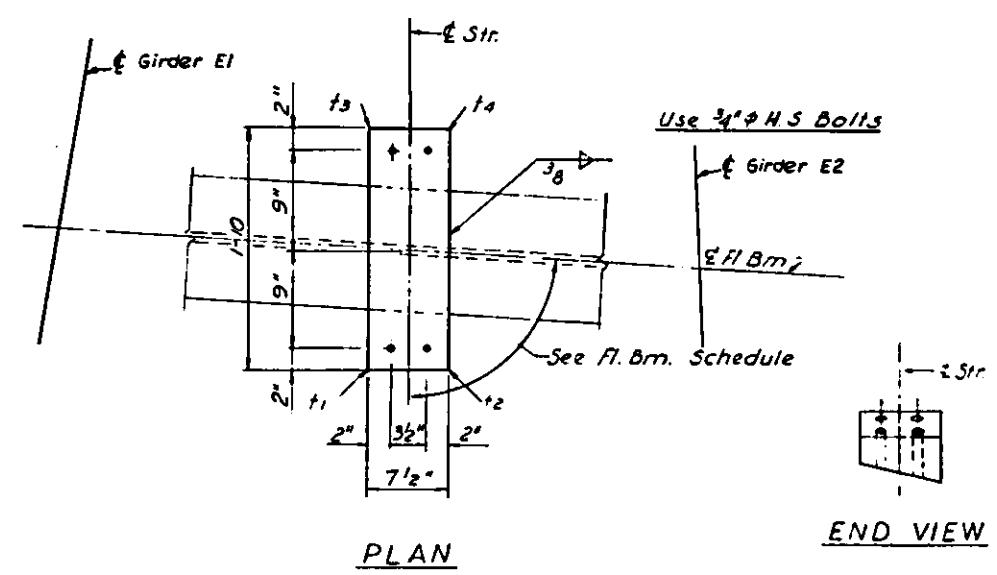

SHIM DETAIL

Shim thickness t_1 , t_2 , t_3 & t_4 shown in the Table are orientated with the Plan View shown above.

DESIGNED BY A.T.
 DRAWN BY L.M.
 CHECKED BY A.T.

STATE OF ILLINOIS
 DEPARTMENT OF PUBLIC WORKS & BLDGS.
 DIVISION OF HIGHWAYS

STRINGER SHIMS
 SPANS E4 THRU E6


POPLAR STREET BRIDGE APPROACHES
 ROADWAY "E"

F.A.I.R.T.-70 ST. CLAIR CO. SECTION 82-34VB-2

H. W. LOCHNER, INC.
 ENGINEERS
 CHICAGO, ILLINOIS


SHEET
 39 of 147

ROUTE NO.	SECTION	COUNTY	TOTAL SHEETS	SHEET NO.
F.A.I. 70	82-3HV-2	ST. CLAIR	252	126
FED. ROAD DIV. NO. 4	ILLINOIS PROJECT			

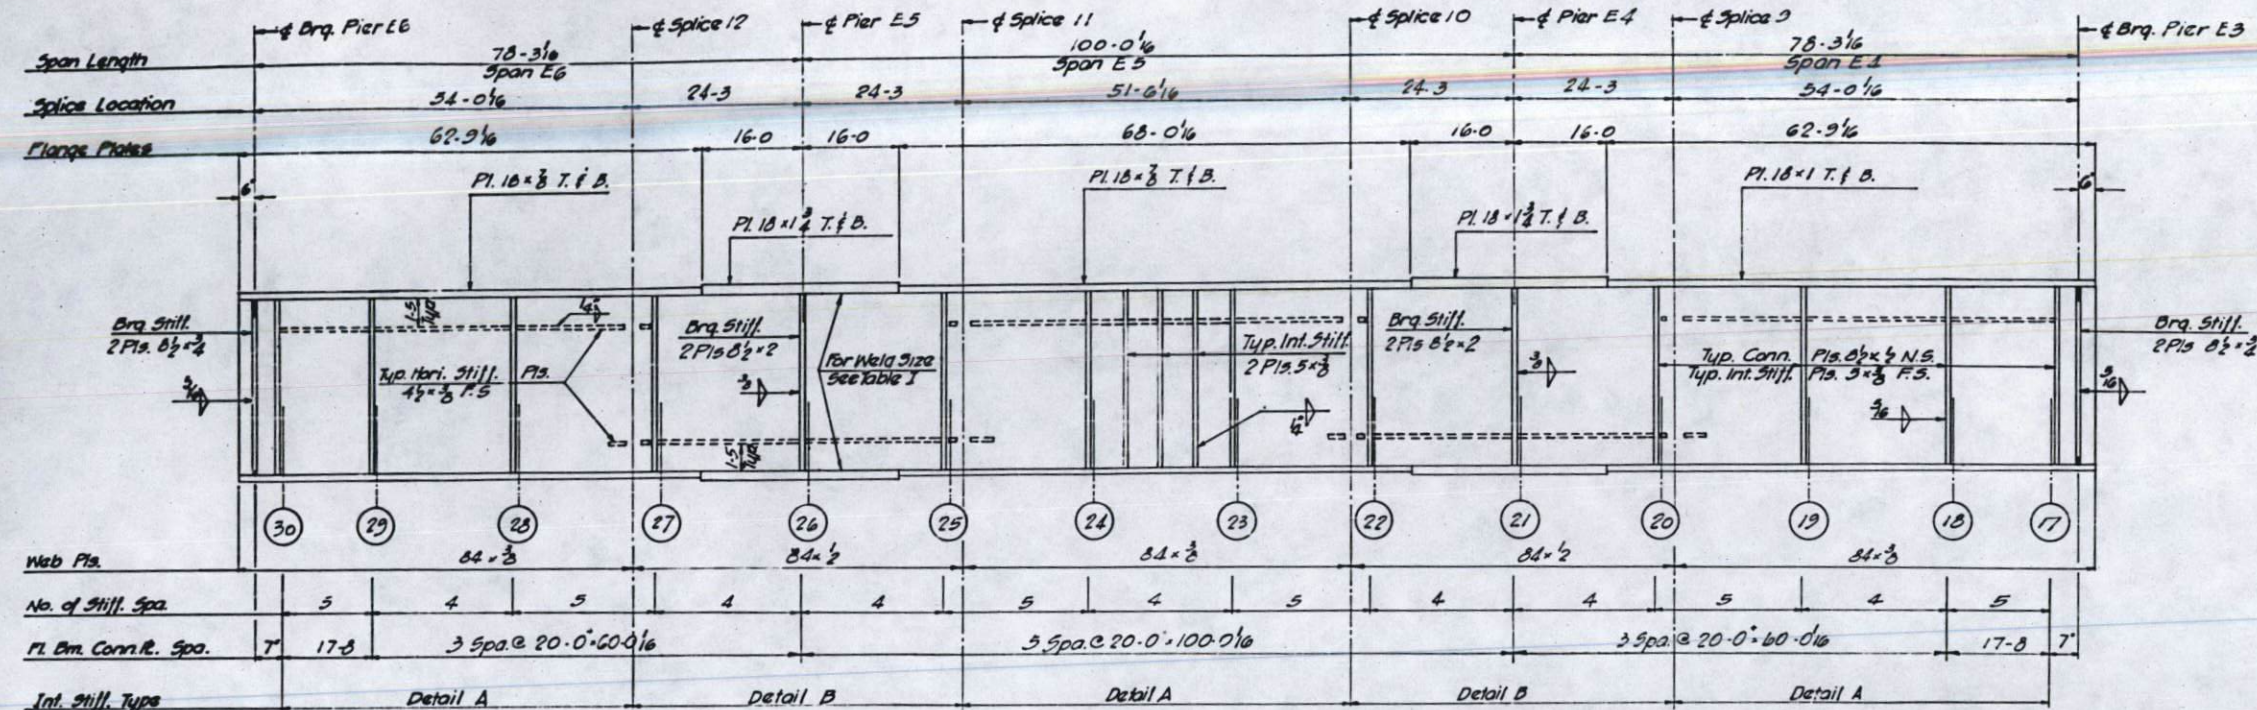

GIRDER E2
Spans E4 thru E6
GIRDER E1 (Opposite Hand)

NOTES:
All longitudinal dimensions shown are given along ϕ of web see Sheet No. 56 & 61
All Bearing Stiffeners and Connection Plates to be vertical.
For Splice, Stiffener, Connection Plate Details and Table I see Sheet No. 97

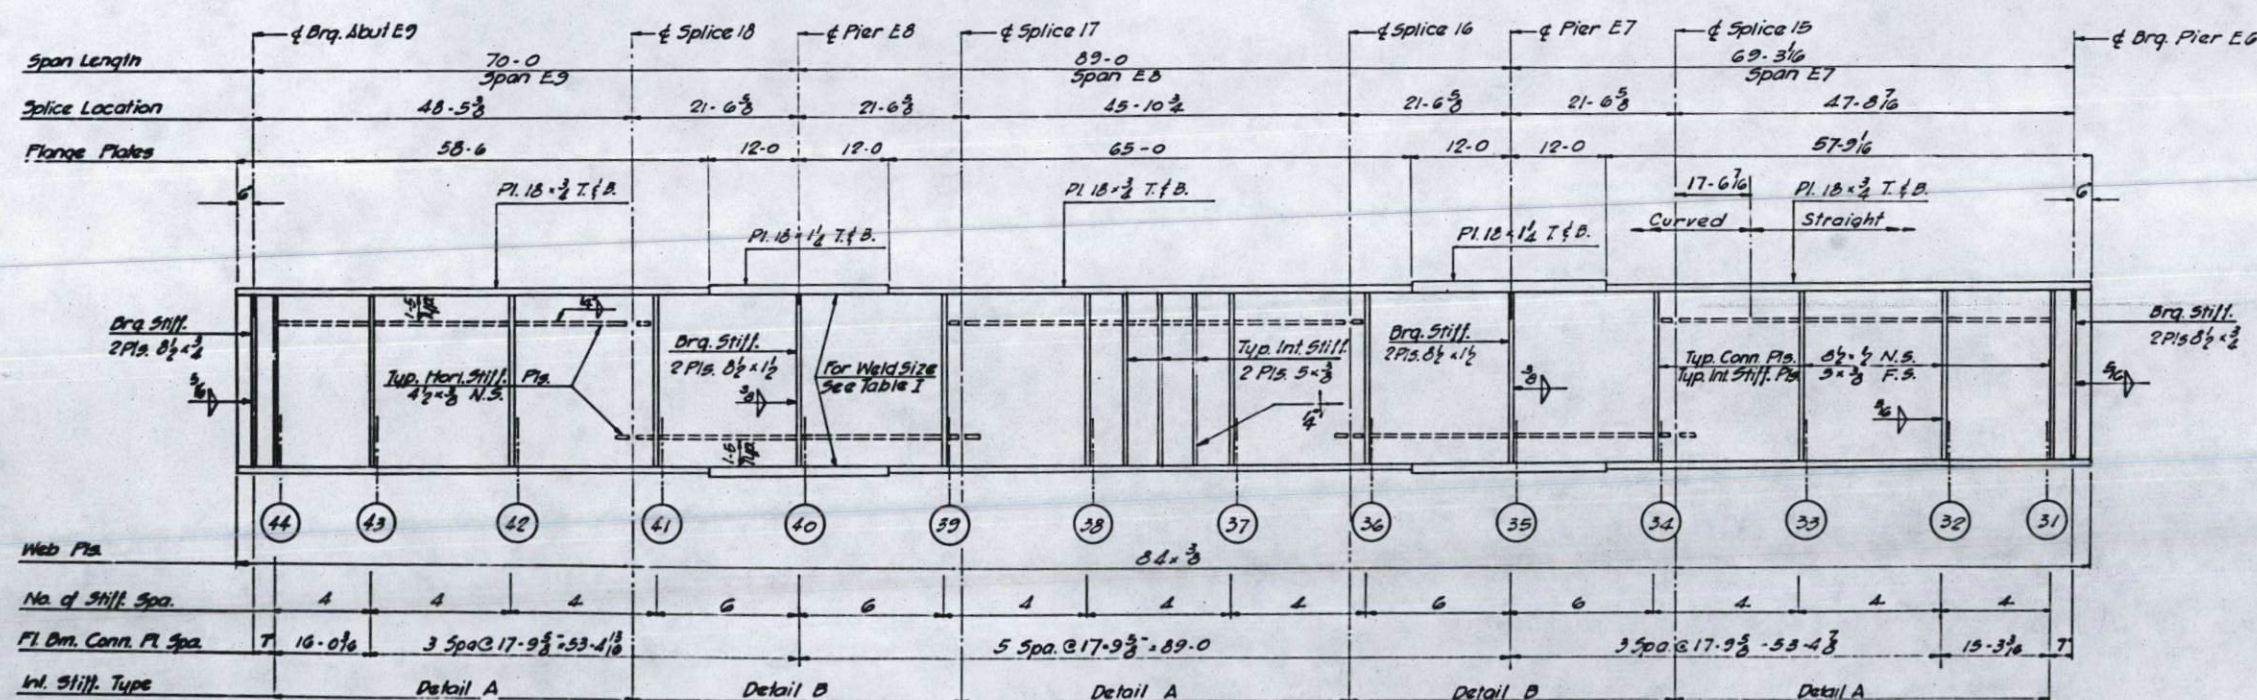

GIRDER E2
Spans E7 thru E9
GIRDER E1 (Opposite Hand)

DESIGNED BY: A.T.
DRAWN BY: V.F.
CHECKED BY: A.T.

STATE OF ILLINOIS
DEPARTMENT OF PUBLIC WORKS & BLDGS.
DIVISION OF HIGHWAYS

GIRDERS E1 AND E2
SPANS E4 THRU E9
POPLAR STREET BRIDGE APPROACHES
ROADWAY "E"


F.A.I. RT. 70 ST. CLAIR CO. SECTION 82-3HV-2

H. W. LOCHNER, INC.
ENGINEERS
CHICAGO, ILLINOIS

SHEET
60 OF 147

Log? bak

ROUTE NO.	SECTION	COUNTY	TOTAL SHEETS	SHEET NO.
F.A.1-70	82-3HVB-2	ST. CLAIR	252	127
FED. ROAD DIV. NO. 4		ILLINOIS	PROJECT	

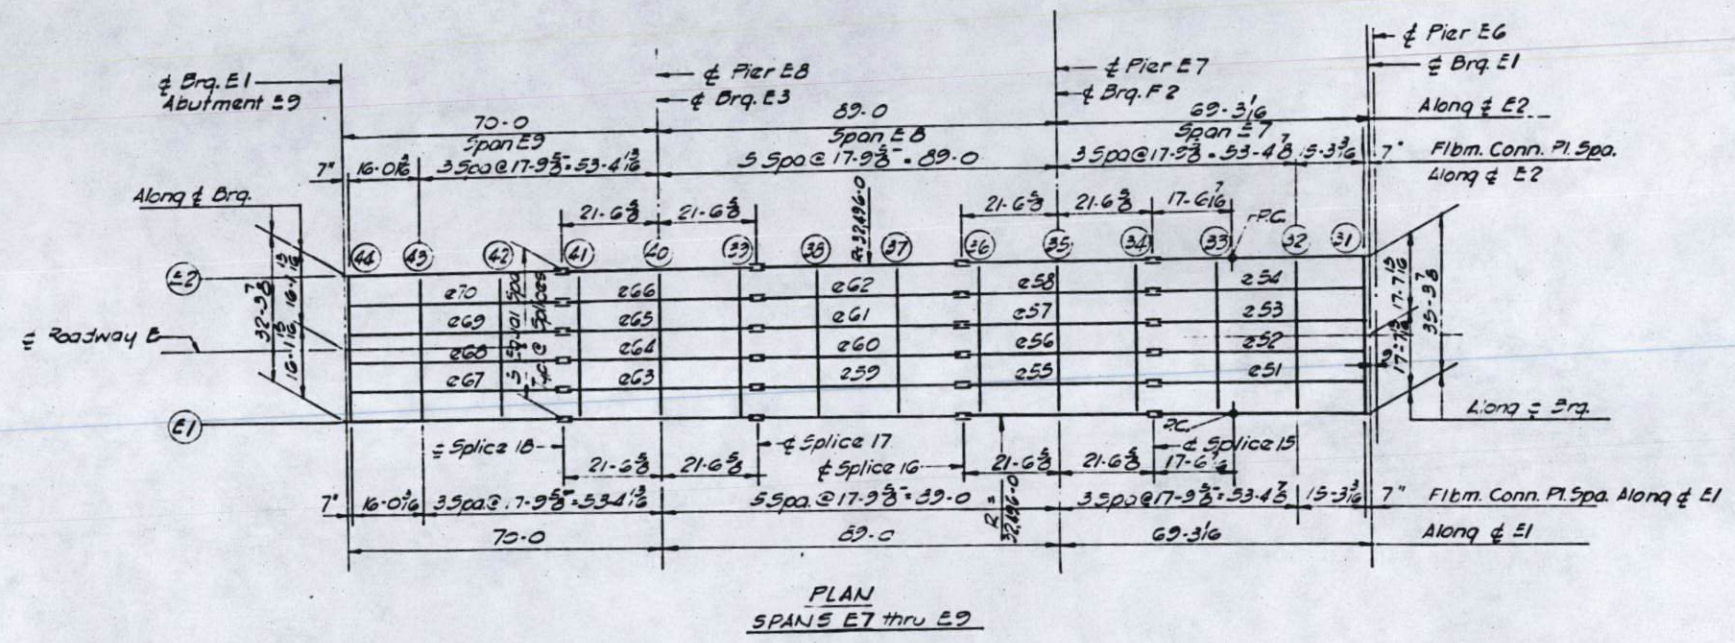

PLAN
SPANS E7 thru E9

* ELEVATION TOP OF GIRDERS
* Lower allelevations .042 ft.

	GIR. E1	GIR. E2	DIFF.
CL. BRG.	437.966	437.966	.000
FLOOR BEAM 31	437.949	437.949	.000
FLOOR BEAM 32	437.494	437.494	.000
FLOOR BEAM 33	436.963	436.963	.000
SPLICE 15	436.544	436.544	.000
FLOOR BEAM 34	436.432	436.432	.000
FLOOR BEAM 35	435.901	435.901	.000
FLOOR BEAM 36	435.870	435.870	.000
SPLICE 16	435.258	435.258	.000
FLOOR BEAM 37	434.839	434.839	.000
FLOOR BEAM 38	434.807	434.807	.000
SPLICE 17	433.887	433.887	.000
FLOOR BEAM 39	433.775	433.775	.000
FLOOR BEAM 40	433.243	433.243	.000
FLOOR BEAM 41	432.711	432.711	.000
SPLICE 18	432.999	432.999	.000
FLOOR BEAM 42	432.179	432.179	.000
FLOOR BEAM 43	431.646	431.646	.000
FLOOR BEAM 44	431.167	431.167	.000
CL. BRG.	431.149	431.149	.000

Note:
Dimensions locating Floor Beams are given to the Floor Beam Conn. Plate see Sketch Sheet No.52

BILL OF MATERIAL	
*Structural Steel	L.S. Lump Sum

Weight of Bearing Assemblies with Lead Plates and Anchor Bolts are Included as Structural Steel
Wt. 6320 Lbs.

STATE OF ILLINOIS
DEPARTMENT OF PUBLIC WORKS & BLDGS.
DIVISION OF HIGHWAYS

FRAMING PLAN
SPANS E7 THRU E9
POPLAR STREET BRIDGE APPROACHES
ROADWAY "E"

F.A.I. RT. 70 ST. CLAIR CO. SECTION- 82-3HVB-2

H. W. LOCHNER, INC.
ENGINEERS
CHICAGO, ILLINOIS

SHEET
61 of 147

DESIGNED BY A.T.
CHECKED BY S.P.
CORRECTED BY S.P.







ROUTE NO.	SECTION	COUNTY	TOTAL SHEETS	SHEET NO.
F.A.I. - 70	82-3HVB-2	ST. CLAIR	252	128
FED. ROAD DIV. NO. 4	ILLINOIS PROJECT			

STRINGER DIMENSIONS

STR	L	S1	S2	S3	S4	B1	B2
51	47'-1 7/16"	15'-3 3/16"		17'-9 5/8"	14'-0 3/8"	90.18.50	89.41.10"
52	47'-1 3/8"	15'-3 3/16"		17'-9 5/8"	14'-5/8"	90.06.17	89.53.40
53	47'-1 3/8"	15'-3 3/16"		17'-9 5/8"	14'-5/8"	89.53.43	90.06.17
54	47'-1 7/16"	15'-3 3/16"		17'-9 5/8"	14'-5/8"	89.41.10	90.18.50
55	43'-1 3/16"	3'-9"	17'-9 5/8"	17'-9 5/8"	3'-9"	90.16.34	89.43.26
56	43'-1 3/16"	3'-9"	17'-9 5/8"	17'-9 5/8"	3'-9"	90.05.31	89.54.29
57	43'-1 3/16"	3'-9"	17'-9 5/8"	17'-9 5/8"	3'-9"	89.54.29	90.05.31
58	43'-1 3/16"	3'-9"	17'-9 5/8"	17'-9 5/8"	3'-9"	89.43.26	90.16.34
59	45'-10 13/16"	14'-5/8"	17'-9 5/8"		14'-5/8"	90.13.44	89.46.16
60	45'-10 13/16"	14'-5/8"	17'-9 5/8"		14'-5/8"	90.04.35	89.55.25
61	45'-10 13/16"	14'-5/8"	17'-9 5/8"		14'-5/8"	89.55.25	90.04.35
62	45'-10 13/16"	14'-5/8"	17'-9 5/8"		14'-5/8"	89.46.16	90.13.44
63	43'-1 3/16"	3'-9"	17'-9 5/8"	17'-9 5/8"	3'-9"	90.10.55	89.49.05
64	43'-1 3/16"	3'-9"	17'-9 5/8"	17'-9 5/8"	3'-9"	90.03.38	89.56.22
65	43'-1 3/16"	3'-9"	17'-9 5/8"	17'-9 5/8"	3'-9"	89.56.22	90.03.38
66	43'-1 3/16"	3'-9"	17'-9 5/8"	17'-9 5/8"	3'-9"	89.49.05	90.10.55
67	47'-10 3/8"	14'-5/8"	17'-9 5/8"		16'-3/16"	90.06.01	89.51.59
68	47'-10 3/8"	14'-5/8"	17'-9 5/8"		16'-3/16"	90.02.40	89.57.20
69	47'-10 3/8"	14'-5/8"	17'-9 5/8"		16'-3/16"	89.57.20	90.02.40
70	47'-10 3/8"	14'-5/8"	17'-9 5/8"		16'-3/16"	89.51.59	90.06.01

FLOOR BEAM DIMENSIONS

FL. BM.	L	F1	F2	F3	F4	F5	A1	A2	A3	A4	A5	A6
31	35'-3 3/4"	7'-0 3/4"	7'-0 3/4"	7'-0 3/4"	7'-0 3/4"	7'-0 3/4"	90.31.44"	90.18.50"	90.06.17"	89.53.43"	89.41.10"	89.28.16"
32	35'-3 3/8"	7'-1 1/16"	7'-1 1/16"	7'-1 1/16"	7'-1 1/16"	7'-1 1/16"	90.31.44"	90.18.50"	90.06.17"	89.53.43"	89.41.10"	89.28.16"
33	34'-8 7/16"	6'-11 1/4"	6'-11 5/16"	6'-11 5/16"	6'-11 5/16"	6'-11 1/4"	90.31.22"	90.18.50"	90.06.17"	89.53.43"	89.41.10"	89.28.38"
34	34'-4 11/16"	6'-10 1/2"	6'-10 9/16"	6'-10 9/16"	6'-10 9/16"	6'-10 1/2"	90.29.29"	90.16.34"	90.05.31"	89.54.29"	89.43.26"	89.30.31"
35	34'-1 1/8"	6'-9 3/4"	6'-9 7/8"	6'-9 7/8"	6'-9 7/8"	6'-9 3/4"	90.27.36"	90.16.34"	90.05.31"	89.54.29"	89.43.26"	89.32.24"
36	33'-9 13/16"	6'-9 1/8"	6'-9 3/16"	6'-9 3/16"	6'-9 3/16"	6'-9 1/8"	90.25.43"	90.16.34"	90.05.31"	89.54.29"	89.43.26"	89.34.17"
37	33'-6 3/4"	6'-8 1/2"	6'-8 9/16"	6'-8 9/16"	6'-8 9/16"	6'-8 1/2"	90.23.50"	90.13.44"	90.04.35"	89.55.25"	89.46.16"	89.36.10"
38	33'-3 7/8"	6'-7 15/16"	6'-8"	6'-8"	6'-8"	6'-7 15/16"	90.21.57"	90.13.44"	90.04.35"	89.55.25"	89.46.16"	89.38.03"
39	33'-1 5/16"	6'-7 7/16"	6'-7 7/16"	6'-7 7/16"	6'-7 7/16"	6'-7 7/16"	90.20.04"	90.10.55"	90.03.38"	89.56.22"	89.49.05"	89.39.56"
40	32'-10 15/16"	6'-6 15/16"	6'-7"	6'-7"	6'-7"	6'-6 15/16"	90.18.11"	90.10.55"	90.03.38"	89.56.22"	89.49.05"	89.41.49"
41	32'-8 3/4"	6'-6 9/16"	6'-6 9/16"	6'-6 9/16"	6'-6 9/16"	6'-6 9/16"	90.16.18"	90.10.55"	90.03.38"	89.56.22"	89.49.05"	89.43.42"
42	32'-6 7/8"	6'-6 1/8"	6'-6 3/16"	6'-6 3/16"	6'-6 3/16"	6'-6 1/8"	90.14.25"	90.08.01"	90.02.40"	89.57.20"	89.51.59"	89.45.35"
43	32'-5 3/16"	6'-5 3/4"	6'-5 7/8"	6'-5 7/8"	6'-5 7/8"	6'-5 3/4"	90.12.32"	90.08.01"	90.02.40"	89.57.20"	89.51.59"	89.47.28"
44	32'-3 7/8"	6'-5 9/16"	6'-5 9/16"	6'-5 9/16"	6'-5 9/16"	6'-5 9/16"	90.10.50"	90.08.01"	90.02.40"	89.57.20"	89.51.59"	89.49.10"

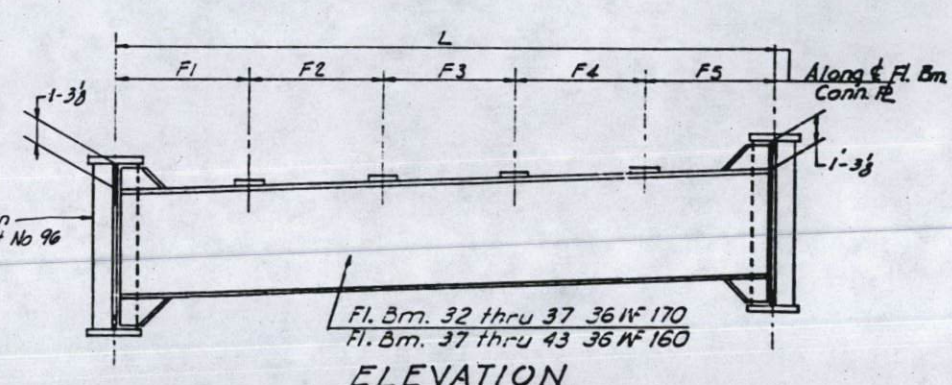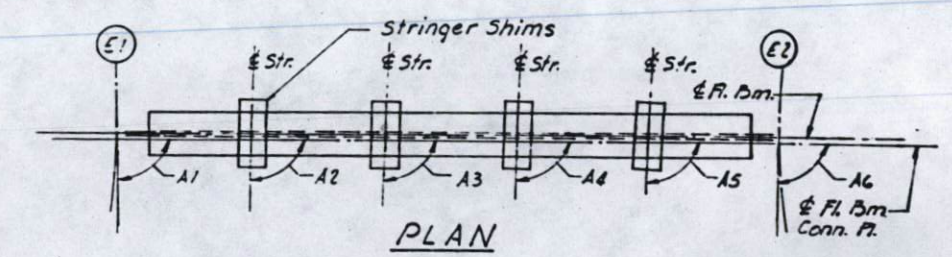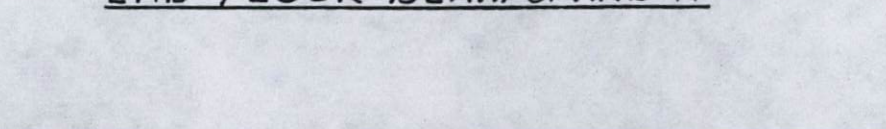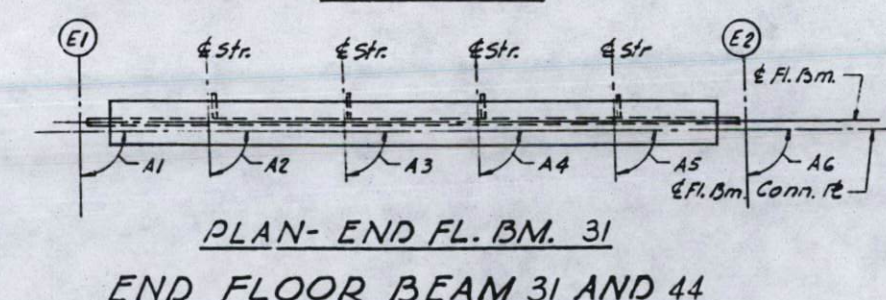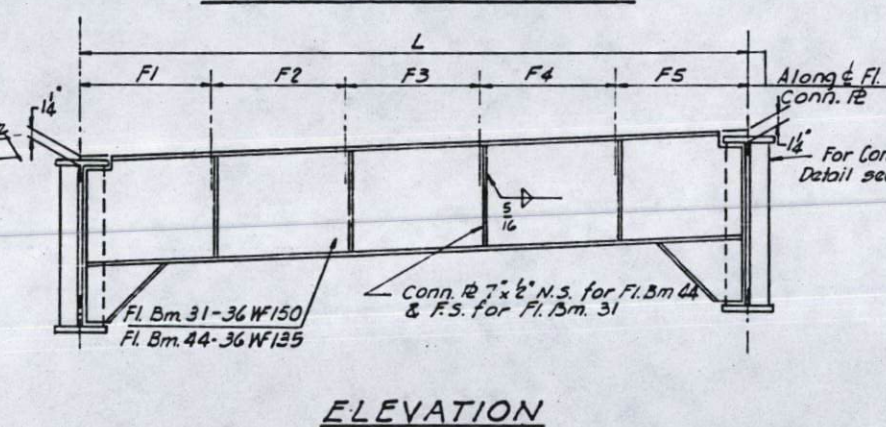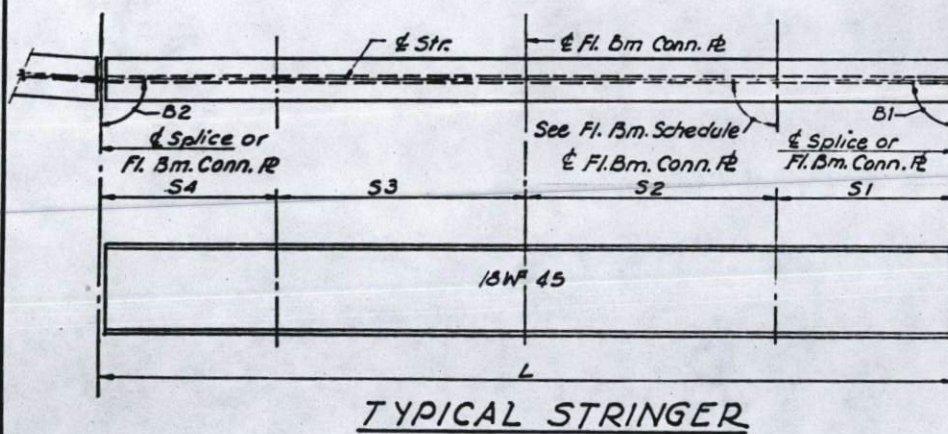

Notes:
 Length L of Stringers and Fl. Bms. is correct as given in the Table, except the increment lengths are given to the nearest 1/8".
 All dimensions are in the horizontal plane.
 For Connection Plate Details see Sheet No. 97

DESIGNED BY A.T.
 DRAWN BY V.T.
 CHECKED BY S.A.D.

STATE OF ILLINOIS
 DEPARTMENT OF PUBLIC WORKS & BLDGS.
 DIVISION OF HIGHWAYS
 STRINGER AND FLOOR BEAM
 SCHEDULE
 SPANS E7 THRU E9
 POPLAR STREET BRIDGE APPROACHES
 ROADWAY "E"
 F.A.I. RT. 70 ST. CLAIR CO. SECTION 82-3HVB-2
 H. W. LOCHNER, INC.
 ENGINEERS
 CHICAGO, ILLINOIS

SHEET
 62 OF 147

ROUTE NO.	SECTION	COUNTY	TOTAL SHEETS	SHEET NO.
F.A.L. - 70	82-3MVB-2	ST. CLAIR	252	129
FED. ROAD DIST. NO. 4		ILLINOIS	PROJECT	


FLOOR BEAM 38 @ 33	T1	T2	T3	T4
STR. 51 THRU 54	1	1	3/8	3/8

FLOOR BEAM 34 THRU 36	T1	T2	T3	T4
STR. 55 THRU 58	1	1	3/8	3/8

FLOOR BEAM 37 THRU 38	T1	T2	T3	T4
STR. 59 THRU 62	1	1	3/8	3/8


FLOOR BEAM 39 THRU 41	T1	T2	T3	T4
STR. 63 THRU 66	1	1	3/8	3/8

FLOOR BEAM 42 @ 43	T1	T2	T3	T4
STR. 67 THRU 70	1	1	3/8	3/8

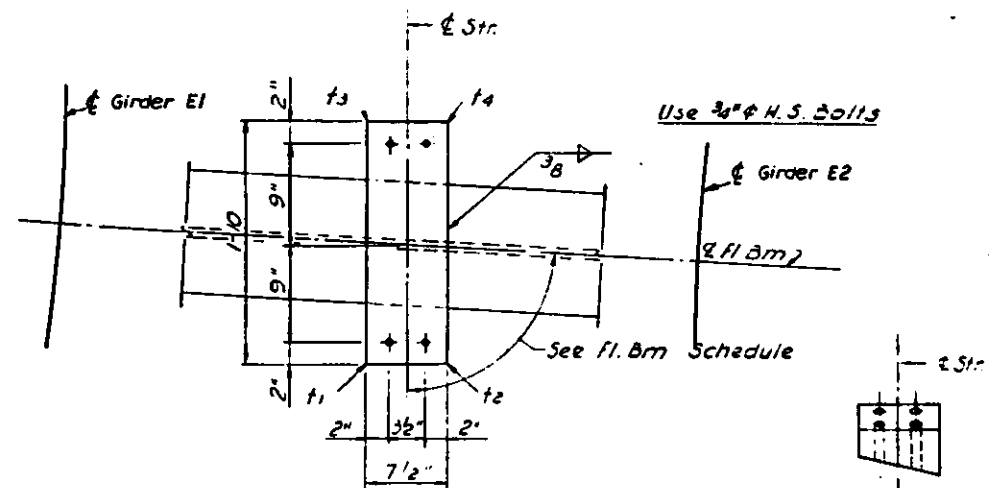


PLAN

END VIEW

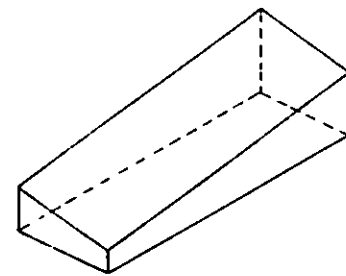

ISOMETRIC VIEW

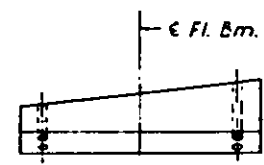

SIDE VIEW

SHIM DETAIL

Shim thickness t_1 , t_2 , t_3 & t_4 shown in the Table are orientated with the Plan View shown above.

DESIGNED BY A.T.
 DRAWN BY L.M.
 CHECKED BY A.T.

STATE OF ILLINOIS
 DEPARTMENT OF PUBLIC WORKS & BLDGS.
 DIVISION OF HIGHWAYS



STRINGER SHIMS
 SPANS E7 THRU E9
 POPLAR STREET BRIDGE APPROACHES
 ROADWAY "E"

F.A.L. 70. ST. CLAIR CO. SECTION 82-3MVB-2

H. W. LOCHNER, INC.
 ENGINEERS
 CHICAGO, ILLINOIS

SHEET
 63 OF 147

ROUTE NO.	SECTION	COUNTY	TOTAL SHEETS	SHEET NO.
F.A.1-70	82-3HVB-2	ST. CLAIR	252	162
FED. ROAD DIV. NO. 4		ILLINOIS	PROJECT	

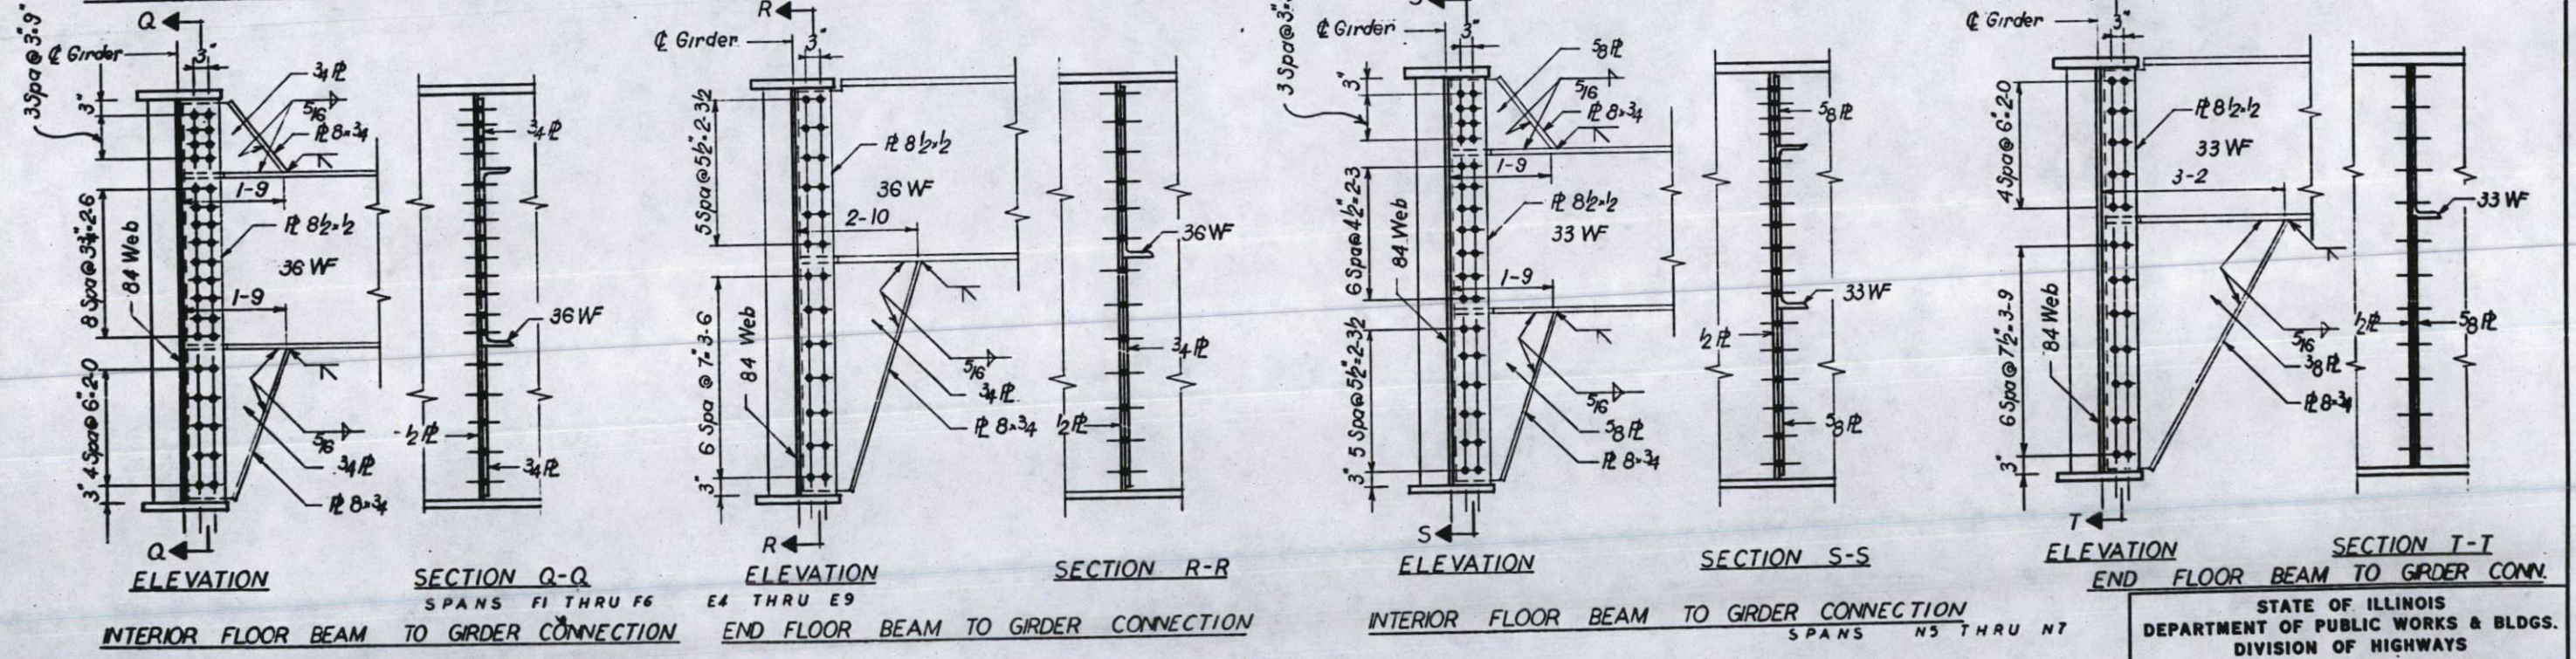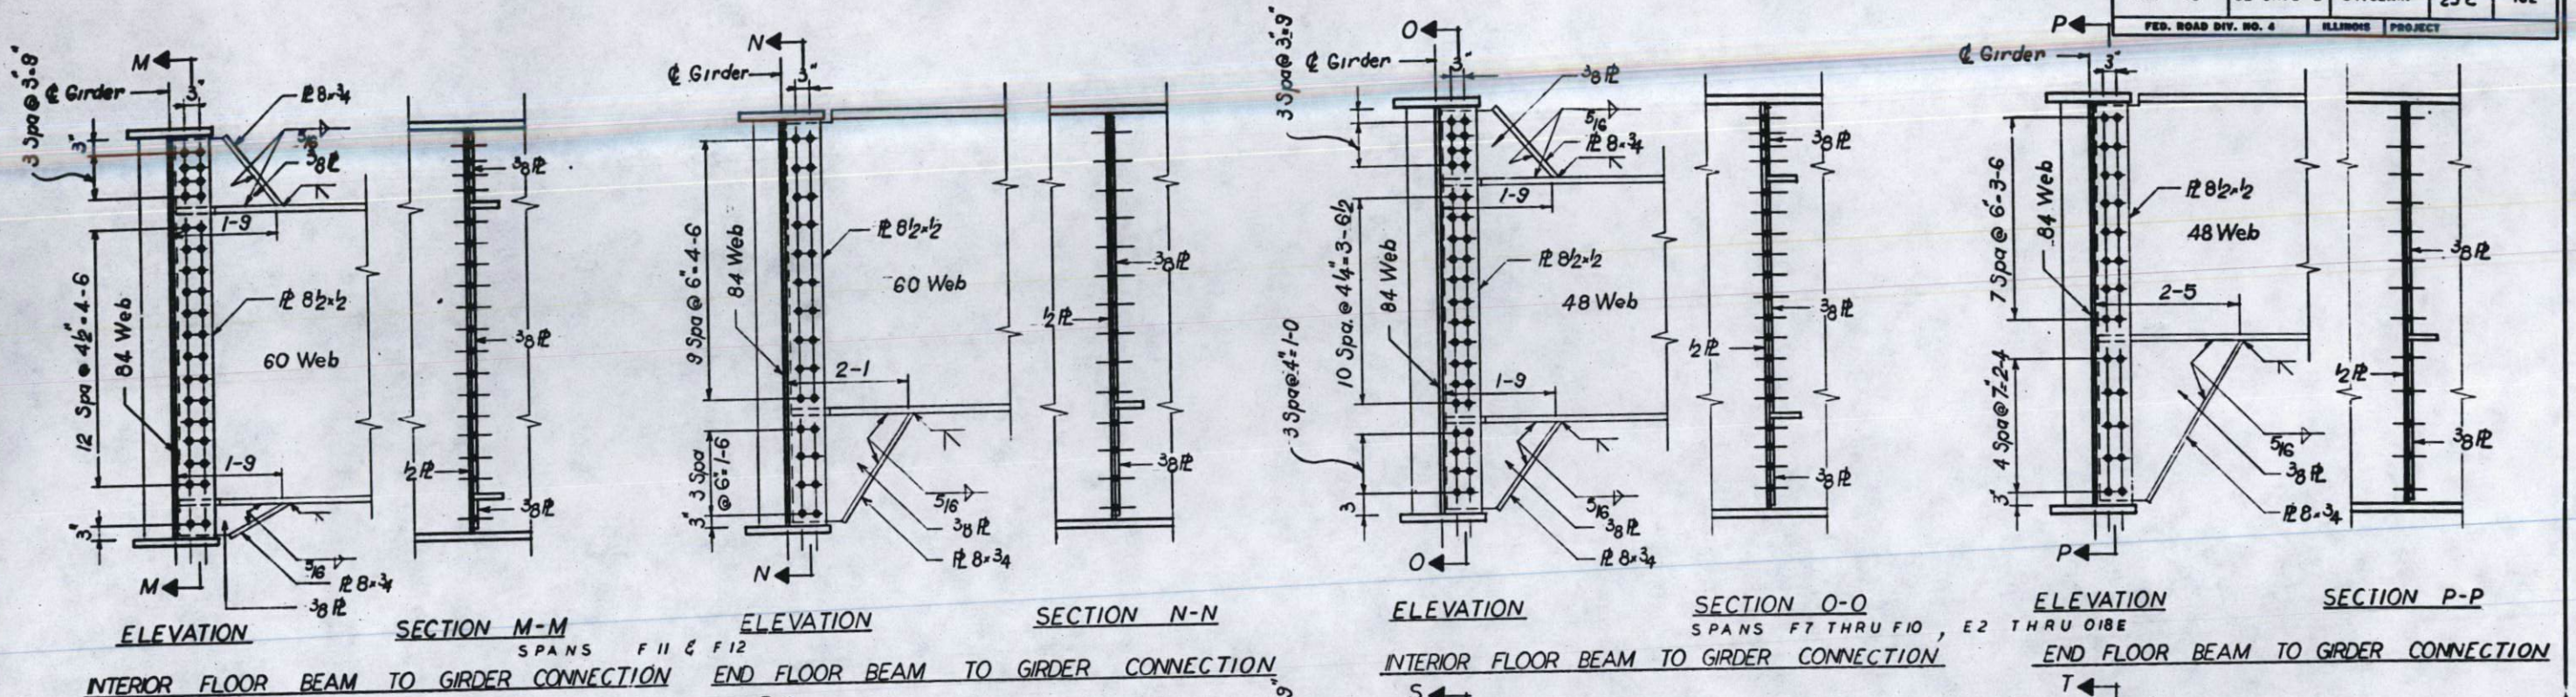




84 WEB GIRDER

For Notes see Sh. 97



DESIGNED BY A.A.
DRAWN BY E.C.
CHECKED BY A.T.

STATE OF ILLINOIS
DEPARTMENT OF PUBLIC WORKS & BLDGS.
DIVISION OF HIGHWAYS
STEEL FRAMING DETAILS
POPLAR STREET BRIDGE APPROACHES
F.A.1.70 ST. CLAIR CO SECTION 82-3HVB-2
H. W. LOCHNER, INC.
ENGINEERS
CHICAGO, ILLINOIS
SHEET
96 of 147



ROUTE NO.	SECTION	COUNTY	TOTAL SHEETS	SHEET NO.
F.A.1 - 70	B2-3HVB-2	ST. CLAIR	252	163
FED. ROAD DIV. NO. 4		ILLINOIS PROJECT		

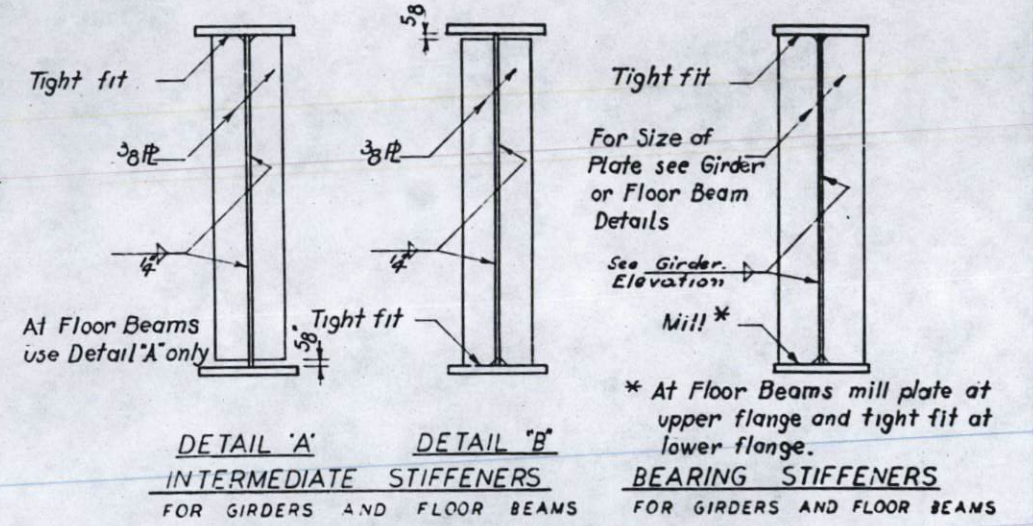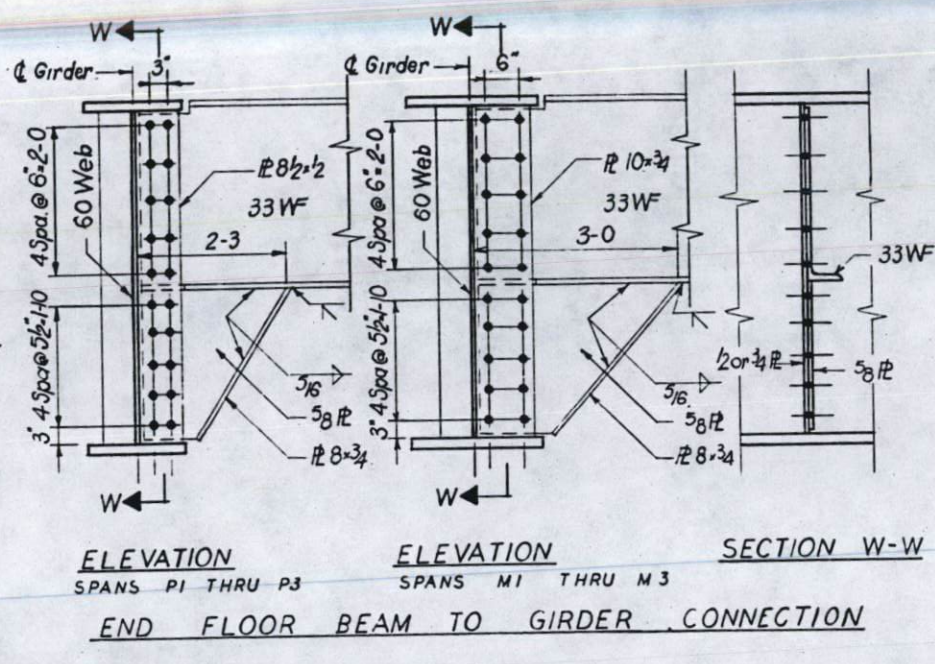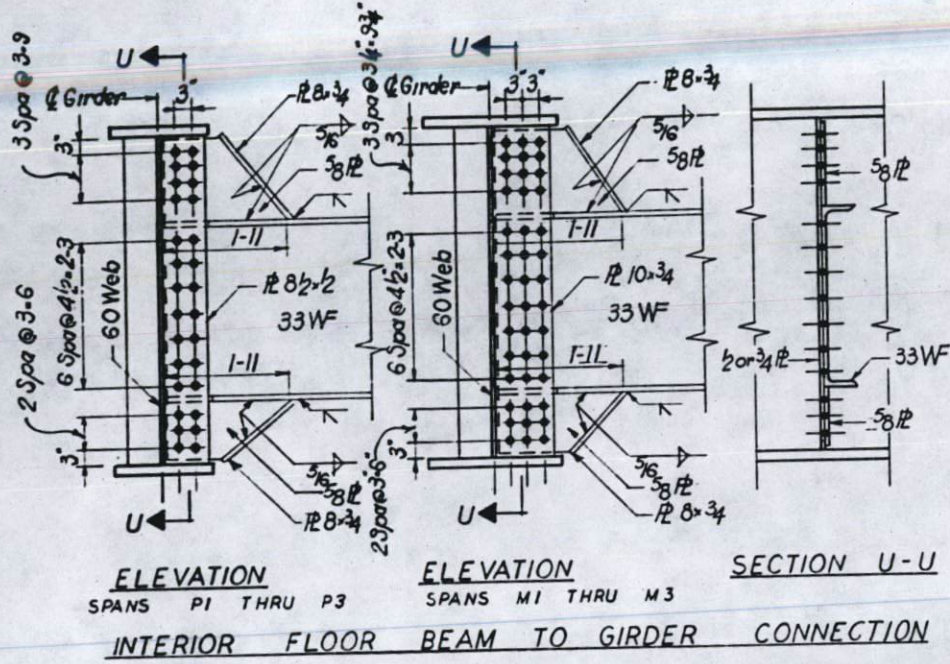

60 WEB GIRDER

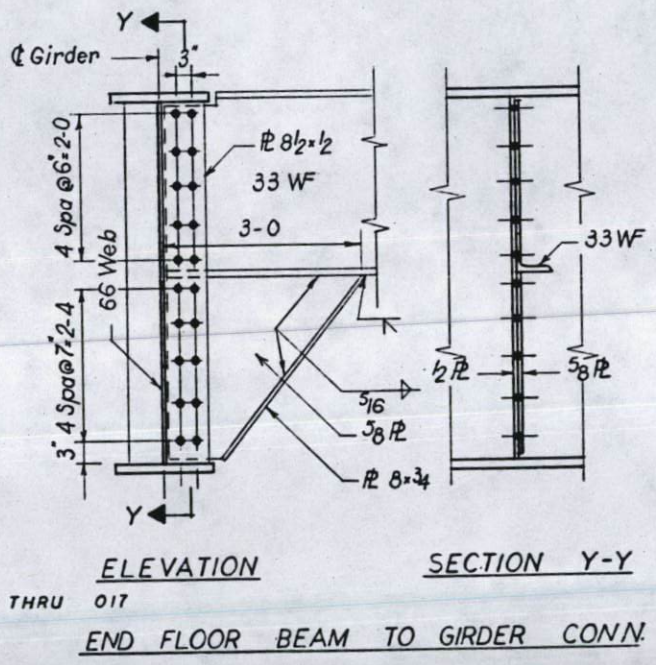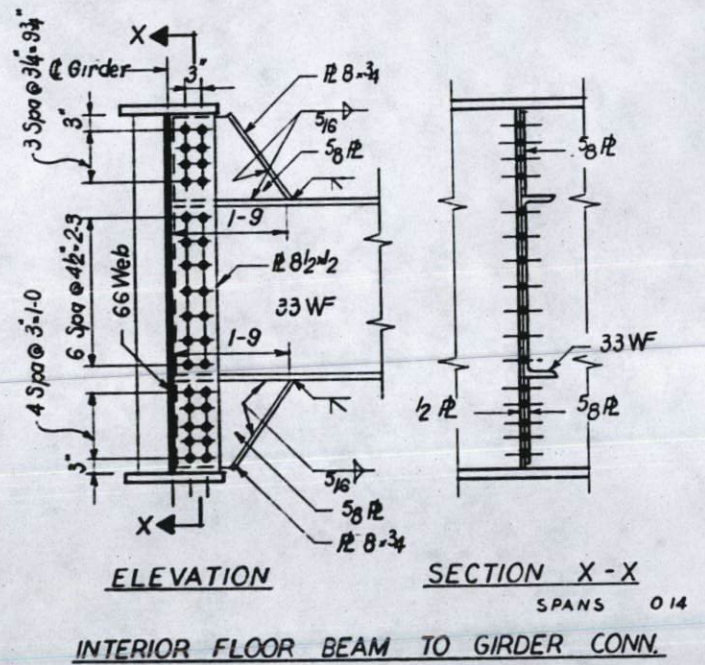

66 WEB GIRDER

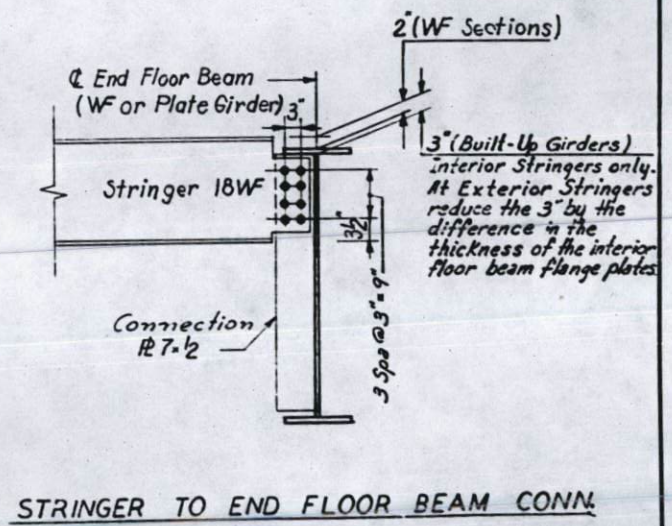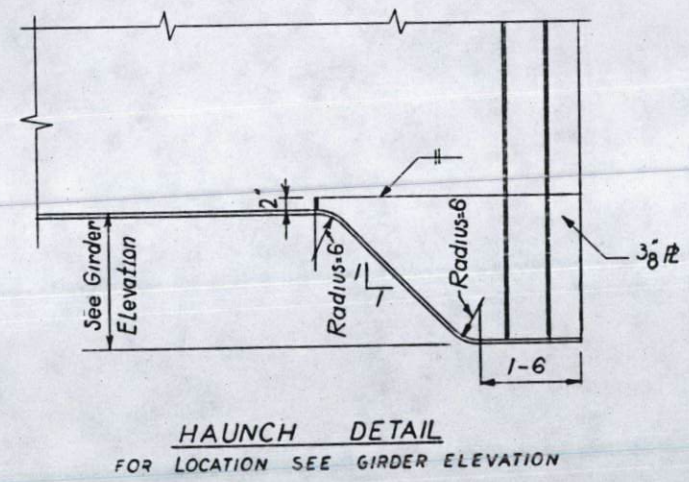

NOTES

For size of flange, plate welds see table I Sh. No. 98. Weld Connection R's to the top flange and tight fit at the bottom flange in areas designated as Detail 'A'. Weld Connection R's to the bottom flange and tight fit at the top flange in areas designated as Detail 'B'. For limits of Detail 'A' or Detail 'B' see the Girder Elevation Drawings.

STATE OF ILLINOIS
DEPARTMENT OF PUBLIC WORKS & BLDGS.
DIVISION OF HIGHWAYS
STEEL FRAMING DETAILS

POPLAR STREET BRIDGE APPROACHES


F.A.I. RT. 70 ST. CLAIR CO. SECTION B2-3HVB-2
H. W. LOCHNER, INC.
ENGINEERS
CHICAGO, ILLINOIS

SHEET
97 of 14.

DESIGNED BY S.K.
DRAWN BY F.C.
CHECKED BY A.T.



ROUTE NO.	SECTION	COUNTY	TOTAL SHEETS	SHEET NO.
F.A.I. - 70	82-3HVB-2	ST. CLAIR	252	164
FED. ROAD DIV. NO. 4		ILLINOIS	PROJECT	

LOCATION	SPlice NO.	SPLICE NO.	DETAIL	GIRDER SECTION		WEB SPLICE		FLANGE SPLICE			
				WEB PLATE	FLANGE PLATES	FILL PLATES	SPLICE PLATES	A	OUTSIDE PLATES	INSIDE PLATES	B
RDWY. "E"	15, 16, 17, 18	60	A	3/8 x 84	18 x 3/4	---	2-13 x 3/8 x 6-6	25	2-18 x 1/2 x 3-11	4-8 x 3/8 x 3-11	8
	10, 11, 12	60	A	3/8 x 1/2 x 84	18 x 7/8	2-64 x 1/8 x 6-6	2-13 x 3/8 x 6-6	25	2-18 x 1/2 x 3-11	4-8 x 3/8 x 3-11	8
	9	60	A	3/8 x 1/2 x 84	18 x 1	2-64 x 1/8 x 6-6	2-13 x 3/8 x 6-6	25	2-18 x 3/8 x 4-9	4-8 x 3/4 x 4-9	10
	3, 4, 5, 6	55	A	3/8 x 1/2 x 84	18 x 1 1/8	2-64 x 1/8 x 6-6	2-13 x 3/8 x 6-6	25	2-18 x 3/8 x 4-9	4-8 x 3/4 x 4-9	10
RDWY. "F"	2, 3, 4, 5, 8, 9, 11	67	A	3/8 x 84	18 x 3/4	---	2-13 x 3/8 x 6-6	25	2-18 x 1/2 x 3-11	4-8 x 3/8 x 3-11	8
	15	74	A	3/8 x 1/2 x 84	18 x 1 1/8	2-64 x 1/8 x 6-6	2-13 x 3/8 x 6-6	25	2-18 x 3/4 x 5-7	4-8 x 7/8 x 5-7	12
	16, 18	74	A	3/8 x 1/2 x 84	18 x 1 1/2	2-64 x 1/8 x 6-6	2-13 x 3/8 x 6-6	25	2-18 x 3/4 x 5-7	4-8 x 7/8 x 5-7	12
	19	74	A	3/8 x 1/2 x 84	18 x 1 3/4	2-64 x 1/8 x 6-6	2-13 x 3/8 x 6-6	25	2-18 x 7/8 x 6-5	4-8 x 1 x 6-5	14
	24, 25, 27	79	A	3/8 x 1/2 x 84	18 x 1 3/4	2-64 x 1/8 x 6-6	2-13 x 3/8 x 6-6	25	2-18 x 7/8 x 6-5	4-8 x 1 x 6-5	14
	28	79	A	3/8 x 1/2 x 84	18 x 1 3/4	2-64 x 1/8 x 6-6	2-13 x 3/8 x 6-6	25	2-18 x 7/8 x 6-5	4-8 x 1 x 6-5	14
RAMP "M"	3	83	B	3/8 x 1/2 x 60	24 x 1/8	2-64 x 1/8 x 4-6	2-13 x 3/8 x 4-6	17	2-24 x 3/4 x 5-7	4-11 x 7/8 x 5-7	12
	4, 7, 10	83	B	3/8 x 1/2 x 60	24 x 1/2	2-64 x 1/8 x 4-6	2-13 x 3/8 x 4-6	17	2-24 x 7/8 x 5-7	4-11 x 1 x 5-7	12
RAMP "N"	5, 7, 11, 13	87	A	3/8 x 84	18 x 1/4	---	2-13 x 3/8 x 6-6	25	2-18 x 3/4 x 5-7	4-8 x 7/8 x 5-7	12
RAMP "O"	3, 7	91	A	3/8 x 66	18 x 1/8	---	2-13 x 3/8 x 5-0	19	2-18 x 3/8 x 4-9	4-8 x 3/4 x 4-9	10
	4, 6	91	A	3/8 x 66	18 x 1	---	2-13 x 3/8 x 5-0	19	2-18 x 1/2 x 3-11	4-8 x 3/8 x 3-11	8
RAMP "P"	5, 7, 11, 13	95	A	3/8 x 1/2 x 60	18 x 1 1/4	2-64 x 1/8 x 4-6	2-13 x 3/8 x 4-6	17	2-18 x 3/8 x 6-5	4-8 x 1 x 6-5	14

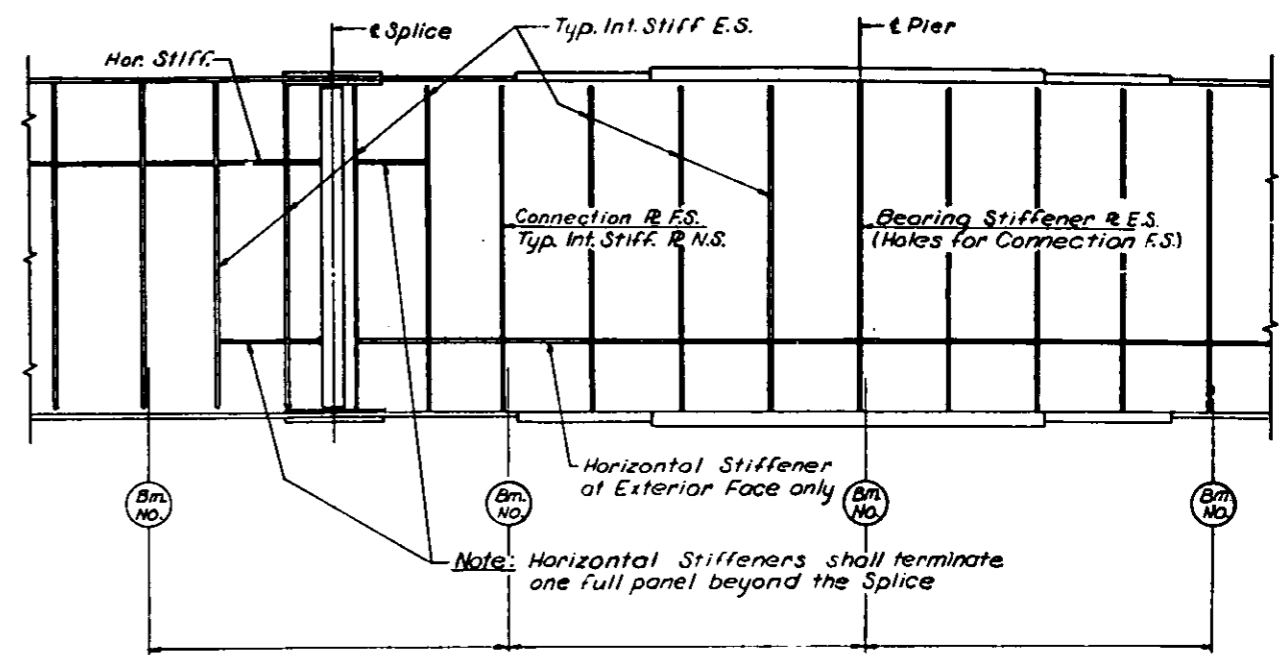

TYPICAL GIRDER DETAILS
(Exterior Face Shown)

Note: All Bearing Stiff. & Conn. R.S. to be Vertical.

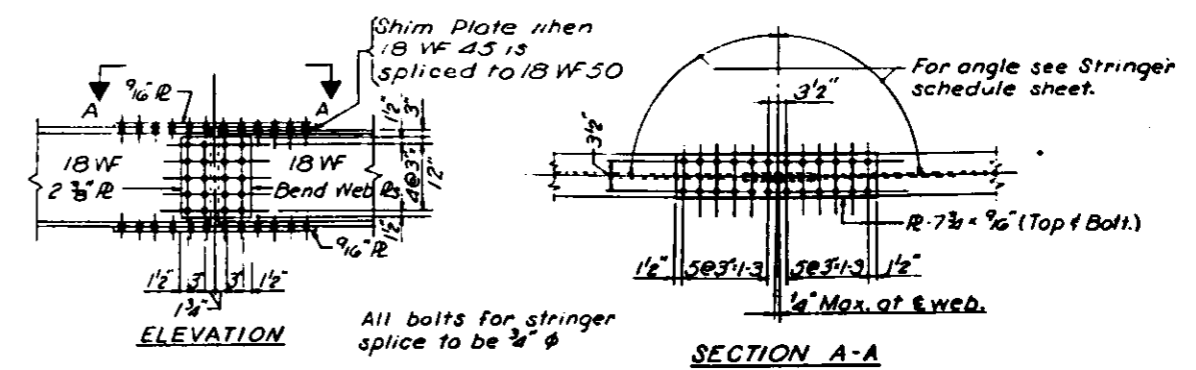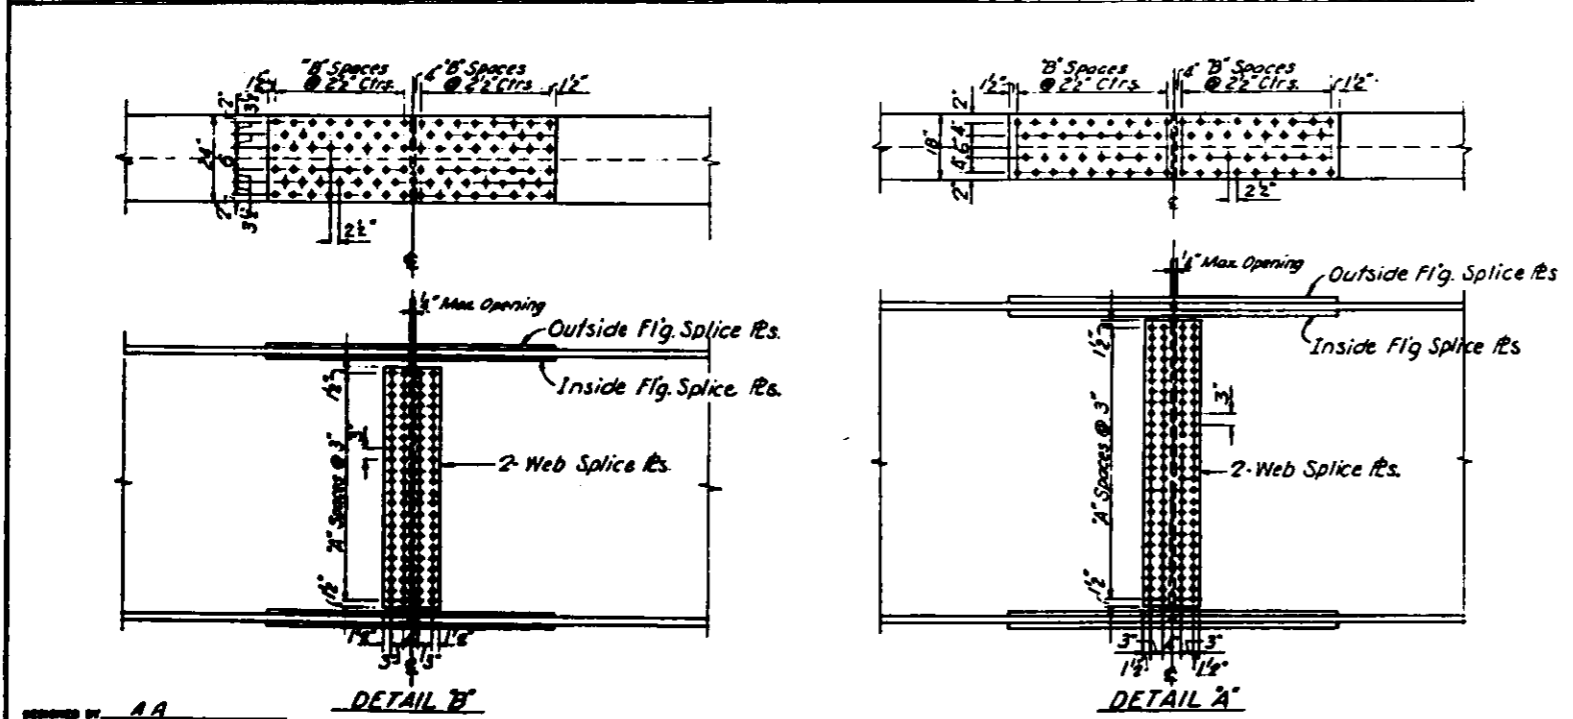

STRINGER SPLICE

Plate Size	Min. Weld Size
To 3/4\" Inclusive	1/4"
Over 3/4\" to 1 1/2"	5/16"
Over 1 1/2\" to 2 1/4"	3/8"
Over 2 1/4\" to 6"	1/2"

STATE OF ILLINOIS
DEPARTMENT OF PUBLIC WORKS & BLDGS.
DIVISION OF HIGHWAYS
GIRDER SPLICES & DETAILS
POPLAR STREET BRIDGE APPROACHES
ROADWAYS "E" & "F" AND RAMPS "M", "N", "O" & "P"

F.A.I. RT. 70 ST. CLAIR CO. SECTION 82-3HVB-2
H. W. LOCHNER, INC.
ENGINEERS
CHICAGO, ILLINOIS

SHEET
98 of 147


DESIGNED BY: A.A.
DRAWN BY: E.C.
CHECKED BY: A.T.

ROUTE NO.	SECTION	COUNTY	TOTAL SHEETS	SHEET NO.
FAI. 70	82-3HVB-2	ST. CLAR	252	158
FED. ROAD DIV. NO. 4		ILLINOIS PROJECT		

TABLE OF SHIMS



LOCATION	PIER	SPAN	GIRDER	SHIM THICKNESS
E6	E6	E1&E2		7/16"
F4	F4	F1&F2		1/2"
F7	F7	F1&F2		1/2"
F10	F10	F1&F2		5/8"
O14	O14	P1&P2		3/4"
O17	O18E	E2		5/8"
P4	P4	P1		1/2"
		P2		3/4"
M3	M4	M1		1/2"
		M2		1/2"
N5	N4	N1&N2		3/8"

Length and Width of Shims to be the same as the corresponding Base Plate.




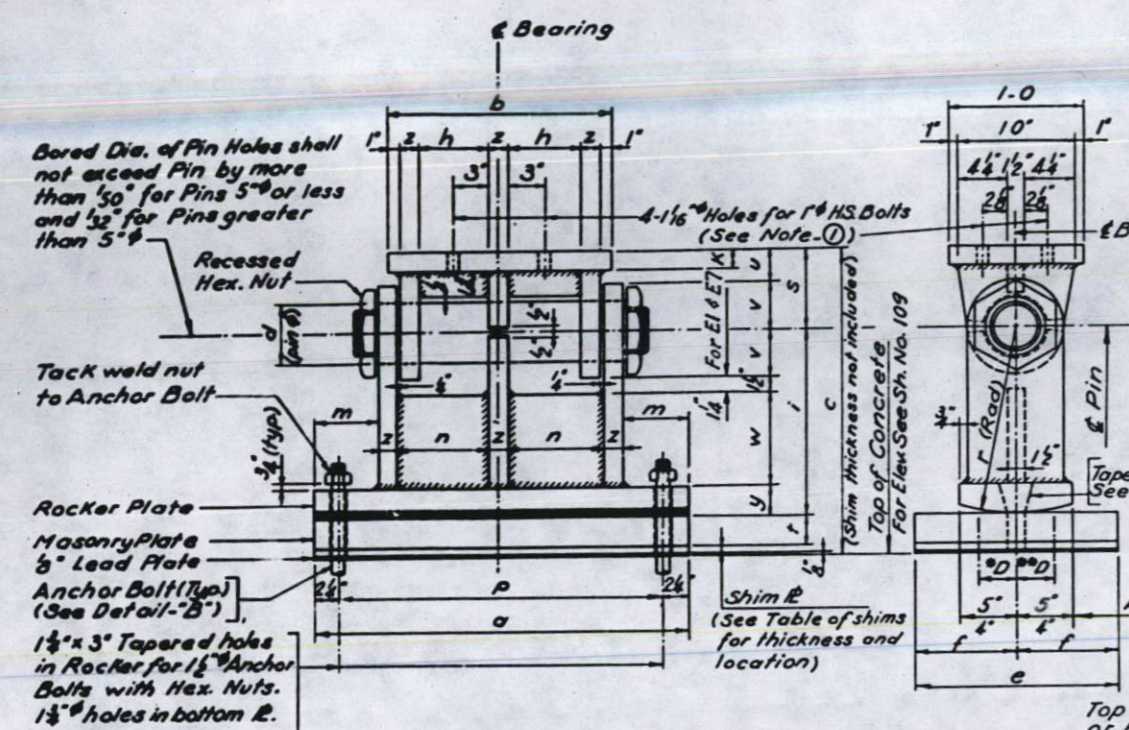


DETAIL OF EXPANSION BEARING
(For Dimensions See Table)
E1 Thru E7

ANCHOR BOLT DIMENSIONS							
Dimension	F1 Thru F3	F6 & F7	E1 & E7	E3 Thru E5	E8	E8	E8
B	5 1/2	6 1/2	7 1/2	9 1/2	11	11	6
C	1-8 1/2	1-9 1/2	1-10 1/2	2-0 1/2	2-2	1-9	

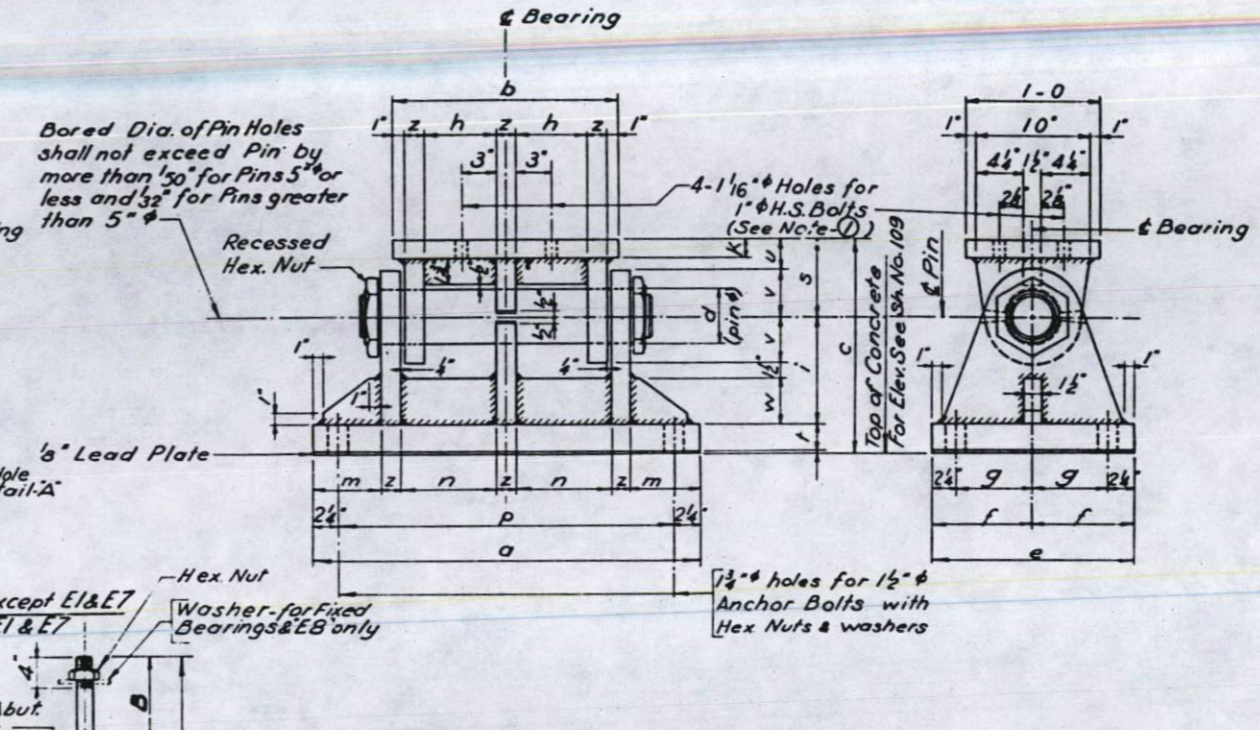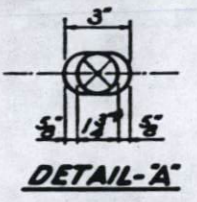


DETAIL OF FIXED BEARING
(For Dimensions See Table)
F1 Thru F7

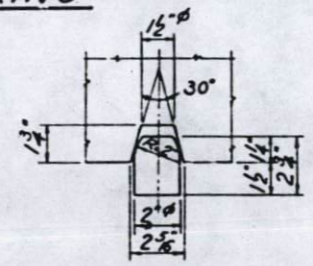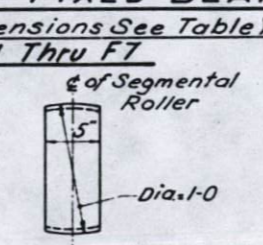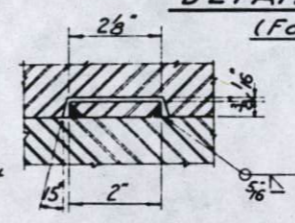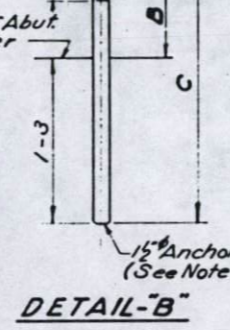

TYPE OF BEARING ASSEMBLY DIMENSIONS																							
TYPE OF BEARING	NO. OF BEARINGS	Dimension																					
		a	b	c	d	e	f	g	h	i	k	m	n	p	r	s	t	u	v	w	y	z	
F1	2	2-7	1-8	1-5 1/2	5	1-0	6	3 1/2	6 1/2	9 1/2	1 1/2	4 1/2	8 1/2	2 1/2	6 1/2	2	2 1/2	3 1/2	4	1 1/2			
F2	2	2-8	1-8	1-6 1/2	5	1-2	7	4 1/2	6 1/2	9 1/2	1 1/2	5	8 1/2	2 1/2	6 1/2	2 1/2	2 1/2	3 1/2	4	1 1/2			
F3	10	2-0	1-8	1-6 1/2	5	1-4	8	5 1/2	6 1/2	9 1/2	1 1/2	6	8 1/2	2 1/2	6 1/2	2 1/2	2 1/2	3 1/2	4	1 1/2			
F4	4	2-0	2-0	1-6 1/2	5	1-4	8	5 1/2	8 1/2	9 1/2	1 1/2	3	4	10 1/2	2 1/2	6 1/2	2 1/2	2 1/2	3 1/2	4	1 1/2		
F5	2	2-0	1-8	1-6 1/2	5 1/2	1-6	9	6 1/2	6 1/2	9 1/2	1 1/2	6	8 1/2	2 1/2	6 1/2	2 1/2	2 1/2	3 1/2	4	1 1/2			
F6	4	3-0	1-8	1-7 1/2	6	1-8	10	7 1/2	6 1/2	9 1/2	2	7	8 1/2	2 1/2	7 1/2	2 1/2	3	4 1/2	4	1 1/2			
F7	2	3-4	2-0	1-8	6 1/2	2-0	10	3 1/2	8	10	2	6 1/2	10 1/2	2 1/2	7 1/2	3 1/2	3	4 1/2	4	1 1/2			
E1	26	2-4	1-6	1-3 1/2	3 1/2	9	4 1/2	5 1/2	7 1/2	16	4	7 1/2	1 1/2	7 1/2	5 1/2	2	2 1/2	3	1 1/2	1 1/2			
E2	16	2-7	1-8	1-7 1/2	5	1-0	6	6 1/2	10	1 1/2	4 1/2	8 1/2	2 1/2	10	6 1/2	2 1/2	2 1/2	3 1/2	2 1/2	2	1 1/2		
E3	2	2-8	1-8	1-6 1/2	5	1-2	7	6 1/2	11	1 1/2	5	8 1/2	2 1/2	11	6 1/2	3	2 1/2	3 1/2	3 1/2	2 1/2	1 1/2		
E4	10	2-0	1-0	1-0	5	1-4	8	7 1/2	10 1/2	1 1/2	5	9 1/2	2 1/2	10 1/2	6 1/2	3 1/2	2 1/2	3 1/2	4 1/2	2 1/2	1 1/2		
E5	4	2-0	1-0	2-3 1/2	5 1/2	1-6	9	7 1/2	1-5	1 1/2	5	9 1/2	2 1/2	1-5	6 1/2	3 1/2	2 1/2	4	8 1/2	2 1/2	1 1/2		
E6	2	3-0	2-0	2-8 1/2	6	1-8	10	8 1/2	1-0	2	5	10 1/2	2 1/2	1-0	7 1/2	4	3	4 1/2	1-1	3 1/2	1 1/2		
E7	4	2-0	2-0	1-3 1/2	3 1/2	9	4 1/2	8 1/2	7 1/2	1 1/2	4	10 1/2	2 1/2	7 1/2	5 1/2	2	2 1/2	3	1 1/2	1 1/2			
E8	2																						

DESIGNED BY A.T.A.M.B.
DRAWN BY S.G.B.
CHECKED BY R.M.R.






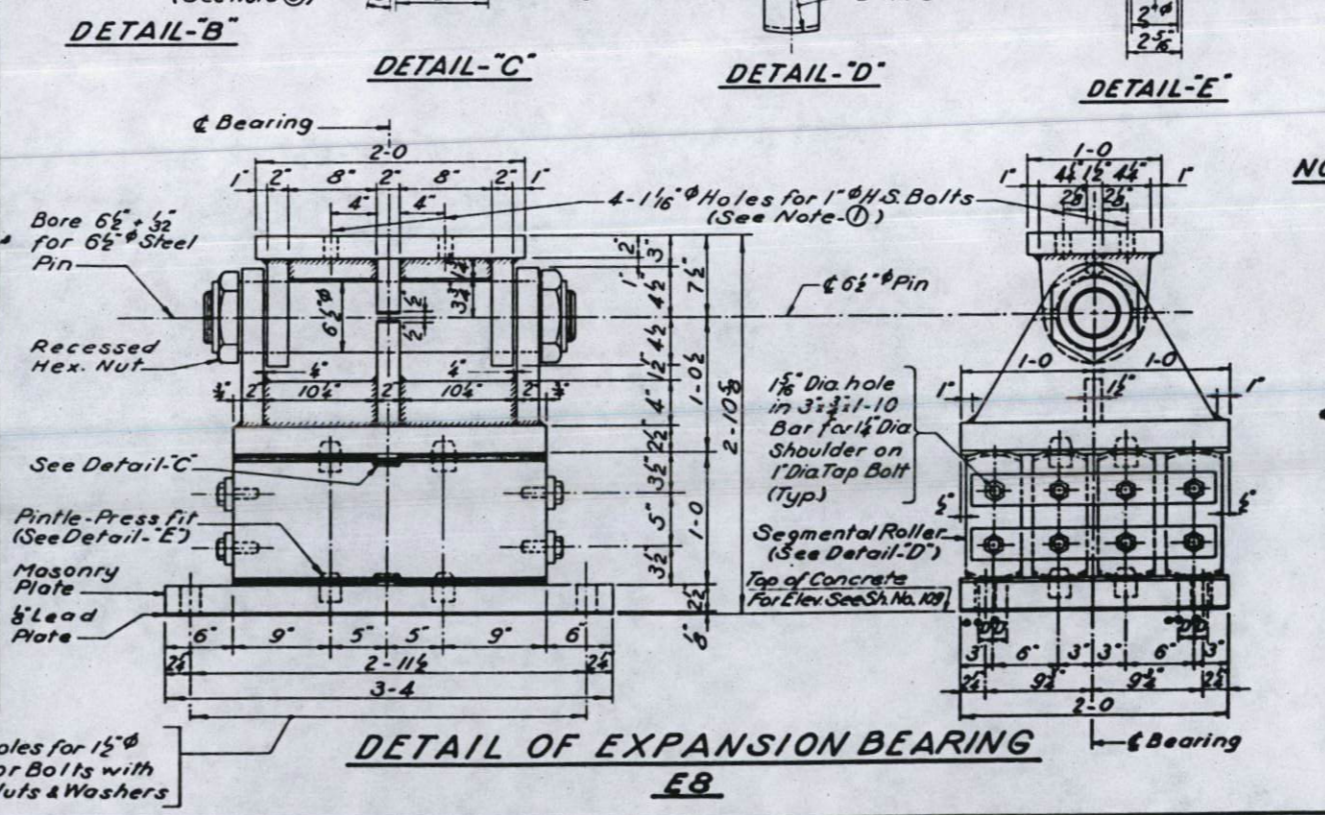


DETAIL OF EXPANSION BEARING
E8

- NOTES:**
- The 1" H.S. Bolts to be Bearing Type. Threads to be excluded from the contact surfaces.
 - Continuous Fillet Welds throughout for all Expansion & Fixed Bearings.
 - Anchor Bolts to be grouted into drilled holes after beams are in place.
 - D = 1/100 ft. of expansion for every 15° below the normal temperature of 50°F.
 - D = 1/100 ft. of expansion for every 15° above the normal temperature of 50°F.

STATE OF ILLINOIS
DEPARTMENT OF PUBLIC WORKS & BLDGS.
DIVISION OF HIGHWAYS
BEARING DETAILS
POPLAR STREET BRIDGE APPROACHES
FAI RT. 70 ST. CLAR CO. SECTION 82-3HVB-2
H. W. LOCHNER, INC. ENGINEERS CHICAGO, ILLINOIS
SHEET 102 of 147

ROUTE NO.	SECTION	COUNTY	TOTAL SHEETS	SHEET NO.
F.A.I. - 70	82-3HVB-2	ST. CLAIR	252	169
FED. ROAD DIV. NO. 4		MARKING	PROJECT	

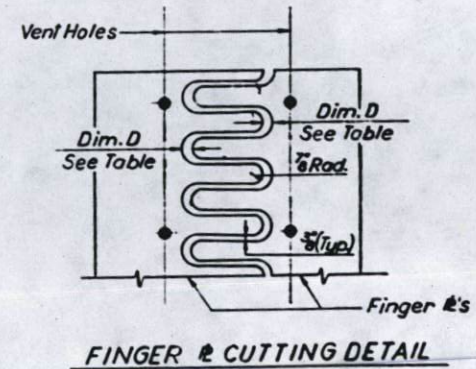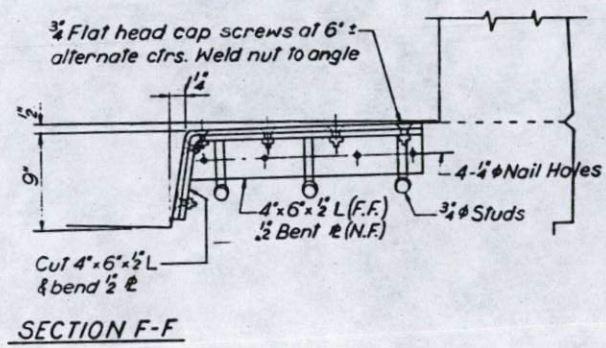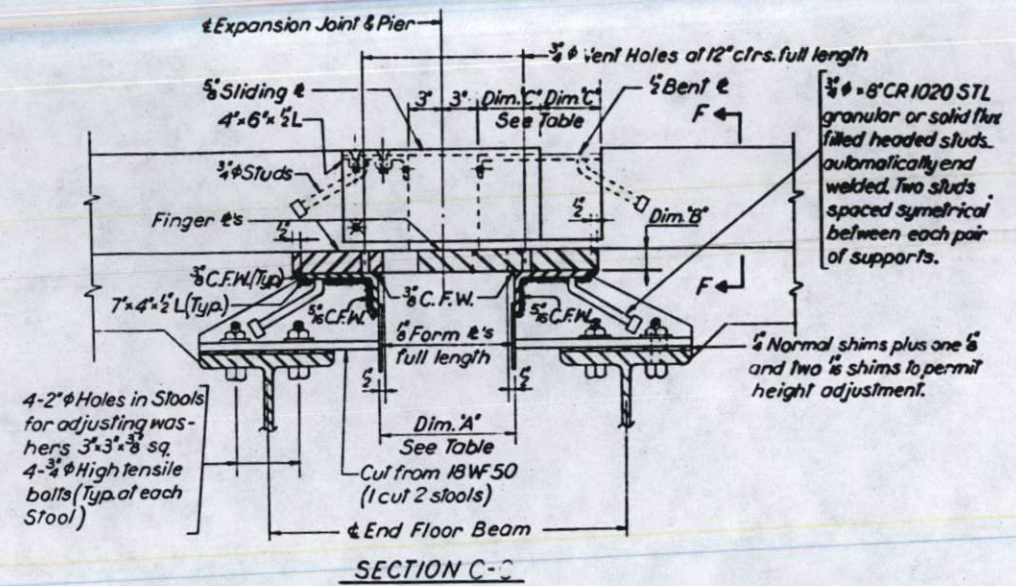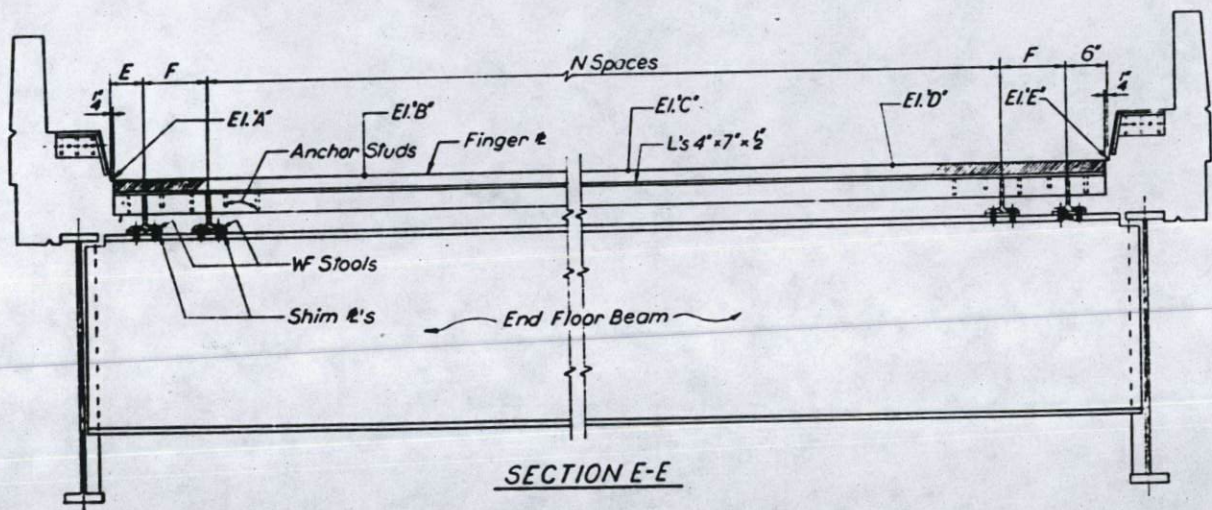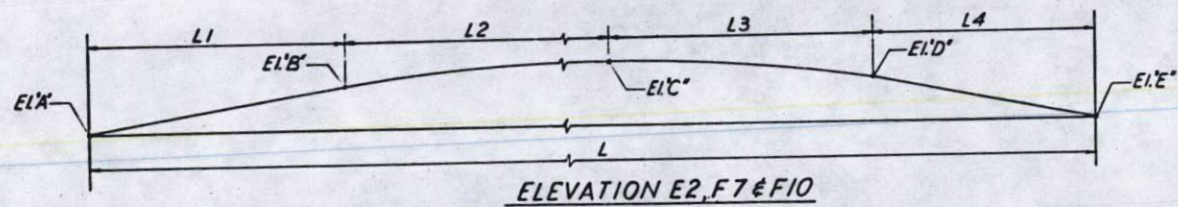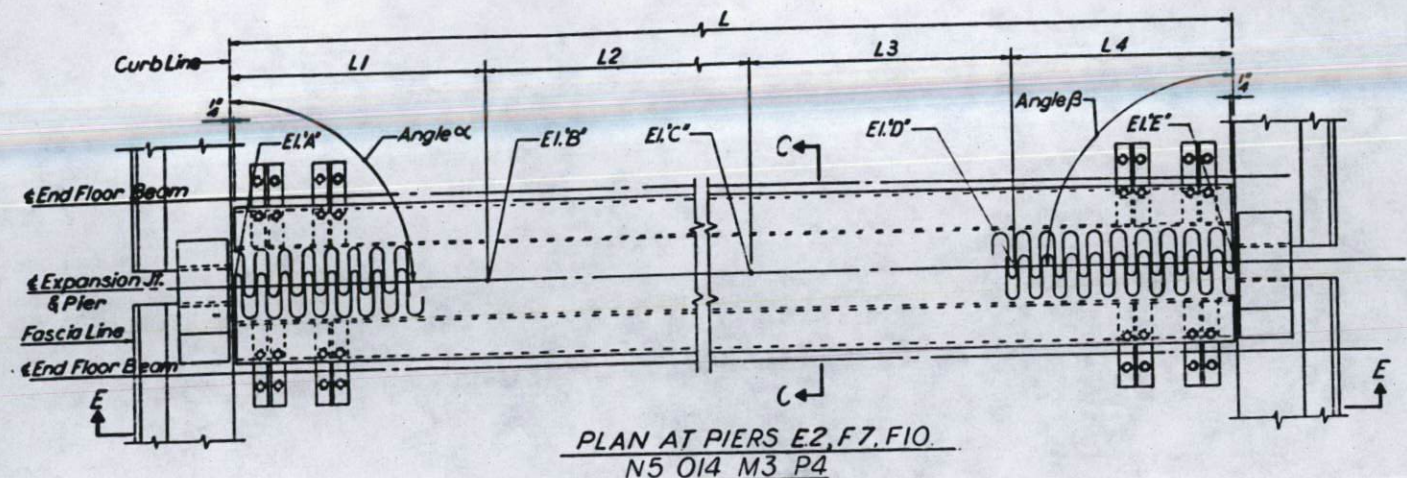

PIER NO.	Dimen. A' at 50°F	Dimen. B' Thickness at 50°F	Dimen. C' at 50°F	Dimen. D' at 50°F
E2	9 1/4"	1 5/8"	3"	2 1/2"
F7	9 1/4"	1 3/8"	3"	2 1/2"
F10	12 1/4"	1 3/8"	4"	3 1/2"
P1	9 3/8"	1 3/8"	3"	2 5/8"
N5	14 1/8"	2 1/4"	4 1/2"	4 1/8"
O14	12 1/4"	1 3/8"	4"	3 1/2"
M3	10"	1 3/8"	3"	2 3/4"
P4	9 1/4"	1 3/8"	3"	2 1/2"

ITEM	UNIT	TOTAL
*Structural Steel	L.S.	Lump Sum

Notes:
 Part of Expansion Device for piers N5, O14 & P4 is obtained from contractor for section 82-3HVF & E1
 Part of Expansion Device for pier M3 is obtained from contractor for section 82-3HB

PIER NO.	ANGLE alpha	ANGLE beta	ELEV. A	ELEV. B	ELEV. C	ELEV. D	ELEV. E	L1	L2	L3	L4	L	E	F	N SPACES	WEIGHT
E2	89°-28'-16"	89°-23'-16"	447.68	447.85	447.97	447.85	447.68	7-10 1/4	12-0	12-0	7-10 1/4	39-8 1/2	1-4 1/2	1-4	18 @ 2-0	7970
F7	90°-39'-55"	90°-39'-55"	446.85	446.94	447.07	446.94	446.85	4-4 1/8	12-0	12-0	4-4 1/8	32-8 1/4	1-10 1/4	1-10	14 @ 2-0	6590
F10	91°-08'-46"	91°-08'-46"	456.57	456.78	456.91	456.78	456.57	10-2 1/2	12-0	12-0	10-2 1/2	44-5	1-9	1-8	20 @ 2-0	10670

NOTE:
 Stool spacing to be adjusted to miss stiffener & connection plates on floor beams.

DESIGNED BY A.J.C.
 DRAWN BY H.B.
 CHECKED BY A.T.

STATE OF ILLINOIS
 DEPARTMENT OF PUBLIC WORKS & BLDGS.
 DIVISION OF HIGHWAYS
 EXPANSION DEVICES
 POPLAR STREET BRIDGE APPROACHES
 F.A.I. RT. - 70 ST. CLAIR CO. SECTION 82-3HVB-2
 H. W. LOCHNER, INC.
 ENGINEERS
 CHICAGO, ILLINOIS
 SHEET
 103 of 147

ROUTE NO.	SECTION	COUNTY	TOTAL SHEETS	SHEET NO.
F.A.I. - 70	82-3HVB-2	ST. CLAIR	252	170
FED. ROAD DIV. NO. 4	ILLINOIS	PROJECT		



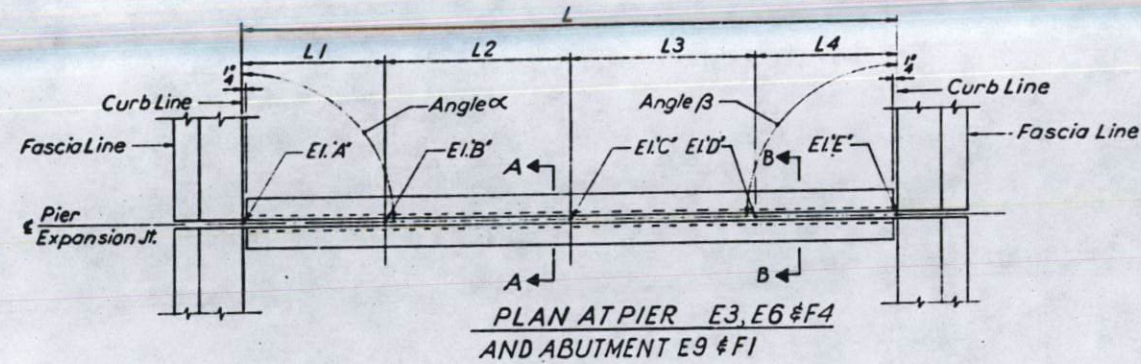


TABLE
FOR ELEVATIONS, LENGTHS, ANGLES & WEIGHTS

PIER NO.	ANGLE α	ANGLE β	ELEV. A'	ELEV. B'	ELEV. C'	ELEV. D'	ELEV. E'	L1	L2	L3	L4	L	WEIGHT
E3	89°-28'-16"	89°-28'-16"	446.27	446.42	446.54	446.42	446.27	7-0 $\frac{3}{8}$	12-0	12-0	7-0 $\frac{3}{8}$	38-1 $\frac{1}{4}$	1050
E6	89°-28'-16"	89°-28'-16"	438.93	439.02	439.15	439.02	438.93	4-8	12-0	12-0	4-8	33-4	920
E9*	89°-49'-18"	89°-49'-18"	432.06	432.13	432.26	432.13	432.06	3-1 $\frac{1}{8}$	12-0	12-0	3-1 $\frac{1}{8}$	30-3 $\frac{3}{4}$	840
F1*	90°-00'-00"	90°-00'-00"	431.92	431.98	432.11	431.98	431.92	3-0	12-0	12-0	3-0	30-0	830
F4	90°-00'-00"	90°-00'-00"	439.41	439.47	439.60	439.47	439.41	3-0	12-0	12-0	3-0	30-0	830

* Abutment

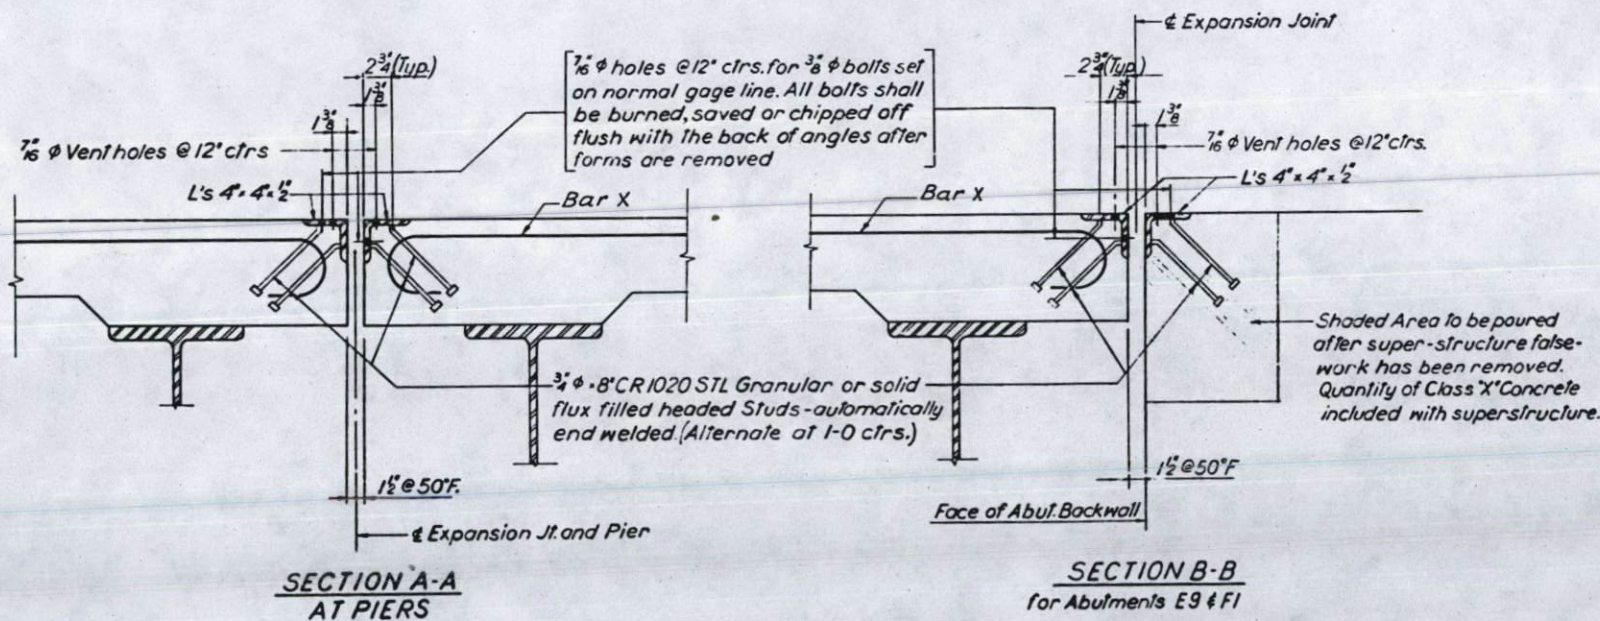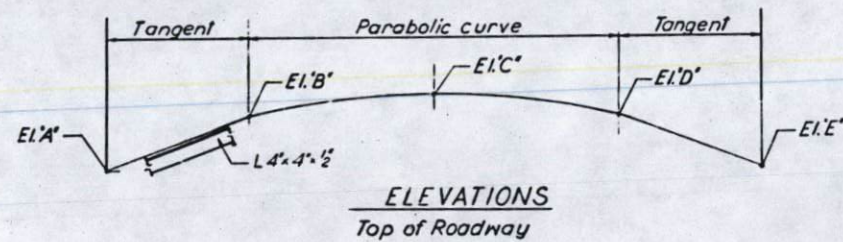

BILL OF MATERIAL

ITEM	UNIT	TOTAL
*Structural Steel	L. S.	Lump Sum

DESIGNED BY A.T.C.
DRAWN BY H.B.
CHECKED BY A.T.

STATE OF ILLINOIS
DEPARTMENT OF PUBLIC WORKS & BLDGS.
DIVISION OF HIGHWAYS

EXPANSION DEVICES

POPLAR STREET BRIDGE APPROACHES


F.A.I. RT. 70 ST. CLAIR CO SECTION 82-3HVB-2

H. W. LOCHNER, INC.
ENGINEERS
CHICAGO, ILLINOIS


SHEET
104 of 147

STATE OF ILLINOIS
DEPARTMENT OF PUBLIC WORKS & BUILDINGS
DIVISION OF HIGHWAYS


PROJECT NO.	82-3448-2	SECTION	ST. CLAIR 252	DATE	1652	SHEET NO.	992
DATE	1-1-70	BY	S.M.	DATE		TOTAL SHEETS	197

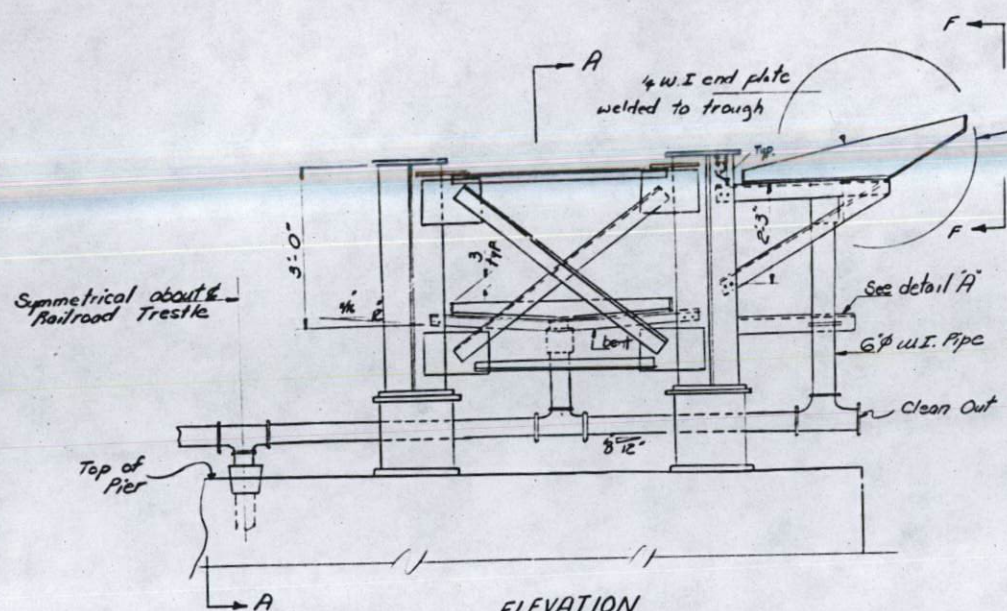

ELEVATION

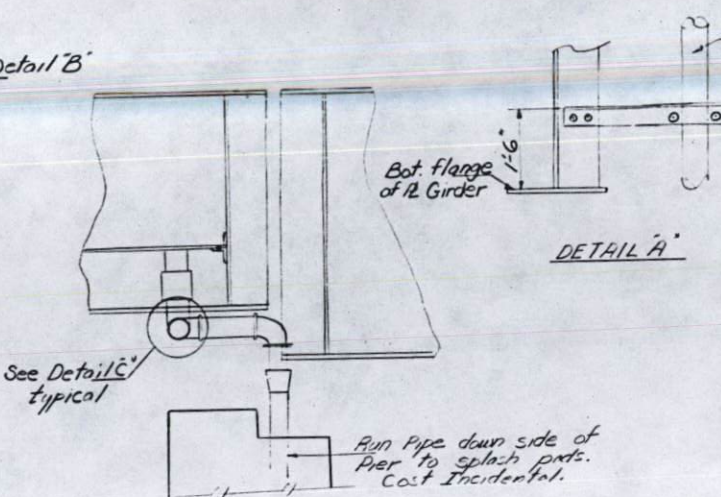

SECTION A-A

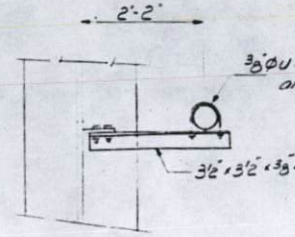


SECTION D-D


Notes:
All Wrought Iron Pipe shall be standard weight, fittings shall be either screw joint or welded joint (See Special Provisions)
The Contractor shall verify all dimensions and conditions existing in the field before ordering materials for protection plate pipe drain system
Protection plate shall extend between each pier adjacent to roadways E and F.
Protection plates shall be billed as Furnishing and Erecting Structural Steel.

BILL OF MATERIALS

Wrought Iron Pipe Drain System	L.S.
Furnishing & Erecting Struct. Steel	33620 lbs

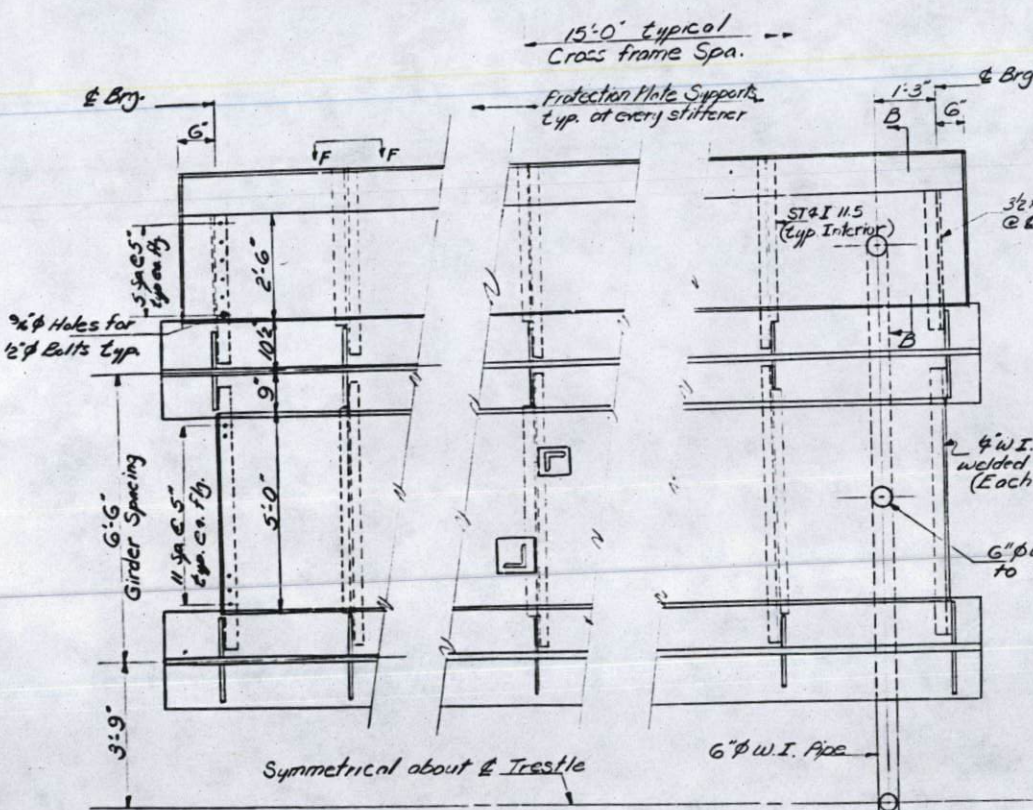


TYPICAL PLAN FOR PROTECTION PLATE
(NO SCALE)

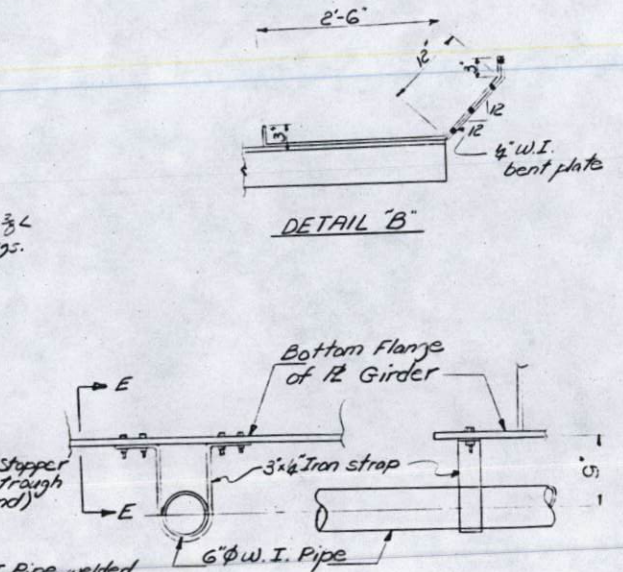


DETAIL C


SECTION E-E

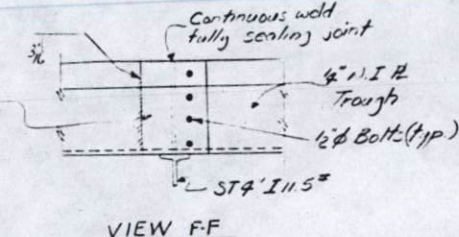


VIEW F-F

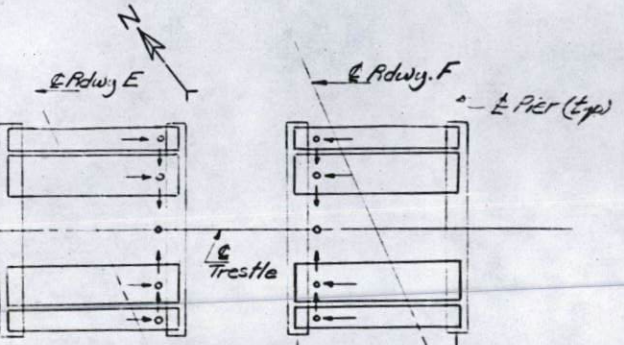


LOCATION PLAN

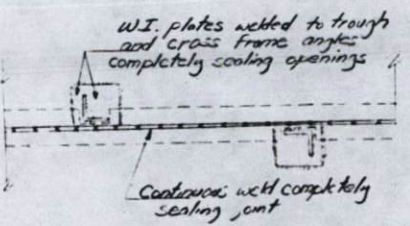

JOINT AT CROSS FRAMES

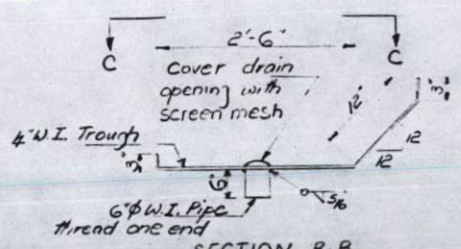

SECTION B-B

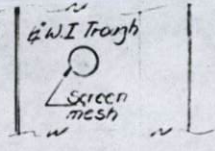


PLAN C-C

PROTECTION PLATE DETAILS
AND PIPE DRAIN SYSTEM
EAT AT 70 ~ SEC. 82-3448-2
ST. CLAIR COUNTY


DESIGNED	19
CHECKED	EXAMINED
DRAWN S.M.	PASSED
CHECKED J.M.J.	APPROVED

Added 6-11-70 S.F.M.

ROUTE NO.	SECTION	COUNTY	TOTAL SHEETS	SHEET NO.
F.A.I. - 70	82-3HVB-2	ST. CLAIR	252	166
FED. ROAD DIV. NO. 4		ILLINOIS	PROJECT	

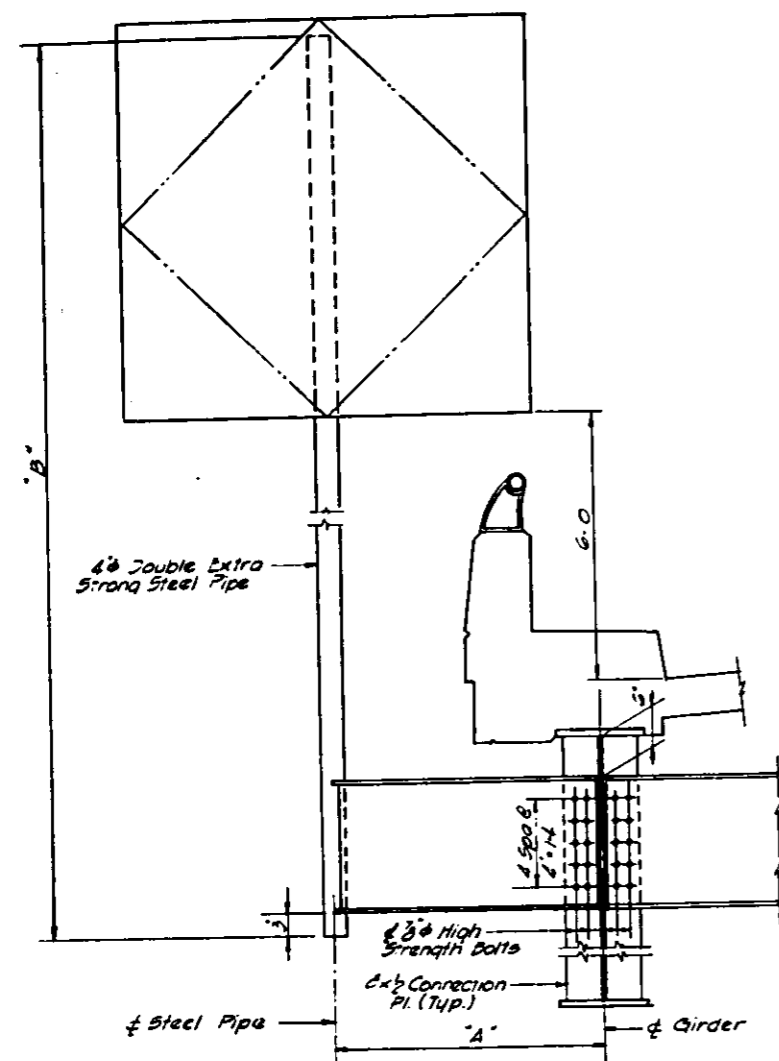

SECTION A-A

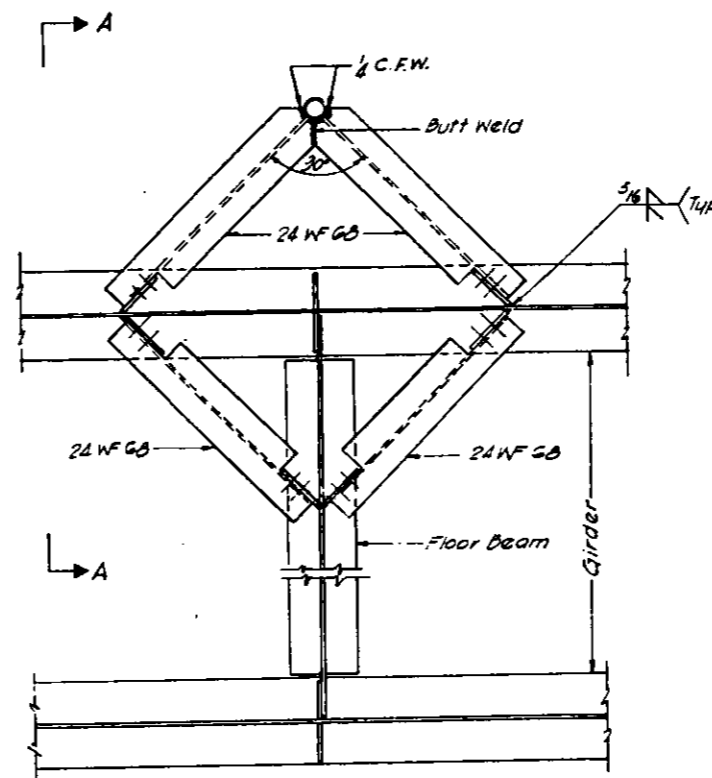

PLAN

NOTE
 8x8 Connection Pls. to be fit to
 Compression flange and undercut
 3/8\"/>

SIGN BRACKET DETAIL
 NO. 29 THRU 34


Table A-1: Sign
 Bracket Dimensions

Sign Bracket	'A'	'B'	For Location See Sheet No
No. 29	3-0	14-8	80
No. 30	3-10	15-4	84
No. 31	3-10	15-4	88
No. 32	3-0	14-8	92
No. 33	3-0	14-8	92
No. 34	3-0	14-8	75


DESIGNED BY A.T.
 DRAWN BY ST
 CHECKED BY RT

STATE OF ILLINOIS
 DEPARTMENT OF PUBLIC WORKS & BLDGS.
 DIVISION OF HIGHWAYS
 SIGN BRACKET DETAILS
 POPLAR STREET BRIDGE APPROACHES
 F.A.I. RT. 70. ST. CLAIR CO. SECTION 82-3HVB-2
 H. W. LOCKNER, INC.
 ENGINEERS
 CHICAGO, ILLINOIS
 SHEET
 100 of 147


ROUTE NO.	SECTION	COUNTY	TOTAL SHEETS	SHEET NO.
F.A.L. - 70	02-34VB-2	ST. CLAIR	252	167
FED. ROAD DIST. NO. 4	ILLINOIS	PROJECT		

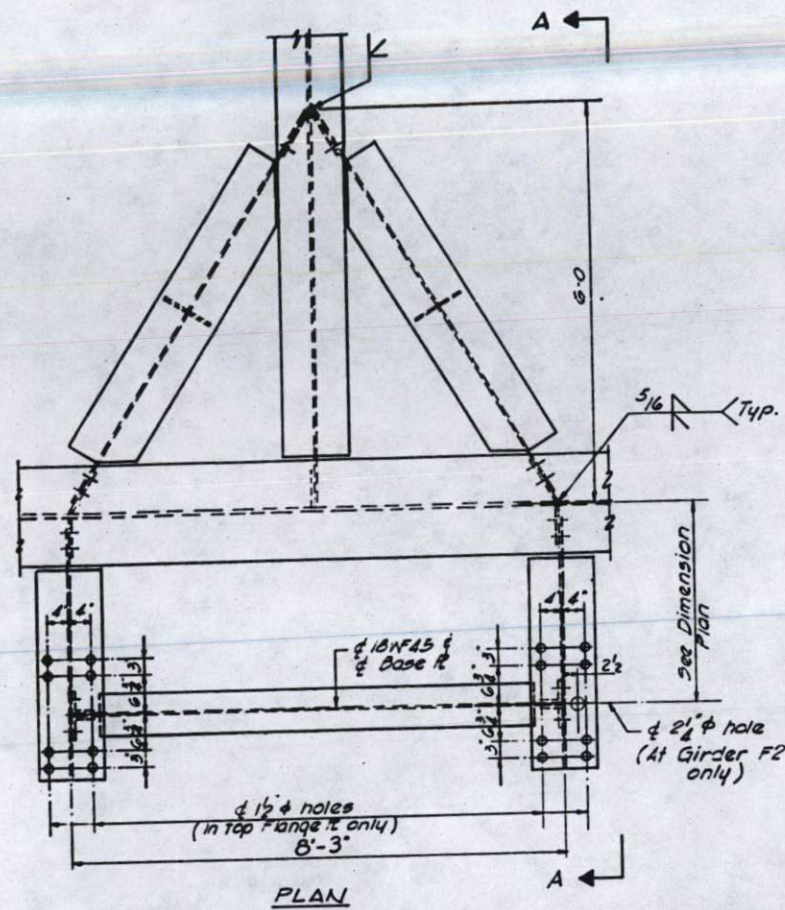


PLAN

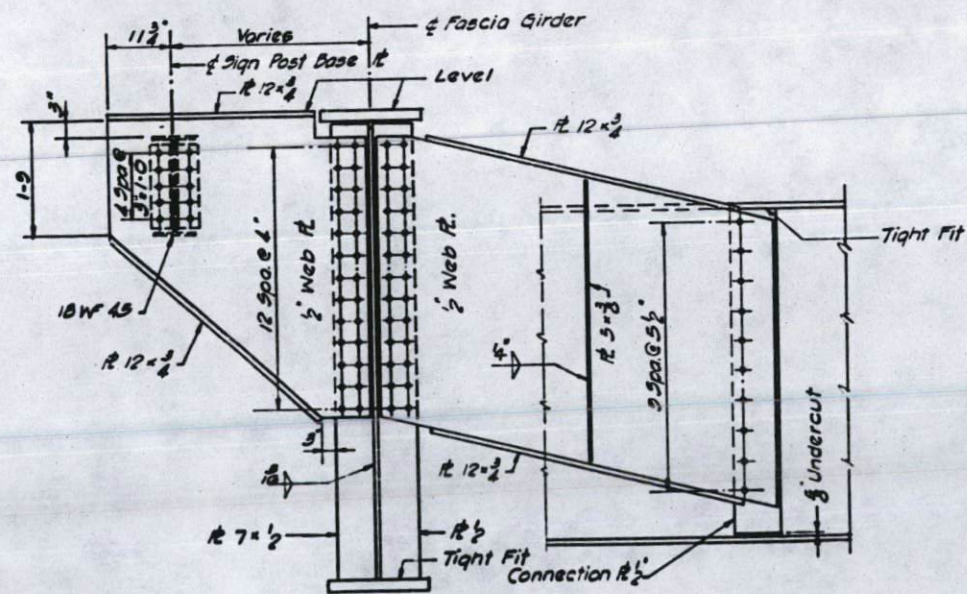

SECTION A-A

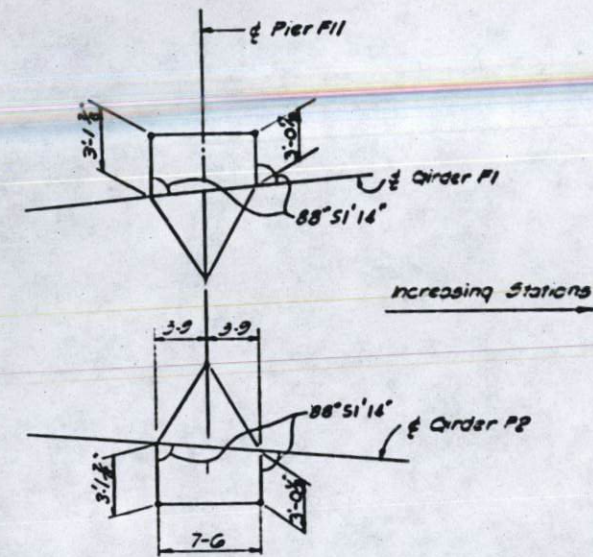

DIMENSION PLAN
TRUSS SIGN SUPPORT
BRACKET NO. 11

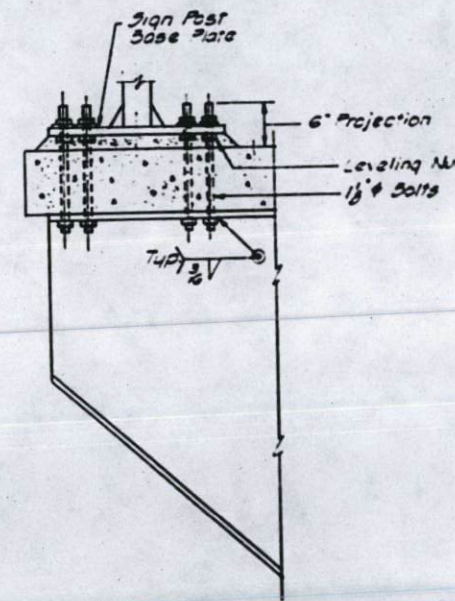

DETAIL OF SIGN
POST BASE PLATE

NOTES:
For location of Truss Sign Support Brackets see Sheet 166. Weight of Truss Sign Support Bracket is included with quantity for Structural Steel.





DESIGNED BY AZ
DRAWN BY VP
CHECKED BY AZ

STATE OF ILLINOIS
DEPARTMENT OF PUBLIC WORKS & EDGS.
DIVISION OF HIGHWAYS

TRUSS SIGN SUPPORT BRACKET
POPLAR STREET BRIDGE APPROACHES

F.A.L. RT. 70 ST. CLAIR CO. SECTION 02-34VB-2 SHEET
R. W. LOCHNER, INC.
ENGINEERS
CHICAGO, ILLINOIS 1 of 147

ROUTE NO.	SECTION	COUNTY	TOTAL SHEETS	SHEET NO.
F.A.1 - 70	82-3HVB-2	ST CLAIR	252	171
FED. ROAD DIV. NO. 4		ILLINOIS	PROJECT	

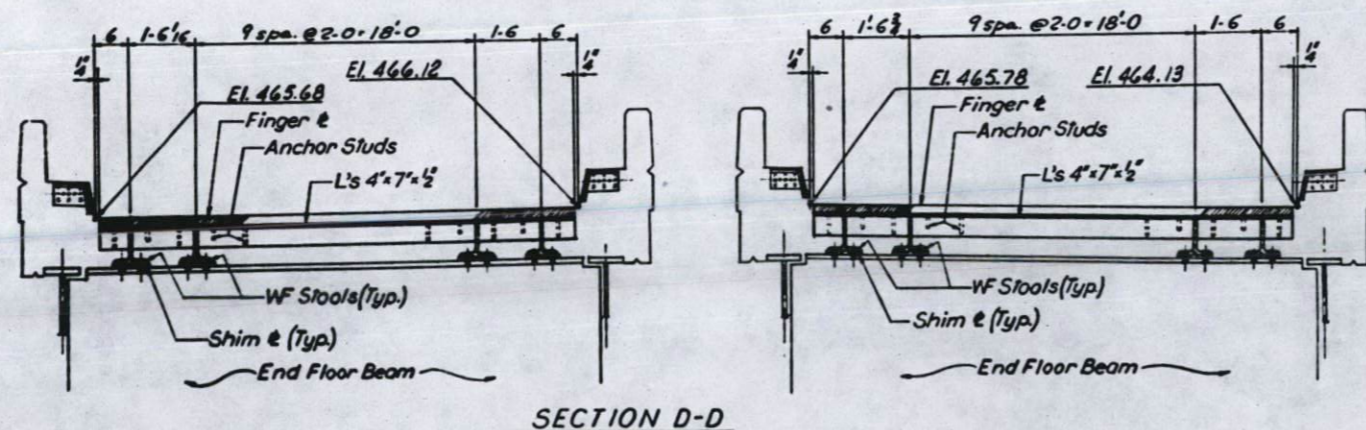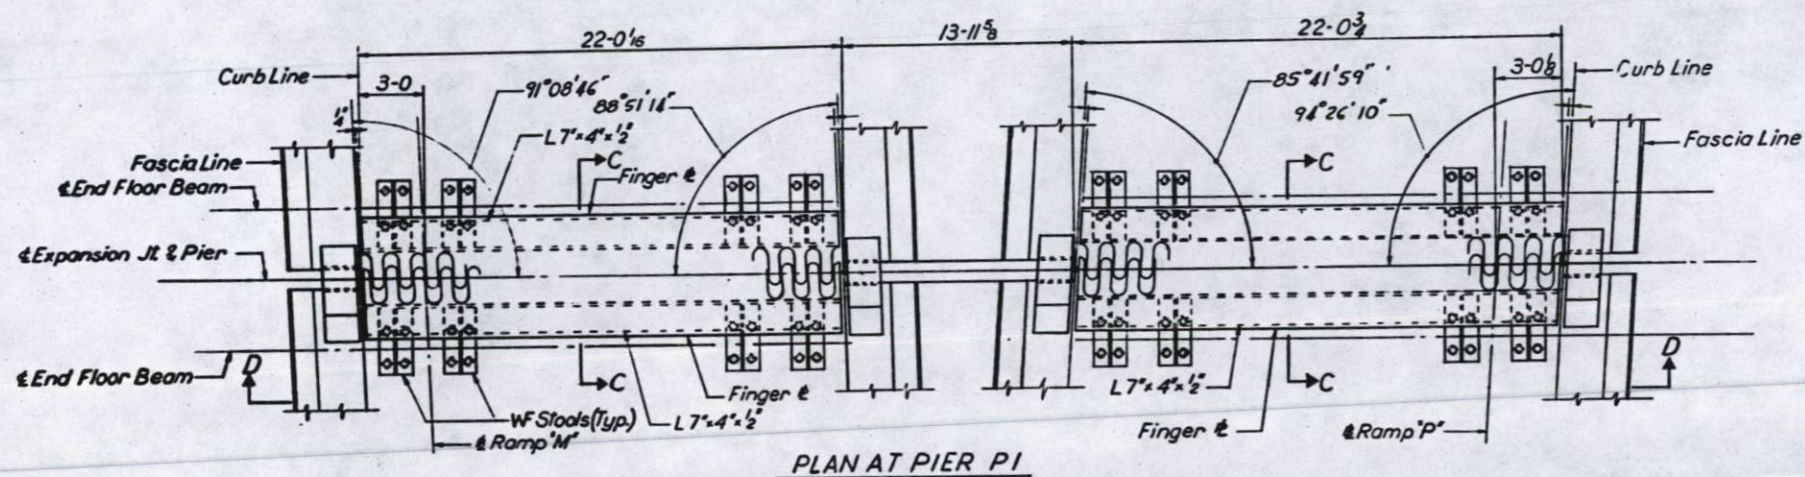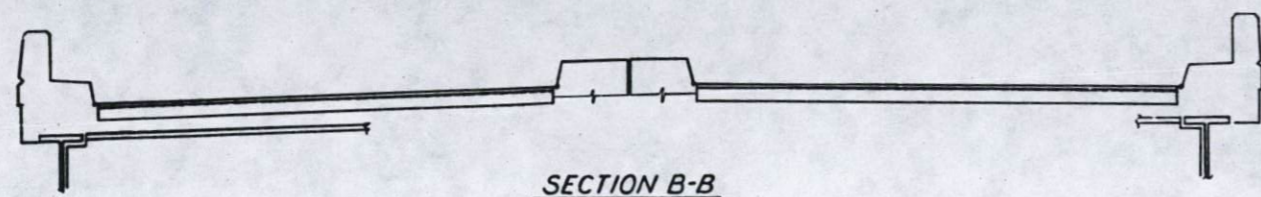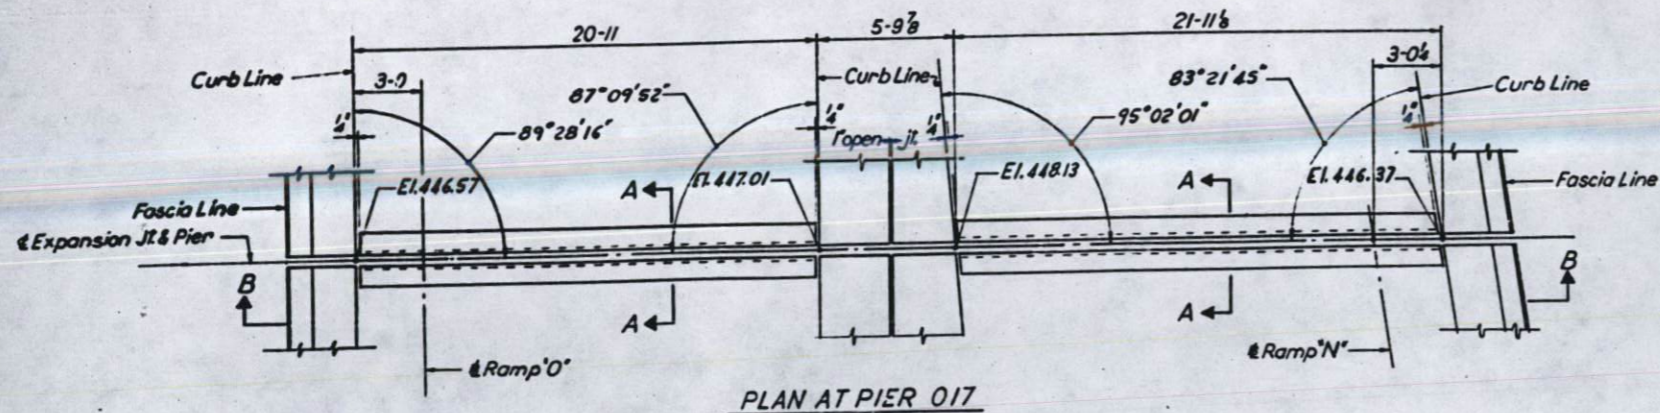

Notes
 For Section A-A see Sh. 104
 For Section C-C see Sh. 103









BILL OF MATERIAL		
ITEM	UNIT	TOTAL
*Structural Steel	L.S.	Lump Sum

STATE OF ILLINOIS
 DEPARTMENT OF PUBLIC WORKS & BLDGS.
 DIVISION OF HIGHWAYS
 EXPANSION DEVICES
 POPLAR STREET BRIDGE APPROACHES
 F.A.I. RT.-70 ST. CLAIR CO. SECTION 82-3HVB-2
 H. W. LOCHNER, INC.
 ENGINEERS
 CHICAGO, ILLINOIS

DESIGNED BY: A.Z.C.
 DRAWN BY: E.C.
 CHECKED BY: R.T.

SHEET
 105 of 147

ROUTE NO.	SECTION	COUNTY	TOTAL SHEETS	SHEET NO.
F.A.I.-70	82-3HVB-2	ST. CLAIR	252	178
FED. ROAD DIV. NO. 4 ILLINOIS PROJECT				

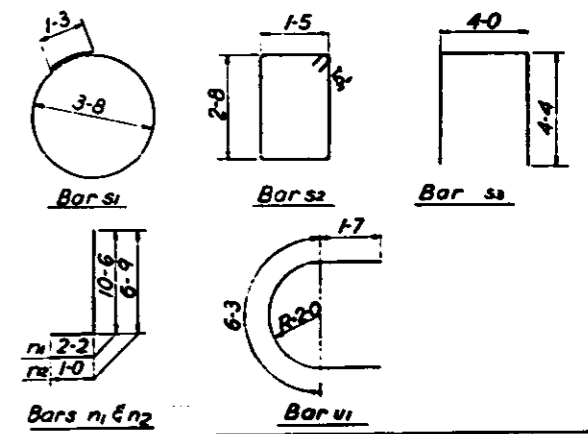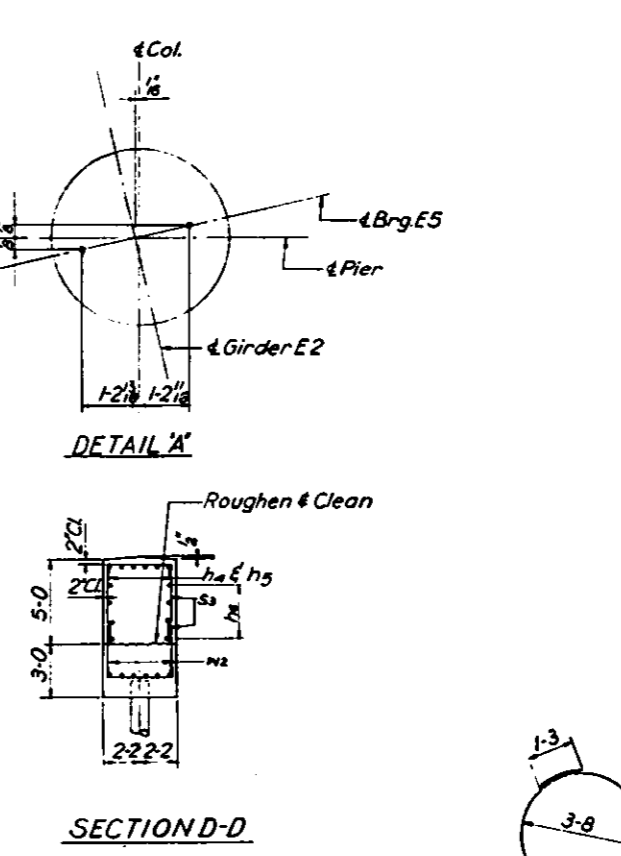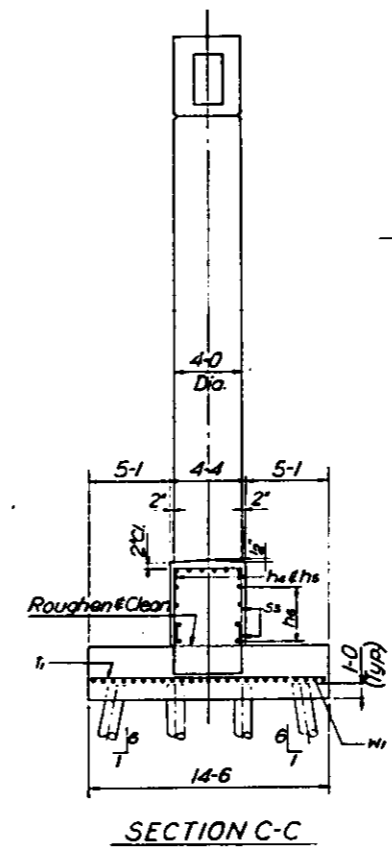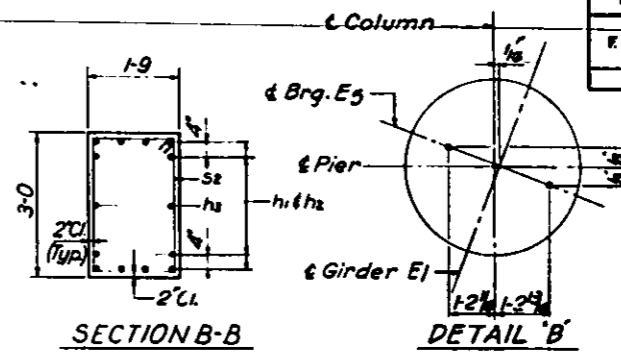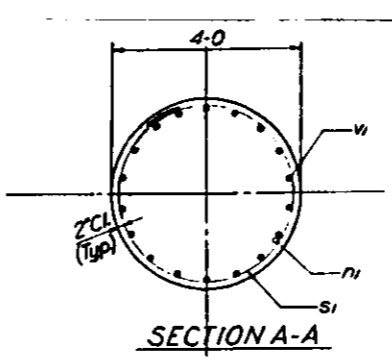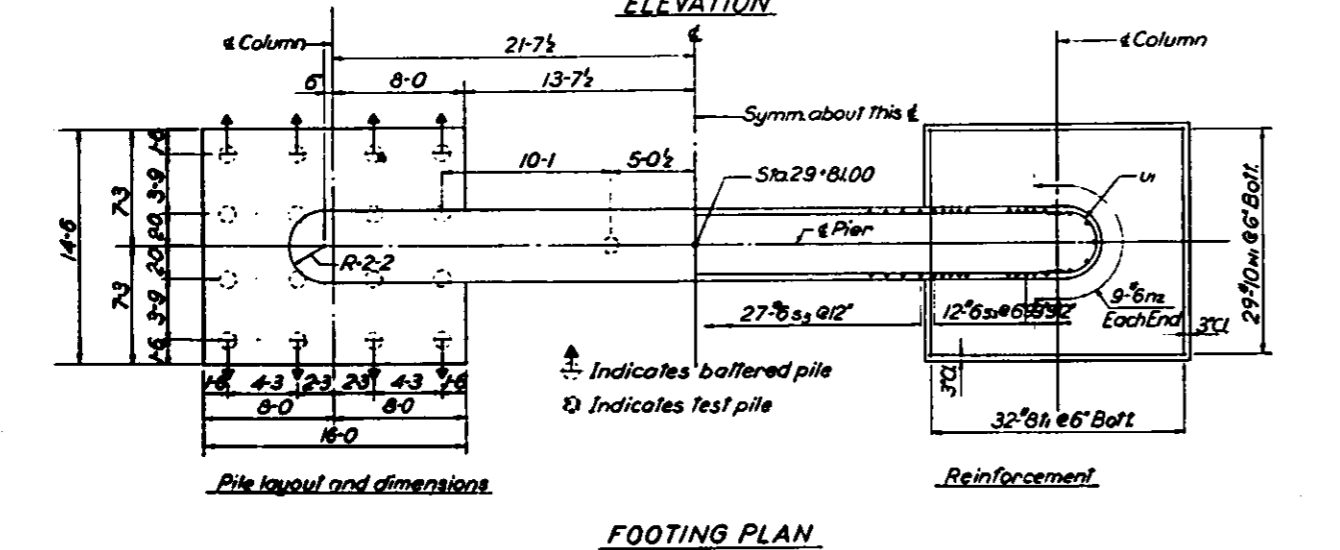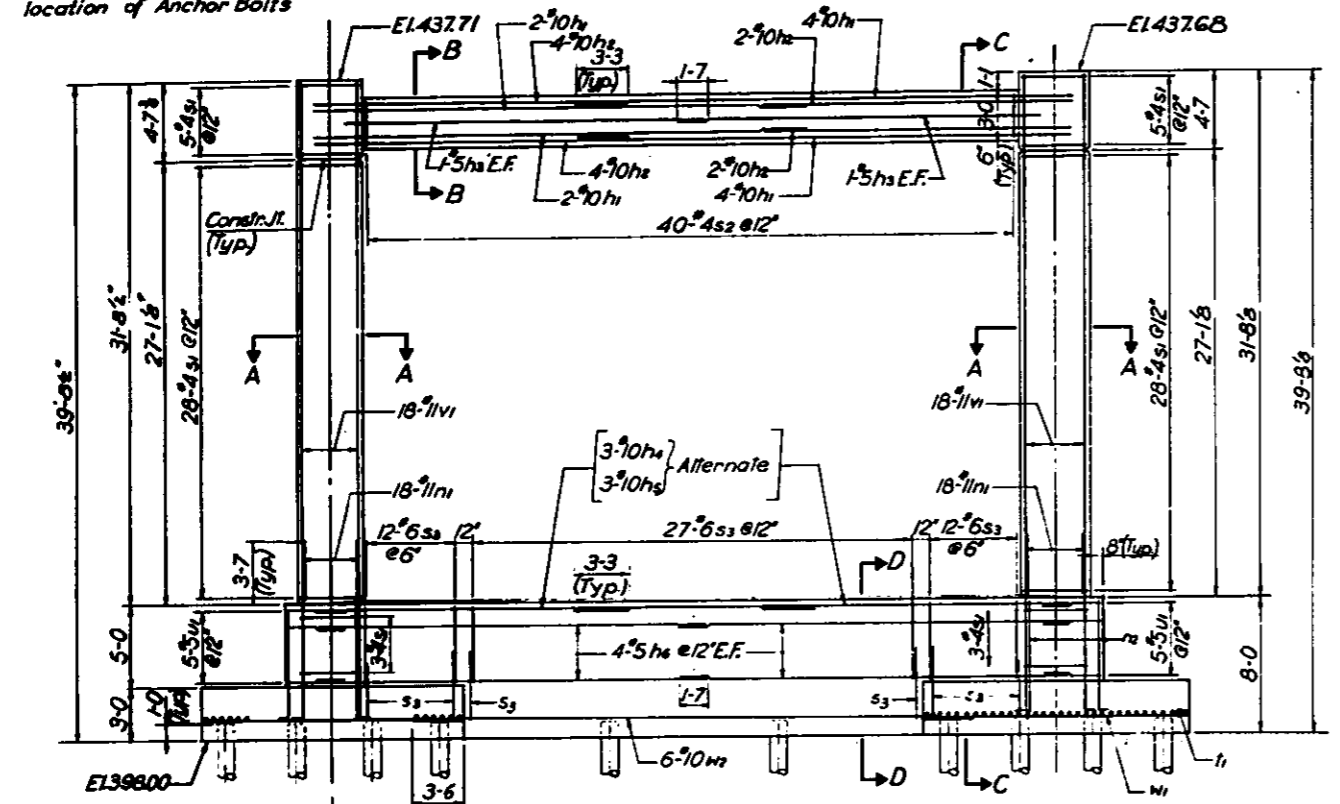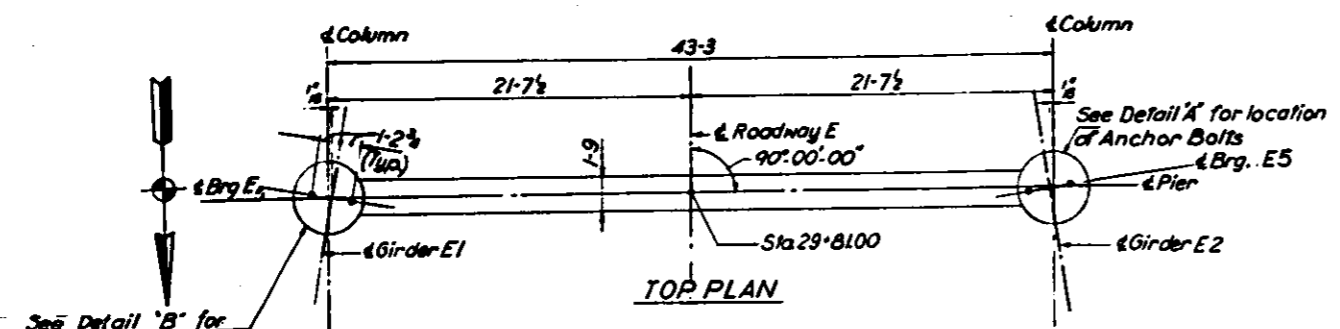

BILL OF MATERIAL				
Mark	Nb	Size	Length	Shape
112 h1	12	10	30-0	—
112 h2	12	10	19-0	—
112 h3	4	5	21-8	—
112 h4	6	10	29-6	—
112 h5	6	10	18-0	—
112 h6	16	5	22-4	—
112 n1	36	11	12-8	—
112 n2	18	6	7-9	—
112 s1	72	3	12-9	○
112 s2	40	3	9-0	□
112 s3	102	5	12-8	□
112 v1	64	3	14-0	—
112 v2	10	5	9-5	—
112 v3	36	11	31-6	—
112 w1	58	10	15-6	—
112 w2	6	10	34-3	—
*See Note 'X' Sheet No. 14				
Item	Unit	Total		
Class 'X' Concrete	CY	139.1		
Reinforcement Bars	Lbs	22,920		
Concrete Piles	LF	1155		
Test Pile	Ea.	1		

PILE DATA
 Type: Concrete
 Required Capacity: 31 Tons
 Est. Length: 35-0
 No. Required: 33
 Test Pile: 1
 *Does not include test pile.

STATE OF ILLINOIS
 DEPARTMENT OF PUBLIC WORKS & BLDGS.
 DIVISION OF HIGHWAYS
PIER E1
 POPLAR STREET BRIDGE APPROACHES
 ROADWAY "E"
 F.A.I. RT. 70 ST. CLAIR CO. SECTION 82-3HVB-2
 H. W. LOCKNER, INC.
 ENGINEERS
 CHICAGO, ILLINOIS
 SHEET
 178 OF 177








DESIGNED BY: E.W.
 DRAWN BY: H.B.
 CHECKED BY: E.L.

ROUTE NO.	SECTION	COUNTY	TOTAL SHEETS	SHEET NO.
F.A.R.-70	82-3HVB-2	ST. CLAIR	252	180
FED. ROAD DIV. NO. 4		ILLINOIS	PROJECT	



BILL OF MATERIAL				
Mark	No.	Size	Length	Shape
114h1	7	#10	20-0	—
114h2	7	#10	16-4	—
114h3	84	#5	21-6	—
114h4	22	#7	5-5	—
114s1	24	#4	12-9	○
114s2	37	#6	6-0	—
114s3	37	#7	12-4	—
114t1	72	#7	10-8	—
114u1	44	#5	9-5	—
114v1	40	#9	11-3	—
114v2	40	#9	8-8	—
114v3	96	#7	21-3	—
114w1	20	#6	24-8	—
114w2	6	#4	24-4	—

*See Note X Sheet No. 14

Item	Unit	Total
Class X Concrete	CY	221.3
Reinforcement Bars	Lbs.	14750
Concrete Piles	L.F.	1155
Test Pile	Ea.	1

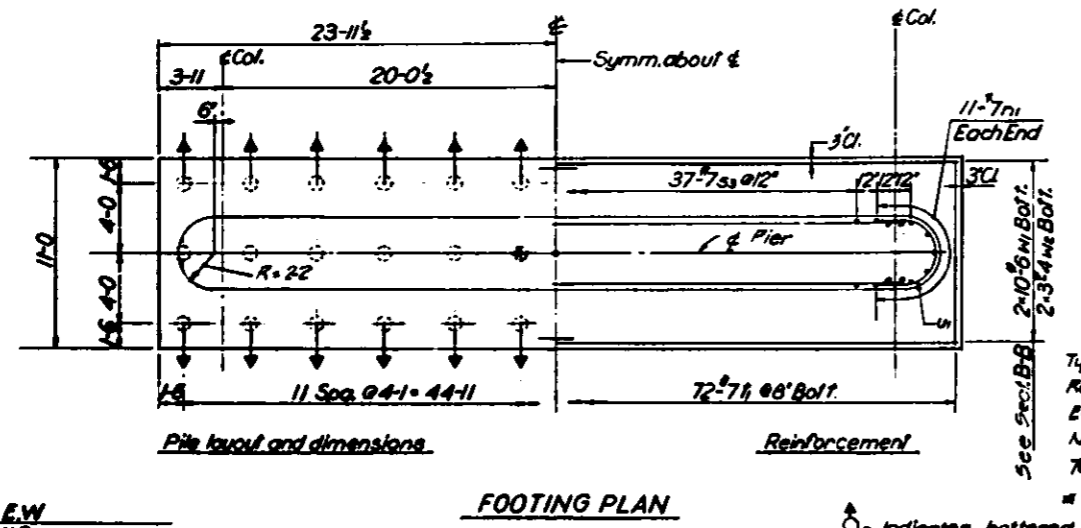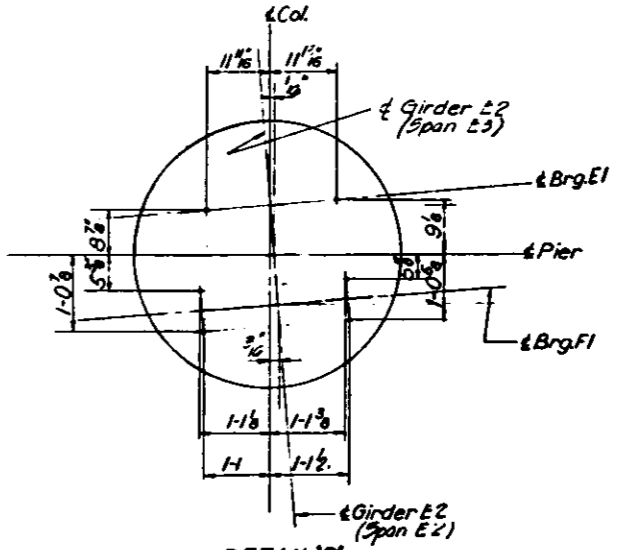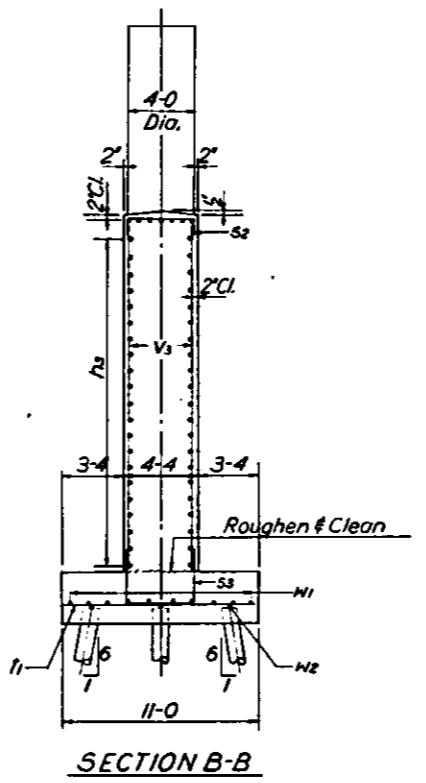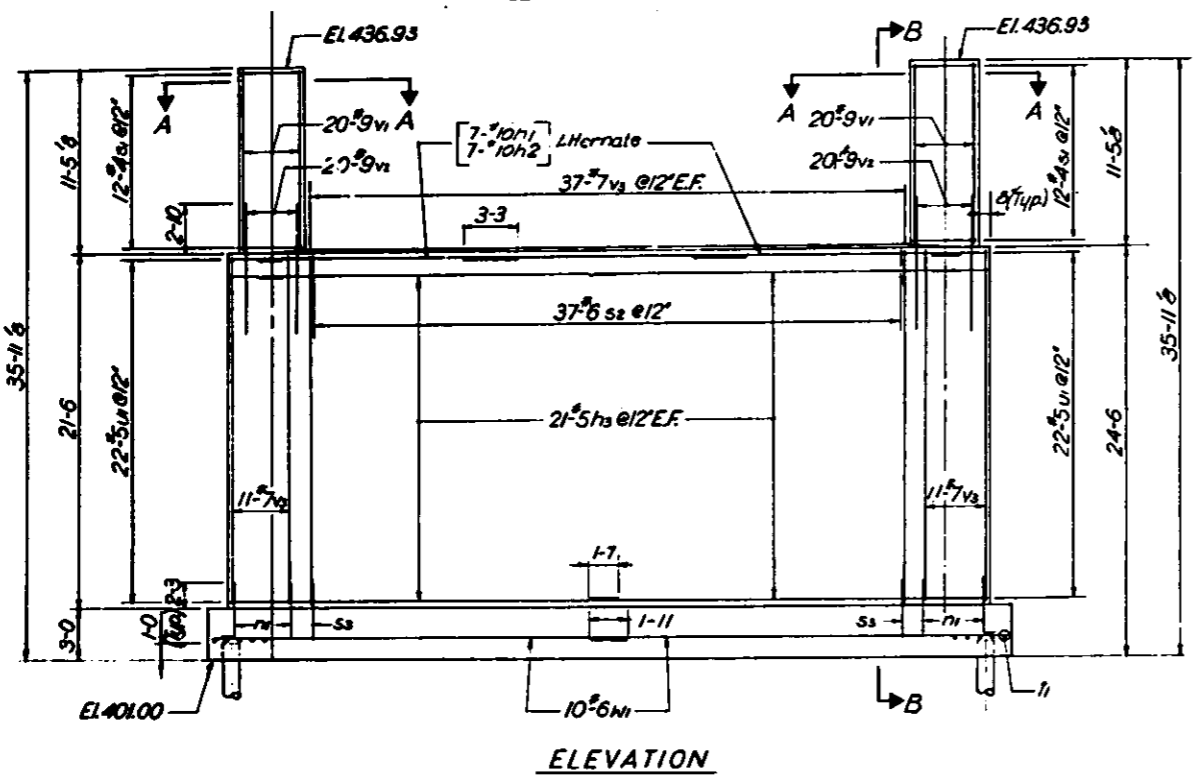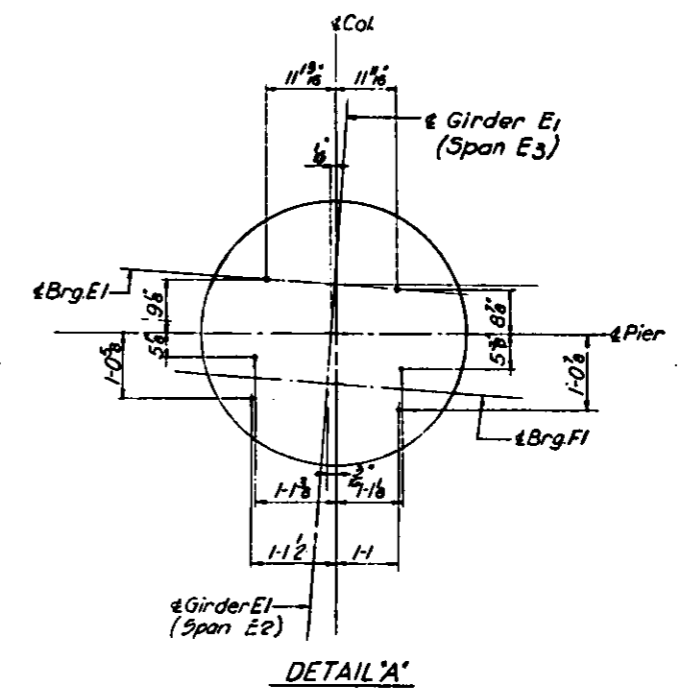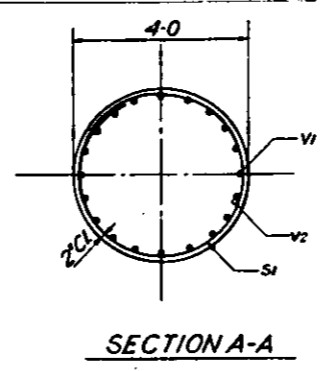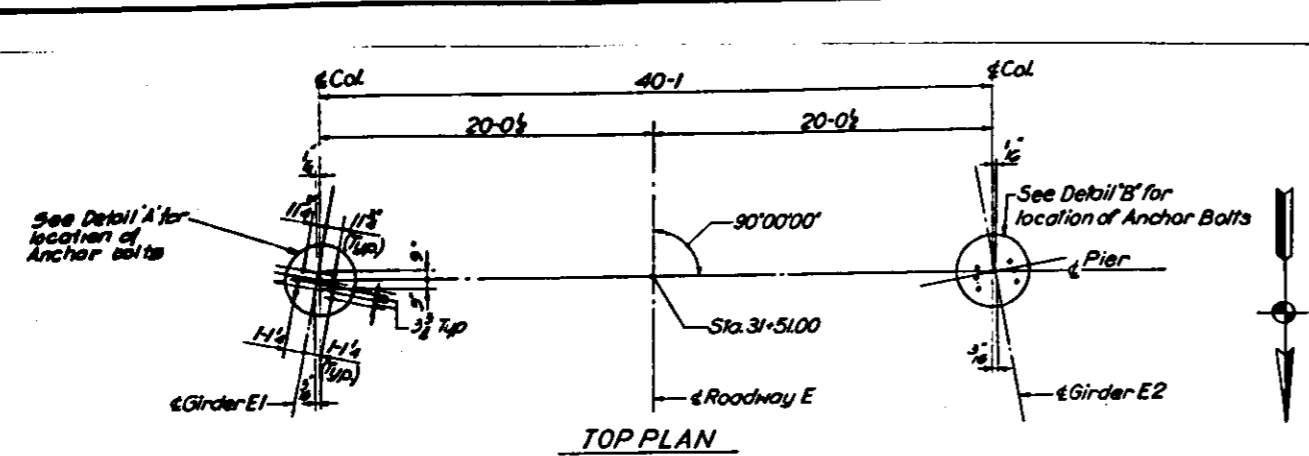

PILE DATA
 Type: Concrete
 Required Capacity: 34 Tons
 Est Length: 33-0
 No. Required: 35
 Test Pile: 1
 * Does not include Test Pile.

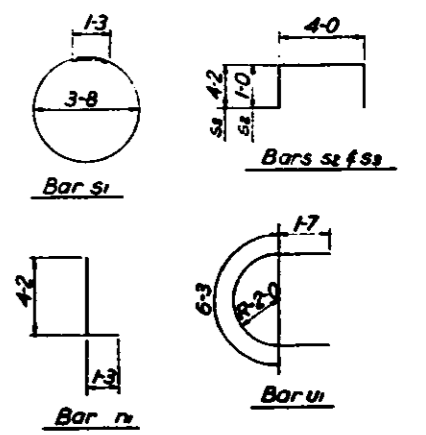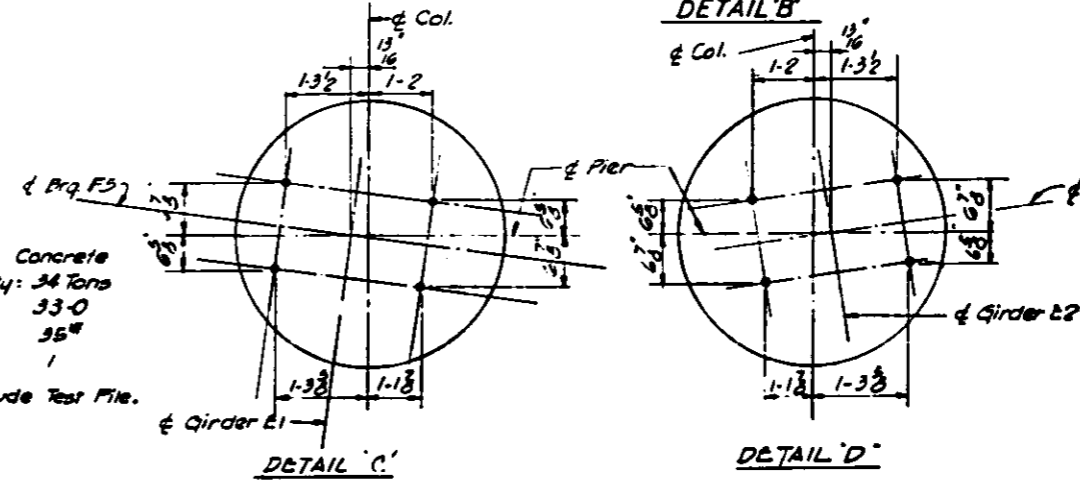


STATE OF ILLINOIS
 DEPARTMENT OF PUBLIC WORKS & BLDGS.
 DIVISION OF HIGHWAYS
PIER E3
 POPLAR STREET BRIDGE APPROACHES
 ROADWAY "E"
 F.A.R. RT. 70 ST. CLAIR CO. SECTION 82-3HVB-2
 H. W. LOCHNER, INC.
 ENGINEERS
 CHICAGO, ILLINOIS
 SHEET 114 of 147


DESIGNED BY: E.W.
 DRAWN BY: H.A.
 CHECKED BY: E.L.

○ - Indicates battered pile
 ● - Indicates Test Pile


ROUTE NO.	SECTION	COUNTY	TOTAL SHEETS	SHEET NO.
F. A. I. - 70	82-3HVB-2	ST. CLAIR	252	121
FED. ROAD DIV. NO. 4		ILLINOIS PROJECT		

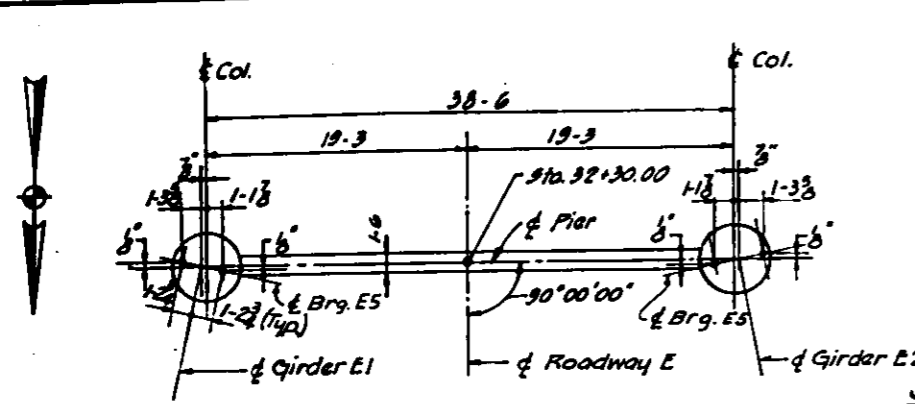

TOP PLAN - PIER E4

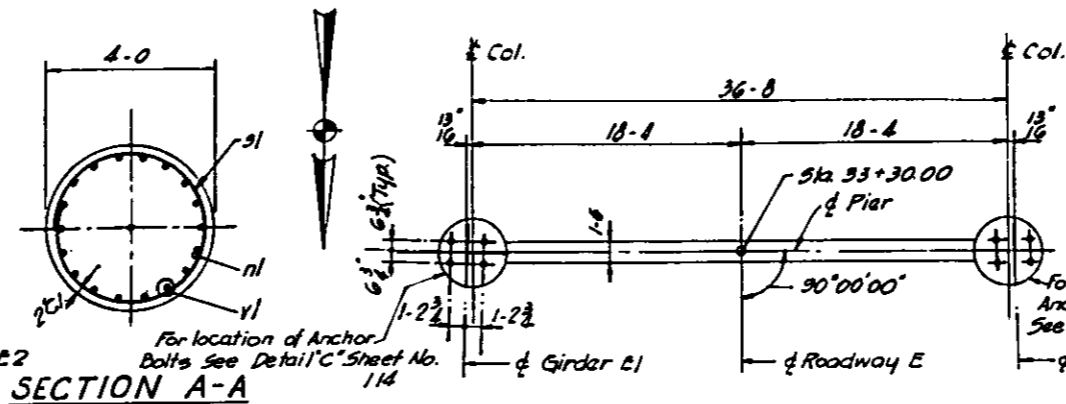


TOP PLAN - PIER E5

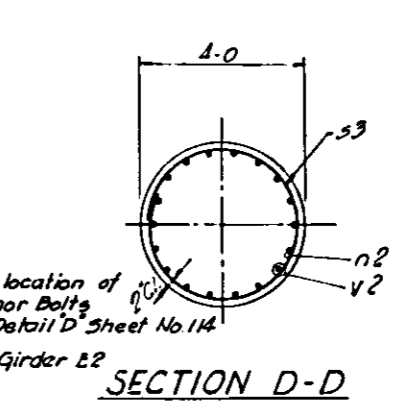


SECTION D-D


SECTION A-A

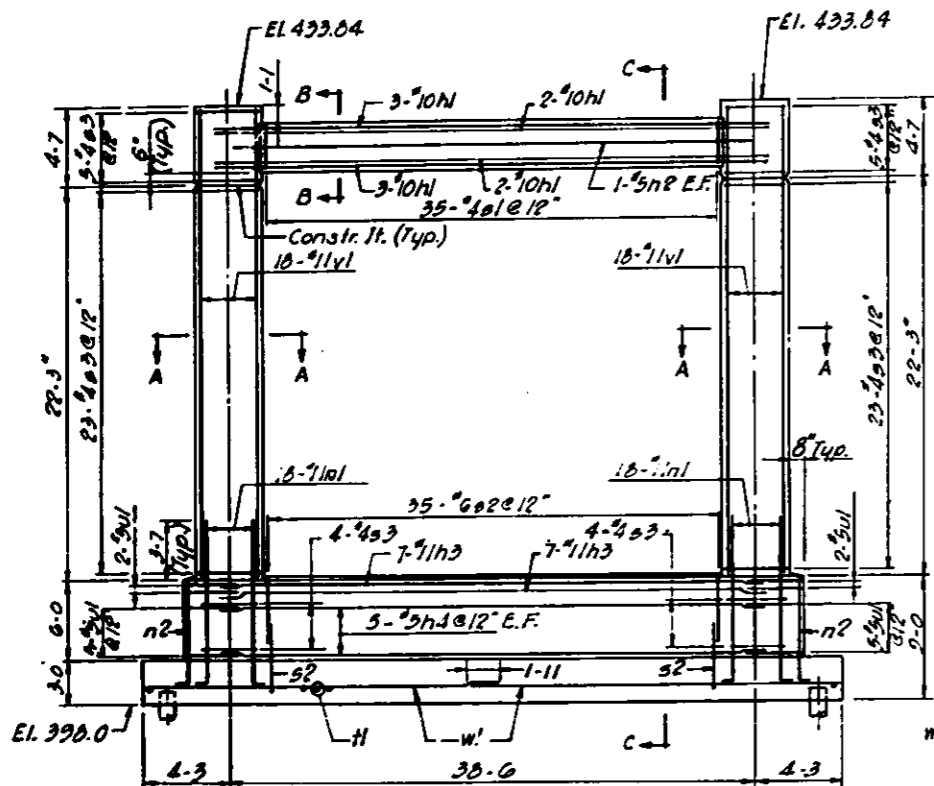

ELEVATION - PIER E4

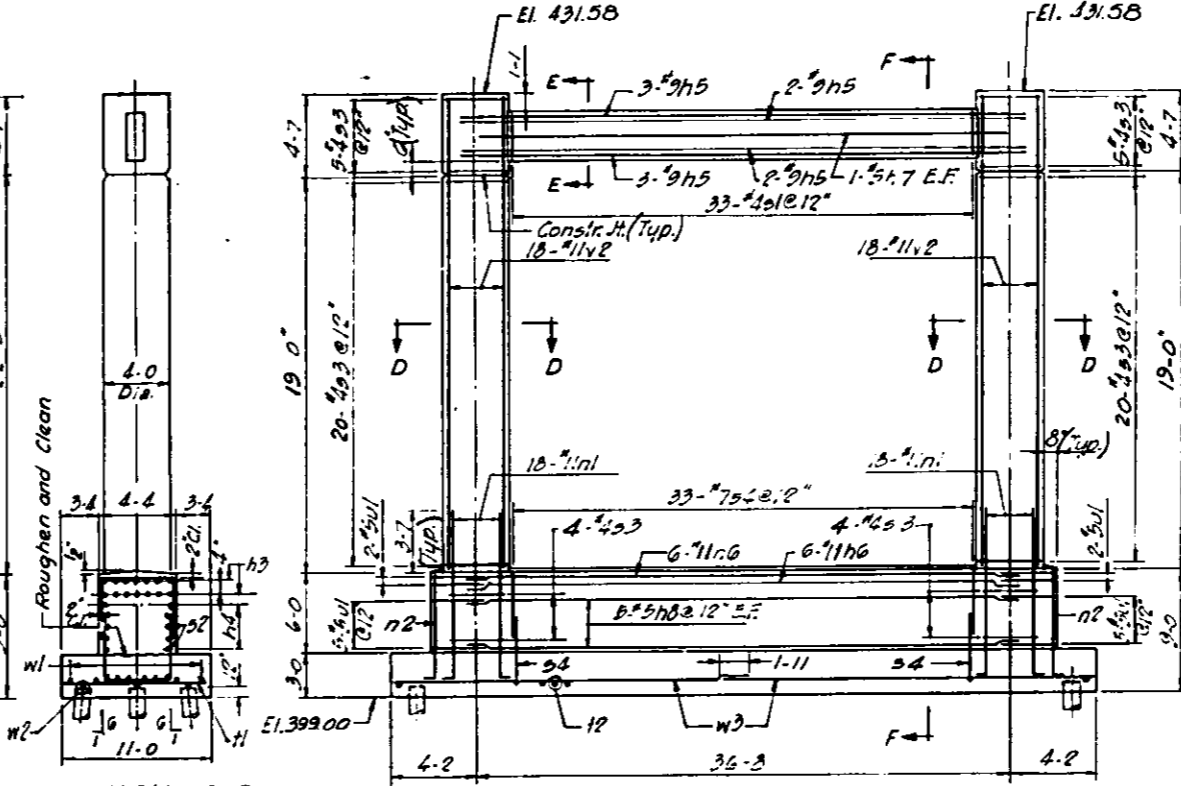


ELEVATION - PIER E5

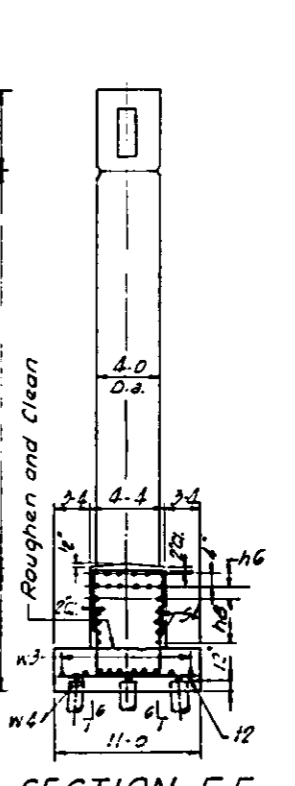


SECTION F-F


SECTION C-C

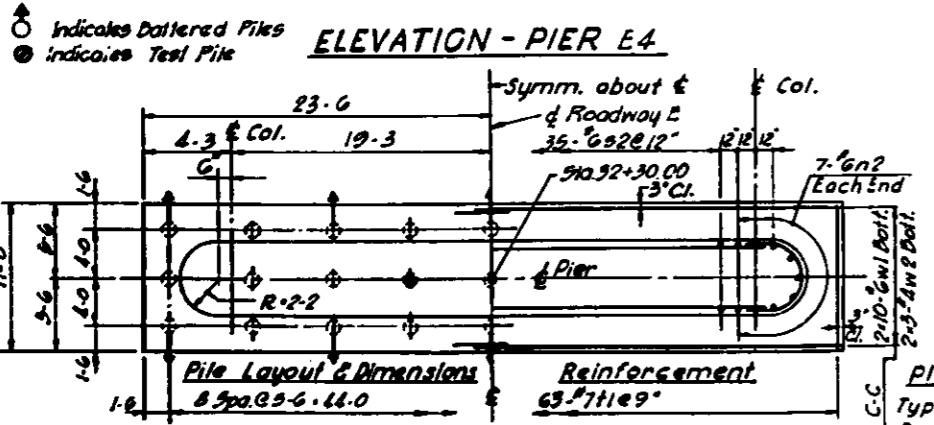


FOOTING PLAN - PIER E4

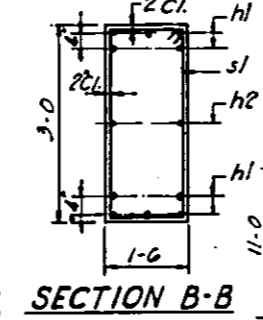

SECTION B-B

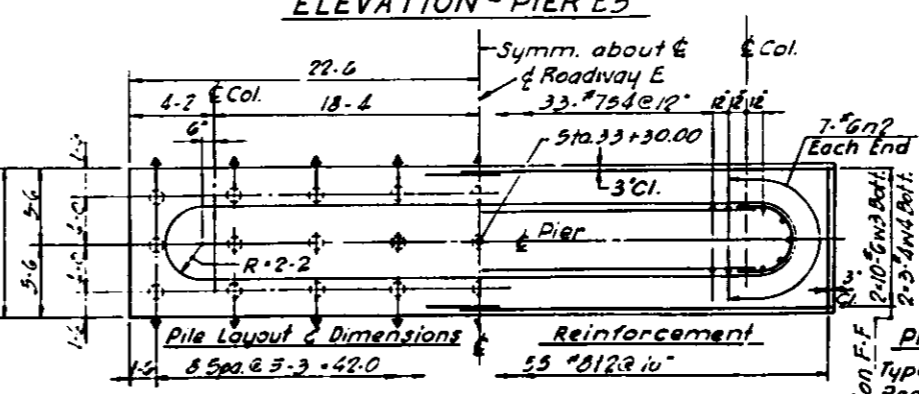


FOOTING PLAN - PIER E5

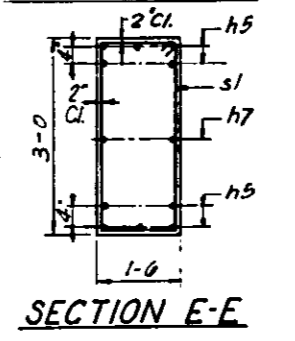

SECTION E-E

BILL OF MATERIAL					
Mark	No. Req'd.	Size	Length	Shape	
115 n1	10	#10	40.10	—	
115 n2	2	#9	37.6	—	
115 n3	14	#11	39.6	—	
115 n4	10	#9	39.6	—	
115 n5	10	#9	39.0	—	
115 n6	12	#11	37.8	—	
115 n7	2	#9	35.8	—	
115 n8	10	#9	37.8	—	
115 n9	36	#11	19.8	—	
115 n10	14	#6	8.9	—	
115 n11	35	#2	8.6	—	
115 n12	70	#6	13.8	—	
115 n13	64	#4	12.9	—	
115 n14	66	#7	18.0	—	
115 v1	36	#11	26.8	—	
115 v2	36	#11	23.5	—	
115 w1	20	#6	28.4	—	
115 w2	6	#4	28.0	—	
115 w3	20	#6	23.2	—	
115 w4	6	#4	28.10	—	
115 u1	14	#5	9.5	—	

Item	Unit	Total
Class 'X' Concrete	C.Y.	128.7
Reinforcement Bars	Lbs.	17,600
Concrete Piles	L.F.	858
Test Piles (concrete)	Ea.	1

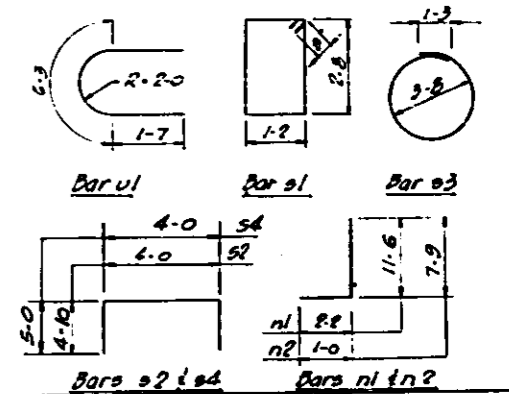

Indicates Dotted Piles
Indicates Test Pile

PILE DATA
Type: Concrete
Req'd. Capacity: 31 Tons
Est. Length: 33-0
No. Req'd: 26
Test Pile: 1
Does not include Test Pile


PILE DATA
Type: Concrete
Req'd. Capacity: 31 Tons
Est. Length: 39-0
No. Req'd: 26
Test Pile: 1
Does not include test Pile

STATE OF ILLINOIS
DEPARTMENT OF PUBLIC WORKS & BLDGS.
DIVISION OF HIGHWAYS
PIERS E4 AND E5
POPLAR STREET BRIDGE APPROACHES
ROADWAY "E"
F. A. I. RT. 70 ST. CLAIR CO. SECTION 82-3HVB-2
H. W. LOCHNER, INC.
ENGINEERS
CHICAGO, ILLINOIS
SHEET 15 OF 147


DESIGNED BY: E.W.
DRAWN BY: J.
CHECKED BY: E.L.

ROUTE NO.	SECTION	COUNTY	TOTAL SHEETS	SHEET NO.
F. A. I.-70	82-3HVB-2	ST. CLAIR	252	182
FED. ROAD DIV. NO. 4 ILLINOIS PROJECT				


BILL OF MATERIAL				
Mark	No. Req'd.	Size	Length	Shape
116H	10	#9	37.8	—
116H2	2	#5	33.0	—
116H3	13	#10	36.4	—
116H4	8	#9	36.4	—
116H5	10	#9	36.4	—
116H6	14	#11	35.0	—
116H7	8	#5	35.0	—
116H8	2	#5	32.6	—
116H9	36	#10	12.1	—
116H10	14	#6	7.9	—
116H11	36	#11	12.8	—
116H12	14	#7	7.11	—
116H13	32	#8	8.6	—
116H14	64	#6	12.8	—
116H15	54	#8	12.9	—
116H16	31	#8	8.0	—
116H17	62	#7	12.0	—
116H18	43	#7	9.5	—
116H19	27	#7	9.5	—
116V1	35	#10	22.5	—
116V2	36	#11	20.1	—
116V3	12	#5	9.5	—
116V4	16	#6	21.0	—
116V5	6	#8	21.6	—
116V6	22	#6	22.1	—
116V7	6	#8	21.9	—
*See Note 'X' Sh. No. 14				
Item	Unit	Total	Pier E6	Pier E7
Class 'X' Concrete	C.Y.	115.6	100.7	
Reinforcement Bars	Lbs.	12,610	14,780	
Concrete Piles	L.F.	667	1012	
Test Piles (Concrete)	Ea.	1	1	

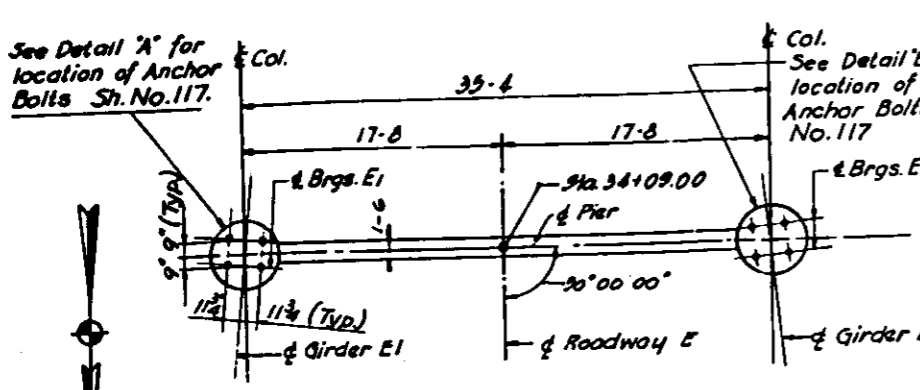


TOP PLAN - PIER E6

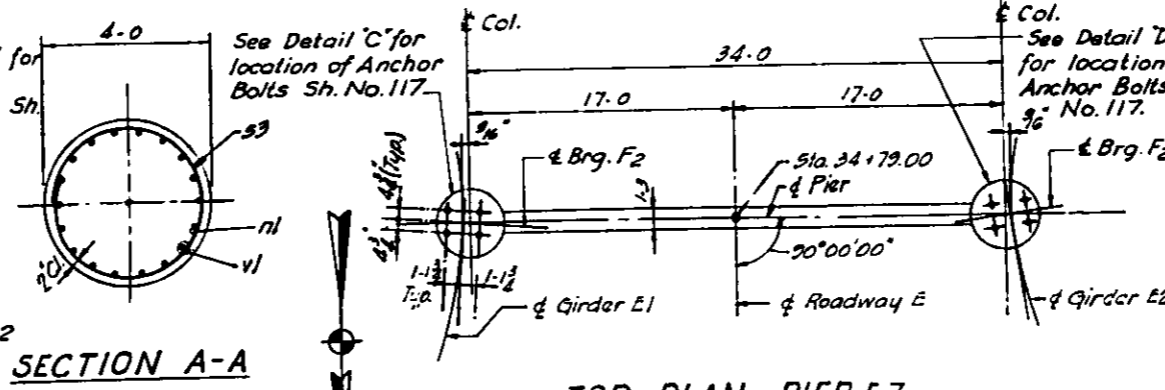


TOP PLAN - PIER E7

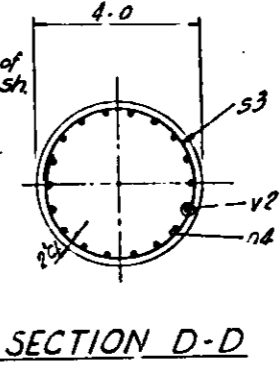


SECTION D-D

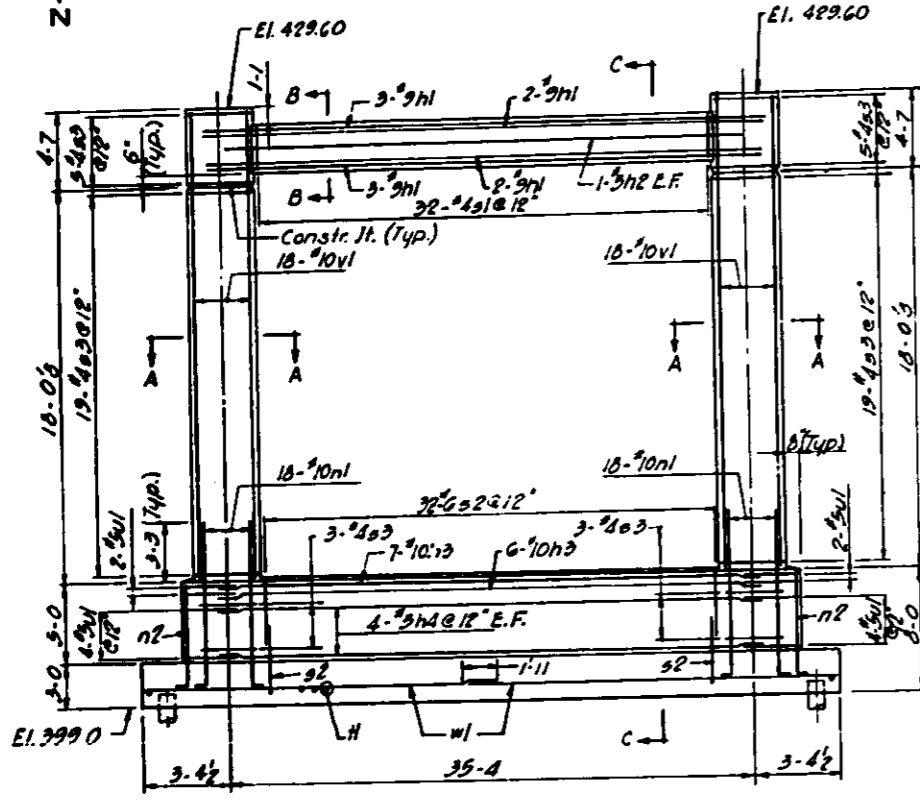


ELEVATION - PIER E6

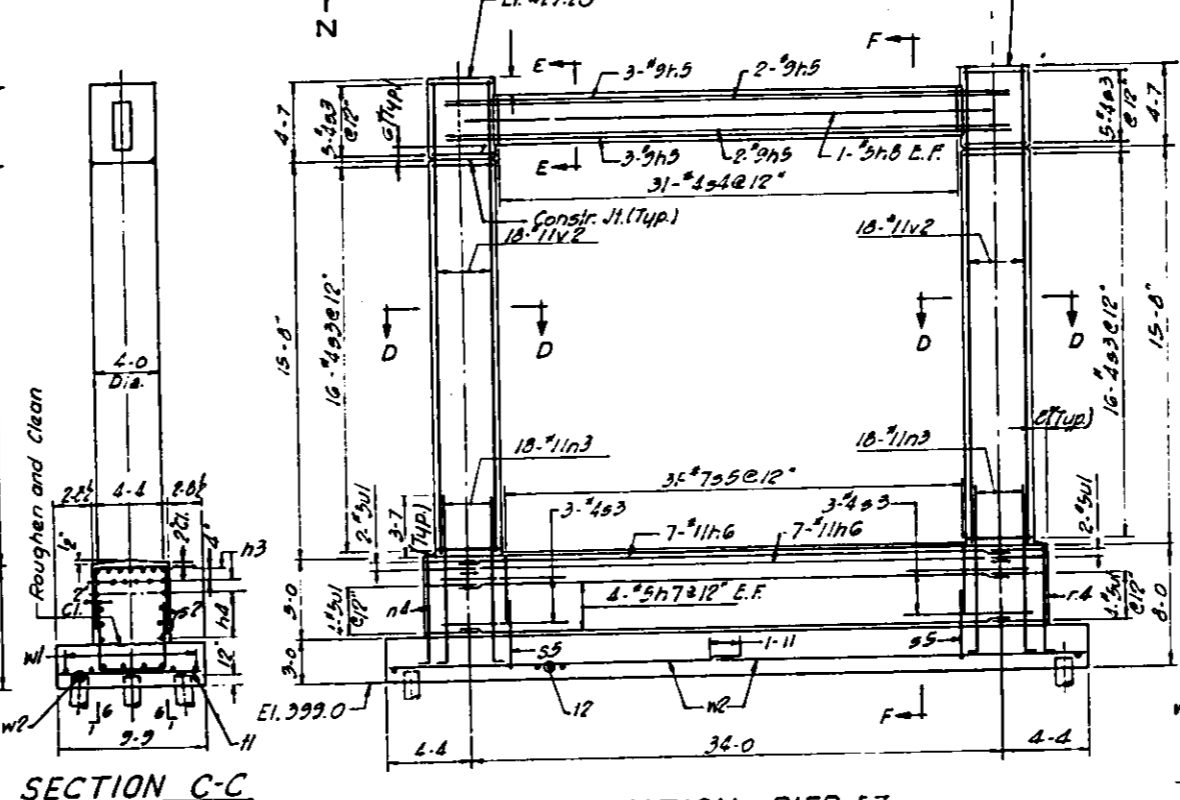


ELEVATION - PIER E7

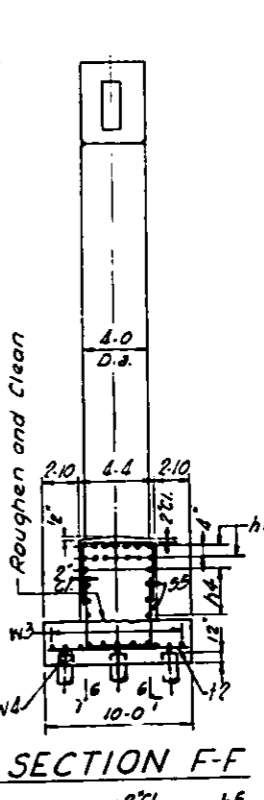

SECTION F-F

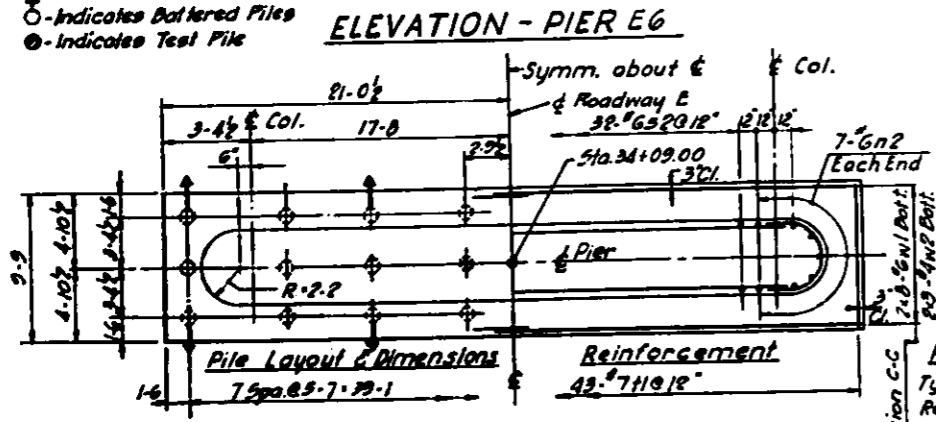


FOOTING PLAN - PIER E6

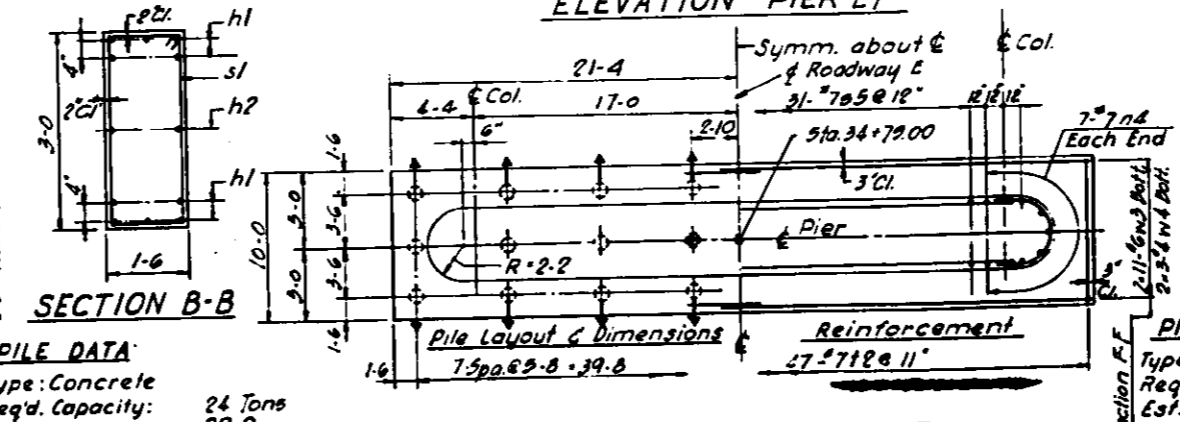

FOOTING PLAN - PIER E7

PILE DATA
 Type: Concrete
 Req'd. Capacity: 24 Tons
 Est. Length: 29.0
 No. Req'd: 23
 Test Pile: 1
 * Does not include Test Pile.

PILE DATA
 Type: Concrete
 Req'd. Capacity: 34 Tons
 Est. Length: 44.0
 No. Req'd: 23
 Test Pile: 1
 * Does not include Test Pile

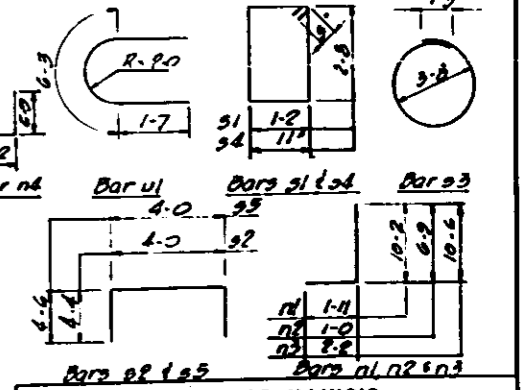

SECTION E-E

STATE OF ILLINOIS
 DEPARTMENT OF PUBLIC WORKS & BLDGS.
 DIVISION OF HIGHWAYS
 PIERS E6 AND E7
 POPLAR STREET BRIDGE APPROACHES
 ROADWAY "E"
 F. A. I. RT. 70 ST. CLAIR CO. SECTION 82-3HVB-2
 N. W. LOCHNER, INC.
 ENGINEERS
 CHICAGO, ILLINOIS
 SHEET
 182 OF 147










DESIGNED BY: E.W.
 DRAWN BY: T.L.
 CHECKED BY: E.L.

ROUTE NO.	SECTION	COUNTY	TOTAL SHEETS	SHEET NO.
E.A.I.-70	82-3HVB-2	ST. CLAIR	252	183
FED. ROAD DIV. NO. 4		ILLINOIS	PROJECT	

BILL OF MATERIAL				
* Mark	No. reqd.	Size	Length	Shape
117 h1	6	"10	35-0	—
117 h2	2	"5	31-4	—
117 h3	12	"11	33-10	—
117 h4	8	"5	33-10	—
117 n1	36	"10	12-1	—
117 n2	14	"6	7-9	—
117 s1	30	"4	8-0	□
117 s2	42	"4	12-9	□
117 s3	60	"6	12-8	□
117 l1	41	"7	8-8	—
117 w1	18	"6	21-3	—
117 w2	6	"4	20-10	—
117 u1	12	"5	9-5	—
117 v1	36	"10	17-2	—

*See Note X Sheet No. 14

Item	Unit	Total
Class X Concrete	C.Y.	90.2
Reinforcement Bars	Lbs.	11,260
Concrete Piles	L.F.	759
Test Pile	Ea.	1

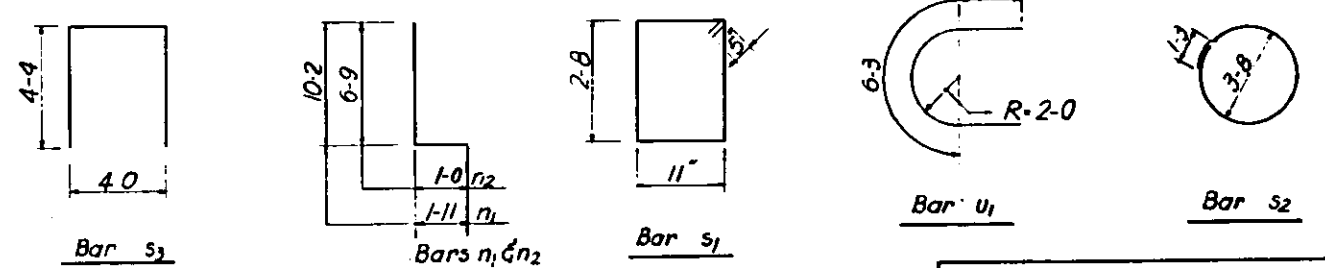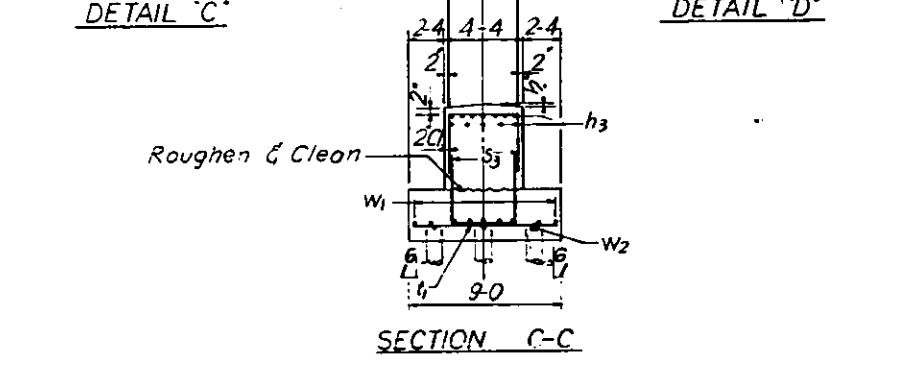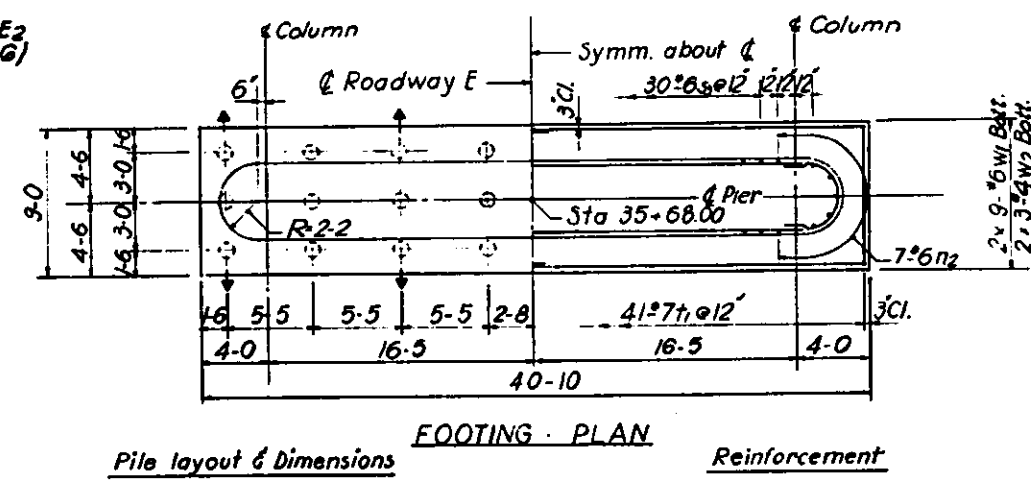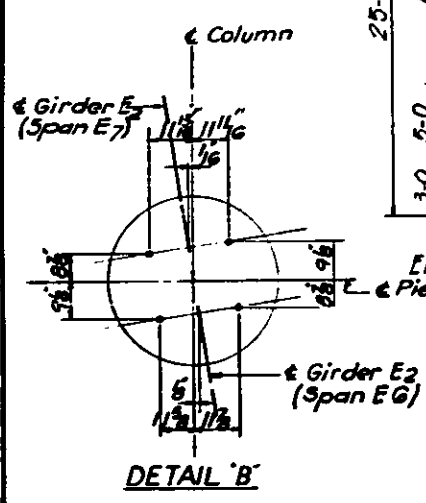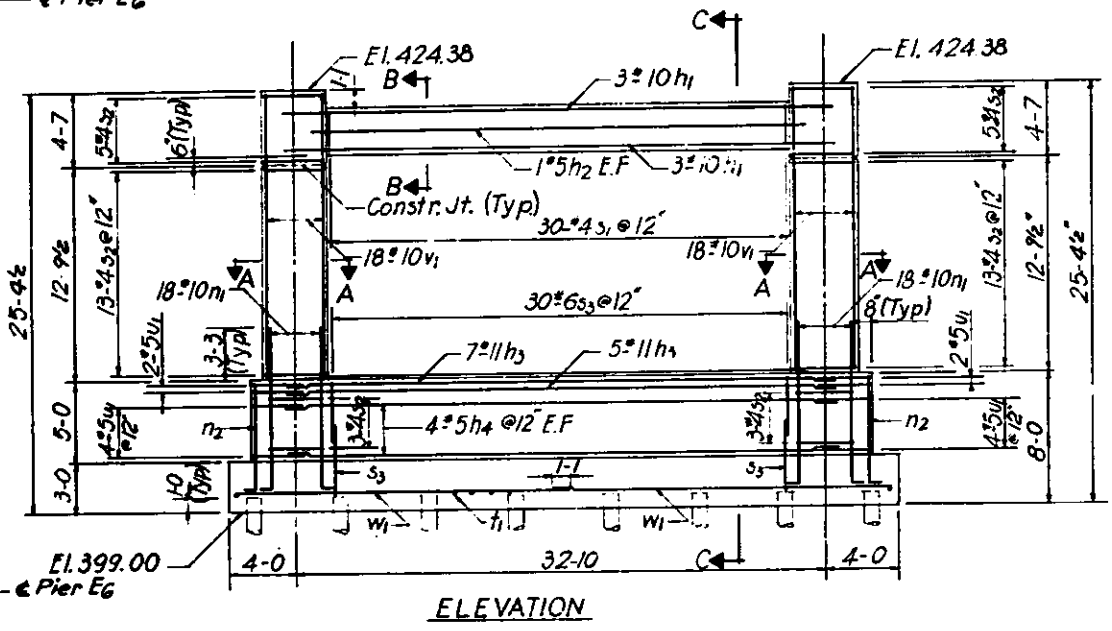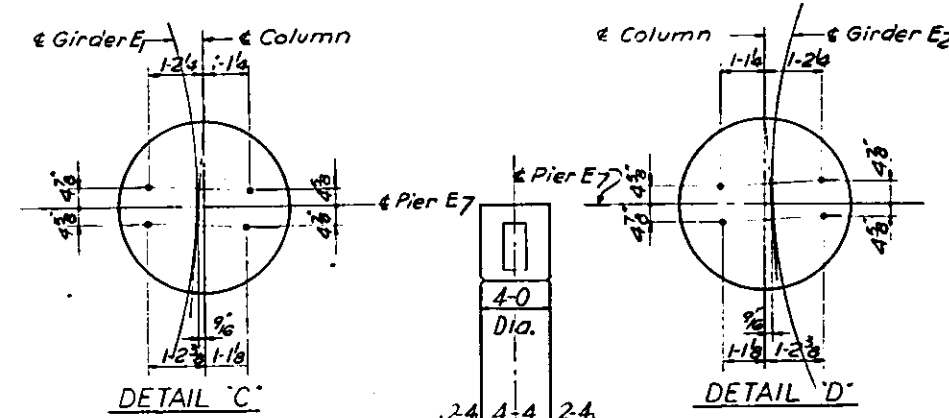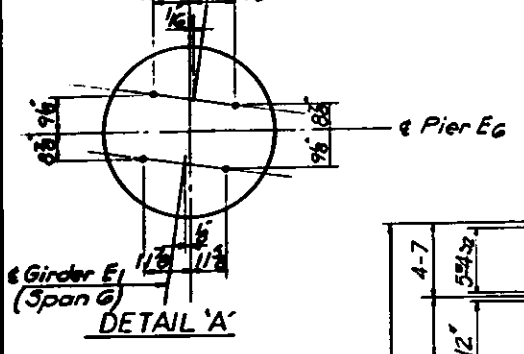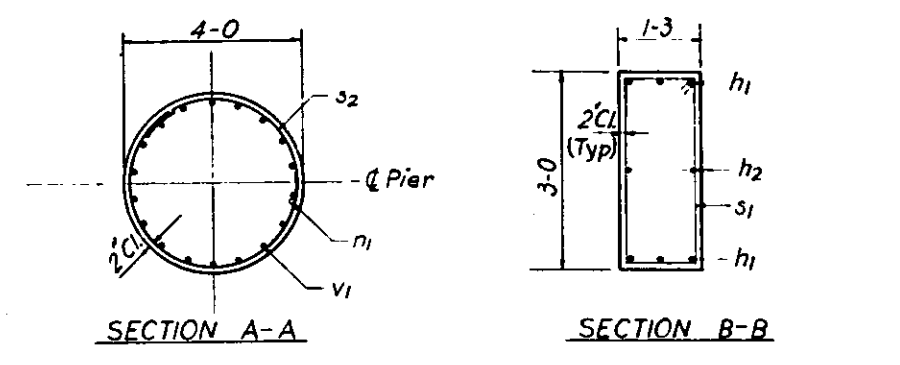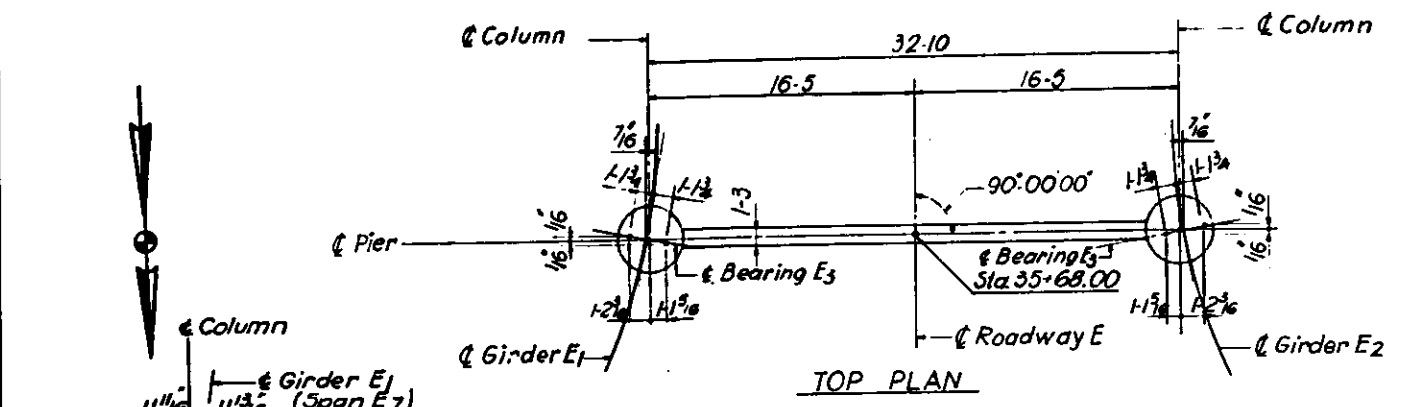

PILE DATA

Type: Concrete
 Required Capacity: 28 Tons
 Est. Length: 33-0
 No. Required: 23 *
 Test pile: 1

* Does not include test pile.

DESIGNED BY: EW.
 CHECKED BY: E.L.

⊙ Indicates test pile
 ⊕ Indicates battered pile

STATE OF ILLINOIS
 DEPARTMENT OF PUBLIC WORKS & BLDGS.
 DIVISION OF HIGHWAYS

PIER E8
 POPLAR STREET BRIDGE APPROACHES
 ROADWAY "E"

F.A.I. RT. 70 ST. CLAIR CO. SECTION 82-3HVB-2
 H. W. LOCHNER, INC.
 ENGINEERS
 CHICAGO, ILLINOIS

SHEET 183 OF 147

