


ROUTE NO.	SECTION	COUNTY	DATE	SHEET NO.
FAI 55		MCLEAN	07	5
FED. ROAD DIST. NO. 7		ILL. HIGH.	FED. AID PROJECT	5 SHEETS

• (57-4)RS-3 & 1

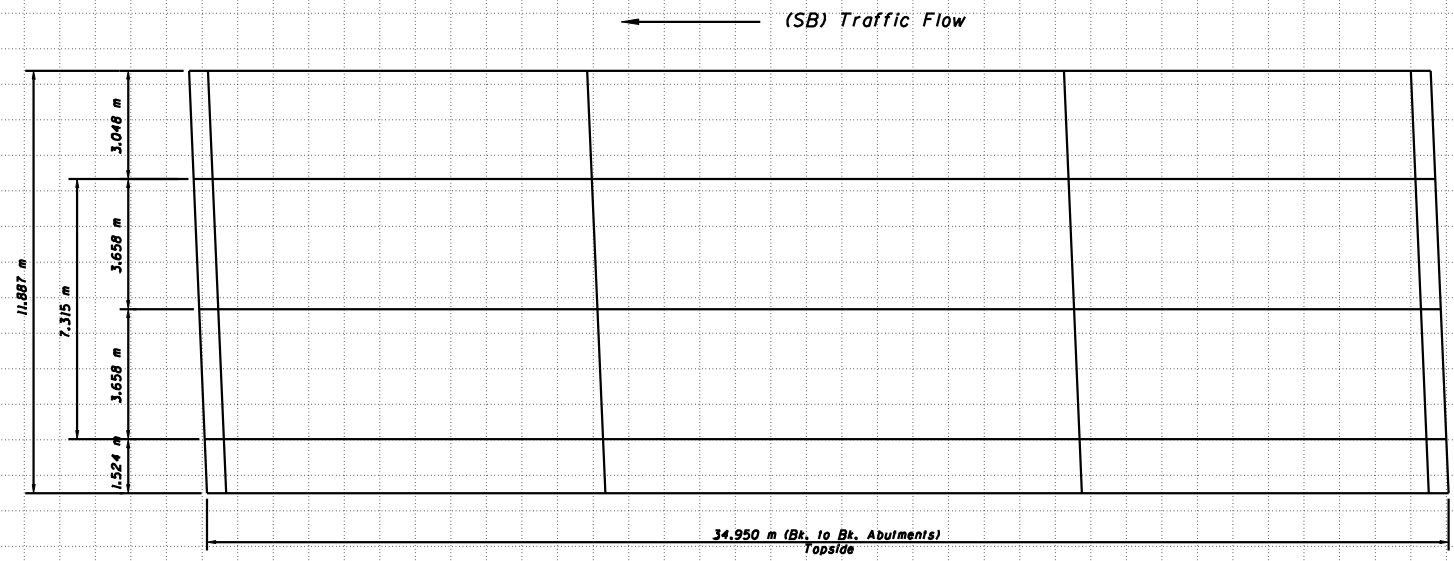

DESIGNED	JDA
CHECKED	JKC
DRAWN	NO
CHECKED	JDA

**AS BUILT
DECK REPAIRS
F.A.I. 55 OVER LINDEN STREET
SECTION (57-4)RS-3 & 1
MCLEAN COUNTY
SN 057-0028 (NB)
SN 057-0029 (SB)
STA. 38+543.992**