

STATE OF ILLINOIS 04-29-2022 LETTING ITEM 199  
 DEPARTMENT OF TRANSPORTATION

F A RTE.	SECTION	COUNTY	TOTAL SHEETS	SHEET NO.
VAR	2021 112 SW	WILL	114	1
		ILLINOIS	CONTRACT NO. 62P35	
* 114 + 3 = 117 TOTAL SHEETS				
* 117 + 3 = 120 TOTAL SHEETS				
<b>D-91-196-21</b>				

FOR INDEX OF SHEETS, SEE SHEET NO. 2


THIS PROJECT IS LOCATED IN  
THE CITY OF JOLIET

**TRAFFIC DATA:**  
 FOR TRAFFIC DATA SEE SHEETS No. 4-9  
 FOR PROJECT LOCATION MAP SEE SHEETS No. 4-9

# PROPOSED HIGHWAY PLANS

**VARIOUS ROUTES  
 VARIOUS LOCATIONS (JOLIET AREA)  
 SECTION: 2021-112-SW  
 ADA IMPROVEMENTS  
 WILL COUNTY**

C-91-235-21

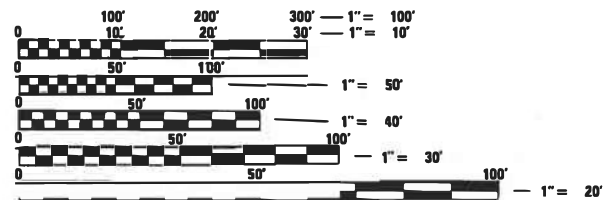


FULL SIZE PLANS HAVE BEEN PREPARED USING STANDARD ENGINEERING SCALES. REDUCED SIZED PLANS WILL NOT CONFORM TO STANDARD SCALES. IN MAKING MEASUREMENTS ON REDUCED PLANS, THE ABOVE SCALES MAY BE USED.

J.U.L.I.E.  
 JOINT UTILITY LOCATION INFORMATION FOR EXCAVATORS  
 1-800-892-0123  
 OR 811

PROJECT ENGINEER: LUKASZ POCIECHA (847) 705-4255  
 PROJECT MANAGER: FAWAD AQUEEL

CONTRACT NO. 62P35

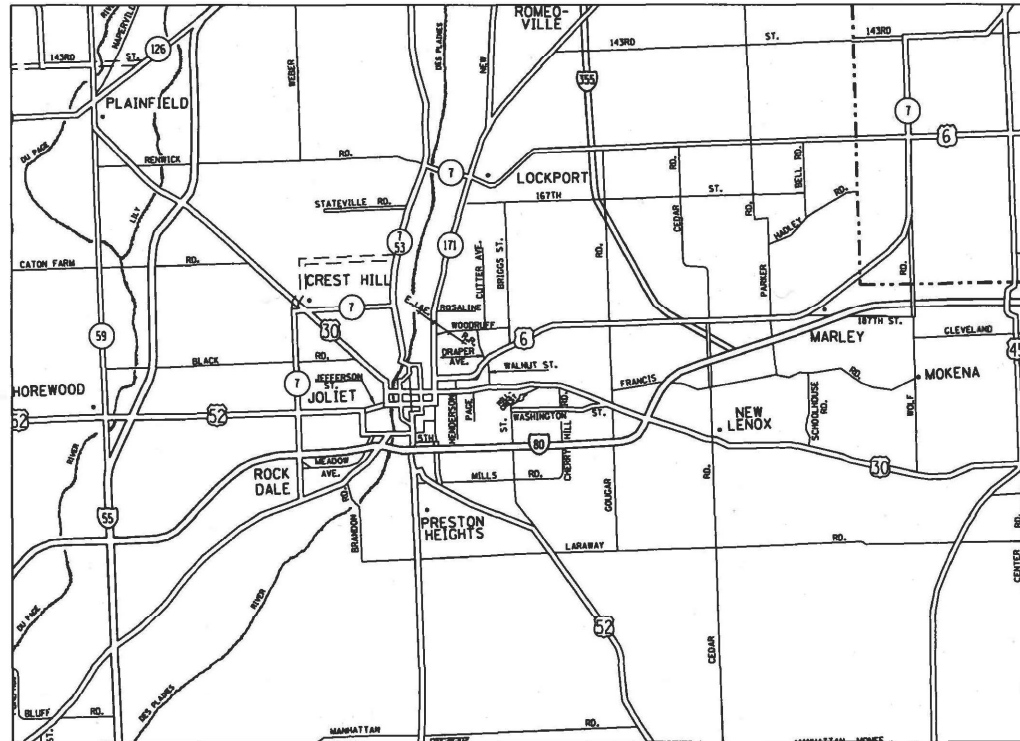

JOLIET TOWNSHIP

GROSS & NET LENGTH = NA (SPOT IMPROVEMENTS)



LOCATION OF SECTION INDICATED THIS: - [black rectangle]

STATE OF ILLINOIS  
 DEPARTMENT OF TRANSPORTATION

SUBMITTED October 18 20 21  
Open Rio 1093 REGIONAL ENGINEER

December 10 20 21  
[Signature] ENGINEER OF DESIGN AND ENVIRONMENT

December 10 20 21  
[Signature] DIRECTOR OF HIGHWAYS PROJECT IMPLEMENTATION 2

**PRINTED BY THE AUTHORITY  
 OF THE STATE OF ILLINOIS**


**GENERAL NOTES (CONTINUED)**

- 23. BEFORE BEGINNING ANY WORK, THE CONTRACTOR SHALL RETAIN AND RECORD FOR FUTURE REFERENCE, ALL EXISTING PAVEMENT MARKING LINES (AND RAISED REFLECTIVE PAVEMENT MARKERS) IN ORDER THAT THESE LOCATIONS CAN BE RE-ESTABLISHED FOR STRIPING. EXACT LOCATIONS OF ALL PAVEMENT MARKINGS SHALL BE AS SHOWN ON THE PLANS OR AS DIRECTED BY THE ENGINEER.
- 24. CURB RAMPS, INCLUDING SIDE CURBS AND SIDE FLARES, WILL BE MEASURED FOR PAVEMENT AS SIDEWALK. ADDITIONAL LOCATIONS FOR CONCRETE CURB TYPE-B WILL BE DETERMINED BY THE RESIDENT ENGINEER.
- 25. PROPOSED CONCRETE CURB AND GUTTER OVER 10 FEET IN LENGTH SHALL BE PAID AS COMBINATION CONCRETE CURB AND GUTTER REMOVAL AND REPLACEMENT.
- 26. PORTLAND CEMENT CONCRETE 4 INCH SHALL BE USED AS THE FOUNDATION UNDER REMOVE AND REINSTALL BRICK PAVER.
- 27. LOCATIONS OF COMBINATION CONCRETE CURB AND GUTTER REMOVAL AND REPLACEMENT (OR COMBINATION CURB AND GUTTER (THE TYPE SPECIFIED ON THE PLANS)), WILL BE DETERMINED IN THE FIELD BY THE RESIDENT ENGINEER / TECHNICIAN.
- 28. PROVIDE CONTINENTAL CROSSWALK STRIPING PARRALLEL TO THE CENTER LINE ACROSS ALL STATE ROUTES (ALL LEGS).
- 29. THIS PROJECT DOES NOT INCLUDE ANY PROPOSED STORM SEWERS, DRAINAGE INLETS, OR ANY EXTENSIVE DRAINAGE WORK.

HOT-MIX ASPHALT MIXTURE REQUIREMENTS		QUALITY MANAGEMENT PROGRAM (OMP)
MIXTURE TYPE	AIR VOIDS	
<b>PARTIAL DEPTH PATCHING, TY II, 3"</b>		
HMA SURFACE COURSE, MIX "D", IL-9.5, N70: 3" ( IN 2 LIFTS)	4% AT 70 GYR.	QC/OA
<b>HMA SURFACE COURSE REMOVAL 3 3/4"</b>		
HMA SURFACE COURSE, MIX "D", IL-9.5, N70: 1 1/2"	4% AT 70 GYR.	QC/OA
HMA BINDER COURSE, IL-19.0, N70: 2 1/4"	4% AT 70 GYR.	QC/OA
<b>PATCHING</b>		
CLASS D PATCHES ( HMA BINDER IL-19 MM)	4% AT 70 GYR.	QC/OA
OMP DESIGNATION: QUALITY CONTROL/QUALITY ASSURANCE (QC/OA); QUALITY CONTROL FOR PERFORMANCE (QCP)		

NOTE 1: THE UNIT WEIGHT USED TO CALCULATE ALL HMA SURFACE MIXTURE QUANTITIES IS 112 LBS/SQ YD/IN.

NOTE 2: THE "AC TYPE" FOR POLYMERIZED HMA MIXES SHALL BE "SBS/SBR PG 76-22" AND FOR NON-POLYMERIZED HMA THE "AC TYPE" SHALL BE "PG 64-22" UNLESS MODIFIED BY RECLAIMED MATERIALS SPECIAL SPECIFICATIONS.

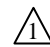**REVIS**  **REVIS** ENTIRE SHEET 4/12/2022

MODEL: Default  
FILE: \\nas01c-pw-bentley.com\PWDOT\Documents\DOT\_Offices\Bhartt\_1\Projects\119621\COData\Drawings\119621-Sub\genere

USER NAME = khans	DESIGNED -	REVISED - #1 - 4/11/2022	<b>STATE OF ILLINOIS DEPARTMENT OF TRANSPORTATION</b>	F.A... RTE.	SECTION	COUNTY	TOTAL SHEETS	SHEET NO.
PLOT SCALE = 100.0000 ' / in.	DRAWN -	REVISED -		VAR.	2021-112-SW	WILL	114	3
PLOT DATE = 4/11/2022	CHECKED -	REVISED -		CONTRACT NO. 62P35				
	DATE -	REVISED -		SCALE:	SHEET	OF	SHEETS	STA.
			ILLINOIS   FED. AID PROJECT					

SUMMARY OF QUANTITIES			CONSTRUCTION TYPE CODE				
CODE NO	ITEM	UNIT	TOTAL QUANTITIES URBAN	100% STATE 0021			
20200100	EARTH EXCAVATION	CU YD	167.7	167.7			
20200200	ROCK EXCAVATION	CU YD	42	42			
21101615	TOPSOIL FURNISH AND PLACE, 4"	SO YD	979.6	979.6			
25000400	NITROGEN FERTILIZER NUTRIENT	POUND	14	14			
25000500	PHOSPHORUS FERTILIZER NUTRIENT	POUND	14	14			
25000600	POTASSIUM FERTILIZER NUTRIENT	POUND	14	14			
25200110	SODDING, SALT TOLERANT	SO YD	979.6	979.6			
25200200	SUPPLEMENTAL WATERING	UNIT	18.6	18.6			
28000500	INLET AND PIPE PROTECTION	EACH	11	11			
40603085	HOT-MIX ASPHALT BINDER COURSE, IL-19.0, N70	TON	17.6	17.6			
<del>40600901</del>	<del>HOT-MIX ASPHALT BINDER COURSE, (HAND METHOD), N70</del>	<del>TON</del>	<del>35</del>	<del>35</del>			
40604062	HOT-MIX ASPHALT SURFACE COURSE, IL-9.5, MIX "D", N70	TON	20.8	20.8			
42001300	PROTECTIVE COAT	SO YD	2636	2636			
42400100	PORTLAND CEMENT CONCRETE SIDEWALK 4 INCH	SO FT	4126	4126			
42400200	PORTLAND CEMENT CONCRETE SIDEWALK 5 INCH	SO FT	11416	11416			
44000100	PAVEMENT REMOVAL	SO YD	5.4	5.4			
42400800	DETECTABLE WARNINGS	SO FT	900	900			

SUMMARY OF QUANTITIES			CONSTRUCTION TYPE CODE				
CODE NO	ITEM	UNIT	TOTAL QUANTITIES URBAN	100% STATE 0021			
44000164	HOT-MIX ASPHALT SURFACE REMOVAL, 3/4"	SO YD	140	140			
<del>44000155</del>	<del>HOT-MIX ASPHALT SURFACE REMOVAL, 1 1/2"</del>	<del>SO YD</del>	<del>50</del>	<del>50</del>			
44000600	SIDEWALK REMOVAL	SO FT	15162	15162			
44201789	CLASS D PATCHES, TYPE II, 12 INCH	SO YD	20	20			
60260100	INLETS TO BE ADJUSTED	EACH	15	15			
60250200	CATCH BASINS TO BE ADJUSTED	EACH	1	1			
60260300	INLETS TO BE ADJUSTED WITH NEW TYPE 1 FRAME, OPEN LID	EACH	6	6			
550A0050	STORM SEWERS, CLASS A, TYPE 1 1/2"	FOOT	10	10			
60266600	VALVE BOXES TO BE ADJUSTED	EACH	12	12			
60200305	CATCH BASINS, TYPE A, 4' DIAMETER, TYPE 3 FRAME AND GRATE	EACH	1	1			
60300350	MANHOLE FRAMES TO BE ADJUSTED	EACH	9	9			
60500050	REMOVING CATCH BASINS	EACH	1	1			
60600605	CONCRETE CURB, TYPE B	FOOT	330	330			
60261200	INLET TO BE ADJUSTED WITH NEW TYPE 10 FRAME AND GRATE	EACH	1	1			
* 66900200	NON-SPECIAL WASTE DISPOSAL	CU YD	279	279			
* 66900530	SOIL DISPOSAL ANALYSIS	EACH	10	10			
* 66901001	REGULATED SUBSTANCES PRE-CONSTRUCTION PLAN	L SUM	1	1			
* 66901003	REGULATED SUBSTANCES FINAL CONSTRUCTION REPORT	L SUM	1	1			
* 66901006	REGULATED SUBSTANCES MONITORING	CAL DA	20	20			
X6700407	ENGINEER'S FIELD OFFICE, TYPE A (D1)	CAL MO	12	12			

\* = SPECIALTY ITEMS

REVISOR SHEET 4/12/2022

FILE NAME =	USER NAME = khans	DESIGNED -	REVISED -
pw\N\dot-pw\benfrey.com\PI\DOT\Documents\DOT_Offices\Distric\Projects\DI\962\CA\DOT\Design\DI\962\SH-S00		DRAWN -	REVISED -
		CHECKED -	REVISED -
		DATE -	REVISED -

STATE OF ILLINOIS  
DEPARTMENT OF TRANSPORTATION

SUMMARY OF QUANTITIES			
SCALE:	SHEET NO.	OF SHEETS	STA. TO STA.

F.A.P. RTE.	SECTION	COUNTY	TOTAL SHEETS	SHEET NO.
VAR.	2021-112-SW	WILL	114	10
			CONTRACT NO. 62P35	
FED. ROAD DIST. NO. 1 ILLINOIS FED. AID PROJECT				

SUMMARY OF QUANTITIES			TOTAL QUANTITIES URBAN	CONSTRUCTION TYPE CODE				
CODE NO	ITEM	UNIT		100% STATE 0021				
67100100	MOBILIZATION	L SUM	1	1				
70102625	TRAFFIC CONTROL AND PROTECTION, STANDARD 701606	L SUM	1	1				
70102630	TRAFFIC CONTROL AND PROTECTION, STANDARD 701601	L SUM	1	1				
70102635	TRAFFIC CONTROL AND PROTECTION, STANDARD 701701	L SUM	1	1				
70102640	TRAFFIC CONTROL AND PROTECTION, STANDARD 701801	L SUM	1	1				
* 72400500	RELOCATE SIGN PANEL ASSEMBLY - TYPE A	EACH	2	2				
* 72400600	RELOCATE SIGN PANEL ASSEMBLY - TYPE B	EACH	7	7				
72400710	RELOCATE SIGN PANEL - TYPE 1	SQ FT	20	20				
* 78000400	THERMOPLASTIC PAVEMENT MARKING - LINE 6"	FOOT	7737	7737				
* 78000600	THERMOPLASTIC PAVEMENT MARKING - LINE 12"	FOOT	1676	1676				
* 78000650	THERMOPLASTIC PAVEMENT MARKING - LINE 24"	FOOT	1109	1109				
* 78009006	MODIFIED URETHANE PAVEMENT MARKING - LINE 6"	FOOT	71	71				
* 85000200	MAINTENANCE OF EXISTING TRAFFIC SIGNAL INSTALLATION	EACH	4	4				
* 78009024	MODIFIED URETHANE PAVEMENT MARKING - LINE 24"	FOOT	71	71				
* 88600600	DETECTOR LOOP REPLACEMENT	FOOT	400	400				

SUMMARY OF QUANTITIES			TOTAL QUANTITIES URBAN	CONSTRUCTION TYPE CODE				
CODE NO	ITEM	UNIT		100% STATE 0021				
89500400	RELOCATE EXISTING PEDESTRIAN PUSH-BUTTON	EACH	43	43				
89502376	REBUILD EXISTING HANDHOLE	EACH	8	8				
X0320050	CONSTRUCTION LAYOUT (SPECIAL)	L SUM	1	1				
X0327611	REMOVE AND REINSTALL BRICK PAVER	SO FT	4126	4126				
78300202	PAVEMENT MARKING REMOVAL - WATER BLASTING	SO FT	7763	7763				
X0327993	STRAIRCASE REMOVAL	L SUM	1	1				
X4240800	DETECTABLE WARNING (SPECIAL)	SO FT	547	547				
X4406230	PARTIAL DEPTH REMOVAL, TYPE 11, 3"	SO YD	70	70				
X4421000	PARTIAL DEPTH PATCHING	TON	6	6				
X4400501	COMBINATION CURB AND GUTTER REMOVAL AND REPLACEMENT LESS THAN OR EQUAL TO 10 FEET	FOOT	37	37				
X5537800	STORM SEWERS TO BE CLEANED 12"	FOOT	480	480				
Z0004562	COMBINATION CONCRETE CURB AND GUTTER REMOVAL AND REPLACEMENT	FOOT	2288	2288				
Z0018500	DRAINAGE STRUCTURES TO BE CLEANED	EACH	24	24				
Z0030850	TEMPORARY INFORMATION SIGNING	SO FT	312	312				
70400100	TEMPORARY CONCRETE BARRIER	FOOT	8	8				
Z0076604	TRAINEES - TRAINING PROGRAM GRADUATE	HOURS	500	500				

\* = SPECIALTY ITEMS  
 REVISIONS: 1/13/2022

FILE NAME =	USER NAME = khans	DESIGNED -	REVISED -
pw\N\dot-pw\benfrey.com\PI\DOT\Documents\DOT - Office\District\Projects\DI\962\CA\DOT\Design\DI\962\SH-S00		DRAWN -	REVISED -
		CHECKED -	REVISED -
		DATE -	REVISED -

**STATE OF ILLINOIS  
DEPARTMENT OF TRANSPORTATION**

SUMMARY OF QUANTITIES			
SCALE:	SHEET NO.	OF SHEETS	STA. TO STA.

F.A.P. RTE.	SECTION	COUNTY	TOTAL SHEETS	SHEET NO.
VAR.	2021-112-SW	WILL	114	11
			CONTRACT NO. 62P35	
FED. ROAD DIST. NO. 1 ILLINOIS FED. AID PROJECT				





N  
SCALE 1:5

ONEIDA ST.

DESIGN Par 12/31/14

CHECK JMA 1/6/15

EXIST. ELEV. = (XXX.XX')

PROPOSED ELEV. = XXX.XX'

EXIST. SLOPE = (X.X%)

PROPOSED SLOPE = X.X%

US RT 30 (CENTER ST.)

30  
ST

JOLIET - US RT 30 (CENTER ST.) AND ONEIDA ST. 10118-SE

E-5.330

ONEIDA ST.

N  
SCALE 1:5

DESIGN Par 1/2/15

CHECK JMA 1/6/15

EXIST. ELEV. = (XXX.XX')


PROPOSED ELEV. = XXX.XX'

\* INLET TO BE ADJUSTED

† EXIST. EOP. ELEVATIONS ARE 0.04' TOO LOW TO MEET EXIST. ENTRANCE ELEVATION, EVEN WHEN ALL RUNNING & CROSS SLOPES ARE MAXIMIZED. THEREFORE, RECOMMEND RESURFACING ADJACENT PAVEMENT. SEE MRP FOR DETAILS

FOR SW CORNER OF US 30 (CENTER ST) AND ONEIDA ST. SEE SHEET 21A

EXIST. DIAGONAL PARKING STALLS

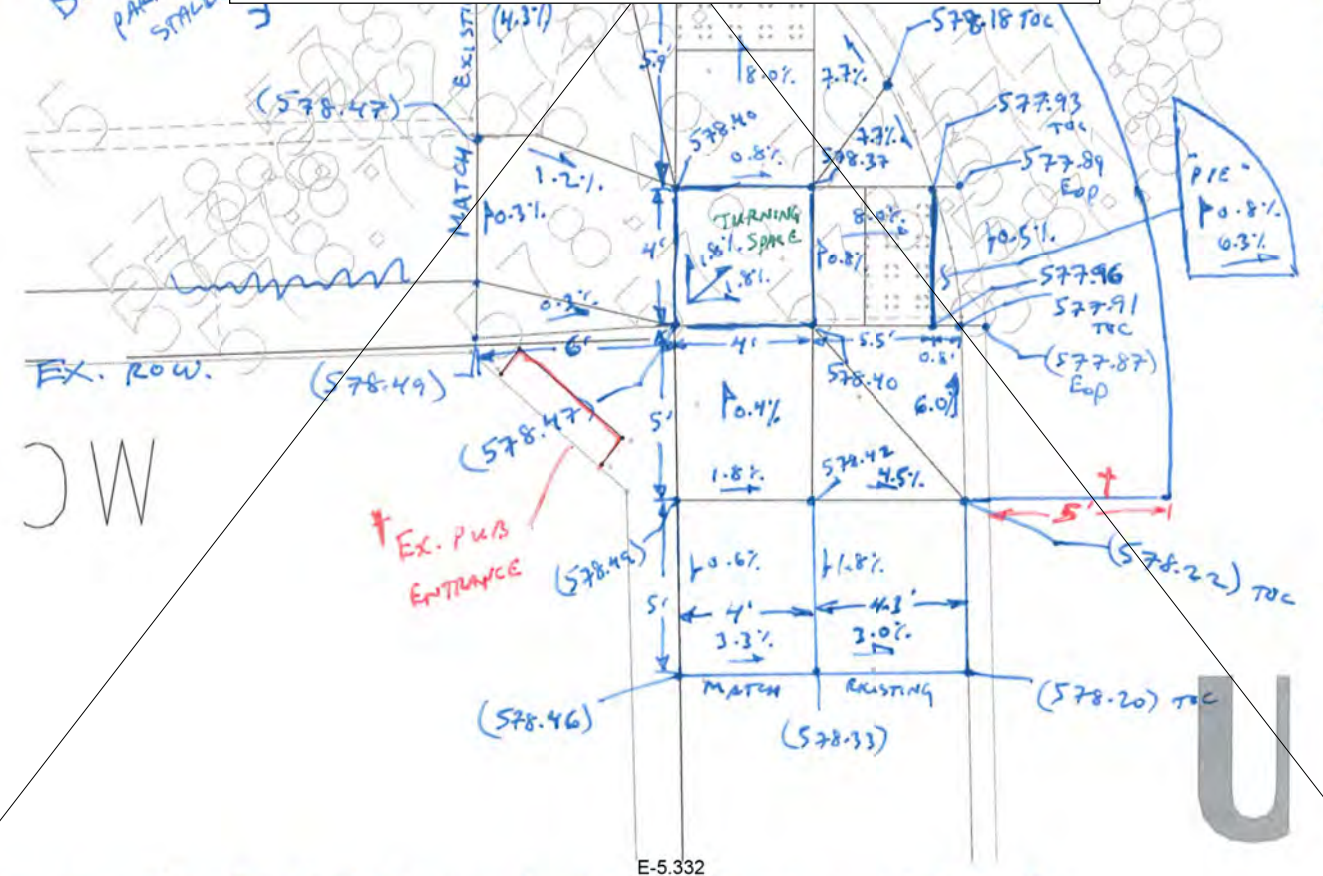

WC

US RT 30 (CENTER ST.)


E-5.332

STATE OF ILLINOIS  
DEPARTMENT OF TRANSPORTATION

JOLIET TOWNSHIP - ADA IMPROVEMENTS  
VARIOUS LOCATIONS (JOLIET TOWNSHIP)

SCALE: SHEET OF SHEETS STA. TO STA.

F.A. RTE.	SECTION	COUNTY	TOTAL SHEETS	SHEET NO.
VAR	2021-112-SW	WILL	114	21
CONTRACT NO. 62P35				
ILLINOIS		FED. AID PROJECT		

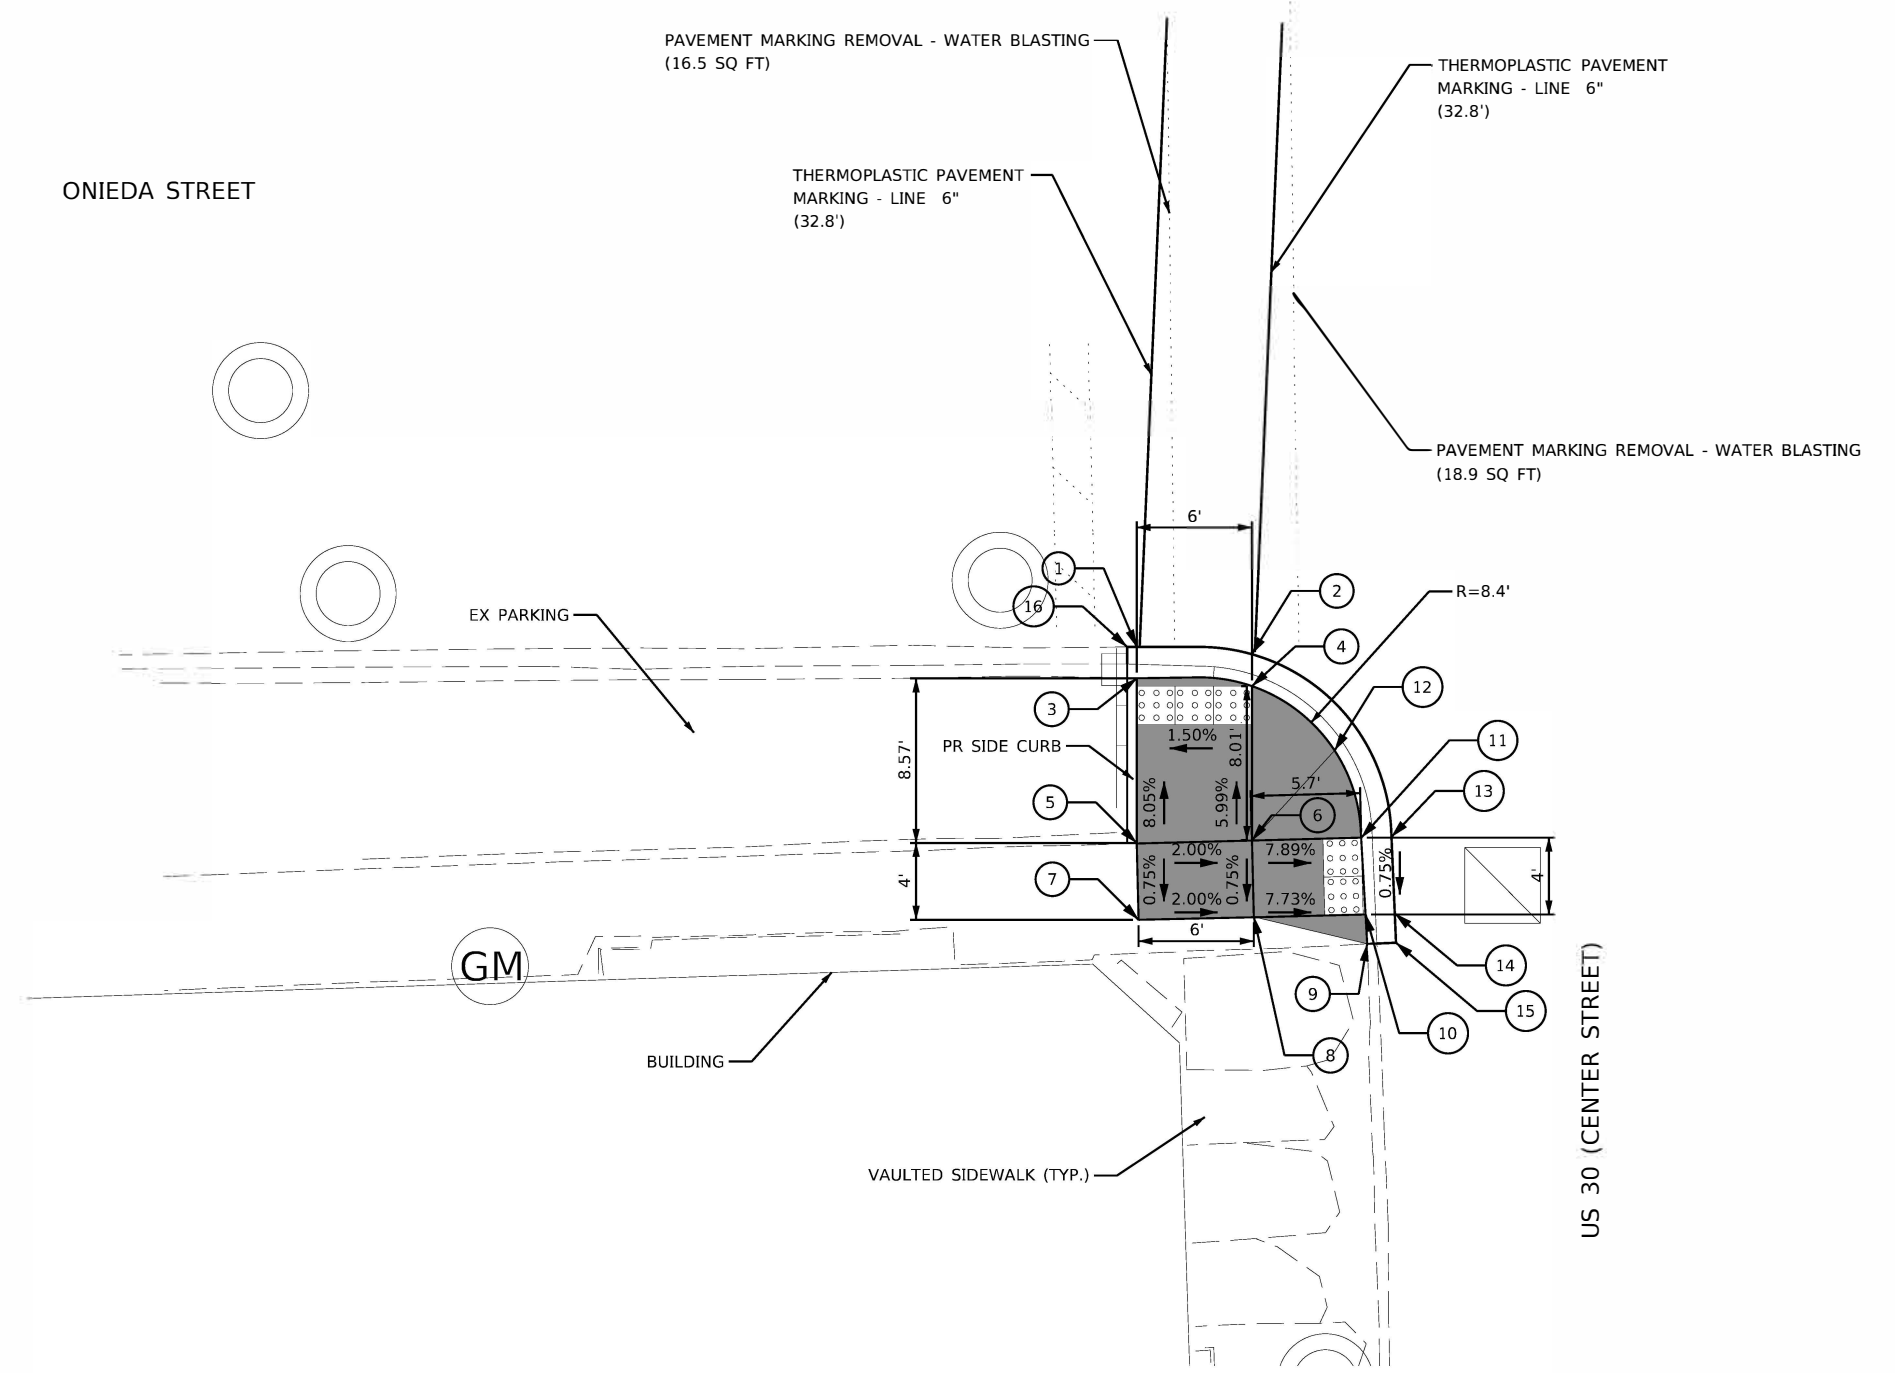


	NORTHING	EASTING	ELEVATION
1	1770027.76	1050499.02	577.71
2	1770027.38	1050505.02	577.80
3	1770026.13	1050499.02	577.75
4	1770025.72	1050505.02	577.84
5	1770017.55	1050499.02	(578.44)
6	1770017.68	1050505.02	578.32
7	1770013.56	1050499.12	(578.41)
8	1770013.71	1050505.12	(578.29)
9	1770012.30	1050511.03	577.99
10	1770013.84	1050510.94	577.84
11	1770017.83	1050510.72	577.87
12	1770022.37	1050509.33	578.11
13	1770017.87	1050512.30	577.83
14	1770013.87	1050512.47	577.80
15	1770012.35	1050512.53	(577.83)
16	1770027.76	1050498.52	(577.63)

**LEGEND**

	DETECTABLE WARNINGS		PCC SIDEWALK, 5 INCH
	EXISTING ELEVATION / SLOPE		
	CONCRETE CURB, TYPE B		
	COMBINATION CONCRETE CURB AND GUTTER		

REFERENCE BENCHMARK ELEVATION: 578.96

BENCHMARK 202: CUT SQUARE AT SOUTHWEST CORNER OF CONCRETE SIGN FOUNDATION AT BW/BW

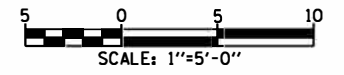

REVISED ENTIRE SHEET 4/13/2022

MODEL: s:\MODEL\NAME: FILE: NAME: 137762\_03\CAD\USHS\ADA\_Ramps\62P35\_ADA 1\_Ramp\_1.dgn

USER NAME = rmitchel	DESIGNED - RAM	REVISED  ADDENDUM A 04/08/22
PLOT SCALE = 1:10	DRAWN - RAM	REVISED -
PLOT DATE = 4/8/2022	CHECKED - CEL	REVISED -
	DATE - 4/8/2022	REVISED -

**STATE OF ILLINOIS  
DEPARTMENT OF TRANSPORTATION**


**JOLIET TOWNSHIP - ADA IMPROVEMENTS  
VARIOUS LOCATIONS (JOLIET TOWNSHIP)**

SCALE: SHEET OF SHEETS STA. TO STA.


F.A. RTE.	SECTION	COUNTY	TOTAL SHEETS	SHEET NO.
VAR	2021-112-SW	WILL	114	21A
			CONTRACT NO. 62P35	
ILLINOIS   FED. AID PROJECT				



	NORTHING	EASTING	ELEVATION
1	1770709.90	1050957.23	(581.38)
2	1770710.09	1050955.64	581.37
3	1770710.24	1050954.45	581.39
4	1770704.61	1050955.45	(581.43)
5	1770704.80	1050953.80	581.42
6	1770700.68	1050953.38	(581.34)
7	1770701.85	1050952.21	581.78
8	1770697.61	1050947.71	(581.55)
9	1770699.23	1050947.91	581.54
10	1770698.02	1050942.73	(581.60)
11	1770699.58	1050942.91	581.59
12	1770699.82	1050942.94	581.59
13	1770720.79	1050950.69	(582.64)
14	1770716.66	1050950.38	582.30
15	1770716.49	1050951.60	582.16
16	1770710.66	1050950.90	581.67
17	1770710.85	1050949.30	581.82
18	1770705.42	1050948.65	581.71
19	1770706.01	1050943.68	581.81
20	1770707.33	1050932.66	(582.59)
21	1770721.36	1050945.96	(582.61)
22	1770711.42	1050944.53	581.91
23	1770710.98	1050944.28	581.91
24	1770712.16	1050933.24	(582.69)

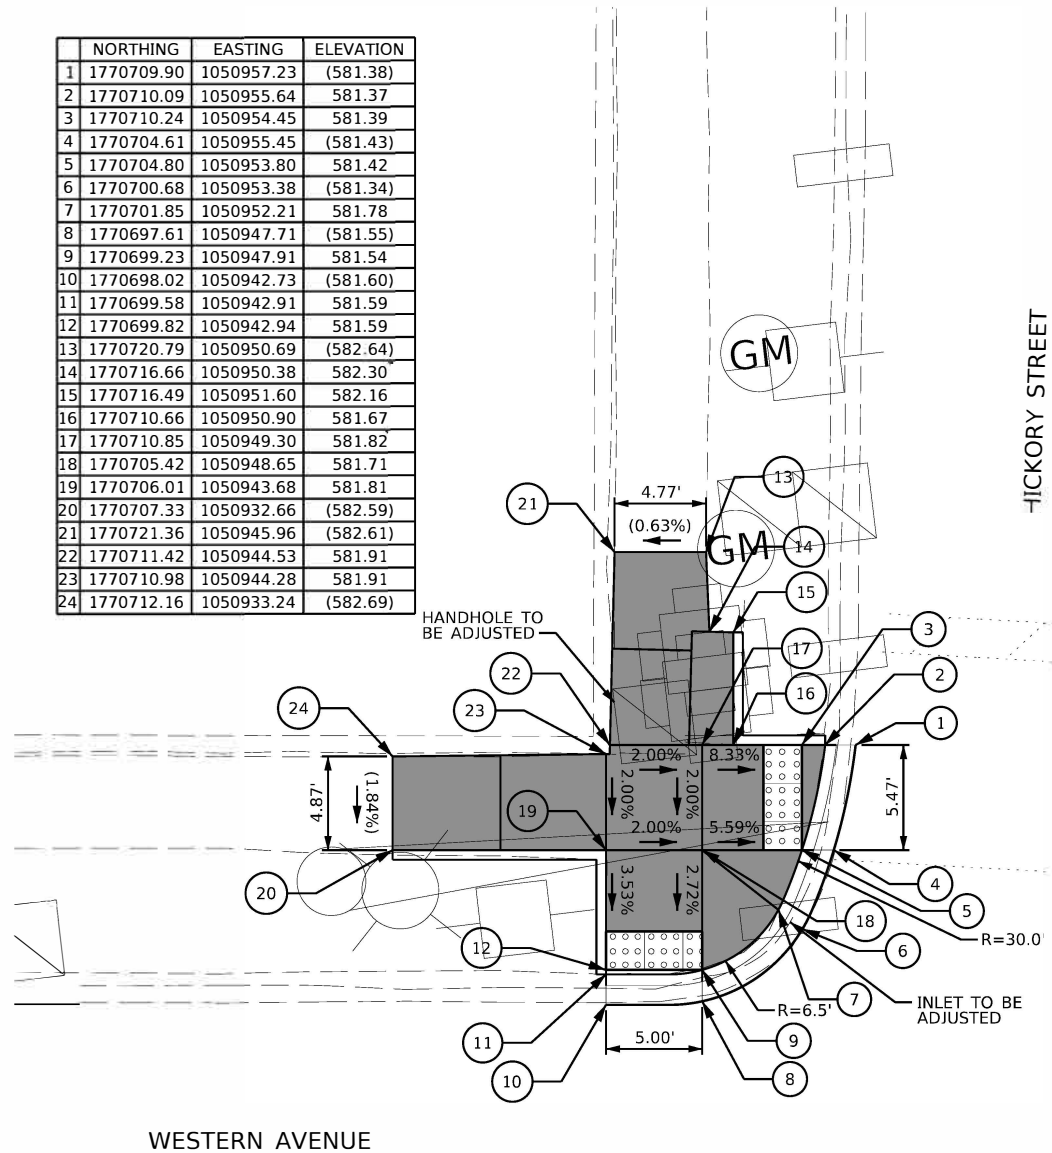

	NORTHING	EASTING	ELEVATION
1	1770710.75	1050992.30	(581.11)
2	1770710.67	1050993.87	(581.52)
3	1770704.34	1050991.89	(581.06)
4	1770704.15	1050993.48	581.05
5	1770696.39	1050994.75	(581.04)
6	1770697.32	1050996.03	581.03
7	1770691.54	1051001.09	(581.09)
8	1770693.16	1051001.32	581.08
9	1770690.80	1051004.54	(581.10)
10	1770692.37	1051004.73	(581.41)
11	1770713.20	1050997.18	(581.77)
12	1770710.38	1050996.85	581.57
13	1770703.84	1050996.08	581.09
14	1770698.33	1051002.06	581.15
15	1770696.84	1051012.81	(581.74)
16	1770712.62	1051002.25	(581.87)
17	1770709.87	1051001.98	581.67
18	1770707.76	1051001.77	581.52
19	1770707.63	1051003.16	581.54
20	1770703.06	1051002.74	581.21
21	1770701.53	1051013.48	(581.80)

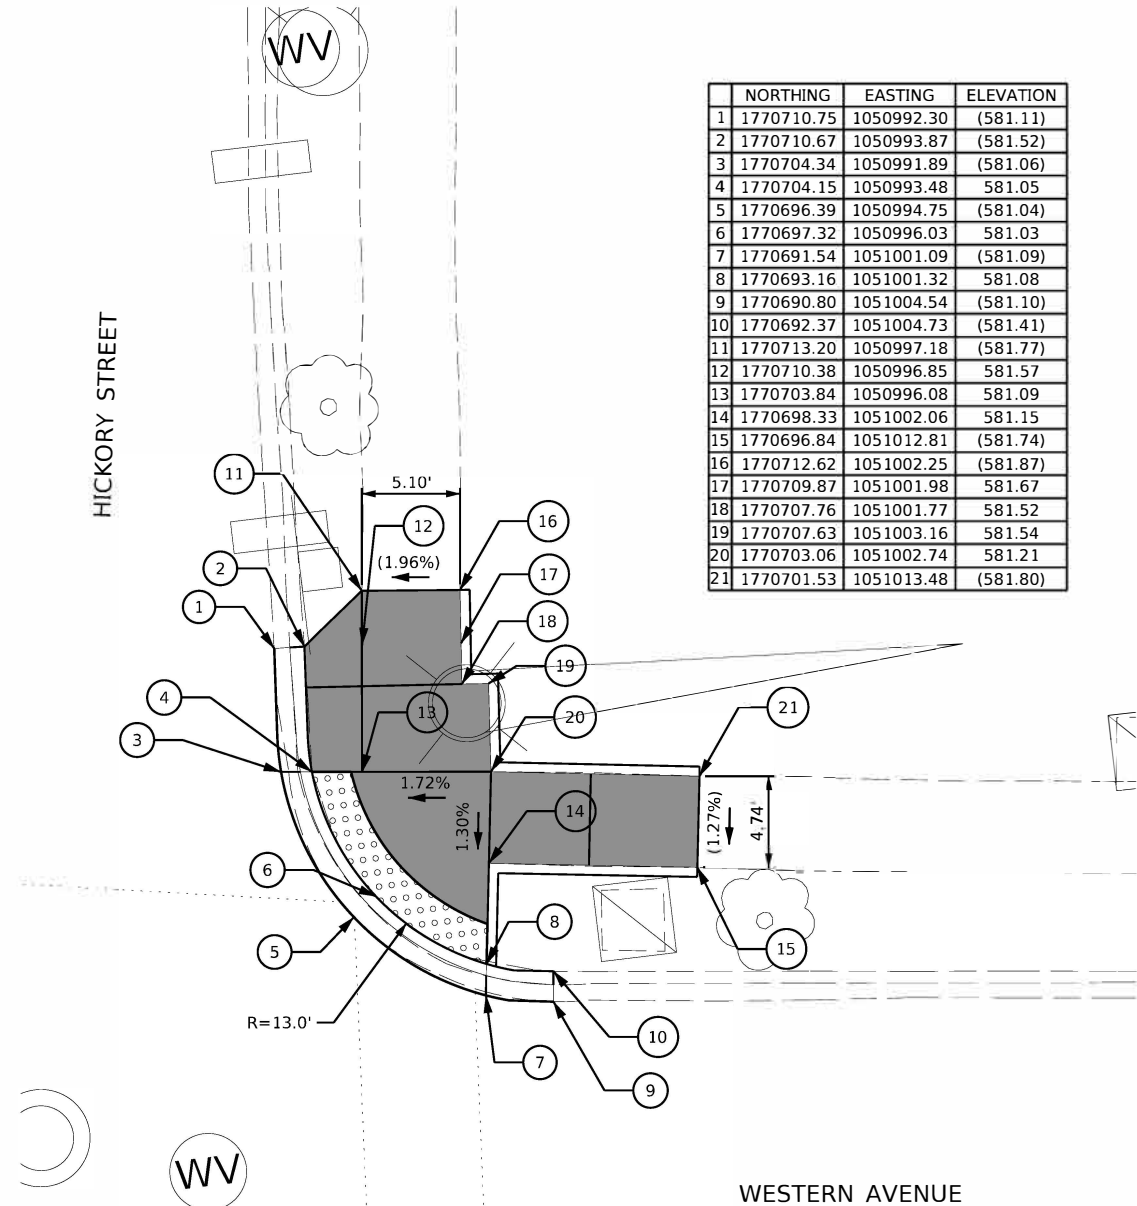


REFERENCE BENCHMARK ELEVATION: 581.93

BENCHMARK 204: CUT SQUARE AT SOUTHWEST CORNER OF TRAFFIC SIGNAL CONTROL BOX FOUNDATION AT NORTHEAST CORNER OF HICKORY ST. AND WESTERN AVE.


**LEGEND**

	DETECTABLE WARNINGS		PCC SIDEWALK, 5 INCH
	EXISTING ELEVATION / SLOPE		CONCRETE CURB, TYPE B
	COMBINATION CONCRETE CURB AND GUTTER		

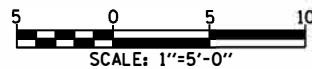

**LEGEND**

	DETECTABLE WARNINGS		PCC SIDEWALK, 5 INCH
	EXISTING ELEVATION / SLOPE		CONCRETE CURB, TYPE B
	COMBINATION CONCRETE CURB AND GUTTER		

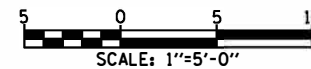

MODEL: \\MODEL\NAME: FILE: NAME: L:\7162\_03\CAD\Drawings\ADA\_Ramps\62P35\_ADA\_2\_Ramps\_2 & 3.dgn

USER NAME = rmitchel	DESIGNED - RAM	REVISED	ADDENDUM A 04/08/22
PLOT SCALE = 1:10	DRAWN - RAM	REVISED -	
PLOT DATE = 4/8/2022	CHECKED - CEL	REVISED -	
	DATE - 4/8/2022	REVISED -	

**STATE OF ILLINOIS  
DEPARTMENT OF TRANSPORTATION**


**JOLIET TOWNSHIP - ADA IMPROVEMENTS  
VARIOUS LOCATIONS (JOLIET TOWNSHIP)**

SCALE: SHEET OF SHEETS STA. TO STA.

F.A. RTE.	SECTION	COUNTY	TOTAL SHEETS	SHEET NO.
VAR	2021-112-SW	WILL	114	28
			CONTRACT NO. 62P35	
ILLINOIS FED. AID PROJECT				

REVISED ENTIRE SHEET 4/13/2022

WESTERN AVENUE

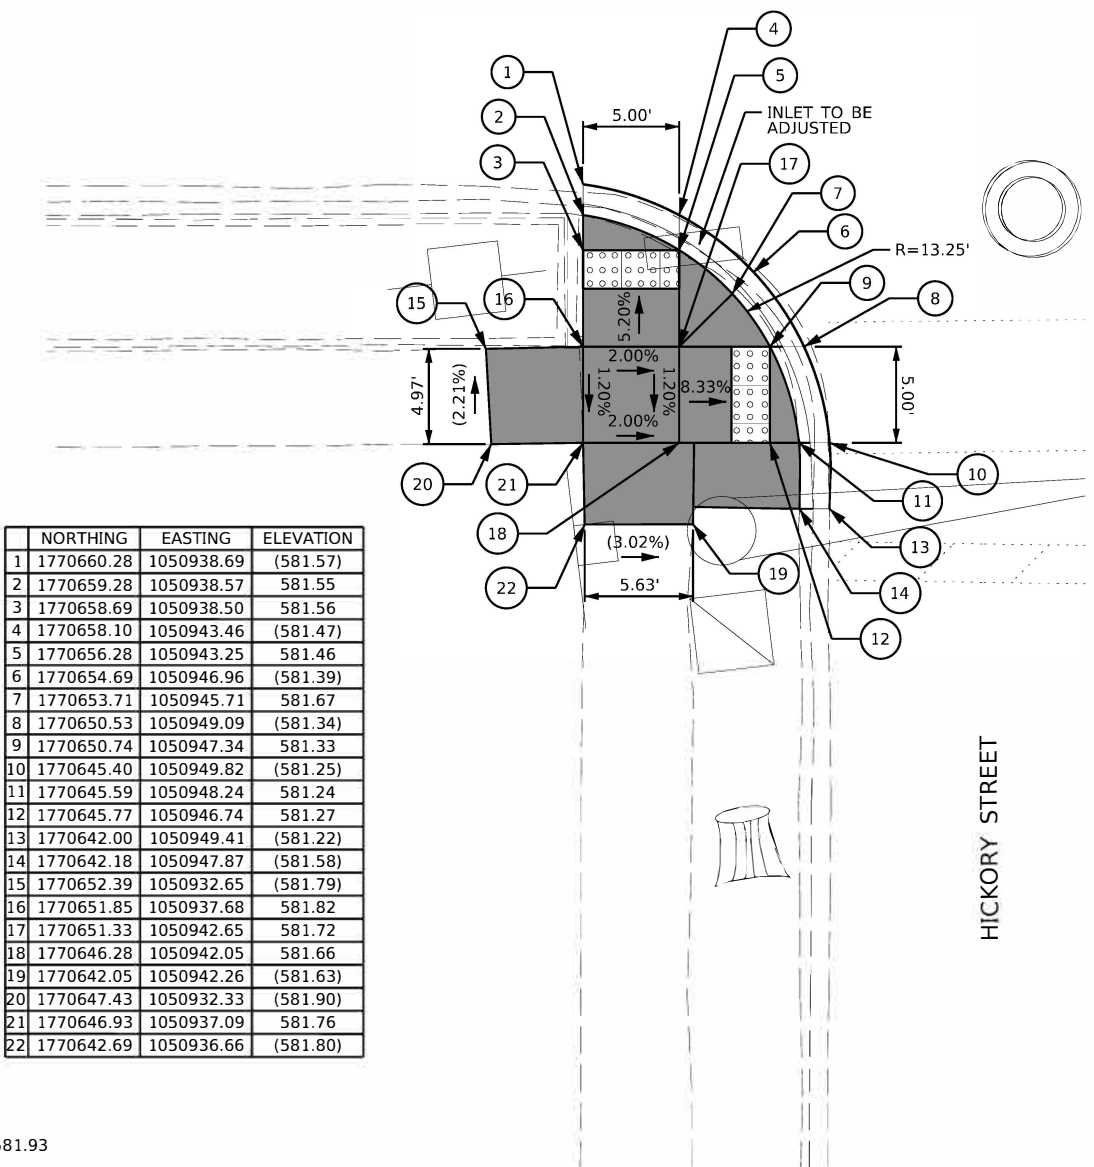


	NORTHING	EASTING	ELEVATION
1	1770660.28	1050938.69	(581.57)
2	1770659.28	1050938.57	581.55
3	1770658.69	1050938.50	581.56
4	1770658.10	1050943.46	(581.47)
5	1770656.28	1050943.25	581.46
6	1770654.69	1050946.96	(581.39)
7	1770653.71	1050945.71	581.67
8	1770650.53	1050949.09	(581.34)
9	1770650.74	1050947.34	581.33
10	1770645.40	1050949.82	(581.25)
11	1770645.59	1050948.24	581.24
12	1770645.77	1050946.74	581.27
13	1770642.00	1050949.41	(581.22)
14	1770642.18	1050947.87	(581.58)
15	1770652.39	1050932.65	(581.79)
16	1770651.85	1050937.68	581.82
17	1770651.33	1050942.65	581.72
18	1770646.28	1050942.05	581.66
19	1770642.05	1050942.26	(581.63)
20	1770647.43	1050932.33	(581.90)
21	1770646.93	1050937.09	581.76
22	1770642.69	1050936.66	(581.80)

REFERENCE BENCHMARK ELEVATION: 581.93


BENCHMARK 204: CUT SQUARE AT SOUTHWEST CORNER OF TRAFFIC SIGNAL CONTROL BOX FOUNDATION AT NORTHEAST CORNER OF HICKORY ST. AND WESTERN AVE.

**LEGEND**

	DETECTABLE WARNINGS		PCC SIDEWALK, 5 INCH
( )	EXISTING ELEVATION / SLOPE		
	CONCRETE CURB, TYPE B		
	COMBINATION CONCRETE CURB AND GUTTER		

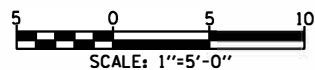


WESTERN AVENUE

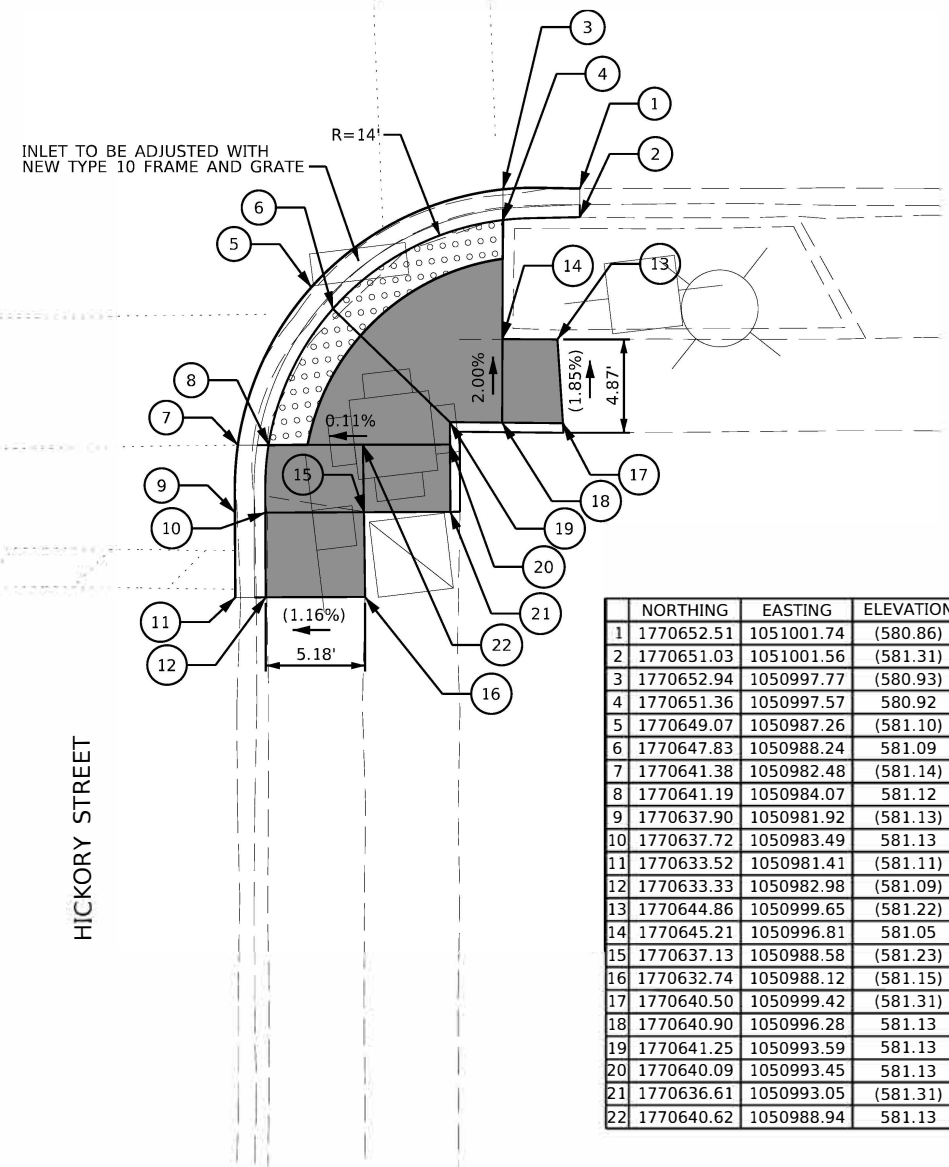

	NORTHING	EASTING	ELEVATION
1	1770652.51	1051001.74	(580.86)
2	1770651.03	1051001.56	(581.31)
3	1770652.94	1050997.77	(580.93)
4	1770651.36	1050997.57	580.92
5	1770649.07	1050987.26	(581.10)
6	1770647.83	1050988.24	581.09
7	1770641.38	1050982.48	(581.14)
8	1770641.19	1050984.07	581.12
9	1770637.90	1050981.92	(581.13)
10	1770637.72	1050983.49	581.13
11	1770633.52	1050981.41	(581.11)
12	1770633.33	1050982.98	(581.09)
13	1770644.86	1050999.65	(581.22)
14	1770645.21	1050996.81	581.05
15	1770637.13	1050988.58	(581.23)
16	1770632.74	1050988.12	(581.15)
17	1770640.50	1050999.42	(581.31)
18	1770640.90	1050996.28	581.13
19	1770641.25	1050993.59	581.13
20	1770640.09	1050993.45	581.13
21	1770636.61	1050993.05	(581.31)
22	1770640.62	1050988.94	581.13

**LEGEND**

	DETECTABLE WARNINGS		PCC SIDEWALK, 5 INCH
( )	EXISTING ELEVATION / SLOPE		
	CONCRETE CURB, TYPE B		
	COMBINATION CONCRETE CURB AND GUTTER		

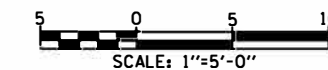

MODEL: 40001001.DWG  
FILE NAME: L:\17762\_03\CAD\17762\_03\62P35\_ADA\_3\_Ramps\_4\_6\_5.dwg

USER NAME = rmitchel	DESIGNED - RAM	REVISED - ADDENDUM A 04/08/22
PLOT SCALE = 1:10	DRAWN - RAM	REVISED -
PLOT DATE = 4/8/2022	CHECKED - CEL	REVISED -
	DATE - 4/8/2022	REVISED -

**STATE OF ILLINOIS  
DEPARTMENT OF TRANSPORTATION**

**JOLIET TOWNSHIP - ADA IMPROVEMENTS  
VARIOUS LOCATIONS (JOLIET TOWNSHIP)**

SCALE: SHEET OF SHEETS STA. TO STA.

F.A. RTE.	SECTION	COUNTY	TOTAL SHEETS	SHEET NO.
VAR	2021-112-SW	WILL	114	29
CONTRACT NO. 62P35			ILLINOIS   FED. AID PROJECT	


REVISD ENTIRE SHEET 4/13/2022



REFERENCE BENCHMARK ELEVATION: 540.11


BENCHMARK 202: CUT SQUARE AT SOUTHEAST CORNER OF CONCRETE TRAFFIC SIGNAL CONTROLLER BOX FOUNDATION

	NORTHING	EASTING	ELEVATION
1	1770645.28	1052370.23	535.98
2	1770641.28	1052369.28	536.06
3	1770645.28	1052368.73	536.02
4	1770641.28	1052367.63	536.10
5	1770645.28	1052364.47	536.29
6	1770641.28	1052364.47	536.34
7	1770645.28	1052360.47	(536.34)
8	1770641.28	1052360.47	(536.40)
9	1770634.18	1052360.47	536.17
10	1770636.82	1052364.47	536.13
11	1770632.41	1052360.47	536.17
12	1770634.69	1052364.47	536.13
13	1770631.69	1052358.36	536.20
14	1770633.34	1052357.85	(536.43)
15	1770639.43	1052366.63	536.30
16	1770648.34	1052370.39	535.96
17	1770648.32	1052368.89	536.17
18	1770638.82	1052360.47	(536.40)

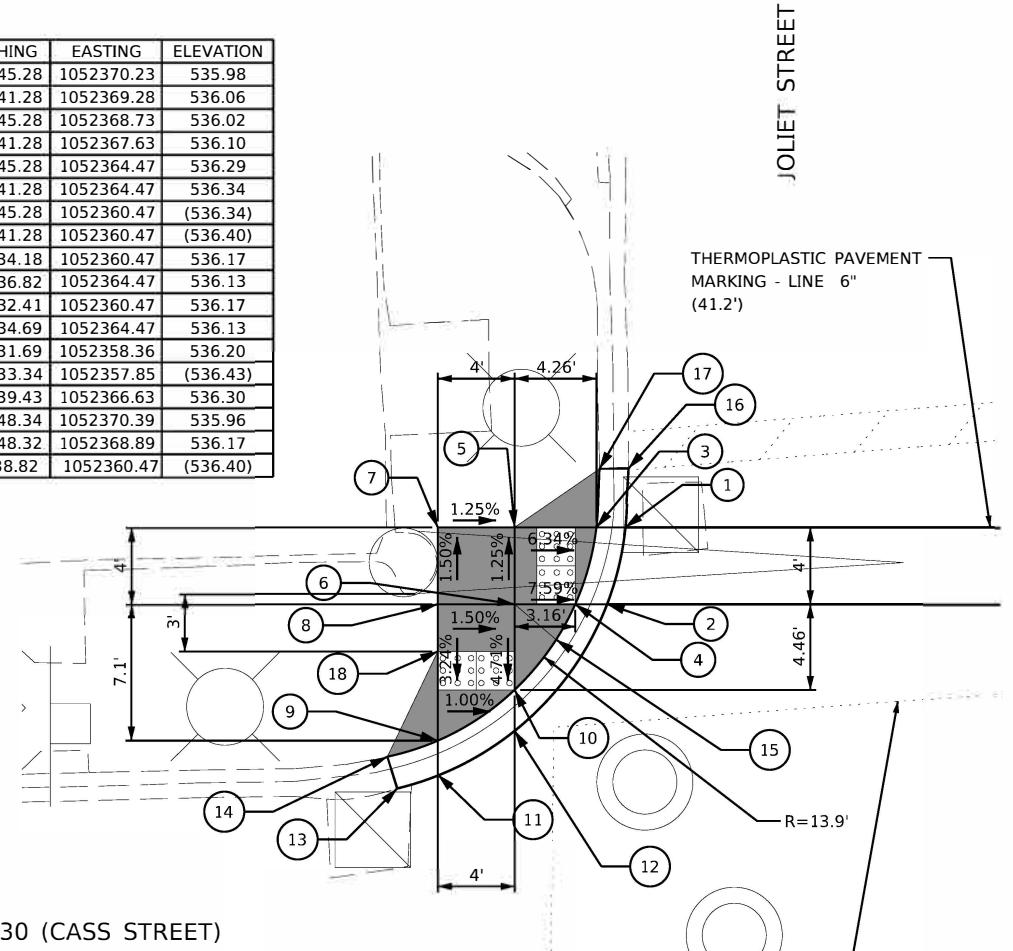


**LEGEND**

	DETECTABLE WARNINGS		PCC SIDEWALK, 5 INCH
	EXISTING ELEVATION / SLOPE		
	CONCRETE CURB, TYPE B		
	COMBINATION CONCRETE CURB AND GUTTER		

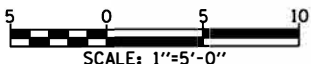


	NORTHING	EASTING	ELEVATION
1	1770645.28	1052411.41	535.96
2	1770635.76	1052419.42	536.07
3	1770637.24	1052419.42	536.07
4	1770641.33	1052419.42	536.09
5	1770645.28	1052419.42	536.11
6	1770645.28	1052415.99	536.05
7	1770645.28	1052412.98	536.00
8	1770651.10	1052415.79	(536.41)
9	1770651.09	1052419.42	(536.53)
10	1770645.28	1052429.37	(536.55)
11	1770641.33	1052429.50	(536.52)

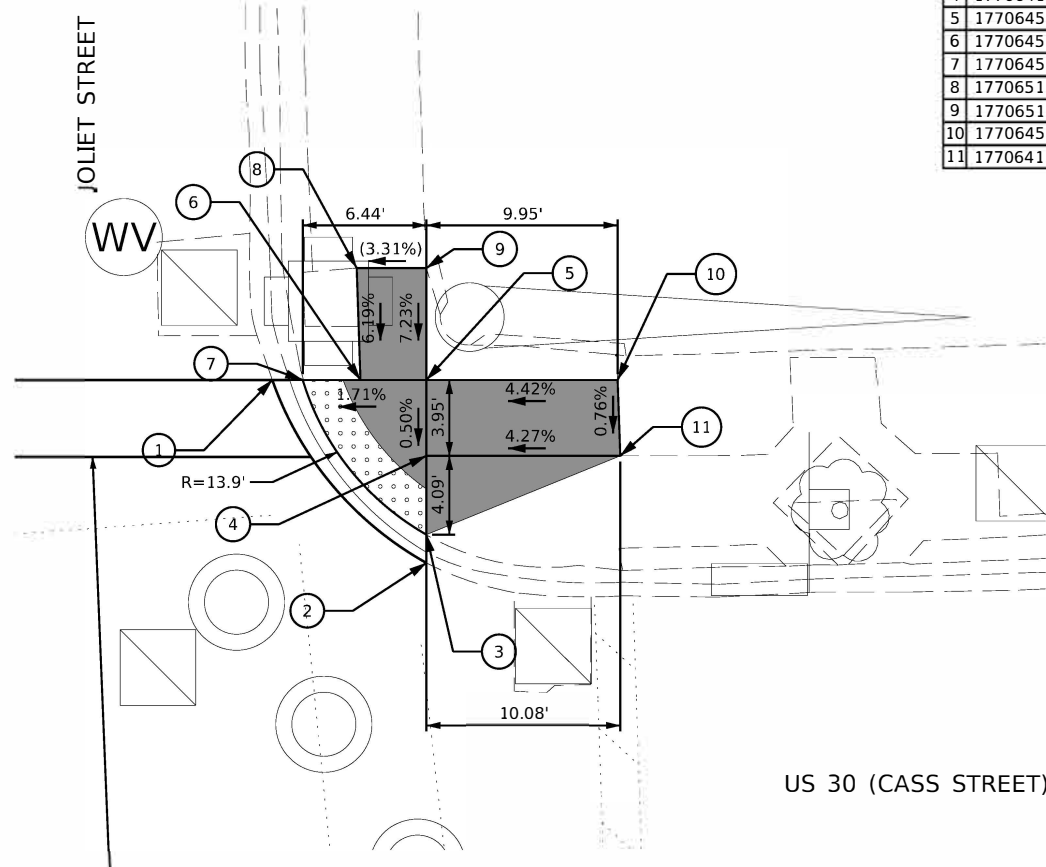

**LEGEND**

	DETECTABLE WARNINGS		PCC SIDEWALK, 5 INCH
	EXISTING ELEVATION / SLOPE		
	CONCRETE CURB, TYPE B		
	COMBINATION CONCRETE CURB AND GUTTER		

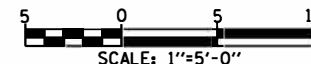

MODEL: #MODELNAME  
FILE: NAME: L:\7162\_03\CAD\Drawings\ADA\_Ramps\62P35\_ADA\_4\_Ramps\_5 & 7.dgn

USER NAME = rmitchel	DESIGNED - RAM	REVISED - ADDENDUM A 04/08/22
PLOT SCALE = 1:10	DRAWN - RAM	REVISED -
PLOT DATE = 4/8/2022	CHECKED - CEL	REVISED -
	DATE - 4/8/2022	REVISED -

STATE OF ILLINOIS  
DEPARTMENT OF TRANSPORTATION

JOLIET TOWNSHIP - ADA IMPROVEMENTS  
VARIOUS LOCATIONS (JOLIET TOWNSHIP)

SCALE: SHEET OF SHEETS STA. TO STA.

1 REVISED ENTIRE SHEET 4/13/2022				
F.A. RTE.	SECTION	COUNTY	TOTAL SHEETS	SHEET NO.
VAR	2021-112-SW	WILL	114	36
			CONTRACT NO. 62P35	
ILLINOIS   FED. AID PROJECT				




REFERENCE BENCHMARK ELEVATION: 539.24

BENCHMARK 207: CUT SQUARE AT NORTHWEST CORNER OF CONCRETE TRAFFIC SIGNAL CONTROLLER BOX FOUNDATION AT SOUTHEAST CORNER OF SCOTT STREET & US 30.



	NORTHING	EASTING	ELEVATION
1	1770660.36	1053533.98	539.12
2	1770662.43	1053539.94	539.12
3	1770661.91	1053533.95	539.12
4	1770664.27	1053539.92	539.13
5	1770668.58	1053533.83	(539.37)
6	1770668.71	1053539.83	539.28
7	1770674.59	1053533.72	(539.32)
8	1770674.71	1053539.72	539.23
9	1770680.58	1053533.59	(539.30)
10	1770680.71	1053539.61	539.21
11	1770683.28	1053533.53	(539.18)
12	1770683.55	1053539.55	(539.08)
13	1770680.82	1053544.78	538.84
14	1770674.82	1053544.65	539.00
15	1770683.96	1053546.23	(538.70)
16	1770683.87	1053544.71	539.20
17	1770668.56	1053543.44	539.54
18	1770660.49	1053530.36	(539.11)
19	1770662.02	1053530.61	539.52
20	1770680.86	1053546.40	538.80
21	1770674.85	1053546.16	538.96

SCOTT STREET

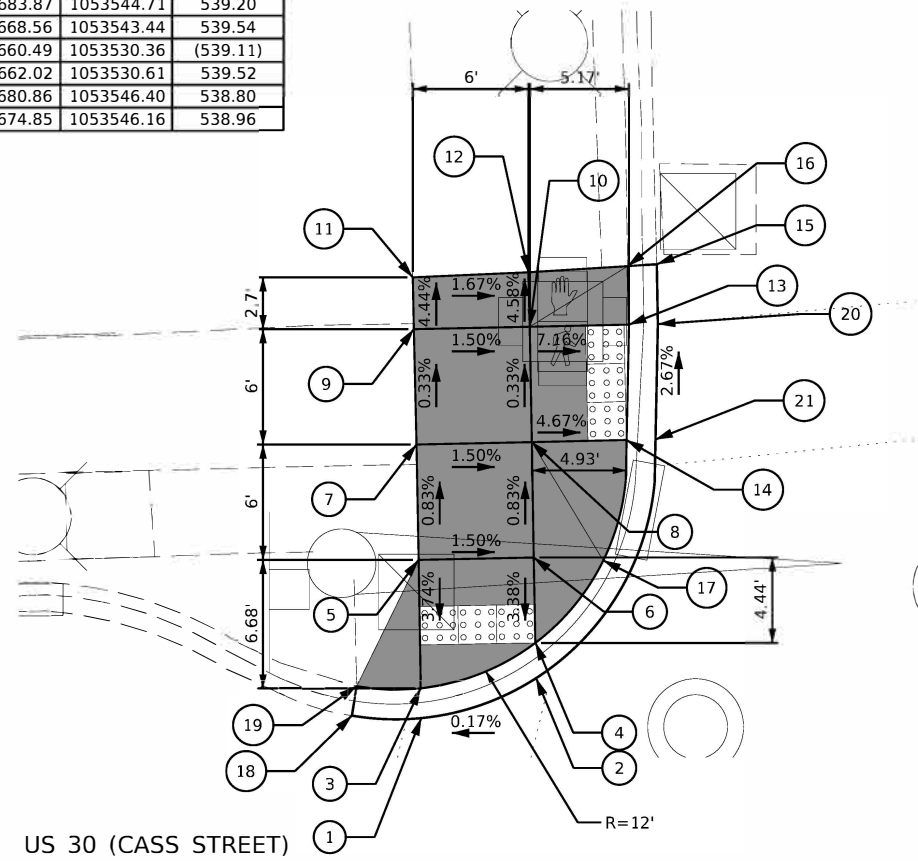


**LEGEND**

	DETECTABLE WARNINGS		PCC SIDEWALK, 5 INCH
( )	EXISTING ELEVATION / SLOPE		
	CONCRETE CURB, TYPE B		
	COMBINATION CONCRETE CURB AND GUTTER		

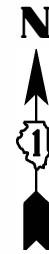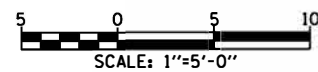


	NORTHING	EASTING	ELEVATION
1	1770682.89	1053585.41	538.37
2	1770676.91	1053587.26	538.45
3	1770682.90	1053586.71	538.37
4	1770676.92	1053589.04	538.45
5	1770682.98	1053596.67	538.49
6	1770676.98	1053596.68	538.48
7	1770683.02	1053602.67	538.58
8	1770677.02	1053602.68	538.57
9	1770683.14	1053607.67	538.31
10	1770677.15	1053607.68	538.50
11	1770672.74	1053602.69	538.31
12	1770673.06	1053596.68	538.29
13	1770671.25	1053602.69	538.31
14	1770671.53	1053596.69	538.29
15	1770685.63	1053585.44	538.34
16	1770685.32	1053586.96	538.63
17	1770671.30	1053605.70	538.12
18	1770672.79	1053605.66	538.56
19	1770674.12	1053593.12	538.40

SCOTT STREET

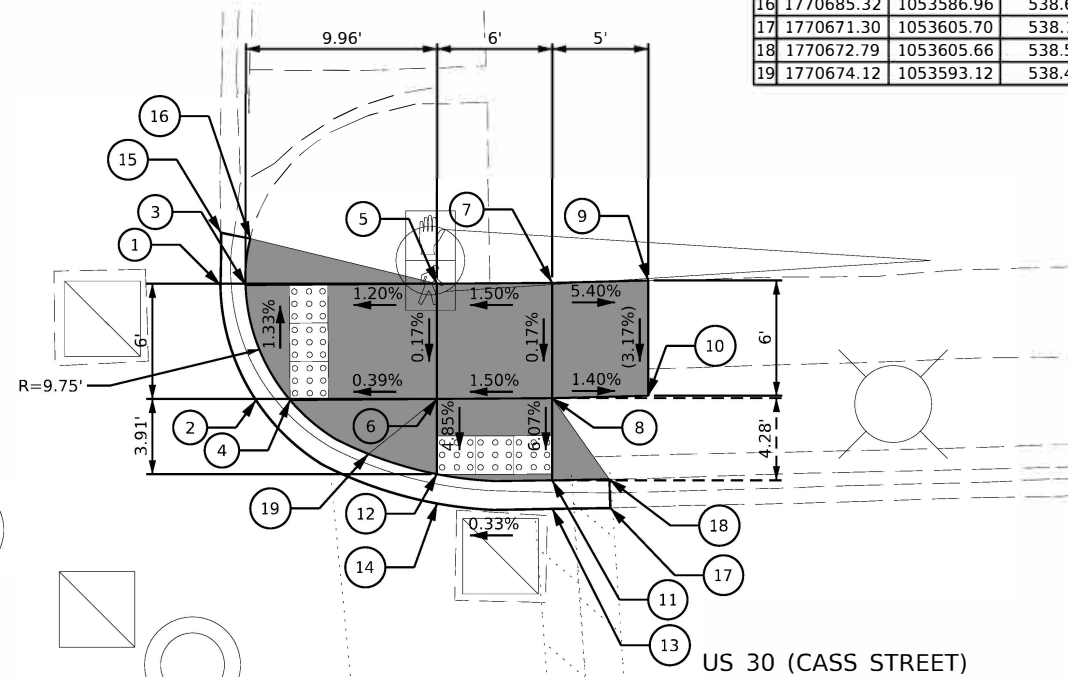

**LEGEND**

	DETECTABLE WARNINGS		PCC SIDEWALK, 5 INCH
( )	EXISTING ELEVATION / SLOPE		
	CONCRETE CURB, TYPE B		
	COMBINATION CONCRETE CURB AND GUTTER		

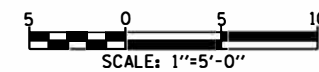

MODEL: \\MODEL\NAME: FILE: NAME: L:\17162\_03\CAD\Drawings\ADA\_Ramps\62P35\_ADA\_5\_Ramps\_8\_9.dgn

USER NAME = rmitchel	DESIGNED - RAM	REVISED - ADDENDUM A 04/08/22
PLOT SCALE = 1:10	DRAWN - RAM	REVISED -
PLOT DATE = 4/8/2022	CHECKED - CEL	REVISED -
	DATE - 4/8/2022	REVISED -

**STATE OF ILLINOIS  
DEPARTMENT OF TRANSPORTATION**

**JOLIET TOWNSHIP - ADA IMPROVEMENTS  
VARIOUS LOCATIONS (JOLIET TOWNSHIP)**

SCALE: SHEET OF SHEETS STA. TO STA.


REVISD ENTIRE SHEET 4/13/2022			
F.A. RTE.	SECTION	COUNTY	TOTAL SHEETS
VAR	2021-112-SW	WILL	114
			NO. 40
			CONTRACT NO. 62P35
ILLINOIS   FED. AID PROJECT			




**LEGEND**

	DETECTABLE WARNINGS		PCC SIDEWALK, 5 INCH
( )	EXISTING ELEVATION / SLOPE		
	CONCRETE CURB, TYPE B		
	COMBINATION CONCRETE CURB AND GUTTER		

US 30 (CASS STREET)

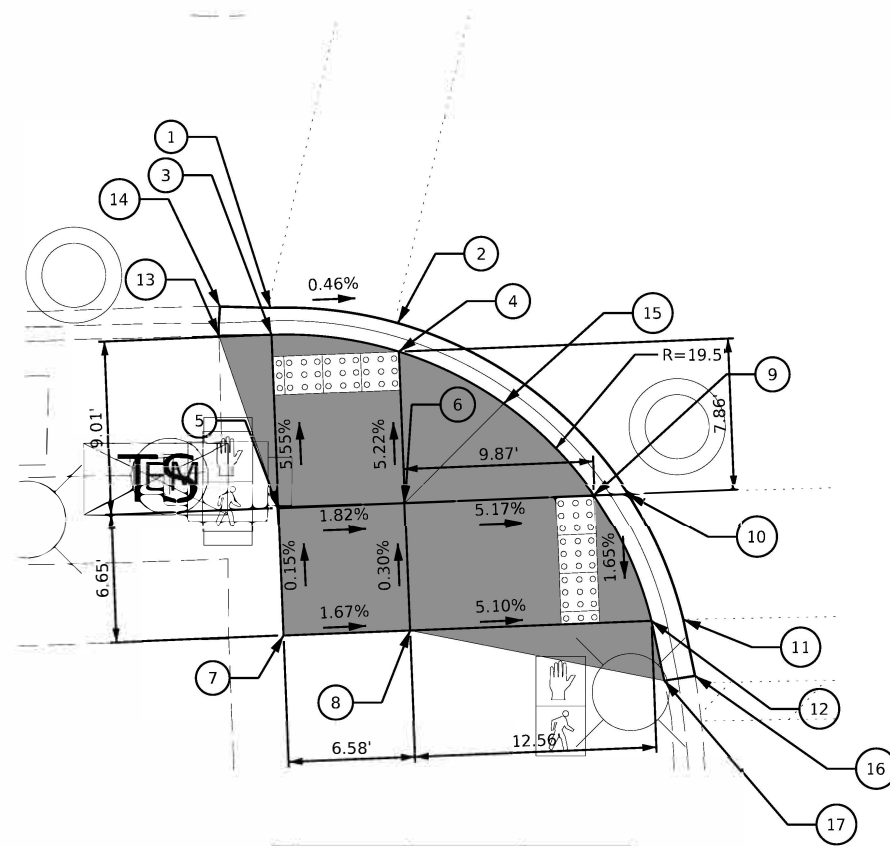

	NORTHING	EASTING	ELEVATION
1	1770632.09	1053526.67	538.88
2	1770631.30	1053533.29	538.89
3	1770630.70	1053526.72	538.92
4	1770629.82	1053533.35	538.89
5	1770621.70	1053527.08	(539.42)
6	1770621.96	1053533.66	539.30
7	1770615.06	1053527.35	(539.43)
8	1770615.32	1053533.93	(539.32)
9	1770622.36	1053543.53	538.79
10	1770622.43	1053545.31	538.79
11	1770615.89	1053548.13	538.64
12	1770615.82	1053546.48	538.68
13	1770630.66	1053523.98	539.00
14	1770632.16	1053524.03	538.87
15	1770627.12	1053538.80	539.32
16	1770612.96	1053548.75	538.62
17	1770612.71	1053547.15	539.00

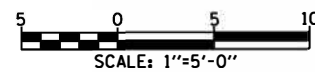


SCOTT STREET

MODEL: \\MODEL\NAME: FILE: NAME: L:\17762\_03\CAD\US30\ADA\_Ramps\62P35\_ADA\_6\_Ramps\_10\_ & 11.dgn


**LEGEND**

	DETECTABLE WARNINGS		PCC SIDEWALK, 5 INCH
( )	EXISTING ELEVATION / SLOPE		
	CONCRETE CURB, TYPE B		
	COMBINATION CONCRETE CURB AND GUTTER		

US 30 (CASS STREET)

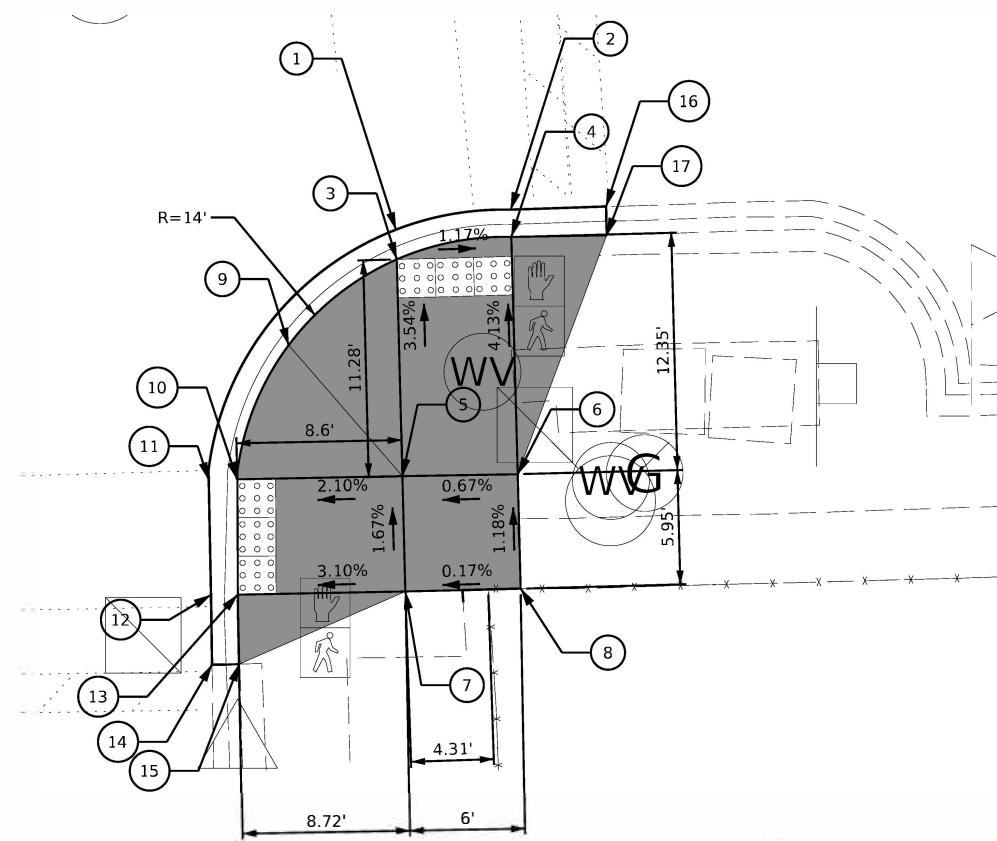

	NORTHING	EASTING	ELEVATION
1	1770636.22	1053597.03	538.27
2	1770637.26	1053603.00	538.20
3	1770634.66	1053597.07	538.27
4	1770635.83	1053603.04	538.20
5	1770623.38	1053597.36	538.67
6	1770623.49	1053603.36	(538.71)
7	1770617.38	1053597.52	(538.77)
8	1770617.54	1053603.52	(538.78)
9	1770630.20	1053591.45	538.94
10	1770623.23	1053588.77	538.49
11	1770623.20	1053587.29	538.49
12	1770617.20	1053587.40	538.50
13	1770617.23	1053588.80	538.50
14	1770613.58	1053587.46	538.53
15	1770613.61	1053588.88	538.82
16	1770637.42	1053607.96	538.33
17	1770635.92	1053607.99	538.48

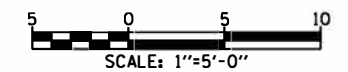

SCOTT STREET

REFERENCE BENCHMARK ELEVATION: 539.24

BENCHMARK 207: CUT SQUARE AT NORTHWEST CORNER OF CONCRETE TRAFFIC SIGNAL CONTROLLER BOX FOUNDATION AT SOUTHEAST CORNER OF SCOTT STREET & US 30.

REVISIONS: 1 REVISED ENTIRE SHEET 4/13/2022

USER NAME = rmitchel	DESIGNED - RAM	REVISED - ADDENDUM A 04/08/22
PLOT SCALE = 1:10	DRAWN - RAM	REVISED -
PLOT DATE = 4/8/2022	CHECKED - CEL	REVISED -
	DATE - 4/8/2022	REVISED -

STATE OF ILLINOIS  
DEPARTMENT OF TRANSPORTATION

JOLIET TOWNSHIP - ADA IMPROVEMENTS  
VARIOUS LOCATIONS (JOLIET TOWNSHIP)

SCALE: SHEET OF SHEETS STA. TO STA.


F.A. RTE.	SECTION	COUNTY	TOTAL SHEETS	SHEET NO.
VAR	2021-112-SW	WILL	114	41
			CONTRACT NO. 62P35	
ILLINOIS FED. AID PROJECT				



	NORTHING	EASTING	ELEVATION
1	1770696.44	1054950.98	(539.85)
2	1770700.66	1054956.98	540.00
3	1770697.95	1054950.98	539.89
4	1770703.11	1054956.98	540.04
5	1770708.36	1054950.98	(540.15)
6	1770708.36	1054956.98	540.22
7	1770714.36	1054950.98	(540.26)
8	1770714.36	1054956.98	(540.31)
9	1770716.24	1054959.66	(540.27)
10	1770716.20	1054961.20	540.14
11	1770714.36	1054959.64	540.14
12	1770714.36	1054961.01	(540.14)
13	1770708.36	1054960.48	(540.18)
14	1770708.36	1054958.98	540.18
15	1770695.54	1054947.55	(539.66)
16	1770696.84	1054947.43	(539.82)
17	1770706.17	1054958.34	540.18

LEGEND	
	DETECTABLE WARNINGS
	EXISTING ELEVATION / SLOPE
	CONCRETE CURB, TYPE B
	COMBINATION CONCRETE CURB AND GUTTER
	PCC SIDEWALK, 5 INCH

EASTERN AVENUE

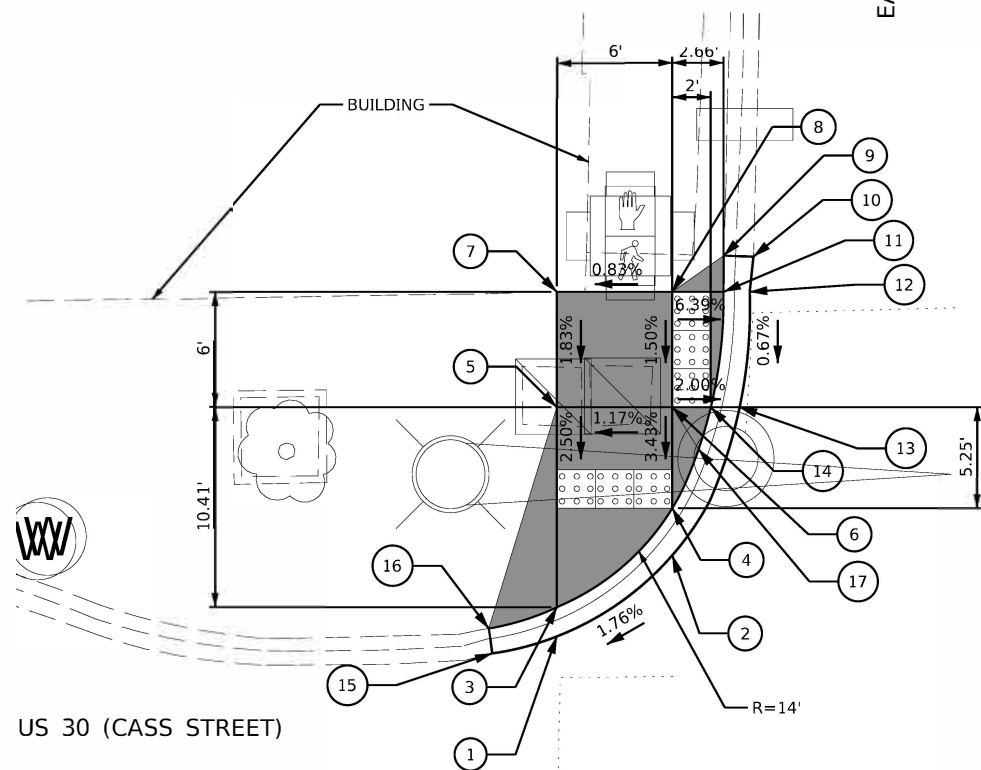

US 30 (CASS STREET)

R=14'



REFERENCE BENCHMARK ELEVATION: 541.76


BENCHMARK 208: CUT SQUARE AT SOUTHWEST CORNER OF CONCRETE TRAFFIC SIGNAL CONTROLLER BOX FOUNDATION AT SOUTHWEST CORNER OF CONCRETE TRAFFIC SIGNAL CONTROLLER BOX FOUNDATION AT NORTHEAST CORNER OF EASTERN AVENUE & US 30.



LEGEND	
	DETECTABLE WARNINGS
	EXISTING ELEVATION / SLOPE
	CONCRETE CURB, TYPE B
	COMBINATION CONCRETE CURB AND GUTTER
	PCC SIDEWALK, 5 INCH


	NORTHING	EASTING	ELEVATION
1	1770714.36	1054989.80	540.56
2	1770708.36	1054989.25	540.69
3	1770714.36	1054991.52	540.60
4	1770708.36	1054990.90	540.69
5	1770714.36	1054998.74	541.16
6	1770708.36	1054998.74	541.07
7	1770714.36	1055004.75	(541.28)
8	1770708.36	1055004.74	(541.16)
9	1770716.34	1055004.79	(541.32)
10	1770721.16	1055004.89	(541.37)
11	1770721.23	1054998.74	(541.08)
12	1770716.34	1054998.74	541.20
13	1770696.01	1054998.72	540.91
14	1770695.39	1055004.72	540.94
15	1770697.40	1054998.72	540.91
16	1770696.84	1055004.72	540.94
17	1770696.54	1055009.04	541.37
18	1770695.17	1055008.99	(540.97)
19	1770716.34	1054992.08	(540.87)
20	1770717.00	1054990.62	(540.39)
21	1770701.39	1054992.99	541.00

EASTERN AVENUE

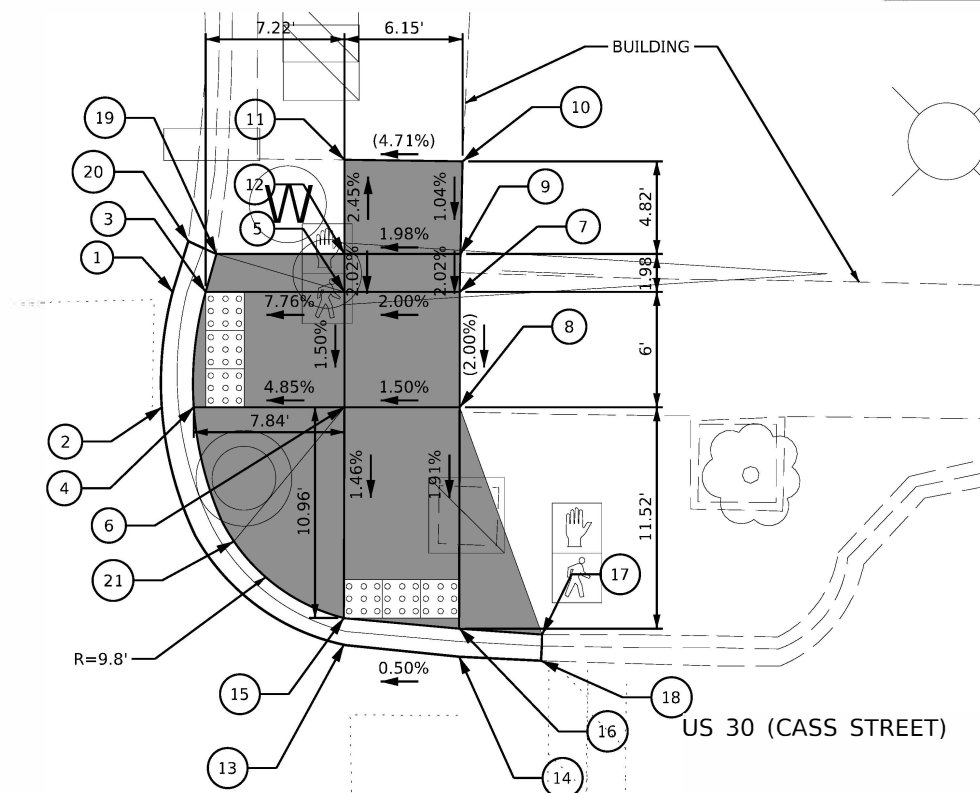

US 30 (CASS STREET)

R=9.8'

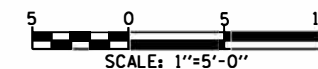

REVISIONS: REVISED ENTIRE SHEET 4/13/2022

MODEL: \\MODEL\NAME: FILE: NAME: L:\17762\_03\CAD\Drawings\ADA\_Ramps\62P35\_ADA 7\_Ramps\_12 & 13.dwg

USER NAME = rmitchel	DESIGNED - RAM	REVISED - ADDENDUM A 04/08/22
PLOT SCALE = 1:10	DRAWN - RAM	REVISED -
PLOT DATE = 4/8/2022	CHECKED - CEL	REVISED -
	DATE - 4/8/2022	REVISED -

STATE OF ILLINOIS DEPARTMENT OF TRANSPORTATION

JOLIET TOWNSHIP - ADA IMPROVEMENTS VARIOUS LOCATIONS (JOLIET TOWNSHIP)

SCALE: SHEET OF SHEETS STA. TO STA.


F.A. RTE.	SECTION	COUNTY	TOTAL SHEETS	SHEET NO.
VAR	2021-112-SW	WILL	114	45
CONTRACT NO. 62P35			ILLINOIS FED. AID PROJECT	

REFERENCE BENCHMARK ELEVATION: 541.76

BENCHMARK 208: CUT SQUARE AT SOUTHWEST CORNER OF CONCRETE TRAFFIC SIGNAL CONTROLLER BOX FOUNDATION AT NORTHEAST CORNER OF EASTERN AVENUE & US 30.



	NORTHING	EASTING	ELEVATION
1	1770663.00	1054949.79	539.81
2	1770657.91	1054955.79	539.89
3	1770661.39	1054949.79	539.81
4	1770655.56	1054955.79	539.89
5	1770651.71	1054949.79	(539.87)
6	1770651.71	1054955.79	539.96
7	1770645.71	1054949.79	(539.90)
8	1770645.71	1054955.79	(540.00)
9	1770651.71	1054957.79	540.00
10	1770645.71	1054959.15	540.03
11	1770651.71	1054959.28	539.99
12	1770645.71	1054960.56	540.03
13	1770663.45	1054948.44	(539.73)
14	1770661.97	1054948.00	(540.16)
15	1770643.41	1054960.73	539.97
16	1770643.25	1054959.31	540.07
17	1770653.11	1054957.17	540.25

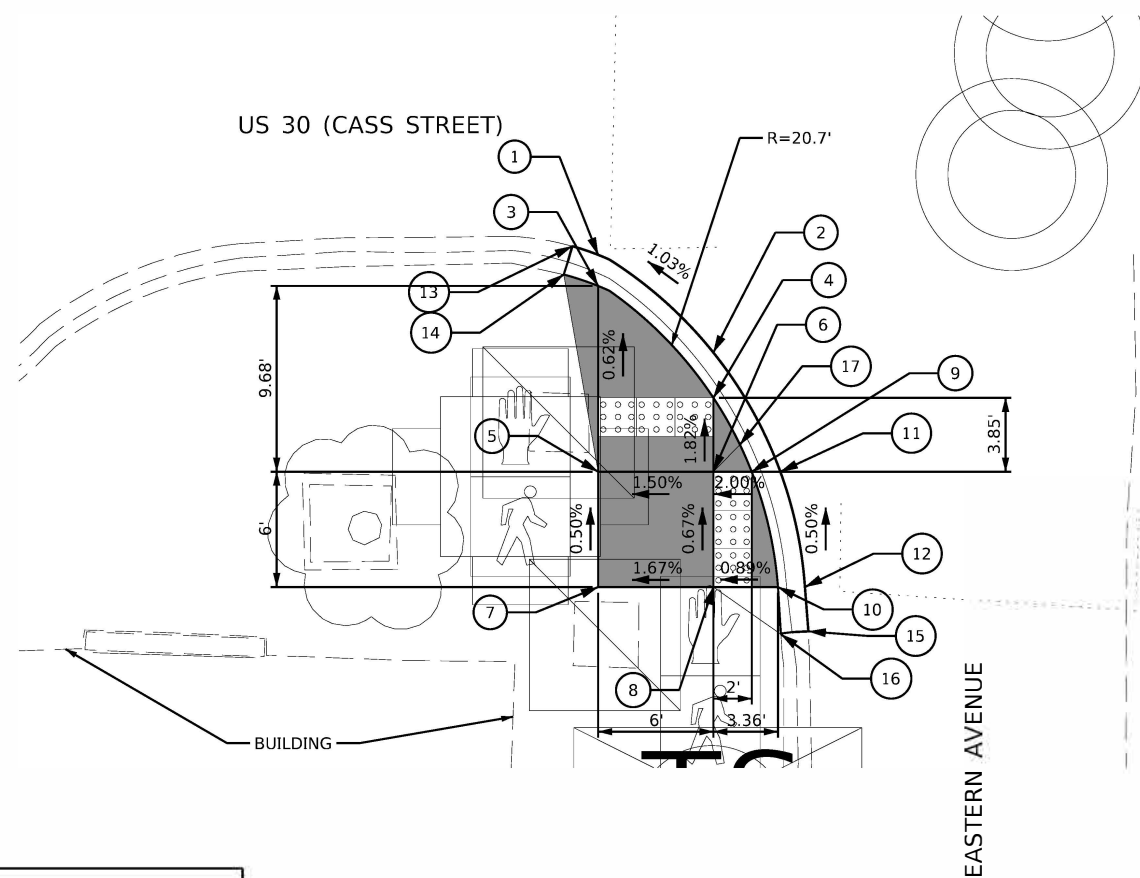

**LEGEND**

	DETECTABLE WARNINGS		PCC SIDEWALK, 5 INCH
( )	EXISTING ELEVATION / SLOPE		
	CONCRETE CURB, TYPE B		
	COMBINATION CONCRETE CURB AND GUTTER		



REVISED ENTIRE SHEET 4/13/2022

MODEL: s:\MODEL\NAME: FILE: NAME: 137762\_03\CAD\USheets\ADA\_Ramps\62P35\_ADA\_R Ramp\_14.dgn

USER NAME = rmitchel	DESIGNED - RAM	REVISED  ADDENDUM A 04/08/22
PLOT SCALE = 1:10	DRAWN - RAM	REVISED -
PLOT DATE = 4/8/2022	CHECKED - CEL	REVISED -
	DATE - 4/8/2022	REVISED -

**STATE OF ILLINOIS  
DEPARTMENT OF TRANSPORTATION**

**JOLIET TOWNSHIP - ADA IMPROVEMENTS  
VARIOUS LOCATIONS (JOLIET TOWNSHIP)**

SCALE: SHEET OF SHEETS STA. TO STA.

F.A. RTE.	SECTION	COUNTY	TOTAL SHEETS	SHEET NO.
VAR	2021-112-SW	WILL	114	46
			CONTRACT NO. 62P35	
ILLINOIS   FED. AID PROJECT				

IL 30 (Jefferson) & Hickory St - 10105 - NW

Design: JMW/7/27/15  
Scale: 1"=5'  
Check: MJB 8/18/15

Existing (xxx.xx)  
Proposed xxx.xx

IL 30 (Jefferson) & Hickory St - 10105 - SE

Design: JMW/7/27/15  
Scale: 1"=5'  
Check: MJB 8/18/15

Existing (xxx.xx)  
Proposed xxx.xx

US Rt 30  
(Jefferson St.)

FOR NW CORNER OF US 30 (JEFFERSON ST)  
AND HICKORY ST. SEE SHEET 51 A

\* move structure over.

E-5.273

E-5.275

REVISION SHEET 4/13/2022

STATE OF ILLINOIS  
DEPARTMENT OF TRANSPORTATION

JOLIET TOWNSHIP - ADA IMPROVEMENTS  
VARIOUS LOCATIONS (JOLIET TOWNSHIP)

F.A. RTE.	SECTION	COUNTY	TOTAL SHEETS	SHEET NO.
VAR	2021-112-SW	WILL	114	51
			CONTRACT NO. 62P35	

SCALE: SHEET OF SHEETS STA. TO STA.

ILLINOIS FED. AID PROJECT

MODEL: Default  
FILE: 10105\_10105.dwg

USER NAME	DESIGNED	REVISION
= khans	-	-
	DRAWN -	REVISION -
	CHECKED -	REVISION -
	DATE -	REVISION -


PLOT SCALE = 100.0000' / in.  
PLOT DATE = 4/11/2022



REFERENCE BENCHMARK ELEVATION: 573.13


BENCHMARK 203: CUT SQUARE AT NORTHEAST CORNER OF CONCRETE TRAFFIC SIGNAL CONTROLLER BOX FOUNDATION AT SOUTHWEST CORNER OF HICKORY & JEFFERSON/US 30.

	NORTHING	EASTING	ELEVATION
1	1769665.27	1050812.88	(572.85)
2	1769665.31	1050818.21	(572.29)
3	1769672.44	1050828.81	(572.31)
4	1769681.82	1050826.01	(572.82)
5	1769682.26	1050821.24	(572.86)
6	1769674.80	1050825.18	(572.34)
7	1769671.74	1050819.13	(572.33)
8	1769672.35	1050814.22	(572.61)
9	1769667.38	1050813.28	(572.67)
10	1769667.38	1050818.54	(572.32)

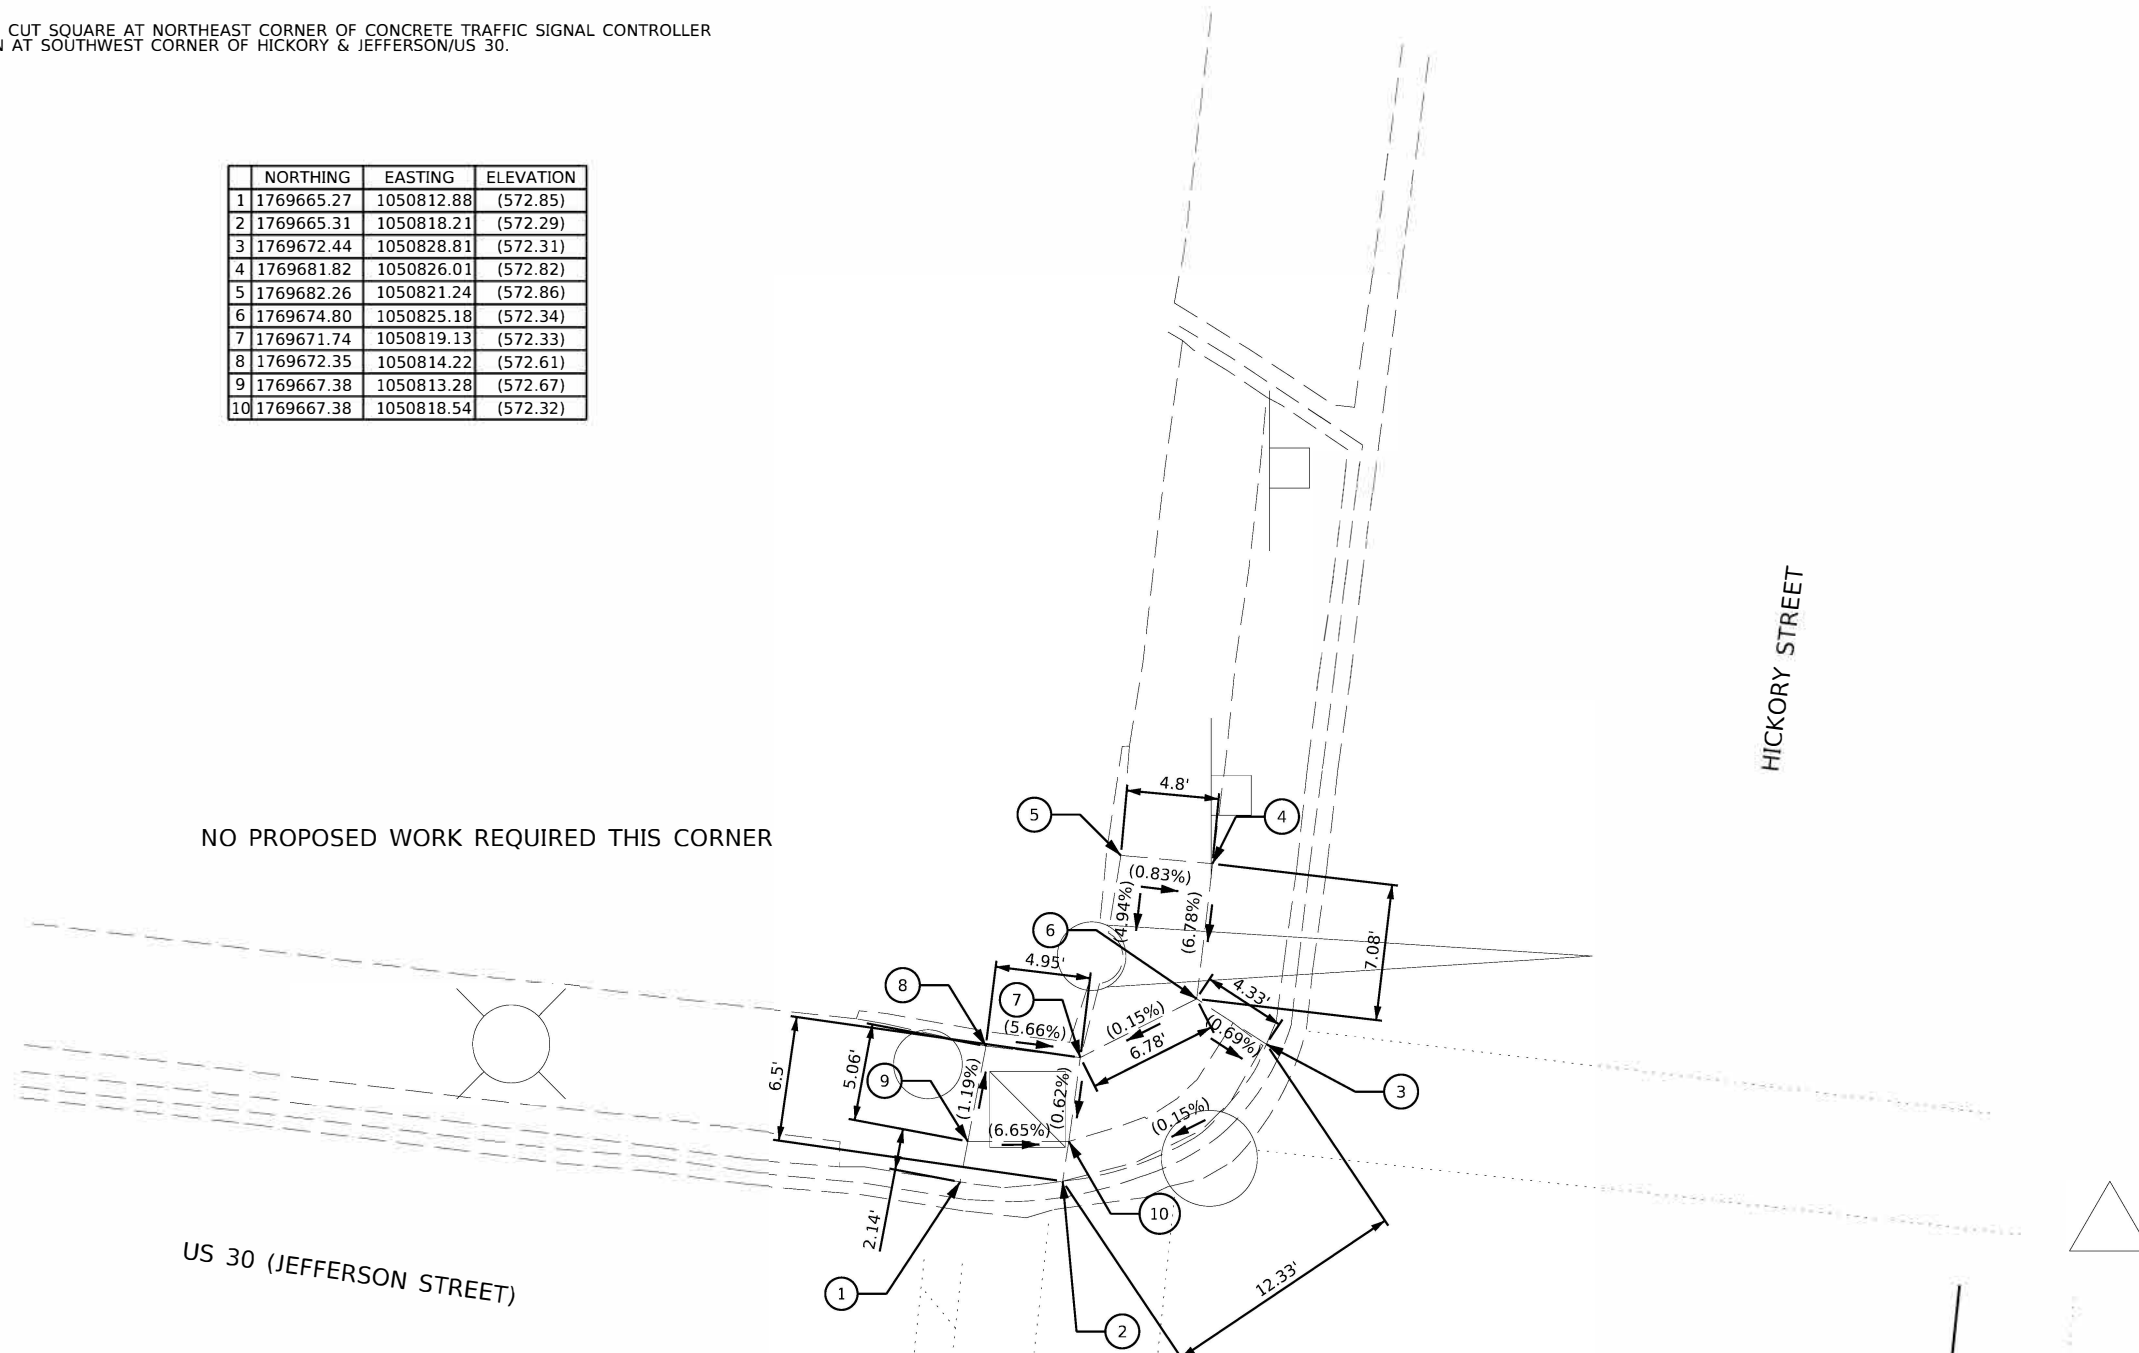

**LEGEND**

	DETECTABLE WARNINGS		PCC SIDEWALK, 5 INCH
	EXISTING ELEVATION / SLOPE		
	CONCRETE CURB, TYPE B		
	COMBINATION CONCRETE CURB AND GUTTER		

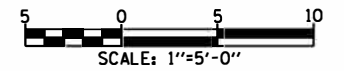

1 REVISED ENTIRE SHEET 4/13/2022

MODEL: 4MODELNAME: FILE: NAME: L:\1762\_03\CAD\Drawings\ADA\_Ramps\62P35\_ADA\_9\_Ramp\_15.dwg

USER NAME = rmitchel	DESIGNED - RAM	REVISED - ADDENDUM A 04/08/22
PLOT SCALE = 1:10	DRAWN - RAM	REVISED -
PLOT DATE = 4/8/2022	CHECKED - CEL	REVISED -
	DATE - 4/8/2022	REVISED -

**STATE OF ILLINOIS  
DEPARTMENT OF TRANSPORTATION**

**JOLIET TOWNSHIP - ADA IMPROVEMENTS  
VARIOUS LOCATIONS (JOLIET TOWNSHIP)**

F.A. RTE.	SECTION	COUNTY	TOTAL SHEETS	SHEET NO.
VAR	2021-112-SW	WILL	114	51A
			CONTRACT NO. 62P35	
ILLINOIS FED. AID PROJECT				



SCALE: SHEET OF SHEETS STA. TO STA.

REFERENCE BENCHMARK ELEVATION: 573.13

BENCHMARK 203: CUT SQUARE AT NORTHEAST CORNER OF CONCRETE TRAFFIC SIGNAL CONTROLLER BOX FOUNDATION AT SOUTHWEST CORNER OF HICKORY & JEFFERSON/US 30.

	NORTHING	EASTING	ELEVATION
1	1769603.41	1050824.94	(572.49)
2	1769607.56	1050823.61	(572.47)
3	1769612.67	1050817.10	(572.45)
4	1769613.79	1050813.04	(572.42)
5	1769607.42	1050811.12	(572.55)
6	1769606.49	1050815.63	(572.54)
7	1769602.68	1050814.72	(572.61)


	NORTHING	EASTING	ELEVATION
1	1769596.19	1050853.96	(571.31)
2	1769600.96	1050855.19	(571.37)
3	1769600.71	1050856.51	571.39
4	1769600.20	1050864.64	571.41
5	1769602.59	1050864.90	571.36
6	1769607.69	1050865.44	571.26
7	1769609.20	1050865.60	(571.22)
8	1769609.29	1050870.62	571.27
9	1769607.81	1050870.46	571.43
10	1769602.06	1050869.84	(571.52)
11	1769599.88	1050869.60	(571.67)
12	1769595.94	1050869.18	(571.94)
13	1769595.76	1050870.05	(572.02)
14	1769595.18	1050869.95	(572.02)
15	1769595.55	1050864.15	(571.76)
16	1769596.11	1050855.25	(571.59)
17	1769608.50	1050876.82	(571.00)
18	1769607.14	1050876.66	(571.45)
19	1769601.33	1050876.08	(571.56)

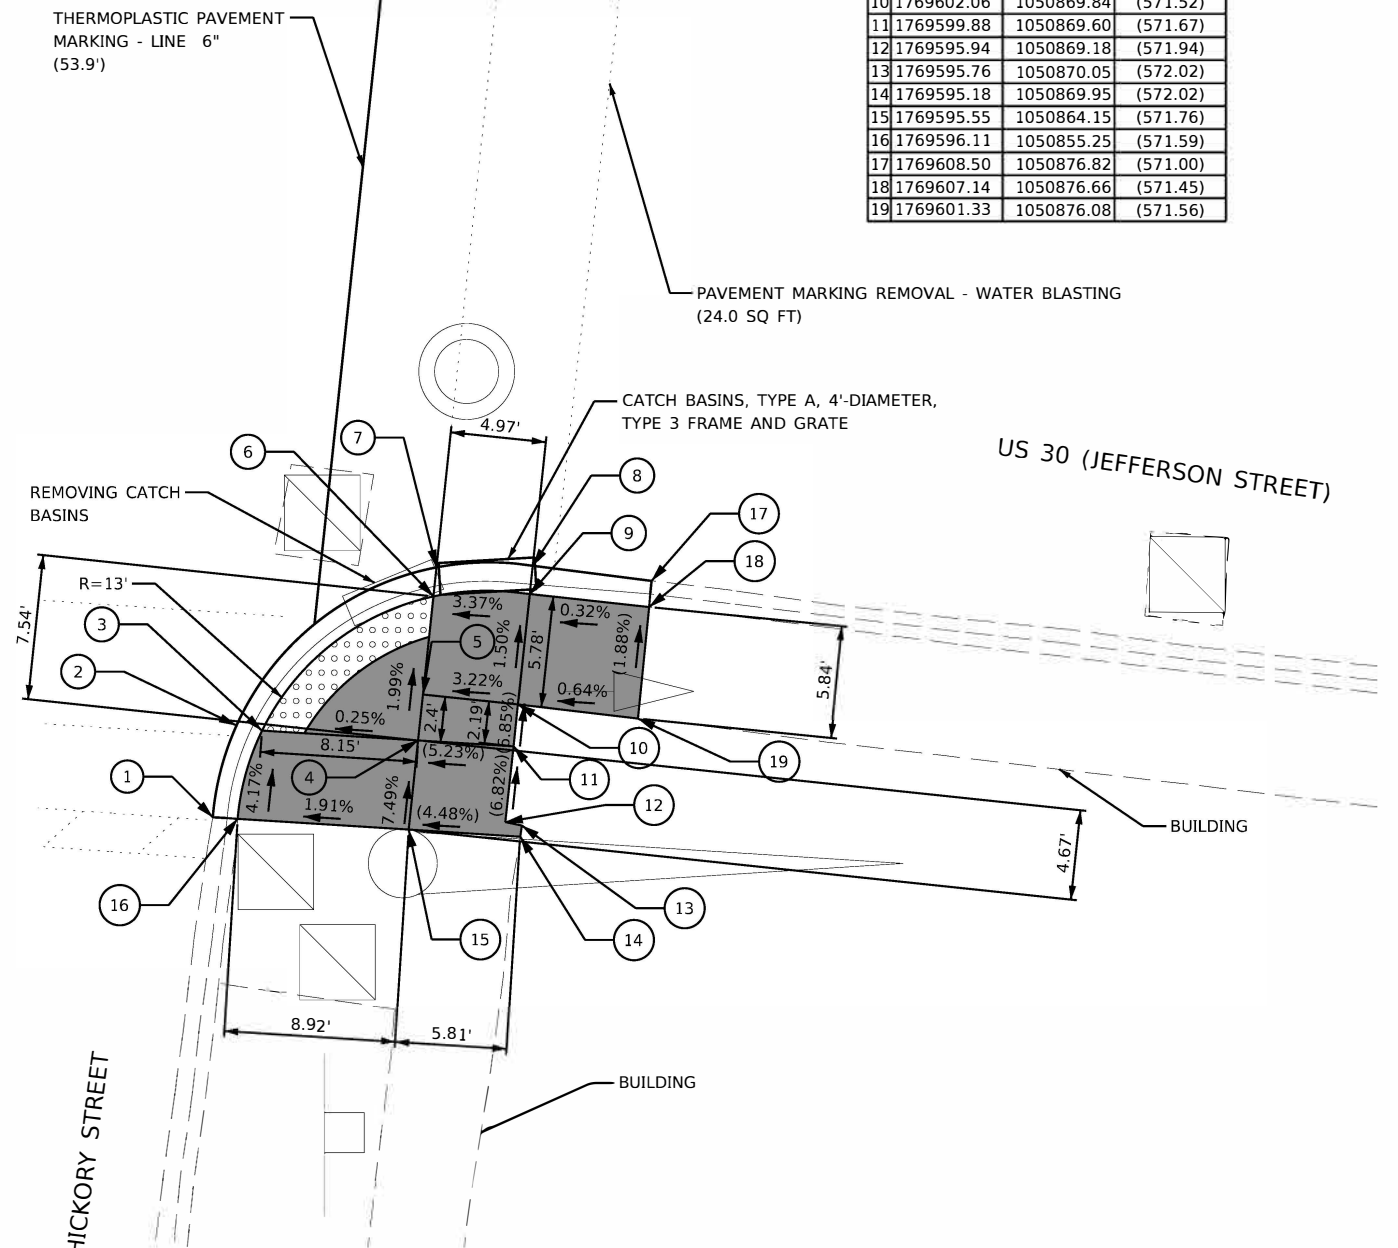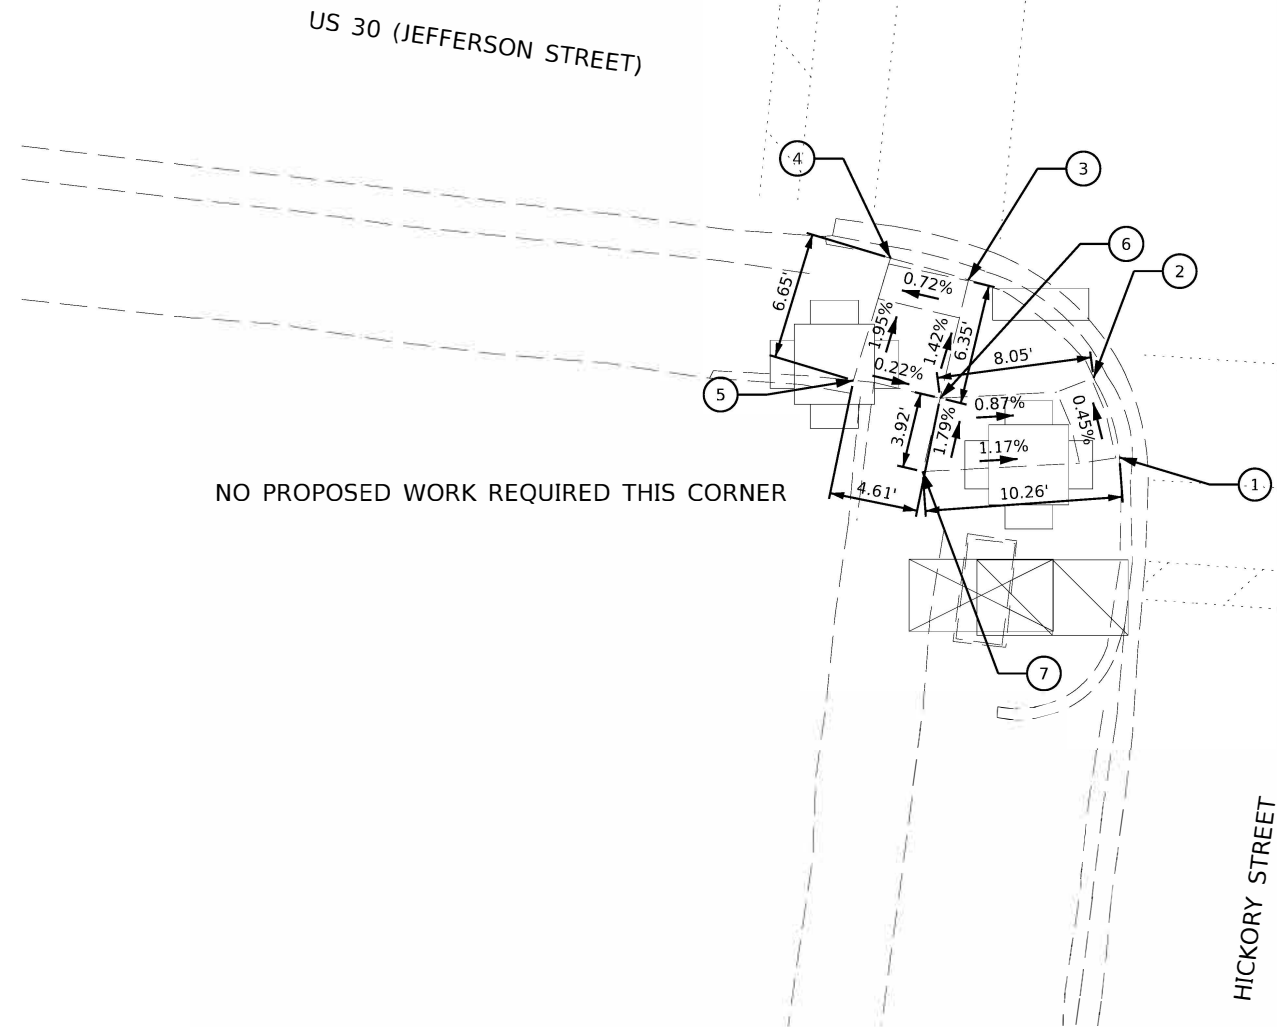

NO PROPOSED WORK REQUIRED THIS CORNER


**LEGEND**

	DETECTABLE WARNINGS		PCC SIDEWALK, 5 INCH
( )	EXISTING ELEVATION / SLOPE		
	CONCRETE CURB, TYPE B		
	COMBINATION CONCRETE CURB AND GUTTER		

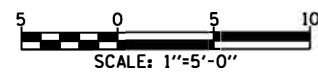

**LEGEND**

	DETECTABLE WARNINGS		PCC SIDEWALK, 5 INCH
( )	EXISTING ELEVATION / SLOPE		
	CONCRETE CURB, TYPE B		
	COMBINATION CONCRETE CURB AND GUTTER		

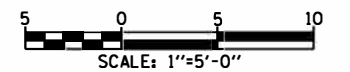

MODEL: \\MODEL\NAMES  
FILE NAME: L:\1762\_03\CAD\Drawings\ADA\_Ramps\62P35\_ADA\_10\_Ramps\_16 & 17.dgn

USER NAME = rmitchel	DESIGNED - RAM	REVISED - ADDENDUM A 04/08/22
PLOT SCALE = 1:10	DRAWN - RAM	REVISED -
PLOT DATE = 4/8/2022	CHECKED - CEL	REVISED -
	DATE - 4/8/2022	REVISED -

**STATE OF ILLINOIS  
DEPARTMENT OF TRANSPORTATION**

**JOLIET TOWNSHIP - ADA IMPROVEMENTS  
VARIOUS LOCATIONS (JOLIET TOWNSHIP)**


SCALE: SHEET OF SHEETS STA. TO STA.

F.A. RTE.	SECTION	COUNTY	TOTAL SHEETS	SHEET NO.
VAR	2021-112-SW	WILL	114	52
CONTRACT NO. 62P35			ILLINOIS FED. AID PROJECT	

REVISD ENTIRE SHEET 4/13/2022




	NORTHING	EASTING	ELEVATION
1	1769594.74	1052385.01	539.26
2	1769596.52	1052385.01	539.30
3	1769600.98	1052385.01	539.35
4	1769607.24	1052394.76	539.25
5	1769607.19	1052393.26	539.29
6	1769611.85	1052394.99	(539.32)
7	1769611.86	1052393.51	(539.63)
8	1769611.55	1052385.01	(539.71)
9	1769611.49	1052383.16	(539.77)
10	1769606.90	1052385.01	539.41
11	1769606.85	1052383.38	539.51
12	1769606.70	1052379.18	(539.77)
13	1769600.98	1052379.45	(539.76)
14	1769595.23	1052379.72	(539.66)
15	1769593.80	1052379.78	(539.26)

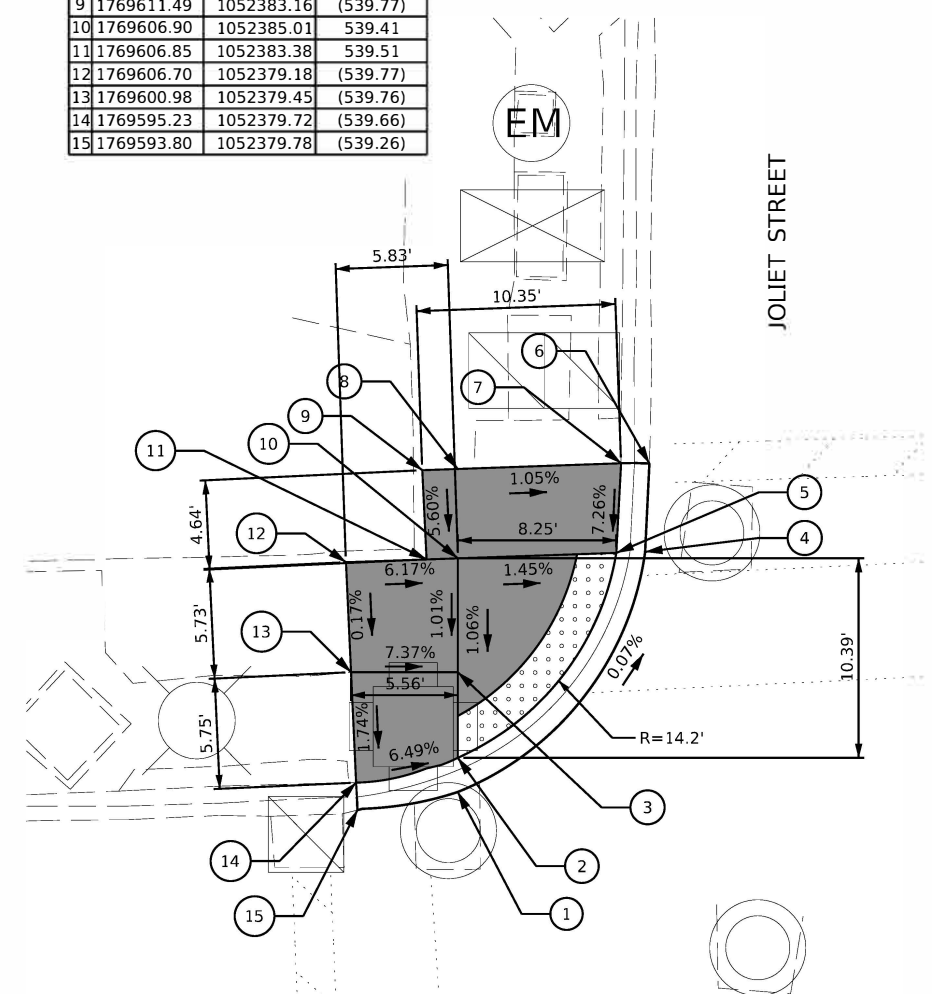

US 30 (JEFFERSON STREET)

**LEGEND**

	DETECTABLE WARNINGS		SODDING, SALT TOLERANT
	EXISTING ELEVATION / SLOPE		
	COMBINATION CONCRETE CURB AND GUTTER		PCC SIDEWALK, 5 INCH

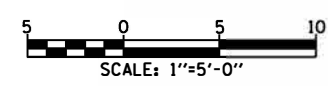


REFERENCE BENCHMARK ELEVATION: 540.11

BENCHMARK 205: CUT SQUARE AT SOUTHEAST CORNER OF CONCRETE TRAFFIC SIGNAL CONTROLLER BOX FOUNDATION.




	NORTHING	EASTING	ELEVATION
1	1769608.10	1052438.96	(539.79)
2	1769608.47	1052444.29	(539.85)
3	1769608.87	1052450.27	(539.91)
4	1769602.11	1052439.25	(539.67)
5	1769602.48	1052444.70	(539.95)
6	1769602.89	1052450.68	(539.89)
7	1769598.99	1052443.84	(539.93)
8	1769599.27	1052449.83	(539.86)
9	1769592.23	1052444.16	(540.04)
10	1769588.92	1052450.32	(540.05)

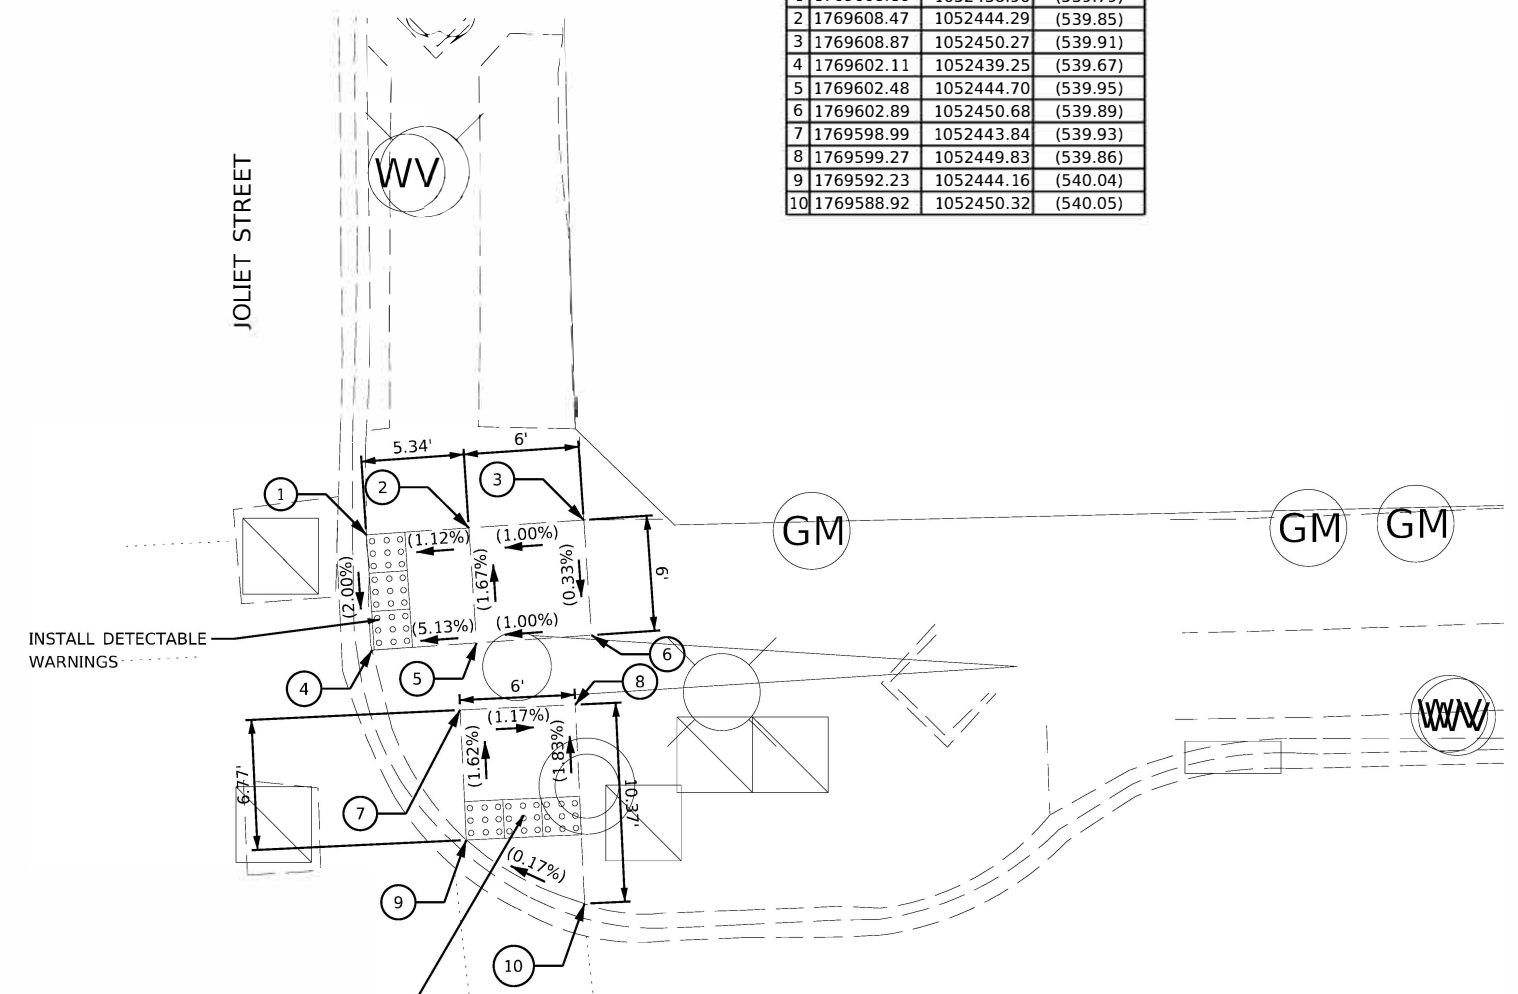

US 30 (JEFFERSON STREET)

**LEGEND**

	DETECTABLE WARNINGS		PCC SIDEWALK, 5 INCH
	EXISTING ELEVATION / SLOPE		
	CONCRETE CURB, TYPE B		
	COMBINATION CONCRETE CURB AND GUTTER		

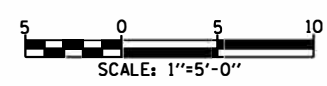

MODEL: s:\MODEL\NAMES FILE: NAME: L17162\_03\CAD\USheets\ADA\_Ramps\62P35\_ADA 11\_Ramps\_18 & 19.dgn

USER NAME = rmitchel	DESIGNED = RAM	REVISED  ADDENDUM A 04/08/22
DRAWN = RAM	CHECKED = CEL	REVISED -
PLOT SCALE = 1:10	DATE = 4/8/2022	REVISED -
PLOT DATE = 4/8/2022		REVISED -

**STATE OF ILLINOIS  
DEPARTMENT OF TRANSPORTATION**

**JOLIET TOWNSHIP - ADA IMPROVEMENTS  
VARIOUS LOCATIONS (JOLIET TOWNSHIP)**

SCALE: SHEET OF SHEETS STA. TO STA.


REVISED ENTIRE SHEET 4/13/2022				
F.A. RTE.	SECTION	COUNTY	TOTAL SHEETS	SHEET NO.
VAR	2021-112-SW	WILL	114	58
			CONTRACT NO. 62P35	
ILLINOIS   FED. AID PROJECT				

**LEGEND**

	DETECTABLE WARNINGS		PCC SIDEWALK, 5 INCH
	EXISTING ELEVATION / SLOPE		
	CONCRETE CURB, TYPE B		
	COMBINATION CONCRETE CURB AND GUTTER		




	NORTHING	EASTING	ELEVATION
1	1769542.16	1052397.49	539.32
2	1769553.89	1052387.65	539.32
3	1769554.60	1052380.19	539.41
4	1769547.61	1052380.47	(539.84)
5	1769547.61	1052387.79	539.41
6	1769541.73	1052380.51	(539.86)
7	1769541.91	1052387.91	539.48
8	1769552.35	1052387.68	539.36
9	1769542.12	1052395.97	539.36
10	1769553.20	1052380.25	539.80
11	1769552.11	1052380.33	(539.83)
12	1769536.88	1052386.51	(539.75)
13	1769537.13	1052396.34	(539.78)
14	1769537.16	1052397.77	(539.36)
15	1769541.98	1052390.46	539.44

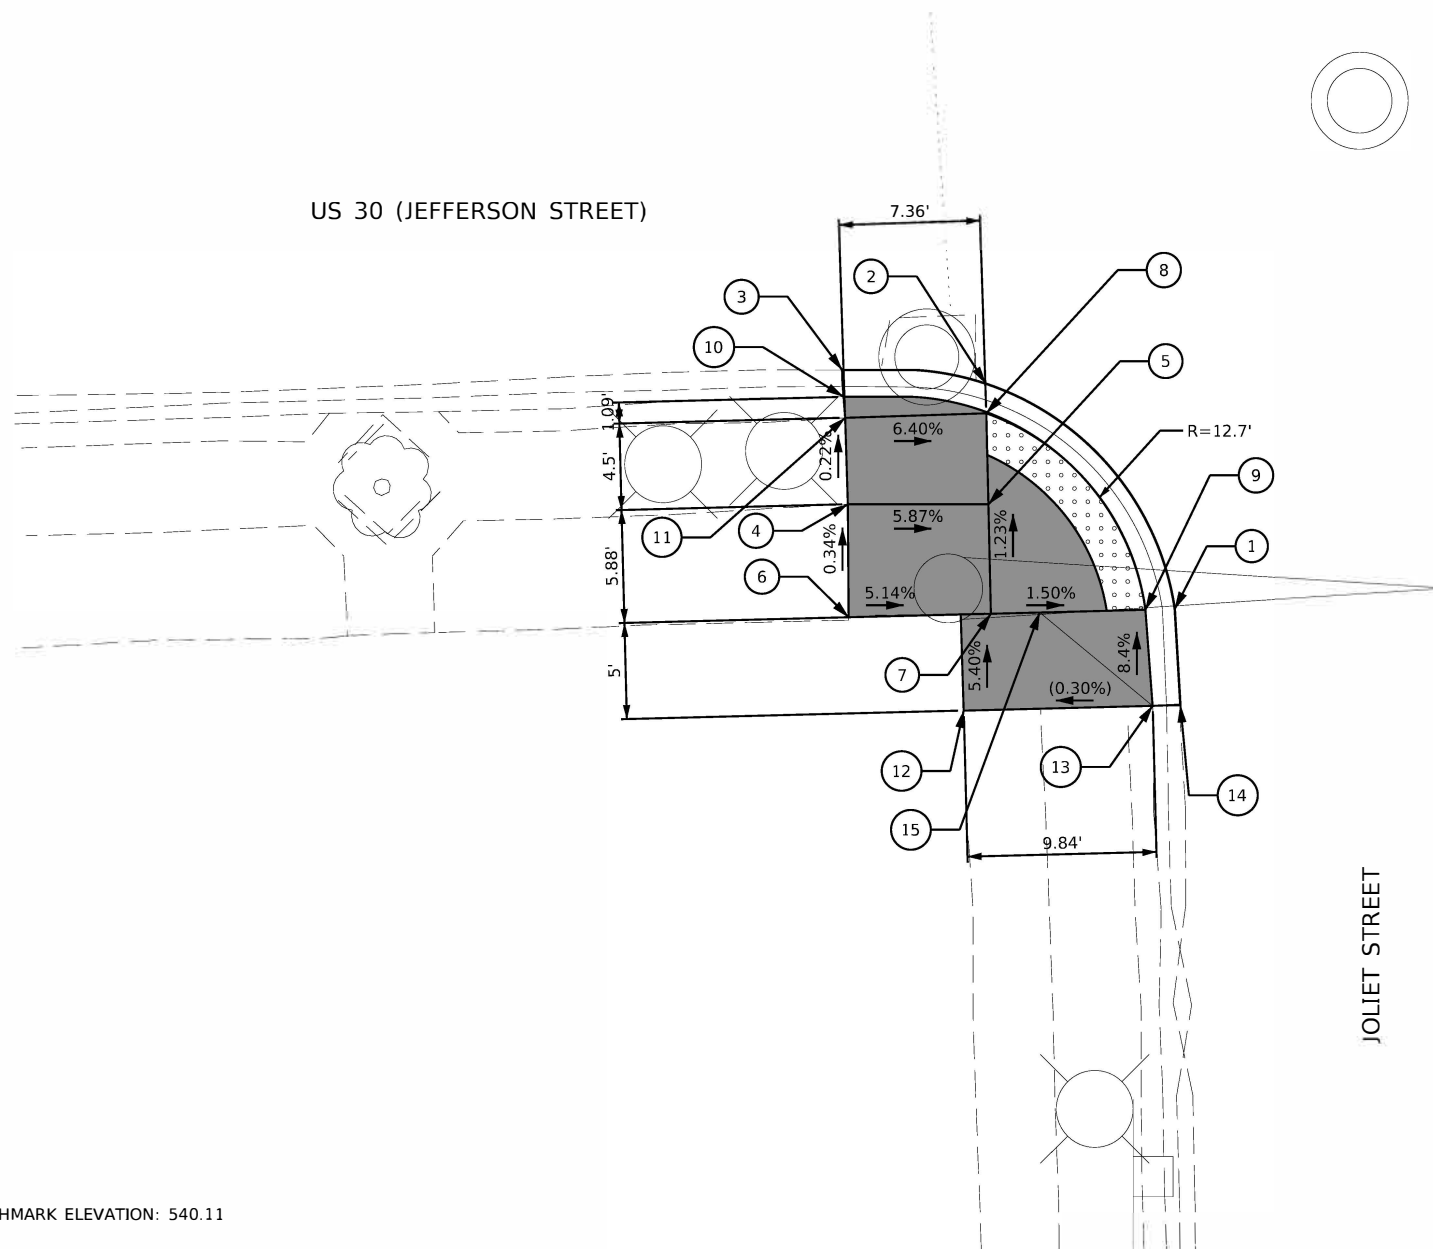

REFERENCE BENCHMARK ELEVATION: 540.11

BENCHMARK 205: CUT SQUARE AT SOUTHEAST CORNER OF CONCRETE TRAFFIC SIGNAL CONTROLLER BOX FOUNDATION.

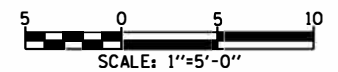

REVISED ENTIRE SHEET 4/13/2022

MODEL: s:\MODEL\NAME: FILE: NAME: 131762\_03\CAD\USheets\ADA\_Ramps\62P35\_ADA\_12\_Ramp\_20.dgn



USER NAME = rmitchel	DESIGNED - RAM	REVISED - ADDENDUM A 04/08/22
	DRAWN - RAM	REVISED -
PLOT SCALE = 1:10	CHECKED - CEL	REVISED -
PLOT DATE = 4/8/2022	DATE - 4/8/2022	REVISED -

**STATE OF ILLINOIS  
DEPARTMENT OF TRANSPORTATION**

**JOLIET TOWNSHIP - ADA IMPROVEMENTS  
VARIOUS LOCATIONS (JOLIET TOWNSHIP)**

SCALE: SHEET OF SHEETS STA. TO STA.

F.A. RTE.	SECTION	COUNTY	TOTAL SHEETS	SHEET NO.
VAR	2021-112-SW	WILL	114	59
			CONTRACT NO. 62P35	
ILLINOIS FED. AID PROJECT				

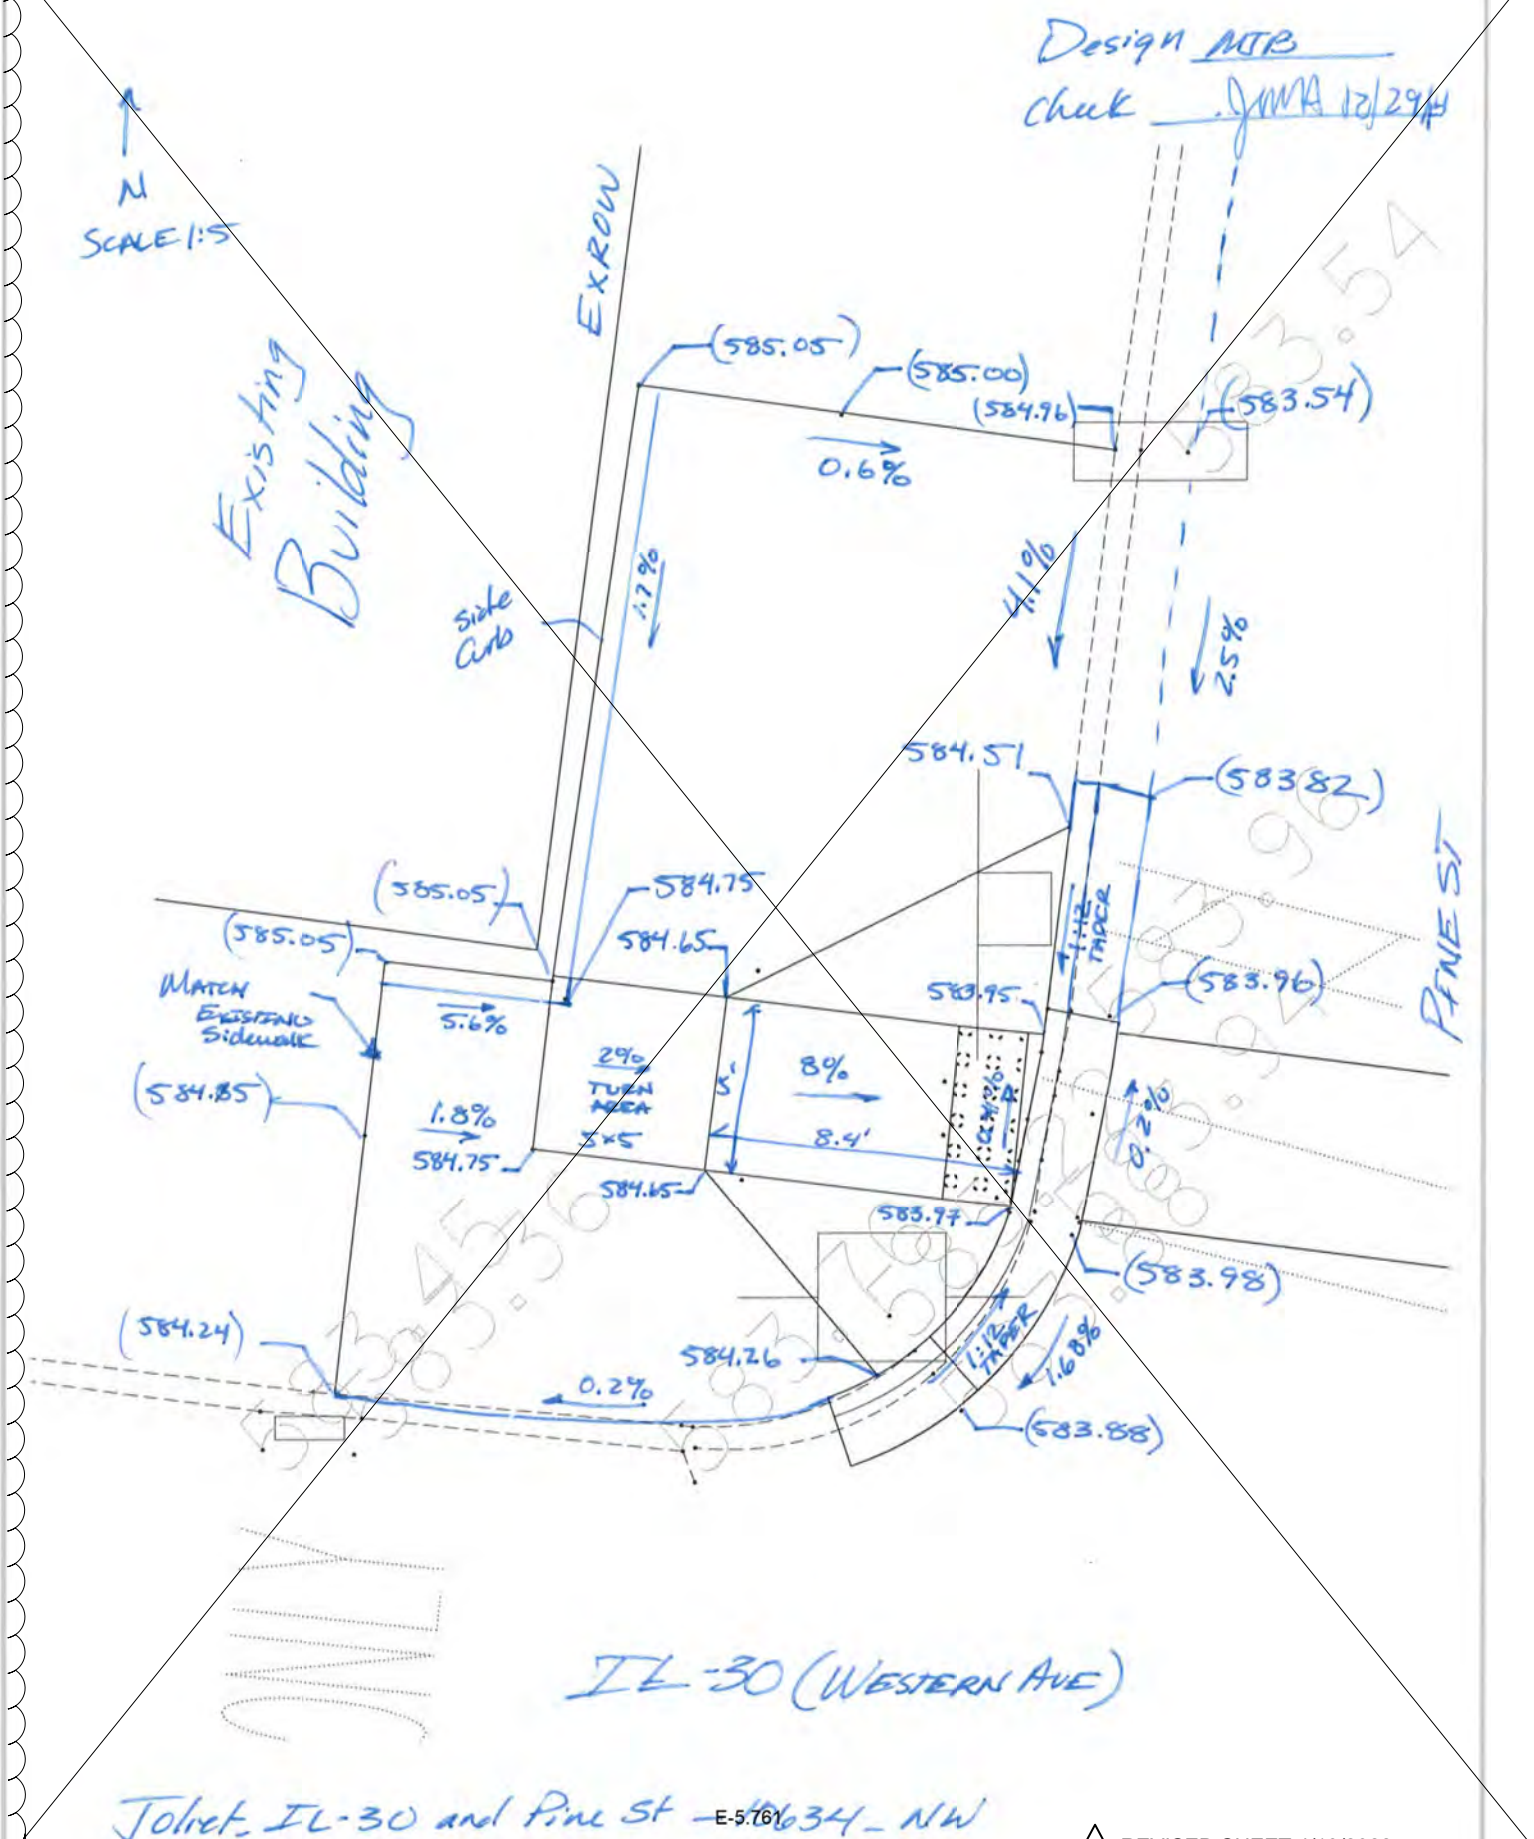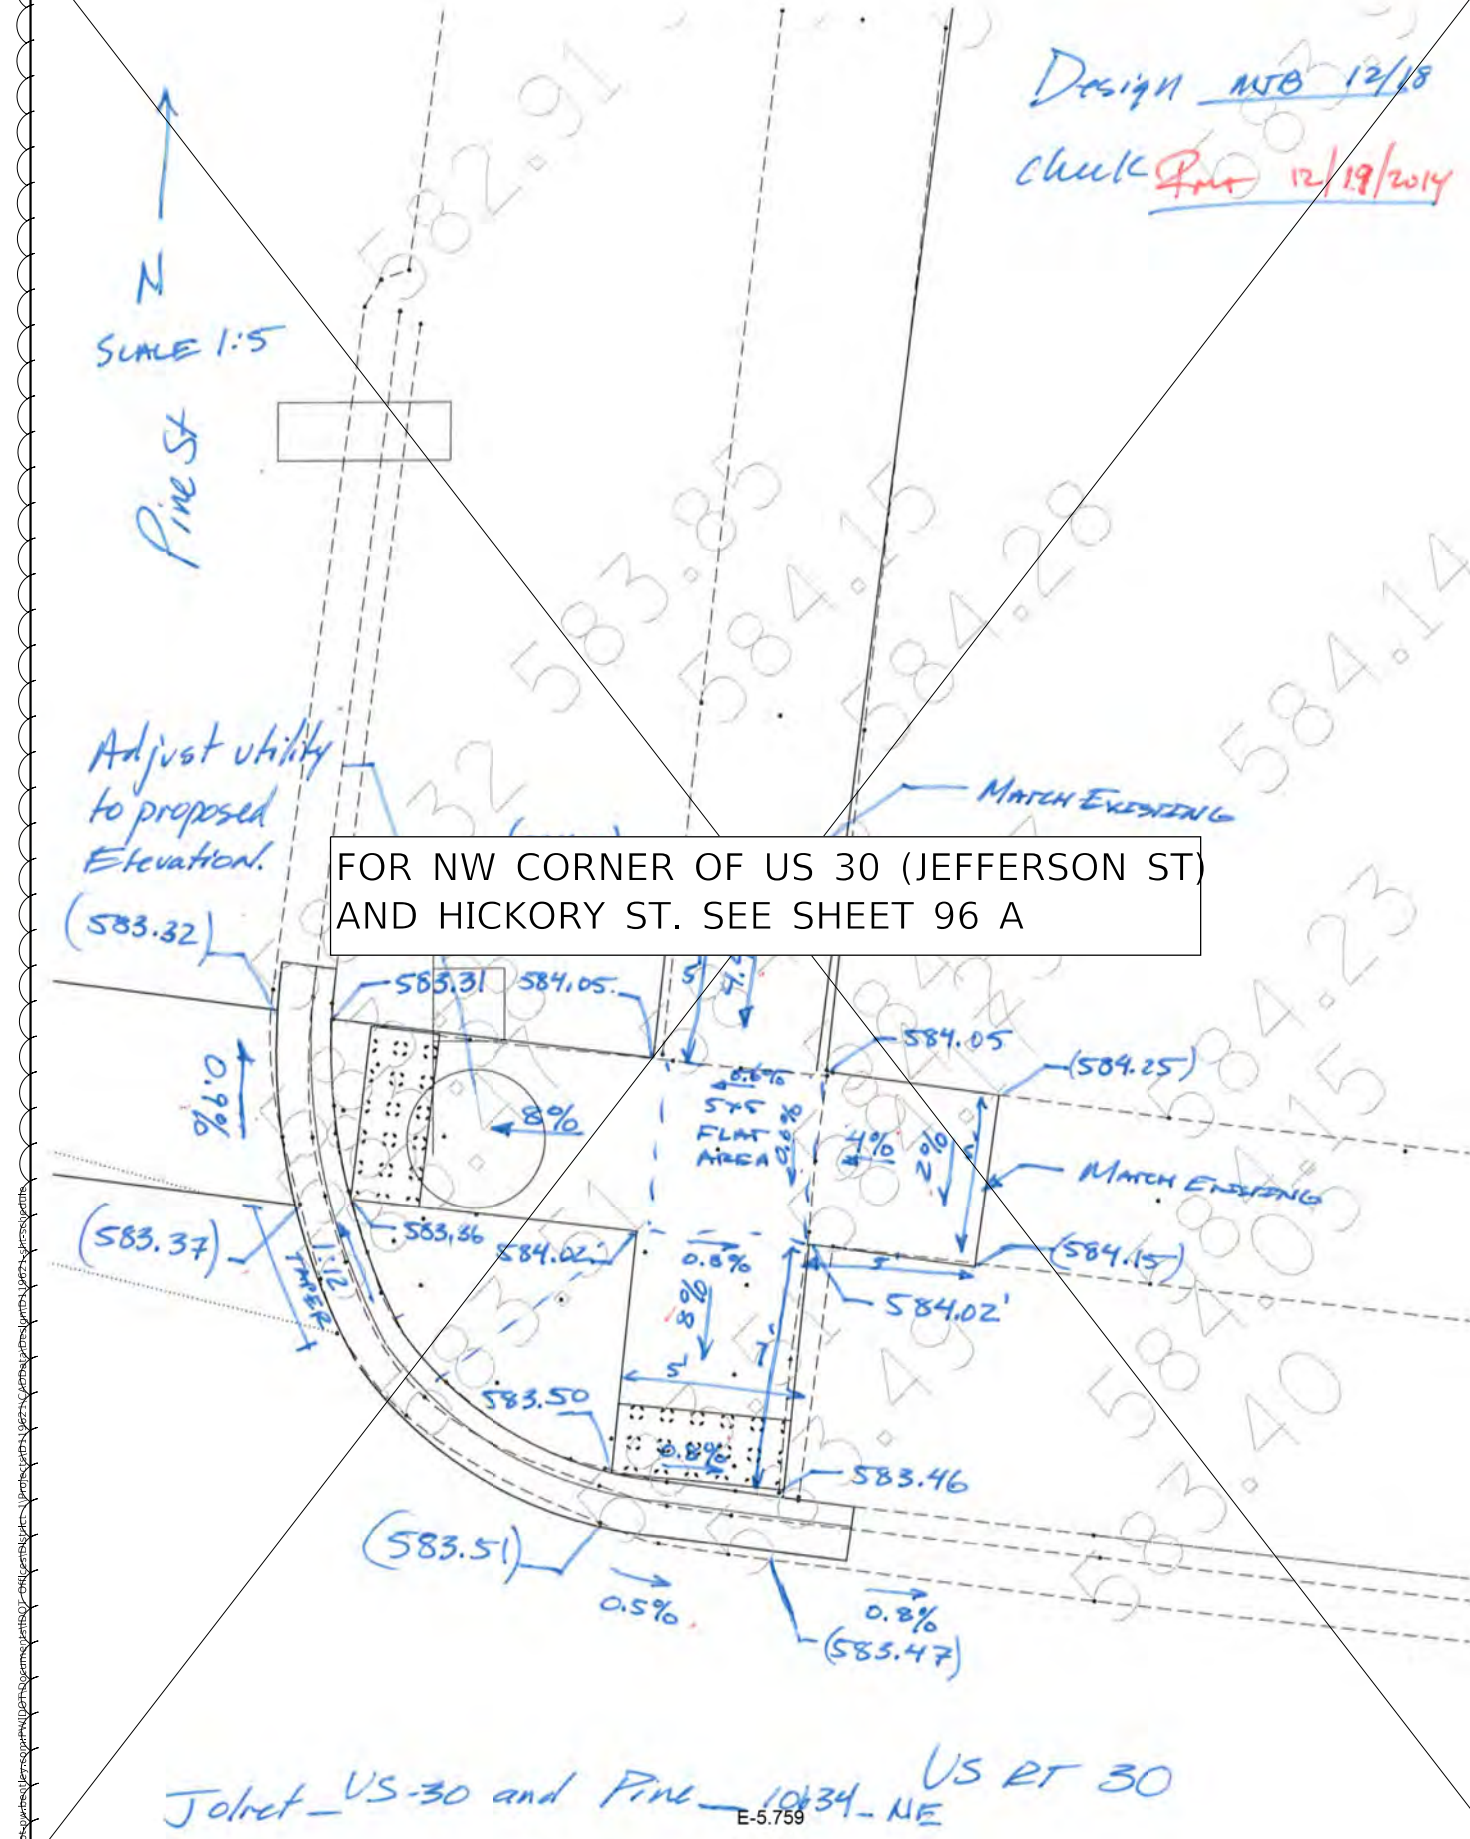

FOR NW CORNER OF US 30 (JEFFERSON ST)  
AND HICKORY ST. SEE SHEET 96 A

Joliet - US-30 and Pine - 10634 - NE US RT 30  
E-5.759

Joliet - IL-30 and Pine St - 10634 - NW  
E-5.761

MODEL: Default  
FILE: Model.dwg

USER NAME = khans	DESIGNED -	REVISED -
	DRAWN -	REVISED -
PLOT SCALE = 100.0000' / in.	CHECKED -	REVISED -
PLOT DATE = 4/11/2022	DATE -	REVISED -

STATE OF ILLINOIS  
DEPARTMENT OF TRANSPORTATION

JOLIET TOWNSHIP - ADA IMPROVEMENTS  
VARIOUS LOCATIONS (JOLIET TOWNSHIP)


SCALE: SHEET OF SHEETS STA. TO STA.

1 REVISED SHEET 4/13/2022

F.A. RTE.	SECTION	COUNTY	TOTAL SHEETS	SHEET NO.
VAR	2021-112-SW	WILL	114	96
			CONTRACT NO. 62P35	
		ILLINOIS FED. AID PROJECT		



	NORTHING	EASTING	ELEVATION
1	1770745.08	1050670.03	(583.33)
2	1770739.99	1050670.45	(583.38)
3	1770744.87	1050671.75	583.37
4	1770739.77	1050672.26	583.42
5	1770743.71	1050681.28	583.98
6	1770738.75	1050680.67	583.90
7	1770743.10	1050686.24	584.05
8	1770738.14	1050685.63	583.98
9	1770742.50	1050691.20	(584.25)
10	1770737.54	1050690.60	(584.16)
11	1770748.67	1050681.88	(584.16)
12	1770748.07	1050686.84	(584.27)
13	1770729.06	1050684.53	(583.48)
14	1770730.87	1050684.75	583.98
15	1770734.38	1050673.38	(583.47)
16	1770735.43	1050674.64	583.97

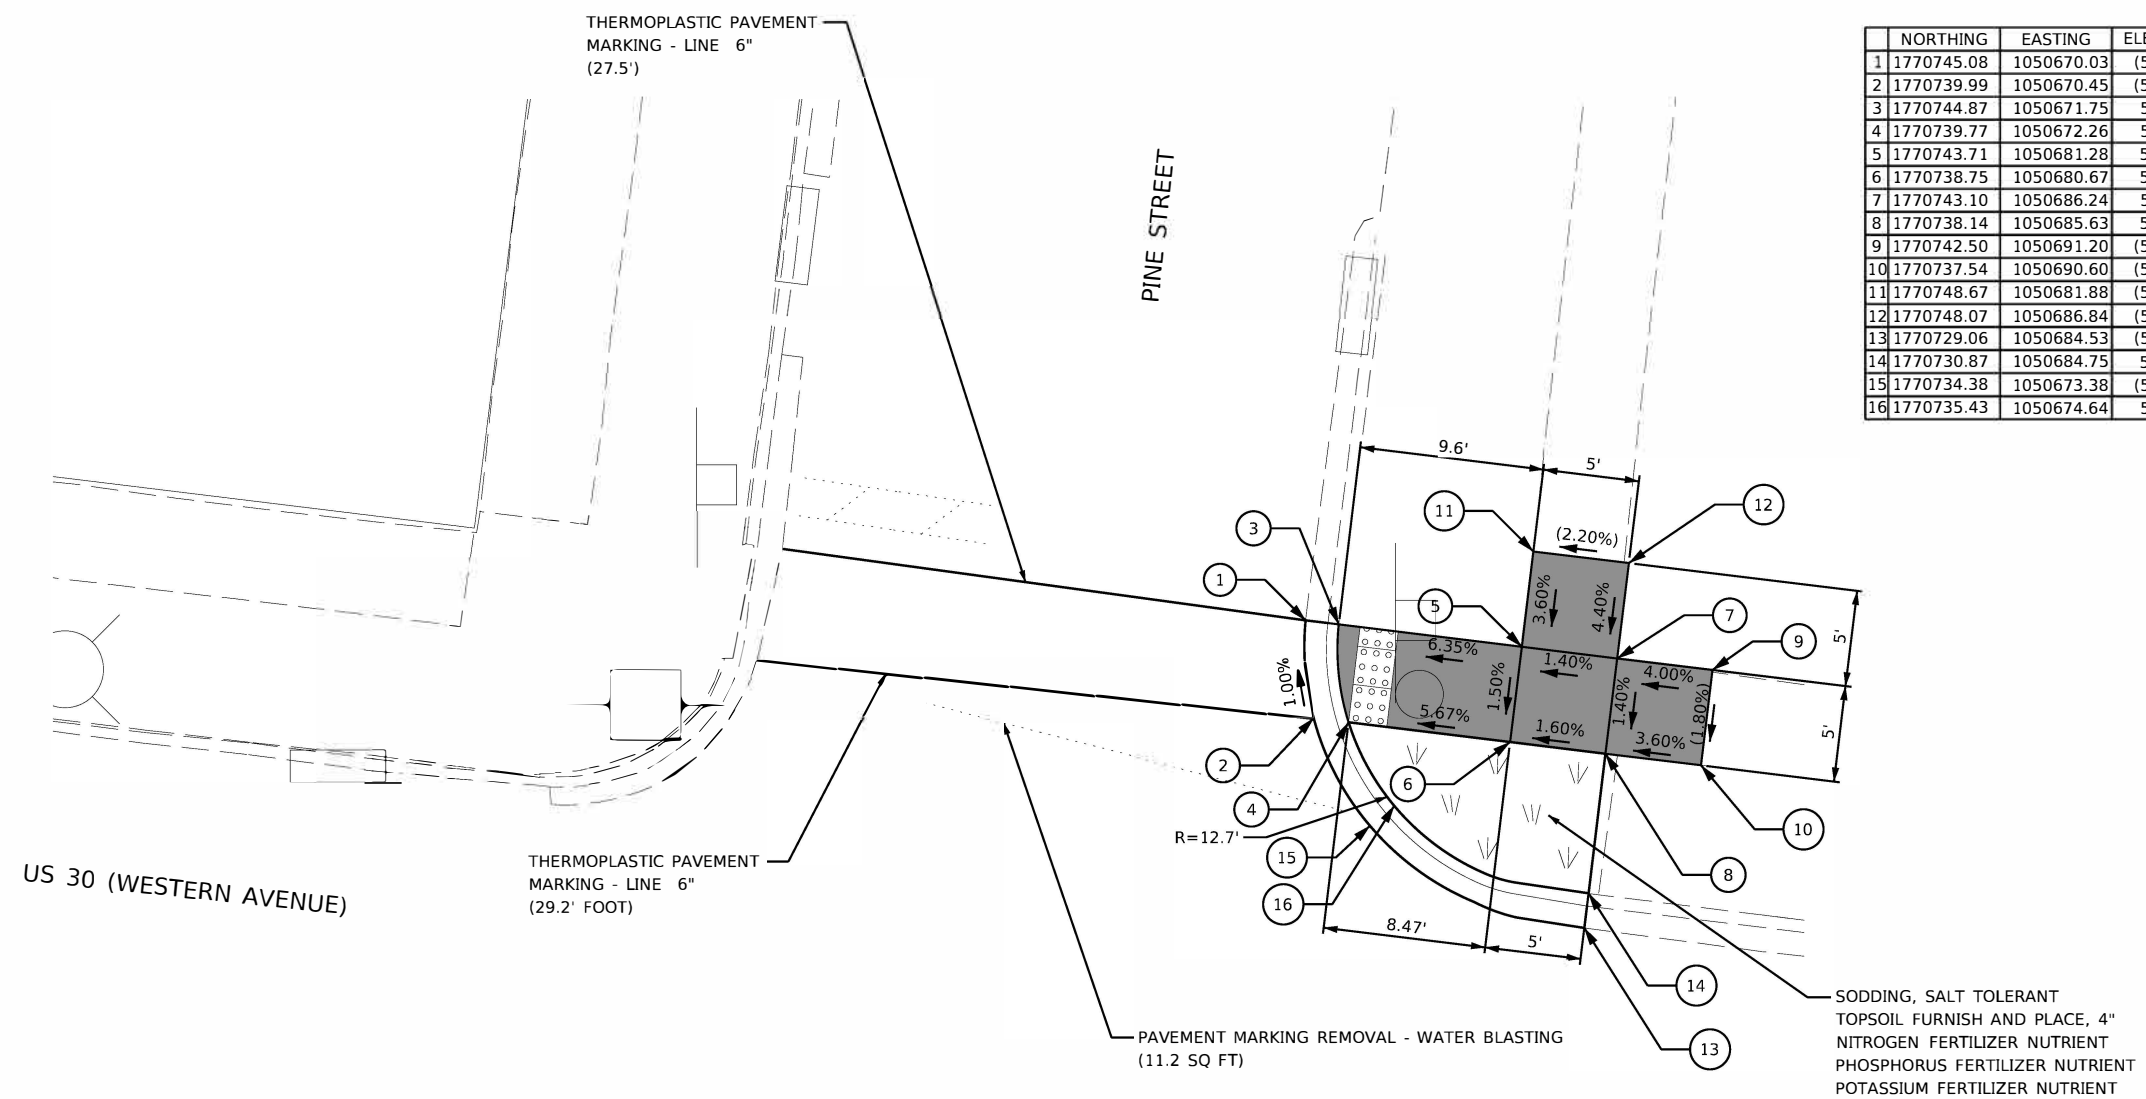


SODDING, SALT TOLERANT  
TOPSOIL FURNISH AND PLACE, 4"  
NITROGEN FERTILIZER NUTRIENT  
PHOSPHORUS FERTILIZER NUTRIENT  
POTASSIUM FERTILIZER NUTRIENT

**LEGEND**

	DETECTABLE WARNINGS		PCC SIDEWALK, 5 INCH
	EXISTING ELEVATION / SLOPE		
	CONCRETE CURB, TYPE B		
	COMBINATION CONCRETE CURB AND GUTTER		

REFERENCE BENCHMARK ELEVATION: 584.47

BENCHMARK 201: CUT SQUARE WITH "X" ON NORTHWEST CORNER OF CONCRETE RETAINING WALL AT S'LY B/C OF US 30 +- W'LY B/C OF PINE EXTENDED.

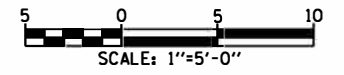

**1** REVISED ENTIRE SHEET 4/13/2022

MODEL: s:\MODEL\NAMES FILE: NAME: 131762\_03\CAD\USHWYS\ADA\_Ramps\62P35\_ADA\_13\_Ramp\_21.dgn

USER NAME = rmitchel	DESIGNED - RAM	REVISED  ADDENDUM A 04/08/22
	DRAWN - RAM	REVISED -
PLOT SCALE = 1:10	CHECKED - CEL	REVISED -
PLOT DATE = 4/8/2022	DATE - 4/8/2022	REVISED -

**STATE OF ILLINOIS  
DEPARTMENT OF TRANSPORTATION**

**JOLIET TOWNSHIP - ADA IMPROVEMENTS  
VARIOUS LOCATIONS (JOLIET TOWNSHIP)**

SCALE: SHEET OF SHEETS STA. TO STA.

F.A. RTE.	SECTION	COUNTY	TOTAL SHEETS	SHEET NO.
VAR	2021-112-SW	WILL	114	96A
			CONTRACT NO. 62P35	
ILLINOIS   FED. AID PROJECT				