



| F.A.I. RTE.                                     | SECTION | COUNTY | TOTAL SHEETS | SHEET NO. |
|---|---------|--------|--------------|-----------|
| 57  | *       | COOK   | 916          | 567       |
| STA. TO STA.                                    |         |        |              |           |
| FED. ROAD DIST. NO. 1 ILLINOIS FED. AID PROJECT |         |        |              |           |
| CONTRACT NO. 62304                              |         |        |              |           |
| *(1516.1, 1717, & 1818) R-4                     |         |        |              |           |

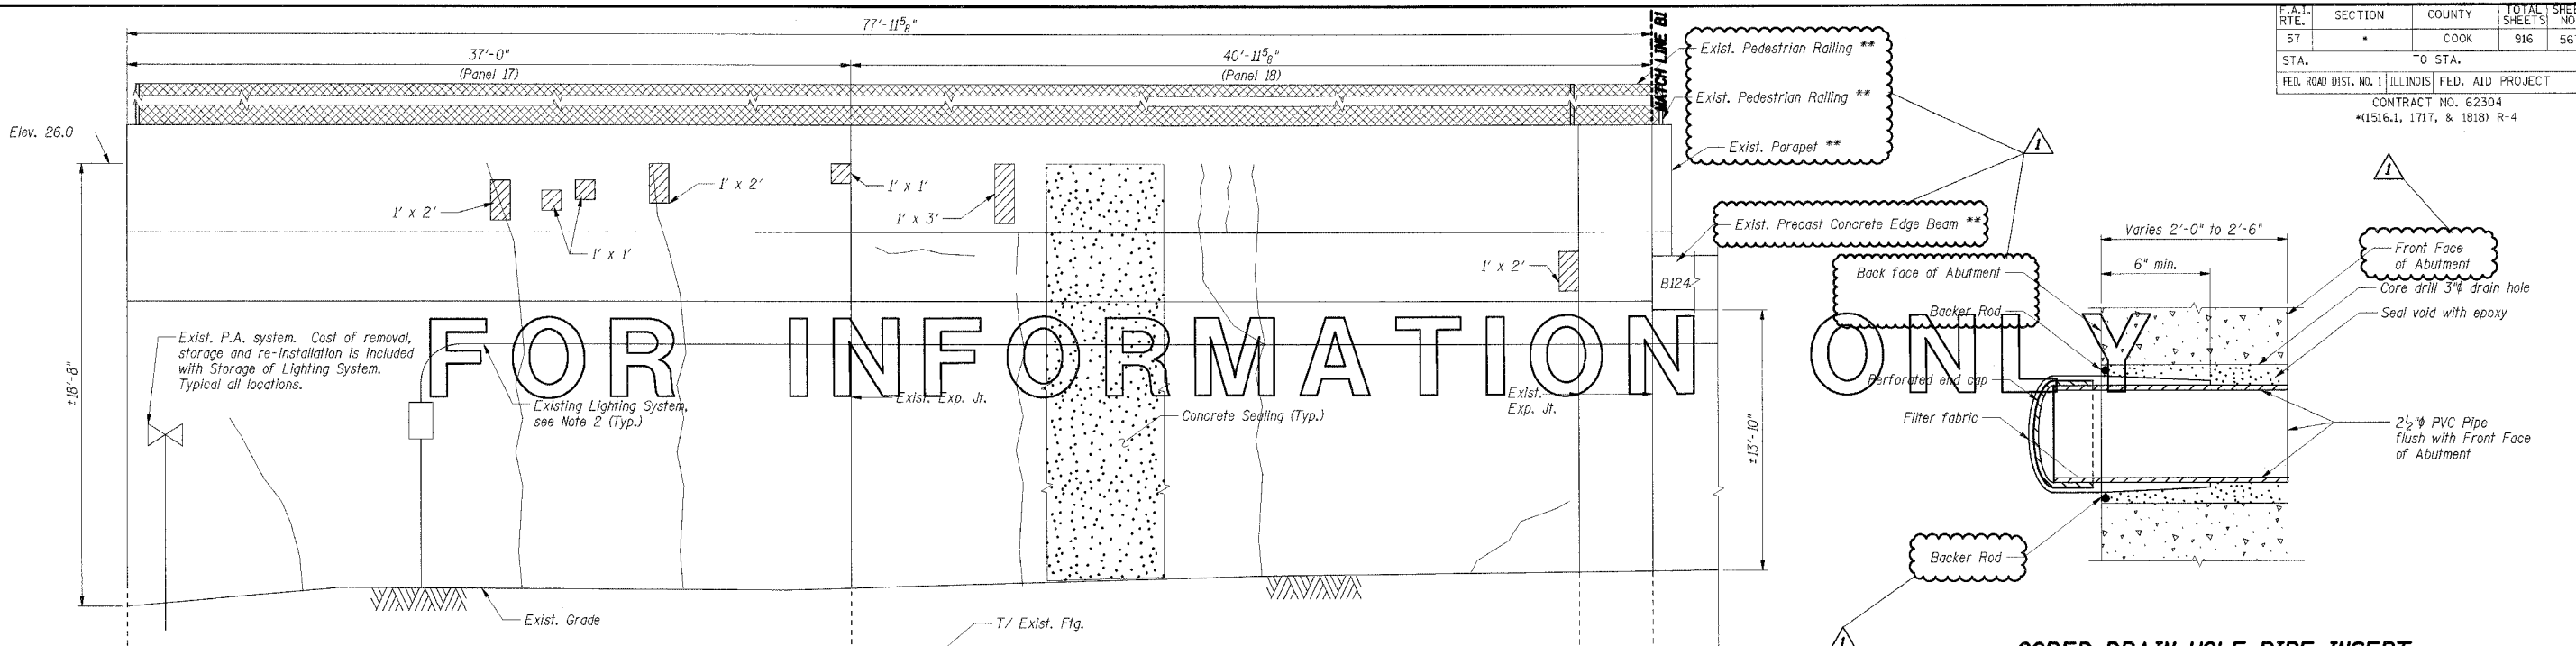

THESE PLANS INCLUDED IN

**EAST ELEVATION - ABUTMENT B (ALONG WORK LINE C)**

Reference Work Line C Reference Work Line B

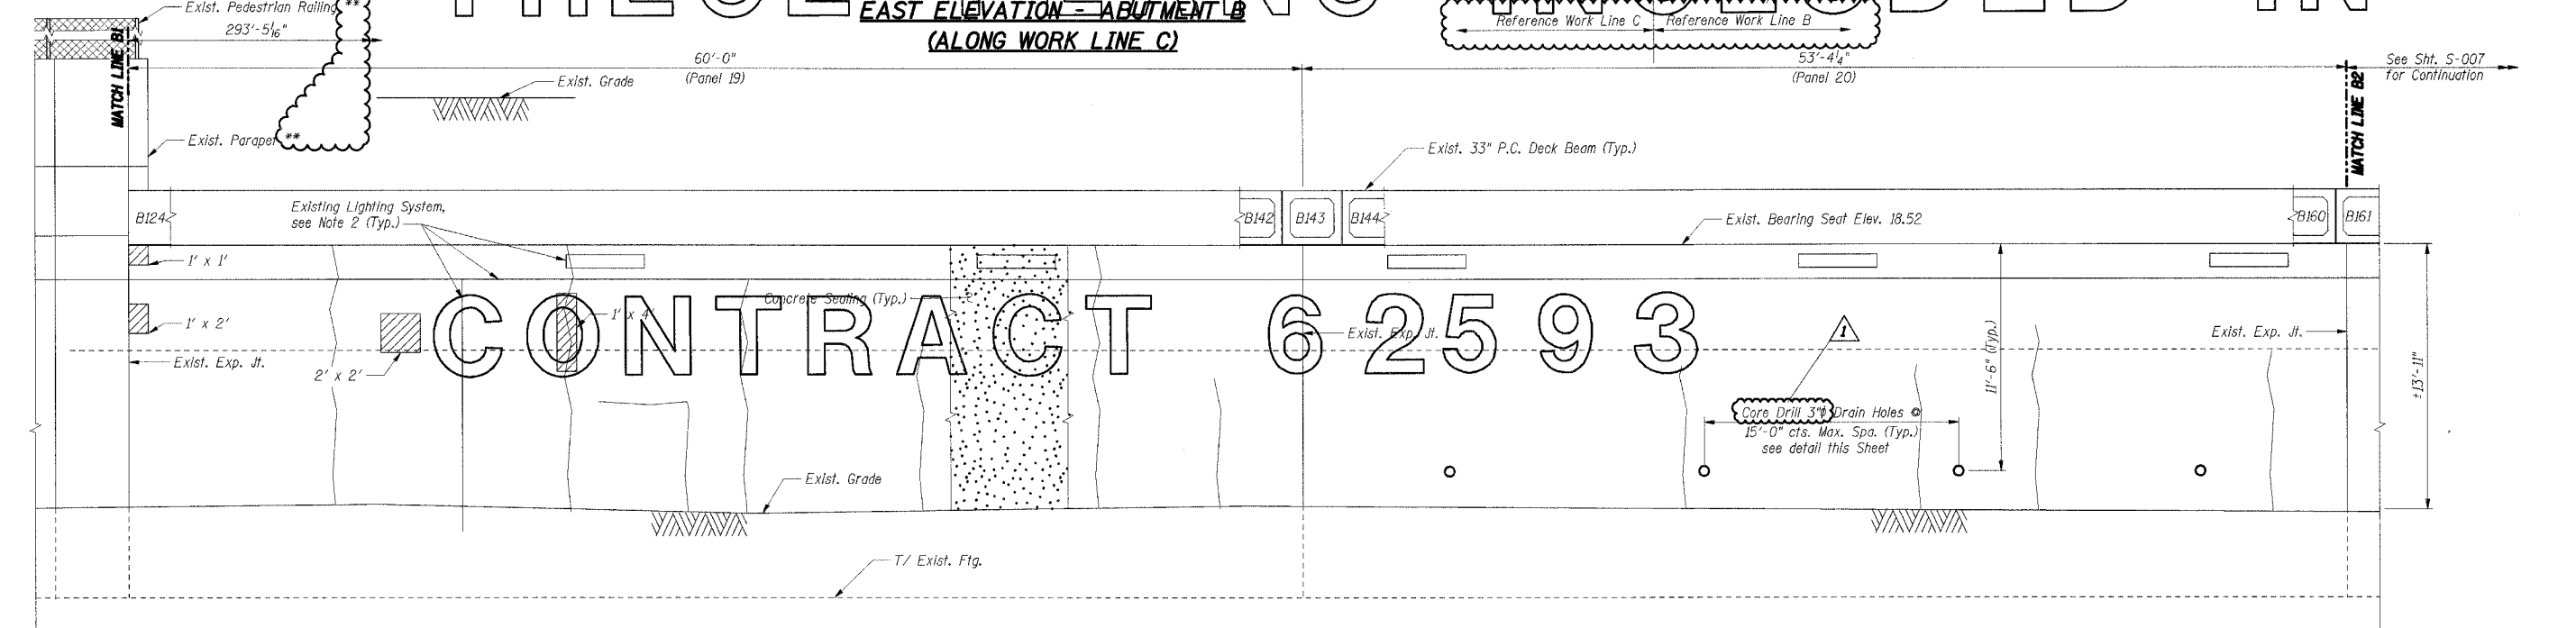


- Notes:**
1. Work this Sheet with Sheet S-007.
  2. Existing Tunnel Lighting System shall be protected and maintained by the Contractor per the Special Provision for PROTECT AND MAINTAIN EXISTING CTA TUNNEL LIGHTING SYSTEM.
  3. Concrete Sealer shall be applied to the abutment walls according to the Special Provision for Concrete Sealer.
  4. Areas of repairs shown are estimated based upon inspection surveys shown in 2004. The Engineer shall document actual locations and types of repairs on As-Built plans.
  5. Date of Survey  
I-94 Tunnel: February 2004  
CTA Tunnel: July 2004
  6. The Contractor shall coordinate work on C.T.A. property with the C.T.A. according to the Special Provisions.
  7. See Sheet S-007 for Bill of Material.

Repairs to the tunnel walls and sealing of C.T.A. tunnel walls shall not be performed until waterproofing membrane installation has been completed by others.

\*\* denotes existing elements constructed by others prior to abutment wall repair.

**INSIDE ELEVATION - ABUTMENT B (ALONG WORK LINE B)**

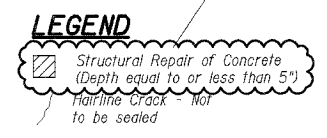

SHT. S-006

| REVISIONS | NAME | DATE |
|-----------|------|------|
|           |      |      |
|           |      |      |
ADDENDUM 1 05/08/06

ILLINOIS DEPARTMENT OF TRANSPORTATION  
 F.A.I. ROUTE 57 (INTERSTATE 57) OVER  
 F.A.I. ROUTE I-94 SB & CTA TRACKS-BRIDGE REPAIRS  
 SN 016-0073  
 COOK COUNTY  
 SECTION (1516.1, 1717, & 1818) R-4  
 ABUTMENT B  
 REPAIRS I  
 DATE: 05/08/06  
 DRAWN BY: VV  
 CHECKED BY: RDS

**TENG**

TENG & ASSOCIATES, INC.  
 BUSINESS ARCHITECTS/PLANNERS  
 205 N. MICHIGAN AVE., CHICAGO, IL 60611  
 TELEPHONE 312.616.0000

Revised - JFS 5/8/06