
AS-BUILT PLANS FOR INFORMATION ONLY

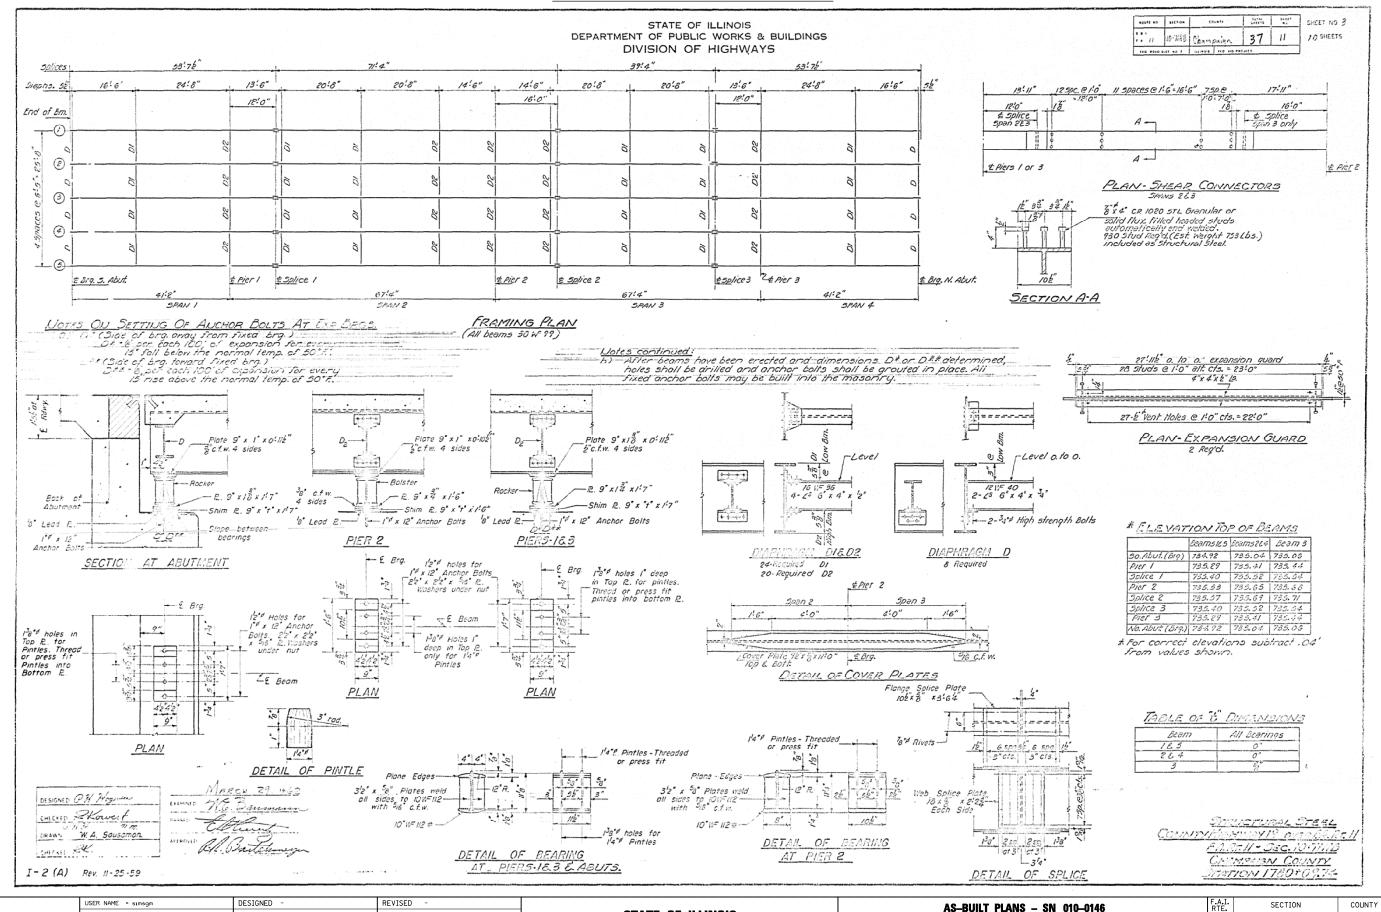

STATE OF ILLINOIS

DEPARTMENT OF TRANSPORTATION

72

TO STA.

FOR INFORMATION ONLY

SHEET NO. 9 OF 10 SHEETS STA.

SCALE:

(10-71HB)BDR,BJR

CHAMPAIGN

14 12

CONTRACT NO. 70865

FILE NAME =

:\pw_work\PWIDOT\SIMSGM\dØ184265\D570865-Bridge Repair Plans.dgr

PLOT DATE = 2/26/2010

DRAWN

DATE

CHECKED

REVISED

REVISED

REVISED