

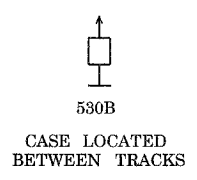


ROUTE NO.	SECTION	COUNTY	TOTAL SHEETS	SHEET NO.
F.A.P. 351	2008-001VB	COOK	579	289
STA.	TO STA.			
FED. ROAD DIST. NO. 7	ILLINOIS	FED. AID PROJECT		
CONTRACT NO. 60E10				

4/14/2008 11:43:59 AM

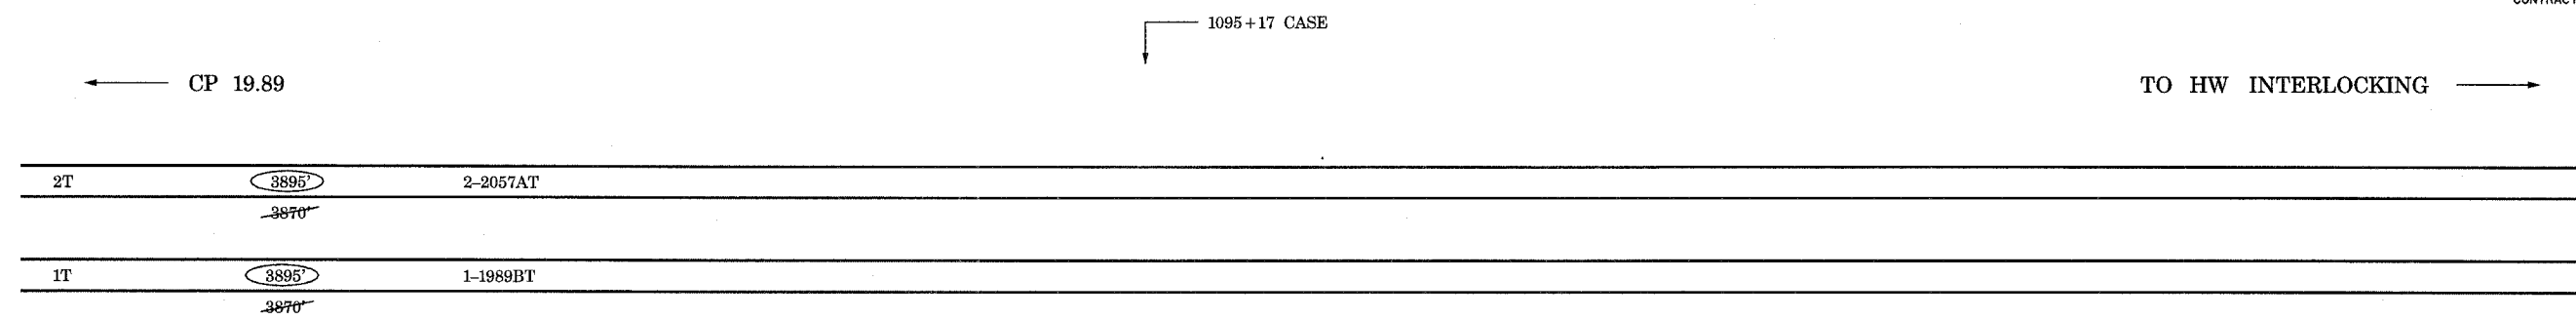

20.68
~~20.56~~

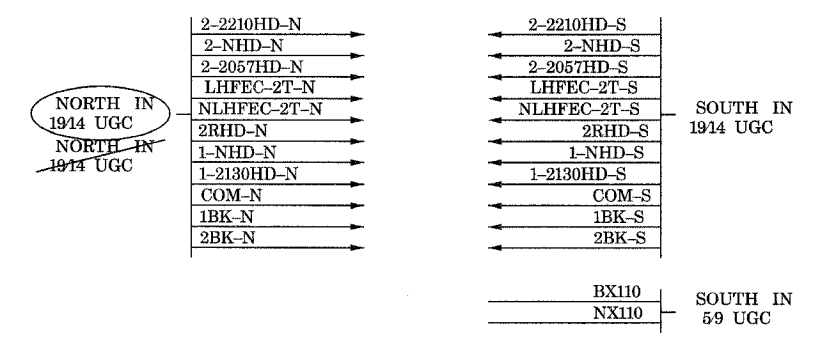

11/30/06 OK

URS 04/10/08 OK


~~YELLOW~~ - IN

RED - OUT

CREW

03/01/09

PHASE 2

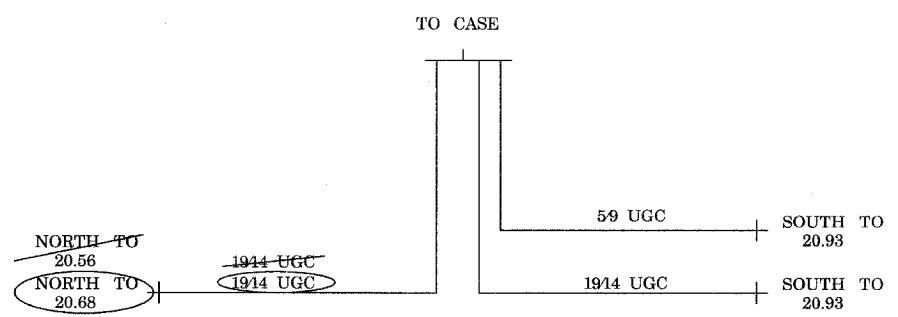

FOR REFERENCE ONLY
(METRA WORK USING CONTRACTOR-SUPPLIED MATERIALS)

REVISIONS	
NAME	DATE

ILLINOIS DEPARTMENT OF TRANSPORTATION
US RTE 6 FROM I-294 TO IL RTE 1
METRA OVER 159TH STREET

METRA SIGNALS
PHASE 2 (SIG. RELOC.) CASE 20.74

SHT. SG-22 OF SG-36
DATE 4/11/2008

DRAWN BY AB
CHECKED BY MAD

q:\17049\signal work for metra\plans\22_ref.dgn