


F.A. RTE.	SECTION	COUNTY	TOTAL SHEETS	SHEET NO.
345	P-91-260.99	Cook	196	51
STA.		TO STA.		
FED. ROAD DIST. NO.		ILLINOIS	FED. AID PROJECT	



MATCH TO PAGE 1

MATCH TO PAGE 2

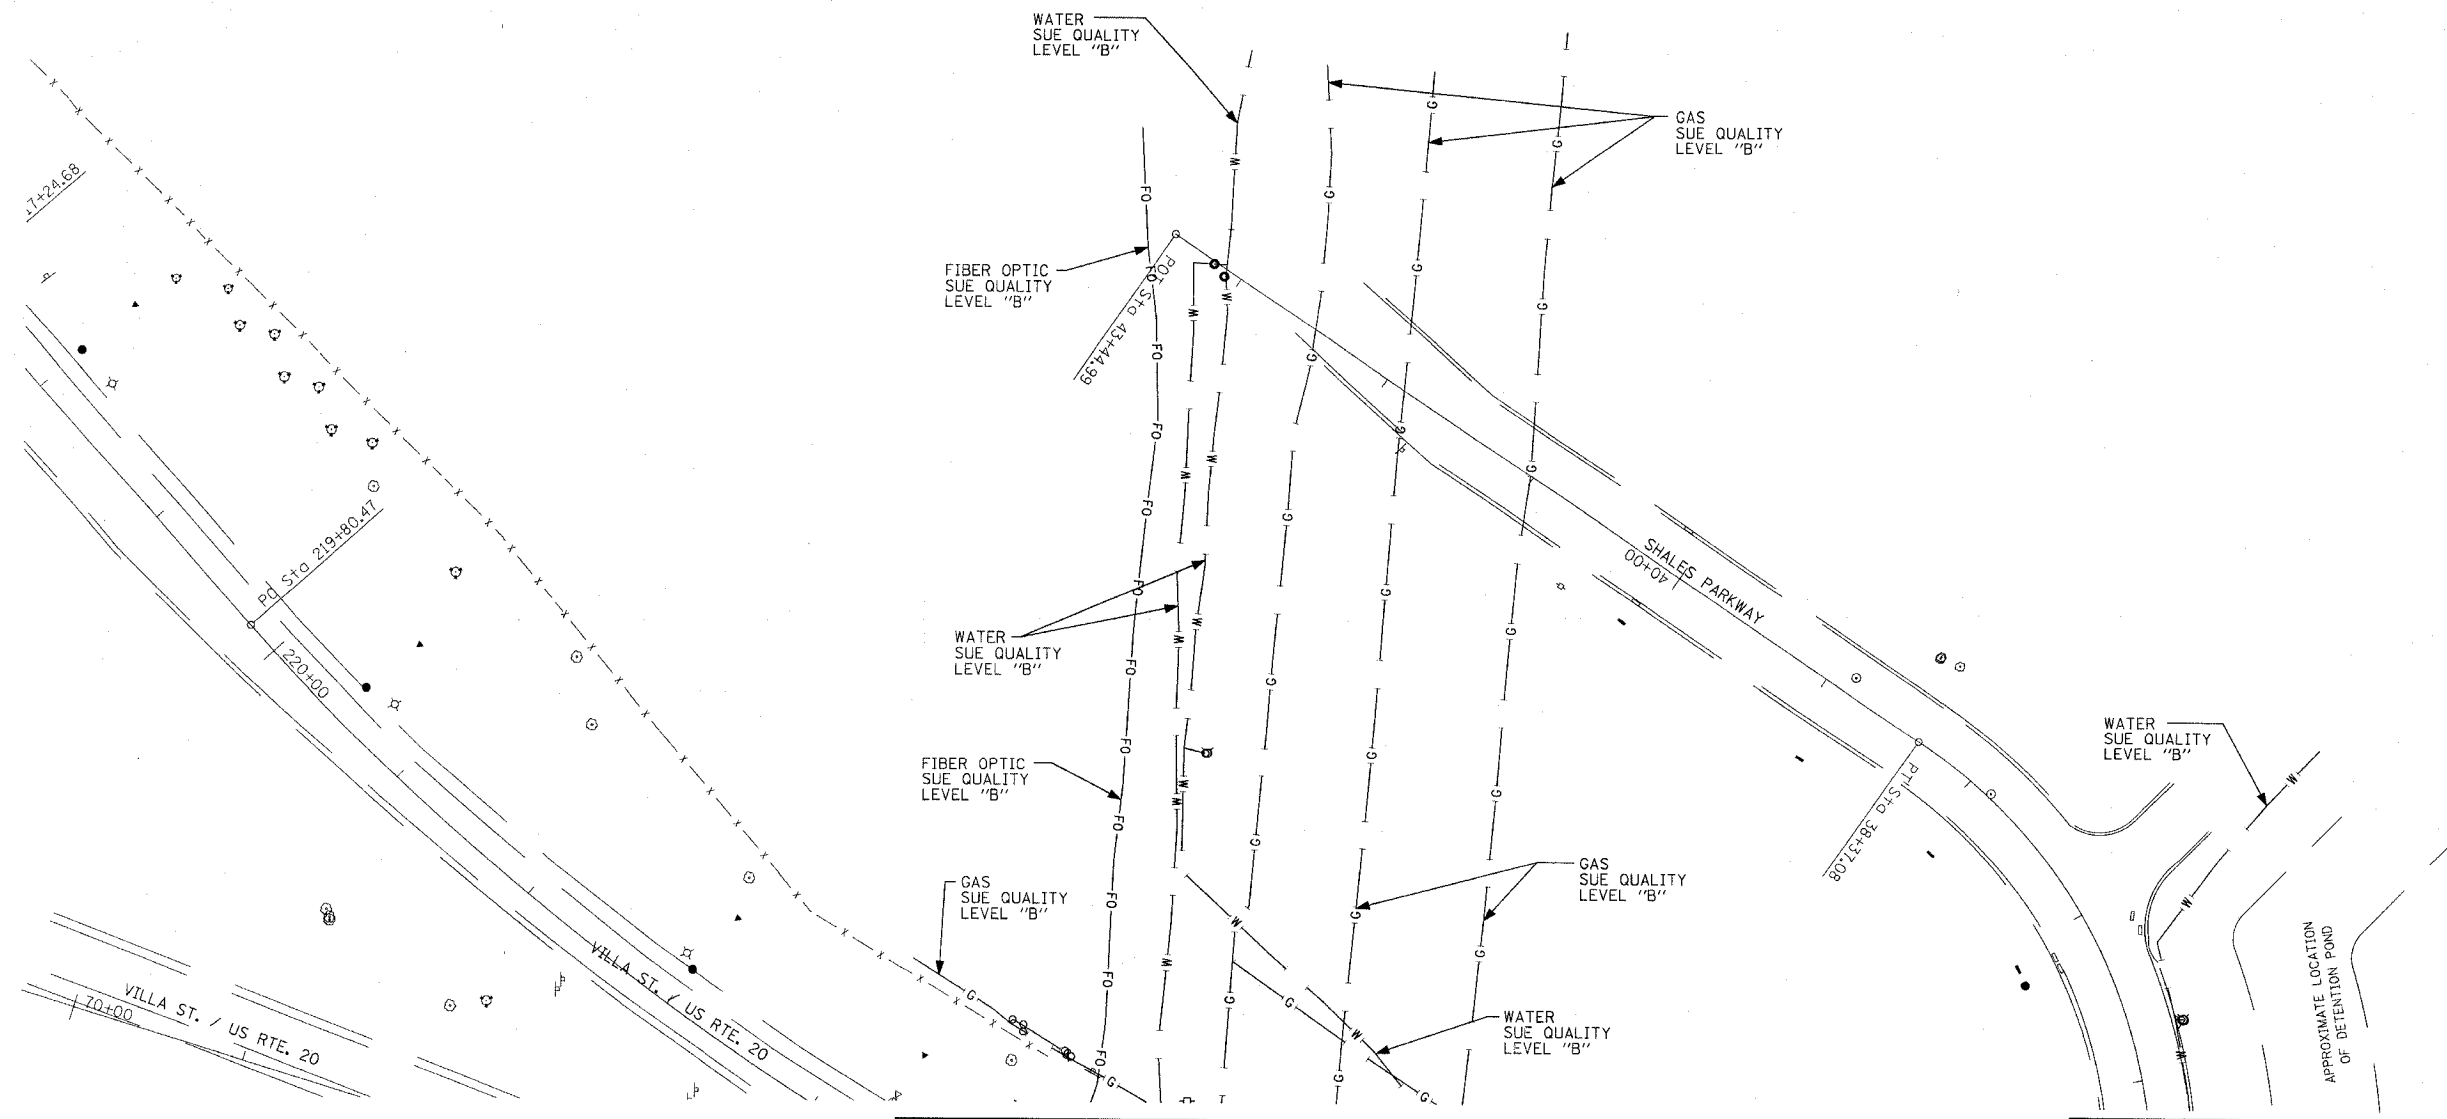

TBE GROUP, INC.
 CIVIL ENGINEERING * TRANSPORTATION * ENVIRONMENTAL
 * PLANNING * UTILITY ENGINEERING/LOCATING
 SOUTHERN REGION: FL, GA, SC, NC
 NORTHERN REGION: IL, IN, MI, OH, MD, NJ, NY
 PA, VA, CANADA
 WESTERN REGION: AZ, NV, NM, TX, CA, OR, UT, WA

IL09500203
 TBE SUE PAGE NO: 3 of 3
 Checked by: *[Signature]*
 SUE Quality Level "A" : Test Holes
 SUE Quality Level "B" : Designating

— SL — SL —	STREET LIGHT
— TS — TS —	TRAFFIC SIGNAL
— T — T —	TELEPHONE
— W —	WATER
— G —	GAS
— FO — FO —	FIBER OPTIC CABLE
— COCE — COCE —	CITY OF CHICAGO ELECTRIC
— E — E —	ELECTRIC
●	TEST HOLE

Utilities shown on these plans as depicted in the legend have been investigated by TBE Group, Inc in accordance with SUE Industry Standards. All other information shown has been provided to TBE Group, Inc by others.

As of 9/03/04 TBE has not received as-built plans from the following utilities for review purposes only. SBC, ComEd and Natural Gas Pipeline of America.

205 W. WACKER DRIVE
 SUITE 1020
 CHICAGO, IL 60606
 (312) 704-1970

REVISIONS	
NAME	DATE

ILLINOIS DEPARTMENT OF TRANSPORTATION
 SUE Investigation of Underground Utilities
 Lake St. (RT-20)
 Elgin, IL
 Contract No: 62617
 SOL "B" DATE : 8/11/2004
 DRAWN BY : KLC
 SCALE 1" = 50'