


STATE OF ILLINOIS  
DEPARTMENT OF PUBLIC WORKS & BUILDINGS  
DIVISION OF HIGHWAYS

ROUTE NO.	SECTION	COUNTY	TOTAL SHEETS	SHEET NO.	SHEET NO. 5
F.A.I. RT. 74	10-4HB-2	CHAMPAIGN	34	11	18 SHEETS
FED. ROAD DIST. NO. 7	ILLINOIS	FED. AID PROJECT			

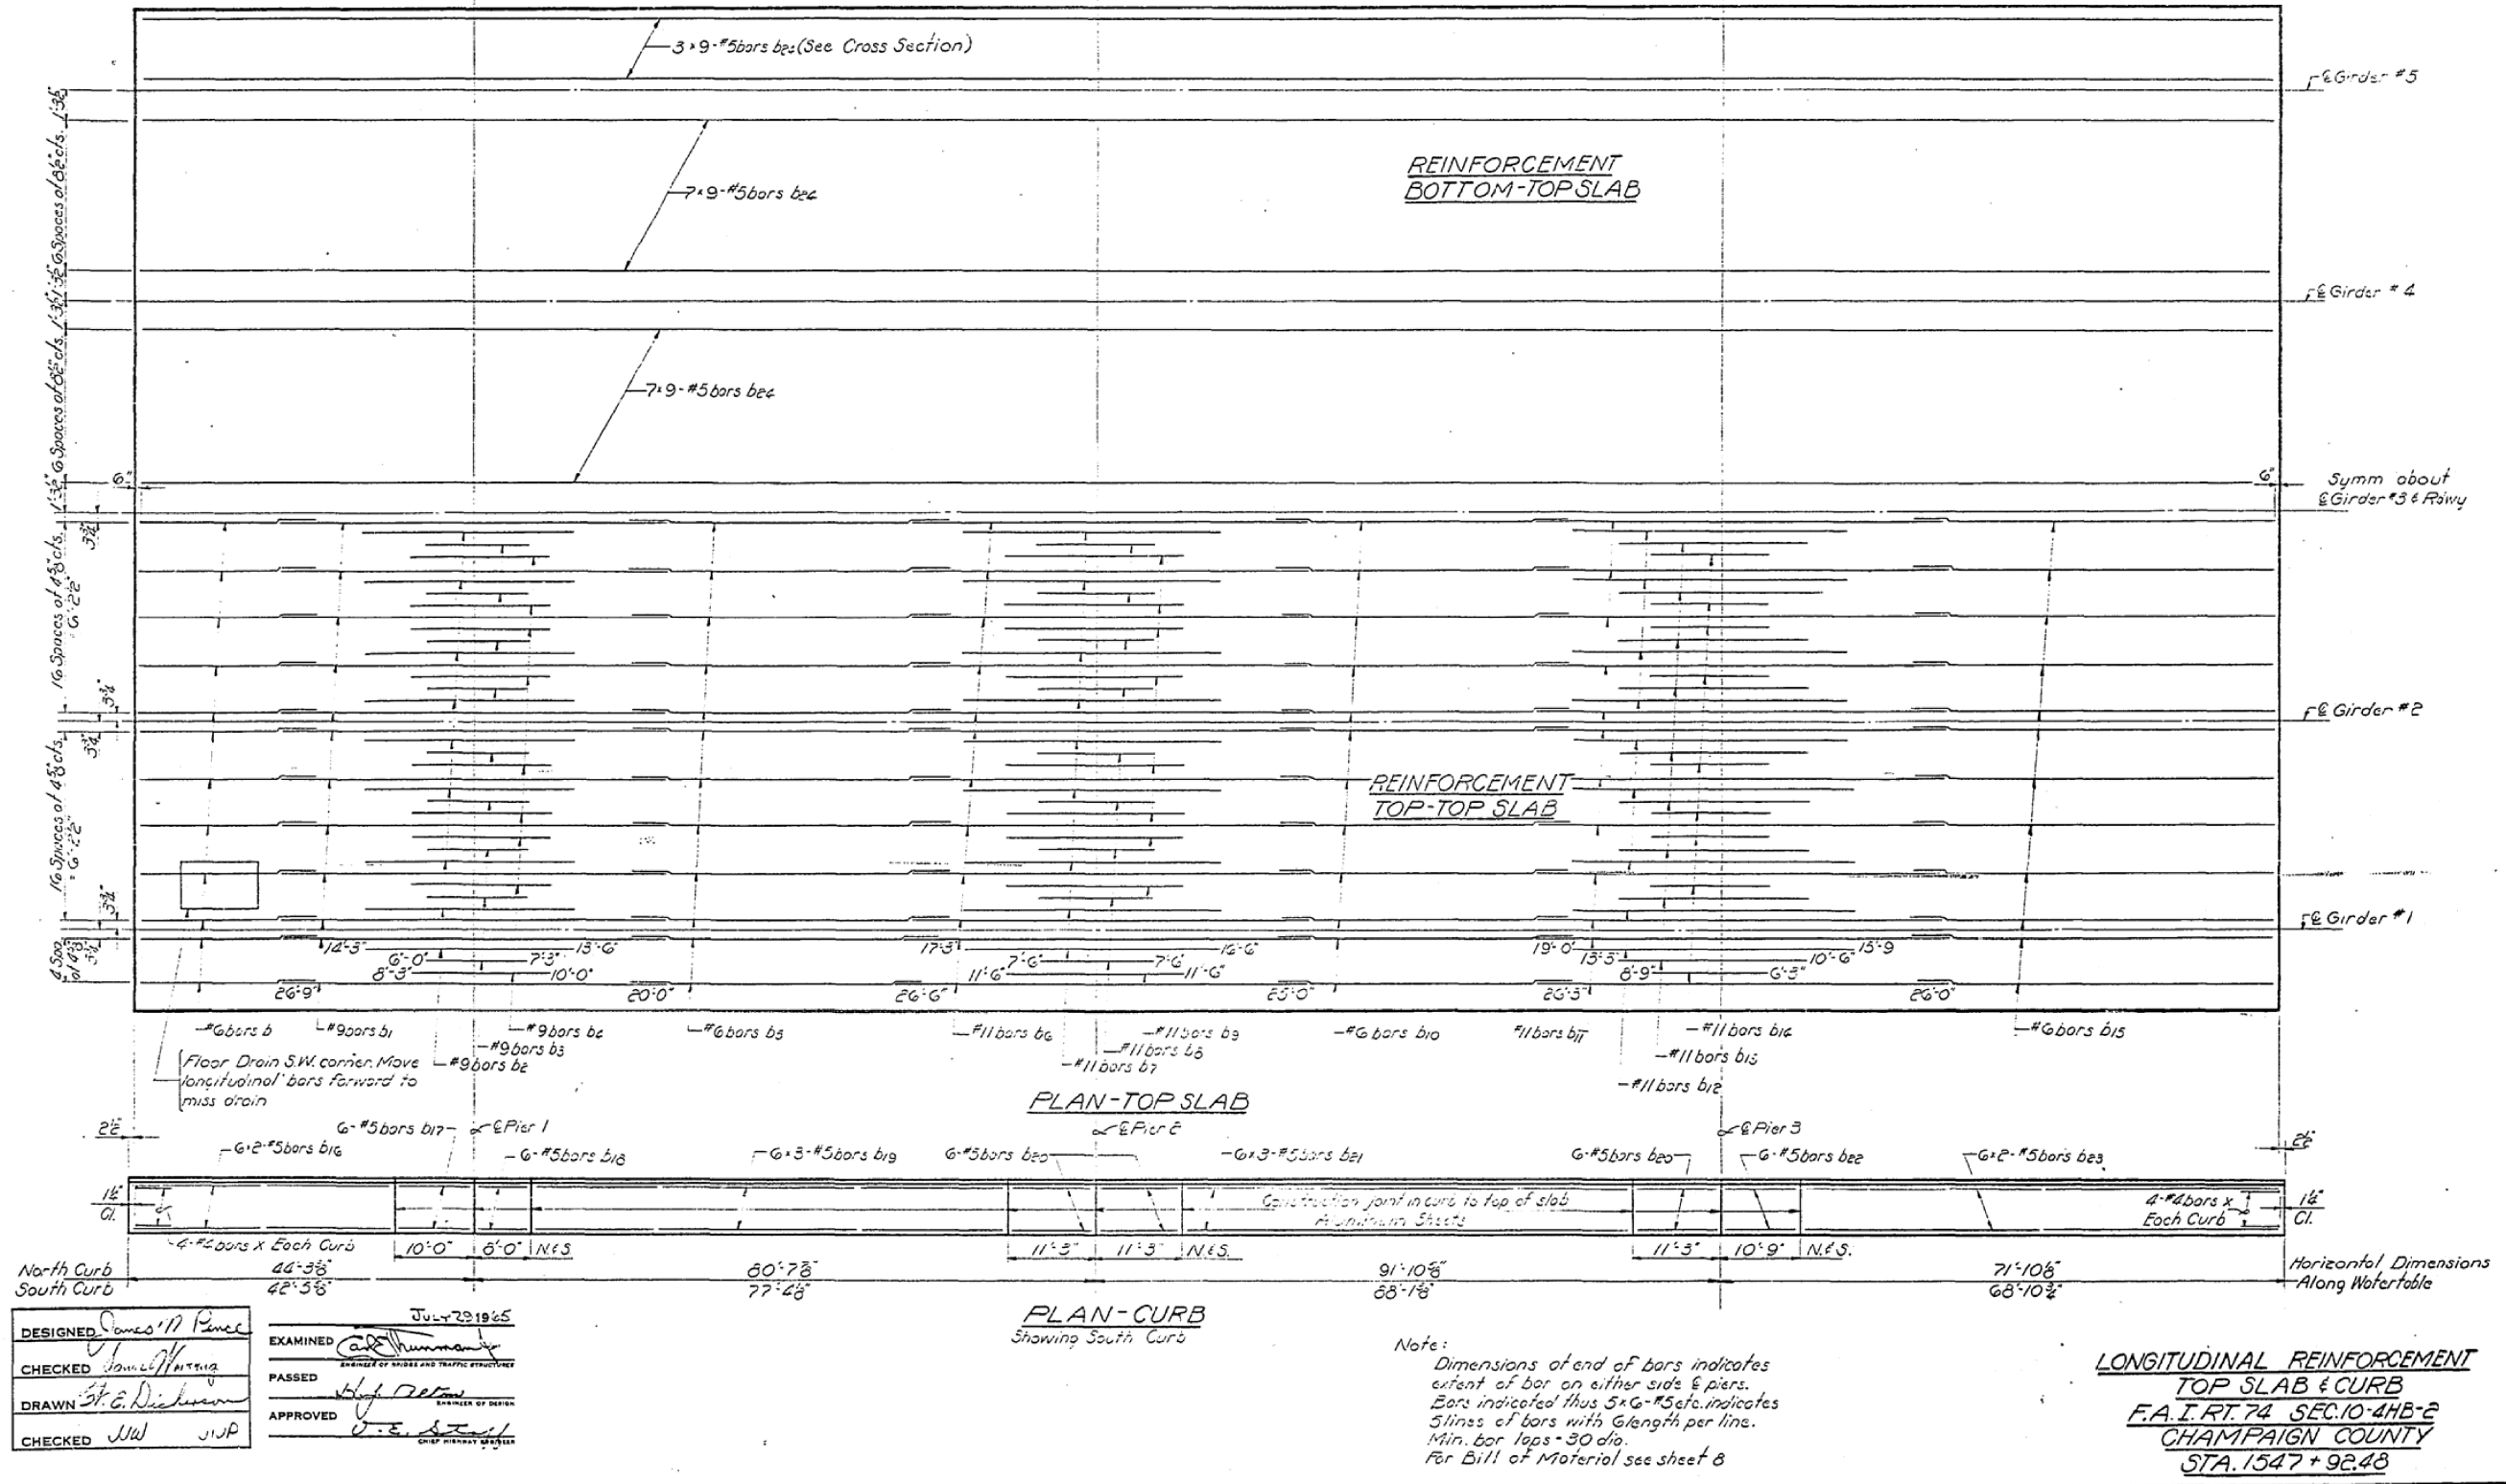

FILE NAME =	USER NAME = cealockbm	DESIGNED BMC	REVISED -	STATE OF ILLINOIS DEPARTMENT OF TRANSPORTATION	AS BUILT PLANS, SN 010-0157	F.A.I. RTE.	SECTION	COUNTY	TOTAL SHEETS	SHEET NO.
ce:\pw\work\p\midot\cealockbm\d0208368\0570700-sht-esbuilts.dgn	DESIGNED BMC	REVISED -	74			10-4BR	CHAMPAIGN	290	152	
PLOT SCALE = 48.0000' / in.	CHECKED -	REVISED -	CONTRACT NO. 70700							
PLOT DATE = 11/9/2012	DATE 8-8-11	REVISED -	FED. ROAD DIST. NO.			ILLINOIS	FED. AID PROJECT			