


For Roil and Parapet Joint Spacing See Sheet 10

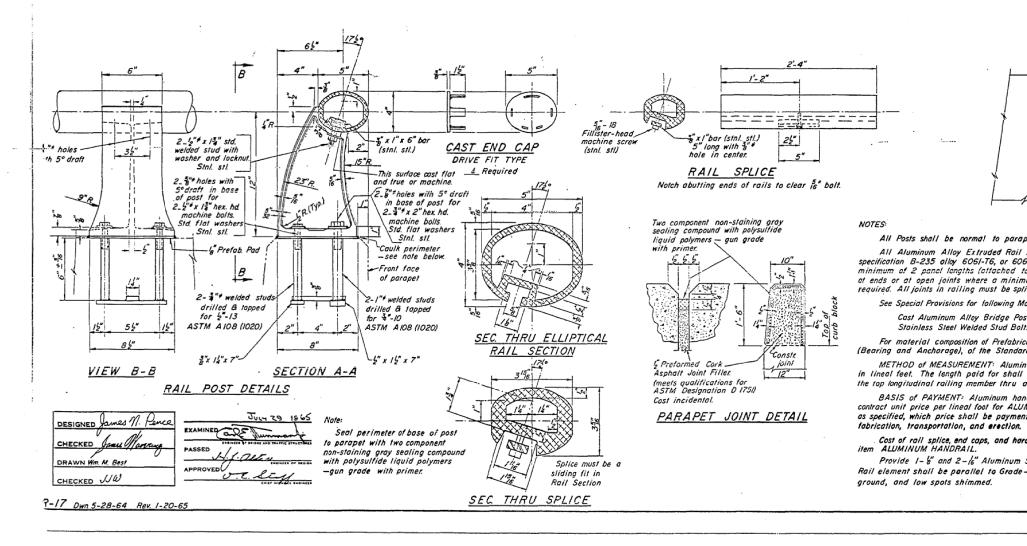

.

FILE NAME =	USER NAME = cearlockbm	DESIGNED BMC	REVISED -			
c:\pw_work\pwidot\cearlockbm\d0208368\D	570700-sht-asbuilts.dgn.dgn	DRAWN BMC	REVISED -	STATE OF ILLINOIS		AS BUILT PLANS, S
	PLOT SCALE = 40.0000 ' / in.	CHECKED -	REVISED -	DEPARTMENT OF TRANSPORTATION		
	PLOT DATE = 11/9/2012	DATE 8-8-11	REVISED -		SCALE: N/A	SHEET NO. 11 OF 17 SHEETS

I Pad, see Article 54.9(I), pecifications. handrail shall be measured the over all length along posts and gaps. Il shall be paid for at the UM HANDRAIL, measured full for all materials, the to be incidental to ms for 25% of the Posts. <u>HANDRAIL DETAILS</u>	Vories see sheet 10
Image: State of the Posts.         Conform to ASTM         and shall extend o         Image: State of the Posts.         BILL OF MATERIAL         Item         Unit         Unit         Item         Unit         Unit         Item         Unit	12" eso A - Bend to-a 764:0"rodius
$\begin{array}{c} \hline & & & & & & & & & & & & & & & & & & $	12" eso A - Bend to-a 764:0"rodius
$\begin{array}{c} \hline \\ \hline $	12" eso A - Bend to-a 764:0"rodius
$\begin{array}{c} \hline \\ \hline $	12" eso A - Bend to-a 764:0"rodius
$\frac{I_{2}^{\prime}}{I_{2}} = \frac{I_{2}^{\prime}}{I_{2}} = \frac{I_{2}^{\prime}}}{I_{2}} = \frac{I_{2}^{\prime}}{I_{2}} = \frac{I_{2}^{\prime}}{I_{2}} = \frac{I_{2}^{\prime}}{I_{2}} = \frac{I_{2}^{\prime}}{I_{2}} = \frac{I_{2}^{\prime}}{I_{2}} = \frac{I_{2}^{\prime}}}{I_{2}} = \frac{I_{2}^{\prime}} = \frac{I_{2}^{\prime}}}{I_{2}} = \frac{I_{2}^{\prime}}}$	12" eso A - Bend to-a 764:0"rodius
For the state of	12" eso A - Bend to-a 764:0"rodius
$\frac{1}{A}  Bend \ ho = a \ 764' O'radius$ $\frac{1}{A}  Bend \ ho = a \ 764' O'radius$ $\frac{1}{A}  Bill  OF  MATERIAL$ $\frac{1}{A}  Bill  Bill $	12" eso A - Bend to-a 764:0"rodius
For the state of	12" eso A - Bend to-a 764:0"rodius
Image: Second state of the second	
EVATION - END POST         Is conform to ASTM         Stand shall extend a         inimum of 3 posts becapit         If I panel length is         per detail.         all specifications         Nog 344-T4.         ashers, and Locknuts.         Pady and the measured he over all length along posts and gaps.         Ishall be poid for at the limit HANDRAIL DETAILS.         Ishall be poid for at the limit HANDRAIL DETAILS.         Ishall be poid for at the limit HANDRAIL DETAILS.         FA.I.RT.74 SEC.10-4HB-2         CHAMPAIGN COUNTY	
EVATION - END POST         I conform to ASTM         G, and shall extend a animum of 3 postel except         I panel length is per detail.         I panel length is per detail.         I specifications         Iloy 344-T4.         ashers, and Locknuts.         Pad, see Article 54.9(!), excitations.         andrail shall be measured he over all length along posts and gaps.         I shall be poid for at the IVM HANDRAIL measured full for all materials,         e to be incidental to         s for 25% of the Posts.         igh spots shall be         Image: Shall be         Image: Shall be         Image: Comparison of the Posts.         Image: Comparison of the Posts.         Image: Post shall be         Image: Sha	
$\begin{array}{rcl} \hline Bill & OF & MATERIAL\\ \hline Bill & OF & MATERIAL\\ \hline Bill & OF & MATERIAL\\ \hline Dispectitications & Dispectitications & Dispectifications & Dispectific$	
5, and shall extend a         animum of 3 posts) except         All panel length is         per detail.         all Specifications         Noy 344-T4.         ashers, and Locknuts         Pad, see Article 54.9(!),         sectifications.         hand for all he measured         he over all length along         psiss and gaps.         1 shall be paid for at the         IM HANDRAIL, measured         full for all materials,         e to be incidental to         s for 25% of the Posts.         igh spots shall be         FA.I.RT.74         SEC.10-4HB-2         CHAMPAIGN COUNTY	
Vashers, and Locknuts I Pad, see Article 54.9(I), pecifications. handrail shall be measured the over all length along posts and gaps. I shall be paid for at the UM HANDRAIL, measured full for all materials, the to be incidental to as far 25% of the Posts. high spats shall be <u>FA.I.RT.74 SEC.10-4HB-2</u> <u>CHAMPAIGN COUNTY</u>	and shall extend a mum of 3 posts) except I panel length is er detail. Specifications: BILL OF MATERIAL Unit Quantity ALUMINUM HANDRAIL Lin. Ft. 536-0
the over all length along mosts and gaps. Il shall be paid for at the UM HANDRAIL, measured full for all materials, the to be incidental to ms for 25% of the Posts. high spots shall be <u>F.A.I.RT.74</u> <u>SEC.10-4HB-2</u> <u>CHAMPAIGN COUNTY</u>	hers, and Locknuts bad, see Article 54.9(!),
full for all materials,         re to be incidental to         ns for 25% of the Posts.         igh spots shall be         FA.I.RT.74         SEC.10-4HB-2         CHAMPAIGN_COUNTY	over all length along ts and gaps. shall be paid for at the
igh spots shall be F.A. I. RT. 74 SEC. 10-4HB-2 CHAMPAIGN COUNTY	A HANDRAIL, measured II for all materials,
	h spots shall be <u>F.A. I. RT. 74</u> <u>SEC. 10-4HB-2</u> CHAMPAIGN COUNTY

F.A.I. RTE.	SECTION	COUNTY	TOTAL SHEETS	SHEET NO.
SN 010-0157 74	10-4BR	CHAMPAIGN	290	158
		CONTRACT	NO. 7	70700
STA TO STA FED. ROAD DI	DIST. NO. ILLINOIS FED. AI	D PROJECT		