# STATE OF ILLINOIS DEPARTMENT OF TRANSPORTATION

INIT DIS CONTRACT NO. 60M88

27+4-1 = 30 TOTAL SHEETS

D-91-194-11

**PROPOSED** HIGHWAY PLANS

F.A.I. ROUTE 55 / I-55 E. FRONTAGE ROAD AT I & M CANAL (THOMAS SECTION 86B-3-1 DILLON DR)

C-91-194-11

PROJECT STP-IPRP(270) **BRIDGE DECK OVERLAY** WILL COUNTY

PROJECT LOCATION 1-55 E. FRONTAGE ROAD AT I& M CANAL STRUCTURE NO. 099-0035

TRAFFIC DATA: EXISTING ADT = 1650 (2016) POSTED SPEED = 35 MPH

FOR INDEX OF SHEETS, SEE SHEET NO. 2

 $\circ$ 

 $\circ$ 

0

 $\bigcirc$ 

PROJECT IS LOCATED IN THE VILLAGE OF CHANNAHON


IMPROVEMENT ENDS STA. 1104+45

ENGINEERING SCALES. REDUCED SIZED PLANS WILL NOT CONFORM TO STANDARD SCALES. IN MAKING MEASUREMENTS

JOINT UTILITY LOCATION INFORMATION FOR EXCAVATION 1-800-892-0123

PROJECT ENGINEER: RAGHAD ADEIS DAHHAN, SE PE (847) 705-4237 PROJECT MANAGER: FAWAD AQUEEL, PE, PTOE (847) 705-4247

CONTRACT NO. 60M88

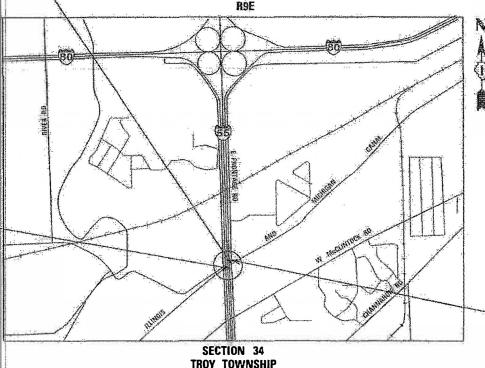

GROSS LENGTH OF PROJECT = 88 FEET = 0.17 MILES NET LENGTH OF PROJECT = 88/FEET = 6.17 MILES



DATE: 3/20/2018 IL LICEN ED PROFESSIONAL LICENSE EXPIRES ON W/30/2018

IMPROVEMENT BEGINS STA. 1095 + 64

STATE OF ILLINOIS DEPARTMENT OF TRANSPORTATION

LOCATION OF SECTION INDICATED THUS: - -

PRINTED BY THE AUTHORITY OF THE STATE OF ILLINOIS

1 REV. 6/4/18

## **SUMMARY OF QUANTITIES**

			CONSTRUCTION	ON CODE
		URBAN		
itt.	3 IAN <del>-</del>	TOTAL	ROADWAY 0013	BRIDGE 0013 86B-3-I
				000-34
		<del></del>		
			-	1
FORSSIGN FERTILIZER NOTNELY	Found	'/		
SUPPLEMENTAL WATERING	UNIT	7	7	
EARTH EXCAVATION	CU YD	790	790	
TOPSOIL FURNISH AND PLACE, 4"	SQ YD	899	899	
SEEDING, CLASS 3	ACRE	0.25	0.25	
HEAVY DUTY EROSION CONTROL BLANKET	SQ YD	899	899	
PERIMETER EROSION BARRIER	FOOT	1285	1285	
AGGREGATE SUBGRADE IMPROVEMENT 12"	SQ YP	585	585	
BITUMINOUS MATERIALS (TACK COAT)	POUND	13	13	
SUBBASE GRANULAR MATERIAL, TYPE C	TON	30	3∂	
HOT-MIX ASPHALT SURFACE REMOVAL - BUTT JOINT	SQ YD	347	347	-
HOT-MIXASPHALT SURFACE COURSE, MiX "D", N70	TON	34	34	
AGGREGATE SHOOLDERS, TYPE B 6"	SO YP	481	481	
	1			
HOT-MIX ASPHALT SHOULDERS, 10"	sqyb	583	583	
	EARTH EXCAVATION  TOPSOIL FURNISH AND PLACE, 4"  SEEDING, CLASS 3  HEAVY DUTY EROSION CONTROL BLANKET  PERIMETER EROSION BARRIER  AGGREGATE SUBGRADE EMPROVEMENT 12"  BITUMINOUS MATERIALS (TACK COAT)  SUBBASE GRANULAR MATERIAL, TYPE C  HOT-MIX ASPHALT SURFACE REMOVAL - BUTT JOINT  HOT-MIX ASPHALT SURFACE COURSE, MIX "D", N70  AGGREGATE SHOOLDERS, TYPE B 6"	TREE REMOVAL (GTO IS UNITS DIAMETER)  NITROGEN FERTILIZER NUTRIENT  POUND  TREE REMOVAL (OVER IS UNITS DIAMETER)  POTASSIUM FERTILIZER NUTRIENT  POUND  SUPPLEMENTAL WATERING  UNIT  EARTH EXCAVATION  CUYD  TOPSOIL FURNISH AND PLACE, 4"  SQYD  SEEDING, CLASS 3  ACRE  HEAVY DUTY EROSION CONTROL BLANKET  SQYD  PERIMETER EROSION BARRIER  FOOT  AGGREGATE SUBGRADE IMPROVEMENT 12"  SQYP  BITUMINOUS MATERIALS (TACK COAT)  SUBBASE GRANULAR MATERIAL, TYPE C  HOT-MIXASPHALT SURFACE REMOVAL - BUTT JOINT  AGGREGATE SHOOLDERS, TYPE B 6"  SO YP  AGGREGATE SHOOLDERS, TYPE B 6"  SO YP	TREE REMOVAL (6 TO IS UNITS DIAMETER)  WITT 165  NITROGEN FERTILIZER NUTRIENT  POUND 17  TREE REMOVAL COVER IS UNISTS DIAMETER)  POUND 17  SUPPLEMENTAL WATERING  UNIT 7  EARTH EXCAVATION  CUYD 790  TOPSOIL FURNISH AND PLACE, 4"  SQYD 899  SEEDING, CLASS 3  ACRE 0.25  HEAVY DUTY EROSION CONTROL BLANKET  SQYD 899  PERIMETER EROSION BARRIER  FOOT 1285  BITUMINOUS MATERIALS (TACK COAT)  SUBBASE GRANGLAR MATERIAL, TYPE 0  HOTMIXASPHALT SURFACE COURSE, MIX "D", N70  TON 34  AGGREGATE SHOOLDERS, TYPE B 6"  SO YP 481  AGGREGATE SHOOLDERS, TYPE B 6"  SO YP 481	ITEM

			URBAN	CONSTRUCT 80% FEE 20% S	DERAL
CODE NO.	ITEM	UNIT	TOTAL QUANTITY	ROADWAY 00/3 URBAN	BRID 001: 86B-3
50102400	CONCRETE REMOVAL	CU YD	3		3
50157300	PROTECTIVE SHIELD	SQ YD	184		184
50300100	FLOOR DRAINS	EACH	4		4
50300260	BRIDGE DECK GROOVING	SQ YD	173		173
Jum	mmmmmmm	m	mm	~~~~	<u>m</u>
* 66900200	NON-SPECIAL WASTE DISPOSAL	CU YD	670	670	3
* 66900450	SPECIAL WASTE PLANS AND REPORTS	LSUM	1	1	1_3_
* [:66900530	SOIL DISPOSAL ANALYSIS	EACH	1	1	] }
Juu		Juu	mun	سسس	لىبا
50900200	STEEL RAILING, TYPE 2399	FOOT	87		87
* \$63000003	STEEL PLATE DEAM GUARDRAIL, TYPEA, 9 FOOT POSTS	FOOT	588	588	
* 63100045	TRAFFIC BARRIER TERMINAL, TYPE 2	EACH	1	1	
* 63100087	TRAFFIC BARRIER TERMINAL, TYPE 6A	EACH	3	3	
* 63100167	TRAFFIC BARRIER TERMINAL, TYPE 1 (SPECIAL) TANGENT	EACH	3	5	
63200310	GUARDRAIL REMOVAL	FOOT	235	235	
63200400	CABLE ROAD GUARD REMOVAL	FOOT	84	84	
67000400	ENGINEER'S FIELD OFFICE, TYPE A	CAL MO	4	4	
}	MOBILIZATION	LSUM	1	1	

\* SPECIALTY ITEMS



_	USER NAME = tmohammed	DESIGNED - TOM	REVISED
e,		DRAWN - YN	REVISED
	PLOT SCALE = 2.0000 ' / in.	CHECKED - MO	REVISED
	PLOT DATE = 3/22/2018	DATE - 03/22/2018	REVISED

STATE OF ILLINOIS
DEPARTMENT OF TRANSPORTATION

					AT I&M S SHEET	
SHEET	1	ΩF	2	SHEFTS	STA	TO STA

SCALE: N/A

## **SUMMARY OF QUANTITIES**

			urban	CONSTRUCT 80% FEI 20% S	DERAL
				ROADWAY	BRIDGE
CODE			TOTAL	0013	0013
NO.	!TEM	UNIT	QUANTITY	URBAN	86B-3-I
70100405	TRAFFIC CONTROL AND PROTECTION, STANDARD 701321	EACH	1	1	
70300100	SHORT TERM PAVEMENT MARKING	FOOT	ui i	n)	-
70200450	CUODT TERM DAVEMENT MARKING REMOVAL	SQ FT	462	402	
70300150	SHORT TERM PAVEMENT MARKING REMOVAL	30.5	1000	102	
70300904	PAVEMENT MARKING TAPE, TYPE IV 4"	FOOT	4765	4765	
70300924	PAVEMENT MARKING TAPE, TYPE IV 24"	FOOT	66	66	
70400100	TEMPORARY CONCRETE BARRIER	FOOT	8%	896	
70400200	RELOCATE TEMPORARY CONCRETE BARRIER	FOOT	1,011	1,011	
70600250	IMPACT ATTENUATORS, TEMPORARY (NON-REDIRECTIVE), TEST LEVEL 3	EACH	2	2	
70600350	IMPACT ATTENUATORS, RELOCATE (NON- REDIRECTIVE), TEST LEVEL 3	EAC⊭i	4	4	
72501000	TERMINAL MARKER - DIRECT APPLIED	EACH	6	6	
		FOOT	0 (77)	71 870	
78009004	MODIFIED URETHANE PAVEMENT MARKING - LINE 4"	FOOI	4,872	4,872	
<u> </u>			-		
78200005	GUARDRAIL REFLECTORS, TYPE A	EACH	26	26	
89000050	TEMPORARY BRIDGE TRAFFIC SIGNAL INSTALLATION	EACH	1	1	-
0300000					

1			.	CONSTRUCT 80% FED	
			URBAN	20% ST	
				ROADWAY	BRIDG
CODE			TOTAL	0013	0013
NO.	ITEM	UNIT	QUANTITY	URBAN	86B-3
X0326131 ~	RELOCATE EXISTING TEMPORARY BRIDGE TRAFFIC SIGNALS	EACH	a	a	
X0327979 ~	PAVEMENT MARKING REMOVAL - GRINDING	SQ FT	1,624	1,624	
X6310088	TRAFFIC BARRIER TERMINAL TYPE 6A (SPECIAL)	EACH	1	1	
X6310188	TRAFFIC BARRIER TERMINAL, TYPE 6A (MODIFIED)	EACH	2	$\frac{2}{2}$	
X6330725	STEEL PLATE BEAM GUARDRAIL (SHORT RADIUS)	FOOT	25	25.00	
<b>x66502</b> 06	WOVEN WIRE FENCE TO BE REMOVED AND RE-ERECTED	FOOT	289	284	
X7010218	TRAFFIC CONTROL AND PROTECTION, (SPECIAL)	EACH	1	1	:
X7015005	CHANGEABLE MESSAGE SIGN	CAL DAY	140	140	
X7030005	TEMPORARY PAVEMENT MARKING REMOVAL	SQFT	2,138	2,138	
Z0006014·	BRIDGE DECK LATEX CONCRETE OVERLAY, 2 1/2 INCHES	SQ YD	173		173
Z0012130	BRIDGE DECK SCARIFICATION 3/4"	SQ YD	173		173
Z0012754 ·	STRUCTURAL REPAIR OF CONCRETE (DEPTH EQUAL TO OR LESS THAN 5 INCHES)	SQ FT	31		31
20013798	CONSTRUCTION LAYOUT	L SUM	1	ı	
Z0016001	DECK SLAB REPAIR (FULL DEPTH, TYPE I)	SQ YD	2		2
Z0016002°	DECK SLAB REPAIR (FULL DEPTH, TYPE II)	SQ YD	29		29
:			-		
Z0030850 ·	TEMPORARY INFORMATION SIGNING	SQFT	52	52	
Z0049790 ′	RELOCATING NAME PLATES	EACH	1		1

\* SPECIALTY ITEMS

9		Ţ
NAME:	111 S. Wacker Drive, Suite 3910	_
ž	Chicago, IL 60606 ENGINEERS & SURVEYORS Ph: 312-235-6783	P


	USER NAME = tmohammed	DESIGNED -	TOM	REVISED -
re,		DRAWN -	YN	REVISED
;	PLOT SCALE = 2.8000 ' / in.	CHECKED -	MO	REVISED
	PLOT DATE = 3/22/2018	DATE -	03/22/2018	REVISED

STATE OF ILLINOIS
DEPARTMENT OF TRANSPORTATION

1–55 E. F Summai							
SHEET	2	OF	2	SHEETS	STA.	TO STA.	

SCALE: N/A

	F.A.I RTE.	SECTION		COUNTY	TOTAL SHEETS	SHEET NO.
	55	86B-3-I	WHLL	27	04	
_				CONTRACT	NO. 60	M88
		ILLINOIS	FED. A	D PROJECT		

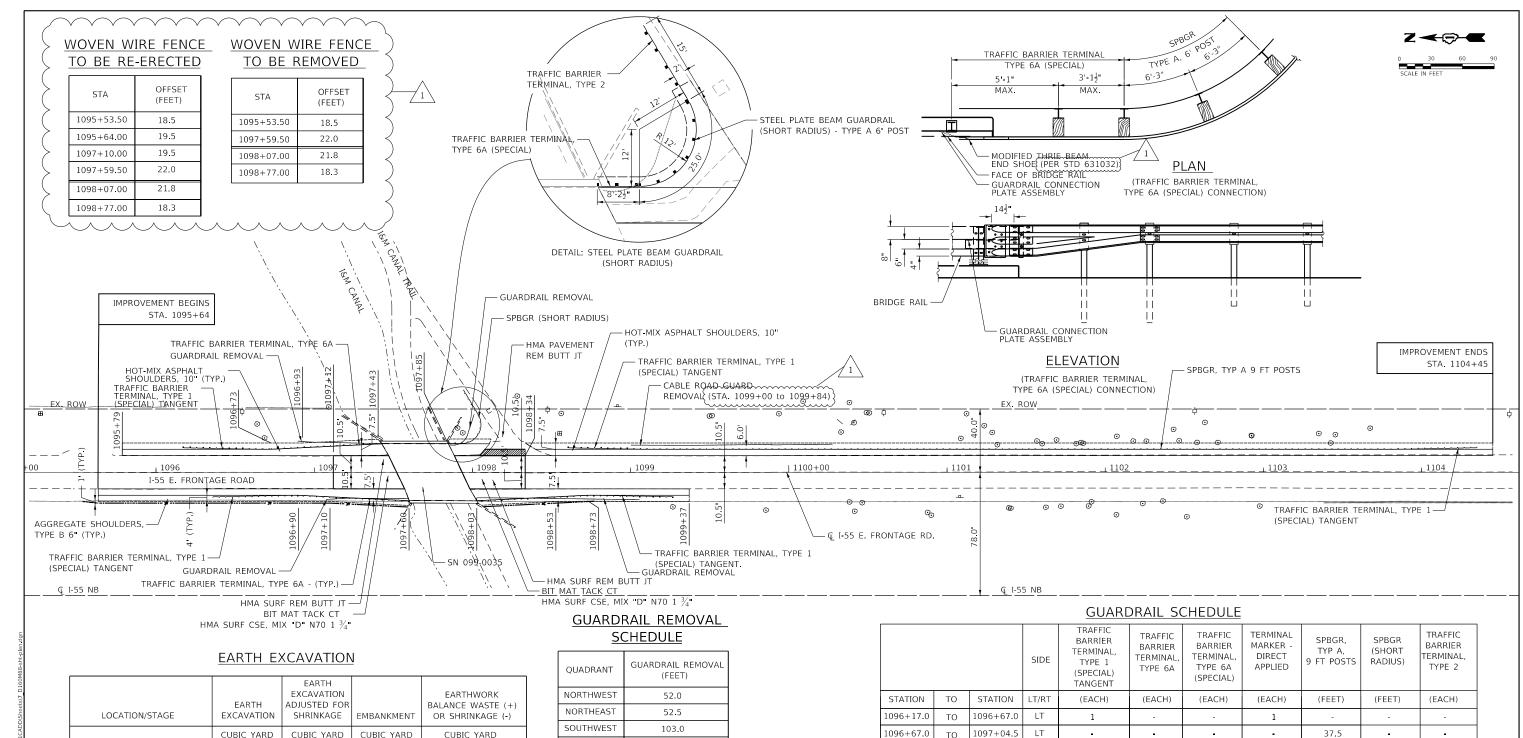

LOCATION/STAGE	EARTH EXCAVATION	EARTH EXCAVATION ADJUSTED FOR SHRINKAGE	EMBANKMENT	EARTHWORK BALANCE WASTE (+) OR SHRINKAGE (-)
	CUBIC YARD	CUBIC YARD	CUBIC YARD	CUBIC YARD
PRE-STAGE				
1095+50 TO 1097+53	70	59	2	57
1098+93 TO 1100+00	148	126	144	-28
PRESTAGE TOTALS	218	185	147	39
STAGE 1				
1095+50 TO 1097+53	80	68	1	67
1098+93 TO 1100+00	75	64	22	41
STAGE 1 TOTALS	155	132	23	108
STAGE 2				
1100+00 TO 1104+40	415	352	362	-9
TOTAL	788	670	532	138

QUADRANT	GUARDRAIL REMOVAL (FEET)
NORTHWEST	52.0
NORTHEAST	52.5
SOUTHWEST	103.0
SOUTHEAST	27.5
TOTAL	235.0
NORTHEAST SOUTHWEST SOUTHEAST	52.5 103.0 27.5

#### PAVEMENT REMOVAL SCHEDULE

LC	OCATION	HOT-MIX ASPHALT SURFACE REMOVAL, BUTT JOINT	
STATION	TO	STATION	(SQ YD)
1097+12	то	1097+52	168
1097+94	ТО	1098+34	179
	TOTAL	347	

						STILDOLL				
			SIDE	TRAFFIC BARRIER TERMINAL, TYPE 1 (SPECIAL) TANGENT	TRAFFIC BARRIER TERMINAL, TYPE 6A	TRAFFIC BARRIER TERMINAL, TYPE 6A (SPECIAL)	TERMINAL MARKER - DIRECT APPLIED	SPBGR, TYP A, 9 FT POSTS	SPBGR (SHORT RADIUS)	TRAFFIC BARRIER TERMINAL, TYPE 2
STATION	TO	STATION	LT/RT	(EACH)	(EACH)	(EACH)	(EACH)	(FEET)	(FEET)	(EACH)
1096+17.0	ТО	1096+67.0	LT	1	-	-	1	-	-	-
1096+67.0	ТО	1097+04.5	LT	-		•	•	37.5	•	
1097+04.5	TO	1097+44.5	LT	=	1	-	-	-	-	-
1096+36.0	ТО	1096+86.0	RT	1	-	-	1	-	-	-
1096+86.0	ТО	1097+23.5	RT	-	=	-	=	37.5	ii ii	=
1097+23.5	TO	1097+63.5	RT	-	1	T.	=	-	Ü	=
1097+85.0	TO	1097+93.0	LT	ı	=	1	=	-	Ш	=
1097+93.0	TO		LT	-	-	-	1	-	25.0	1
1098+60.0	ТО	1099+10.0	LT	1			1	-	-	-
1099+10.0	TO	1103+85.0	LT	-			-	475	-	-
1103+85.0	ТО	1104+35.0	LT	1			1	-	-	-
1097+99.5	ТО	1098+39.5	RT	-	1	ū	=	-	1	-
1098+39.5	ТО	1098+77.0	RT	=	-	-	-	37.5	-	-
1098+77.0	ТО	1099+27.0	RT	1	-	•	1	-	-	-
	TC	DTAL		5	3	1	6	587.5	25.0	1

-	USER NAME = mokrent	DESIGNED	-	TOM	REVISED	-	05/23/2018	/1\	
°,[		DRAWN	-	YN	REVISED	-			
	PLOT SCALE = 60.6640 / in.	CHECKED	-	MO	REVISED	-			
	PLOT DATE = 5/24/2018	DATE	-	04/30/2018	REVISED	_			

STATE OF ILLINOIS **DEPARTMENT OF TRANSPORTATION** 

	I–55 E. FRONTAGE ROAD AT I&M CANAL								
PLAN & SCHEDULE OF QUANTITIES									
201	CHEET	-	OF	-	CHEETC	CTA	т.	O CTA	

F.A.I RTE.	SECT	TION		COUNTY	TOTAL SHEETS	SHEET NO.
55	86B-3-I			WILL	27	07
			CONTRACT	NO. 60	88MC	
		ILLINOIS	ID PROJECT			

#### MAINTENANCE OF TRAFFIC GENERAL NOTES

- 1. THE MAINTENANCE OF TRAFFIC CONTROL (MOT) PLANS SHALL SERVE AS A GUIDE FOR SAFE DIVERSION OF TRAFFIC DURING EXECUTION OF THIS CONTRACT. HOWEVER, THE CONTRACTOR MAY MODIFY THE MOT PLANS TO MEET CONSTRUCTION NEEDS BUT NOT AT THE EXPENSE OF PUBLIC SAFETY OR CONVENIENCE. ANY CHANGES TO THE MOT PLANS SHALL BE SUBMITTED TO THE ENGINEER FOR APPROVAL.
- 2. THE ENGINEER SHALL BE INFORMED 48 HOURS IN ADVANCE OF ANY CHANGE TO THE MOT PLANS.
- 3. LONGITUDINAL DIMENSIONS MAY BE ADJUSTED SLIGHTLY TO FIT FIELD CONDITIONS.
- 4. ALL VEHICLES, EQUIPMENT, WORKERS, AND THEIR ACTIVITIES ARE RESTRICTED AT ALL TIMES TO ONE SIDE OF THE PAVEMENT UNLESS OTHERWISE AUTHORIZED BY THE ENGINEER.
- 5. ALL EXISTING PAVEMENT MARKINGS IN CONFLICT WITH THE MAINTENANCE OF TRAFFIC STRIPING SHALL BE REMOVED. THIS WORK WILL BE PAID FOR AT THE CONTRACT UNIT PRICE PER SQUARE FOOT, "PAVEMENT MARKING REMOVAL" OF DESIGNATED METHOD.
- 6. THE CONTRACTOR SHALL REMOVE ALL PAVEMENT MARKING TAPE WHICH CONFLICTS WITH THE NEXT STAGE OR FINAL STRIPING. REMOVAL OF TEMPORARY PAVEMENT MARKING TAPE WILL BE PAID FOR AT THE CONTRACT UNIT PRICE PER SQUARE FOOT, "TEMPORARY PAVEMENT MARKING REMOVAL".
- 7. ALL TRAFFIC CONTROL DEVICES USED FOR THE MAINTENANCE OF TRAFFIC, AS DETAILED ON THE PLANS, OR HIGHWAY STANDARD SHALL BE REFLECTORIZED PRIOR TO INSTALLATION AND CLEANED AS SPECIFIED IN THE MAINTENANCE OF TRAFFIC SPECIAL PROVISION OR AS DIRECTED BY THE ENGINEER.
- 8. ALL DRUMS, VERTICAL PANELS, AND BARRICADES ADJACENT TO THE EDGE OF TRAVELED WAY SHALL BE EQUIPPED WITH STEADY-BURNING BIDIRECTIONAL LIGHTS.
- 9. TEMPORARY CONCRETE BARRIER SHALL BE USED ACROSS THE BRIDGE WHEN SPECIFIED IN THE PLANS.
- 10. ALL EXISTING SIGNS WITHIN THE LIMITS OF MAINTENANCE OF TRAFFIC WHICH ARE OBSCURED BY OR OTHERWISE INTERFERED WITH BY THE CONSTRUCTION OPERATIONS AND MAINTENANCE OF TRAFFIC, SHALL BE COVERED OR REMOVED BY THE CONTRACTOR UNLESS SPECIFIED IN THE PLANS OR WHEN DIRECTED BY THE ENGINEER. THIS WORK SHALL BE IN ACCORDANCE WITH ARTICLE 107.25 OF THE IDOT STANDARD SPECIFICATIONS.
- 11. TEMPORARY, OFF-PEAK HOUR LANE CLOSURES MUST BE REQUESTED THROUGH THE ENGINEER AND AS SPECIFIED IN THE SPECIAL PROVISIONS. WHEN OFF-PEAK HOUR OR WEEKEND LANE CLOSURES ARE REQUIRED, A PORTABLE CHANGEABLE MESSAGE SIGN SHALL BE INSTALLED ONE WEEK PRIOR TO THE CLOSURE. THE MESSAGE SIGN WORDING AND LOCATION WILL BE DETERMINED BY THE ENGINEER.
- 12. THE CONTRACTOR SHALL PLACE A CHANGEABLE MESSAGE SIGN AT EACH END OF THE PROJECT AND/OR AS DIRECTED BY THE ENGINEER TO INFORM MOTORISTS OF UPCOMING CONSTRUCTION ACTIVITIES. THE MESSAGE SIGNS WITH THE APPROPRIATE INFORMATION SHALL BE IN PLACE TWO WEEKS BEFORE START OF CONSTRUCTION ACTIVITY. THIS WORK IS TO BE PAID FOR AT THE CONTRACT UNIT PRICE PER CALENDAR DAY, "CHANGEABLE MESSAGE SIGN".
- 13. ALL TEMPORARY INFORMATION SIGNS SHALL BE PAID FOR SEPARATELY AT THE CONTRACT UNIT PRICE PER SQUARE FOOT FOR "TEMPORARY INFORMATION SIGNING".
- 14. HIGH-INTENSITY FLASHING LIGHTS SHALL BE USED ON EACH APPROACH IN ADVANCE OF THE WORK ZONE DURING HOURS OF DARKNESS AND INSTALLED ABOVE THE FIRST TWO SIGNS IN EACH SERIES.
- 15. THE ENGINEER MUST BE NOTIFIED AT LEAST 72 HOURS PRIOR TO PLACING THE TEMPORARY TRAFFIC SIGNALS IN OPERATION SO THAT ARRANGEMENTS CAN BE MADE TO INSPECT THE INSTALLATION AND SET THE TIMING OF THE SIGNALS. THE CONTRACTOR SHALL FURNISH TIMING CYCLE GEARS OF 60, 65, 70, 80, 90, 100, AND 120 SECONDS FOR THE CONTROLLER.
- 16. FOR ADDITIONAL TEMPORARY TRAFFIC SIGNAL INFORMATION, SEE IDOT STANDARD 701321.
- 17. FOR ADDITIONAL BRIDGE CONSTRUCTION STAGING INFORMATION, SEE STRUCTURAL PLANS.

#### SUGGESTED CONSTRUCTION SEQUENCING

### PRE STAGE

CONSTRUCTION

INSTALL TEMPORARY TRAFFIC SIGNALS AND ASSOCIATED MOT ITEMS.

GRADE ALONG NORTHBOUND LANE FOR SHOULDERS.

REMOVE EXISTING GUARDRAIL AND TERMINAL SECTIONS ALONG NORTHBOUND LANE.

PLACE HMA AND AGGREGATE SHOULDER ON NORTHBOUND SHOULDER

PLACE NEW GUARDRAIL (INCLUDING STEEL PLATE BEAM GUARDRAIL (SHORT RADIUS)) AND TERMINAL SECTIONS (INCLUDING TYPE 6A (MODIFIED) ATTACHED TO EXISTING PARPAPETS). TRAFFIC BARRIER TERMINAL, TYPE 6A AND TYPE 6A (SPECIAL) WILL NOT BE ATTACHED AT THIS TIME.

MAINTENANCE OF TRAFFIC

UTILIZE STANDARD 701301

#### STAGE 1

CONSTRUCTION:

SOUTHBOUND LANE:

REMOVE EXISTING GUARDRAIL AND TERMINAL SECTIONS.

GRADE ALONG SOUTHBOUND LANE FOR SHOULDERS.

PERFORM BRIDGE DECK PATCHING.

PERFORM BRIDGE DECK SCARIFICATION 3/4".

PLACE 21/2" BRIDGE DECK LATEX CONCRETE OVERLAY.

PLACE 1¾" HMA SURFACE COURSE.

INSTALL STEEL RAILING, TYPE 2399.

PLACE NEW GUARDRAIL WITH TERMINAL SECTIONS.

CONSTRUCT HMA AND AGGREGATE SHOULDER ON SOUTHBOUND SHOULDER.

CONSTRUCT BUTT JOINTS

MAINTENANCE OF TRAFFIC:

UTILIZE MAINTENANCE OF TRAFFIC DETAILS IN THE PLANS AND STANDARD 701321.

#### STAGE 2

CONSTRUCTION

NORTHBOUND LANE:

PERFORM BRIDGE DECK PATCHING.

PERFORM BRIDGE DECK SCARIFICATION  $\mbox{\em 3}_{4}$ ".

PLACE 2½" BRIDGE DECK LATEX CONCRETE OVERLAY.

PLACE  $1^{3}\!\!\!/$  HMA SURFACE COURSE.

INSTALL STEEL RAILING, TYPE 2399.

CONSTRUCT REMAINING SHOULDERS FOR NORTHBOUND.



REMOVE TRAFFIC BARRIER TERMINALS, TYPE 6A (MODIFIED) ATTACHED TO BRIDGE AND REPLACE WITH TYPE 6A AND TYPE 6A (SPECIAL).

PLACE NEW GUARDRAIL WITH TERMINAL SECTIONS.

MAINTENANCE OF TRAFFIC:

UTILIZE MAINTENANCE OF TRAFFIC DETAILS IN THE PLANS AND STANDARD 701321.

#### STAGE 3

CONSTRUCTION:

SCALE: N/A

PLACE PERMANENT PAVEMENT MARKINGS AND RAISED REFLECTIVE PAVEMENT MARKERS.

MAINTENANCE OF TRAFFIC:

UTILIZE STANDARD 701301.



USER NAME = mokrent	DESIGNED -	TOM	REVISED - 05/23/2018	
	DRAWN -	YN	REVISED -	
PLOT SCALE = 2.0000 ' / in.	CHECKED -	MO	REVISED -	1
PLOT DATE = 5/24/2018	DATE -	04/30/2018	REVISED -	

STATE OF ILLINOIS
DEPARTMENT OF TRANSPORTATION

I-55 E.F	RONTA	GE ROAD	AT I&M	CANAL	
TRAFFIC	CONT	ROL GENE	RAL NOTE	S AND	
SUGGEST	ED CO	NSTRUCTI	ON SEQU	<b>ENCING</b>	
CHEET	1 05	) CUEETO	CTA		TO 6

F.A.I RTE	SECT	ΓΙΟΝ		COUNTY	TOTAL SHEETS	SHE
55	86B	86B-3-I			27	08
				CONTRACT	NO. 6	38M0
		ILLINOIS	FED. A	ID PROJECT		

