
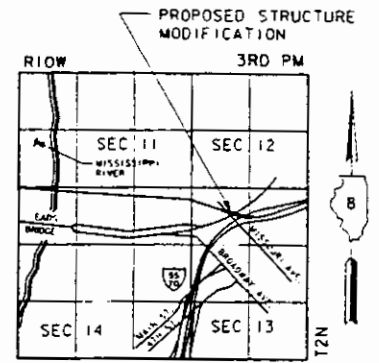


*IBR-I APPROACH BRIDGE

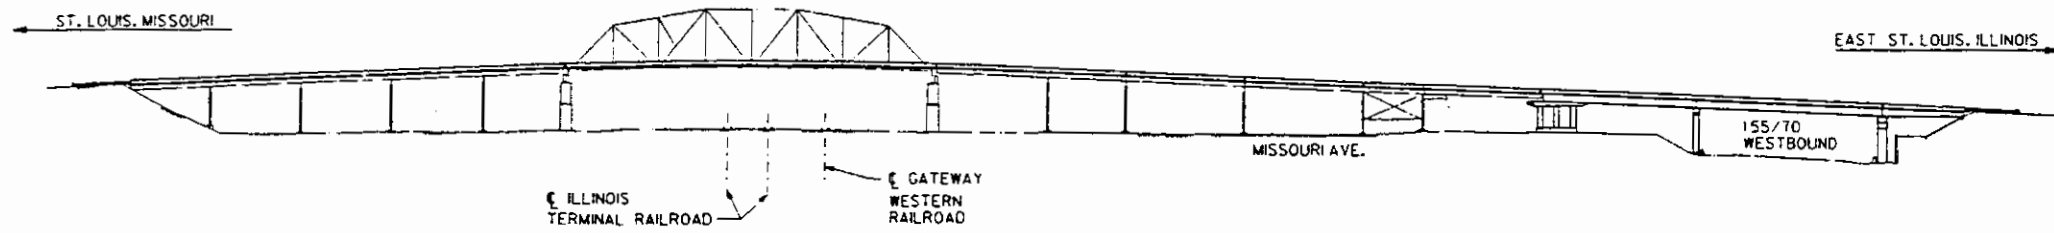

LOCATION PLAN

INDEX OF DRAWINGS

1. INDEX OF DRAWINGS
2. GENERAL PLAN AND ELEVATION - SHEET 1
3. GENERAL PLAN AND ELEVATION - SHEET 2
4. GENERAL NOTES AND ESTIMATED QUANTITIES
5. CONCRETE REPAIRS AT PIER 36
6. CONCRETE REPAIRS AT PIER 37
7. CONCRETE REPAIRS AT PIER 43A
8. REPLACEMENT BEARINGS AT PIERS 36 AND 37
9. REPLACEMENT BEARINGS AT BENT 41
10. ANCHOR BOLT DETAILS FOR BEARINGS
11. STEEL REPAIRS AT BENTS 39 AND 40
12. FLOORBEAM AND CAP BEAM REPAIRS
13. STRINGER REPAIR DETAILS
14. DRAINAGE SYSTEM REPAIRS AT BENT 41
15. TABLE OF STEEL REPAIRS AND PAINT TOUCH-UP LOCATIONS
16. MEDIAN SPANS 33 THRU 42
17. MEDIAN SPANS 43, 44, 45A, 46A AND 47A
18. MEDIAN DETAILS
19. COLUMN PROTECTION AT MISSOURI AVE.
20. NOT USED
21. NOT USED

FILE: N:\010840\MLK\MLKSCVR.DGN
DATE: DECEMBER 1997
LEVELS PLOTTED: ALL
JOB 40

DESIGNED	
CHECKED	J. CORLEY
DRAWN	B.C. KATES
CHECKED	

PREPARED BY:
SVERDRUP CIVIL, INCORPORATED
MARYLAND HEIGHTS, MISSOURI



Stephen W. Yordy 4/22/98
STEPHEN W. YORDY
LICENSED STRUCTURAL ENGINEER
NO. 81-4852
LICENSE EXPIRES: 11-30-98

REHABILITATION FOR
APPROACH BRIDGE OVER
I-55/70 W.B., MISSOURI AVE.
AND RAILROADS
INDEX OF DRAWINGS



STRUCTURE NO. 155/70
STA. 65+00 (FAP 799) ST. CLAIR CO.

SECTION IBR-I

SHEET NO. 1 OF 2

FOR INFORMATION ONLY

*1BR-I APPROACH BRIDGE

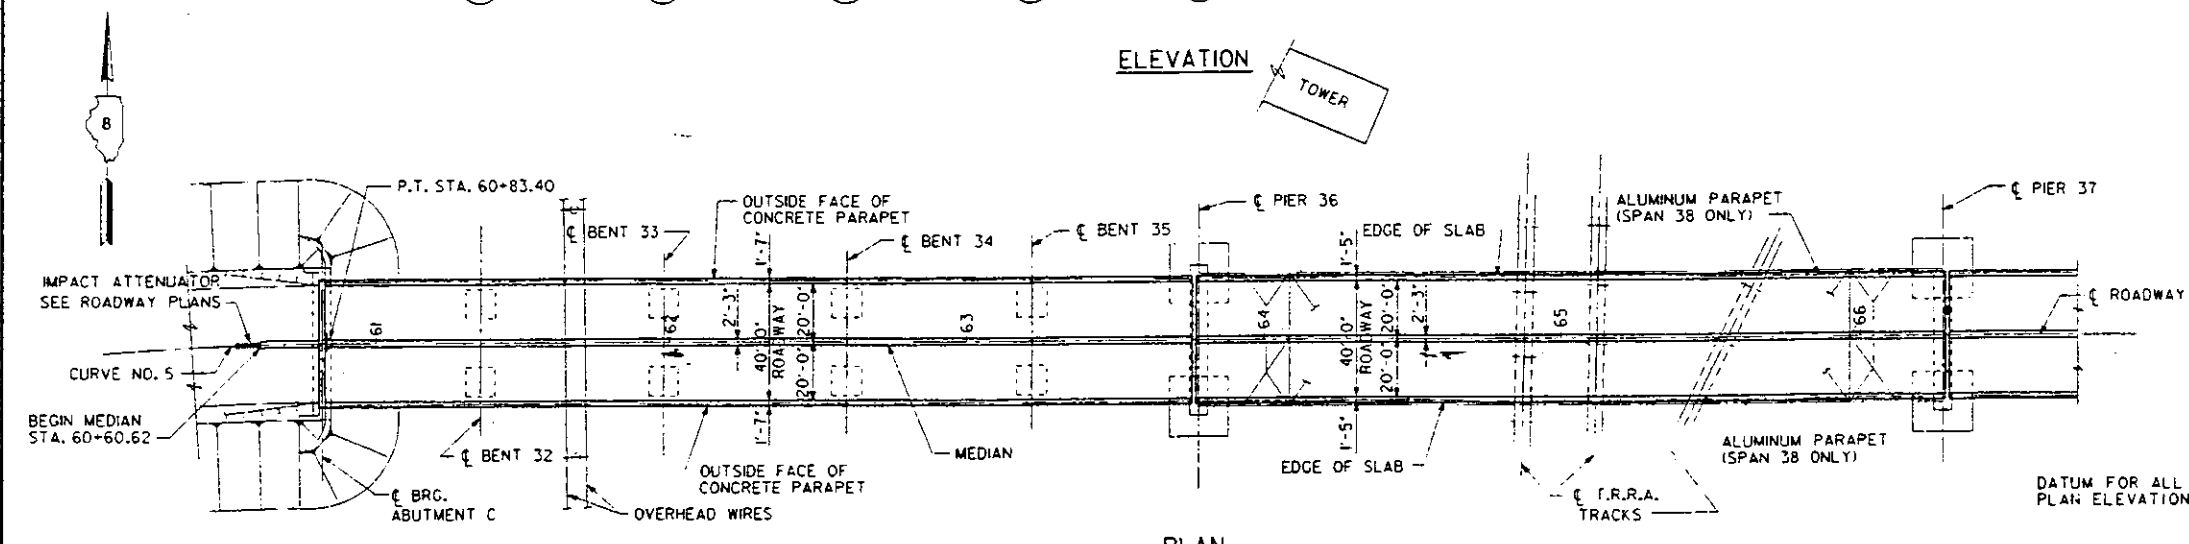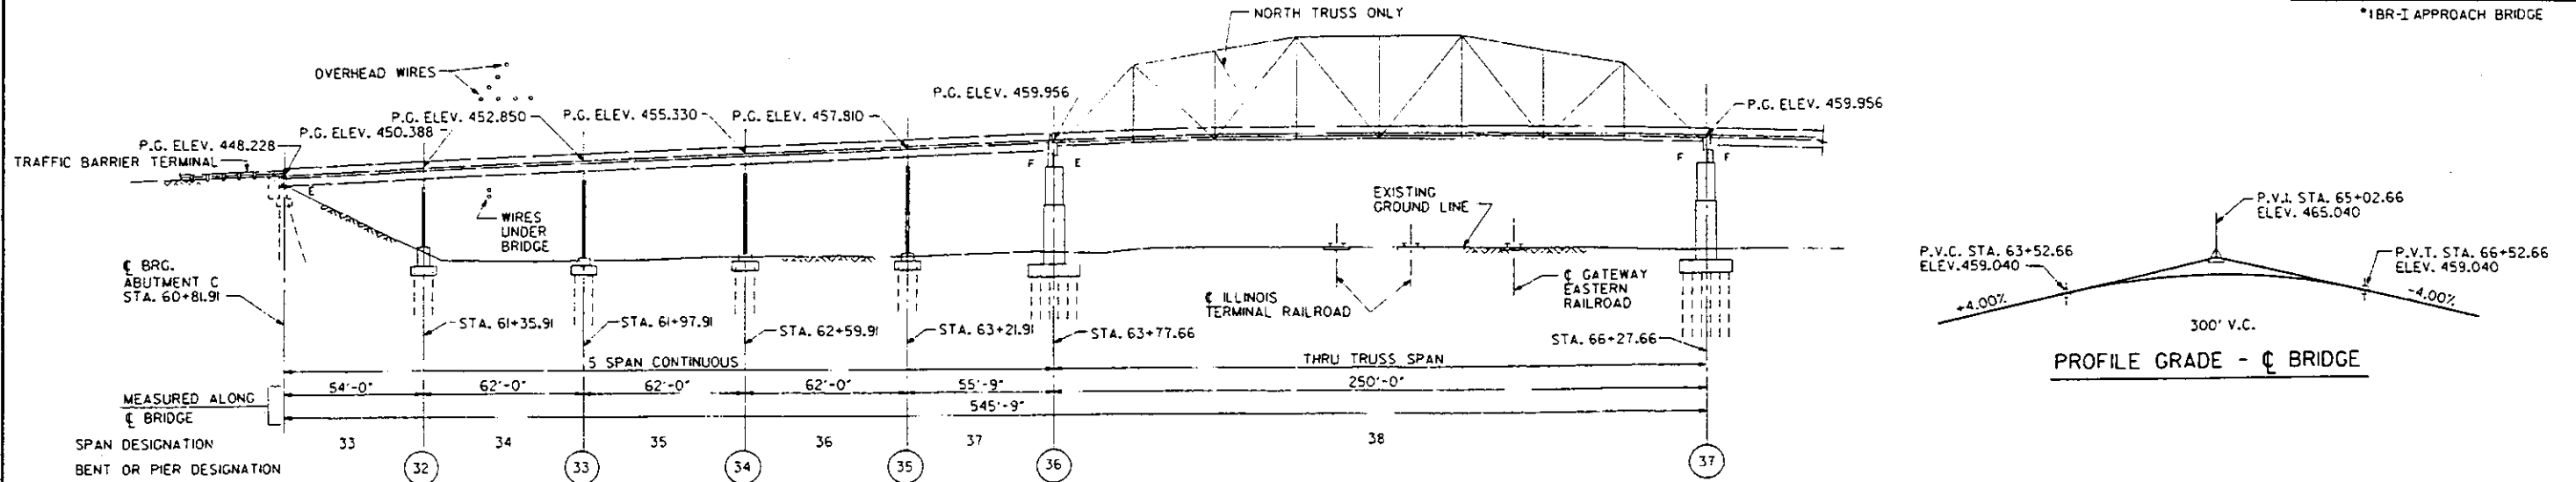

ELEVATION REFERENCES
NOTE: ALL ELEVATIONS REFER TO U.S.C.&G. SURVEY - 1929 GENERAL ADJUSTMENT. REFERENCE IS GIVEN TO MEMPHIS DATUM DUE TO ELEVATIONS ON ORIGINAL BRIDGE PLANS BEING REFERENCED TO THIS DATUM.

CURVE DATA

CURVE NO. 5	P.I. 5A	CURVE NO. 6	CURVE NO. 7
P.I. STA. = 59+63.15	P.I. STA. = 66+27.70	P.I. STA. = 74+93.65	P.I. STA. = 123+28.11
$\Delta = 141^{\circ}54'58''$ RT.	$\Delta = 0^{\circ}0'34''$ LT.	$\Delta = 37^{\circ}51'18''$ LT.	$\Delta = 35^{\circ}40'47''$ RT.
D = 6'-10"-00"	NO CURVE	D = 5'-23"-00"	D = 2'-36"-16"
R = 929.12'		R = 1064.32'	R = 2200.00'
T = 121.63'		T = 364.97'	T = 708.03'
L = 241.88'		L = 703.19'	L = 1370.00'
E = 7.93'		E = 60.84'	E = 111.13'
P.C. STA. = 58+41.52		P.C. STA. = 71+28.68	P.C. STA. = 116+20.08
P.T. STA. = 60+83.40		P.T. STA. = 78+31.87	P.T. STA. = 129+90.08

LEVELS PLOTTED DATE: DECEMBER 1997
ALL
FILE: I:\010840\MLK\MLKSGPOI.DGN
PRF: MLKSGPOI

DESIGNED _____
CHECKED J. CORLEY
DRAWN B.C. KATES
CHECKED _____



PREPARED BY
SVERDRUP CIVIL, INCORPORATED
MARYLAND HEIGHTS, MISSOURI

REHABILITATION FOR
APPROACH BRIDGE OVER
I-55/70 W.B., MISSOURI AVE.
AND RAILROADS
GENERAL PLAN AND ELEVATION
SHEET 1

STRUCTURE NO. 082-6003
STA. 65+00 (FAP 799) ST. CLAIR CO.

SECTION 99-1 SHEET NO. 7 OF 21

FOR INFORMATION ONLY

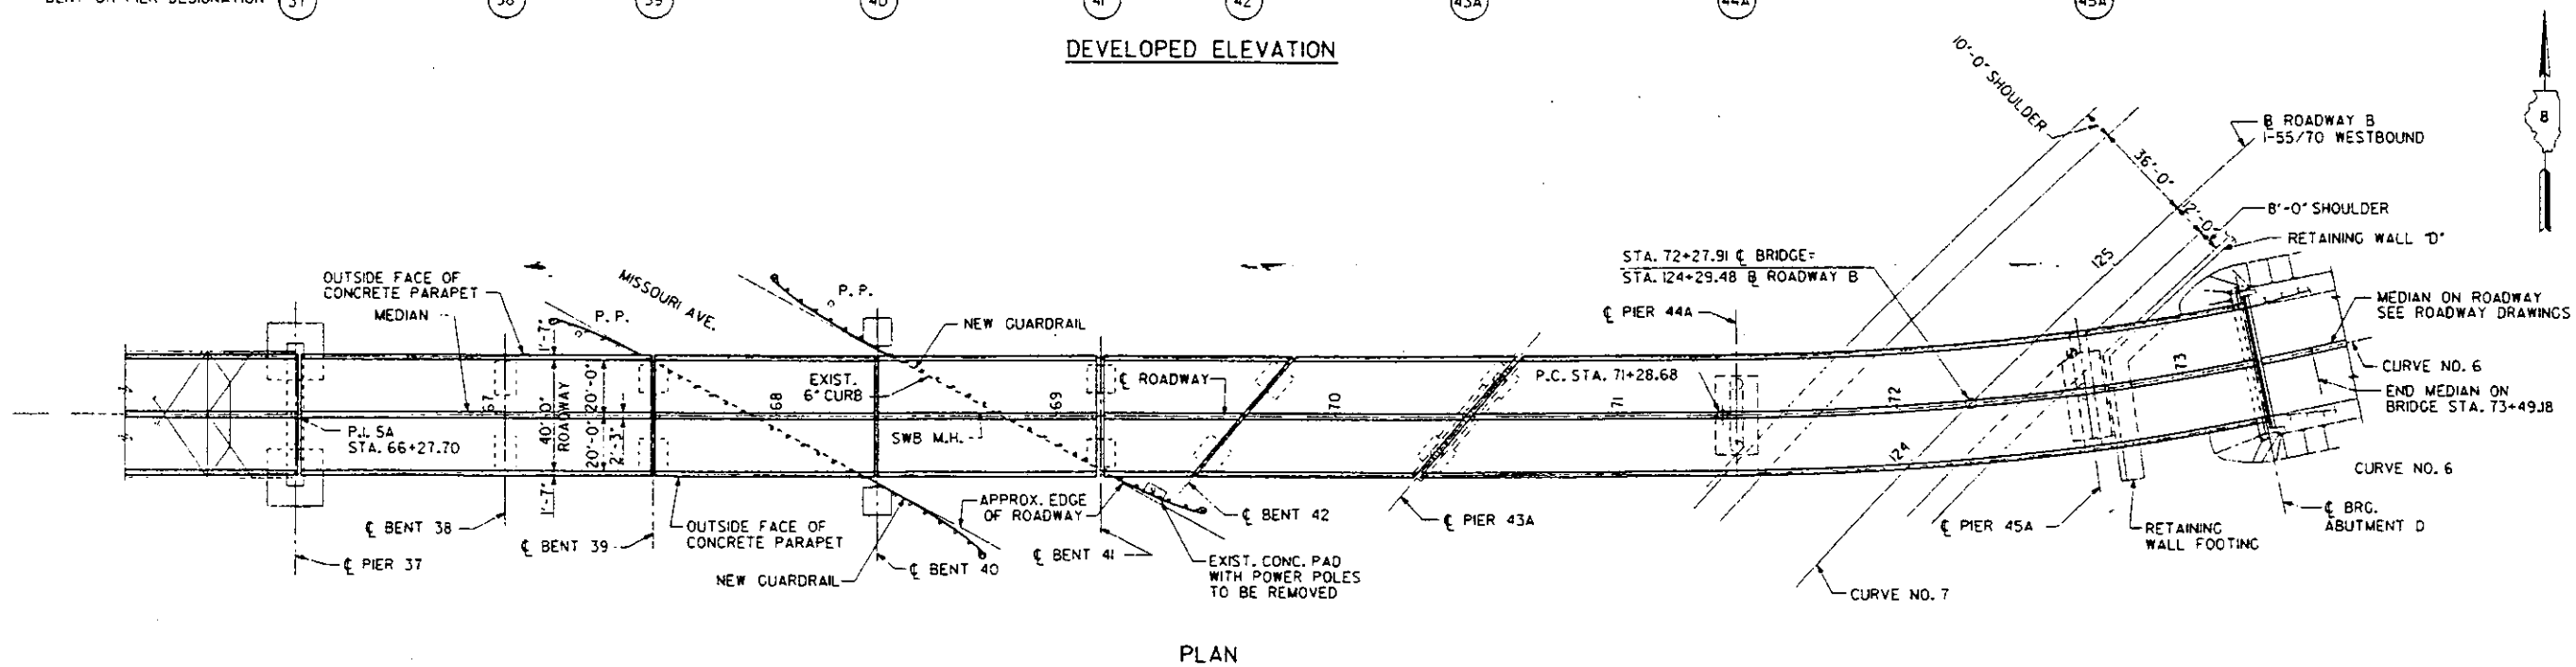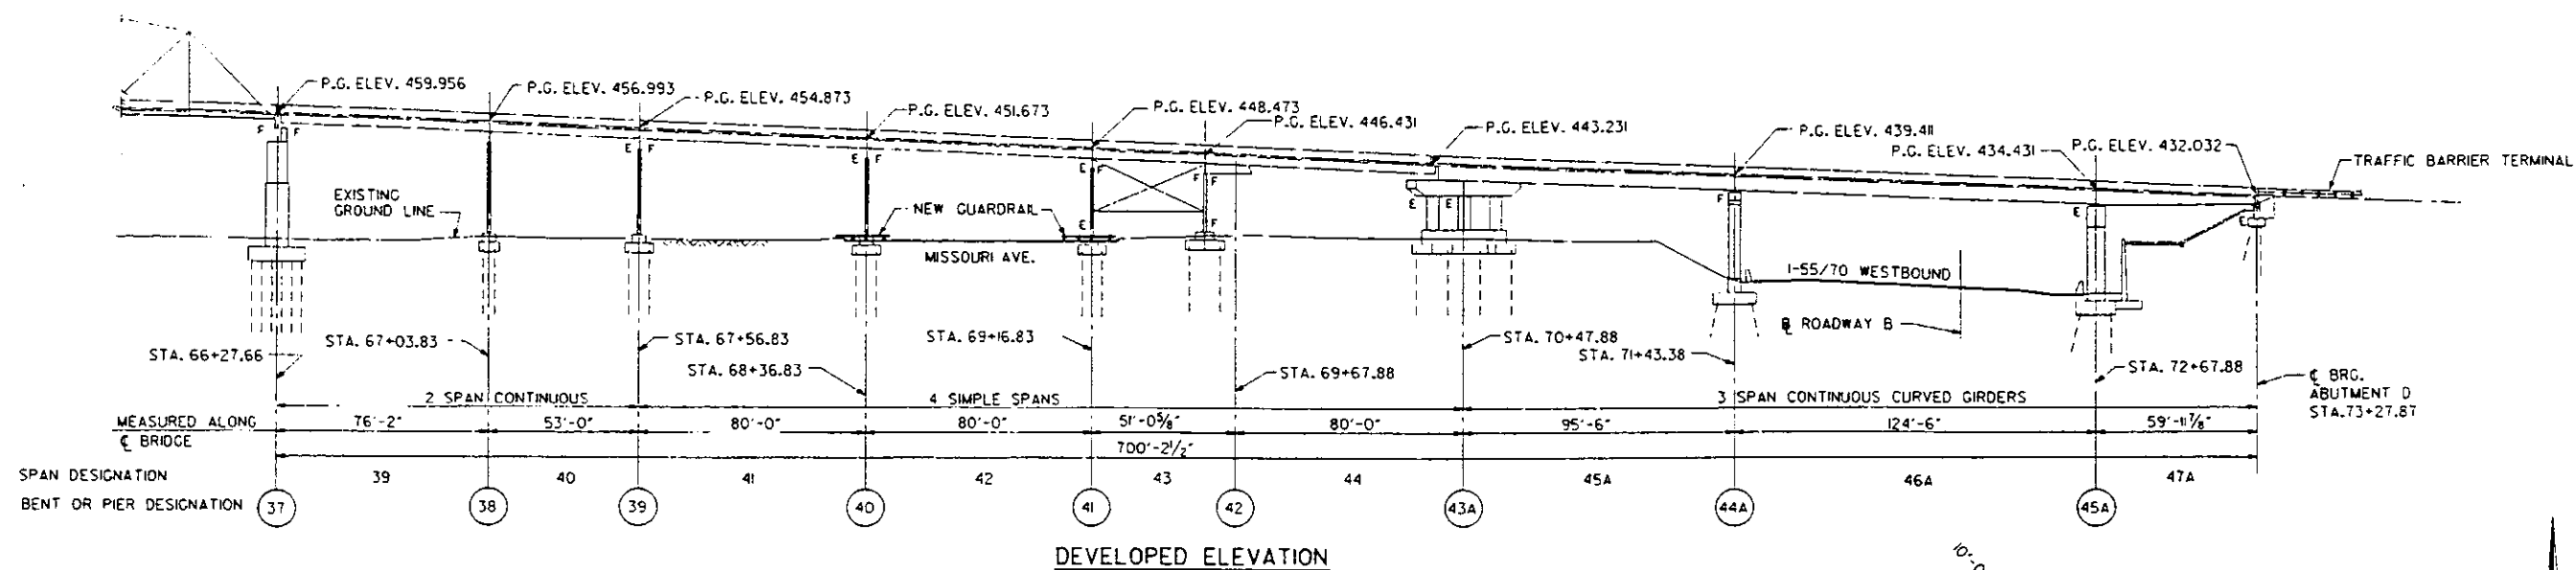

FILE:10840.MLK1.MKSGP02.DGN
 PRF:MLKSGP02
 LEVELS PLOTTED DATE: DECEMBER 1997
 ALL

DESIGNED	
CHECKED	J. CORLEY
DRAWN	B.C. KATES
CHECKED	

PREPARED BY:
 SVERDRUP CIVIL, INCORPORATED
 MARYLAND HEIGHTS, MISSOURI

REHABILITATION FOR
 APPROACH BRIDGE OVER
 I-55/70 W.B., MISSOURI AVE.
 AND RAILROADS
 GENERAL PLAN AND ELEVATION
 SHEET 2

STRUCTURE NO. 082-6003
 STA. 65+00 (FAP 799) ST. CLAIR CO.

SECTION 1BR-I

SHEET NO. 3 OF 21

FOR INFORMATION ONLY

GENERAL NOTES

CONSTRUCTION SPECIFICATIONS: THE 1997 EDITION OF THE STATE OF ILLINOIS DEPARTMENT OF TRANSPORTATION'S "STANDARD SPECIFICATIONS FOR ROAD AND BRIDGE CONSTRUCTION", ADDENDUMS AND THE SPECIAL PROVISIONS SHALL GOVERN.

FASTENERS SHALL BE 3/4" DIA. HIGH STRENGTH BOLTS IN 3/8" DIA. HOLE UNLESS OTHERWISE NOTED.

ALL NEW STRUCTURAL STEEL SHALL BE AASHTO M-270, GRADE 36 EXCEPT AS NOTED.

THE INORGANIC ZINC PRIMER / ACRYLIC / ACRYLIC PAINT SYSTEM SHALL BE USED FOR SHOP AND FIELD PAINTING OF NEW STRUCTURAL STEEL EXCEPT WHERE OTHERWISE NOTED. THE COLOR OF THE FINAL FINISH COAT FOR ALL STEEL SHALL MATCH CARBOLINE PAINT COLOR NO. 0233. SEE SPECIAL PROVISIONS FOR "CLEANING AND PAINTING NEW METAL STRUCTURES".

EXISTING STRUCTURAL STEEL SHALL ONLY BE CLEANED AND PAINTED AS REQUIRED BY THE SPECIAL PROVISION "CLEANING AND PAINTING ADJACENT AREAS OF EXISTING STEEL STRUCTURES".

THE CONTRACTOR SHALL FURNISH THE ILLINOIS DEPARTMENT OF TRANSPORTATION 5 GALLONS OF THE FINAL FINISH COAT PAINT, FOR FUTURE TOUCH UP.

CLEANING AND PAINTING SPECIFIED AREAS OF EXISTING STRUCTURAL STEEL SHALL BE IN ACCORDANCE WITH THE SPECIAL PROVISION FOR "CLEANING AND PAINTING EXISTING STEEL STRUCTURES". PAINTING ON THIS CONTRACT WILL INCLUDE SPECIFIED AREAS NOTED IN THE PLANS, AND CLEANING SHALL BE BY METHOD 2. THE ALUMINUM EPOXY MASTIC ACRYLIC PAINT SYSTEM SHALL BE USED FOR PAINTING THE SPECIFIED AREAS. THE COLOR OF THE FINAL FINISH COAT SHALL MATCH CARBOLINE PAINT COLOR NO. 0233.

FIELD WELDING TO EXISTING STEEL EXCEPT AS NOTED ON THE DRAWINGS SHALL NOT BE PERMITTED WITHOUT THE APPROVAL OF THE ENGINEER.

PLAN DIMENSIONS AND DETAILS RELATIVE TO THE EXISTING STRUCTURE HAVE BEEN TAKEN FROM EXISTING PLANS AND INSPECTION DATA AND ARE SUBJECT TO NOMINAL CONSTRUCTION VARIATIONS. IT SHALL BE THE CONTRACTOR'S RESPONSIBILITY TO VERIFY SUCH DIMENSIONS AND DETAILS IN THE FIELD AND MAKE NECESSARY APPROVED ADJUSTMENTS PRIOR TO CONSTRUCTION OR ORDERING OF MATERIALS. SUCH VARIATIONS SHALL NOT BE CAUSE FOR ADDITIONAL COMPENSATION FOR A CHANGE IN THE SCOPE OF WORK, HOWEVER, THE CONTRACTOR WILL BE PAID FOR THE QUANTITY ACTUALLY FURNISHED AT THE UNIT PRICE BID FOR THE WORK.

ALL TRANSVERSE AND LONGITUDINAL DIMENSIONS ARE MEASURED HORIZONTALLY.

AFTER STEEL HAS BEEN CLEANED, UNSUITABLE RIVETS SHALL BE REMOVED AND REPLACED WITH HIGH STRENGTH BOLTS AS DIRECTED BY THE ENGINEER, AND SHALL BE CONSIDERED INCIDENTAL TO THE PRICE BID FOR "FURNISHING AND ERECTING STRUCTURAL STEEL".

BURNING OF EXISTING RIVET HEADS TO REMOVE RIVETS IS NOT PERMITTED, EXCEPT AS SPECIFIED IN THE SPECIAL PROVISIONS.

PROTECTIVE COAT SHALL BE APPLIED TO BOTH ROADWAY FACES AND THE TOP OF THE CONCRETE MEDIAN BARRIER IN ACCORDANCE WITH ARTICLE 503.19.

BRIDGE SEAT SEALER SHALL BE APPLIED TO THE SEAT AREA OF PIER 36, PIER 37 AND PIER 43A.

PLANS OF THE EXISTING STRUCTURE FAP 799 APPROACH BRIDGE OVER I-55/70 W.B., MISSOURI AVE. AND TRRA (S.N. 082-6003) MAY BE OBTAINED FROM THE ILLINOIS DEPARTMENT OF TRANSPORTATION.

REINFORCEMENT BARS SHALL CONFORM TO THE REQUIREMENTS OF AASHTO M-31, M-42 OR M-53, GRADE 60.

THIS EXISTING STRUCTURAL STEEL COATING CONTAINS LEAD. THE CONTRACTOR SHOULD TAKE APPROPRIATE PRECAUTIONS TO DEAL WITH THE PRESENCE OF LEAD ON THIS PROJECT.

SCOPE OF WORK

1. REMOVE AND REPLACE BEARINGS AT PIERS 36, 37 AND BENT 41.
2. PROVIDE CONCRETE AND EPOXY CRACK REPAIRS AT BENTS 36, 37 AND 43A.
3. REMOVE AND REPLACE GUSSET PLATE AT NORTH COLUMN/BENT CAP AT BENT 39.
4. INSTALL WEB PATCH PLATES AT LOCATIONS SHOWN.
5. REPLACE DRAINAGE TROUGH AND ADJUST DRAIN PIPE AT BENT 41.
6. PAINT ALL NEW STEEL AND CLEAN AND PAINT EXISTING STEEL AT LOCATIONS LISTED.
7. REMOVE EXISTING CONCRETE PAD AND UTILITY POLE AND INSTALL GUARDRAIL AT MISSOURI AVE. AS SHOWN.
8. CAST CONCRETE MEDIAN BETWEEN THE LIMITS SHOWN.
9. BRIDGE WILL BE OPEN TO TRAFFIC DURING BRIDGE REHABILITATION.

TOTAL BILL OF MATERIAL

CODE NO.	ITEM	UNIT	TOTAL
	FORMED CONCRETE REPAIR (DEPTH EQUAL TO OR LESS THAN 5")	SQ. FT.	476
	EPOXY CRACK SEALING	FOOT	152
	BRIDGE SEAT SEALER	SQ. FT.	841
	CONC REMOVAL SPEC	SQ. YD.	3.5
	STRUCTURAL STEEL REPAIR	POUND	3080
	CLEANING AND PAINTING STEEL BRIDGE	LUMP SUM	1
	FURNISHING AND ERECTING STRUCTURAL STEEL	POUND	14836
	STRAIGHTEN BENT MEMBERS	LUMP SUM	1
	JACK AND REMOVE EXISTING BEARINGS	EACH	22
	TEMPORARY BRACING SYSTEM	LUMP SUM	1
	ELASTOMERIC BEARING ASSEMBLY, TYPE II (SPECIAL)	EACH	7
	CONCRETE SUPERSTRUCTURE	CU. YD.	160.6
	DRAINAGE SYSTEM REPAIRS	LUMP SUM	1
	REINFORCEMENT BARS (EPOXY COATED)	POUND	28460
	TRAFFIC BARRIER TERMINAL, TYPE 1 (SPECIAL)	EACH	4
	STEEL PLATE BEAM GUARD RAIL TYPE A	FOOT	200
	GUARDRAIL MARKERS TYPE B	EACH	4
	TERMINAL MARKERS - DIRECT APPLIED	EACH	4
	PROTECTIVE COAT	SQ. YD.	925
	POWER TOOL RESIDUE CONTAINMENT & DISPOSAL	LUMP SUM	1

DESIGN STRESSES - EXISTING STRUCTURE

DESIGN TRAFFIC LANES: FOUR - 10' LANES, NO SHOULDERS
18' ± VERTICAL CLEARANCE (CENTER LANES)
14' MINIMUM VERTICAL CLEARANCE (CURB LANES) AASHTO 1944

DESIGN SPECIFICATIONS: AASHTO 1944
LOADING: H20-44
NO FUTURE WEARING SURFACE

REINFORCED CONCRETE:
DECK SLAB $f_c = 1,000$ PSI, N=10
SUBSTRUCTURE $f_c = 1,000$ PSI, N=10
 $f_c = 60$ PSI - FOOTINGS

STRUCTURAL STEEL: CARBON (A7) $f_s = 18,000$ PSI

DESIGN STRESSES - 1988 REHABILITATION

DESIGN TRAFFIC LANES: FOUR - 10' LANES, NO SHOULDERS
17' MINIMUM VERTICAL CLEARANCE

DESIGN SPECIFICATIONS: AASHTO - 1983 AND MANUAL FOR MAINTENANCE INSPECTION FOR BRIDGES - 1983, BOTH WITH 1984, 1985 AND 1986 INTERIMS

LOADING: HS20-44
25 PSF FUTURE WEARING SURFACE- SPANS 45A, 46A AND 47A ONLY.

REINFORCED CONCRETE:
DECK SLAB $f_c = 3,500$ PSI, N=9
SUBSTRUCTURE $f_c = 1,400$ PSI, N=9
REINFORCING STEEL $f_y = 60,000$ PSI
 $f_s = 24,000$ PSI
 $f_s = 20,000$ PSI } AASHTO M-183
 $f_y = 36,000$ PSI }
 $f_s = 27,000$ PSI } AASHTO M-223,
 $f_y = 50,000$ PSI } GRADE 50

DESIGN STRESSES - 1997 REHABILITATION

DESIGN TRAFFIC LANES: TWO - 14' LANES, 4' OUTSIDE SHOULDERS
17' MINIMUM VERTICAL CLEARANCE

DESIGN SPECIFICATIONS: AASHTO - 1996

LOADING: HS20-44
25 PSF FUTURE WEARING SURFACE- SPANS 45A, 46A AND 47A ONLY.

REINFORCED CONCRETE:
DECK SLAB $f_c = 3,500$ PSI, N=9
SUBSTRUCTURE $f_c = 1,400$ PSI, N=9
REINFORCING STEEL $f_y = 60,000$ PSI
 $f_s = 24,000$ PSI
 $f_s = 20,000$ PSI } AASHTO M-270,
 $f_y = 36,000$ PSI } GRADE 36

REHABILITATION FOR
APPROACH BRIDGE OVER
I-55/70 W.B., MISSOURI AVE.
AND RAILROADS

GENERAL NOTES AND ESTIMATED QUANTITIES

STRUCTURE NO. 082-6003
STA. 65+00 (FAP 799) ST. CLAIR CO.

PREPARED BY:
SVERDRUP CIVIL, INCORPORATED
MARYLAND HEIGHTS, MISSOURI




SECTION 1BR-1

SHEET NO. 4 OF 21


10840
FILE: M010840404MLKSGNOT.DGN
LEVELS PLOTTED ALL
DATE: OCT. 23, 1987
PREF: MLKSGNOT

DESIGNED	
CHECKED	
J. CORLEY	
DRAWN	
B.C. KATES	
CHECKED	

FOR INFORMATION ONLY

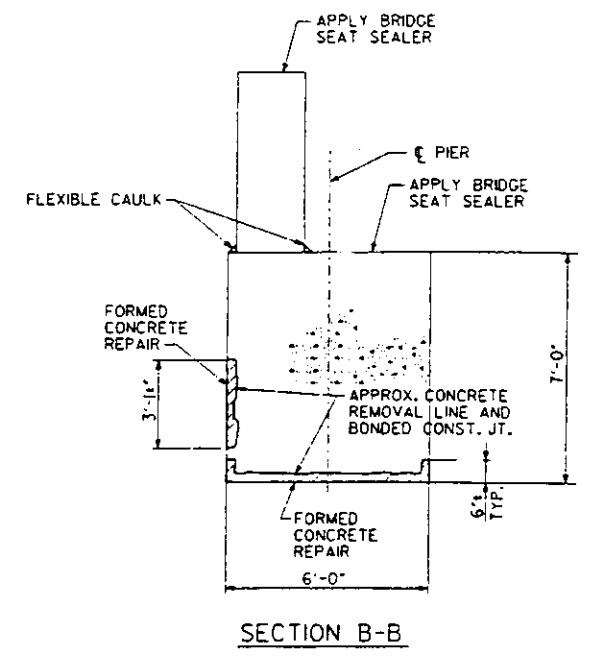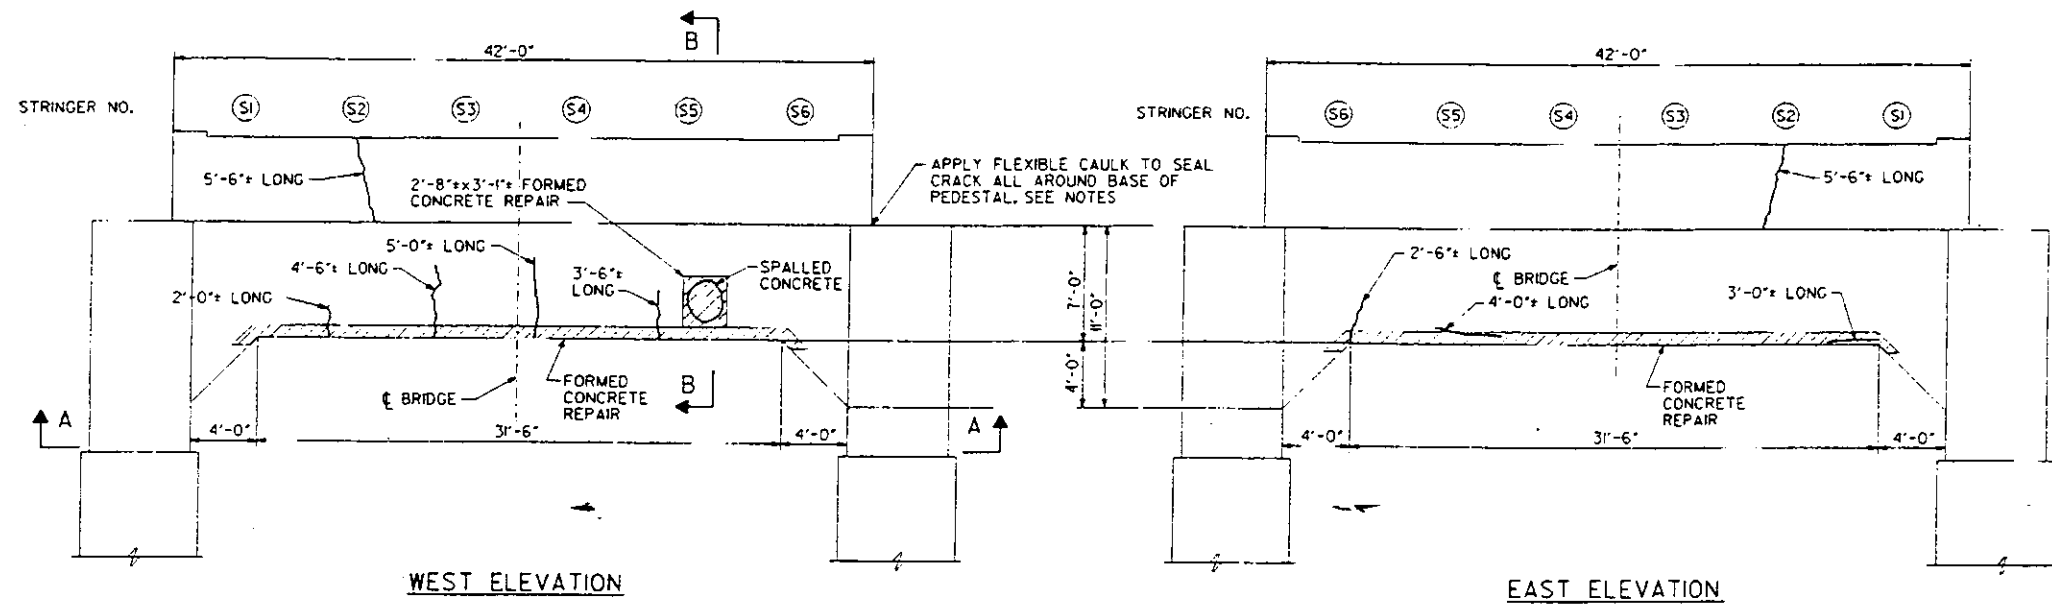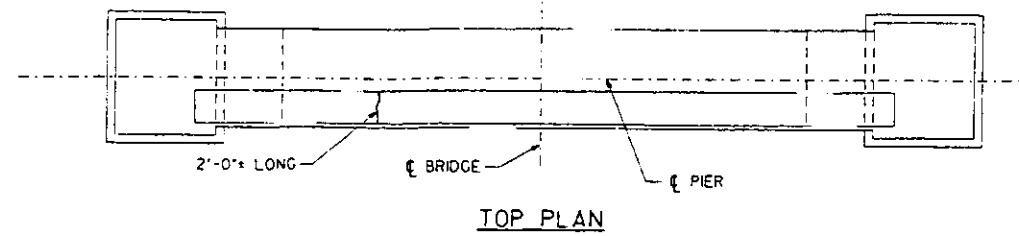

ESTIMATED BILL OF MATERIALS		
ITEM	UNIT	TOTAL
FORMED CONCRETE REPAIR (DEPTH EQUAL TO OR LESS THAN 5")	SQ. FT.	236
EPOXY CRACK SEALING	FOOT	81
BRIDGE SEAT SEALER	SO. FT.	321

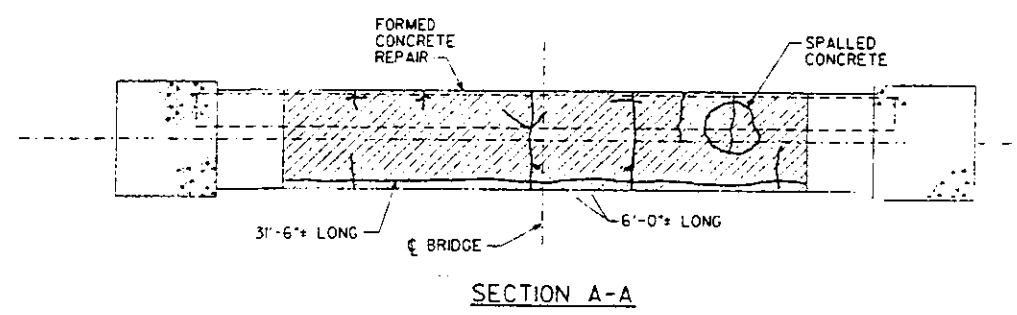

CONCRETE REPAIR NOTES

THE QUANTITIES SHOWN FOR FORMED CONCRETE REPAIR AND EPOXY CRACK SEALING ARE ESTIMATED FROM FIELD INSPECTION PERFORMED DURING OCTOBER 1997.
THE EXTENT OF REQUIRED REPAIRS SHALL BE VERIFIED BY THE ENGINEER IN THE FIELD AND SHOWN ON AS-BUILT PLANS.
FLEXIBLE CAULK SHALL BE A SILICONE BASE CAULK THAT ADHERES TO CONCRETE AND STAYS FLEXIBLE AFTER CURING. THE COST OF FLEXIBLE CAULK COMPLETE IN PLACE SHALL BE CONSIDERED INCIDENTAL TO OTHER ITEMS OF WORK.

LEGEND

- FORMED CONCRETE REPAIR
- EPOXY CRACK SEAL

11 ELS PLOTTED DATE: DECEMBER 997
 F. ERIND0840:MKMILY SPR36.DGN
 PREF. MK SPR36
 JOB NO.






DESIGNED	
CHECKED	J. CORLEY
DRAWN	B.C. KATES
CHECKED	

PREPARED BY:
SVERDRUP CIVIL, INCORPORATED
MARYLAND HEIGHTS, MISSOURI

REHABILITATION FOR
APPROACH BRIDGE OVER
I-55/70 W.B., MISSOURI AVE.
AND RAILROADS

CONCRETE REPAIRS AT DED. TO

STRUCTURE NO. 082-6003
STA. 65+00 (FAP 799) ST. CLAIR CO.

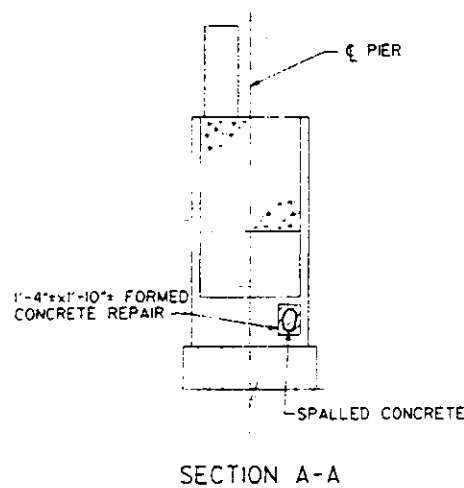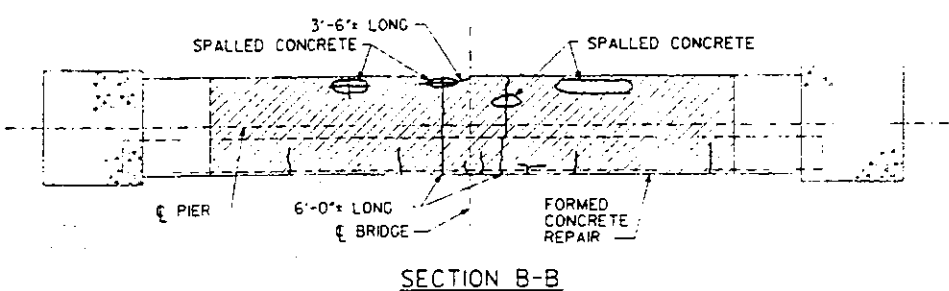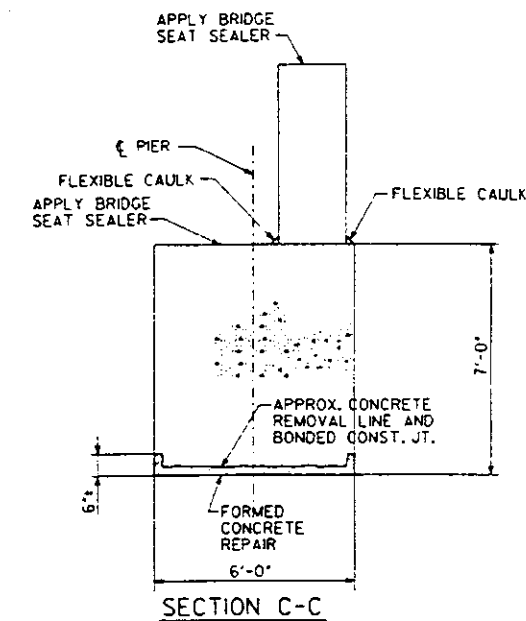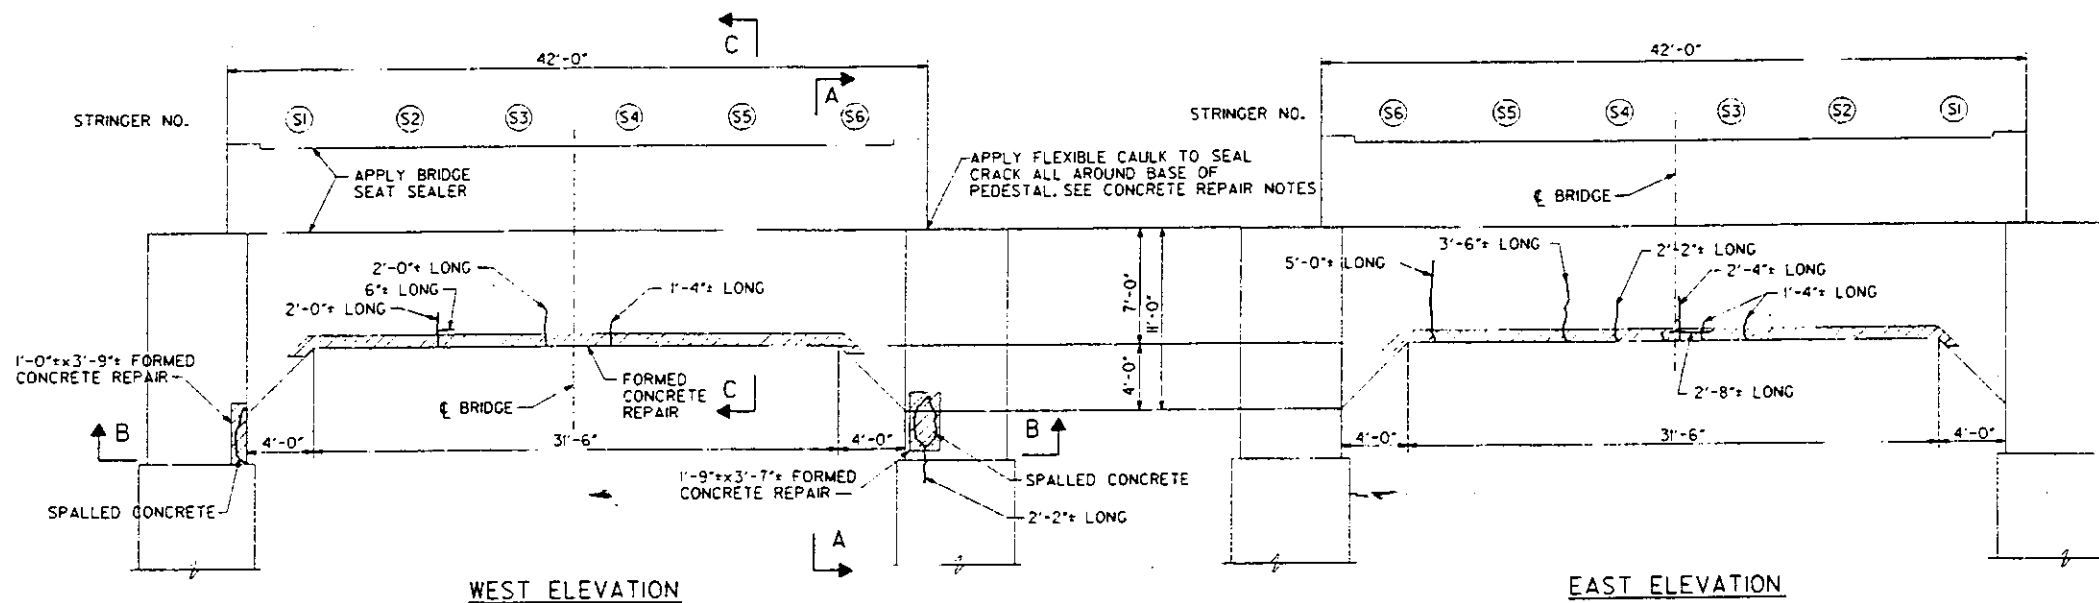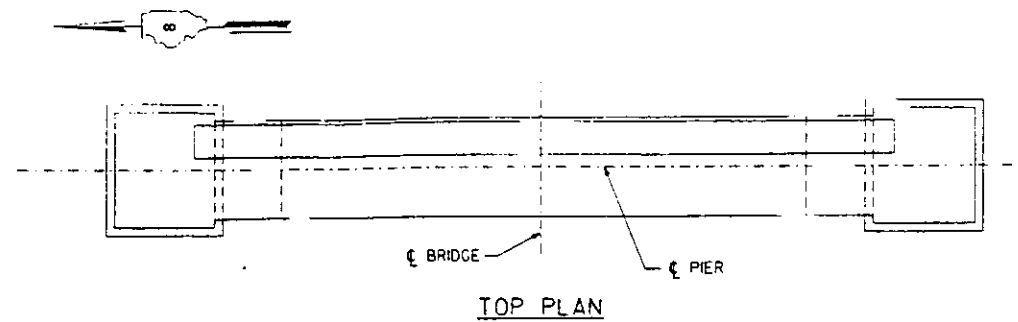

ESTIMATED BILL OF MATERIALS		
ITEM	UNIT	TOTAL
FORMED CONCRETE REPAIR (DEPTH EQUAL TO OR LESS THAN 5")	SQ. FT.	240
EPOXY CRACK SEALING	FOOT	42
BRIDGE SEAT SEALER	SQ. FT.	321

NOTE
FOR CONCRETE REPAIR NOTES, SEE SHEET 5.

REHABILITATION FOR
APPROACH BRIDGE OVER
I-55/70 W.B., MISSOURI AVE.
AND RAILROADS
CONCRETE REPAIRS AT PIER 37

NO. 01 6003
STA. 65+00 (FAP 799) ST. CLAIR CO.

PREPARED BY:
SVERDRUP CIVIL, INCORPORATED
MAYLAND HEIGHTS, MISSOURI

SECTION IBR-1

SHEET NO. 6 OF 21

0840 FILE: H01080401X.MLKSPR37.DGN DATE: DECEMBER, 1997 LEVELS PLOTTED ALL


DESIGNED
CHECKED J. CORLEY
DRAWN B. C. KATES
CHECKED

FOR INFORMATION ONLY


STATE OF ILLINOIS
DEPARTMENT OF TRANSPORTATION

ROUTE NO.	SECTION	COUNTY	LOCAL SHEET	SHEET NO.
FAP 799	#	ST. CLAIR	179	127
PROJECT				


*1BR-I APPROACH BRIDGE

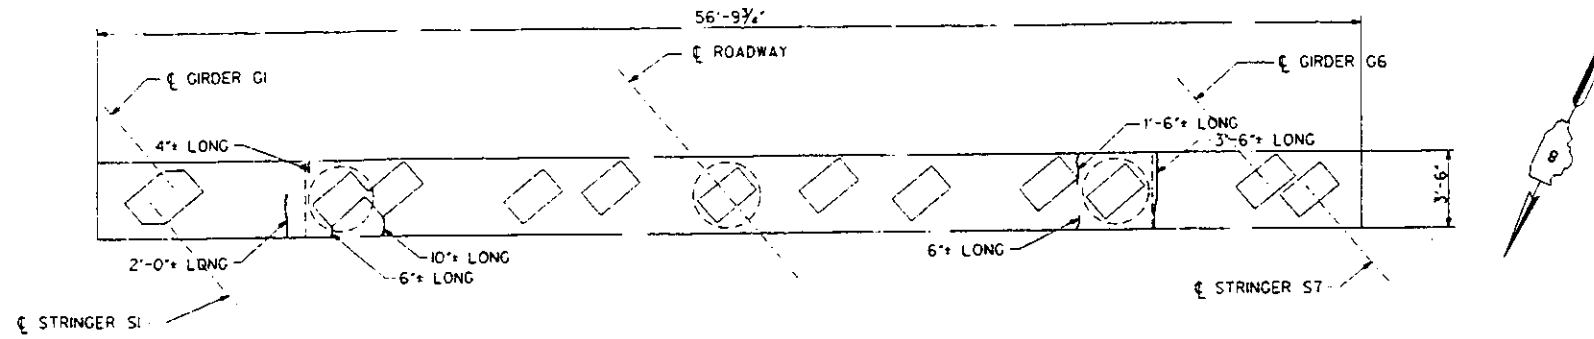

TOP PLAN

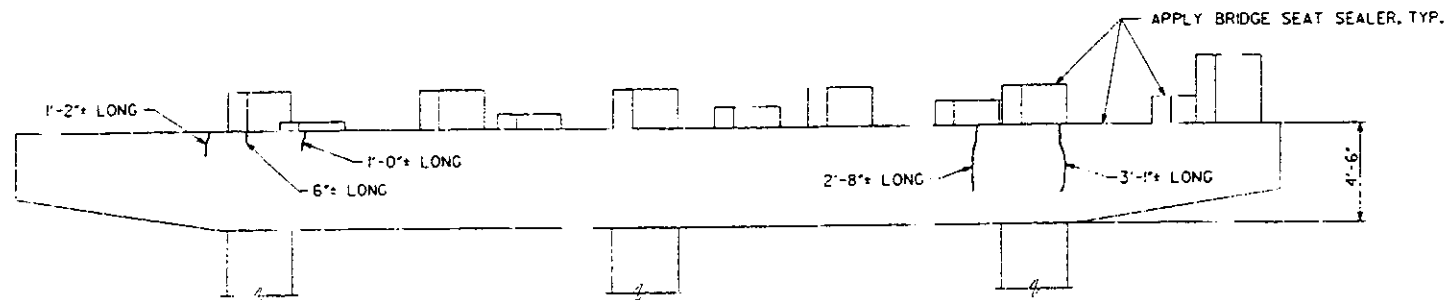

NORTH ELEVATION

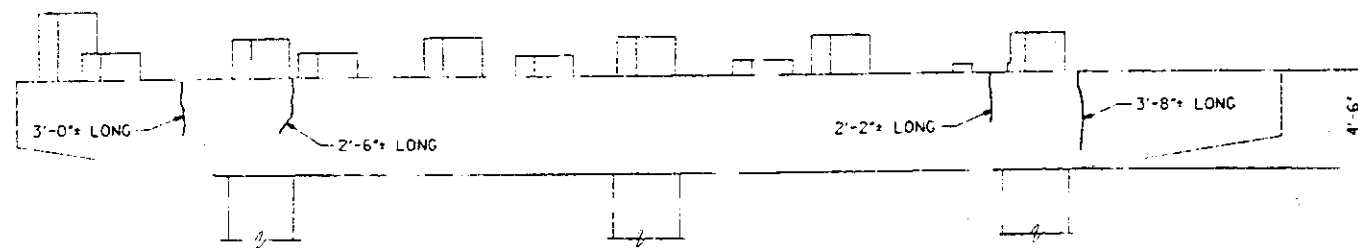

SOUTH ELEVATION

ESTIMATED BILL OF MATERIALS		
ITEM	UNIT	TOTAL
EPOXY CRACK SEALING	FOOT	29
BRIDGE SEAT SEALER	SO. FT.	199

NOTE
FOR CONCRETE REPAIR NOTES, SEE SHEET 5.

REHABILITATION FOR
APPROACH BRIDGE OVER
I-55/70 W.B., MISSOURI AVE.
AND RAILROADS
CONCRETE REPAIRS AT PIER 43A

STRUCTURE NO. 6002
STA. 65+00 (FAP 799) ST. CLAIR CO.

PREPARED BY:
SYVERDRUP CIVIL, INCORPORATED
MAYLAND HEIGHTS, MISSOURI

SECTION BR-I

SHEET NO. 7 OF 21

DATE: DECEMBER 17, 1977
 PLOTTED
 FILE: I:\NOI\08\01\K\MLK\SP43A.DGN
 PLOT: MLK\SP43A

DESIGNED	
CHECKED	J. CORLEY
DRAWN	B.C. KATES
CHECKED	




FOR INFORMATION ONLY

NOTES - JACKING AND REMOVAL OF EXISTING BEARINGS


MINIMUM JACK CAPACITY SHALL BE 58 TONS.
SEE SPECIAL PROVISIONS FOR ADDITIONAL REQUIREMENTS.
JACKS SHALL NOT BE PLACED DIRECTLY UNDERNEATH DIAPHRAGMS.

NOTES


JACKING SHALL BE REQUIRED FOR THE REMOVAL AND REPLACEMENT OF ALL BEARINGS SCHEDULED FOR REPLACEMENT (SEE TABLE).
ANCHOR BOLTS SHALL BE REMOVED OR CUT OFF AND GROUND FLUSH WITH TOP OF CONCRETE.
FOR ANCHOR BOLT INSTALLATION, SEE SHEET 10.
ANCHOR BOLT SHALL BE FURNISHED WITH 1 STANDARD PLATE WASHER AND 1 HEAVY HEX. NUT.
ALL MATERIAL SHALL CONFORM TO AASHTO M-270 GR. 36 UNLESS OTHERWISE NOTED.
BEARING STEEL SHALL BE PAINTED IN ACCORDANCE WITH THE PAINTING REQUIREMENTS FOR NEW STRUCTURAL STEEL, SEE SPECIAL PROVISIONS.
SURFACE FINISHES SHALL CONFORM TO SURFACE ROUGHNESS REQUIREMENTS AS DEFINED IN ANSI B46.1, SURFACE ROUGHNESS, WAVINESS AND LAY, PART 1.

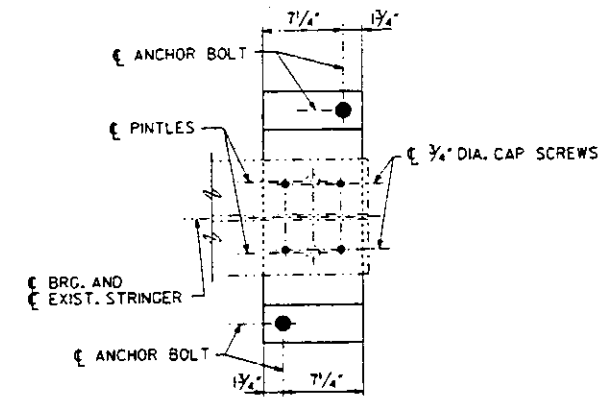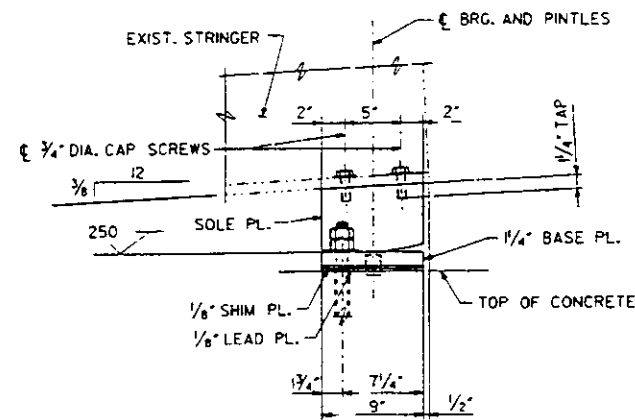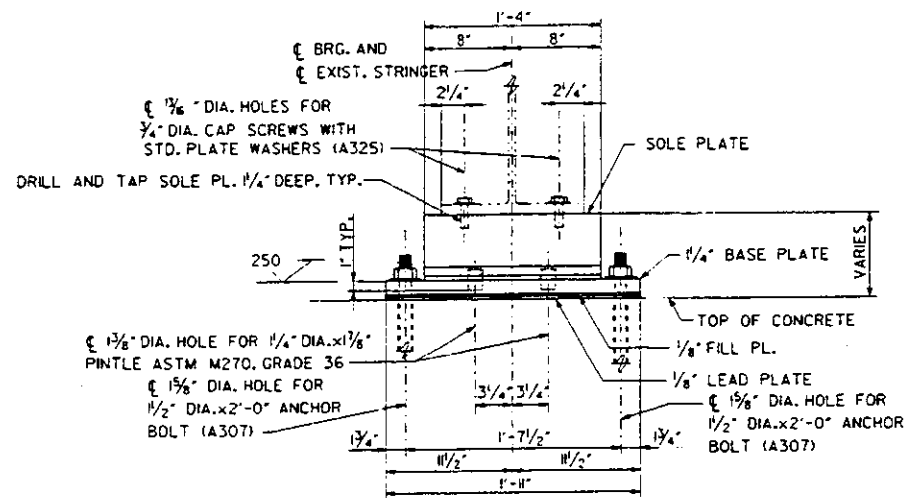

REPLACEMENT BEARINGS FOR STRINGERS S1 THRU S7 AT PIER 36 SPAN 37 AND PIER 37 SPAN 39 (14 BEARINGS REQUIRED)

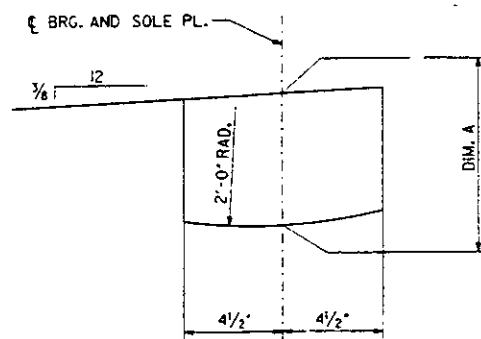

SOLE PLATE DETAIL

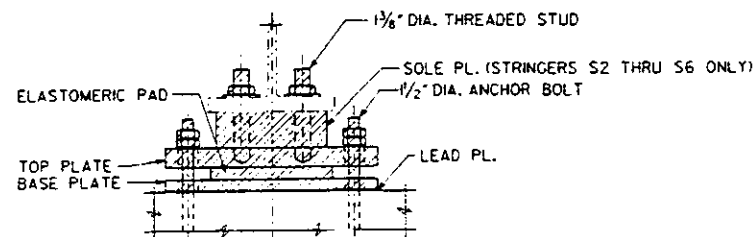

NOTE: ALL ITEMS INDICATED TO BE REMOVED

EXISTING BEARING REMOVAL DETAIL

NOTE: STRINGERS S2 THRU S6 SHOWN, STRINGERS S1 AND S7 SIMILAR.

STRINGER DESIGNATION	PIER 36 DIM. A	PIER 37 DIM. A	WEIGHT PER BEARING*	
			PIER 36	PIER 37
S1 AND S7	2 1/2'	3 1/4'	210 LBS.	238 LBS.
S2 AND S6	4 1/2'	5 1/4'	303 LBS.	331 LBS.
S3 AND S5	5 3/4'	6 1/4'	344 LBS.	373 LBS.
S4	6 1/4'	6 3/4'	357 LBS.	386 LBS.

* WEIGHT OF THE BEARINGS SHOWN INCLUDES ALL PLATES (STEEL AND LEAD, EXCEPT SHIM PACK) BOLTS, NUTS AND WASHERS AND SHALL BE PAID AT THE UNIT PRICE BID FOR FURNISHING AND ERECTING STRUCTURAL STEEL.

NOTE: SOLE PLATE HEIGHTS HAVE BEEN CALCULATED FROM PLANS OF EXISTING STRUCTURE. ALL BEARINGS SHALL BE DELIVERED WITH A 1/2" SHIM PACK TO ACCOMMODATE ADJUSTMENTS FOR EXISTING CONDITIONS, AS REQUIRED.

	REACTION TABLE	
	SPAN 37 PIER 36	SPAN 39 PIER 37
R ₀ (kips)	16.2	32.5
R ₁ (kips)	38.9	28.1
R ₂ (kips)	10.9	7.1
R TOTAL (kips)	66.0	67.7

REHABILITATION FOR APPROACH BRIDGE OVER I-55/70 W.B., MISSOURI AVE. AND RAILROADS

REPLACEMENT BEARINGS AT PIERS 36 AND 37

STRUCTURE NO. 082-6003
STA. 65+00 (FAP 799) ST. CLAIR CO.

PREPARED BY
SVERDRUP CIVIL, INCORPORATED
MARYLAND HEIGHTS, MISSOURI

SECTION 1BR-1

SHEET NO. 8 OF 21

10B40
 FILE IN 10B40: M.L.K.M.L.K.S.S.005.DGN
 PRF: M.L.K.S.S.005
 LEVELS PLOTTED
 DATE: DECEMBER 1997
 ALL

DESIGNED	B.C. KATES
CHECKED	M.A. BANASHEK
DRAWN	J. CORLEY
CHECKED	B.C. KATES

FOR INFORMATION ONLY

The Illinois Coil-Lock Anchor Bolt is a proprietary item which is the property of the Illinois Department of Transportation. Use, reproduction or disclosure without express written permission is prohibited and protected under Federal copyright laws. The production and the fabrication of this bolt for use on highway projects in the State of Illinois shall be permitted and there shall be no incurred charges or fees to the manufacturer or the fabricator for producing or fabricating this bolt.

MATERIALS FOR ILLINOIS COIL-LOCK ANCHOR BOLT

The anchor bolt shall be fabricated from cold drawn or hot finished seamless carbon steel mechanical tubing conforming to ASTM A 519, Grade 1025, CW and supplied with hexagonal nuts and cut washers.
The coil wire shall be made of any suitable soft steel wire.
The finished anchor bolt shall be cleaned of rust and other foreign materials and wrapped or packaged to prevent contamination until they are installed.
The epoxy grout shall be a two-component, epoxy resin bonding system conforming to ASTM C 881, Type I, Grade I and of a Class suitable for the temperature at installation.

GENERAL NOTES

Holes in the masonry for anchor bolts shall be drilled through the base plates to the diameter and depth shown or according to the manufacturer's recommendation after new bearings are in final position.
Prior to setting the bolts, the holes shall be dry and all dust and loose particles shall be removed by the use of compressed air or vacuuming.
The anchor bolts, furnished and installed and including the epoxy grout or capsules shall not be paid for separately but shall be included in the unit bid price for "Furnishing and Erecting Structural Steel".
The anchor bolts, nuts and washers shall be completely coated by either the hot-dipped process conforming to AASHTO M-232 or the mechanical plating method conforming to ASTM B695, class 50. Zinc coated nuts shall be tapped oversized in accordance with the requirements of AASHTO M291 and shall meet the supplementary requirements sl.1 thru sl.2.1 of the same specifications for lubricant and testing.


INSTALLATION PROCEDURE for the ILLINOIS COIL-LOCK ANCHOR BOLT

1. With the coil wire in place, the bolt shall be inserted into the hole and turned clockwise to a snug fit in the hole. Nut and washer shall be placed on the bolt. The nut shall be tensioned until the steel base plates are held securely to the concrete bearing seat.
2. Epoxy grout shall be pumped through the zerk fitting with a pressure gun. Pumping shall continue until the epoxy overflows the hole around the bolt shank. After pumping is discontinued, excess epoxy shall be immediately wiped off.


ALTERNATE ANCHOR BOLTS

The Contractor may use, at his option, the capsule or the adhesive cartridge type anchor rods that have been previously tested and given a prior approval by the Department. The Contractor shall install these anchor rods in pre-drilled holes according to the manufacturer's recommendations and procedures.
The capsule or the adhesive cartridge type anchor rods shall be a two part system composed of:
1. A threaded rod stud with nut and washer of the type specified.
2. A sealed glass capsule or a sealed glass adhesive cartridge containing premeasured amounts of the adhesive chemical.

D	E	H	K	"d"
1/2"	1 1/8"	1 1/2"	3"	1/4"
3/4"	1 3/8"	1 3/4"	2"	3/8"
1 1/2"	1 5/8"	1 7/8"	2 1/8"	1/2"
2"	2 1/8"	2 1/4"	2 3/8"	5/8"
2 1/2"	2 5/8"	2 3/4"	3 1/8"	3/4"

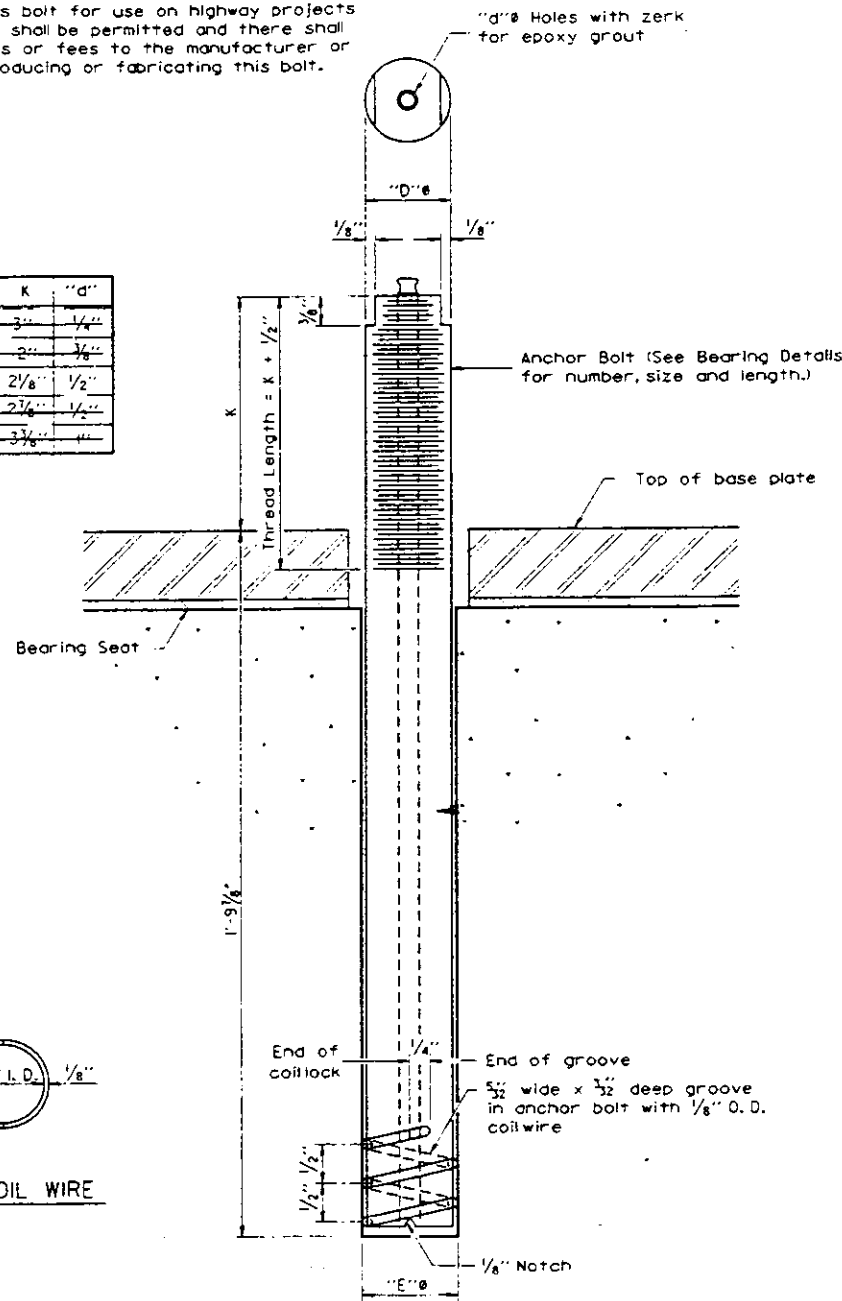

ILLINOIS COIL-LOCK ANCHOR BOLT

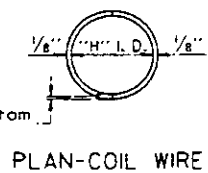

FILE: PHOTOGRAPHIC ANCHOR.DGN
LEV: S P: OTTED DATE: DECEMBER 1997
ALL

DESIGNED	
CHECKED	
JCC	
DRAWN	
B. STATES	
CHECKED	

ABB-1 4-30-97

PREPARED BY:
SVERDRUP CIVIL, INCORPORATED
MARTLAND HEIGHTS, MISSOURI

REHABILITATION FOR
APPROACH BRIDGE OVER
I-55/70 W.B., MISSOURI AVE.
AND RAILROADS




ANCHOR BOLT DETAILS
FOR BEARINGS

STRUCTURE NO. 082-6003
STA. 65+00 (FAP 799) ST. CLAIR CO.

SECTION BR-1



SHEET NO. 10 OF 21

FOR INFORMATION ONLY

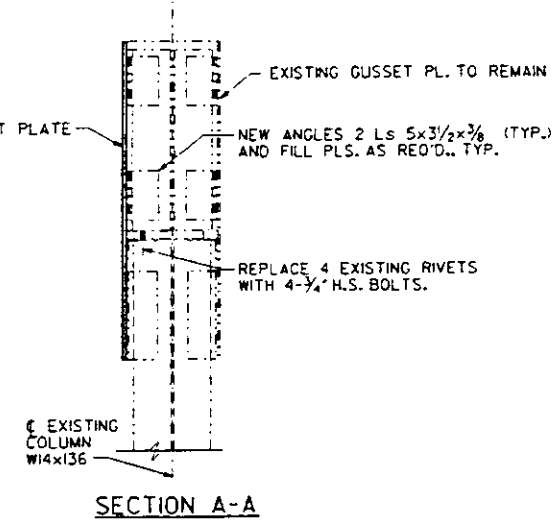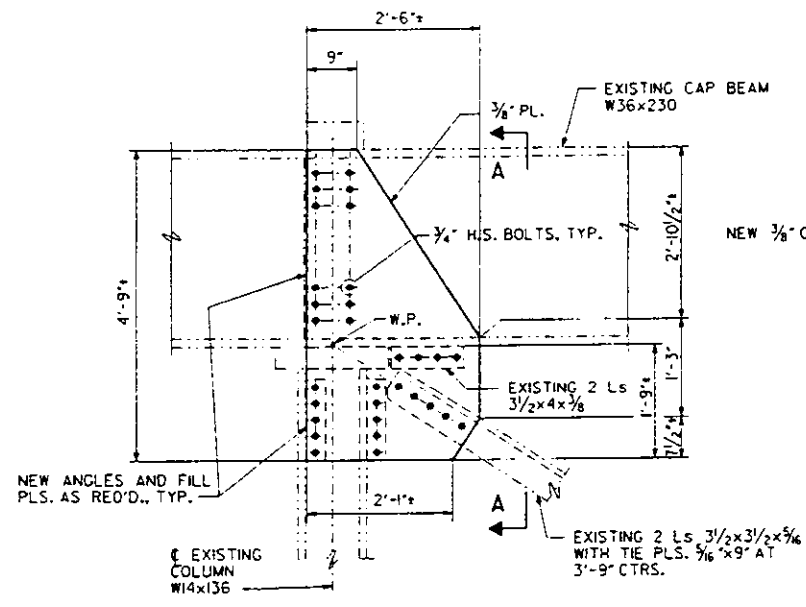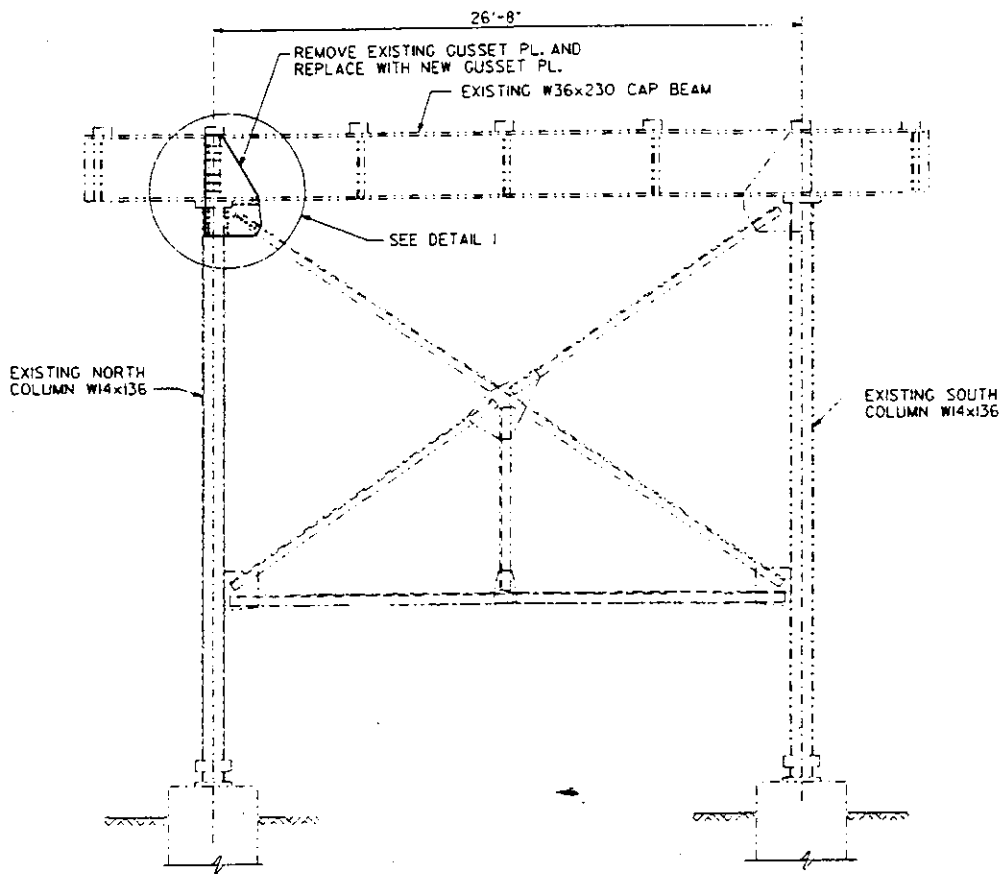

DETAIL I

NOTE: DIMENSIONS SHOWN ARE APPROXIMATE AND MUST BE FIELD VERIFIED BEFORE FABRICATION.
REPLACE EXISTING RIVETS WITH 3/4" H.S. BOLTS, TYP. NUMBER AND LOCATION OF HOLES TO MATCH EXISTING CONNECTION. EXISTING 3/8" PLATE MAY BE USED AS TEMPLATE FOR NEW MEMBER HOLES (TYP.).

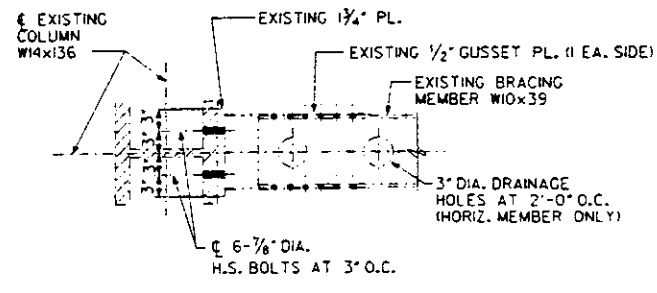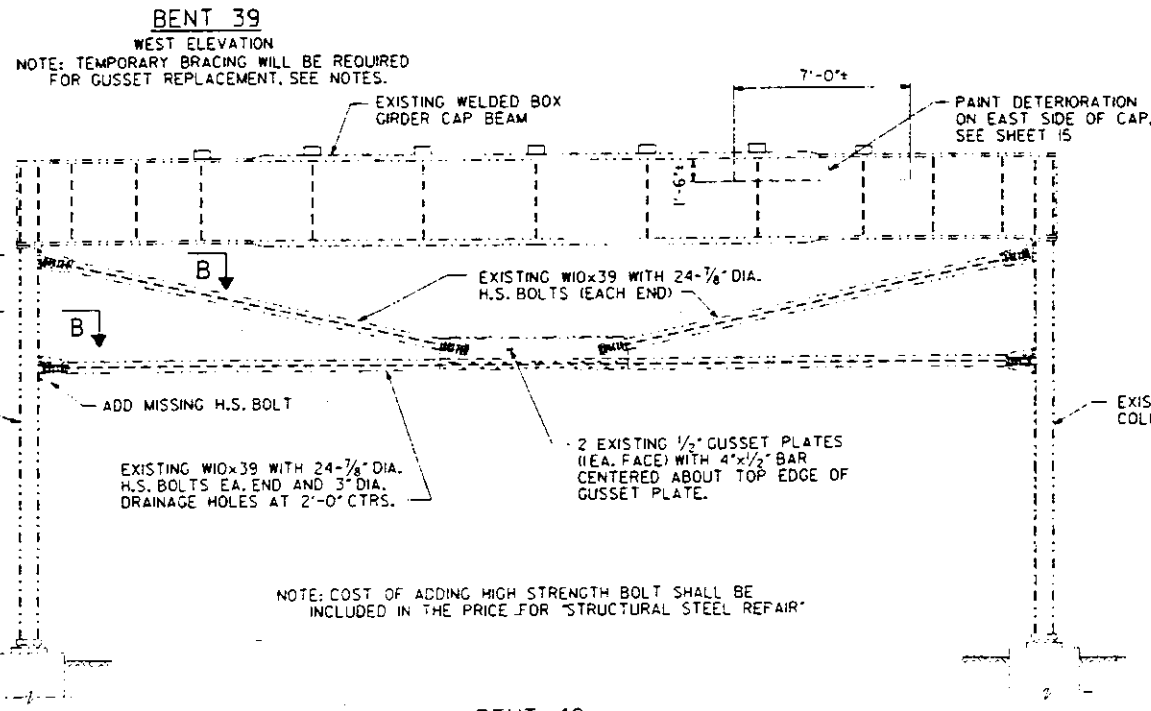

SECTION B-B

NOTES

THE CONTRACTOR SHALL SUBMIT FOR APPROVAL BY THE ENGINEER, DESIGN AND DETAILS OF TEMPORARY BRACING OF COLUMN FOR THE REPLACEMENT OF THE GUSSET PLATE AT BENT 39. TEMPORARY BRACING SHALL BE DESIGNED TO ACCOMMODATE LOADS OF 72K HORIZONTALLY AND 50K VERTICALLY, WHICH INCLUDES A FACTOR OF SAFETY OF 1.5.

THE COST OF TEMPORARY BRACING SHALL BE INCLUDED IN THE PRICE BID FOR "TEMPORARY BRACING SYSTEM"

NOTE: COST OF ADDING HIGH STRENGTH BOLT SHALL BE INCLUDED IN THE PRICE FOR "STRUCTURAL STEEL REPAIR"

BENT 40 WEST ELEVATION

PREPARED BY:
SVERDRUP CIVIL, INCORPORATED
MARYLAND HEIGHTS, MISSOURI

SECTION 1BR-I

SHEET NO. 7 OF 21

LEVELS PLOTTED DATE: DECEMBER 1997 ALL

FILE: E:\10108\40MLK\MLK555004.DGN PRF: MLK55004

10358

DESIGNED _____
CHECKED J. CORLEY
DRAWN B.C. KATES
CHECKED _____


FOR INFORMATION ONLY

REHABILITATION FOR
APPROACH BRIDGE OVER
I-55/70 W.B., MISSOURI AVE.
AND RAILROADS

STEEL REPAIRS AT BENTS 39 AND 40


STRUCTURE NO. 082-6003
STA. 65+00 (FAP 799) ST. CLAIR CO.

*IBR-I APPROACH BRIDGE

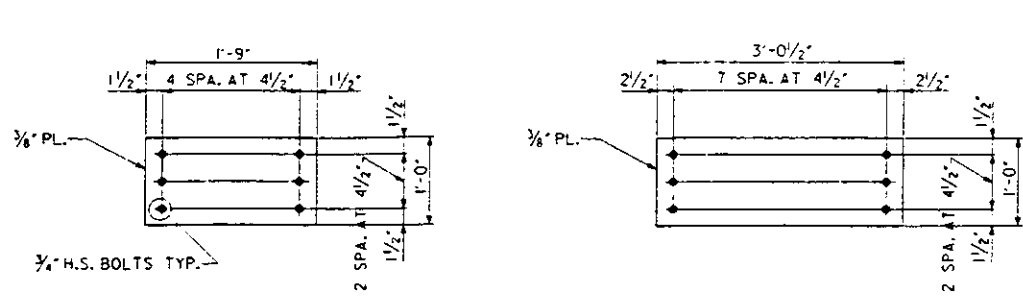


PATCH PLATE A


PATCH PLATE B

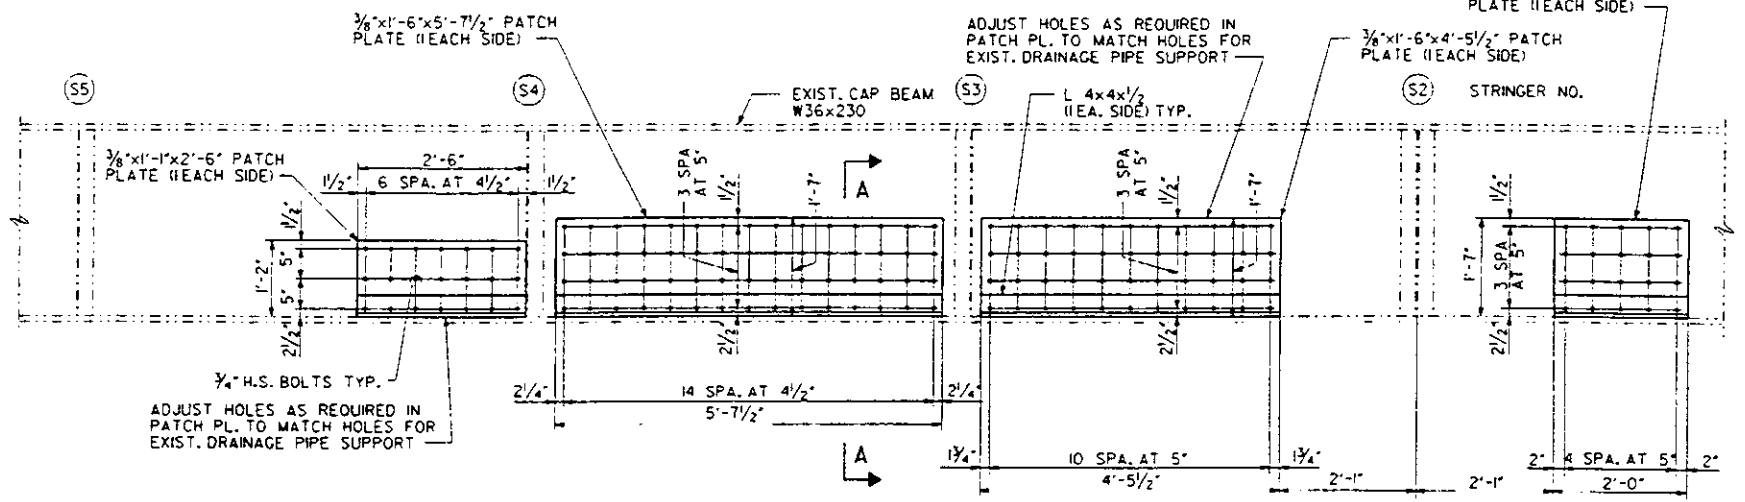


(EAST ELEVATION)
BENT 41 CAP BEAM WEB REPAIR

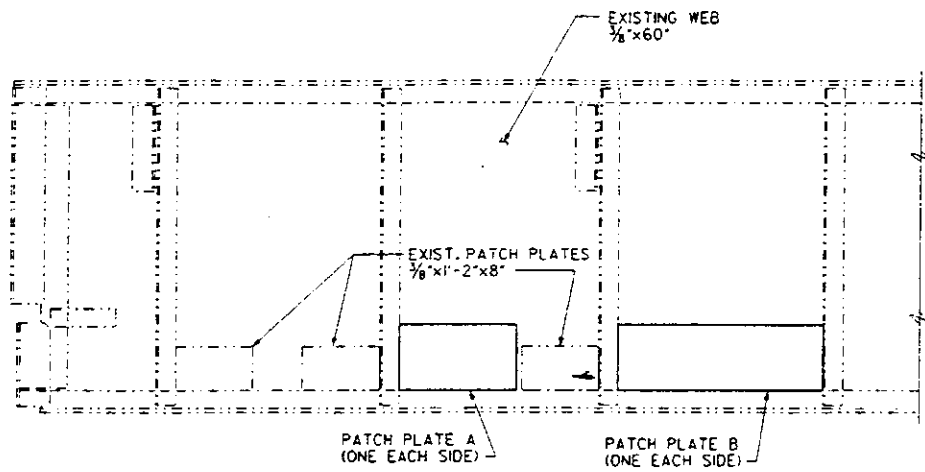


NORTH END AT PANEL POINT L6 SPAN 38
FLOORBEAM WEB REPAIRS

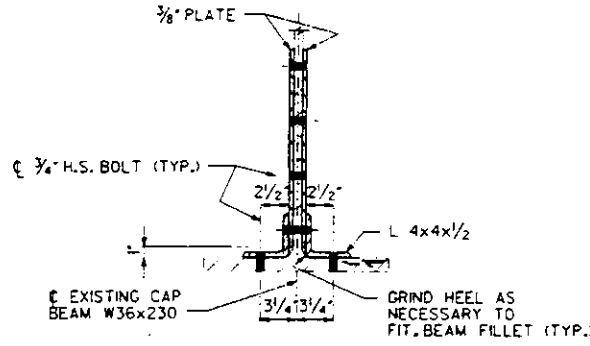

SECTION A-A

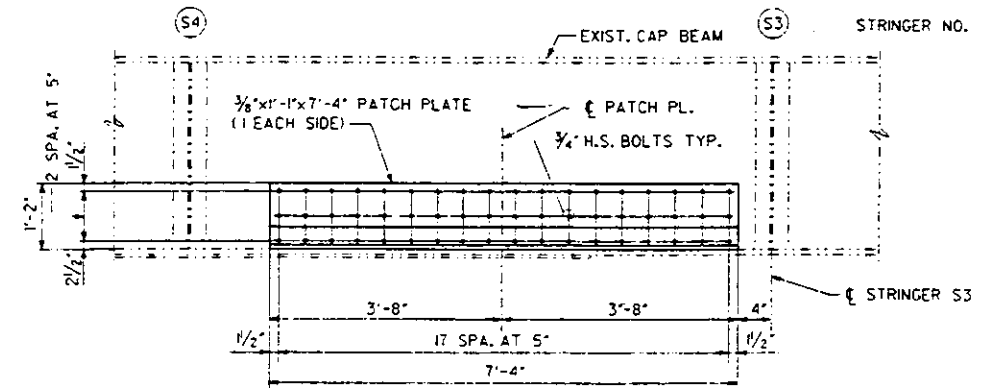

(UPSTATION ELEVATION)
BENT 42 CAP BEAM WEB REPAIR

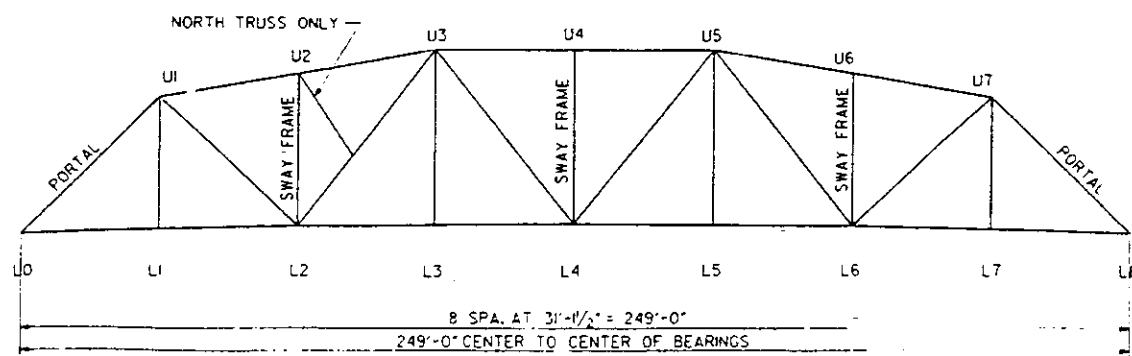

(SOUTH ELEVATION)
TRUSS PANEL POINT NUMBERING - SPAN 38

NOTES
THE COST OF TEMPORARY SUPPORT OF DRAINAGE PIPE AS REQUIRED FOR INSTALLATION OF PATCH PLATES SHALL BE CONSIDERED INCLUDED IN THE PRICE BID FOR "DRAINAGE SYSTEM REPAIR".
STRINGERS, BEARINGS, GUSSET PL., DRAINAGE PIPES, ETC. NOT SHOWN FOR CLARITY.

REHABILITATION FOR
APPROACH BRIDGE OVER
I-55/70 W.B., MISSOURI AVE.
AND RAILROADS

FLOORBEAM AND CAP BEAM REPAIRS

STRUCTURE NO. 082-6003
STA. 65+00 (FAP 799) ST. CLAIR CO.

PREPARED BY:
SVERDRUP CIVIL, INCORPORATED
MARYLAND HEIGHTS, MISSOURI

SECTION IBR-1

SHEET NO. 12 OF 21


FOR INFORMATION ONLY

JOB NO. FILE NO. 0101040401 K.M.L.K.S5G02.DGN DATE: DECEMBER 1997
LEVELS PLOTTED ALL
PRT. M.L.K.S5G02


DESIGNED
CHECKED
DRAWN
B.C. KATES
CHECKED

ROUTE NO.	SECTION	COUNTY	TOTAL SHEETS	SHEET NO.
FAP 799	*	ST. CLAIR	179	133
LL/MS	PROJECT			


*IBR-I APPROACH BRIDGE

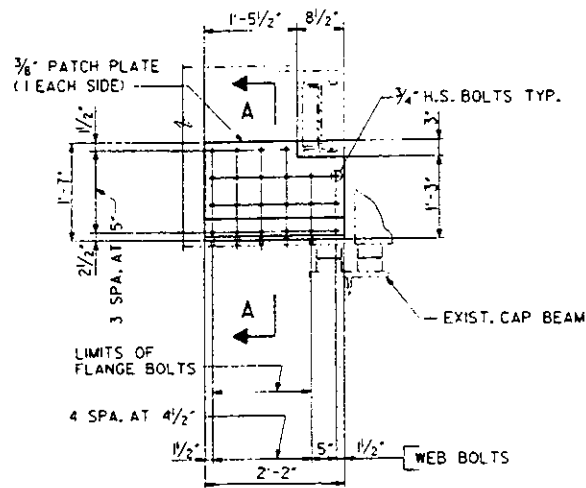

STRINGER S3 AND S5 WEB REPAIR
BENT 39 SPAN 40

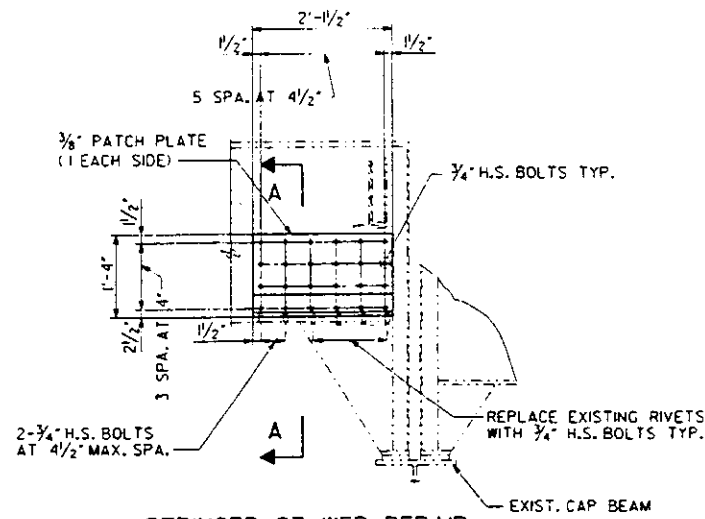


STRINGER S3 WEB REPAIR
BENT 42 SPAN 43

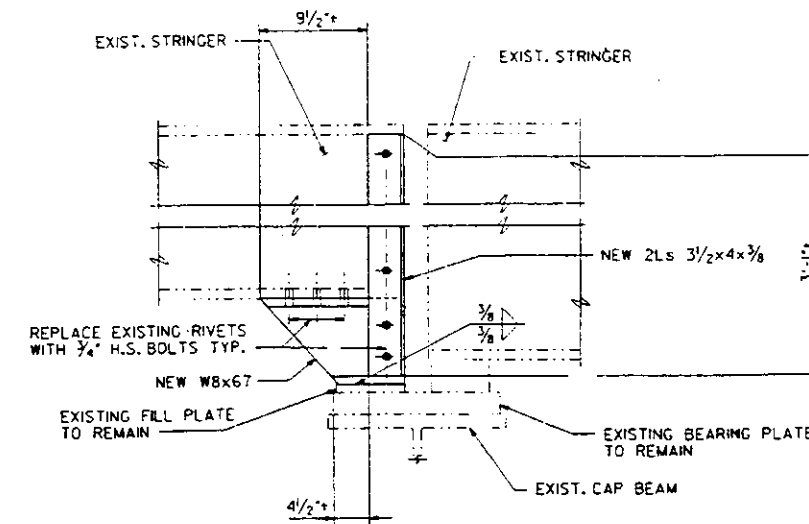


STRINGER S6 PEDESTAL REMOVAL AND REPLACEMENT
BENT 41 SPAN 43

NOTES: NUMBER AND LOCATION OF HOLES FOR EXISTING RIVETS TO MATCH EXISTING CONNECTION. EXISTING MEMBERS MAY BE USED AS TEMPLATE FOR NEW MEMBER HOLES (TYP.). EXISTING L 3 1/2 x 4 x 3/8 BEARING STIFFENER ANGLES AND W8x67 BEARING PEDESTAL SHALL BE REPLACED.

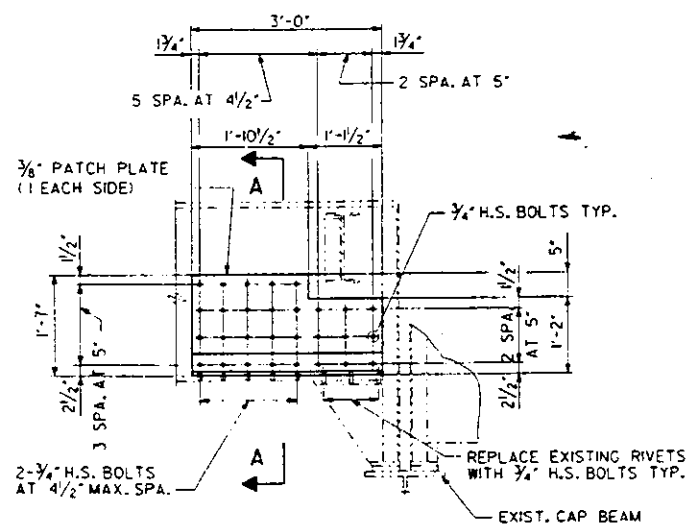

STRINGER S3 WEB REPAIR
BENT 41 SPAN 43

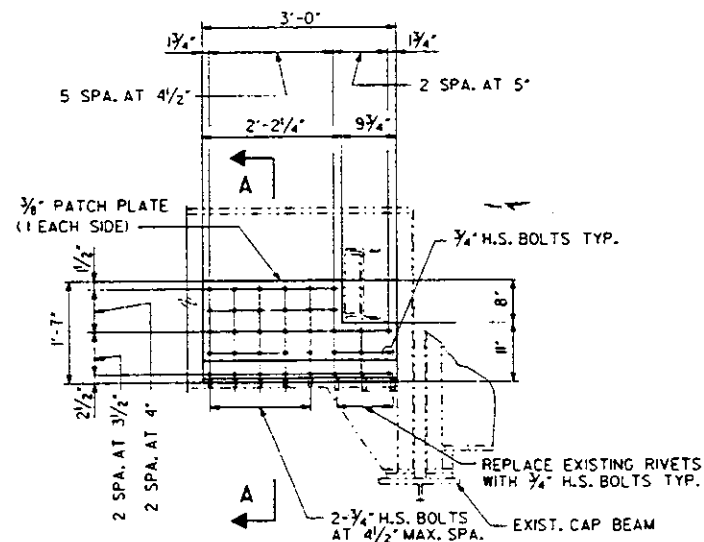


STRINGER S5 WEB REPAIR
BENT 41 SPAN 43

NOTES - JACKING AND REMOVAL OF EXISTING STRINGER PEDESTAL

MINIMUM JACK CAPACITY SHALL BE 50 TONS. SEE SPECIAL PROVISIONS FOR ADDITIONAL REQUIREMENTS. JACKS SHALL NOT BE PLACED DIRECTLY UNDERNEATH DIAPHRAGMS.

NOTES

JACKING SHALL BE REQUIRED FOR THE REMOVAL AND REPLACEMENT OF STRINGER S6 PEDESTAL AND STIFFENER ANGLES, BENT 41 SPAN 43. JACKING OF STRINGER S6 SHALL BE INCLUDED IN THE PRICE BID FOR JACK AND REMOVE EXISTING BEARINGS.

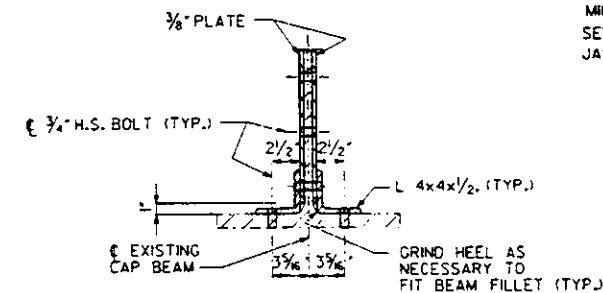

SECTION A-A

DATE: DECEMBER 1997
LEVELS PLOTTED ALL
FILE: N:\JOB\40\ANI\KMLXSSG01.DGN
PRF: MLXSSG01

DESIGNED	
CHECKED	J. CORLEY
DRAWN	B.C. KATES
CHECKED	

PREPARED BY:
SVERDRUP CIVIL, INCORPORATED
MARYLAND HEIGHTS, MISSOURI

REHABILITATION FOR
APPROACH BRIDGE OVER
I-55/70 W.B., MISSOURI AVE.
AND RAILROADS

STRINGER REPAIR DETAILS

STRUCTURE NO. 082-6003
STA. 65+00 (FAP 799) ST. CLAIR CO.


FOR INFORMATION ONLY

SECTION BR-1

SHEET NO. 13 OF 21


ROUTE NO.	SECTION	COUNTY	TOTAL SHEETS	SHEET
FAP 799		ST. CLAIR	179	134
BLANK		PROJECT		

*1BR-I APPROACH BRIDGE

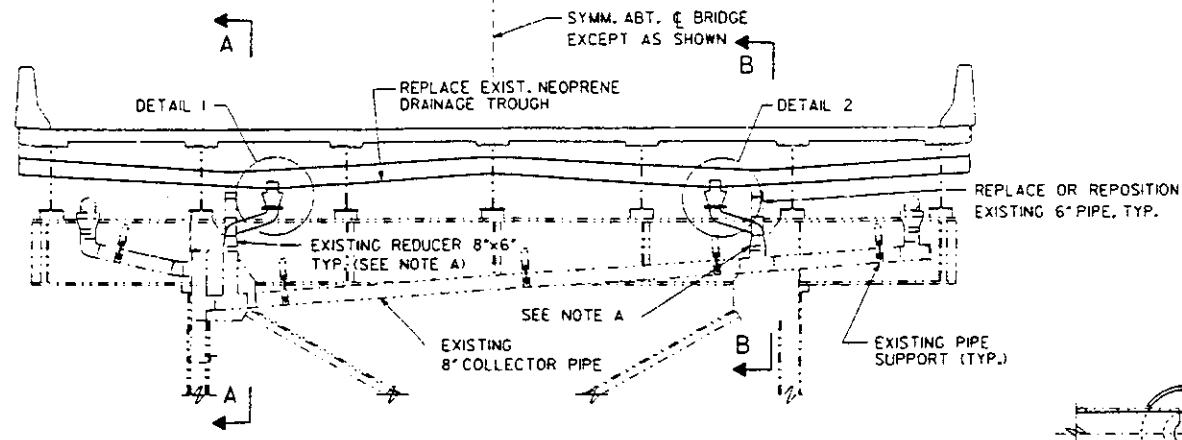


DRAINAGE TROUGH REPAIRS AT BENT 41


NOTE A: RECONFIGURE EXISTING REDUCER AS REQUIRED TO MAXIMIZE SLOPE.

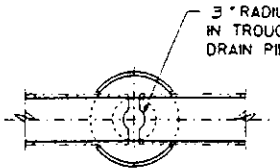

SECTION E-E

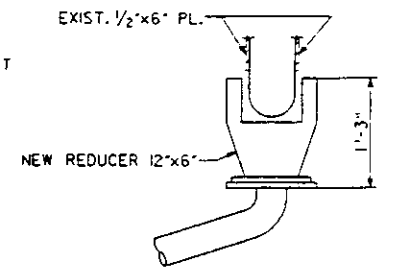


SECTION F-F

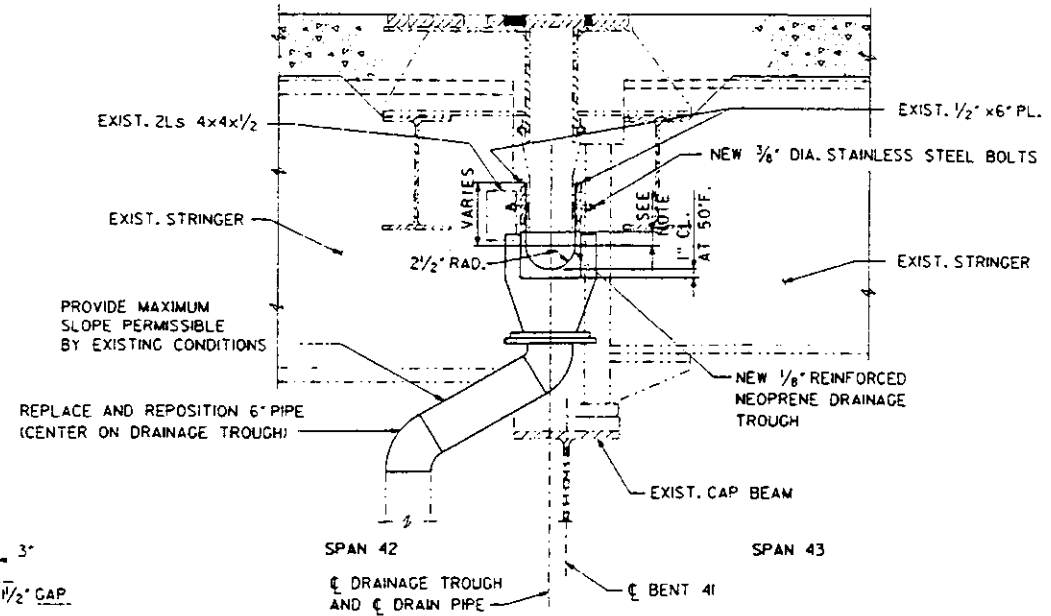


SECTION A-A SHOWN
SECTION B-B SIMILAR

NOTE: DIMENSION VARIES EXCEPT AT THE C BRIDGE AND THE END OF TROUGH. AT THESE LOCATIONS THE DIMENSION SHALL BE 1 3/4\"/>

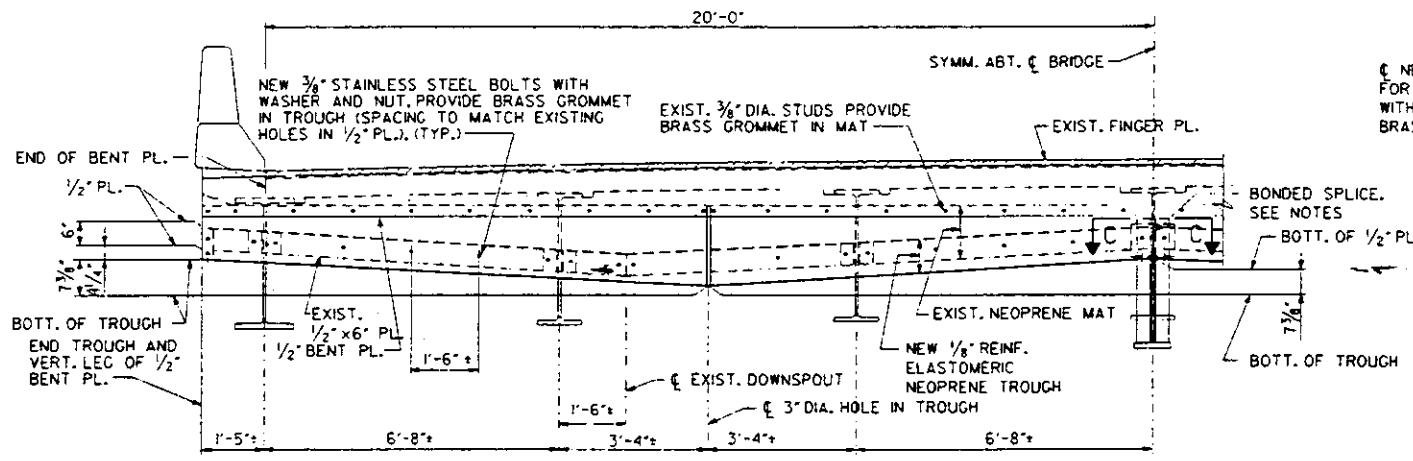


SECTION AT DRAINAGE TROUGH


NOTE: THE NEOPRENE TROUGH SHALL BE JOINED WITH A BONDED SPLICE. THE SPLICE SHALL BE MADE IN SUCH A MANNER AS TO PROVIDE A STRONG AND WATER TIGHT SEAL, USING AN ADHESIVE AS RECOMMENDED BY THE MANUFACTURER FOR BONDING NEOPRENE.

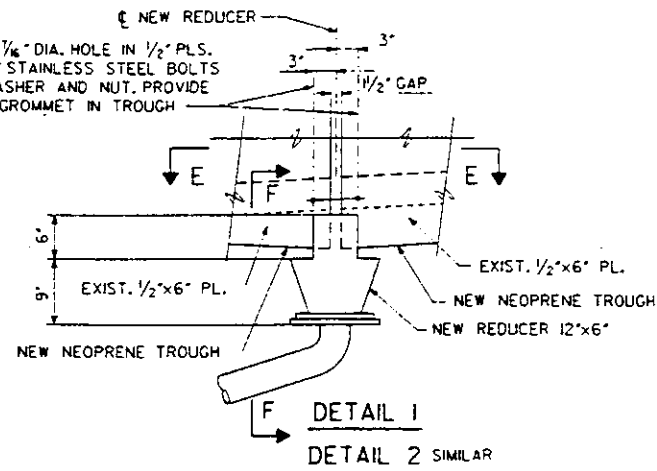


DETAIL 1
DETAIL 2 SIMILAR

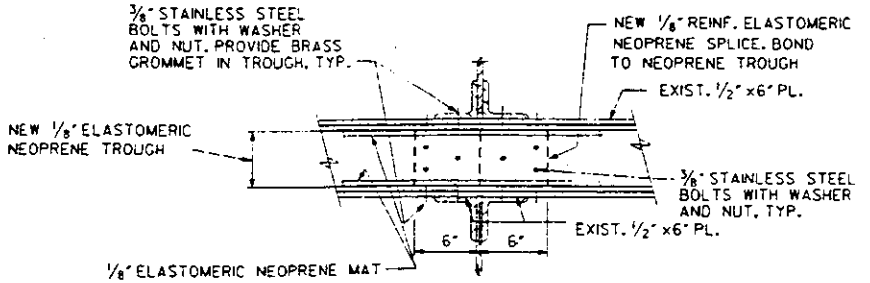

SECTION C-C

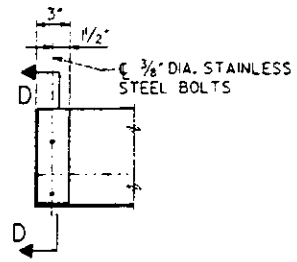

SECTION AT END OF TROUGH

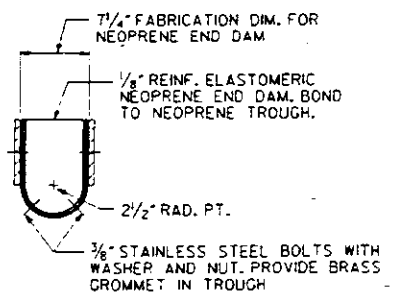

SECTION D-D

NOTES

THE COST OF THE ELASTOMERIC NEOPRENE TROUGH COMPLETE IN PLACE SHALL BE INCLUDED IN THE PRICE BID FOR "DRAINAGE SYSTEM REPAIR"; SEE SPECIAL PROVISIONS.

REHABILITATION FOR
APPROACH BRIDGE OVER
I-55/70 W.B., MISSOURI AVE.
AND RAILROADS

DRAINAGE SYSTEM REPAIRS AT BENT 41

STRUCTURE NO. 082-6003
STA. 65+00 (FAP 799) ST. CLAIR CO.

PREPARED BY:
SVERDRUP CIVIL, INCORPORATED
HARTLAND HEIGHTS, MISSOURI


SECTION BR-I

SHEET NO. 14 OF 21


10840
 FILE NO: 081041M.K.M.L.K.S500.3.D0N
 PRT M.L.R.S5003
 LEVELS PLOTTED ALL
 DATE: DECEMBER 1937

DESIGNED	
CHECKED	J. CORLEY
DRAWN	B.C. KATES
CHECKED	

FOR INFORMATION ONLY

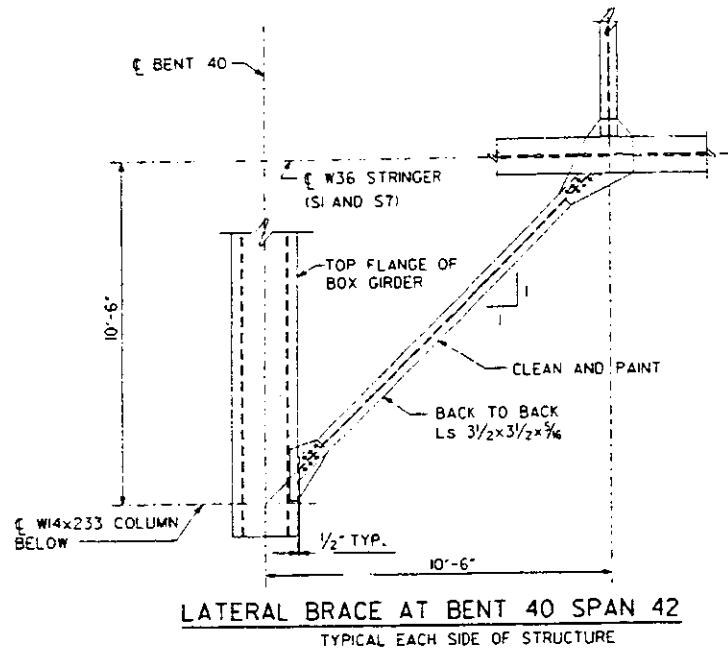


BENT NUMBER	SPAN NUMBER	SHEET NUMBER	LOCATION	REMARKS
40	42	15	LATERAL BRACE	CLEAN AND PAINT LATERAL BRACE, BOTH SIDES OF STRUCTURE
40	42	11	BENT CAP WEB	CLEAN AND PAINT DETERIORATED AREAS ON EAST SIDE NEAR SOUTH COLUMN
40	42		EXTERIOR STRINGER	CLEAN AND PAINT DETERIORATED AREAS ALONG WEB AND BOTTOM FLANGE
41	42	9	STRINGERS S1 AND S7	CLEAN AND PAINT EXISTING BEARINGS

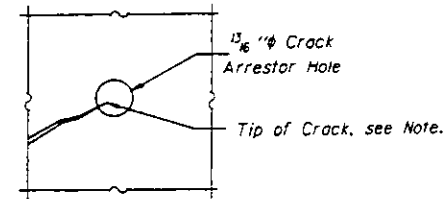


CRACK ARRESTOR HOLE DETAIL


Note: Locate crack tip using liquid dye penetrant or magnetic particle testing. Drill 1 5/8" φ Crack Arrestor hole at the crack tip. After crack arrestor hole has been drilled, dye penetrant or magnetic particle testing shall be used to verify that the drilled hole has captured the crack tip. Cost shall be included in the cost of "Structural Steel Repairs".

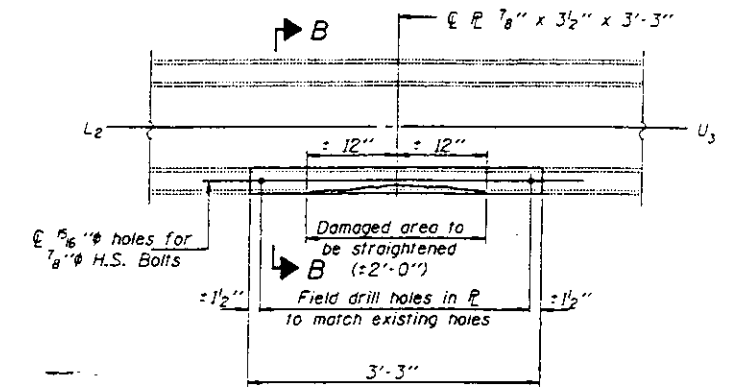

REPAIR L2-U3

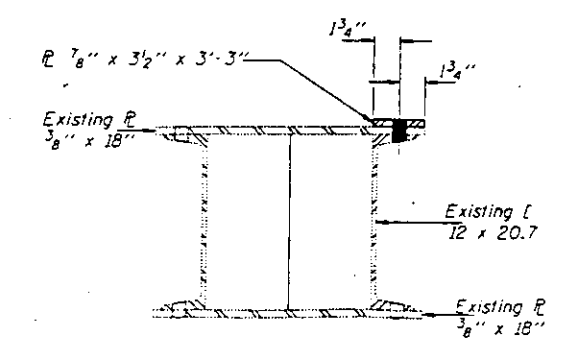

SECTION B-B

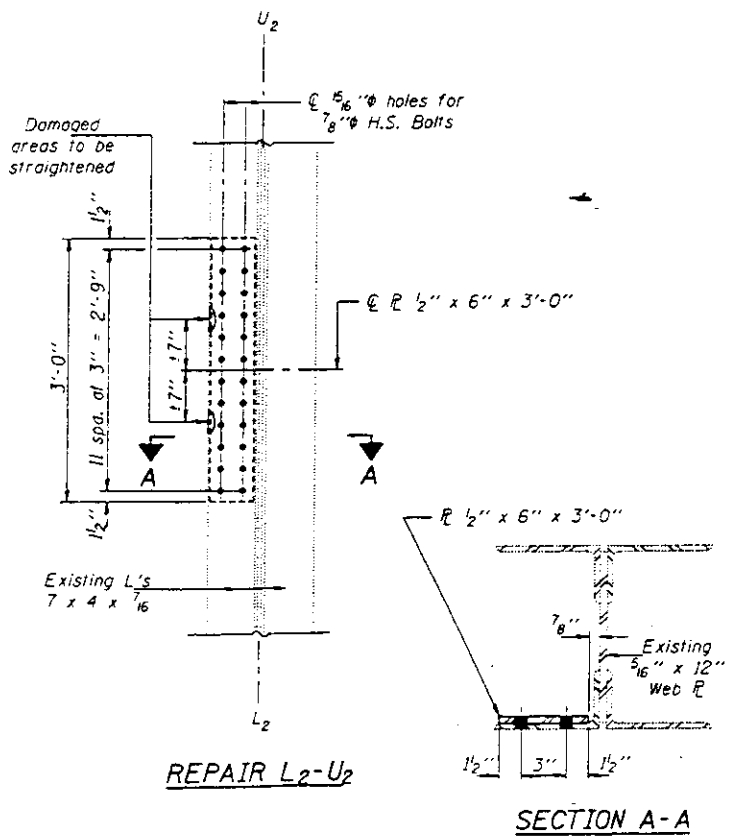

REPAIR L2-U2

SECTION A-A

BENT NUMBER	SPAN NUMBER	SHEET NUMBER	LOCATION	REMARKS
36	37	8	BEARINGS	REMOVE AND REPLACE FIXED BEARINGS STRINGERS S1- S7
	38	12	PANEL POINT L6	INSTALL PATCH PLATES ON BOTH SIDES OF FLOORBEAM WEB
37	39	8	BEARINGS	REMOVE AND REPLACE FIXED BEARINGS STRINGERS S1- S7
39	40	11	NORTH COLUMN	REMOVE EXISTING COLUMN TO CAP BEAM CONNECTION GUSSET PLATE ON WEST SIDE OF BENT 39 AND REPLACE WITH NEW PLATE
39	40	13	STRINGERS S3 AND S5	INSTALL PATCH PLATES ON BOTH SIDES OF STRINGER WEBS
40		11	NORTH COLUMN	INSTALL MISSING BOLT FOR LATERAL BRACING CONNECTION
41		12	BENT CAP BEAM	INSTALL PATCH PLATES ON BOTH SIDES OF BENT CAP WEB
41	42	9	BEARINGS	REMOVE AND REPLACE EXPANSION BEARINGS, STRINGERS SITHRU S7
41	43	13	STRINGERS S3 AND S5	INSTALL PATCH PLATES ON BOTH SIDES OF STRINGER WEBS
41	43	13	STRINGERS S6	INSTALL FILL AND PATCH PLATES ON BOTH SIDES OF BEARING PEDESTAL WEB
42		12	BENT CAP BEAM	INSTALL PATCH PLATES ON BOTH SIDES OF BENT CAP WEB
42	43	13	STRINGERS S3	INSTALL PATCH PLATES ON BOTH SIDES OF STRINGER WEBS
*	38	15	L2 U2	Straighten & Plate
*	38	15	L2 U3	Straighten & Plate
*	38	15	L4 U3	Drill Crack Arresting Hole & Grind
*	38	15	L3 U3	Straighten Only
*	38	15	West End Portal	Drill Crack Arresting Hole & Grind

* For Truss Panel Point Numbering, SPAN 38, see Sheet 12 of 21.
Straighten according to Special Provision "Straighten Bent Members".

REHABILITATION FOR
APPROACH BRIDGE OVER
I-55/70 W.B., MISSOURI AVE.
AND RAILROADS

TABLE OF STEEL REPAIRS AND
PAINT TOUCH-UP LOCATIONS

STRUCTURE NO. 082-6003
STA. 65+00 (FAP 799) ST. CLAIR CO.

DATE: DECEMBER 17
L.L. ELS PLOTTED
FILE: 01030404.MINI.PAINT.DGN
JOB NO.
DESIGNED
CHECKED
DRAWN
CHECKED

DESIGNED
CHECKED
DRAWN
CHECKED

PREPARED BY:
SVERDRUP CIVIL, INCORPORATED
MARYLAND HEIGHTS, MISSOURI


SECTION BR-1

SHEET NO. 15 OF 21


FOR INFORMATION ONLY

STATE OF ILLINOIS
DEPARTMENT OF TRANSPORTATION


ROUTE NO.	SECTION	COUNTY	DATE	SHEET
FAP 799	*	ST. CLAIR	179	136

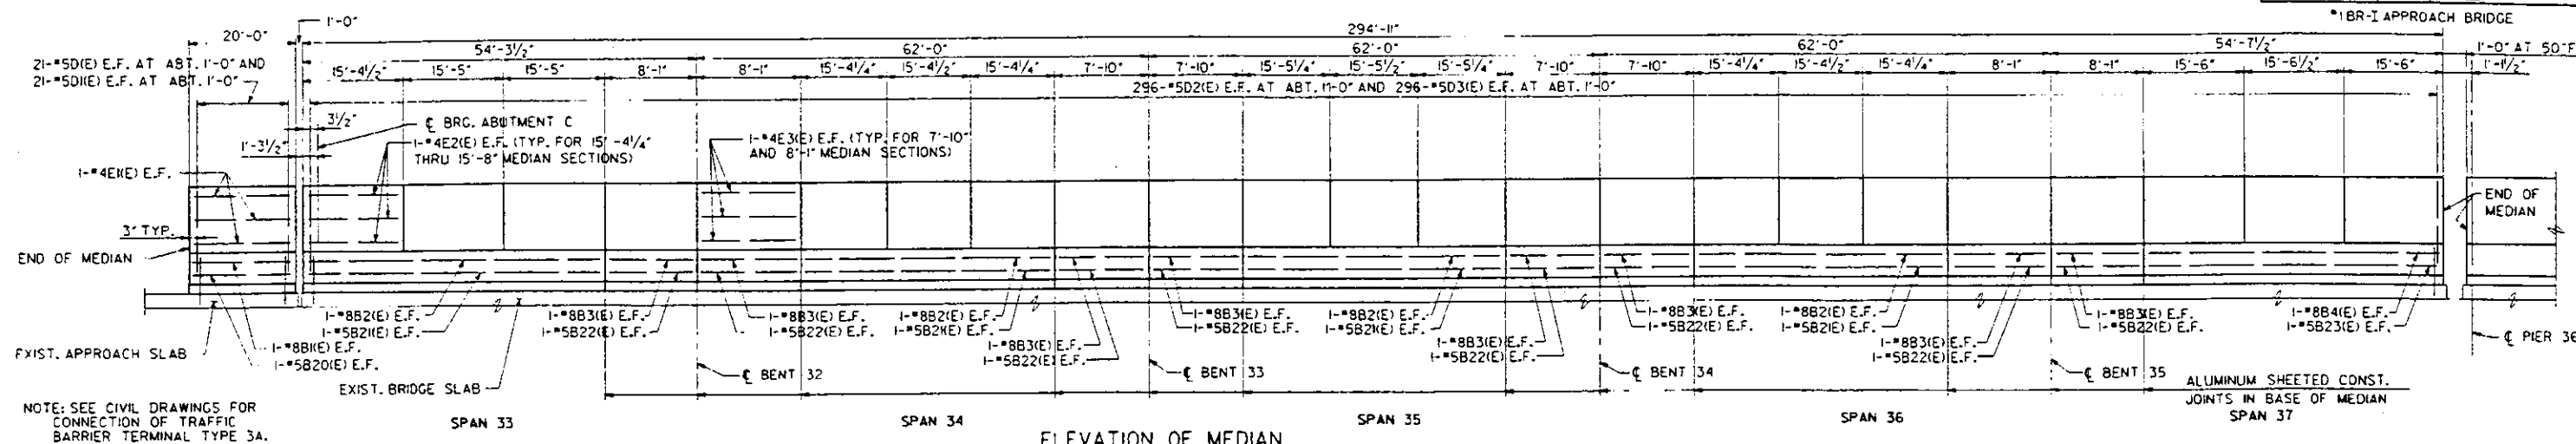

ELEVATION OF MEDIAN

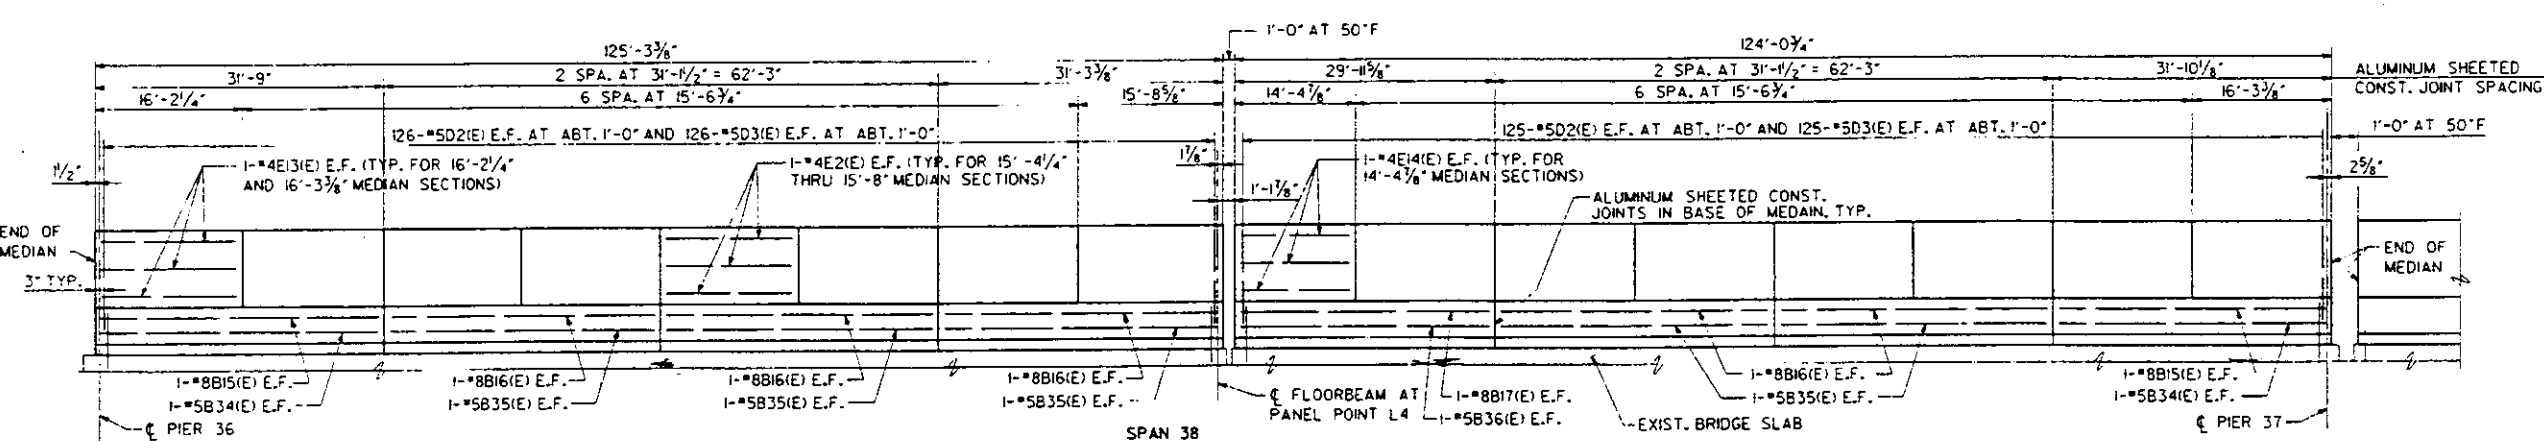

ELEVATION OF MEDIAN

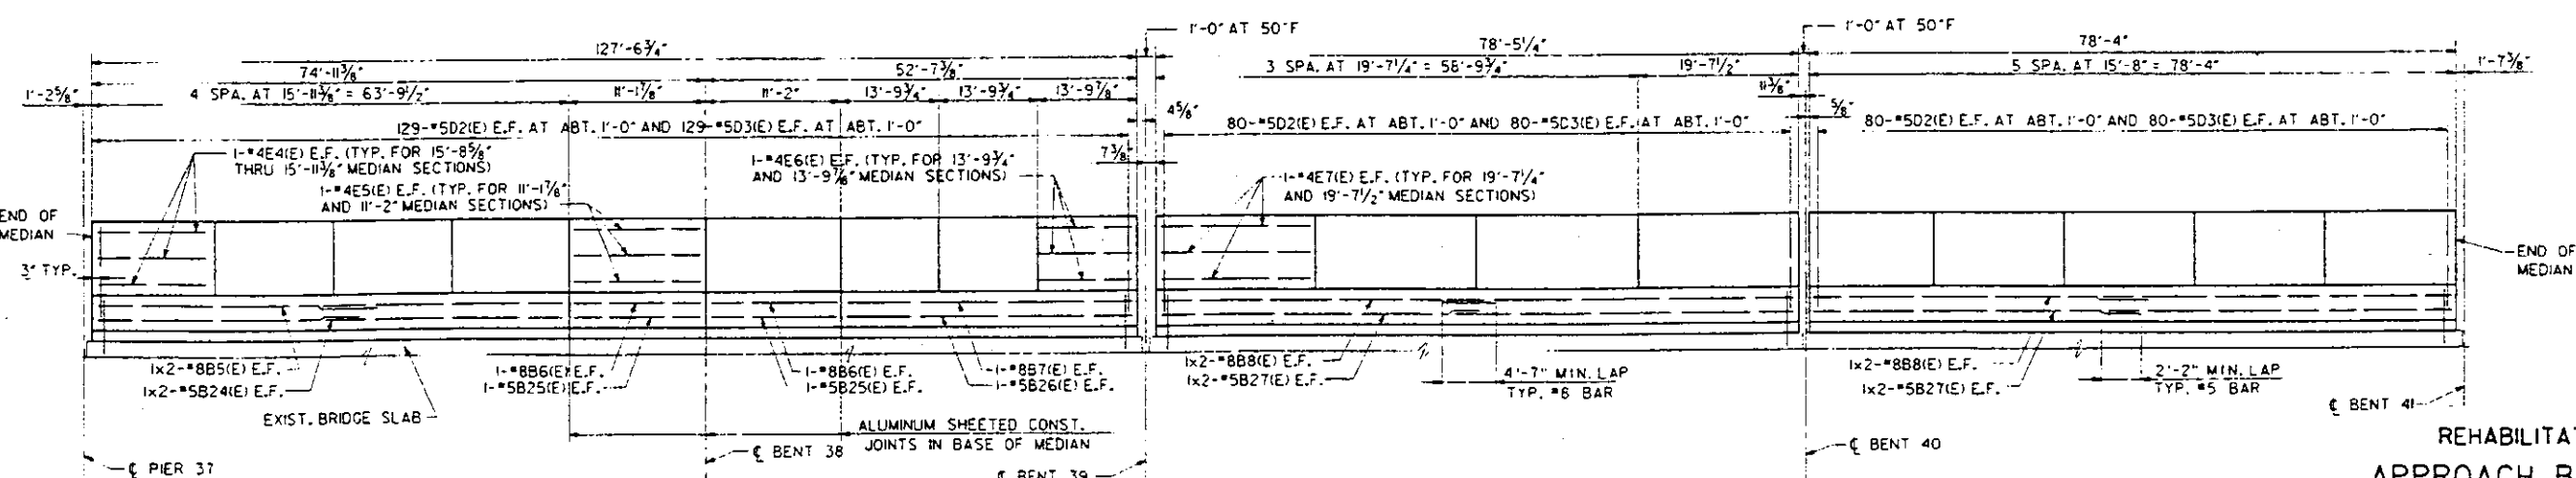

ELEVATION OF MEDIAN

NOTES

E.F. INDICATES EACH FACE.
ALL DIMENSIONS ARE MEASURED ALONG ϵ ROADWAY.
FOR BILL OF MATERIAL, SEE SHEET 18.
FOR SLIDING PLATE DETAILS, SEE SHEET 18.

REHABILITATION FOR
APPROACH BRIDGE OVER
I-55/70 W.B., MISSOURI AVE.
AND RAILROADS

MEDIAN - SPANS 33 THRU 42

STRUCTURE NO. 082-6003
STA. 65+00 (FAP 799) ST. CLAIR CO.

PREPARED BY:
SVERDRUP CIVIL INCORPORATED
MARYLAND HEIGHTS, MISSOURI

SECTION 1BR-1

SHEET NO. 16 OF 21




10840
 DATE: DECEMBER 17
 L.E. L.S. PLOTTED
 ALL
 PREPARED BY: C.B. GARRIGAN
 CHECKED BY: C.B. GARRIGAN

B.C. KATES	DESIGNED
R. RILEY	CHECKED
J. CORLEY	DRAWN
B.C. KATES	CHECKED

FOR INFORMATION ONLY


ROUTE NO.	SECTION	COUNTY	TOTAL LENGTH	SHEET NO.
FAP 799	*	ST. CLAIR	1.77	137
LANDS		PROJECT		

*1BR-I APPROACH BRIDGE

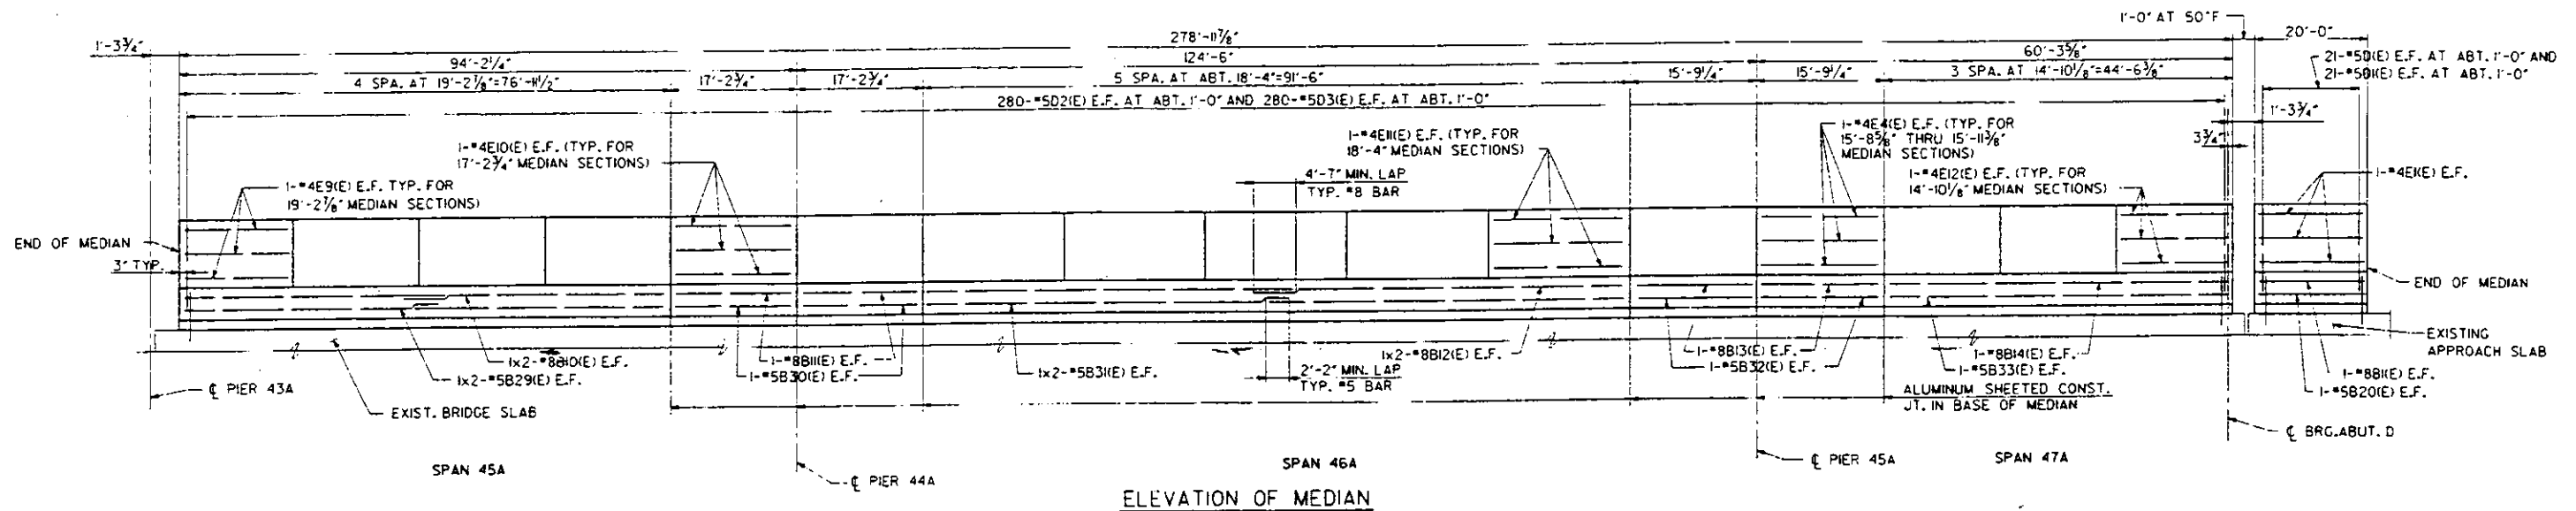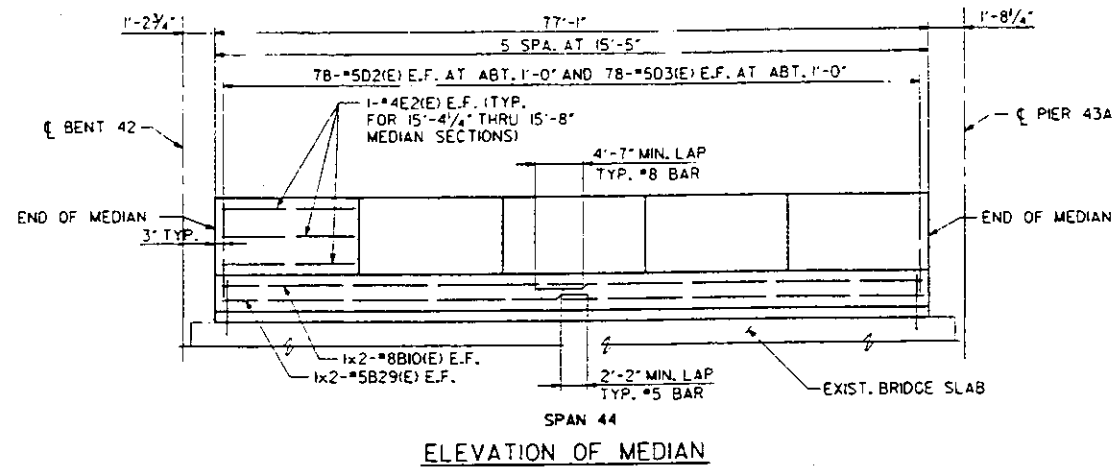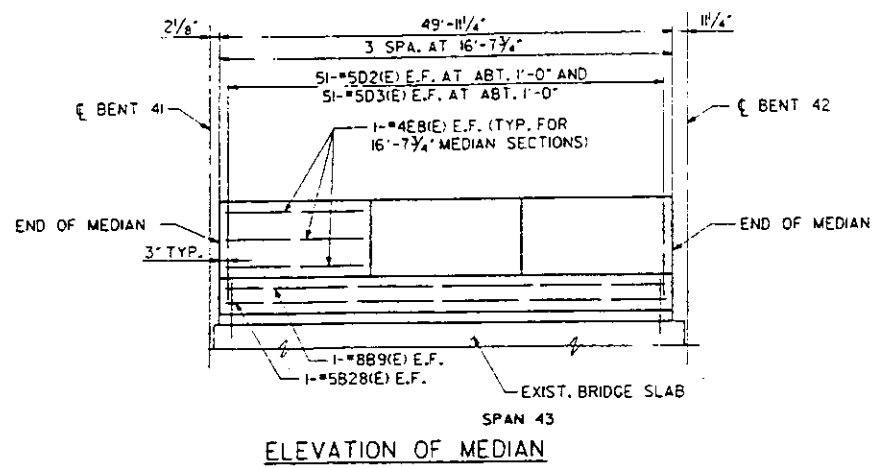


NOTE: SEE CIVIL DRAWINGS FOR CONTINUATION OF MEDIAN

1/2" PREFORMED CORK JT. FILLER IN ACCORDANCE WITH ARTICLES 105LO6 OR 105LO7. COST INCLUDED IN THE PRICE BID FOR CONCRETE SUPERSTRUCTURE.

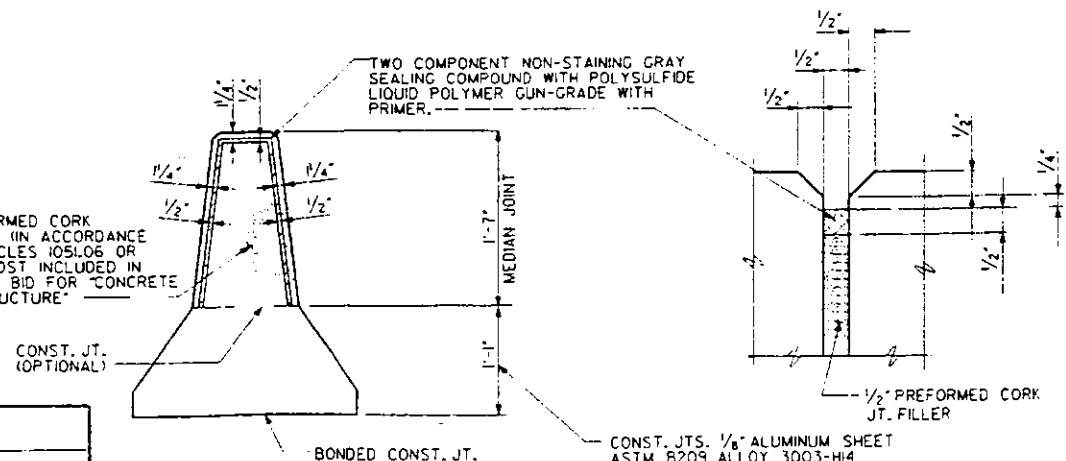

NOTE: ALL EDGES SHALL HAVE A 1/4" CHAMFER, EXCEPT AS SHOWN.

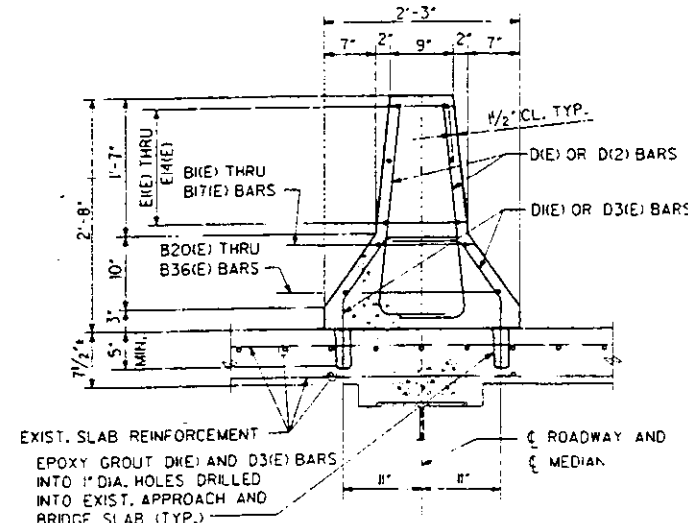

NOTE: SECTION THRU BRIDGE SLAB SHOWN, SECTION THRU APPROACH SLAB SIMILAR

REHABILITATION FOR
APPROACH BRIDGE OVER
I-55/70 W.B., MISSOURI AVE.
AND RAILROADS
MEDIAN - SPANS 43, 44,
45A, 46A AND 47A
STRUCTURE NO. 082-6003
STA. 65+00 (FAP 799) ST. CLAIR CO.

PREPARED BY:
SVERDRUP CIVIL INCORPORATED
MARIETTA, MISSOURI


SECTION 1BR-I

SHEET NO. 17 OF 21


10840
FILE # 10840/AM/K/C6BARR2.DGN
PRJ: C6BARR2
LEVELS PLOTTED ALL
DATE: DECEMBER 1997

DESIGNED	B.C. KATES
CHECKED	R. RILEY
DRAWN	J.G. CORLEY
CHECKED	B.C. KATES

FOR INFORMATION ONLY

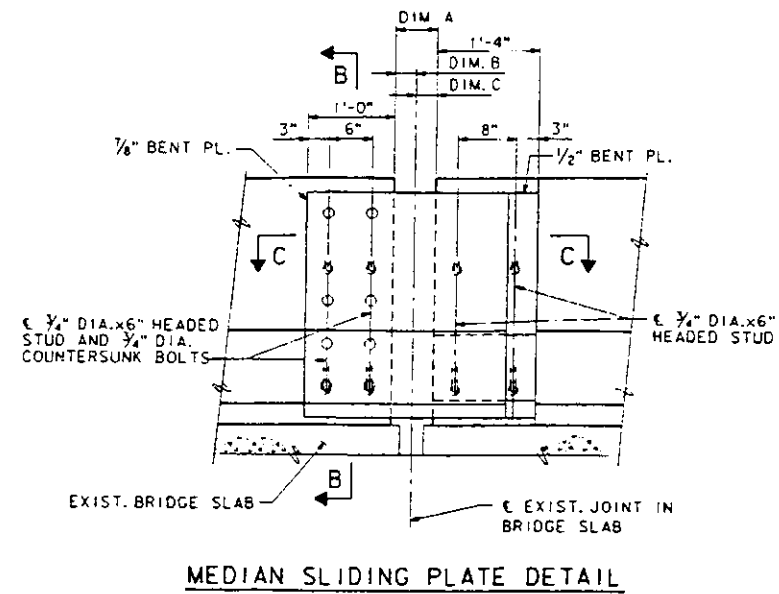

MEDIAN SLIDING PLATE DETAIL

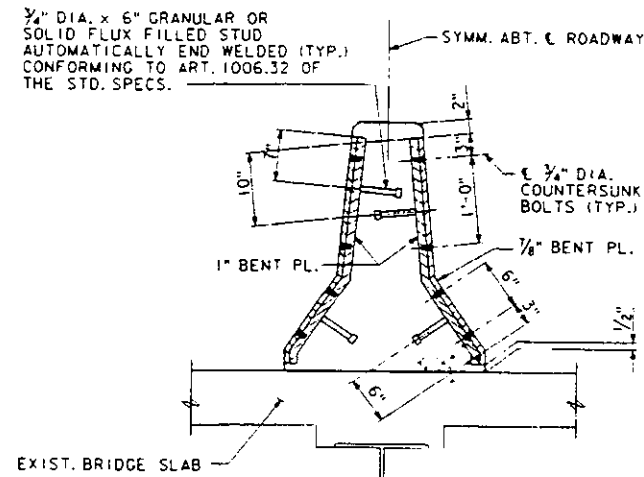

SECTION B-B

NOTE: SLIDING PLATES ON BRIDGE SHOWN, SLIDING PLATES AT ABUTMENTS, ON APPROACH SLAB SIMILAR.

SLIDING PLATE DATA					
LOCATION	DIM. A*	DIM. B*	DIM. C*	DIM. D*	DIM. E
ABUTMENT C	1'-0"	6"	6"	4"	3'-0"
PIER 36	1'-0"	6"	6"	4"	3'-0"
PANEL POINT L4	1'-0"	6"	6"	4"	3'-0"
PIER 37	1'-0"	6"	6"	4"	3'-0"
BENT 39	1'-0"	6"	6"	4"	3'-0"
BENT 40	1'-0"	6"	6"	4"	3'-0"
BENT 41	1'-9/2"	1'-6 1/2"	2 1/2"	3 1/2"	3'-10"
BENT 42	2'-2"	1'-1"	1'-1"	4"	4'-2"
PIER 43A	3'-0"	1'-6"	1'-6"	4"	5'-0"
ABUTMENT D	1'-0"	6"	6"	4"	3'-0"


* AT 50°F

A TOTAL WEIGHT OF 10,381 LBS. OF STRUCTURAL STEEL IS REQUIRED FOR THE SLIDING PLATE ASSEMBLIES.

NOTE: WEIGHT OF STRUCTURAL STEEL INCLUDES ALL PLATES, WELDED STUDS AND COUNTERSUNK BOLTS.

THE COST OF SLIDING PLATES COMPLETE IN PLACE SHALL BE INCLUDED IN THE PRICE BID FOR "FURNISHING AND ERECTING STRUCTURAL STEEL"

SLIDING PLATES SHALL BE GALVANIZED IN ACCORDANCE WITH THE REQUIREMENTS OF AASHTO M 111 (ASTM A123).

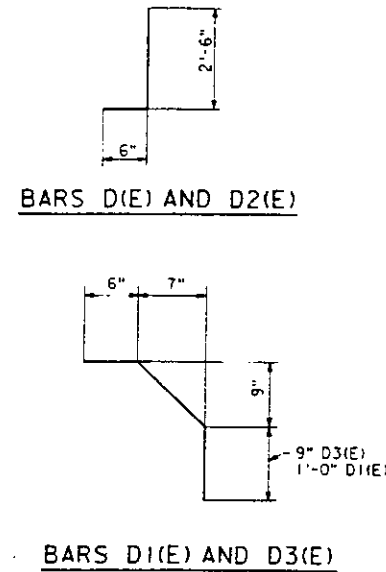


BARS D1(E) AND D3(E)

BILL OF MATERIAL


MEDIAN									
BAR	NO.	SIZE	LENGTH	SHAPE	BAR	NO.	SIZE	LENGTH	SHAPE
B1(E)	4	#8	19'-9"	=====	B31(E)	4	#5	46'-9"	=====
B2(E)	8	#8	45'-10"	=====	B32(E)	4	#5	15'-7"	=====
B3(E)	16	#8	7'-7"	=====	B33(E)	2	#5	44'-4"	=====
B4(E)	2	#8	46'-4"	=====	B34(E)	4	#5	31'-6"	=====
B5(E)	4	#8	34'-1"	=====	B35(E)	10	#5	30'-11"	=====
B6(E)	4	#8	10'-11"	=====	B36(E)	2	#5	29'-9"	=====
B7(E)	2	#8	41'-3"	=====					
B8(E)	8	#8	41'-4"	=====					
B9(E)	2	#8	49'-9"	=====					
B10(E)	8	#8	40'-8"	=====					
B11(E)	4	#8	17'-0"	=====					
B12(E)	4	#8	47'-11"	=====	D1(E)	84	#5	3'-0"	=====
B13(E)	4	#8	15'-7"	=====	D1(E)	84	#5	2'-5"	=====
B14(E)	2	#8	44'-4"	=====	D2(E)	2490	#5	3'-0"	=====
B15(E)	4	#8	31'-6"	=====	D3(E)	2490	#5	2'-2"	=====
B16(E)	10	#8	30'-11"	=====					
B17(E)	2	#8	29'-9"	=====					
					E1(E)	12	#4	19'-9"	=====
					E2(E)	222	#4	15'-2"	=====
					E3(E)	48	#4	7'-7"	=====
					E4(E)	42	#4	15'-6"	=====
B20(E)	4	#5	19'-9"	=====	E5(E)	12	#4	10'-11"	=====
B21(E)	8	#5	45'-10"	=====	E6(E)	18	#4	13'-7"	=====
B22(E)	16	#5	7'-7"	=====	E7(E)	24	#4	19'-5"	=====
B23(E)	2	#5	46'-4"	=====	E8(E)	18	#4	16'-5"	=====
B24(E)	4	#5	32'-11"	=====	E9(E)	24	#4	19'-0"	=====
B25(E)	4	#5	10'-11"	=====	E10(E)	12	#4	17'-0"	=====
B26(E)	2	#5	41'-3"	=====	E11(E)	30	#4	18'-0"	=====
B27(E)	8	#5	40'-2"	=====	E12(E)	18	#4	14'-8"	=====
B28(E)	2	#5	49'-9"	=====	E13(E)	12	#4	16'-0"	=====
B29(E)	8	#5	39'-6"	=====	E14(E)	6	#4	14'-2"	=====
B30(E)	4	#5	17'-0"	=====					

CONCRETE SUPERSTRUCTURE	CU. YDS.	160.6
REINFORCEMENT BARS (EPOXY COATED)	LBS.	28,458

REINFORCEMENT BARS MARKED (E) SHALL BE EPOXY COATED.

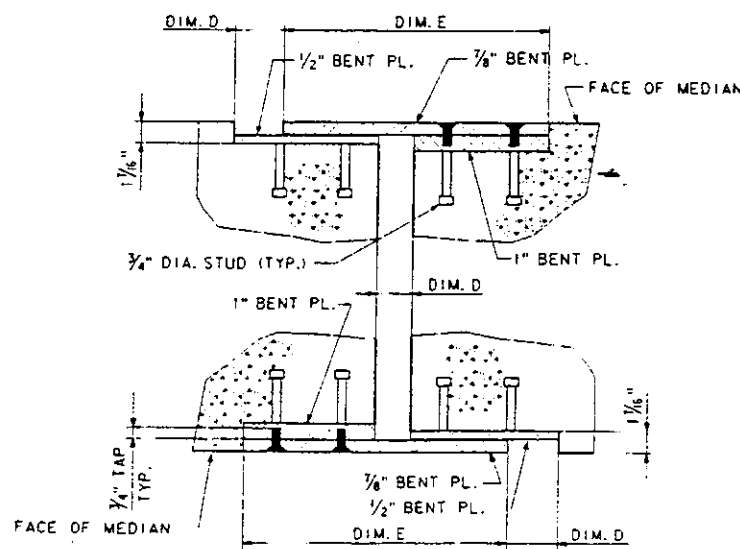

SECTION C-C

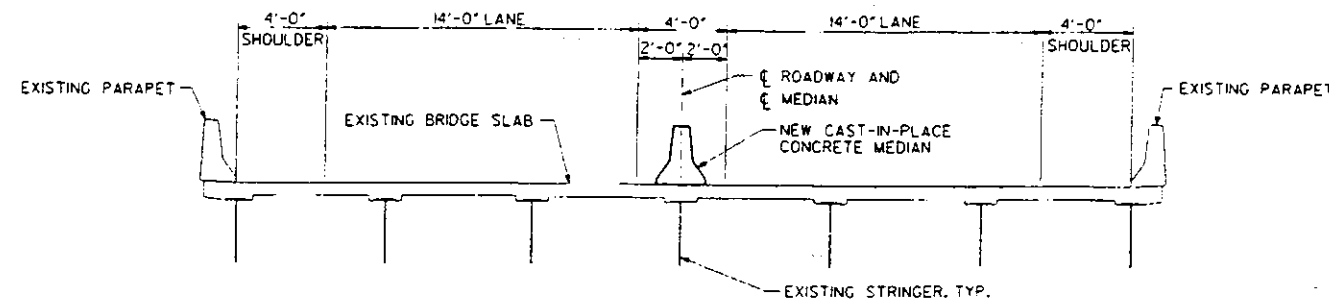

TYPICAL SECTION THRU BRIDGE SLAB

REHABILITATION FOR
APPROACH BRIDGE OVER
I-55/70 W.B., MISSOURI AVE.
AND RAILROADS

MEDIAN DETAILS

STRUCTURE NO. 082-6003
STA. 65+00 (FAP 799) ST. CLAIR CO.

10840
FILE: N010840.MLK:CGARR3.DGN
PRF:CGARR3
LEVELS PLOTTED DATE: DECEMBER, 1997
ALL

B.C. KATES
DESIGNED
R. RILEY
CHECKED
J. CORLEY
DRAWN
S.C. KAEMMERER
CHECKED

PREPARED BY:
SVERDRUP CIVIL INCORPORATED
MARYLAND HEIGHTS, MISSOURI

SECTION BR-1

SHEET NO. 18 OF 21



FOR INFORMATION ONLY

STATE OF ILLINOIS
DEPARTMENT OF TRANSPORTATION

ROUTE NO.	SECTION	COUNTY	TOTAL SHEETS	SHEET NO.
179	*	ST. CLAIR	179	139
FAP TYP		PROJECT		

*1BR-1 APPROACH BRIDGE

NEXT SHEET IS 142

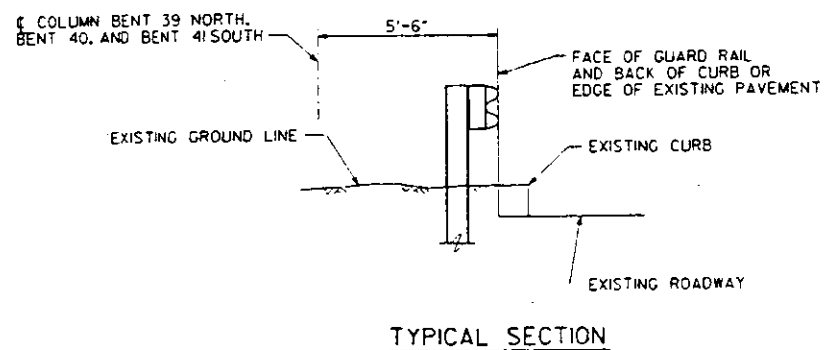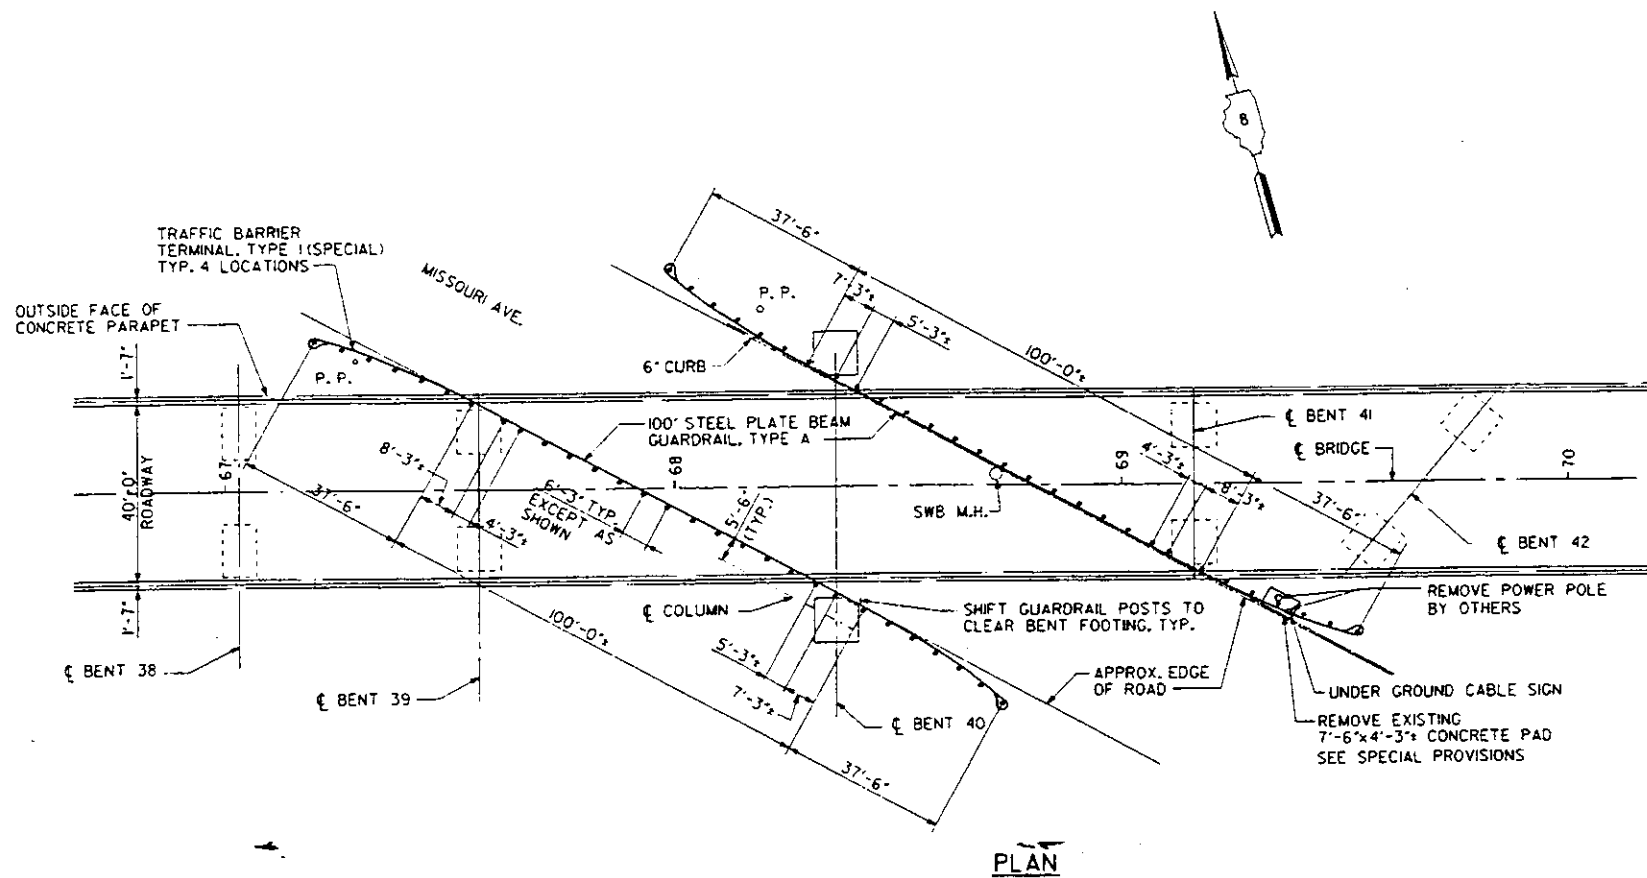

10840
 FILE NO. 10840
 PLOTTER: MKL/KS/OLDGN
 ALL
 LEVELS PLOTTED
 DATE: DECEMBER 1997

DESIGNED	
CHECKED	J. CORLEY
DRAWN	B.C. KATES
CHECKED	

PREPARED BY:
SVERDRUP CIVIL, INCORPORATED
MARYLAND HEIGHTS, MISSOURI

REHABILITATION FOR
APPROACH BRIDGE OVER
I-55/70 W.B., MISSOURI AVE.
AND RAILROADS

COLUMN PROTECTION AT MISSOURI AVE.

STRUCTURE NO. 082-6003
STA. 65+00 (FAP 799) ST. CLAIR CO.



FOR INFORMATION ONLY

SECTION 1BR-1

SHEET NO. 19 OF 21

ROUTE NO.	SECTION	COUNTY	DATE
FAP 799	*	ST. CLAIR	252
PROJECT		PROJECT	


* IBR-1 APPROACH BRIDGE

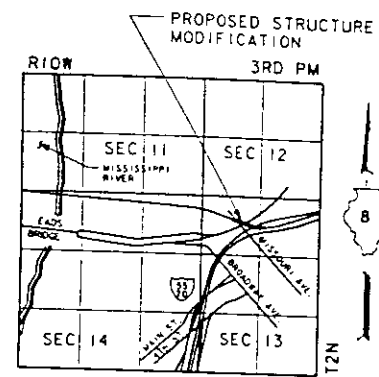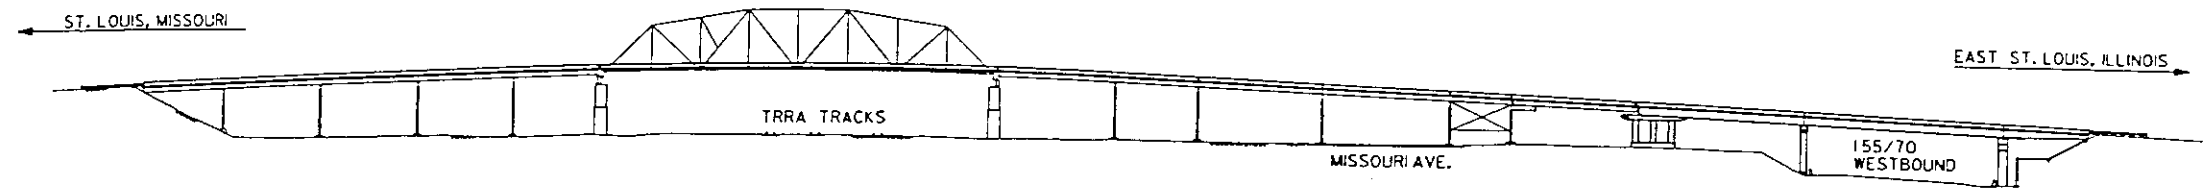

LOCATION PLAN

INDEX OF DRAWINGS

- | | |
|--|--|
| <ul style="list-style-type: none"> 1. INDEX OF DRAWINGS 2. GENERAL PLAN AND ELEVATION - SPANS 33 THRU 38 3. GENERAL PLAN AND ELEVATION - SPANS 39 THRU 47A 4. GENERAL NOTES AND ESTIMATED QUANTITIES 5. DEMOLITION - EXISTING SPANS 46 THRU 50 6. SUBSTRUCTURE LAYOUT - SPANS 45A THRU 47A 7. TOP OF SLAB ELEVATIONS - SPANS 33 THRU 37 8. TOP OF SLAB ELEVATIONS - SPANS 33 THRU 37 9. TOP OF SLAB ELEVATIONS - SPANS 39 THRU 44 10. TOP OF SLAB ELEVATIONS - SPANS 39 THRU 44 11. TOP OF SLAB ELEVATIONS - SPANS 45A THRU 47A 12. TOP OF SLAB ELEVATIONS - SPANS 45A THRU 47A 13. SLAB PLAN - SPANS 33 THRU 37 14. SLAB PLAN - SPANS 39 THRU 42 15. SLAB PLAN - SPANS 43 AND 44 16. SLAB PLAN - SPANS 45A THRU 47A 17. SLAB DETAILS - SPANS 33 THRU 37 AND 39 THRU 47A 18. PARAPET - SPANS 33 THRU 37 AND 39 THRU 42 19. PARAPET - SPANS 43 AND 44 20. PARAPET - SPANS 45A THRU 47A 21. SLAB AND PARAPET BILL OF MATERIALS SPANS 33 THRU 37 AND 39 THRU 47A 22. SLAB PLAN - SPAN 38 23. SLAB DETAILS - SPAN 38 24. ALUMINUM PARAPET - SPAN 38 25. ALUMINUM PARAPET - SPAN 38 26. ALUMINUM PARAPET - SPAN 38 27. FINGER PLATE EXPANSION DEVICE AT BENT 41 28. NEOPRENE EXPANSION DEVICES 29. PREFORMED JOINT SEALS 30. DRAINAGE LOCATION PLAN AND DRAIN PIPE SUPPORTS △ 31. DRAINAGE SCUPPER DETAILS (SPECIAL) 32. DRAINAGE DETAILS 33. DRAINAGE DETAILS 34. DRAINAGE DETAILS 35. LIGHTING PLAN AND DETAILS 36. FRAMING PLAN - SPANS 33 THRU 37 | <ul style="list-style-type: none"> 37. FRAMING PLAN - SPANS 39 THRU 44 38. STEEL DETAILS - SPANS 33 THRU 37 AND 39 THRU 44 39. STEEL DETAILS - SPANS 33 THRU 37 AND 39 THRU 44 40. BEARINGS AT ABUTMENT C, BENTS AND PIERS 32 THRU 38 41. BEARINGS AT BENTS 39 AND 40 AND HINGE DETAILS 42. BEARINGS AT BENTS 41 AND 42 43. BEARINGS AT PIER 43A 44. MOMENTS AND REACTIONS - SPANS 33 THRU 37 AND 39 THRU 44 45. FRAMING PLAN - SPANS 45A THRU 47A 46. CROSS FRAMES AND DIAPHRAGMS - SPANS 45A THRU 47A 47. FIELD SPLICES - SPANS 45A THRU 47A 48. BEARINGS AT PIERS 43A THRU 45A 49. BEARINGS AT PIER 43A AND ABUTMENT D 50. MOMENTS AND REACTIONS - SPANS 45A THRU 47A 51. TRUSS LAYOUT AND STRESS SHEET - SPAN 38 52. FRAMING PLAN - SPAN 38 53. EXISTING FLOORBEAM REPAIRS - SPAN 38 54. EXISTING FLOORBEAM REPAIRS - SPAN 38 55. NEW FLOORBEAM AT L4 - SPAN 38 56. PORTALS AND SWAY FRAMES - SPAN 38 57. ABUTMENT C 58. ABUTMENT C 59. ABUTMENT D 60. PIERS 36 AND 37 61. PIER 43A 62. PIER 43A 63. PIER 44A △ 64. PIER 44A AND 45A 65. PIER 45A 66. PIER 45A 67. CONCRETE PILE ALTERNATES 68. ANCHOR BOLT DETAILS 69. SLOPE PAVEMENT 70. BENT REPAIR SCHEDULE AND TYPICAL DETAILS 71. BENTS 32 THRU 35, 38 AND 42 72. BENTS 39 AND 41 73. BENT 40 74. LONGITUDINAL BRACING, SPAN 43 75. LONGITUDINAL BRACING, SPAN 43 |
|--|--|

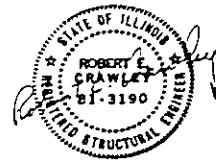

[Handwritten Signature]

APPROVED
FOR STRUCTURAL ADEQUACY ONLY
[Handwritten Signature]

REHABILITATION FOR
APPROACH BRIDGE OVER
I-55/70 W.B., MISSOURI AVE. AND TRR.

INDEX OF DRAWINGS

STRUCTURE NO. 082-6003
STA. 65+00 (FAP 799) ST. CLAIR CO.

PREPARED BY:
SVERDRUP CORPORATION
ST. LOUIS, MISSOURI

REV. 12-4-87

SECTION IBR-1

SHEET NO. 1 OF 75

FOR INFORMATION ONLY






24-UC-1-1987 10-01

FILE: ZF3JUSJDETAIL 47.DGN
 875b.7 PRF:DETAIL47
 LEVELS PLOTTED 35 56 63
 DATE: OCT. 23, 1987

DESIGNED	
CHECKED	
K. SCHULT	
DRAIN	
D.J. SCHREMP	
CHECKED	

ROUTE NO.	SECTION	COUNTY	TOTAL SHEETS	SHEET NO.
FAP 799		ST. CLAIR	252	150

*IBR-1 APPROACH BRIDGE

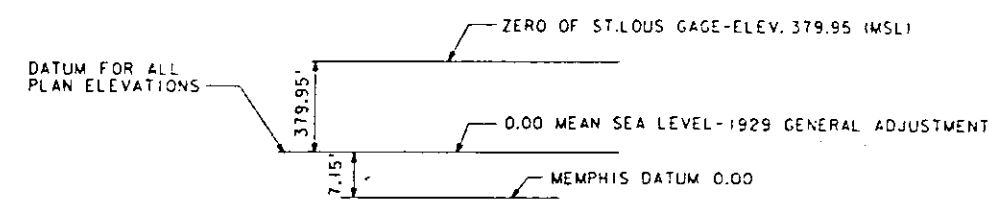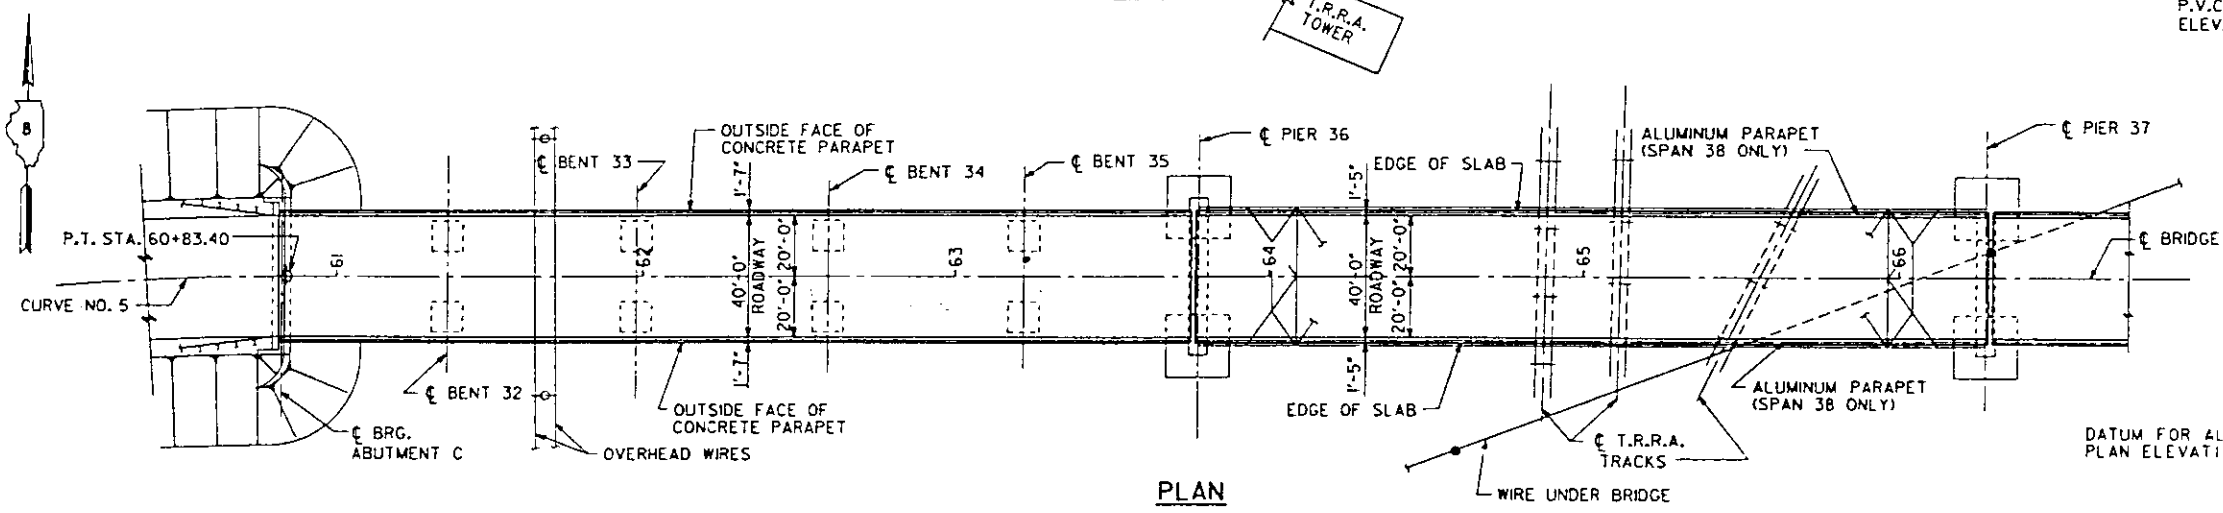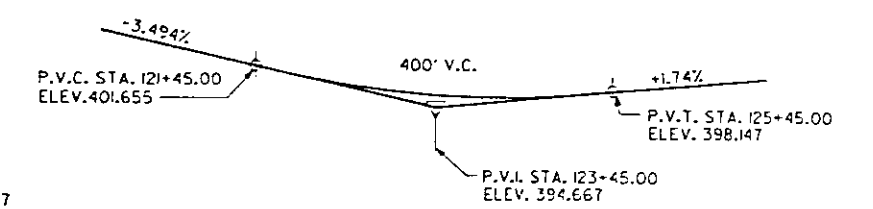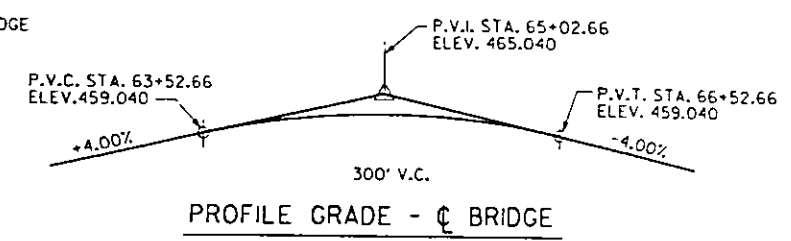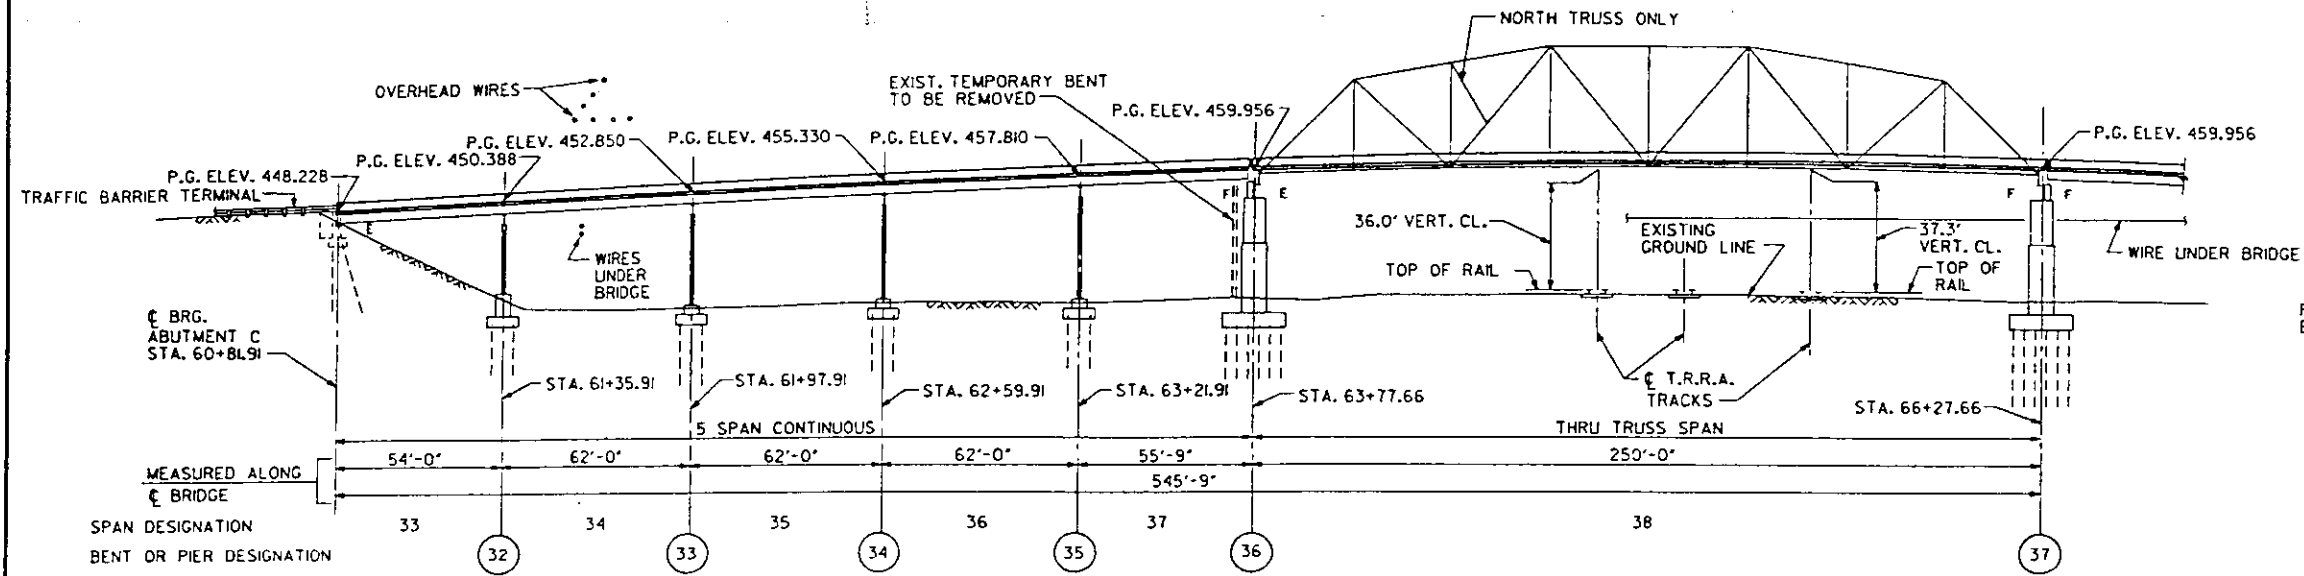

ELEVATION REFERENCES
NOTE: ALL ELEVATIONS REFER TO U.S.C.&G. SURVEY-1929 GENERAL ADJUSTMENT. REFERENCE IS GIVEN TO MEMPHIS DATUM DUE TO ELEVATIONS ON ORIGINAL BRIDGE PLANS BEING REFERENCED TO THIS DATUM.

CURVE DATA

CURVE NO. 5	P.I. 5A	CURVE NO. 6	CURVE NO. 7
P.I. STA. = 59+63.75	P.I. STA. = 66+27.70	P.I. STA. = 74+93.65	P.I. STA. = 123+28.11
$\Delta = 14^\circ-54'-58''$	$\Delta = 0^\circ-01'-34''$ LT.	$\Delta = 37^\circ-51'-18''$	$\Delta = 35^\circ-40'-47''$
D = 6'-10'-00"	NO CURVE	D = 5'-23'-00"	D = 2'-36'-16"
R = 929.12'		R = 1064.32'	R = 2200.00'
T = 121.63'		T = 364.97'	T = 708.03'
L = 241.88'		L = 703.19'	L = 1370.00'
E = 7.93'		E = 60.84'	E = 111.13'
P.C. STA. = 58+41.52		P.C. STA. = 71+28.68	P.C. STA. = 116+20.08
P.T. STA. = 60+83.40		P.T. STA. = 78+31.87	P.T. STA. = 129+90.08
S.E. = SEE SHEET 8		S.E. = SEE SHEET 12	S.E. = 0.0727 1/4

BENCH MARKS

- B.M. 12 - CHISELED SQUARE ON SOUTH END OF WINGWALL OF ABUTMENT C
26' RT. STA. 60+77
ELEVATION = 448.52
- B.M. R 146 - C & GS BENCH MARK DISC ON TOP OF THE SOUTH CORNER OF CONCRETE BASE OF THE S.W. LEG BENT 42
16' RT. STA. 69+65
ELEVATION = 419.21
- B.M. 13 - CHISELED SQUARE ON NORTH END OF WINGWALL OF ABUTMENT D
26' LT. STA. 73+28
ELEVATION = 432.45

NOTES
ALL STEEL BENTS HAVE FIXED ROCKERS TOP AND BOTTOM.

REHABILITATION FOR
APPROACH BRIDGE OVER
I-55/70 W.B., MISSOURI AVE. AND TRRA

GENERAL PLAN AND ELEVATION
SPANS 33 THRU 38

STRUCTURE NO. 082-6003
STA. 65+00 (FAP 799) ST. CLAIR CO.

LEVELS PLOTTED DATE: OCT. 23, 1987
 FILE: ZF3151JMLKGPES.DGN
 PRF: MLKGPES

DESIGNED	
CHECKED	S. KAEMMERER
DRAWN	D. SCHREMP
CHECKED	

PREPARED BY:
SYVERDRUP CORPORATION
ST. LOUIS, MISSOURI


SECTION IBR-1

SHEET NO. 2 OF 75


FOR INFORMATION ONLY

ROUTE NO.	SECTION	COUNTY	TOTAL SHEETS	SHEET NO.
I-55/70	•	ST. CLAIR	252	151
ELEMENT		PROJECT		

*IBR-1 APPROACH BRIDGE

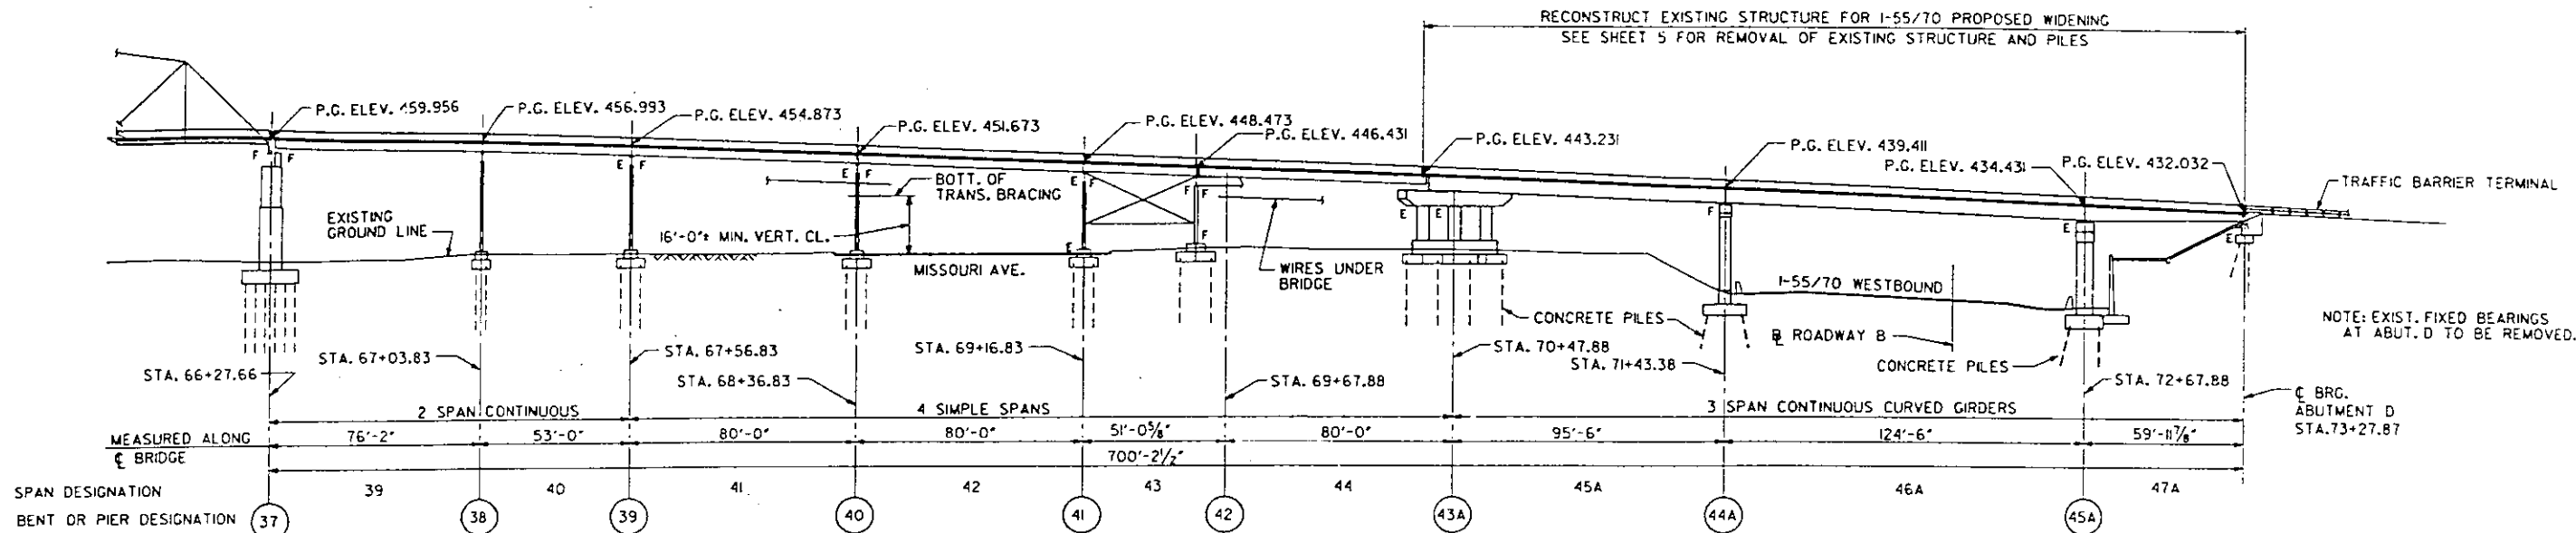

DEVELOPED ELEVATION

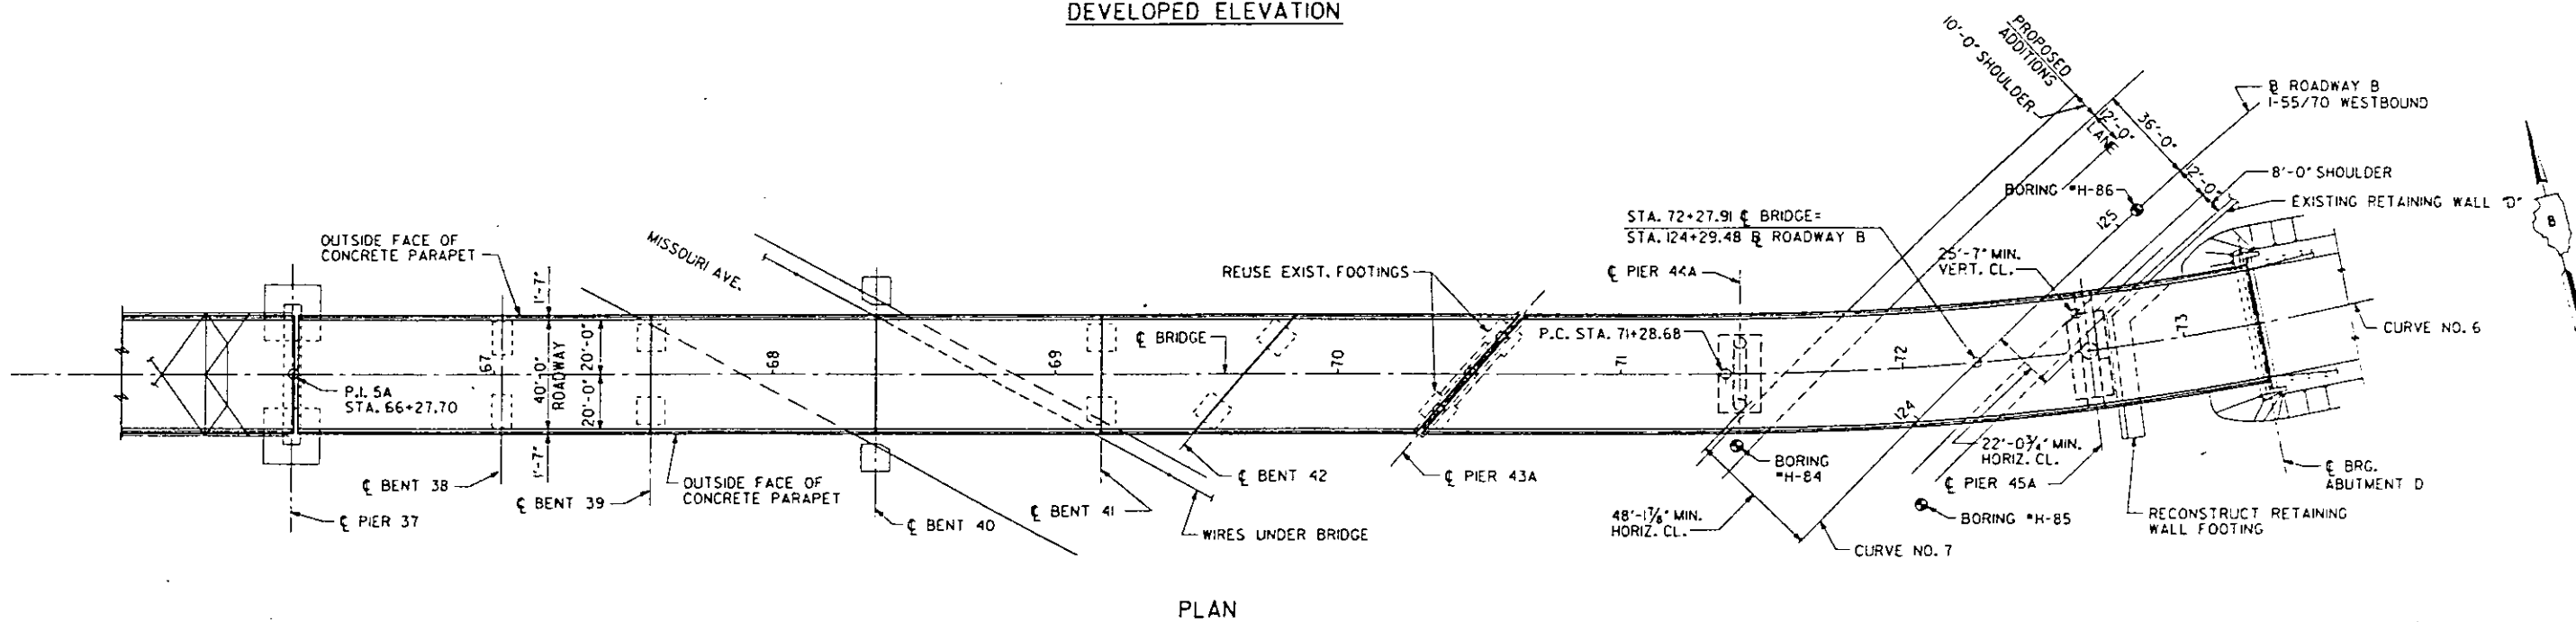

PLAN

NOTES

ALL STEEL BENTS HAVE FIXED ROCKERS TOP AND BOTTOM EXCEPT AS NOTED.

REHABILITATION FOR
APPROACH BRIDGE OVER
I-55/70 W.B., MISSOURI AVE. AND TRRA

GENERAL PLAN AND ELEVATION
SPANS 39 THRU 47A

STRUCTURE NO. 082-6003
STA. 65+00 (FAP 799) ST. CLAIR CO.

DESIGNED	
CHECKED	KAEEMMER
CHECKED	J. SCHREMP
CHECKED	

PREPARED BY:
SYVERDRUP CORPORATION
ST. LOUIS, MISSOURI

SECTION IBR-1

SHEET NO. 3 OF 75

FOR INFORMATION ONLY

2:20, 24, 26, 27, 28, 35, 38, 39, 42, 43, 50, 56 & 63

TOTAL BILL OF MATERIAL Δ

ITEM	UNIT	SUB-STR.	SUPER-STR.	TOTAL
CONCRETE REMOVAL	CU. YD.	41	—	41
REMOVAL OF EXISTING BRIDGE DECK	SO. YD.	—	5,780	5,780
REMOVE AND REINSTALL STRINGERS (SPAN 44)	LS	—	1	1
REMOVAL OF EXISTING STRUCTURES (SPANS 46 THRU 50)	LS	—	1	1
REMOVE TEMPORARY STEEL BENT	LS	1	—	1
FURNISHING AND ERECTING STRUCTURAL STEEL	LS	—	0.3	0.3
STRUCTURAL STEEL REPAIR	LBS.	16,100	18,400	34,500 Δ
STRUCTURAL STEEL REMOVAL (SPANS 33 TO 44)	LS	—	0.2	0.2
REPLACE RIVETS WITH HS BOLTS	EACH	—	280	280
STUD SHEAR CONNECTORS	EACH	—	3,867	3,867
JACK AND REPOSITION ROLLER BEARINGS	EACH	—	5	5
Δ ELASTOMERIC BEARING ASSEMBLY TYPE I	EACH	—	46	46
Δ ELASTOMERIC BEARING ASSEMBLY TYPE II	EACH	—	6	6
CLASS X CONCRETE SUPERSTRUCTURE	CU. YD.	—	1,523	1,523
CLASS X CONCRETE	CU. YD.	435	—	435
REINFORCEMENT BARS	LBS.	33,283	—	33,283
REINFORCEMENT BARS, EPOXY COATED	LBS.	—	388.5#	388.5#
STRUCTURE EXCAVATION	CU. YD.	825	—	825
FURNISHING CONCRETE PILES	LIN. FT.	2,543	—	2,543
DRIVING CONCRETE PILES	LIN. FT.	2,543	—	2,543
TEST PILE - CONCRETE	EACH	3	—	3
PREFORMED JOINT SEAL (2 1/2")	LIN. FT.	—	129	129
PREFORMED JOINT SEAL (1 1/4")	LIN. FT.	—	98	98
NEOPRENE EXPANSION JOINT (4")	LIN. FT.	—	84	84
NEOPRENE EXPANSION JOINT (2 1/2")	LIN. FT.	—	96	96
SLOPEWALL 4 INCH	SO. YD.	950	—	950
SLOPEWALL REMOVAL	SO. YD.	805	—	805
EXPANSION BOLTS 3/4" ϕ	EACH	40	—	40
PROTECTIVE COAT **	SO. YD.	—	6,420	6,420
REINFORCED NEOPRENE EXPANSION JOINT TREATMENT	LIN. FT.	—	43	43
SPECIAL DRAINAGE SCUPPERS (20" x 27")	EACH	—	35	35
DRAINAGE SYSTEM	LS	—	0.2	0.2
ALUMINUM PARAPET	LIN. FT.	—	502	502
CLEANING AND PAINTING STEEL BRIDGE	LS	—	0.2	0.2
NAME PLATES	EACH	1	—	1
EPOXY MORTAR REPAIR	CU. FT.	8	—	8
BRIDGE SEAT SEALER	LS	0.4	—	0.4
HANDRAIL REMOVAL	LIN. FT.	—	2,495	2,495
TEMPORARY SHEET PILING	SO. FT.	1340	—	1340
DEWATERING	LS	1	—	1
REPAIR CONCRETE STRUCTURES	SO. FT.	16	—	16

** PROTECTIVE COAT QUANTITY INCLUDES DECK SURFACE. SEE SPECIAL PROVISIONS FOR CURING AND TEXTURE. Δ

STATION 65+00
REHABILITATED 198 BY
STATE OF ILLINOIS
FAP 799 SEC. 1BR-1
F.A. PROJECT BHF-799(9)
LOADING HS20
STR. NO. 082-6003

NAME PLATE

SEE ILL. STD. 2113
NOTE: LOCATE NAME PLATE ON NORTH PARAPET AT ABUTMENT D.

DESIGNED	_____
CHECKED	_____
D. RIEHL	_____
B. BARN	_____
D. SCHREMP	_____
CHECKED	_____

STATE OF ILLINOIS
DEPARTMENT OF TRANSPORTATION

GENERAL NOTES Δ

CONSTRUCTION SPECIFICATIONS: THE 1983 EDITION OF THE STATE OF ILLINOIS DEPARTMENT OF TRANSPORTATION'S "STANDARD SPECIFICATIONS FOR ROAD AND BRIDGE CONSTRUCTION", ADDENDUMS AND THE SPECIAL PROVISIONS SHALL GOVERN.

ALL STRUCTURAL STEEL CONNECTIONS SHALL BE MADE WITH HIGH STRENGTH BOLTS EXCEPT AS NOTED.

HIGH STRENGTH BOLT CONNECTIONS SHALL CONFORM TO THE REQUIREMENTS OF THE LATEST ISSUE OF THE SPECIFICATIONS FOR STRUCTURAL JOINTS USING ASTM A325 (AASHTO M-164) BOLTS FOR SLIP-CRITICAL CONNECTION, EXCEPT TIGHTENING METHODS USING EITHER THE LOAD INDICATING WASHERS OR THE CALIBRATED WRENCH ARE NOT ALLOWED.

SIZE OF BOLTS ARE SHOWN ON PLANS. HOLES SHALL BE 1/16" LARGER THAN BOLT SIZE EXCEPT AS NOTED OTHERWISE. THE SYMBOL \star SHALL INDICATE EITHER SHOP OR FIELD CONNECTIONS.

ALL NEW STRUCTURAL STEEL SHALL BE AASHTO M-183, EXCEPT OTHERWISE NOTED.

Δ CALCULATED WEIGHT OF STRUCTURAL STEEL =
797,700 LBS. - AASHTO M-183
60,900 LBS. - AASHTO M-223 (GRADE 50)

CALCULATED WEIGHT OF STRUCTURAL STEEL REPAIR =
29,300 LBS. - AASHTO M-183
5,200 LBS. - AASHTO M-223 (GRADE 50)

ESTIMATED WEIGHT OF STRUCTURAL STEEL REMOVAL =
240 TONS (SPANS 33 TO 44)

THE ROADWAY EXPANSION PLATES SHALL BE FLAME CUT AS PROVIDED IN ARTICLE 507.04 (I) OF THE STANDARD SPECIFICATIONS.

ALL NEW STRUCTURAL STEEL SHALL BE PAINTED WITH ZINC-SILICATE AND VINYL PAINT SYSTEM EXCEPT AS OTHERWISE NOTED.

Δ FOR PAINTING OF EXISTING STRUCTURAL STEEL, SEE SPECIAL PROVISIONS.

FIELD WELDING TO EXISTING STEEL SHALL NOT BE PERMITTED EXCEPT AS APPROVED BY THE ENGINEER.

FIELD WELDING OF CONSTRUCTION ACCESSORIES TO NEW STEEL WILL NOT BE PERMITTED TO THE BOTTOM FLANGE OF BEAMS OR GIRDERS NOR TO THE TOP FLANGE FOR A DISTANCE EQUAL TO ONE-FOURTH THE SPAN LENGTH EACH WAY FROM THE SUPPORTS. FIELD WELDING IN OTHER AREAS WILL BE PERMITTED ONLY WHEN APPROVED BY THE ENGINEER.

ANCHOR BOLTS SHALL BE SET BEFORE BOLTING DIAPHRAGMS OVER SUPPORTS.

THE MAIN LOAD CARRYING MEMBER COMPONENTS SUBJECT TO TENSILE STRESS SHALL CONFORM TO THE SUPPLEMENTAL REQUIREMENTS FOR NOTCH TOUGHNESS ZONE 2. THESE COMPONENTS ARE THE TENSION FLANGES, WEBS AND ALL SPLICE PLATE MATERIAL OF THE STEEL GIRDERS OR WIDE FLANGE STRINGERS.

REINFORCEMENT BARS SHALL CONFORM TO THE REQUIREMENTS OF AASHTO M31, M-42 OR M53, GRADE 60. UNLESS OTHERWISE DETAILED, ALL HOOKS SHOWN ARE AASHTO STANDARD HOOKS. ALL REINFORCING STEEL SHALL BE DETAILED IN ACCORDANCE WITH THE STANDARD PRACTICE OF THE CRSI.

PLAN DIMENSIONS AND DETAILS RELATIVE TO EXISTING STRUCTURE HAVE BEEN TAKEN FROM EXISTING PLANS AND SURVEY DATA AND ARE SUBJECT TO NOMINAL CONSTRUCTION VARIATIONS. IT SHALL BE THE CONTRACTOR'S RESPONSIBILITY TO VERIFY SUCH DIMENSIONS AND DETAILS IN THE FIELD AND MAKE NECESSARY APPROVED ADJUSTMENTS PRIOR TO CONSTRUCTION OR ORDERING OF MATERIALS. SUCH VARIATIONS SHALL NOT BE CAUSE FOR ADDITIONAL COMPENSATION FOR A CHANGE IN THE SCOPE OF WORK, HOWEVER, THE CONTRACTOR WILL BE PAID FOR THE QUANTITY ACTUALLY FURNISHED AT THE UNIT PRICE BID FOR THE WORK.

CONCRETE BEARING SEAT SURFACES SHALL BE CONSTRUCTED OR ADJUSTED TO THE DESIGNATED ELEVATIONS WITHIN A TOLERANCE OF 1/8". ADJUSTMENT SHALL BE MADE EITHER BY GRINDING THE SURFACE OR BY SHIMMING THE BEARING. TWO 1/8" ADJUSTMENT SHIMS, OF THE DIMENSIONS OF THE BOTTOM BEARING PLATE, SHALL BE PROVIDED FOR EACH BEARING IN ADDITION TO ALL OTHER PLATES OR SHIMS.

IF SECTION MONUMENTS AND/OR PERMANENT BENCHMARKS ARE ENCOUNTERED WITHIN THE PAVEMENT OR PARAPET AREAS BEING REHABILITATED, THE CONTRACTOR SHALL ADJUST SAME AS DIRECTED BY THE ENGINEER. PAYMENT TO BE MADE IN ACCORDANCE WITH ARTICLE 109.04 OF THE "STANDARD SPECIFICATIONS".

DIMENSIONS ARE MEASURED AT A TEMPERATURE OF 50°F.

ALL TRANSVERSE AND LONGITUDINAL DIMENSIONS ARE MEASURED HORIZONTALLY.

EXPANSION BOLTS SHALL CONSIST OF APPROVED EXPANSION ANCHORS, PROVIDING MINIMUM CERTIFIED PROOF LOAD = 4,080 LBS., AND 3/4" DIA. x 12" HOOKED BOLTS.

ROADWAY EXPANSION GUARDS SHALL BE ASSEMBLED IN SHOP IN THE PROPER POSITION WITH ENDS IN PLACE AND SHALL BE LEFT ASSEMBLED FOR SHOP INSPECTION.

AFTER STEEL HAS BEEN CLEANED, UNSUITABLE RIVETS SHALL BE REMOVED AND REPLACED WITH H.S. BOLTS AS DIRECTED BY THE ENGINEER, AND SHALL BE PAID FOR AS "REPLACE RIVETS WITH H.S. BOLTS."

ALL EXISTING TOP SURFACES AND RECONCRETE TOP SURFACES OF EXISTING PIERS AND ABUTMENT SEATS SHALL RECEIVE BRIDGE SEAT SEALER TREATMENT (ESTIMATED QUANTITY = 1320 SO. FT.)

BURNING OF EXISTING RIVET HEADS TO REMOVE RIVETS IS NOT PERMITTED, EXCEPT AS SPECIFIED IN SPECIAL PROVISIONS.

WELDED STUD CONNECTORS SHALL CONFORM TO THE REQUIREMENTS OF STANDARD SPECIFICATIONS ARTICLE 710.38.

FOR THE "CLEANING AND PAINTING STEEL BRIDGE" ITEM THE ESTIMATED QUANTITY OF REMAINING STEEL = 800 TONS.

ALL STRUCTURAL STEEL FABRICATORS PERFORMING WORK ON THE MAIN LOAD CARRYING COMPONENTS OF STEEL STRUCTURES SHALL BE CERTIFIED UNDER THE APPROPRIATE CATEGORY OF THE AMERICAN INSTITUTE OF STEEL CONSTRUCTION (AISC) QUALITY CERTIFICATION PROGRAM AS FOLLOWS:

(A) FABRICATORS OF WELDED PLATE GIRDERS, BOX GIRDERS, TRUSSES AND ARCHES SHALL BE CERTIFIED UNDER CATEGORY III (AISC).

(B) FABRICATORS OF ROLLED BEAM STRUCTURES, EITHER SIMPLE SPAN OR CONTINUOUS, AND OVERHEAD SIGN STRUCTURES SHALL BE CERTIFIED UNDER CATEGORY I (AISC).

THE INFORMATION SHOWN FOR TEMPORARY SHEET PILING IS ESTIMATED. IT IS THE CONTRACTOR'S RESPONSIBILITY TO PROVIDE A DESIGN OF TEMPORARY SHEET PILING AND ASSOCIATED MEMBERS, IF REQUIRED, SUBJECT TO APPROVAL OF THE ENGINEER.

Δ FOR BORING DATA, SEE PROPOSAL.

ROUTE NO.	SECTION	COUNTY	TOTAL SHEETS	SHEET NO.
FAP 799	*	ST. CLAIR	252	152

*1BR-1 APPROACH BRIDGE

SCOPE OF WORK

- REMOVE AND RECONSTRUCT EXISTING SUPERSTRUCTURE AND SUBSTRUCTURE SPANS 46 THRU 50 TO PROVIDE FOR PROPOSED FUTURE WIDENING OF WESTBOUND I-55/70. CONSTRUCT NEW PIERS 43A, 44A AND 45A.
- REMOVE EXISTING DECK, EXPANSION DEVICES, CURBS AND RAILING IN ALL SPANS. REPLACE DECK USING 7 1/2" CONCRETE SLAB.
- REMOVE AND REPLACE ENTIRE DRAINAGE SYSTEM.
- PROVIDE NEW ROADWAY LIGHTING.
- REPLACE ALL EXTERIOR STRINGERS AND THEIR BEARINGS.
- REPLACE AND MODIFY FLOORBEAMS AND LOWER LATERAL GUSSET PLATES IN SPAN 38 AS INDICATED.
- REMOVE AND REPLACE DIAPHRAGMS AS INDICATED.
- REPAIR TRUSS MEMBERS AS INDICATED.
- MODIFY TRUSS PORTALS AND SWAY FRAMES TO PROVIDE 17.0 FT. VERTICAL CLEARANCE.
- REMOVE AND REPLACE ENTIRE BENT 40. REPLACE AND MODIFY STEEL BENT CAP BEAMS, COLUMNS AND BRACING AS INDICATED.
- CLEAN, ADJUST AND REPLACE EXISTING ROLLER BEARINGS AT ABUTMENT C.
- CLEAN AND PAINT ALL STRUCTURAL STEEL.
- BRIDGE WILL BE CLOSED TO TRAFFIC DURING BRIDGE REHABILITATION.
- THE CONTRACTOR'S METHOD AND SEQUENCE OF DECK REMOVAL AND REPLACEMENT, AND OTHER STRUCTURE REPLACEMENTS AND REPAIRS SHALL MAINTAIN STABILITY AND SAFETY OF THE STRUCTURE.

DESIGN STRESSES - EXISTING STRUCTURE

DESIGN TRAFFIC LANES: FOUR - 10' LANES, NO SHOULDERS
18' VERTICAL CLEARANCE (CENTER LANES)
14' MINIMUM VERTICAL CLEARANCE (CURB LANES) AASHTO 1944

DESIGN SPECIFICATIONS: AASHTO 1944
LOADING: HS20-44
NO FUTURE WEARING SURFACE

REINFORCED CONCRETE:
DECK SLAB $f_c = 1,000$ PSI, N=10
SUBSTRUCTURE $f_c = 1,000$ PSI, N=10
 $f_s = 60$ PSI - FOOTINGS

STRUCTURAL STEEL:
CARBON (A7) $f_s = 18,000$ PSI

DESIGN STRESSES - REHABILITATION

DESIGN TRAFFIC LANES: FOUR - 10' LANES, NO SHOULDERS
17' MINIMUM VERTICAL CLEARANCE

DESIGN SPECIFICATIONS: AASHTO - 1983 AND MANUAL FOR MAINTENANCE INSPECTION FOR BRIDGES - 1983, BOTH WITH 1984, 1985 AND 1986 INTERIMS
LOADING: HS20-44
25 PSF FUTURE WEARING SURFACE - SPANS 45A, 46A AND 47A ONLY.

REINFORCED CONCRETE:
DECK SLAB $f_c = 3,500$ PSI, N=9
SUBSTRUCTURE $f_c = 1,400$ PSI, N=9
REINFORCING STEEL $f_y = 60,000$ PSI
 $f_s = 24,000$ PSI

STRUCTURAL STEEL:
 $f_s = 20,000$ PSI } AASHTO M-183
 $f_y = 36,000$ PSI }
 $f_s = 27,000$ PSI } AASHTO M-223, GRADE 50
 $f_y = 50,000$ PSI }

REHABILITATION FOR
APPROACH BRIDGE OVER
I-55/70 W.B., MISSOURI AVE. AND TRRA

GENERAL NOTES AND
ESTIMATED QUANTITIES

STRUCTURE NO. 082-6003
STA. 65+00 (FAP 799) ST. CLAIR CO.

PREPARED BY:
SVERDRUP CORPORATION
ST. LOUIS, MISSOURI

12-18-87

REV. 12-4-87

SECTION 1BR-1


SHEET NO. 4 OF 75

FOR INFORMATION ONLY




DATE: OCT. 23, 1987
LEVELS PLOTTED
56.63
FILED AT MISSOURI TAIL 77.DGN
17581
17581

*IBR-1 APPROACH BRIDGE

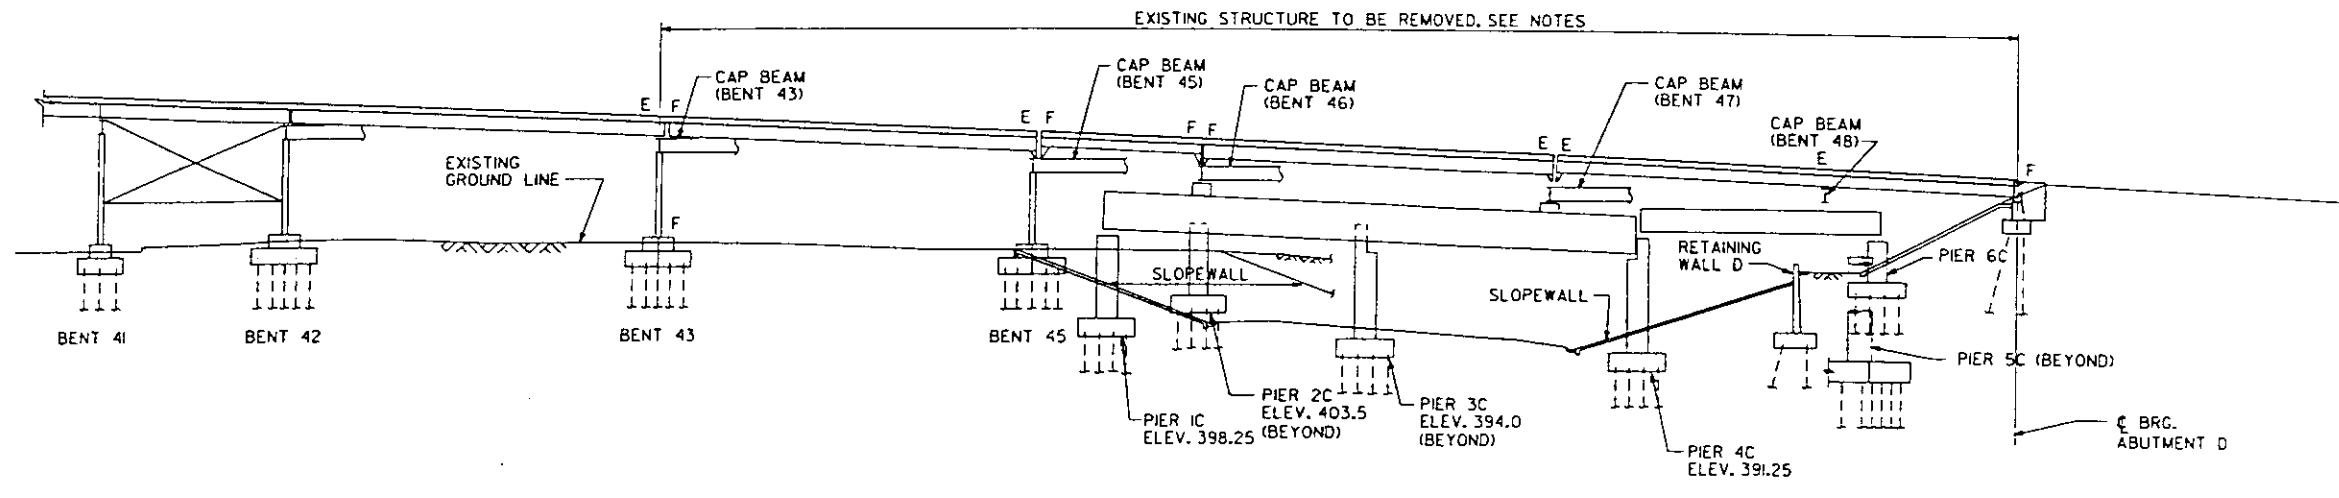

ELEVATION

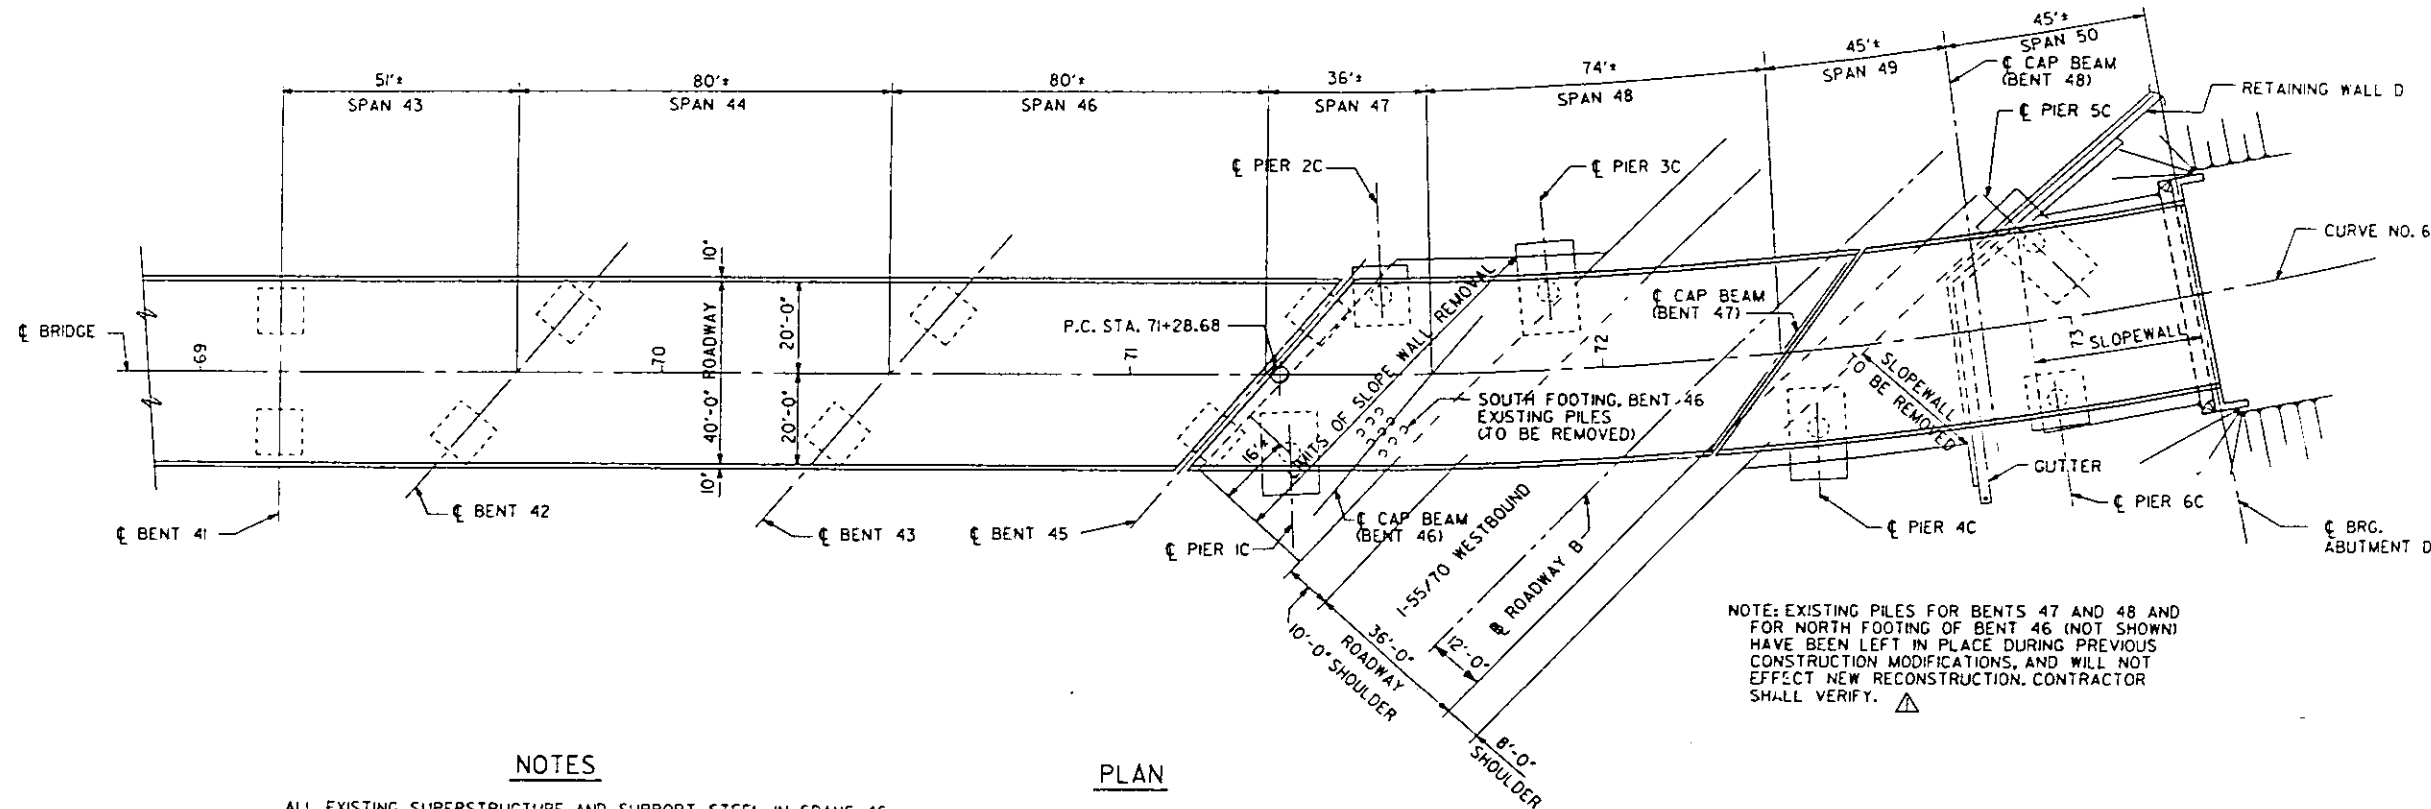

PLAN

NOTE: EXISTING PILES FOR BENTS 47 AND 48 AND FOR NORTH FOOTING OF BENT 46 (NOT SHOWN) HAVE BEEN LEFT IN PLACE DURING PREVIOUS CONSTRUCTION MODIFICATIONS, AND WILL NOT EFFECT NEW RECONSTRUCTION. CONTRACTOR SHALL VERIFY. ⚠

NOTES

- ALL EXISTING SUPERSTRUCTURE AND SUPPORT STEEL IN SPANS 46 THRU 50 IS TO BE REMOVED.
- BENT 43 IS TO BE REMOVED TO TOP OF FOOTINGS.
- BENT 45, PIERS 1C AND 2C ARE TO BE REMOVED INCLUDING PILES. EXISTING PILES ADJACENT TO PIER 1C SHALL BE REMOVED.
- (SOUTH FOOTING, BENT 46).
- COLUMNS OF PIERS 3C AND 4C ARE TO BE REMOVED TO TOP OF FOOTING.
- SLOPEWALL IN FRONT OF RETAINING WALL AND AS NOTED ADJACENT TO PIER 1C SHALL BE REMOVED.
- PORTIONS OF RETAINING WALL FOOTING SHALL BE REMOVED, SEE DETAILS.

DESIGNED	
CHECKED	
D. GRIFFIN	
DRAWN	
R.F. BECK	
CHECKED	

REHABILITATION FOR
APPROACH BRIDGE OVER
I-55/70 W.B., MISSOURI AVE. AND TRF
DEMOLITION
EXISTING SPANS 46 THRU 50
STRUCTURE NO. 082-6003
STA. 65+00 (FAP 799) ST. CLAIR CO.


PREPARED BY:
SYVERUP CORPORATION
ST. LOUIS, MISSOURI

REV. 12-4-87

SECTION IBR-1

SHEET NO. 5 OF 75

FOR INFORMATION ONLY

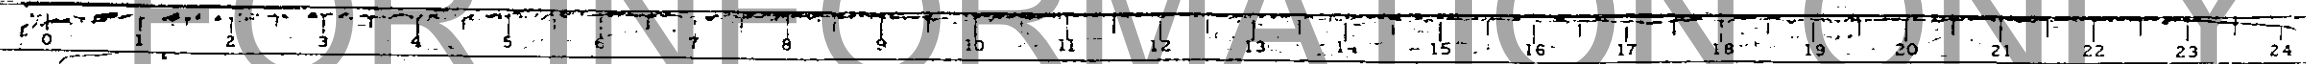


4-DEC-1987 10:41

FILE: ZF31151JDETAIL42.DGN
PRF:DETAIL42
LEVELS PLOTTED DATE: OCT. 23, 1987
2 24 26 27 28 35 39 56 63

ROUTE NO.	SECTION	COUNTY	TOTAL SHEETS	SHEET NO.
FAP 799	4	ST. CLAIR	252	154
ELEMENTS		PROJECT		

* I BR-1 APPROACH BRIDGE

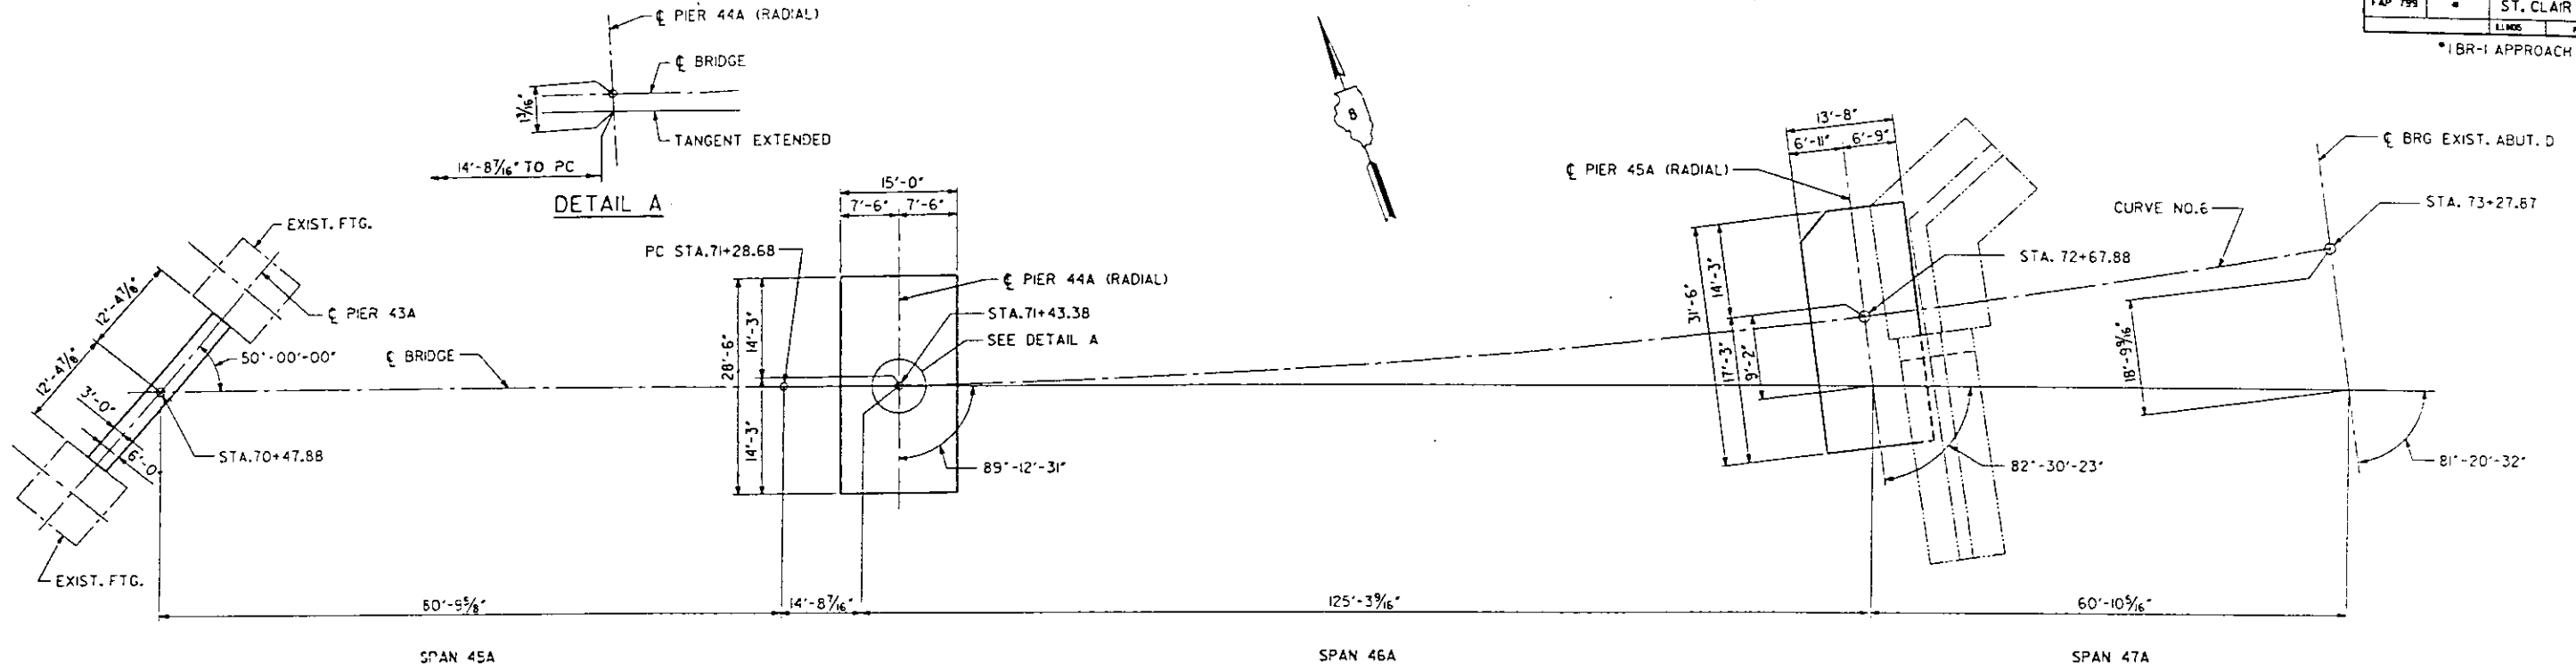

PLAN

7F316101DETAIL93.DGN
 158 882
 LEVELS PLOTTED
 DATE: OCT. 23, 1987
 35 56 63
 DETAIL 93

DESIGNED	D.J. SCHREMP
CHECKED	R.D. NIEMIETZ
DRAWN	M.J. JALINSKY
CHECKED	R.F. BECK


PREPARED BY:
SVERDRUP CORPORATION
ST. LOUIS, MISSOURI

REHABILITATION FOR
APPROACH BRIDGE OVER
I-55/70 W.B., MISSOURI AVE. AND TRRA
SUBSTRUCTURE LAYOUT
SPANS 45A THRU 47A
STRUCTURE NO. 082-6003
STA. 65+00 (FAP 799) ST. CLAIR CO.

SECTION I BR-1


SHEET NO. 6 OF 75

FOR INFORMATION ONLY

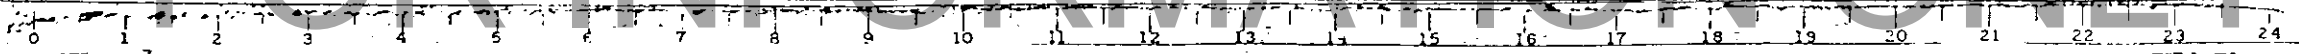


*1BR-1 APPROACH BRIDGE.

LINE	LOCATION	STATION	OFFSET	THEORETICAL GRADE ELEVATION	THEORETICAL GRADE ELEVATION ADJUSTED FOR DEAD LOAD DEFLECTION
24	S1	63+21.910	-20.000	457.560	457.560
24	S2	63+21.910	-13.333	457.699	457.699
24	S3	63+21.910	-6.667	457.782	457.782
24	S4	63+21.910	0.000	457.810	457.810
24	S5	63+21.910	6.667	457.782	457.782
24	S6	63+21.910	13.333	457.699	457.699
24	S7	63+21.910	20.000	457.560	457.560
25	S1	63+31.910	-20.000	457.960	457.967
25	S2	63+31.910	-13.333	458.099	458.107
25	S3	63+31.910	-6.667	458.182	458.190
25	S4	63+31.910	0.000	458.210	458.218
25	S5	63+31.910	6.667	458.182	458.190
25	S6	63+31.910	13.333	458.099	458.107
25	S7	63+31.910	20.000	457.960	457.967
26	S1	63+41.910	-20.000	458.360	458.377
26	S2	63+41.910	-13.333	458.499	458.519
26	S3	63+41.910	-6.667	458.582	458.602
26	S4	63+41.910	0.000	458.610	458.630
26	S5	63+41.910	6.667	458.582	458.602
26	S6	63+41.910	13.333	458.499	458.519
26	S7	63+41.910	20.000	458.360	458.377
27	S1	63+51.910	-20.000	458.760	458.782
27	S2	63+51.910	-13.333	458.899	458.925
27	S3	63+51.910	-6.667	458.982	459.008
27	S4	63+51.910	0.000	459.010	459.036
27	S5	63+51.910	6.667	458.982	459.008
27	S6	63+51.910	13.333	458.899	458.925
27	S7	63+51.910	20.000	458.760	458.782
28	S1	63+61.910	-20.000	459.149	459.167
28	S2	63+61.910	-13.333	459.288	459.309
28	S3	63+61.910	-6.667	459.371	459.392
28	S4	63+61.910	0.000	459.399	459.420
28	S5	63+61.910	6.667	459.371	459.392
28	S6	63+61.910	13.333	459.288	459.309
28	S7	63+61.910	20.000	459.149	459.167
29	S1	63+75.910	-20.000	459.648	459.648
29	S2	63+75.910	-13.333	459.787	459.787
29	S3	63+75.910	-6.667	459.870	459.870
29	S4	63+75.910	0.000	459.898	459.898
29	S5	63+75.910	6.667	459.870	459.870
29	S6	63+75.910	13.333	459.787	459.787
29	S7	63+75.910	20.000	459.648	459.648

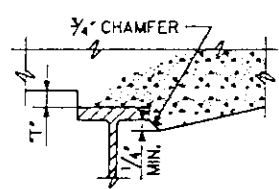


FILLET HEIGHTS


TO DETERMINE 'T': AFTER ALL STRUCTURAL STEEL HAS BEEN ERECTED, ELEVATIONS OF THE TOP FLANGES OF THE STRINGERS SHALL BE TAKEN AT INTERVALS SHOWN ON THE PLAN. THESE ELEVATIONS SUBTRACTED FROM THE 'THEORETICAL GRADE ELEVATION ADJUSTED FOR THE DEAD LOAD DEFLECTION' MINUS SLAB THICKNESS, EQUALS THE FILLET HEIGHTS 'T' ABOVE TOP FLANGES OF STRINGERS.

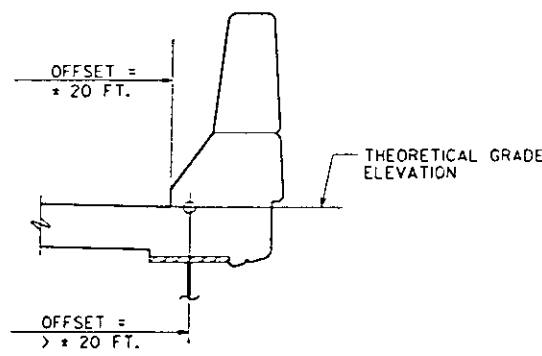

THEORETICAL GRADE ELEVATIONS FOR OFFSETS GREATER THAN +/- 20 FT.

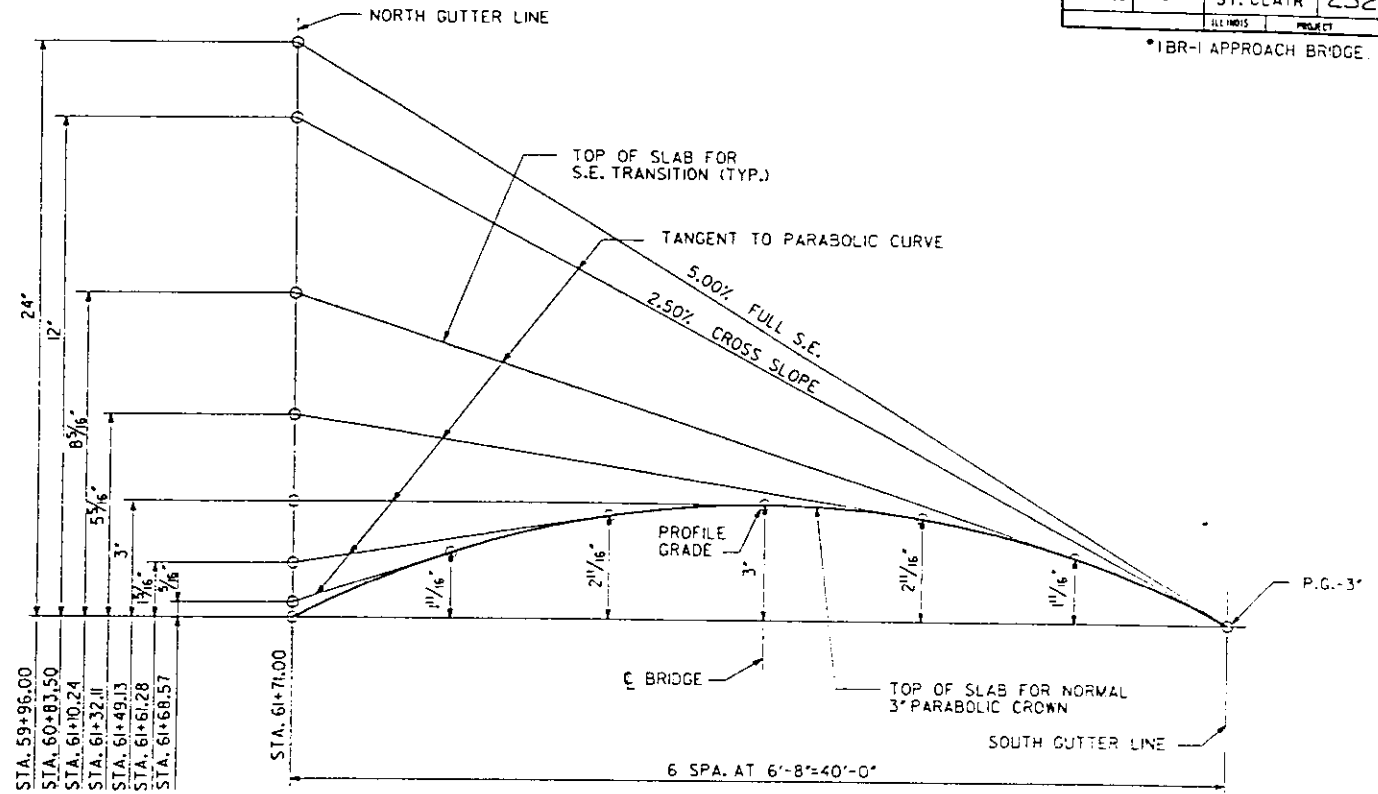

SUPERELEVATION TRANSITION CURVE NO. 5

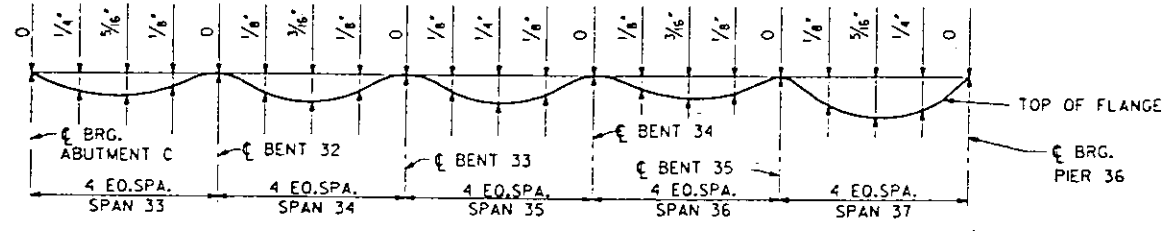

DEAD LOAD DEFLECTION DIAGRAM
(INCLUDES WEIGHT OF CONCRETE ONLY)

NOTE: THE ABOVE DEFLECTIONS ARE NOT TO BE USED IN THE FIELD IF THE ENGINEER IS WORKING FROM THE 'THEORETICAL GRADE ELEVATION ADJUSTED FOR DEAD LOAD DEFLECTION'.

REHABILITATION FOR
APPROACH BRIDGE OVER
I-55/70 W.B., MISSOURI AVE. AND TRR,

TOP OF SLAB ELEVATIONS
SPANS 33 THRU 37

STRUCTURE NO. 062-6003
STA. 65+00 (FAP 799) ST. CLAIR CO.


DESIGNED	D. SCHREMP
CHECKED	M. SCHURK
DRAWN	J.G. CORLEY
CHECKED	M. SCHURK

PREPARED BY:
SVERDRUP CORPORATION
ST. LOUIS, MISSOURI

SECTION BR-1


SHEET NO. 8 OF 75

FILE: ZP315117ISEMLK12A.DGN
 DATE: OCT. 23, 1987
 LEVELS PLOTTED
 35 56 58 & 63
 REF: TSEM.LK12A

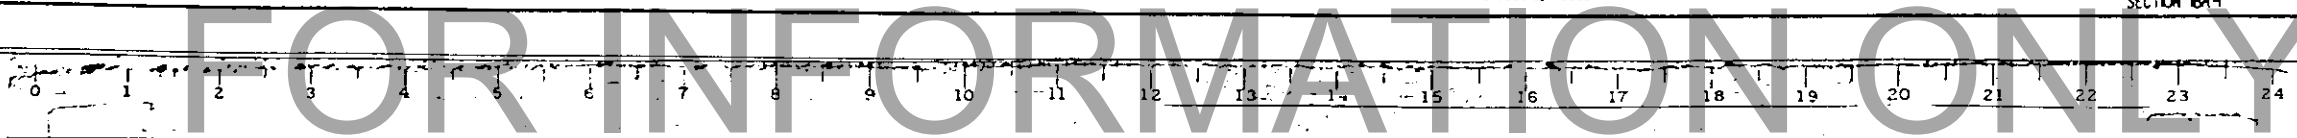

STATE OF ILLINOIS
DEPARTMENT OF TRANSPORTATION

ROUTE NO.	SECTION	COUNTY	FILE NO.	SHEET NO.
FAP 799	*	ST. CLAIR	252	157
LINES		PROJECT		

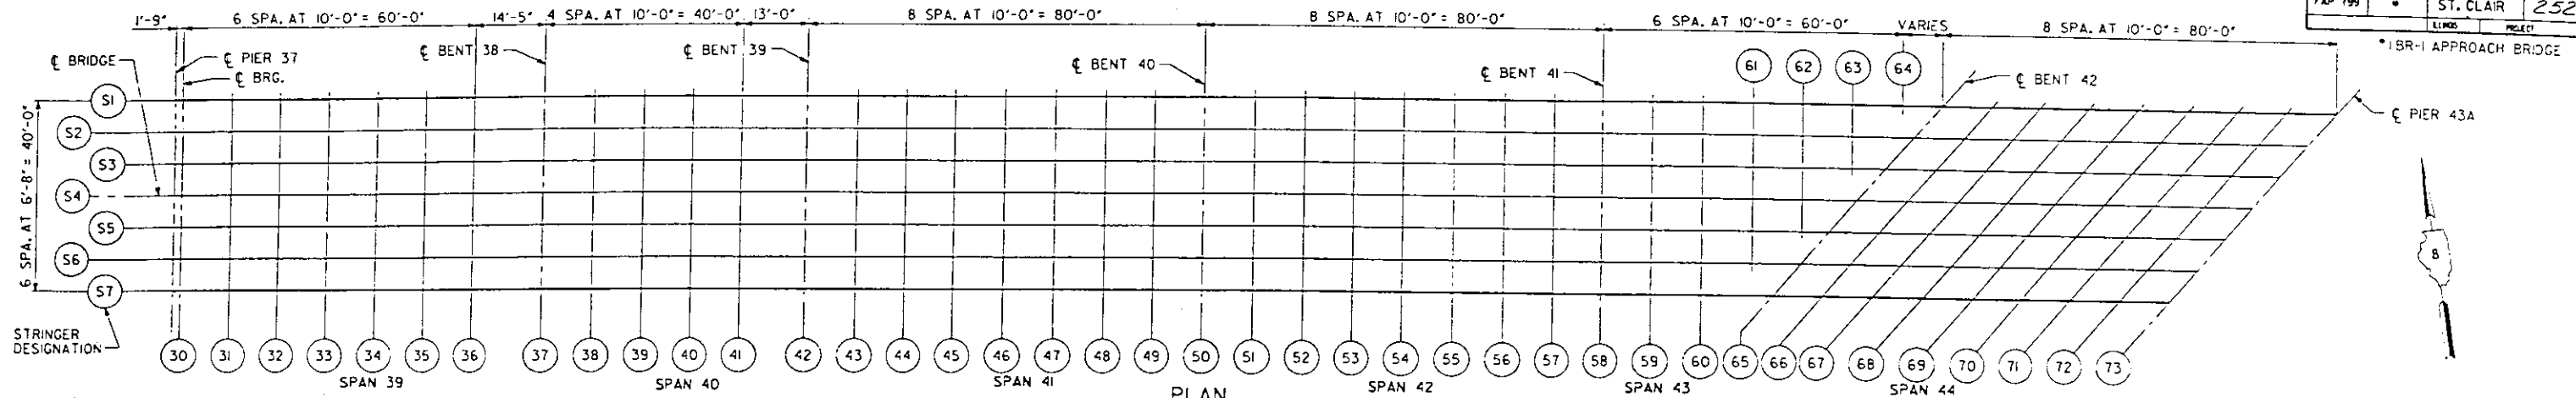

SPAN 39				SPAN 40				SPAN 41				SPAN 42				SPAN 43				SPAN 44									
LINE	LOCATION	STATION	OFFSET	THEORETICAL GRADE ELEVATION	THEORETICAL GRADE ELEVATION ADJUSTED FOR DEAD LOAD DEFLECTION	LINE	LOCATION	STATION	OFFSET	THEORETICAL GRADE ELEVATION	THEORETICAL GRADE ELEVATION ADJUSTED FOR DEAD LOAD DEFLECTION	LINE	LOCATION	STATION	OFFSET	THEORETICAL GRADE ELEVATION	THEORETICAL GRADE ELEVATION ADJUSTED FOR DEAD LOAD DEFLECTION	LINE	LOCATION	STATION	OFFSET	THEORETICAL GRADE ELEVATION	THEORETICAL GRADE ELEVATION ADJUSTED FOR DEAD LOAD DEFLECTION	LINE	LOCATION	STATION	OFFSET	THEORETICAL GRADE ELEVATION	THEORETICAL GRADE ELEVATION ADJUSTED FOR DEAD LOAD DEFLECTION
30	S1	66+29.410	-20.000	459.648	459.648	36	S1	66+89.410	-20.000	457.320	457.343	42	S1	67+56.827	-20.000	454.623	454.623	48	S1	68+16.827	-20.000	452.223	452.223						
30	S2	66+29.410	-13.333	459.787	459.787	36	S2	66+89.410	-13.333	457.459	457.487	42	S2	67+56.827	-13.333	454.762	454.762	48	S2	68+16.827	-13.333	452.362	452.362						
30	S3	66+29.410	-6.667	459.870	459.870	36	S3	66+89.410	-6.667	457.542	457.570	42	S3	67+56.827	-6.667	454.845	454.845	48	S3	68+16.827	-6.667	452.445	452.445						
30	S4	66+29.410	0.000	459.898	459.898	36	S4	66+89.410	0.000	457.570	457.598	42	S4	67+56.827	0.000	454.873	454.873	48	S4	68+16.827	0.000	452.473	452.473						
30	S5	66+29.410	6.667	459.870	459.870	36	S5	66+89.410	6.667	457.542	457.570	42	S5	67+56.827	6.667	454.845	454.845	48	S5	68+16.827	6.667	452.445	452.445						
30	S6	66+29.410	13.333	459.787	459.787	36	S6	66+89.410	13.333	457.459	457.487	42	S6	67+56.827	13.333	454.762	454.762	48	S6	68+16.827	13.333	452.362	452.362						
30	S7	66+29.410	20.000	459.648	459.648	36	S7	66+89.410	20.000	457.320	457.343	42	S7	67+56.827	20.000	454.623	454.623	48	S7	68+16.827	20.000	452.223	452.223						

DATED OCT. 23, 1987
 LEVELS PLOTTED 35.56 & 63
 E:\ZF\JULIEM\K14.DGN
 D. SCHREMP DESIGNED
 M. SCHURK CHECKED
 C. DEED DRAWN
 M. SCHURK CHECKED

NOTE

FOR DEAD LOAD DEFLECTION DIAGRAM, FILET HEIGHTS DETAIL AND LINES 53 THRU 73 DATA, SEE SHEET 10.

REHABILITATION FOR
APPROACH BRIDGE OVER
I-55/70 W.B., MISSOURI AVE. AND TRRA

TOP OF SLAB ELEVATIONS
SPANS 39 THRU 44

STRUCTURE NO. 062-6003
STA. 65+00 (FAP 799) ST. CLAIR CO.

PREPARED BY:
SVERDRUP CORPORATION
ST. LOUIS, MISSOURI


SECTION IBR-1

SHEET NO. 9 OF 75

FOR INFORMATION ONLY

STATE OF ILLINOIS
DEPARTMENT OF TRANSPORTATION

ROUTE NO.	SECTION	COUNTY	TOTAL SHEETS	SHEET NO.
FAP 799	•	ST. CLAIR	252	159
PROJECT			PROJECT	
* IBR-1 APPROACH BRIDGE				

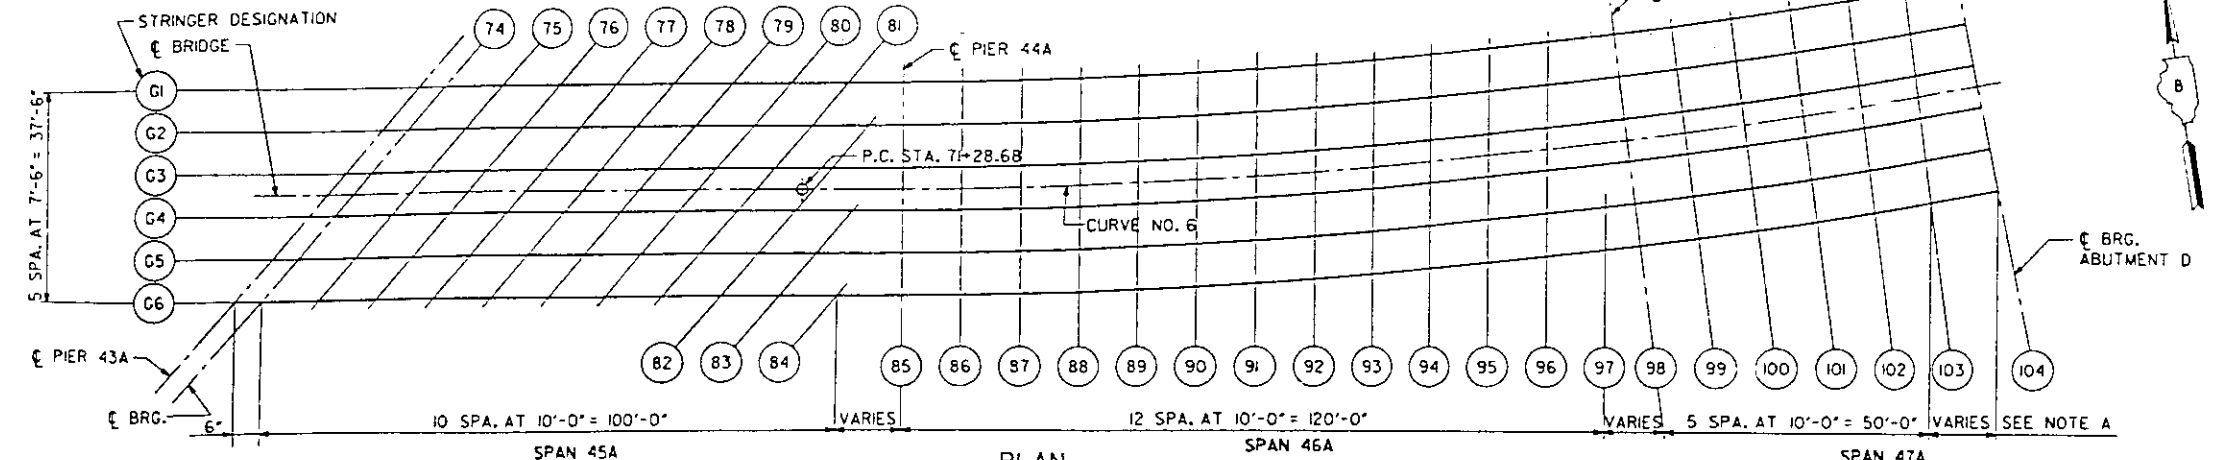

NOTE A: POINTS FOR ELEVATIONS AT 10' INTERVALS AND AS NOTED ARE ALONG EACH INDIVIDUAL GIRDER. STATIONS AND OFFSETS OF THESE POINTS ARE RADIAL TO ϵ BRIDGE.

PLAN

LINE	LOCATION	STATION	OFFSET	THEORETICAL GRADE ELEVATION	THEORETICAL GRADE ELEVATION ADJUSTED FOR DEAD LOAD DEFLECTION	LINE	LOCATION	STATION	OFFSET	THEORETICAL GRADE ELEVATION	THEORETICAL GRADE ELEVATION ADJUSTED FOR DEAD LOAD DEFLECTION	LINE	LOCATION	STATION	OFFSET	THEORETICAL GRADE ELEVATION	THEORETICAL GRADE ELEVATION ADJUSTED FOR DEAD LOAD DEFLECTION
74	G1	70+64.113	-18.750	442.362	442.362	81	G1	71+34.209	-18.750	439.563	439.557	89	G1	71+84.097	-18.750	437.584	437.662
74	G2	70+57.820	-11.250	442.755	442.755	81	G2	71+27.820	-11.250	440.013	440.012	89	G2	71+83.807	-11.250	437.906	437.987
74	G3	70+51.527	-3.750	443.077	443.077	81	G3	71+21.527	-3.750	440.435	440.445	89	G3	71+83.521	-3.750	438.226	438.302
74	G4	70+45.233	3.750	443.328	443.328	81	G4	71+15.233	3.750	440.831	440.860	89	G4	71+83.240	3.750	438.544	438.616
74	G5	70+38.940	11.250	443.518	443.518	81	G5	71+08.940	11.250	441.203	441.248	89	G5	71+82.962	11.250	438.862	438.930
74	G6	70+32.647	18.750	443.640	443.640	81	G6	71+02.647	18.750	441.547	441.618	89	G6	71+82.688	18.750	439.178	439.237
75	G1	70+74.113	-18.750	441.962	441.970	82	G2	71+37.918	-11.250	439.633	439.630	90	G1	71+94.277	-18.750	437.180	437.272
75	G2	70+67.820	-11.250	442.355	442.371	82	G3	71+31.537	-3.750	440.078	440.079	90	G2	71+93.914	-11.250	437.525	437.622
75	G3	70+61.527	-3.750	442.677	442.697	82	G4	71+25.233	3.750	440.455	440.507	90	G3	71+93.557	-3.750	437.868	437.961
75	G4	70+55.233	3.750	442.941	442.968	82	G5	71+18.940	11.250	440.885	440.911	90	G4	71+93.204	3.750	438.209	438.297
75	G5	70+48.940	11.250	443.164	443.193	82	G6	71+12.647	18.750	441.251	441.300	90	G5	71+92.857	11.250	438.549	438.635
75	G6	70+42.647	18.750	443.335	443.369	82	G6	71+06.350	18.750	441.589	441.645	90	G6	71+92.514	18.750	438.887	438.962
76	G1	70+84.113	-18.750	441.562	441.575	83	G4	71+35.210	3.750	440.159	440.161	91	G1	72+04.456	-18.750	436.777	436.875
76	G2	70+77.820	-11.250	441.955	441.981	83	G5	71+28.937	11.250	440.569	440.579	91	G2	72+04.021	-11.250	437.145	437.249
76	G3	70+71.527	-3.750	442.282	442.318	83	G6	71+22.647	18.750	440.955	440.981	91	G3	72+03.592	-3.750	437.510	437.610
76	G4	70+65.233	3.750	442.572	442.621	84	G6	71+32.578	18.750	440.661	440.668	91	G4	72+03.169	3.750	437.874	437.970
76	G5	70+58.940	11.250	442.825	442.878	85	G1	71+43.380	-18.750	439.199	439.199	91	G5	72+02.752	11.250	438.236	438.331
76	G6	70+52.647	18.750	443.034	443.097	85	G2	71+37.083	-11.250	439.584	439.584	91	G6	72+02.341	18.750	438.596	438.680
77	G1	70+94.113	-18.750	441.162	441.175	85	G3	71+30.786	-3.750	439.969	439.969	92	G1	72+14.635	-18.750	436.370	436.465
77	G2	70+87.820	-11.250	441.555	441.586	85	G4	71+24.489	3.750	440.354	440.354	92	G2	72+14.218	-11.250	436.743	436.845
77	G3	70+81.527	-3.750	441.899	441.942	85	G5	71+18.192	11.250	440.739	440.739	92	G3	72+13.801	-3.750	437.115	437.215
77	G4	70+75.233	3.750	442.213	442.277	85	G6	71+11.895	18.750	441.124	441.124	92	G4	72+13.384	3.750	437.487	437.583
77	G5	70+68.940	11.250	442.493	442.562	86	G1	71+53.559	-18.750	438.796	438.812	92	G5	72+12.967	11.250	437.859	437.955
77	G6	70+62.647	18.750	442.735	442.819	86	G2	71+47.262	-11.250	439.181	439.197	92	G6	72+12.550	18.750	438.231	438.317
78	G1	71+04.113	-18.750	440.762	440.771	86	G3	71+40.965	-3.750	439.566	439.582	93	G1	72+24.815	-18.750	435.963	436.047
78	G2	70+97.820	-11.250	441.160	441.188	86	G4	71+34.718	3.750	439.951	439.967	93	G2	72+24.398	-11.250	436.338	436.429
78	G3	70+91.527	-3.750	441.525	441.568	86	G5	71+28.471	11.250	440.336	440.352	93	G3	72+23.981	-3.750	436.714	436.804
78	G4	70+85.233	3.750	441.861	441.927	86	G6	71+22.224	18.750	440.721	440.737	93	G4	72+23.564	3.750	437.089	437.177
78	G5	70+78.940	11.250	442.166	442.243	87	G1	71+63.739	-18.750	438.392	438.429	93	G5	72+23.147	11.250	437.463	437.552
78	G6	70+72.647	18.750	442.438	442.534	87	G2	71+57.492	-11.250	438.777	438.814	93	G6	72+22.730	18.750	437.838	437.919
79	G1	71+14.113	-18.750	440.362	440.364	87	G3	71+51.245	-3.750	439.162	439.199	94	G1	72+34.994	-18.750	435.555	435.621
79	G2	71+07.820	-11.250	440.772	440.792	87	G4	71+45.008	3.750	439.547	439.584	94	G2	72+34.577	-11.250	435.934	436.007
79	G3	71+01.527	-3.750	441.157	441.193	87	G5	71+38.761	11.250	439.932	439.969	94	G3	72+34.160	-3.750	436.312	436.386
79	G4	70+95.233	3.750	441.514	441.575	87	G6	71+32.514	18.750	440.317	440.354	94	G4	72+33.743	3.750	436.690	436.763
79	G5	70+88.940	11.250	441.843	441.917	88	G1	71+73.918	-18.750	437.988	438.047	94	G5	72+33.326	11.250	437.068	437.143
79	G6	70+82.647	18.750	442.140	442.237	88	G2	71+67.671	-11.250	438.373	438.432	94	G6	72+32.909	18.750	437.445	437.514
80	G1	71+24.113	-18.750	439.963	439.958	88	G3	71+61.424	-3.750	438.758	438.817	95	G1	72+45.173	-18.750	435.148	435.192
80	G2	71+17.820	-11.250	440.391	440.399	88	G4	71+55.177	3.750	439.143	439.202	95	G2	72+44.756	-11.250	435.530	435.580
80	G3	71+11.527	-3.750	440.794	440.817	88	G5	71+48.930	11.250	439.528	439.587	95	G3	72+44.339	-3.750	435.911	435.962
80	G4	71+05.233	3.750	441.171	441.218	88	G6	71+42.683	18.750	439.913	440.000	95	G4	72+43.922	3.750	436.291	436.343
80	G5	70+98.940	11.250	441.522	441.584	89	G1	71+84.097	-18.750	439.298	439.357	95	G5	72+43.505	11.250	436.672	436.726
80	G6	70+92.647	18.750	441.844	441.932	89	G2	71+77.850	-11.250	439.683	439.742	95	G6	72+43.088	18.750	437.052	437.103

LEVELS PLOTTED DATE: OCT. 23, 1987 35.56 & 63
DESIGNED BY: D. SCHREMP
CHECKED BY: M. SCHURK
DRAWN BY: J.G. CORLEY
M. SCHURK CHECKED

NOTE
FOR DEAD LOAD DEFLECTION DIAGRAM, FILLET HEIGHTS DETAIL AND LINES 102 THRU 104 DATA, SEE SHEET 12.

REHABILITATION FOR
APPROACH BRIDGE OVER
I-55/70 W.B., MISSOURI AVE. AND TRRA
TOP OF SLAB ELEVATIONS
SPANS 45A THRU 47A
STRUCTURE NO. 082-6003
STA. 65+00 (FAP 799) ST. CLAIR CO.

PREPARED BY:
SVERDRUP CORPORATION
ST. LOUIS, MISSOURI


SECTION IBR-1

SHEET NO. 1 OF 75

FOR INFORMATION ONLY


*1 BR-1 APPROACH BRIDGE

LINE	LOCATION	STATION	OFFSET	THEORETICAL GRADE ELEVATION	THEORETICAL GRADE ELEVATION ADJUSTED FOR DEAD LOAD DEFLECTION
102	G1	73+08.597	-18.750	432.611	432.609
102	G2	73+08.307	-11.250	432.975	432.972
102	G5	73+08.021	-3.750	433.339	433.337
102	G4	73+07.740	3.750	433.703	433.702
102	G5	73+07.462	11.250	434.067	434.065
102	G6	73+07.188	18.750	434.430	434.428
103	G1	73+18.777	-18.750	432.204	432.205
103	G2	73+18.414	-11.250	432.571	432.571
103	G3	73+18.057	-3.750	432.938	432.938
103	G4	73+17.704	3.750	433.304	433.304
103	G5	73+17.357	11.250	433.671	433.671
103	G6	73+17.014	18.750	434.037	434.036
104	G1	73+28.562	-18.750	431.813	431.813
104	G2	73+29.284	-11.250	432.177	432.177
104	G3	73+28.009	-3.750	432.540	432.540
104	G4	73+27.739	3.750	432.903	432.903
104	G5	73+27.472	11.250	433.267	433.267
104	G6	73+27.209	18.750	433.630	433.630

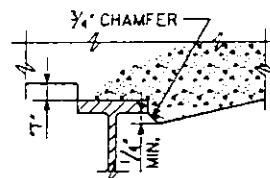


FILLET HEIGHTS

TO DETERMINE 'T': AFTER ALL STRUCTURAL STEEL HAS BEEN ERECTED, ELEVATIONS OF THE TOP FLANGES OF THE GIRDERS SHALL BE TAKEN AT INTERVALS SHOWN ON THE PLAN. THESE ELEVATIONS SUBTRACTED FROM THE 'THEORETICAL GRADE ELEVATION ADJUSTED FOR THE DEAD LOAD DEFLECTION' MINUS SLAB THICKNESS, EQUALS THE FILLET HEIGHTS 'T' ABOVE TOP FLANGES OF GIRDERS.

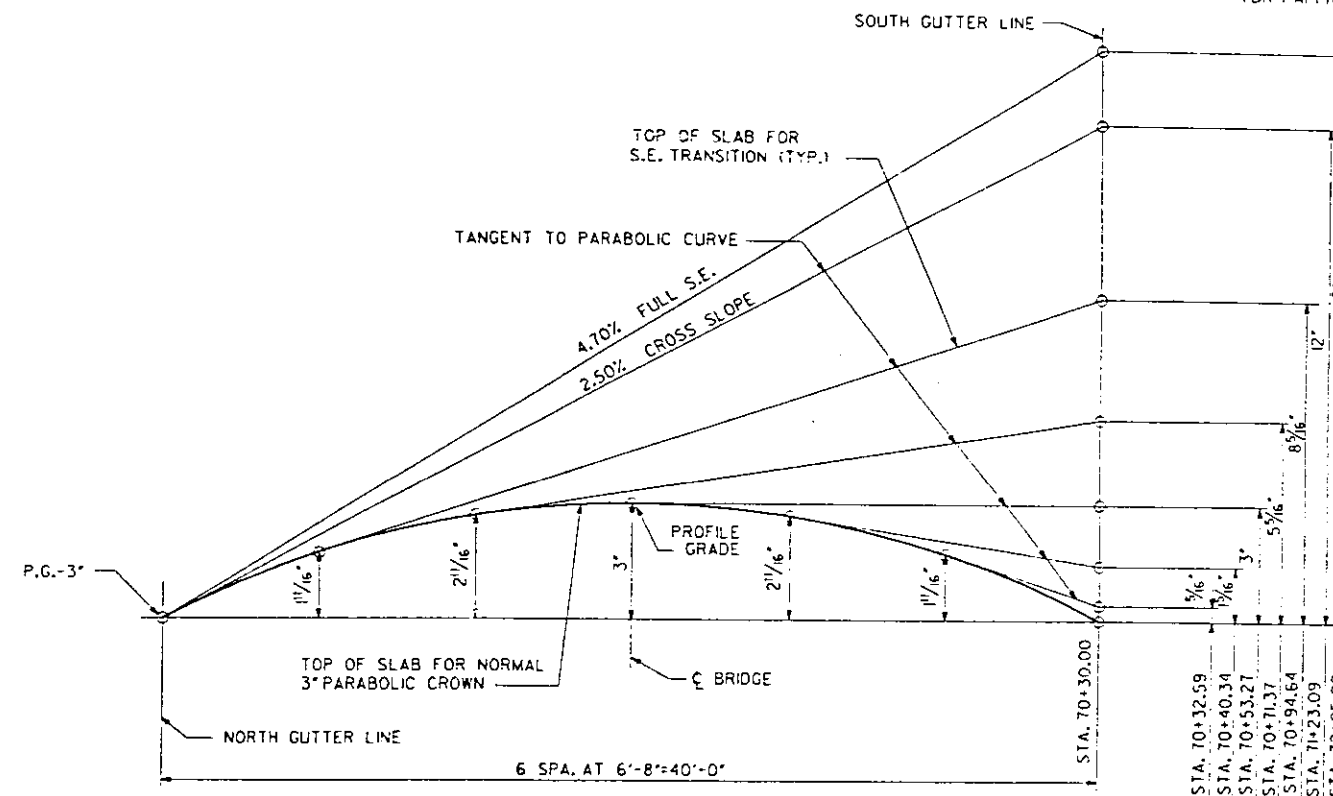

**SUPERELEVATION TRANSITION
CURVE NO. 6**

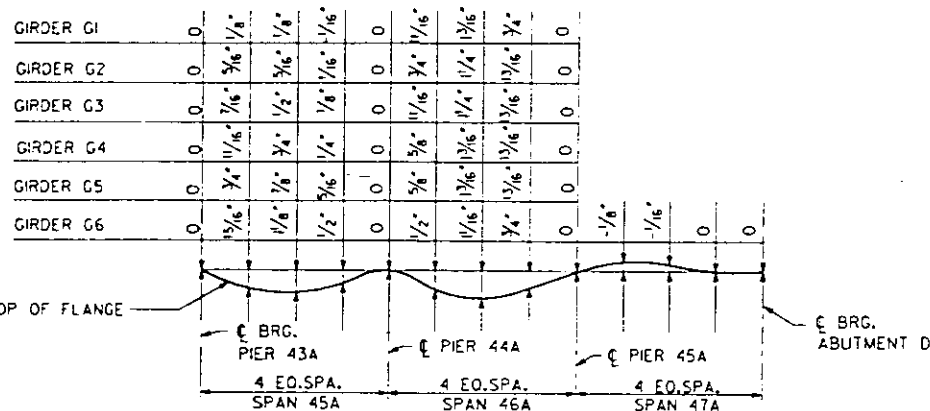

DEAD LOAD DEFLECTION DIAGRAM

(INCLUDES WEIGHT OF CONCRETE ONLY)

NOTE: THE ABOVE DEFLECTIONS ARE NOT TO BE USED IN THE FIELD IF THE ENGINEER IS WORKING FROM THE 'THEORETICAL GRADE ELEVATION ADJUSTED FOR DEAD LOAD DEFLECTION'.

REHABILITATION FOR
APPROACH BRIDGE OVER
I-55/70 W.B., MISSOURI AVE. AND TRRA

TOP OF SLAB ELEVATIONS
SPANS 45A THRU 47A

STRUCTURE NO. 082-6003
STA. 65+00 (FAP 759) ST. CLAIR CO.


D. SCHREMP
DESIGNED
M. SCHURK
CHECKED
J.G. CORLEY
DRAWN
M. SCHURK
CHECKED

PREPARED BY
SYVERDRUP CORPORATION
ST. LOUIS, MISSOURI

SECTION 1BR-1

SHEET NO. 12 OF 75


FOR INFORMATION ONLY

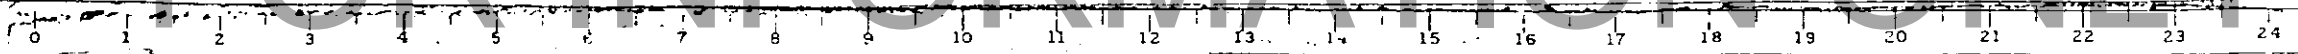


DATE: OCT. 23, 1987
 LEVELS PLOTTED 35 56 58 & 63
 PLOT BY: TSEMLKISA
 158 33

ROUTE NO.	SECTION	COUNTY	TOTAL SHEETS	SHEET NO.
FAP 799	*	ST. CLAIR	252	161
ELINES		PROJECT		

* IBR-1 APPROACH BRIDGE

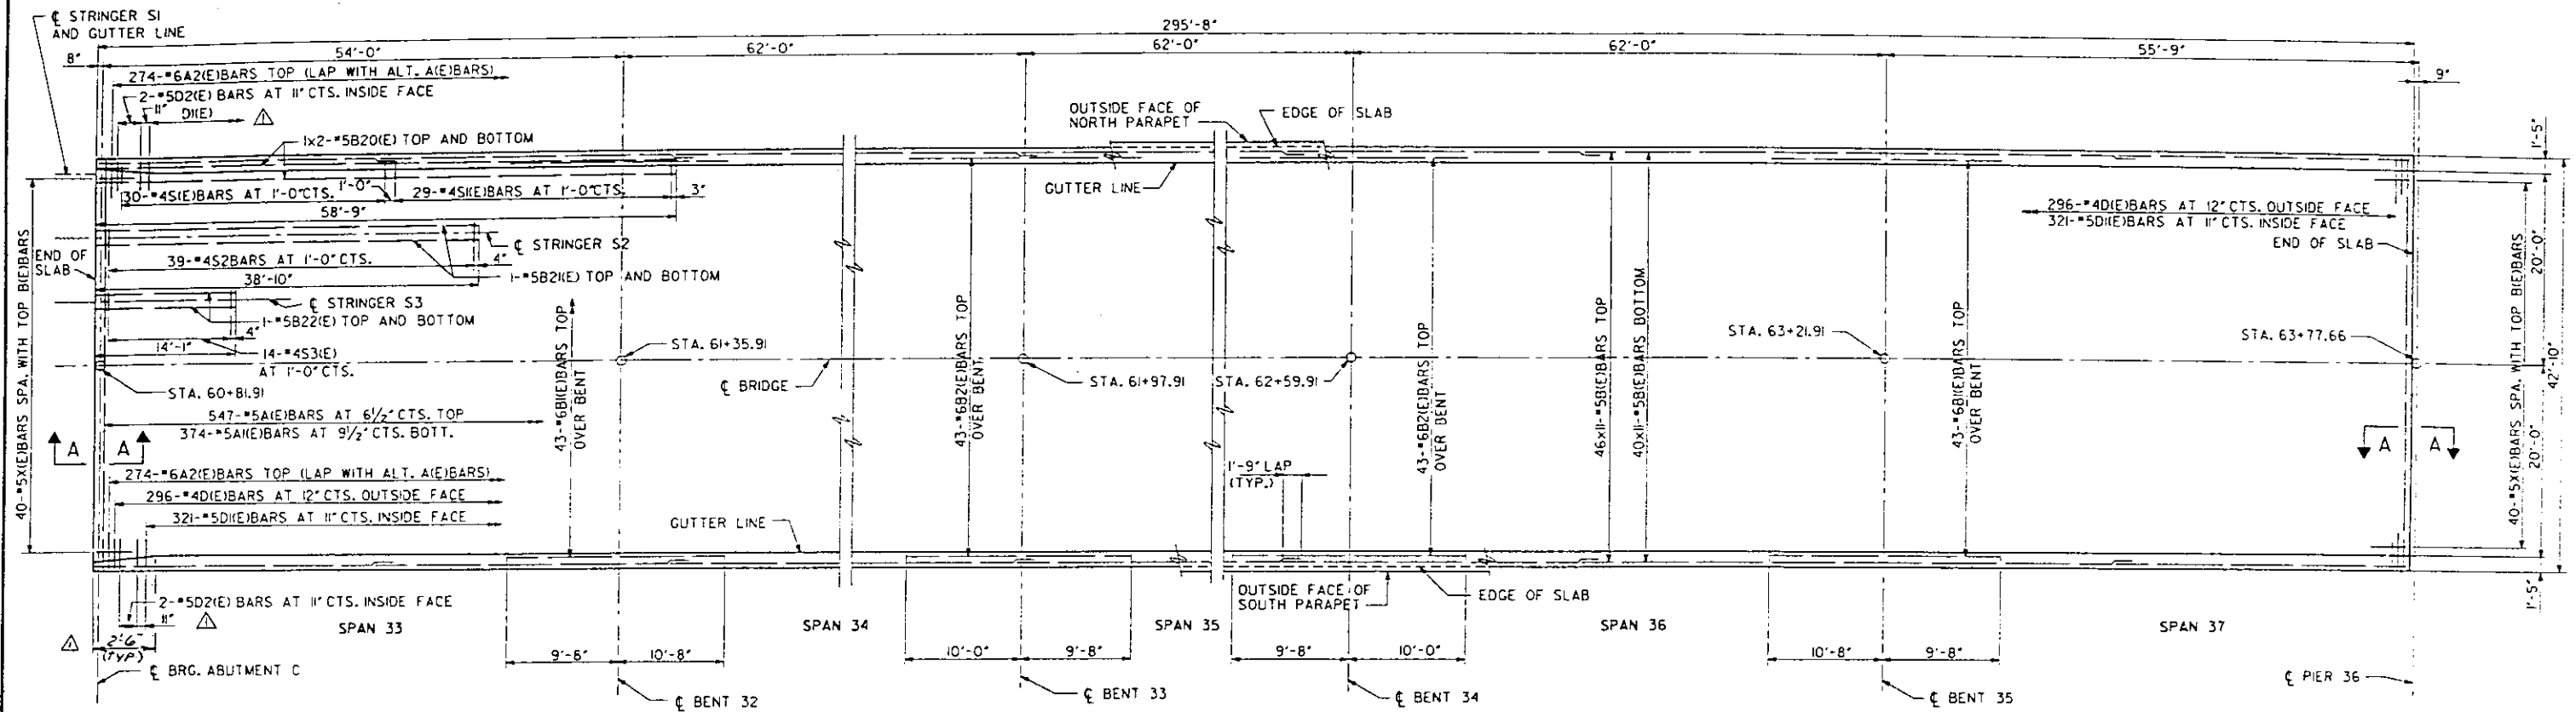

PLAN

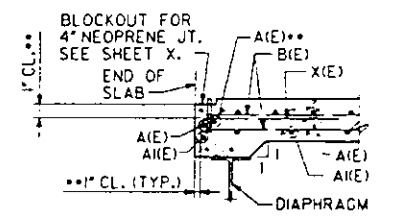

SECTION A-A Δ
 ** PLACE A(E) BAR IN BACK OF ANCHOR BOLT AS SHOWN IF REQUIRED TO MAINTAIN 1" CL. (1-0-1/2") ANCHOR BOLTS SHOULD BE TIED TO A(E) BAR.

NOTES

WORK THIS SHEET WITH SHEETS 17, 18 AND 21.
 D(E) BARS LOCATED NEAR END OF PARAPET SHALL BE SET BACK TO CLEAR BLOCKOUT FOR EXPANSION JOINT BY 1 INCH.
 BARS BILLED AS: 46x9-#5 ETC. INDICATES 46 LINES OF BARS WITH 9 LENGTHS PER LINE.
 DRAINAGE SCUPPERS NOT SHOWN, SEE SHEET 30 AND 31 FOR LOCATION AND DETAILS.
 FOR LOCATION AND DETAILS OF ROADWAY LIGHTING, SEE SHEET 35.
 LONGITUDINAL BARS SHALL BE SPACED AS SHOWN IN CROSS SECTIONS.

REHABILITATION FOR
 APPROACH BRIDGE OVER
 I-55/70 W.B., MISSOURI AVE. AND TRRA

SLAB PLAN - SPANS 33 THRU 37

STRUCTURE NO. 082-6003
 STA. 65+00 (FAP 799) ST. CLAIR CO.

R. NIEMETZ	DESIGNED
K. LARSON	CHECKED
J. CORLEY	DRAWN
P.W. CLARK	CHECKED

PREPARED BY
 SVERDRUP CORPORATION
 ST. LOUIS, MISSOURI


Δ REV. 12-4-87

SECTION IBR-1


SHEET NO. 13 OF 75

FOR INFORMATION ONLY


0351 FILE: ZF31051JSLAB1.DGN
 LEVELS PLOTTED 35,56,57,58 & 63
 DATE: OCT. 23, 1987
 PRF: SLAB11
 B75835

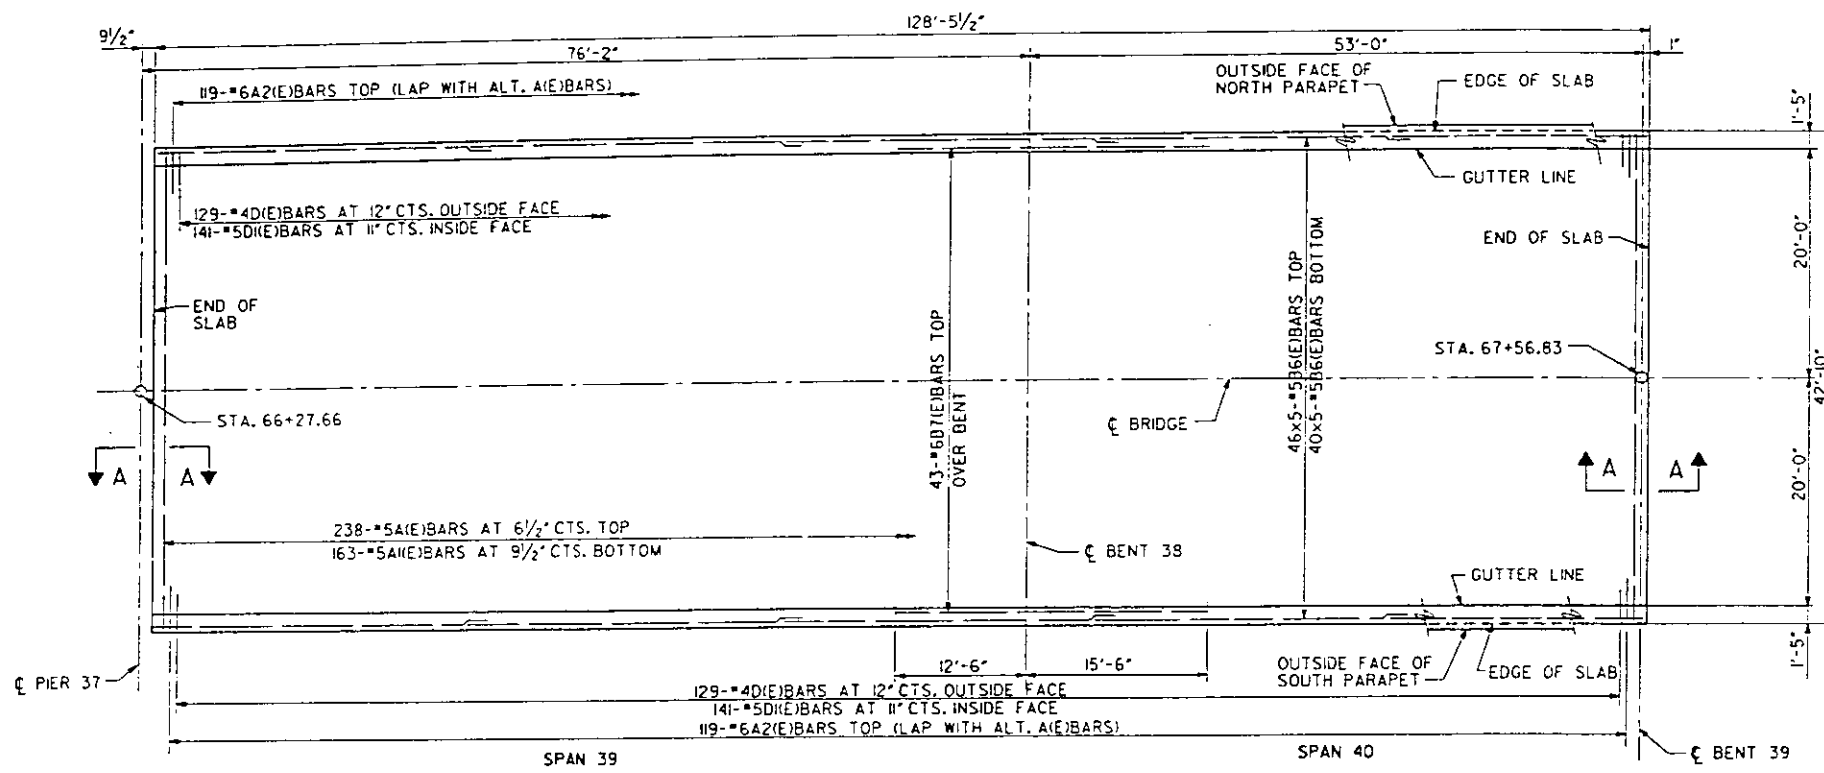


PLAN

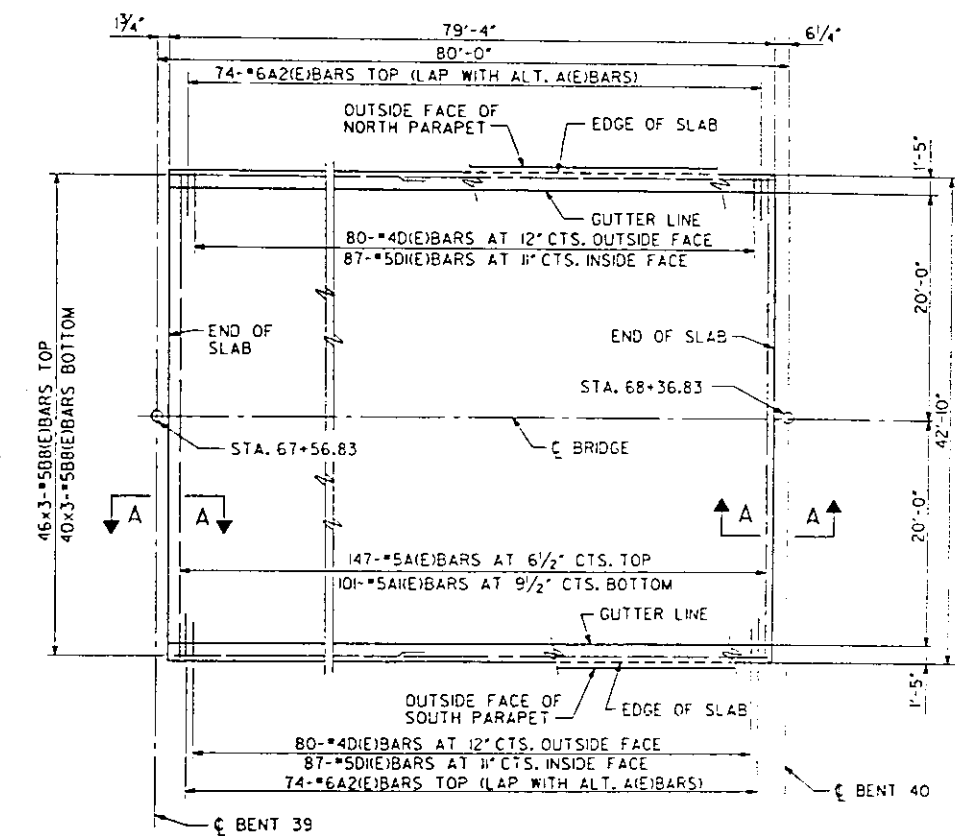


PLAN

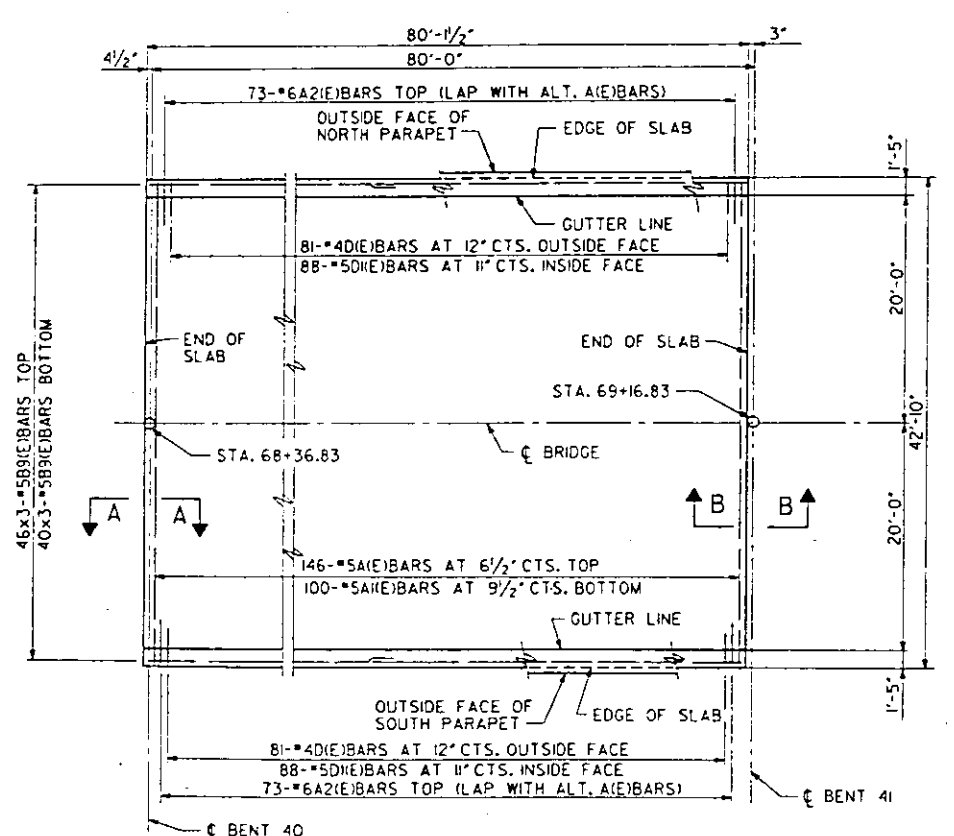

PLAN

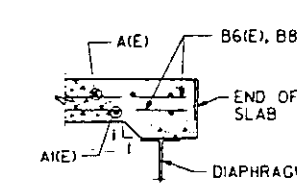

SECTION A-A

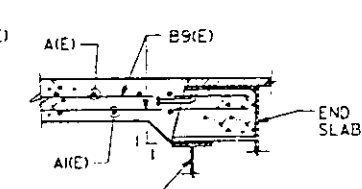

SECTION B-B

NOTES

WORK THIS SHEET WITH SHEETS 17, 18 AND 21.
D(E) BARS LOCATED NEAR END OF PARAPET SHALL BE SET BACK TO CLEAR BLOCKOUT FOR EXPANSION JOINT BY 1 INCH.
BARS BILLED AS: 46x9-#5 ETC. INDICATES 46 LINES OF BARS WITH 9 LENGTHS PER LINE.
DRAINAGE SCUPPERS NOT SHOWN, SEE SHEETS 30 AND 31 FOR LOCATION AND DETAILS.
ALL LONGITUDINAL BARS SHALL BE LAPPED 1'-9" MINIMUM.
FOR LOCATION AND DETAILS OF ROADWAY LIGHTING, SEE SHEET 35.
LONGITUDINAL BARS SHALL BE SPACED AS SHOWN IN CROSS SECTIONS.

REHABILITATION FOR
APPROACH BRIDGE OVER
I-55/70 W.B., MISSOURI AVE. AND TRRA

SLAB PLAN - SPANS 39 THRU 42

STRUCTURE NO. 082-6003
STA. 65+00 (FAP 799) ST. CLAIR CO.

10355
 ET 2F 3(15) JSLAB13.DGN
 15841
 LEVELS PLOTTED DATE: OCT. 23, 1987
 35, 56, 57 & 63


R. NIEMIETZ	DESIGNED
K. LARSON	CHECKED
J. CORLEY	DRAWN
P.W. CLARK	CHECKED

PREPARED BY:
SVERDRUP CORPORATION
ST. LOUIS, MISSOURI


SECTION I BR-1

SHEET NO. 14 OF 75

FOR INFORMATION ONLY

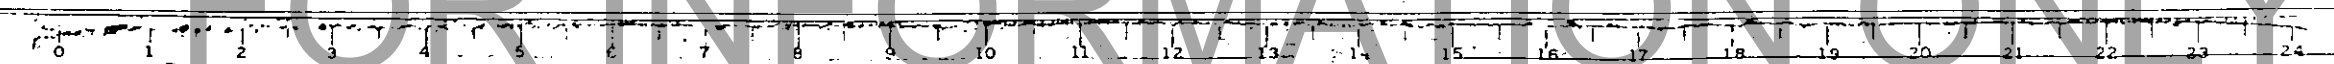


*IBR-1 APPROACH BRIDGE

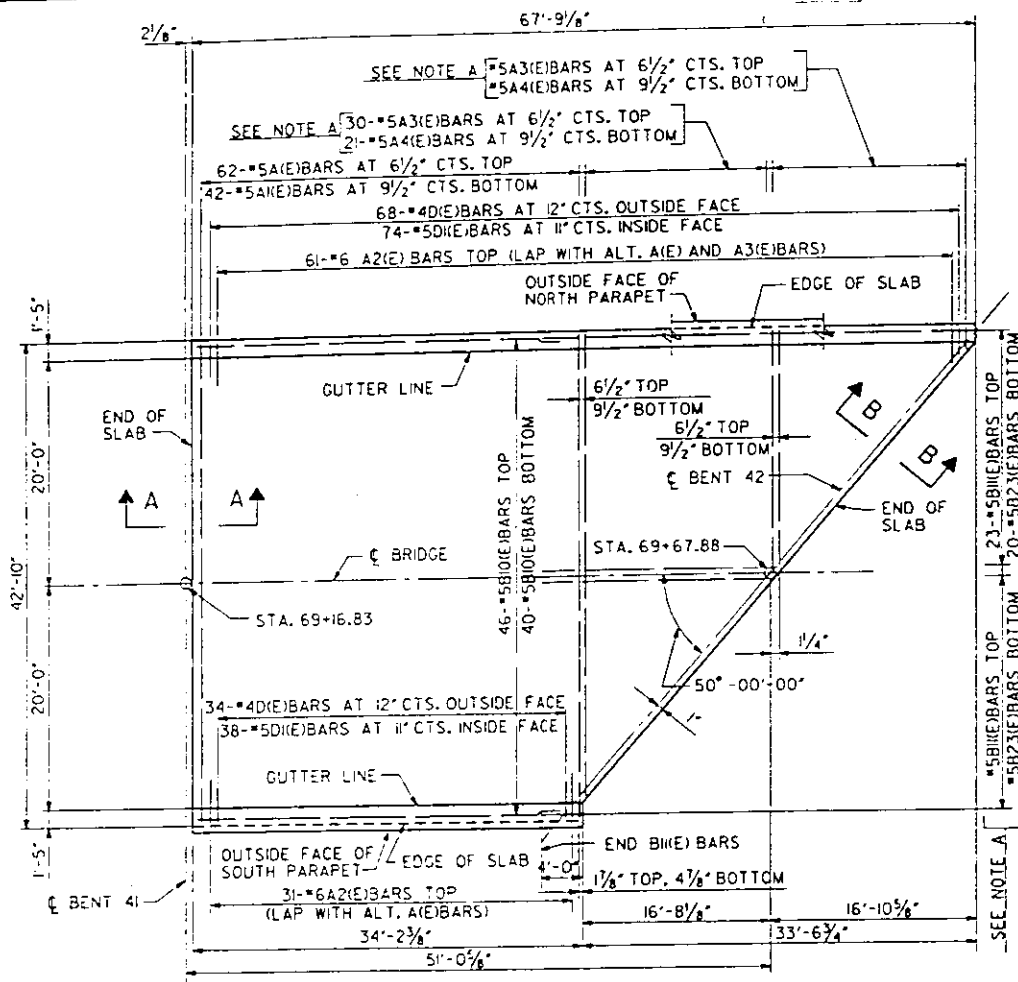


SPAN 43
PLAN

NOTE A: BARS A3(E), A4(E), B1(E) AND B2(E) TO BE CUT IN FIELD. SEE FIELD CUTTING DIAGRAM, SEE SHEET X.

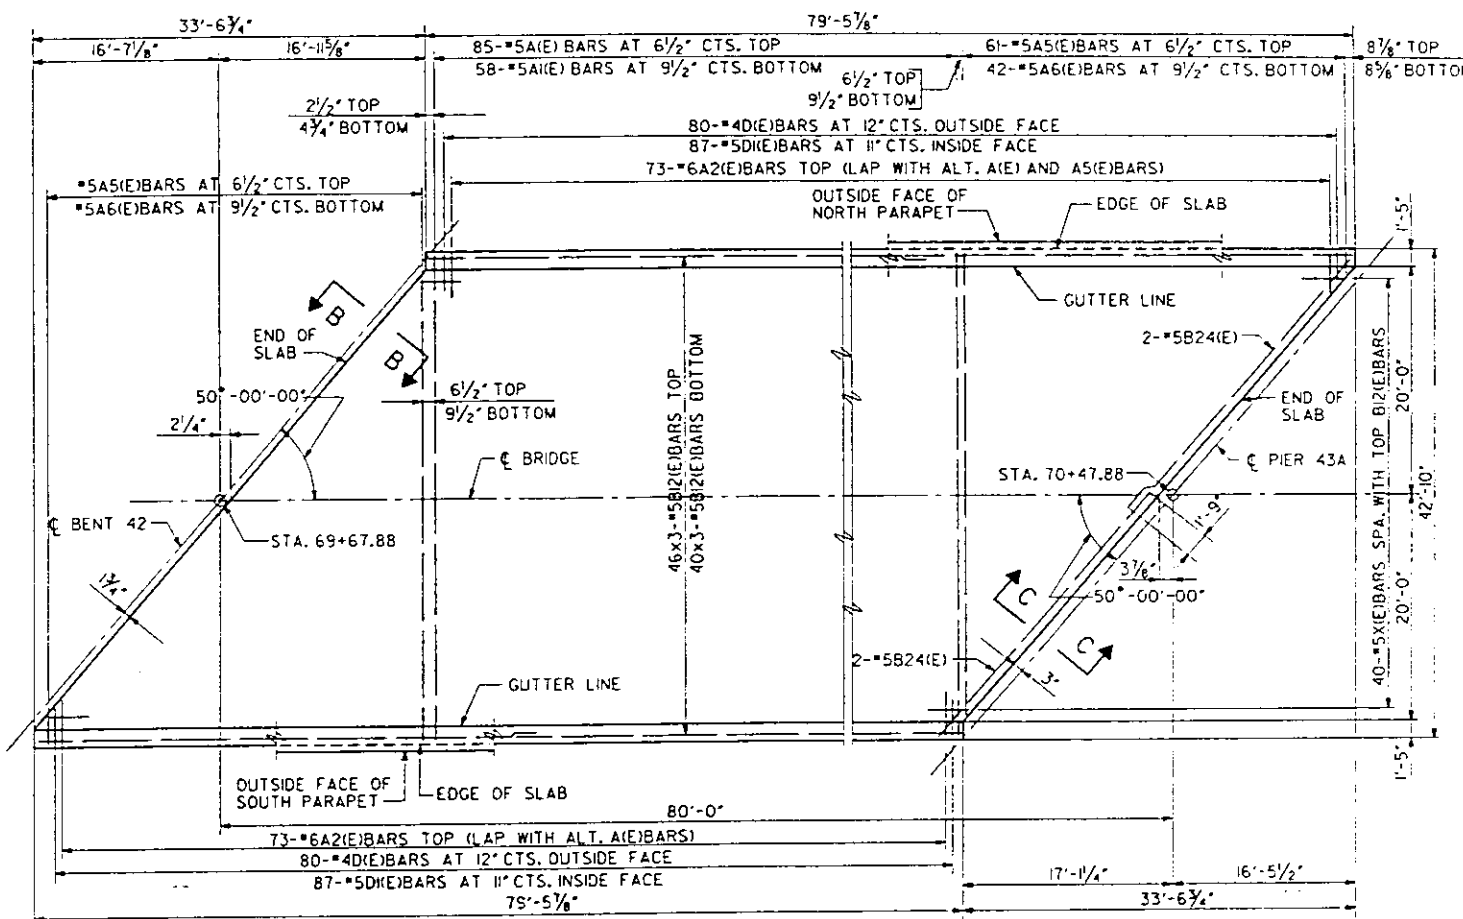

SPAN 44
PLAN

NOTE: A5(E) AND A6(E)BARS TO BE FULL LENGTH, CUT TO FIT SKEW AND USE REMAINDER OF BARS IN OPPOSITE END OF SLAB

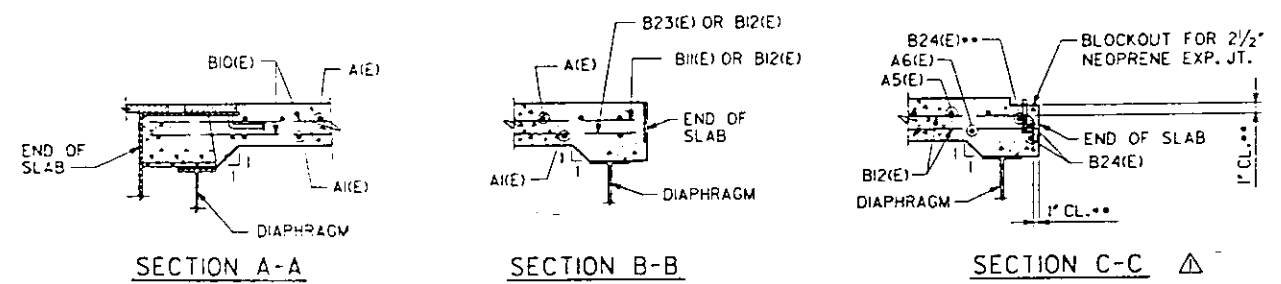

** PLACE B24(E) BARS IN BACK OF ANCHOR BOLT AS SHOWN IF REQUIRED TO MAINTAIN 1" CL. (1+0-1/8"). ANCHOR BOLTS SHOULD BE TIED TO B24(E) BARS.

NOTES

- WORK THIS SHEET WITH SHEETS 17, 19 AND 21.
- D1(E) BARS LOCATED NEAR END OF PARAPET SHALL BE SET BACK TO CLEAR BLOCKOUT FOR EXPANSION JOINT BY 1 INCH.
- BARS BILLED AS: 46x9-#5 ETC. INDICATES 46 LINES OF BARS WITH 9 LENGTHS PER LINE.
- DRAINAGE SCUPPERS NOT SHOWN, SEE SHEETS 30 AND 31 FOR LOCATION AND DETAILS.
- ALL LONGITUDINAL BARS SHALL BE LAPPED 1'-9" MINIMUM.
- FOR LOCATION AND DETAILS OF ROADWAY LIGHTING, SEE SHEET 35.
- LONGITUDINAL BARS SHALL BE SPACED AS SHOWN IN CROSS SECTIONS.

REHABILITATION FOR
APPROACH BRIDGE OVER
I-55/70 W.B., MISSOURI AVE. AND TRRA

SLAB PLAN - SPANS 43 AND 44

STRUCTURE NO. 082-6003
STA. 65+00 (FAP 799) ST. CLAIR CO.

DESIGNED	R. NIEMIETZ
CHECKED	K. LARSON
CHECKED	J.G. CORLEY
DRAWN	P.W. CLARK
CHECKED	

PREPARED BY:
SYVERDRUP CORPORATION
ST. LOUIS, MISSOURI

REV. 12-4-87


SECTION IBR-1

SHEET NO. 15 OF 75

FOR INFORMATION ONLY

LEVELS PLOTTED DATE: OCT. 23, 1987
 35, 56, 57, 58 & 63
 P. 68
 F:\ZF31\ISH\JSL\LAB14.DGN
 LAB14

*1 BR-1 APPROACH BRIDGE

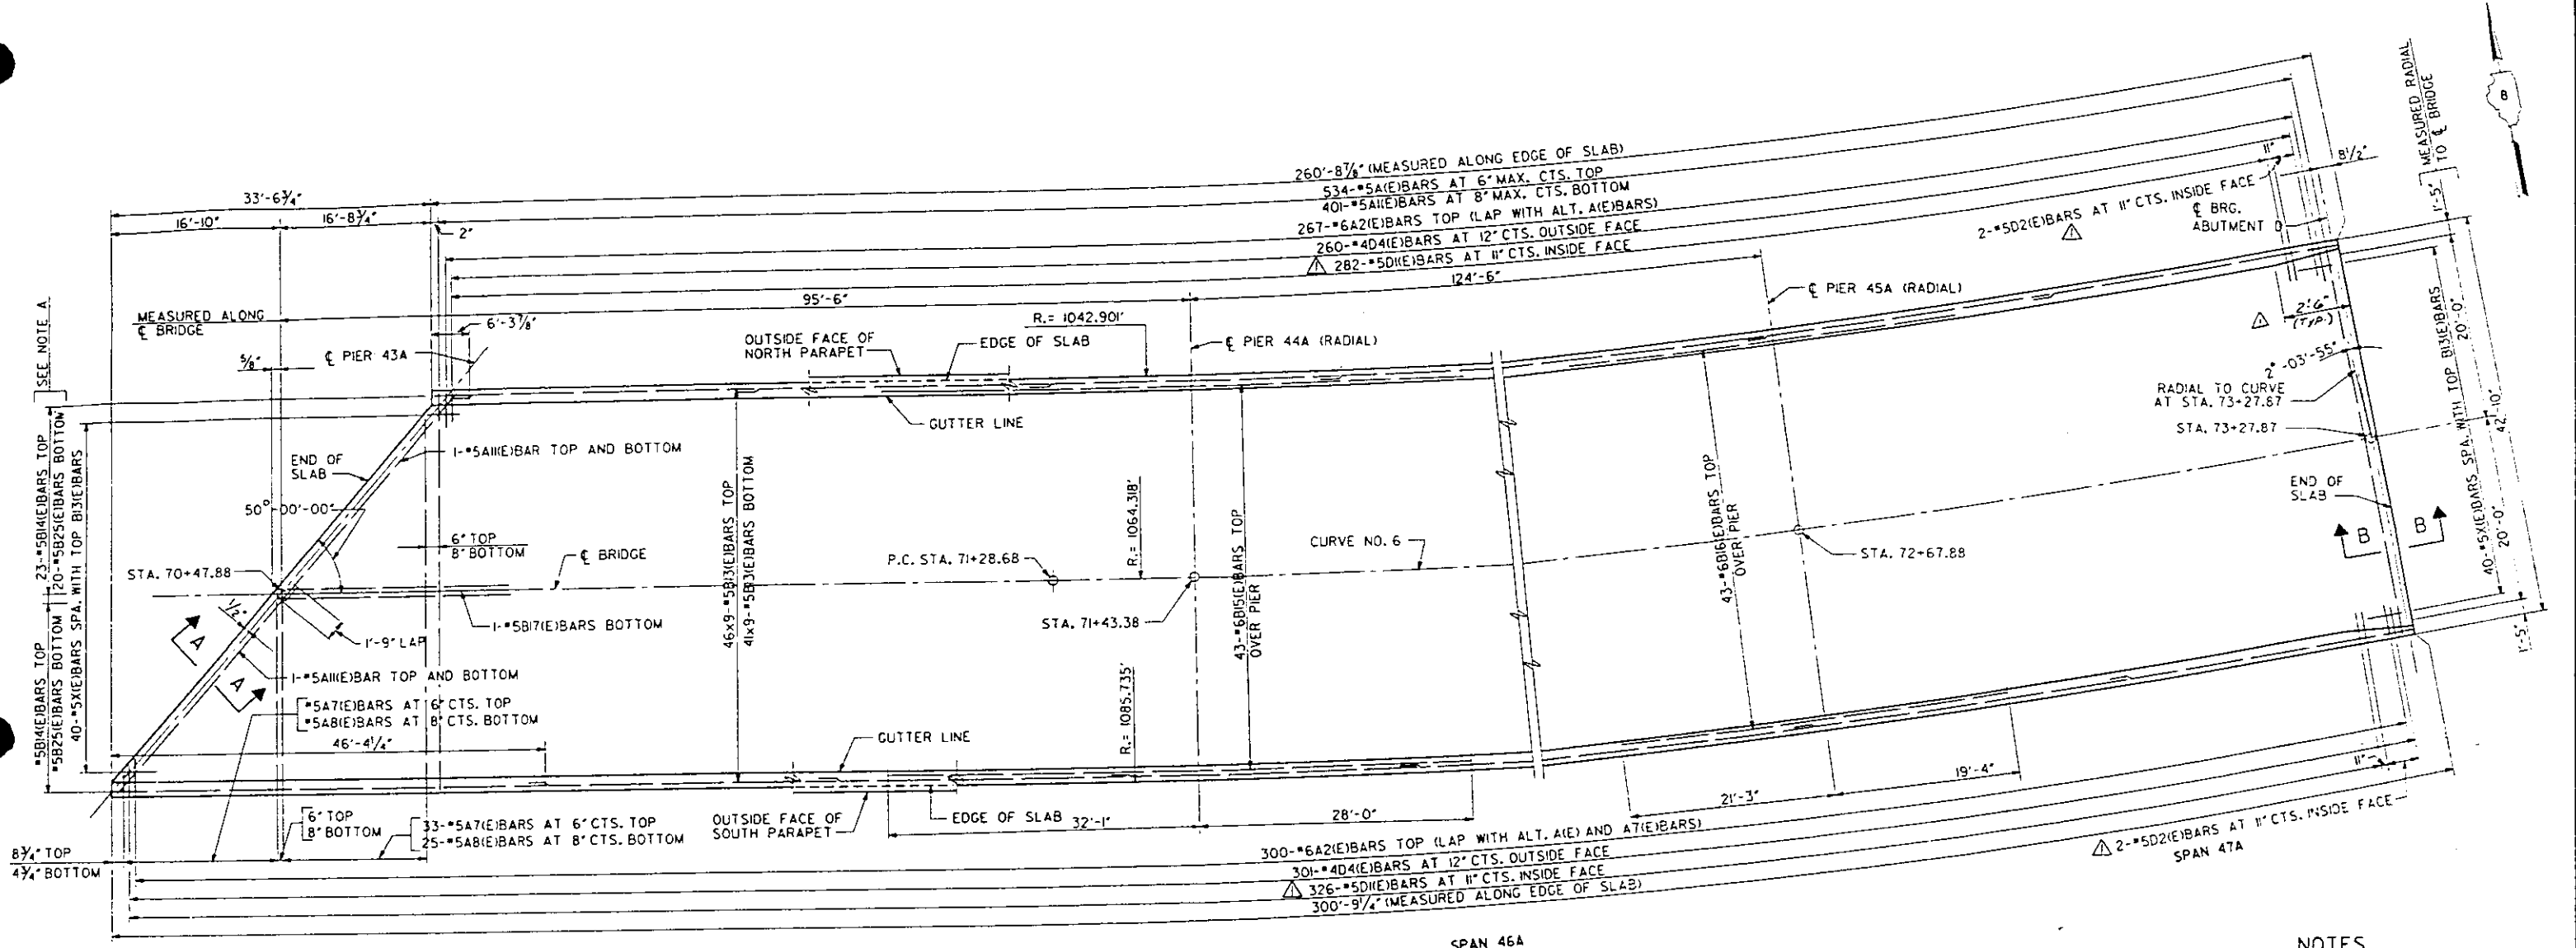


NOTE A: BARS B14(E), B25(E), A7(E) AND A8(E) TO BE CUT IN FIELD. SEE FIELD CUTTING DIAGRAM. B14(E) BARS ARE TO BE PLACED AND LAPPED WITH B13(E) BARS.

PLAN


NOTES

WORK THIS SHEET WITH SHEETS 17, 20 AND 21. D1(E) BARS LOCATED NEAR END OF PARAPET SHALL BE SET BACK TO CLEAR BLOCKOUT FOR EXPANSION JOINT BY 1 INCH. BARS BILLED AS: 46x9-#5 ETC. INDICATES 46 LINES OF BARS WITH 9 LENGTHS PER LINE. DRAINAGE SCUPPERS NOT SHOWN, SEE SHEETS 30 AND 31, FOR LOCATION AND DETAILS. ALL LONGITUDINAL BARS SHALL BE LAPPED 1'-9" MINIMUM. FOR LOCATION AND DETAILS OF ROADWAY LIGHTING, SEE SHEET 35. FOR CONDUIT IN SLAB, SEE ELECTRICAL DRAWINGS. LONGITUDINAL BARS SHALL BE SPACED AS SHOWN IN CROSS SECTIONS.

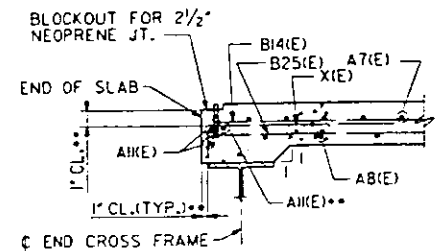

SECTION A-A

** PLACE A1(E) BARS IN BACK OF ANCHOR BOLT IF REQUIRED TO MAINTAIN 1" CL. (+0-1/8"). ANCHOR BOLTS SHOULD BE TIED TO A1(E) BARS.

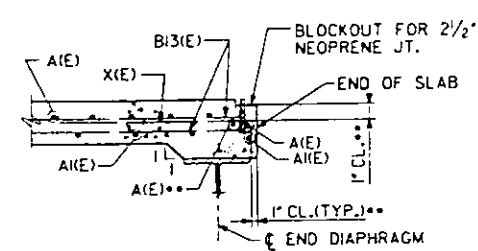

SECTION B-B

** PLACE A1(E) BAR IN BACK OF ANCHOR BOLT IF REQUIRED TO MAINTAIN 1" CL. (+0-1/8"). ANCHOR BOLTS SHOULD BE TIED TO A1(E) BAR.

DESIGNED	R. NIEMIETZ
CHECKED	K. LARSON
CHECKED	J.G. CORLEY
DRAWN	P.W. CLARK
CHECKED	

PREPARED BY:
SVERDRUP CORPORATION
ST. LOUIS, MISSOURI

REV. 12-4-87

SECTION BR-1


STRUCTURE NO. 082-6003
STA. 65+00 (FAP 799) ST. CLAIR CO.

SHEET NO. 16 OF 75

FOR INFORMATION ONLY


138 770 SLABS
 LEVELS PLOTTED
 DATE: 01-23-1987
 35, 56, 57, 58 & 63

*IBR-1 APPROACH BRIDGE

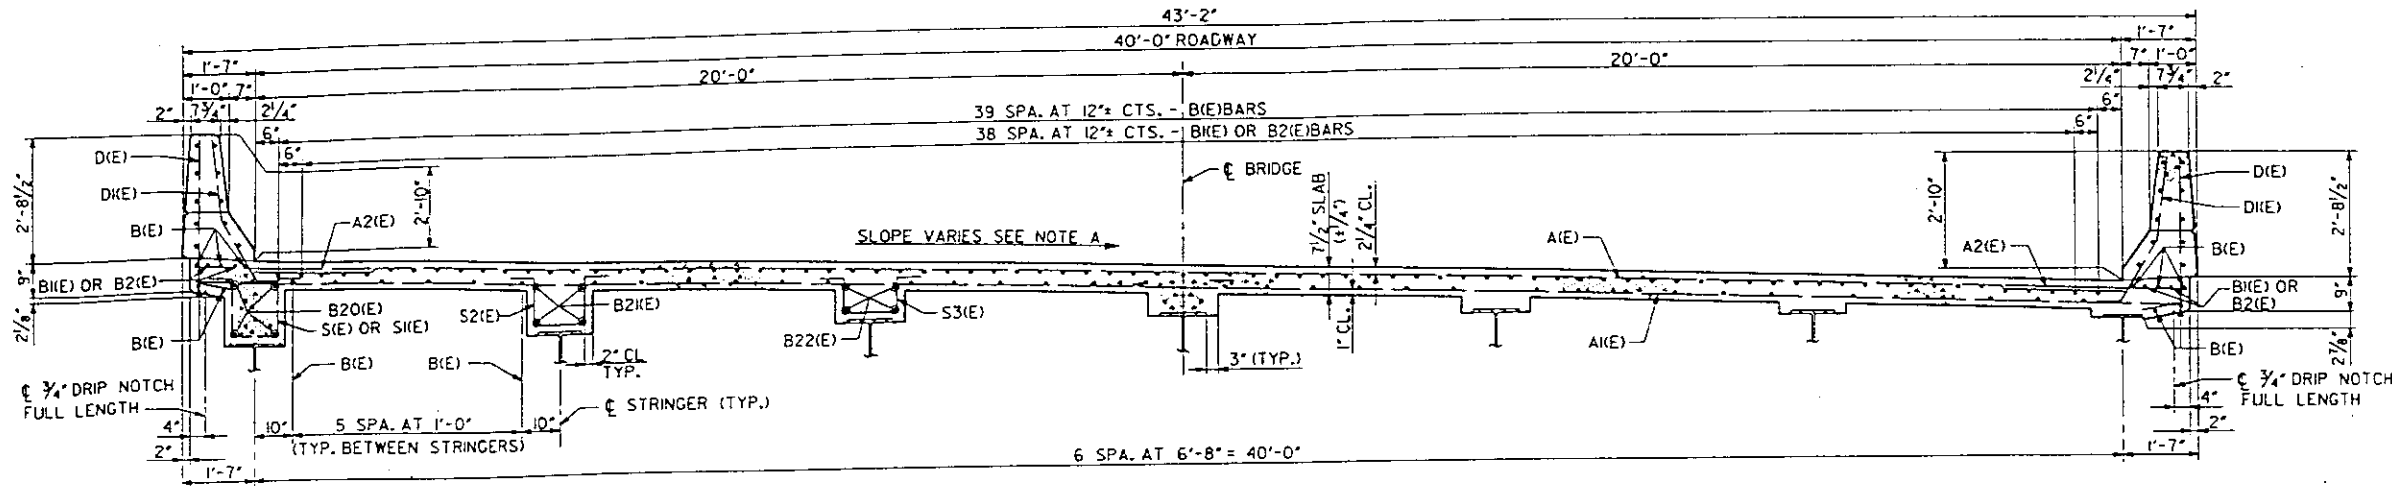


CROSS SECTION FOR SPANS 33 AND 34


NOTE A: FOR TOP OF SLAB STA. 60+81.24 TO STA. 61+71.00 SEE SUPERELEVATION TRANSITION.
TOP OF SLAB FROM STA. 61+71.00 TO STA. 61+97.91 IS A PARABOLIC CROWN WITH A 3" MIDORDINATE AT ϵ BRIDGE.

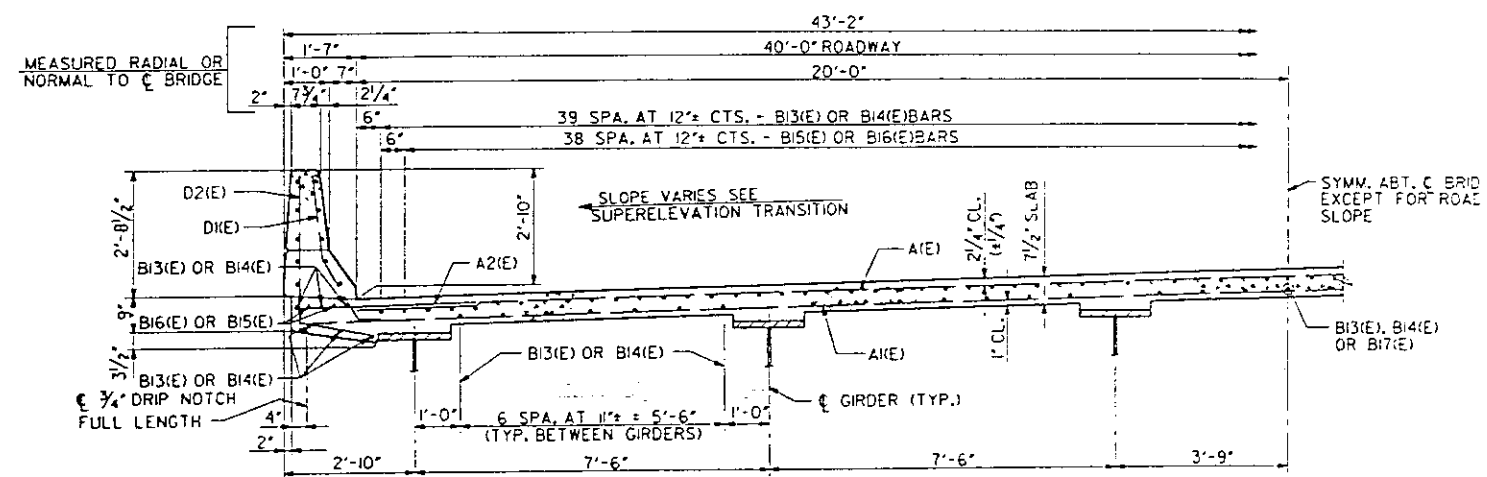

CROSS SECTION FOR SPANS 45A THRU 47A

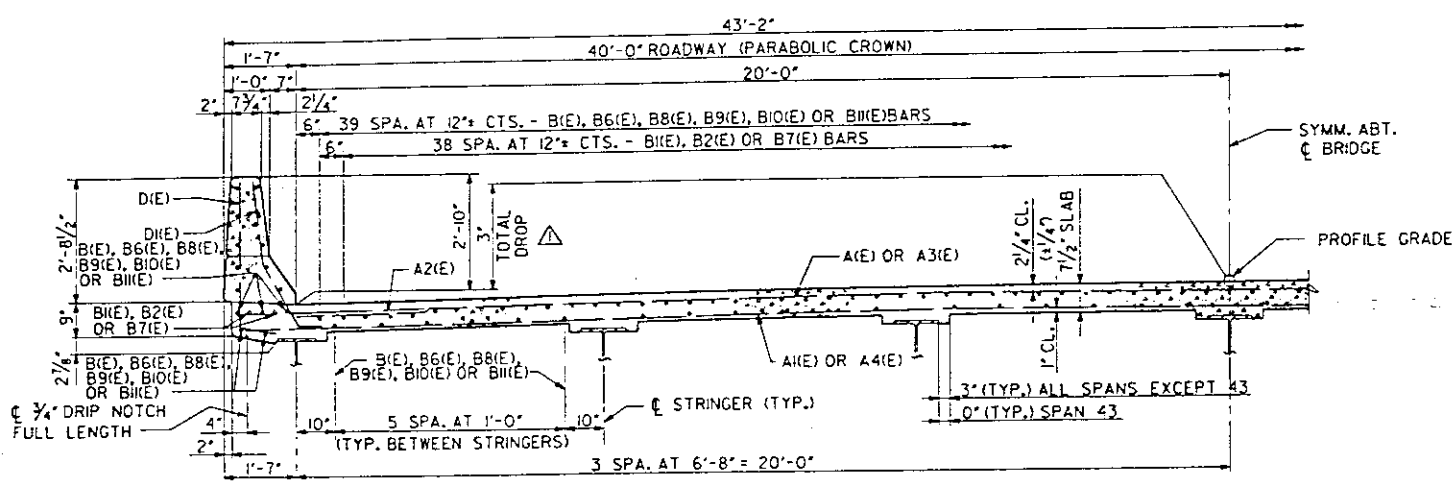

CROSS SECTION FOR SPANS 35 THRU 37 AND 39 THRU 43

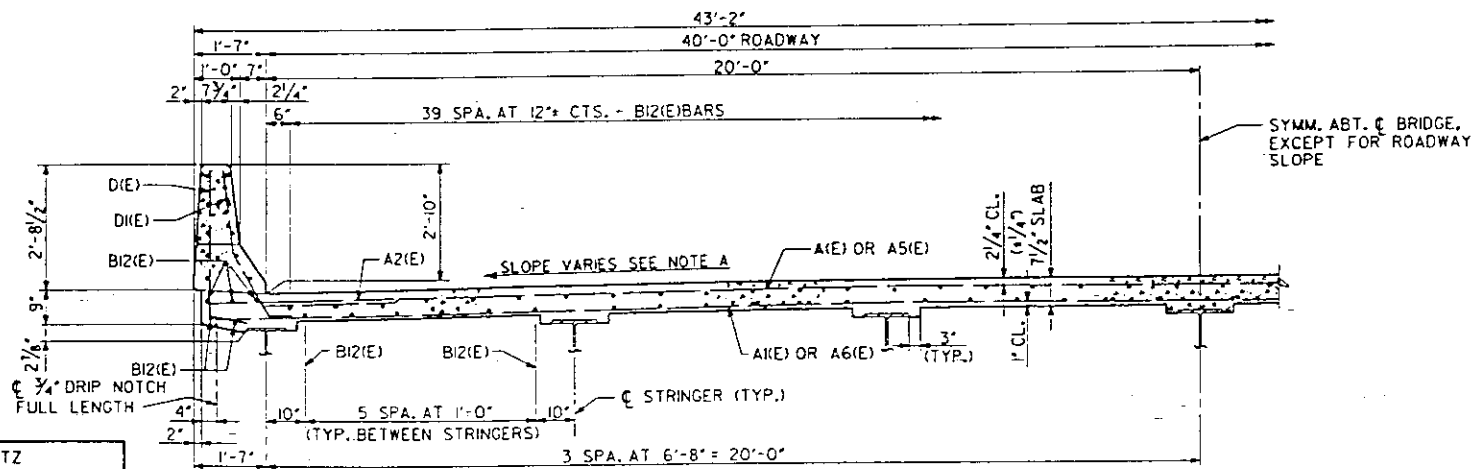

CROSS SECTION FOR SPAN 44

NOTE A: TOP OF SLAB FROM STA. 69+51.29 TO STA. 70+30.00 IS A PARABOLIC CROWN WITH A 3" MIDORDINATE AT ϵ BRIDGE.
FOR STA. 70+30.00 TO STA. 72+05.00 SEE SUPERELEVATION TRANSITION.

NOTES

WORK THIS SHEET WITH SHEETS 13 THRU 16.
FOR SUPERELEVATION TRANSITIONS, SEE SHEETS 7, 8, 14 AND 15.

REHABILITATION FOR
APPROACH BRIDGE OVER
I-55/70 W.B., MISSOURI AVE. AND TRF

SLAB DETAILS - SPANS
33 THRU 37 AND 39 THRU 47A

STRUCTURE NO. 082-6003
STA. 65+00 (FAP 799) ST. CLAIR CO.

10358
875854
F31(5)JSLABIA.DGN
SLABIA
LEVELS PLOTTED
35.56, 57.58 & 63
DATE: OCT. 23, 1987

R. NIEMIETZ
DESIGNED
K. LARSON
CHECKED
J.G. CORLEY
DRAWN
P.W. CLARK
CHECKED


PREPARED BY:
SVERDRUP CORPORATION
ST. LOUIS, MISSOURI

REV. 12-4-87

SECTION IBR-1

SHEET NO. 17 OF 75


FOR INFORMATION ONLY

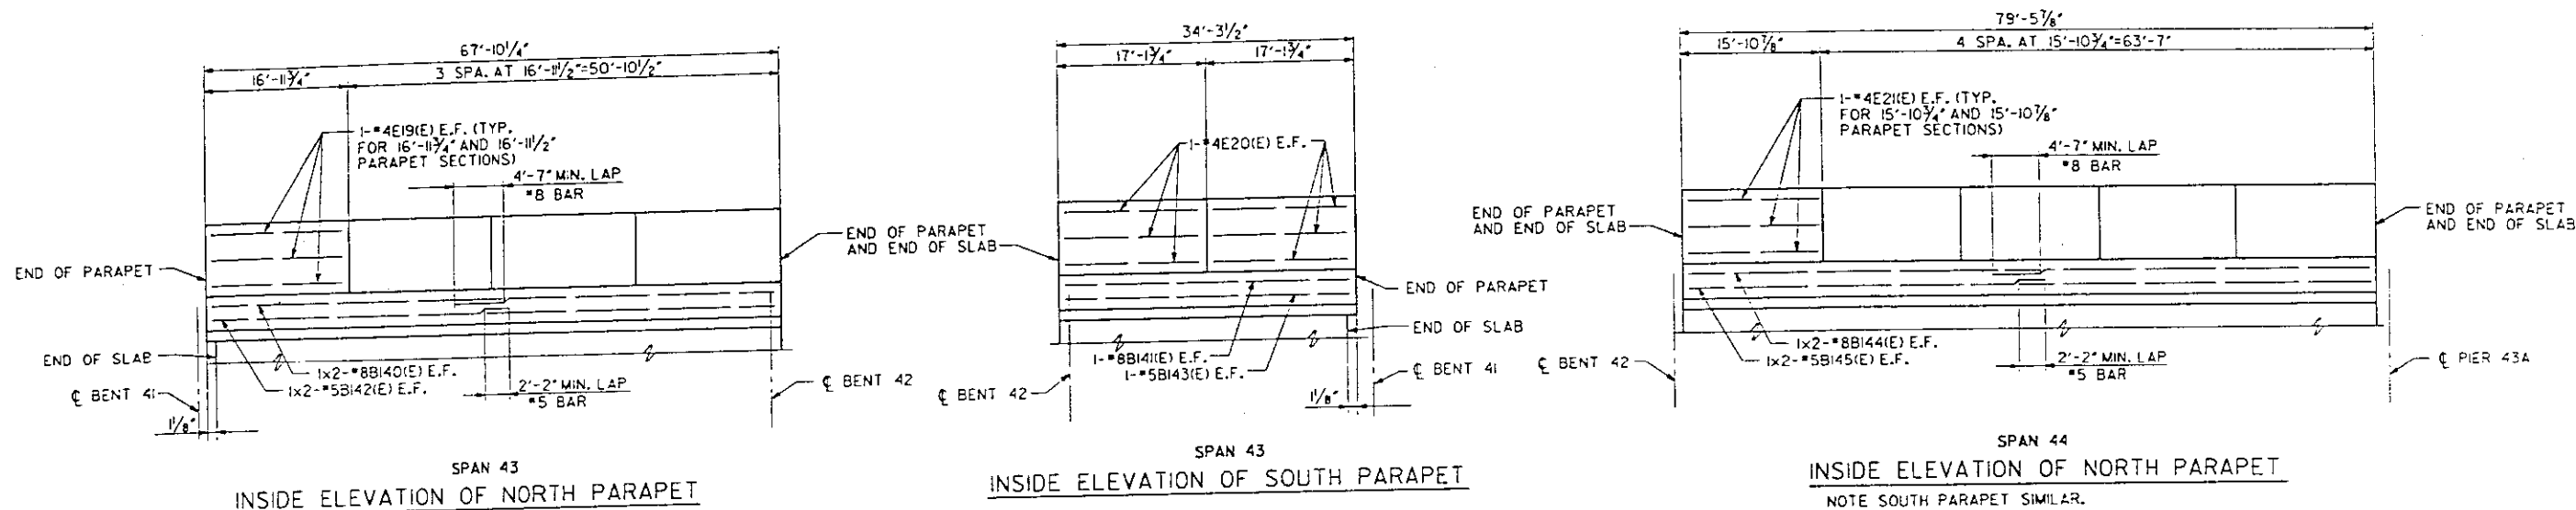

SPAN 43
INSIDE ELEVATION OF NORTH PARAPET


SPAN 43
INSIDE ELEVATION OF SOUTH PARAPET

SPAN 44
INSIDE ELEVATION OF NORTH PARAPET
NOTE SOUTH PARAPET SIMILAR.

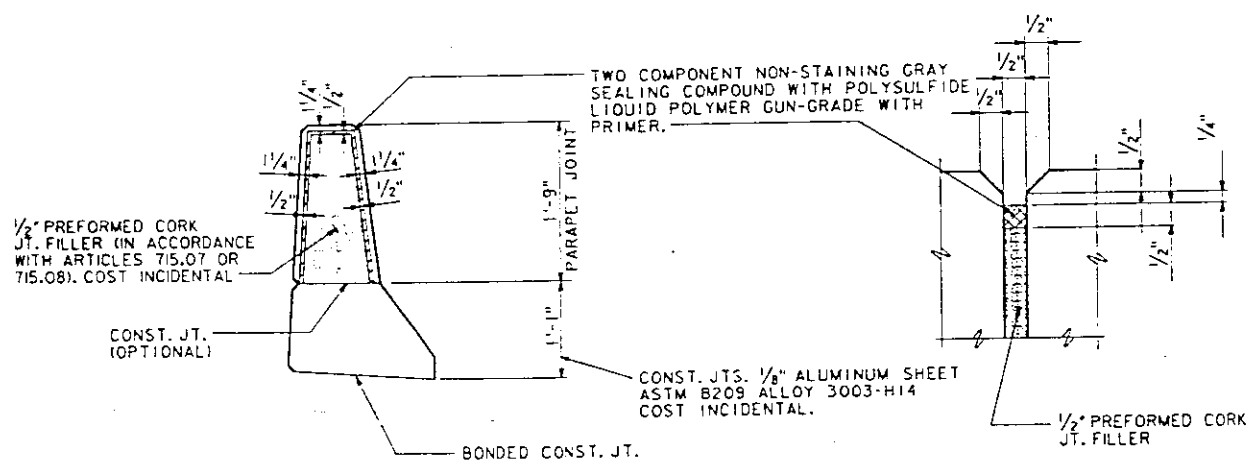

PARAPET JOINT DETAILS

NOTE: ALL EDGES SHALL HAVE A 3/4" CHAMFER, EXCEPT AS SHOWN.

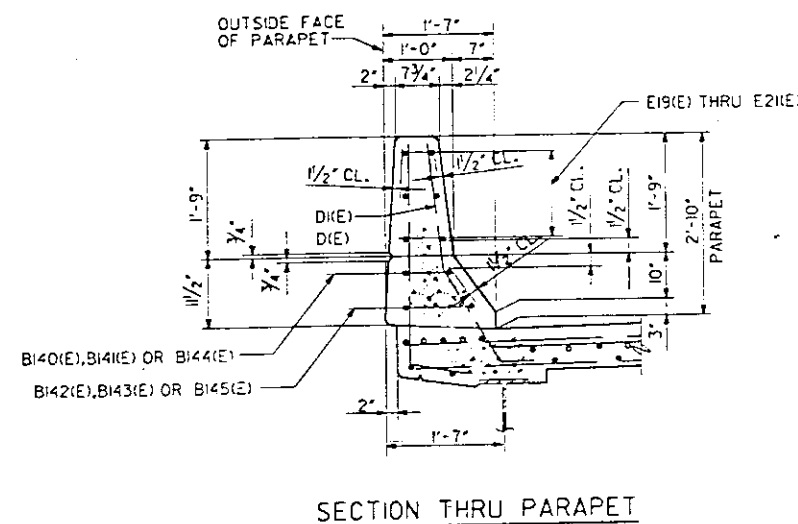

SECTION THRU PARAPET

NOTES

E.F. INDICATES EACH FACE.
ALL DIMENSIONS ARE MEASURED ALONG OUTSIDE FACE OF PARAPETS.
FOR BILL OF MATERIAL, SEE SHEET 21.
FOR LOCATION AND DETAILS OF ROADWAY LIGHTING, SEE SHEET 35.
SEE ELECTRICAL DRAWINGS FOR LOCATION AND LIMITS OF CONDUIT IN PARAPETS.

REHABILITATION FOR
APPROACH BRIDGE OVER
I-55/70 W.B., MISSOURI AVE. AND TR
PARAPET - SPANS 43 AND 44

STRUCTURE NO. 082-6003
STA. 65+00 (FAP 799) ST. CLAIR CO.

PREPARED BY:
SVERDRUP CORPORATION
ST. LOUIS, MISSOURI


SECTION IBR-1


SHEET NO. 19 OF 17

10358
875880
ZF3(15)DETAIL 96.DGN
DETAIL 96
LEVELS PLOTTED
35.56.57.58.63
DATE: OCT. 23, 1987


DESIGNED	R. NIEMIETZ
CHECKED	K. LARSON
DRAWN	J.G. CORLEY
CHECKED	P.W. CLARK

FOR INFORMATION ONLY

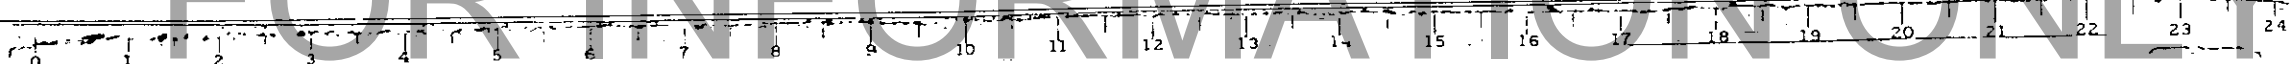

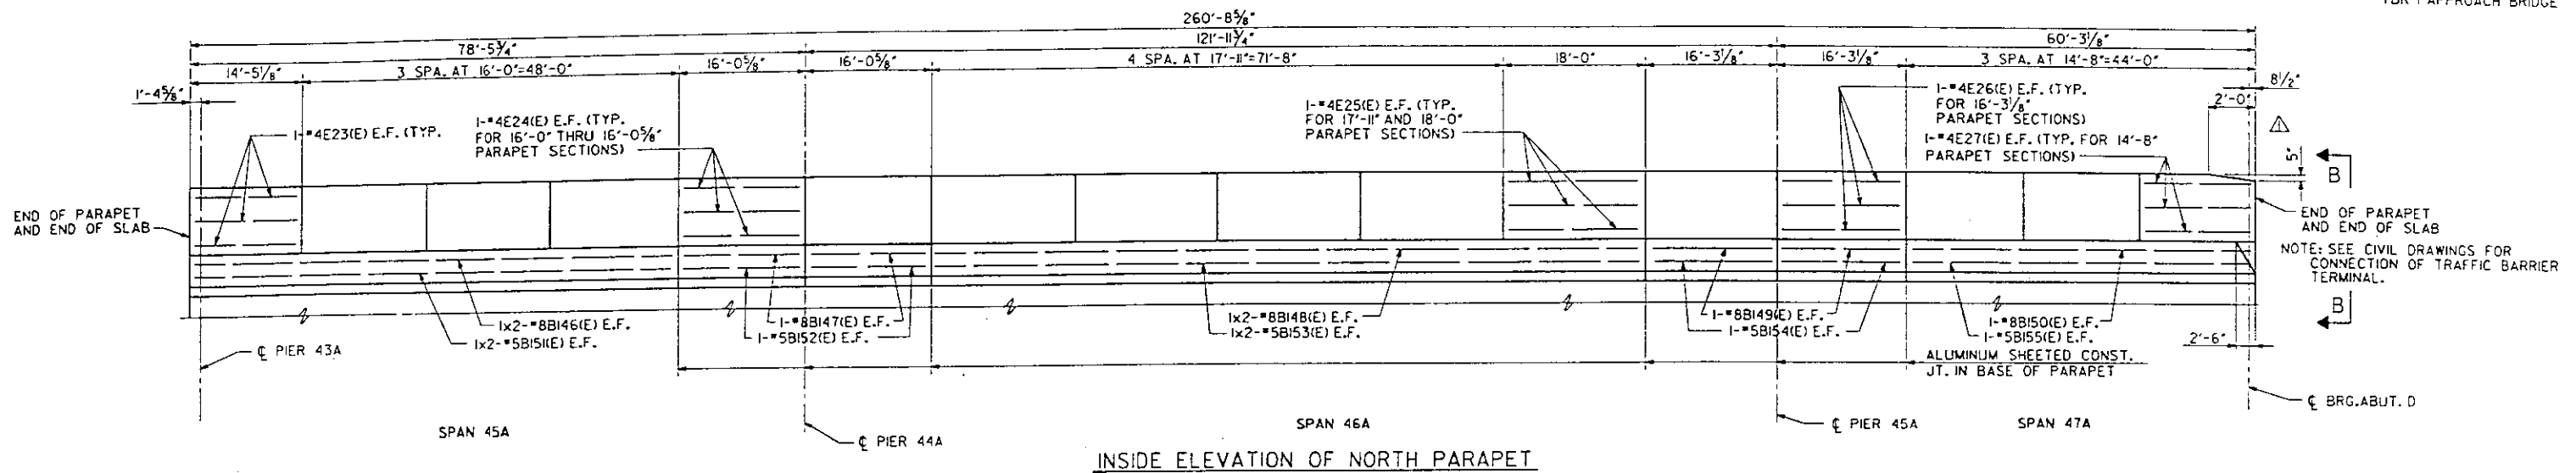


INSIDE ELEVATION OF NORTH PARAPET

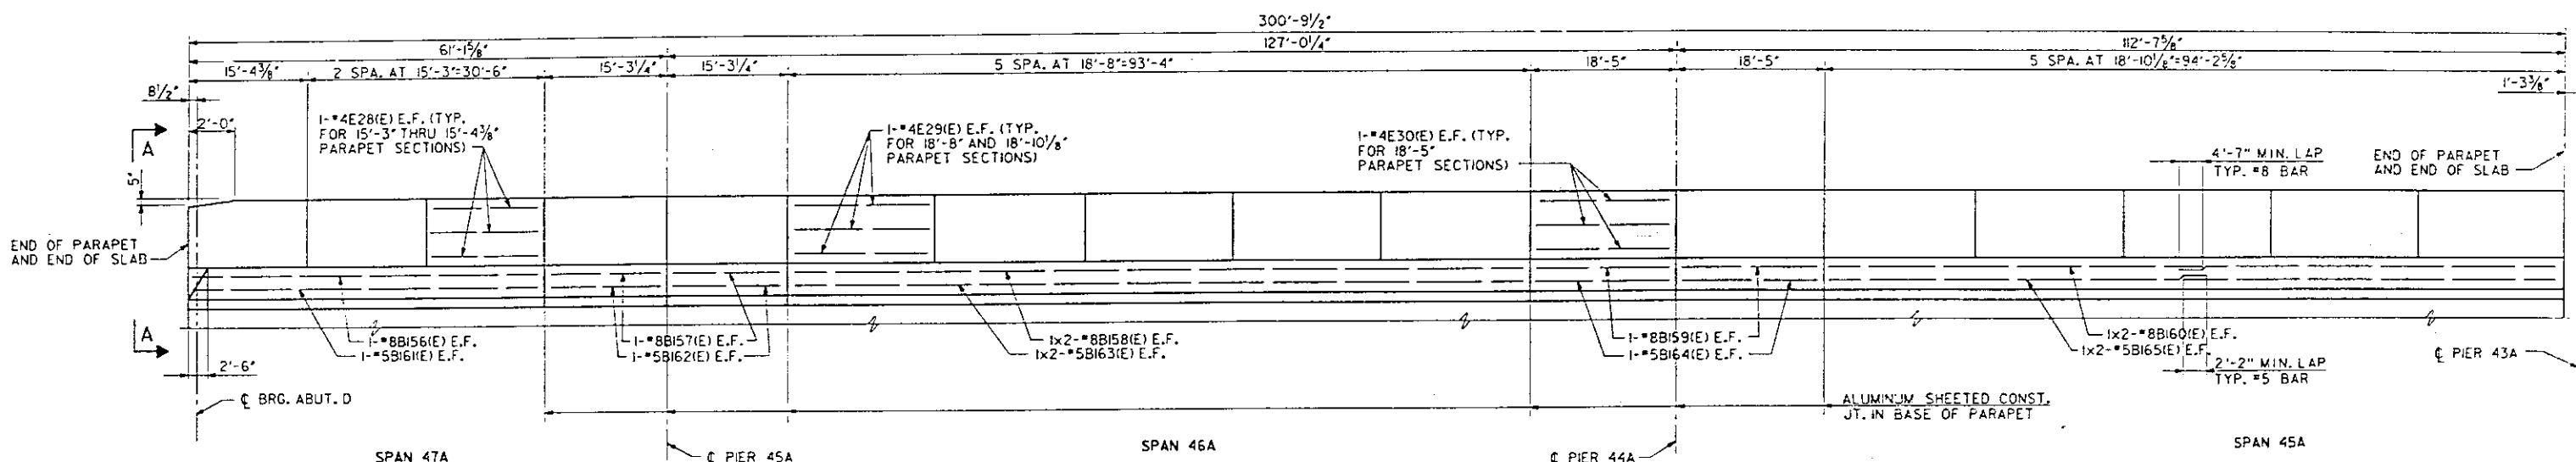


INSIDE ELEVATION OF SOUTH PARAPET

NOTE: SEE CIVIL DRAWINGS FOR CONNECTION OF TRAFFIC BARRIER TERMINAL.

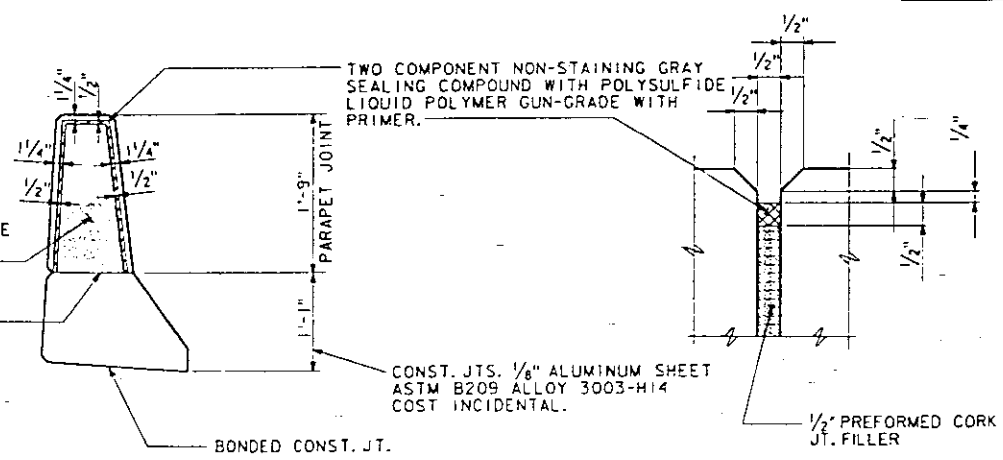


PARAPET JOINT DETAILS

NOTE: ALL EDGES SHALL HAVE A 1/4" CHAMFER, EXCEPT AS SHOWN.

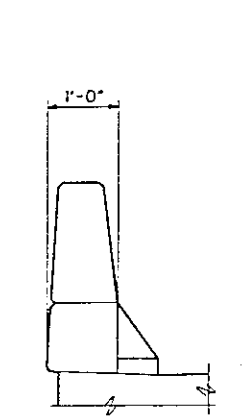

VIEW A-A
VIEW B-B OPPOSITE HAND

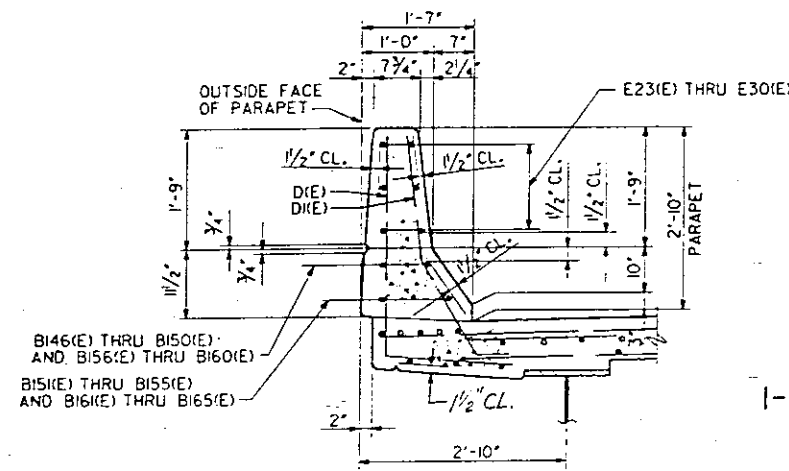

SECTION THRU PARAPET

NOTES

E.F. INDICATES EACH FACE.
ALL DIMENSIONS ARE MEASURED ALONG OUTSIDE FACE OF PARAPETS, UNLESS OTHERWISE NOTED.
FOR BILL OF MATERIAL, SEE SHEET 21.
FOR LOCATION AND DETAILS OF ROADWAY LIGHTING, SEE SHEETS 35.
SEE ELECTRICAL DRAWINGS FOR LOCATION AND LIMITS OF CONDUIT IN PARAPET.

REHABILITATION FOR
APPROACH BRIDGE OVER
I-55/70 W.B., MISSOURI AVE. AND TRRA
PARAPET - SPANS 45A THRU 47A

STRUCTURE NO. 082-6003
STA. 65+00 (FAP 799) ST. CLAIR CO.

LEVELS PLOTTED DATE: OCT. 23, 1987
F.31(51)JDE:TAIL 95.DGN 35.56.57.58.63
PREF. DETAIL 95

DESIGNED	R. NIEMIETZ
CHECKED	K. LARSON
CHECKED	J.G. CORLEY
DRAWN	P.W. CLARK
CHECKED	

PREPARED BY
SVERDRUP CORPORATION
ST. LOUIS, MISSOURI

REV. 12-4-87

SECTION IBR-1


SHEET NO. 20 OF 75

FOR INFORMATION ONLY

* IBR M.L.KING BRIDGE

BILL OF MATERIAL

SPANS 33 THRU 37					SPANS 39 AND 40					SPAN 41					SPAN 42					SPAN 43					SPAN 44					SPANS 45A THRU 47A									
BAR	NO.	SIZE	LENGTH	SHAPE	BAR	NO.	SIZE	LENGTH	SHAPE	BAR	NO.	SIZE	LENGTH	SHAPE	BAR	NO.	SIZE	LENGTH	SHAPE	BAR	NO.	SIZE	LENGTH	SHAPE	BAR	NO.	SIZE	LENGTH	SHAPE	BAR	NO.	SIZE	LENGTH	SHAPE	BAR	NO.	SIZE	LENGTH	SHAPE
A1(E)	921	*5	42'-7"	---	A1(E)	401	*5	42'-7"	---	A1(E)	248	*5	42'-7"	---	A1(E)	246	*5	42'-7"	---	A1(E)	104	*5	42'-7"	---	A1(E)	143	*5	42'-7"	---	A1(E)	935	*5	42'-7"	---					
A2(E)	548	*6	4'-0"	---	A2(E)	238	*6	4'-0"	---	A2(E)	148	*6	4'-0"	---	A2(E)	146	*6	4'-0"	---	A2(E)	92	*6	4'-0"	---	A2(E)	146	*6	4'-0"	---	A2(E)	567	*6	4'-0"	---					
B1(E)	946	*5	28'-5"	---	B6(E)	430	*5	27'-1"	---	B8(E)	258	*5	27'-6"	---	B9(E)	258	*5	27'-10"	---	B10(E)	86	*5	31'-10"	---	B12(E)	258	*5	27'-7"	---	B13(E)	783	*5	30'-0"	---					
B2(E)	86	*6	20'-4"	---	B7(E)	43	*6	28'-0"	---	B109(E)	8	*8	41'-10"	---	B110(E)	8	*8	42'-4"	---	B11(E)	23	*5	41'-3"	---	B14(E)	23	*5	52'-5"	---										
B20(E)	8	*5	30'-2"	---	B106(E)	8	*8	34'-3"	---	B125(E)	8	*5	40'-8"	---	B126(E)	8	*5	41'-1"	---	B23(E)	20	*5	41'-3"	---	B15(E)	43	*6	60'-0"	---										
B21(E)	4	*5	38'-8"	---	B107(E)	8	*8	10'-11"	---	D1(E)	160	*4	3'-11"	---	B140(E)	4	*8	36'-1"	---	B16(E)	43	*6	40'-7"	---															
B22(E)	4	*5	13'-11"	---	B108(E)	4	*8	41'-8"	---	D1(E)	174	*5	3'-11"	---	B141(E)	2	*8	34'-0"	---	B17(E)	1	*5	26'-2"	---															
B100(E)	4	*8	46'-4"	---	B122(E)	8	*5	33'-1"	---	D1(E)	162	*4	3'-11"	---	B142(E)	4	*5	34'-10"	---	B25(E)	20	*5	52'-5"	---															
B101(E)	16	*8	7'-10"	---	B123(E)	8	*5	10'-11"	---	D1(E)	176	*5	3'-11"	---	B143(E)	2	*5	34'-0"	---	B146(E)	4	*8	33'-5"	---															
B102(E)	8	*8	45'-10"	---	B124(E)	4	*5	41'-8"	---	D1(E)	3	*6	4'-5"	---	D1(E)	102	*4	3'-11"	---	B147(E)	4	*8	15'-9"	---															
B103(E)	16	*8	7'-7"	---	D1(E)	258	*4	3'-11"	---	D1(E)	5	*6	8'-11"	---	D1(E)	174	*5	3'-11"	---	B148(E)	4	*8	47'-0"	---															
B104(E)	4	*8	46'-1"	---	D1(E)	282	*5	3'-11"	---	E7(E)	48	*4	19'-7"	---	E2(E)	60	*4	15'-7"	---	B149(E)	4	*8	16'-0"	---															
B105(E)	4	*8	46'-8"	---	D10(E)	3	*6	4'-5"	---	BX(E)	16	*5	3'-0"	---	D1(E)	40	*5	4'-1"	---	B150(E)	2	*8	43'-9"	---															
B116(E)	4	*5	46'-4"	---	D11(E)	5	*6	8'-11"	---	E4(E)	60	*4	15'-9"	---	BX(E)	16	*5	3'-0"	---	B151(E)	4	*5	32'-2"	---															
B117(E)	16	*5	7'-10"	---	E4(E)	48	*4	15'-9"	---	BX(E)	16	*5	3'-0"	---	E19(E)	24	*4	16'-8"	---	B152(E)	4	*5	15'-9"	---															
B118(E)	8	*5	45'-10"	---	E5(E)	24	*4	10'-11"	---	E4(E)	16	*5	3'-0"	---	E20(E)	12	*4	16'-10"	---	B153(E)	4	*5	45'-9"	---															
B119(E)	16	*5	7'-7"	---	E6(E)	36	*4	13'-8"	---	E19(E)	16	*5	3'-0"	---	BX(E)	16	*5	3'-0"	---	B154(E)	4	*5	16'-0"	---															
B120(E)	4	*5	46'-1"	---	BX(E)	32	*5	3'-0"	---	E20(E)	16	*5	3'-0"	---	BX(E)	16	*5	3'-0"	---	B155(E)	2	*5	43'-9"	---															
B121(E)	4	*5	46'-8"	---	CLASS X CONCRETE SS	CU. YDS.	99.6			BX(E)	16	*5	3'-0"	---	BX(E)	16	*5	3'-0"	---	B156(E)	2	*8	45'-7"	---															
D1(E)	592	*4	3'-11"	---	REINFORCEMENT BARS EPOXY COATED	LBS.	22,345			CLASS X CONCRETE SS	CU. YDS.	100.9			REINFORCEMENT BARS EPOXY COATED	LBS.	14,116			B157(E)	4	*8	15'-0"	---															
D1(E)	642	*5	3'-11"	---	CLASS X CONCRETE SS	CU. YDS.	161.5			CLASS X CONCRETE SS	CU. YDS.	63.7			REINFORCEMENT BARS EPOXY COATED	LBS.	22,545			B158(E)	4	*8	48'-10"	---															
D2(E)	4	*5	3'-2"	---	REINFORCEMENT BARS EPOXY COATED	LBS.	38,169			CLASS X CONCRETE SS	CU. YDS.	102.1			REINFORCEMENT BARS EPOXY COATED	LBS.	22,545			B159(E)	4	*8	18'-2"	---															
D10(E)	6	*6	4'-5"	---	SS INDICATES SUPERSTRUCTURE					CLASS X CONCRETE SS	CU. YDS.	370.0								B160(E)	4	*8	49'-3"	---															
D11(E)	10	*6	8'-11"	---						REINFORCEMENT BARS EPOXY COATED	LBS.	89,738								B161(E)	2	*5	45'-7"	---															
E1(E)	144	*4	15'-1"	---																B162(E)	4	*5	15'-0"	---															
E11(E)	48	*4	7'-10"	---																B163(E)	4	*5	47'-8"	---															
E2(E)	48	*4	7'-7"	---																B164(E)	4	*5	18'-2"	---															
E3(E)	36	*4	15'-4"	---																B165(E)	4	*5	48'-1"	---															
S1(E)	30	*4	4'-7"	---																D1(E)	608	*5	3'-11"	---															
S11(E)	29	*4	3'-11"	---																D2(E)	4	*5	3'-2"	---															
S2(E)	39	*4	4'-0"	---																D4(E)	561	*4	4'-11"	---															
S3(E)	14	*4	3'-6"	---																D10(E)	6	*6	4'-5"	---															
X1(E)	80	*5	4'-1"	---																D11(E)	10	*6	8'-11"	---															
BX1(E)	64	*5	3'-0"	---																E23(E)	6	*4	14'-2"	---															
CLASS X CONCRETE SS	CU. YDS.	370.0																		E24(E)	30	*4	15'-9"	---															
REINFORCEMENT BARS EPOXY COATED	LBS.	89,738																		E25(E)	30	*4	17'-8"	---															

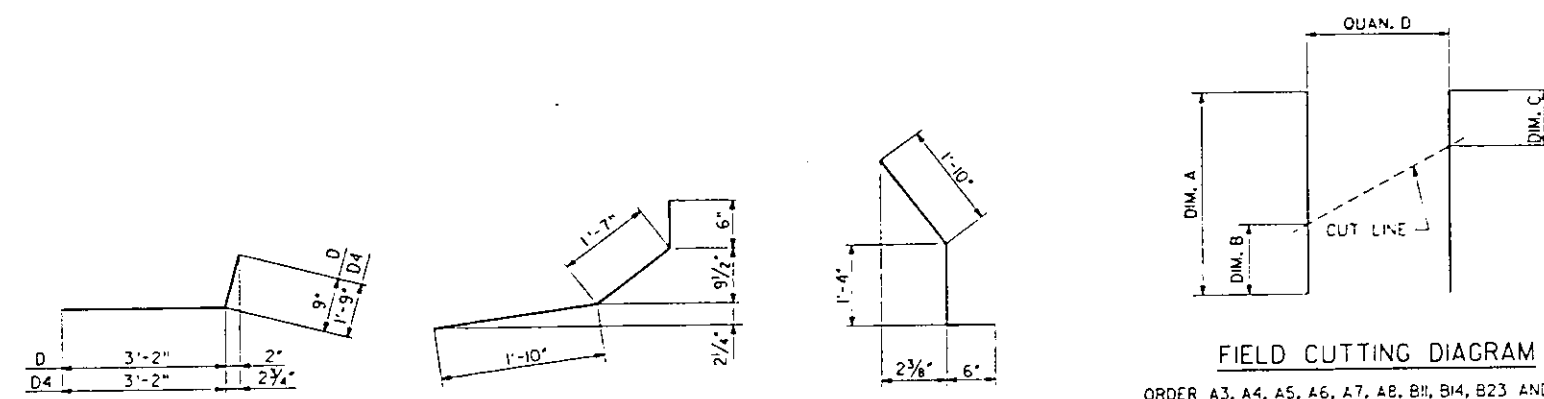

ORDER A3, A4, A5, A6, A7, AB, B11, B14, B23 AND B25 BARS FULL LENGTH, CUT TO FIT AS SHOWN AND USE REMAINING BARS AS INDICATED IN PLAN.

BAR	DIM. A	DIM. B	DIM. C	QUAN. D
A3	43'-1"	2'-6"	21'-10"	30
A4	42'-6"	1'-11"	21'-9"	21
A5	42'-7"	1'-11"	1'-11"	61
A6	42'-6"	1'-11"	1'-11"	42
A7	42'-8"	2'-0"	21'-7"	33
AB	42'-1"	1'-7"	21'-5"	25
B11	41'-3"	3'-10"	21'-0"	23
B14	52'-5"	6'-2"	26'-3"	23
B23	41'-3"	3'-10"	21'-0"	20
B25	52'-5"	6'-2"	26'-3"	20

NOTES
FOR LOCATION OF BX(E) BARS, SEE SHEETS 30 AND 31.
FOR LOCATION OF D10(E) AND D11(E) BARS, SEE SHEET 35.

REHABILITATION FOR
APPROACH BRIDGE OVER
I-55/70 W.B., MISSOURI AVE. AND TRRA
SLAB AND PARAPET BILL OF MATERIALS
SPANS 33 THRU 47A

STRUCTURE NO. 082-6003
STA. 65+00 (FAP 799) ST. CLAIR CO.

REV. 12-4-87

PREPARED BY:
SYVERDRUP CORPORATION
ST. LOUIS, MISSOURI


SECTION IBR-1

SHEET NO. 2 OF 75

3350 FILE: ZF31051.DBAR3.DGN
 LEVELS PLOTTED DATE: OCT. 23, 1987
 56, 57 & 63
 87593



DESIGNED
CHECKED
S. KAEMMERER
DRAWN
R.F. BECK
CHECKED

FOR INFORMATION ONLY

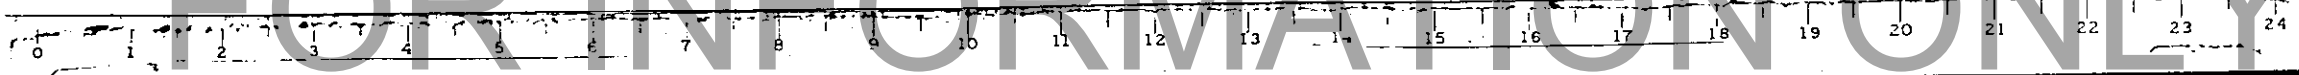


ROUTE NO.	SECTION	COUNTY	TOTAL SHEETS	SHEET NO.
FAP 799		ST. CLAIR	252	170
		LINE	PROJECT	

*IBR-1 APPROACH BRIDGE

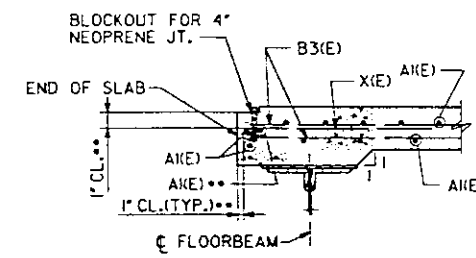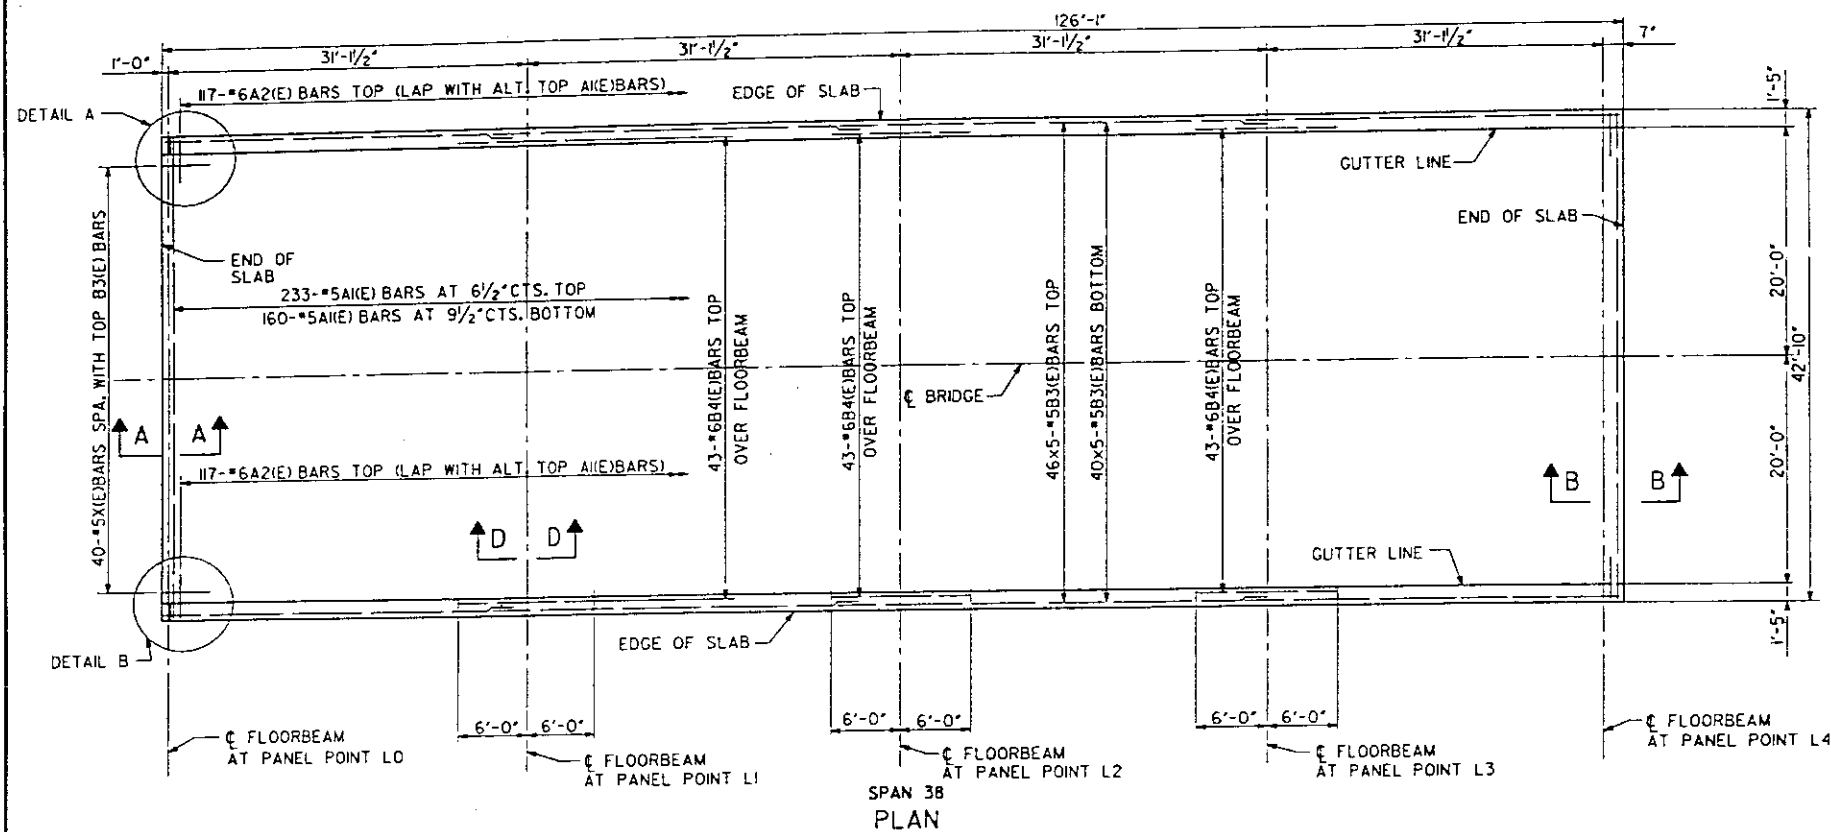


SECTION A-A


** PLACE A1(E) BARS IN BACK OF ANCHOR BOLT IF REQUIRED TO MAINTAIN 1" CL. (+0-1/8"). ANCHOR BOLTS SHOULD BE TIED TO A1(E) BAR.

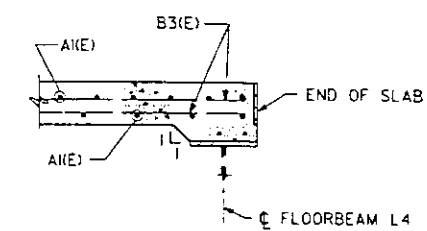

SECTION B-B


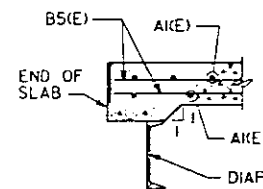


SECTION C-C

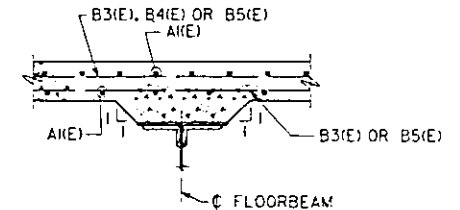


SECTION D-D

TYPICAL AT FLOORBEAMS L3 THRU L5 AND L5 THRU L7.

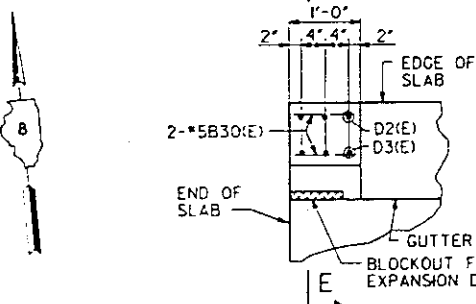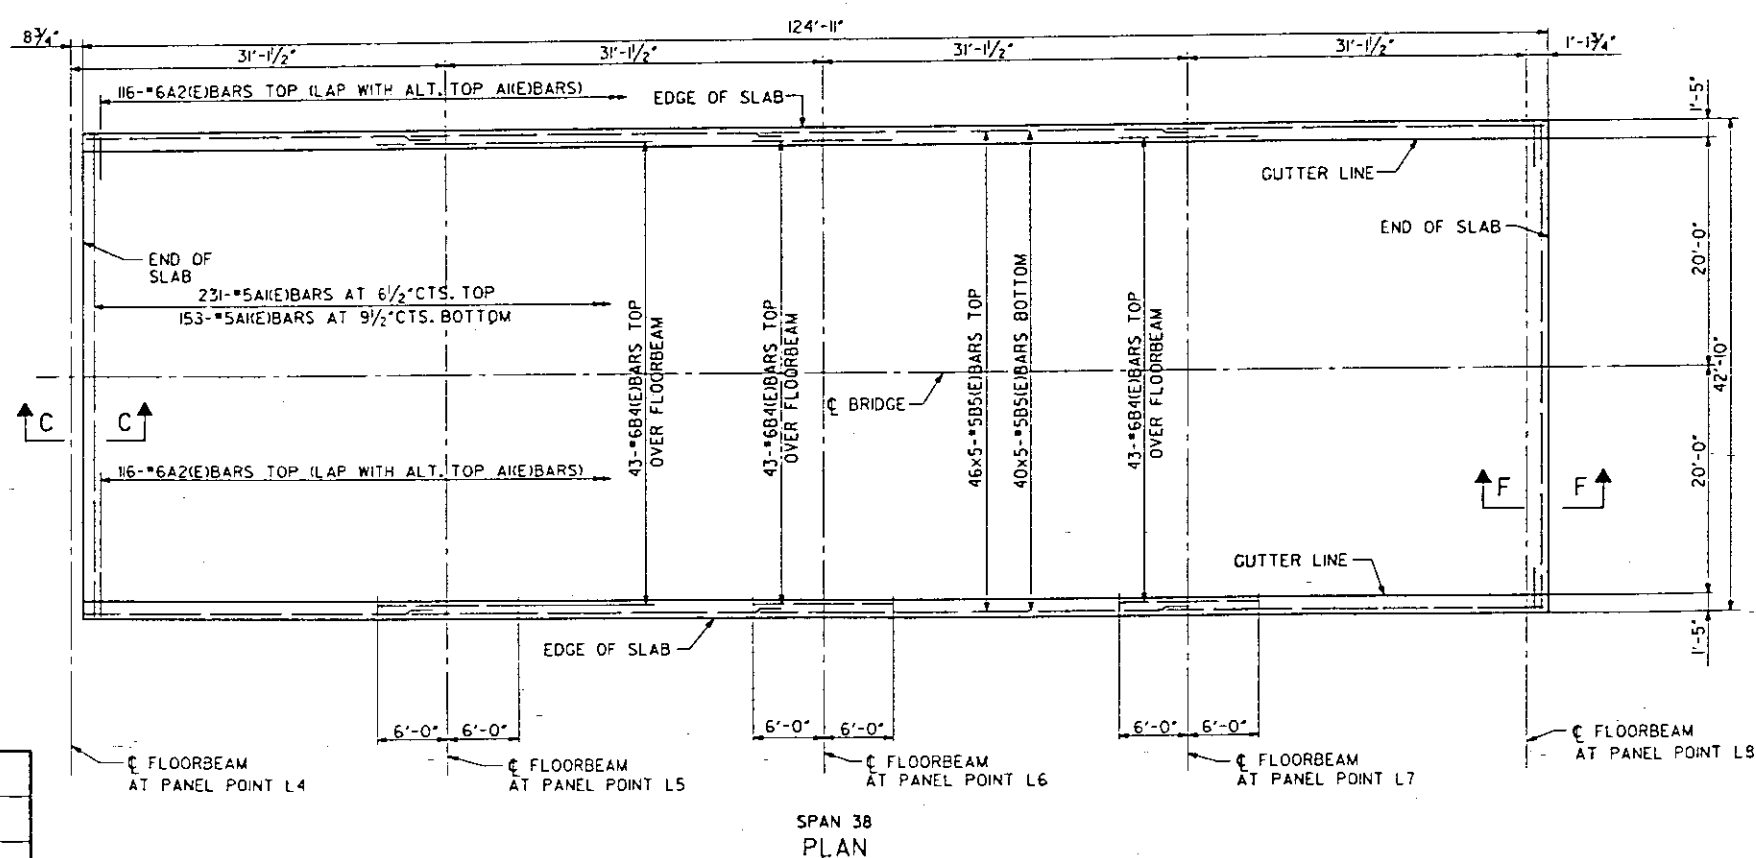

DETAIL A


DETAIL B OPPOSITE HAND

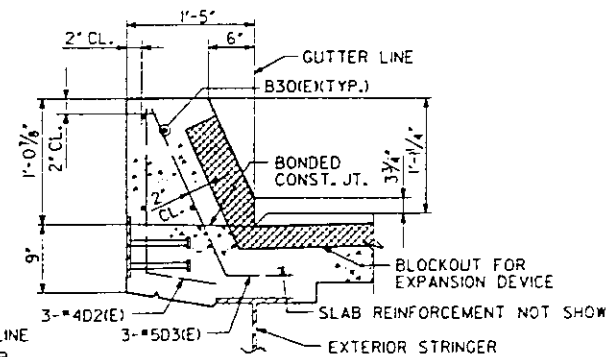

SECTION E-E

NOTES

WORK THIS SHEET WITH SHEETS 23, 24 AND 26.
BARS BILLED AS: 46x9-#5 ETC. INDICATES 46 LINES OF BARS WITH 9 LENGTHS PER LINE.
DRAINAGE SCUPPERS NOT SHOWN, SEE SHEET 30 AND 31 FOR LOCATION AND DETAILS.
ALL LONGITUDINAL BARS SHALL BE LAPPED 1'-9" MINIMUM.
LONGITUDINAL BARS SHALL BE SPACED AS SHOWN IN CROSS SECTIONS.

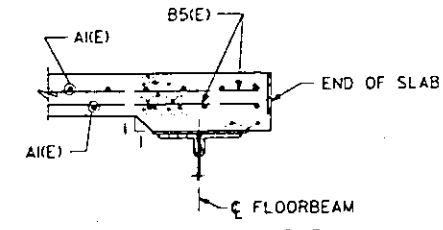

SECTION F-F

REHABILITATION FOR
APPROACH BRIDGE OVER
I-55/70 W.B., MISSOURI AVE. AND TRRA

SLAB PLAN - SPAN 38

STRUCTURE NO. 082-6003
STA. 65+00 (FAP 799) ST. CLAIR CO.

LEVELS PLOTTED DATE: OCT. 23, 1987
35, 56, 57, 58 & 63
FILE: E:\31\5\JSL14B12.DGN
PRF: SLAB2
875636

DESIGNED	R. NIEMIETZ
CHECKED	K. LARSON
DESIGNED	J. CORLEY
CHECKED	P. W. CLARK

PREPARED BY:
SVERDRUP CORPORATION
ST. LOUIS, MISSOURI

REV. 12-4-87


SECTION IBR-1

SHEET NO. 22 OF 75



FOR INFORMATION ONLY

ROUTE NO.	SECTION	COUNTY	TOTAL SHEETS	SHEET NO.
FAP 799	*	ST. CLAIR	252	1
LINE		PROJECT		

*1BR-1 APPROACH BRIDGE

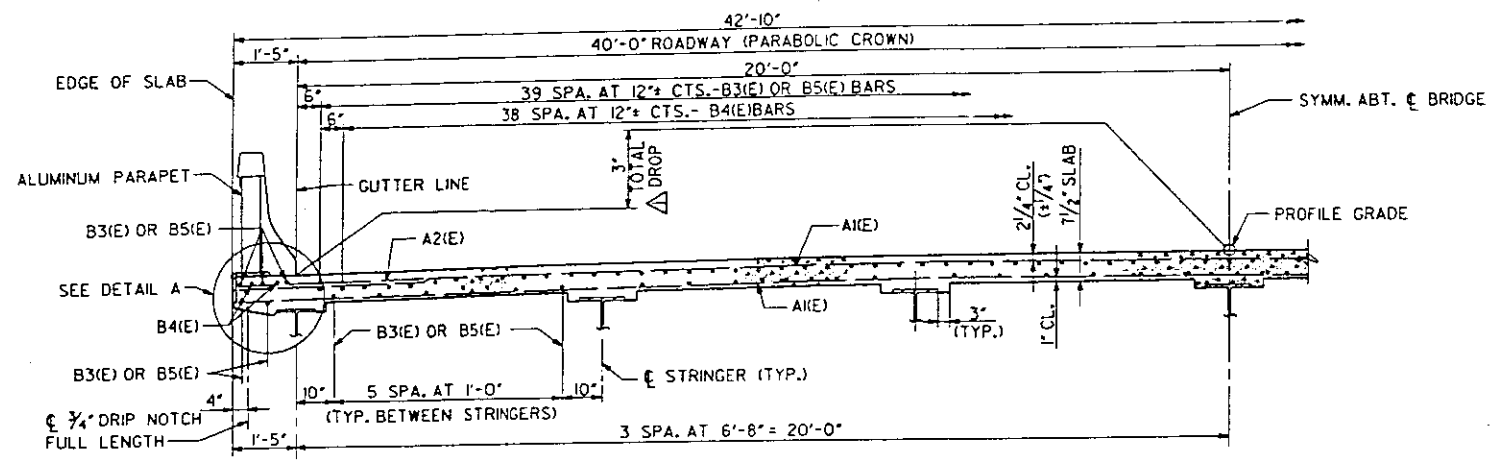

CROSS SECTION FOR SPAN 38

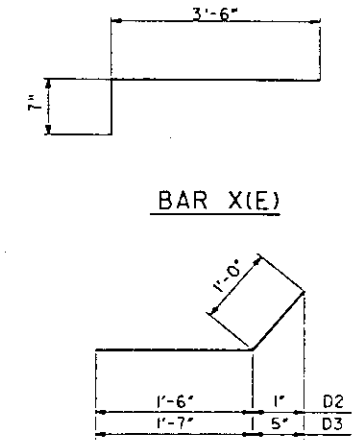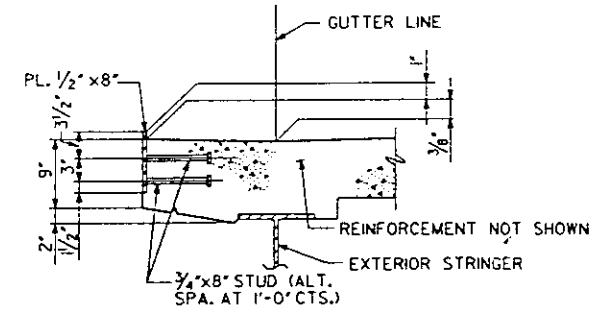


BAR	NO.	SIZE	LENGTH	SHA
A1(E)	782	#5	42'-7"	---
A2(E)	466	#6	4'-0"	---
B3(E)	430	#5	26'-7"	---
B4(E)	258	#6	12'-0"	---
B5(E)	430	#5	26'-4"	---
B30(E)	8	#5	9"	---
D2(E)	6	#4	2'-6"	---
D3(E)	6	#5	2'-7"	---
X(E)	40	#5	4'-1"	---
BX(E)	64	#5	3'-0"	---

CLASS X CONCRETE SS	CU. YDS.	26
REINFORCEMENT BARS EPOXY COATED	LBS.	66.

REINFORCEMENT BARS DESIGNATED (E) SH BE EPOXY COATED, SS INDICATED SUPERSTRUCTURE

LOCATION ALONG STRINGER	STRINGERS						
	S1	S2	S3	S4	S5	S6	S7
L0	3/4"	3/4"	13/16"	13/16"	13/16"	3/4"	3/4"
1/4	13/16"	13/16"	13/16"	13/16"	13/16"	13/16"	13/16"
1/2	13/16"	13/16"	13/16"	13/16"	13/16"	13/16"	13/16"
3/4	13/16"	13/16"	13/16"	13/16"	13/16"	13/16"	13/16"
L1	7/8"	13/16"	13/16"	13/16"	13/16"	13/16"	13/16"
1/4	13/16"	13/16"	13/16"	13/16"	13/16"	13/16"	13/16"
1/2	13/16"	13/16"	13/16"	13/16"	13/16"	13/16"	13/16"
3/4	13/16"	13/16"	13/16"	13/16"	13/16"	13/16"	13/16"
L2	11/16"	13/16"	13/16"	13/16"	13/16"	13/16"	13/16"
1/4	13/16"	13/16"	13/16"	13/16"	13/16"	13/16"	13/16"
1/2	13/16"	13/16"	13/16"	13/16"	13/16"	13/16"	13/16"
3/4	13/16"	13/16"	13/16"	13/16"	13/16"	13/16"	13/16"
L3	13/16"	13/16"	13/16"	13/16"	13/16"	13/16"	13/16"
1/4	13/16"	13/16"	13/16"	13/16"	13/16"	13/16"	13/16"
1/2	13/16"	13/16"	13/16"	13/16"	13/16"	13/16"	13/16"
3/4	13/16"	13/16"	13/16"	13/16"	13/16"	13/16"	13/16"
L4	1"	13/16"	13/16"	13/16"	13/16"	13/16"	13/16"
1/4	13/16"	13/16"	13/16"	13/16"	13/16"	13/16"	13/16"
1/2	13/16"	13/16"	13/16"	13/16"	13/16"	13/16"	13/16"
3/4	13/16"	13/16"	13/16"	13/16"	13/16"	13/16"	13/16"
L5	7/8"	13/16"	13/16"	13/16"	13/16"	13/16"	13/16"
1/4	13/16"	13/16"	13/16"	13/16"	13/16"	13/16"	13/16"
1/2	13/16"	13/16"	13/16"	13/16"	13/16"	13/16"	13/16"
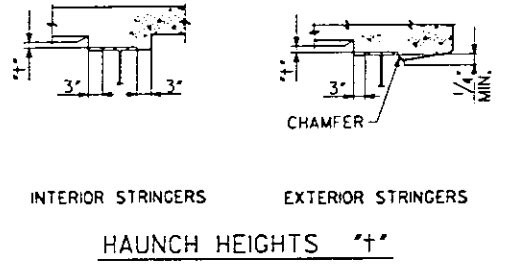

DESIGNED	R. NIEMIETZ
CHECKED	K. LARSON
DRAWN	J.G. CORLEY
CHECKED	P.W. CLARK

NOTES
WORK THIS SHEET WITH SHEET 22.
FOR LOCATION OF BX(E) BARS, SEE SHEETS 30 AND


REHABILITATION FOR
APPROACH BRIDGE OVER
I-55/70 W.B., MISSOURI AVE. AND TRF


SLAB DETAILS - SPAN 38
STRUCTURE NO. 082-6003
STA. 65+00 (FAP 799) ST. CLAIR CO.

PREPARED BY:
SVERDRUP CORPORATION
ST. LOUIS, MISSOURI
REV. 12-4-87

FOR INFORMATION ONLY


4-DEC-1987
LEVELS PLOTTED
DATE: OCT. 23, 1987
FILE: ZF316JSLAB2A.DGN
PRF: SLAB2A
35-56.51,58 & 63

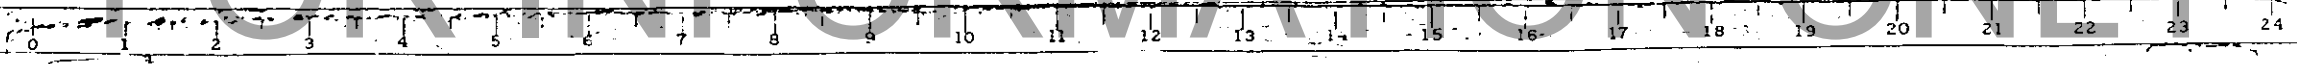

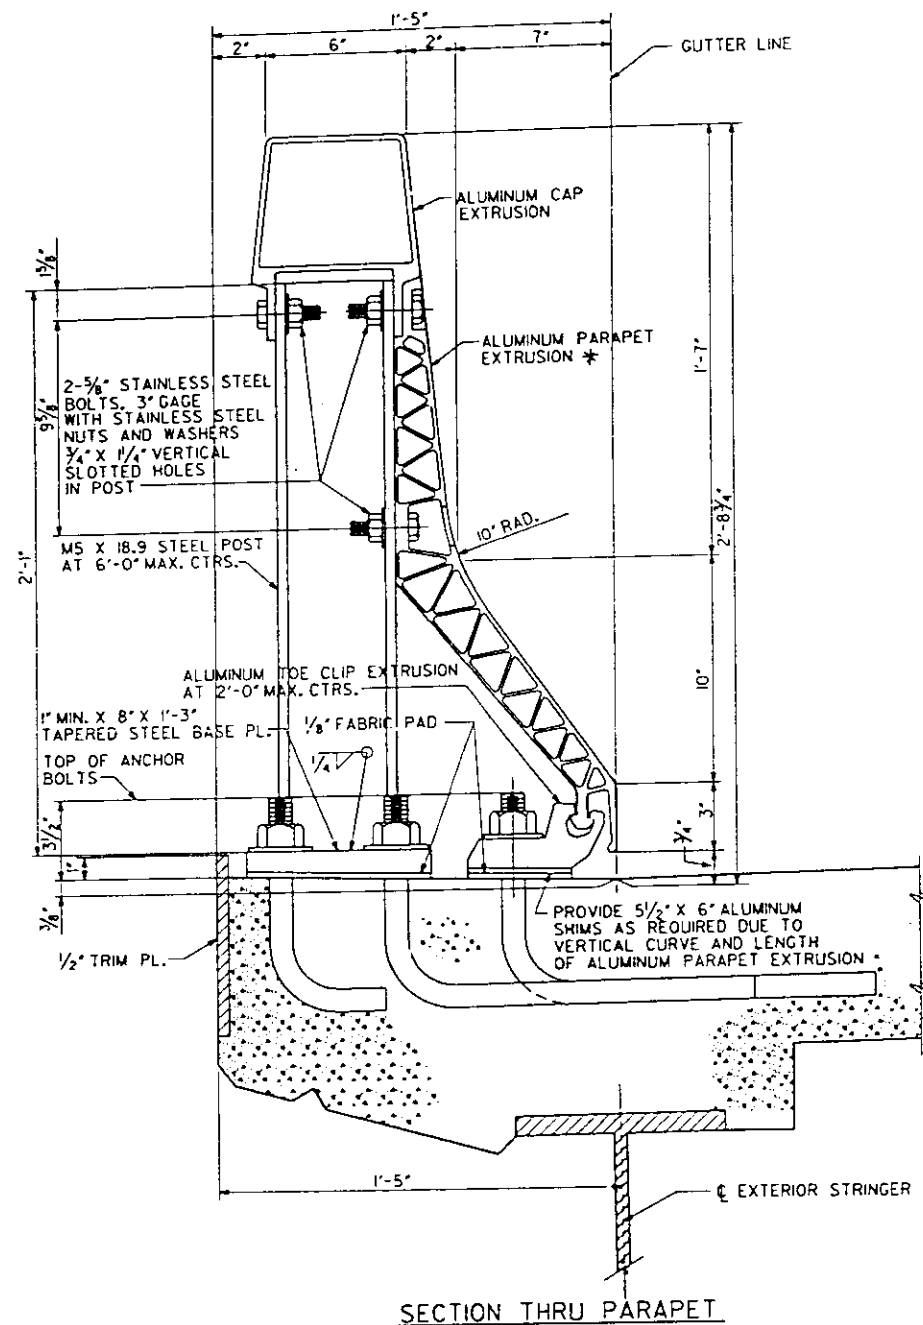


SECTION THRU PARAPET

* A two piece extrusion will be allowed in lieu of the one piece shown Δ

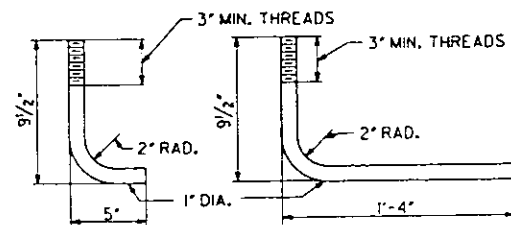

ANCHOR BOLT DETAILS

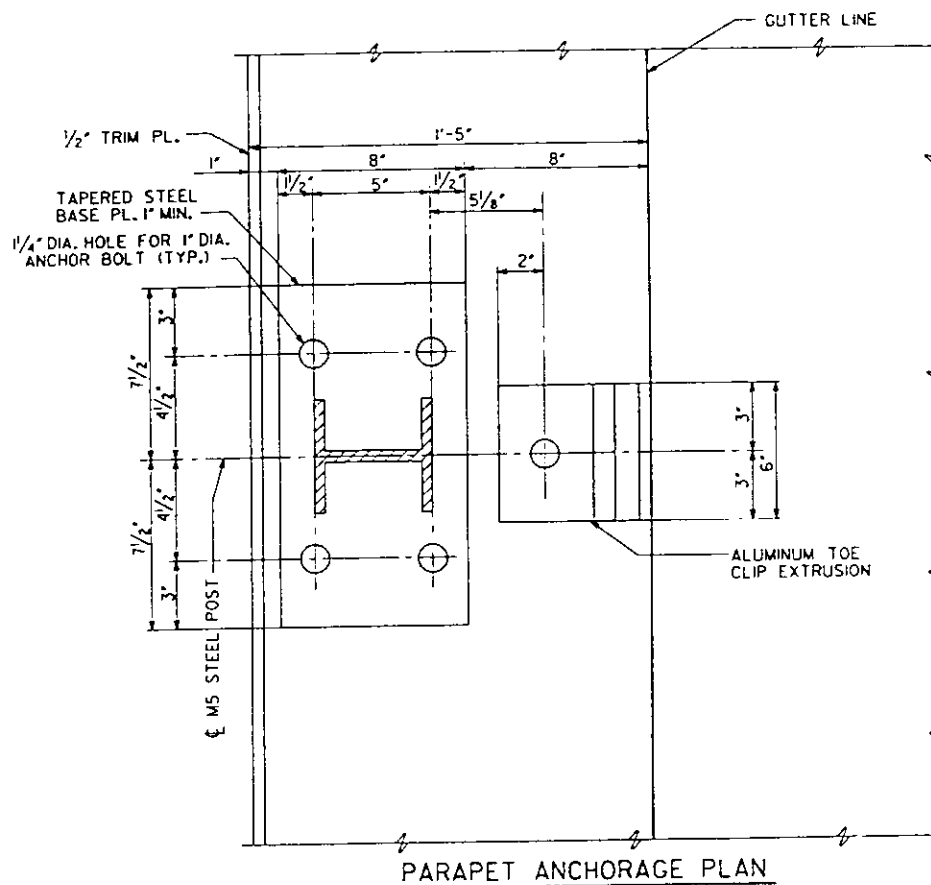

PARAPET ANCHORAGE PLAN

NOTES

- ALUMINUM ALLOY PARAPET SHALL CONFORM TO ASTM B221 ALLOY 6061-T6, EXCEPT FOR SPLICE PLATE WHICH SHALL CONFORM TO ASTM B209 OR B221 ALLOY 6061-T6.
- ALL STEEL SHAPES AND PLATES SHALL CONFORM TO THE REQUIREMENTS OF AASHTO M-183 EXCEPT POSTS SHALL CONFORM TO AASHTO M-188.
- PARAPET SHALL BE IN ACCORDANCE WITH SECTION 508 OF THE STANDARD SPECIFICATIONS, EXCEPT AS NOTED AND SHALL BE PAID FOR AT THE CONTRACT UNIT PRICE PER LINEAL FOOT FOR ALUMINUM PARAPET.
- ALL PORTIONS OF STEEL POSTS IN CONTACT WITH ALUMINUM SHALL RECEIVE TWO COATS OF ASPHALT PAINT CONFORMING TO SECTION 714.08, AND SHALL BE TYPE B.
- ALL STAINLESS STEEL HARDWARE FOR RAILINGS SHALL CONFORM TO SECTION 710.37.
- ALL POST AND ANCHOR DEVICES SHALL BE GALVANIZED AFTER SHOP FABRICATION IN ACCORDANCE WITH AASHTO M-11 AND ASTM A-385.
- ANCHOR BOLT MATERIAL SHALL CONFORM TO THE REQUIREMENTS OF AASHTO M-183.
- NUT AND WASHER MATERIAL FOR ANCHOR BOLTS SHALL CONFORM TO THE REQUIREMENTS OF ASTM A-307.
- ANCHOR BOLTS, WASHERS AND NUTS SHALL BE GALVANIZED IN ACCORDANCE WITH AASHTO M-232.
- THE UNIT PRICE PER LINEAL FOOT SHALL INCLUDE CAPS, PARAPET EXTRUSIONS, TOE CLIPS, POSTS, BASE PLATES, SPLICE AND SLIDING PLATES, BOLTS, NUTS, WASHERS, SHIMS, FABRIC PADS AND ANCHOR BOLTS ALONG WITH COMPLETE INSTALLATION.

REHABILITATION FOR
APPROACH BRIDGE OVER
I-55/70 W.B., MISSOURI AVE. AND TRRA

ALUMINUM PARAPET
SPAN 38

STRUCTURE NO. 082-6003
STA. 65+00 (FAP 799) ST. CLAIR CO.

PREPARED BY:
SYVERDRUP CORPORATION
ST. LOUIS, MISSOURI

Δ Rev. 12-4-87


SECTION IBR-1

SHEET NO. 24 OF 75


0358
REV. 2F3105H00DETAIL87.DGN
LEVELS PLOTTED DATE: OCT. 23, 1987
35, 56, 58 & 63
87S867 PRFT DETAIL 87

DESIGNED	
CHECKED	J.G. CORLEY
DRAWN	J. KORPI
CHECKED	


FOR INFORMATION ONLY

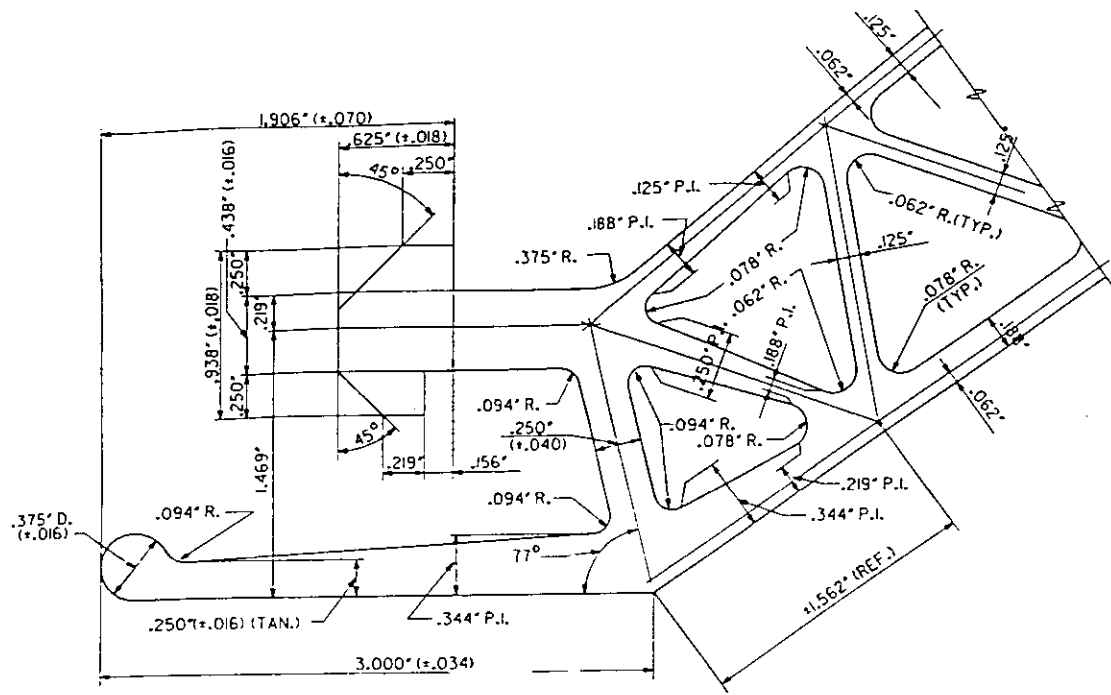


DETAIL A

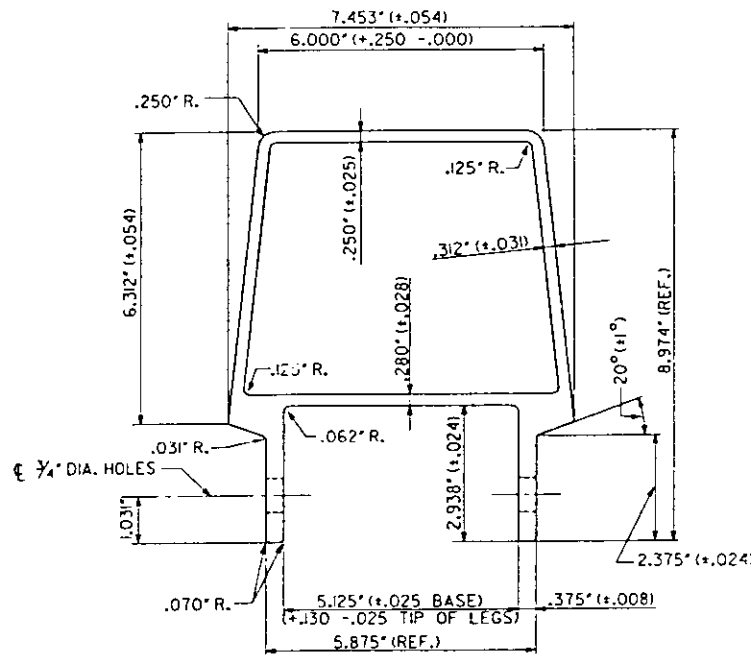


ALUMINUM CAP EXTRUSION

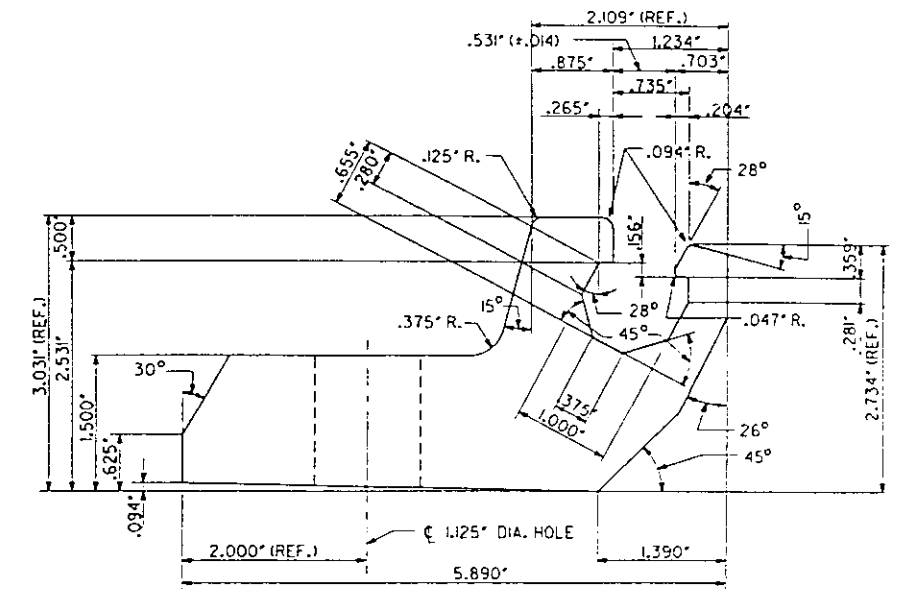


ALUMINUM TOE CLIP EXTRUSION

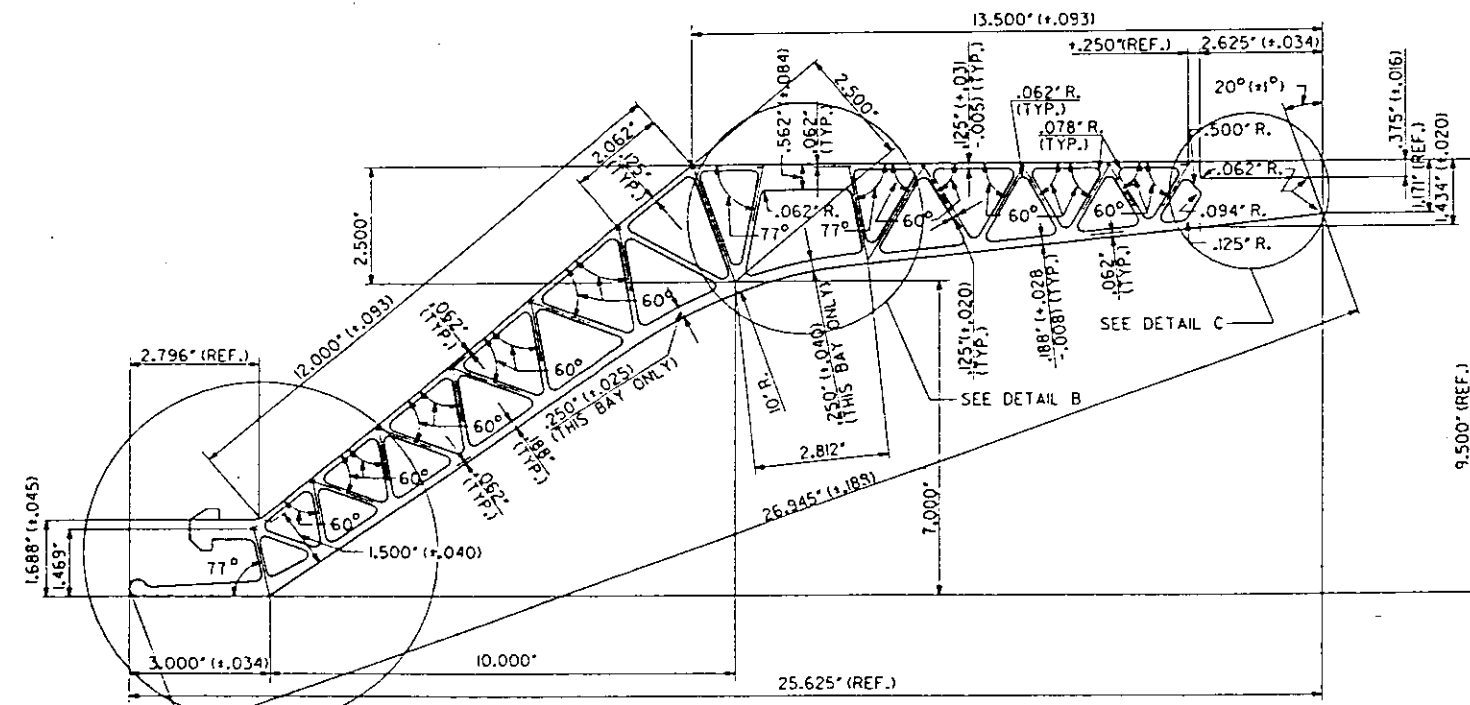

ALUMINUM PARAPET EXTRUSION

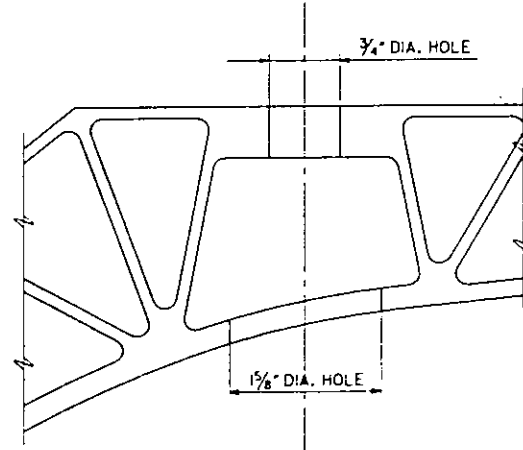

DETAIL B

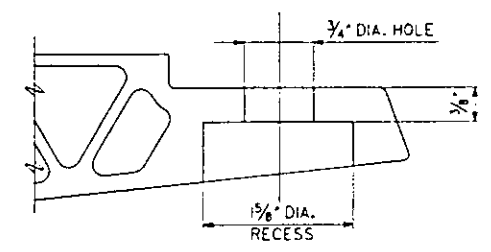

DETAIL C

REHABILITATION FOR
APPROACH BRIDGE OVER
I-55/70 W.B., MISSOURI AVE. AND TRR.

ALUMINUM PARAPET
SPAN 38

STRUCTURE NO. 082-6003
STA. 65+00 (FAP 799) ST. CLAIR CO.

PREPARED BY
SVERDRUP CORPORATION
ST. LOUIS, MISSOURI


SECTION I BR-1


SHEET NO. 25 OF 75

LEVELS PLOTTED DATE: OCT. 23, 1987
35.56 & 63
FILE: ZF3115JDDTAIL86.DGN
DETAIL86



DESIGNED
CHECKED
J.G. CORLEY
DRAWN
J. KORPI
CHECKED

FOR INFORMATION ONLY


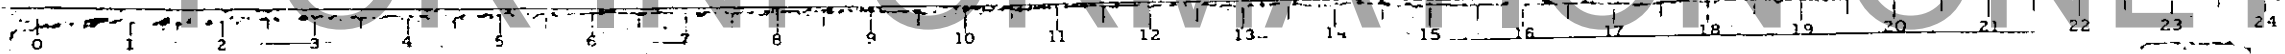


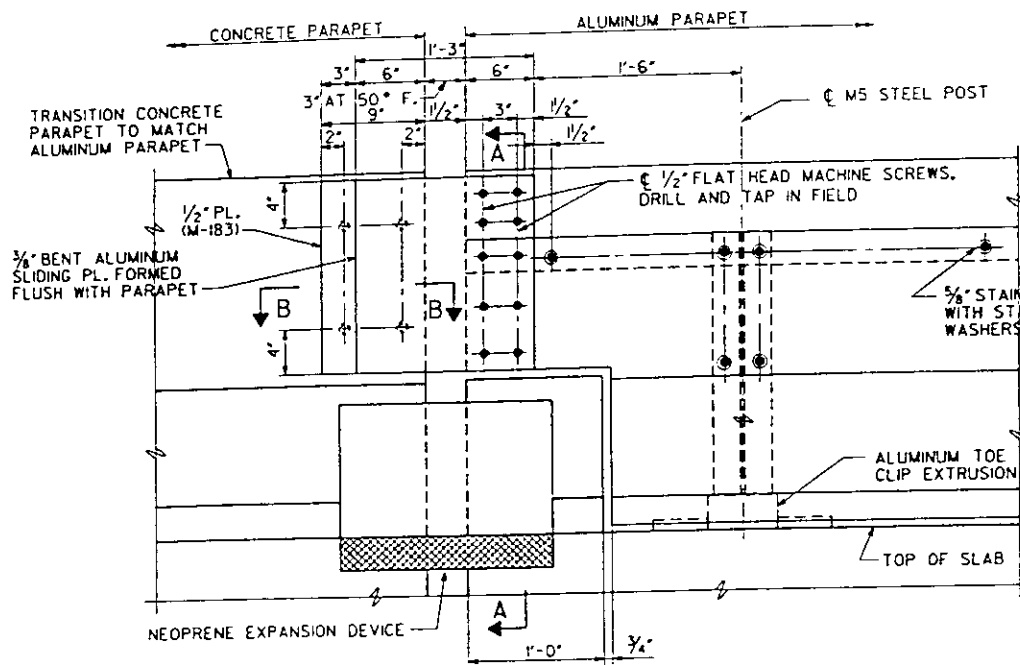


EXPANSION JOINT AT PIER 36

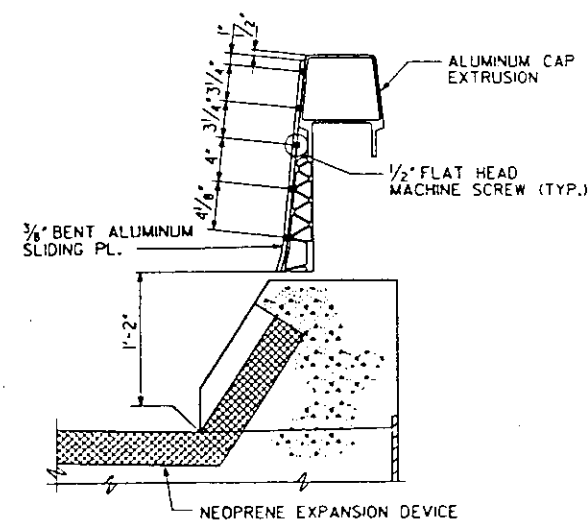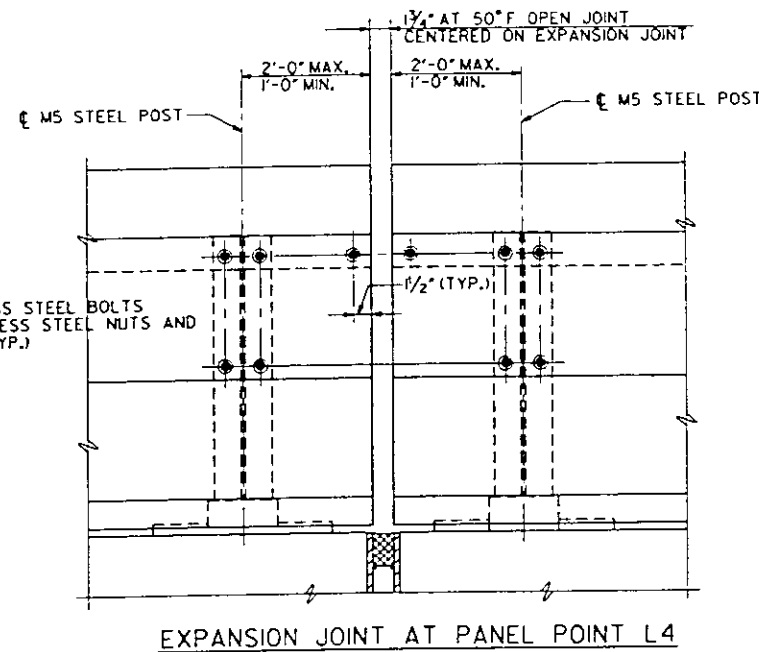


SECTION A-A

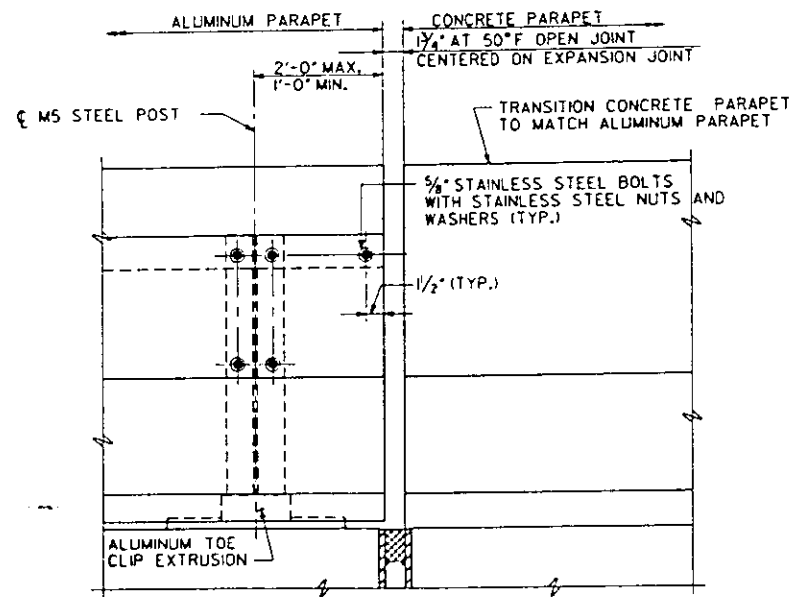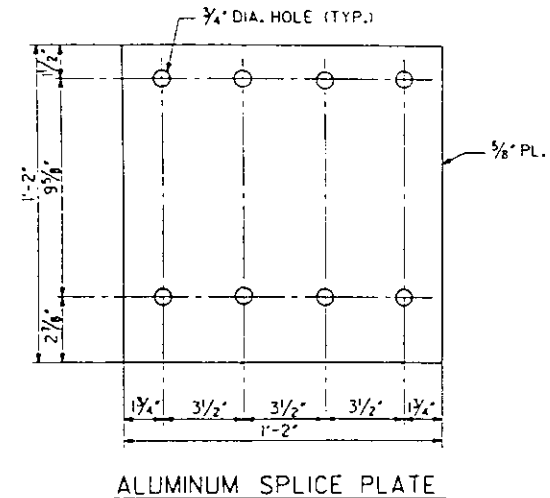

EXPANSION JOINT AT PIER 37

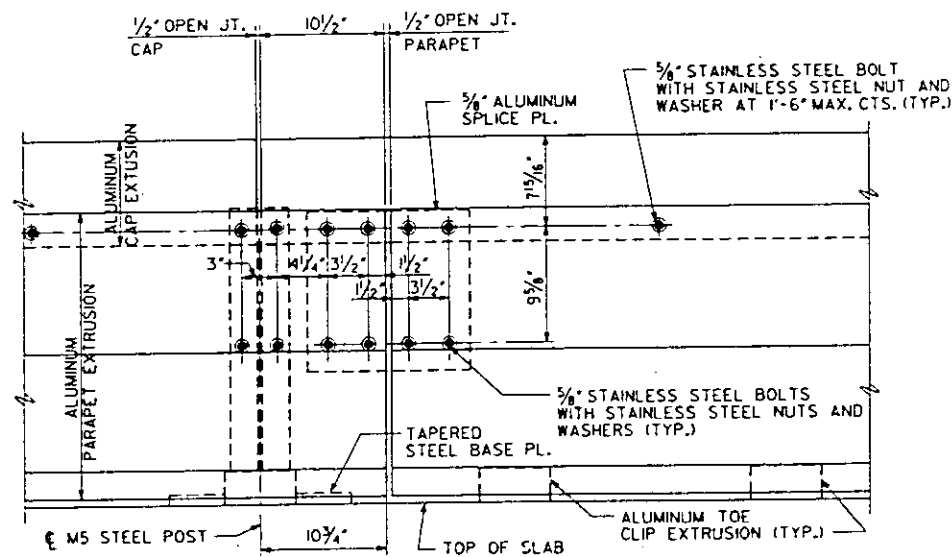

PARAPET SPLICE DETAIL

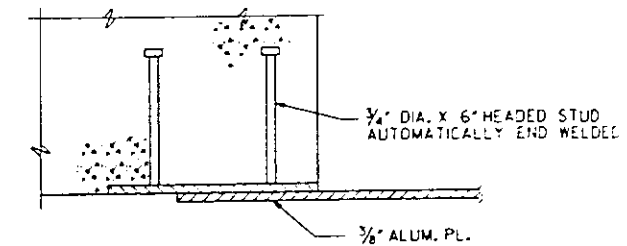

SECTION B-B

REHABILITATION FOR
APPROACH BRIDGE OVER
I-55/70 W.B., MISSOURI AVE. AND TRRA

ALUMINUM PARAPET
SPAN 38

STRUCTURE NO. 082-6003
STA. 65+00 (FAP 799) ST. CLAIR CO.

PREPARED BY
SYVERDRUP CORPORATION
ST. LOUIS, MISSOURI


SECTION IBR-1


SHEET NO. 26 OF 75

LEVELS PLOTTED DATE: OCT. 23, 1987
35.56, 58 & 63
158
168
FILE: ZF31051.DETAIL.BB.DGN
PRF: DETAIL.BB


DESIGNED	
CHECKED	J.G. COLREY
DESIGNED	J. KORPI
CHECKED	

FOR INFORMATION ONLY

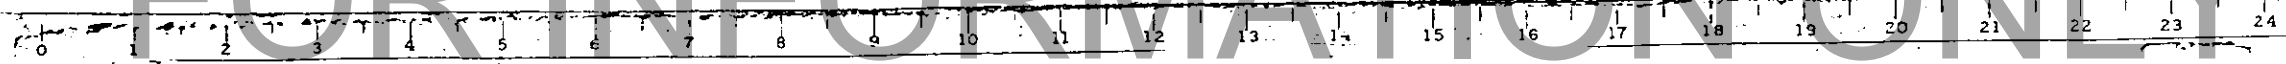


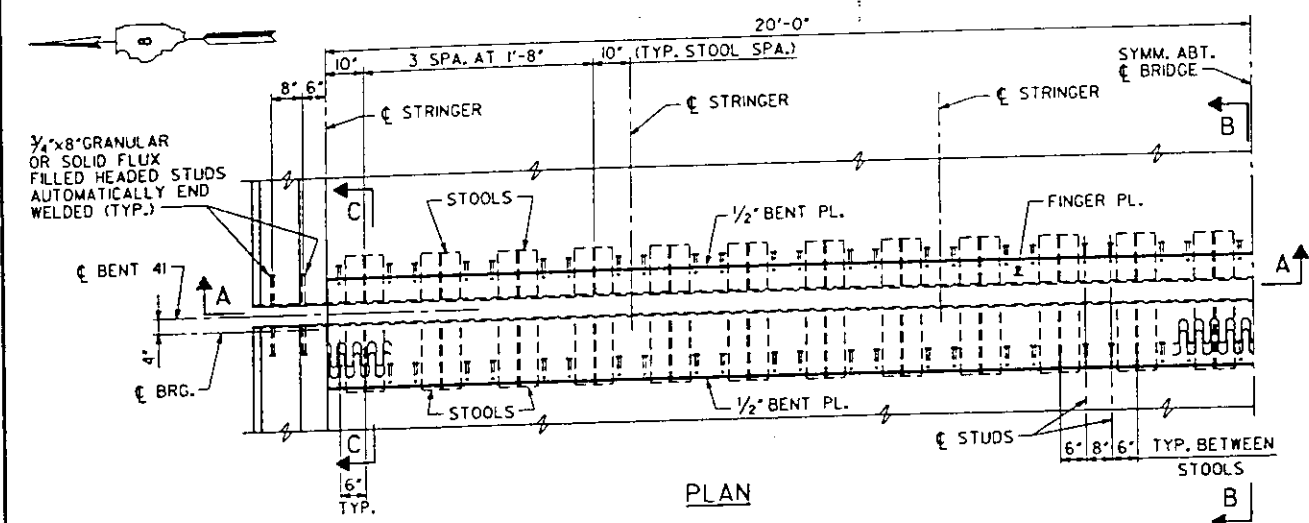

PLAN

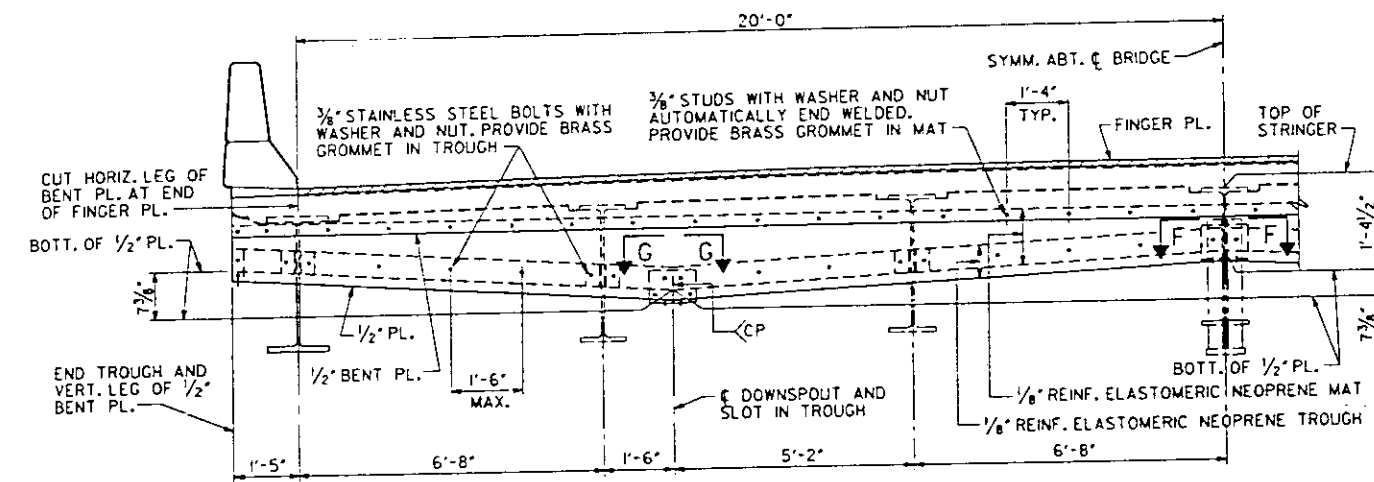


SECTION A-A

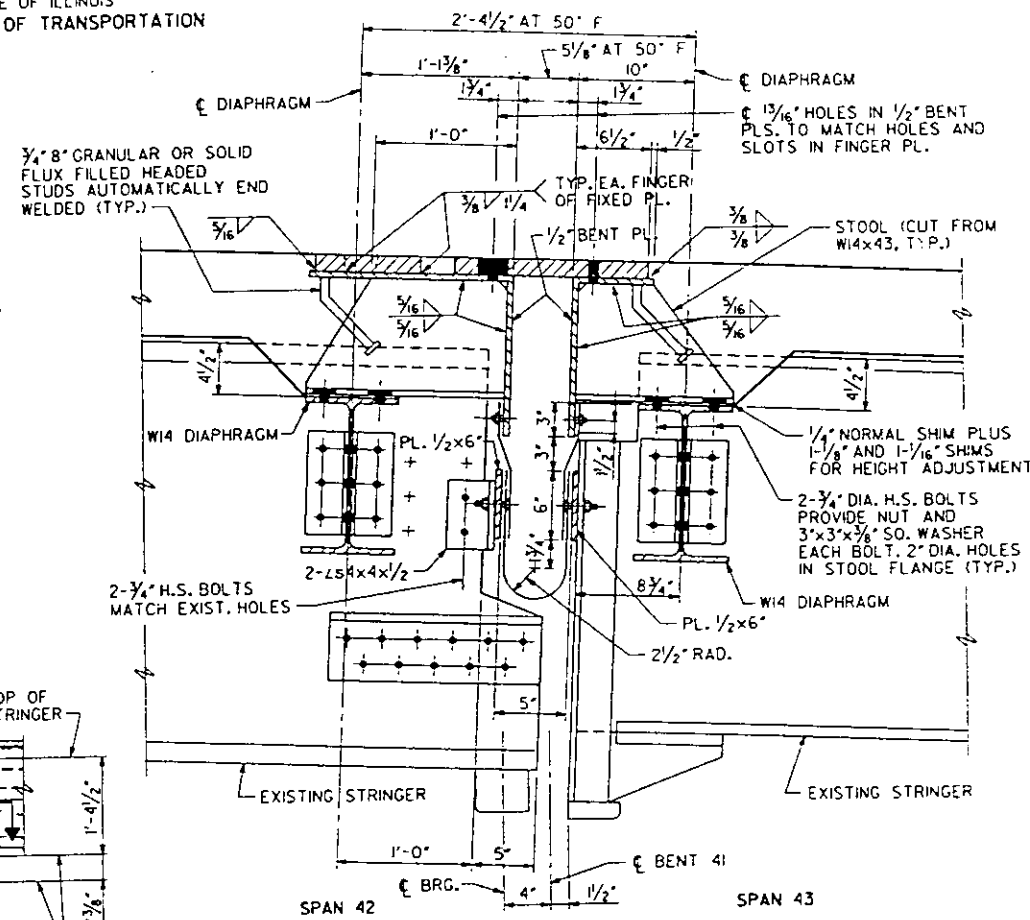


SECTION B-B

NOTE: TROUGH CONNECTION SHOWN IN SPAN 43 IS TYPICAL FOR STRINGERS S4, S5 AND S6. CONNECTION AT STRINGERS S1, S2, S3 AND S7 WILL BE SAME AS SHOWN IN SPAN 42.

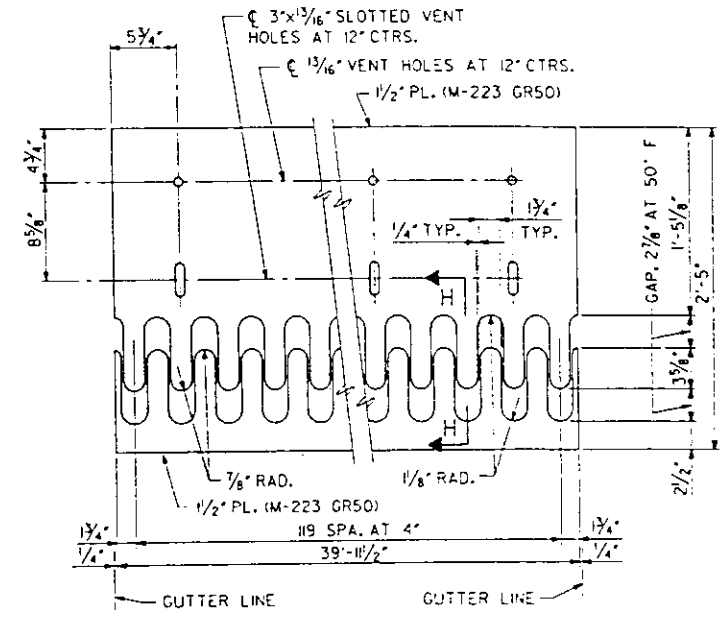


FINGER PLATE DETAIL

NOTE: PLATE SHALL BE FLAME CUT USING 1/4\"/>

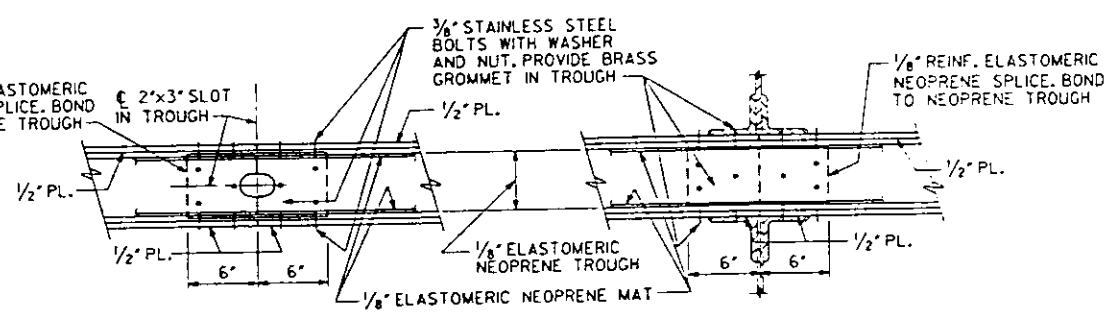


SECTION G-G


SECTION F-F

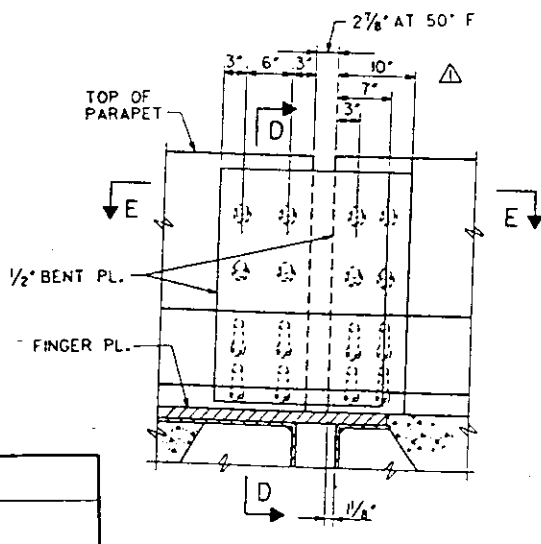

SECTION C-C

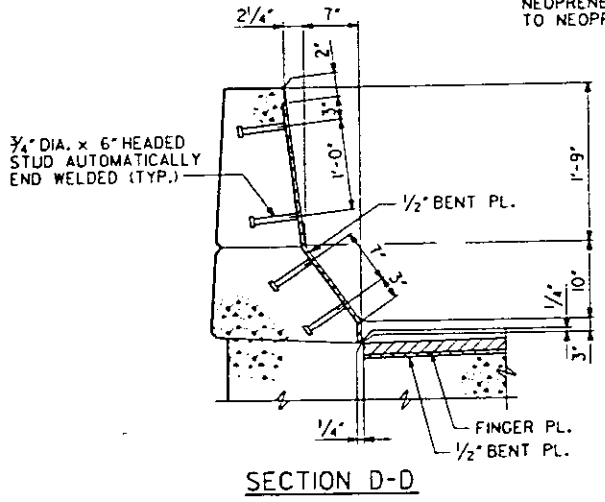


SECTION D-D

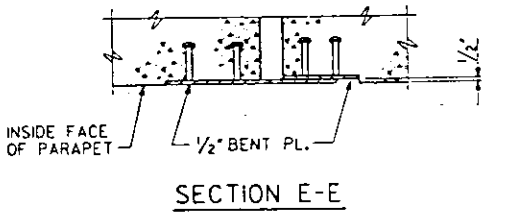

SECTION E-E

SECTION AT END OF TROUGH

SECTION H-H

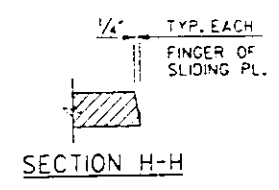

SECTION H-H

NOTES

ALL MATERIAL SHALL CONFORM TO AASHTO M-183 UNLESS OTHERWISE NOTED.
EXPANSION DEVICE SHALL BE FABRICATED TO FIT CROWN AND GRADE OF ROADWAY.
ALL PLATES, STUDS, STOOLS AND BOLTS FOR EXPANSION DEVICE SHALL BE INCLUDED IN THE PRICE BID FOR 'STRUCTURAL STEEL'.
THE COST OF THE ELASTOMERIC NEOPRENE MAT AND TROUGH COMPLETE IN PLACE SHALL BE FULLY COVERED UNDER THE PRICE BID FOR 'REINFORCED NEOPRENE EXPANSION JOINT TREATMENT'. SEE SPECIAL PROVISIONS.

REHABILITATION FOR
APPROACH BRIDGE OVER
I-55/70 W.B., MISSOURI AVE. AND TRRA
FINGER PLATE EXPANSION DEVICE
AT BENT 4I

STRUCTURE NO. 082-6003
STA. 65+00 (FAP 799) ST. CLAIR CO.

DESIGNED	R. NIEMIETZ
CHECKED	P. CLARK
DRAWN	C. DEED
CHECKED	J.M. KORPI

PREPARED BY
SYVERDRUP CORPORATION
ST. LOUIS, MISSOURI

REV. 12-4-87

SECTION IBR-1

SHEET NO. 27 OF 75

FOR INFORMATION ONLY

DATE: OCT. 23, 1987
 LEVELS PLOTTED 35 56 58 63
 558 5480
 ZF310510DETAL23.DGN
 PRF, DETAIL 23

Joint Size	"C" at 50°F	"D" at 50°F	Location
2 1/2"	2 1/2"	1 3/4" MIN.	AT PIER 43A AND ABUT.D
4"	3"	2 1/2" MIN.	AT ABUT. C AND PIER 36


INSTALLATION NOTES

- Install sponge mandrels into positions shown to form flap convolution.
- Install parapet or sidewalk piece (trim roadway flap to fit before applying epoxy).
- Install continuous seal in roadway.
- Install anchor blocks as indicated.


NOTE A: Maximum spacing of anchor bolts shall be 12" centers.

SKREW LIMITATIONS

The details of the anchor blocks and the elastomeric membrane in the parapet, as shown, are for up to 50° skew. For skews greater than 50° the anchor blocks and the elastomeric membrane, installed in accordance with dimension "D" might require modifications to insure a minimum clearance of 1/2" from centerline of anchor studs to edge of parapet opening. The anchor blocks and the elastomeric membrane shall also be installed to the top of the parapet with the anchor studs spaced at ±12" cts.

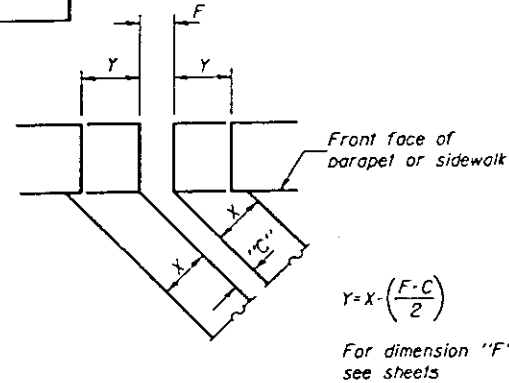

FORMING BLOCKOUT SKETCH

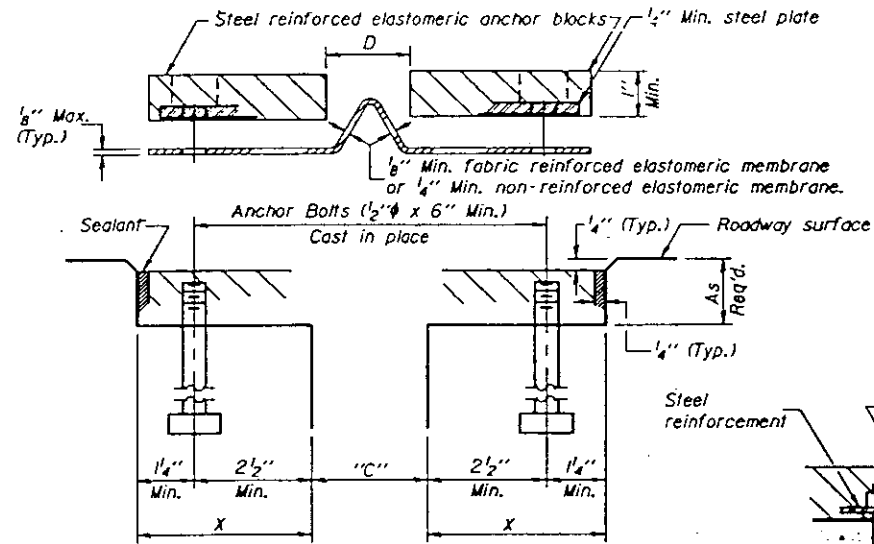


CROSS SECTION


ANCHOR BLOCK REINFORCEMENT WITH ASPHALT SURFACE

GENERAL NOTES


Continuous Seal Neoprene Expansion Joint shall consist of molded anchor blocks of elastomer and steel, field assembled over continuous lengths of elastomeric membrane. See Special Provisions.
The elastomeric membrane shall be premolded with a single or a double upward convolution that will have a "memory" to return to its molded position upon joint closure.
The steel reinforcement must extend up the back face of anchor blocks when asphalt surfaces are used but is optional in concrete blockout.
The convolution length shall be such that the extended length will not be greater than the manufactured length when the joint is fully expanded in its design range and will not protrude above the anchor blocks when the joint is fully compressed.
Joint openings shall be adjusted in accordance with Article 503.07(c) of the Standard Specifications when the deck is poured at an ambient temperature other than 50° F.
The parapet and sidewalk flaps may be furnished factory vulcanized to the roadway membrane provided the centerline of the convolution is maintained and the process and method meet the approval of the Engineer.
Anchor bolts, washers and nuts, to be plated against corrosion in accordance with the special provisions, shall be zinc-coated by the mechanical plating method conforming to ASTM B695, class 50. Zinc-coated nuts shall be tapped oversize in accordance with the requirements of AASHTO M291 and shall meet the supplementary requirements S1.1 thru S12.1 of the same specifications for lubricant and testing.

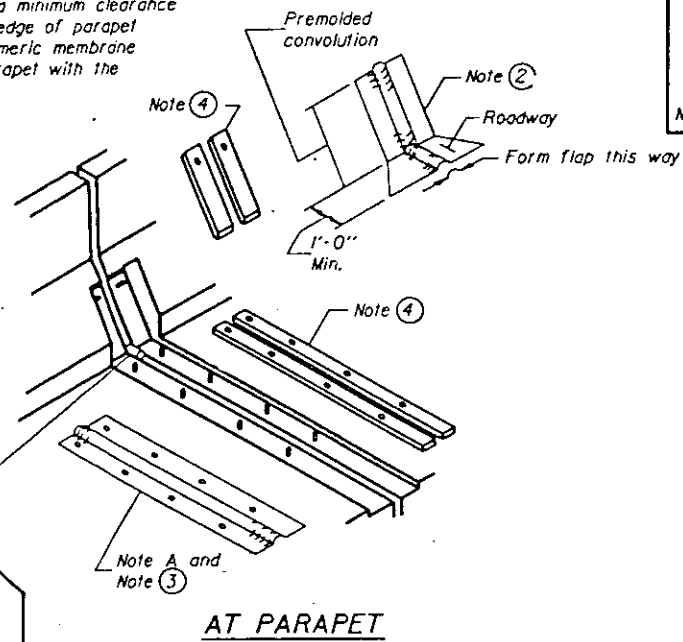


AT PARAPET

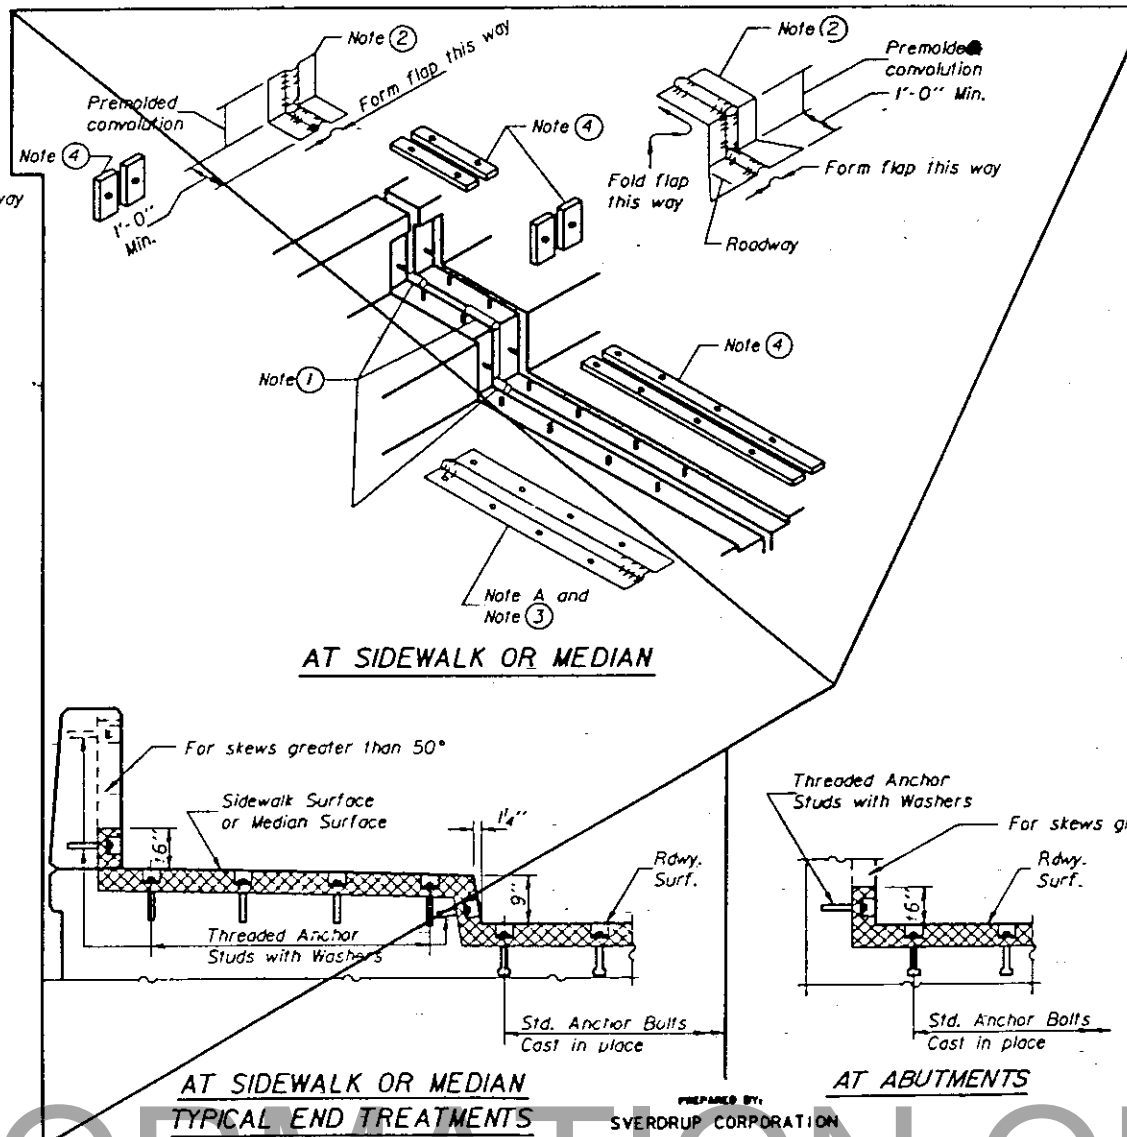


AT SIDEWALK OR MEDIAN

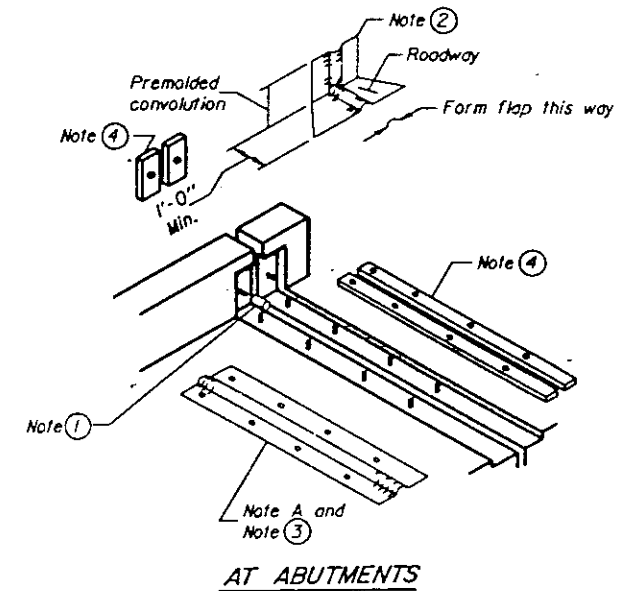


AT ABUTMENTS

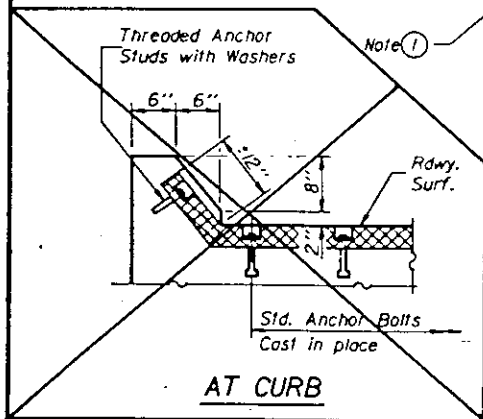


AT CURB

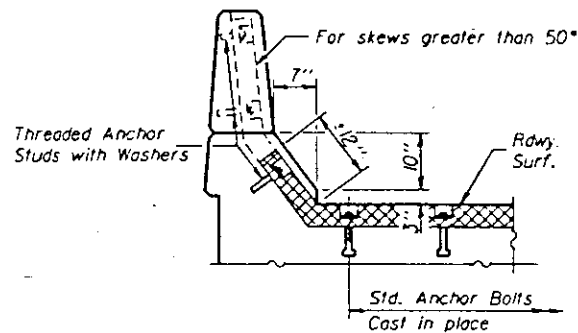

AT PARAPET

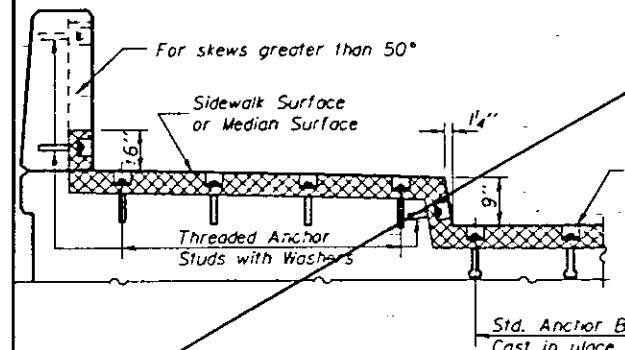

AT SIDEWALK OR MEDIAN TYPICAL END TREATMENTS

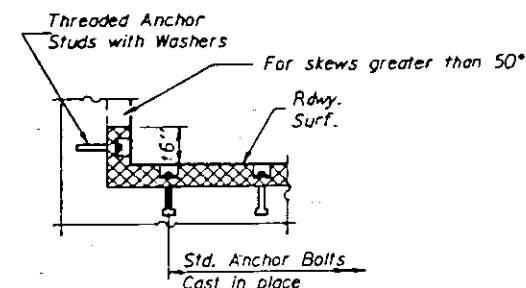

AT ABUTMENTS

REHABILITATION FOR
APPROACH BRIDGE OVER
I-55/70 W.B., MISSOURI AVE. AND TRR

NEOPRENE EXPANSION DEVICES

STRUCTURE NO. 082-6003
STA. 65+00 (FAP 799) ST. CLAIR CO.

DESIGNED _____
CHECKED _____
DRAWN _____
CHECKED P.W. Clark
EJ-CS 12-1-83

PREPARED BY:
SVERDRUP CORPORATION
ST. LOUIS, MISSOURI

SECTION 1BR-1


SHEET NO. 28 OF 75

FOR INFORMATION ONLY


OCT 23, 1987




*IBR-1 APPROACH BRIDGE

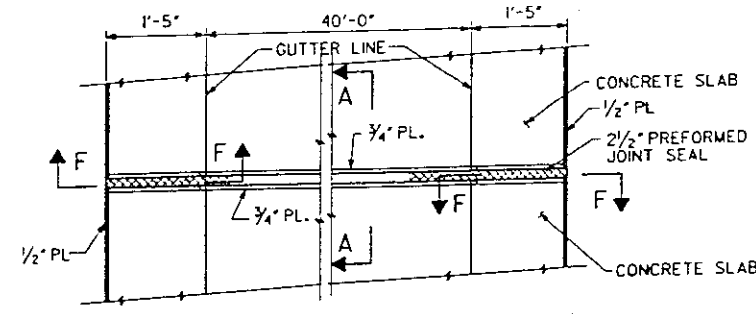


PART PLAN AT PANEL POINT L4
NOTE: ALUMINUM PARAPET NOT SHOWN.

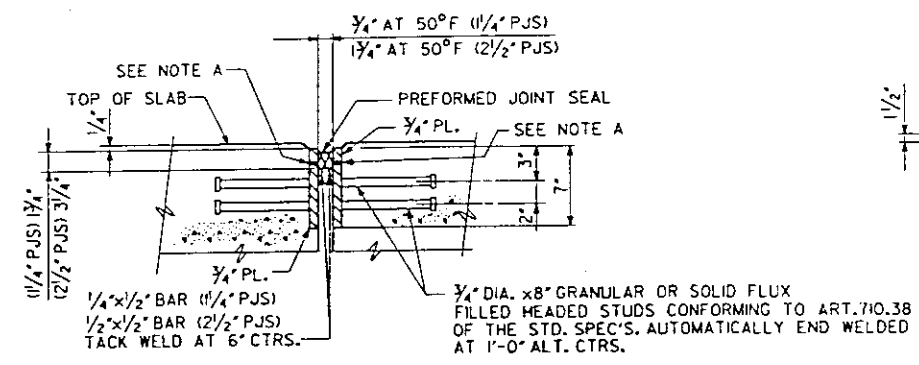


NOTE A: PROVIDE 3/16" HOLES AT 12" CTS. FOR 3/8" BOLTS. ALL BOLTS SHALL BE BURNED, SAWED OR CHIPPED OFF FLUSH WITH THE PLATES AFTER FORMS ARE REMOVED.

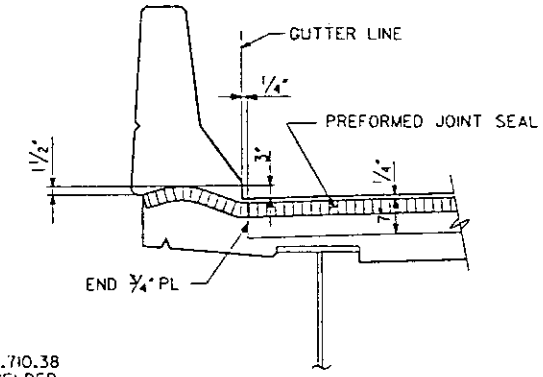


SECTION B-B

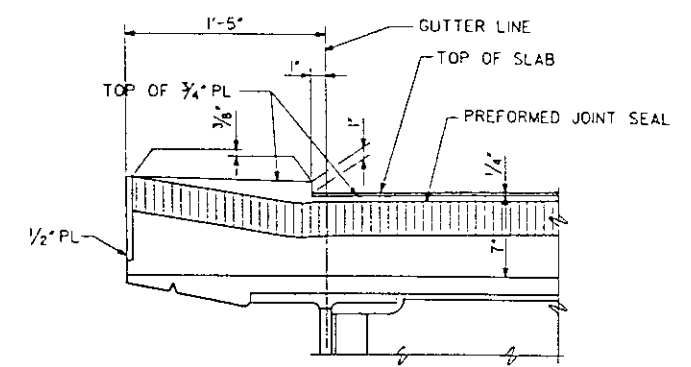


SECTION F-F
SECTION C-C IS OPPOSITE HAND.

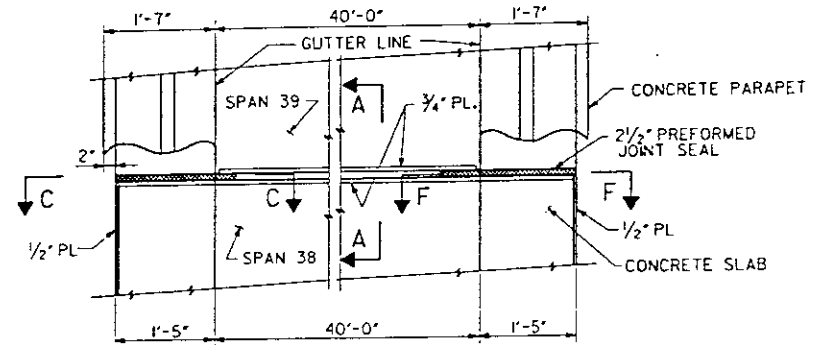


PART PLAN AT PIER 37
NOTE: ALUMINUM PARAPET OF SPAN 38, NOT SHOWN.

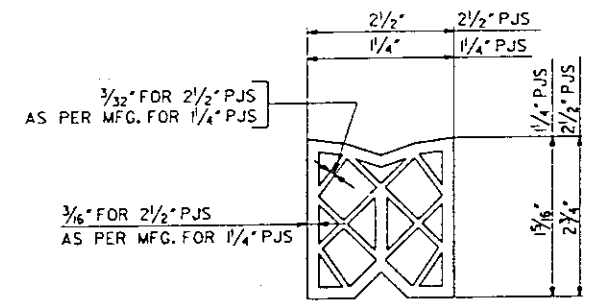

PREFORMED JOINT SEAL

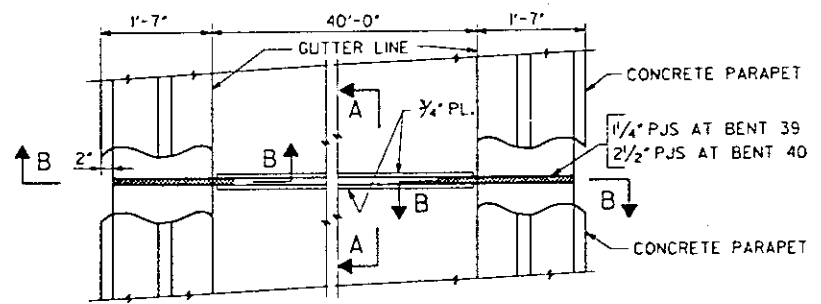

PART PLAN AT BENTS 39 AND 40

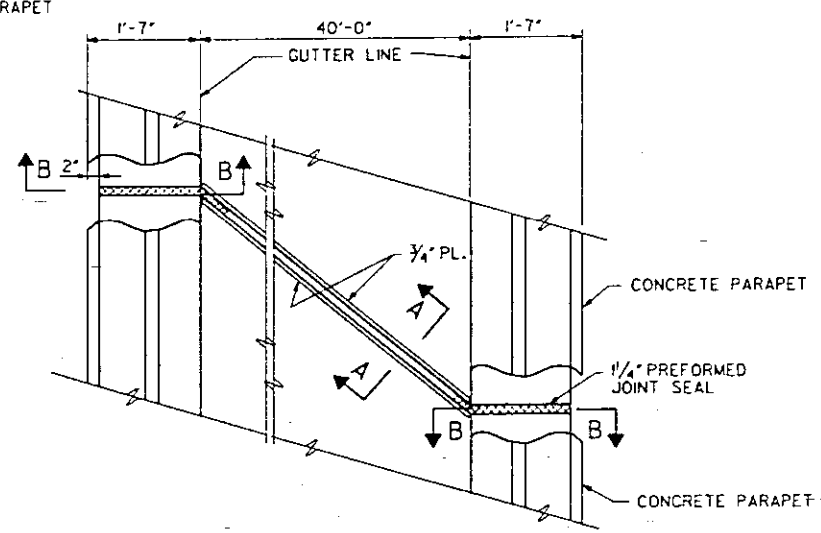

PART PLAN AT BENT 42

NOTES

EXPANSION JOINT PLATES SHALL BE FABRICATED TO FIT TOP OF THE ROADWAY.

REHABILITATION FOR
APPROACH BRIDGE OVER
I-55/70 W.B., MISSOURI AVE. AND TRR.

PREFORMED JOINT SEALS

STRUCTURE NO. 082-6003
STA. 65+00 (FAP 799) ST. CLAIR CO.

PREPARED BY:
SYVERDRUP CORPORATION
ST. LOUIS, MISSOURI

SECTION IBR-1


SHEET NO. 29 OF 75




28-OCT-15 36

DATE: OCT. 23, 1987
LEVELS PLOTTED 35, 56, 58 & 63
FILE: ZF3H9J0DETAIL82.DGN
35860 PRF.DETAIL82


DESIGNED	
CHECKED	J.G. CORLEY
DRAWN	P.W. CLARK
CHECKED	

FOR INFORMATION ONLY

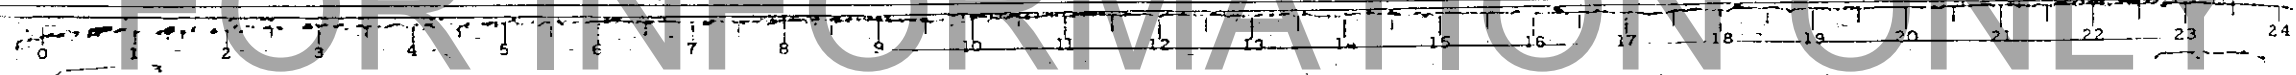


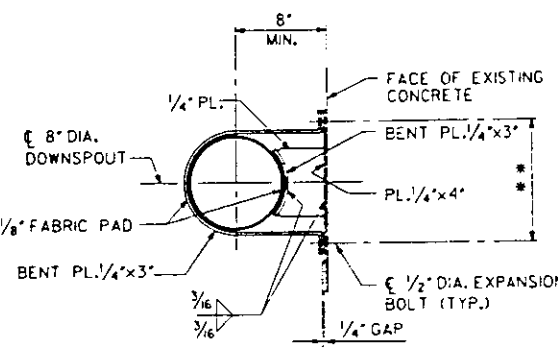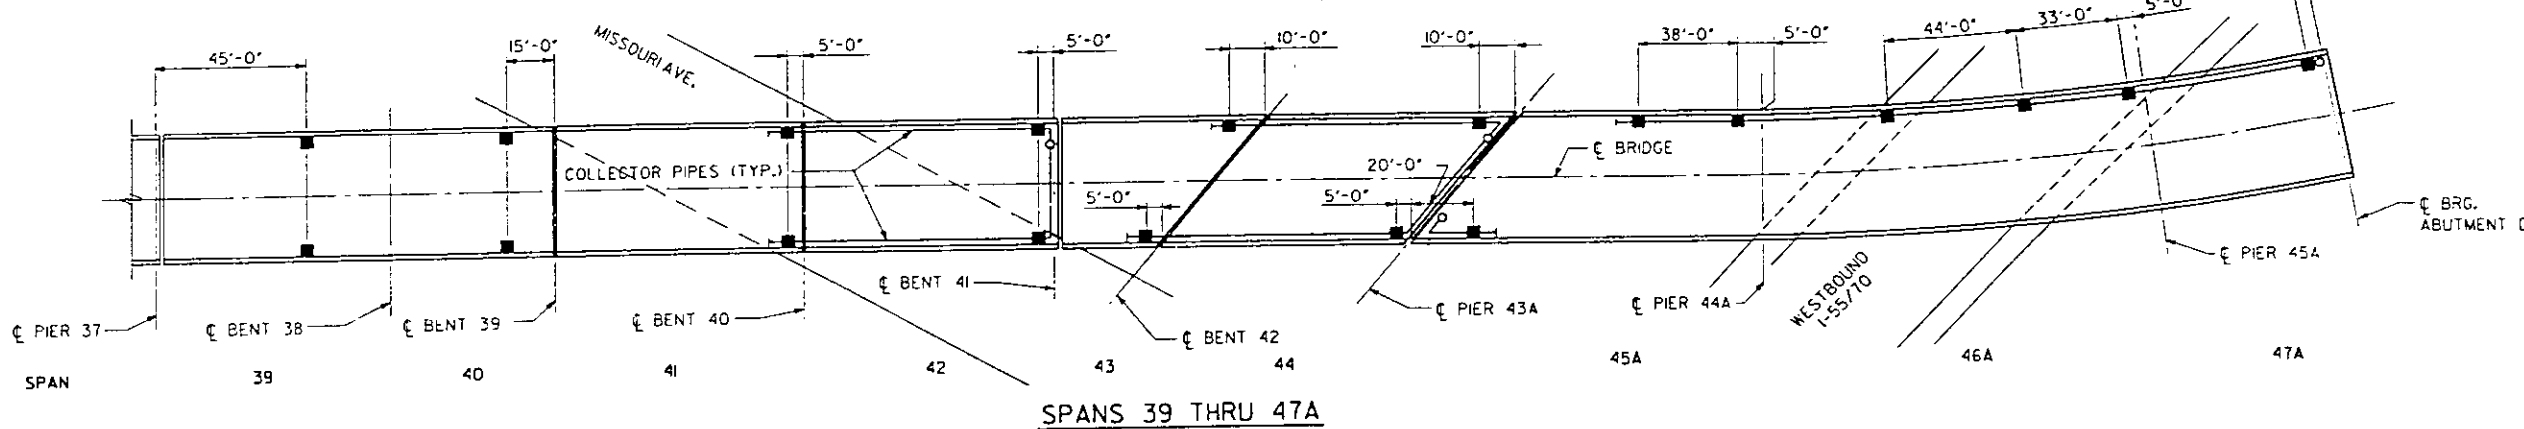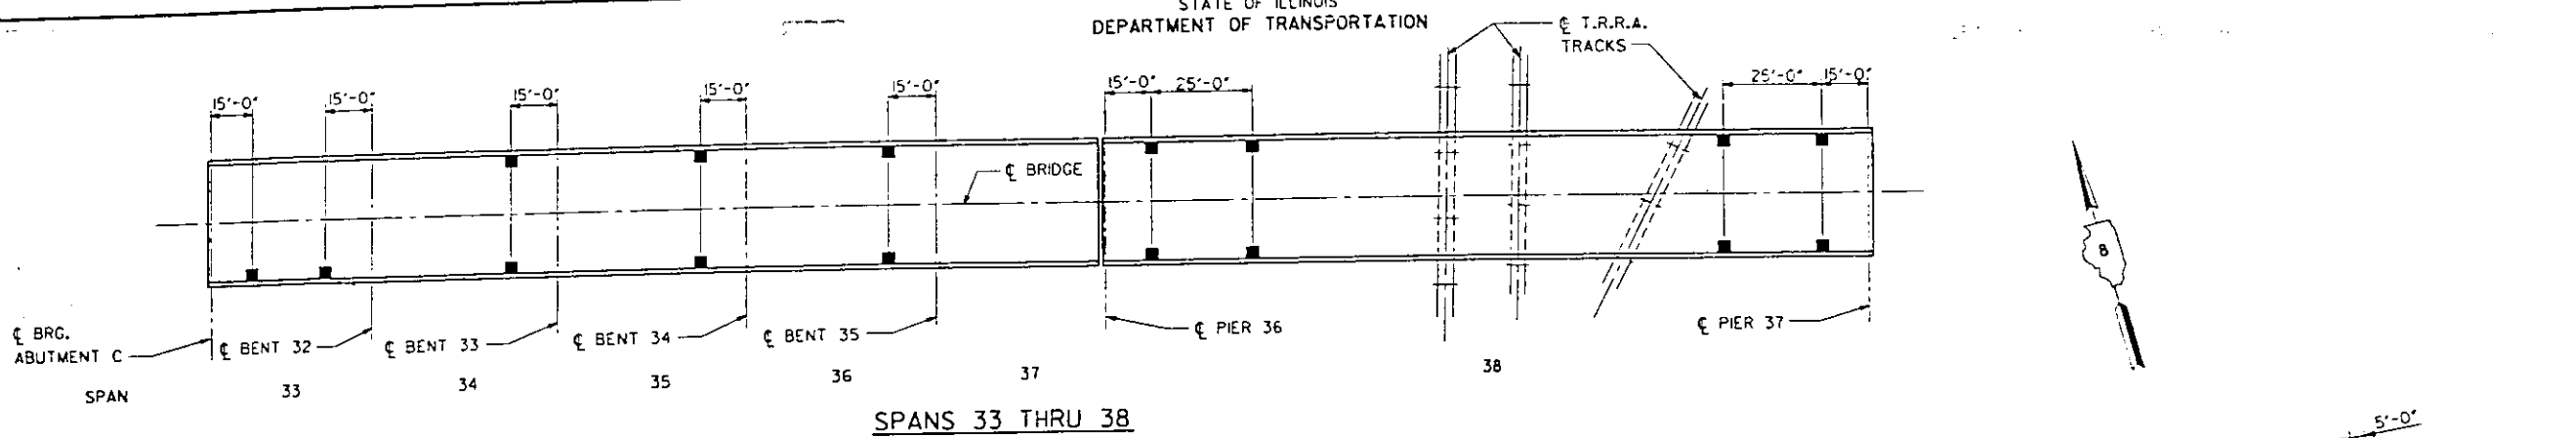


TYPE A PIPE SUPPORT Δ

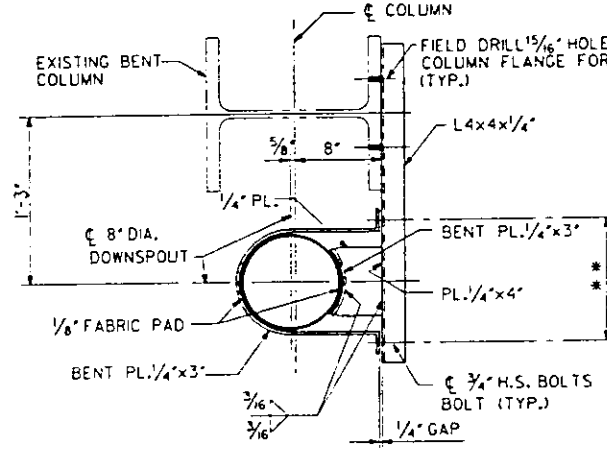

TYPE B PIPE SUPPORT Δ

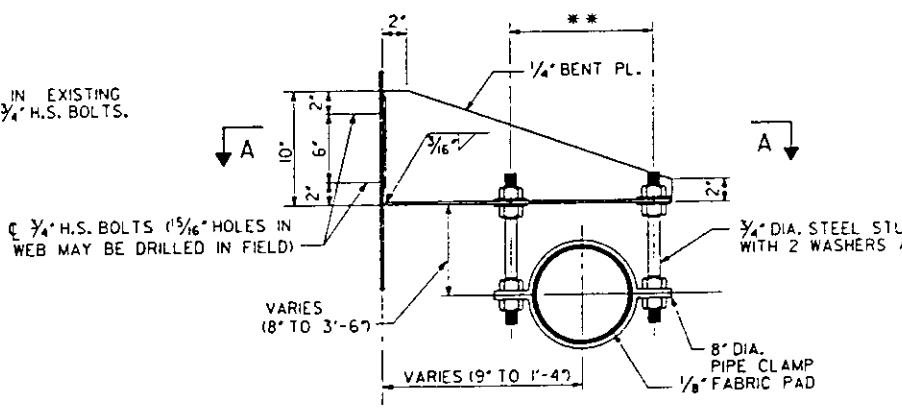

TYPE C PIPE SUPPORT Δ

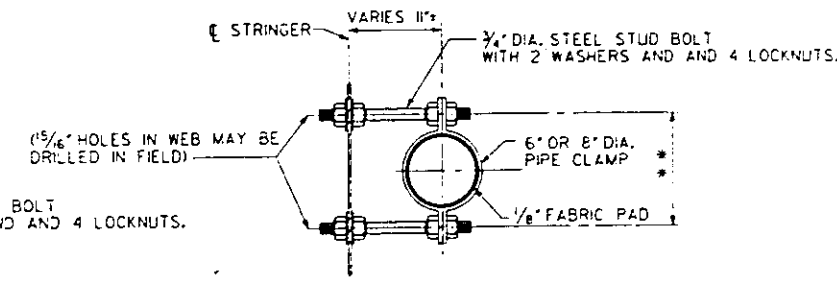

TYPE D PIPE SUPPORT Δ

NOTES

- INDICATES DRAINAGE SCUPPER. DRAIN SPACING IS MEASURED ALONG GUTTER LINE. DRAINS MAY BE SHIFTED SLIGHTLY FROM THE LOCATION SHOWN TO CLEAR EXISTING OBSTRUCTIONS.
- ALL COLLECTOR PIPES AND FITTINGS, EXCEPT AS NOTED, SHALL BE REINFORCED THERMOSETTING PLASTIC (FIBERGLASS), SEE SPECIAL PROVISIONS.
- HORIZONTAL COLLECTOR PIPE RUNS SHALL HAVE A MINIMUM SLOPE OF 1/4" PER FOOT EXCEPT AS NOTED.
- 3/4" DIA. STUD BOLTS SHALL CONFORM TO A-16.4 AND SHALL HAVE 6" OF THREADS AT EACH END.

REHABILITATION FOR
APPROACH BRIDGE OVER
I-55/70 W.B., MISSOURI AVE. AND TRR/

DRAINAGE LOCATION PLAN
AND DRAIN PIPE SUPPORTS

STRUCTURE NO. 082-6003
STA. 65+00 (FAP 799) ST. CLAIR CO.

FILED: 2/3/87
 DATE: OCT. 23, 1987
 LEVELS PLOTTED
 35, 56, 58, 63
 DESIGNED BY: _____
 CHECKED BY: S. STEGMAN
 DRAWN BY: J. LENZ
 CHECKED BY: _____


DESIGNED BY: LENZ ENGINEERING, INC. ST. LOUIS, MISSOURI
 PREPARED BY: SVERDRUP CORPORATION ST. LOUIS, MISSOURI


REV. 12-4-87

SECTION IBR-1


SHEET NO. 30 OF 75

FOR INFORMATION ONLY

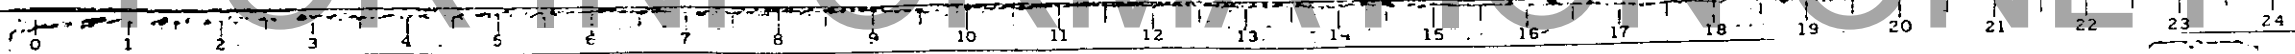


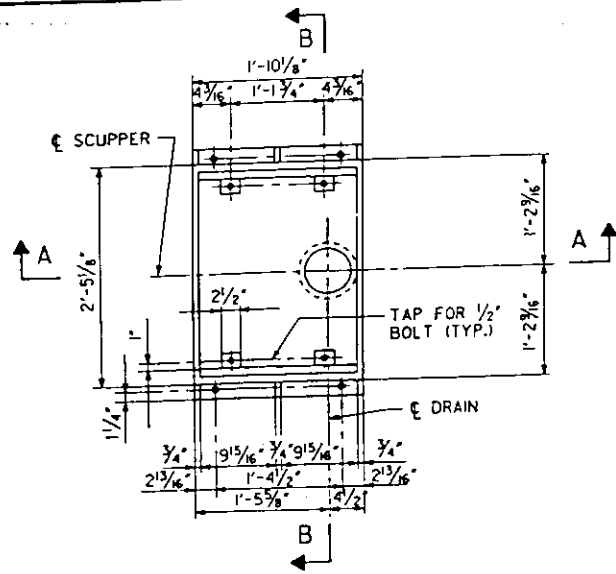


PLAN

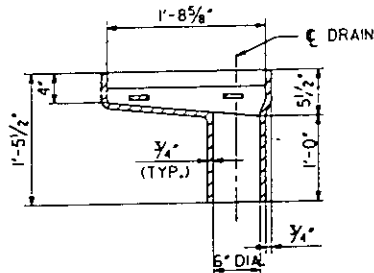


SECTION A-A

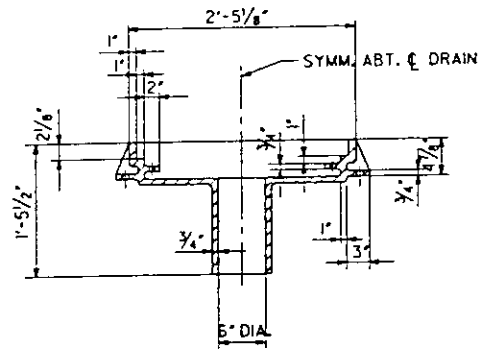


SECTION B-B

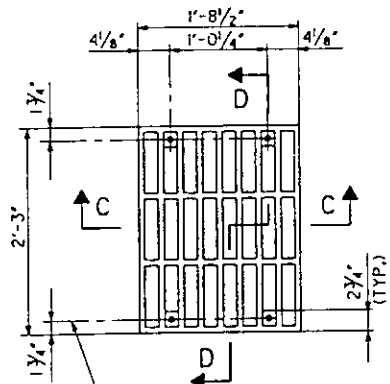

PLAN

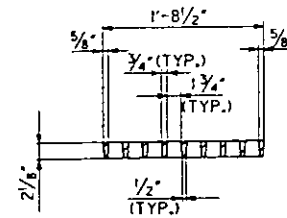


SECTION C-C

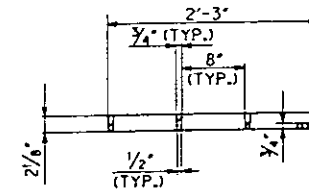

SECTION D-D


SPECIAL DRAINAGE SCUPPER Δ

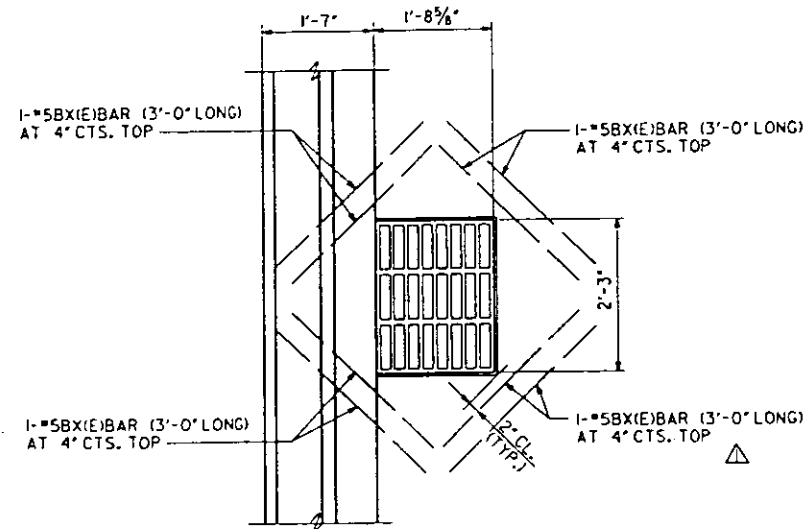

PLAN - REINFORCEMENT AT DRAINAGE SCUPPER

NOTE: REINFORCEMENT SHALL CLEAR DRAINAGE SCUPPERS. CUT LONGITUDINAL AND TRANSVERSE BARS AS REQUIRED.

SCUPPER GRATE

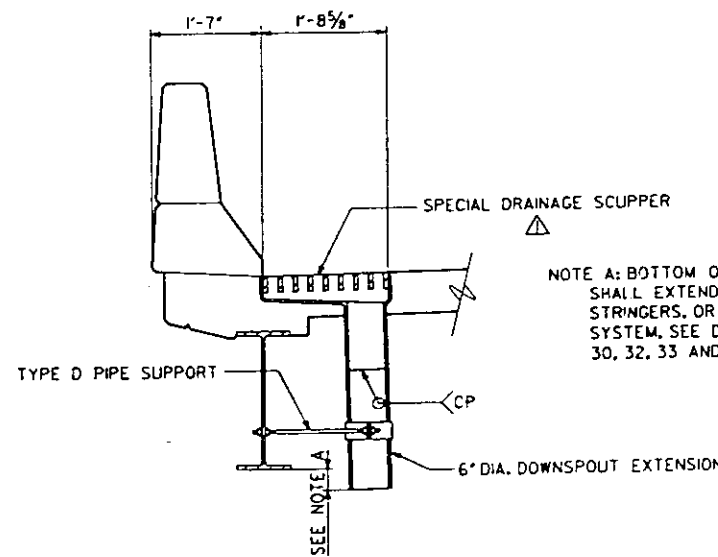

TYPICAL SECTION AT DRAINAGE SCUPPER

NOTE A: BOTTOM OF OPEN DOWNSPOUT EXTENSION SHALL EXTEND 3\"/>

NOTES

DRAINAGE SCUPPERS SHALL BE GRAY CAST IRON CONFORMING TO THE REQUIREMENTS OF AASHTO M-105, CLASS 30.
BOLTS AND WASHERS SHALL CONFORM TO THE REQUIREMENTS OF ASTM A-307.
ALL BOLTS AND WASHERS SHALL BE GALVANIZED IN ACCORDANCE WITH AASHTO M-232.
AS AN ALTERNATE BOLTS AND WASHERS MAY BE STAINLESS STEEL CONFORMING TO THE REQUIREMENTS OF ASTM A-193, TYPE 304.
COST OF THE GRATE, FRAME, DOWNSPOUT, BOLTS AND WASHERS INCLUDING COMPLETE INSTALLATION OF SCUPPER SHALL BE PAID FOR AT THE UNIT BID PRICE FOR "SPECIAL DRAINAGE SCUPPER" Δ

REHABILITATION FOR
APPROACH BRIDGE O / ER
I-55/70 W.B., MISSOURI AVE. AND TRR

Δ SPECIAL DRAINAGE SCUPPER DETAILS

STRUCTURE NO. 082-6003
STA. 65+00 (FAP 799) ST. CLAIR CO.


DESIGNED BY: LENZ ENGINEERING, INC. ST. LOUIS, MISSOURI
PREPARED BY: SYVERDRUP CORPORATION ST. LOUIS, MISSOURI

REV. 12-4-87

SECTION BR-1

SHEET NO. 3 OF 75


FOR INFORMATION ONLY

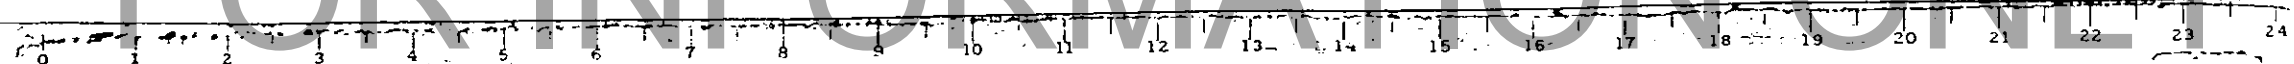


35,56,58 & 63
 DATE: OCT. 23, 1987
 LEVELS PLOTTED
 FILE: ZF31051.DETAIL105.DGN
 PRF DETAIL105

DESIGNED	
CHECKED	S. STEGMAN
DRAWN	J. LENZ
CHECKED	


• 1BR-1 APPROACH BRIDGE

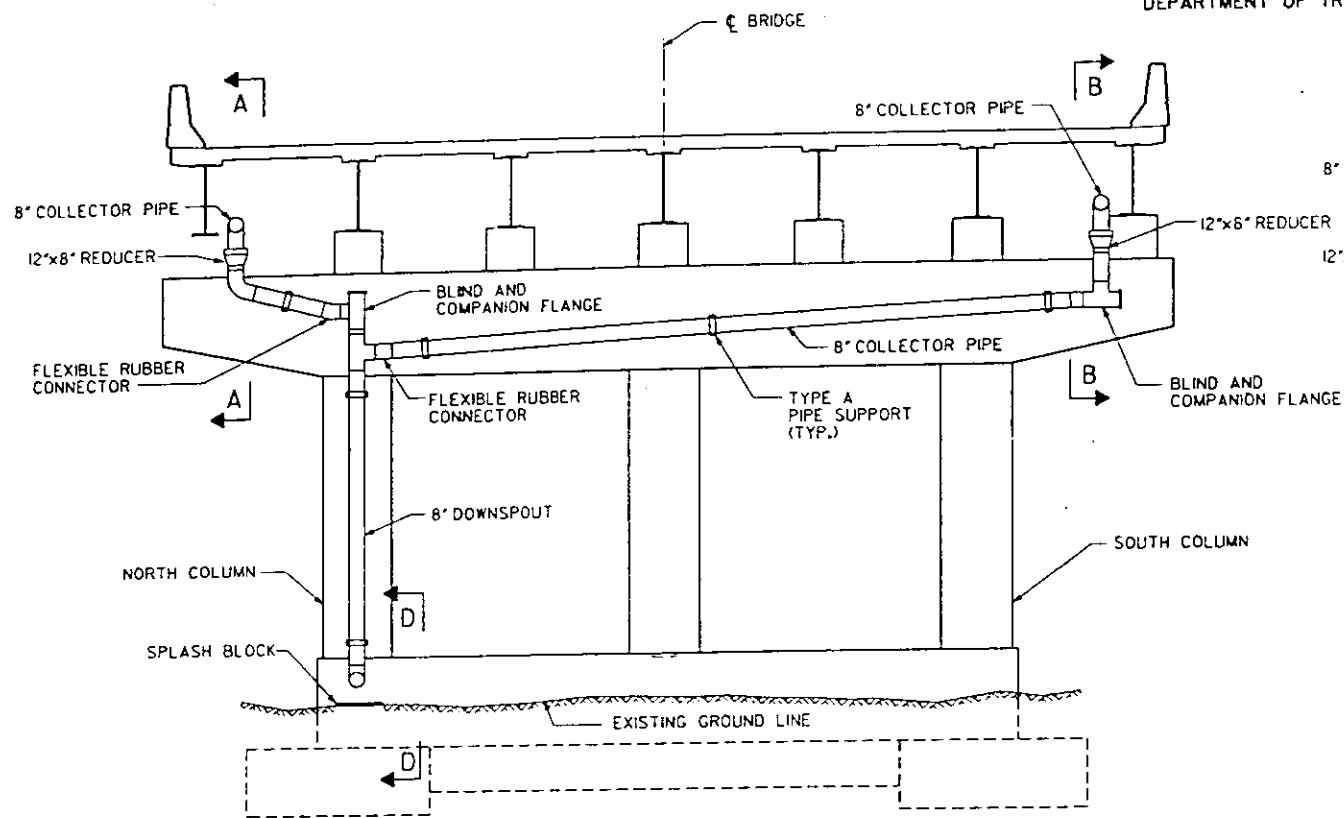


DRAINAGE COLLECTION AND DOWNSPOUT AT PIER 43A

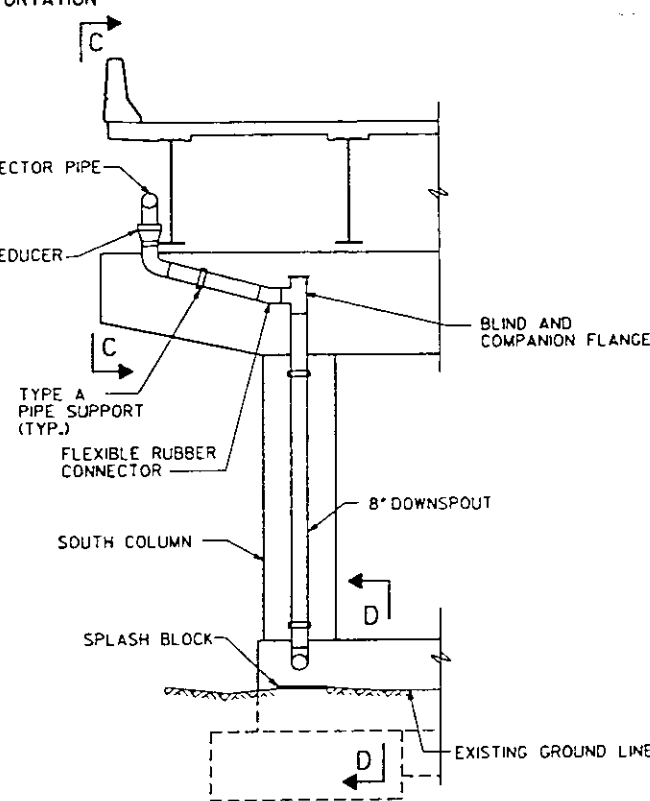



DRAINAGE COLLECTION AND DOWNSPOUT AT PIER 43A

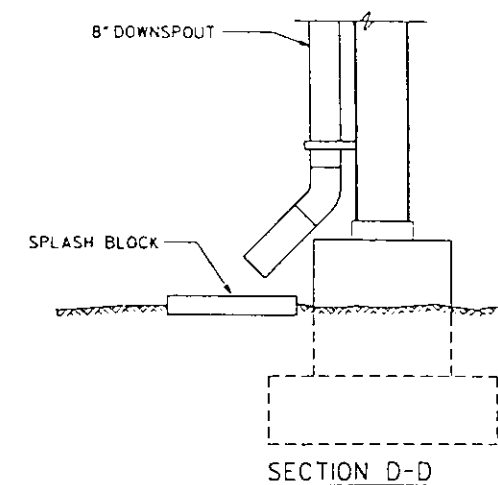

NOTE: SPLASH BLOCK SHALL BE 2' X 4' CLASS X CONCRETE. COST INCIDENTAL.

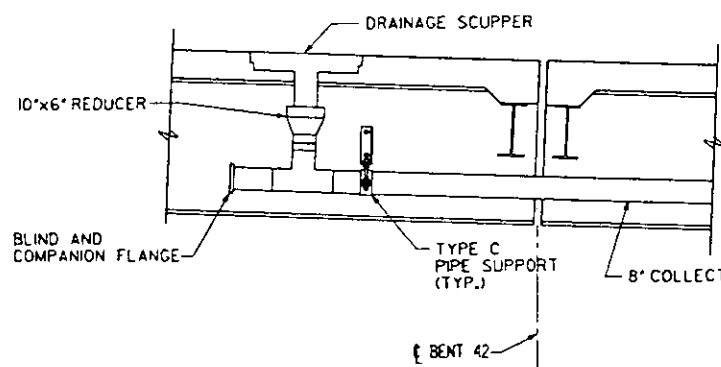

SECTION A-A (SHOWN)
SECTION B-B (OPP. HAND AND SIMILAR)

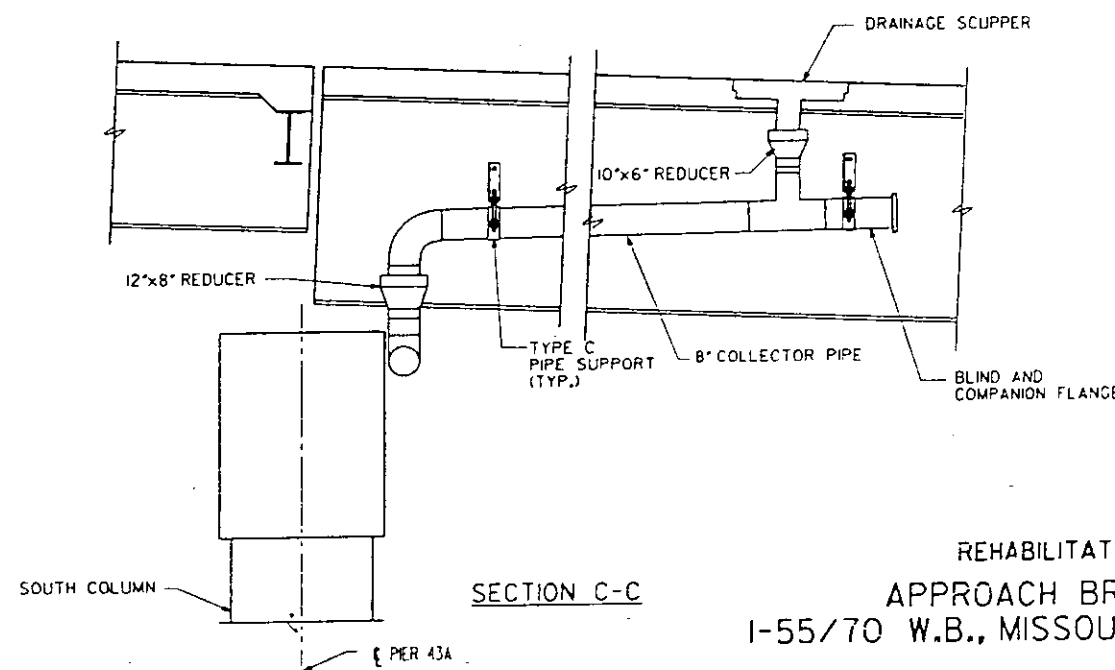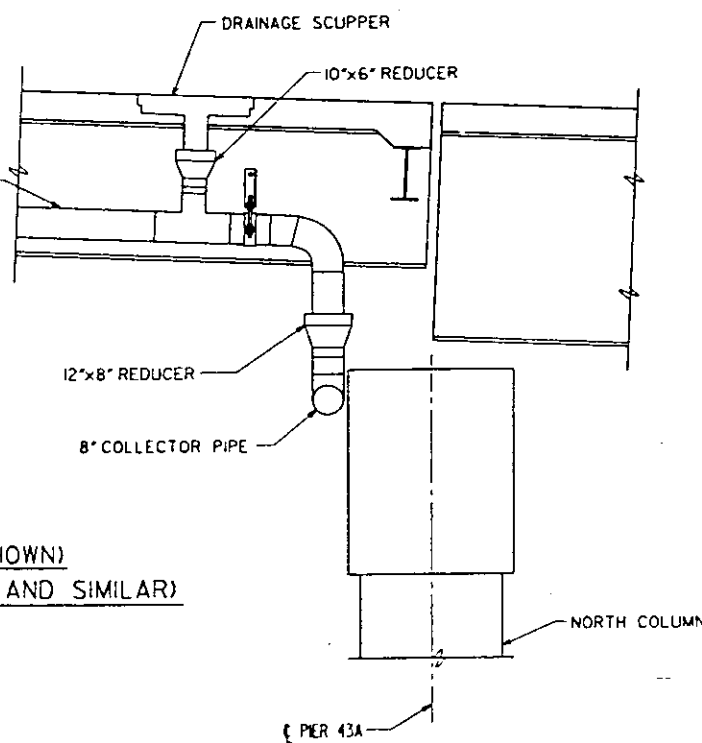

SECTION C-C

REHABILITATION FOR
APPROACH BRIDGE OVER
I-55/70 W.B., MISSOURI AVE. AND TRRA

DRAINAGE SYSTEM - SPANS 43 THRU 45A

STRUCTURE NO. 082-6003
STA. 65+00 (FAP 799) ST. CLAIR CO.

DESIGNED BY:
LENZ ENGINEERING, INC.
ST. LOUIS, MISSOURI


PREPARED BY:
SVERDRUP CORPORATION
ST. LOUIS, MISSOURI

SECTION 1BR-1

SHEET NO. 32 OF 75


DATE: OCT. 23, 1987
 LEVELS PLOTTED 35, 56, 63
 APPR'D: J. LENZ
 CHECKED: S. STEGMAN
 DRAWN: J. LENZ

FOR INFORMATION ONLY

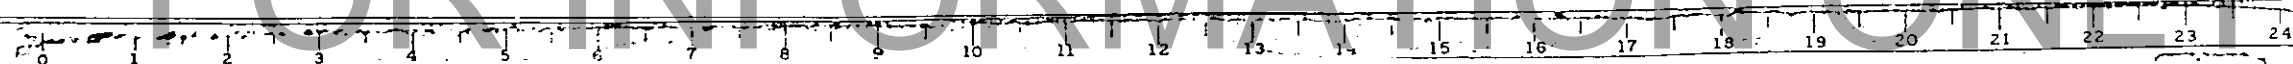


ROUTE NO.	SECTION	COUNTY	TEN SHEETS	SHEET NO.
FAP 799	•	ST. CLAIR	252	181
ELONG.		PROJECT		


*IBR-1 APPROACH BRIDGE

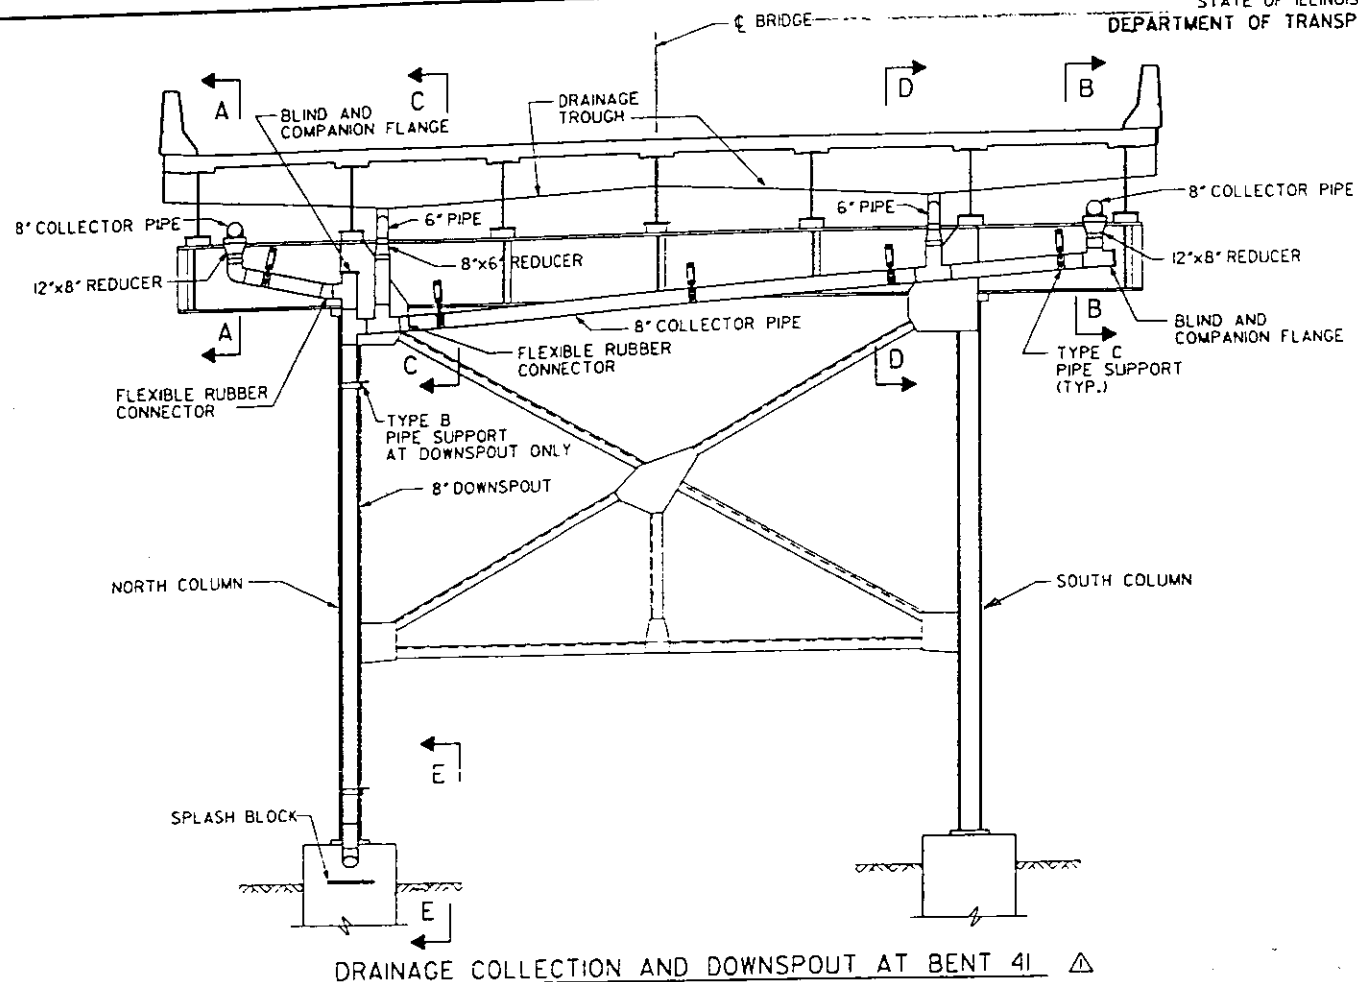


DRAINAGE COLLECTION AND DOWNSPOUT AT BENT 41

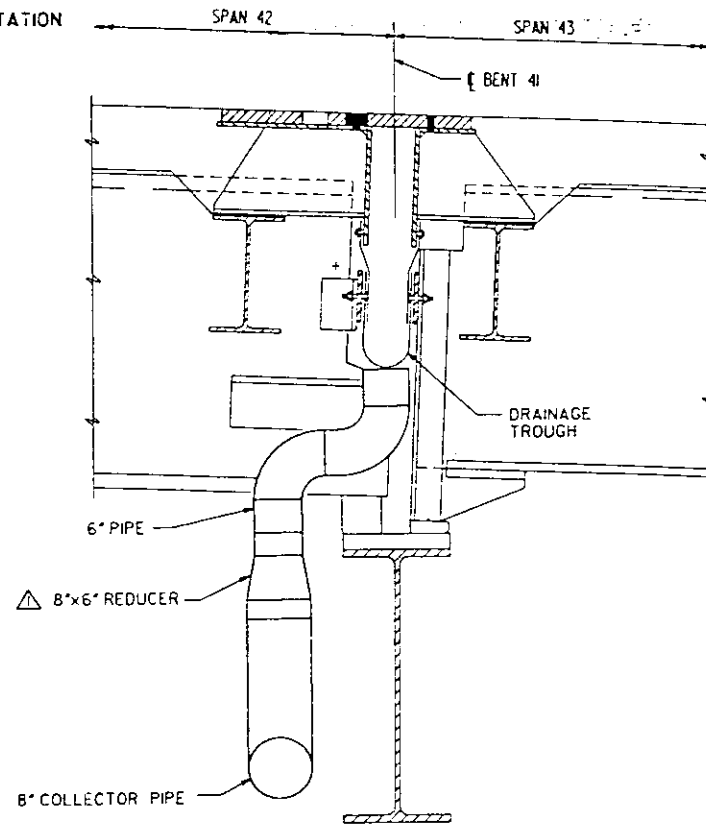

SECTION C-C (SHOWN)
SECTION D-D (OPPOSITE HAND AND SIMILAR)

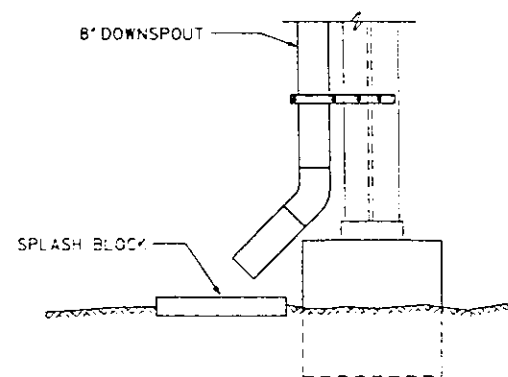

SECTION E-E
NOTE: SPLASH BLOCK SHALL BE 2' X 4' CLASS X CONCRETE. COST INCIDENTAL.

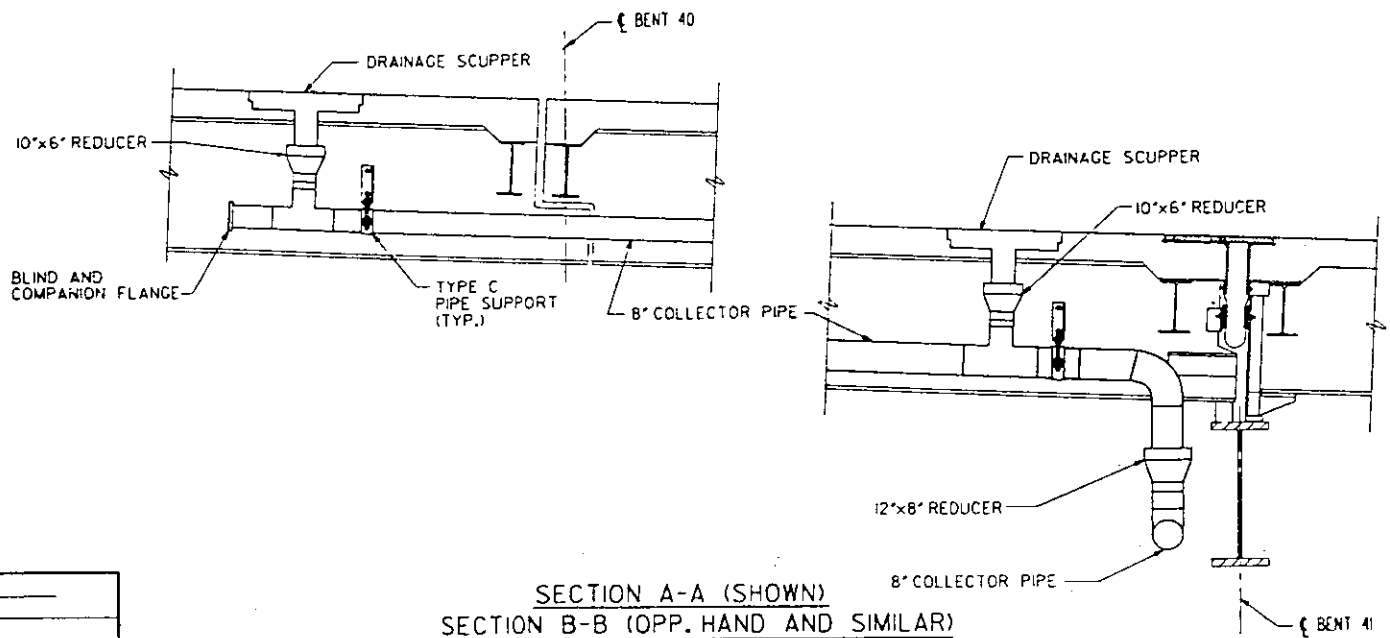

SECTION A-A (SHOWN)
SECTION B-B (OPP. HAND AND SIMILAR)

REHABILITATION FOR
APPROACH BRIDGE OVER
I-55/70 W.B., MISSOURI AVE. AND TRRA
DRAINAGE SYSTEM - SPANS 41 THRU 42

STRUCTURE NO. 082-6003
STA. 65+00 (FAP 799) ST. CLAIR CO.

LEVELS PLOTTED DATE: OCT. 23, 1987
35.56, 58.63

DESIGNED	_____
CHECKED	_____
DRAWN	_____
CHECKED	_____

DESIGNED BY: LENZ ENGINEERING, INC. ST. LOUIS, MISSOURI
PREPARED BY: SYVERDRUP CORPORATION ST. LOUIS, MISSOURI

REV. 12-4-87

SECTION BR-1


SHEET NO. 33 OF 75

FOR INFORMATION ONLY




ROUTE NO.	SECTION	COUNTY	TOTAL SHEETS	SHEET NO.
FAP 799	*	ST. CLAIR	252	182
LINE		PROJECT		


* I BR-1 APPROACH BRIDGE

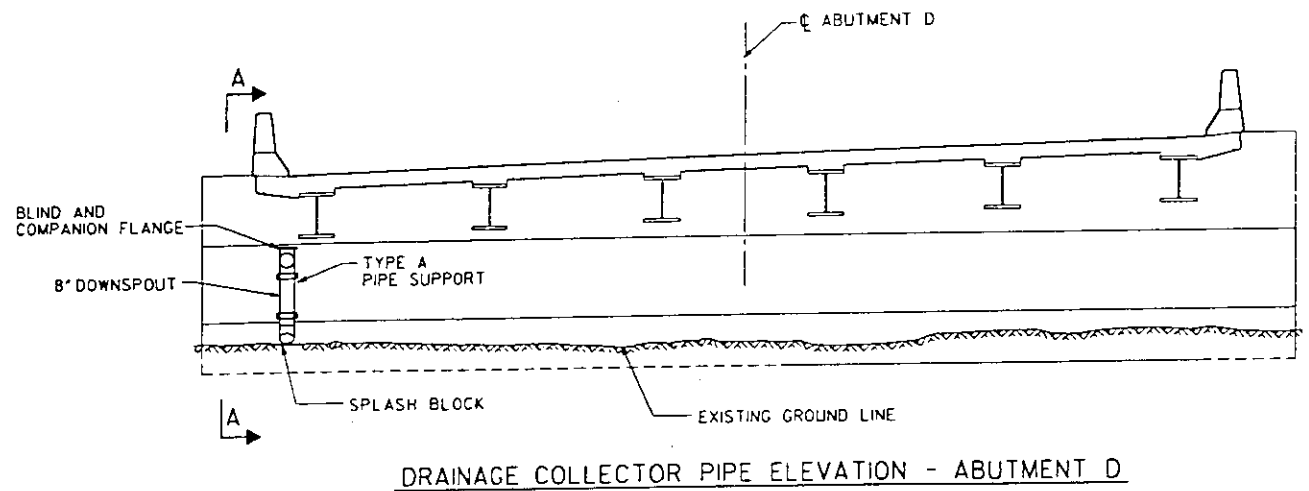

DRAINAGE COLLECTOR PIPE ELEVATION - ABUTMENT D

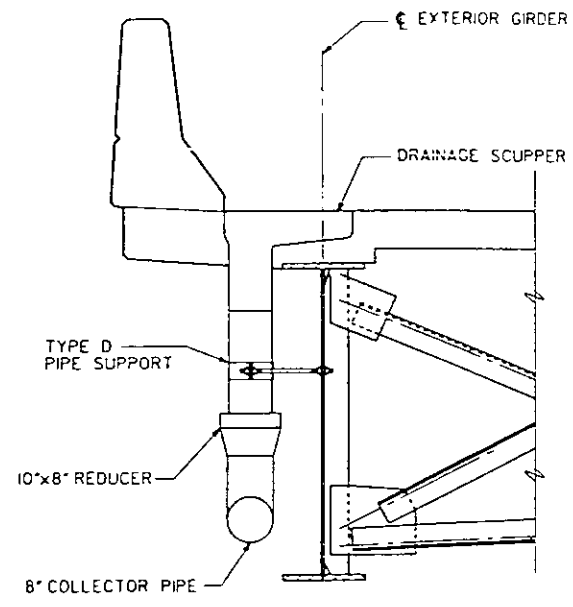

SECTION B-B

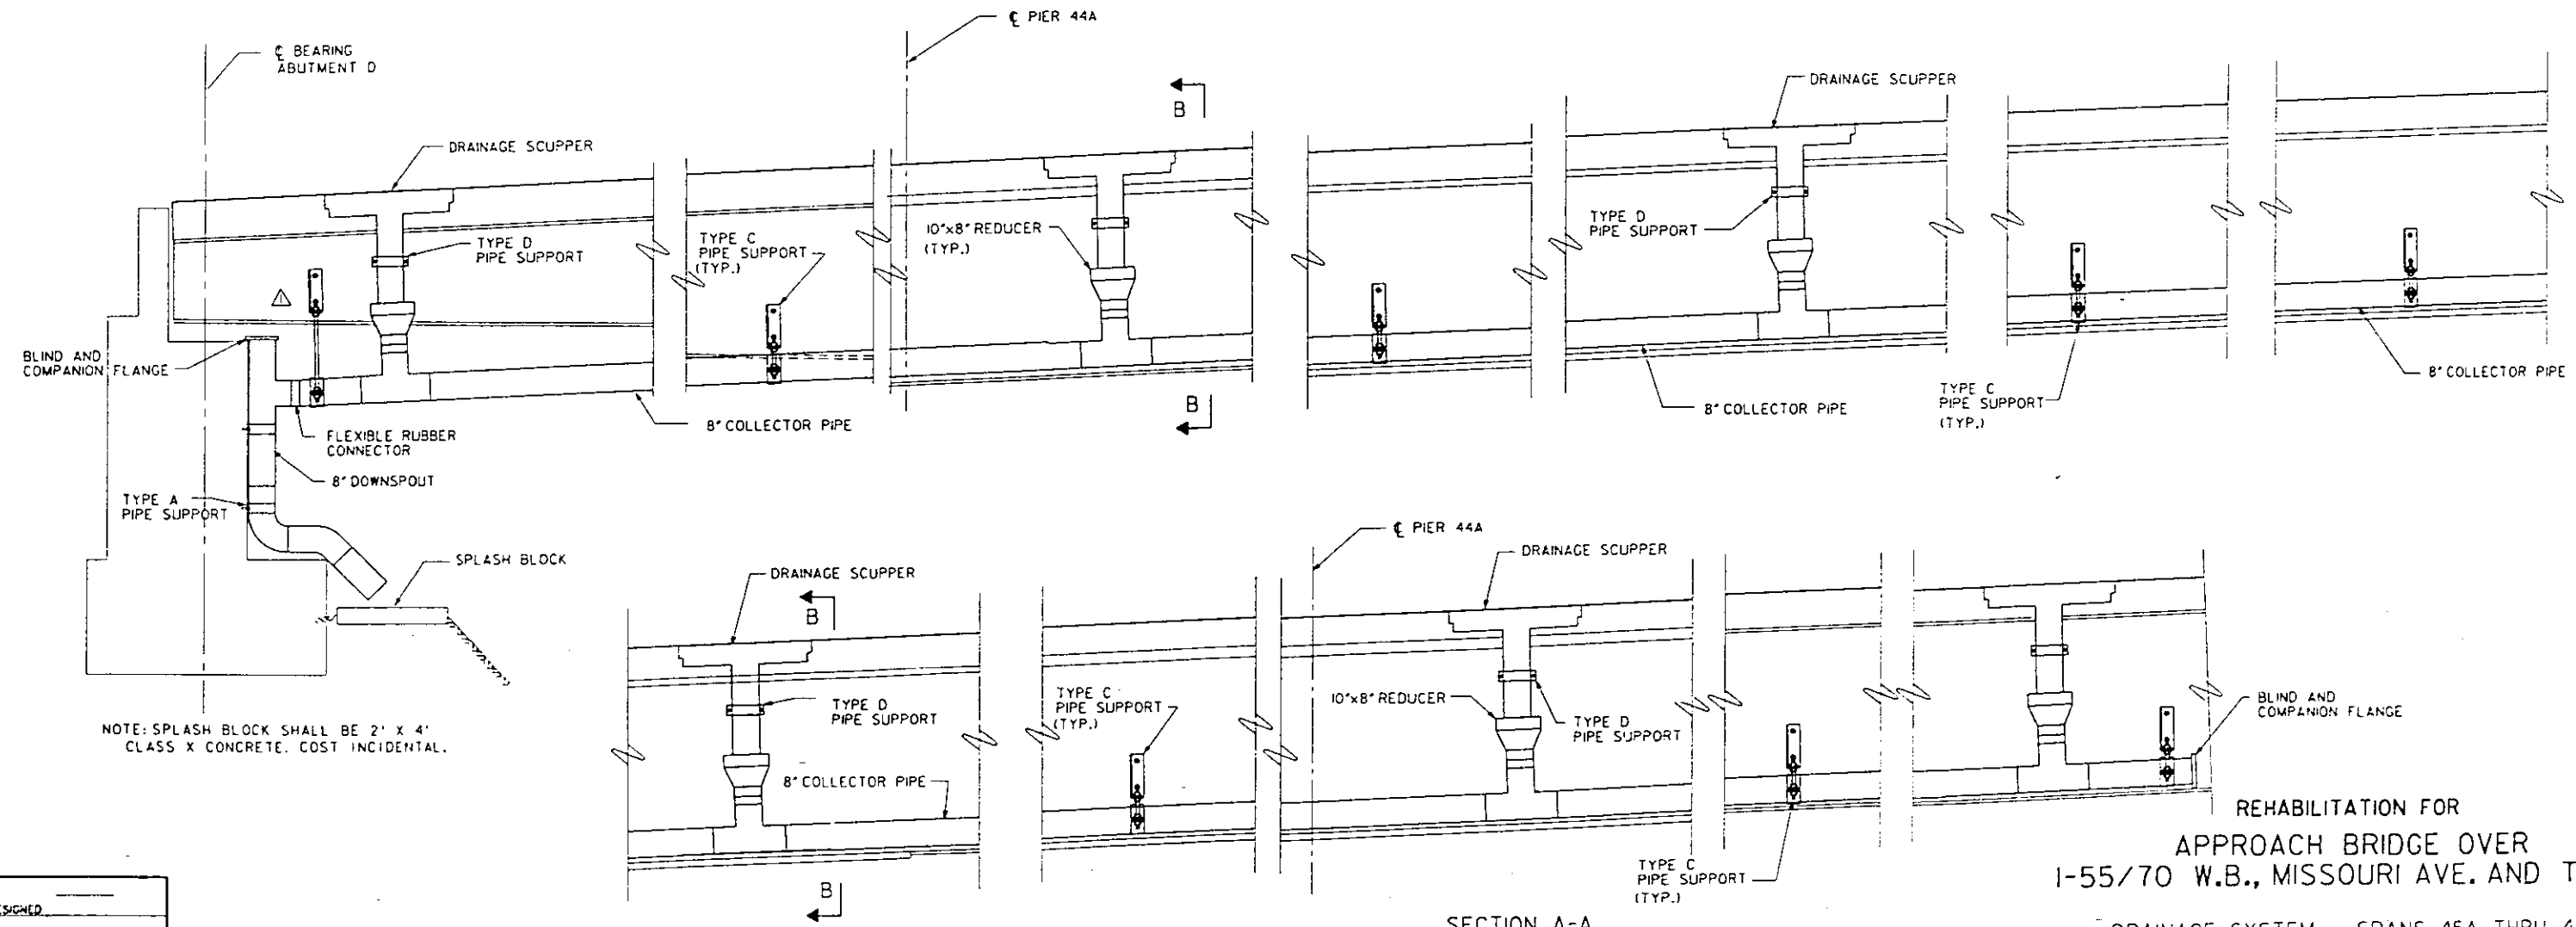

SECTION A-A

NOTE: SPLASH BLOCK SHALL BE 2' X 4' CLASS X CONCRETE. COST INCIDENTAL.

REHABILITATION FOR
APPROACH BRIDGE OVER
I-55/70 W.B., MISSOURI AVE. AND TRR
DRAINAGE SYSTEM - SPANS 45A THRU 47A

DESIGNED	_____
CHECKED	M. J. JALINSKY
DRAWN	J. LENZ
CHECKED	_____

DESIGNED BY: LENZ ENGINEERING, INC. ST. LOUIS, MISSOURI
PREPARED BY: SYERDRUP CORPORATION ST. LOUIS, MISSOURI

REV. 12-4-87


SECTION I BR-1

STRUCTURE NO. 082-6003
STA. 65+00 (FAP 799) ST. CLAIR CO.


SHEET NO. 34 OF 75

FOR INFORMATION ONLY


10358 FILE: ZF3405UDETAL109.DGN DATE: OCT. 23, 1987
 LEVELS PLOTTED 35 56 57 58 63
 4-DEU-1 12:12

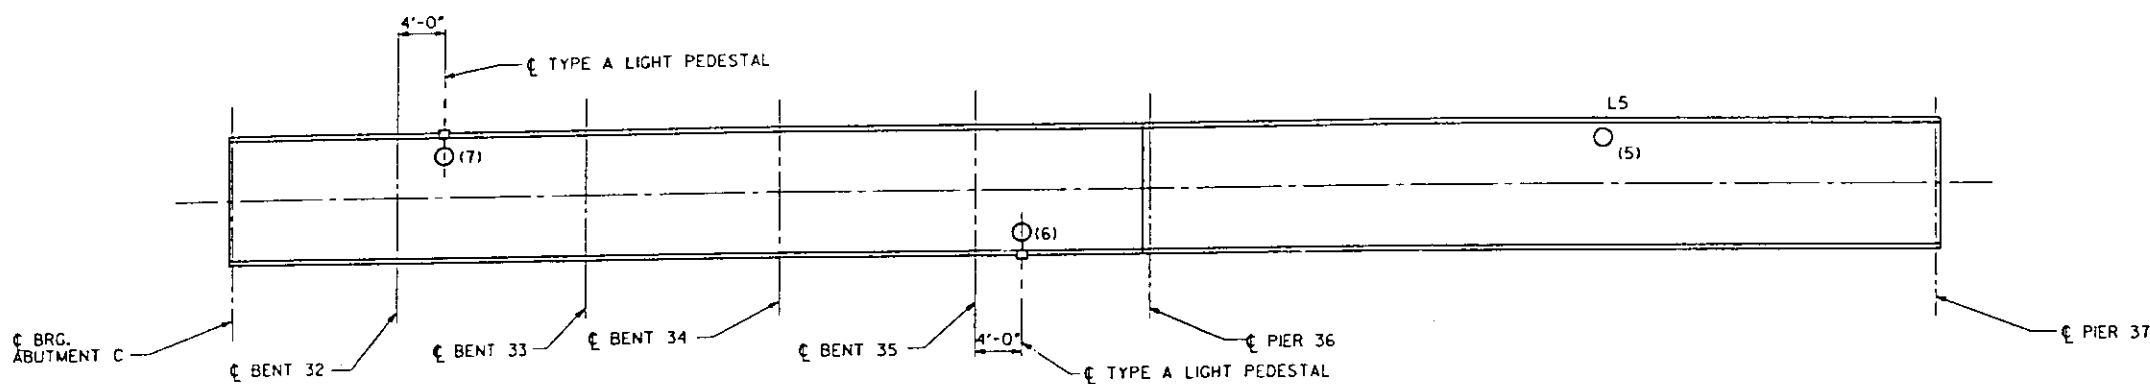


SPANS 33 THRU 38

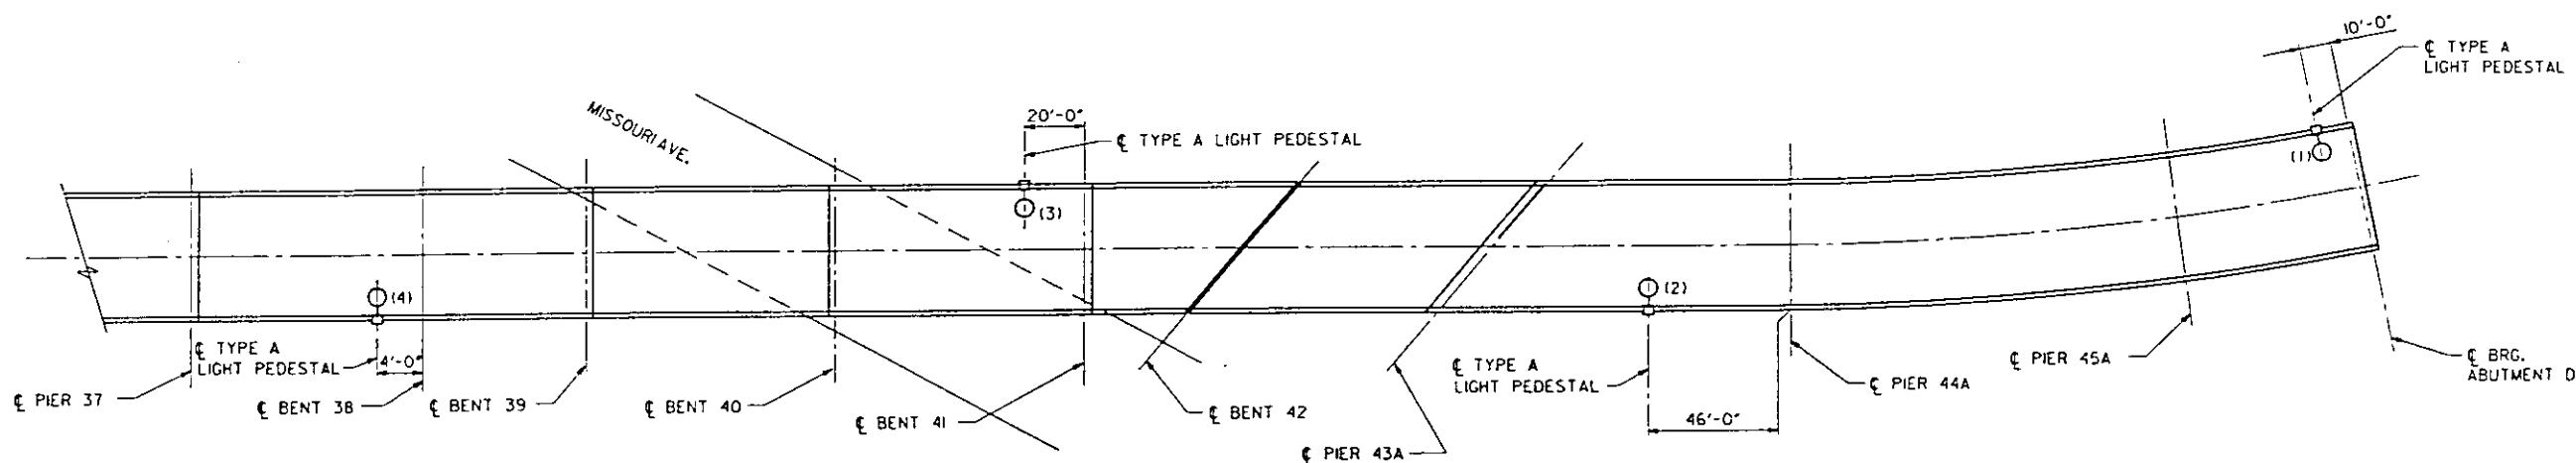


SPANS 39 THRU 47A

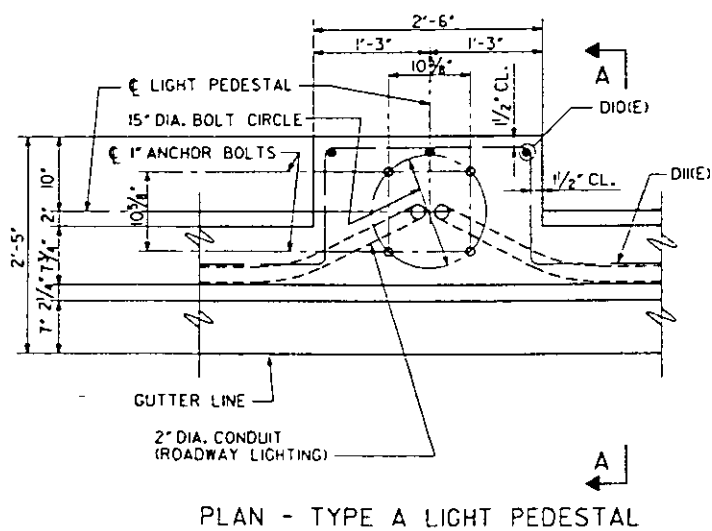

PLAN - TYPE A LIGHT PEDESTAL

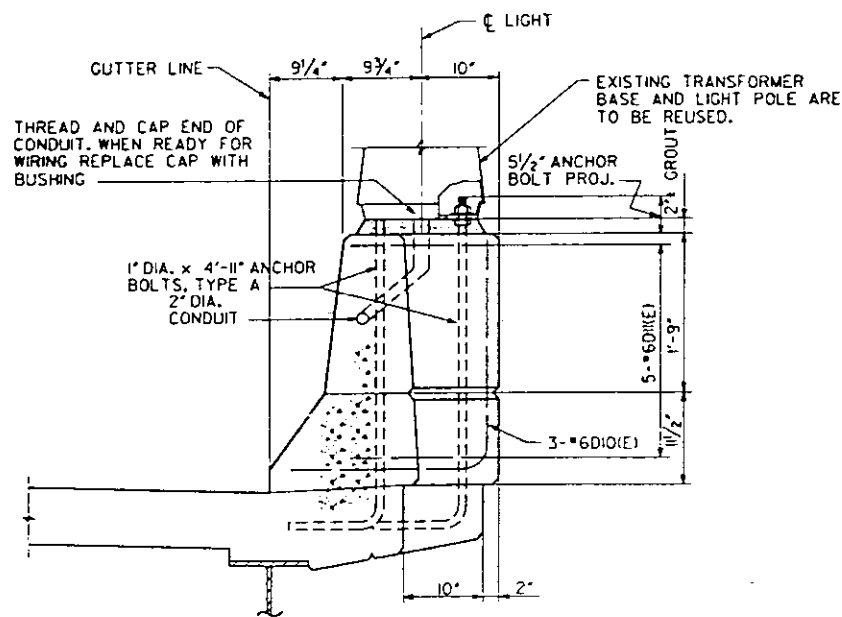

SECTION A-A

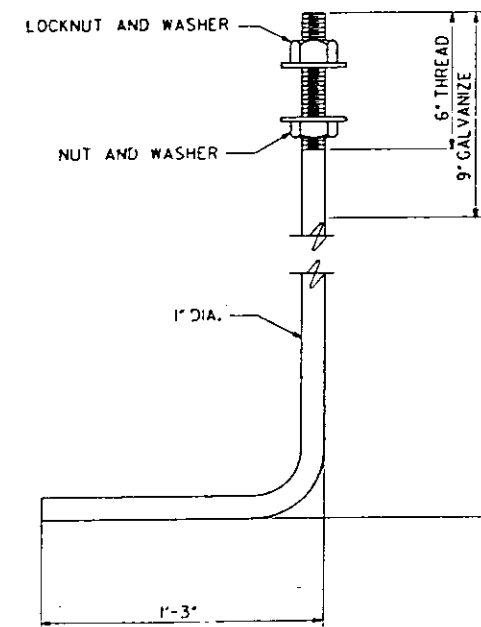

TYPE A
ANCHOR BOLT DETAIL

NOTES
SEE LIGHTING ELEMENTARY DIAGRAM AND ROADWAY LIGHTING PLAN FOR SYMBOLS, CONDUIT AND WIRING DETAILS.
ALL EXISTING ROADWAY LIGHTING TO BE REMOVED. SEE SPECIAL PROVISIONS.
MATERIAL FOR ANCHOR BOLTS SHALL CONFORM TO AASHTO M-183.

REHABILITATION FOR
APPROACH BRIDGE OVER
I-55/70 W.B., MISSOURI AVE. AND TRR
LIGHTING PLAN AND DETAILS

STRUCTURE NO. 082-6003
STA. 65+00 (FAP 799) ST. CLAIR CO.

PREPARED BY:
SVERDRUP CORPORATION
ST. LOUIS, MISSOURI

SECTION IBR-1

SHEET NO. 35 OF 75



FOR INFORMATION ONLY

LEVELS PLOTTED DATE: OCT. 23, 1987
35, 56, 57, 58 AND 63
FILE: F:\J15\JDE\TAIL\B3.DGN
8 PRF: DETAIL B3

DESIGNED
CHECKED
S. STEGMAN
DRAWN
P.W. CLARK
CHECKED

0 1 2 3 4 5 6 7 8 9 10 11 12 13 14 15 16 17 18 19 20 21 22 23 24

ROUTE NO.	SECTION	COUNTY	TOTAL SHEETS	SHEET NO.
FAP 799	*	ST. CLAIR	252	184
PROJECT		*1BR-1 APPROACH BRIDGE		

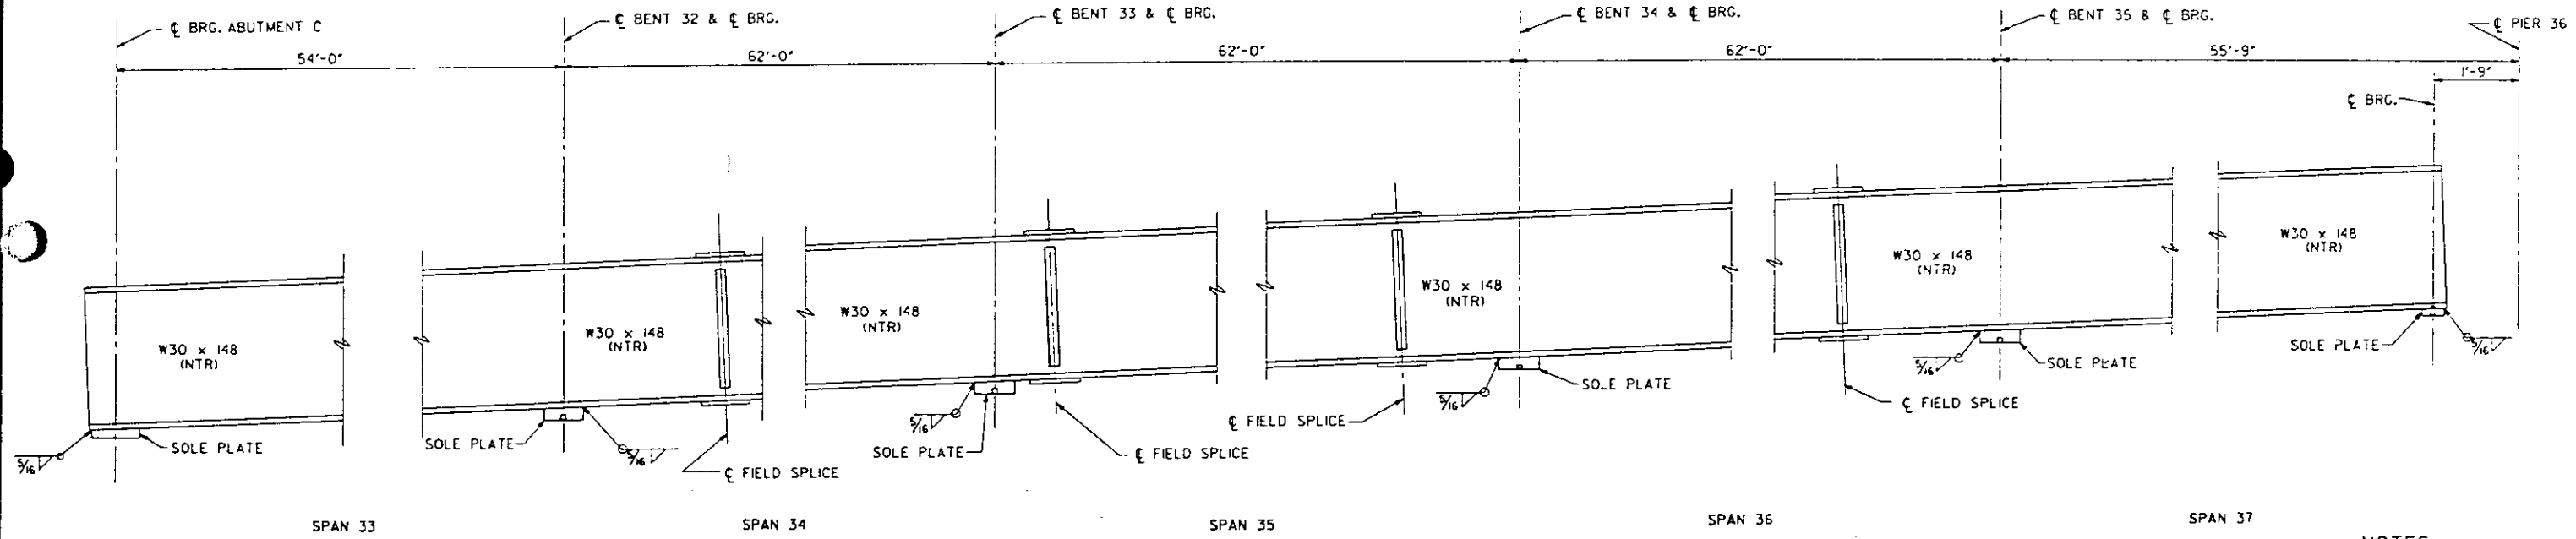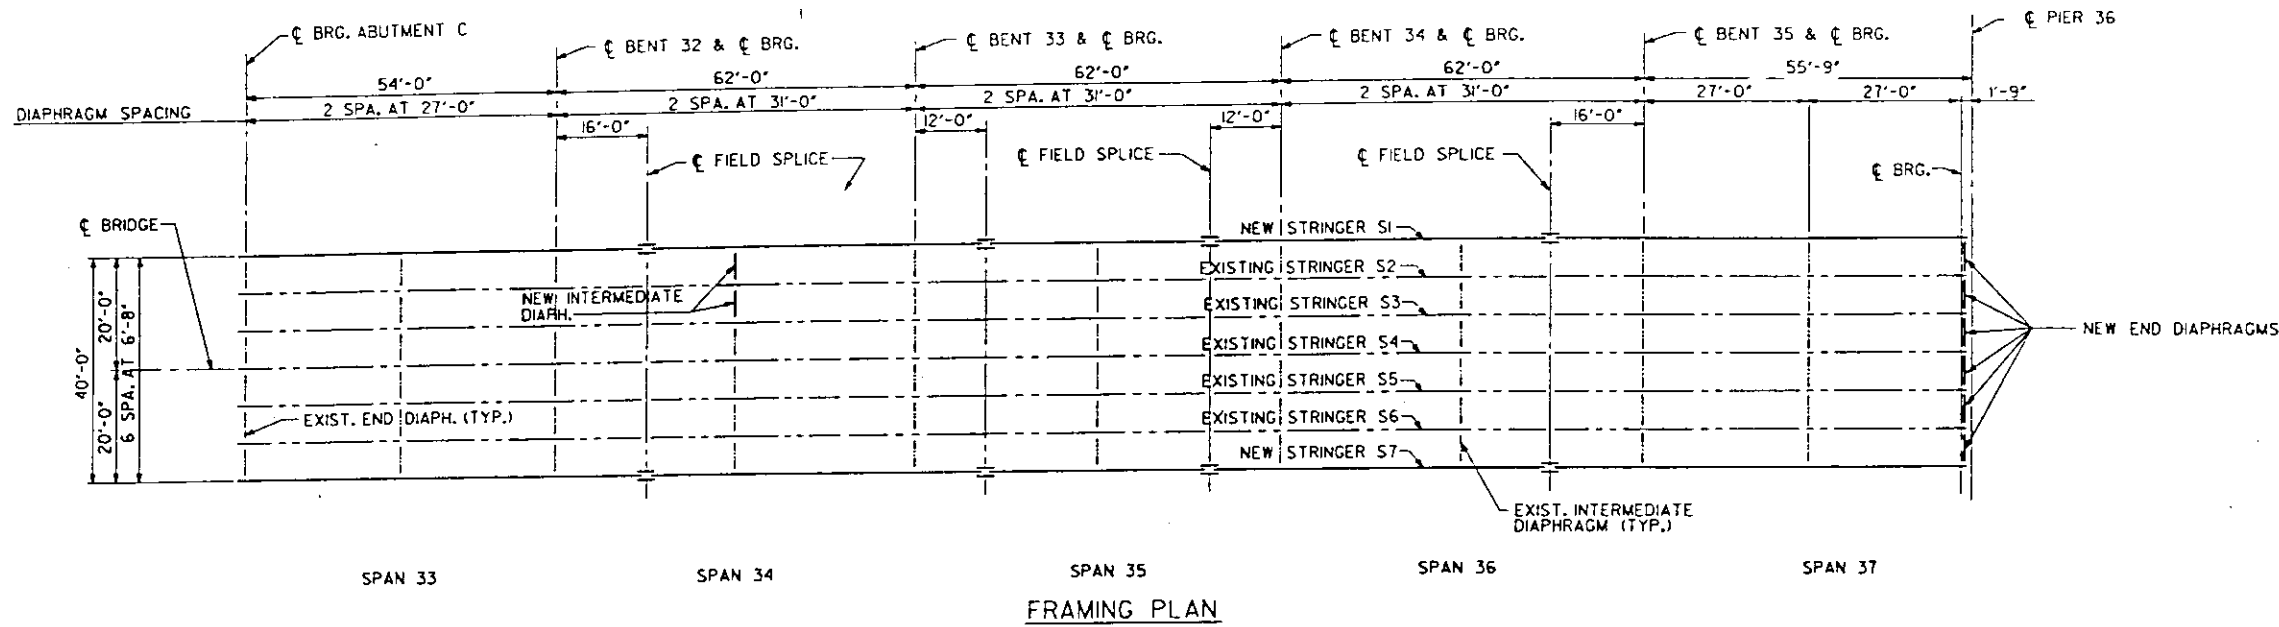

ELEVATION - NEW STRINGERS S1 AND S7

NOTES

NTR INDICATES MATERIAL SUBJECT TO NOTCH TOUGHNESS REQUIREMENT.
NEW STRINGERS AND DIAPHRAGMS REPLACE EXISTING MEMBERS.

REHABILITATION FOR
APPROACH BRIDGE OVER
I-55/70 W.B., MISSOURI AVE. AND TRRA

FRAMING PLAN - SPANS 33 THRU 37

STRUCTURE NO. 082-6003
STA. 65+00 (FAP 799) ST. CLAIR CO.

PREPARED BY:
SVERDRUP CORPORATION
ST. LOUIS, MISSOURI

SECTION 1BR-1


SHEET NO. 36 OF 75

FOR INFORMATION ONLY


1586 FILE: Z:\3151\JML\KFP2.DGN
 1926 MLXFP2
 LEVELS PLOTTED DATE: OCT. 23, 1987
 35 56 63

DESIGNED	A.D. NG
CHECKED	K. LARSON
DRAWN	J.O. SMITH
CHECKED	R.F. BECK


*IBR-1 APPROACH BRIDGE

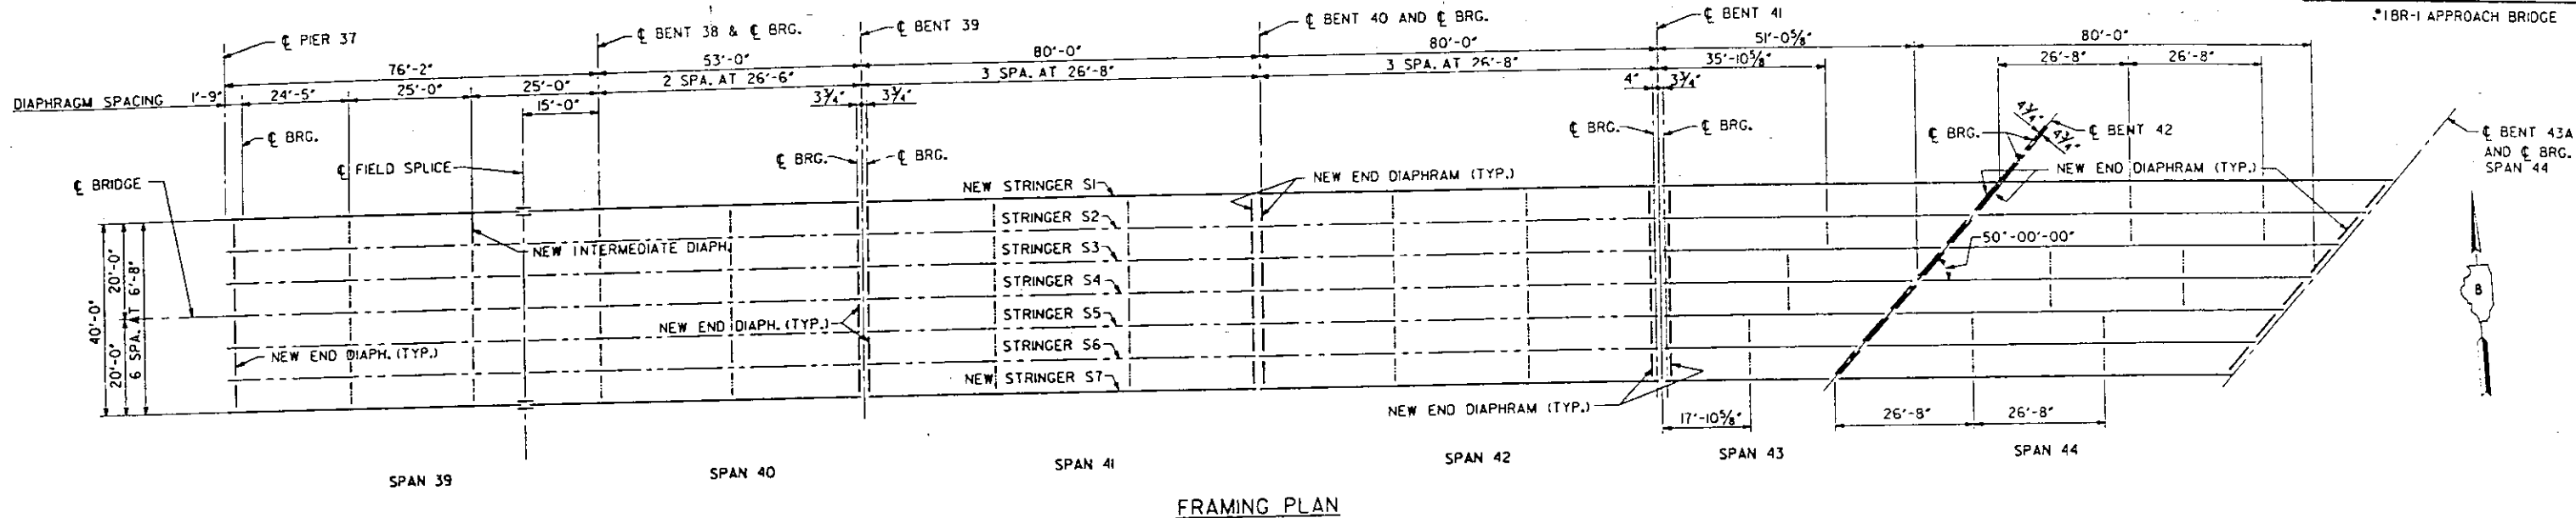


FRAMING PLAN

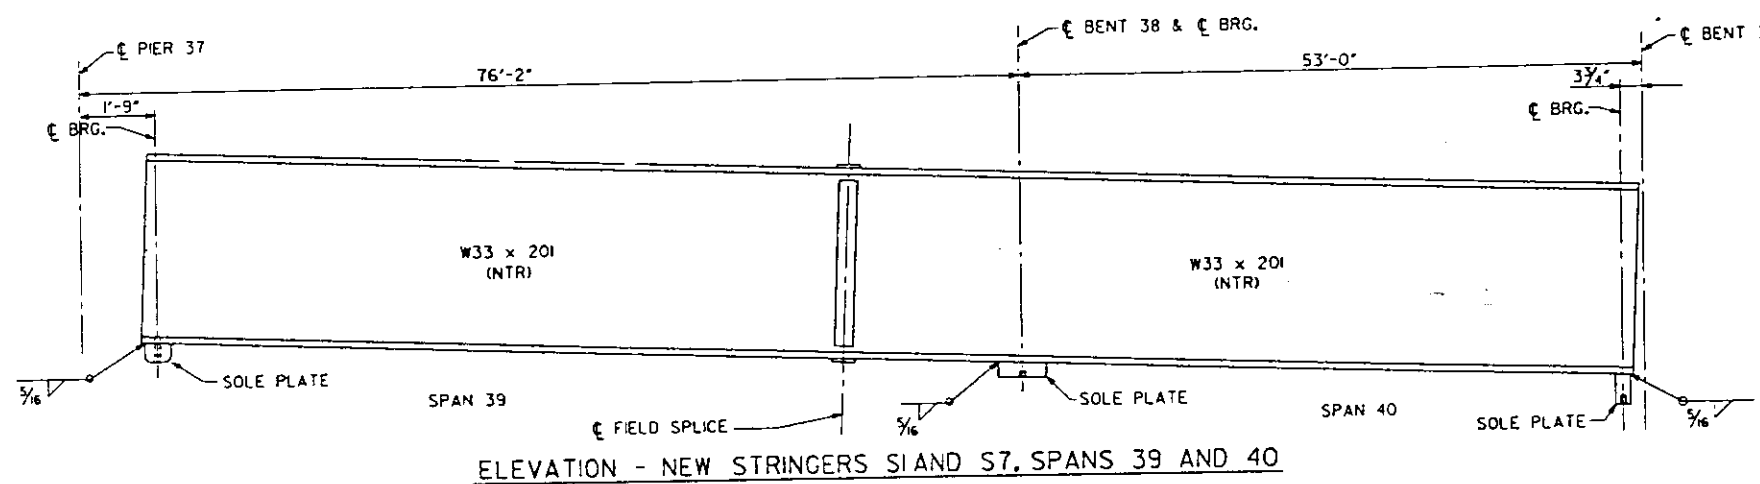

ELEVATION - NEW STRINGERS S1 AND S7, SPANS 39 AND 40

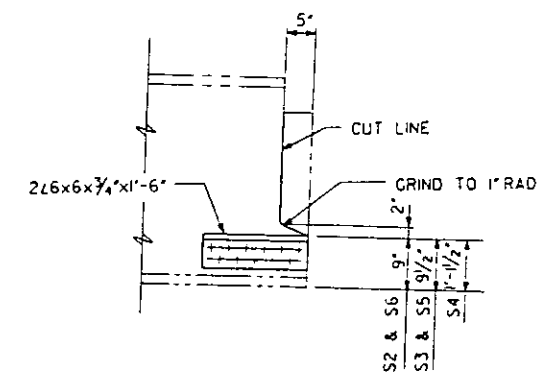

MODIFICATIONS TO EXISTING STRINGERS IN SPAN 42 AT BENT 41
FOR OTHER MODIFICATIONS SEE EXPANSION DEVICE AT BENT 41.

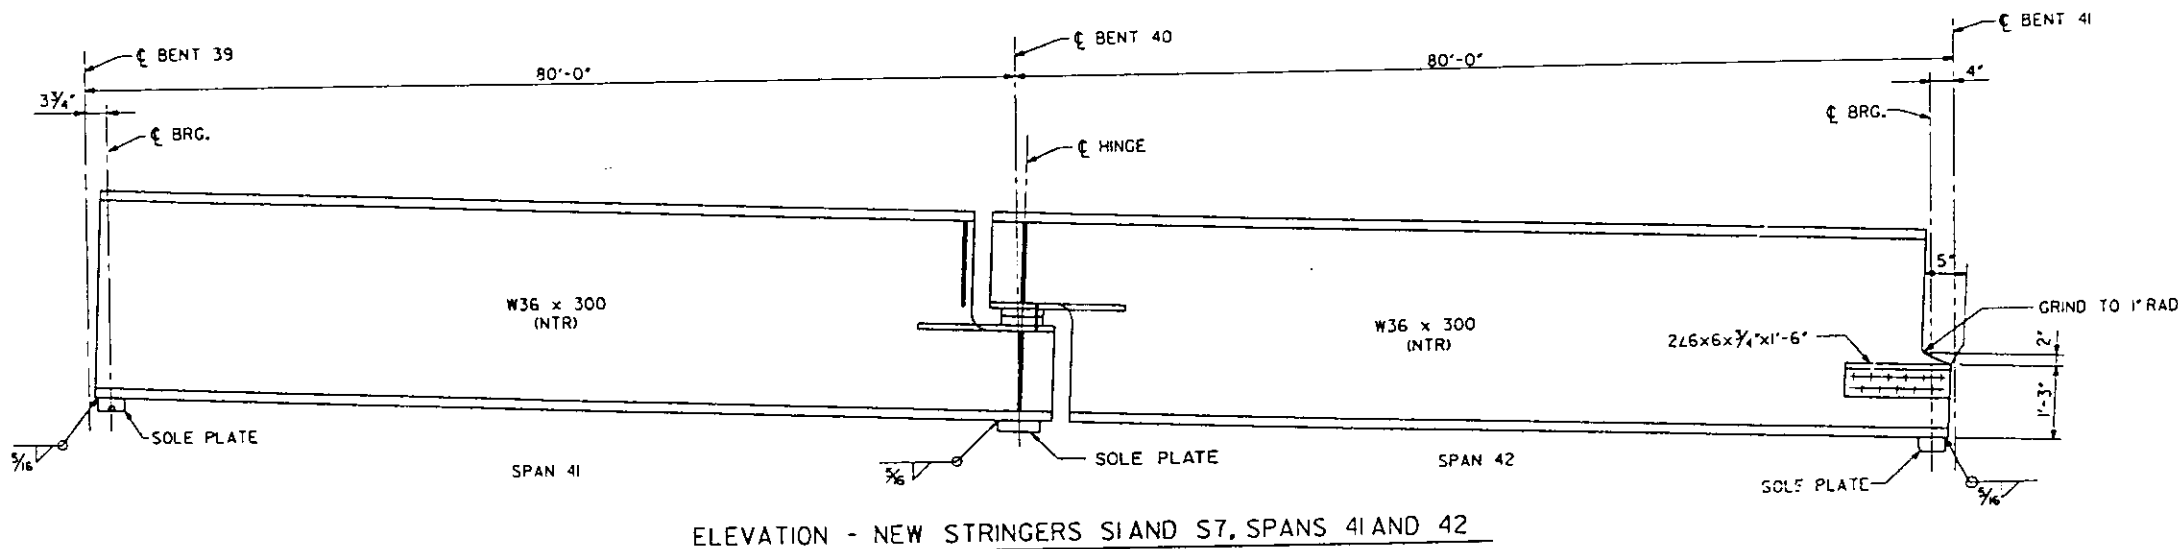

ELEVATION - NEW STRINGERS S1 AND S7, SPANS 41 AND 42

NOTES

NTR INDICATES MATERIAL SUBJECT TO NOTCH TOUGHNESS REQUIREMENT.
NEW STRINGERS AND DIAPHRAGMS REPLACE EXISTING MEMBERS.

REHABILITATION FOR
APPROACH BRIDGE OVER
I-55/70 W.B., MISSOURI AVE. AND TRR.

FRAMING PLAN SPANS 39 THRU 44

STRUCTURE NO. 082-6003
STA. 65+00 (FAP 799) ST. CLAIR CO.

A.D. NG	DESIGNED
K.D. LARSON	CHECKED
J.O. SMITH	DRAWN
R.F. BECK	CHECKED

PREPARED BY
SEVERDUP CORPORATION
ST. LOUIS, MISSOURI


SECTION IBR-1

SHEET NO. 37 OF 75


FOR INFORMATION ONLY

28-OCT-1987 10:27
LEVELS PLOTTED DATE: OCT. 23, 1987
FILE: ZF31(05)MLKFP14.DGN
35.56 AND 63
5950 PRF. MLKFP14


ROUTE NO.	SECTION	COUNTY	10' IN SHEETS	SHEET NO.
FAP 799	#	ST. CLAIR	252	18
PROJECT		*IBR-1 APPROACH BRIDGE		

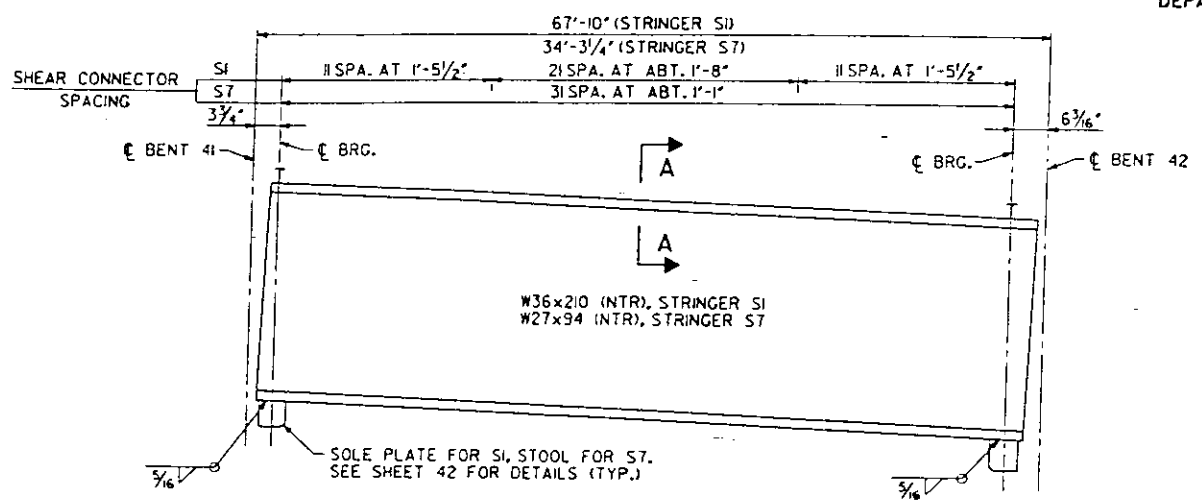


ELEVATION - NEW STRINGERS S1 AND S7, SPAN 43

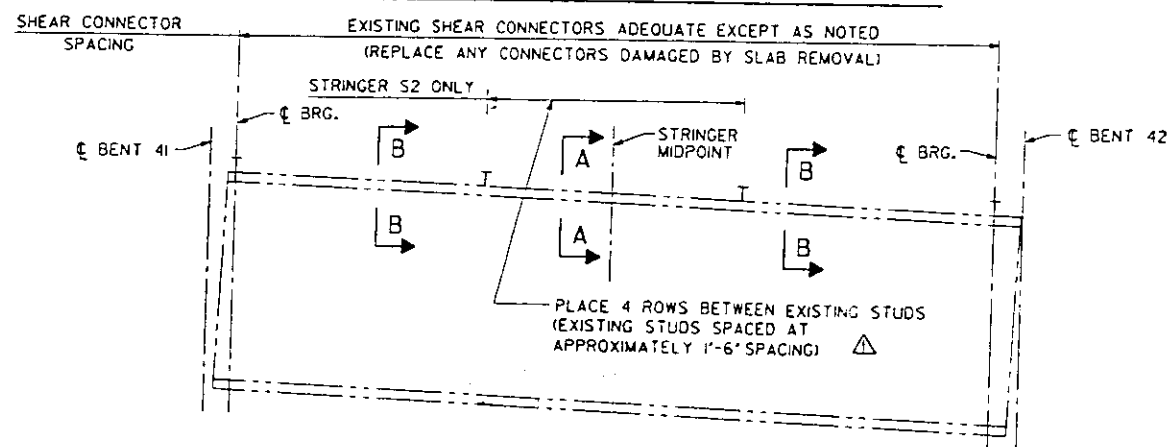


ELEVATION - EXISTING STRINGERS S2 THRU S6, SPAN 43

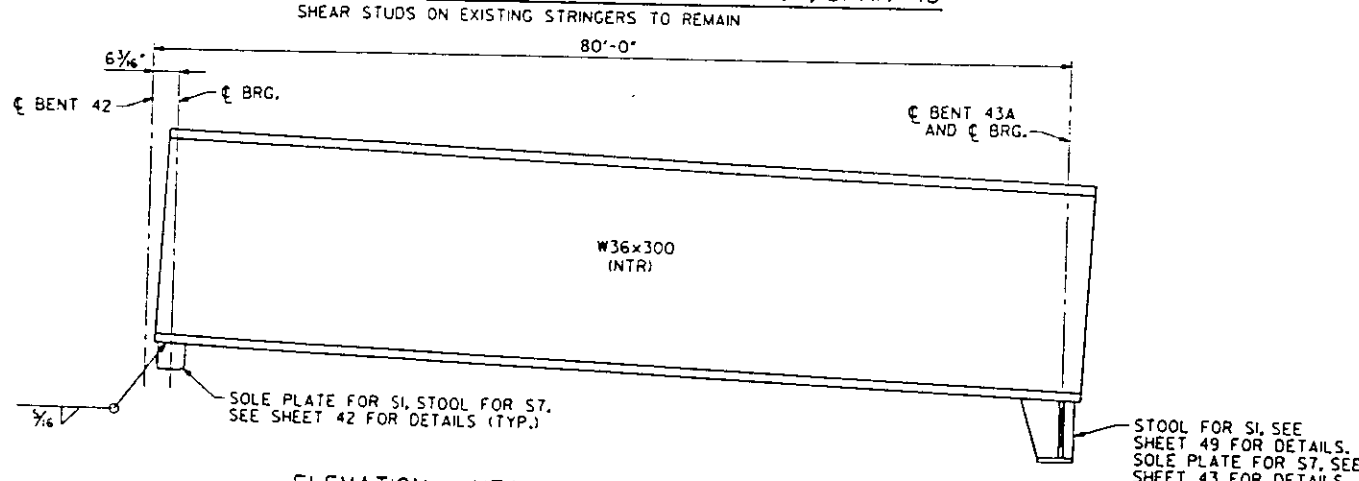

ELEVATION - NEW STRINGERS S1 AND S7, SPAN 44

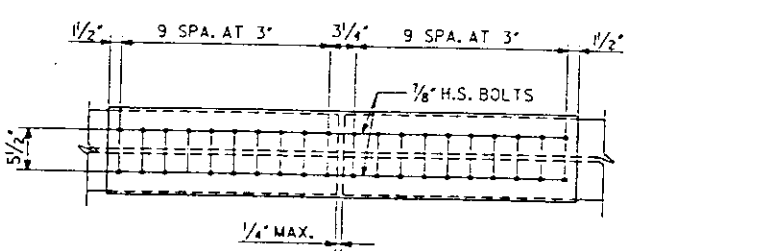


FLANGE SPLICE PLAN

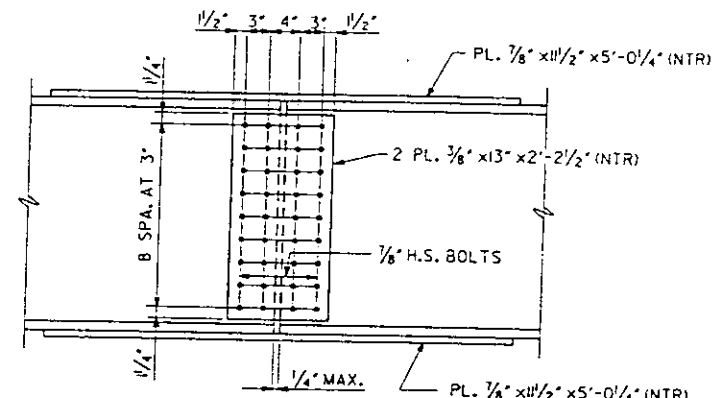


WEB SPLICE ELEVATION

STRINGER FIELD SPLICE - SPANS 34, 35 AND 36

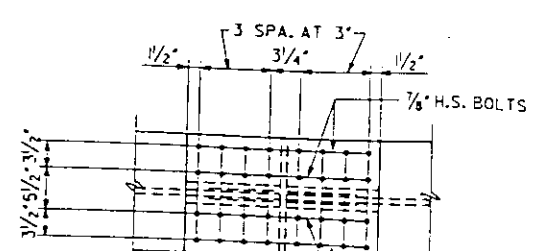

FLANGE SPLICE PLAN

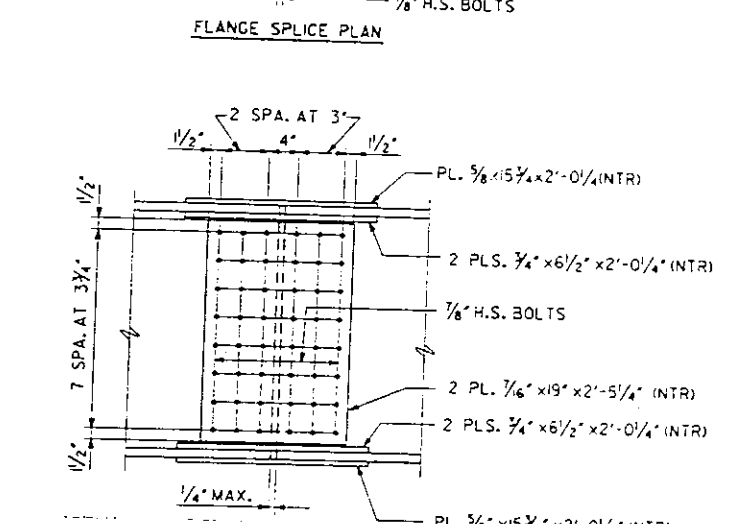


WEB SPLICE ELEVATION


STRINGER FIELD SPLICE - SPAN 39

NOTES

NTR INDICATES MATERIAL SUBJECT TO NOTCH TOUGHNESS REQUIREMENT.

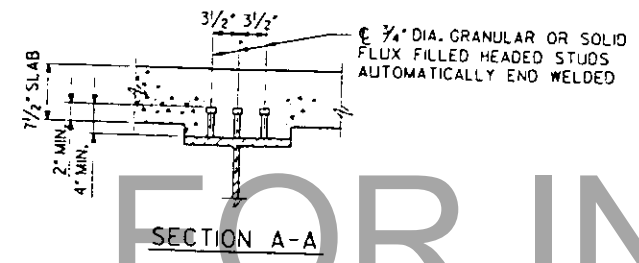

SECTION A-A

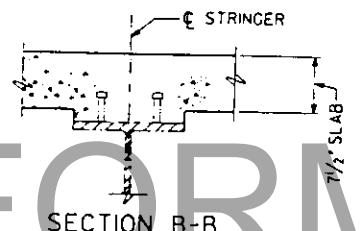

SECTION B-B

4-DEC-1987
 LEVELS PLOTTED DATE: OCT. 23, 1987
 FILE: I511JDE FAL 20.DGN
 35 56 58 63
 PRF: DETAIL 20
 10358
 R. NIEMIETZ
 K. LARSON
 J.O. SMITH
 R.F. BECK

DESIGNED	R. NIEMIETZ
CHECKED	K. LARSON
DRAWN	J.O. SMITH
CHECKED	R.F. BECK


PREPARED BY
SYVERDRUP CORPORATION
ST. LOUIS, MISSOURI

REV. 12-4-87

SECTION IBR-1


REHABILITATION FOR
APPROACH BRIDGE OVER
I-55/70 W.B., MISSOURI AVE. AND TRR/
STEEL DETAILS - SPANS 33 THRU 37
AND 39 THRU 44
STRUCTURE NO. 082-6003
STA. 65+00 (FAP 799) ST. CLAIR CO.

FOR INFORMATION ONLY

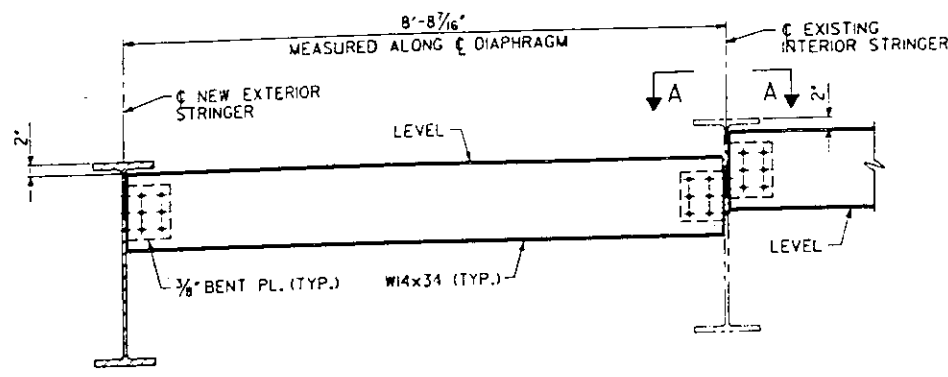


END DIAPHRAGMS - BENTS 42 AND 43A

NOTE: REUSE HOLES IN EXISTING INTERIOR STRINGERS FOR NEW DIAPHRAGM CONNECTION.

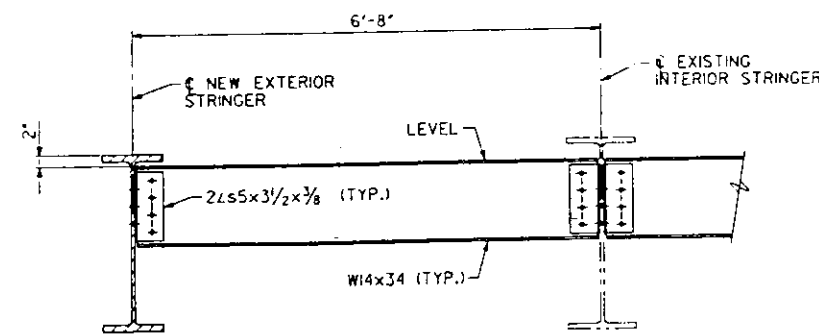


INTERMEDIATE DIAPHRAGMS - SPANS 34 AND 39
END DIAPHRAGMS - BENT 39

NOTE: REUSE HOLES IN EXISTING INTERIOR STRINGERS FOR NEW DIAPHRAGM CONNECTION.

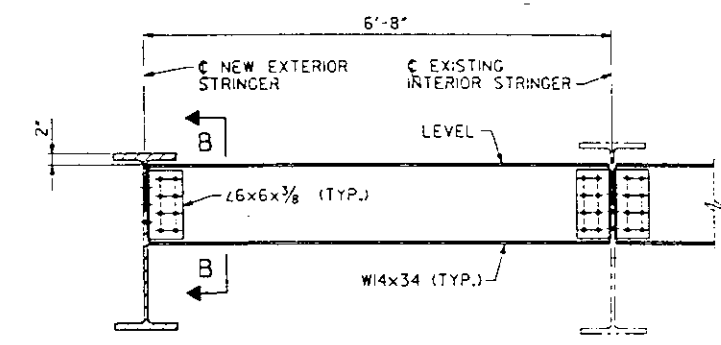


NOTE: REUSE HOLES IN EXISTING INTERIOR STRINGERS FOR NEW DIAPHRAGM CONNECTION.

END DIAPHRAGMS - PIERS 36 AND 37

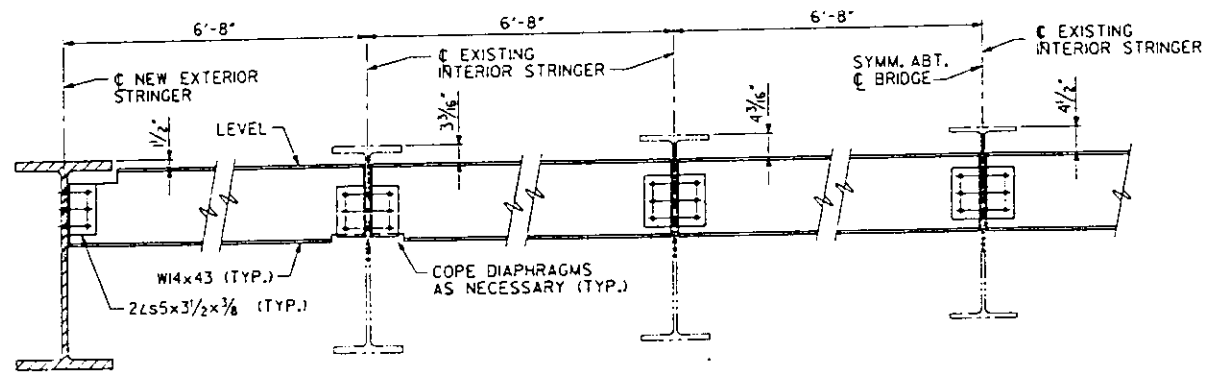


END DIAPHRAGMS AT BENT 41 - SPANS 42 AND 43

NOTE: REUSE HOLES IN EXISTING INTERIOR STRINGERS FOR NEW DIAPHRAGM CONNECTION.

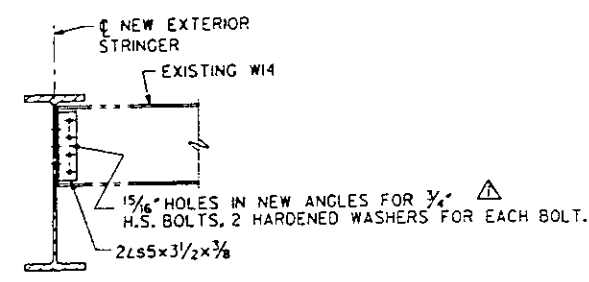


END DIAPHRAGM CONN. - ABUT. C
INTERMEDIATE DIAPHRAGM CONN.
SPANS 33 THRU 37 AND 39 THRU 44
TO NEW EXTERIOR STRINGERS

NOTE: REUSE HOLES IN EXISTING W14 FOR NEW STRINGER CONNECTION. (40 LOCATIONS)

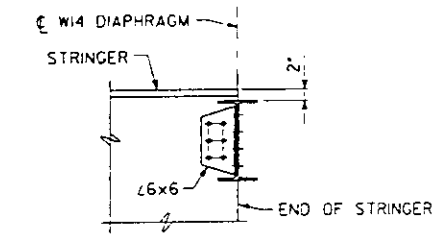

SECTION B-B

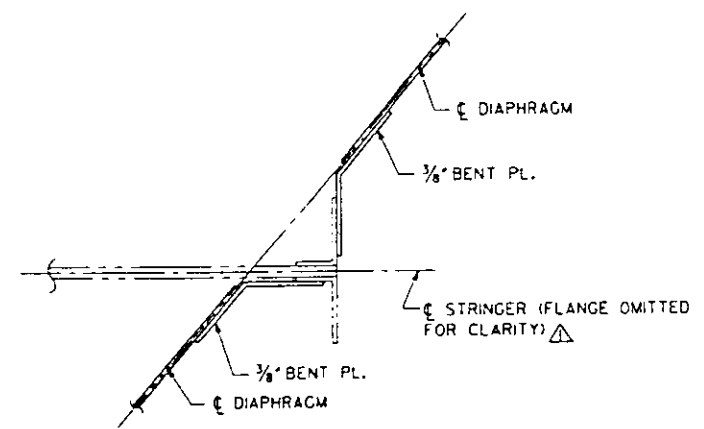

SECTION A-A

NOTES

WORK THIS SHEET WITH SHEETS 36 AND 37.
FOR CONNECTIONS TO DIAPHRAGM WEBS, PROVIDE 1 1/4\"/>

REHABILITATION FOR
APPROACH BRIDGE OVER
I-55/70 W.B., MISSOURI AVE. AND TRF

STEEL DETAILS
SPANS 33 THRU 37 AND 39 THRU 44

STRUCTURE NO. 082-6003
STA. 65+00 (FAP 799) ST. CLAIR CO.

PREPARED BY
SYVERDRUP CORPORATION
ST. LOUIS, MISSOURI

REV. 12-4-87

SECTION IBR-1



SHEET NO. 39 OF 75

4-DEC-11 112

LEVELS PLOTTED DATE: OCT. 23, 1987
35 56 58 63
FILE: ZF3051JDDetail0100N
87S913 PRF Detail 01


DESIGNED	R. NIEMIETZ
CHECKED	K. LARSON
DRAWN	C. DEED
CHECKED	A. MYERS

FOR INFORMATION ONLY

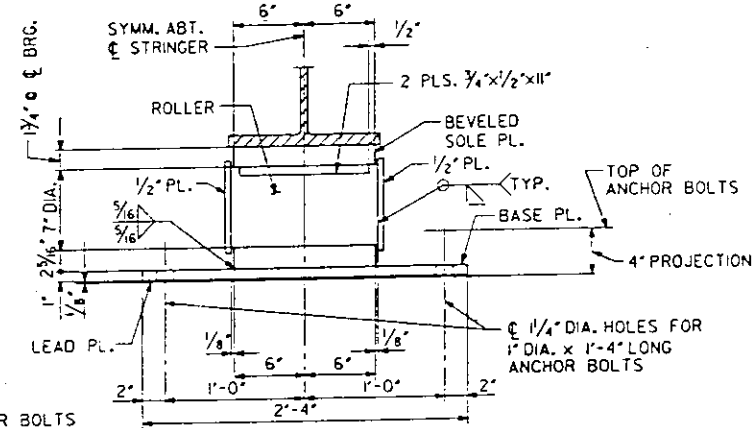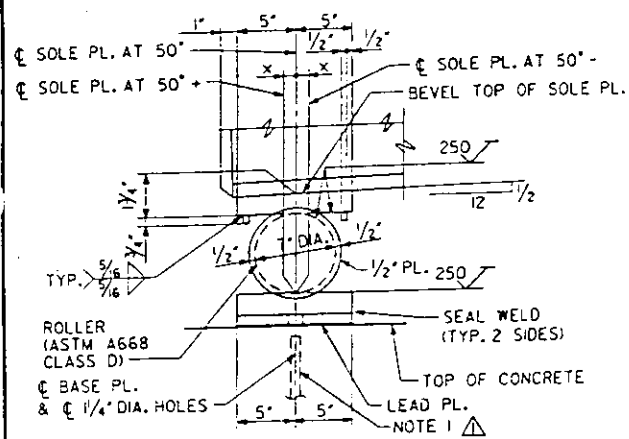



BEARINGS FOR EXTERIOR STRINGERS AT ABUTMENT C

NOTE: $x = \frac{1}{16}''$ FOR EACH 20' CHANGE IN TEMPERATURE. EXISTING INTERIOR STRINGER BEARINGS TO BE CHECKED AND REALIGNED ACCORDINGLY. SEE SPECIAL PROVISIONS.

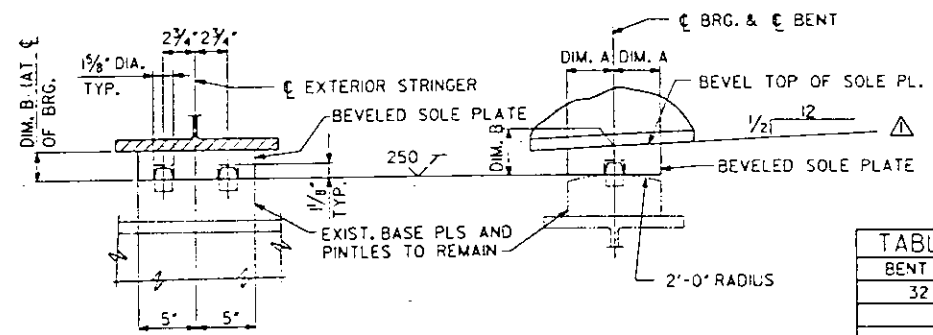

BEARINGS FOR EXTERIOR STRINGER AT BENTS 32, 33, 34, 35 AND 38


BENT DESIGNATION	DIM. A	DIM. B
32 THRU 34	4"	1 1/4"
35	4"	2"
38	4"	2 1/8"

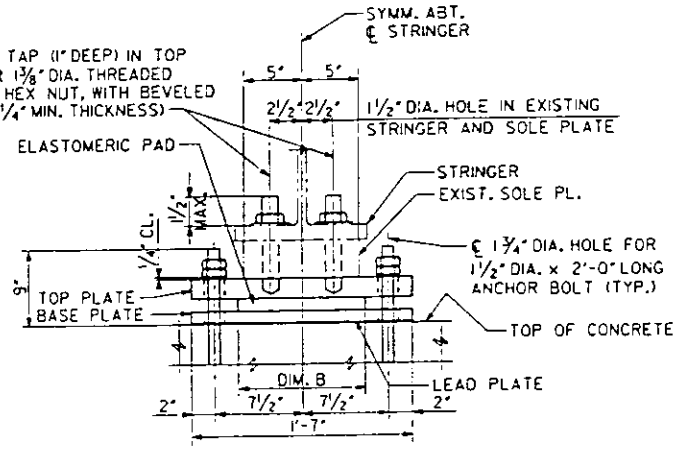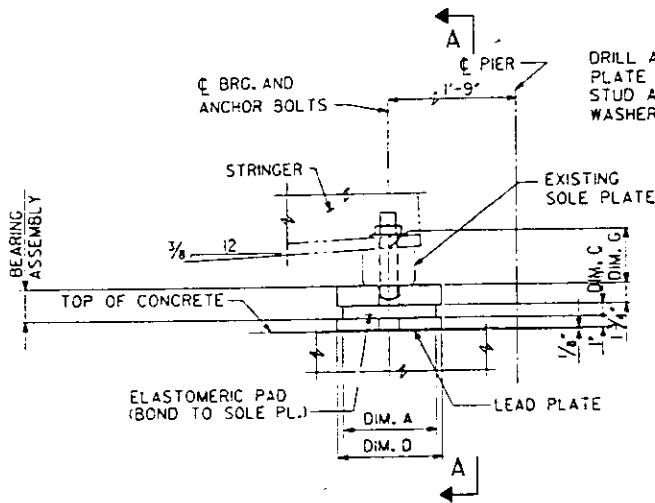


BEARINGS FOR INTERIOR STRINGERS AT FIXED PIERS 36 AND 37 (10 REQUIRED)

PIER DESIGNATION	DIM. A	DIM. B	DIM. C	DIM. D
36	8"	8"	1 1/8"	9"
37	9"	1'-0"	1 1/16"	10"

STRINGER DESIGNATION	DIM. G
S2, S6	2 1/4"
S3, S5	3 1/4"
S4	3 3/8"

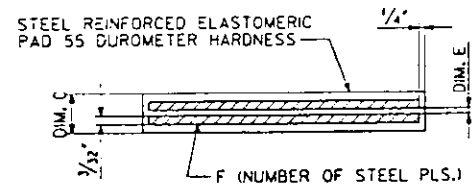


PIER DESIGNATION	DIM. C	DIM. E	F
36	1 1/8"	3/16"	2
37	1 1/16"	3/8"	3

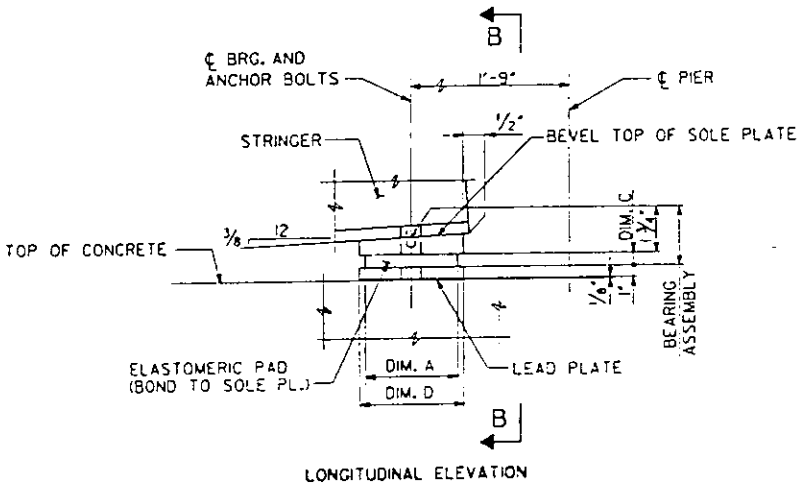

BEARINGS FOR EXTERIOR STRINGERS AT FIXED PIERS 36 AND 37 (4 REQUIRED)

PIER DESIGNATION	DIM. A	DIM. B	DIM. C	DIM. D
36	8"	11"	1 1/8"	9"
37	9"	1'-0"	1 1/16"	10"

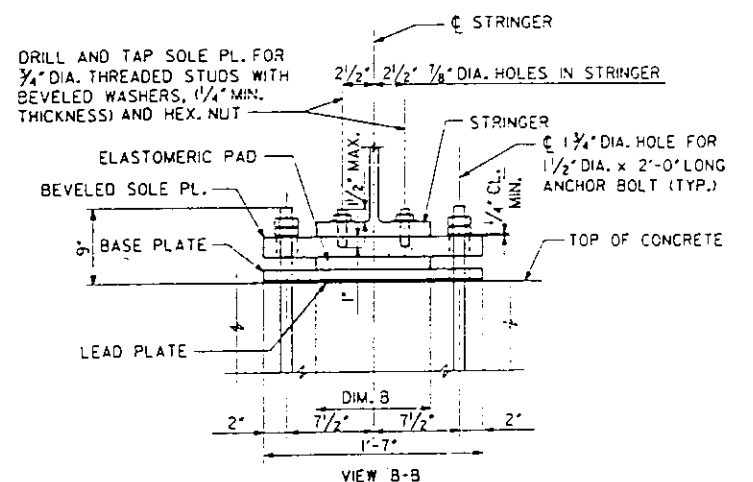

NOTES

BEARINGS AT PIERS 36 AND 37 WILL BE PAID FOR AS ELASTOMERIC BEARING ASSEMBLY, TYPE (104 REQUIRED).
BASE PLATES AND LEAD PLATES FOR BEARINGS AT PIERS 36 AND 37 SHALL BE INCLUDED IN WEIGHT AND COST FOR STRUCTURAL STEEL.
FOR ANCHOR BOLT INSTALLATION, SEE SHEET 68.

REHABILITATION FOR APPROACH BRIDGE OVER I-55/70 W.B., MISSOURI AVE. AND TRRA

BEARINGS AT ABUTMENT C, BENTS AND PIERS 32 THRU 38

STRUCTURE NO. G82-6003
STA. 65+00 (FAP 799) ST. CLAIR CO.

PREPARED BY:
SYVERDRUP CORPORATION
ST. LOUIS, MISSOURI

REV. 12-4-87


SECTION 1BR-1

SHEET NO. 40 OF 75


FOR INFORMATION ONLY

LEVELS PLOTTED DATE: OCT. 23, 1987
 35, 56, 58 AND 63
 58 2F31(5)JIDETAL19.DGN
 10/23/87 PRF:JLH/SL

DESIGNED	A. NG
CHECKED	K. LARSON
CHECKED	J.O. SMITH
CHECKED	ORARN
CHECKED	R.F. BECK

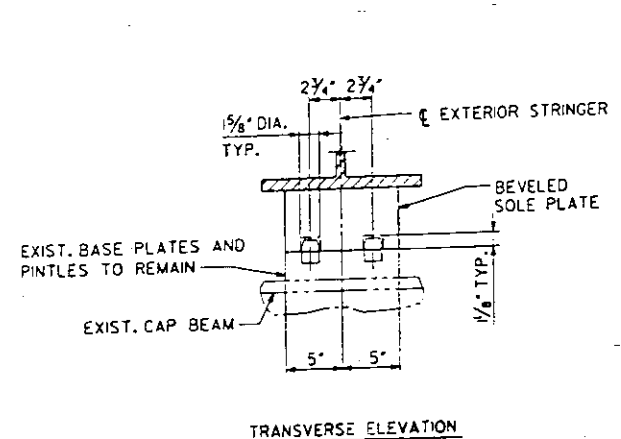


TRANSVERSE ELEVATION

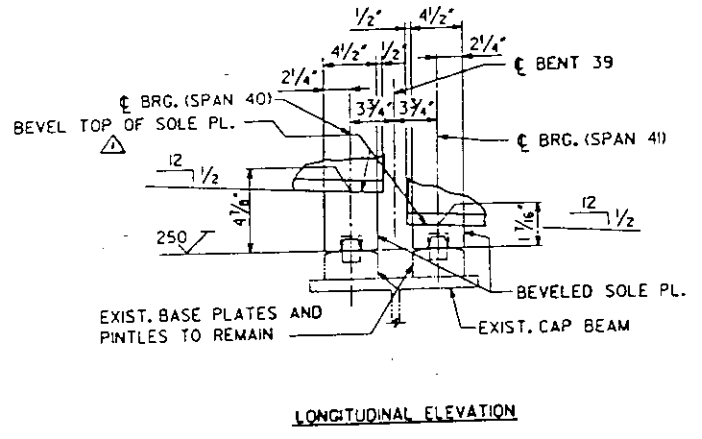


LONGITUDINAL ELEVATION

BEARINGS FOR EXTERIOR STRINGERS AT BENT 39

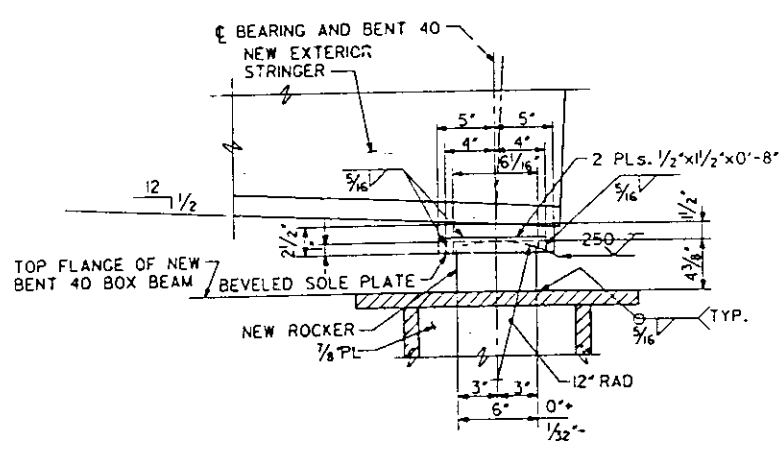


LONGITUDINAL ELEVATION


BEARINGS FOR EXTERIOR STRINGERS AT BENT 40

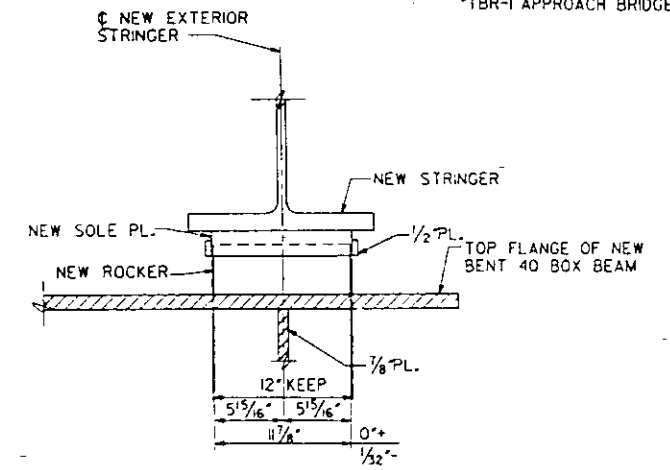


TRANSVERSE ELEVATION

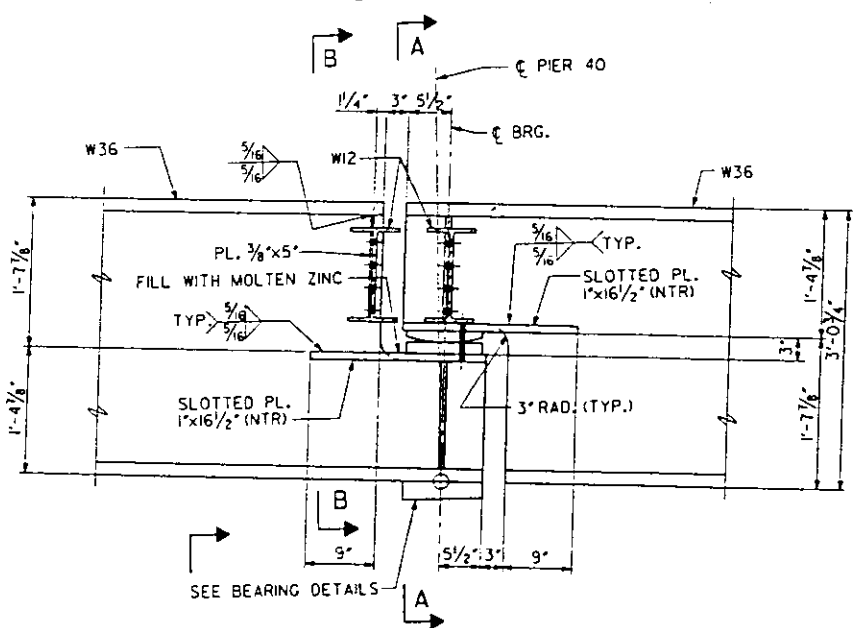

HINGE DETAILS - PIER 40
(EXTERIOR STRINGERS)

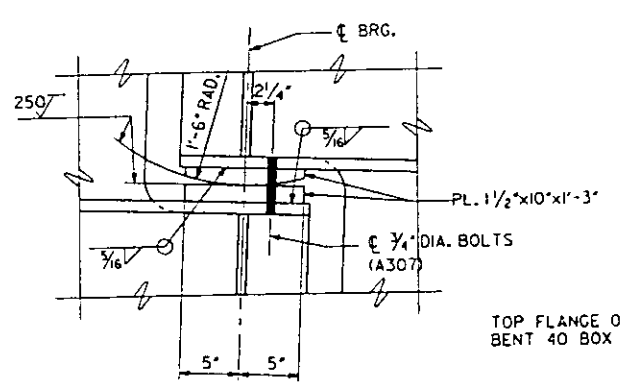


HINGE BEARING DETAIL

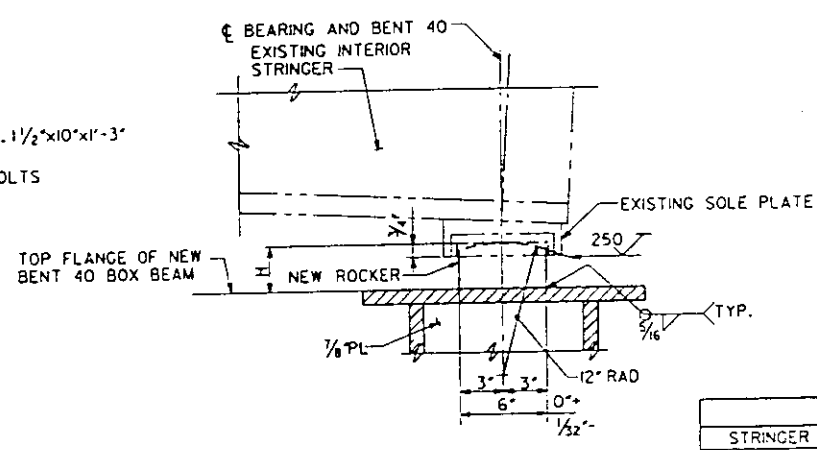


LONGITUDINAL ELEVATION

BEARINGS FOR INTERIOR STRINGERS AT BENT 40

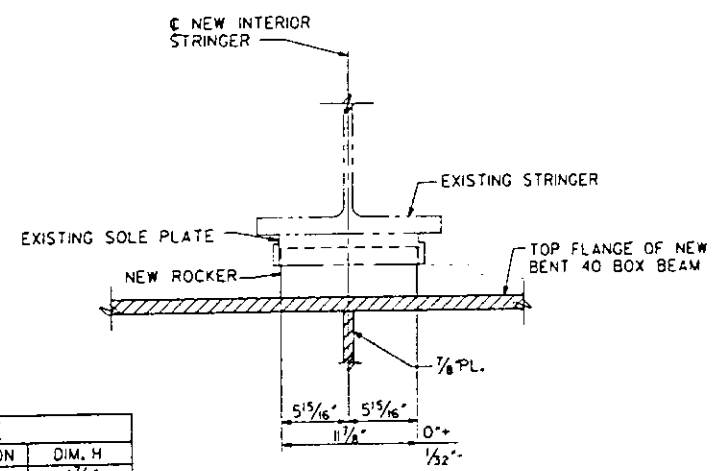


TRANSVERSE ELEVATION

TABLE	
STRINGER DESIGNATION	DIM. H
S2 AND S6	4 1/8"
S3 AND S5	5 1/8"
S4	6 3/8"

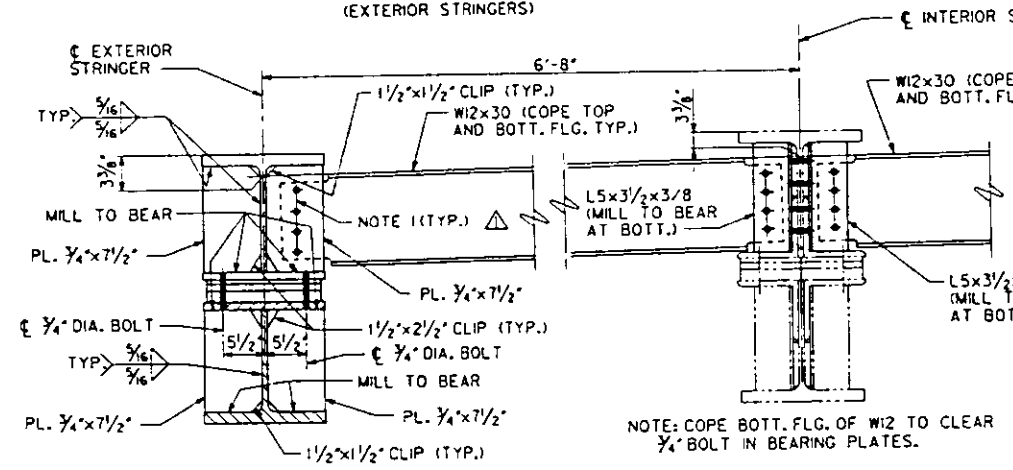

SECTION A-A

NOTE: REUSE HOLES IN EXISTING INTERIOR STRINGERS FOR NEW DIAPHRAGM CONNECTION.

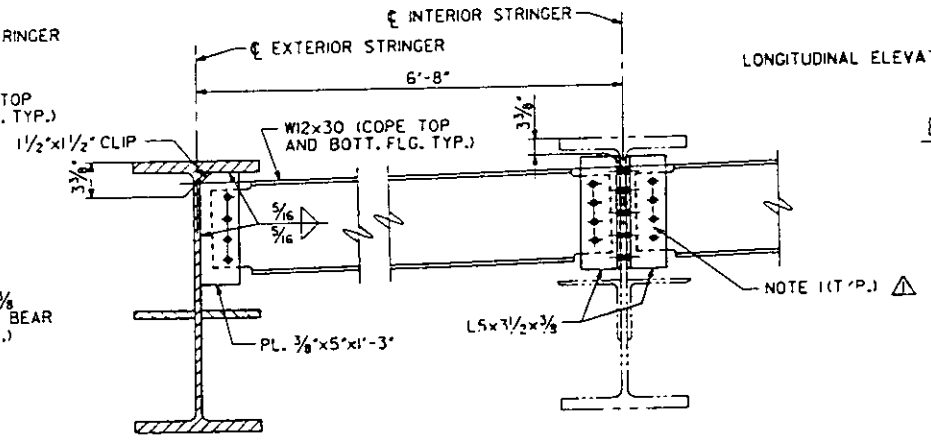

SECTION B-B

NOTE: REUSE HOLES IN EXISTING INTERIOR STRINGERS FOR NEW DIAPHRAGM CONNECTION.

NOTE 1: PROVIDE 1 3/16\"/>

NOTES
ALL MATERIAL SHALL CONFORM TO AASHTO M-183 UNLESS OTHERWISE NOTED.
NTR INDICATES MATERIAL SUBJECT TO NOTCH TOUGHNESS REQUIREMENTS.
SEE SHEET 73 FOR BENT 40 DETAILS.
ALL BOLTED CONNECTIONS SHALL BE 3/4\"/>

REHABILITATION FOR
APPROACH BRIDGE OVER
I-55/70 W.B., MISSOURI AVE. AND TRR
BEARINGS AT BENTS 39 AND 40
AND HINGE DETAILS

STRUCTURE NO. 082-6003
STA. 65+00 (FAP 799) ST. CLAIR CO.

PREPARED BY
SYVERDRUP CORPORATION
ST. LOUIS, MISSOURI


REV. 12-4-87


SECTION 1BR-1

SHEET NO. 41 OF 75

4-DEC-1987 1:0


FILE: 2F3151J0E1106.DGN
LEVELS PLOTTED DATE: OCT. 23, 1987
35, 56, 58, 63
939
R.F. BECK
CHECKED

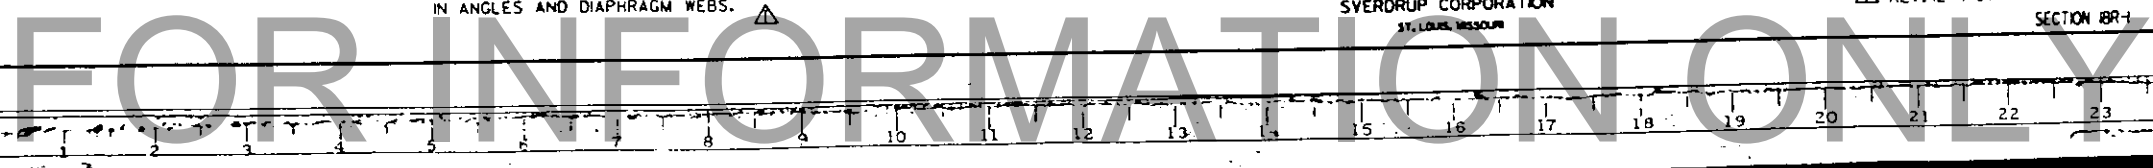

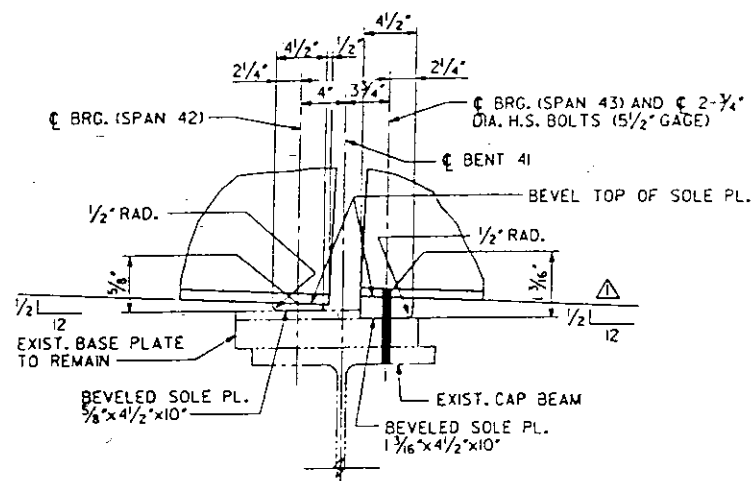


BEARINGS FOR STRINGER S1 AT BENT 41

NOTE: FOR CLARITY EXISTING 1/2\"/>

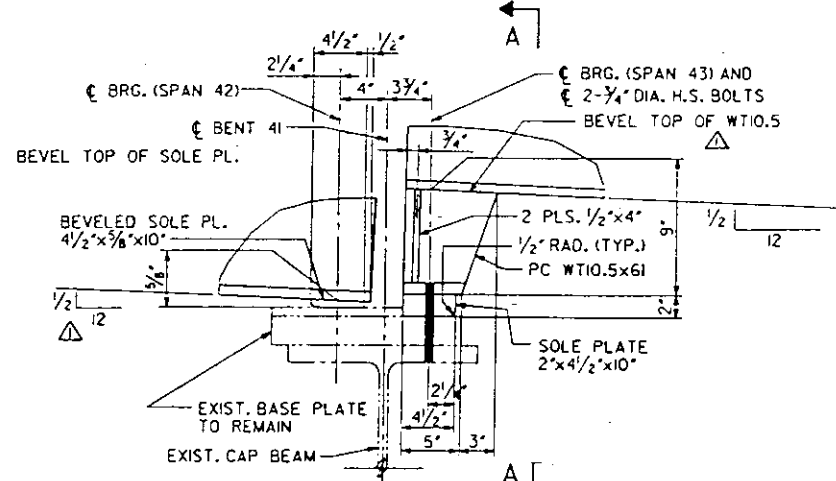


BEARINGS FOR STRINGER S7 AT BENT 41

NOTE: FOR CLARITY EXISTING 1/2\"/>

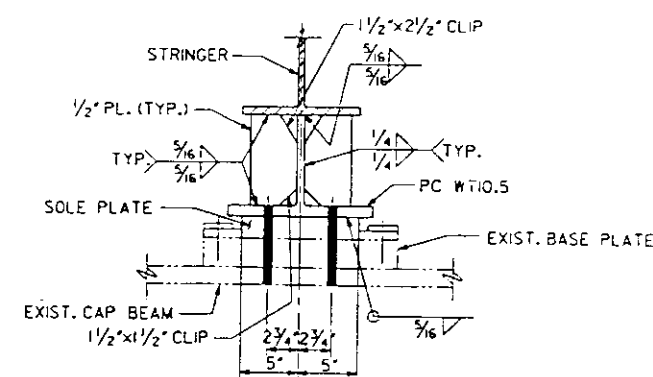


SECTION A-A

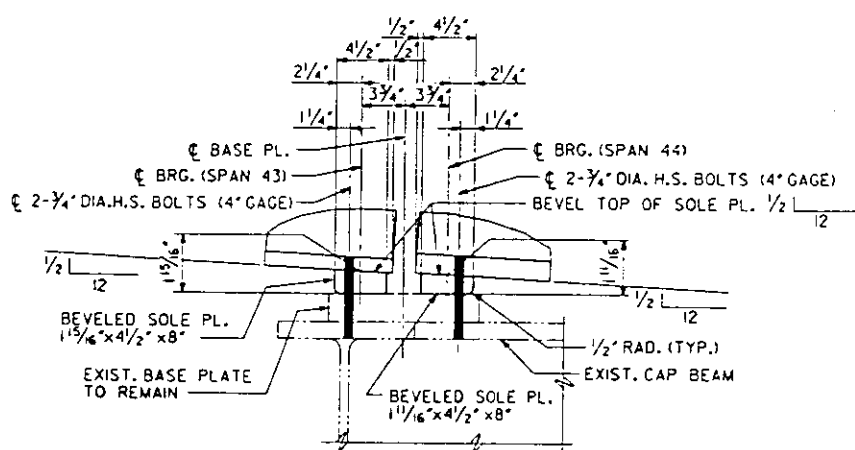


BEARINGS FOR STRINGER S1 AT BENT 42

NOTE: REUSE EXISTING HOLES IN CAP BEAM AND BASE PLATE FOR NEW STRINGER AND SOLE PLATE CONNECTION.

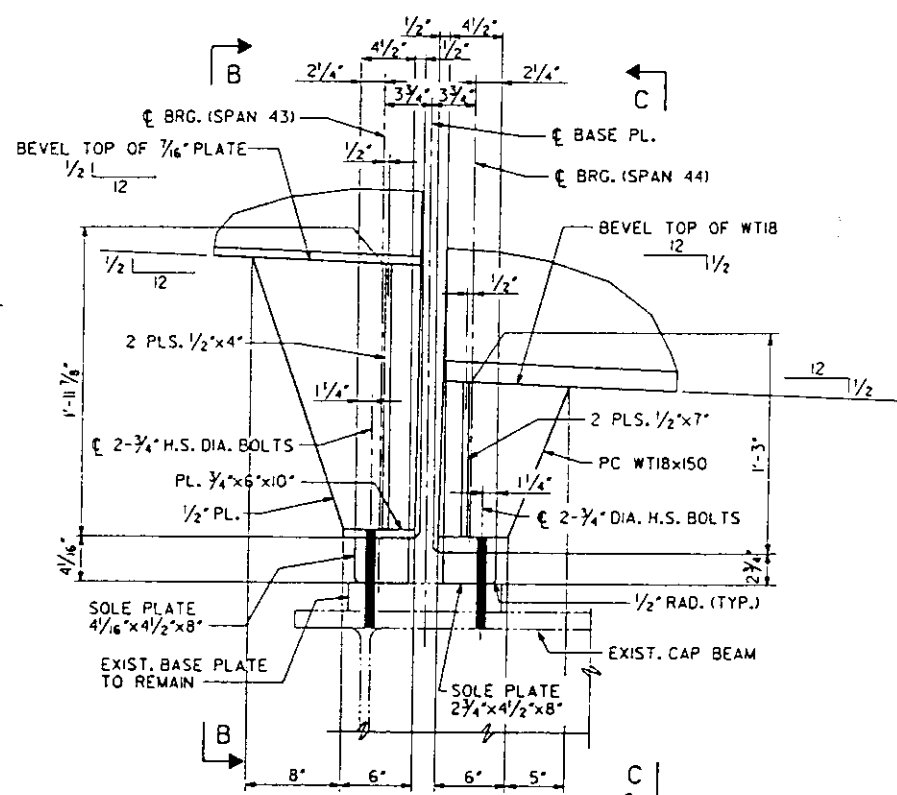


BEARINGS FOR STRINGER S7 AT BENT 42

NOTE: REUSE EXISTING HOLES IN CAP BEAM AND BASE PLATE FOR NEW STRINGER AND SOLE PLATE CONNECTION.

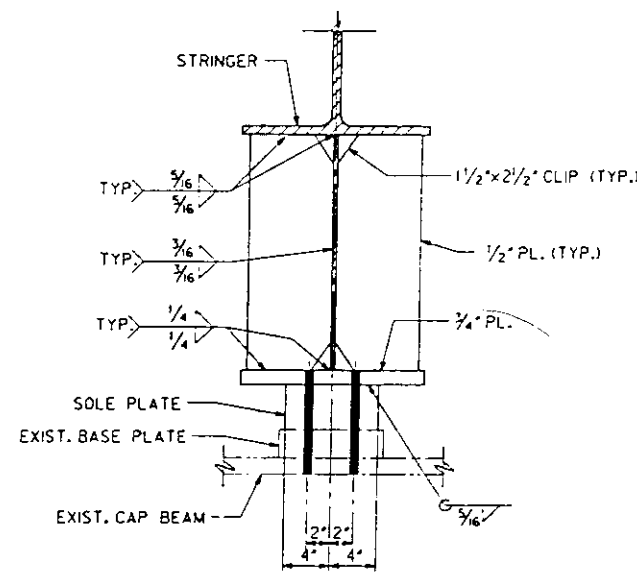

SECTION B-B

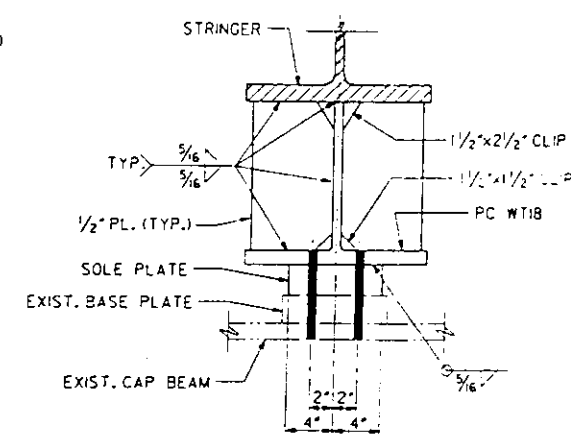

SECTION C-C

REHABILITATION FOR
APPROACH BRIDGE OVER
I-55/70 W.B., MISSOURI AVE. AND TRRA
BEARINGS AT BENTS 41 AND 42

STRUCTURE NO. 082-6003
STA. 65+00 (FAP 799) ST. CLAIR CO.

DESIGNED	K. LARSON
CHECKED	R. NIEMETZ
DRAWN	S. STEGMAN
CHECKED	R.F. BECK

PREPARED BY
SVERDRUP CORPORATION
ST. LOUIS, MISSOURI

REV. 12-4-87


SECTION IBR-1

SHEET NO. 42 OF 75

FOR INFORMATION ONLY


10358 FILE: ZF3105.DDE T108.DGN
 12/23/87
 LEVELS PLOTTED
 35.56.58.63
 12/23/87

*IBR-1 APPROACH BRIDGE

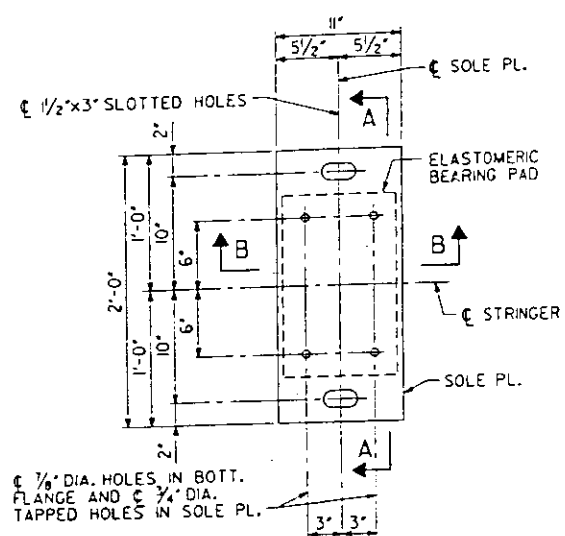


PLAN - BEARING ASSEMBLY

BEARING AT PIER 43A FOR STRINGER S7

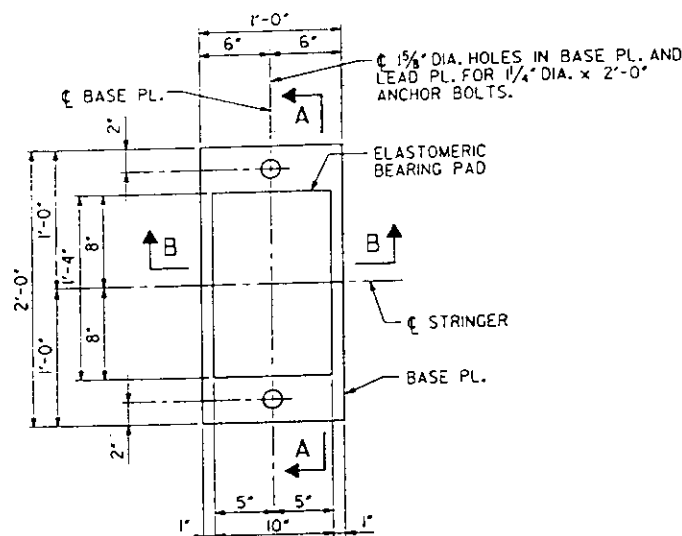


PLAN - BASE PLATE

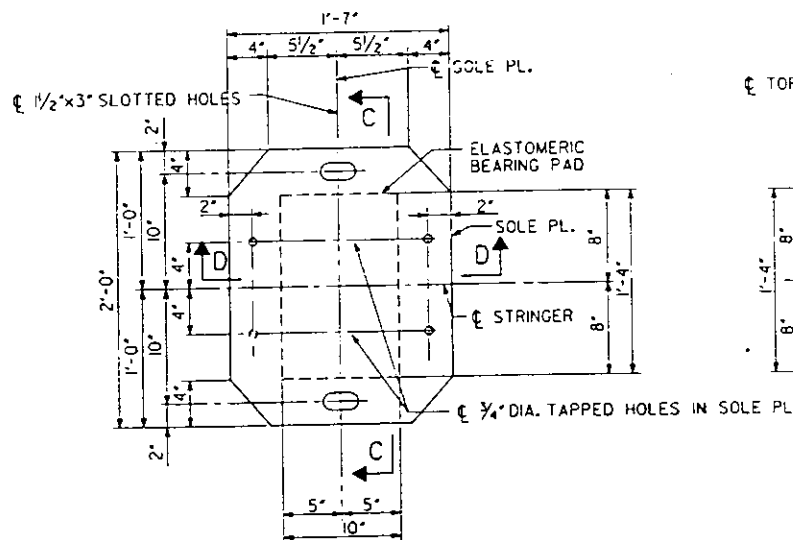


PLAN - BEARING ASSEMBLY


BEARING AT PIER 43A
FOR STRINGERS S2 THRU S6

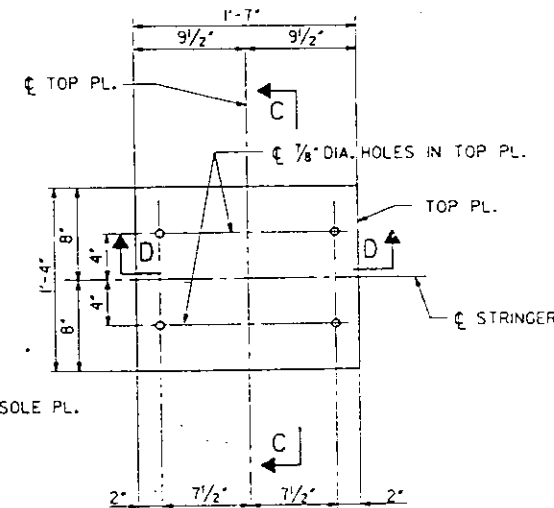

PLAN - TOP PLATE

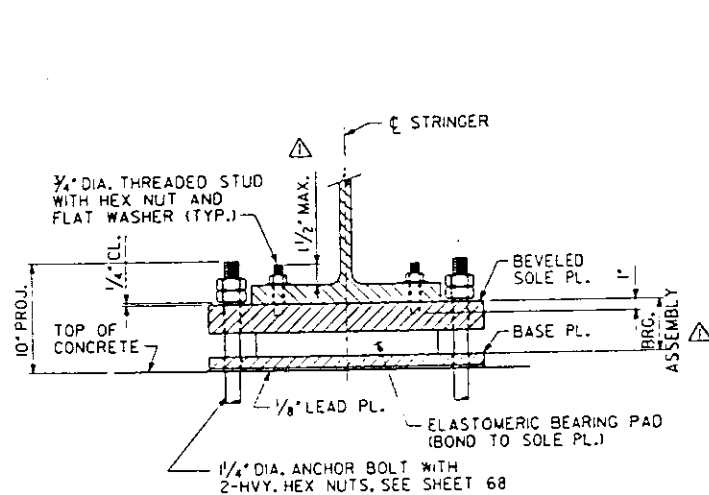


SECTION A-A

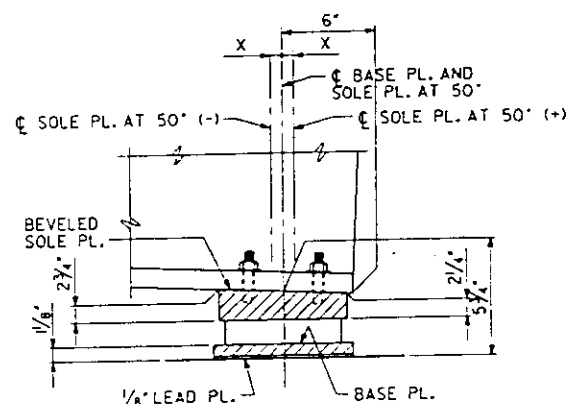


SECTION B-B

NOTE: X = 1/8" FOR EACH 20° F.
CHANGE FROM 50° F. TEMPERATURE.

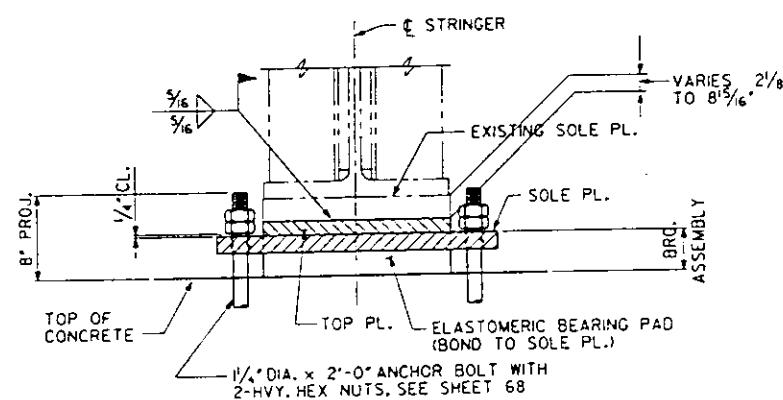

SECTION C-C

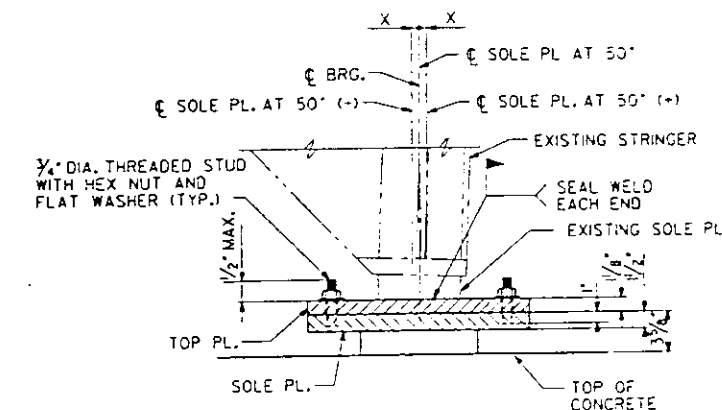

SECTION D-D

NOTE: X = 1/8" FOR EACH 20° F.
CHANGE FROM 50° F. TEMPERATURE.

NOTES

- ALL MATERIALS SHALL CONFORM TO AASHTO M-83, UNLESS OTHERWISE NOTED.
- BEARINGS SHALL BE PAID FOR AS ELASTOMERIC BEARING ASSEMBLY TYPE 116 (REQUIRED).
- TOP PLATE, BASE PLATE AND LEAD PLATES SHALL BE INCLUDED IN WEIGHT AND COST FOR STRUCTURAL STEEL.

REHABILITATION FOR
APPROACH BRIDGE OVER
I-55/70 W.B., MISSOURI AVE. AND TRRA
BEARINGS AT PIER 43A

STRUCTURE NO. 082-6003
STA. 65+00 (FAP 799) ST. CLAIR CO.

FOR INFORMATION ONLY

K.D. LARSON	DESIGNED
R.D. NIEMIETZ	CHECKED
C. DEED	DRAWN
R.F. BECK	CHECKED

PREPARED BY:
SVERDRUP CORPORATION
ST. LOUIS, MISSOURI

REV. 12-4-87

SECTION IBR-1

SHEET NO. 43 OF 75

4-DEC-1987 10:32

LEVELS PLOTTED DATE: OCT. 23, 1987

FILE: ZF\ST\DETAIL\103.DGN

35 56 58 63

875935 PRF:DETAIL103

SPANS 33 THRU 37

STRINGERS S1 AND S7						STRINGERS S2 THRU S6					
MOMENT TABLE						MOMENT TABLE					
	SPANS 33&37	BENTS 32&35	SPANS 34&36	BENTS 33&34	SPAN 35		SPANS 33&37	BENTS 32&35	SPANS 34&36	BENTS 33&34	SPAN 35
I _s	(IN ⁴)	6680	6680	6680	6680	I _s	(IN ⁴)	7450	7450	7450	7450
S _s	(IN ³)	436	436	436	436	S _s	(IN ³)	448	448	448	448
Q	(kips/ft)	1.040	1.040	1.040	1.040	Q	(kips/ft)	0.785	0.785	0.785	0.785
M _Q	(ft/kips)	222	356	160	325	M _Q	(ft/kips)	168	268	120	247
M _L	(ft/kips)	328	261	308	269	M _L	(ft/kips)	338	269	317	277
M _i	(ft/kips)	92	71	82	72	M _i	(ft/kips)	95	73	85	74
M TOTAL	(ft/kips)	642	688	550	666	M TOTAL	(ft/kips)	601	610	522	598
f _s TOTAL	(ksi)	17.67	18.94	15.14	18.33	f _s TOTAL	(ksi)	16.10	16.34	13.98	16.02
REACTION TABLE						REACTION TABLE					
	ABUTMENT C & BENT 36	BENTS 32&35	BENTS 33&34		ABUTMENT C & BENT 36	BENTS 32&35	BENTS 33&34				
R _Q	(kips)	21.5	67.5	63.5	R _Q	(kips)	50.9	48.3			
R _L	(kips)	25.8	35.6	36.1	R _L	(kips)	38.9	46.7			
R _i	(kips)	7.2	9.7	9.6	R _i	(kips)	10.9	12.8			
R TOTAL	(kips)	54.5	112.8	109.2	R TOTAL	(kips)	66.0	110.4			

SPANS 39 AND 40

STRINGERS S1 AND S7				STRINGERS S2 THRU S6			
MOMENT TABLE				MOMENT TABLE			
	SPAN 39	BENT 38	SPAN 40		SPAN 39	BENT 38	SPAN 40
I _s	(IN ⁴)	11500	11500	I _s	(IN ⁴)	12100	12100
S _s	(IN ³)	684	684	S _s	(IN ³)	664	664
Q	(kips/ft)	1.090	1.090	Q	(kips/ft)	0.840	0.840
M _Q	(ft/kips)	484	601	M _Q	(ft/kips)	373	464
M _L	(ft/kips)	486	342	M _L	(ft/kips)	501	352
M _i	(ft/kips)	122	90	M _i	(ft/kips)	126	93
M TOTAL	(ft/kips)	1092	1033	M TOTAL	(ft/kips)	1000	909
f _s TOTAL	(ksi)	19.16	18.12	f _s TOTAL	(ksi)	18.07	16.4
REACTION TABLE				REACTION TABLE			
	BENT 37	BENT 38	BENT 39		BENT 37	BENT 38	BENT 39
R _Q	(kips)	32.5	89.0	R _Q	(kips)	25.0	68.7
R _L	(kips)	28.1	39.9	R _L	(kips)	41.6	51.2
R _i	(kips)	7.1	10.6	R _i	(kips)	10.4	13.6
R TOTAL	(kips)	67.7	139.5	R TOTAL	(kips)	77.0	133.5

SPANS 41, 42 AND 44

STRINGERS S1 AND S7				STRINGERS S2 THRU S6			
MOMENT TABLE				MOMENT TABLE			
	20300		20290		1110		1105
I _s	(IN ⁴)	20300	I _s	(IN ⁴)	20290	S _s	(IN ³)
S _s	(IN ³)	1110	S _s	(IN ³)	1105	Q	(kips/ft)
Q	(kips/ft)	1.246	Q	(kips/ft)	0.965	M _Q	(ft/kips)
M _Q	(ft/kips)	972	M _Q	(ft/kips)	753	M _L	(ft/kips)
M _L	(ft/kips)	677	M _L	(ft/kips)	694	M _i	(ft/kips)
M _i	(ft/kips)	166	M _i	(ft/kips)	170	M TOTAL	(ft/kips)
M TOTAL	(ft/kips)	1815	M TOTAL	(ft/kips)	1617	f _s TOTAL	(ksi)
f _s TOTAL	(ksi)	19.62	f _s TOTAL	(ksi)	17.56		
REACTION TABLE				REACTION TABLE			
	(kips)		(kips)		(kips)		(kips)
R _Q	49.8	R _Q	38.6	R _L	37.5	R _L	43.1
R _L	37.5	R _L	43.1	R _i	9.2	R _i	10.6
R _i	9.2	R _i	10.6	R TOTAL	96.5	R TOTAL	92.3
R TOTAL	96.5	R TOTAL	92.3				

SPAN 43

MOMENT TABLE									
		STRINGERS							
		S1	S2	S3	S4	S5	S6	S7	
I _s	(IN ⁴)	13200	11300	9012	7450	5360	4470	3270	
I _c (n)	(IN ⁴)	27135	26546	22394	18951	14486	12673	8980	
I _c (3n)	(IN ⁴)	19709	-	-	-	-	-	6504	
S _s	(IN ³)	719	621	503	448	355	299	243	
S _c (n)	(IN ³)	964	868	716	642	525	454	364	
S _c (3n)	(IN ³)	859	-	-	-	-	-	326	
Q	(kips/ft)	0.746	0.847	0.815	0.806	0.789	0.773	0.636	
M _Q	(ft/kips)	429	410	327	263	204	154	93	
f _s Q non-comp.	(ksi)	7.16	7.92	7.81	7.04	6.90	6.18	4.61	
S _Q	(kips/ft)	0.410	-	-	-	-	-	0.410	
M _{SQ}	(ft/kips)	236	-	-	-	-	-	60	
f _s S _Q comp.	(ksi)	3.29	-	-	-	-	-	2.22	
M _{SQ}	(ft/kips)	573	512	452	392	331	271	205	
M _i	(ft/kips)	148	137	124	111	97	81	62	
f _s L + I comp.	(ksi)	8.98	8.97	9.65	9.40	9.78	9.30	8.80	
f _s TOTAL	(ksi)	19.43	16.89	17.46	16.44	16.68	15.48	15.64	
VR	(kips)	46.13	46.91	46.39	45.7	44.76	43.37	40.18	
REACTION TABLE									
	(kips)		(kips)		(kips)		(kips)		
R _Q	39.2	R _L	26.4	R _L	23.1	R _L	20.6	R _L	17.9
R _L	36.6	R _L	41.6	R _L	41.0	R _L	40.2	R _L	39.3
R _i	9.5	R _i	11.1	R _i	11.3	R _i	11.4	R _i	11.4
R TOTAL	85.3	R TOTAL	79.1	R TOTAL	75.4	R TOTAL	72.2	R TOTAL	68.7

NOTES

I_s AND S_s ARE THE MOMENT OF INERTIA AND SECTION MODULUS OF THE STEEL SECTION USED IN COMPUTING f_s (TOTAL).
I_c AND S_c ARE THE MOMENT OF INERTIA AND SECTION MODULUS OF THE COMPOSITE SECTION USED IN COMPUTING f_s (TOTAL).
VR IS THE MAXIMUM L + IMPACT SHEAR RANGE IN SPAN.
M_Q - MOMENT DUE TO DEAD LOADS ON NON-COMPOSITE SECTION.
M_{SQ} - MOMENT DUE TO DEAD LOADS ON COMPOSITE SECTION.
M_L - MOMENT DUE TO LIVE LOAD ON COMPOSITE SECTION.
M_i - MOMENT DUE TO LIVE LOAD ON NON-COMPOSITE SECTION.
I - LIVE LOAD IMPACT
STRINGERS S1 AND S7 ARE NEW, STRINGERS S2 - S6 ARE ORIGINAL CONSTRUCTION.

REHABILITATION FOR
APPROACH BRIDGE OVER
I-55/70 W.B., MISSOURI AVE. AND TRRA
MOMENTS AND REACTIONS
SPANS 33 THRU 37 AND 39 THRU 44

STRUCTURE NO. 082-6003
STA. 65+00 (FAP 799) ST. CLAIR CO.

PREPARED BY:
SYVERDRUP CORPORATION
ST. LOUIS, MISSOURI

SECTION IBR-1

SHEET NO. 44 OF 75

FOR INFORMATION ONLY

356
LEVELS PLOTTED DATE: OCT. 23, 1987
56 & 63
ZF3JMSJ, DETAIL 92.DGN
PRF, DETAIL 92

K.D. LARSON
DESIGNED
R.D. NIEMIETZ
CHECKED
J.G. CORLEY
DRAWN
R.F. BECK
CHECKED

* I BR-1 APPROACH BRIDGE

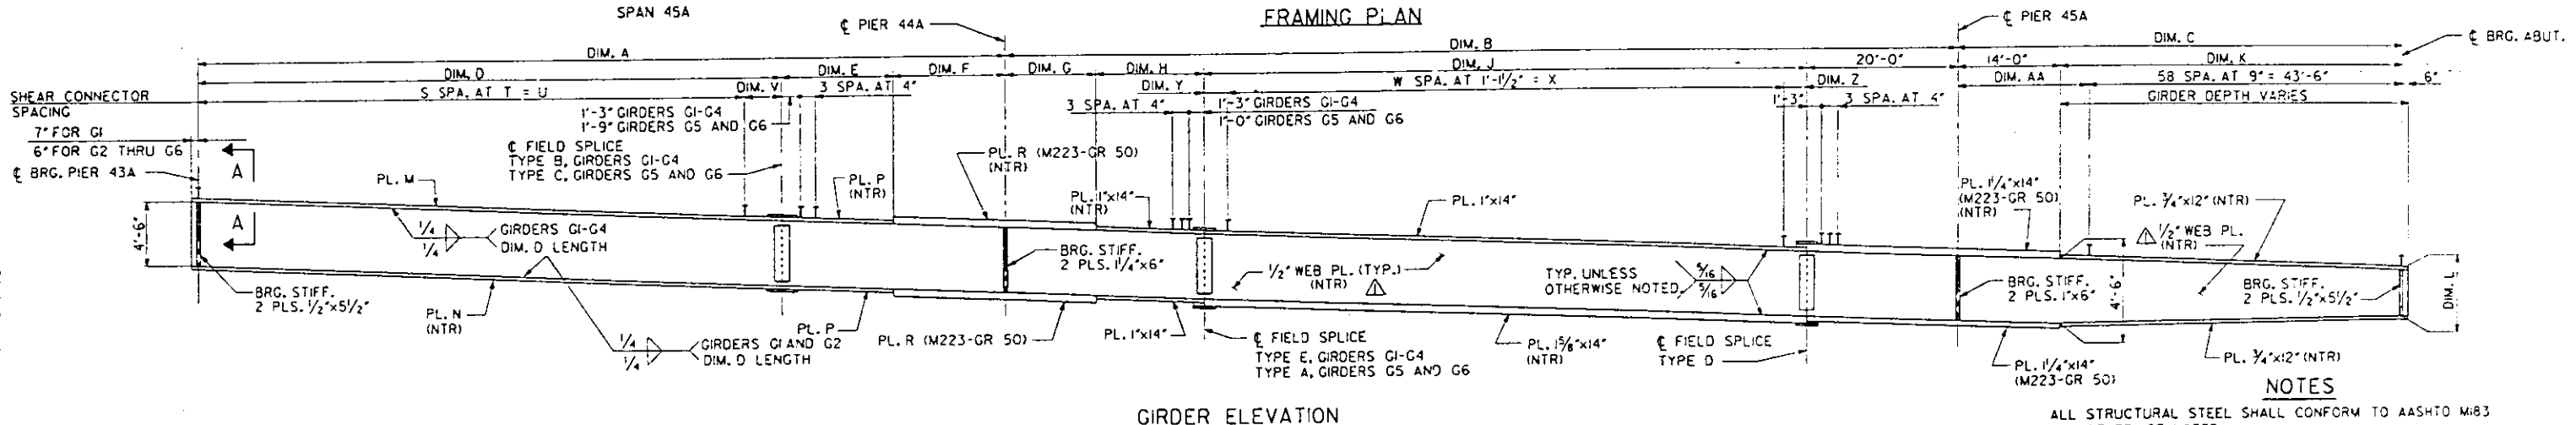
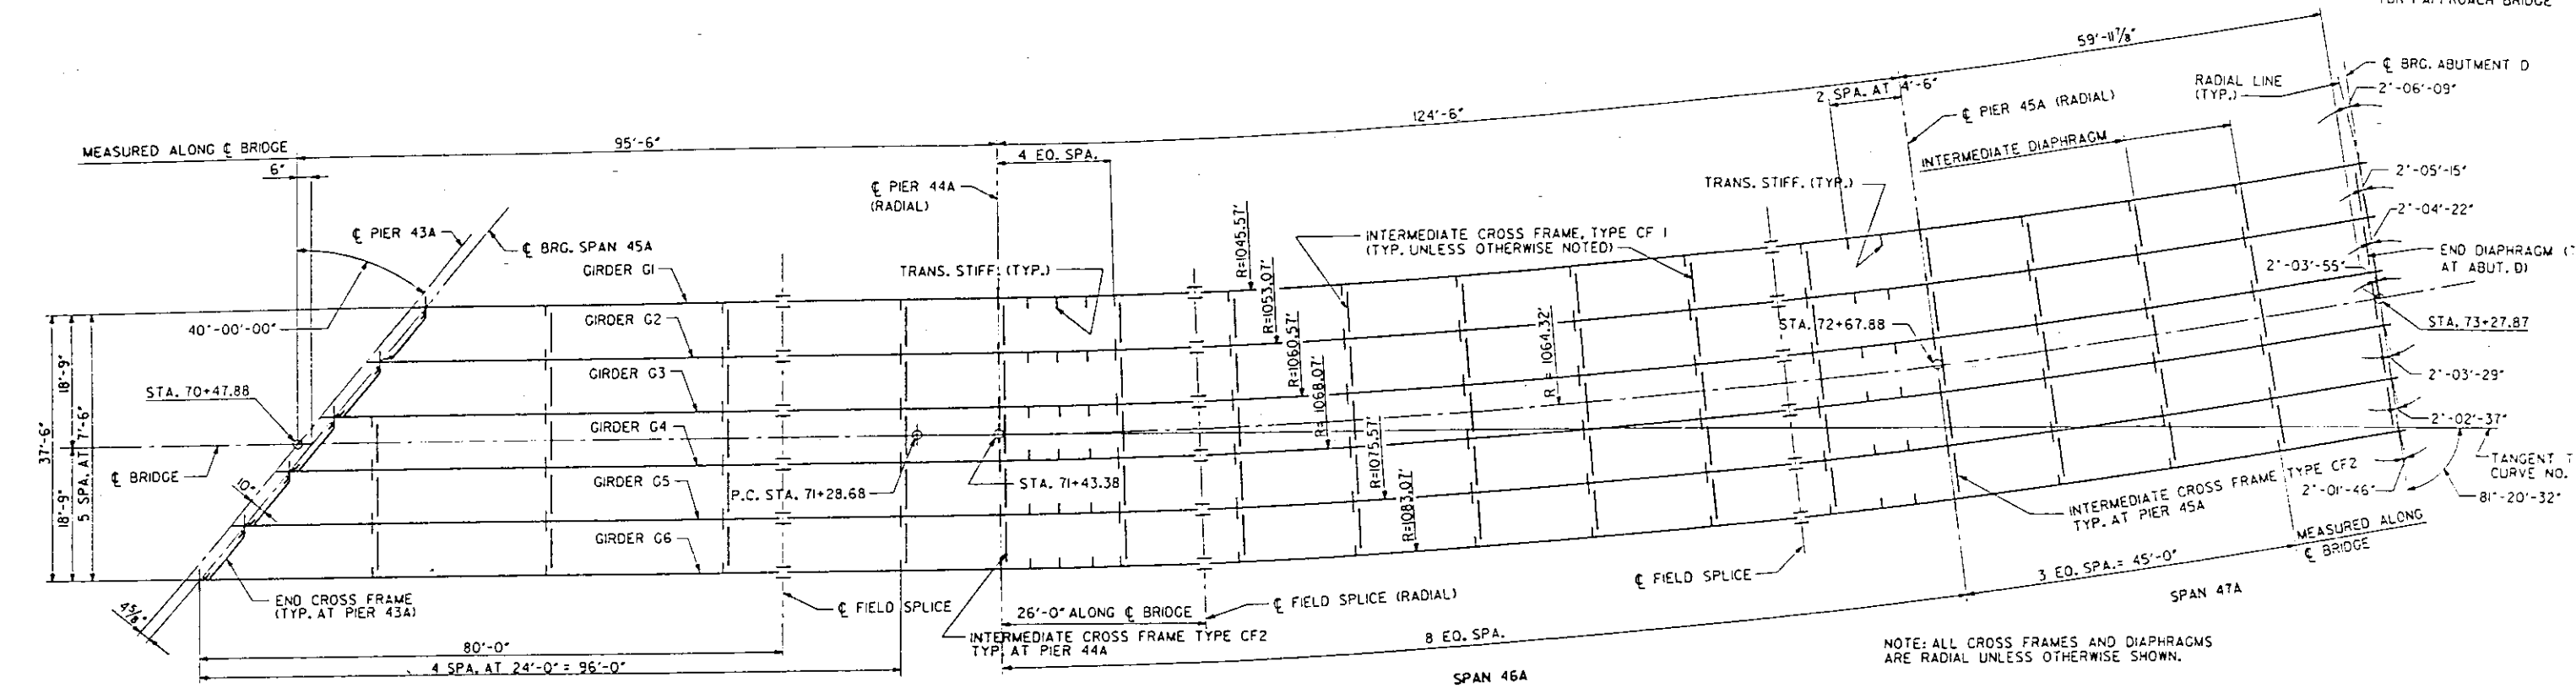


TABLE OF GIRDER VARIABLES

GIRDER	DIM. A	DIM. B	DIM. C	DIM. D	DIM. E	DIM. F	DIM. G	DIM. H	DIM. J	DIM. K	DIM. L	PL. M	PL. N	PL. P	PL. R	S	T	U	V	W	X	DIM. Y	DIM. Z	DIM. AA
G1	79'-0 1/8"	122'-3 1/16"	59'-7 7/16"	48'-6 3/4"	17'-5 3/4"	13'-0"	25'-6 1/2"	0'-0"	76'-9 3/16"	45'-7 7/16"	2'-0 1/16"	3/4"x12"	3/4"x12"	3/4"x12"	1/2"x14"	59	9 1/2"	46'-8 1/2"	1'-9 3/8"	65	73'-1 1/2"	1'-10"	1'-9 1/16"	16'-1 3/16"
G2	85'-4 1/8"	123'-2 3/16"	59'-9 3/16"	54'-9 3/16"	17'-6 3/16"	13'-0"	25'-8 1/16"	0'-0"	77'-5 1/2"	45'-9 3/16"	2'-4 1/16"	3/4"x12"	3/4"x12"	3/4"x12"	1/2"x14"	61	10 1/2"	53'-4 1/2"	1'-5 5/16"	66	74'-3"	1'-7 1/4"	1'-7 1/4"	16'-3 3/16"
G3	91'-9 3/8"	124'-0 1/4"	59'-11"	61'-1 1/8"	15'-8 3/16"	15'-0"	25'-10 3/4"	0'-0"	78'-2"	45'-11"	2'-8 1/16"	3/4"x12"	1"x12"	3/4"x12"	1 1/8"x14"	60	1'-0"	60'-0"	1'-1 1/16"	66	74'-3"	2'-0"	1'-11"	16'-5"
G4	98'-2 3/8"	124'-11 1/4"	60'-0 3/16"	67'-4 3/16"	15'-9 1/16"	15'-0"	26'-1 1/8"	0'-0"	78'-10 1/8"	46'-0 3/16"	3'-1 1/16"	3/4"x12"	1"x12"	3/4"x12"	1 1/8"x14"	61	1'-1"	66'-1"	1'-3 5/16"	67	75'-4 1/2"	1'-9"	1'-8 3/4"	16'-6 3/16"
G5	104'-7 1/8"	125'-9 1/16"	60'-2 5/16"	73'-8 3/16"	15'-10 1/16"	15'-0"	16'-0"	10'-3 3/16"	79'-6 1/2"	46'-2 3/16"	3'-5 1/2"	1"x12"	1 1/8"x14"	1"x14"	1 1/8"x14"	64	1'-1 1/2"	72'-0"	1'-8 3/16"	68	76'-6"	1'-6"	1'-6 1/2"	16'-8 5/16"
G6	110'-11 1/8"	126'-8 3/16"	60'-4 1/2"	80'-0"	15'-11 3/16"	15'-0"	16'-0"	10'-5 1/2"	80'-2 3/16"	46'-4 1/2"	3'-9 3/8"	1"x12"	1 1/8"x14"	1"x14"	1 1/8"x14"	67	1'-2"	78'-2"	1'-10"	68	76'-6"	1'-10"	1'-10 3/16"	16'-10 1/2"

NOTES

ALL STRUCTURAL STEEL SHALL CONFORM TO AASHTO M183 UNLESS OTHERWISE NOTED.
ALL DIMENSIONS SHOWN ARE HORIZONTAL MEASUREMENTS ALONG GIRDE
ALL STIFFENERS, CROSS FRAMES AND DIAPHRAGMS ARE TO BE VERTIC
ON THE FINAL POSITION.
NTR INDICATES MATERIAL SUBJECT TO NOTCH TOUGHNESS REQUIREMEN
FOR SECTION A-A, SEE SHEET 46.
FOR CROSS FRAME AND DIAPHRAGMS DETAILS SEE SHEET 46.
FOR FIELD SPlice DETAILS SEE SHEET 47.
FOR BEARING DETAILS SEE SHEET 48 AND 49.
FOR CAMBER DIAGRAM SEE SHEET 47.

REHABILITATION FOR
APPROACH BRIDGE OVER
I-55/70 W.B., MISSOURI AVE. AND TR

FRAMING PLAN
SPANS 45A THRU 47A

STRUCTURE NO. 082-6003
STA. 65+00 (FAP 799) ST. CLAIR CO.

PREPARED BY:
SVERDRUP CORPORATION
ST. LOUIS, MISSOURI

REV. 12-4-87

SECTION I BR-1


SHEET NO. 45 OF 75

4-DEC-1987 32


DATE: OCT. 23, 1987
LEVELS PLOTTED 35, 56, 63
FILE: ZF3161/DETAIL 37.DGN
PRF: DETAIL 37

R. NIEMIETZ
DESIGNED
A. NG
CHECKED
S. STEGMAN
DRAWN
J. KORPI
CHECKED


FOR INFORMATION ONLY

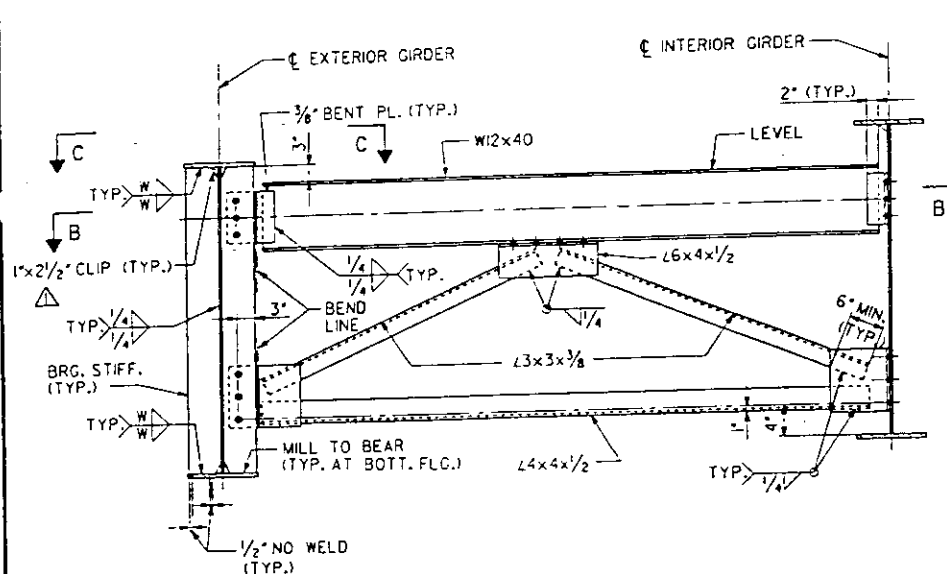


DEVELOPED VIEW
END CROSS FRAME AT PIER 43A

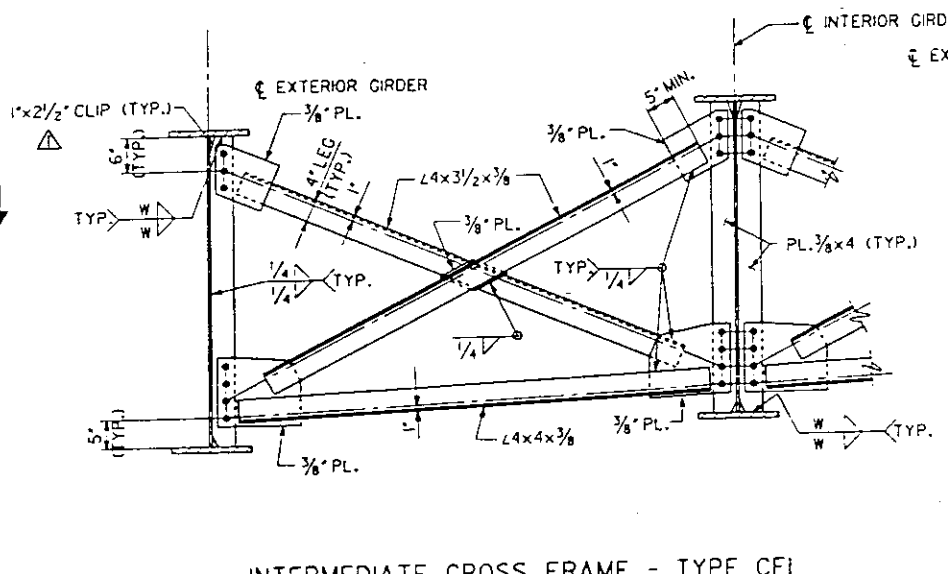


INTERMEDIATE CROSS FRAME - TYPE CF1

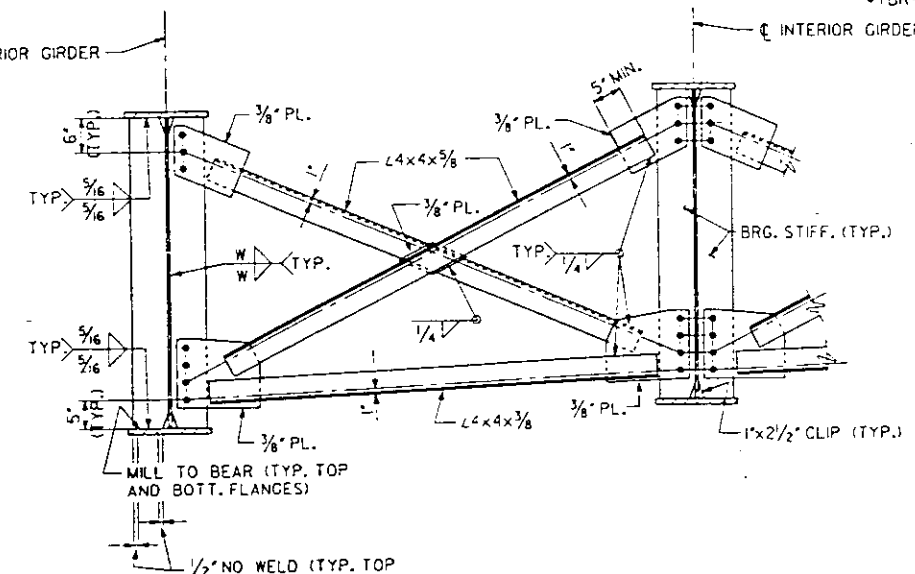


INTERMEDIATE CROSS FRAME - TYPE CF2

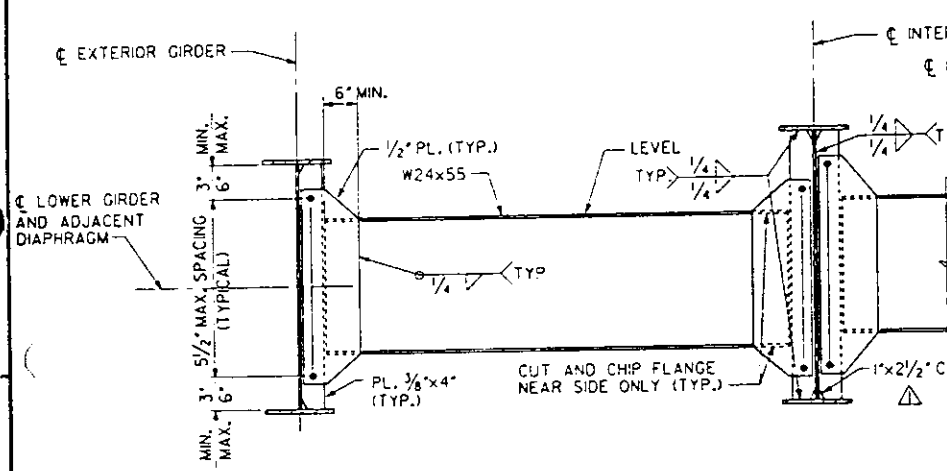

INTERMEDIATE DIAPHRAGM

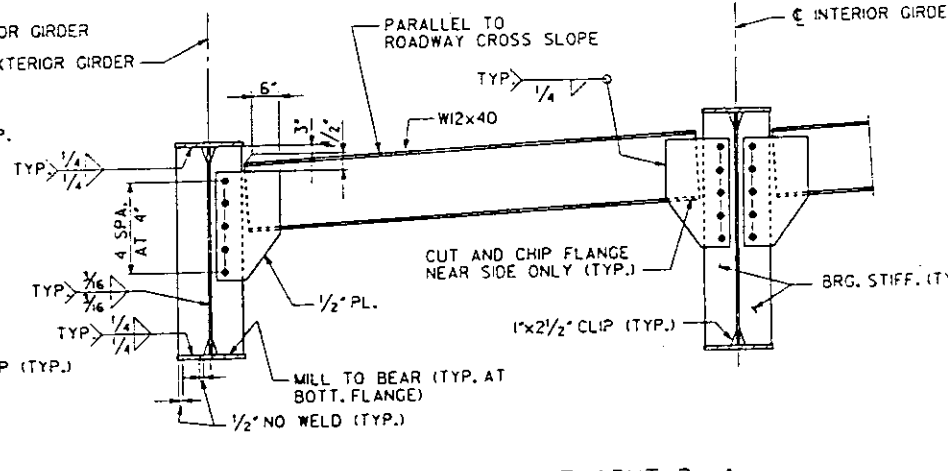


END DIAPHRAGM AT ABUT. D

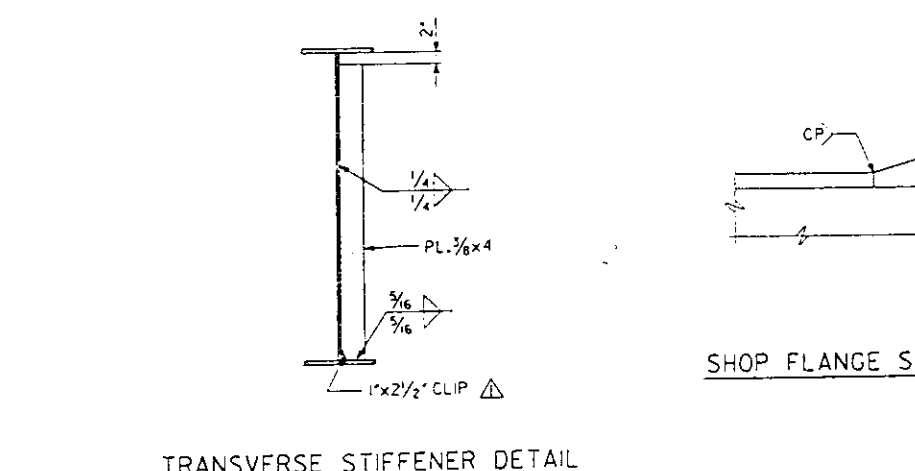


TRANSVERSE STIFFENER DETAIL


SHOP FLANGE SPLICE DETAIL

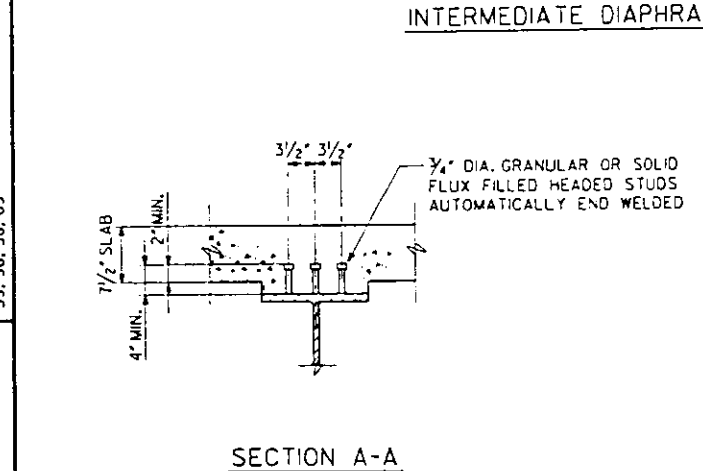

SECTION A-A

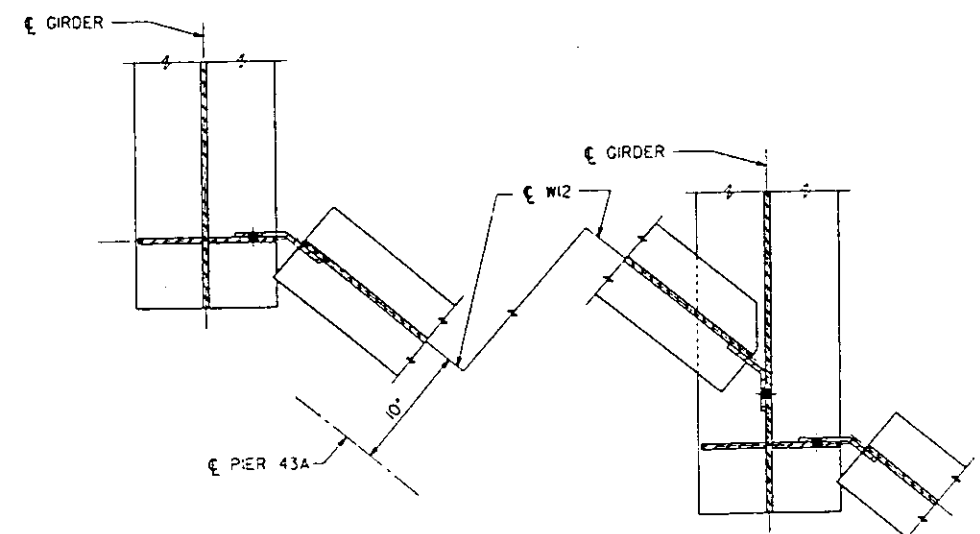

SECTION B-B

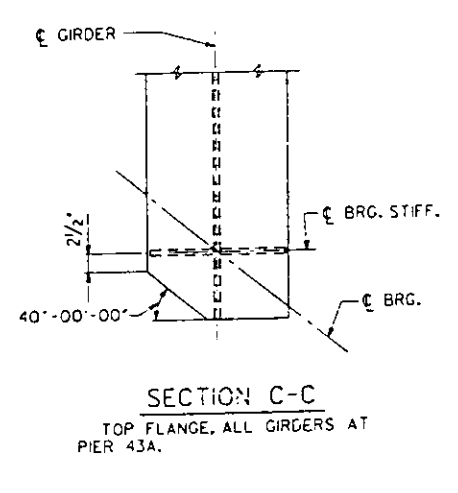

SECTION C-C
TOP FLANGE, ALL GIRDERS AT
PIER 43A.

WELD TABLE	
PL. SIZE	WELD SIZE, W
OVER 1/2" TO 3/4"	1/4"
OVER 3/4"	5/16"

• PL. SIZE IS THE THICKNESS OF THE THICKER PART JOINED.

NOTES
ALL FASTENERS SHALL BE 7/8" DIA. HIGH STRENGTH BOLTS WITH 1/16" DIA. OPEN HOLES UNLESS OTHERWISE NOTED. TWO HARDENED WASHERS SHALL BE REQUIRED FOR ALL H.S. BOLTS. ALL STIFFENERS, CROSS FRAMES AND DIAPHRAGMS SHALL BE VERTICAL IN THE COMPLETED STRUCTURE.

REHABILITATION FOR
APPROACH BRIDGE OVER
I-55/70 W.B., MISSOURI AVE. AND TRRA
CROSS FRAMES AND DIAPHRAGMS
SPANS 45A THRU 47A

STRUCTURE NO. 082-6003
STA. 65+00 (FAP 799) ST. CLAIR CO.

DESIGNED	R. NIEMIETZ
CHECKED	A. NG
DRAWN	S. STEGMAN
	J. KORPI

PREPARED BY
SYVERDRUP CORPORATION
ST. LOUIS, MISSOURI

REV. 12-4-87


SECTION IBR-1

SHEET NO. 46 OF 75


FOR INFORMATION ONLY

DATE: OCT. 23, 1987
LEVELS PLOTTED
35, 56, 58, 63
FILE: 15130DETAIL 40.DGN
40
94


*IBR-1 APPROACH BRIDGE

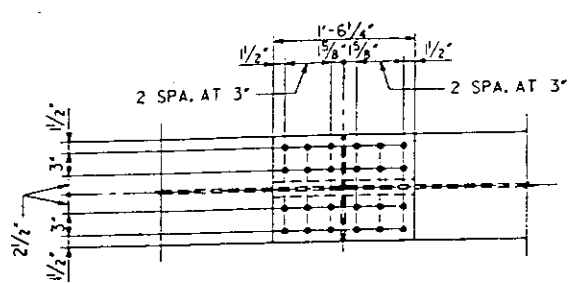


PLAN - FLANGE SPLICES

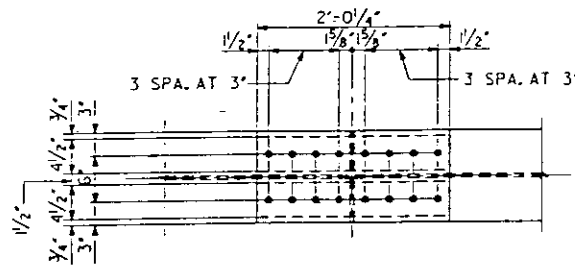


PLAN - FLANGE SPLICES

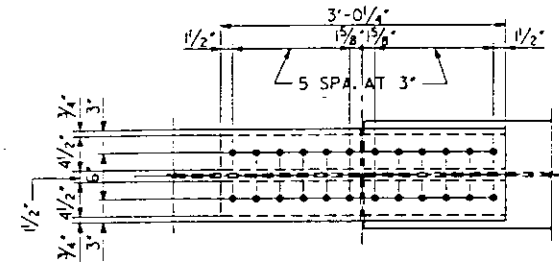

PLAN - TOP FLANGE SPLICE

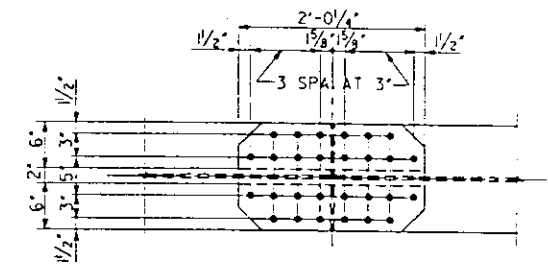


PLAN - TOP FLANGE SPLICE

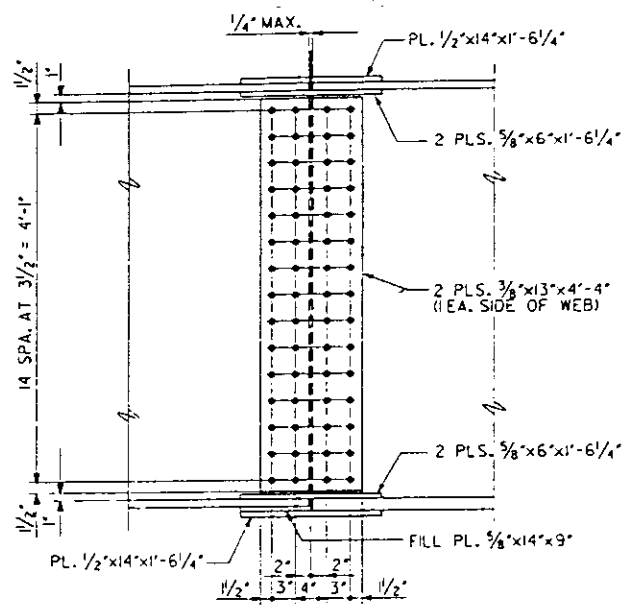


WEB SPLICE ELEVATION

TYPE A SPLICE

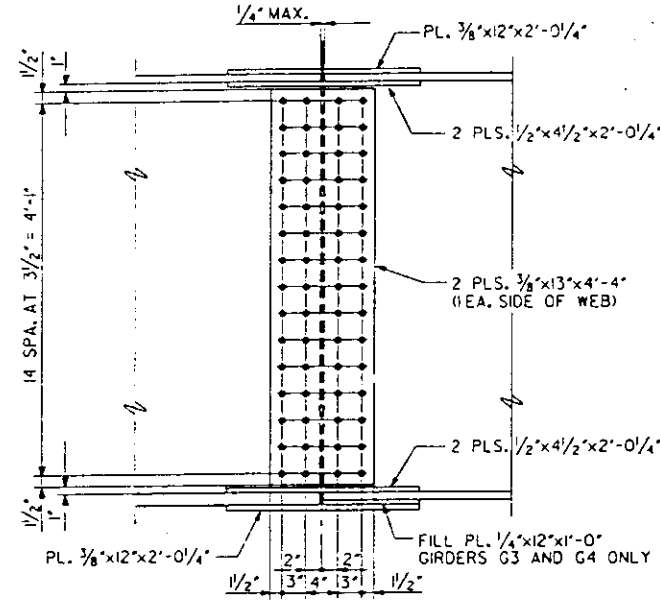


WEB SPLICE ELEVATION

TYPE B SPLICE

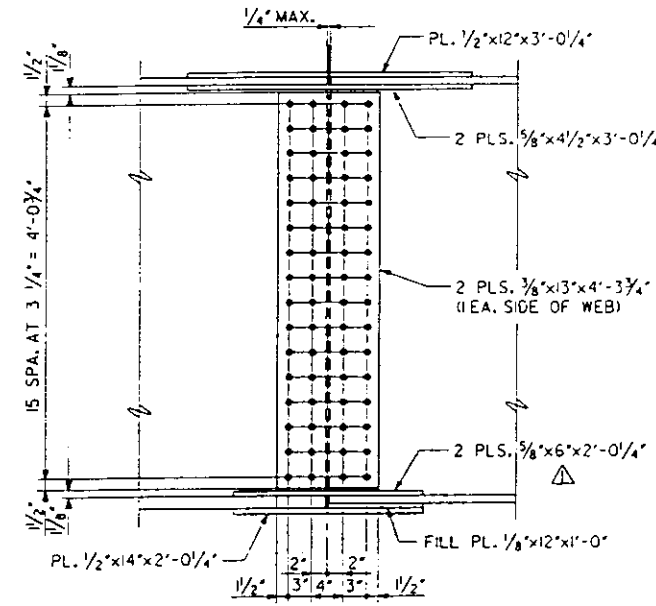


WEB SPLICE ELEVATION

TYPE C SPLICE

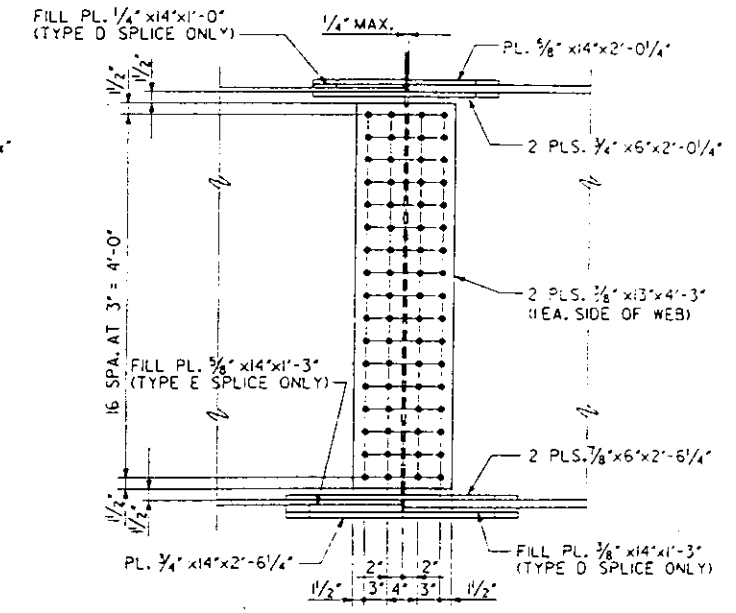


WEB SPLICE ELEVATION


TYPE D AND E SPLICES

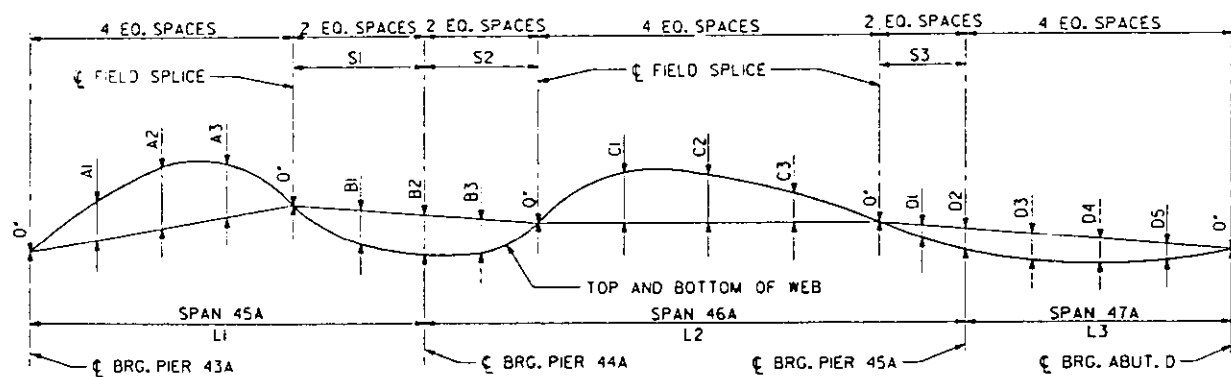

CAMBER DIAGRAM

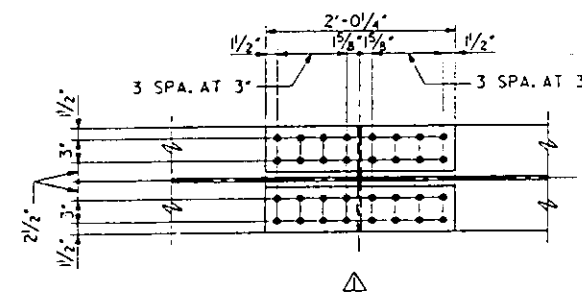

PLAN - BOTTOM FLANGE SPLICE

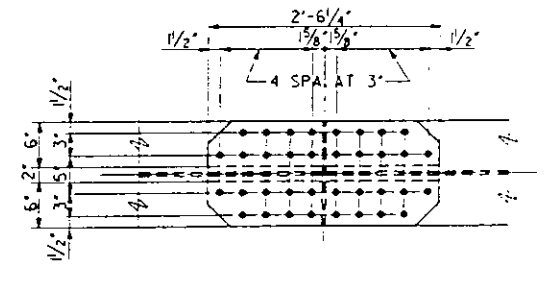

PLAN - BOTTOM FLANGE SPLICE

NOTES
ALL STRUCTURAL STEEL FOR SPLICE PLATES SHALL BE SUBJECT TO NOTCH TOUGHNESS REQUIREMENTS. ALL FASTENERS SHALL BE 3/8\"/>

GIRDER	S1	S2	S3	A1	A2	A3	B1	B2	B3	C1	C2	C3	D1	D2	D3	D4	D5	L1	L2	L3
G1	30'-5 3/4"	25'-6 1/2"	20'-0"	1/8"	3/8"	1/8"	3/8"	1/8"	1/4"	3/8"	13/16"	3/8"	1/4"	1/16"	1/2"	3/8"	1/8"	79'-0 1/8"	122'-3 1/16"	59'-7 3/16"
G2	30'-6 1/2"	25'-8 1/16"	20'-0"	1/4"	3/8"	1/4"	3/8"	1/2"	3/8"	3/8"	13/16"	3/8"	1/4"	1/2"	3/8"	3/8"	1/8"	85'-4 3/8"	123'-2 3/16"	59'-9 3/16"
G3	30'-8 3/8"	25'-10 3/4"	20'-0"	3/8"	3/8"	3/8"	3/8"	1/2"	3/8"	3/8"	13/16"	3/8"	1/4"	1/2"	3/8"	1/8"	91'-9 3/8"	124'-0 3/4"	59'-11"	
G4	30'-9 1/16"	26'-1 1/8"	20'-0"	3/16"	3/8"	3/8"	3/8"	1/2"	3/8"	3/8"	13/16"	3/8"	1/4"	1/2"	3/8"	1/8"	98'-2 3/8"	124'-11 1/4"	60'-0 13/16"	
G5	30'-10 1/4"	26'-3 3/4"	20'-0"	3/16"	3/4"	3/8"	3/8"	1/2"	3/8"	3/8"	13/16"	3/8"	1/4"	1/16"	3/8"	3/8"	1/8"	104'-7 1/8"	125'-9 13/16"	60'-2 5/8"
G6	30'-11 1/8"	26'-5 1/2"	20'-0"	3/4"	1 1/16"	3/4"	1/8"	3/8"	3/8"	3/8"	13/16"	3/8"	1/4"	1/16"	3/8"	3/8"	1/8"	110'-11 1/8"	126'-8 3/16"	60'-4 1/2"

REHABILITATION FOR
APPROACH BRIDGE OVER
I-55/70 W.B., MISSOURI AVE. AND ITRA

FIELD SPLICES
SPANS 45A THRU 47A

STRUCTURE NO. 082-6003
STA. 65+00 (FAP 799) ST. CLAIR CO.

PREPARED BY
SYVERDRUP CORPORATION
ST. LOUIS, MISSOURI

REV. 12-4-87













SECTION 13R-1

SHEET NO. 47 OF 75

FOR INFORMATION ONLY

4-DEC-1987 14:2

LEVELS PLOTTED DATE OCT. 23, 1987
FILE: Z31051\SPLICE43A.DGN
35, 56 AND 63
PFI SPLICE43A

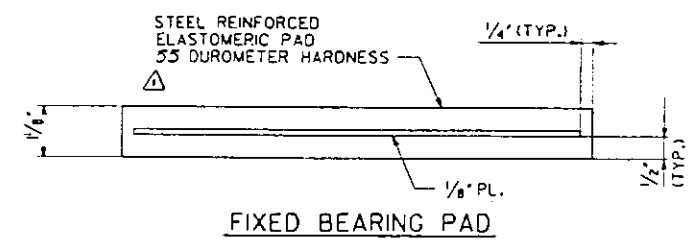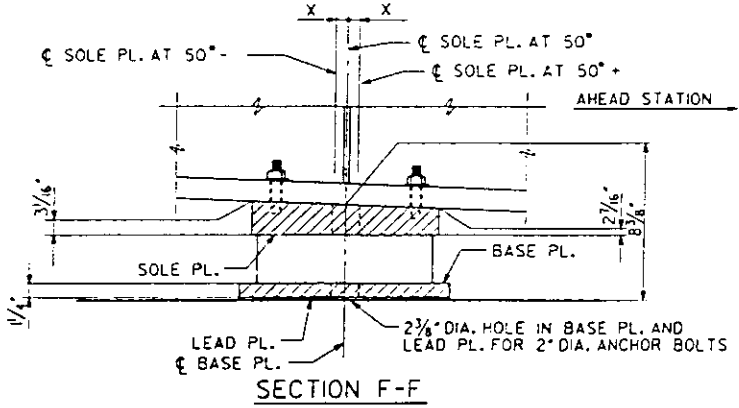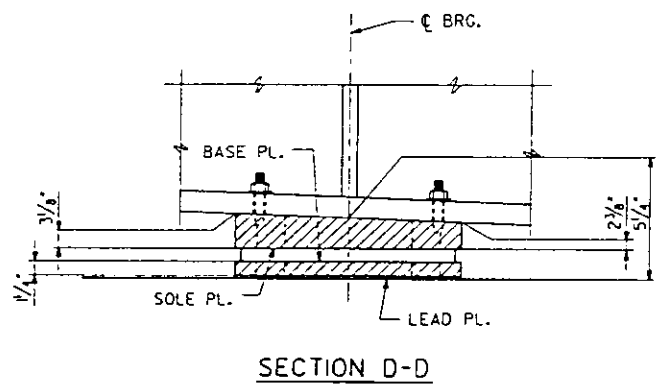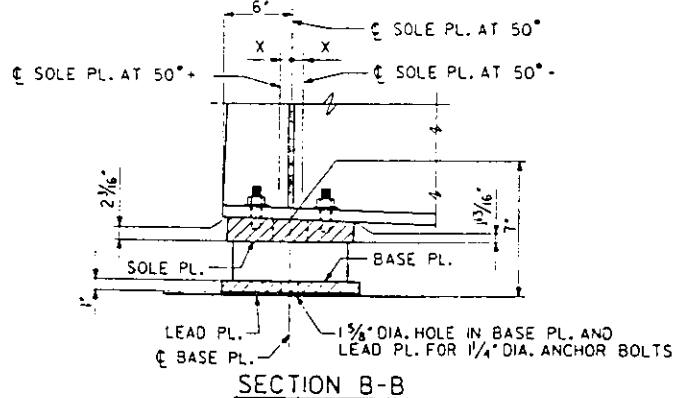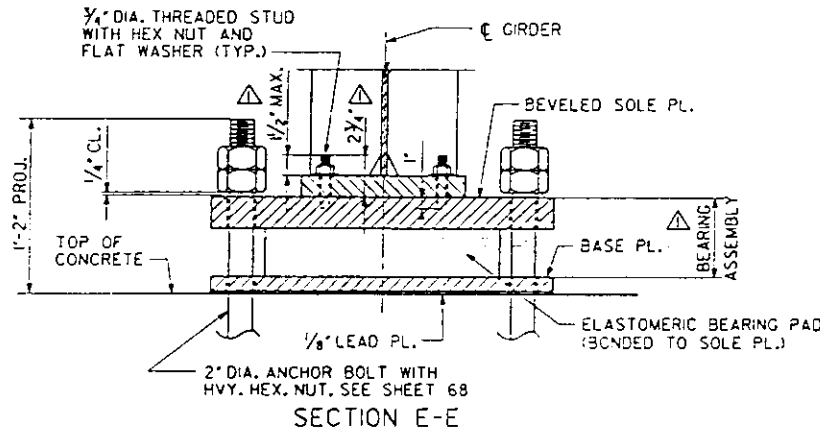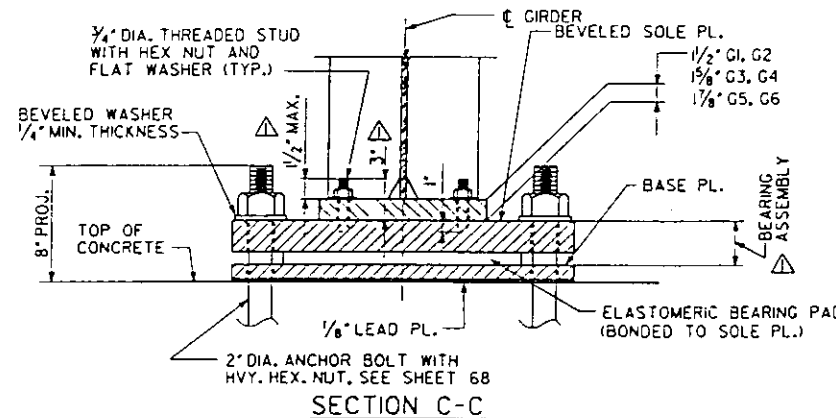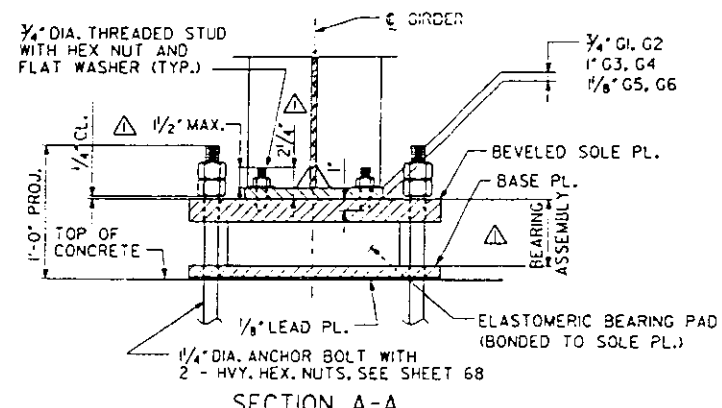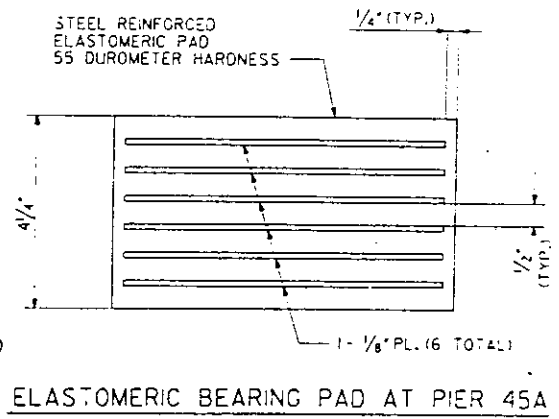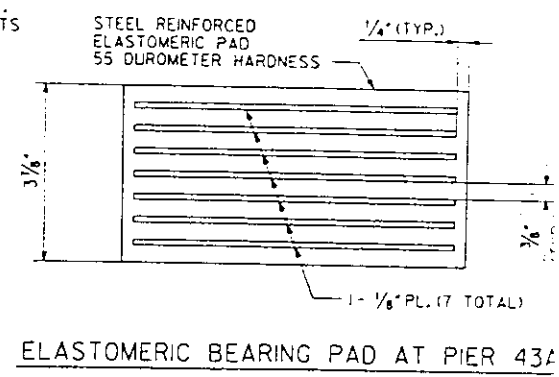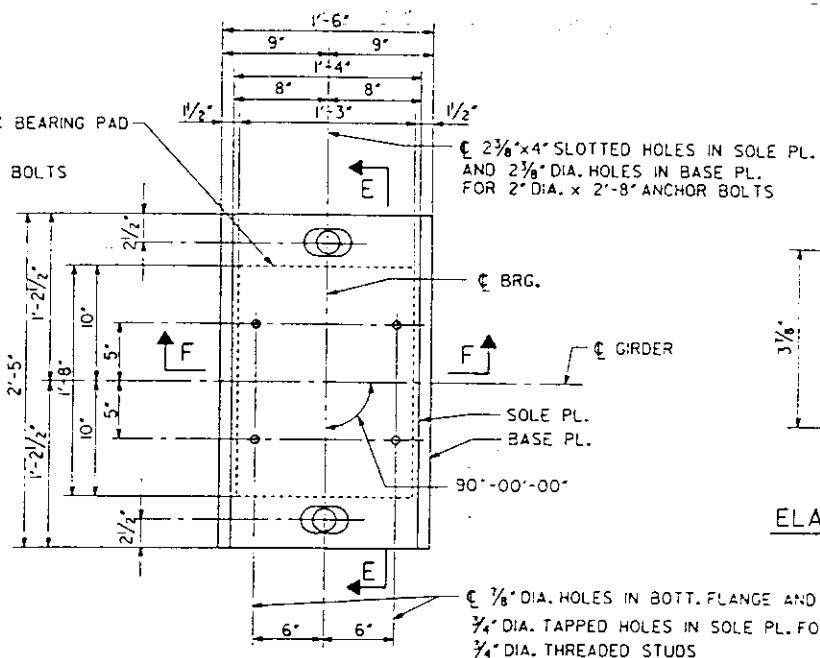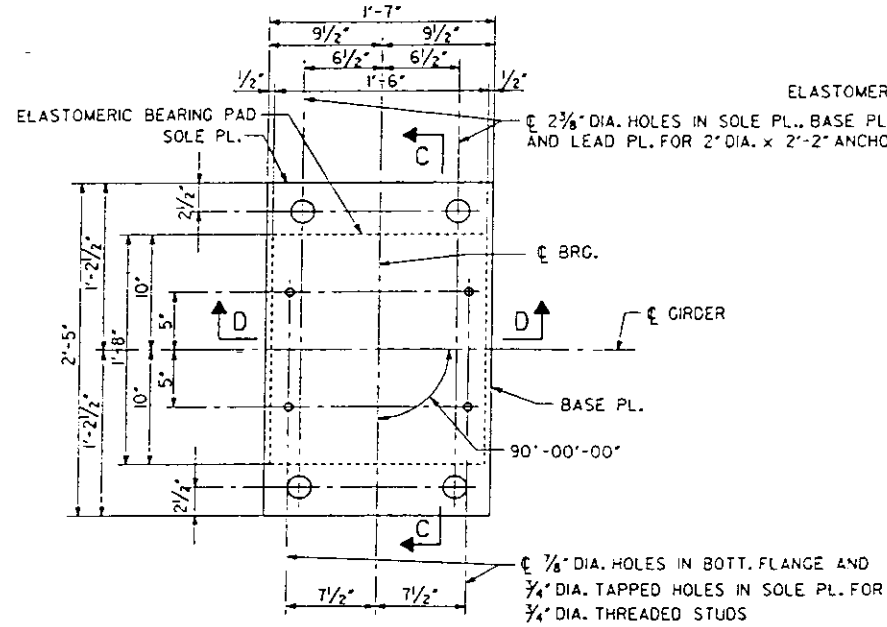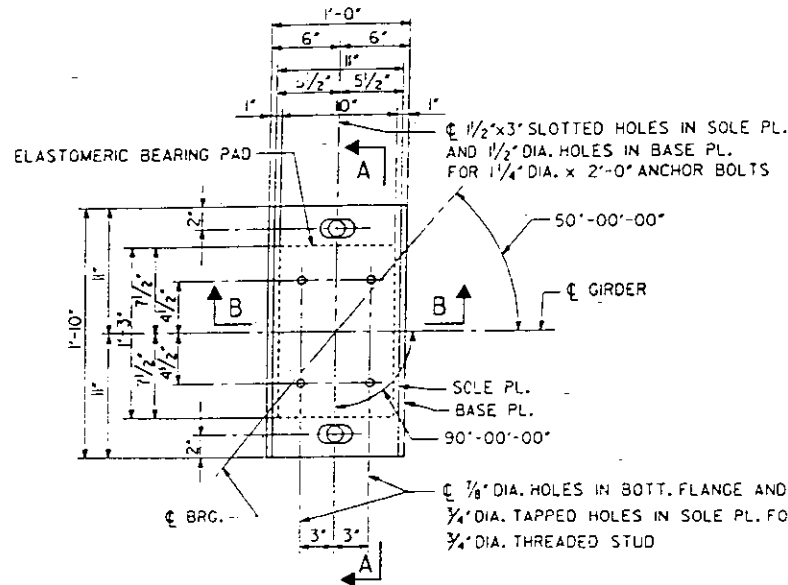

NOTES

ALL STRUCTURAL STEEL FOR BEARINGS SHALL CONFORM TO AASHTO M183.
FLAT WASHERS TO BE ASTM F844.
FOR BEARING DETAIL FOR GIRDER G1 AT PIER 43A, SEE SHEET BEARINGS SHALL BE PAID FOR AS ELASTOMERIC BEARING ASSEMBLY TYPE 1.
BASE PLATES AND LEAD PLATES SHALL BE INCLUDED IN WEIGHT AND COST FOR STRUCTURAL STEEL.

NOTE: X = 3/16" FOR EACH 20° F. CHANGE IN TEMPERATURE.

REHABILITATION FOR
APPROACH BRIDGE OVER
I-55/70 W.B., MISSOURI AVE. AND TR
BEARINGS AT
PIERS 43A THRU 45A

STRUCTURE NO. 082-6003
STA. 65+00 (FAP 799) ST. CLAIR CO.

PREPARED BY:
SVERDRUP CORPORATION
ST. LOUIS, MISSOURI

REV. 12-4-87

SECTION IBR-1

SHEET NO. 48 OF



FOR INFORMATION ONLY

4-DEC-1987
 DATE: OCT. 23, 1987
 LEVELS PLOTTED: 35, 56, 58, 63
 FILE: ZF3E151JBRG43A.DGN
 PRF: BRG43A

R. NIEMIETZ
 DESIGNED
 A. NG
 CHECKED
 S. STEGMAN
 DRAWN
 J. KORPI
 CHECKED

GIRDER	DIM. X FOR EACH 20° F. CHANGE IN TEMP.
G2	1/8"
G3 - G5	3/32"
G6	1/16"


ROUTE NO.	SHEET	COUNTY	TOTAL SHEETS
FAP 799	•	ST. CLAIR	252
PROJECT	IBR-1 APPROACH BRIDGE		

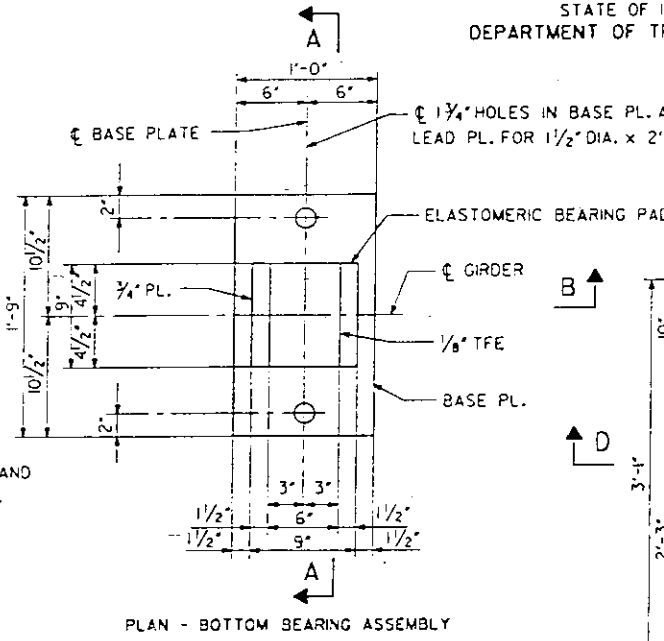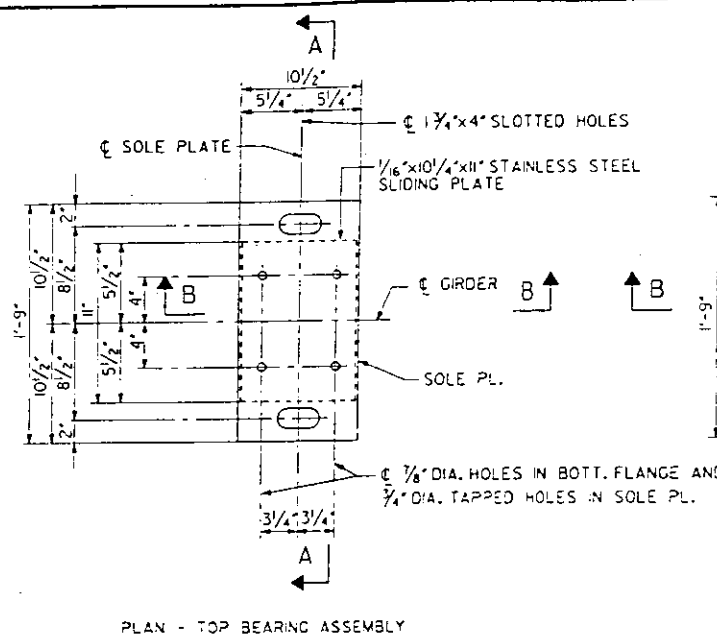



EXPANSION BEARING AT ABUTMENT D

ELASTOMERIC BEARING ASSEMBLY-TYPE II (6 REQUIRED)





NOTES: TFE SHALL HAVE DIMPLED SURFACE (1/4" DIA. DIMPLES, 1/16" DEEP ON 1/2" CENTERS, OR EQUIVALENT) AND BE BONDED TO ELASTOMERIC PAD TOP PLATE, WITH A TWO-COMPONENT MEDIUM VISCOSITY EPOXY RESIN, CONFORMING TO THE REQUIREMENTS OF THE FEDERAL SPECIFICATION MMM-A-134, TYPE I, OVER THE FULL CONTACT AREA. BONDING OF THE 1/8" TFE SHEET DURING VULCANIZING PROCESS WILL BE PERMITTED PROVIDED THE PROCESS AND METHOD OF ADJUSTING ASSEMBLY HEIGHT IS APPROVED BY THE ENGINEER.

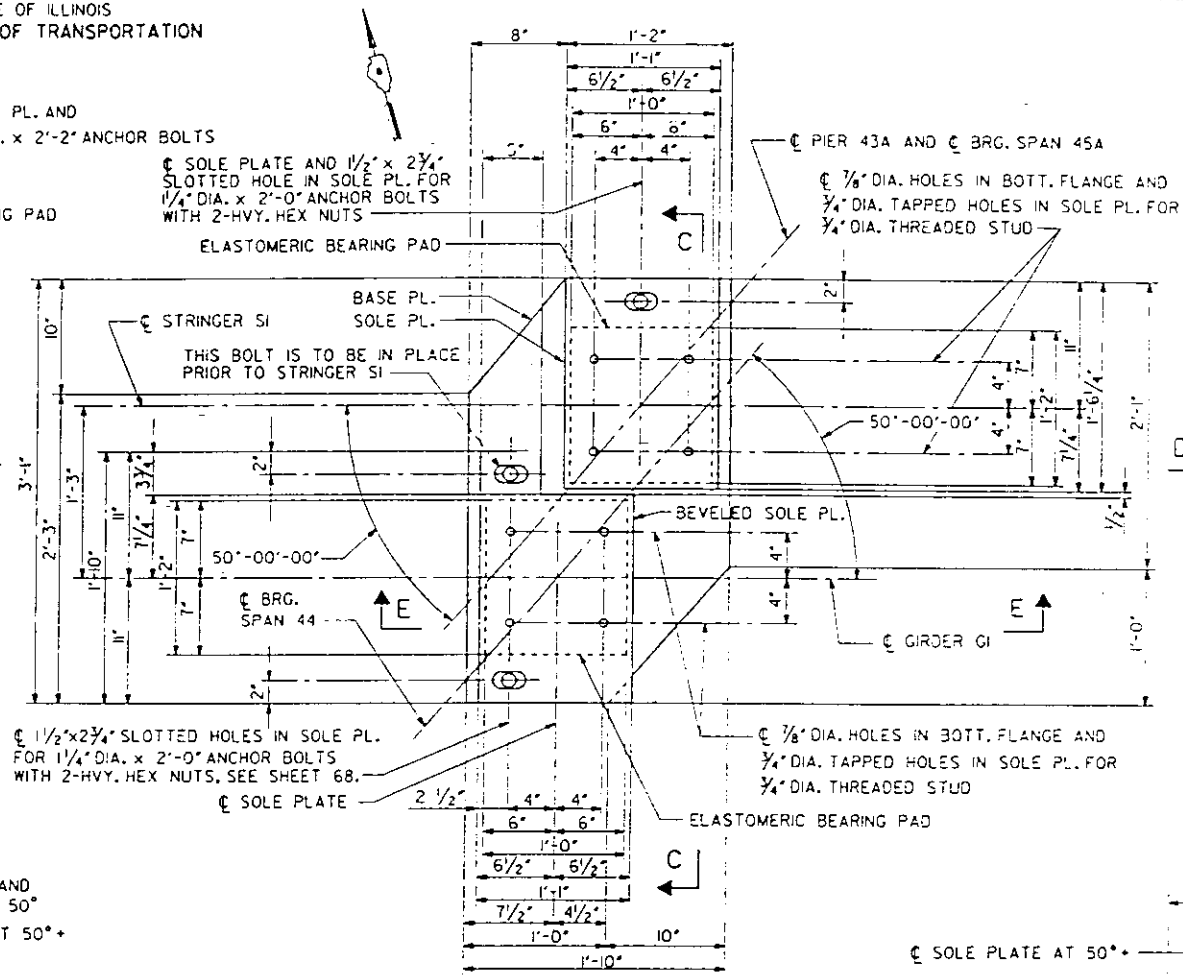

ELASTOMERIC BEARING ASSEMBLY TYPE I (2 REQUIRED)

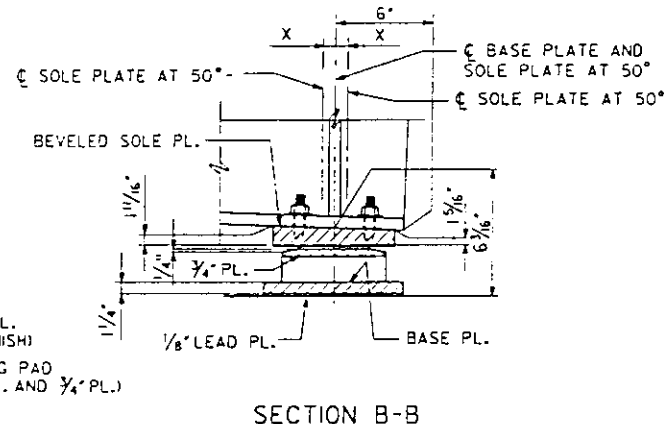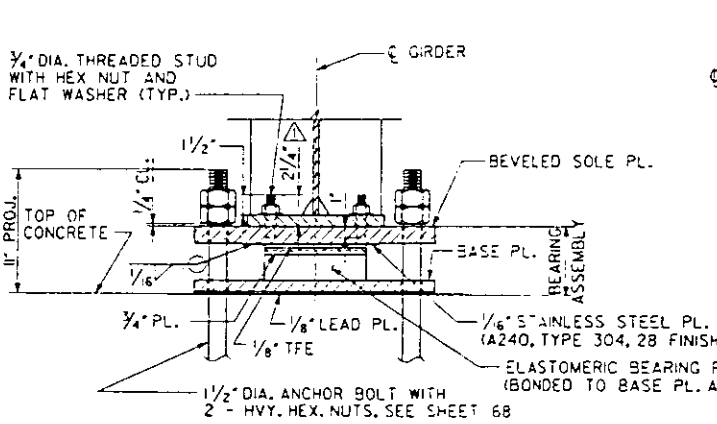

NOTE: X = 3/16" FOR EACH 20° F. CHANGE FROM 50° F. TEMPERATURE.

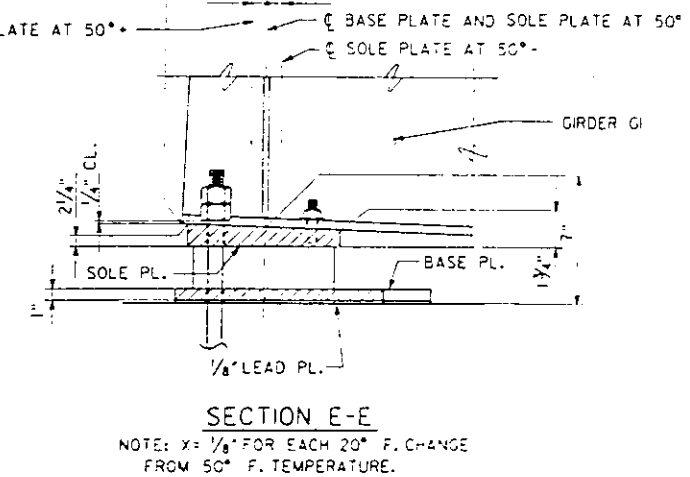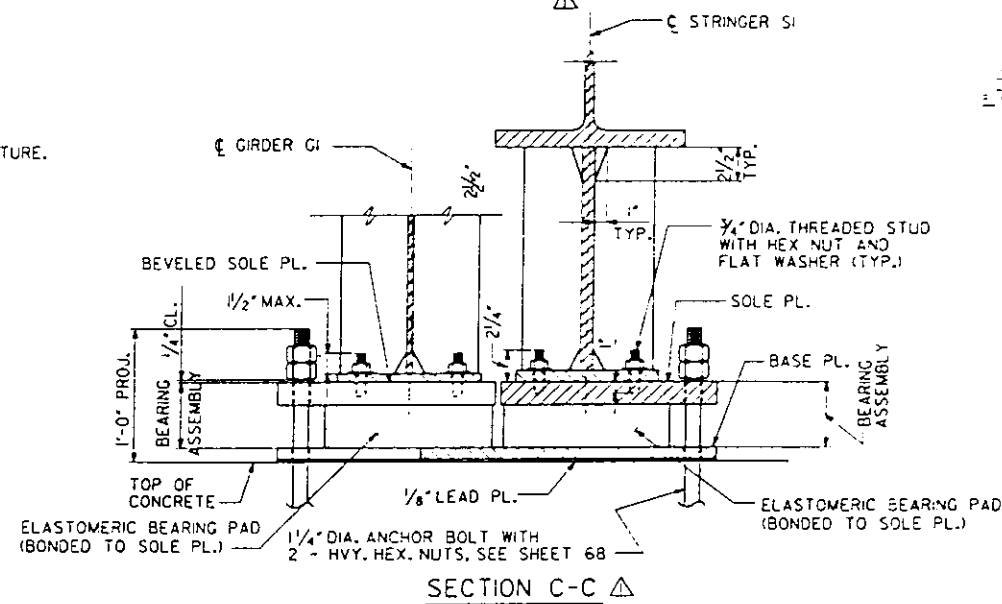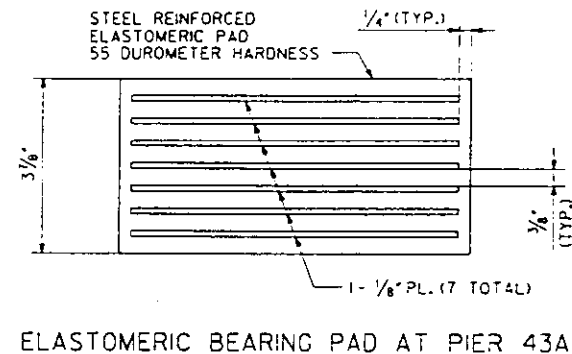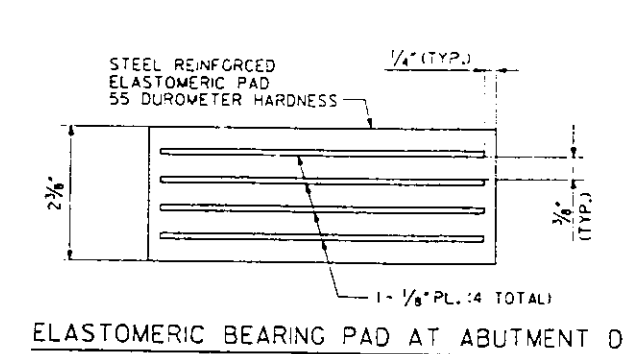

NOTE: X = 1/8" FOR EACH 20° F. CHANGE FROM 50° F. TEMPERATURE.

NOTES: ALL STRUCTURAL STEEL FOR BEARINGS SHALL CONFORM TO AASHTO M-183, EXCEPT AS NOTED. THREADED STUDS AND NUTS SHALL CONFORM TO M-183. FLAT WASHERS TO BE ASTM F844. BASE PLATES AND LEAD PLATES SHALL BE INCLUDED IN WEIGHT AND COST FOR STRUCTURAL STEEL.

REHABILITATION FOR
APPROACH BRIDGE OVER
I-55/70 W.B., MISSOURI AVE. AND TRRA
BEARINGS AT
PIER 43A AND ABUTMENT D

STRUCTURE NO. 082-6003
STA. 65+00 (FAP 799) ST. CLAIR CO.

PREPARED BY
SVERDRUP CORPORATION
ST. LOUIS, MISSOURI

REV. 2-4-87

SECTION IBR-1

SHEET NO. 49 OF 75

FOR INFORMATION ONLY

4-DEC-1987
 DATE: OCT. 23, 1987
 LEVELS PLOTTED
 35, 56, 58, 63
 FILE: ZF31C1JBR43B.DGN
 PRF: DRG43B
 875922

DESIGNED	R. NIEMIETZ
CHECKED	K. LARSON
CHECKED	S. STEGMAN
CHECKED	J. KORPI

STATE OF ILLINOIS
DEPARTMENT OF TRANSPORTATION

ROUTE NO.	SECTION	COUNTY	SHEET NO.	TOTAL SHEETS
FAP 799	*	ST. CLAIR	252	19
PROJECT		PROJECT		

*1BR-1 APPROACH BRIDGE

INTERIOR GIRDER G2 MOMENT TABLE

	0.4 SPAN 45A	PIER 44A	0.5 SPAN 46A	PIER 45A	0.6 SPAN 47A
I _s (in ⁴)	20051	38904	33790	33275	1185
I _{c n} (in ⁴)	48309	---	77902	---	28056
I _{c 3n} (in ⁴)	36115	---	56712	---	2117
S _s (in ³)	723	1365	1366	1178	517
S _{c n} (in ³)	1018	---	1770	---	731
S _{c 3n} (in ³)	926	---	1631	---	669
Q (kips/ft.)	0.893	1.231	0.960	1.231	0.893
M _Q (ft-kips)	327	1706	876	1338	28
S _Q (kips/ft.)	0.304	---	0.304	---	0.304
M _{S Q} (ft-kips)	147	---	338	---	35
M _L (ft-kips)	---	760	---	672	---
M _{S L} (ft-kips)	722	---	1097	---	488
M _I (ft-kips)	171	166	222	155	132
5/3(M _L + I+CF) (ft-kips)	1488	1563	2227	1396	1046
M _a (ft-kips)	2551	4250	4473	3554	1442
fs _Q non-comp (ksi)	5.43	15.00	7.70	13.63	0.65
fs _Q comp. (ksi)	1.91	---	2.49	---	0.63
fs _{5/3(L + I+CF)} (ksi)	17.54	13.74	15.10	14.22	17.17
fw (ksi)	---	3.02	2.66	2.93	2.16
fs (overload) (ksi)	24.88	28.74	25.29	27.85	18.45
fs (total) non-compact (ksi)	32.34	37.36	32.88	36.21	23.99
F _b (ksi)	36.00	45.67	36.00	45.67	36.00
VR (kips)	46.20	---	49.90	---	44.90

INTERIOR GIRDER G4 MOMENT TABLE

	0.4 SPAN 45A	PIER 44A	0.5 SPAN 46A	PIER 45A	0.6 SPAN 47A
I _s (in ⁴)	22236	41767	33790	33275	13864
I _{c n} (in ⁴)	54930	---	77902	---	34227
I _{c 3n} (in ⁴)	40518	---	56712	---	25707
S _s (in ³)	754	1459	1366	1178	584
S _{c n} (in ³)	1181	---	1770	---	825
S _{c 3n} (in ³)	1076	---	1631	---	753
Q (kips/ft.)	0.904	1.236	0.960	1.231	0.893
M _Q (ft-kips)	878	1628	869	1314	36
S _Q (kips/ft.)	0.304	---	0.304	---	0.304
M _{S Q} (ft-kips)	196	---	338	---	38
M _L (ft-kips)	---	828	---	675	---
M _{S L} (ft-kips)	819	---	1115	---	493
M _I (ft-kips)	186	176	224	155	134
5/3(M _L + I+CF) (ft-kips)	1675	1695	2260	1401	1056
M _a (ft-kips)	3054	4320	4509	3530	1469
fs _Q non-comp (ksi)	7.61	13.39	7.63	13.39	0.74
fs _Q comp. (ksi)	2.19	---	2.49	---	0.61
fs _{5/3(L + I+CF)} (ksi)	17.02	13.94	15.32	14.27	15.36
fw (ksi)	---	2.87	2.67	2.90	1.95
fs (overload) (ksi)	26.82	27.33	25.44	27.66	16.71
fs (total) non-compact (ksi)	34.87	35.52	33.07	35.96	21.72
F _b (ksi)	36.00	45.67	36.00	45.67	36.00
VR (kips)	47.20	---	50.00	---	45.10

EXTERIOR GIRDER G6 MOMENT TABLE

	0.4 SPAN 45A	PIER 44A	0.5 SPAN 46A	PIER 45A	0.6 SPAN 47A
I _s (in ⁴)	27403	47553	33790	33275	16884
I _{c n} (in ⁴)	63590	---	77902	---	4130
I _{c 3n} (in ⁴)	46954	---	56712	---	30817
S _s (in ³)	1045	1647	1366	1178	654
S _{c n} (in ³)	1392	---	1770	---	923
S _{c 3n} (in ³)	1277	---	1631	---	841
Q (kips/ft.)	0.927	1.248	0.960	1.231	0.893
M _Q (ft-kips)	757	2284	0.808	1271	57
S _Q (kips/ft.)	0.304	---	0.304	---	0.304
M _{S Q} (ft-kips)	290	---	327	---	40
M _L (ft-kips)	---	954	---	703	---
M _{S L} (ft-kips)	974	---	1137	---	510
M _I (ft-kips)	206	196	226	161	137
5/3(M _L + I+CF) (ft-kips)	1967	1941	2301	1458	1092
M _a (ft-kips)	3318	5493	4467	3348	1546
fs _Q non-comp (ksi)	8.59	16.64	7.10	12.94	1.05
fs _Q comp. (ksi)	2.73	---	2.41	---	0.57
fs _{5/3(L + I+CF)} (ksi)	16.96	14.14	15.60	14.85	14.20
fw (ksi)	---	3.23	2.64	2.92	1.85
fs (overload) (ksi)	28.38	30.78	25.11	27.79	15.82
fs (total) non-compact (ksi)	36.89	40.01	32.64	36.13	20.57
F _b (ksi)	36.00	45.67	36.00	45.67	36.00
VR (kips)	48.40	---	50.10	---	46.10

△ INCLUDES EFFECT OF SECONDARY FORCES
△ INCLUDES STRESSES DUE TO SECONDARY FORCES AND CENTRIFUGAL LOADS.

GIRDER REACTION TABLE

	INTERIOR GIRDER G2				INTERIOR GIRDER G4				EXTERIOR GIRDER G6			
	PIER 43A	PIER 44A	PIER 45A	ABUT. D	PIER 43A	PIER 44A	PIER 45A	ABUT. D	PIER 43A	PIER 44A	PIER 45A	ABUT. D
Q (kips)	34.4	149.7	131.0	17.0	40.7	157.6	130.1	17.3	50.9	174.3	128.3	18.4
L (kips)	47.9	75.4	70.9	44.9	48.6	78.1	71.2	44.9	49.5	82.7	72.3	45.0
I (kips)	11.3	16.4	16.4	12.1	11.0	16.6	16.4	12.1	10.5	17.0	16.5	12.1
SECONDARY (kips)	---	---	---	---	---	3.8	4.2	0.2	---	19.6	20.6	2.2
TOTAL (kips)	93.6	241.5	218.3	74.0	100.3	256.1	221.9	74.5	110.9	293.6	237.7	77.7

NOTES

M_a (APPLIED MOMENT) = 1.3 (M_Q + M_{S Q} + 5/3 (M_L + I+CF))
I_s AND S_s ARE THE MOMENT OF INERTIA AND SECTION MODULUS OF THE STEEL SECTION USED IN COMPUTING fs (TOTAL AND OVERLOAD).
I_c AND S_c ARE THE MOMENT OF INERTIA AND SECTION MODULUS OF THE COMPOSITE SECTION USED IN COMPUTING fs (TOTAL AND OVERLOAD).
VR IS THE MAXIMUM L + IMPACT SHEAR RANGE IN SPAN.
fs (total) IS THE SUM OF THE STRESSES DUE TO
1.3 (M_Q + M_{S Q} + 5/3 (M_L + I+CF))
fs (overload) IS THE SUM OF THE STRESSES DUE TO
M_Q + M_{S Q} + 5/3 (M_L + I+CF)
fw FACTORED NORMAL WARPING STRESS DUE TO CURVATURE.
M_Q - MOMENT DUE TO DEAD LOADS ON NON-COMPOSITE SECTION.
M_{S Q} - MOMENT DUE TO DEAD LOADS ON COMPOSITE SECTION.
M_L - MOMENT DUE TO LIVE LOAD ON COMPOSITE SECTION.
M_L - MOMENT DUE TO LIVE LOAD ON NON-COMPOSITE OR COMPOSITE SECTION.
I - LIVE LOAD IMPACT
F_b - MAXIMUM ALLOWABLE STRESS F_bU OR F_by COMPUTED ACCORDING TO AASHTO (GUIDE TO HORIZ. CURVED HIGHWAY BRIDGES SECT. 2.12(2), 2.16 AND 2.19).

REHABILITATION FOR
APPROACH BRIDGE OVER
I-55/70 W.B., MISSOURI AVE. AND TRRA
MOMENTS AND REACTIONS
SPANS 45A THRU 47A

STRUCTURE NO. 082-6003
STA. 65+00 (FAP 799) ST. CLAIR CO.

PREPARED BY:
SYVERDRUP CORPORATION
ST. LOUIS, MISSOURI

REV. 12-4-87

SECTION 1BR-1

SHEET NO. 50 OF 75






FOR INFORMATION ONLY

4-DEC-1987 13:00

LEVELS PLOTTED DATE: OCT. 23, 1987 35.56.63

FILE: ZF31051J02TAIL07.DGN
PRF: DETAIL07
875946

DESIGNED	K. LARSON
CHECKED	R. NIEMIETZ
DRAWN	J.G. CORLEY
CHECKED	R.F. BECK

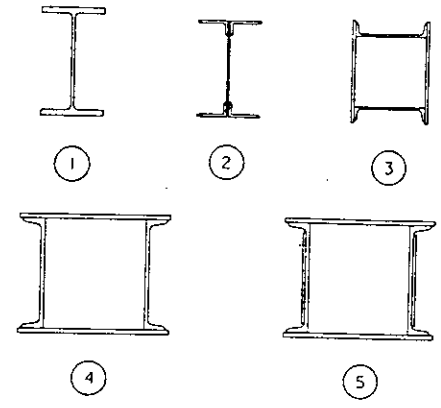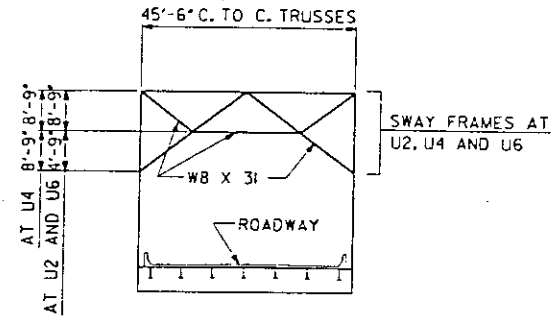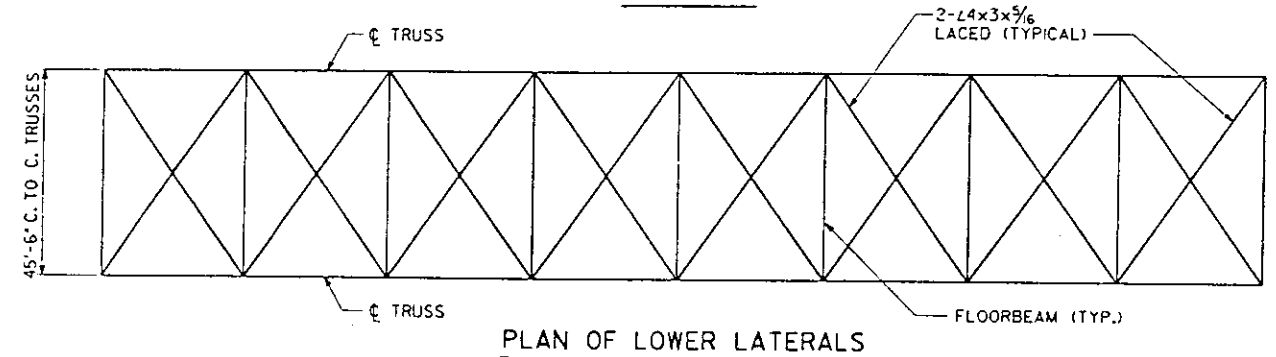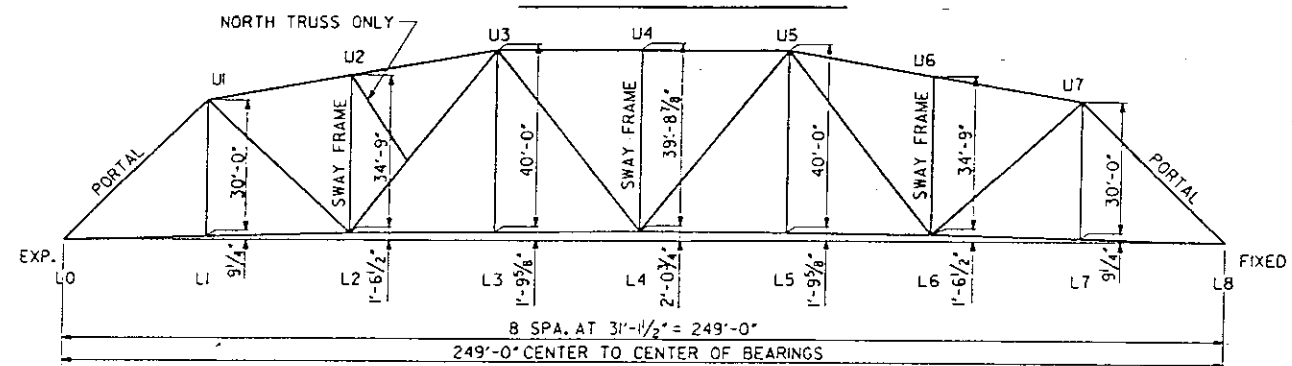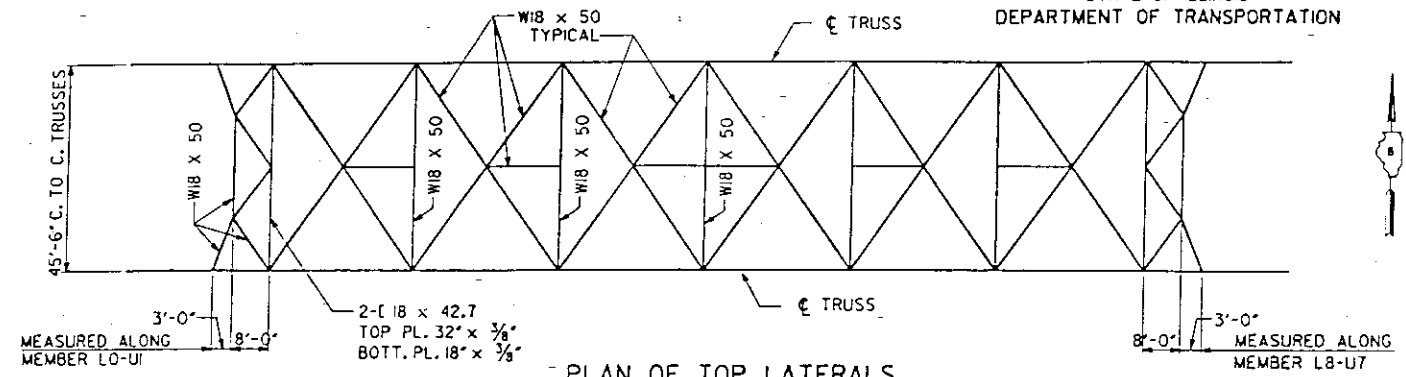

STRESS TABLE SHAPE DESIGNATION

MEMBER	DL		LL		IMP		DL+LL+IMP		ACT S/R	CAPACITY			EFF AREA		L/R	S.P.	SECTION
	KIP	KIP	KIP	KIP	KIP	KIP	KIP	KIP		TENS	COMP	CONN	TENS	COMP			
										KSI	KIP	KIP	KIP	SO IN			
L0-U1	-555	0	-203	0	-27	-555	-785						60.21	67.8	4	1-PL 24 X 3/8 1-PL(24-9) X 1/4 2-C 18 X 58.0	
U1-U3	-600	0	-219	0	-29	-600	-848					58.34	49.5	4	1-PL 24 X 3/8 1-PL(24-9) X 1/4 2-C 18 X 58.0		
U3-U4	-690	0	-252	0	-33	-690	-975					69.59	52.5	5	1-PL 24 X 3/8 1-PL(24-9) X 1/4 2-W PL 15 X 3/8 2-C 18 X 58.0		
L0-L2	400	147	0	19	0	566	400	4.00	746				41.45		4	1-PL 24 X 1/2 1-PL(24-9) X 1/4 2-C 18 X 42.7	
L2-L4	645	235	0	31	0	911	645	4.42	1084				60.21		4	1-PL 24 X 3/8 1-PL(24-9) X 1/4 2-C 18 X 58.0	
U1-L2	268	111	-27 NOTE 2	17	-9 NOTE 2	396	232	6.84	431		422	23.97			1	W 12 X 85	
L2-U3	-86	61 NOTE 2	-69	16 NOTE 2	-12	-9	-167			-282	-260		22.20	106.1	3	2-W PL 18 X 3/8 2-C (12-6) X 20.7	
U3-L4	79	71 NOTE 2	-50 NOTE 2	14 NOTE 2	-11 NOTE 2	164	18	7.76	339		260	18.81			3	2-W PL 16 X 3/8 2-C (12-6) X 20.7	
L1-U1	89	89 NOTE 2	0	27 NOTE 2	0	205	89	6.80	307		227	17.06			1	W 12 X 58	
L2-U2	-15	0	0	0	0	-15	-15			-245	-162		22.23	134.1	2	1-PL 12 X 3/8 4-L7 X 4 X 1/8	
L3-U3	91	89 NOTE 2	0	27 NOTE 2	0	207	91	6.80	307		227	17.06			1	W 12 X 58	
L4-U4	-16	0	0	0	0	-16	-16			-213	-162		22.23	153.3	2	1-PL 12 X 3/8 4-L7 X 4 X 1/8	
U2-M2.5	0	0	0	0	0	0	0			258	-147	115	12.88	13.20	1	W 12 X 45 (BRACE STRUT-WEST HALF NORTH TRUSS ONLY)	

NOTES

- SPAN IS SYMMETRICAL ABOUT U4-L4 EXCEPT AS NOTE 2.
- MEMBER FORCE GOVERNED BY TRUCK LOADING.

REHABILITATION FOR
APPROACH BRIDGE OVER
I-55/70 W.B., MISSOURI AVE. AND
TRUSS LAYOUT AND STRESS SHEET
SPAN 38

STRUCTURE NO. 082-6003
STA. 65+00 (FAP 799) ST. CLAIR CO.

PREPARED BY:
SVERDRUP CORPORATION
ST. LOUIS, MISSOURI

REV. 12-4-87

SECTION IBR-1

SHEET NO. 510

FOR INFORMATION ONLY



4 JUL 1987 10:11

LEVELS PLOTTED DATE: OCT. 23, 1987 35 56 57 63

58 FILE: Z:\JIS\JAP\BRSTRS.DGN 15900 PRF: APPBRSTRS

X	DESIGNED
X	CHECKED
	J. CORLEY
	DRAWN
	J. KORPI
	CHECKED



*IBR-1 APPROACH BRIDGE

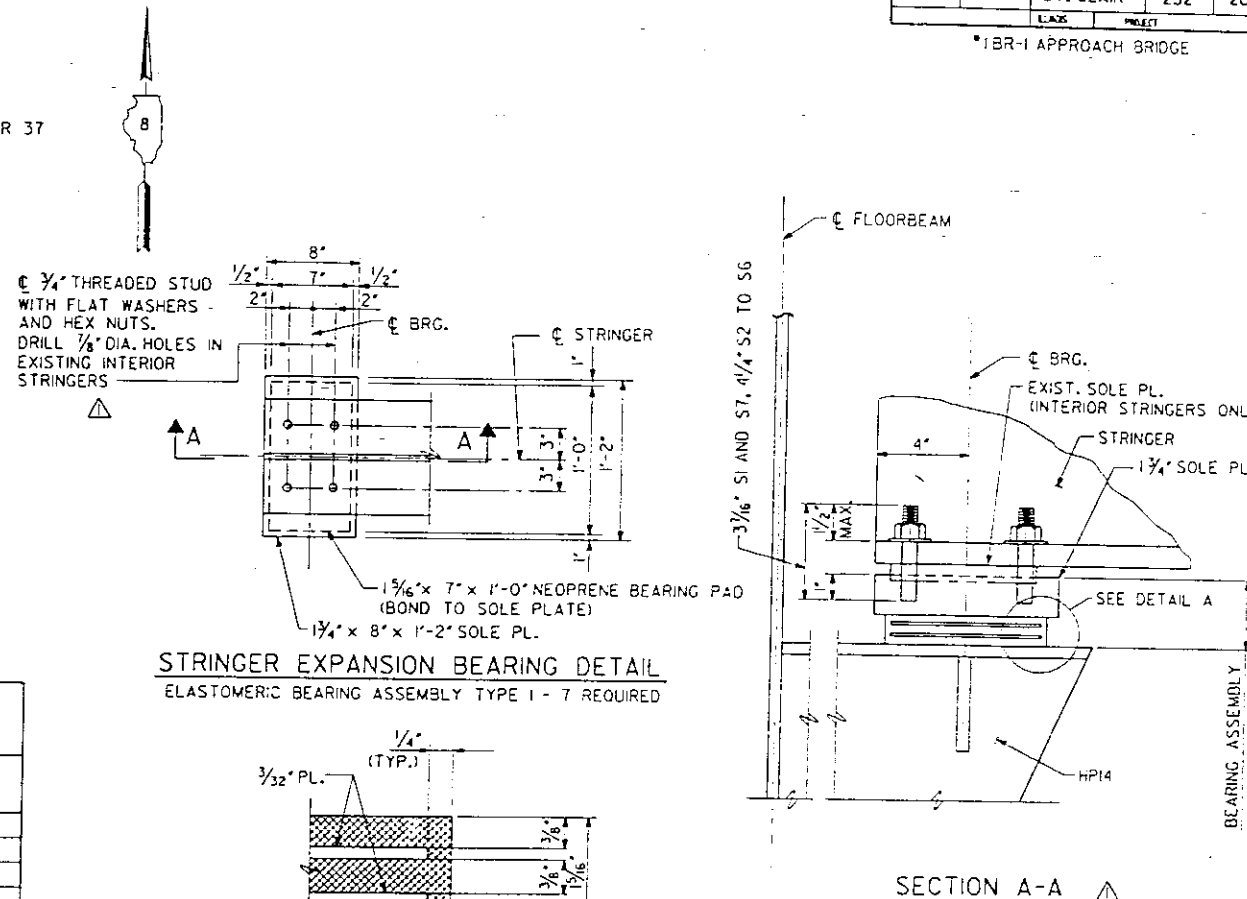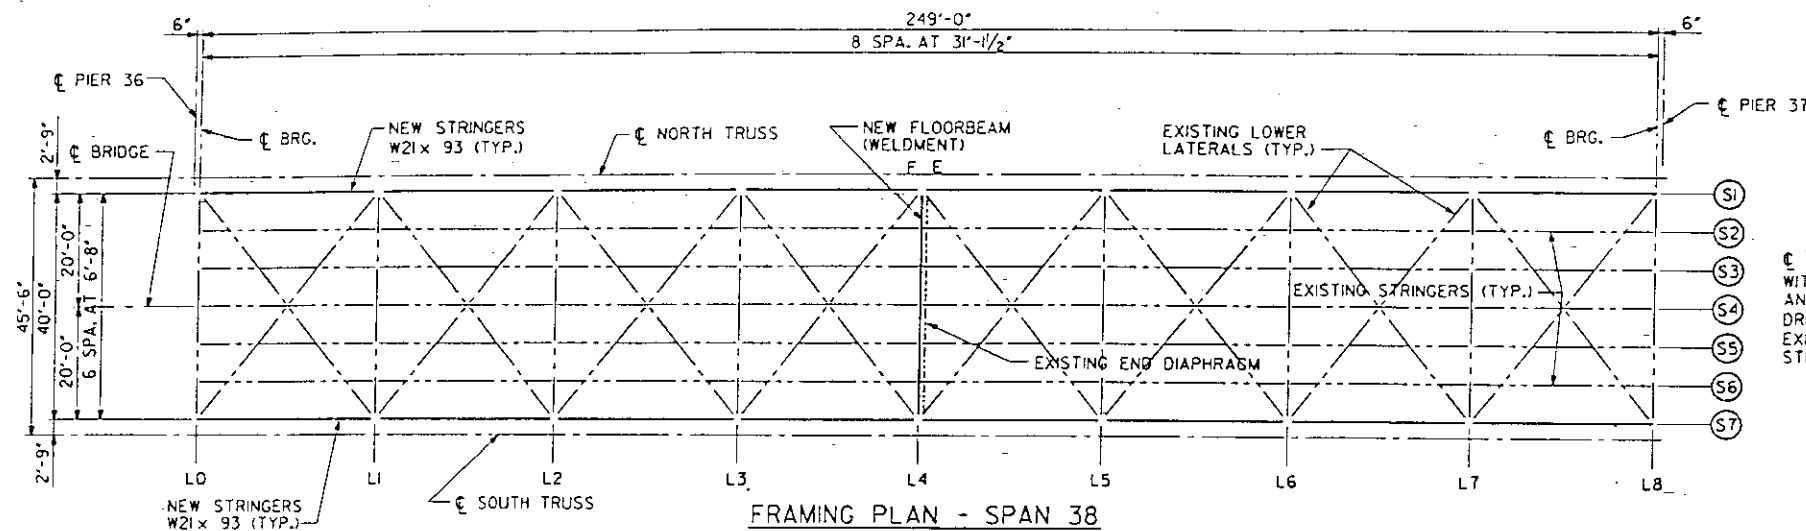

EXISTING FLOORBEAM ELEVATIONS		
LOCATION	ASSUMED TOP OF FLOORBEAM	REMARKS
L0	P.G. - 10 ¹ / ₂ "	BACK OF TOP FLANGE ANGLE BASED ON SURVEY DATA AND ASSUMED NEGLIGIBLE CHANGE IN DEAD LOAD DEFLECTIONS
L1	P.G. - 12 ¹ / ₈ "	
L2	P.G. - 10 ⁷ / ₁₆ "	
L3	P.G. - 12 ⁵ / ₈ "	
L4	P.G. - 10 ¹¹ / ₁₆ "	
L5	P.G. - 12 ¹ / ₈ "	
L6	P.G. - 10 ⁵ / ₁₆ "	
L7	P.G. - 11 ¹ / ₂ "	
L8	P.G. - 9 ³ / ₈ "	

NEW FLOORBEAM ELEVATIONS		
LOCATION	ASSUMED TOP OF FLOORBEAM	REMARKS
L0	P.G. - 10 ¹ / ₂ "	
L2	P.G. - 10 ⁷ / ₁₆ "	
L4	P.G. - 11 ³ / ₁₆ "	
L8	P.G. - 9 ³ / ₈ "	
L1, L3, L5, L6 AND L7		ORIGINAL FLANGE ANGLE UNDISTURBED

NEW STRINGER SETTING ELEVATIONS	
LOCATION	ASSUMED TOP OF STRINGER
L0	P.G. - 11 ¹ / ₄ "
L1	P.G. - 11 ⁵ / ₁₆ "
L2	P.G. - 11 ³ / ₁₆ "
L3	P.G. - 11 ⁷ / ₁₆ "
L4	P.G. - 11 ⁵ / ₁₆ "
L5	P.G. - 11 ⁵ / ₁₆ "
L6	P.G. - 11 ¹ / ₁₆ "
L7	P.G. - 10 ¹¹ / ₁₆ "
L8	P.G. - 10 ³ / ₈ "

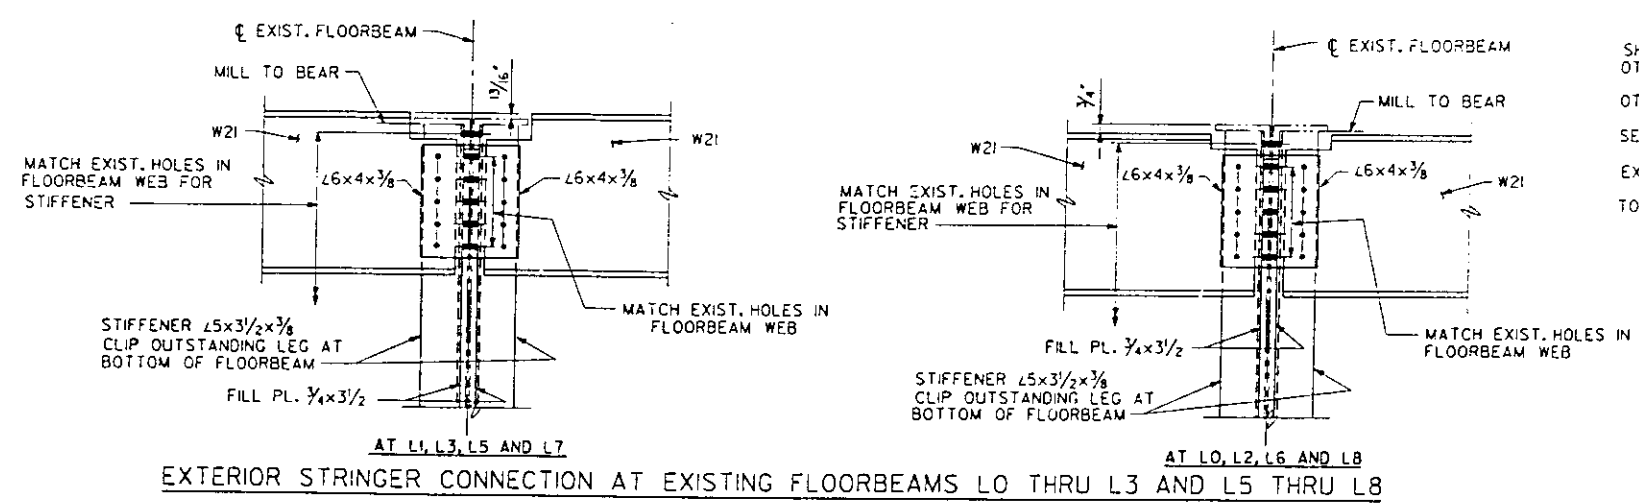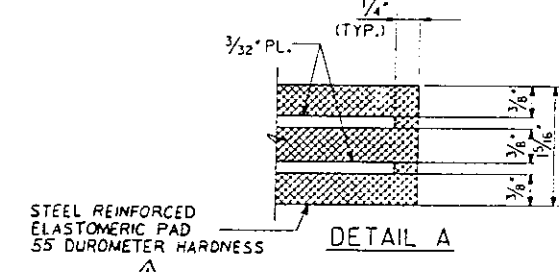

NOTES

ALL BOLTED CONNECTIONS SHOWN ON THIS SHEET SHALL BE MADE WITH 7/8" H.S. BOLTS UNLESS OTHERWISE NOTED.

ALL MATERIAL SHALL BE AASHTO M-183 UNLESS OTHERWISE NOTED.

FOR DRAINAGE SCUPPER LOCATIONS AND DETAILS SEE SHEETS 30 AND 31.

NEW FLOORBEAM AND STRINGERS REPLACE EXISTING MEMBERS.

ALL NEW STRINGER MATERIAL IS SUBJECT TO NOTCH TOUGHNESS REQUIREMENTS.

REHABILITATION FOR
APPROACH BRIDGE OVER
I-55/70 W.B., MISSOURI AVE. AND TRRA

FRAMING PLAN - SPAN 38

STRUCTURE NO. 082-6003
STA. 65+00 (FAP 799) ST. CLAIR CO.

K. LARSON
DESIGNED
R. NIEMETZ
CHECKED
C. DEED
DRAWN
A. MYERS
CHECKED

PREPARED BY
SVERDRUP CORPORATION
ST. LOUIS, MISSOURI

REV. 12-4-87

SECTION IBR-1

SHEET NO. 52 OF 75


LEVELS PLOTTED DATE: OCT. 23, 1987
35 56 58 63

ET 2F3115JMLKFP13.DGN
JF1 MLKFP13


FOR INFORMATION ONLY

ROUTE NO.	SECTION	COUNTY	10' IN. SHEETS
FAP 799	*	ST. CLAIR	252
		LINE	PROJECT


* IBR-1 APPROACH BRIDGE

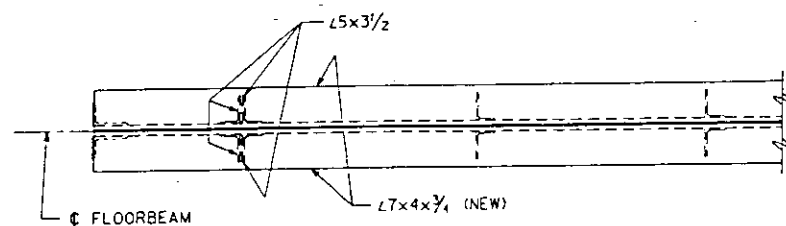

PARTIAL TOP PLAN

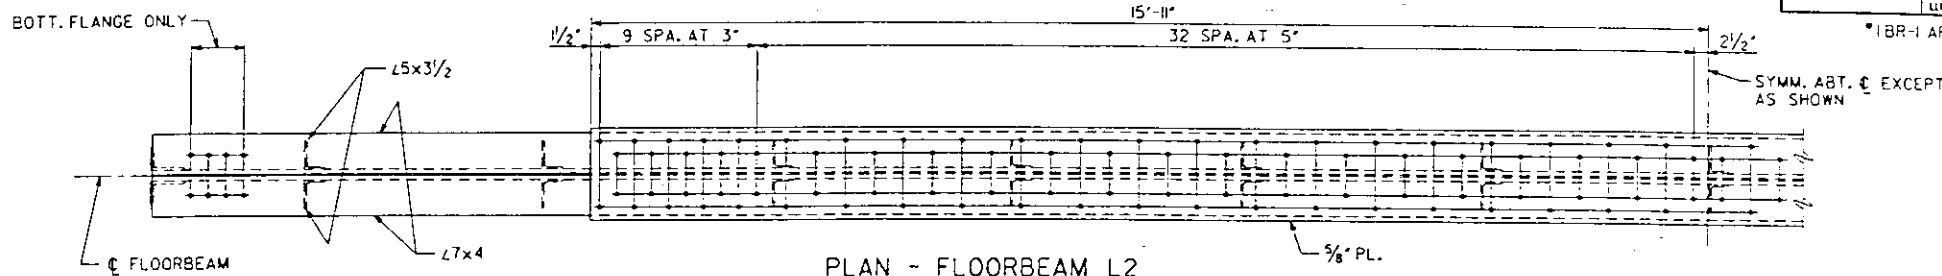


PLAN - FLOORBEAM L2
(TOP FLANGE SHOWN, BOTT. FLANGE SIMILAR)

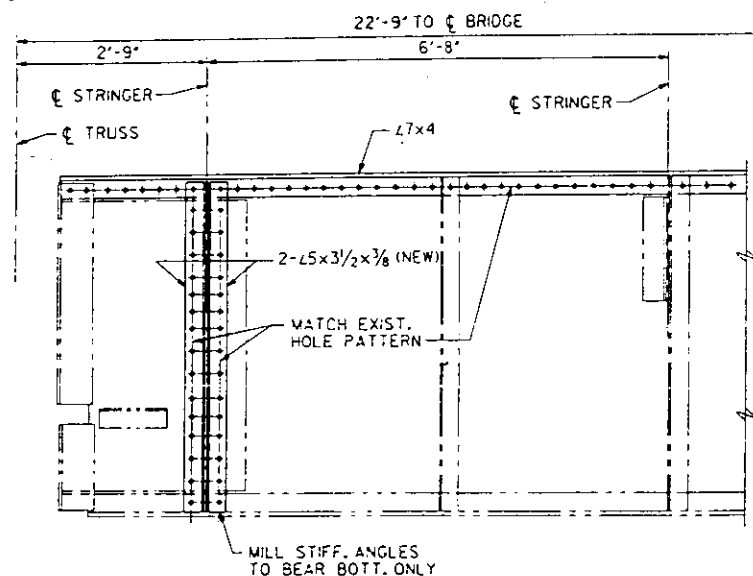


PARTIAL ELEVATION

FLOORBEAM AT PANEL POINTS L0 AND L8

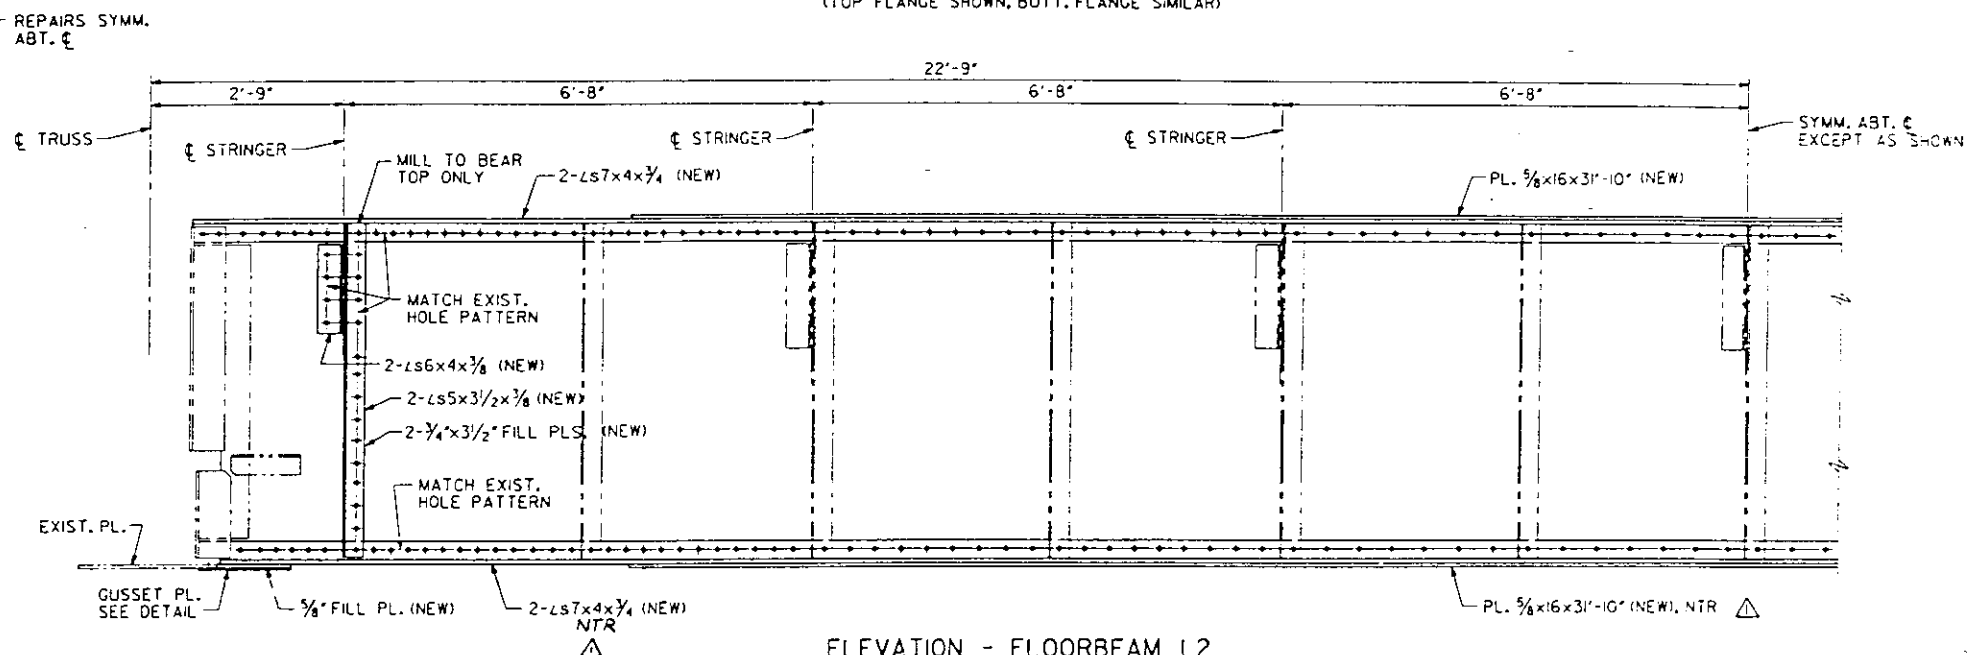


ELEVATION - FLOORBEAM L2

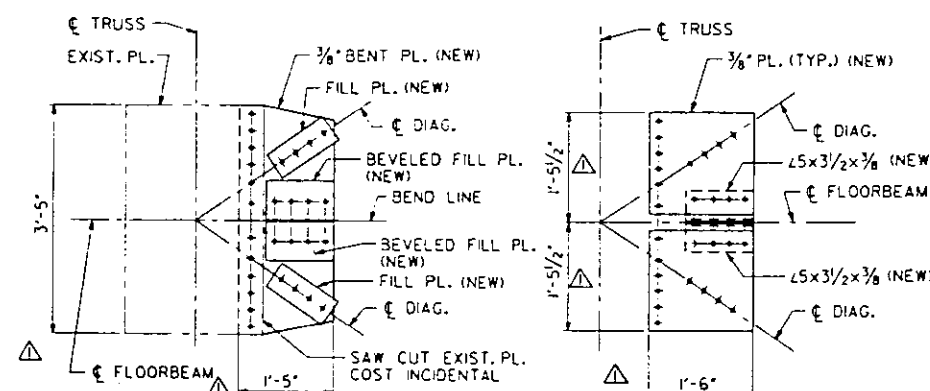


NOTE: MATCH EXIST. HOLE PATTERNS
LOWER GUSSET PLATE DETAIL
AT PANEL POINTS L2 (NORTH AND SOUTH)
AND L6 (SOUTH)


NOTE: MATCH EXIST. HOLE PATTERNS
UPPER LOWER LATERAL
GUSSET PLATE DETAIL
AT PANEL POINT L1

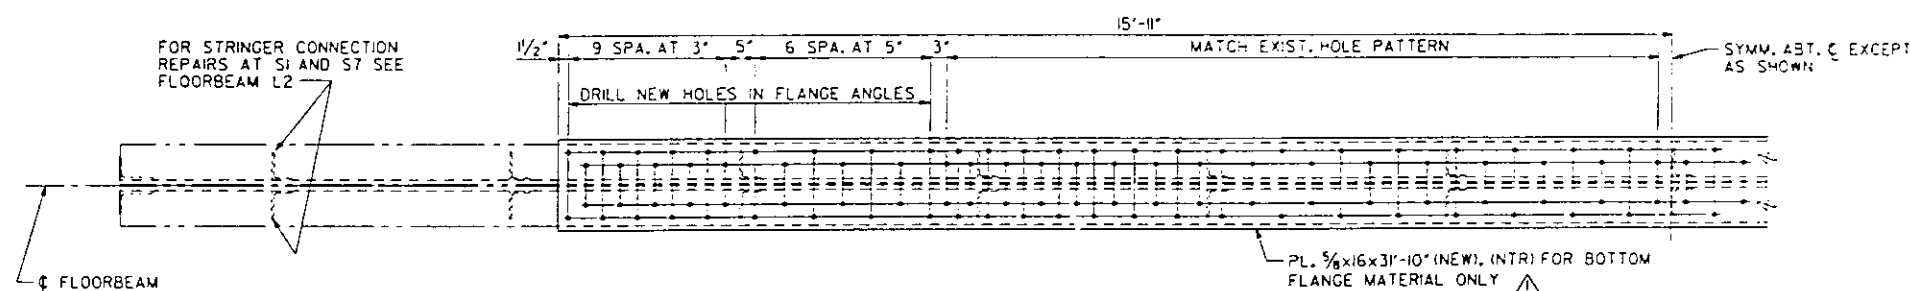

PLAN - FLOORBEAMS L1, L3, L5, L6 AND L7
(TOP FLANGE SHOWN, BOTT. FLANGE SIMILAR)

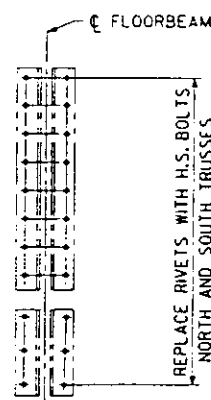

FLOORBEAM END CONNECTION DETAIL
(TYP. AT ALL FLOORBEAMS EXCEPT L0, L4 AND L8)

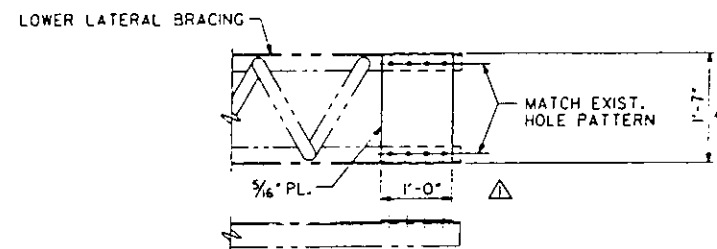

BATTEN PLATE DETAIL
NOTE: REPLACE EXIST. BATTEN PLATES AT END OF
ALL LOWER LATERAL BRACING MEMBERS
(32 PLATES REQUIRED)

NOTES
ALL BOLTED CONNECTIONS SHOWN ON THIS SHEET SHALL
BE MADE WITH 3/8" H.S. BOLTS UNLESS OTHERWISE NOTED.
ALL NEW MATERIAL REPLACES EXISTING MATERIAL.
NTR INDICATES MATERIAL SUBJECT TO NOTCH TOUGHNESS
REQUIREMENTS.

REHABILITATION FOR
APPROACH BRIDGE OVER
I-55/70 W.B., MISSOURI AVE. AND TRR.
EXISTING FLOORBEAM REPAIRS
SPAN 38

STRUCTURE NO. 082-6003
STA. 65+00 (FAP 799); ST. CLAIR CO.

PREPARED BY
SVERDRUP CORPORATION
ST. LOUIS, MISSOURI

REV. 12-4-87


SECTION IBR-1

SHEET NO. 53 OF 75


LEVELS PLOTILO [DATE: OCT. 23, 1987]
FILE: ZF316JLJDE FAL 74.00N
875845 PRJ: DETAIL 74

A.T. MYERS	DESIGNED
K. LARSON	CHECKED
C. REED	DRAWN
J. KORPI	CHECKED


FOR INFORMATION ONLY

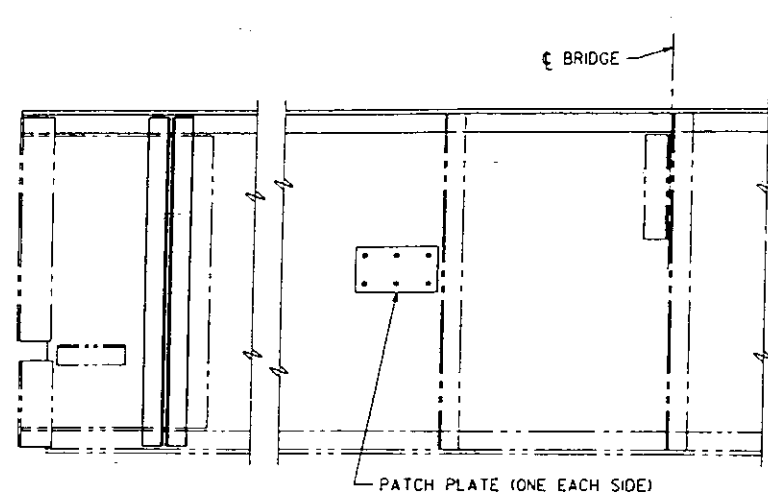

NORTH END AT PANEL POINT L0

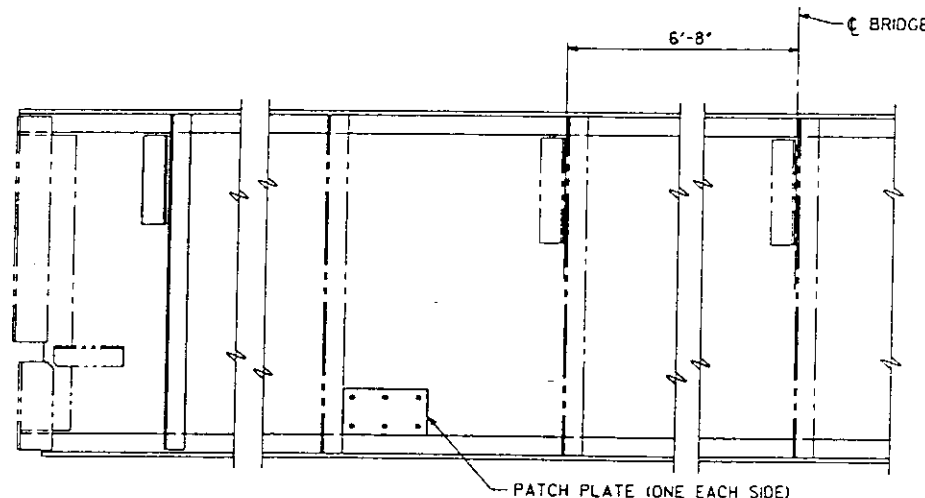


NORTH END AT PANEL POINT L2

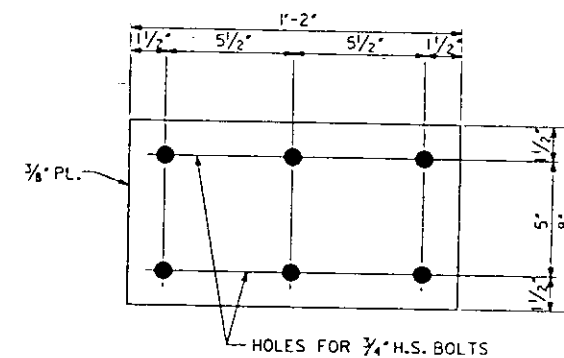


PATCH PLATE DETAIL

(14 REQUIRED)
NOTE: DRILL NEW HOLES IN FLOORBEAM WEB.

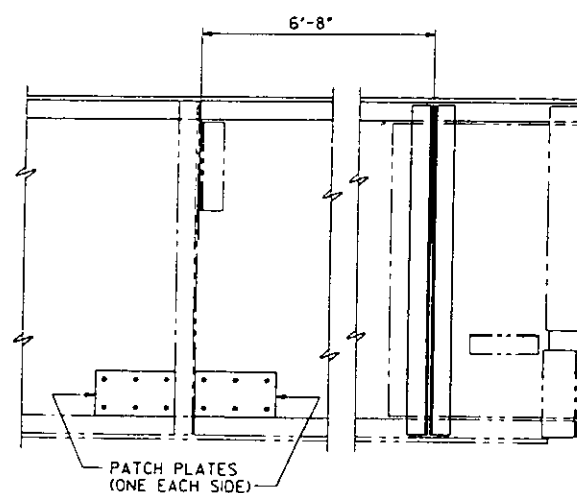

SOUTH END AT PANEL POINT L8

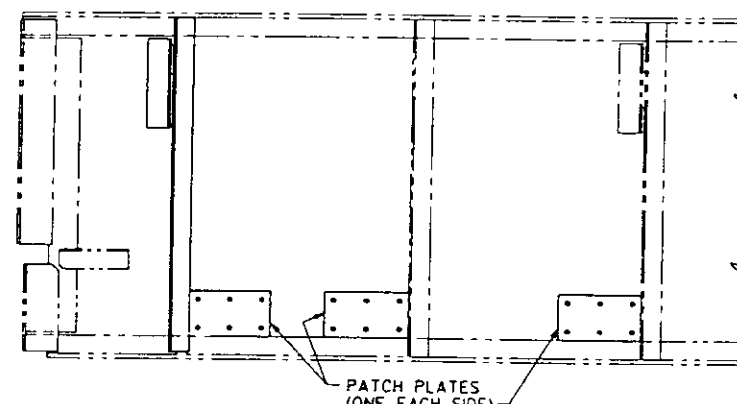

NORTH END AT PANEL POINT L6

FLOORBEAM WEB REPAIRS

NOTE: PATCH PLATES SHALL BE CENTERED AS NEARLY AS POSSIBLE OVER THE HOLE IN THE WEB PLATE.
FILL SURFACE IRREGULARITIES (FULL AREA OF PATCH PLATES) WITH AN APPROVED SILICON CAULKING BEFORE BOLTING PLATES. (COST INCIDENTAL)

FILE: ZF315151DETAIL 75.DGN
 DATE: OCT. 23, 1987
 LEVELS PLOTTED: 35 56 63
 PRT: DETAIL 75

DESIGNED	
CHECKED	C. DEED
DRAWN	J. KORPI
CHECKED	

PREPARED BY:
SYERORUP CORPORATION
ST. LOUIS, MISSOURI

REHABILITATION FOR
APPROACH BRIDGE OVER
I-55/70 W.B., MISSOURI AVE. AND TRRA
EXISTING FLOORBEAM REPAIRS
SPAN 38


STRUCTURE NO. 082-6003
STA. 65+00 (FAP 799) ST. CLAIR CO.

SECTION 1BR-1


SHEET NO. 54 OF 75

FOR INFORMATION ONLY

*1BR-1 APPROACH BRIDGE

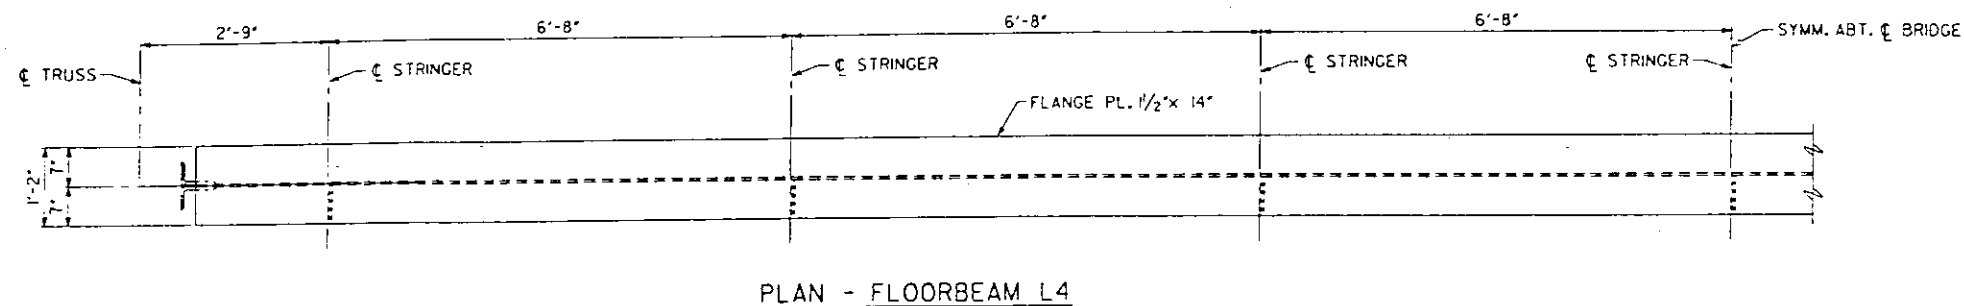


PLAN - FLOORBEAM L4

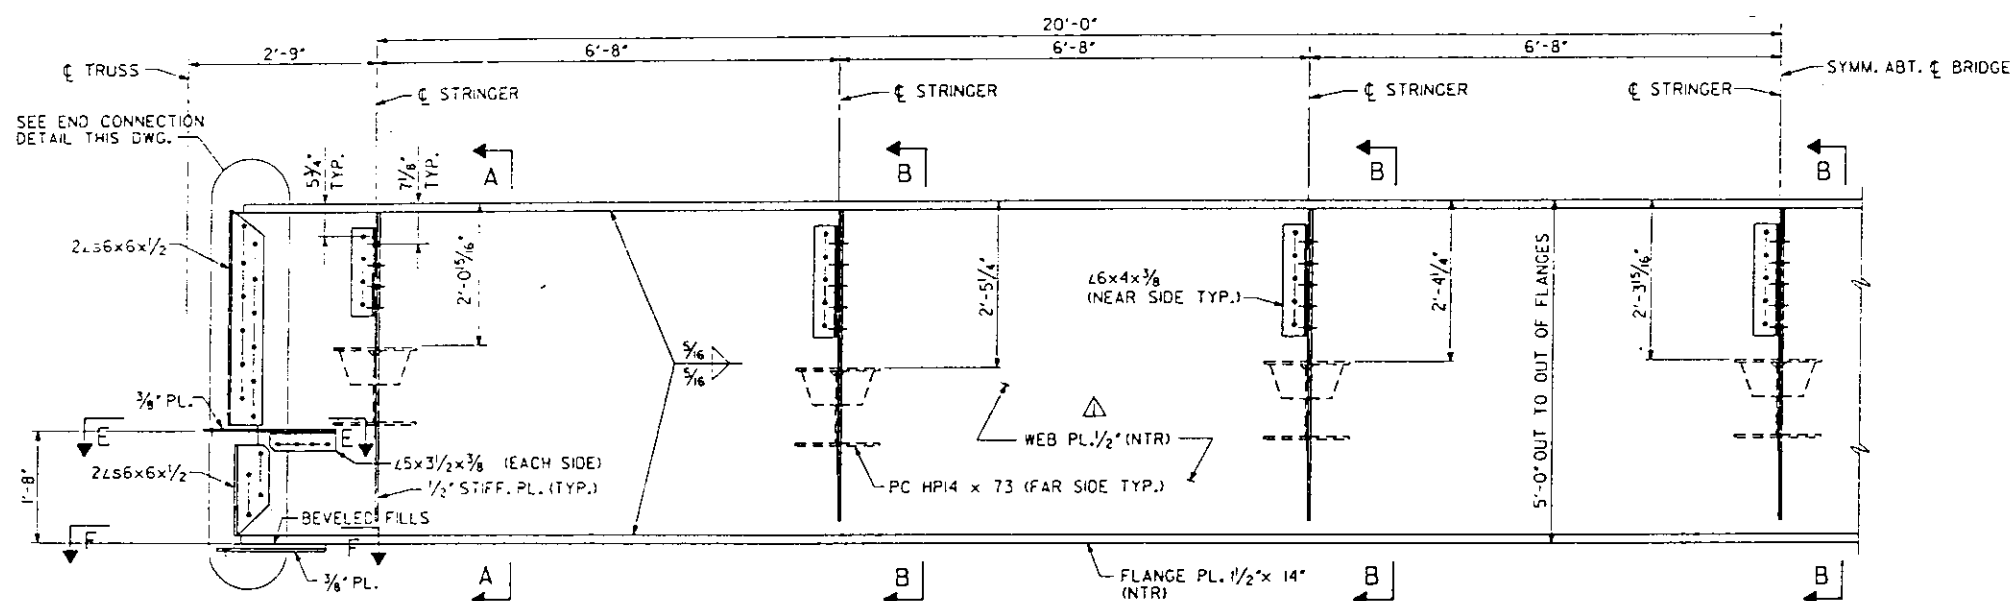


ELEVATION - FLOORBEAM L4


NOTE: "NTR" INDICATES MATERIAL SUBJECT TO NOTCH TOUGHNESS REQUIREMENTS.

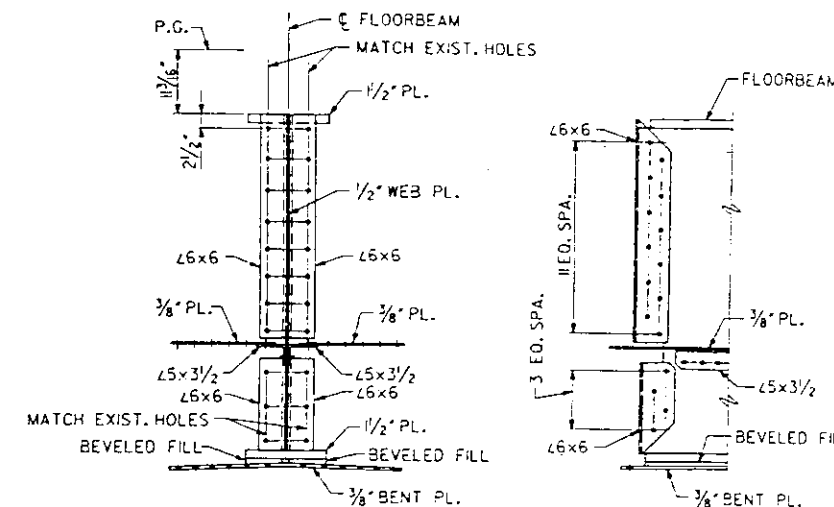


END CONNECTION

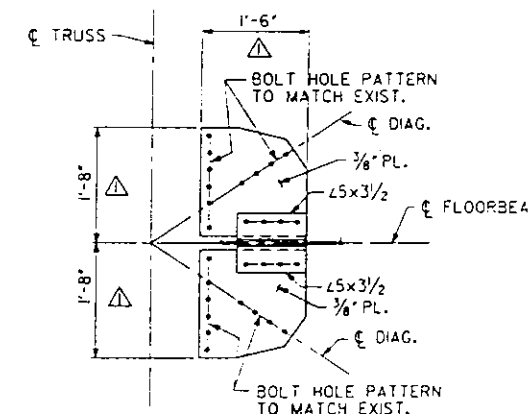


SECTION E-E

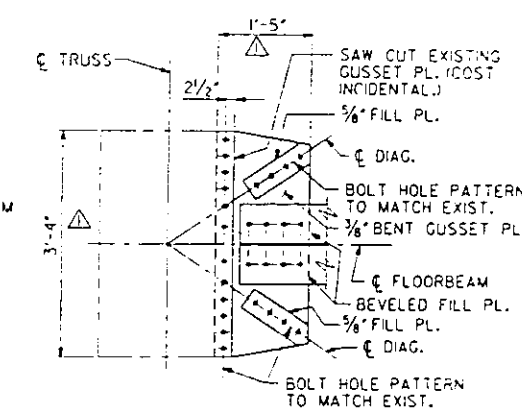


SECTION F-F

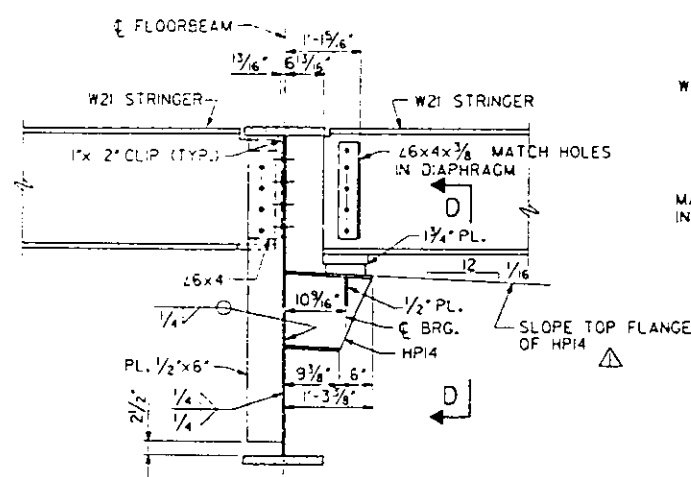

SECTION A-A

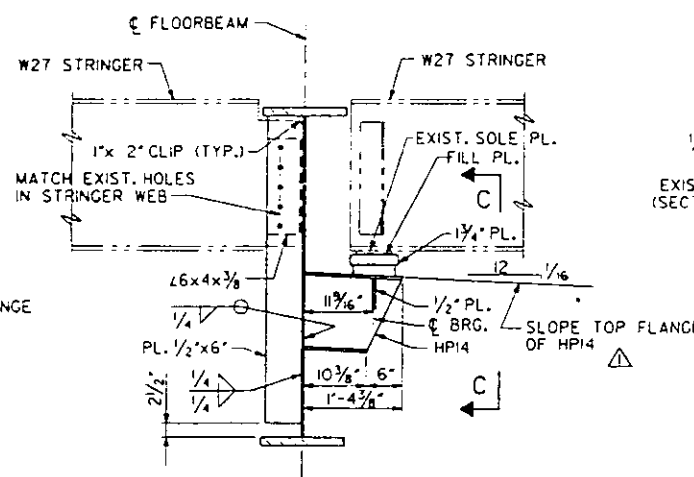

SECTION B-B

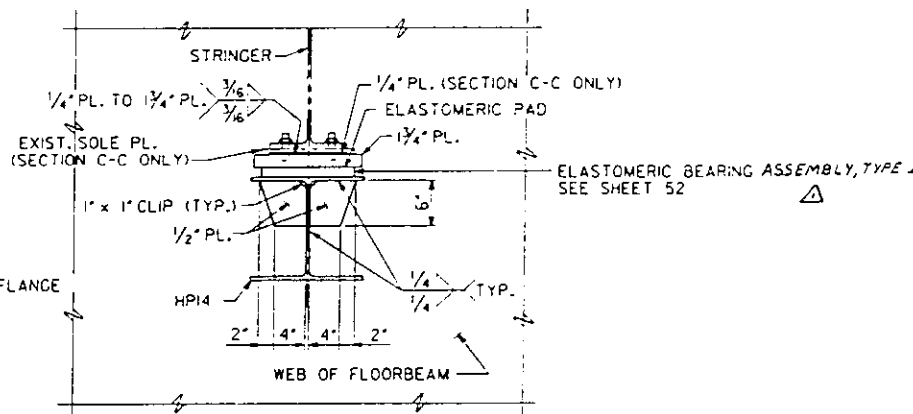

VIEW C-C (SHOWN)
VIEW D-D (SIMILAR)

NOTES

ALL BOLTED CONNECTIONS SHOWN ON THIS SHEET SHALL BE 3/8" H.S. BOLTS UNLESS OTHERWISE NOTED.
ALL MATERIAL SHALL BE AASHTO M-83 UNLESS OTHERWISE NOTED.

ELASTOMERIC BEARING ASSEMBLY, TYPE I
SEE SHEET 52

REHABILITATION FOR
APPROACH BRIDGE OVER
I-55/70 W.B., MISSOURI AVE. AND TRRA
NEW FLOORBEAM AT PANEL POINT L4
SPAN 38

STRUCTURE NO. 082-6003
STA. 65+00 (FAP 799) ST. CLAIR CO.

PREPARED BY:
SVERDRUP CORPORATION
ST. LOUIS, MISSOURI

REV. 12-4-87

SECTION 1BR-1

SHEET NO. 55 OF 75


LEVELS PLOTTED DATE: OCT. 23, 1987
35.56.58 AND 63
158 17Z3109J001 TAIL 73.DGN
3844 17Z3109J001 TAIL 73

R. NIEMIETZ
DESIGNED
K. LARSON
CHECKED
C. DEED
DRAWN
A. MYERS
CHECKED


FOR INFORMATION ONLY

ROUTE NO.	SECTION	COUNTY	TOTAL SHEETS	SHEET NO.
FAP 799		ST. CLAIR	252	204


* IBR-1 APPROACH BRIDGE

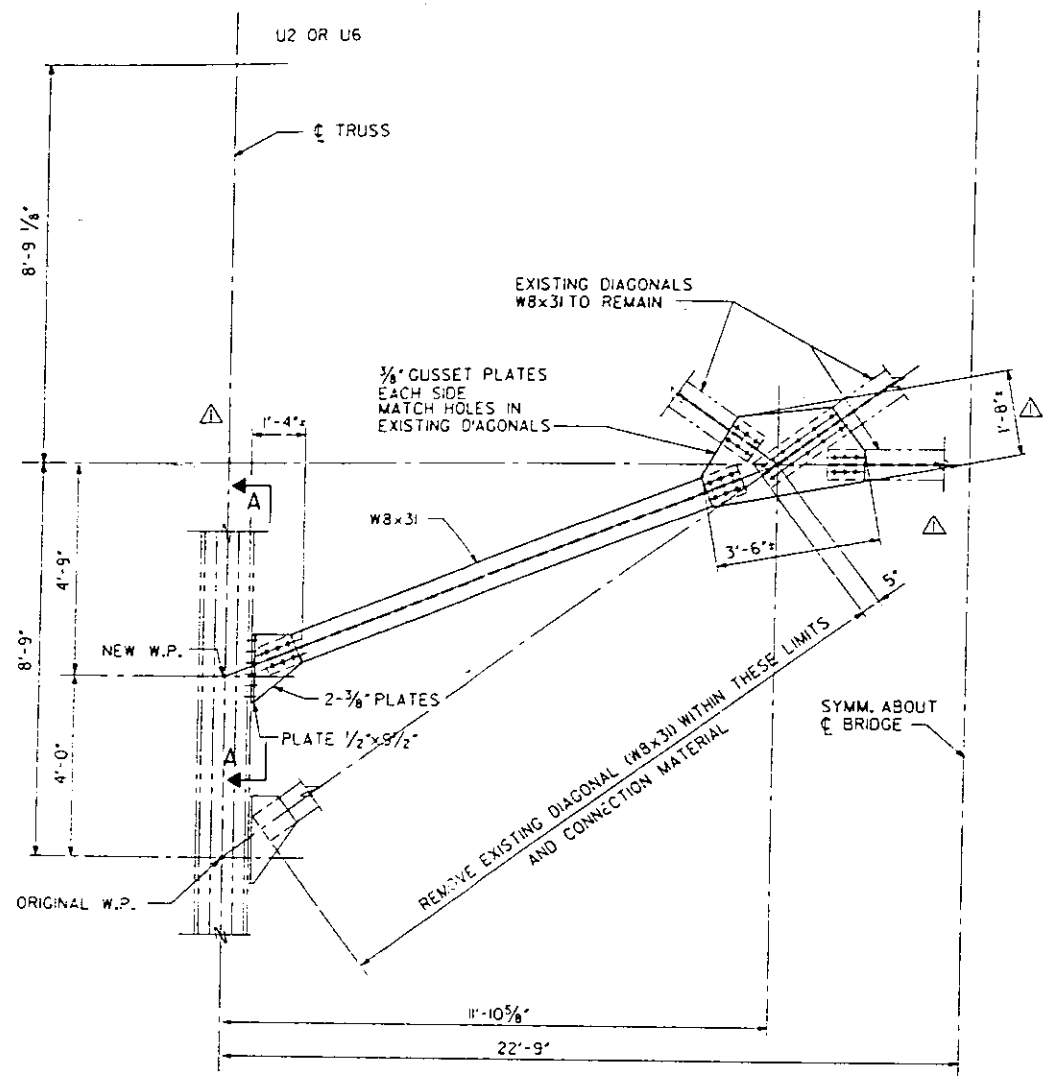

SPAN 38 SWAY FRAMES U2 AND U6

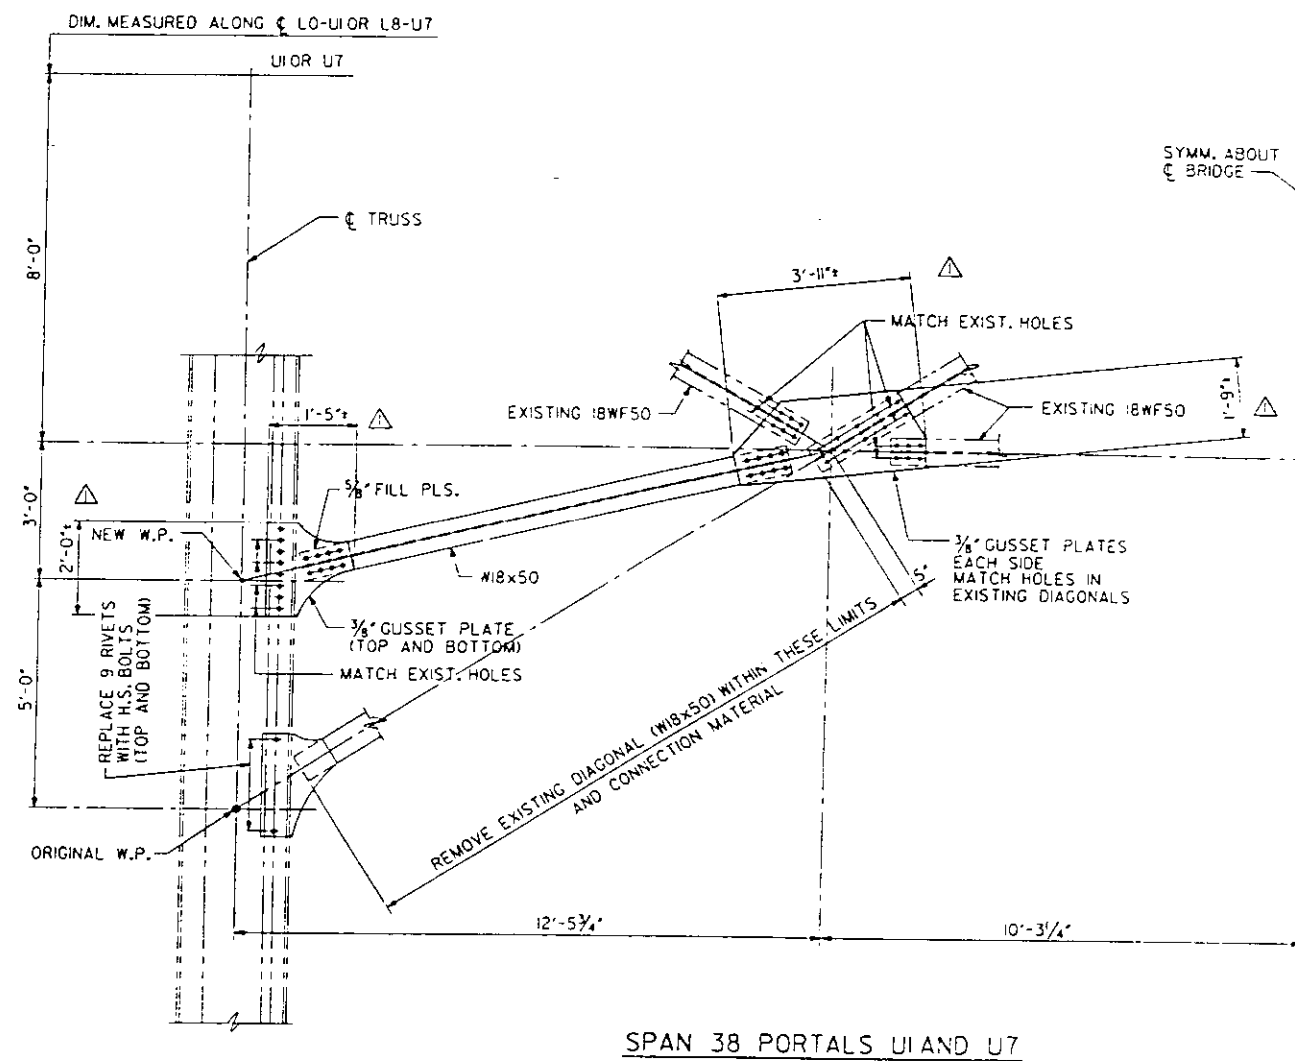

SPAN 38 PORTALS UI AND U7

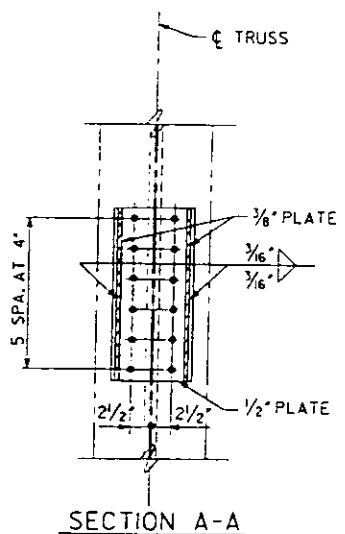

SECTION A-A

NOTES

PROVIDE NEW PLATES, FILLS AND BEAMS TO INCREASE VERTICAL CLEARANCE.
ALL CONNECTIONS TO BE MADE WITH 3/8" DIA. H.S. BOLTS.

REHABILITATION FOR
APPROACH BRIDGE OVER
I-55/70 W.B., MISSOURI AVE. AND TRRA

PORTALS AND SWAY FRAMES - SPAN 38

STRUCTURE NO. 082-6003
STA. 65+00 (FAP 799) ST. CLAIR CO.

DESIGNED	R.D. NIEMIETZ
CHECKED	A.D. NG
DRAWN	M.J. JALINSKY
CHECKED	J. KORPI

PREPARED BY
SYERORUP CORPORATION
ST. LOUIS, MISSOURI

REV. 12-4-87






SECTION IBR-1

SHEET NO. 56 OF 75

FOR INFORMATION ONLY



FILE: ZF31051DETAIL94.DGN
 DATE: OCT. 23, 1987
 LEVELS PLOTTED
 35 56 58 63
 PR1 DETAIL 94

ROUTE NO.	SECTION	COUNTY	TOTAL SHEETS
FAP 799		ST. CLAIR	252
PROJECT		*IBR-1 APPROACH BRIDGE	

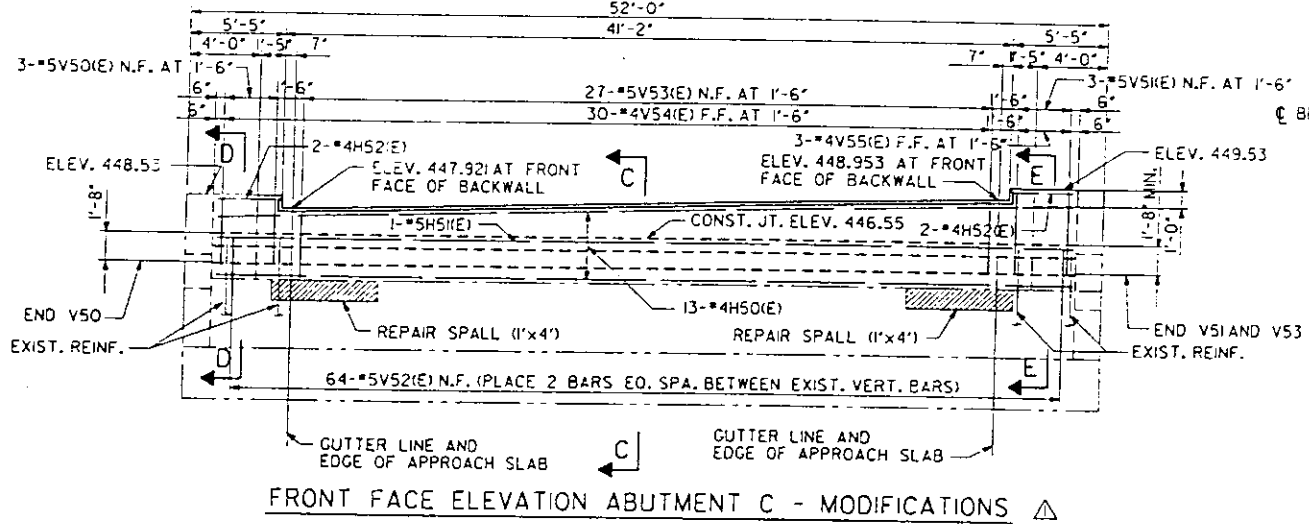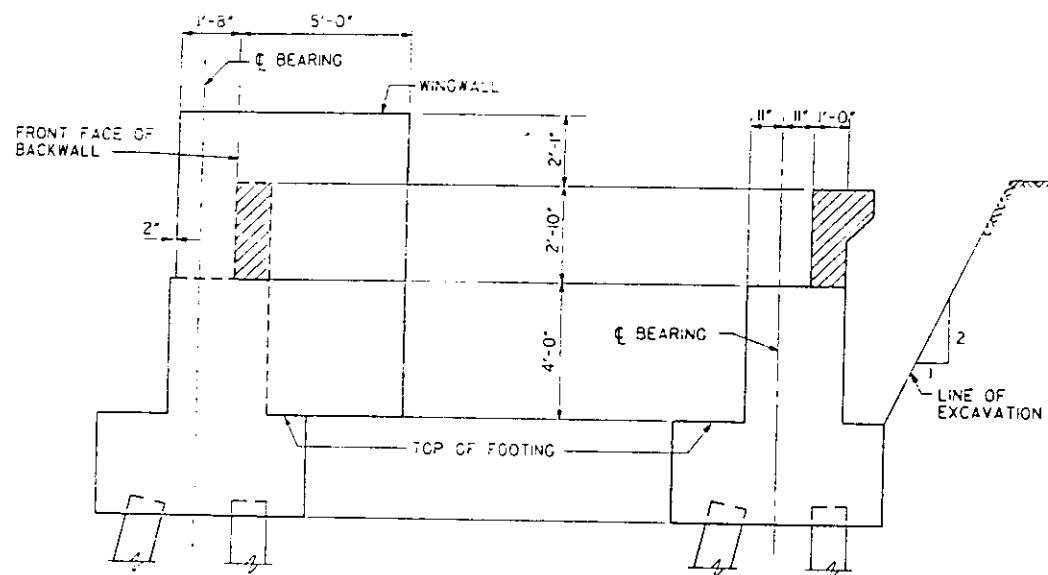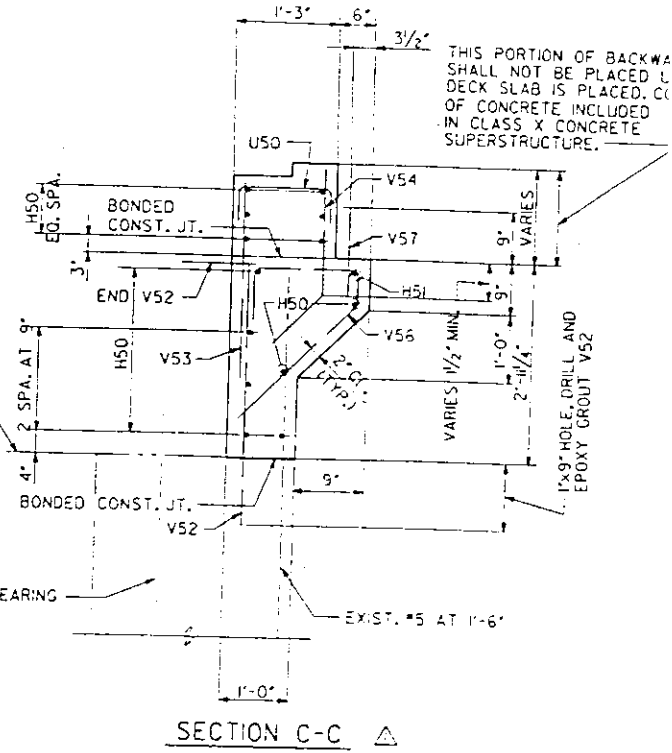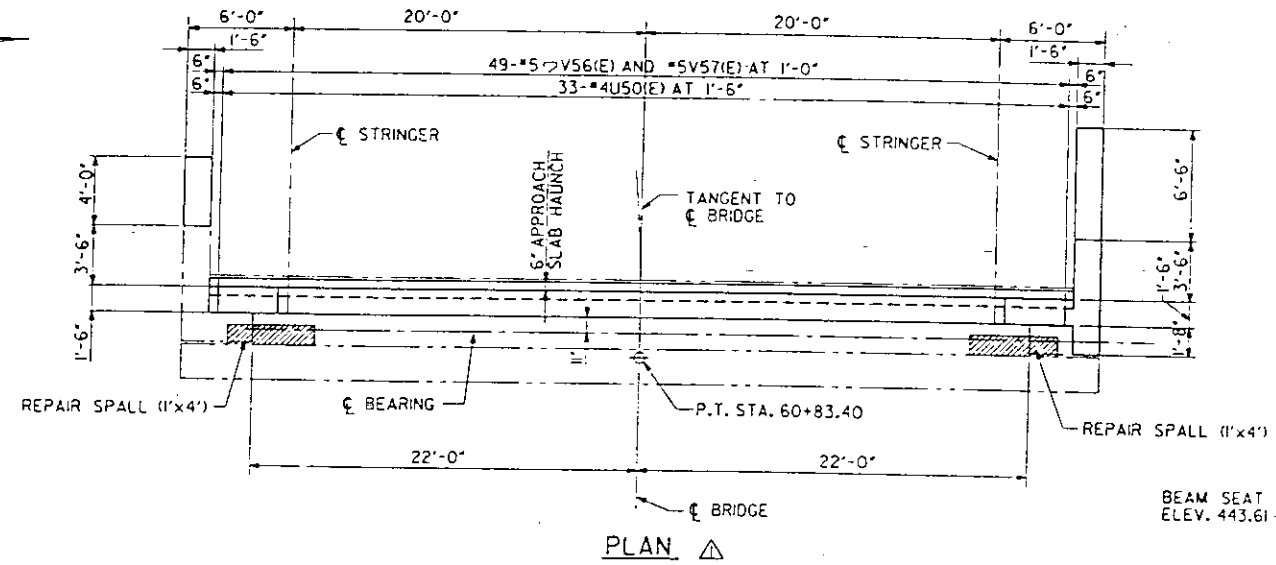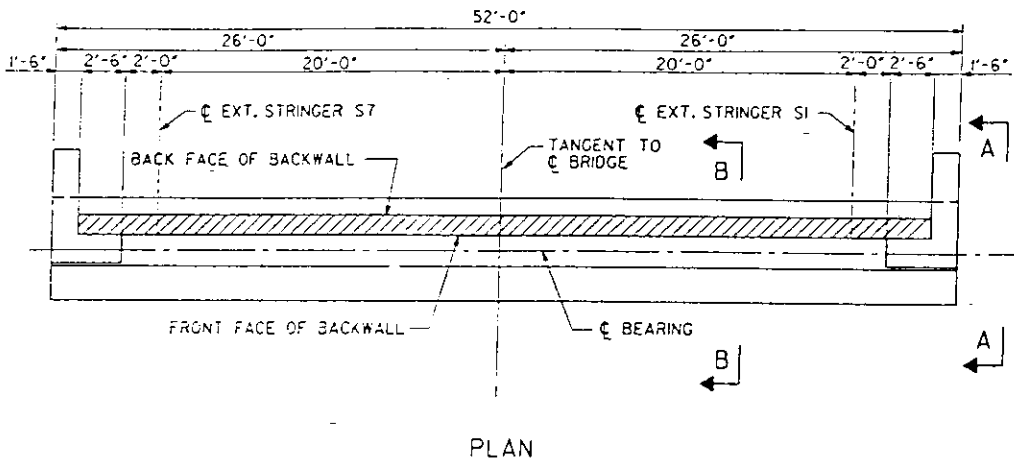

NOTES Δ

WORK THIS SHEET WITH SHEET 58.
IF AN EXISTING VERTICAL REINF. BAR IS DETERMINED UNUSABLE BY THE ENGINEER, THE CONTRACTOR SHALL REPLACE IT (#5) BY DRILLING A 1" DIA. HOLE 9" DEEP AND EPOXY GROUT IN THE REPLACEMENT BAR.
N.F. INDICATES NEAR FACE.
F.F. INDICATES FAR FACE.
E.F. INDICATES EACH FACE.
INTERFACE OF EXISTING CONCRETE TO NEW CONCRETE SHALL BE A BONDED CONSTRUCTION JOINT IN ACCORDANCE WITH ARTICLE 504.13(a)(2) OF THE STANDARD SPECIFICATIONS.
REPAIR OF SPALLED AREAS SHALL BE PAID FOR AS REPAIR CONCRETE STRUCTURES (16 SQ. FT.)

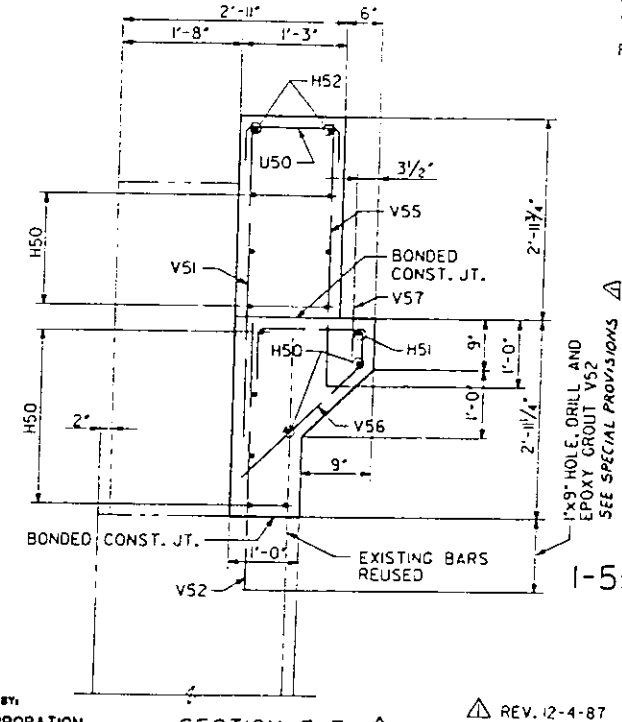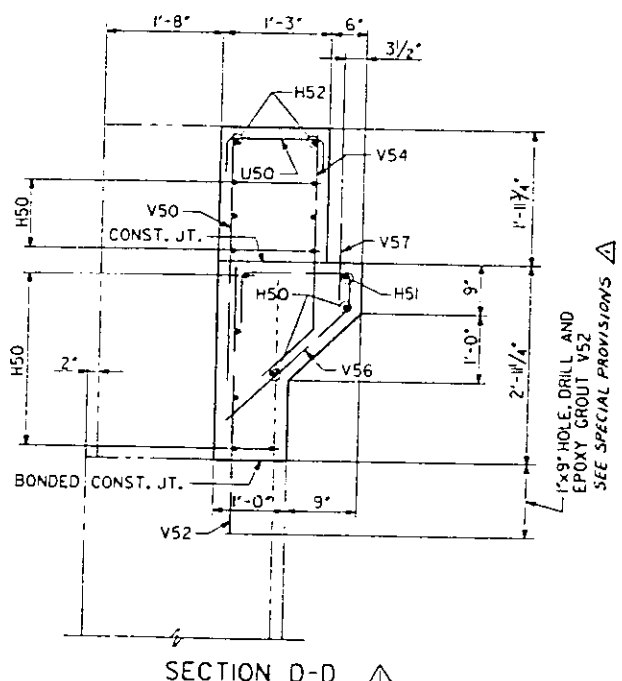

ABUTMENT C - DEMOLITION


NOTE: HATCHED AREA SHOWN THUS INDICATES LIMIT OF CONCRETE TO BE REMOVED.
EXCAVATION BEHIND ABUTMENT SHALL BE FROM INSIDE FACE TO INSIDE FACE OF WINGWALL AND IT SHALL BE ACCOMPLISHED BEFORE REMOVAL OF THE CONCRETE SLAB IN SPAN 33.
BACKFILL SHALL NOT BE PLACED BEHIND ABUTMENT UNTIL THE NEW DECK AND PARAPET IS IN PLACE.
EXISTING REINFORCING PROTRUDING INTO THE CONCRETE REMOVAL AREA SHALL REMAIN AND SHALL BE THOROUGHLY CLEANED.

M. SCHURK	DESIGNED
S.W. YORDY	CHECKED
D. SPINK	DRAWN
J. KORPI	CHECKED

PREPARED BY:
SVERDRUP CORPORATION
ST. LOUIS, MISSOURI

REV. 12-4-87

STRUCTURE NO. G82-6003
STA. 65+00 (FAP 799) ST. CLAIR CO.

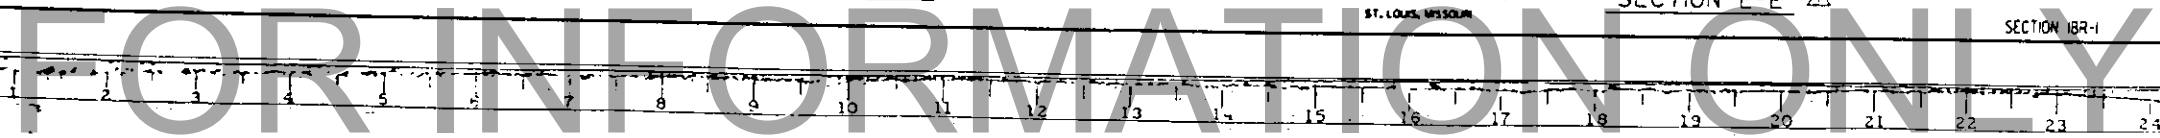

ROUTE NO.	SECTION	COUNTY	TOWNSHIP	SHEET NO.	TOTAL SHEETS
FAP 799	*	ST. CLAIR	252	2	
		LENGTH			

*1BR-1 APPROACH BRIDGE

BILL OF MATERIAL Δ

ABUTMENT				
BAR	NO.	SIZE	LENGTH	SHAPE
V50(E)	3	#5	3'-7"	
V51(E)	3	#5	4'-7"	
V52(E)	64	#5	3'-6"	
V53(E)	27	#5	3'-10"	
V54(E)	20	#4	3'-5"	
V55(E)	3	#4	3'-10"	
V56(E)	49	#5	4'-8"	
V57(E)	49	#5	1'-4"	
V58	8	#4	8'-3"	
V59	10	#4	10'-0"	
U50(E)	33	#4	2'-3"	
H50(E)	13	#4	48'-8"	
H51(E)	1	#5	48'-8"	
H52(E)	4	#4	3'-7"	
H53	2	#4	2'-10"	
H54	2	#4	5'-3"	
H55	8	#4	4'-7"	
H56	2	#4	5'-4"	
H57	2	#4	3'-4"	
H58	2	#4	8'-0"	
H59	2	#4	12'-10"	
H60	2	#4	13'-6"	
H61	6	#4	7'-1"	
REPAIR CONCRETE STRUCTURES			50. FT.	16.0
CLASS X CONCRETE			CU. YDS.	16.0
REINFORCEMENT BARS			LBS.	231
REINFORCEMENT BARS EPOXY COATED			LBS.	1,283
EXP. BOLTS 3/4" X 1'-0"			EACH	10
STRUCTURE EXCAVATION			CU. YDS.	65
CONCRETE REMOVAL			CU. YDS.	7.4

REINFORCEMENT BARS DESIGNATED (E) SHALL BE EPOXY COATED.

NOTES Δ


ALL DIMENSIONS ARE IN FEET AND INCHES.

REHABILITATION FOR
APPROACH BRIDGE OVER
I-55/70 W.B., MISSOURI AVE. AND TRRA

ABUTMENT C

STRUCTURE NO. C82-6003
STA. 65+00 (FAP 799) ST. CLAIR CO.


SECTION 1BR-1 SHEET NO. 58 OF 75

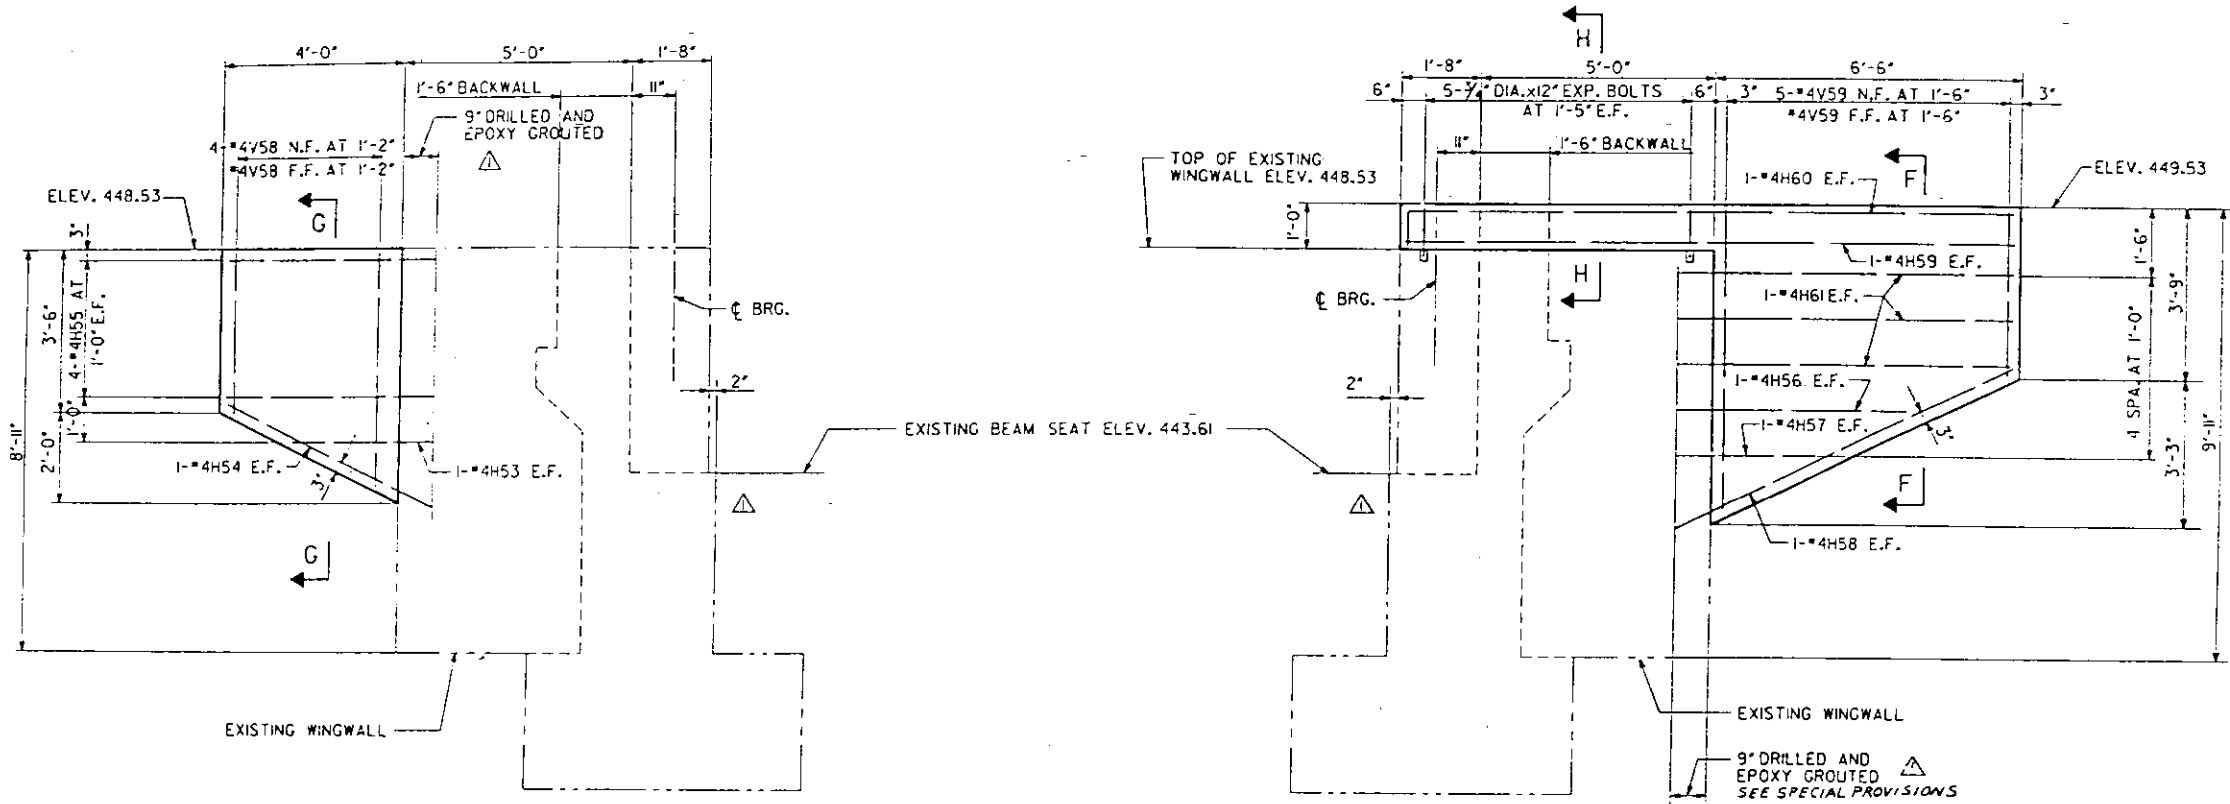

ELEVATION - SOUTH WINGWALL



ELEVATION - NORTH WINGWALL

NOTE: V58 AND V59 BARS ARE TO BE CUT AS INDICATED IN FIELD CUTTING DIAGRAM.

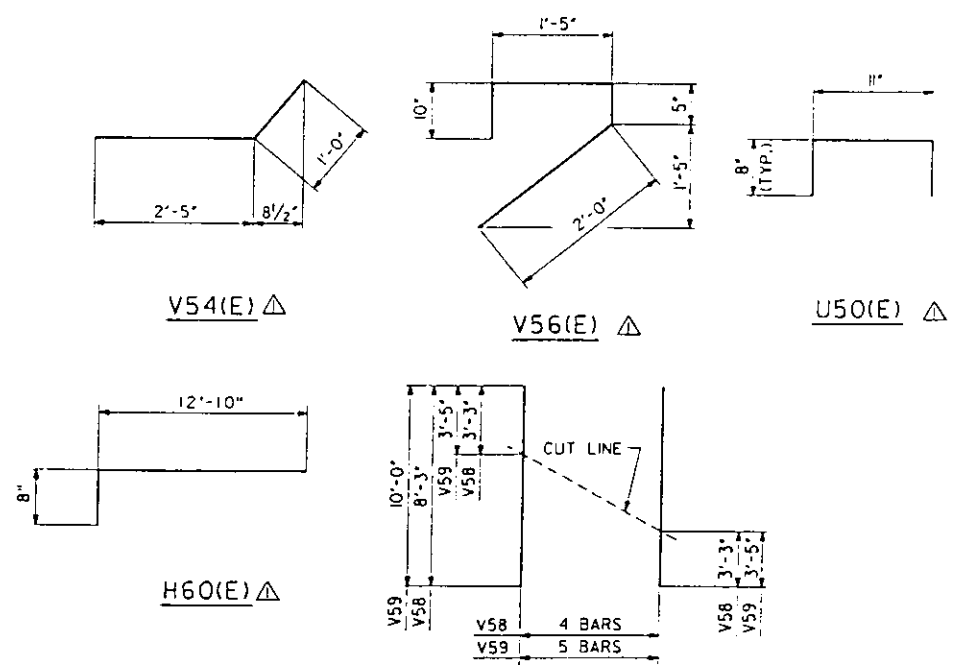

FIELD CUTTING DIAGRAM
V58(E) AND V59(E) Δ

ORDER V58 AND V59 BARS FULL LENGTH.
CUT TO FIT AS SHOWN AND USE REMAINING BARS AS INDICATED IN PLAN.

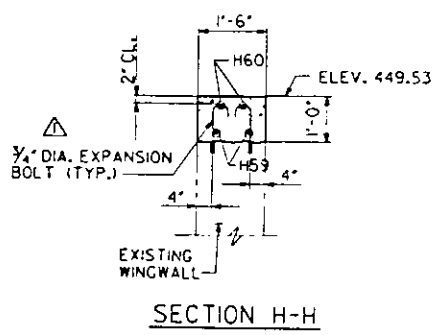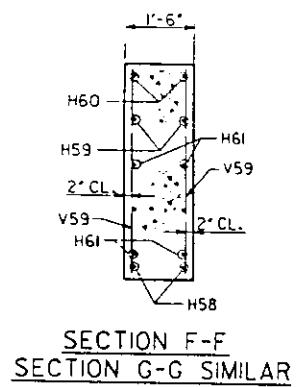

SECTION H-H

DESIGNED	M. SCHURK
CHECKED	S. YORDY
DRAWN	D. SPINK
	I. KORPI







PREPARED BY
SYVERDRUP CORPORATION
ST. LOUIS, MISSOURI

REV. 12-4-87

FOR INFORMATION ONLY

4-DEC-1987 18:10

DATE: OCT. 23, 1987
LEVELS PLOTTED 35 56 57 63
FILE: ZF3(51)DETAIL 35.DGN
PRF: DETAIL 35
875013

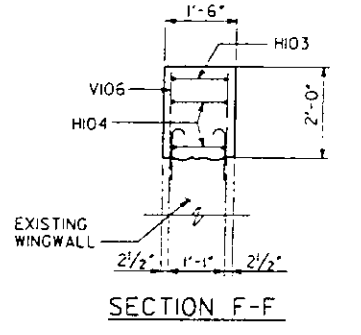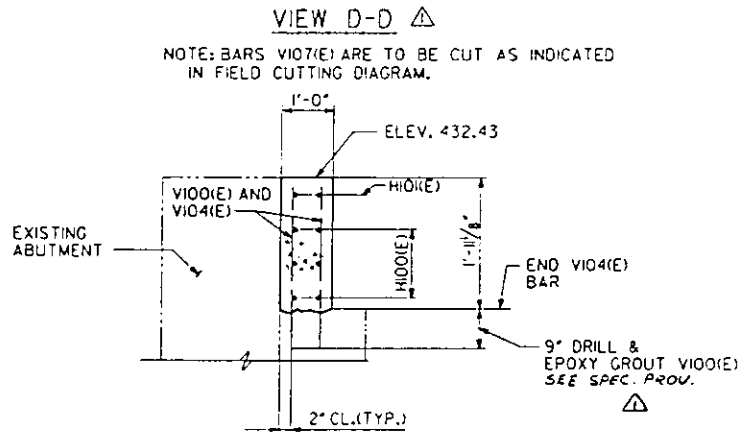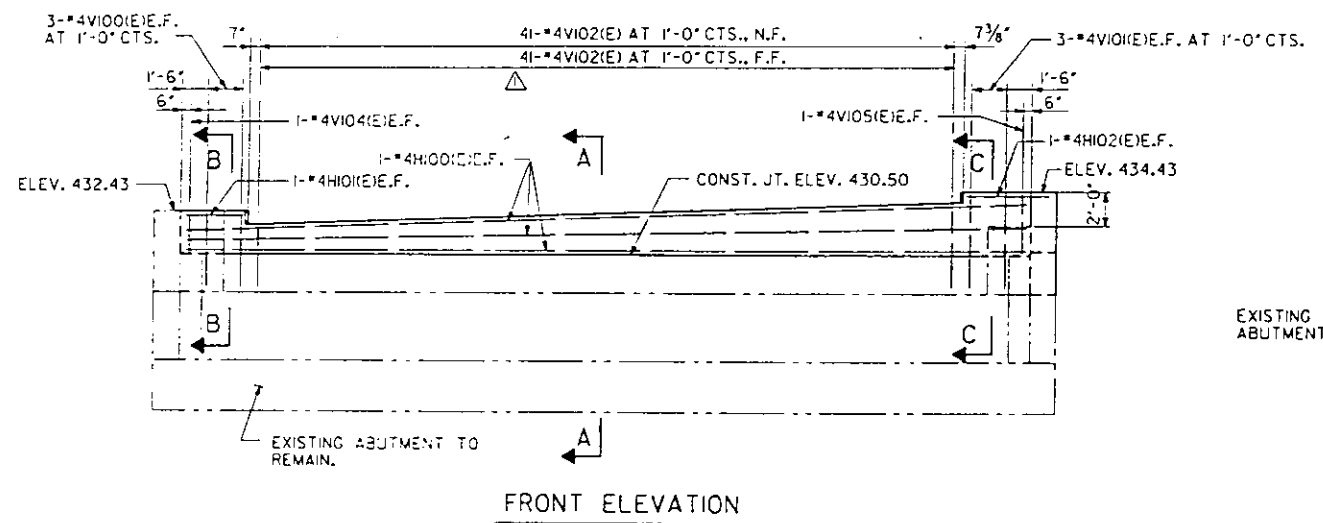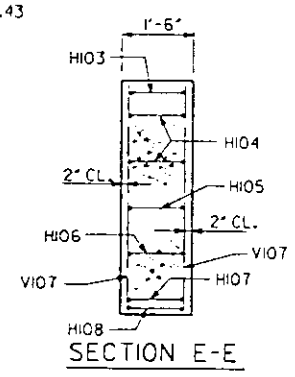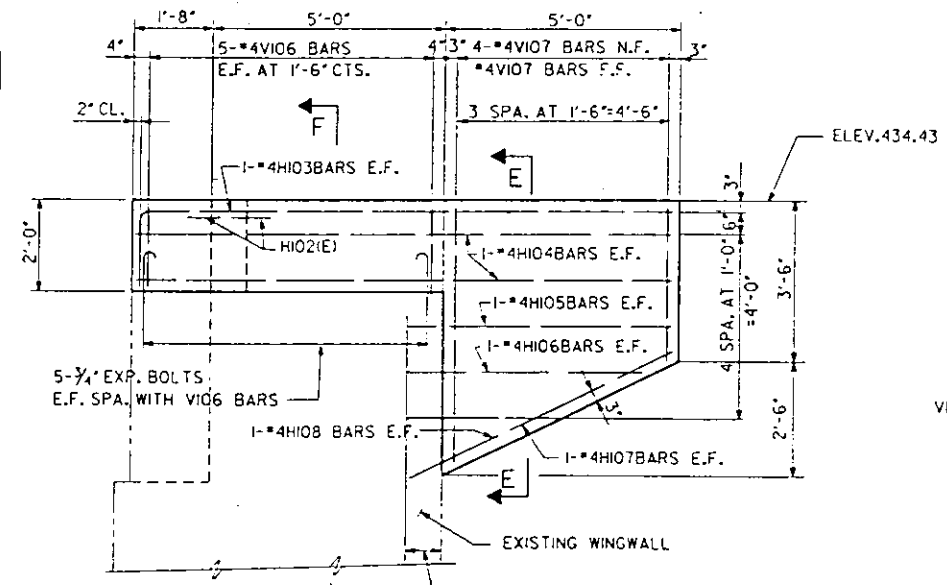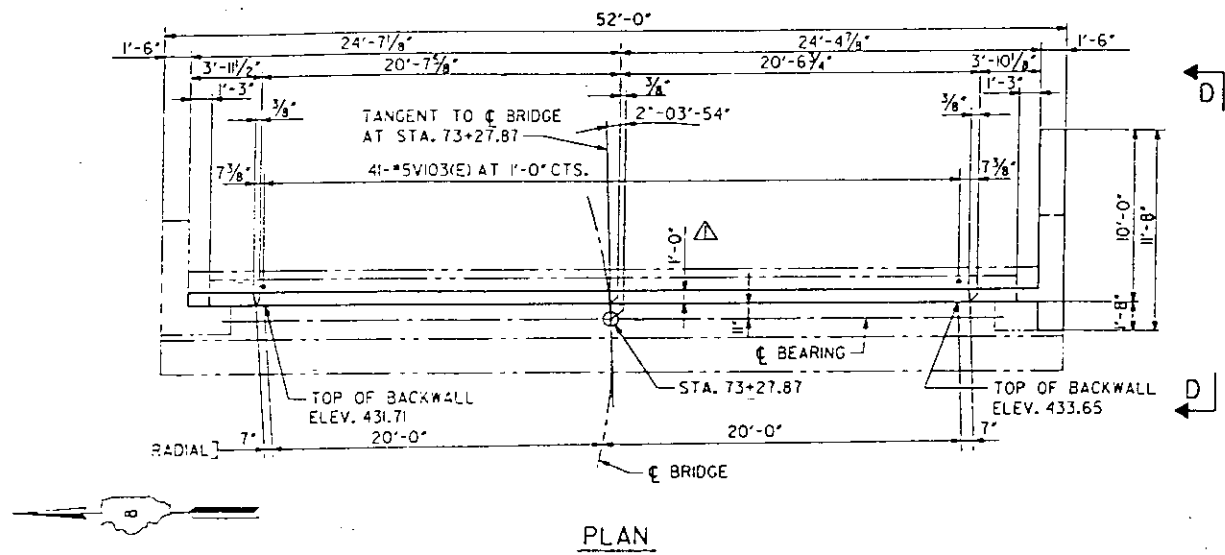





NOTE: BLOCKOUT FOR EXPANSION DEVICE IS NOT SHOWN. BARS VIO2(E) ARE TO BE CUT AS INDICATED IN FIELD CUTTING DIAGRAM.

BILL OF MATERIAL				
BAR NO.	SIZE	LENGTH	SHAPE	
HIO0(E)	#4	48'-8"		
HIO1(E)	#4	3'-7"		
HIO2(E)	#4	5'-8"		
HIO3	#4	13'-0"		
HIO4	#4	11'-4"		
HIO5	#4	5'-5"		
HIO6	#4	4'-10"		
HIO7	#4	2'-10"		
HIO8	#4	6'-2"		
VIO0(E)	#3	2'-6"		
VIO1(E)	#3	4'-6"		
VIO2(E)	#2	6'-6"		
VIO3(E)	#4	1'-6"		
VIO4(E)	#4	1'-9"		
VIO5(E)	#2	3'-9"		
VIO6	#4	1'-8"		
VIO7	#4	8'-10"		
CLASS X CONCRETE			CU. YDS.	5.2
REINFORCEMENT BARS			LBS.	130
EPOXY COATED			LBS.	649
EXP. BOLTS 3/4" x 1'-0"			EACH	10
STRUCTURE EXCAVATION			CU. YDS.	35

REINFORCEMENT BARS DESIGNATED (E) SHALL BE EPOXY COATED.

NOTES

INTERFACE OF EXISTING CONCRETE TO NEW CONCRETE SHALL BE BONDED CONST. JT. IN ACCORDANCE WITH STANDARD SPECIFICATION ARTICLE 504.13(1)(d). E.F. INDICATES EACH FACE. F.F. INDICATES FAR FACE. N.F. INDICATES NEAR FACE. EXCAVATION BEHIND ABUTMENT SHALL BE FROM INSIDE FACE TO INSIDE FACE OF WINGWALLS AND IT SHALL BE ACCOMPLISHED BEFORE REMOVAL OF THE CONCRETE DECK IN ADJACENT SPAN. BACKFILL BEHIND ABUTMENT SHALL NOT BE PLACED UNTIL THE NEW DECK AND PARAPETS ARE IN PLAC.

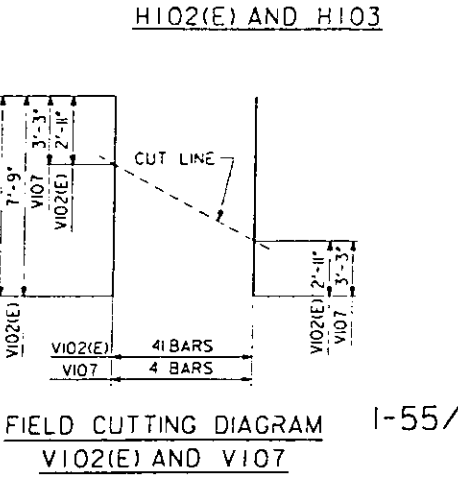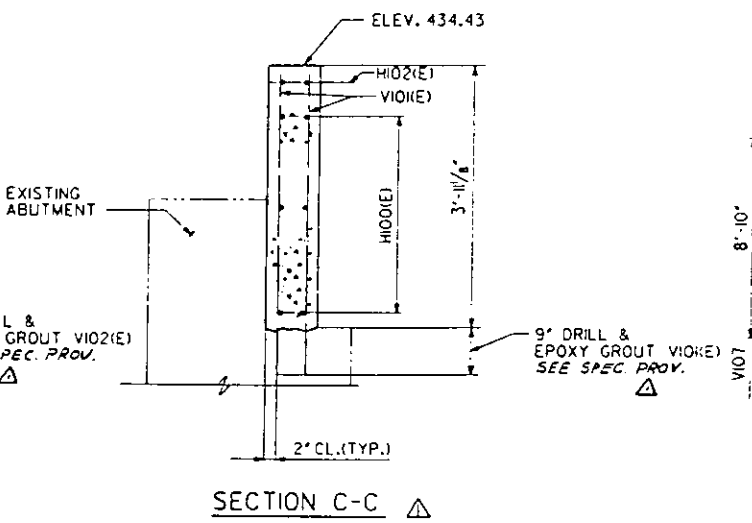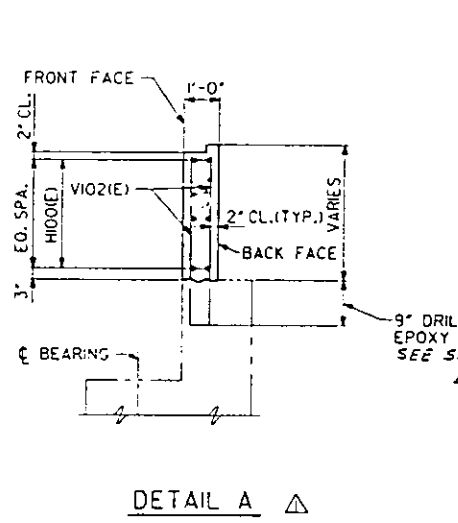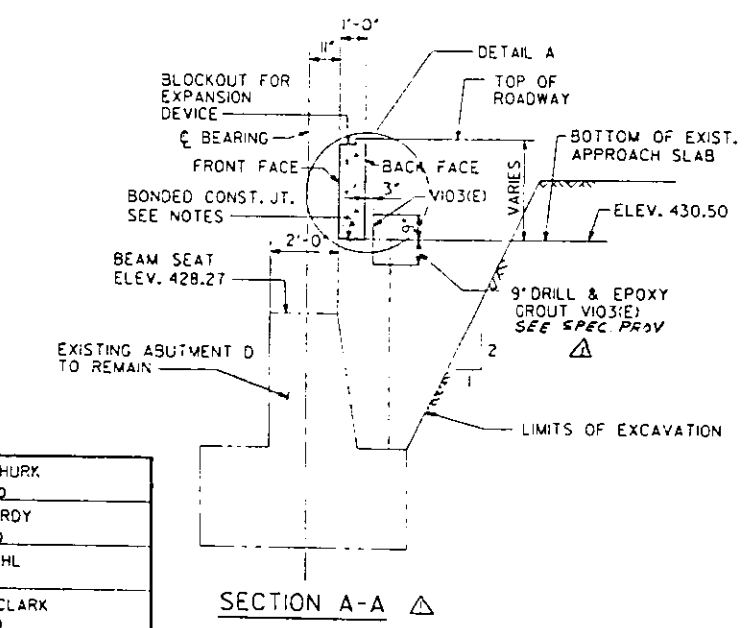

ORDER VIO2 AND VIO7 BARS FULL LENGTH. CUT TO FIT AS SHOWN AND USE REMAINING BARS AS INDICATED IN PLAN.

REHABILITATION FOR
APPROACH BRIDGE OVER
I-55/70 W.B., MISSOURI AVE. AND TRRA
ABUTMENT D


STRUCTURE NO. 082-6003
STA. 65+00 (FAP 799) ST. CLAIR CO.

M. SCHURK	DESIGNED
S. YORDY	CHECKED
D. RIEHL	CHECKED
P.W. CLARK	CHECKED

PREPARED BY:
SYVERORUP CORPORATION
ST. LOUIS, MISSOURI


REV. 12-4-87 SECTION IBR-1

DATE: OCT. 23, 1987
LEVELS PLOTTED 35 56 57 58 63
FILE: ZP310510.DETAIL 46.DGN
PREF: DETAIL 46

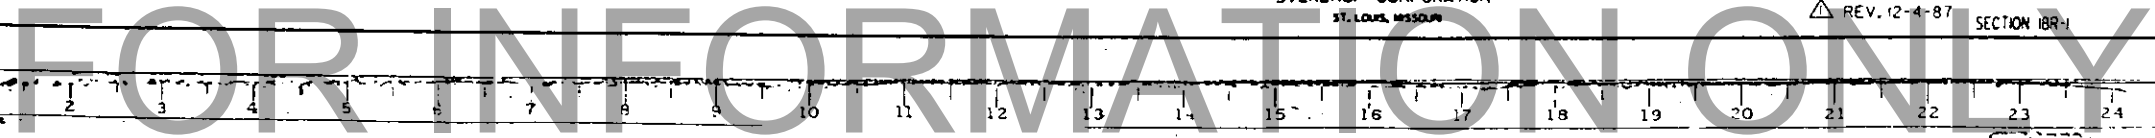


ROUTE NO.	SECTION	COUNTY	TOTAL SHEETS	SHEET NO.
FAP 799	*	ST. CLAIR	252	20
LIMITS		PROJECT		


*1BR-1 APPROACH BRIDGE

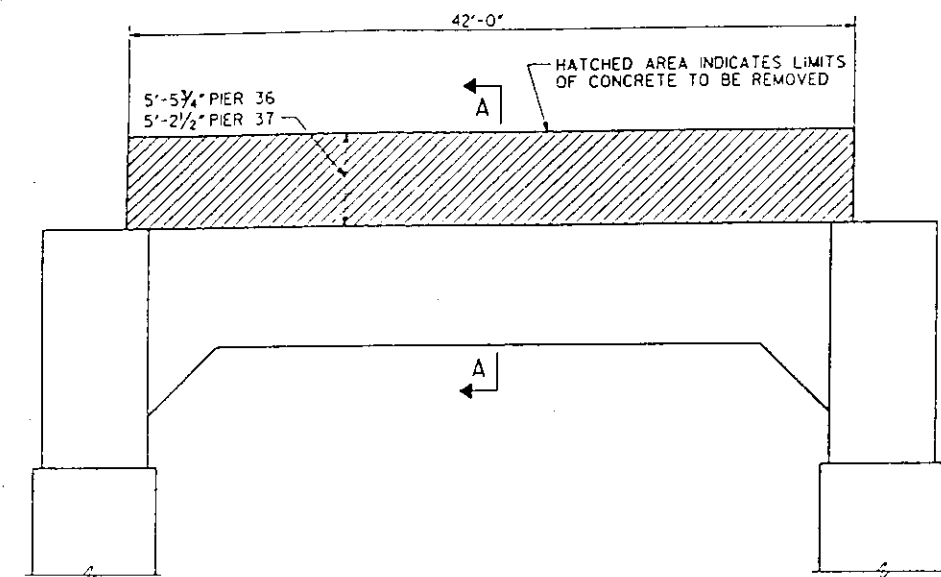


ELEVATION - DEMOLITION

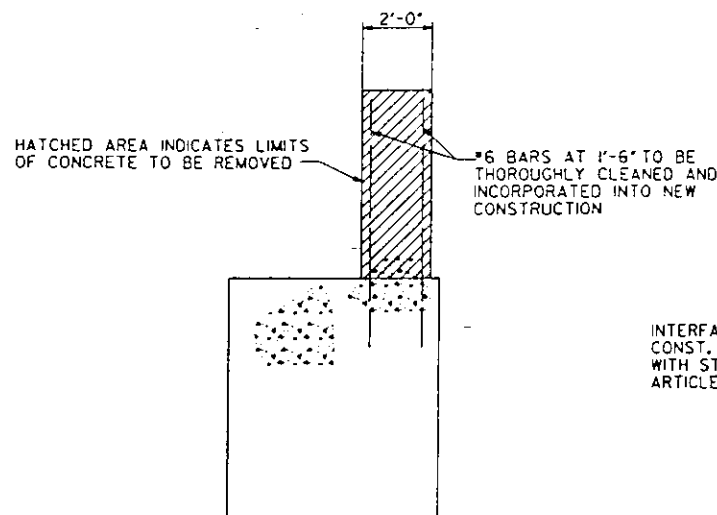


SECTION A-A

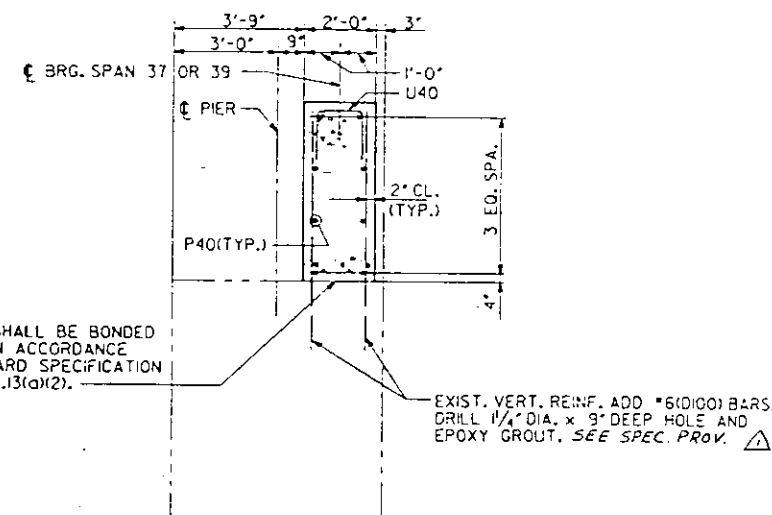


SECTION B-B Δ

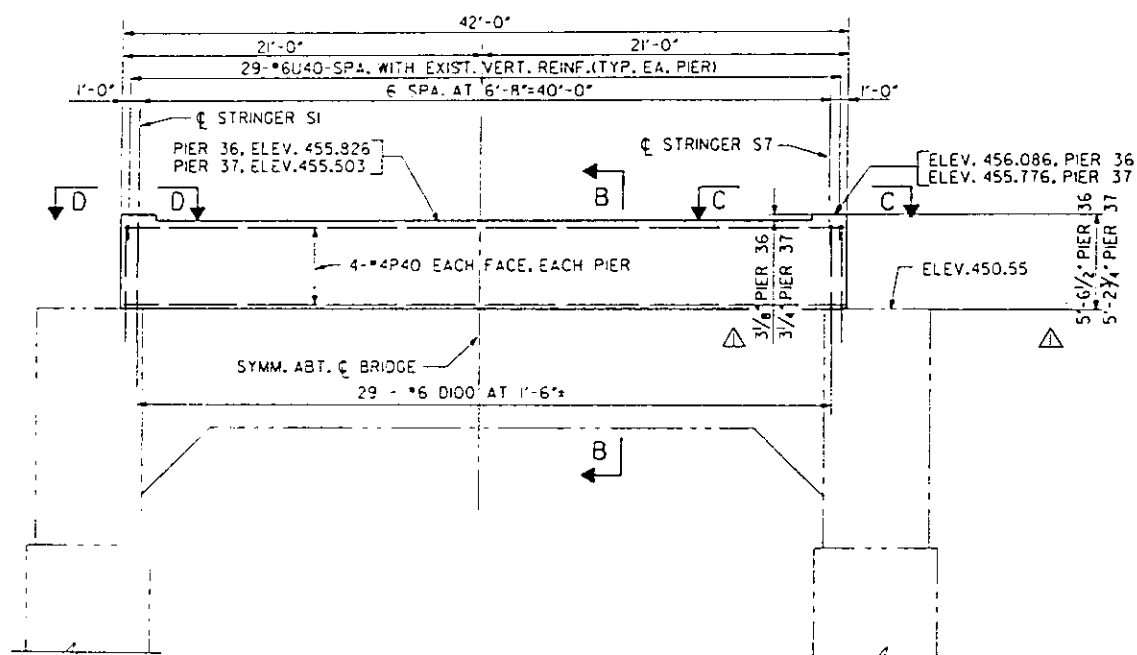

ELEVATION - MODIFICATION

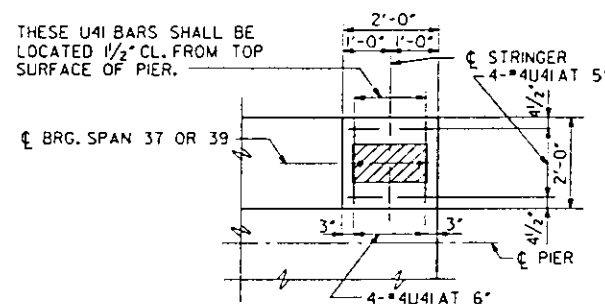

VIEW C-C (SHOWN)
VIEW D-D (OPPOSITE HAND)

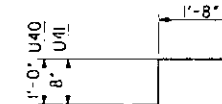

BAR U40 & U41

BILL OF MATERIAL Δ				
BAR	NO.	SIZE	LENGTH	SHAPE
U40	58	6	3'-8"	□
U41	32	4	3'-0"	□
P40	16	4	4'-8"	□
D100	116	6	5'-7"	□
CONCRETE REMOVAL			CU. YDS.	33.
CLASS X CONCRETE			CU. YDS.	32.
REINFORCEMENT BARS			LBS.	500

NOTES

SPACE REINFORCEMENT #4 CAP TO MISS DRILLED IN ANCHOR BOLTS.

REHABILITATION FOR
APPROACH BRIDGE OVER
I-55/70 W.B., MISSOURI AVE. AND TRRA

PIERS 36 AND 37

STRUCTURE NO. 082-6003
STA. 65+00 (FAP 799) ST. CLAIR CO.

PREPARED BY:
SYVERDRUP CORPORATION
ST. LOUIS, MISSOURI

REV. 12-4-87

SECTION 1BR-1

SHEET NO. 60 OF 75

FOR INFORMATION ONLY




4-DEC-1987 17:57

LEVELS PLOTTED DATE: OCT. 23, 1987
35.56, 57.58 & 63


FILE: ZF31(5)1(D)DETAIL 97.DGN
87SR81 PRF:DETAIL 97

DESIGNED	A.D. NG
CHECKED	X. LARSON
DRAWN	J.G. CORLEY
CHECKED	R.F. BECK


*IBR-I APPROACH BRIDGE

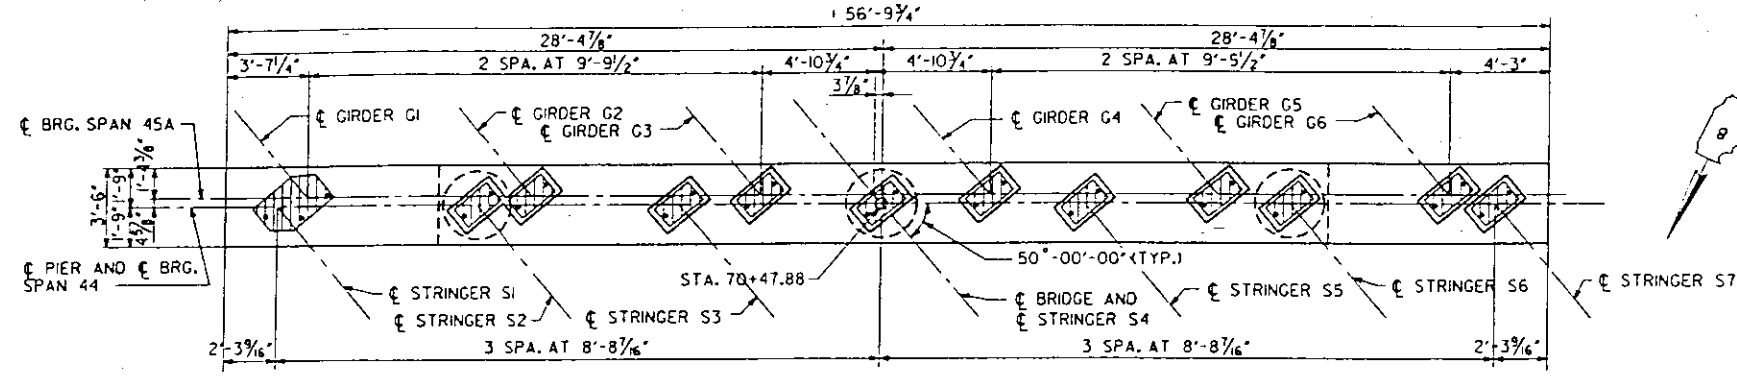


PLAN

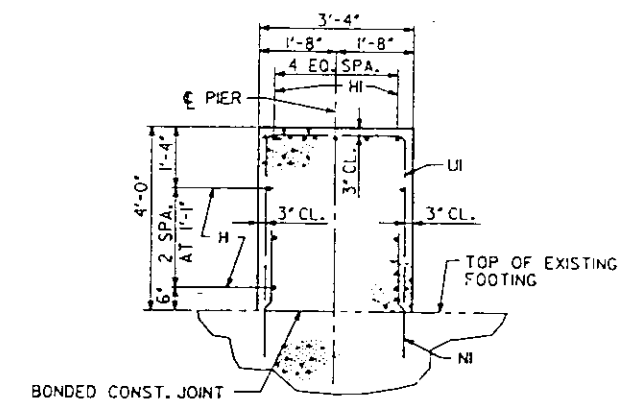


SECTION A-A

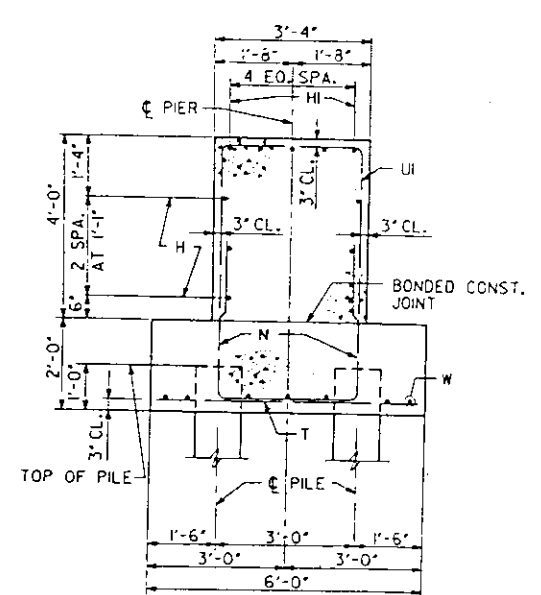


SECTION B-B

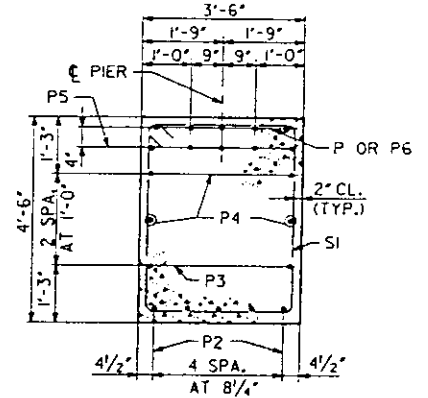

SECTION THRU CAP
NOTE: PEDESTALS NOT SHOWN.

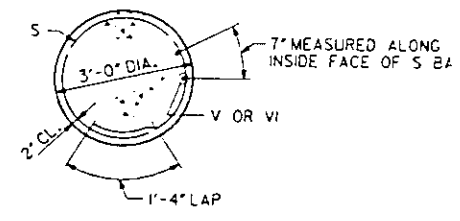


SECTION THRU COLUMN

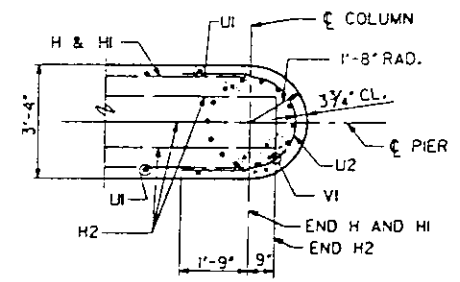


SECTION C-C

NOTES

- WORK THIS SHEET WITH SHEETS 62.
- BONDED CONSTRUCTION JOINTS SHALL BE IN ACCORDANCE WITH STD. SPEC. ART. 504.13(A)(2).
- SPACE REINFORCEMENT IN CAP TO MISS DRILLED IN ANCHOR BOLTS.
- DRILLED HOLES INTO EXISTING CONCRETE FOR REINFORCING BARS SHALL BE 1/2\"/>
- E.F. INDICATES EACH FACE.
- EXISTING CONCRETE SHALL BE THOROUGHLY CLEANED BEFORE PLACING NEW CONCRETE.

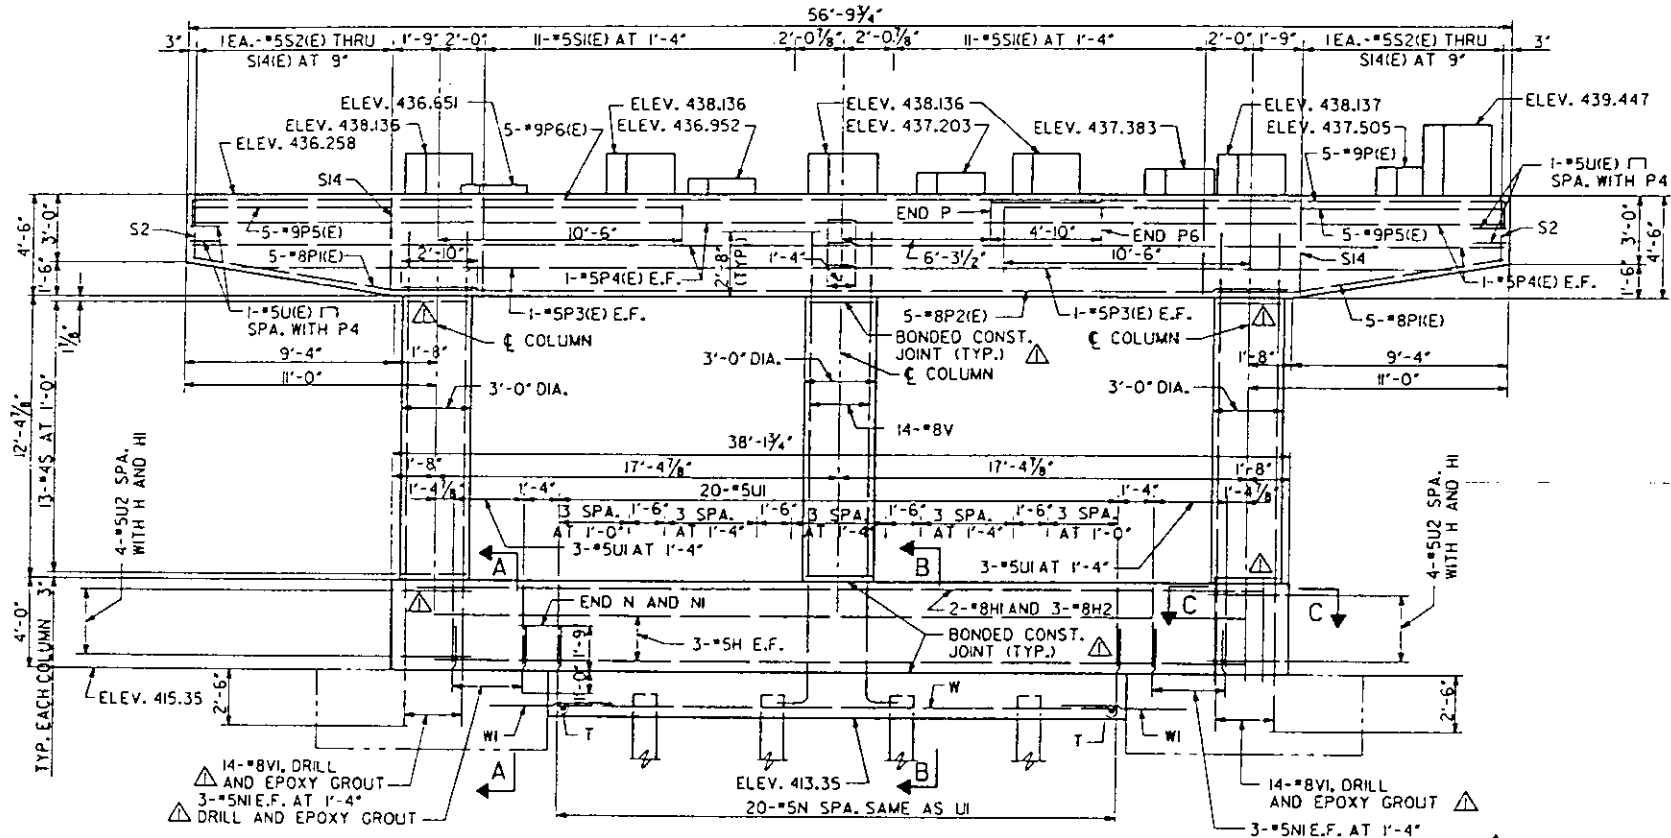

ELEVATION

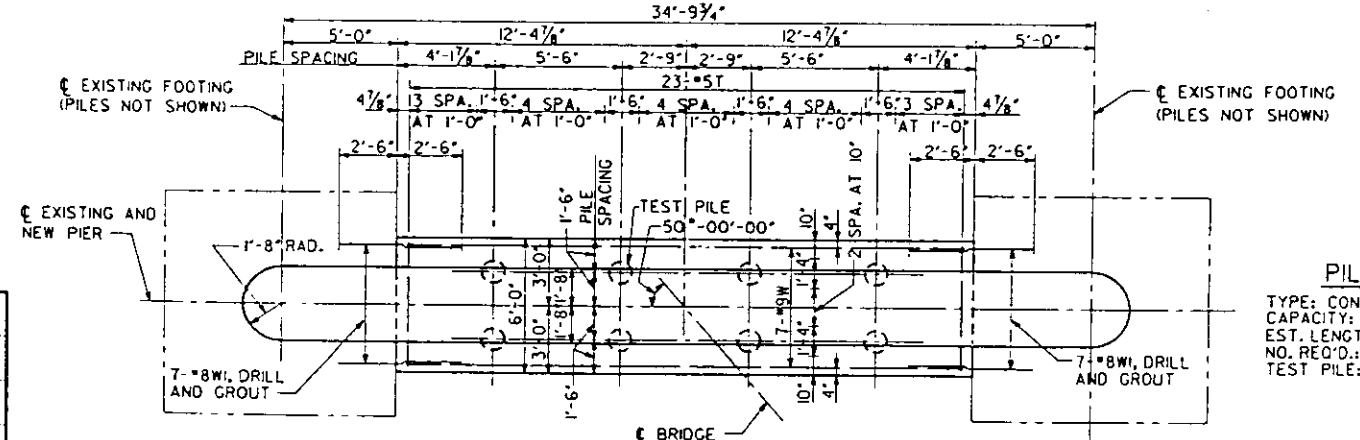

FOOTING PLAN

PILE DATA
TYPE: CONCRETE
CAPACITY: 30 TON
EST. LENGTH: 35 FT.
NO. REQ'D: 7 (NOT INCLUDING TEST PILE)
TEST PILE: ONE REQUIRED

DESIGNED	K. LARSON
CHECKED	R. NIEMIETZ
DRAWN	J.G. CORLEY
CHECKED	R.F. BECK

FILE: ZF3H(S)DETAIL B.DGN
DATE: OCT. 23, 1987
LEVELS PLOTTED
35,56,57,58 & 63

PREPARED BY:
SYVERDRUP CORPORATION
ST. LOUIS, MISSOURI

REV. 12-4-87

SECTION IBR-I

SHEET NO. 61 OF 75


FOR INFORMATION ONLY

REHABILITATION FOR
APPROACH BRIDGE OVER
I-55/70 W.B., MISSOURI AVE. AND TRRA


PIER 43A

STRUCTURE NO. 082-6003
STA. 65+00 (FAP 799) ST. CLAIR CO.


X = 6 1/8" GIRDERS G2 - G6
7 1/16" STRINGERS S2 - S7
Y = 5 1/16" GIRDERS G2 - G6
6 1/16" STRINGERS S2 - S7

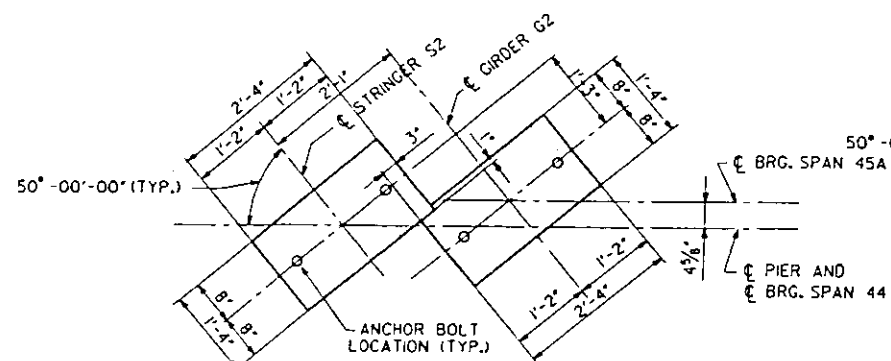


PEDESTAL PLAN
GIRDER G2 AND STRINGER S2

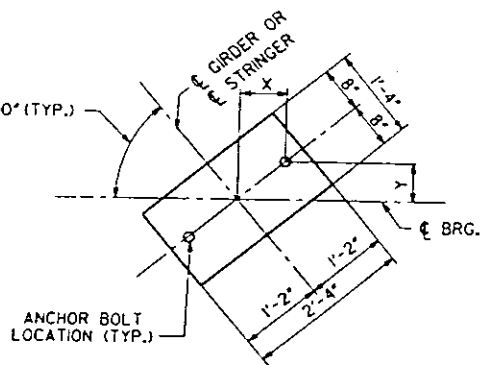

PEDESTAL PLAN
GIRDERS G3 THRU G6 AND
STRINGERS S3 THRU S7

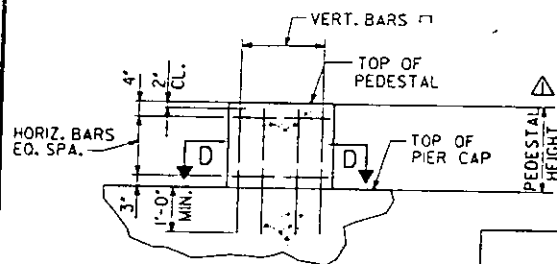





ELEVATION

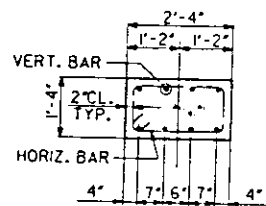


SECTION D-D

PEDESTAL REINFORCEMENT

GIRDER OR STRINGER	VERT. BARS	HORIZ. BARS	PEDESTAL HT.
G2	4-#4U3(E)		4 3/4"
G3	4-#4U4(E)	1-#4S15(E)	8 3/8"
G4	4-#4U5(E)	2-#4S15(E)	11 3/4"
G5	4-#4U6(E)	2-#4S15(E)	1'-1 1/2"
G6	4-#4U7(E)	2-#4S15(E)	1'-3"
S2	4-#4U8(E)	3-#4S15(E)	1'-10 1/2"
S3	4-#4U8(E)	3-#4S15(E)	1'-10 1/2"
S4	4-#4U8(E)	3-#4S15(E)	1'-10 1/2"
S5	4-#4U8(E)	3-#4S15(E)	1'-10 1/2"
S6	4-#4U8(E)	3-#4S15(E)	1'-10 1/2"
S7	4-#4U9(E)	4-#4S15(E)	3'-2 1/4"

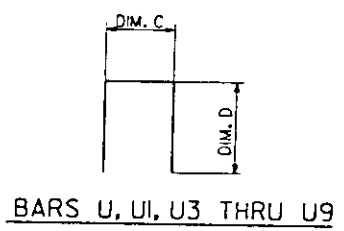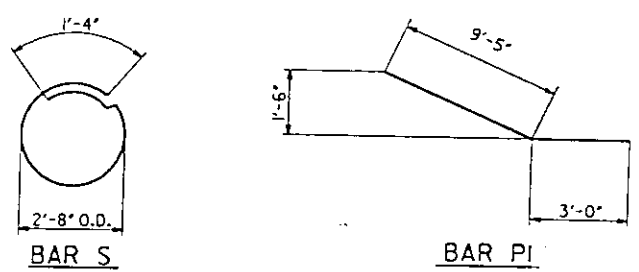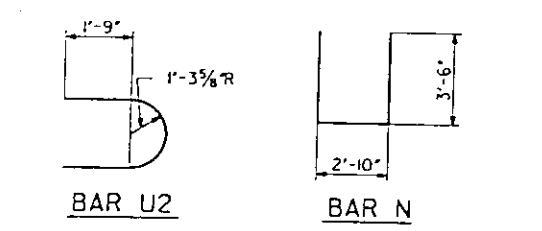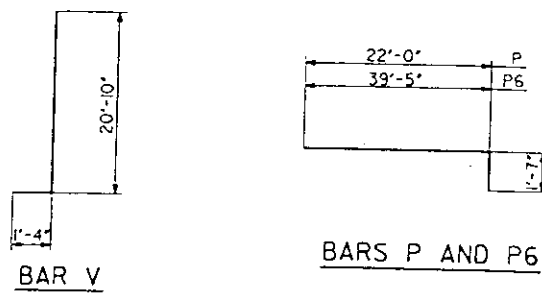

BAR	DIM. C	DIM. D
U	3'-0 1/2"	10"
UI	2'-10"	3'-8"
U3	11"	1'-3"
U4	11"	1'-7"
U5	11"	1'-10"
U6	11"	2'-0"
U7	11"	2'-1"
U8	11"	2'-9"
U9	11"	4'-1"

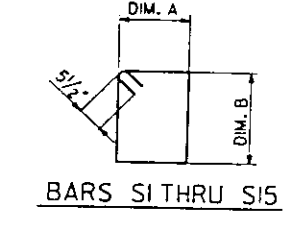

BAR	DIM. A	DIM. B
SI	3'-2"	4'-2"
S2	3'-2"	2'-8 1/2"
S3	3'-2"	2'-10"
S4	3'-2"	2'-11 1/2"
S5	3'-2"	3'-1"
S6	3'-2"	3'-2 1/4"
S7	3'-2"	3'-3 3/4"
S8	3'-2"	3'-5"
S9	3'-2"	3'-6 1/2"
S10	3'-2"	3'-8"
S11	3'-2"	3'-9 1/2"
S12	3'-2"	3'-11"
S13	3'-2"	4'-0 1/2"
S14	3'-2"	4'-2"
S15	1'-0"	2'-0"

BILL OF MATERIAL									
BAR	NO.	SIZE	LENGTH	SHAPE	BAR	NO.	SIZE	LENGTH	
H	6	#5	34'-9"		S13(E)	2	#5	15'-4"	
HI	2	#8	34'-9"		S14(E)	2	#5	15'-7"	
H2	3	#8	36'-3"		S15(E)	26	#4	6'-9"	
N	20	#5	9'-10"		T	23	#5	5'-8"	
NI	12	#5	2'-9"		U(E)	4	#5	4'-9"	
P(E)	5	#9	23'-7"		UI	26	#5	10'-2"	
PI(E)	10	#8	12'-5"		U2	8	#5	7'-9"	
P2(E)	5	#8	37'-8"		U3(E)	4	#4	3'-5"	
P3(E)	4	#5	26'-6"		U4(E)	4	#4	4'-1"	
P4(E)	8	#5	28'-11"		U5(E)	4	#4	4'-7"	
P5(E)	10	#9	21'-4"		U6(E)	4	#4	4'-11"	
P6(E)	5	#9	42'-0"		U7(E)	4	#4	5'-1"	
S	39	#4	9'-9"		U8(E)	20	#4	6'-5"	
S1(E)	22	#5	15'-7"		U9(E)	4	#4	9'-1"	
S2(E)	2	#5	12'-8"		V	14	#8	22'-2"	
S3(E)	2	#5	12'-11"		VI	28	#8	21'-7"	
S4(E)	2	#5	13'-2"						
S5(E)	2	#5	13'-5"		W	7	#9	24'-6"	
S6(E)	2	#5	13'-8"		WI	14	#8	5'-0"	
S7(E)	2	#5	13'-11"						
S8(E)	2	#5	14'-1"						
S9(E)	2	#5	14'-4"		CLASS X CONCRETE			CU. YDS.	
S10(E)	2	#5	14'-7"		REINFORCEMENT BARS			LBS.	
S11(E)	2	#5	14'-10"		REINFORCEMENT BARS EPOXY COATED			LBS.	
S12(E)	2	#5	15'-1"		FURNISHING CONCRETE PILES			LIN. FT.	
					DRIVING CONCRETE PILES			LIN. FT.	
					TEST PILE - CONCRETE			EACH	
					STRUCTURE EXCAVATION			CU. YDS.	

NOTES
WORK THIS SHEET WITH SHEET 61.

REHABILITATION FOR
APPROACH BRIDGE OVER
I-55/70 W.B., MISSOURI AVE. AND TRI

PIER 43A

STRUCTURE NO. 082-6003
STA. 65+00 (FAP 79S) ST. CLAIR CO.

PREPARED BY
SVERDRUP CORPORATION
ST. LOUIS, MISSOURI

REV. 12-4-87 SECTION 1BR-1

SHEET NO. 62 OF 75








FOR INFORMATION ONLY

5-DEC-1987
LEVELS PLOTTED DATE: OCT. 23, 1987
FILE: ZP3(KIS)IDEDETAIL.BIA.DGN
35.56.57.58 & 63
PRF:DETAIL.BIA

K. LARSON
DESIGNED
R. NIEMIETZ
CHECKED
J.G. CORLEY
DRAWN
R.F. BECK
CHECKED

ROUTE NO.	SECTION	COUNTY	TOTAL SHEETS	SHEET NO.
FAP 799		ST. CLAIR	252	211
PROJECT				

*1BR-1 APPROACH BRIDGE

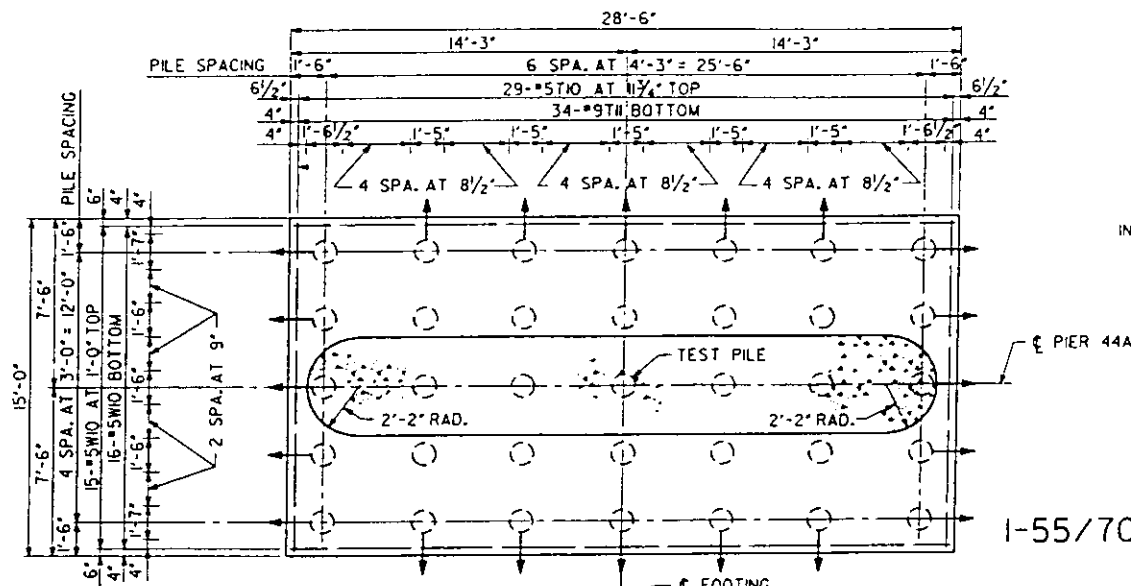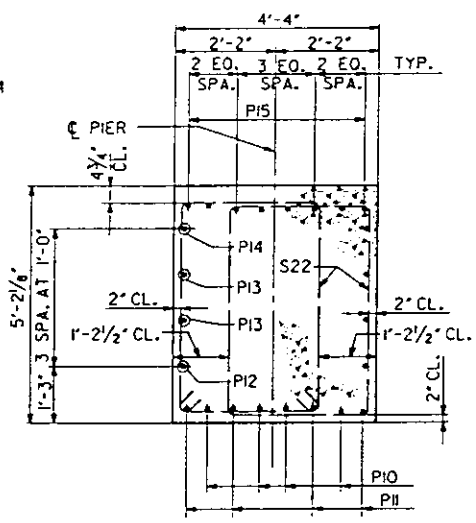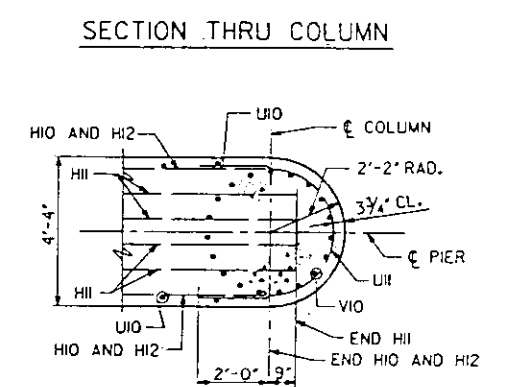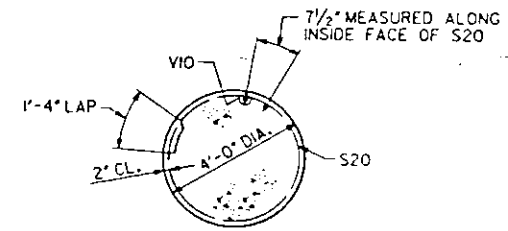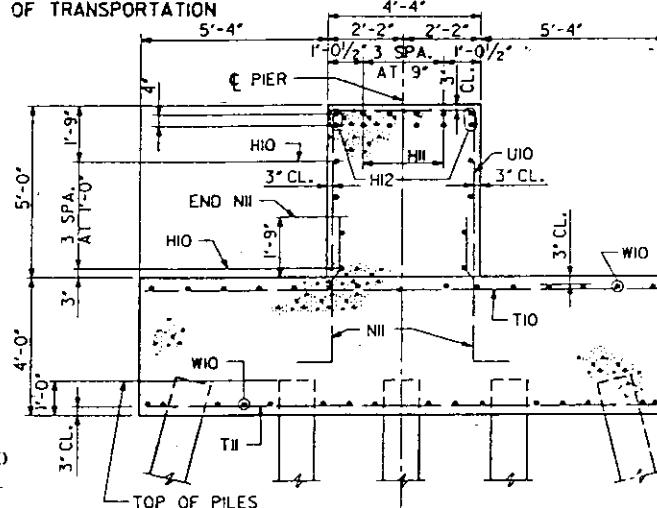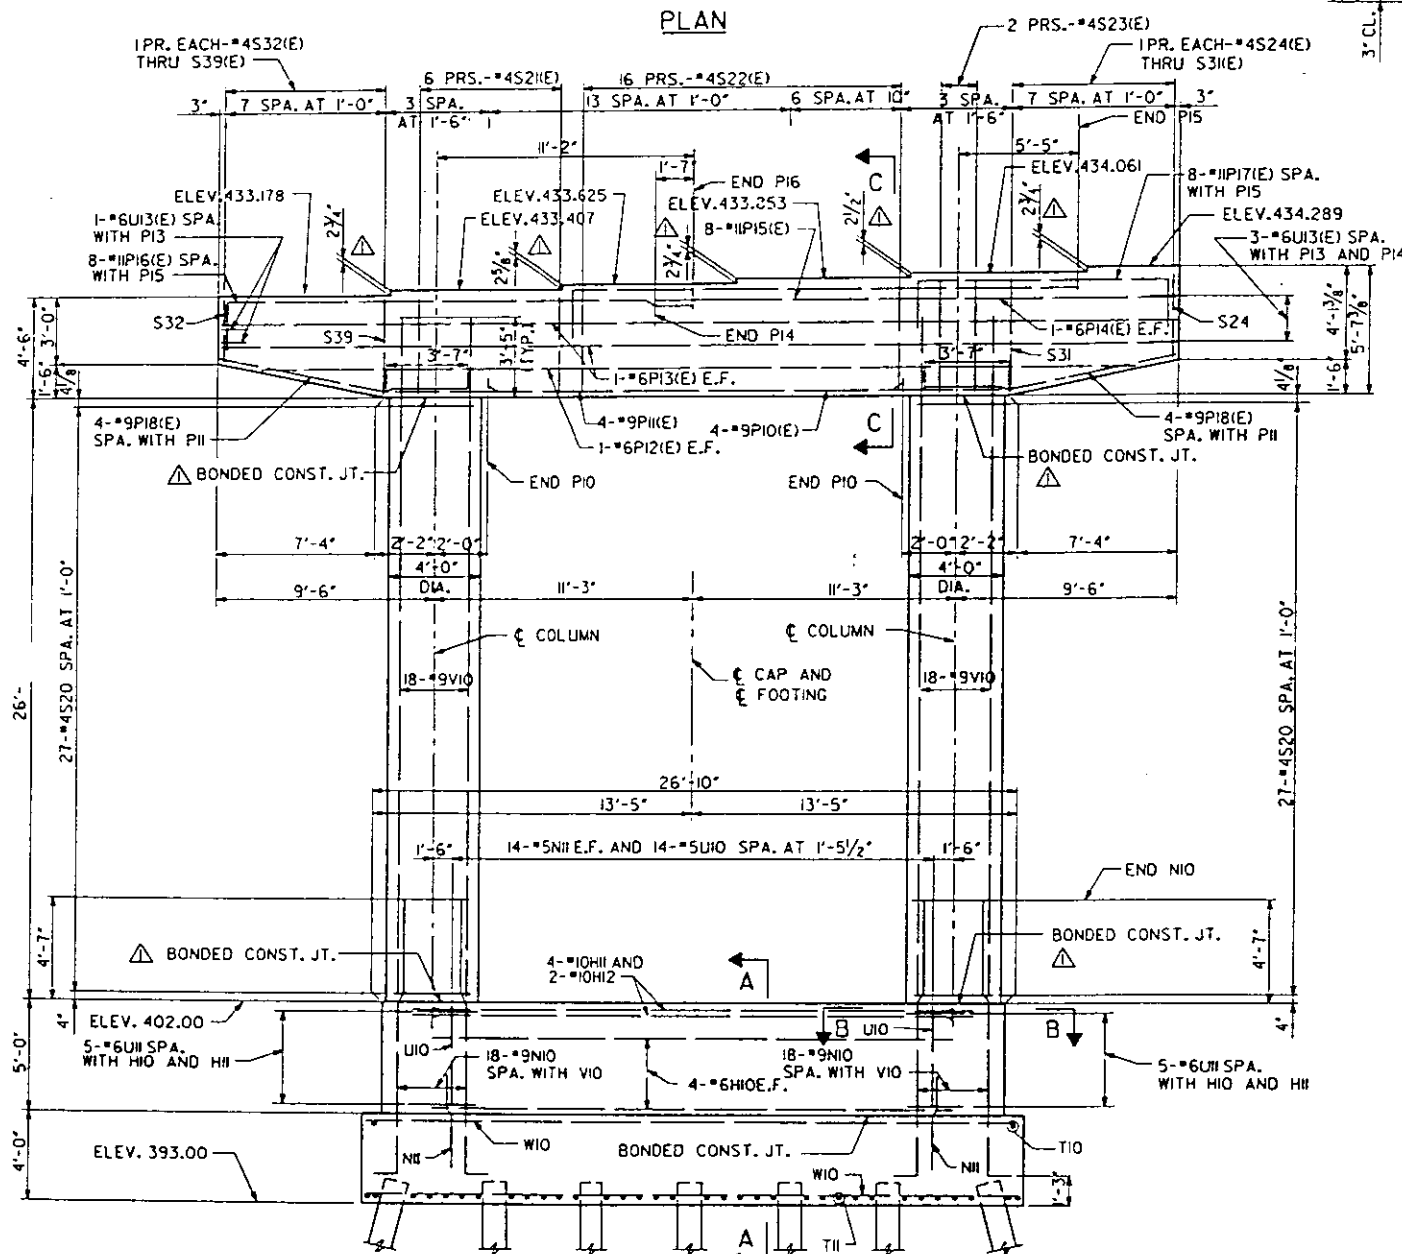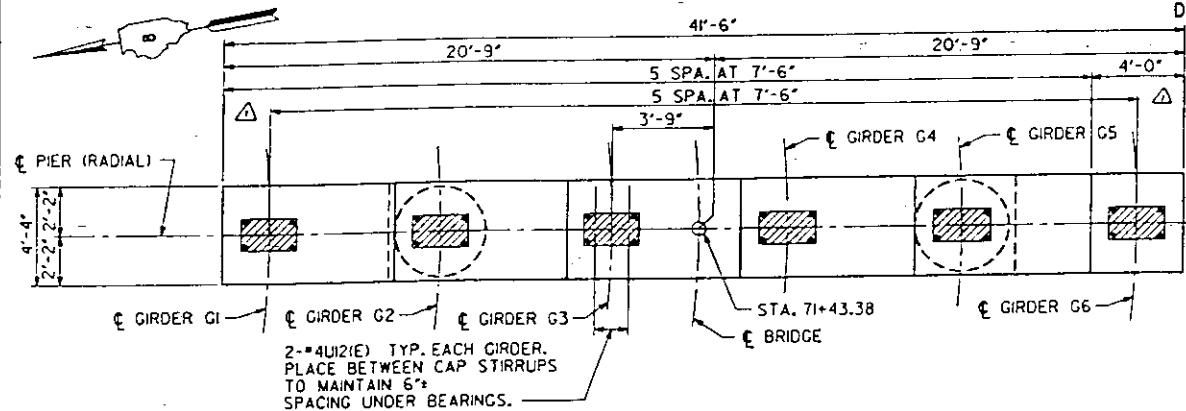

NOTES Δ
SPACE REINFORCEMENT IN CAP TO MISS DRILLED IN ANCHOR BOLTS. E.F. INDICATES EACH FACE.

REHABILITATION FOR
APPROACH BRIDGE OVER
I-55/70 W.B., MISSOURI AVE. AND TRRA
PIER 44A

A.D. NG DESIGNED
K. LARSON CHECKED
C. DEED DRAWN
R.F. BECK CHECKED

PILE DATA
TYPE: CONCRETE
CAPACITY: 45 TON
EST. LENGTH: 36 FT.
NO. REQ'D: 34 (NOT INCLUDING TEST PILE)
TEST PILE: ONE REQUIRED

NOTE: PILE SPACING SHOWN IS MEASURED AT ELEV. 393.00.
INDICATES PILE IS BATTERED 3 IN 12 IN DIRECTION SHOWN.

PREPARED BY:
SVERDRUP CORPORATION
ST. LOUIS, MISSOURI

REV. 12-4-87 SECTION 1BR-1








STRUCTURE NO. 082-6003
STA. 65+00 (FAP 799) ST. CLAIR CO.

SHEET NO. 63 OF 75

FOR INFORMATION ONLY

LEVELS PLOTTED DATE: OCT. 23, 1987
FILE: ZF34151.DETAIL.B0.DGN
35,56,57,58 & 63
15865 PRF1 DETAIL B0

ROUTE NO.	SECTION	COUNTY	TOTAL SHEETS
FAP 799	*	ST. CLAIR	252
			PROJECT
			ILLINOIS
			PROJECT
			* I BR-1 APPROACH BRIDGE

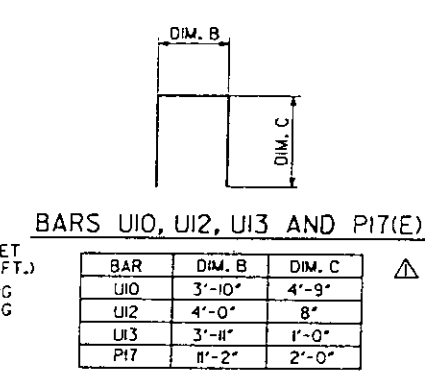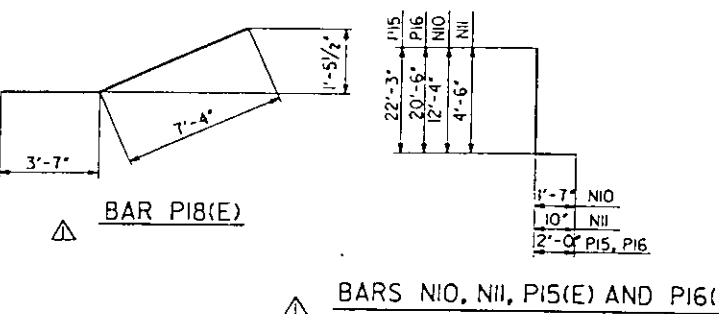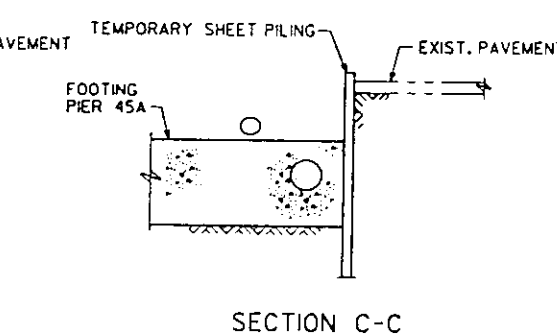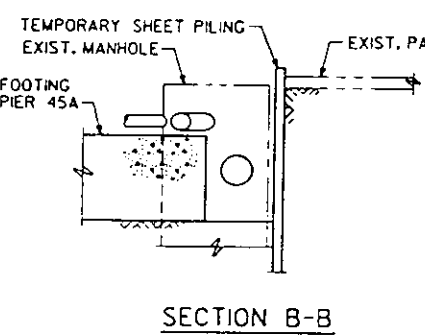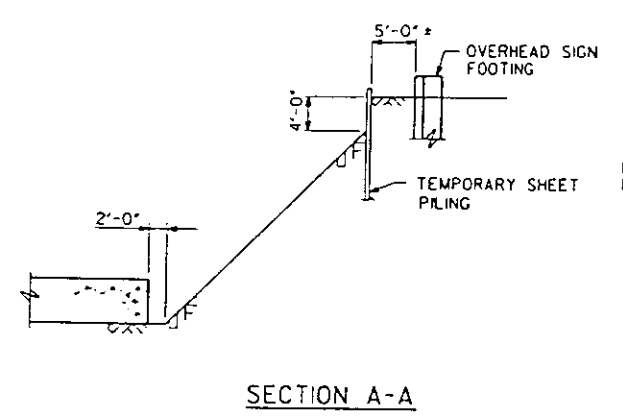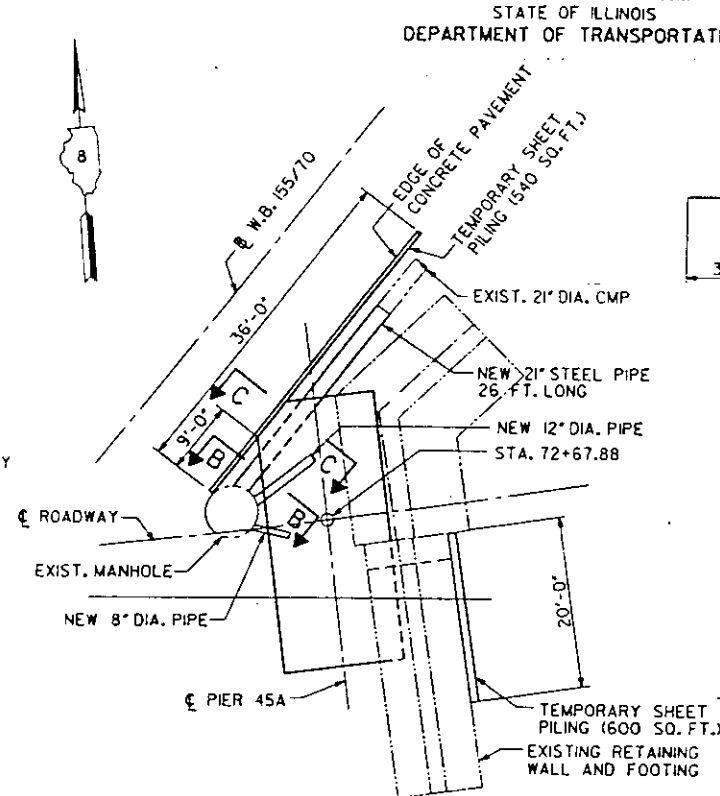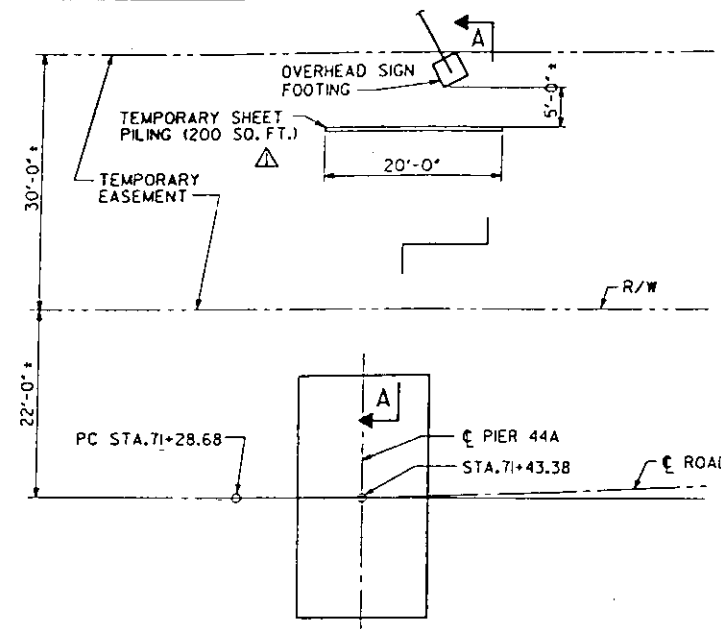

BAR	DIM. B	DIM. C
U10	3'-10"	4'-9"
U12	4'-0"	8"
U13	3'-11"	1'-0"
P17	11'-2"	2'-0"

BAR	DIM. A
S21	4'-2"
S22	4'-7 1/4"
S23	5'-0 1/2"
S24	3'-7 1/4"
S25	3'-9 3/4"
S26	4'-0"
S27	4'-2 1/2"
S28	4'-5"
S29	4'-7 1/2"
S30	4'-10"
S31	5'-0 1/2"
S32	2'-8 1/2"
S33	2'-11"
S34	3'-1 1/2"
S35	3'-4"
S36	3'-6 1/2"
S37	3'-9"
S38	3'-11 1/4"
S39	4'-1 3/4"

BILL OF MATERIAL - PIER 44A									
BAR	NO.	SIZE	LENGTH	SHAPE	BAR	NO.	SIZE	LENGTH	SHAPE
H10	8	*6	22'-6"	—	S33(E)	2	*4	12'-6"	□
H11	8	*10	24'-0"	—	S34(E)	2	*4	12'-11"	□
H12	4	*10	22'-6"	—	S35(E)	2	*4	13'-4"	□
N10	36	*9	13'-11"	L	S36(E)	2	*4	13'-9"	□
N11	28	*5	5'-4"	L	S37(E)	2	*4	14'-2"	□
					S38(E)	2	*4	14'-7"	□
					S39(E)	2	*4	15'-0"	□
P10(E)	4	*9	18'-6"	—					
P11(E)	4	*9	26'-9"	—	T10	29	*5	14'-6"	—
P12(E)	2	*6	37'-4"	—	T11	34	*9	14'-6"	—
P13(E)	4	*6	41'-2"	—					
P14(E)	2	*6	22'-3"	—	U10	14	*5	13'-4"	□
P15(E)	8	*11	24'-3"	□	U11	10	*6	9'-10"	□
P16(E)	8	*11	22'-6"	□	U12	12	*4	5'-4"	□
P17(E)	8	*11	15'-2"	□	U13	5	*6	5'-11"	□
P18(E)	8	*9	10'-11"	□					
S20	54	*4	12'-10"	○	V10	36	*9	30'-1"	—
S21(E)	12	*4	15'-0"	□	W10	31	*5	28'-0"	—
S22(E)	32	*4	15'-11"	□					
S23(E)	4	*4	16'-9"	□	TEMPORARY SHEET PILING			SO. FT.	200
S24(E)	2	*4	13'-11"	□	CLASS X CONCRETE			CU. YDS.	139.5
S25(E)	2	*4	14'-4"	□	REINFORCEMENT BARS			LBS.	10,930
S26(E)	2	*4	14'-8"	□	REINFORCEMENT BARS EPOXY COATED			LBS.	4,780
S27(E)	2	*4	15'-1"	□	FURNISHING CONCRETE PILES			LIN. FT.	1,224
S28(E)	2	*4	15'-6"	□	DRIVING CONCRETE PILES			LIN. FT.	1,224
S29(E)	2	*4	15'-11"	□	TEST PILE - CONCRETE			EACH	1
S30(E)	2	*4	16'-4"	□	STRUCTURE EXCAVATION			CU. YDS.	400
S31(E)	2	*4	16'-9"	□					
S32(E)	2	*4	12'-1"	□					

REINFORCEMENT BARS (E) SHALL BE EPOXY COATED.

NOTES

COST OF TEMPORARY SHORING FOR PIERS 44A AND 45A SHALL BE INCIDENTAL TO COST OF STRUCTURE EXCAVATION.

REHABILITATION FOR
APPROACH BRIDGE OVER
I-55/70 W.B., MISSOURI AVE. AND TRRA

PIER 44A AND 45A

STRUCTURE NO. 082-6003
STA. 65+00 (FAP 799) ST. CLAIR CO.


PREPARED BY:
SVERDRUP CORPORATION
ST. LOUIS, MISSOURI

REV. 12-4-87

SECTION I BR-1

SHEET NO. 64 OF 75

FOR INFORMATION ONLY

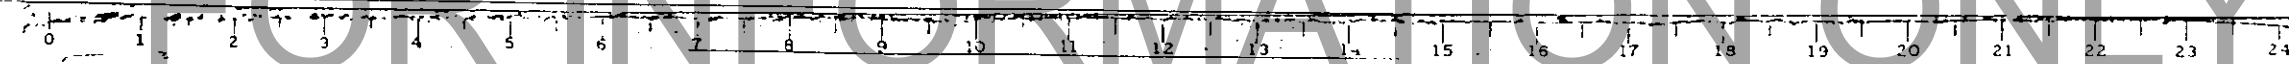



5-DEC-1987 08:46

LEVELS PLOTTED DATE: OCT. 23, 1987 56, 57 & 63
FILE: ZF34(5)JDETL80A.DGN
875979 PRF1 DETL 80A

DESIGNED	
CHECKED	J.G. CORLEY
DRAWN	R.F. BECK
CHECKED	






ROUTE NO.	SECTION	COUNTY
FAP 799	ST. CLAIR	
LEADS	PROJECT	

* I BR-1 APPROACH BRIDGE

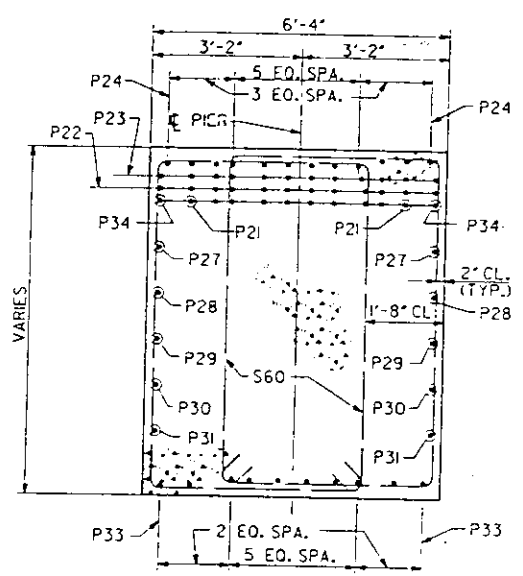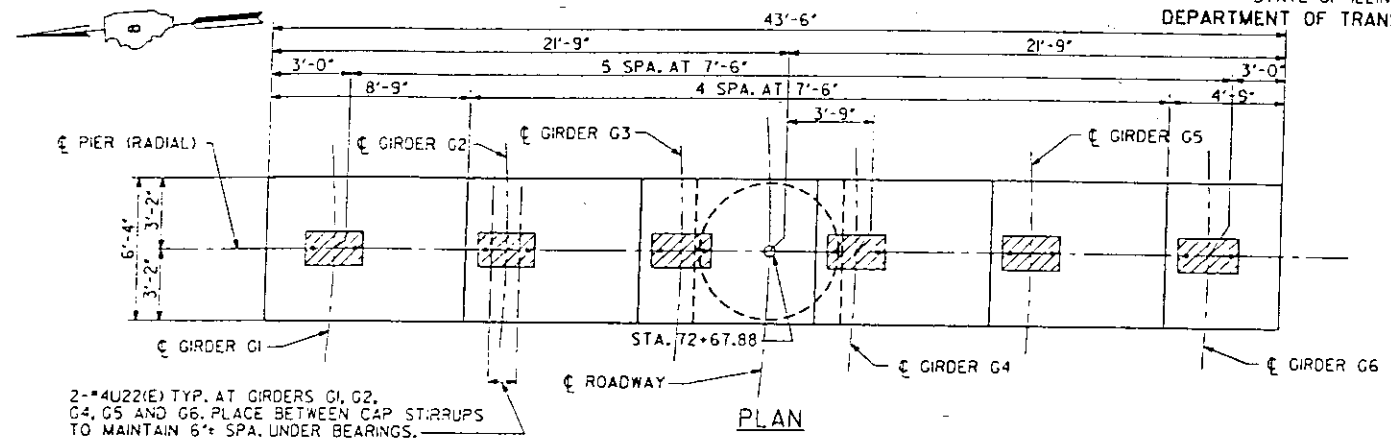

BILL OF MATERIAL

BAR	NO.	SIZE	LENGTH	SHAPE	BAR	NO.	SIZE	LENGTH
P21(E)	10	#9	29'-2"		S66(E)	2	#6	22'-1"
P22(E)	12	#11	28'-4"		S67(E)	2	#6	21'-5"
P23(E)	12	#11	28'-11"		S68(E)	2	#6	20'-11"
P24(E)	12	#8	10'-2"		S69(E)	2	#6	20'-3"
P25(E)	12	#8	13'-3"		S70(E)	2	#6	19'-9"
P26(E)	12	#8	7'-0"		S71(E)	2	#6	19'-1"
P27(E)	2	#5	43'-2"		S72(E)	2	#6	18'-6"
P28(E)	2	#5	41'-0"		S73(E)	2	#6	18'-4"
P29(E)	2	#5	37'-8"		S74(E)	2	#6	17'-5"
P30(E)	2	#5	29'-11"		S75(E)	2	#6	16'-7"
P31(E)	2	#5	21'-7"					
P32(E)	10	#6	23'-0"		T20	10	#6	14'-6"
P33(E)	10	#6	23'-5"		T21	16	#8	15'-0"
P34(E)	2	#9	44'-9"		T22	6	#6	13'-10"
					T23	3	#5	6'-0"
S40	27	#4	19'-2"		T24	2	#5	9'-3"
S41(E)	2	#6	16'-6"		T25	2	#5	11'-4"
S42(E)	2	#6	17'-1"		T26	32	#6	13'-2"
S43(E)	2	#6	17'-8"					
S44(E)	2	#6	18'-3"		U21	6	#5	9'-5"
S45(E)	2	#6	18'-9"		U22	10	#4	8'-0"
S46(E)	2	#6	19'-4"					
S47(E)	2	#6	19'-11"		V21	36	#10	31'-3"
S48(E)	2	#6	21'-1"		V22	36	#10	12'-11"
S49(E)	2	#6	21'-7"					
S50(E)	2	#6	22'-1"		W20	34	#10	31'-0"
S51(E)	2	#6	22'-7"		W21	3	#10	20'-3"
S52(E)	2	#6	23'-1"		W22	3	#10	22'-6"
S53(E)	2	#6	23'-7"		W23	4	#10	22'-0"
S54(E)	2	#6	24'-7"		W24	14	#5	7'-9"
S55(E)	2	#6	24'-11"					
S56(E)	2	#6	25'-3"		TEMPORARY SHEET PILING		SO. FT.	
S57(E)	8	#6	25'-4"		CLASS X CONCRETE		CU. YDS.	
S58(E)	2	#6	26'-2"		REINFORCEMENT BARS		LBS.	
S59(E)	2	#6	25'-7"		REINFORCEMENT BARS		LBS.	
S60(E)	2	#6	24'-11"		EPOXY COATED		LBS.	
S61(E)	2	#6	24'-4"		FURNISHING CONCRETE PILES		LIN. FT.	
S62(E)	2	#6	23'-9"		DRIVING CONCRETE PILES		LIN. FT.	
S63(E)	2	#6	23'-2"		TEST PILE - CONCRETE		EACH	
S64(E)	2	#6	22'-7"		STRUCTURE EXCAVATION		CU. YDS.	
S65(E)	2	#6	22'-8"					

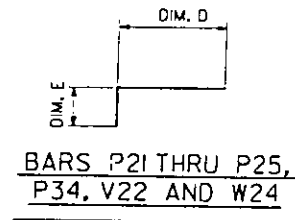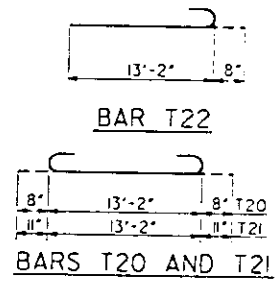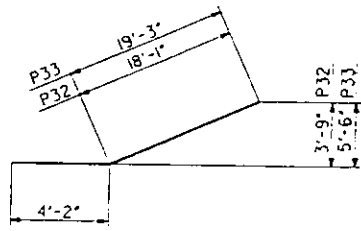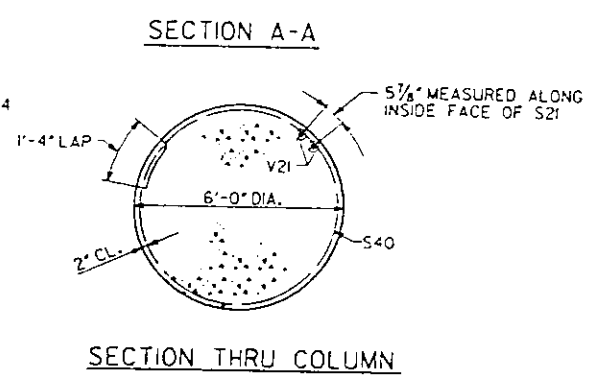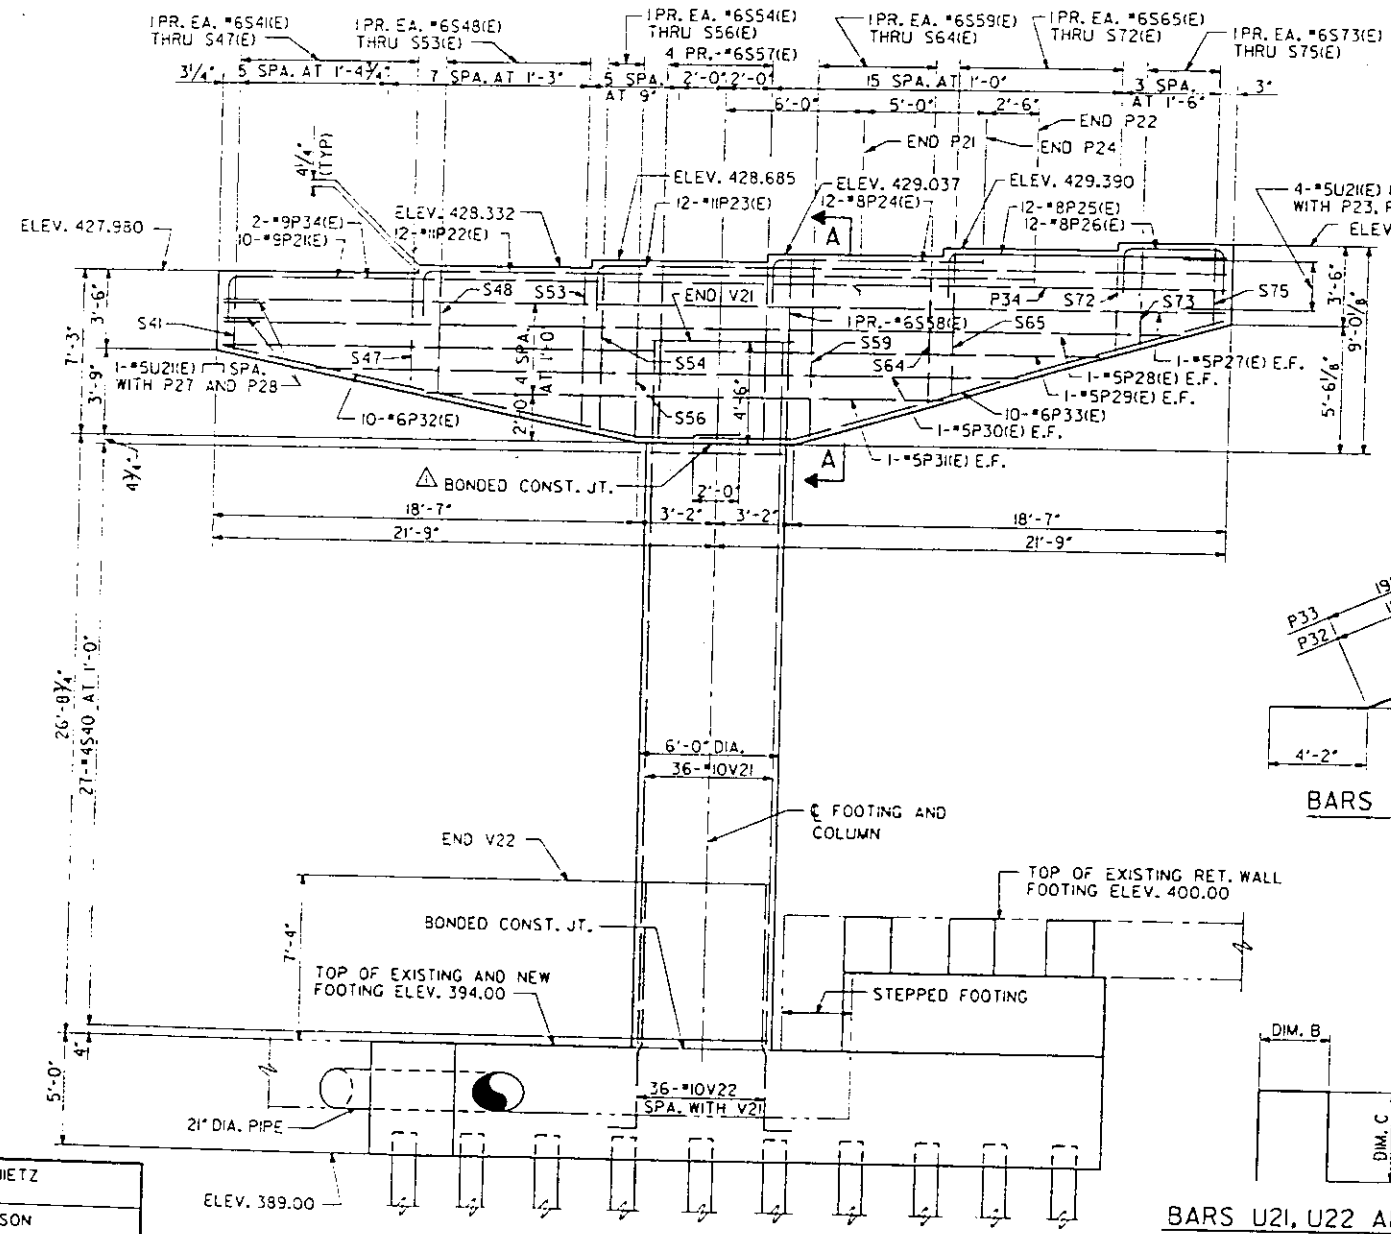


BARS S41 THRU S75

BAR	DIM. A	BAR	DIM. A
S41	3'-2 1/2"	S59	7'-8 3/4"
S42	3'-6"	S60	7'-5"
S43	3'-9 1/2"	S61	7'-1 1/2"
S44	4'-0 3/4"	S62	6'-10"
S45	4'-4"	S63	6'-6 1/2"
S46	4'-7 1/2"	S64	6'-3"
S47	4'-11"	S65	6'-3 1/2"
S48	5'-6"	S66	6'-0"
S49	5'-9"	S67	5'-8"
S50	6'-0"	S68	5'-5"
S51	6'-3"	S69	5'-1"
S52	6'-6"	S70	4'-9 3/4"
S53	6'-9"	S71	4'-6"
S54	7'-3"	S72	4'-2 1/2"
S55	7'-5"	S73	4'-1 1/2"
S56	7'-7"	S74	3'-8 1/4"
S57	7'-7 1/2"	S75	3'-3"
S58	8'-0 1/4"		

BARS U21, U22 AND P26

BAR	DIM. B	DIM. C
U21	5'-10 1/2"	1'-9"
U22	6'-0"	1'-0"
P26	4'-4"	1'-4"

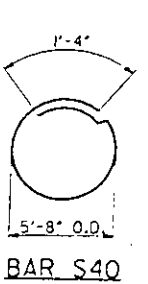

R. NIEMIETZ
DESIGNED
K. LARSON
CHECKED
J.C. CORLEY
DRAWN
R.F. BECK
CHECKED

ELEVATION
NOTE: FOOTING REINFORCEMENT NOT SHOWN.
FOR DETAILS OF DRAINAGE SYSTEM
NOT SHOWN, SEE DRAINAGE PLAN
STA. 72+50 TO 76+76

NOTES
REINFORCEMENT BARS (E) SHALL BE EPOXY COATED.
QUANTITY SHOWN FOR STRUCTURE EXC. INCLUDE THE AMOUNT BEING EXISTING RETAINING WALL.
SPACE REINFORCEMENT IN CAP TO MISS DRILL IN ANCHOR BOLTS.
E.F. INDICATES EACH FACE.
WORK THIS SHEET WITH SHEET 66.
BONDED CONSTRUCTION JOINTS SHALL BE IN ACCORDANCE WITH STD. SPEC. ART. 504.13 (A)(2).

REHABILITATION FOR
APPROACH BRIDGE OVER
I-55/70 W.B., MISSOURI AVE. AND TR
PIER 45A

STRUCTURE NO. C82-6003
STA. 65+00 (FAP 799) ST. CLAIR CO.

PREPARED BY
SVERDRUP CORPORATION
ST. LOUIS, MISSOURI


REV. 12-4-87

SECTION 13R-1

SHEET NO. 65 OF 7


FOR INFORMATION ONLY

0358 FILE: ZF3151100179.DGN LEVELS PLOTTED DATE: OCT. 23, 1987 35, 56, 57, 58 & 63 875858 PRF: DETAIL 79

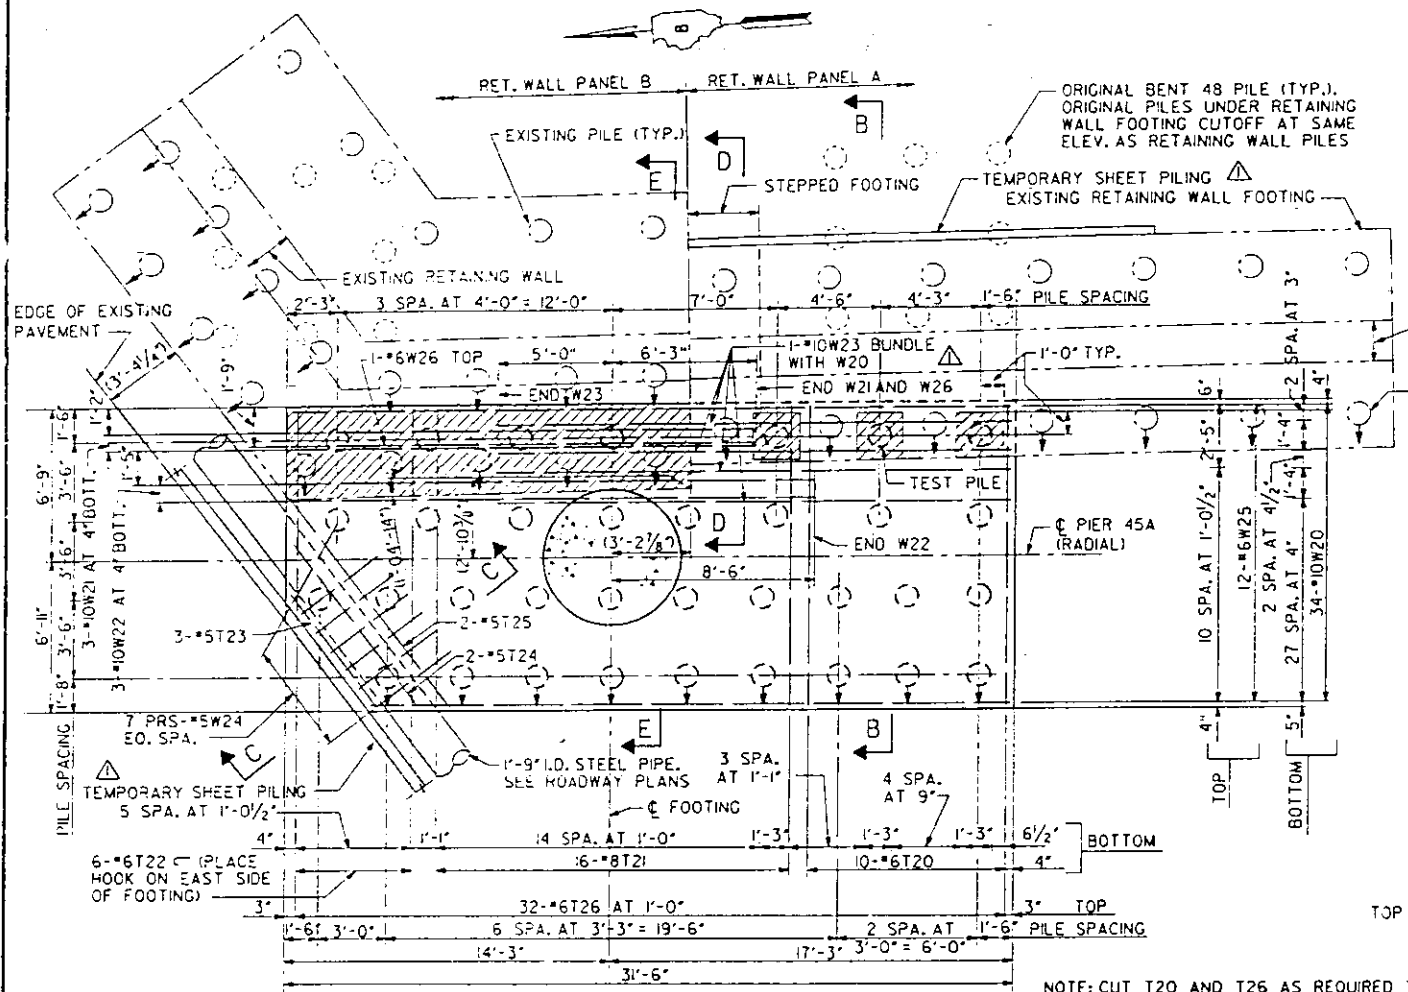


FOOTING PLAN

INDICATES PILES BATTERED 2 IN 12 IN DIRECTION SHOWN.
PILE SPACING SHOWN IS MEASURED AT BOTTOM OF FOOTING.
OUTLINE OF EXISTING RET. WALL AND DIMENSIONS SHOWN IN PARENTHESIS ARE BASED ON PLAN DIMENSIONS AND MAY OR MAY NOT REPRESENT THE ACTUAL LOCATION OF THE RET. WALL. THE CONTRACTOR SHALL VERIFY THE ACTUAL LOCATION IN THE FIELD.
FOR DETAILS OF DRAINAGE SYSTEM, NOT SHOWN, SEE DRAINAGE PLAN STA. 72+50 TO 76+76, AND SHEET 64.

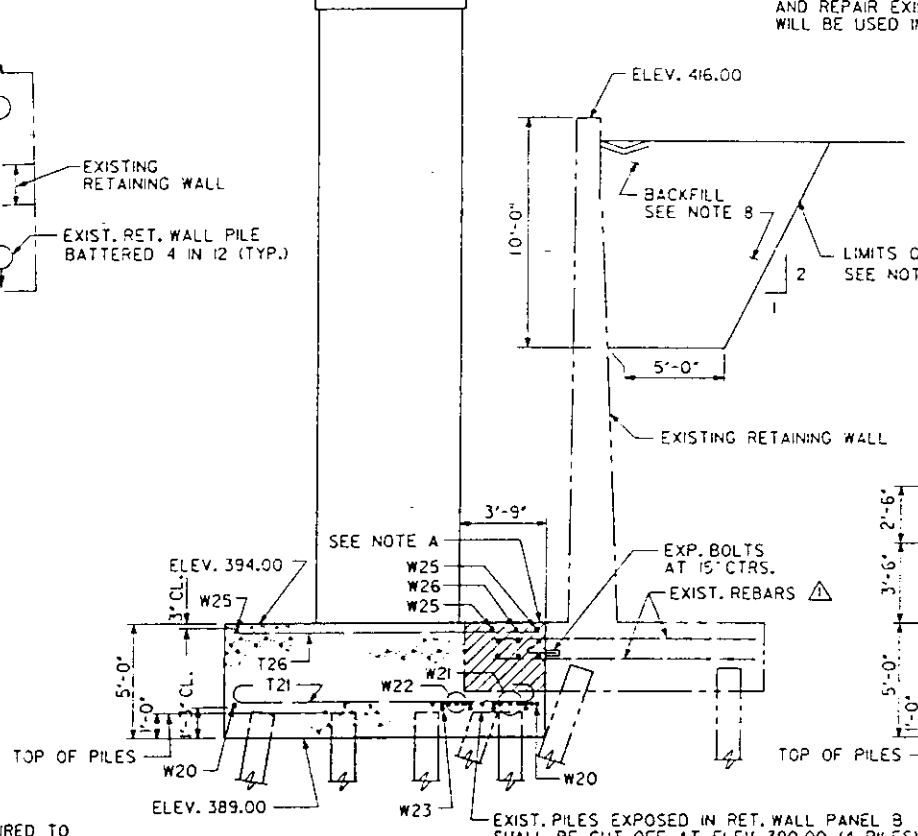

SECTION E-E

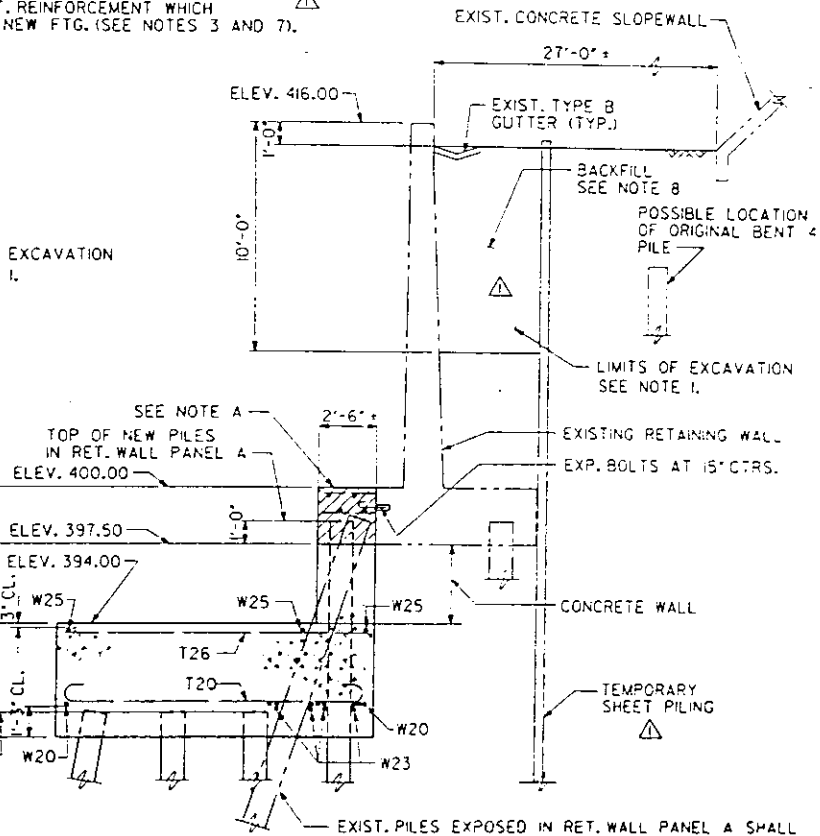

SECTION B-B

SUGGESTED SEQUENCE OF FOOTING CONSTRUCTION


- INSTALL TEMPORARY SHEET PILING ADJACENT TO EXISTING RET. WALL PANEL A. EXCAVATE BEHIND EXISTING RETAINING WALL TO LIMITS SHOWN AND FOR A DISTANCE OF 2'-0" BEYOND SOUTH END OF RETAINING WALL. EXCAVATE AREA TO BE SLOPED TO MAINTAIN DRAINAGE AT ALL TIMES DURING PIER FOOTING AND COLUMN CONSTRUCTION.
- EXCAVATE TO ELEV. 400 ON WEST SIDE OF EXISTING RETAINING WALL.
- REMOVE PORTIONS OF EXISTING FOOTING CONCRETE IN PANEL A AS SHOWN IN THE FOOTING PLAN. CUT AND BEND EXISTING REINFORCEMENT. AUGER 1'-6" DIA. HOLES FOR PILES DOWN TO ELEV. 389. DRIVE PILES, REPAIR REINFORCEMENT BARS BY FULL PENETRATION BUTT WELD OR WELDED LAP SPLICE AS APPROVED BY THE ENGINEER. DUE TO RESTRICTED LOCATION, PILE CUT-OFF FOR NEW PILES IN RETAINING WALL PANEL A MAY BE MADE ABOVE TOP OF EXISTING RETAINING WALL FOOTING (ELEV. 400.00) AND DRIVEN TO TOP OF PILE LOCATION SHOWN. CONTRACTOR SHALL PROTECT PILE TOP TO AVOID DAMAGE. COST OF THE ABOVE WORK SHALL BE INCIDENTAL TO CONCRETE PILES.
- FILL AUGERED HOLE VOIDS WITH SAND AND REPLACE CLASS X CONCRETE IN FOOTING.
- AFTER NEW CONCRETE IN EXISTING FOOTING HAS CURED FOR A MINIMUM OF SEVEN (7) DAYS, EXCAVATE TO ELEV. 394, STABILIZE MATERIAL UNDER EXISTING RETAINING WALL IN PANEL A WITH SOIL-CEMENT GROUT OR BY OTHER METHOD ACCEPTABLE TO ENGINEER (COST INCIDENTAL).
- AFTER STABILIZATION OF MATERIAL TO ELEV. 394 IS COMPLETE, EXCAVATE FOR REMAINDER OF FOOTING. STABILIZE MATERIAL UNDER EXISTING RETAINING WALL IN PANEL A TO ELEV. 389 IN A SIMILAR MANNER AS IN NOTE 5 ABOVE.
- REMOVE PORTION OF EXISTING STEPPED FOOTING BETWEEN ELEV. 394.00 AND 391.00 AND EXISTING FOOTING CONCRETE IN PANEL B AS SHOWN IN FOOTING PLAN. CLEAN AND REUSE EXISTING FOOTING REINFORCEMENT IN PANEL B IN NEW FOOTING. REPAIR DAMAGED REINFORCEMENT AS IN NOTE 3 ABOVE. CUT OFF EXISTING PILES AS SHOWN. DRIVE PILES AND CONSTRUCT FOOTING. CONSTRUCT CLASS X CONCRETE WALL UNDER RETAINING WALL PANEL A BETWEEN ELEV. 394.00 AND ELEV. 397.50.
- BACKFILL BEHIND EXISTING RETAINING WALL SHALL NOT BE PLACED UNTIL THE FOOTING FOR PIER 45A IS COMPLETE AND THE FOOTING CONCRETE HAS CURED FOR A MINIMUM OF SEVEN (7) DAYS. PLACEMENT AND COMPACTION OF BACKFILL SHALL COMPLY WITH ARTICLE 502.11 OF THE STANDARD SPECIFICATIONS.
- REPAIR OF REINFORCEMENT AND OTHER WORK REQUIRED SHALL BE CONSIDERED INCIDENTAL TO STRUCTURE EXCAVATION.

NOTES


WORK THIS SHEET WITH SHEET 65.
ALL EXISTING REINFORCEMENT BARS SHALL BE THOROUGHLY CLEANED PRIOR TO PLACING CONCRETE.
THE CONTRACTOR SHALL PROVIDE TEMPORARY SHEET PILING TO MAINTAIN THE SUBSURFACE STABILITY UNDER THE EXISTING PANEL A FOOTING AND ADJACENT TO W.B. 55/70 DURING HIS CONSTRUCTION OPERATIONS.
HATCHED AREAS SHOWN THUS INDICATES LIMITS OF REMOVAL OF CONCRETE.

PILE DATA

TYPE: CONCRETE
CAPACITY: 41 TONS
NO. AND EST. LENGTH: 31 - 32 FT.
NO. AND EST. LENGTH: 2 - 4 FT. (NOT INCLUDING TEST PILE)
TEST PILE: ONE REQUIRED

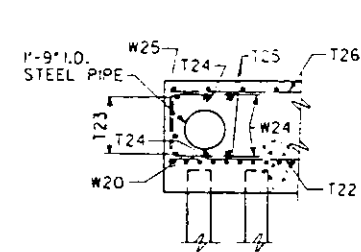

SECTION C-C

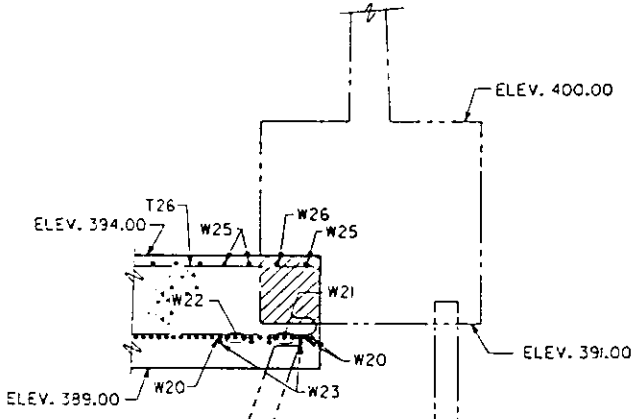

SECTION D-D

DESIGNED	R. NIEMIETZ
CHECKED	K. LARSON
DRAWN	J.G. CORLEY
CHECKED	R.F. BECK

4-DEC-1987 1P.5
 LEVELS PLOTTED 35 56 57 58 63
 FILE: ZF31(5) DETAIL 78.DGN
 R75924 PRF DETAIL 78

REHABILITATION FOR
APPROACH BRIDGE OVER
I-55/70 W.B., MISSOURI AVE. AND TRRA

PIER 45A

STRUCTURE NO. 082-6003
STA. 65+00 (FAP 799) ST. CLAIR CO.

PREPARED BY:
SYVERDRUP CORPORATION
ST. LOUIS, MISSOURI








REV. 12-4-87

SECTION IBR-1

SHEET NO. 66 OF 75



DATE	SECTION	COUNTY	SHEET
FAP-799	16	ST. CLAIR	252
PROJECT		PROJECT	

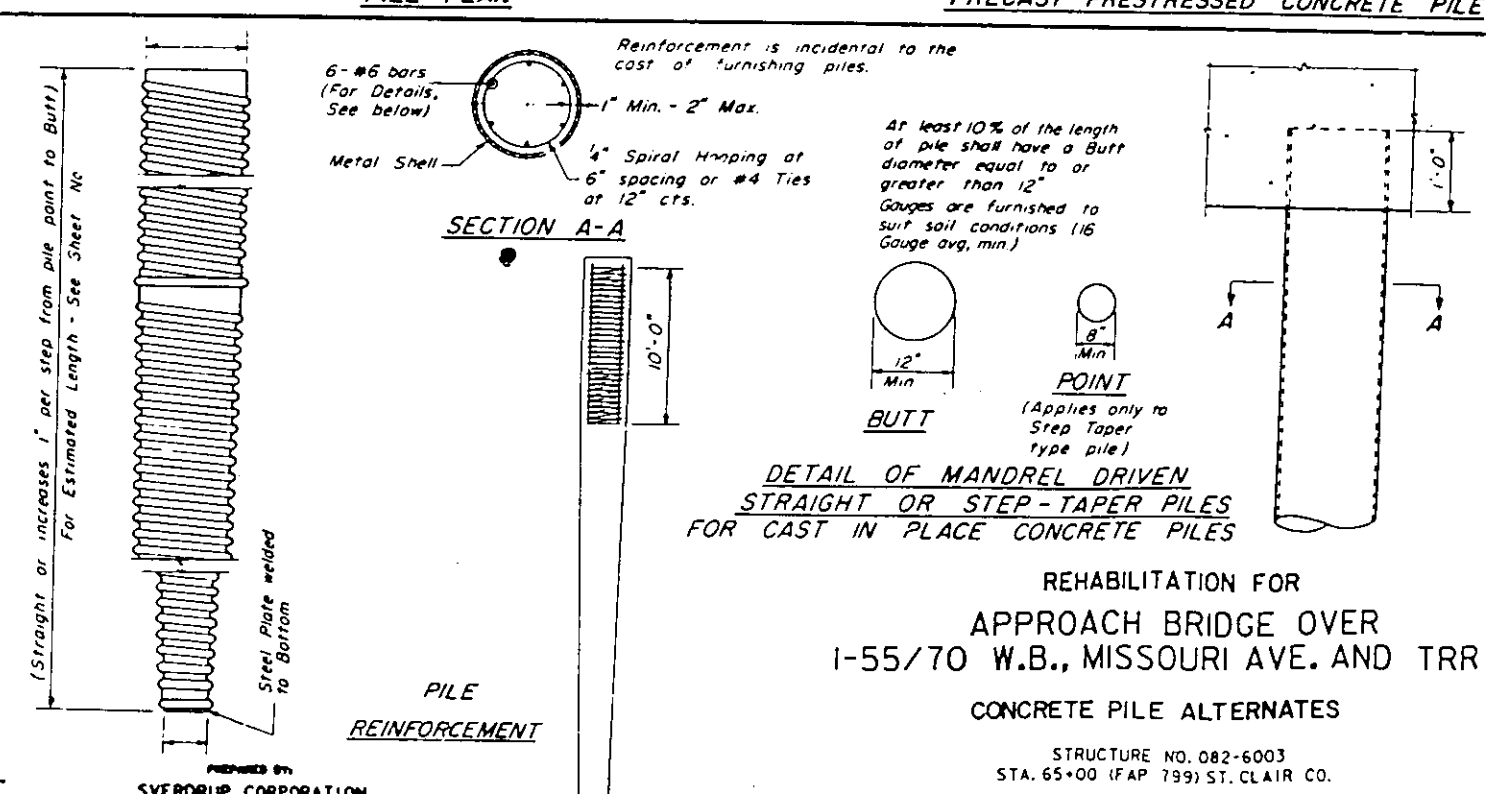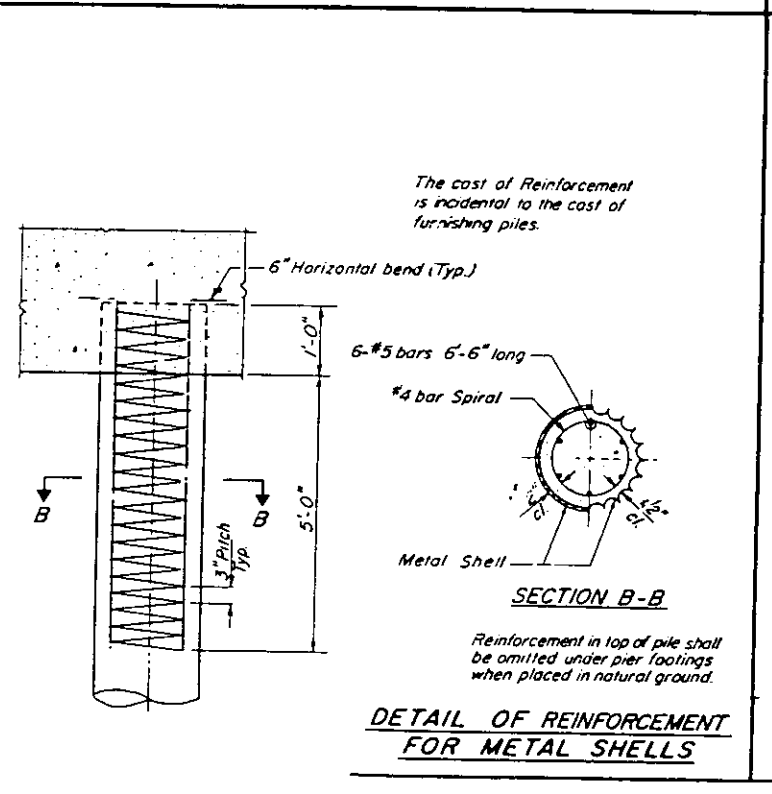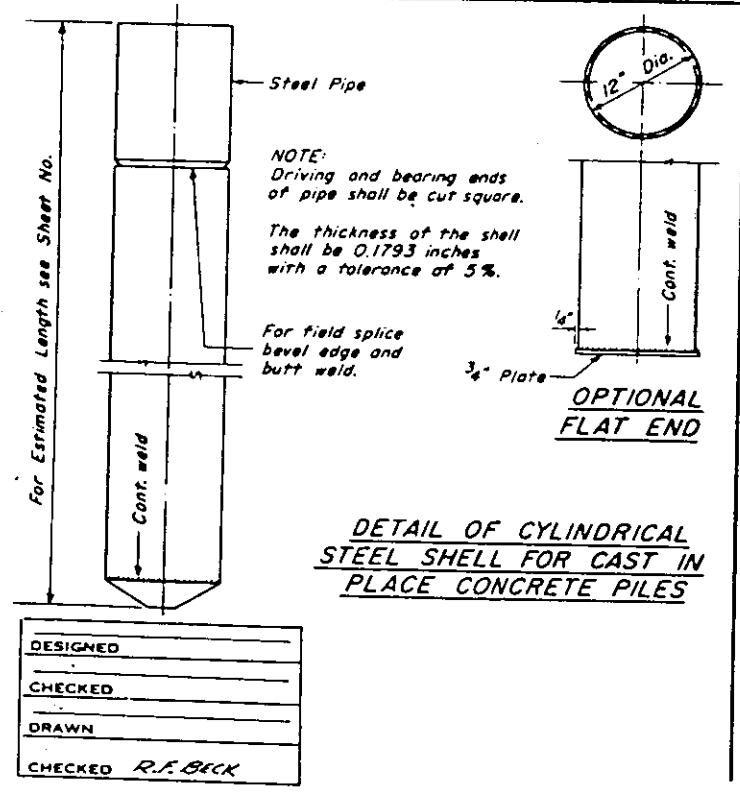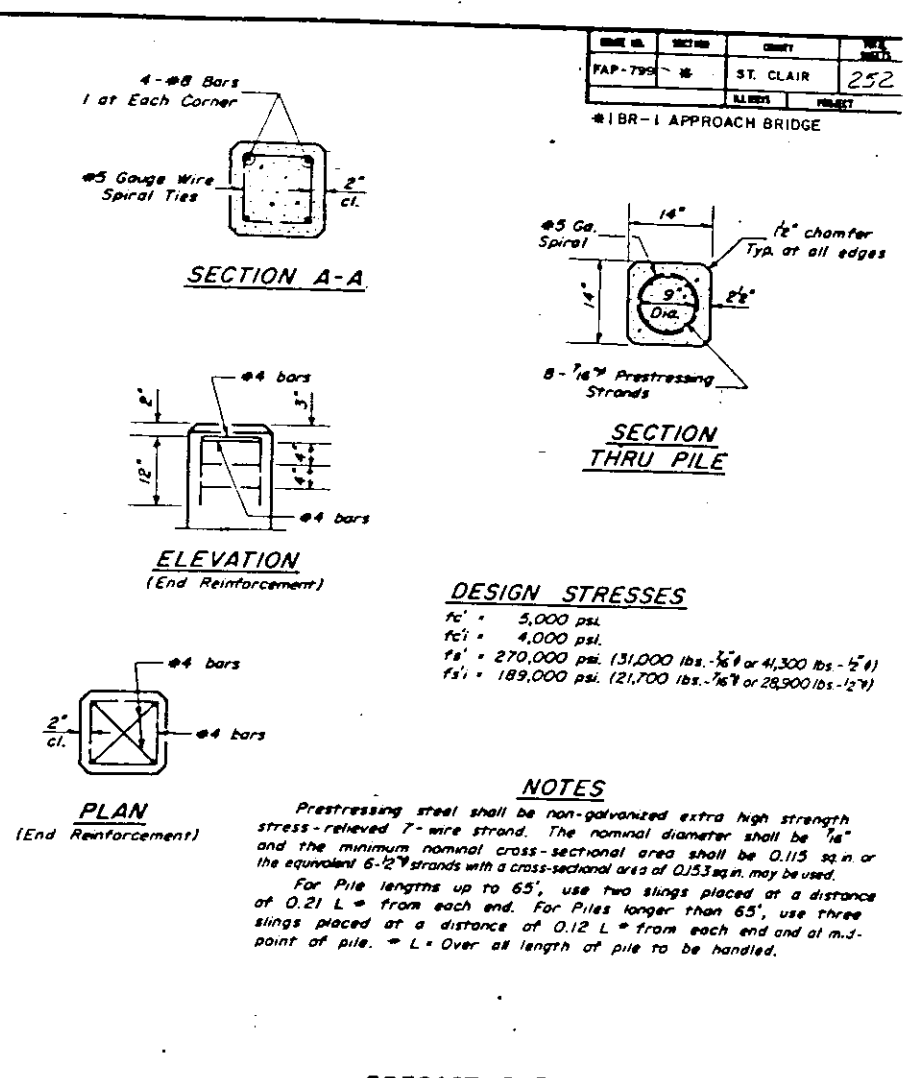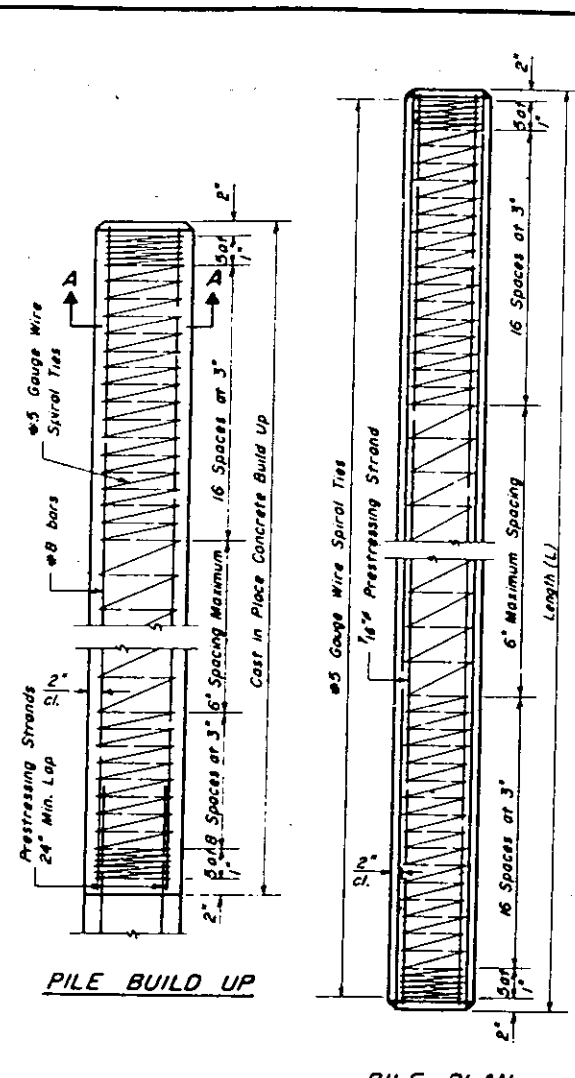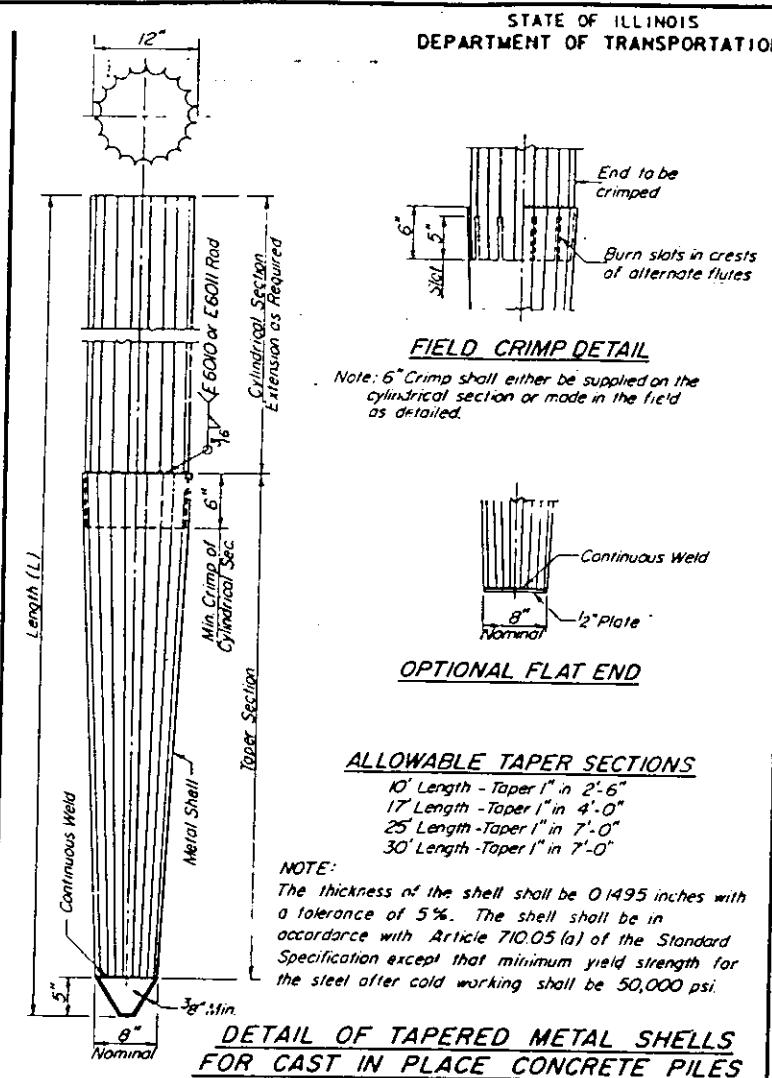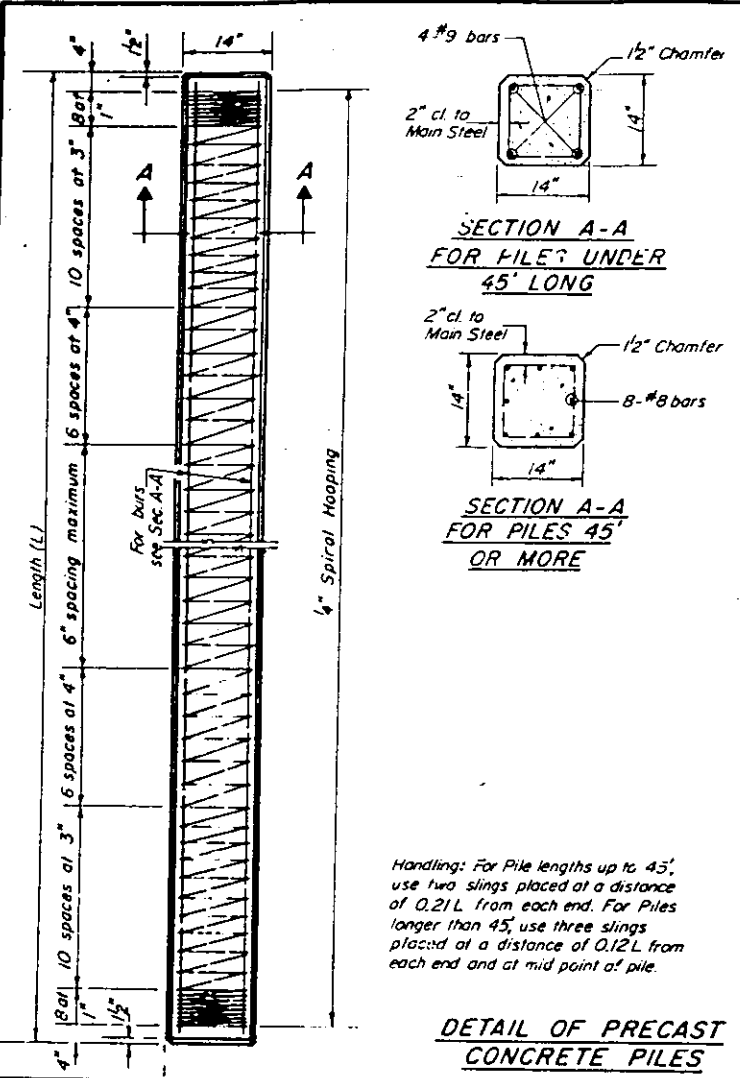

DESIGNED	
CHECKED	
DRAWN	
CHECKED	R.F. BECK

OCT. 23, 1987

PREPARED BY
SVERDRUP CORPORATION
ST. LOUIS, MISSOURI

SECTION SR-1

SHEET NO. 67 OF 75


FOR INFORMATION ONLY

REHABILITATION FOR
APPROACH BRIDGE OVER
I-55/70 W.B., MISSOURI AVE. AND TRR
CONCRETE PILE ALTERNATES


STRUCTURE NO. 082-6003
STA. 65+00 (FAP 799) ST. CLAIR CO.

The Illinois Coil-Lock Anchor Bolt is a proprietary item which is the property of the Illinois Department of Transportation. Use, reproduction or disclosure without express written permission is prohibited and protected under Federal copyright laws. The production and the fabrication of this bolt for use on highway projects in the State of Illinois shall be permitted and there shall be no incurred charges or fees to the manufacturer or the fabricator for producing or fabricating this bolt.

D	E	H	K	"d"	T
1"	1/8"	13/16"	*	1/4"	4"
1 1/4"	1 3/8"	1 1/16"	*	1/4"	6"
1 1/2"	1 5/8"	1 3/16"	*	1/4"	6"
2"	2 1/8"	1 3/16"	*	1/2"	6"

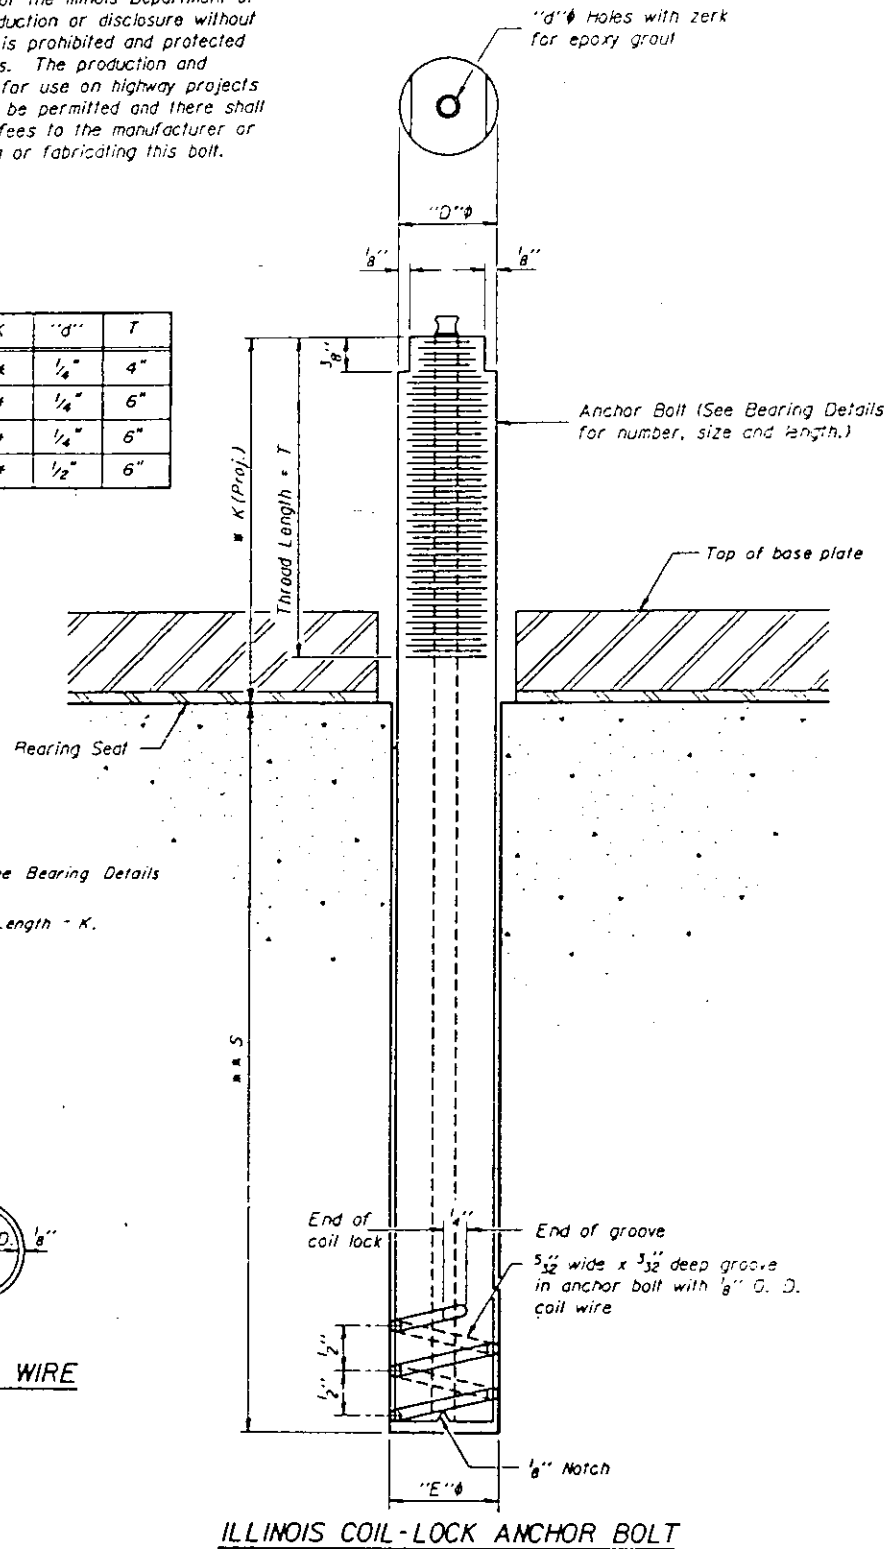

NOTES:
 * For dimension K, see Bearing Details
 * S (embedment) = Length - K.

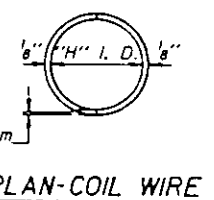

ILLINOIS COIL-LOCK ANCHOR BOLT

MATERIALS FOR ILLINOIS COIL-LOCK ANCHOR BOLT

The anchor bolt shall be fabricated from cold drawn or hot finished seamless carbon steel mechanical tubing conforming to ASTM A519, Grade 1025 and supplied with two hexagonal nuts.
 The coil wire shall be made of any suitable soft steel wire.
 The finished anchor bolt shall be cleaned of rust and other foreign materials and wrapped or packaged to prevent contamination until they are installed.
 The epoxy grout shall be a two-component, epoxy resin bonding system conforming to ASTM C881, Type 1, Grade I and of a Class suitable for the temperature at installation.

INSTALLATION PROCEDURE for the ILLINOIS COIL-LOCK ANCHOR BOLT

1. With the coil wire in place, the bolt shall be inserted into the hole and turned clockwise to a snug fit in the hole. Nut shall be placed on the bolt. Nut shall be finger tight prior to placing epoxy grout.
2. Epoxy grout shall be pumped through the zerk fitting with a pressure gun. Pumping shall continue until the epoxy overflows the hole around the bolt shank. After pumping is discontinued, excess epoxy shall be immediately wiped off.
3. After grout has set loosen nut to obtain the required clearance between the nut and the sole plate.

ALTERNATE ANCHOR BOLTS

The Contractor may use, at his option, the capsule or the adhesive cartridge type anchor rods that have been previously tested and given a prior approval by the Department. The Contractor shall install these anchor rods in pre-drilled holes in accordance with the manufacturer's recommendations and procedures.
 The capsule or the adhesive cartridge type anchor rods shall be a two part system composed of:
 1. A threaded rod stud with nut and washer conforming to ASTM A307.
 2. A sealed glass capsule or a sealed glass adhesive cartridge containing premeasured amounts of the adhesive chemical.

GENERAL NOTES

Holes in the masonry for anchor bolts shall be drilled through the base plates to the diameter and depth shown or in accordance with the manufacturer's recommendation after beams or girders have been erected and adjusted.
 Prior to setting the bolts, the holes shall be dry and all dust and loose particles shall be removed by the use of compressed air or vacuuming.
 The anchor bolts, furnished and installed and including the epoxy grout or capsules shall not be paid for separately but shall be included in the unit bid price for "Furnishing and Erecting Structural Steel".
 Anchor bolts, nuts and washers shall be completely coated by either the hot-dipped process conforming with AASHTO M232 or the mechanical plating method conforming to ASTM B695, Class Zinc coated nuts shall be tapped oversize in accordance with the requirements of AASHTO M291 and shall meet the supplementary requirements of SI.1 thru SI.2.1 of the same specifications for lubrication and testing.
 See Sheets 40, 43, 48 and 49 for lengths of anchor bolts and projection required.

DESIGNED	_____
CHECKED	_____
DRAWN	_____
CHECKED	_____

ABB-1 12-1-83


PREPARED BY:
SVERDRUP CORPORATION
ST. LOUIS, MISSOURI

REV. 12-4-87 SECTION 1BR-1


REHABILITATION FOR
 APPROACH BRIDGE OVER
 I-55/70 W.B., MISSOURI AVE. AND TRF
 ANCHOR BOLT DETAILS

STRUCTURE NUMBER: 6604
 STA. 65+00 TO 65+100


OCT. 23, 1967

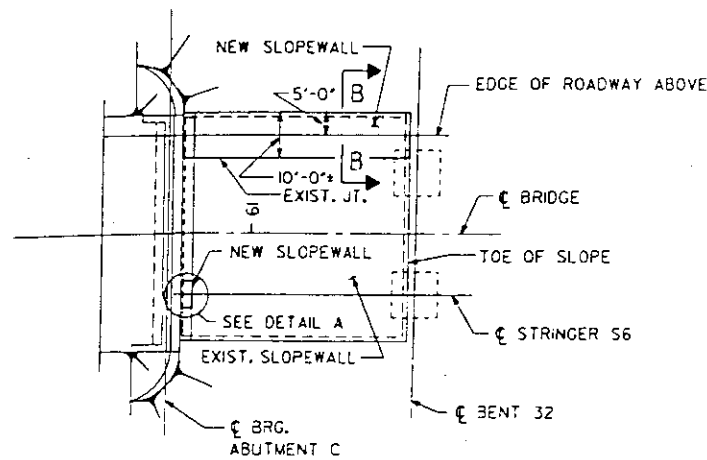


PLAN

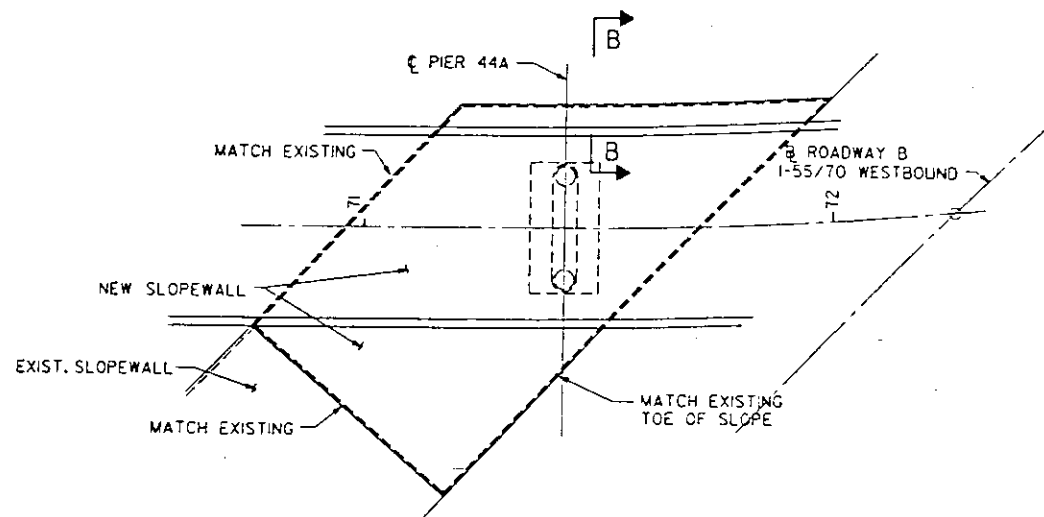


PLAN

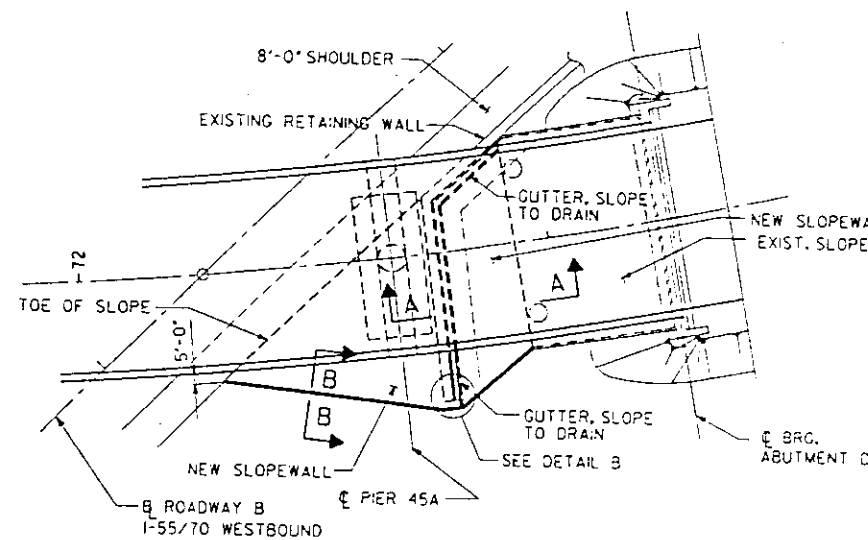


PLAN

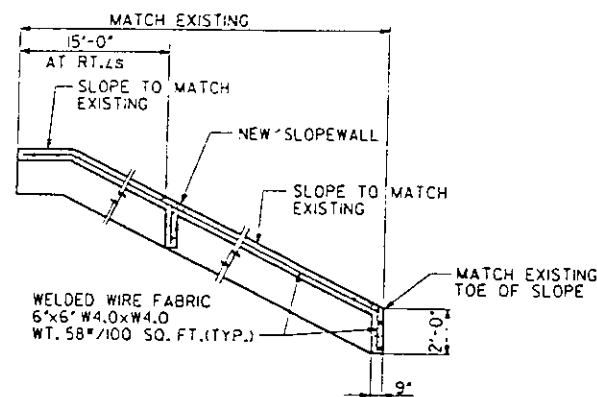


TYPICAL SECTION THRU SLOPE PAVEMENT

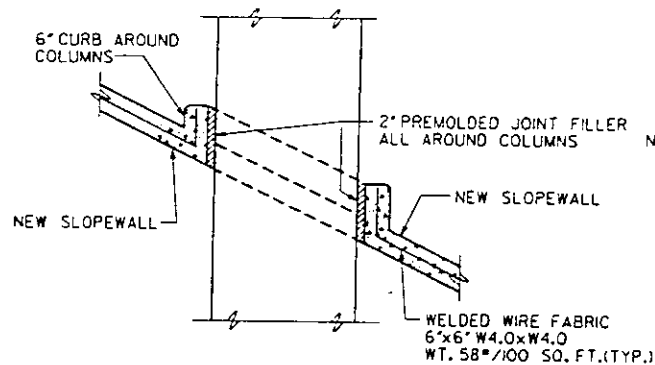


TYPICAL SECTION THRU SLOPEWALL AT PIER 44A

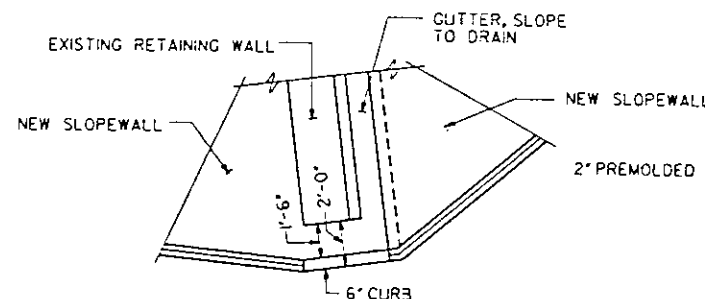


DETAIL B

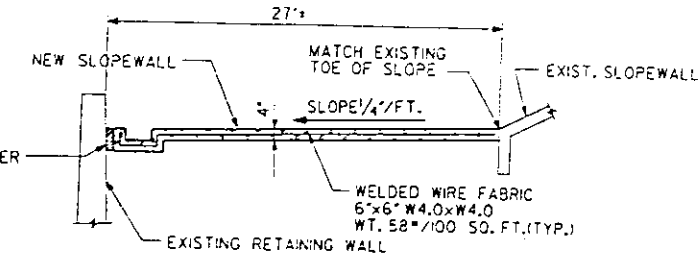


SECTION A-A

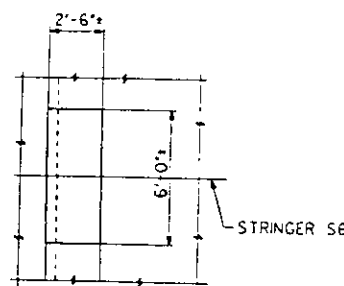

DETAIL A

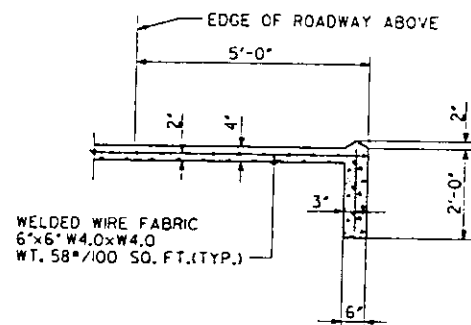

SECTION B-B

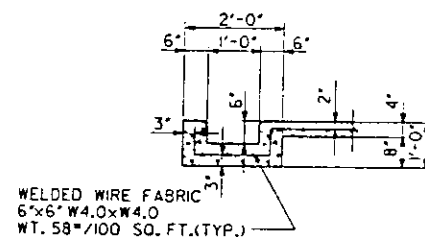

SECTION THRU GUTTER



SECTION THRU 6" CURB

REHABILITATION FOR
APPROACH BRIDGE OVER
I-55/70 W.B., MISSOURI AVE. AND TRR.
SLOPE PAVEMENT

STRUCTURE NO. 082-6003
STA. 65+00 (FAP 799) ST. CLAIR CO.

PREPARED BY
SVERDRUP CORPORATION
ST. LOUIS, MISSOURI

SECTION 1BR-1

SHEET NO. 63 OF 75

FOR INFORMATION ONLY

28-OCT-1987

FILE: 2F3151JDETAIL104.DGN
LEVELS PLOTTED DATE: OCT. 23, 1987
35,56,57,58 AND 63
875929 PRF, DETAIL104

DESIGNED	D.J. SCHREMP
CHECKED	R.F. BECK
DRAWN	J.G. CORLEY
CHECKED	A. MYERS

BENT REPAIR SCHEDULE

ROUTE NO.	SECTION	COUNTY	TOTAL SHEETS
FAP 799	•	ST. CLAIR	252
		ELEMENT	PROJECT

BENT	NOTE	CAP BEAMS		BRACING			CONNECTIONS		BENT 40	PEDESTALS		REMARKS
		AJ	A2	B1	B2	B3	C1	C2	D1	E1	E2	
32	71	-	-	-	1	1	-	-	-	-	-	EXPOSE BURIED SOUTH COLUMN BASE PLATE **
33	71	-	-	-	2	3	-	-	-	-	-	
34	71	-	-	-	1	1	-	-	-	1	-	
35	71	-	-	-	-	1	1	-	-	1	-	
38	71	-	-	-	1	1	-	-	-	2	-	
39	72	-	-	5	-	-	5	-	-	-	1	
40	73	1	-	-	-	-	-	1	-	-	-	REMOVE DEBRIS AT NORTH COLUMN BASE **
41	72	-	1	5	-	-	4	-	-	-	1	
42	71	1	-	5	-	-	4	2	-	2	-	
SPAN OF LONGITUDINAL BRACING												
43NORTH	74	-	-	3	-	-	5	-	-	-	-	
43SOUTH	75	-	-	5	-	-	6	-	-	-	-	REMOVE CONCRETE SIDEWALK IN AREA **

BENT REPAIR ITEMS ** COST INCIDENTAL

These notes are applicable to the following items only:
Bents 32 thru 35 and 38 thru 42 and
Longitudinal Bracing at Span 43.

Refer to "BENT REPAIR SCHEDULE" this sheet, for location
and quantities of items referred in these notes.

Replacement implies replacing member or plate with new
item of size indicated. Existing dimensions and work
points shall be used unless noted. H.S. bolts shall be used for
reconnection using existing rivet locations. Do not weld to
existing steel.

3/4" Dia. H.S. bolts shall be used except as noted.

A. CAP BEAMS

1. COVER PLATE CAP BEAM
Provide top and bottom cover plates as noted on plans.
Stiffeners within cover plated zone to be replaced as
indicated on plans and sections. Use tap bolts at
bearing plates within cover plated zone to provide
seal fastening.

2. REPLACE STIFFENERS
Replace existing stiffeners at locations noted on plans.
Refer to Bent Elevation and section.

B. BRACING - TRANSVERSE AND LONGITUDINAL

1. REPLACE BRACING MEMBER
Remove existing member and replace with new shape as
noted below. New transverse bracing member shall be
5/16" bent plate per DETAIL A. Longitudinal members
shall be as noted on plans.
Bent plate members may be fabricated in sections and shop spliced
to required length. Splice shall be butt-weld per SECTION A.
Existing gusset plates to remain unless noted.

2. REPLACE LATTICE BAR
Remove existing deteriorated lattice bars in areas
located on plans. Replace per DETAIL B using H.S. bolts.
Bid quantities are listed in the schedule. Additional
bars may require replacement, due to further deterioration,
as directed by Engineer.

3. REPLACE BATTEN PLATE
Remove existing deteriorated batten plates in areas
located on plans. Replace per DETAIL C using H.S. bolts.

C. CONNECTIONS

1. REPLACE GUSSET PLATE
Remove and replace existing gusset plates. Refer to
"Transverse Bracing Typical Replacement Connections",
this sheet, for sizes and bolt requirements.
For Longitudinal Bracing connections, refer to Span 43 details, Sheet 75.
Replace any fill plates.

2. REPLACE RIVETS
Replace all rivets connecting bottom flange of cap beam
to horiz. angles at cap beam-to-column connection
with 3/4" H.S. bolts.


D. BENT 40 REPLACEMENT

1. REPLACEMENT
Replace existing steel bent with new frame per dwgs.
Existing concrete pedestals to be used. Note the existence of
a steel frame currently strapped to Pier 36 that will be available to
aid in shoring during construction.
See Sheet 73 for Bent 40 General notes.


E. PEDESTALS

1. CLEARING AND GRADING
Remove trees. Regrade / Backfill to top of pile cap.


2. PATCH COLUMN PEDESTALS
Repair cracks and patch spalling in column pedestals.
Remove fractured concrete. Repair with epoxy concrete.
See sheet 72 for details.

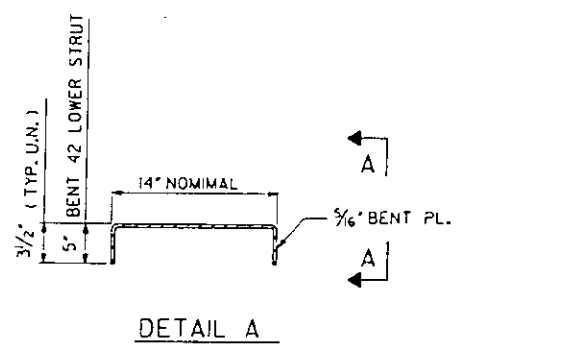


DETAIL A
TYPICAL BENT PLATE REPLACEMENT MEMBER

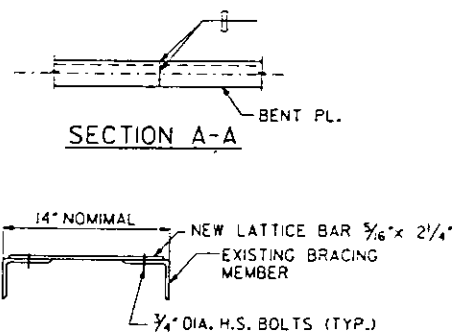


SECTION A-A
DETAIL B
TYPICAL REPLACEMENT LATTICE BAR

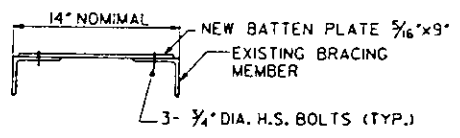

DETAIL C
TYPICAL REPLACEMENT BATTEN PLATE

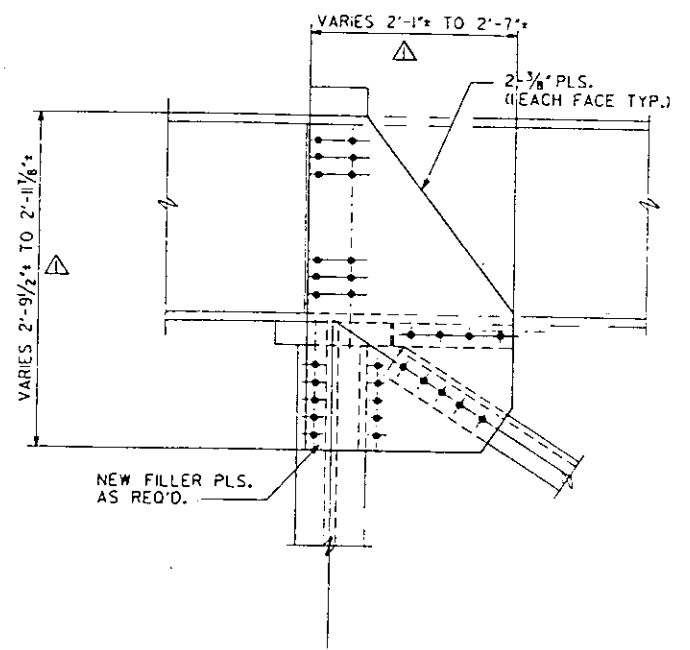

NUMBER AND LOCATION OF HOLES TO MATCH
EXISTING CONNECTION. EXISTING HOLES MAY BE
USED AS TEMPLATE FOR NEW MEMBER HOLES (TYP.)

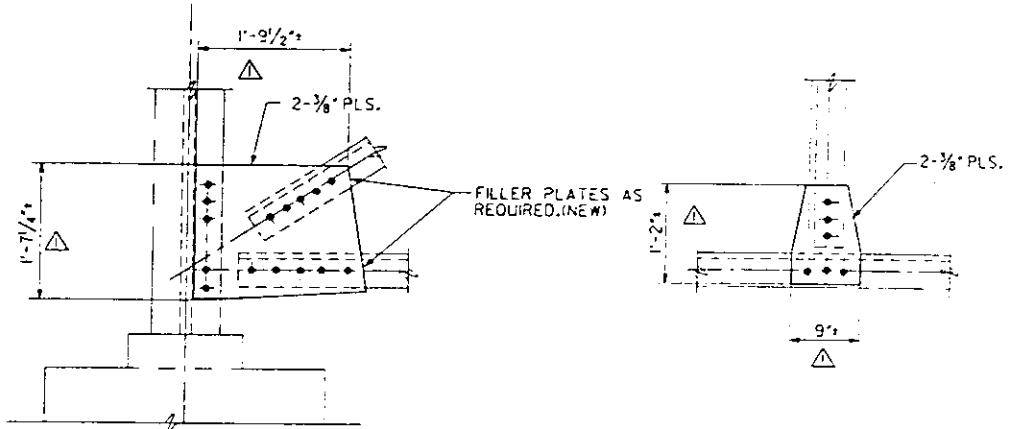

TRANSVERSE BRACING TYPICAL REPLACEMENT CONNECTIONS

10358 FILE: ZF310511BREP2.DGN
 875967 PPF: BREP2
 LEVELS PLOTTED DATE: OCT. 23, 1987
 35 56 57 63

J. BARTELS	DESIGNED
V.C. LISCHER	CHECKED
M.J. JALINSKY	QMAN
J. BARTELS	CHECKED

DESIGNED BY:
FLEMING CORPORATION
ST. LOUIS, MISSOURI

PREPARED BY:
SVERDRUP CORPORATION
ST. LOUIS, MISSOURI

REV. 12-4-87

SECTION 18R-1

REHABILITATION FOR
APPROACH BRIDGE OVER
I-55/70 W.B., MISSOURI AVE. AND TRRA


BENT REPAIR SCHEDULE
AND TYPICAL DETAILS
STRUCTURE NO. 692-6003
STA. 65+00 (FAP 799) ST. CLAIR CO.

SHEET NO. 70 OF 75


FOR INFORMATION ONLY

ROUTE NO.	SECTION	COUNTY	TOTAL SHEETS
FAP 799	•	ST. CLAIR	252
ELIMOS	PROJECT		


*IBR-1 APPROACH BRIDGE

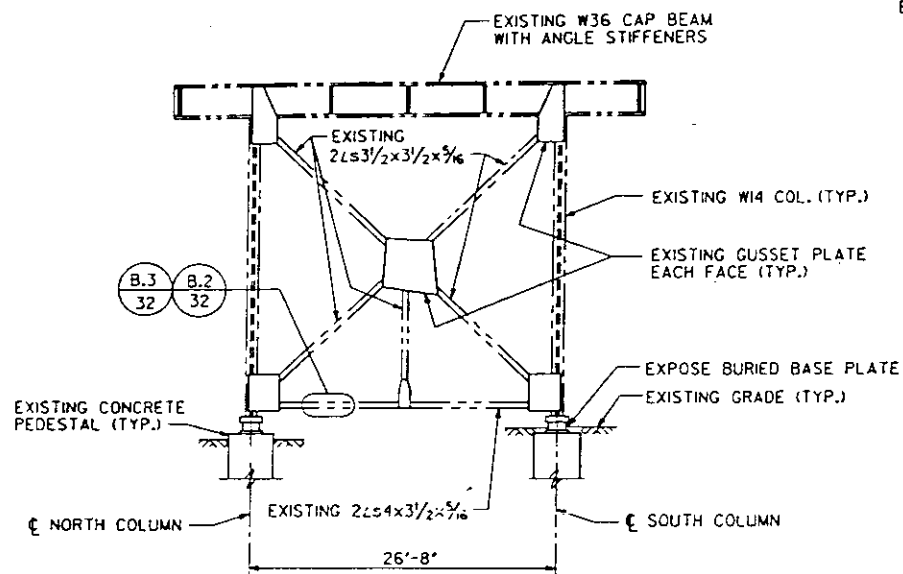


BENT 32

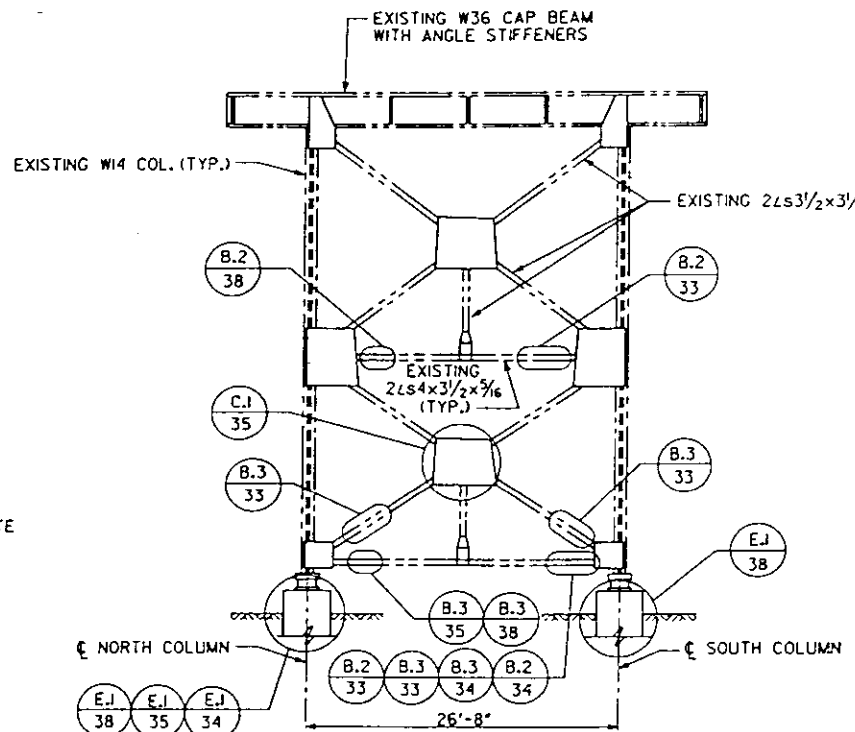

BENTS 33 THRU 35 AND 38

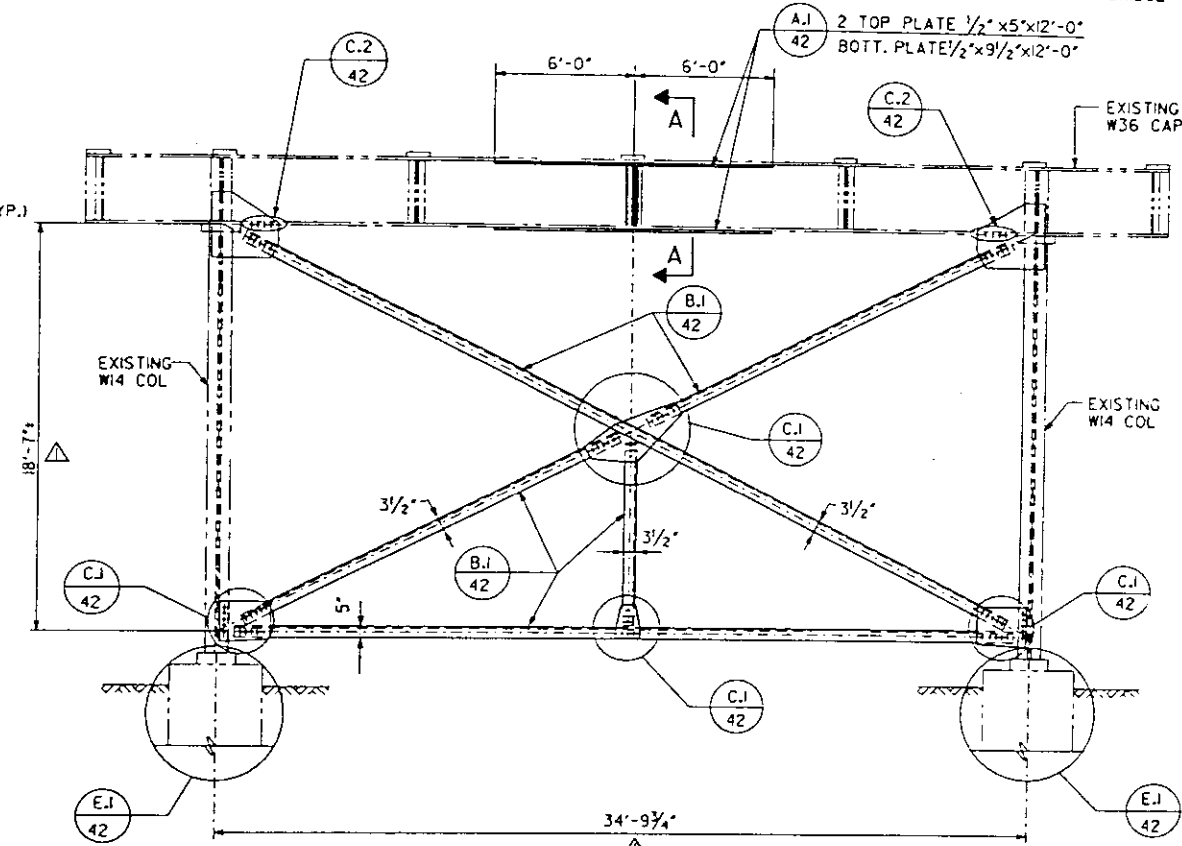

BENT 42
WEST ELEVATION

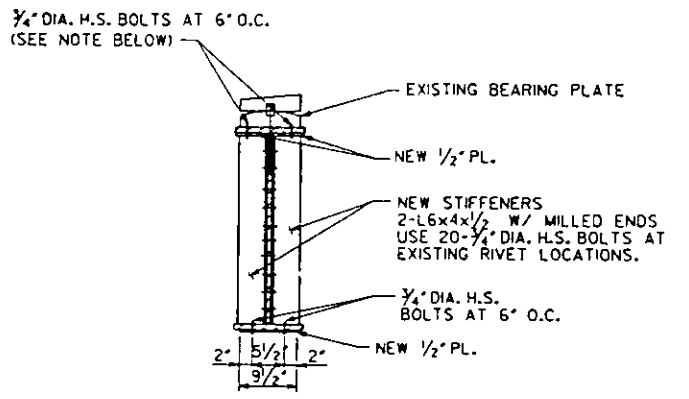

SECTION A-A

NOTE: USE TAP BOLTS AT EXISTING BEARING PLATES TO PROVIDE SEALING FASTENERS AT TOP COVER PLATE.

⊙ BENT REPAIR ITEM NOTE - SEE SHEET 70
⊙ BENT NUMBER

5-DEC-1987-08

LEVELS PLOTTED DATE: OCT. 23, 1987
35, 56 AND 63

FILE: ZF3153JDETAILS.DGN
1045 PRF DETAILS3

DESIGNED	R.L. MACKAY
CHECKED	V.C. LISCHER
ORAIN	D.J. SCHREMP
CHECKED	J. BARTELS


DESIGNED BY: FLEMING CORPORATION
PREPARED BY: SYVERDRUP CORPORATION
ST. LOUIS, MISSOURI


STRUCTURE NO. 082-6003
STA. 65+00 (FAP 799) ST. CLAIR CO.

REV. 12-4-87 SECTION 1BR-1


SHEET NO. 71 OF 75

FOR INFORMATION ONLY

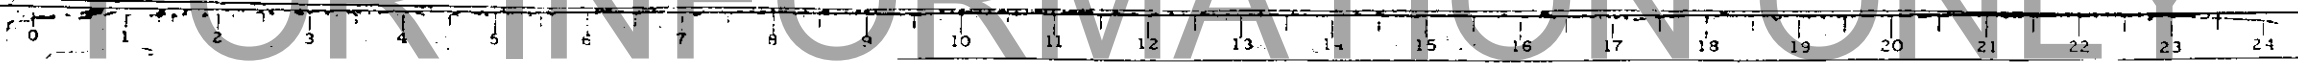


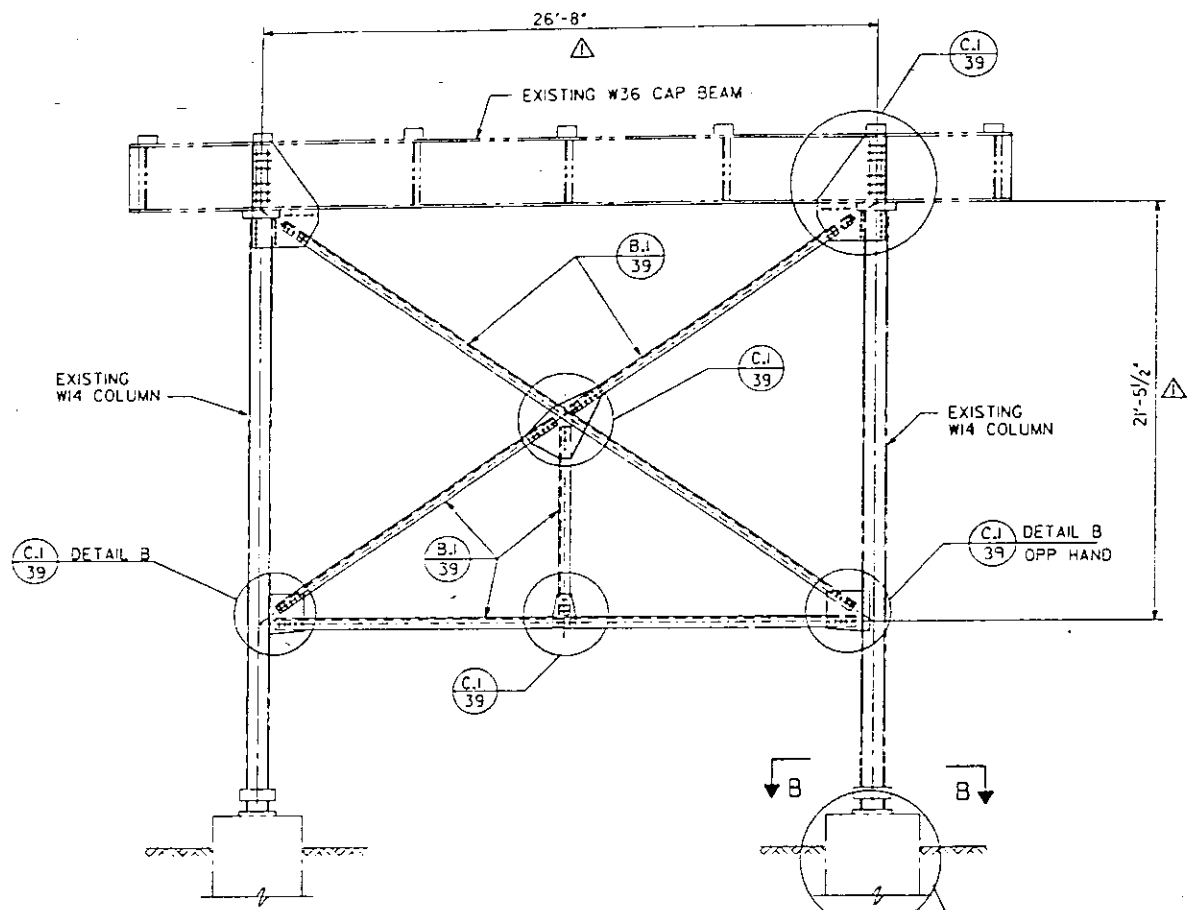


BENT 39
WEST ELEVATION

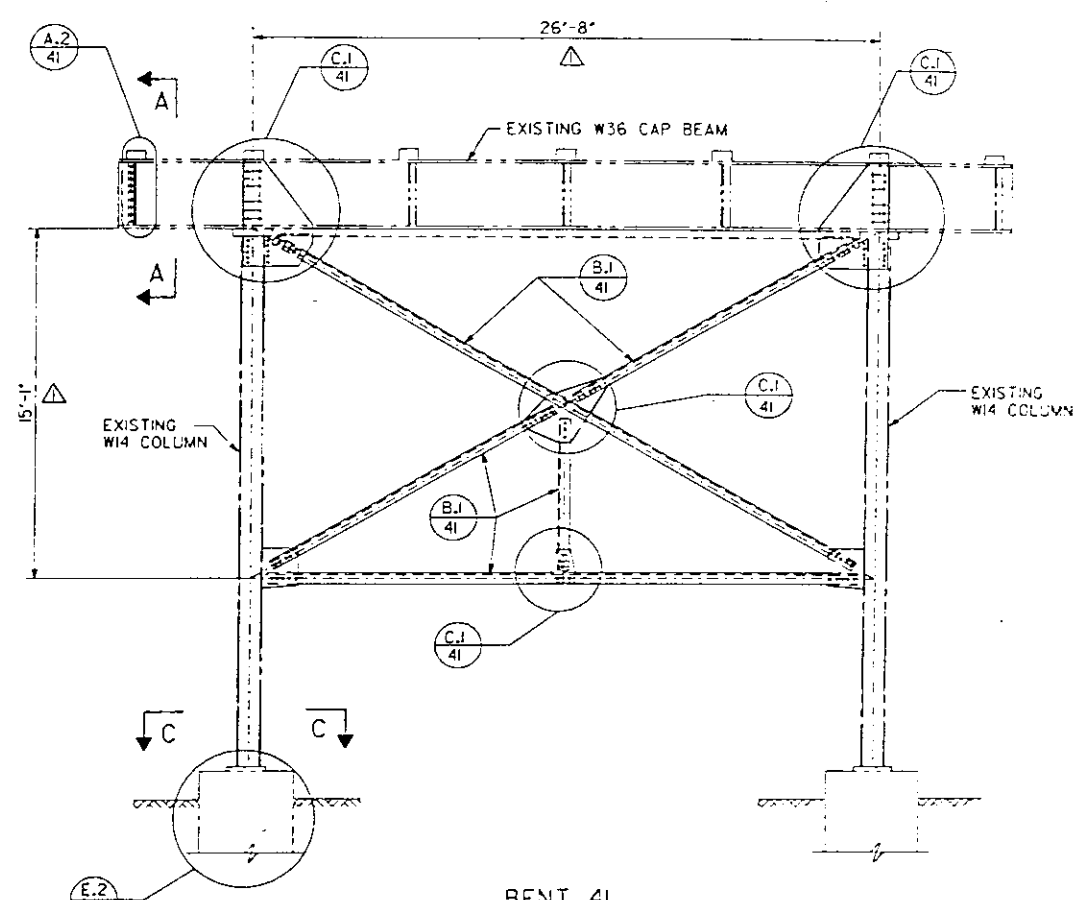


BENT 41
WEST ELEVATION

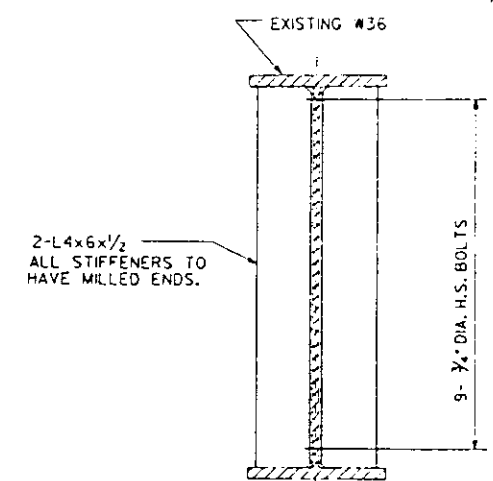

SECTION A-A

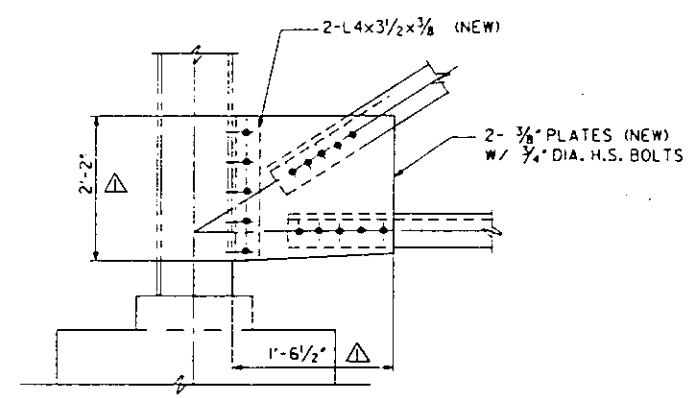


DETAIL B

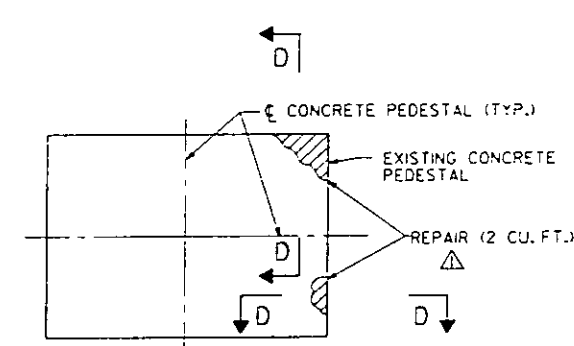


SECTION B-B

NOTE: COLUMN BASE PLATE OMITTED FOR CLARITY.

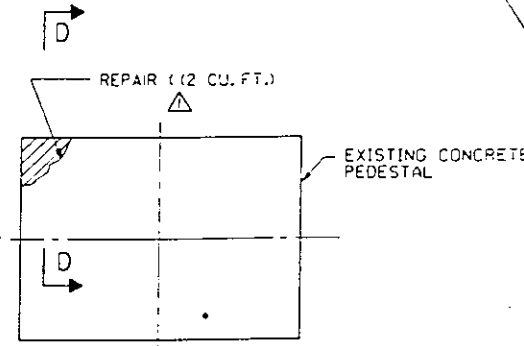

SECTION C-C

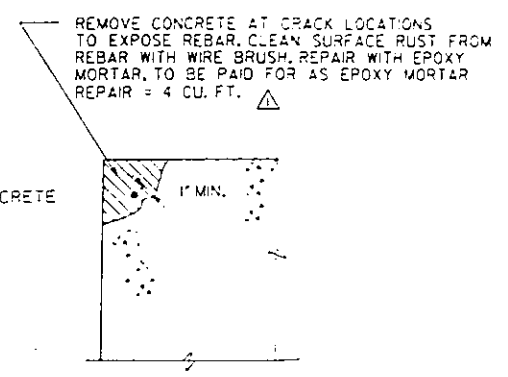

SECTION D-D

REHABILITATION FOR
APPROACH BRIDGE OVER
I-55/70 W.B., MISSOURI AVE. AND TR
BENTS 39 AND 41

STRUCTURE NO. 082-6003
STA. 65+00 (FAP 799) ST. CLAIR CO.

4-DEC-1987 5:59
 J358 FILE: ZF31(5)BENT39.DGN DATE: OCT. 23, 1987
 75968 PRF: BENT39 35 56 58 63

DESIGNED	J. BARTELS
CHECKED	V. C. LISCHER
CHECKED	M. J. JALINSKY
DRAWN	ORRAN
CHECKED	J. BARTELS

BENT REPAIR ITEM NOTE - SEE SHEET 70
 BENT NUMBER

DESIGNED BY: FLEMING CORPORATION, ST. LOUIS, MISSOURI
 PREPARED BY: SYVERDRUP CORPORATION, ST. LOUIS, MISSOURI

REV. 12-4-87




SECTION 1BR-1

SHEET NO. 72 OF


FOR INFORMATION ONLY

ROUTE NO.	SECTION	COUNTY	TOTAL SHEETS
FAP 799		ST. CLAIR	252
		BRIDGE	
		PROJECT	


IBR-1 APPROACH BRIDGE

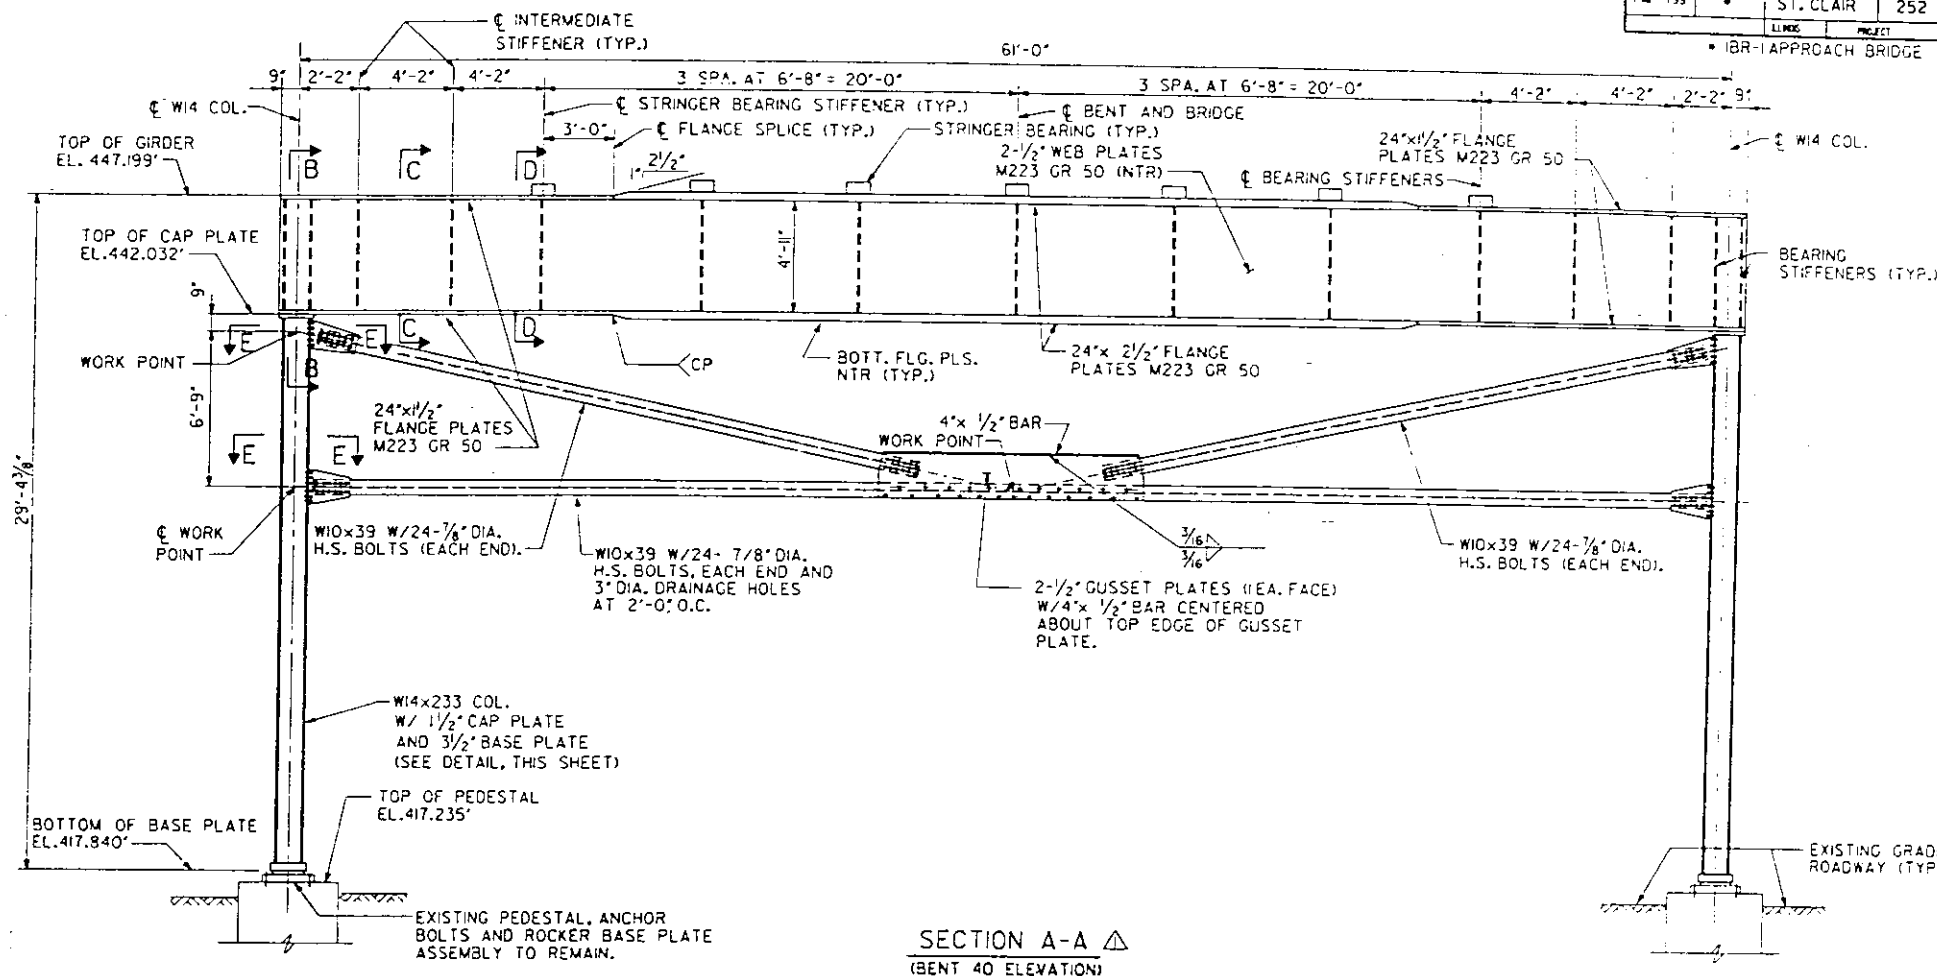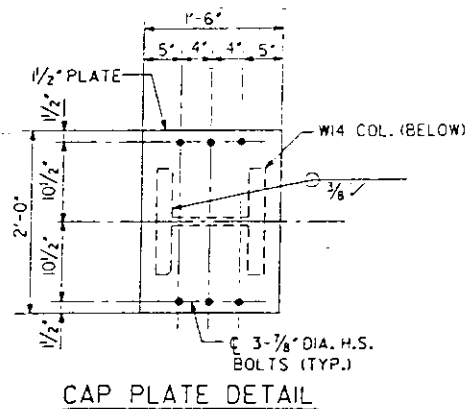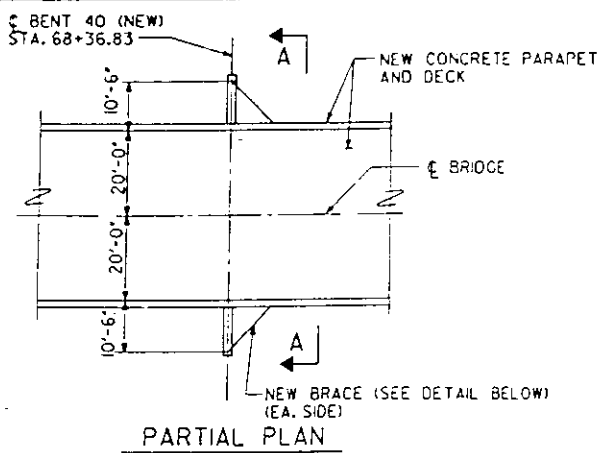


SECTION A-A
(BENT 40 ELEVATION)

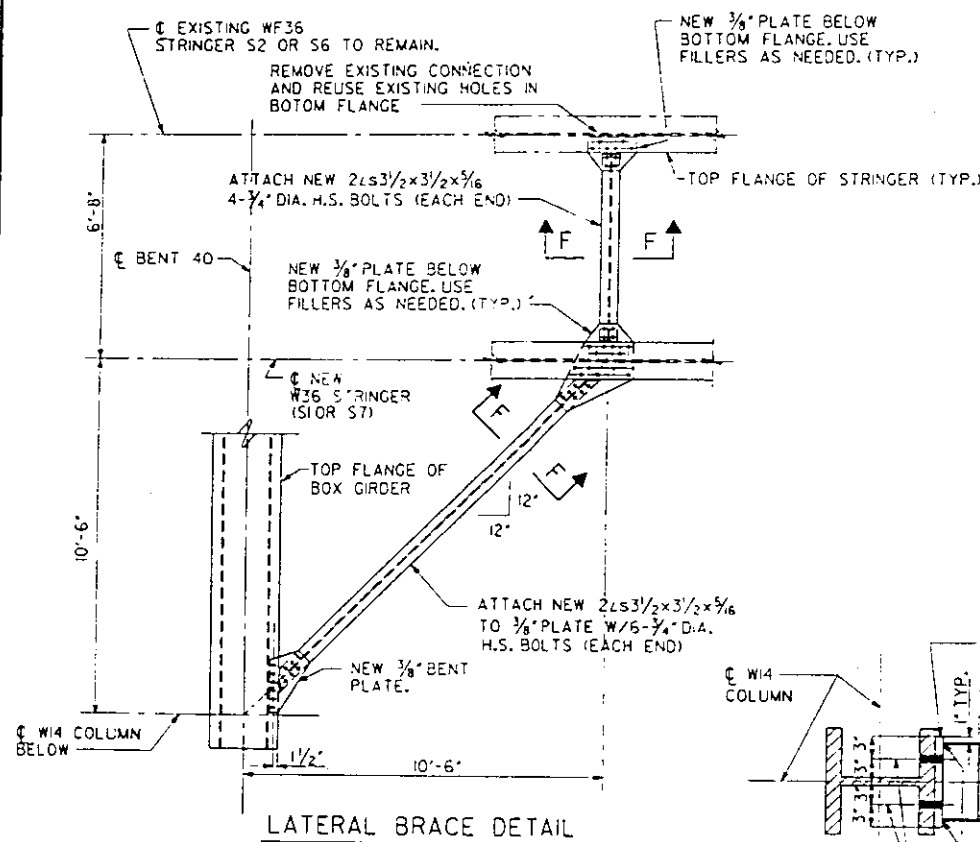


LATERAL BRACE DETAIL

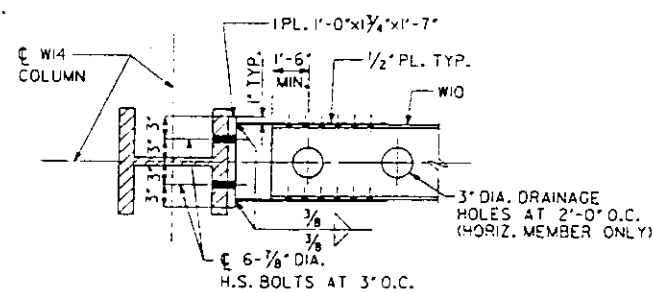

SECTION E-E

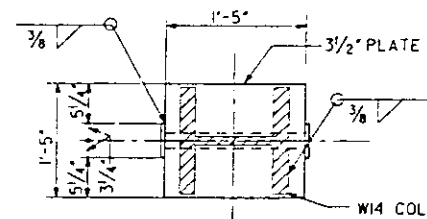


BASE PLATE DETAIL

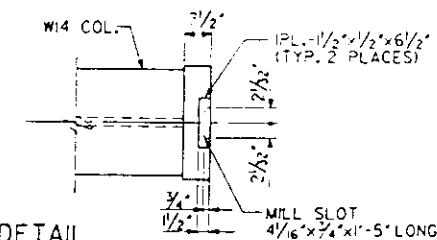


NOTES


ALL STEEL SHALL BE AASHTO M-183 EXCEPT AS NOTED.
NTR INDICATES MATERIAL SUBJECT TO NOTCH TOUGHNESS REQUIREMENTS.

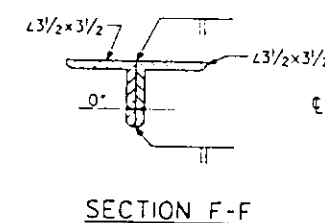


SECTION F-F

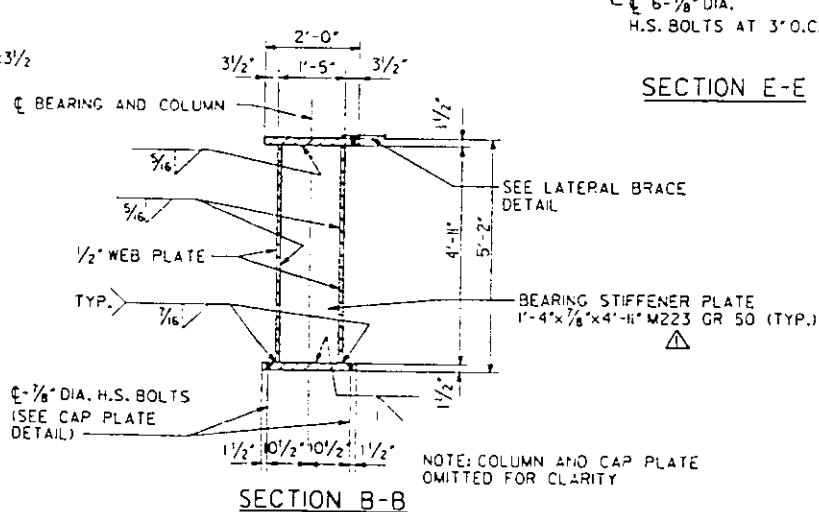

SECTION B-B

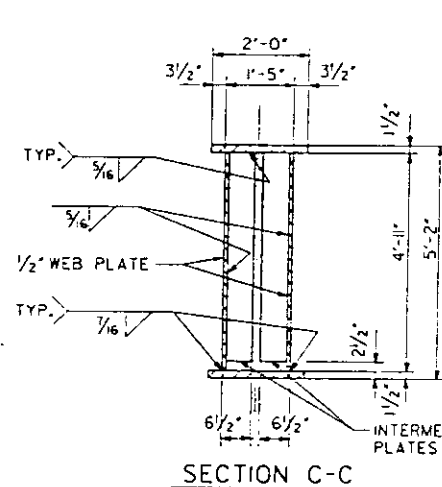

SECTION C-C

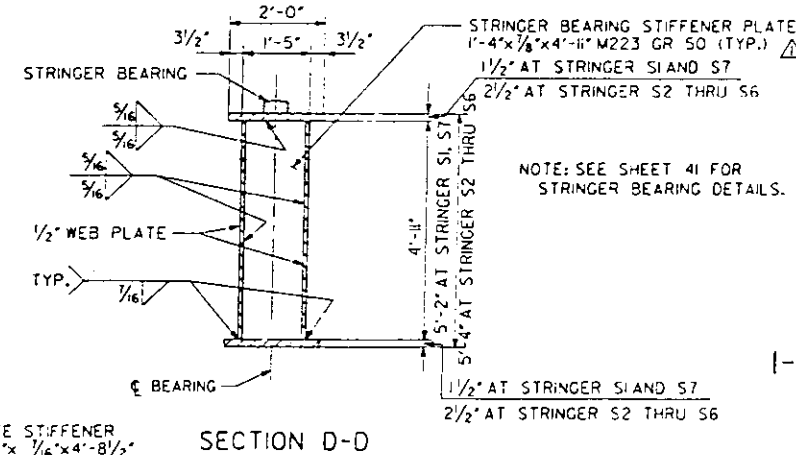

SECTION D-D

NOTE: SEE SHEET 41 FOR STRINGER BEARING DETAILS.

REHABILITATION FOR
APPROACH BRIDGE OVER
I-55/70 W.B., MISSOURI AVE. AND TRR/
BENT 40

STRUCTURE NO. 082-6003
STA. 65+00 (FAP 799) ST. CLAIR CO.

DESIGNED BY: FLEMING CORPORATION
ST. LOUIS, MISSOURI
PREPARED BY: SYVERDRUP CORPORATION
ST. LOUIS, MISSOURI

REV. 12-4-87

SECTION IBR-1


SHEET NO. 73 OF 75

FOR INFORMATION ONLY


4-DEC-1987

LEVELS PLOTTED DATE: OCT. 23, 1987
35,56.63
FILE: ZF31515IBENT40.DGN
175969 PRF: BENT40


R.L. MACKAY
DESIGNED
V.C. LISCHER
CHECKED
M.J. JALINSKY
DRAWN
R.L. MACKAY
CHECKED

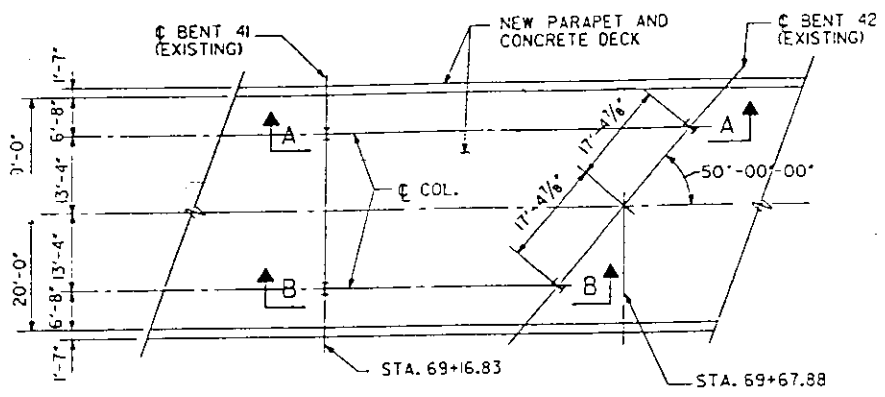


PARTIAL PLAN VIEW
(SEE SHEET 75 FOR ELEVATION B-B)

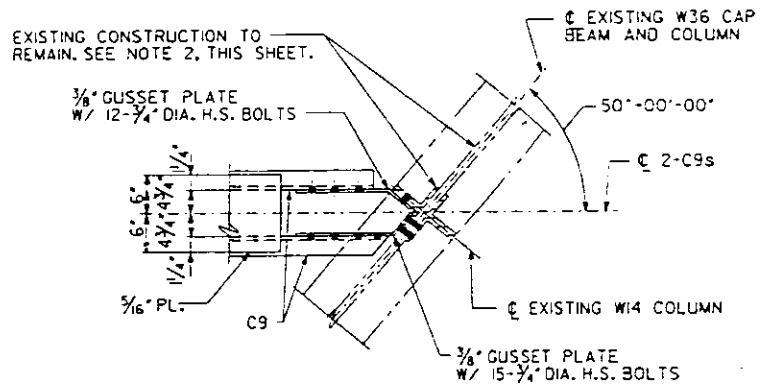


SECTION D-D

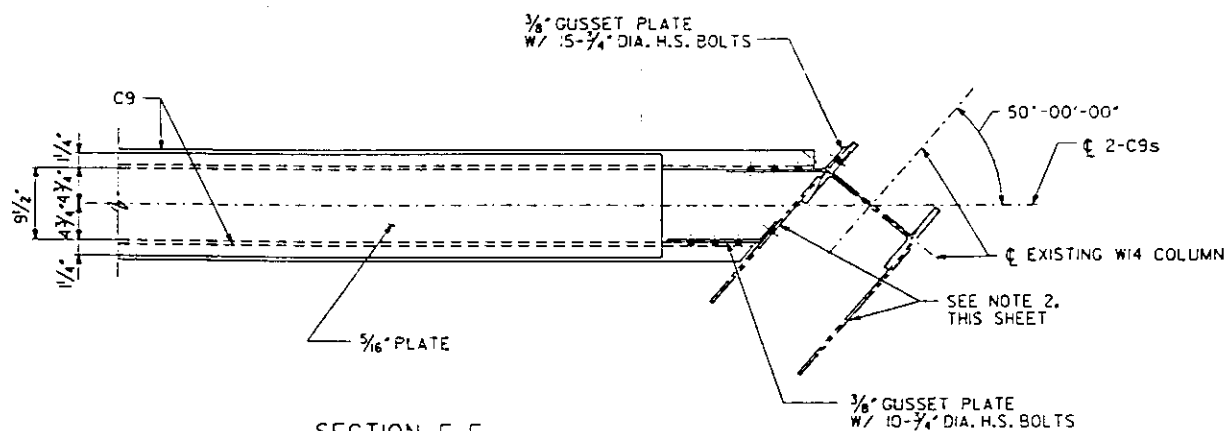


SECTION E-E

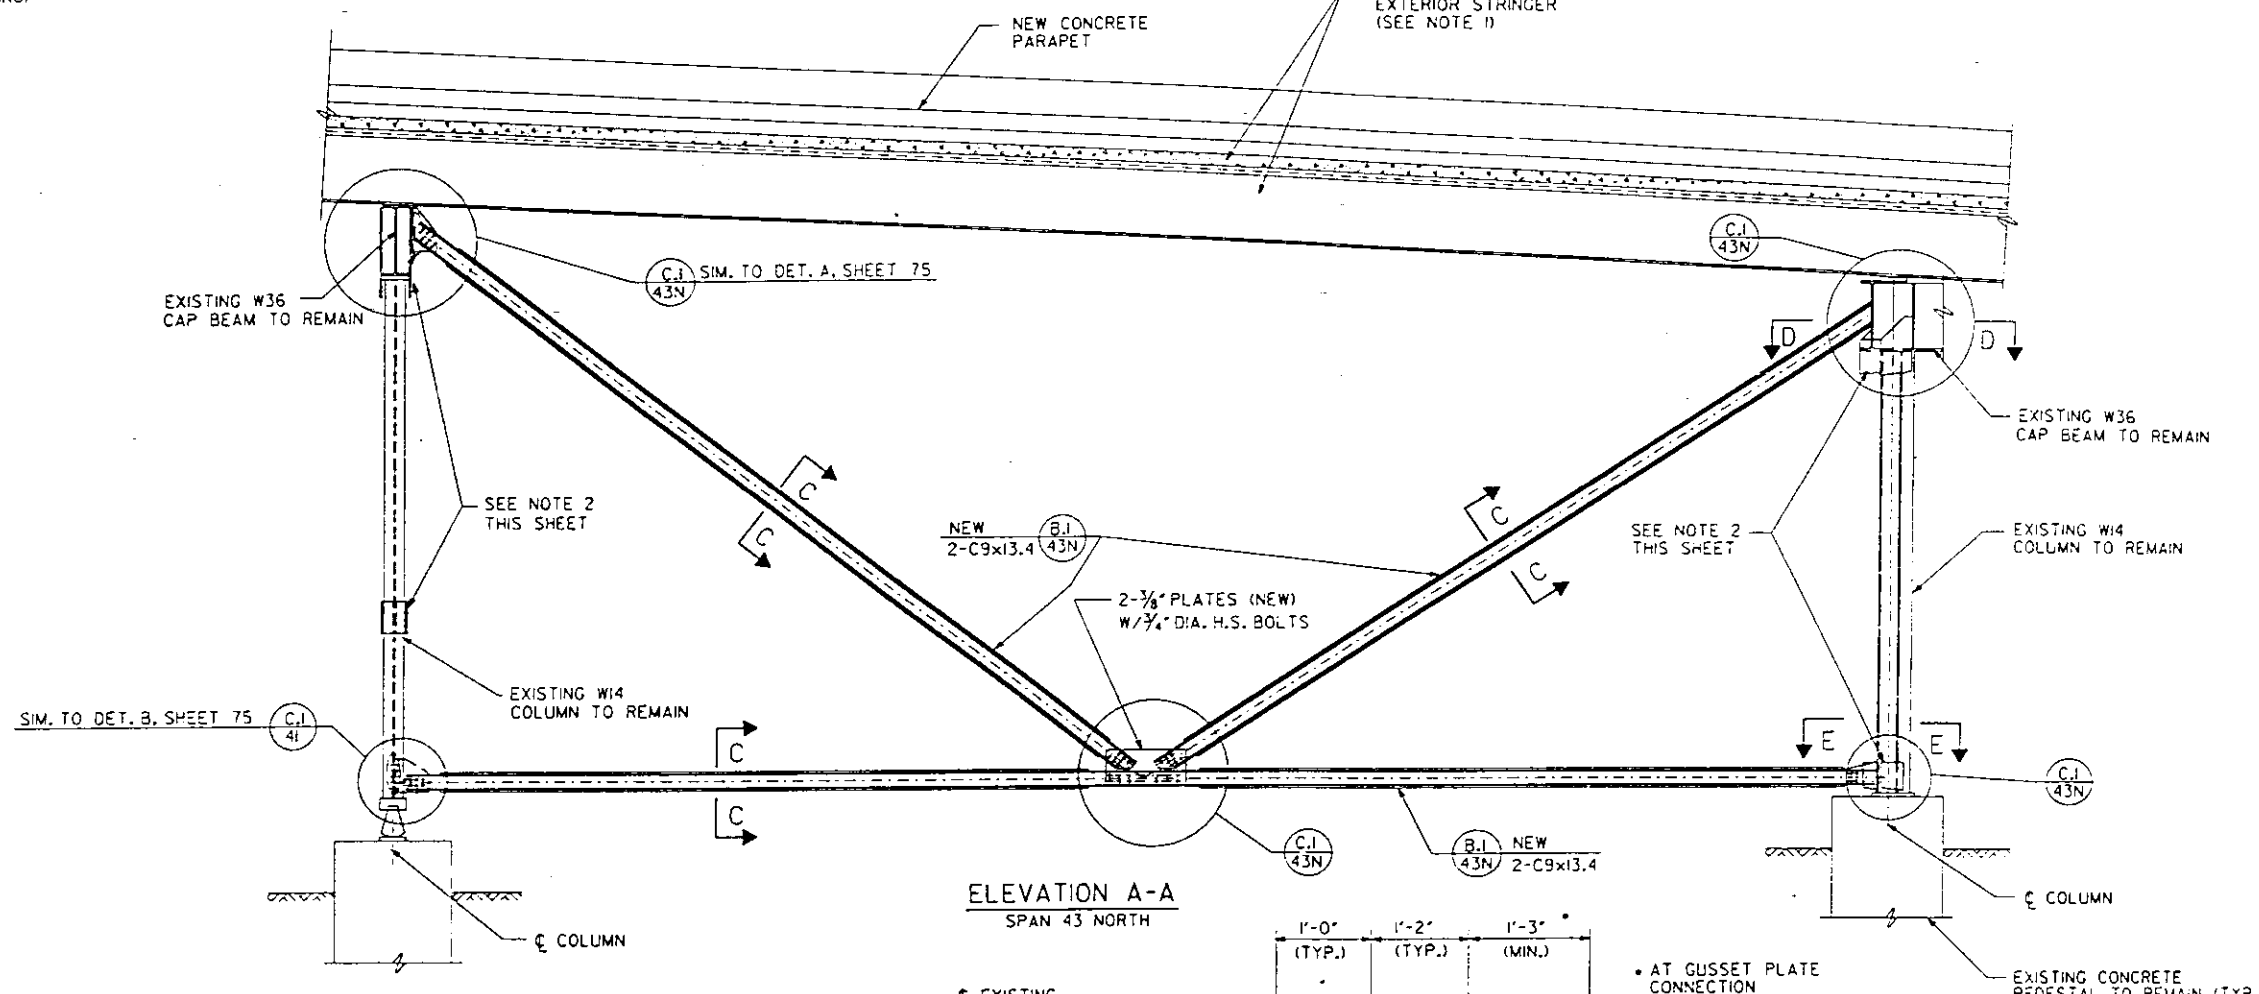

ELEVATION A-A
SPAN 43 NORTH

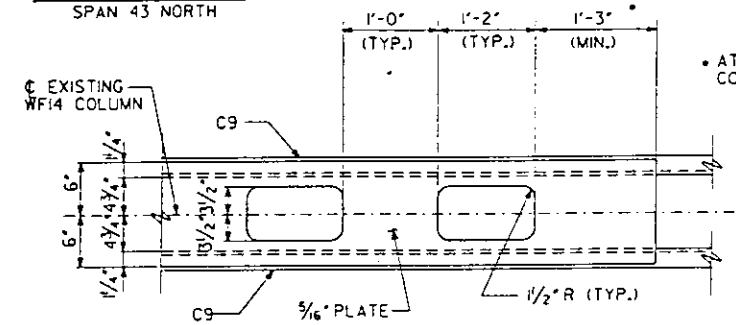

DETAIL A

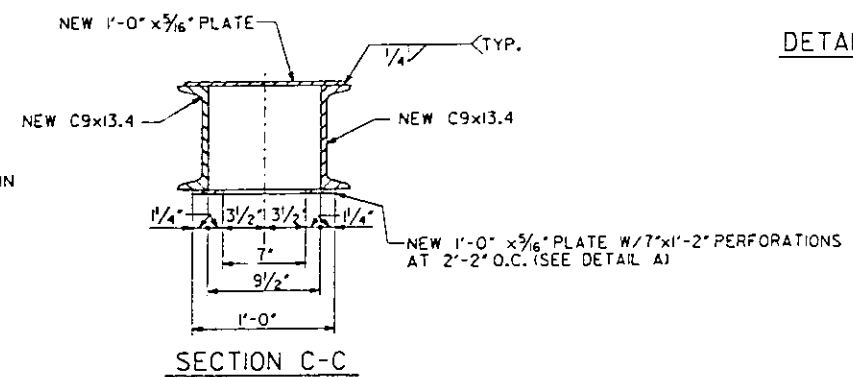

SECTION C-C

- NOTES:
1. STRINGER CONNECTIONS NOT SHOWN FOR CLARITY.
 2. COORDINATE THE WORK AS SHOWN ON THIS SHEET WITH THE WORK REQUIRED FOR BENTS 41 AND 42. SEE SHEETS 72 AND 71 RESPECTIVELY.

⊙ BENT REPAIR ITEM NOTE - SEE SHEET 70
⊙ BENT NUMBER

REHABILITATION FOR
APPROACH BRIDGE OVER
I-55/70 W.B., MISSOURI AVE. AND TRRA
LONGITUDINAL BRACING, SPAN 43 NORTH

STRUCTURE NO. 082-6003
STA. 65+00 (FAP 799) ST. CLAIR CO.


DESIGNED BY	R.L. MACKAY
CHECKED BY	V.C. LISCHER
DRAWN BY	M.J. JALINSKY
DATE	10/11/81

DESIGNED BY
FLEMING CORPORATION
ST. LOUIS, MISSOURI


PREPARED BY
SYVERDRUP CORPORATION
ST. LOUIS, MISSOURI

FOR INFORMATION ONLY


ROUTE NO.	SECTION	COUNTY	STA. SHEETS	SHEET
FAP 799	*	ST. CLAIR	252	223
PROJECT		*1BR-1 APPROACH BRIDGE		

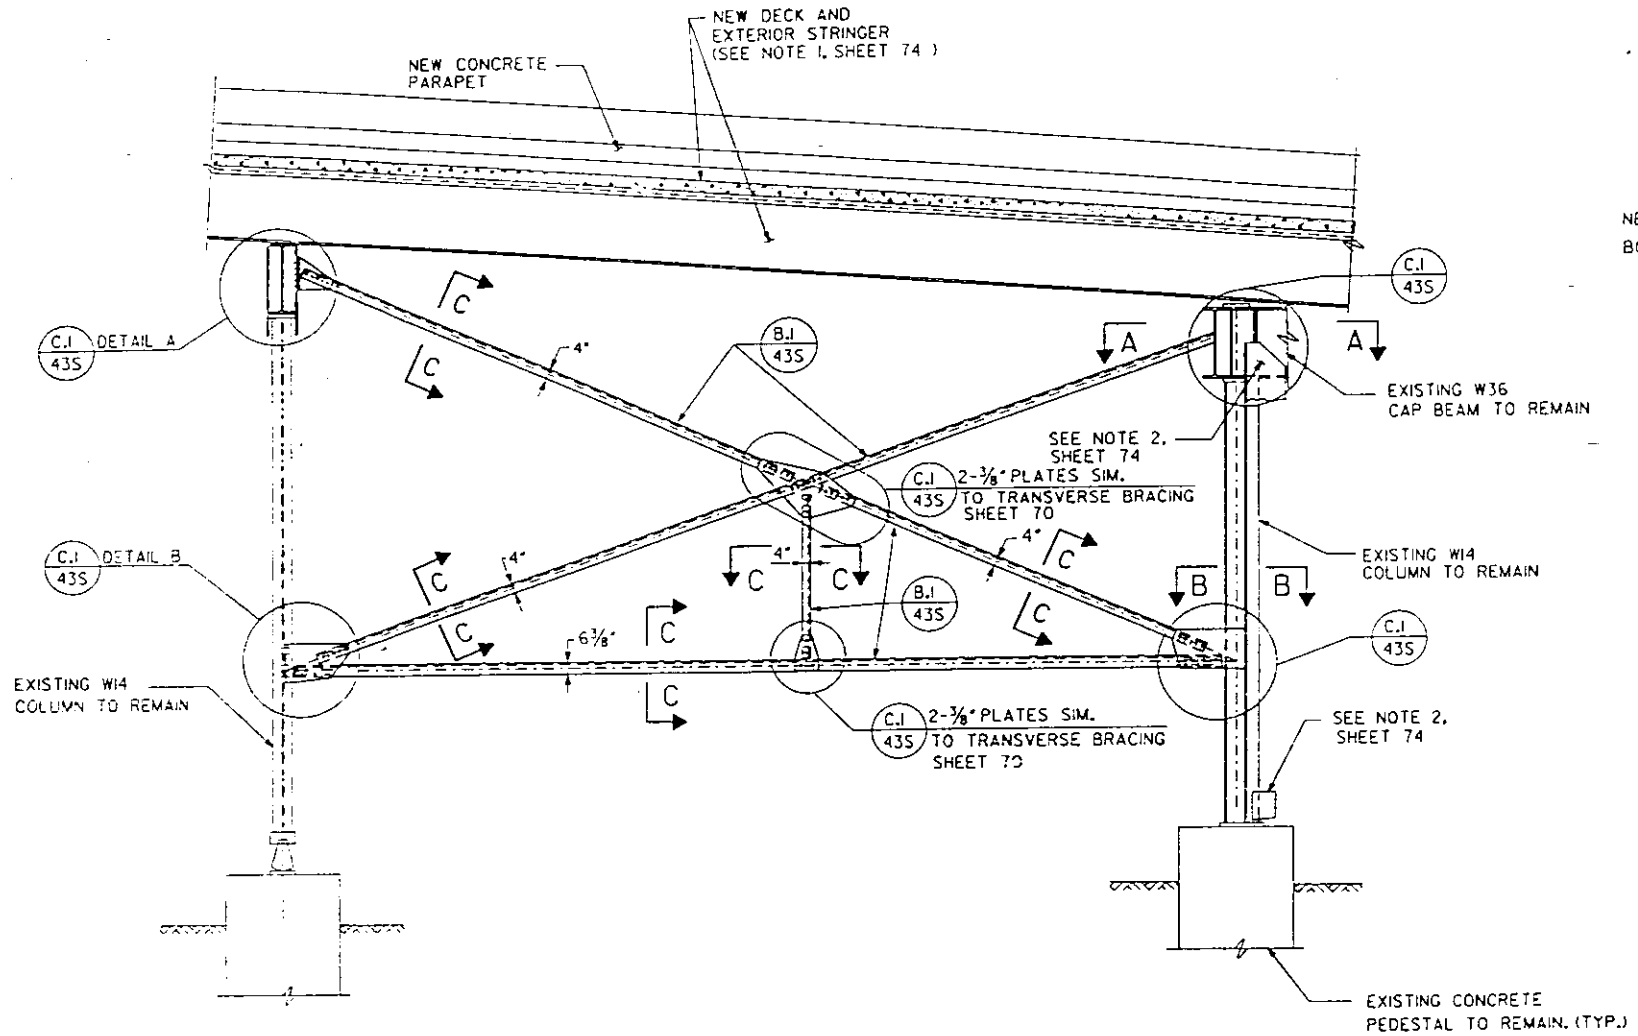


ELEVATION B-B
SPAN 43 SOUTH

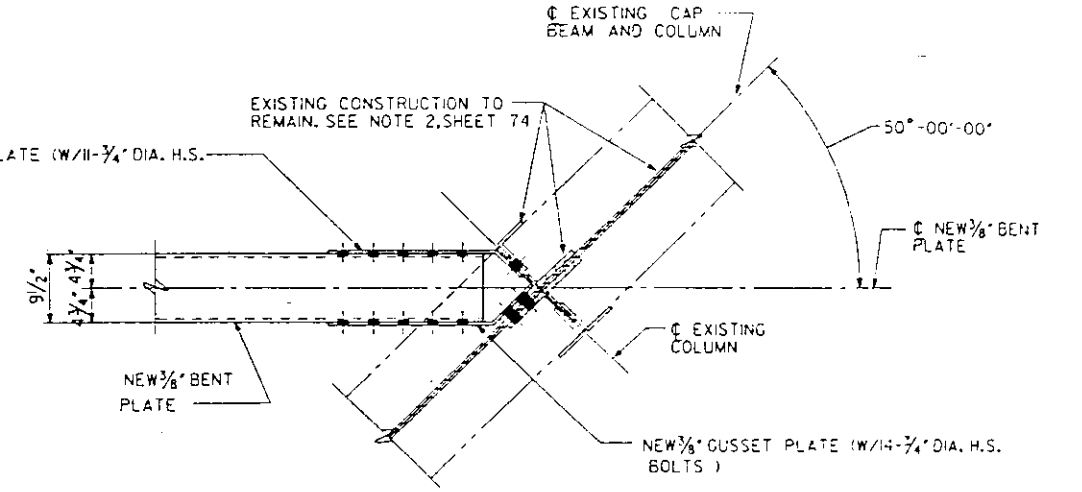


SECTION A-A

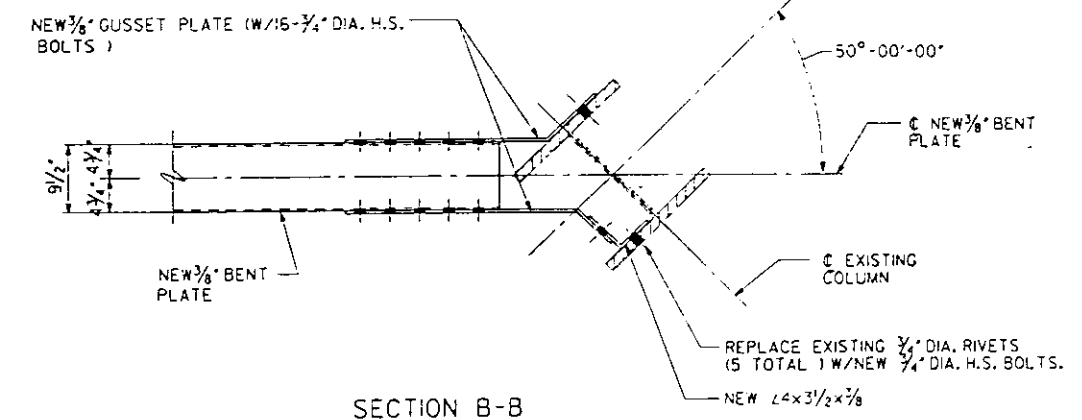


SECTION B-B

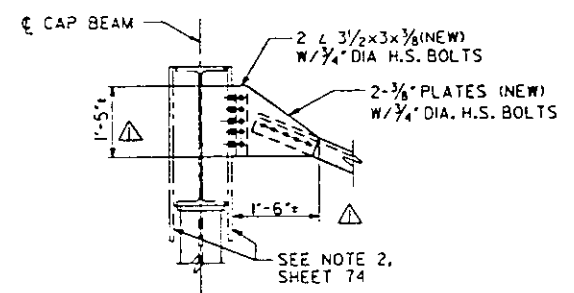

DETAIL A

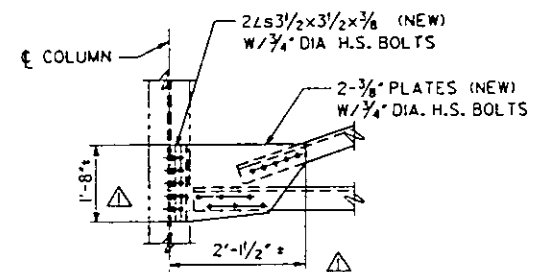

DETAIL B

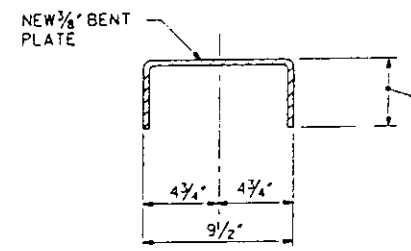

SECTION C-C

BENT REPAIR ITEM NOTE - SEE SHEET 70
BENT NUMBER

REHABILITATION FOR
APPROACH BRIDGE OVER
I-55/70 W.B., MISSOURI AVE. AND TRRA
LONGITUDINAL BRACING, SPAN 43 SOUTH

STRUCTURE NO. 082-6003
STA. 65+00 (FAP 799) ST. CLAIR CO.

FOR INFORMATION ONLY

DESIGNED BY: FLEMING CORPORATION
ST. LOUIS, MISSOURI

PREPARED BY: SVERDRUP CORPORATION
ST. LOUIS, MISSOURI

REV. 12-4-87


SECTION 1BR-1

SHEET NO. 75 OF 75

LEVELS PLOTTED DATE: OCT. 23, 1987
S:\15SPAN43A.DGN
R.L. MACKAY
SIGNED
A.C. LISHER
CHECKED
M.J. JALINSKY
DRAWN
DETAILS

MISSISSIPPI RIVER BRIDGE

CITY OF EAST ST. LOUIS

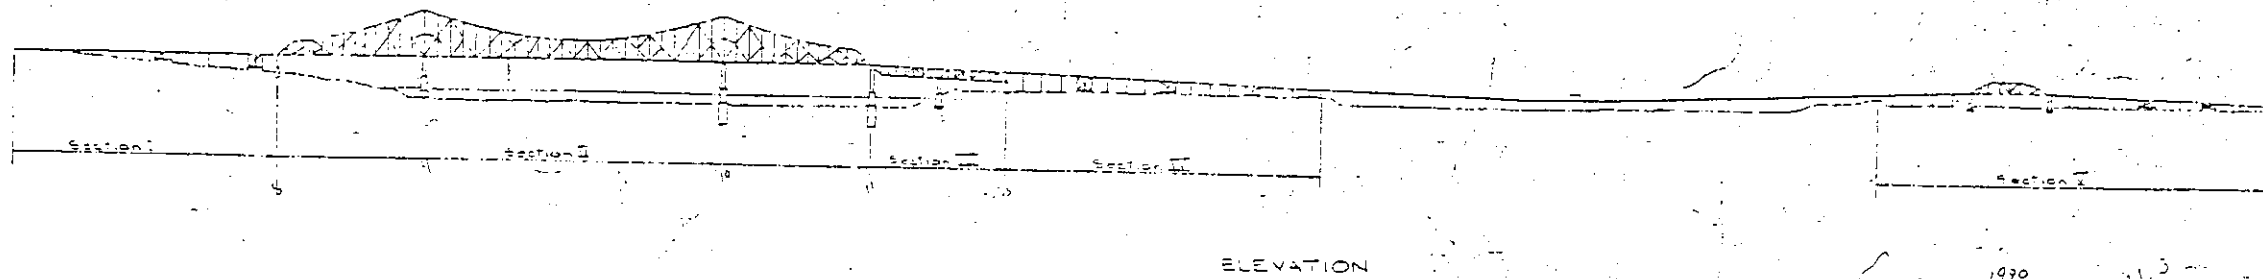


ELEVATION

1970

RECEIVED
BUREAU OF BRIDGES
AND STRUCTURES
DEC 4 1970

RGH DISO.
JTC SON.
INFO. CIRD.

SN 082-6003

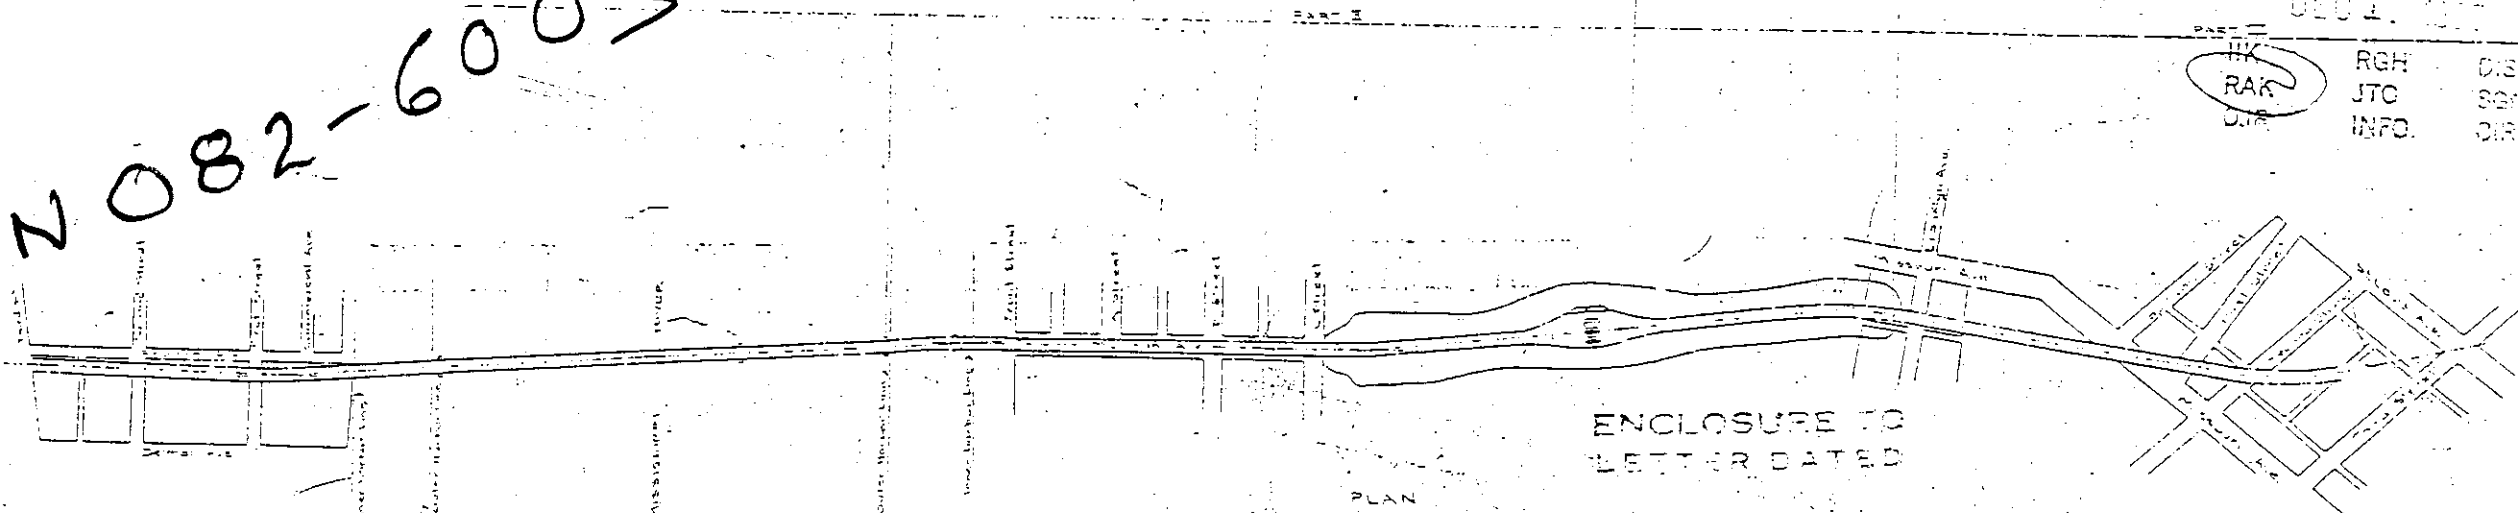

ENCLOSURE TO
LETTER DATED

NOV 16 1986

OVERGRUP & PARCEL AND ASSOCIATES, INC.



INDEX OF DRAWINGS

SHEET NO.	DESCRIPTION	SHEET NO.	DESCRIPTION	SHEET NO.	DESCRIPTION	SHEET NO.	DESCRIPTION
101	GENERAL PLAN - PART I	117	TYPICAL DETAILS - SECTION III	133	213' SPANS TRUSS DETAILS U ₀ -U ₂ (SPAN NO. 12)	149	WING WALL SECTIONS 3N, 4N, 5N, 6N, 7N & 8N
102	GENERAL PLAN - PART II	118	TYPICAL FLOOR DETAILS - SECTION III	134	213' SPANS TRUSS DETAILS U ₃ -U ₄	150	WING WALL SECTIONS 3S, 4S, 5S & 6S
103	GENERAL PLAN - PART III	119	SHOE DETAILS - 213' AND 249' SPANS	135	213' SPANS TRUSS DETAILS U ₀ -U ₂ (SPAN NO. 13)	151	FLOOR DRAINS, LIGHTING STANDARDS & RAILINGS
104	LOCATION PLAN - SECTION I	120	TYPICAL DETAILS SECTION III	136	TYPICAL DETAILS - SECTION II AND BENT NO. 38	152	ROADWAY DETAILS - ABUTMENT "A" TO PIER NO. 6
105	LOCATION PLAN - SECTION II	121	DETAILS AT PIER NO. 11	137	TYPICAL DETAILS BENTS NO. 39 AND NO. 41	153	ROADWAY DETAILS - PIER NO. 6 TO PIER NO. 13
106	LOCATION PLAN - SECTION III	122	PIERS NO. 8, NO. 12 AND NO. 13	138	BENT NO. 42	154	ROADWAY DETAILS - PIER 13 TO ABUT "B", ABUT "C" - PIER 41
107	LOCATION PLAN - SECTION IV	123	PIERS NO. 36 AND NO. 37	139	BENT NO. 43	155	ROADWAY DETAILS - PIER NO. 41 TO ABUTMENT "D"
108	LOCATION PLAN - SECTION V	124	ABUTMENTS B, C AND D	140	BENT NO. 45	156	GENERAL DETAILS AND BAR LIST
109	STRESS SHEET - SECTION I	125	PIER NO. 9	141	BENT NO. 46	157	ROADWAY DETAILS - SPAN NO. 10
110	STRESS SHEET - SECTION II	126	PIER NO. 10	142	BENT NO. 47	158	PAVEMENT DETAILS - ABUT "B" TO ABUT "C"
111	STRESS SHEET - SECTION III	127	PIER NO. 11	143	GENERAL LAYOUT AND BENT NO. 48	159	PAVEMENT DETAILS
112	STRESS SHEET - SECTION IV	128	BENT NO. 40	144	CANTILEVER SPAN STRESS SHEET	160	PAVEMENT DETAILS
113	STRESS SHEET - 249 FT. SPAN	129	BENT NO. 41				

SHEET NO.	DESCRIPTION	SHEET NO.	DESCRIPTION
165	TOLL OFFICE BUILDING DETAILS	500	TRAFFIC APPROACH - ST. LOUIS, MO
166	TOLL PLAZA AREA DETAILS	501	ALLEY AT ABUT "A" - ST. LOUIS APPROACH
167	DRAINAGE DETAILS - ABUT "B" TO ABUT "C"	502	BUILDINGS TO BE WRECKED - ST. LOUIS PLAZA
168	DRAINAGE DETAILS - ABUT "B" TO ABUT "C"	N.L.I.	LAYOUT OF NAVIGATION LIGHTS
180	TOLL OFFICE BUILDING - HEATING DETAILS		
201	TRAFFIC LIGHTS - THIRD ST. & ST. LOUIS AVE. INTERSEC		
250	2ND STREET - ST. LOUIS AVE. INTERCHANGE - PAVING		
251	TRAFFIC MARKS		
300	TOLL PLAZA CANOPY		
301	TOLL GATES		
302	TOLL PLAZA AREA		

MISSISSIPPI RIVER BRIDGE
BETWEEN
THIRD ST., EAST ST. LOUIS, ILL.
AND
THIRD ST., ST. LOUIS, MO.
FOR


El. 500.7
(Memphis Datum)

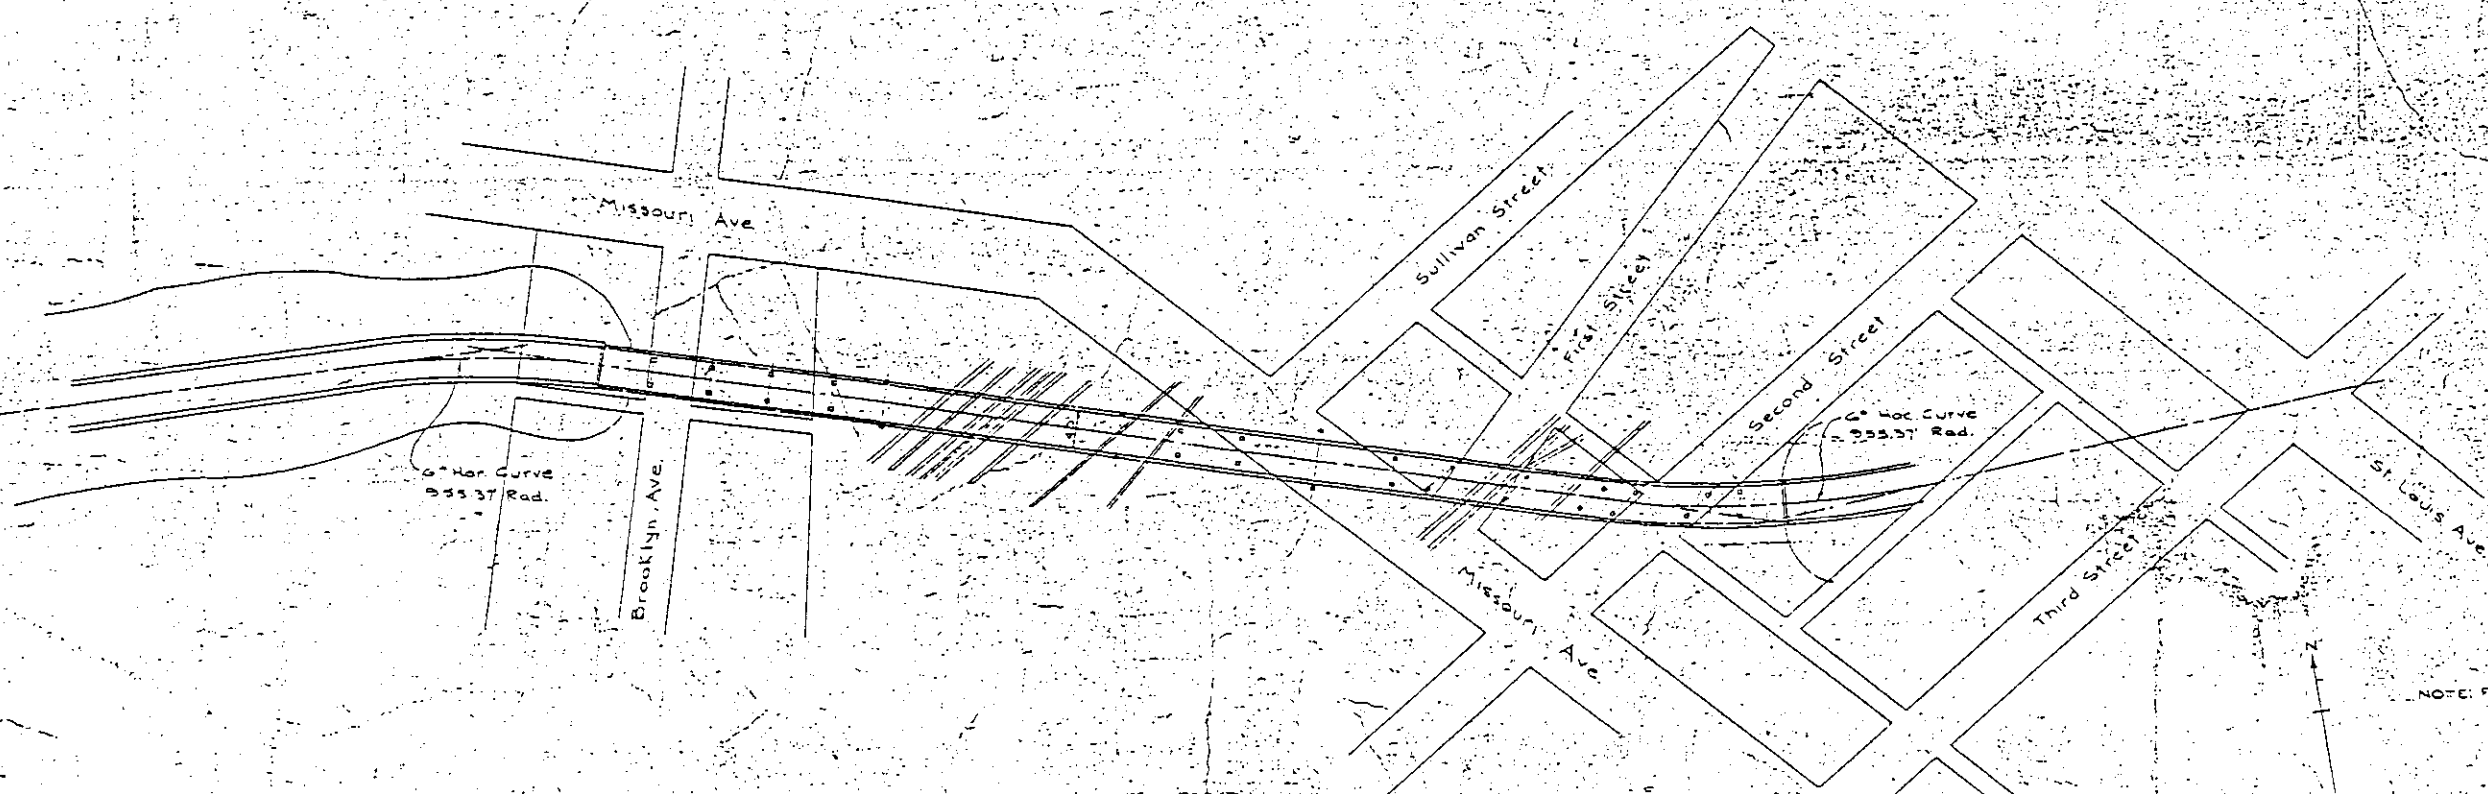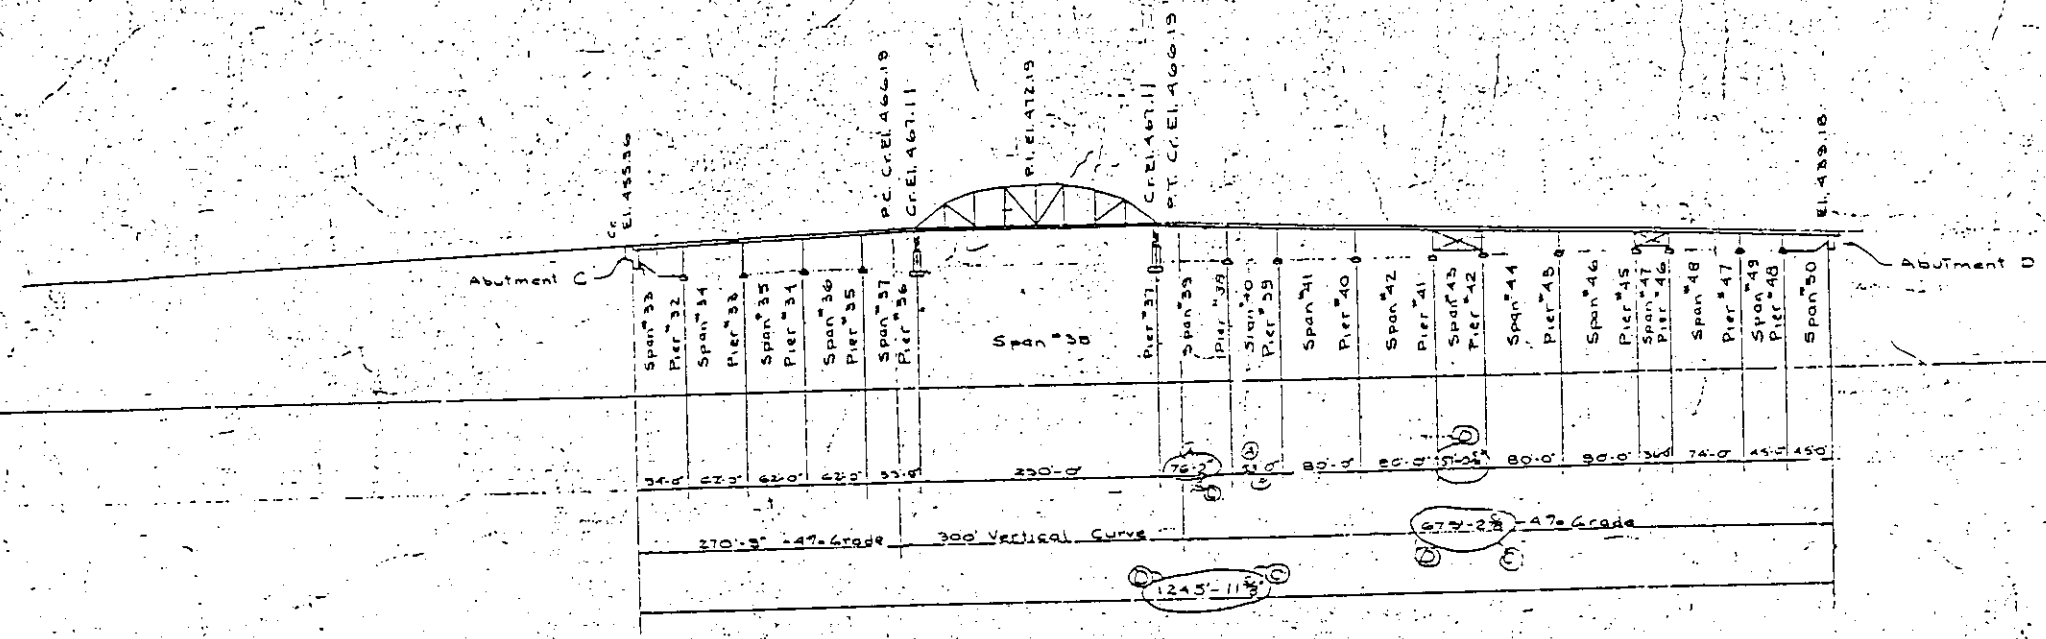

- Revision (A) Span 45 Lengthened 12'-2"
- Revision (B) Dimension Changes 14'
- Revision (C) Pier 39 Relp. 9'-15"
- Revision (D) Spans 39 & 40 7'-2"

FOR INFORMATION ONLY

MISSISSIPPI RIVER BRIDGE
BETWEEN
THIRD STREET, ST. LOUIS, MO.
AND
THIRD ST. ST. LOUIS, MO.
FOR THE
CITY OF EAST ST. LOUIS.

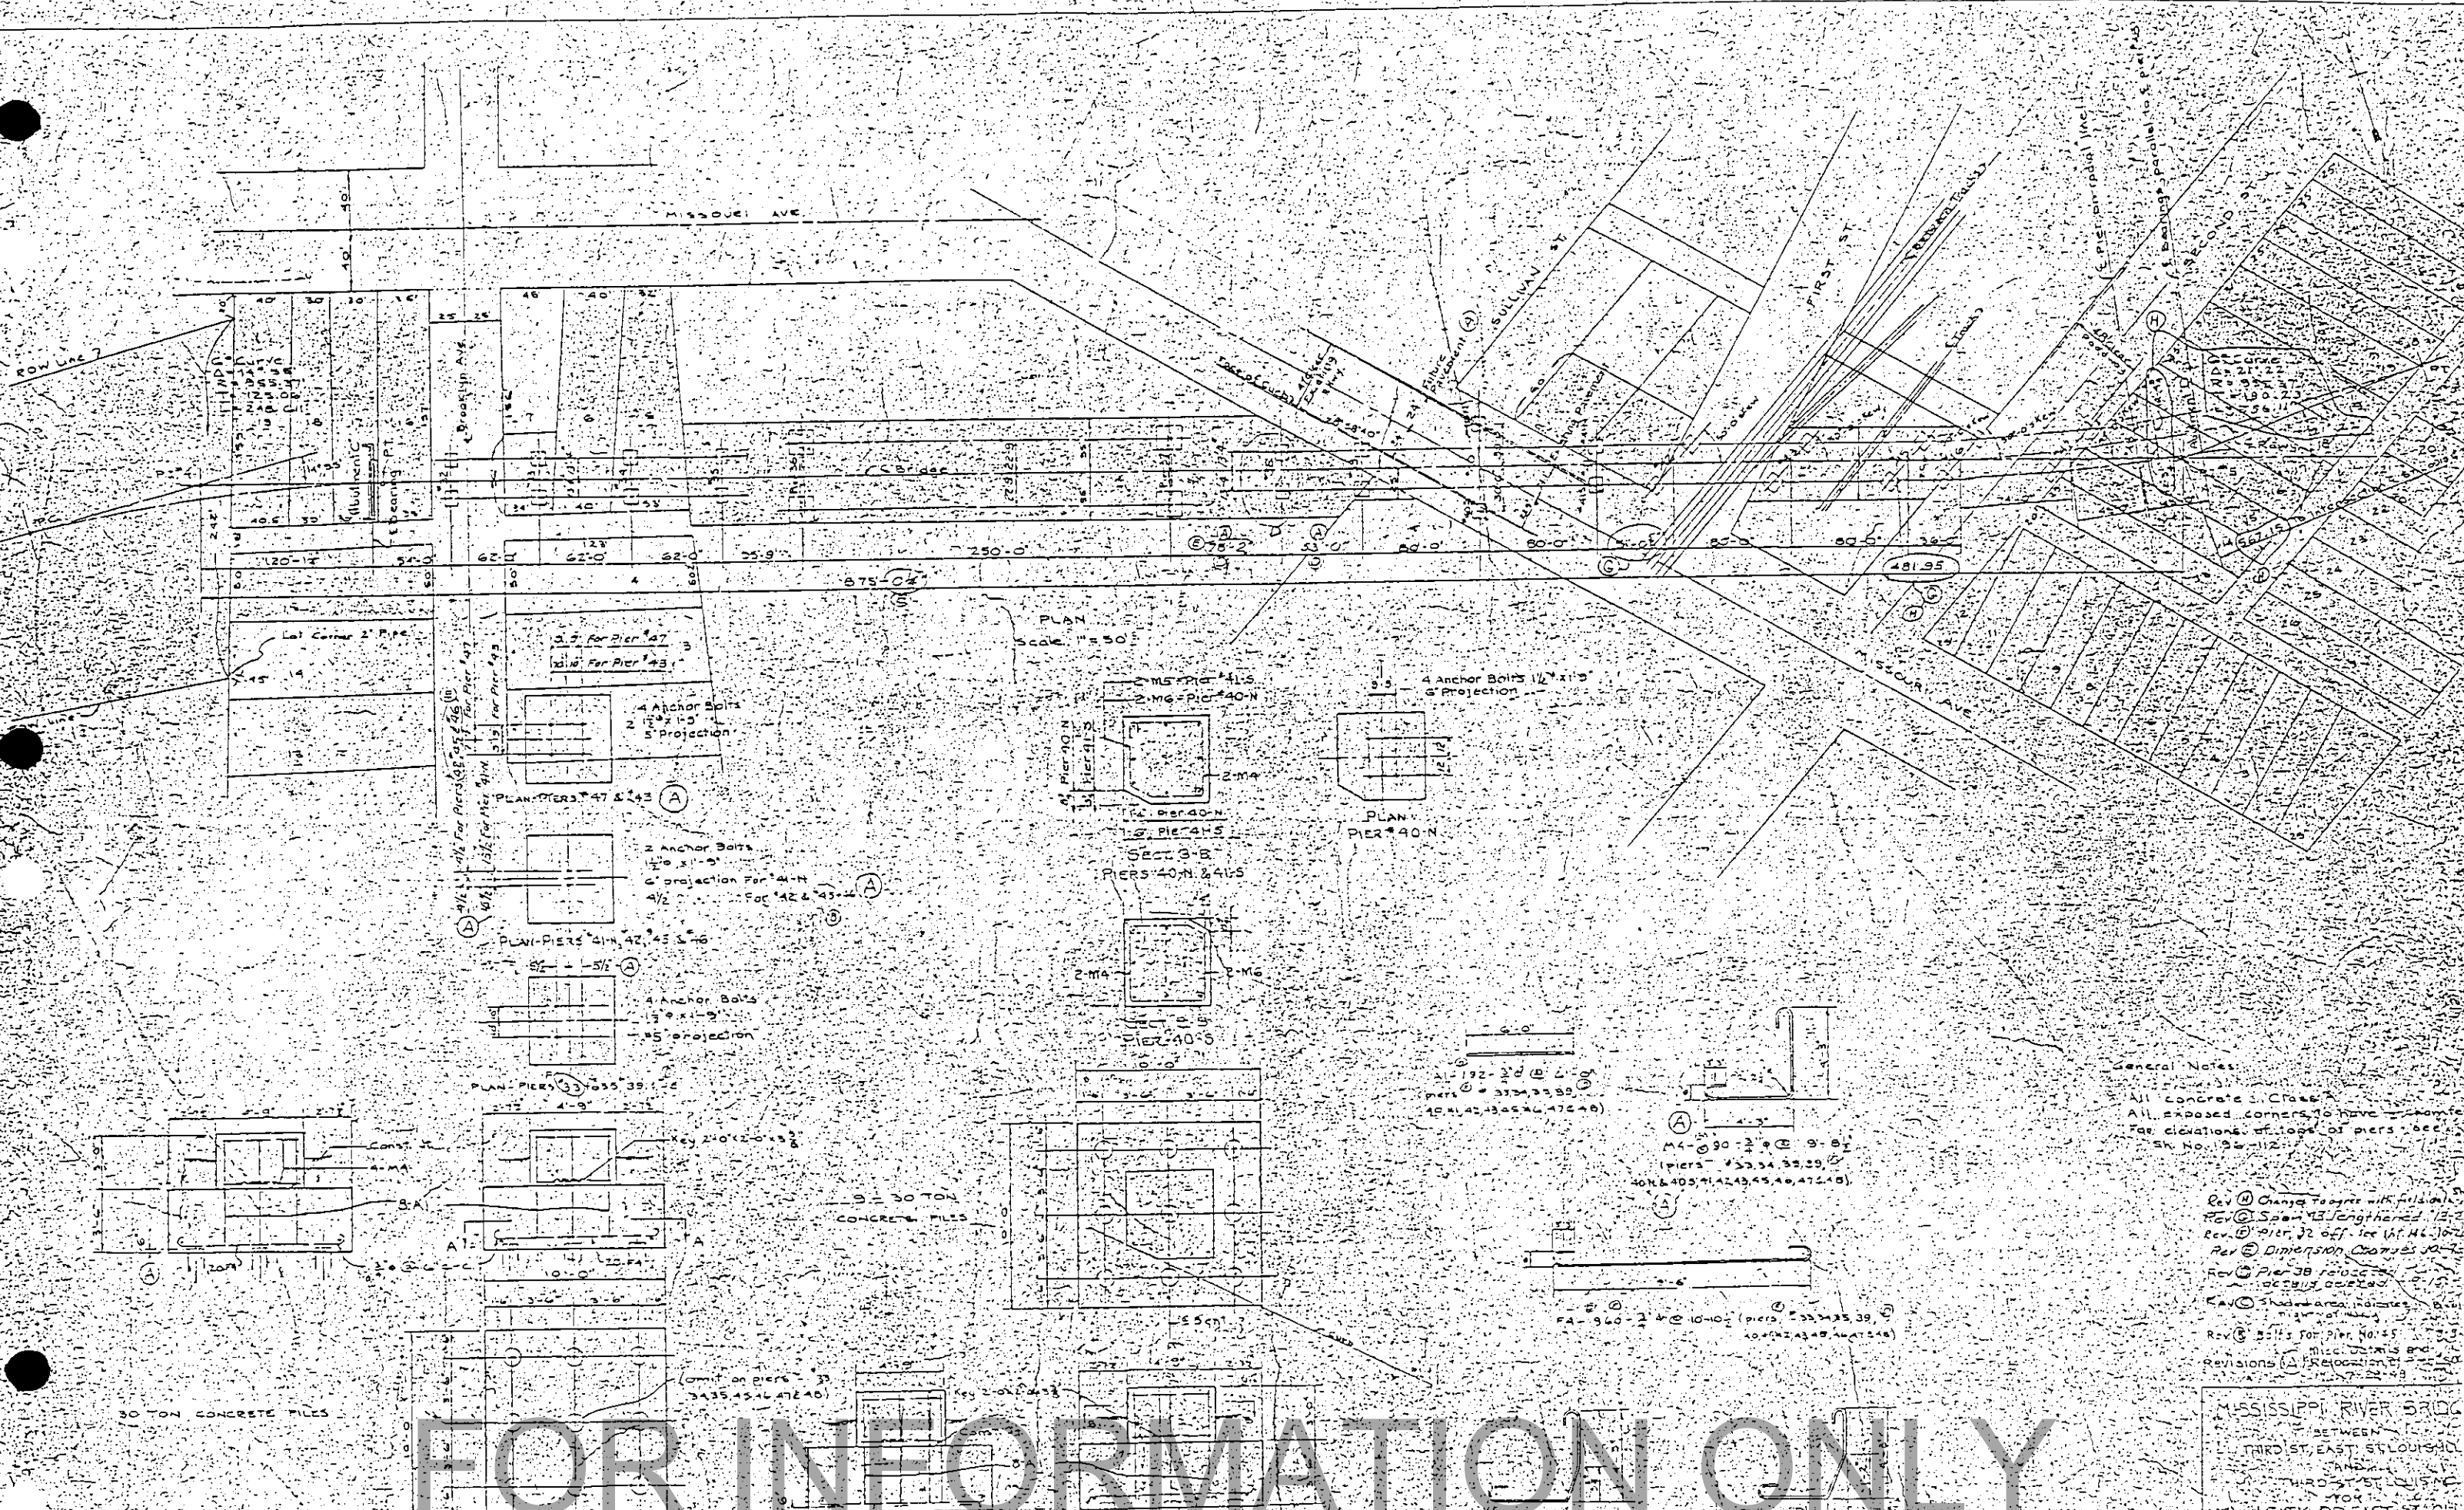

General Notes
 All concrete 3 Class
 All exposed corners to have chamfer
 For elevations of tops of piers see
 Sh. No. 95-112

- Rev (A) Change to agree with field data
- Rev (B) Span #13 lengthened 12'-2"
- Rev (C) Pier 32 off - see Vfr. H. 6-10-72
- Rev (D) Dimension Changes 30-72
- Rev (E) Pier 38 relocated - see Vfr. H. 6-10-72
- Rev (F) Shaded area indicates field work
- Rev (G) Bolts for Pier No. 55







MISSISSIPPI RIVER BRIDGE
 BETWEEN
 THIRD ST. EAST ST. LOUIS MO.
 AND
 THIRD ST. ST. LOUIS MO.
 FOR
 CITY OF EAST ST. LOUIS MO.

FOR INFORMATION ONLY

STRESSES & SECTIONS IN BENT #40

MEMBER	D.L.	L.L.	IMP	TOTAL	ALLOW UNIT STRESS	AREA REQ'D	AREA USED GROSS	NET	SECTION
U _o U _o	-291	-120	-32	-443			67.06		2-27WF114
L _o L _o	-402	+171	+26	-205	18.0	24.2N	39.98	35.73	14WF136
U _o L _o	-378	-103	-49	-530	18.0	33.5N			"
L _o U _o	-143	-145	+38	-250	14.0	23.26	25.56		14WF87
U _o L _o	-143	-71	-25	-239	14.0	18.84	20.00		14WF68

* Excess section for bending

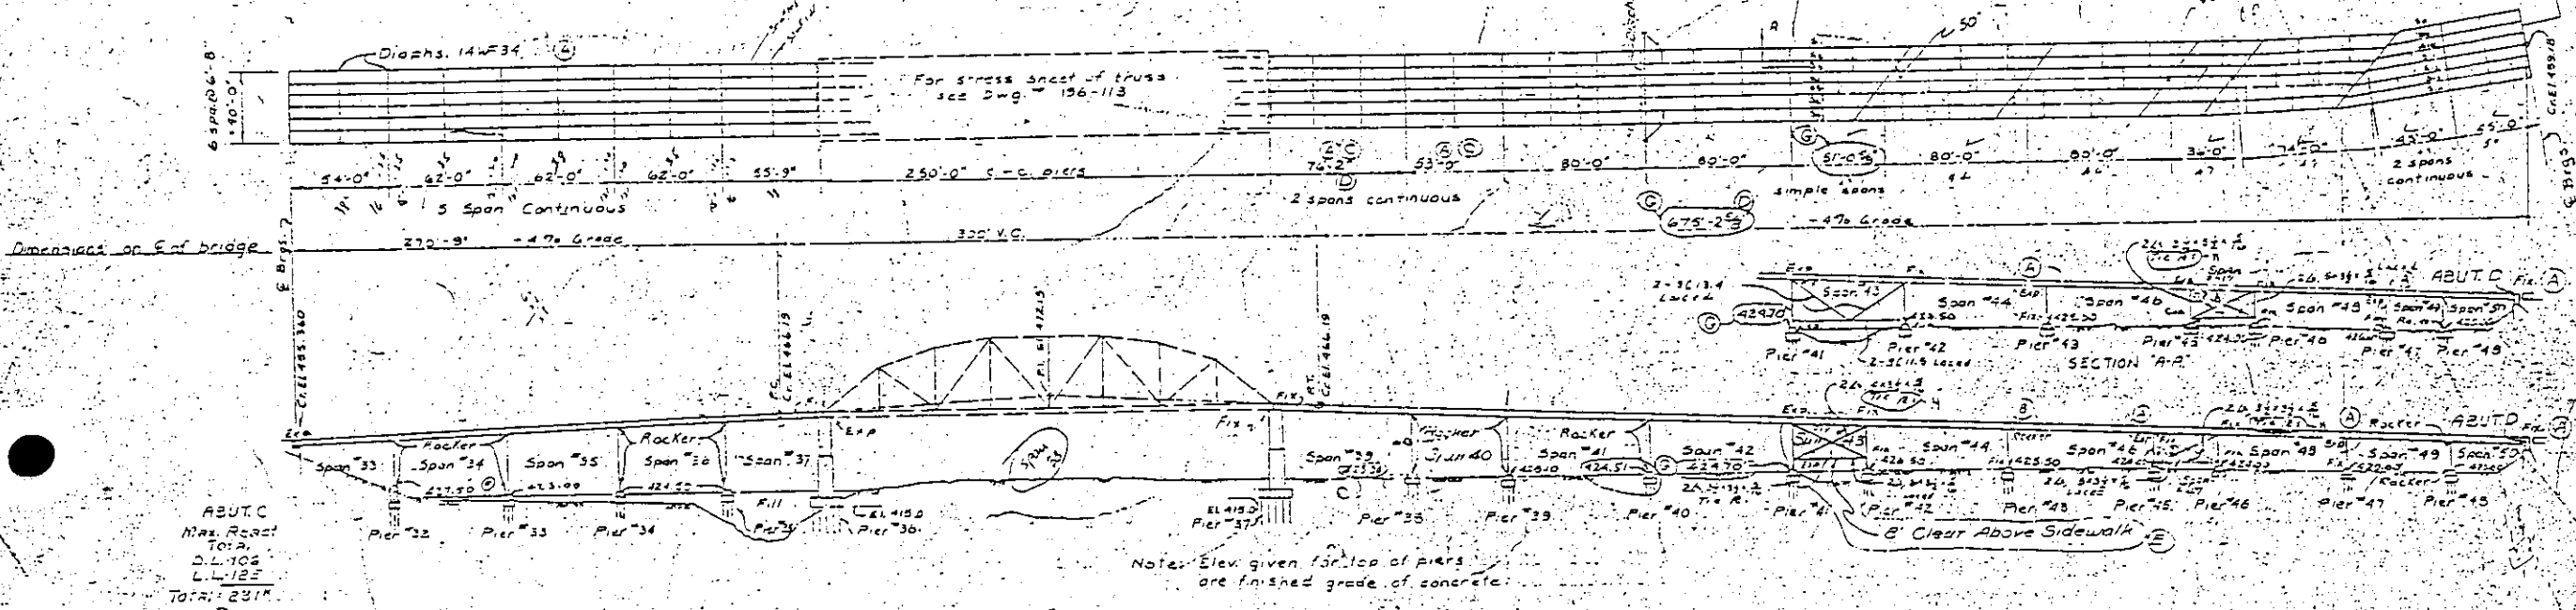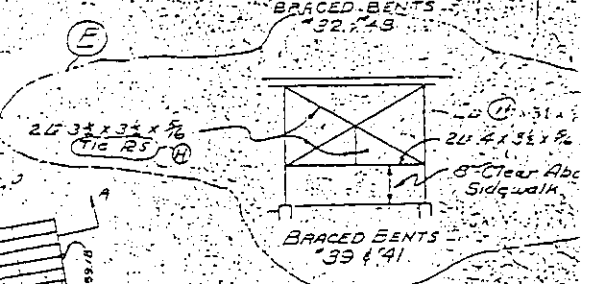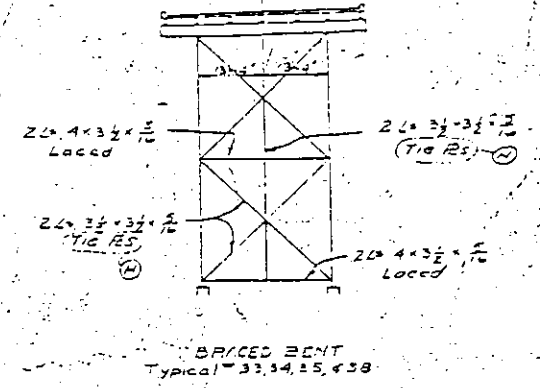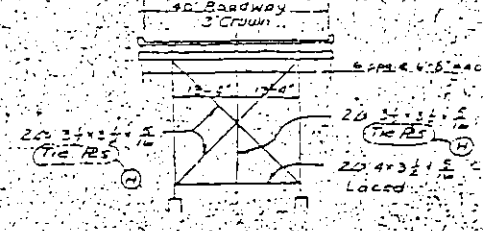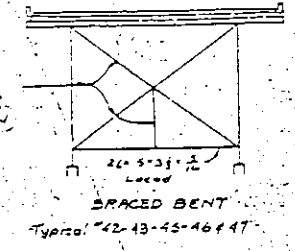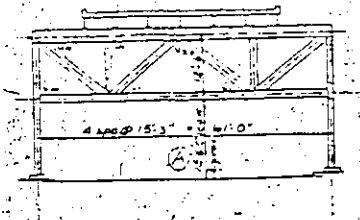

MAXIMUM STRINGER REACTIONS FROM CONTINUOUS SPANS (KIPS)

LOCATION	MEMBER	D.L.	L.L.	IMP	TOTAL
Abut C Pier 33	Int. Str.	19.3	14.6	2.1	36.0
	Ext. Str.	45.4	47.1	12.7	105.2
Bents 32-35	Int. Str.	42.8	24.7	6.7	74.2
	Ext. Str.	46.1	47.7	12.9	106.7
Bent 33	Int. Str.	18.5	29.5	7.8	55.8
	Ext. Str.	16.2	15.3	4.1	35.6
Bent 35	Int. Str.	61.7	54.9	13.7	130.3
	Ext. Str.	53.9	27.2	7.1	88.2
Bent 47 (From Span 4)	S ₁	2.0	11.3	3.4	16.7
	S ₂	6.0	22.9	6.9	35.8
Bent 48	S ₁	12.3	24.5	7.3	44.1
	S ₂	14.4	26.5	7.9	48.8
Abut D	S ₁	17.0	25.2	8.4	50.6
	S ₂	17.7	15.5	4.6	37.8
Bent 48	S ₁	30.1	15.6	5.9	51.6
	S ₂	33.6	35.0	11.4	80.0
Bent 48	S ₁	34.9	39.3	11.8	86.0
	S ₂	41.0	41.3	12.6	94.9
Bent 48	S ₁	50.0	45.8	12.5	108.3
	S ₂	47.6	25.3	7.5	80.4
Abut D	S ₁	12.9	15.3	4.0	32.2
	S ₂	12.3	24.5	7.3	44.1
Abut D	S ₁	11.3	25.5	7.0	43.8
	S ₂	11.2	25.5	7.5	44.2
Abut D	S ₁	8.5	19.1	3.9	31.5
	S ₂	8.5	19.1	3.9	31.5

STRESSES & SECTIONS IN FLOORBEAMS

MEMBER	SHEAR IN KIPS				MOMENT IN KIP-FT.				SECTION
	D.L.	L.L.	IMP	TOTAL	D.L.	L.L.	IMP	TOTAL	
Em. 32,33,34,35	76.1	64.7	19.5	160.3	810	521	156	1487	36WF230
Beam 35	90.0	71.3	21.4	182.7	474	582	175	1231	36WF230
Beam 39	84.0	64.3	19.3	167.6	426	517	155	1098	36WF230
Beam 41	58.7	66.3	19.0	144.0	423	495	143	1075	36WF230
Beam 42	88.7	63.3	19.0	171.0	558	650	195	1404	36WF260
Beam 43	175.3	70.8	21.2	277.3	747	744	226	1727	See Note below
Beam 45	75.4	55.0	17.4	150.8	533	600	180	1233	36WF230
Beam 46	62.5	56.1	16.9	145.5	452	579	173	1210	36WF230
Beam 47	72.0	52.4	17.5	141.9	395	646	194	1235	36WF230
Beam 48	48.1	58.3	17.5	123.9	573	534	152	1235	36WF230

* Built up section, 4L 8x6x3/4 - 1 web plate 60x7/8

STRESSES & SECTIONS IN STRINGERS

MEMBER	SHEAR IN KIPS				MOMENT IN KIP-FT.				SECTION
	D.L.	L.L.	IMP	TOTAL	D.L.	L.L.	IMP	TOTAL	
S ₁ 33-37 Int. Str.	24.9	31.3	8.9	65.1	256	289	81	626	33WF141
" Ext. Str.	22.1	16.7	4.7	43.5	227	152	43	422	30WF108
S ₂ 39-40 Int. Str.	35.0	37.1	9.2	81.3	437	378	112	927	36WF194
" Ext. Str.	30.2	19.5	4.7	54.4	377	209	59	645	33WF141
S ₃ 42-44 Int. Str.	35.2	34.3	8.4	77.9	704	582	142	1428	36WF300
" Ext. Str.	20.1	18.1	4.4	42.6	562	355	75	992	36WF230
S ₄ 47 Int. Str.	12.7	25.0	7.5	45.2	114	265	62	441	27WF102
" Ext. Str.	11.0	12.1	4.0	27.1	99	108	33	240	24WF76
S ₅ 48 Int. Str.	30.7	23.1	8.3	62.1	569	515	130	1214	36WF230
" Ext. Str.	23.0	7.4	4.4	34.8	451	270	65	786	36WF170
S ₆ 49-50 S ₁	22.9	16.7	4.3	43.9	383	235	61	684	36WF150
" S ₂	24.9	30.6	8.2	63.7	388	392	105	885	36WF182
" S ₃	21.4	29.4	8.1	58.9	302	342	94	738	36WF150
" S ₄	10.3	28.2	8.0	46.5	241	364	86	691	33WF141
" S ₅	16.6	27.0	7.9	51.5	192	263	77	532	30WF124
" S ₆	14.3	25.8	7.7	47.8	142	230	63	441	30WF108
" S ₇	10.4	15.0	3.9	29.3	85	121	30	236	27WF94
" S ₈	17.3	15.1	4.5	36.9	123	157	28	308	27WF94
" S ₉	15.3	25.9	8.4	49.6	155	173	52	380	27WF94
" S ₁₀	19.2	28.9	8.7	56.8	153	184	55	392	27WF102
" S ₁₁	20.5	29.3	8.7	58.5	185	211	62	458	30WF116
" S ₁₂	22.7	25.7	8.7	57.1	272	230	70	519	30WF124
" S ₁₃	26.4	32.6	9.6	68.6	279	374	81	634	30WF172
" S ₁₄	26.3	18.1	5.3	49.7	290	167	49	506	30WF124

* No holes in floor beams of C bridge

STRESSES IN COLUMNS

BENT	COLUMN LOAD - KIPS				SECTION
	D.L.	L.L.	IMP	TOTAL	
# 32-35	178	131	35	344	14WF87
# 38	221.1	143.5	42.0	406.6	12WF103
# 39	192.5	129.1	38.7	360.3	14WF142
# 40	272.0	122.2	33.5	428.5	14WF237
# 41	207.6	126.0	38.4	374.0	14WF136
# 42-North	207.6	126.0	38.4	374.0	14WF119
# 43	246.0	143.6	43.1	432.7	14WF119
# 45	170.4	117.4	35.2	323.0	14WF78
# 46	156.0	113.9	34.2	304.1	14WF74
# 47	176.0	125.0	37.5	338.5	14WF103
# 48	176.1	121.5	36.5	334.1	14WF78
# 42-South	207.6	126.0	38.4	374.0	14WF119

* Excess for bending

General Notes:
Live Load - H20-44
Design Spec. - AASHTO 1944

Revision (A) to R. in. of L. Span 43 lengthened 12'.
Rev. (B) Piers 40 & 41 Imp. 2.5'
Rev. (C) Pier 32 raised 10.2'
Rev. (D) Changes in Bents 39 & 41.
Rev. (E) Span 34 changed 10.7'
Rev. (F) Spans 37 & 38 changed 9.7'
Rev. (G) Rafter of Bent 40 Fire 12.5'
Revision (H) Spans 38 & 40 changed.
Stringer reactions 216.5 kips.

MISSISSIPPI RIVER BRIDGE
BETWEEN
THIRD ST. EAST, ST. LOUIS,
MO.
AND
THIRD ST. ST. LOUIS,
MO.
CITY OF EAST ST. LOUIS,
MO.

INFORMATION ONLY

STRESSES IN 249' TRUSS

MEMBER	DEAD LOAD	LIVE LOAD	IMPACT	TOTAL WIND	TOTAL WIND	TOTAL WIND	TOTAL WIND	ALLOWED STRESS		AREA REQ.		SECTION
								DESIGN	ALLOWED	GROSS NET	EFFECTIVE NET	
L0-U1	-552	-201	-25	-781	-781	-781	-781	12.5	56.6	66.2		2" 10" 55", 1 pl. 24" 1/2", 1 pl. 24" 1/2
U1-U3	-592	-200	-27	-819	-819	-819	-819	14.4	56.9	58.3		2" 10" 55", 2 pls. 24" 1/2
U3-U5	-679	-232	-31	-942	-942	-942	-942	14.4	65.5	63.6		2" 10" 55", 2 pls. 24" 1/2, 2 pls. 15" 1/2
U5-U7	-502	-200	-27	-819	-819	-819	-819	14.4	56.9	58.3		Same as U1-U3
U7-L6	-552	-201	-25	-781	-781	-781	-781	13.6	56.6	60.2		Same as L0-U1
L0-L2	+397	+145	+19	+561	+561	+561	+561	16.0	31.1	43.0	35.0	2" 10" 54.27, 1 pl. 24" 1/2, 1 pl. 24" 1/2
L2-L4	+633	+277	+23	+933	+933	+933	+933	18.0	49.1	60.2	49.2	2" 10" 55, 1 pl. 24" 1/2, 1 pl. 24" 1/2
L4-L6	+635	+217	+23	+854	+854	+854	+854	18.0	49.1	60.2	45.2	Same as L2-L4
L6-L8	+397	+145	+19	+561	+561	+561	+561	18.0	31.1	43.0	35.0	Same as L0-L2
U1-L2	+255	+112	+17	+384	+384	+384	+384	15.0	21.5	25.0	21.8	12" WF 65
L2-U3	-89	+81	-12	-182	-182	-182	-182	15.0	22.2			2" 10" 20.7, 2 pls. 15" 1/2
U3-L4	+45	-47	-10	-12	-12	-12	-12	15.0	9.0	19.4	15.7	2" 10" 20.7, 2 pls. 16" 1/2
L4-U5	+45	-47	-10	-12	-12	-12	-12	15.0	9.0	19.4	15.7	Same as U3-L4
U5-L6	-89	+81	-12	-182	-182	-182	-182	15.0	22.2			Same as L2-U3
L6-U7	+255	+112	+17	+384	+384	+384	+384	15.0	21.5	25.0	21.8	Same as U1-L2
U1-L1	+109	+63	+13	+187	+187	+187	+187	18.0	10.3	17.0	14.5	12" WF 55
U2-L2	-12			-12	NON-NORMAL					22.2		4" 7" 4" 7/8, 1 pl. 12" 5/8
U3-L3	+109	+63	+13	+187	+187	+187	+187	18.0	10.3	17.0	14.5	12" WF 55
U4-L4	-14			-14	NON-NORMAL					22.2		4" 7" 4" 7/8, 1 pl. 12" 5/8
U5-L5	+109	+63	+13	+187	+187	+187	+187	18.0	10.3	17.0	14.5	Same as U3-L3
U6-L6	-12			-12	NON-NORMAL					22.2		Same as U2-L2
U7-L7	+109	+63	+13	+187	+187	+187	+187	18.0	10.3	17.0	14.5	Same as U1-L1


+ Indicates Tension
- Indicates Compression
Stresses given in Kips
Areas given in sq. in.
Unit stresses given in Kips per sq. in.

x Includes reversal increment.
* 15% Side Plates will be used for wind moment where required.


STRESSES IN FLOOR BEAMS & STRINGERS

MEMBER	SHEAR IN 1000 LBS.			MOMENT IN 1000 FT LBS.			SECTION
	DEAD	LIVE	IMPACT	DEAD	LIVE	IMPACT	
STRINGER S1	10.2	12.7	3.5	26.7	23.5	27.0	21" WF 68
STRINGER S2	11.0	17.0	6.1	45.1	66.5	53.0	27" WF 94
FL. BEAM F0 & F8	41.1	54.0	15.0	111.0	476	204	4" 7" 4" 7/8, 1 pl. 60" 1/2
FL. BEAM F1 & F7	79.0	69.0	20.2	169.1	927	735	4" 7" 4" 7/8, 1 pl. 60" 1/2, 2 pls. 16" 1/2


SPECIFICATIONS: AASHO-1944 EDITION
LIVE LOAD: H20-44 (75% of 4 Lanes Loaded For Truss & FLOOR)
MATERIAL: A.S.T.M.-A7-46 (Carbon Steel)
RIVETS: 7/8" - Except in Lacing Bars of Bottom Laterals

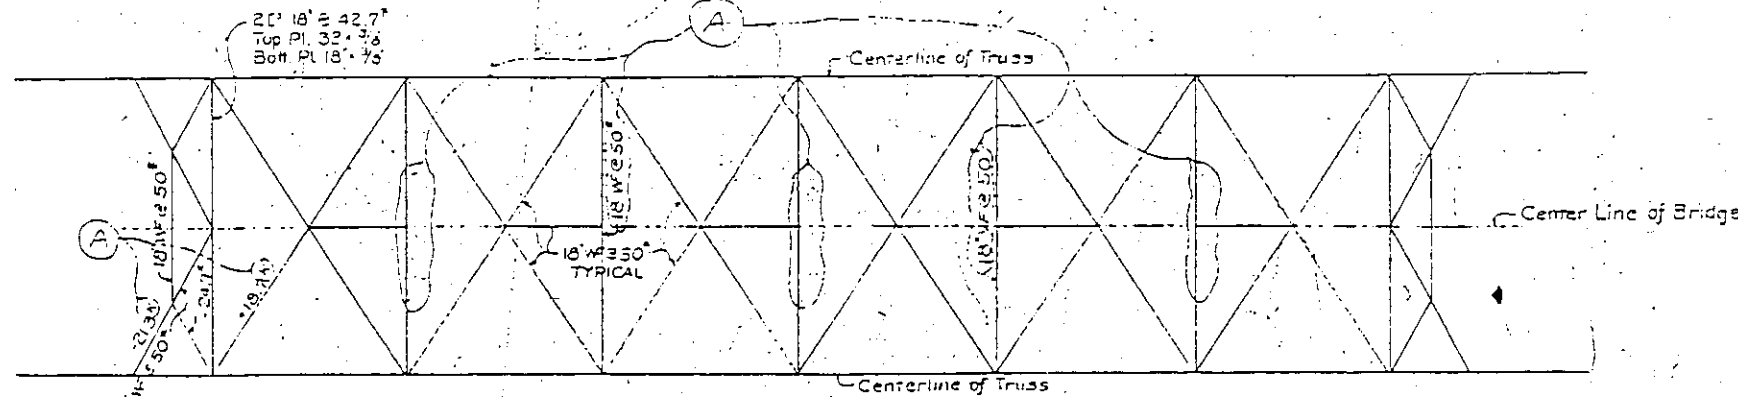

PLAN OF TOP LATERALS

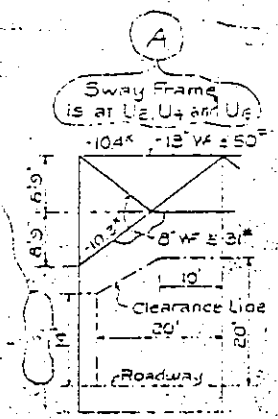


HALF SECTION A-A

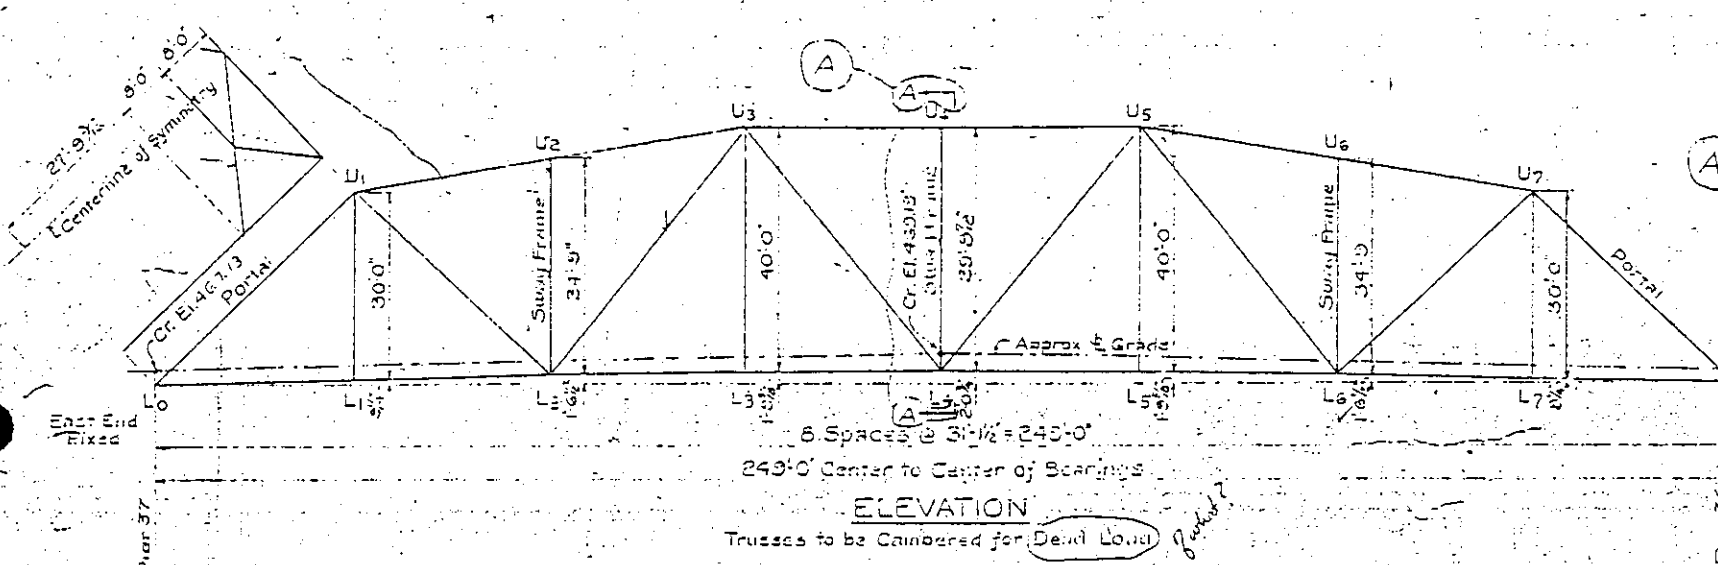

ELEVATION


Trusses to be Cambered for Dead Load

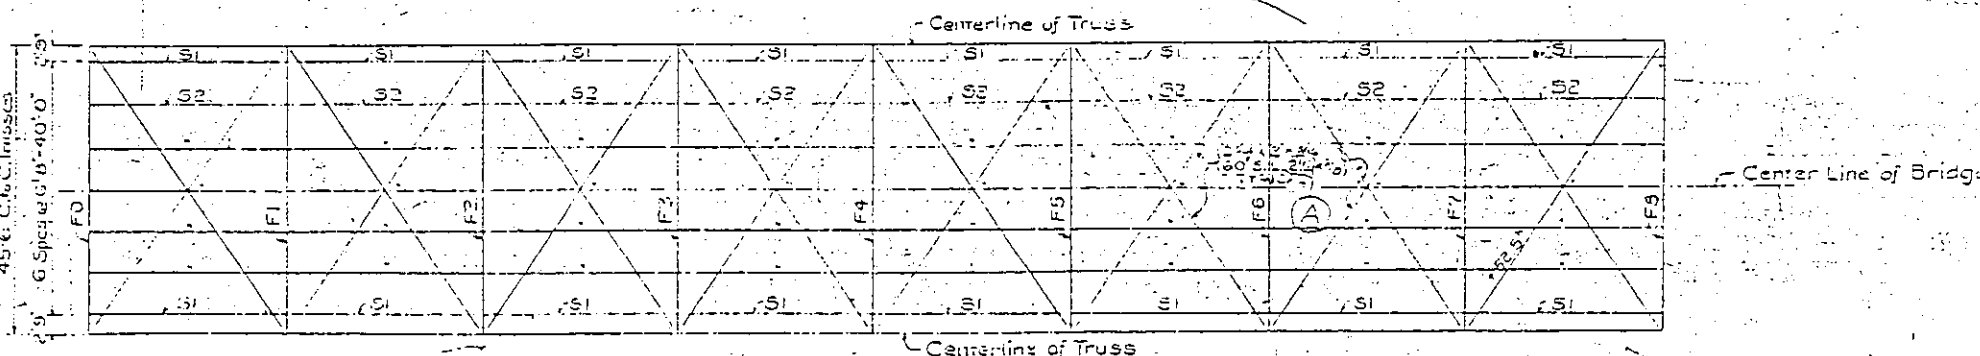





PLAN OF FLOOR SYSTEM AND BOTTOM LATERALS

FOR INFORMATION ONLY


Revisions (A) July 13-48
MISSISSIPPI RIVER BRIDGE BETWEEN THIRD ST. EAST ST. LOUIS AND THIRD ST. ST. LOUIS FOR CITY OF EAST ST. LOUIS

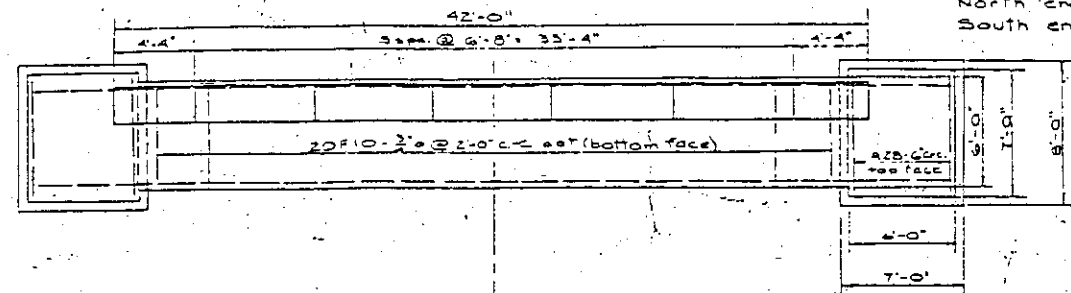


North end Pier #36
South end Pier #37

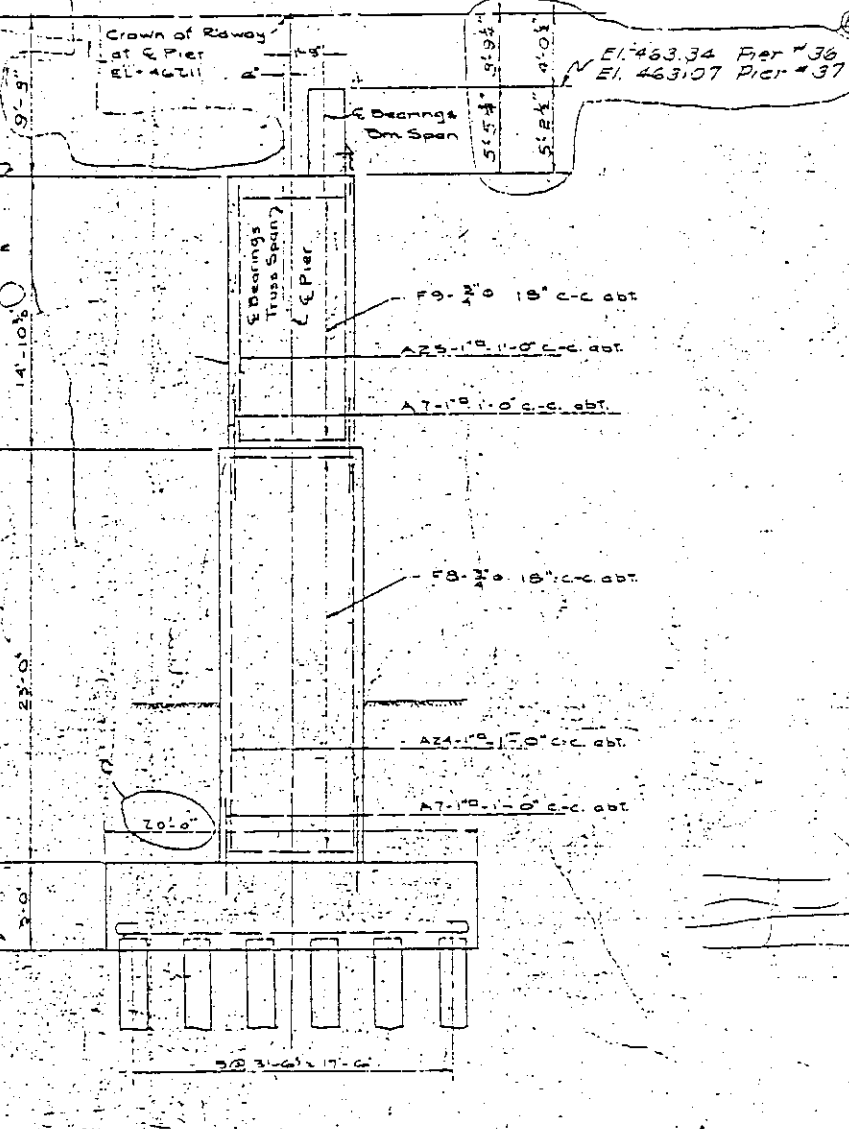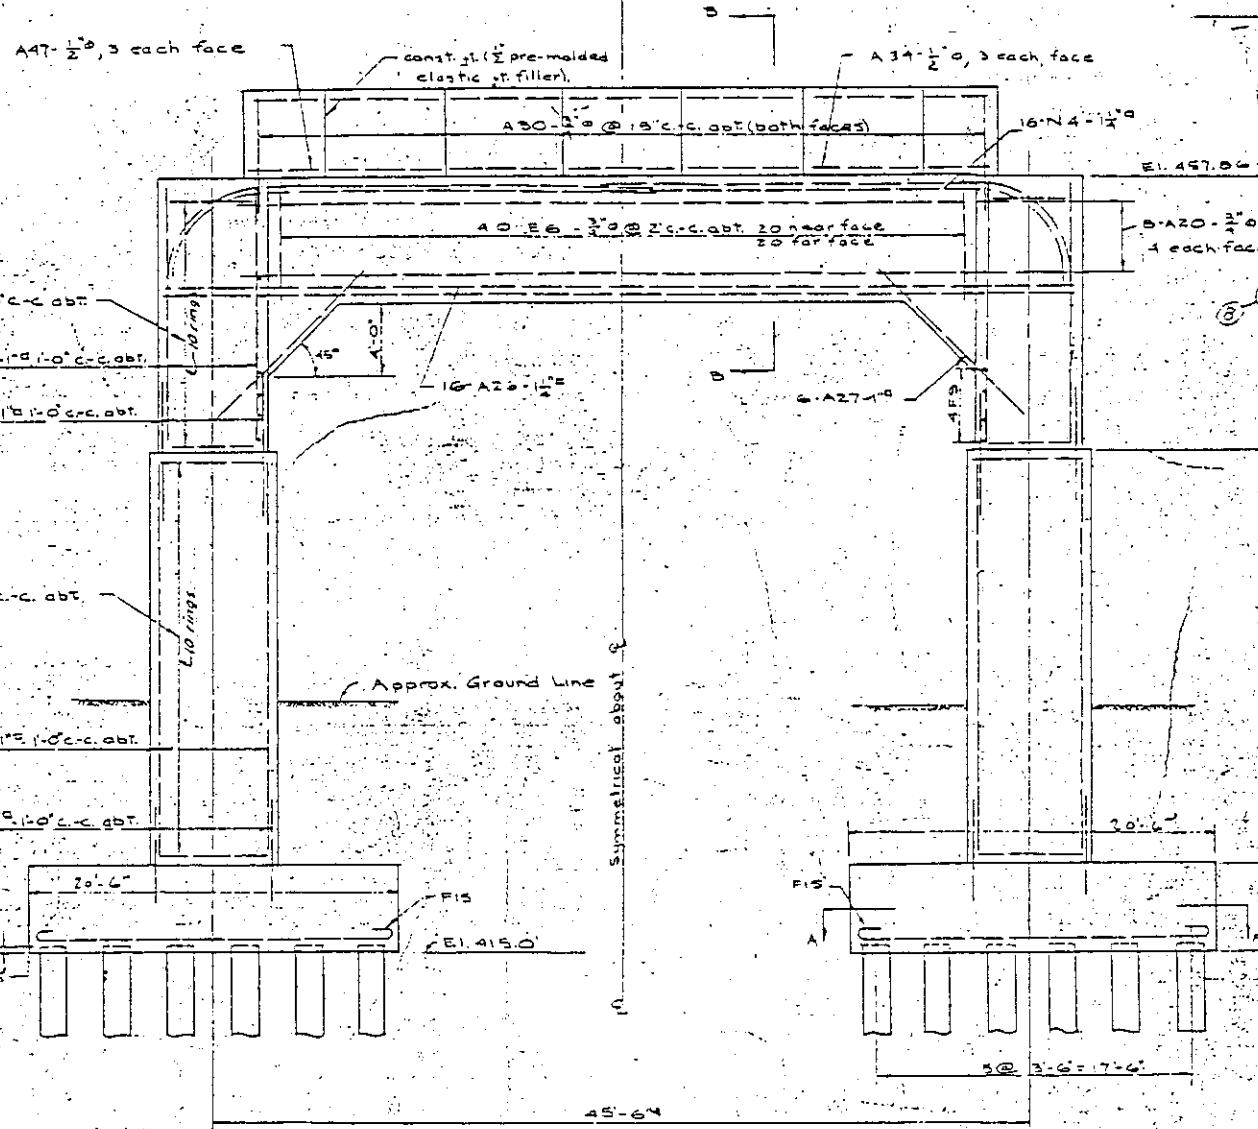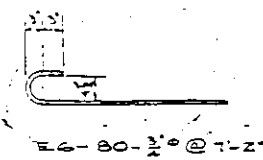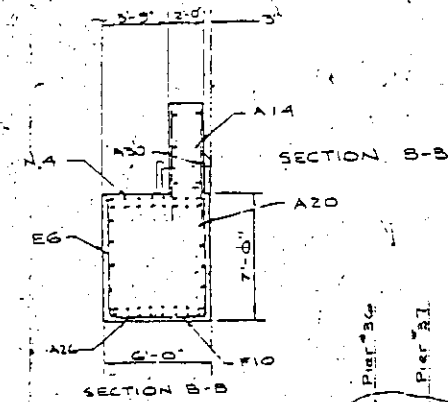

- A7-224-1" @ 7'-0" (piers #36 & 37)
- A24-120-1" @ 22'-5" ()
- A25-104-1" @ 14'-7" ()
- A26-32-1/2" @ 31'-0" ()
- A27-24-3/4" @ 12'-0" ()
- A28-48-3/4" @ 6'-6" ()
- A14-60-1/2" @ 2'-2" ()
- A30-116-3/4" @ 7'-9" ()
- A20-12-3/4" @ 43'-0" ()
- A47-24-1/2" @ 3'-10" ()

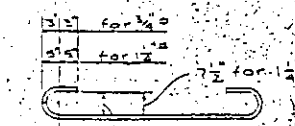

- F8-125-3/4" @ 8'-10" (piers #36 & 37)
- F9-158-3/4" @ 7'-10" ()
- F10-128-3/4" @ 6'-10" ()
- F15-240-1" @ 22'-5" ()

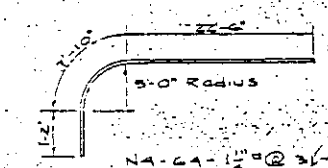



Notes:
All piles steel shell concrete filled
Piles to be driven to 80 ton capacity
All concrete class K

Rev. (A) Pier Name
Rev. (B) Pier Top Elevation added
Revision (C) Date Added 10-28-64


MISSISSIPPI RIVER BRIDGE
BETWEEN
THIRD ST. EAST ST. LOUIS, MO.
AND
THIRD ST. ST. LOUIS, MO.
FOR
CITY OF EAST ST. LOUIS

PIERS #36 & 37
Scale 1/8" = 1'-0"

FOR INFORMATION ONLY

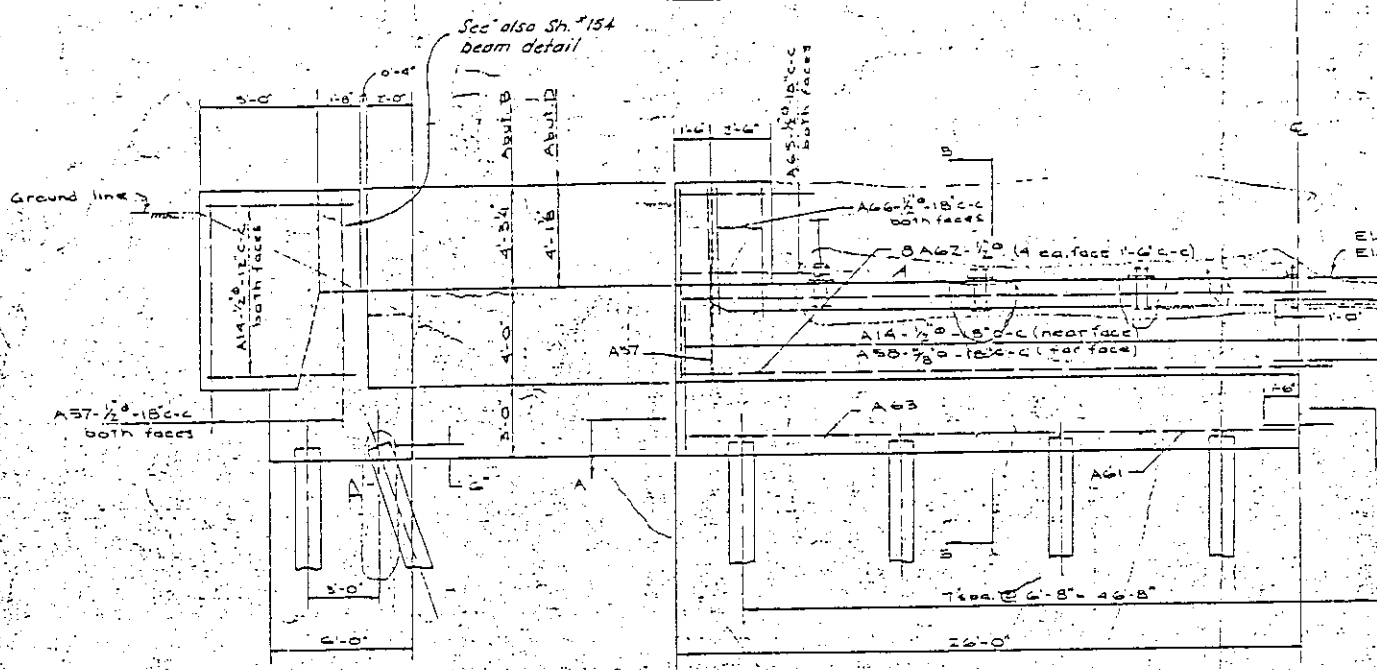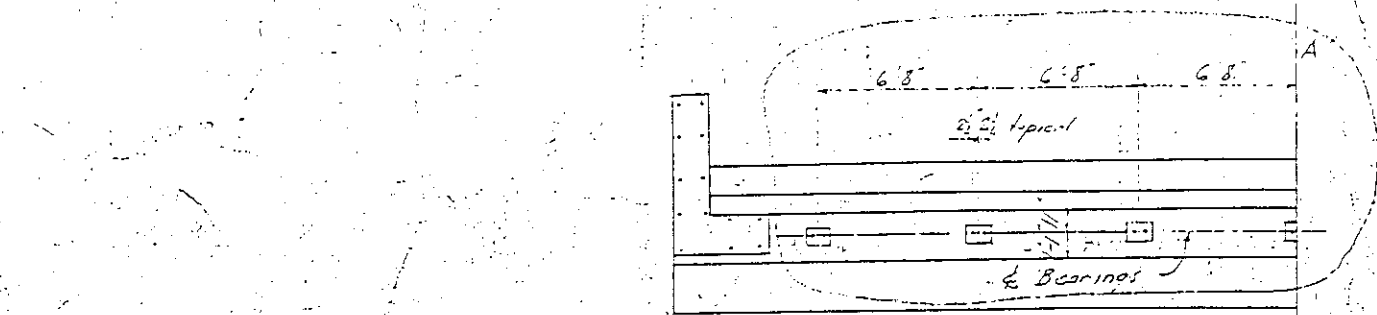

NORTH ELEVATION

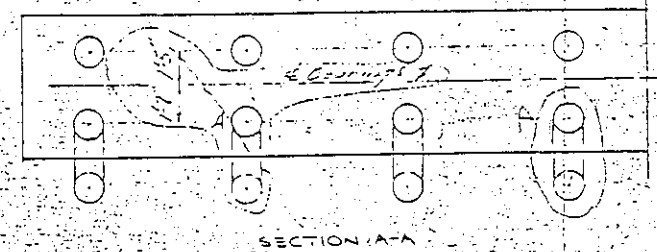


SECTION A-A

ABUTMENTS 'B' & 'D'

A14	23	25	@	8	3
A15	36	28	@	7	8
A16	70	8	@	6	4
A17	35	8	@	8	0
A57	35	28	@	5	3
A60	24	28	@	27	3
A61	36	28	@	26	8
A62	45	3	@	18	6
A63	10	7	@	8	0
A64	40	2	@	5	6
A65	10	5	@	15	0

Notes:
 All piles Steel Shell concrete filled.
 Piles to be driven to 30 ton capacity
 All Concrete Class "A"

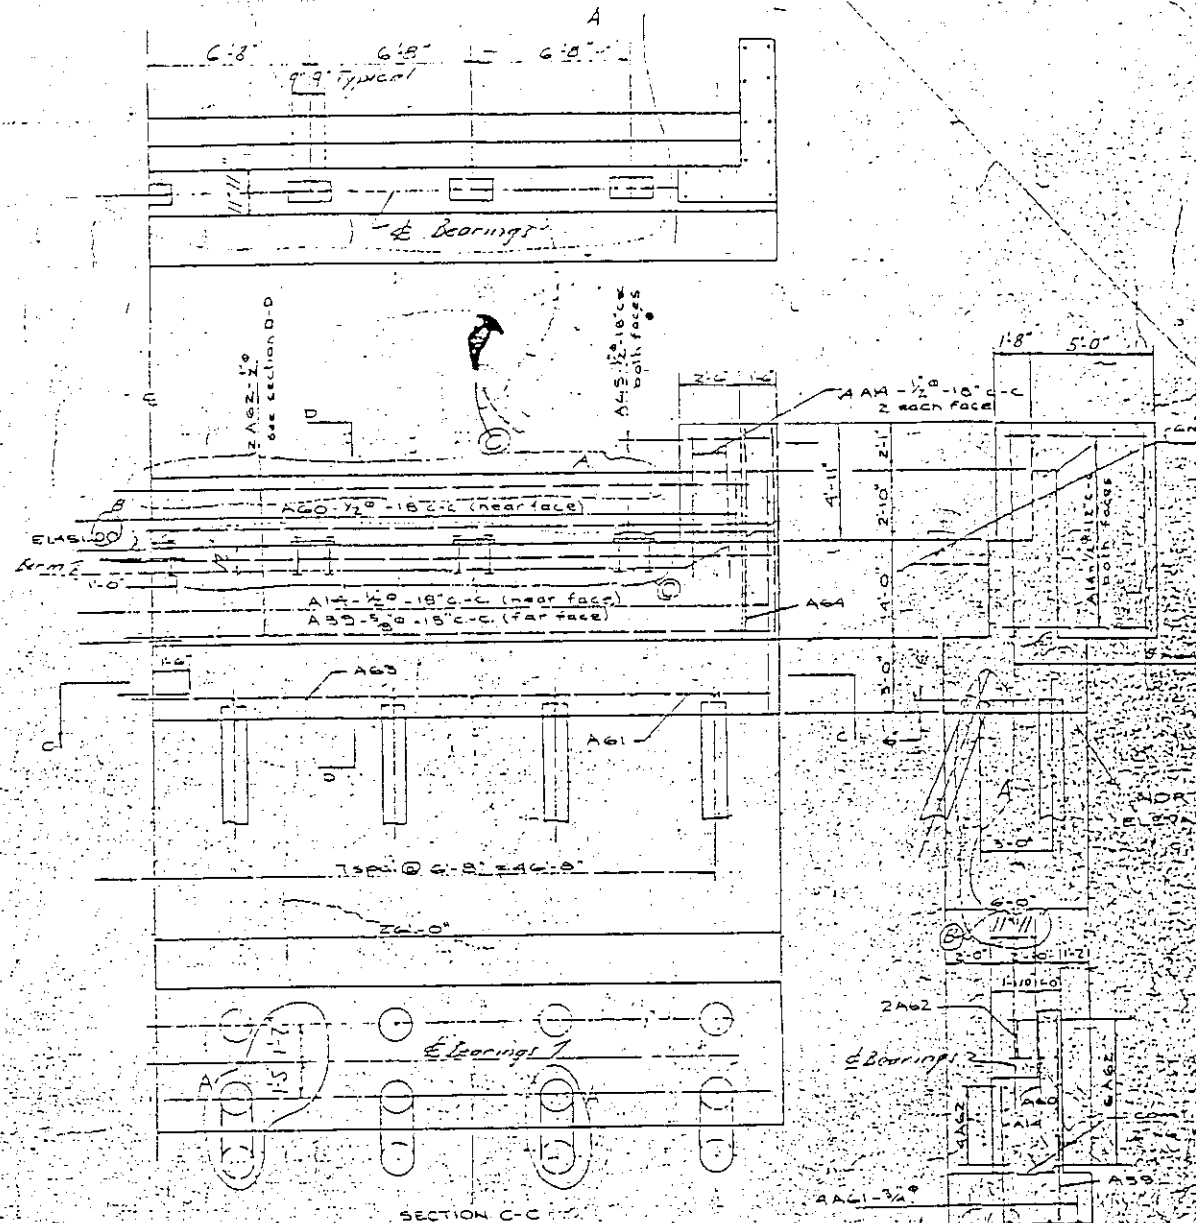

SECTION C-C

ABUTMENT 'C'


SECTION D-D

Rev. C Anchor bolts added.
 Rev. B floor and dimension of
 bearings & etc. added.
 Pile from Low River channel

MISSISSIPPI RIVER BE
 BETWEEN
 THIRD ST. EAST ST. LOUIS
 AND
 THIRD ST. ST. LOUIS MO
 FOR

FOR INFORMATION ONLY

40'-0" FLOWY

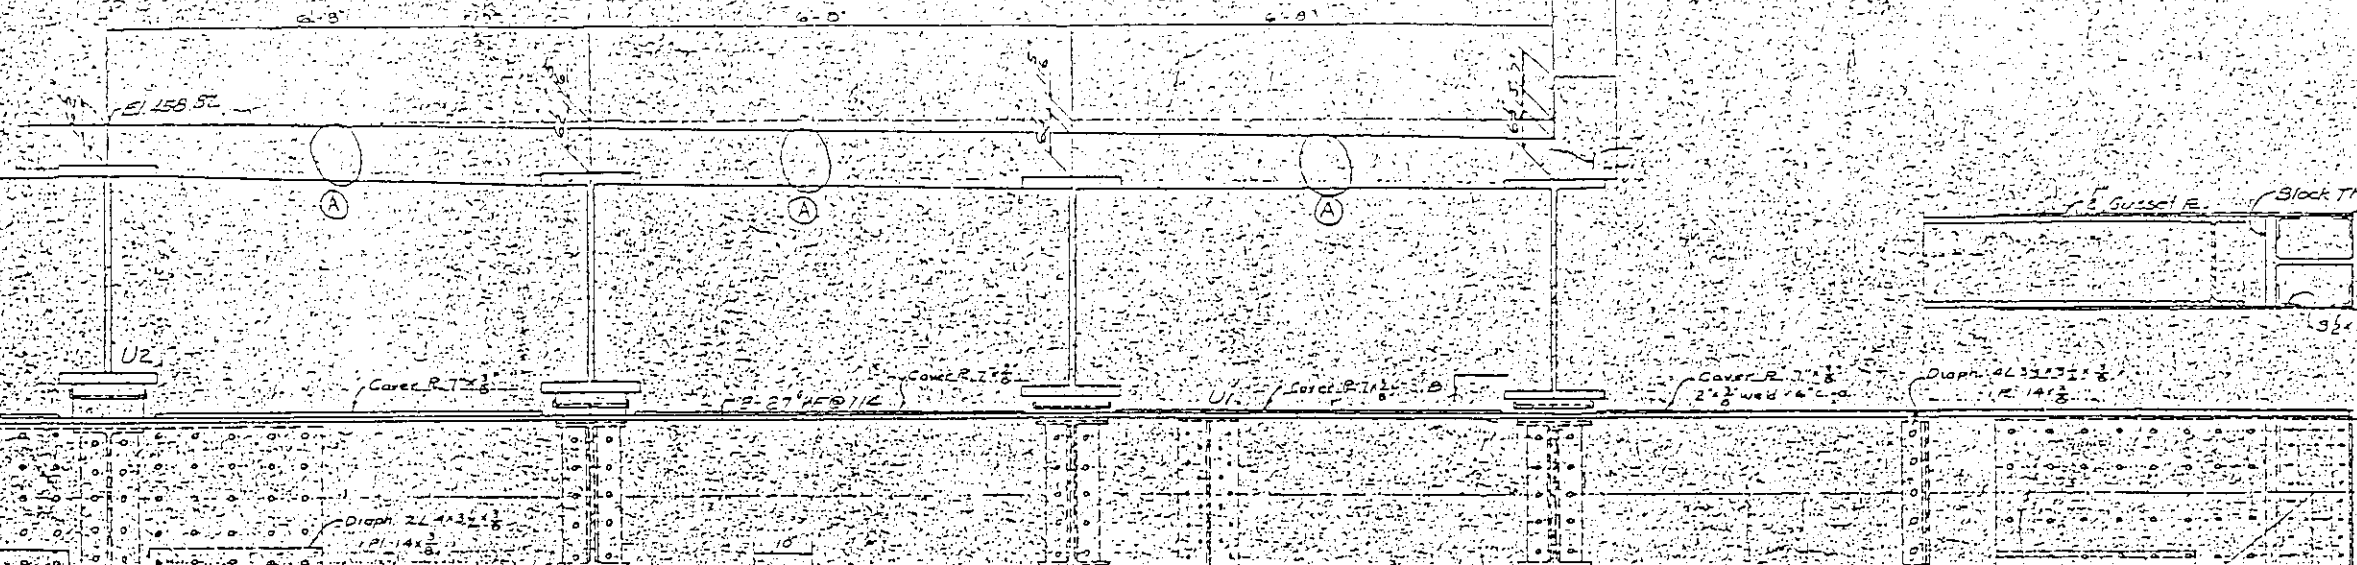


Block This Flange To 4" To bottom of gusset pl.

3/4" x 3/8" EL

Cover PL 2" x 3" w/ 1/8" C.A.


Diaph. 2L 4x3 1/2 x 1/8

Diaph. 2L 4x3 1/2 x 1/8

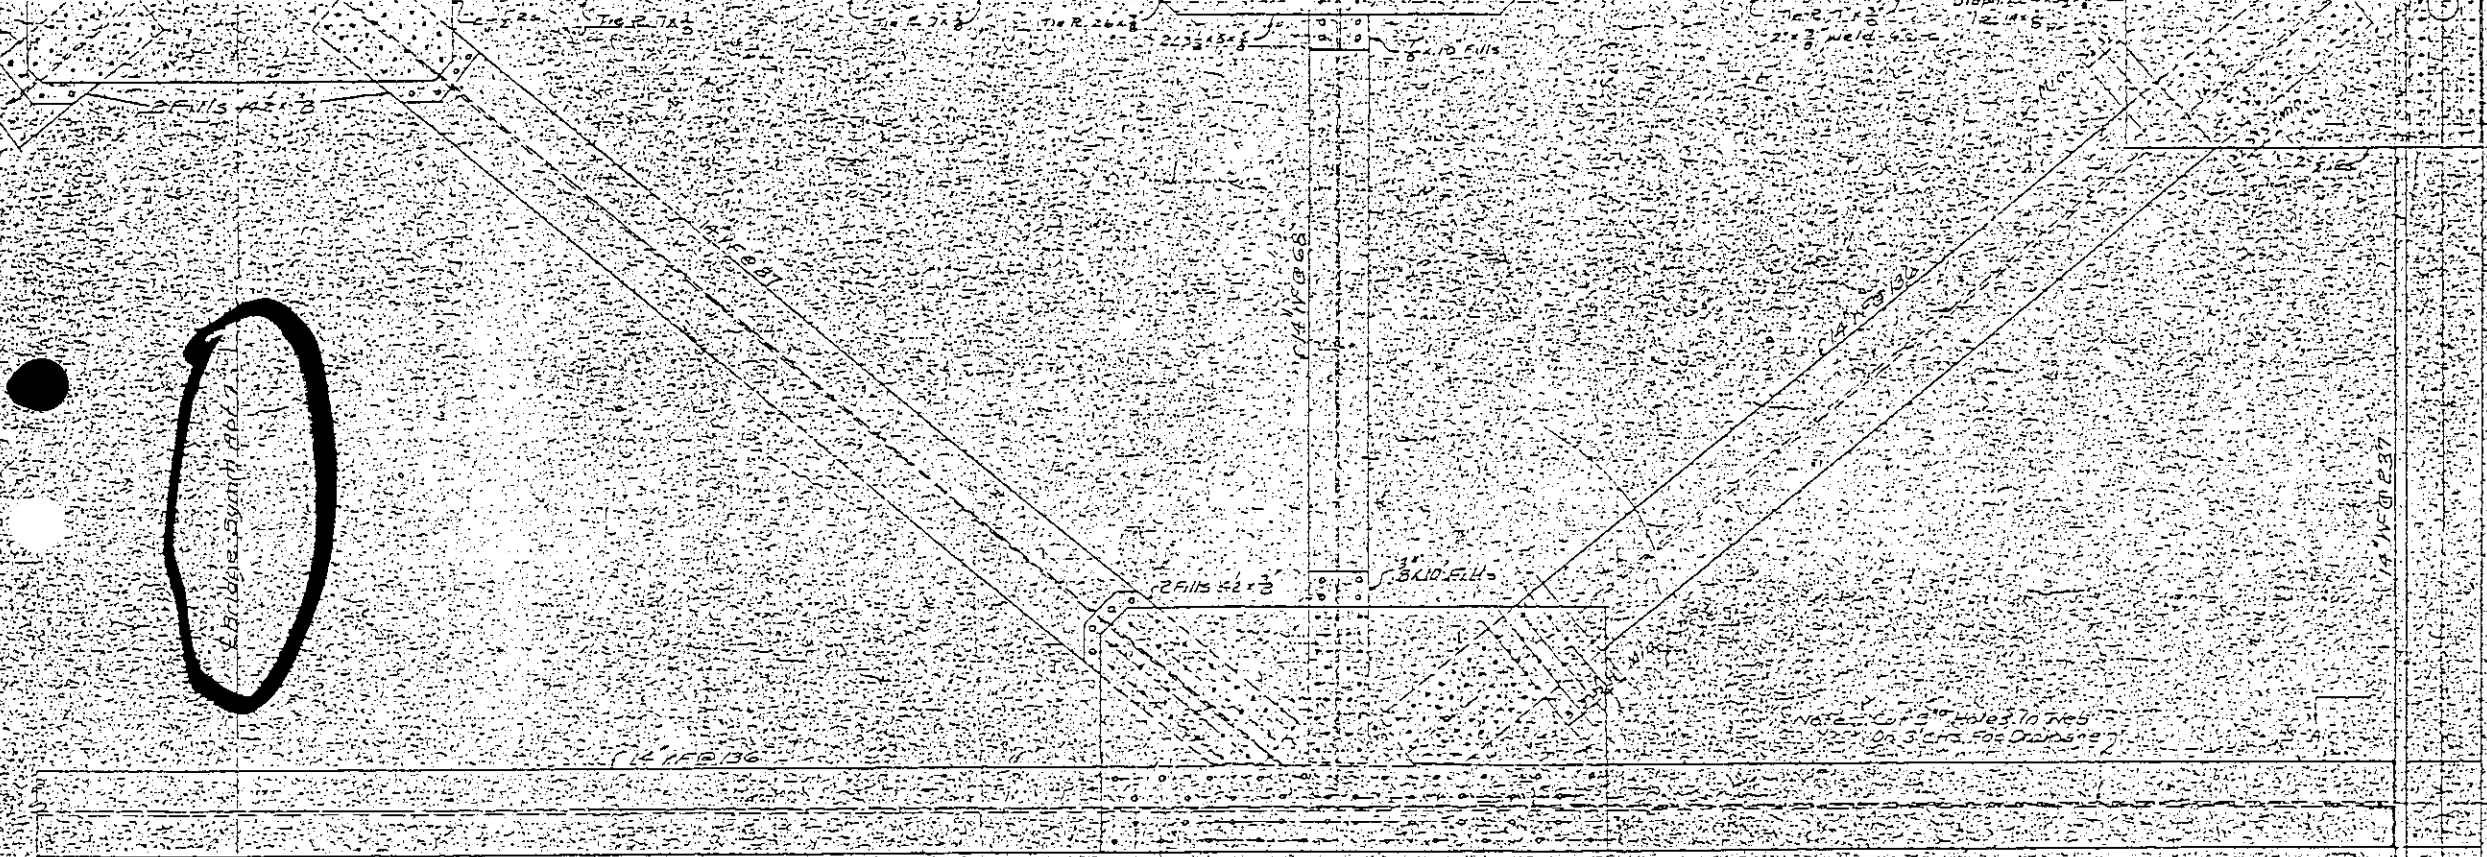


3/4" FILL

NOTE: Use 3" Holes in Web on 3' CFS for Diaphragm

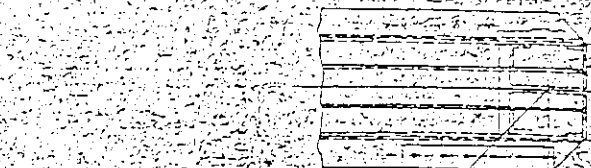

VIEW B-B

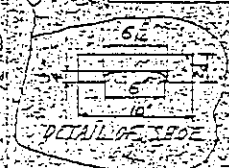

DETAIL OF SHOE

TYPICAL SECTION thru BENT



SECTION A-A







ELEVATION OF BENT 40

Bent 40

MISSISSIPPI RIVER



FOR INFORMATION ONLY

12 82

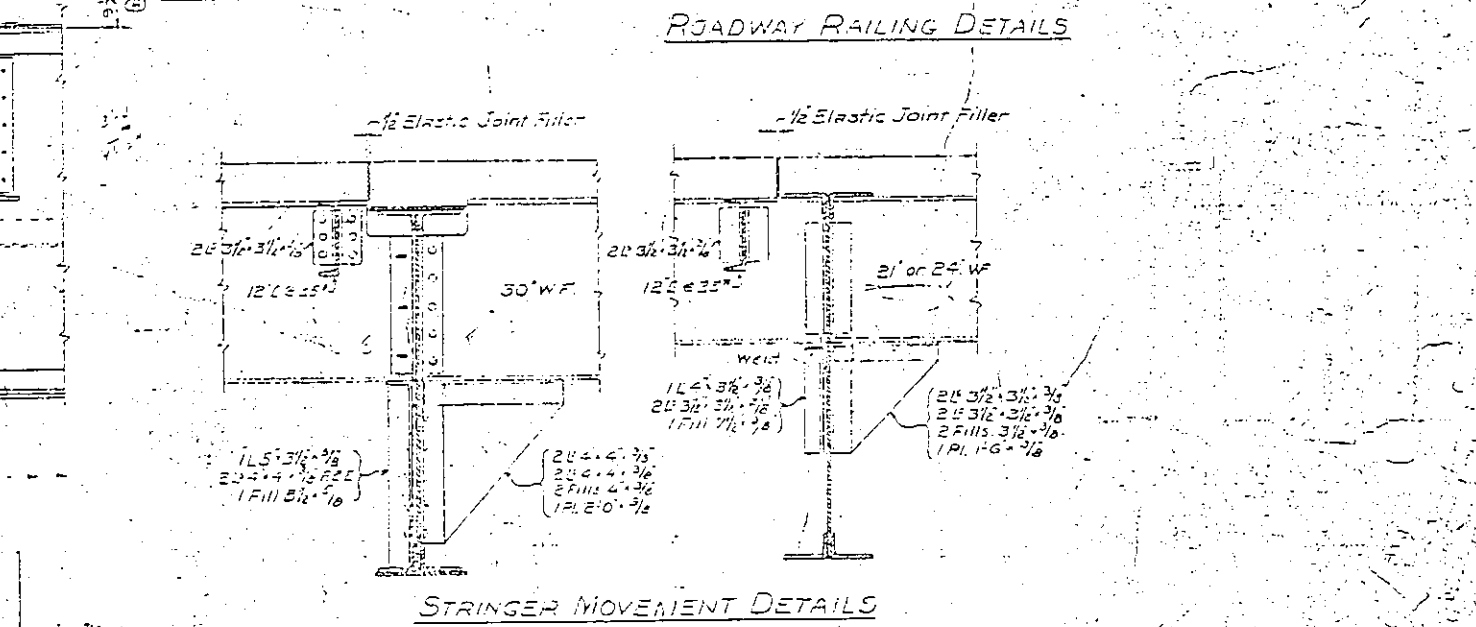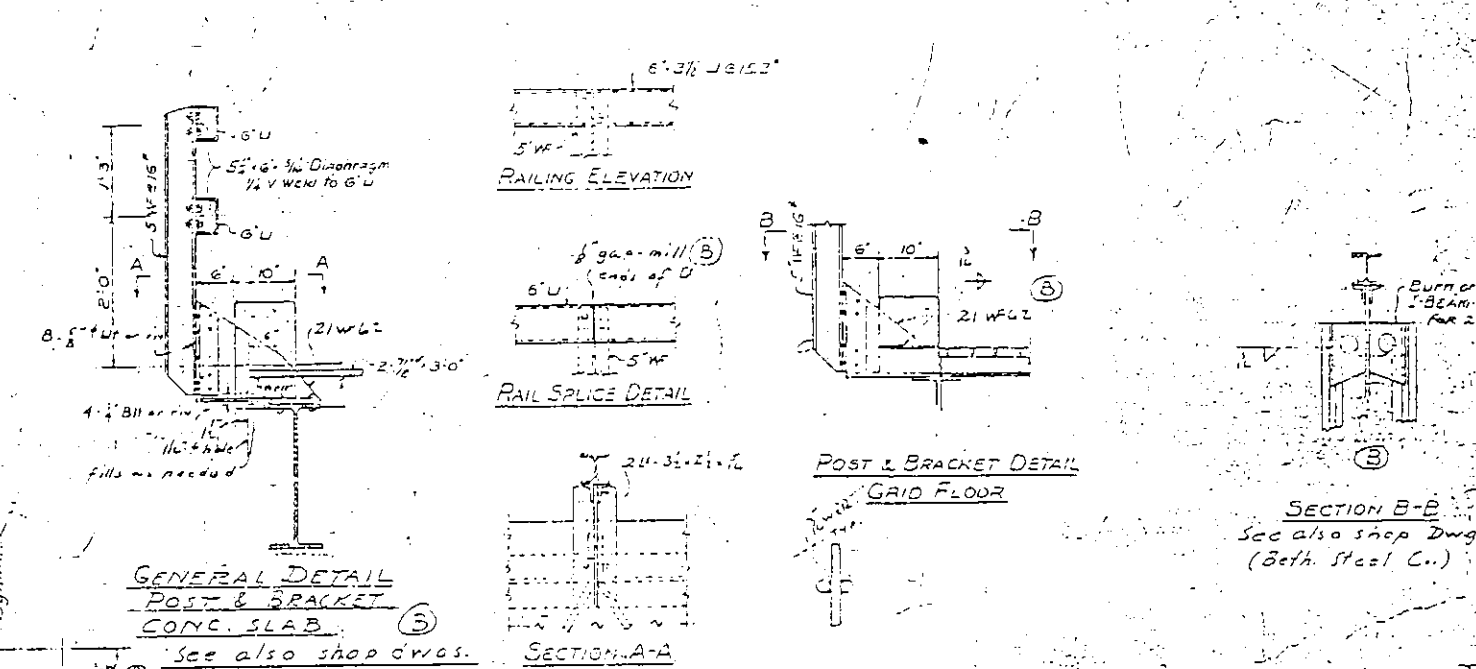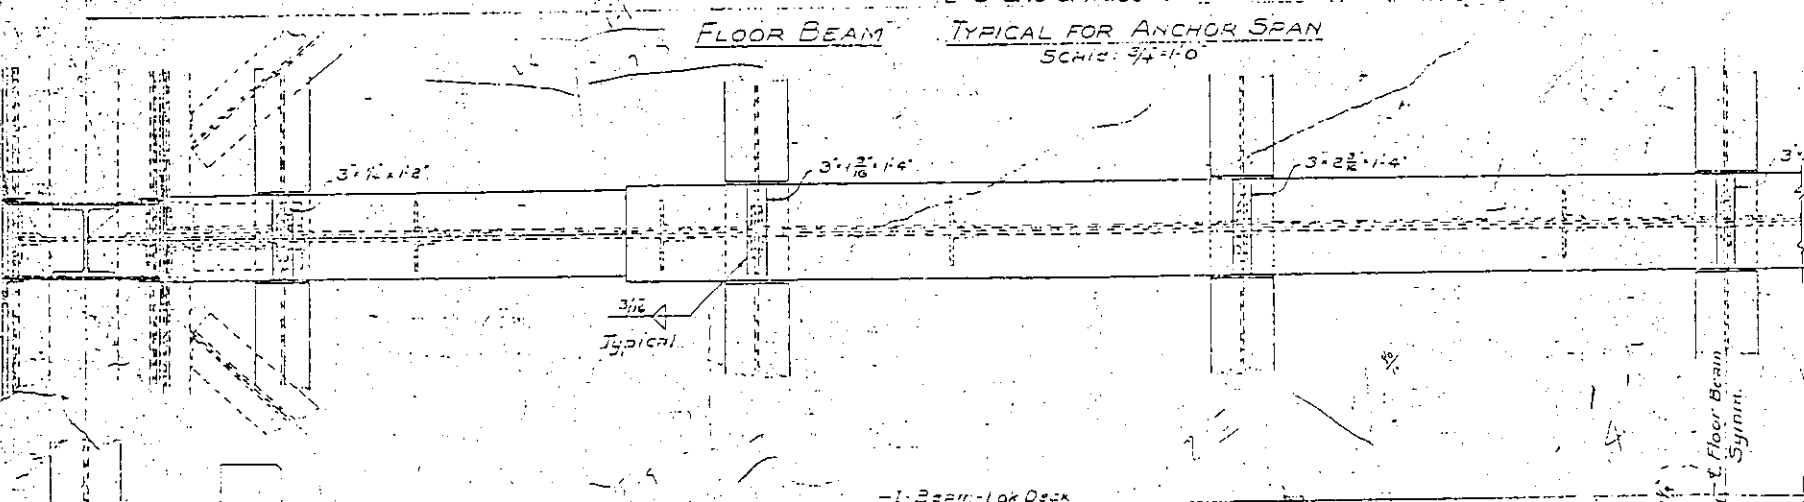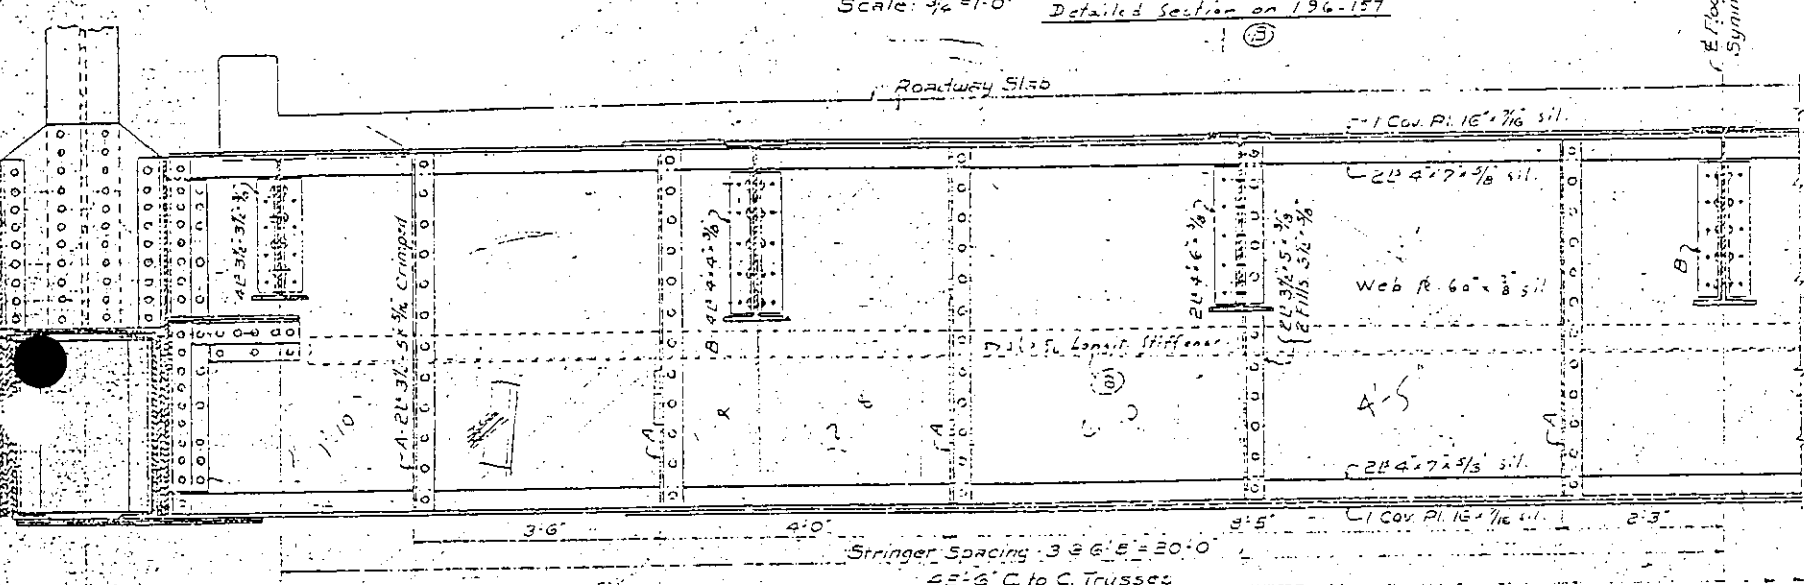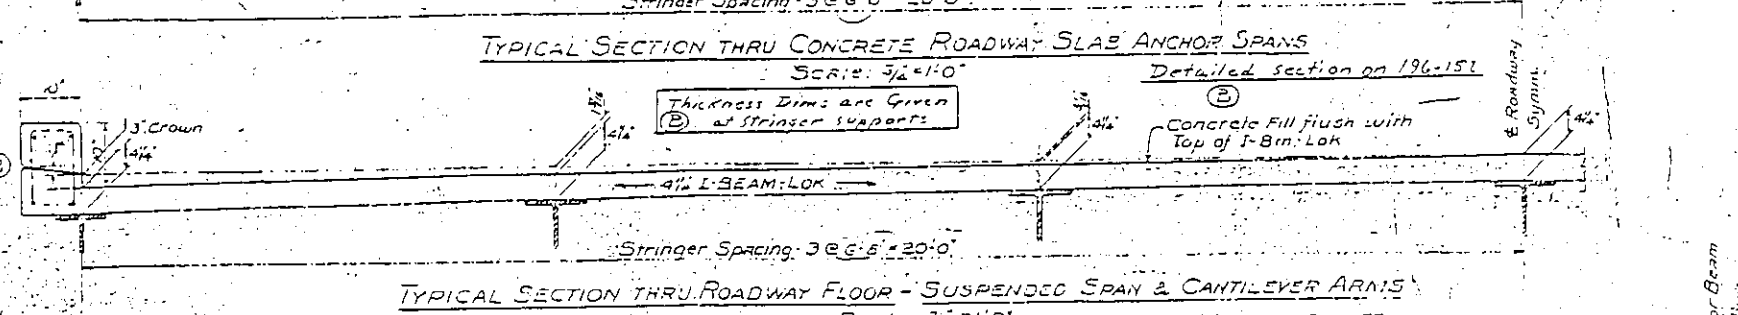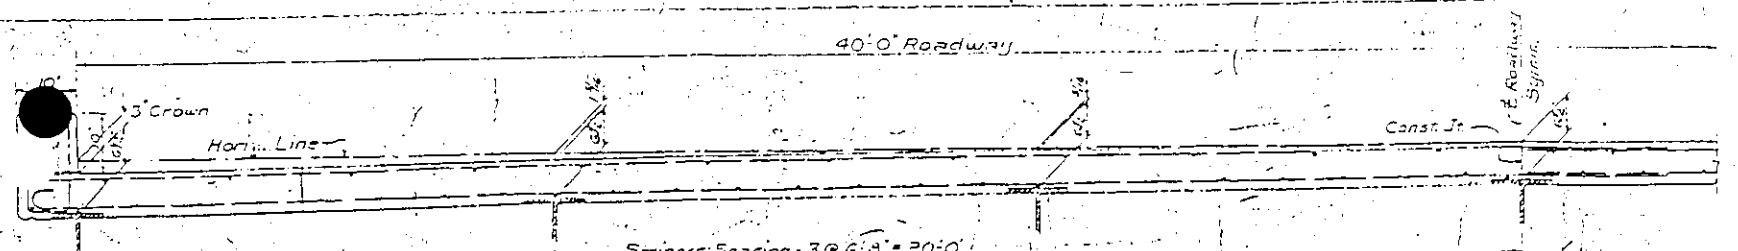


FOR INFORMATION ONLY


Rev. @ - As built
 MISSISSIPPI RIVER BRIDGE
 BETWEEN
 THIRD ST. EAST ST. LOUIS, MO.
 AND
 THIRD ST. ST. LOUIS, MO.

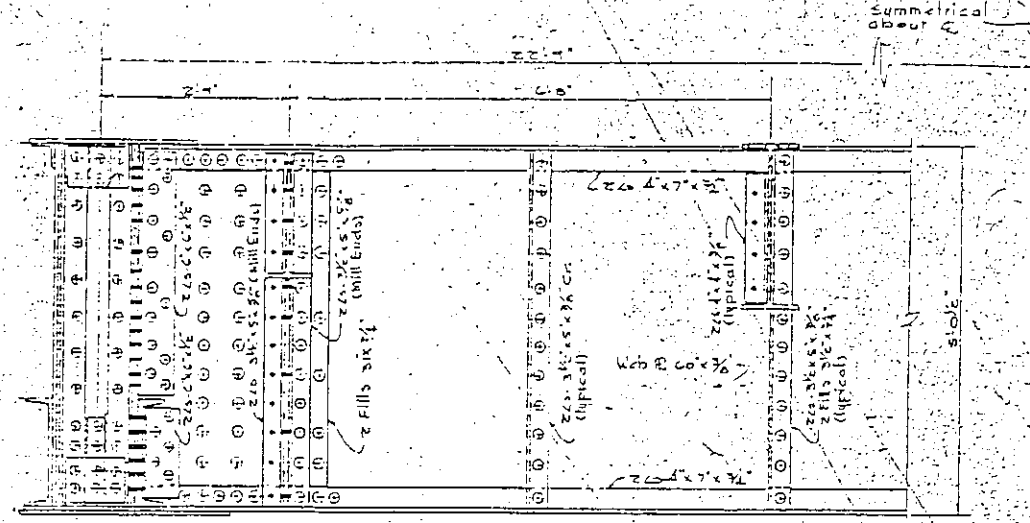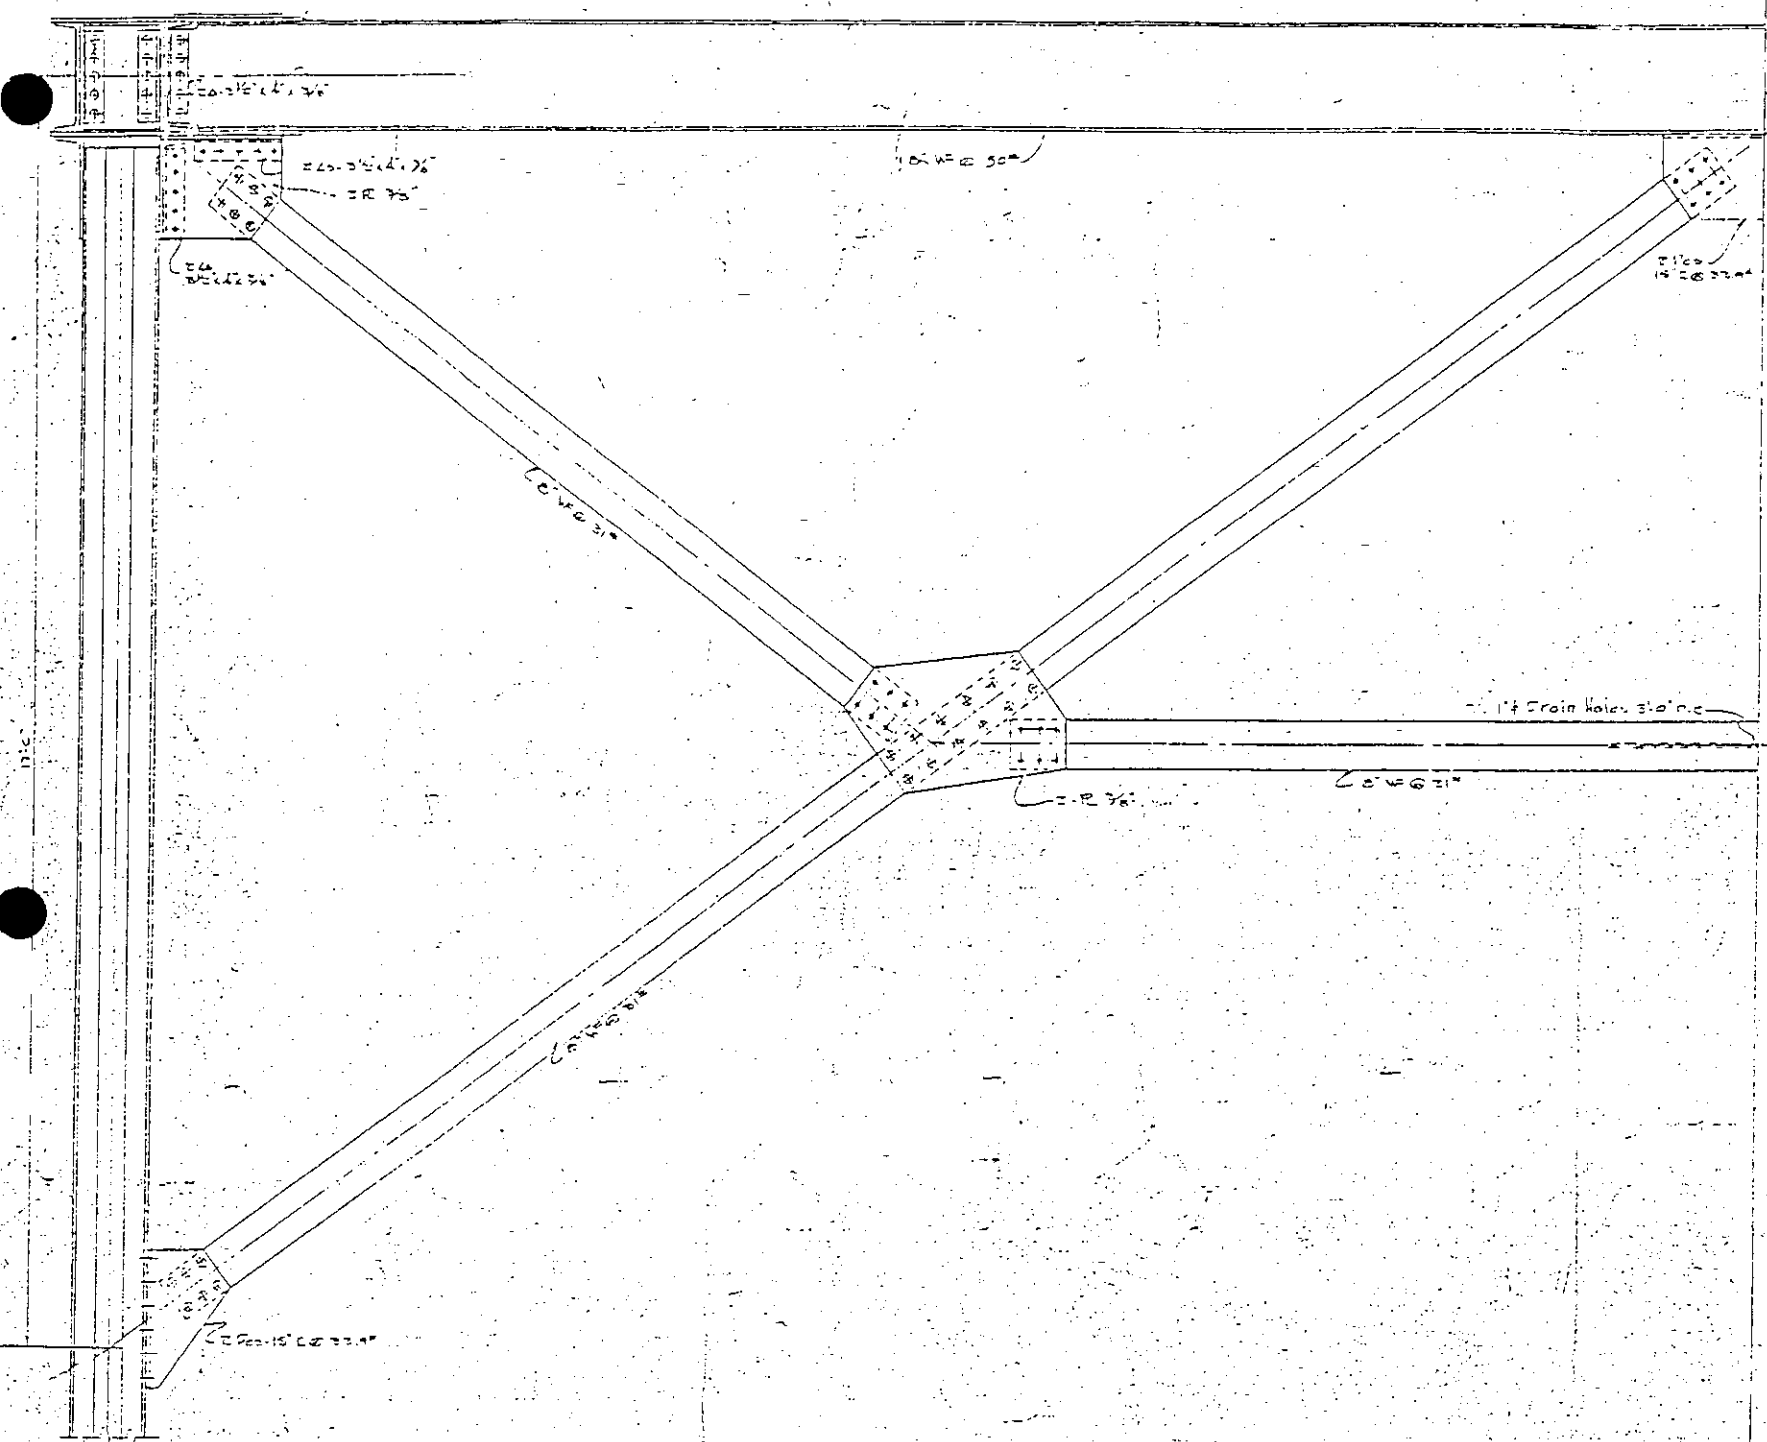


END FLOOR BEAM

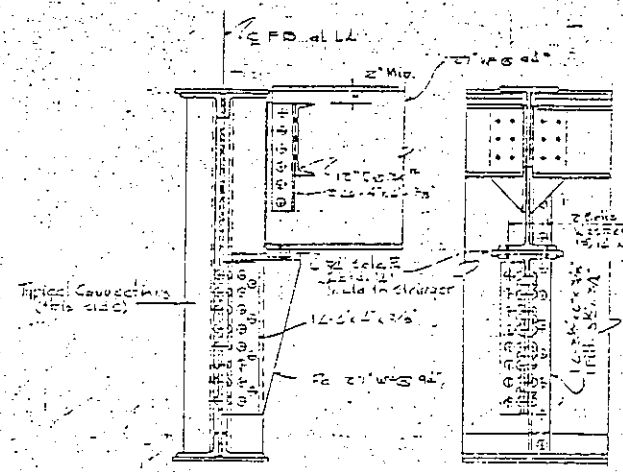



27" STRINGER CONNECTION
AT L-4

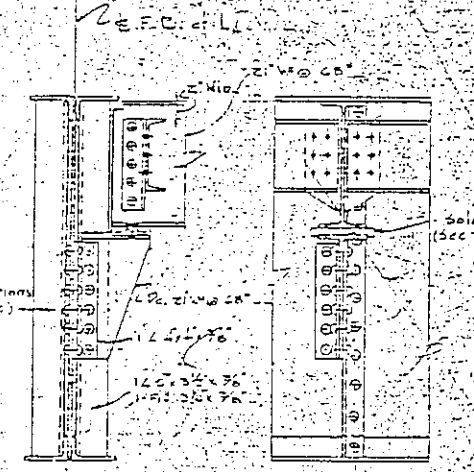

21" STRINGER CONNECTION
AT L-4

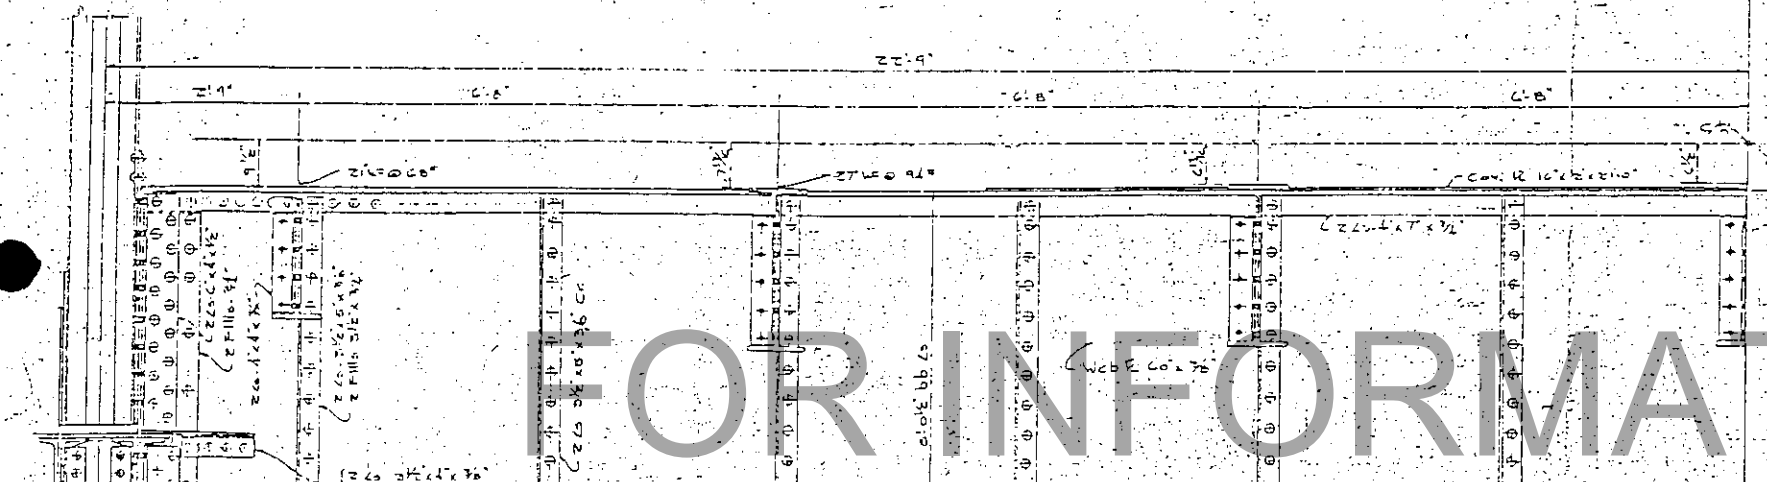


FOR INFORMATION ONLY

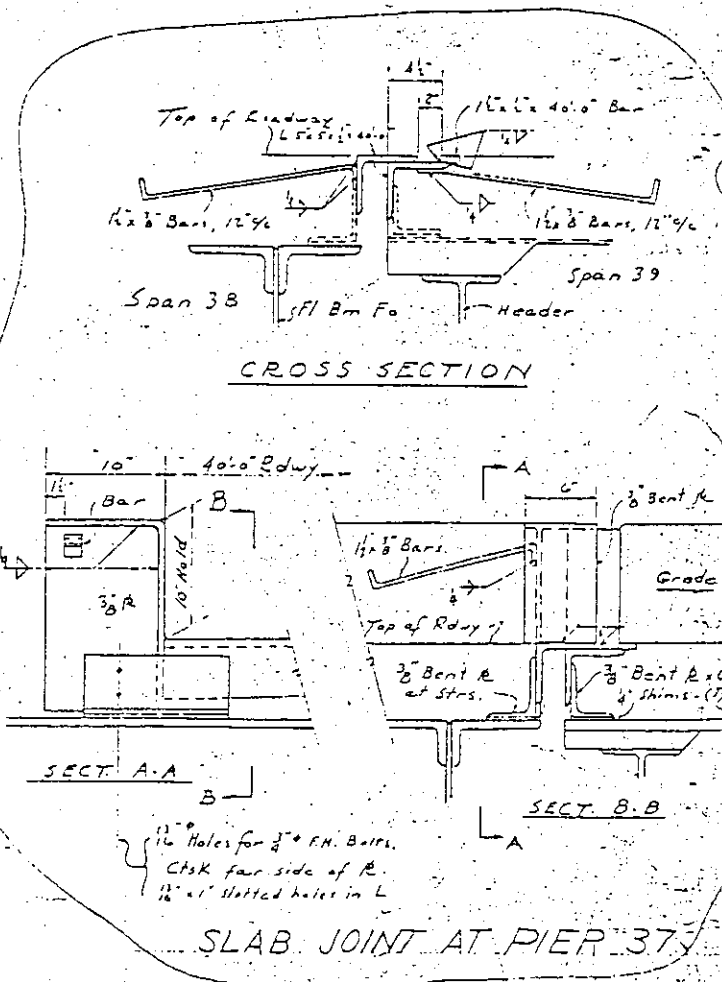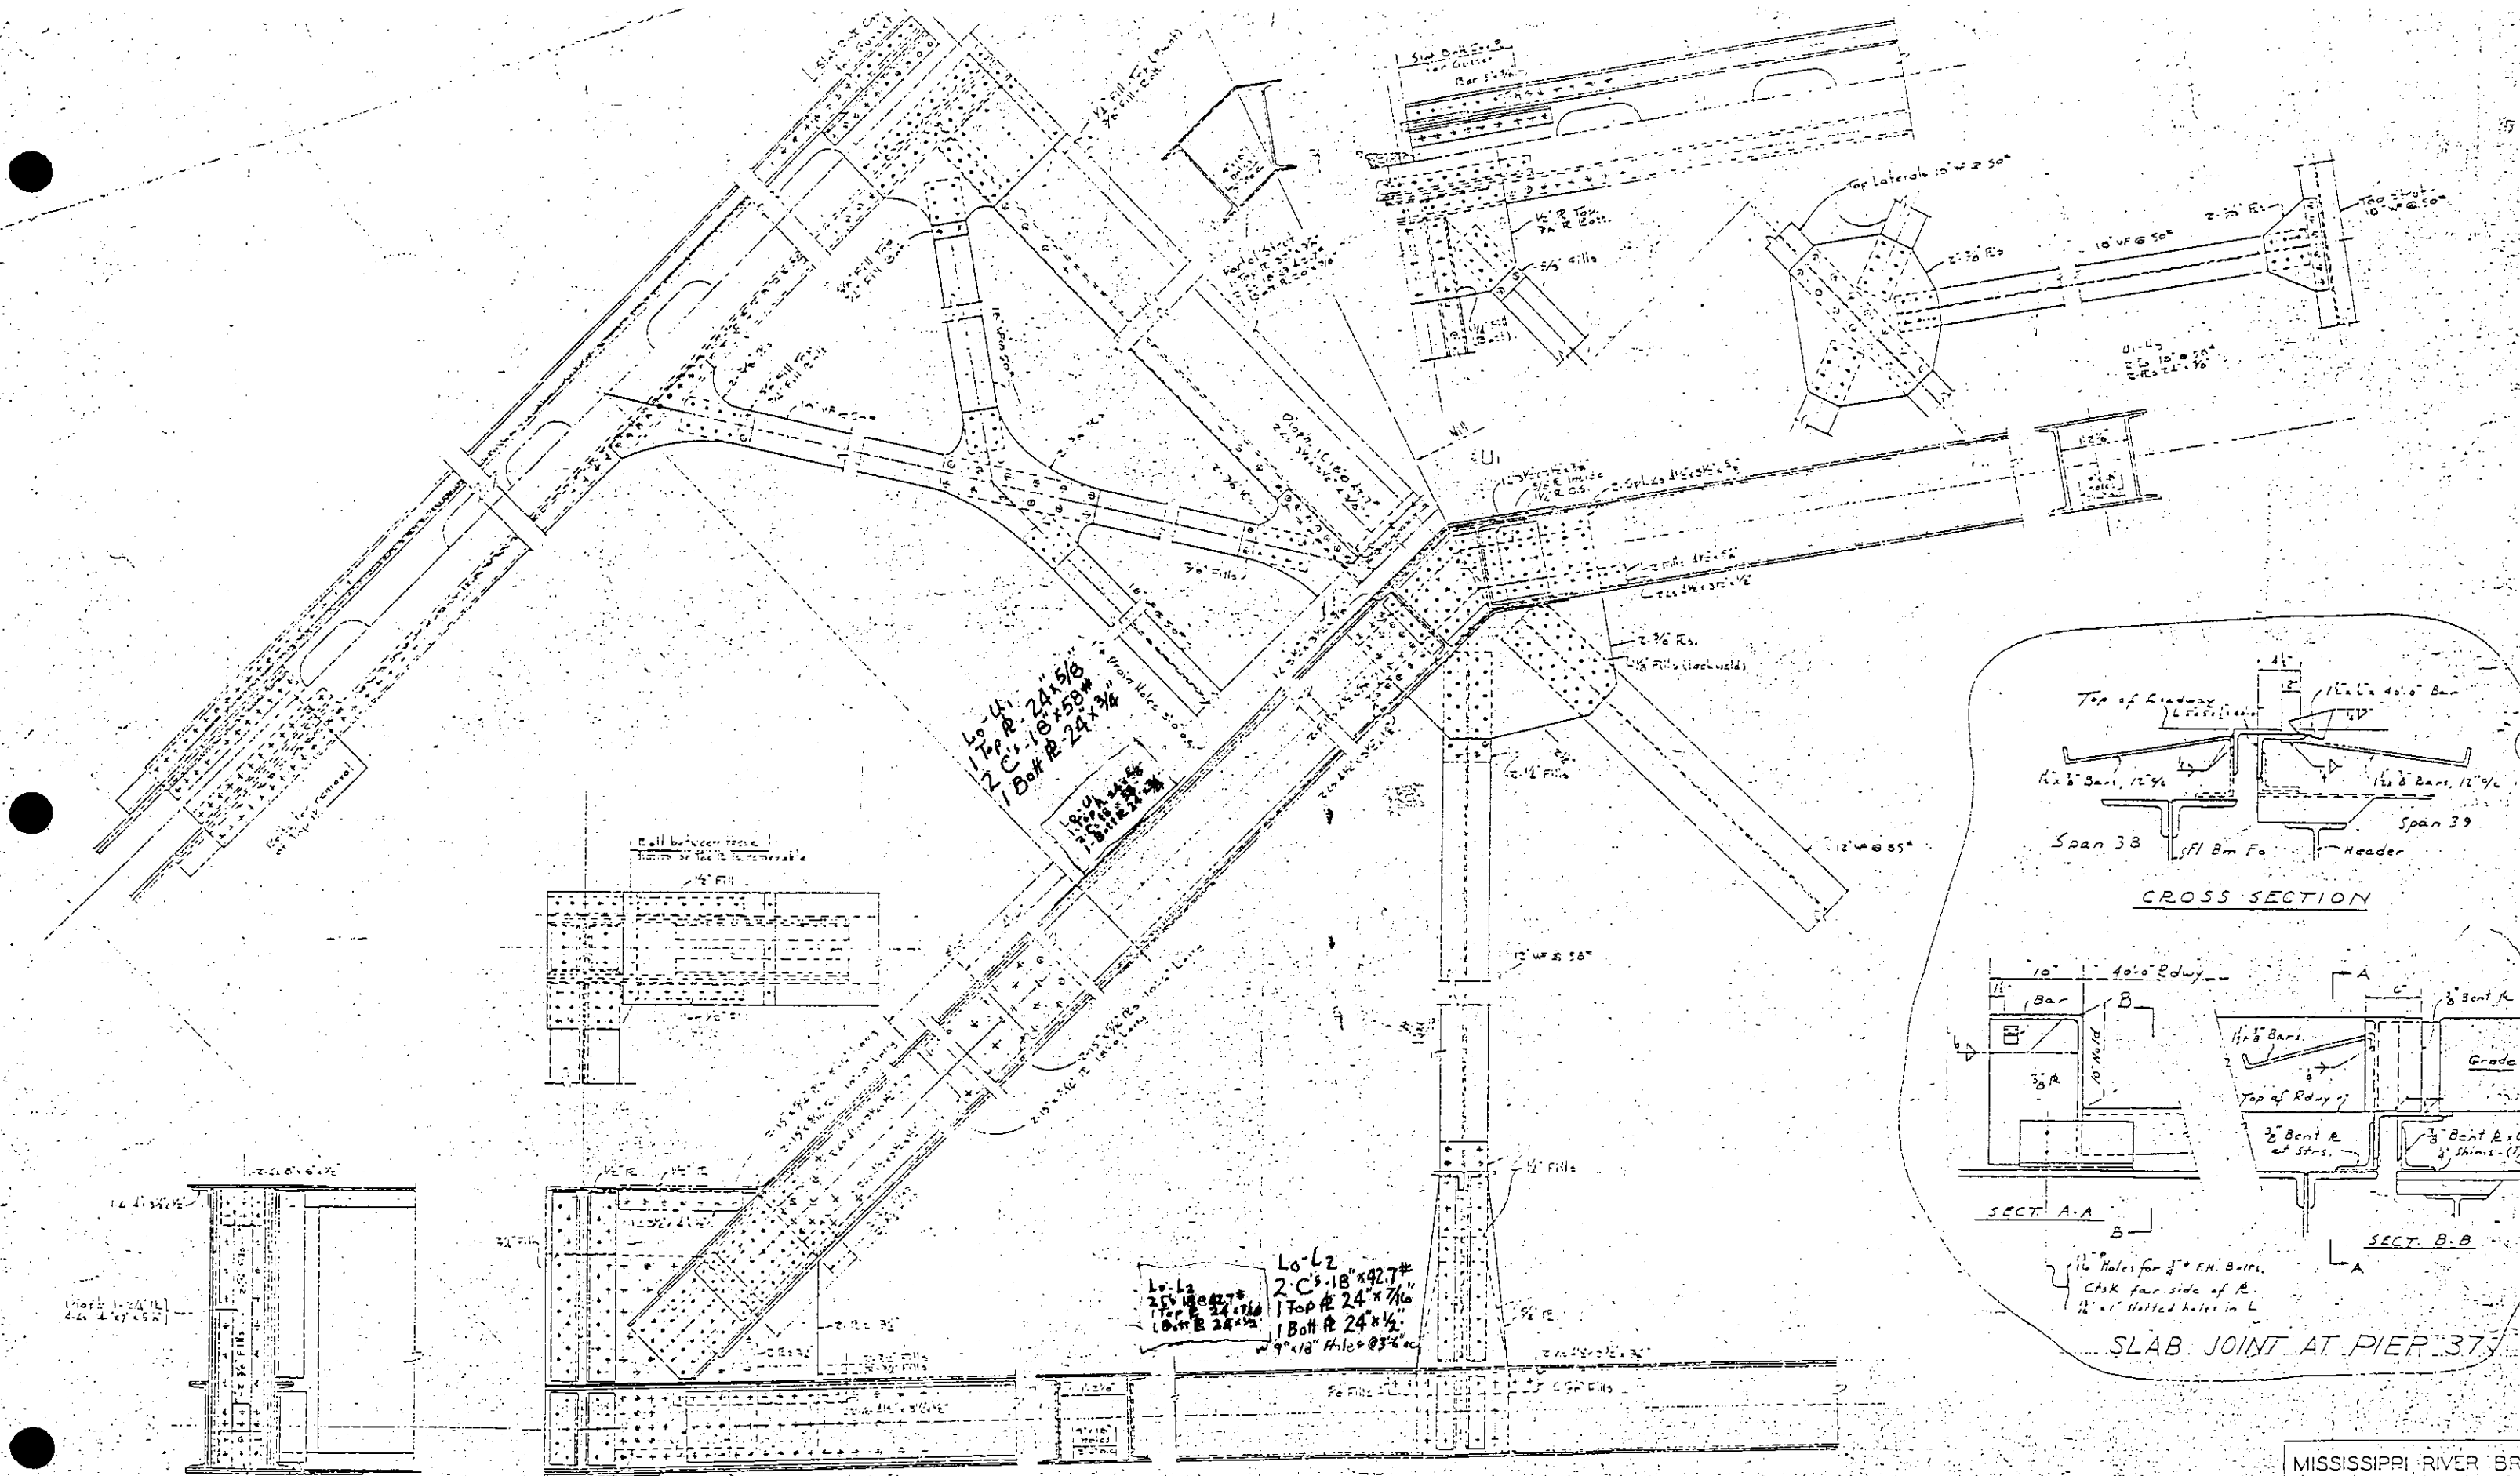

FOR INFORMATION ONLY












MISSISSIPPI RIVER BR
 BETWEEN
 THIRD ST, EAST ST. LOUIS,
 AND
 7 THIRD ST, ST. LOUIS, MO
 FOR
 CITY OF EAST ST. LOUIS
 249' SPAN

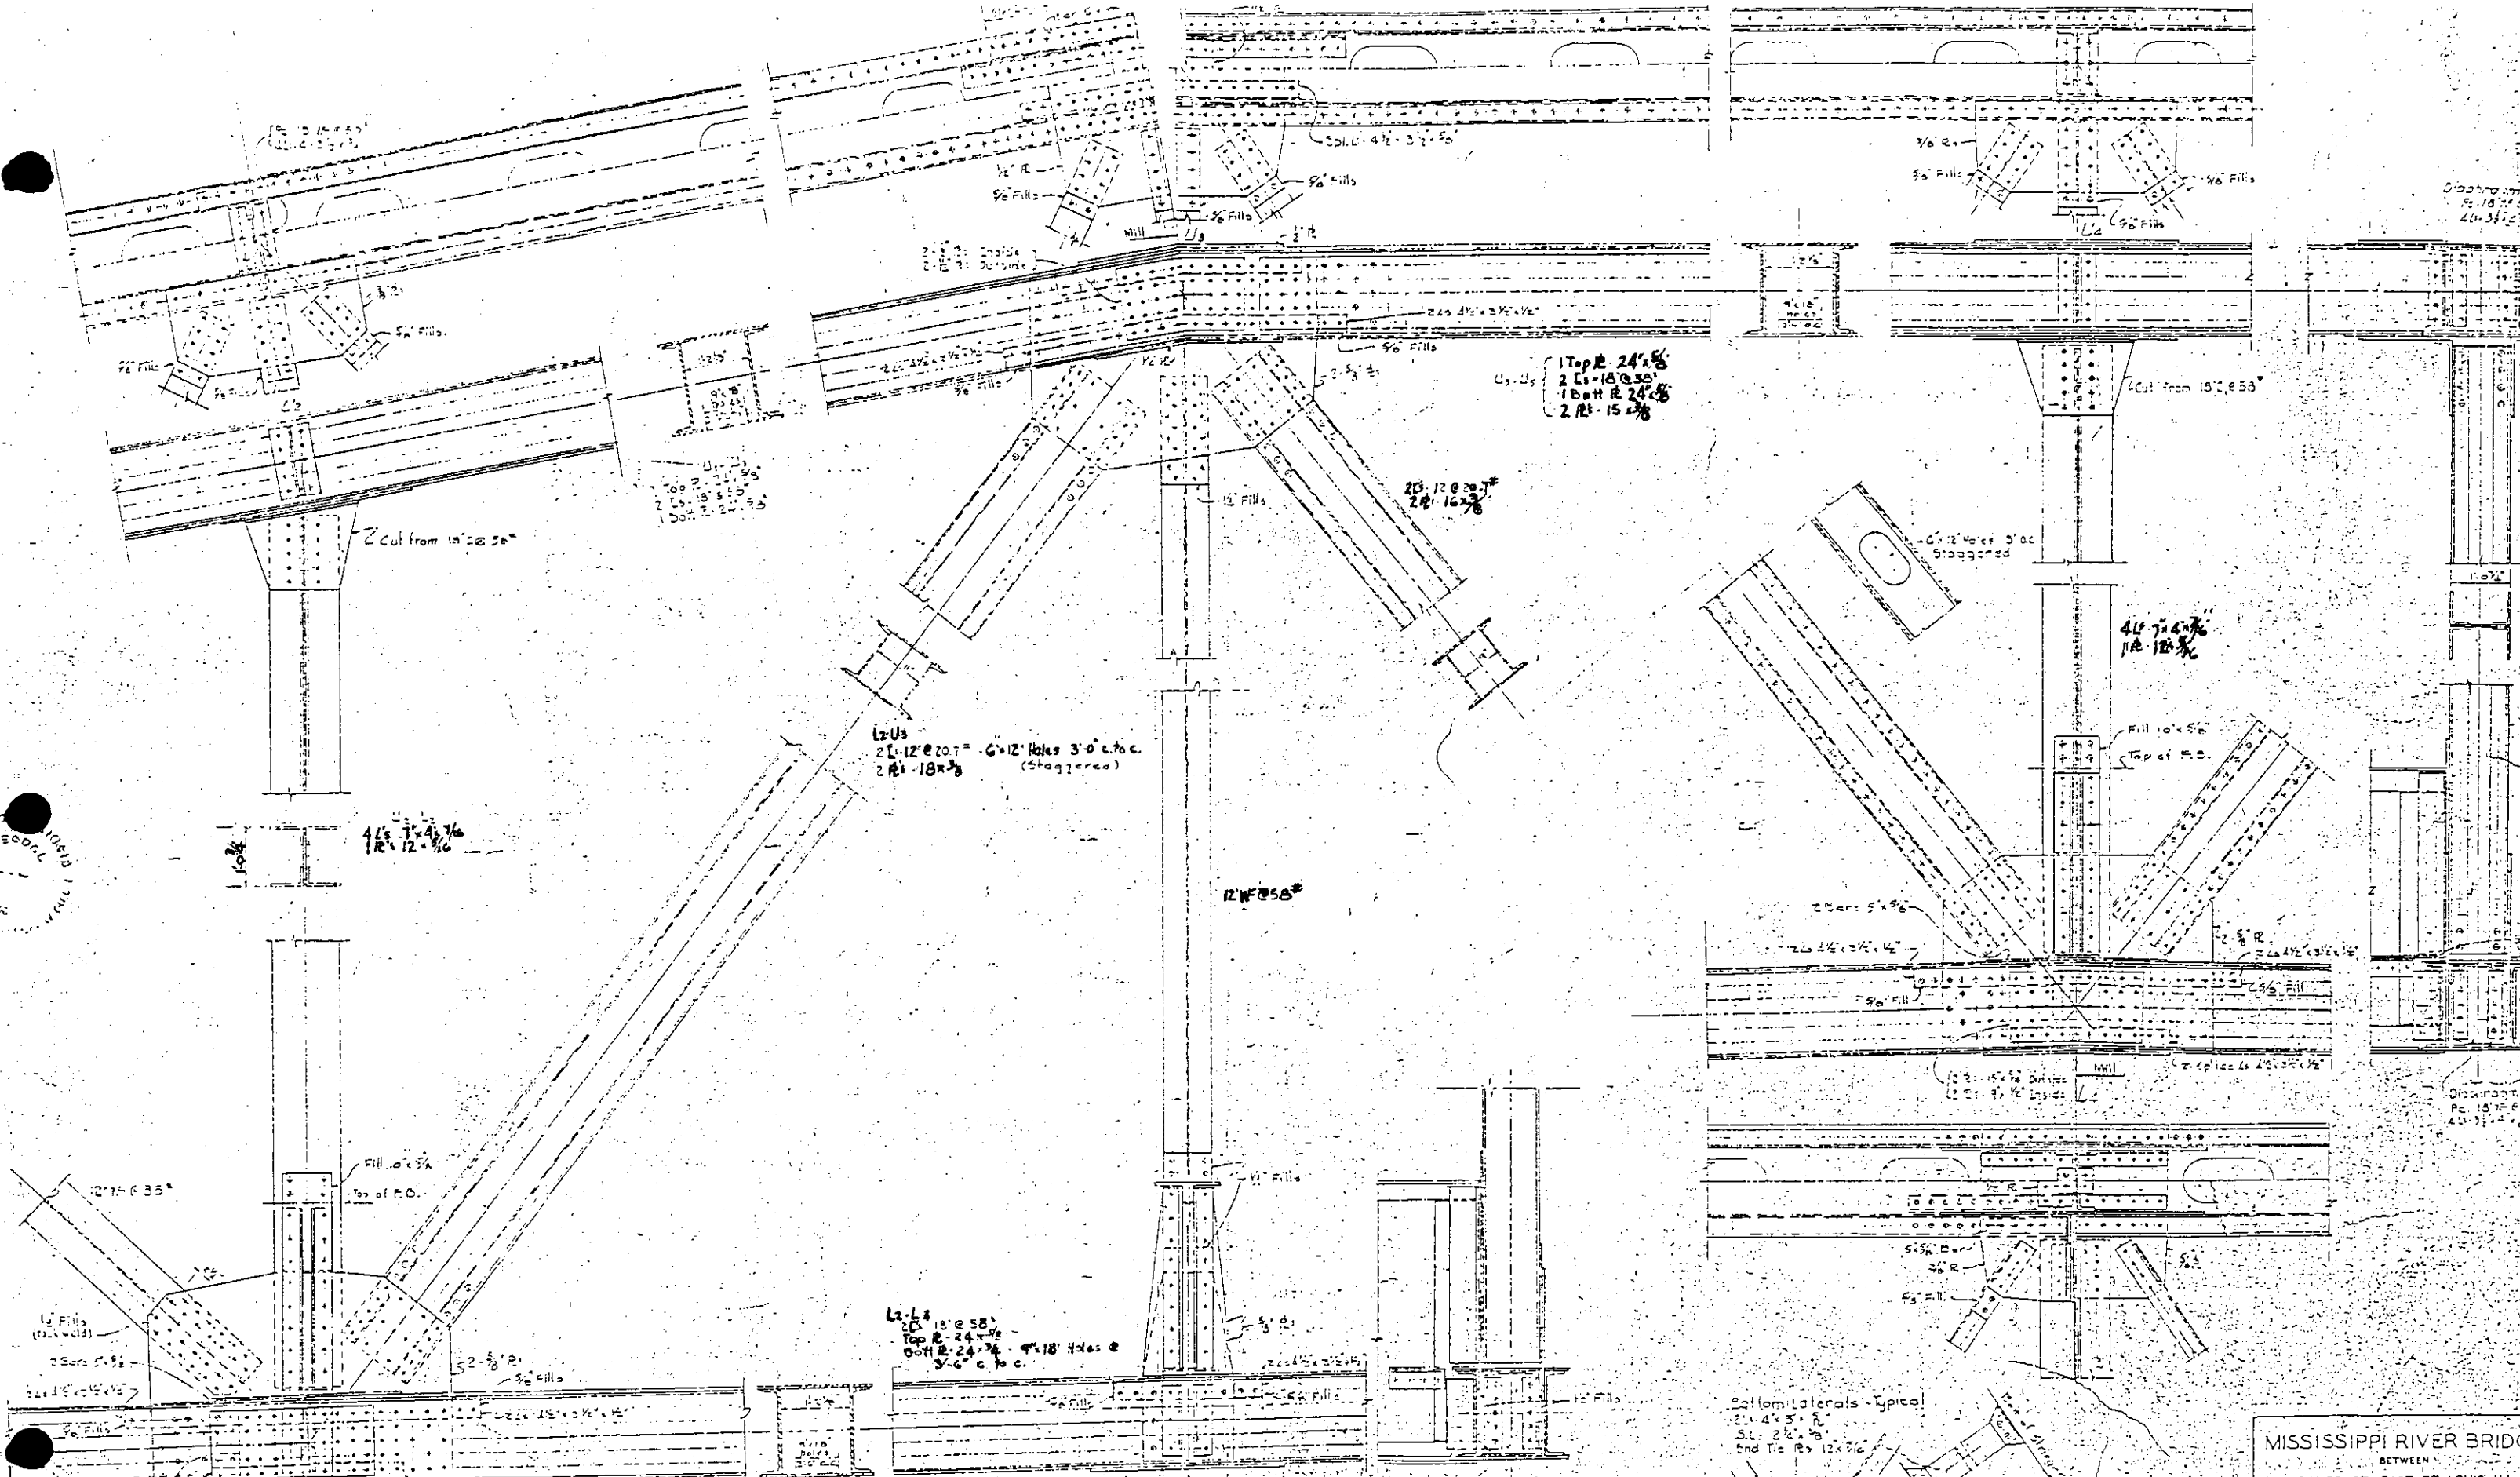

MISSISSIPPI RIVER BRIDGE

FOR INFORMATION ONLY

MISSISSIPPI RIVER BRIDGE
 BETWEEN
 THIRD ST. EAST ST. LOUIS, ILL.
 AND
 THIRD ST. ST. LOUIS, MO.
 FOR
 CITY OF EAST ST. LOUIS
 (249' SPAN)
 TRUSS DETAILS

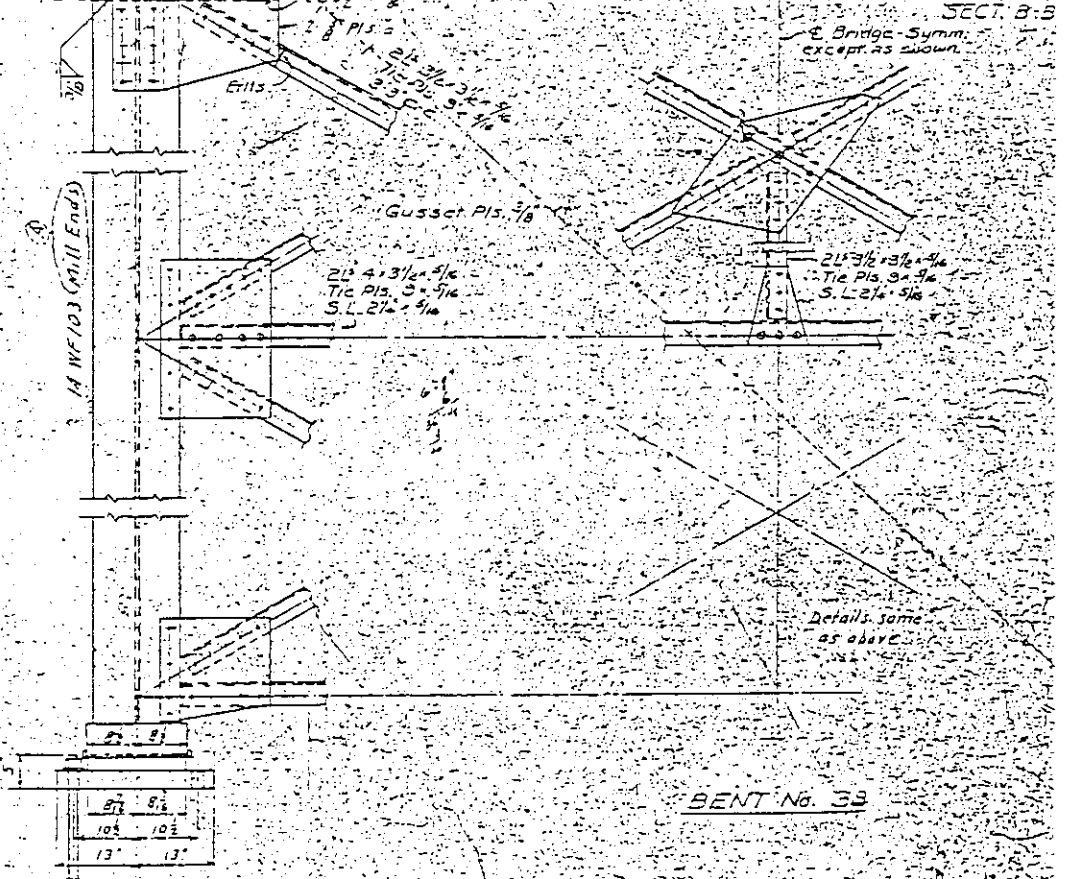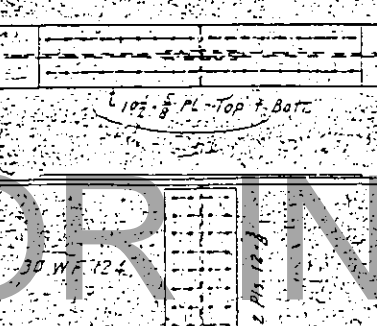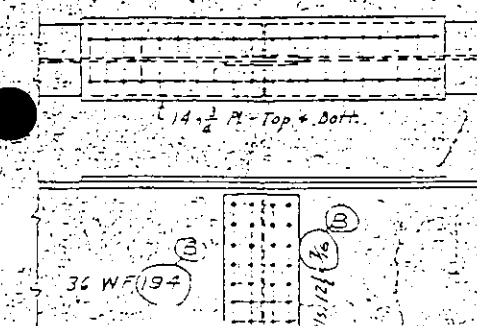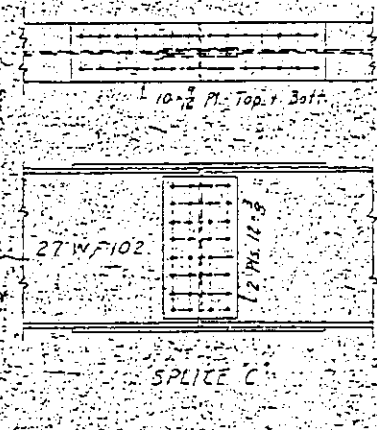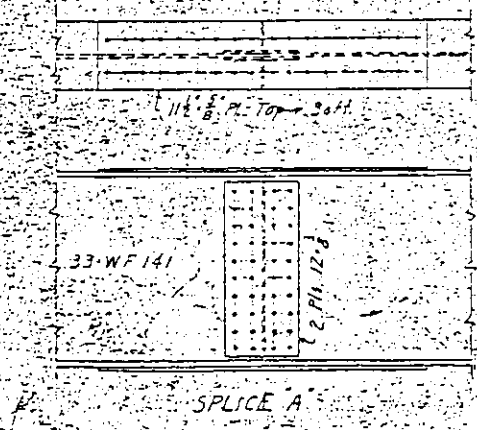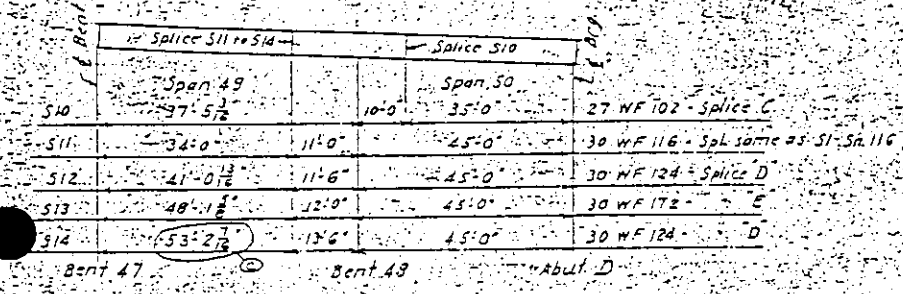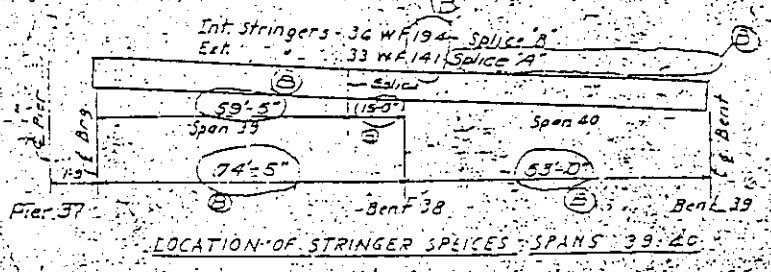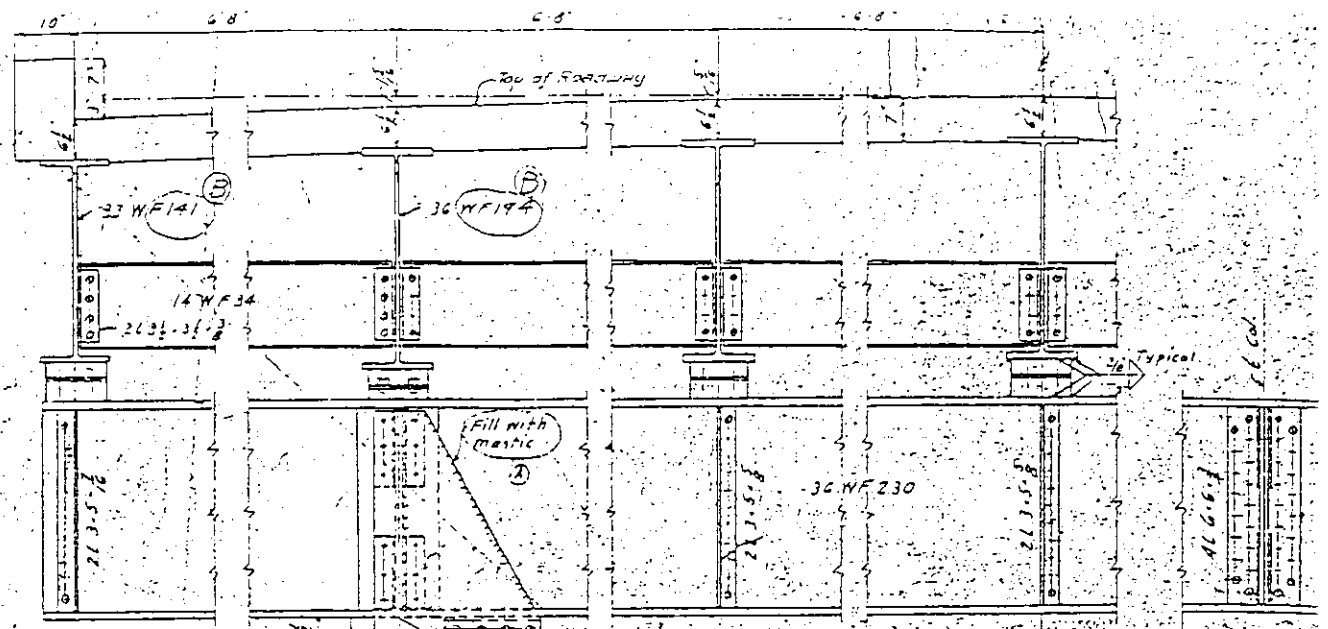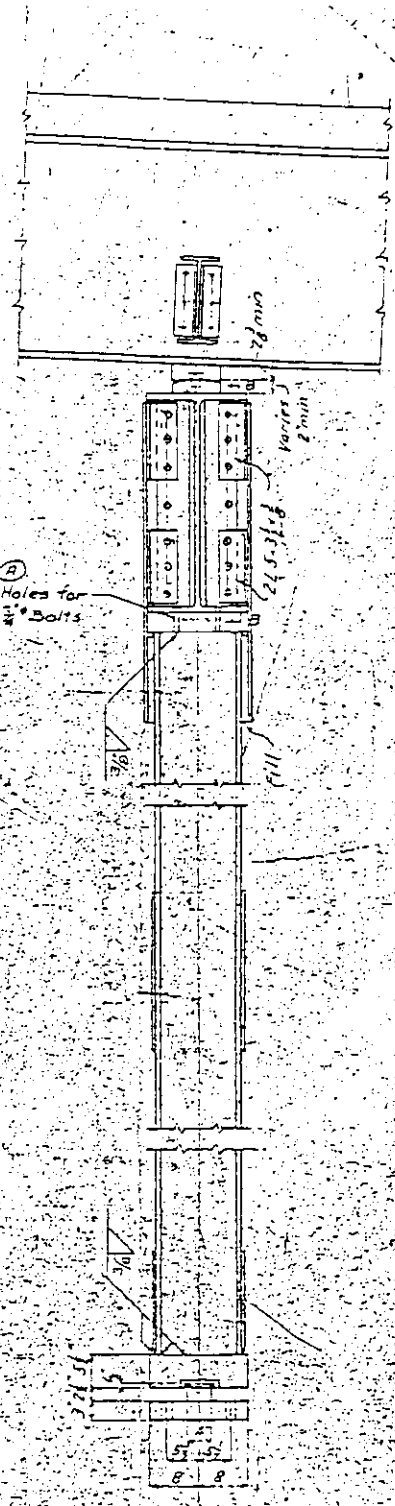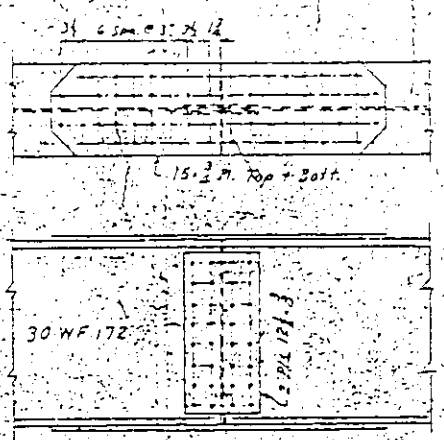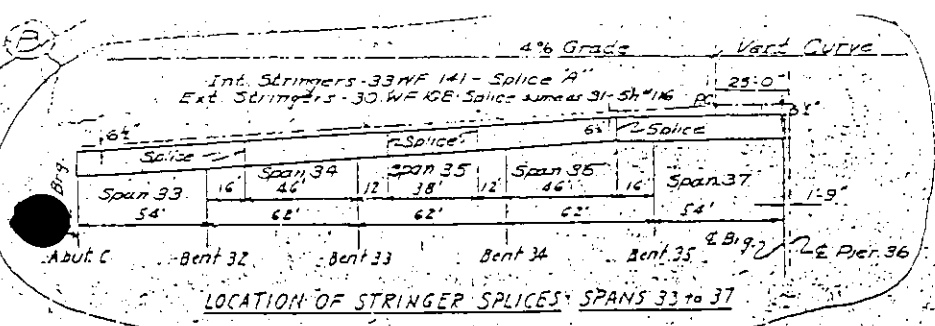



GENERAL NOTES:

- Rivets: 3/4" diam. unless noted.
- Open Holes: 1 1/2" diam. unless noted.
- Bearings and Anchorages shall be set as provided in Section 2-10-50 of the AASHTO S14 Specs.
- Expansion Bearings on Abutment C similar to Abutment A - 5" x 115.
- Fixed Bearings on Piers 36 and 37 and Abutment D similar to Abutment B - 5" x 120.
- Rocker Bearings under stringers for Bents 32, 33, 34, 35 and 40 same as Bent #1 - 5" x 115.
- Rocker Bearings at bottom of columns for Bents 32, 33, 34, 35 and 40 same as Bent #2 - 5" x 115.

Rev. © Dim Corrected
 Rev. (B) Changes in Spans 39-40
 Rev. (C) Changes in Spans 39-40
 Holes in Col. Hd. Added
 Rev. (D) Mill. Cols. - Rev. Gen. Note: Add Note

MISSISSIPPI RIVER BRIDGE
 BETWEEN
 THIRD ST. EAST ST. LOUIS, MO.
 AND
 THIRD ST. ST. LOUIS, MO.
 CITY OF EAST ST. LOUIS, MO.
 TYPICAL DETAILS -
 SECTION 2 AND BENT NO. 33

FOR INFORMATION ONLY

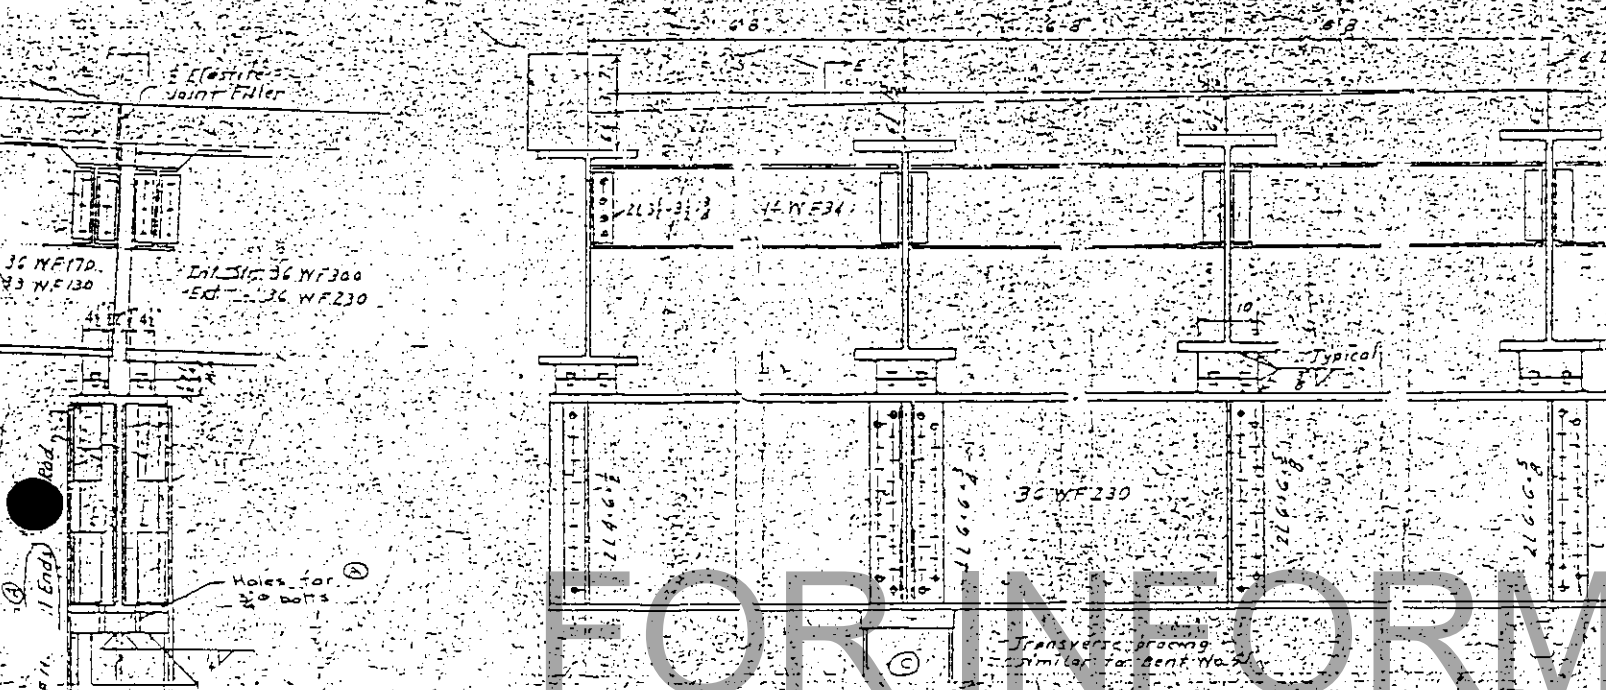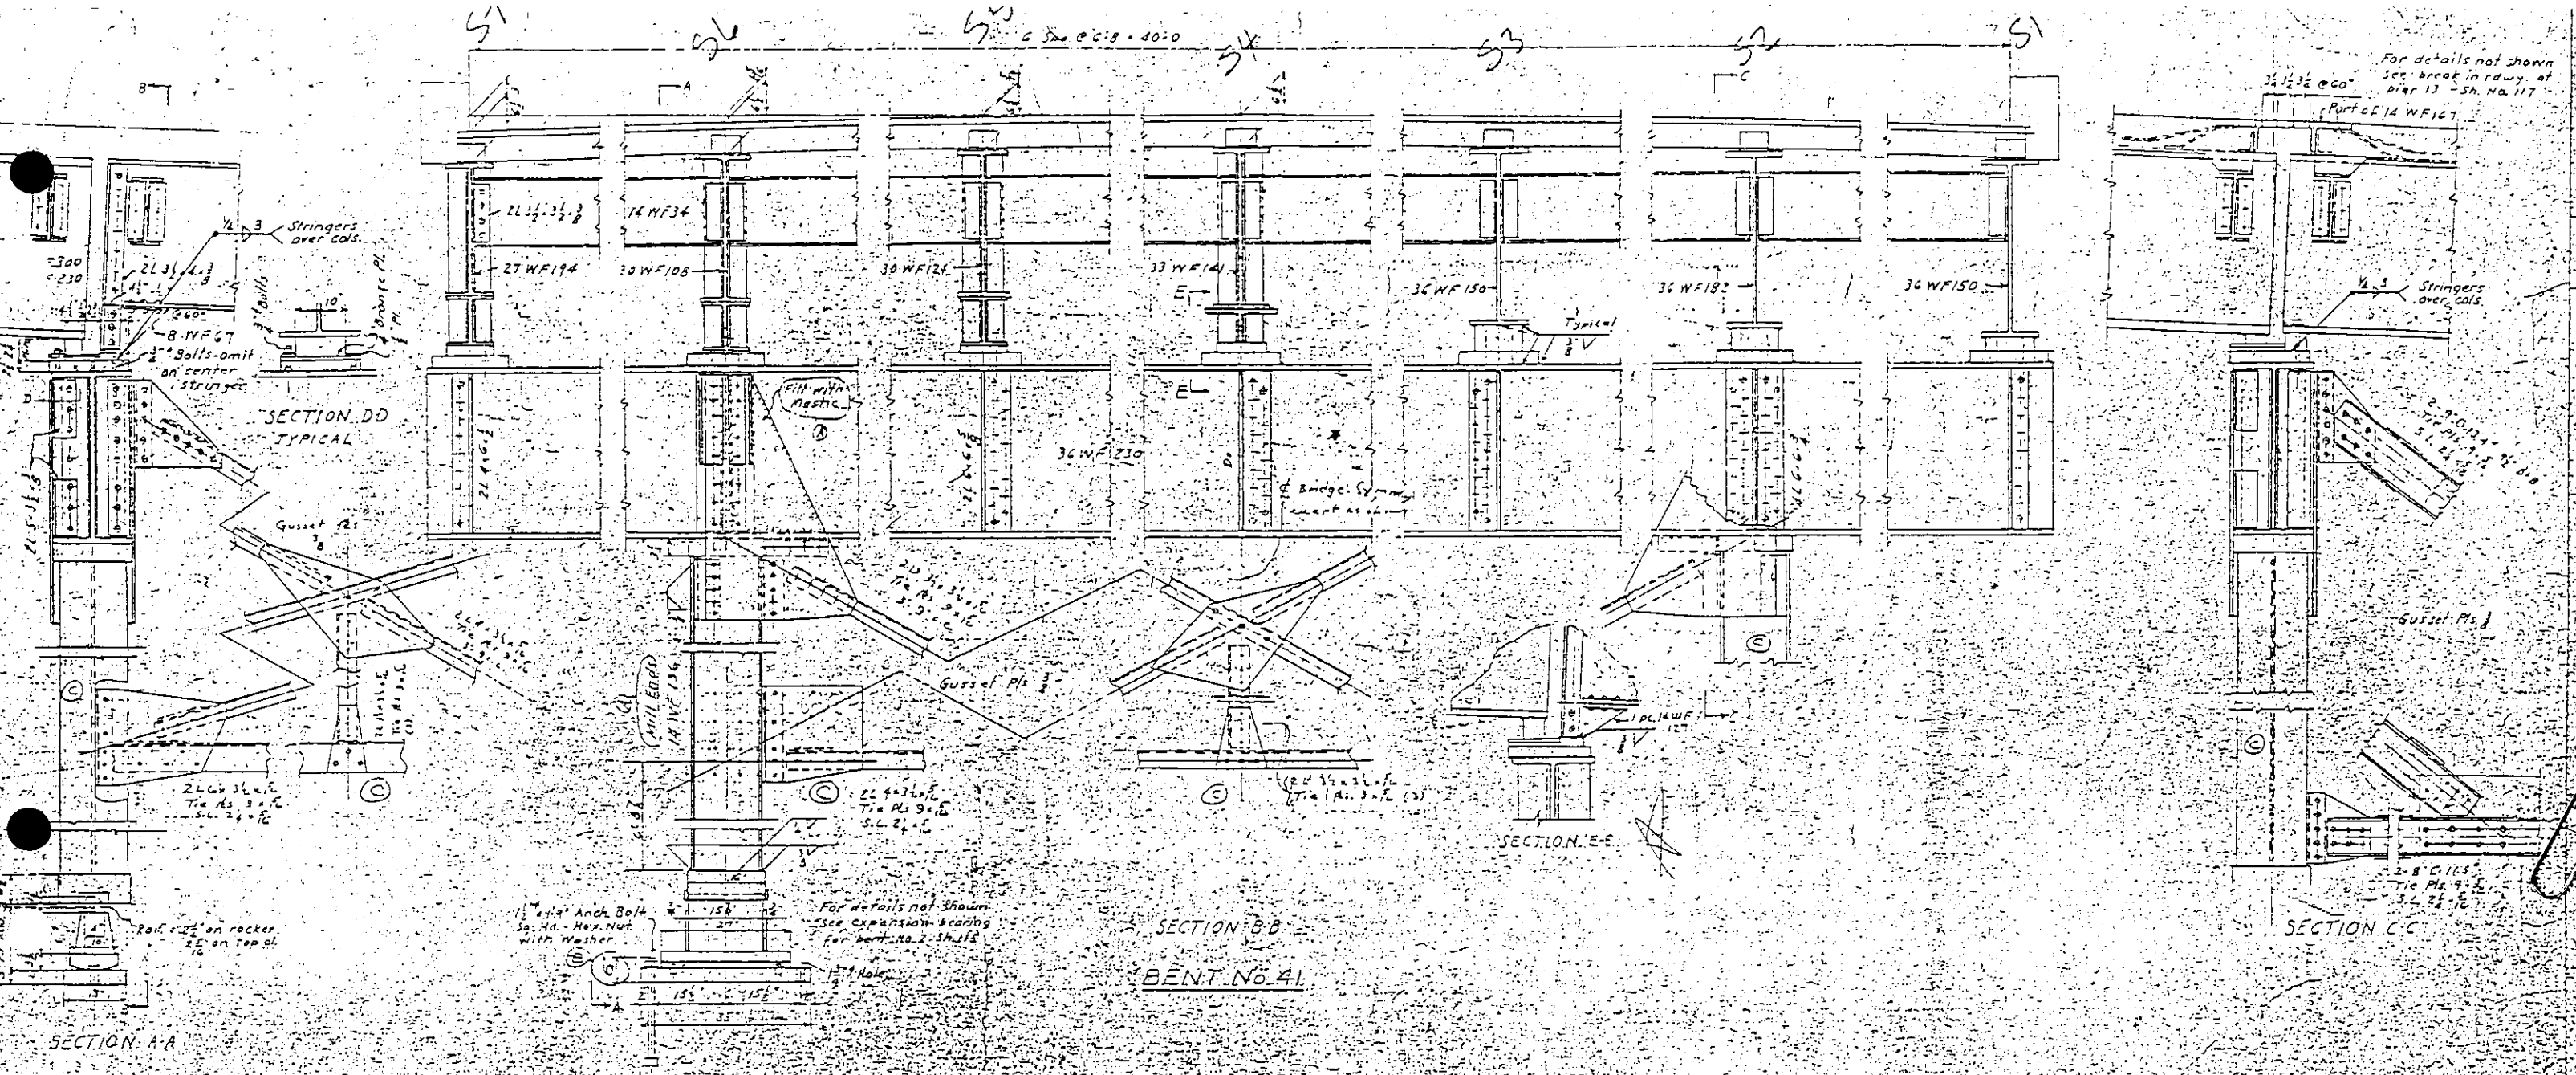










GENERAL NOTES:
 Rivets 3/4" diam.
 Open Holes 1 3/8" diam. unless noted.
 Bearings and Anchorage similar to Sec. 804 of the AASHTO Std. Specs.

Rev. C Cols turned 30° brg. raised - 8-19
 Rev. B Anchor Bolt changed to 3" dia - 8-19
 Holes in Col. HD added - 8-19
 Rev. A Mill Gas. Add mastic - 8-19

MISSISSIPPI RIVER BRIDGE
 BETWEEN
 THIRD ST. EAST, ST. LOUIS, ILL.
 AND
 THIRD ST. ST. LOUIS, MO.
 FOR
 CITY OF EAST-ST. LOUIS

TYPICAL DETAILS

FOR INFORMATION ONLY

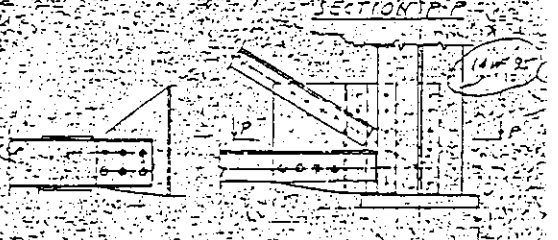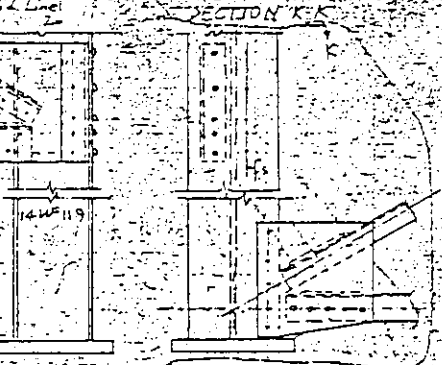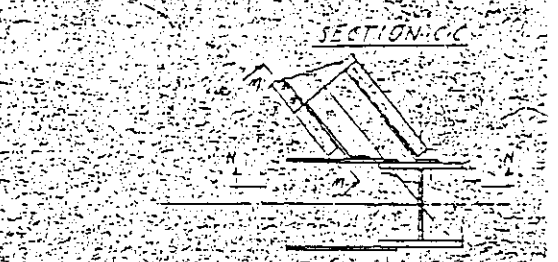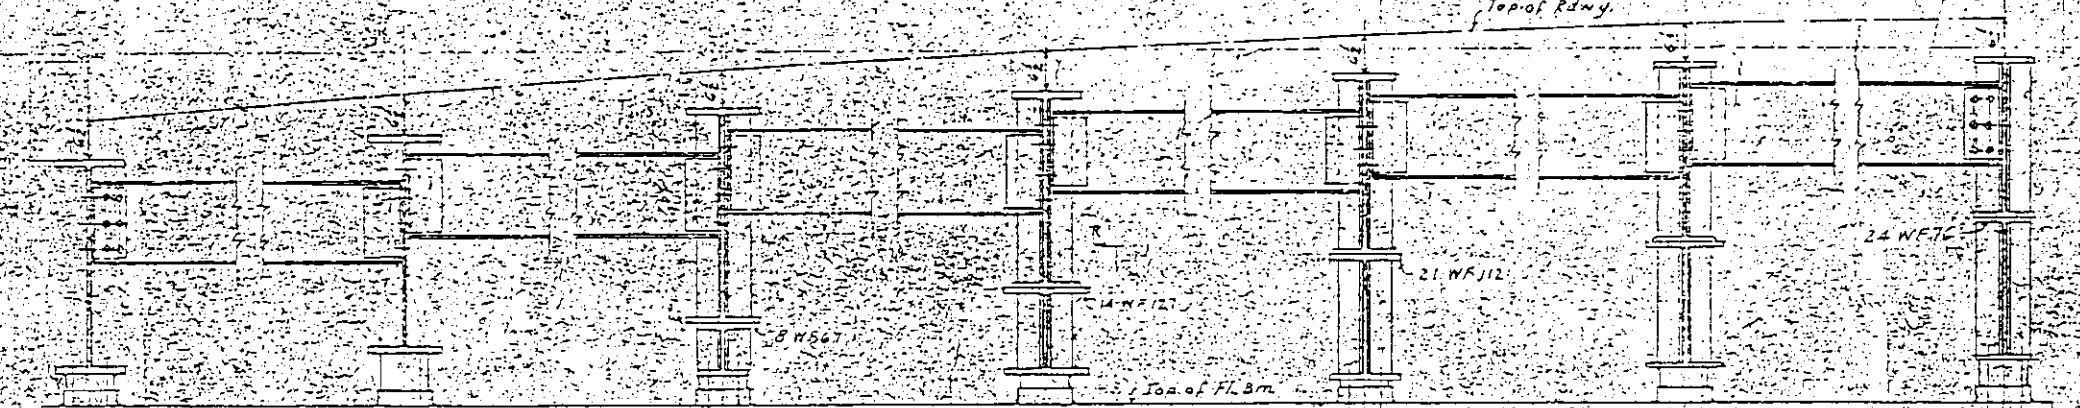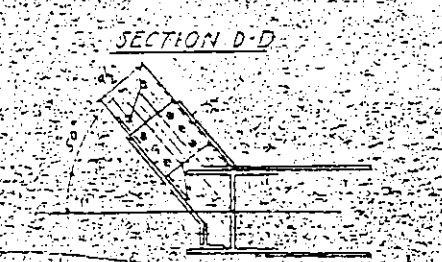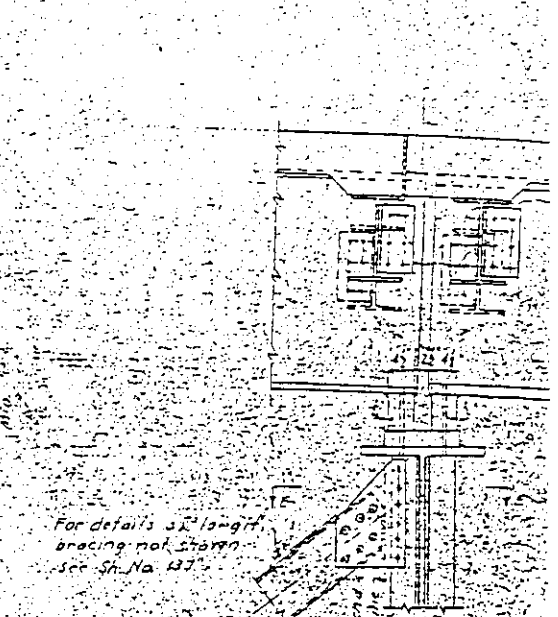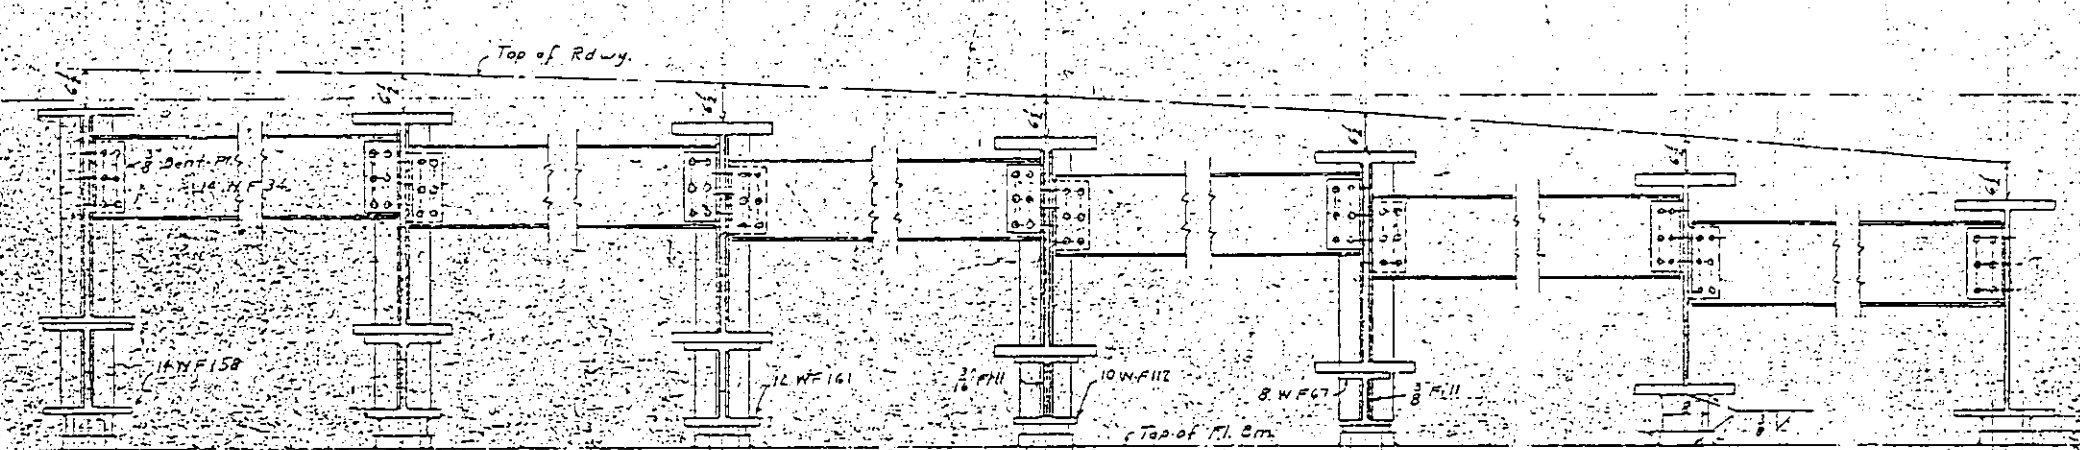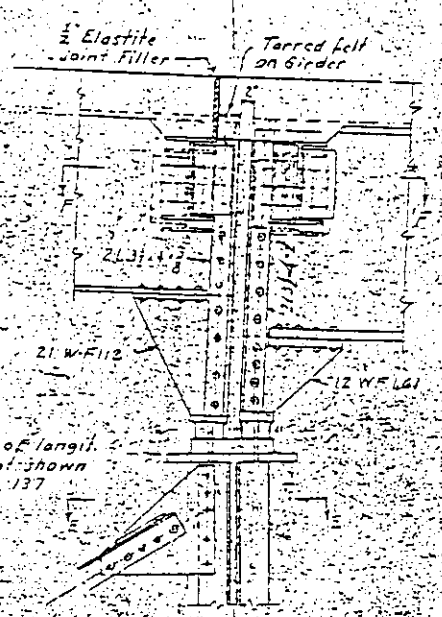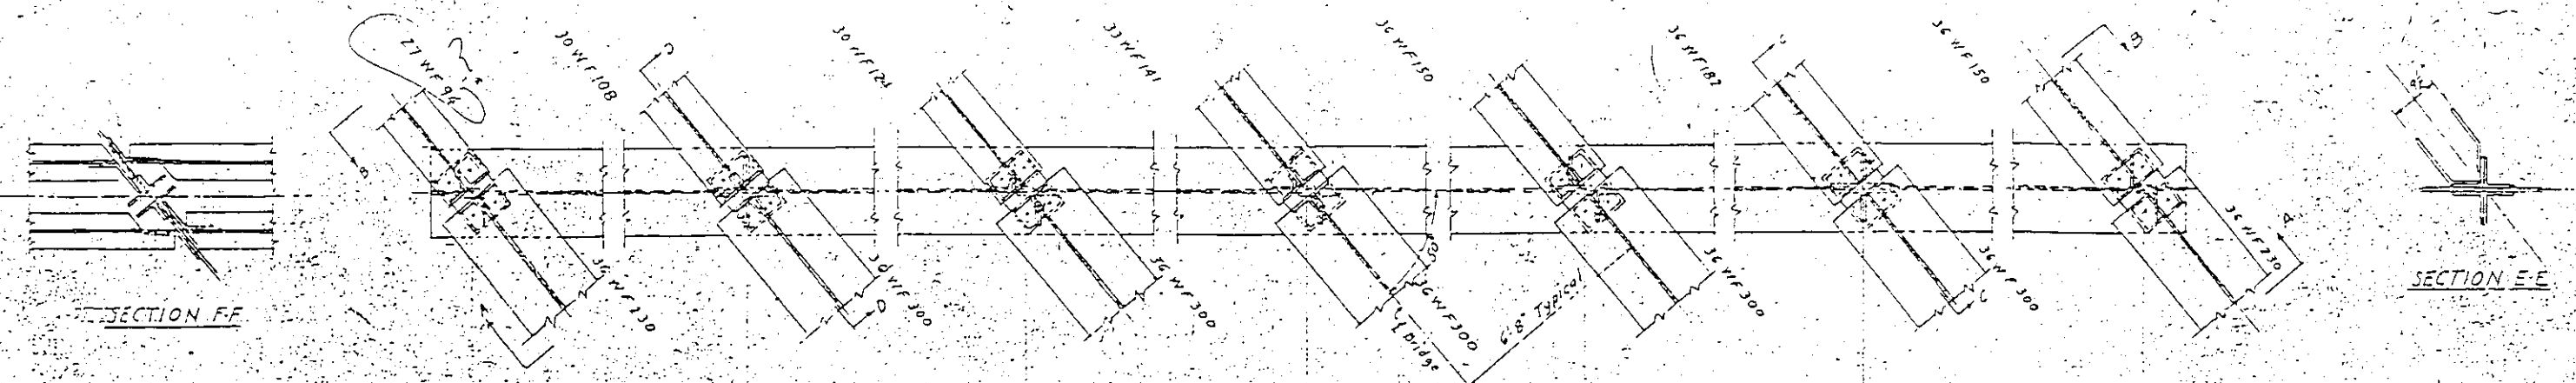







SECTION M-M
SECTION N-N
NORTH COLUMN BASE

Rev. B) Misc. Connections
Holes in Col. Hd. Added
Rev. C) Mill. Coll. Add. Plastic.

MISSISSIPPI RIVER BRID
BETWEEN
THIRD ST. EAST ST. LOUIS, IL
AND
THIRD ST. ST. LOUIS, MO.
FOR
CITY OF EAST ST. LOUIS
BENT NO. 42

FOR INFORMATION ONLY

SH. NO. 137

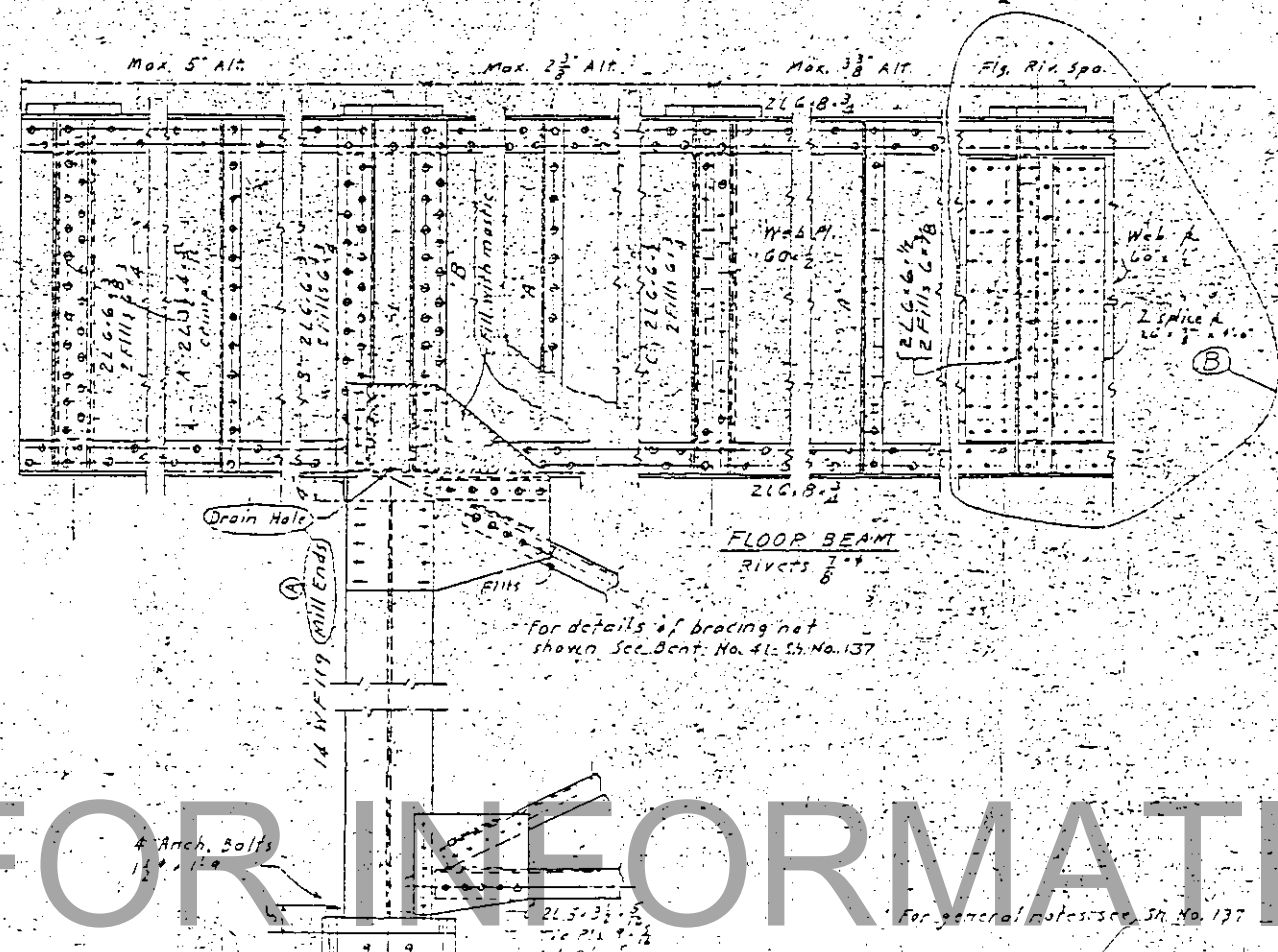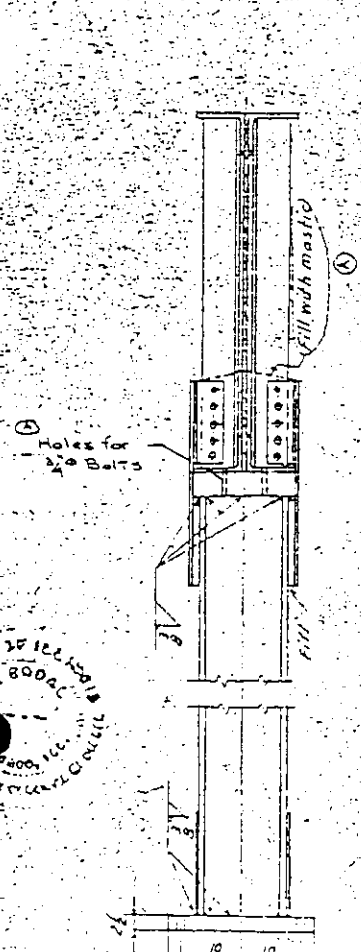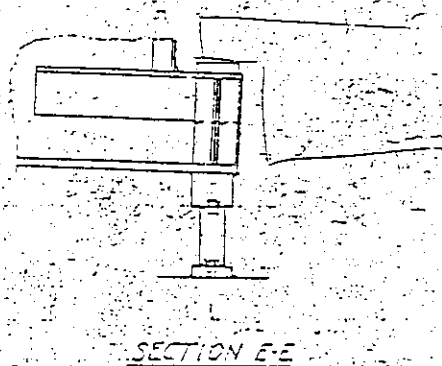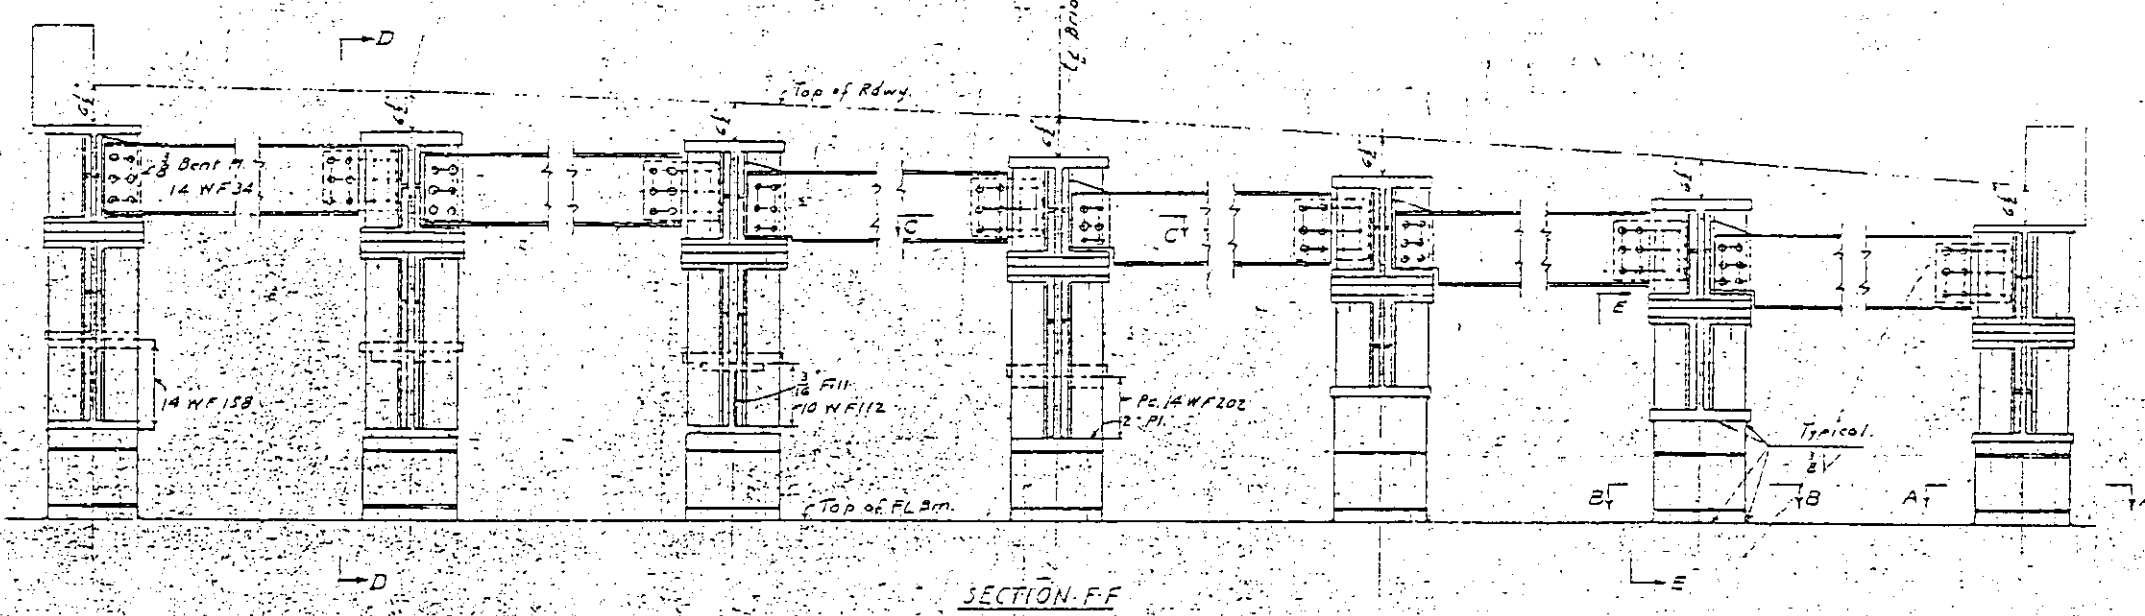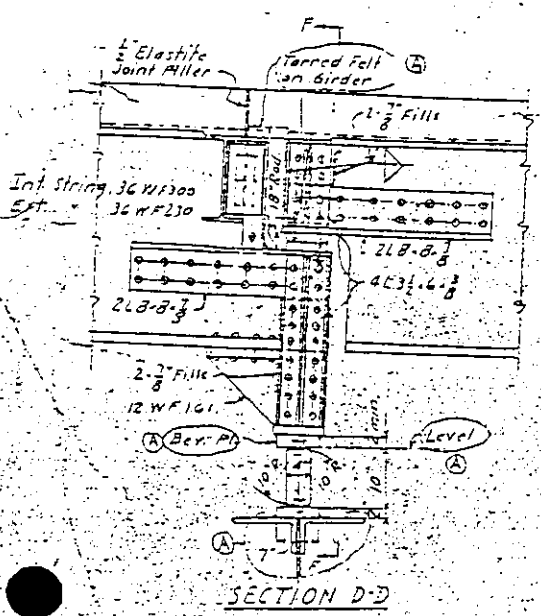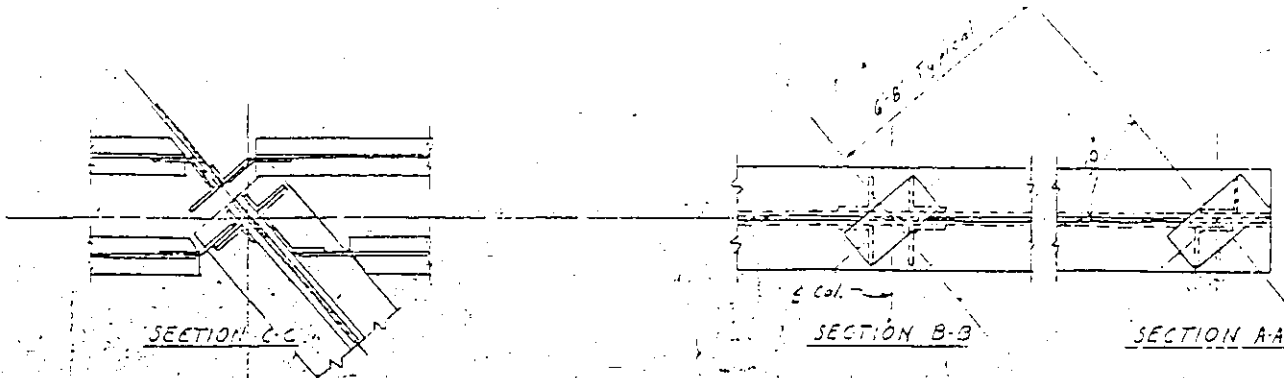

Rev. ① Center-Web Splice Anchor
 Made in Cal. Hd. Road
 Revision ② Coll. Milled & Disc. ③


MISSISSIPPI RIVER BR
 BETWEEN
 THIRD ST. EAST ST. LOUIS,
 AND
 THIRD ST. ST. LOUIS, MO.
 FOR
 CITY OF EAST ST. LOUIS

BENT 43

FOR INFORMATION ONLY

SECTION EE

SECTION FF

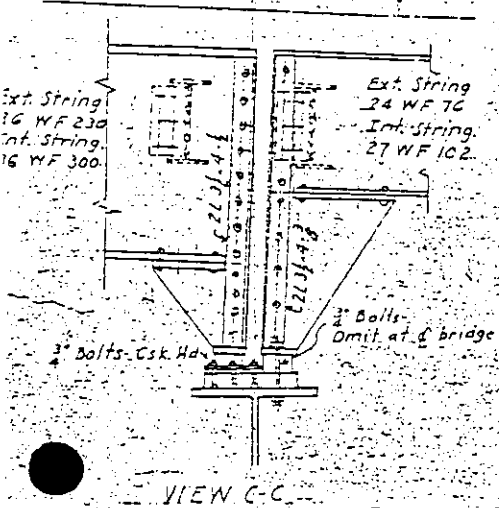

SECTION A-A

SECTION D-D

SECTION B-B

SECTION G-G

ELEVATION OF FLOOR BEAM







NOTE: For general notes and details of bracing

For details of break in roadway not shown see pier 12 - Sh. No. 117

Rev (B) Angle change
Holes in Col. not needed
Revision (C) Cells milled & brg. made false


MISSISSIPPI RIVER BRIDGE
BETWEEN
THIRD ST. EAST ST. LOUIS, MO.
AND
THIRD ST. ST. LOUIS, MO.
FOR
CITY OF EAST ST. LOUIS

FOR INFORMATION ONLY

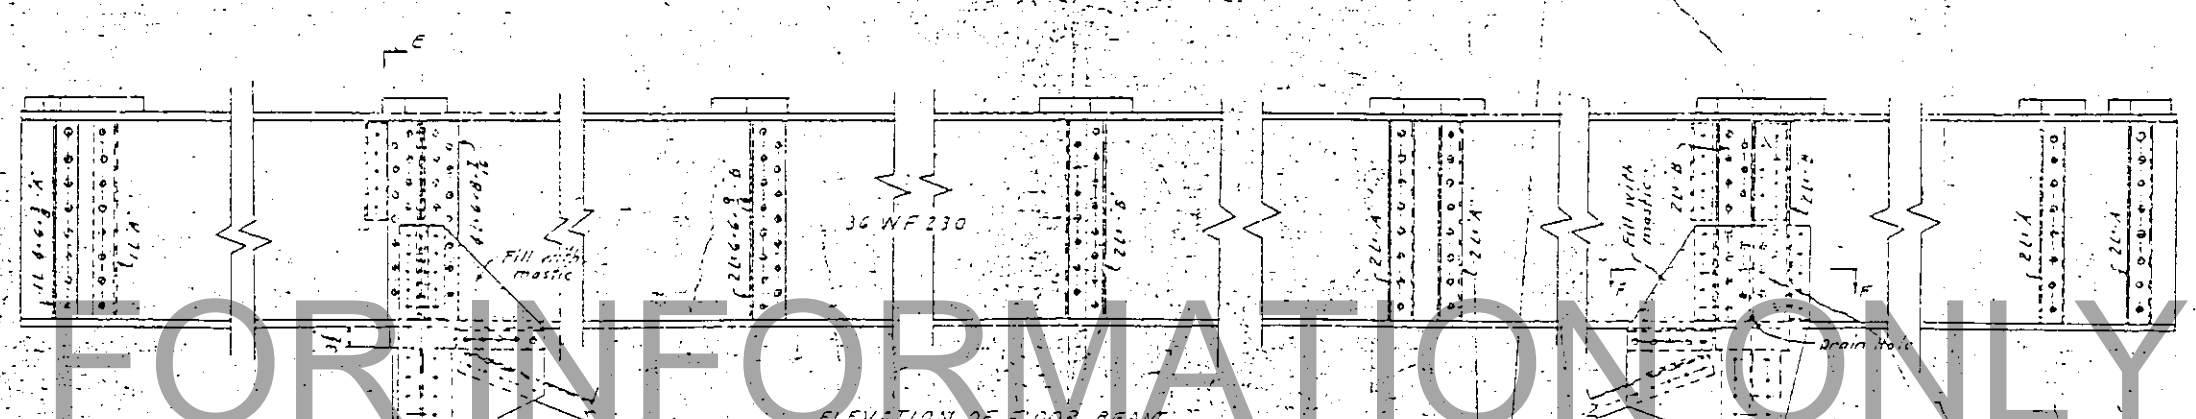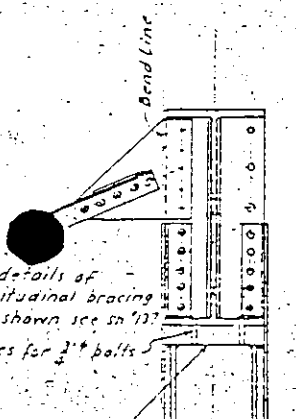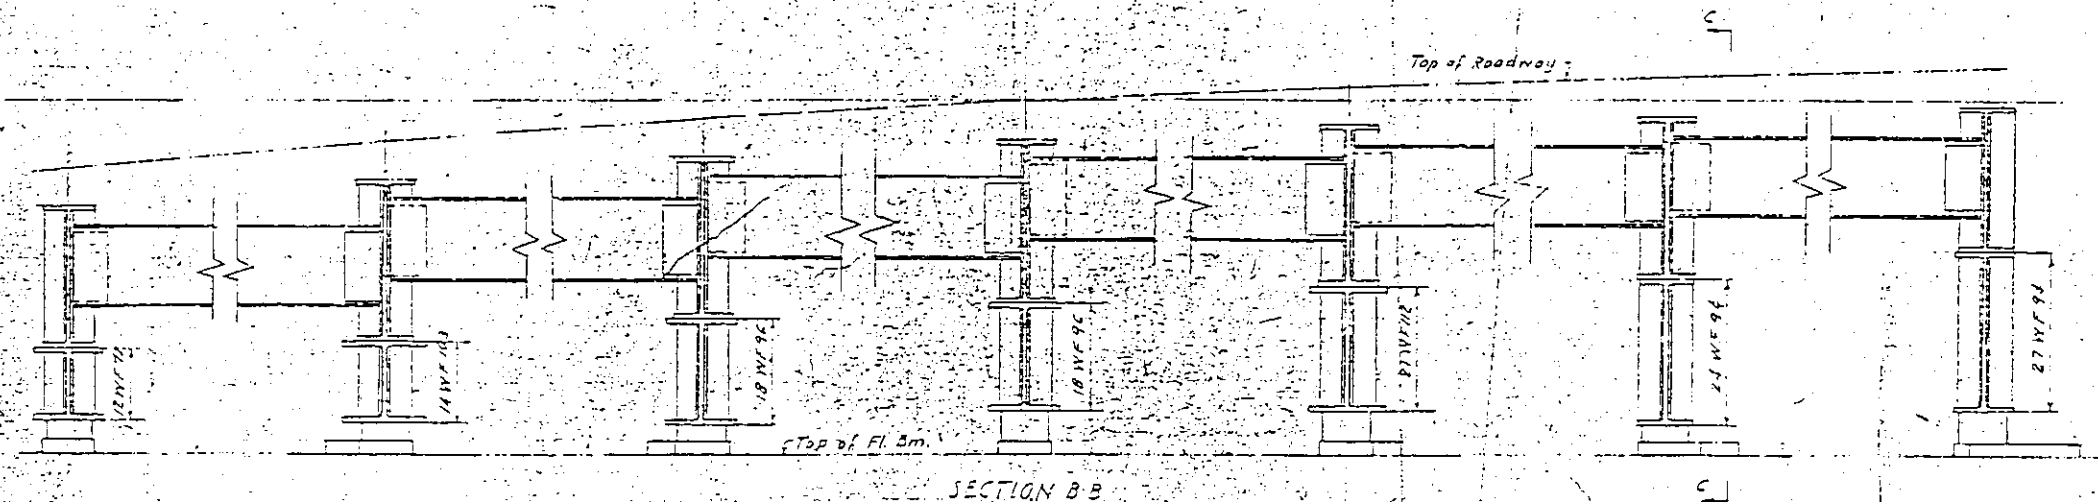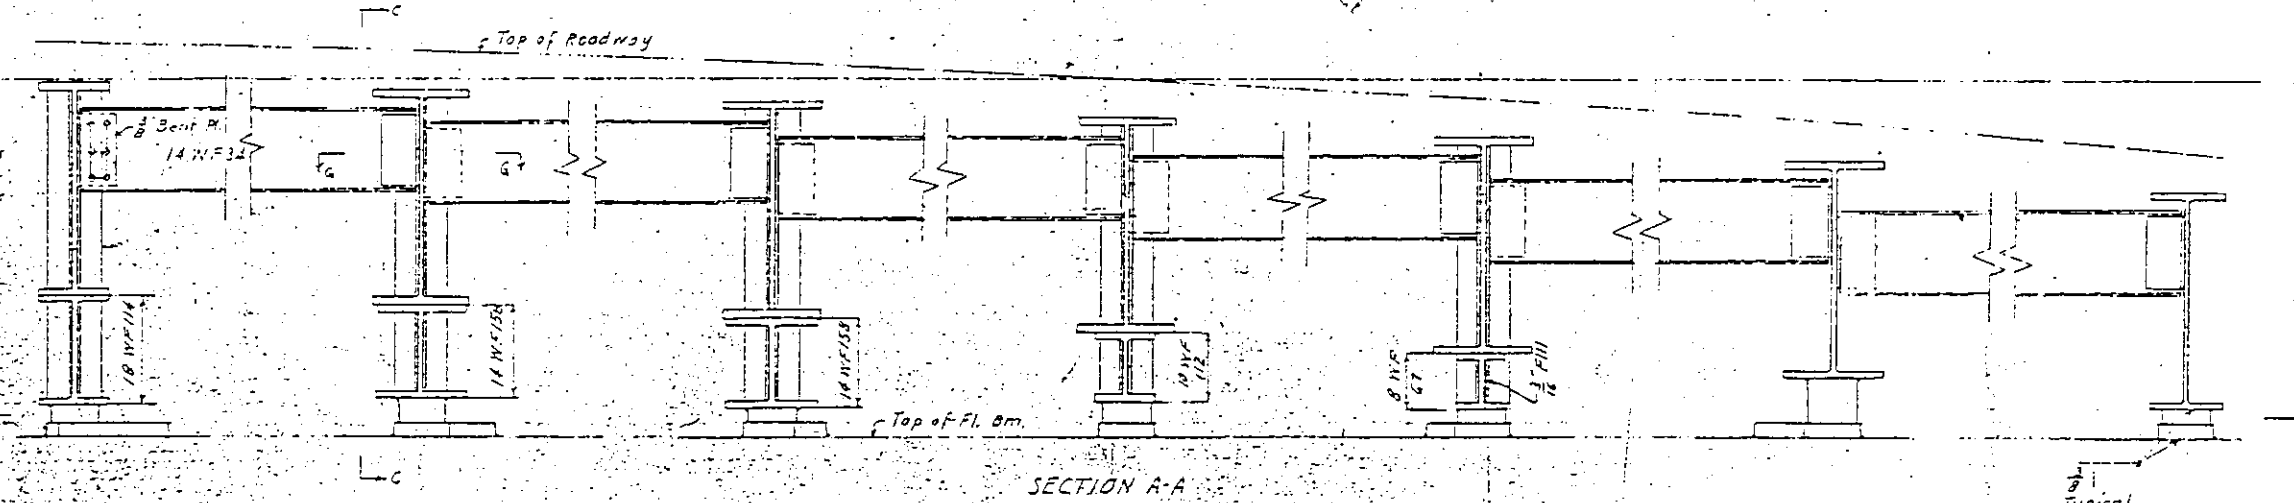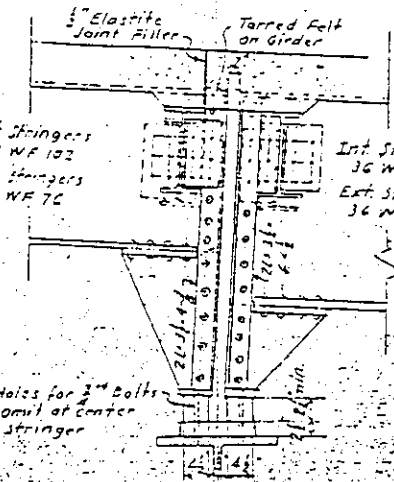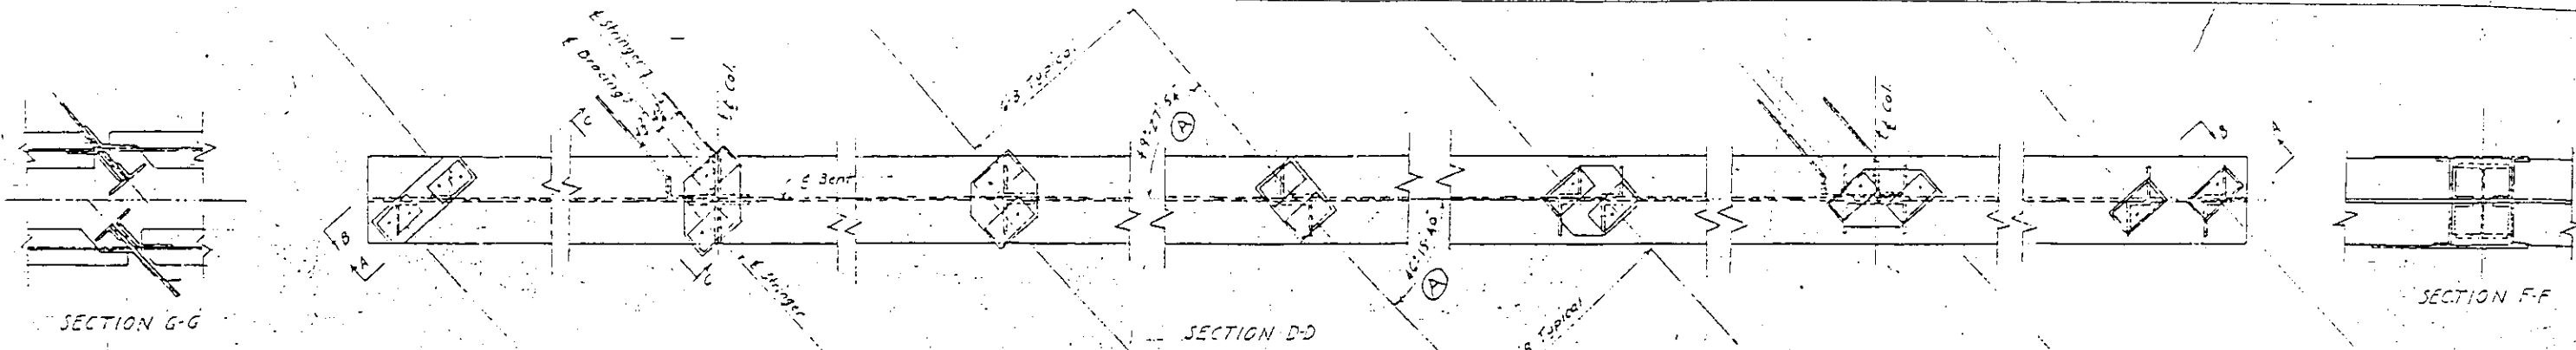


Rev. A Angles Changed S-49
 MISSISSIPPI RIVER BRIDGE
 BETWEEN
 THIRD ST. EAST ST. LOUIS, ILL.
 AND
 THIRD ST. ST. LOUIS, ILL.
 FOR
 CITY OF EAST ST. LOUIS




FOR INFORMATION ONLY

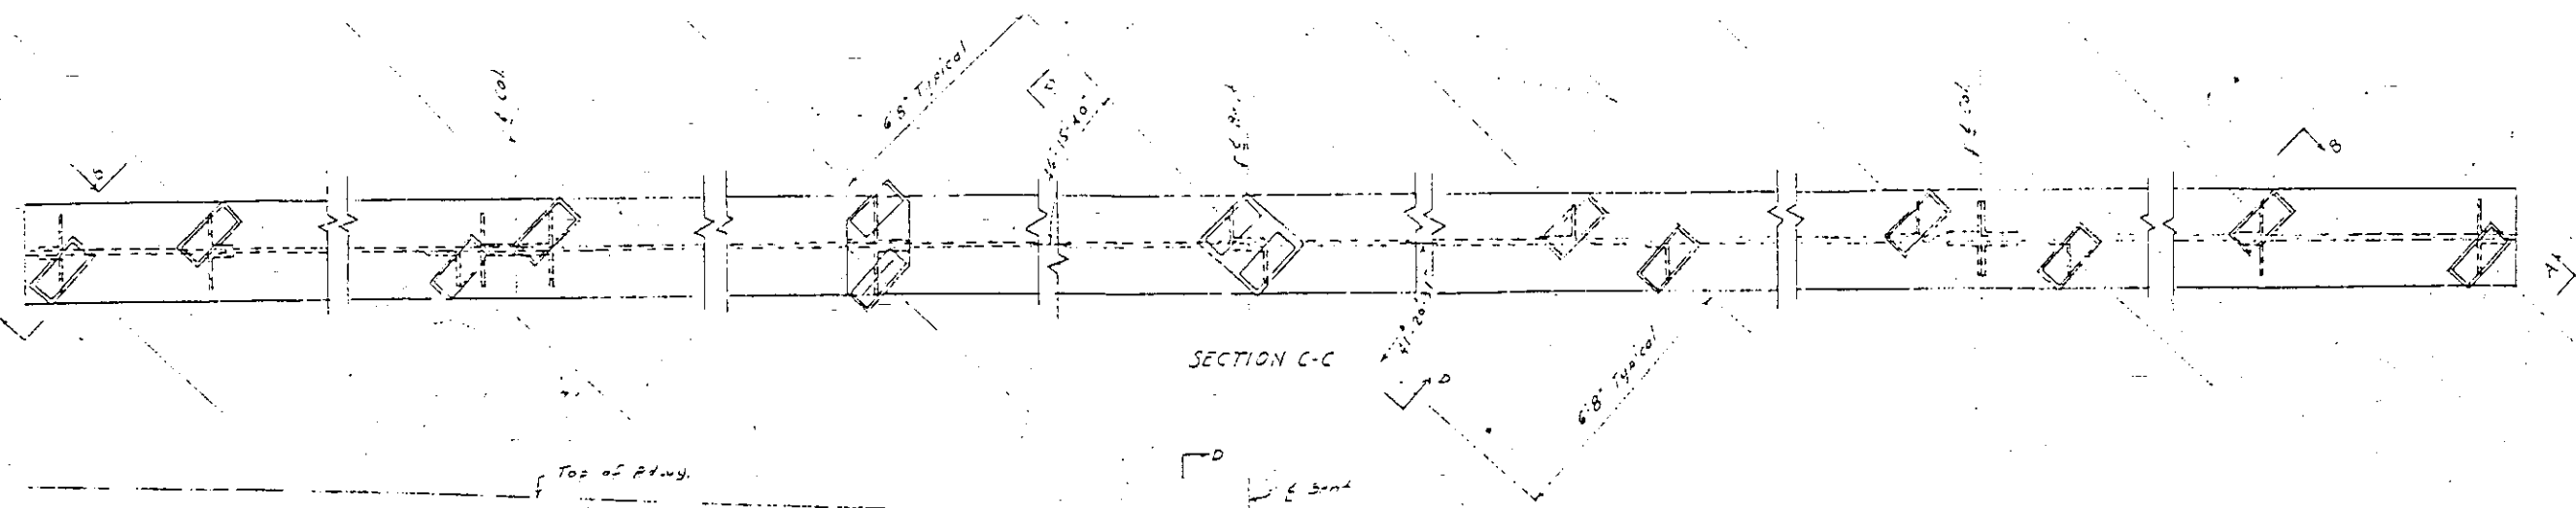

in details of break in floor
see Pier 12-34 Ha 117

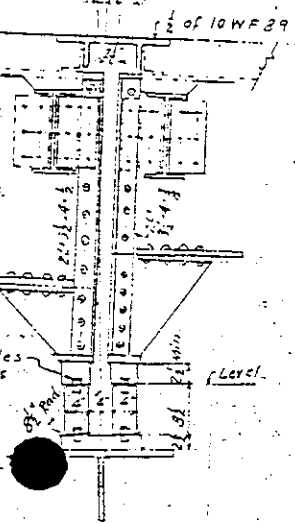


SECTION D-D

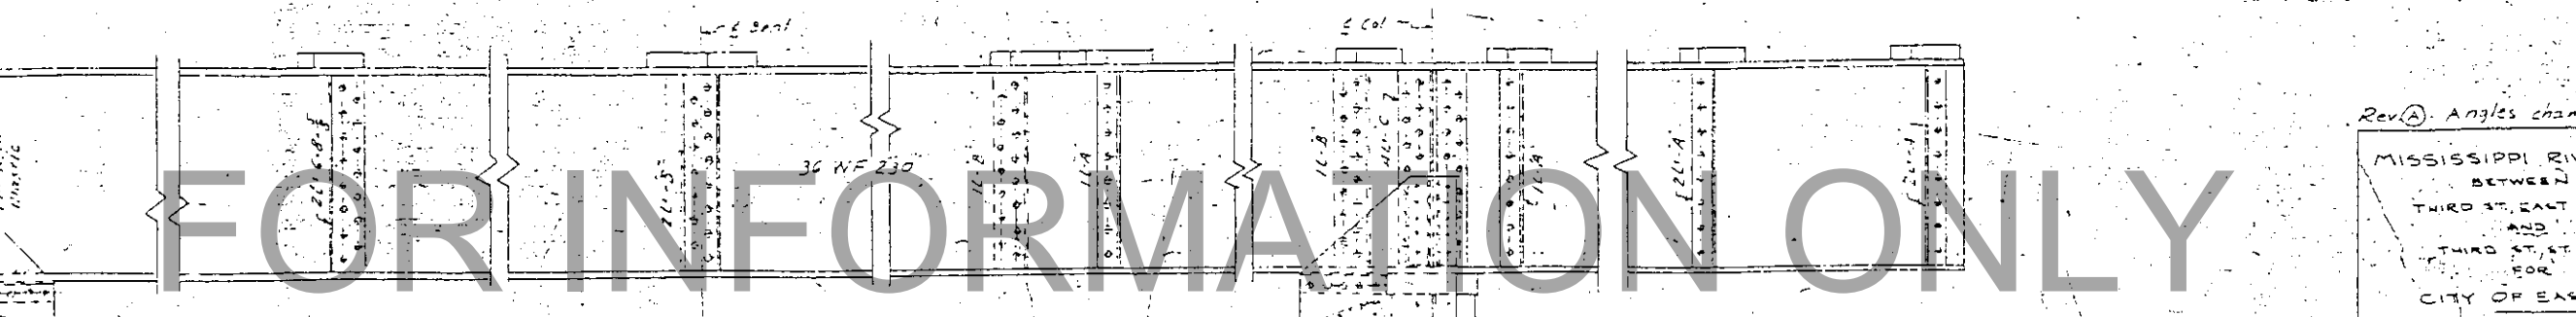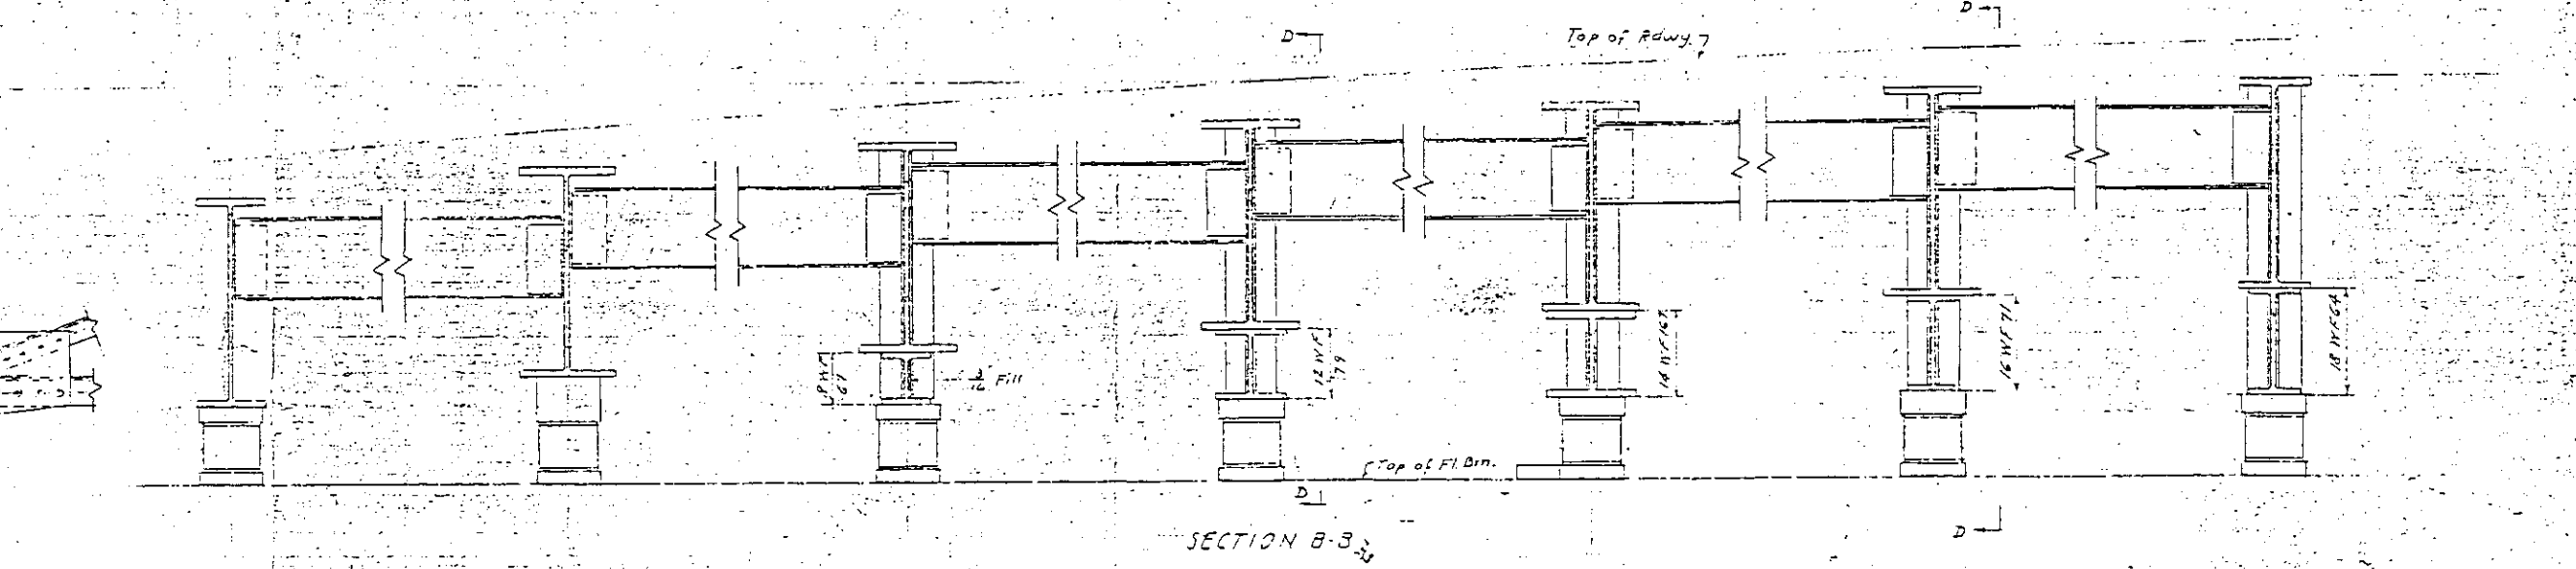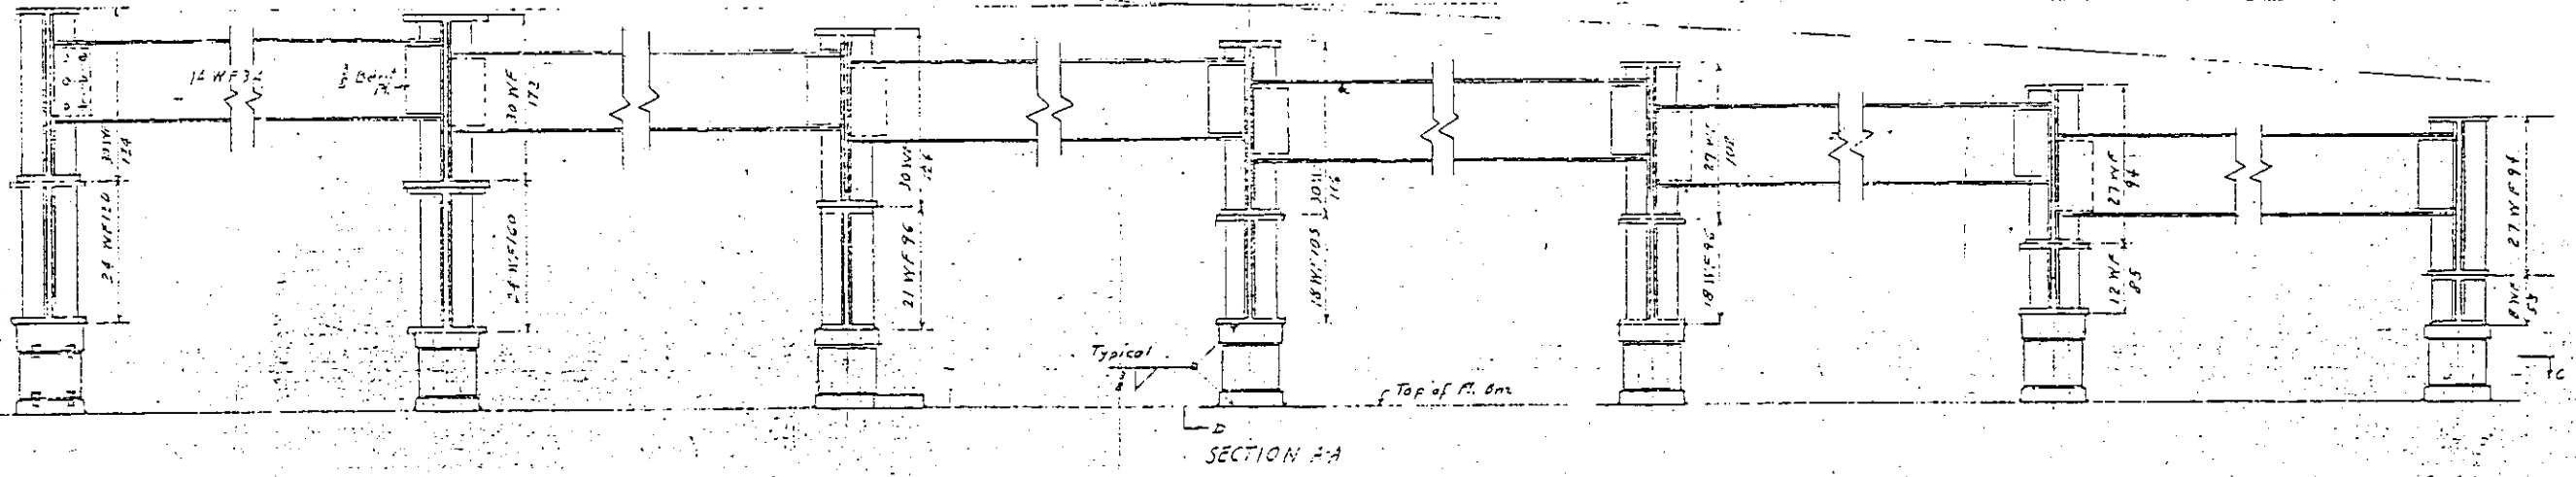

FOR INFORMATION ONLY

Rev. A. Angles changed. 5-6-49

MISSISSIPPI RIVER BRIDGE
BETWEEN
THIRD ST. EAST ST. LOUIS, ILL.
AND
THIRD ST. ST. LOUIS, MO.
FOR
CITY OF EAST ST. LOUIS

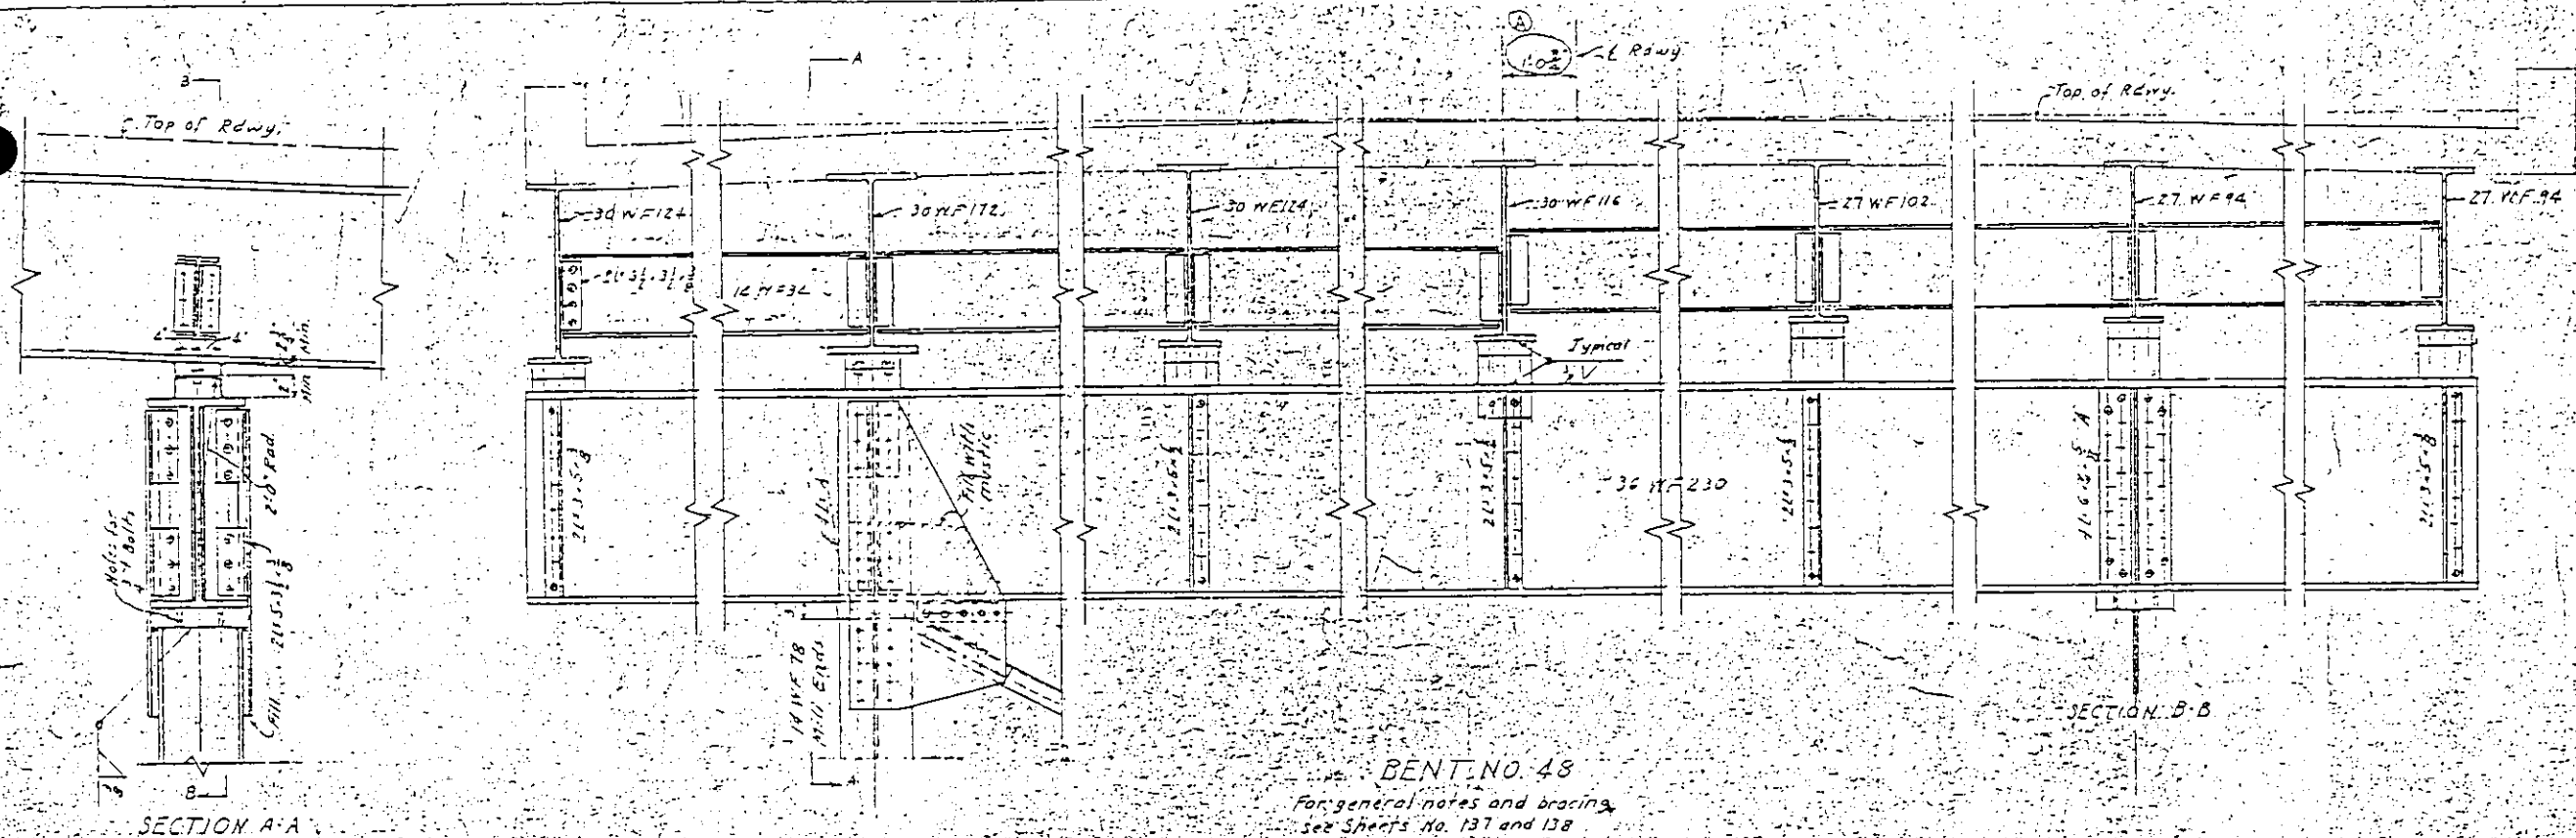

BENT NO. 48
 For general notes and bracing
 see Sheets No. 137 and 138
 Base of column same as Bent No. 1 - sh. No. 115





GENERAL LAYOUT BENT NO. 45 TO ABUT. D





FOR INFORMATION ONLY

Revision 1 Relocation of Abut. D
 Stringer S14
 Ed 50 11-29

MISSISSIPPI RIVER BRIDGE
 BETWEEN
 TWO ST. EAST ST. LOUIS, MO.
 AND
 TWO ST. WEST ST. LOUIS, MO.
 FOR
 EAST ST. LOUIS, MO.

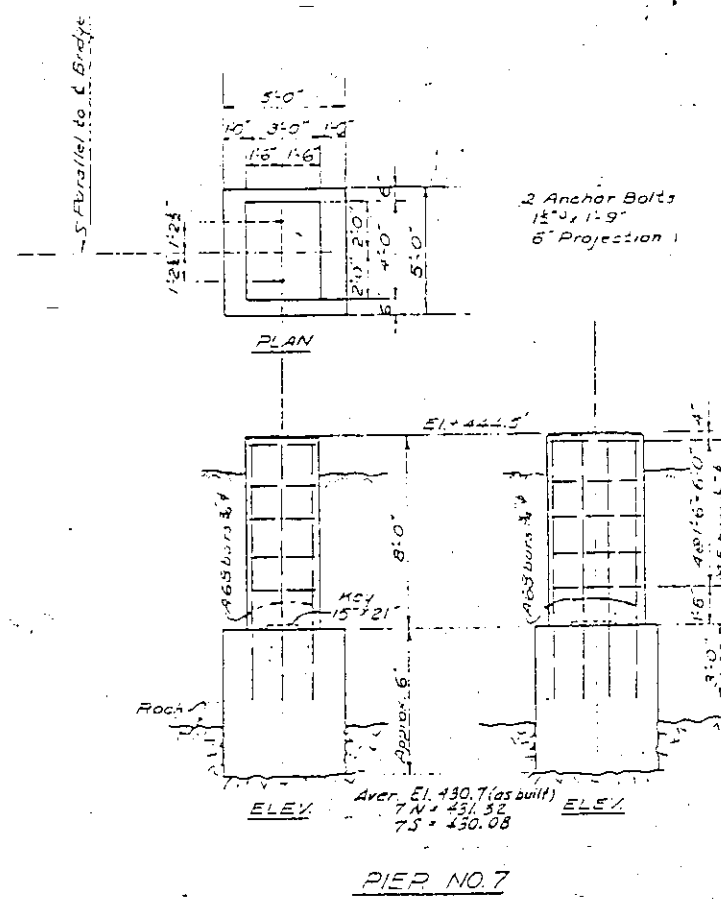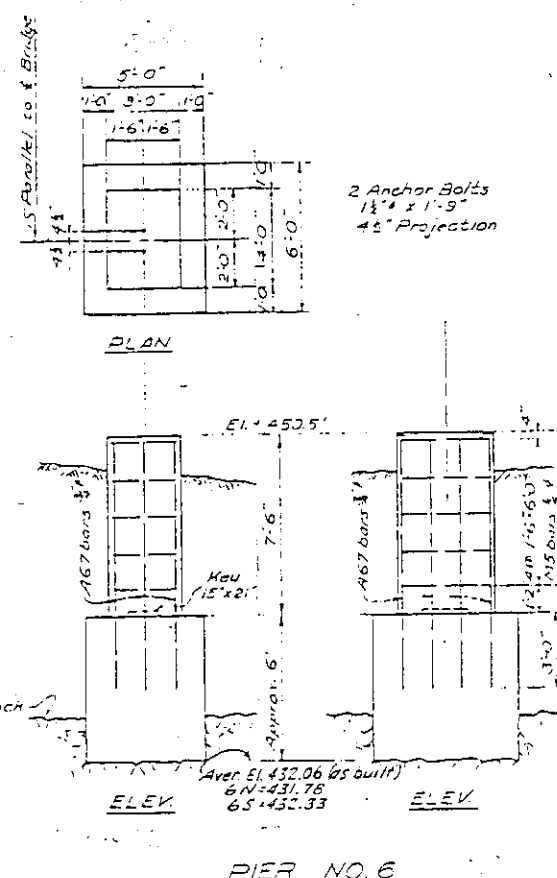

A67-20- $\frac{3}{4}$ " ϕ x 10'-3"
A68-20- $\frac{3}{4}$ " ϕ x 10'-9"
A1-32- $\frac{3}{4}$ " ϕ x 6'-0"
A63-16- $\frac{3}{4}$ " ϕ x 7'-3"

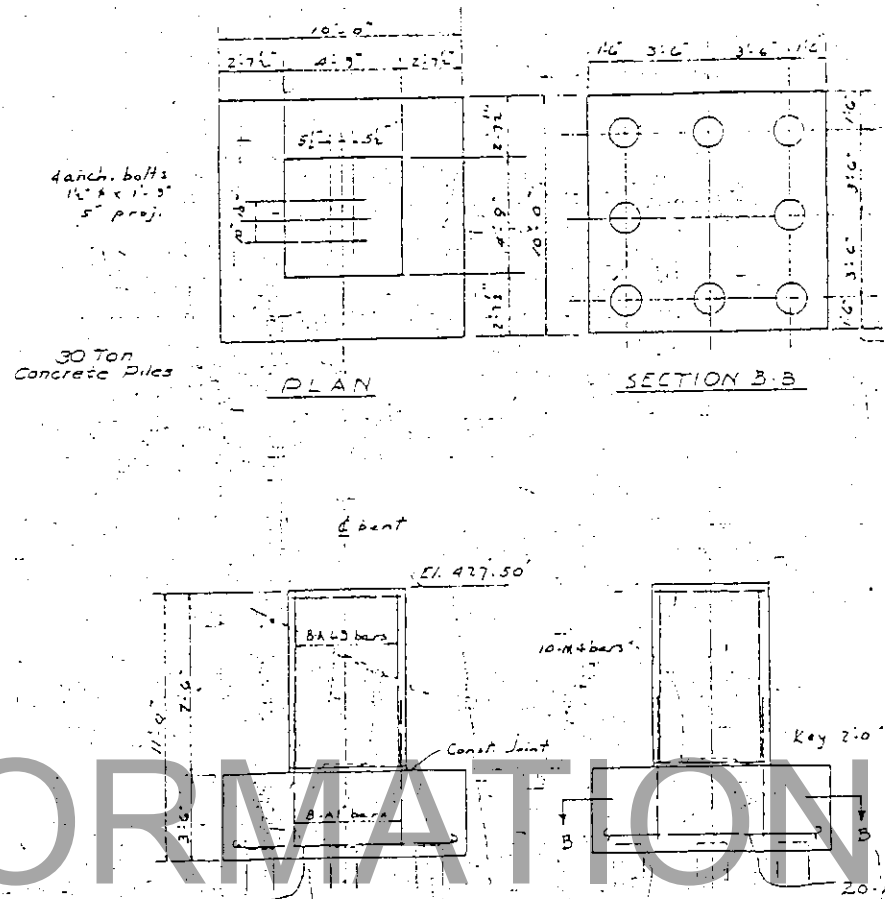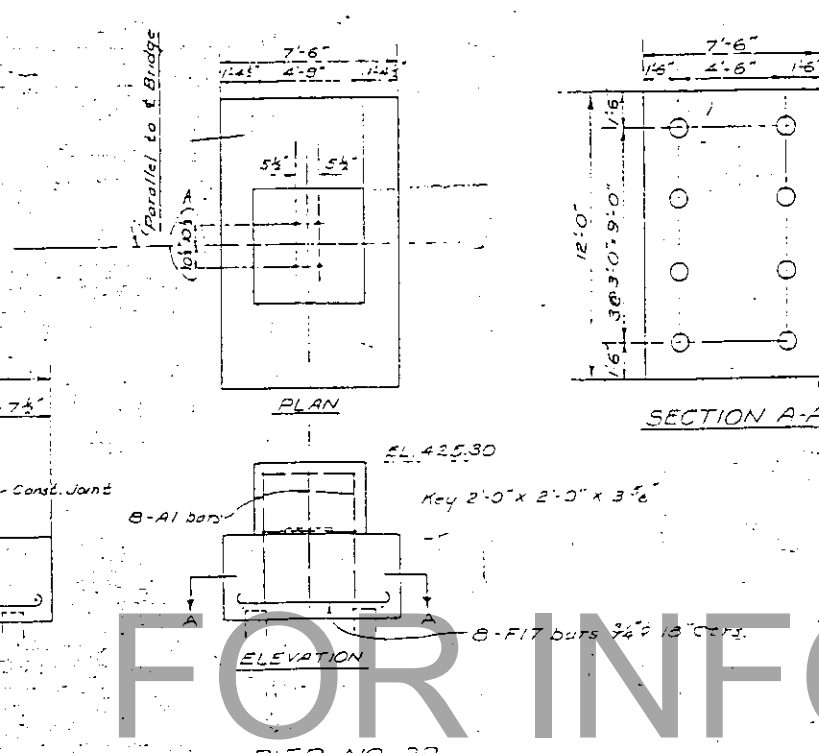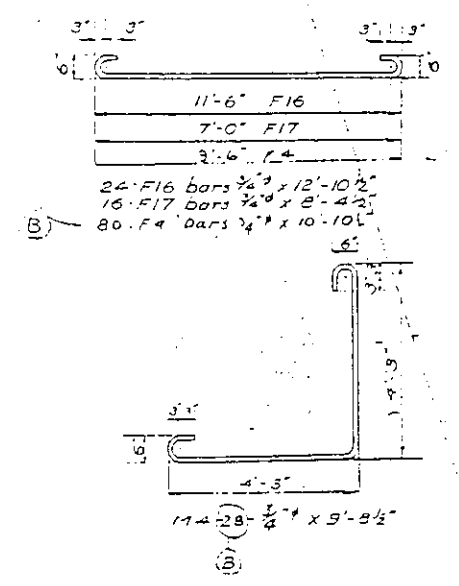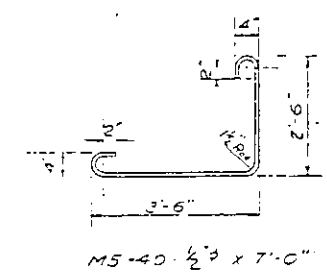


NOTE: ALL CONCRETE CLASS "A"
MIN. COVERING OF REINFORCING BARS
ALL EXPOSED CORNERS TO HAVE 2" CHG

Rev. B. Pier 32 added (from sheet 106)
Rev. A. DIMENSIONS CHANGES IN GENERAL

MISSISSIPPI RIVER BRIDGE
BETWEEN
THIRD ST. EAST ST. LOUIS, IL.
AND
THIRD ST. ST. LOUIS, MO.
FOR
CITY OF EAST ST. LOUIS, MO.

FOR INFORMATION ONLY

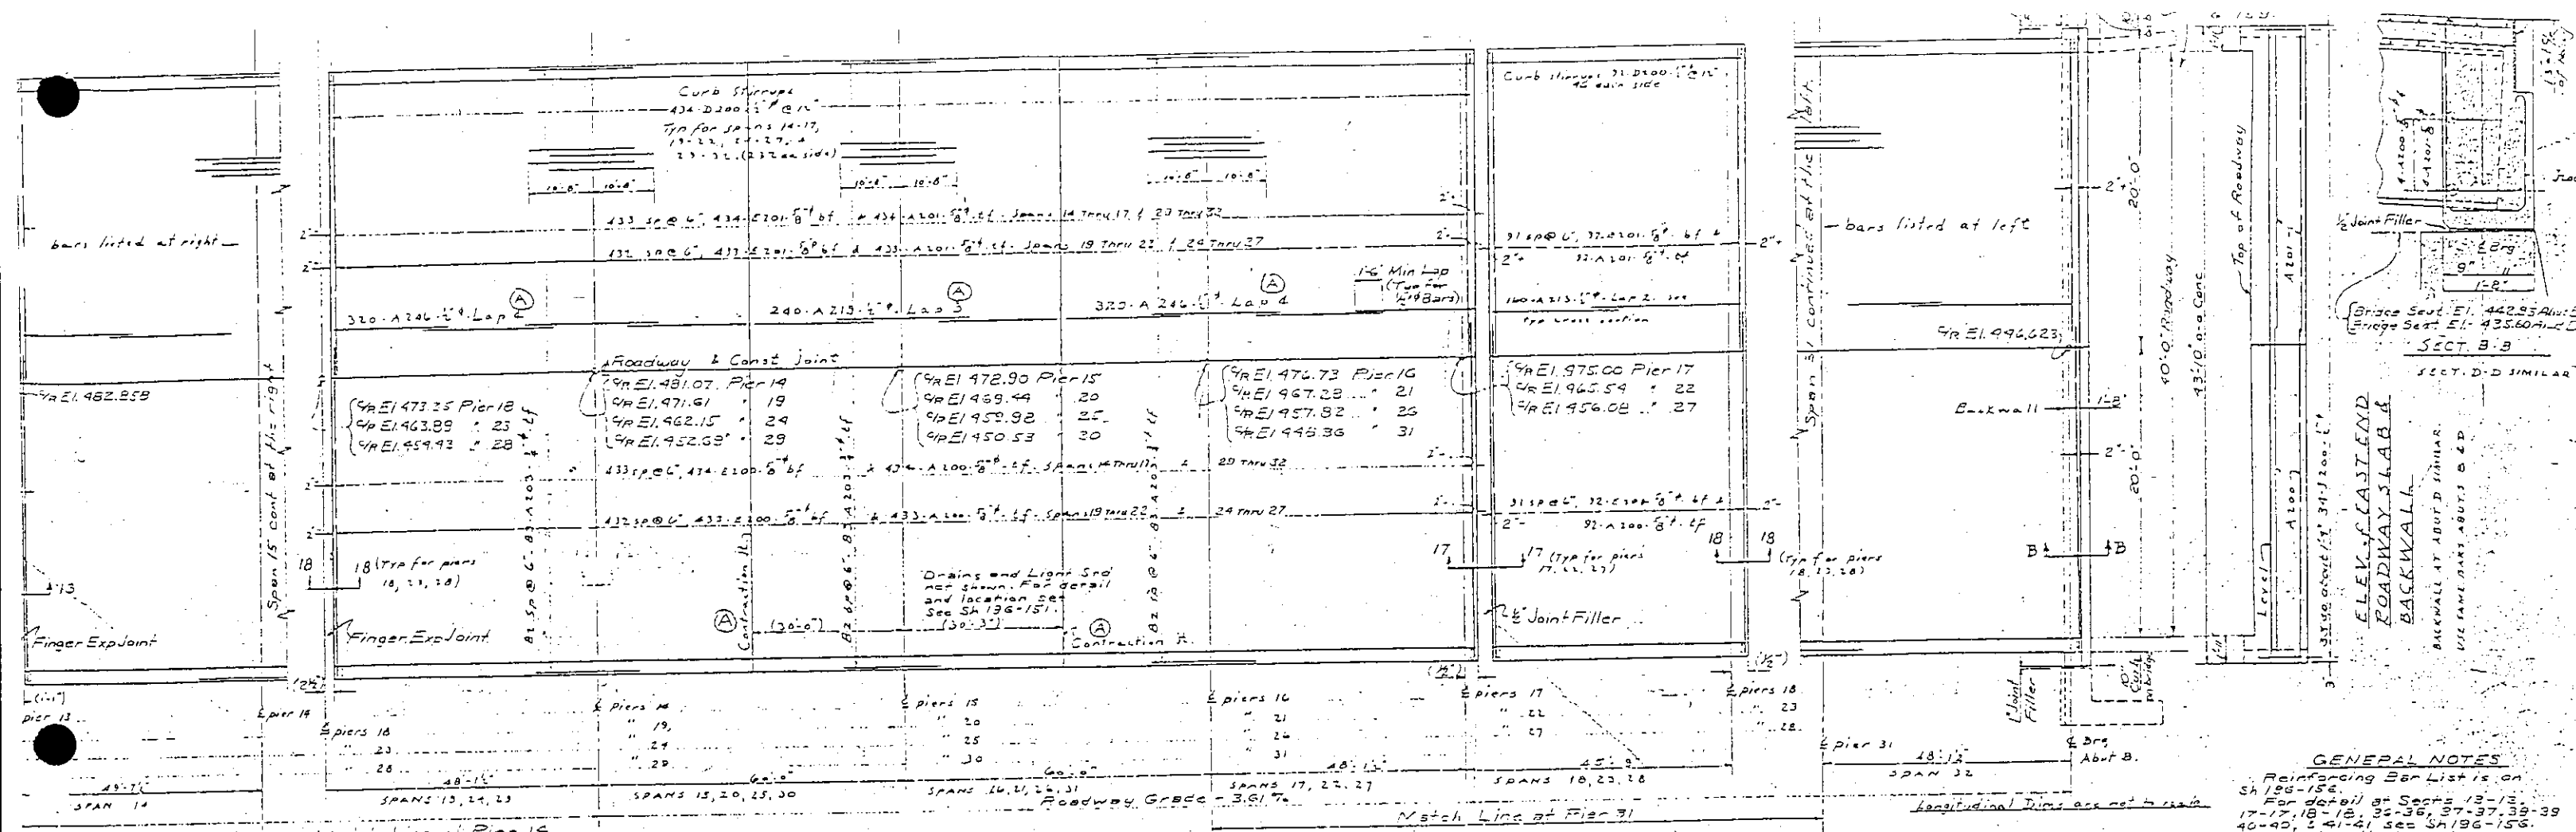

GENERAL NOTES

Reinforcing Bar List is on Sh 196-156.

For detail of Spans 13-15, 17-19, 21, 23, 25, 27, 29, 31, 33, 35, 37, 39, 41, 43, see Sh 196-155.

For detail of Spans 16-18, 20, 22, 24, 26, 28, 30, 32, 34, 36, 38, 40, 42, 44, see Sh 196-154.

For detail of Spans 14-16, 18, 20, 22, 24, 26, 28, 30, 32, 34, 36, 38, 40, 42, 44, see Sh 196-152.

Dims in (in) are approximate and are to be used only for estimating purposes.

For Typical Cross-Section thru Roadway Slab see Sh 196-152.

For Detail of Walling Posts and Brackets see Structural Steel Shop Plans.

Center Contraction Joints over floor beams or diaphragms indicated. Edge with approved edging tool.

Stop longitudinal bars each side of contraction joint.

Use B x 4 except min of 4L max of 6L.

Width of flange or 12" min.

Use B x 4 except min of 4L max of 6L.



Edge with approved edging tool.

Rev. (A) Contraction Joints Added 6-10-4

Abut. detailed on Sh 196-124

Match detailed on Sh 196-159

For detail and spacing of curb drain openings see Sh 196-151. Center openings over splash protection channels or locate to discharge into curb drain troughs.

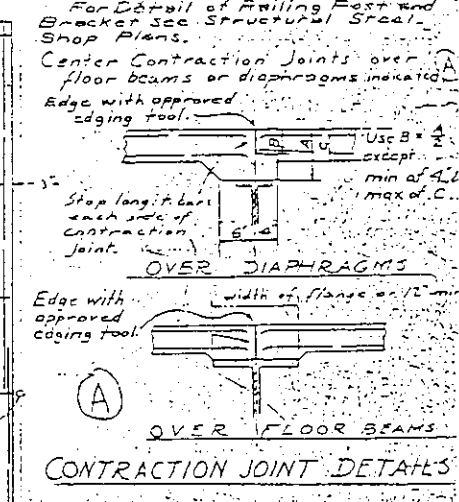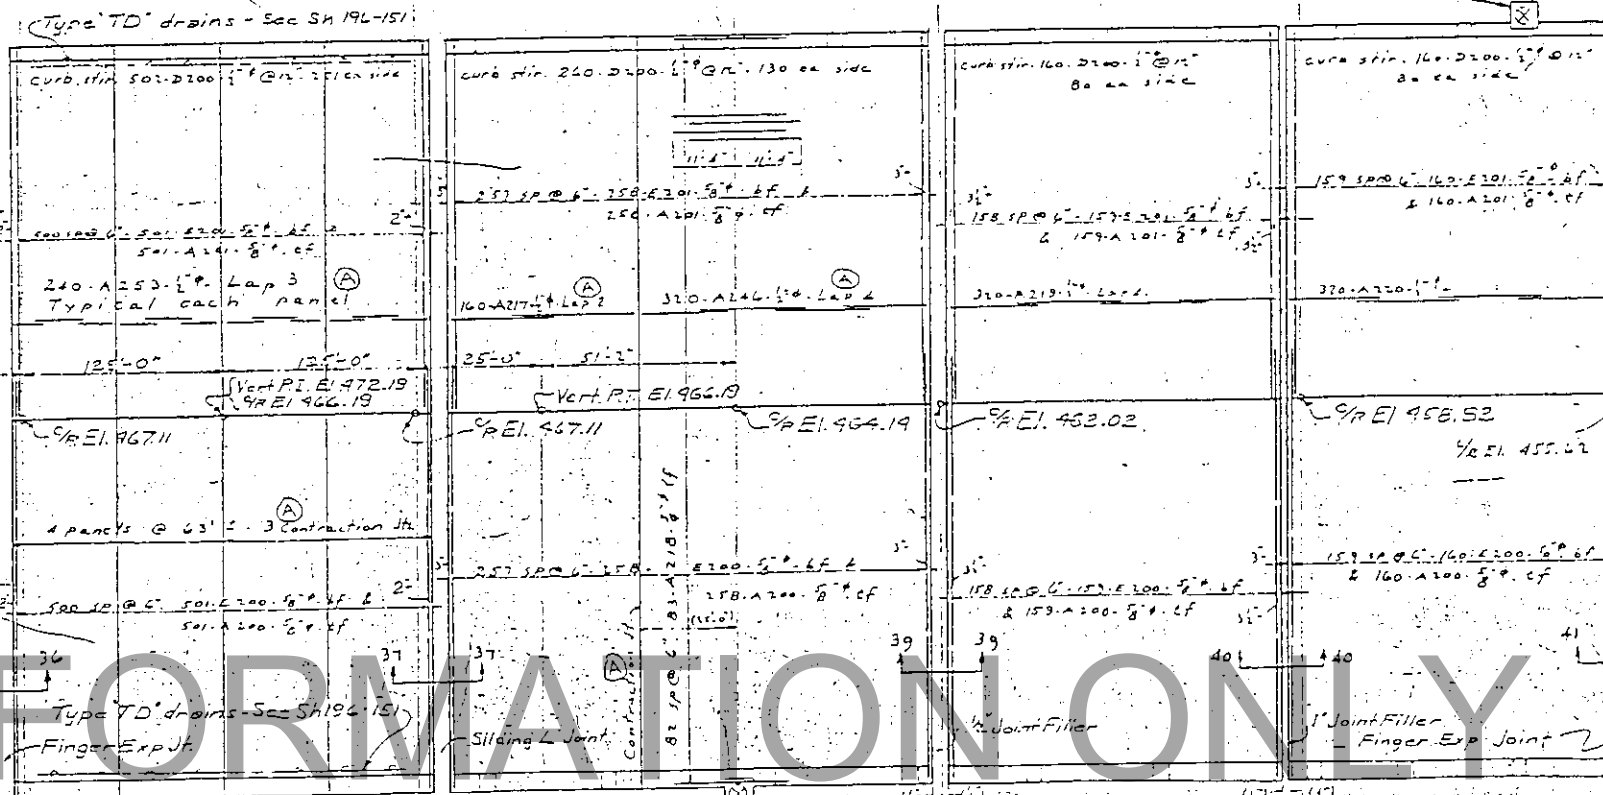

MISSISSIPPI RIVER BRIDGE

BETWEEN

THIRD ST. EAST ST. LOUIS, IL.


AND

THIRD ST. ST. LOUIS, MO.

FOR

CITY OF EAST ST. LOUIS.

FOR INFORMATION ONLY

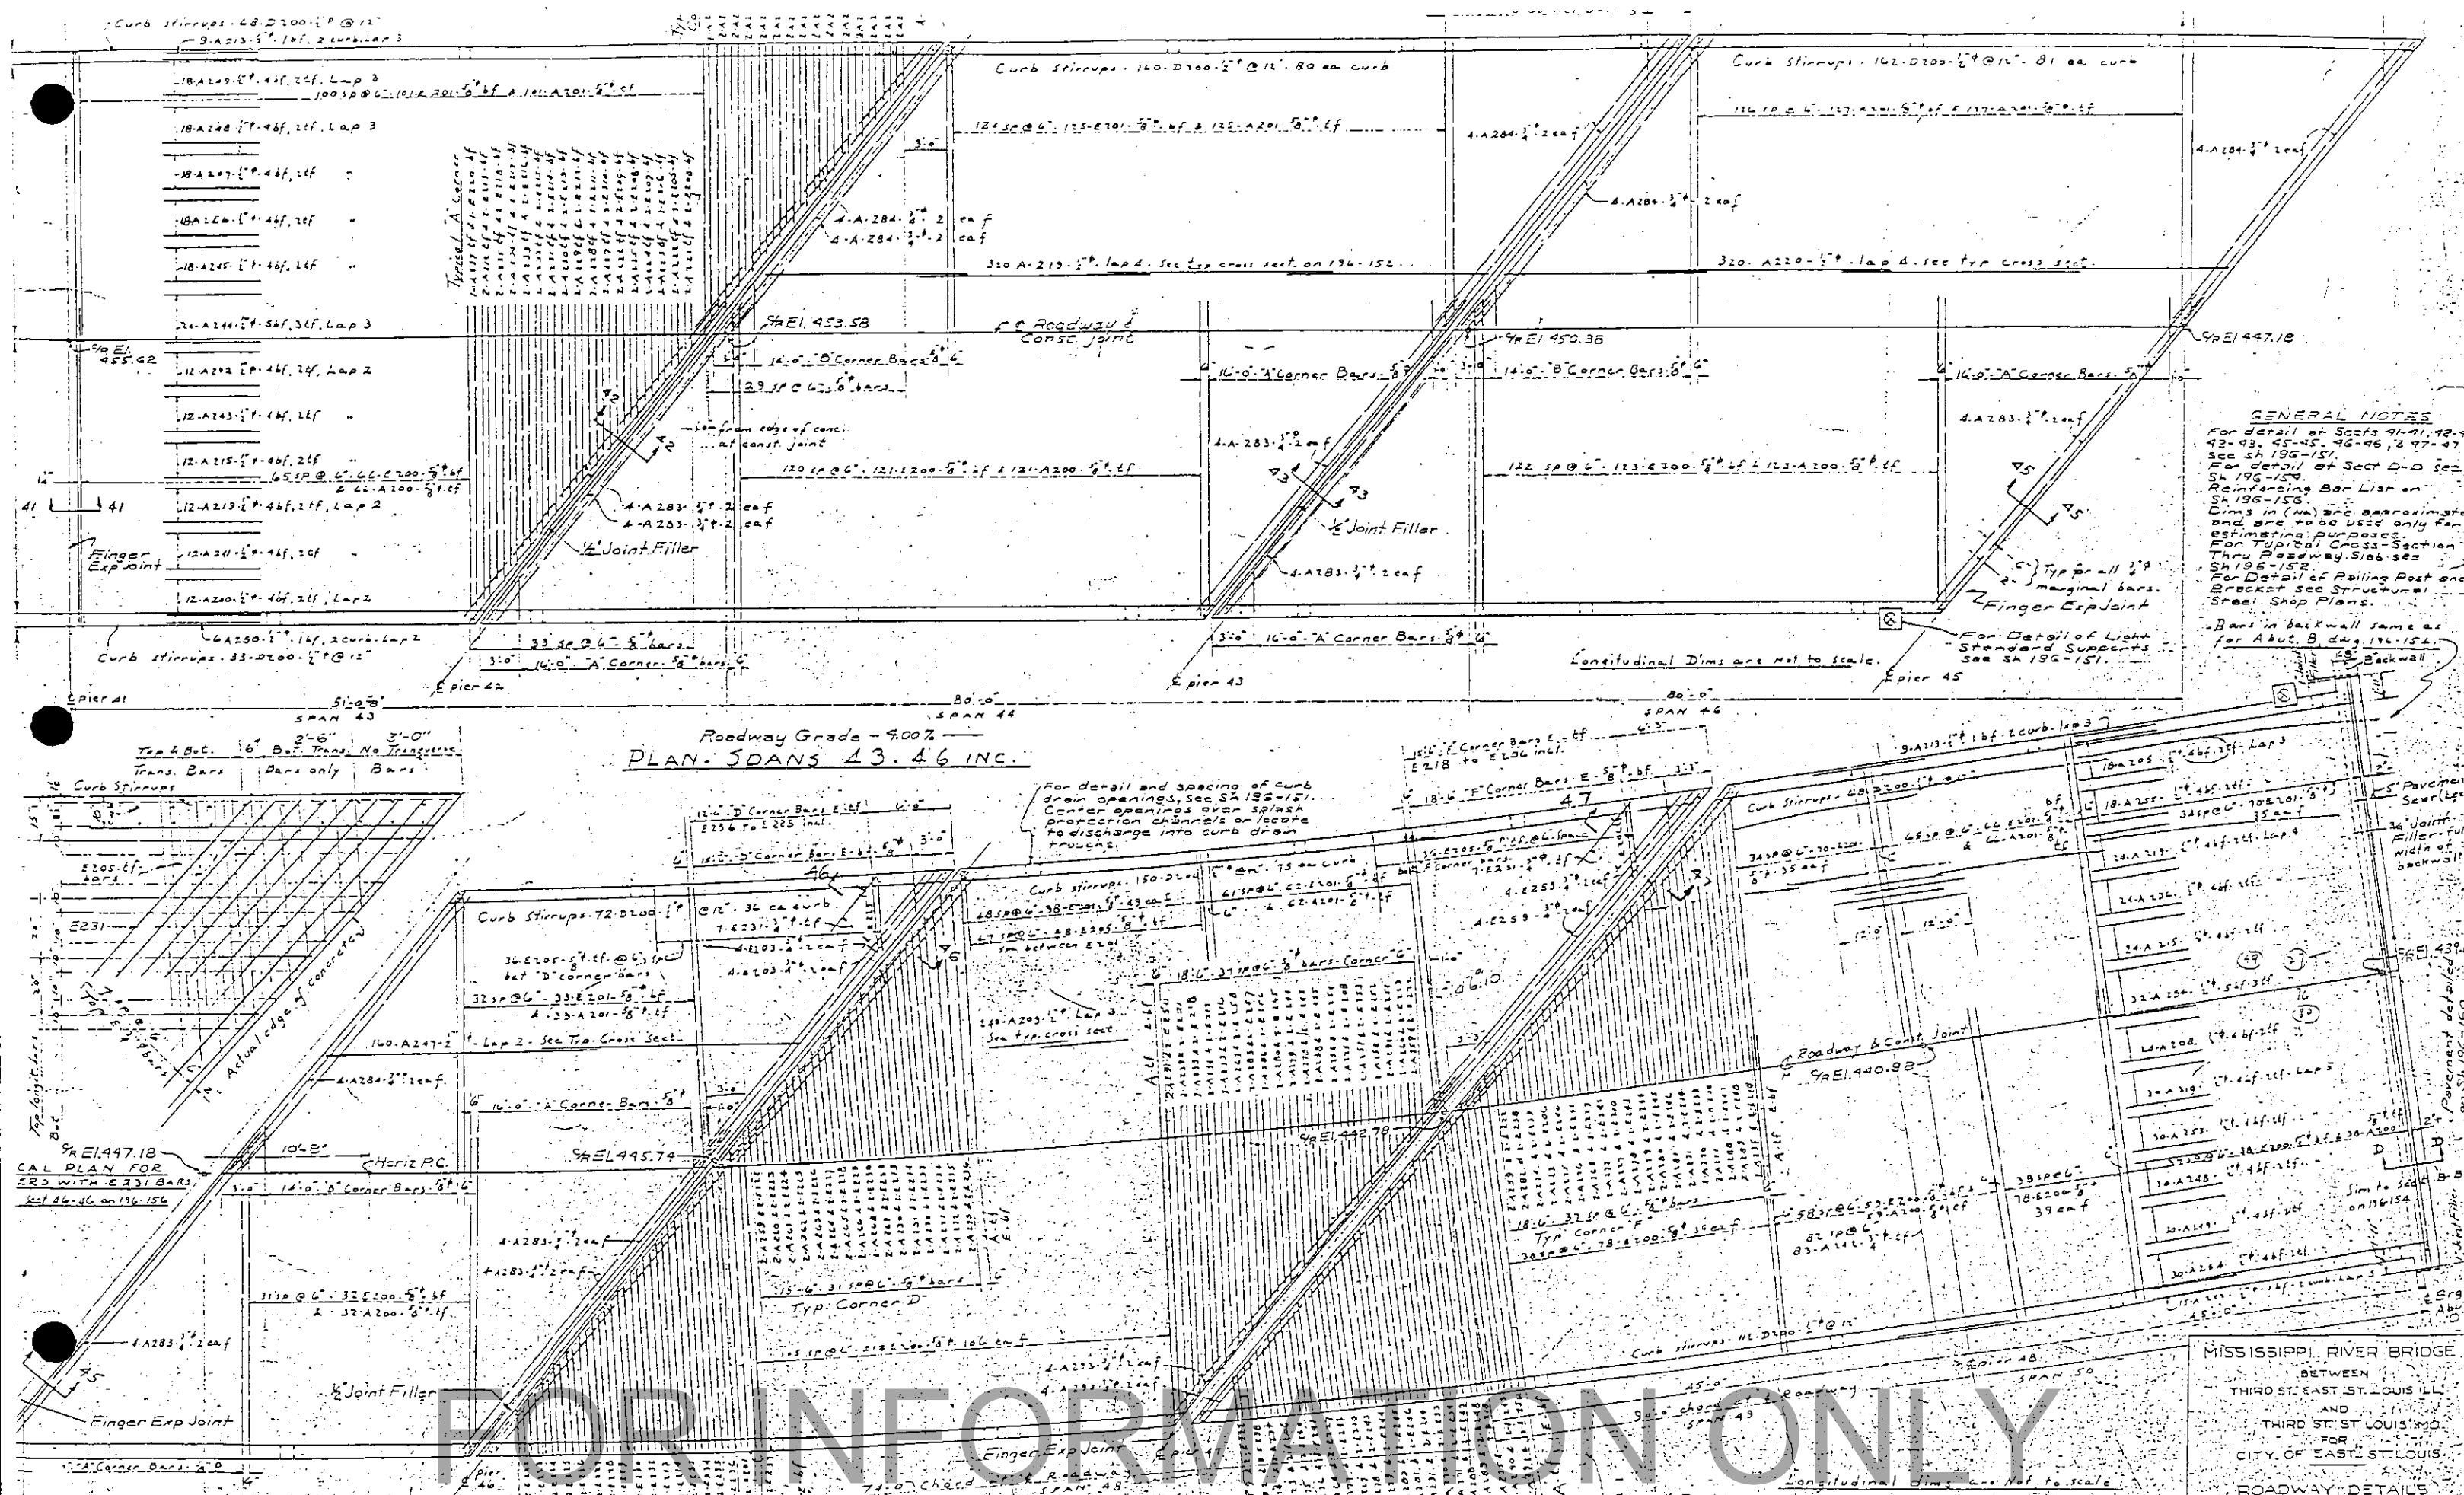

GENERAL NOTES
 For detail of Sects 41-41, 42-42, 43-43, 44-44, 45-45, 46-46, 47-47 - see SH 196-151.
 For detail of Sect D-D see SH 196-152.
 Reinforcing Bar List on SH 196-153.
 Cords in (N) are approximate and are not to be used for estimating purposes.
 For Typical Cross-Section thru Roadway Slab see SH 196-152.
 For Detail of Piling Post and Bracket see Structural Steel Shop Plans.
 Bars in backwall same as for Abut. B div. 196-152.

Roadway Grade - 9.00%
PLAN - SPANS 43, 46 INC.

For detail and spacing of curb drain openings, see SH 196-151. Center openings over splash protection channels or locate to discharge into curb troughs.



MISSISSIPPI RIVER BRIDGE
 BETWEEN
 THIRD ST. EAST ST. LOUIS, ILL.
 AND
 THIRD ST. ST. LOUIS, MO.
 FOR
 CITY OF EAST ST. LOUIS.
 ROADWAY DETAILS
 RFR NO. 1 TO ABUT. D.

FOR INFORMATION ONLY

BAR LIST

FOR DWGS 196-152 TO 157 INCL.

BAR	#	Total Length	Quant.	Total Weight	
1.2.8.4	3/8	14'-4"	2	30	
1.2.8.7	3/8	21'-7"	2	45	
1.2.8.8	3/8	18'-0"	4	75	
1.2.8.9	3/8	19'-0"	4	79	
1.2.9.0	3/8	20'-11"	2	44	
1.2.9.1	3/8	21'-10"	4	91	
1.2.9.2	3/8	5'-0"	2	10	
1.2.9.3	3/4	32'-9"	8	392	
1.2.9.4	1/2	23'-6"	160	2512	
1.2.9.5	3/8	13'-0"	83	1621	
1.2.9.6	3/8	21'-2"	14	309	
1.2.9.7	3/8	23'-6"	498	7818	
1.2.9.8	3/8	22'-11"	1200	18370	
1.2.9.9	3/8	22'-6"	2916	43527	
1.2.9.10	3/8	25'-11"	160	2770	
1.2.9.11	3/8	17'-0"	83	2119	
1.2.9.12	3/8	20'-11"	1666	23279	
1.2.9.13	3/8	12'-2"	640	9049	
1.2.9.14	3/8	3'-3"	26	88	
1.2.9.15	3/8	4'-3"	26	120	
1.2.9.16	3/8	5'-7"	30	175	
1.2.9.17	3/8	6'-10"	26	185	
1.2.9.18	3/8	8'-0"	26	232	
1.2.9.19	3/8	9'-3"	26	251	
1.2.9.20	3/8	10'-5"	30	326	
1.2.9.21	3/8	11'-7"	26	312	
1.2.9.22	3/8	12'-9"	26	346	
1.2.9.23	3/8	13'-11"	30	435	
1.2.9.24	3/8	15'-4"	34	535	
1.2.9.25	3/8	16'-3"	26	241	
1.2.9.26	3/8	17'-7"	26	513	
1.2.9.27	3/8	18'-7"	28	545	
1.2.9.28	3/8	19'-11"	26	540	
1.2.9.29	3/8	21'-6"	504	7238	
1.2.9.30	3/8	22'-4"	7	163	
1.2.9.31	3/8	10'-2"	2	21	
1.2.9.32	3/8	20'-8"	2	43	
1.2.9.33	3/8	18'-3"	12	146	
1.2.9.34	3/8	19'-9"	12	158	
1.2.9.35	3/8	18'-0"	83	2242	
1.2.9.36	3/8	25'-11"	12	192	
1.2.9.37	3/8	18'-6"	24	297	
1.2.9.38	3/8	19'-8"	18	232	
1.2.9.39	3/8	20'-5"	2393	39323	
1.2.9.40	3/8	18'-1"	160	1933	
1.2.9.41	3/8	22'-3"	28	713	
1.2.9.42	3/8	23'-1"	48	740	
1.2.9.43	3/8	17'-0"	6	68	
1.2.9.44	3/8	23'-3"	1600	24850	
1.2.9.45	3/8	24'-0"	15	240	
1.2.9.46	3/8	21'-9"	390	12884	
1.2.9.47	3/8	23'-9"	62	924	
1.2.9.48	3/8	25'-9"	18	310	
1.2.9.49	3/8	9'-1"	2	19	
1.2.9.50	3/8	7'-0"	2	15	
1.2.9.51	3/8	6'-0"	2	13	
1.2.9.52	3/8	3'-0"	10	31	
1.2.9.53	3/8	4'-1"	6	26	
1.2.9.54	3/8	5'-2"	4	22	
1.2.9.55	3/8	6'-3"	4	26	
1.2.9.56	3/8	7'-4"	4	31	
1.2.9.57	3/8	8'-5"	8	70	
1.2.9.58	3/8	9'-6"	4	20	
1.2.9.59	3/8	10'-7"	4	44	
1.2.9.60	3/8	11'-9"	4	49	
1.2.9.61	3/8	12'-9"	2	53	
1.2.9.62	3/8	16'-4"	8	134	
1.2.9.63	3/8	17'-2"	8	143	
1.2.9.64	3/8	18'-3"	4	76	
1.2.9.65	3/8	19'-4"	4	81	
1.2.9.66	3/8	22'-10"	23.5	8742	
1.2.9.67	3/8	20'-4"	20.7	8950	
1.2.9.68	3/8	23'-5"	24.0	138	
1.2.9.69	3/4	27'-10"	28.6	6	
1.2.9.70	5/8	3'-3"	3'-10"	26	104
1.2.9.71	5/8	4'-5"	5'-0"	259	1351
1.2.9.72	5/8	5'-7"	6'-2"	34	215
1.2.9.73	5/8	6'-10"	7'-5"	26	201
1.2.9.74	5/8	8'-0"	8'-7"	28	251
1.2.9.75	5/8	9'-3"	9'-10"	26	267
1.2.9.76	5/8	10'-5"	11'-0"	32	390
1.2.9.77	5/8	11'-7"	12'-2"	26	330
1.2.9.78	5/8	12'-9"	15'-2"	26	362
1.2.9.79	5/8	13'-11"	14'-6"	32	512
1.2.9.80	5/8	15'-1"	15'-8"	42	686
1.2.9.81	5/8	16'-3"	16'-10"	26	456
1.2.9.82	5/8	17'-7"	18'-2"	28	531
1.2.9.83	5/8	18'-7"	19'-2"	28	560
1.2.9.84	5/8	19'-11"	20'-6"	30	621
1.2.9.85	5/8	21'-2"	21'-9"	14	318
1.2.9.86	5/8	22'-4"	22'-11"	7	167
1.2.9.87	5/8	20'-8"	21'-3"	2	42
1.2.9.88	5/8	3'-0"	3'-7"	14	52
1.2.9.89	5/8	4'-1"	4'-8"	8	39
1.2.9.90	5/8	5'-2"	5'-9"	6	38
1.2.9.91	5/8	6'-3"	6'-10"	8	57
1.2.9.92	5/8	7'-4"	7'-11"	8	68
1.2.9.93	5/8	8'-5"	9'-0"	16	150
1.2.9.94	5/8	9'-6"	10'-1"	8	82
1.2.9.95	5/8	10'-7"	11'-2"	8	93
1.2.9.96	5/8	11'-9"	12'-2"	8	103
1.2.9.97	5/8	12'-9"	13'-4"	8	111
1.2.9.98	5/8	16'-1"	16'-8"	16	278
1.2.9.99	5/8	17'-2"	17'-9"	16	286
1.2.9.100	5/8	18'-3"	18'-10"	8	157
1.2.9.101	5/8	19'-4"	19'-11"	8	166
1.2.9.102	5/8	21'-7"	22'-2"	2	46
1.2.9.103	5/8	3'-9"	4'-2"	6	27
1.2.9.104	5/8	4'-8"	5'-3"	6	33
1.2.9.105	5/8	6'-7"	7'-2"	8	60
1.2.9.106	5/8	7'-7"	8'-2"	8	68
1.2.9.107	5/8	9'-6"	10'-1"	8	82
1.2.9.108	5/8	11'-4"	11'-11"	10	124
1.2.9.109	5/8	12'-2"	12'-11"	10	155
1.2.9.110	5/8	13'-5"	13'-10"	10	142
1.2.9.111	5/8	14'-2"	14'-9"	8	123
1.2.9.112	5/8	18'-0"	18'-7"	8	158
1.2.9.113	5/8	19'-0"	19'-7"	8	163
1.2.9.114	5/8	20'-11"	21'-6"	2	45
1.2.9.115	5/8	21'-10"	22'-5"	4	57
1.2.9.116	5/8	5'-0"	5'-7"	2	12
1.2.9.117	5/8	6'-0"	6'-7"	2	14
1.2.9.118	5/8	7'-0"	7'-7"	2	16
1.2.9.119	5/8	9'-1"	9'-5"	2	20
1.2.9.120	5/8	10'-2"	10'-9"	2	22
1.2.9.121	5/8	12'-4"	12'-11"	2	31
1.2.9.122	5/8	15'-5"	16'-0"	2	33
1.2.9.123	5/8	16'-5"	17'-0"	2	35
1.2.9.124	5/8	30'-0"	30'-8"	8	368

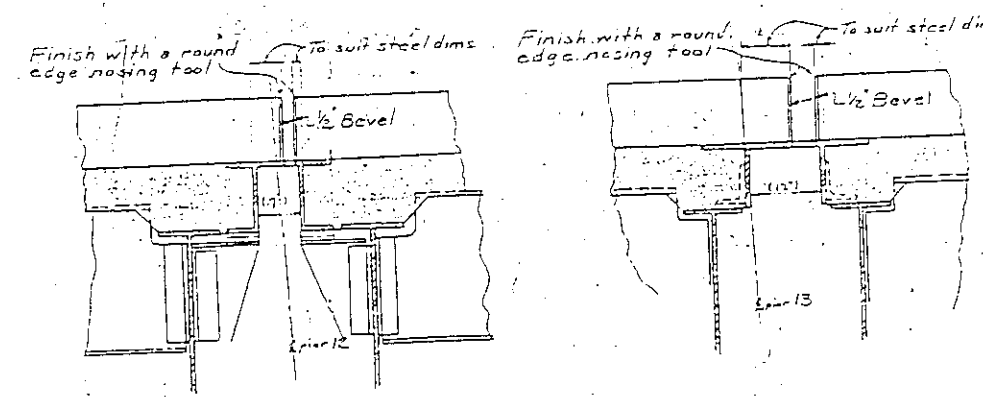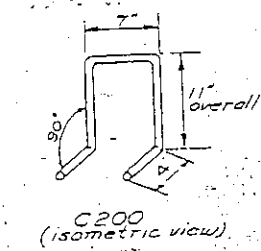


SECT. 12-12

SECT. 13-13


TYPICAL DETAIL FOR ALL LOW FLANGES (see Typical Details on Sh. 196-152 for dimensions at top of stringer)

SECT. 17-17


SECT. 18-18

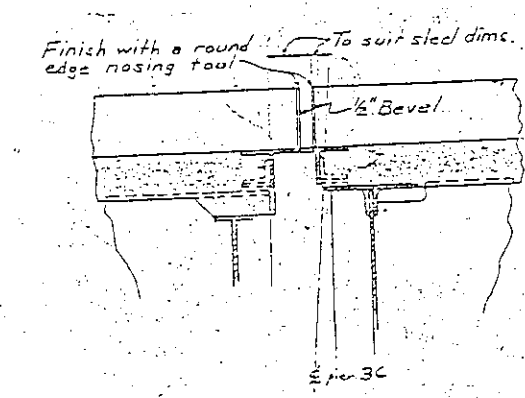


SECT. 36-36

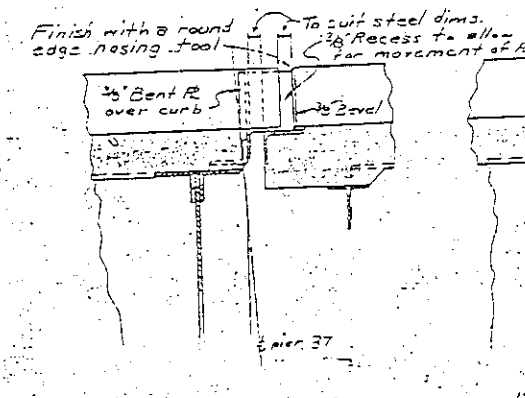


SECT. 37-37

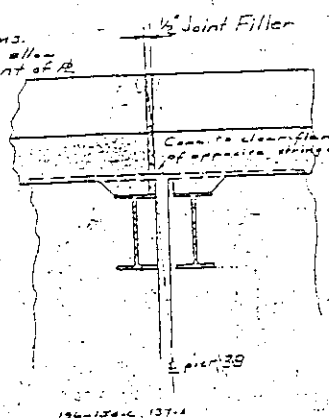


SECT. 39-39

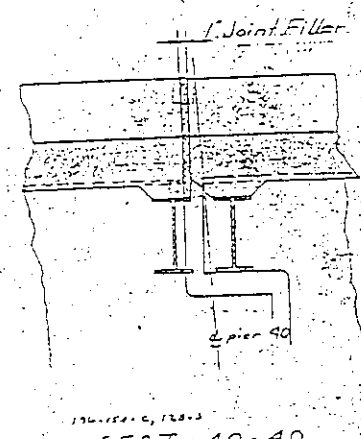


SECT. 40-40

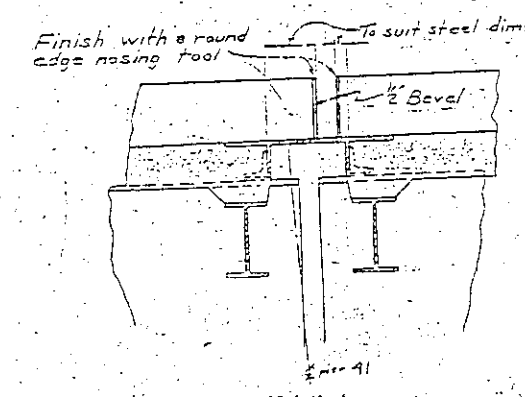


SECT. 41-41

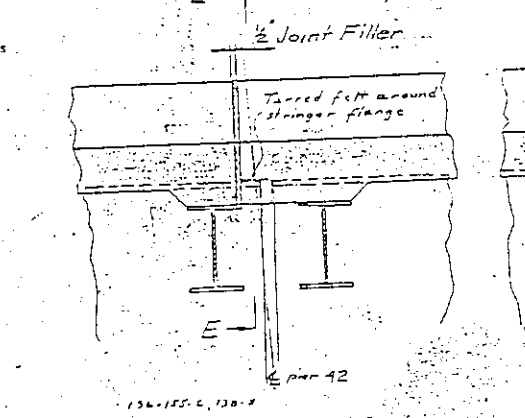

SECT. 42-42

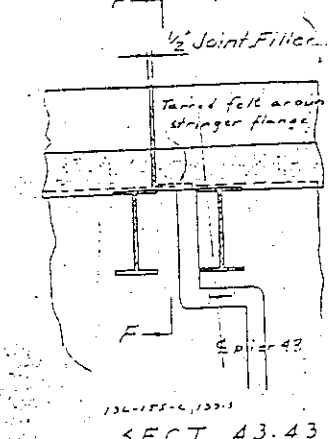

SECT. 43-43

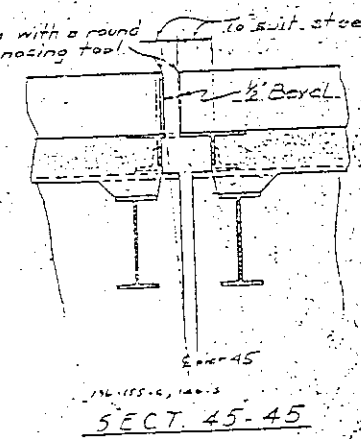

SECT. 45-45

GENERAL NOTES

- For Location of Sects 12-12 & 13-13 see Sh 196-153.
- For Location of Sects 13-13, 17-17, 18-18, 36-36, 37-37, 39-39, 40-40, and 41-41 see Sh 196-154.
- For Location of Sects 41-41, 42-42, 43-43, 45-45, 46-46, & 47-47 see Sh 196-155.
- For Typical Cross Section Thru Roadway Slab see Sh 196-152.
- Dims in (No) are approximate and are to be used only for estimating.
- Purposes: No. above Section Titles are Sheet Nos. above Section Titles and not dwgs. C = Concrete, S = Steel, and N = covered by a note not shown in detail.
- For detail of Piling Post and Bracket see Structural Steel Shop Plans.

Revision A Bar Changes - 6-10-

MISSISSIPPI RIVER BRIDGE
BETWEEN
THIRD ST. EAST ST. LOUIS, ILL.
AND
THIRD ST. ST. LOUIS, MO.
FOR
CITY OF EAST ST. LOUIS

FOR INFORMATION ONLY