



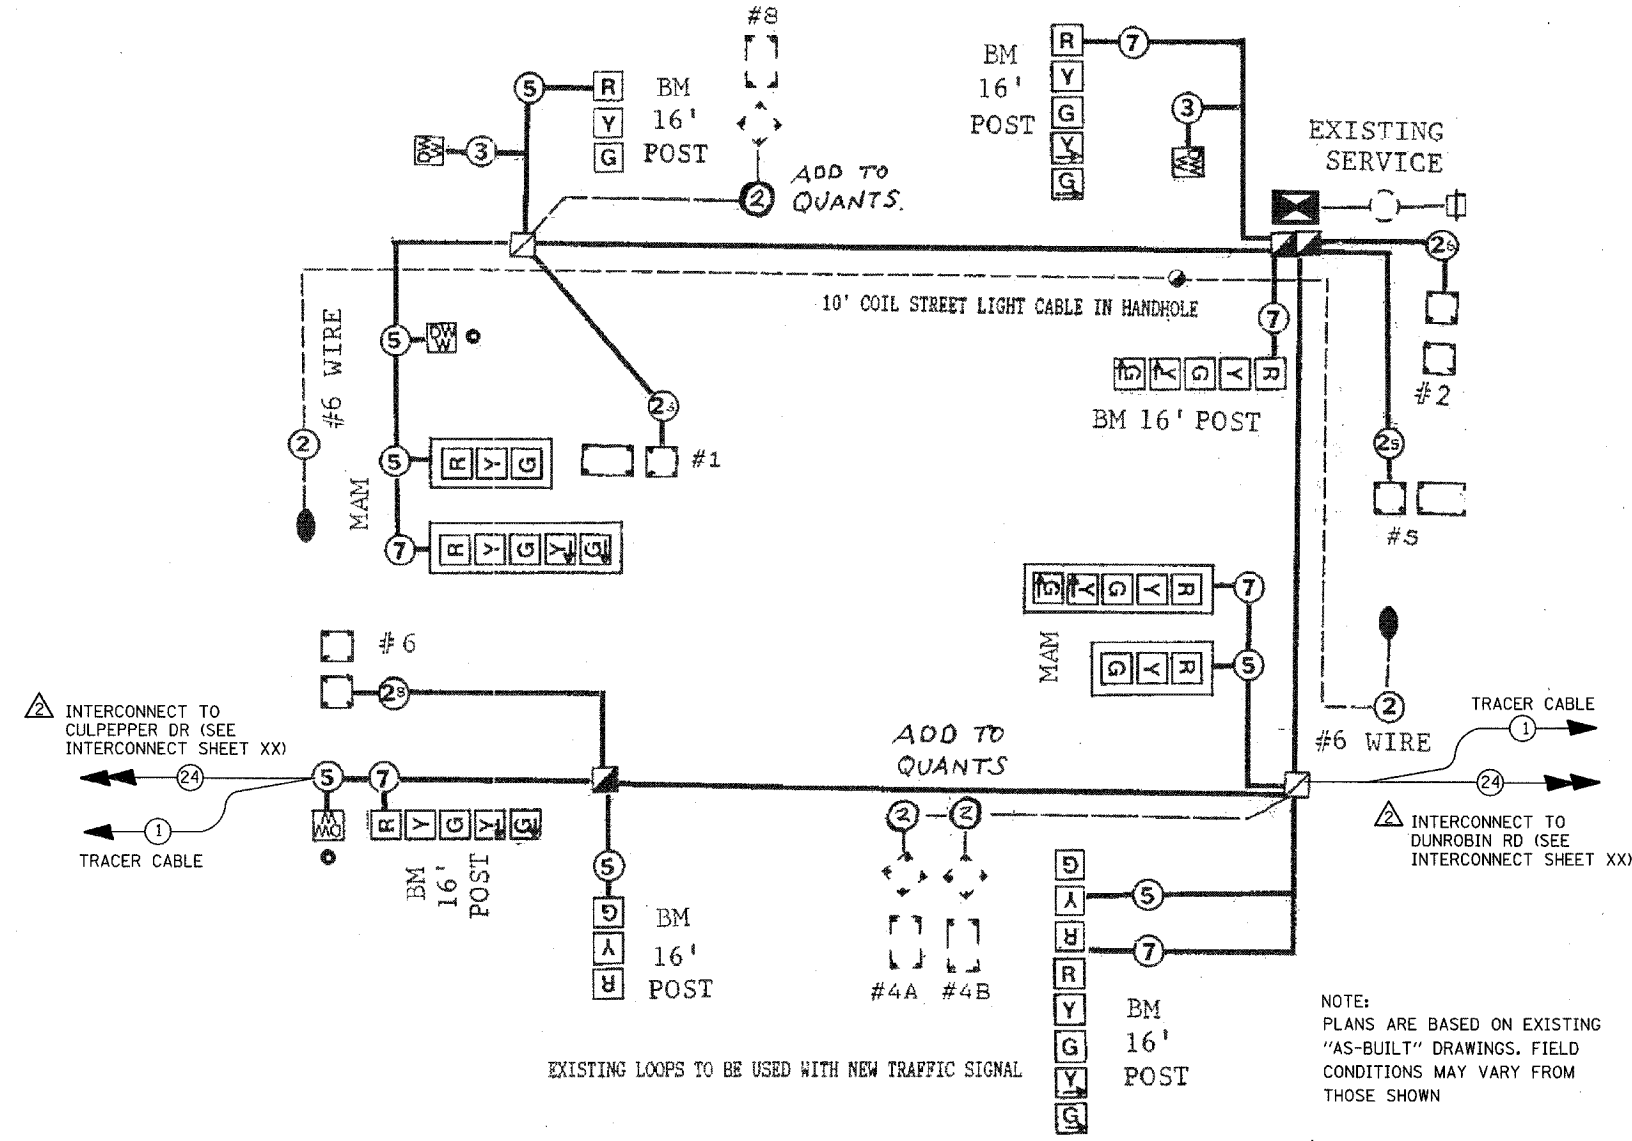

PROPOSED SEQUENCE OF OPERATION																		
PHASE	1+5			1+6			2+5			2+6			4+8			FLASH		
MOVEMENT	↑ ↓			↑ ↓			← →			← →			↑ ↓					
CHANGE TO:	1+6	2+5	2+6	2+6	2+6	2+6	2+6	2+6	4+8	4+8	4+8	1+5	1+6	1+6	1+6			
INTERVAL	1	2A	2B	2C	3	4	5	6	7	8	9	10	11	12	13A	13B	13C	13D
NAPER BLVD NB	R	R	R	R	G	G	R	R	G	G	Y	R	R	R	R	R	R	R
NAPER BLVD SB	R	R	R	R	R	R	G	G	G	G	Y	R	R	R	R	R	R	R
GREEN TRAILS EB	R	R	R	R	R	R	R	R	R	R	R	R	G	G	Y	R	R	R
GREEN TRAILS WB	R	R	R	R	R	R	R	R	R	R	R	R	G	G	Y	R	Y	R
WEST CROSSWALK GREEN TRAILS	DW	DW	DW	DW	DW	DW	W	W	W	FL	DW	DW	DW	DW	DW	DW	DW	D
SOUTH CROSSWALK NAPER BLVD	DW	DW	DW	DW	DW	DW	DW	DW	DW	DW	DW	W	FL	DW	DW	DW	DW	R

- NOTE:
- 1) AN 8 PHASE CONTROLLER SHALL BE INSTALLED, AS SPECIFIED.
 - 2) PHASES 1+6, 2+5, AND 2+6 SHALL NOT CLEAR TO PHASE 1+5.
 - 3) PHASE 2+6 SHALL BE SET TO MIN RECALL
 - 4) SET WALK TO "REST" FOR PED CROSSING GREEN TRAILS (WEST SIDE OF NAPER BLVD)

TRAFFIC SIGNAL LEGEND

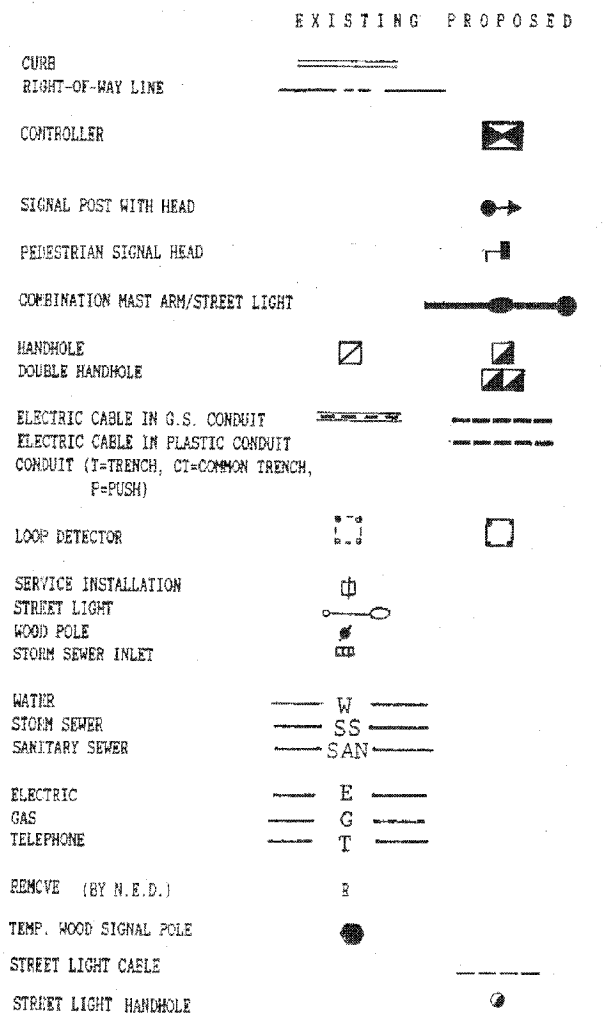

NOTE:
PLANS ARE BASED ON EXISTING "AS-BUILT" DRAWINGS. FIELD CONDITIONS MAY VARY FROM THOSE SHOWN

- INSTALLATION OF EMERGENCY VEHICLE PREEMPTION 3-25-02 SEE REVISED PLANS PREPARED BY CHRISTOPHER BURKE ENGR.
- INSTALLATION OF FIBER OPTIC INTERCONNECT TO NORTH ON NAPER BLVD, HOBSON TO DUNROBIN

LEGEND

PROPOSED FIBER OPTIC CABLE IN CONDUIT, NO. 62.5/125, MMI 2F SMI 2F

PROPOSED ELECTRIC CABLE, 17C (AS SPECIFIED)

AS BUILT PLANS



TURN ON 8 30PM 87 TIME: 10:45

TRAFFIC SIGNAL
NAPER BLVD/GREEN TRAILS
NAPERVILLE, IL.

DRAWN BY: FCS DATE: 5 DECEMBER 1986 SCALE: 1"=20'

PAUL C. BOX & ASSOCIATES
9933 LAWLER, NAPERVILLE, ILLINOIS 60077
TELEPHONE (312) 375-0050

JOB NUMBER: AC-129
DRAWING NUMBER: 45

REVISIONS	
NAME	DATE

ILLINOIS DEPARTMENT OF TRANSPORTATION
NAPER BOULEVARD INTERCONNECT

GREEN TRAILS DRIVE
CABLE PLAN

SCALE: NTS
DATE: _____

DRAWN BY: JS
CHECKED BY: DJ

DATE: 05/10/2005 12:01:00 PM
FILE NAME: P:\Road\GTC\31\1.dgn
PLOT SCALE: 1/2"=1'-0"
REFERENCE: REF