


FOR INFORMATION ONLY

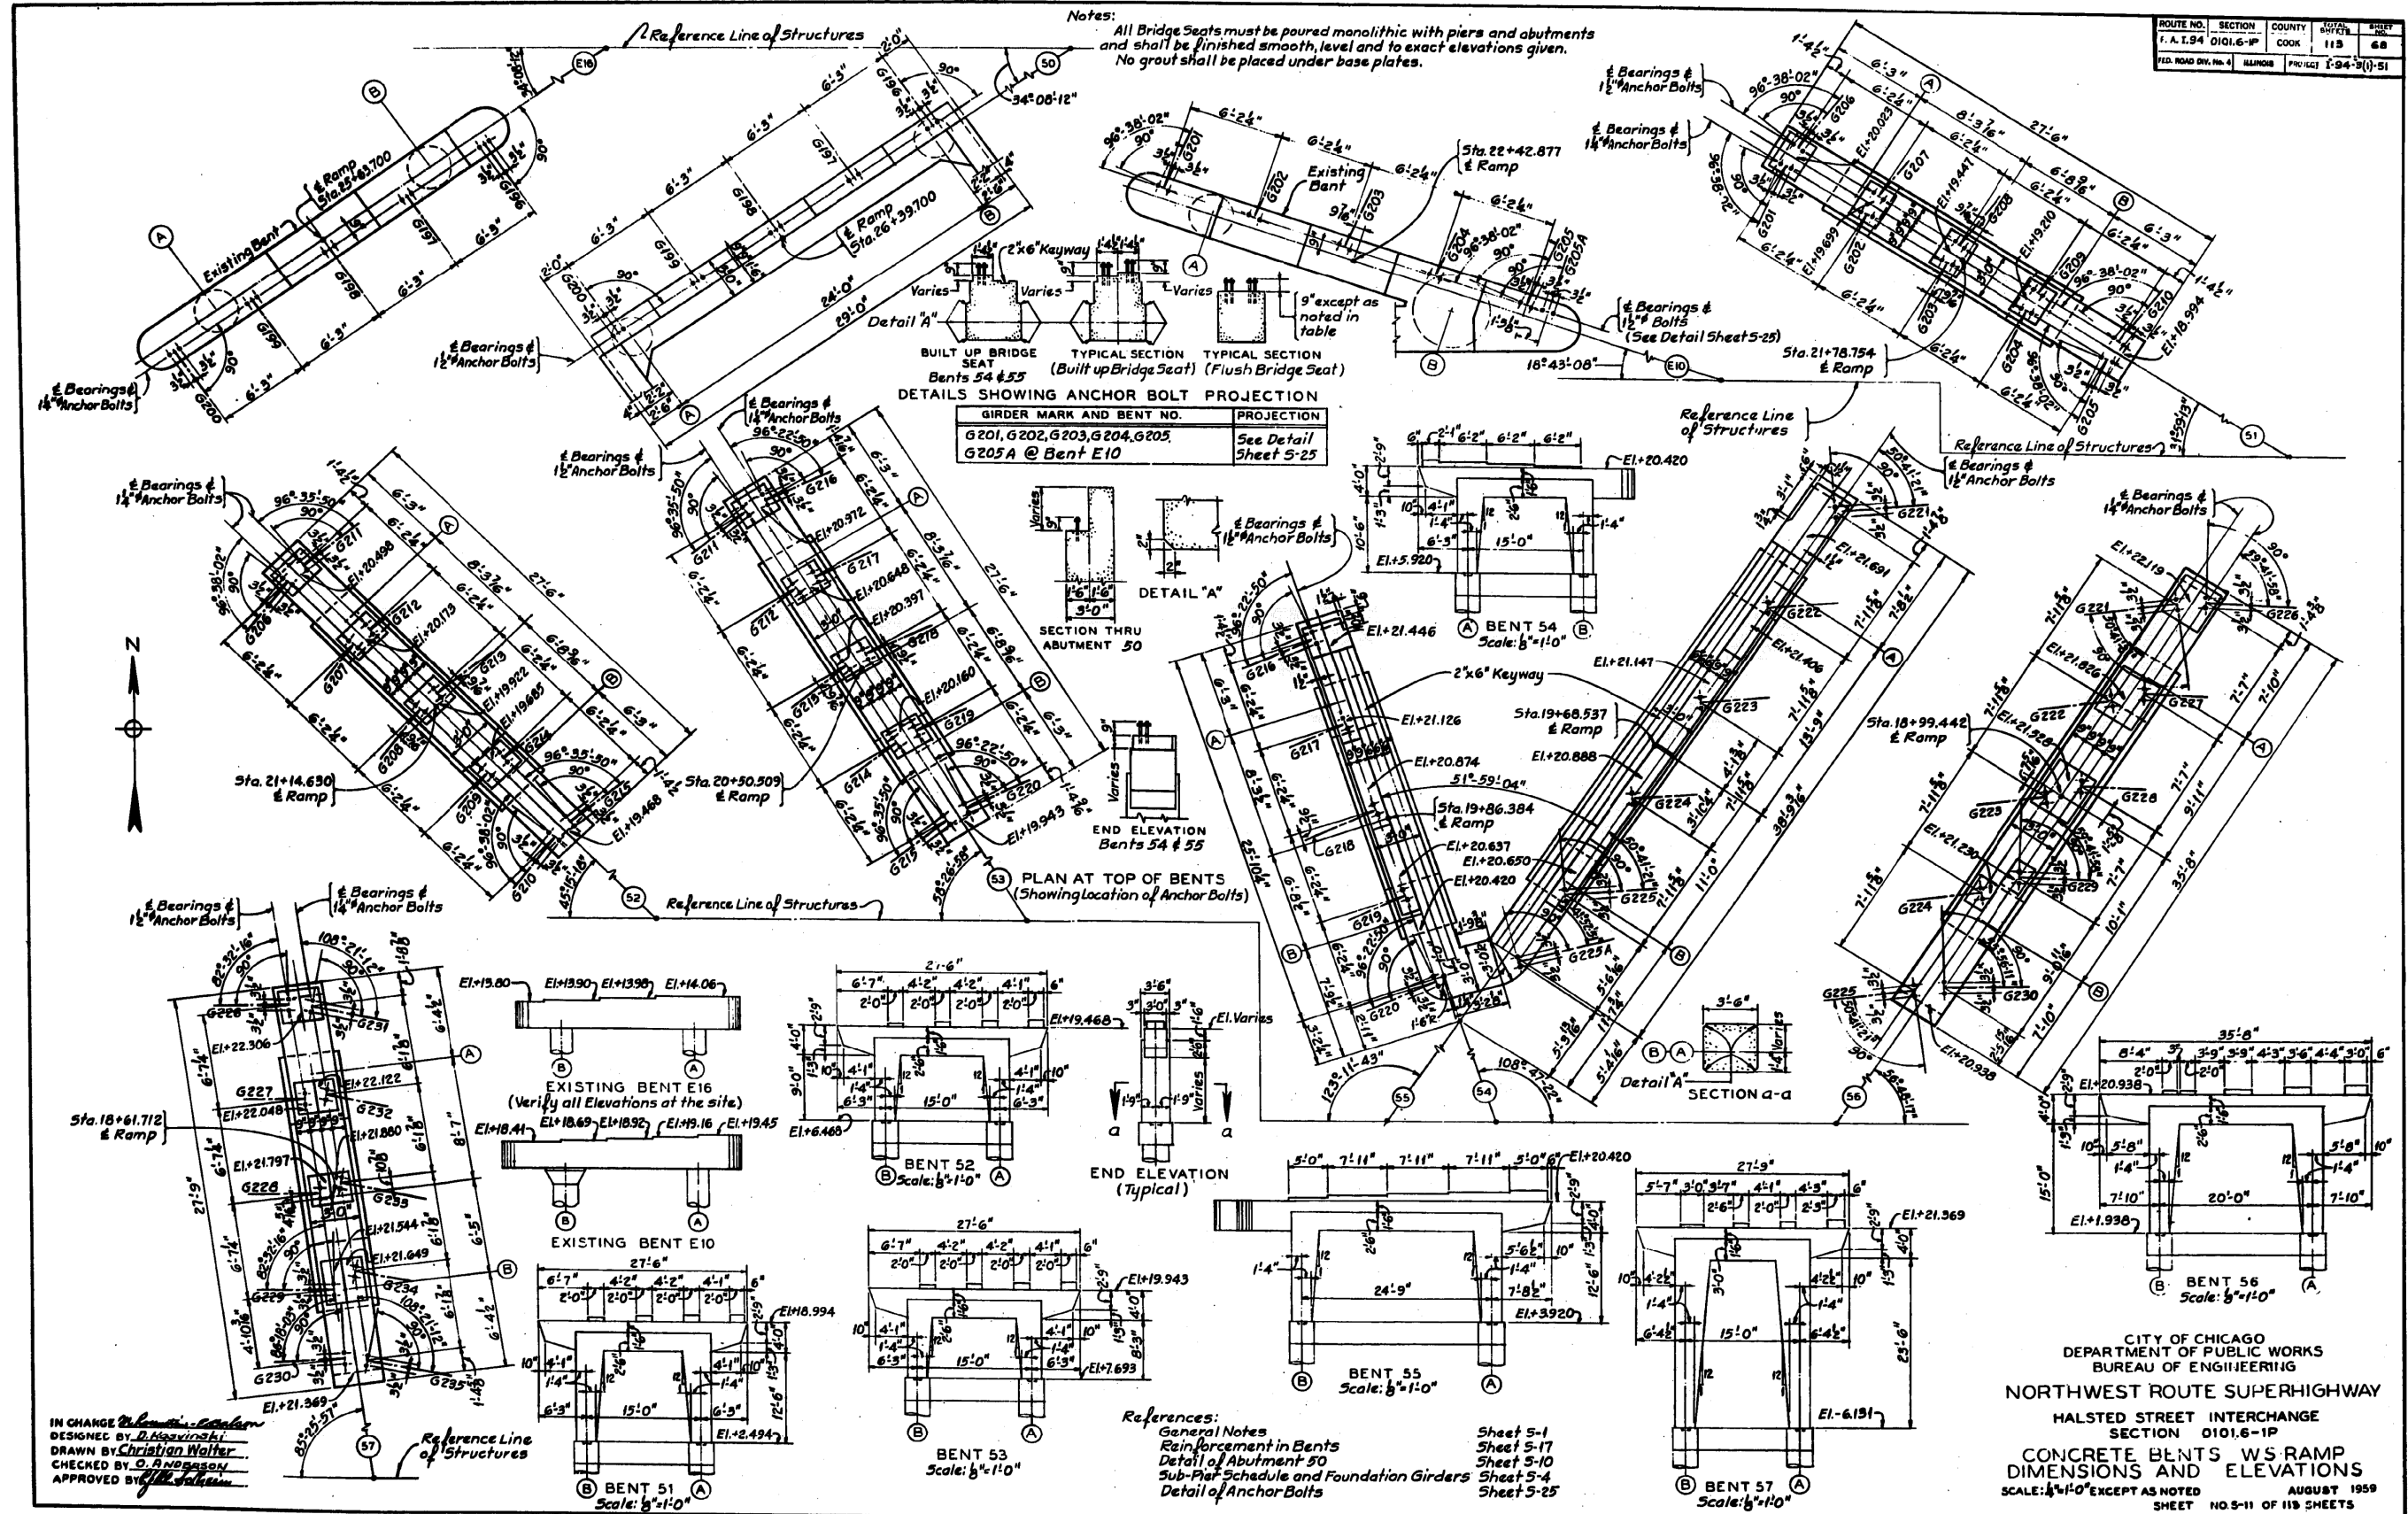

ROUTE NO.	SECTION	COUNTY	TOTAL SHEETS	SHEET NO.
F. A. I. 94	0101.6-1P	COOK	113	68
FED. ROAD DIST. NO. 4	SECTION	PROJECT NO.	1-94-3(1)-51	

Notes:
All Bridge Seats must be poured monolithic with piers and abutments and shall be finished smooth, level and to exact elevations given. No grout shall be placed under base plates.

DETAILS SHOWING ANCHOR BOLT PROJECTION

GIRDER MARK AND BENT NO.	PROJECTION
G 201, G 202, G 203, G 204, G 205	See Detail Sheet 5-25
G 205 A @ Bent E 10	See Detail Sheet 5-25

IN CHANGE
DESIGNED BY
DRAWN BY
CHECKED BY
APPROVED BY

CITY OF CHICAGO
DEPARTMENT OF PUBLIC WORKS
BUREAU OF ENGINEERING
NORTHWEST ROUTE SUPERHIGHWAY
HALSTED STREET INTERCHANGE
SECTION 0101.6-1P
CONCRETE BENTS W/S RAMP
DIMENSIONS AND ELEVATIONS
SCALE: 1/4"=1'-0" EXCEPT AS NOTED
AUGUST 1959
SHEET NO. 5-11 OF 113 SHEETS

FILE PATH = C:\P\Projects\14-0425 - 60W28 Structure\14-0425-60W28-Struct-Built-16.dgn



D160W28-sht-AS-BUILT-16.dgn
USER NAME = ayeuengh
PLOT SCALE = 1:8000 / in.
PLOT DATE = 4/25/2014

DESIGNED -
DRAWN -
CHECKED -
DATE - 04/28/14

STATE OF ILLINOIS
DEPARTMENT OF TRANSPORTATION

EXISTING AS-BUILTS
SN 016-2449 & SN 016-2451
SCALE: NTS SHEET 16 OF 48 SHEETS STA. TO STA.

F.A.I. RTE.	SECTION	COUNTY	TOTAL SHEETS	SHEET NO.
90/94/290	2013-010R	COOK	747	486
CONTRACT NO. 60W28				ILLINOIS FED. AID PROJECT