


FOR INFORMATION ONLY

ROUTE NO.	SECTION	COUNTY	TOTAL SHEETS	SHEET NO.
F. A. 194	0101.6-1P	COOK	113	69
ILL. ROAD DIV. No. 4	ALLIANCE	PROJECT	1-94-(3)-51	



FILE PATH = C:\Projects\14-0425 - 60W28 Structure\Bulbs\0101028-struct-AS-BUILT-17.dgn

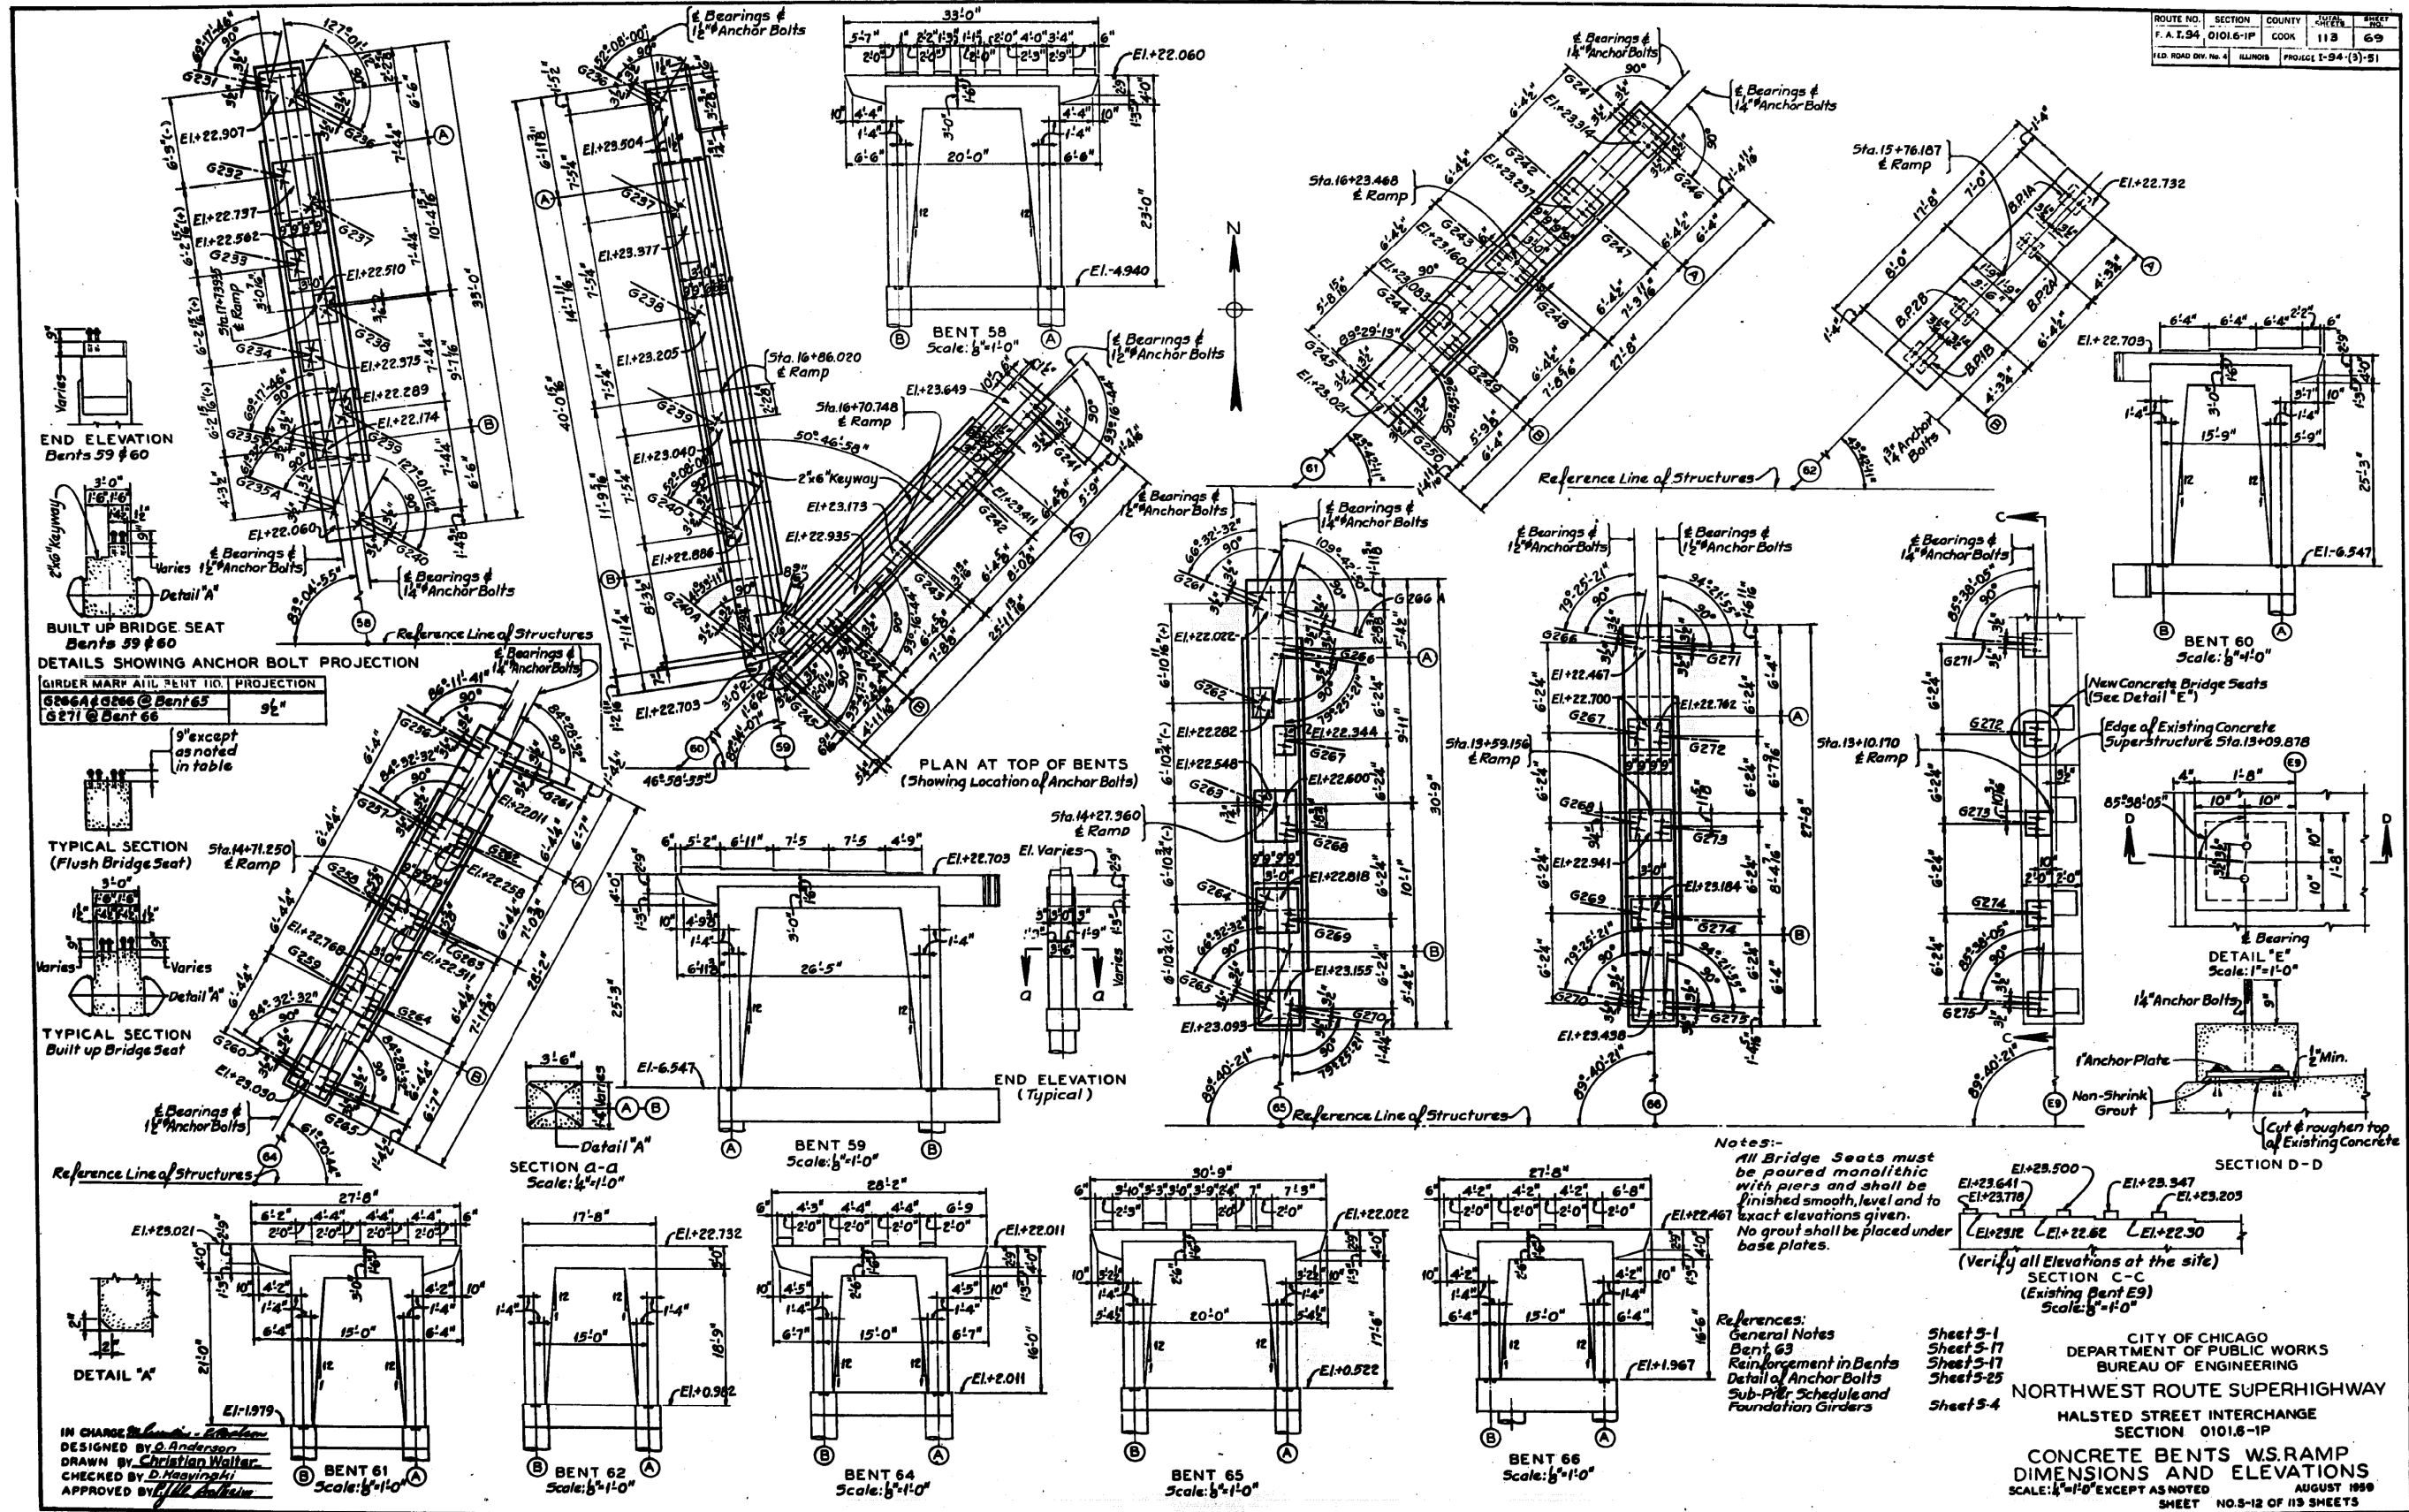

D:\60W28-struct-AS-BUILT-17.dgn  
 USER NAME = ayeung  
 PLOT SCALE = 1:8000 / in.  
 PLOT DATE = 4/25/2014

DESIGNED -	REVISED -
DRAWN -	REVISED -
CHECKED -	REVISED -
DATE - 04/28/14	REVISED -

STATE OF ILLINOIS  
 DEPARTMENT OF TRANSPORTATION

EXISTING AS-BUILTS  
 SN 016-2449 & SN 016-2451  
 SCALE: NTS SHEET 17 OF 48 SHEETS STA. TO STA.

F.A.I. RTE.	SECTION	COUNTY	TOTAL SHEETS	SHEET NO.
90/94/290	2013-010R	COOK	747	487
CONTRACT NO. 60W28				ILLINOIS FED. AID PROJECT

CITY OF CHICAGO  
 DEPARTMENT OF PUBLIC WORKS  
 BUREAU OF ENGINEERING  
 NORTHWEST ROUTE SUPERHIGHWAY  
 HALSTED STREET INTERCHANGE  
 SECTION 0101.6-1P  
 CONCRETE BENTS W.S.RAMP  
 DIMENSIONS AND ELEVATIONS  
 SCALE: 1/4" = 1'-0" EXCEPT AS NOTED  
 SHEET NO. 3-12 OF 113 SHEETS