


FOR INFORMATION ONLY



FILE PATH = C:\Projects\11-0425 - 60W28 Structure\11-0425-AS-BUILT-19.dgn

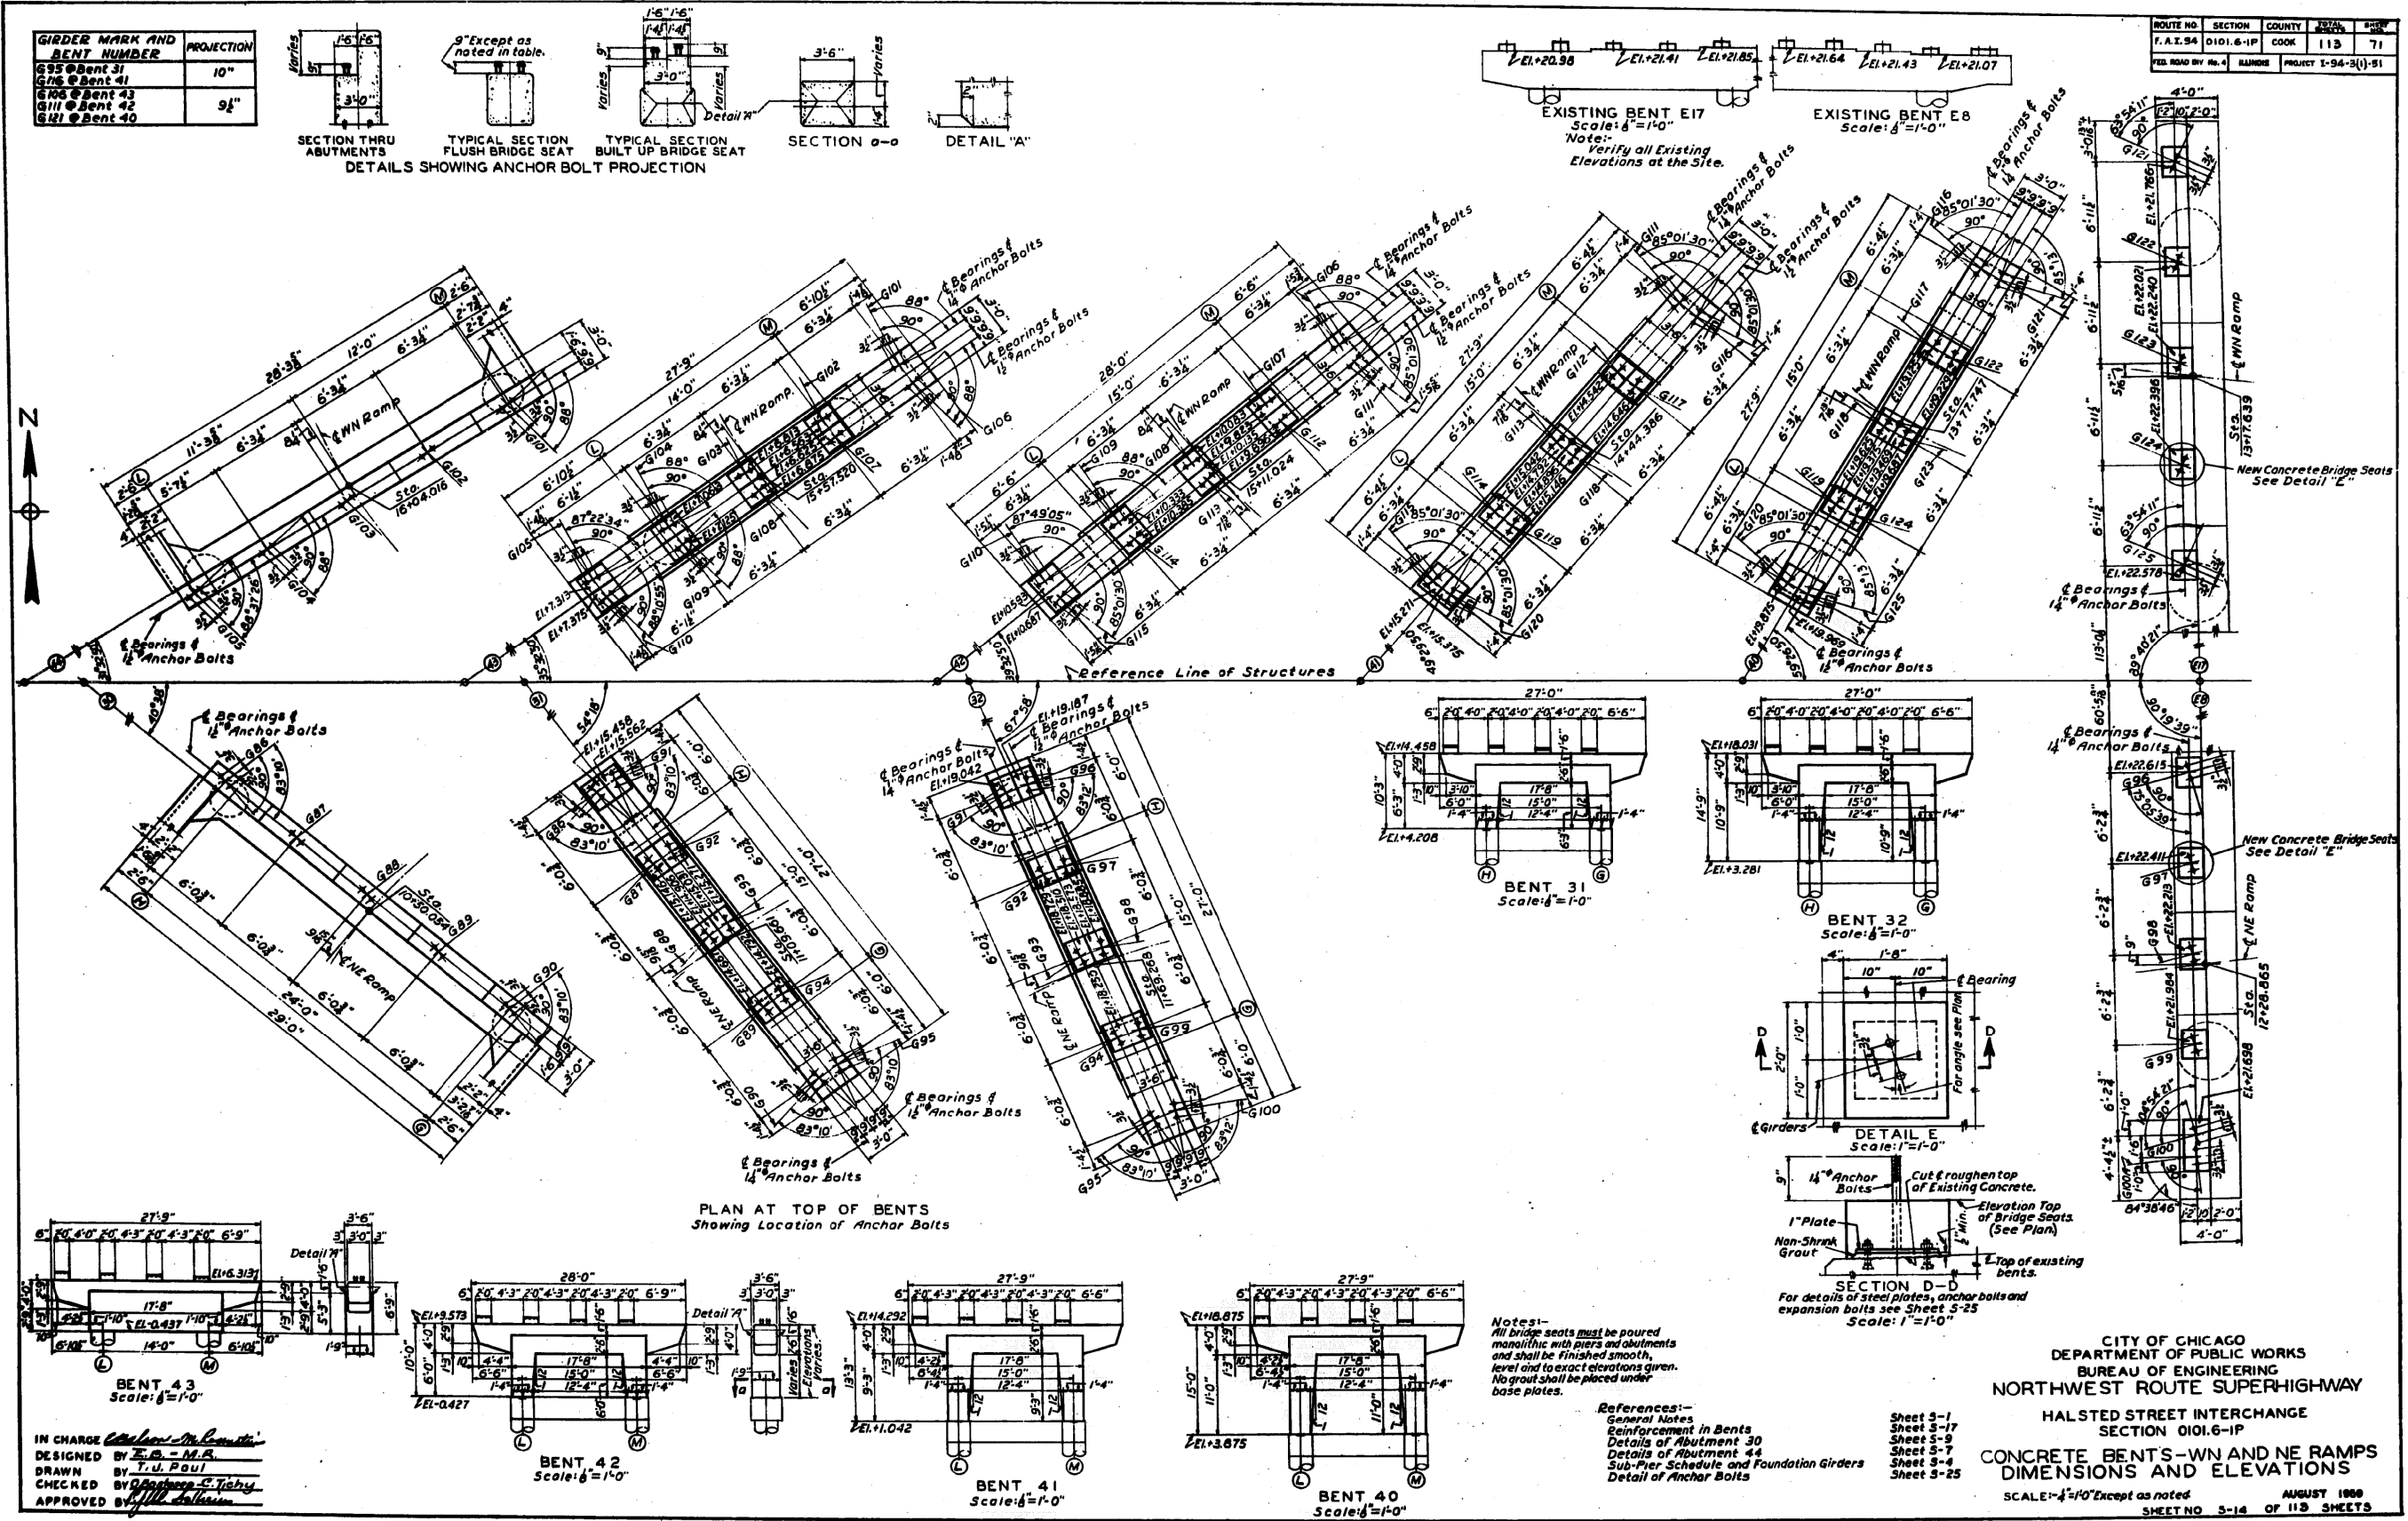

D160W28-sht-AS-BUILT-19.dgn
 USER NAME = auyeuongh
 PLOT SCALE = 1:8000 / 1"
 PLOT DATE = 4/25/2014

DESIGNED -
 DRAWN -
 CHECKED -
 DATE - 04/28/14

REVISED -
 REVISED -
 REVISED -
 REVISED -

STATE OF ILLINOIS
 DEPARTMENT OF TRANSPORTATION

EXISTING AS-BUILTS
 SN 016-2449 & SN 016-2451

SCALE: NTS SHEET 19 OF 48 SHEETS STA. TO STA.

| F.A.I. RTE. | SECTION | COUNTY | TOTAL SHEETS | SHEET NO. |
|---------------------------|-----------|--------|--------------|--------------------|
| 90/94/290 | 2013-010R | COOK | 747 | 489 |
| | | | | CONTRACT NO. 60W28 |
| ILLINOIS FED. AID PROJECT | | | | |