



FOR INFORMATION ONLY

ROUTE NO.	SECTION	COUNTY	SHEET	OF
F.A.I. 94	0101.6-1P	COOK	113	76
FED. ROAD DIST. NO. 4	ILLINOIS	PROJECT	I-94-3(1)-51	

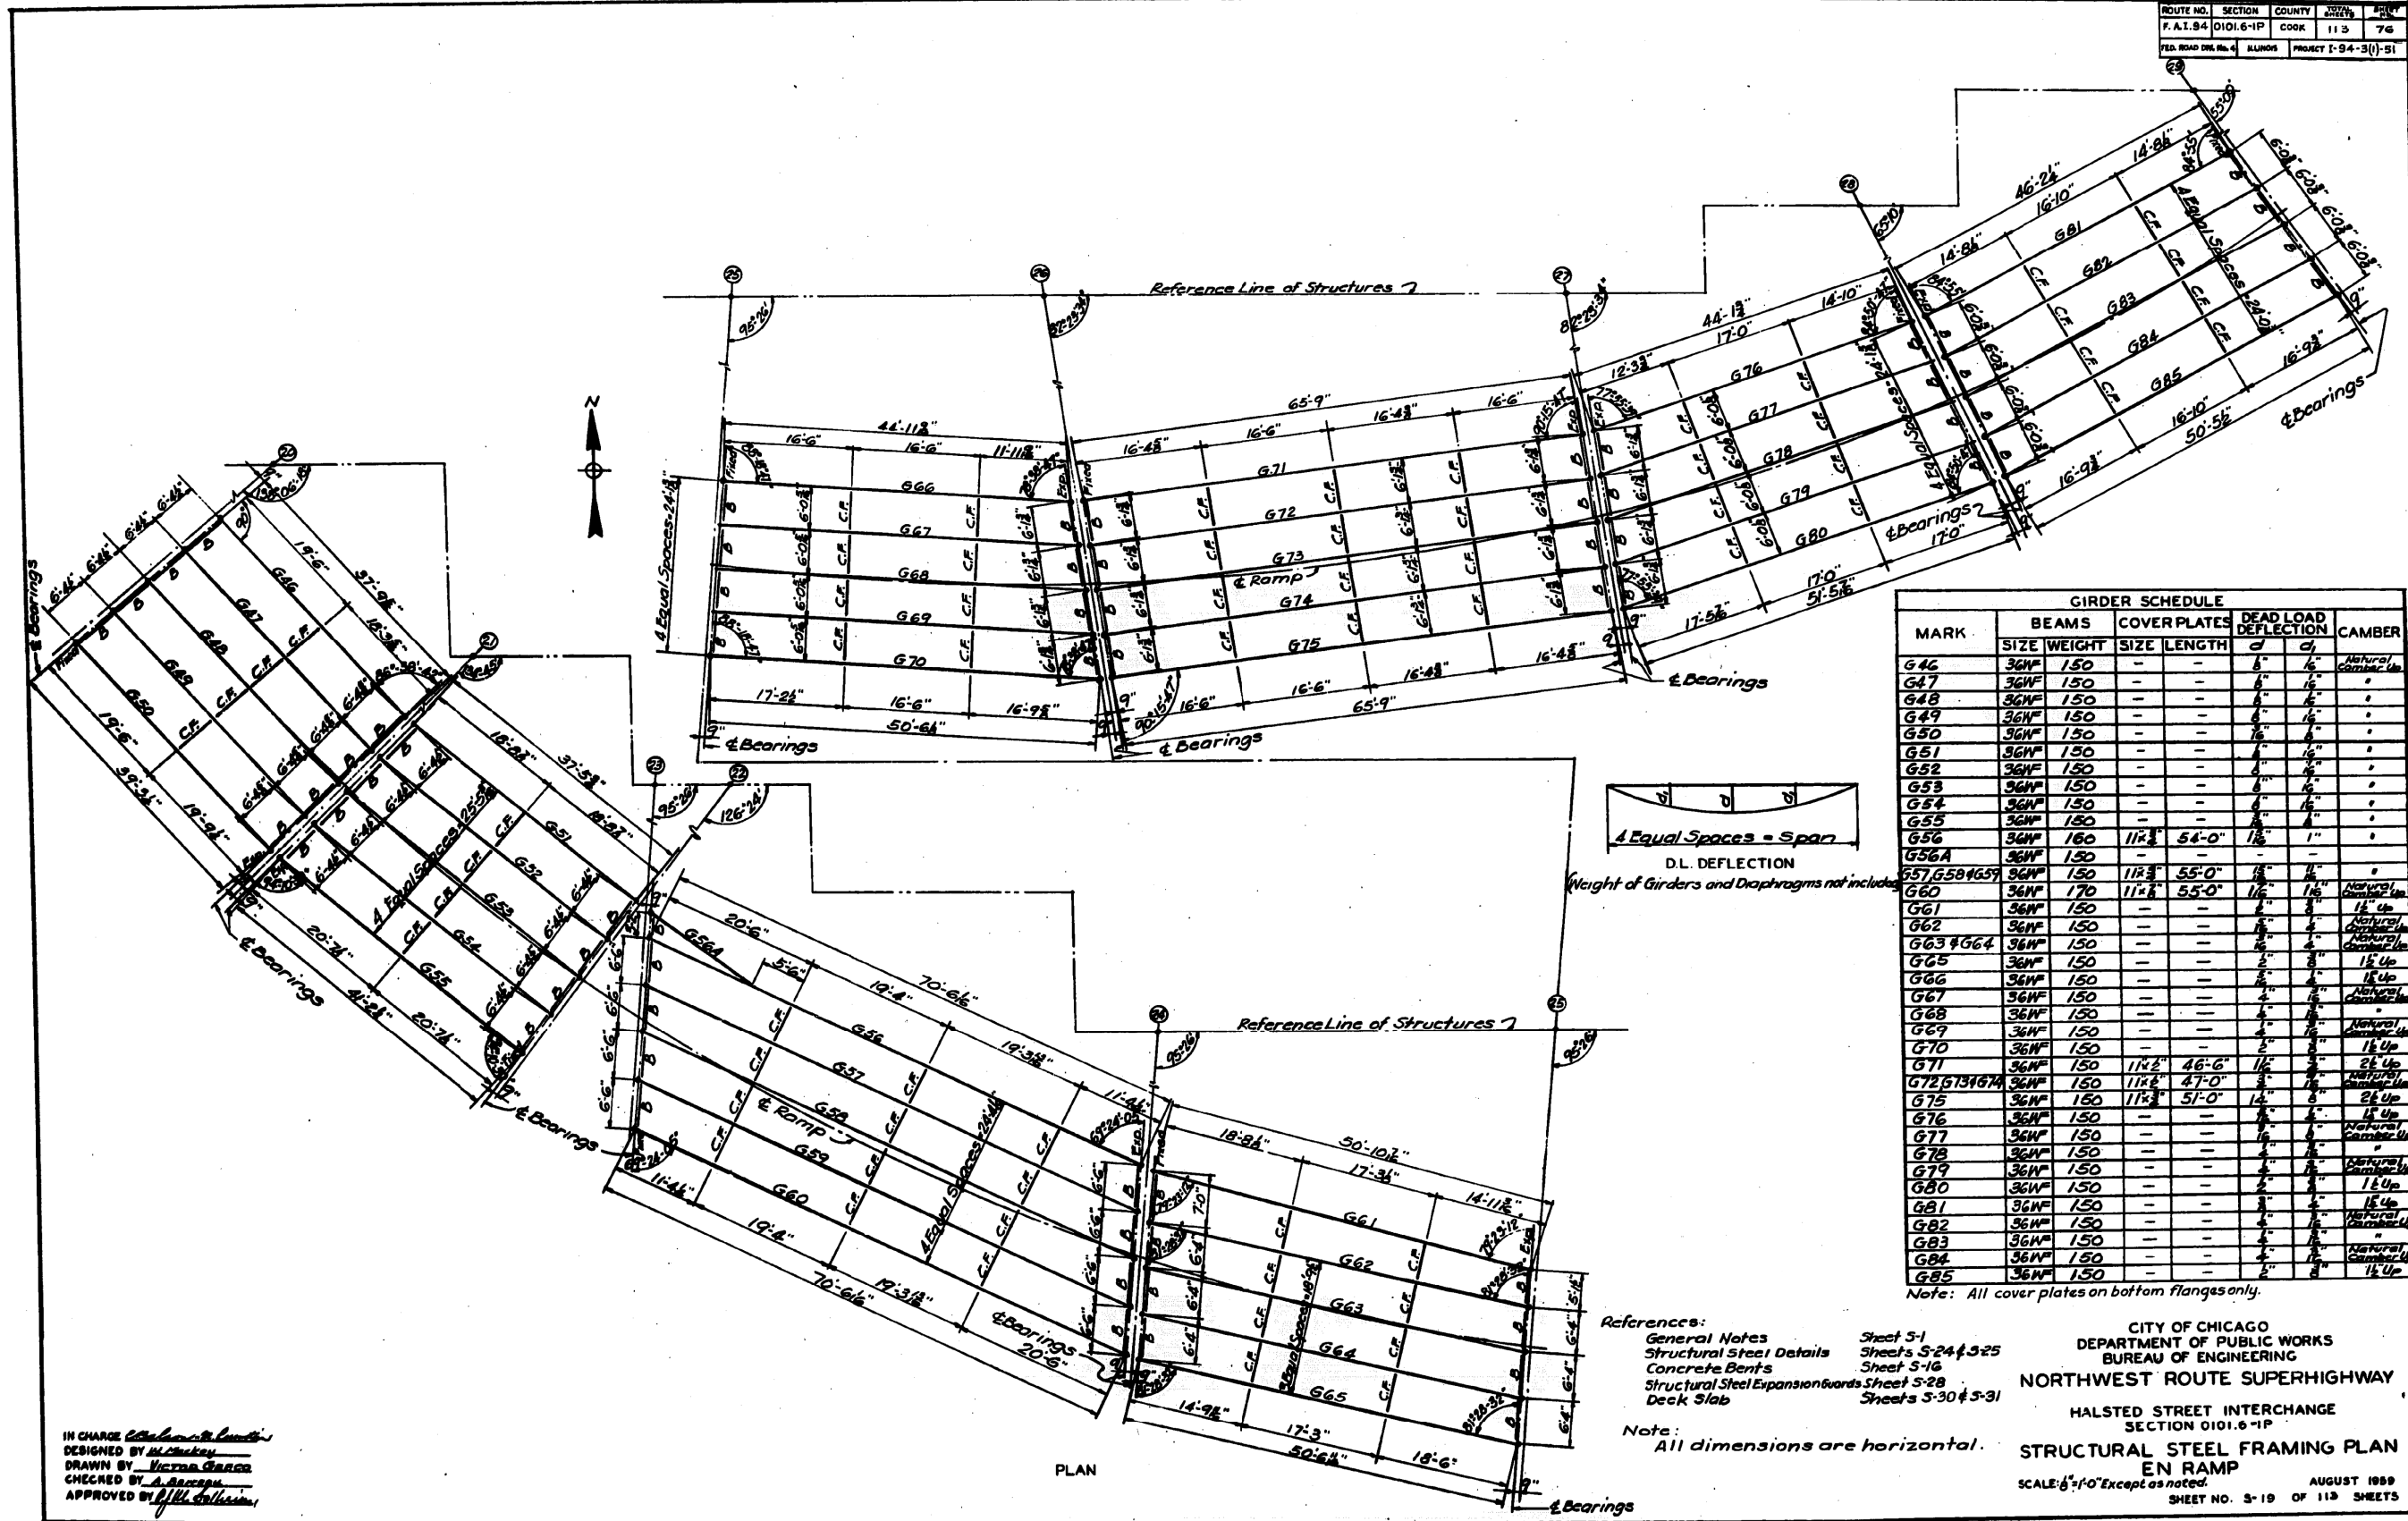

MARK	BEAMS		COVER PLATES		DEAD LOAD DEFLECTION		CAMBER
	SIZE	WEIGHT	SIZE	LENGTH	d	c	
G46	36WF	150	-	-	1/2"	1/2"	Natural Camber Up
G47	36WF	150	-	-	1/2"	1/2"	"
G48	36WF	150	-	-	1/2"	1/2"	"
G49	36WF	150	-	-	1/2"	1/2"	"
G50	36WF	150	-	-	1/2"	1/2"	"
G51	36WF	150	-	-	1/2"	1/2"	"
G52	36WF	150	-	-	1/2"	1/2"	"
G53	36WF	150	-	-	1/2"	1/2"	"
G54	36WF	150	-	-	1/2"	1/2"	"
G55	36WF	150	-	-	1/2"	1/2"	"
G56	36WF	160	11x3"	54'-0"	1/2"	1/2"	"
G56A	36WF	150	-	-	-	-	"
G57, G58, G59	36WF	150	11x3"	55'-0"	1/2"	1/2"	"
G60	36WF	170	11x3"	55'-0"	1/2"	1/2"	Natural Camber Up
G61	36WF	150	-	-	1/2"	1/2"	1 1/2" Up
G62	36WF	150	-	-	1/2"	1/2"	Natural Camber Up
G63 & G64	36WF	150	-	-	1/2"	1/2"	Natural Camber Up
G65	36WF	150	-	-	1/2"	1/2"	1 1/2" Up
G66	36WF	150	-	-	1/2"	1/2"	1 1/2" Up
G67	36WF	150	-	-	1/2"	1/2"	Natural Camber Up
G68	36WF	150	-	-	1/2"	1/2"	Natural Camber Up
G69	36WF	150	-	-	1/2"	1/2"	1 1/2" Up
G70	36WF	150	-	-	1/2"	1/2"	1 1/2" Up
G71	36WF	150	11x2"	46'-6"	1/2"	1/2"	2 1/2" Up
G72, G73, G74	36WF	150	11x2"	47'-0"	1/2"	1/2"	Natural Camber Up
G75	36WF	150	11x3"	51'-0"	1/2"	1/2"	2 1/2" Up
G76	36WF	150	-	-	1/2"	1/2"	1 1/2" Up
G77	36WF	150	-	-	1/2"	1/2"	Natural Camber Up
G78	36WF	150	-	-	1/2"	1/2"	"
G79	36WF	150	-	-	1/2"	1/2"	Natural Camber Up
G80	36WF	150	-	-	1/2"	1/2"	1 1/2" Up
G81	36WF	150	-	-	1/2"	1/2"	1 1/2" Up
G82	36WF	150	-	-	1/2"	1/2"	Natural Camber Up
G83	36WF	150	-	-	1/2"	1/2"	"
G84	36WF	150	-	-	1/2"	1/2"	Natural Camber Up
G85	36WF	150	-	-	1/2"	1/2"	1 1/2" Up

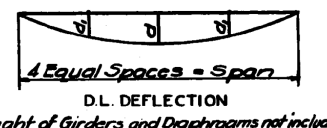

References:  
 General Notes Sheet 5-1  
 Structural Steel Details Sheets 5-24 & 5-25  
 Concrete Bents Sheet 5-16  
 Structural Steel Expansion Joints Sheet 5-28  
 Deck Slab Sheets 5-30 & 5-31

Note:  
 All dimensions are horizontal.

CITY OF CHICAGO  
 DEPARTMENT OF PUBLIC WORKS  
 BUREAU OF ENGINEERING  
 NORTHWEST ROUTE SUPERHIGHWAY  
 HALSTED STREET INTERCHANGE  
 SECTION 0101.6-1P  
 STRUCTURAL STEEL FRAMING PLAN  
 EN RAMP  
 SCALE: 1/4" = 1'-0" Except as noted.  
 AUGUST 1999  
 SHEET NO. 3-19 OF 113 SHEETS

IN CHARGE: *[Signature]*  
 DESIGNED BY: *[Signature]*  
 DRAWN BY: *[Signature]*  
 CHECKED BY: *[Signature]*  
 APPROVED BY: *[Signature]*

FILE PATH = C:\Projects\14-0425 - 60W28 StructSteel\14-0425-sht-AS-BUILT-24.dgn



D160W28-sht-AS-BUILT-24.dgn  
 USER NAME = ayeunghg  
 PLOT SCALE = 1:8000 / 1" = 80'-0"  
 PLOT DATE = 4/25/2014

DESIGNED	-	REVISED	-
DRAWN	-	REVISED	-
CHECKED	-	REVISED	-
DATE	04/28/14	REVISED	-

STATE OF ILLINOIS  
 DEPARTMENT OF TRANSPORTATION

EXISTING AS-BUILTS  
 SN 016-2449 & SN 016-2451  
 SCALE: NTS SHEET 24 OF 48 SHEETS STA. TO STA.

F.A.I. RTE.	SECTION	COUNTY	TOTAL SHEETS	SHEET NO.
90/94/290	2013-010R	COOK	747	494
CONTRACT NO. 60W28				
ILLINOIS FED. AID PROJECT				