


FOR INFORMATION ONLY

ROUTE NO.	SECTION	COUNTY	DATE	SHEET
F.A.I. 94	0101.6-1P	COOK	113	77
FED. ROAD DIST. NO.	PLANING	PROJECT	I-94-3(1)-91	

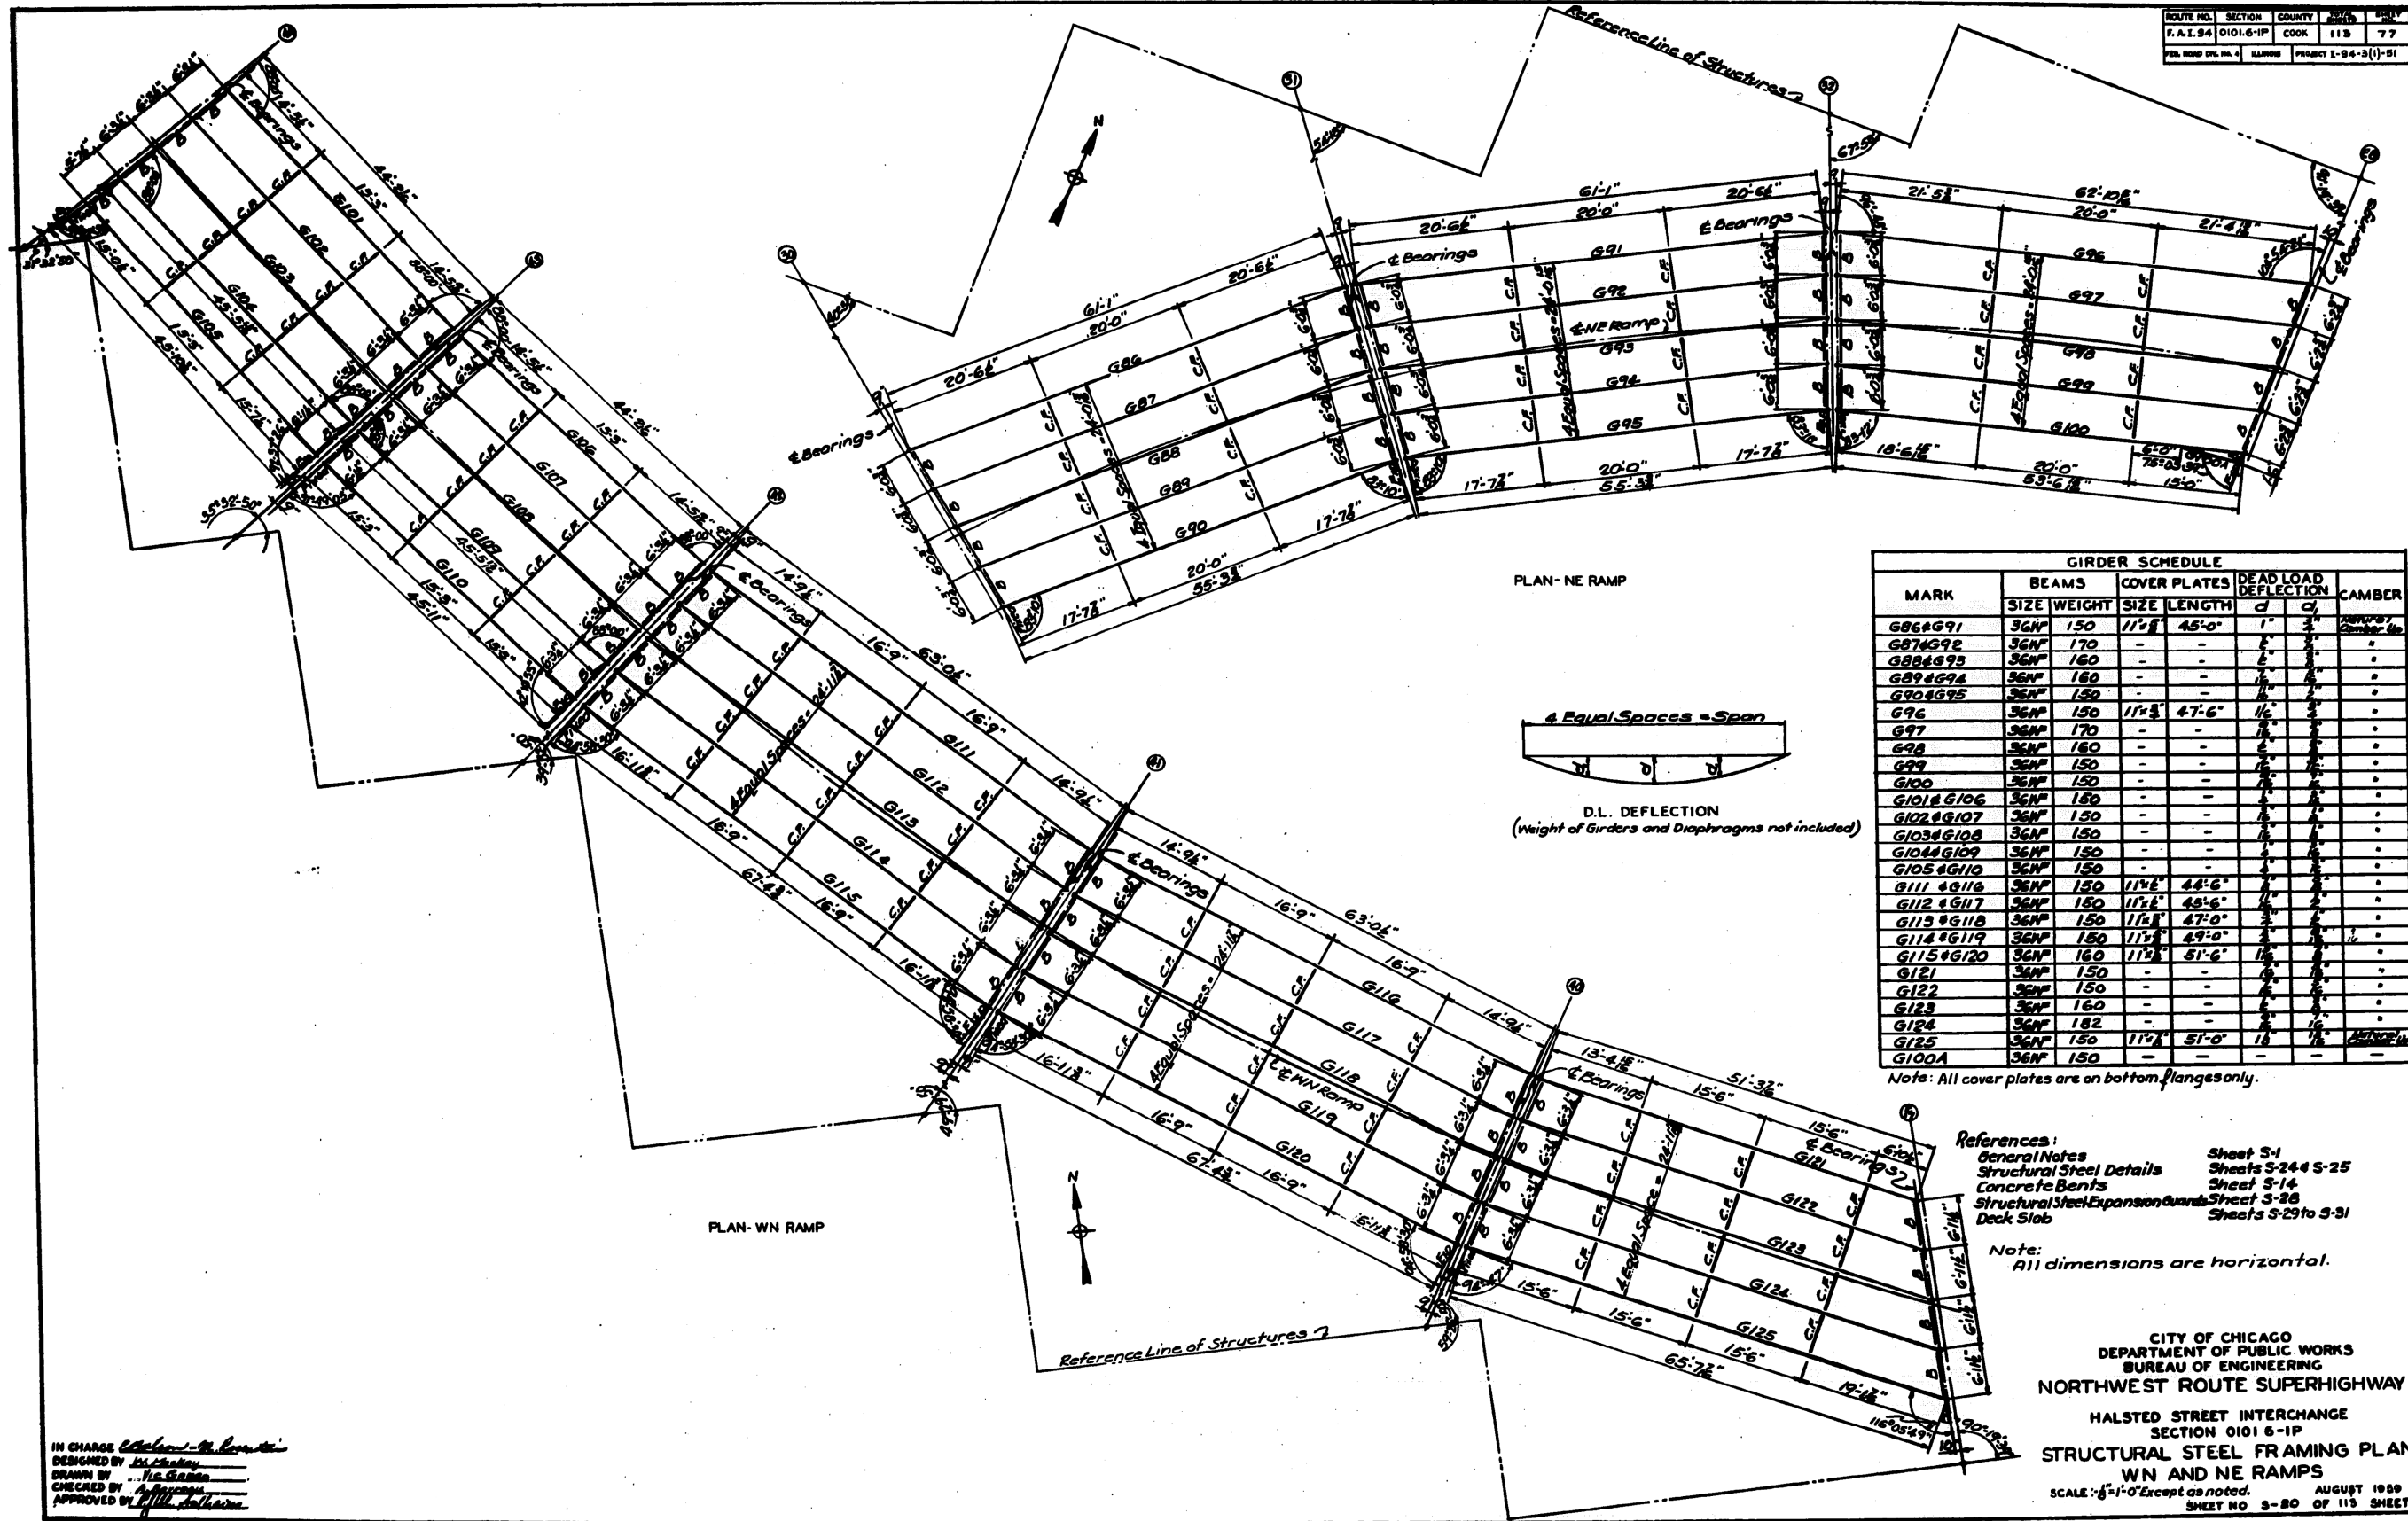

MARK	BEAMS		COVER PLATES		DEAD LOAD DEFLECTION		CAMBER
	SIZE	WEIGHT	SIZE	LENGTH	C	D	
G86 & G91	36N	150	11'-8"	45'-0"	1"	2"	
G87 & G92	36N	170	-	-	-	-	
G88 & G93	36N	160	-	-	-	-	
G89 & G94	36N	160	-	-	-	-	
G90 & G95	36N	150	-	-	-	-	
G96	36N	150	11'-8"	47'-6"	1 1/2"	2"	
G97	36N	170	-	-	-	-	
G98	36N	160	-	-	-	-	
G99	36N	150	-	-	-	-	
G100	36N	150	-	-	-	-	
G101 & G106	36N	180	-	-	-	-	
G102 & G107	36N	150	-	-	-	-	
G103 & G108	36N	150	-	-	-	-	
G104 & G109	36N	150	-	-	-	-	
G105 & G110	36N	150	-	-	-	-	
G111 & G116	36N	150	11'-8"	44'-6"	1 1/2"	2"	
G112 & G117	36N	150	11'-8"	45'-6"	1 1/2"	2"	
G113 & G118	36N	150	11'-8"	47'-0"	1 1/2"	2"	
G114 & G119	36N	150	11'-8"	49'-0"	1 1/2"	2"	
G115 & G120	36N	160	11'-8"	51'-6"	1 1/2"	2"	
G121	36N	150	-	-	-	-	
G122	36N	150	-	-	-	-	
G123	36N	160	-	-	-	-	
G124	36N	182	-	-	-	-	
G125	36N	150	11'-8"	51'-0"	1 1/2"	2"	
G100A	36N	150	-	-	-	-	

Note: All cover plates are on bottom flanges only.

- References:
- General Notes
 - Structural Steel Details
 - Concrete Bents
 - Structural Steel Expansion Joints
 - Deck Slab
- Sheet S-1
Sheets S-244 S-25
Sheet S-14
Sheet S-28
Sheets S-29 to S-31

Note: All dimensions are horizontal.

CITY OF CHICAGO
DEPARTMENT OF PUBLIC WORKS
BUREAU OF ENGINEERING
NORTHWEST ROUTE SUPERHIGHWAY
HALSTED STREET INTERCHANGE
SECTION 0101.6-1P
STRUCTURAL STEEL FRAMING PLAN
WN AND NE RAMPS
SCALE: 1/8"=1'-0" Except as noted. AUGUST 1989
SHEET NO 3-80 OF 113 SHEETS

IN CHARGE: *[Signature]*
DESIGNED BY: *[Signature]*
DRAWN BY: *[Signature]*
CHECKED BY: *[Signature]*
APPROVED BY: *[Signature]*

FILE PATH = C:\Projects\14-0425 - 60W28 Structure\14-0425-AS-BUILT-25.dgn



D160W28-sht-AS-BUILT-25.dgn
USER NAME = ayeungh
PLOT SCALE = 1:8000 / in.
PLOT DATE = 4/25/2014

DESIGNED	-	REVISED	-
DRAWN	-	REVISED	-
CHECKED	-	REVISED	-
DATE	04/28/14	REVISED	-

STATE OF ILLINOIS
DEPARTMENT OF TRANSPORTATION

EXISTING AS-BUILTS
SN 016-2449 & SN 016-2451

SCALE: NTS SHEET 25 OF 48 SHEETS STA. TO STA.

F.A.I. RTE.	SECTION	COUNTY	TOTAL SHEETS	SHEET NO.
90/94/290	2013-010R	COOK	747	495
CONTRACT NO. 60W28				ILLINOIS FED. AID PROJECT