


AS BUILT PLANS

STATE OF ILLINOIS  
 DEPARTMENT OF TRANSPORTATION  
 DIVISION OF HIGHWAYS  
**PLANS FOR PROPOSED  
 FEDERAL AID HIGHWAY**




FOR INDEX OF SHEETS, SEE SHEET NO.2  
 FOR SUMMARY OF QUANTITIES, SEE SHEET NO.3-4

F.A.I. RTE.	SECTION	COUNTY	TOTAL SHEETS	SHEET NO.
57	*	FRANKLIN	155	1
* 28(5B-1,5B,2B,1B)D; 28(5VB,3VB-1)I				

D-99-036-90

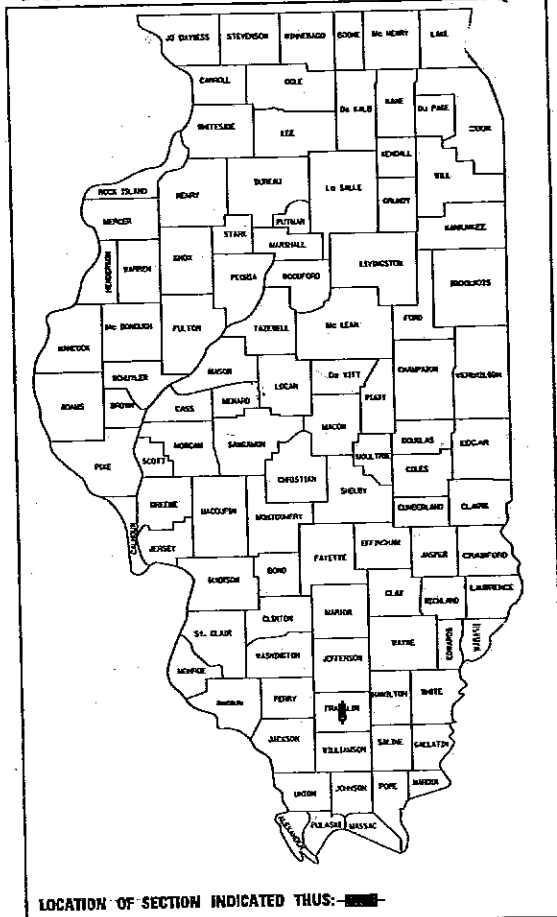

F.A.I. ROUTE 57  
 SECTION 28(5B-1,5B,2B,1B)D; 28(5VB,3VB-1)I  
 FRANKLIN COUNTY  
 PROJECT NO. IM-57-2(132)63  
 C-99-006-91

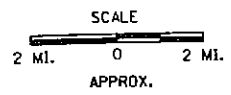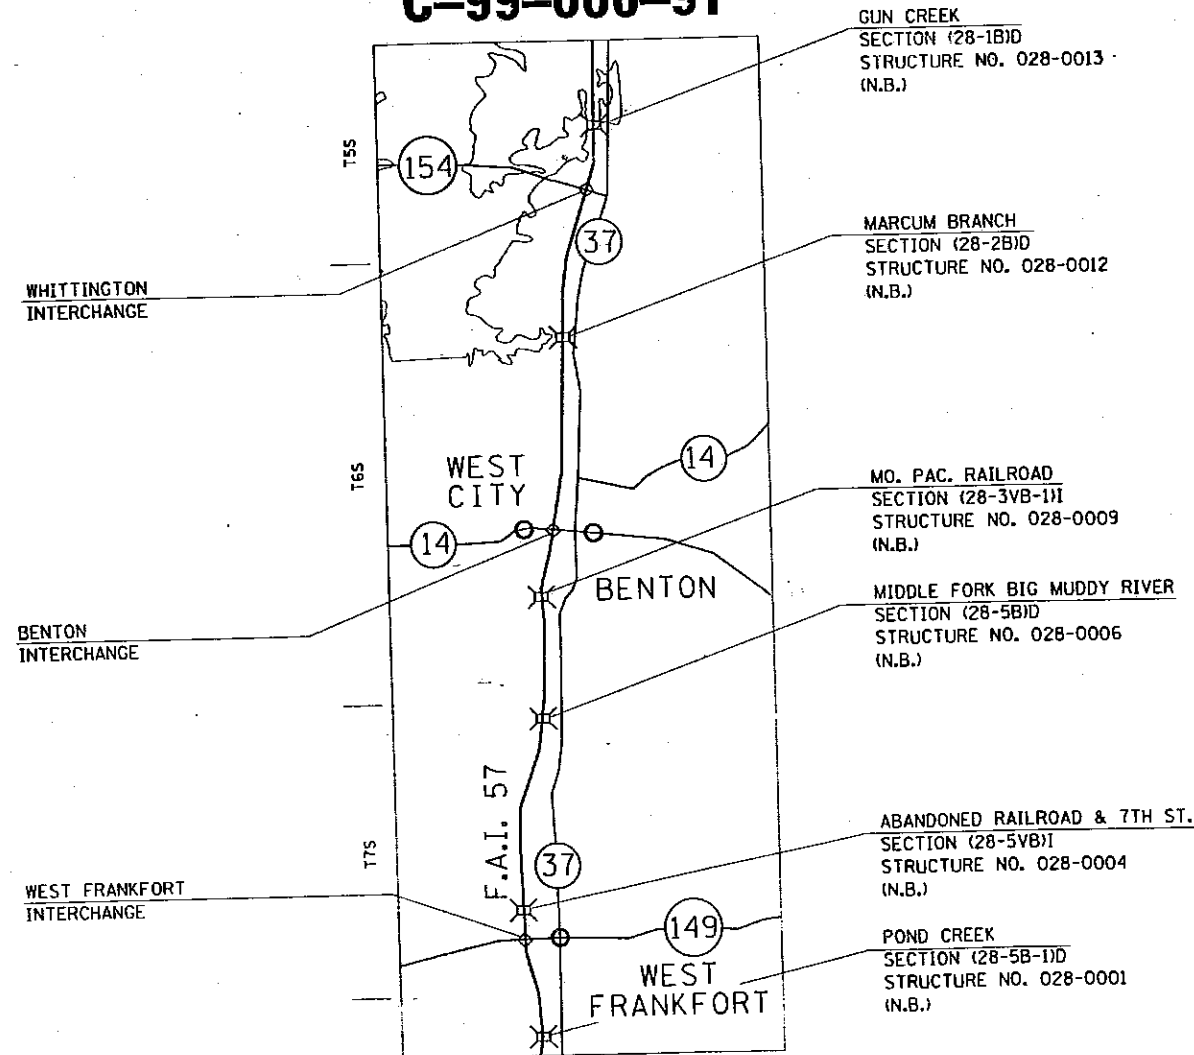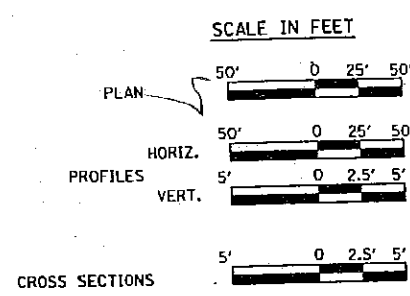

STATE OF ILLINOIS  
 DEPARTMENT OF TRANSPORTATION  
 DIVISION OF HIGHWAYS

SUBMITTED 5/106 19 92  
*Ralph C. Weber* DISTRICT ENGINEER

EXAMINED \_\_\_\_\_ 19 \_\_\_\_\_  
 ENGINEER OF PLANS AND CONTRACTS

PASSED June 12 19 98  
*Harry D. Gould* ENGINEER OF DESIGN

APPROVED June 12 19 98  
*Ralph C. Weber* DIRECTOR, DIVISION OF HIGHWAYS

JULIE 1-800-892-0123

CONTRACT NO. 98148

PROJECT ENGINEER: JOSE RUIZ  
 SOUND LEADER: ED SHAFER

SUMMARY OF CHANGES TO FINAL PLANS

SHEET # 2A	REVISION TO INDEX
SHEET # 14	BIT SHLD REM & REPL (12")
SHEET # 15	BIT SHLD REM & REPL (12")
SHEET # 29A	DIAPHRAGM REPAIR AND ENCASEMENT
SHEET # 31A	WELDING DETAILS FOR BEARING ASSEMBLIES
SHEET # 41	BIT SHLD REM & REPL (12")
SHEET # 42	BIT SHLD REM & REPL (12")
SHEET # 56A	DIAPHRAGM REPAIR AND ENCASEMENT
SHEET # 58A	WELDING DETAILS FOR BEARING ASSEMBLIES
SHEET # 64	DIMENSION CORRECTION
SHEET # 75A	SLOPEWALL REVISION
SHEET # 76	BIT SHLD REM & REPL (12")
SHEET # 77	BIT SHLD REM & REPL (12")
SHEET # 87	SPLICE CORRECTION
SHEET # 88	GRADE CORRECTION
SHEET # 89	DIMENSION CORRECTION
SHEET # 90	DIMENSION CORRECTION
SHEET # 90A	DIAPHRAGM REPAIR AND ENCASEMENT
SHEET # 101	APPROACH SHLD REVISION
SHEET # 102	APPROACH SHLD REVISION
	DIMENSION CORRECTION
SHEET # 105	DIMENSION CORRECTION
SHEET # 114	BIT SHLD REM & REPL (12")
SHEET # 115	BIT SHLD REM & REPL (12")
SHEET # 130A	DIAPHRAGM REPAIR AND ENCASEMENT
SHEET # 133A	WELDING DETAILS FOR BEARING ASSEMBLIES



# SUMMARY OF QUANTITIES

P.A. & E.C.	SECTION	COUNTY	TOTAL SHEETS	SHEET NO.
57	*	FRANKLIN	155	3
STA.		TO STA.		
FED. ROAD DIST. NO.		SHEET		FED. AID PROJECT
* 2B(5B-1,5B,2B,1B);2B(5VB,3VB-1)				

CODE NUMBER	CONSTRUCTION TYPE CODE	ITEM	UNIT	PROJECT TOTAL QUANTITY	SFTY-30 BRIDGE APPROACHES	SFTY-2D STRUCTURES 028-0009 028-0004	X071-2A STRUCTURES: 028-0013 028-0012 028-0006 028-0001	N.B. STRUCTURE NUMBER AND NAME					028-0001 POND CREEK
								028-0013 GUN CREEK	028-0012 MARCUM BRANCH	028-0009 MO. PAC. R.R.	028-0006 MIDDLE FORK OF BIG MUDDY RIVER	028-0004 C. & E.I. R.R. & 7TH ST.	
20200100		EARTH EXCAVATION	CU YD	8,962	8,962	--	--	3,627	2,164	47	1,591	33	1,500
40500300		BITUMINOUS MIXTURE COMPLETE	TON	9,167	9,167	--	--	2,344	2,454	--	2,291	--	2,078
50102400		CONCRETE REMOVAL	CU YD	70.6	--	31.6	39.0	9	9	21.4	12.0	10.2	9
50104720		REMOVAL OF EXISTING CONCRETE DECK	EACH	4	--	--	4	1	1	--	1	--	1
50200100		STRUCTURE EXCAVATION	CU YD	194	--	--	194	23	22	--	127	--	22
50200300		COFFERDAM EXCAVATION	CU YD	52	--	--	52	--	--	--	52	--	--
50200500		COFFERDAMS	EACH	2	--	--	2	--	--	--	2	--	--
50300100		FLOOR DRAINS	EACH	65	--	--	65	18	12	--	21	--	14
50300120		PREFORMED JOINT SEAL 2 1/2"	LIN FT	136	--	--	136	43	49	--	--	--	44
50300130		PREFORMED JOINT SEAL 4"	LIN FT	219	--	83	136	43	49	--	--	83	44
50300150		NEOPRENE EXPANSION JOINT 2"	LIN FT	167	--	125	42	--	--	125	42	--	--
50300160		NEOPRENE EXPANSION JOINT 4"	LIN FT	42	--	--	42	--	--	--	42	--	--
50300250		CLASS X CONCRETE SUPERSTRUCTURE	CU YD	1,049.1	--	--	1,049.1	215.4	177.2	--	469.4	--	187.1
50300300		PROTECTIVE COAT	SQ YD	4,134	--	--	4,134	852	672	--	1,920	--	690
50300310		ELASTOMERIC BEARING ASSEMBLY, TYPE I	EACH	70	--	--	70	21	14	--	21	--	14
50300320		ELASTOMERIC BEARING ASSEMBLY, TYPE II	EACH	28	--	--	28	--	7	--	14	--	7
50400300		CLASS X CONCRETE	CU YD	89.3	--	30.7	58.6	--	--	20.75	58.6	9.95	--
50700400		FURNISHING AND ERECTING STRUCTURAL STEEL	POUND	32,510	--	3,180	29,330	10,450	9,190	--	--	3,180	9,690
50700500		STUD SHEAR CONNECTORS	EACH	16,555	--	--	16,555	3,094	3,255	--	7,056	--	3,150
50700705		JACK AND REMOVE EXISTING BEARINGS	EACH	120	--	--	120	28	28	--	36	--	28
51101279		PIPE CULVERTS, TYPE 2 RCCP 24"	LIN FT	258	258	--	--	258	--	--	--	--	--
51115979		REINFORCED CONCRETE PIPE ELBOW 24"	EACH	1	1	--	--	1	--	--	--	--	--
51125133		PIPE CULVERTS, TYPE 2, 18" (DETOUR)	LIN FT	248	248	--	--	248	--	--	--	--	--
51200200		REINFORCEMENT BARS, EPOXY COATED	POUND	258,885	--	5,335	253,550	51,380	41,230	3,930	116,790	1,405	44,150
51301600		FURNISHING STEEL PILES HP 12 X 53	LIN FT	208	--	--	208	--	--	--	208	--	--
51301700		FURNISHING STEEL PILES HP 12 X 74	LIN FT	225	--	--	225	--	--	--	225	--	--
51302700		DRIVING STEEL PILES	LIN FT	433	--	--	433	--	--	--	433	--	--
51303600		TEST PILE STEEL HP 12 X 53	EACH	2	--	--	2	--	--	--	2	--	--
51400100		NAME PLATES	EACH	4	--	--	4	1	1	--	1	--	1
61246400		INLET BOX, STANDARD 235B	EACH	1	1	--	--	1	--	--	--	--	--
61262700		INLETS TO BE RECONSTRUCTED	EACH	1	1	--	--	1	--	--	--	--	--
61701430		BITUMINOUS SHOULDER REMOVAL	SO YDS	3,658	3,658	--	--	788	932	--	1,010	--	928
62800000		STEEL PLATE BEAM GUARD RAIL, TYPE A	LIN FT	2,725	2,725	--	--	250	525	750	450	325	425

MAP NO. 11, 14, 15, 16, 999, 1000.





PLAN SHEET	SECTION	COUNTY	TOTAL SHEETS	SHEET NO.
57	*	FRANKLIN	155	5
STA.	TO STA.			
FILE, ROAD DIST. NO.	BRANCH	FILE AND PROJECT		
* 28(5B-1,5B,2B,1B)D; 28(5VB,3VB-1)I				

# SCHEDULES OF QUANTITIES

## EARTHWORK

BALANCE NO.	LOCATION	EARTH EXCAVATION	FILL	EXCAVATION REQUIRED TO COMPLETE THE FILL	REMARKS
		CU. YDS.	CU. YDS.	CU. YDS.	
	GUN CREEK				
1	NORTH CROSS-OVERS	178	1,059	1,184	OBTAIN 1,184 CU. YD. FROM BAL. *6
2	SOUTH CROSS-OVERS	187	1,774	2,078	OBTAIN 2,078 CU. YD. FROM BAL. *6
	MARCUM BRANCH				
3	NORTH CROSS-OVERS	154	874	972	OBTAIN 972 CU. YD. FROM BAL. *6
4	SOUTH CROSS-OVERS	157	804	881	OBTAIN 881 CU. YD. FROM BAL. *6
5	MO PAC RR	-	37	47	OBTAIN 47 CU. YD. FROM BAL. *6
6	WHITTINGTON INTER. RAMP "A" INFIELD	5,162	-	-	PLACE 5,162 CU. YD. IN BALS. *1, 2, 3, 4, & 5
	MIDDLE FORK OF BIG MUDDY RIVER				
7	NORTH CROSS-OVERS	189	563	546	OBTAIN 546 CU. YD. FROM BAL. *12
8	SOUTH CROSS-OVERS	196	659	660	OBTAIN 660 CU. YD. FROM BAL. *12
9	C&EI RR AND 7TH ST.	-	26	33	OBTAIN 33 CU. YD. FROM BAL. *12
	POND CREEK				
10	NORTH CROSS-OVERS	167	580	585	OBTAIN 585 CU. YD. FROM BAL. *12
11	SOUTH CROSS-OVERS	139	580	609	OBTAIN 609 CU. YD. FROM BAL. *12
12	WEST FRANKFORT INTER. RAMP "C" INFIELD	2,433	-	-	PLACE 2,433 CU. YD. IN BALS. *7, 8, 9, 10, & 11
TOTALS		8,962	6,956	-	

## SEEDING & MULCHING

LOCATION	CLASS II SEEDING	NITROGEN FERTILIZER NUTRIENT	PHOSPHOROUS FERTILIZER NUTRIENT	POTASSIUM FERTILIZER NUTRIENT	AGRICULTURAL GROUND LIMESTONE	MULCH METHOD 3
	ACRE	POUND	POUND	POUND	POUND	TON
GUN CREEK						
NORTH CROSS-OVERS	0.60	48	192	96	1.2	1.2
SOUTH CROSS-OVERS	0.60	48	192	96	1.2	1.2
MARCUM BRANCH						
NORTH CROSS-OVERS	0.60	48	192	96	1.2	1.2
SOUTH CROSS-OVERS	0.60	48	192	96	1.2	1.2
MO PAC RAILROAD						
NORTH	0.10	8	32	16	0.2	0.2
SOUTH	0.10	8	32	16	0.2	0.2
WHITTINGTON INTERCHANGE						
RAMP "A" INFIELD	2	160	640	320	4	4
MIDDLE FORK OF BIG MUDDY RIVER						
NORTH CROSS-OVERS	0.60	48	192	96	1.2	1.2
SOUTH CROSS-OVERS	0.60	48	192	96	1.2	1.2
C&EI RAILROAD & 7TH ST.						
NORTH	0.10	8	32	16	0.2	0.2
SOUTH	0.10	8	32	16	0.2	0.2
POND CREEK						
NORTH CROSS-OVERS	0.60	48	192	96	1.2	1.2
SOUTH CROSS-OVERS	0.60	48	192	96	1.2	1.2
WEST FRANKFORT INTERCHANGE						
RAMP "C" INFIELD	1.1	88	352	176	2.2	2.2
TOTAL	8.3	644	2,656	1,328	16.6	16.6




S. N. NO.	SECTION	COUNTY	TOTAL SHEETS	SHEET NO.
57	*	FRANKLIN	155	6
STA.		TO STA.		
FILE NO. DIST. NO.		BALANCE	FILE NO. PROJECT	
* 28(5B-1,5B,2B,1B)D:28(5VB,3VB-1)I				

## GUARDRAIL

LOCATION	QUAD.	S.P.B.G.R. REMOVAL LIN. FT.	S.P.B.G.R. TYPE A LIN. FT.	TRAFFIC BARRIER TERMINAL							TEMPORARY GUARDRAIL LIN. FT.
				TYPE 1	TYPE 2	TYPE 4	TYPE 5	TYPE 6	TYPE 7	TYPE 10	
				EACH	EACH	EACH	EACH	EACH	EACH	EACH	
STRUCTURE NO. 028-0013 GUN CREEK	N. E.	62.5	50	--	--	--	1	--	--	--	--
	S. E.	100	100	1	--	--	--	1	--	--	--
	S. W.	150	100	--	--	1	--	1	--	--	487.5
	N. W.	--	--	--	--	--	--	--	--	--	--
<b>TOTALS</b>		<b>312.5</b>	<b>250</b>	<b>1</b>	<b>--</b>	<b>1</b>	<b>1</b>	<b>2</b>	<b>--</b>	<b>--</b>	<b>487.5</b>
STRUCTURE NO. 028-0012 MARCUM BRANCH	N. E.	187.5	50	--	1	--	1	--	--	--	--
	S. E.	100	350	1	--	--	--	1	--	--	--
	S. W.	137.5	125	--	--	1	--	1	--	--	137.5
	N. W.	--	--	--	--	--	--	--	--	--	--
<b>TOTALS</b>		<b>425</b>	<b>525</b>	<b>1</b>	<b>1</b>	<b>1</b>	<b>1</b>	<b>2</b>	<b>--</b>	<b>--</b>	<b>137.5</b>
STRUCTURE NO. 028-0009 MOPAC RAILROAD	N. E.	112.5	62.5	--	1	--	--	--	--	1	--
	S. E.	125	387.5	1	--	--	--	--	1	--	--
	S. W.	137.5	300	1	--	--	--	--	1	--	--
	N. W.	--	--	--	--	--	--	--	--	--	--
<b>TOTALS</b>		<b>375</b>	<b>750</b>	<b>2</b>	<b>1</b>	<b>--</b>	<b>--</b>	<b>--</b>	<b>2</b>	<b>1</b>	<b>--</b>
STRUCTURE NO. 028-0006 MIDDLE FORK BIG MUDDY RIVER	N. E.	125	112.5	--	1	--	1	--	--	--	--
	S. E.	100	75	--	--	--	--	1	--	--	--
	S. W.	137.5	262.5	1	--	--	--	1	--	--	137.5
	N. W.	--	--	--	--	--	--	--	--	--	--
<b>TOTALS</b>		<b>362.5</b>	<b>450</b>	<b>1</b>	<b>1</b>	<b>--</b>	<b>1</b>	<b>2</b>	<b>--</b>	<b>--</b>	<b>137.5</b>
STRUCTURE NO. 028-0004 C&E I RAILROAD	N. E.	62.5	62.5	--	--	--	--	--	--	1	--
	S. E.	500	50	1	--	--	--	--	1	--	--
	S. W.	137.5	212.5	1	--	--	--	--	1	--	--
	N. W.	--	--	--	--	--	--	--	--	--	--
<b>TOTALS</b>		<b>700</b>	<b>325</b>	<b>2</b>	<b>--</b>	<b>--</b>	<b>--</b>	<b>--</b>	<b>2</b>	<b>1</b>	<b>--</b>
STRUCTURE NO. 028-0001 POND CREEK	N. E.	200	--	--	--	--	--	--	--	--	--
	S. E.	100	150	1	--	--	--	1	--	--	--
	S. W.	137.5	275	1	--	--	--	1	--	--	125
	N. W.	--	--	--	--	--	--	--	--	--	--
<b>TOTALS</b>		<b>437.5</b>	<b>425</b>	<b>2</b>	<b>--</b>	<b>--</b>	<b>--</b>	<b>2</b>	<b>--</b>	<b>--</b>	<b>125</b>
<b>PROJECT TOTALS</b>		<b>2,612.5</b>	<b>2,725</b>	<b>9</b>	<b>3</b>	<b>2</b>	<b>3</b>	<b>8</b>	<b>4</b>	<b>2</b>	<b>887.5</b>




ROUTE NO.	SEC.	COUNTY	TOTAL SHEETS	SHEET NO.
EAL 57	*	FRANKLIN	155	7
FED. ROAD DIST. NO. 7		ILLINOIS	PROJECT	

\* SEC. 28 (58-1, 58, 28, JB) D  
28 (5VB, 3VB-1) I

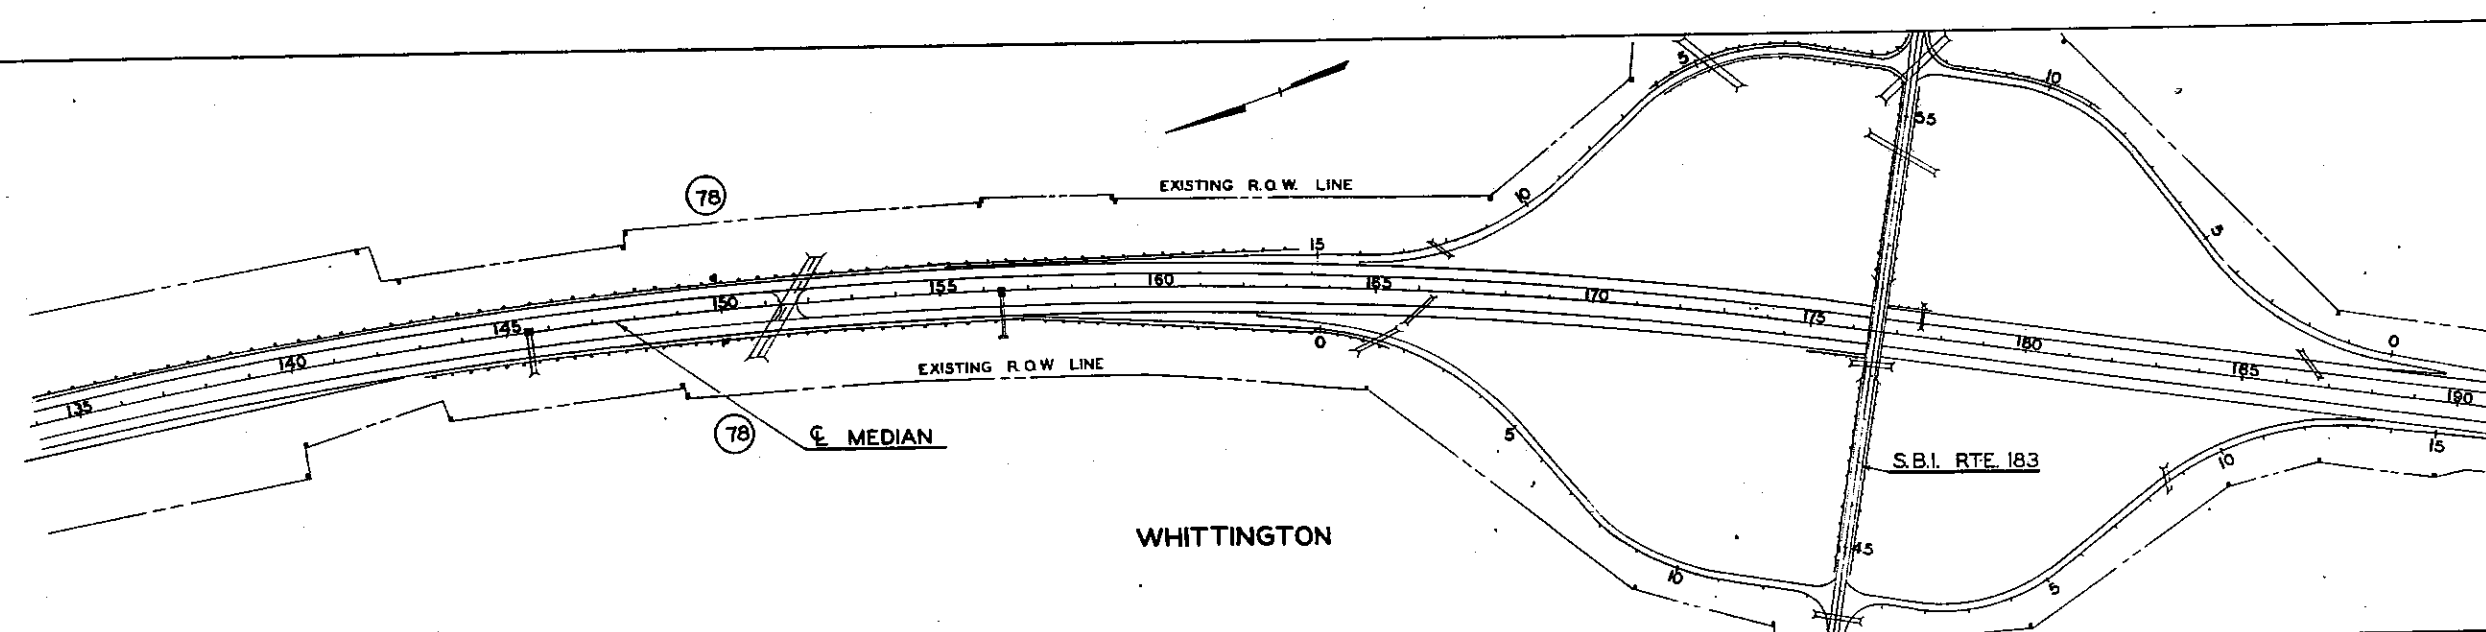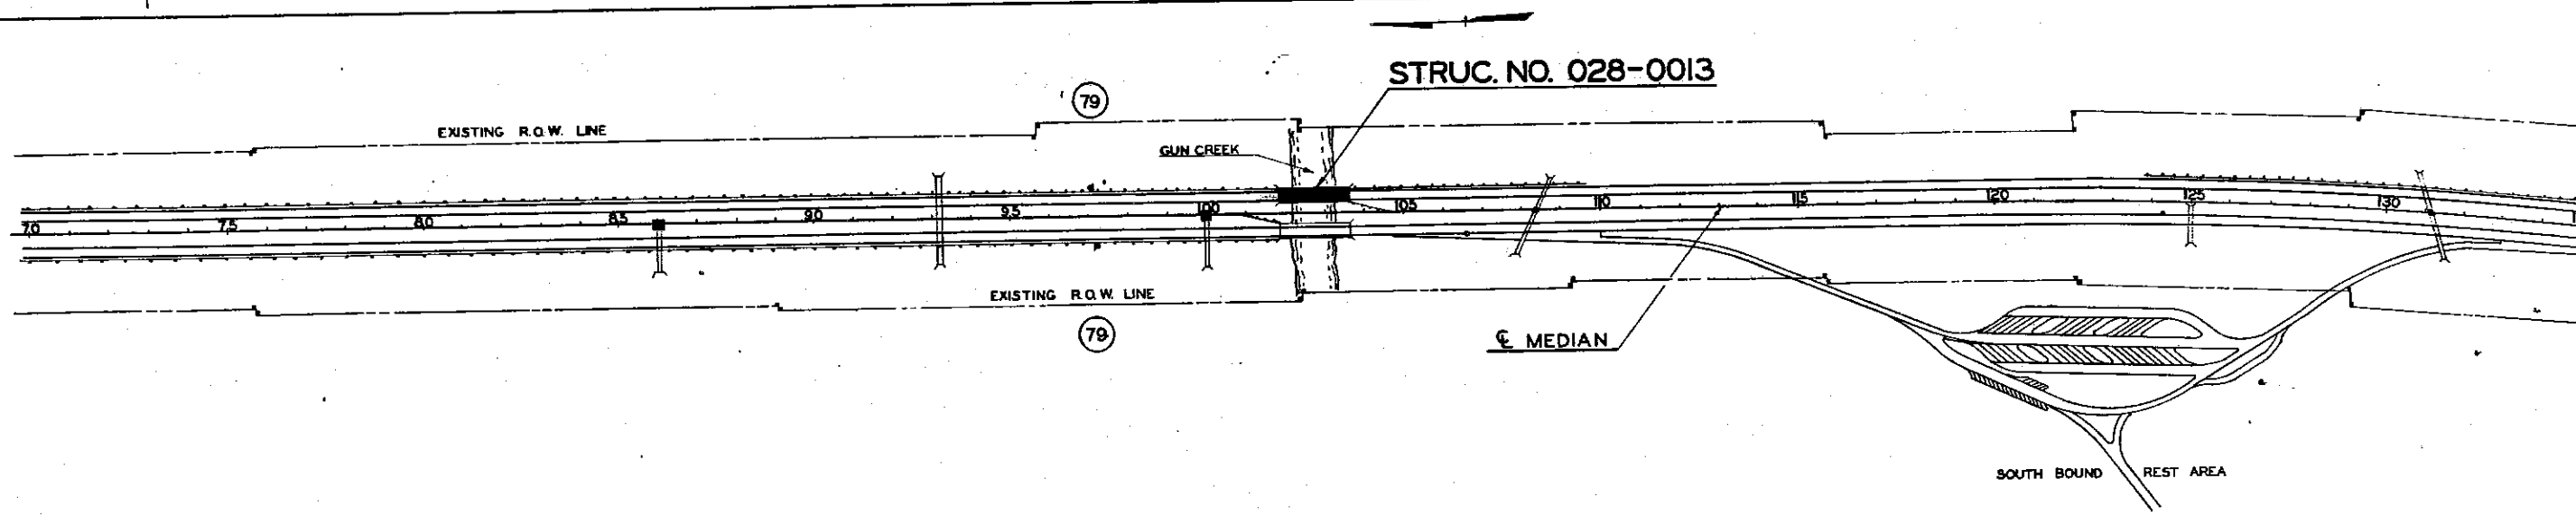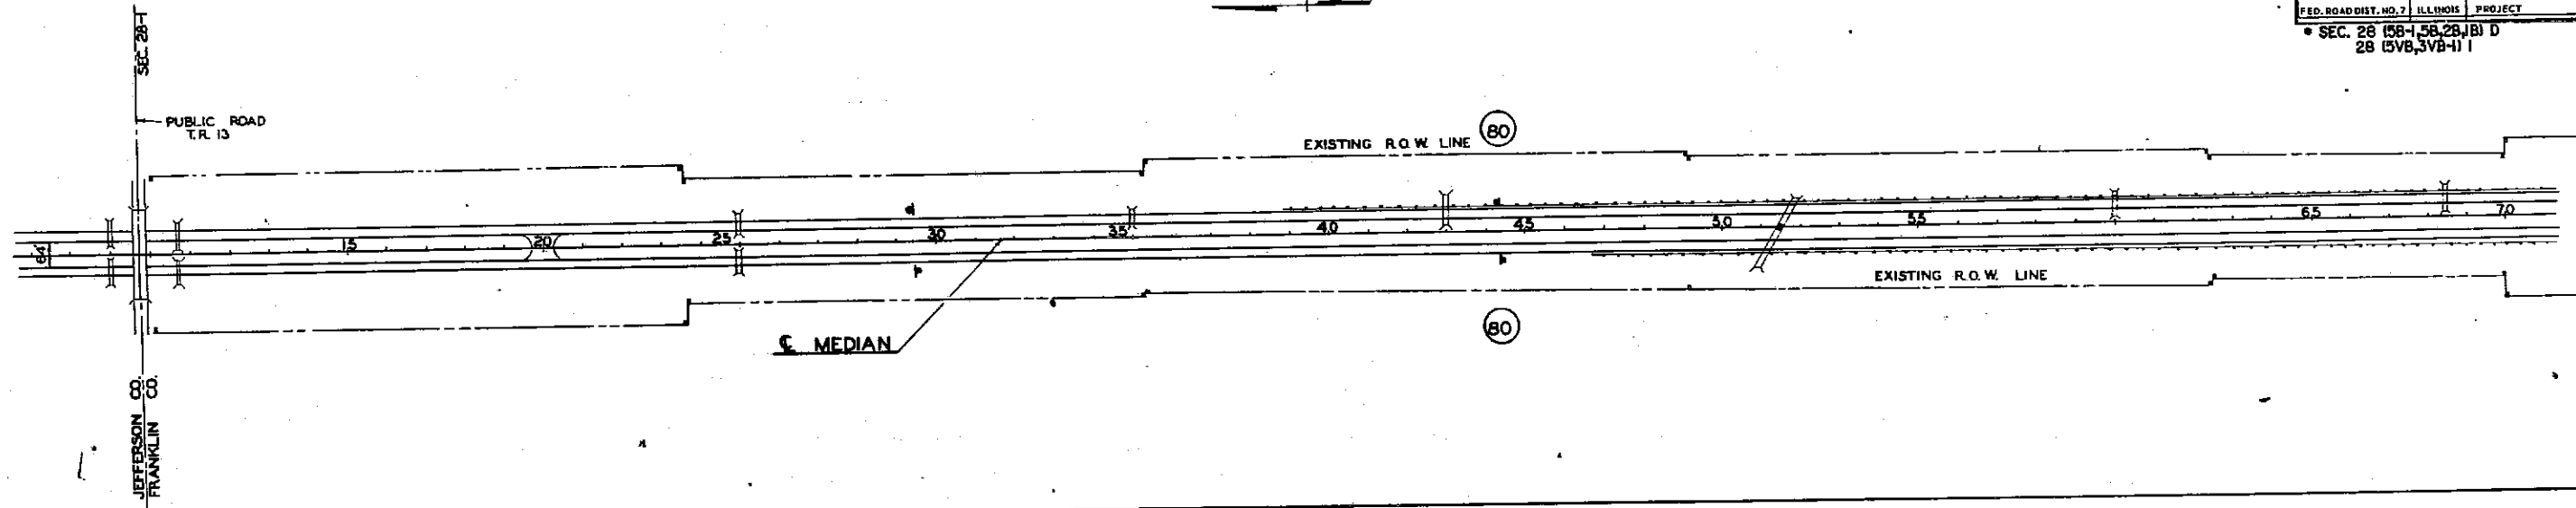




ROUTE NO.	SEC.	COUNTY	TOTAL SHEETS	SHEET NO.
F.A.I. 57		FRANKLIN	155	8

SEC. 28 (58-1, 58-2, 1B) D  
28 (5VB, 5VB-1) I

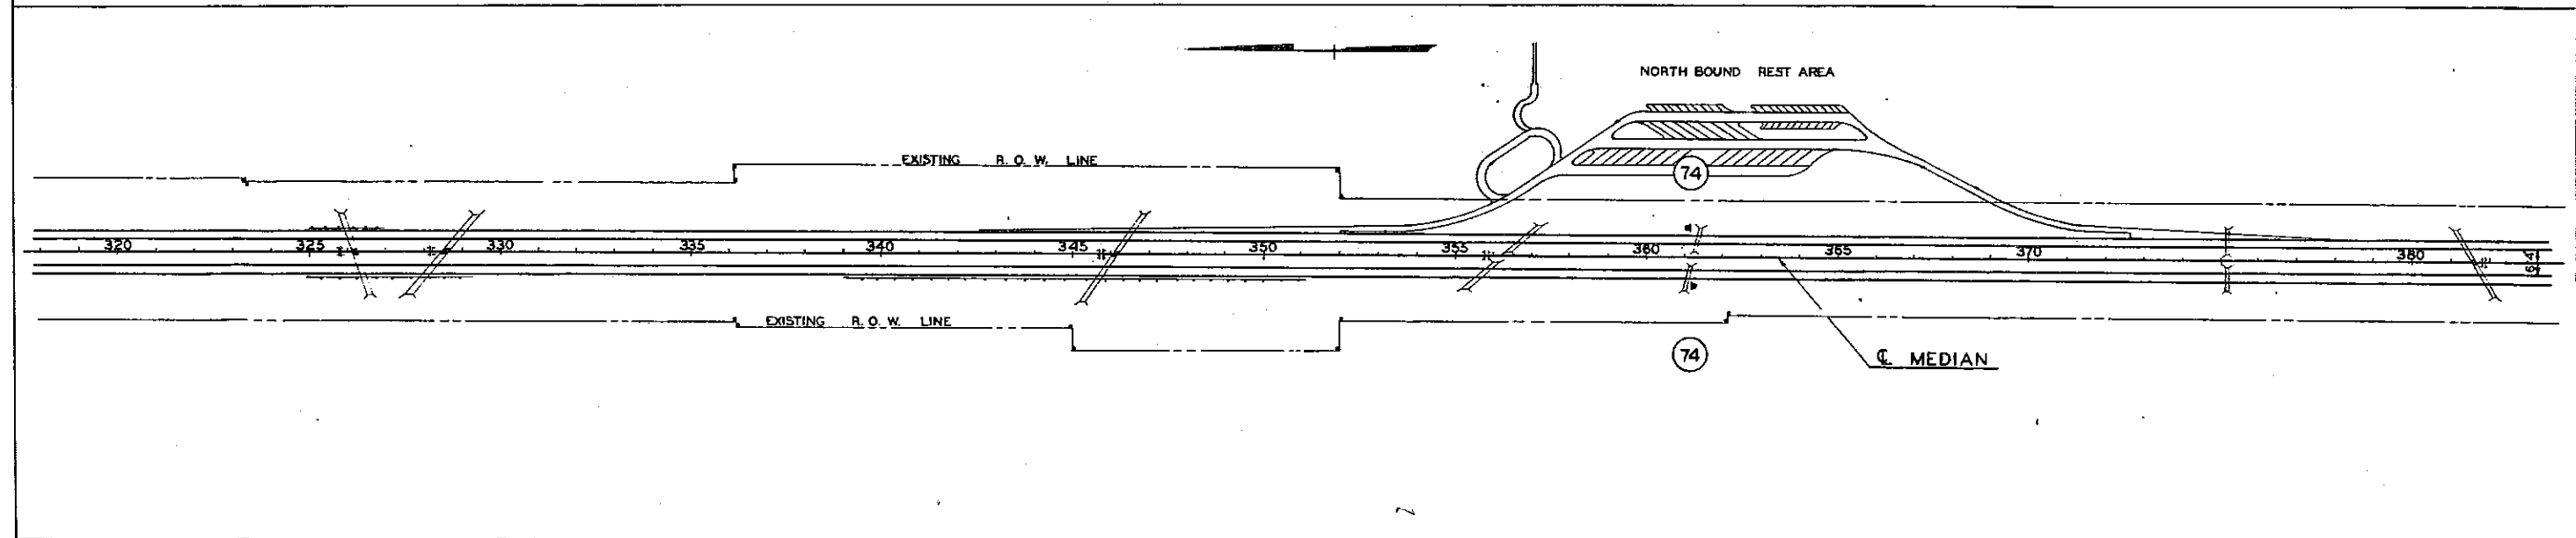
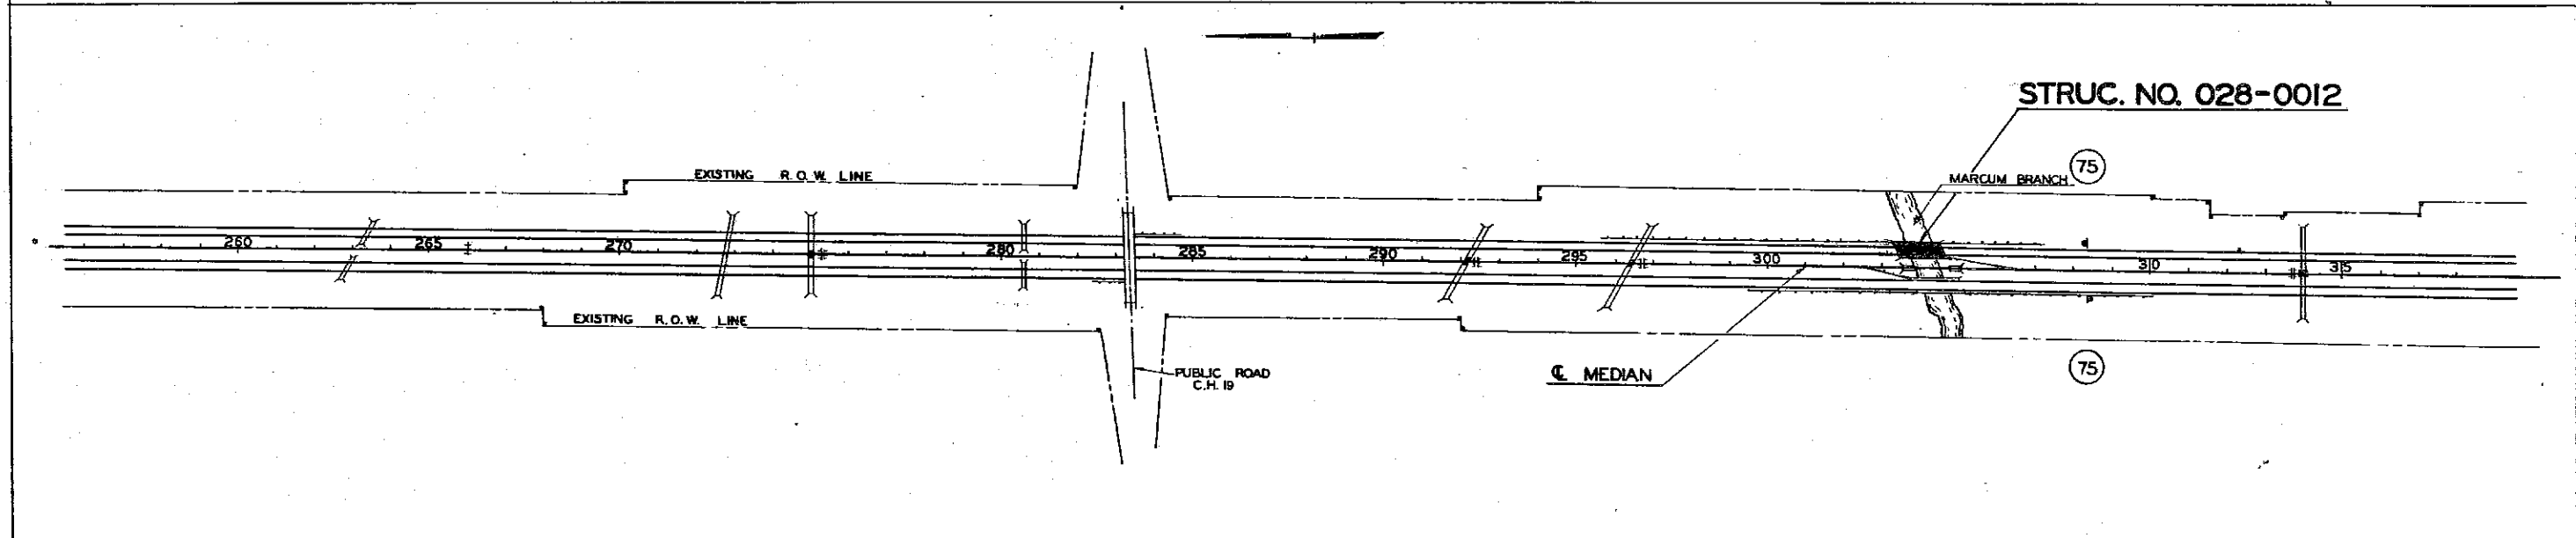
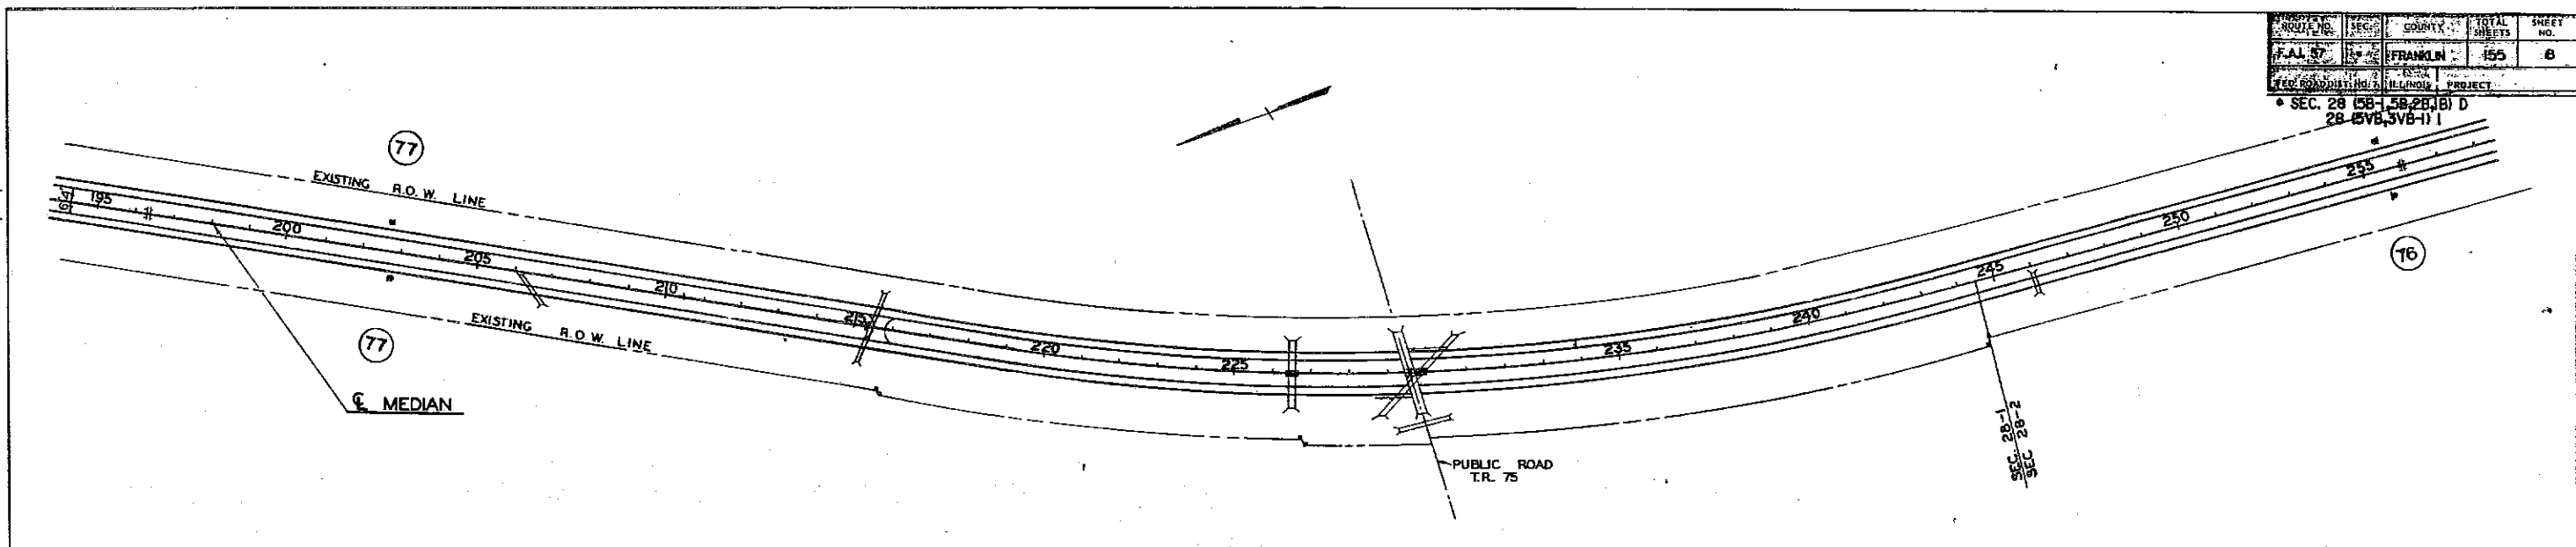


ROUTE NO.	SEC.	COUNTY	TOTAL SHEETS	SHEET NO.
F.A.I. 57		FRANKLIN	155	9
FED. ROAD DIST. NO. 7		ILLINOIS	PROJECT	

\* SEC. 28 (58-1, 58-2, 1B) D  
28 (5VB, 5VB-1) I

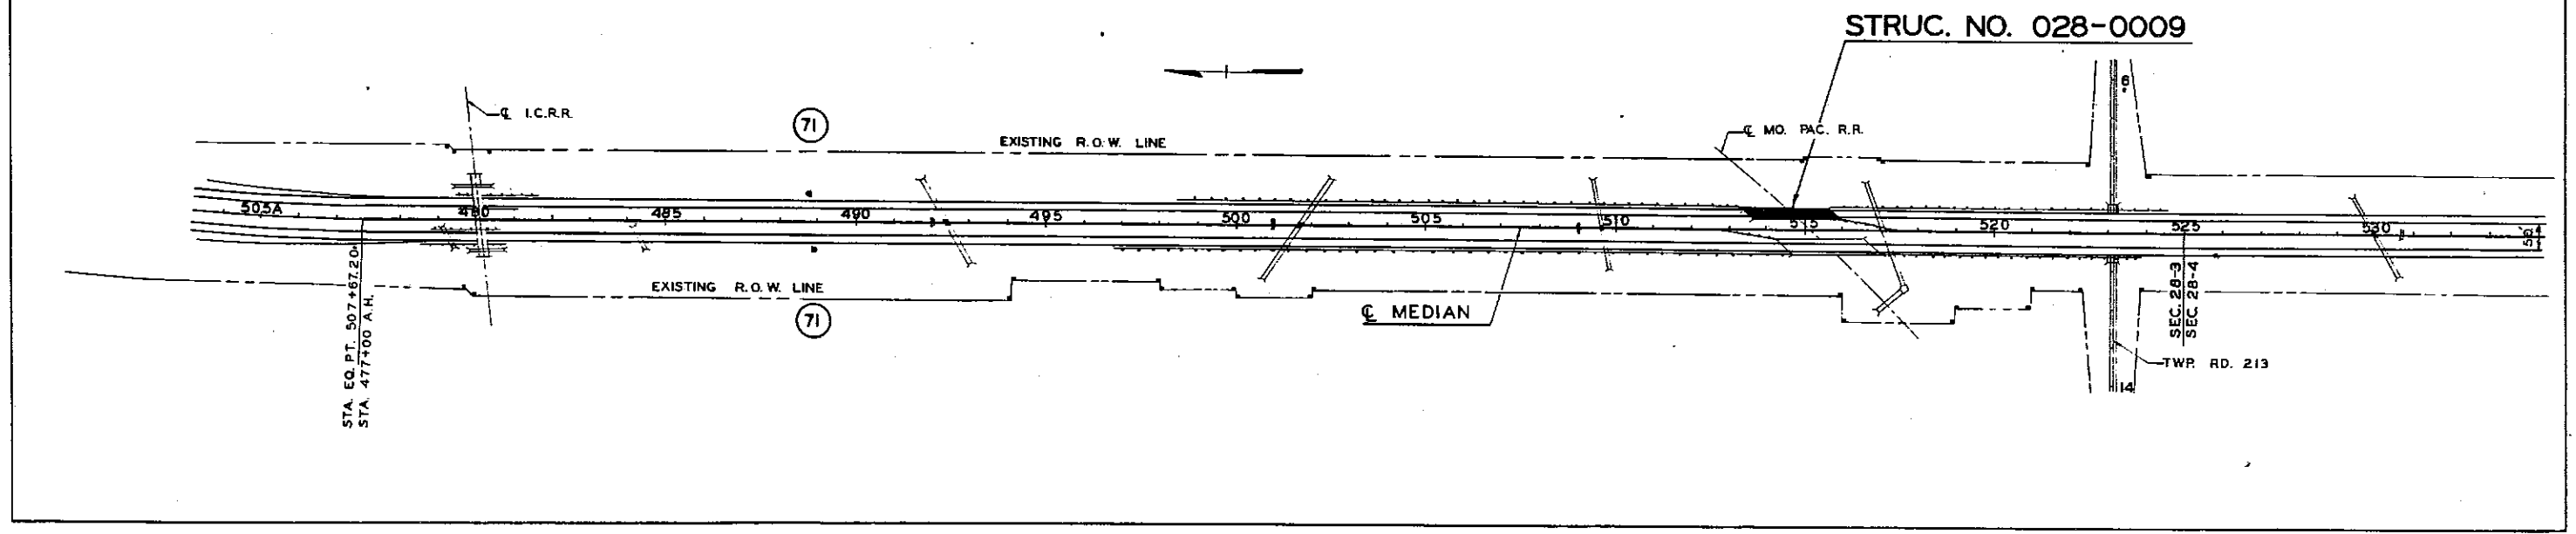
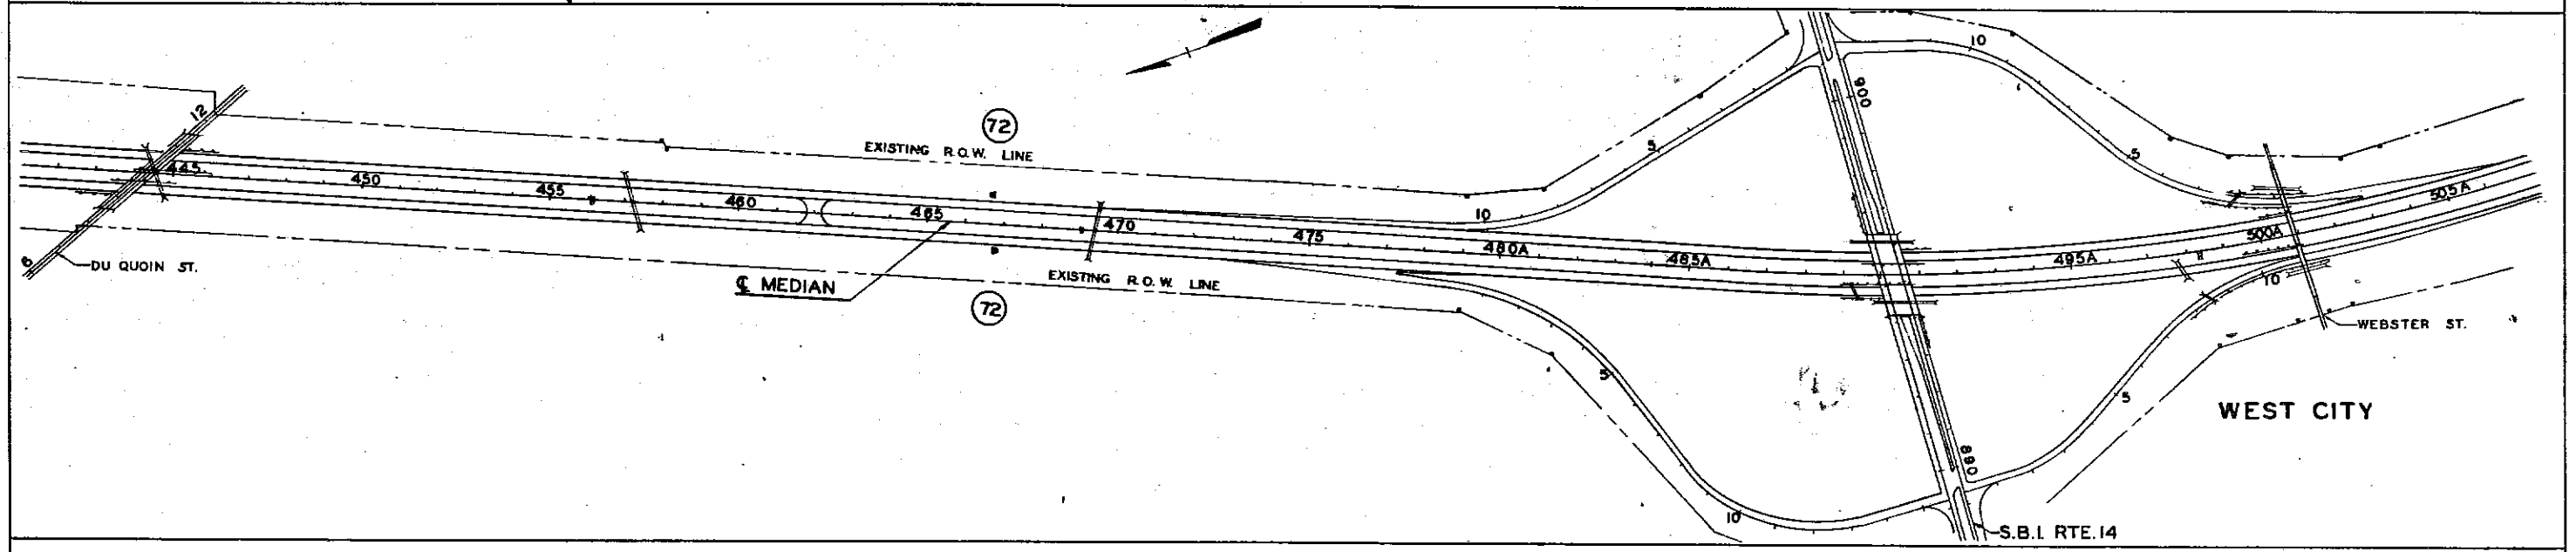
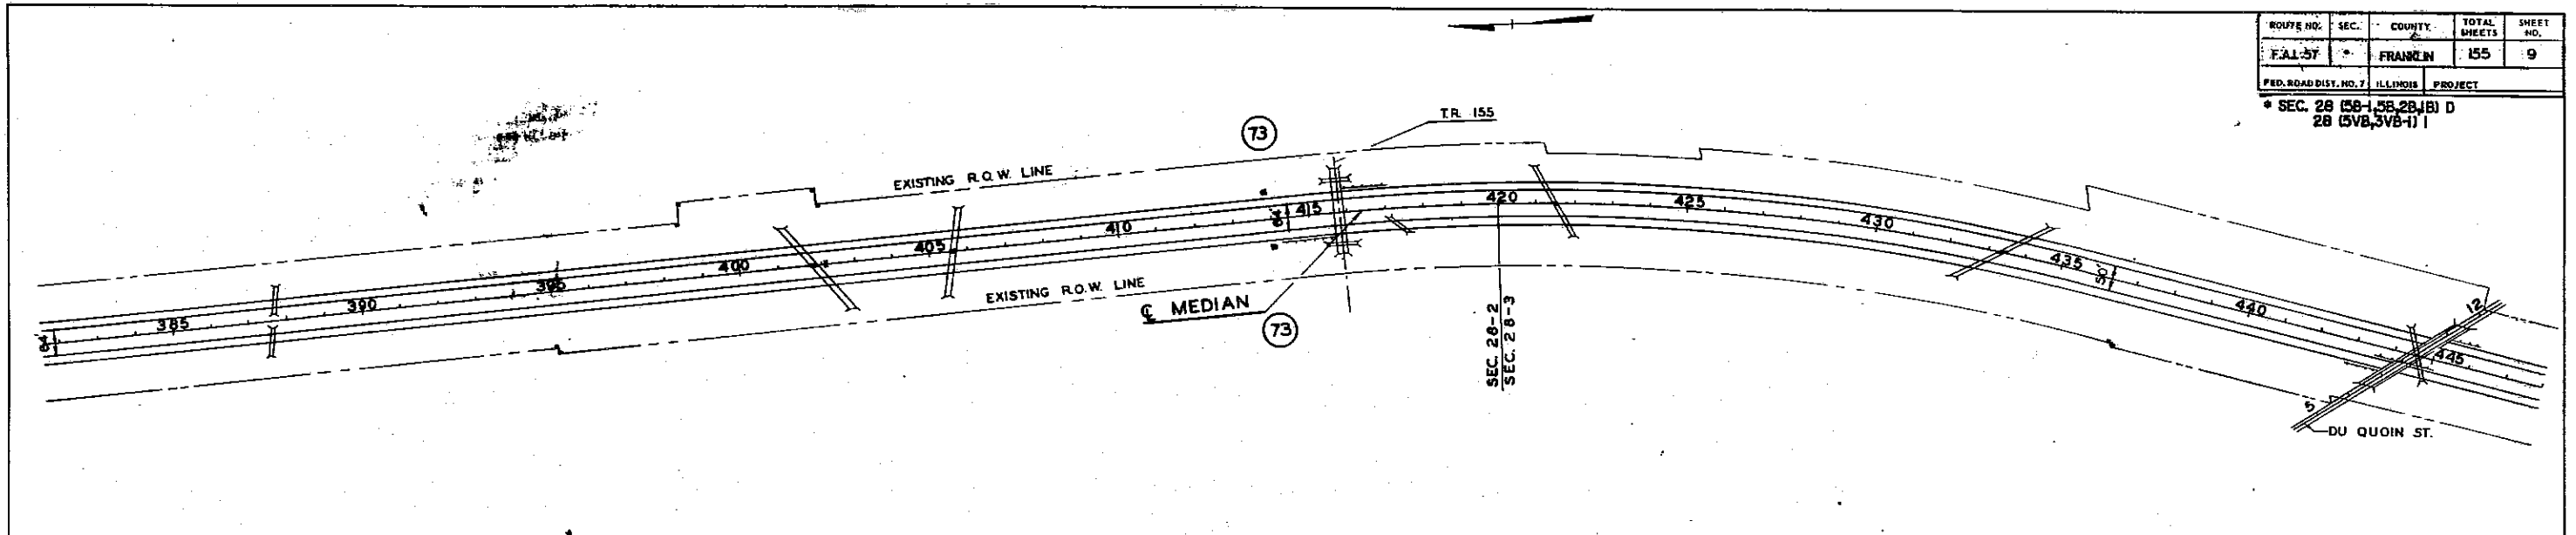


ROUTE NO.	ARC.	COUNTY	TOTAL SHEETS	SHEET NO.
F.A.I. BY:		FRANKLIN	155	10
FED. ROAD DIST. NO. 7	ILLINOIS	PROJECT	SEC. 28 (58-1, 58-28, 51) D 28 (5VB, 5VB-1) I	

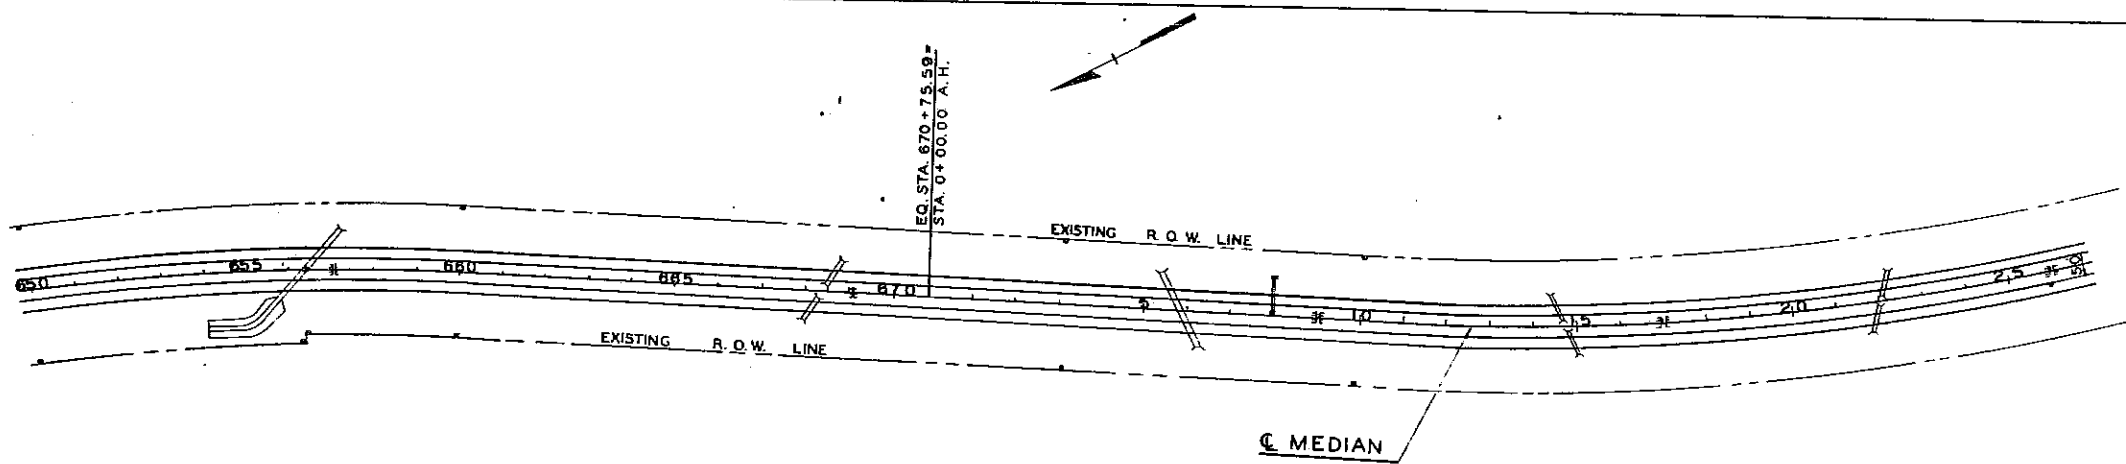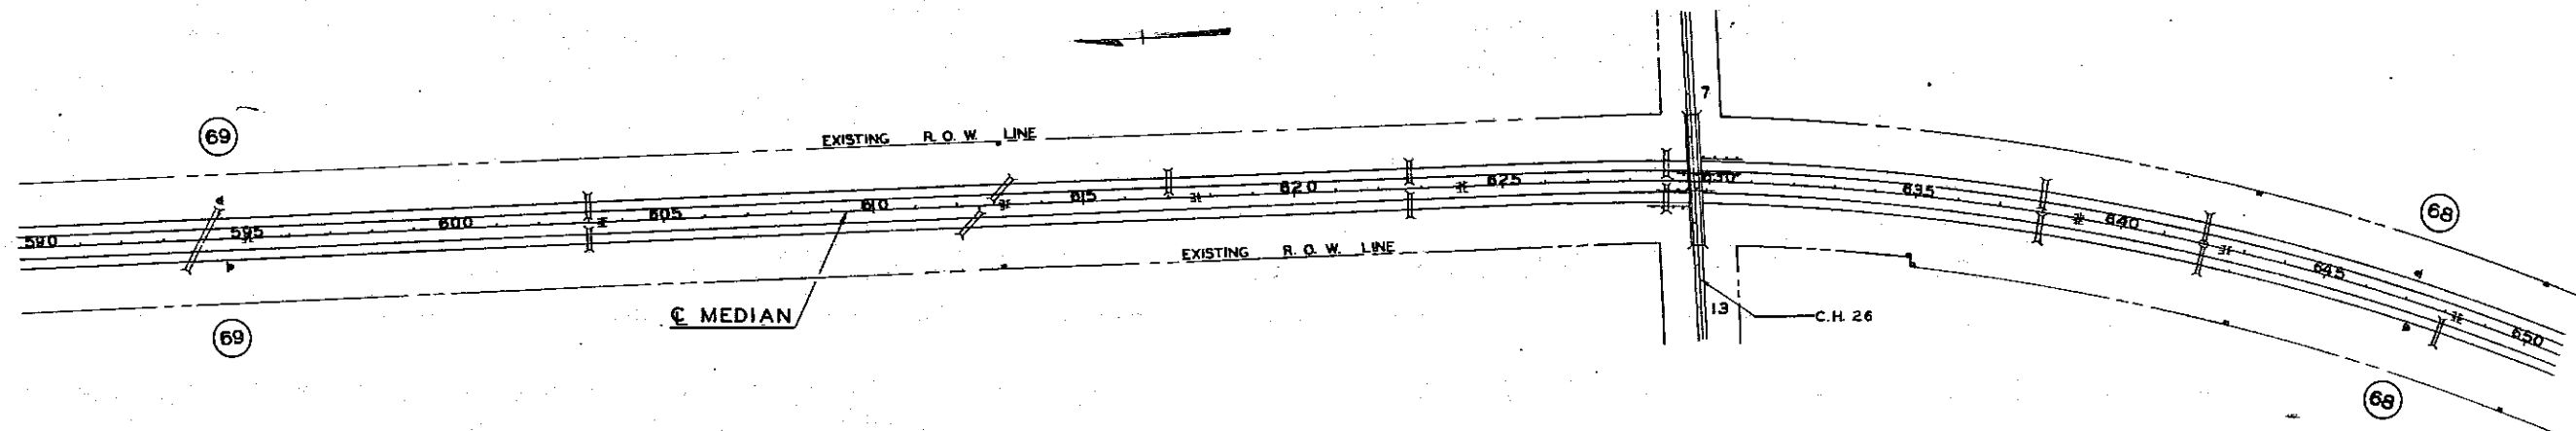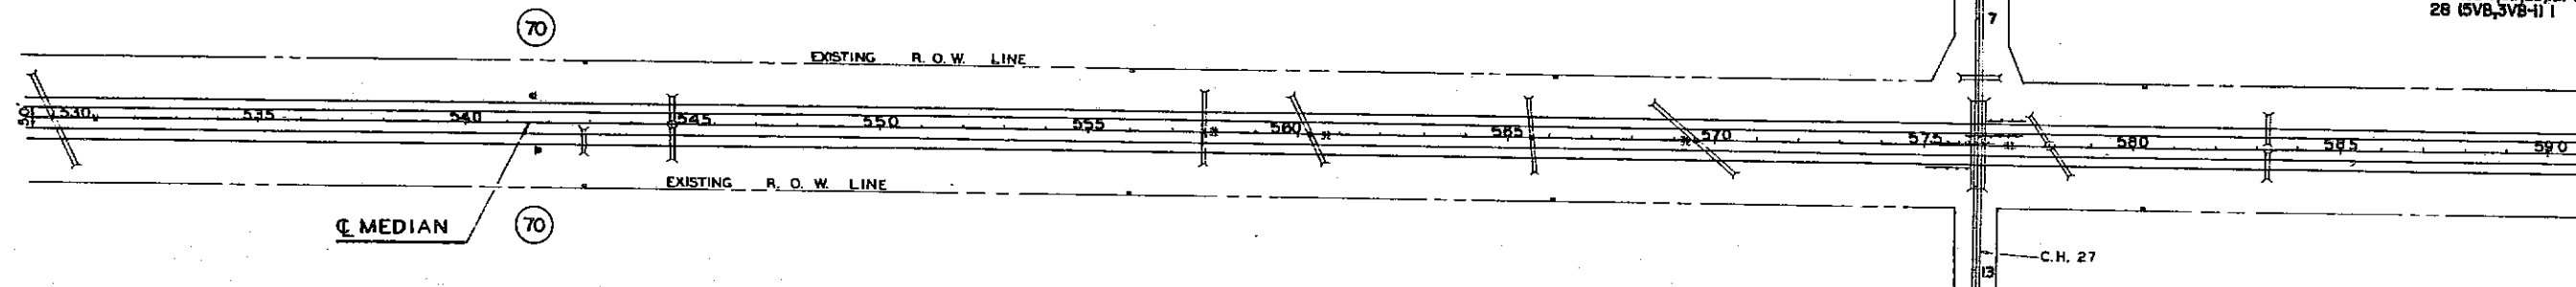

ROUTE NO.	SEC.	COUNTY	TOTAL SHEETS	SHEET NO.
F.A.I. 57	*	FRANKLIN	155	11




FED. ROAD DIST. NO. 7 ILLINOIS PROJECT  
 \* SEC. 28 (58-1,58,28JB) D  
 28 (5VB,3VB-1) I

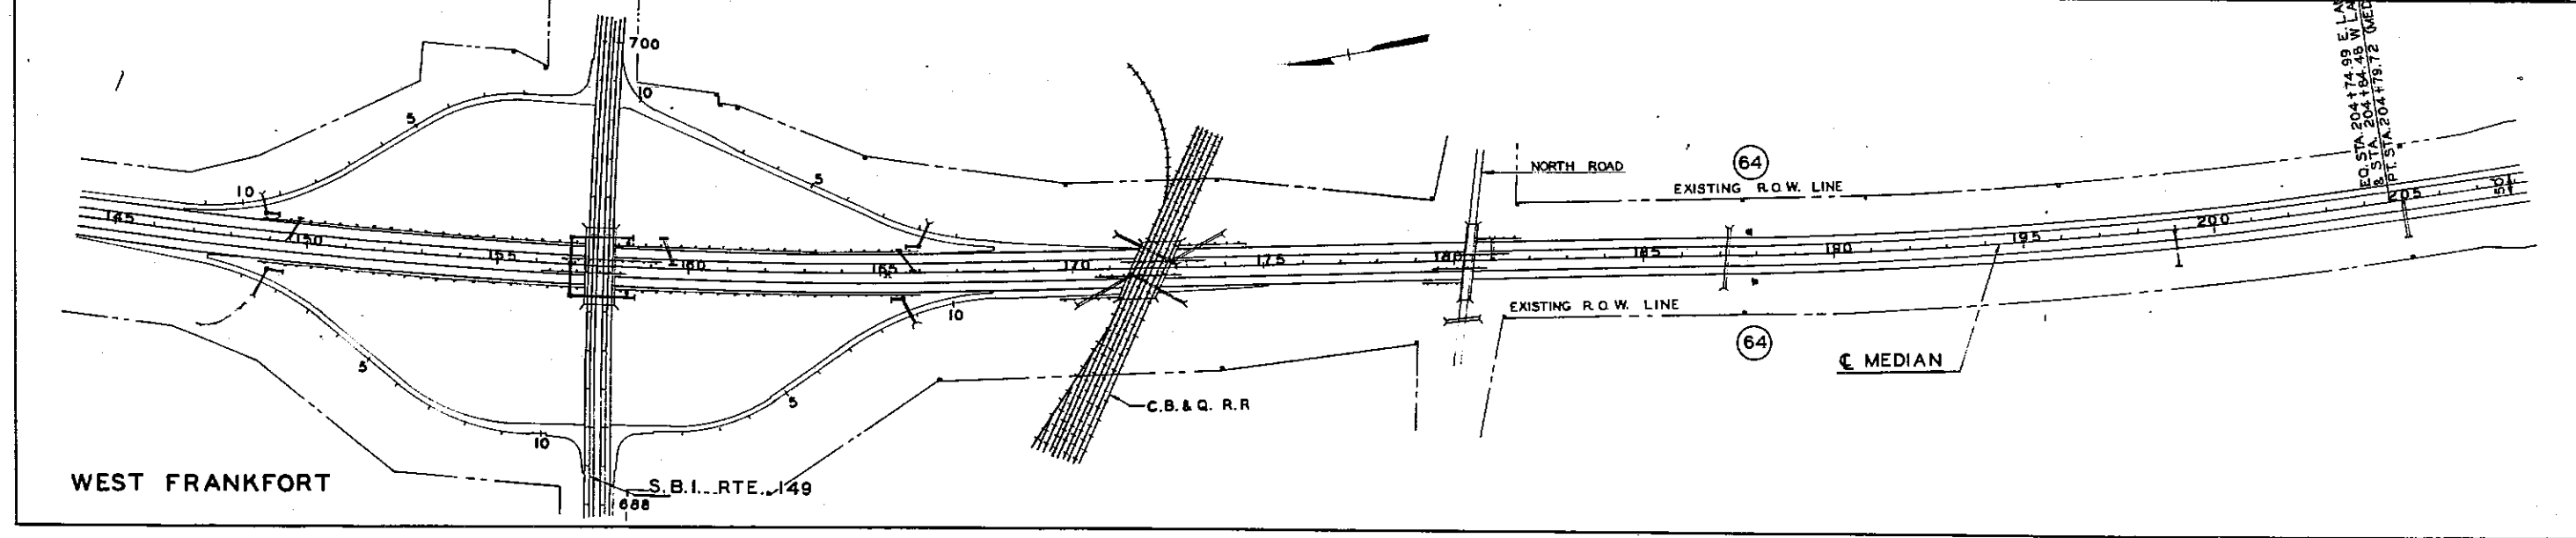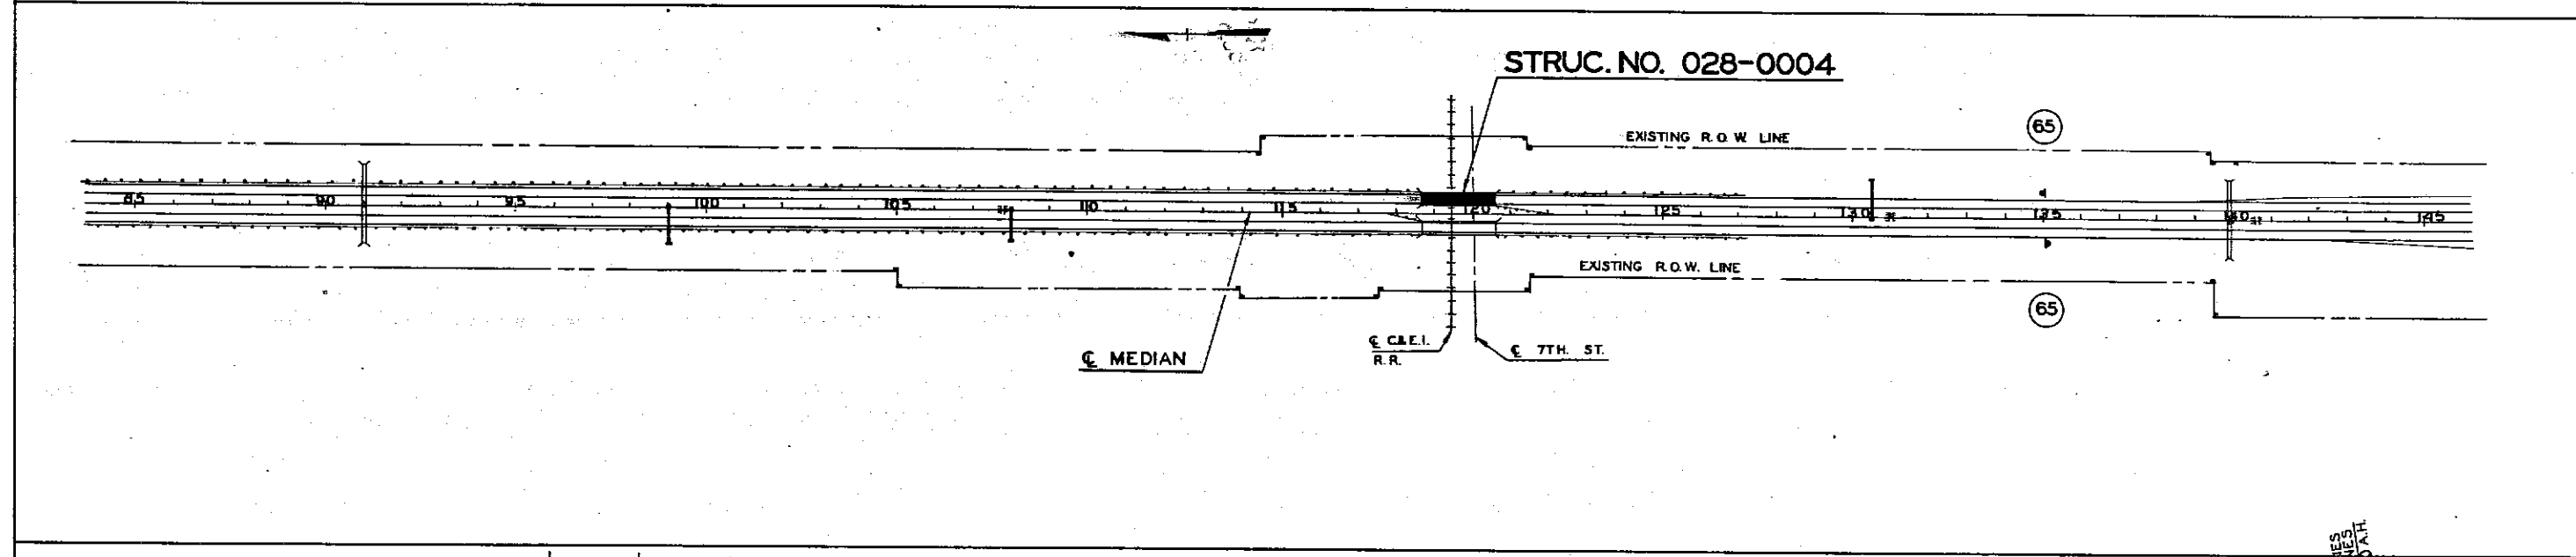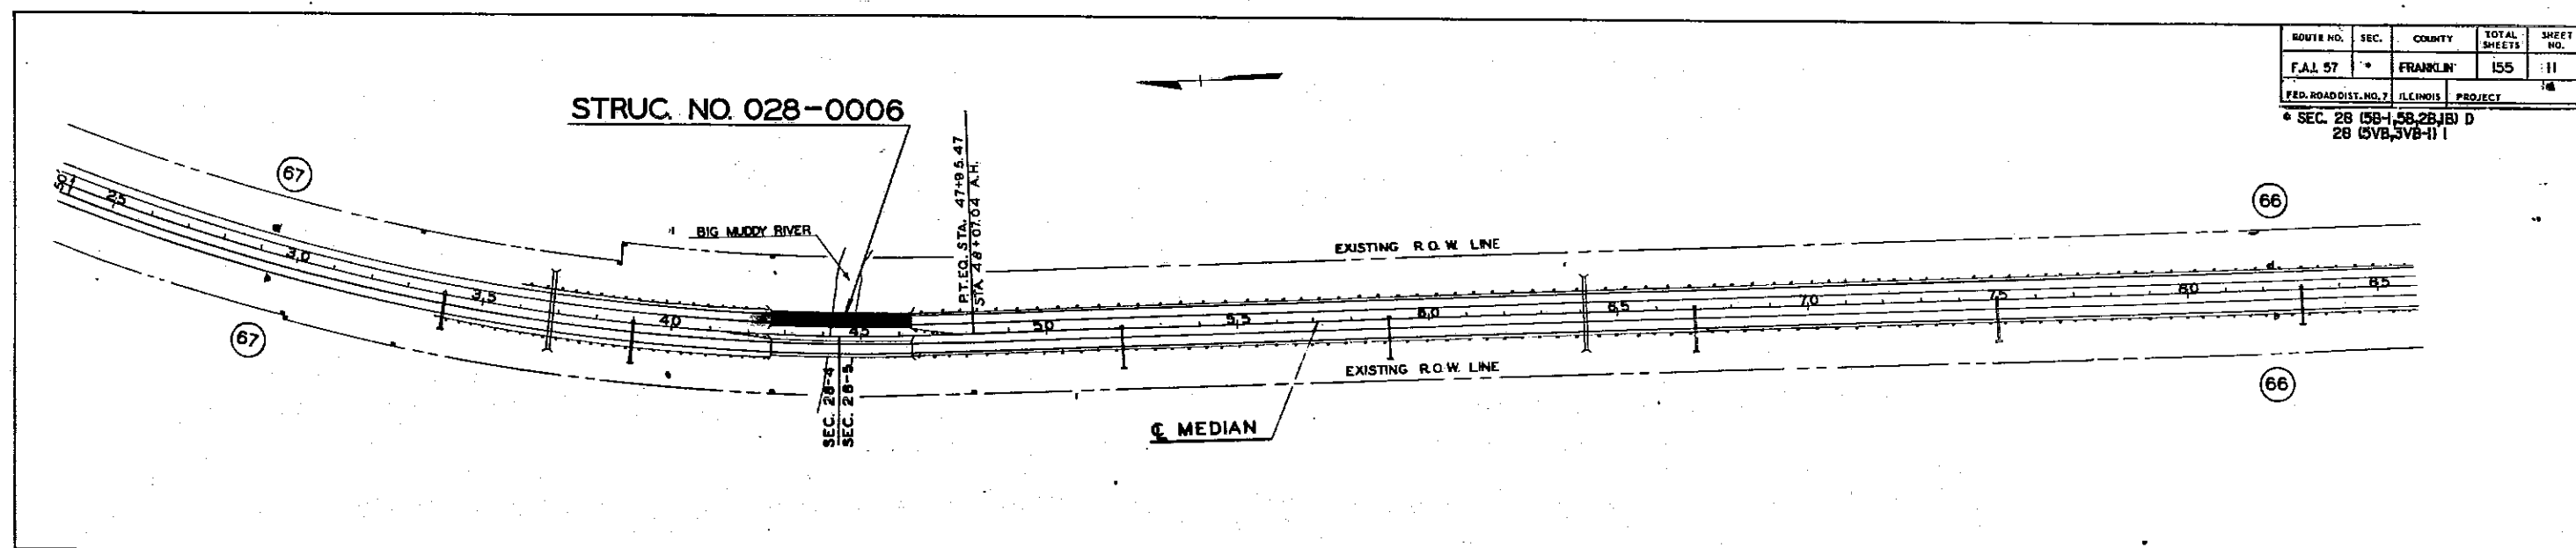





ROUTE NO.	SEC.	COUNTY	TOTAL SHEETS	SHEET NO.
F.A.I. 57		FRANKLIN	155	12
FED. ROAD DIST. NO. 7	ILLINOIS	PROJECT		
* SEC. 28 (58-1,58,28) D-1		28 (5VB,5VB-1) H		

STRUC. NO. 028-0001

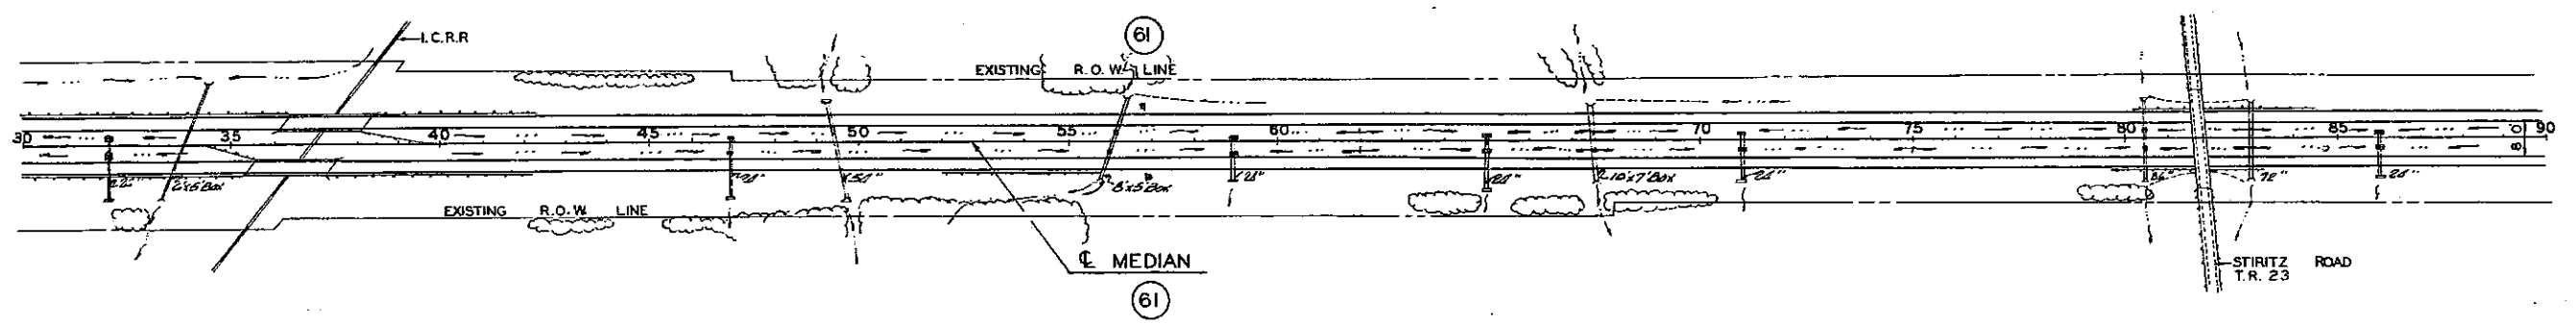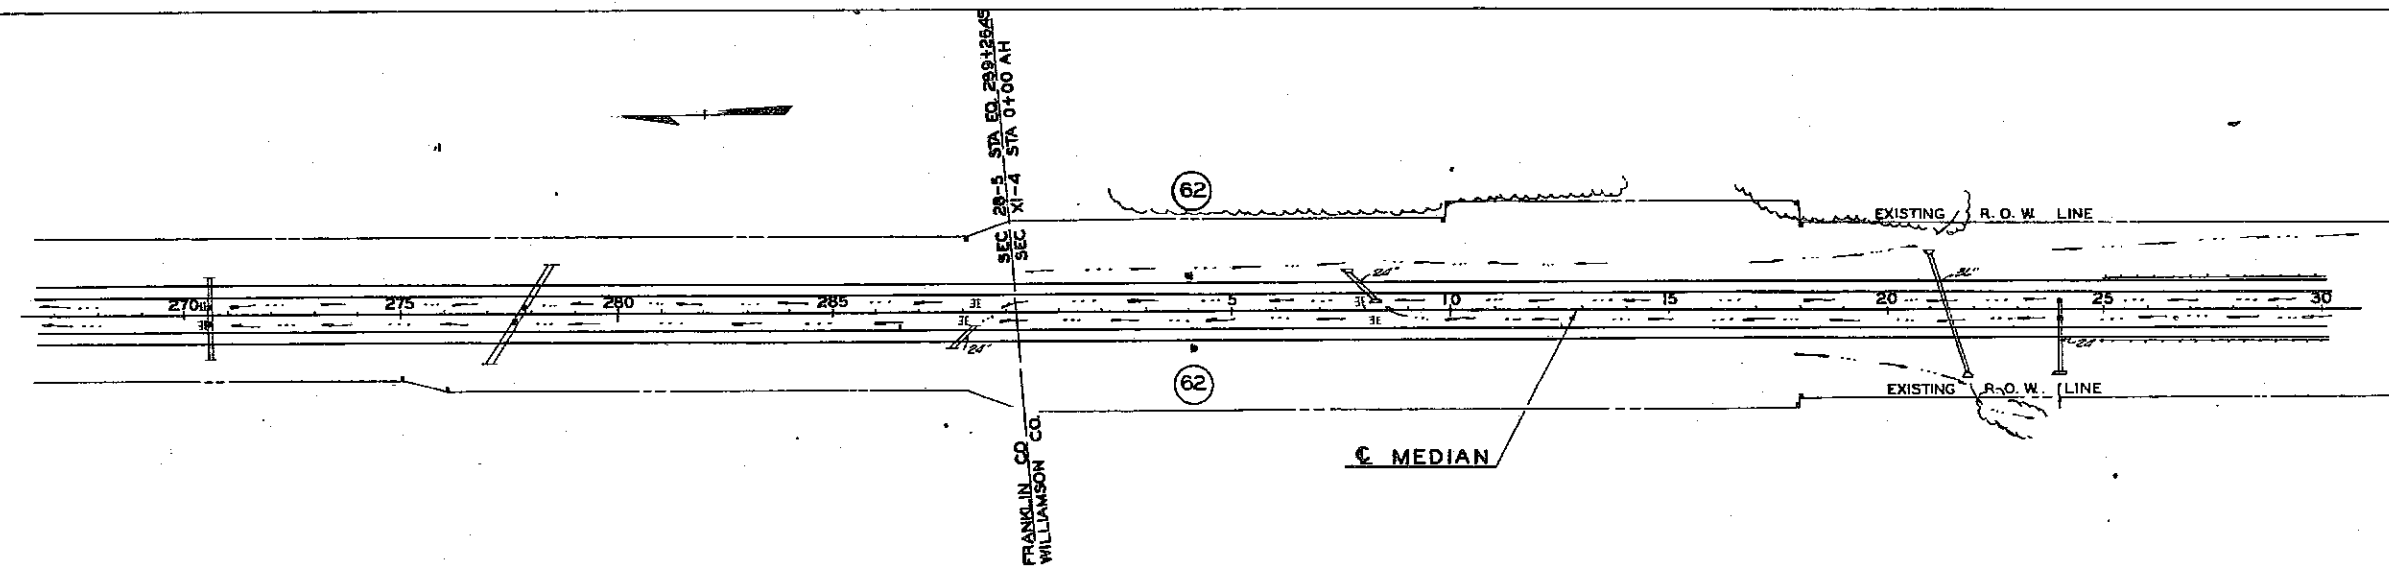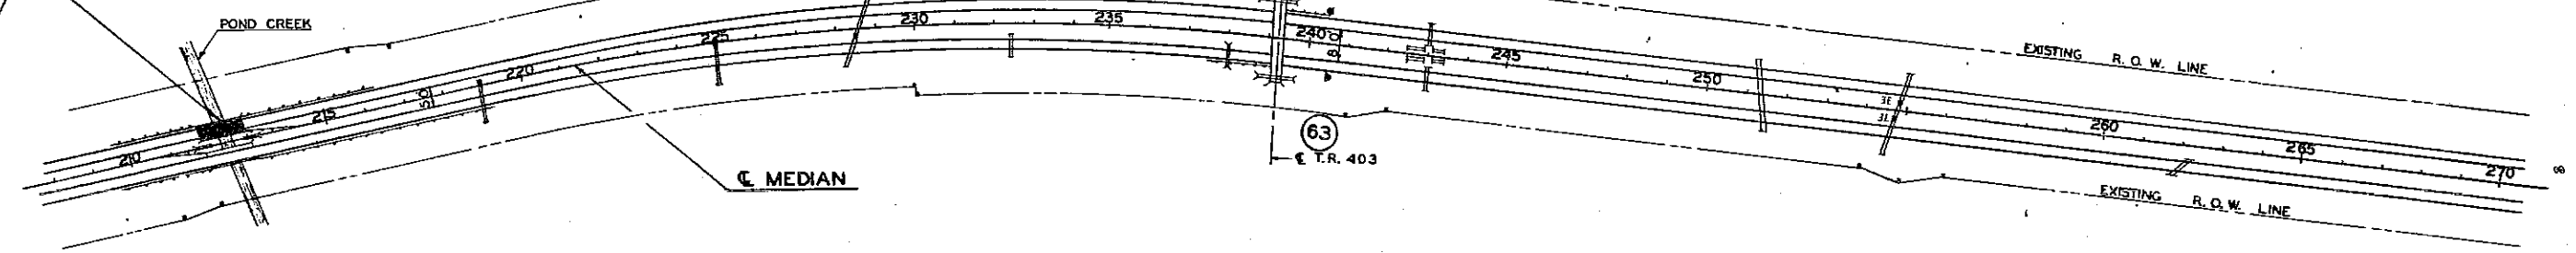


PAN. NO.	SECTION	COUNTY	TOTAL SHEETS	SHEET NO.
57	*	FRANKLIN	155	13
STA.	TO STA.			
FED. ROAD DIST. NO.	ILLINOIS	FED. AID PROJECT		
* 28 (SB-1, 5B, 2B, 1B) D; 28 (5VB, 3VB-1) I				

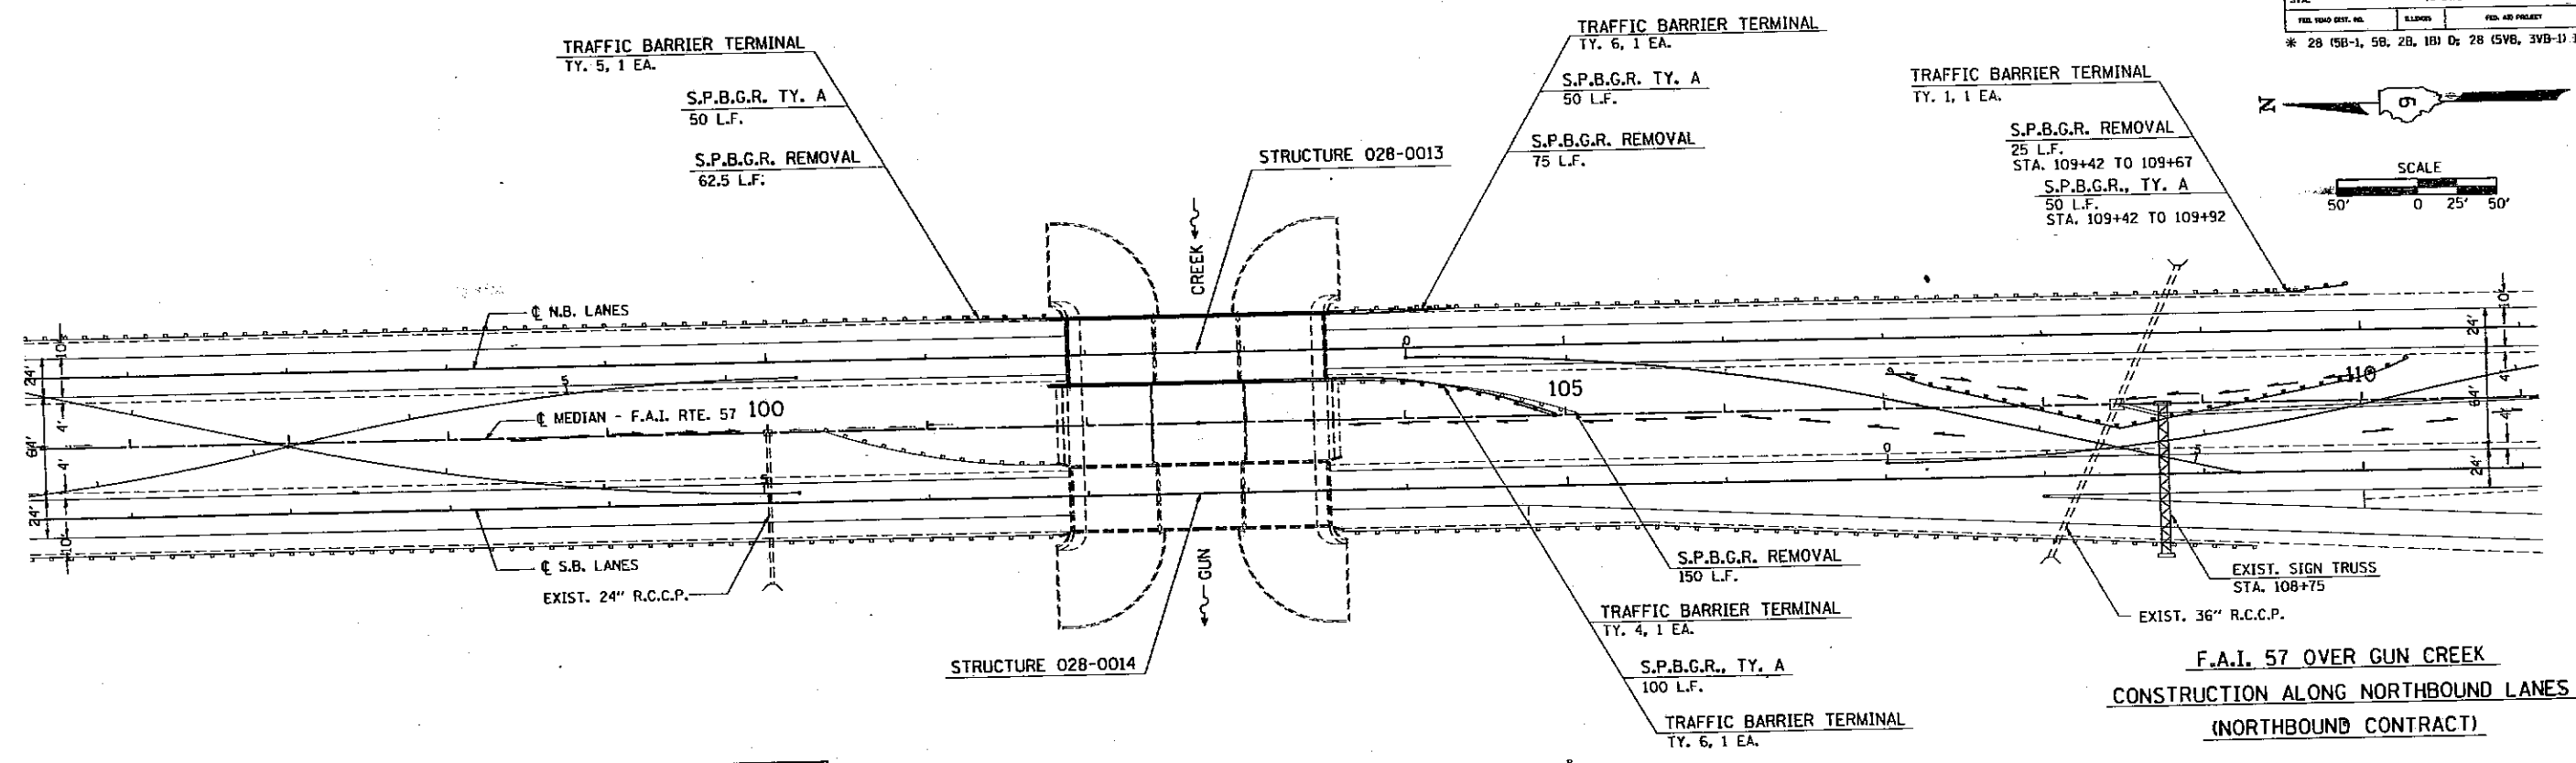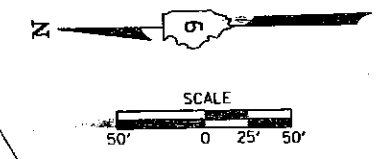

OFFSET MEDIAN GUARDRAIL IN ACCORDANCE WITH STD. 2339, EXCEPT SET STA. 0+00 AT THE APPROACH END OF THE TYPE 6 TERMINAL.

F.A.I. 57 OVER GUN CREEK  
CONSTRUCTION ALONG NORTHBOUND LANES  
(NORTHBOUND CONTRACT)

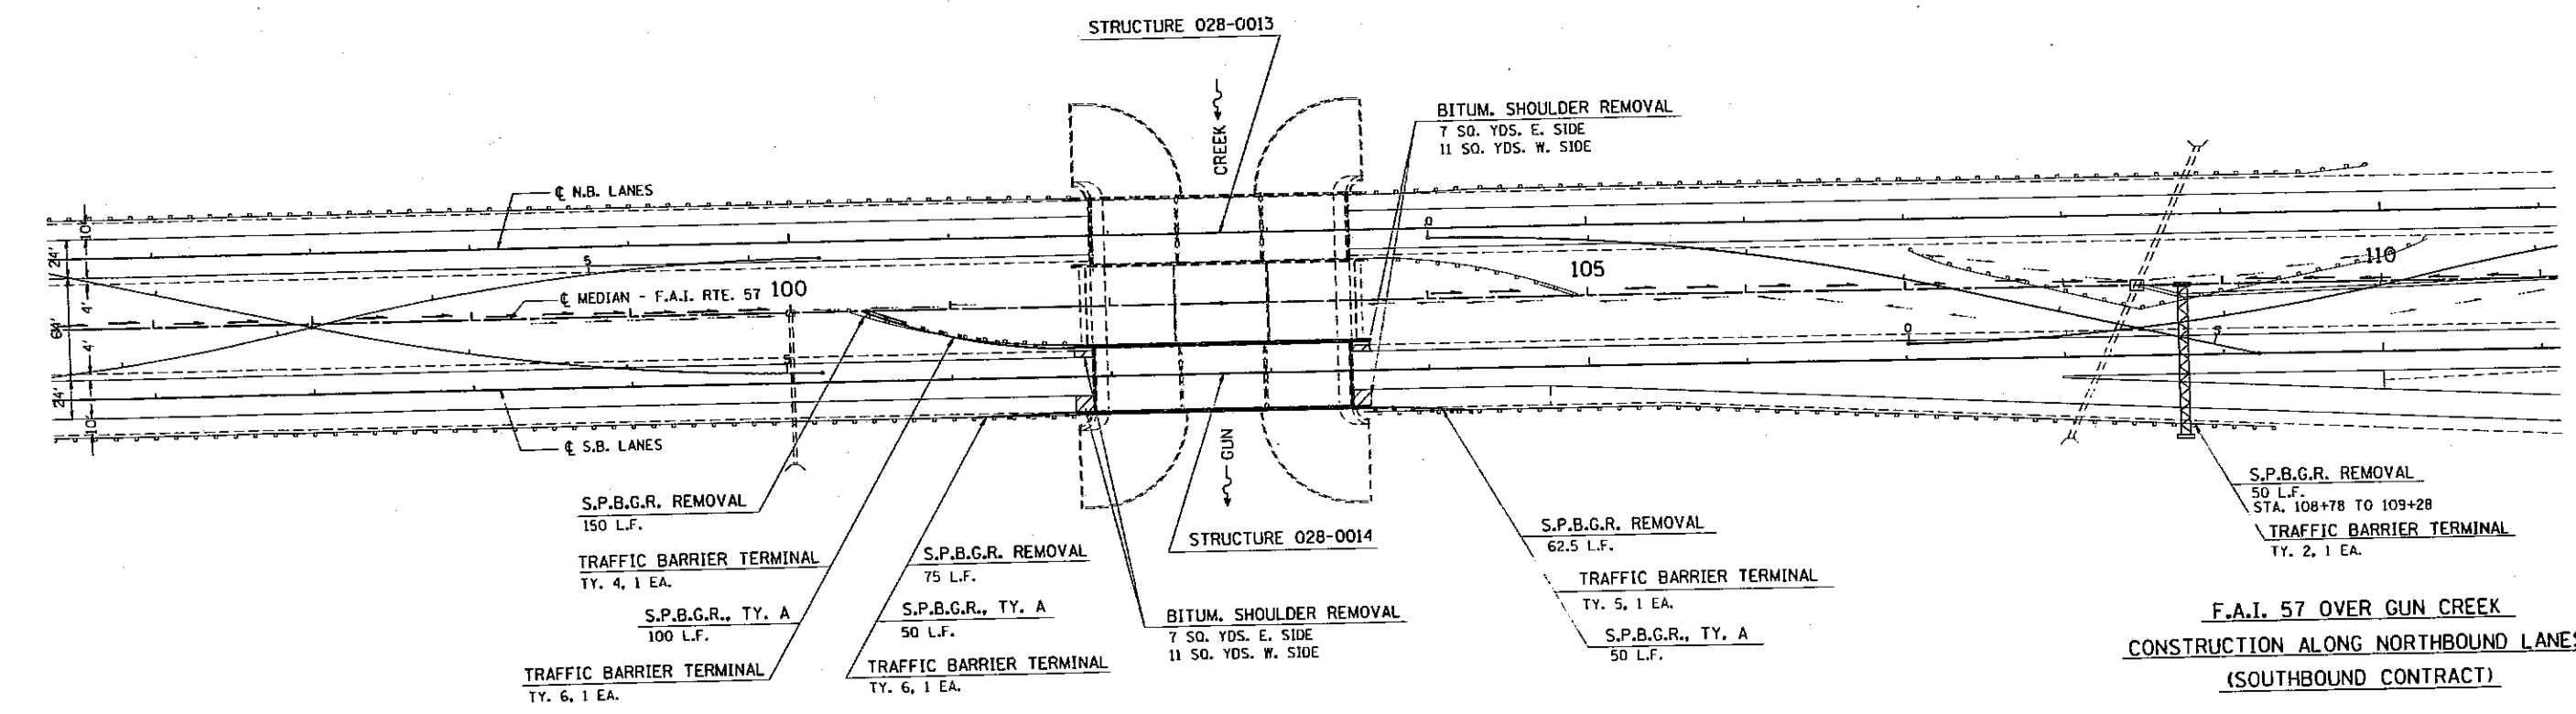

F.A.I. 57 OVER GUN CREEK  
CONSTRUCTION ALONG NORTHBOUND LANES  
(SOUTHBOUND CONTRACT)

PREPARED BY: CIVIL ENGINEER  
 DRAWN BY: CIVIL ENGINEER  
 CHECKED BY: CIVIL ENGINEER  
 APPROVED BY: CIVIL ENGINEER  
 DATE: 11/15/55












DATE	TIME	LOCATION	DEPTH

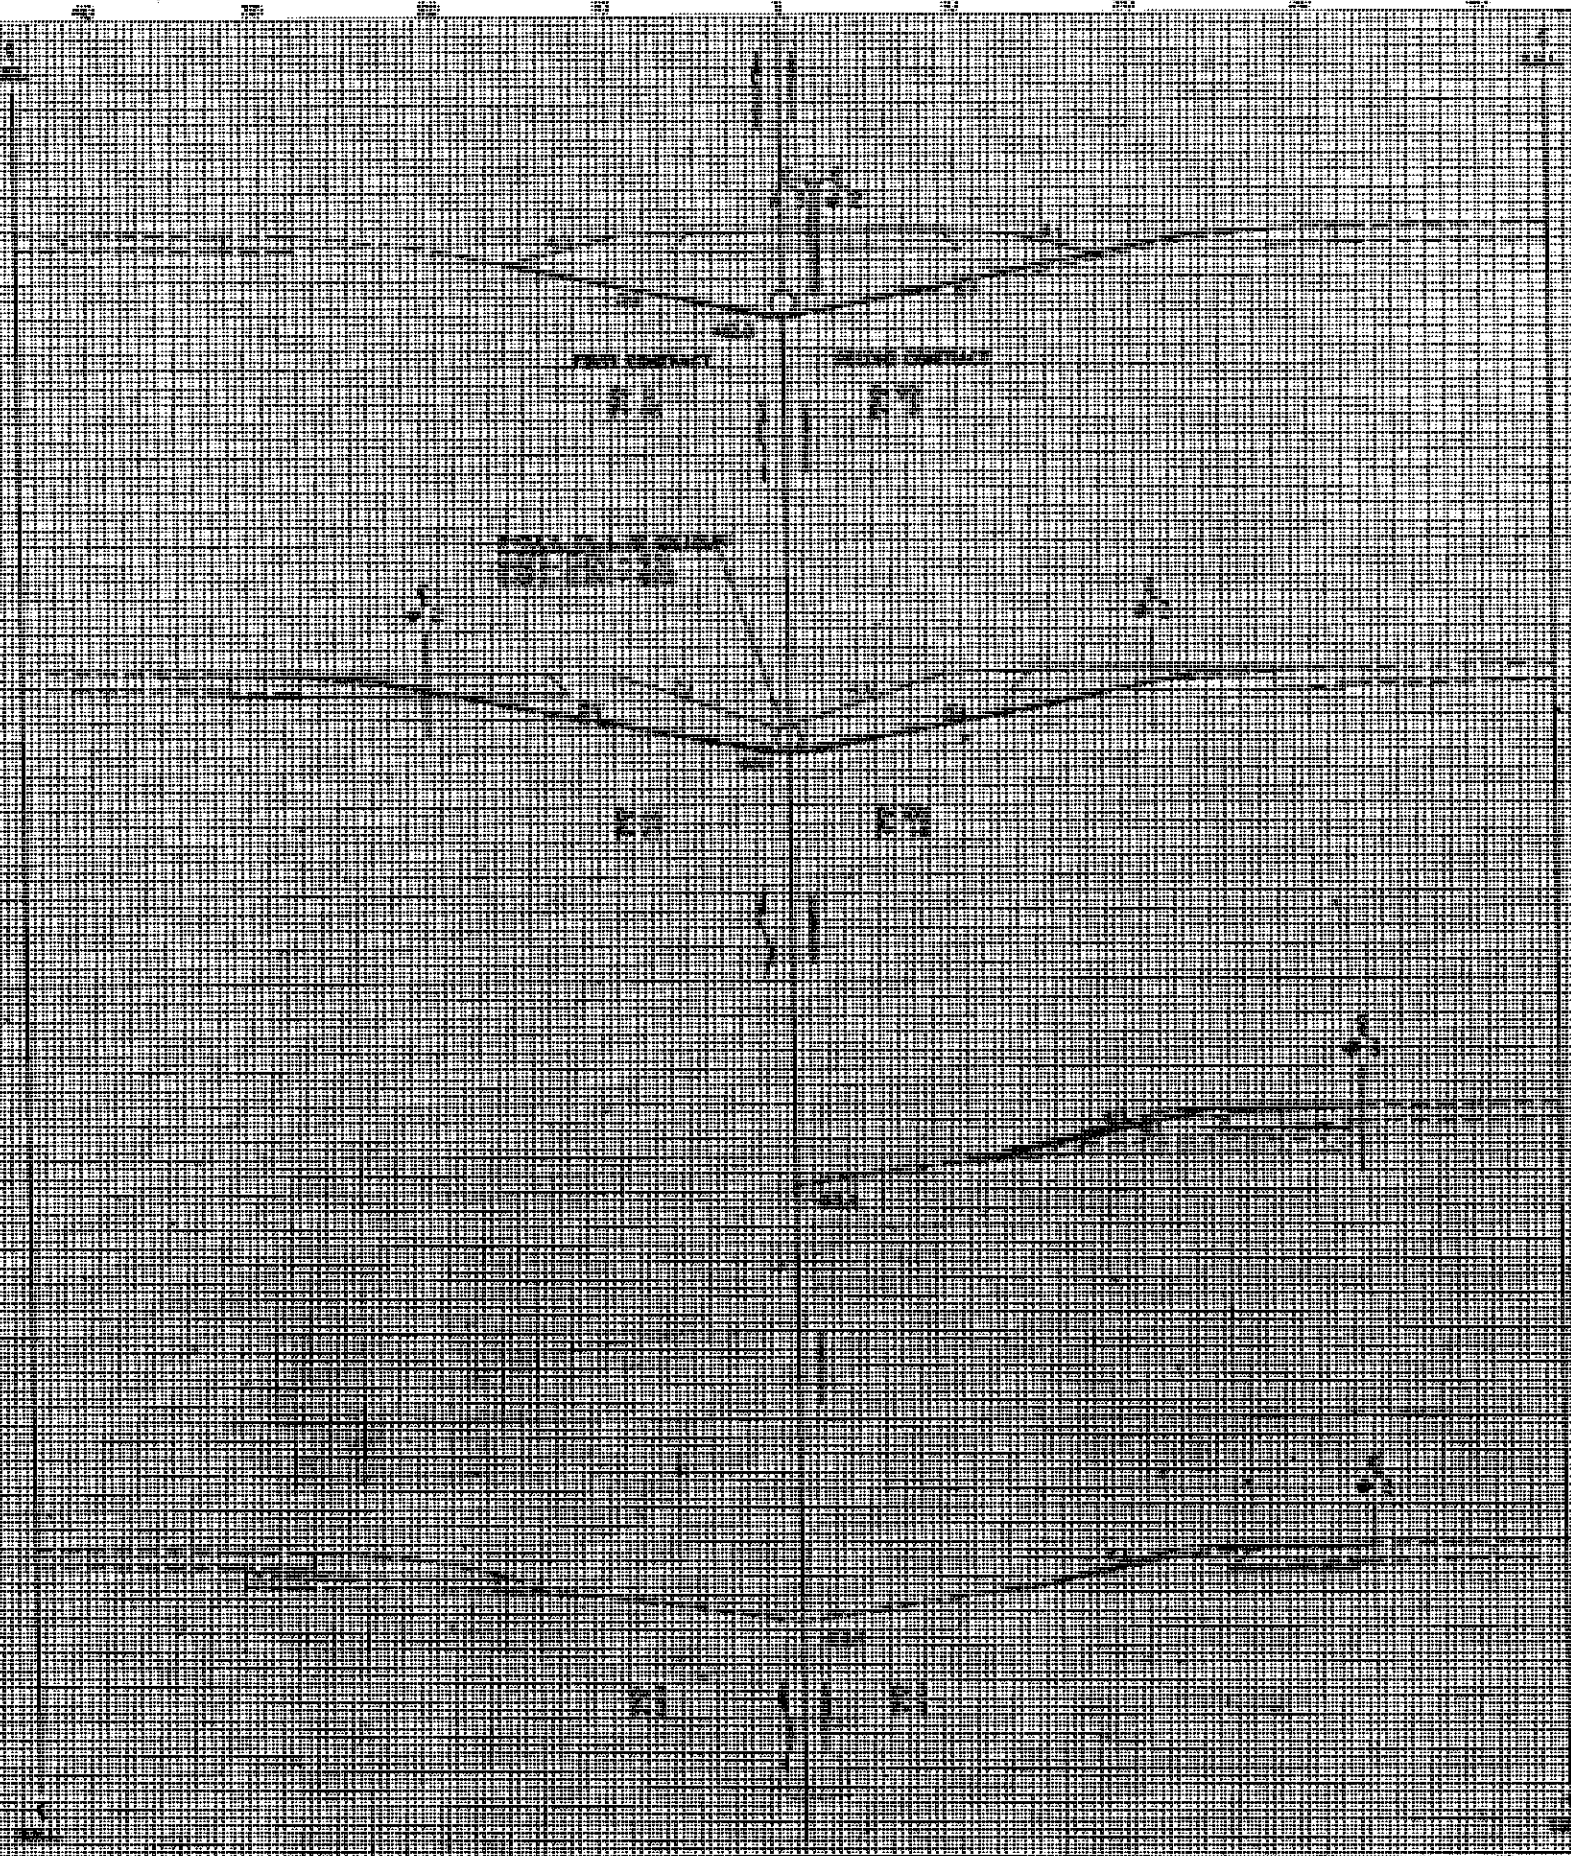

DATE	TIME	LOCATION	DEPTH

DATE	TIME	LOCATION	DEPTH



FINAL SURVEY NOTE BOOK


DATE: \_\_\_\_\_

NO. \_\_\_\_\_

ORIGINAL SURVEY NOTE BOOK

DATE: \_\_\_\_\_

NO. \_\_\_\_\_

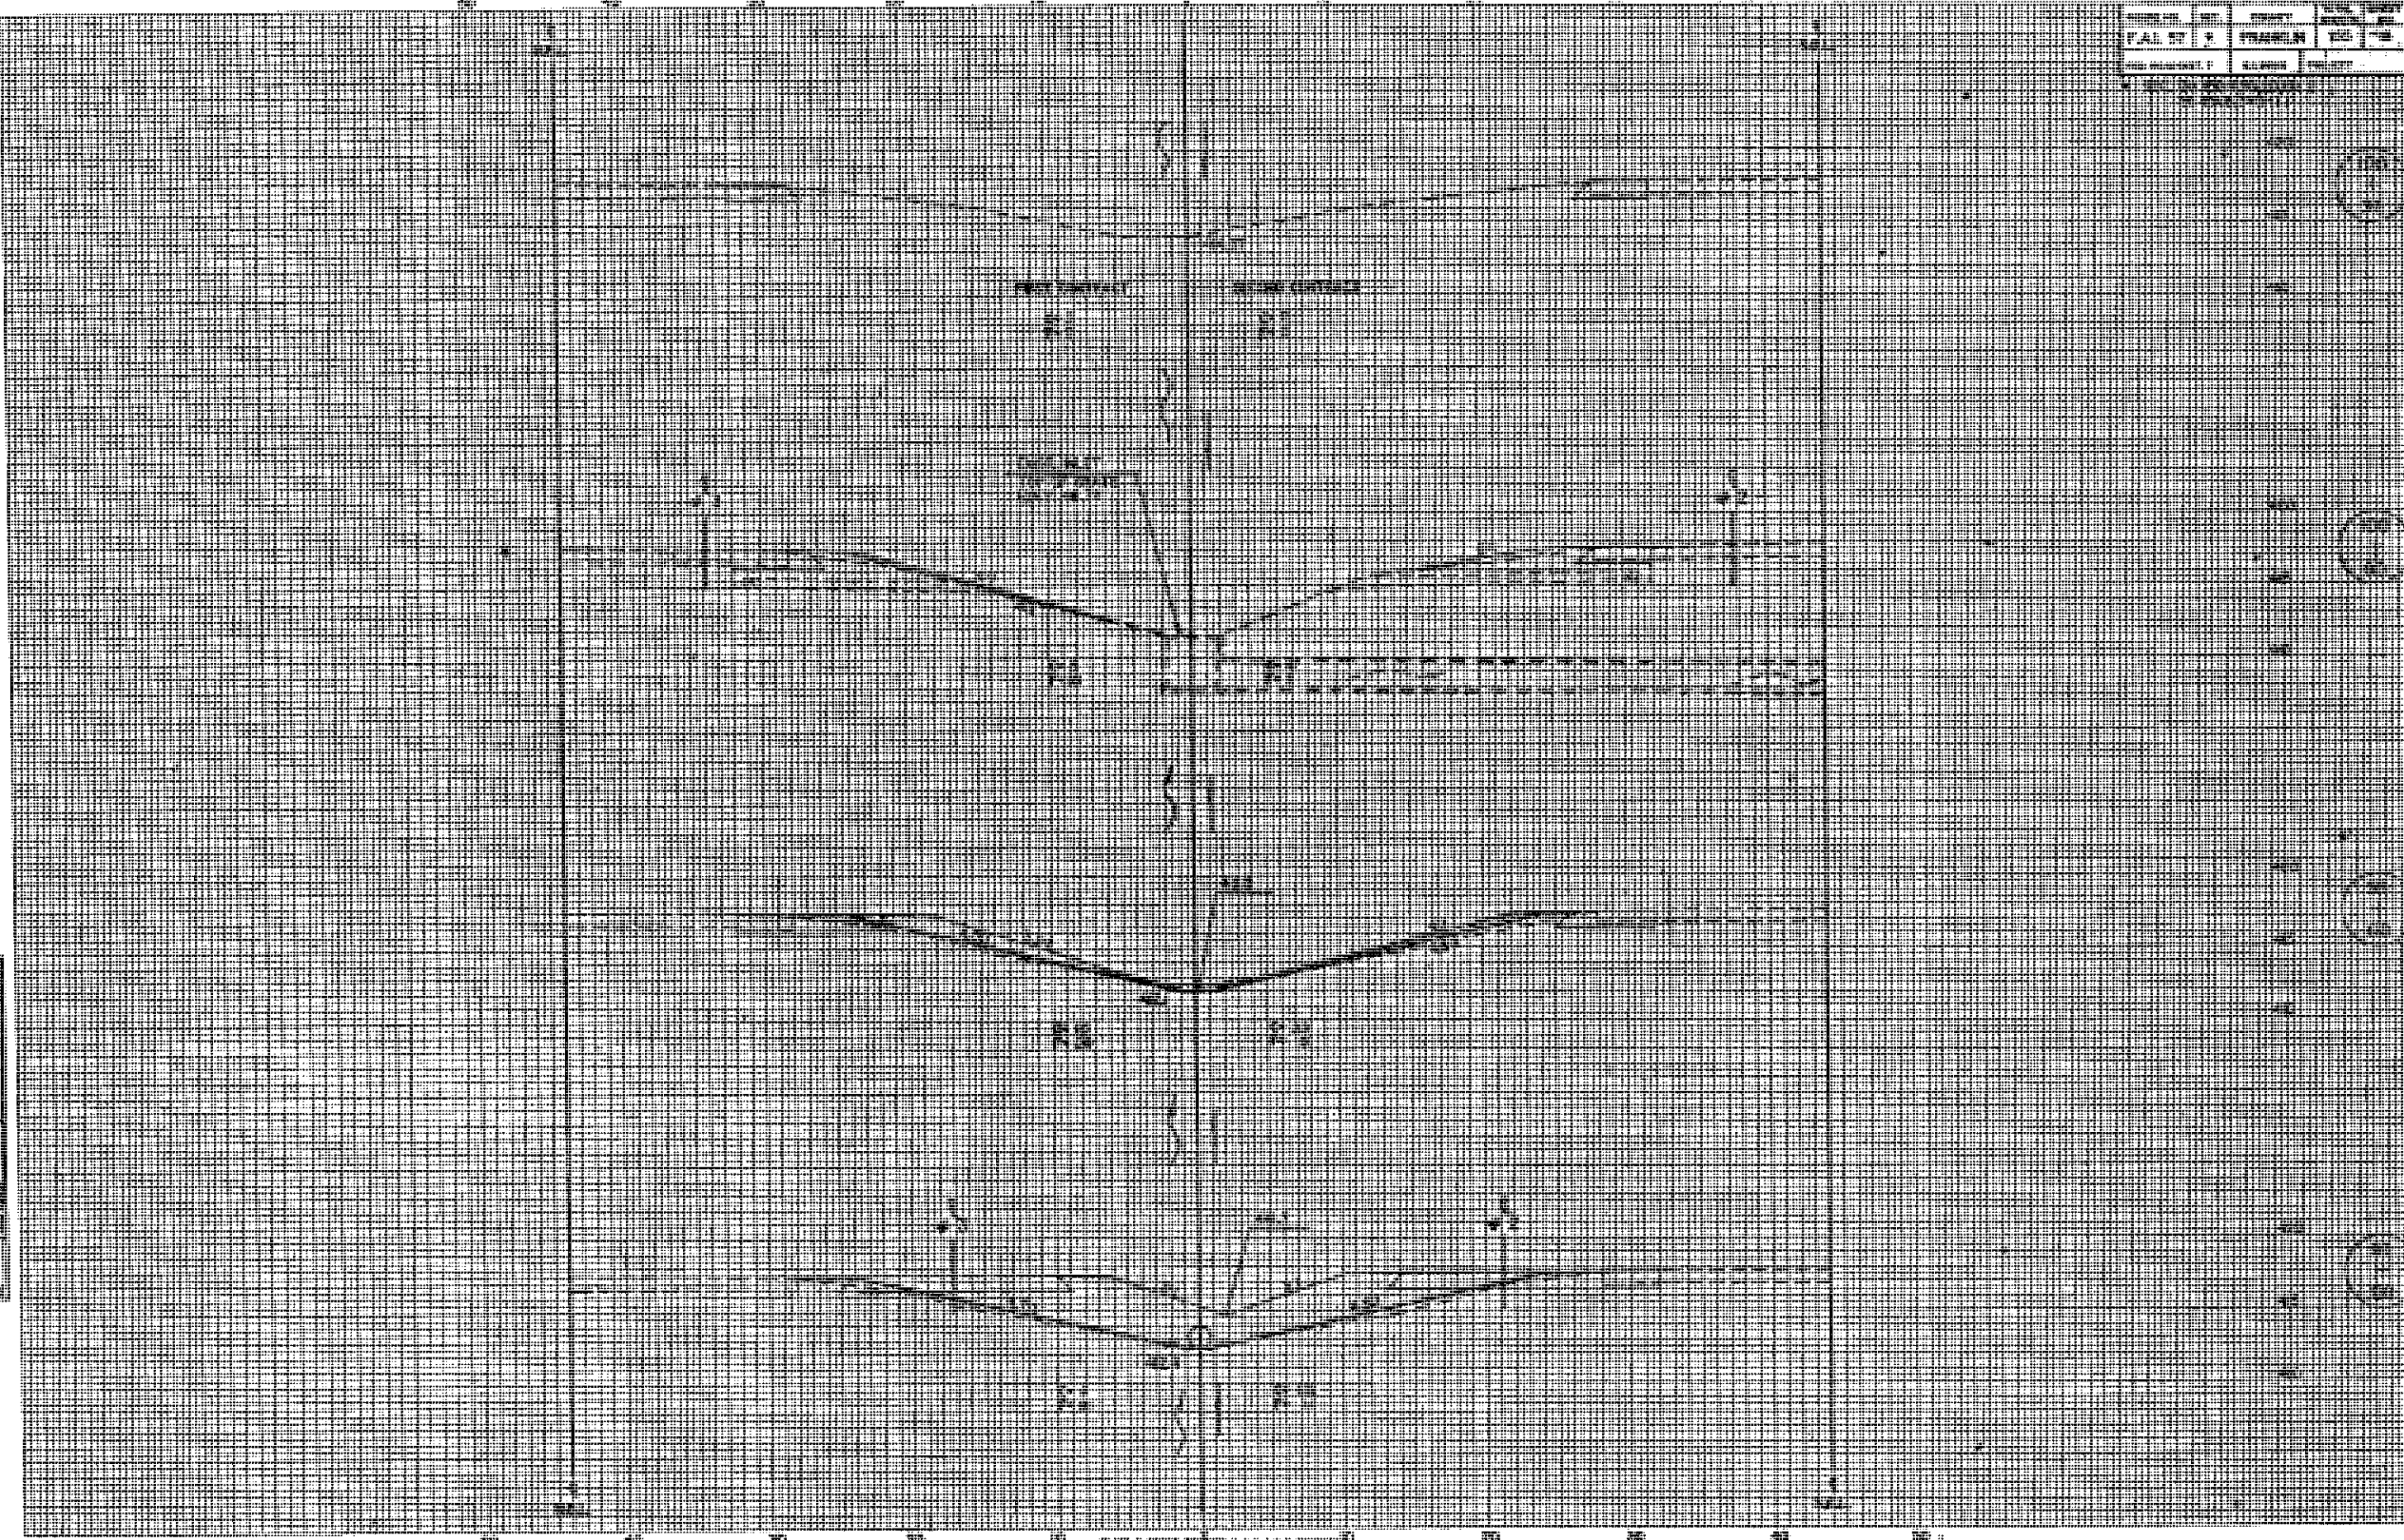



DATE	TIME	TEMP.	WIND	MOON	SEA

DATE	TIME	TEMP.	WIND	MOON	SEA


SURVEYOR  
 ASSISTANT  
 BOATSWAIN  
 TENDERS  
 HELM  
 LOGGERS

FINAL SURVEY  
 NOTE BOOK  
 No.

DATE	TIME	TEMP.	WIND	MOON	SEA

SURVEYOR  
 ASSISTANT  
 BOATSWAIN  
 TENDERS  
 HELM  
 LOGGERS

DRYDIAL SURVEY  
 NOTE BOOK  
 No.

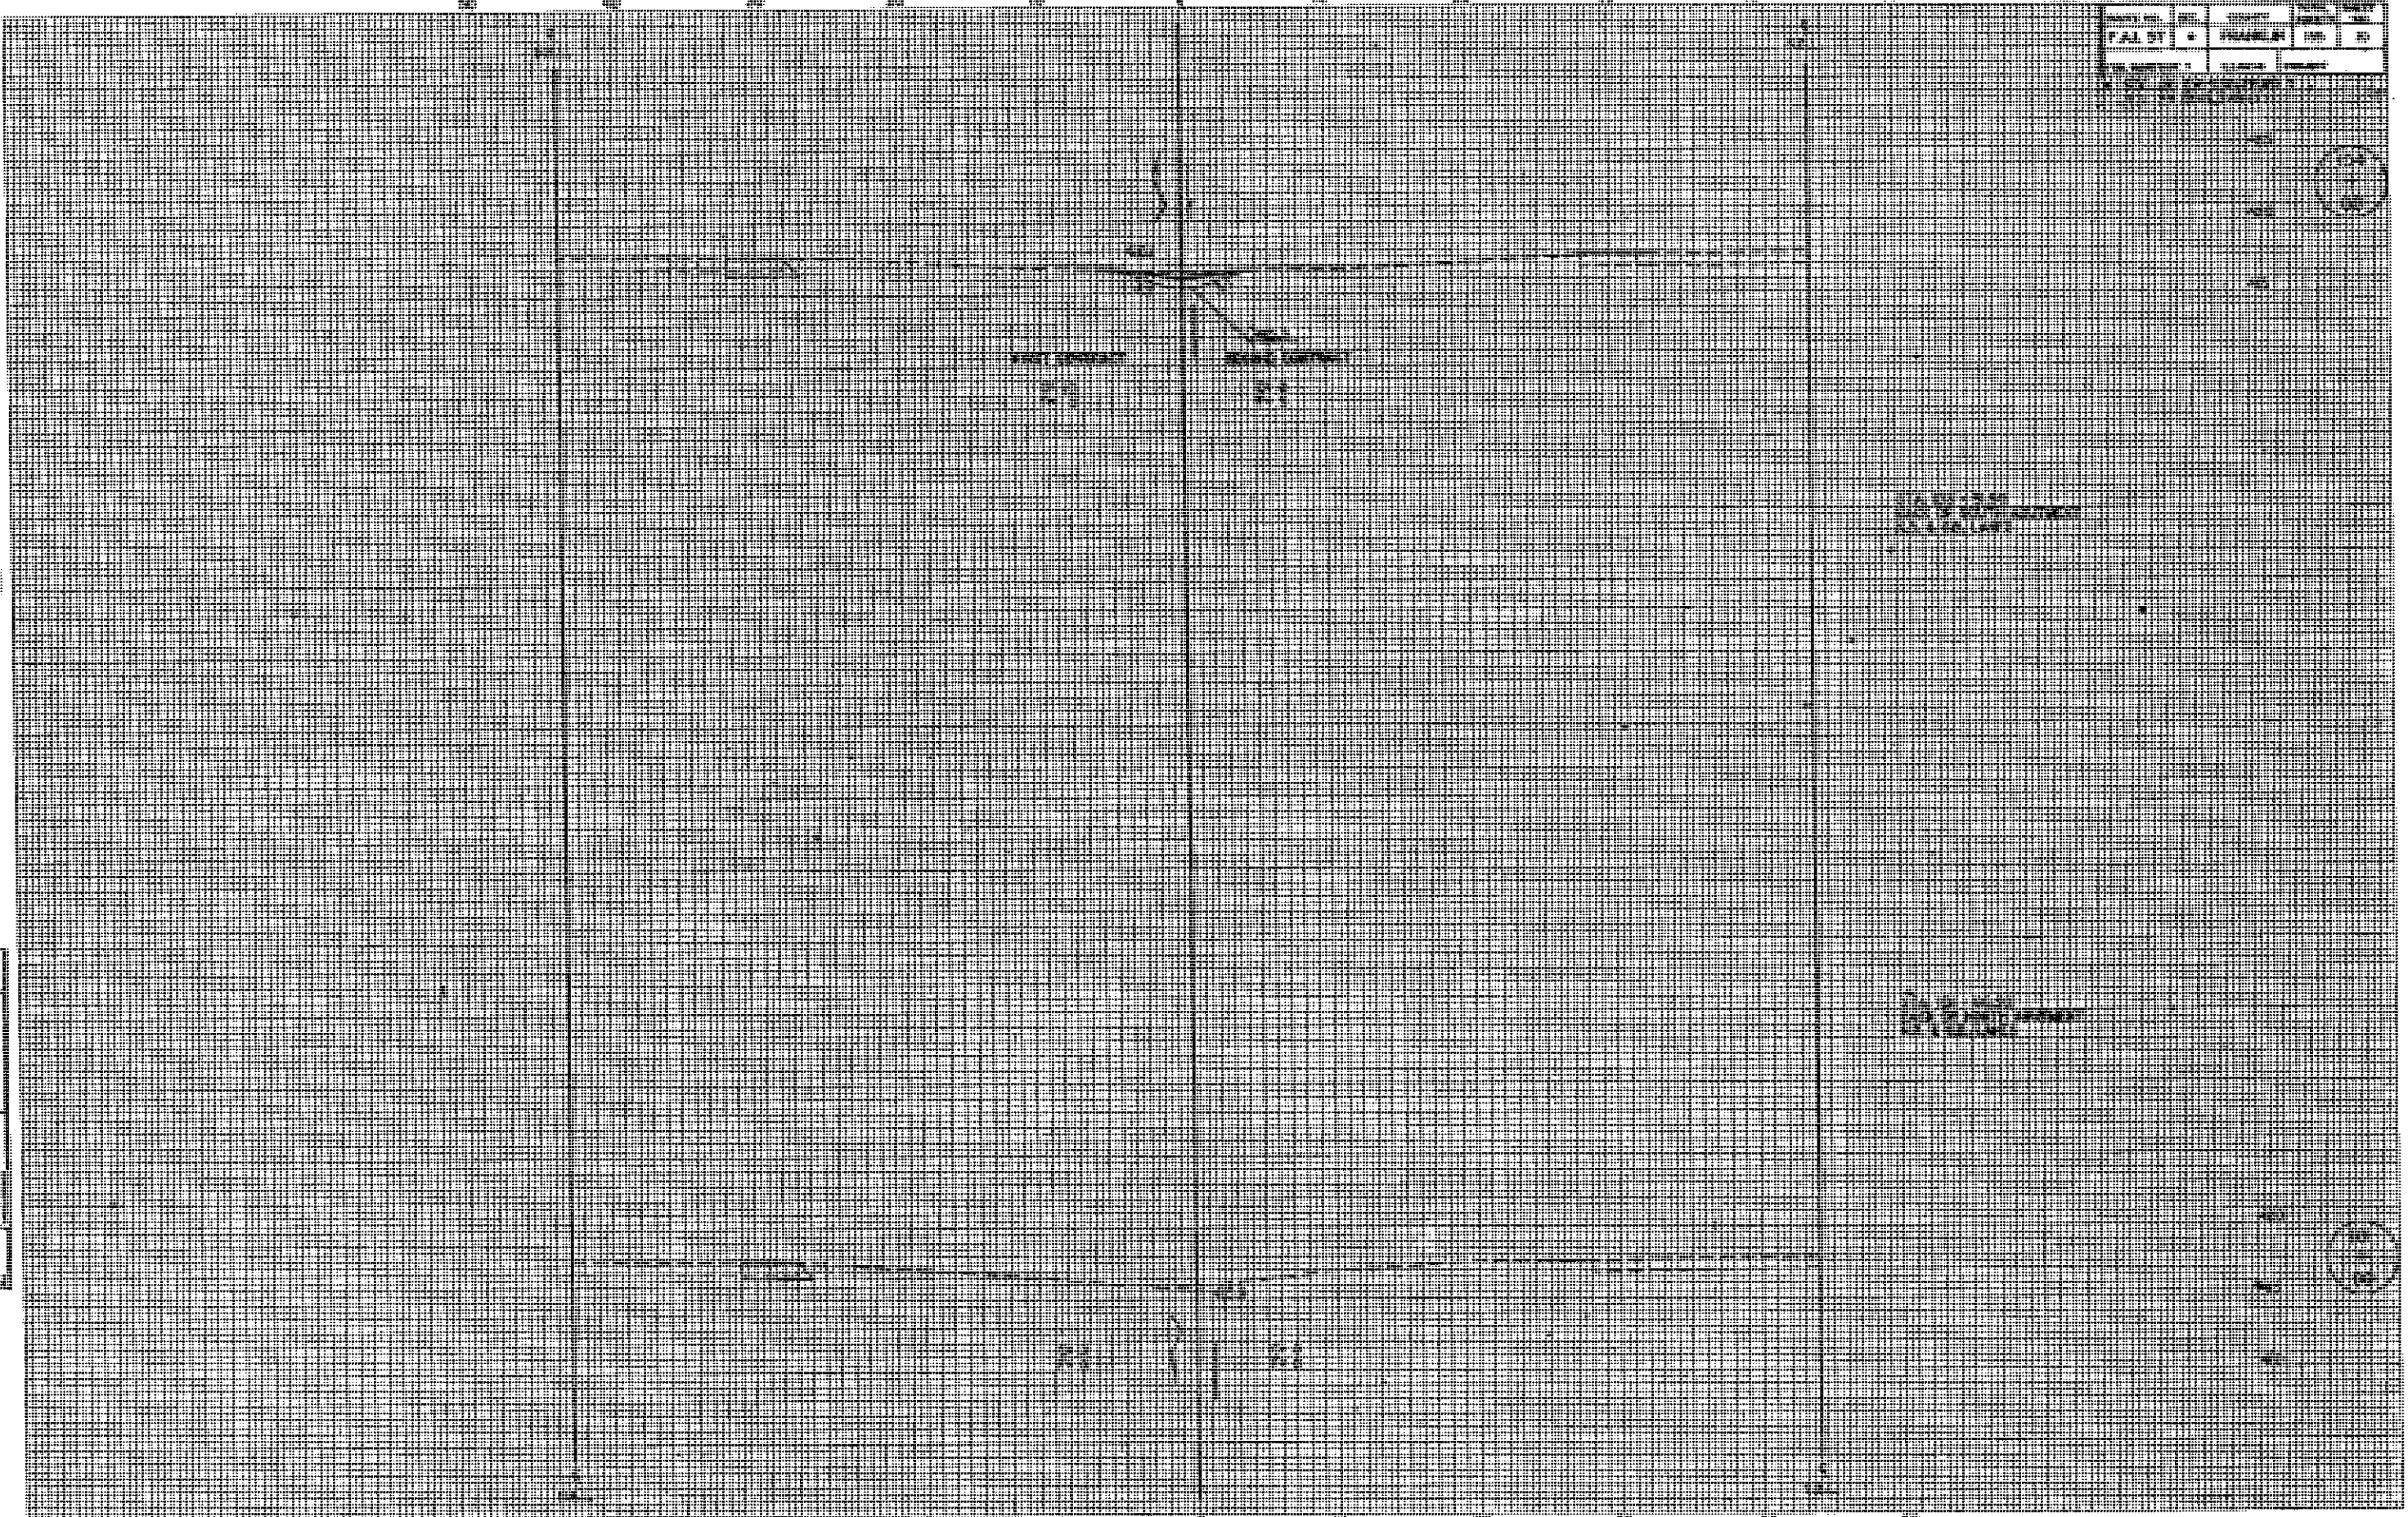

PUBLISHED BY THE UNITED STATES GOVERNMENT  
 GEOLOGICAL SURVEY



DATE	NO.	SCALE	PROJECT

FINAL SURVEY NOTE BOOK

DATE \_\_\_\_\_

NO. \_\_\_\_\_

PROJECT \_\_\_\_\_

SCALE \_\_\_\_\_


ORIGINAL SURVEY NOTE BOOK

DATE \_\_\_\_\_

NO. \_\_\_\_\_

PROJECT \_\_\_\_\_


SCALE \_\_\_\_\_

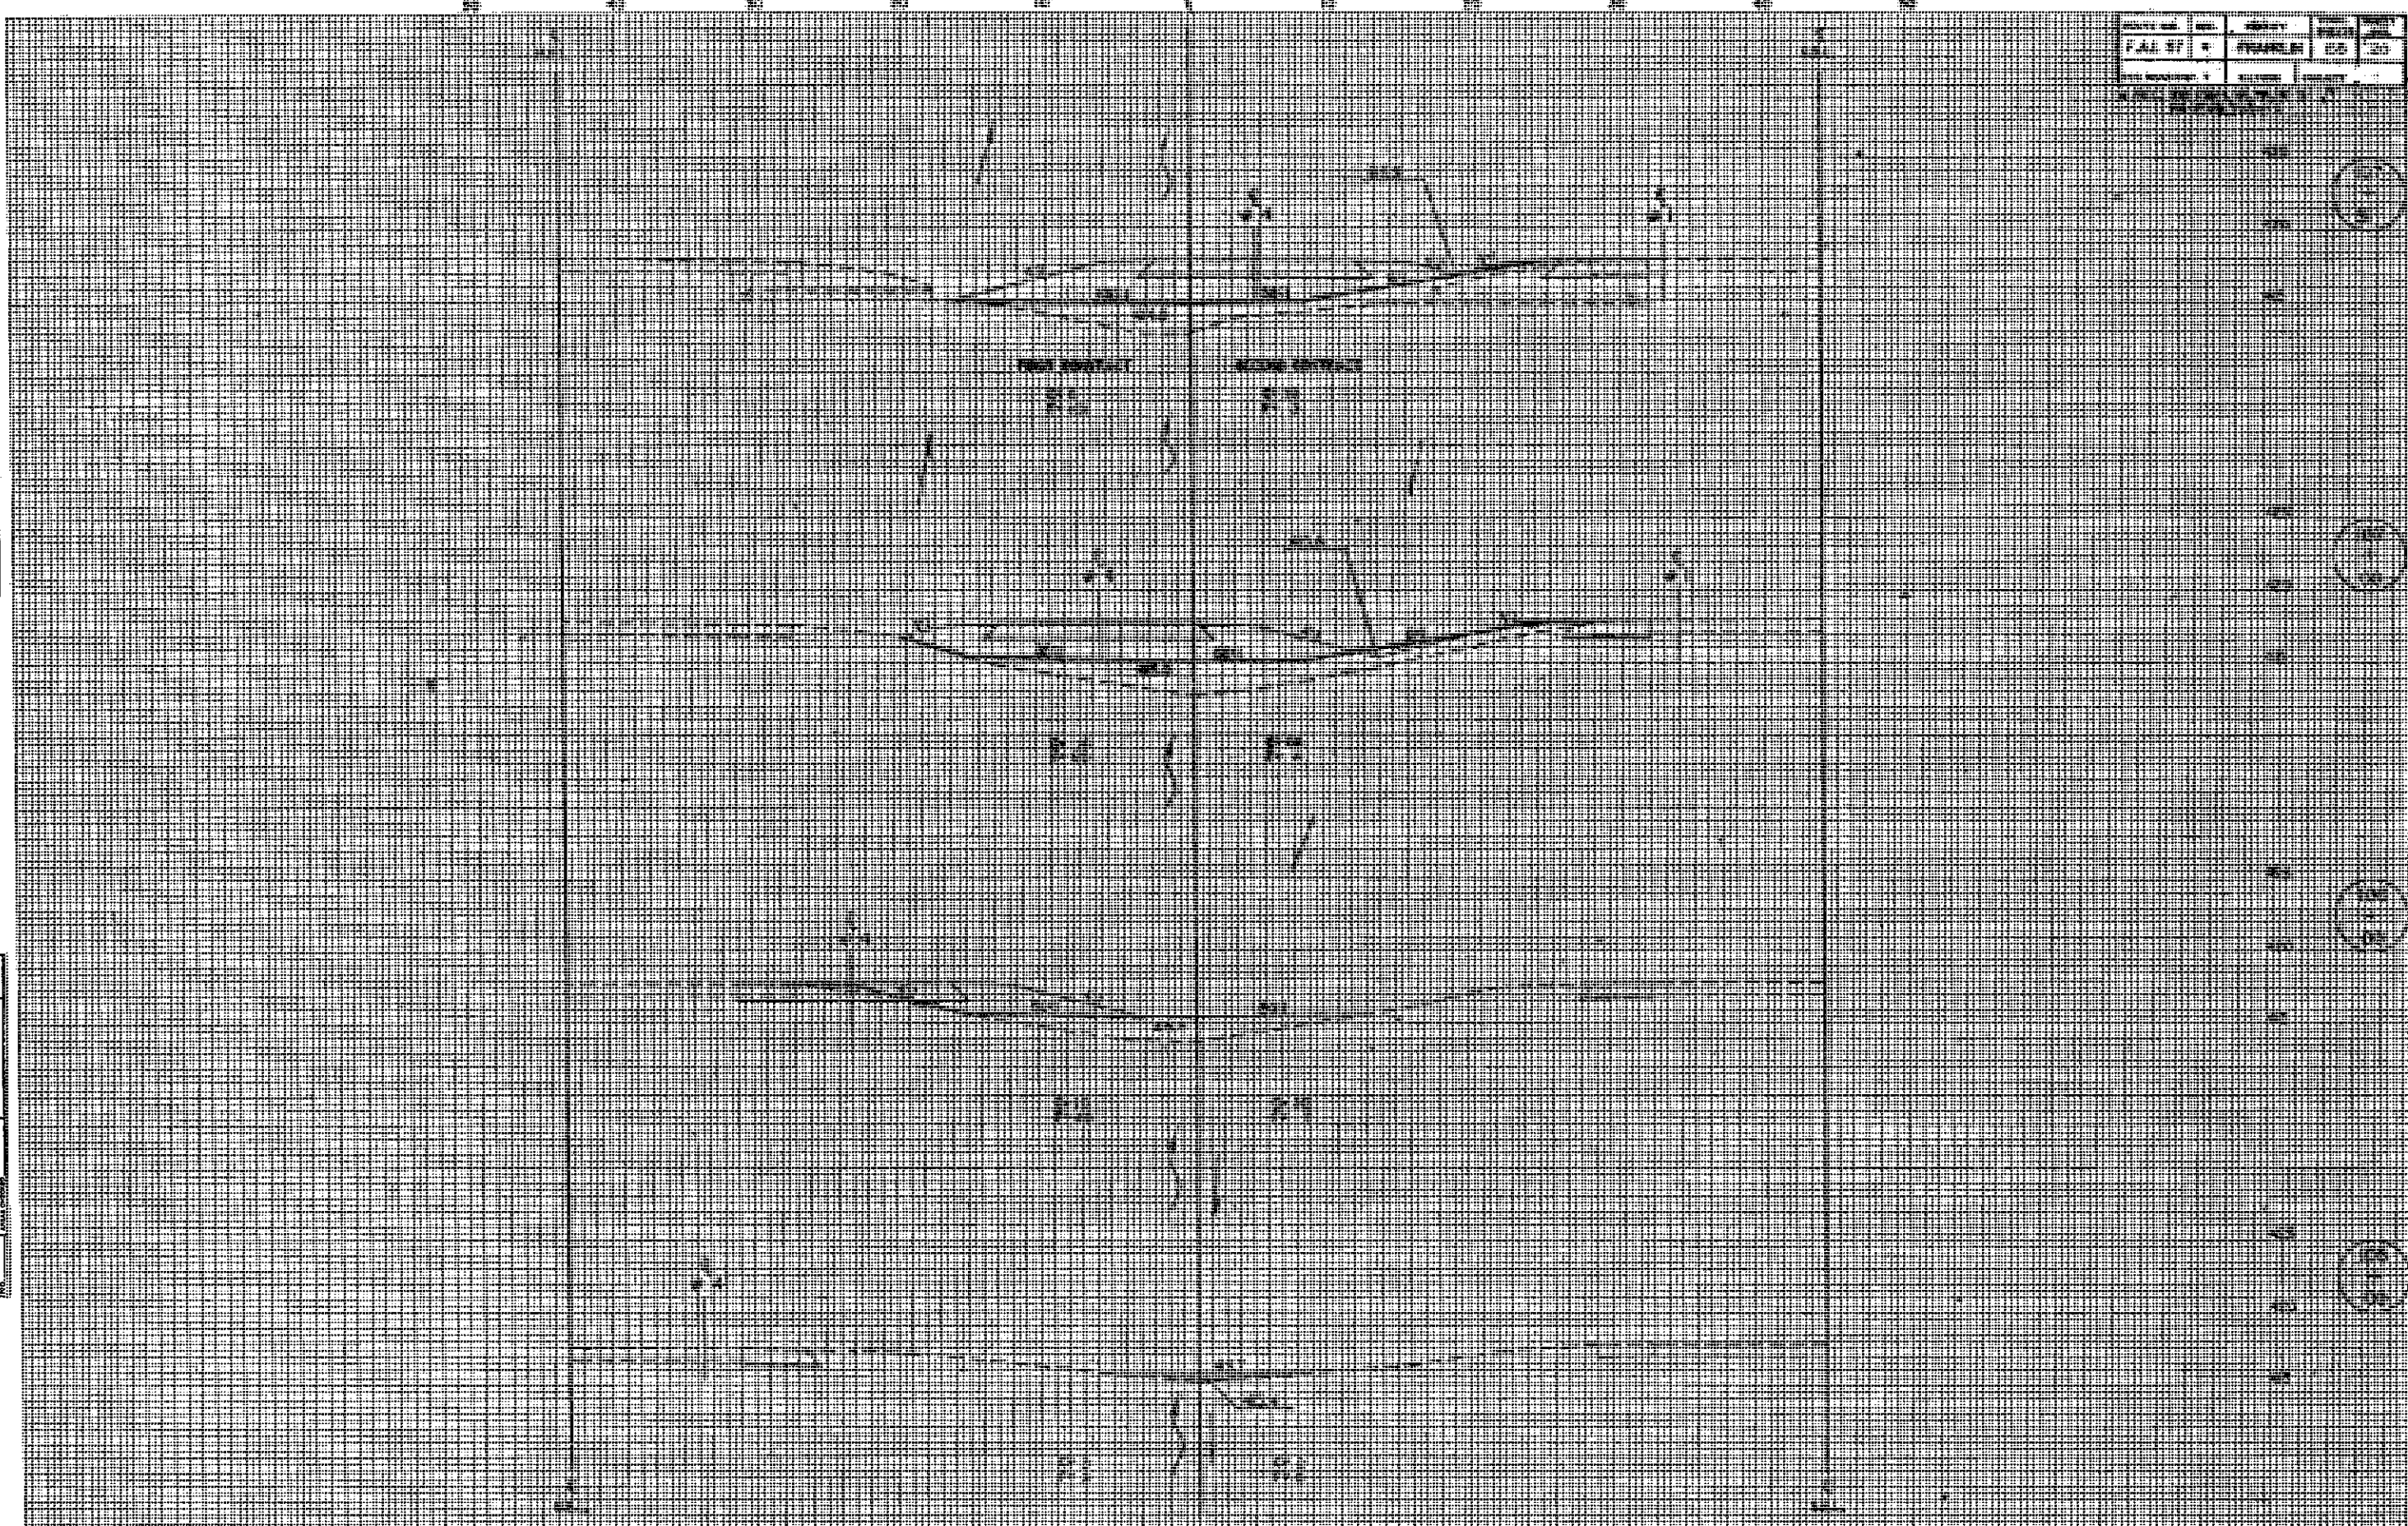



JAMAICA SURVEY  
 NOTE BOOK  
 No. \_\_\_\_\_  
 DATE \_\_\_\_\_  
 TIME \_\_\_\_\_  
 TEMP \_\_\_\_\_  
 WIND \_\_\_\_\_  
 SEA \_\_\_\_\_  
 SKY \_\_\_\_\_  
 REMARKS \_\_\_\_\_

JAMAICA SURVEY  
 NOTE BOOK  
 No. \_\_\_\_\_  
 DATE \_\_\_\_\_  
 TIME \_\_\_\_\_  
 TEMP \_\_\_\_\_  
 WIND \_\_\_\_\_  
 SEA \_\_\_\_\_  
 SKY \_\_\_\_\_  
 REMARKS \_\_\_\_\_

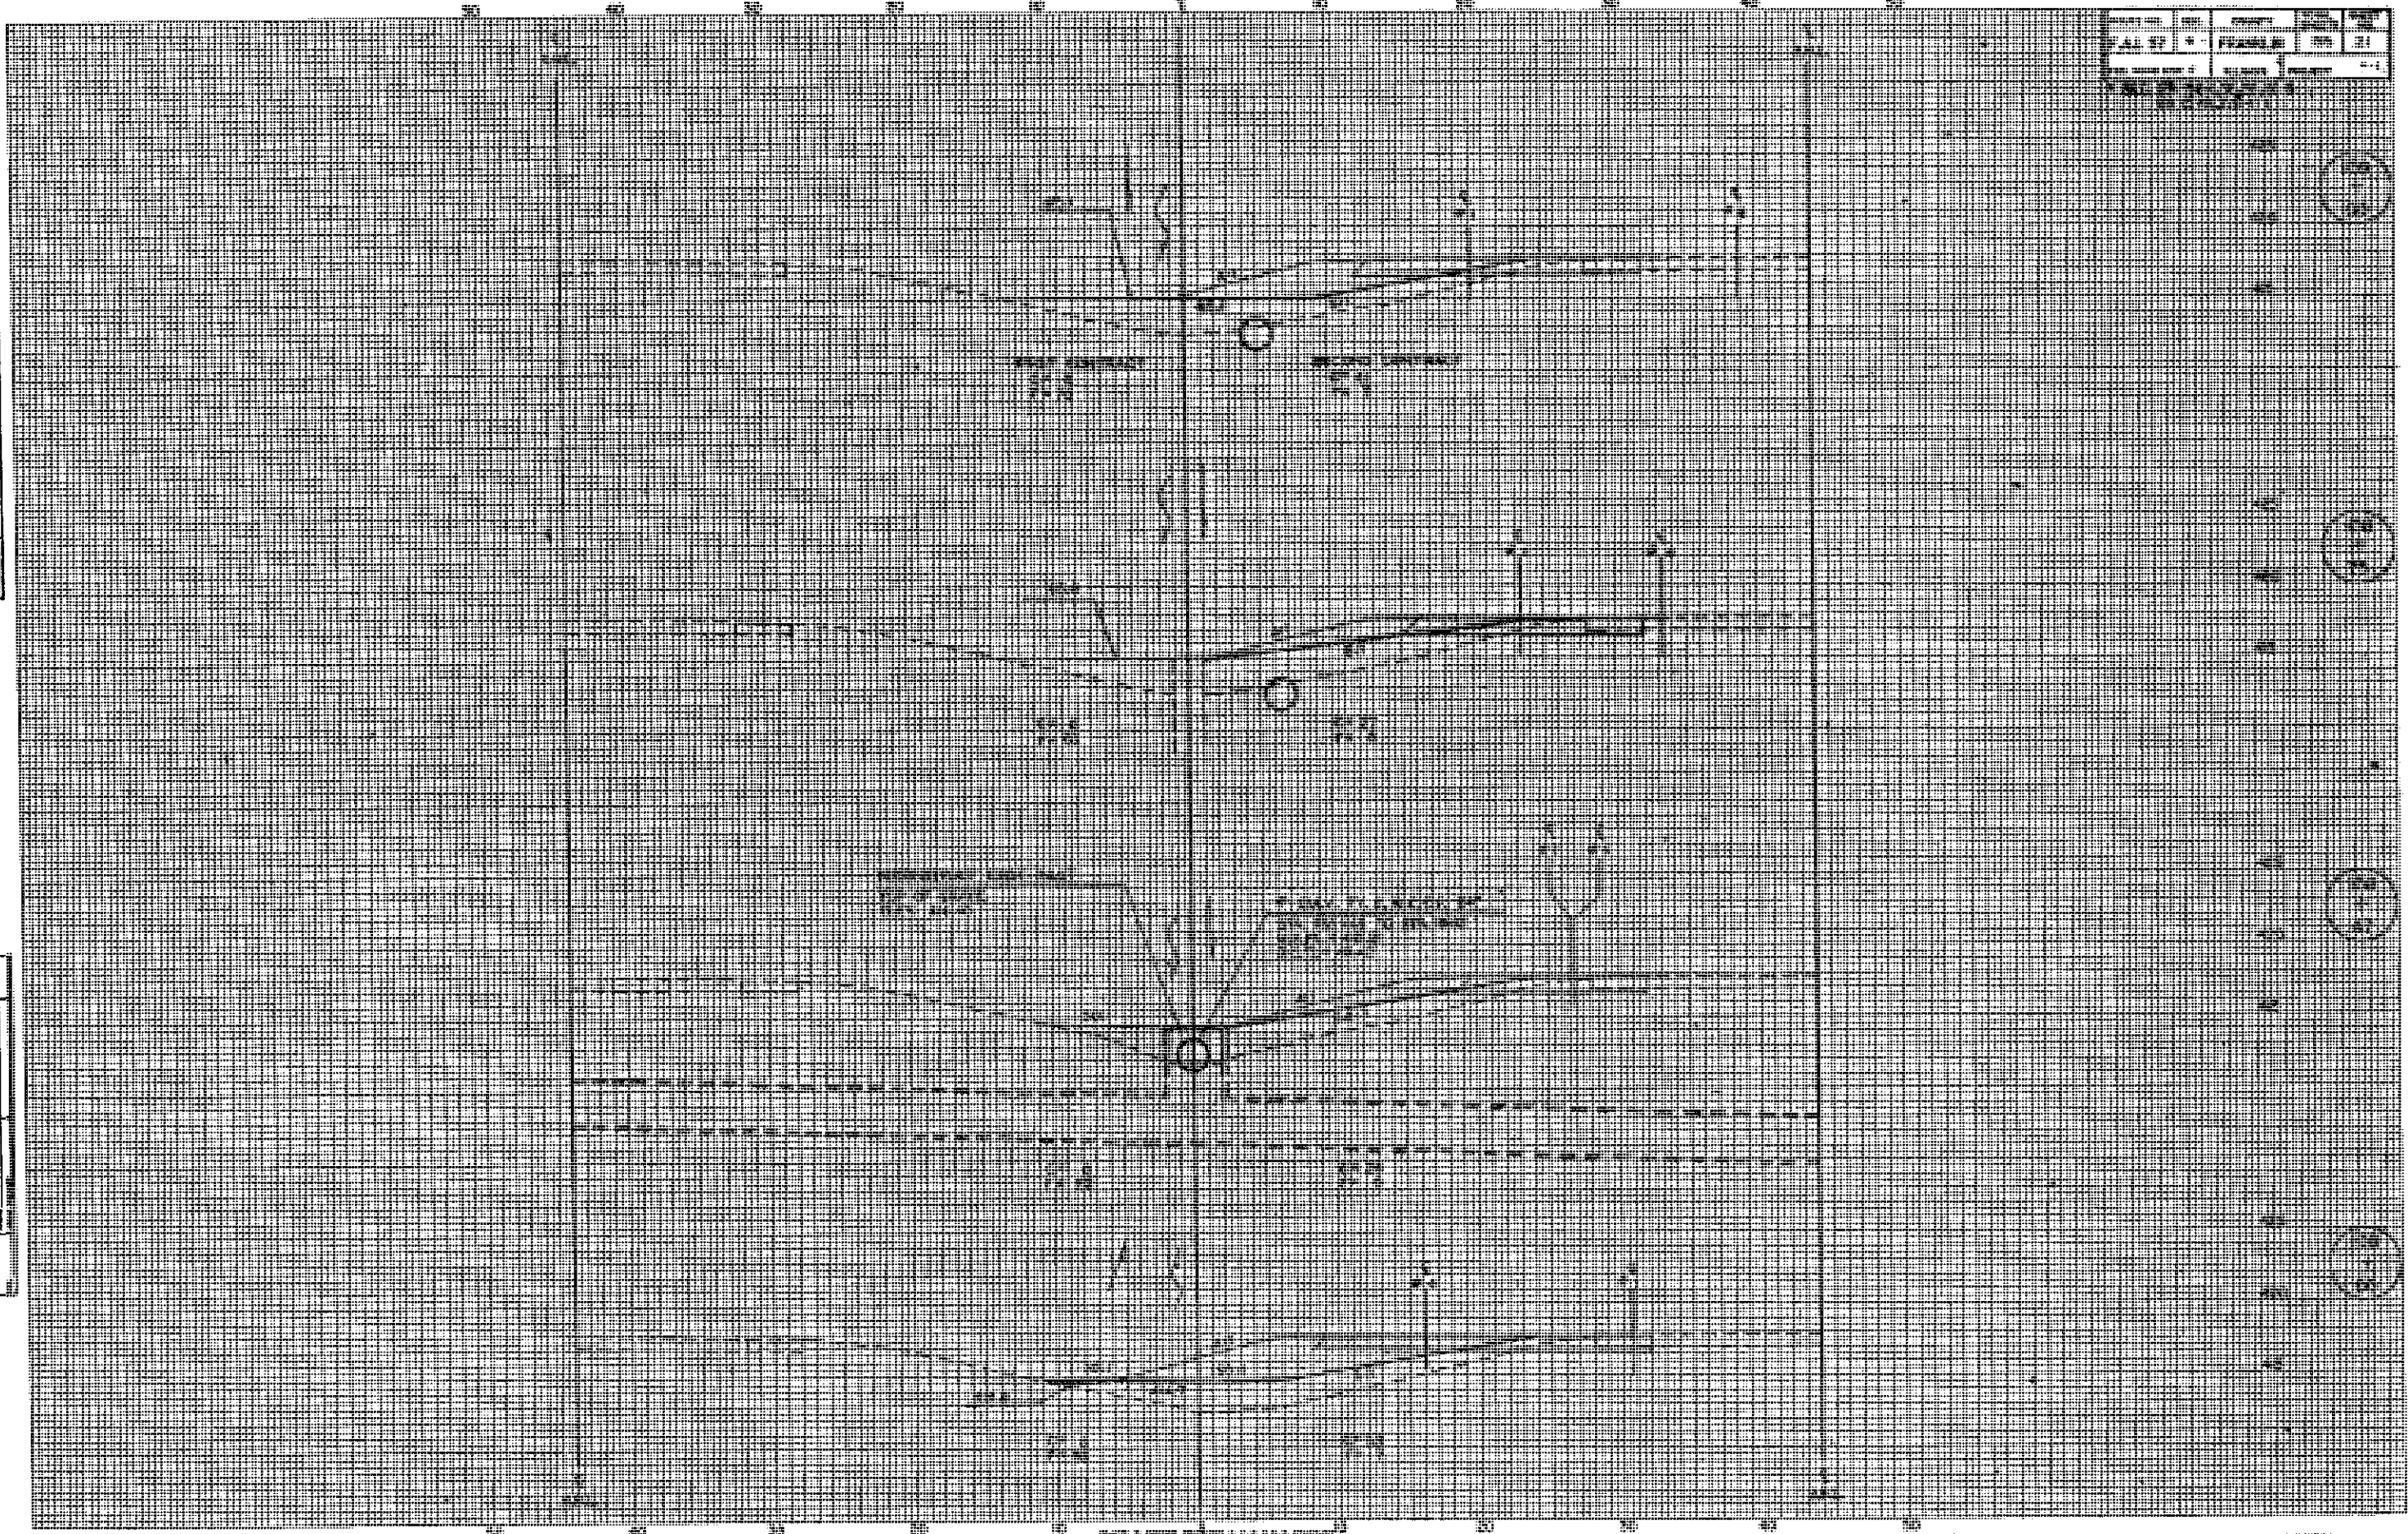




DATE	NO.	SECTION	PLAT
FALL 19	1	FRANKLIN	25
SECTION 1	BLANK		

DATE	NO.
SECTION	PLAT
ORIGINAL SURVEY NOTE BOOK	

DATE	NO.
SECTION	PLAT
ORIGINAL SURVEY NOTE BOOK	

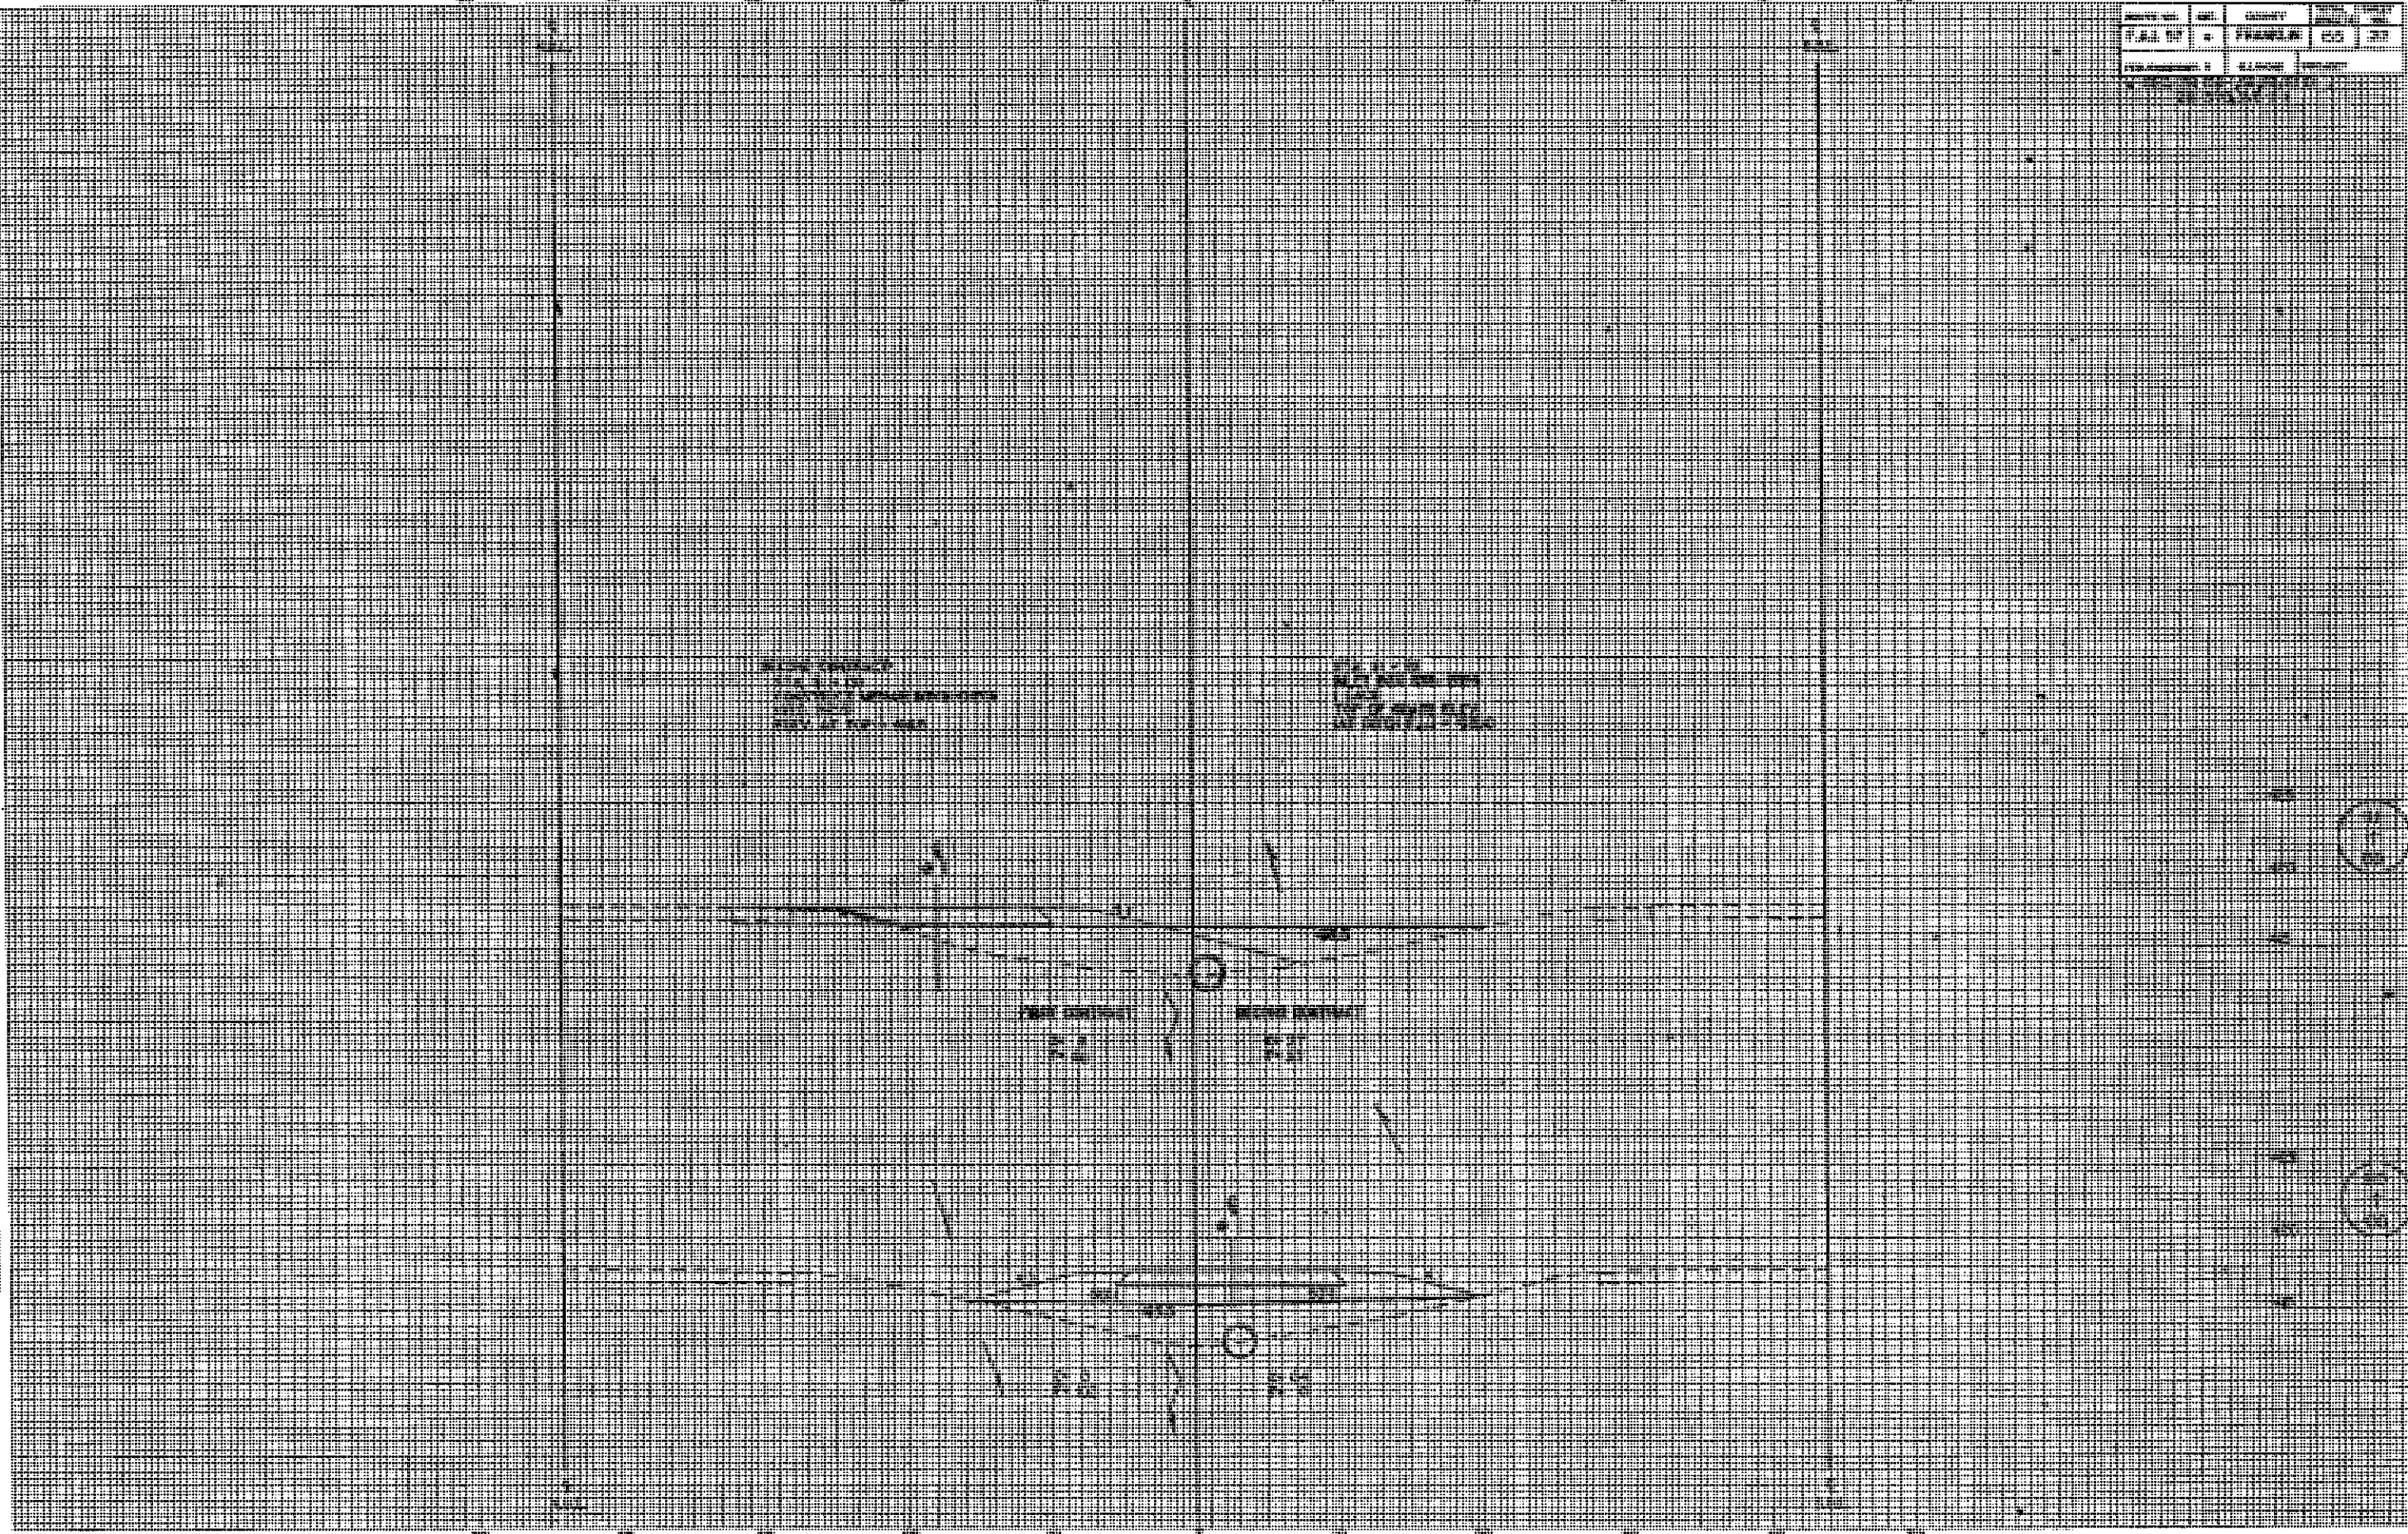




DATE	TIME	LOCATION	WIND	TEMP
FALL ST	+	FRANKLIN	BS	210
PROJECT				

DATE	TIME	LOCATION	WIND	TEMP

DATE	TIME	LOCATION	WIND	TEMP

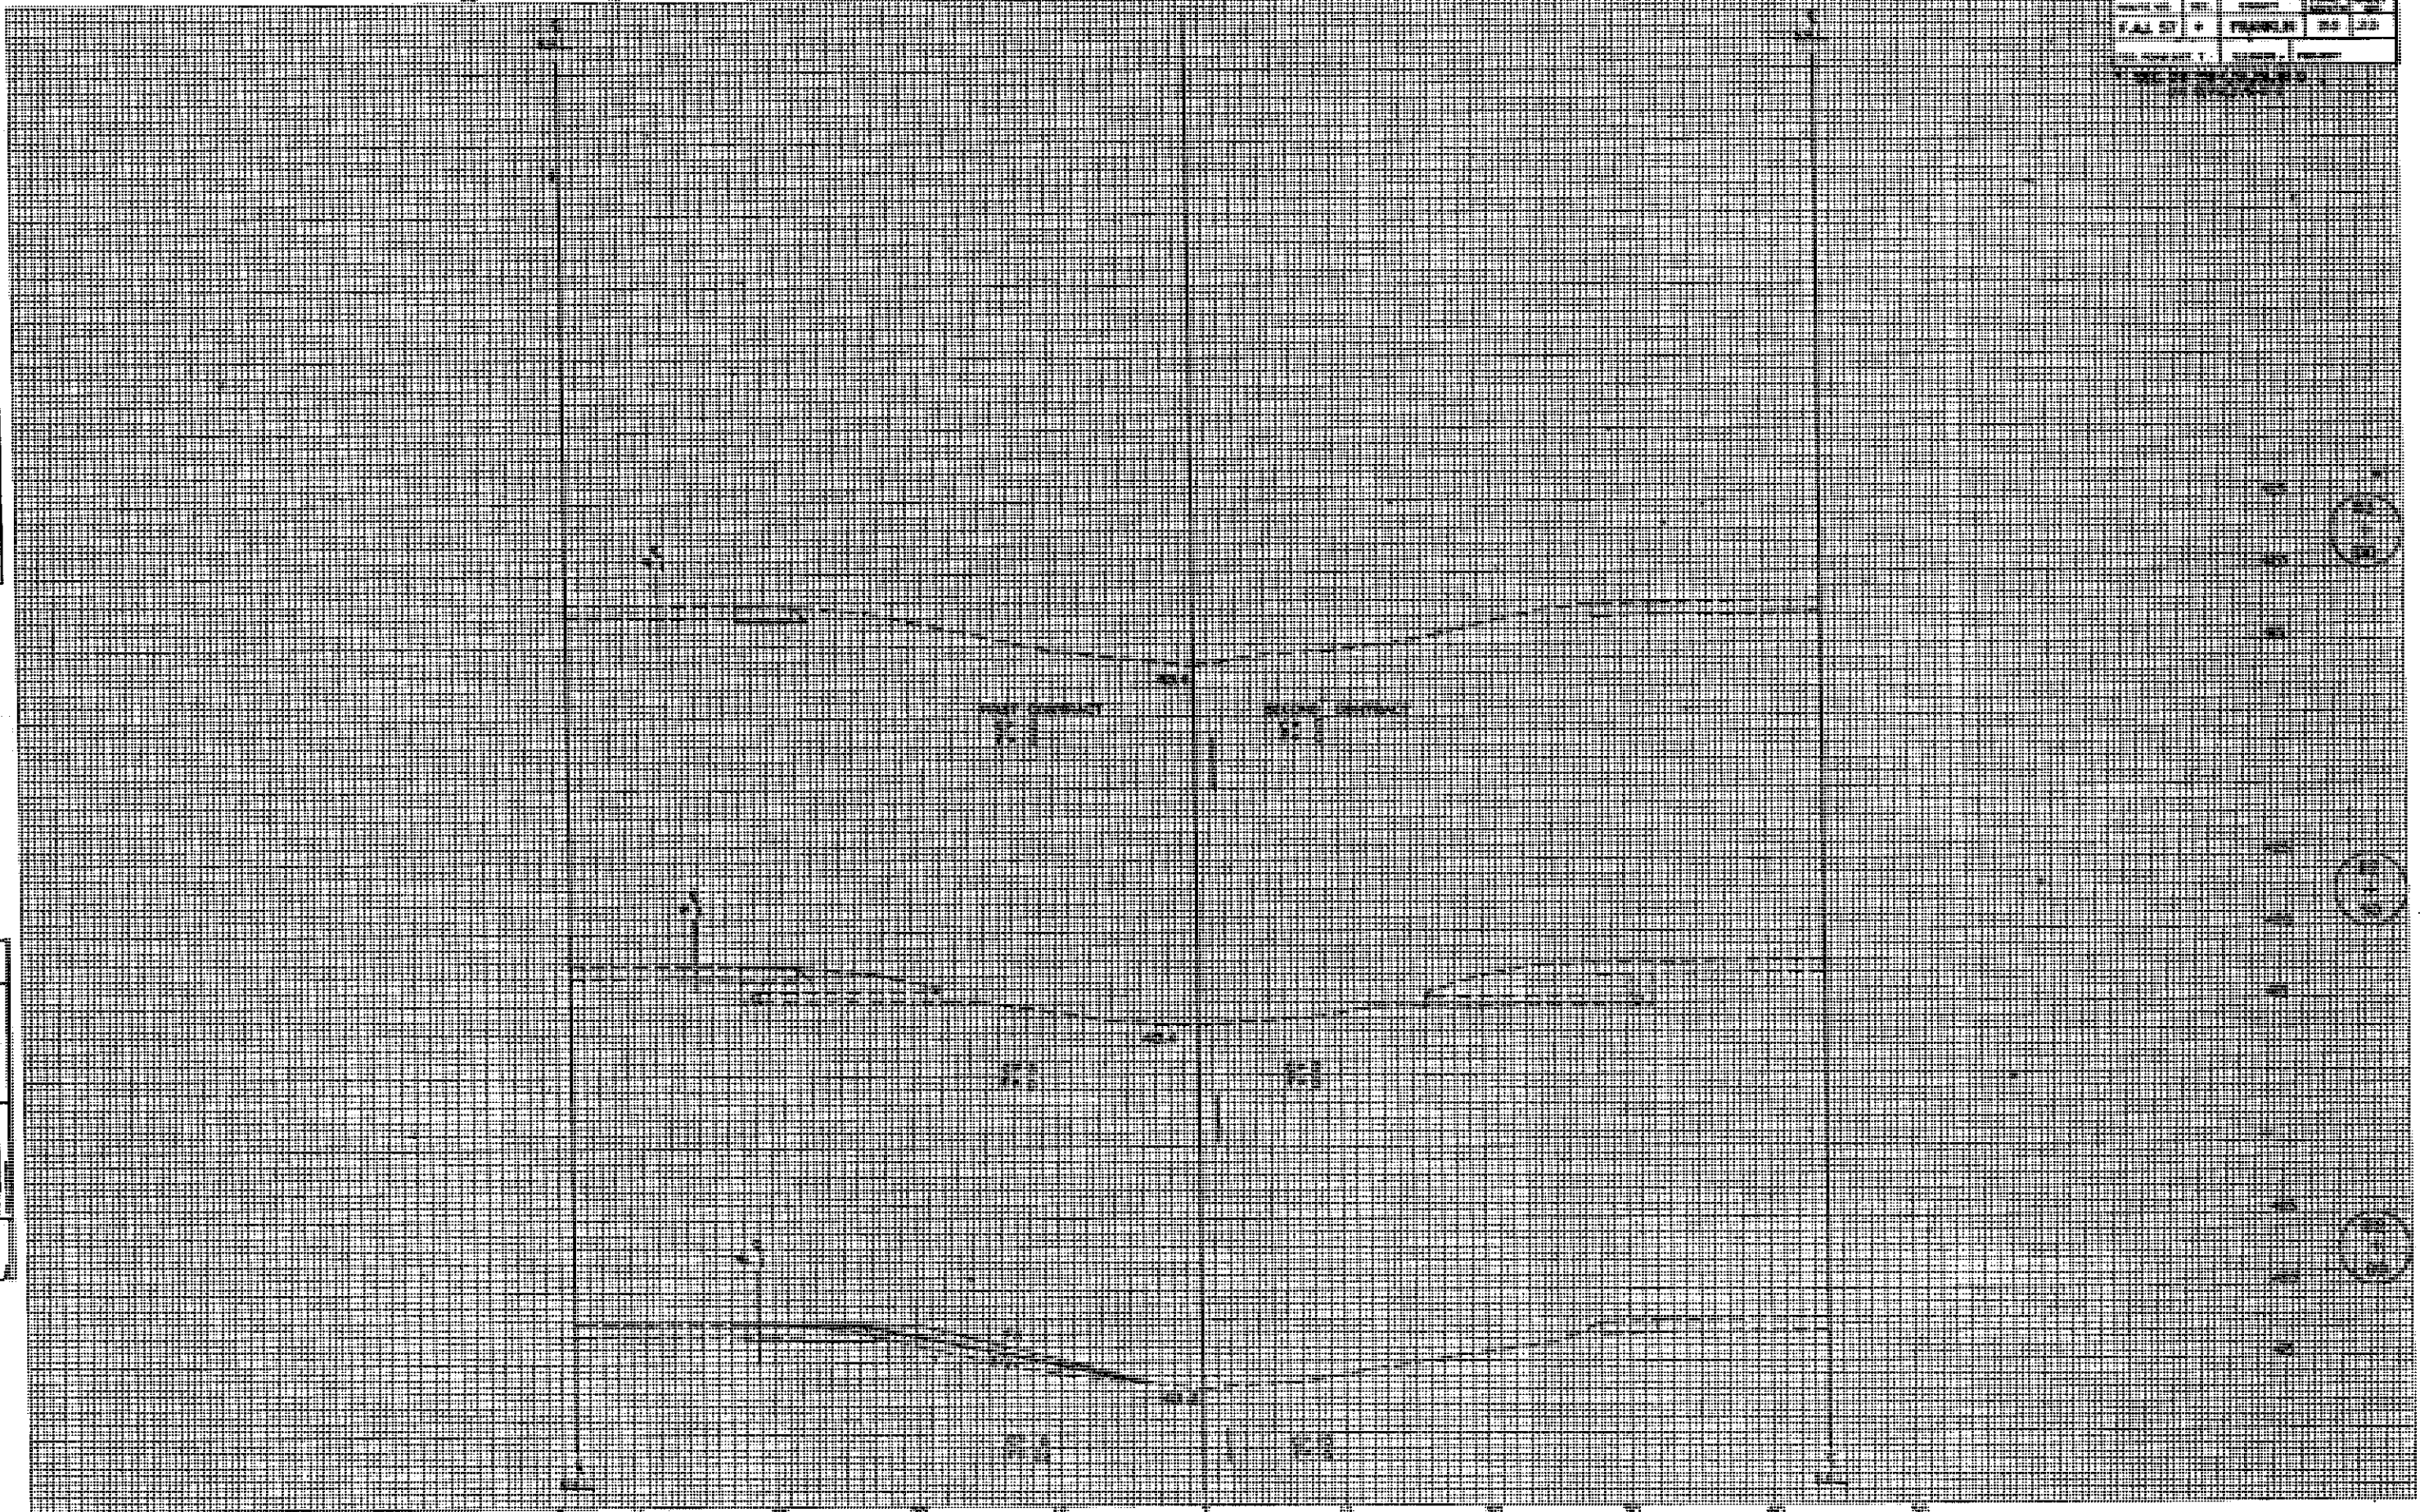

UNIVERSITY OF TORONTO LIBRARY

OLIN GREEN



Bench Mark: Top of 1/2" bolt imbedded in the S.E. corner of the east handrail on the southbound lane of the Gun Creek Bridge. Elev. 419.91

Existing structure: 028-0013 N.B. Built as F.A.I. Route 57 28-1B-F in 1962. The superstructure consists of R.C. deck supported on 3 span continuous W.F. beams. Temporary median cross-overs shall be utilized to divert traffic over adjacent bridge (028-0014 S.B.) during reconstruction.

STATE OF ILLINOIS  
DEPARTMENT OF TRANSPORTATION

ROUTE NO.	SECTION	COUNTY	LENS	POST	SHEET NO. 1
F.A.I. 57		FRANKLIN	155	24	16 SHEETS
PROJECT NO. 028-1B1D					

GENERAL NOTES

Field welding of construction accessories will not be permitted to the bottom flange of beams nor to the top flange for a distance equal to one-fourth the span length each way from the pier supports. Field welding in other areas will be permitted only when approved by the Engineer.

Reinforcement bars shall conform to the requirements of AASHTO M-31, M-42 or M-53 Grade 60.

Plan dimensions and details relative to existing structures have been taken from existing plans and Field Survey Elevations and are subject to nominal construction variations. It shall be the Contractor's responsibility to verify such dimensions and details in the field and make necessary approved adjustments prior to construction or ordering of materials. Such variations shall not be cause for additional compensation for a change in the scope of the work, however, the contractor will be paid for the quantity actually furnished of the unit price bid for the work.

Bearing seat surfaces shall be constructed or adjusted to the designated elevations within a tolerance of 1/8 inch. Adjustment shall be made by shimming the bearing. Two 1/2" adjusting shims, of the dimensions of the top bearing plate, shall be provided for each new bearing in addition to all other plates or shims.


The Contractor will be required to mark on top of the concrete deck, the locations of the top flange of all the steel beams, prior to any removal of the bridge concrete deck. Saw cutting directly over the top of the beam flanges is not permitted.

All top surfaces of the abutment seat area shall receive "Bridge Seat Sealer." Estimated quantity = 147 Sq. Ft.

The first two coats of the Lead and Chromate free Alkyd Paint System shall be used for shop and field painting of new structural steel.

Structural steel shall only be cleaned and painted as required by the special provision "Cleaning and Painting New Steel and Adjacent Areas of Existing Steel Structures".

Prior to pouring the new concrete for the deck, all loose rust, loose mill scale, and all other foreign material shall be removed from the embedded portions of flanges of stringers. The removal shall be accomplished in accordance with the requirements of the SSPC Surface Preparation Specifications SP-11 for power tool cleaning or SP-2 for hand tool cleaning. Cost shall be incidental to concrete removal.

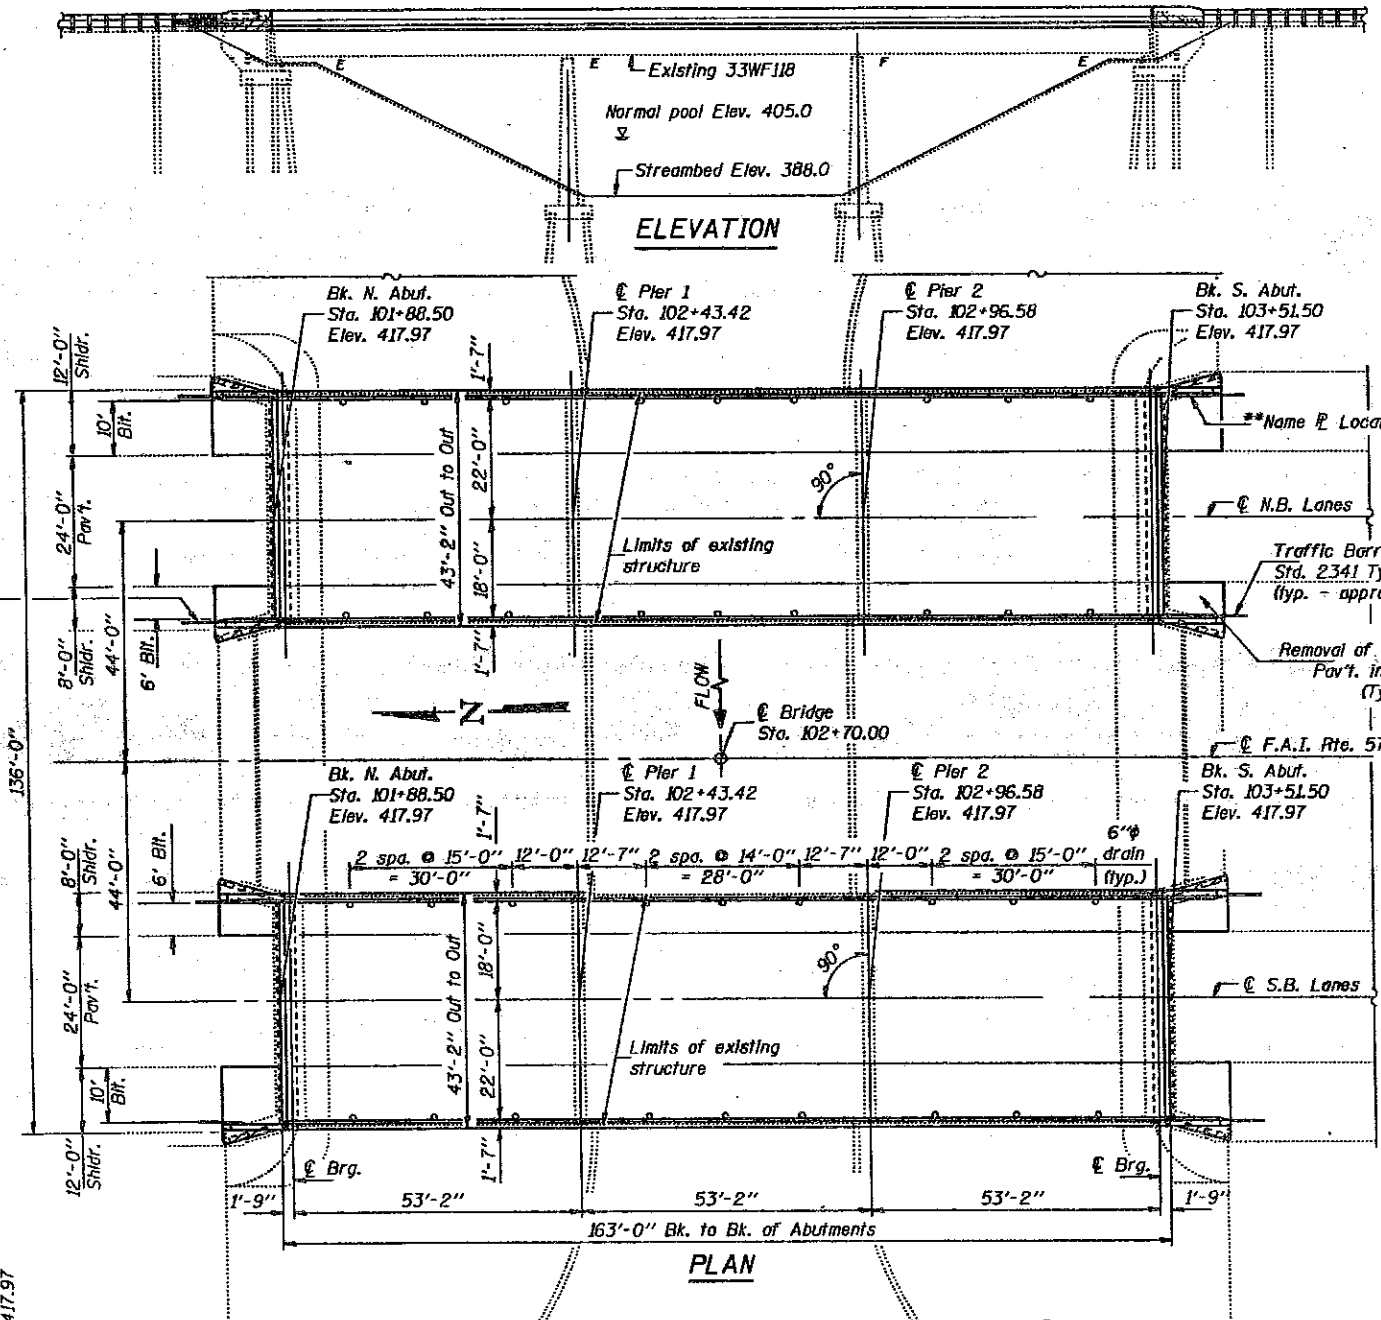

Traffic Barrier Terminal  
Std. 2340 Type 5  
(typ. - exit end)

Traffic Barrier Terminal  
Std. 2341 Type 6  
(typ. - approach end only)

Removal of Existing Bit. Appr. Shldr.  
Pav't. included in Rdwy. Plan.  
(Typ. all locations)


STATION 102 + 70.00  
BUILT 199 BY  
STATE OF ILLINOIS  
F.A.I. RT.57 SEC.(28-1B1D)  
F.A. PROJ. 028-1B1D  
LOADING HS20  
STR. NO. 028-0013

NAME PLATE  
See Std. 2113  
\*\*\*Existing Name Plate to be cleaned and relocated next to the new Name Plate on the New Parapet. Cost incidental to "Name Plates."

TOTAL BILL OF MATERIAL

ITEM	UNIT	SUPER	SUB	TOTAL
Concrete Removal	Cu. Yd.		9	9
Removal of Existing Concrete Deck	Each	1		1
Structure Excavation	Cu. Yd.		23	23
Floor Drains	Each	18		18
Preformed Joint Seal 2 1/2"	Lin. Ft.	43		43
Preformed Joint Seal 4"	Lin. Ft.	43		43
Class X Concrete Superstructure	Cu. Yd.	215.4		215.4
Protective Coat	Sq. Yd.	852		852
Elastomeric Bearing Assembly, Type I	Each	21		21
Structural Steel	Lbs.	10,450		10,450
Stud Shear Connectors	Each	3094		3094
Reinforcement Bars, Epoxy Coated	Pound	51,380		51,380
Name Plates	Each	1		1
Bridge Seat Sealer	L.S.		0.25	0.25
Jack and Remove Existing Brqs.	Each	28		28
Bridge Deck Grooving	Sq. Yd.	713		713

\*\*\* Includes deck & top and inside face of parapet.  
\*\* Includes removal of existing railing and expansion plates.

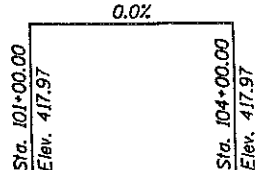

PROFILE GRADE  
(F.A.I. 57 along @ pavement)

DESIGNED: Michael A. Anderson, P.E.  
CHECKED: [Signature]  
DRAWN: E. Vann Taylor  
CHECKED: MAS, GAG

EXAMINED: [Signature]  
PASSED: [Signature]  
APPROVED: [Signature]

NOTE: Only the Northbound Structure is included in the Contract.

DESIGN SPECIFICATIONS


1989 AASHTO, 1990 & 1991 Interim Specifications & Seismic Retrofitting Guidelines for Highway Bridges.

LOADING HS 20-44 & ALT.

Allow 25#/sq. ft. for future wearing surface.

DESIGN STRESSES


FIELD UNITS  
New Construction  
 $f'_c = 3,500$  psi  
 $f_y = 60,000$  psi (Reinf.)  
 $f_y = 36,000$  psi (Str. Steel - M270 Gr. 36)  
Old Construction  
 $f_s = 20,000$  psi (Exist. Structural Steel)

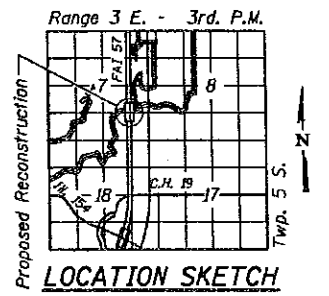

GENERAL PLAN  
F.A.I. ROUTE 57 OVER  
GUN CREEK  
F.A.I. ROUTE 57 SECTION (28-1B1D)  
FRANKLIN COUNTY  
STATION 102+70.00  
STRUCTURE NUMBER 028-0013 (N.B.)

STATE OF ILLINOIS  
DEPARTMENT OF TRANSPORTATION


PROJECT NO.	DISTRICT	COUNTY	SECTION	SHEET NO.
F.A.I. 57		FRANKLIN	155	25
FED. ROAD DIST. NO. 7		SHEET NO. 2		
"28-1B)D"		16 SHEETS		

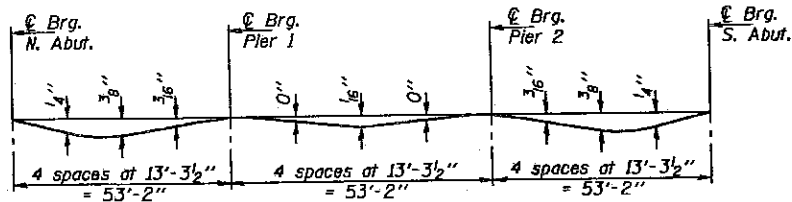

**DEAD LOAD DEFLECTION DIAGRAM**


(Includes weight of concrete only)

Note: The above deflections are not to be used in the field if the engineer is working from the grade elevations adjusted for dead load deflections as shown on Sheet #3 of 16.

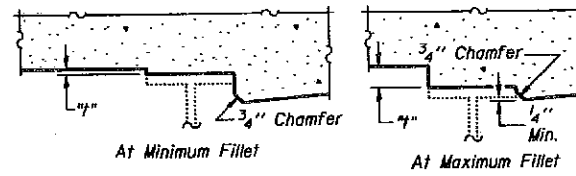

To determine "f": After all structural steel has been erected, elevations of the top flanges of the beams shall be taken at intervals shown below. These elevations subtracted from the "Theoretical Grade Elevations Adjusted for Dead Load Deflection" shown on Sheet #3 of 16, minus slab thickness, equals the fillet heights "f" above top flange of beams.

**FILLET HEIGHTS**

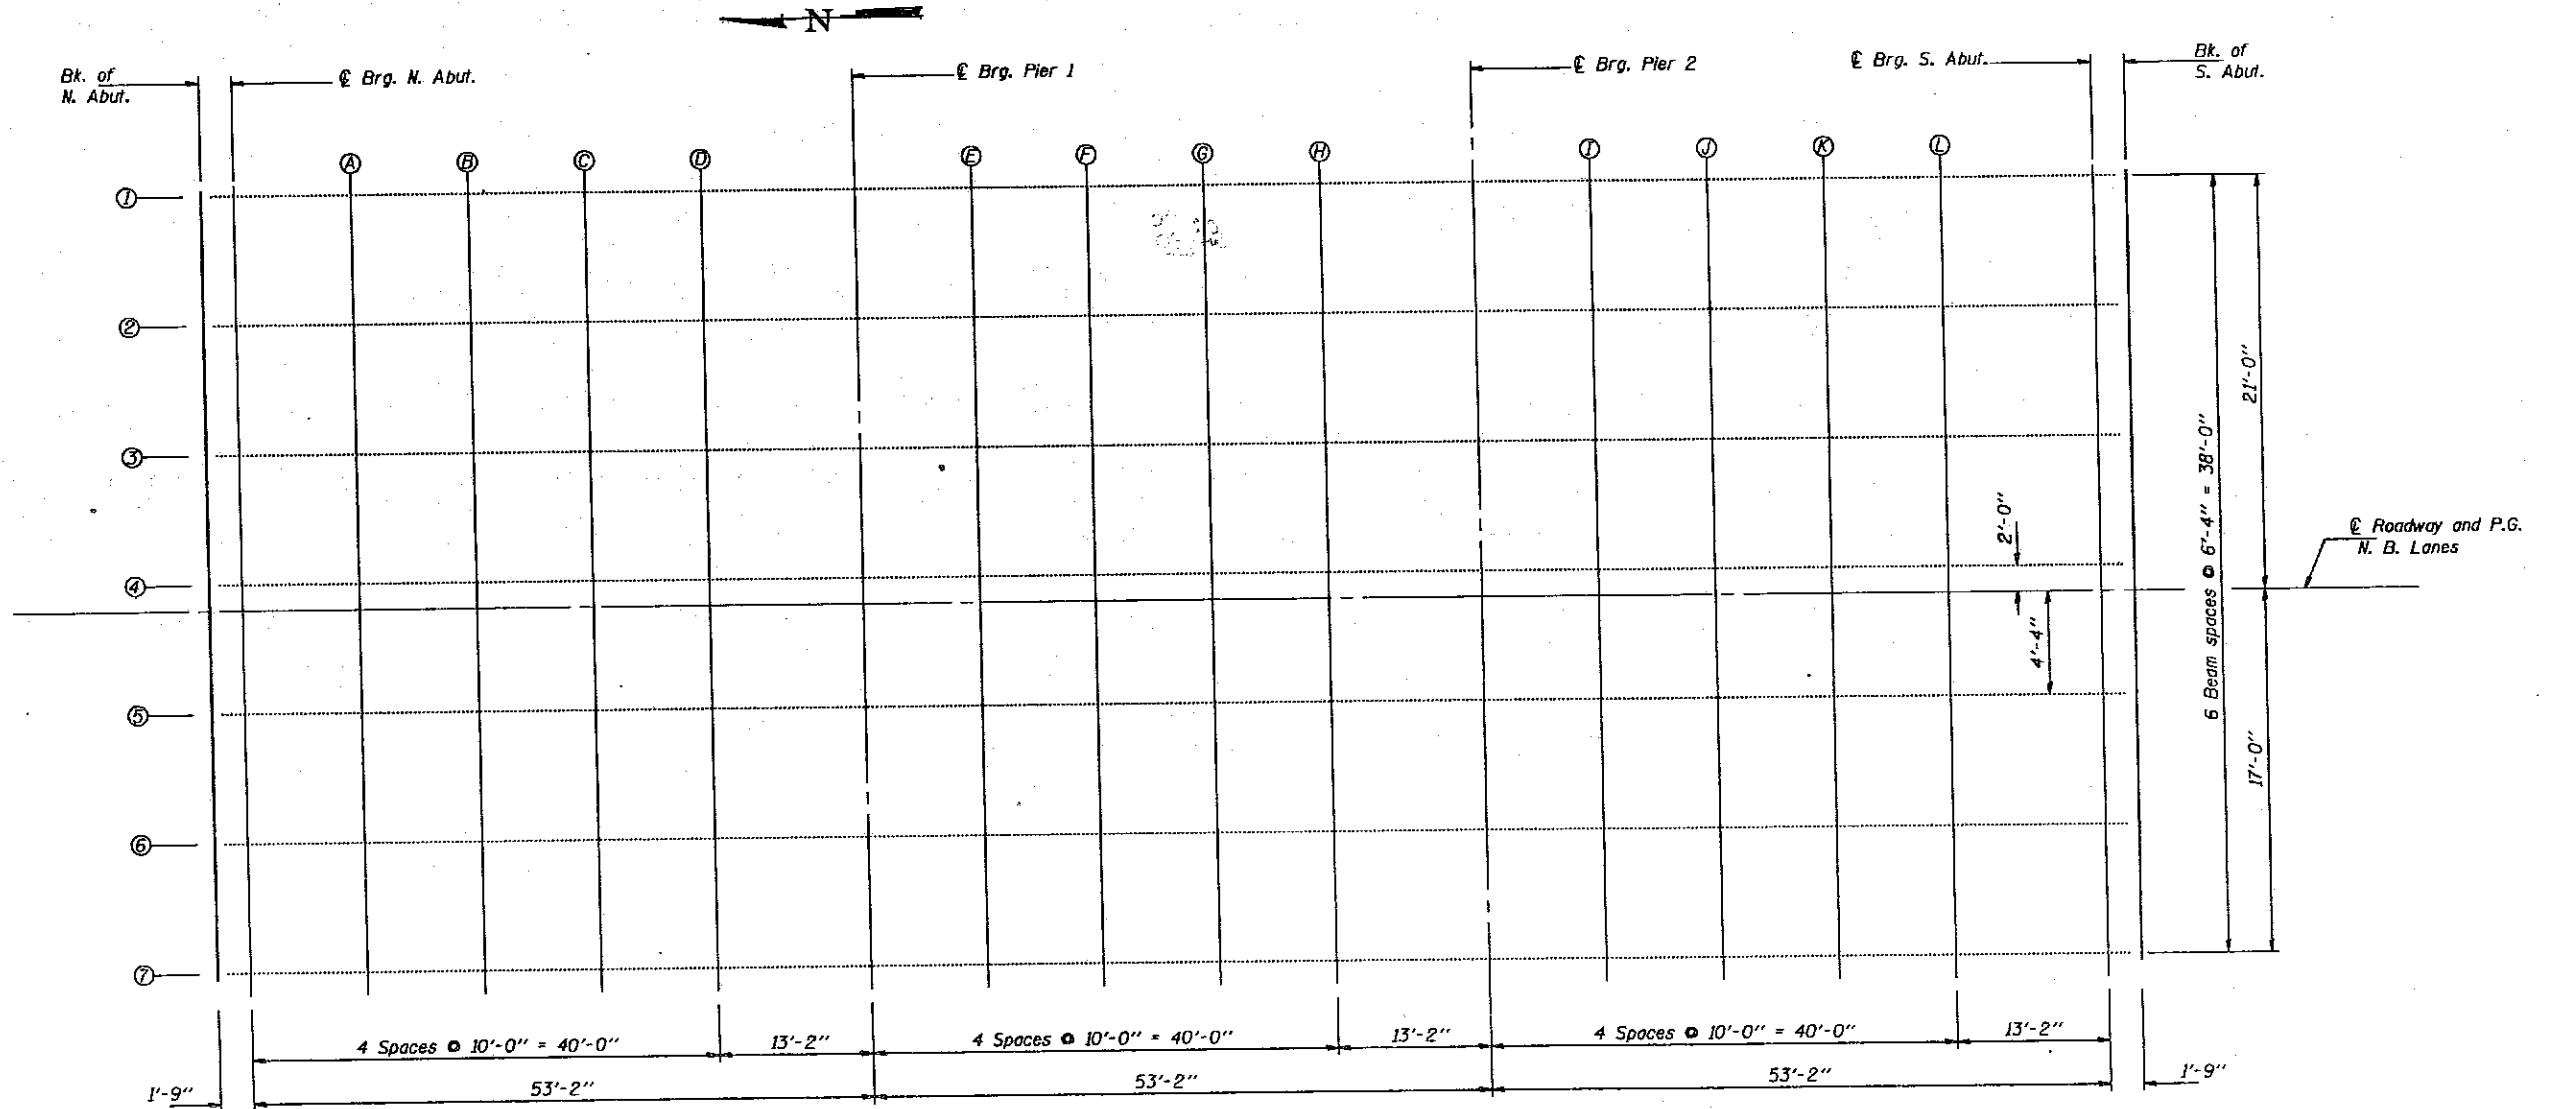

**PLAN**

DESIGNED Michael A. Stephenson, RSC  
CHECKED Shaker Asfour, GAG  
DRAWN E. Vern Teulor  
CHECKED MAS, GAG

May 22 1992  
EXAMINED [Signature]  
PASSED [Signature]  
APPROVED [Signature]  
DIRECTOR OF HIGHWAY

TOP OF SLAB ELEVATIONS  
F.A.I. RT. 57 SEC. (28-1B)D  
FRANKLIN COUNTY  
STATION 102+70.00

STATE OF ILLINOIS  
DEPARTMENT OF TRANSPORTATION

ROUTE NO.	SECTION	COUNTY	MILES	SHEET NO.	TOTAL SHEETS
P.A.L. 57		FRANKLIN	155	26	16 SHEETS
FED. ROAD DIST. NO. 7		BLANKS	FED. AID PROJECT		

\*28-1B1D

☉ BEAM 1

Location	Station	Offset	Theoretical Grade Elevations	Theoretical Grade Elevations Adjusted For Dead Load Deflection
BK. N. ABUT.	10188.500	21.000	417.658	417.658
☉ BRG. N. ABUT.	10190.250	21.000	417.658	417.658
A	10200.250	21.000	417.658	417.675
B	10210.250	21.000	417.658	417.685
C	10220.250	21.000	417.658	417.695
D	10230.250	21.000	417.658	417.675
☉ BRG. PIER 1	10243.417	21.000	417.658	417.658
E	10253.417	21.000	417.658	417.658
F	10263.417	21.000	417.658	417.659
G	10273.417	21.000	417.658	417.660
H	10283.417	21.000	417.658	417.658
☉ BRG. PIER 2	10296.583	21.000	417.658	417.658
I	10306.583	21.000	417.658	417.671
J	10316.583	21.000	417.658	417.681
K	10326.583	21.000	417.658	417.686
L	10336.583	21.000	417.658	417.681
☉ BRG. S. ABUT.	10349.750	21.000	417.658	417.658
BK. S. ABUT.	10351.500	21.000	417.658	417.658

☉ BEAM 2

Location	Station	Offset	Theoretical Grade Elevations	Theoretical Grade Elevations Adjusted For Dead Load Deflection
BK. N. ABUT.	10188.500	14.667	417.790	417.790
☉ BRG. N. ABUT.	10190.250	14.667	417.790	417.790
A	10200.250	14.667	417.790	417.807
B	10210.250	14.667	417.790	417.816
C	10220.250	14.667	417.790	417.816
D	10230.250	14.667	417.790	417.806
☉ BRG. PIER 1	10243.417	14.667	417.790	417.790
E	10253.417	14.667	417.790	417.790
F	10263.417	14.667	417.790	417.791
G	10273.417	14.667	417.790	417.792
H	10283.417	14.667	417.790	417.790
☉ BRG. PIER 2	10296.583	14.667	417.790	417.790
I	10306.583	14.667	417.790	417.802
J	10316.583	14.667	417.790	417.813
K	10326.583	14.667	417.790	417.818
L	10336.583	14.667	417.790	417.813
☉ BRG. S. ABUT.	10349.750	14.667	417.790	417.790
BK. S. ABUT.	10351.500	14.667	417.790	417.790

☉ BEAM 3

Location	Station	Offset	Theoretical Grade Elevations	Theoretical Grade Elevations Adjusted For Dead Load Deflection
BK. N. ABUT.	10188.500	8.333	417.910	417.910
☉ BRG. N. ABUT.	10190.250	8.333	417.910	417.910
A	10200.250	8.333	417.910	417.927
B	10210.250	8.333	417.910	417.936
C	10220.250	8.333	417.910	417.936
D	10230.250	8.333	417.910	417.926
☉ BRG. PIER 1	10243.417	8.333	417.910	417.910
E	10253.417	8.333	417.910	417.910
F	10263.417	8.333	417.910	417.911
G	10273.417	8.333	417.910	417.912
H	10283.417	8.333	417.910	417.910
☉ BRG. PIER 2	10296.583	8.333	417.910	417.910
I	10306.583	8.333	417.910	417.922
J	10316.583	8.333	417.910	417.933
K	10326.583	8.333	417.910	417.938
L	10336.583	8.333	417.910	417.933
☉ BRG. S. ABUT.	10349.750	8.333	417.910	417.910
BK. S. ABUT.	10351.500	8.333	417.910	417.910

☉ BEAM 4

Location	Station	Offset	Theoretical Grade Elevations	Theoretical Grade Elevations Adjusted For Dead Load Deflection
BK. N. ABUT.	10188.500	2.000	417.967	417.967
☉ BRG. N. ABUT.	10190.250	2.000	417.967	417.967
A	10200.250	2.000	417.967	417.984
B	10210.250	2.000	417.967	417.993
C	10220.250	2.000	417.967	417.993
D	10230.250	2.000	417.967	417.983
☉ BRG. PIER 1	10243.417	2.000	417.967	417.967
E	10253.417	2.000	417.967	417.967
F	10263.417	2.000	417.967	417.968
G	10273.417	2.000	417.967	417.969
H	10283.417	2.000	417.967	417.967
☉ BRG. PIER 2	10296.583	2.000	417.967	417.967
I	10306.583	2.000	417.967	417.979
J	10316.583	2.000	417.967	417.990
K	10326.583	2.000	417.967	417.995
L	10336.583	2.000	417.967	417.990
☉ BRG. S. ABUT.	10349.750	2.000	417.967	417.967
BK. S. ABUT.	10351.500	2.000	417.967	417.967

☉ ROADWAY AND P. G.

Location	Station	Offset	Theoretical Grade Elevations	Theoretical Grade Elevations Adjusted For Dead Load Deflection
BK. N. ABUT.	10188.500	0.000	417.970	417.970
☉ BRG. N. ABUT.	10190.250	0.000	417.970	417.970
A	10200.250	0.000	417.970	417.988
B	10210.250	0.000	417.970	417.997
C	10220.250	0.000	417.970	417.997
D	10230.250	0.000	417.970	417.987
☉ BRG. PIER 1	10243.417	0.000	417.970	417.970
E	10253.417	0.000	417.970	417.970
F	10263.417	0.000	417.970	417.972
G	10273.417	0.000	417.970	417.972
H	10283.417	0.000	417.970	417.970
☉ BRG. PIER 2	10296.583	0.000	417.970	417.970
I	10306.583	0.000	417.970	417.983
J	10316.583	0.000	417.970	417.994
K	10326.583	0.000	417.970	417.998
L	10336.583	0.000	417.970	417.993
☉ BRG. S. ABUT.	10349.750	0.000	417.970	417.970
BK. S. ABUT.	10351.500	0.000	417.970	417.970

☉ BEAM 5

Location	Station	Offset	Theoretical Grade Elevations	Theoretical Grade Elevations Adjusted For Dead Load Deflection
BK. N. ABUT.	10188.500	-4.333	417.954	417.954
☉ BRG. N. ABUT.	10190.250	-4.333	417.954	417.954
A	10200.250	-4.333	417.954	417.971
B	10210.250	-4.333	417.954	417.980
C	10220.250	-4.333	417.954	417.980
D	10230.250	-4.333	417.954	417.970
☉ BRG. PIER 1	10243.417	-4.333	417.954	417.954
E	10253.417	-4.333	417.954	417.954
F	10263.417	-4.333	417.954	417.955
G	10273.417	-4.333	417.954	417.956
H	10283.417	-4.333	417.954	417.954
☉ BRG. PIER 2	10296.583	-4.333	417.954	417.954
I	10306.583	-4.333	417.954	417.966
J	10316.583	-4.333	417.954	417.977
K	10326.583	-4.333	417.954	417.982
L	10336.583	-4.333	417.954	417.977
☉ BRG. S. ABUT.	10349.750	-4.333	417.954	417.954
BK. S. ABUT.	10351.500	-4.333	417.954	417.954

☉ BEAM 6

Location	Station	Offset	Theoretical Grade Elevations	Theoretical Grade Elevations Adjusted For Dead Load Deflection
BK. N. ABUT.	10188.500	-10.667	417.871	417.871
☉ BRG. N. ABUT.	10190.250	-10.667	417.871	417.871
A	10200.250	-10.667	417.871	417.889
B	10210.250	-10.667	417.871	417.898
C	10220.250	-10.667	417.871	417.898
D	10230.250	-10.667	417.871	417.888
☉ BRG. PIER 1	10243.417	-10.667	417.871	417.871
E	10253.417	-10.667	417.871	417.871
F	10263.417	-10.667	417.871	417.873
G	10273.417	-10.667	417.871	417.874
H	10283.417	-10.667	417.871	417.871
☉ BRG. PIER 2	10296.583	-10.667	417.871	417.871
I	10306.583	-10.667	417.871	417.884
J	10316.583	-10.667	417.871	417.895
K	10326.583	-10.667	417.871	417.900
L	10336.583	-10.667	417.871	417.894
☉ BRG. S. ABUT.	10349.750	-10.667	417.871	417.871
BK. S. ABUT.	10351.500	-10.667	417.871	417.871

☉ BEAM 7

Location	Station	Offset	Theoretical Grade Elevations	Theoretical Grade Elevations Adjusted For Dead Load Deflection
BK. N. ABUT.	10188.500	-17.000	417.741	417.741
☉ BRG. N. ABUT.	10190.250	-17.000	417.741	417.741
A	10200.250	-17.000	417.741	417.759
B	10210.250	-17.000	417.741	417.768
C	10220.250	-17.000	417.741	417.768
D	10230.250	-17.000	417.741	417.758
☉ BRG. PIER 1	10243.417	-17.000	417.741	417.741
E	10253.417	-17.000	417.741	417.741
F	10263.417	-17.000	417.741	417.743
G	10273.417	-17.000	417.741	417.743
H	10283.417	-17.000	417.741	417.741
☉ BRG. PIER 2	10296.583	-17.000	417.741	417.741
I	10306.583	-17.000	417.741	417.754
J	10316.583	-17.000	417.741	417.765
K	10326.583	-17.000	417.741	417.769
L	10336.583	-17.000	417.741	417.764
☉ BRG. S. ABUT.	10349.750	-17.000	417.741	417.741
BK. S. ABUT.	10351.500	-17.000	417.741	417.741

Note: Work this sheet with sheet #2 of 16.

DESIGNED <i>Michael A. Johnson, E.S.</i>
CHECKED <i>Shaker Aslam, GAG</i>
DRAWN <i>E. Vern Taylor</i>
CHECKED <i>MAS, GAG</i>


MAY 22 1992  
 EXAMINED *Orsi J. Kaspar*  
 PASSED *Ralph E. Anderson*  
 APPROVED \_\_\_\_\_  
DIRECTOR OF HIGHWAYS

E-S 1-6-82


TOP OF SLAB ELEVATIONS  
 F.A.I. RT. 57 SEC. (28-1B1D)  
 FRANKLIN COUNTY  
 STATION 102+70.00

STATE OF ILLINOIS  
DEPARTMENT OF TRANSPORTATION

PROJECT NO.	SECTION	COUNTY	SHEET NO.	TOTAL SHEETS
57		FRANKLIN	155	27
SHEET NO. 4				
16 SHEETS				

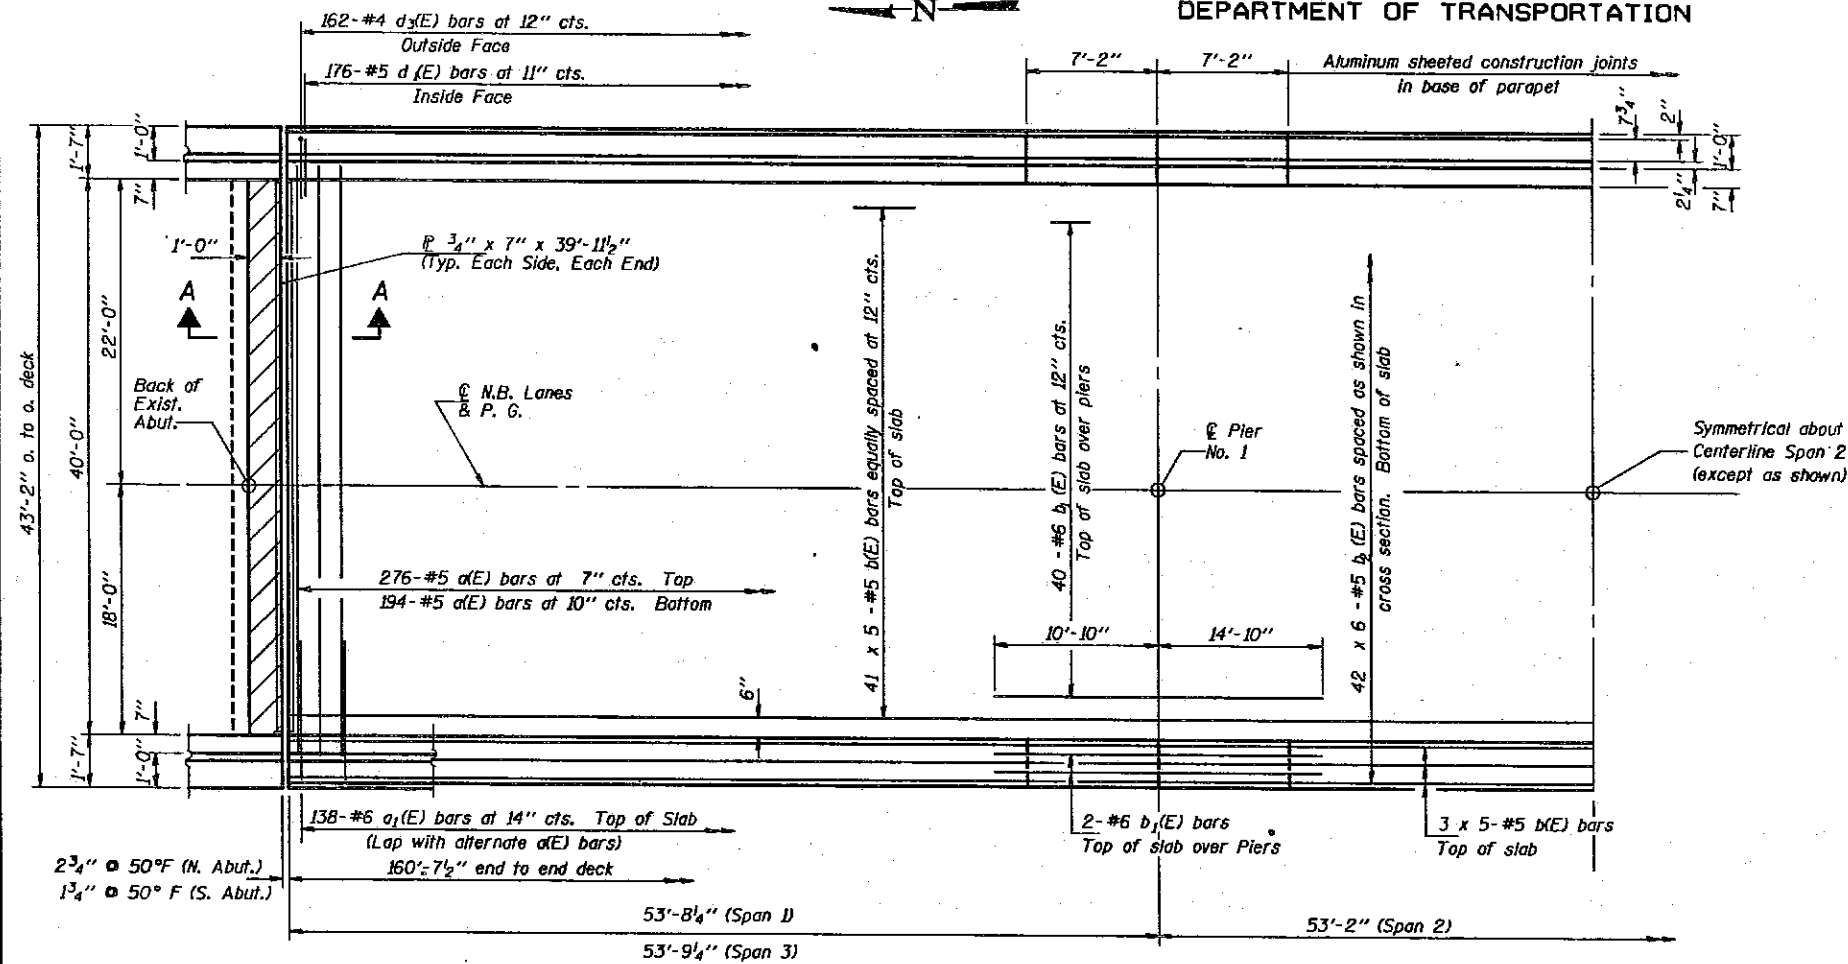

HALF PLAN

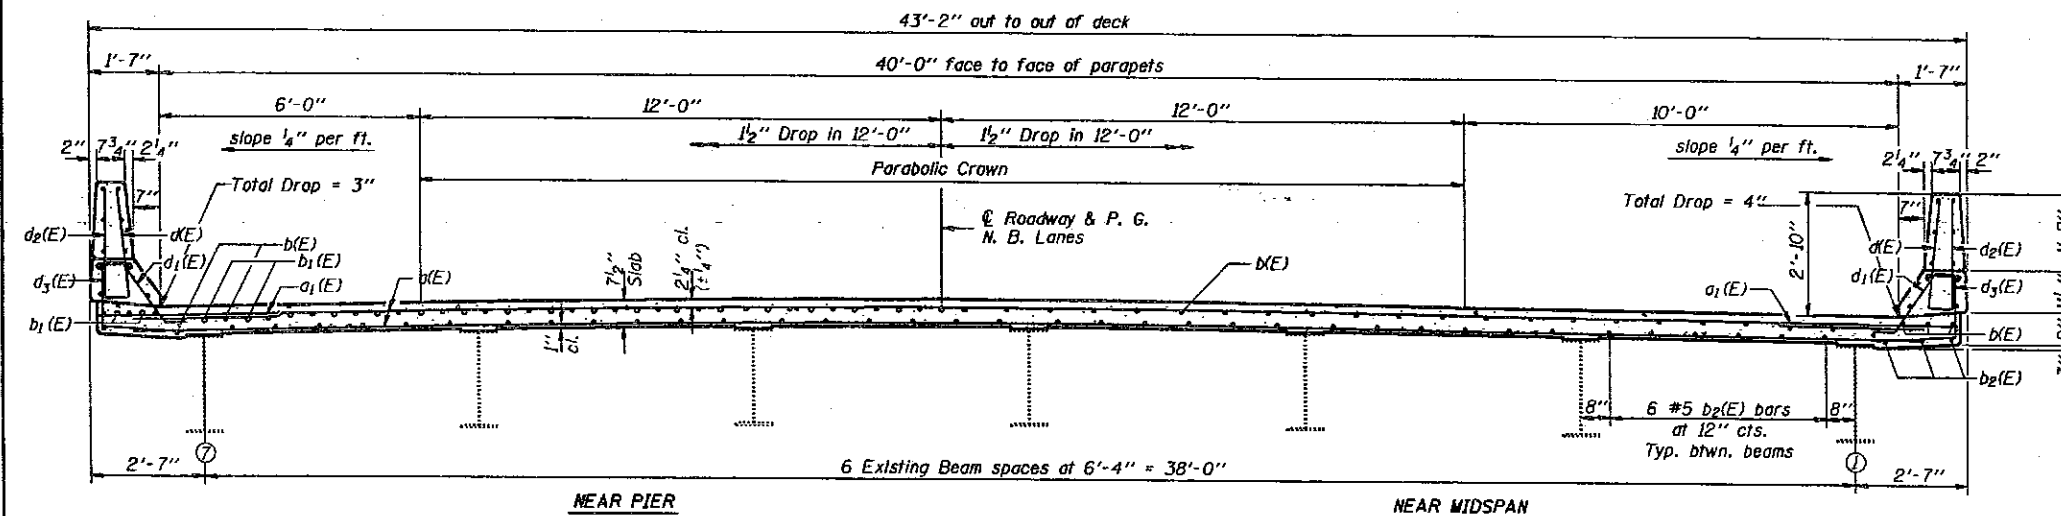

CROSS SECTION  
(Looking North)

Notes: See sheets #5 and #6 of 16 for superstructure details, parapet reinforcement and Bill of Material.  
Reinforcement bars designated (E) shall be epoxy coated.  
Reinforcement bars indicated thus 40 x 4 #5 etc. indicates 40 lines of bars with 4 lengths per line.  
See sheet #1 of 16 for drain locations and sheet #5 of 16 for details.  
Hatched area to be poured after superstructure forms have been removed. Quantity of concrete to be included with Class X Concrete Superstructure.  
For Sec. A-A See Sht. 6 of 16.

MIN. BAR LAPS  
#5 bars = 1'-8"

DESIGNED	Michael A. Sigler, R.S.
CHECKED	Shaker Astor, GAG
DRAWN	E. Vern Taylor
CHECKED	MAS, GAG

May 22 1992  
EXAMINED *[Signature]*  
PASSED *[Signature]*  
APPROVED \_\_\_\_\_  
DIRECTOR OF HIGHWAYS

S-1-0 12-31-87

SUPERSTRUCTURE  
F.A.I. RT. 57 SEC. (28-1B)D  
FRANKLIN COUNTY  
STATION 102+70.00







STATE OF ILLINOIS  
DEPARTMENT OF TRANSPORTATION

ROUTE NO.	DISTRICT	COUNTY	JOB SHEETS	SHEET	SHEET NO. 6 16 SHEETS
U.S. 57		FRANKLIN	155	29	
FED. ROAD DIST. NO. 7		ILLINOIS	FED. AID PROJECT		


\*28-1B10

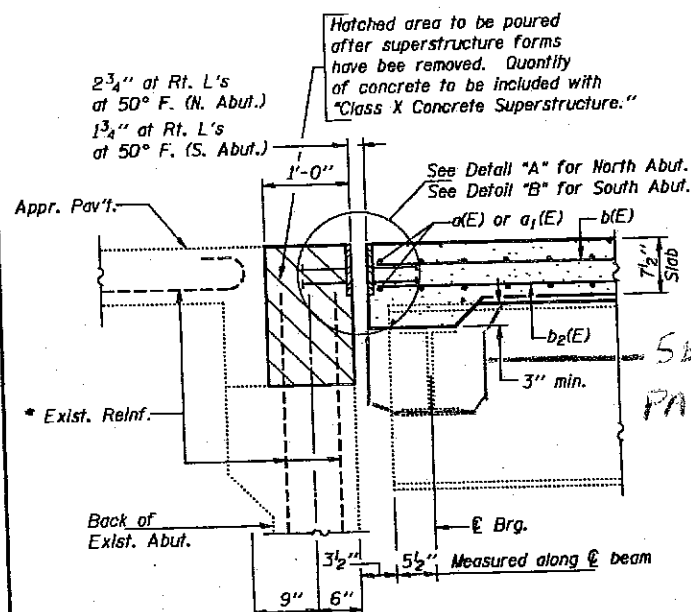

SECTION A-A

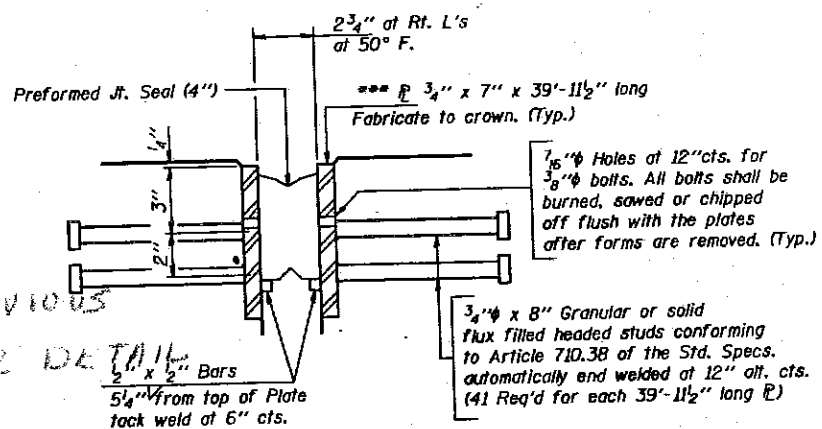

DETAIL "A"

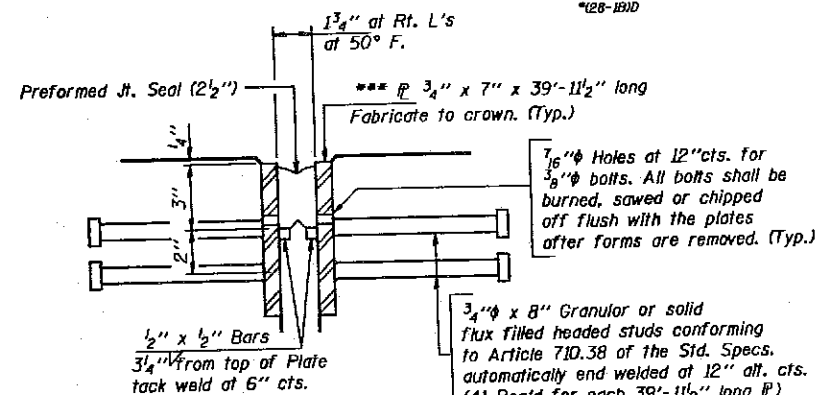

DETAIL "B"


\*\*\* Furnish in segments of 20 ft. maximum length. Maximum space between installed segments shall be 3/6". Seal space with Silicone Sealant suitable for Structural Steel.

SEE PREVIOUS PAGE FOR DETAIL


Notes: After fabrication all surfaces of the steel plates shall be given one shop coat of paint specified for Structural Steel. No field painting required.

\*\*Reinforcement is included in Abutment & Approach Slab Bill of Material.


\* Existing vertical Reinforcement in the back wall and the longitudinal reinforcement in the approach slab shall be cleaned and straightened and incorporated into new construction. Cost incidental to "Concrete Removal."

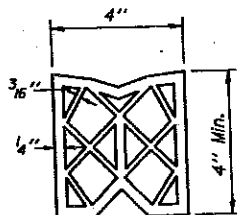


PREFORMED JOINT SEAL (4")  
North Abutment

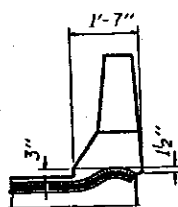


END TREATMENT  
Typ. for (4") and (2 1/2").

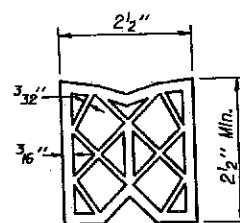


PREFORMED JOINT SEAL (2 1/2")  
South Abutment

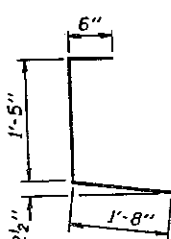

BAR d3(E)

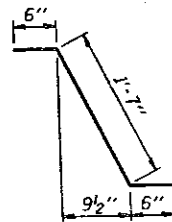

BAR d1(E)

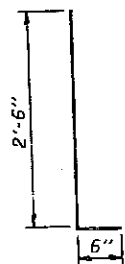

BARS d(E) & d2(E)

SUPERSTRUCTURE  
BILL OF MATERIAL

Bar	No.	Size	Length	Shape
d(E)	470	#5	41'-2"	—
a1(E)	276	#6	4'-0"	—
b(E)	235	#5	33'-5"	—
b1(E)	88	#6	25'-8"	—
b2(E)	252	#5	28'-2"	—
d1(E)	352	#5	3'-0"	L
d2(E)	324	#4	3'-0"	L
d3(E)	324	#4	3'-7"	L
e1(E)	48	#4	6'-11"	—
e2(E)	72	#4	15'-3"	—
e3(E)	24	#4	19'-2"	—
e4(E)	16	#8	6'-11"	—
e5(E)	8	#8	46'-3"	—
e6(E)	4	#8	38'-7"	—
e7(E)	16	#5	6'-11"	—
e8(E)	8	#5	46'-3"	—
e9(E)	4	#5	38'-7"	—
Reinforcement Bars, Epoxy Coated			Lbs.	47,920
Class X Concrete Superstructure			Cu. Yd.	215.4

Reinforcement bars designated (E) shall be epoxy coated.

SUPERSTRUCTURE DETAILS  
F.A.I. RT. 57 SEC. (28-1B10)  
FRANKLIN COUNTY  
STATION 102+70.00

DESIGNED: Michael A. Stephenson, RSC  
CHECKED: Shaker Ashour, GAG  
DRAWN: E. Vern Taylor  
CHECKED: M.S. GAG

EXAMINED: [Signature]  
PASSED: [Signature]  
APPROVED: [Signature]

May 22 1992

STATE OF ILLINOIS  
DEPARTMENT OF TRANSPORTATION

PROJECT NO.	SECTION	COUNTY	DATE	SHEET NO.
P.A. 57	*	FRANKLIN	155	90
PUBLISHED SHEET NO. 7		SHEET NO.		16 SHEETS
*28-IBJD				

**\* INTERIOR BEAM MOMENT TABLE**

	0.4 Sp. 1 or 0.6 Sp. 3	Pier 1 or Pier 2	0.5 Sp. 2
$I_s$ (in <sup>4</sup> )	5900	5900	5900
$I_c$ (in <sup>4</sup> )	15782		15782
$S_s$ (in <sup>3</sup> )	359	359	359
$S_c$ (in <sup>3</sup> )	530		530
$\phi$ (K/ft.)	.75	1.03	.75
$M\phi$ (K)	169	271	53
$f_s \phi$ non-comp (k.s.i.)	5.6	9.1	1.8
$s\phi$ (K/ft.)	.276		.276
$M_s\phi$ (K)	69		37
$M\phi$ (K)	329	160	267
$M$ (Imp) (K)	92	45	75
$M$ (Total) (K)	490	205	379
$f_s$ (Comp) (k.s.i.)	11.1	6.9	8.6
$f_s$ (Total) (k.s.i.)	16.7	16.0	10.4
VR (K)	41		40

**\* INTERIOR BEAM REACTION TABLE**

	Abuts.	Piers
$R\phi$ (K)	22.2	59.7
$R\phi$ (K)	32.8	38.4
Imp. (K)	9.2	10.8
$R$ (Total) (K)	64.2	108.9

**\* Service Load Values.**

$I_s$  and  $S_s$  are the moment of inertia and section modulus of the steel section used in computing  $f_s$  (Total).

$I_c$  and  $S_c$  are the moment of inertia and section modulus of the composite section used in computing  $f_s$  (Total).

VR is the maximum live Load + Impact shear range in span.

$M$  (Total) =  $M_s \phi + (M \phi + I)$






$f_s$  (Total) is the sum of the stresses due to  $[M \phi + M_s \phi + (M \phi + I)]$

$M \phi$  is the Moment due to Dead Loads on non-composite section.

$M_s \phi$  is the Moment due to Dead Loads on composite section.

$M \phi$  is the Moment due to Live Loads on non-composite or composite section.

$I$  is the Live Load Impact.

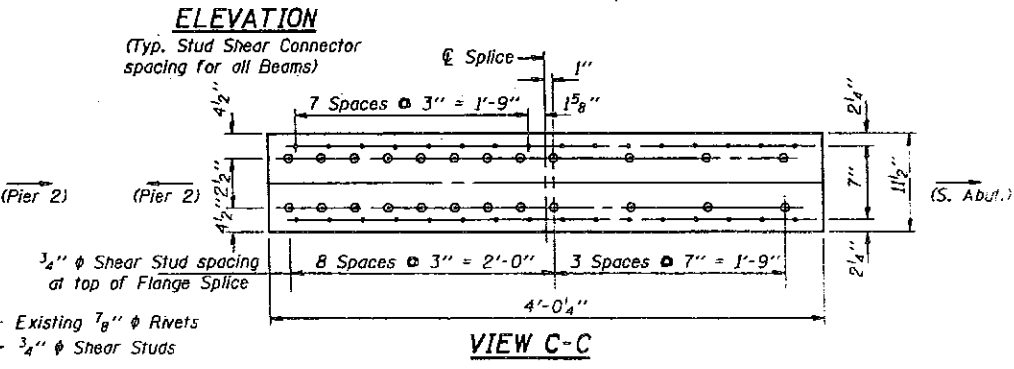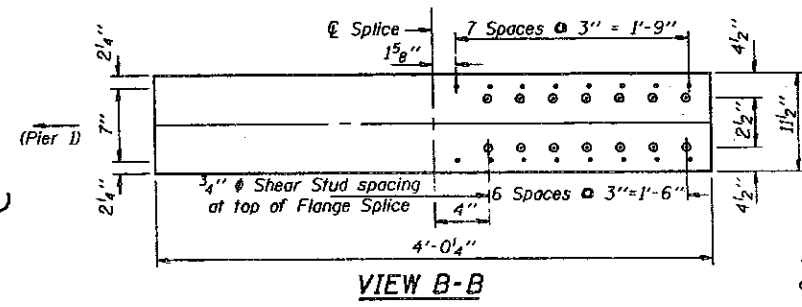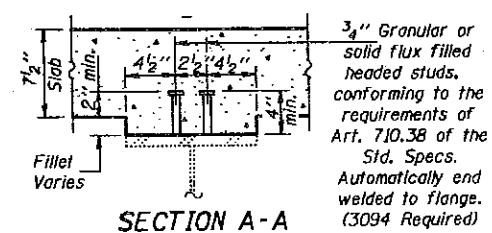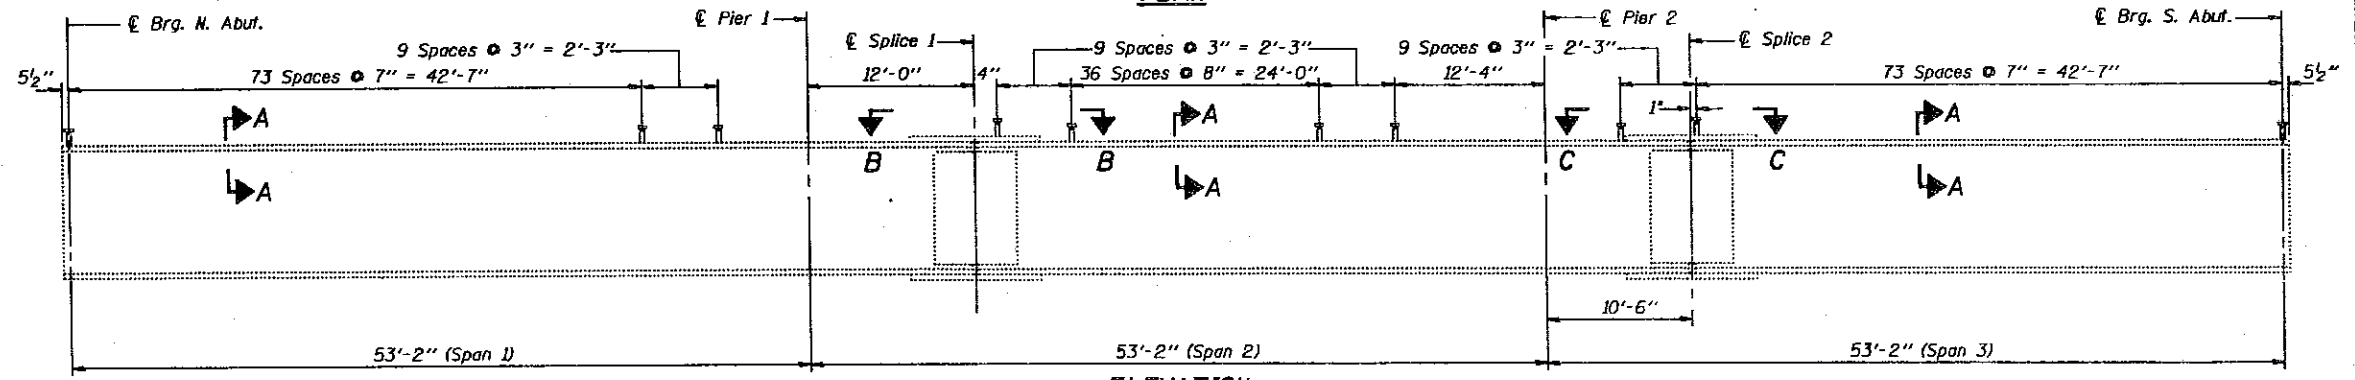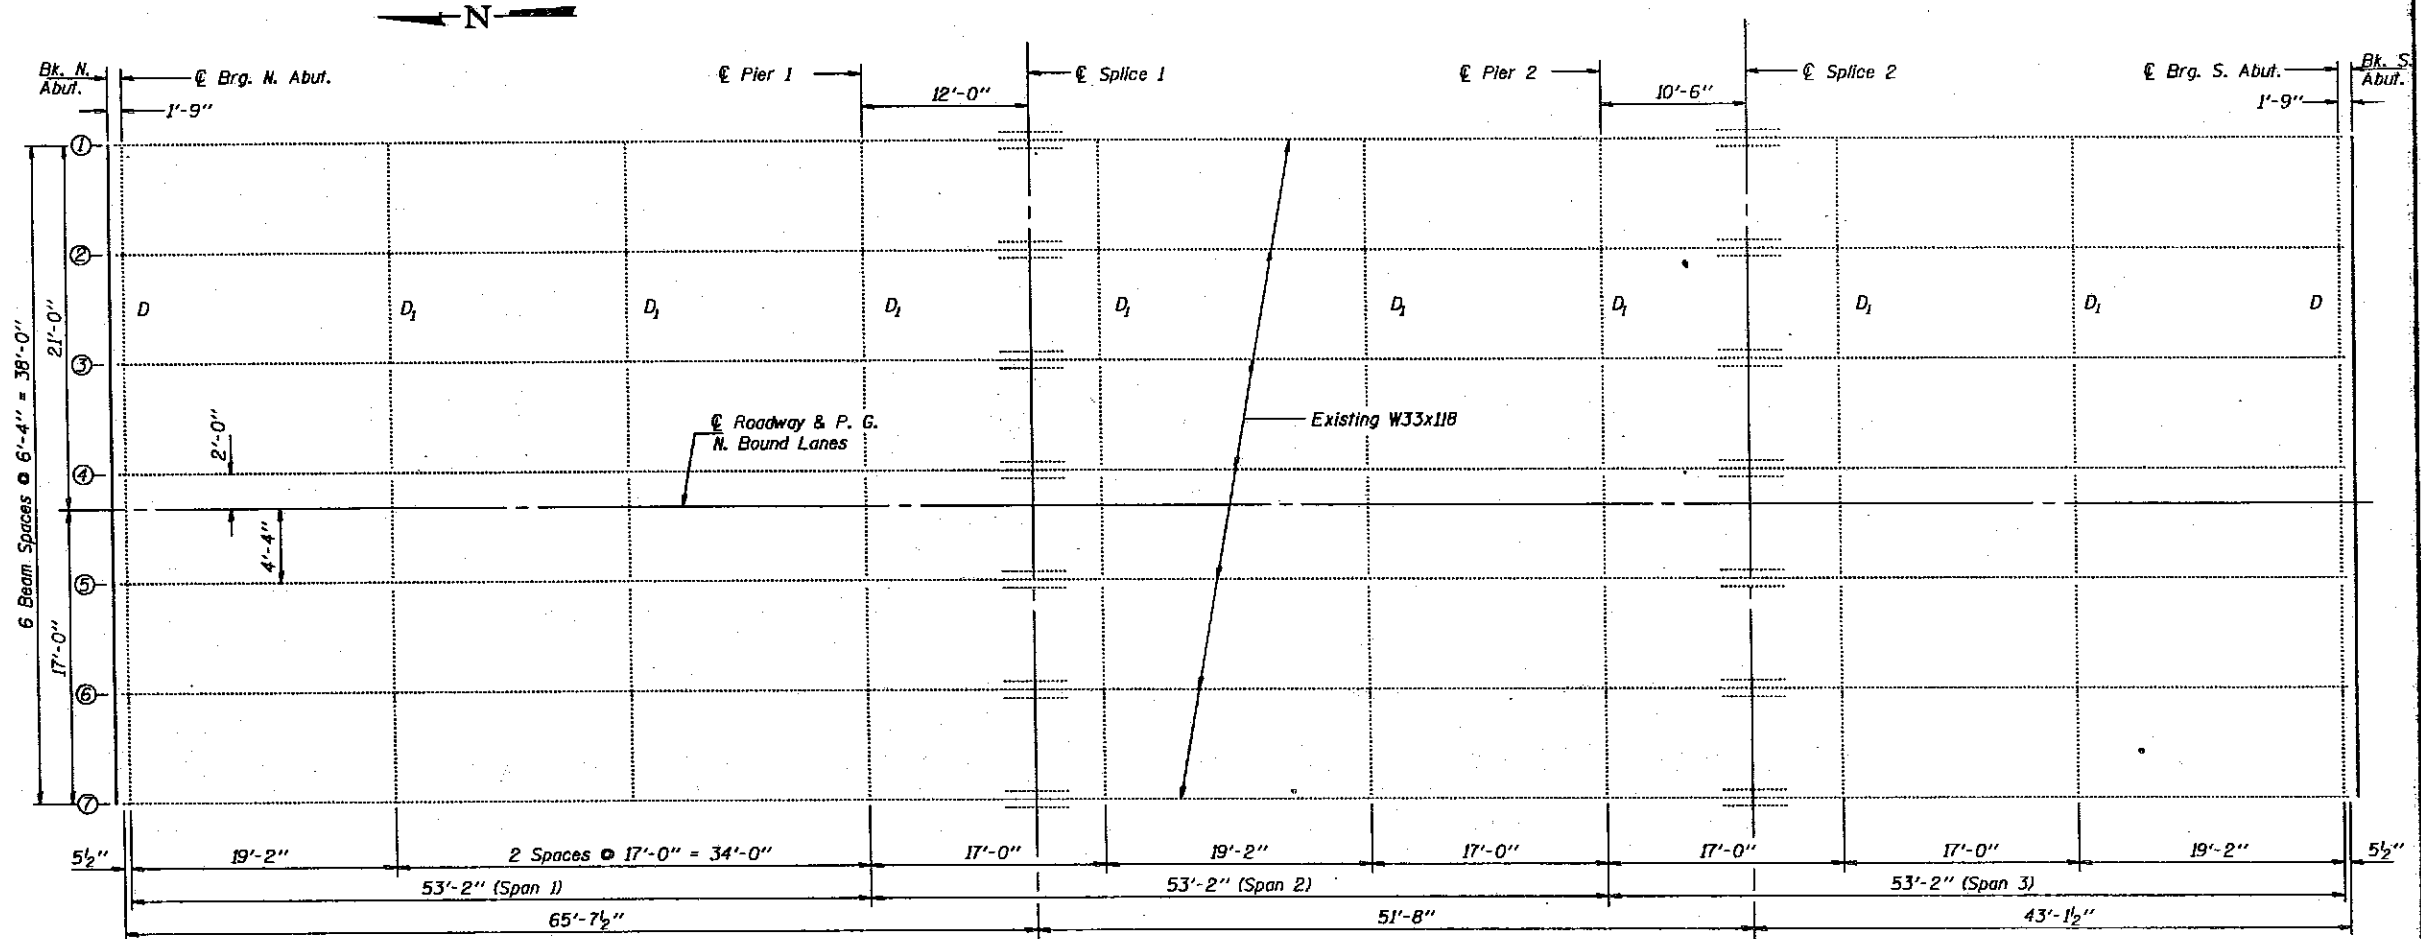

DESIGNED Michael A. Stephenson, R.S.  
CHECKED Shaker Atour, G.A.G.  
DRAWN E. Vern Taylor  
CHECKED MAS, G.A.G.


EXAMINED May 22 1992  
PASSED [Signature]  
APPROVED [Signature]  
DIRECTOR OF HIGHWAYS

STRUCTURAL STEEL DETAILS  
F.A.I. RT. 57 SEC. (28-IBJD)  
FRANKLIN COUNTY  
STATION 102+70.00


STATE OF ILLINOIS  
DEPARTMENT OF TRANSPORTATION

ROUTE NO.	SECTION	COUNTY	MILES	SHEET	SHEET NO. 8
F.A.I. 57	*	FRANKLIN	155	31	16 SHEETS
FED. ROAD DIST. NO. 7	BRIDGE	FED. AID PROJECT			

(28-1B1D)

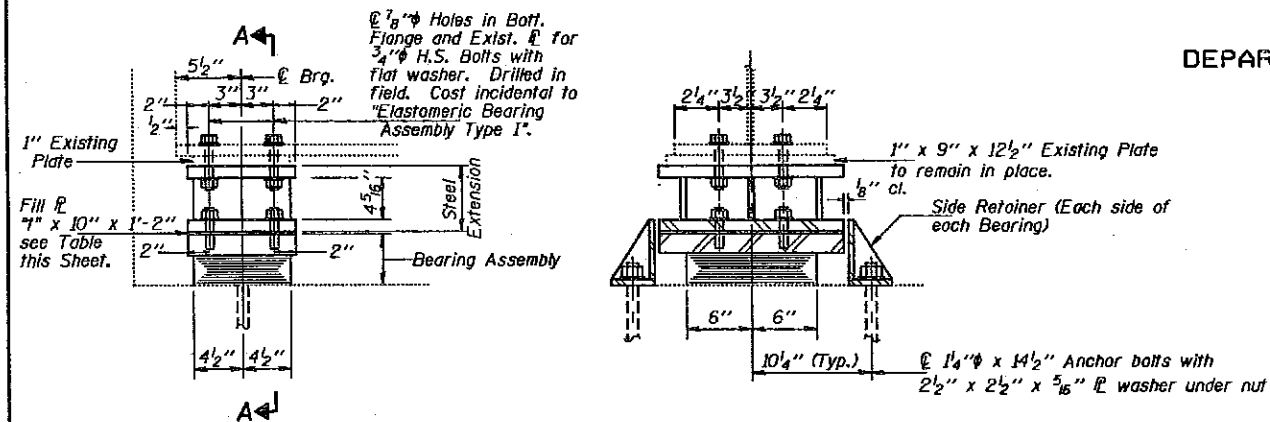


ELEVATION AT NORTH ABUT. SECTION A-A  
TYPE I ELASTOMERIC EXP. BRG.

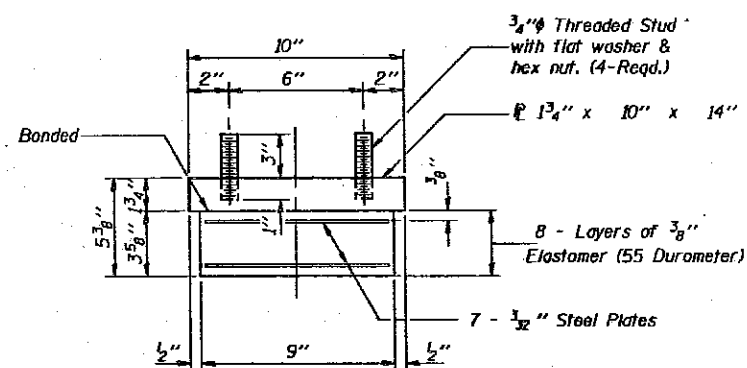

BEARING ASSEMBLY

Note: Shim plates shall not be placed under Bearing Assembly.

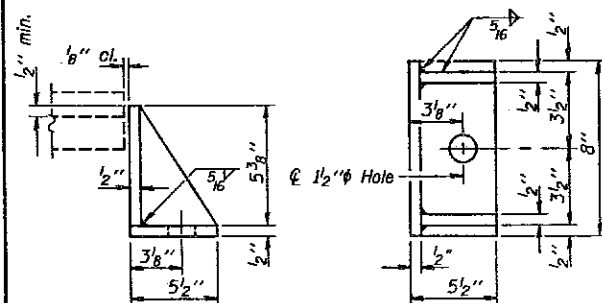


SIDE RETAINER


Equivalent rolled angle with stiffeners will be allowed in lieu of welded plates.

DESIGNED Michael A. Stephens, P.E.  
CHECKED S.A. Astor, GAG  
DRAWN E. Vern Taylor  
CHECKED MAS, GAG

EXAMINED May 22 1992  
PASSED [Signature]  
APPROVED [Signature]  
DIRECTOR OF HIGHWAYS

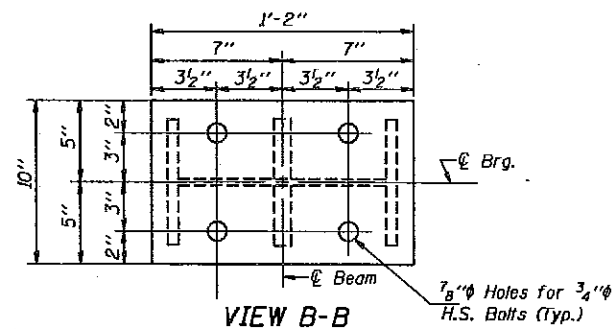


VIEW B-B

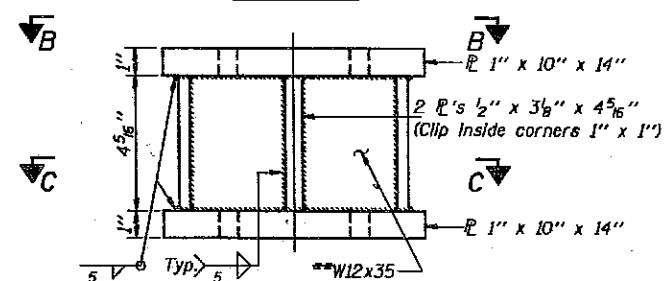

STEEL EXTENSION AT NORTH ABUT.

\*\*Equivalent welded plates will be allowed in lieu of W12x35 section.

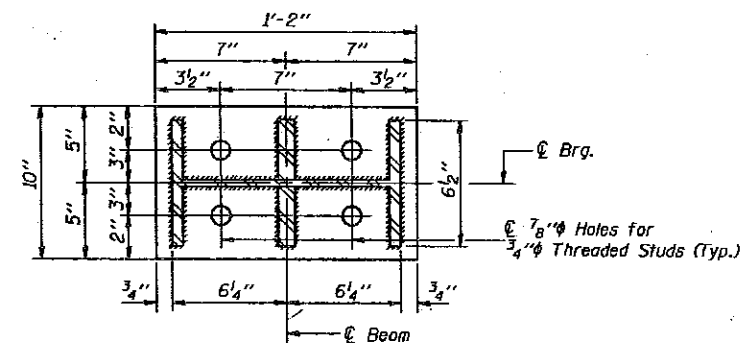

SECTION C-C

BILL OF MATERIAL

Item	Unit	Total
Elastomeric Bearing Assembly Type I	Each	7
Jack and Remove Existing Bearings	Each	7

\*\*\* See Sheet 11 of 16 for the Jacking locations.

\* Based on the existing elevations shown on sheet #11 of 16. The Contractor shall verify these elevations and make adjustments if necessary. Cost incidental.

Dimension / Location	Bm. #1	Bm. #2	Bm. #4	Bm. #5	Bm. #6	Bm. #7
* Dim. "1"	1/16"	1/8"	1/8"	1 3/8"	1 1/4"	9/16"

Beam #3, No Fill Required.

For anchor bolt installation details see sheet #12 of 16. Existing anchor bolts which are not under side retainer shall be covered with a 2" thick layer of cement mortar. Cost incidental to "Jack and Remove Existing Bearing". For anchor bolt location see sheets #13 and 14 of 16.


NORTH ABUTMENT  
BEARING DETAILS  
F.A.I. RT. 57 SEC. (28-1B1D)  
FRANKLIN COUNTY  
STATION 102+70.00








STATE OF ILLINOIS  
DEPARTMENT OF TRANSPORTATION


ROUTE NO.	SECTION	COUNTY	JOB	"SHEET"	SHEET NO. 11
F.A.I. 57		FRANKLIN	155	34	16 SHEETS
FED. ROAD DIST. NO. 1	ALIGNMENT	FED. AID PROJECT			
*28-1B2D					

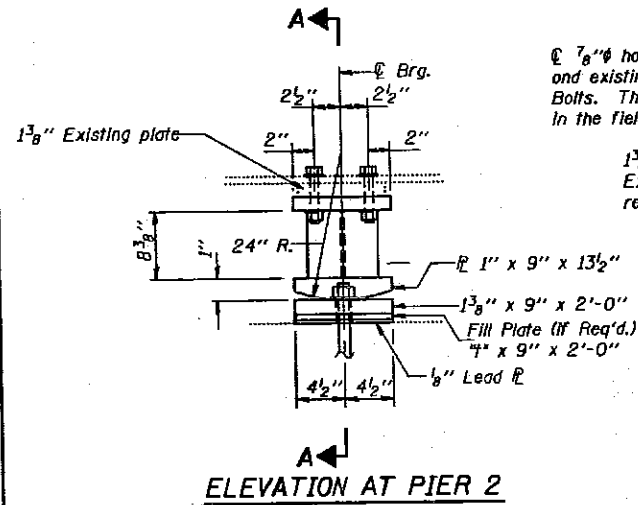

**FIXED BEARING**

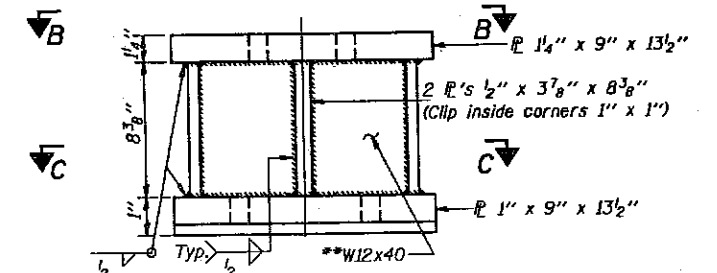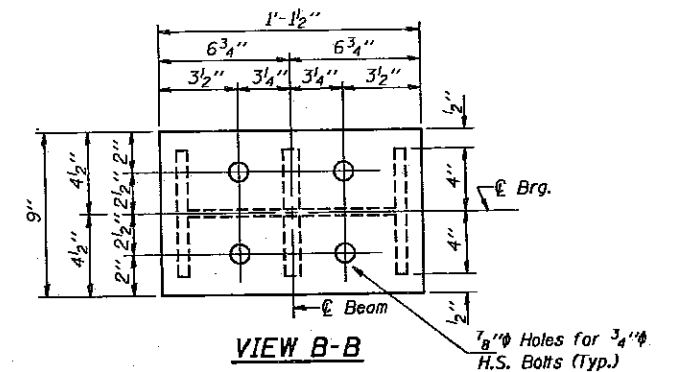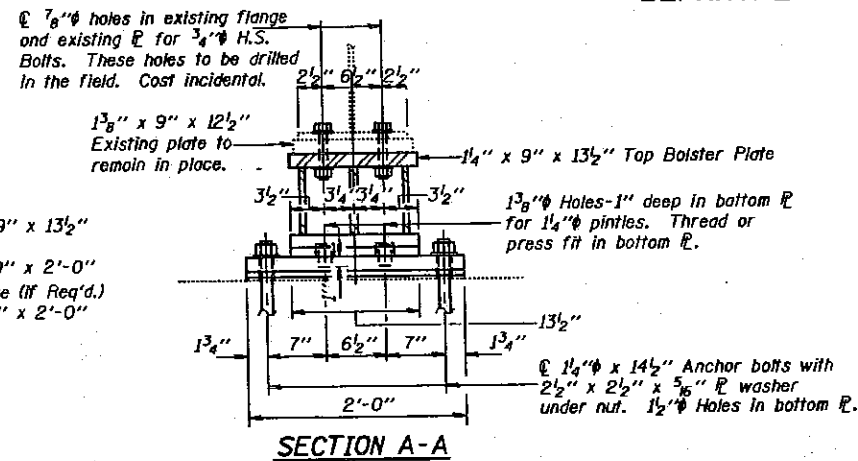



**STEEL EXTENSION AT PIER 2**  
\*\* Equivalent welded plates will be allowed in lieu of W12x40 section.

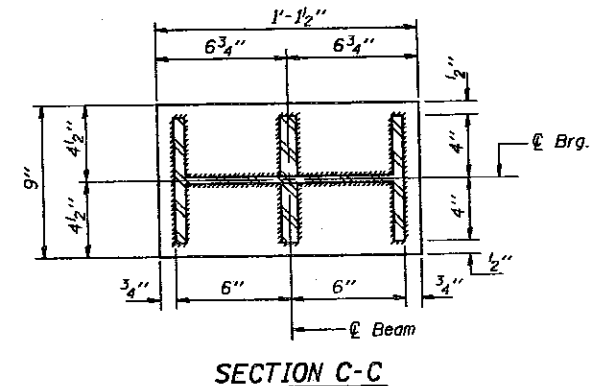

**\*EXISTING SEAT ELEVATIONS**

Location	N. Abut.	Pier #1	Pier #2	S. Abut.
Beam #1	413.19	413.12	413.12	413.12
Beam #2	413.31	413.23	413.24	413.26
Beam #3	413.45	413.36	413.37	413.41
Beam #4	413.41	413.36	413.37	413.38
Beam #5	413.38	413.36	413.37	413.35
Beam #6	413.30	413.27	413.28	413.28
Beam #7	413.23	413.19	413.21	413.23

\* From Field Survey

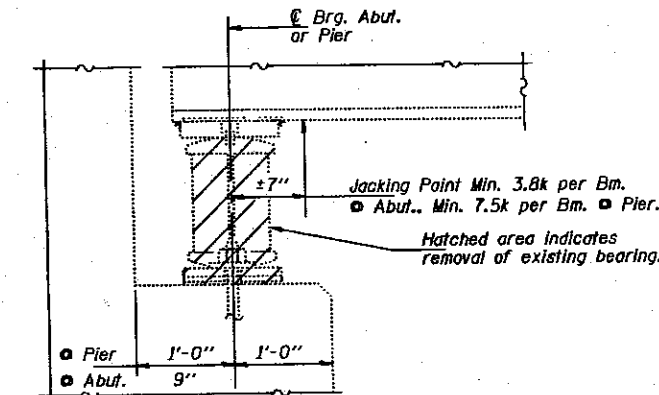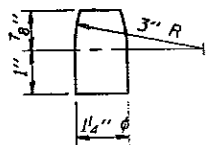

Notes:

The maximum dead load reaction with the deck removed per bearing at each abutment is 3.8 kips and at each Pier is 7.5 kips. Bearing removal and replacement shall be completed before new deck is poured.

For anchor bolt installation details see sheet #12 of 16. Existing anchor bolts which are not under side retainer shall be covered with a 2" thick layer of cement mortar. Cast incidental to "Jack and Remove Existing Bearing." For anchor bolt Location see Sheets #13 and #14 of 16.

Dimension / Location	Bm. #1	Bm. #2	Bm. #3	Bm. #4	Bm. #5	Bm. #6
" Dim. "4"	1/16"	3/16"	1/8"	13/16"	5/8"	1/16"

Beam #7, No Fill  $\bar{r}$  Required.  
\* Based on the existing elevations shown in table on this sheet. The Contractor shall verify these elevations and make adjustments if necessary. Cost incidental.

**JACK AND REMOVE EXISTING BEARING PROCEDURE**

- The Contractor shall submit for approval by the Engineer, plans for jacking prior to commencing any work at the bearings. Dead Load = 3.8K at each beam at abutments and 7.5K at each beam at piers without concrete deck. Jack Capacity = 8 Tons min.
- Jacking and removing existing bearings shall be done after deck removal is completed and before the new deck is poured.
- All beams at one abutment or at one pier shall be lifted simultaneously.
- Jacking shall be limited to a maximum of 1/4" lift.
- The existing anchor bolts shall be removed or cut off flush and grind smooth with the bridge seat. The rockers and bottom plates shall be removed leaving the existing top plate intact. The existing holes shall be filled with concrete and new holes drilled at locations specified. The bottom flange area of the beam and existing top plate shall be cleaned and painted as required and as specified for structural steel prior to placing the new elastomeric bearings.
- The new elastomeric bearings and steel extensions shall be placed and the jacks shall be lowered before the new deck is poured.

**BILL OF MATERIAL**

Item	Unit	Total
Jack and Remove Existing Bearings	Each	7

**PIER 2  
BEARING DETAILS  
F.A.I. RT. 57 SEC. (28-1B)D  
FRANKLIN COUNTY  
STATION 102+70.00**

DESIGNED	Michael A. Stephenson, E.S.
CHECKED	Shaker Aston, GAG
DRAWN	E. Vern Taylor
CHECKED	MAS, GAG


EXAMINED	May 22 1992 [Signature]
PASSED	[Signature]
APPROVED	[Signature]

STATE OF ILLINOIS  
DEPARTMENT OF TRANSPORTATION

ROUTE NO.	SECTION	COUNTY	STATION	SHEET NO.
57		FRANKLIN	155	35
FEDERAL AID PROJECT NO. 128-1B10				

The Illinois Coil-Lock Anchor Bolt is a proprietary item which is the property of the Illinois Department of Transportation. Use, reproduction or disclosure without express written permission is prohibited and protected under Federal copyright laws. The production and fabrication of this bolt for use on highway projects in the State of Illinois shall be permitted and there shall be no incurred charges or fees to the manufacturer or the fabricator for producing or fabricating this bolt.

D	E	H	K	"d"
1"	1 1/8"	1 5/16"	1 3/4"	1/4"
1 1/4"	1 3/8"	1 1/8"	2"	3/8"
1 1/2"	1 5/8"	1 5/16"	2 1/8"	1/2"
2"	2 1/8"	1 15/16"	2 7/8"	1/2"
2 1/2"	2 5/8"	2 5/16"	3 3/8"	1"

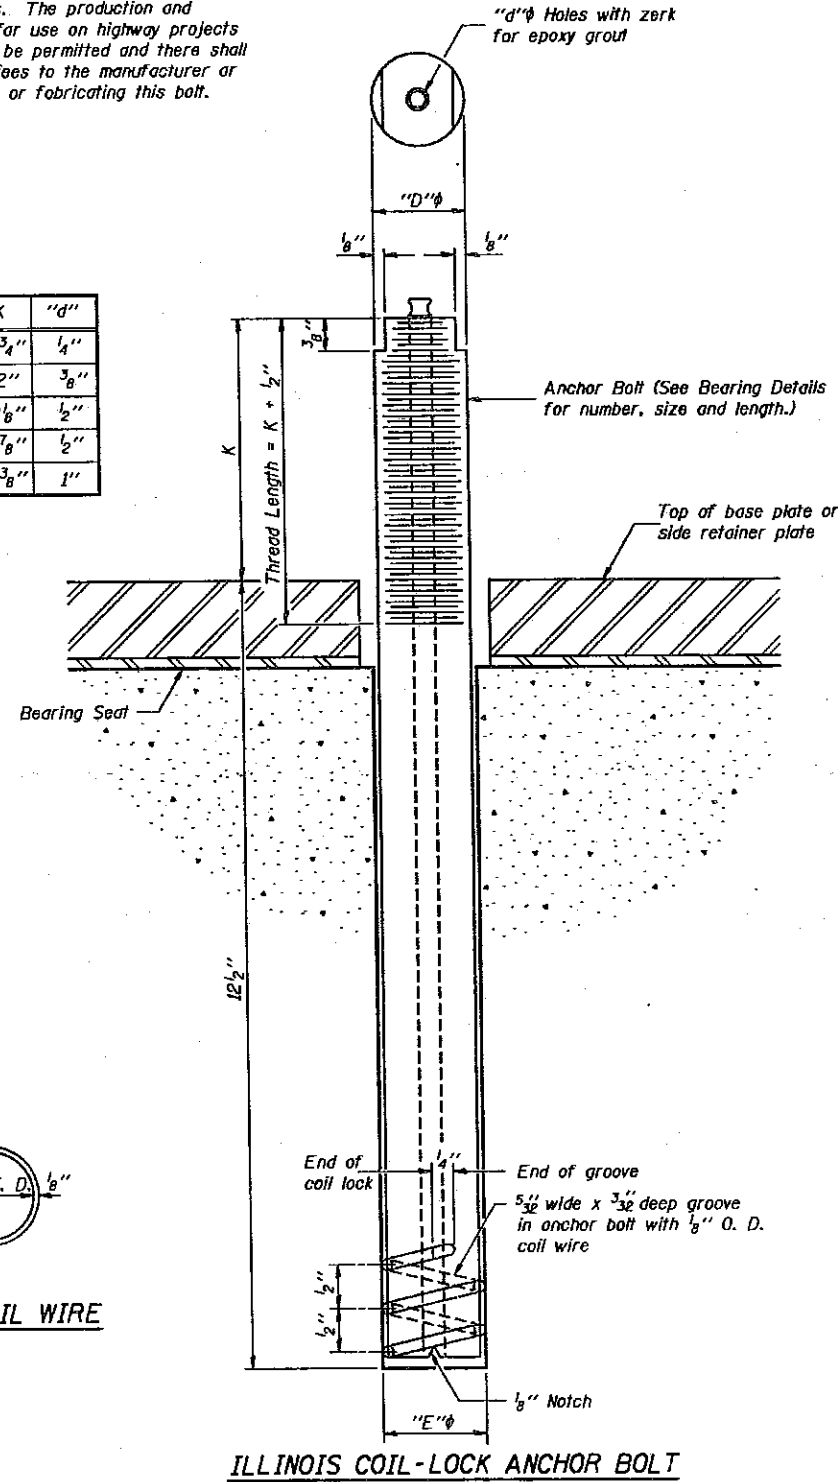

MATERIALS FOR ILLINOIS COIL-LOCK ANCHOR BOLT

The anchor bolt shall be fabricated from cold drawn or hot finished seamless carbon steel mechanical tubing conforming to ASTM A519, Grade 1026 and supplied with hexagonal nuts and cut washers.  
The coil wire shall be made of any suitable soft steel wire.  
The finished anchor bolt shall be cleaned of rust and other foreign materials and wrapped or packaged to prevent contamination until they are installed.  
The epoxy grout shall be a two-component, epoxy resin bonding system conforming to ASTM C881, Type I, Grade 1 and of a Class suitable for the temperature at installation.

INSTALLATION PROCEDURE for the ILLINOIS COIL-LOCK ANCHOR BOLT

1. With the coil wire in place, the bolt shall be inserted into the hole and turned clockwise to a snug fit in the hole. Nut and washer shall be placed on the bolt. The nut shall be tensioned until the steel base plates are held securely to the concrete bearing seat.
2. Epoxy grout shall be pumped through the zerk fitting with a pressure gun. Pumping shall continue until the epoxy overflows the hole around the bolt shank. After pumping is discontinued, excess epoxy shall be immediately wiped off.

ALTERNATE ANCHOR BOLTS

The Contractor may use, at his option, the capsule or the adhesive cartridge type anchor rods that have been previously tested and given a prior approval by the Department. The Contractor shall install these anchor rods in pre-drilled holes in accordance with the manufacturer's recommendations and procedures.  
The capsule or the adhesive cartridge type anchor rods shall be a two part system composed of:  
1. A threaded rod stud with nut and washer conforming to ASTM A307.  
2. A sealed glass capsule or a sealed glass adhesive cartridge containing premeasured amounts of the adhesive chemical.

GENERAL NOTES

Holes in the masonry for anchor bolts shall be drilled through the base plates to the diameter and depth shown or in accordance with the manufacturer's recommendation after beams or girders have been erected and adjusted.  
Prior to setting the bolts, the holes shall be dry and all dust and loose particles shall be removed by the use of compressed air or vacuuming.  
The anchor bolts, furnished and installed including the epoxy grout or capsules shall not be paid for separately but shall be included in the unit bid price for "Furnishing and Erecting Structural Steel".

DESIGNED Michael A. Schuman, EIT  
CHECKED shakerstour, GAG  
DRAWN E. Vern Taylor  
CHECKED MMS, GAG

EXAMINED May 22 1992  
PASSED Ralph E. Anderson  
APPROVED


ABB-1 12-1-83

ANCHOR BOLT DETAILS  
FOR BEARINGS  
F.A.I. RT. 57 SEC. (28-1B)D  
FRANKLIN COUNTY  
STATION 102+70.00




STATE OF ILLINOIS  
DEPARTMENT OF TRANSPORTATION

ROUTE NO.	SECTION	BRIDGE	SPAN	SHEET	SHEET NO. 13 16 SHEETS
F.A.I. 57		FRANKLIN	155	36	
FED. ROAD DIST. NO. 7	LINE	FED. AID PROJECT			
*(28-1B1D)					

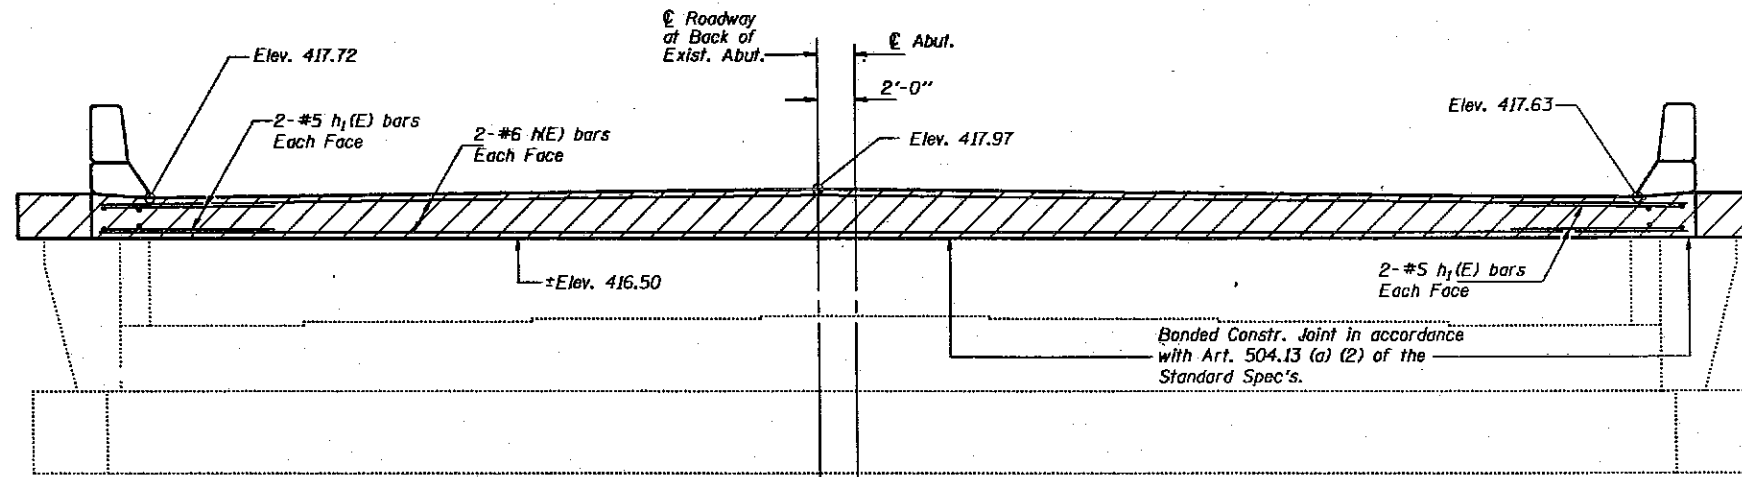

ELEVATION  
(Looking North)

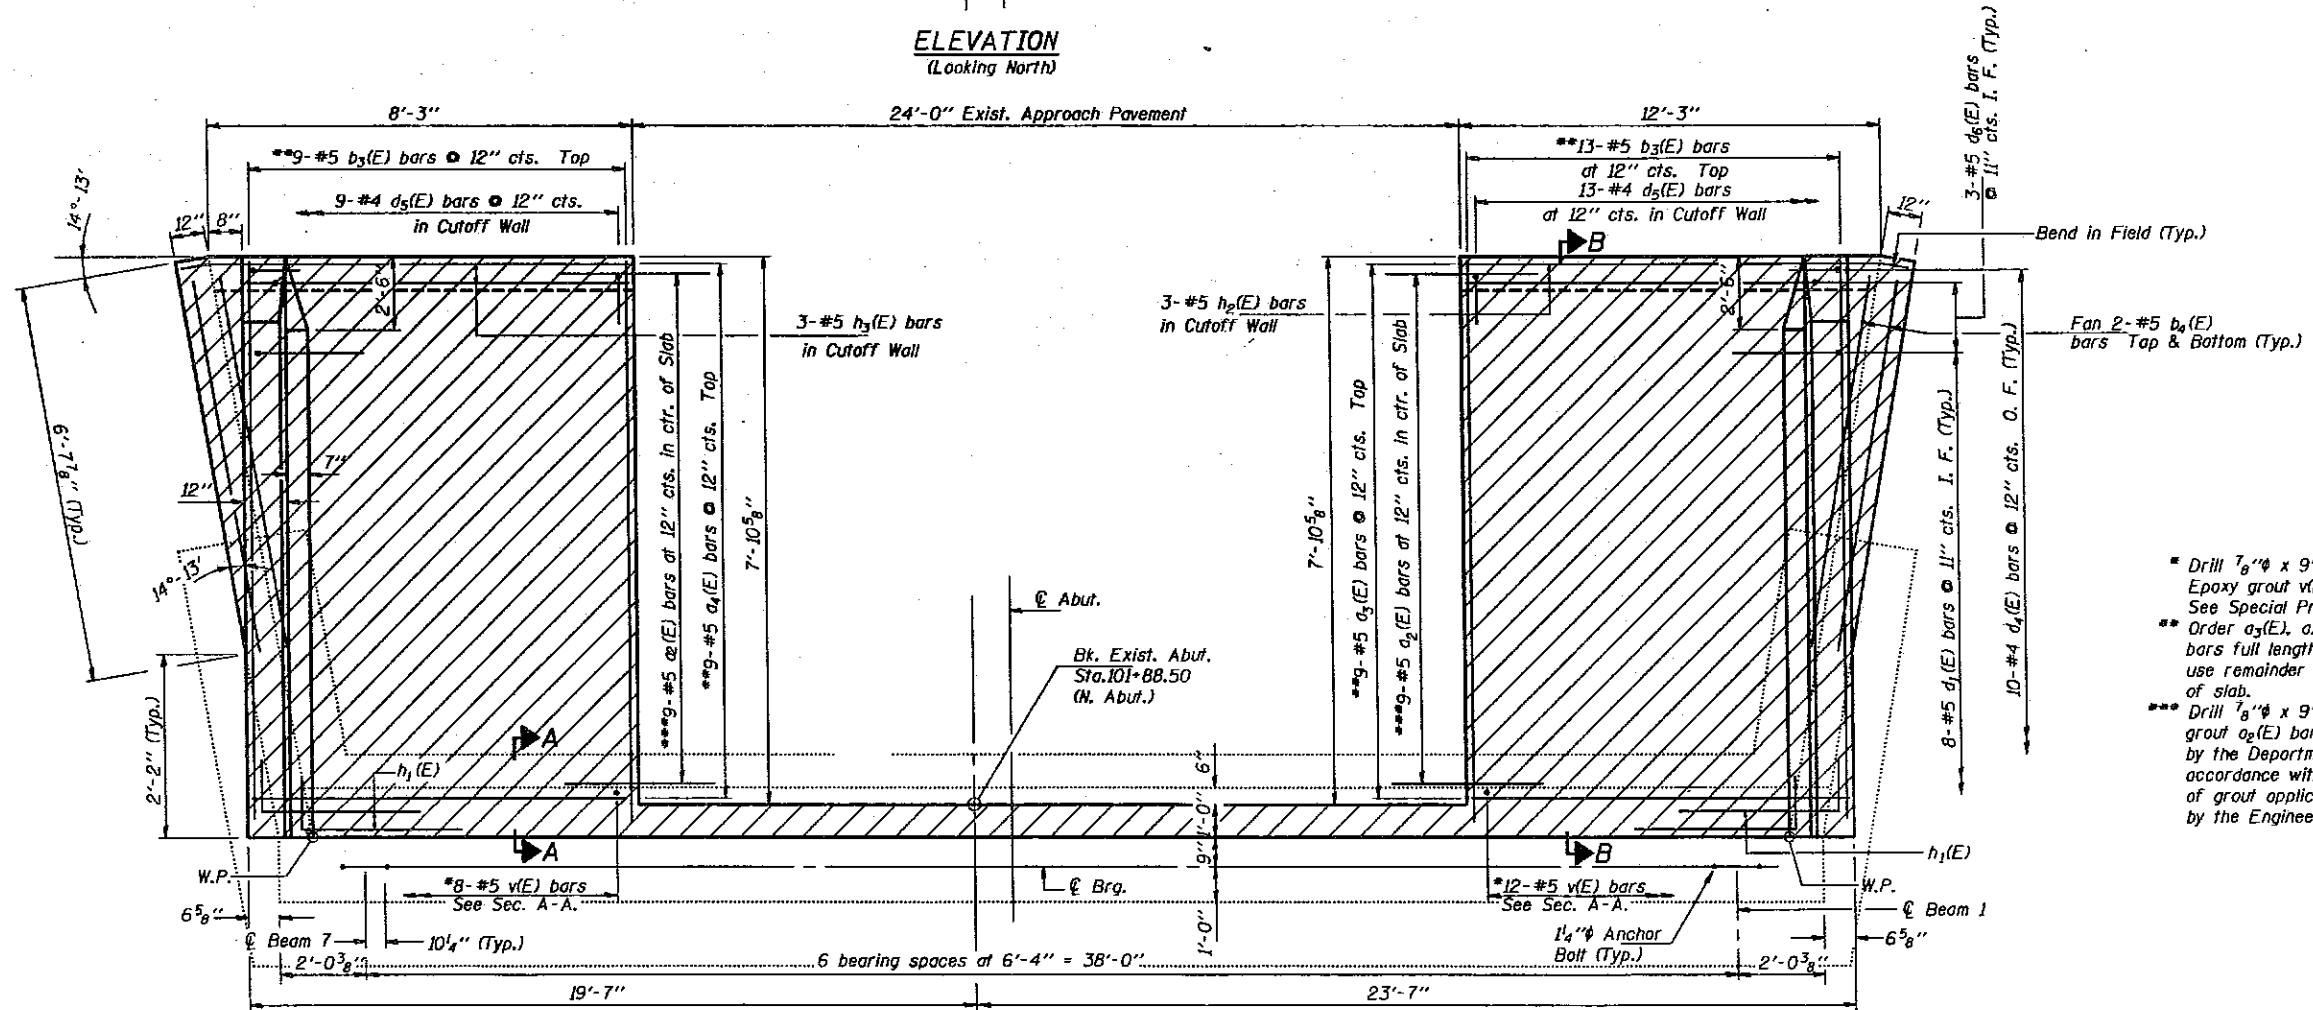

PLAN

- \* Drill  $\frac{7}{8}$ "  $\phi$  x 9" Min. hole. Epoxy grout v(E) bars. See Special Provisions.
- \*\* Order  $a_3(E)$ ,  $a_4(E)$  and  $b_3(E)$  bars full length. Cut to fit and use remainder of bars in bottom of slab.
- \*\*\* Drill  $\frac{7}{8}$ "  $\phi$  x 9" Min. hole. Epoxy grout  $a_2(E)$  bars. Use a grout approved by the Department or epoxy grout in accordance with BSP-11. The method of grout application shall be approved by the Engineer. See Special Provisions.

Notes: Hatched area to be poured after superstructure forms have been removed. Quantity of concrete included with "Class X Concrete Superstructure" on sheet #6 of 16. Quantity for End Posts billed with "Class X Conc. Superstr." Existing reinforcement extending into removed area shall be cleaned, straightened and incorporated into the new construction. Reinforcement bars designated (E) shall be epoxy coated. Bars indicated thus 2 x 2-#6 etc. indicates 2 lines of bars with 2 lengths per line. For anchor bolt installation details see sheet #12 of 16. All edges shall have Standard  $\frac{3}{4}$ " chamfer. Work this sheet with sheet #15 of 16.


NORTH ABUTMENT  
F.A.I. RT. 57 SEC. (28-1B1D)  
FRANKLIN COUNTY  
STATION 102+70.00

DESIGNED Michael A. Stephens, P.E.
CHECKED Shaker Asfury, GAG
DRAWN E. Vann Taylor
CHECKED MAS, GAG


May 22 1992  
EXAMINED [Signature]  
PASSED [Signature]  
APPROVED [Signature]  
DIRECTOR OF HIGHWAYS

STATE OF ILLINOIS  
DEPARTMENT OF TRANSPORTATION

ROUTE NO.	DISTRICT	COUNTY	SECTION	SHEET NO.	SHEET NO. 14
F.A.I. 57		FRANKLIN	155	37	16 SHEETS
FED. ROAD DIST. NO. 7		ILLINOIS		FED. AID PROJECT-	
*28-1B/D					

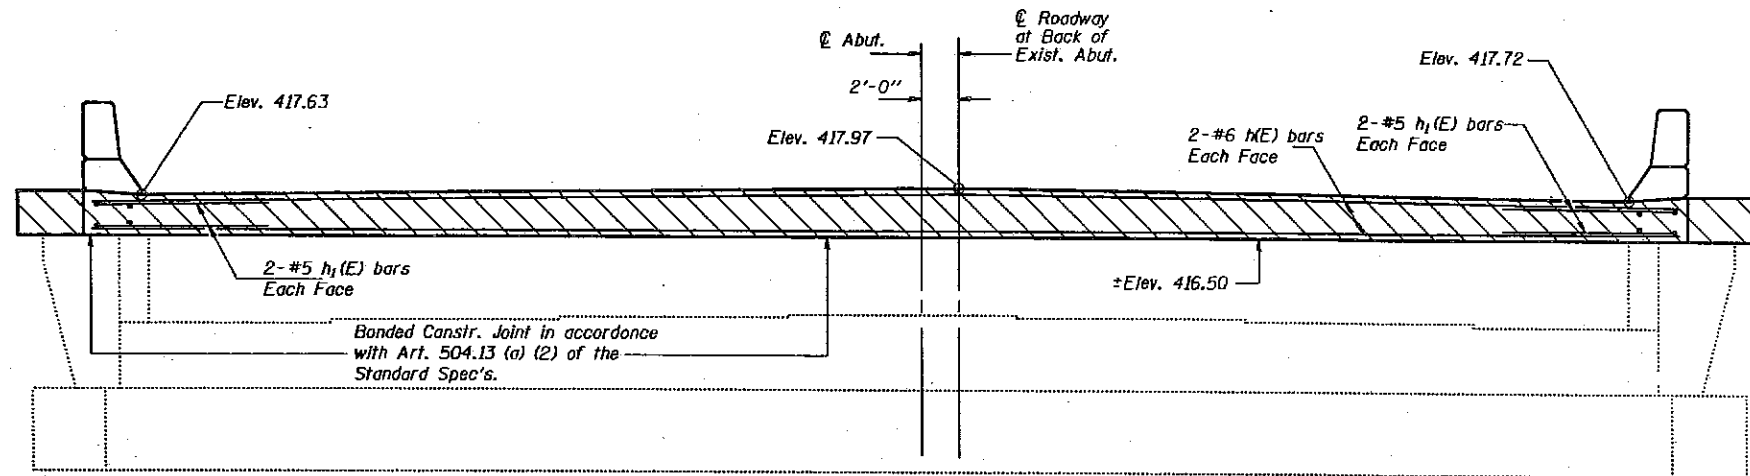

ELEVATION  
(Looking North)

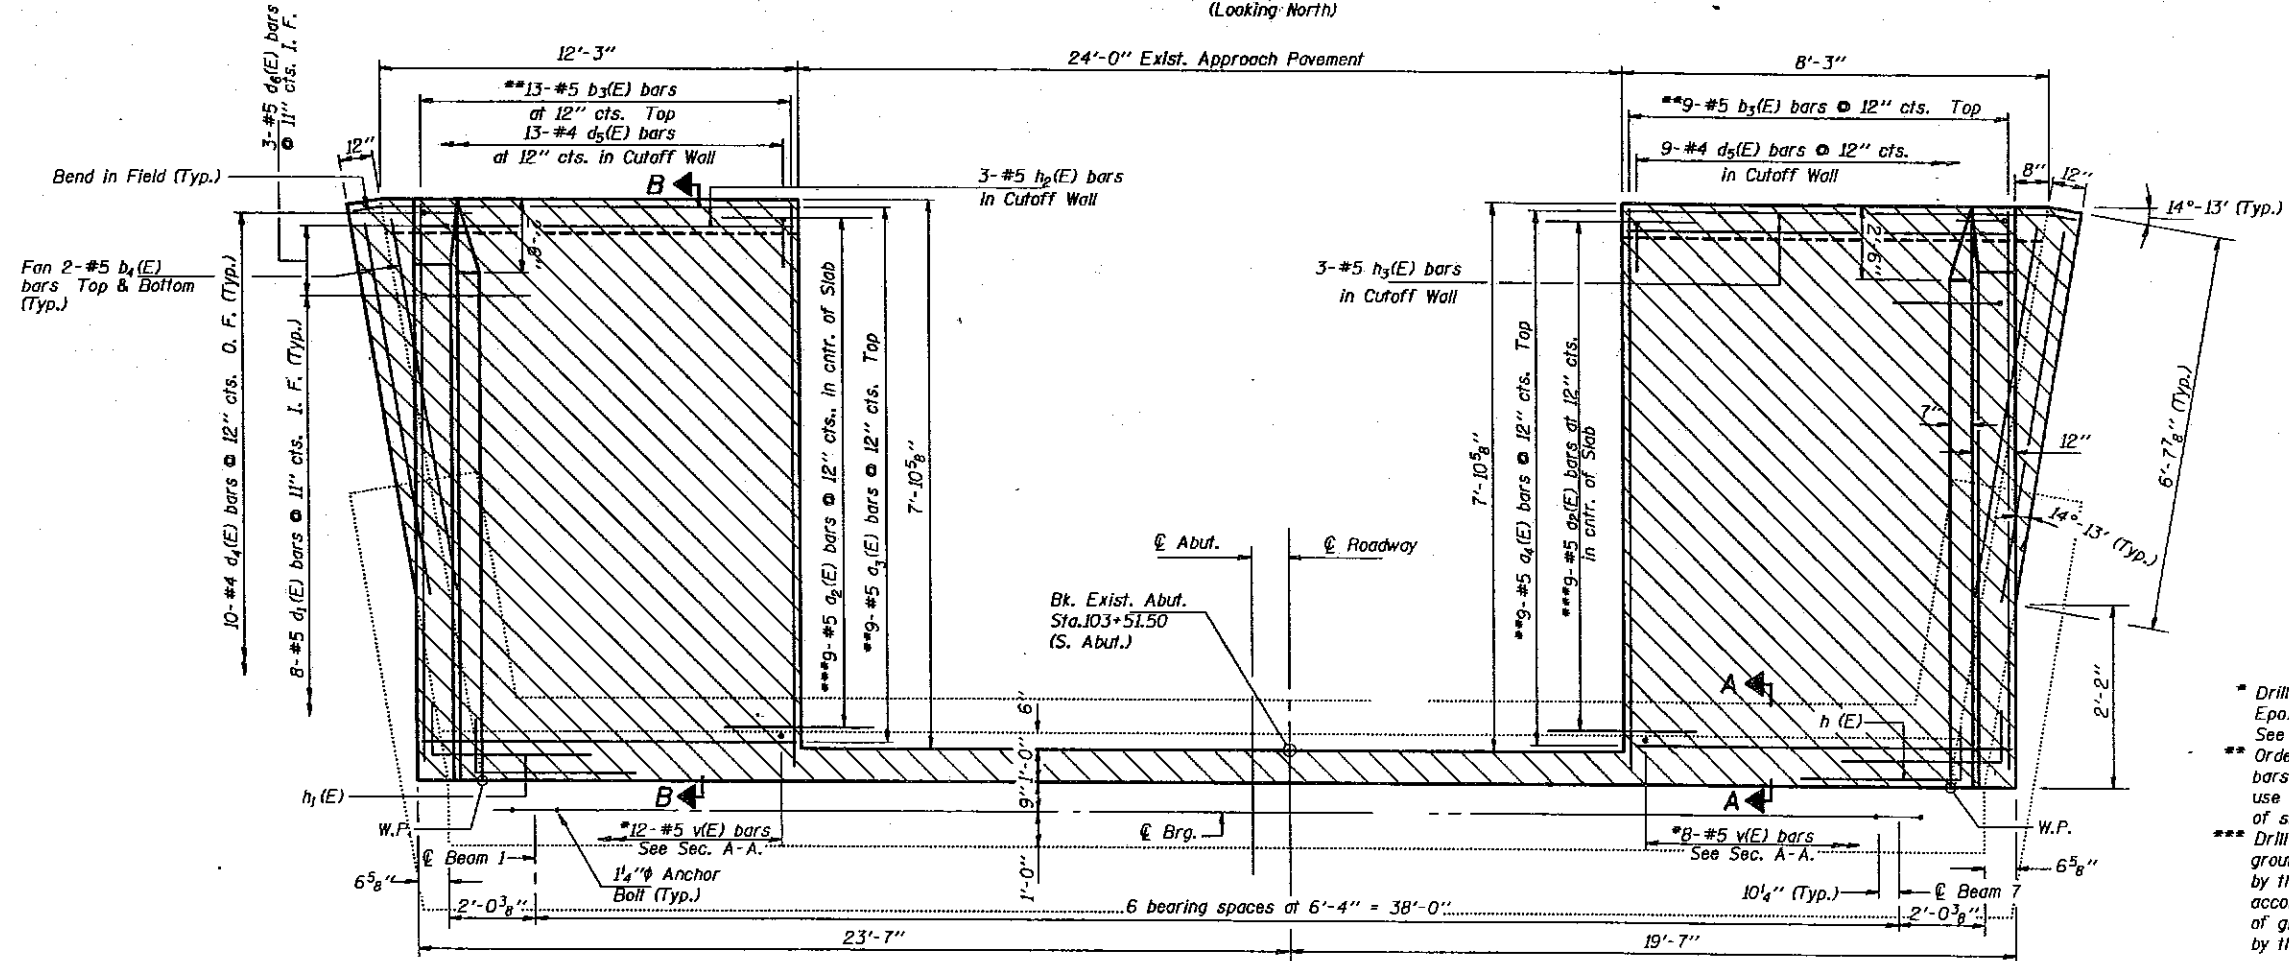

- \* Drill  $\frac{1}{8}$ "  $\phi$  x 9" Min. hole. Epoxy grout v(E) bars. See Special Provisions.
- \*\* Order  $a_3(E)$ ,  $a_4(E)$  and  $b_3(E)$  bars full length. Cut to fit and use remainder of bars in bottom of slab.
- \*\*\* Drill  $\frac{1}{8}$ "  $\phi$  x 9" Min. hole. Epoxy grout  $a_2(E)$  bars. Use a grout approved by the Department or epoxy grout in accordance with BSP-11. The method of grout application shall be approved by the Engineer. See Special Provisions.


**PLAN** Notes: Hatched area to be poured after superstructure forms have been removed. Quantity of concrete included with "Class X Concrete Superstructure" on sheet #6 of 16. Quantity for End Post is billed with "Class X Conc. Superstr." Existing reinforcement extending into removed area shall be cleaned, straightened and incorporated into the new construction. Reinforcement bars designated (E) shall be epoxy coated. Bars indicated thus 2 x 2-#6 etc. indicates 2 lines of bars with 2 lengths per line. For anchor bolt installation details see sheet #12 of 16. All edges shall have Standard  $\frac{3}{4}$ " chamfer. Work this sheet with sheet #15 of 16.

DESIGNED <i>Michael A. Stephenson, P.E.</i>	EXAMINED <i>Greg J. Kaspar</i>
CHECKED <i>Shaker Ashour, GAG</i>	PASSED <i>Ralph E. Anderson</i>
DRAWN <i>E. Vern Taylor</i>	APPROVED
CHECKED <i>MAS, GAG</i>	DIRECTOR OF HIGHWAYS


**SOUTH ABUTMENT**  
F.A.I. RT. 57 SEC. (28-1B/D)  
FRANKLIN COUNTY  
STATION 102+70.00

STATE OF ILLINOIS  
DEPARTMENT OF TRANSPORTATION


ROUTE NO.	SECTION	COUNTY	SHEETS	SHEET NO.
F.A.I. 57		FRANKLIN	155	30
SHEET NO. 15				
16 SHEETS				

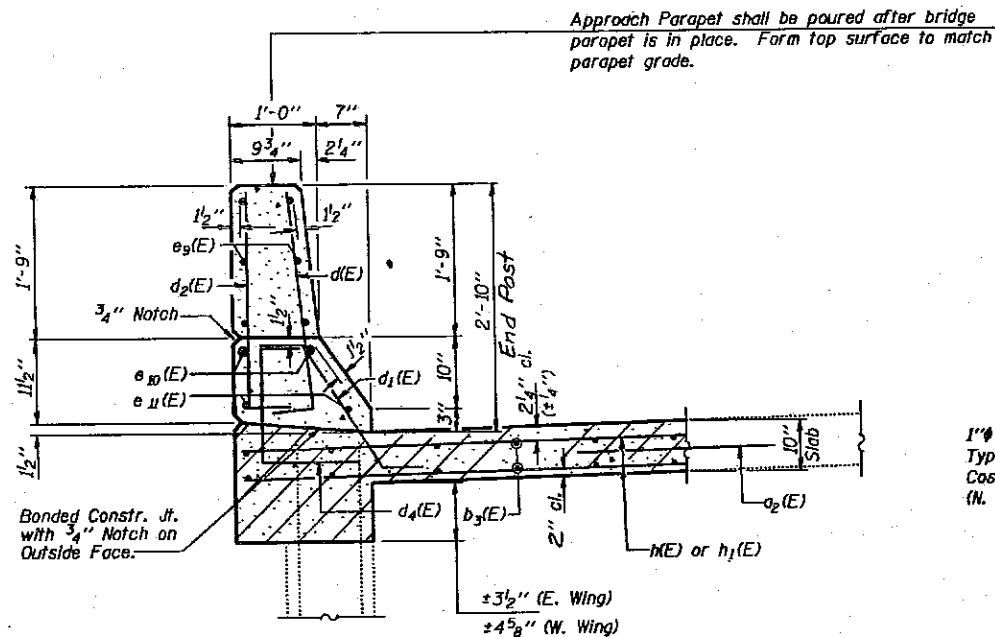

SECTION E-E

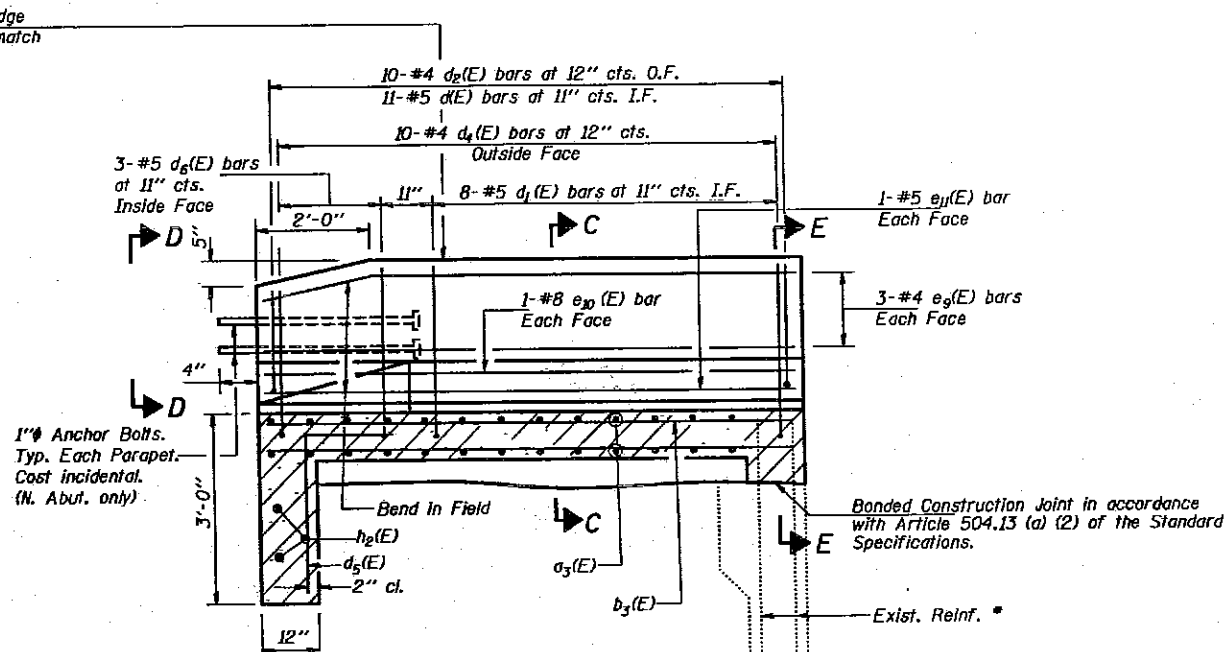

SECTION B-B

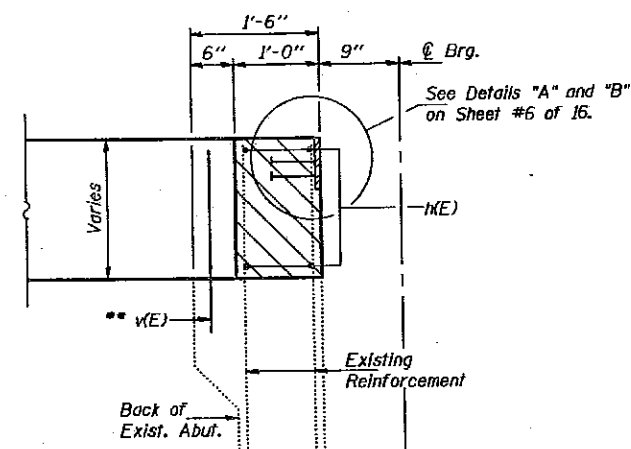

SECTION A-A

\*\* Drill 7/8" x 9" min. holes and epoxy grout v(E) bars in accordance with Special Provision BSP-11 or grout approved by the Department. Cost shall be incidental to "Reinforcement Bars (Epoxy Coated)".


\* Existing Reinforcement extending into new Construction shall be cleaned, straightened and incorporated into new Construction. Cost is incidental to "Concrete Removal."

ABUTMENTS & APPROACHES  
BILL OF MATERIAL


Bar	No.	Size	Length	Shape
a <sub>2</sub> (E)	36	#5	3'-0"	—
a <sub>3</sub> (E)	18	#5	26'-0"	—
a <sub>4</sub> (E)	18	#5	18'-0"	—
b <sub>3</sub> (E)	44	#5	17'-2"	—
b <sub>4</sub> (E)	16	#5	7'-6"	—
d(E)	44	#5	3'-0"	L
d <sub>1</sub> (E)	32	#5	2'-7"	L
d <sub>2</sub> (E)	40	#4	3'-0"	L
d <sub>4</sub> (E)	40	#4	3'-8"	L
d <sub>5</sub> (E)	44	#4	4'-6"	L
d <sub>6</sub> (E)	12	#5	2'-9"	L
e <sub>9</sub> (E)	24	#4	8'-7"	—
e <sub>10</sub> (E)	8	#8	8'-7"	—
e <sub>11</sub> (E)	8	#5	8'-7"	—
h(E)	8	#6	39'-9"	—
h <sub>1</sub> (E)	16	#5	6'-6"	L
h <sub>2</sub> (E)	6	#5	12'-0"	—
h <sub>3</sub> (E)	6	#5	8'-0"	—
v(E)	40	#5	2'-0"	—
Reinforcement Bars, Epoxy Coated			Lbs.	3,460

Reinforcement bars designated (E) shall be epoxy coated.


Notes: Work this sheet with Sheets #13 & #14 of 16.

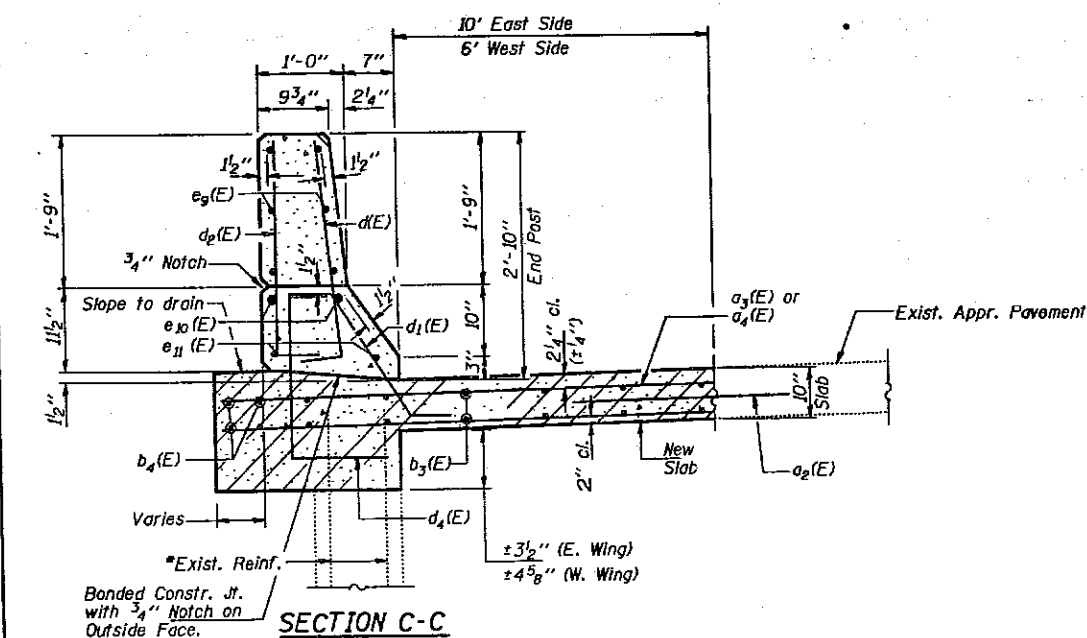

SECTION C-C

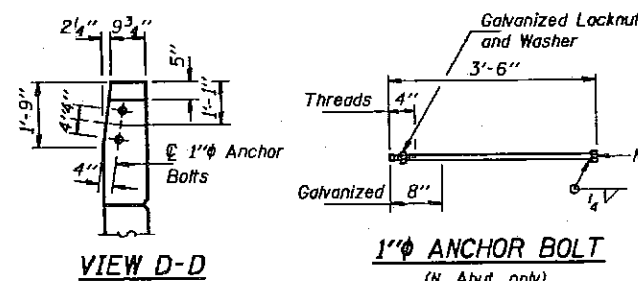

VIEW D-D

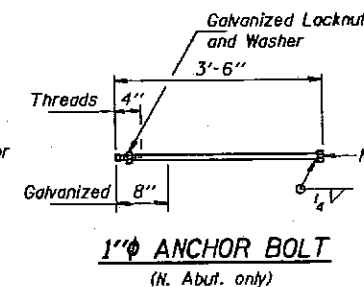


1" ANCHOR BOLT  
(N. Abut. only)

Notes: Area to be poured after Superstructure forms have been removed.  
Concrete quantity to be billed with "Class X Concrete Superstructure." See Sheet #6 of 16.  
Reinforcement bars designated (E) shall be Epoxy coated.

DESIGNED Michael A. Stephenson, EIT  
CHECKED Shaker Atlow, GAG  
DRAWN E. Vern Taylor  
CHECKED MAS, GAG

EXAMINED May 22 1992  
PASSED Raj D. Kaspar, ENGINEER OF BRIDGE DESIGN  
APPROVED Ralph E. Anderson, ENGINEER OF BRIDGES AND STRUCTURES  
DIRECTOR OF HIGHWAYS

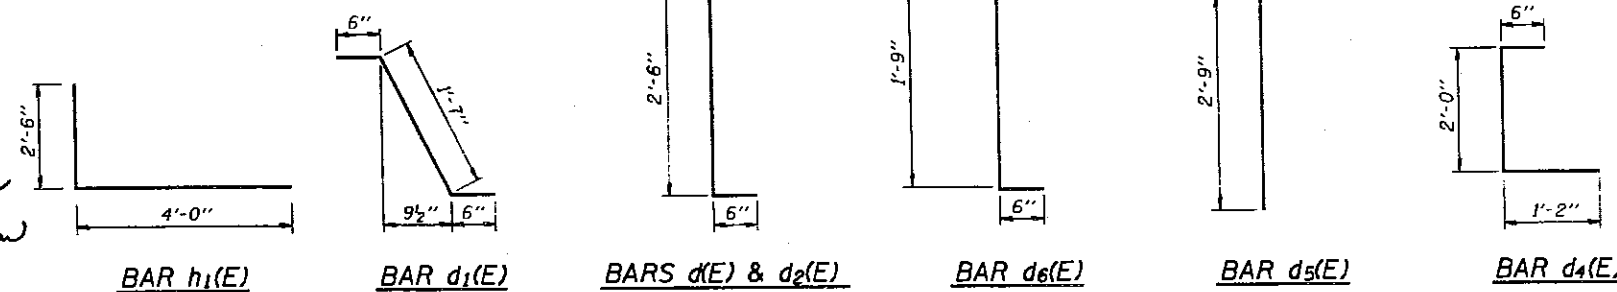


NORTH AND SOUTH ABUTMENT DETAILS  
F.A.I. RT. 57 SEC. (28-1B)D  
FRANKLIN COUNTY  
STATION 102+70.00


STATE OF ILLINOIS  
DEPARTMENT OF TRANSPORTATION

ROUTE NO.	DISTRICT	COUNTY	SECTION	"E"1	SHEET NO. 16
F.A.I. 57		FRANKLIN	155	39	16 SHEETS
FUEL POND DIST. NO. *		CLASSIFICATION	FUEL POND PROJECT		
* (28-1B)D					


\* These dimensions are along front face of hatched area.

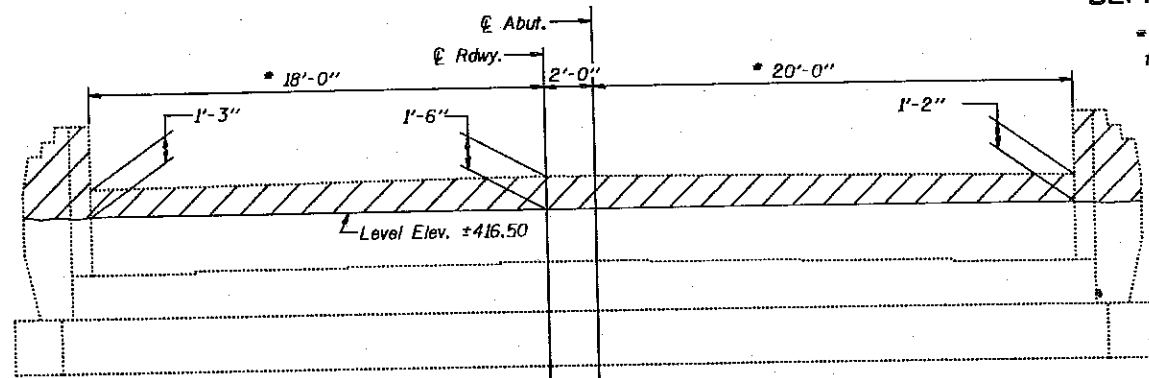


ELEVATION  
(Looking North)

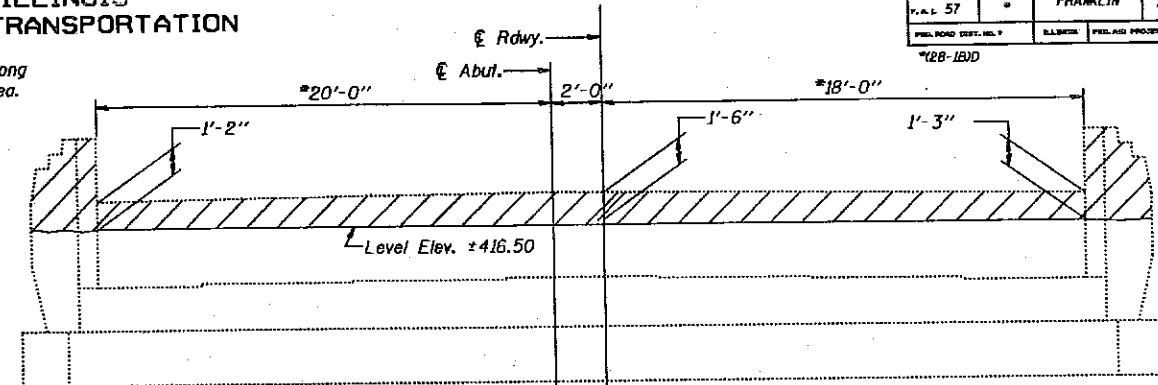


ELEVATION  
(Looking South)

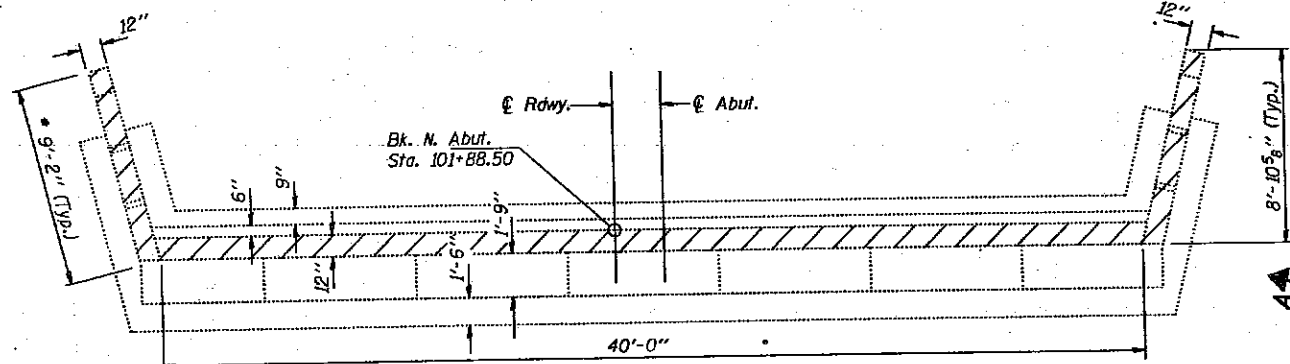

PLAN

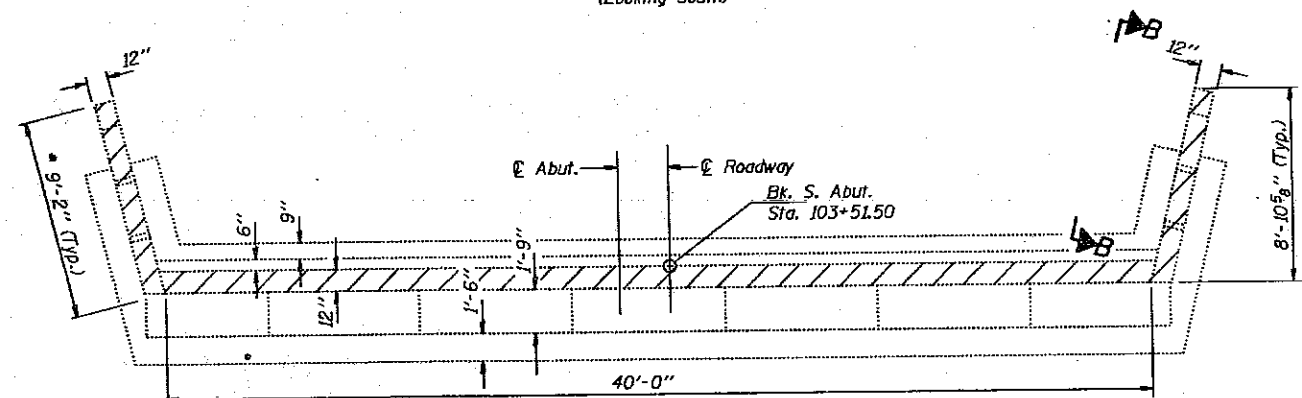


PLAN

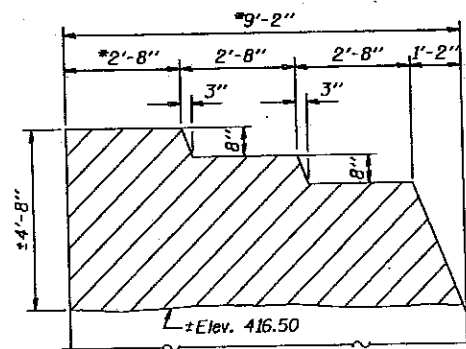

VIEW A-A

NORTH ABUTMENT DETAILS

\* Inside Face of wing

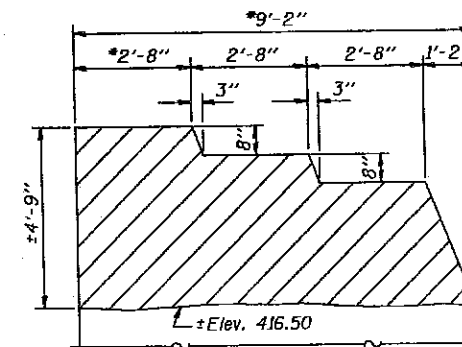

VIEW B-B

SOUTH ABUTMENT DETAILS

Notes: Hatched area indicates Concrete Removal.  
For existing shoulder pavement removal see Roadway Plans.

DESIGNED <i>Michael A. Stephenson, R.R.</i>
CHECKED <i>Shaker Astour, GAG</i>
DRAWN <i>E. Vern Taylor</i>
CHECKED <i>Mrs. GAG</i>

MAY 22 1992

EXAMINED <i>Ray J. Kasper</i>
PASSED <i>Ralph E. Anderson</i>
APPROVED _____
DIRECTOR OF HIGHWAYS

TWO ABUTMENTS  
BILL OF MATERIAL

Item	Unit	Total
Concrete Removal	Cu. Yd.	9

CONCRETE REMOVAL DETAILS  
FOR EXISTING ABUTMENTS  
F.A.I. RT. 57 SEC. (28-1B)D  
FRANKLIN COUNTY  
STATION 102+70.00








SECTION	COUNTY	TOTAL SHEETS	SHEET NO.
57	FRANKLIN	155	42

STA. TO STA. TO STA. TO STA.

\* 28 (5B-1, 5B, 2B, 1B) D: 2B (5VB, 3VB):1:1

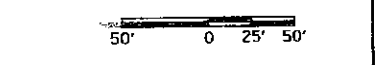


EQ. P.T. STA. 6+43.25 BK. (C CROSSOVER NO. 1)=  
38' LT. STA. 313+50.00 AH. (I-57)

**CURVE DATA CROSSOVER NO. 4**  
 P.I. STA= 1+61.59  
 $\Delta$ = 12°-52'-22"  
 D= 4°-00'-00"  
 R= 1432.39'  
 T= 161.59'  
 L= 321.82'  
 E= 9.09'  
 P.C. STA= 0+00.00  
 P.T. STA= 3+21.82


**CURVE DATA CROSSOVER NO. 1**  
 P.I. STA= 1+61.59  
 $\Delta$ = 12°-52'-22"  
 D= 4°-00'-00"  
 R= 1432.39'  
 T= 161.59'  
 L= 321.82'  
 E= 9.09'  
 P.C. STA= 0+00.00  
 P.T. STA= 3+21.82

B.M. IRON PIN & CAP 25'  
 LT. C S.B. LANES  
 STA. 330+00, ELEV. 429.23

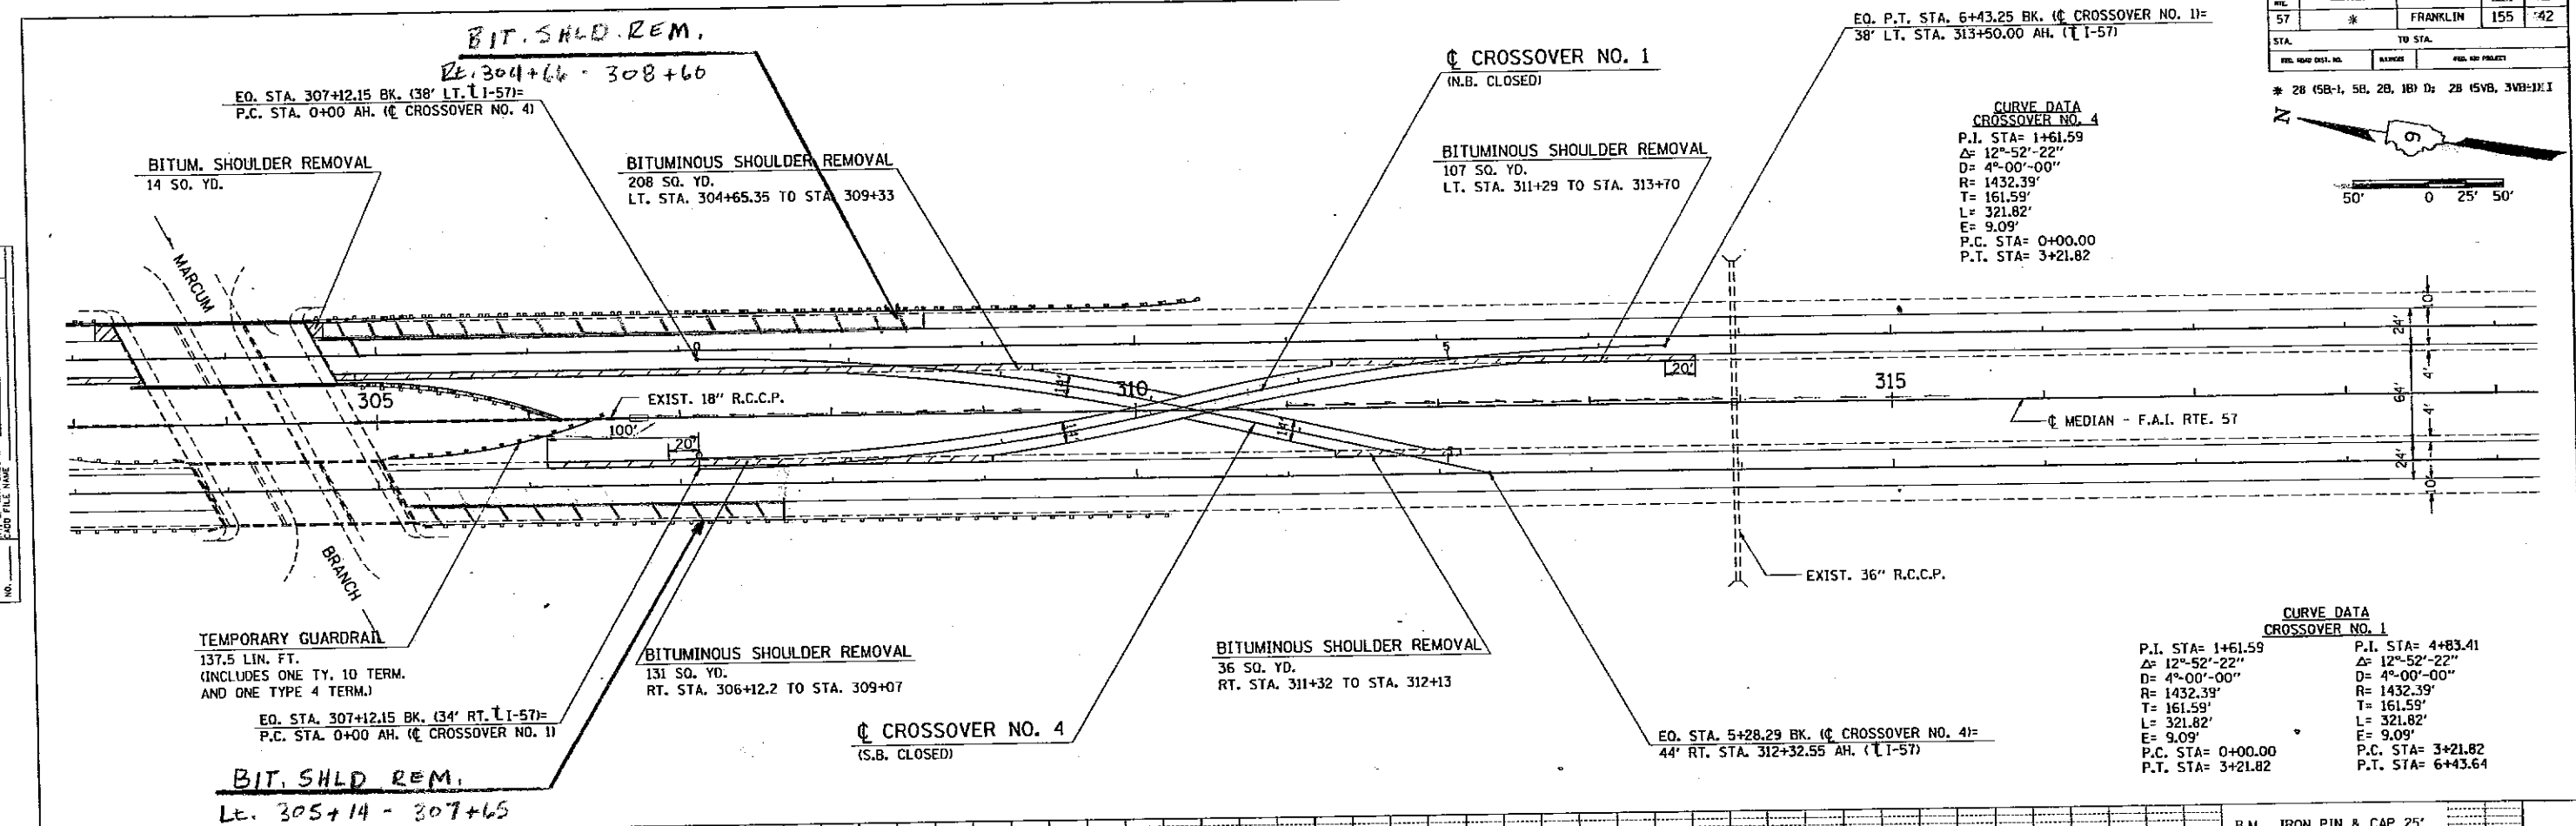

DATE	BT
APPROVED	BY
DESIGNED	BY
CHECKED	BY
DATE	BT

DATE	BT
APPROVED	BY
DESIGNED	BY
CHECKED	BY
DATE	BT

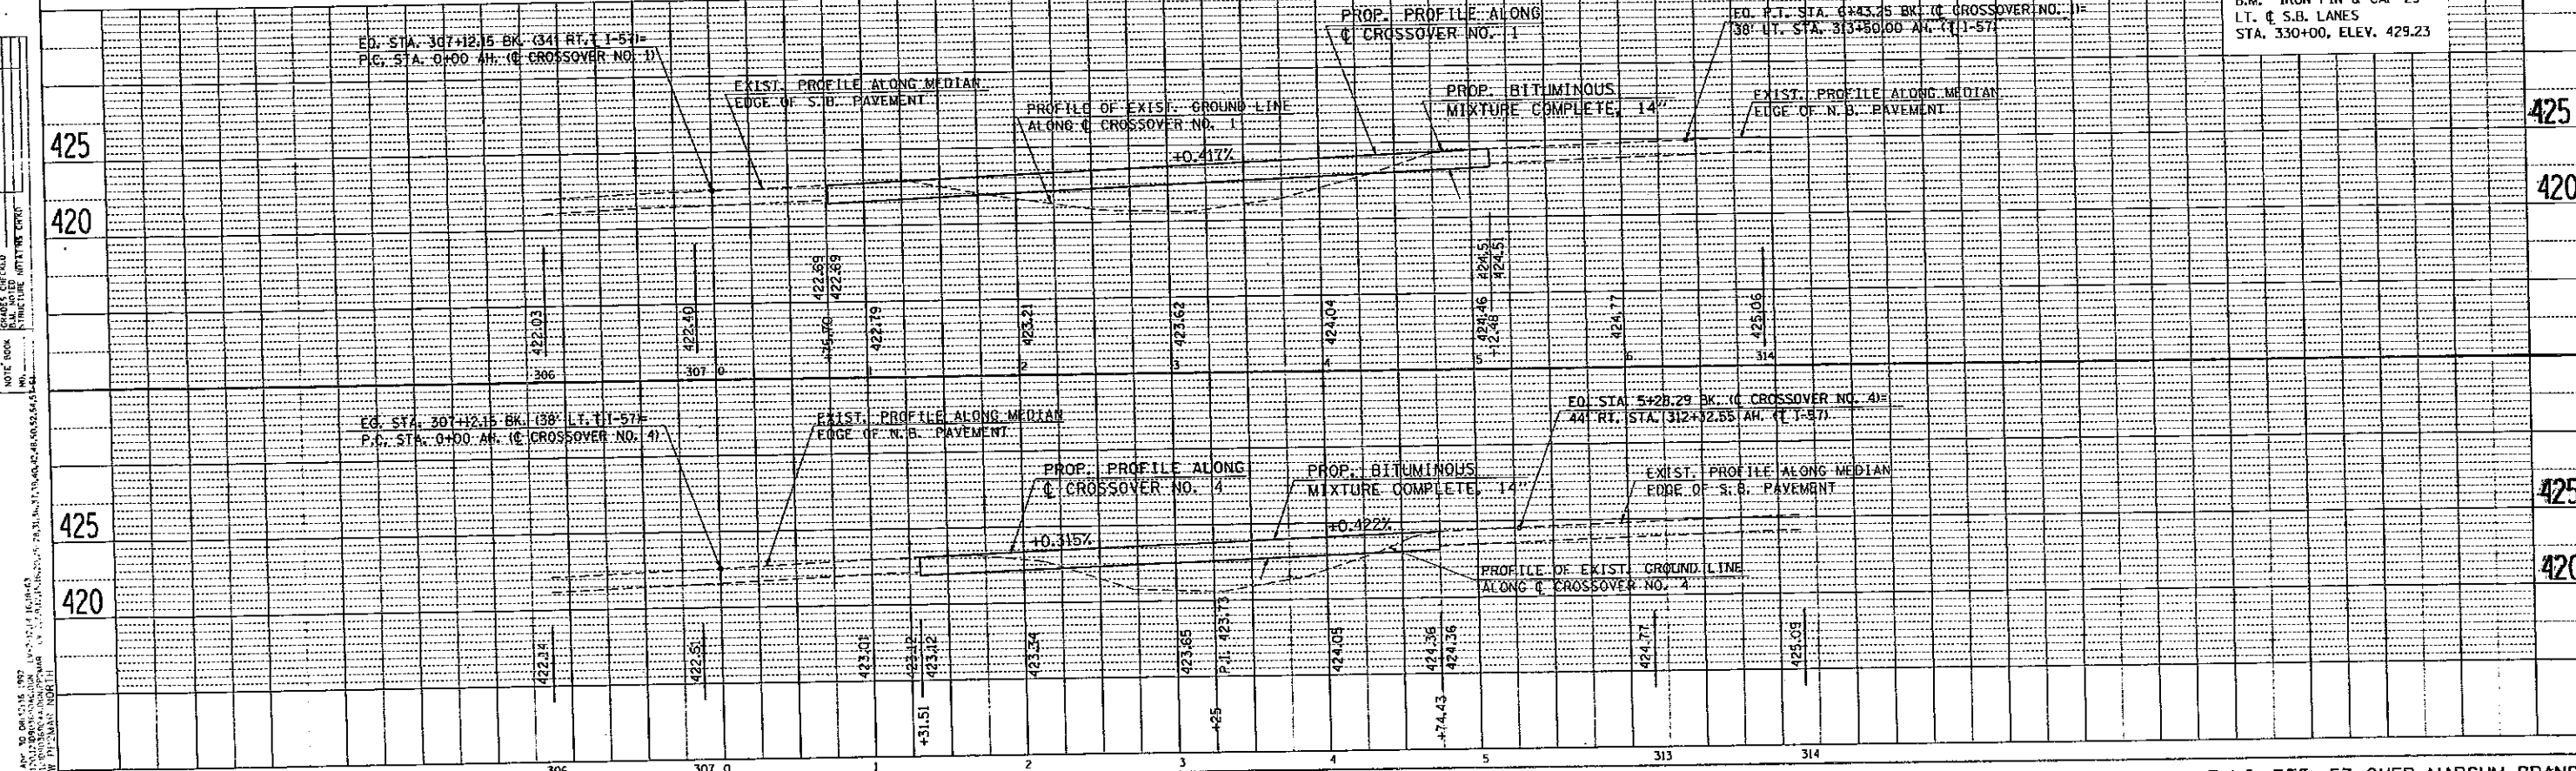



50 40 30 20 10 T 10 20 30 40 50

ROUTE NO.	SEC.	COUNTY	TOTAL SHEETS	SHEET NO.
F.A.I. 57	*	FRANKLIN	155	43
FED. ROAD DIST 7	R.L.W.O.S.	PROJECT		
SEC 20 50 1 50 20 10 10		29 (2V, 3V, 11)		

296  
11  
00

295  
11  
00

294  
11  
00

LEGEND:

NORTHBOUND CONTRACT	—
SOUTHBOUND CONTRACT	—
N.B. CONTRACT DITCH	—
S.B. CONTRACT DITCH	—

EXIST. INLET  
STA 296 + 01  
TOP OF GRAZE  
ELEV. 423.82

FIRST CONTRACT

SECOND CONTRACT

425.3

426.2

N.B.

S.B.

N.B.

S.B.

50 40 30 20 10 10 20 30 40 50

PLATE 3 CROSS SECTION O. P. & R. E. STANDARD  
DETZGER CORPORATION

MARCUM BRANCH

DATE	
REVISION	
BY	
DATE	
NO.	

DATE	
REVISION	
BY	
DATE	
NO.	
























50 40 30 20 10 10 20 30 40 50

ROUTE NO.	SEC.	COUNTY	TOTAL SHEETS	SHEET NO.
F.A.I. 57	*	FRANKLIN	155	49
FED. ROAD DIST. 7		ILLINOIS	PROJECT	
# SEC. 28 158-18 28 158-18 10-1		28 158-18 11-1		

FIELD SURVEY NOTE BOOK  
 No. \_\_\_\_\_  
 DATE \_\_\_\_\_  
 DRAWN BY \_\_\_\_\_  
 CHECKED BY \_\_\_\_\_  
 PLANNED BY \_\_\_\_\_  
 AREA ENGINEER \_\_\_\_\_

FIELD SURVEY NOTE BOOK  
 No. \_\_\_\_\_  
 DATE \_\_\_\_\_  
 DRAWN BY \_\_\_\_\_  
 CHECKED BY \_\_\_\_\_  
 PLANNED BY \_\_\_\_\_  
 AREA ENGINEER \_\_\_\_\_

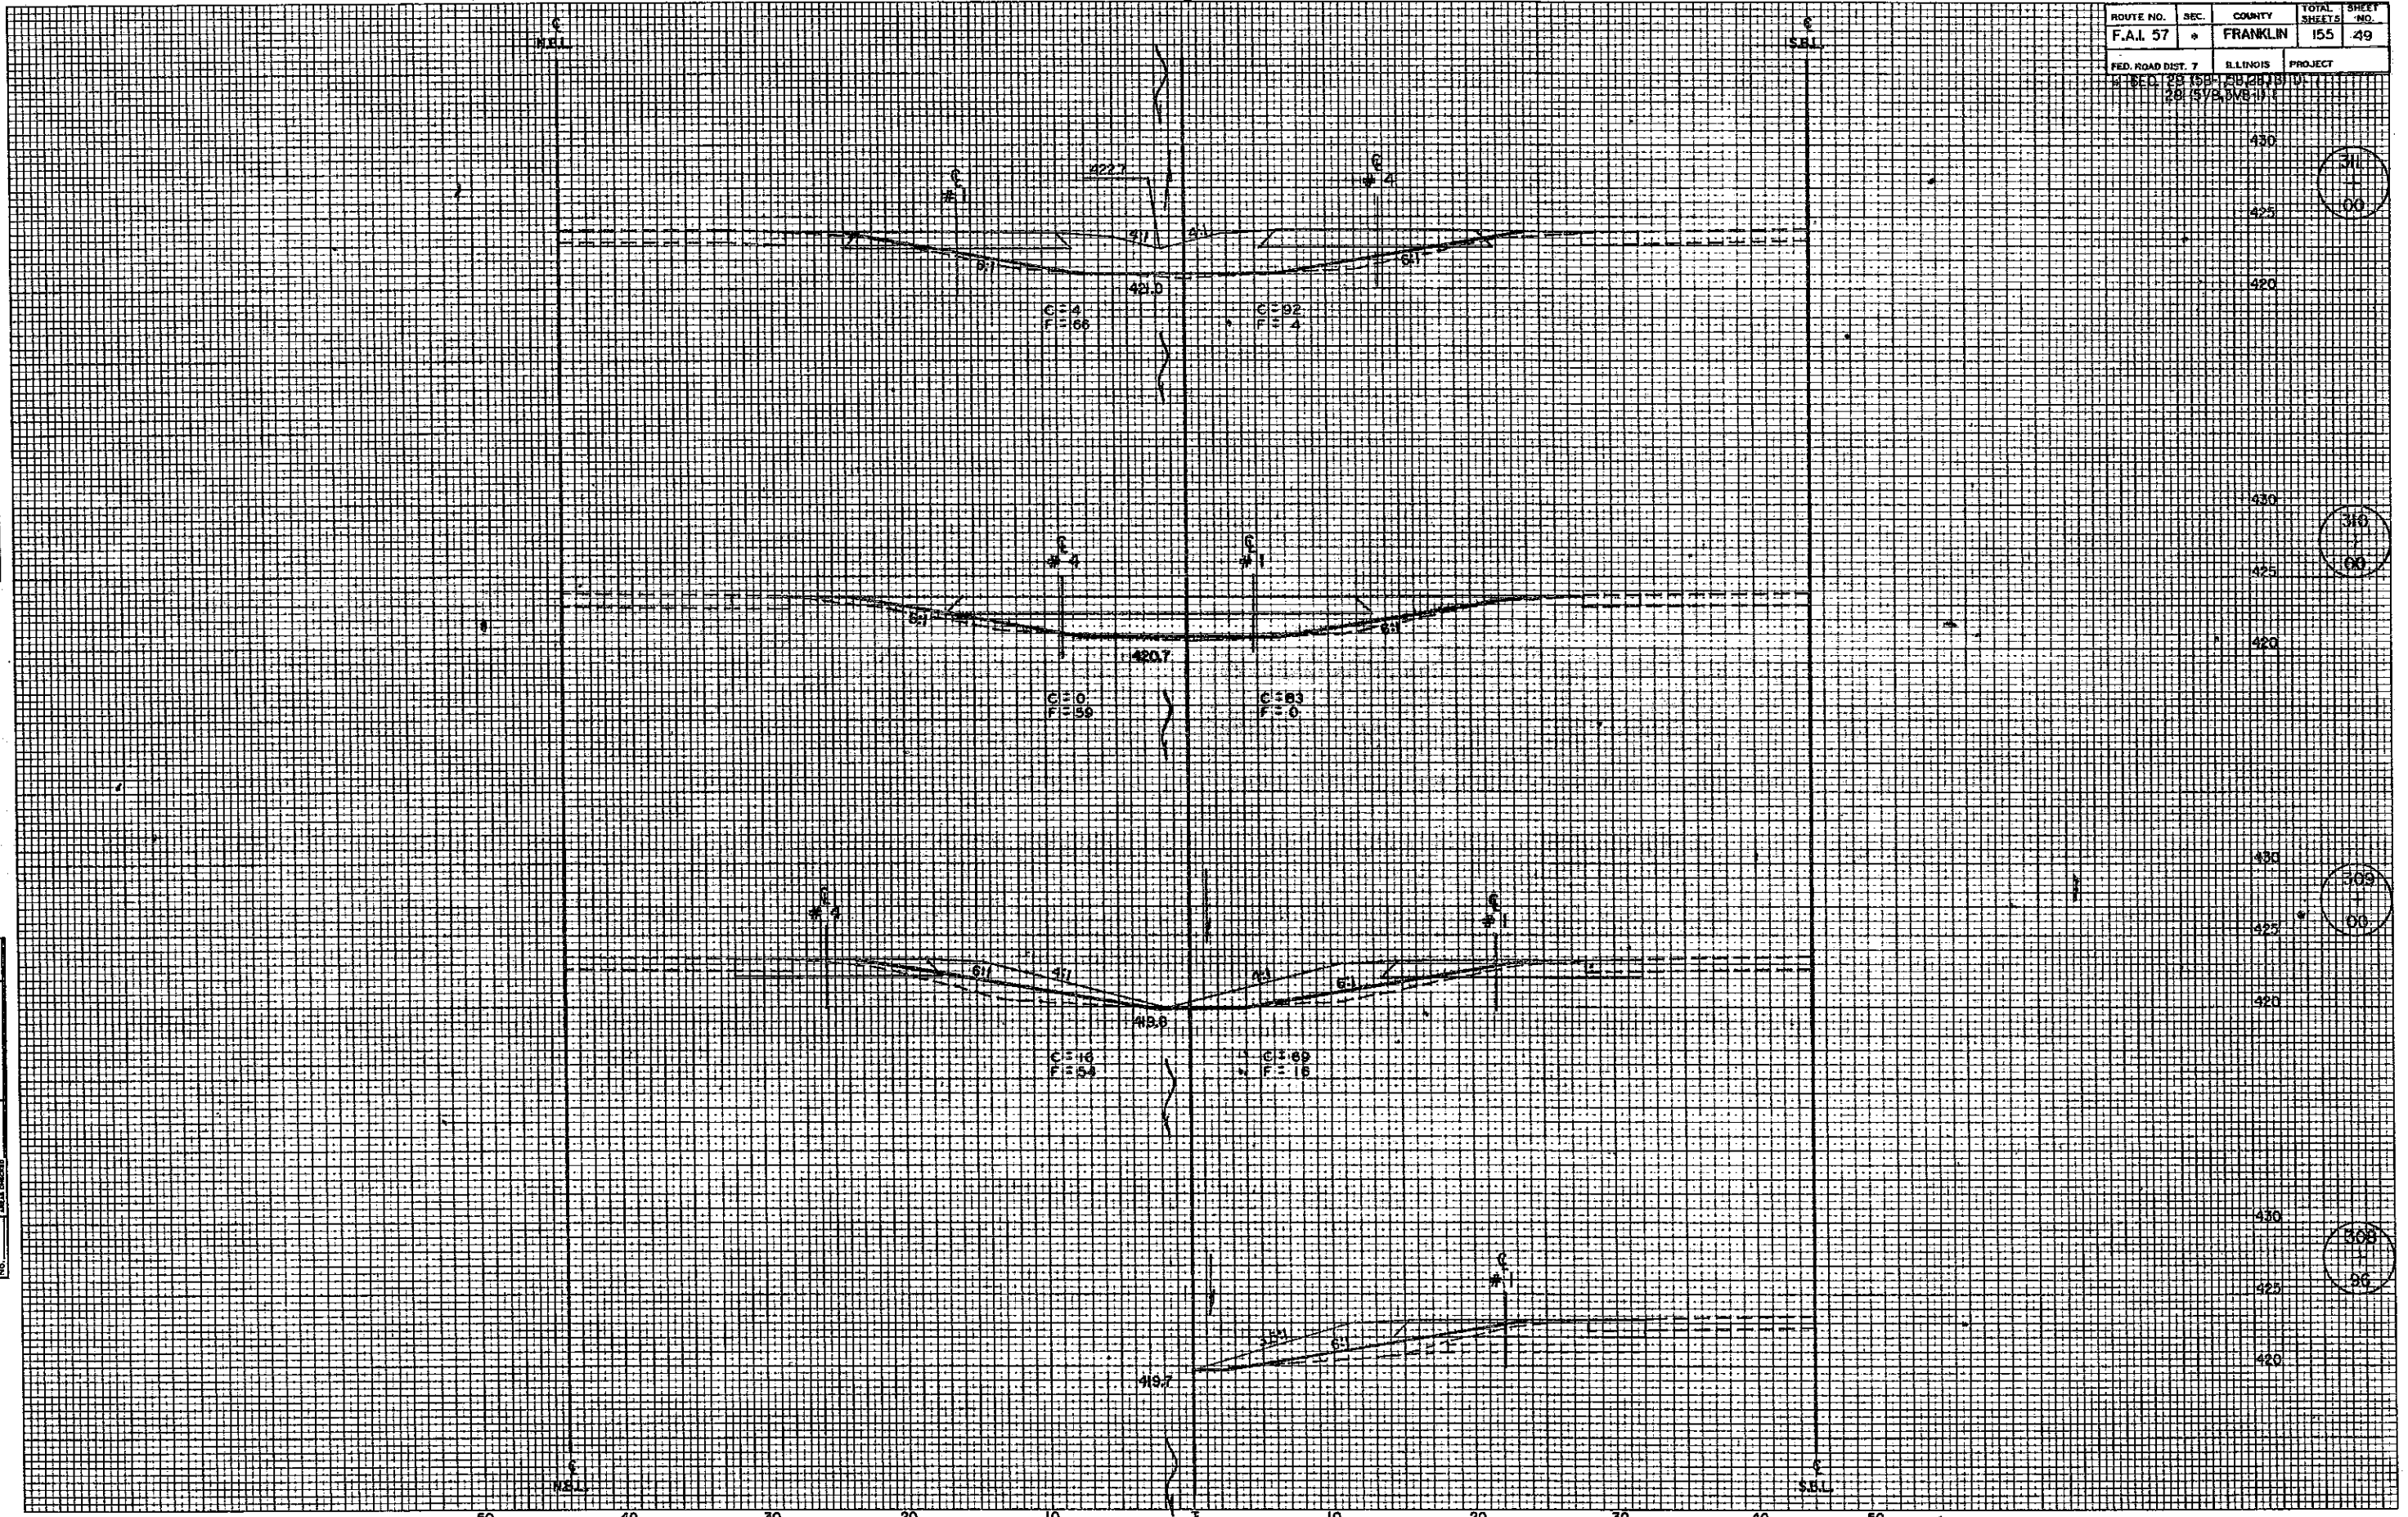

311  
1  
00

316  
1  
00

309  
1  
00

308  
1  
00

PLATE 3 CROSS SECTION O.P.R. & E. STANDARD  
 DETROIT CORPORATION

MARCUM BRANCH



ROUTE NO.	SEC.	COUNTY	TOTAL SHEETS	SHEET NO.
F.A.I. 57	*	FRANKLIN	155	50
FED. ROAD DIST. 7		ILLINOIS	PROJECT	
* SEC. 29 15N 28E 10E 25 15N 28E 10E				

FINAL SURVEY NOTE BOOK No. \_\_\_\_\_

DATE \_\_\_\_\_

BY \_\_\_\_\_

CHECKED BY \_\_\_\_\_

FINAL SURVEY NOTE BOOK No. \_\_\_\_\_

DATE \_\_\_\_\_

BY \_\_\_\_\_

CHECKED BY \_\_\_\_\_

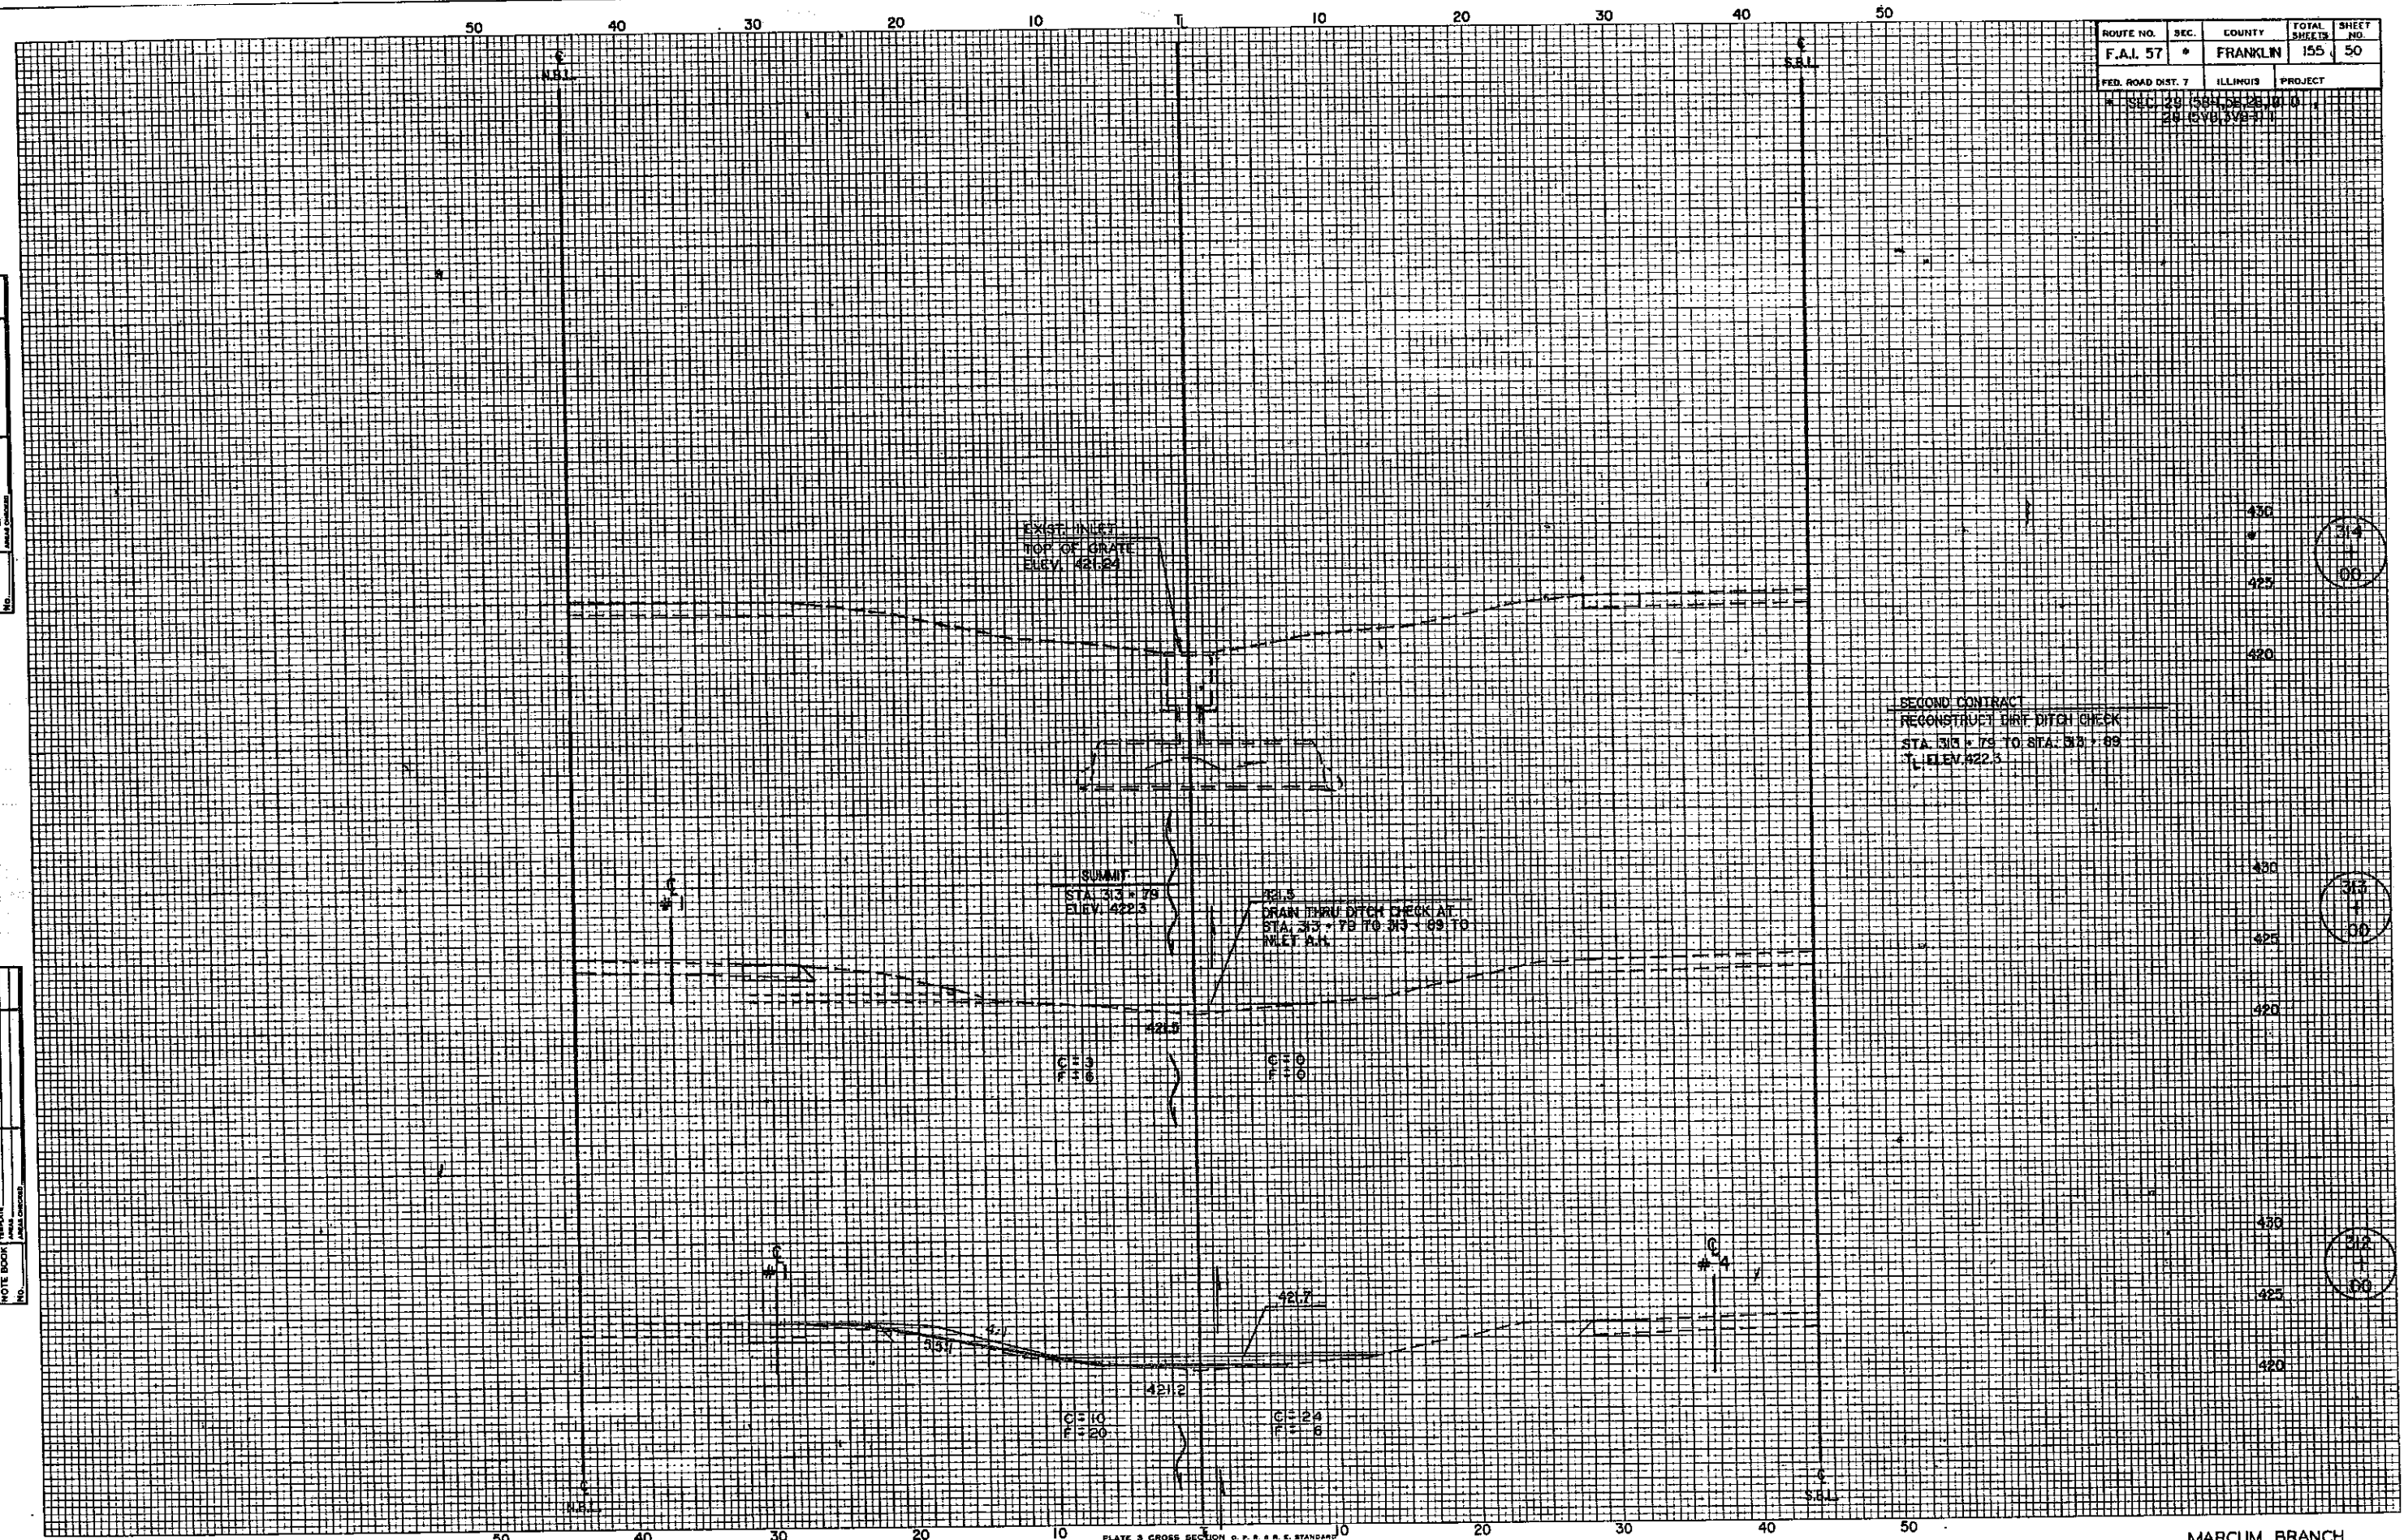


PLATE 3 CROSS SECTION D. P. R. & R. E. STANDARD  
BETZOLD CORPORATION

MARCUM BRANCH

STATE OF ILLINOIS  
DEPARTMENT OF TRANSPORTATION

ROUTE NO.	SECTION	COUNTY	SHEET NO.	TOTAL SHEETS
F.A.I. RT. 57	28-2B	FRANKLIN	51	16

Existing Structures: #028-0011 (S.B.) & #028-0012 (N.B.) are each 127'-6" long and 42'-0" wide. Built as F.A.I. Rte. 57, Section 28-2B at Sta. 304+25 in 1962 consists of RC Deck supported on 3 span continuous wide flange beams. Temporary median crossovers shall be utilized to divert traffic over adjacent bridge during reconstruction. Bench Mark: "□" Cut on top of N.E. end of West handrail of Southbound Lane of bridge over Marcum Branch. Elevation 424.81. No Salvage.

GENERAL NOTES

Fasteners shall be high strength bolts. Bolts 7/8" φ, open holes 5/8" φ, unless otherwise noted.

Field welding of construction accessories will not be permitted to the bottom flange of beams nor to the top flange for a distance equal to one-fourth the span length each way from the pier supports. Field welding in other areas will be permitted only when approved by the Engineer.

Reinforcement bars shall conform to the requirements of AASHTO M-31, M-42 or M-53 Grade 60.

Plan dimensions and details relative to existing structure have been taken from existing plans and field survey and are subject to nominal construction variations. It shall be the Contractor's responsibility to verify such dimensions and details in the field and make necessary approved adjustments prior to construction or ordering of materials. Such variations shall not be cause for additional compensation for a change in the scope of the work, however, the Contractor will be paid for the quantity actually furnished at the unit price bid for the work.

Two 1/2" adjusting shims, of the dimensions of the bottom bearing plate, shall be provided for each bearing in addition to all other plates or shims. For Type I Elastomeric Bearings, shims of the dimensions of the top plate shall be provided and placed as detailed.

The Contractor will be required to mark, on top of the concrete deck, the locations of the top flange of all the steel beams, prior to any removal of the bridge concrete deck. Saw cutting directly over the top of the beam flanges is not permitted.

All top surfaces of the abutments shall receive Bridge Seat Sealer. Estimated quantity = 189 Sq. Ft.


The first two coats of the Lead and Chromate free Alkyd Paint System shall be used for shop and field painting of new structural steel.

Structural steel shall only be cleaned and painted as required by the Special Provision "Cleaning and Painting New Steel and Adjacent Areas of Existing Steel Structures".

Prior to pouring the new concrete for the deck, all loose rust, loose mill scale and all other foreign material shall be removed from the embedded portions of flanges of stringers. The removal shall be accomplished in accordance with the requirements of the SSPC Surface Preparation Specifications SP-11 for power tool cleaning or SP-2 for hand tool cleaning. Cost shall be incidental to "Concrete Removal".


For cantilever forming brackets see Special Provisions.

STATION 304+25.00  
REBUILT BY  
STATE OF ILLINOIS  
F.A.I. RT. 57 SEC. (28-2B)D  
F.A. PROJECT: 14-57-2(192)03  
LOADING HS20 & ALT.  
STR. NO. 028-0012  
**NAME PLATE**  
See Std. 2.113

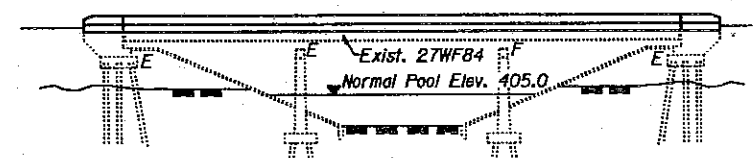


ELEVATION

Existing Name Plate to be cleaned and relocated. Cost incidental to "Name Plates".

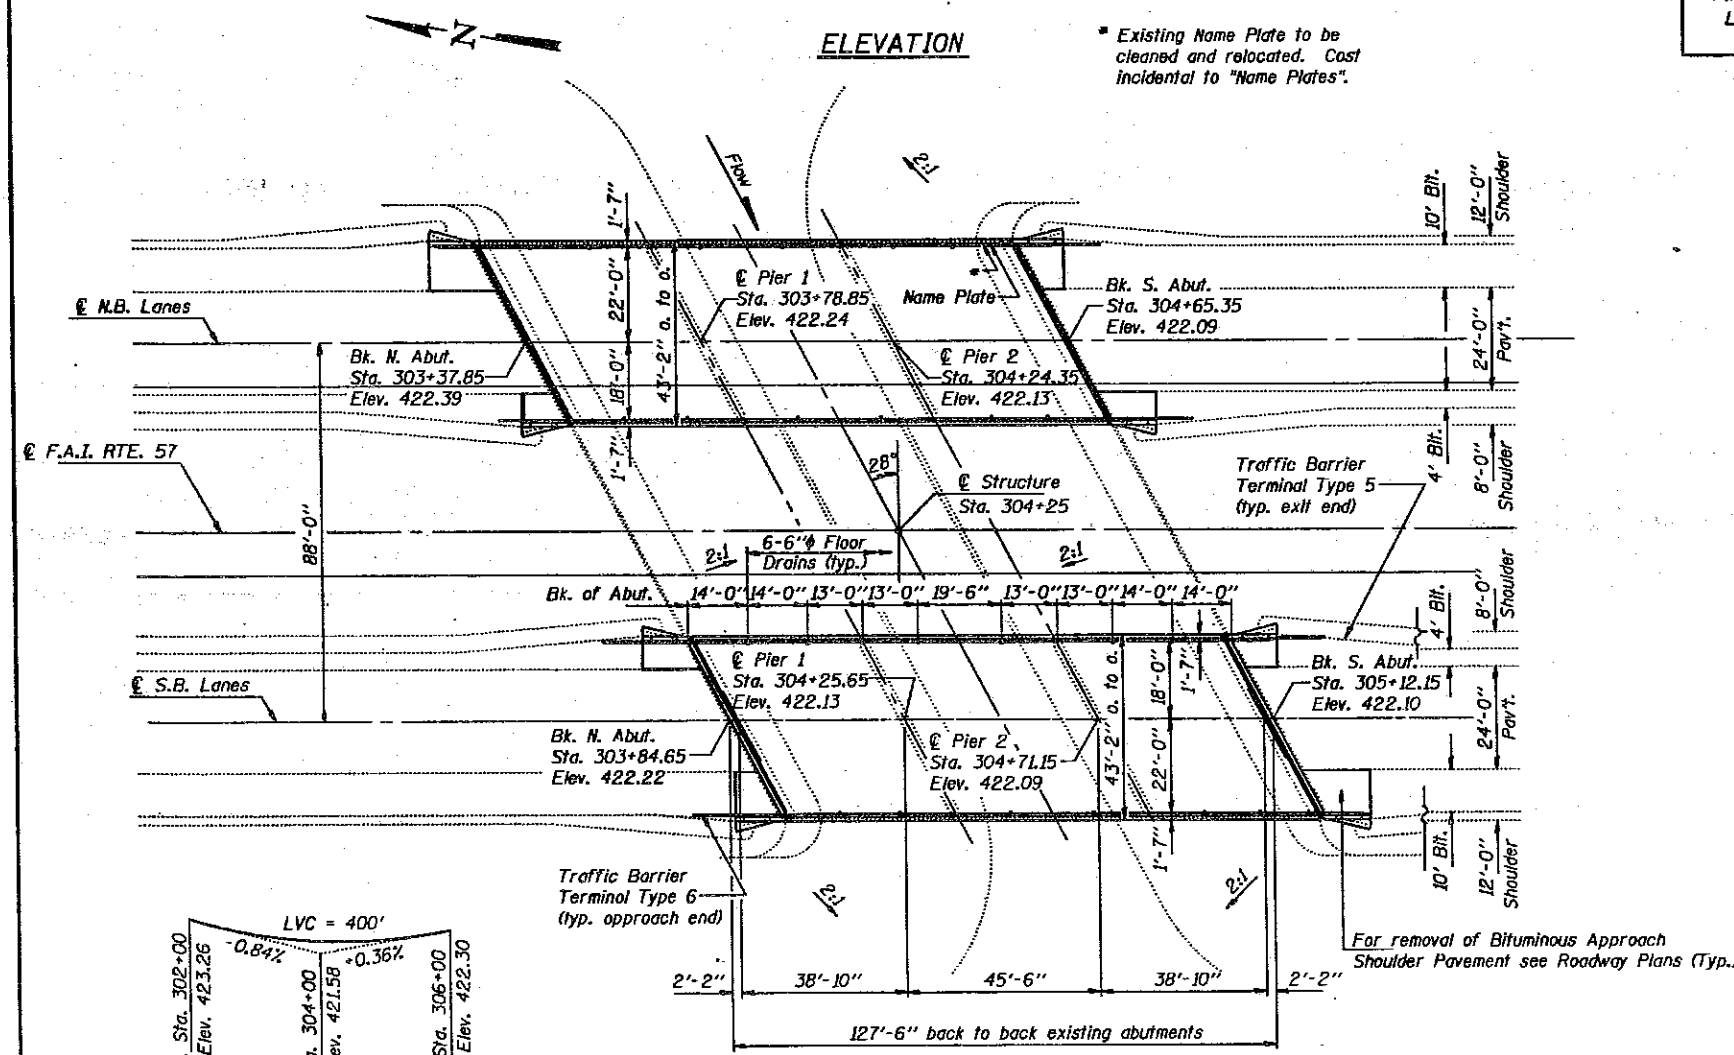

PLAN

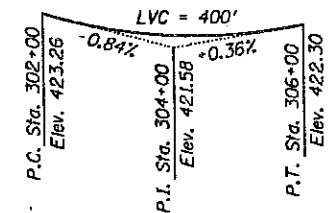

PROFILE GRADE  
F.A. Route 57 (along E pavement)


TOTAL BILL OF MATERIAL

ITEM	UNIT	SUPER	SUB	TOTAL
Concrete Removal	Cu. Yd.		9	9
Structure Excavation	Cu. Yd.		22	22
Removal of Existing Concrete Deck	Each	1		1
Floor Drains	Each	12		12
Preformed Joint Seal 2 1/2"	Lin. Ft.	49		49
Preformed Joint Seal 4"	Lin. Ft.	49		49
Class X Concrete Superstructure	Cu. Yd.	177.2		177.2
Protective Coat	Sq. Yd.	672		672
Elastomeric Bearing Assembly, Type I	Each	14		14
Elastomeric Bearing Assembly, Type II	Each	7		7
Structural Steel	Lbs.	9190		9190
Stud Shear Connectors	Each	3255		3255
Reinforcement Bars, Epoxy Coated	Pound	37690	3540	41230
Name Plates	Each	1		1
Bridge Seat Sealer	L. Sum		0.25	0.25
Jack and Remove Existing Bearings	Each	28		28
Bridge Deck Grooving	Sq. Yd.	555		555

\*\* Includes the removal of existing steel railing.  
\*\*\* Quantity includes bridge deck surface.

DESIGN SPECIFICATIONS  
1989 AASHTO, 1990 & 1991 Interim Specifications  
LOADING HS 20-44 & ALT.  
Allow 25#/sq. ft. for future wearing surface.

DESIGN STRESSES  
FIELD UNITS  
New Construction  
f<sub>c</sub> = 3,500 psi  
f<sub>y</sub> = 60,000 psi (Reinf.)  
Old Construction  
f<sub>s</sub> = 20,000 psi (Structural Steel)

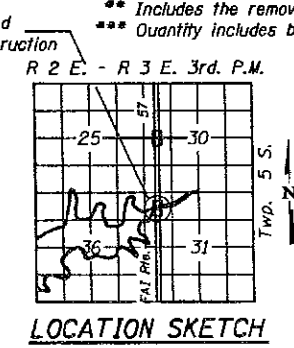

LOCATION SKETCH

GENERAL PLAN  
F.A.I. ROUTE 57 OVER  
MARCUM BRANCH  
F.A.I. ROUTE 57 SECTION (28-2B)D  
FRANKLIN COUNTY  
STATION 304+25.00  
STRUCTURE NUMBER 028-0012 (N.B.)

DESIGNED John Ciccone  
CHECKED Paul W. Sweet JRS  
DRAWN Paul W. Sweet JRS  
CHECKED JLC JDC


EXAMINED [Signature]  
PASSED [Signature]  
APPROVED [Signature]  
DIRECTOR OF HIGHWAYS

May 22 1992

Note: Only the Northbound structure is included in this contract.




STATE OF ILLINOIS  
DEPARTMENT OF TRANSPORTATION

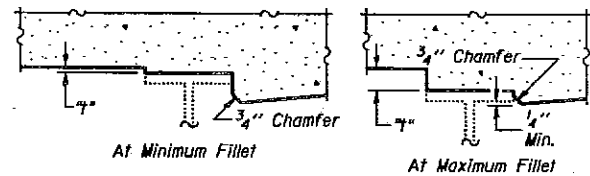

ROUTE NO.	SECTION	COUNTY	DATE	SHEET NO.
F.A.I. RT.	28-2B	FRANKLIN	1955	52
FEDERAL AID DIST. NO. 7		ILLINOIS	FEDERAL PROJECT	

SHEET NO. 2  
16 SHEETS

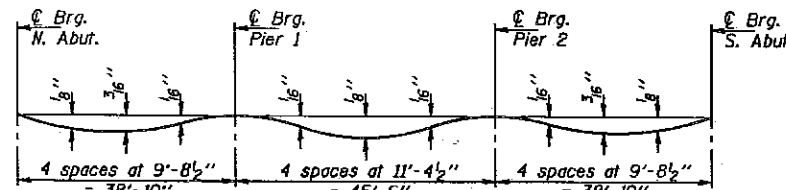

**DEAD LOAD DEFLECTION DIAGRAM**

(Includes weight of concrete only)

Note: The above deflections are not to be used in the field if the engineer is working from the grade elevations adjusted for dead load deflections as shown below.

To determine "T": Elevations of the top flanges of the beams shall be taken at intervals shown below. These elevations subtracted from the "Theoretical Grade Elevations Adjusted for Dead Load Deflection" shown below, minus slab thickness, equals the fillet heights "T" above top flange of beams.

**FILLET HEIGHTS**

**☉ BEAM 1**

Location	Station	Offset	Theoretical Grade Elevations	Theoretical Grade Elevations Adjusted For Dead Load Deflection
Bk. of N. Abut.	30326.684	-21.000	422.124	422.124
E Brg. N. Abut.	30328.851	-21.000	422.114	422.114
A	30338.851	-21.000	422.070	422.081
B	30348.851	-21.000	422.030	422.043
C	30358.851	-21.000	421.992	421.998
E Brg. Pier 1	30367.684	-21.000	421.961	421.981
D	30377.684	-21.000	421.929	421.933
E	30387.684	-21.000	421.899	421.908
F	30397.684	-21.000	421.873	421.880
G	30407.684	-21.000	421.850	421.853
E Brg. Pier 2	30413.184	-21.000	421.838	421.838
H	30423.184	-21.000	421.820	421.827
I	30433.184	-21.000	421.804	421.818
J	30443.184	-21.000	421.792	421.802
E Brg. S. Abut.	30452.017	-21.000	421.783	421.783
Bk. of S. Abut.	30454.184	-21.000	421.781	421.781

**☉ BEAM 2**

Location	Station	Offset	Theoretical Grade Elevations	Theoretical Grade Elevations Adjusted For Dead Load Deflection
Bk. of N. Abut.	30330.052	-14.667	422.241	422.241
E Brg. N. Abut.	30332.218	-14.667	422.231	422.231
A	30342.218	-14.667	422.188	422.199
B	30352.218	-14.667	422.148	422.161
C	30362.218	-14.667	422.111	422.117
E Brg. Pier 1	30371.052	-14.667	422.081	422.081
D	30381.052	-14.667	422.050	422.055
E	30391.052	-14.667	422.022	422.031
F	30401.052	-14.667	421.997	422.004
G	30411.052	-14.667	421.975	421.977
E Brg. Pier 2	30416.552	-14.667	421.964	421.964
H	30426.552	-14.667	421.946	421.953
I	30436.552	-14.667	421.932	421.945
J	30446.552	-14.667	421.920	421.930
E Brg. S. Abut.	30455.385	-14.667	421.912	421.912
Bk. of S. Abut.	30457.552	-14.667	421.911	421.911

**EAST LONGITUDINAL BONDED CONSTRUCTION JOINT**

Location	Station	Offset	Theoretical Grade Elevations	Theoretical Grade Elevations Adjusted For Dead Load Deflection
Bk. of N. Abut.	30331.469	-12.000	422.290	422.290
E Brg. N. Abut.	30333.636	-12.000	422.280	422.280
A	30343.636	-12.000	422.238	422.248
B	30353.636	-12.000	422.198	422.211
C	30363.636	-12.000	422.162	422.168
E Brg. Pier 1	30372.469	-12.000	422.132	422.132
D	30382.469	-12.000	422.101	422.106
E	30392.469	-12.000	422.074	422.082
F	30402.469	-12.000	422.049	422.056
G	30412.469	-12.000	422.027	422.030
E Brg. Pier 2	30417.969	-12.000	422.016	422.016
H	30427.969	-12.000	421.999	422.006
I	30437.969	-12.000	421.985	421.999
J	30447.969	-12.000	421.974	421.984
E Brg. S. Abut.	30456.803	-12.000	421.967	421.967
Bk. of S. Abut.	30458.969	-12.000	421.965	421.965

**☉ BEAM 3**

Location	Station	Offset	Theoretical Grade Elevations	Theoretical Grade Elevations Adjusted For Dead Load Deflection
Bk. of N. Abut.	30333.419	-8.333	422.346	422.346
E Brg. N. Abut.	30335.586	-8.333	422.336	422.336
A	30345.586	-8.333	422.295	422.305
B	30355.586	-8.333	422.256	422.269
C	30365.586	-8.333	422.220	422.226
E Brg. Pier 1	30374.419	-8.333	422.191	422.191
D	30384.419	-8.333	422.161	422.165
E	30394.419	-8.333	422.133	422.142
F	30404.419	-8.333	422.109	422.116
G	30414.419	-8.333	422.088	422.091
E Brg. Pier 2	30419.919	-8.333	422.078	422.078
H	30429.919	-8.333	422.061	422.068
I	30439.919	-8.333	422.048	422.061
J	30449.919	-8.333	422.037	422.047
E Brg. S. Abut.	30458.752	-8.333	422.030	422.030
Bk. of S. Abut.	30460.919	-8.333	422.029	422.029

**☉ BEAM 4**

Location	Station	Offset	Theoretical Grade Elevations	Theoretical Grade Elevations Adjusted For Dead Load Deflection
Bk. of N. Abut.	30336.787	-2.000	422.388	422.388
E Brg. N. Abut.	30338.953	-2.000	422.379	422.379
A	30348.953	-2.000	422.338	422.349
B	30358.953	-2.000	422.300	422.314
C	30368.953	-2.000	422.266	422.272
E Brg. Pier 1	30377.787	-2.000	422.237	422.237
D	30387.787	-2.000	422.208	422.213
E	30397.787	-2.000	422.182	422.191
F	30407.787	-2.000	422.159	422.166
G	30417.787	-2.000	422.139	422.141
E Brg. Pier 2	30423.287	-2.000	422.129	422.129
H	30433.287	-2.000	422.113	422.120
I	30443.287	-2.000	422.101	422.114
J	30453.287	-2.000	422.091	422.101
E Brg. S. Abut.	30462.120	-2.000	422.085	422.085
Bk. of S. Abut.	30464.287	-2.000	422.084	422.084

**☉ ROADWAY AND P. G.**

Location	Station	Offset	Theoretical Grade Elevations	Theoretical Grade Elevations Adjusted For Dead Load Deflection
Bk. of N. Abut.	30337.850	0.000	422.387	422.387
E Brg. N. Abut.	30340.017	0.000	422.378	422.378
A	30350.017	0.000	422.337	422.348
B	30360.017	0.000	422.300	422.313
C	30370.017	0.000	422.265	422.272
E Brg. Pier 1	30378.850	0.000	422.237	422.237
D	30388.850	0.000	422.209	422.213
E	30398.850	0.000	422.183	422.192
F	30408.850	0.000	422.160	422.167
G	30418.850	0.000	422.140	422.143
E Brg. Pier 2	30424.350	0.000	422.130	422.130
H	30434.350	0.000	422.115	422.122
I	30444.350	0.000	422.103	422.116
J	30454.350	0.000	422.094	422.104
E Brg. S. Abut.	30463.183	0.000	422.088	422.088
Bk. of S. Abut.	30465.350	0.000	422.087	422.087

**☉ BEAM 5**

Location	Station	Offset	Theoretical Grade Elevations	Theoretical Grade Elevations Adjusted For Dead Load Deflection
Bk. of N. Abut.	30340.154	4.333	422.361	422.361
E Brg. N. Abut.	30342.321	4.333	422.352	422.352
A	30352.321	4.333	422.312	422.323
B	30362.321	4.333	422.275	422.288
C	30372.321	4.333	422.241	422.248
E Brg. Pier 1	30381.154	4.333	422.214	422.214
D	30391.154	4.333	422.186	422.191
E	30401.154	4.333	422.161	422.170
F	30411.154	4.333	422.139	422.146
G	30421.154	4.333	422.119	422.122
E Brg. Pier 2	30426.654	4.333	422.110	422.110
H	30436.654	4.333	422.096	422.103
I	30446.654	4.333	422.084	422.098
J	30456.654	4.333	422.076	422.085
E Brg. S. Abut.	30465.487	4.333	422.071	422.071
Bk. of S. Abut.	30467.654	4.333	422.070	422.070

**☉ BEAM 6**

Location	Station	Offset	Theoretical Grade Elevations	Theoretical Grade Elevations Adjusted For Dead Load Deflection
Bk. of N. Abut.	30343.522	10.667	422.265	422.265
E Brg. N. Abut.	30345.688	10.667	422.256	422.256
A	30355.688	10.667	422.217	422.228
B	30365.688	10.667	422.181	422.194
C	30375.688	10.667	422.148	422.155
E Brg. Pier 1	30384.522	10.667	422.122	422.122
D	30394.522	10.667	422.095	422.099
E	30404.522	10.667	422.071	422.080
F	30414.522	10.667	422.050	422.057
G	30424.522	10.667	422.031	422.034
E Brg. Pier 2	30430.022	10.667	422.023	422.023
H	30440.022	10.667	422.009	422.016
I	30450.022	10.667	421.999	422.012
J	30460.022	10.667	421.991	422.001
E Brg. S. Abut.	30468.855	10.667	421.987	421.987
Bk. of S. Abut.	30471.022	10.667	421.986	421.986

**WEST LONGITUDINAL BONDED CONSTRUCTION JOINT**

Location	Station	Offset	Theoretical Grade Elevations	Theoretical Grade Elevations Adjusted For Dead Load Deflection
Bk. of N. Abut.	30344.363	12.250	422.230	422.230
E Brg. N. Abut.	30346.530	12.250	422.221	422.221
A	30356.530	12.250	422.182	422.193
B	30366.530	12.250	422.147	422.160
C	30376.530	12.250	422.114	422.120
E Brg. Pier 1	30385.363	12.250	422.088	422.088
D	30395.363	12.250	422.061	422.066
E	30405.363	12.250	422.037	422.046
F	30415.363	12.250	422.016	422.023
G	30425.363	12.250	421.999	422.001
E Brg. Pier 2	30430.863	12.250	421.990	421.990
H	30440.863	12.250	421.977	421.984
I	30450.863	12.250	421.966	421.980
J	30460.863	12.250	421.959	421.969
E Brg. S. Abut.	30469.697	12.250	421.955	421.955
Bk. of S. Abut.	30471.863	12.250	421.955	421.955


**☉ BEAM 7**

Location	Station	Offset	Theoretical Grade Elevations	Theoretical Grade Elevations Adjusted For Dead Load Deflection
Bk. of N. Abut.	30346.889	17.000	422.121	422.121
E Brg. N. Abut.	30349.056	17.000	422.112	422.112
A	30359.056	17.000	422.074	422.085</




STATE OF ILLINOIS  
DEPARTMENT OF TRANSPORTATION

ROUTE NO.	SECTION	COUNTY	DATE	SHEET	SHEET NO. 4 16 SHEETS
155	28-28(D)	FRANKLIN	1955	54	
PROJECT NO. 155-28(D)		ILLINOIS			

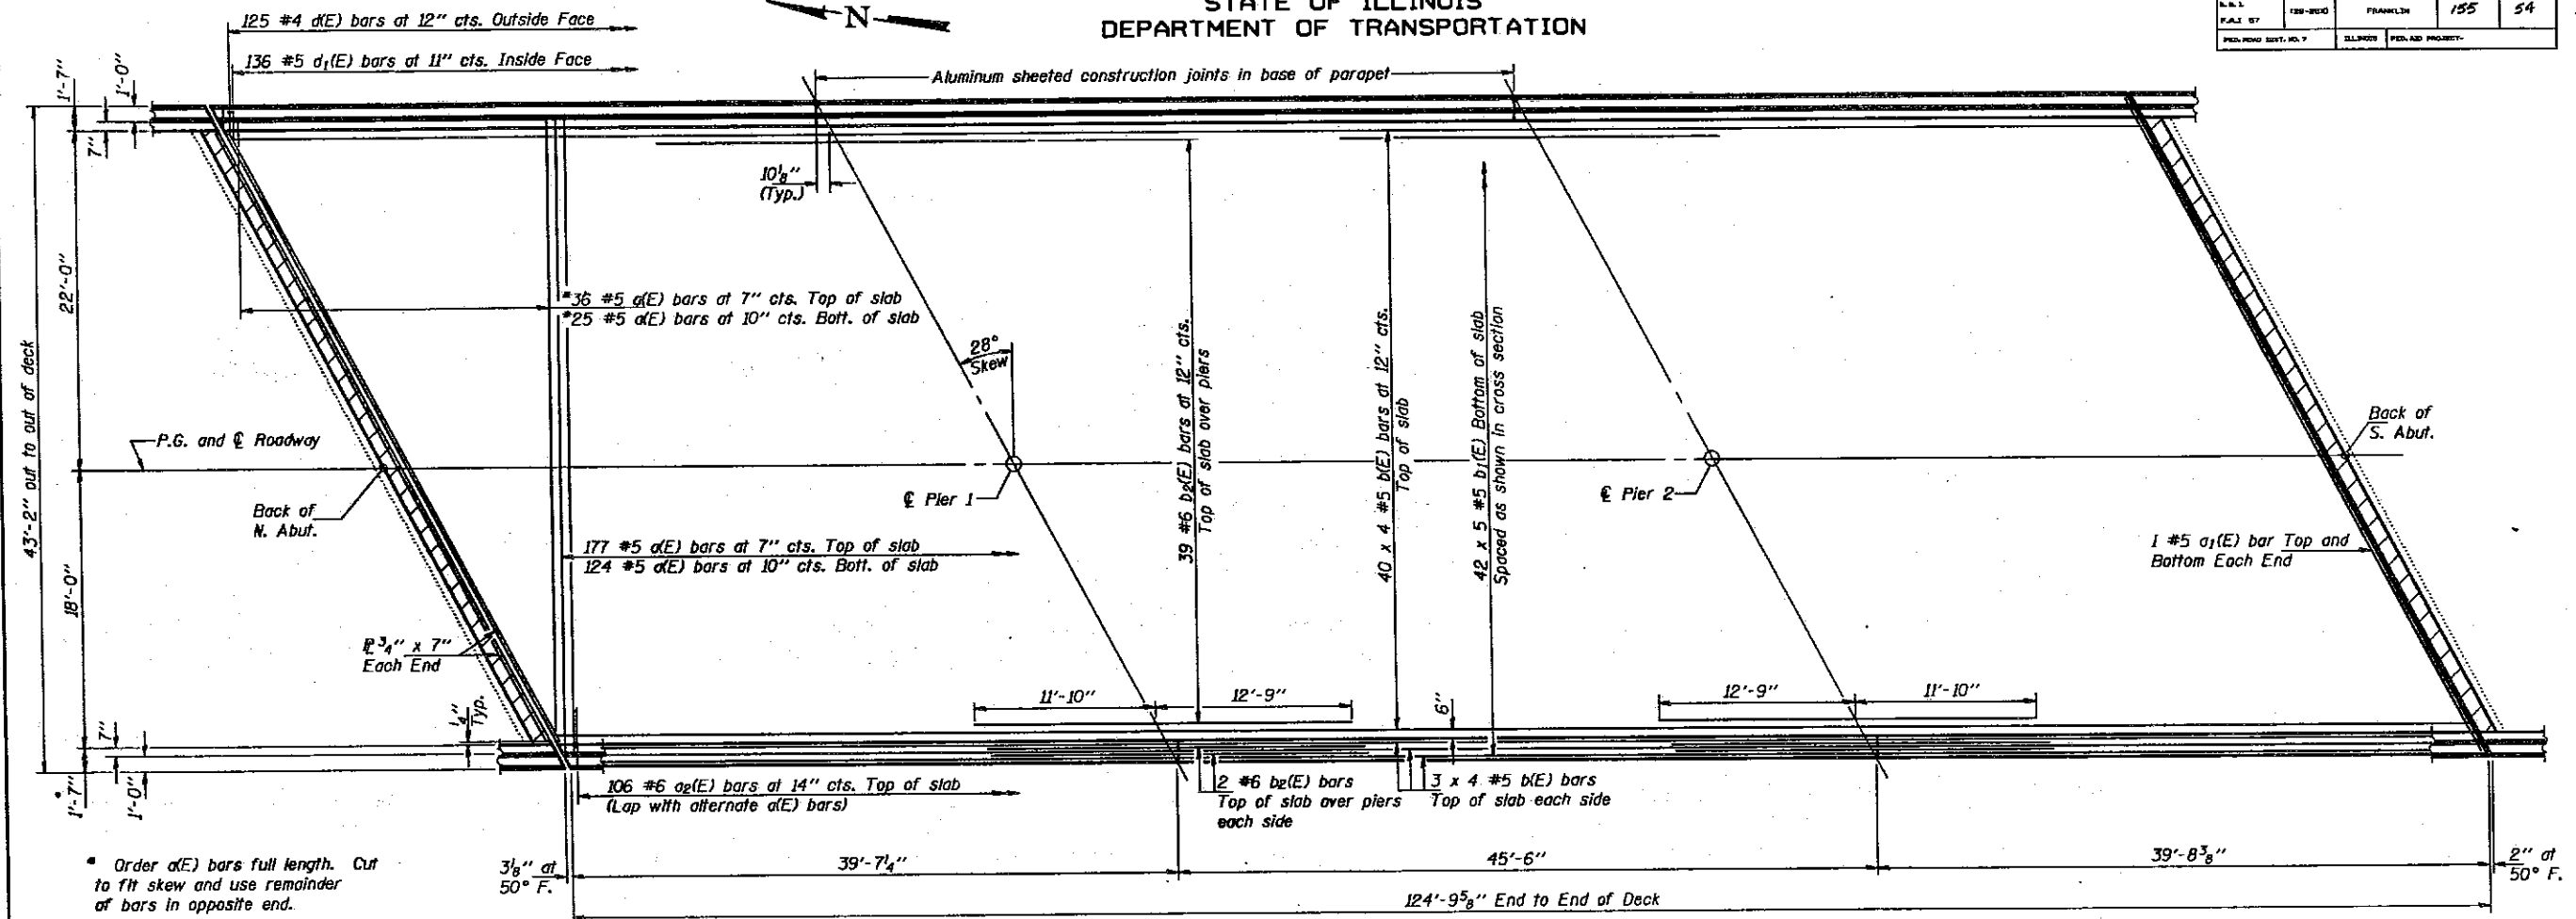

• Order d(E) bars full length. Cut to fit skew and use remainder of bars in opposite end.

PLAN

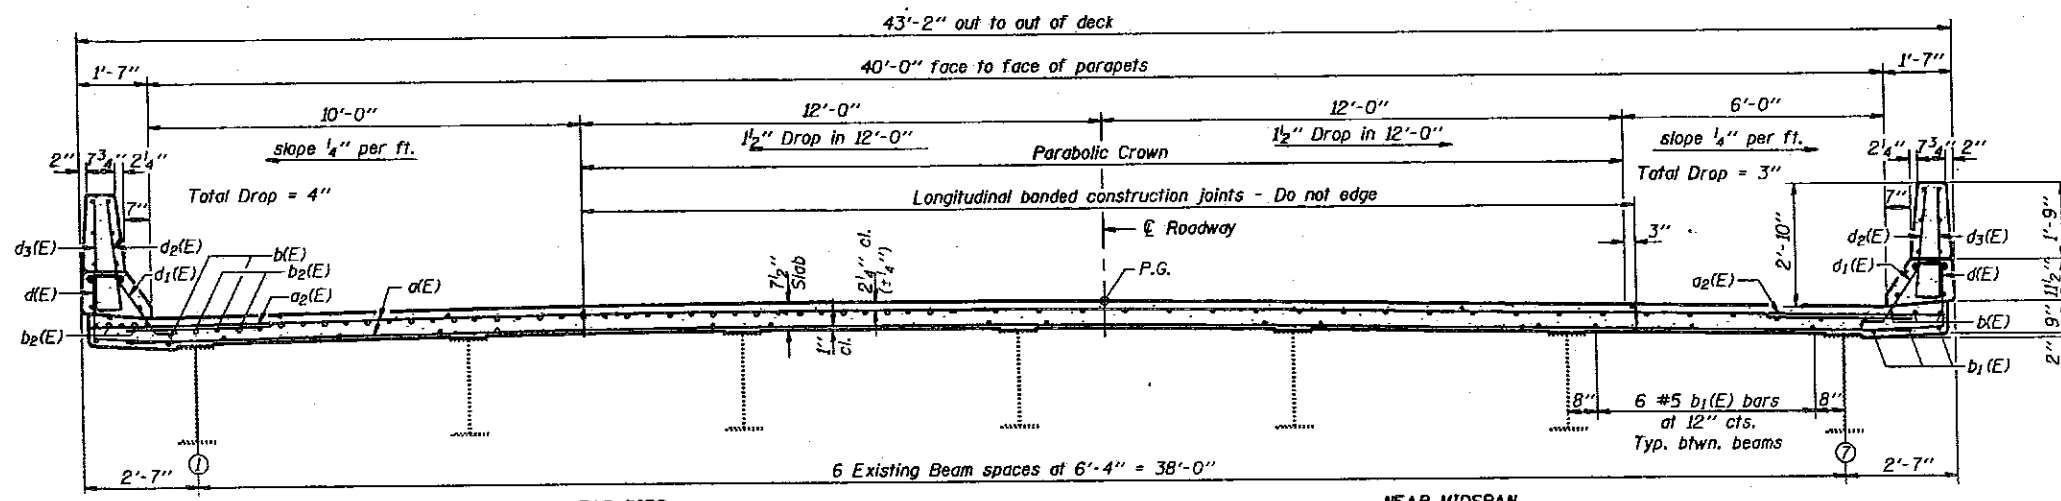

CROSS SECTION  
(Looking South)

Notes: See sheets #5 and #6 of 16 for superstructure details, parapet reinforcement and Bill of Material.  
Reinforcement bars designated (E) shall be epoxy coated.  
Reinforcement bars indicated thus 40 x 4 #5 etc. indicates 40 lines of bars with 4 lengths per line.  
See sheet #1 of 16 for drain locations and sheet #5 of 16 for details.  
Hatched area to be poured after superstructure forms have been removed. Quantity of concrete to be included with Class X Concrete Superstructure.

MIN. BAR LAPS  
#5 bars = 1'-8"

DESIGNED <i>John Cissone</i>	EXAMINED <i>May 22 1952</i>
CHECKED <i>Paul J. Sutherland</i>	PASSED <i>Robert E. Anderson</i>
DRAWN <i>Joe Sutherland</i>	APPROVED _____
CHECKED <i>JLC</i>	DIRECTOR OF HIGHWAYS

SUPERSTRUCTURE  
F.A.I. RT. 57 SEC. (28-2B)D  
FRANKLIN COUNTY  
STATION 304+25.00








STATE OF ILLINOIS  
DEPARTMENT OF TRANSPORTATION

ROUTE NO.	SECTION	COUNTY	DATE	SHEET NO.
F.A.I. 57	28-2B	FRANKLIN	155	56
DESIGNED BY		DRAWN BY		PROJECT NO.




16 SHEETS

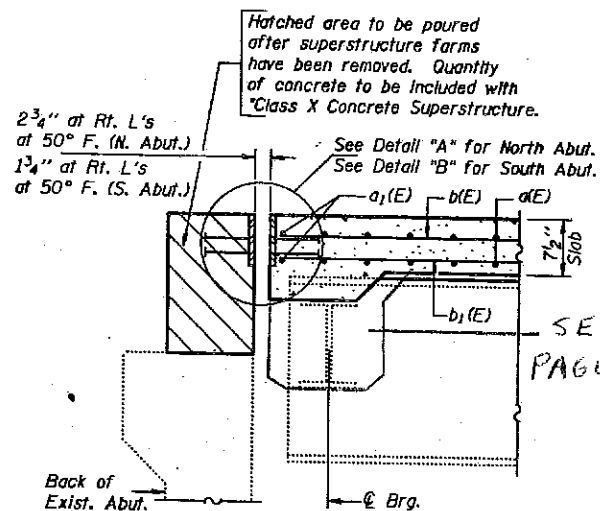

SECTION THRU ABUTMENTS  
North Abut. Looking East  
South Abut. Looking West

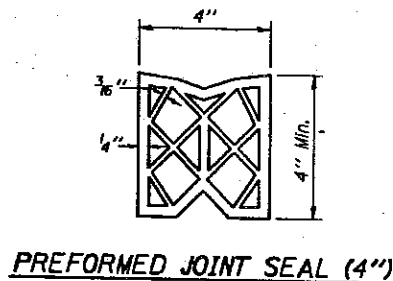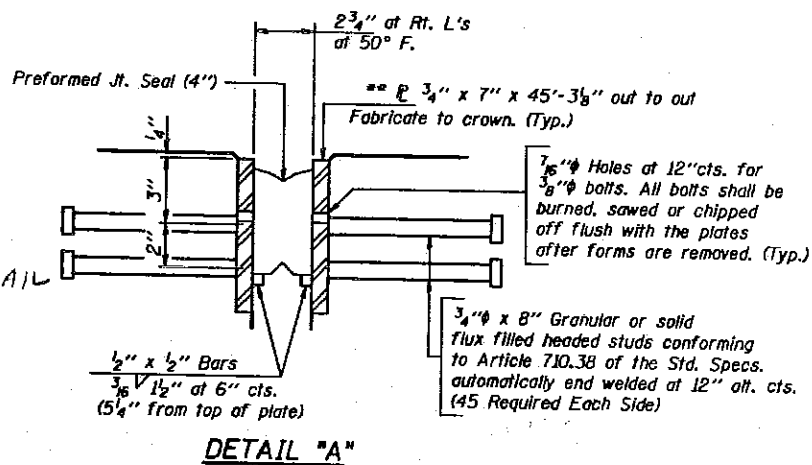

\*\* Furnish in segments of 20 ft. maximum length. Maximum space between installed segments shall be 3/16". Seal space with Silicone Sealant suitable for Structural Steel.

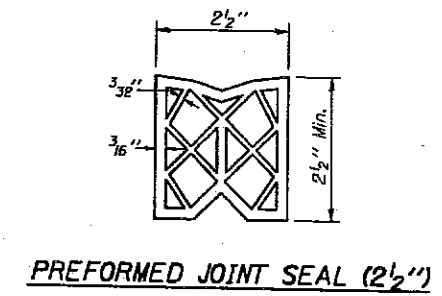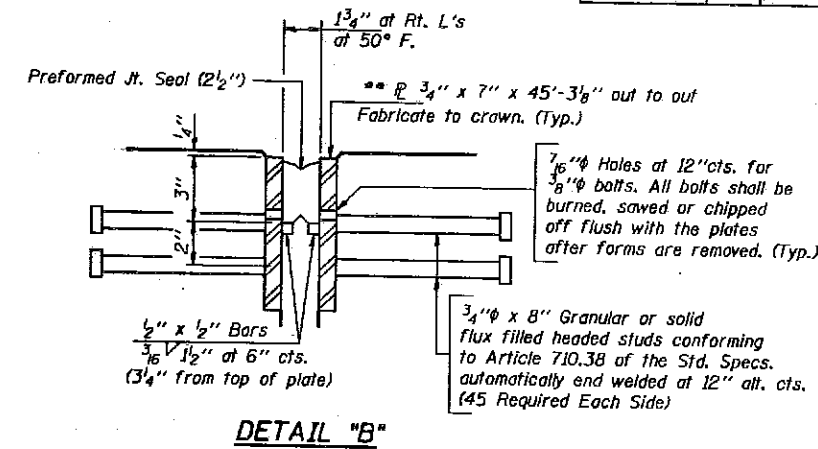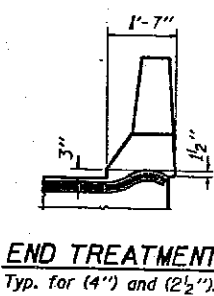

BILL OF MATERIAL


Bar	No.	Size	Length	Shape
a(E)	362	#5	41'-2"	
a1(E)	4	#5	48'-2"	
a2(E)	212	#6	4'-0"	
b(E)	184	#5	32'-5"	
b1(E)	210	#5	26'-3"	
b2(E)	86	#6	24'-7"	
d(E)	250	#4	3'-8"	
d1(E)	272	#5	2'-7"	
d2(E)	272	#5	3'-0"	
d3(E)	250	#4	3'-0"	
e(E)	36	#4	19'-7"	
e1(E)	6	#4	18'-11"	
e2(E)	36	#4	14'-11"	
e3(E)	6	#4	20'-2"	
e4(E)	4	#8	39'-5"	
e5(E)	2	#8	38'-9"	
e6(E)	4	#8	45'-3"	
e7(E)	2	#8	40'-1"	
e8(E)	4	#5	39'-5"	
e9(E)	2	#5	38'-7"	
e10(E)	4	#5	45'-3"	
e11(E)	2	#5	40'-3"	
Reinforcement Bars, Epoxy Coated		Lbs.	37690	
Class X Concrete Superstructure		Cu. Yd.	177.2	

Reinforcement bars designated (E) shall be epoxy coated.

Note: After fabrication all surfaces of the steel plates shall be given one shop coat of paint specified for Structural Steel. No field painting required.

DESIGNED John Sisson  
CHECKED [Signature]  
DRAWN Joe Sutherland  
CHECKED JLC PDC


MAY 22 1992  
EXAMINED [Signature]  
PASSED [Signature]  
APPROVED [Signature]  
DIRECTOR OF HIGHWAYS

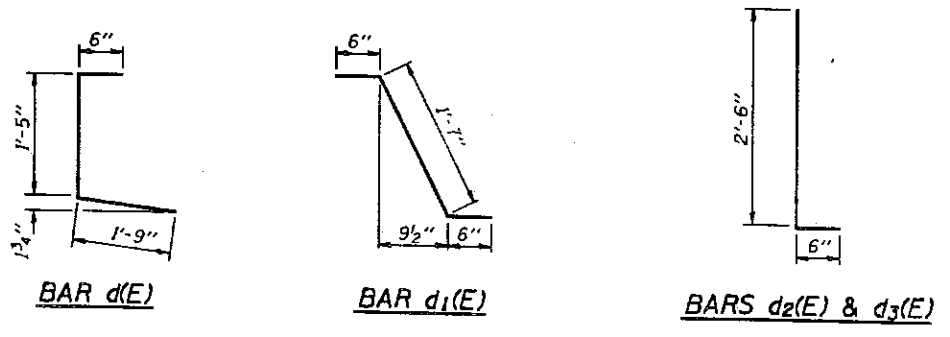


SUPERSTRUCTURE DETAILS  
F.A.I. RT. 57 SEC. (28-2B)D  
FRANKLIN COUNTY  
STATION 304+25.00

STATE OF ILLINOIS  
DEPARTMENT OF TRANSPORTATION


ROUTE NO.	SECTION	COUNTY	SHEETS	NO.	SHEET NO. 7
F.A.I. 57	28-28D	FRANKLIN	155	57	16 SHEETS
FILE NO. DIST. NO. 1	ILLINOIS	FILE NO. PROJECT			

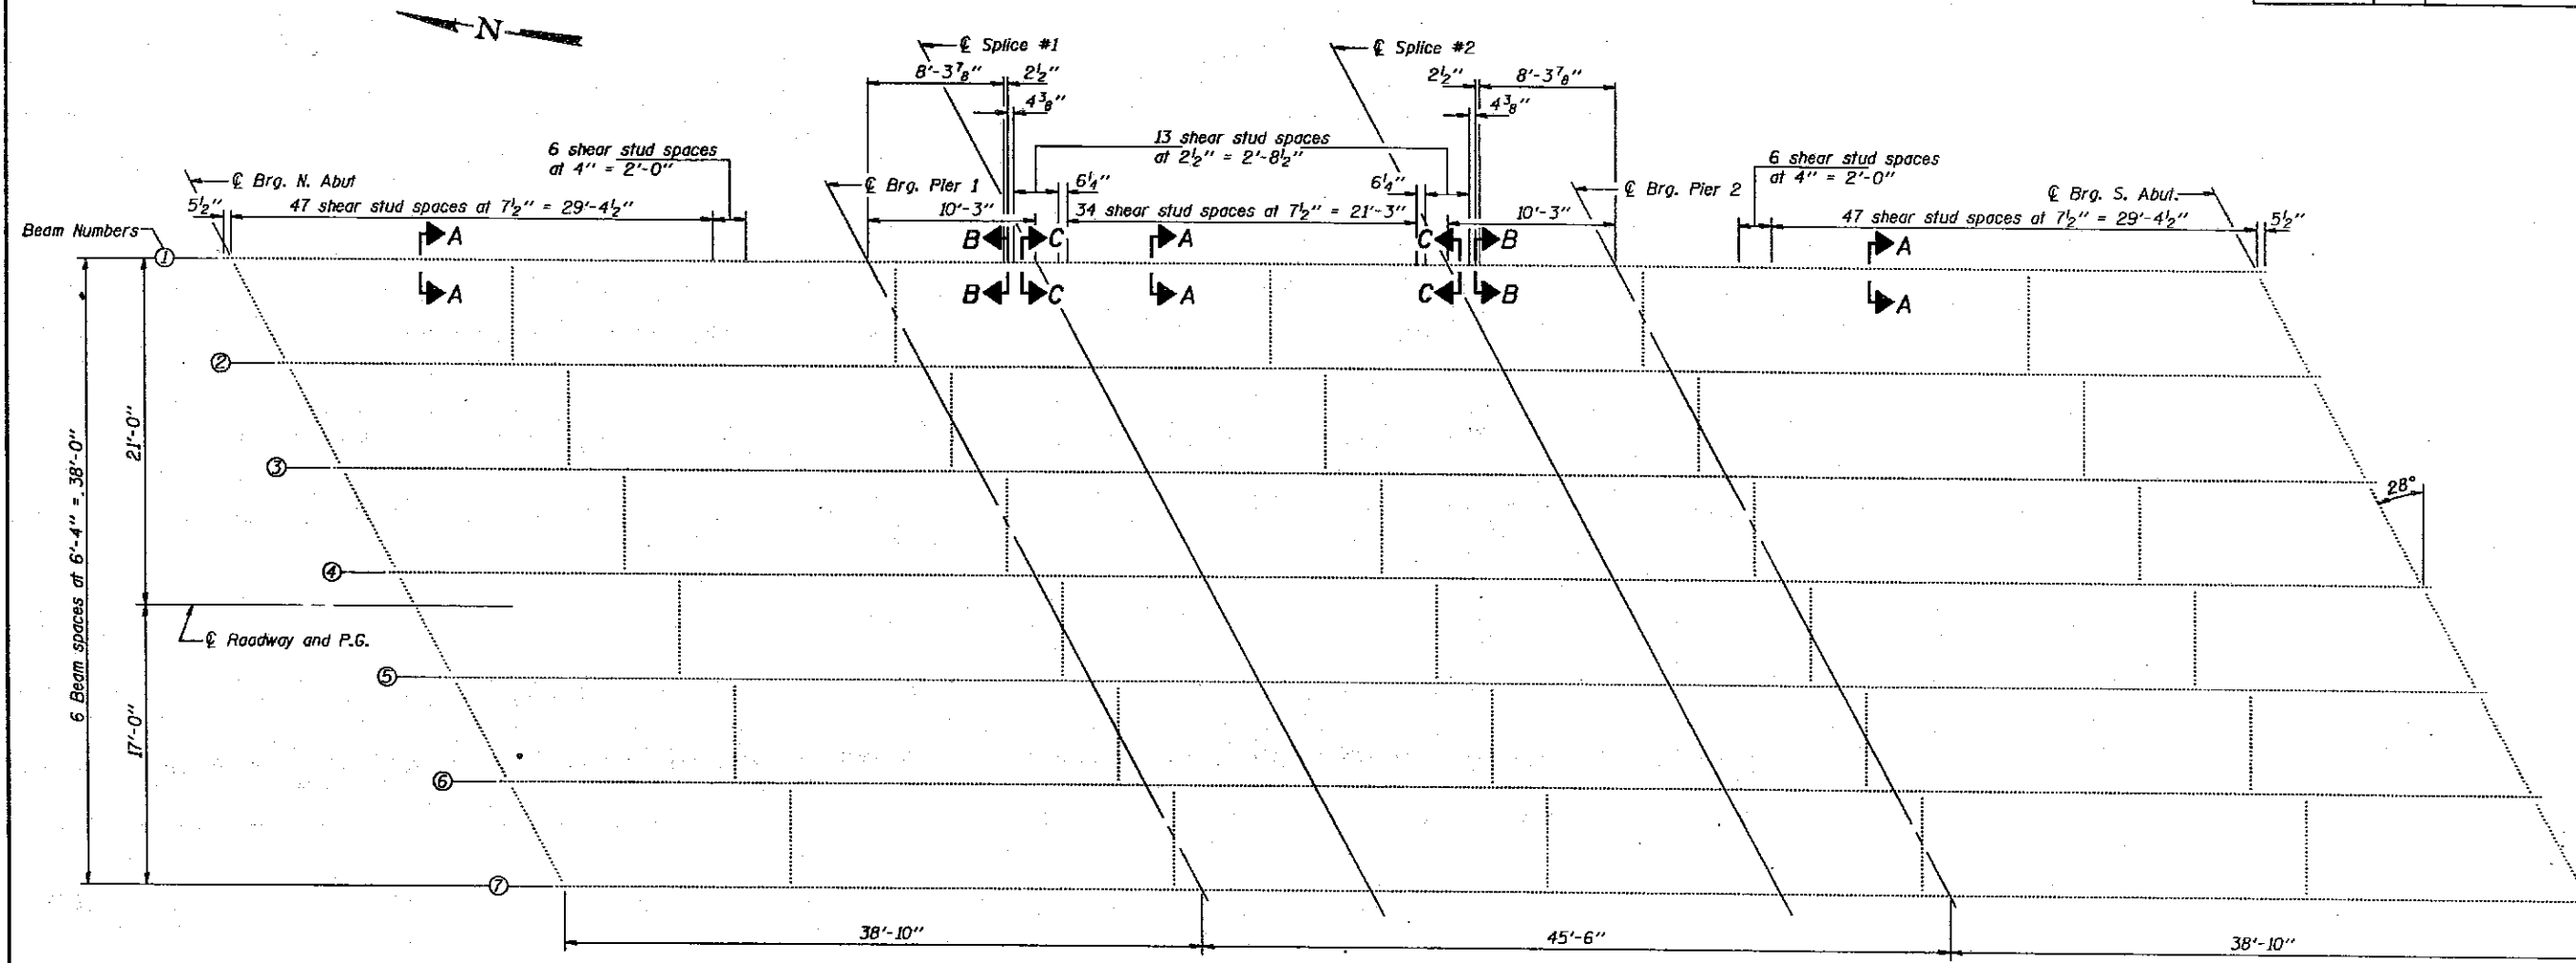


**PLAN**  
(Shear Studs Typ. All Beams)

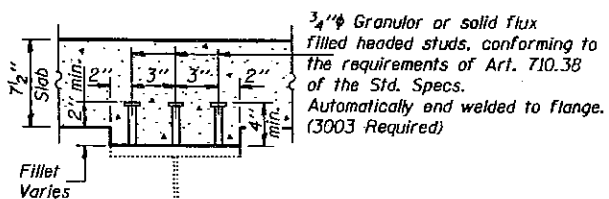

**SECTION A-A**

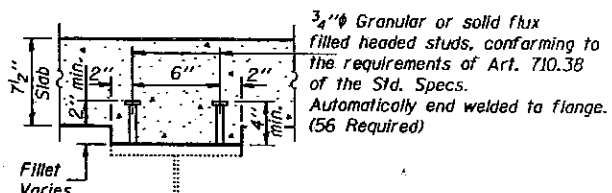

**SECTION B-B**

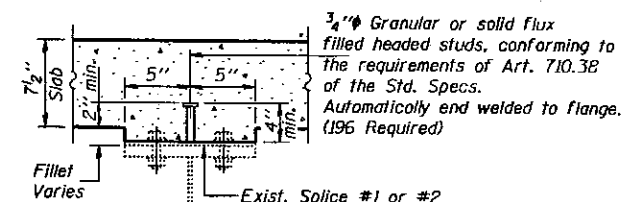

**SECTION C-C**




DESIGNED John Ciccone  
CHECKED John D. Conrad  
DRAWN Joe Sutherland  
CHECKED JLC PDC

EXAMINED May 22 1992  
Ralph E. Anderson  
ENGINEER OF BRIDGES AND STRUCTURES  
APPROVED \_\_\_\_\_  
DIRECTOR OF HIGHWAYS

**STRUCTURAL STEEL DETAILS**  
**F.A.I. RT. 57 SEC. (28-2B)D**  
**FRANKLIN COUNTY**  
**STATION 304+25.00**

STATE OF ILLINOIS  
DEPARTMENT OF TRANSPORTATION

ROUTE NO.	SECTION	COUNTY	MILES	POST	SHEET NO. 8
F.A.I. NO.	(28-2B)	FRANKLIN	155	58	16 SHEETS
PROJ. ROAD DIST. NO. 1	ILLINOIS	TYPE NO. PROJECT			

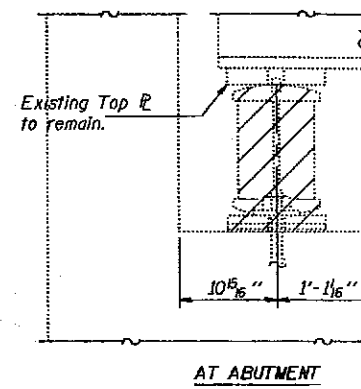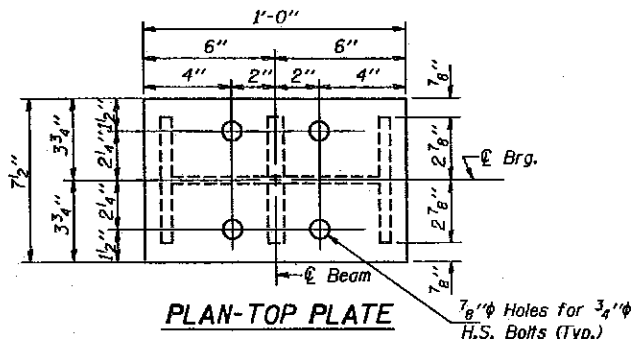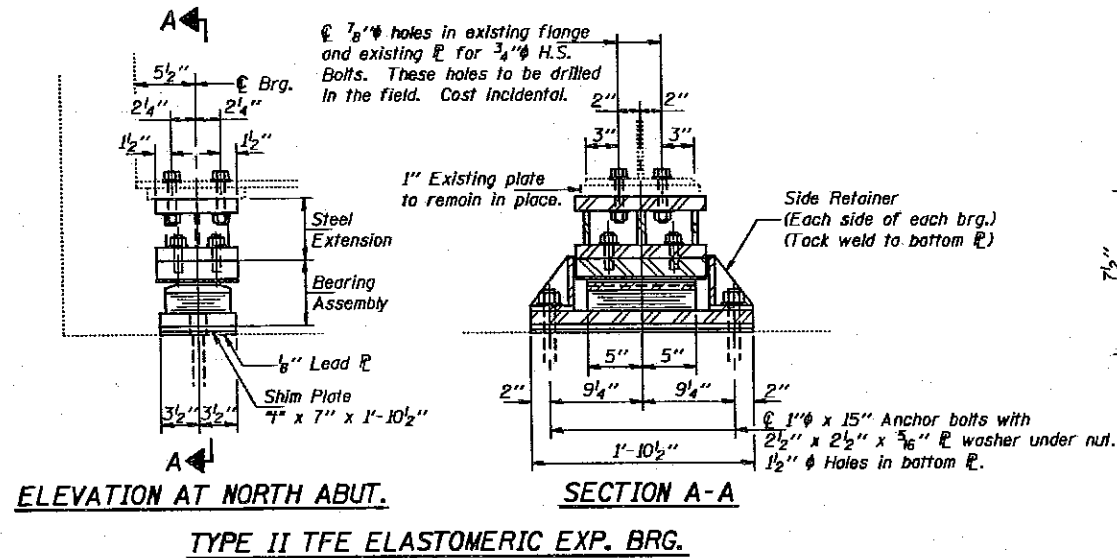

**INTERIOR BEAM MOMENT TABLE**





	0.4 Sp. 1 or 0.6 Sp. 3	Pier 1 or Pier 2	0.5 Sp. 2
$I_s$ (in <sup>4</sup> )	2850	2850	2850
$I_c$ (n=9) (in <sup>4</sup> )	8361	8361	8361
$I_c$ (n=27) (in <sup>4</sup> )	6285	6285	6285
$S_s$ (in <sup>3</sup> )	213	213	213
$S_c$ (n=9) (in <sup>3</sup> )	326	326	326
$S_c$ (n=27) (in <sup>3</sup> )	296	296	296
$\bar{r}$ (K/ft.)	.705	.980	.705
$M\bar{r}$ (K)	77.3	163	56.7
$f_s\bar{r}$ non-comp (k.s.i.)	4.4	9.2	3.2
$s\bar{r}$ (K/ft.)	.275	---	.275
$M_s\bar{r}$ (K)	34.8	---	33.9
$f_s\bar{r}$ (comp) (k.s.i.)	1.4	---	1.4
$M\bar{r}$ (K)	213	110	219.7
$M$ (Imp) (K)	63.2	32.6	65.2
(Total) (K)	276.2	142.6	284.9
$f_s$ (k.s.i.)	10.2	8.0	10.5
$f_s$ (Total) (k.s.i.)	16.0	17.2	15.1
$VR$ (K)	43.2	---	45.9

\*\* For n = 27.

**INTERIOR BEAM REACTION TABLE**

	Abuts.	Piers
$R\bar{r}$ (K)	10.5	33.0
$R\bar{r}$ (K)	30.3	37.3
Imp. (K)	9.0	11.1
$R$ (Total) (K)	49.8	81.4




$I_s$  and  $S_s$  are the moment of inertia and section modulus of the steel section used in computing  $f_s$  (Total).  
 $I_c$  and  $S_c$  are the moment of inertia and section modulus of the composite section used in computing  $f_s$  (Total).  
 $VR$  is the maximum live Load + Impact shear range in span.

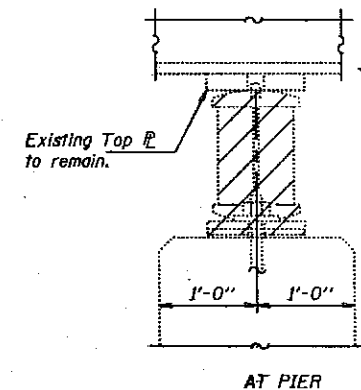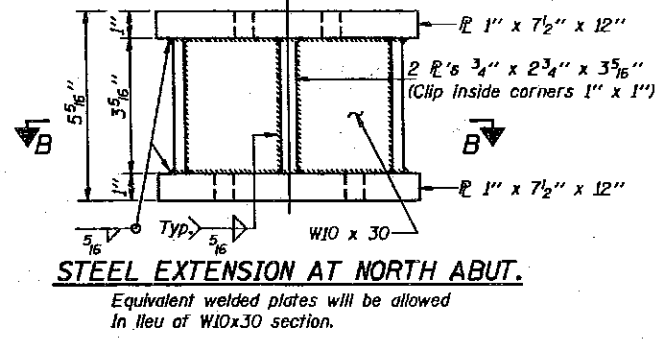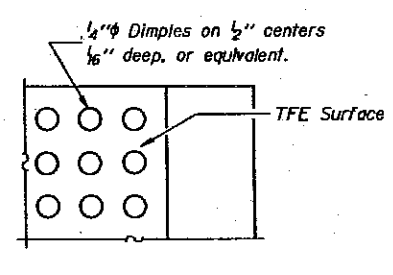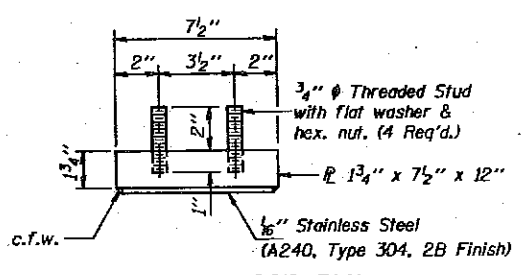

**JACK AND REMOVE EXISTING BEARING**  
 Hatched areas indicate Removal of Existing Bearing. See sheets #8, #9 & #10 of 16 for new brg. details.


**JACK AND REMOVE EXISTING BEARING PROCEDURE**

- The Contractor shall submit for approval by the Engineer, plans for jacking prior to commencing any work at the bearings. Dead Load = 3.0K at each beam at abutments and 6.0K at each beam at piers without concrete. Min. Jack Capacity at each beam shall be 5 Tons.
- Jacking and removing existing bearings shall be done after deck removal is completed and before the new deck is poured.
- All beams at one abutment or at one pier shall be lifted simultaneously.
- Jacking shall be limited to a maximum of 1/4".
- Remove the existing anchor bolts flush with the concrete surface and grind smooth. The rockers and bottom plates shall be removed, leaving the existing top plate intact. The bottom flange area of the beam and existing top plate shall be cleaned and painted as specified for structural steel.
- The new bearings and steel extensions shall be installed in place and the jacks shall be lowered before the new deck is poured.

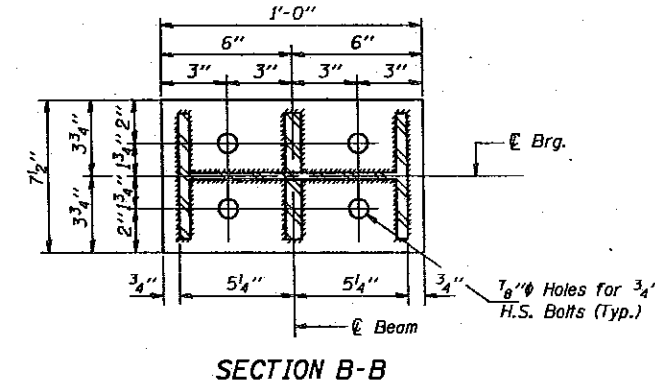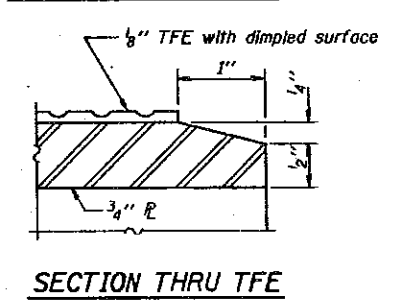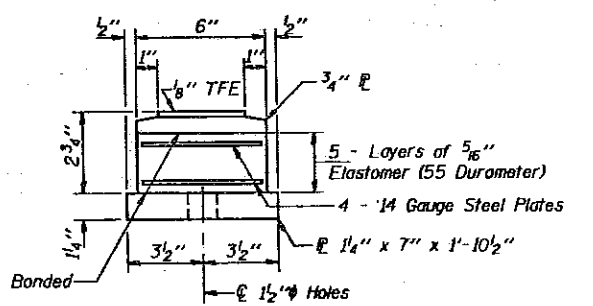


Note: The 1/8" TFE sheet shall be bonded directly to the top steel plate with a two-component, medium viscosity epoxy resin, conforming to the requirements of the Federal Specification MMM-A-134, Type I. The bond agent shall be applied on the full area of the contact surfaces.

Bonding of 1/8" TFE sheet during vulcanizing process will be permitted provided the process and method of adjusting assembly height is approved by the Engineer.

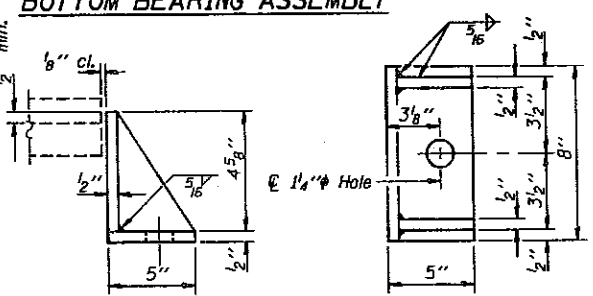

Equivalent rolled angle with stiffeners will be allowed in lieu of welded plates.

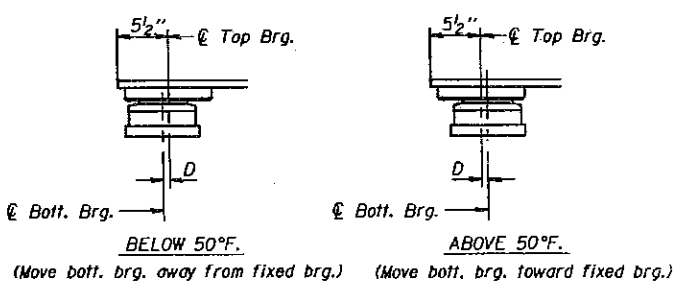

Notes: For anchor bolt installation details see sheet #16 of 16. For anchor bolt location see sheet #10 of 16. For shim plate thickness see sheet #10 of 16.

**BILL OF MATERIAL**

Item	Unit	Total
Elastomeric Bearing Assembly Type II	Each	7
Jack and Remove Existing Bearings	Each	7

**NORTH ABUTMENT BEARING DETAILS**  
 F.A.I. RT. 57 SEC. (28-2B)D  
 FRANKLIN COUNTY  
 STATION 304+25.00

DESIGNED John Cicoms	EXAMINED <i>Origi D. Kasper</i>
CHECKED <i>R.H. D. Conner</i>	PASSED <i>Ralph E. Anderson</i>
DRAWN Joe Sutherland	APPROVED
CHECKED JLC PDC	DIRECTOR OF HIGHWAYS


May 22 1992






STATE OF ILLINOIS  
DEPARTMENT OF TRANSPORTATION


ROUTE NO.	SECTION	COUNTY	MILES	POST	SHEET NO. 10
F.A.I. BY	DESIGN	FRANKLIN	155	60	
PROJECT NO.	DATE	PROJECT			

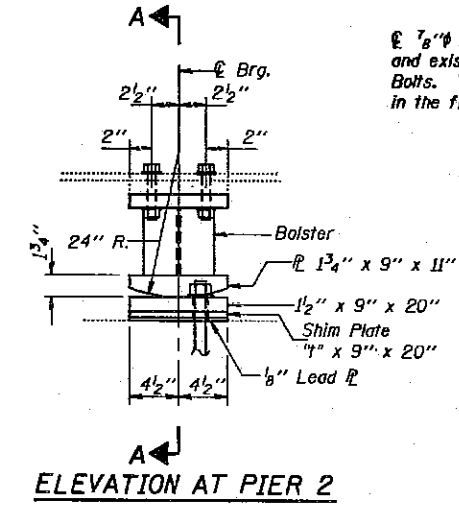


ELEVATION AT PIER 2

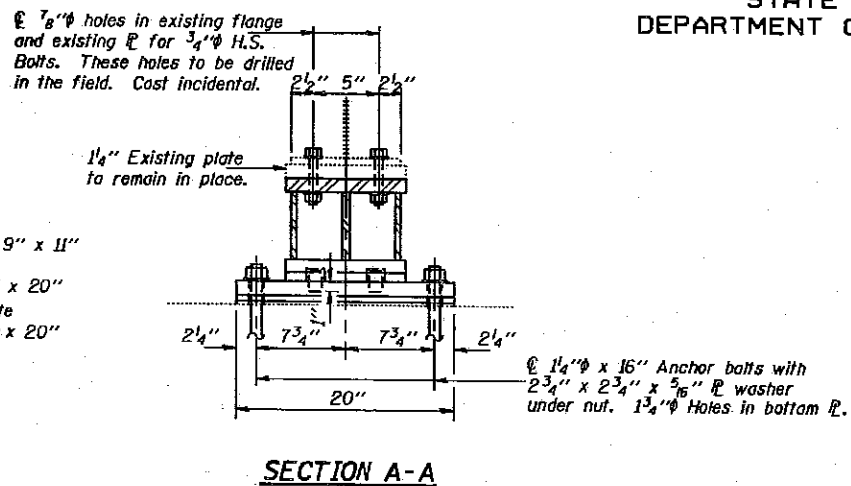

SECTION A-A

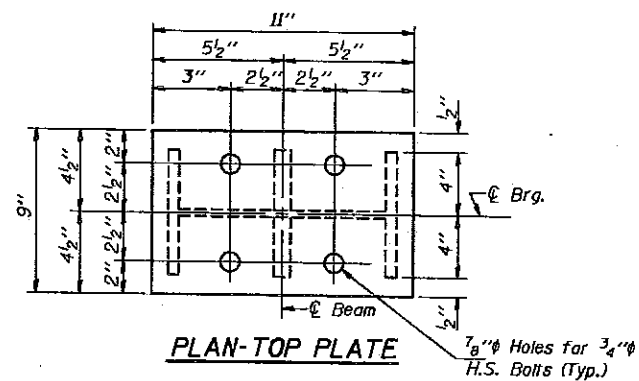


PLAN-TOP PLATE

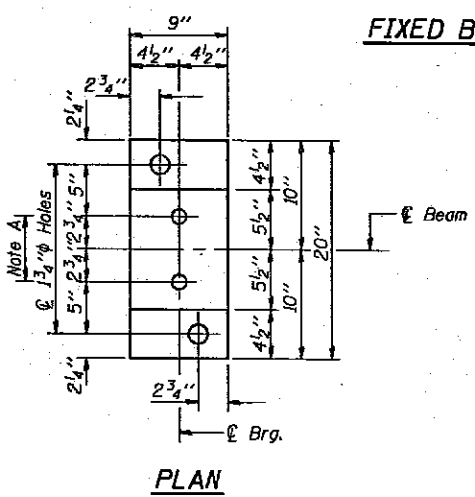


PLAN

FIXED BEARING

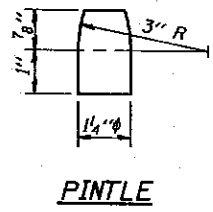


PINTLE

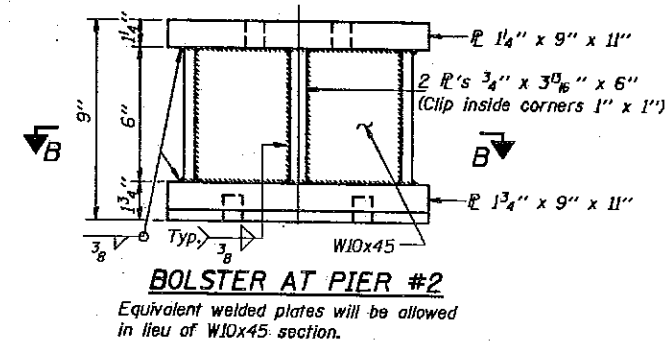

BOLSTER AT PIER #2

Equivalent welded plates will be allowed in lieu of W10x45 section.

Note A:  
1 3/8 inch Holes-1 inch deep in bolster for 1 1/4 inch pintles. Thread or press fit in bottom R.

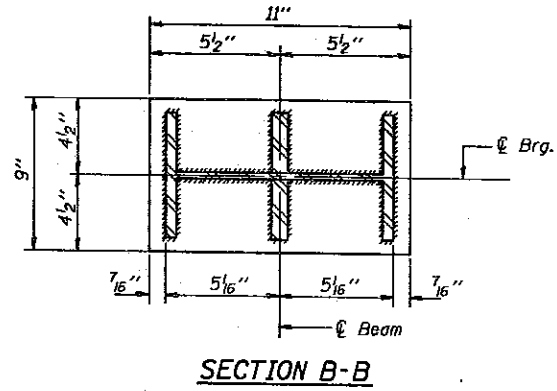

SECTION B-B

TABLE OF 4" DIMENSIONS

Location	N. Abut.	Pier #1	Pier #2	S. Abut.
Beam #1	1/2"	1/2"	1/2"	2"
Beam #2	9"	1/2"	9"	9"
Beam #3	7"	3/4"	13"	8"
Beam #4	15"	9"	5"	6"
Beam #5	1 1/4"	1"	1 1/2"	1 1/2"
Beam #6	1 1/4"	7/8"	1 1/2"	1 1/2"
Beam #7	1"	5/8"	1 1/2"	1 1/2"

FIELD SURVEY SEAT ELEVATIONS

Location	N. Abut.	Pier #1	Pier #2	S. Abut.
Beam #1	418.16	417.95	417.88	417.82
Beam #2	418.27	418.07	418.00	417.94
Beam #3	418.35	418.16	418.09	418.03
Beam #4	418.40	418.22	418.15	418.09
Beam #5	418.33	418.16	418.09	418.03
Beam #6	418.24	418.08	418.01	417.95
Beam #7	418.11	417.96	417.89	417.83


\* Based on the field survey seat elevations shown on this sheet. The Contractor shall verify these elevations in the field and make adjustments if necessary. Cost incidental.

Notes: For anchor bolt installation details see sheet #16 of 16. See sheet #8 of 16 for Jack and Remove Existing Bearing Procedure.


DESIGNED John Ciccone  
 CHECKED Patricia O'Connell  
 DRAWN Joe Sutherland  
 CHECKED JLC MSC

EXAMINED May 22 1992  
 PASSED Ralph E. Anderson  
 APPROVED \_\_\_\_\_

ENGINEER OF BRIDGES AND STRUCTURES  
 DIRECTOR OF HIGHWAYS

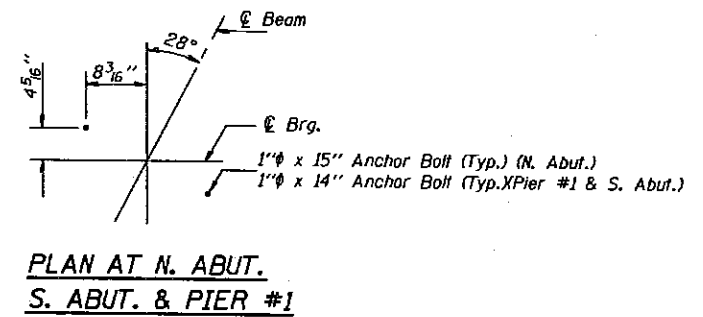

PLAN AT N. ABUT.  
S. ABUT. & PIER #1

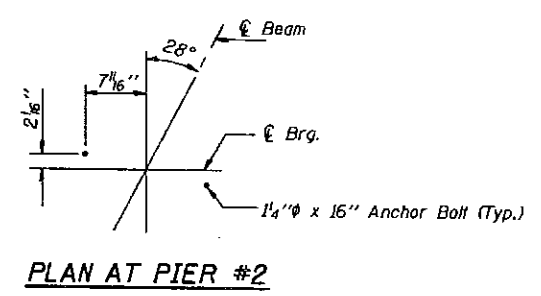


PLAN AT PIER #2

PIER 2  
BEARING DETAILS  
F.A.I. RT. 57 SEC. (28-2B)D  
FRANKLIN COUNTY  
STATION 304+25.00


STATE OF ILLINOIS  
DEPARTMENT OF TRANSPORTATION

ROUTE NO.	SECTION	COUNTY	MILE	POST	SHEET NO. 11 OF 16 SHEETS
S.N.C.	CON-SECT	FRANKLIN	155	61	
FILED BY	DATE	PROJECT			
FILED NO.	DATE	PROJECT			


\* These dimensions are along front face of hatched area.

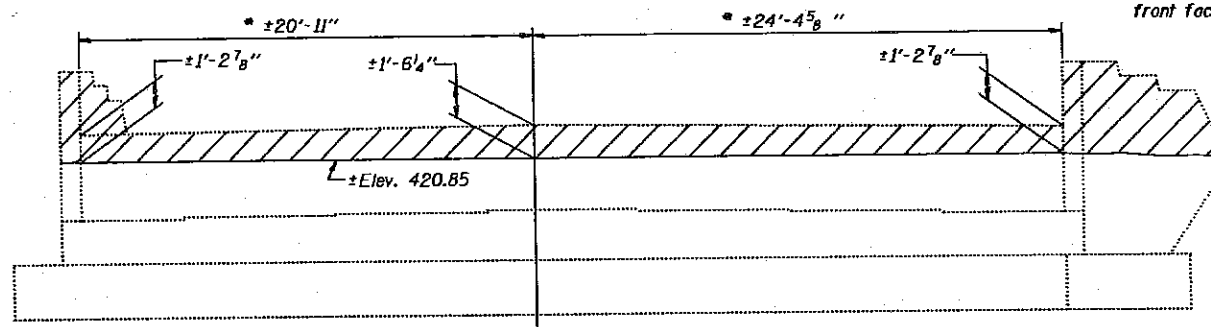


**ELEVATION**  
(Looking North)

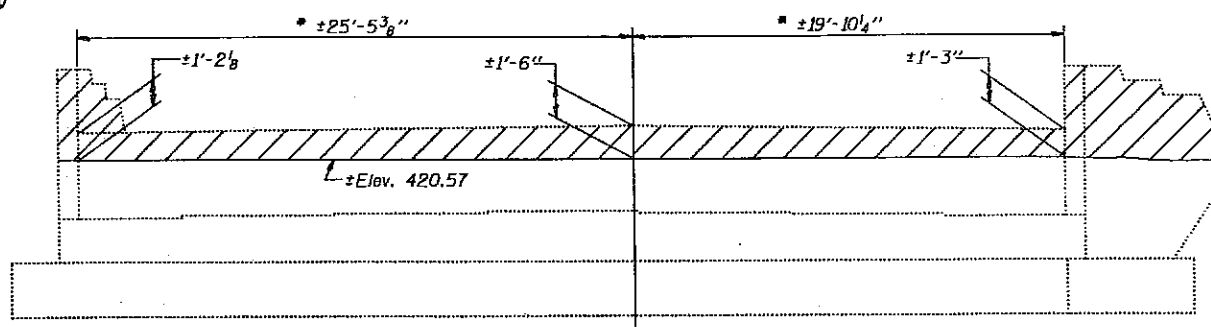


**ELEVATION**  
(Looking South)

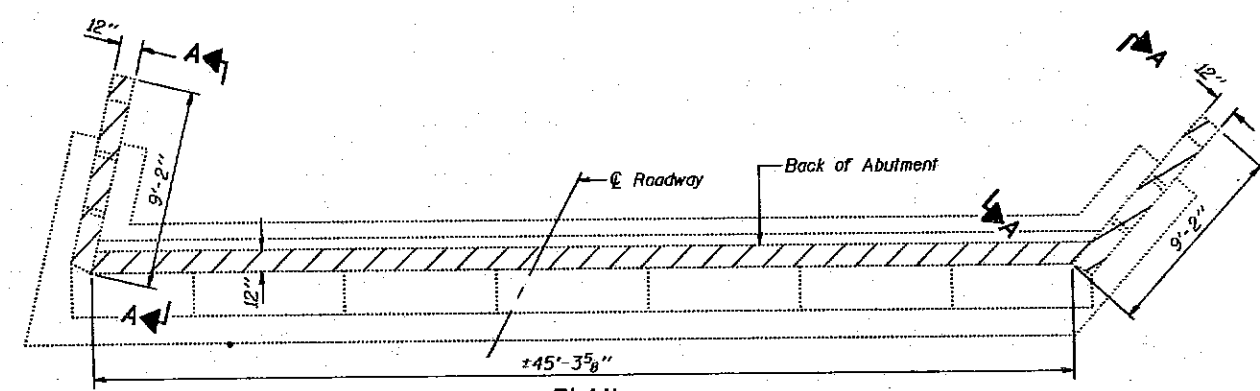


**PLAN**

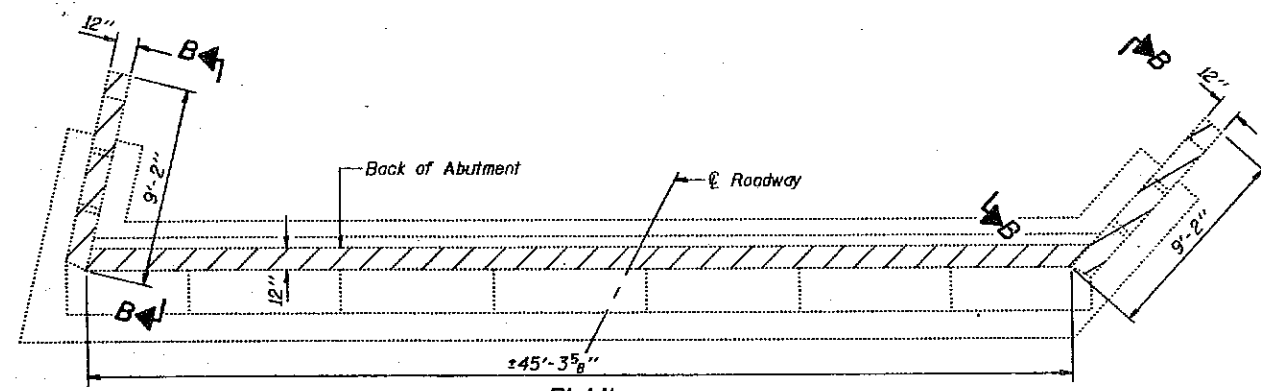

**PLAN**

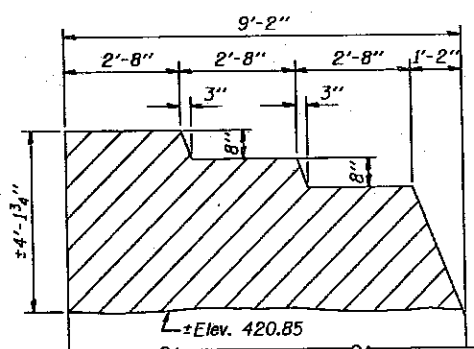

**VIEW A-A**

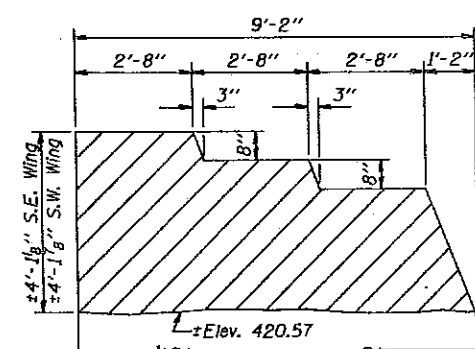

**VIEW B-B**

**NORTH ABUTMENT DETAILS**

**SOUTH ABUTMENT DETAILS**

Notes: Hatched areas indicate Concrete Removal.  
For existing shoulder pavement removal see Roadway Plans.  
Existing reinforcement extending into removed area shall be cleaned, straightened and incorporated into the new construction.

DESIGNED <i>John Sweeney</i>	EXAMINED <i>Ray J. Decker</i>
CHECKED <i>Peter S. Jones</i>	PASSED <i>Ralph E. Anderson</i>
DRAWN <i>Joe Sutherland</i>	APPROVED _____
CHECKED <i>JLC PD</i>	DIRECTOR OF HIGHWAYS

May 22 1992


**TWO ABUTMENTS  
BILL OF MATERIAL**

Item	Unit	Total
Concrete Removal	Cu. Yd.	9

**CONCRETE REMOVAL DETAILS  
FOR EXISTING ABUTMENTS  
F.A.I. RT. 57 SEC. (28-2B)D  
FRANKLIN COUNTY  
STATION 304+25.00**


STATE OF ILLINOIS  
DEPARTMENT OF TRANSPORTATION

ROUTE NO.	SECTION	COUNTY	MILE	POST	SHEET NO. 12
155	28-2B	FRANKLIN	155	62	16 SHEETS
DESIGNED BY		DRAWN BY		CHECKED BY	
JLC		R. Doty		JLC	
DESIGNED		DRAWN		CHECKED	
JLC		R. Doty		JLC	

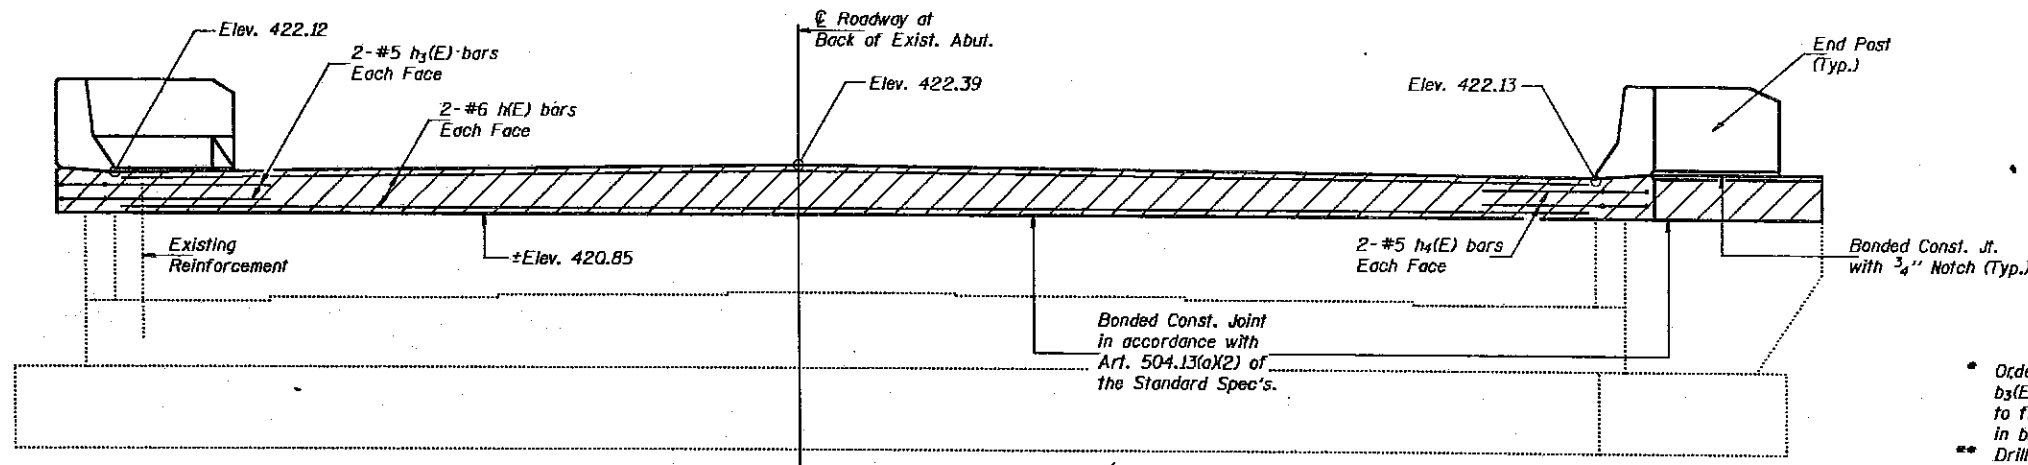

- Order  $a_3(E)$ ,  $a_4(E)$ ,  $a_5(E)$ ,  $a_7(E)$ ,  $b_3(E)$  and  $b_5(E)$  bars full length. Cut to fit and use remainder of bars in bottom of slab.
- Drill  $7/8"$   $\phi$  x 9" Min. hole. Epoxy grout  $a_5(E)$  bars. Use a grout approved by the Department or epoxy grout in accordance with BSP-11. The method of grout application shall be approved by the Engineer. See Special Provisions.

ELEVATION  
(Looking North)

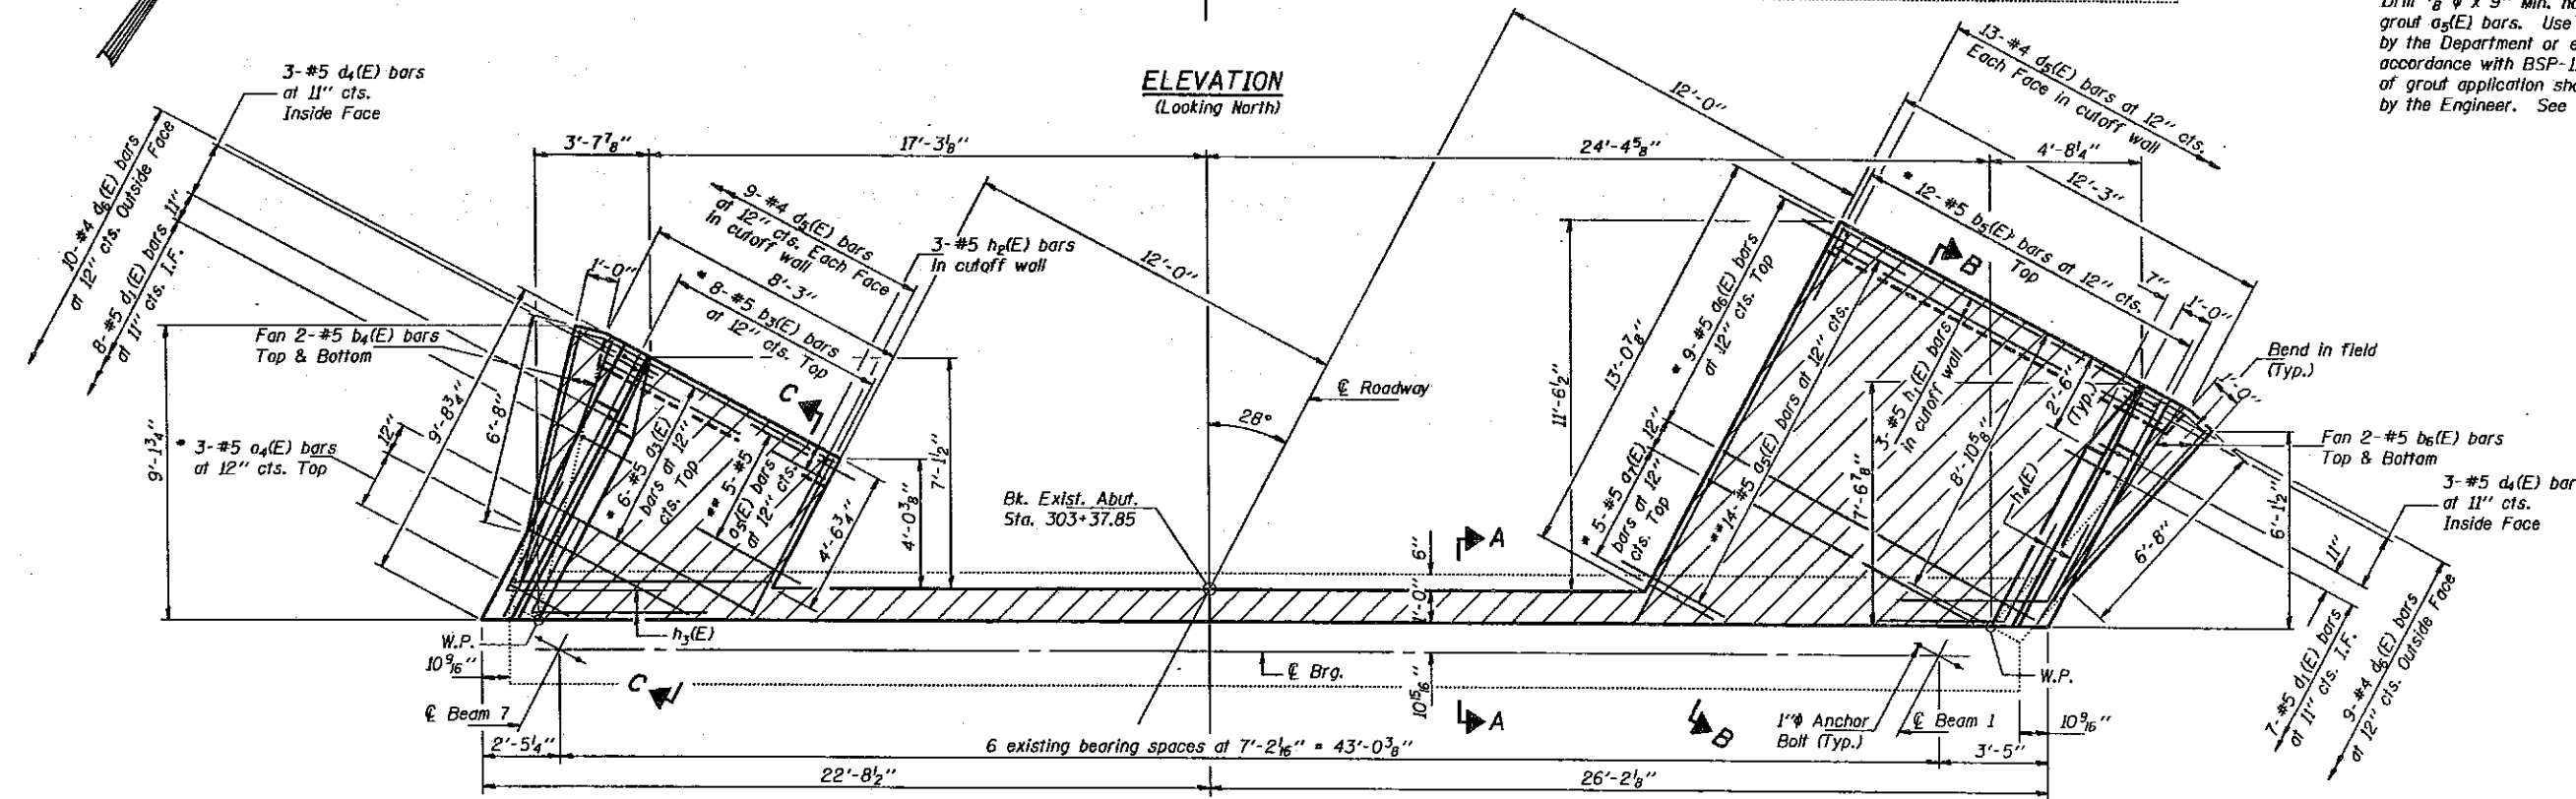

PLAN

Notes: Hatched area to be poured after superstructure forms have been removed. Quantity of concrete for hatched area and end post is included with "Class X Concrete Superstructure" on sheet #6 of 16. Existing reinforcement extending into removed area shall be cleaned, straightened and incorporated into the new construction. Reinforcement bars designated (E) shall be epoxy coated. For anchor bolt installation details see sheet #16 of 16. For anchor bolt location detail see sheet #10 of 16. All edges shall have standard  $3/4"$  chamfer. Work this sheet with sheet #13 of 16.

DESIGNED	John Ciccone	EXAMINED	May 22 1992
CHECKED	R. Doty	PASSED	Ralph E. Anderson
DRAWN	R. Doty	APPROVED	
CHECKED	JLC		





NORTH ABUTMENT  
F.A.I. RT. 57 SEC. (28-2B)D  
FRANKLIN COUNTY  
STATION 304+25.00






STATE OF ILLINOIS  
DEPARTMENT OF TRANSPORTATION

ROUTE NO.	SECTION	COUNTY	JOB NO.	SHEET NO.
F.A.I. 57	28-2BID	FRANKLIN	155	63
FED. ROAD DIST. NO. 7			ILLINOIS	FED. AID PROJECT

GHEET NO. 13  
16 SHEETS

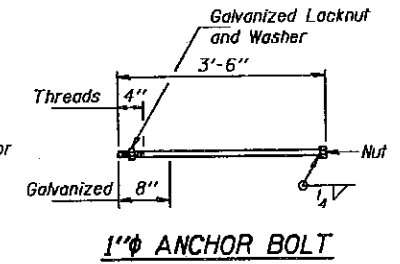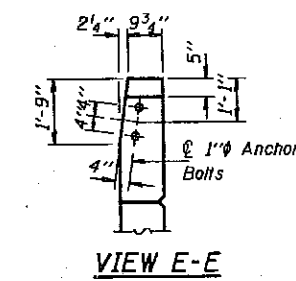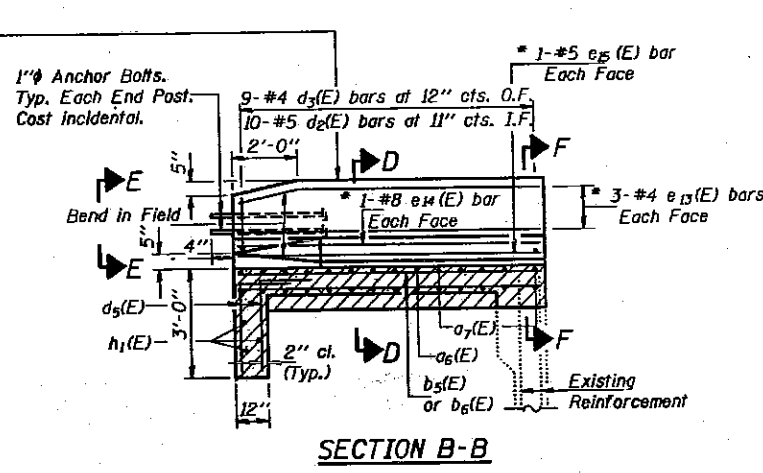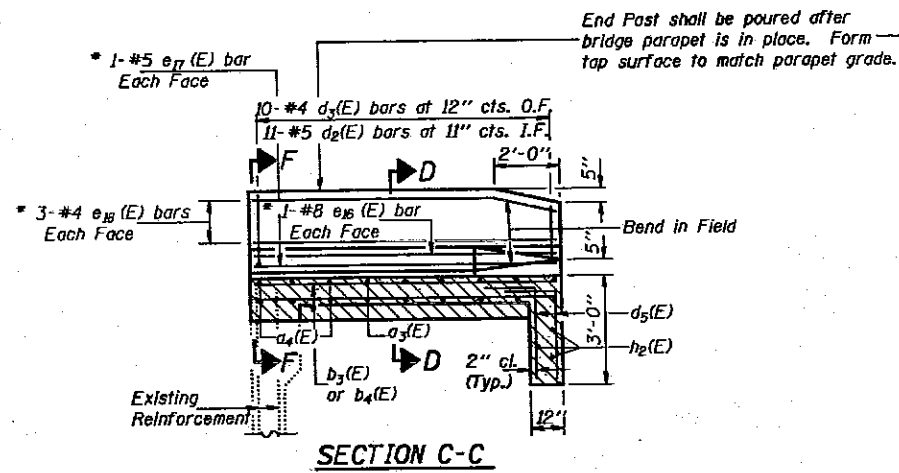

\* Cut to fit. Cost incidental.

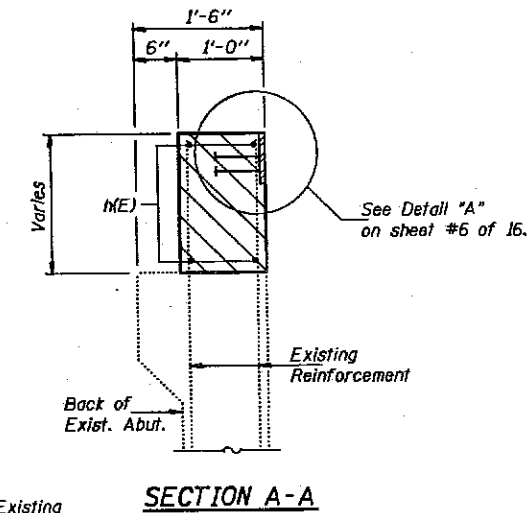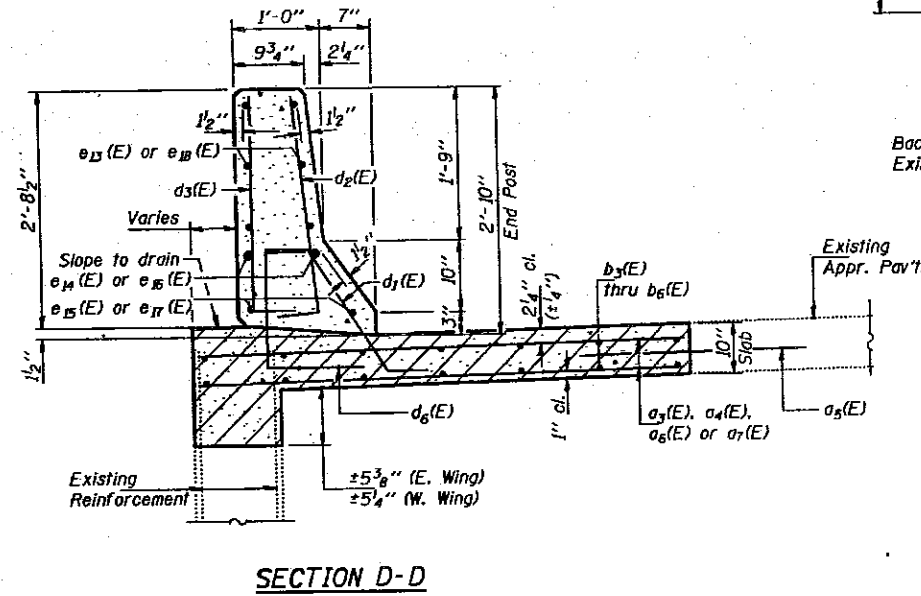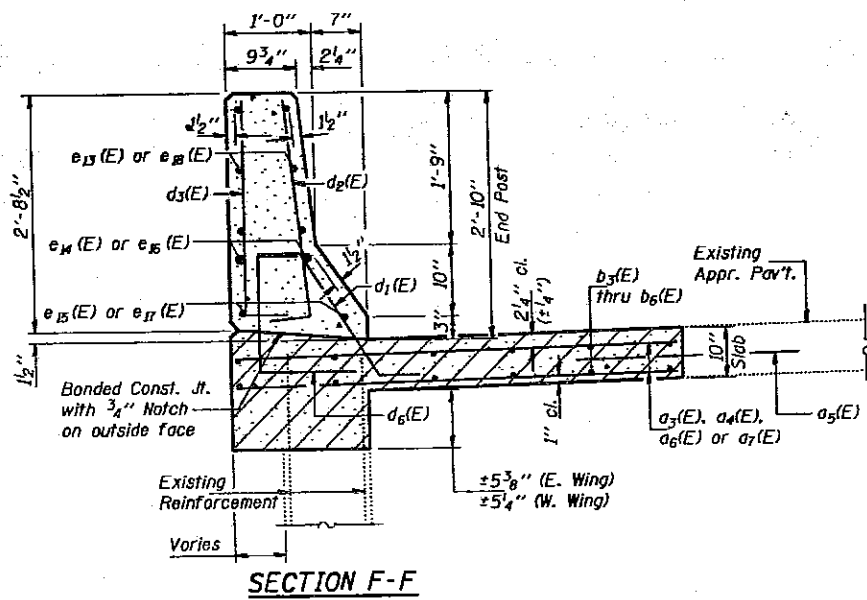

BILL OF MATERIAL


Bar	No.	Size	Length	Shape
a3(E)	6	#5	16'-4"	
a4(E)	3	#5	7'-4"	
a5(E)	19	#5	3'-0"	
a6(E)	9	#5	24'-2"	
a7(E)	5	#5	10'-4"	
b3(E)	8	#5	14'-10"	
b4(E)	4	#5	8'-2"	
b5(E)	12	#5	21'-9"	
b6(E)	4	#5	7'-9"	
d1(E)	15	#5	2'-7"	
d2(E)	21	#5	3'-0"	
d3(E)	19	#4	3'-0"	
d4(E)	6	#5	2'-4"	
d5(E)	44	#4	4'-1"	
d6(E)	19	#4	4'-0"	
e13(E)	6	#4	8'-3"	
e14(E)	2	#8	8'-3"	
e15(E)	2	#5	8'-6"	
e16(E)	2	#8	9'-5"	
e17(E)	2	#5	9'-5"	
e18(E)	6	#4	9'-5"	
h(E)	4	#6	45'-0"	
h1(E)	3	#5	11'-9"	
h2(E)	3	#5	7'-9"	
h3(E)	4	#5	6'-6"	
h4(E)	4	#5	6'-6"	
Reinforcement Bars, Epoxy Coated		Lbs.	1840	
Structure Excavation		Cu. Yd.	11	

Reinforcement bars designated (E) shall be epoxy coated.


NORTH ABUTMENT DETAILS  
F.A.I. RT. 57 SEC. (28-2BID)  
FRANKLIN COUNTY  
STATION 304+25.00

DESIGNED John Ciccone  
CHECKED P.T. & S. Chappin  
DRAWN Joe Sutherland  
CHECKED JLC P.D.


EXAMINED May 22 1992  
PASSED Ralph E. Anderson  
APPROVED  
DIRECTOR OF HIGHWAYS

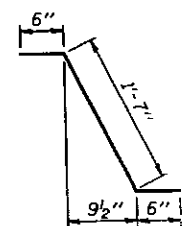


BAR d1(E)

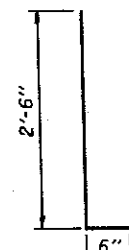


BARS d2(E) & d3(E)

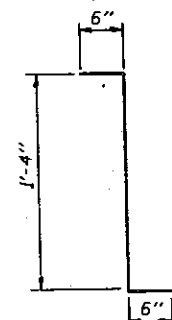


BAR d4(E)

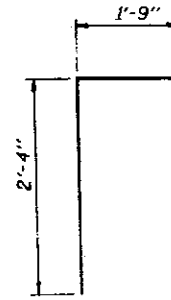

BAR d5(E)

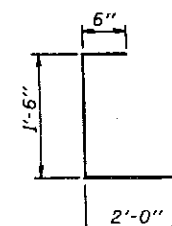

BAR d6(E)

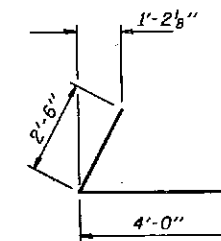

BAR h3(E)




BAR h4(E)




STATE OF ILLINOIS  
DEPARTMENT OF TRANSPORTATION

ROUTE NO.	SECTION	COUNTY	JOB	DATE	SHEET NO. 15
F.A.I. RT.	28-2BD	FRANKLIN	155	65	16 SHEETS
DESIGNED BY	ILLINOIS	DESIGNED BY			

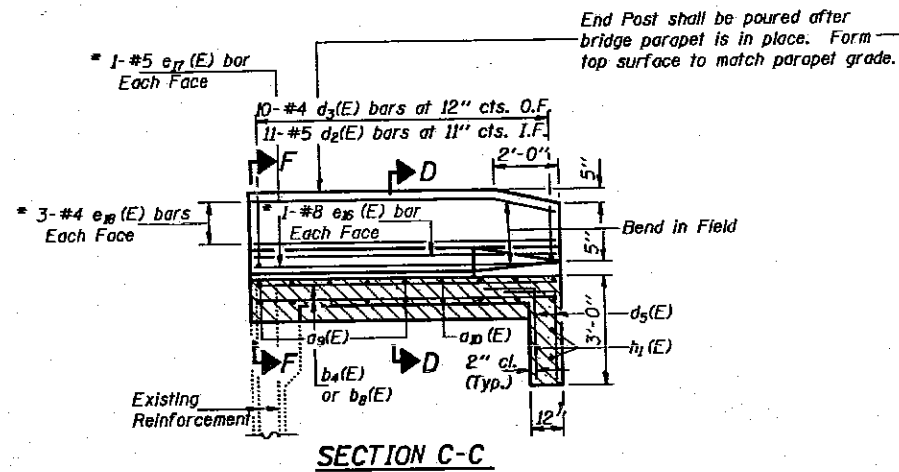


SECTION C-C

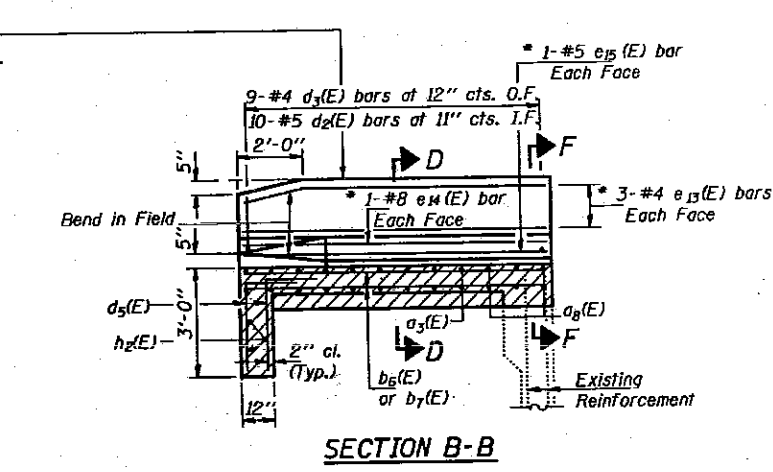


SECTION B-B


\* Cut to fit. Cost incidental.

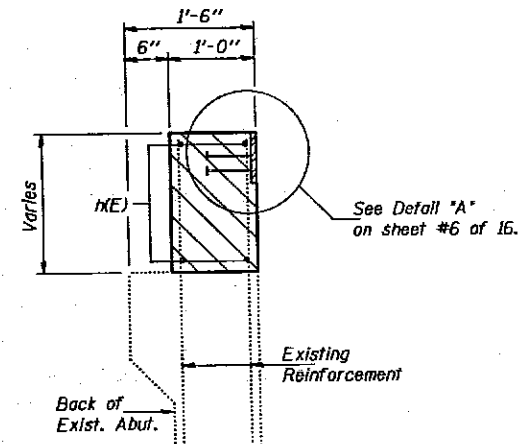


SECTION A-A

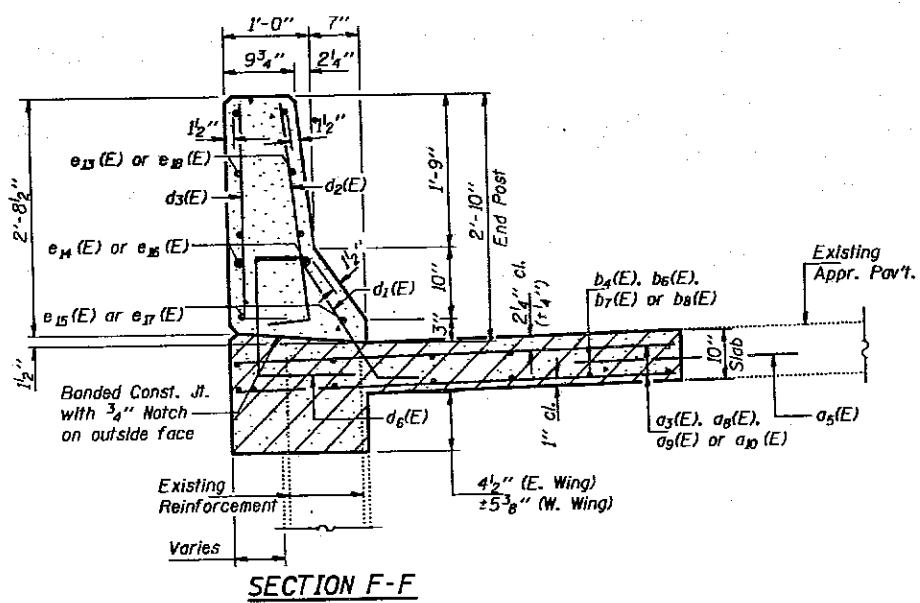


SECTION F-F

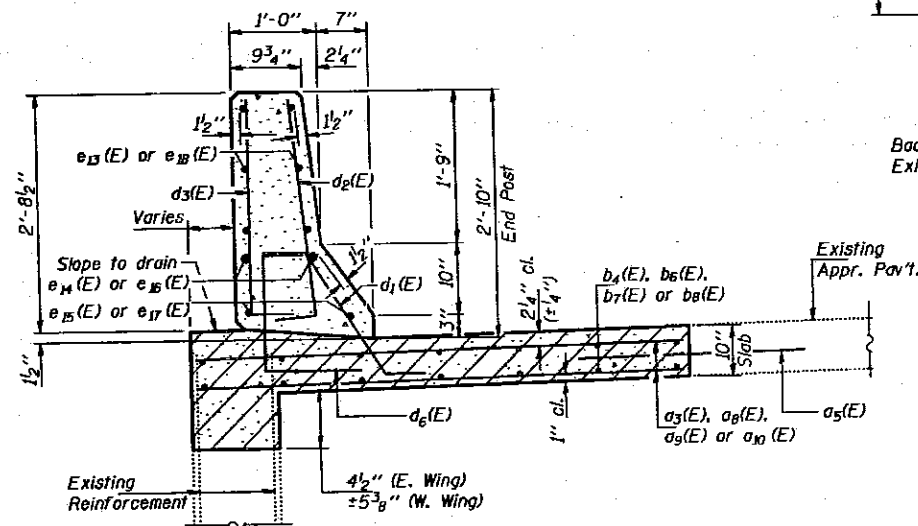


SECTION D-D

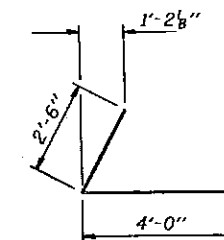


BAR h3(E)

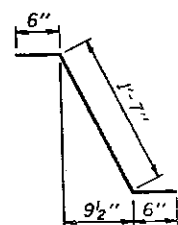


BAR d1(E)

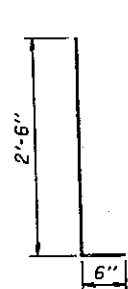


BARS d2(E) & d3(E)

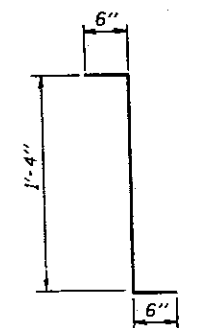


BAR d4(E)

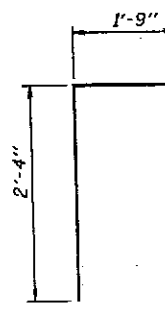

BAR d5(E)

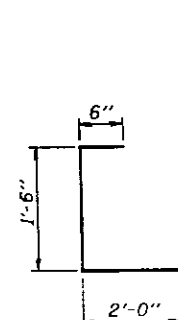

BAR d6(E)

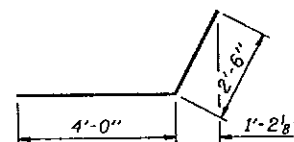

BAR h4(E)

BILL OF MATERIAL

Bar	No.	Size	Length	Shape
a3(E)	9	#5	16'-4"	
a5(E)	15	#5	3'-0"	
a6(E)	3	#5	7'-0"	
a9(E)	5	#5	13'-6"	
a10(E)	4	#5	25'-2"	
b4(E)	4	#5	8'-2"	
b6(E)	4	#5	7'-9"	
b7(E)	8	#5	19'-6"	
b8(E)	12	#5	12'-9"	
d1(E)	15	#5	2'-7"	
d2(E)	21	#5	3'-0"	
d3(E)	19	#4	3'-0"	
d4(E)	6	#5	2'-4"	
d5(E)	44	#4	4'-1"	
d6(E)	19	#4	4'-0"	
e13(E)	6	#4	8'-3"	
e14(E)	2	#8	8'-3"	
e15(E)	2	#5	8'-6"	
e16(E)	2	#8	9'-5"	
e17(E)	2	#5	9'-5"	
e18(E)	6	#4	9'-5"	
h1(E)	4	#6	45'-0"	
h2(E)	3	#5	11'-9"	
h3(E)	3	#5	7'-9"	
h4(E)	4	#5	6'-6"	
h4(E)	4	#5	6'-6"	
Reinforcement Bars, Epoxy Coated				Lbs. 1700
Structure Excavation				Cu. Yd. 11

Reinforcement bars designated (E) shall be epoxy coated.

SOUTH ABUTMENT DETAILS  
F.A.I. RT. 57 SEC. (28-2BD)  
FRANKLIN COUNTY  
STATION 304+25.00

DESIGNED	John Ciccone
CHECKED	Pat D. [Signature]
DRAWN	Joe Sutherland
CHECKED	JLC [Signature]

EXAMINED	May 22 1992	[Signature]
PASSED	[Signature]	[Signature]
APPROVED	[Signature]	[Signature]




STATE OF ILLINOIS  
DEPARTMENT OF TRANSPORTATION

ROUTE NO.	SECTION	QUALITY	DATE	REV	SHEET NO. 16
F.A.I. RT.	28-250	FRANKLIN	155	60	16 SHEETS
PROJECT NO. 1	ILLINOIS	PELAD PROJECT			

The Illinois Coil-Lock Anchor Bolt is a proprietary item which is the property of the Illinois Department of Transportation. Use, reproduction or disclosure without express written permission is prohibited and protected under Federal copyright laws. The production and the fabrication of this bolt for use on highway projects in the State of Illinois shall be permitted and there shall be no incurred charges or fees to the manufacturer or the fabricator for producing or fabricating this bolt.

D	E	H	K	"d"
1"	1 1/8"	3/16"	1 3/4"	1/4"
1 1/4"	1 3/8"	1/16"	2"	3/8"
1 1/2"	1 5/8"	1 5/16"	2 1/8"	1/2"
2"	2 1/8"	1 13/16"	2 7/8"	1/2"
2 1/2"	2 5/8"	2 5/16"	3 3/8"	1"

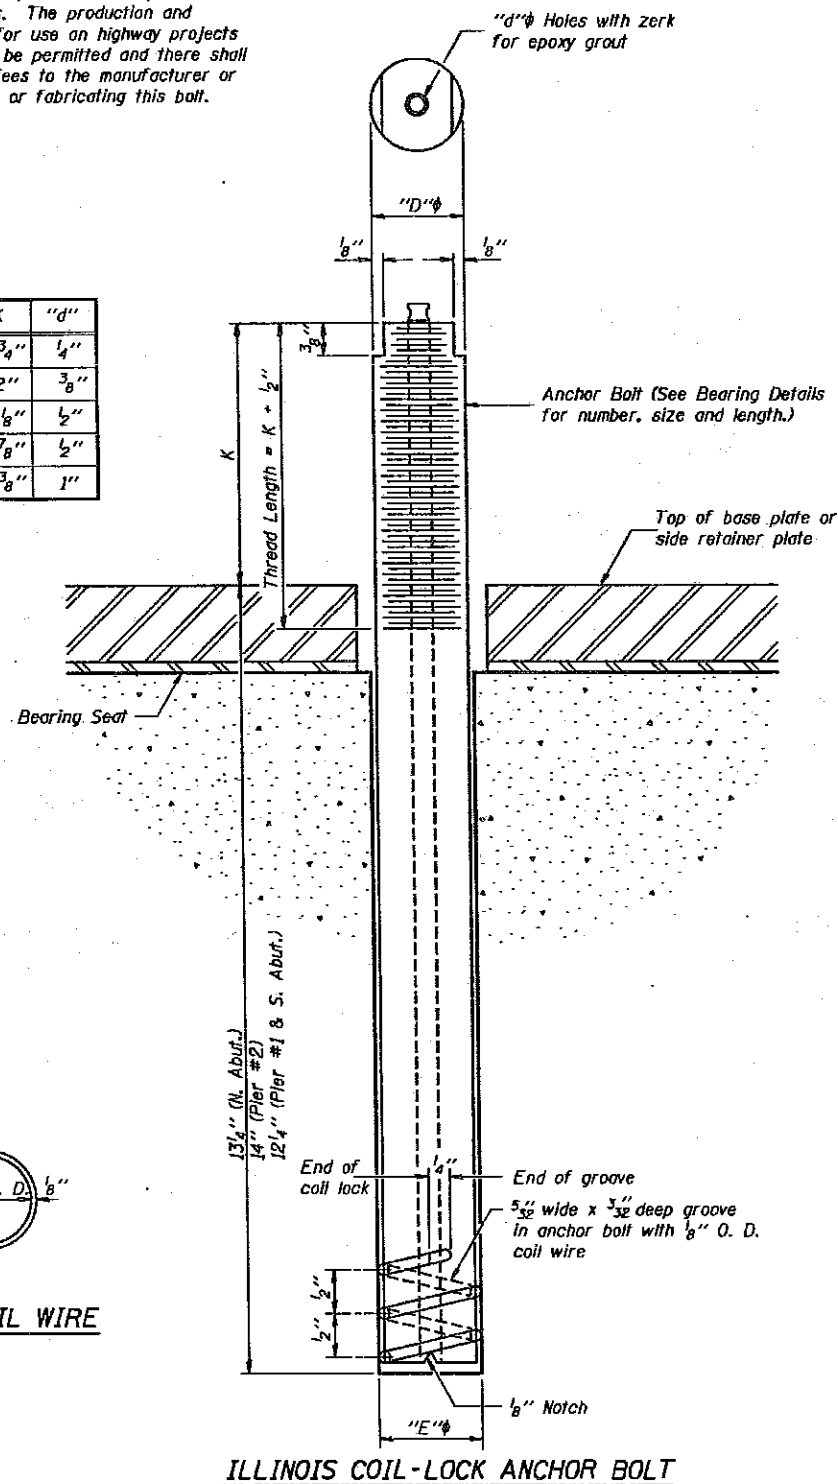

MATERIALS FOR ILLINOIS COIL-LOCK ANCHOR BOLT

The anchor bolt shall be fabricated from cold drawn or hot finished seamless carbon steel mechanical tubing conforming to ASTM A519, Grade 1026 and supplied with hexagonal nuts and cut washers.  
The coil wire shall be made of any suitable soft steel wire.  
The finished anchor bolt shall be cleaned of rust and other foreign materials and wrapped or packaged to prevent contamination until they are installed.  
The epoxy grout shall be a two-component, epoxy resin bonding system conforming to ASTM CBBL Type I, Grade 1 and of a Class suitable for the temperature at installation.

INSTALLATION PROCEDURE for the ILLINOIS COIL-LOCK ANCHOR BOLT

1. With the coil wire in place, the bolt shall be inserted into the hole and turned clockwise to a snug fit in the hole. Nut and washer shall be placed on the bolt. The nut shall be tensioned until the steel base plates are held securely to the concrete bearing seat.
2. Epoxy grout shall be pumped through the zerk fitting with a pressure gun. Pumping shall continue until the epoxy overflows the hole around the bolt shank. After pumping is discontinued, excess epoxy shall be immediately wiped off.

ALTERNATE ANCHOR BOLTS

The Contractor may use, at his option, the capsule or the adhesive cartridge type anchor rods that have been previously tested and given a prior approval by the Department. The Contractor shall install these anchor rods in pre-drilled holes in accordance with the manufacturer's recommendations and procedures.  
The capsule or the adhesive cartridge type anchor rods shall be a two part system composed of:  
1. A threaded rod stud with nut and washer conforming to ASTM A307.  
2. A sealed glass capsule or a sealed glass adhesive cartridge containing premeasured amounts of the adhesive chemical.

GENERAL NOTES

Holes in the masonry for anchor bolts shall be drilled through the base plates to the diameter and depth shown or in accordance with the manufacturer's recommendation after beams or girders have been erected and adjusted.  
Prior to setting the bolts, the holes shall be dry and all dust and loose particles shall be removed by the use of compressed air or vacuuming.  
The anchor bolts, furnished and installed and including the epoxy grout or capsules shall not be paid for separately but shall be included in the unit bid price for "Furnishing and Erecting Structural Steel".

DESIGNED <i>John Sweeney</i>	EXAMINED <i>May 22 1992</i>
CHECKED <i>John S. Sweeney</i>	PASSED <i>Ralph E. Anderson</i>
DRAWN <i>Joe Sutherland</i>	APPROVED _____
CHECKED <i>JLC</i>	DIRECTOR OF HIGHWAYS

ABB-1 12-1-83


ANCHOR BOLT DETAILS  
FOR BEARINGS  
F.A.I. RT. 57 SEC. (28-2B)D  
FRANKLIN COUNTY  
STATION 304+25.00



DATE	NO.	TYPE	SCALE	BY
FALL 57	101	TRAIL	1:2500	...

DATE	NO.	TYPE	SCALE	BY
FIELD SURVEY NOTE BOOK				
NO. 101				

DATE	NO.	TYPE	SCALE	BY
FIELD SURVEY NOTE BOOK				
NO. 101				

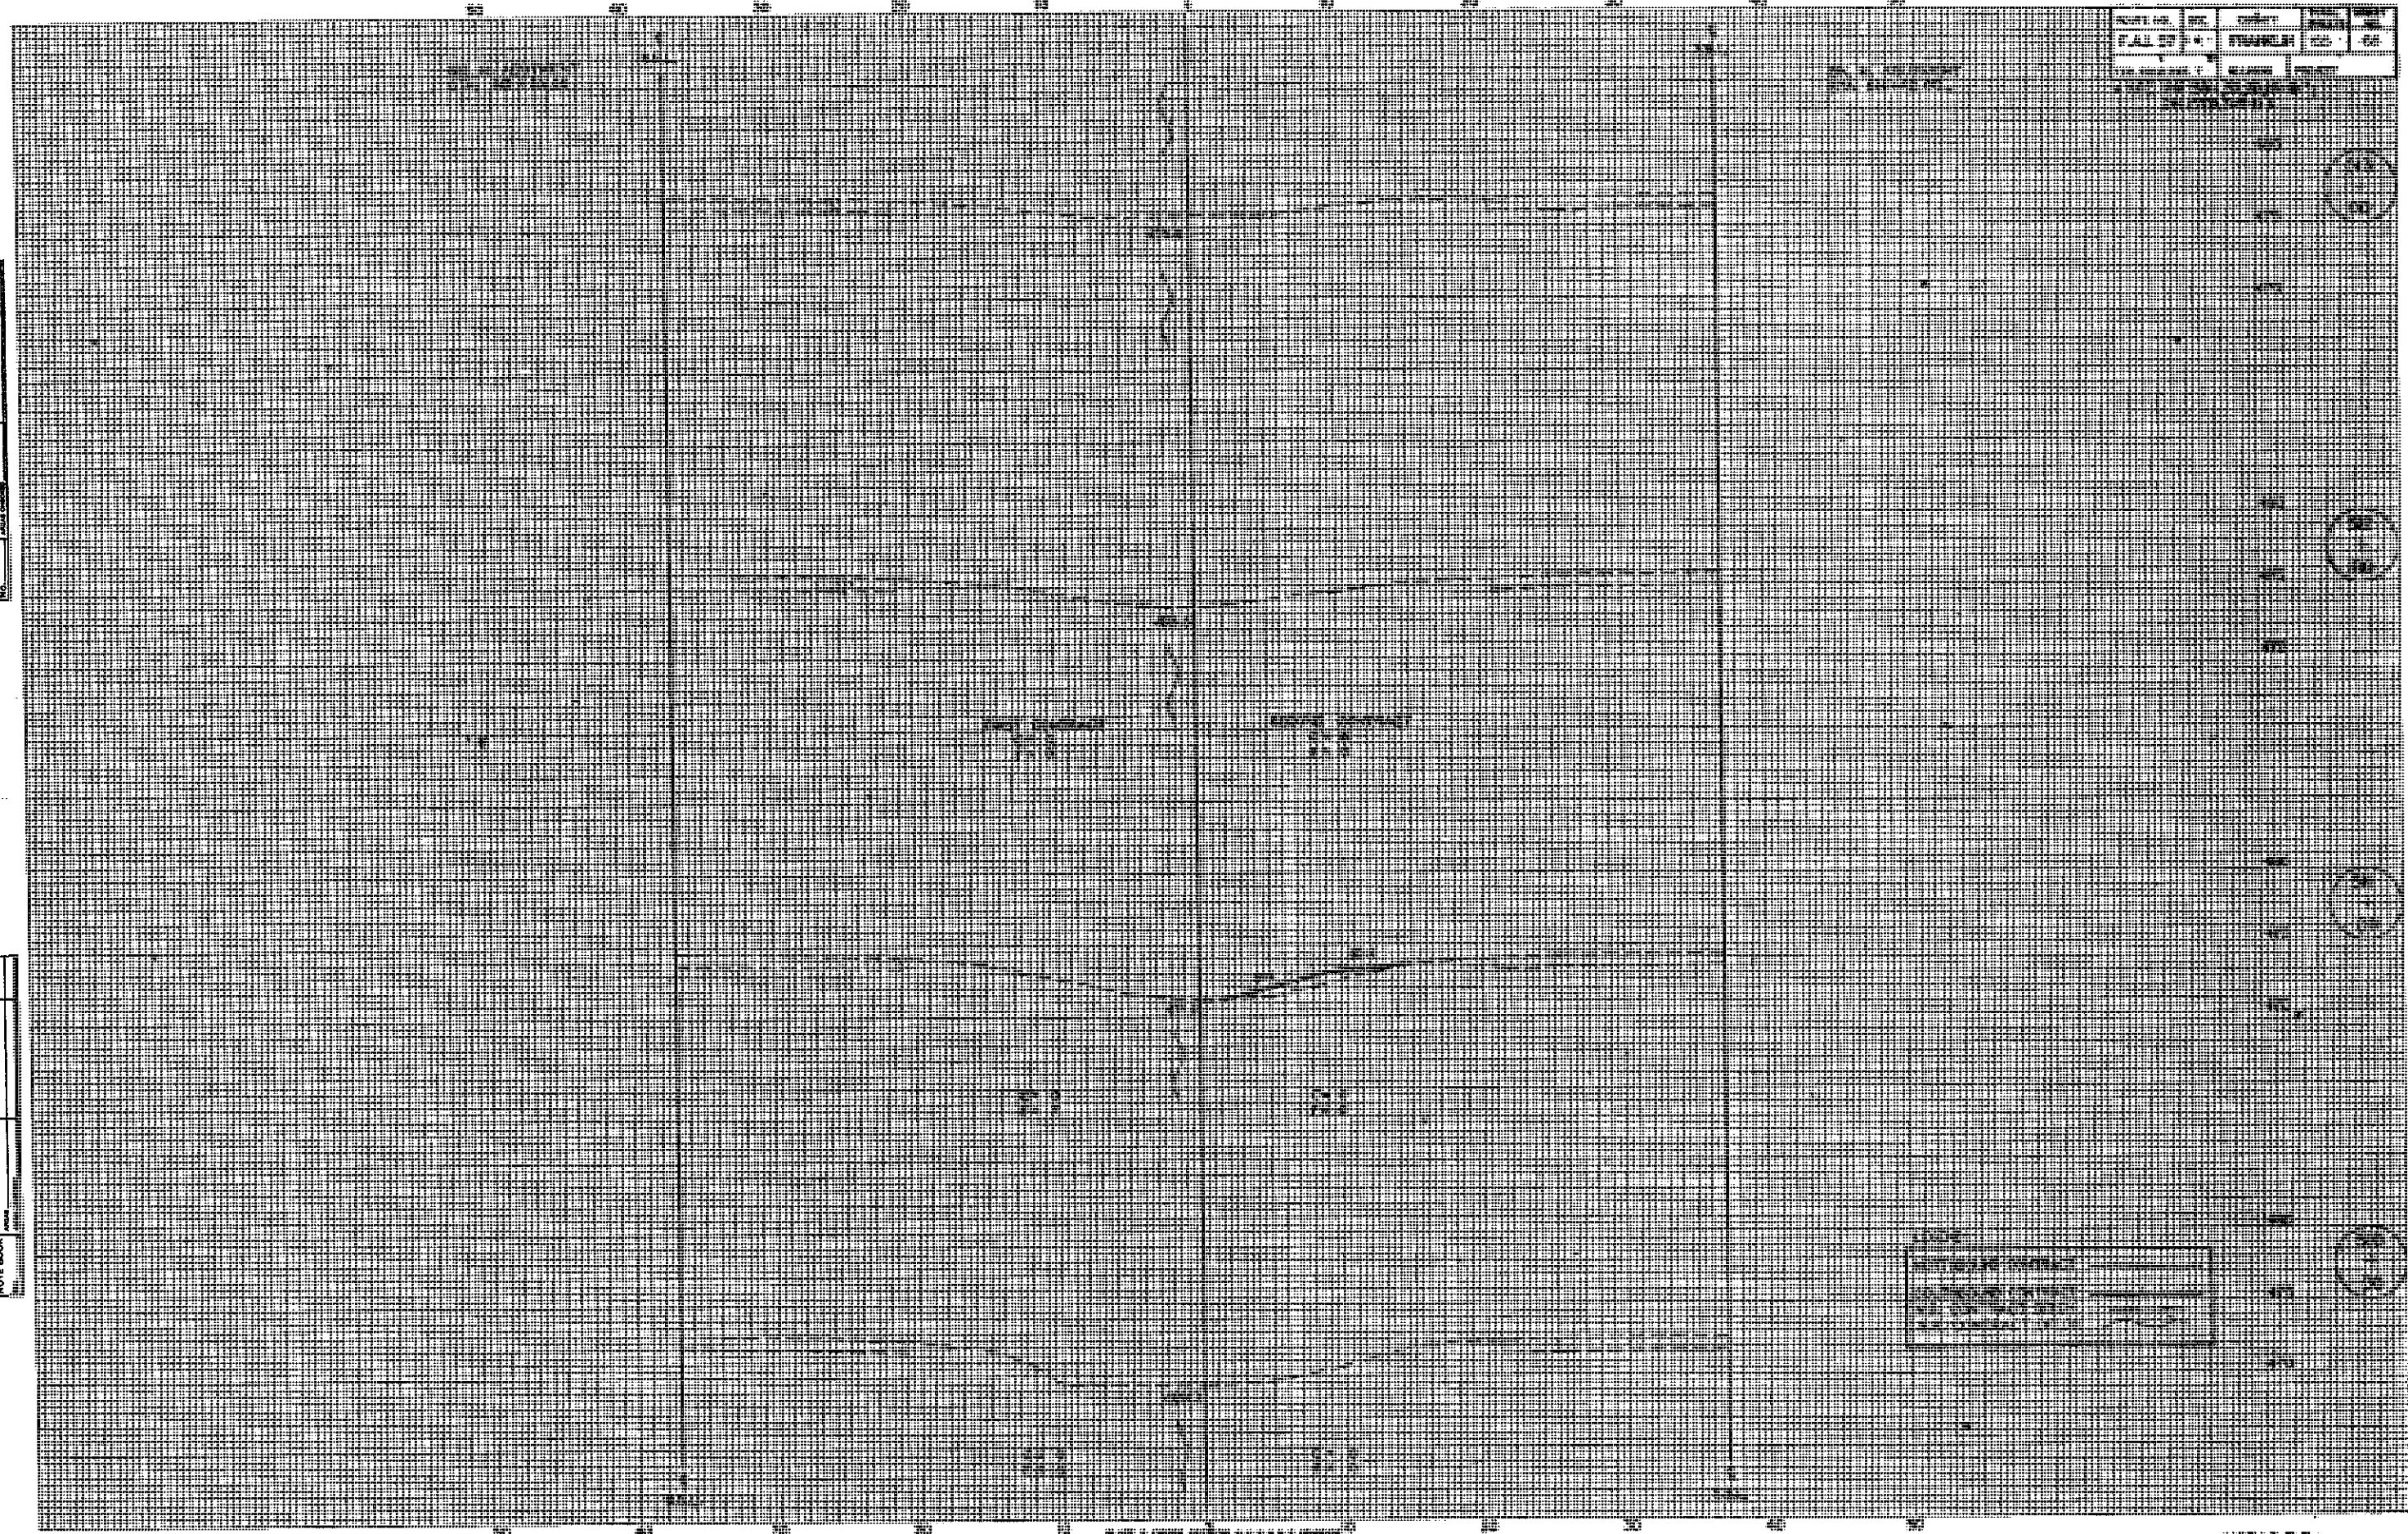

NO. 101




DATE	TIME	LOCATION	TYPE	REMARKS

DATE	TIME	LOCATION	TYPE	REMARKS

GENERAL SAFETY NOTE BOOK

DATE	TIME	LOCATION	TYPE	REMARKS

GENERAL SAFETY NOTE BOOK

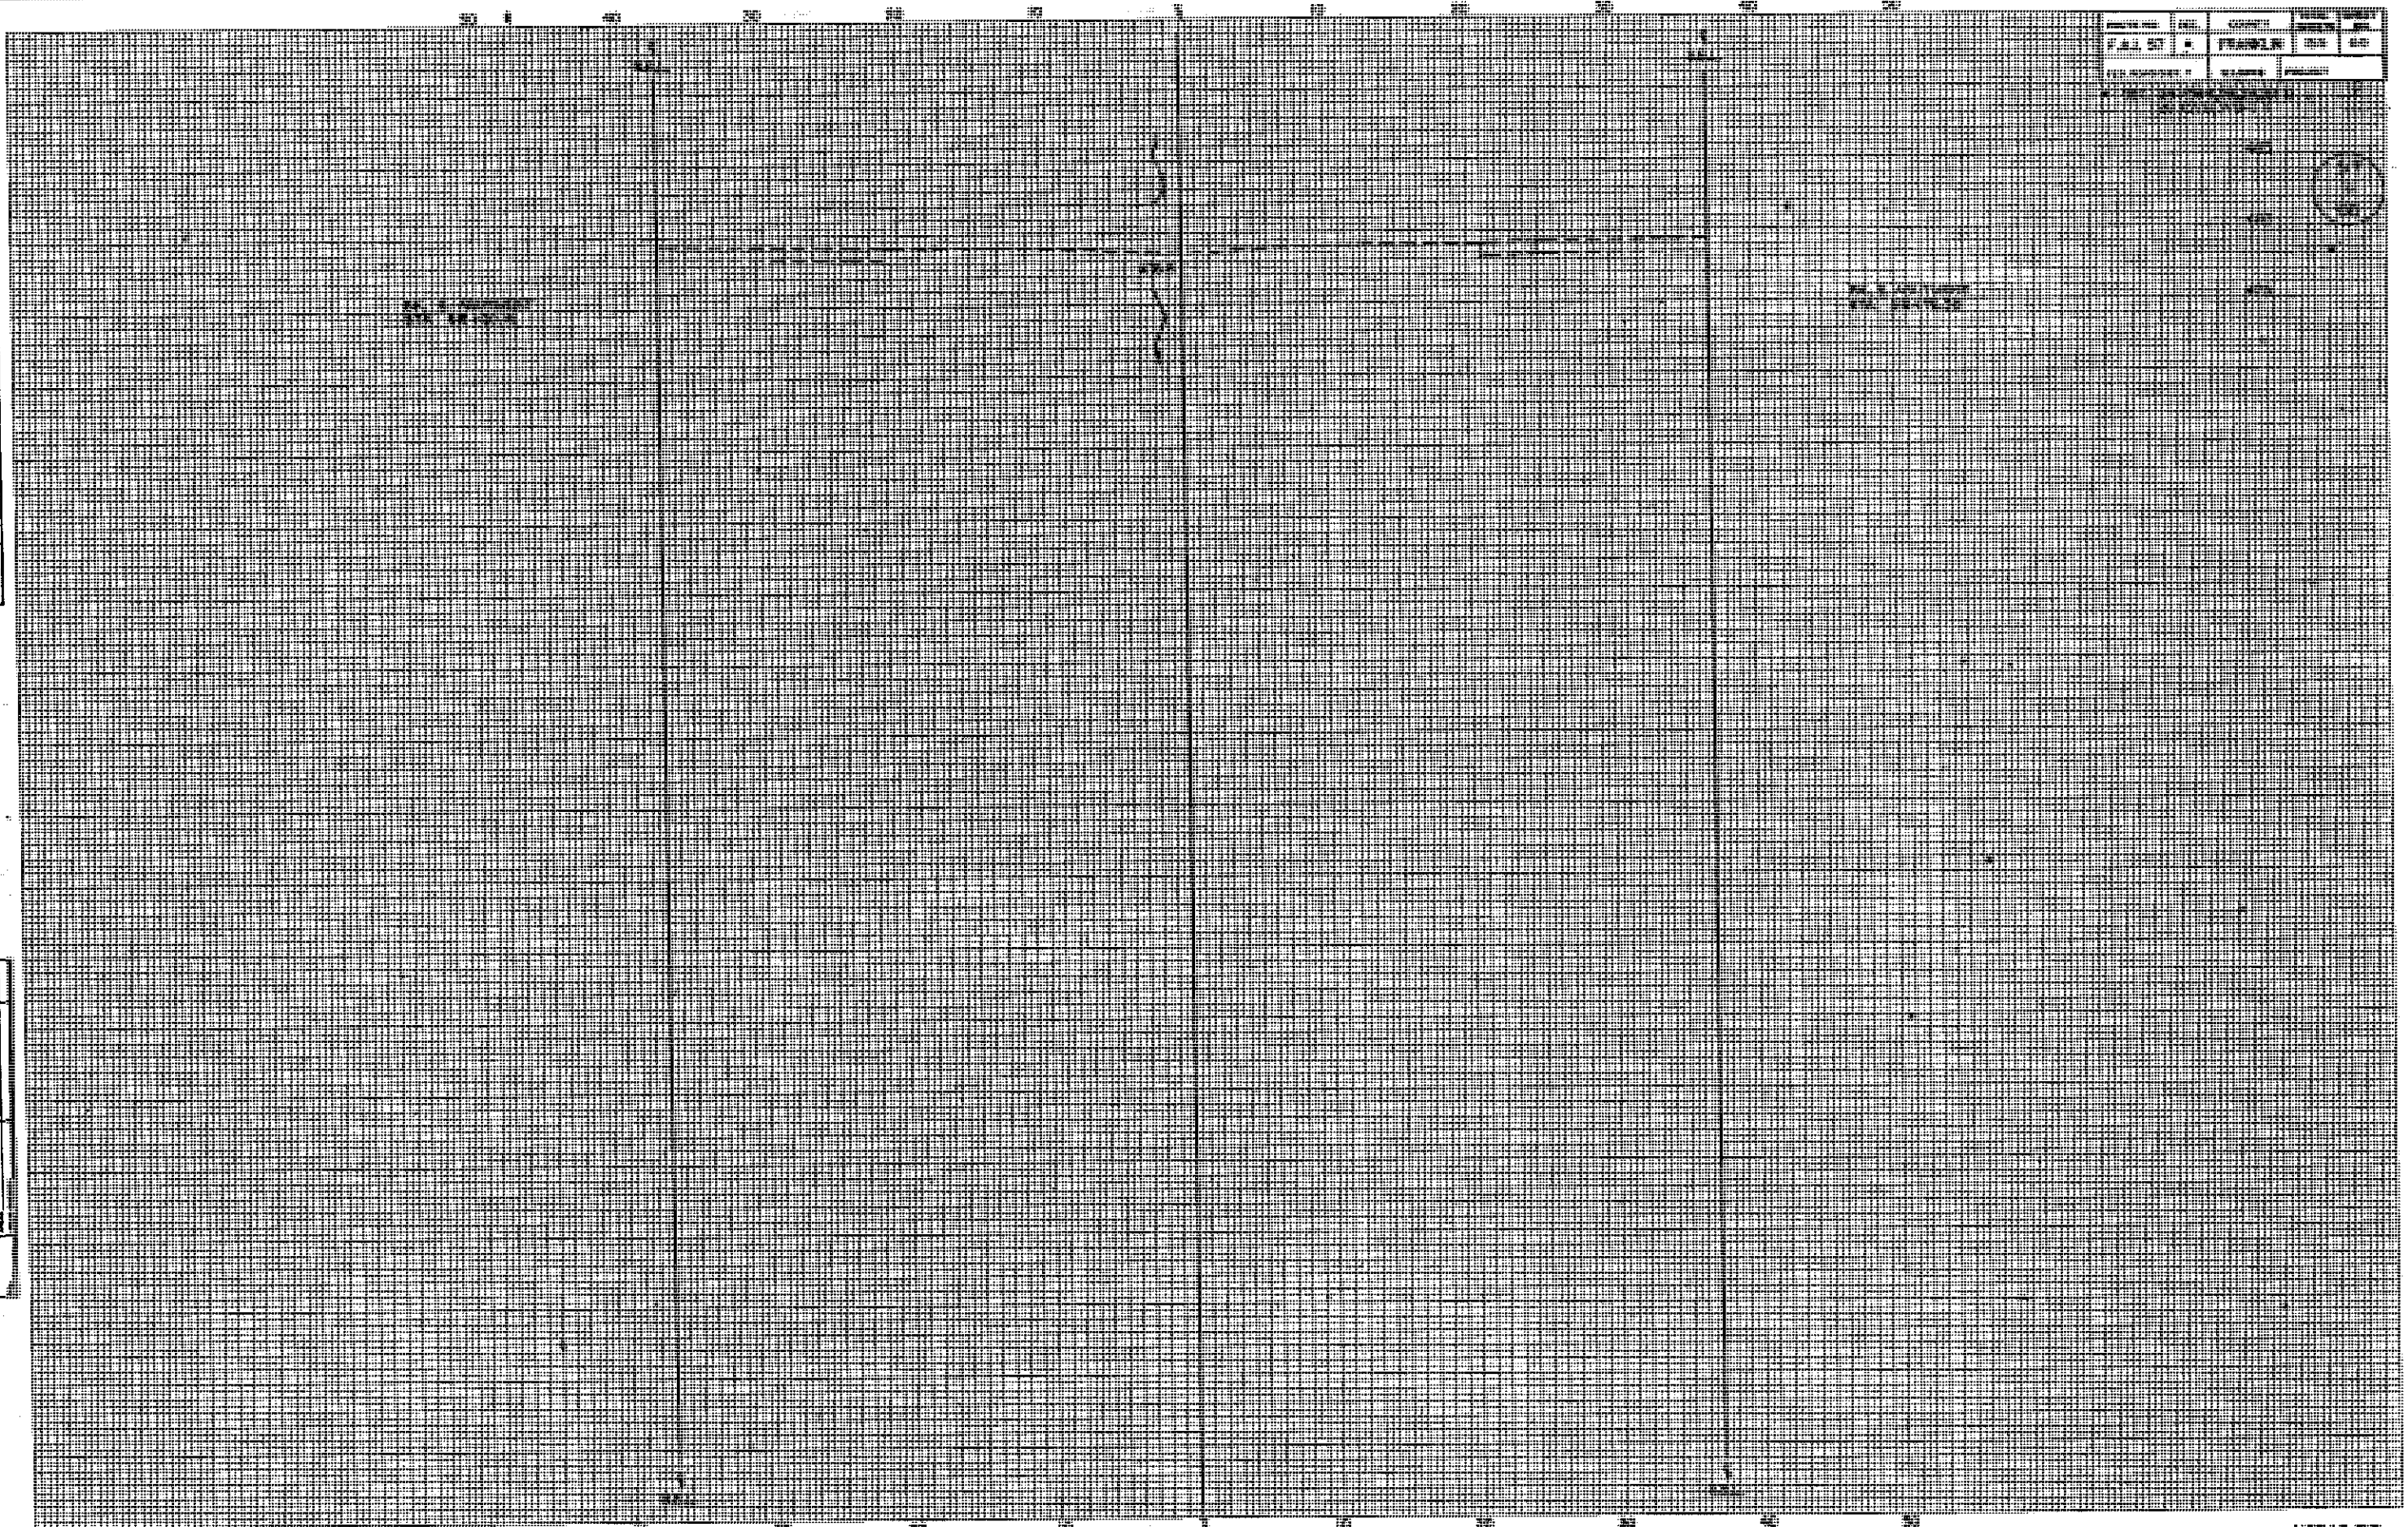






STATE OF ILLINOIS  
DEPARTMENT OF TRANSPORTATION


ROUTE NO.	SECTION	COUNTY	SERIAL	SHEET	SHEET NO. 1 4 SHEETS
F.A.I. 57		FRANKLIN	155	71	
FED. ROAD DIST. NO. 7		ILLINOIS	FED. AID PROJECT		

**GENERAL NOTES**

Reinforcement bars shall conform to the requirements of AASHTO M-31, M-42 or M-53 Grade 60.  
Traffic control shall be determined by the District.  
Prior to pouring the new concrete for the deck, all loose rust, loose mill scale, and all other foreign material shall be removed from the embedded portions of flanges of girders. The removal shall be accomplished in accordance with the requirements of the SSPC Surface Preparation Specifications SP11 for Power Tool Cleaning or SP2 for Hand Tool Cleaning. Cost shall be incidental to Concrete Removal.  
Plan dimensions and details relative to existing structure have been taken from existing plans and are subject to nominal construction variations. It shall be the Contractor's responsibility to verify such dimensions and details in the field and make necessary approved adjustments prior to construction or ordering of materials. Such variations shall not be cause for additional compensation for a change in the scope of the work, however, the Contractor will be paid for the quantity actually furnished at the unit price bid for the work.  
The first bridge Post and Insert at each corner shall be removed, cleaned and reinstalled in new construction. Cost incidental to "Concrete Removal".

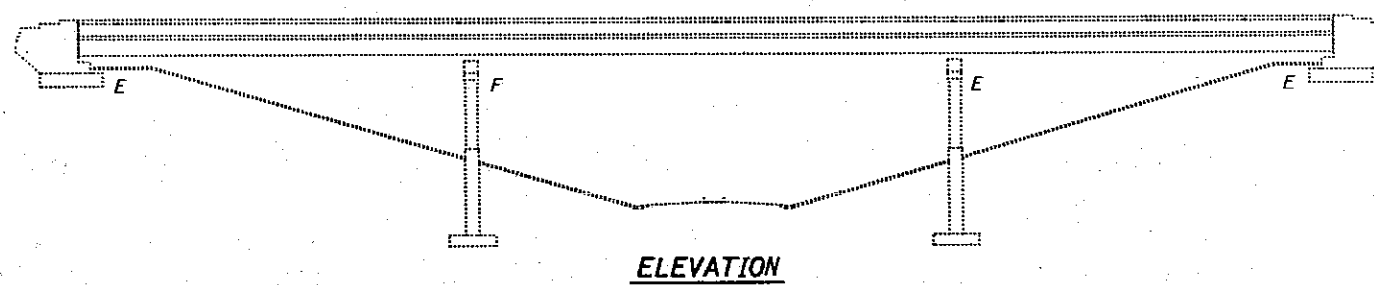

**ELEVATION**

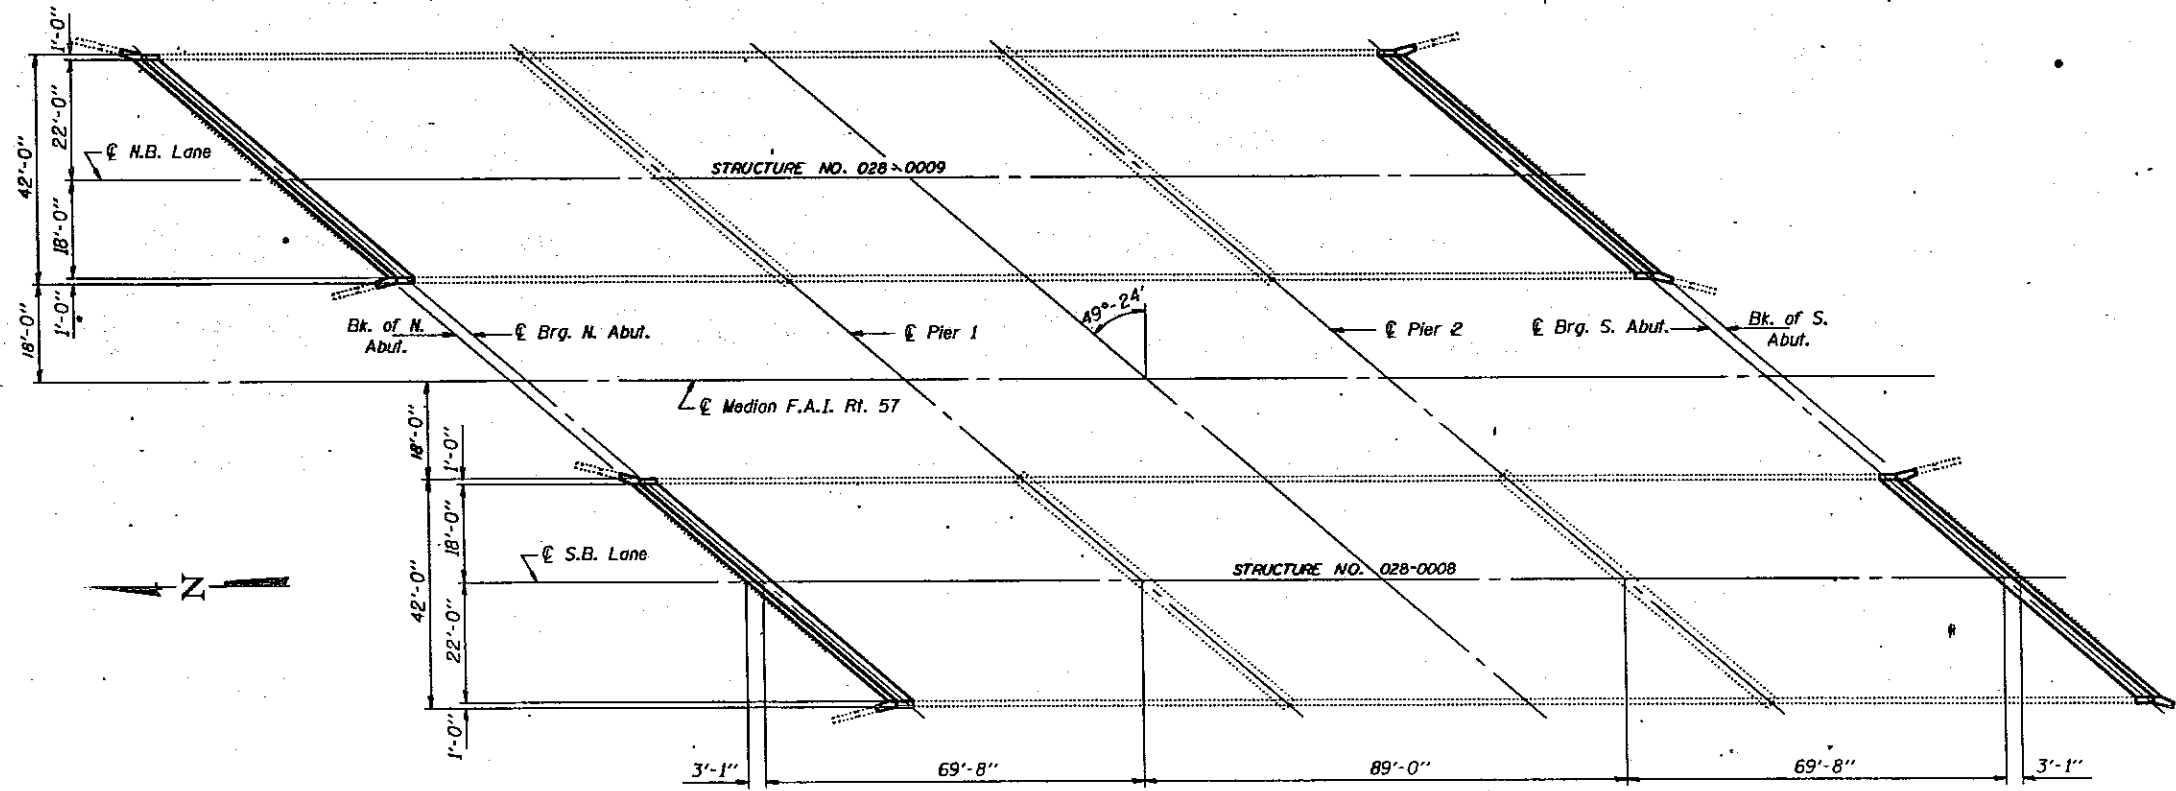

**PLAN**

**TOTAL BILL OF MATERIAL**

ITEM	UNIT	QUANTITY
Concrete Removal	Cu. Yd.	42.8
Class X Concrete	Cu. Yd.	41.5
Reinforcement Bars, Epoxy Coated	Pound	7860
Neoprene Expansion Joint 2"	Lin. Ft.	250

NOTE: QUANTITIES IN THE ABOVE BILL OF MATERIAL ARE FOR BOTH BRIDGES.

DESIGNED <i>Paul Summer</i>	EXAMINED <i>John E. Hagan</i>
CHECKED <i>BRT</i>	PASSED
DRAWN <i>Paul Summer</i>	APPROVED
CHECKED <i>BRT</i>	


February 7, 1992  
ENGINEER OF STRUCTURAL SERVICES  
ENGINEER OF BRIDGES AND STRUCTURES  
DIRECTOR OF HIGHWAYS

**JOINT REPLACEMENT DETAILS**  
F.A.I. RT. 57 SEC. (28-3VB-D) I  
FRANKLIN COUNTY  
STA. 515+16.08  
STR. No. ~~028-0008~~ & 028-0009




STATE OF ILLINOIS  
DEPARTMENT OF TRANSPORTATION


ROUTE NO.	SECTION	COUNTY	STATION	SHEET	SHEET NO. 2
F.A.I. 57		FRANKLIN	155	72	4 SHEETS
FEDERAL DIST. NO. 1	ILLINOIS	FED. AID PROJECT			

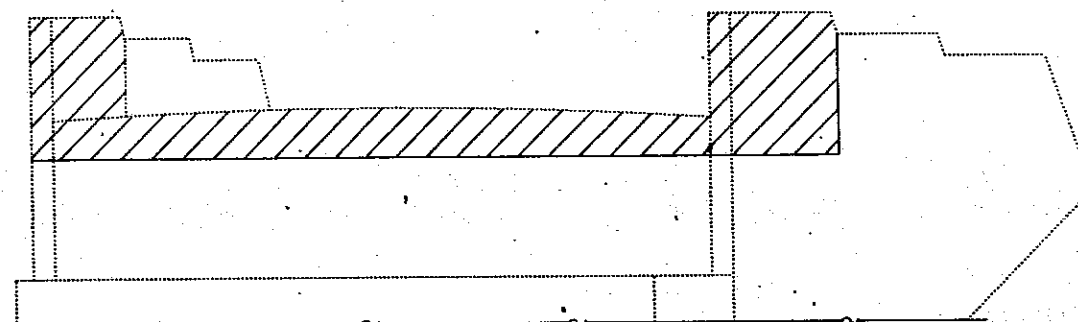


EXISTING ELEVATION

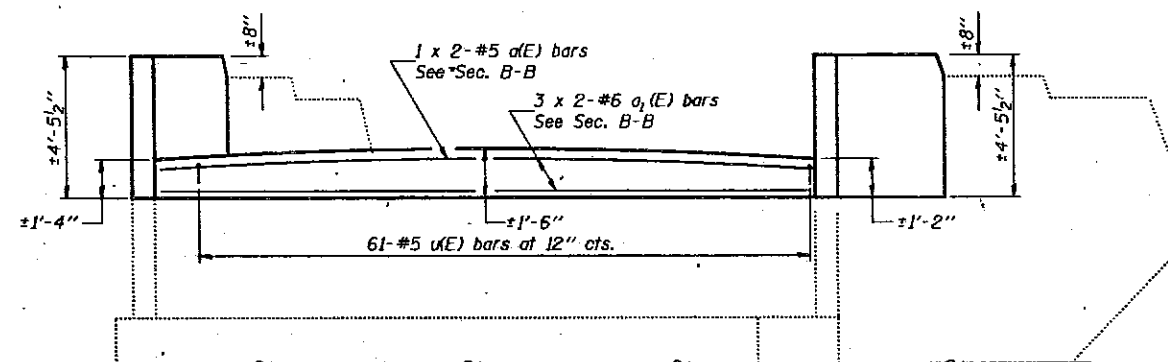


PROPOSED ELEVATION

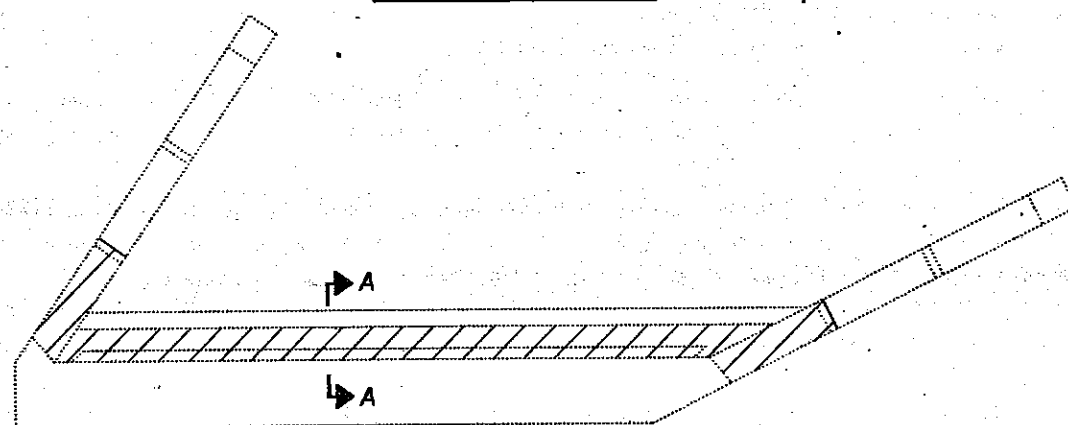


EXISTING PLAN

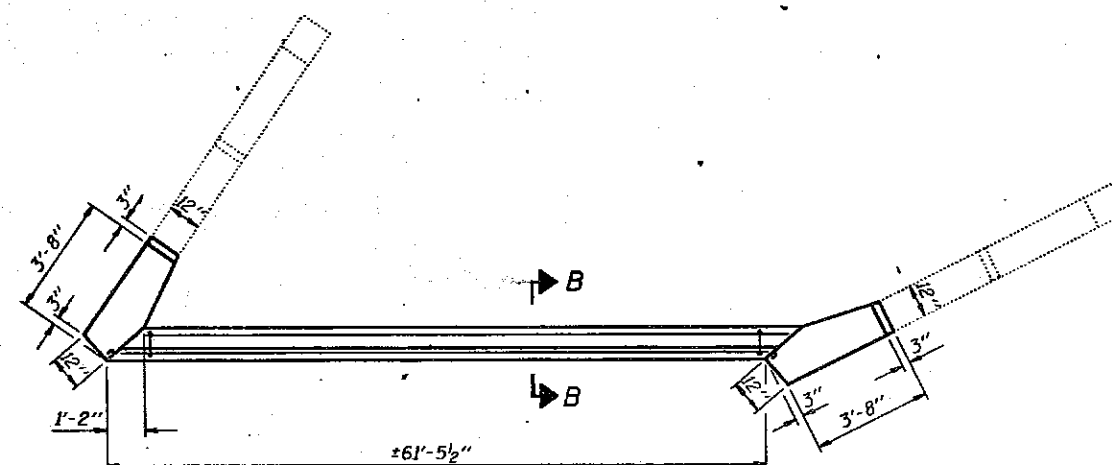

PROPOSED PLAN

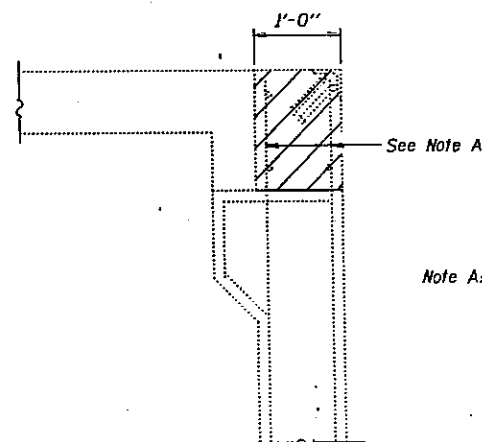

SECTION A-A

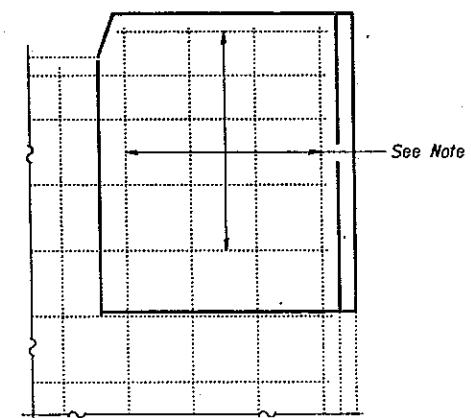

WING WALL ELEVATION

Notes: For Section A-A and B-B see Sheet 3.  
For bar details and Bill of Material see Sheet 3.  
Bars indicated thus 3 x 2-#6 ect. indicates 3 lines of bars with 2 lengths per line.  
Reinforcement bars designated (E) shall be epoxy coated.  
Hatched area indicates Concrete Removal.

Note A: Existing Reinforcement shall be cleaned, straightened and incorporated into the new construction. Cost incidental to "Concrete Removal."


DESIGNED <i>Paul Summer</i>	EXAMINED <i>John E. Adams</i>	February 7 19 72
CHECKED <i>BRT</i>	PASSED	
DRAWN <i>Paul Summer</i>	APPROVED	
CHECKED <i>BRT</i>		

JOINT REPLACEMENT DETAILS  
F.A.I. RT. 57 SEC. (28-3VB-1) I  
FRANKLIN COUNTY  
STA. 515+16.08  
STR. No. ~~028-0008~~ & 028-0009




STATE OF ILLINOIS  
DEPARTMENT OF TRANSPORTATION

STATE NO.	SECTION	COUNTY	JOB NO.	"E"	SHEET NO.
F.A.I. 57		FRANKLIN	155	73	4 SHEETS
PRELIMINARY DESIG. NO. 7	ILLINOIS	PUBLISHED PROJECT			

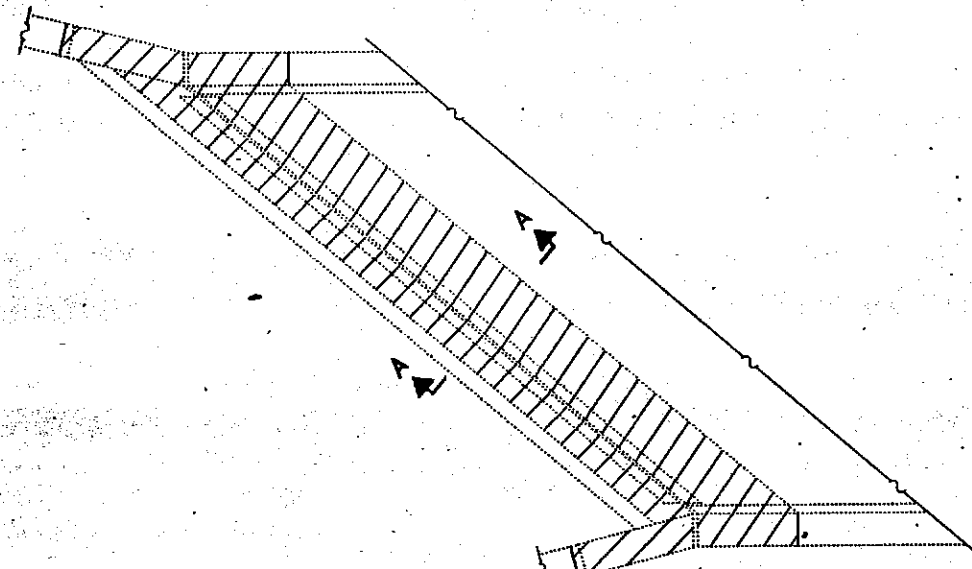


EXISTING PARTIAL PLAN

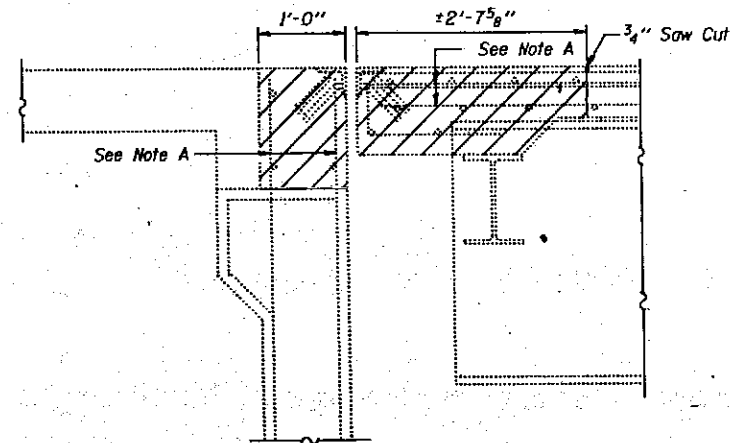


SECTION A-A

Note A: Existing Reinforcement shall be cleaned, straightened and incorporated into the new construction. Cost incidental to Concrete Removal.


\*Place d(E) bars in back of anchor bolts as shown if required to maintain 1" cl. (+0-1/2"). Anchor bolts should be tied to d(E) and u(E) bars.

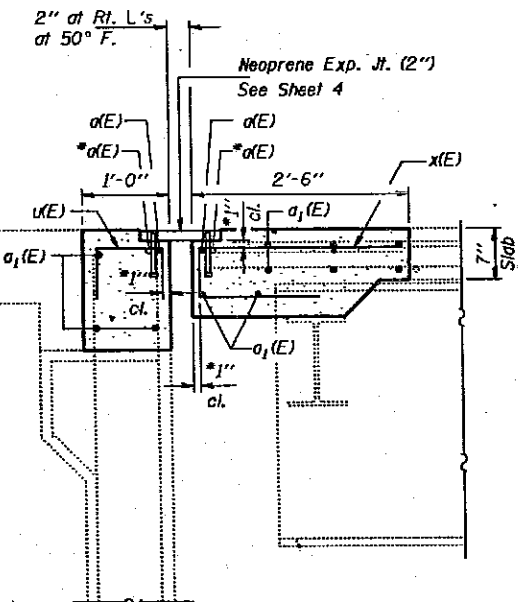


SECTION B-B

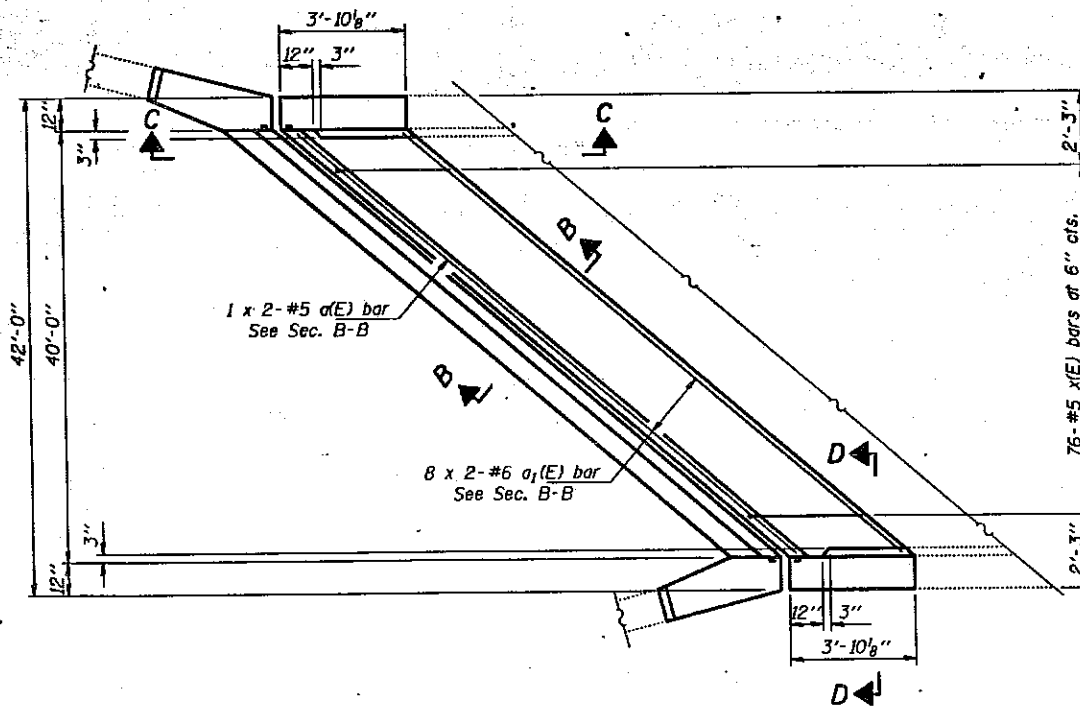


PROPOSED PARTIAL PLAN

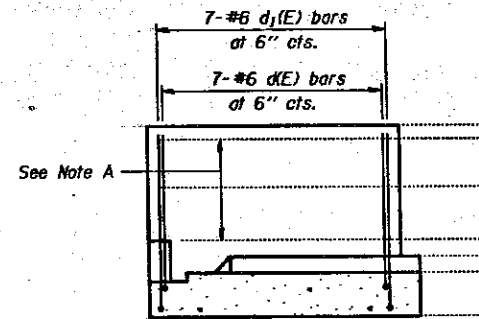


SECTION C-C

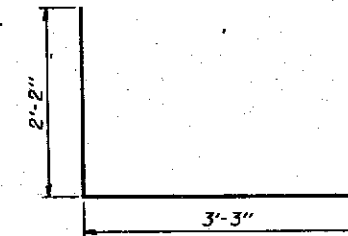


BAR d(E)

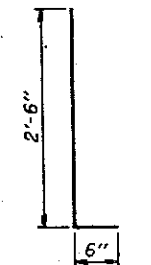


BAR d1(E)

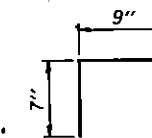

BAR u(E)

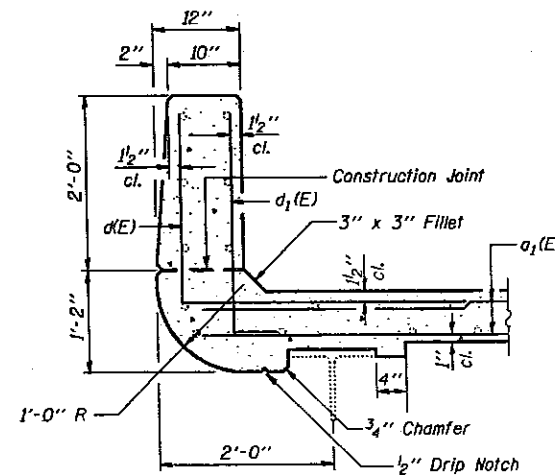

SECTION D-D

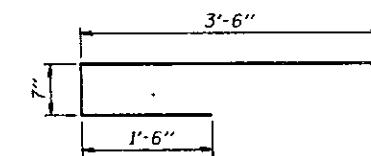

BAR x(E)

BILL OF MATERIAL

Bar	No.	Size	Length	Shape
d(E)	16	#5	32'-7"	—
a1(E)	88	#6	32'-10"	—
d(E)	56	#6	5'-6"	┌
d1(E)	56	#6	3'-0"	┌
u(E)	244	#5	1'-11"	┐
x(E)	304	#5	5'-7"	┌
Concrete Removal		Cu. Yd.	42.8	
Class X Concrete		Cu. Yd.	41.5	
Reinforcement Bars, Epoxy Coated		Lbs.	7860	

Notes: Bars indicated thus 3 x 2-#6 ect. indicates 3 lines of bars with 2 lengths per line. Reinforcement bars designated (E) shall be epoxy coated. Hatched area indicates Concrete Removal. QUANTITIES IN THE ABOVE BILL OF MATERIAL ARE FOR BOTH BRIDGES.



JOINT REPLACEMENT DETAILS  
F.A.I. RT. 57 SEC. (28-3VB-1) I  
FRANKLIN COUNTY  
STA. 515+16.08  
STR. No. 028-0008 & 028-0009


DESIGNED	Paul Sumner	February 7 1972
CHECKED	BRT	EXAMINED
DRAWN	Paul Sumner	PASSED
CHECKED	BRT	APPROVED

# DETAIL OF SLOPEWALL REMOVAL & REPLACEMENT

(TO BE USED AT WEST CORNERS  
OF MIDDLE FORK BIG MUDDY RIVER BRIDGE)

## LEGEND

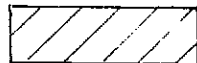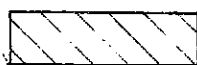-  SLOPEWALL REMOVAL
-  PROPOSED SLOPEWALL, 6"

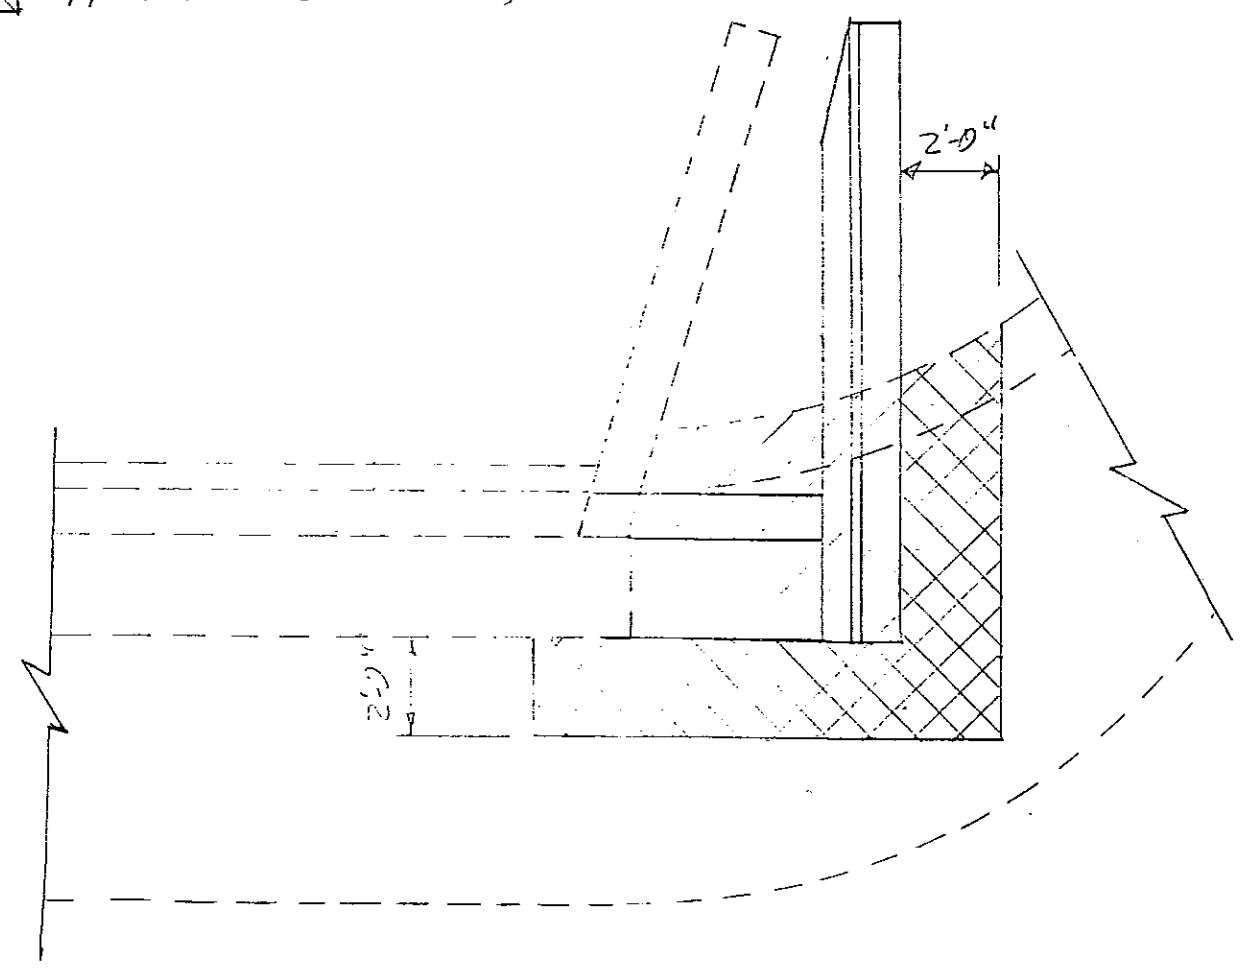

F.A.I. RTE. 57 OVER MIDDLE FORK BIG MUDDY RIVER

Joint Size	"C" at 50°F	"D" at 50°F
2"	2"	1 1/2" Min.
2 1/2"	2 1/2"	1 3/4" Min.
4"	3"	2 1/2" Min.


**INSTALLATION NOTES**

- Install sponge mandrels into positions shown to form flap convolution.
- Install parapet or sidewalk piece (trim roadway flap to fit before applying epoxy).
- Install continuous seal in roadway.
- Install anchor blocks as indicated.


NOTE A: Maximum spacing of anchor bolts shall be 12" centers.

**SKIEW LIMITATIONS**

The details of the anchor blocks and the elastomeric membrane in the parapet, as shown, are for up to 50° skew. For skews greater than 50°, the anchor blocks and the elastomeric membrane, installed in accordance with dimension "D", might require modifications to insure a minimum clearance of 1 1/2" from centerline of anchor studs to edge of parapet opening. The anchor blocks and the elastomeric membrane shall also be installed to the top of the parapet with the anchor studs spaced at ±12" cts.

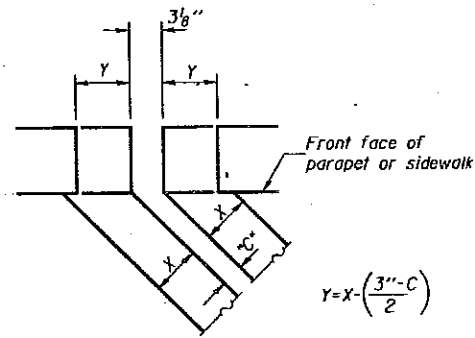

**FORMING BLOCKOUT SKETCH**

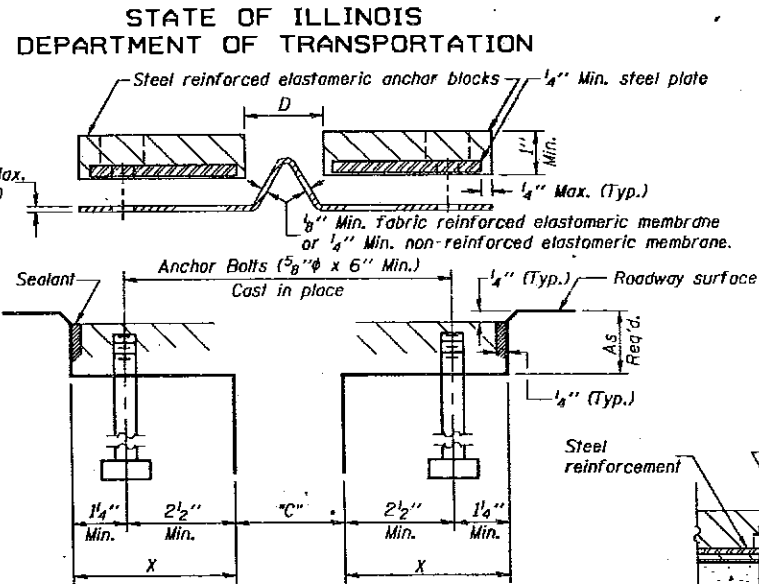


**CROSS SECTION**


**ANCHOR BLOCK REINFORCEMENT WITH ASPHALT SURFACE**

**GENERAL NOTES**


Continuous Seal Neoprene Expansion Joint shall consist of molded anchor blocks of elastomer and steel, field assembled over continuous lengths of elastomeric membrane.  
 The elastomeric membrane shall be premolded with a single or a double upward convolution that will have a "memory" to return to its molded position upon joint closure.  
 The steel reinforcement must extend up the back face of anchor blocks when asphalt surfaces are used but is optional in concrete blockout.  
 The convolution length shall be such that the extended length will not be greater than the manufactured length when the joint is fully expanded in its design range and will not protrude above the anchor blocks when the joint is fully compressed.  
 Joint openings shall be adjusted in accordance with Article 503.07(c) of the Standard Specifications when the deck is poured at an ambient temperature other than 50° F.  
 The parapet and sidewalk flaps may be furnished factory vulcanized to the roadway membrane provided the centerline of the convolution is maintained and the process and method meet the approval of the Engineer.

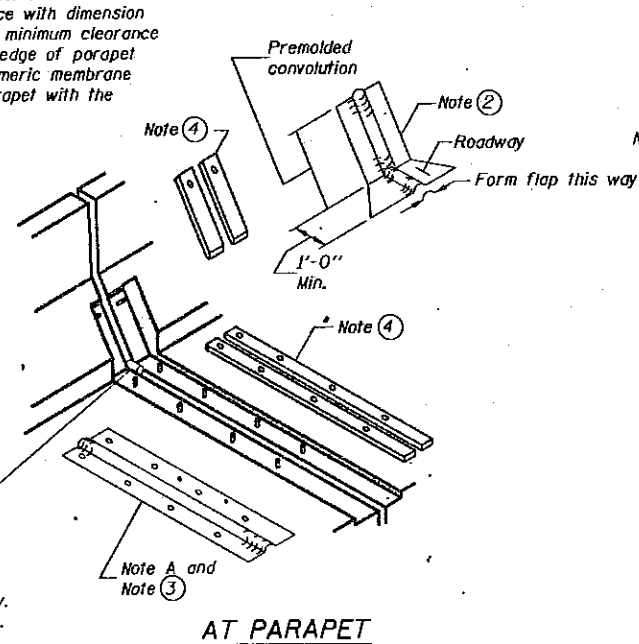


**AT CURB**

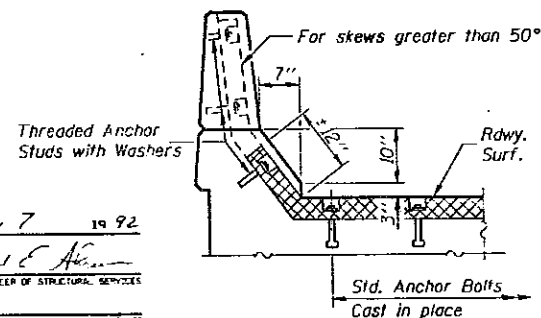


**AT PARAPET**

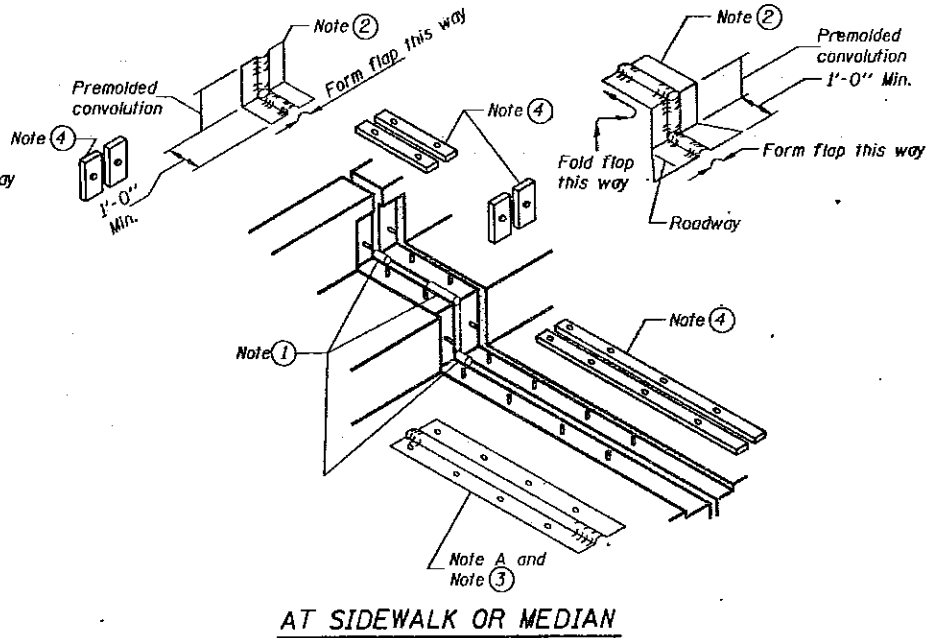


**AT SIDEWALK OR MEDIAN**

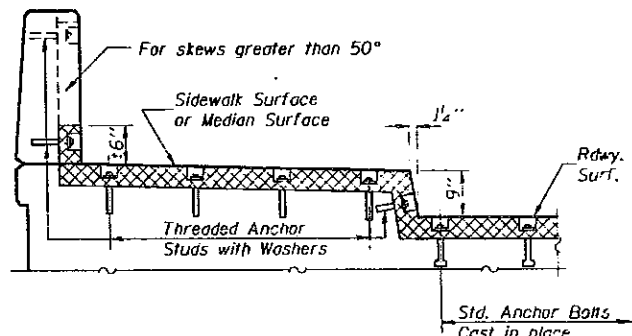

**AT SIDEWALK OR MEDIAN TYPICAL END TREATMENTS**

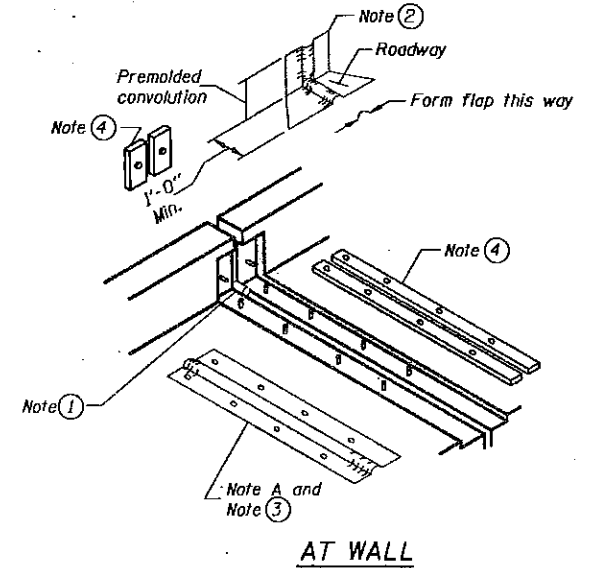

**AT WALL**

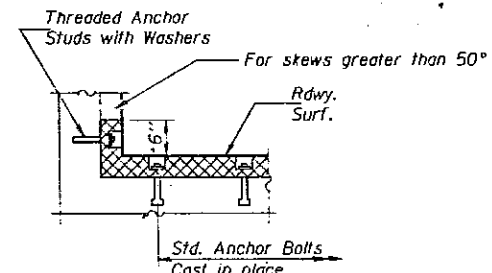

**AT WALL**

DESIGNED Paul Summer  
 CHECKED BRT  
 DRAWN Paul Summer  
 CHECKED BRT

February 7 1992  
 EXAMINED [Signature]  
 PASSED [Signature]  
 APPROVED [Signature]

EJ-CS 6-1-89

CONTINUOUS SEAL TYPE  
 NEOPRENE EXPANSION JOINTS  
 For 2", 2 1/2" and 4" Movement



JOINT REPLACEMENT DETAILS  
 F.A.I. RT. 57 SEC. (28-3VB-1) I  
 FRANKLIN COUNTY  
 STA. 515+16.08  
 STR. No. 028-0008 & 028-0009






SECTION	COUNTY	TOTAL SHEETS	SHEET NO.
57	FRANKLIN	155	76

\* 28 (58-1, 58, 28, 18) D : 28 (58, 38, 31) I

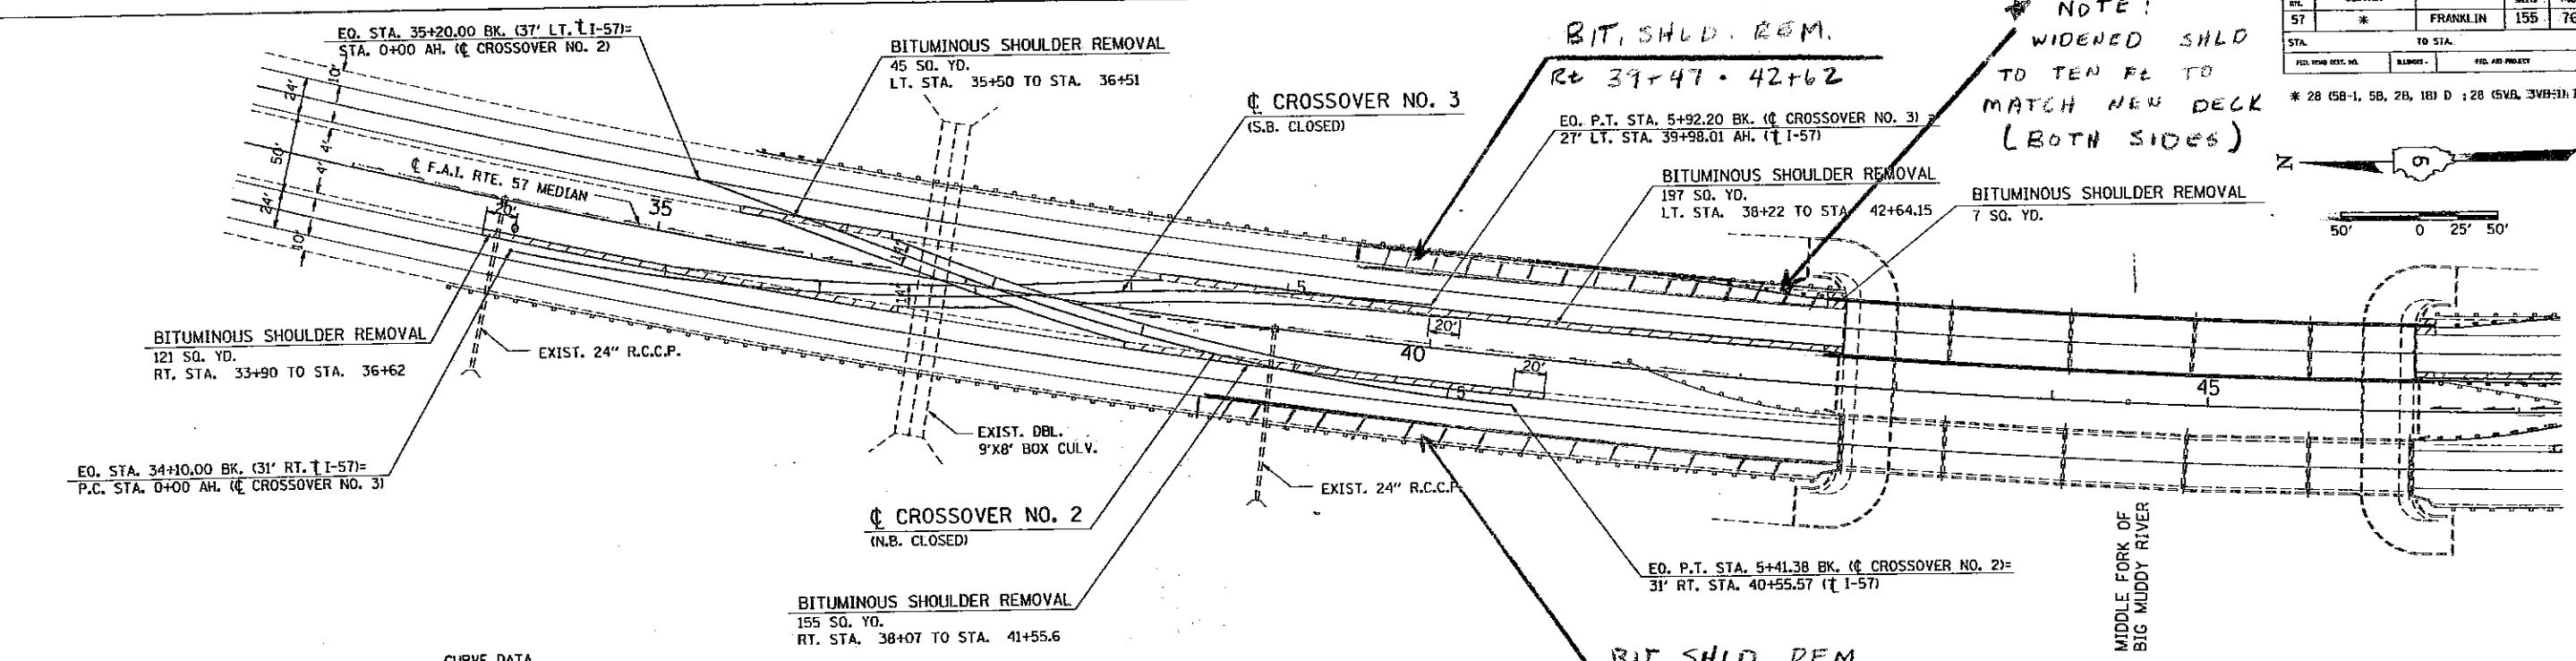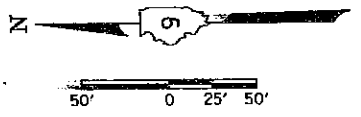

CURVE DATA CROSSOVER NO. 2		CURVE DATA CROSSOVER NO. 3	
P.I. STA= 3+61.23	Δ= 14°-29'-25"	P.I. STA= 1+82.10	Δ= 14°-29'-25"
D= 4°-00'-00"	R= 1432.39'	P.I. STA= 4+77.48	Δ= 9°-11'-53"
T= 182.10'	L= 362.26'	D= 4°-00'-00"	R= 1432.39'
E= 11.53'	P.C. STA= 1+79.13	T= 115.22'	L= 229.95'
P.T. STA= 5+41.38	P.T. STA= 3+62.25	E= 4.63'	P.C. STA= 3+62.25
		P.T. STA= 5+92.21	

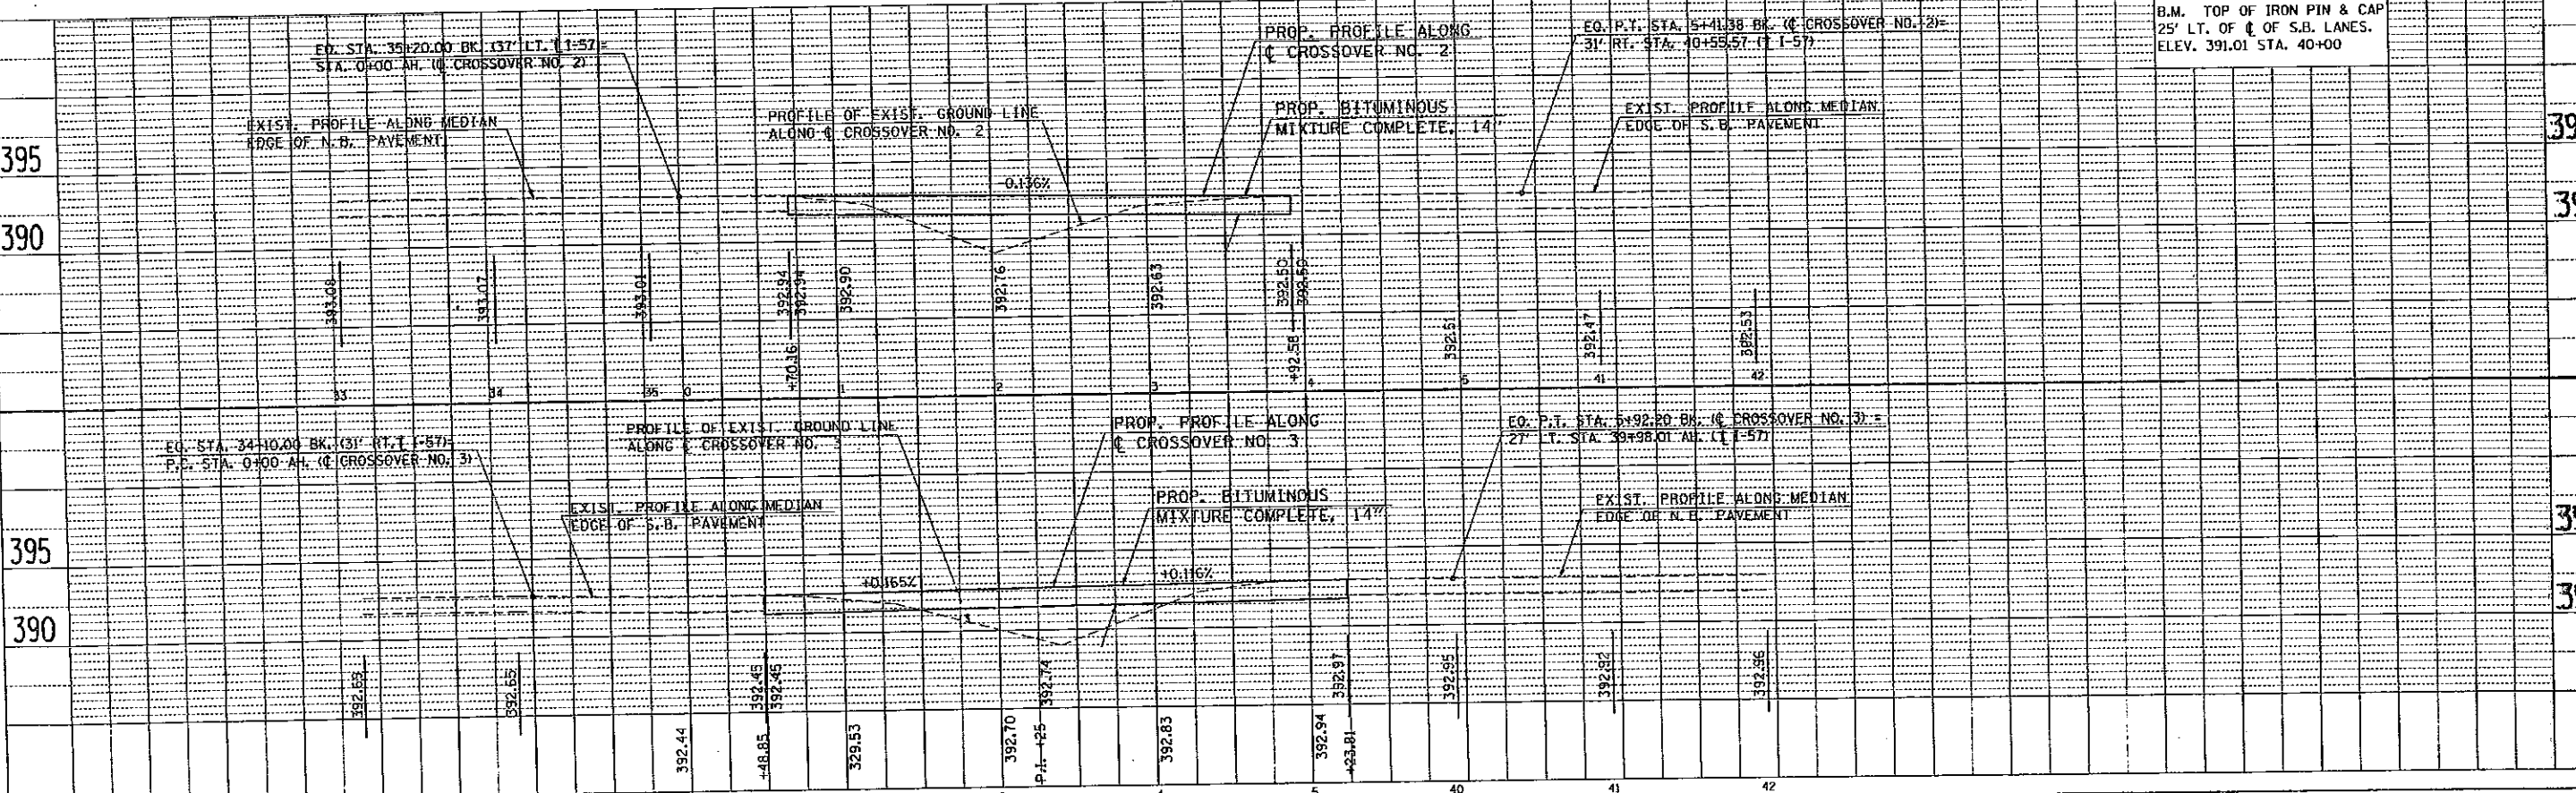

DATE: \_\_\_\_\_ BY: \_\_\_\_\_

REVISIONS:

1. \_\_\_\_\_

2. \_\_\_\_\_

3. \_\_\_\_\_

DATE: \_\_\_\_\_ BY: \_\_\_\_\_

REVISIONS:

1. \_\_\_\_\_

2. \_\_\_\_\_

3. \_\_\_\_\_

DATE: \_\_\_\_\_ BY: \_\_\_\_\_

REVISIONS:

1. \_\_\_\_\_

2. \_\_\_\_\_

3. \_\_\_\_\_













100

100

1	1
2	1
3	1
1	1
2	1
3	1
ROUTE NO.	SEC.	COUNTY	TOTAL SHEETS	SHEET NO.
F.A.J. 57		FRANKLIN	155	81
FED. ROAD DIST. 7	ILLINOIS	PROJECT		
SEC. 26 (S.W. 1/4) 26 (S.W. 1/4) 11				

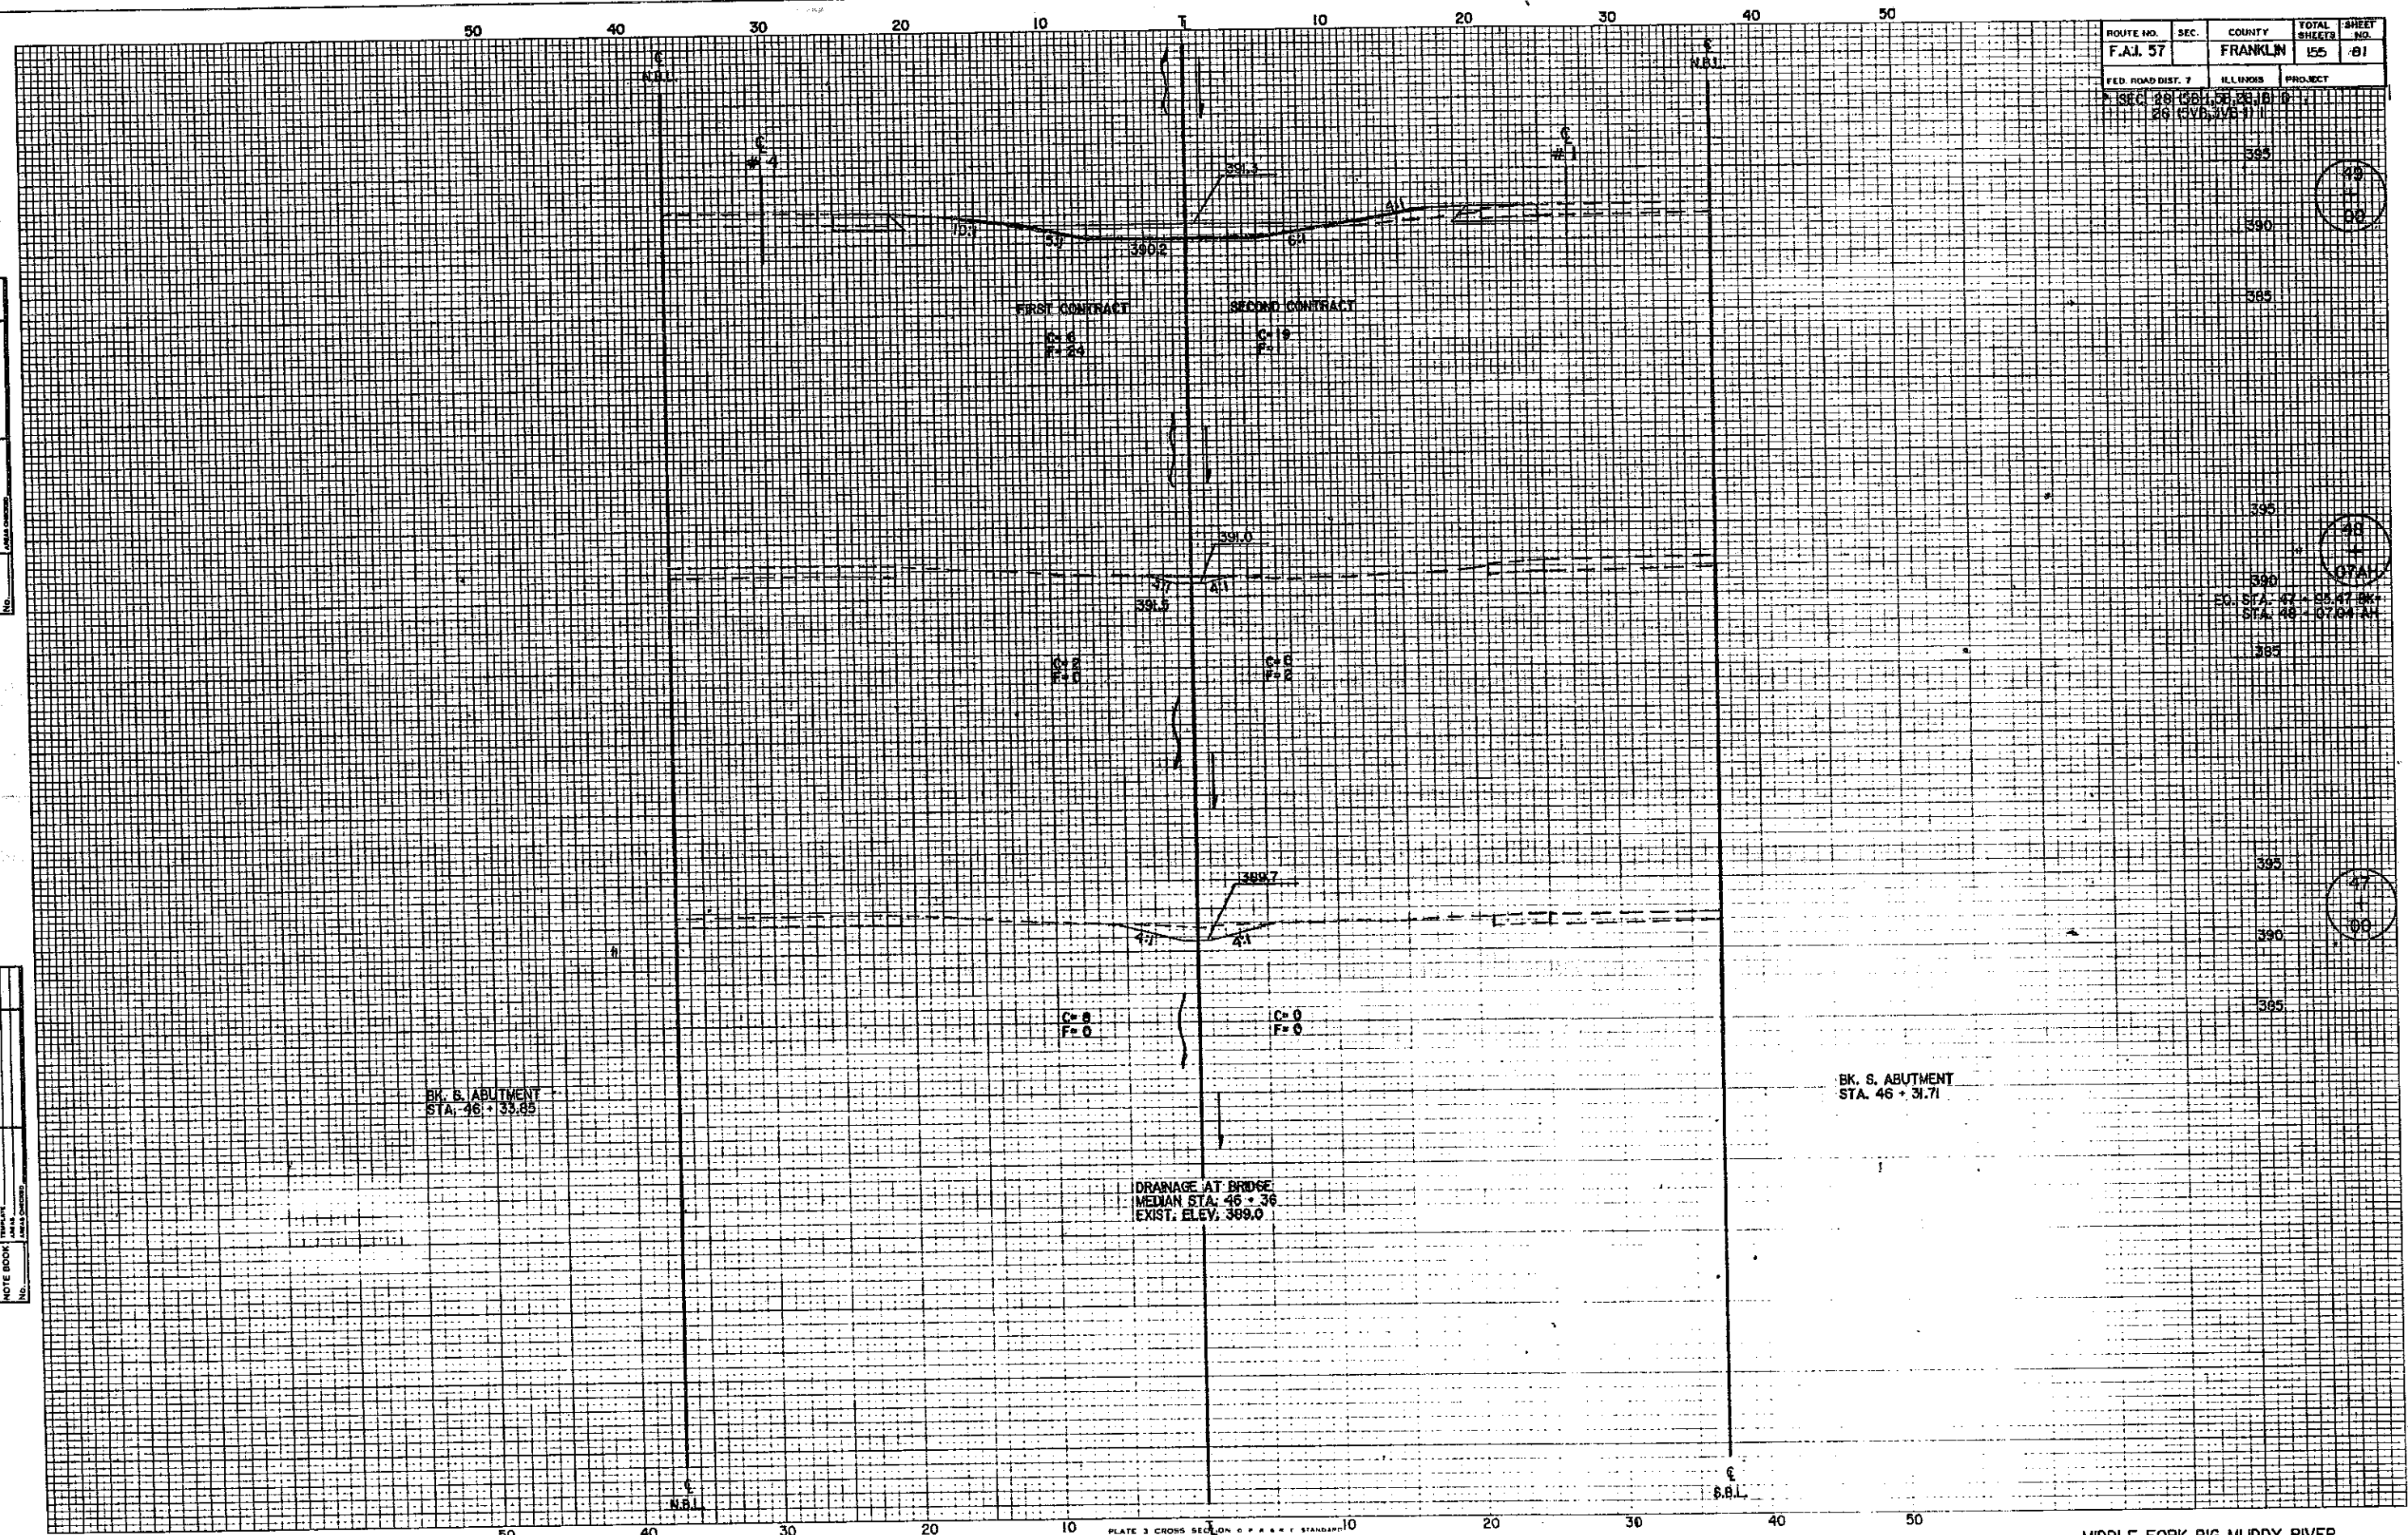

39  
100

39  
100

39  
100


EQ. STA. 47 + 35.47 BK.  
STA. 48 + 07.04 BK.

FINAL SURVEY NOTE BOOK

FINAL SURVEY NOTE BOOK



DATE	BY	PROJECT	NO.

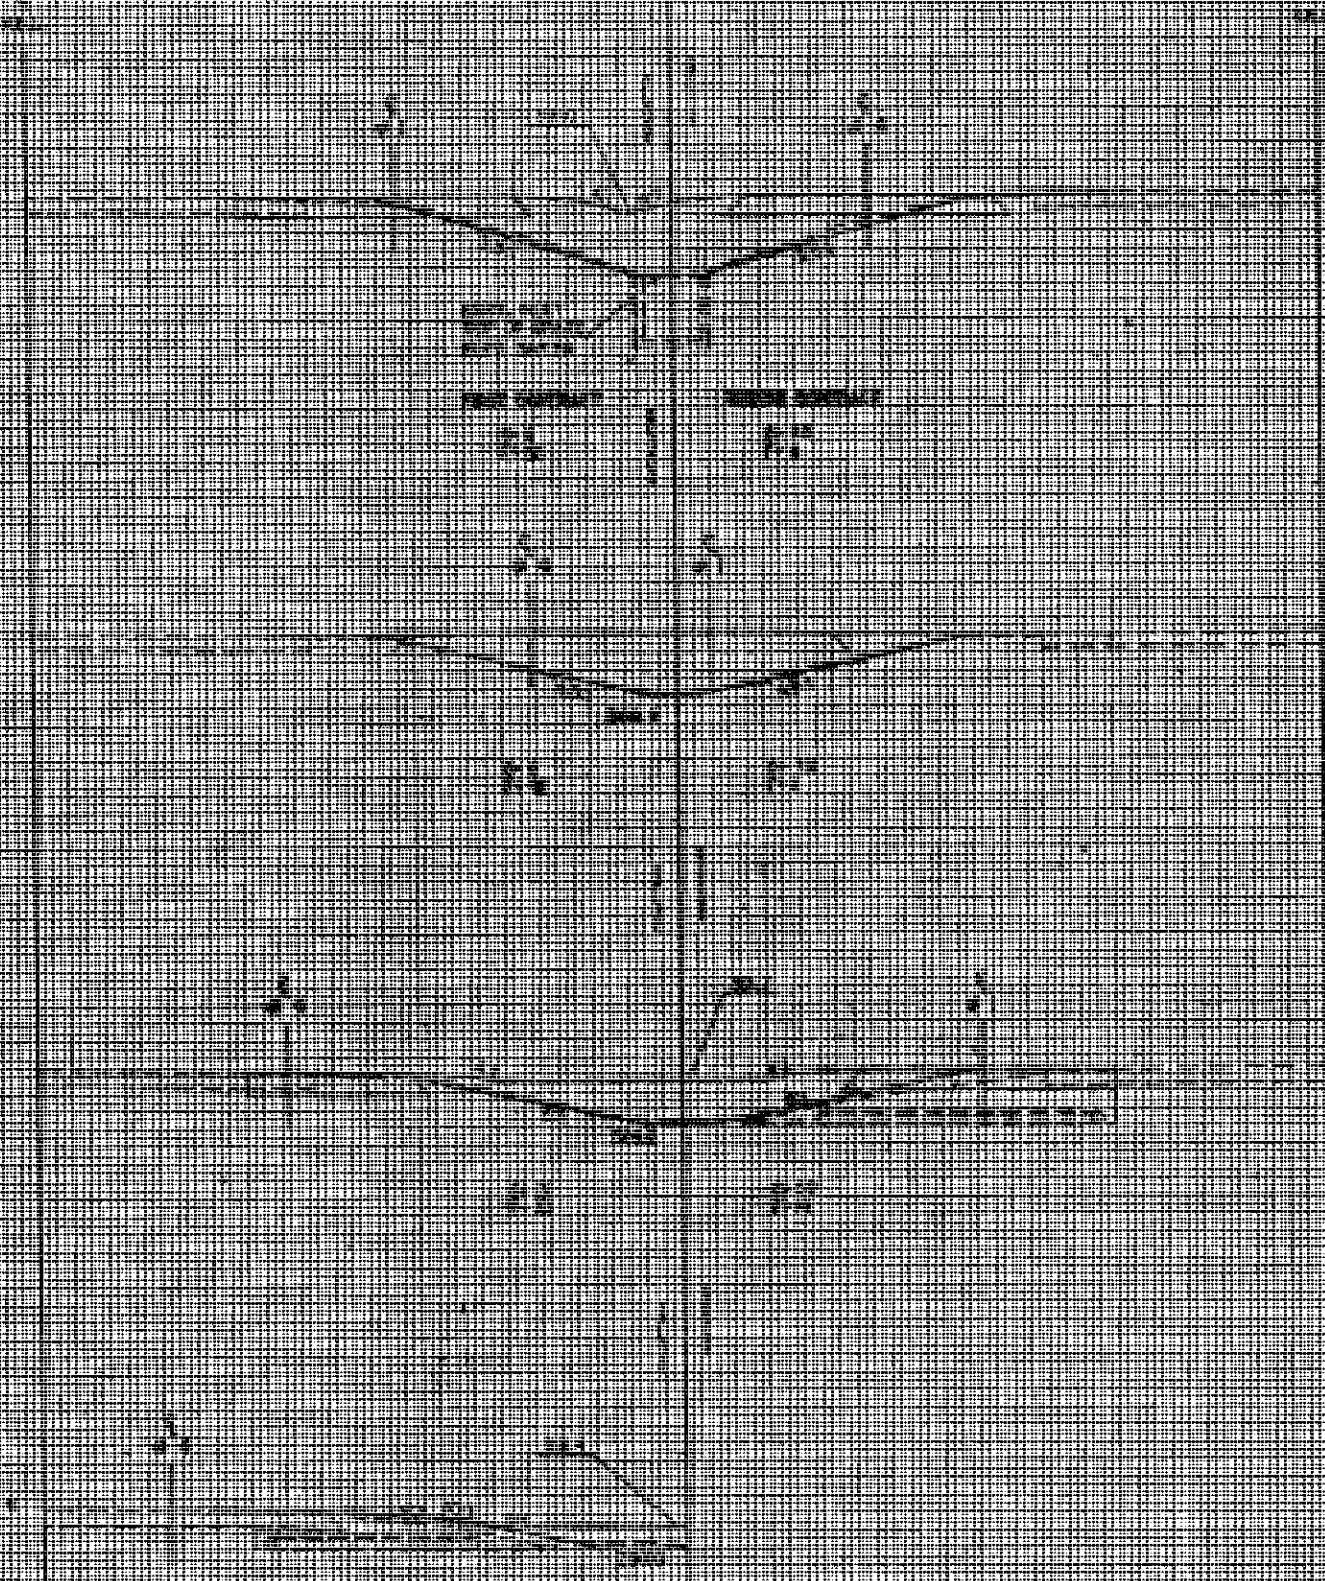

DATE	BY	PROJECT	NO.




DATE	TIME	TEMPERATURE	WIND	MOON

DATE	TIME	TEMPERATURE	WIND	MOON

FINAL SURVEY NOTE BOOK

DATE	TIME	TEMPERATURE	WIND	MOON

FINAL SURVEY NOTE BOOK

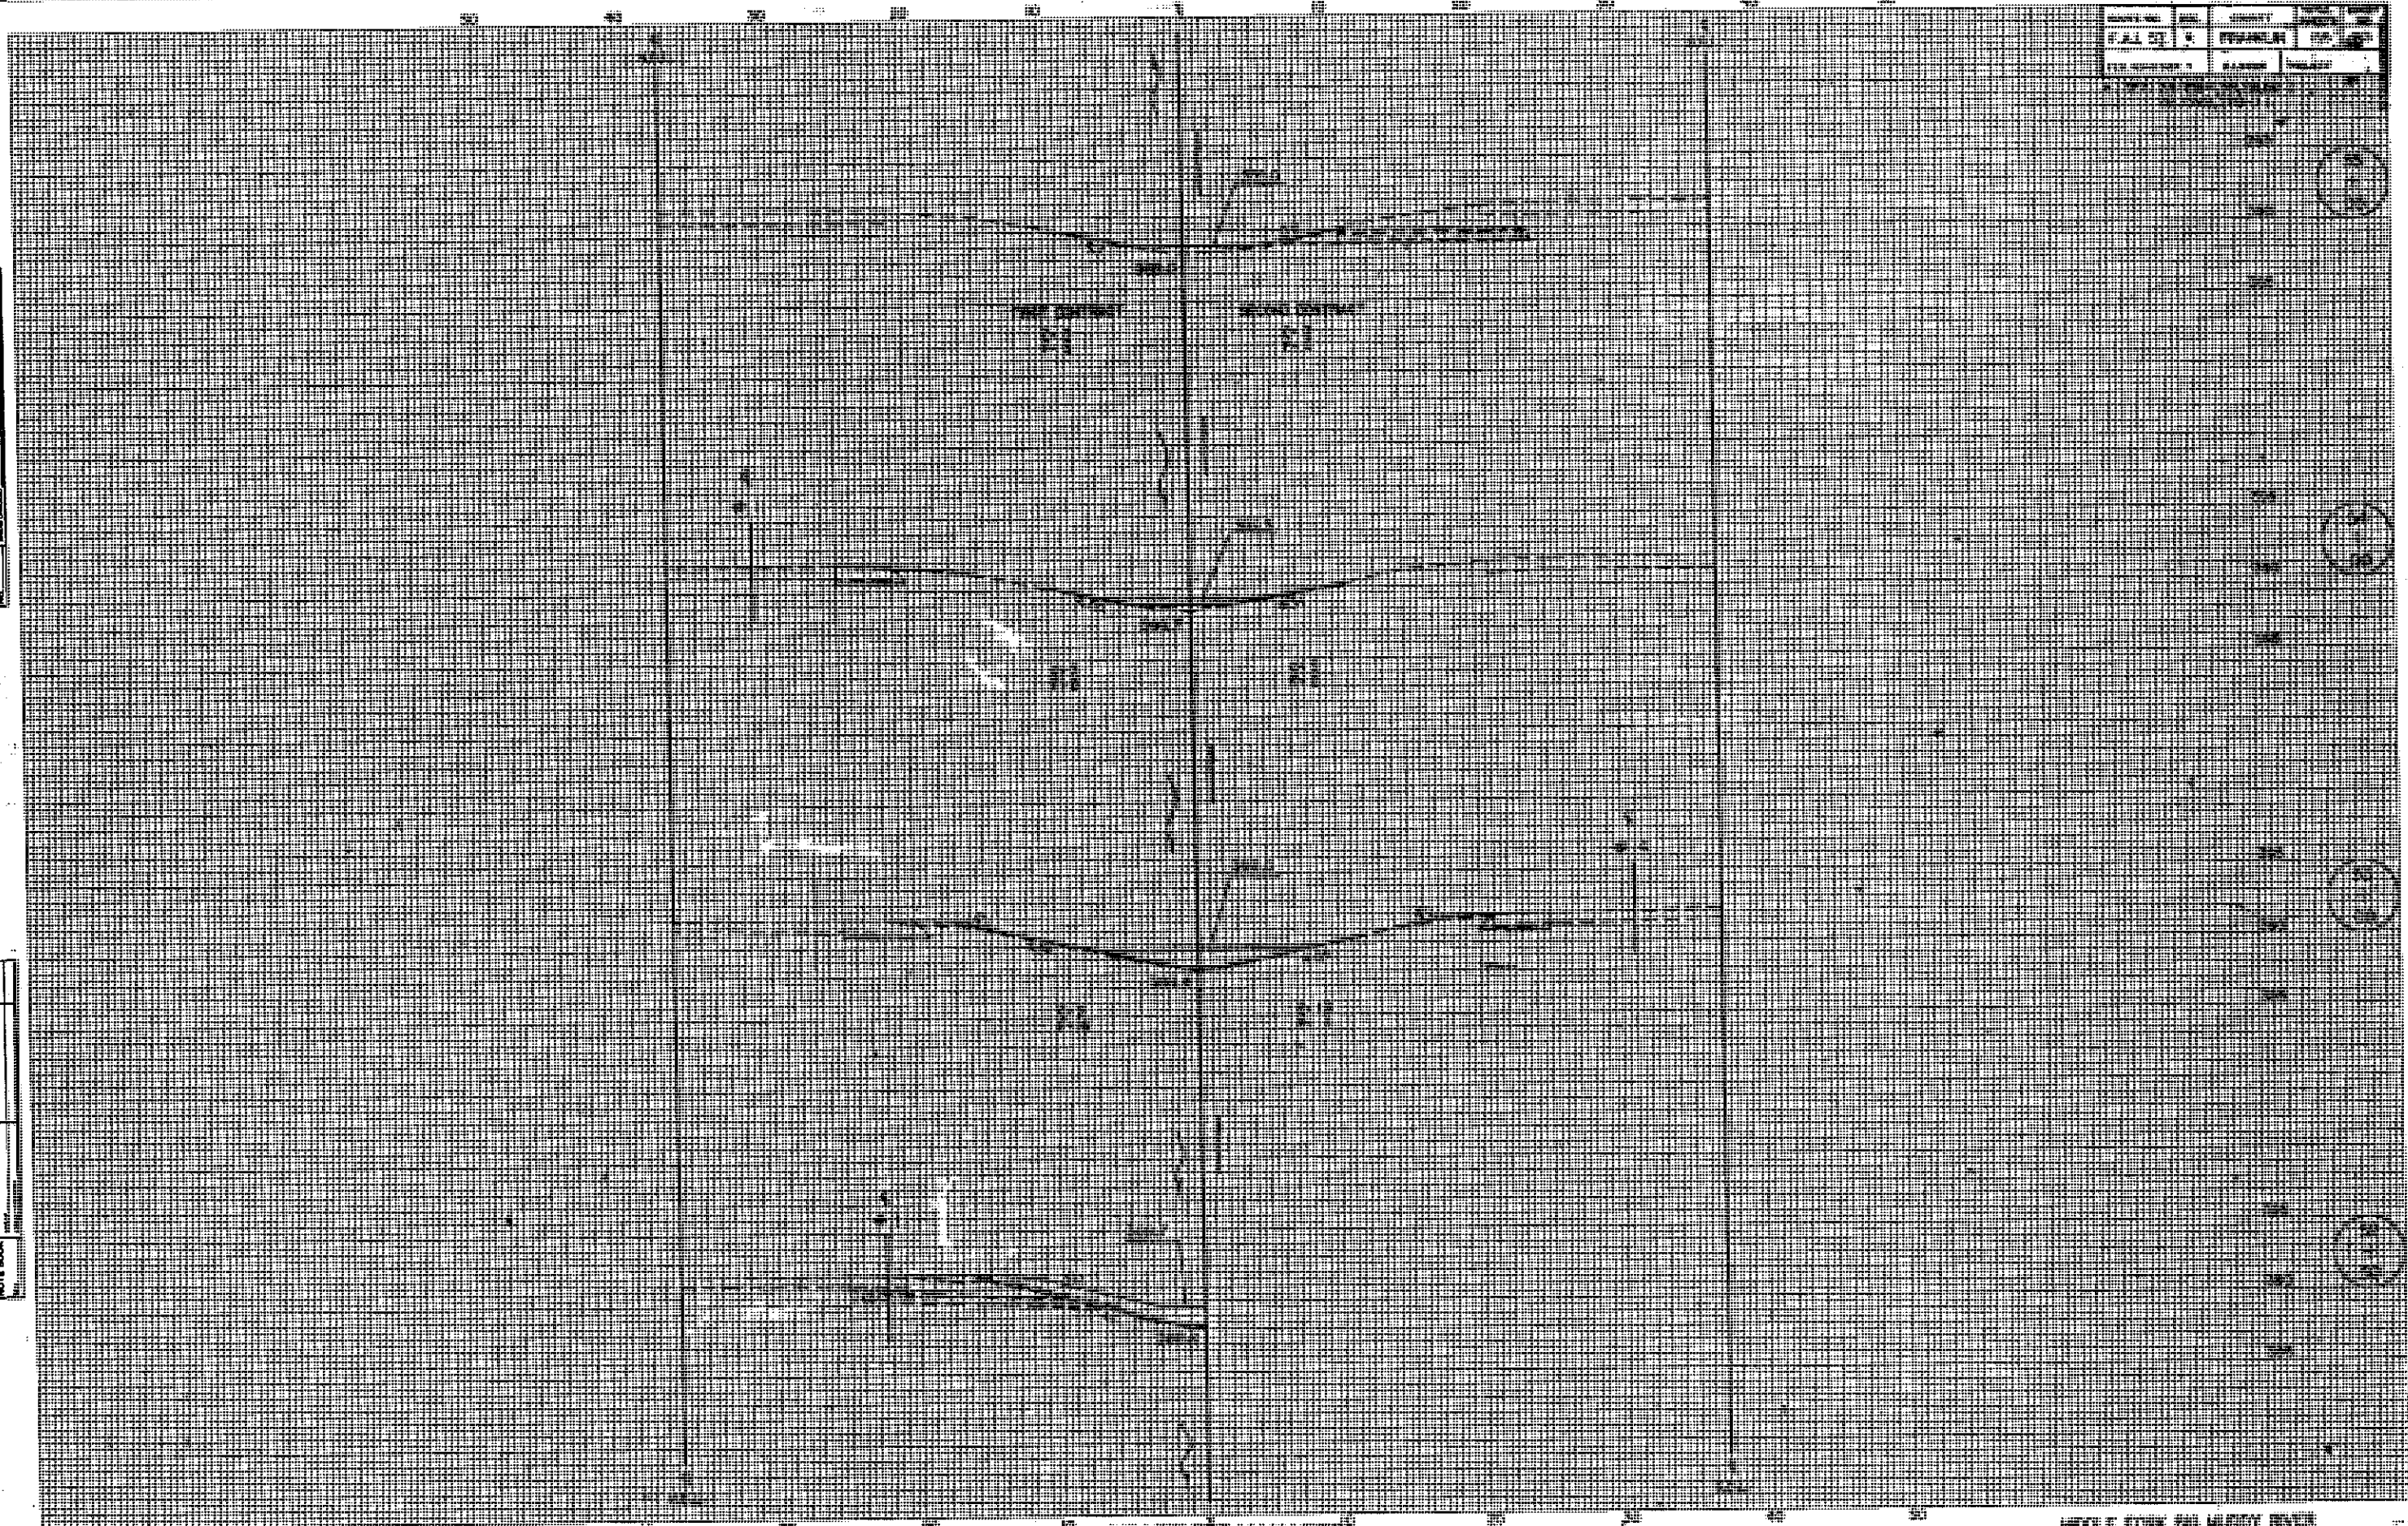

SCALE FOR THE SURVEY



DATE	TIME	TEMP	WIND	MOON	SEA

SMALL SURVEY NOTE BOOK

DATE: \_\_\_\_\_

TIME: \_\_\_\_\_

TEMP: \_\_\_\_\_

WIND: \_\_\_\_\_

MOON: \_\_\_\_\_

SEA: \_\_\_\_\_

SMALL SURVEY NOTE BOOK

DATE: \_\_\_\_\_


TIME: \_\_\_\_\_

TEMP: \_\_\_\_\_

WIND: \_\_\_\_\_

MOON: \_\_\_\_\_

SEA: \_\_\_\_\_

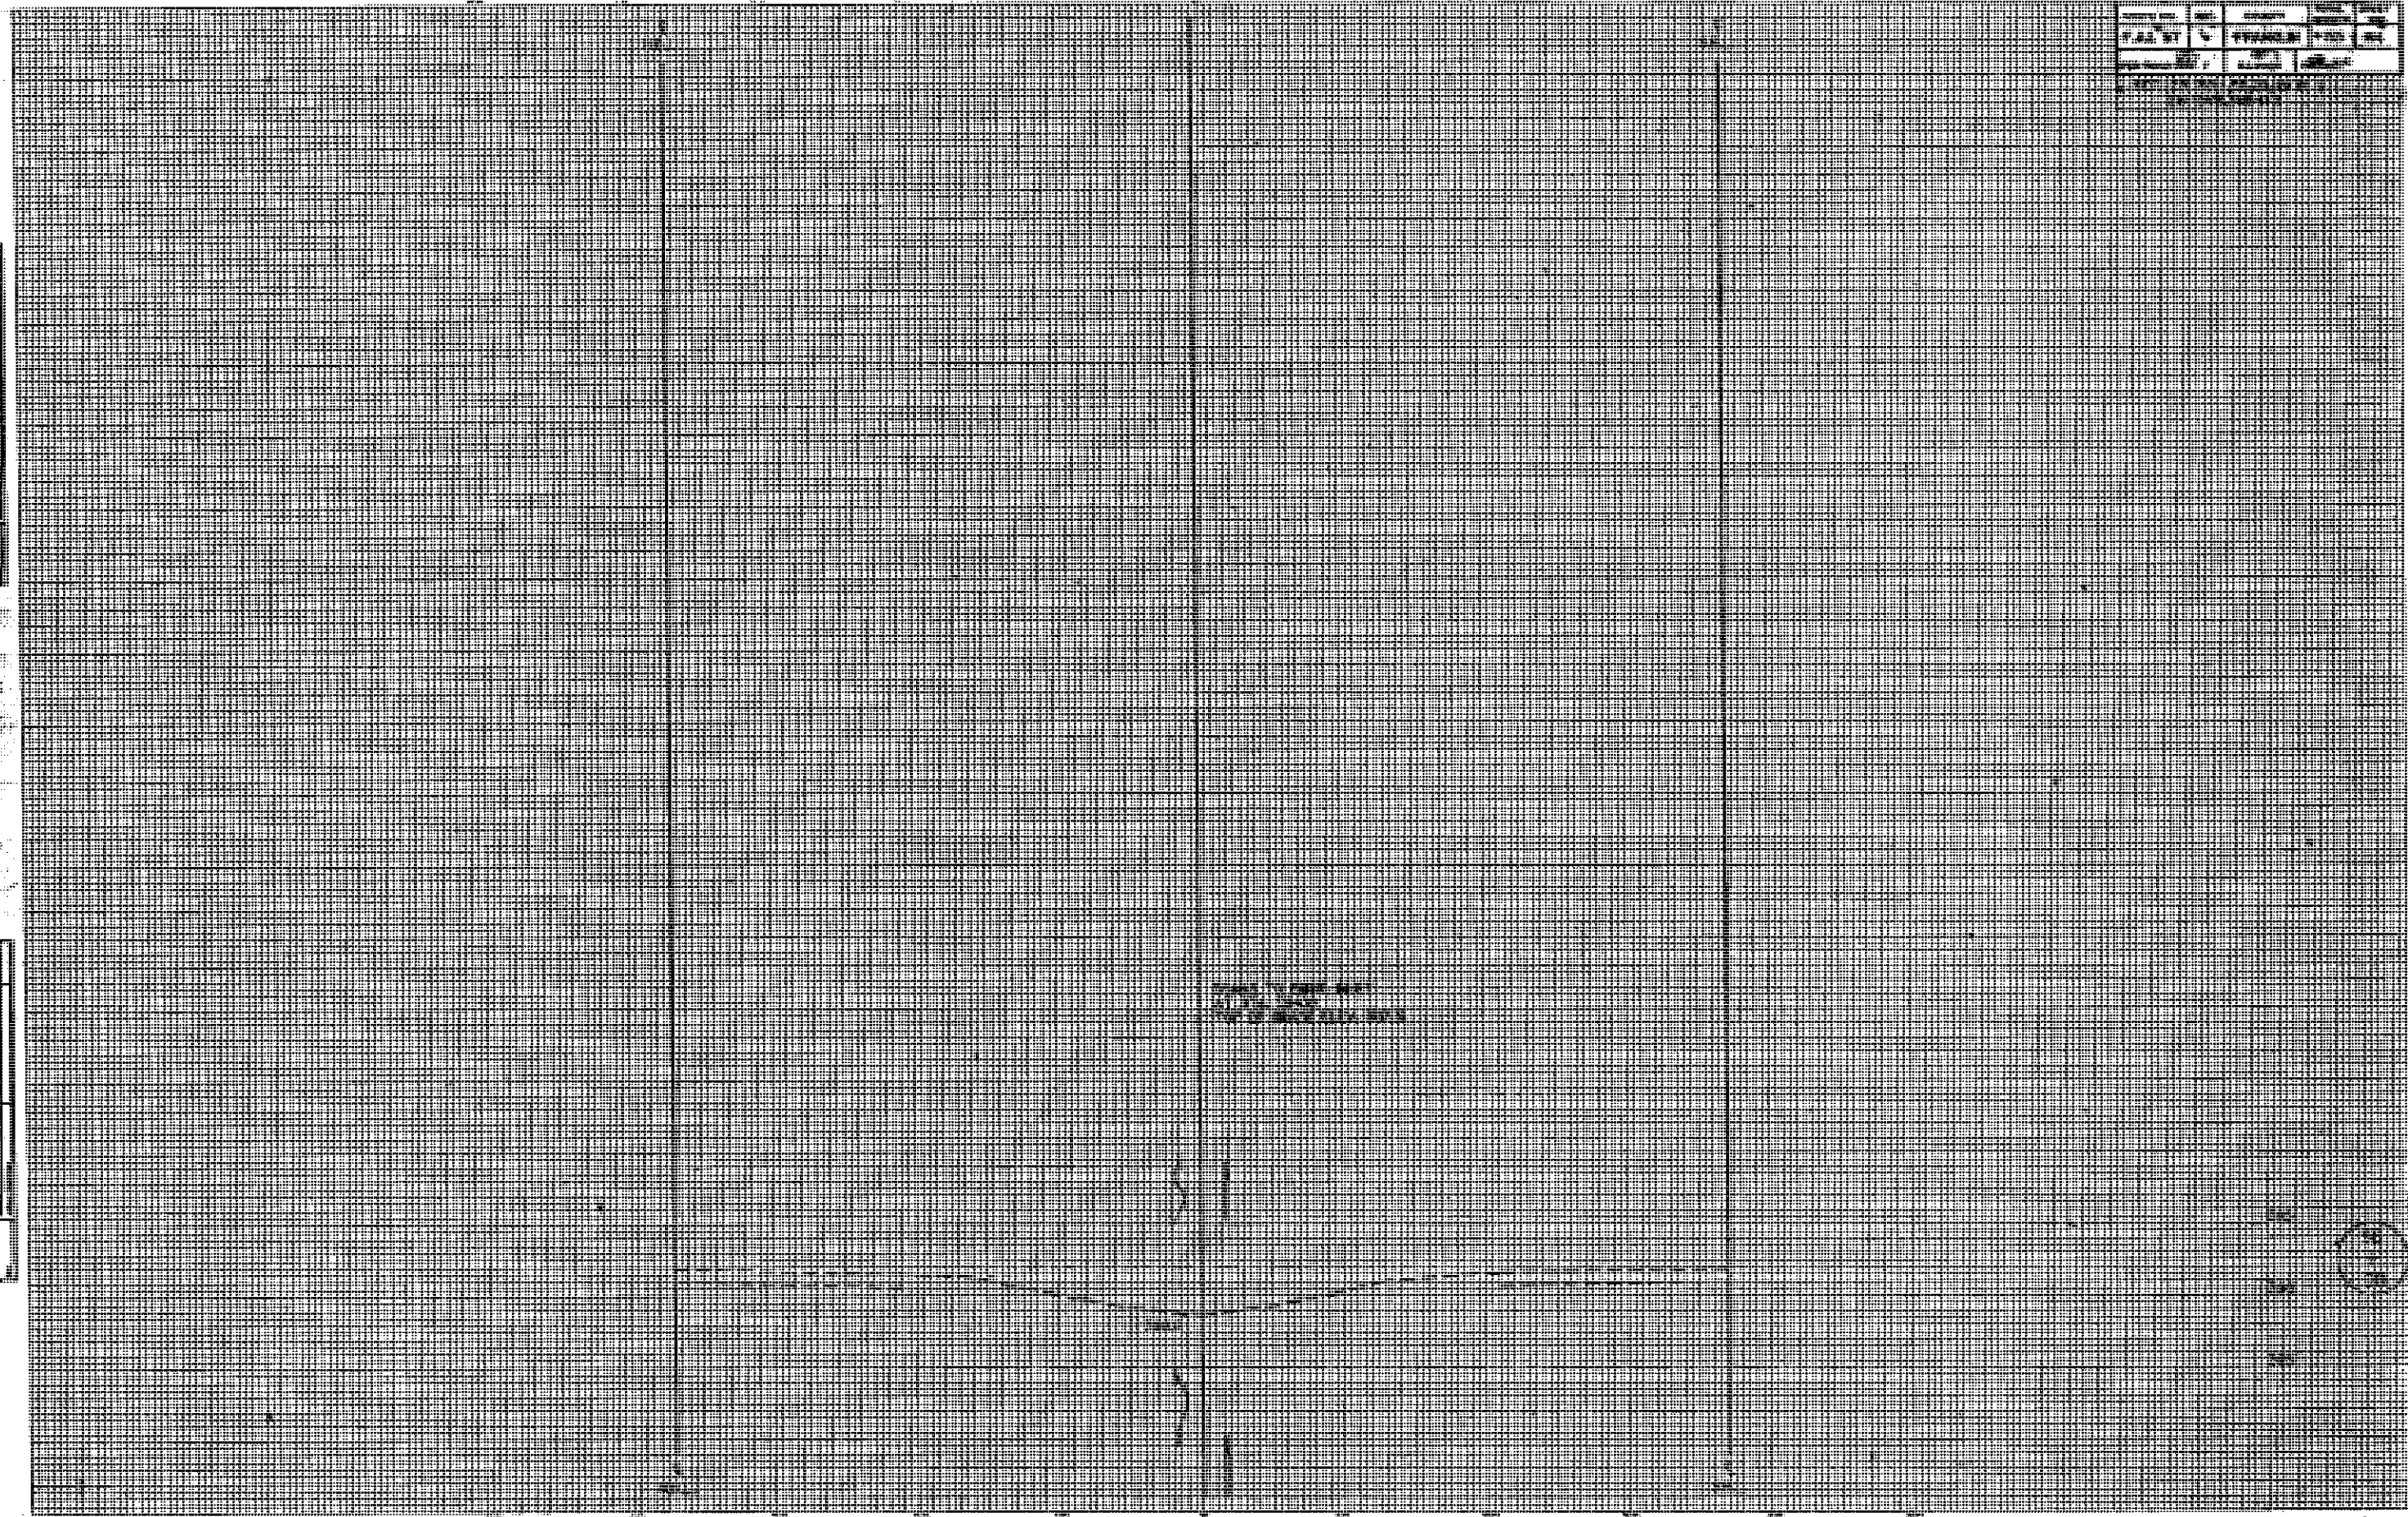


SCALE 1:10000

WIDE FORK OF HADY RIVER

ROUTE NO.	SECTION	COUNTY	JOB	"S"	SHEET NO. 1
F.A.I. 57	(28-5B) D	FRANKLIN	155	65	22 SHEETS
FED. ROAD DIST. NO. 7		ILLINOIS	FED. AID PROJECT		

STATE OF ILLINOIS  
DEPARTMENT OF TRANSPORTATION

Bench Mark: "□" Cut in N.E. handrail on the N.E. corner of Middle Fork of Big Muddy River bridge - Southbound Lanes. Sta. 44+49.00 Elevation 395.13.  
Existing Structure: D28-0006 (NB), Built as FAI Route 57, Sec. 28-5(B-F) in 1962. The superstructure consists of 5 spans of continuous WF beams with an R.C. deck. The bridge will be rehabilitated in accordance with the scope of work shown below.  
Temporary median crossovers shall be utilized to divert traffic over adjacent bridge (028-0007 S.B.) during reconstruction. No salvage.

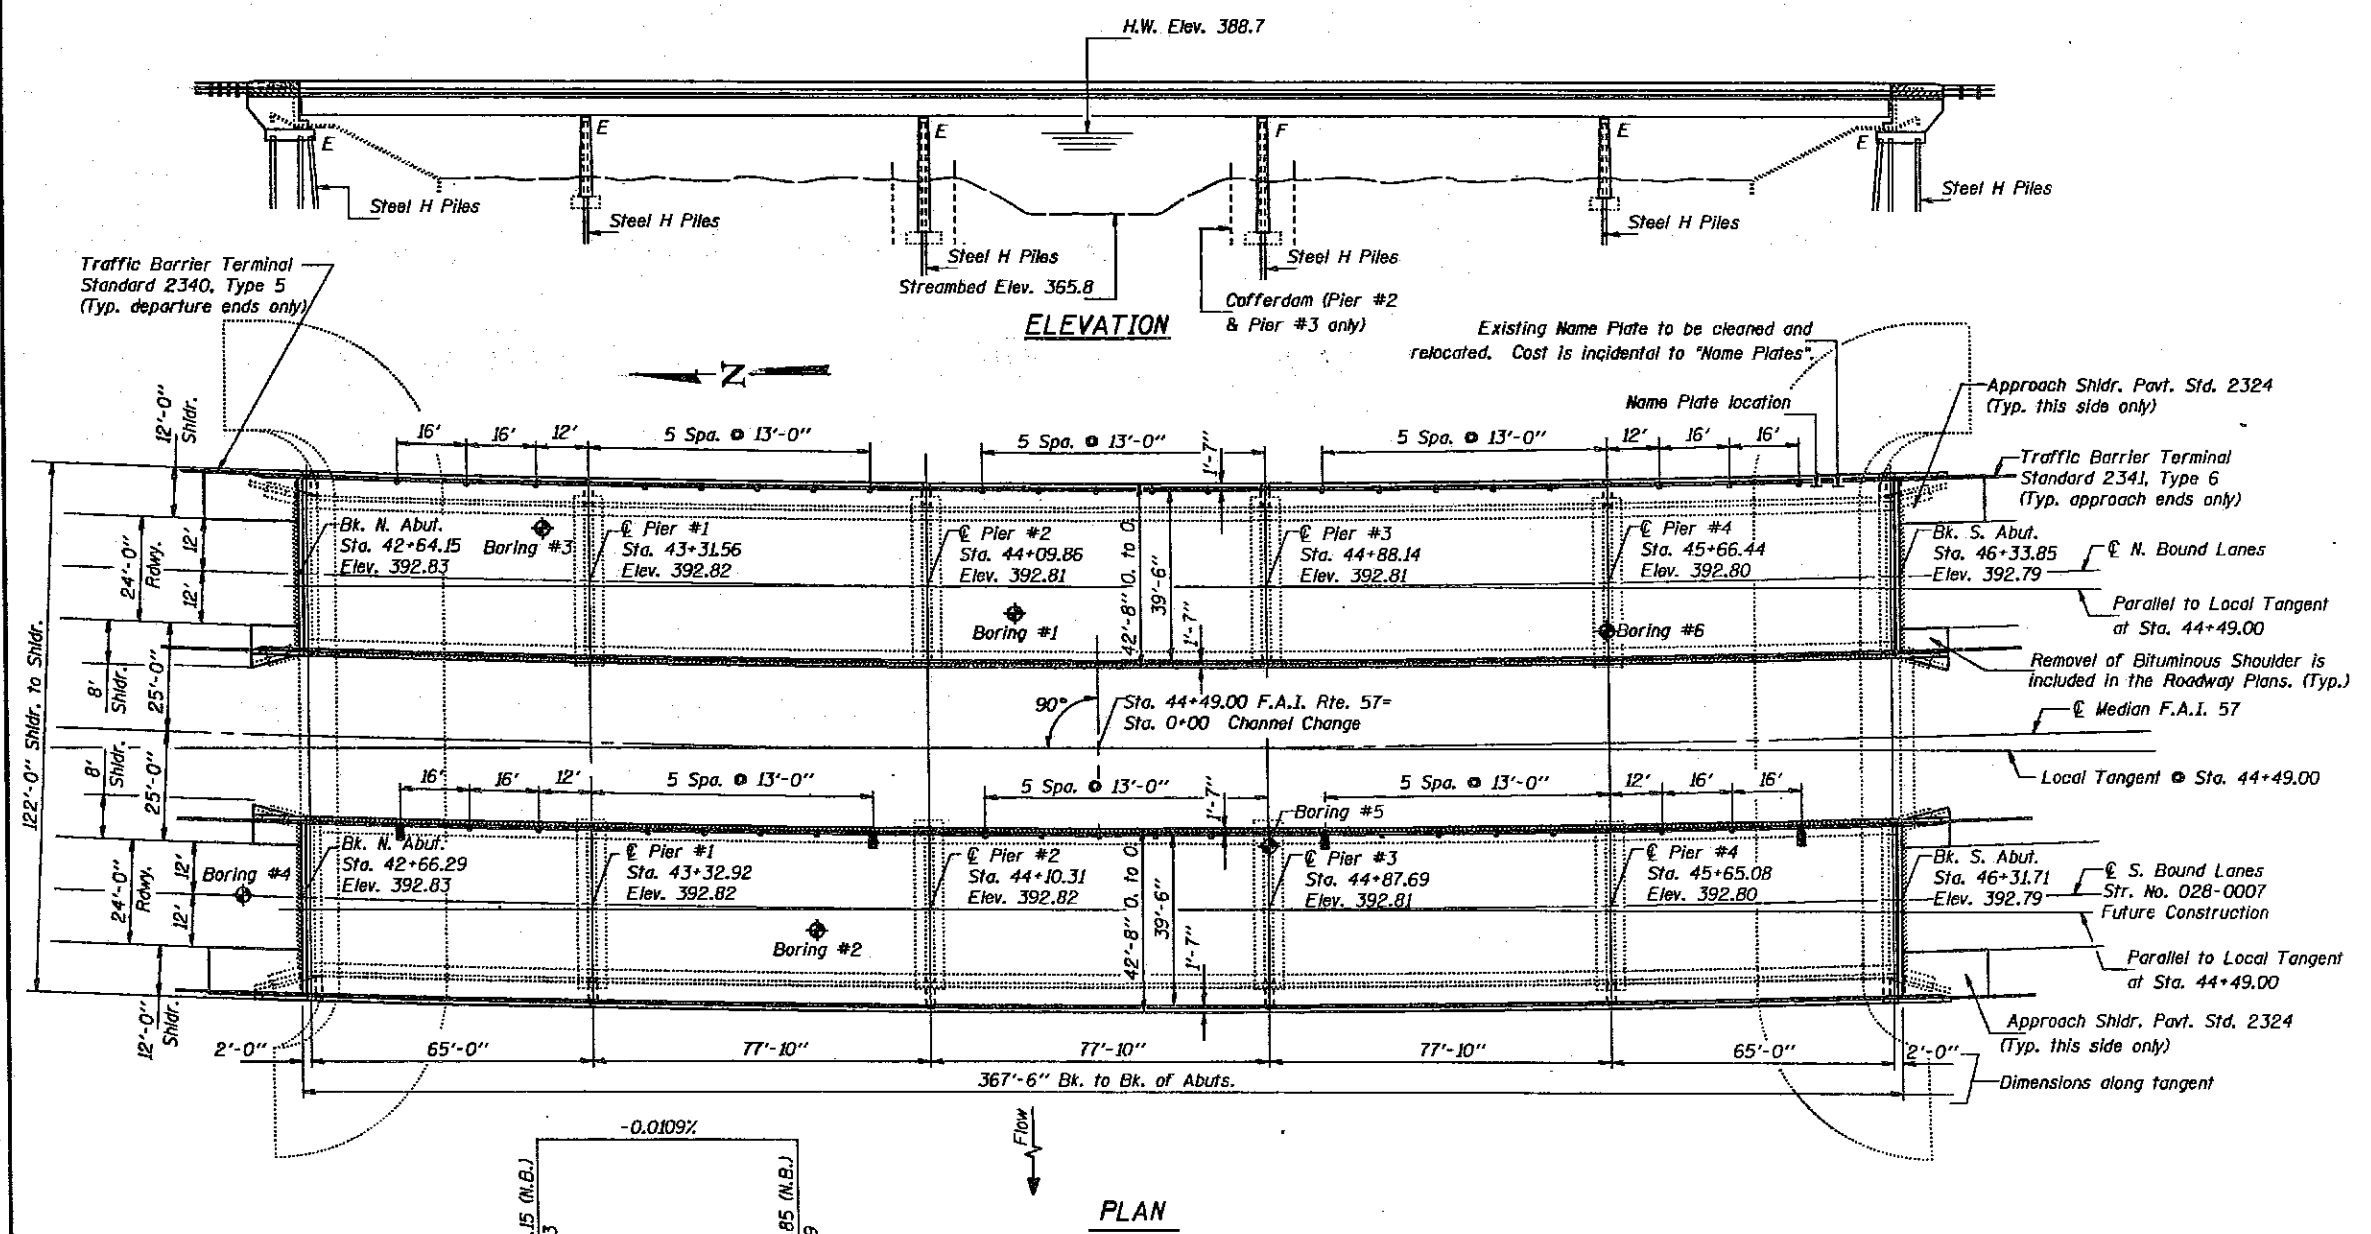

Notes:  
Only the North Bound Structure is included in the Contract.

**CURVE DATA**  
 $\Delta = 34^{\circ}-04'-30''$   
 $D = 0^{\circ}-54'$   
 $T = 1950.92'$   
 $L = 3786.11'$   
 $E = 292.22'$   
 $R = 6366.26'$   
 $S.E. = +0.020'$

STATION 44+49.00  
REBUILT 199 BY  
STATE OF ILLINOIS  
F.A.I. RT. 57 SEC. (28-5B)D  
F.A. PROJ. IM-57-2(89)263  
LOADING HS20 & ALT.  
STR. NO. 028-0006


**NAME PLATE**  
(North Bound Lanes)  
See Std. 2113

**DESIGN SPECIFICATIONS**  
1989 AASHTO, 1990, 1991 Interim Specifications & Seismic Retrofitting Guidelines for Highway Bridges

**LOADING HS 20-44 & Alt.**  
Allow 25# / sq. ft. for future wearing surface.

**DESIGN STRESSES**

**FIELD UNITS**  
**New Construction**  
 $f'_c = 3,500$  psi  
 $f_y = 60,000$  psi (Reinf.)  
 $f_s = 27,000$  psi (Structural Steel M270 Gr. 50)  
 $f_s = 20,000$  psi (Structural Steel M270 Gr. 36)  
**Old Construction**  
 $f_s = 20,000$  psi (Structural Steel)

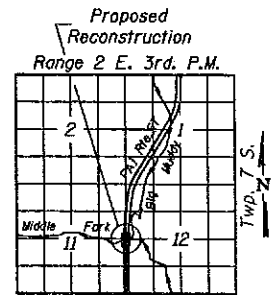

LOCATION SKETCH

GENERAL PLAN  
F.A.I. ROUTE 57 OVER  
MIDDLE FORK OF BIG MUDDY RIVER  
FRANKLIN COUNTY  
STATION 44+49.00  
STRUCTURE NUMBER 028-0006 (N.B.)

DESIGNED: *[Signature]*  
CHECKED: MICHAEL ABITONUN  
Paul W. Sweet, W.D.C.  
DRAWN: John F. Schneller Jr.  
CHECKED: *[Signature]* GMA

EXAMINED: *[Signature]*  
PASSED: *[Signature]*  
APPROVED: *[Signature]*  
DIRECTOR OF HIGHWAYS

**PROPOSED PROFILE GRADE**  
F.A. Route 57 (along & pavement)

May 22 1992



STATE OF ILLINOIS  
DEPARTMENT OF TRANSPORTATION

ROUTE NO.	SECTION	COUNTY	MILE	SHEET	SHEET NO. 2
F.A.I. 57	(28-5B) D	FRANKLIN	155	86	22 SHEETS
FED. ROAD DIST. NO. 1		BALANCE	PRELIM. PROJECT		

GENERAL NOTES

Fasteners shall be high strength bolts. Bolts  $\frac{7}{8}$ " $\phi$ , open holes  $\frac{5}{16}$ " $\phi$ , unless otherwise noted.

Calculated weight of Structural Steel M270 Gr. 50 = 51,330 Lbs.  
Calculated weight of Structural Steel M270 Gr. 36 = 18,430 Lbs  
Field welding of construction accessories will not be permitted to the bottom flange of beams nor to the top flange for a distance equal to one-fourth the span length each way from the pier supports. Field welding in other areas will be permitted only when approved by the Engineer.

Anchor bolts shall be set before bolting diaphragms over supports.  
The main load carrying member components subject to tensile stress shall conform to the Supplemental Requirements for Notch Toughness Zone 2. These Components are the wide flange beams and all splice plate material of the wide flange beams.

Reinforcement bars shall conform to the requirements of AASHTO M-31, M-42 or M-53 Grade 60.

All top surfaces of the Abutments shall receive "Bridge Seat Sealer". Estimated quantity = 167 Sq. Ft.

The contractor shall drive 2 (two) Steel HP12 x 53 test piles in permanent locations 1 (one) at the North Abutment and 1 (one) at South Abutment as directed by the Engineer before ordering the remainder of the piles.

The first two coats of the Lead and Chromate free Alkyd Paint System shall be used for shop and field painting of the new Structural Steel.

Structural steel shall only be cleaned and painted as required by the Special Provision "Cleaning and Painting New Steel and Adjacent Areas of Existing Steel Structures".

Plan dimensions and details relative to existing structure have been taken from existing plans and field survey elevations and are subject to nominal construction variations. It shall be the Contractor's responsibility to verify such dimensions and details in the field and make necessary approved adjustments prior to construction or ordering of materials. Such variations shall not be cause for additional compensation for a change in the scope of the work, however, the contractor will be paid for the quantity actually furnished at the unit price bid for the work.

Bearing seat surfaces shall be constructed or adjusted to the designated elevations within a tolerance of  $\frac{1}{8}$  inch. Adjustment shall be made either by grinding the surface or by shimming the bearing. Two  $\frac{1}{8}$ " adjusting shims, of the dimensions of the bottom bearing plate, shall be provided for each bearing in addition to all other plates or shims. For Type I Elastomeric Bearings, shims of the dimensions of top plate shall be provided and placed as detailed.


The Contractor will be required to mark, on top of the concrete deck, the locations of the top flange of all the steel beams, prior to any removal of the bridge concrete deck. Saw cutting directly over the top of the beam flanges is not permitted.

Prior to pouring the new concrete for the deck, all loose rust, loose mill scale and all other foreign material shall be removed from the embedded portions of flanges of stringers. The removal shall be accomplished in accordance with the requirements of the SSPC Surface Preparation Specifications SP-11 for Power Tool Cleaning or SP-2 for hand tool cleaning. Cost shall be incidental to "Concrete Removal".

TOTAL BILL OF MATERIAL

ITEM	UNIT	SUPER	SUB	TOTAL
Concrete Removal	Cu. Yd.		12	12
Removal of Existing Concrete Deck	Each	1		1
Structure Excavation	Cu. Yd.		127	127
Floor Drains	Each	21		21
Class X Concrete Superstructure	Cu. Yd.	469.4		469.4
Protective Coat	Sq. Yd.	1,920		1,920
Elastomeric Bearing Assembly Type I	Each		21	21
Elastomeric Bearing Assembly Type II	Each		14	14
Class X Concrete	Cu. Yd.		58.6	58.6
Structural Steel	L.S.	1		1
Stud Shear Connectors	Each	7,056		7,056
Reinforcement Bars, Epoxy Coated	Pound	108,840	7,950	116,790
Steel Piles HP12 x 53	Lin. Ft.		208	208
Steel Piles HP12 x 74	Lin. Ft.		225	225
Test Pile Steel HP12 x 53	Each		2	2
Name Plates	Each	1		1
Bridge Seat Sealer	L.S.		0.25	0.25
Neoprene Expansion Joint 2"	Lin. Ft.	42		42
Neoprene Expansion Joint 4"	Lin. Ft.	42		42
Jack and Remove Existing Bearings	Each		36	36
Cofferdams	Each		2	2
Cofferdam Excavation	Cu. Yd.		52	52
Bridge Deck Grooving	Sq. Yd.	1,603		1,603

\* Top and inside faces of Parapets and Deck.

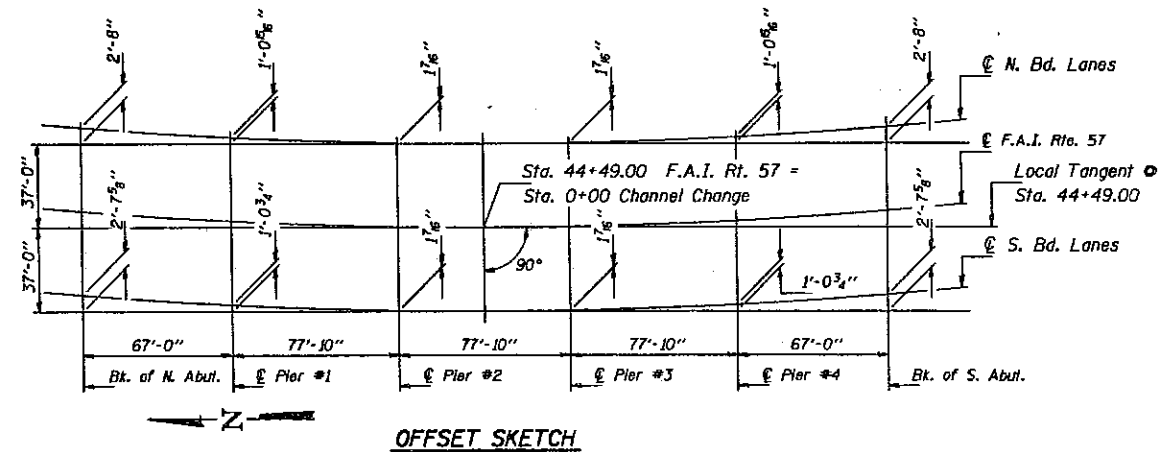

OFFSET SKETCH

DESIGNED *John F. Schneller Jr.*  
CHECKED MICHAEL ADITO GUND  
Paul W. Sweet, W.D.C.  
DRAWN John F. Schneller Jr.  
CHECKED JAB GAA

EXAMINED *Ralph E. Anderson*  
PASSED *Ralph E. Anderson*  
APPROVED \_\_\_\_\_  
DIRECTOR OF HIGHWAYS


GENERAL PLAN DETAILS  
F.A.I. RT 57 SEC. (28-5B)D  
FRANKLIN COUNTY  
STATION 44+49.00



STATE OF ILLINOIS  
DEPARTMENT OF TRANSPORTATION

ROUTE NO.	SECTION	COUNTY	SPAN	"BE"'	SHEET NO. J
F.A.I. 57	(28-5B) D	FRANKLIN	155	87	22 SHEETS
FED. ROAD DIST. NO. 7	ILLINOIS	FED. AID PROJECT			

BEAM #1A					BEAM #1					BEAM #2					BEAM #3				
Location	Station	Offset	Theoretical Grade Elevations	Theoretical Grade Elevations Adjusted For Dead Load Deflection	Location	Station	Offset	Theoretical Grade Elevations	Theoretical Grade Elevations Adjusted For Dead Load Deflection	Location	Station	Offset	Theoretical Grade Elevations	Theoretical Grade Elevations Adjusted For Dead Load Deflection	Location	Station	Offset	Theoretical Grade Elevations	Theoretical Grade Elevations Adjusted For Dead Load Deflection
Bk. No. Abut.	4263.536	-20.949	392.411	392.411	Bk. No. Abut.	4263.683	-15.949	392.511	392.511	Bk. No. Abut.	4263.871	-8.532	392.639	392.639	Bk. No. Abut.	4264.059	-3.115	392.768	392.768
Br. No. Abut.	4265.555	-20.954	392.411	392.411	Br. No. Abut.	4265.700	-15.954	392.511	392.511	Br. No. Abut.	4265.886	-9.537	392.639	392.639	Br. No. Abut.	4266.072	-3.120	392.767	392.767
A	4275.650	-20.972	392.409	392.427	A	4275.788	-15.972	392.509	392.527	A	4275.964	-9.555	392.638	392.656	A	4276.139	-3.138	392.766	392.784
B	4285.746	-20.973	392.408	392.438	B	4285.875	-15.973	392.508	392.538	B	4286.041	-9.556	392.636	392.666	B	4286.206	-3.139	392.765	392.785
C	4295.841	-20.959	392.407	392.439	C	4295.962	-15.959	392.507	392.539	C	4296.118	-9.542	392.636	392.668	C	4296.273	-3.125	392.764	392.796
D	4305.936	-20.929	392.407	392.433	D	4306.050	-15.929	392.507	392.533	D	4306.195	-9.512	392.635	392.661	D	4306.340	-3.095	392.764	392.796
E	4316.032	-20.884	392.407	392.421	E	4316.137	-15.884	392.507	392.521	E	4316.272	-9.467	392.635	392.649	E	4316.406	-3.050	392.763	392.777
F	4326.127	-20.822	392.407	392.410	F	4326.224	-15.822	392.507	392.510	F	4326.346	-9.405	392.635	392.639	F	4326.473	-2.988	392.763	392.776
Pier #1	4331.174	-20.785	392.407	392.407	Pier #1	4331.267	-15.785	392.507	392.507	Pier #1	4331.387	-9.368	392.635	392.635	Pier #1	4331.506	-2.951	392.764	392.764
G	4341.269	-20.700	392.408	392.414	G	4341.354	-15.700	392.508	392.514	G	4341.463	-9.283	392.636	392.642	G	4341.572	-2.867	392.764	392.770
H	4348.335	-20.631	392.408	392.422	H	4348.414	-15.631	392.508	392.522	H	4348.516	-9.214	392.637	392.651	H	4348.618	-2.797	392.765	392.779
I	4361.452	-20.820	392.403	392.428	I	4361.521	-15.821	392.503	392.518	I	4361.610	-9.405	392.631	392.656	I	4361.699	-2.988	392.760	392.784
J	4371.543	-20.950	392.399	392.430	J	4371.604	-15.950	392.499	392.530	J	4371.683	-9.534	392.628	392.658	J	4371.761	-3.118	392.756	392.786
K	4381.634	-21.064	392.396	392.419	K	4381.689	-16.064	392.496	392.519	K	4381.756	-9.647	392.624	392.648	K	4381.824	-3.231	392.753	392.776
L	4391.726	-21.161	392.393	392.409	L	4391.771	-16.162	392.493	392.509	L	4391.829	-9.745	392.621	392.637	L	4391.887	-3.329	392.750	392.766
M	4401.818	-21.243	392.390	392.397	M	4401.855	-16.244	392.490	392.497	M	4401.903	-9.827	392.618	392.625	M	4401.951	-3.411	392.747	392.754
Pier #2	4409.723	-21.297	392.388	392.388	Pier #2	4409.754	-16.297	392.488	392.488	Pier #2	4409.794	-9.880	392.617	392.617	Pier #2	4409.834	-3.464	392.745	392.745
N	4419.816	-21.350	392.386	392.396	N	4419.839	-16.350	392.486	392.496	N	4419.868	-9.934	392.614	392.624	N	4419.898	-3.517	392.743	392.752
O	4429.908	-21.388	392.384	392.403	O	4429.923	-16.388	392.484	392.503	O	4429.943	-9.972	392.612	392.631	O	4429.962	-3.555	392.741	392.760
P	4440.001	-21.470	392.383	392.408	P	4440.008	-16.410	392.483	392.508	P	4440.017	-9.994	392.611	392.637	P	4440.026	-3.577	392.739	392.765
Q	4450.093	-21.417	392.381	392.413	Q	4450.092	-16.417	392.481	392.513	Q	4450.091	-10.000	392.610	392.641	Q	4450.090	-3.583	392.738	392.769
R	4460.186	-21.407	392.380	392.405	R	4460.177	-16.407	392.480	392.505	R	4460.166	-9.990	392.609	392.633	R	4460.154	-3.574	392.737	392.761
S	4470.278	-21.381	392.380	392.397	S	4470.262	-16.381	392.480	392.497	S	4470.240	-9.965	392.608	392.625	S	4470.218	-3.548	392.737	392.754
T	4480.371	-21.340	392.380	392.387	T	4480.346	-16.340	392.480	392.487	T	4480.314	-9.924	392.608	392.615	T	4480.282	-3.507	392.736	392.744
Pier #3	4488.277	-21.297	392.380	392.380	Pier #3	4488.245	-16.297	392.480	392.480	Pier #3	4488.206	-9.880	392.608	392.608	Pier #3	4488.166	-3.464	392.736	392.736
U	4498.369	-21.227	392.380	392.389	U	4498.330	-16.227	392.480	392.489	U	4498.279	-9.811	392.608	392.617	U	4498.229	-3.394	392.737	392.746
V	4508.460	-21.142	392.381	392.398	V	4508.413	-16.142	392.481	392.498	V	4508.353	-9.725	392.607	392.627	V	4508.293	-3.309	392.737	392.755
W	4518.552	-21.040	392.381	392.406	W	4518.497	-16.041	392.481	392.506	W	4518.426	-9.624	392.611	392.635	W	4518.356	-3.208	392.738	392.763
X	4528.643	-20.923	392.383	392.413	X	4528.580	-15.923	392.483	392.513	X	4528.499	-9.507	392.611	392.641	X	4528.419	-3.091	392.739	392.770
Y	4538.734	-20.790	392.384	392.408	Y	4538.663	-15.791	392.484	392.508	Y	4538.572	-9.374	392.611	392.641	Y	4538.481	-2.958	392.741	392.764
Z	4548.825	-20.631	392.386	392.400	Z	4548.754	-15.631	392.486	392.500	Z	4548.663	-9.214	392.612	392.629	Z	4548.572	-2.797	392.743	392.764
AI	4558.916	-20.700	392.384	392.390	AI	4558.846	-15.700	392.484	392.490	AI	4558.755	-9.283	392.612	392.618	AI	4558.664	-2.867	392.741	392.747
Pier #4	4566.826	-20.785	392.381	392.381	Pier #4	4566.733	-15.785	392.481	392.481	Pier #4	4566.613	-9.368	392.610	392.610	Pier #4	4566.494	-2.951	392.738	392.738
BI	4571.873	-20.822	392.380	392.383	BI	4571.776	-15.822	392.480	392.483	BI	4571.652	-9.405	392.608	392.611	BI	4571.527	-2.988	392.737	392.748
CI	4581.964	-20.884	392.378	392.392	CI	4581.863	-15.884	392.478	392.492	CI	4581.728	-9.467	392.606	392.620	CI	4581.594	-3.050	392.734	392.748
DI	4592.055	-20.929	392.376	392.402	DI	4591.950	-15.929	392.476	392.501	DI	4591.805	-9.512	392.604	392.630	DI	4591.660	-3.095	392.732	392.758
EI	4602.146	-20.959	392.374	392.406	EI	4602.038	-15.959	392.474	392.506	EI	4601.882	-9.542	392.602	392.634	EI	4601.727	-3.125	392.731	392.763
FJ	4612.237	-20.973	392.373	392.403	FJ	4612.125	-15.973	392.473	392.503	FJ	4611.959	-9.556	392.601	392.631	FJ	4611.794	-3.139	392.729	392.759
GI	4622.328	-20.972	392.372	392.390	GI	4622.212	-15.972	392.472	392.490	GI	4622.036	-9.555	392.600	392.618	GI	4621.861	-3.136	392.728	392.746
Br. So. Abut.	4632.445	-20.954	392.371	392.371	Br. So. Abut.	4632.300	-15.954	392.471	392.471	Br. So. Abut.	4632.114	-9.537	392.599	392.599	Br. So. Abut.	4631.928	-3.120	392.728	392.728
Bk. So. Abut.	4634.464	-20.949	392.371	392.371	Bk. So. Abut.	4634.317	-15.929	392.471	392.471	Bk. So. Abut.	4634.128	-9.532	392.599	392.599	Bk. So. Abut.	4633.941	-3.115	392.727	392.727

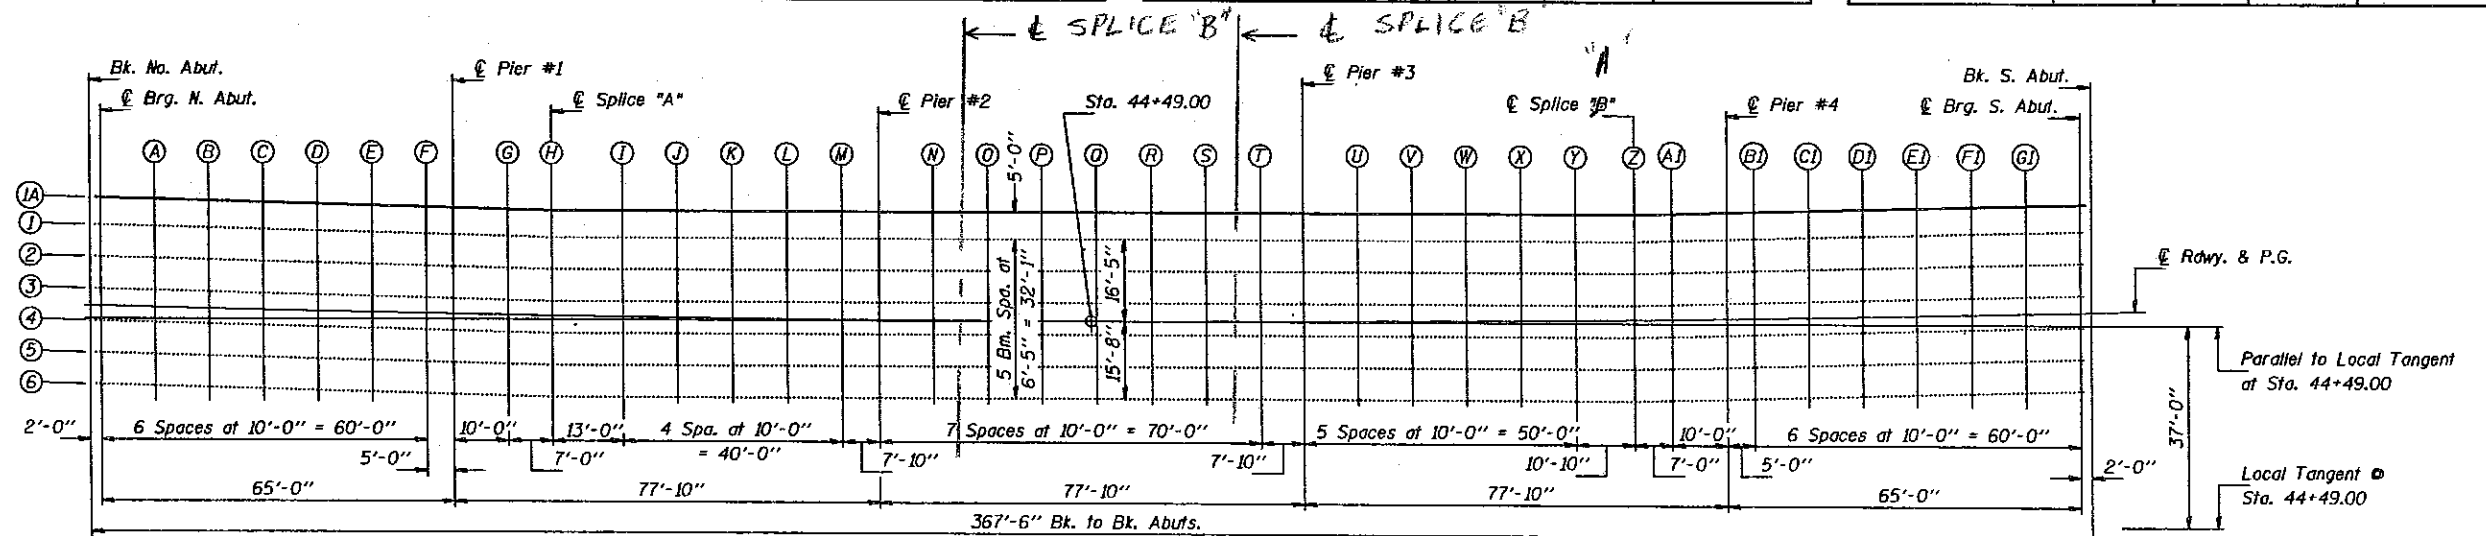

DESIGNED *John F. Schneller Jr.*  
 CHECKED *Michael Antonow*  
 DRAWN *John F. Schneller Jr.*  
 CHECKED *J.B. GPA*

EXAMINED *Greg J. Kaspar*  
 PASSED *Ralph E. Anderson*  
 APPROVED \_\_\_\_\_  
 DIRECTOR OF HIGHWAYS

May 22 1992


PLAN

NOTE:  
 Work this sheet with sheet  
 #4 of 22.

TOP OF SLAB ELEVATIONS  
 F.A.I. RT 57 SEC. (28-5B)D  
 FRANKLIN COUNTY  
 STATION 44+49.00

STATE OF ILLINOIS  
DEPARTMENT OF TRANSPORTATION


ROUTE NO.	SECTION	COUNTY	MILES	SHEET NO.
F.A.I. 57	(28-5B)	FRANKLIN	153	22
F.A.I. 57		FRANKLIN COUNTY		22 SHEETS

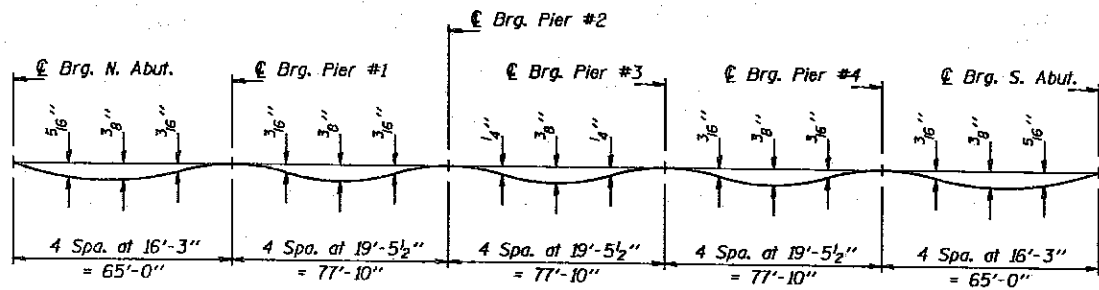

**DEAD LOAD DEFLECTION DIAGRAM**

(Includes weight of concrete only)

Note: The above deflections are not to be used in the field if the engineer is working from the grade elevations adjusted for dead load deflections as shown below and on sheet #3 of 22.

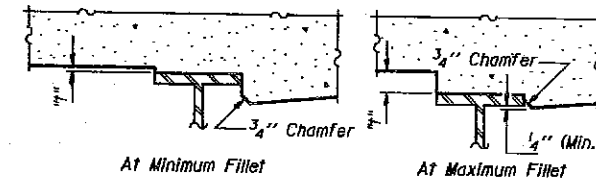

To determine "f": After all structural steel has been erected, elevations of the top flanges of the beams shall be taken at intervals shown on sheets #3 & #4 of 22. These elevations subtracted from the "Theoretical Grade Elevations Adjusted for Dead Load Deflection" shown on sheets #3 & #4 of 22, minus slab thickness, equals the fillet heights "f" above top flange of beams.

**FILLET HEIGHTS**

**RDWY & P.G.**

Location	Station	Offset	Theoretical Grade Elevations	Theoretical Grade Elevations Adjusted For Dead Load Deflection
Bt. No. Abut.	4264.150	0.000	392.830	392.830
Br. No. Abut.	4266.162	0.000	392.830	392.830
A	4276.225	0.000	392.829	392.847
B	4286.287	0.000	392.829	392.858
C	4296.348	0.000	392.827	392.858
D	4306.409	0.000	392.825	392.851
E	4316.470	0.000	392.824	392.838
F	4326.531	0.000	392.823	392.826
Br. No. Pier #1	4331.561	0.000	392.823	392.823
B	4341.621	0.000	392.822	392.828
H	4348.663	0.000	392.821	392.835
I	4351.740	0.000	392.819	392.844
J	4371.799	0.000	392.818	392.848
K	4381.859	0.000	392.817	392.840
L	4391.917	0.000	392.816	392.832
M	4401.976	0.000	392.815	392.823
Br. No. Pier #2	4409.856	0.000	392.814	392.814
N	4419.914	0.000	392.813	392.823
O	4429.973	0.000	392.812	392.831
P	4440.031	0.000	392.811	392.837
Q	4450.090	0.000	392.810	392.841
R	4460.148	0.000	392.809	392.833
S	4470.206	0.000	392.807	392.825
T	4480.265	0.000	392.806	392.813
Br. No. Pier #3	4488.144	0.000	392.805	392.805
U	4498.203	0.000	392.804	392.813
V	4508.262	0.000	392.803	392.821
W	4518.321	0.000	392.802	392.826
X	4528.380	0.000	392.801	392.831
Y	4538.439	0.000	392.800	392.823
Z	4549.497	0.000	392.799	392.815
AI	4558.556	0.000	392.798	392.804
Br. No. Pier #4	4566.439	0.000	392.797	392.797
BI	4571.469	0.000	392.796	392.800
CI	4581.530	0.000	392.795	392.809
DI	4591.591	0.000	392.794	392.820
EI	4601.652	0.000	392.793	392.825
FI	4611.713	0.000	392.792	392.828
GI	4621.775	0.000	392.791	392.809
Br. No. So. Abut.	4631.838	0.000	392.790	392.790
Bt. So. Abut.	4633.850	0.000	392.790	392.790

**BEAM #4**

Location	Station	Offset	Theoretical Grade Elevations	Theoretical Grade Elevations Adjusted For Dead Load Deflection
Bt. No. Abut.	4264.246	3.302	392.896	392.896
Br. No. Abut.	4266.258	3.297	392.896	392.896
A	4276.314	3.279	392.894	392.912
B	4286.371	3.278	392.893	392.923
C	4296.428	3.292	392.892	392.924
D	4306.484	3.322	392.892	392.918
E	4316.541	3.367	392.892	392.906
F	4326.597	3.429	392.892	392.895
Br. No. Pier #1	4331.625	3.466	392.892	392.892
G	4341.681	3.550	392.892	392.898
H	4348.720	3.619	392.893	392.907
I	4361.787	3.428	392.892	392.913
J	4371.840	3.298	392.894	392.915
K	4381.892	3.189	392.891	392.904
L	4391.945	3.088	392.878	392.894
M	4401.999	3.006	392.875	392.892
Br. No. Pier #2	4409.874	2.853	392.873	392.873
N	4419.927	2.899	392.871	392.881
O	4429.981	2.862	392.869	392.888
P	4440.035	2.840	392.868	392.893
Q	4450.089	2.833	392.866	392.898
R	4460.143	2.843	392.865	392.890
S	4470.197	2.868	392.865	392.882
T	4480.251	2.910	392.865	392.872
Br. No. Pier #3	4488.126	2.953	392.865	392.865
U	4498.180	3.022	392.865	392.874
V	4508.233	3.107	392.865	392.883
W	4518.286	3.208	392.866	392.891
X	4528.338	3.325	392.868	392.898
Y	4538.391	3.458	392.869	392.892
Z	4549.440	3.620	392.871	392.885
AI	4558.493	3.800	392.869	392.875
Br. No. Pier #4	4566.375	3.466	392.866	392.866
BI	4571.403	3.429	392.865	392.868
CI	4581.459	3.367	392.863	392.877
DI	4591.516	3.322	392.861	392.887
EI	4601.572	3.292	392.859	392.891
FI	4611.629	3.278	392.858	392.888
GI	4621.686	3.279	392.857	392.875
Br. No. So. Abut.	4631.742	3.297	392.856	392.856
Bt. So. Abut.	4633.754	3.302	392.856	392.856

**BEAM #5**

Location	Station	Offset	Theoretical Grade Elevations	Theoretical Grade Elevations Adjusted For Dead Load Deflection
Bt. No. Abut.	4264.433	9.719	393.024	393.024
Br. No. Abut.	4266.442	9.714	393.024	393.024
A	4276.489	9.696	393.023	393.041
B	4286.536	9.695	393.021	393.051
C	4296.582	9.709	393.021	393.053
D	4306.628	9.739	393.020	393.046
E	4316.675	9.784	393.020	393.034
F	4326.721	9.846	393.020	393.023
Br. No. Pier #1	4331.744	9.883	393.020	393.020
G	4341.790	9.987	393.021	393.027
H	4348.822	10.036	393.021	393.035
I	4361.876	9.844	393.016	393.043
J	4371.918	9.715	393.013	393.043
K	4381.960	9.601	393.009	393.033
L	4392.003	9.504	393.006	393.022
M	4402.046	9.422	393.003	393.010
Br. No. Pier #2	4409.913	9.369	393.002	393.002
N	4419.957	9.316	392.999	393.009
O	4430.001	9.278	392.997	393.016
P	4440.044	9.256	392.996	393.022
Q	4450.088	9.250	392.995	393.026
R	4460.132	9.260	392.994	393.018
S	4470.176	9.285	392.993	393.010
T	4480.219	9.326	392.993	393.000
Br. No. Pier #3	4488.086	9.369	392.993	392.993
U	4498.130	9.439	392.993	393.002
V	4508.173	9.524	392.994	393.012
W	4518.216	9.625	392.995	393.020
X	4528.258	9.741	392.996	393.026
Y	4538.300	9.874	392.998	393.021
Z	4549.342	10.036	393.000	393.014
AI	4558.385	9.967	392.998	393.004
Br. No. Pier #4	4566.256	9.883	392.995	392.995
BI	4571.279	9.846	392.993	392.996
CI	4581.325	9.784	392.991	393.005
DI	4591.372	9.739	392.989	393.015
EI	4601.418	9.709	392.987	393.019
FI	4611.464	9.695	392.986	393.016
GI	4621.511	9.696	392.985	393.003
Br. No. So. Abut.	4631.558	9.714	392.984	392.984
Bt. So. Abut.	4633.567	9.719	392.984	392.984

**BEAM #6**


Location	Station	Offset	Theoretical Grade Elevations	Theoretical Grade Elevations Adjusted For Dead Load Deflection
Bt. No. Abut.	4264.620	16.135	393.153	393.153
Br. No. Abut.	4266.627	16.131	393.152	393.152
A	4276.663	16.113	393.151	393.169
B	4286.700	16.112	393.150	393.180
C	4296.736	16.126	393.149	393.181
D	4306.772	16.156	393.148	393.174
E	4316.809	16.201	393.148	393.162
F	4326.845	16.263	393.148	393.151
Br. No. Pier #1	4331.862	16.299	393.148	393.149
G	4341.898	16.384	393.148	393.155
H	4348.923	16.453	393.150	393.164
I	4361.964	16.260	393.145	393.169
J	4371.996	16.131	393.141	393.171
K	4382.028	16.018	393.138	393.181
L	4392.061	15.920	393.134	393.181
M	4402.094	15.839	393.132	393.159
Br. No. Pier #2	4409.953	15.786	393.130	393.130
N	4419.986	15.733	393.128	393.137
O	4430.020	15.695	393.126	393.145
P	4440.053	15.673	393.124	393.150
Q	4450.087	15.667	393.123	393.154
R	4460.121	15.676	393.122	393.146
S	4470.154	15.702	393.122	393.139
T	4480.188	15.743	393.121	393.129
Br. No. Pier #3	4488.047	15.786	393.121	393.121
U	4498.080	15.855	393.122	393.131
V	4508.113	15.940	393.122	393.140
W	4518.146	16.041	393.123	393.148
X	4528.179	16.157	393.124	393.155
Y	4538.210	16.290	393.126	393.149
Z	4549.243	16.453	393.126	393.142
AI	4558.276	16.384	393.126	393.132
Br. No. Pier #4	4566.138	16.299	393.123	393.123
BI	4571.155	16.263	393.122	393.125
CI	4581.191	16.201	393.119	393.133
DI	4591.228	16.156	393.117	393.143
EI	4601.264	16.125	393.116	393.148
FI	4611.300	16.112	393.114	393.144
GI	4621.337	16.113	393.113	393.131
Br. No. So. Abut.	4631.373	16.131	393.113	393.113
Bt. So. Abut.	4633.380	16.135	393.112	393.112

DESIGNED *John F. Schneller Jr.*  
CHECKED *Michael Abitola*  
DRAWN *John F. Schneller Jr.*  
CHECKED *GRA*


EXAMINED *Ortiz J. Lopez*  
PASSED *Ralph E*

STATE OF ILLINOIS  
DEPARTMENT OF TRANSPORTATION

ROUTE NO.	SECTION	COUNTY	SHEETS	SHEET	SHEET NO.
F.A.I. 57	(28-5B)	FRANKLIN	155	69	22 SHEETS
PROJ. ROAD DIST. NO. 7		ILLINOIS	FED. AID PROJECT		

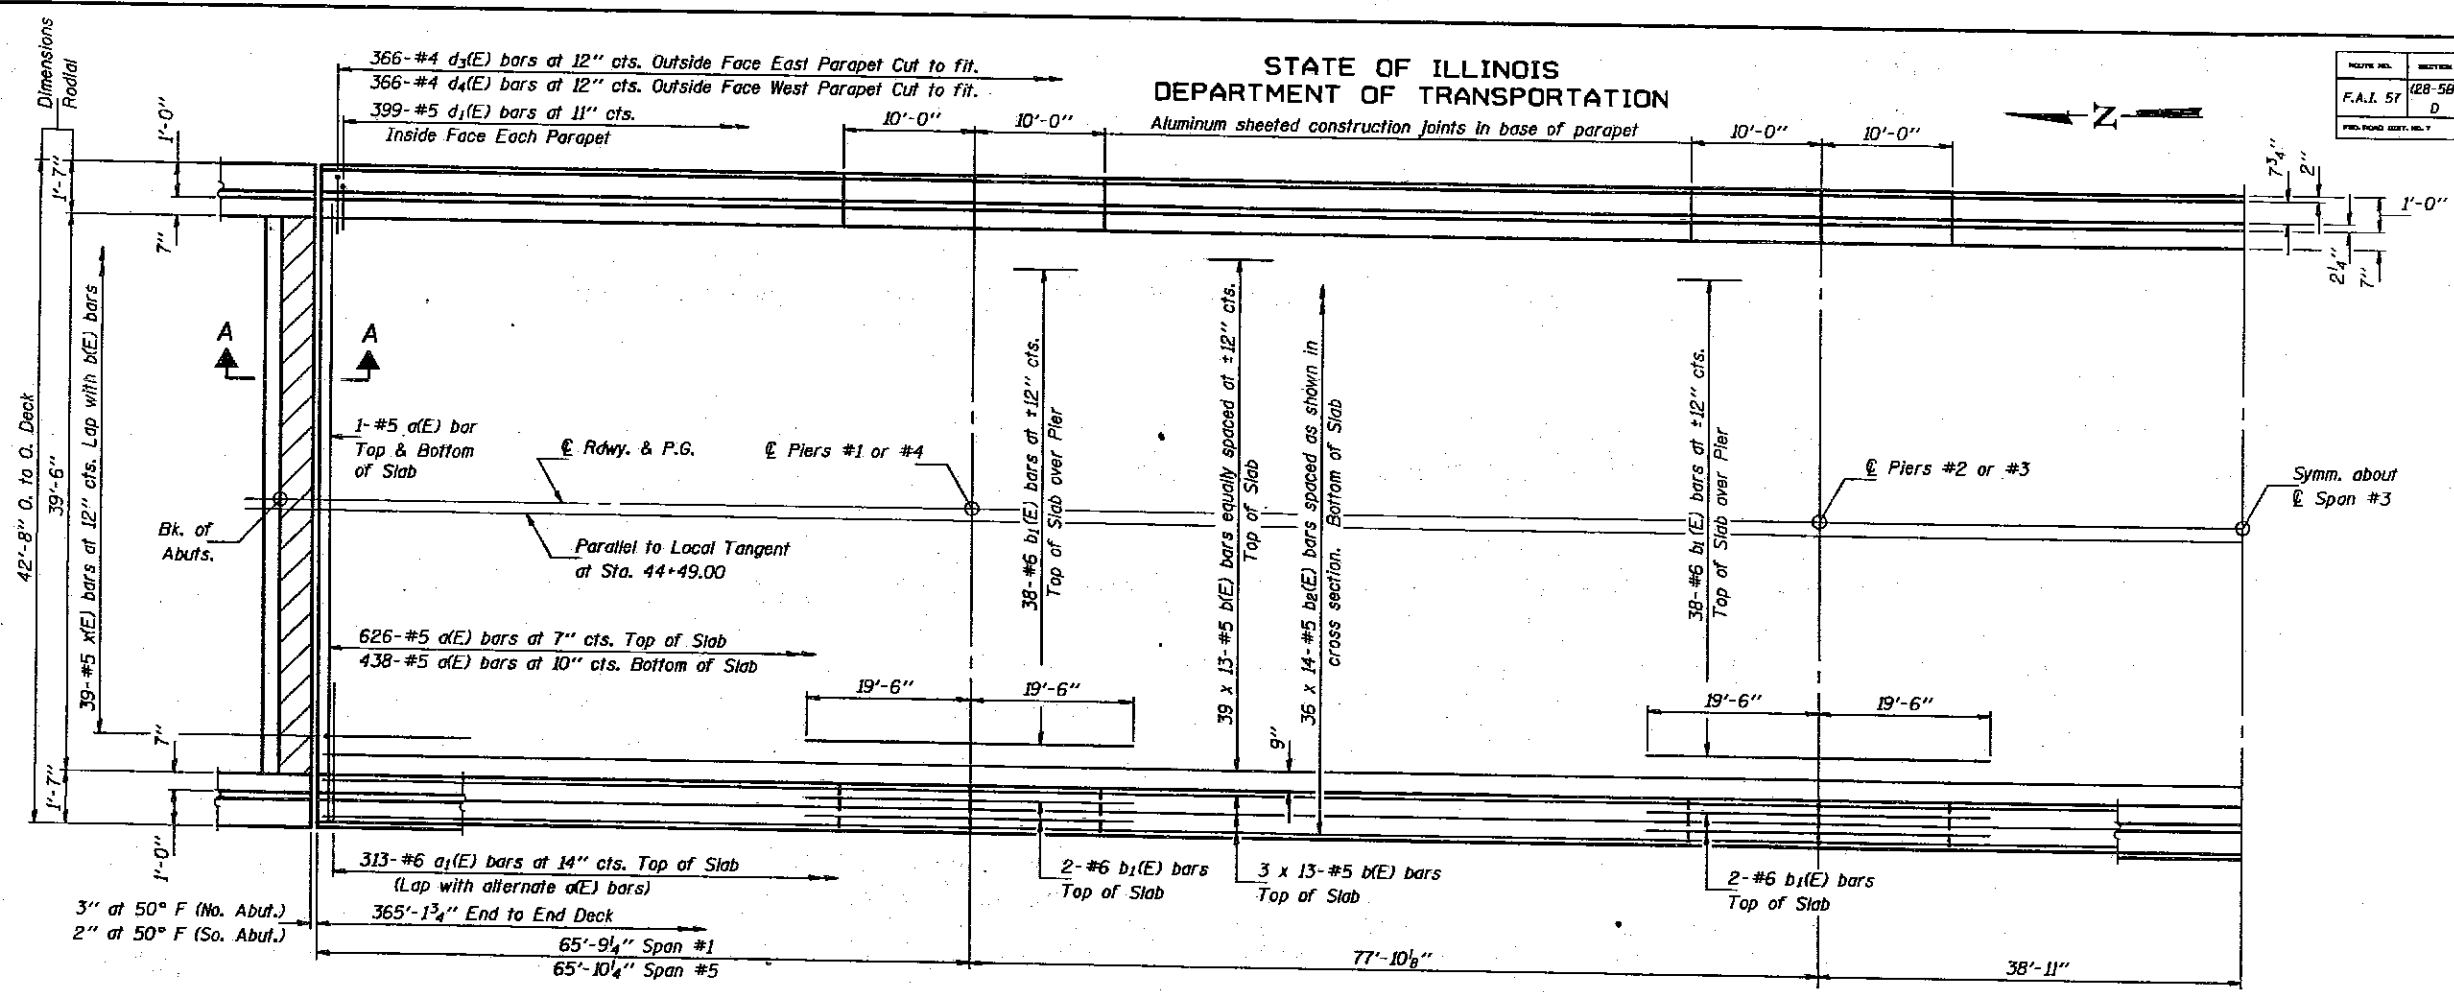

HALF PLAN

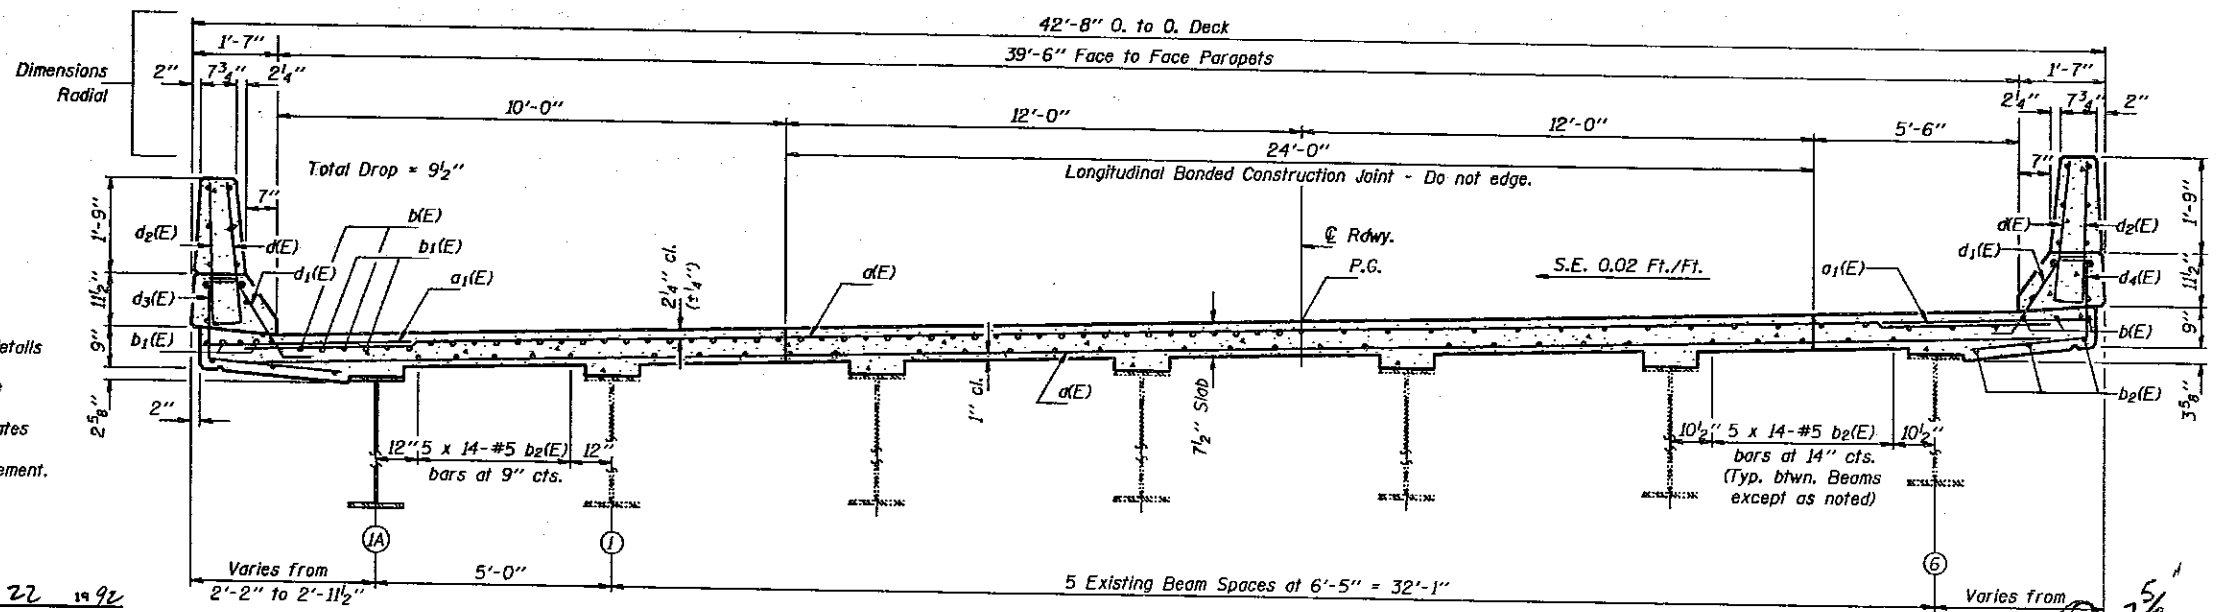

CROSS SECTION  
(Looking South)

**MIN. BAR LAPS**  
#5 (E) bar = 2'-2"

Notes: See Sheet #6 of 22 for superstructure details and Bill of Material.  
Reinforcement bars designated (E) shall be epoxy coated.  
Bars indicated thus 20 x 3-#5 etc. indicates 20 lines of bars with 3 lengths per line.  
See Sheet #6 of 22 for parapet reinforcement.



DESIGNED *John F. Schneller Jr.*  
CHECKED *Michael A. ...*  
DRAWN *John F. Schneller Jr.*  
CHECKED *GPA*

EXAMINED *Ralph E. ...*  
PASSED *Ralph E. ...*  
APPROVED *Ralph E. ...*

**SUPERSTRUCTURE**  
F.A.I. RT. 57 SEC. (28-5B)D  
FRANKLIN COUNTY  
STA. 44+49.00



2" at Rt. L's at 50° F (S. Abut.)  
3" at Rt. L's at 50° F (N. Abut.)

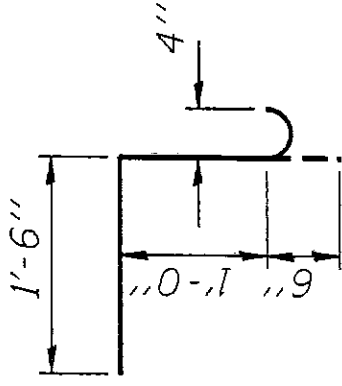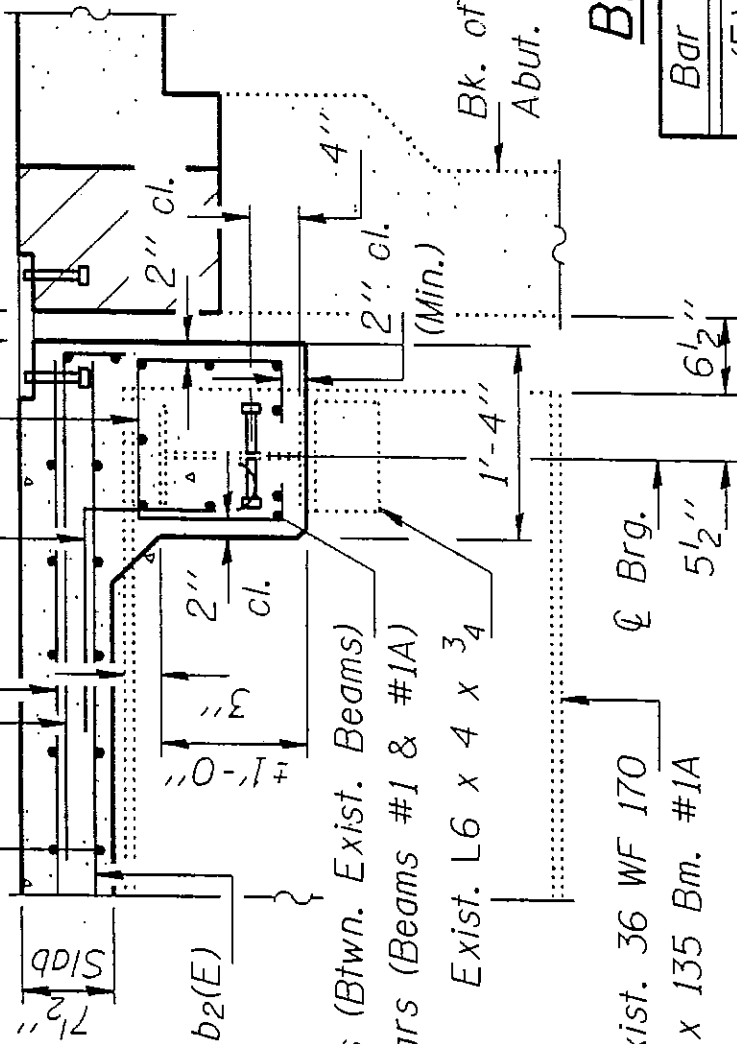


BAR a3(E)

BILL OF MATERIAL

Bar	No.	Size	Length	Shape
a3(E)	72	#4	3'-0"	┌
a4(E)	72	#4	3'-8"	┌
a5(E)	90	#4	6'-1"	—
a6(E)	18	#4	4'-8"	—
Reinforcement Bars (Epoxy Coated)			Lbs.	740
Class X Concrete			Cu. Yd.	3.7
Stud Shear Connectors			Each	144

Reinforcement Bars designated (E) shall be epoxy coated.

SECTION A-A

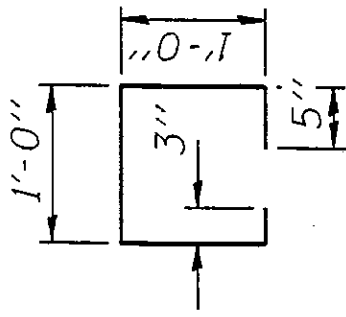

BAR a4(E)

a5(E) bars (Btwn. Exist. Beams)  
a6(E) bars (Beams #1 & #1A)  
Exist. L6 x 4 x 3/4

Exist. 36 WF 170  
New W36 x 135 Bm. #1A

∅ Brg.


Bk. of Abut.

7 1/2" Sidb


(Min.)

STATE OF ILLINOIS  
DEPARTMENT OF TRANSPORTATION

ROUTE NO.	SECTION	COUNTY	POST MILE	SHEET	SHEET NO.
F.A.I. 57	(28-5B)	FRANKLIN	155	90	22 SHEETS
FED. ROAD DIST. NO. 7	ALTERN.	PREL. OR. PROJECT			

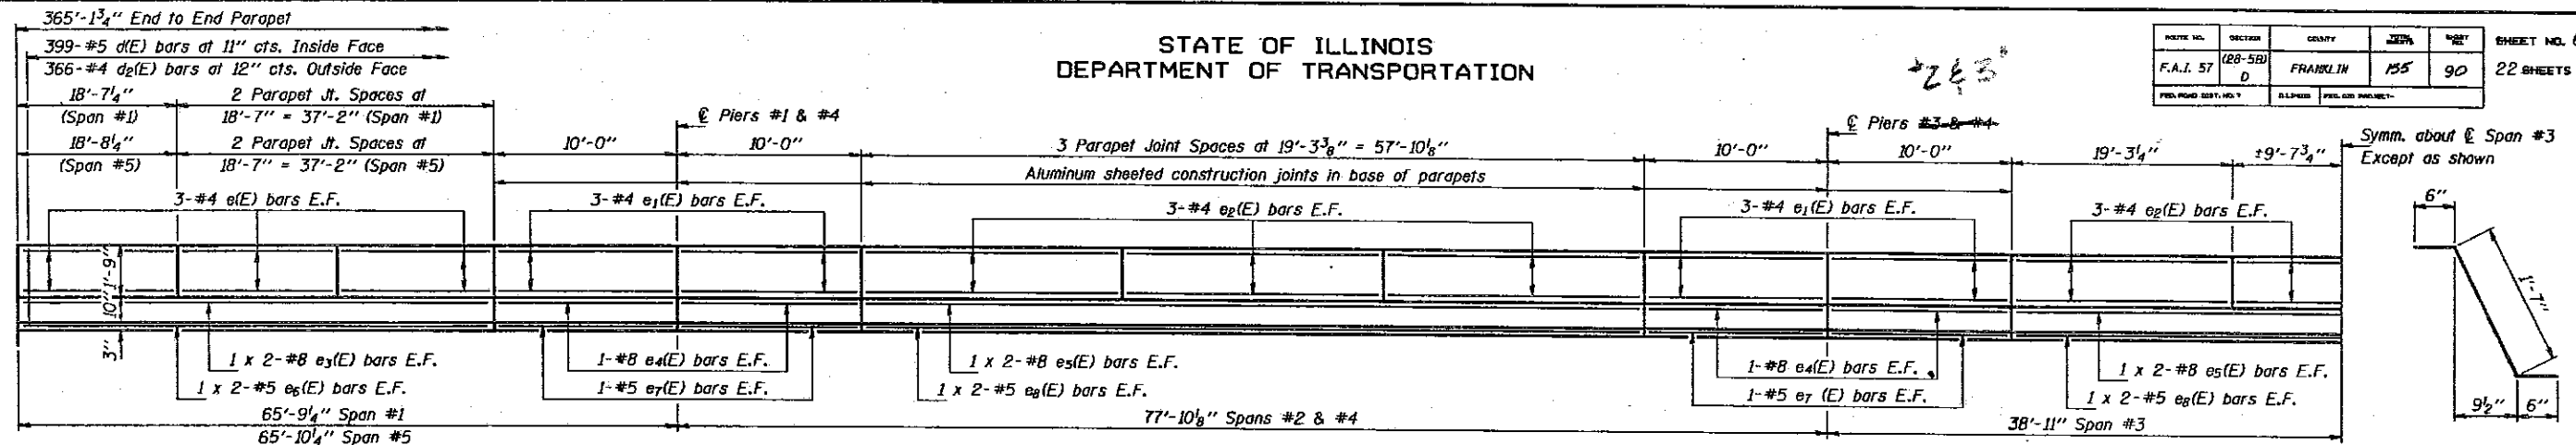

INSIDE ELEVATION OF PARAPET

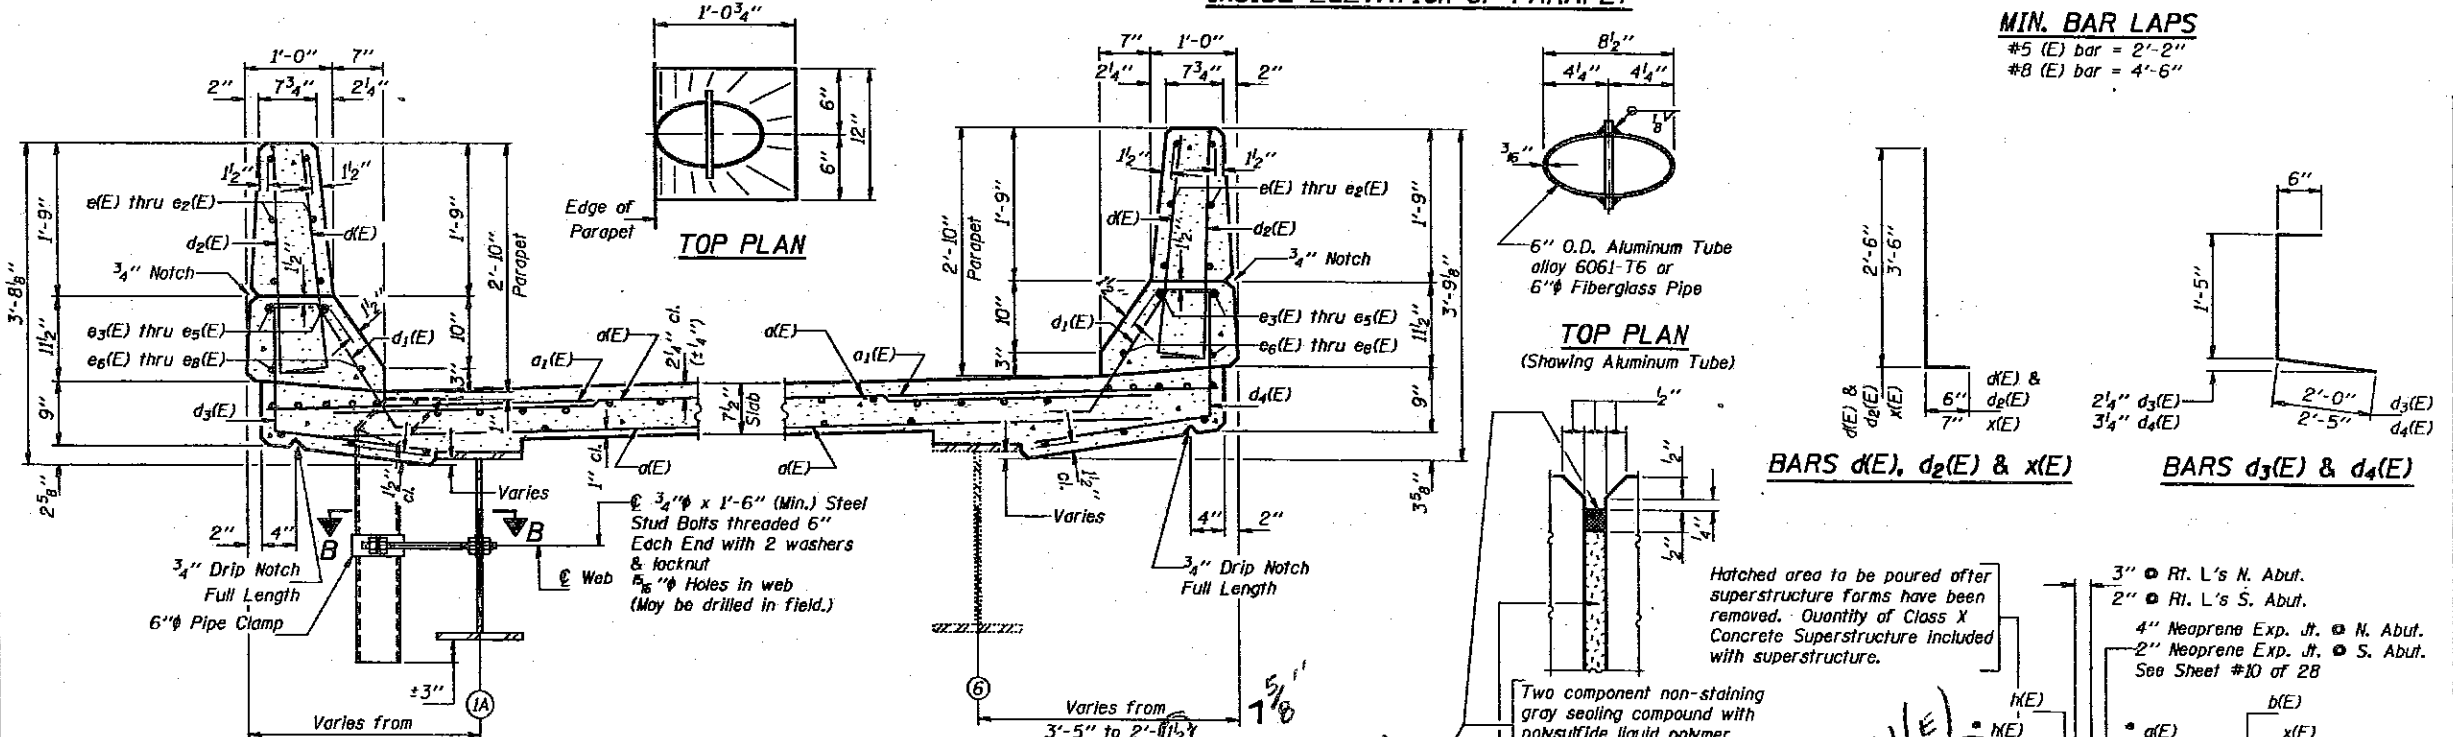

MIN. BAR LAPS  
#5 (E) bar = 2'-2"  
#8 (E) bar = 4'-6"




SUPERSTRUCTURE  
BILL OF MATERIAL

Bar	No.	Size	Length	Shape
a(E)	1068	#5	40'-6"	—
a <sub>1</sub> (E)	626	#6	4'-0"	—
b(E)	585	#5	30'-1"	—
b <sub>1</sub> (E)	168	#6	39'-0"	—
b <sub>2</sub> (E)	504	#5	28'-1"	—
d(E)	798	#5	3'-0"	—
d <sub>1</sub> (E)	798	#5	2'-7"	—
d <sub>2</sub> (E)	732	#4	3'-0"	—
d <sub>3</sub> (E)	366	#4	3'-11"	—
d <sub>4</sub> (E)	366	#4	4'-4"	—
e(E)	72	#4	18'-4"	—
e <sub>1</sub> (E)	96	#4	9'-9"	—
e <sub>2</sub> (E)	108	#4	19'-0"	—
e <sub>3</sub> (E)	16	#8	30'-0"	—
e <sub>4</sub> (E)	32	#8	9'-9"	—
e <sub>5</sub> (E)	24	#8	31'-1"	—
e <sub>6</sub> (E)	16	#5	28'-10"	—
e <sub>7</sub> (E)	32	#5	9'-9"	—
e <sub>8</sub> (E)	24	#5	30'-0"	—
x(E)	78	#5	4'-1"	—
Reinforcement Bars (Epoxy Coated)		Lbs.	108,840	
Class X Concrete Superstructure		Cu. Yds.	469.4	


Reinforcement bars designated (E) shall be epoxy coated.  
Bars indicated thus 1 x 2-#5 etc. indicates 1 line of bars with 2 lengths per line.

SECTION THRU EAST PARAPET

SECTION THRU WEST PARAPET

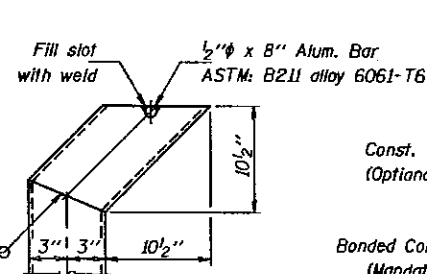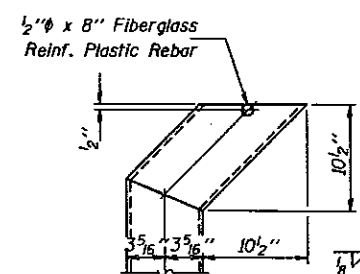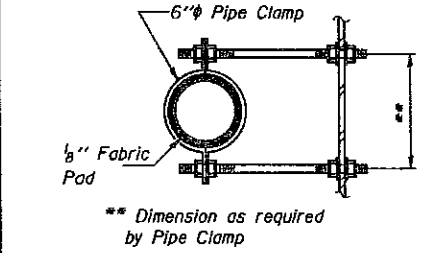

PARAPET JOINT DETAILS

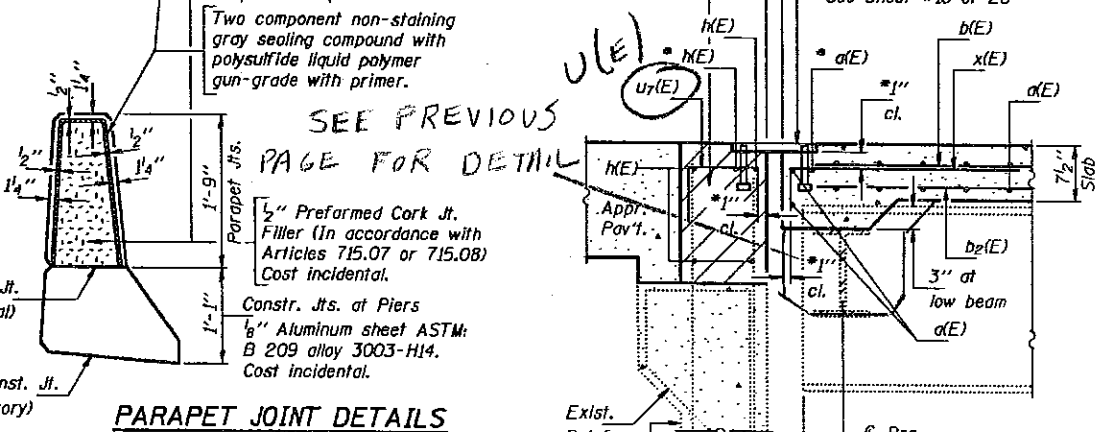

SECTION A-A

Place a(E) bars and x(E) bars in back of anchor bolts as shown if required to maintain 1" cl. (+0-1/4"). Anchor bolts should be tied to a(E) and x(E)

SUPERSTRUCTURE  
F.A.I. RT. 57 SEC. (28-5B)D  
FRANKLIN COUNTY  
STA. 44+49.00

DESIGNED: [Signature]  
CHECKED: MICHAEL ABITOGAUN  
DRAWN: John F. Schnelzer Jr.  
CHECKED: [Signature]

EXAMINED: [Signature]  
PASSED: [Signature]  
APPROVED: [Signature]  
DIRECTOR OF HIGHWAYS

Notes:  
The exterior surfaces of the Floor Drain shall be painted with the final finish coat painting specified for Structural Steel. The exterior surface of the Aluminum tube shall be cleaned and given a washcoat pretreatment in accordance with Steel Structural Painting Council's Spec. SSPC-SPI & SSPC-Paint 27 prior to painting. Fiberglass to have prewash as per MIL-P-15328 prior to painting.  
Fiberglass pipe shall conform to ASTM: D2996, with short-time rupture strength hoop tensile stress of 30,000 p.s.i. minimum. The surface of the Fiberglass pipe shall be free of bond inhibiting agents.

Joint Size	"C" at 50°F	"D" at 50°F
2"	2"	1 1/2" Min.
2 1/2"	2 1/2"	1 3/4" Min.
4"	3"	2 1/2" Min.

STATE OF ILLINOIS  
DEPARTMENT OF TRANSPORTATION

GENERAL NOTES

Continuous Seal Neoprene Expansion Joint shall consist of molded anchor blocks of elastomer and steel, field assembled over continuous lengths of elastomeric membrane.

The elastomeric membrane shall be premolded with a single or a double upward convolution that will have a "memory" to return to its molded position upon joint closure.

The steel reinforcement must extend up the back face of anchor blocks when asphalt surfaces are used but is optional in concrete blockout.

The convolution length shall be such that the extended length will not be greater than the manufactured length when the joint is fully expanded in its design range and will not protrude above the anchor blocks when the joint is fully compressed.

Joint openings shall be adjusted in accordance with Article 503.07(c) of the Standard Specifications when the deck is poured at an ambient temperature other than 50° F.

The parapet and sidewalk flaps may be furnished factory vulcanized to the roadway membrane provided the centerline of the convolution is maintained and the process and method meet the approval of the Engineer.

INSTALLATION NOTES



- 1 Install sponge mandrels into positions shown to form flap convolution.
- 2 Install parapet or sidewalk piece (trim roadway flap to fit before applying epoxy).
- 3 Install continuous seal in roadway.
- 4 Install anchor blocks as indicated.

NOTE A: Maximum spacing of anchor bolts shall be 12" centers.



SKEW LIMITATIONS

The details of the anchor blocks and the elastomeric membrane in the parapet, as shown, are for up to 50° skews.


For skews greater than 50°, the anchor blocks and the elastomeric membrane, installed in accordance with dimension "D", might require modifications to insure a minimum clearance of 1/2" from centerline of anchor studs to edge of parapet opening. The anchor blocks and the elastomeric membrane shall also be installed to the top of the parapet with the anchor studs spaced at ±12" cts.

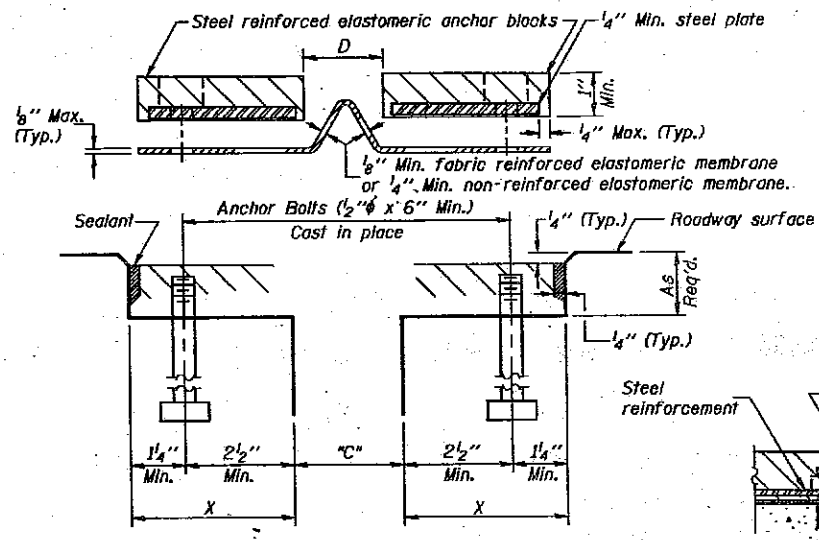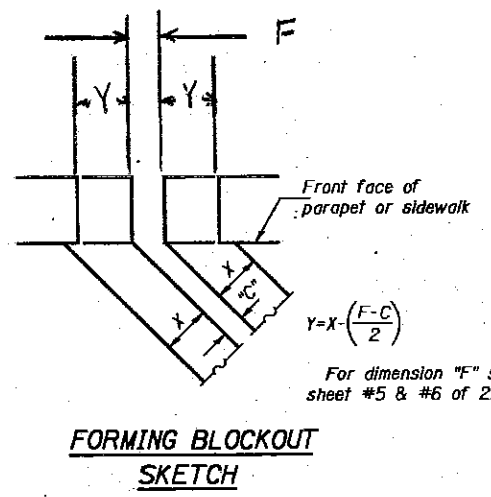


ANCHOR BLOCK REINFORCEMENT WITH ASPHALT SURFACE

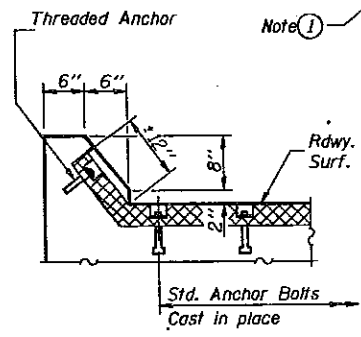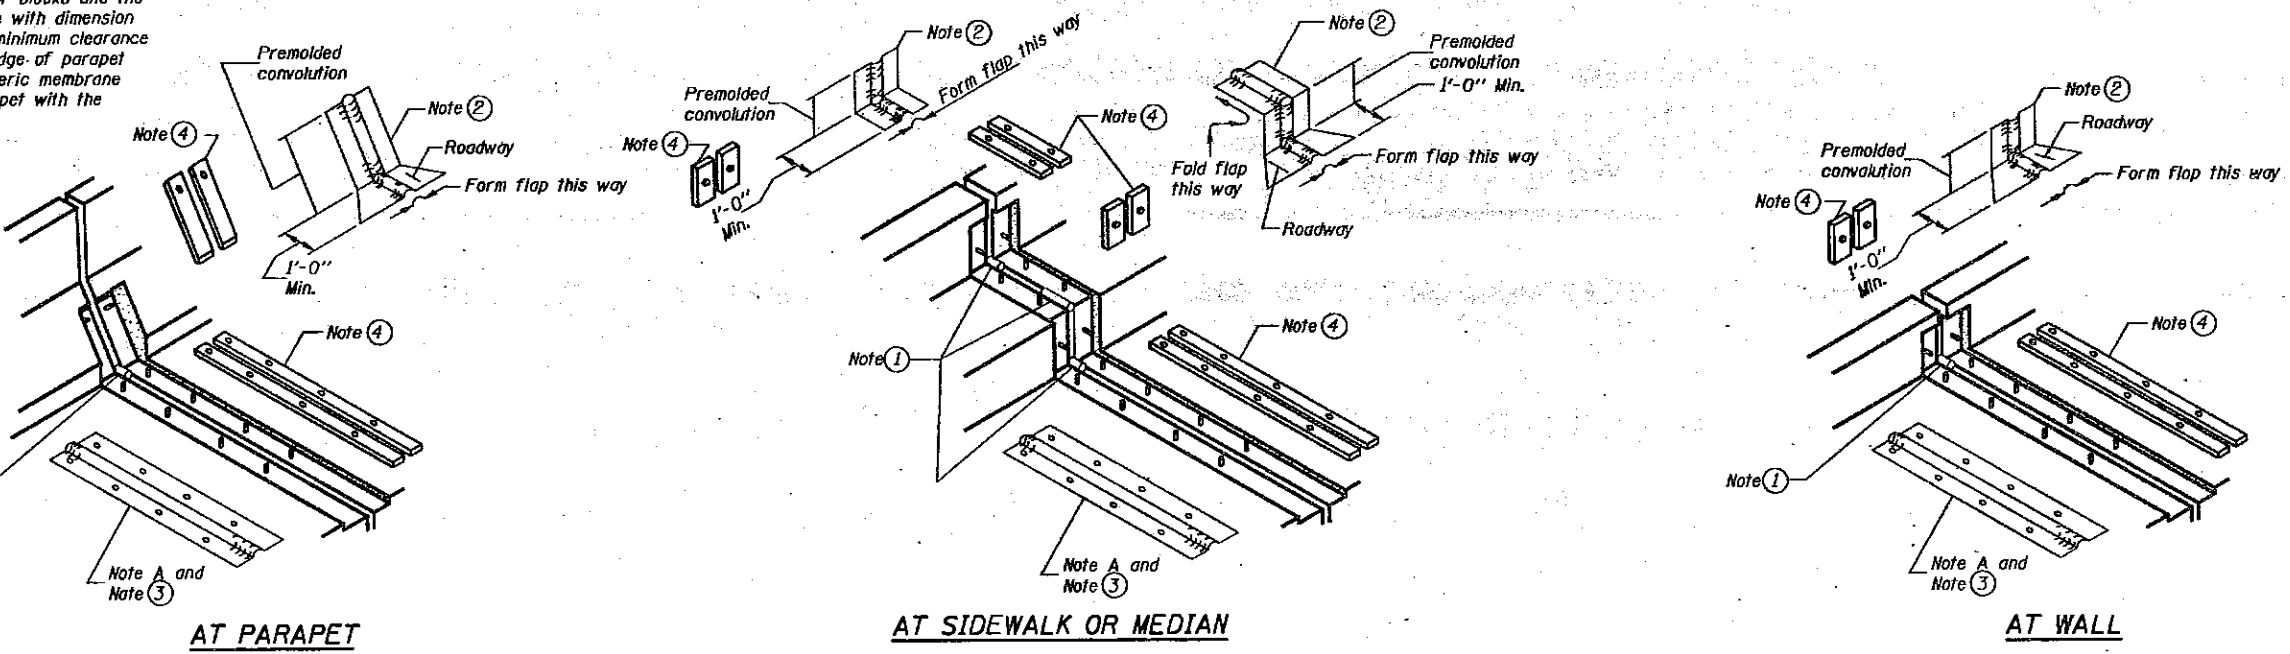


AT CURB

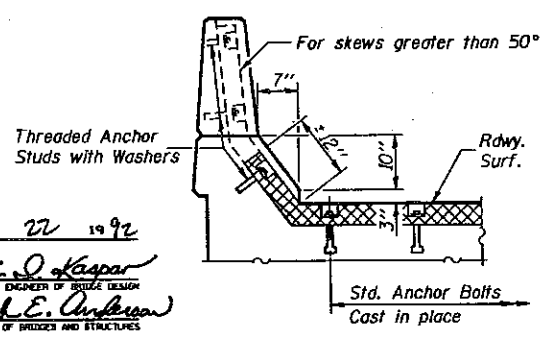

AT PARAPET

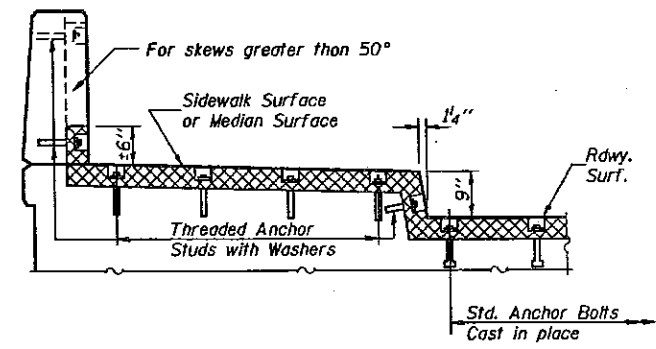

AT SIDEWALK OR MEDIAN  
TYPICAL END TREATMENTS

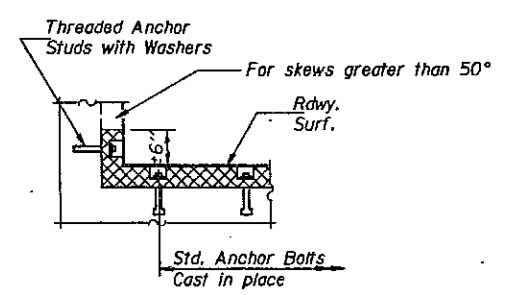

AT WALL

CONTINUOUS SEAL TYPE  
NEOPRENE EXPANSION JOINTS  
For 2", 2 1/2" and 4" Movement

F.A.I. RT. 57 SEC. (28-5B)D  
FRANKLIN COUNTY  
STA. 44+49.00


DESIGNED: *John F. Schneller Jr.*  
CHECKED: *Michael Antoski*  
DRAWN: *John F. Schneller Jr.*  
CHECKED: *GRA*  
EJ-CS

EXAMINED: *May 22 1992*  
PASSED: *Ralph E. Anderson*  
APPROVED: *[Signature]*  
DIRECTOR OF HIGHWAYS




STATE OF ILLINOIS  
DEPARTMENT OF TRANSPORTATION


ROUTE NO.	DISTRICT	COUNTY	SECTION	SHEET NO.
F.A.I. 57	(28-5B) D	FRANKLIN	155	92
SHEET NO. 8				22 SHEETS

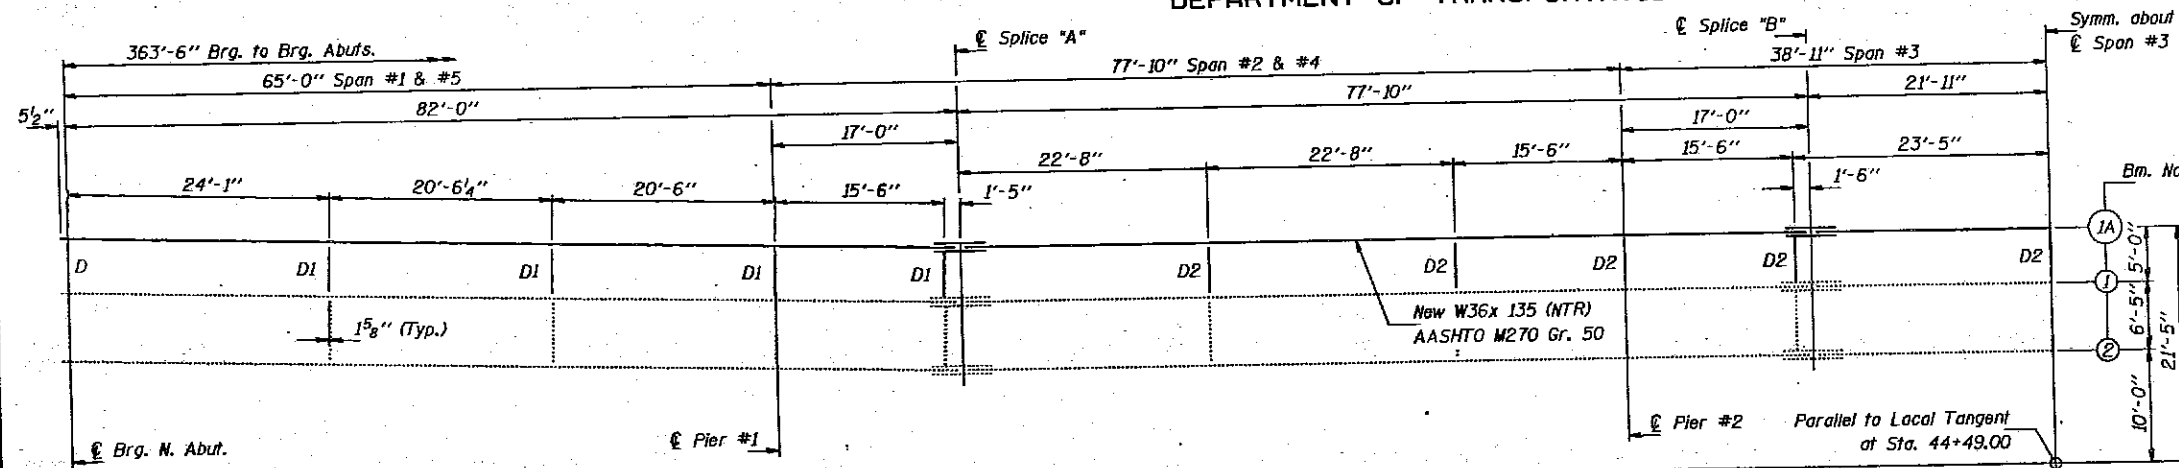


HALF PLAN - NORTH BD. LANES

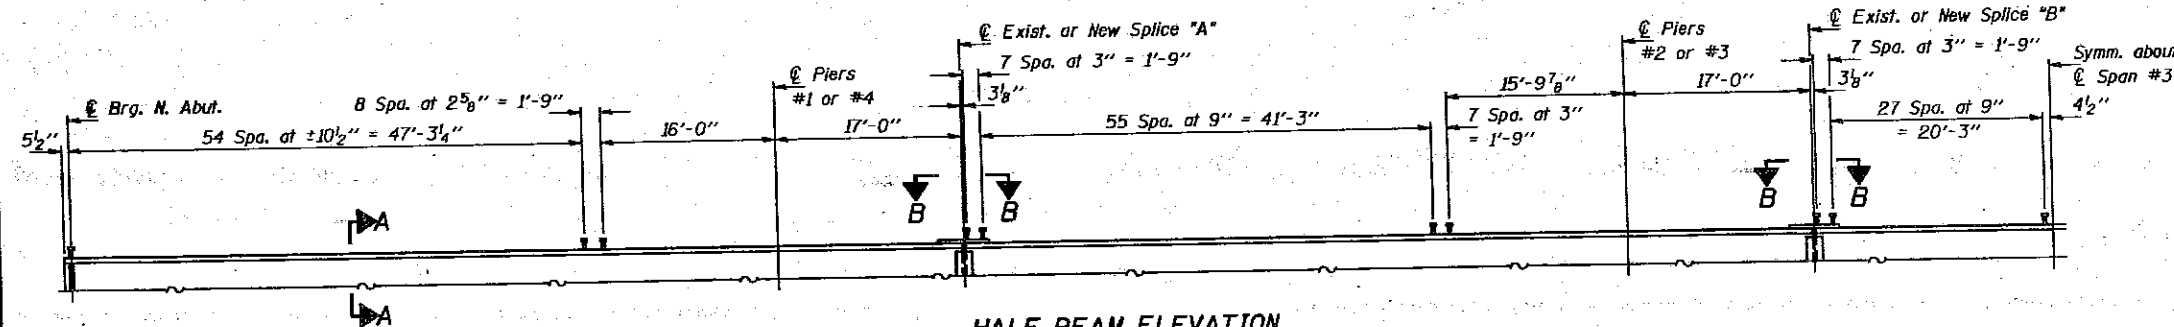


HALF BEAM ELEVATION  
(Stud Shear Connector Spacing for all Beams)

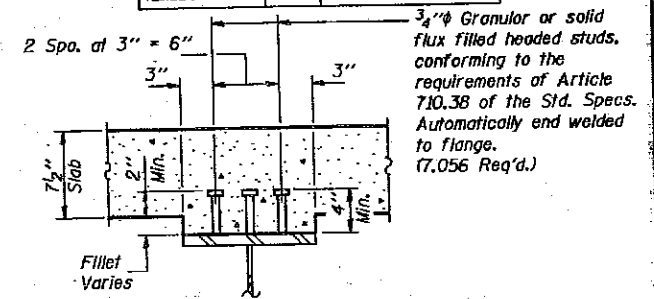


SECTION A-A

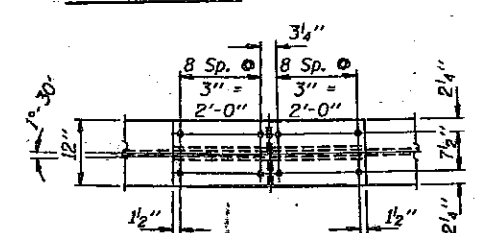


PLAN-SPLICE "A"

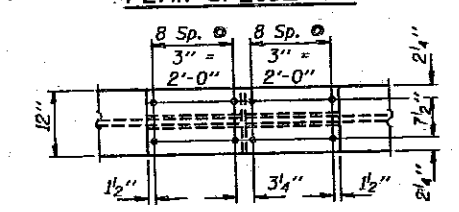


PLAN-SPLICE "B"

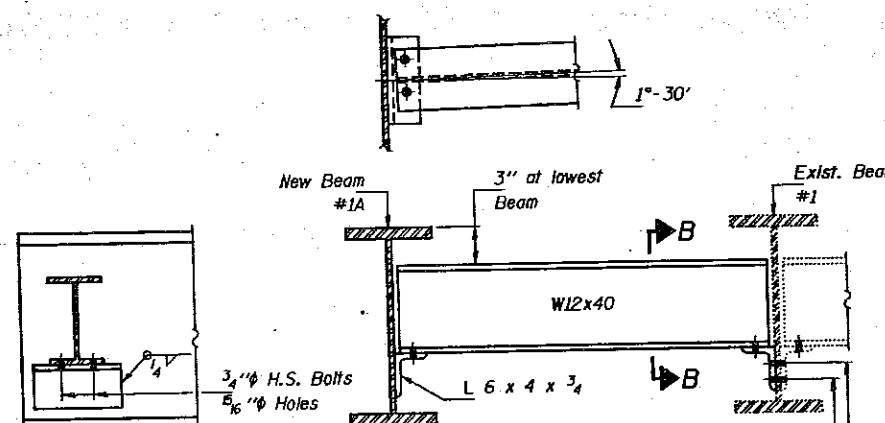

DIAPHRAGM D  
(D = 2 Required)

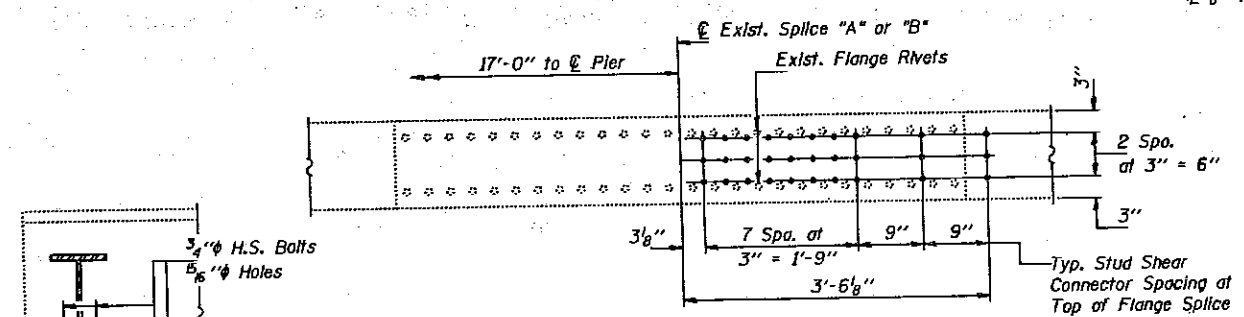


VIEW B-B  
(At Existing Beams #1 thru #6)

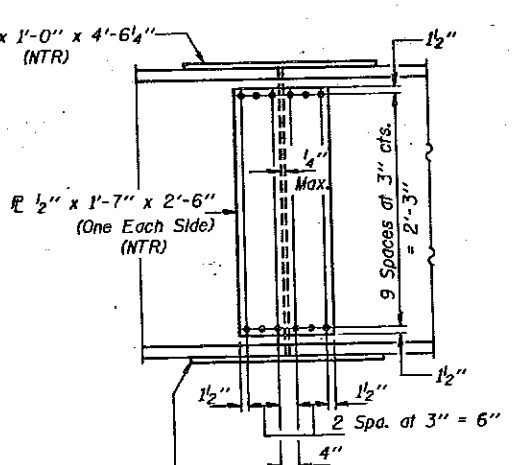

FIELD SPLICE DETAIL  
(Use 7/8" H.S. Bolts)

All new splice plate material shall be AASHTO M270 Gr. 50.

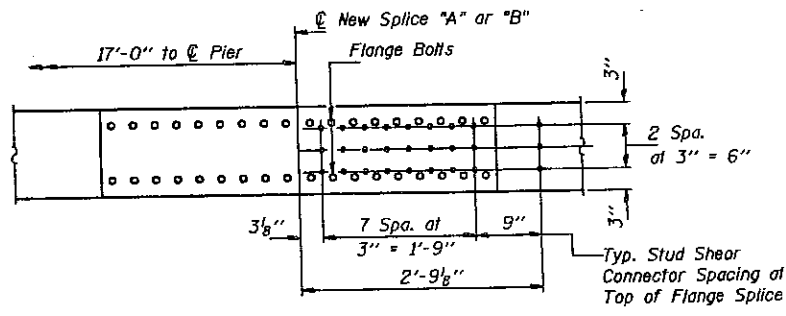

VIEW B-B  
(At New Beam #1A)

Remove existing rivets or bolts. Field drill 5/16" holes in new angles using holes in existing beams as a template. Existing bolts and rivets are to be replaced by 3/4" H.S. Bolt. Cost of Rivet and Bolt Removal and Field Drilling is incidental to "Structural Steel".


Note: Two hardened washers shall be required over all 5/16" holes. "NTR" denotes Notch Toughness Requirements.

DESIGNED	EXAMINED	DATE
CHECKED	PASSED	MAY 22 1992
DRAWN	APPROVED	
CHECKED		

STRUCTURAL STEEL  
F.A.I. RT. 57 SEC. (28-5B)D  
FRANKLIN COUNTY  
STA. 44+49.00


STATE OF ILLINOIS  
DEPARTMENT OF TRANSPORTATION

ROUTE NO.	SECTION	COUNTY	MILES	POST	SHEET NO.
F.A.I. 57	(28-5B) D	FRANKLIN	155	93	22 SHEETS
FED. ROAD DIST. NO. 7	ILLINOIS	FED. AID PROJECT			

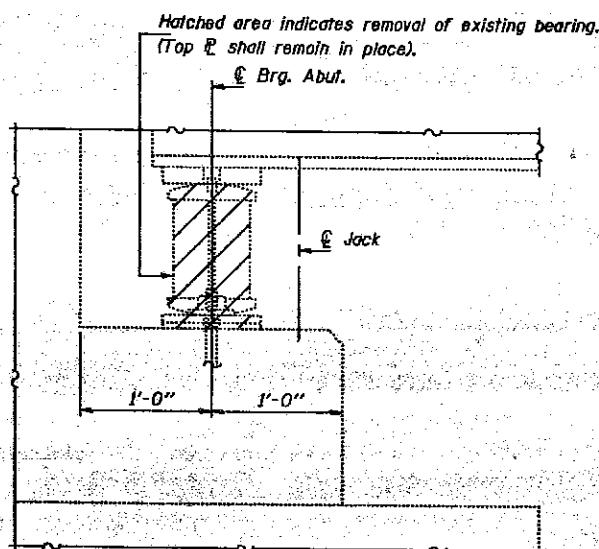

**JACK AND REMOVE EXISTING BEARINGS**

(Dimensions are at Rt. L's)  
(Typ. for all Abutments)

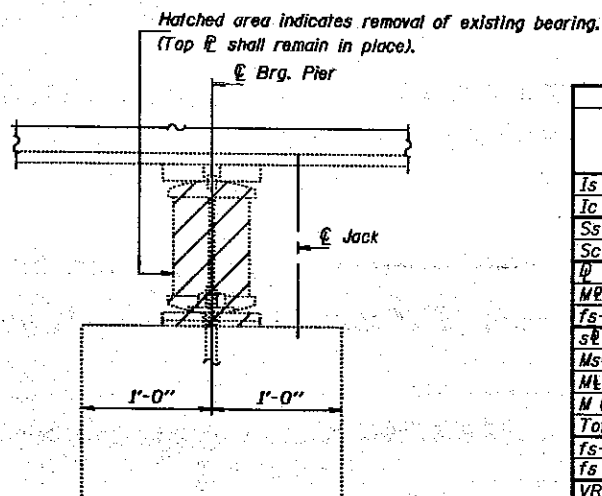

**JACK AND REMOVE EXISTING BEARINGS**

(Dimensions are at Rt. L's)  
(Typ. for all Piers)

**EXIST. BEAM MOMENT TABLE**

	0.4 Sp. #1 or 0.6 Sp. #5	Pier #1 or Pier #4	0.5 Sp. #2 or 0.5 Sp. #4	Pier #2 or Pier #3	0.5 Sp. #3
Is (in <sup>4</sup> )	10500	10500	10500	10500	10500
Ic (in <sup>4</sup> )	24819		24819		24819
Ss (in <sup>3</sup> )	580	580	580	580	580
Sc (in <sup>3</sup> )	810		810		810
W (K/ft.)	.82	1.116	.82	1.116	.82
M <sub>R</sub> (K)	247	545	203	537	209
fs-non-comp (k.s.l.)	5.1	11.3	4.2	11.1	4.3
s <sub>fl</sub> (K/ft.)	.296		.296		.296
M <sub>sfl</sub> (K)	102		101		99
M <sub>L</sub> (K)	447	276	469	296	472
M (Imp) (K)	118	70	115	73	116
Total (K)	667	346	685	369	687
fs-(comp) (k.s.l.)	9.9	7.2	10.1	7.6	10.2
fs (Total) (k.s.l.)	15.0	18.5	14.3	18.7	14.5
VR (K)	48.3		41.4		41.2

**NEW BEAM MOMENT TABLE**

	0.4 Sp. #1 or 0.6 Sp. #5	Pier #1 or Pier #4	0.5 Sp. #2 or 0.5 Sp. #4	Pier #2 or Pier #3	0.5 Sp. #3
Is (in <sup>4</sup> )	7800	7800	7800	7800	7800
Ic (in <sup>4</sup> )	19426		19426		19426
Ss (in <sup>3</sup> )	439	439	439	439	439
Sc (in <sup>3</sup> )	631		631		631
W (K/ft.)	.82	1.116	.82	1.116	.82
M <sub>R</sub> (K)	247	543	203	536	209
fs-non-comp (k.s.l.)	6.8	14.8	5.5	14.6	5.7
s <sub>fl</sub> (K/ft.)	.296		.296		.296
M <sub>sfl</sub> (K)	102		102		101
M <sub>L</sub> (K)	449	271	470	291	475
M (Imp) (K)	117	69	118	72	117
Total (K)	668	340	690	363	693
fs-(comp) (k.s.l.)	12.7	9.3	13.1	9.9	13.2
fs (Total) (k.s.l.)	19.5	24.1	18.6	24.5	18.9
VR (K)	48.3		41.4		41.2

**NEW & EXIST. BEAM REACTION TABLE**




	Abutments	Pier #1 & #4	Pier #2 & #3
R <sub>P</sub> (K)	27.9	88.1	86.8
R <sub>L</sub> (K)	35.1	45.9	47.3
Imp. (K)	9.3	11.7	11.7
R (Total) (K)	72.3	145.7	145.8

Is and Ss are the moment of inertia and section modulus of the steel section used in computing fs (Total).  
Ic and Sc are the moment of inertia and section modulus of the composite section used in computing fs (Total).  
VR is the maximum live Load + Impact shear range in span.

**PROCEDURE FOR JACKING AND REMOVING OF EXISTING BEARINGS**

The Contractor shall submit plans for Jacking and Cribbing, to the Engineer for approval, prior to commencing any work at the Bearings.  
Jacking and Removing Existing Bearings shall be done after existing deck removal is completed and before new deck is poured.  
All Beams at locations to be lifted simultaneously.  
The maximum dead load reaction with deck removed (per Bearing) at each Abutment is 5.0 kips and 16.5 kips at each Pier.  
Jacking shall be limited to a maximum 1/4" lift to remove the Existing Bearing Assembly.  
The Jack capacity for each beam is 5 Tons at Abutments and 20 Tons at Piers. Set Jacks so that Beams can be lowered 1/4" from original position.  
The bottom flange area of the Beam and Existing Top Plate shall be cleaned and painted as required and specified for Structural Steel.  
The new Bearings and Steel Extensions shall be in place and the Jacks shall be lowered before the new concrete Deck is poured. Lower all Beams simultaneously in 1/4" increments.

Note: Two hardened washers shall be required over all 5/16" holes.

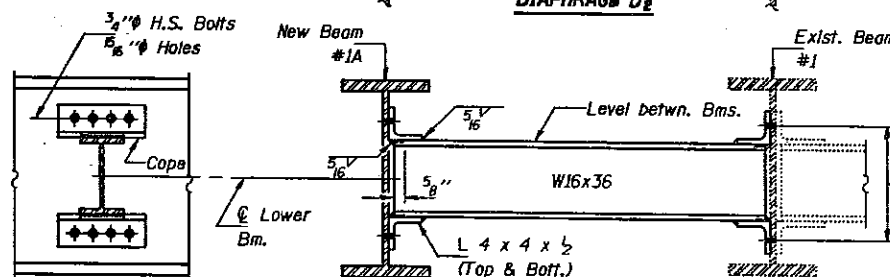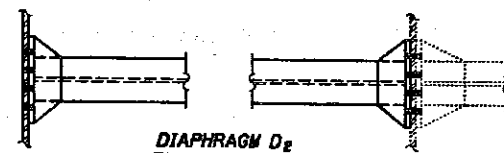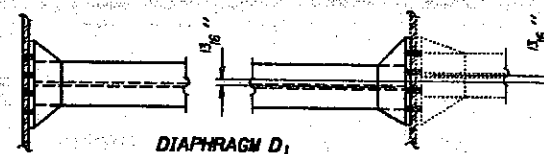

**DIAPHRAGM D<sub>1</sub> & D<sub>2</sub>**

(D<sub>1</sub> = 8 Required)  
(D<sub>2</sub> = 9 Required)

Remove existing rivets or bolts. Field drill 5/16" holes in new angles using holes in existing beams as a template. Existing bolts and rivets are to be replaced by 3/4" H.S. Bolt. Cost of Rivet and Bolt Removal and Field Drilling is incidental to "Structural Steel".

**\* TOP OF BEAM ELEVATIONS**

Loc.	Gir.	Beam #1A
© Brg. N. Abut.		391.74
© Brg. Pier #1		391.70
© Splice "A"		391.69
© Brg. Pier #2		391.68
© Splice "B"		391.66
© Splice "B"		391.66
© Brg. Pier #3		391.66
© Splice "A"		391.67
© Brg. Pier #4		391.68
© Brg. S. Abut.		391.70

\* For Fabrication only.

DESIGNED: *[Signature]*  
CHECKED: MICHAEL ABIJOGUN  
DRAWN: John F. Schneller Jr.  
CHECKED: *[Signature]* GRA

EXAMINED: *[Signature]* Kasper  
PASSED: *[Signature]* E. Anderson  
APPROVED: \_\_\_\_\_  
DIRECTOR OF HIGHWAYS


May 22 1992

STRUCTURAL STEEL  
F.A.I. RT. 57 SEC. (28-5B)D  
FRANKLIN COUNTY  
STA. 44+49.00

STATE OF ILLINOIS  
DEPARTMENT OF TRANSPORTATION

STATE NO.	SECTION	COUNTY	DATE	SHEET	SHEET NO.
F.A.I. 57	(28-5B)	FRANKLIN	1955	94	22 SHEETS
FED. ROAD DIST. NO. 7	ALTERN.	FED. AID PROJECT			


\* Cost of drilling holes in existing bottom flanges and existing 1" plate in field is incidental to "Elastomeric Bearing Assembly Type II".

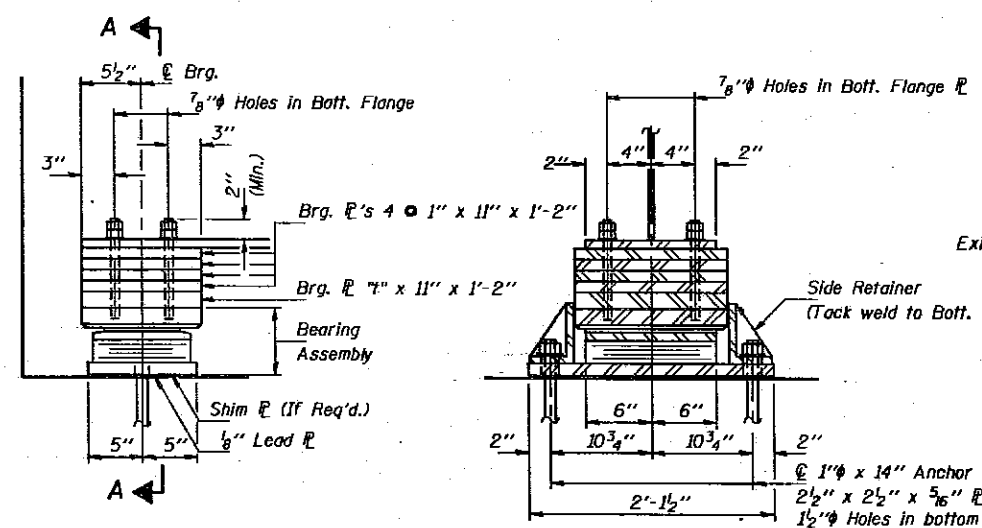

ELEVATION AT N. ABUT.

SECTION A-A


TYPE II TFE ELASTOMERIC EXP. BRG. BEAM #1A  
(1 Required)

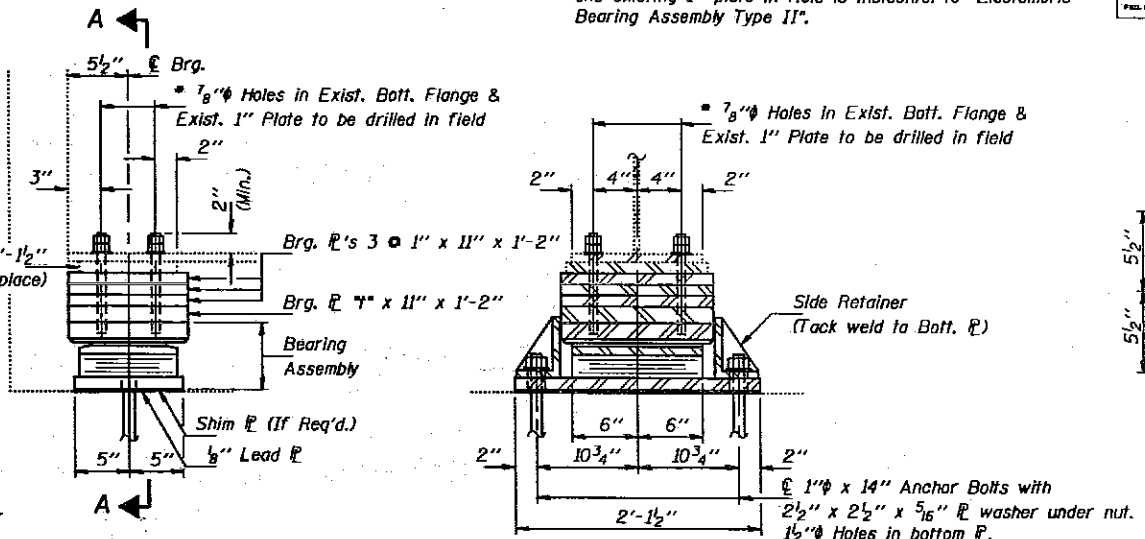

ELEVATION AT N. ABUT.

SECTION A-A

TYPE II TFE ELASTOMERIC EXP. BRG. BEAMS #1 THRU #6  
(6 Required)

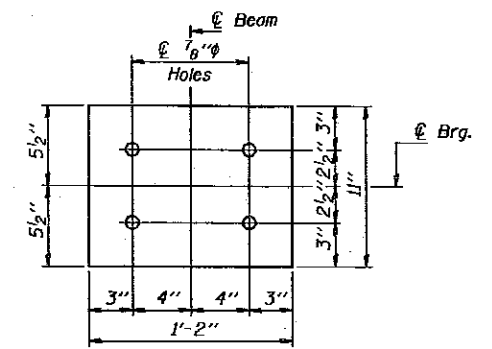


BEARING PLATE


\*\* BEARING PLATE 4" DIMENSIONS

Dim.	Bm.	1A	#1	#2	#3	#4	#5	#6
"		1 1/4"	3/4"	1/16"	1/16"	1/16"	5/16"	7/8"


\*\* Based on the survey elevations. The contractor shall verify and make adjustments if necessary.

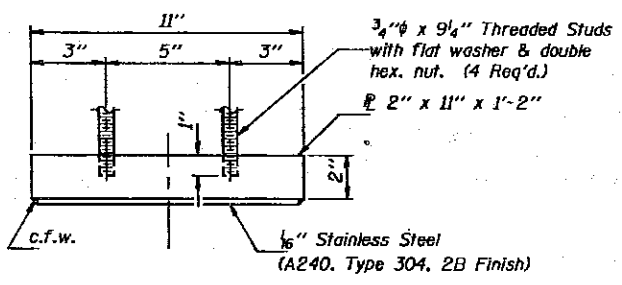


TOP BEARING ASSEMBLY

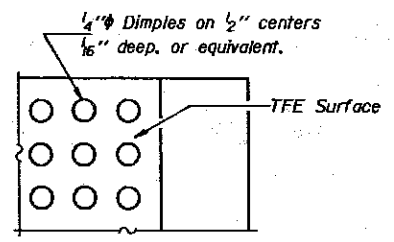


PLAN-TFE SURFACE

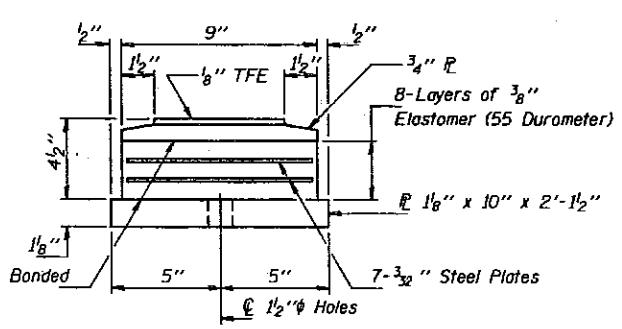

BOTTOM BEARING ASSEMBLY

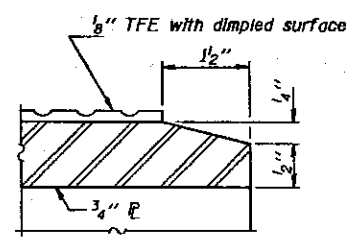

SECTION THRU TFE

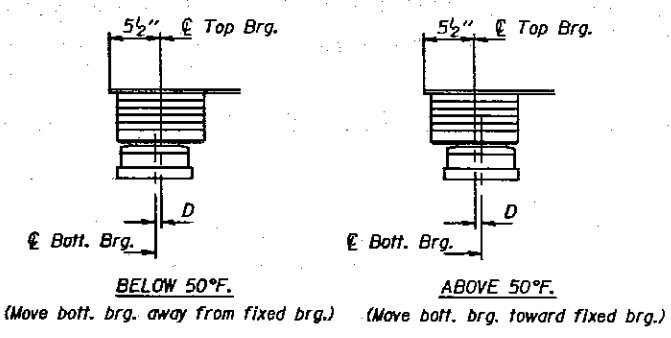

SETTING ANCHOR BOLTS AT EXP. BRG.  
D=1/8" per each 100' of expansion for every 15° temp. change from the normal temp. of 50°F.

Notes: See sheet #16 of 16 for Anchor Bolt Installation. Existing Anchor Bolts to be cut off flush with top of cap and grind smooth. Cost incidental to "Jack and Remove Existing Bearing." If it is necessary to remove the existing Diaphragms in order to drill holes for the new Anchor Bolts, the contractor shall replace all diaphragm connectors with the same size H.S. Bolts. Cost incidental. Weight of Steel Shim Plates, Lead Plates, Anchor Bolts, nuts and washers and Side Retainers is included in "Structural Steel".

BILL OF MATERIAL


Item	Unit	Total
Elastomeric Bearing Assembly Type II	Each	7
Jack and Remove Existing Bearings	Each	6

DESIGNED *Michael A. Bolin*  
CHECKED *Michael A. Bolin*  
DRAWN *John F. Schneller Jr.*  
CHECKED *JAB GPA*

EXAMINED *Paul E. Anderson*  
PASSED *Paul E. Anderson*  
APPROVED *Paul E. Anderson*  
DIRECTOR OF HIGHWAYS

May 22 1992

Note: The 1/8" TFE sheet shall be bonded directly to the top steel plate with a two-component, medium viscosity epoxy resin, conforming to the requirements of the Federal Specification MNM-A-134, Type I. The bond agent shall be applied on the full area of the contact surfaces. Bonding of 1/8" TFE sheet during vulcanizing process will be permitted provided the process and method of adjusting assembly height is approved by the Engineer.

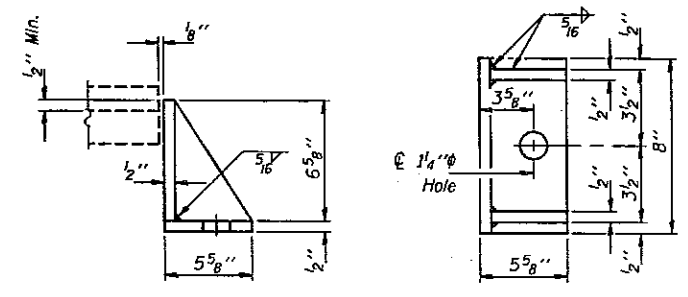

SIDE RETAINER-N. ABUT.  
Equivalent rolled angle with stiffeners will be allowed in lieu of welded plates.


BEARING DETAILS  
NORTH ABUTMENT  
F.A.I. RT. 57 SEC. (28-5B)D  
FRANKLIN COUNTY  
STA. 44+49.00



STATE OF ILLINOIS  
DEPARTMENT OF TRANSPORTATION

ROUTE NO.	DISTRICT	COUNTY	SECTION	DATE	SHEET NO. II
F.A.I. 57	(28-5B) D	FRANKLIN	155	95	22 SHEETS
FULL YEAR COST, \$	BALANCE	PERCENT PROGRESS			


\* Cost of drilling holes in existing bottom flanges and existing 1" plate in field is incidental to "Elastomeric Bearing Assembly Type II".

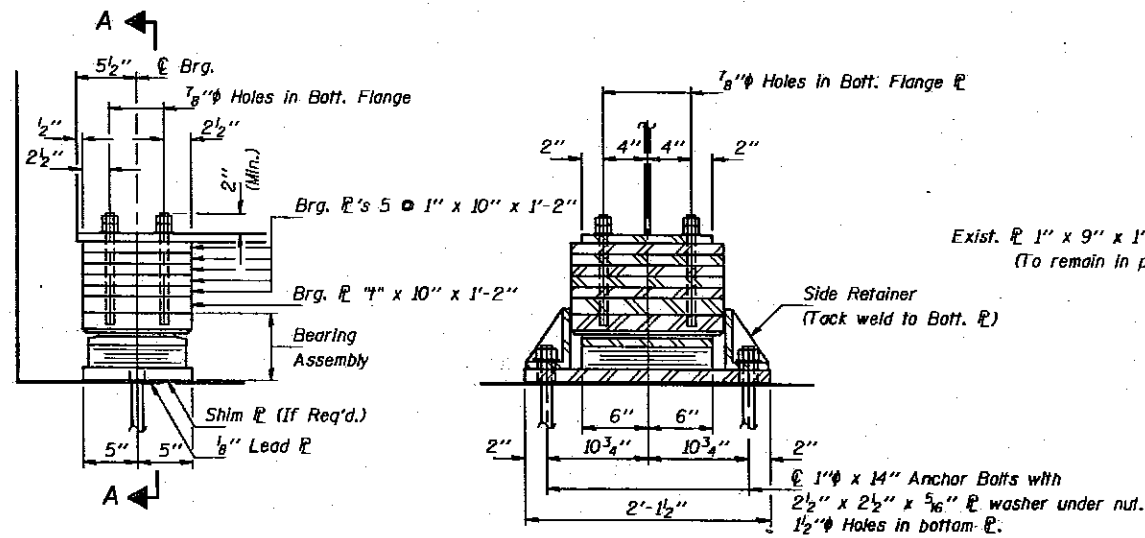

ELEVATION AT S. ABUT.

SECTION A-A


TYPE II TFE ELASTOMERIC EXP. BRG. BEAM #1A  
(1 Required)

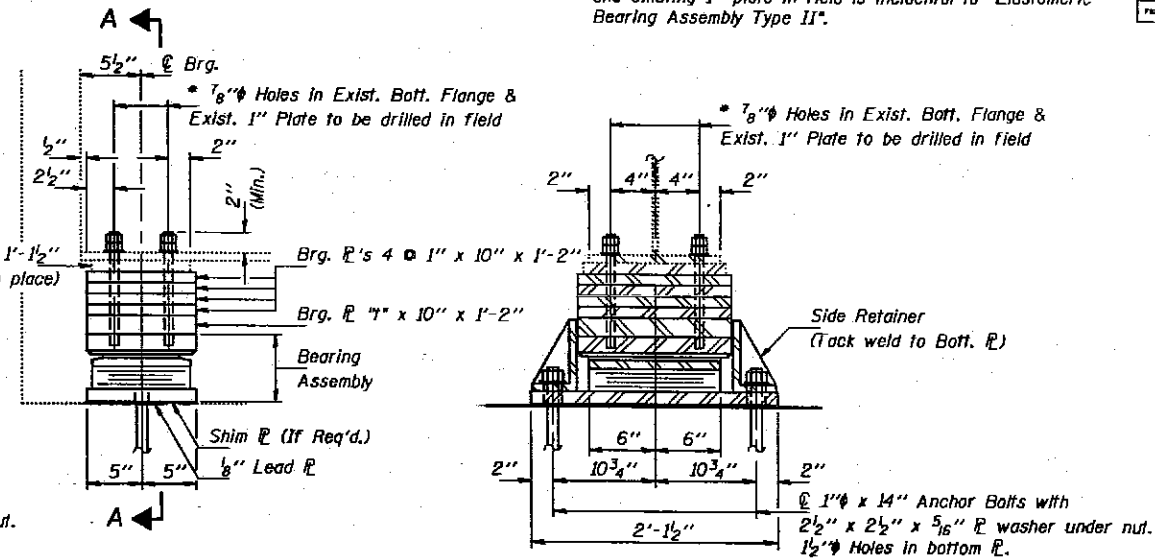

ELEVATION AT S. ABUT.

SECTION A-A

TYPE II TFE ELASTOMERIC EXP. BRG. BEAMS #1 THRU #6  
(6 Required)

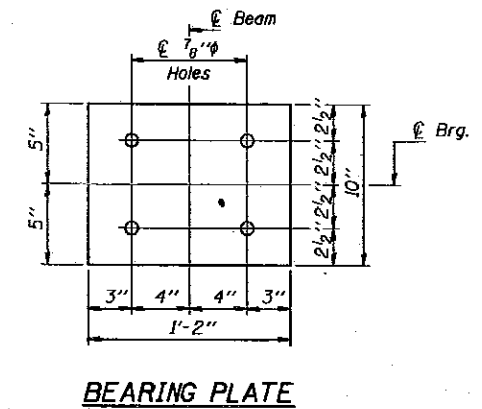


BEARING PLATE


\*\* BEARING PLATE "I" DIMENSIONS

Dim.	Beam	#1A	#1	#2	#3	#4	#5	#6
7"		1 1/8"	5/8"	5/8"	3/4"	3/4"	5/8"	5/8"


\*\* Based on the survey elevations. The contractor shall verify and make adjustments if necessary.

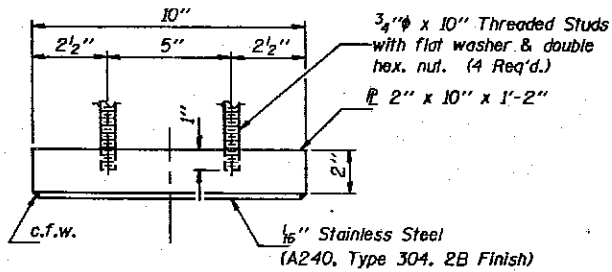


TOP BEARING ASSEMBLY

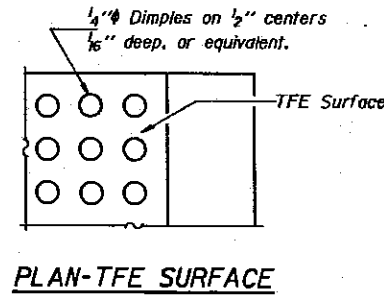


PLAN-TFE SURFACE

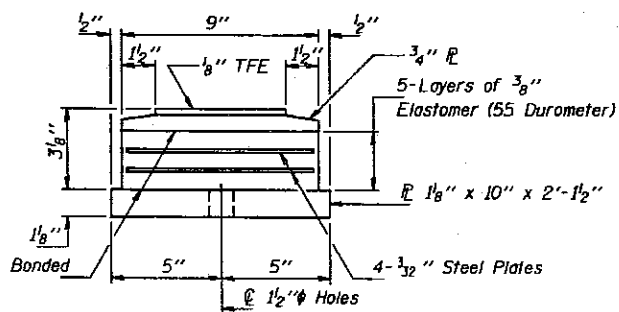

BOTTOM BEARING ASSEMBLY

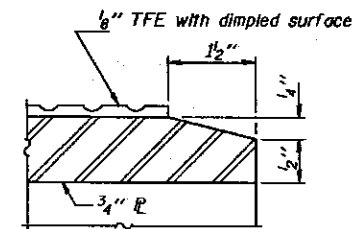

SECTION THRU TFE

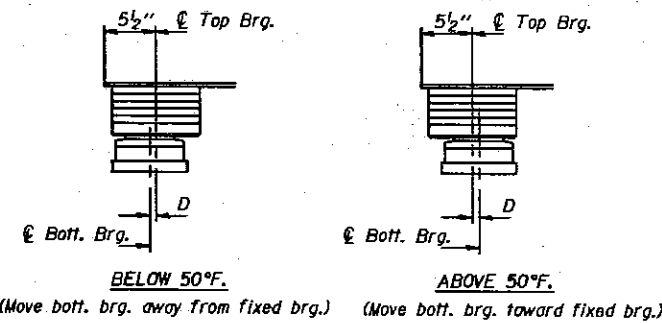

SETTING ANCHOR BOLTS AT EXP. BRG.

D = 1/8" per each 100' of expansion for every 15° temp. change from the normal temp. of 50°F.


Notes: See sheet #16 of 16 for Anchor Bolt installation. Existing Anchor Bolts to be cut off flush with top of cap and grind smooth. Cost incidental to "Jack and Remove Existing Bearing." If it is necessary to remove the existing Diaphragms in order to drill holes for the new Anchor Bolts, the contractor shall replace all diaphragm connectors with the same size H.S. Bolts. Cost incidental. Weight of Steel Shim Plates, Lead Plates, Anchor Bolts, nuts and washers and Side Retainers is included in "Structural Steel".

BILL OF MATERIAL

Item	Unit	Total
Elastomeric Bearing Assembly Type II	Each	7
Jack and Remove Existing Bearings	Each	6

DESIGNED: *John F. Schneller Jr.*  
CHECKED: MICHAEL ABITOGAN  
DRAWN: John F. Schneller Jr.  
CHECKED: J.P. GRA  
EXAMINED: *Raj S. Kaper*  
PASSED: *Ralph E. Anderson*  
APPROVED: \_\_\_\_\_  
DIRECTOR OF HIGHWAYS

Note: The 1/8" TFE sheet shall be bonded directly to the top steel plate with a two-component, medium viscosity epoxy resin, conforming to the requirements of the Federal Specification MM-A-134, Type I. The bond agent shall be applied on the full area of the contact surfaces. Bonding of 1/8" TFE sheet during vulcanizing process will be permitted provided the process and method of adjusting assembly height is approved by the Engineer.

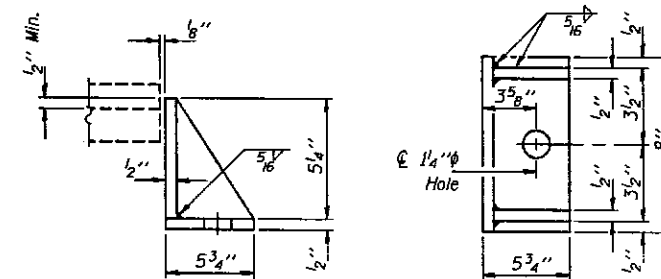


SIDE RETAINER-S. ABUT.

Equivalent rolled angle with stiffeners will be allowed in lieu of welded plates.

BEARING DETAILS  
SOUTH ABUTMENT  
F.A.I. RT. 57 SEC. (28-5B)D  
FRANKLIN COUNTY  
STA. 44+49.00

STATE OF ILLINOIS  
DEPARTMENT OF TRANSPORTATION


ROUTE NO.	SECTION	COUNTY	DATE	SHEET	SHEET NO. 12
F.A.I. 57	(28-5B) D	FRANKLIN	1955	96	22 SHEETS
PROJ. ROAD DIST. NO. 1	SUBDIVISION	PREL. AND PROJECT			

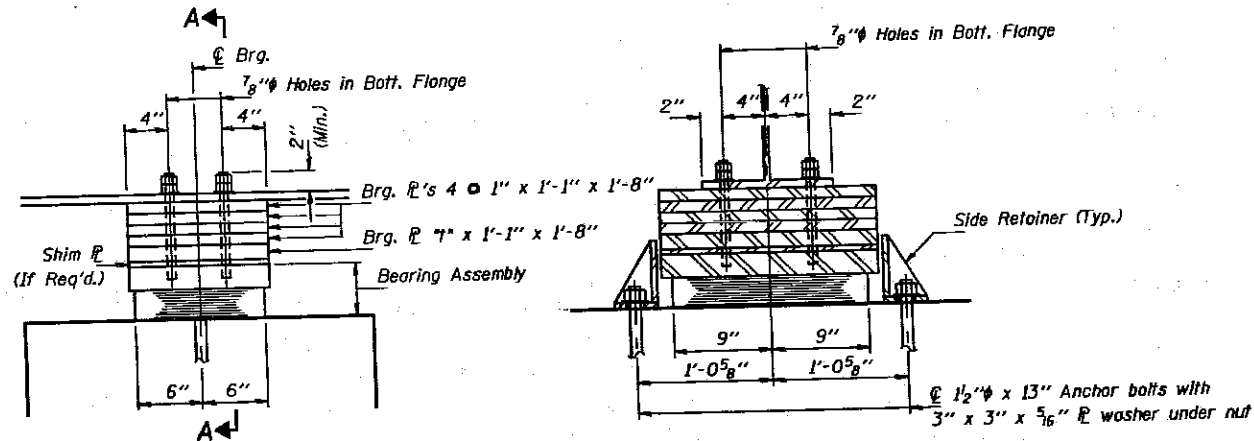

ELEVATION AT PIER #1

SECTION A-A

TYPE I ELASTOMERIC EXP. BRG. BEAM #1A  
(1 Required)

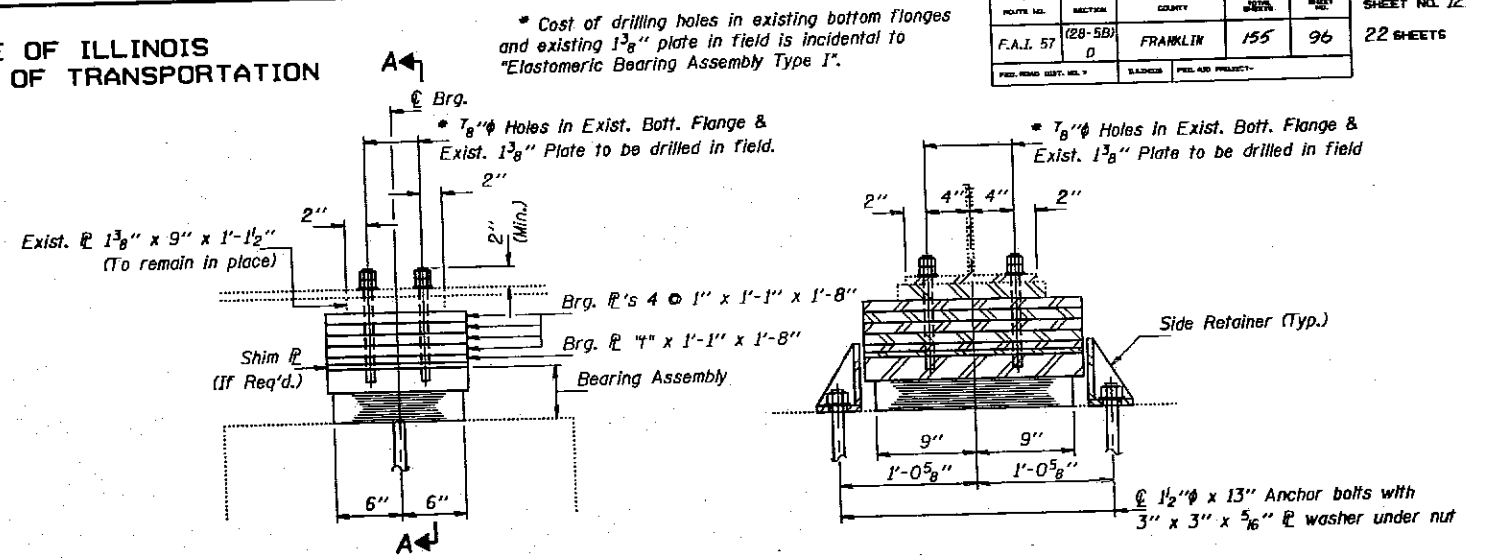

ELEVATION AT PIER #1


SECTION A-A

TYPE I ELASTOMERIC EXP. BRG. BEAMS #1 THRU #6  
(6 Required)

BEARING PLATE "4" DIMENSIONS


Dim.	Bm	1A	#1	#2	#3	#4	#5	#6
"4"		1 5/8"	7/8"	7/8"	1"	5/8"	1 1/8"	1"

\*\* Based on the survey elevations. The contractor shall verify and make adjustments if necessary.

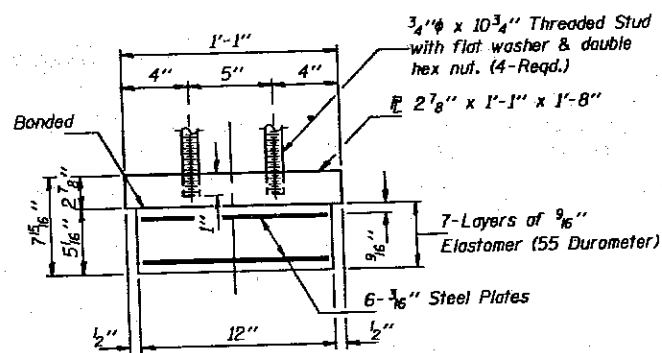

BEARING ASSEMBLY

Note: Shim plates shall not be placed under Bearing Assembly.

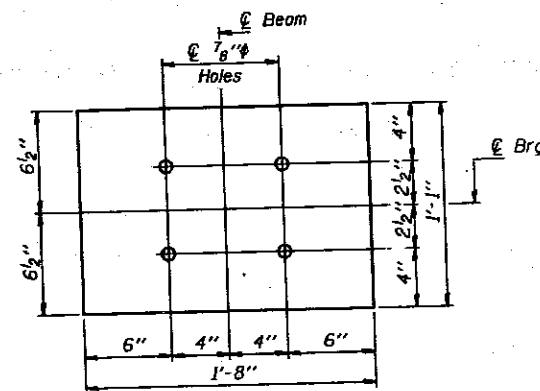


BEARING PLATE

Notes: See sheet #16 of 16 for Anchor Bolt installation. Existing Anchor Bolts to be cut off flush with top of cap and grind smooth. Cost incidental to "Jack and Remove Existing Bearing." If it is necessary to remove the existing Diaphragms in order to drill holes for the new Anchor Bolts, the contractor shall replace all diaphragm connectors with the same size H.S. Bolts. Cost incidental. Weight of Steel Shim Plates, Anchor Bolts, nuts and washers and Side Retainers is included in "Structural Steel".

BILL OF MATERIAL

Item	Unit	Total
Elastomeric Bearing Assembly Type I	Each	7
Jack and Remove Existing Bearings	Each	6

BEARING DETAILS - PIER #1  
F.A.I. RT. 57 SEC. (28-5B)D  
FRANKLIN COUNTY  
STA. 44+49.00

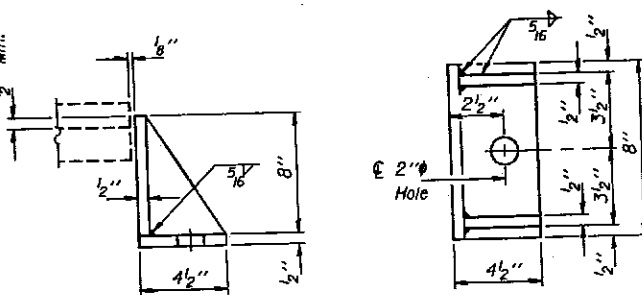

SIDE RETAINER-PIER #1

Equivalent rolled angle with stiffeners will be allowed in lieu of welded plates.


DESIGNED <i>Michael A. Blotz</i>	EXAMINED <i>Orsi J. Kaspar</i>
CHECKED <i>Michael A. Blotz</i>	PASSED <i>Ralph E. Anderson</i>
DRAWN <i>John F. Schneller Jr.</i>	APPROVED _____
CHECKED <i>GR</i>	DIRECTOR OF HIGHWAYS

May 22 1972


STATE OF ILLINOIS  
DEPARTMENT OF TRANSPORTATION

PROJECT NO.	SECTION	QUANTITY	DATE	SHEET	SHEET NO. 13
F.A.I. 57	(28-5B)	FRANKLIN	155	97	22 SHEETS
FUEL HOSE DIST. NO. 1	MARKED	FILE NO. PROJECT			


\* Cost of drilling holes in existing bottom flanges and existing 1 3/8" plate in field is incidental to "Elastomeric Bearing Assembly Type I".

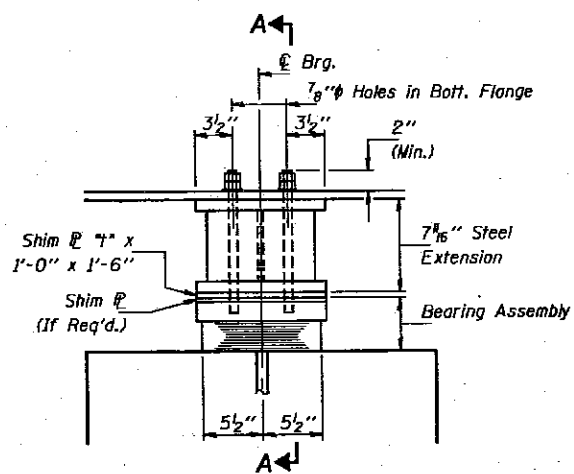


ELEVATION AT PIER #2

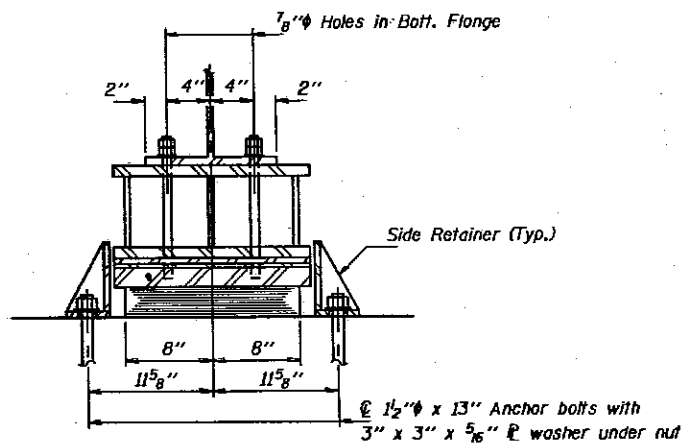

SECTION A-A

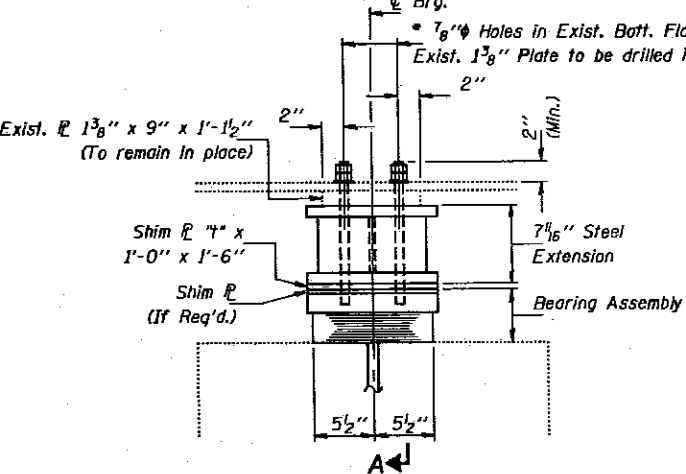

ELEVATION AT PIER #2

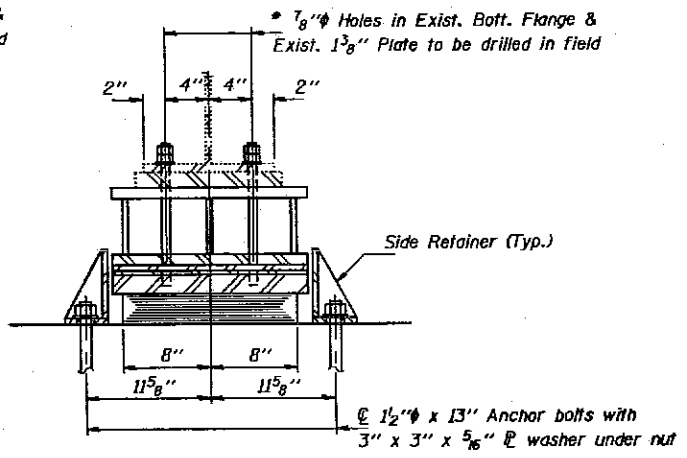

SECTION A-A


TYPE I ELASTOMERIC EXP. BRG. BEAM #1A  
(1 Required)

TYPE I ELASTOMERIC EXP. BRG. BEAMS #1 THRU #6  
(6 Required)

SHIM PLATE "4" DIMENSIONS


Dim.	Beam	#1	#2	#3	#4	#5	#6
7"	1 7/16"	0	0	1/8"	1/16"	3/16"	3/16"

\*\* Based on the survey elevations. The contractor shall verify and make adjustments if necessary.

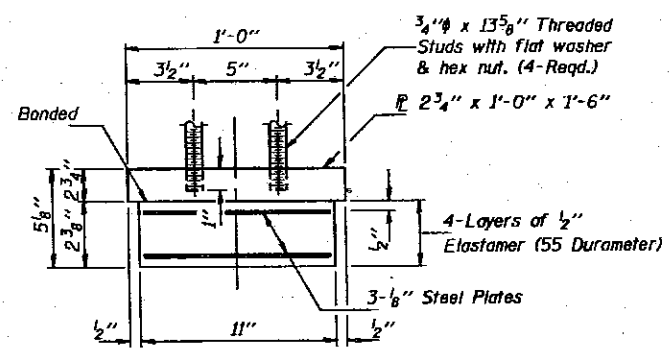


BEARING ASSEMBLY

Note: Shim plates shall not be placed under Bearing Assembly.

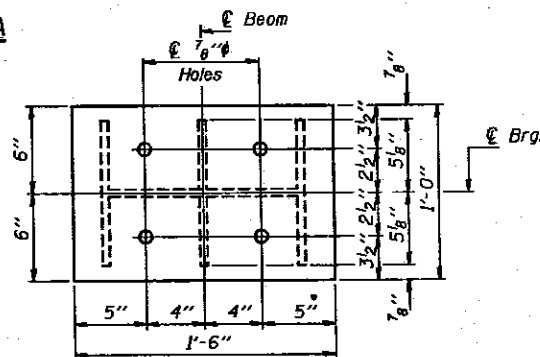


TOP PLATE

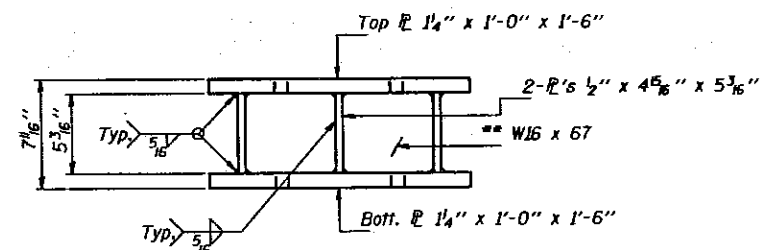


ELEVATION

\*\* Equivalent welded plates will be allowed in lieu of W16 x 67.

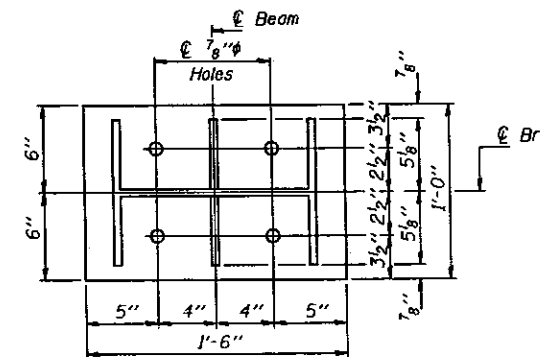

BOTTOM PLATE

STEEL EXTENSION

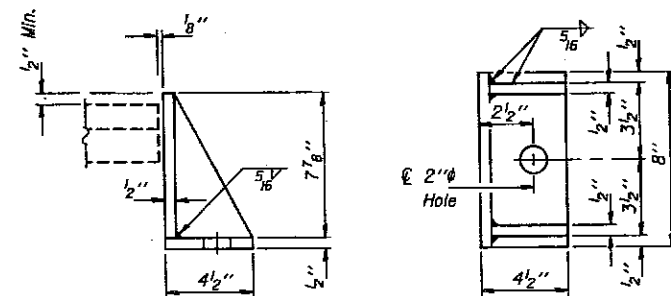

SIDE RETAINER-PIER #2

Equivalent rolled angle with stiffeners will be allowed in lieu of welded plates.

DESIGNED <i>R. Behr</i>	EXAMINED <i>May 22 1992</i>
CHECKED <i>Michael Aditogwa</i>	PASSED <i>Ralph E. Anderson</i>
DRAWN <i>John F. Schneller Jr.</i>	APPROVED _____
CHECKED <i>DB GFA</i>	DIRECTOR OF HIGHWAYS

Notes: See sheet #16 of 16 for Anchor Bolt installation. Existing Anchor Bolts to be cut off flush with top of cap and grind smooth. Cost incidental to "Jack and Remove Existing Bearing." If it is necessary to remove the existing Diaphragms in order to drill holes for the new Anchor Bolts, the contractor shall replace all diaphragm connectors with the same size H.S. Bolts. Cost incidental. Weight of Steel Shim Plates, Steel Extensions, Anchor Bolts, nuts and washers and Side Retainers is included in "Structural Steel".

BILL OF MATERIAL

Item	Unit	Total
Elastomeric Bearing Assembly Type I	Each	7
Jack and Remove Existing Bearings	Each	6


BEARING DETAILS - PIER #2  
F.A.I. RT. 57 SEC. (28-5B)D  
FRANKLIN COUNTY  
STA. 44+49.00



STATE OF ILLINOIS  
DEPARTMENT OF TRANSPORTATION


\*\*\* Cost of drilling holes in existing bottom flanges and existing 1 3/8" plate in field is incidental to "Structural Steel".

ROUTE NO.	DISTRICT	COUNTY	SECTION	SHEET	SHEET NO. 14
F.A.I. 57	(28-5B)	FRANKLIN	155	98	22 SHEETS
FUEL ROAD DIST. NO. 7		MILEAGE		PERCENTAGE	

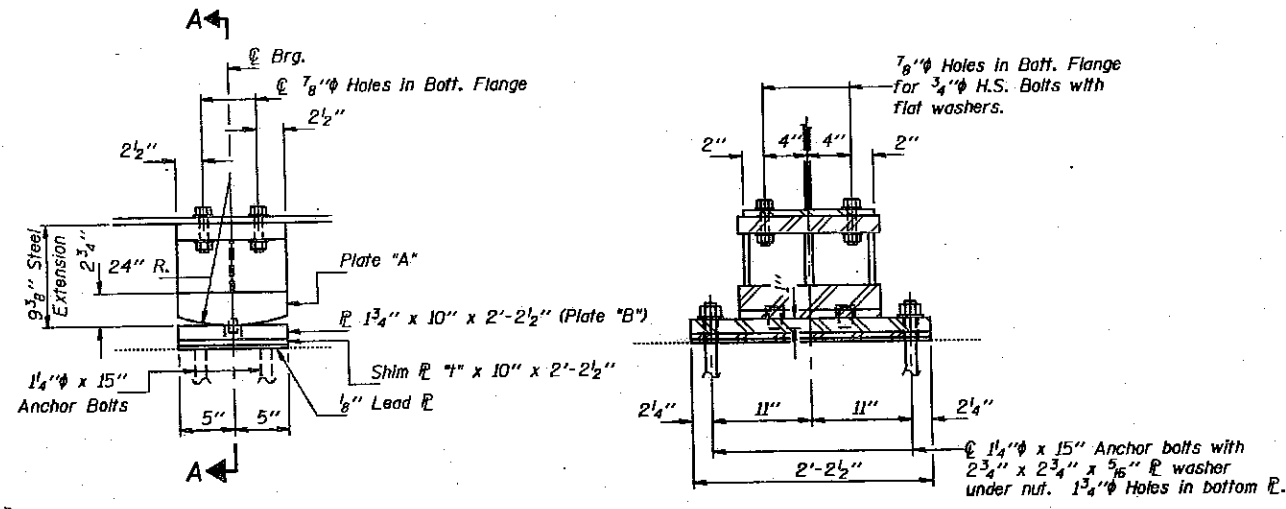

ELEVATION AT PIER 3


SECTION A-A

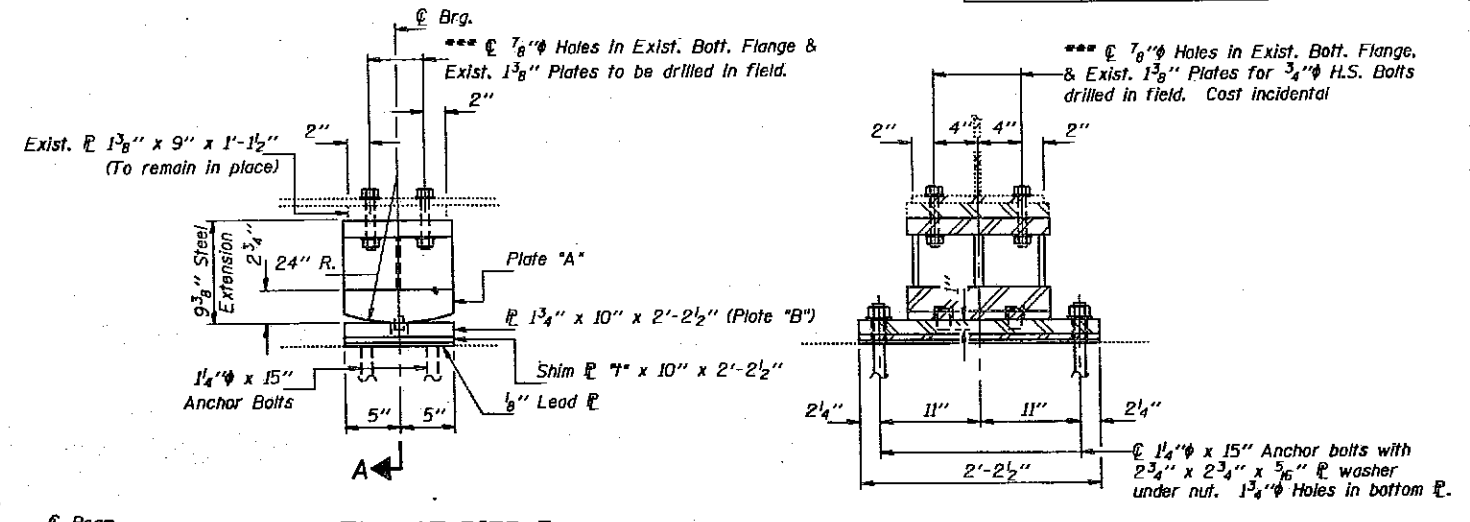

ELEVATION AT PIER 3

SECTION A-A


FIXED BEARING BEAM #1A  
(1 Required)

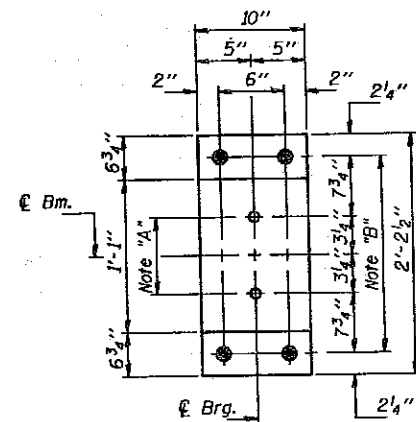


PLAN-BOTTOM PLATE "B"

Note "A"  
1 3/8" Holes 1" deep in Bottom Plate "A" for 1 1/4" Pintles. Thread or press fit pintles in Bottom Plate "B".


Note "B"  
1 3/8" Holes for 1 1/4" Anchor Bolts 2 3/4" x 2 3/4" x 5/16" Washer under nut.

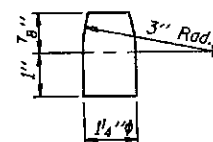

PINTLE

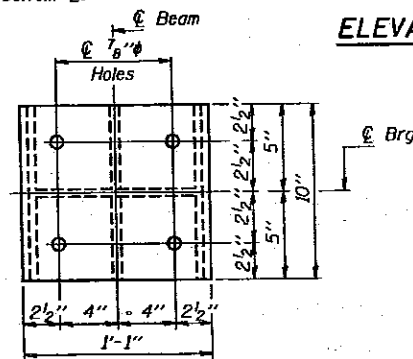


TOP PLATE

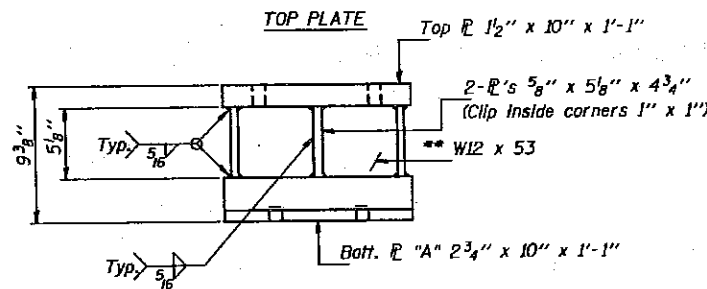

ELEVATION

\*\* Equivalent welded plates will be allowed in lieu of W12 x 53.

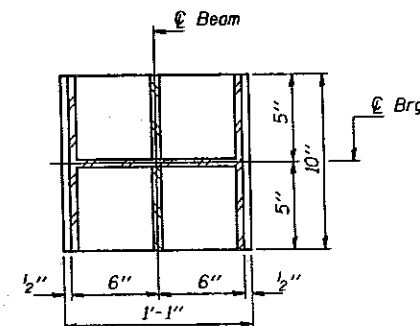

BOTTOM PLATE "A"

STEEL EXTENSION

FIXED BEARING BEAMS #1 THRU #6  
(6 Required)

\* SHIM PLATE "4" DIMENSIONS

Dim.	Bm.	1A	#1	#2	#3	#4	#5	#6
7"	15/16"	0	0	1/8"	1/8"	3/16"	3/16"	

\* Based on the survey elevations. The contractor shall verify and make adjustments if necessary.

Notes: See sheet #16 of 16 for Anchor Bolt installation. Existing Anchor Bolts to be cut off flush with top of cap and grind smooth. Cast incidental to "Jack and Remove Existing Bearing." If it is necessary to remove the existing Diaphragms in order to drill holes for the new Anchor Bolts, the contractor shall replace all diaphragm connectors with the same size H.S. Bolts. Cast incidental. Weight of Steel Shim Plates, Lead Plates, Anchor Bolts, nuts and washers, 3/4" H.S. Bolts, nuts and flat washers and Steel Extensions is included in "Structural Steel".

DESIGNED *[Signature]*  
CHECKED *[Signature]*  
DRAWN John F. Schneller Jr.  
CHECKED *[Signature]*


EXAMINED *[Signature]*  
PASSED *[Signature]*  
APPROVED *[Signature]*  
DIRECTOR OF HIGHWAYS

May 22 1992


BEARING DETAILS - PIER #3  
F.A.I. RT. 57 SEC. (28-5B)D  
FRANKLIN COUNTY  
STA. 44+49.00

STATE OF ILLINOIS  
DEPARTMENT OF TRANSPORTATION


ROUTE NO.	SECTION	COUNTY	DATE	REV.	SHEET NO. 15
F.A.I. 57	(28-5B) D	FRANKLIN	1/55	99	22 SHEETS
FED. ROAD DIST. NO. 7					

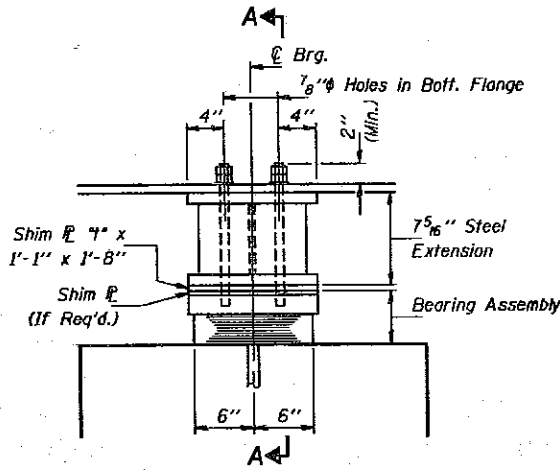


ELEVATION AT PIER #4

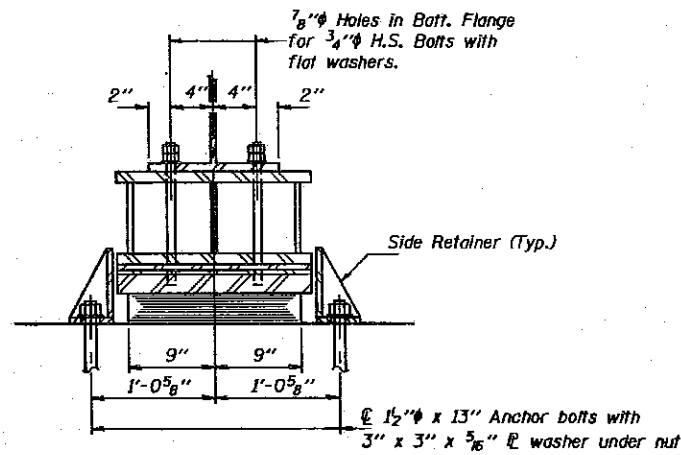

SECTION A-A

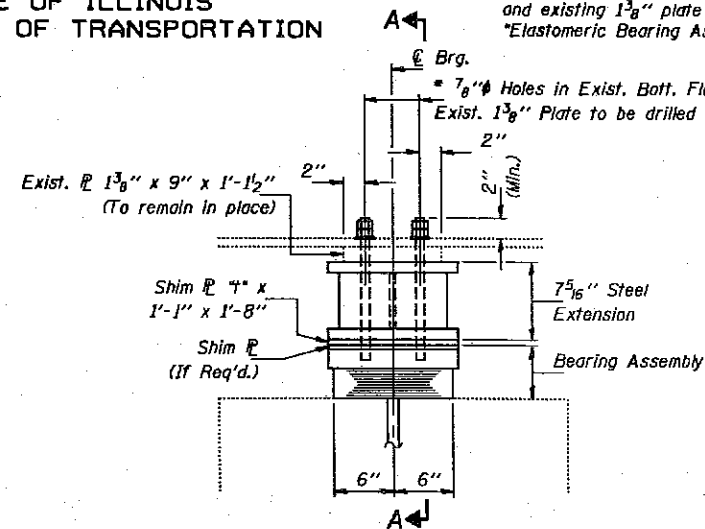


ELEVATION AT PIER #4

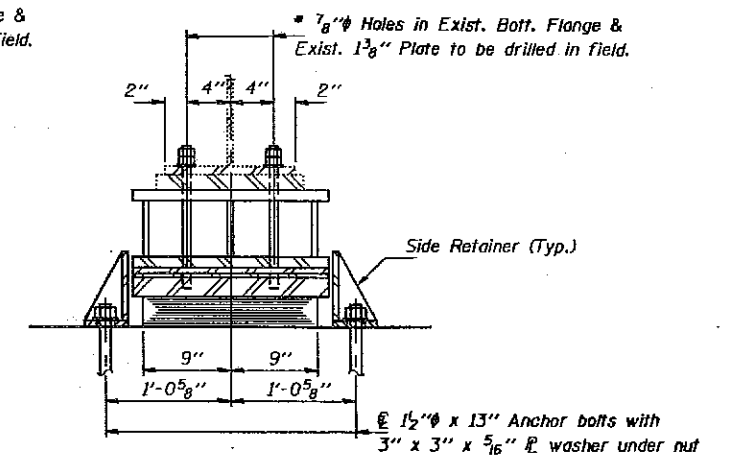

SECTION A-A


TYPE I ELASTOMERIC EXP. BRG. BEAM #1A  
(1 Required)

TYPE I ELASTOMERIC EXP. BRG. BEAMS #1 THRU #6  
(6 Required)

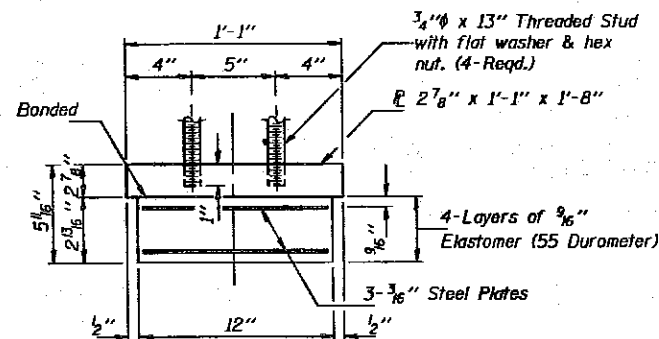


BEARING ASSEMBLY

Note: Shim plates shall not be placed under Bearing Assembly.

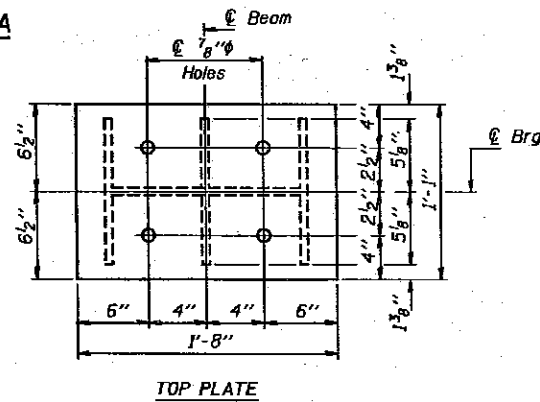


TOP PLATE

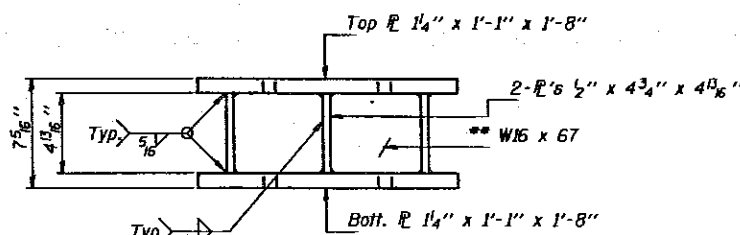

ELEVATION

\*\* Equivalent welded plates will be allowed in lieu of W16 x 67.

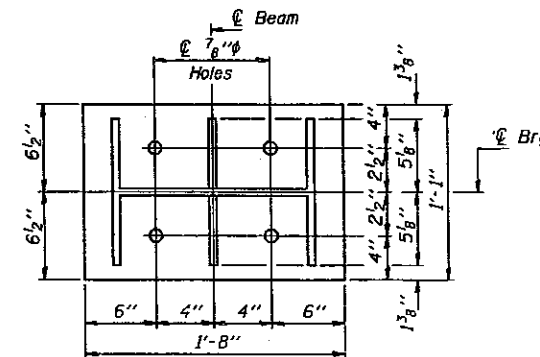

BOTTOM PLATE


STEEL EXTENSION

SHIM PLATE "I" DIMENSIONS

Dim.	Beam	#1	#2	#3	#4	#5	#6
1"	1 1/2"	0	0	1/16"	1/16"	3/16"	1/8"

\*\* Based on the survey elevations. The contractor shall verify and make adjustments if necessary.

Notes: See sheet #16 of 16 for Anchor Bolt installation. Existing Anchor Bolts to be cut off flush with top of cap and grind smooth. Cost incidental to "Jack and Remove Existing Bearing." If it is necessary to remove the existing Diaphragms in order to drill holes for the new Anchor Bolts, the contractor shall replace all diaphragm connectors with the same size H.S. Bolts. Cost incidental. Weight of Steel Shim Plates, Steel Extensions, Anchor Bolts, nuts and washers and Side Retainers is included in "Structural Steel".

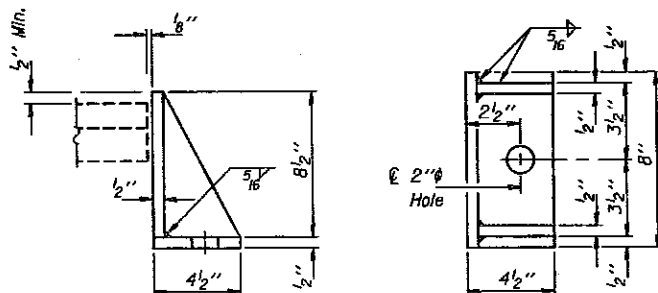

SIDE RETAINER-PIER #4

Equivalent rolled angle with stiffeners will be allowed in lieu of welded plates.

DESIGNED <i>John F. Schneller Jr.</i>	EXAMINED <i>Paul E. Anderson</i>
CHECKED <i>Michael Aditobun</i>	PASSED <i>Paul E. Anderson</i>
DRAWN <i>John F. Schneller Jr.</i>	APPROVED <i>Paul E. Anderson</i>
CHECKED <i>LAG GPA</i>	DIRECTOR OF HIGHWAYS

May 22 1992

BILL OF MATERIAL

Item	Unit	Total
Elastomeric Bearing Assembly Type I	Each	7
Jack and Remove Existing Bearings	Each	6

BEARING DETAILS - PIER #4  
F.A.I. RT. 57 SEC. (28-5B)D  
FRANKLIN COUNTY  
STA. 44+49.00


STATE OF ILLINOIS  
DEPARTMENT OF TRANSPORTATION

ROUTE NO.	SHEET NO.	COUNTY	DATE	"P" NO.	SHEET NO. 16
F.A.I. 57	(28-5B) 0	FRANKLIN	155	100	22 SHEETS
FED. ROAD DIST. NO. 7	BRIDGE	FURNISH AND PROJECT			


The Illinois Coil-Lock Anchor Bolt is a proprietary item which is the property of the Illinois Department of Transportation. Use, reproduction or disclosure without express written permission is prohibited and protected under Federal copyright laws. The production and the fabrication of this bolt for use on highway projects in the State of Illinois shall be permitted and there shall be no incurred charges or fees to the manufacturer or the fabricator for producing or fabricating this bolt.

D	E	H	K	"d"
1"	1 <sup>1</sup> / <sub>8</sub> "	3 <sup>1</sup> / <sub>16</sub> "	1 <sup>3</sup> / <sub>4</sub> "	1/4"
1 <sup>1</sup> / <sub>4</sub> "	1 <sup>3</sup> / <sub>8</sub> "	1 <sup>1</sup> / <sub>16</sub> "	2"	3/8"
1 <sup>1</sup> / <sub>2</sub> "	1 <sup>5</sup> / <sub>8</sub> "	1 <sup>5</sup> / <sub>16</sub> "	2 <sup>1</sup> / <sub>8</sub> "	1/2"
2"	2 <sup>1</sup> / <sub>8</sub> "	1 <sup>9</sup> / <sub>16</sub> "	2 <sup>7</sup> / <sub>8</sub> "	1/2"
2 <sup>1</sup> / <sub>2</sub> "	2 <sup>5</sup> / <sub>8</sub> "	2 <sup>3</sup> / <sub>16</sub> "	3 <sup>3</sup> / <sub>8</sub> "	1"

LOCATION	"L"
No. Abutment	1'-0 <sup>1</sup> / <sub>4</sub> "
Pier #1	10' <sup>6</sup> / <sub>8</sub> "
Pier #2	10' <sup>6</sup> / <sub>8</sub> "
Pier #3	1'-1"
Pier #4	10' <sup>6</sup> / <sub>8</sub> "
So. Abutment	1'-0 <sup>1</sup> / <sub>4</sub> "

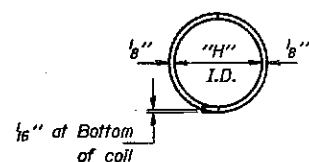

PLAN-COIL WIRE

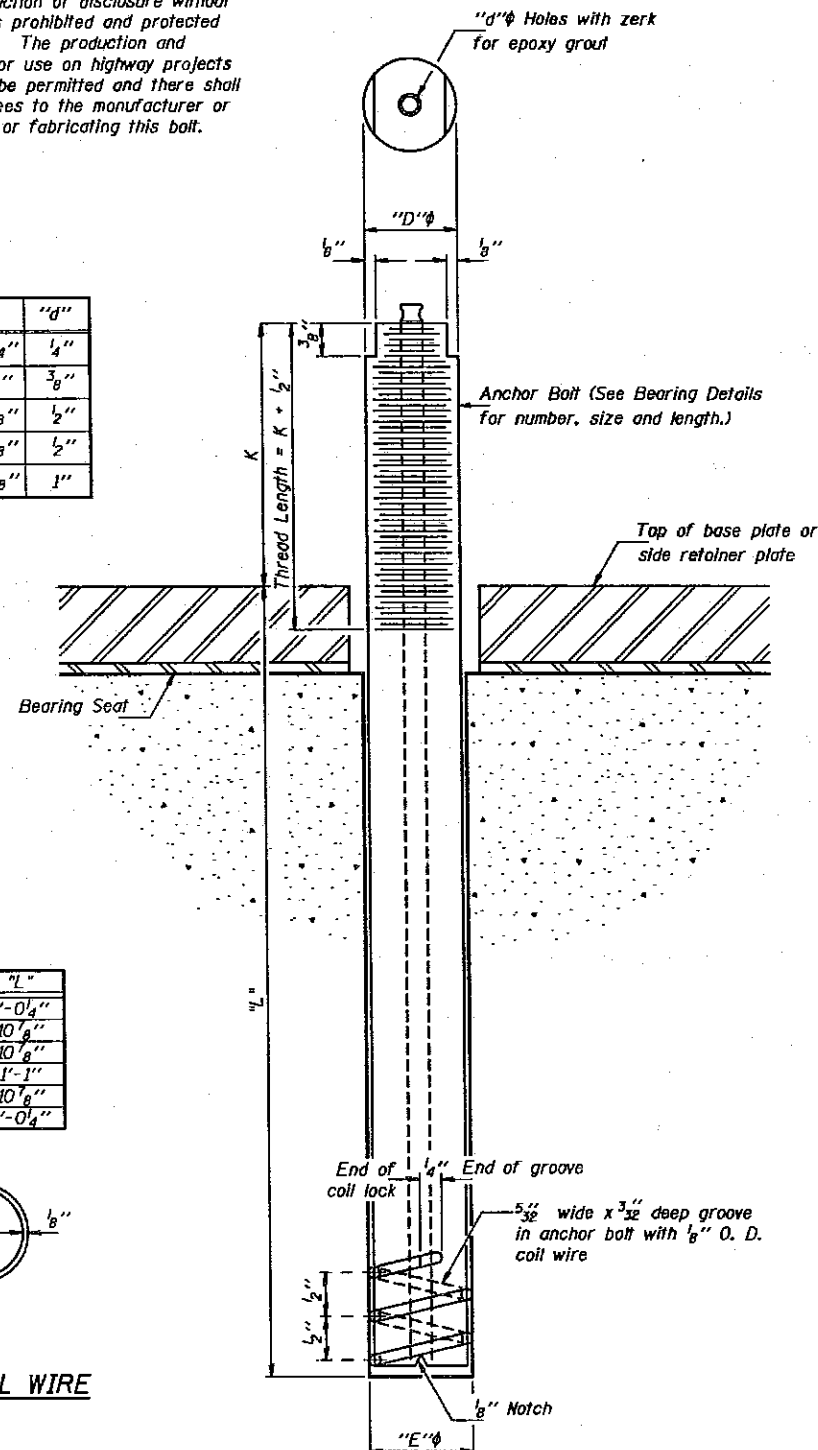

ILLINOIS COIL-LOCK ANCHOR BOLT

MATERIALS FOR ILLINOIS COIL-LOCK ANCHOR BOLT

The anchor bolt shall be fabricated from cold drawn or hot finished seamless carbon steel mechanical tubing conforming to ASTM A519, Grade 1026 and supplied with hexagonal nuts and cut washers.  
The coil wire shall be made of any suitable soft steel wire.  
The finished anchor bolt shall be cleaned of rust and other foreign materials and wrapped or packaged to prevent contamination until they are installed.  
The epoxy grout shall be a two-component, epoxy resin bonding system conforming to ASTM C881, Type I, Grade 1 and of a Class suitable for the temperature at installation.

INSTALLATION PROCEDURE for the ILLINOIS COIL-LOCK ANCHOR BOLT

1. With the coil wire in place, the bolt shall be inserted into the hole and turned clockwise to a snug fit in the hole. Nut and washer shall be placed on the bolt. The nut shall be tensioned until the steel base plates are held securely to the concrete bearing seat.
2. Epoxy grout shall be pumped through the zerk fitting with a pressure gun. Pumping shall continue until the epoxy overflows the hole around the bolt shank. After pumping is discontinued, excess epoxy shall be immediately wiped off.

ALTERNATE ANCHOR BOLTS

The Contractor may use, at his option, the capsule or the adhesive cartridge type anchor rods that have been previously tested and given a prior approval by the Department. The Contractor shall install these anchor rods in pre-drilled holes in accordance with the manufacturer's recommendations and procedures.  
The capsule or the adhesive cartridge type anchor rods shall be a two part system composed of:  
1. A threaded rod stud with nut and washer conforming to ASTM A307.  
2. A sealed glass capsule or a sealed glass adhesive cartridge containing premeasured amounts of the adhesive chemical.

GENERAL NOTES

Holes in the masonry for anchor bolts shall be drilled through the base plates to the diameter and depth shown or in accordance with the manufacturer's recommendation after beams or girders have been erected and adjusted.  
Prior to setting the bolts, the holes shall be dry and all dust and loose particles shall be removed by the use of compressed air or vacuuming.  
The anchor bolts, furnished and installed and including the epoxy grout or capsules shall not be paid for separately but shall be included in the unit bid price for "Furnishing and Erecting Structural Steel".

DESIGNED *Michael Abitochin*  
CHECKED *Michael Abitochin*  
DRAWN *John F. Schneller Jr.*  
CHECKED *AD GPA*

EXAMINED *May 22 1992*  
PASSED *Ralph E. Anderson*  
APPROVED \_\_\_\_\_  
DIRECTOR OF HIGHWAY

ABB-1 12-1-83

ANCHOR BOLT DETAILS  
FOR BEARINGS  
F.A.I. RT. 57 SEC. (28-5B)D  
FRANKLIN COUNTY  
STA. 44+49.00













STATE OF ILLINOIS  
DEPARTMENT OF TRANSPORTATION

ROUTE NO.	SECTION	COUNTY	MILE	POST	SHEET NO. 19
F.A.I. 57	(28-5B) D	FRANKLIN	155	103	22 SHEETS
FILE NO. DIST. NO. 1		ADDRESS	PREPARED BY		

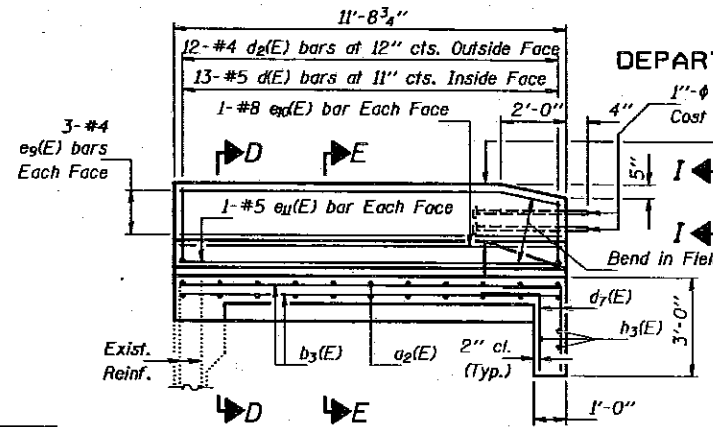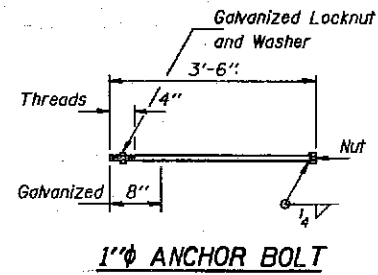

1" Anchor Bolts. (Typ. No. Abut. only)  
Cost incidental to Bridge Structure.  
End Post shall be poured after bridge parapet is in place. Form top surface to match parapet grade.



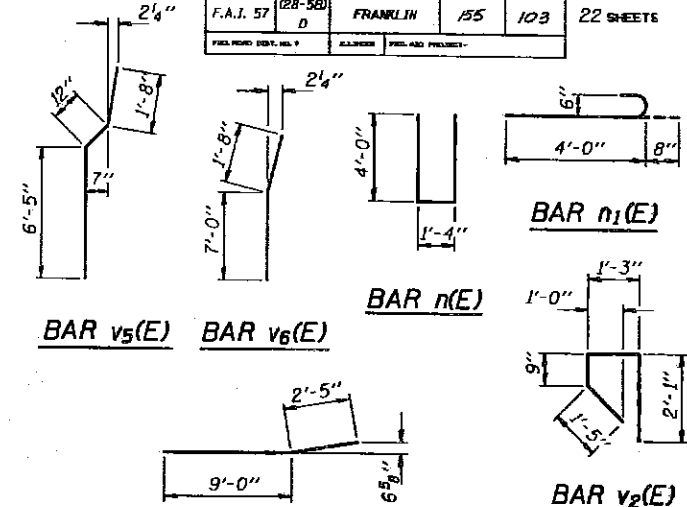
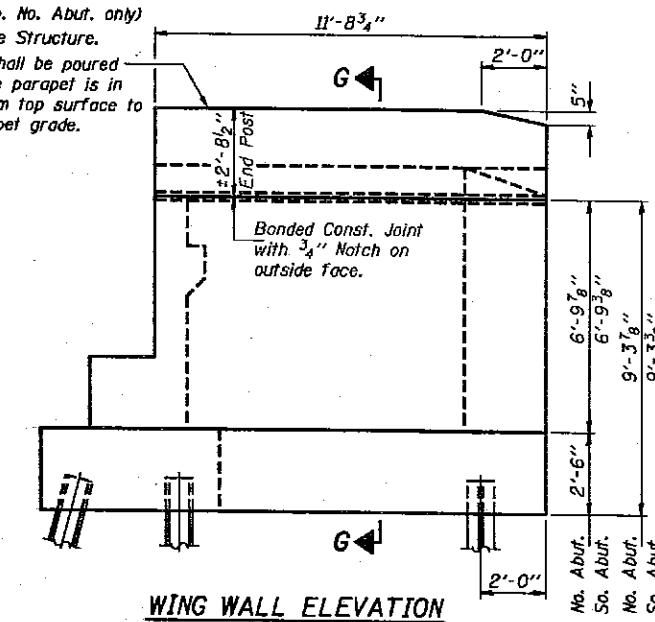
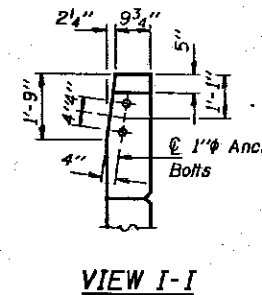
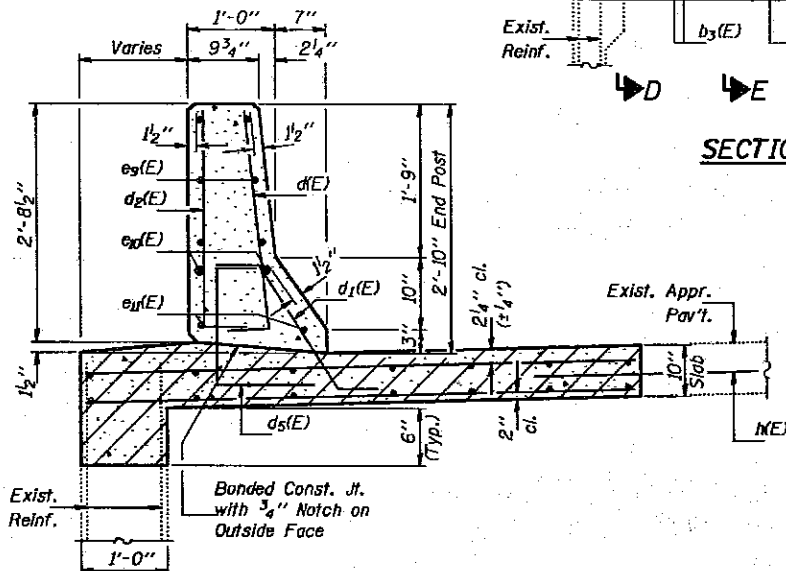


**TWO ABUTMENTS  
BILL OF MATERIAL**

Bar	No.	Size	Length	Shape
d <sub>2</sub> (E)	22	#5	15'-6"	
b <sub>3</sub> (E)	36	#5	11'-5"	
d(E)	26	#5	3'-0"	
d <sub>1</sub> (E)	18	#5	2'-7"	
d <sub>2</sub> (E)	24	#4	3'-0"	
d <sub>3</sub> (E)	24	#4	4'-0"	
d <sub>4</sub> (E)	6	#5	2'-7"	
d <sub>7</sub> (E)	32	#4	4'-0"	
e <sub>9</sub> (E)	12	#4	11'-5"	
e <sub>10</sub> (E)	4	#8	11'-5"	
e <sub>11</sub> (E)	4	#5	11'-5"	
h(E)	64	#5	3'-0"	
h <sub>1</sub> (E)	32	#5	6'-7"	
h <sub>2</sub> (E)	8	#6	39'-3"	
h <sub>3</sub> (E)	6	#5	8'-3"	
h <sub>4</sub> (E)	26	#4	11'-5"	
h <sub>5</sub> (E)	18	#4	11'-5"	
n(E)	20	#6	9'-4"	
n <sub>1</sub> (E)	12	#6	4'-8"	
p(E)	14	#7	5'-5"	
p <sub>1</sub> (E)	12	#7	15'-0"	
s(E)	10	#4	9'-5"	
s <sub>1</sub> (E)	30	#4	9'-5"	
t(E)	16	#5	5'-3"	
u(E)	80	#5	1'-11"	
v(E)	20	#5	5'-11"	
v <sub>1</sub> (E)	20	#5	4'-0"	
v <sub>2</sub> (E)	10	#5	5'-6"	
v <sub>3</sub> (E)	24	#6	9'-1"	
v <sub>4</sub> (E)	12	#5	2'-0"	
v <sub>5</sub> (E)	18	#6	9'-1"	
v <sub>6</sub> (E)	6	#6	8'-8"	
w(E)	24	#5	9'-3"	
Class X Concrete		Cu. Yds.	22.2	
Reinforcement Bars (Epoxy Coated)		Lbs.	5,230	
Steel Piles HP12 x 53		Lin. Ft.	208	
Test Piles Steel HP12 x 53		Each	2	
Structure Excavation		Cu. Yds.	114	

For details of bars d(E) thru d<sub>2</sub>(E) see sheet #6 of 22.

**ABUTMENT DETAILS**  
F.A.I. RT. 57 SEC. (28-5B)D  
FRANKLIN COUNTY  
STA. 44+49.00

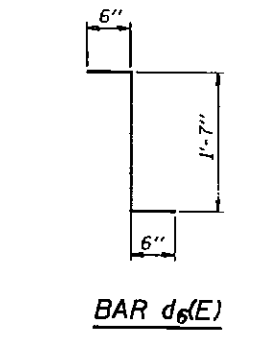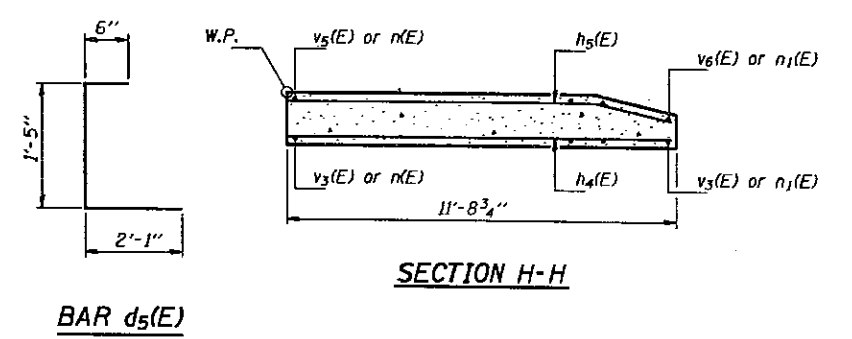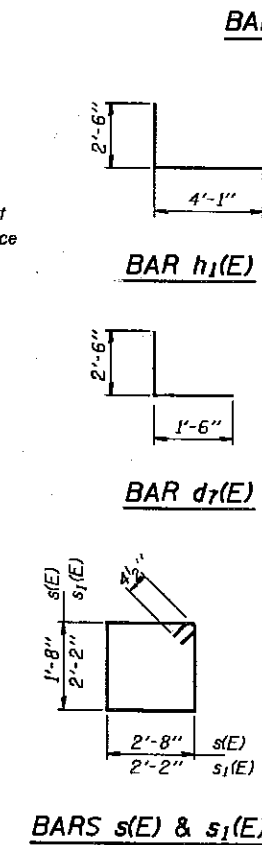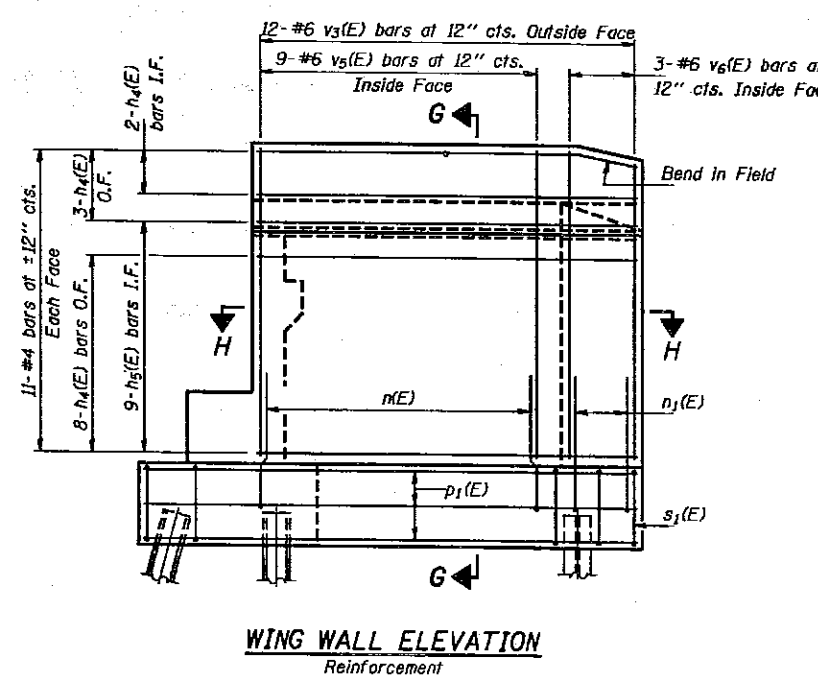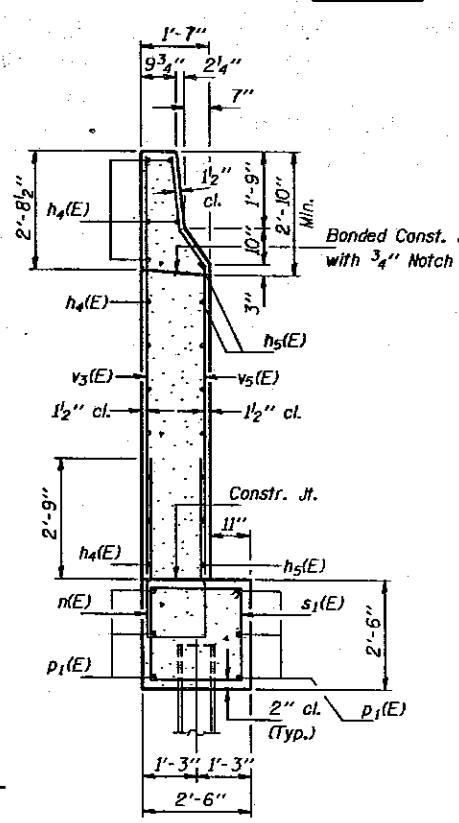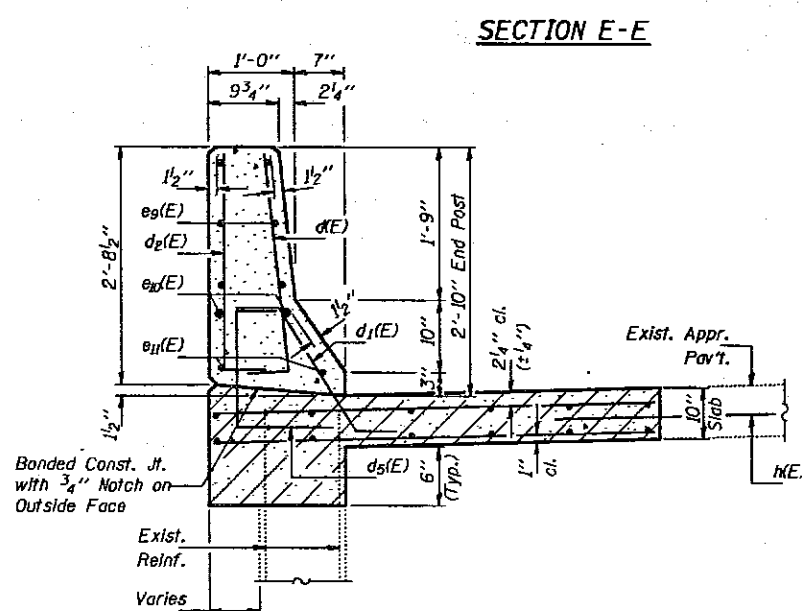

DESIGNED *John F. Schneller Jr.*  
CHECKED *Michael A. Hoffmann*  
DRAWN *John F. Schneller Jr.*  
CHECKED *GRA*

EXAMINED *David J. Kasper*  
DESIGNER OF BRIDGE DESIGN  
PASSED *Ralph E. Anderson*  
APPROVED  
DIRECTOR OF HIGHWAYS

May 22 1982



STATE OF ILLINOIS  
DEPARTMENT OF TRANSPORTATION









ROUTE NO.	SECTION	COUNTY	SERIAL	"SHEET"	SHEET NO. 20
F.A.I. 57	(28-5B) D	FRANKLIN	155	104	22 SHEETS
FED. ROAD DIST. NO. 7	BLDG. NO.	PAVING PROJECT			

Notes: For Anchor Bolt installation details see sheet #16 of 22.

\* Drill  $7/8"$   $\phi$  x 9" Min. hole. Epoxy grout  $h_6(E)$  bars. Use a grout approved by the Department or epoxy grout in accordance with BSP-11. The method of grout application shall be approved by the Engineer. See Special Provisions.

**PILE DATA**

Type: Steel (HP12 x 74)  
Capacity: Drive to Refusal  
Est. Length: 47 Ft. Pier #1  
Est. Length: 61 Ft. Pier #4  
No. Req'd: 1 Each Pier

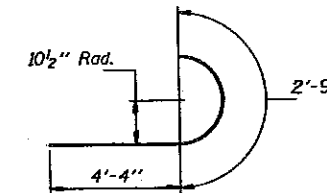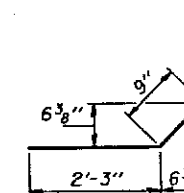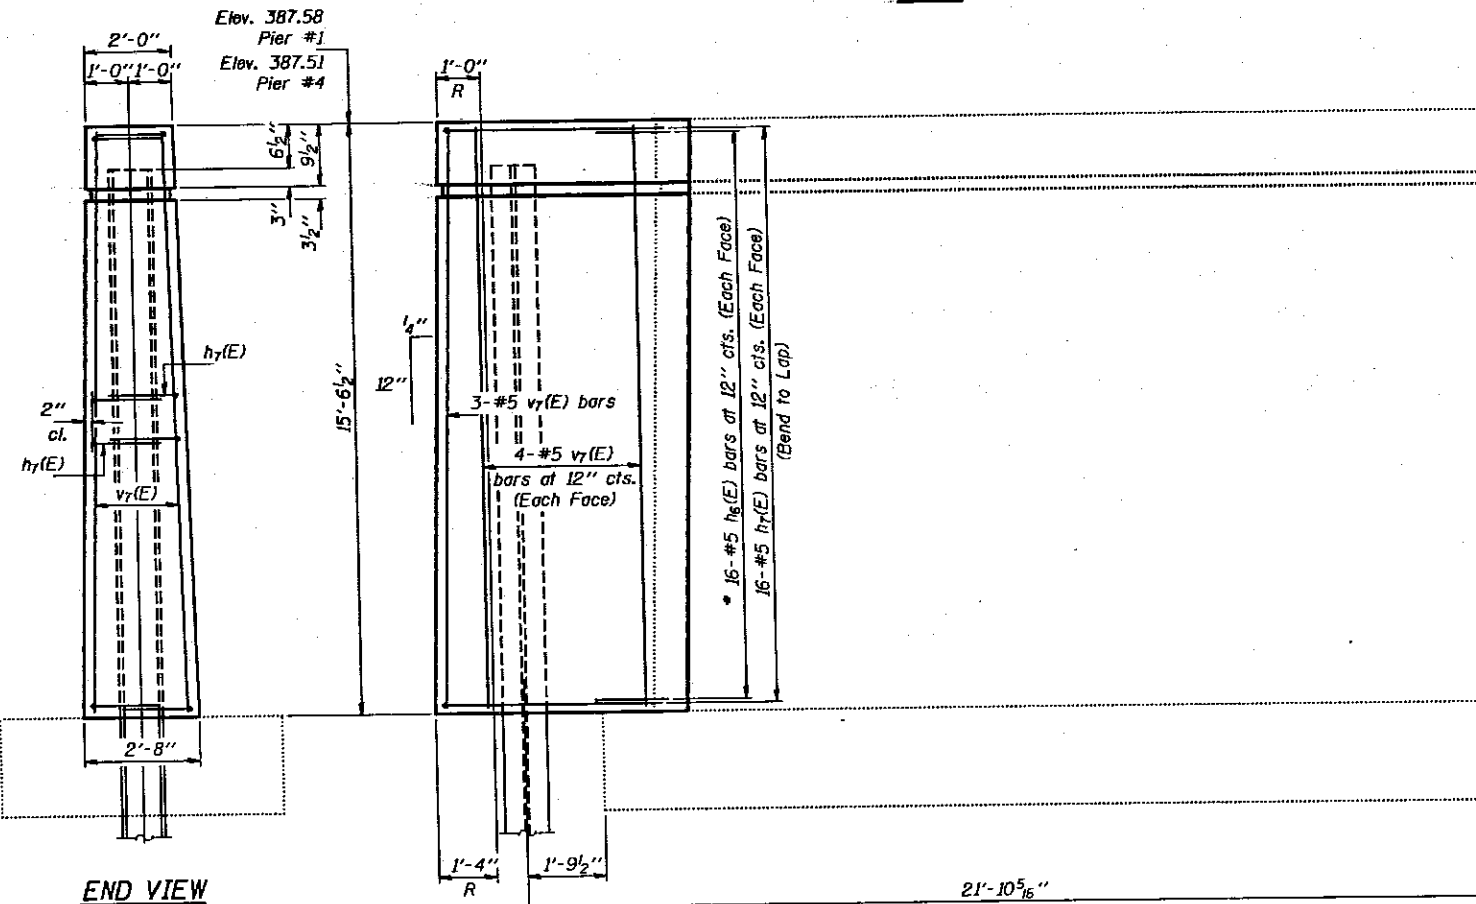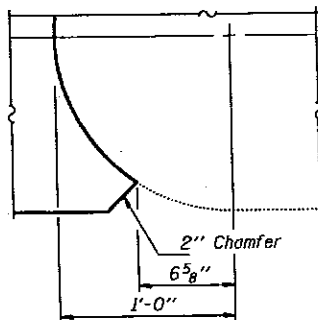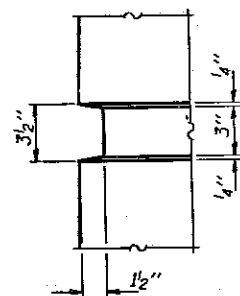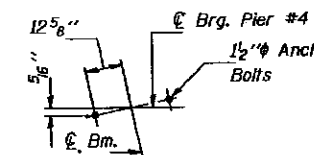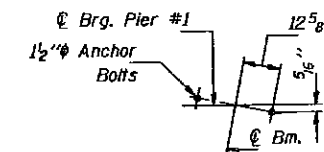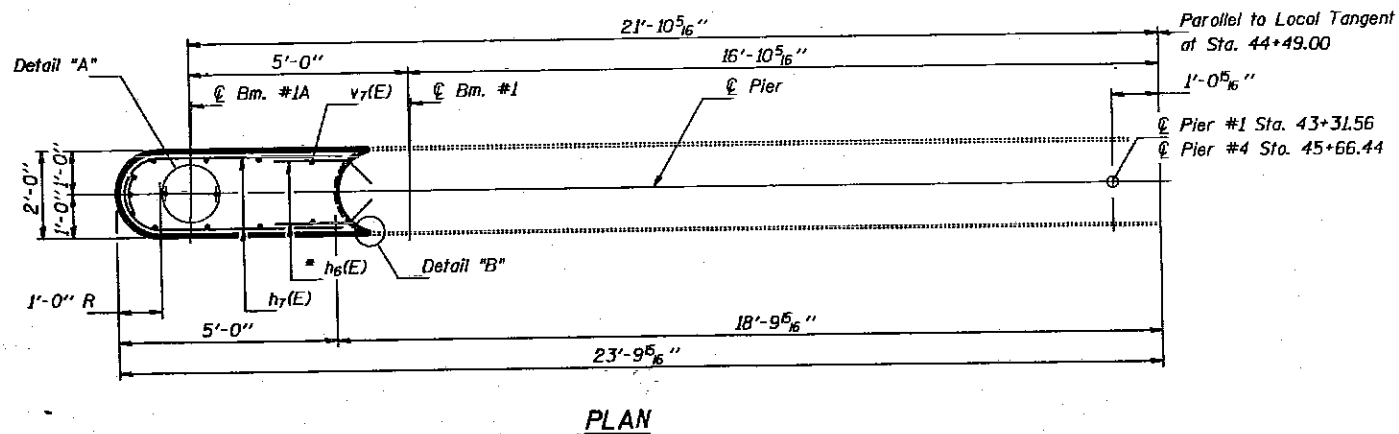

**BILL OF MATERIAL**

Bar	No.	Size	Length	Shape
h <sub>6</sub> (E)	64	#5	3'-0"	—
h <sub>7</sub> (E)	64	#5	7'-1"	—
v <sub>7</sub> (E)	22	#5	15'-3"	—
Class X Concrete		Cu. Yd.	13.4	
Reinforcement Bars, Epoxy Coated		Lbs.	1,020	
Structure Excavation		Cu. Yd.	13	
Steel Piles HP12 x 74		L.in. Ft.	108	

Reinforcement Bars designated (E) shall be epoxy coated.

**ELEVATION**  
(Looking South)

DESIGNED *[Signature]*  
CHECKED MICHAEL ABITO GUN  
DRAWN John F. Schneller Jr.  
CHECKED *[Signature]* GFA

EXAMINED *[Signature]* May 22 1992  
PASSED *[Signature]*  
APPROVED *[Signature]*  
DIRECTOR OF HIGHWAYS

PIERS #1 & #4  
F.A.I. RT. 57 SEC. (28-5B)D  
FRANKLIN COUNTY  
STA. 44+49.00

STATE OF ILLINOIS  
DEPARTMENT OF TRANSPORTATION









ROUTE NO.	SECTION	COUNTY	MILES	POST	SHEET NO. 21
F.A.I. 57	(28-5B) D	FRANKLIN	155	105	22 SHEETS
F.A.I. FORM 501, REV. 7-78		BLANK	F.A.I. PROJ. NO.		

Notes: For Anchor Bolt Installation details see sheet #16 of 22.

\* Drill  $7/8"$   $\phi$  x 9" Min. hole. Epoxy grout  $h_6(E)$  bars. Use a grout approved by the Department or epoxy grout in accordance with BSP-11. The method of grout application shall be approved by the Engineer. See Special Provisions.

**PILE DATA**

Type: Steel (HP12 x 74)  
Capacity: Drive to Refusal  
Est. Length: 55 Ft. Pier #2  
Est. Length: 62 Ft. Pier #3  
No. Req'd: 1 Each Pier

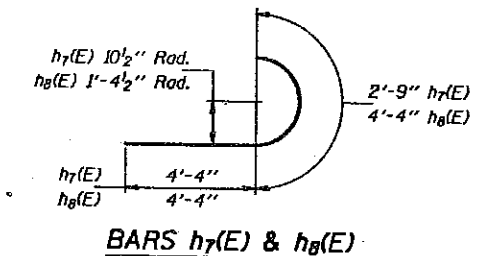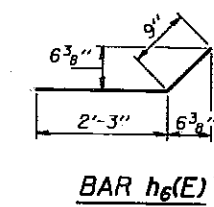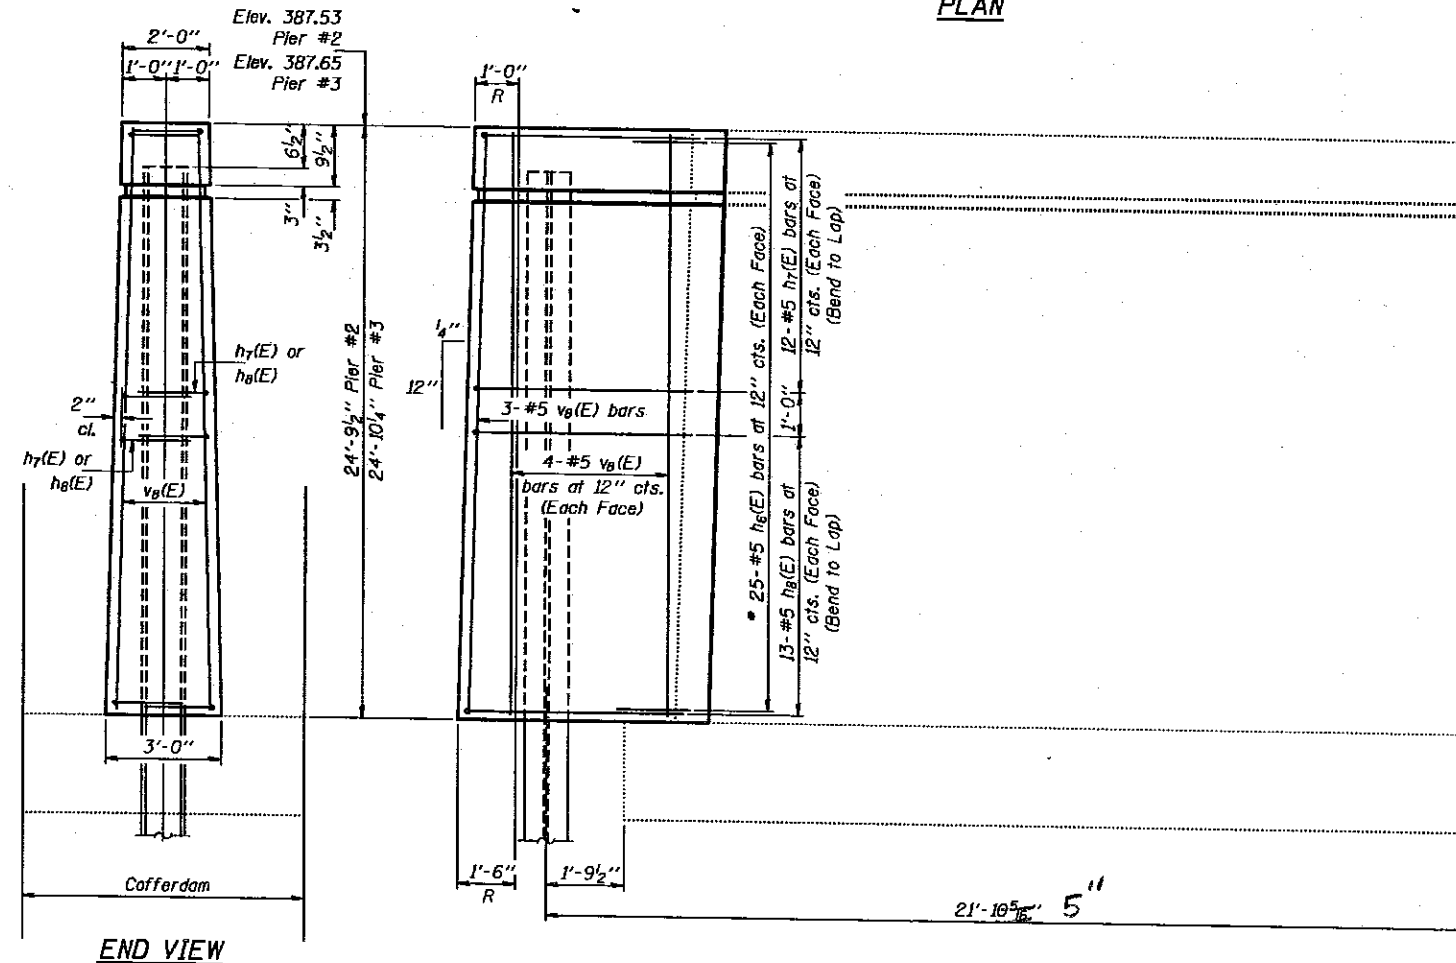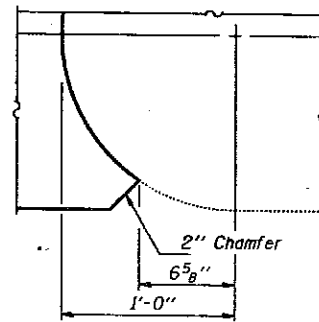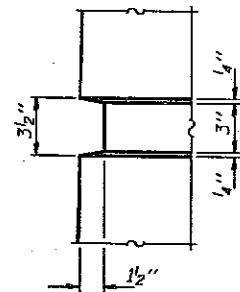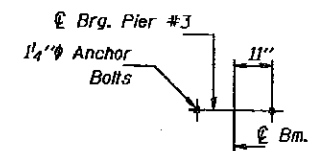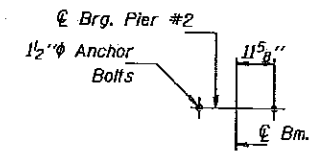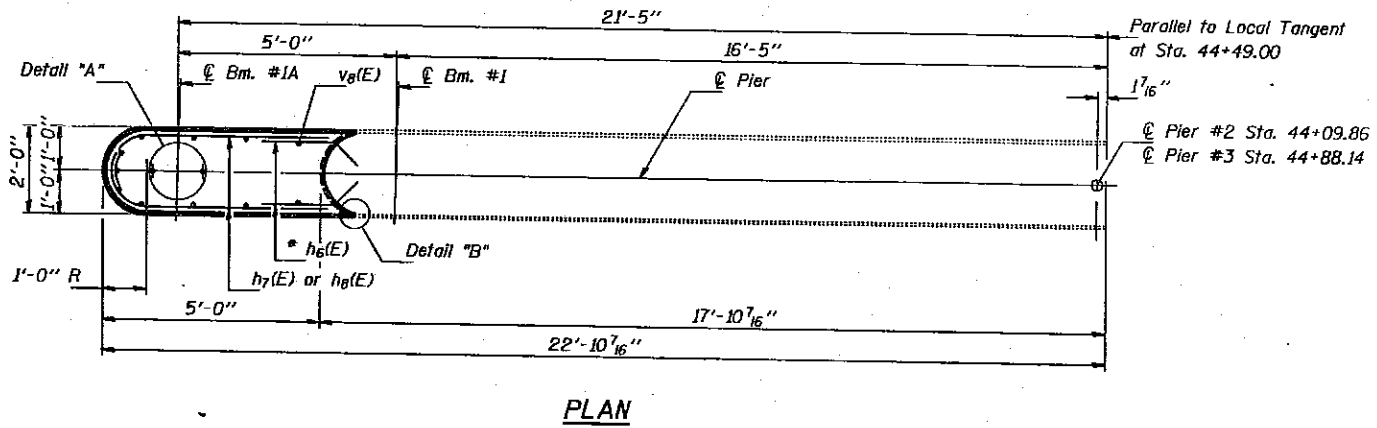

**BILL OF MATERIAL**

Bar	No.	Size	Length	Shape
$h_6(E)$	100	#5	3'-0"	—
$h_7(E)$	48	#5	7'-1"	—
$h_8(E)$	52	#5	8'-8"	—
$v_8(E)$	22	#5	24'-6"	—
Class X Concrete			Cu. Yd.	23.0
Reinforcement Bars, Epoxy Coated			Lbs.	1,700
Cofferdams			Each	2
Cofferdam Excavation			Cu. Yd.	52
Steel Piles HP12 x 74			Lin. Ft.	117





PIERS #2 & #3  
F.A.I. RT. 57 SEC. (28-5B)D  
FRANKLIN COUNTY  
STA. 44+49.00

DESIGNED *Michael Abitocun*  
CHECKED MICHAEL ABITOCUN  
DRAWN John F. Schneller Jr.  
CHECKED *John F. Schneller Jr.*

EXAMINED *May 22 1992*  
PASSED *Ralph E. Anderson*  
APPROVED \_\_\_\_\_  
DIRECTOR OF HIGHWAYS

STATE OF ILLINOIS  
DEPARTMENT OF TRANSPORTATION

ROUTE NO.	SECTION	COUNTY	SHEET	DATE	SHEET NO.
F.A.I. 57	(28-5B) D	FRANKLIN	155	106	22 SHEETS
FED. ROAD DIST. NO. 1	PROJECT	FED. AID PROJECT			

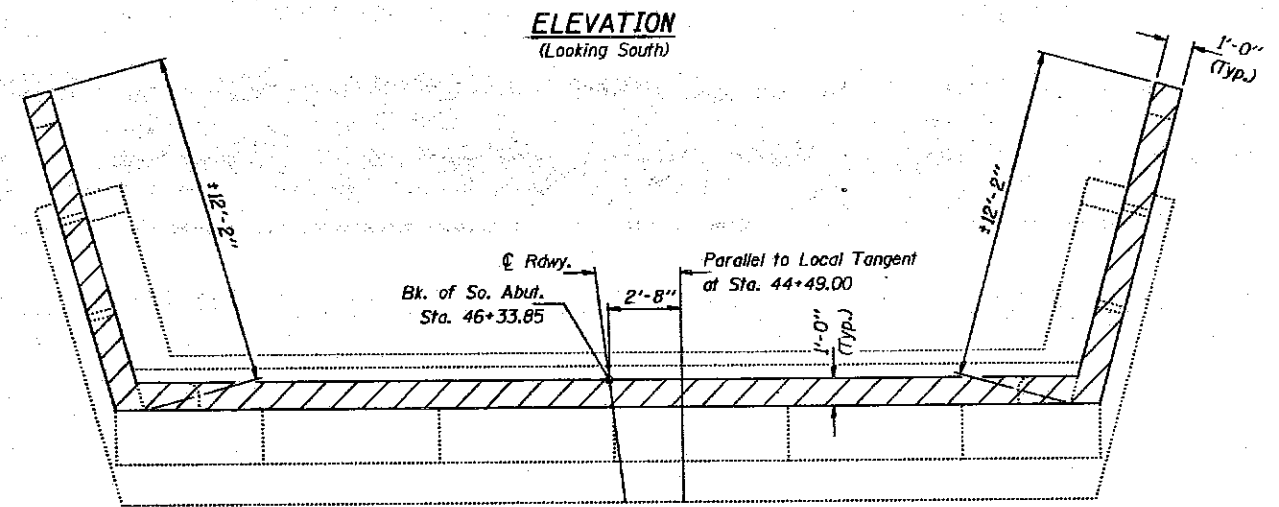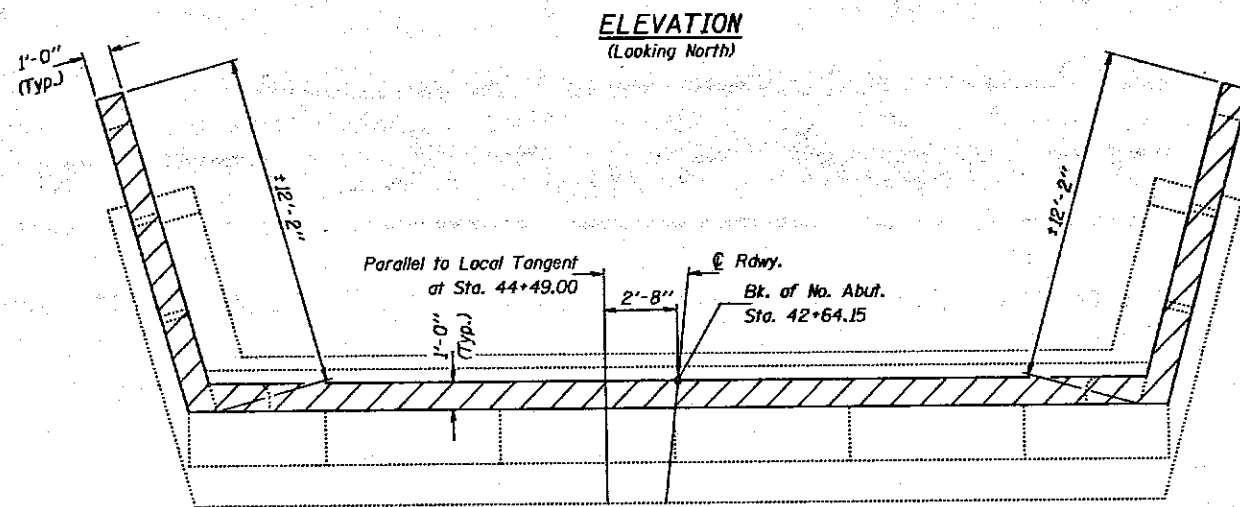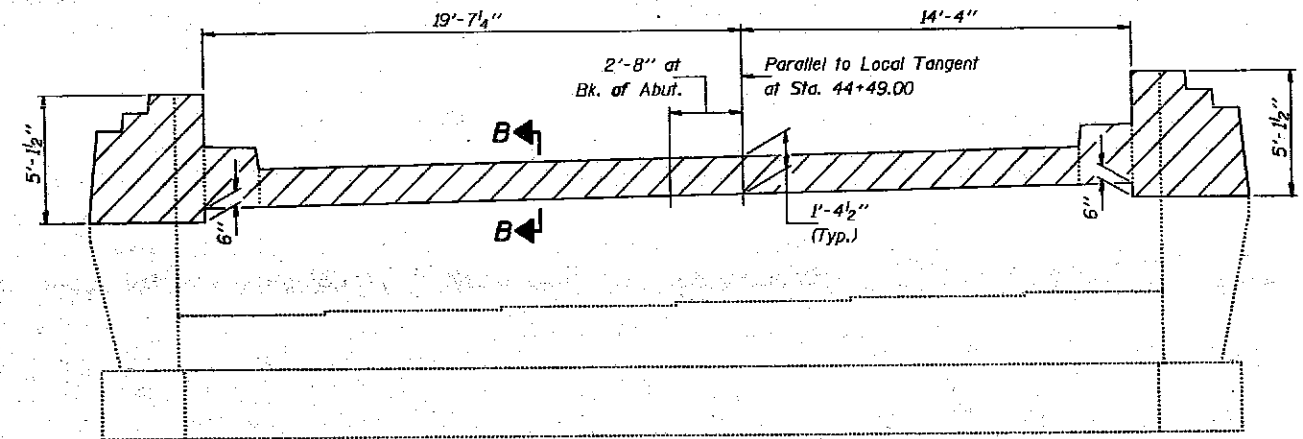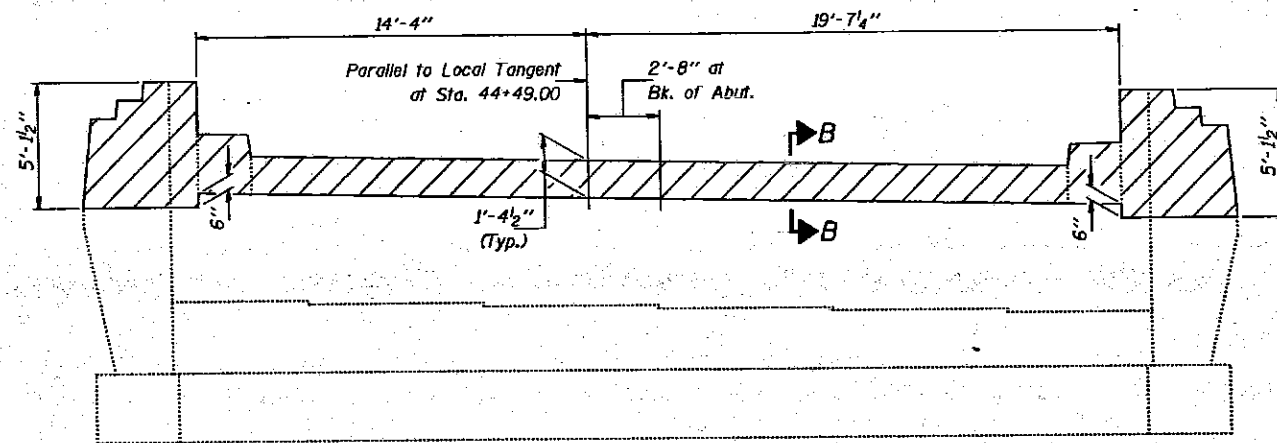


ELEVATION  
(Looking North)

ELEVATION  
(Looking South)

PLAN

PLAN

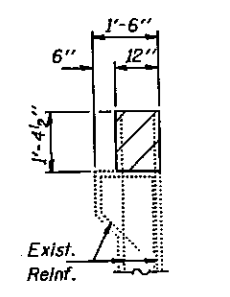

SECTION B-B

Notes: Hatched area indicates "Concrete Removal".  
Existing reinforcement extending into new construction shall be cleaned, straightened, and incorporated into new construction. Cost incidental to "Concrete Removal".  
Existing reinforcement not extending into new construction shall be cut off flush and covered with a 2" layer of cement grout. Cost incidental to "Concrete Removal".  
For existing shoulder pavement removal see Roadway Plans.

BILL OF MATERIAL

ITEM	UNIT	TOTAL
Concrete Removal	Cu. Yd.	12

CONCRETE REMOVAL  
F.A.I. RT. 57 SEC. (28-5B)D  
FRANKLIN COUNTY  
STA. 44+49.00

DESIGNED *James Baker*  
CHECKED MICHAEL ABIDGUN  
DRAWN John F. Schneller Jr.  
CHECKED *AB* *GPA*

EXAMINED *May 22 1972*  
*Ray D. Kaspar*  
ENGINEER OF BRIDGE DESIGN



PASSED *Ralph E. Anderson*  
ENGINEER OF BRIDGES AND STRUCTURES

APPROVED \_\_\_\_\_  
DIRECTOR OF HIGHWAYS





F.A.I. RTE.	SECTION	COUNTY	TOTAL SHEETS	SHEET NO.
57	*	FRANKLIN	155	107
STA.	TO STA.			
FED. ROAD DIST. NO.	STATE	FED. AID PROJECT		
* 28 (5B-1, 5B, 2B, 1B) D ; 28 (5VB, 3VB) I				

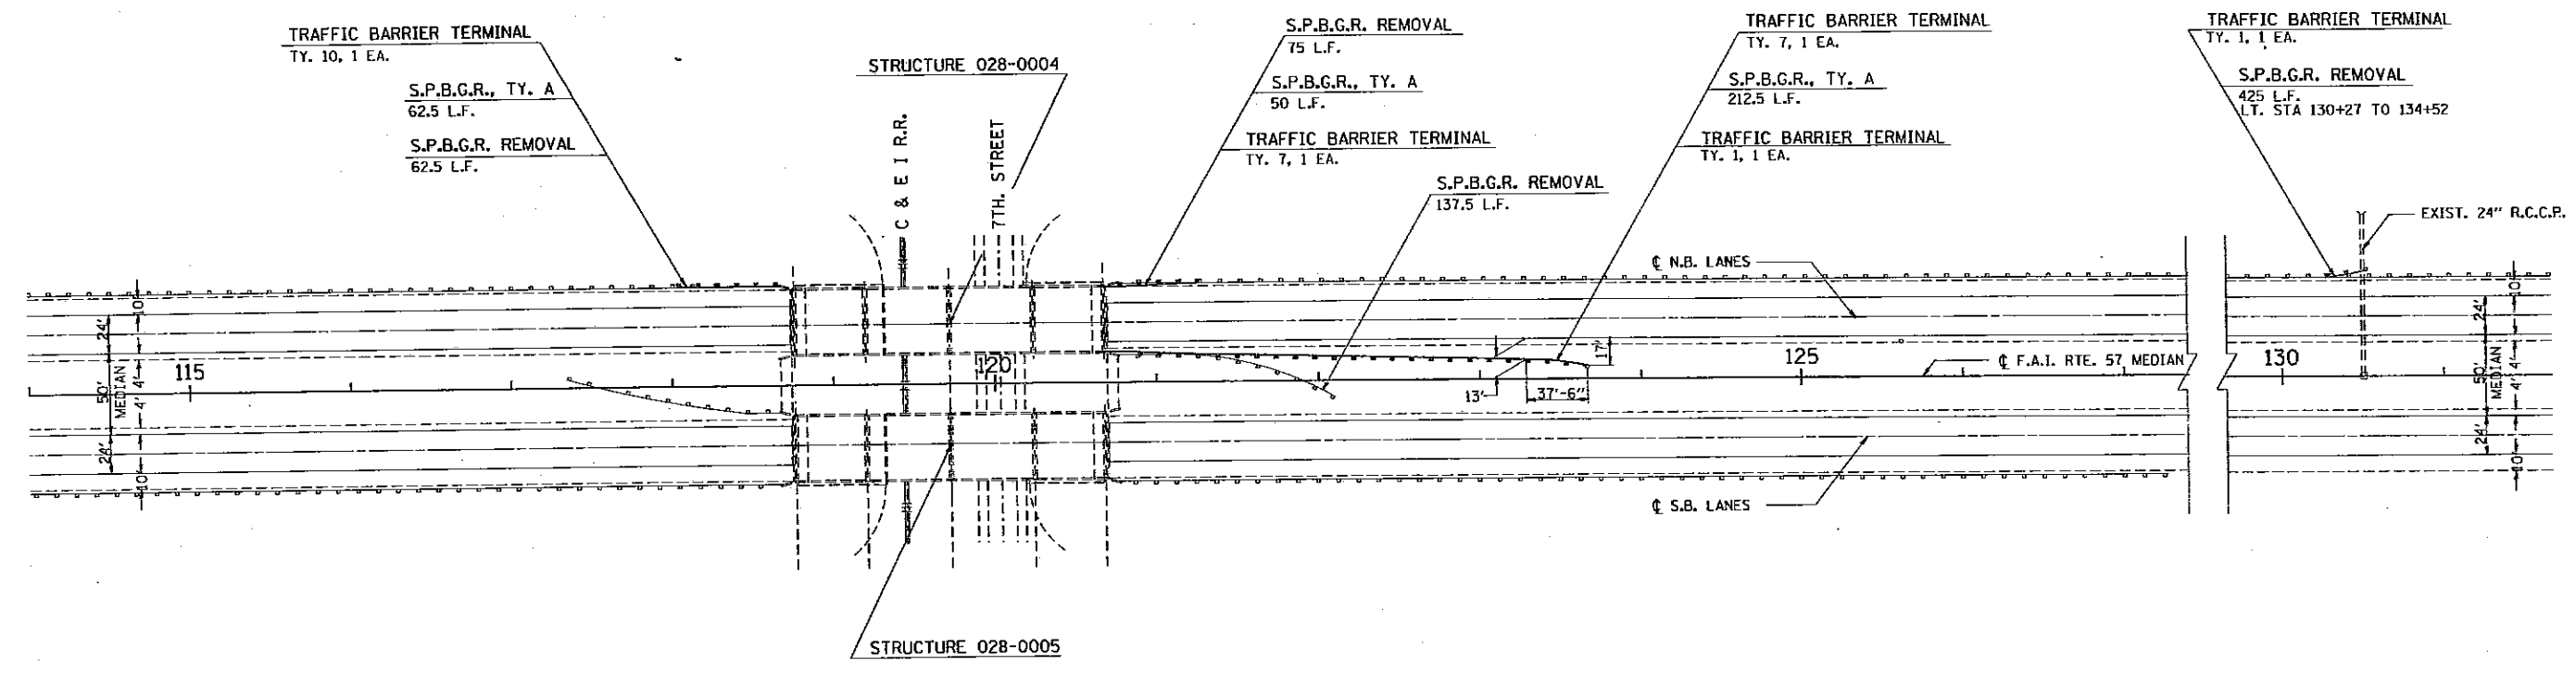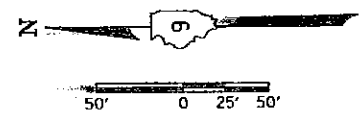

F.A.I. 57 OVER C & E I RAILROAD  
AND 7TH STREET  
CONSTRUCTION ALONG NORTHBOUND LANES  
(NORTHBOUND CONTRACT)

NO. 407 28 0102541 1992  
FRANKLIN COUNTY  
CONTRACT NO. 28 (5VB, 3VB) I  
VIEW C&EIR NORTH

50 40 30 20 10 1 10 20 30 40 50

ROUTE NO.	SEC.	COUNTY	TOTAL SHEETS	SHEET NO.
F.A. 57	*	FRANKLIN	155	108

FED. ROAD DIST.	ILLINOIS	PROJECT
7		

FINAL SURVEY NOTE BOOK


DATE: \_\_\_\_\_ BY: \_\_\_\_\_

NO. \_\_\_\_\_

FINAL SURVEY NOTE BOOK

DATE: \_\_\_\_\_ BY: \_\_\_\_\_

NO. \_\_\_\_\_

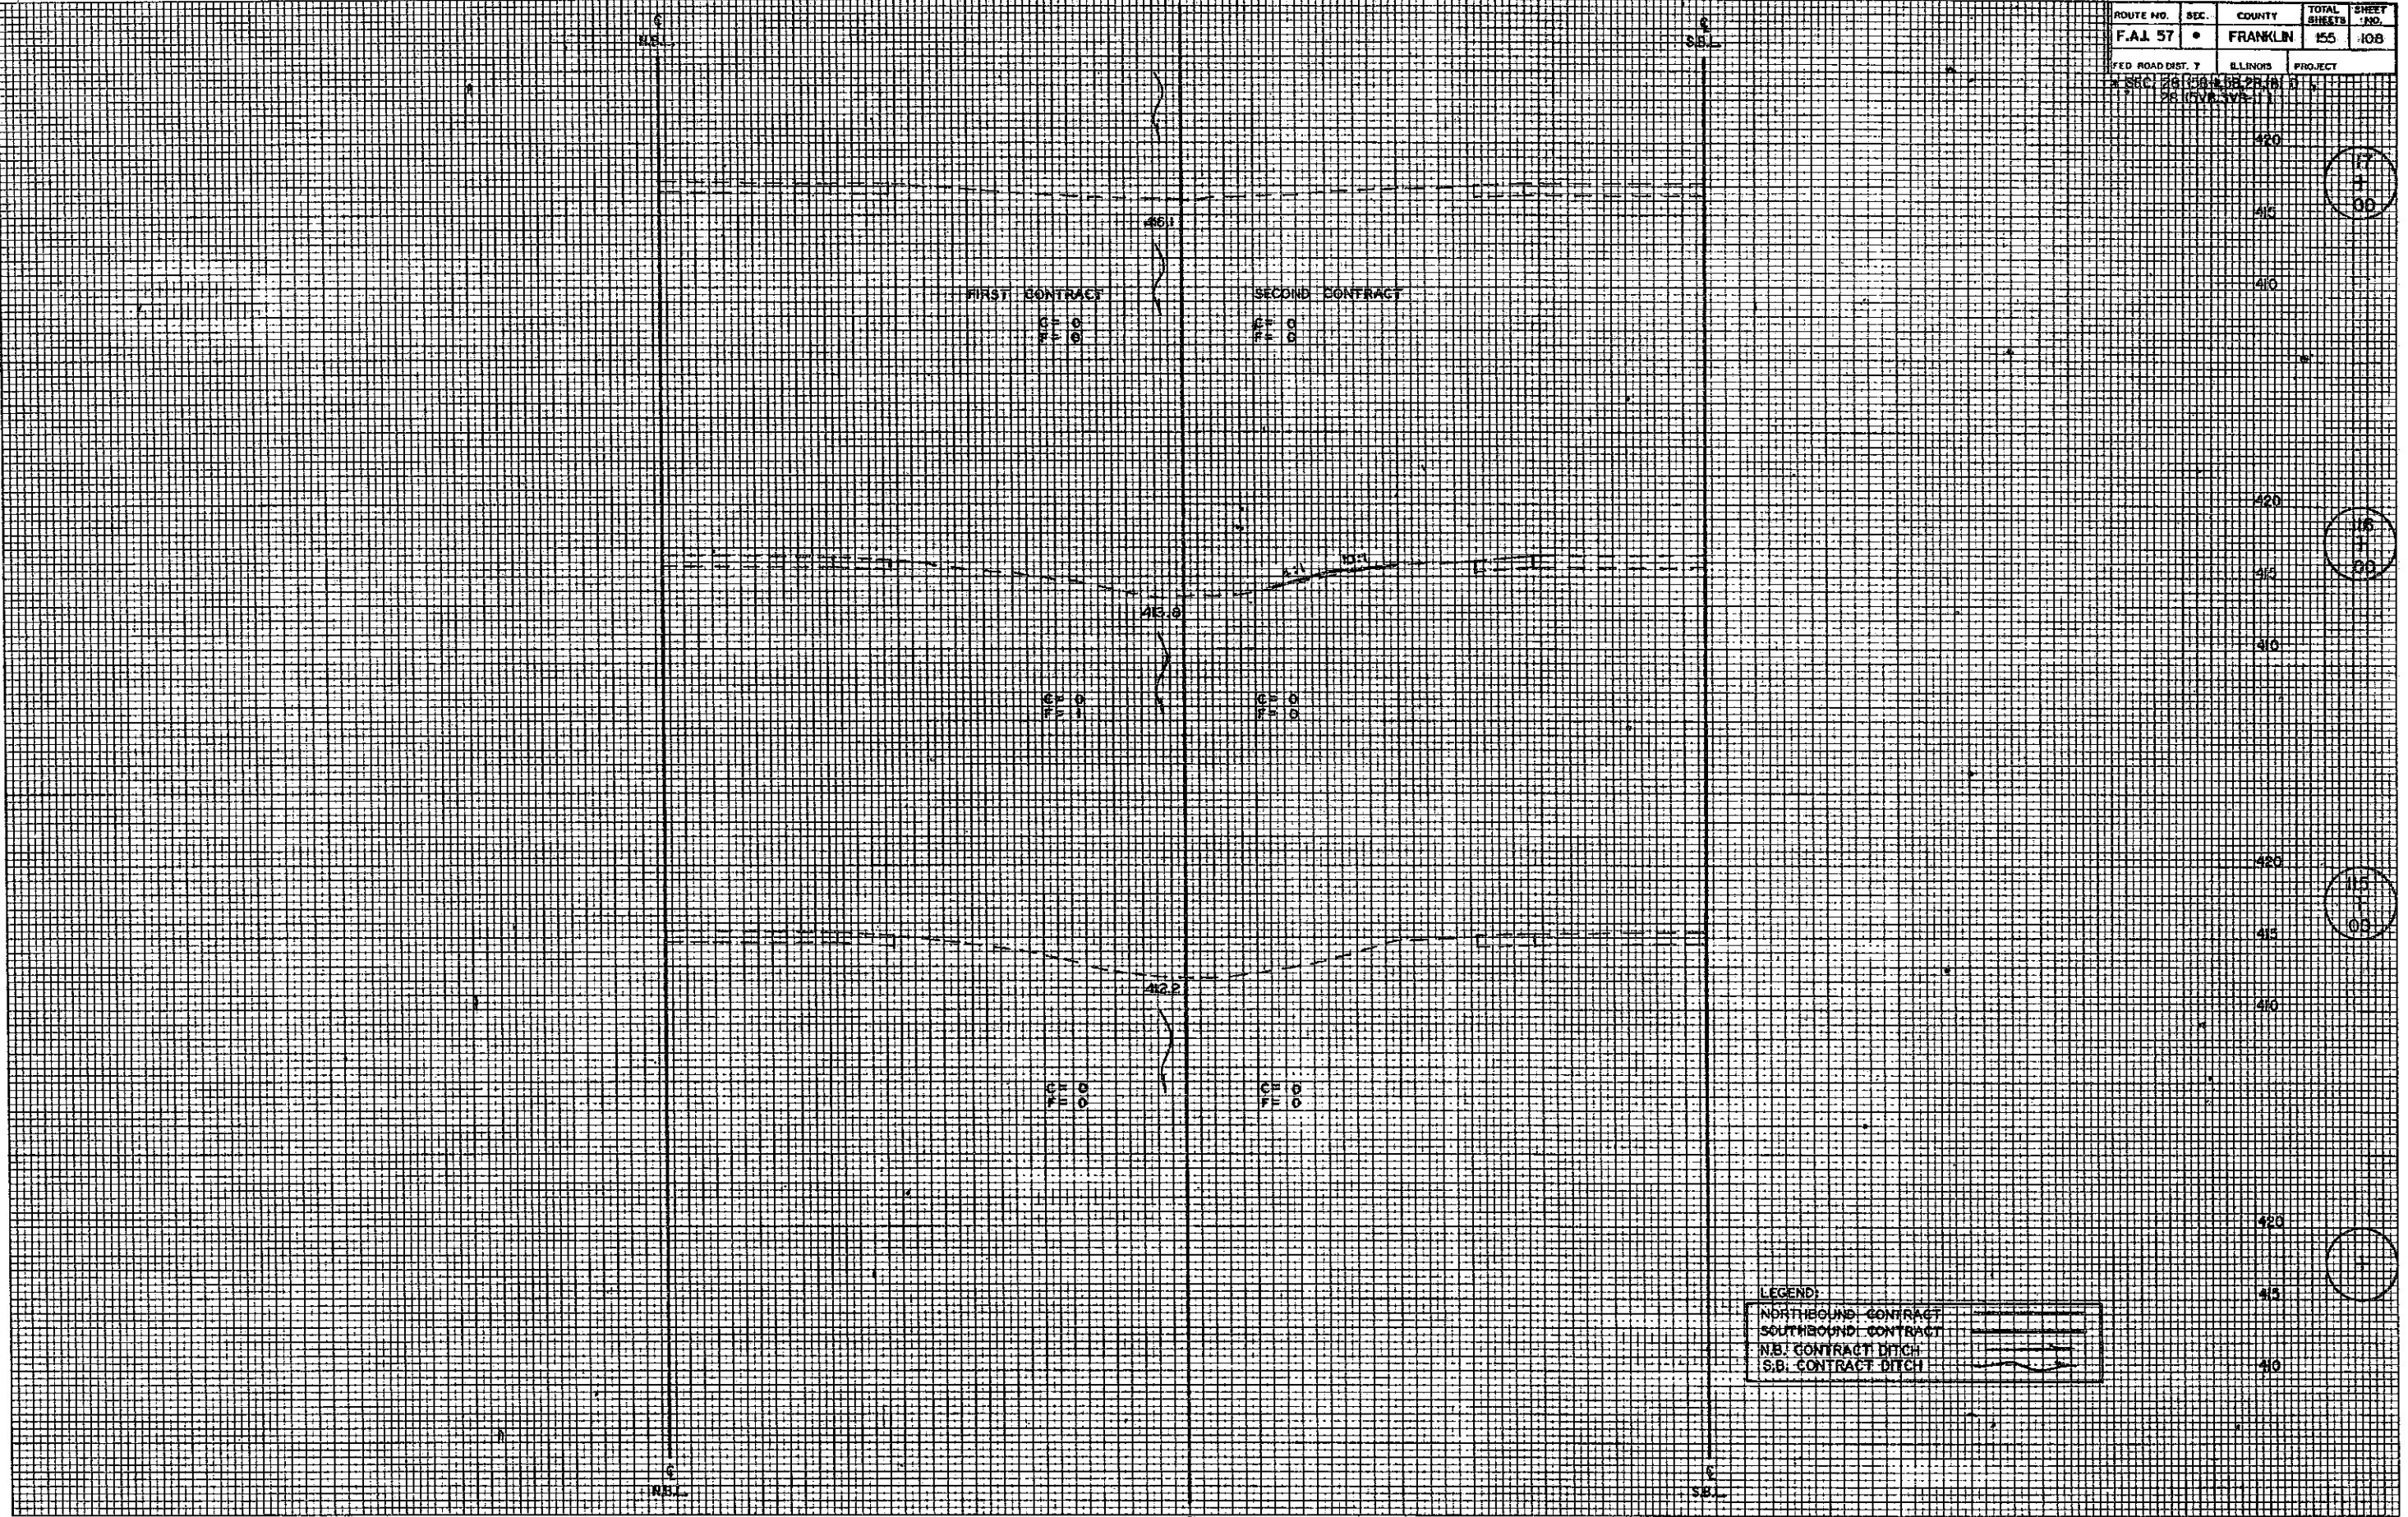

FIRST CONTRACT

SECOND CONTRACT

CP 0  
FP 0

CP 0  
FP 0

CP 0  
FP 1

CP 0  
FP 0

CP 0  
FP 0

CP 0  
FP 0

LEGEND:

NORTHBOUND CONTRACT	
SOUTHBOUND CONTRACT	
N.B. CONTRACT DITCH	
S.B. CONTRACT DITCH	




50 40 30 20 10 10 20 30 40 50

ROUTE NO.	SEC.	COUNTY	TOTAL SHEETS	SHEET NO.
F.A.I. 57	*	FRANKLIN	155	109
FED. ROAD DIST. 7		ILLINOIS	PROJECT	
SEC. 20, 58, 59, 60, 61, 62			201540, 201541, 201542	

DATE	
BY	
REVISION	
PLANNING	
DESIGN	
CONSTRUCTION	
OPERATION	
MAINTENANCE	
NO. _____	

DATE	
BY	
REVISION	
PLANNING	
DESIGN	
CONSTRUCTION	
OPERATION	
MAINTENANCE	
NO. _____	

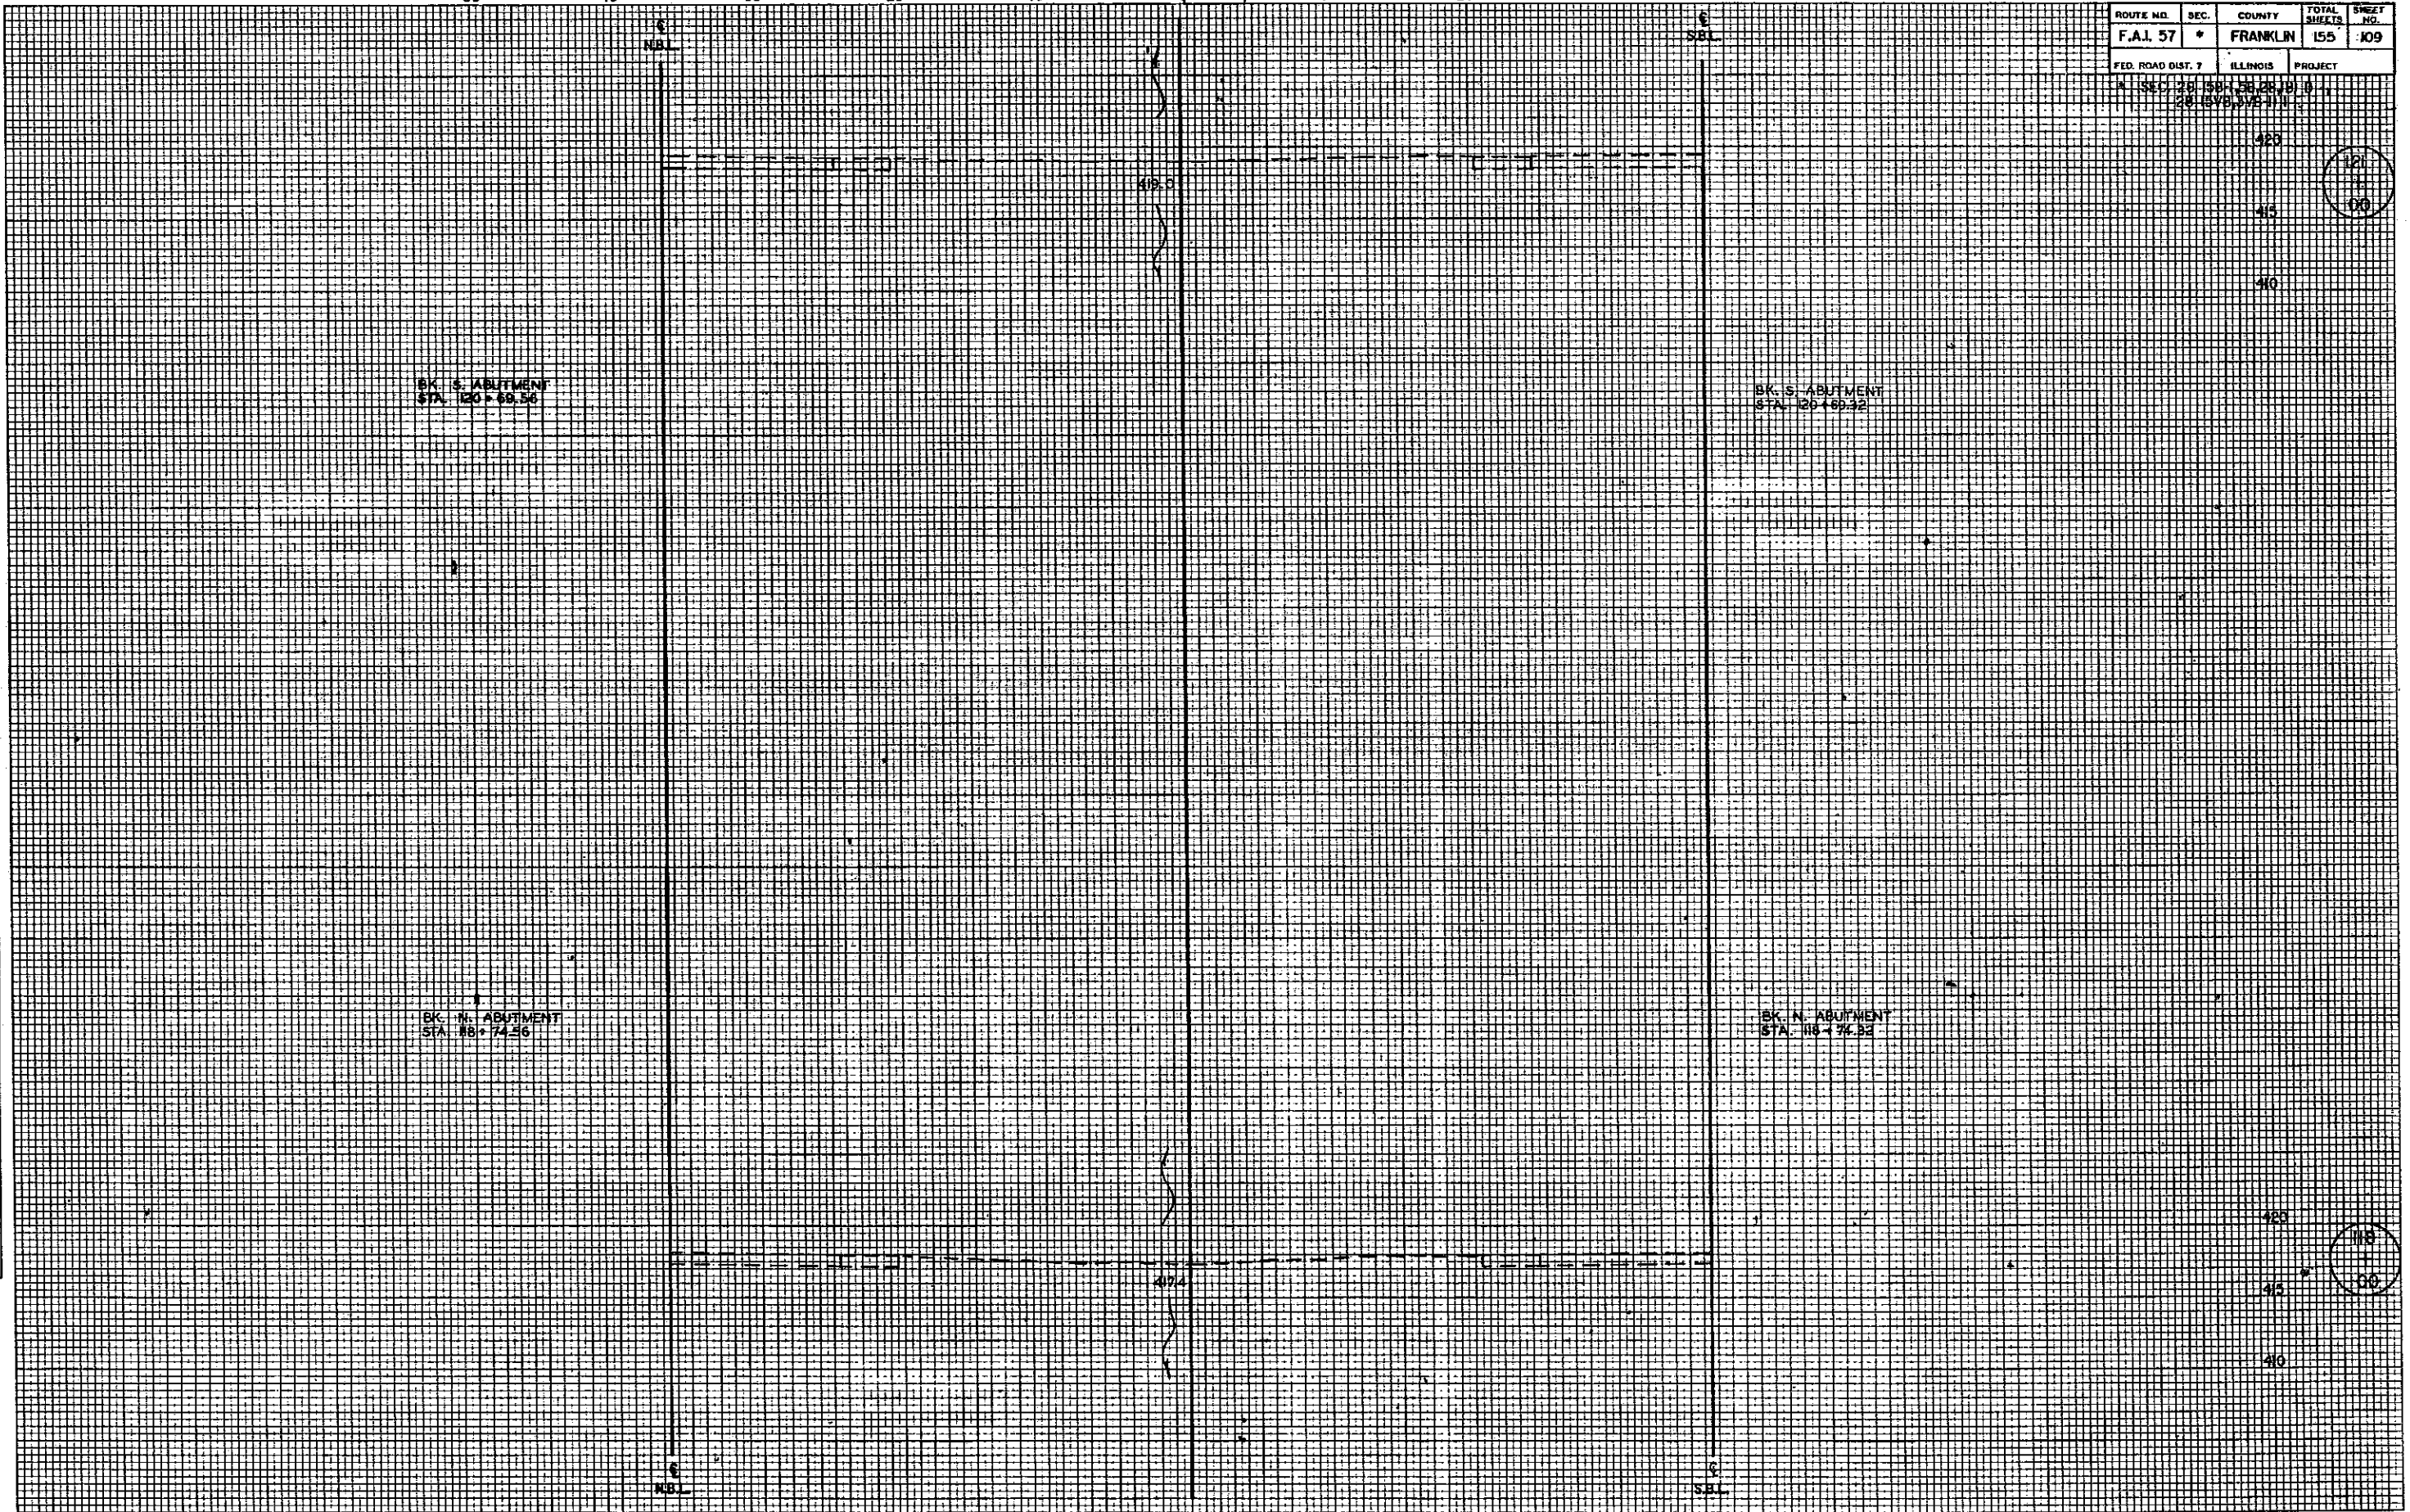

121  
109

118  
109

PLATE 3 CROSS SECTION D. P. R. E. STANDARD  
DETROIT CORPORATION

C. & E. I. R. R. & 7TH ST.



50 40 30 20 10 10 20 30 40 50


ROUTE NO.	SEC.	COUNTY	TOTAL SHEETS	SHEET NO.
F.A.I. 57	*	FRANKLIN	155	110
FED. ROAD DIST. 7		ILLINOIS	PROJECT	
SEC. 26, 30, 33, 36, 6267,				

STATE OF ILLINOIS  
DEPARTMENT OF TRANSPORTATION


ROUTE NO.	SECTION	COUNTY	SHEET	SHEET NO. 1
F.A.I. 57		FRANKLIN	155	III
FED. ROAD DIST. NO. 1		ILL. PROJ. NO.		FED. PROJ. NO.
				2 SHEETS

**GENERAL NOTES**


Reinforcement bars shall conform to the requirements of AASHTO M-31, M-42 or M-53 Grade 60.  
 Traffic control shall be determined by the District.  
 Prior to pouring the new concrete for the deck, all loose rust, loose mill scale, and all other foreign material shall be removed from the embedded portions of flanges of girders. The removal shall be accomplished in accordance with the requirements of the SSPC Surface Preparation Specifications SP11 for Power Tool Cleaning or SP2 for Hand Tool Cleaning. Cost shall be incidental to Concrete Removal.  
 Plan dimensions and details relative to existing structure have been taken from existing plans and are subject to nominal construction variations. It shall be the Contractor's responsibility to verify such dimensions and details in the field and make necessary approved adjustments prior to construction or ordering of materials. Such variations shall not be cause for additional compensation for a change in the scope of the work, however, the Contractor will be paid for the quantity actually furnished at the unit price bid for the work.  
 The first bridge Post and Insert at each corner shall be removed, cleaned and reinstalled in new construction. Cost incidental to "Concrete Removal".  
 After fabrication all surfaces of the steel plates shall be given one shop coat of the zinc-silicate and vinyl paint system. Cost incidental to "Furnishing and Erecting Structural Steel".

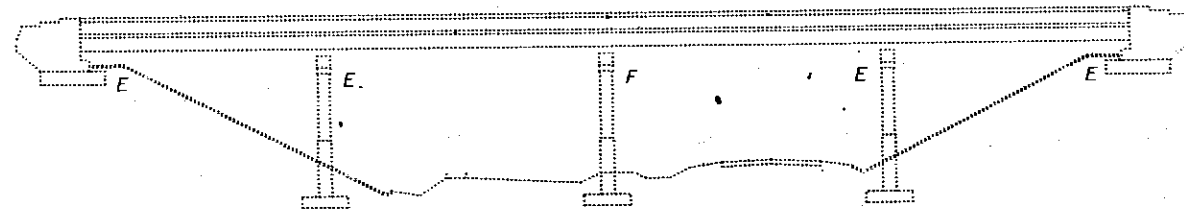

ELEVATION

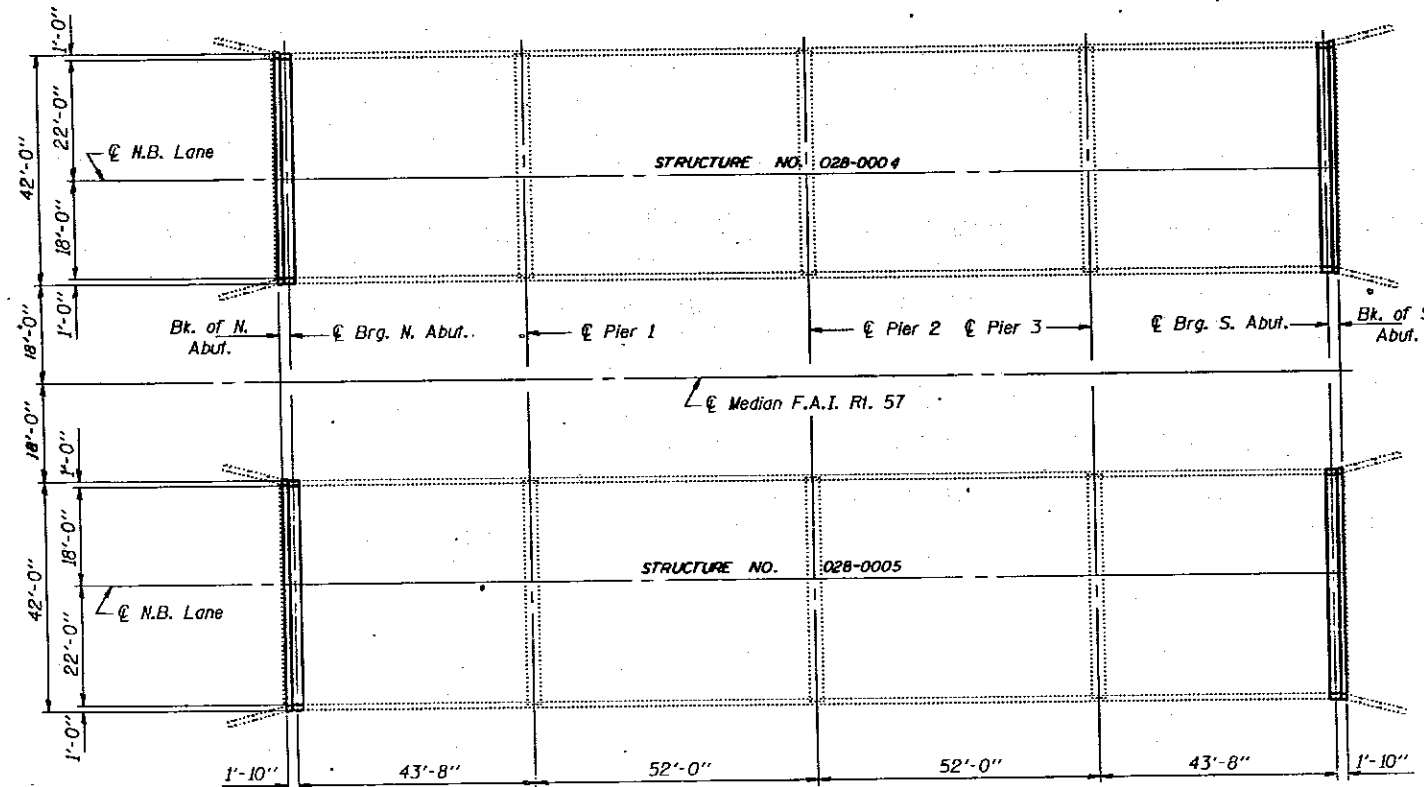

PLAN

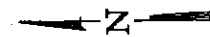

**TOTAL BILL OF MATERIAL**

ITEM	UNIT	QUANTITY
Concrete Removal	Cu. Yd.	20.4
Class X Concrete	Cu. Yd.	19.9
Reinforcement Bars, Epoxy Coated	Pound	2810
Preformed Joint Seal 4"	Lin. Ft.	165
Furnishing and Erecting Structural Steel	Pound	6360

NOTE: QUANTITIES IN THE ABOVE BILL OF MATERIAL ARE FOR BOTH BRIDGES.

DESIGNED <i>Paul Sumner</i>	EXAMINED <i>John E. Adams</i>
CHECKED <i>BRT</i>	PASSED
DRAWN <i>Paul Sumner</i>	APPROVED
CHECKED <i>BRT</i>	


February 7 1992  
 ENGINEER OF STRUCTURAL SERVICES  
 ENGINEER OF BRIDGES AND STRUCTURES  
 DIRECTOR OF HIGHWAYS

**JOINT REPLACEMENT DETAILS**  
 F.A.I. RT. 57 SEC. (28-5VB) I  
 FRANKLIN COUNTY  
 STA. 119+71.94  
 STR. No. 028-0004 & 028-0005




STATE OF ILLINOIS  
DEPARTMENT OF TRANSPORTATION


PROJECT NO.	SECTION	GROUP	DATE	SHEET NO.
F.A.I. 57		FRANKLIN	155	112
SHEET NO. 2				
2 SHEETS				

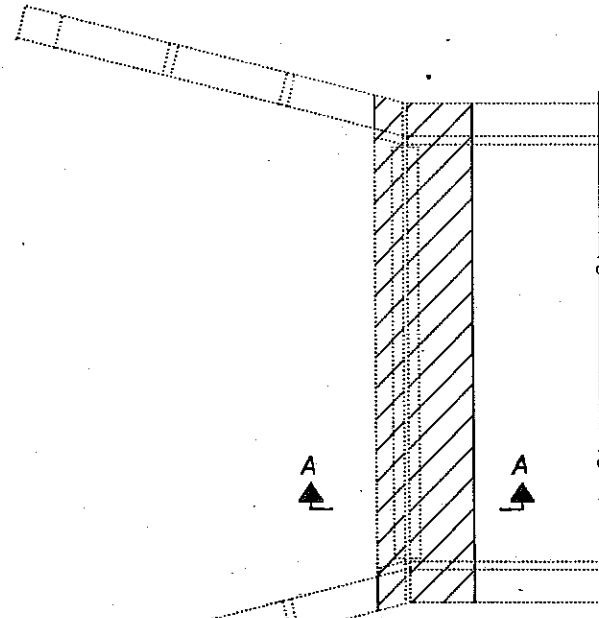

EXISTING PARTIAL PLAN

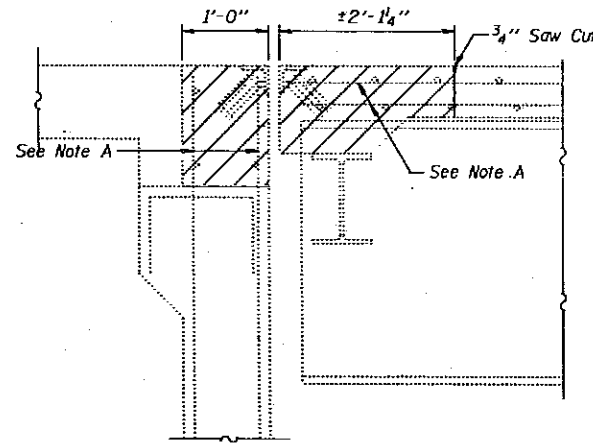


SECTION A-A

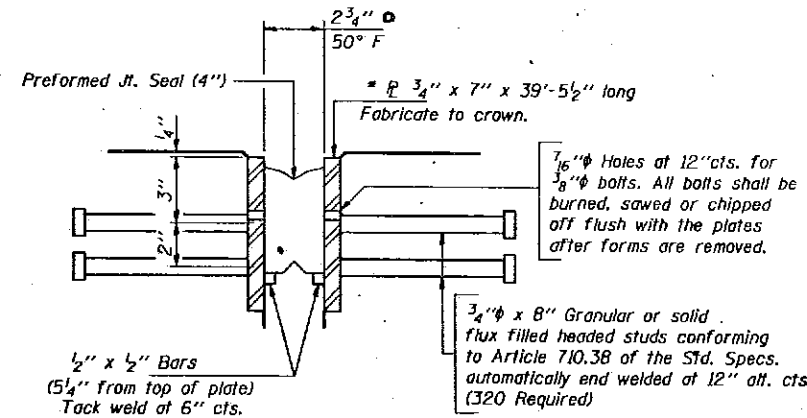


DETAIL A

Furnish in segments of 20 ft. maximum length. Maximum space between installed segments shall be 3/16". Seal space with Silicone Sealant suitable for Structural Steel.


Note A: Existing Reinforcement shall be cleaned, straightened and incorporated into the new construction. Cost incidental to "Concrete Removal."

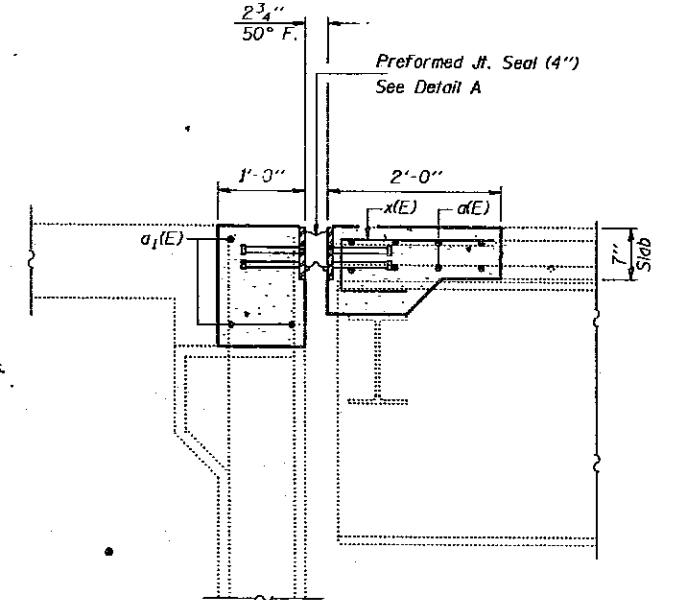


SECTION B-B

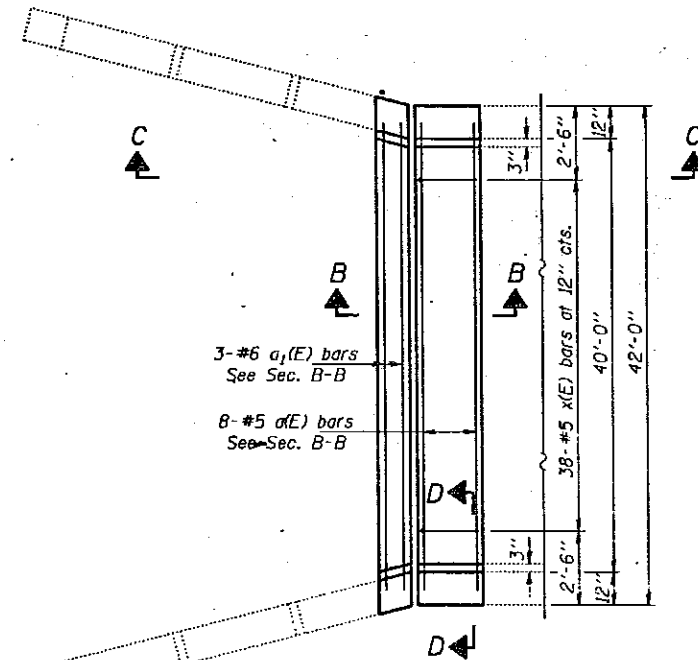


PROPOSED PARTIAL PLAN

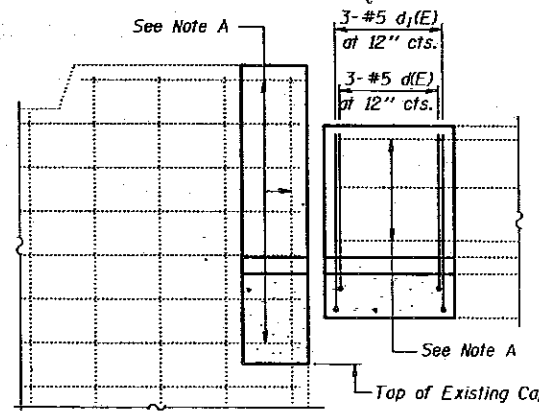


SECTION C-C

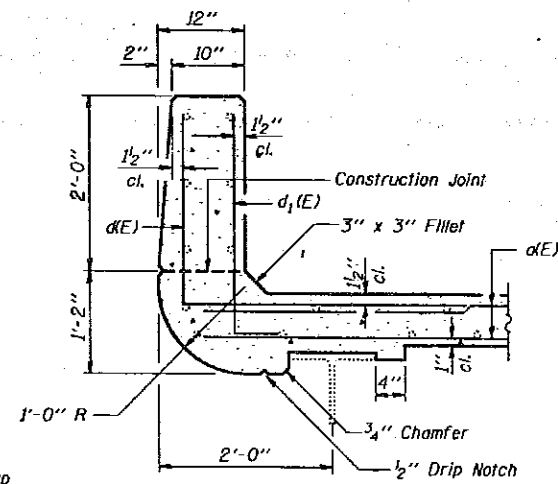

SECTION D-D

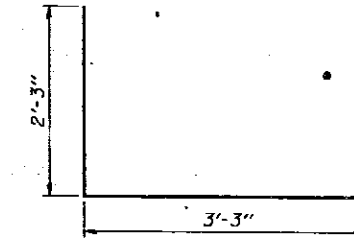

BAR d(E)

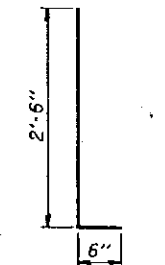

BAR d1(E)


BILL OF MATERIAL

Bar	No.	Size	Length	Shape
d(E)	32	#5	41'-0"	—
d1(E)	12	#6	41'-0"	—
d(E)	24	#5	5'-6"	—
d1(E)	24	#5	3'-0"	—
x(E)	152	#5	3'-1"	—
Concrete Removal			Cu. Yd.	20.4
Class X Concrete			Cu. Yd.	19.9
Reinforcement Bars, Epoxy Coated			Lbs.	2810


Notes: Reinforcement bars designated (E) shall be epoxy coated.  
Hatched area indicates Concrete Removal.  
QUANTITIES IN ABOVE BILL OF MATERIAL ARE FOR BOTH BRIDGES.

DESIGNED Paul Sumner  
CHECKED BRT  
DRAWN Paul Sumner  
CHECKED BRT


February 7 1972  
EXAMINED Todd E. ...  
PASSED  
APPROVED

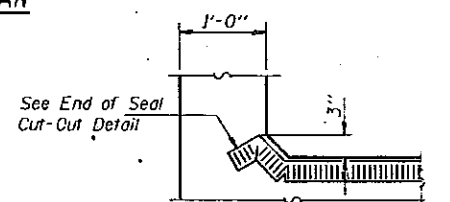


TYPICAL END OF SEAL TREATMENT

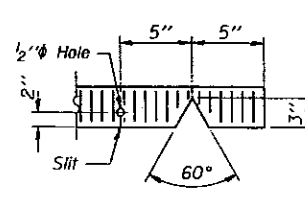

SEAL CUT-OUT

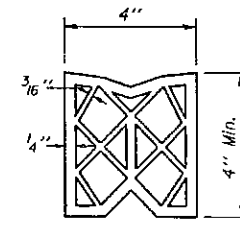

PREFORMED JOINT SEAL (4'')

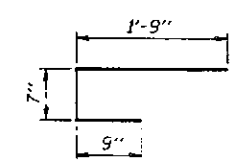

BAR x(E)

JOINT REPLACEMENT DETAILS  
F.A.I. RT. 57 SEC. (28-5VB) I  
FRANKLIN COUNTY  
STA. 119+71.94  
STR. No. 028-0004 & 028-0005









ROUTE NO.	SEC.	COUNTY	TOTAL SHEETS	SHEET NO.
F.A. 57	*	FRANKLIN	155	116
ROAD DIST. 7		ILLINOIS	PROJECT	

DATE	
BY	
REVISION	
NO.	
DATE	
BY	
REVISION	
NO.	

DATE	
BY	
REVISION	
NO.	
DATE	
BY	
REVISION	
NO.	

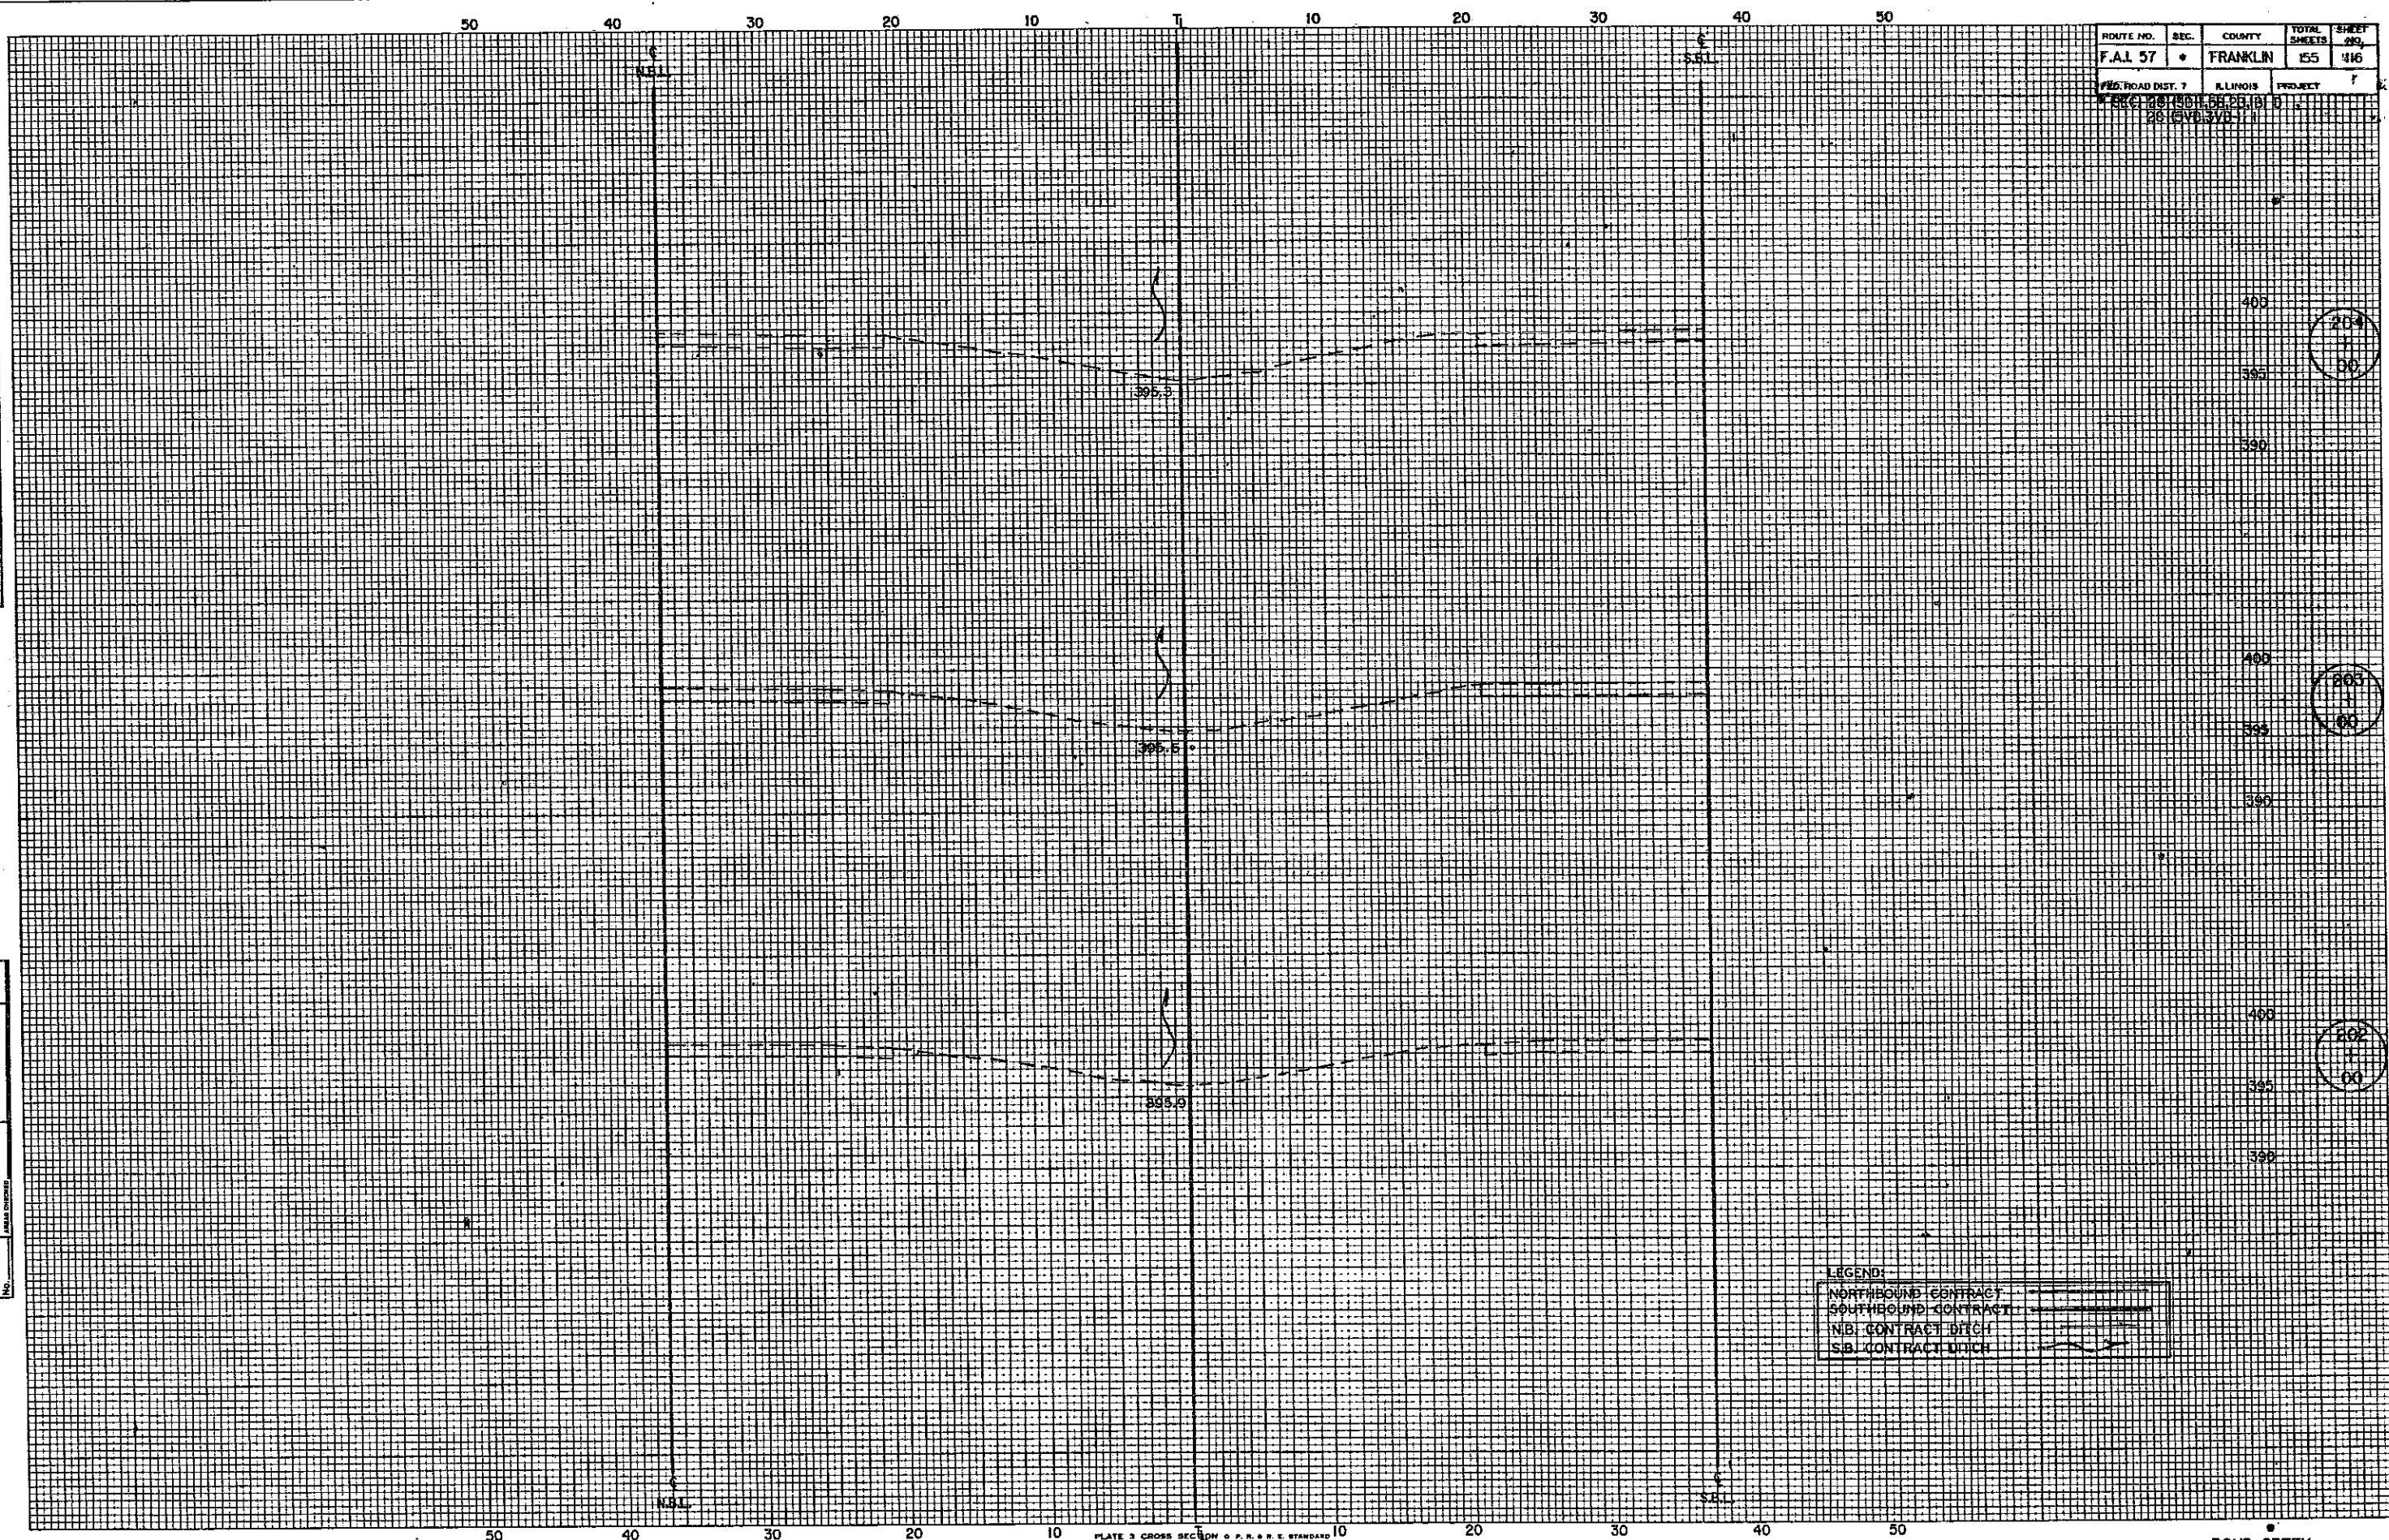


PLATE 3 CROSS SECTION OF P. R. & R. E. STANDARD  
 DENTZLER CORPORATION


POND CREEK



ROUTE NO.	SEC.	COUNTY	TOTAL SHEETS	SHEET NO.
F.A.I 57	*	FRANKLIN	155	117
FED. ROAD DIST. 7		ILLINOIS	PROJECT	
* SEC. 28		581, 582, 583, 584	20 (ENR 375 11)	

DATE	
BY	
FOR	
BY	
FOR	
DATE	
BY	
FOR	
BY	
FOR	
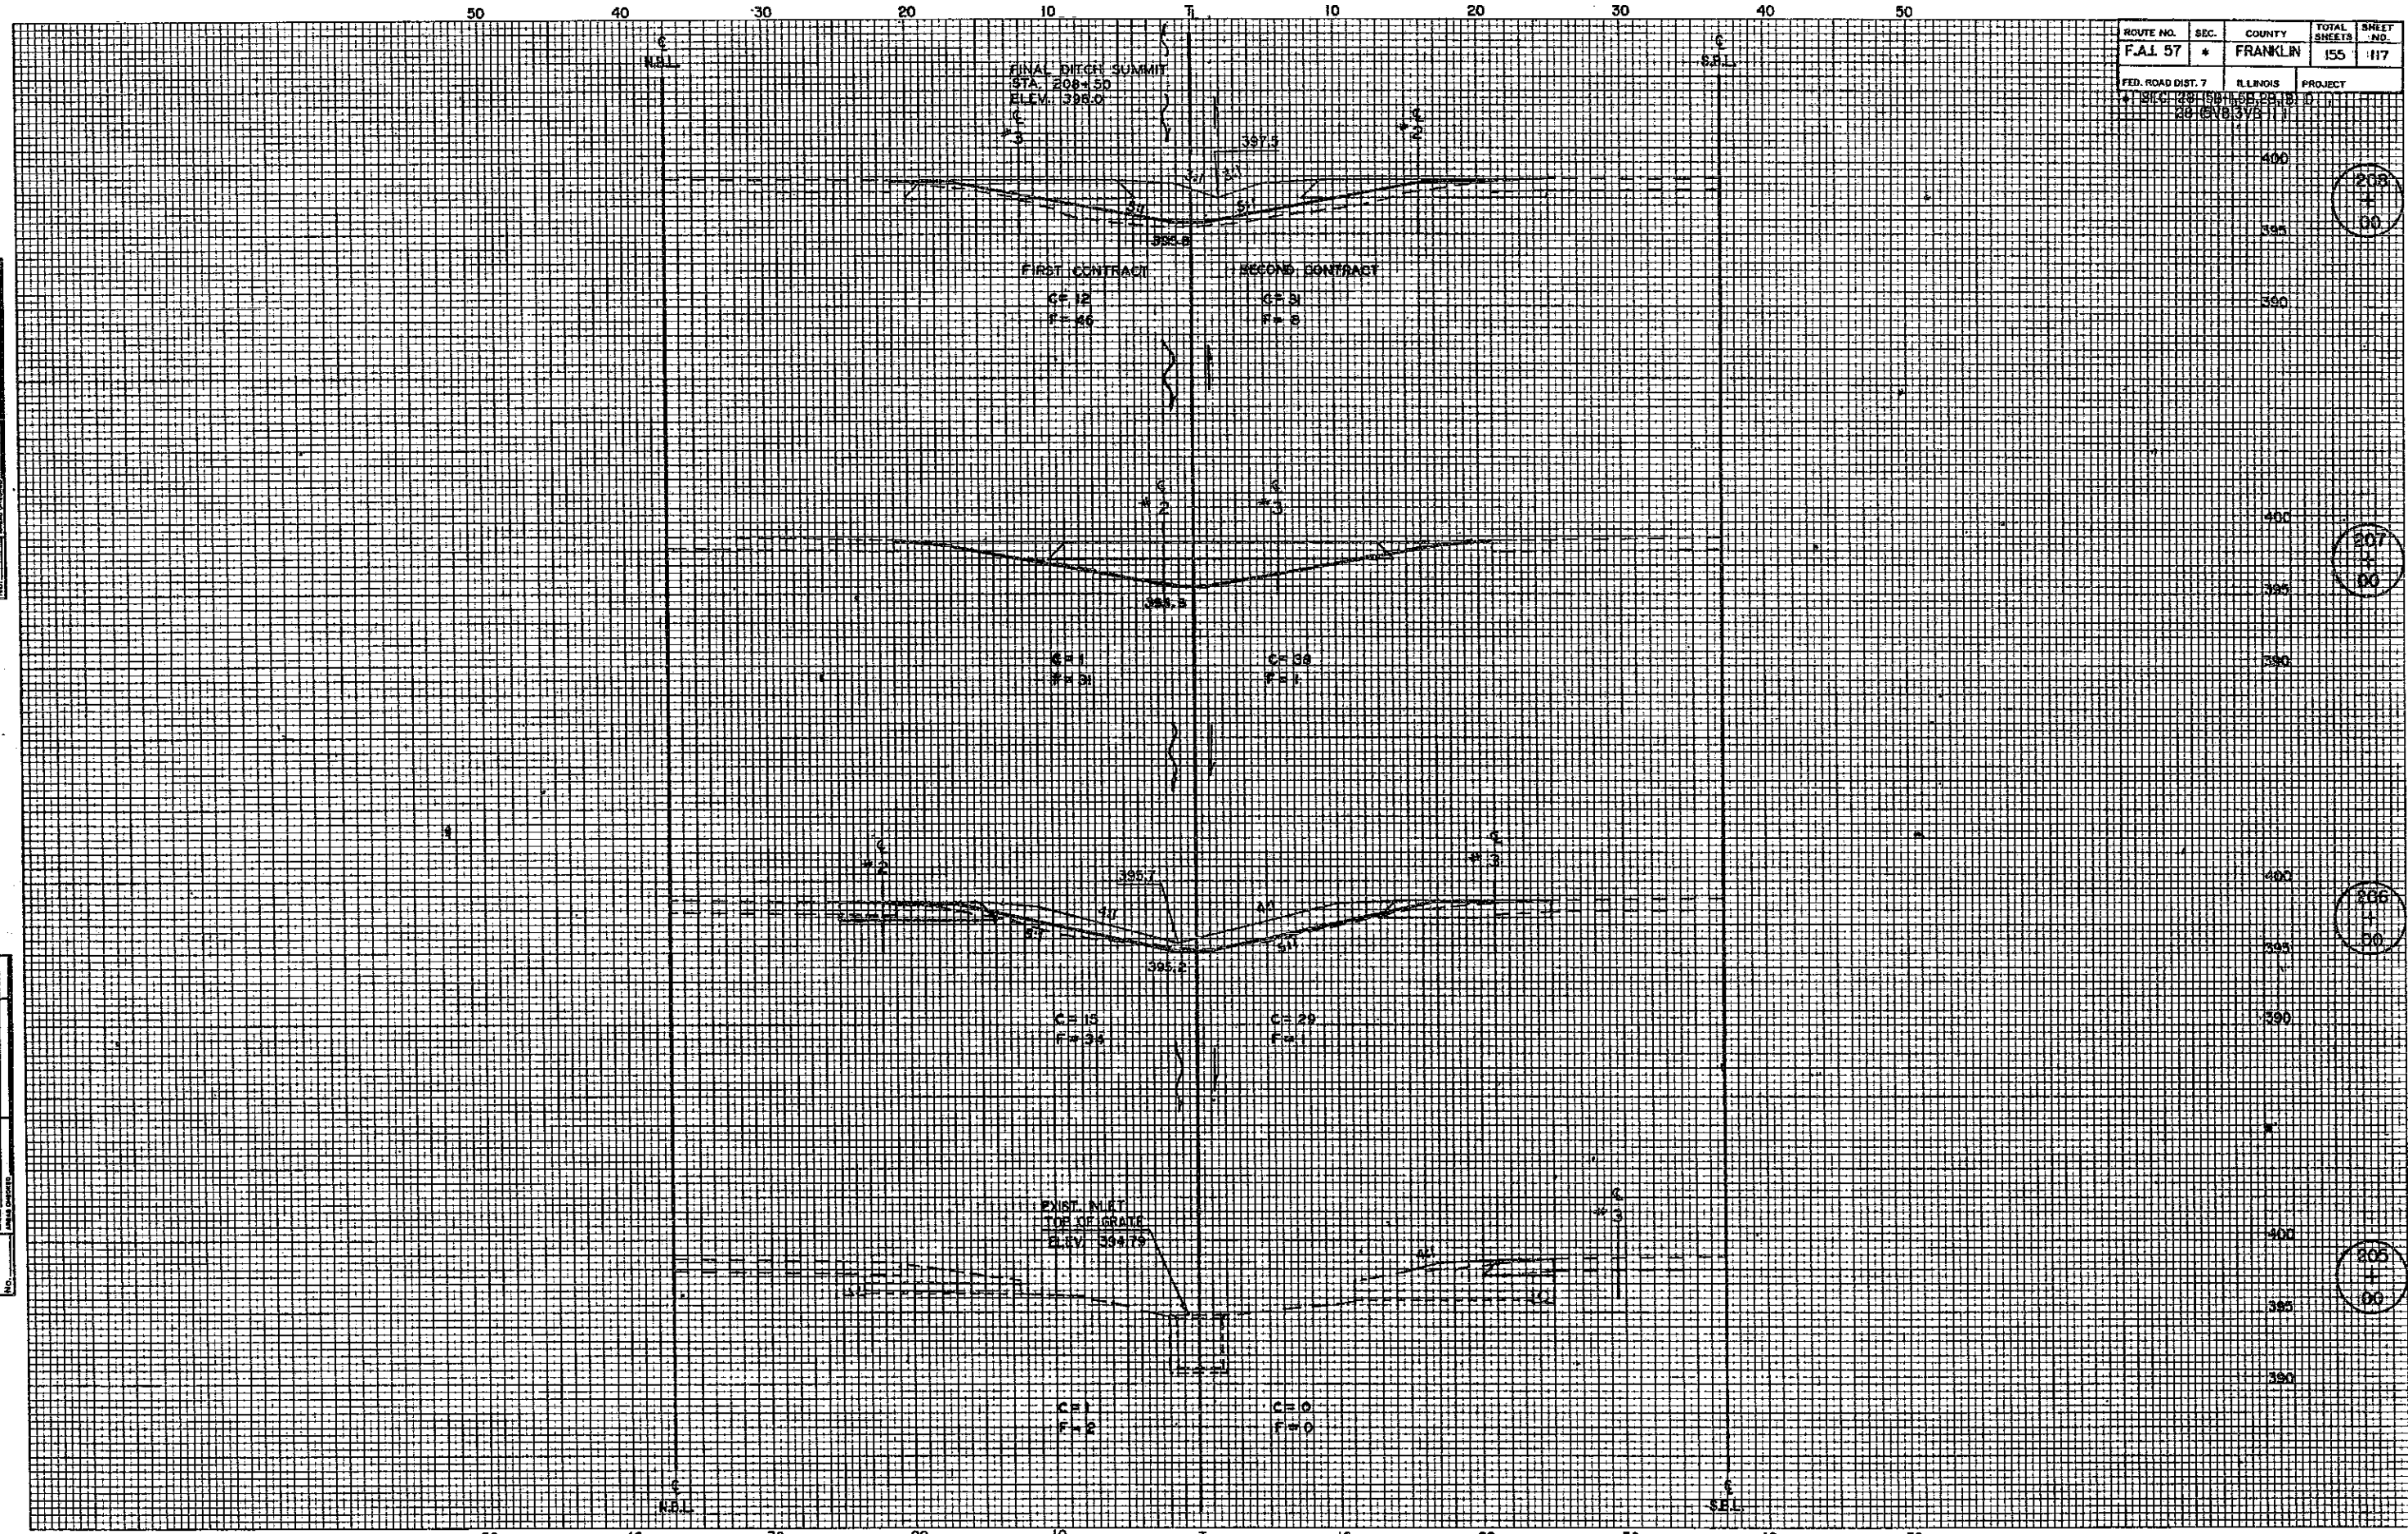

208  
+  
00

207  
+  
00

206  
+  
00

205  
+  
00



DATE	BY	PROJECT	SCALE	DATE
7.21.57		FRANKLIN	1:100	1957
DRAWN BY		CHECKED BY		

FINAL SURVEY NOTE BOOK

NO. \_\_\_\_\_

DATE \_\_\_\_\_

BY \_\_\_\_\_

PROJECT \_\_\_\_\_

SCALE \_\_\_\_\_

DATE \_\_\_\_\_

ORIGINAL SURVEY NOTE BOOK

NO. \_\_\_\_\_





DATE \_\_\_\_\_

BY \_\_\_\_\_

PROJECT \_\_\_\_\_

SCALE \_\_\_\_\_

DATE \_\_\_\_\_

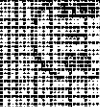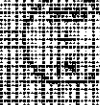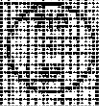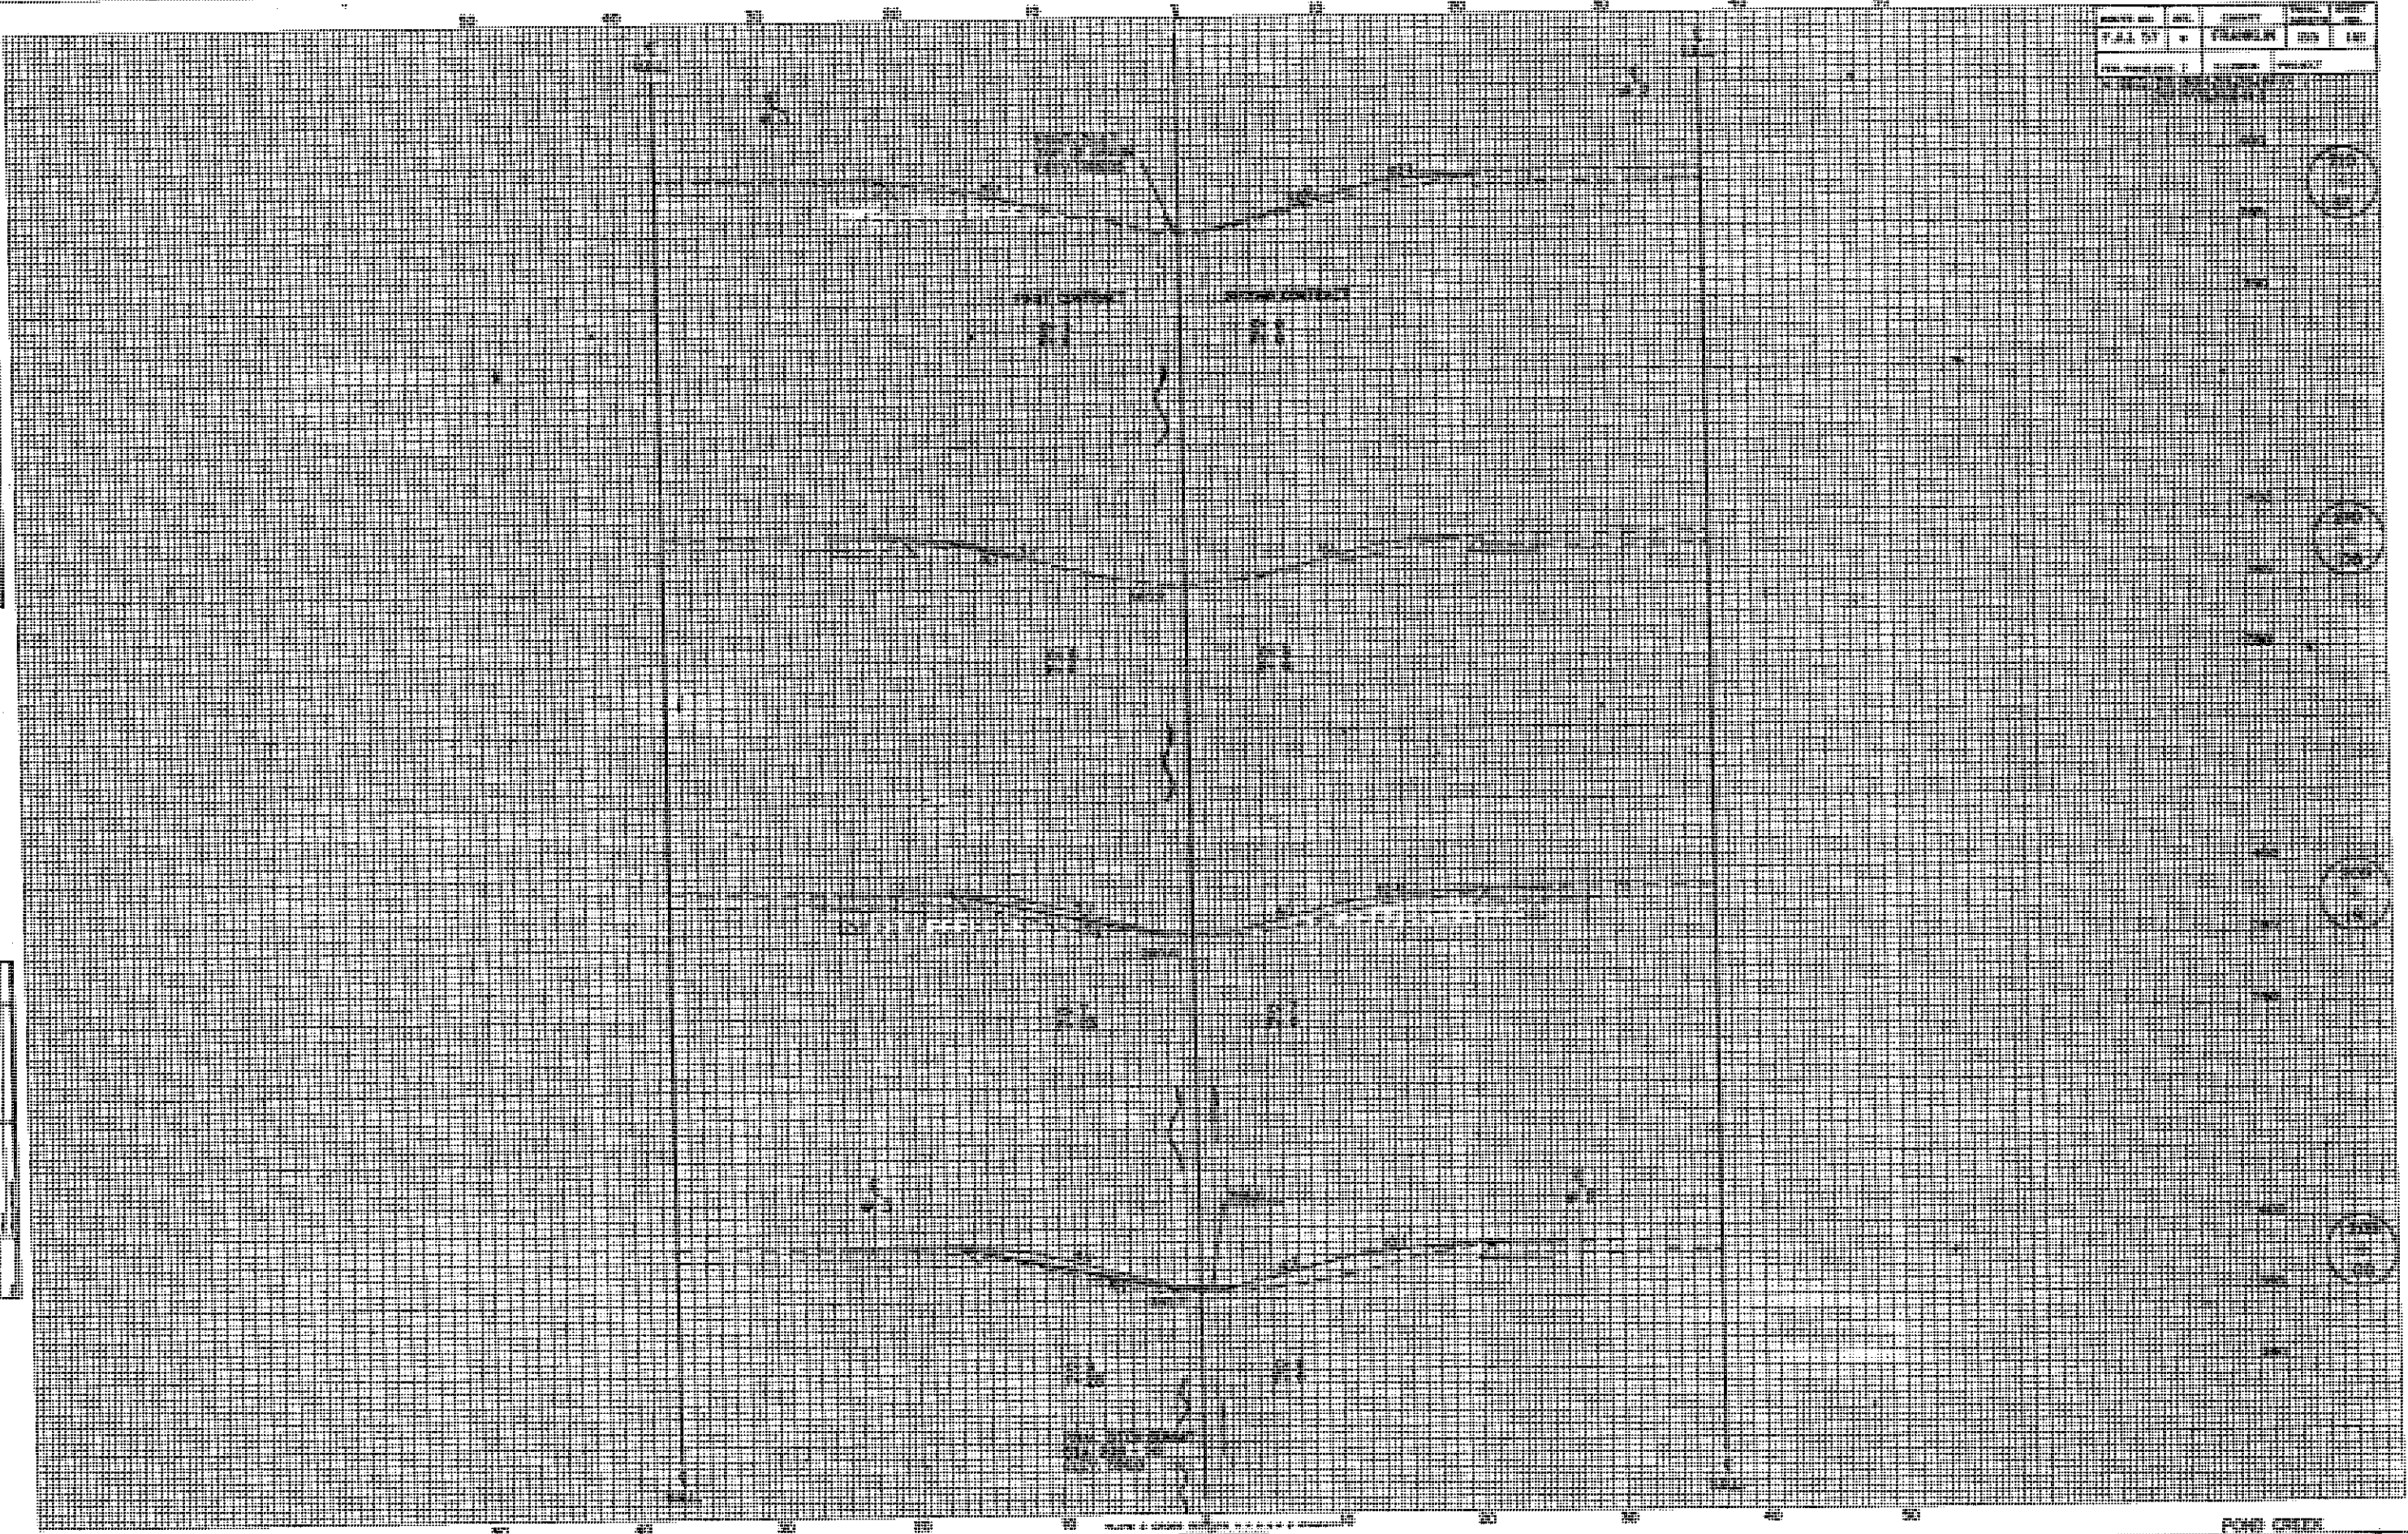




DATE	TIME	TEMP	WIND	SEA	REMARKS

NO.	DATE	TIME	TEMP	WIND	SEA	REMARKS

FIELD SURVEY NOTE BOOK

NO.	DATE	TIME	TEMP	WIND	SEA	REMARKS






FIELD SURVEY NOTE BOOK

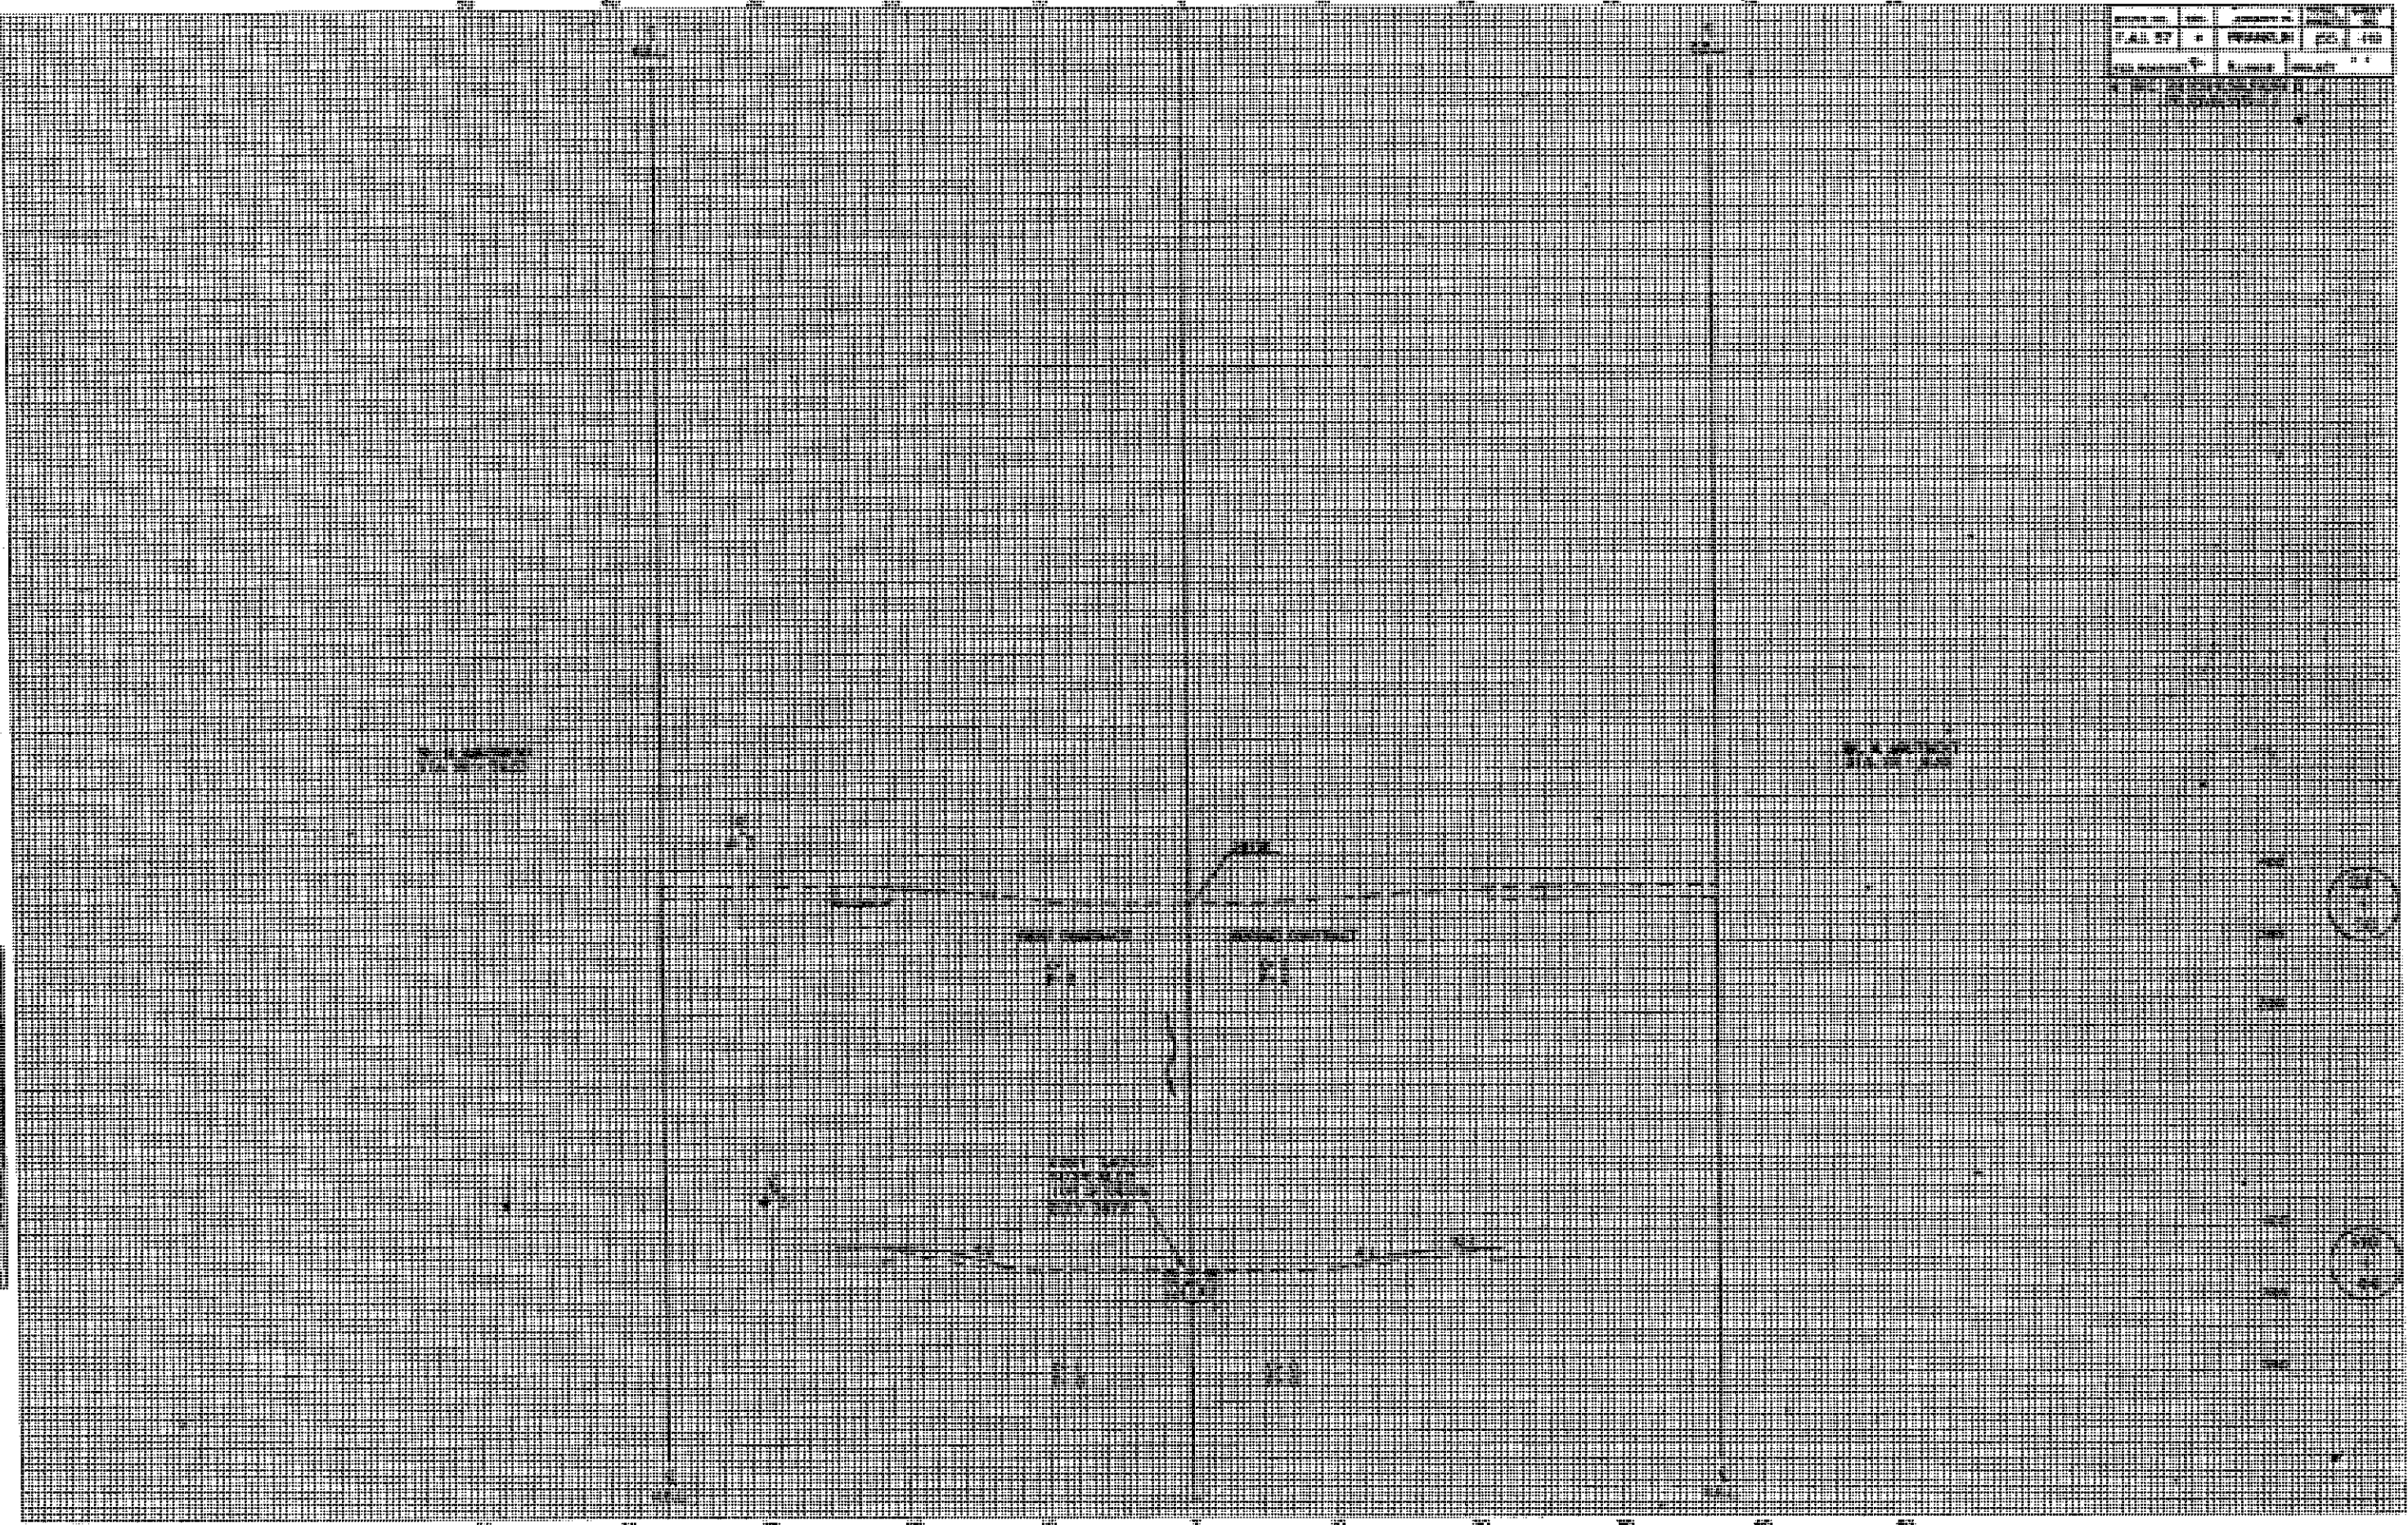



FINAL SURVEY NOTE BOOK

FINAL SURVEY NOTE BOOK

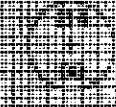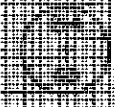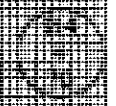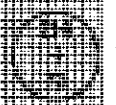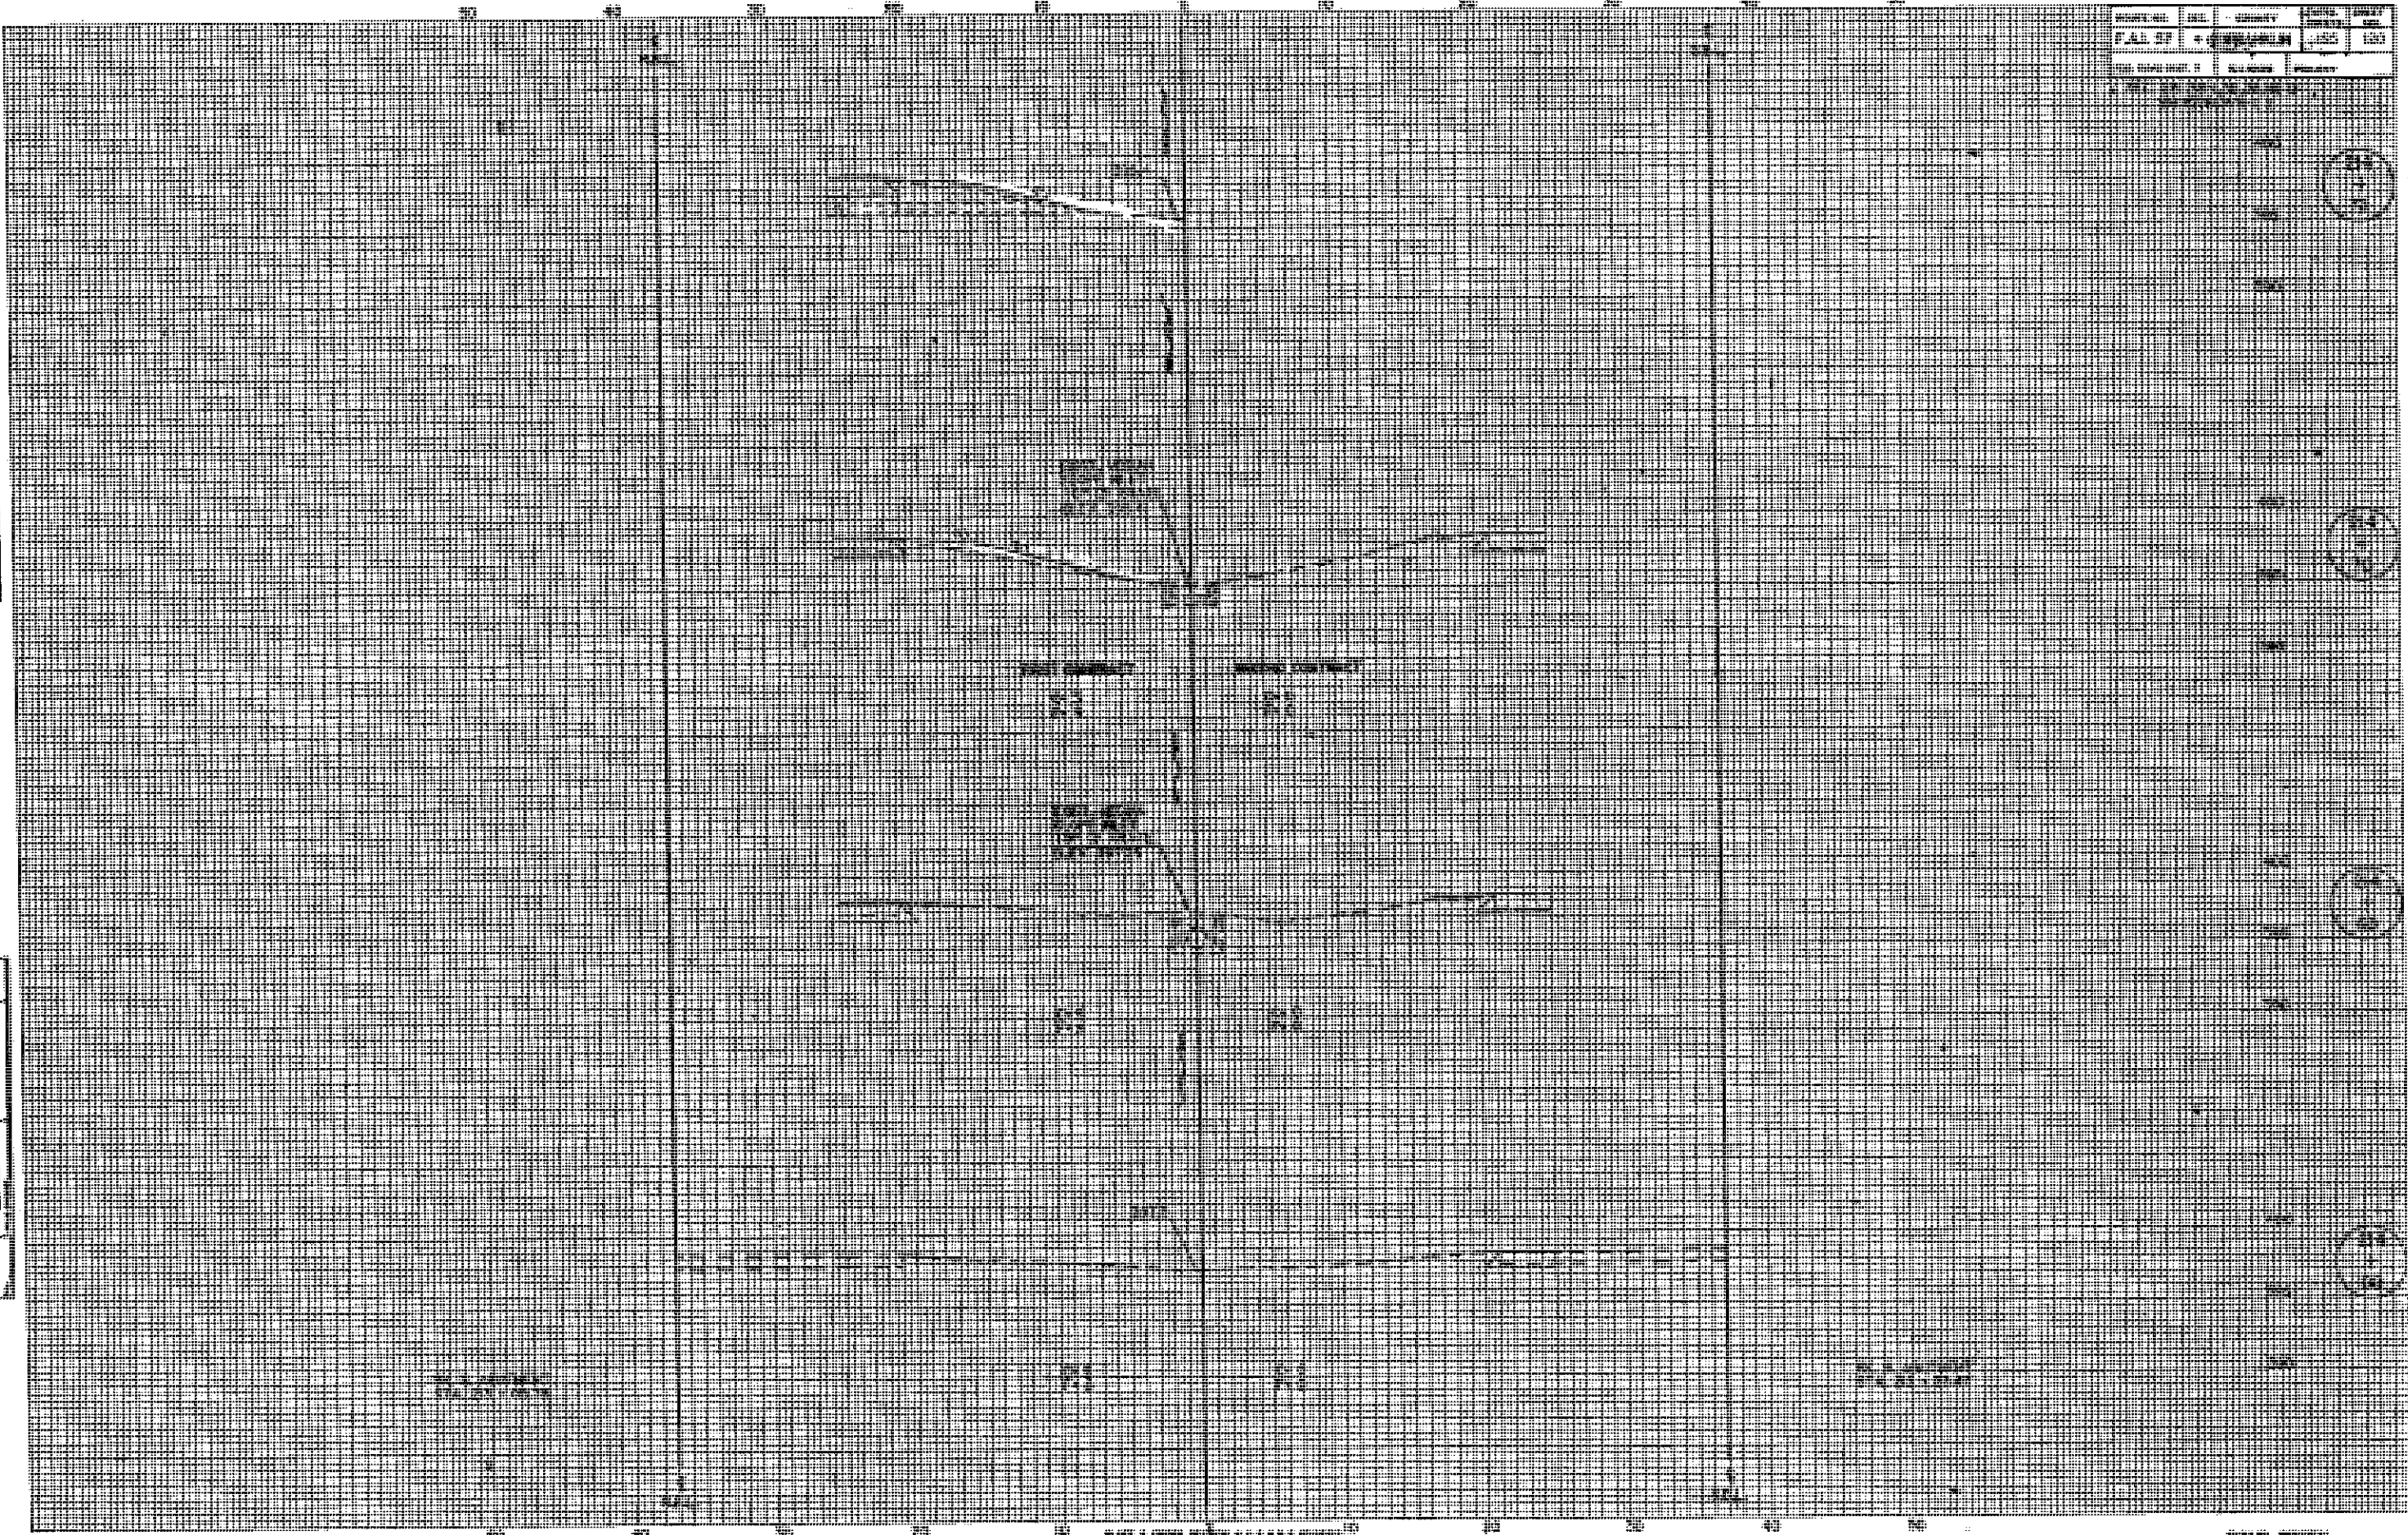




DATE	TIME	LOCATION	WIND	TEMP	MOON	SEA

FULL  
 SORTED  
 NOTE BOOK  
 No.

DATE	TIME	LOCATION	WIND	TEMP	MOON	SEA

ORIGINAL  
 SORTED  
 NOTE BOOK  
 No.

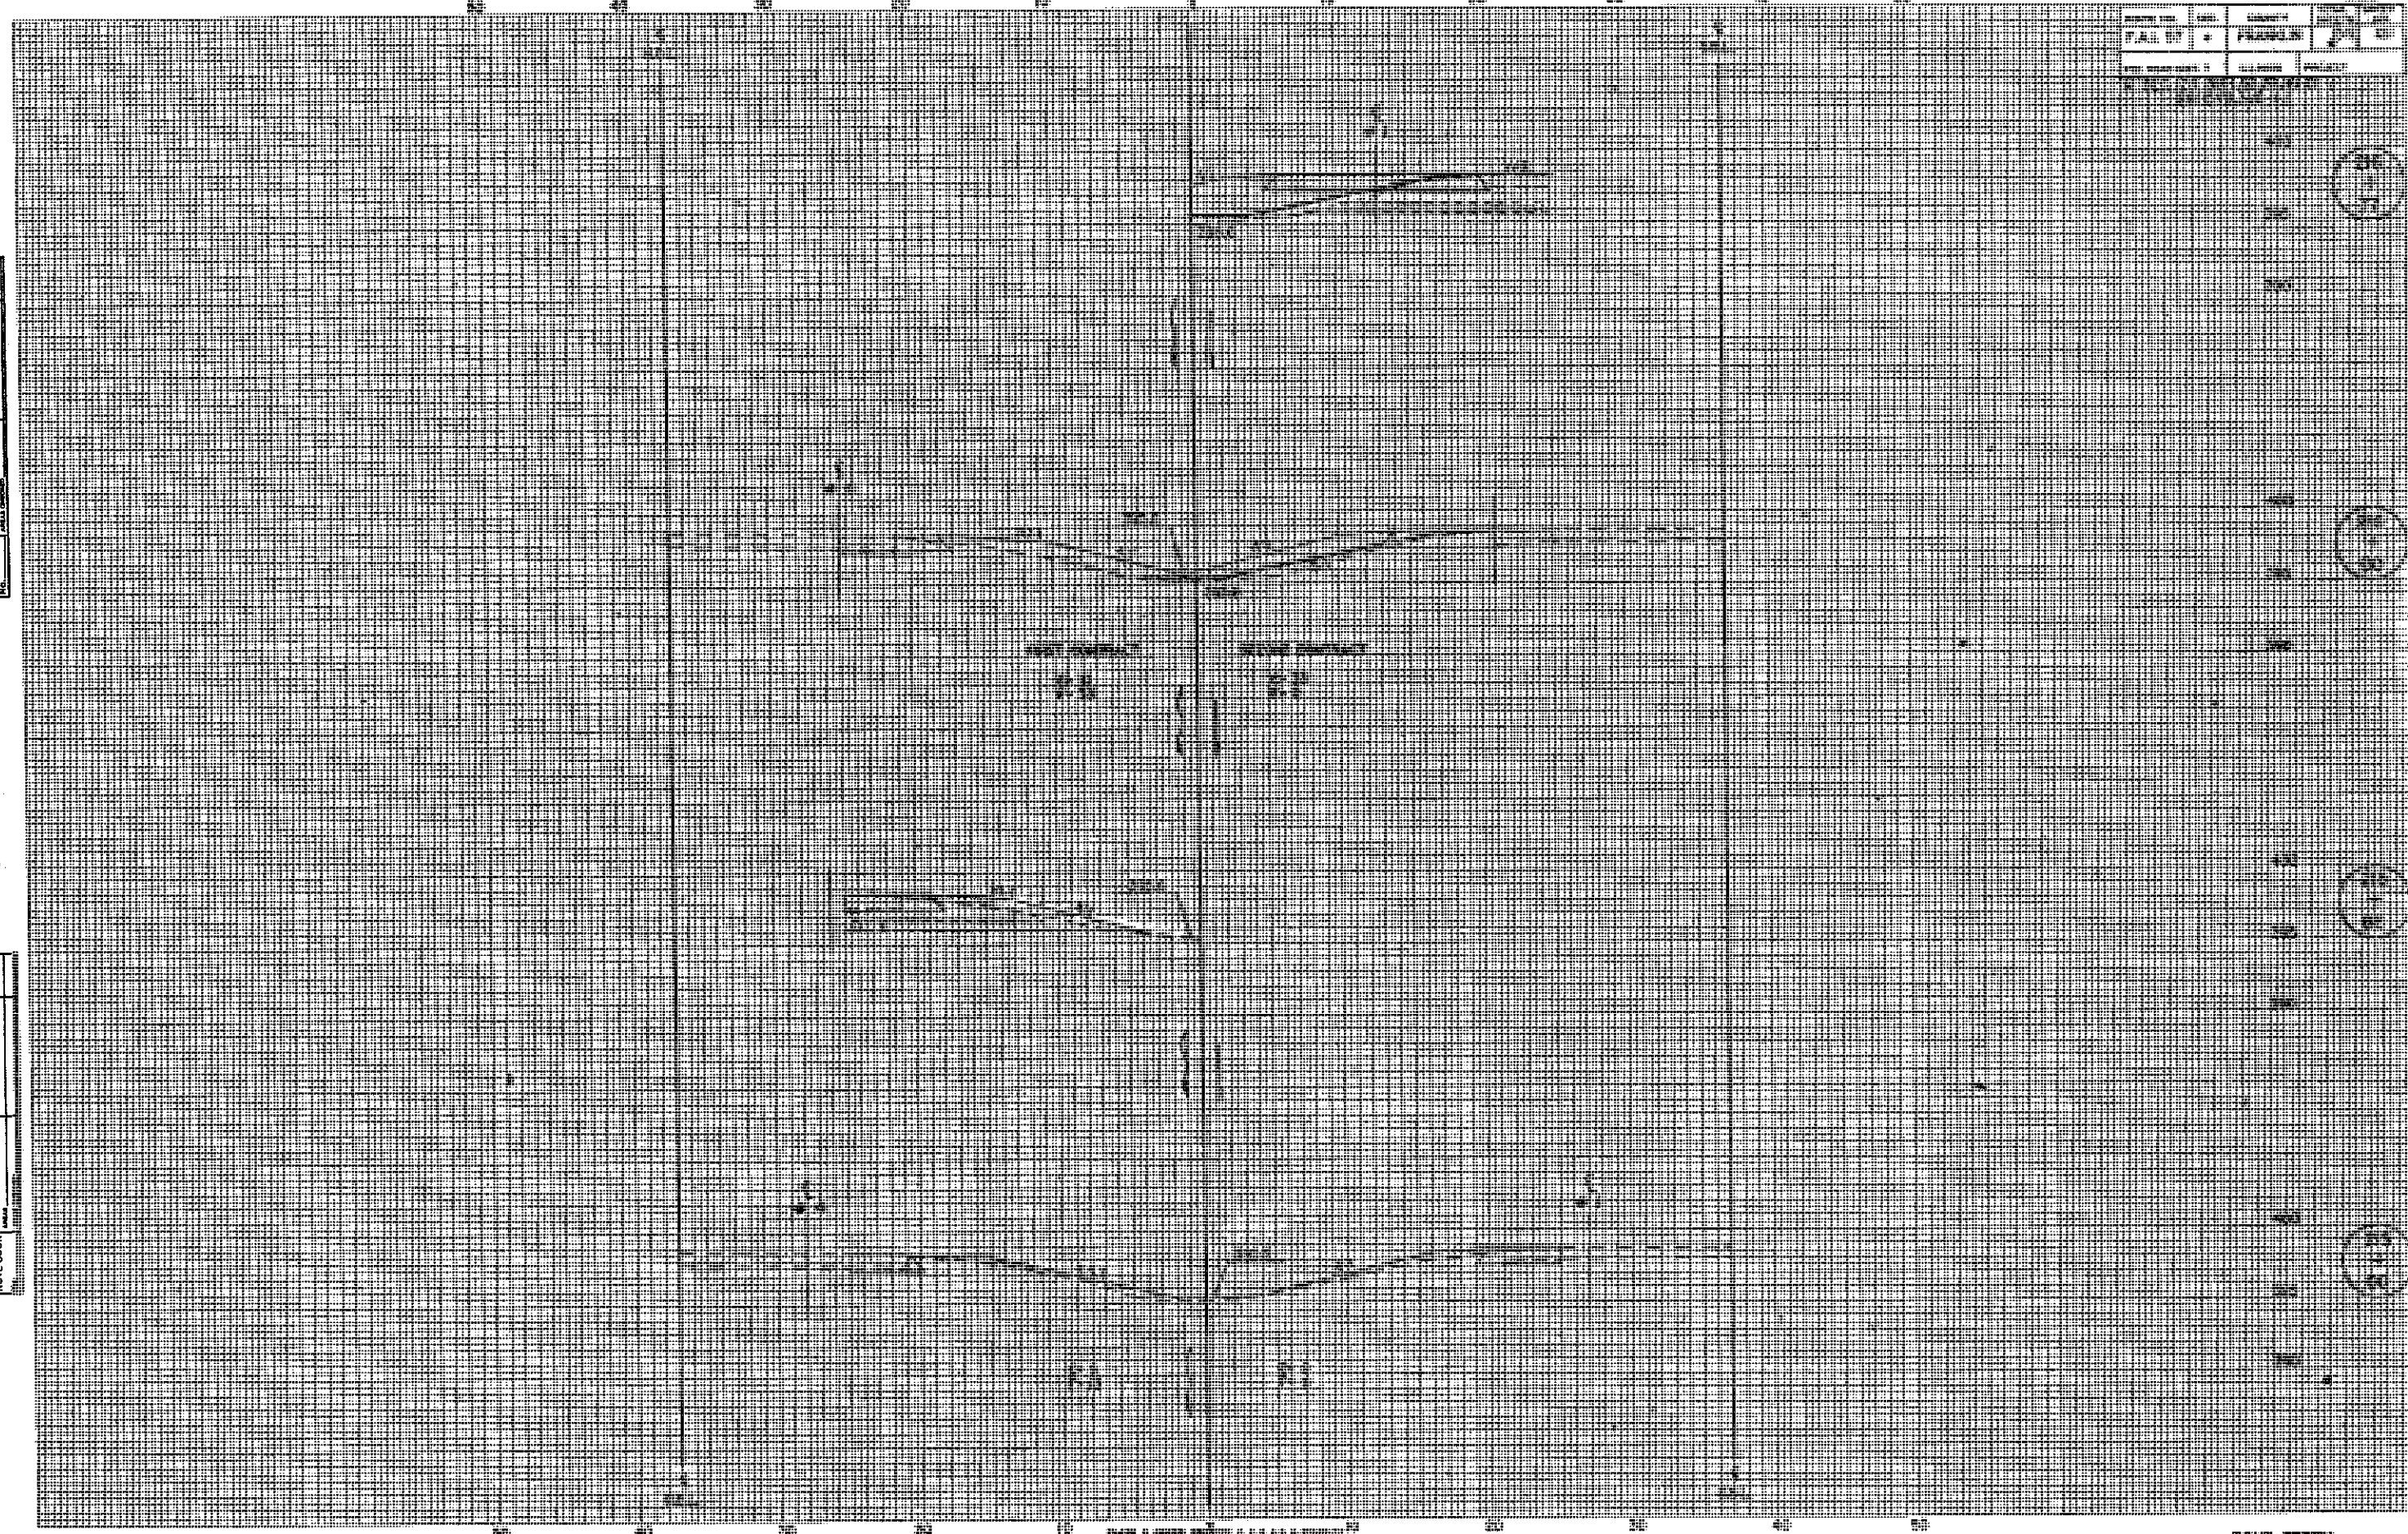




DATE	TIME	LOCATION	WIND	TEMP	REL. HUM.	SEA	WAVE	SWELL	STATE

FALL SAFETY NOTE BOOK	
DATE	TIME
LOCATION	WIND
TEMP	REL. HUM.
SEA	WAVE
SWELL	STATE

FALL SAFETY NOTE BOOK	
DATE	TIME
LOCATION	WIND
TEMP	REL. HUM.
SEA	WAVE
SWELL	STATE

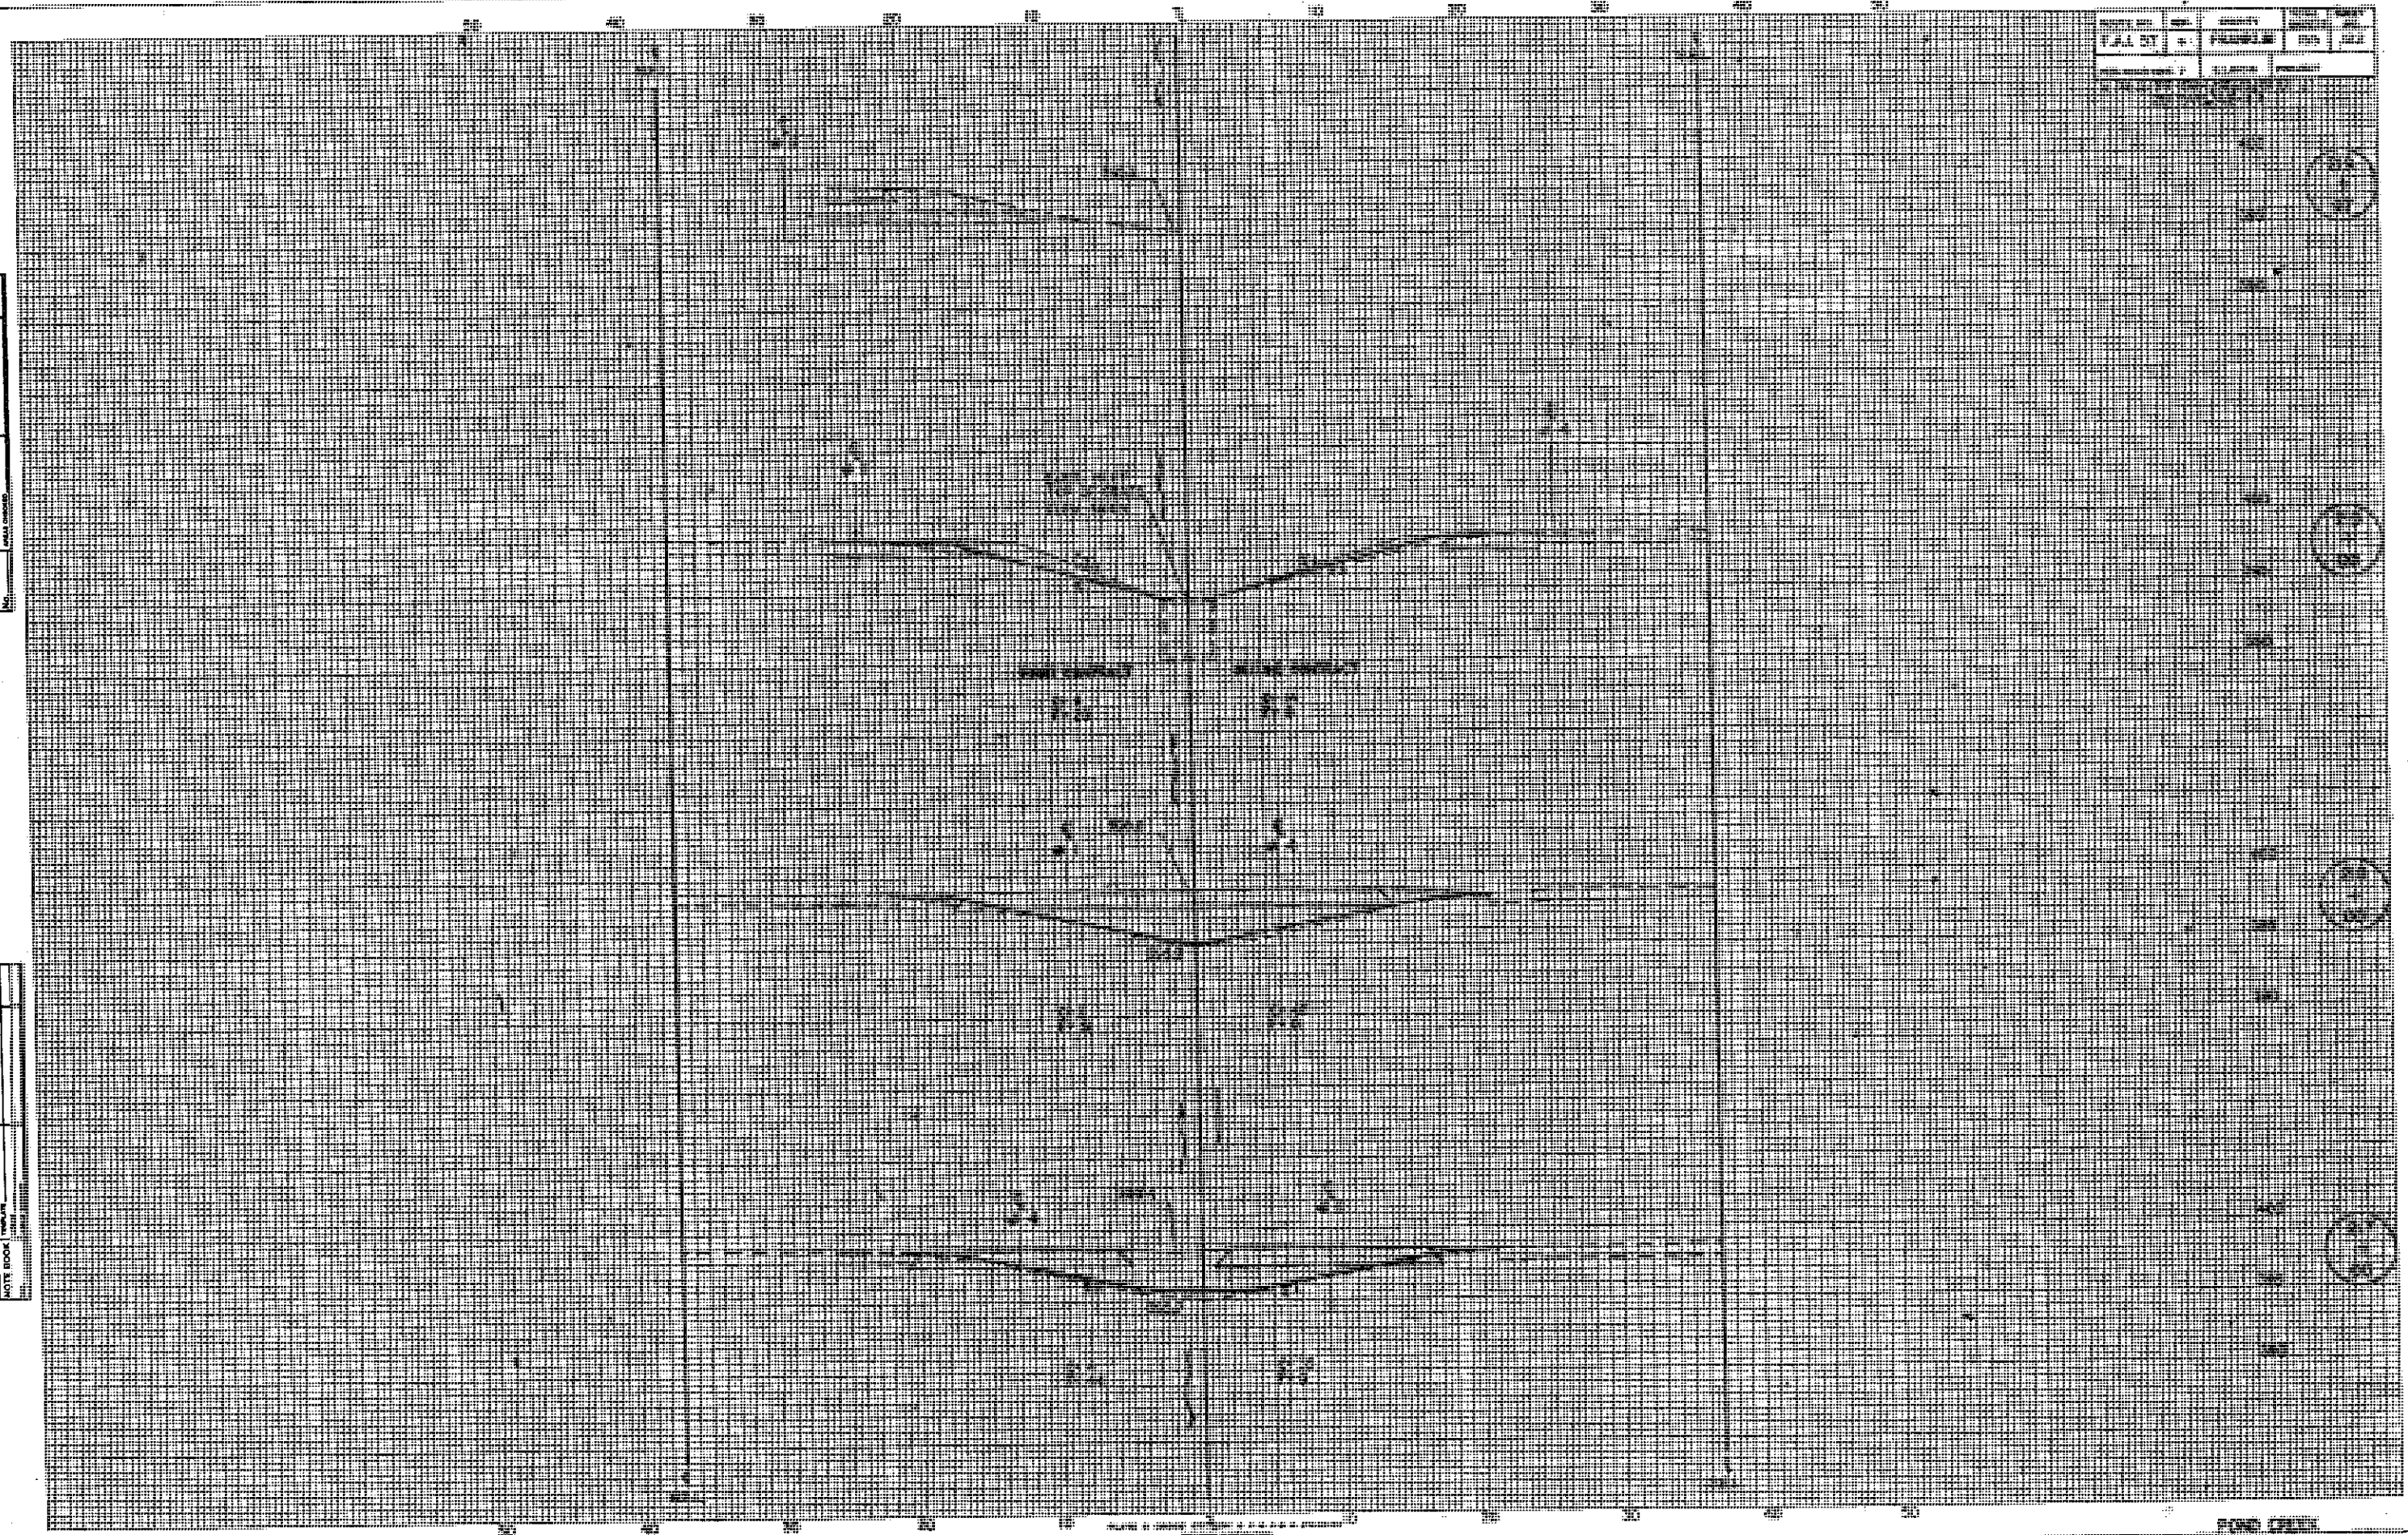




SECTION	DATE	TIME
FALL ST	+	FOURTH
NO. 1		125

DATE	TIME
NO.	




DATE	TIME
NO.	

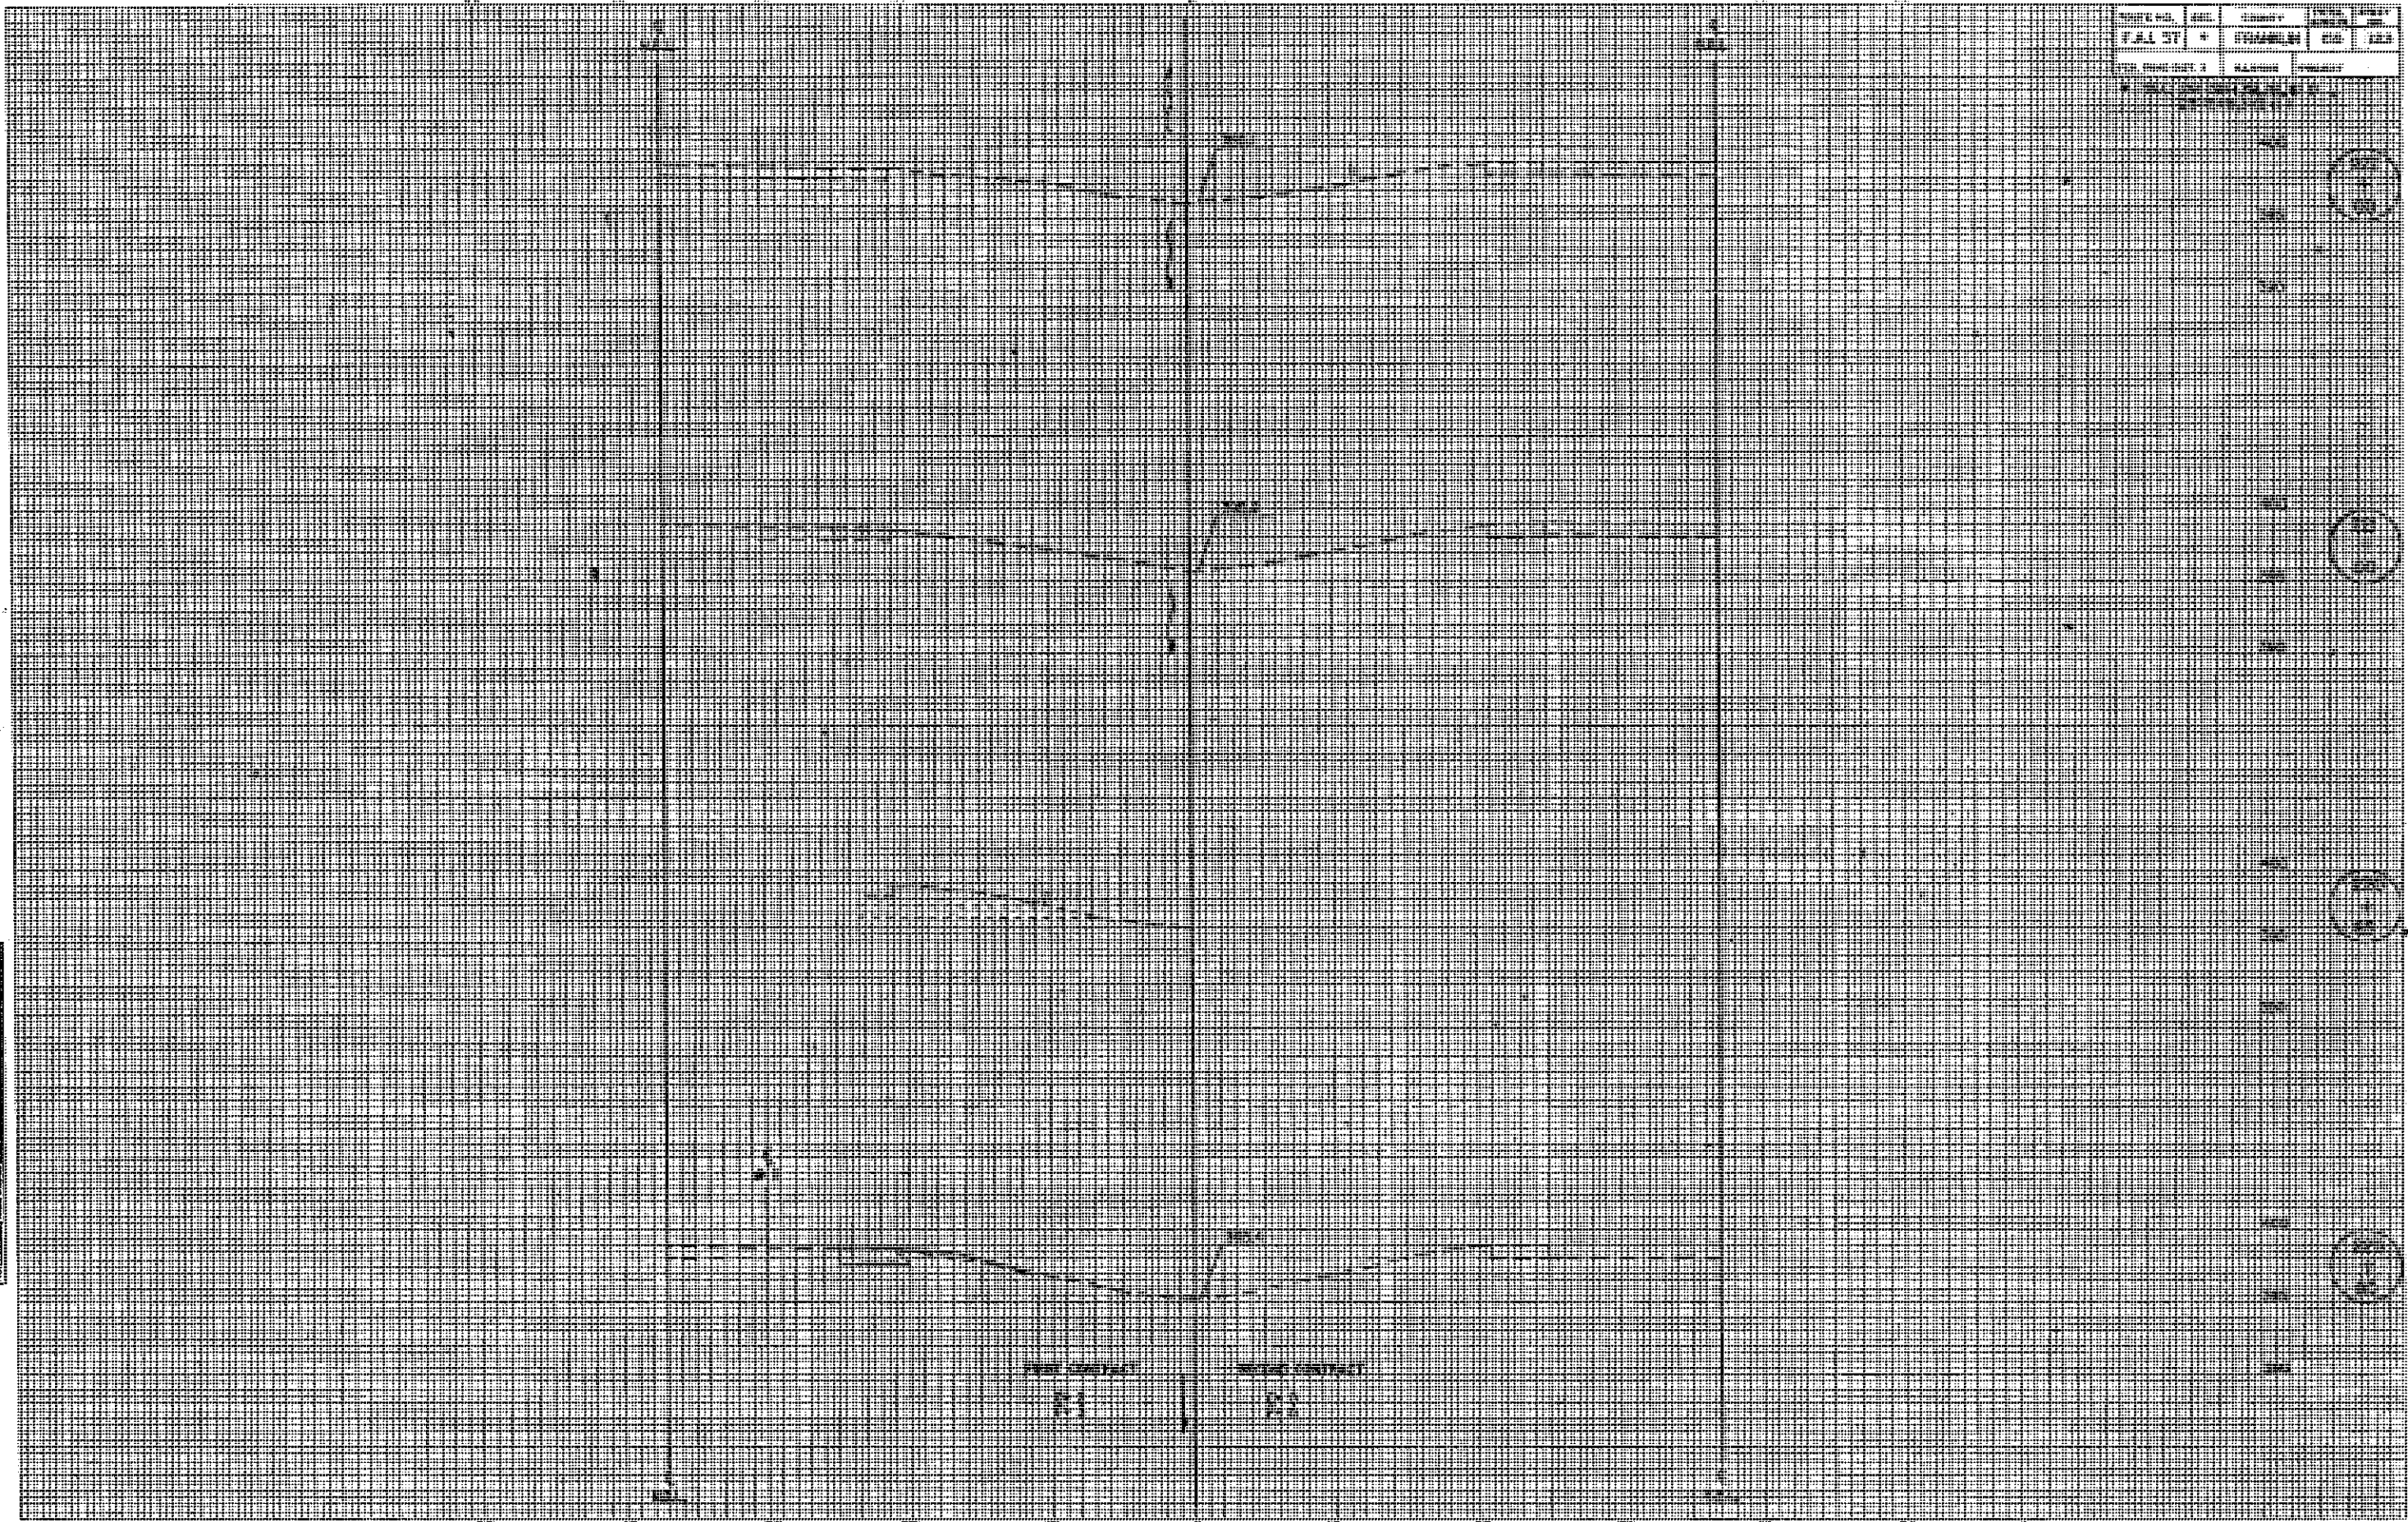

FUND CREEK



DATE	NO.	PROJECT	SCALE
1954	10	PAINT	1/2" = 1'

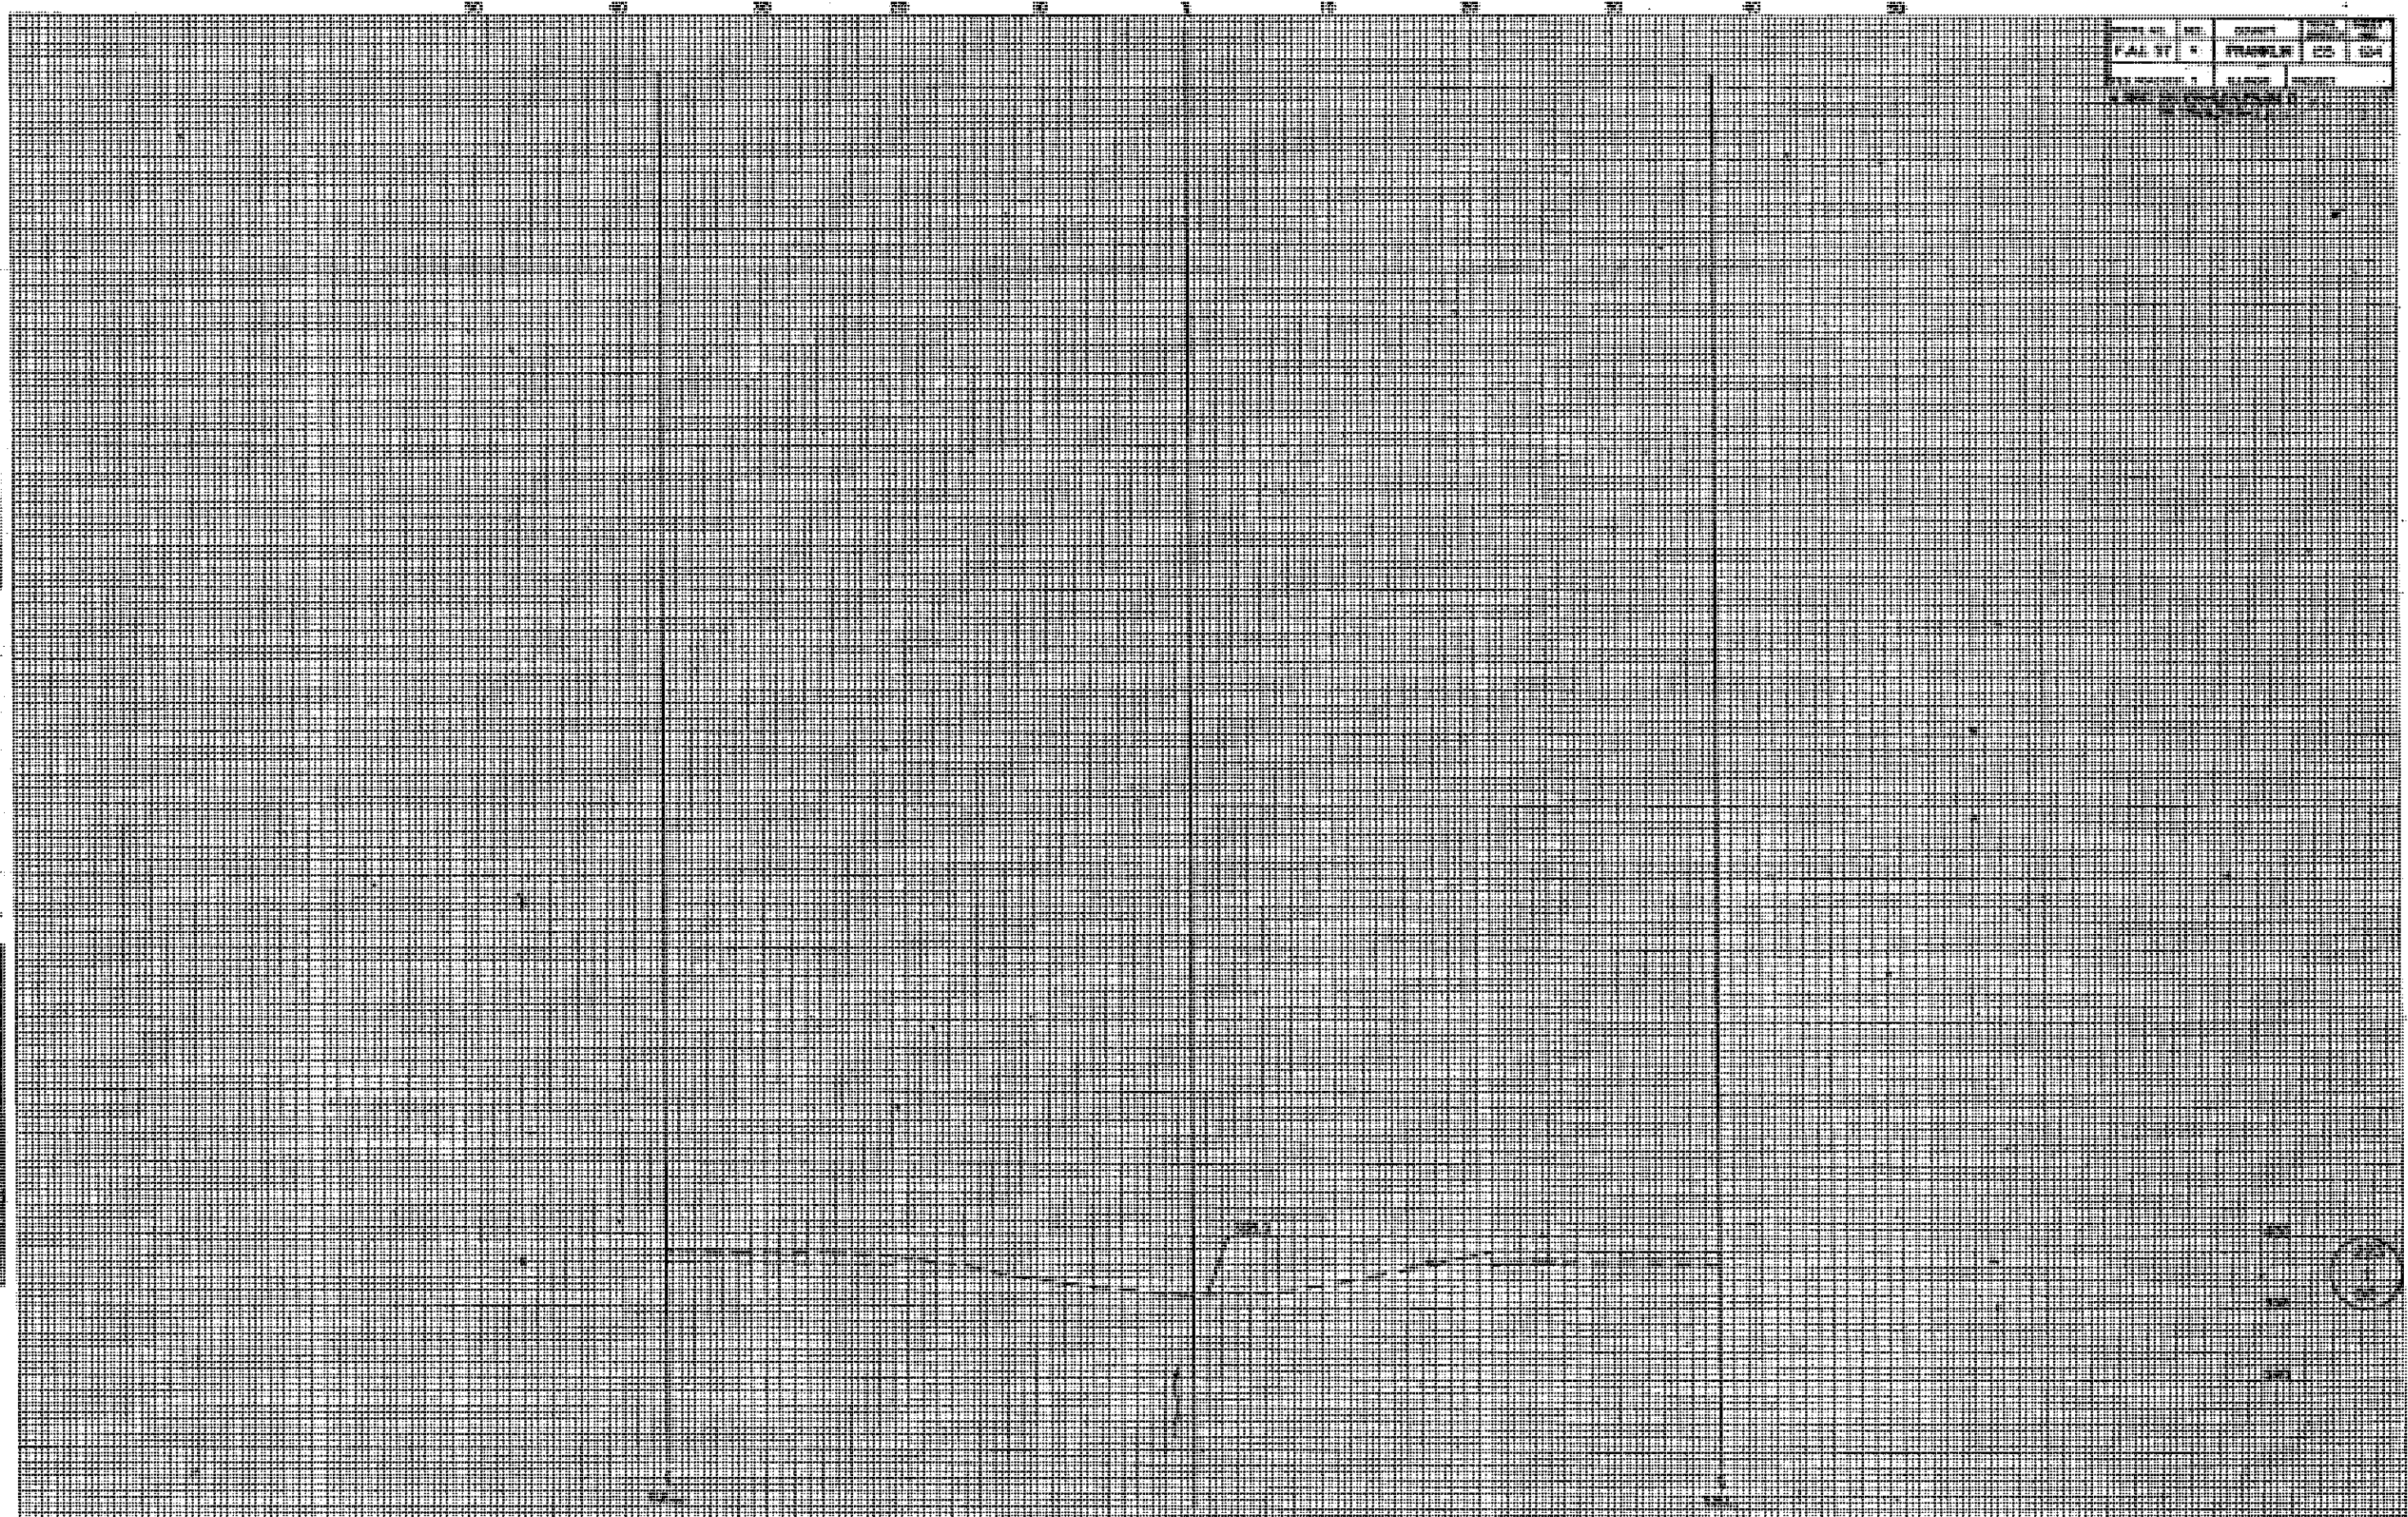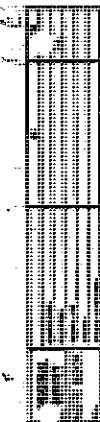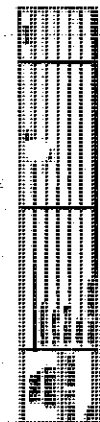

Copyright © 1954 by the American Society of Civil Engineers



DATE	SECTION	COUNTY	JOB NO.	"BY"	SHEET NO. /
P.L.L. BY	DESIGN	FRANKLIN	155	125	16 SHEETS
FIELD NO. 028-001	SECTION	FRANKLIN	155	125	

STATE OF ILLINOIS  
DEPARTMENT OF TRANSPORTATION

Bench Mark:  $\square$  Cut in S.W. corner of East abutment of Pond Creek Bridge -  
Northbound Lane, Sta. 212+50 - Elevation 399.40  
Existing Structure: 028-0001 (N.B.) Built as F.A.I. Route 57, Sec. 28-5B-1 in 1961 Superstructure consists of R.C.  
deck supported on a 3 span continuous W.F. beams. Temporary median cross-overs shall be utilized to divert traffic over  
adjacent bridge 028-0002 (S.B.) during reconstruction.


No Salvage

GENERAL NOTES



Field welding of construction accessories will not be permitted to the bottom flange of beams nor to the top flange for a distance equal to one-fourth the span length each way from the pier supports. Field welding in other areas will be permitted only when approved by the Engineer.  
For cantilever forming bracket, See Special Provisions.  
Reinforcement bars shall conform to the requirements of AASHTO M-31, M-42 or M-53 Grade 60.  
Pion dimensions and details relative to existing structure have been taken from existing plans and field survey and are subject to nominal construction variations. It shall be the Contractor's responsibility to verify such dimensions and details in the field and make necessary approved adjustments prior to construction or of materials. Such variations shall not be cause for additional compensation for a change in the scope of the work, however, the Contractor will be paid for the quantity actually furnished at the unit price bid for the work.  
All beams shall be lowered 1/8" from original position. (See Sht. #8 of 16)  
Two 1/8" adjusting shims, of the dimensions of the bottom bearing plate, shall be provided for each bearing in addition to all other plates or shims. For Type I Elastomeric Bearings, shims of the dimensions of top plate shall be provided and placed as detailed.  
The Contractor will be required to mark, on top of the concrete deck, the locations of the top flange of all the steel beams, prior to any removal of the bridge concrete deck. Saw cutting directly over the top of the beam flanges is not permitted.  
All top surfaces of the abutments shall receive Bridge Seat Sealer.  
Estimated quantity = 177 Sq. Ft.  
The first two coats of the Lead and Chromate free Alkyd Paint System shall be used for shop and field painting of new structural steel.

STATION 212+50.00  
REBUILT BY  
STATE OF ILLINOIS  
F.A.I. RT. 57 SEC. (28-5B-1D)  
F.A. PROJECT: M-57-2(12)63  
LOADING HS20 & ALT.  
STR. NO. 028-0001

NAME PLATE  
See Std. 2113

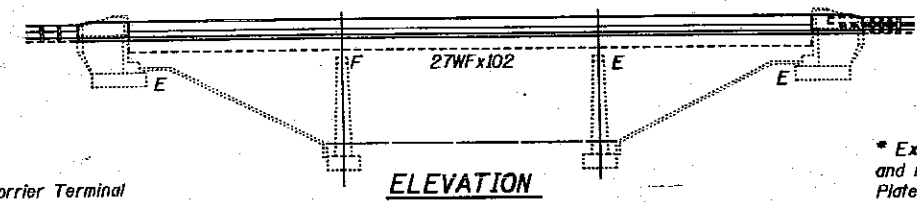

\* Existing Name Plate to be cleaned and relocated next to new Name Plate. Cost incidental.

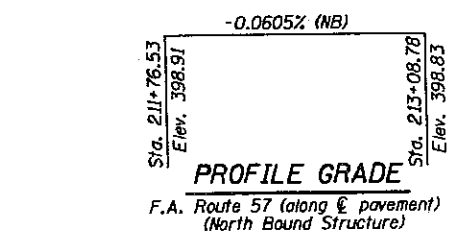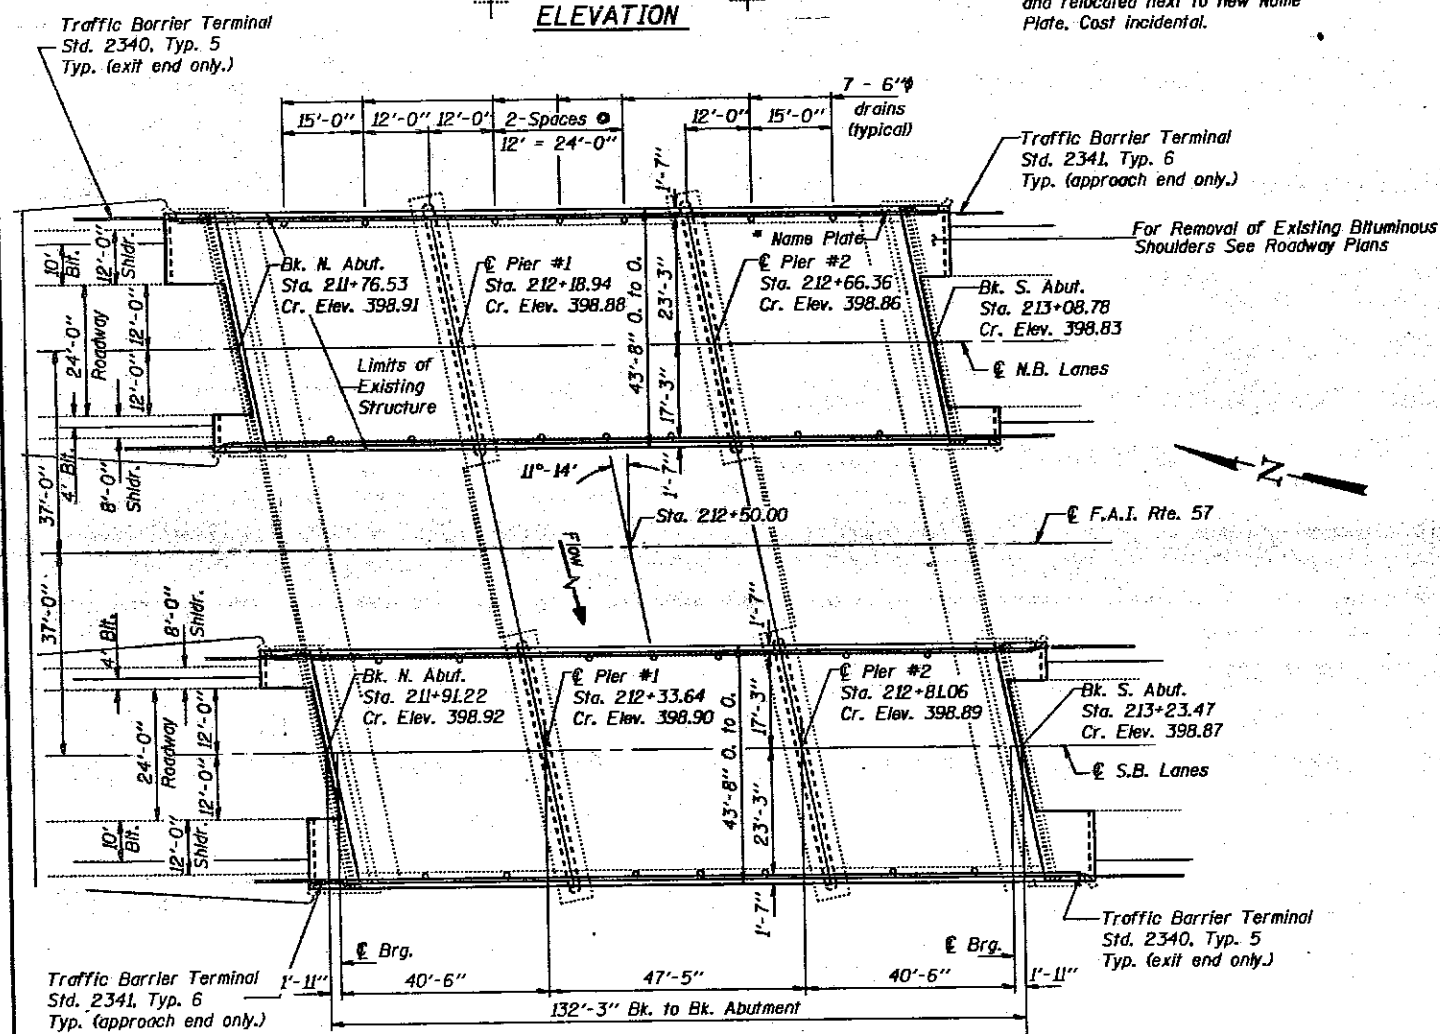

DESIGNED *Richard J. Chaput*  
CHECKED *Shawn P. Daniels*  
DRAWN *Paul W. Sweet*  
CHECKED *RJC RIB GLE*

EXAMINED *May 22 1992*  
PASSED *Ralph E. Anderson*  
APPROVED

Note:  
Only the North bound structure is included in this contract.  
South bound structure shown for information only.

Structural steel shall only be cleaned and painted as required by the Special Provision "Cleaning and Painting New Steel and Adjacent Areas of Existing Steel Structures".  
Prior to Welding Studs and pouring the new concrete for the deck, all loose rust, loose mill scale and all other foreign material shall be removed from the embedded portions of flanges of stringers. The removal shall be accomplished in accordance with the requirements of the SSPC Surface Preparation Specifications SP-11 for power tool cleaning or SP-2 for hand tool cleaning. Cost shall be incidental to "Removal of Existing Concrete Deck".

TOTAL BILL OF MATERIAL

ITEM	UNIT	SUPER	SUB	TOTAL
Concrete Removal	Cu. Yd.		9	9
Removal of Existing Concrete Deck	Each	1		1
Floor Drains	Each	14		14
Preformed Joint Seal 2 1/2"	Lin. Ft.	44		44
Preformed Joint Seal 4"	Lin. Ft.	44		44
Class X Concrete Superstructure	Cu. Yd.	187.1		187.1
Protective Coat	Sq. Yd.	690		690
Elastomeric Bearing Assembly, Type I	Each	14		14
Elastomeric Bearing Assembly, Type II	Each	7		7
Structural Steel	Lbs.	9,690		9,690
Stud Shear Connectors	Each	3,150		3,150
Reinforcement Bars, Epoxy Coated	Pound	44,150		44,150
Name Plates	Each	1		1
Bridge Seat Sealer	L. Sum	0.25		0.25
Jack and Remove Existing Bearings	Each	28		28
Bridge Deck Grooving	Sq. Yd.	584		584
Structure Excavation	Cu. Yd.		22.0	22.0

DESIGN SPECIFICATIONS


1989 AASHTO with 1990 & 1991 Interims & Seismic Retrofitting Guidelines for Highway Bridges.

LOADING HS 20-44 & Alt.

Allow 25# / sq. ft. for future wearing surface.


DESIGN STRESSES

FIELD UNITS  
New Construction  
 $f'_c = 3,500$  psi  
 $f_y = 60,000$  psi (Reinf.)  
 $f_y = 33,000$  psi (Existing Structural Steel)  
 $f_y = 36,000$  psi (New Structural Steel)

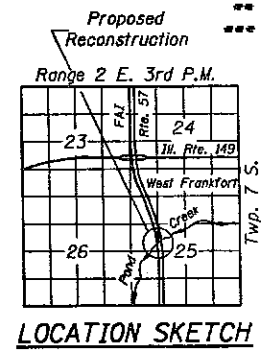


GENERAL PLAN  
F.A.I. ROUTE 57 OVER  
POND CREEK  
F.A.I. ROUTE 57 SECTION (28-5B-1D)  
FRANKLIN COUNTY  
STATION 212+50.00  
STRUCTURE NUMBER 028-0001 (N.B.)

STATE OF ILLINOIS  
DEPARTMENT OF TRANSPORTATION

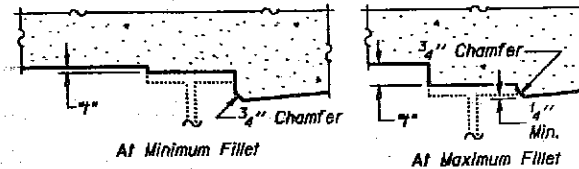

ROUTE NO.	SECTION	QUANTITY	AREA	FEET	SHEET NO. 2 16 SHEETS
F.A.I. 57	28B-5B-DD	FRANKLIN CO.	155	126	

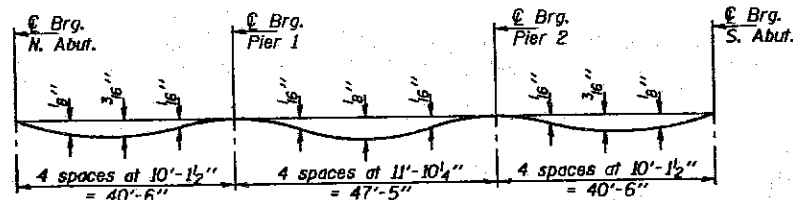

DEAD LOAD DEFLECTION DIAGRAM

(Includes weight of concrete only)

Note: The above deflections are not to be used in the field if the engineer is working from the grade elevations adjusted for dead load deflections as shown below.

BEAM 1

Location	Station	Offset	Theoretical Grade Elevations	Theoretical Grade Elevations Adjusted For Dead Load Deflection
Bk. N. Abut.	21171.986	-22.875	398.562	398.562
Br. N. Abut.	21173.902	-22.875	398.561	398.561
A	21183.902	-22.875	398.555	398.566
	21193.902	-22.875	398.549	398.563
	21203.902	-22.875	398.543	398.550
Br. Pier 1	21214.402	-22.875	398.537	398.537
	21224.402	-22.875	398.531	398.536
	21234.402	-22.875	398.524	398.534
	21244.402	-22.875	398.518	398.527
	21254.402	-22.875	398.512	398.516
	21264.402	-22.875	398.506	398.508
Br. Pier 2	21271.819	-22.875	398.502	398.509
	21281.819	-22.875	398.496	398.510
	21291.819	-22.875	398.490	398.501
	21302.319	-22.875	398.483	398.483
Bk. S. Abut.	21304.236	-22.875	398.482	398.482

BEAM 2

Location	Station	Offset	Theoretical Grade Elevations	Theoretical Grade Elevations Adjusted For Dead Load Deflection
Bk. N. Abut.	21173.302	-16.250	398.699	398.699
Br. N. Abut.	21175.218	-16.250	398.698	398.698
A	21185.218	-16.250	398.692	398.703
	21195.218	-16.250	398.686	398.700
	21205.218	-16.250	398.680	398.687
Br. Pier 1	21215.718	-16.250	398.674	398.674
	21225.718	-16.250	398.668	398.673
	21235.718	-16.250	398.661	398.671
	21245.718	-16.250	398.655	398.664
	21255.718	-16.250	398.649	398.653
	21265.718	-16.250	398.643	398.645
Br. Pier 2	21273.135	-16.250	398.639	398.646
	21283.135	-16.250	398.633	398.647
	21293.135	-16.250	398.627	398.638
	21303.635	-16.250	398.620	398.620
Bk. S. Abut.	21305.552	-16.250	398.619	398.619

EAST LONGITUDINAL BONDED CONSTRUCTION JOINT

Location	Station	Offset	Theoretical Grade Elevations	Theoretical Grade Elevations Adjusted For Dead Load Deflection
Bk. N. Abut.	21174.146	-12.000	398.786	398.786
Br. N. Abut.	21176.063	-12.000	398.785	398.785
A	21186.063	-12.000	398.779	398.790
	21196.063	-12.000	398.773	398.787
	21206.063	-12.000	398.767	398.774
Br. Pier 1	21216.563	-12.000	398.760	398.760
	21226.563	-12.000	398.754	398.760
	21236.563	-12.000	398.748	398.758
	21246.563	-12.000	398.742	398.751
	21256.563	-12.000	398.736	398.740
	21265.979	-12.000	398.732	398.732
Br. Pier 2	21273.979	-12.000	398.728	398.733
	21283.979	-12.000	398.720	398.734
	21293.979	-12.000	398.714	398.725
	21304.479	-12.000	398.707	398.707
Bk. S. Abut.	21306.396	-12.000	398.706	398.706

BEAM 3

Location	Station	Offset	Theoretical Grade Elevations	Theoretical Grade Elevations Adjusted For Dead Load Deflection
Bk. N. Abut.	21174.618	-9.625	398.830	398.830
Br. N. Abut.	21176.535	-9.625	398.829	398.829
A	21186.535	-9.625	398.823	398.835
	21196.535	-9.625	398.817	398.831
	21206.535	-9.625	398.811	398.819
Br. Pier 1	21217.035	-9.625	398.805	398.805
	21227.035	-9.625	398.799	398.804
	21237.035	-9.625	398.793	398.802
	21247.035	-9.625	398.787	398.795
	21257.035	-9.625	398.781	398.784
	21264.451	-9.625	398.776	398.776
Br. Pier 2	21274.451	-9.625	398.770	398.777
	21284.451	-9.625	398.764	398.778
	21294.451	-9.625	398.758	398.770
	21304.951	-9.625	398.752	398.752
Bk. S. Abut.	21306.868	-9.625	398.750	398.750

BEAM 4

Location	Station	Offset	Theoretical Grade Elevations	Theoretical Grade Elevations Adjusted For Dead Load Deflection
Bk. N. Abut.	21175.934	-3.000	398.903	398.903
Br. N. Abut.	21177.851	-3.000	398.901	398.901
A	21187.851	-3.000	398.895	398.907
	21197.851	-3.000	398.889	398.904
	21207.851	-3.000	398.883	398.891
Br. Pier 1	21218.351	-3.000	398.877	398.877
	21228.351	-3.000	398.871	398.878
	21238.351	-3.000	398.865	398.874
	21248.351	-3.000	398.859	398.867
	21258.351	-3.000	398.853	398.857
	21265.767	-3.000	398.848	398.848
Br. Pier 2	21275.767	-3.000	398.842	398.849
	21285.767	-3.000	398.836	398.850
	21295.767	-3.000	398.830	398.842
	21306.267	-3.000	398.824	398.824
Bk. S. Abut.	21308.184	-3.000	398.823	398.823

ROADWAY AND P. G.

Location	Station	Offset	Theoretical Grade Elevations	Theoretical Grade Elevations Adjusted For Dead Load Deflection
Bk. N. Abut.	21176.530	0.000	398.910	398.910
Br. N. Abut.	21178.447	0.000	398.909	398.909
A	21188.447	0.000	398.903	398.914
	21198.447	0.000	398.897	398.911
	21208.447	0.000	398.891	398.898
Br. Pier 1	21218.947	0.000	398.884	398.884
	21228.947	0.000	398.878	398.883
	21238.947	0.000	398.872	398.882
	21248.947	0.000	398.866	398.875
	21258.947	0.000	398.860	398.864
	21266.363	0.000	398.856	398.856
Br. Pier 2	21276.363	0.000	398.850	398.857
	21286.363	0.000	398.844	398.858
	21296.363	0.000	398.838	398.849
	21306.863	0.000	398.831	398.831
Bk. S. Abut.	21308.780	0.000	398.830	398.830

BEAM 5

Location	Station	Offset	Theoretical Grade Elevations	Theoretical Grade Elevations Adjusted For Dead Load Deflection
Bk. N. Abut.	21177.250	3.625	398.898	398.898
Br. N. Abut.	21179.167	3.625	398.897	398.897
A	21189.167	3.625	398.891	398.902
	21199.167	3.625	398.885	398.899
	21209.167	3.625	398.879	398.888
Br. Pier 1	21219.667	3.625	398.872	398.872
	21229.667	3.625	398.866	398.871
	21239.667	3.625	398.860	398.870
	21249.667	3.625	398.854	398.863
	21259.667	3.625	398.848	398.852
	21267.084	3.625	398.844	398.844
Br. Pier 2	21277.084	3.625	398.838	398.845
	21287.084	3.625	398.832	398.846
	21297.084	3.625	398.825	398.837
	21307.584	3.625	398.819	398.819
Bk. S. Abut.	21309.500	3.625	398.818	398.818

BEAM 6

Location	Station	Offset	Theoretical Grade Elevations	Theoretical Grade Elevations Adjusted For Dead Load Deflection
Bk. N. Abut.	21178.566	10.250	398.818	398.818
Br. N. Abut.	21180.483	10.250	398.817	398.817
A	21190.483	10.250	398.810	398.822
	21200.483	10.250	398.804	398.819
	21210.483	10.250	398.798	398.806
Br. Pier 1	21220.983	10.250	398.792	398.792
	21230.983	10.250	398.786	398.791
	21240.983	10.250	398.780	398.789
	21250.983	10.250	398.774	398.782
	21260.983	10.250	398.768	398.772
	21268.400	10.250	398.763	398.763
Br. Pier 2	21278.400	10.250	398.757	398.764
	21288.400	10.250	398.751	398.765
	21298.400	10.250	398.745	398.757
	21308.900	10.250	398.739	398.739
Bk. S. Abut.	21310.816	10.250	398.738	398.738

WEST LONGITUDINAL BONDED CONSTRUCTION JOINT

Location	Station	Offset	Theoretical Grade Elevations	Theoretical Grade Elevations Adjusted For Dead Load Deflection
Bk. N. Abut.	21178.914	12.000	398.784	398.784
Br. N. Abut.	21180.831	12.000	398.783	398.783
A	21190.831	12.000	398.776	398.788
	21200.831	12.000	398.770	398.785
	21210.831	12.000	398.764	398.772
Br. Pier 1	21221.331	12.000	398.758	398.758
	21231.331	12.000	398.752	398.757
	21241.331	12.000	398.746	398.755
	21251.331	12.000	398.740	398.748
	21261.331	12.000	398.734	398.738
	21268.747	12.000	398.729	398.729
Br. Pier 2	21278.747	12.000	398.723	398.730
	21288.747	12.000	398.717	398.731
	21298.747	12.000	398.711	398.723
	21309.247	12.000	398.705	398.705
Bk. S. Abut.	21311.164	12.000	398.704	398.704


BEAM 7

Location	Station	Offset	Theoretical Grade Elevations	Theoretical Grade Elevations Adjusted For Dead Load Deflection
Bk. N. Abut.	21179.882	16.875	398.682	398.682
Br. N. Abut.	21181.799	16.875	398.681	398.681
A	21191.799	16.875	398.674	398.686
	21201.799	16.875	398.668	398.683
	21211.799	16.875	398.662	398.670
Br. Pier 1	21222.299	16.875	398.656	398.656
	21232.299	16.875	398.650	398.655
	21242.299	16.875	398.644	398.653
	21252.299	16.875	398.638	398.646
	21262.299	16.875	398.632	398.636
	21269.716	16.875	398.627	398.627
Br. Pier 2	21279.716	16.875	398.621	398.628
	21289.716	16.875	398.615	398.629
	21299.716	16.875	398.609	398.621
	21310.216	16.875	398.603	398.603
Bk. S. Abut.	21312.133	16.875	398.602	398.602



STATE OF ILLINOIS  
DEPARTMENT OF TRANSPORTATION

ROUTE NO.	SECTION	DATE	JOB	"BY"	SHEET NO. 3
F.A.I. RT.	28-5B-110	FRANKLIN	155	127	16 SHEETS
PROJECT DIST. NO. 7	ILLINOIS	ILLINOIS PROJECT			

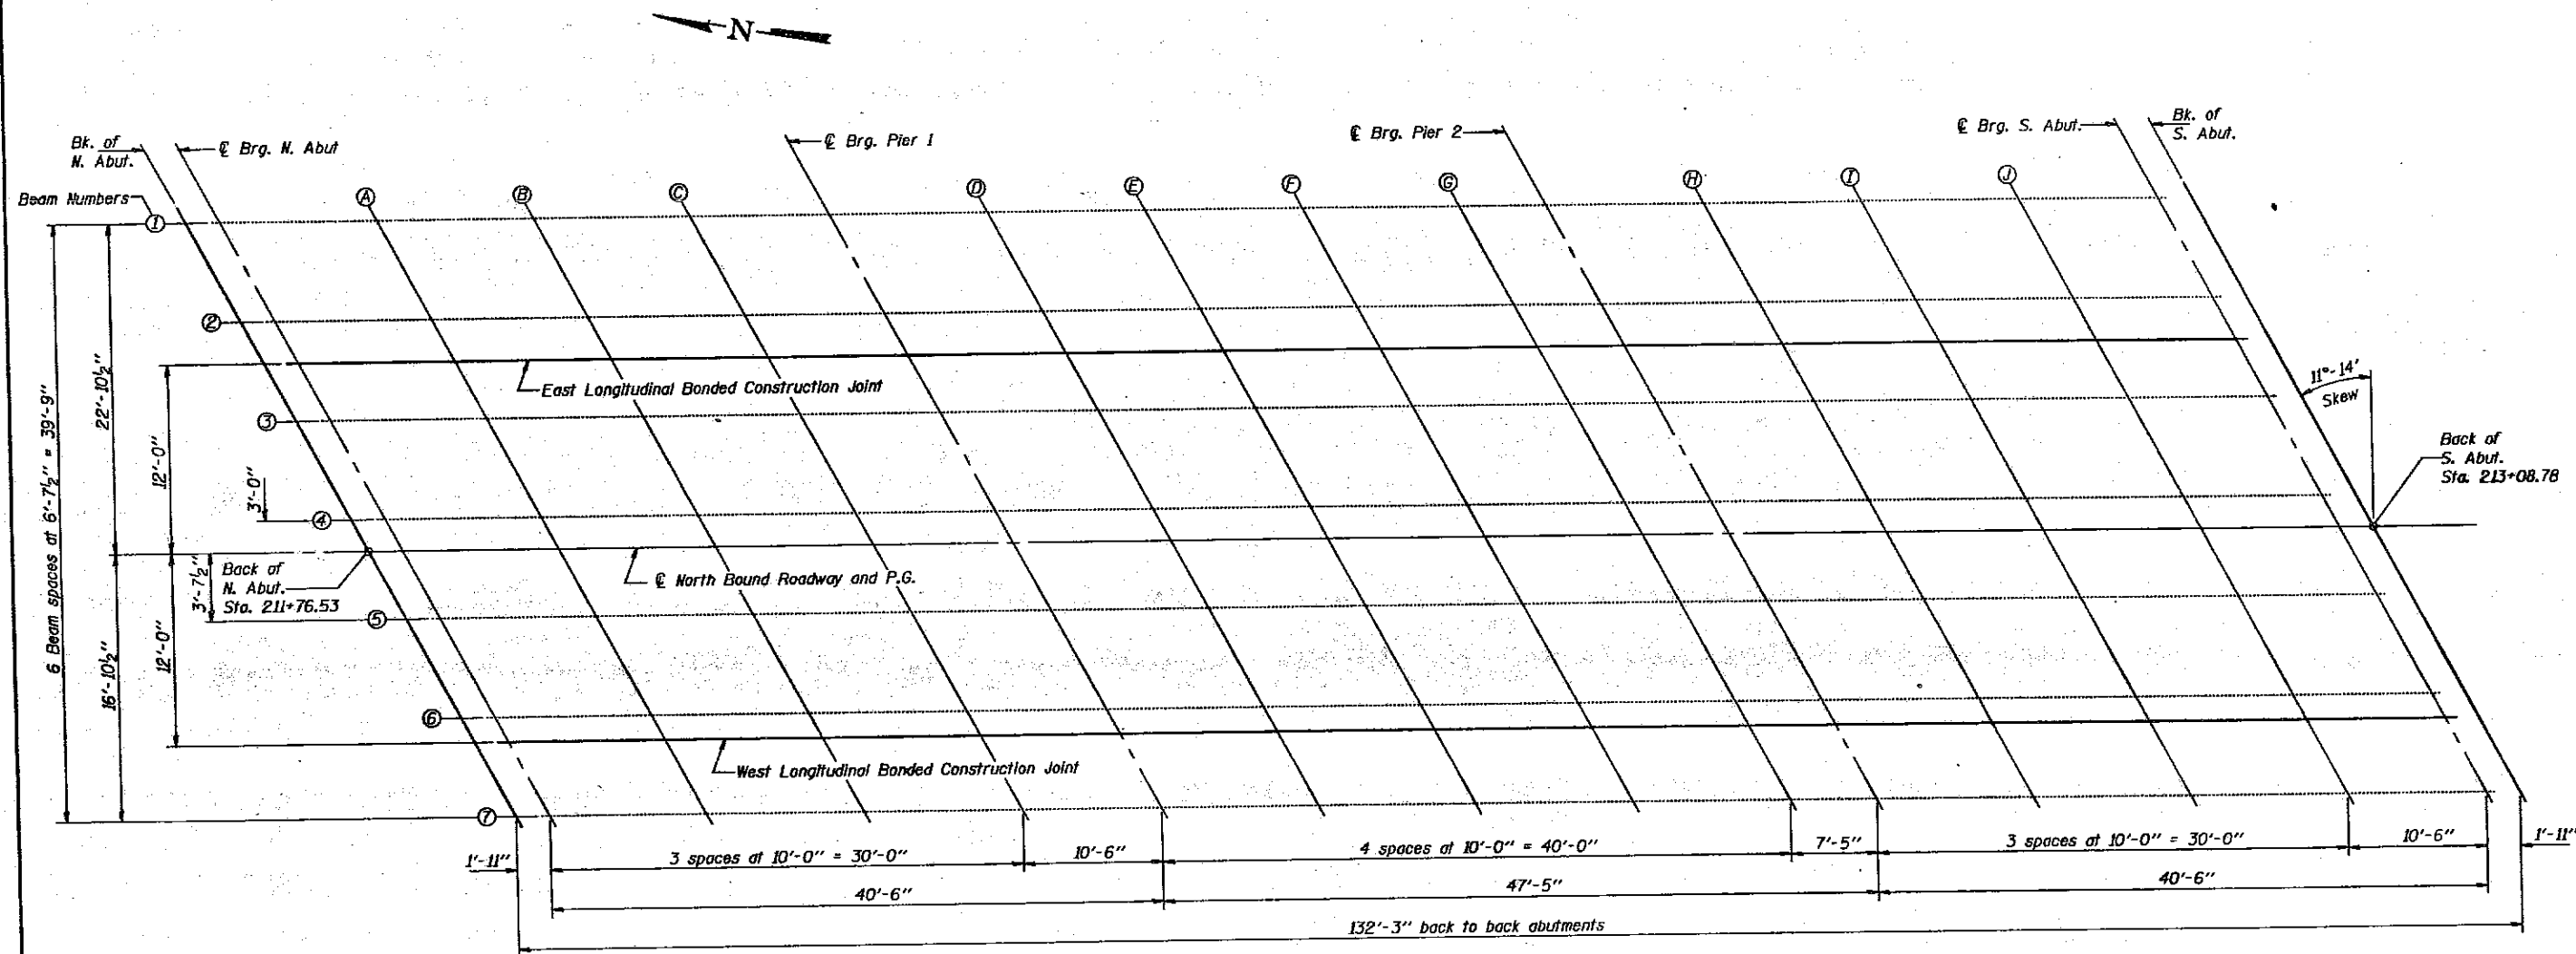

PLAN

Work this sheet with sheet #2 of 16.

DESIGNED *Richard J. Chaput*  
 CHECKED *Thomas P. Ruzickowski*  
 DRAWN *Paul W. Sweet*  
 CHECKED *RSC* *OK R18*


EXAMINED *Origi D. Kaspar*  
 PASSED *Ralph E. Anderson*  
 APPROVED \_\_\_\_\_  
 DIRECTOR OF HIGHWAYS

MAY 22 1992


TOP OF SLAB ELEVATIONS  
 F.A.I. RT. 57 SEC. (28-5B-110)  
 FRANKLIN COUNTY  
 STATION 212+50.00

STATE OF ILLINOIS  
DEPARTMENT OF TRANSPORTATION

ROUTE NO.	SECTION	COUNTY	MILES	POST MILE	SHEET NO. 4
F.A.I. 57	28-5B-1D	FRANKLIN	155	120	16 SHEETS
FED. ROAD DIST. NO. 7		BILLED	PREL. AND PROJECT		

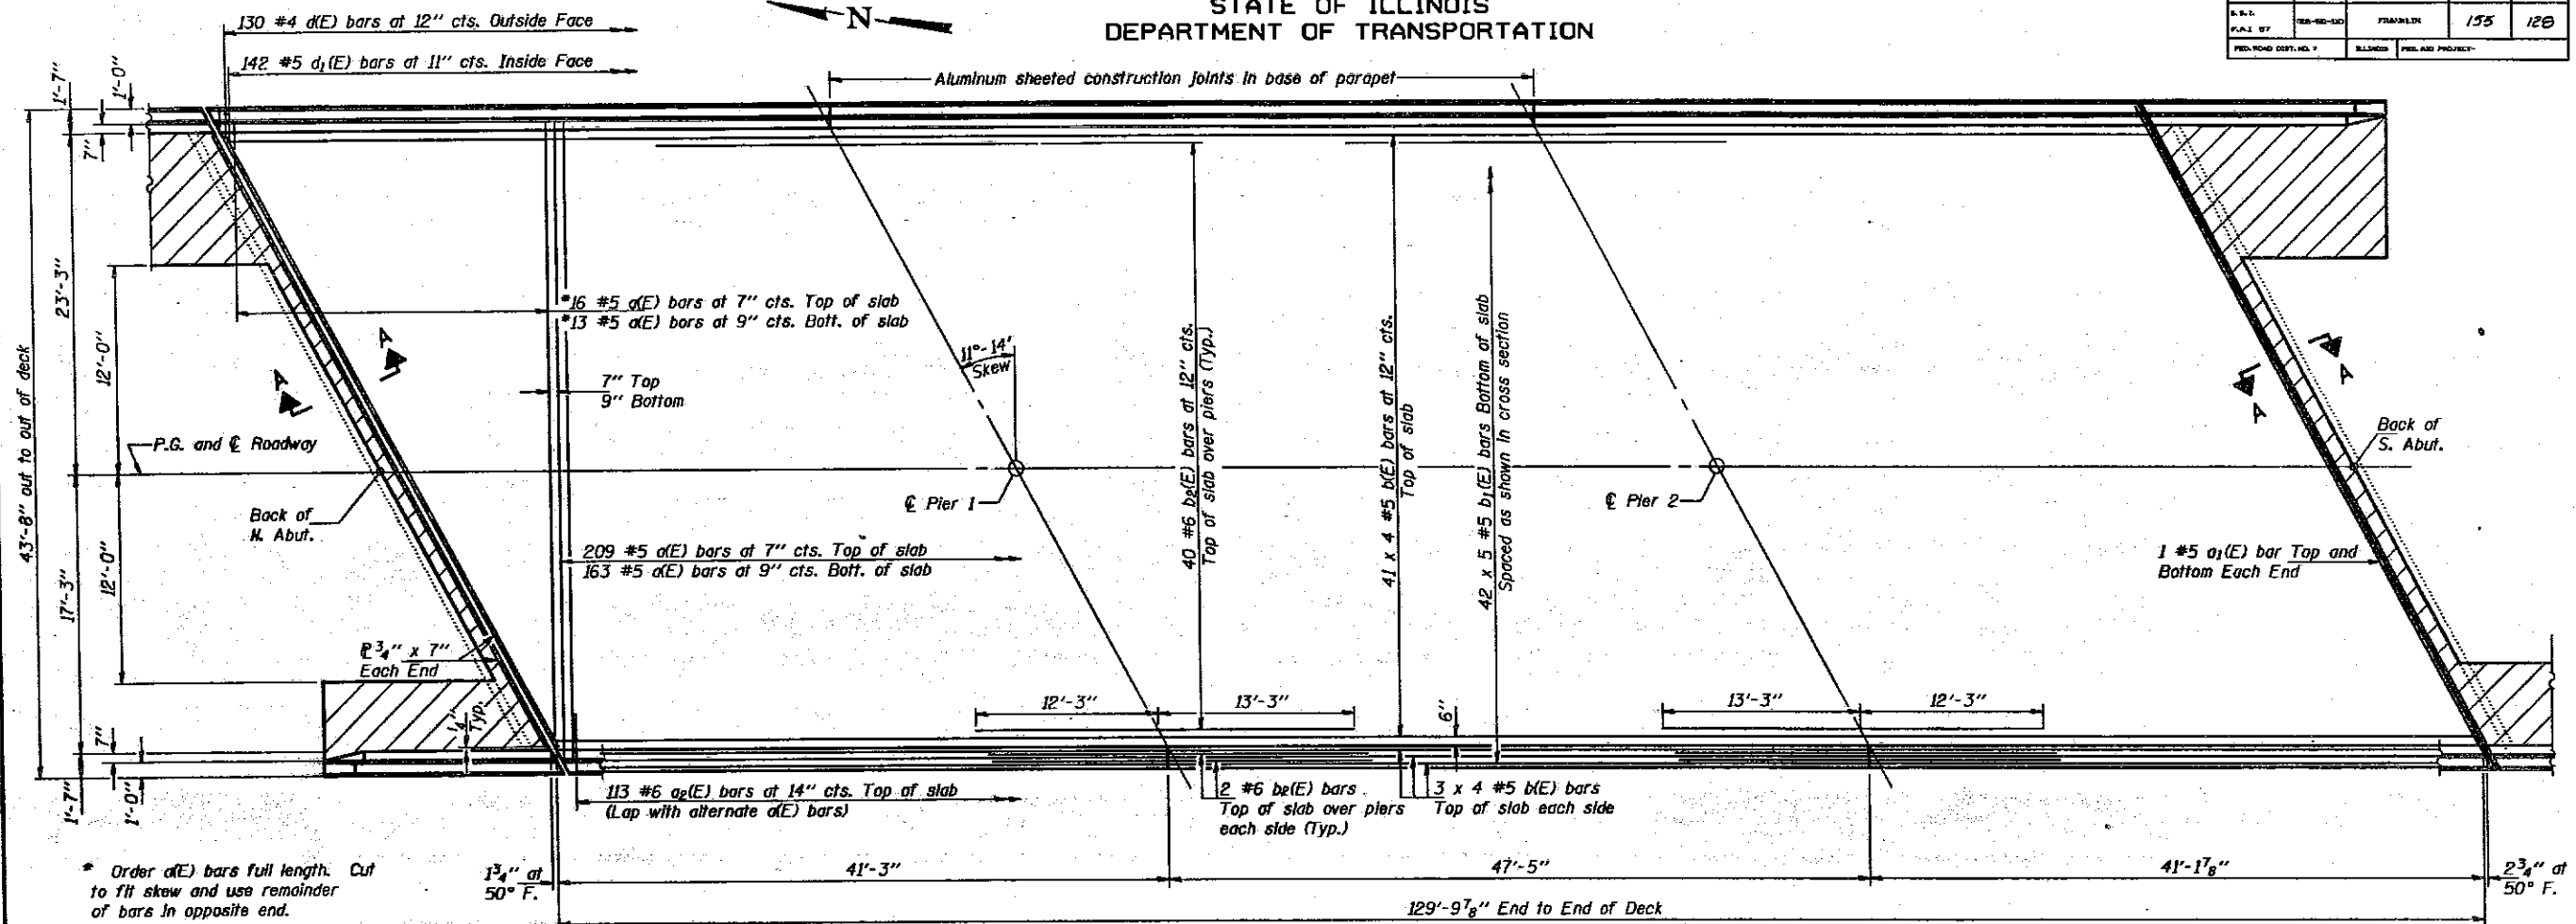

PLAN

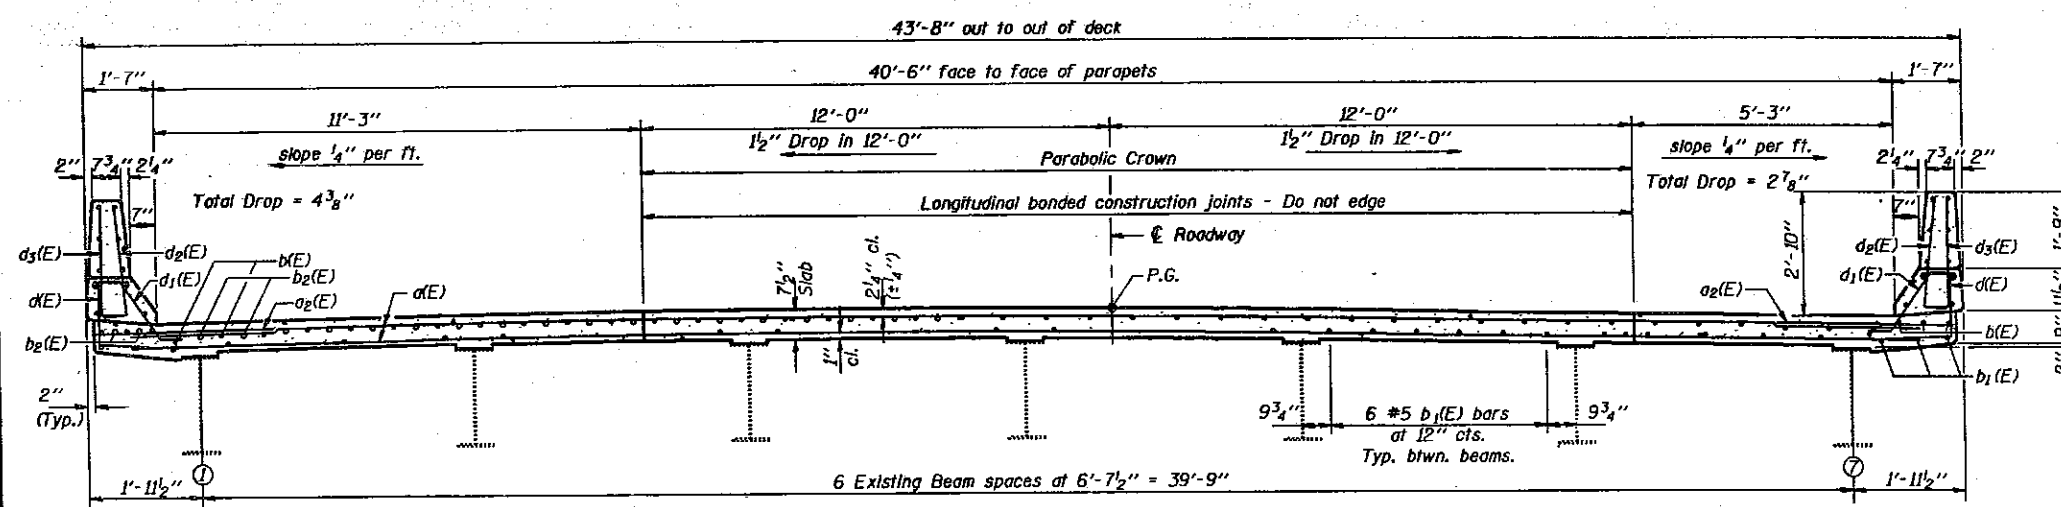

CROSS SECTION  
(Looking South)

Notes: See sheets #5 and #6 of 16 for superstructure details, parapet reinforcement and Bill of Material.  
Reinforcement bars designated (E) shall be epoxy coated.  
Reinforcement bars indicated thus 40 x 4 #5 etc. indicates 40 lines of bars with 4 lengths per line.  
See sheet #1 of 16 for drain locations and sheet #5 of 16 for details.  
See sheets #13 & 15 of 16 for Approach shoulder details.

MIN. BAR LAPS  
#5 bars = 1'-9"

DESIGNED *Richard J. Chapp*  
CHECKED *Shirley P. Nardis*  
DRAWN *Paul W. Sweet*  
CHECKED *RJC CBE RIB*

EXAMINED *May 22 1992*  
*Greg J. Kasper*  
PASSED *Robert E. Anderson*  
APPROVED \_\_\_\_\_  
DIRECTOR OF HIGHWAYS

SUPERSTRUCTURE  
F.A.I. RT. 57 SEC. (28-5B-1D)  
FRANKLIN COUNTY  
STATION 212+50.00






STATE OF ILLINOIS  
DEPARTMENT OF TRANSPORTATION


ROUTE NO.	SECTION	COUNTY	DATE	SHEET	SHEET NO. 6 OF 16 SHEETS
F.A.I. 57	(28-5B-10)	FRANKLIN	1955	150	
PROJ. AND DIST. NO.	ILLINOIS	FED. AID PROJECT			

Hatched area to be poured after superstructure forms have been removed. Quantity of concrete to be included with "Class X Concrete Superstructure" that is shown on this Sheet.

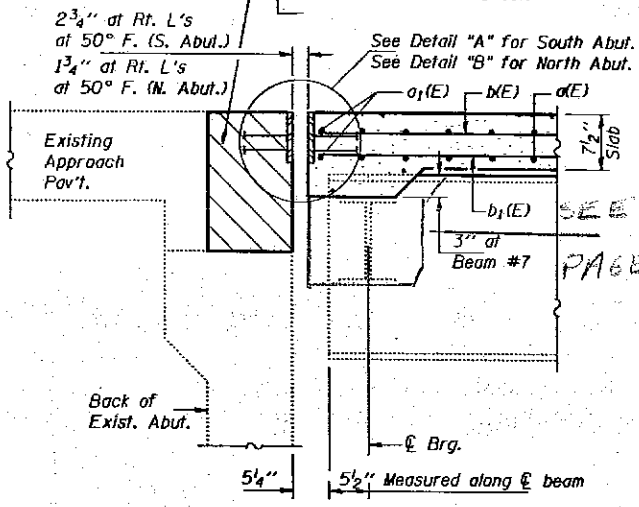


SECTION A-A

SEE PREVIOUS PAGE FOR DETAIL

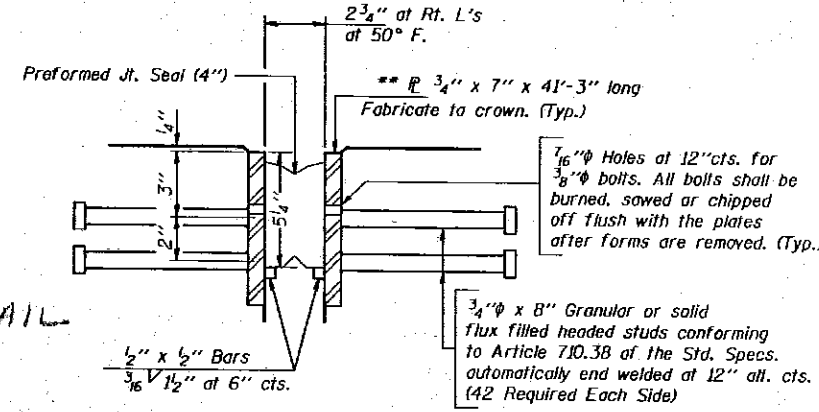


DETAIL "A"

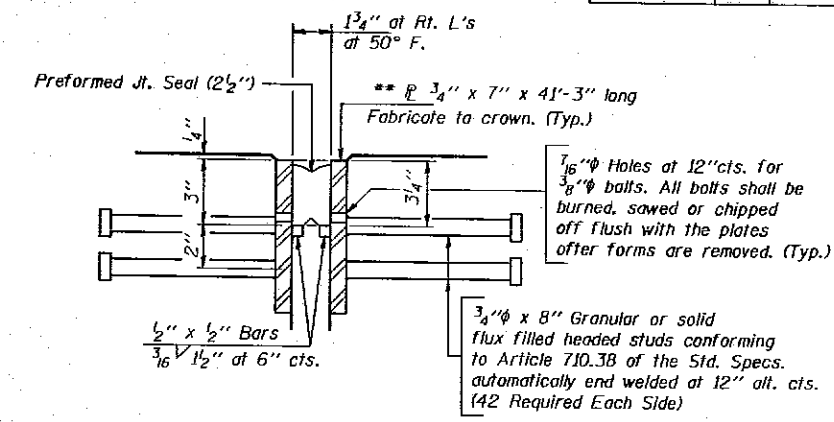


DETAIL "B"


\*\* Furnish in segments of 20 ft. maximum length. Maximum space between installed segments shall be 3/16". Seal space with Silicone Sealant suitable for Structural Steel. After fabrication all surfaces of the steel plates shall be given one shop coat of paint specified for New Structural Steel. No field painting required.

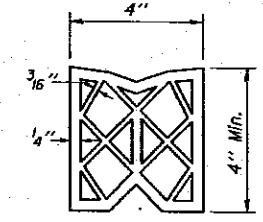


PREFORMED JOINT SEAL (4'')

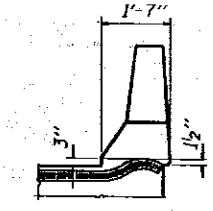


END TREATMENT  
Typ. for (4'') and (2 1/2'')

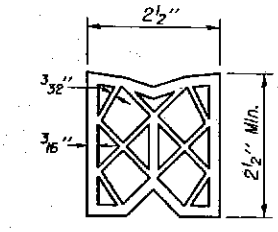


PREFORMED JOINT SEAL (2 1/2'')

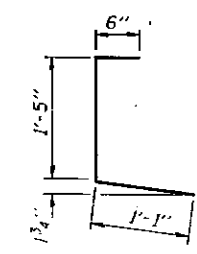

BAR d(E)

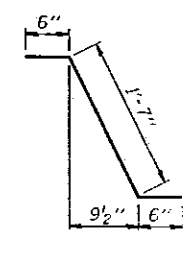

BAR d1(E)

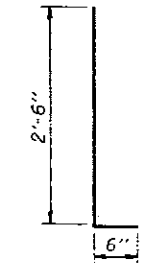

BARS d2(E) & d3(E)

BILL OF MATERIAL

Bar	No.	Size	Length	Shape
a(E)	401	#5	41'-8"	
a1(E)	4	#5	42'-6"	
a2(E)	226	#6	4'-0"	
b(E)	188	#5	33'-8"	
b1(E)	210	#5	27'-3"	
b2(E)	88	#6	25'-6"	
d(E)	260	#4	3'-0"	L
d1(E)	284	#5	2'-7"	L
d2(E)	284	#5	3'-0"	L
d3(E)	260	#4	3'-0"	L
e(E)	48	#4	20'-4"	
e1(E)	36	#4	15'-6"	
e2(E)	8	#8	40'-10"	
e3(E)	4	#8	47'-1"	
e4(E)	8	#5	40'-10"	
e5(E)	4	#5	47'-1"	

Reinforcement Bars, Epoxy Coated	Lbs.	40,540
Class X Concrete Superstructure	Cu. Yd.	187.1

Reinforcement bars designated (E) shall be epoxy coated.


SUPERSTRUCTURE DETAILS  
F.A.I. RT. 57 SEC. (28-5B-10)  
FRANKLIN COUNTY  
STATION 212+50.00

DESIGNED *Richard J. Chaput*  
CHECKED *James P. Rasmussen*  
DRAWN *Paul W. Sweet*  
CHECKED *RJC CE RB*

EXAMINED *May 22 1952*  
*Ernst J. Kaspar*  
PASSED *Ralph E. Anderson*  
APPROVED \_\_\_\_\_  
DIRECTOR OF HIGHWAYS


STATE OF ILLINOIS  
DEPARTMENT OF TRANSPORTATION

ROUTE NO.	SECTION	COUNTY	SHEETS	"OF"	SHEET NO. 7
F.A.I. RT.	28-5B-11C	FRANKLIN	155	131	16 SHEETS
FED. ROAD DIST. NO. 7	ILLINOIS	FED. AID PROJECT			

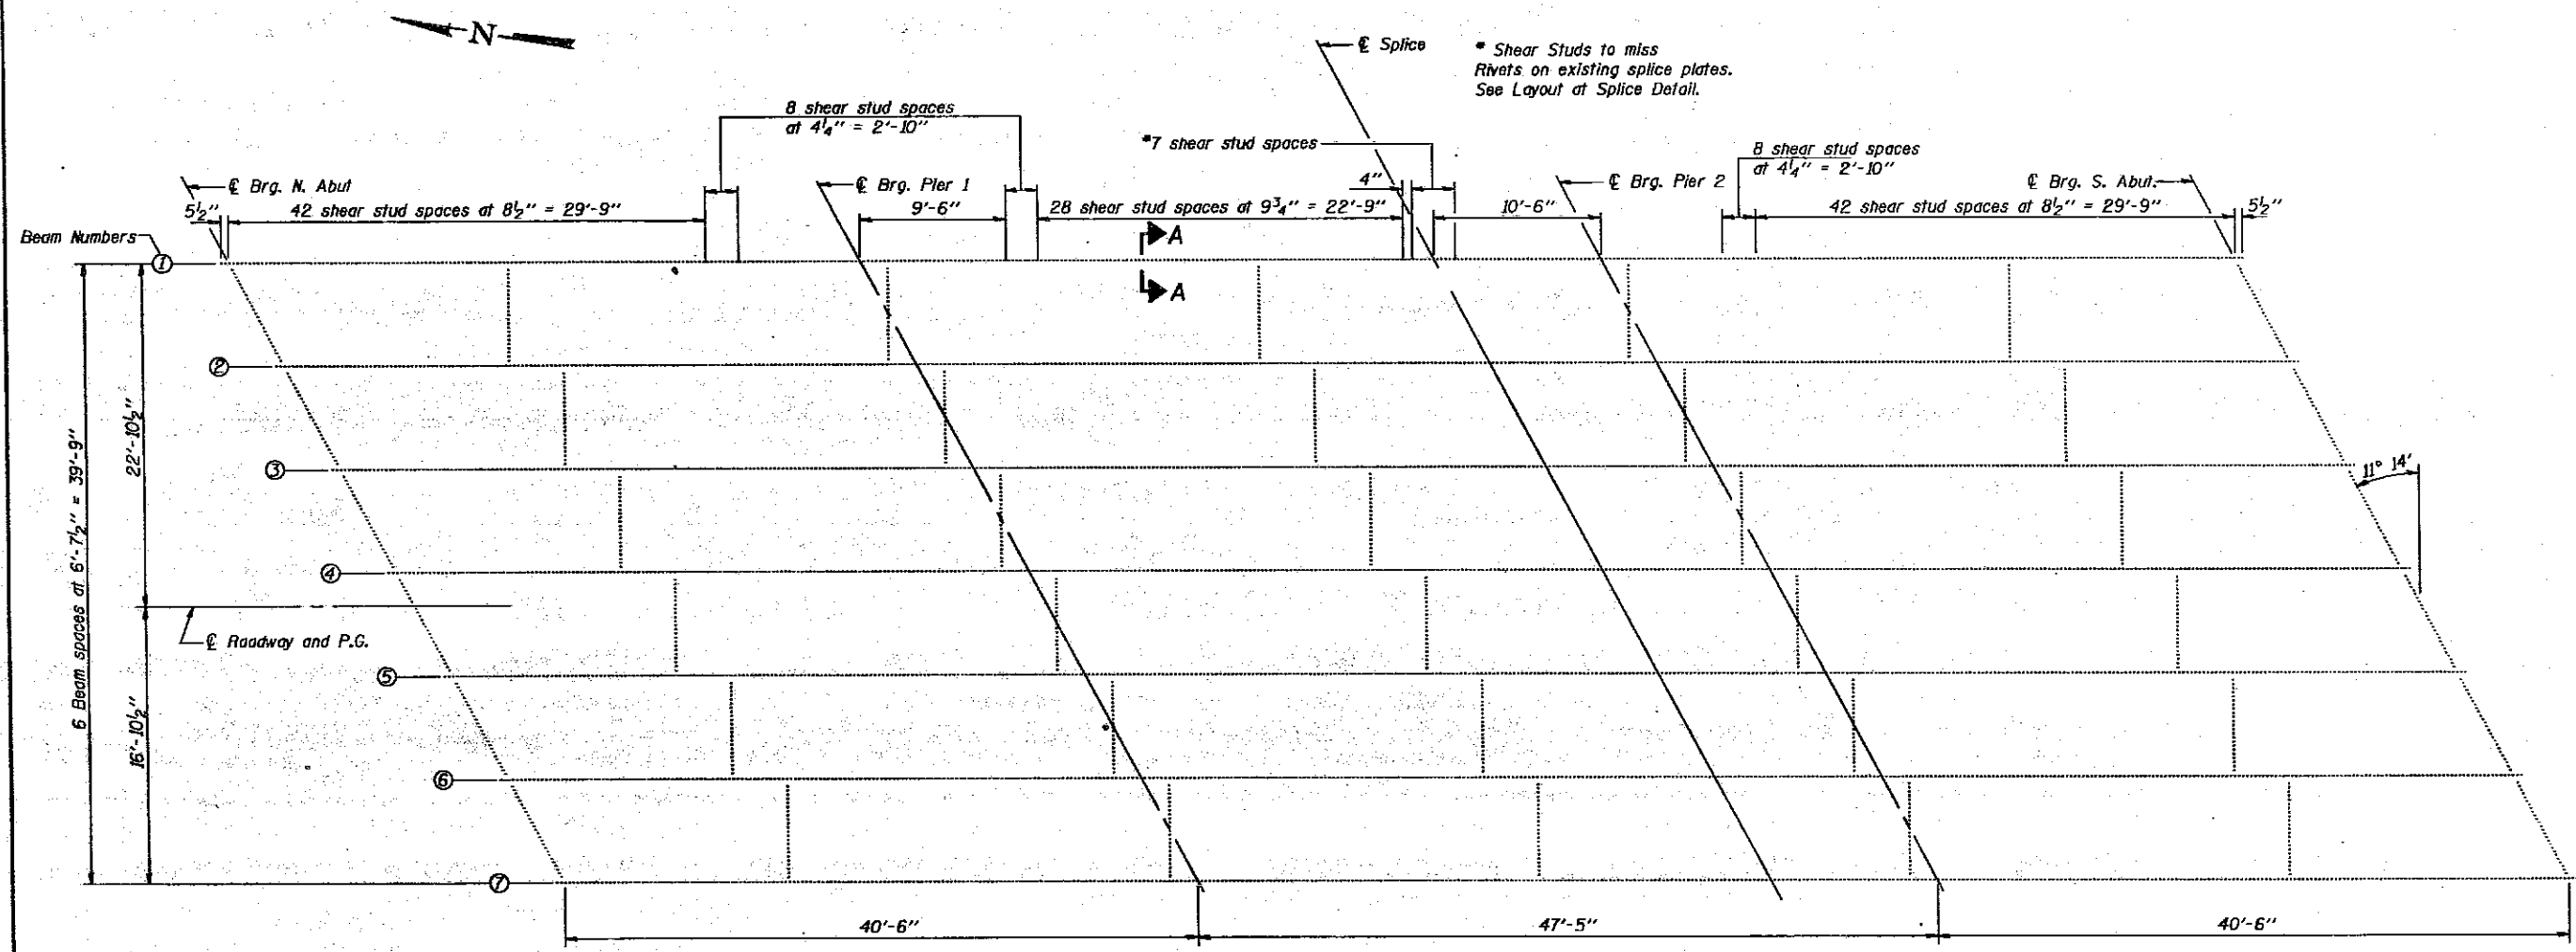

\* Shear Studs to miss Rivets on existing splice plates. See Layout at Splice Detail.

3/4" Granular or solid flux filled headed studs, conforming to the requirements of Art. 710.38 of the Std. Specs. Automatically end welded to flange. (3150 Required)

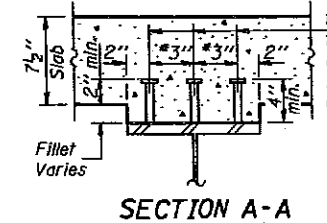


PLAN

	Abuts.	Piers
R <sub>p</sub> (K)	15.9	49.0
R <sub>l</sub> (K)	32.2	39.3
Imp. (K)	9.7	11.6
R (Total) (K)	57.8	99.9

Is and Ss are the moment of inertia and section modulus of the steel section used in computing f<sub>s</sub>(Total), and f<sub>s</sub>(Overload).  
Ic and Sc are the moment of inertia and section modulus of the composite section used in computing, and f<sub>s</sub>(Overload).  
VR is the maximum Live Load + Impact shear range in span.  
Ma (Applied Moment) = 1.3 [M<sub>p</sub> + Ms<sub>p</sub> + 5/3(M<sub>l</sub> + I)]  
Mu is the Full Plastic Moment Capacity computed according to AASHTO 10.48.1 & 10.50.1.1  
fs (Overload) is the sum of stresses the due to [M<sub>p</sub> + Ms<sub>p</sub> + 5/3(M<sub>l</sub> + I)]  
fs (Total) is the sum of stresses the due to 1.3 [M<sub>p</sub> + Ms<sub>p</sub> + 5/3(M<sub>l</sub> + I)]. at unbraced, Non-compact, section.  
M<sub>p</sub> - Moment due to dead load on non-composite section.  
Ms<sub>p</sub> - Moment due to dead load on composite section.  
M<sub>l</sub> - Moment due to live load on non-composite section.  
I - Live load impact.

	0.4 Sp. 1 or 0.6 Sp. 3	Pier 1 or Pier 2	0.5 Sp. 2
Is (in <sup>4</sup> )	3604	3604	3604
Ic (n=9) (in <sup>4</sup> )	10448	10448	10448
Ic (n=27) (in <sup>4</sup> )	7732	7732	7732
Ss (in <sup>3</sup> )	266	266	266
Sc (n=9) (in <sup>3</sup> )	405	405	405
Sc (n=27) (in <sup>3</sup> )	367	367	367
Ip (K/ft.)	.748	1.01	.748
M <sub>p</sub> (K)	89.3	183.6	65.3
fs <sub>p</sub> non-comp (k.s.i.)	4.0	8.3	2.9
s <sub>p</sub> (K/ft.)	.262	.262	.262
Ms <sub>p</sub> (K)	36.1	34.9	34.9
fs <sub>p</sub> (comp) (k.s.i.)	1.2	1.1	1.1
M <sub>l</sub> (K)	237.3	122.9	245.1
M (Imp) (K)	71.2	36.2	70.8
5/3 (M <sub>l</sub> + I) (K)	514.2	265.2	526.5
fs 5/3(I + I) (k.s.i.)	15.2	11.9	15.6
Mo (K)	831.0	583.0	815.0
Mu (K)	1657	1657	1657
fs (Overload) (k.s.i.)	20.4	20.2	19.6
fs (Total) (k.s.i.)	26.3	26.3	26.3
VR (K)	45.4	48.5	48.5

\*\* For n = 27.

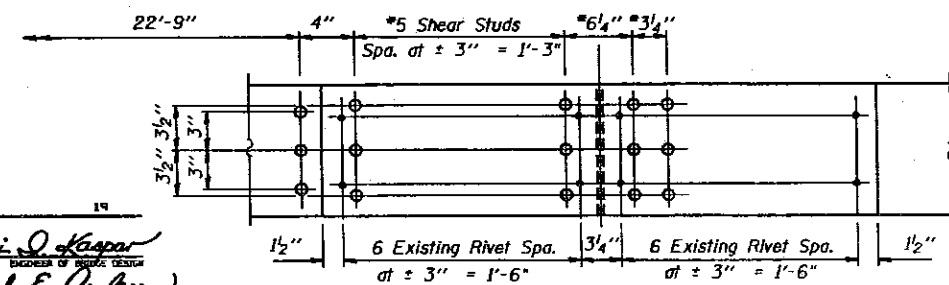




LAYOUT AT SPLICE

DESIGNED Richard J. Chaput  
CHECKED Thomas P. Amick  
DRAWN Paul W. Sweet  
CHECKED R3c R1B G2

EXAMINED Craig J. Kaspar  
PASSED Ralph E. Anderson  
APPROVED

STRUCTURAL STEEL DETAILS  
F.A.I. RT. 57 SEC. (28-5B-11D)  
FRANKLIN COUNTY  
STATION 212+50.00

STATE OF ILLINOIS  
DEPARTMENT OF TRANSPORTATION

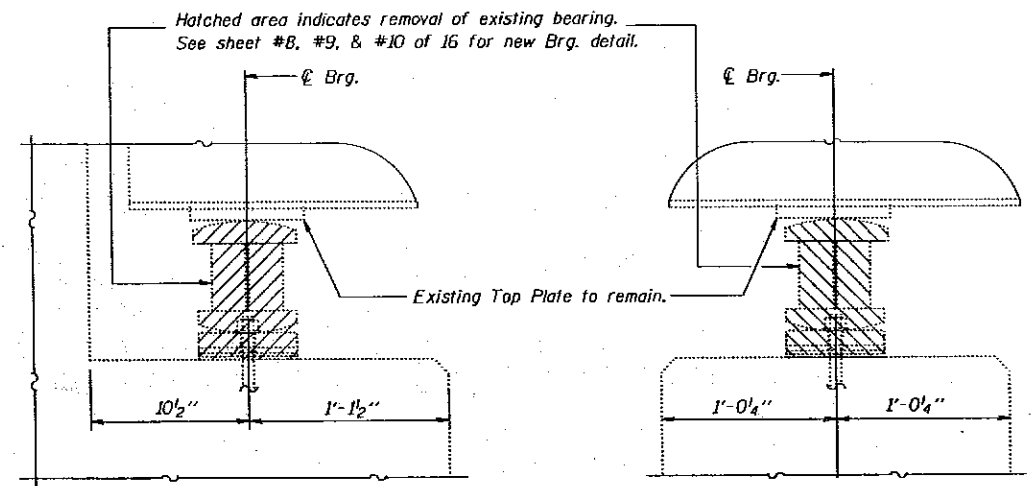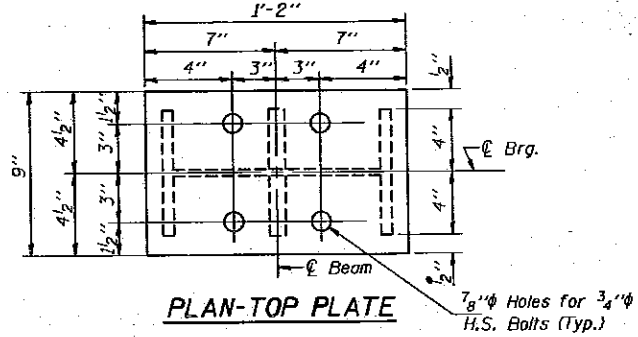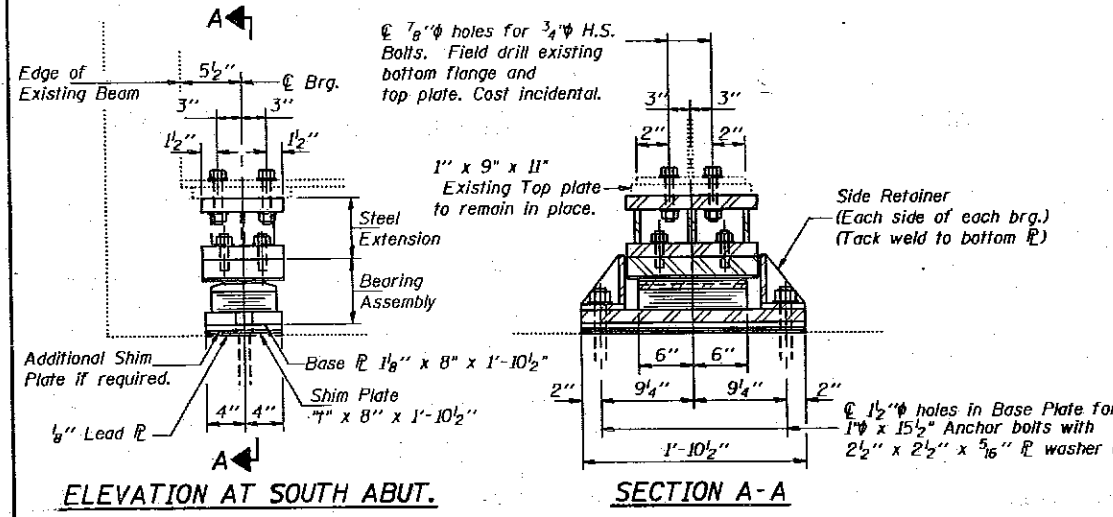


JACK AND REMOVE EXISTING BEARING  
(Dimension are at Rt. L's)


JACK AND REMOVE EXISTING BEARING PROCEDURE

1. The Contractor shall submit for approval by the Engineer, plans for jacking & cribbing prior to commencing any work at the bearings.
2. Jacking and removing existing bearings shall be done after deck removal is completed and before the new deck is poured.
3. All beams, all locations shall be lifted simultaneously.
4. Jacking shall be limited to a maximum of 1/4" lift to remove the existing bearing assembly, utilizing a jack or series of jacks. The max. dead load reaction at each beam with the deck removed is 6.0K at Piers and 1.9K at Abutments. The Minimum Jack Capacity for each beam is 5 Ton at Piers and 2 Ton at Abutments. Set jacks so that beams can be lowered approximately 1 1/8" from original position.
5. Remove the existing anchor bolts flush with the concrete surface and grind smooth. The rocker and bottom plates shall be removed leaving the existing top plate intact. The bottom flange area of the beam and existing top plate shall be cleaned and painted as specified for Structural Steel.
6. The new bearings and steel extensions shall be in place and the jacks shall be lowered before the new deck is poured. Lower all Beams simultaneously in 1/4" increments.


TYPE II TFE ELASTOMERIC EXP. BRG.

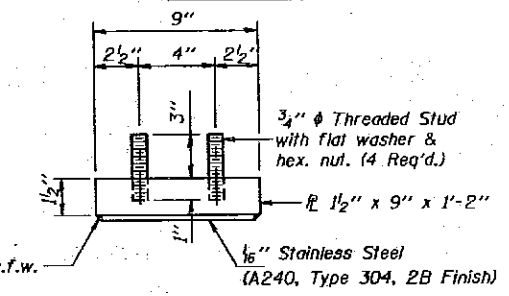


TOP BEARING ASSEMBLY

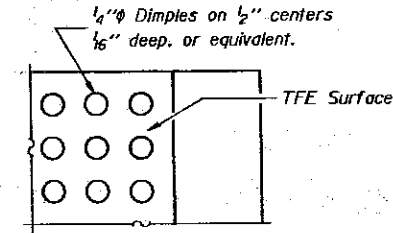


PLAN-TFE SURFACE

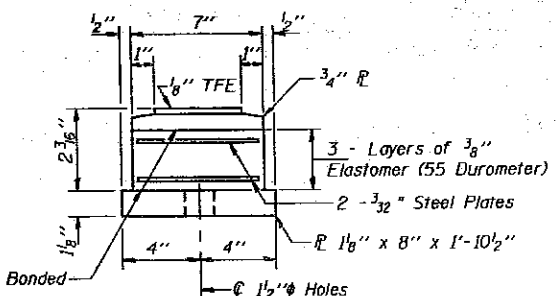

BOTTOM BEARING ASSEMBLY

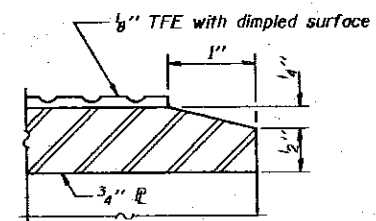

SECTION THRU TFE

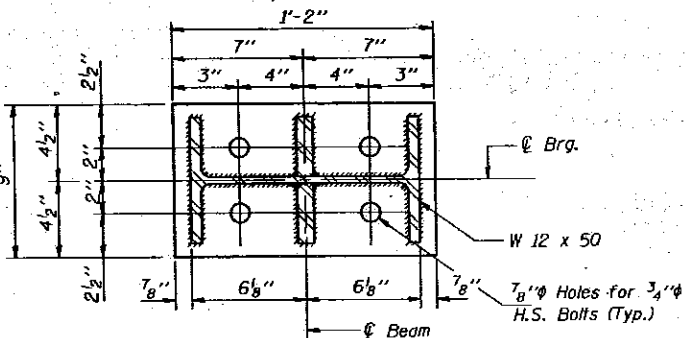


STEEL EXTENSION AT SOUTH ABUT.

Equivalent welded plates will be allowed in lieu of W12 x 50 section.

SECTION B-B


Note: The 1/8" TFE sheet shall be bonded directly to the top steel plate with a two-component, medium viscosity epoxy resin, conforming to the requirements of the Federal Specification MMM-A-134, Type I. The bond agent shall be applied on the full area of the contact surfaces.

Bonding of 1/8" TFE sheet during vulcanizing process will be permitted provided the process and method of adjusting assembly height is approved by the Engineer.

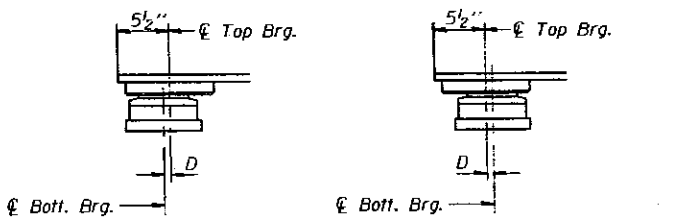

SETTING ANCHOR BOLTS AT EXP. BRG.

D=5/8" per each 100' of expansion for every 15° temp. change from the normal temp. of 50°F.

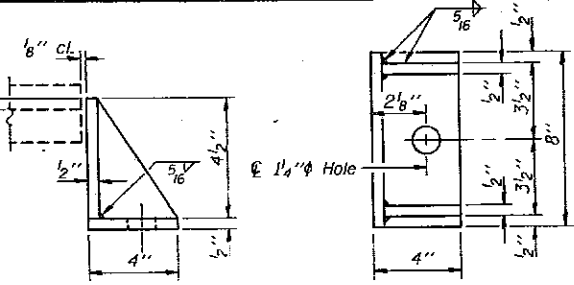

SIDE RETAINER

Equivalent rolled angle with stiffeners will be allowed in lieu of welded plates.

DESIGNED	Richard J. Choquet	EXAMINED	Gregory J. Kasper
CHECKED	Paul W. Sweet	PASSED	Ralph E. Anderson
DRAWN	Paul W. Sweet	APPROVED	
CHECKED	RJC RIB GWC		

DATE: May 22 1992

Notes: For anchor bolt installation details see sheet #16 of 16. For table of Shim Plate "T" Dimensions see sheet #10 of 16. Anchor Bolts, Side Retainers, Shim Plates, Lead Plates, and Steel Extension Assemblies are included in the "Structural Steel" Quantity. See sheet #14 of 16 for anchor bolt layout at South Abutment.

BILL OF MATERIAL


Item	Unit	Total
Elastomeric Bearing Assembly Type II	Each	7
Jack and Remove Existing Bearings	Each	7

SOUTH ABUTMENT  
BEARING DETAILS  
F.A.I. RT. 57 SEC. (28-5B-10)  
FRANKLIN COUNTY  
STATION 212+50.00




STATE OF ILLINOIS  
DEPARTMENT OF TRANSPORTATION


PROJECT NO.	SECTION	COUNTY	DATE	SHEET
F.A.I. RT. 57	28-5B-11D	FRANKLIN	155	133
SHEET NO. 9				
16 SHEETS				

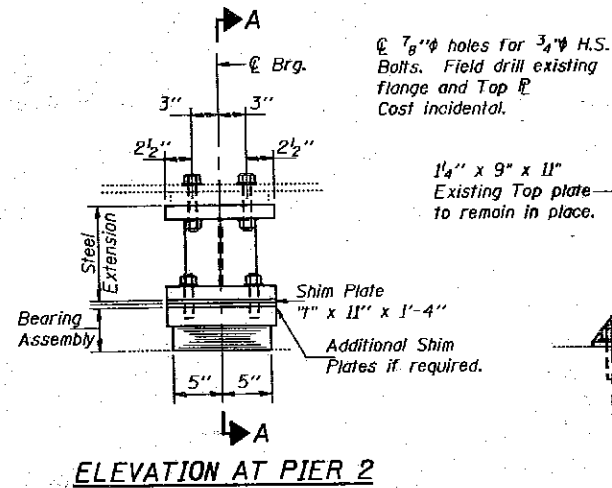


ELEVATION AT PIER 2

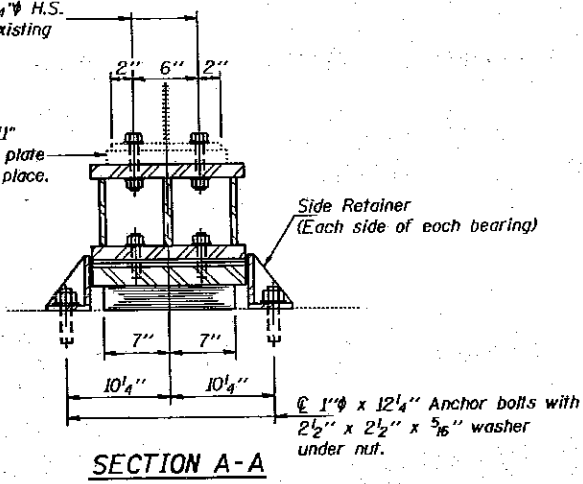

SECTION A-A

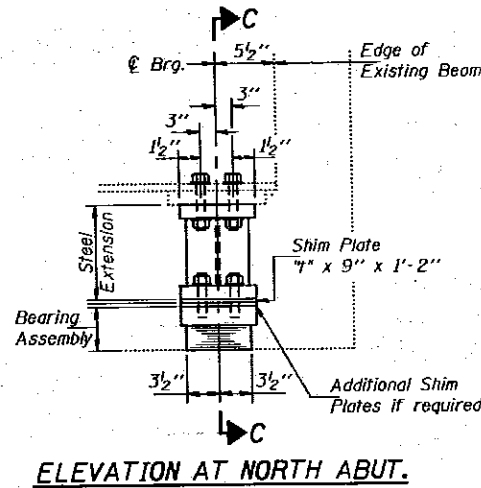


ELEVATION AT NORTH ABUT.

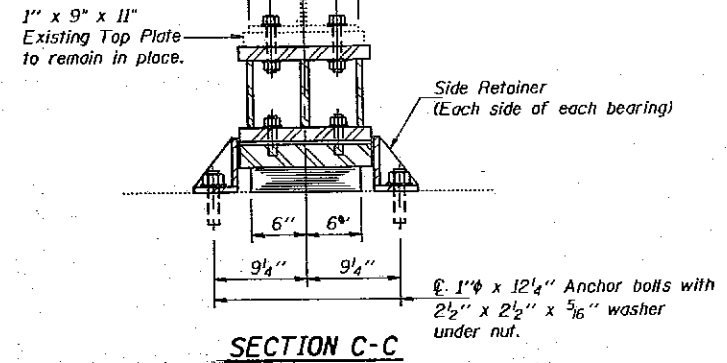


SECTION C-C


TYPE I ELASTOMERIC EXP. BRG.

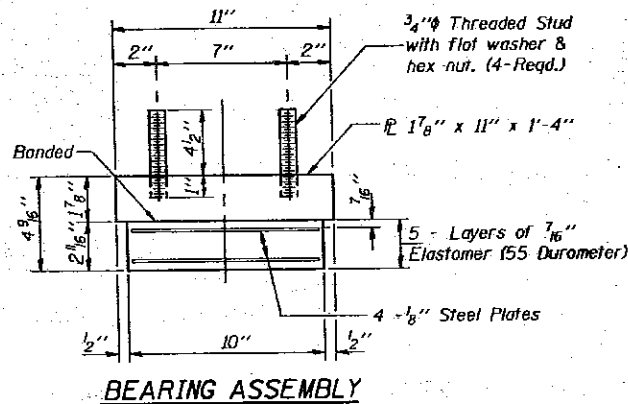


BEARING ASSEMBLY

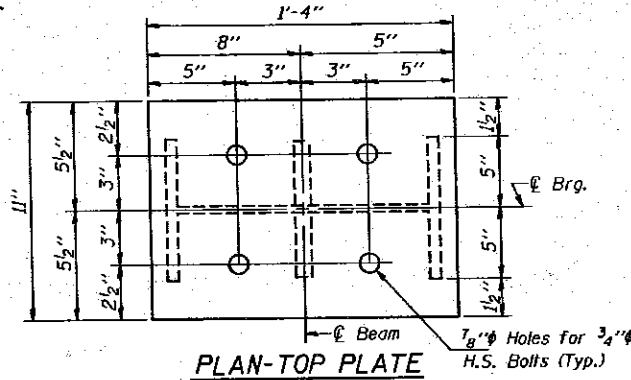


PLAN-TOP PLATE

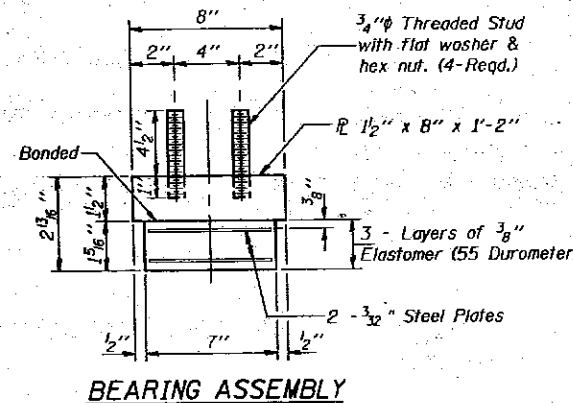


BEARING ASSEMBLY

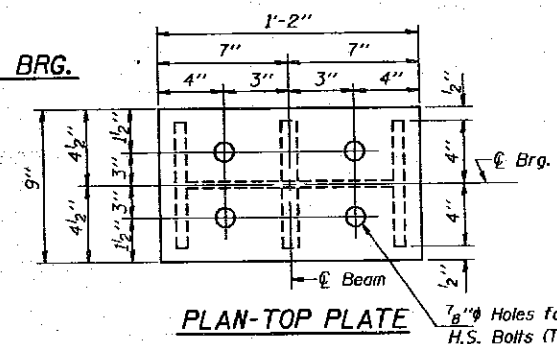


PLAN-TOP PLATE

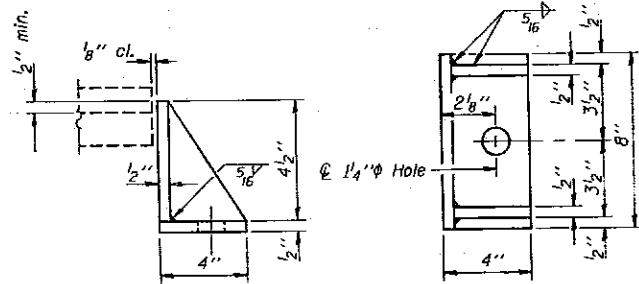


SIDE RETAINER

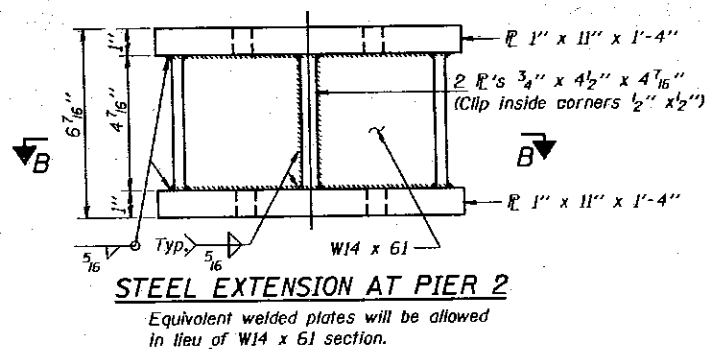


STEEL EXTENSION AT PIER 2

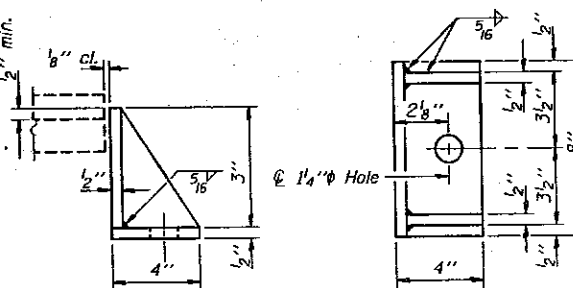

SIDE RETAINER

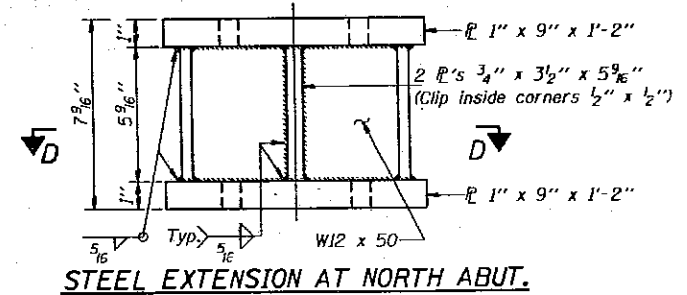

STEEL EXTENSION AT NORTH ABUT.

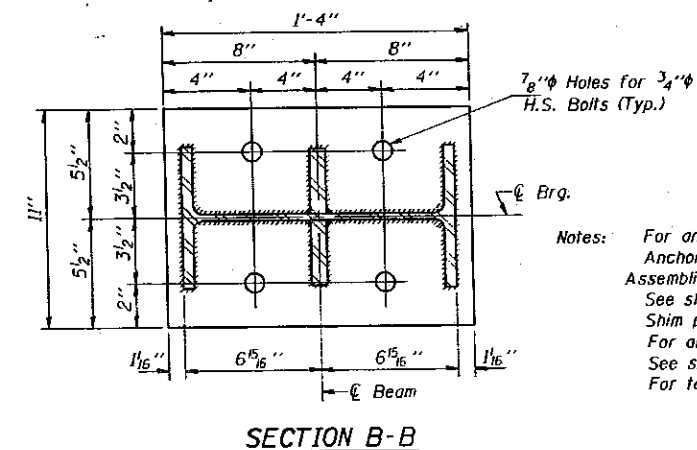

SECTION B-B

Notes:  
 For anchor bolt installation details see sheet #16 of 16.  
 Anchor bolts, Side Retainers, Shim plates, Lead Plates, and Steel Extension Assemblies included in "Structural Steel" Quantity.  
 See sheet #8 of 16 for Jack and Remove Existing Bearing Procedure.  
 Shim plates shall not be placed under Bearing Assembly.  
 For anchor bolt location at Pier #2 See sheet #10 of 16.  
 See sheet #12 of 16 for anchor bolt layout at North Abutment.  
 For table of Shim Plate "A" Dimensions see sheet #10 of 16.

SECTION D-D  
BILL OF MATERIAL

Item	Unit	Total
Elastomeric Bearing Assembly Type 1	Eac.	14
Jack and Remove Existing Bearings	Eac.	14




PIER 2 AND NORTH ABUTMENT  
BEARING DETAILS  
F.A.I. RT. 57 SEC. (28-5B-11D)  
FRANKLIN COUNTY  
STATION 212+50.00

DESIGNED	Richard J. Chapp
CHECKED	Paul W. Sweet
DRAWN	Paul W. Sweet
CHECKED	RJC RIB GLE




EXAMINED	May 22 1992
PASSED	Ralph E. Anderson
APPROVED	DIRECTOR OF HIGHWAYS

STATE OF ILLINOIS  
DEPARTMENT OF TRANSPORTATION

ROUTE NO.	SECTION	TRAFFIC	DATE	SHEET	SHEET NO. 10 16 SHEETS
P.A.I. BY	DESIGNED BY	FRANKLIN	155	134	
PRIOR PROJECT NO. 7	DESIGNED	REL. AND PROJECT			

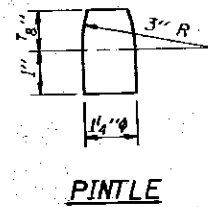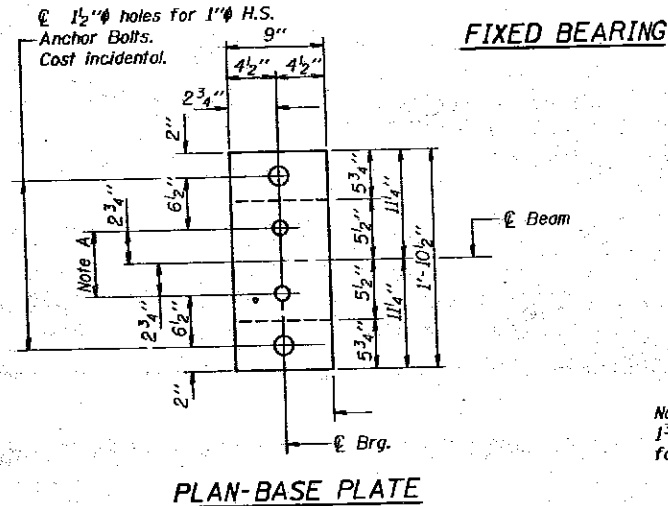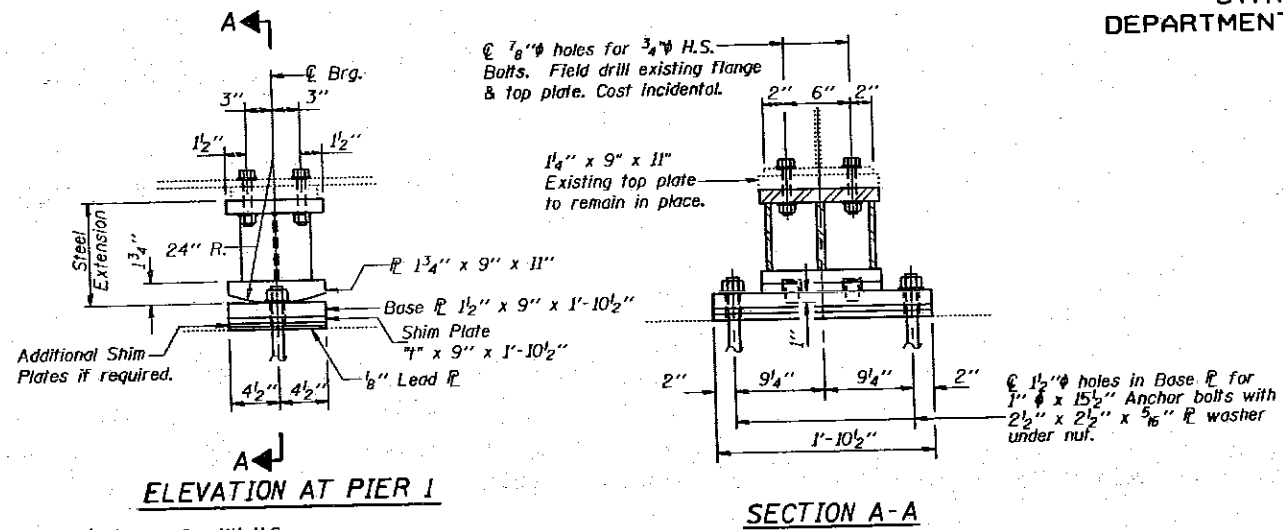

Note A:  
1 3/8"  $\phi$  Holes-1" deep in bottom  $\bar{L}$  of Steel Extension for 1 1/4"  $\phi$  pintles. Thread or press fit Pintles in Base  $\bar{L}$ .

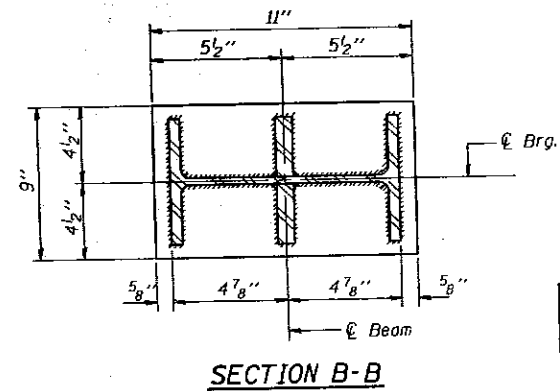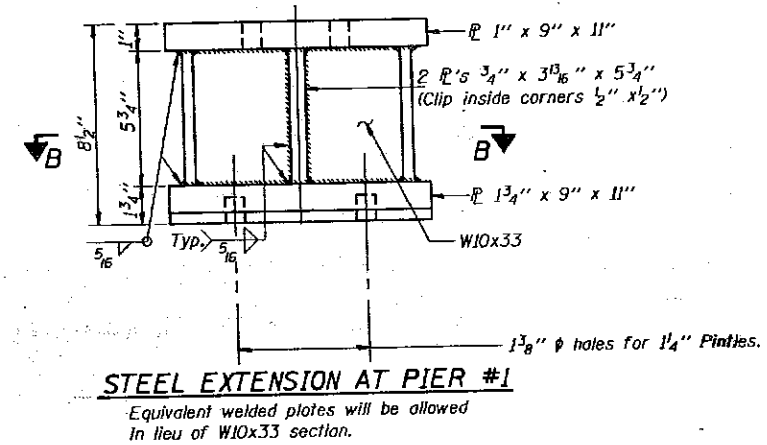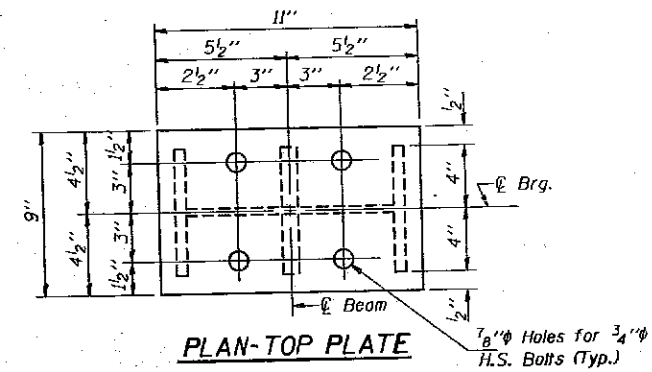

**BILL OF MATERIAL**

Item	Unit	Total
Jack and Remove Existing Bearings	Each	7

Notes: For anchor bolt installation details see sheet #15 of 16.  
See sheet #8 of 16 for Jack and Removal Existing Bearing Procedure.



**\* TABLE OF "I" DIMENSIONS**

Location	N. Abut.	Pier #1	Pier #2	S. Abut.
Beam #1	1/2"	1/2"	1/2"	1/2"
Beam #2	2 1/8"	2 1/4"	2 1/8"	2 1/4"
Beam #3	5/8"	3/4"	3/4"	3/4"
Beam #4	1 1/2"	1 5/8"	1 5/8"	1 5/8"
Beam #5	1 5/8"	1 1/2"	1 1/2"	1 5/8"
Beam #6	5/8"	1/2"	5/8"	5/8"
Beam #7	2 1/4"	2"	2"	1 7/8"

\* Dimensions are based on Field survey. The contractor shall verify & make adjustments as necessary.

DESIGNED <i>Richard J. Dwyer</i>
CHECKED <i>Paul W. Sweet</i>
DRAWN <i>Paul W. Sweet</i>
CHECKED <i>RJC RB GGE</i>









EXAMINED <i>Greg J. Kaspar</i>
PASSED <i>Paul E. Anderson</i>
APPROVED

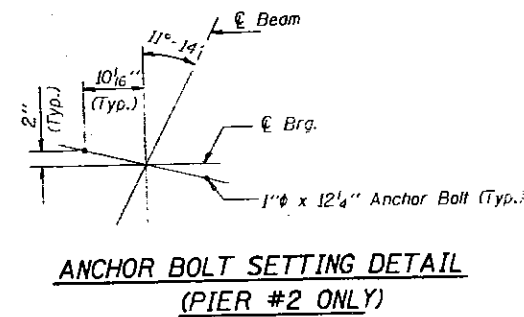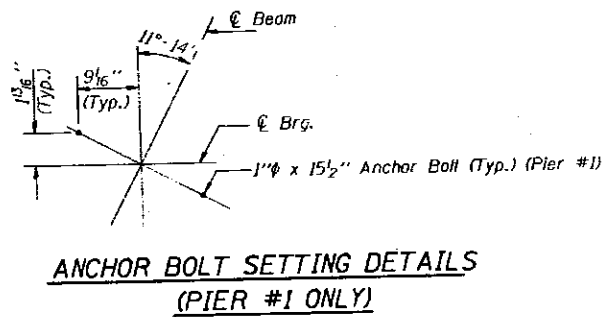

**PIER 1  
BEARING DETAILS  
F.A.I. RT. 57 SEC. (28-5B-11D)  
FRANKLIN COUNTY  
STATION 212+50.00**

STATE OF ILLINOIS  
DEPARTMENT OF TRANSPORTATION

ROUTE NO.	DISTRICT	COUNTY	LETS	POST	SHEET NO. 11
155	135	FRANKLIN	155	135	16 SHEETS

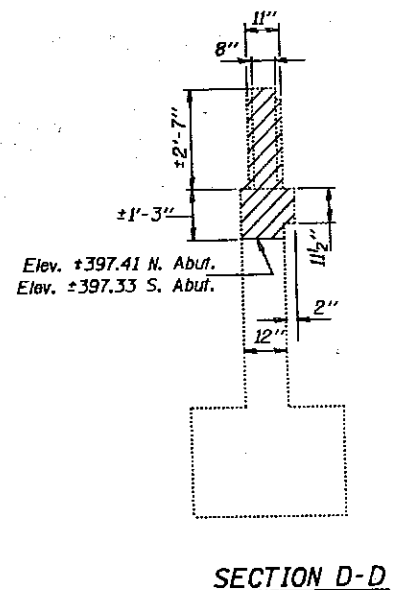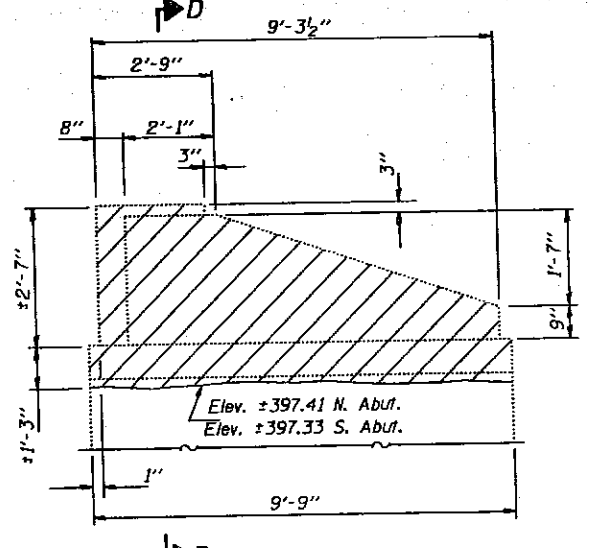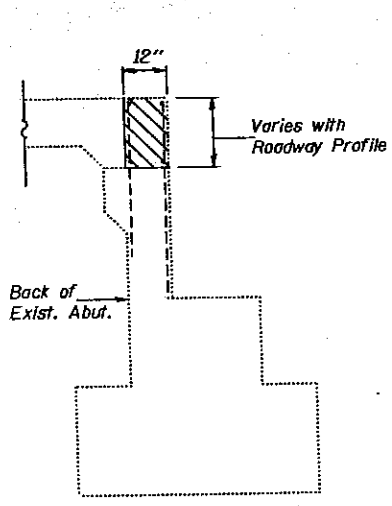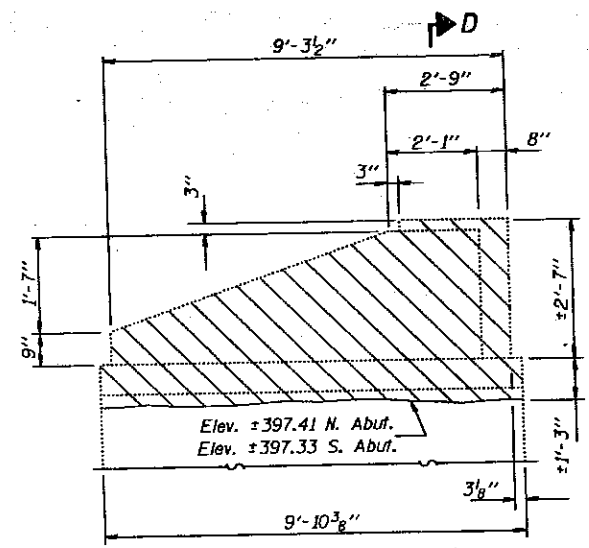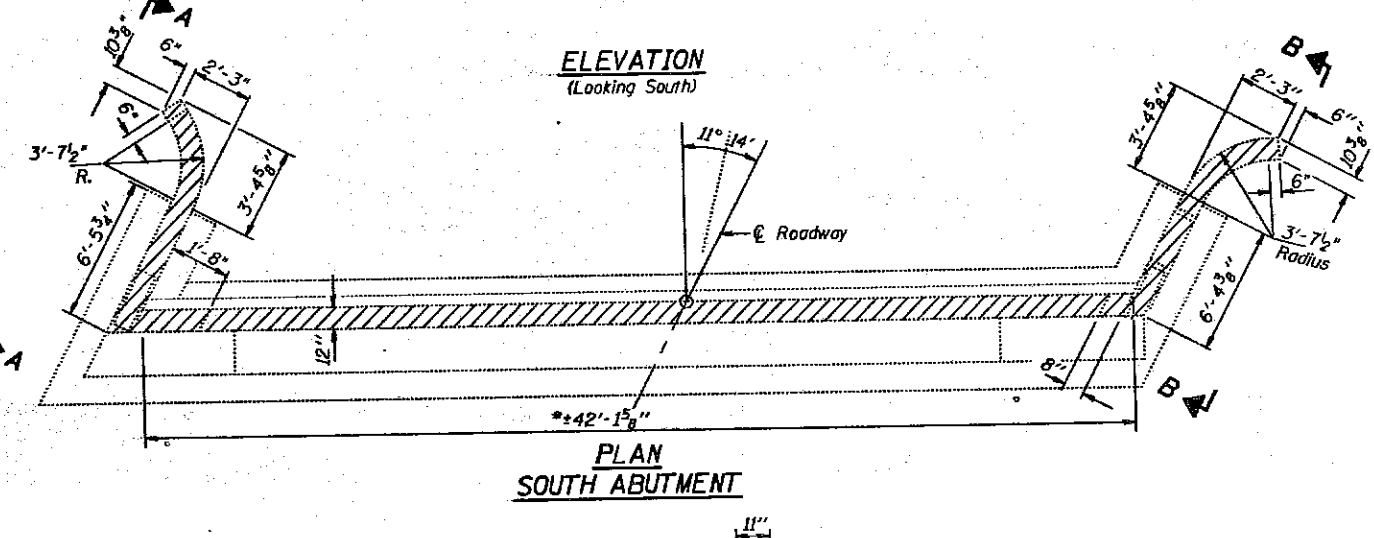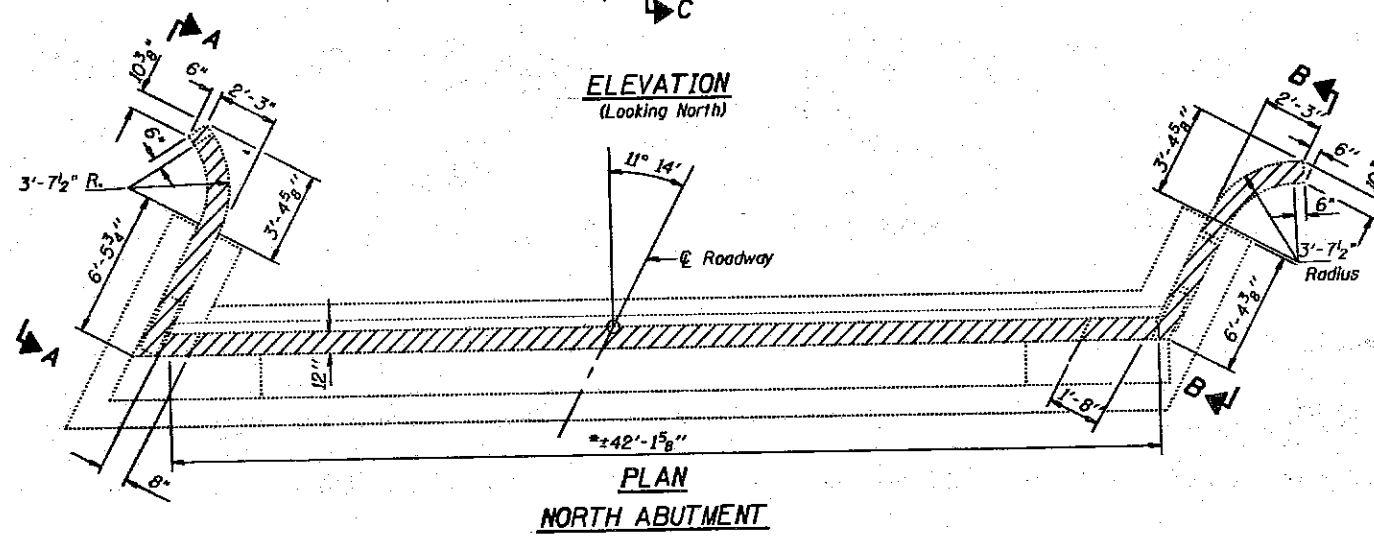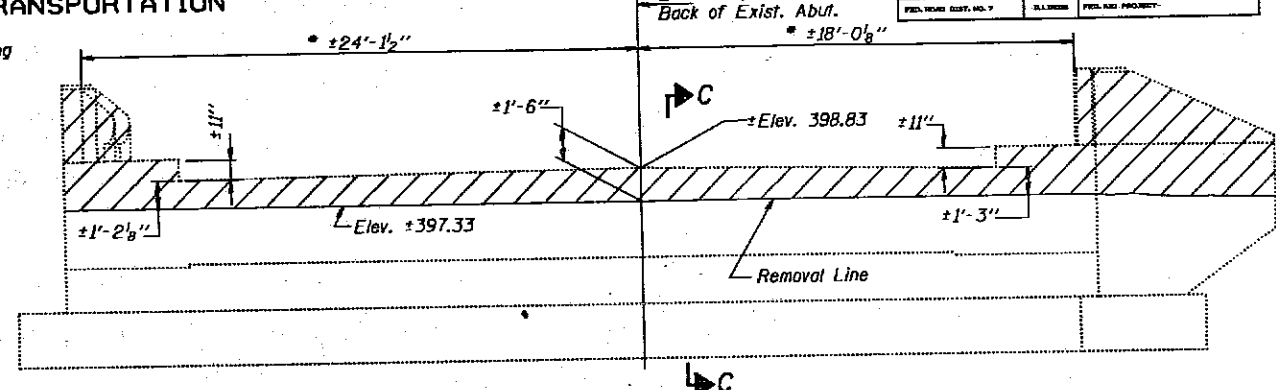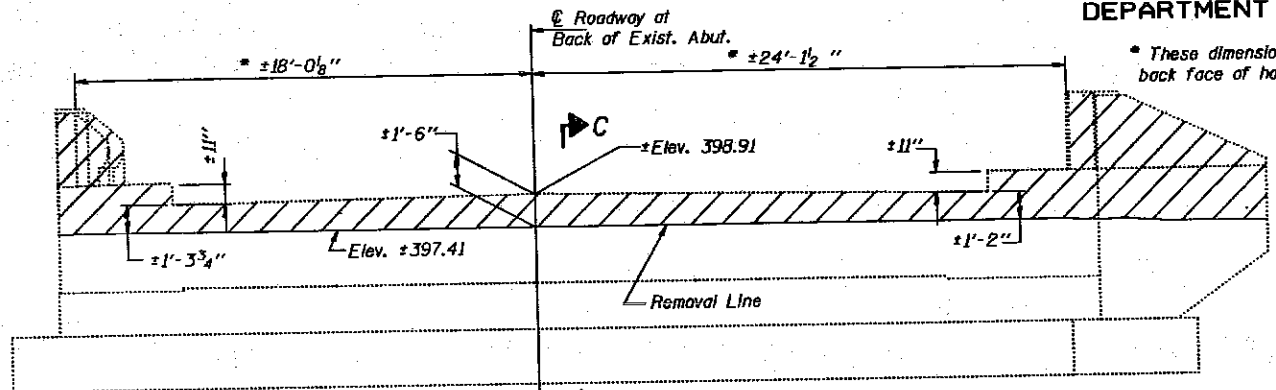

TWO ABUTMENTS  
BILL OF MATERIAL

Item	Unit	Total
Concrete Removal	Cu. Yd.	9

CONCRETE REMOVAL DETAILS  
FOR EXISTING ABUTMENTS  
F.A.I. RT. 57 SEC. (28-5B-1D)  
FRANKLIN COUNTY  
STATION 212+50.00

Notes: Hatched area indicates "Concrete Removal".  
For existing shoulder pavement removal see Roadway Plans.  
Existing vertical reinforcement shall be cleaned,  
straightened and incorporated into the new construction  
Cost incidental to "Concrete Removal".

DESIGNED *Richard J. Chapt*  
CHECKED *Ernest P. Davidson*  
DRAWN *Paul W. Sweet*  
CHECKED *R.C. RIB GLE*


EXAMINED *Greg J. Kasper*  
PASSED *Ralph E. Anderson*  
APPROVED \_\_\_\_\_

May 22 1992




STATE OF ILLINOIS  
DEPARTMENT OF TRANSPORTATION

ROUTE NO.	ACTION	COUNTY	DATE	POST	SHEET NO. 12
155	28-5B-1D	FRANKLIN	1/55	136	16 SHEETS
FILE NO.	DESIGNER	ILLINOIS	PREPARED PROJECT		

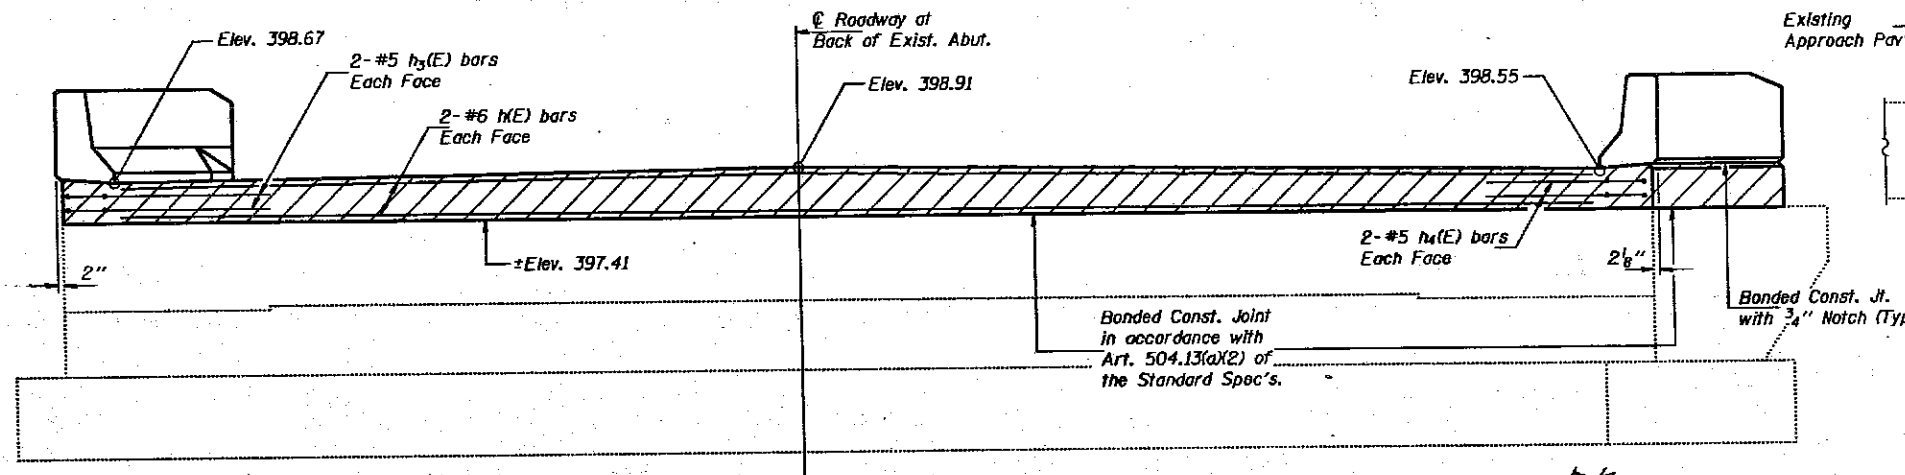

ELEVATION  
(Looking North)

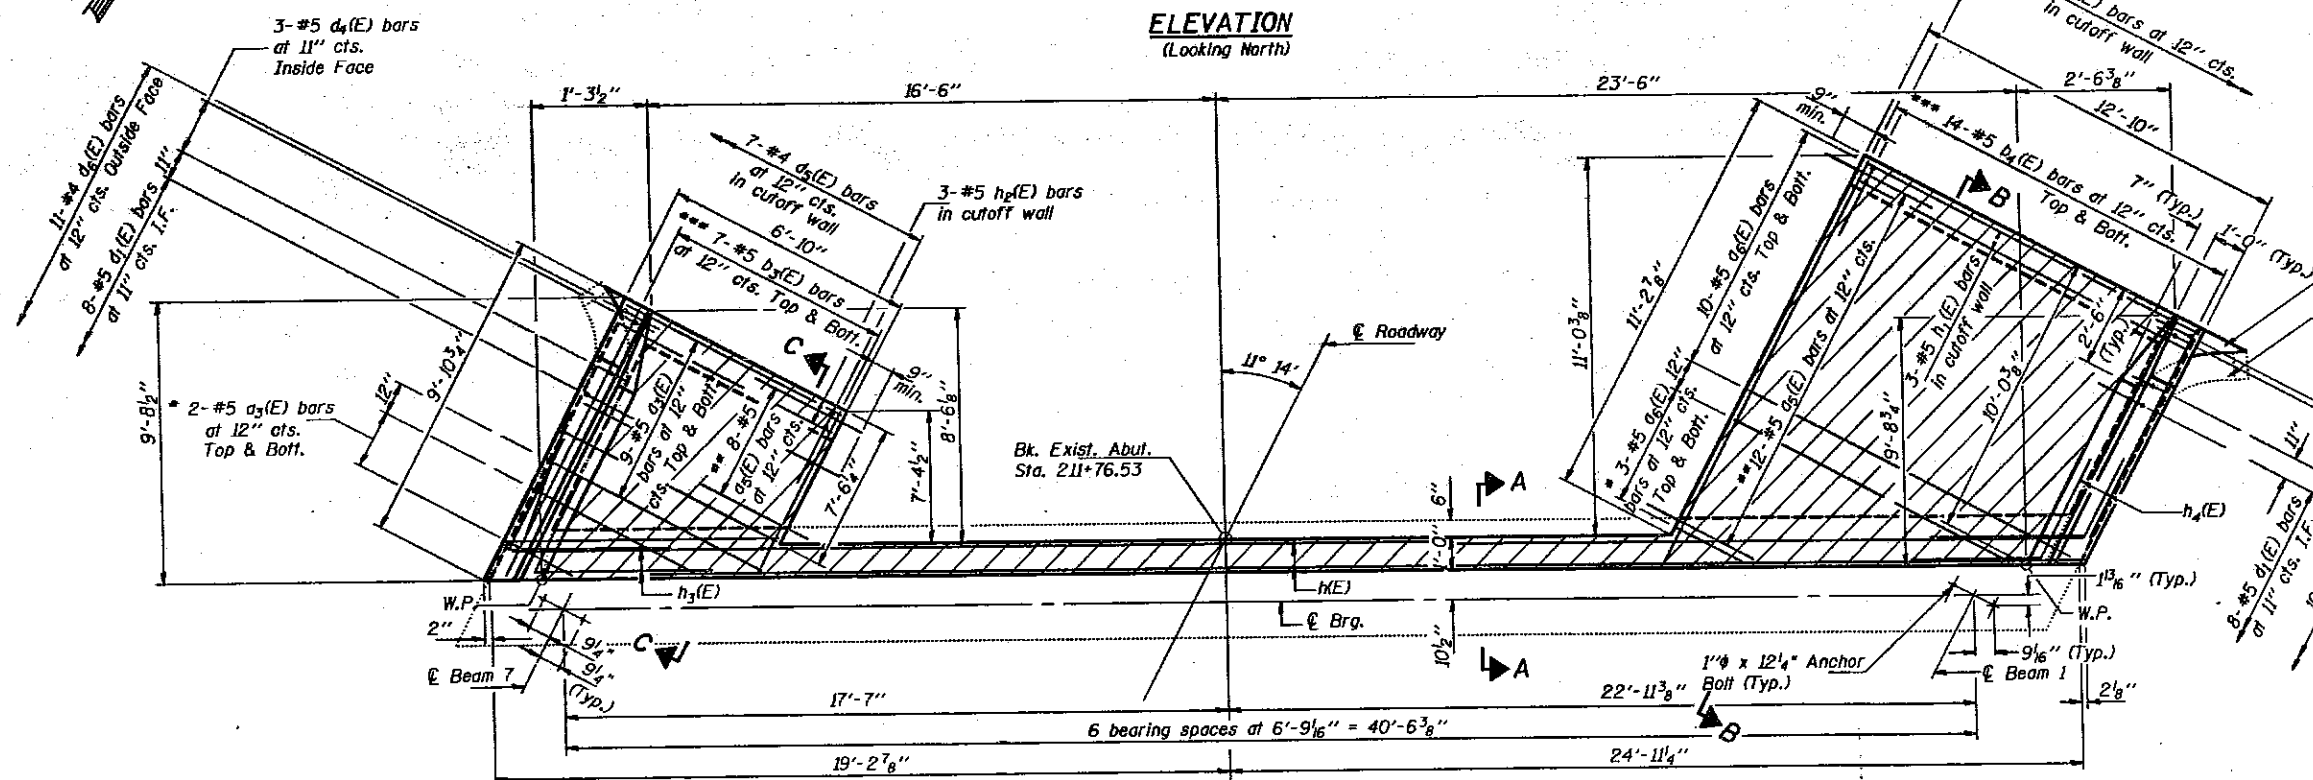

PLAN

\* Order  $a_3(E)$  and  $a_6(E)$  bars full length. Cut to fit and use remainder of bars in bottom of slab.  
 \*\* Drill  $7/8"$   $\phi$  x 9" Min. hole in existing approach Pavement. Epoxy grout  $a_5(E)$  bars. Use a grout approved by the Department or epoxy grout in accordance with BSP-11. The method of grout application shall be approved by the Engineer. See Special Provisions.

Extend toewall to Face of existing wingwall and slope to drain. (Typ.)  
 Grout existing surface smooth and slope to drain after concrete removal. (Typ.)  
 3-#5  $d_4(E)$  bars at 11" cts. Inside Face

\*\*\* Order  $b_3(E)$  and  $b_4(E)$  bars full length. Cut to fit as shown in Field Cutting Diagram on sheet #13 of 16 and use remainder of bars in bottom of slab directly below top bars.

Notes: Hatched area to be poured after superstructure forms have been removed. Quantity of concrete included with "Class X Concrete Superstructure" on sheet #6 of 16.  
 Existing reinforcement extending into new construction shall be cleaned, straightened and incorporated into the new construction.  
 Reinforcement bars designated (E) shall be epoxy coated.  
 For anchor bolt installation details see sheet #16 of 16.  
 Concrete Quantity for End Posts is included in "Class X Concrete Superstructure".  
 All edges shall have standard  $3/4"$  chamfer, Except as Noted.



DESIGNED *Richard J. Chaput*  
 CHECKED *Phyllis P. Davis*  
 DRAWN *Paul W. Sweet*  
 CHECKED *RJC MB GBC*

EXAMINED *Orsi J. Kaspa*  
 PASSED *Ralph E. Anderson*  
 APPROVED \_\_\_\_\_  
 DIRECTOR OF HIGHWAYS











NORTH ABUTMENT  
 F.A.I. RT. 57 SEC. (28-5B-1D)  
 FRANKLIN COUNTY  
 STATION 212+50.00

STATE OF ILLINOIS  
DEPARTMENT OF TRANSPORTATION

ROUTE NO.	SECTION	COUNTY	DATE	SHEET NO.
F.A.I. 57	28-5B-DD	FRANKLIN	1/55	13
SHEET NO. 13				
16 SHEETS				

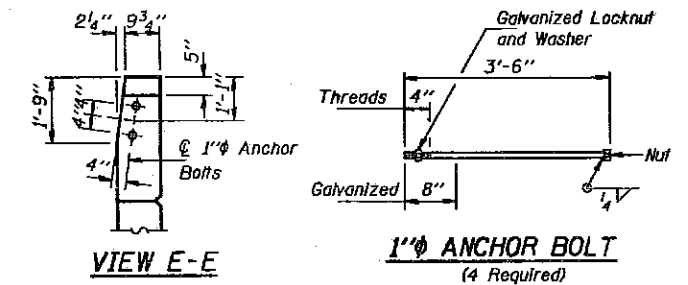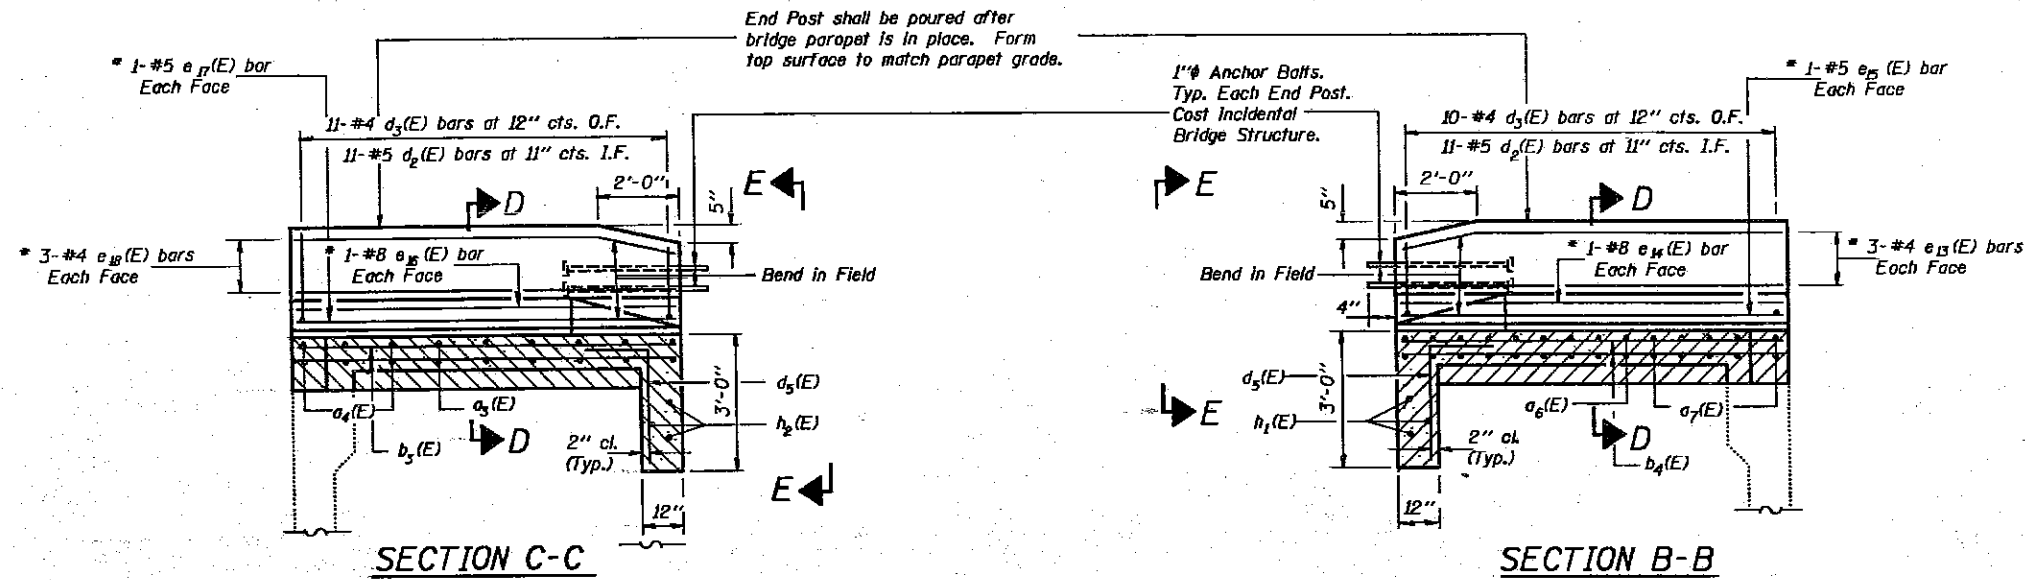

\* Order End Post  $e_{13}(E)$  thru  $e_{17}(E)$  bars full length, cut to fit skew in the field.

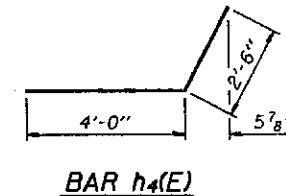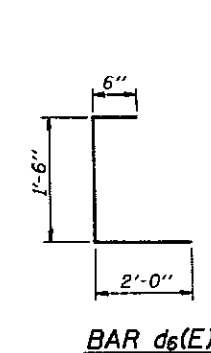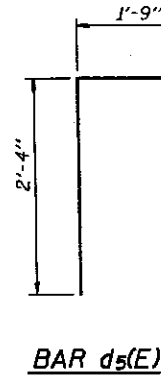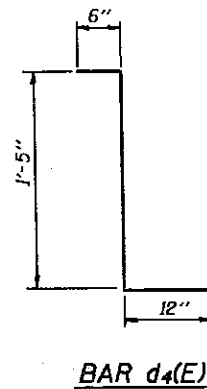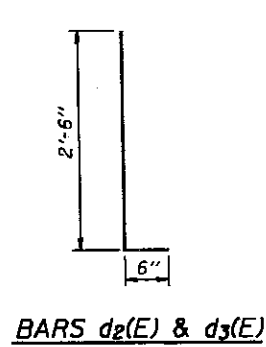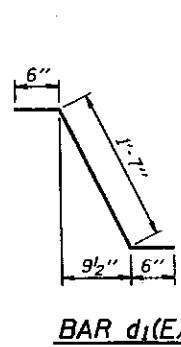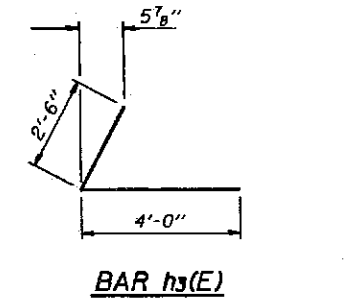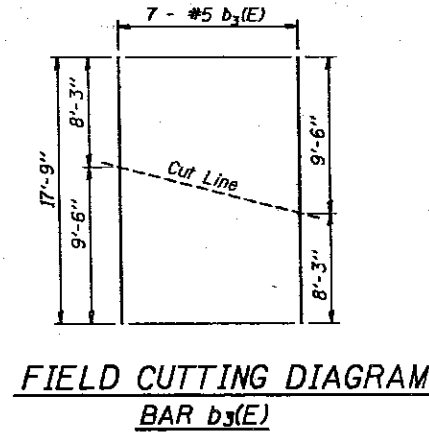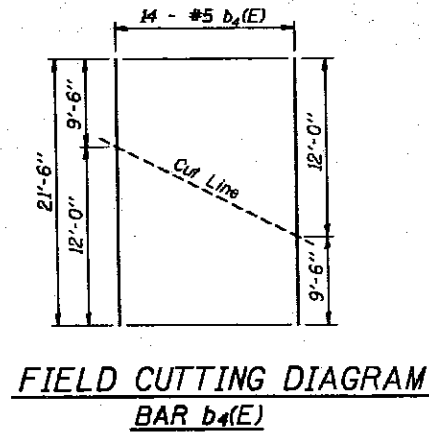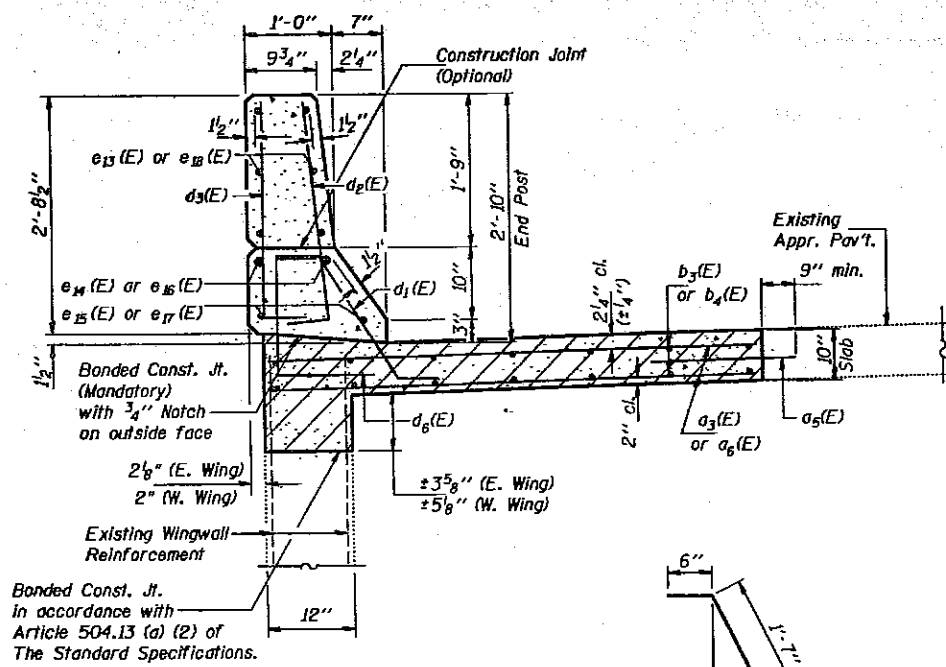

BILL OF MATERIAL

Bar	No.	Size	Length	Shape
$d_3(E)$	20	#5	6'-7"	—
$d_5(E)$	20	#5	3'-0"	—
$d_6(E)$	23	#5	12'-7"	—
$b_3(E)$	7	#5	17'-9"	—
$b_4(E)$	14	#5	21'-6"	—
$d_1(E)$	16	#5	2'-7"	L
$d_2(E)$	22	#5	3'-0"	L
$d_3(E)$	21	#4	3'-0"	L
$d_4(E)$	6	#5	2'-11"	L
$d_5(E)$	21	#4	4'-1"	L
$d_6(E)$	21	#4	4'-0"	L
$e_{13}(E)$	6	#4	9'-9"	—
$e_{14}(E)$	2	#8	9'-9"	—
$e_{15}(E)$	2	#5	9'-9"	—
$e_{16}(E)$	2	#8	9'-7"	—
$e_{17}(E)$	2	#5	9'-7"	—
$e_{18}(E)$	6	#4	9'-7"	—
$h(E)$	4	#6	43'-6"	—
$h_1(E)$	3	#5	12'-7"	—
$h_2(E)$	3	#5	6'-7"	—
$h_3(E)$	4	#5	6'-6"	—
$h_4(E)$	4	#5	6'-6"	—
Reinforcement Bars, Epoxy Coated		Lbs.	1,870	
Structure Excavation		Cu. Yd.	11.0	



Reinforcement bars designated (E) shall be epoxy coated.

DESIGNED <i>Richard J. Chappert</i>	EXAMINED <i>Mary N. 1992</i>
CHECKED <i>Paul W. Sweet</i>	PASSED <i>Robert E. Anderson</i>
DRAWN <i>Paul W. Sweet</i>	APPROVED _____
CHECKED <i>RJC RIB GLE</i>	DIRECTOR OF HIGHWAYS


NORTH ABUTMENT DETAILS  
F.A.I. RT. 57 SEC. (28-5B-DD)  
FRANKLIN COUNTY  
STATION 212+50.00

STATE OF ILLINOIS  
DEPARTMENT OF TRANSPORTATION

ROUTE NO.	SECTION	CORNER	JOB NO.	SHEET NO.
F.A.I. RT. 57	28-5B-10	FRANKLIN	155	190
SHEET NO. 14 16 SHEETS				

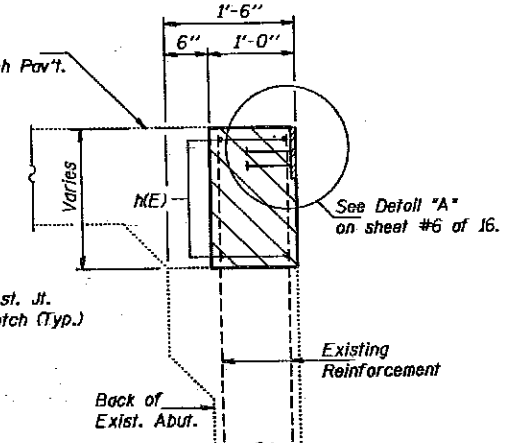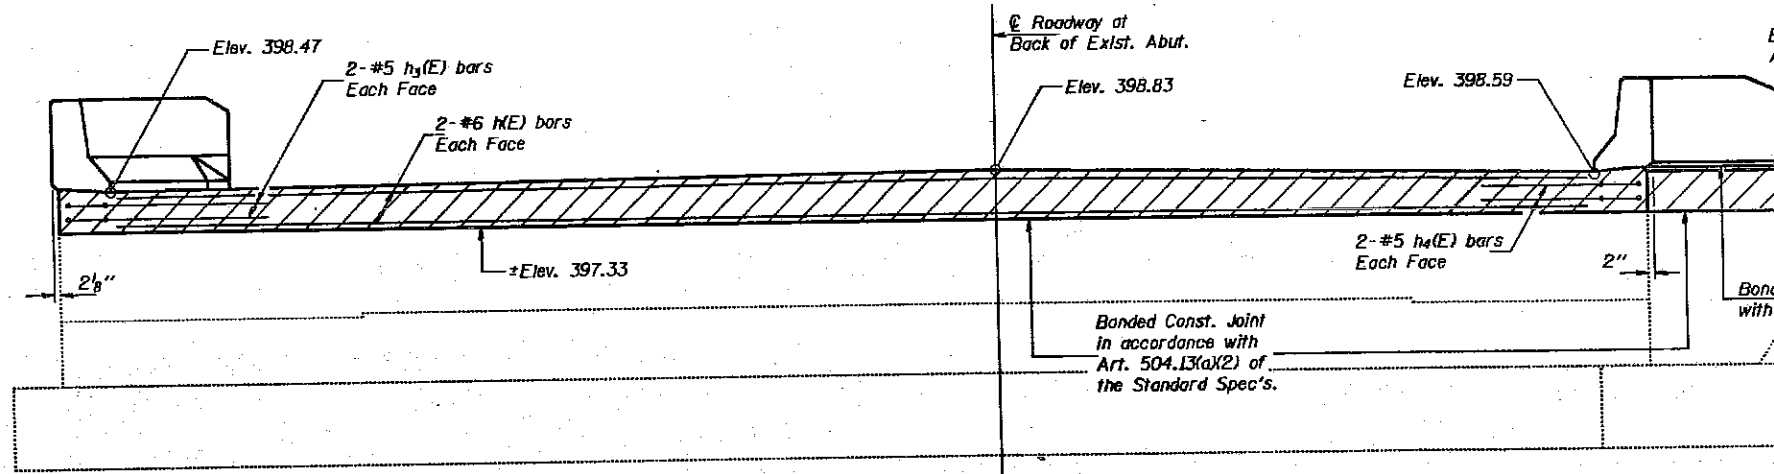

ELEVATION  
(Looking South)

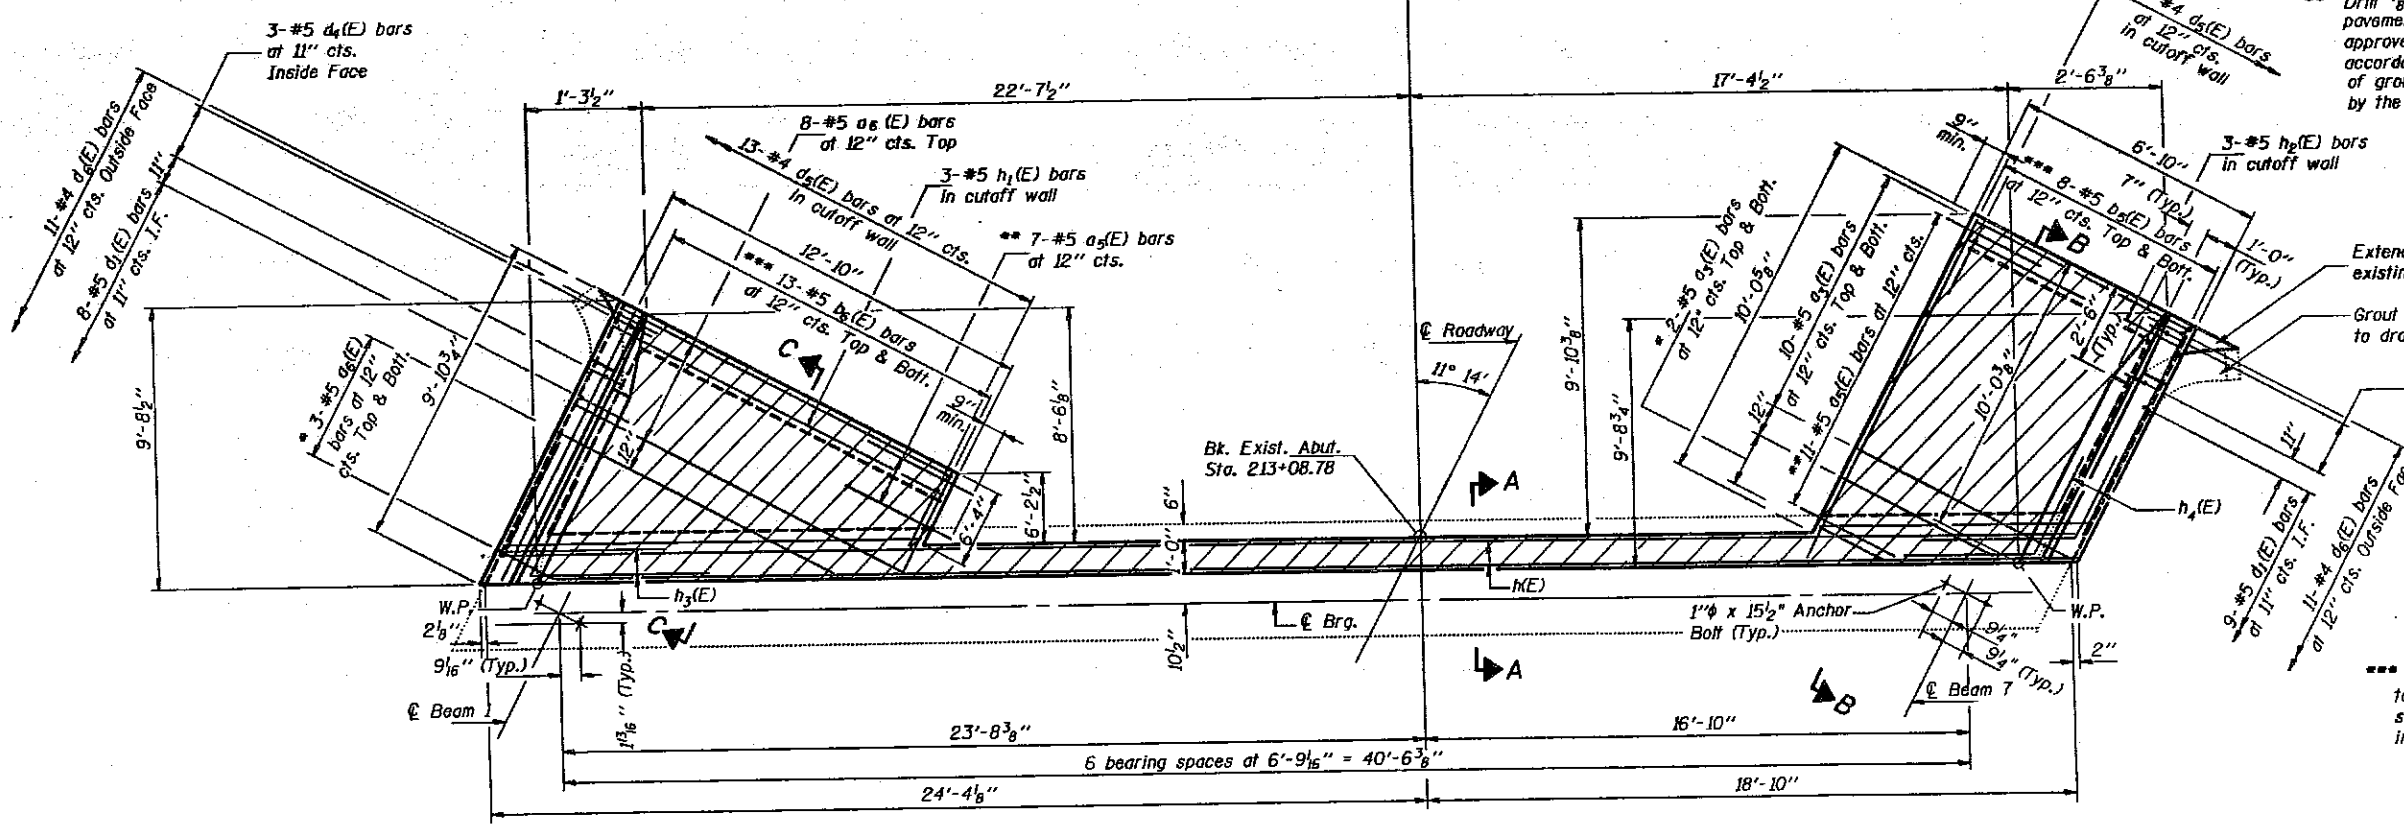

PLAN

\* Order  $a_3(E)$  and  $a_6(E)$  bars full length. Cut to fit and use remainder of bars in bottom of slab.  
 \*\* Drill  $7/8"$  x  $9"$  Min. hole in existing approach pavement epoxy grout  $a_3(E)$  bars. Use a grout approved by the Department or epoxy grout in accordance with BSP-11. The method of grout application shall be approved by the Engineer. See Special Provisions.

Extend to wall to Face of existing wingwall and slope to drain. (Typ.)  
 Grout existing surface smooth and slope to drain after concrete removal. (Typ.)

\*\*\* Order  $b_2(E)$  and  $b_6(E)$  bars full length. Cut to fit as shown in Field Cutting Diagram on sheet #15 of 16 and use remainder of bars in bottom of slab directly below top bars.

Notes: Hatched area to be poured after superstructure forms have been removed. Quantity of concrete included with "Class X Concrete Superstructure" on sheet #6 of 16.  
 Existing reinforcement extending into removed area shall be cleaned, straightened and incorporated into the new construction.  
 Reinforcement bars designated (E) shall be epoxy coated.  
 For anchor bolt installation details see sheet #16 of 16.  
 Concrete Quantity for End Posts is included in "Class X Concrete Superstructure".  
 All edges shall have standard  $3/4"$  chamfer.

DESIGNED *Rohand I Chapit*  
 CHECKED *Edward P. Nutschkaal*  
 DRAWN *Paul W. Sweet*  
 CHECKED *RJC RMB GLE*

EXAMINED *Origi J. Kaspar*  
 PASSED *Ralph E. Anderson*  
 APPROVED \_\_\_\_\_

MAY 22 1992


ENGINEER OF BRIDGE DESIGN  
 DESIGNER OF BRIDGES AND STRUCTURES  
 DIRECTOR OF HIGHWAYS

SOUTH ABUTMENT  
 F.A.I. RT. 57 SEC. (28-5B-10)  
 FRANKLIN COUNTY  
 STATION 212+50.00




STATE OF ILLINOIS  
DEPARTMENT OF TRANSPORTATION

ROUTE NO.	SECTION	COUNTY	DATE	BY	SHEET NO. 15
28-5B-110	FRANKLIN	155	139		16 SHEETS

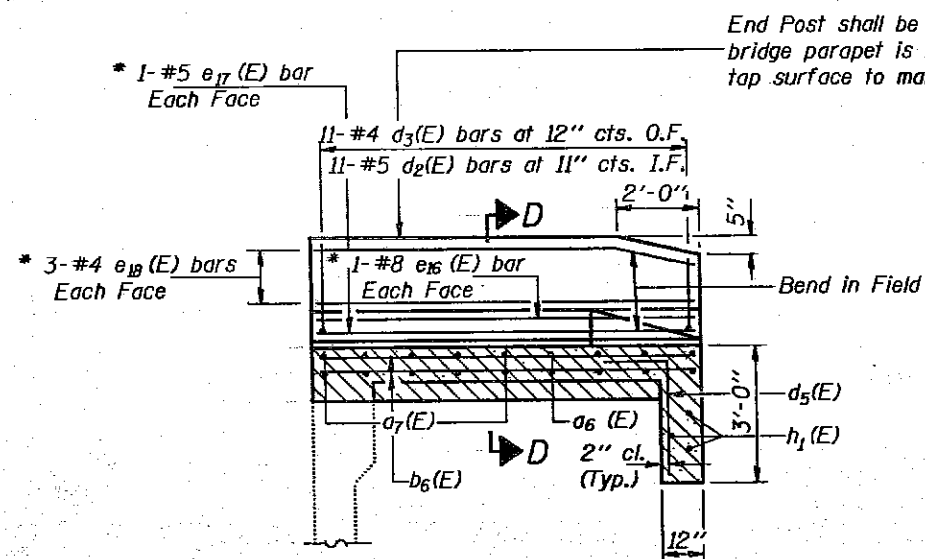

SECTION C-C

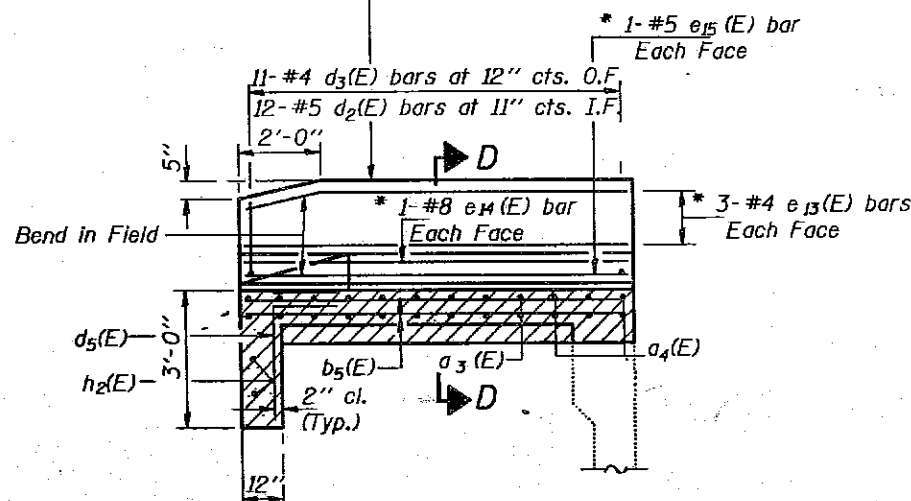


SECTION B-B

\* Order End Post e13(E) thru e18(E) bars full length, cut to fit skew in the field.


BILL OF MATERIAL

Bar	No.	Size	Length	Shape
a3(E)	22	#5	6'-7"	
a5(E)	18	#5	3'-0"	
a6(E)	19	#5	12'-7"	
b5(E)	8	#5	20'-3"	
b6(E)	13	#5	16'-6"	
d1(E)	17	#5	2'-7"	L
d2(E)	23	#5	3'-0"	L
d3(E)	22	#4	3'-0"	L
d4(E)	6	#5	2'-11"	L
d5(E)	21	#4	4'-1"	L
d6(E)	22	#4	4'-0"	L
e13(E)	6	#4	9'-9"	
e14(E)	2	#8	9'-9"	
e15(E)	2	#5	9'-9"	
e16(E)	2	#8	9'-7"	
e17(E)	2	#5	9'-7"	
e18(E)	6	#4	9'-7"	
h(E)	4	#6	43'-6"	
h1(E)	3	#5	12'-7"	
h2(E)	3	#5	6'-7"	
h3(E)	4	#5	6'-6"	L
h4(E)	4	#5	6'-6"	L
Reinforcement Bars, Epoxy Coated		Lbs.	1,740	
Structure Excavation		Cu. Yd.	110	


Reinforcement bars designated (E) shall be epoxy coated.

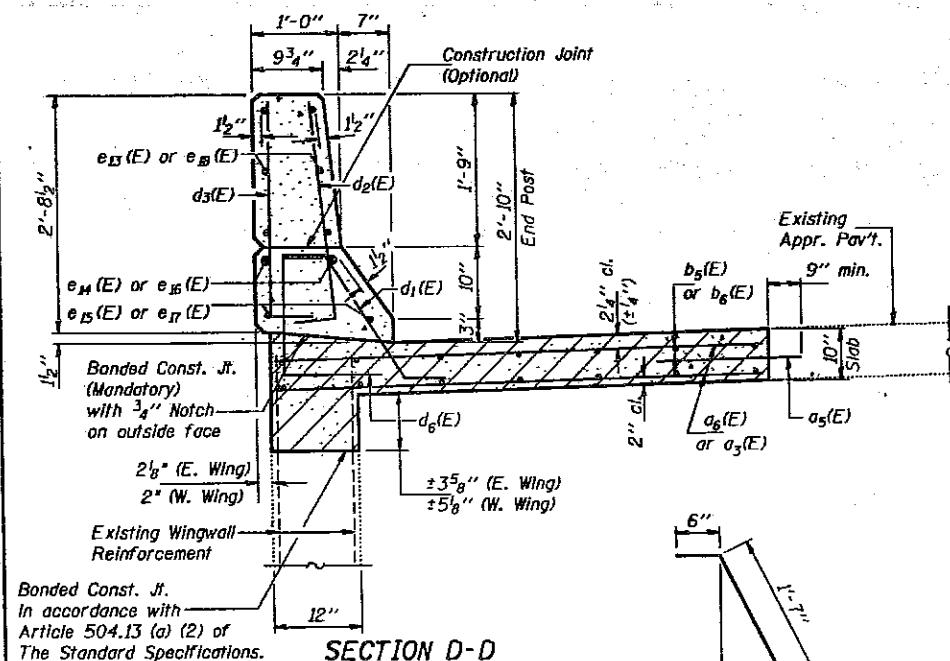


SECTION D-D

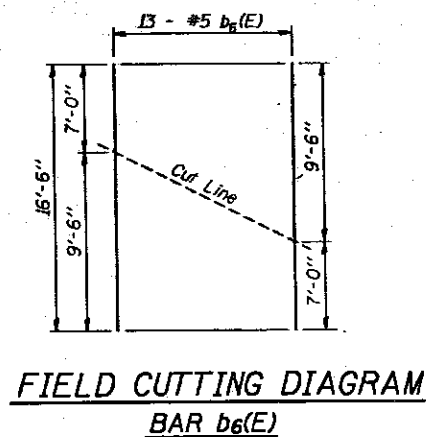


FIELD CUTTING DIAGRAM BAR b6(E)

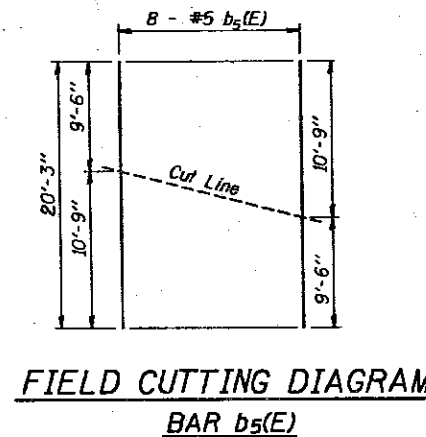


FIELD CUTTING DIAGRAM BAR b5(E)

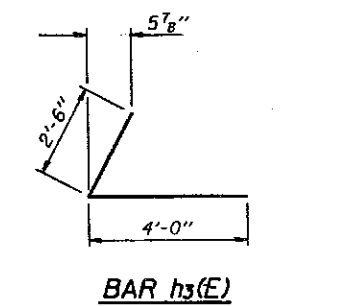


BAR h3(E)

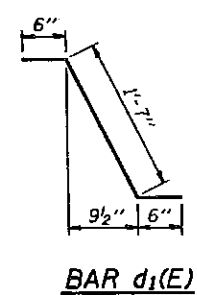


BAR d1(E)

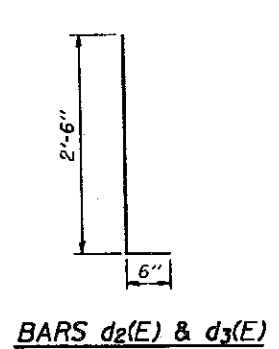


BARS d2(E) & d3(E)

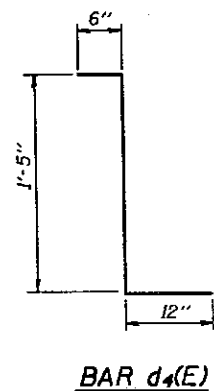


BAR d4(E)

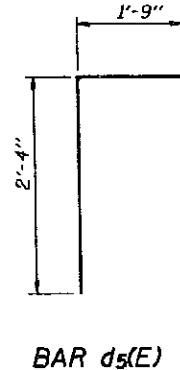

BAR d5(E)

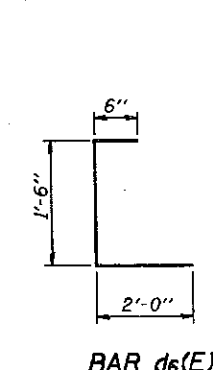

BAR d6(E)

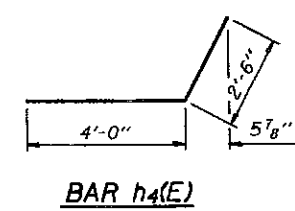

BAR h4(E)

DESIGNED <i>Richard J. Chisput</i>	EXAMINED <i>May 22 1992</i>
CHECKED <i>Paul W. Sweet</i>	PASSED <i>Ralph E. Anderson</i>
DRAWN <i>Paul W. Sweet</i>	APPROVED
CHECKED <i>RJC RJB GGL</i>	DIRECTOR OF HIGHWAYS


SOUTH ABUTMENT DETAILS  
F.A.I. RT. 57 SEC. (28-5B-110)  
FRANKLIN COUNTY  
STATION 212+50.00

The Illinois Coil-Lock Anchor Bolt is a proprietary item which is the property of the Illinois Department of Transportation. Use, reproduction or disclosure without express written permission is prohibited and protected under Federal copyright laws. The production and the fabrication of this bolt for use on highway projects in the State of Illinois shall be permitted and there shall be no incurred charges or fees to the manufacturer or the fabricator for producing or fabricating this bolt.

STATE OF ILLINOIS  
DEPARTMENT OF TRANSPORTATION

ROUTE NO.	SECTION	COUNTY	STATION	"B"	SHEET NO. 16
F.A.I. RT.	28-58-110	FRANKLIN	155	140	16 SHEETS
FED. ROAD DEPT. NO. 7	ILLINOIS	FED. AID PROJECT			

D	E	H	K	"d"
1"	1 1/8"	3 1/16"	1 3/4"	1/4"
1 1/4"	1 3/8"	1 1/16"	2"	3/8"
1 1/2"	1 5/8"	1 5/16"	2 1/8"	1/2"
2"	2 1/8"	1 3/16"	2 7/8"	1/2"
2 1/2"	2 5/8"	2 5/16"	3 3/8"	1"

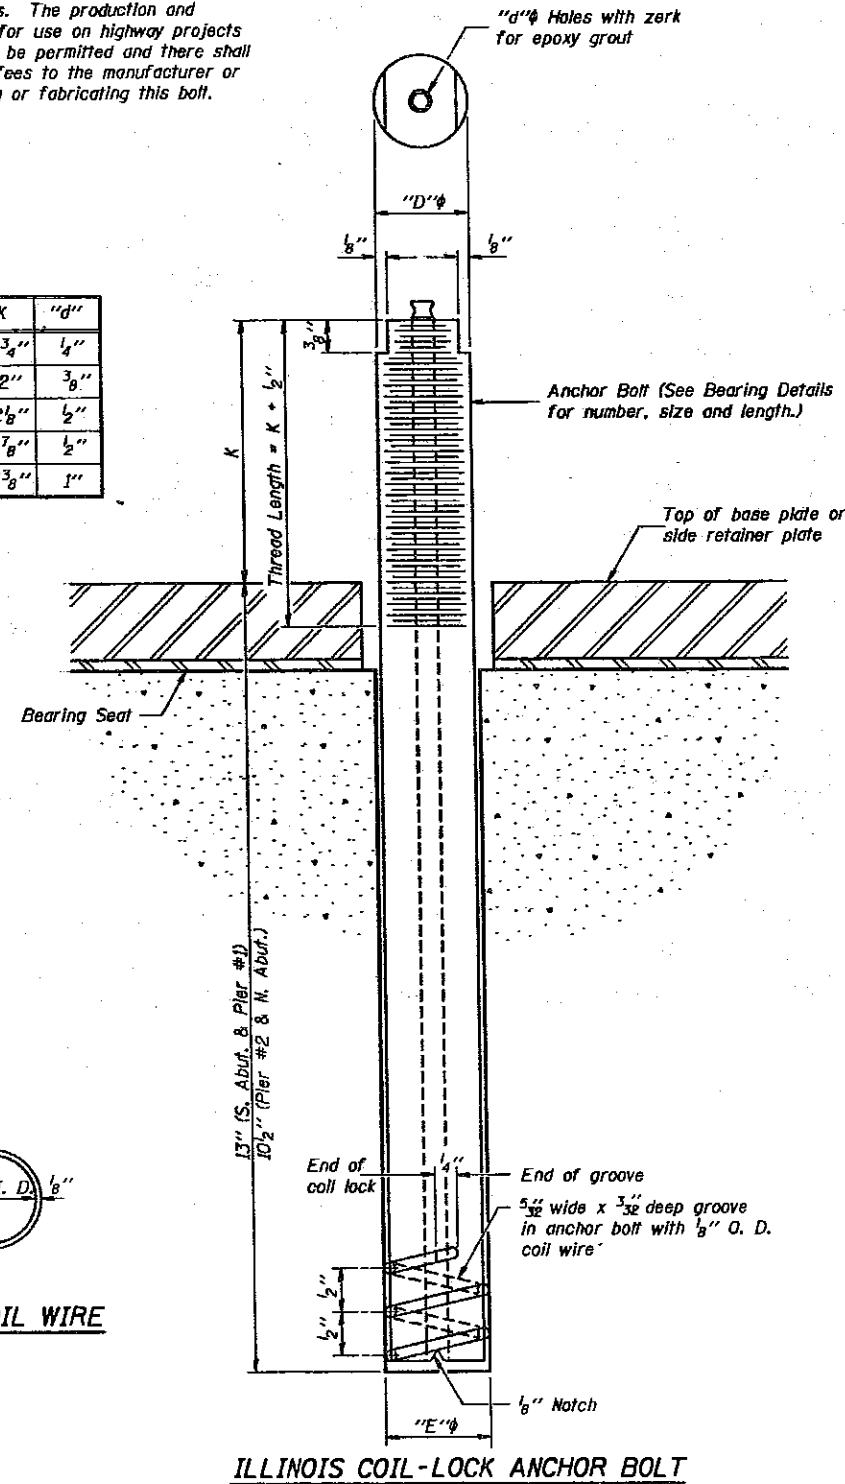

MATERIALS FOR ILLINOIS COIL-LOCK ANCHOR BOLT

The anchor bolt shall be fabricated from cold drawn or hot finished seamless carbon steel mechanical tubing conforming to ASTM A519, Grade 1026 and supplied with hexagonal nuts and cut washers.  
The coil wire shall be made of any suitable soft steel wire.  
The finished anchor bolt shall be cleaned of rust and other foreign materials and wrapped or packaged to prevent contamination until they are installed.  
The epoxy grout shall be a two-component, epoxy resin bonding system conforming to ASTM C881, Type I, Grade 1 and of a Class suitable for the temperature at installation.

GENERAL NOTES

Holes in the masonry for anchor bolts shall be drilled through the base plates to the diameter and depth shown or in accordance with the manufacturer's recommendation after beams or girders have been erected and adjusted.  
Prior to setting the bolts, the holes shall be dry and all dust and loose particles shall be removed by the use of compressed air or vacuuming.  
\* The anchor bolts, furnished and installed including the epoxy grout or capsules shall not be paid for separately but shall be included in the unit bid price for "Furnishing and Erecting Structural Steel".

INSTALLATION PROCEDURE for the ILLINOIS COIL-LOCK ANCHOR BOLT

1. With the coil wire in place, the bolt shall be inserted into the hole and turned clockwise to a snug fit in the hole. Nut and washer shall be placed on the bolt. The nut shall be tensioned until the steel base plates are held securely to the concrete bearing seat.
2. Epoxy grout shall be pumped through the zerk fitting with a pressure gun. Pumping shall continue until the epoxy overflows the hole around the bolt shank. After pumping is discontinued, excess epoxy shall be immediately wiped off.


ALTERNATE ANCHOR BOLTS

The Contractor may use, at his option, the capsule or the adhesive cartridge type anchor rods that have been previously tested and given a prior approval by the Department. The Contractor shall install these anchor rods in pre-drilled holes in accordance with the manufacturer's recommendations and procedures.  
The capsule or the adhesive cartridge type anchor rods shall be a two part system composed of:  
1. A threaded rod stud with nut and washer conforming to ASTM A307.  
2. A sealed glass capsule or a sealed glass adhesive cartridge containing premeasured amounts of the adhesive chemical.


ANCHOR BOLT DETAILS  
FOR BEARINGS  
F.A.I. RT. 57 SEC. (28-58-110)  
FRANKLIN COUNTY  
STATION 212+50.00

DESIGNED *R. L. J. Chapp*  
CHECKED *Thomas T. ...*  
DRAWN *Paul W. Sweet*  
CHECKED *RJC RAB GSE*  
EXAMINED *May 22 1992*  
PASSED *Ralph E. ...*  
APPROVED \_\_\_\_\_  
ABB-1 12-1-83

ROUTE NO.	SEC.	COUNTY	TOTAL SHEETS	SHEET NO.
F.A.I. 57	*	FRANKLIN	155	141
FED. ROAD DIST. 7		ILLINOIS	PROJECT	
* SEC. 28 (5B-1,5B,2B,1B) D 28 (5VB,3VB-1) I				

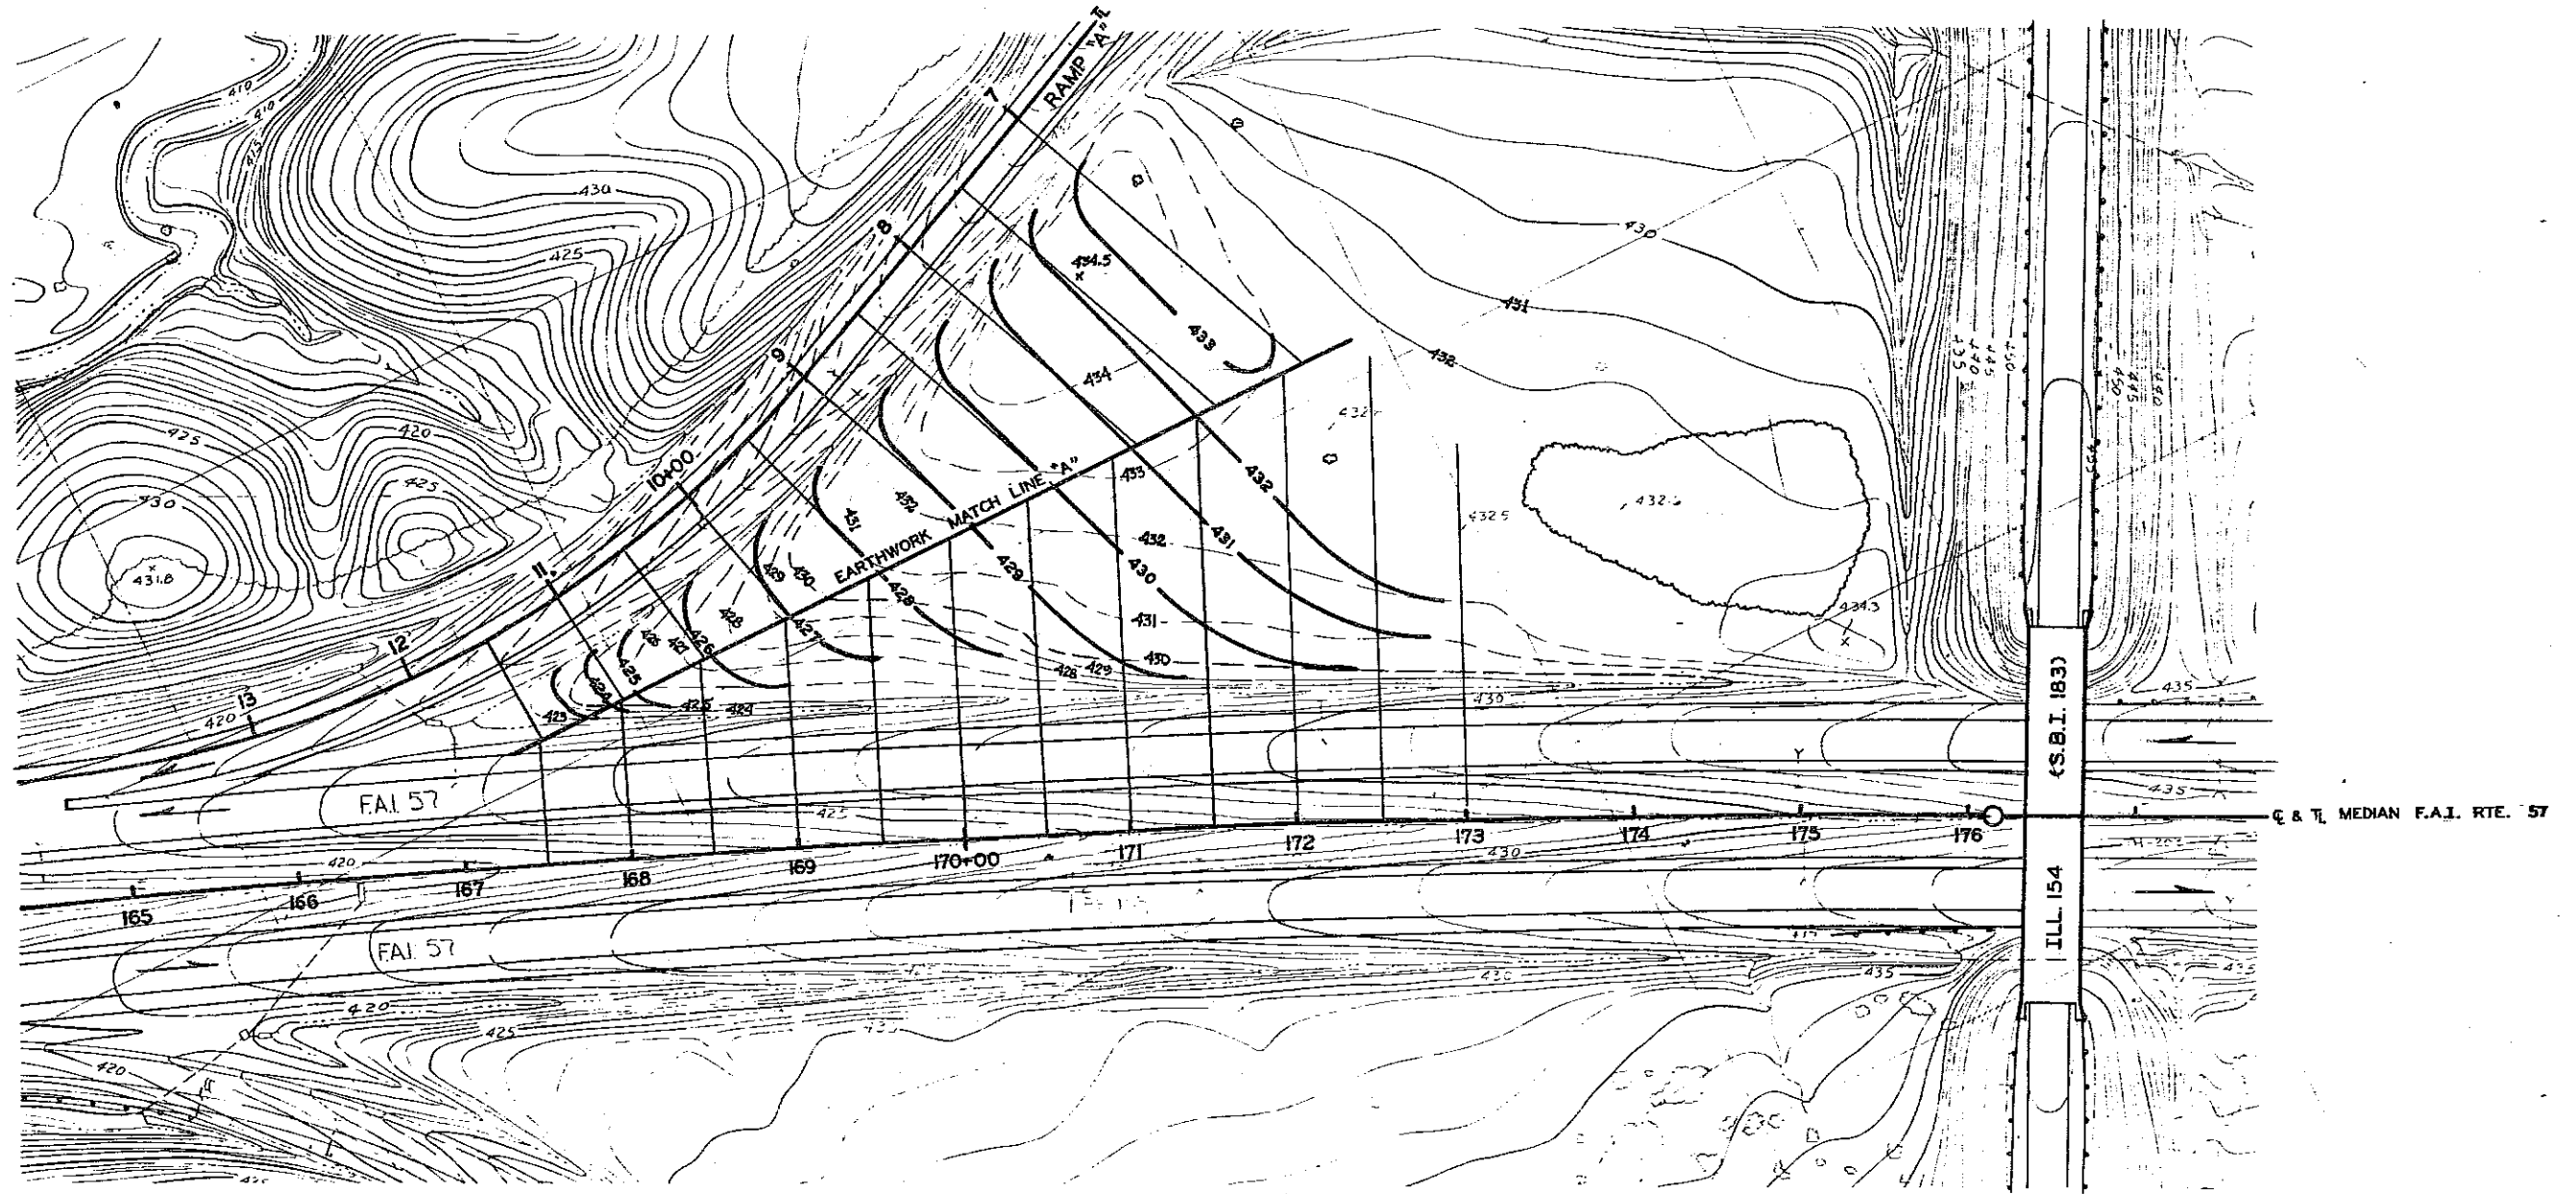

WHITTINGTON INTERCHANGE  
RAMP "A"  
INFIELD GRADING

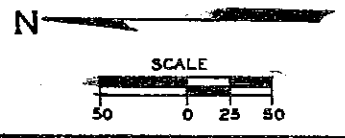

















117  
118  
119

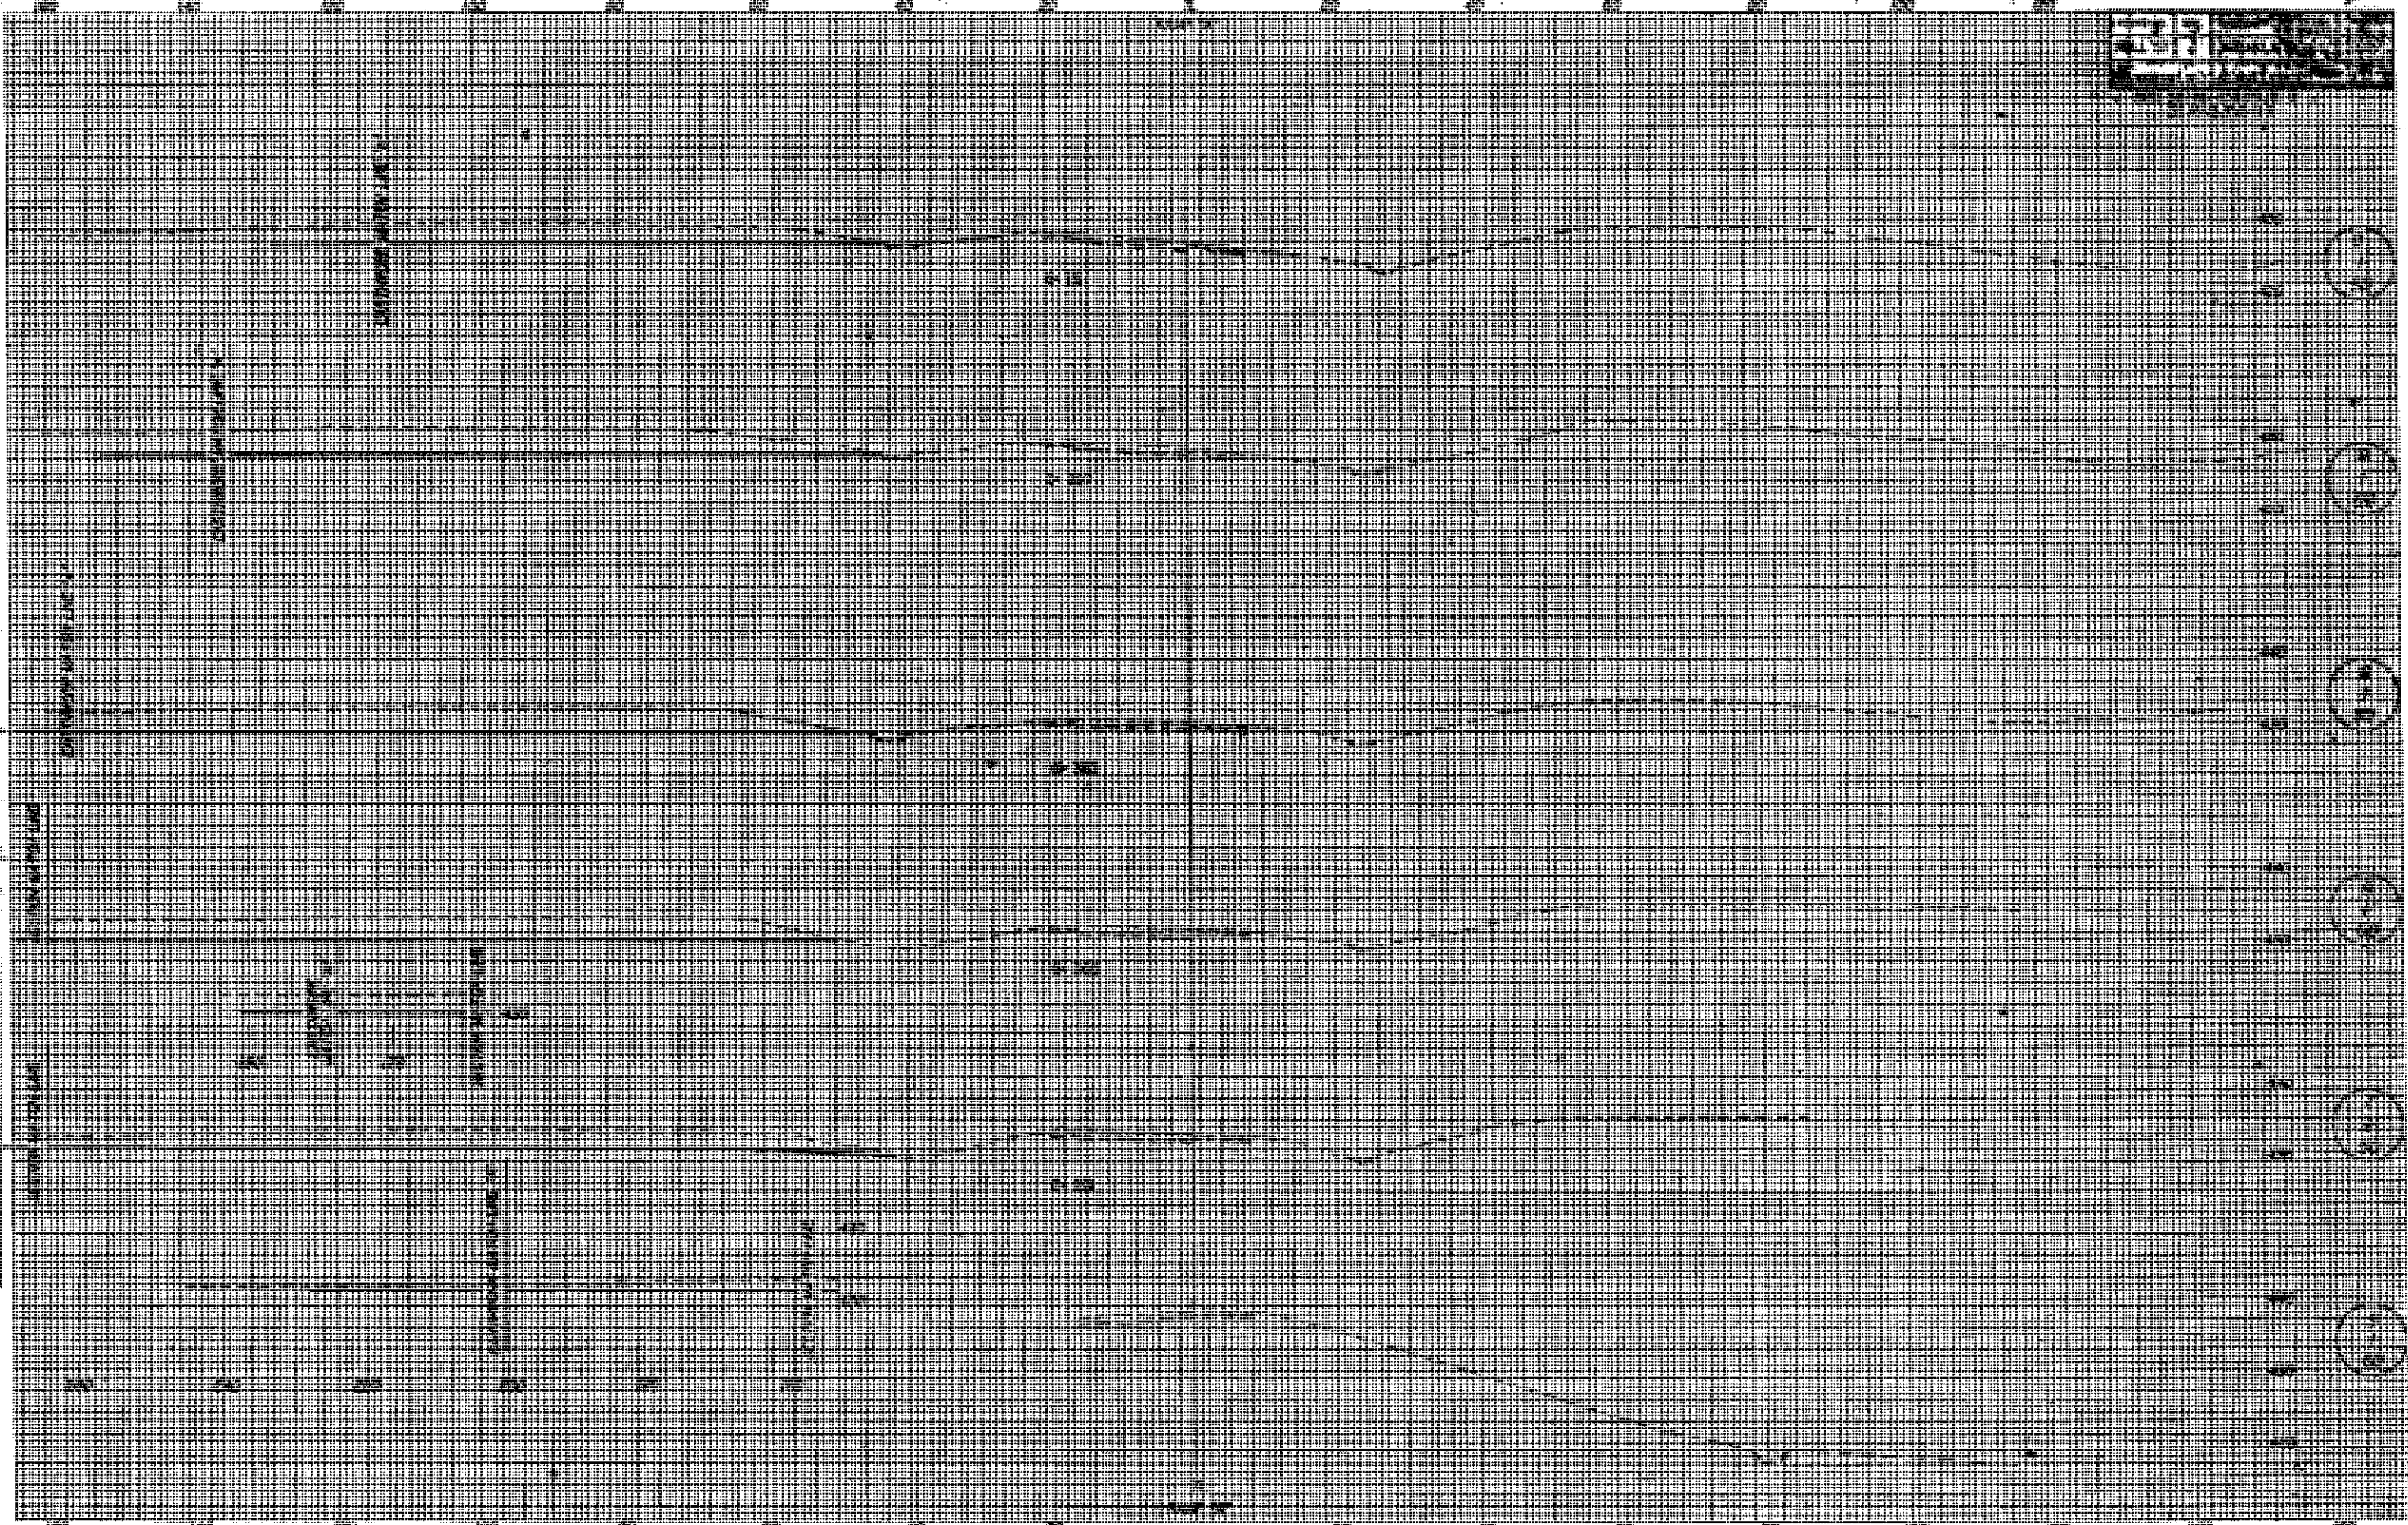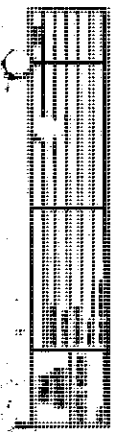


FRANKLIN COUNTY ENGINEERING CORPORATION  
DARTMOUTH COLLEGE






ROUTE NO.	SEC.	COUNTY	TOTAL SHEETS	SHEET NO.
F.A.I. 57	*	FRANKLIN	155	147
FED. ROAD DIST. 7	ILLINOIS	PROJECT		
* SEC. 28 (5B-1,5B,2B,JB) D , 28 (5VB,3VB-11)				

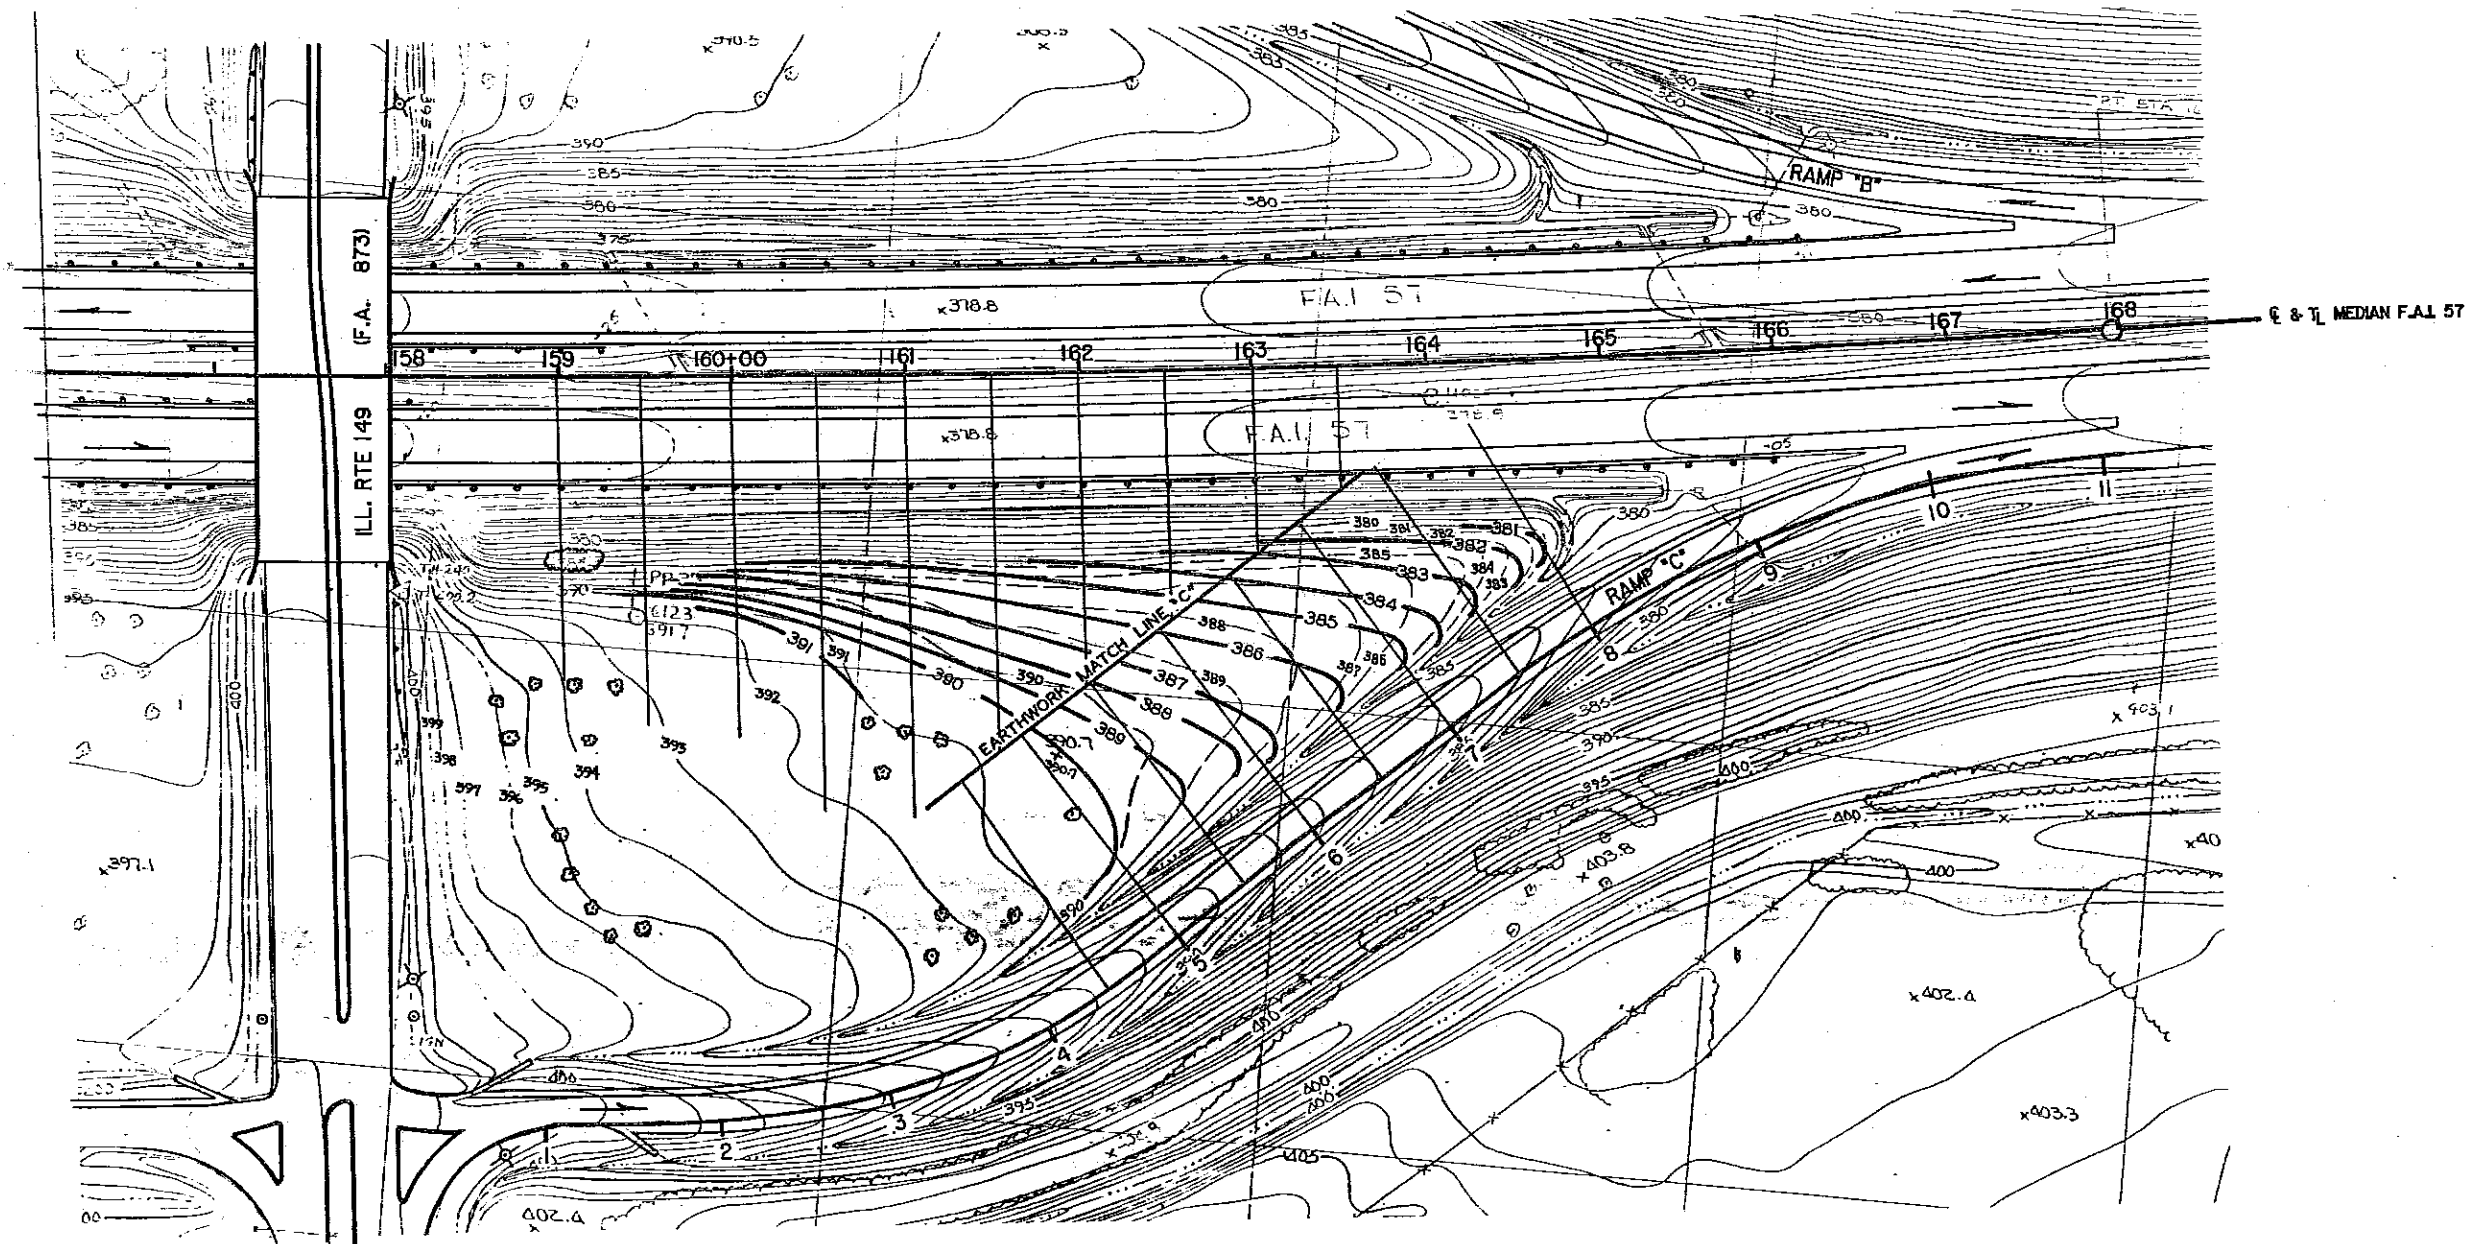

**WEST FRANKFORT INTERCHANGE  
RAMP "C"  
INFIELD GRADING**

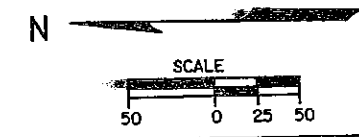








DATE: 11/15/57  
PROJECT: F.A.I. 57  
SHEET: 1 OF 1


FINAL SURVEY NOTE BOOK  
No. \_\_\_\_\_  
DATE: \_\_\_\_\_  
PROJECT: \_\_\_\_\_  
SHEET: \_\_\_\_\_

FINAL SURVEY NOTE BOOK  
No. \_\_\_\_\_  
DATE: \_\_\_\_\_  
PROJECT: \_\_\_\_\_  
SHEET: \_\_\_\_\_

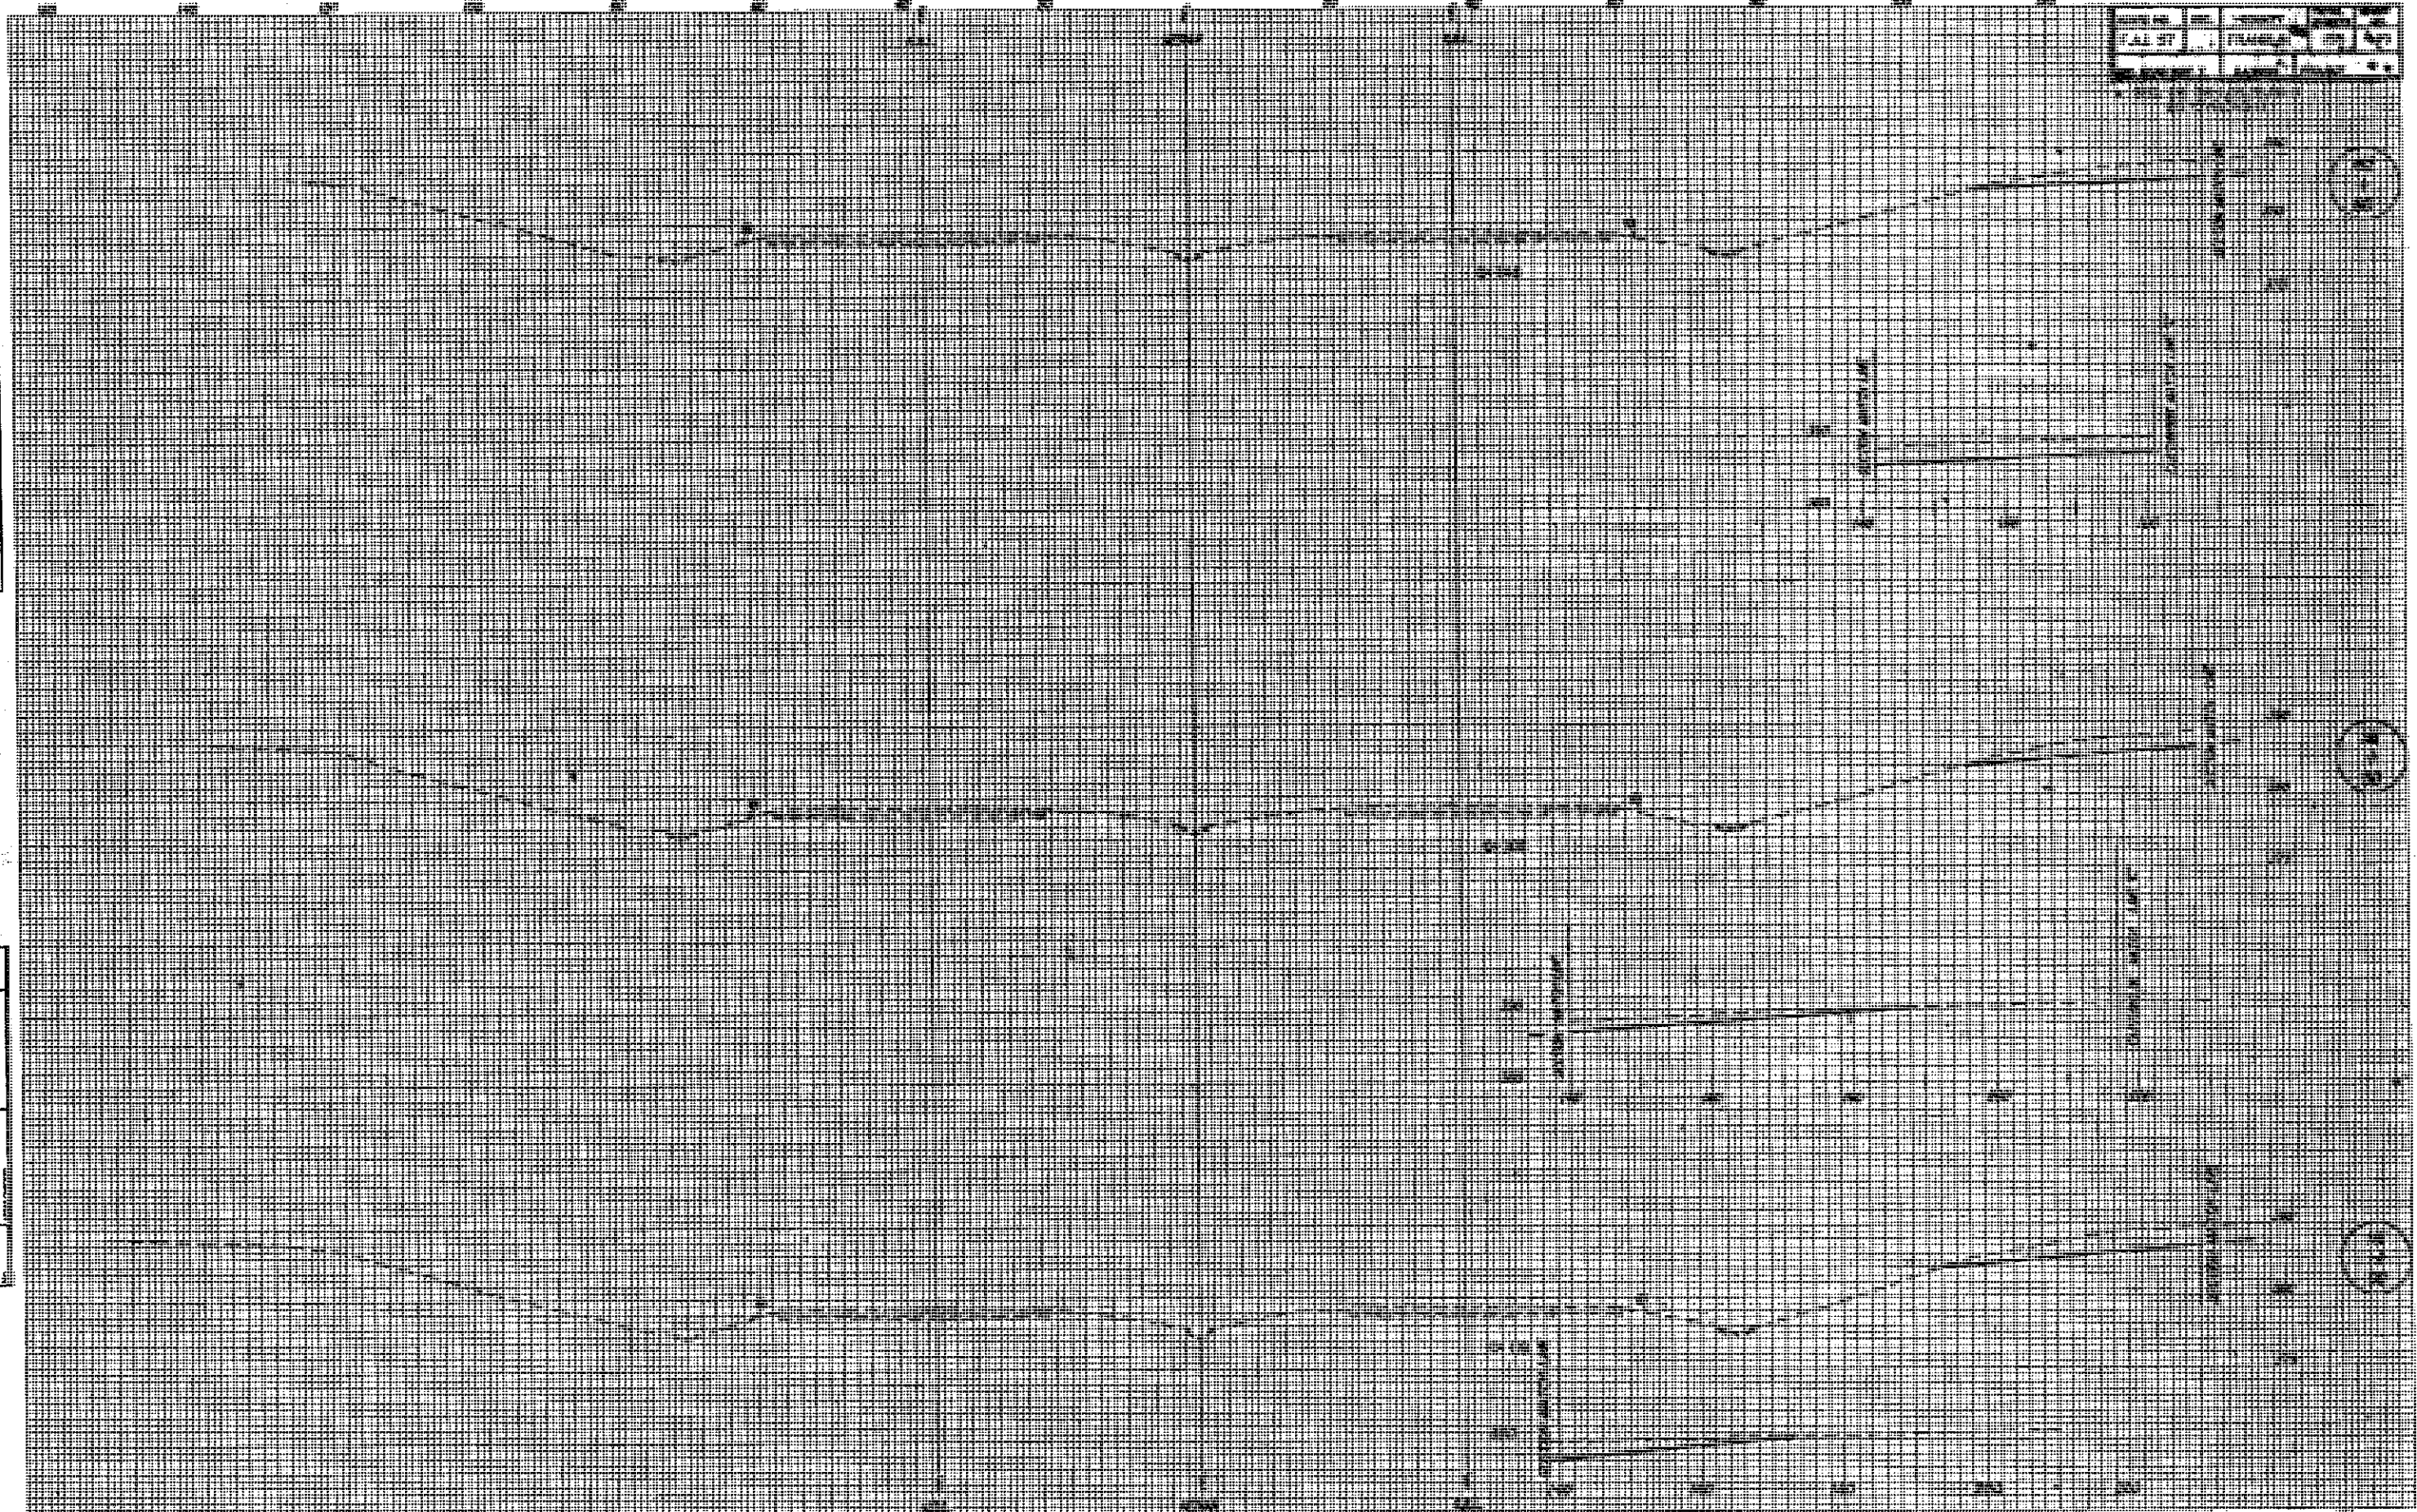



ROUTE NO.	SEC.	COUNTY	TOTAL SHEETS	SHEET NO.
F.A. 57		FRANKLIN	155	150
ROAD DIST. 7		PROJECT		
SEC. 26 150-155 26th D. 26 150-155				

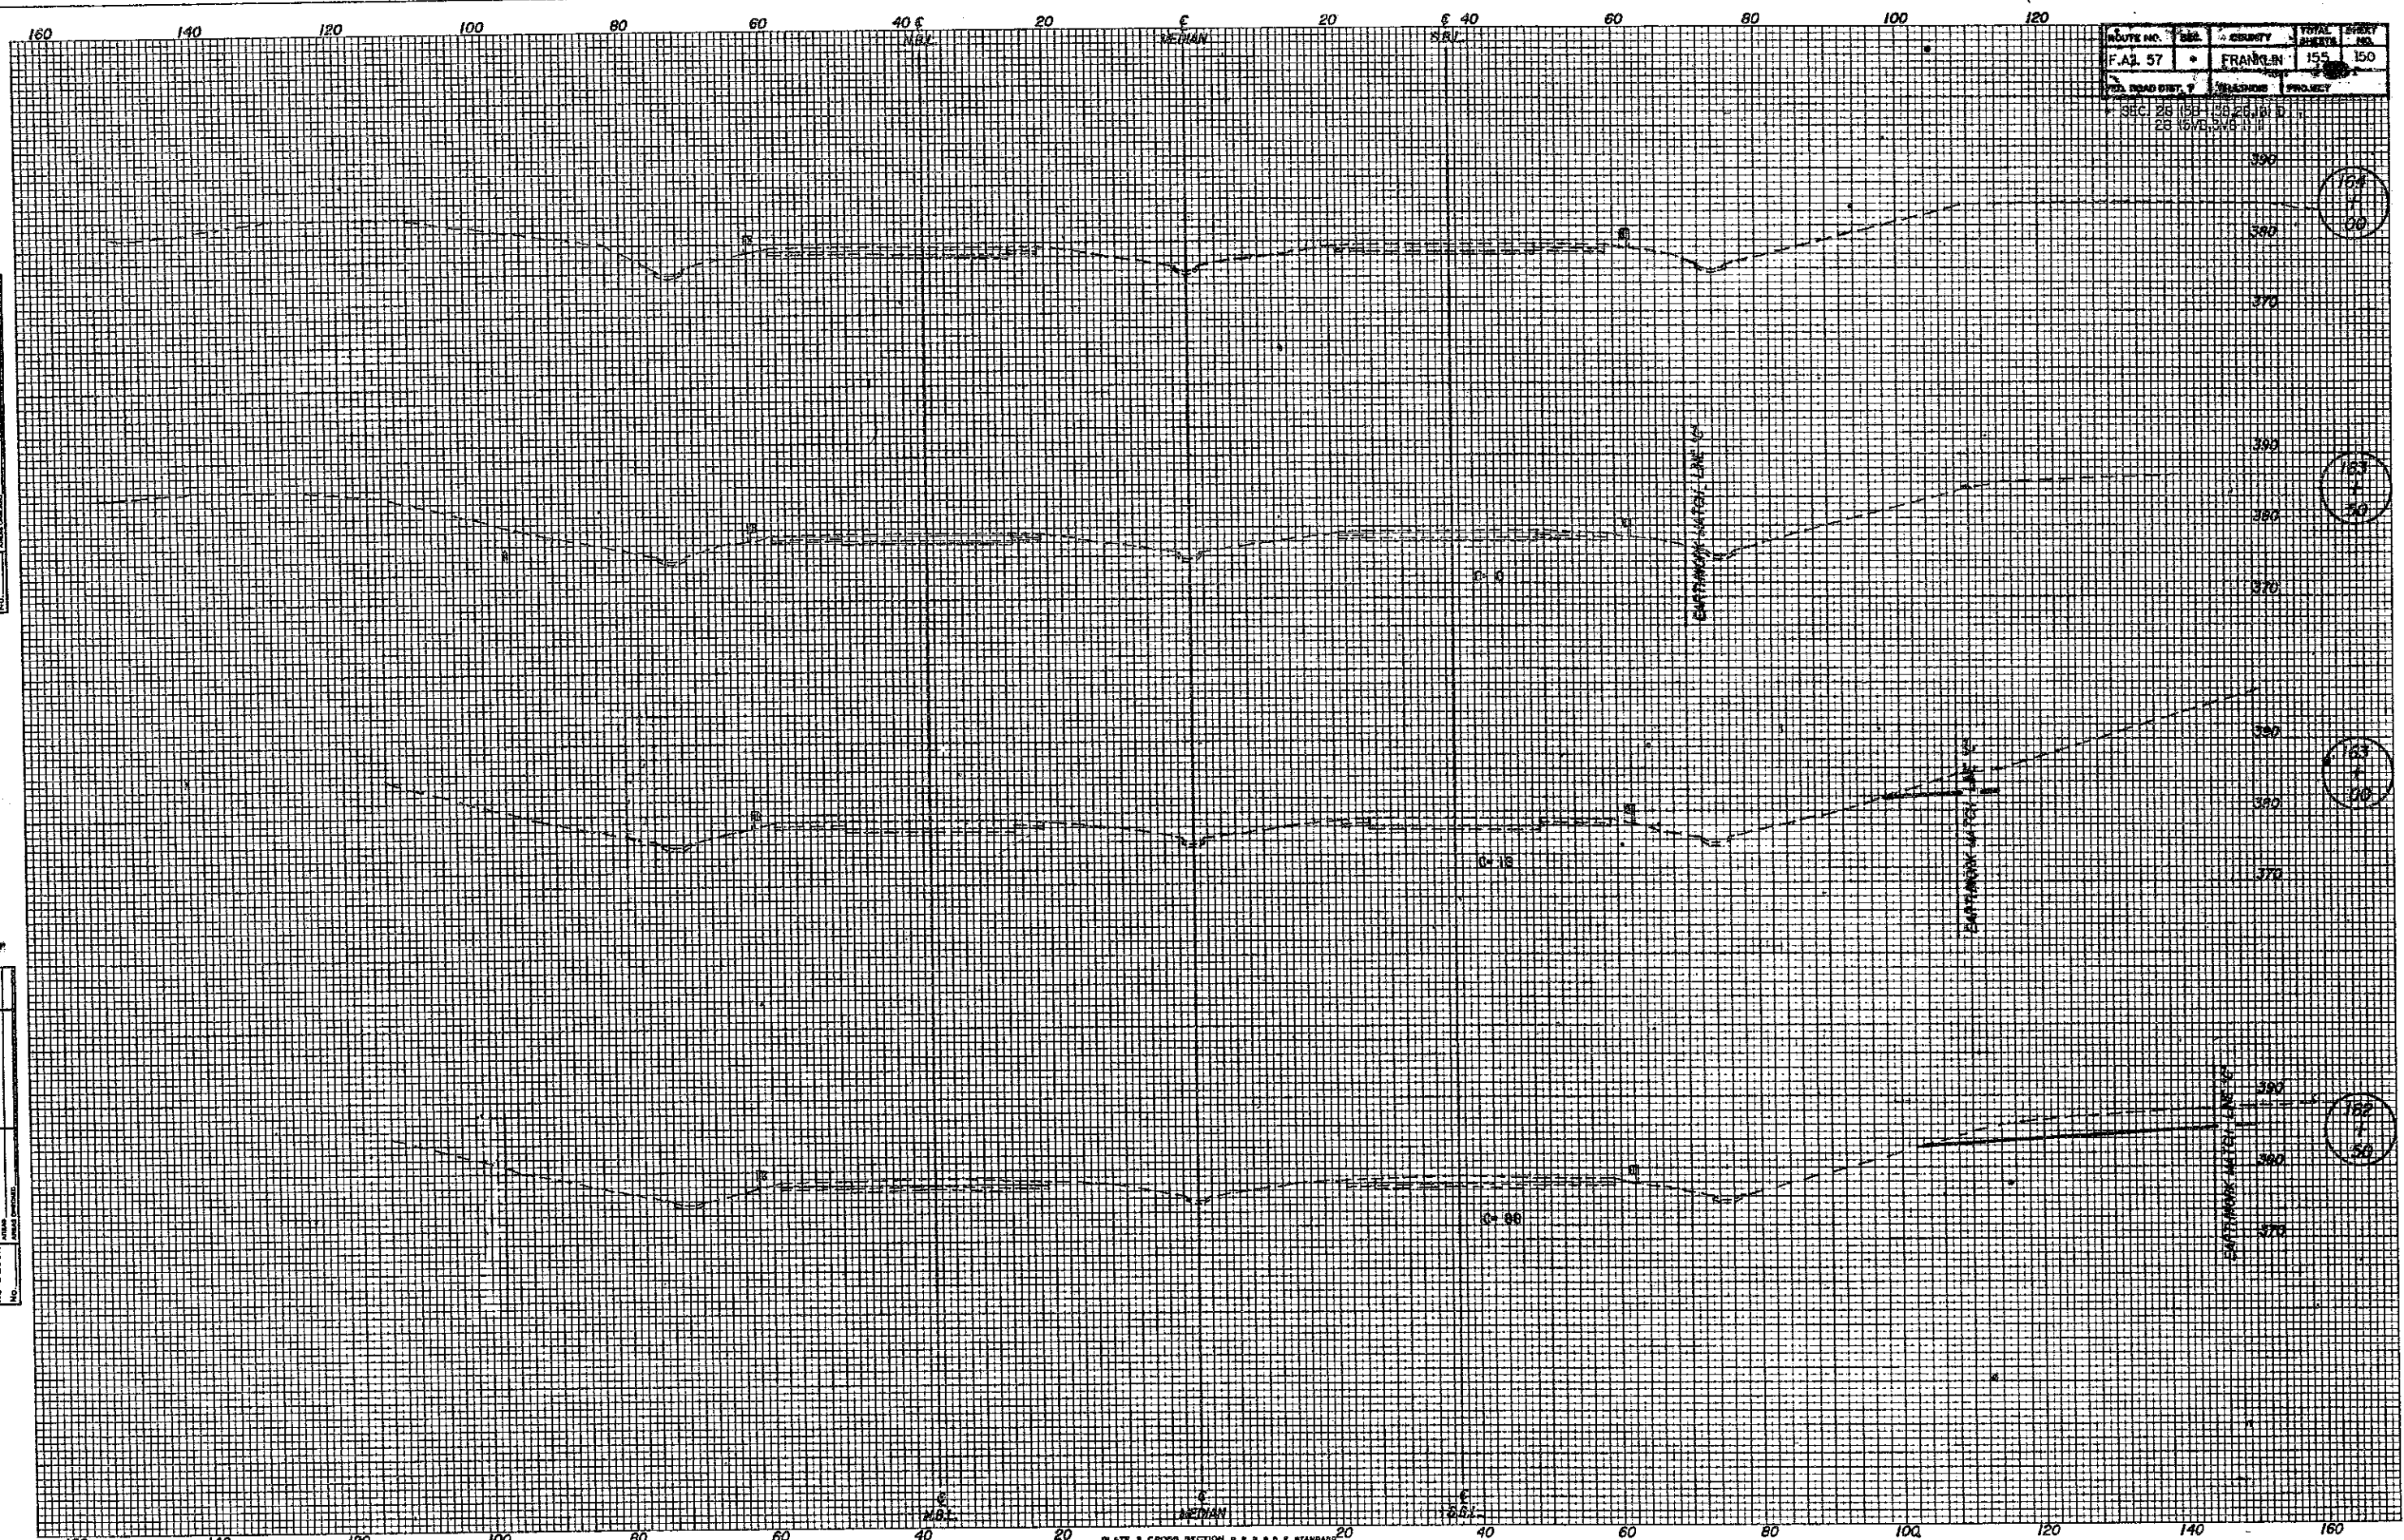

DATE	
BY	
CHECKED	
APPROVED	
NO. OF SHEETS	
NO. OF SHEETS USED	
NO. OF SHEETS LEFT	
NO. OF SHEETS USED	
NO. OF SHEETS LEFT	
NO. OF SHEETS USED	
NO. OF SHEETS LEFT	


DATE	
BY	
CHECKED	
APPROVED	
NO. OF SHEETS	
NO. OF SHEETS USED	
NO. OF SHEETS LEFT	
NO. OF SHEETS USED	
NO. OF SHEETS LEFT	
NO. OF SHEETS USED	
NO. OF SHEETS LEFT	



DATE	SCALE	PROJECT	NO.

DATE	SCALE	PROJECT	NO.
PREPARED BY: _____ CHECKED BY: _____ IN CHARGE: _____ DATE: _____			
FINAL SURVEY NOTE BOOK No. _____			

DATE	SCALE	PROJECT	NO.
PREPARED BY: _____ CHECKED BY: _____ IN CHARGE: _____ DATE: _____			
FINAL SURVEY NOTE BOOK No. _____			

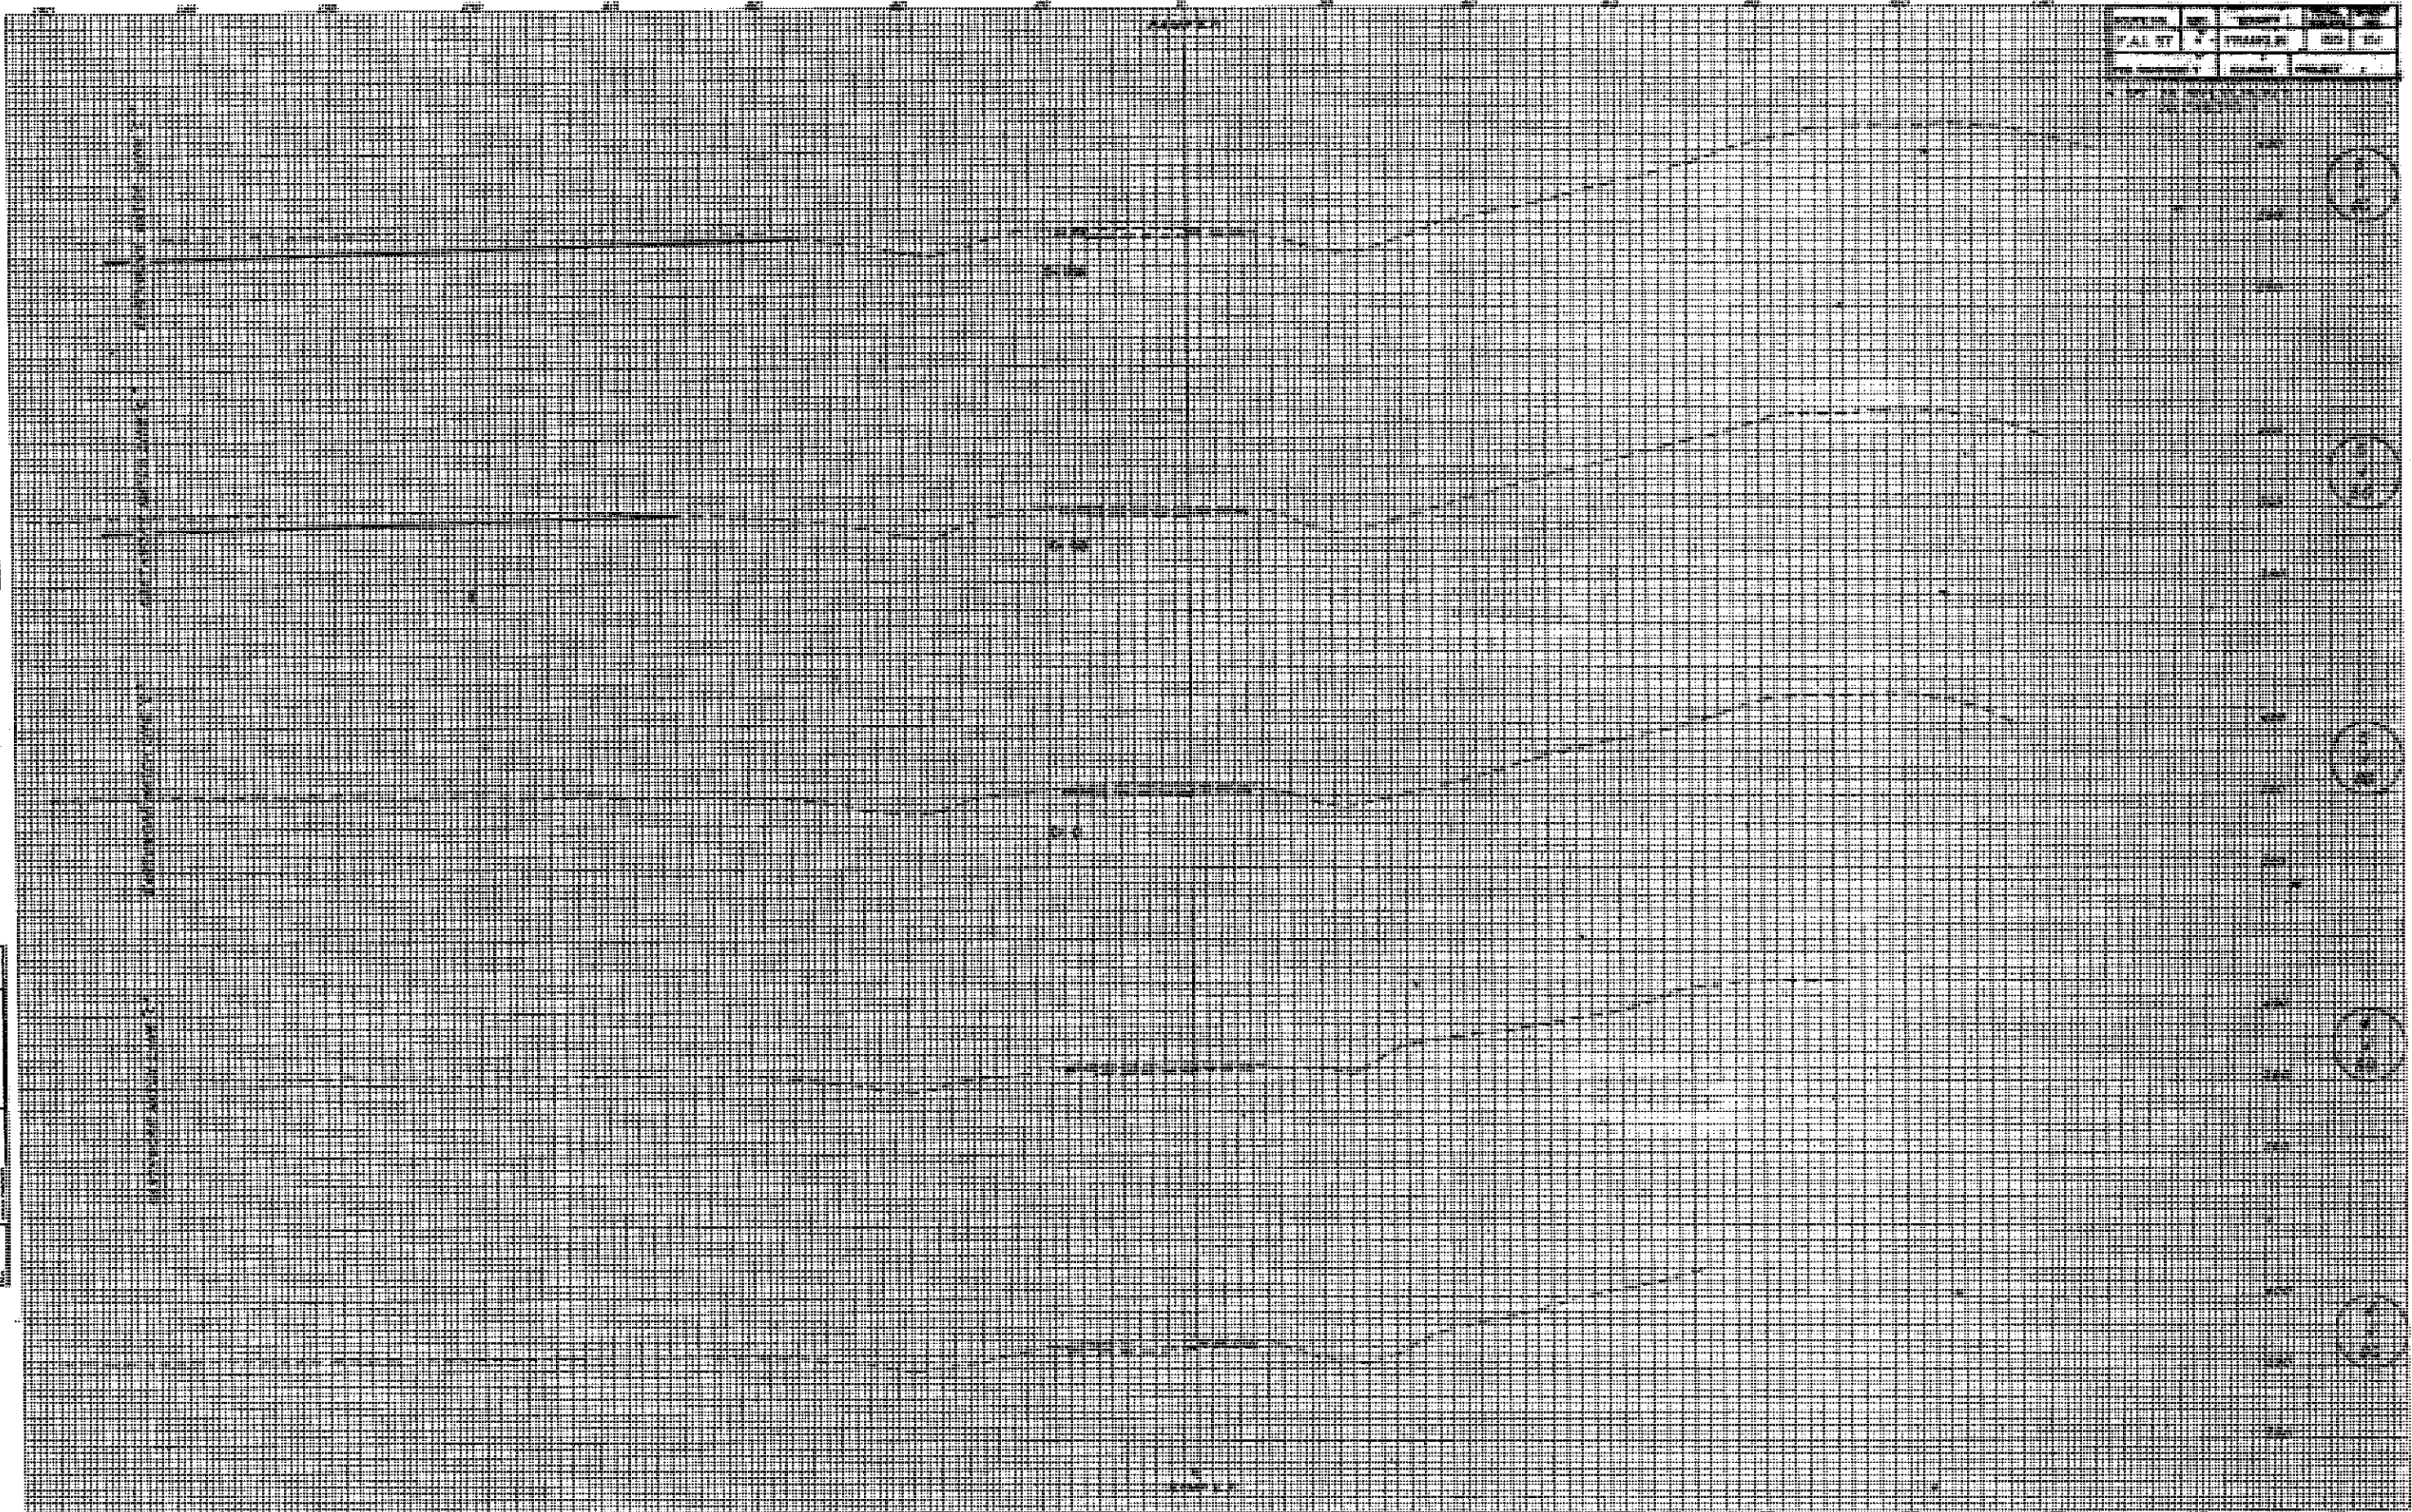


PRINTED IN GREAT BRITAIN BY THE UNIVERSITY OF LONDON PRESS LTD. PRINTED BY THE UNIVERSITY OF LONDON PRESS LTD.



DATE	BY	SCALE	PROJECT


DATE	BY
PROJECT	
SCALE	
BY	
DATE	

DATE	BY
PROJECT	
SCALE	
BY	
DATE	


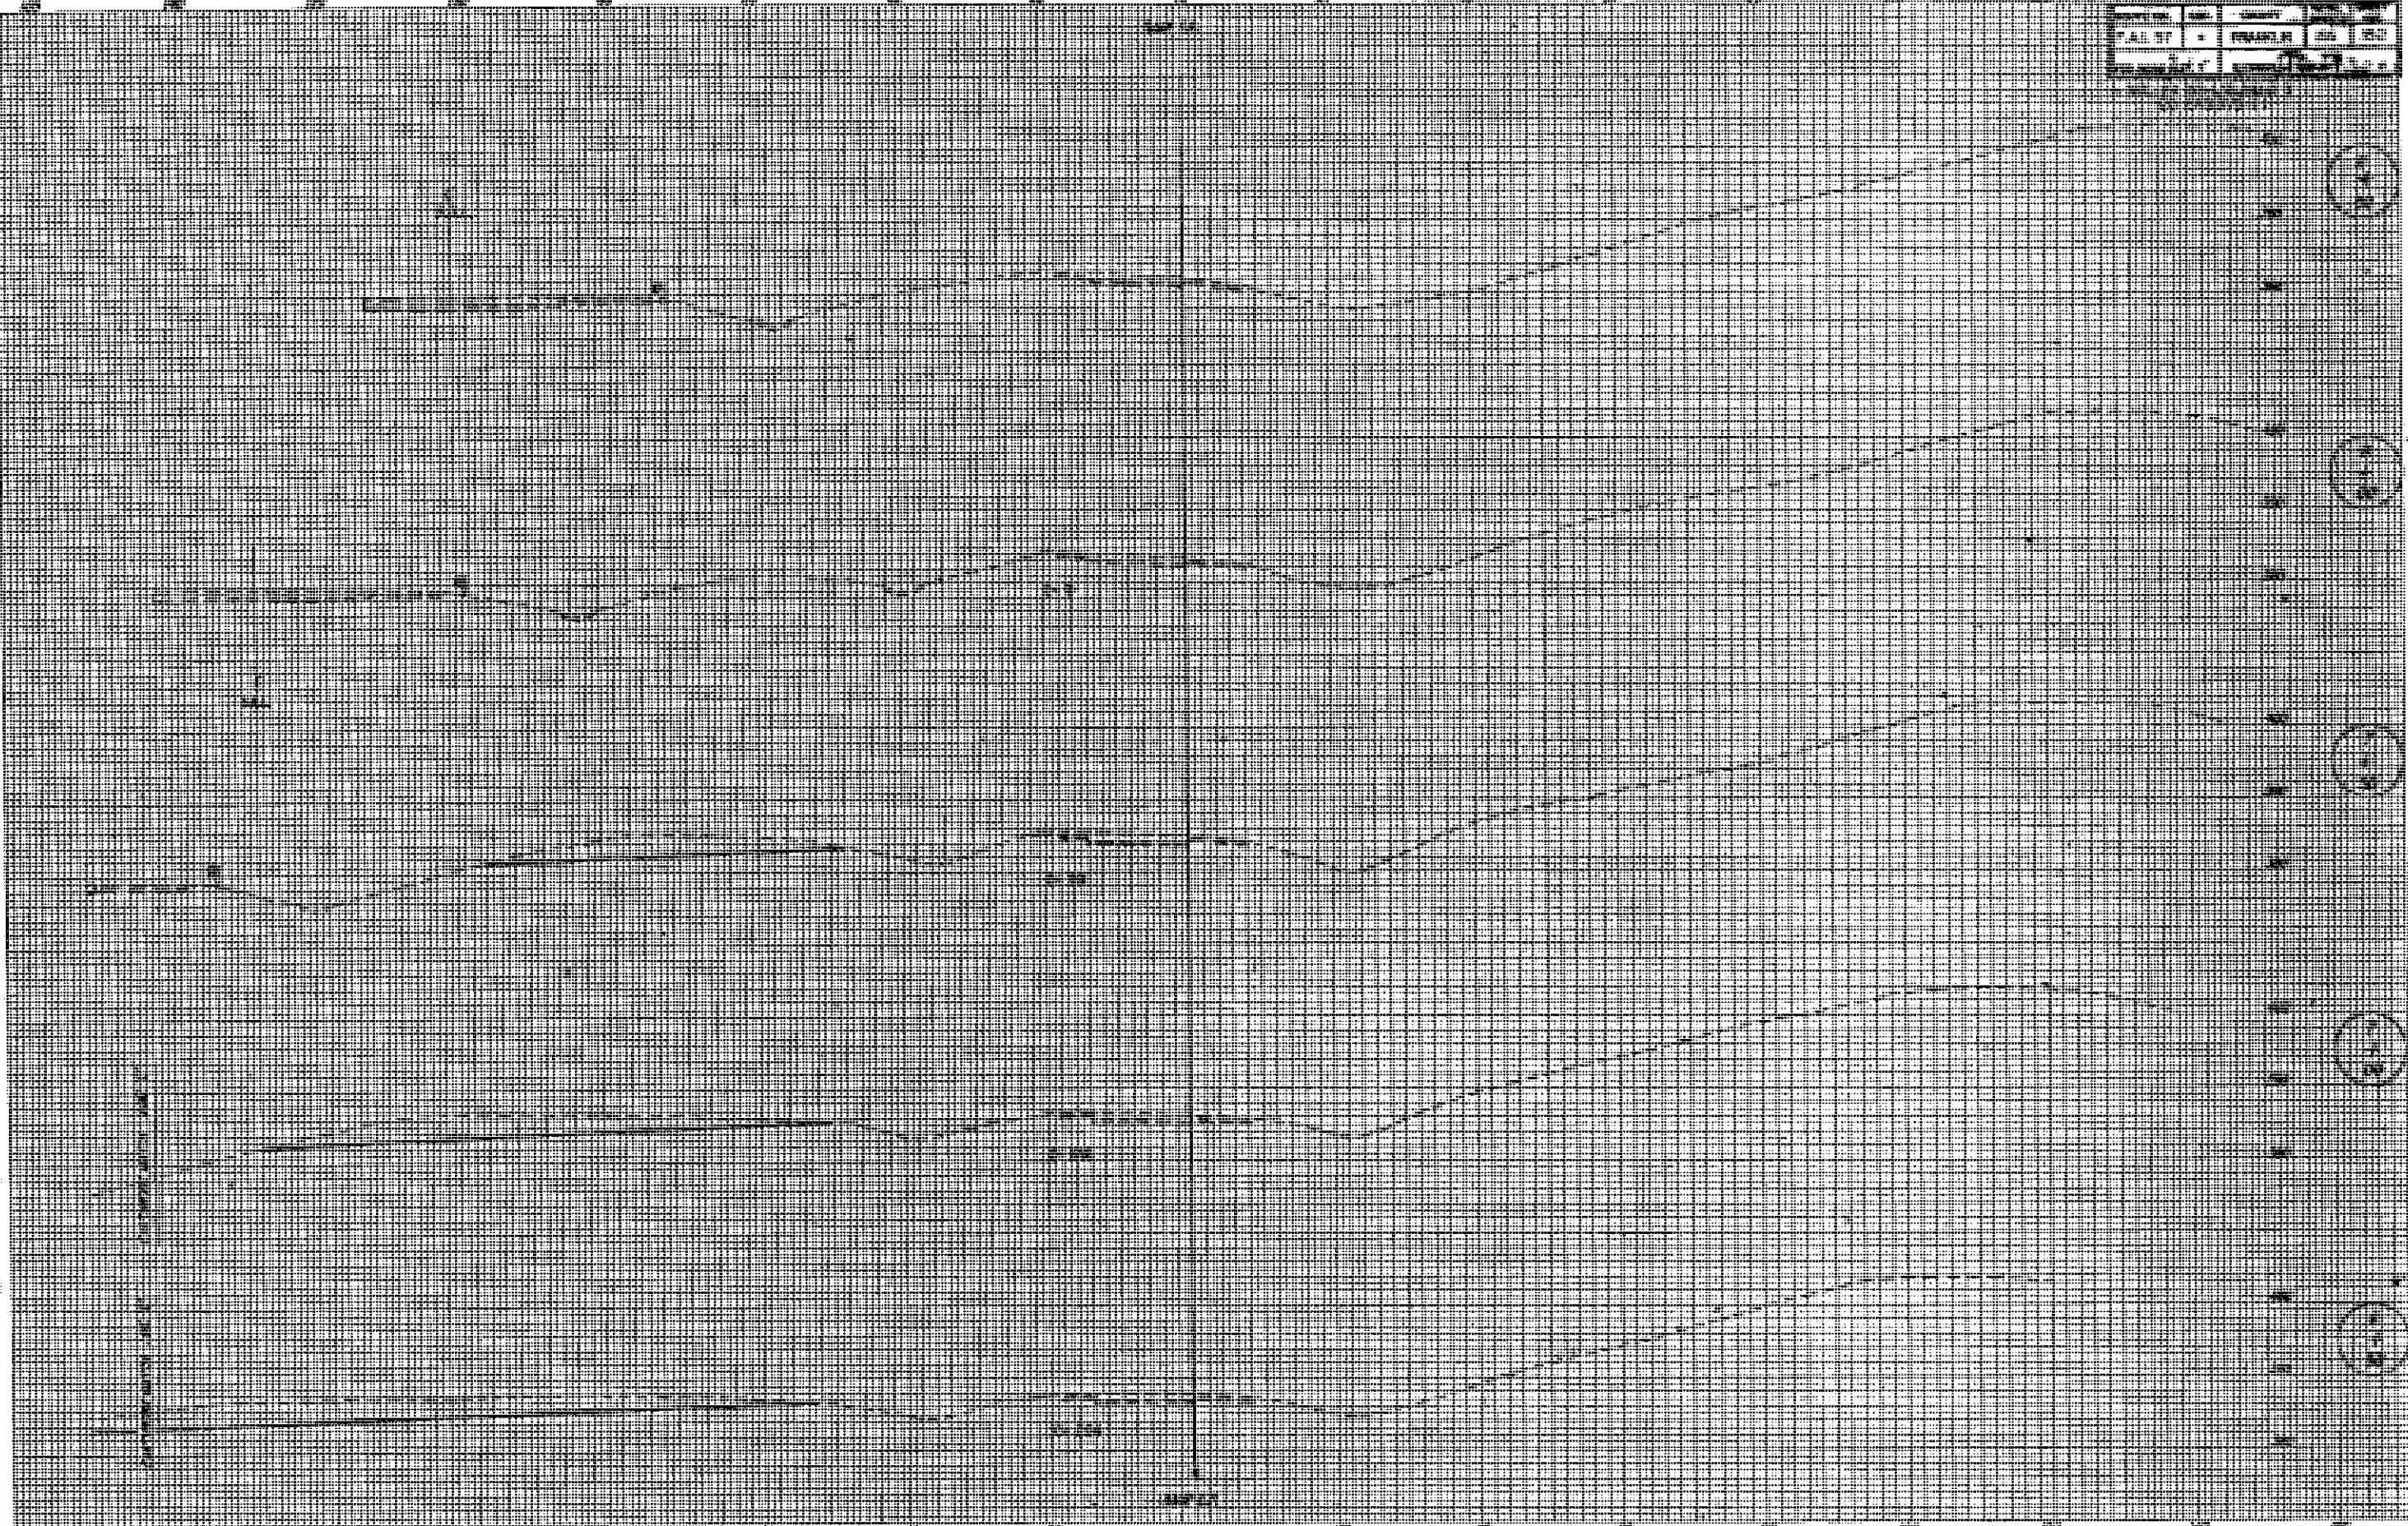


# DETAILS OF MEDIAN CROSSOVERS

SHEET NO.	SECTION	COUNTY	TOTAL SHEETS	SHEET NO.
57	#	FRANKLIN	155	153
STA.		TO STA.		
DES. ROAD DIST. NO.		DIVISION		YEAR AND PROJECT
* 28(5B-1,5B,2B,1B)D;28(5VB,3VB-1)I				

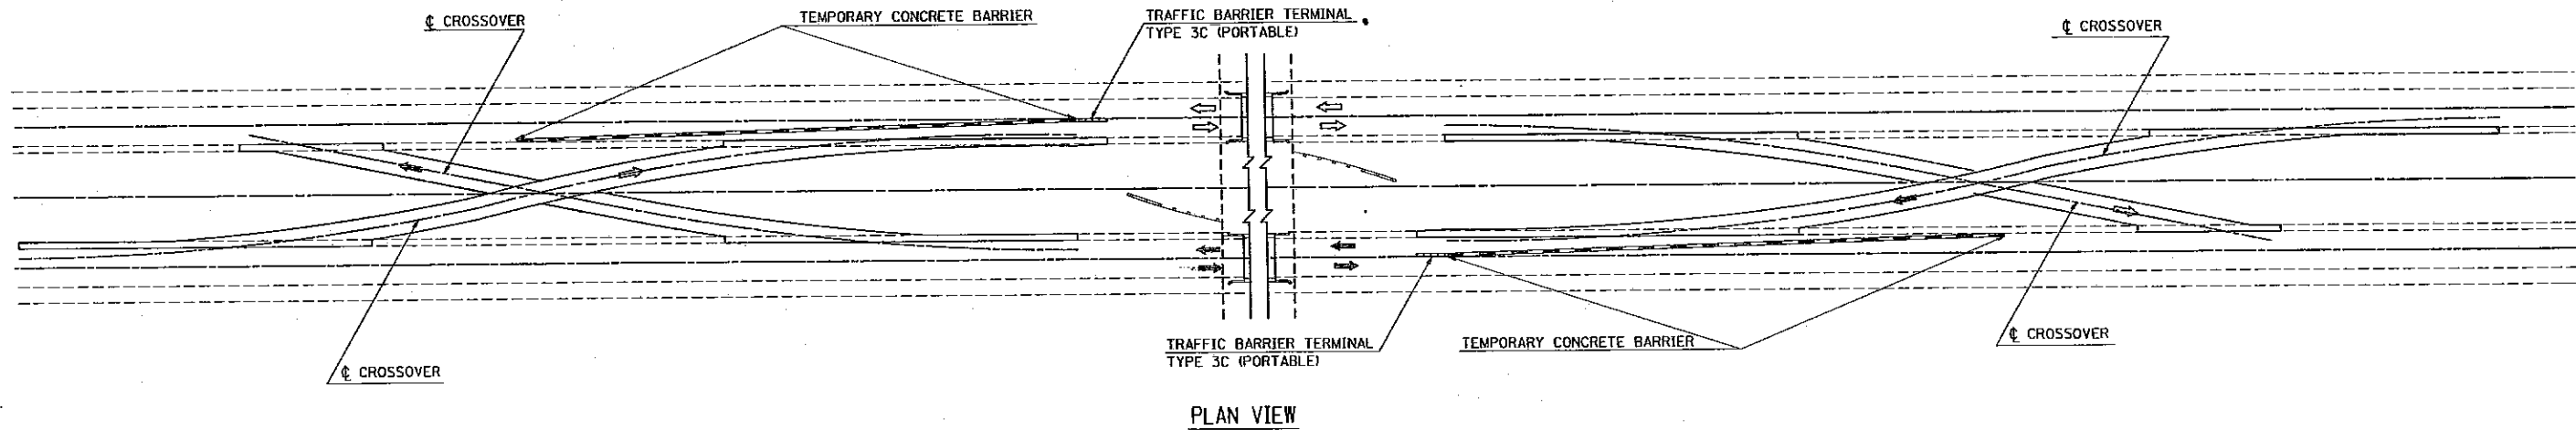

NOTE: WHEN NOT IN USE MEDIAN CROSSOVERS SHALL BE CLOSED TO TRAFFIC BY PLACING TYPE III BARRICADES AT EACH END OF THE CROSSOVER, COSTS TO BE INCLUDED IN THE PRICE FOR TRAFFIC CONTROL AND PROTECTION 2417. UPON COMPLETION OF THE NORTHBOUND CONTRACT, THESE BARRICADES SHALL REMAIN IN PLACE AND BECOME PROPERTY OF THE STATE.

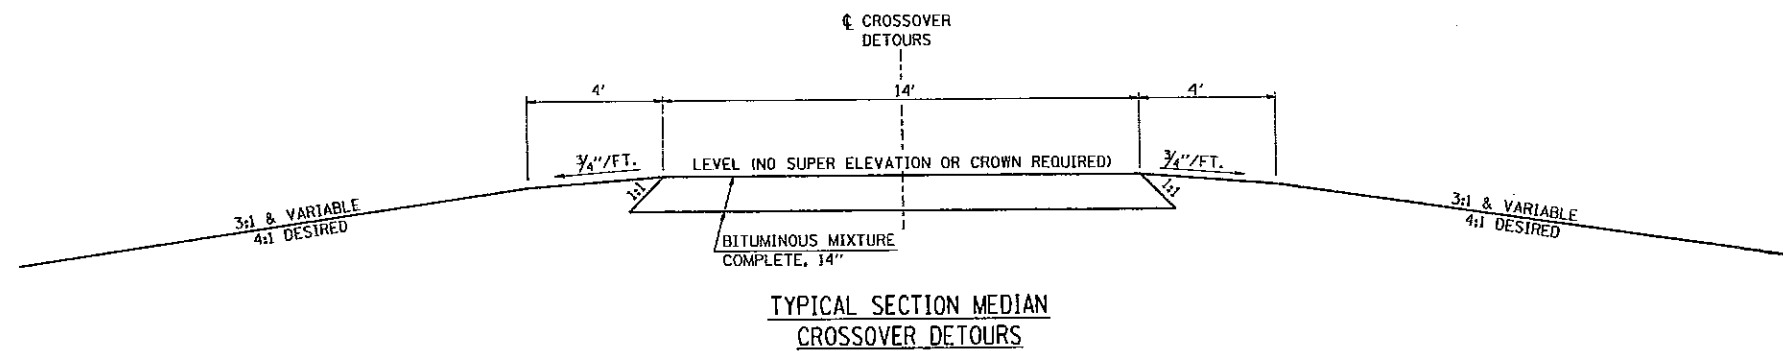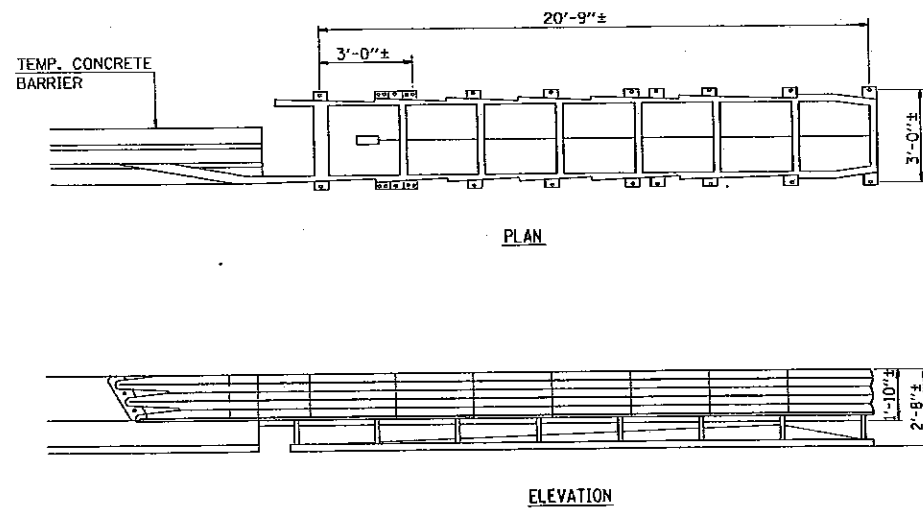


**TRAFFIC BARRIER TERMINAL, TYPE 3C, PORTABLE**  
(G.R.E.A.T. SYSTEM)



P. A. & TITLE	SECTION	COUNTY	TOTAL SHEETS	SHEET NO.
57	*	FRANKLIN	155	154
STA. TO STA.		FED. AID PROJECT		
* 2815B-1,5B,28,1B1D;285VB,3VB-111				

## SEEDING & MULCHING

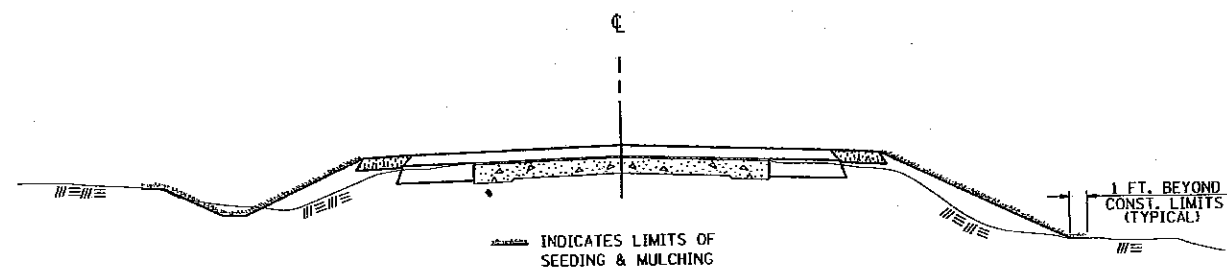

### GENERAL NOTES

IN GENERAL, ALL EARTH SURFACES DISTURBED DURING CONSTRUCTION OPERATIONS SHALL BE SEEDED AND MULCHED UPON COMPLETION OF ALL GRADING OPERATIONS.

FERTILIZER NUTRIENTS AND LIMESTONE SHALL BE APPLIED TO ALL SEEDED AREAS.

THE RATES OF APPLICATION OF FERTILIZER, MULCH AND LIMESTONE SHALL BE AS SPECIFIED IN THE SPECIAL PROVISIONS.


SECTIONS 642 AND 643 OF THE STANDARD SPECIFICATIONS SHALL GOVERN THIS WORK EXCEPT AS SPECIFIED HEREIN OR AS NOTED IN THE SPECIAL PROVISIONS.

REVISIONS	
REDRAWN	2-15-89

STD. 9-12

## DETAIL OF INLETS TO BE RECONSTRUCTED

TO BE USED: STA. 108+47 (GUN CREEK)

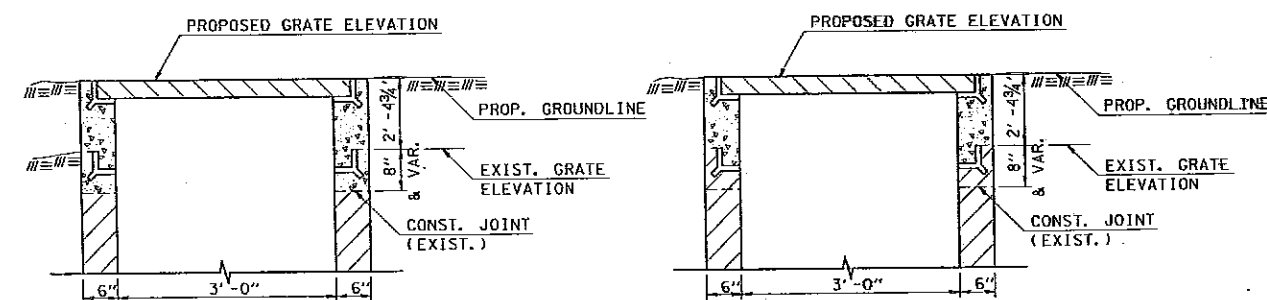

OPTION I

OPTION II

### GENERAL NOTES

THE CONTRACTOR MUST VERIFY EXISTING DIMENSIONS PRIOR TO ORDERING FRAMES AND GRATES.

FOR DETAILS OF GRATING AND FRAME, SEE STANDARD 2240. CLASS X CONCRETE SHALL BE USED THROUGHOUT. EXPOSED CONCRETE EDGES SHALL BE BEVELED  $\frac{3}{4}$ ". THE FLUSH INLET BOX COVER FOR MEDIAN SHALL BE PAID FOR AT THE CONTRACT UNIT PRICE FOR INLETS TO BE RECONSTRUCTED WHICH PRICE SHALL BE PAYMENT IN FULL FOR FURNISHING ALL MATERIALS AND FOR CONSTRUCTING THE WORK IN PLACE, ACCORDING TO DETAILS OF OPTION I OR OPTION II AS FOLLOWS:


#### OPTION I

REMOVE ALL CONCRETE ABOVE CONSTRUCTION JOINT, CAREFULLY CLEAN ALL CONCRETE FROM EXISTING FRAME AND GRATE, CONSTRUCT INLET TO NEW GRADE USING CLEANED FRAME AND GRATE.


#### OPTION II

REMOVE EXISTING GRATE (PROPERTY OF STATE OF ILLINOIS) CONSTRUCT INLET TO NEW GRADE USING NEW FRAME AND GRATE. STORE EXISTING GRATE ON R.O.W. AS DIRECTED BY THE ENGINEER.




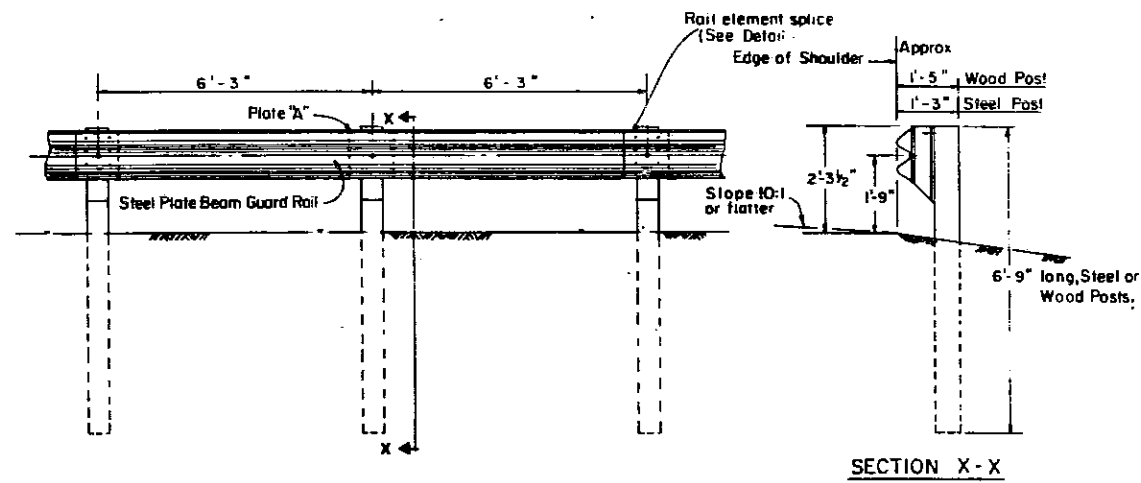


**TYPE A**  
(6'-3" Typical Post Spacing)

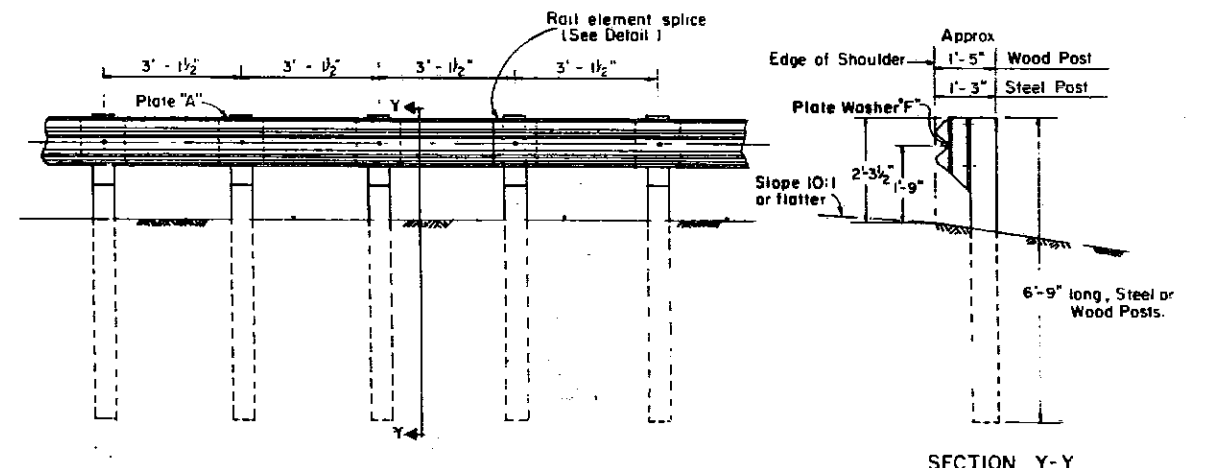

**TYPE B**  
(3'-1 1/2" Closed Post Spacing)

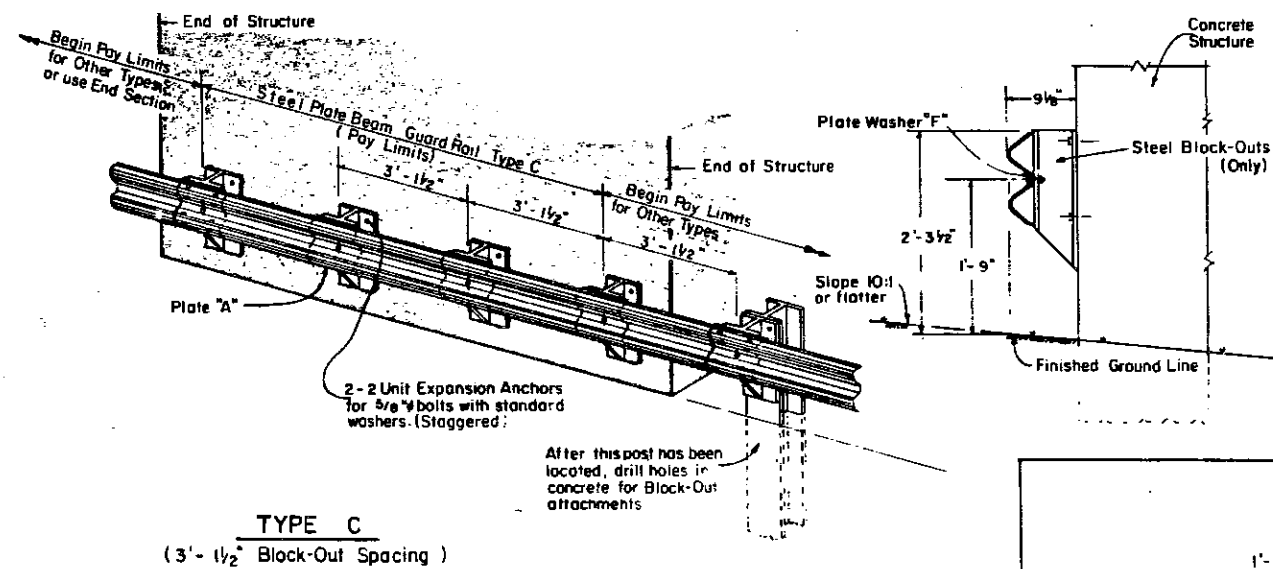


**TYPE C**  
(3'-1 1/2" Block-Out Spacing)

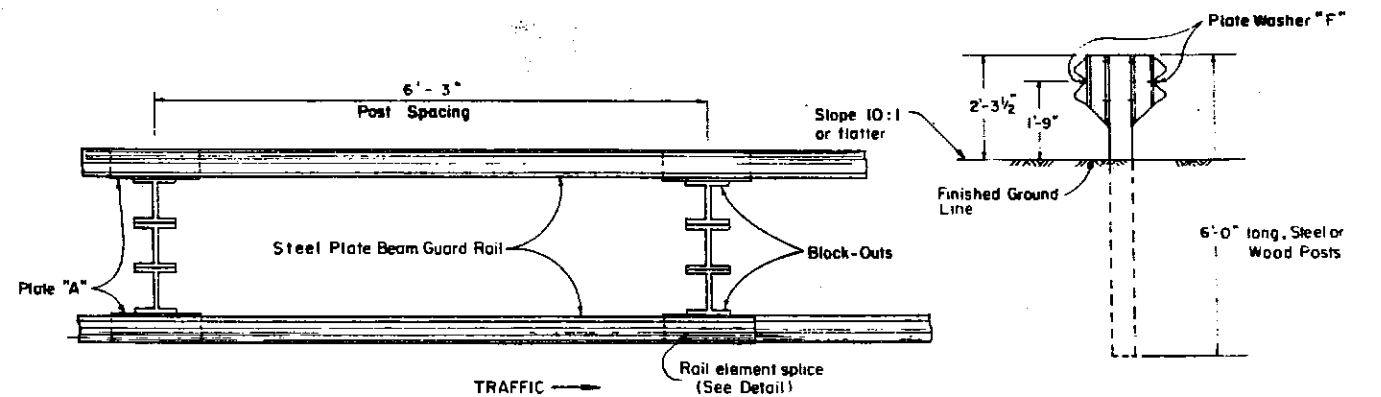

**TYPE D**  
(Double Steel Plate Beam Guard Rail,  
with 6'-3" Typical Post Spacing)

**NOTE:** Rail element lap in direction of traffic of the adjacent lane for all types

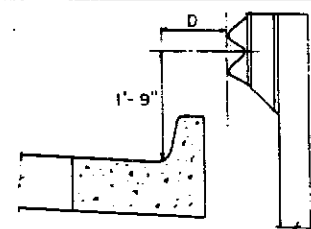

**GUARD RAIL PLACED BEHIND CURB**

D = 0'-0" desirable to 1'-0" maximum.  
If it is necessary for D to be more than one foot and less than ten feet, Type M2 curb and gutter (Std. 2130) shall be used in front of and in advance of the guardrail.

Illinois Department of Transportation

PASSED April 9, 1990  
John E. ...  
Engineer of Policies and Procedures

APPROVED April 9, 1990  
...  
Engineer of Design

ISSUED 2-11-90




**STEEL PLATE BEAM GUARD RAIL**  
**TYPES A, B, C & D**

Sheet 1 of 2 Sheets


**STANDARD 2230-16**

Full Size DWG 5




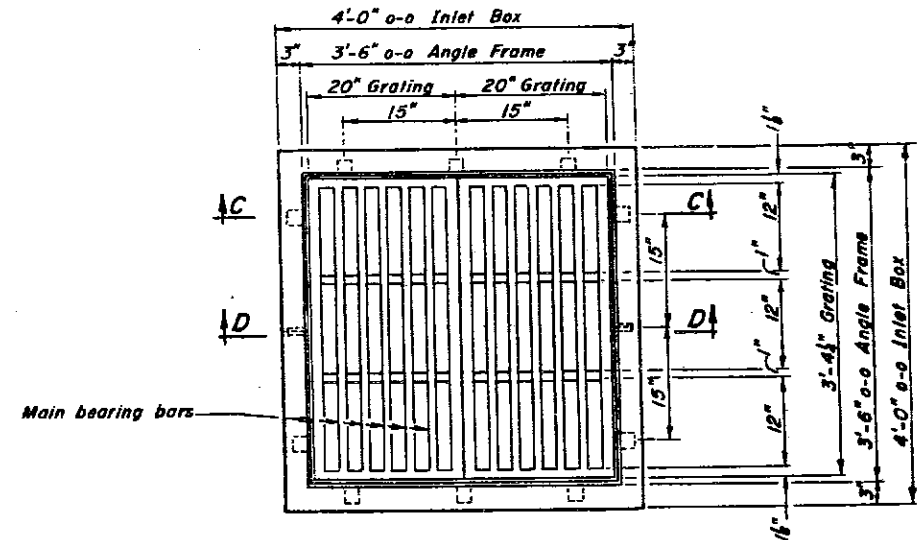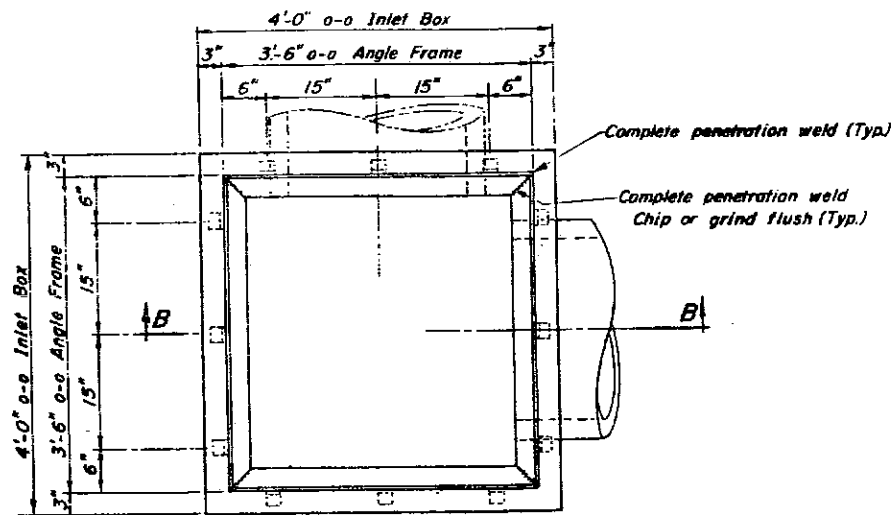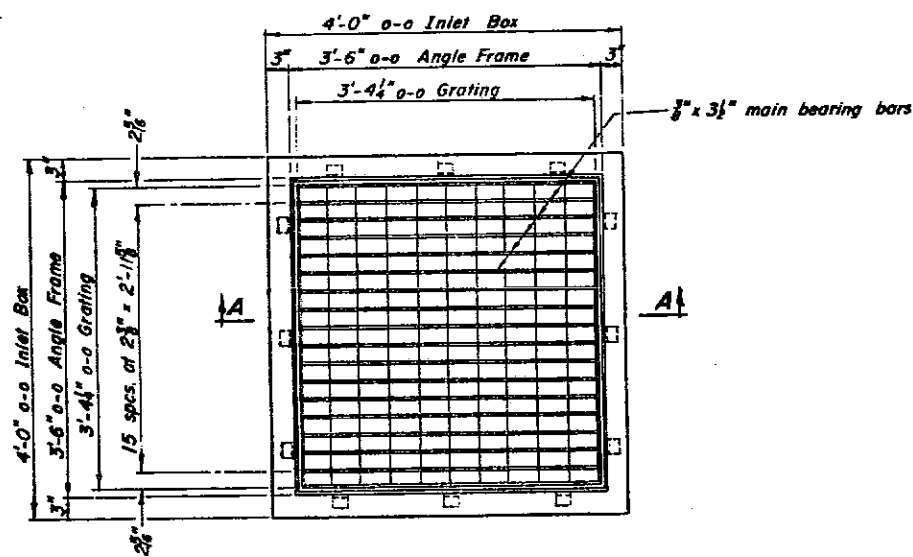


PLAN VIEW  
(Grating omitted for clarity)

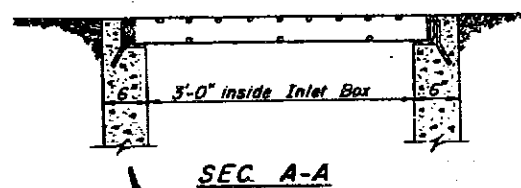


SEC. A-A

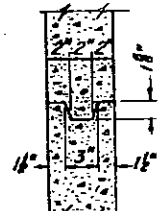

DETAIL of  
OPTIONAL JOINT

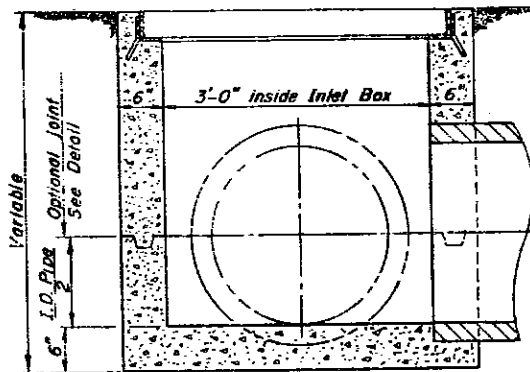


SEC. B-B

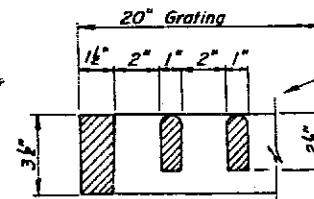


SEC. C-C

NOTE  
The cast iron angle frame may be furnished in one piece in lieu of the two pieces as shown. The ears for bolting the two pieces together must be replaced with a tab for anchoring.

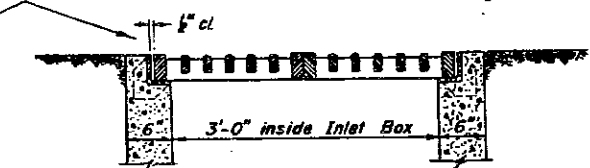

SEC. D-D

CAST FRAME & GRATE

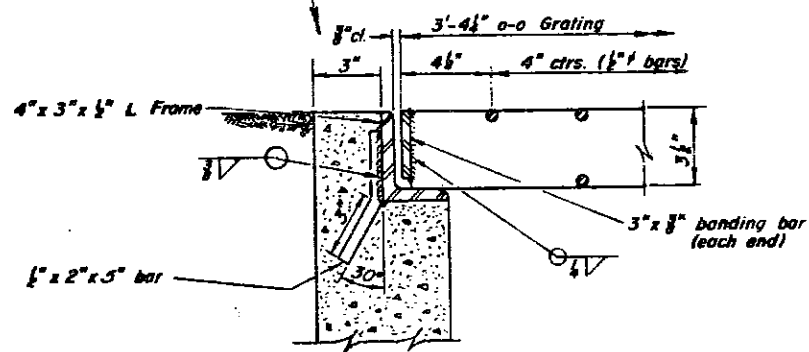

STEEL FRAME & GRATE

GENERAL NOTES

Class X concrete or precast concrete shall be used throughout. Precast concrete shall be in accordance with Sections 505.01 thru 505.05 of the Standard Specifications except that the concrete strength shall be 4000 p.s.i. after 28 days.

Shop drawings shall not be required for these inlet boxes. Exposed concrete edges shall be beveled 3/8". The steel grating shall have the main bearing bars running parallel to the centerline of the median. The main bearing bars shall be as specified or shall be 3/4" in depth and have a minimum section modulus of 3.78 inches cubed per foot width of grating with a maximum spacing of the main bearing bars equal to 3" c. to c. and a minimum spacing of 2" c. to c. The grating shall seat firmly in the frame but shall not be secured to the frame. The grating shall be cut in such manner that all riveted or welded connections are left in tact. The edges of the main bearing bars shall be laterally supported by transverse bars. Grating shall be approved by the Engineer.

All shop welding shall be done in accordance with the current specifications of the American Welding Society for Welded Highway and Railway Bridges. Welding of gratings or frames will not be permitted after galvanizing of the gratings and frames.


Steel grating and steel frames shall conform to Article 710.04 of the Standard Specifications and shall be galvanized to AASHTO Specification Mill after fabrication.

The cast grating shall conform to Article 710.18 of the Standard Specifications. (Grade 60-40-18) or Article 710.17 of the Std. Specs and proof-load tested in accordance with Federal Specifications RR-F-62. The proof-load shall be 25,000 lbs. on a 9" x 3" cast block.

The cast frames shall conform to Article 710.17 of the Standard Specifications. The cast grating and frames shall not be galvanized.

The Contract Unit Price each for Flush Inlet Box for Median (2240) shall include frame and grate (either steel or ductile iron) and Class X concrete or Precast concrete, and bedding when required.

A 3" deep sand bedding conforming to Article 703.01 (FA 1 or FA 2) shall be provided under full length and width of precast unit, and all voids around pipe entrance, both inside and outside, shall be sealed with mortar.

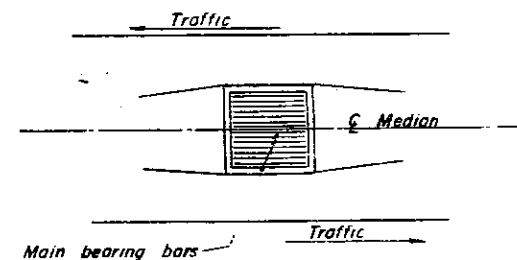

Sketch showing location and direction of main bearing bars in relation to Median

FLUSH INLET BOX  
for MEDIAN

STANDARD 2240-5

(Full Size)

Missouri Department of Transportation


PASSED Sept 28, 1979

APPROVED Sept 28, 1979

Engineer of Design


B-4.01e

Remove concrete in pipe along these lines.  
Clean reinforcement for either tied or welded  
laps of longitudinal and circumferential  
reinforcement.

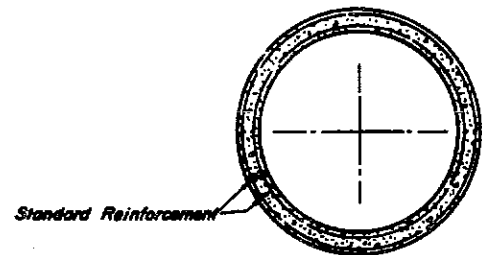


Standard Reinforcement


TRANSVERSE SECTION

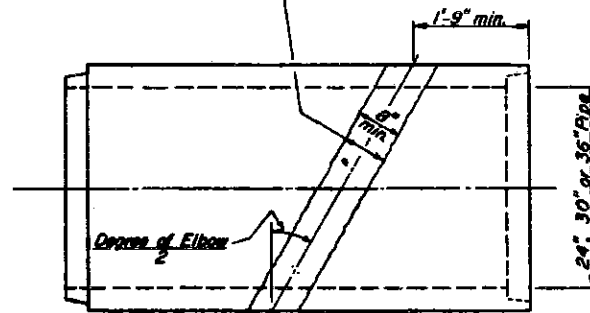

PLAN  
Reinforced Concrete Pipe

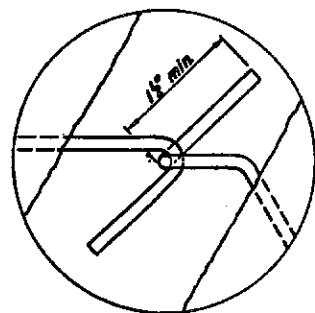


Tied Lap

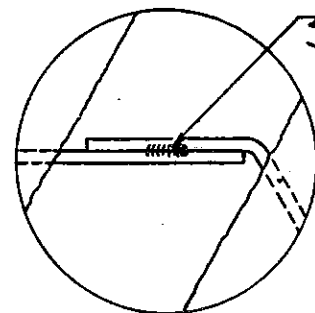

Welded Lap

DETAIL A

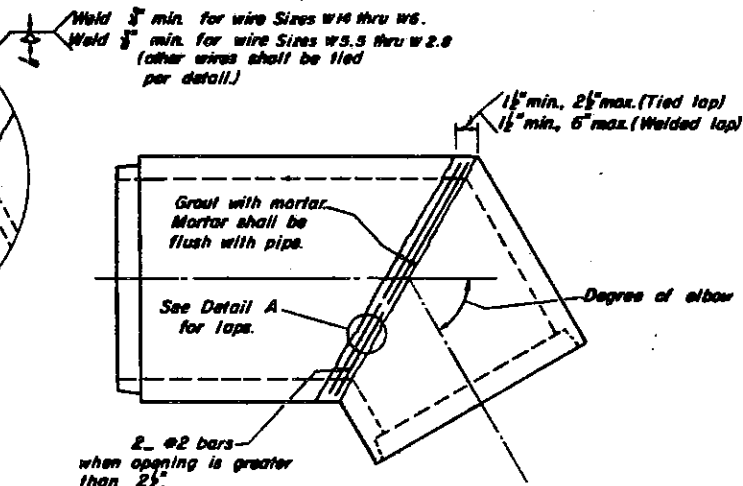

PLAN  
Reinforced Concrete  
Pipe Elbow

**NOTES:**

Reinforced Concrete Pipe shall conform to AASHTO M-170

Additional reinforcement shall conform to AASHTO M-31 or M-53


Degree of elbow and Pipe size required shall be as indicated on detail plan for each individual installation.

Cement mortar with bonding agent shall be approved by the Engineer.


Basis of Payment—Reinforced Concrete Pipe Elbow shall be paid for at the contract unit price "each" complete in place for the pipe size specified. The section of pipe which includes the elbow will not be included in the lineal foot measurement of the pipe run in which it is included.

Pipe Dia.	Approx. Wt. (lbs.)	Wall	A	B	C	D	E	G	R	Slope
12"	530	2"	4"	2'-0"	4'-0"	6'-0"	2'-0"	9"	3:1	
15"	740	2 1/2"	6"	2'-3"	3'-10"	6'-1"	2'-6"	11"	3:1	
18"	990	2 1/2"	9"	2'-3"	3'-10"	6'-1"	3'-0"	12"	3:1	
21"	1280	2 1/2"	9"	2'-11"	3'-2"	6'-1"	3'-6"	13"	3:1	
24"	1520	3"	9 1/2"	3'-7 1/2"	2'-6"	6'-1 1/2"	4'-0"	14"	3:1	
27"	1930	3 1/2"	10 1/2"	4'-0"	2'-1 1/2"	6'-1 1/2"	4'-6"	14 1/2"	3:1	
30"	2190	3 1/2"	1'-0"	4'-6"	1'-7 1/2"	6'-1 1/2"	5'-0"	15"	3:1	
33"	3200	3 1/2"	1'-1 1/2"	4'-10 1/2"	3'-3 1/2"	8'-1 1/2"	5'-6"	17 1/2"	3:1	
36"	4000	4"	1'-3"	5'-3"	2'-10 1/2"	8'-4 1/2"	6'-0"	20"	3:1	
42"	5380	4 1/2"	1'-9"	5'-3"	2'-11"	8'-2"	6'-6"	22"	3:1	
48"	6550	5"	2'-0"	6'-0"	2'-2"	8'-2"	7'-0"	22"	3:1	
54"	8240	5 1/2"	2'-3"	5'-5"	2'-11"	8'-4"	7'-6"	24"	24:1	
60"	8730	6"	2'-11"	5'-0"	3'-3"	8'-3"	8'-0"	5"	2:1	
66"	10710	6 1/2"	2'-6"	6'-0"	2'-3"	8'-3"	8'-6"	5 1/2"	2:1	
72"	12520	7"	3'-0"	6'-6"	1'-9"	8'-3"	9'-0"	6"	186:1	
78"	14770	7 1/2"	3'-0"	7'-6"	1'-9"	9'-3"	9'-6"	6 1/2"	182:1	
84"	18160	8"	3'-0"	7'-6"	1'-9"	9'-3"	10'-0"	6 1/2"	15:1	


\*Radius as furnished by manufacturer

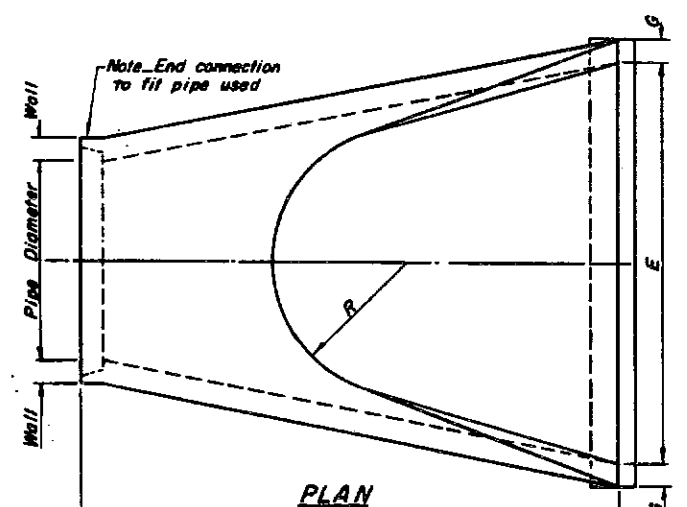

PLAN

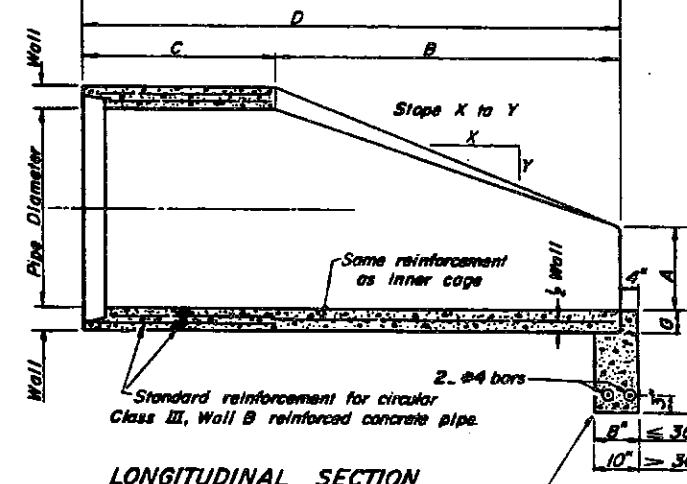

LONGITUDINAL SECTION

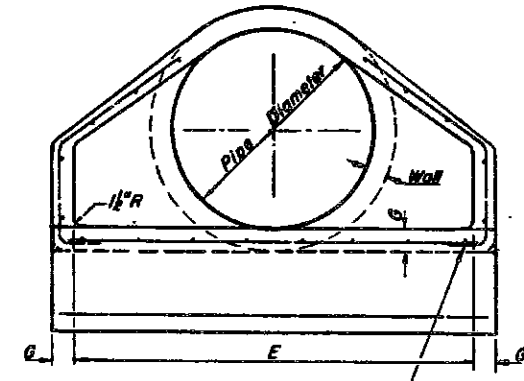

END VIEW

**NOTES:**

1. Precast concrete flared end sections shall conform to the applicable requirements of AASHTO M-170 Class III, Wall B reinforced concrete pipe.
2. Precast concrete flared end section for pipe diameter required shall be as indicated on detail plan for each individual installation.
3. The end block shall be placed prior to the installation of the flared end section. The end block shall be backfilled in accordance with Art. 502.11 of the Standard Specifications, cost incidental to End Section.

Precast or Cast in Place  
End Block.  
(See Note 3)


**REINFORCED CONCRETE  
PIPE ELBOW**

**PRECAST REINFORCED CONCRETE  
FLARED END SECTION**

**STANDARD 2262-4**  
(Full Size)


Missouri Department of Transportation		ISSUED 3-4-69	
PASSED <u>Nov. 21, 1974</u>		REVISIONS	
<u>Paul E. [Signature]</u> Engineer of Bridge and Traffic Structures		W.F.	1-17-72
APPROVED <u>Nov. 21, 1974</u>		D.W.W.	2-1-74
<u>[Signature]</u> Engineer of Design		W.M.B.	8-11-78
		D.W.W.	10-27-78

**TYPICAL APPLICATIONS OF TYPE III BARRICADES CLOSING A ROAD**

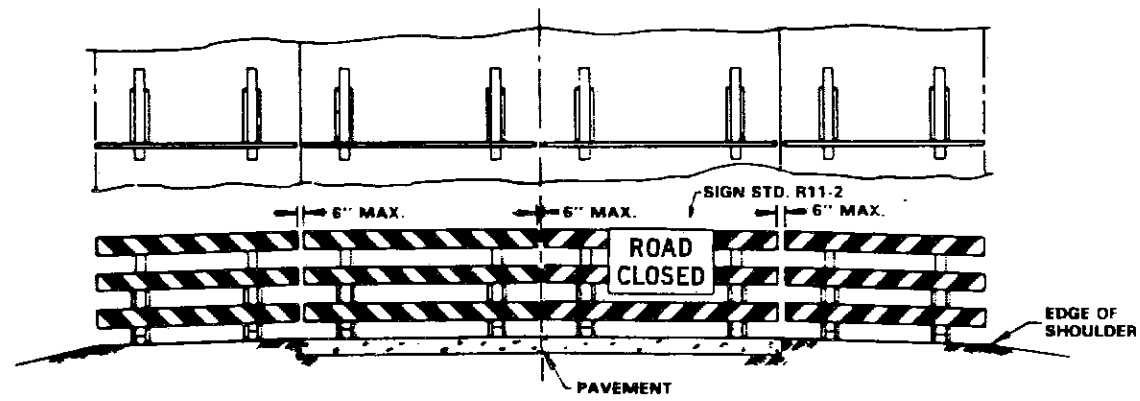

ROAD CLOSED TO ALL TRAFFIC


Reflectorized striping may be omitted on the back side of the barricades. The barricades shall be to the edge of the shoulders except when otherwise directed by the Engineer or shown on the detailed construction plans.

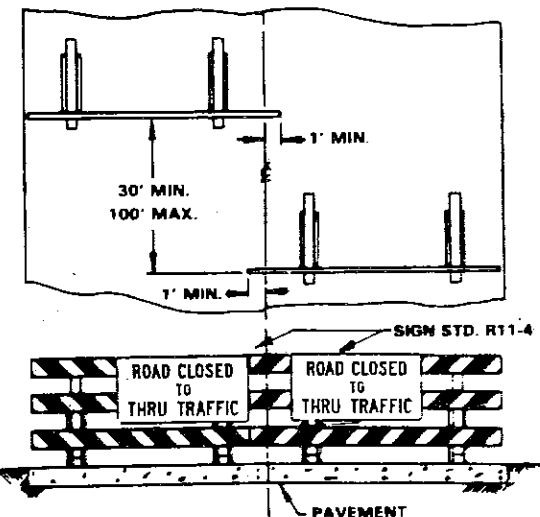

ROAD CLOSED TO ALL THRU TRAFFIC


Reflectorized striping shall appear on both sides of barricades. The barricades shall be to the edge of the pavement, except when otherwise directed by the Engineer or shown on the detailed construction plans.

**ARROW BOARDS**

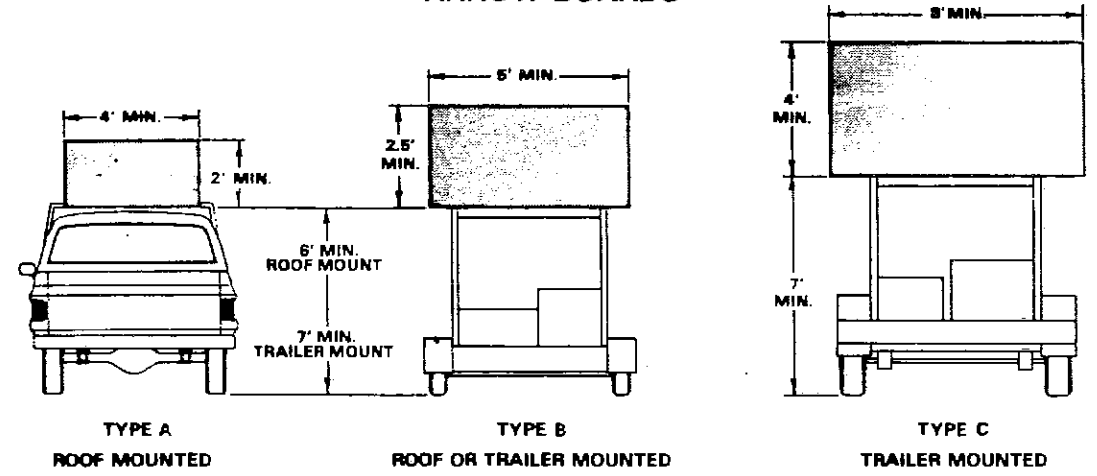


Arrow boards shall conform to Article 718.22 of the Standard Specifications. On roads with speeds of 45 miles per hour and above, Type C units are to be used for all operations 24 hours or more in duration and Type B units may be used for operations less than 24 hours in duration. Type A, B or C units may be used for all operations on roads with speeds less than 45 miles per hour. Arrow boards shall not be used to direct passing moves into lanes used by opposing traffic.

**WORK LIMIT SIGNING**

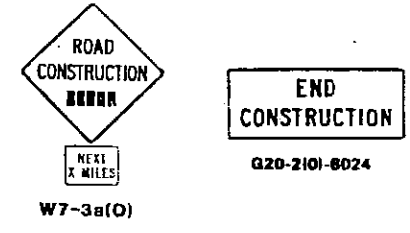

The NEXT X MILES supplemental plate shall be installed below the first warning sign in the series of all projects over two miles in length. The END CONSTRUCTION sign shall also be erected near the end of these projects, unless another project is within 2 miles beyond the end of the job.

**TYPICAL SIGN INSTALLATIONS**

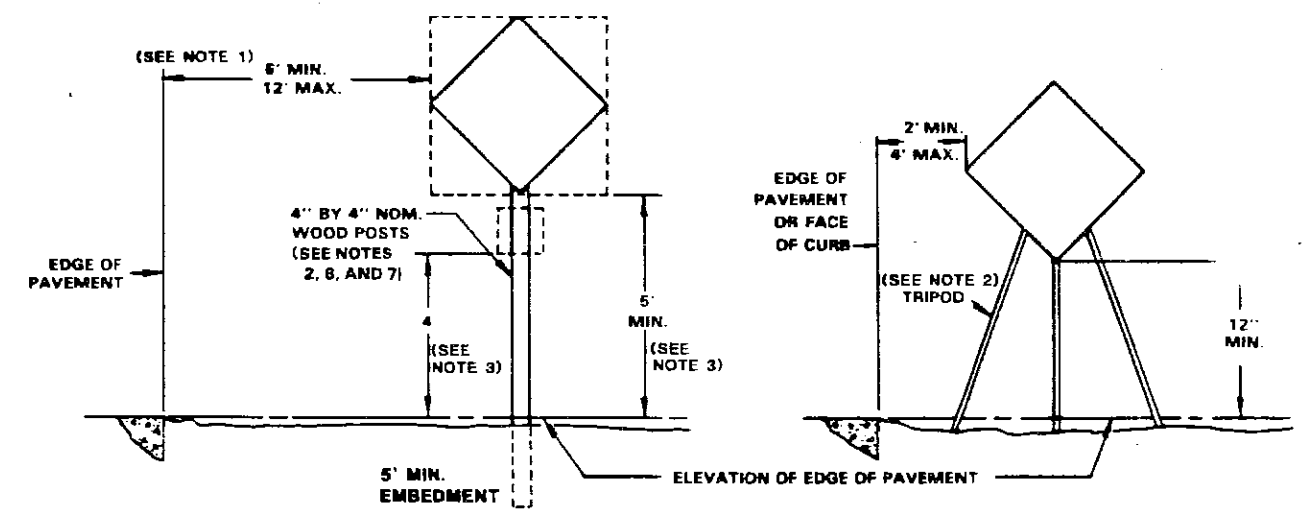

- 2 ft. minimum to face of curb.
- Alternate designs and or materials may be permitted when authorized by the Engineer. All materials shall be substantial and durable.
- Add 2 ft. if parking exists within 200 ft. in advance of the sign location or if pedestrian movement is likely to occur at any time during the project.
- Signs on temporary supports shall be within 20° of a vertical position.
- Weights of concrete, stone, or brick will not be allowed and all weights used to stabilize signs other than sandbags must be rigidly attached to the sign support as close to the ground as possible.
- Two posts shall be used for signs greater than 16 sq. ft. in area or where the height between the sign and the ground exceeds 7 ft. Bracing no heavier than 2" x 4" wood may be used for added support. Any brace placed parallel to the road shall be sloped down toward approaching traffic.
- If approved by the Engineer, skids may be used to support signs where posts are impractical. If used, they shall not exceed the structural design of Type III barricades and shall be no greater than 4 ft. in length.

**TYPICAL APPLICATION OF TRAFFIC CONTROL DEVICES HIGHWAY CONSTRUCTION AND CONTRACT MAINTENANCE**

SHEET 1 OF 2  
**STANDARD 2298-9**

Illinois Department of Transportation



Approved: 2/4/82

*R. Jones*  
Engineer of Traffic


F-600h



**TYPE I BARRICADES**

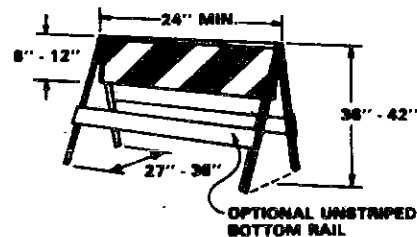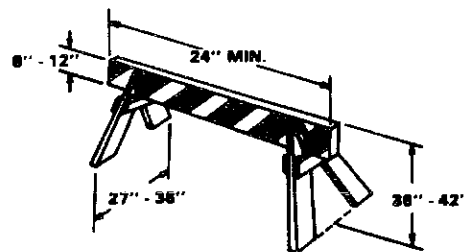



**TYPE II BARRICADES**

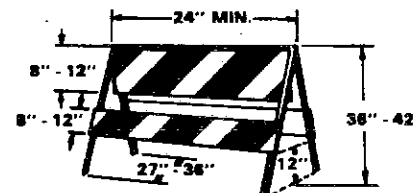


**GENERAL NOTES**

1. Type I Barricades are intended for use on lower speed roads and shall not be used where normal speeds are greater than 40 MPH unless the reflective area of the upper rail is at least 288 square inches.
2. Type I and Type II Barricades shall not be intermixed within an individual string of barricades.
3. Type III Barricades are intended for road and lane closures and shall not be used for channelization or delineation.
4. All heights shown shall be measured above the pavement surface.
5. Unless otherwise noted, the reflective sheeting used for barricades, drums, and vertical panels shall meet the requirements of Article 718.17 and 718.18 of the Standard Specifications for Road and Bridge Construction.
6. All barricades and vertical panels shall have alternating reflectorized white and reflectorized orange stripes sloping downward at 45° toward the side on which traffic will pass. Barricade stripes shall be 6 inches in width on barricades 36 inches or greater in length and 4 inches in width on barricades less than 36 inches in length. Type I and Type II Barricades shall be striped on both sides. Type III Barricades shall be striped on both sides where traffic approaches from either direction. Vertical panels placed on the outside of curves shall be striped on both sides. The predominant color for other barricade components shall be white or silver, except that unpainted galvanized metal or aluminum components may be used.
7. Drums shall be non-metallic and have alternating reflectorized orange and reflectorized white horizontal, circumferential stripes 4 inches in width. There shall be at least two orange and at least two white stripes on each drum. If nonreflective spaces are left between the orange and white stripes, they shall be no more than 2 inches in width. All nonreflective portions of the drums shall be orange or white. Drums may be slightly conical in shape and may have one or more flat surfaces to minimize rolling when hit.
8. Frames for Type I and Type II Barricades shall be designed so as to provide a stable support and should be constructed of light weight steel or aluminum angles or tubing, wood, plastic, or rubber and have no rigid stay bracing for "A" frame designs. As Type III Barricades are only used at closures, they may be constructed of heavier materials than Type I or Type II Barricades. However, they should not have any vertical or sloping supports heavier than 4-inch by 4-inch lumber, 2-inch by 2-inch by 1/8-inch steel tubing, or 2-inch by 2-inch by 3/16-inch steel angles.
9. Barricade rails shall be no heavier than 1-inch thick lumber or plywood except for the "sawhorse" design Type I Barricade which may have a rail no heavier than 2-inch thick lumber. Other light weight weather resistant materials such as plastic, fiberglass or sheet aluminum may be used. Barricade rails may be sloping or vertical. Nominal lumber dimensions may be used to satisfy wooden barricade component dimensions.
10. The name and phone number only of an agency, contractor, or supplier may be shown on the nonreflective surface of the face part of a barricade. Such identification shall be in one colored nonreflective with letters not to exceed 1-inch in height.
11. When used, warning lights on barricades, drums, or vertical panels shall be mounted above the top of the device to the side on which traffic will pass and shall not obscure any reflectorized portion of the device.
12. Weights of concrete, stone, or brick will not be allowed and all weights used to stabilize barricades other than sandbags must be rigidly attached to the legs of the barricades as close to the ground as possible. No sandbags will be allowed on the top rail of barricades. Sandbags may be placed on barricade legs, over striped bottom rails not facing traffic, over unstriped bottom rails, or suspended from the barricade rail or frame in such a manner so that the bulk of the sand is at least 18 inches below the top of the barricade. Drums may be weighted internally with just enough sand, water, or other material to provide stability.
13. Cones shall be constructed of durable material able to withstand abuse by vehicular traffic. Minimum weights shall be 4 pounds for 18 inch, 7 pounds for 28 inch, and 10 pounds for 36 inch cones with a minimum of 80 percent of the total weight in the base. On fully access-controlled facilities, cones shall be a minimum of 28 inches in height. Reflectorized cones shall only be used as specified on the plans or as approved by the Engineer. When used, reflectorized cones shall be a minimum 28 inches in height and shall have two reflective bands; one a minimum of six inches wide placed three inches from the top of the cone and the other a minimum of four inches wide placed two inches below the six inch band.
14. Vertical panels may be either post mounted, frame supported or attached to the top of a barrier. Post mounted vertical panels shall be firmly attached to light weight wood or metal posts with the top a minimum height of 48 inches above the pavement surface. Frame supported vertical panels shall conform to General Notes 8, 9, 10 and 12 of this Standard and shall only be used where normal speeds are 40 MPH or less with the top a minimum height of 35 inches above the pavement surface.

**TYPE III BARRICADES**

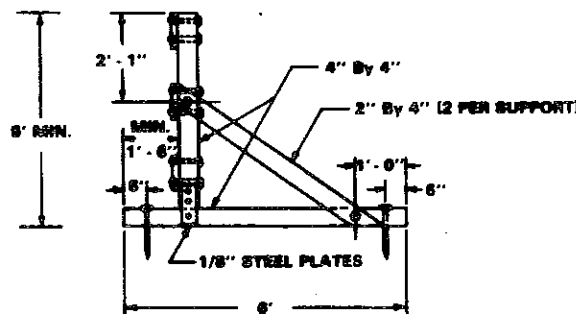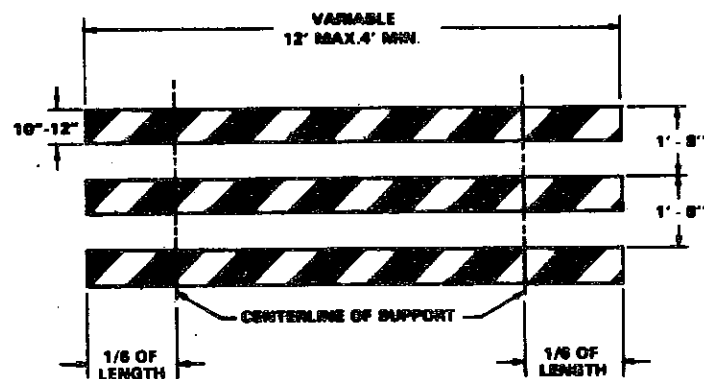


TYPICAL WOOD SUPPORT

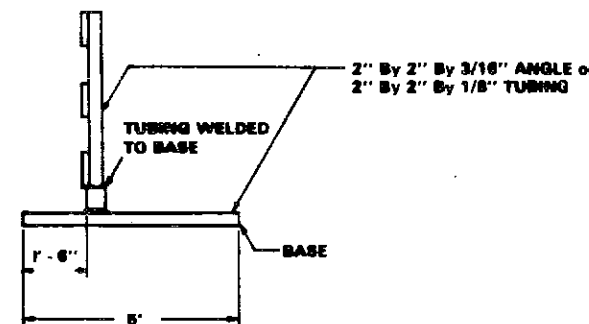


TYPICAL STEEL SUPPORT


**HIGH LEVEL WARNING DEVICE**

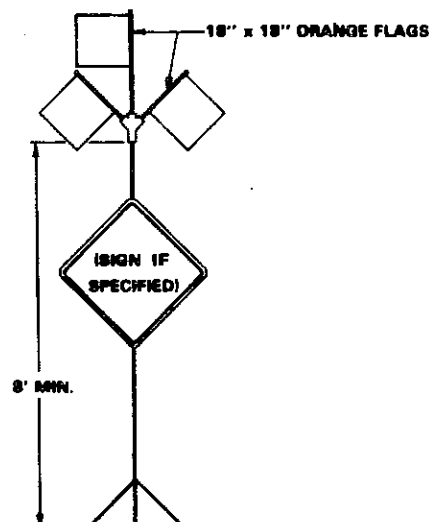


**DRUMS**

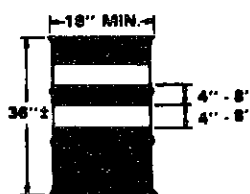

**CONES**

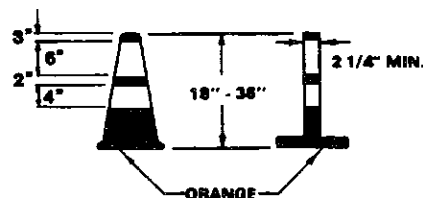


**VERTICAL PANELS**

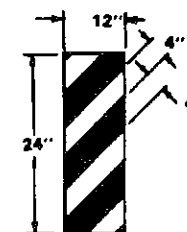


SEE NOTE 14 FOR SUPPORT OR MOUNTING REQUIREMENTS

Illinois Department of Transportation  
 Approved: 2/4/82  
 R.W. Jones  
 Engineer of Traffic


**DESIGN OF TRAFFIC CONTROL DEVICES FOR  
 HIGHWAY CONSTRUCTION AND CONTRACT MAINTENANCE**  
**STANDARD 2299-13**

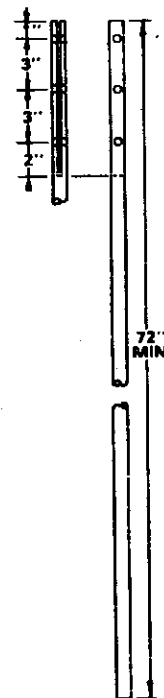

STAFF

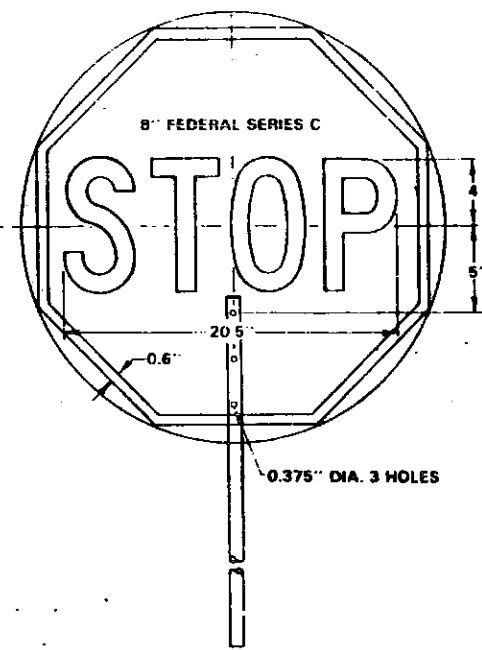

FRONT SIDE

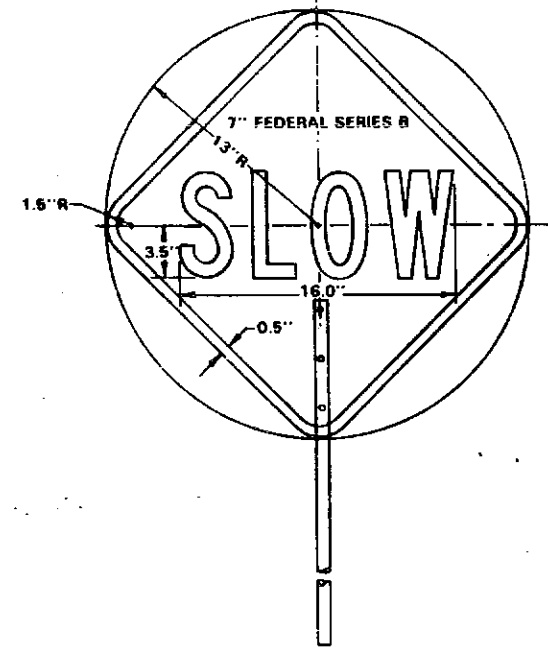

REVERSE SIDE

GENERAL NOTES


1. The "STOP" face shall consist of white letters and border on a red reflectorized background.
2. The "SLOW" face shall consist of black letters and border on an orange reflectorized background.
3. Areas outside sign borders shall be light blue or black.
4. The sign blank may be octagonal in shape in lieu of circular.
5. The portion of the staff within the sign face shall match the sign colors.
6. All colors and letters shall meet applicable federal standards.
7. The staff shall consist of two sections joined by a coupling located 60 in. from the bottom of the staff. Alternate designs may be used when approved by the Engineer. All materials shall be substantial and durable.
8. This sign shall be furnished by the contractor and shall be used by the flagger in lieu of flags or other signaling devices. The cost of furnishing and maintaining the sign shall be considered incidental to the contract and no additional compensation will be allowed.

Illinois Department of Transportation  
 Approved October 21, 1983  
*[Signature]*  
 Engineer of Traffic


FLAGGER TRAFFIC CONTROL SIGN  
 STANDARD 2300-3

F-6-03C


A. FOR ANY OPERATION THAT ENCKOACHES IN THE AREA BETWEEN THE CENTER LINE AND A LINE 2 FT. OUTSIDE THE EDGE OF THE PAVEMENT FOR A PERIOD OF LESS THAN 15 MINUTES.

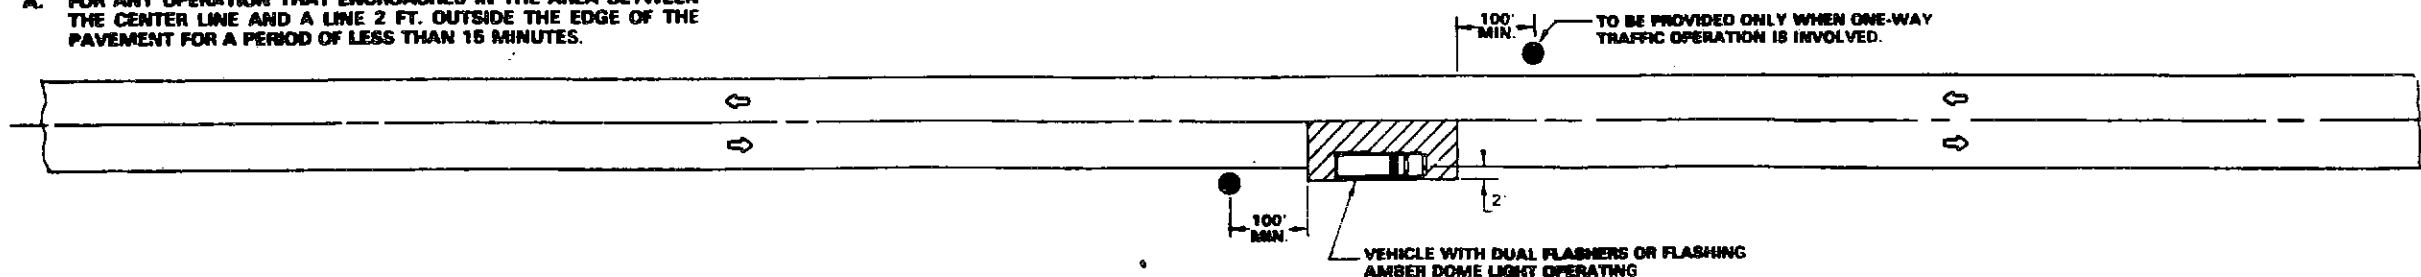

B. FOR ANY OPERATION THAT ENCKOACHES IN THE AREA BETWEEN THE CENTER LINE AND A LINE 2 FT. OUTSIDE THE EDGE OF THE PAVEMENT FOR A PERIOD IN EXCESS OF 15 MINUTES BUT LESS THAN 60 MINUTES.

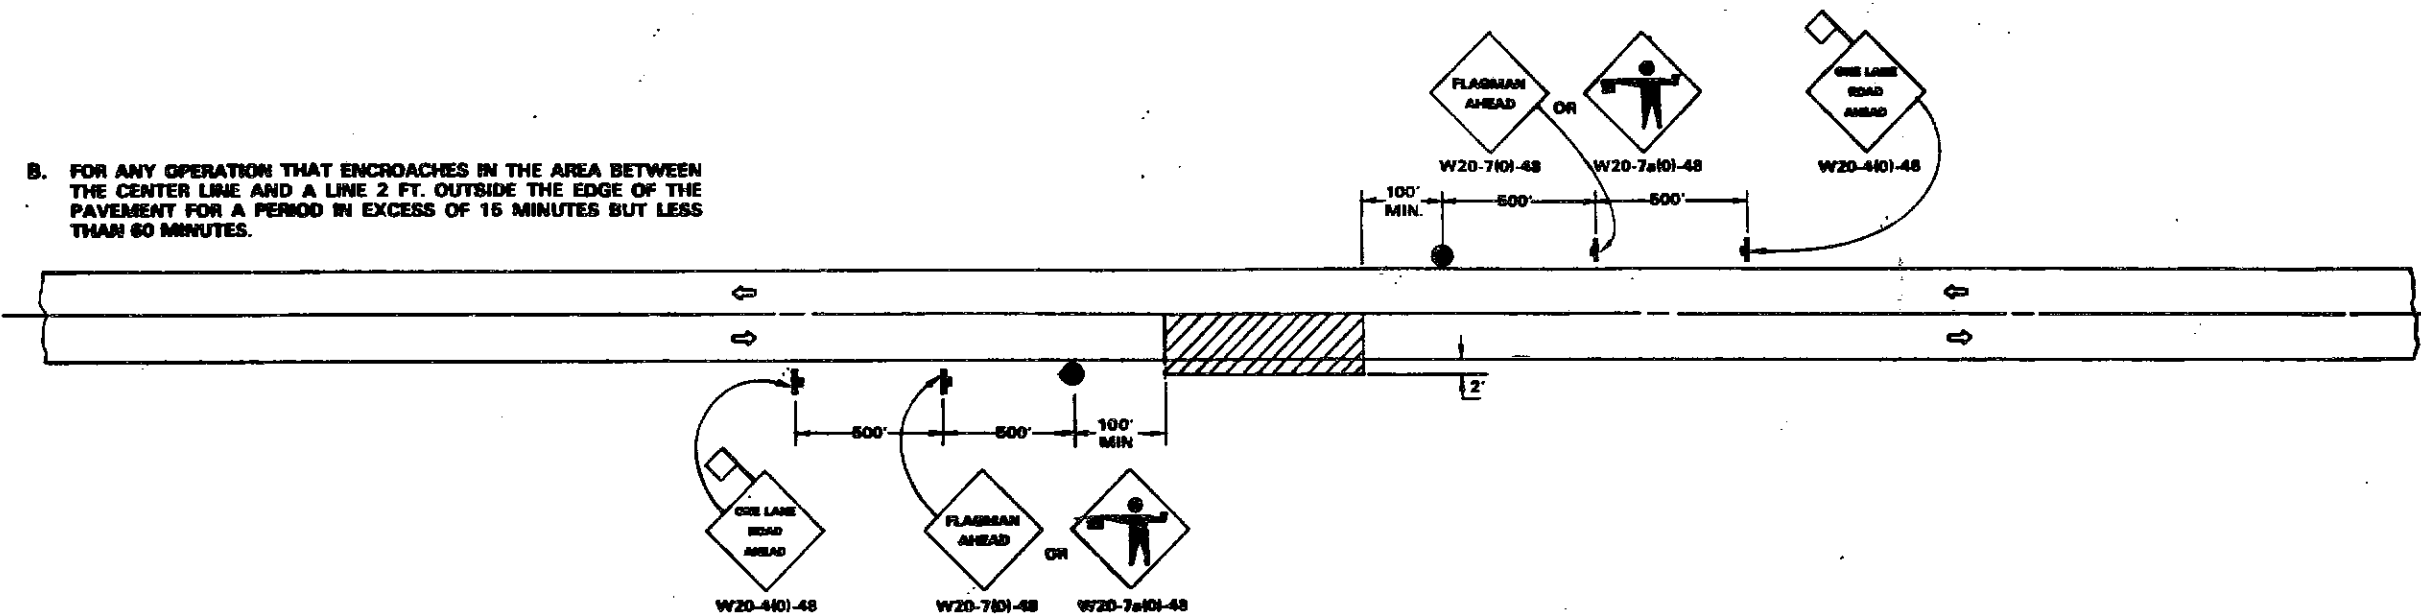

C. FOR ANY OPERATION THAT IS MORE THAN 2 FT. OUTSIDE THE EDGE OF THE PAVEMENT FOR A PERIOD OF LESS THAN 60 MINUTES.

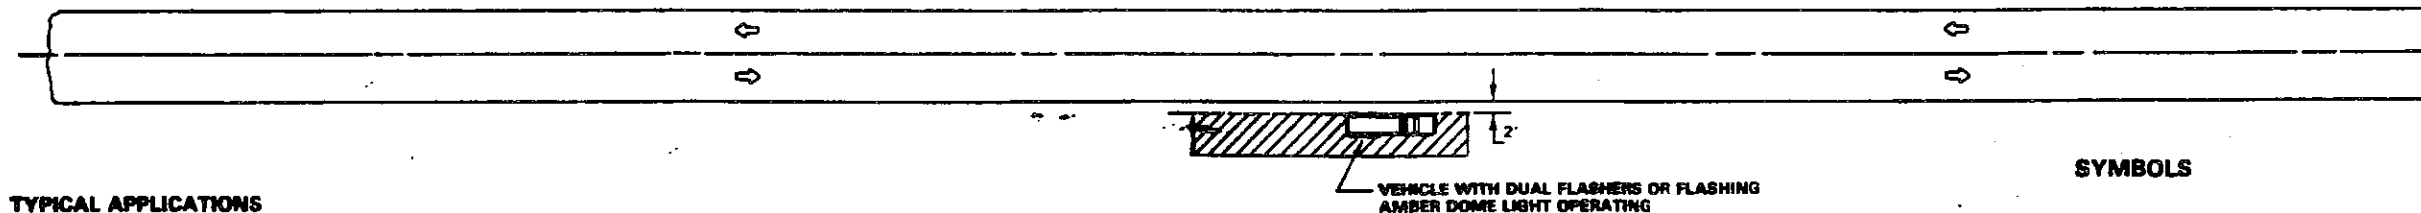

**TYPICAL APPLICATIONS**

- Marking Patches
- Field Survey
- String Line
- Utility Operation
- Cleaning Up Debris on Pavement

**GENERAL NOTES**

1. Construction operations shall be confined to one traffic lane. On two-lane roads, at least 500 ft. of both traffic lanes shall be available for traffic movement at intervals not greater than 1,000 ft. and a complete traffic control plan must be approved for any project expected to exceed 1,000 ft. in length.
2. The flaggers shall be in sight of each other or in direct communication at all times.
3. All signs are to be removed at completion of each operation.
4. For multilane roadways the flagger shown for traffic approaching from the opposite direction will be positioned as directed by the Engineer, the advance warning signs for traffic approaching from the opposite direction omitted, and the ONE LANE ROAD AHEAD sign changed to RIGHT (LEFT) LANE CLOSED AHEAD.
5. Longitudinal dimensions may be adjusted to fit field conditions. The lateral placement of the flaggers may be varied from that shown.

**SYMBOLS**

- Work Area
- 18 in. X 18 in. (minimum) Orange Flag
- Sign on Portable or Permanent Support
- Flagger with Traffic Control Sign


Illinois Department of Transportation  
 Approved October 21, 1983  
 [Signature]  
 Engineer of Traffic

**TYPICAL APPLICATION OF TRAFFIC CONTROL DEVICES  
 HIGHWAY CONSTRUCTION AND CONTRACT MAINTENANCE**  
 SHORT-TIME OPERATIONS  
 DAY OR NIGHT OPERATIONS  
**STANDARD 2307-6**


E-6 12D



**DETAIL A**

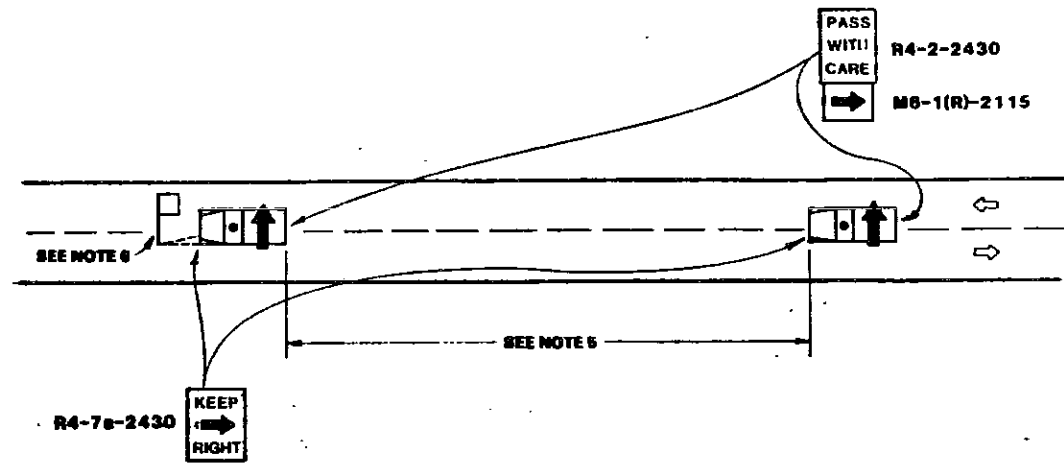

**DETAIL B**

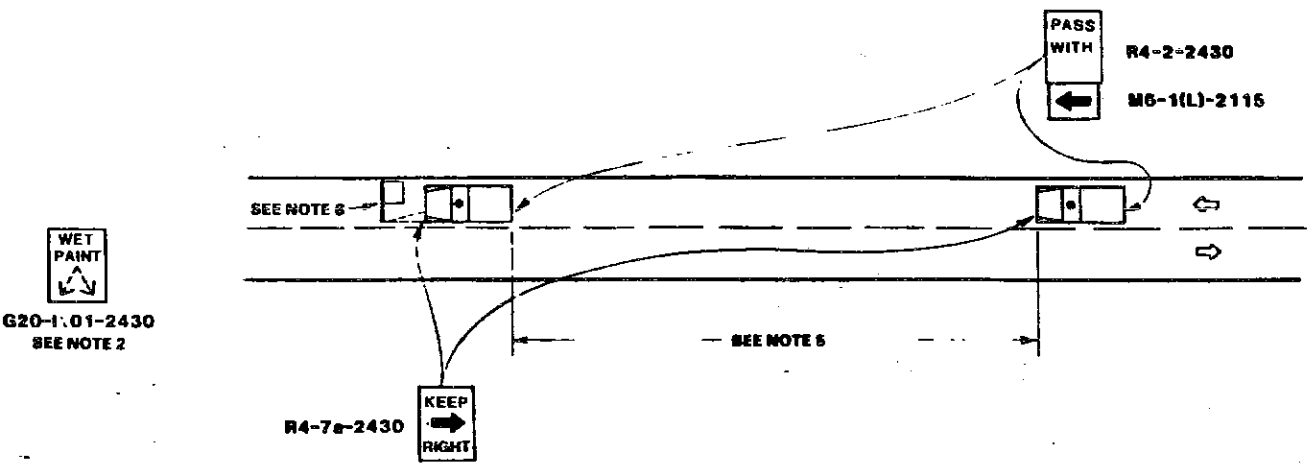


**GENERAL NOTES**

1. For shoulder operations not encroaching on the pavement, use DETAIL A, Sheet 2.
2. During pavement marking operations, WET PAINT signs with appropriate arrow(s) shall be mounted on the back of the striper and following vehicle where necessary to reduce tracking.
3. In areas where the shoulder is inadequate for motorists to pass the convoy, the arrow boards shall be changed from the flashing arrow mode to a flashing hazard mode. In no case shall the arrow boards be visible to traffic approaching the front of the convoy in the open lane. Arrow boards shall never flash to indicate passing on the left on a two-lane, two-way roadway.
4. All vehicles shall have headlights and emergency flashers operating and shall display an amber colored oscillating, rotating or flashing light(s). At least one amber light is to be visible from any direction.
5. Trailing vehicles shall be at least 200 feet behind the lead vehicles with the distance varying depending upon the terrain and susceptibility of any pavement marking to wheel tracking.
6. If a guide wheel is used in pavement marking operations, it shall be equipped with a flag as shown.

**TYPICAL APPLICATIONS**

- Landscaping work
- Utility work
- Pavement marking
- Weed spraying
- Rodometer measurements
- Debris clean-up
- Crack pouring

**SYMBOLS**

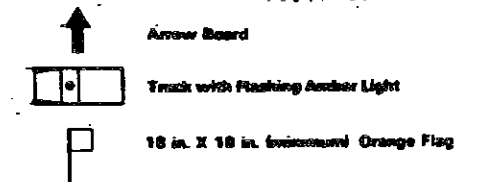


**TYPICAL APPLICATION OF TRAFFIC CONTROL DEVICES  
HIGHWAY CONSTRUCTION AND CONTRACT MAINTENANCE**

**RURAL, DAY OR NIGHT MOVING OPERATIONS**

Where, at any time, any vehicle, equipment, workers or their activities will require a continuous or intermittent moving operation where the average speed of movement is greater than 1 MPH.

SHEET 1 OF 2  
**STANDARD 2308-5**

Illinois Department of Transportation  
Approved: 7 JUNE 1988  
*A. W. Jones*  
Engineer of Traffic  
Issued 7/10/88

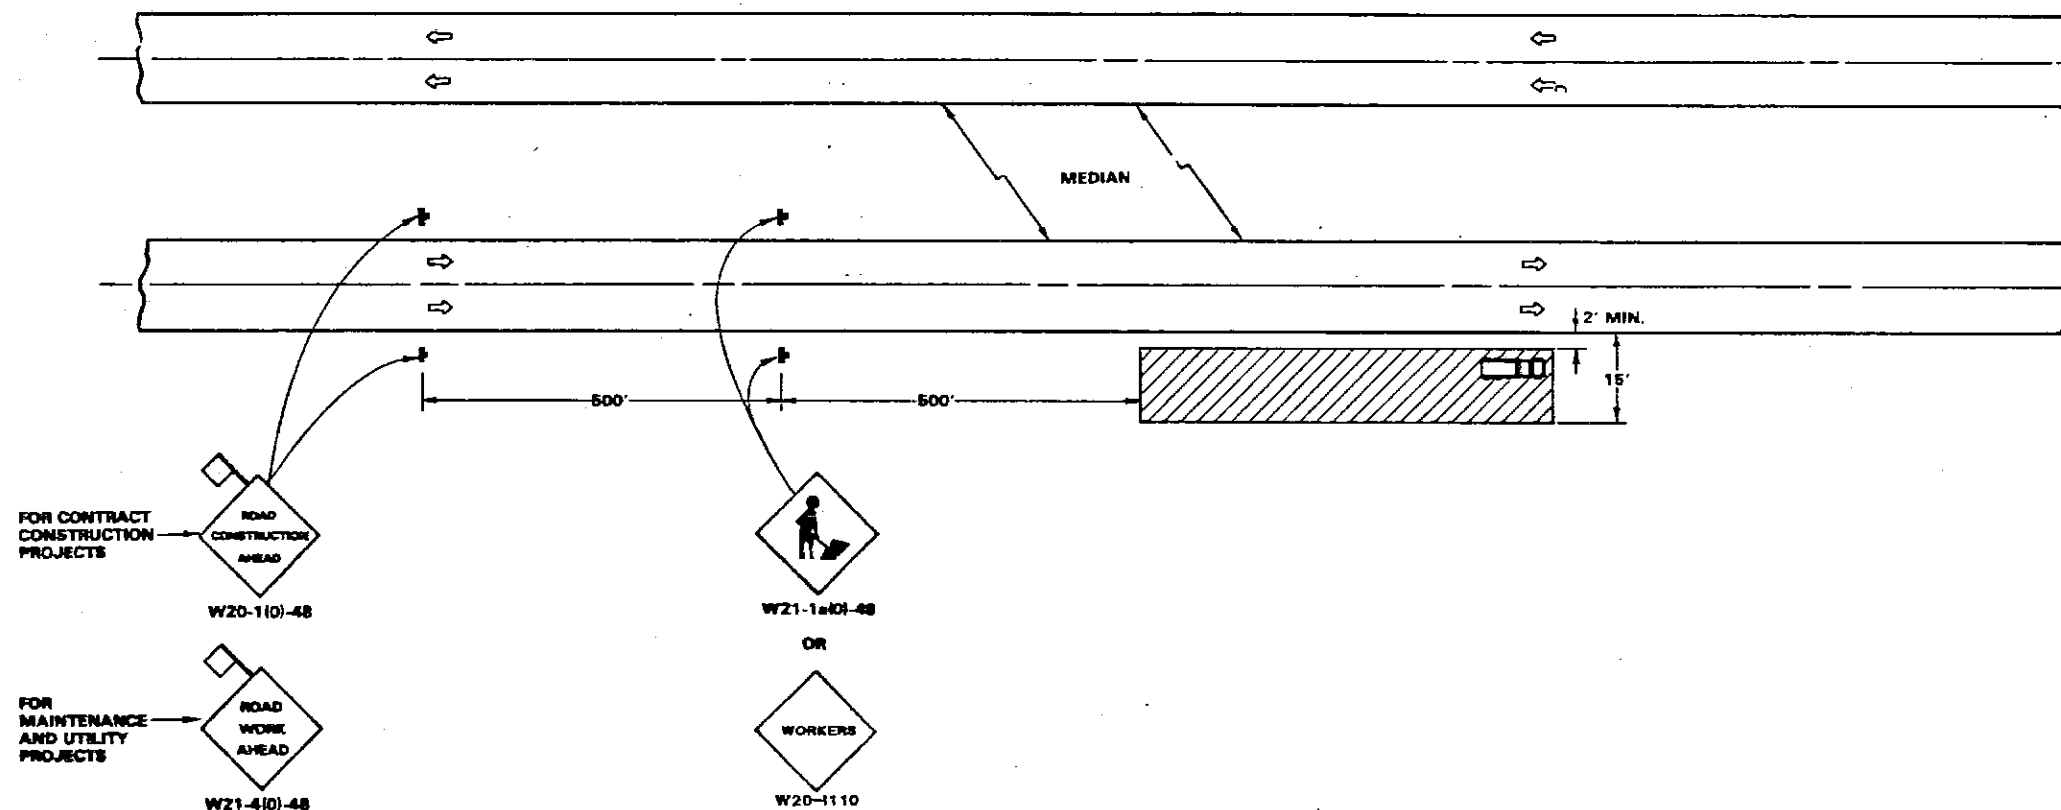

**TYPICAL APPLICATIONS**

- Utility Operations
- Culvert Extensions
- Side Slope Changes
- Guard Rail Installation and Maintenance
- Delineator Installation
- Landscaping Operations
- Sign Installation and Maintenance
- Shoulder Repair

**GENERAL NOTES**

1. If the work operation does not exceed 60 minutes, traffic control may be in conformance with STANDARD 2307.
2. Worker signs are to be removed when no work is being performed. Any unattended obstacle or excavation in the work area which in the opinion of the Engineer constitutes a hazard shall be protected by barricades at 50 ft. centers, with flashing lights at night. If the hazard exceeds 100 ft. in length, steady burning lights shall be substituted for flashing lights. When the distance is greater than 250 ft., barricade spacing may be increased to 100 ft.
3. If the work operation requires that four or more work vehicles enter through traffic lanes in a one hour period, a flagger shall be provided and a Flagger sign shall be substituted for the Worker sign.
4. Signs mounted in the median may be omitted when the median is less than 10 feet wide.
5. This standard also applies when work is being performed on a multilane undivided highway. Under these conditions the signs normally mounted in the median shall be omitted.
6. Longitudinal dimensions may be adjusted to fit field conditions.

**SYMBOLS**

- Work Area
- 18 in. X 18 in. (minimum) Orange Flag
- Sign on Portable or Permanent Support

**TYPICAL APPLICATION OF TRAFFIC CONTROL DEVICES  
HIGHWAY CONSTRUCTION AND CONTRACT MAINTENANCE**

MULTILANE, DIVIDED AND UNDIVIDED,  
RURAL DAY OR NIGHT OPERATIONS.

Where at any time, any vehicle, equipment,  
workers or their activities will encroach in the  
area closer than 15 ft. but not closer than 2 ft.  
to the edge of pavement.


**STANDARD 2314-6**

Illinois Department of Transportation

Approved: 2/14/82

*W. Jones*  
Engineer of Traffic

STANDARD 2314-6

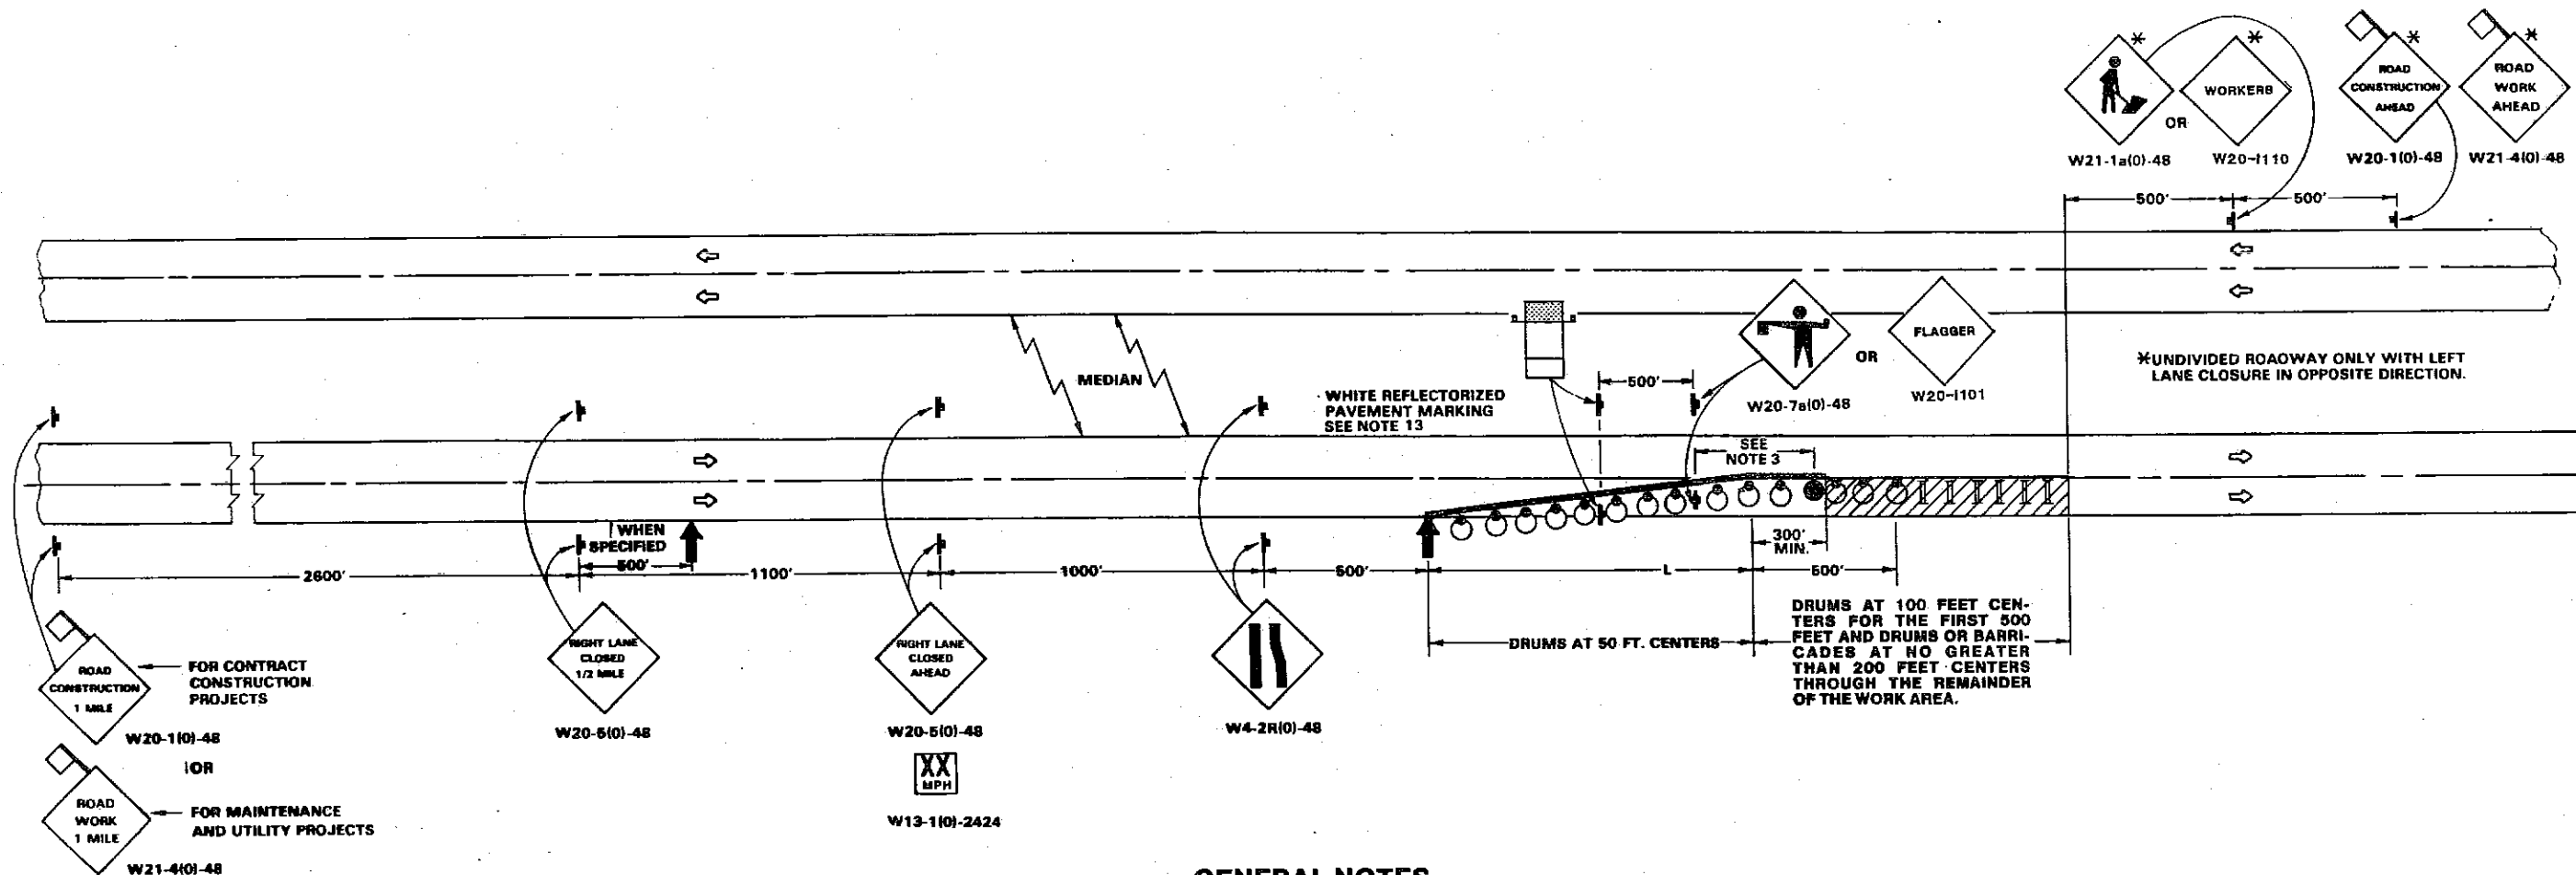

**GENERAL NOTES**

- The "L" distance equals the lane width times the taper ratio.
- When no work is being performed, the flagger will not be required. If the flagger is not present, the Flagger and Worker signs shall be removed or covered.
- The Construction Speed Limit sign and the Flagger sign shall be moved as necessary to maintain a spacing of 500 feet to 1.5 miles between the flagger and the Flagger sign.
- This standard also applies when work is being performed in the left lane. Under these conditions, LEFT LANE CLOSED signs shall be substituted for RIGHT LANE CLOSED signs. On undivided highways, signs shall be added in the opposite direction as shown. On left lane closures with narrow medians, the arrow board at the beginning of the lane closure shall be relocated behind the taper as necessary so that a clearance of at least 4 ft. can be maintained from the opposing traffic.
- The speed limit to be shown on the Construction Speed Limit signs and Advisory Speed plates shall be 10 miles per hour less than the normal posted speed limit or 45 MPH, whichever is less. The signs shall not be used where the normal posted speed limit is below 45 miles per hour.
- The flashing lights on the Construction Speed Limit signs shall be activated only when workers are present in a lane adjacent to one open to traffic. At all other times, the flashing lights shall be turned off and the signs may be removed.
- Median signs may be omitted when the median is less than 10 feet wide.
- This standard does not apply when work is being performed in the middle lane(s) of a six or more lane highway. Special plans approved by the Engineer will be required.
- Cones may be substituted for barricades or drums at half the spacing during day operations. On fully access-controlled facilities, cones shall be a minimum of 28 in. in height.
- Steady burning lights will not be required on drums for day operations. All drum lights shall be monodirectional.
- All signs shall be post-mounted if the closure time exceeds four days.
- Flashing lights shall be used on each approach in advance of the work area during hours of darkness and installed above the first two signs in each series.
- ReflectORIZED temporary pavement marking tape shall be placed throughout the taper and for 300 feet along-side the work area where the closure time is greater than fourteen days. The edge line shall be yellow for left lane closures. Raised reflectORIZED pavement markers at 25 ft. centers may be used to supplement the pavement marking tape.
- Longitudinal dimensions may be adjusted to fit field conditions. The lateral placement of the flagger may be varied from that shown. The flagger shown at the beginning of the work area shall be stationed approximately 200 feet in advance of the work party.
- At all times when workers are present, a flagger shall be positioned in advance of the first work operation as shown. (See Note 2) An additional flagger, as required by Paragraph 10 of Article 107.14 of the Standard Specifications, shall be positioned in advance of each separate activity of the operation that requires frequent encroachment into a lane open to traffic.
- Form BT 725 is required.

Normal Posted Speed m.p.h.	Taper Ratio ft./ft.
85	85/1
80	80/1
55	55/1
50	50/1
45 or less	45/1

**SYMBOLS**

- Construction Speed Limit Sign
- Work Area
- Arrow Board
- Sign on Portable or Permanent Support
- Flagger with Traffic Control Sign (Note 15)
- Barricade or Drum
- Drum with Steady Burning Light
- 18 in. X 18 in. (minimum) Orange Flag

**TYPICAL APPLICATION OF TRAFFIC CONTROL DEVICES  
HIGHWAY CONSTRUCTION AND CONTRACT MAINTENANCE**  
MULTILANE, DIVIDED AND UNDIVIDED, RURAL  
OPERATIONS EXCEEDING ONE DAYLIGHT OPERATION



Where, at any time, any vehicle, equipment, workers or their activities will encroach on any portion of the lane immediately adjacent to the shoulder or on the shoulder within 2 feet of the edge of pavement.

**STANDARD 2316-13**

Illinois Department of Transportation  
Approved 2/4/92  
*R. Jones*  
Engineer of Traffic

F-6211



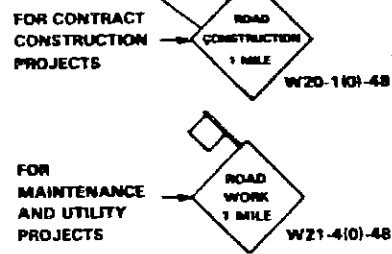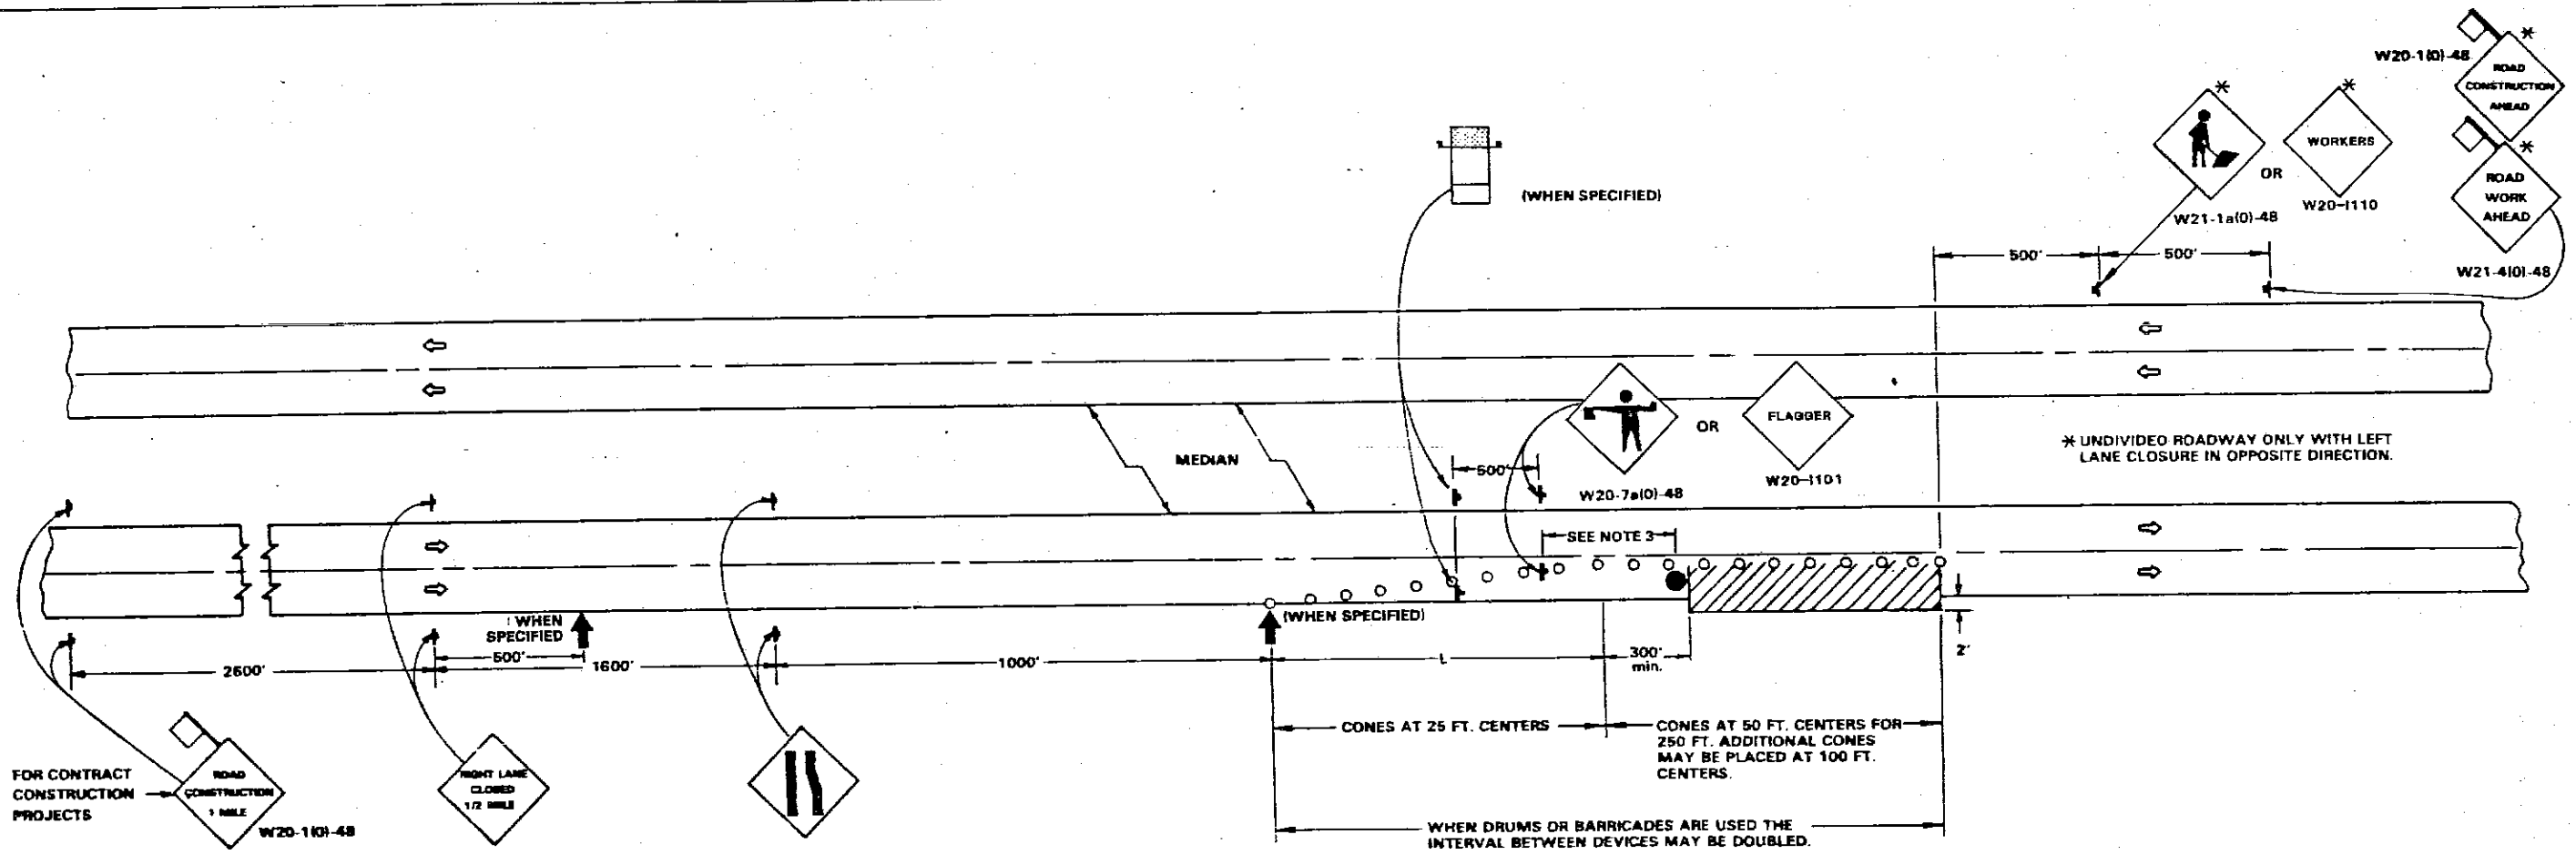


**GENERAL NOTES**

- The "L" distance equals the lane width times the taper ratio.
- When no work is being performed, the flagger will not be required. If the flagger is not present, the Flagger and Worker signs shall be removed or covered.
- The Construction Speed Limit signs (when specified) and the Flagger signs shall be moved as necessary to maintain a spacing of 500 feet to 1.5 miles between the Flagger and Flagger signs.
- This standard also applies when work is being performed in the left lane. Under these conditions, LEFT LANE CLOSED signs shall be substituted for RIGHT LANE CLOSED signs. On undivided highways, signs shall be added in the opposite direction as shown and cones shall be placed along the center line throughout the taper and work area. On left lane closures with narrow medians, the arrow board at the beginning of the lane closure (when specified) shall be relocated behind the taper as necessary so that a clearance of at least 4 ft. can be maintained from the opposing traffic.
- The speed limit to be shown on the Construction Speed Limit signs and Advisory Speed plates shall be 10 miles per hour less than the normal posted speed limit or 45 MPH, whichever is less. The signs shall not be used where the normal posted speed limit is below 45 miles per hour.
- The flashing lights on the Construction Speed Limit signs shall be activated only when workers are present in a lane adjacent to one open to traffic. At all other times, the flashing lights shall be turned off and the signs may be removed.
- All signs, cones, barricades and drums are to be removed at completion of the day's operations and the work area opened to traffic.
- Median signs may be omitted when the median is less than 10 feet wide.
- This standard does not apply when work is being performed in the middle lane(s) of a six or more lane highway. Special plans approved by the Engineer will be required.
- On fully access-controlled facilities, cones shall be a minimum of 28 in. in height.
- Longitudinal dimensions may be adjusted to fit field conditions. The lateral placement of the flagger may be varied from that shown. The flagger shown at the beginning of the work area shall be stationed approximately 200 feet in advance of the work party.
- At all times when workers are present, a flagger shall be positioned in advance of the first work operation as shown. (See Note 2) An additional flagger, as required by Paragraph 10 of Article 107.14 of the Standard Specifications, shall be positioned in advance of each separate activity of the operation that requires frequent encroachment into a lane open to traffic.
- Form BT 725 may be required.

Normal Posted Speed m.p.h.	Taper Ratio ft./ft.
65	65/1
60	60/1
55	55/1
50	50/1
45 or less	45/1

**SYMBOLS**

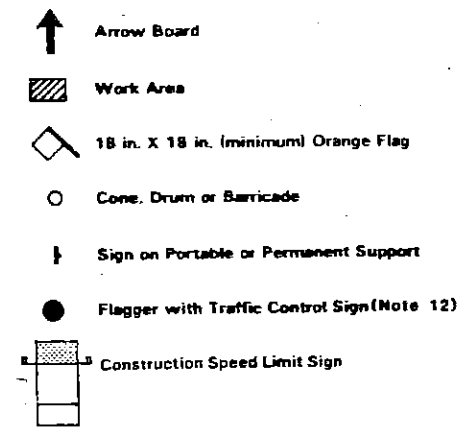

**TYPICAL APPLICATIONS**

- Pavement Patch
- Utility Operations
- Bituminous Resurfacing

**TYPICAL APPLICATION OF TRAFFIC CONTROL DEVICES  
HIGHWAY CONSTRUCTION AND CONTRACT MAINTENANCE**


MULTILANE, DIVIDED AND UNDIVIDED,  
RURAL DAY OPERATIONS ONLY

Where, at any time, any vehicle, equipment, workers or their activities will encroach on any portion of the lane immediately adjacent to the shoulder or on the shoulder within 2 ft. of the edge of pavement.


**STANDARD 2315-8**

Illinois Department of Transportation  
 Approved: 2/4/82  
 [Signature] Engineer of Traffic

1020

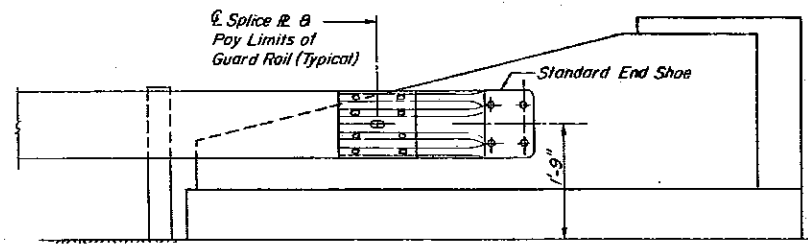


ELEVATION

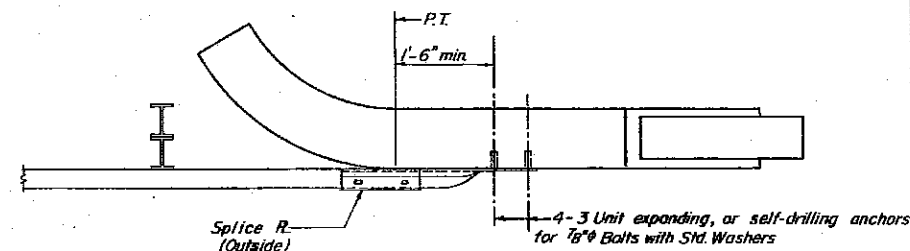


PLAN

CURVED WING

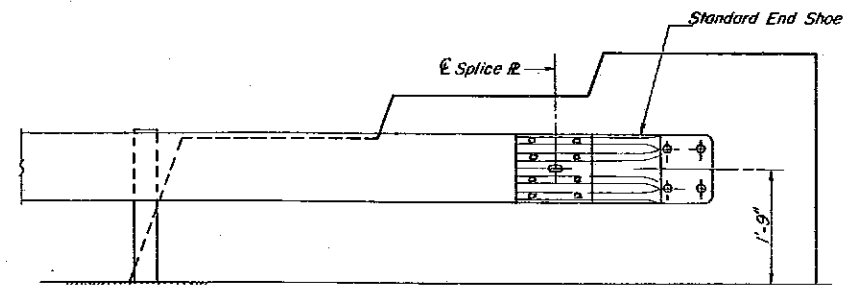


ELEVATION

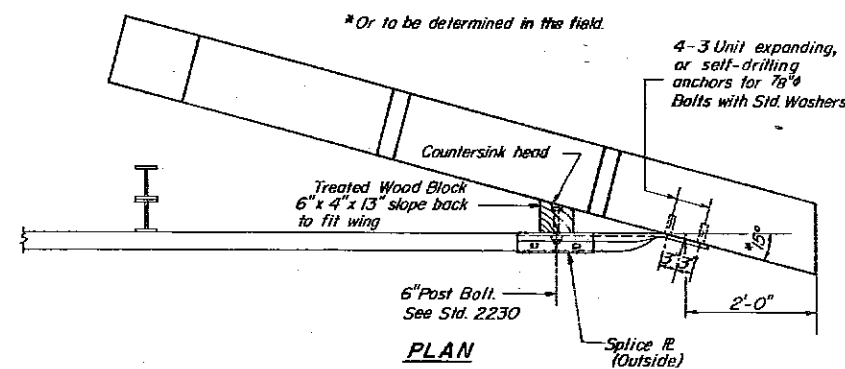


PLAN

FLARED WING

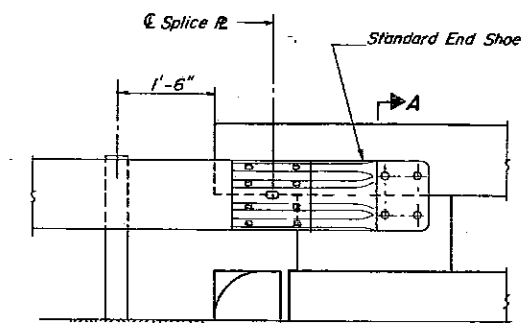


ELEVATION

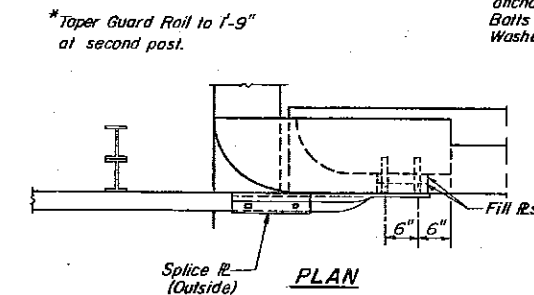


PLAN


R.C. HANDRAIL

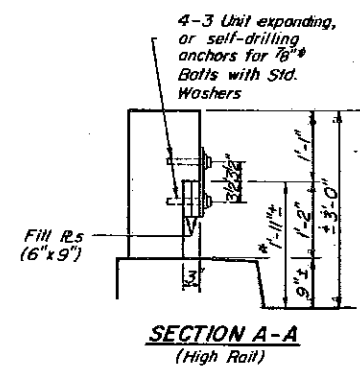


SECTION A-A  
(High Rail)

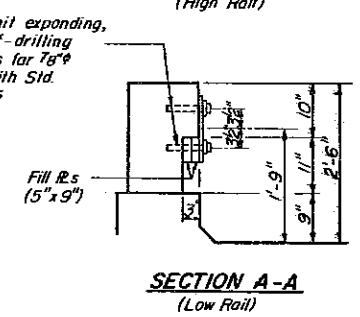

SECTION A-A  
(Low Rail)

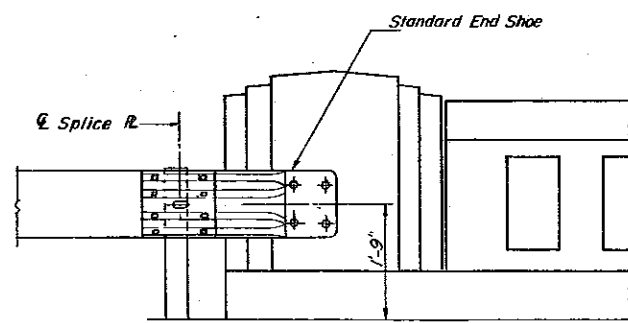

ELEVATION

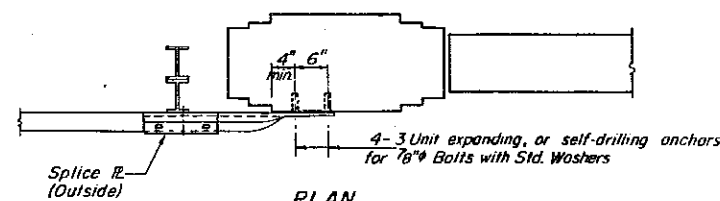

PLAN

CONCRETE HANDRAIL

NOTES

For details of guardrail not shown see Standard 2230.

The Standard End Shoe shall be attached to the existing concrete with Pre-drilled or Self-drilling anchor bolts. The anchor cone shall be set flush with the surface of the concrete. Externally threaded studs protruding from the surface of the concrete will not be permitted.

The Standard End Shoe shall be placed between the splice plate and the rail element.

The minimum edge distance (distance from any anchor to edge of existing concrete) shall be six (6) inches unless otherwise shown.

If the existing name plate is covered completely or partially by the end shoe, the name plate shall be moved to an adjacent area along the rail or end post. The cost of moving the name plate shall be included in the cost of TRAFFIC BARRIER TERMINAL, TYPE 10.

Pay limits of guardrail shall be at center of end shoe splice.

The cost of the Standard End Shoes, Splice Plate, any required blocks and plates, and all fasteners shall be included in the cost of TRAFFIC BARRIER TERMINAL, TYPE 10 (One Each).

When a bridge expansion joint exists between the End Shoe and the first post, all splice bolts at the End Shoe shall be fitted with a locknut or double nuts tightened only to a point that will allow guardrail movement.


PASSED	AUG 31 1979
APPROVED	AUG 31 1979
ISSUED 9-25-70	

TRAFFIC BARRIER TERMINAL  
TYPE 10  
STANDARD 2326-3


Full Size

F-3-216


OFFSETS TO FACE OF RAIL (Feet)				
Post	X	TYPE 1A		
		Y (4')	Y (3')	Y (2')
①	37.22	4.00	3.00	2.00
②	31.09	2.79	2.09	1.40
③	24.92	1.79	1.34	0.90
④	20.79	1.25	0.94	0.62
⑤	16.64	0.80	0.60	0.40
⑥	12.49	0.45	0.34	0.23
⑦	6.25	0.11	0.08	0.06
⑧	0.00	0.00	0.00	0.00

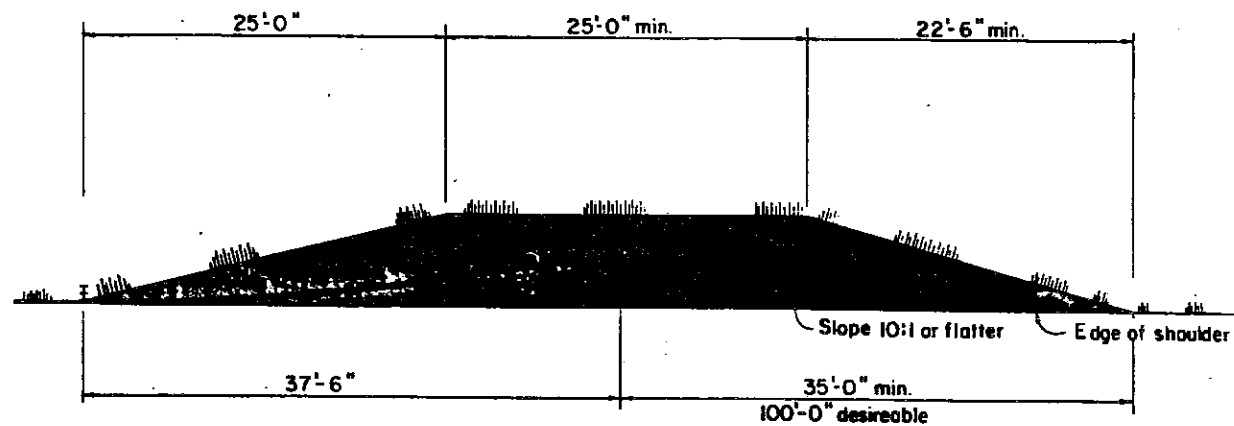


SHOULDER WIDENING TRANSITION

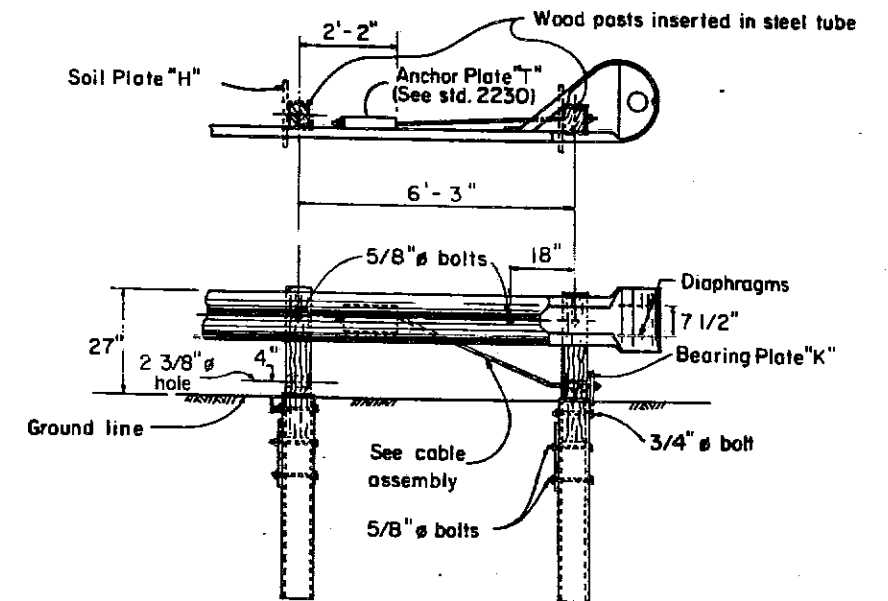

WOOD BREAKAWAY POSTS  
TUBULAR STEEL FOUNDATIONS

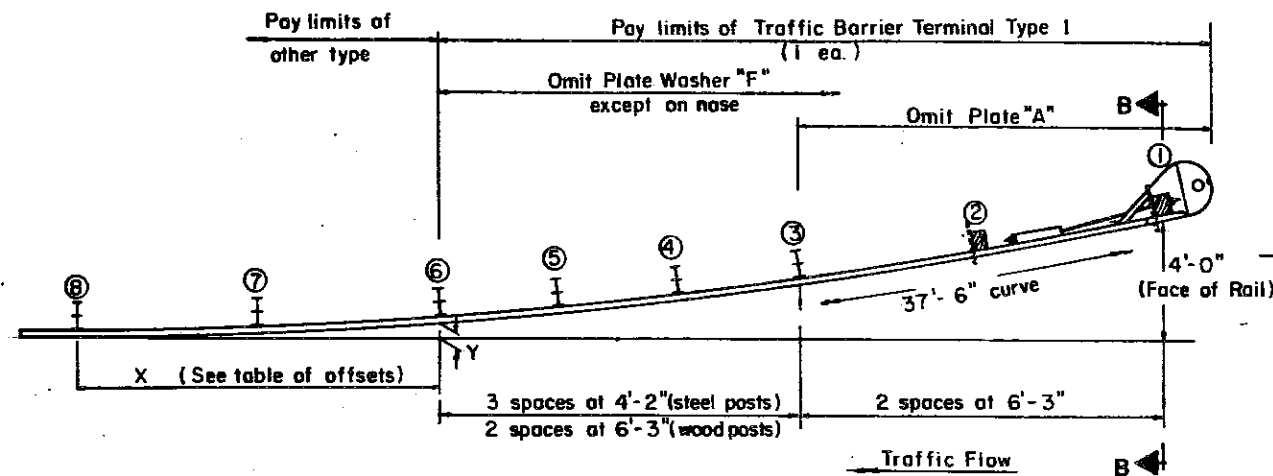


PLAN TYPE 1

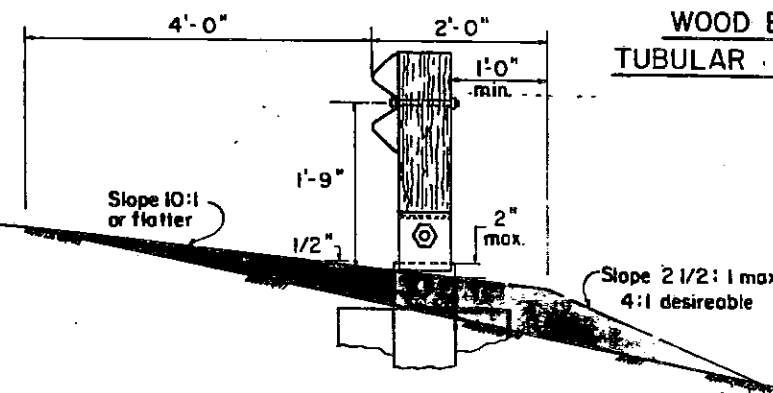


SECTION B-B

\* If fill height exceeds 5'-0", use 3:1 max.

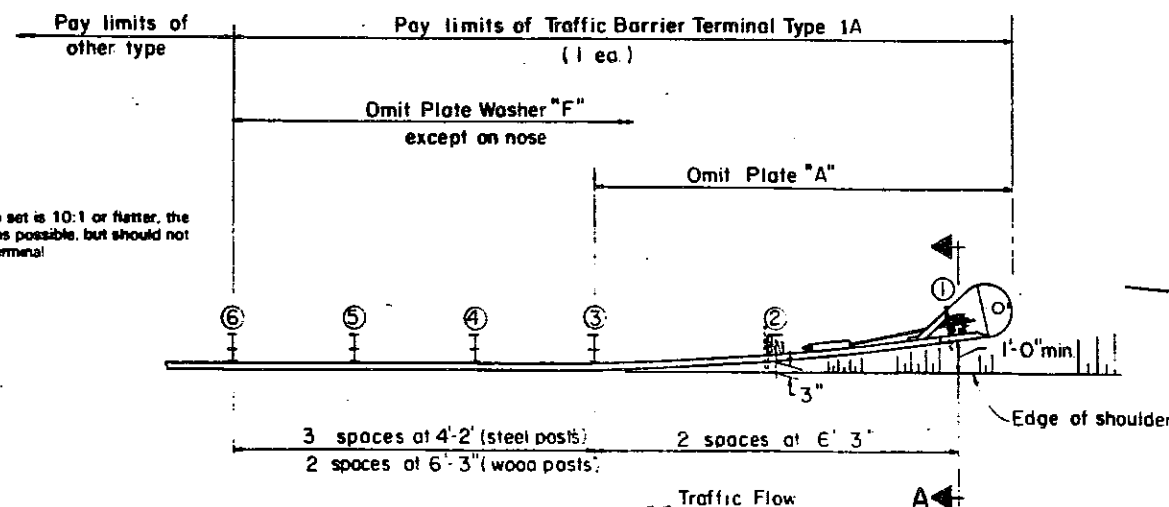

PLAN TYPE 1A

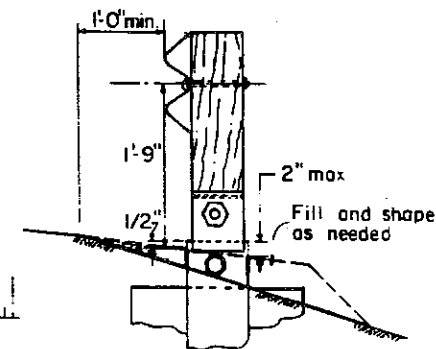

SECTION A-A

GENERAL NOTES

- See Standard 2230 for details of guard rail not shown.
- All steel parts shall be galvanized after fabrication.
- Posts at locations 1 & 2 shall be wood breakaway posts. Posts other than 1 & 2 may be either standard wood posts or steel posts, at the option of the Contractor. If standard wood posts are used, one post shall be located midway between and in lieu of posts 4 & 5. For Terminal Type 1, the offset (Y) for this post shall be 1.00 foot.
- The wood breakaway posts shall be treated and conform to the requirements of Art. 711.06 of the Standard Specifications
- A two-piece assembly may be substituted for the one-piece nose shown above
- Hollow structural tubing shall conform to the requirements of ASTM A-500 grade B or A-501.
- The Bearing Plate "K" shall be held in position by (2) two eightpenny nails driven into the post and bent over the top of the plate

NOTE

If the surface upon which the barrier is to be set is 10:1 or flatter, the Type 1A Terminal should be flared as much as possible, but should not exceed the offsets provided for the Type 1 Terminal

Missouri Department of Transportation









PASSED... 30... 1987

APPROVED... 30... 1987

Engineer of Design

TRAFFIC BARRIER  
TERMINAL TYPE 1 & 1A  
(Sheet 1 of 2)  
STANDARD 2336-4



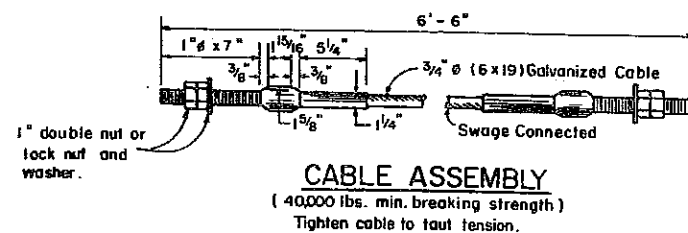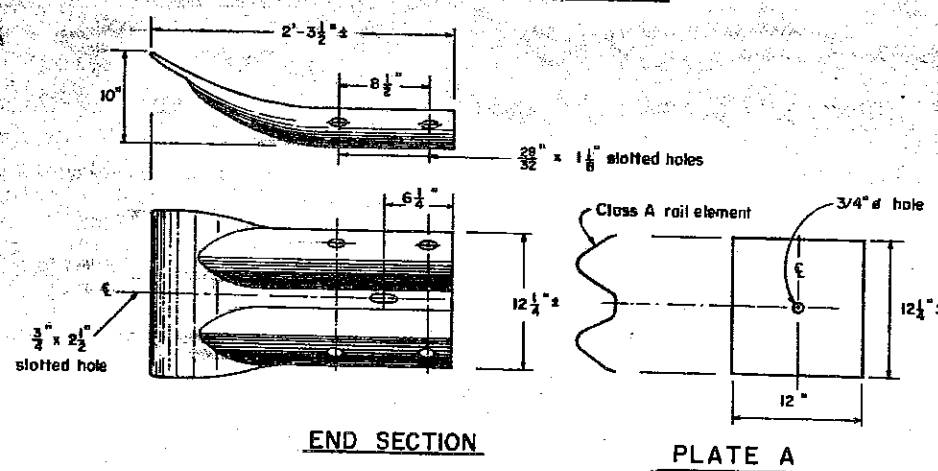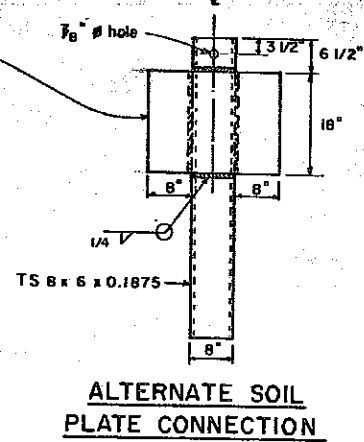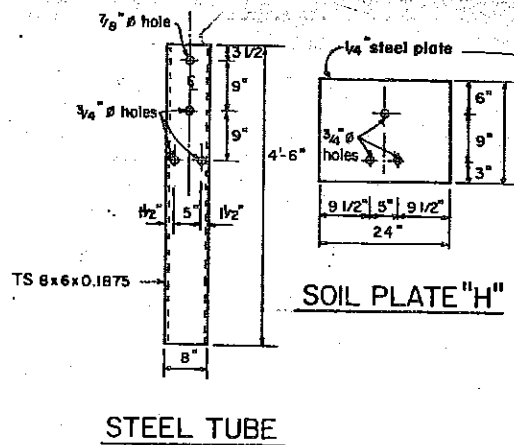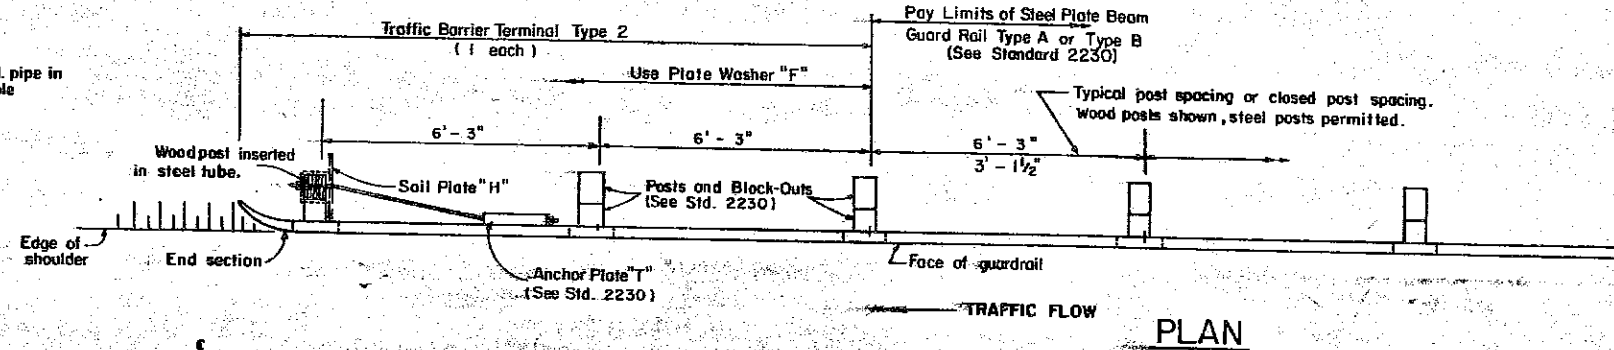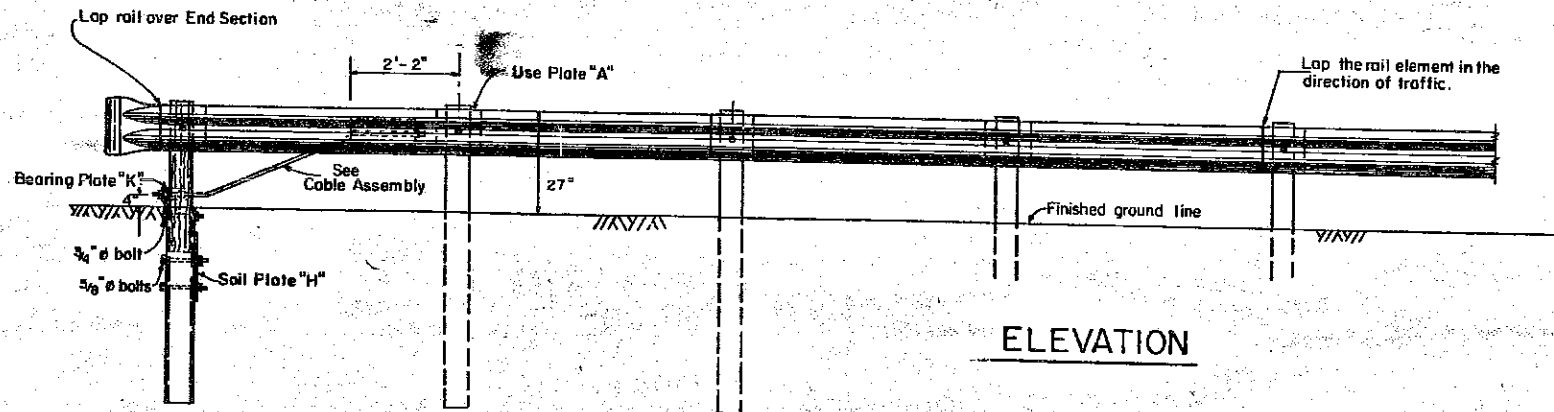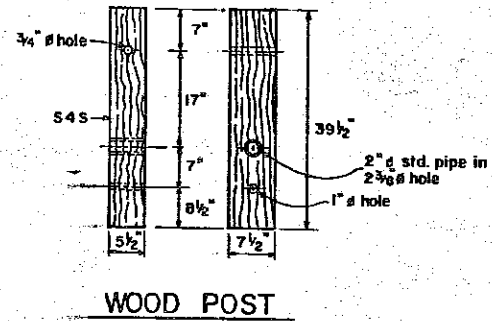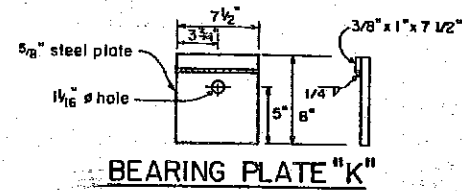

**NOTES:**





See Standard 2230 for details of Guardrail not shown.  
The wood posts shall be treated and conform to the requirements of Article 711.06 of the Standard Specifications.  
All steel parts shall be galvanized after fabrication.  
Use Plate Washer "T" at all posts (See Std. 2230).

Illinois Department of Transportation  
PASSED Feb 3 1981  
Engineer of Design Operations  
APPROVED Feb 3 1981  
Engineer of Design

ISSUED 8-1-77










**TRAFFIC BARRIER  
TERMINAL TYPE 2  
STANDARD 2337-2**  
Full Size

F-326 b

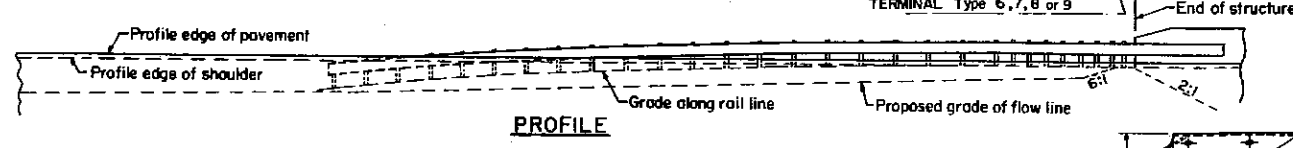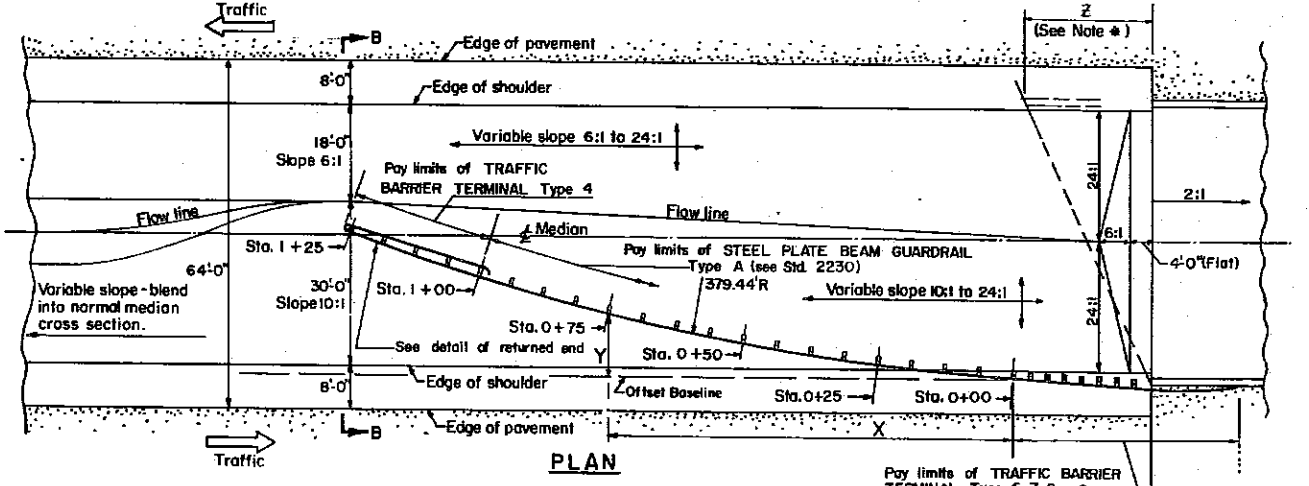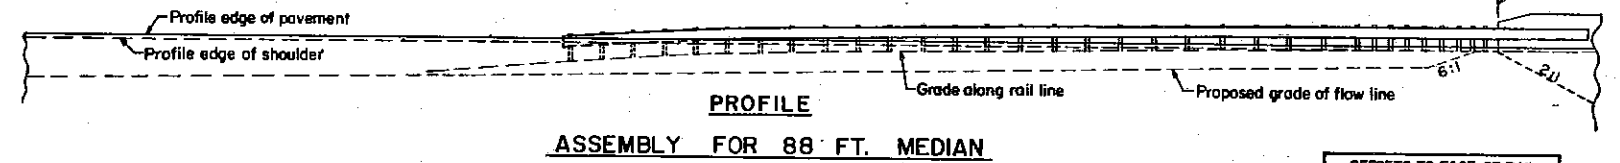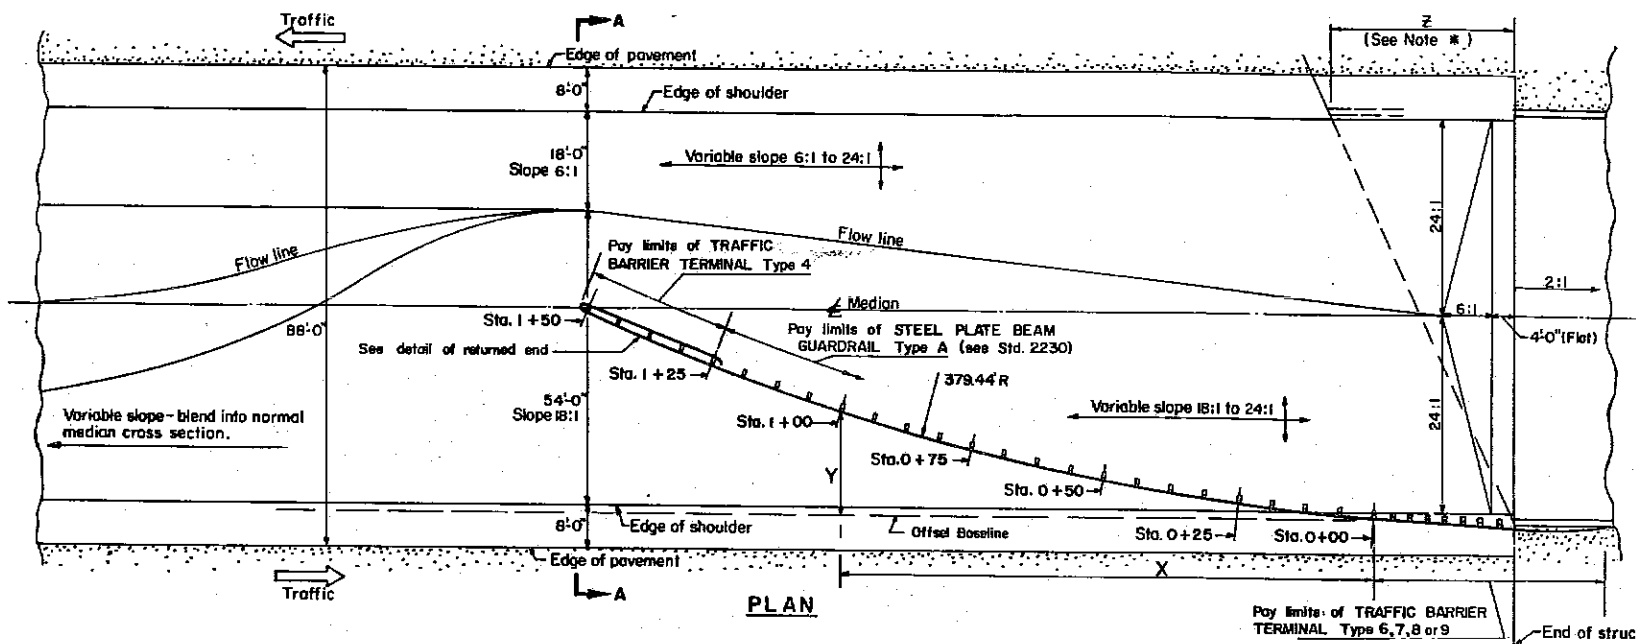

STATION	Distance	Offset
0+00	0.00'	0.00'
0+25	24.93'	1.83'
0+50	49.68'	5.28'
0+75	74.16'	10.37'
1+00	98.24'	17.05'
1+25	121.83'	25.30'
1+50	144.83'	35.09'

Offsets (Y) are measured between the face of rail and the Offset Baseline, which is parallel to the pavement edge and passes through Sta. 0+00. The location of Sta. 0+00 will vary, being dependent on structure details and the type of Traffic Barrier Terminal utilized.

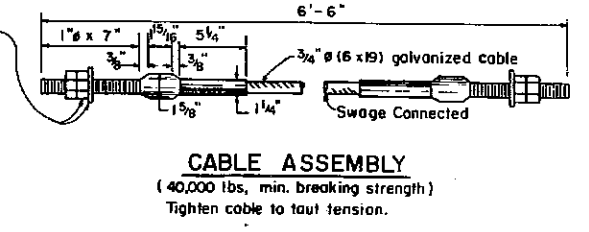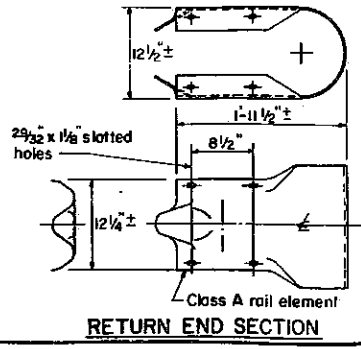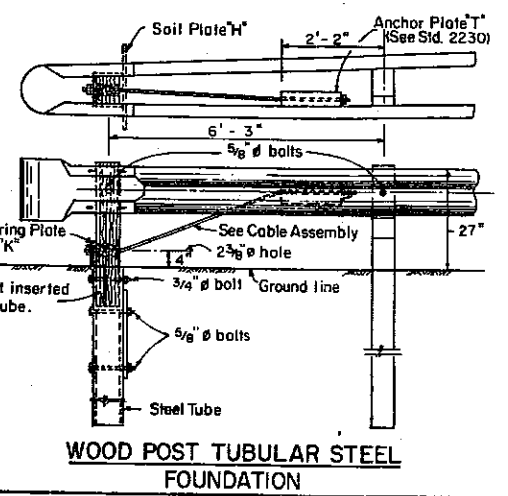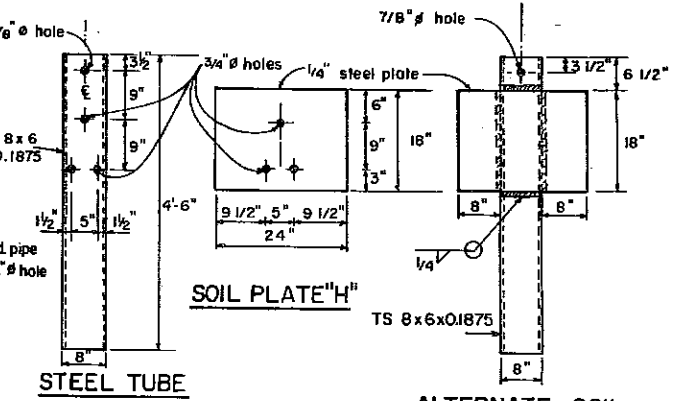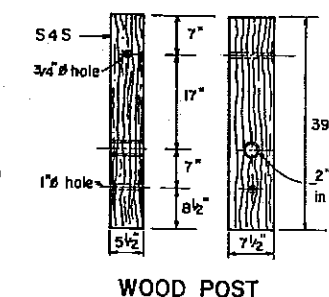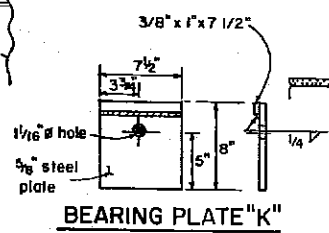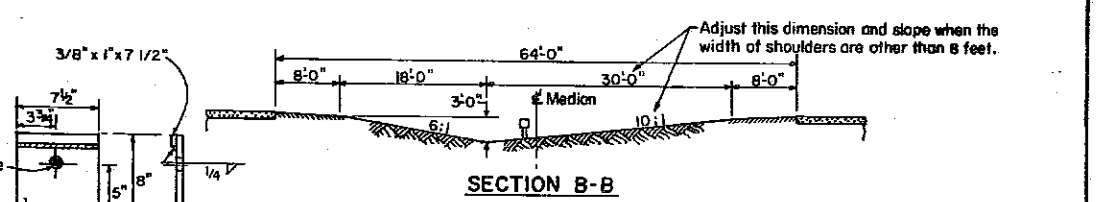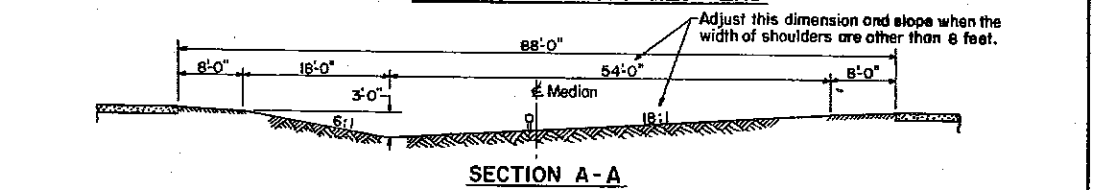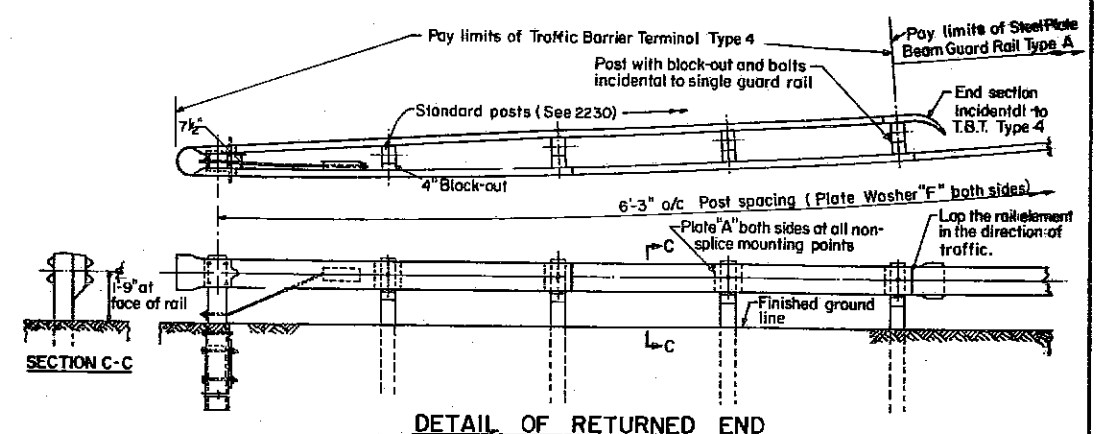


Illinois Department of Transportation  
 PASSED May 20, 1981  
 APPROVED May 20, 1981  
 Engineer of Design Operation  
 Engineer of Design


**GENERAL NOTES**  
 For details of Guardrail not shown, see Standard 2230.  
 When pavement is on a curved alignment, guardrail shall be approximately curved to match the alignment.  
 For dual structures that are 90° or skewed left forward, the length of guardrail shown is appropriate.  
 For dual structures skewed right forward the nose of the Type 4 Terminal shall be positioned longitudinally away from the structures for a distance equal to dimension Z. Appropriate adjustments to the length of the Type A Guardrail and its offsets (Y) shall be calculated and used. All additional lengths of guardrail shall be in increments of 12'-6".  
 All steel parts shall be galvanized after fabrication.  
 The wood posts shall be treated and conform to the requirements of Article 711.06 of the Standard Specifications.

**TRAFFIC BARRIER  
 TERMINAL TYPE 4  
 STANDARD 2339-2**  
 (Full Size) W.F.







F-328 b

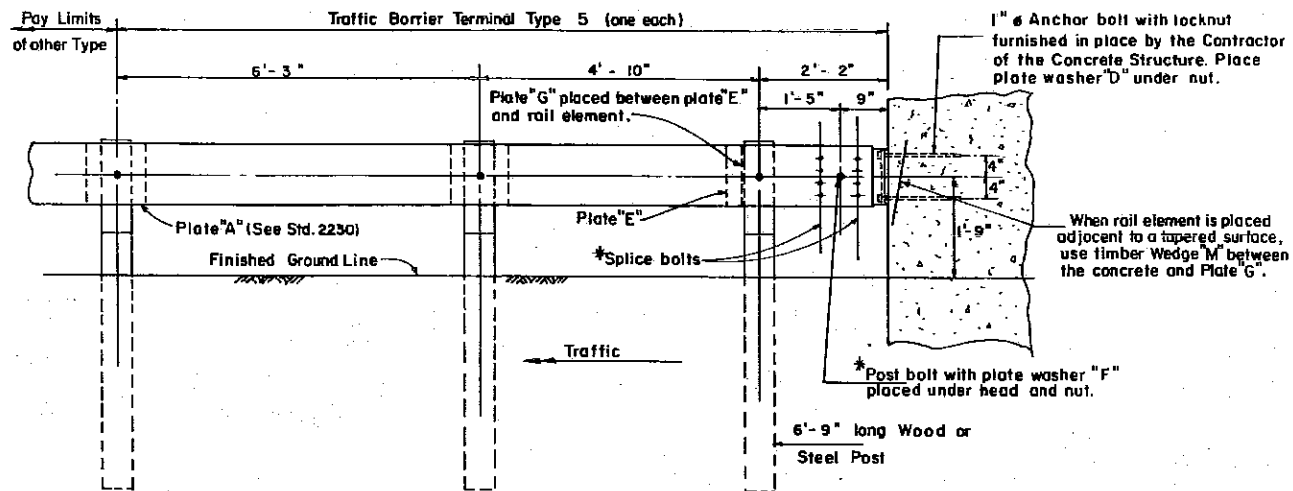

TRAFFIC BARRIER TERMINAL TYPE 5  
ANCHORING RAIL ELEMENT TO CONCRETE BRIDGE PARAPET

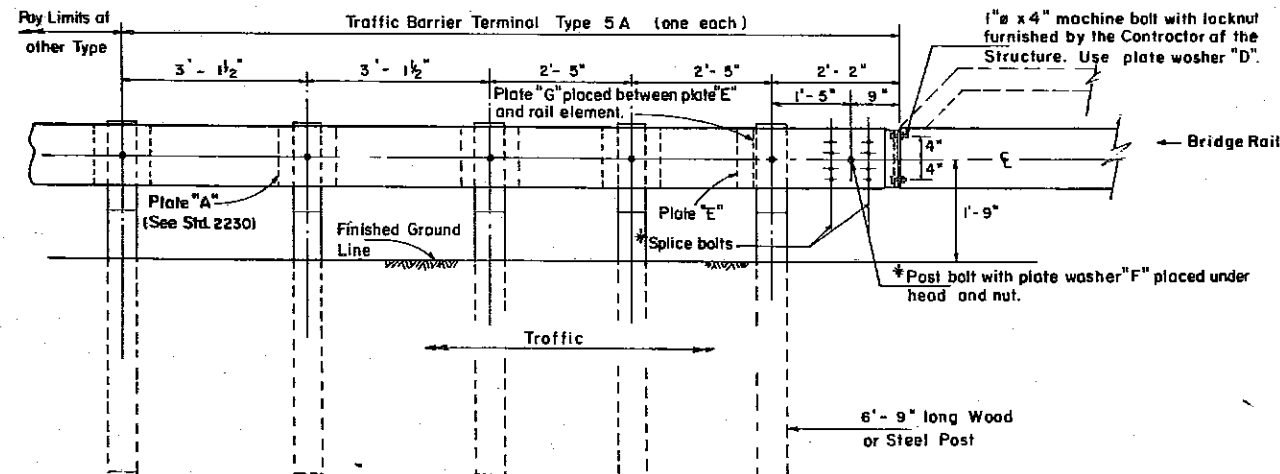

TRAFFIC BARRIER TERMINAL TYPE 5A  
ANCHORING RAIL ELEMENT TO TYPE "S", "S-1", "T" or "T-1" BRIDGE RAIL

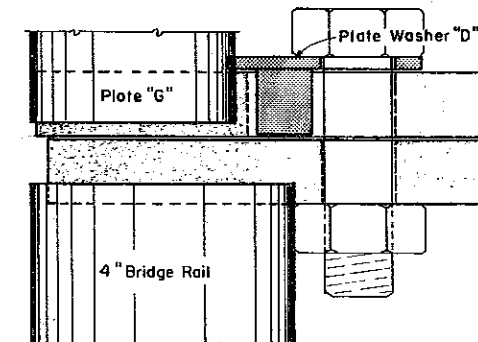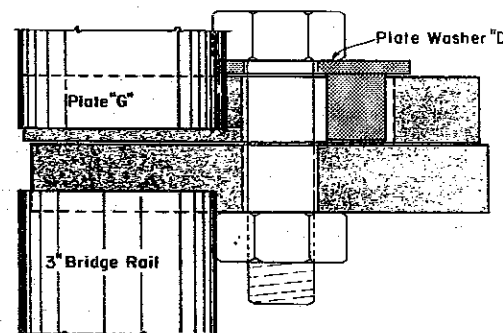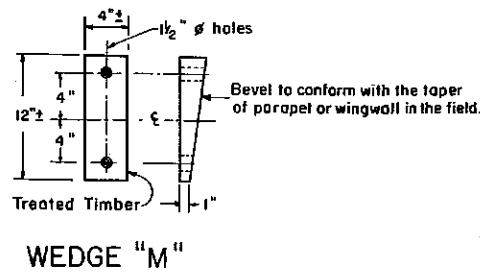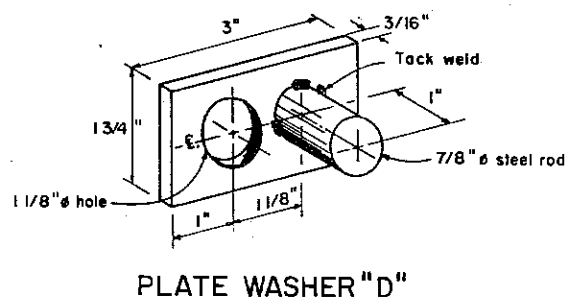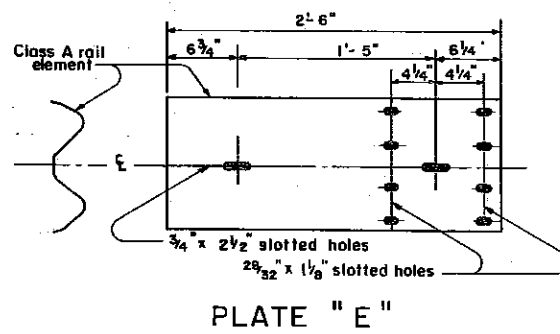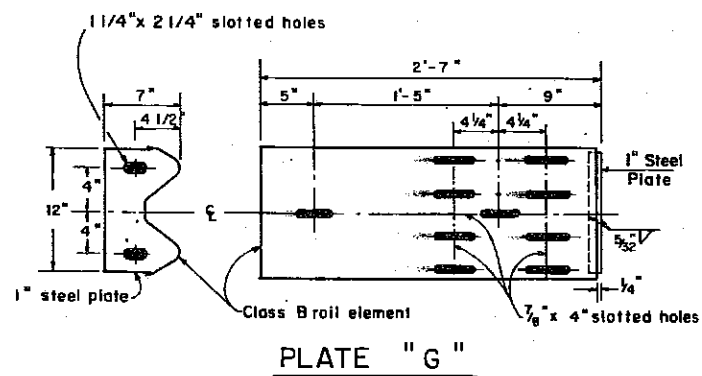

ORIENTATION OF PLATE WASHER "D"  
(Top View)

NOTES:

Install the face of the guardrail flush with the face of the bridge rail or parapet. Install plate washer "D" so that the 1" projection fills the remainder of the slotted holes in the 1" end plate on plate "G" after the 1"  $\phi$  bolts are in place.

\*Bolts shall be provided with lock nut or double nut and shall be tightened only to a point that will allow plate "G" to be free to move when an expansion joint exists below the connector.

See Standard 2230 for details of guardrail not shown.

Illinois Department of Transportation

PASSED June 20, 1984

John E. Eberly  
Engineer of Policy and Procedures

APPROVED June 20, 1984

John E. Eberly  
Engineer of Design

ISSUED 9-30-77






TRAFFIC BARRIER TERMINAL  
TYPE 5 & 5A

STANDARD 2340 - 4

(Full Size) D.W.W. Sr.

F-329 D



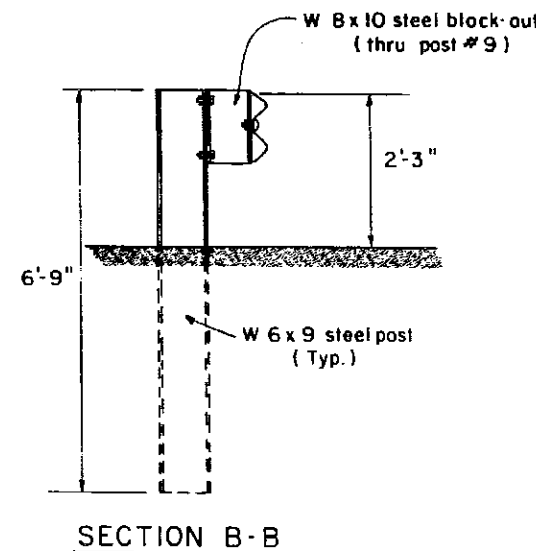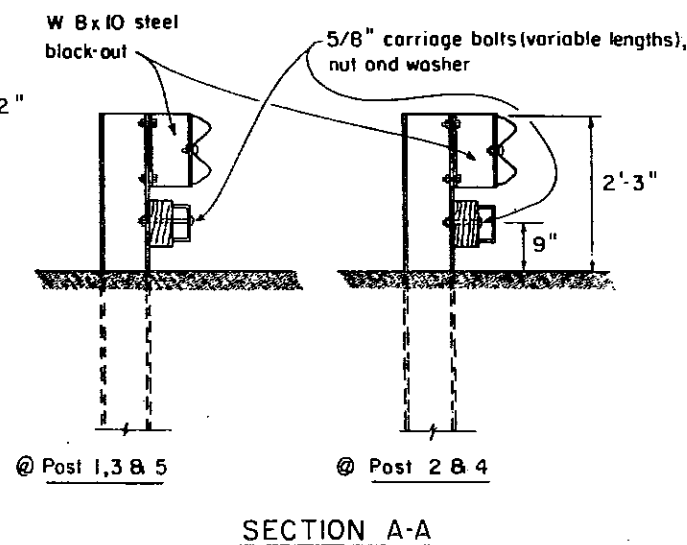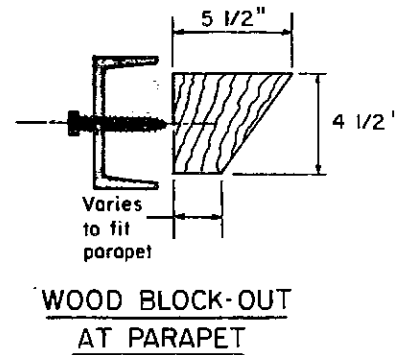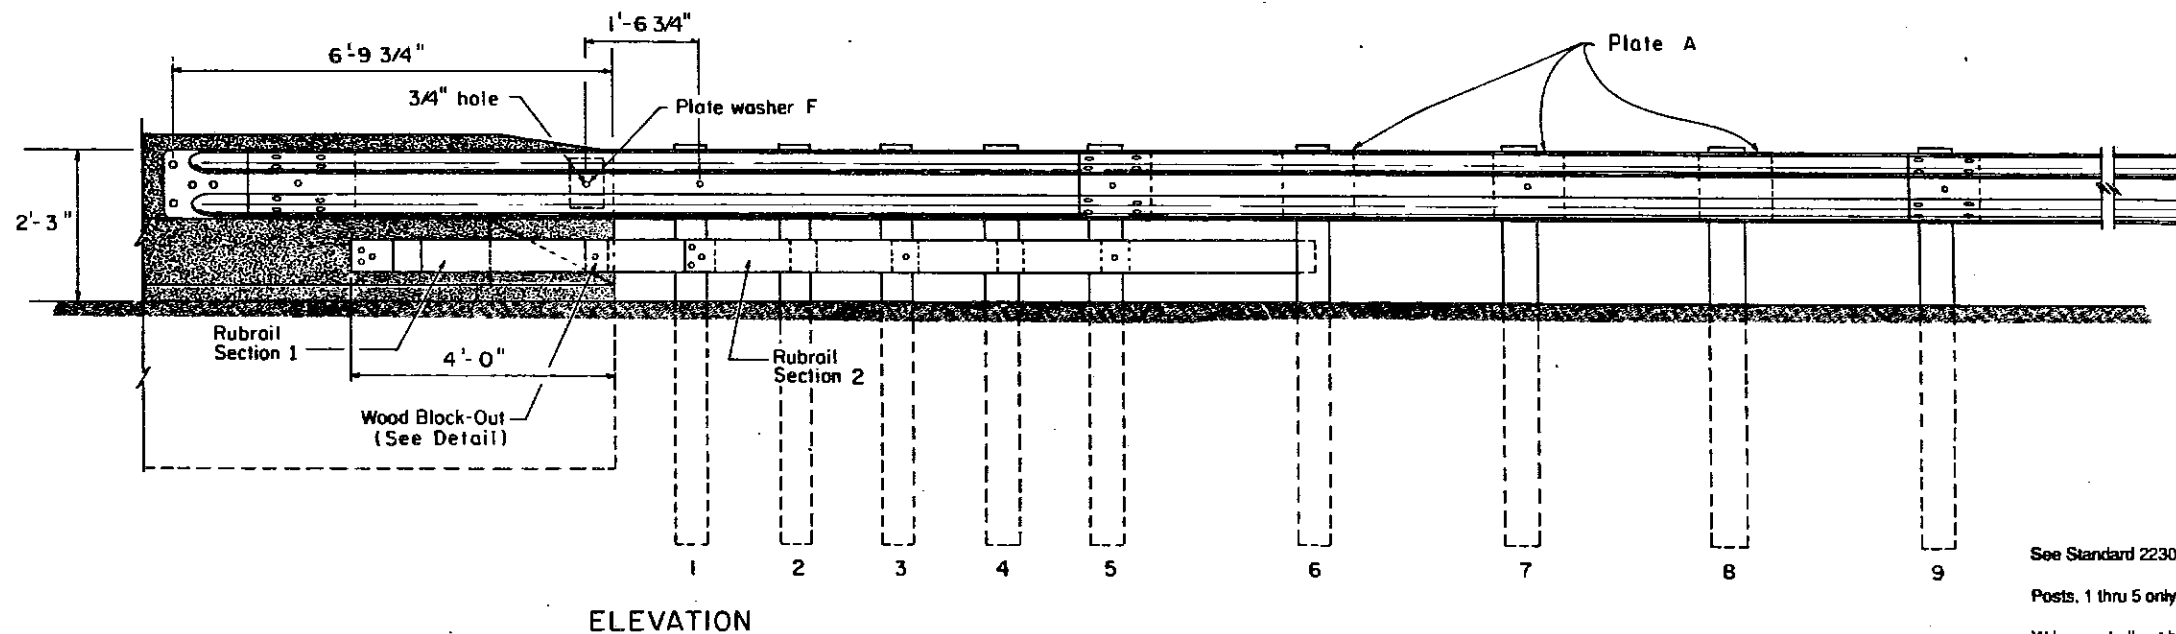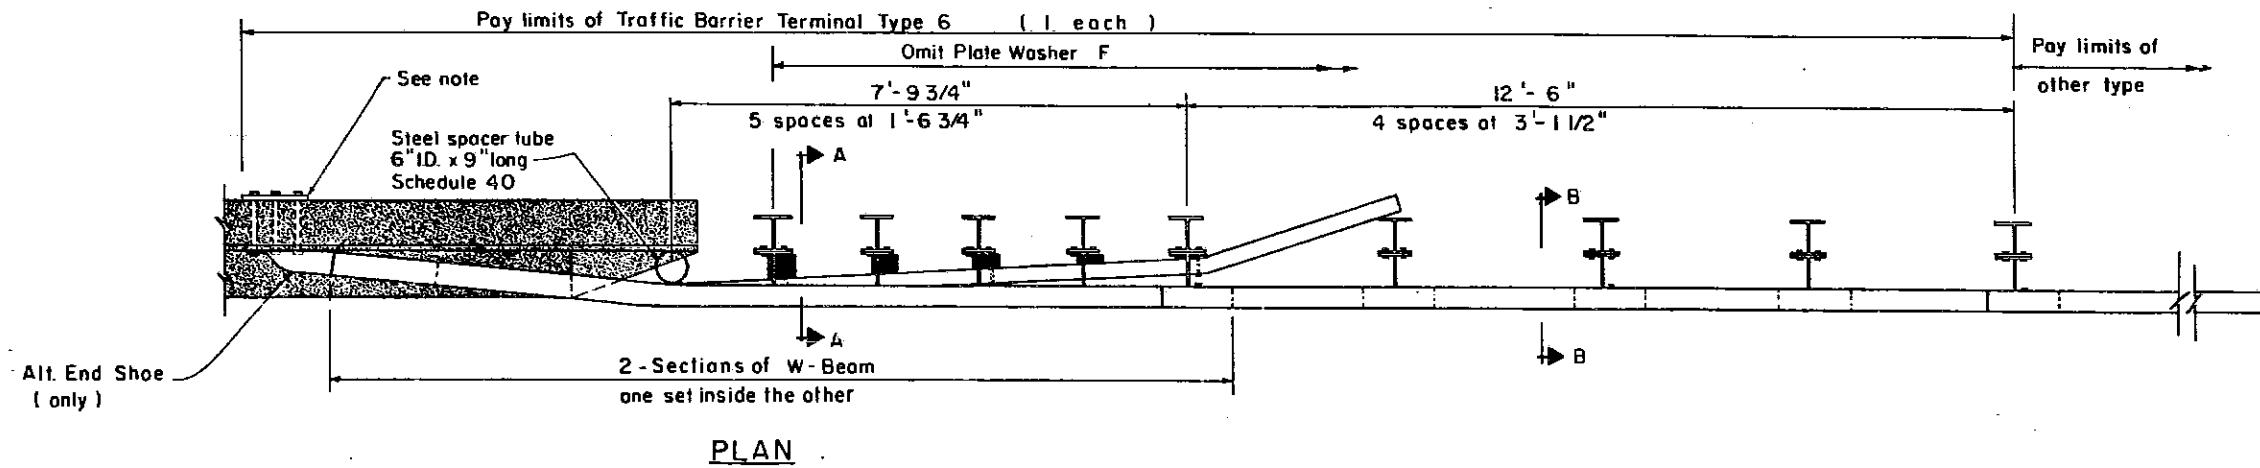

**GENERAL NOTES**

- See Standard 2230 for details of guardrail not shown.
- Posts 1 thru 5 only, require the hole 18 1/2" from the top of post.
- W-beam shall not be bolted to posts 2 thru 4, 6 and 8.
- Rubrail sections and the bearing plate shall conform to the requirements of AASHTO M-183. They shall be galvanized after fabrication in accordance with AASHTO M-111.
- The rubrail shall be fastened to the parapet/support by three 5/8" x 6" long hex bolts with 5/8" expansion anchors or other approved cast-in-place insert devices.
- The end shoe shall be fastened to the parapet/support by four 7/8" x 6" long hex bolts conforming to ASTM A-325 with approved 7/8" cast-in-place insert device. An alternate method which uses thru drilled holes with 5/8" bearing plate may also be used.
- Steel spacer tube shall be galvanized in accordance with Article 710.33 (b)(1) of the Standard Specifications.
- The Wood Block-Out shall be treated in accordance with Article 711.12 of the Standard Specifications.

Illinois Department of Transportation

PASSED Nov 18 1991

APPROVED Nov 18 1991

ISSUED 8-1-77


Engineer of Design

**TRAFFIC BARRIER  
TERMINAL TYPE 6** (Sheet 1 of 2)


STANDARD 2341-4

(Full Size) D.W.W.Sr


# EARTH MEDIAN DITCH CHECK

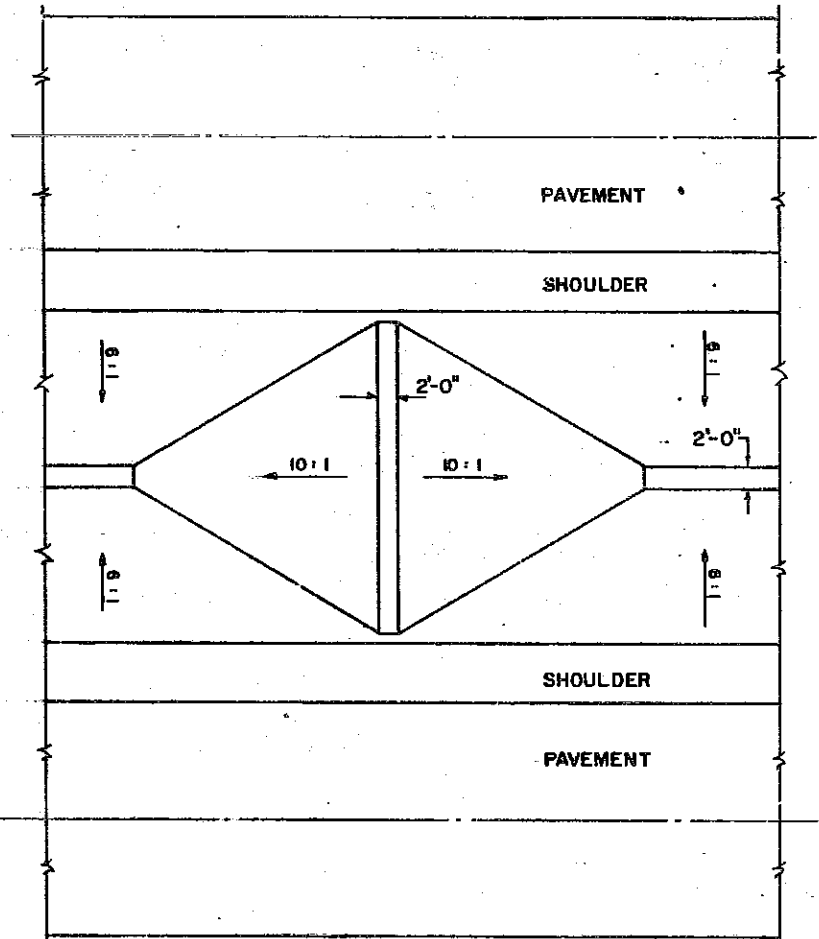


**DITCH CHECK FOR NARROW MEDIAN**

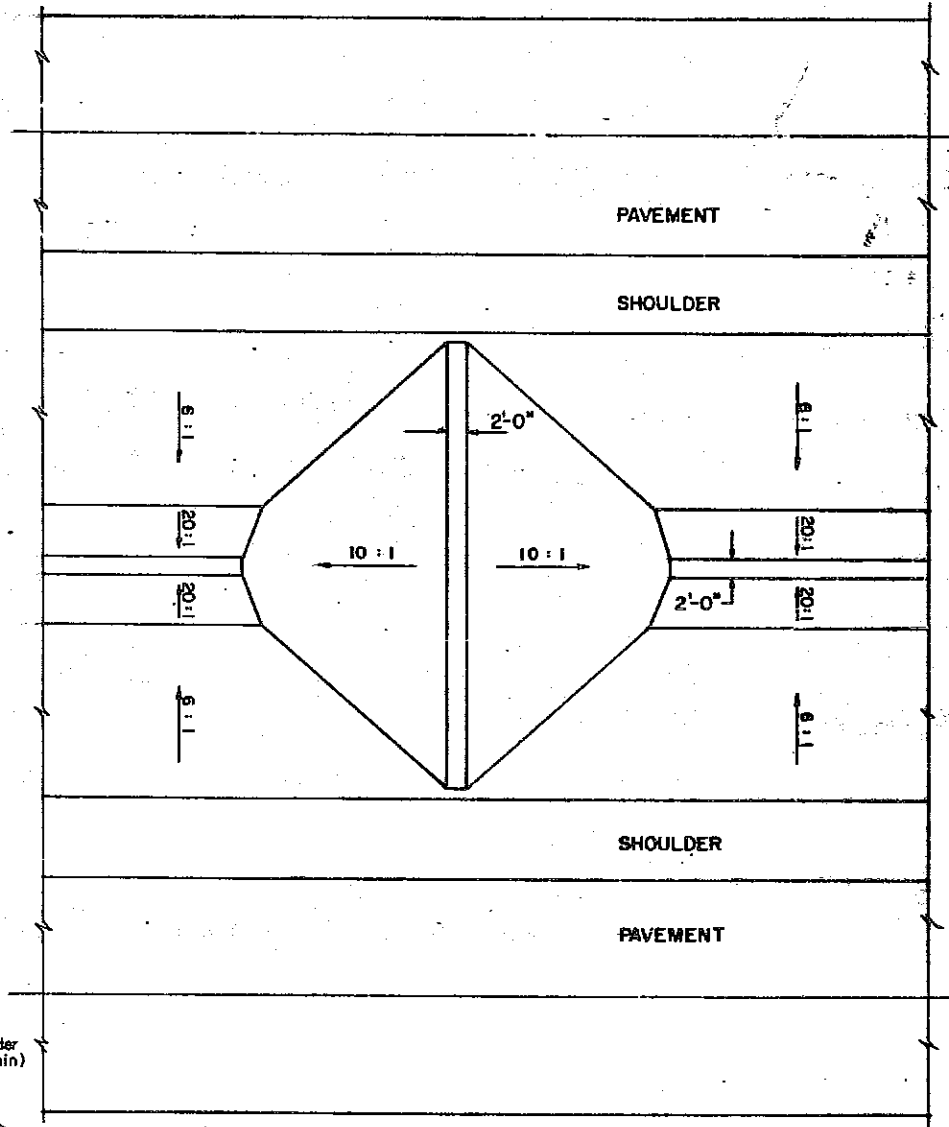

**DITCH CHECK FOR WIDE MEDIAN**

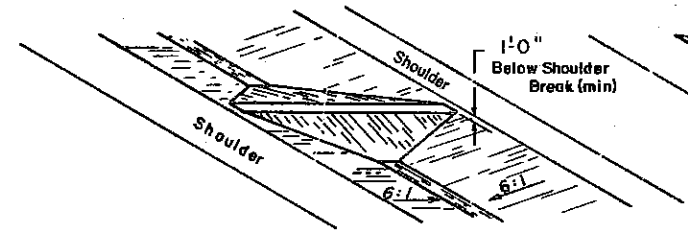

**VIEW OF  
NARROW MEDIAN**

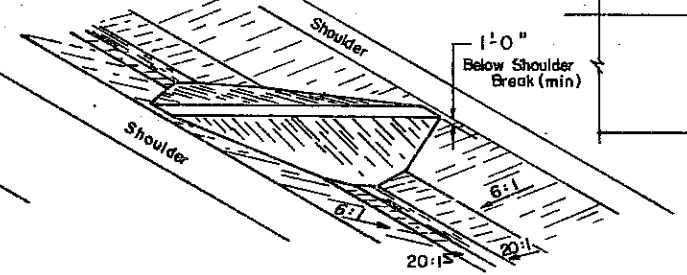

**VIEW OF  
WIDE MEDIAN**

GENERAL NOTES

Earth Median Ditch Check shall be constructed of the same materials, finished and seeded in the same manner as the adjacent embankment. Quantities will be measured and paid for in accordance with the provisions of the Standard Specifications for the appropriate materials required.




Top of Ditch Check shall be a minimum of 1'-0" below shoulder edge. In order to reduce embankment cost this distance may be increased if justified by hydraulic studies.

STATE OF ILLINOIS DEPARTMENT OF TRANSPORTATION	ISSUED 12-9-74
PASSED _____ 1974	REVISIONS
Engineer of Design Operations	
APPROVED Dec 9 1974	
<i>Thomas A. Bright</i> Engineer of Design	


STANDARD 2355

D.W.W. Sr. 11-25-74






A-12.20

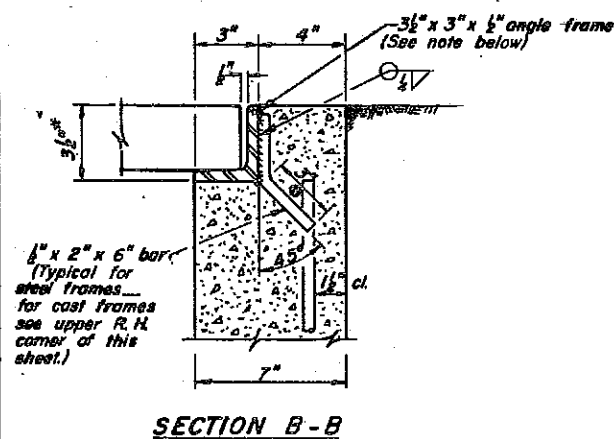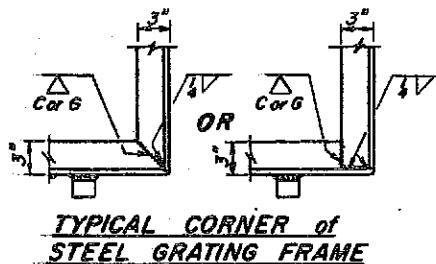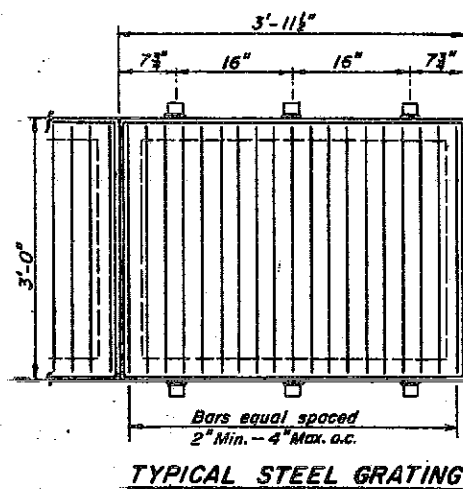



**\*NOTE:**  
The dimensions of the angle iron frames shall be as shown except that the 3 1/2" leg dimension may vary according to type of grating used. In all cases, the surface shall be flush with the top edge of frame, sidewalls and headwall. All frames shall be galvanized and anchored in concrete. They shall be factory assembled and all joints shall be welded per detail.

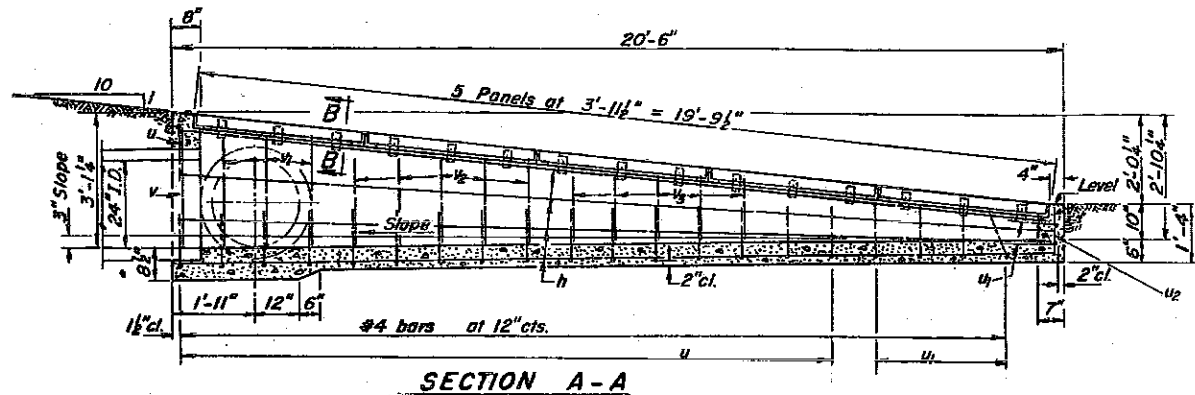

Note: Culvert pipe may exit from the side (or sides) by changing reinforcement bars in that area and in the headwall end of box.

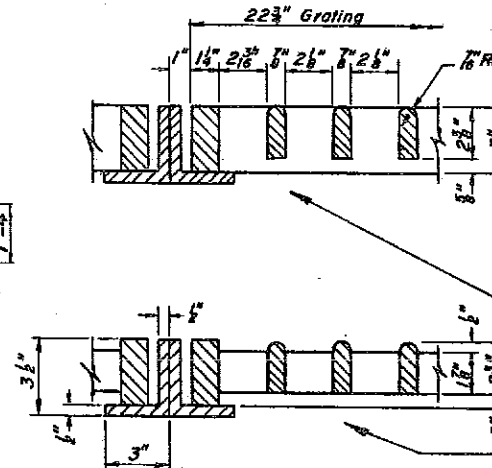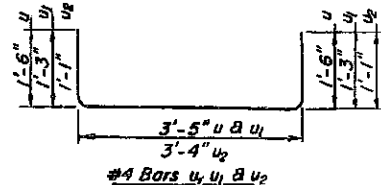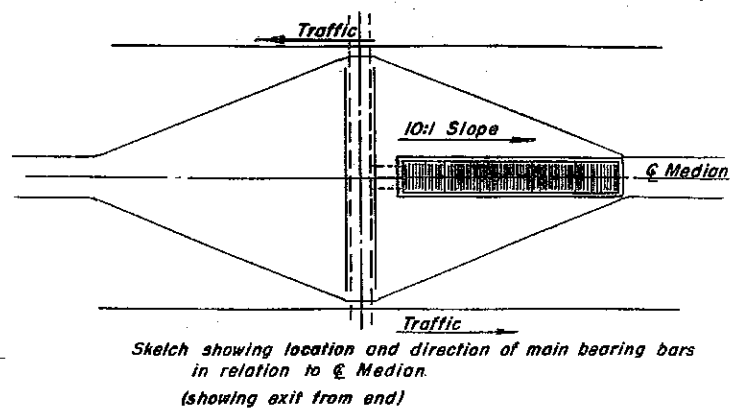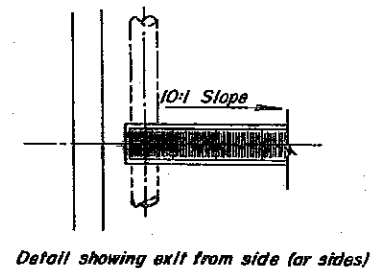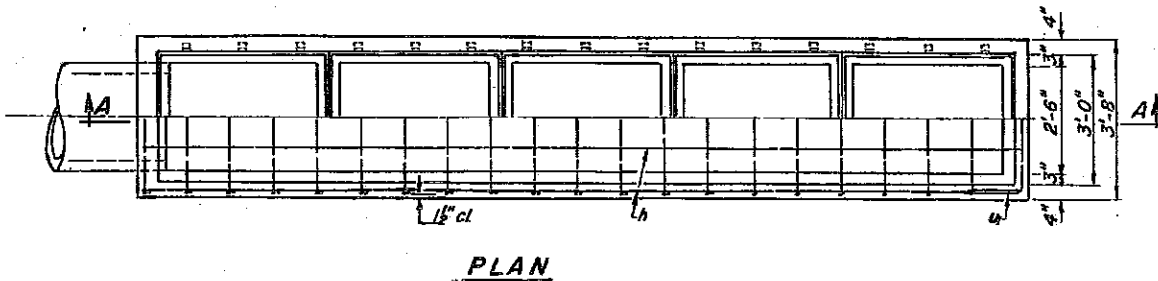

Class X concrete or precast concrete shall be used throughout. Precast concrete shall be in accordance with Sections 505.01 thru 505.05 of the Standard Specifications except that the concrete strength shall be 4000 p.s.i. after 28 days. A 3" deep sand bedding conforming to Article 703.01 (FA 1 or FA 2) shall be provided under full length and width of precast unit, and all voids around pipe entrance, both inside and outside, shall be sealed with mortar. Exposed edges shall be beveled 1/4". Shop drawings shall not be required for these inlet boxes.

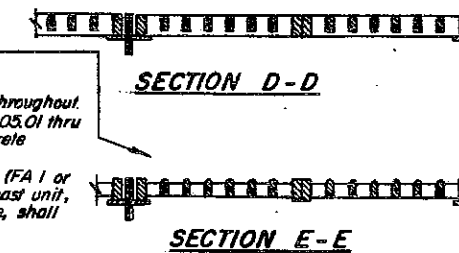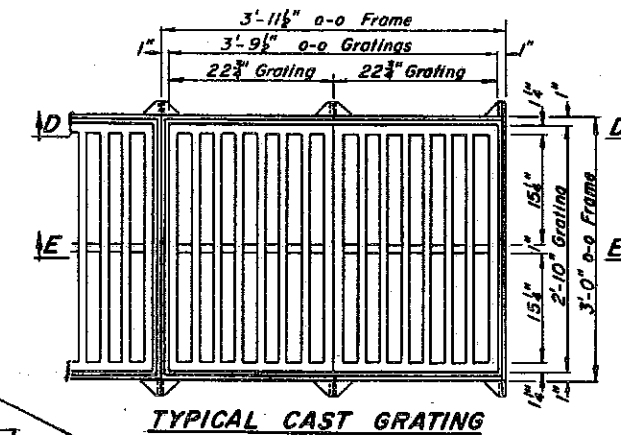

The steel grating shall have the main bearing bars running perpendicular to the centerline of the inlet box. The main bearing bars shall have a minimum section modulus of 2.47 inches cube per foot width of grating. The grating shall seat firmly in the frame but shall not be secured to the frame. The length and width of grating shall be such as to leave no more than 1/8" clearance on either side when in place in the frame. The grating shall be cut in such manner that all riveted or welded connections are left intact. Grating shall be approved by the Engineer. Steel grating and frames shall conform to Article 710.04 of the Standard Specifications and shall be galvanized to AASHTO designation M III after fabrication. The cast grating shall conform to Article 710.15 of the Standard Specifications (Grade 60-40-18) or Article 710.17 of the Std Specs and proof-load tested in accordance with Federal Specifications RR-F-621. The proof-load shall be 25,000 lbs. on a 9" x 9" cast block. The cast frames shall conform to Article 710.17 of the Standard Specifications. The cast grating and frames shall not be galvanized. For backfilling and embankment, see Standard Specifications. Minimum bar laps shall be 1'-1" unless otherwise specified. The main bearing bars of steel grating shall be rectangular or a modified "I" in shape (cross section) but shall not have any flanges which would retain trash. The edges of the main bearing bars shall be laterally supported by transverse bars. Pressure lock type steel grating and riveted steel grating with reticulate bars will be accepted for galvanizing in accordance with AASHTO Specification M III. The Contractor may use at his option the steel frames and grating or the cast frames and grating, but will not be allowed to use the steel grating with cast frames nor the cast grating with steel frames.

The contract unit price "Each" for INLET BOX STANDARD 2358 in place, shall include the frames and grating, class X or precast concrete, reinforcement bars, and bedding when required.

Material required for one Inlet Box

Bar	No.	Size	Length
h	10	#4	20'-0"
u	17	#4	6'-5"
u <sub>1</sub>	6	#4	5'-11"
u <sub>2</sub>	1	#4	5'-6"
v	2	#4	2'-9"
v <sub>1</sub>	6	#4	2'-6"
v <sub>2</sub>	10	#4	2'-0"
v <sub>3</sub>	10	#4	1'-6"
Concrete - Class X or Precast	Cu Yds.		3.2
Reinf Bars	Lbs.		270
Grating	Sq. Ft.		56.0

**INLET BOX for MEDIAN DITCH CHECK (10:1 Slope) with 24" I. D. CULVERT**  
(Flow line of box is below flow line of median.)

**STANDARD 2358-3**  
(Full Size)

Illinois Department of Transportation


PASSED Dec 31 1979  
Engineer of Bridges and Traffic Structures

APPROVED Dec 31 1979  
Engineer of Design

ISSUED 4-23-75


B4.27g



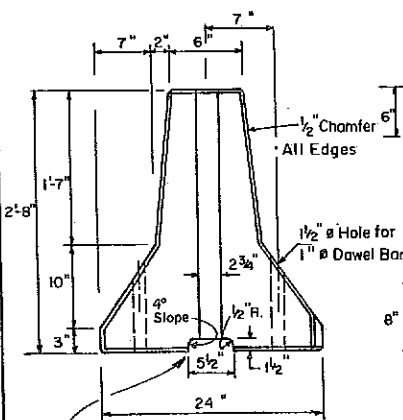


**END VIEW**


Optional Keyway shown

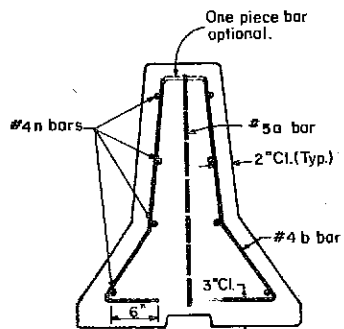


**SECTION A-A**  
(Showing Bar Reinforcement)

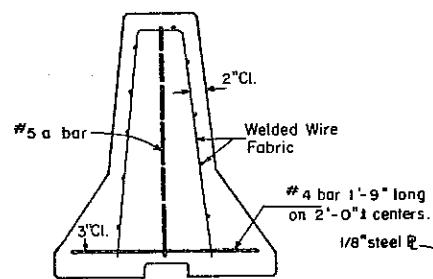


**SECTION A-A**  
(Showing Alternate Welded Wire Reinforcement)

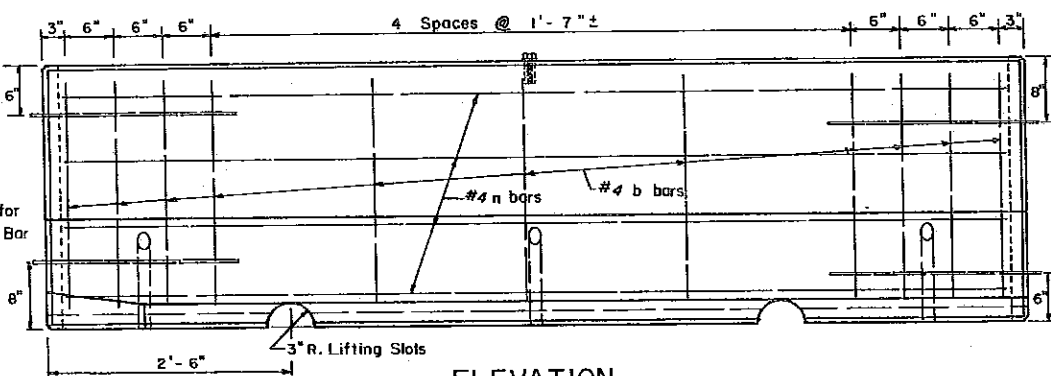

**ELEVATION**

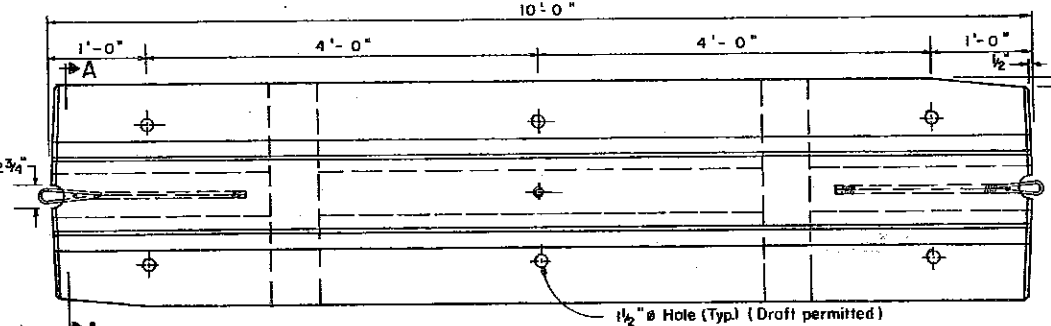


**PLAN**

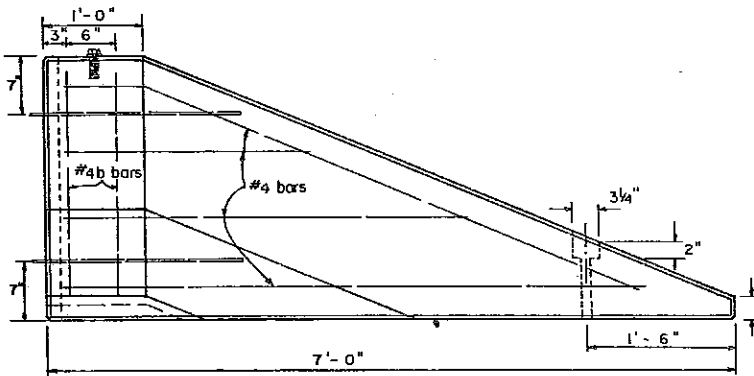


**TERMINAL SECTION**


1/2" Ø Hole for 1" x 3'-0" Drift Pin. Drive or Drill into place. Grout hole after removal.

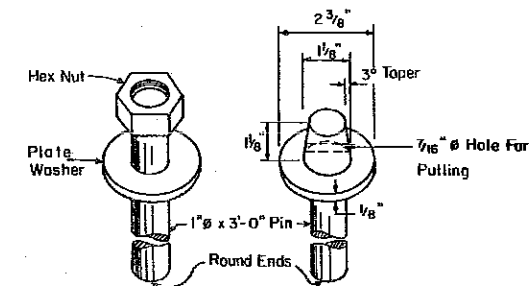


**ALTERNATE DRIFT PINS**

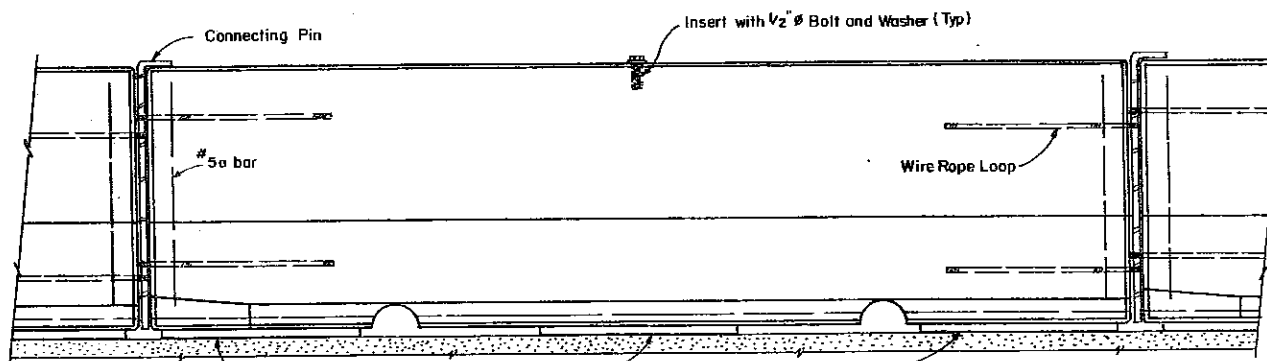

**TYPICAL INSTALLATION WITH STYROFOAM PADS**

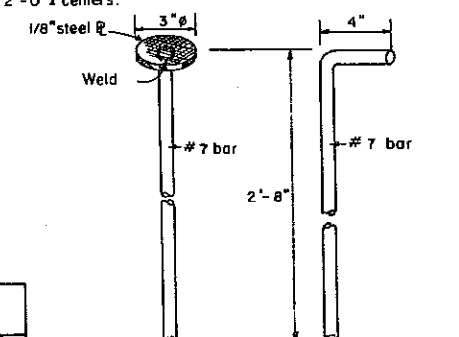

**ALTERNATE CONNECTING PINS**

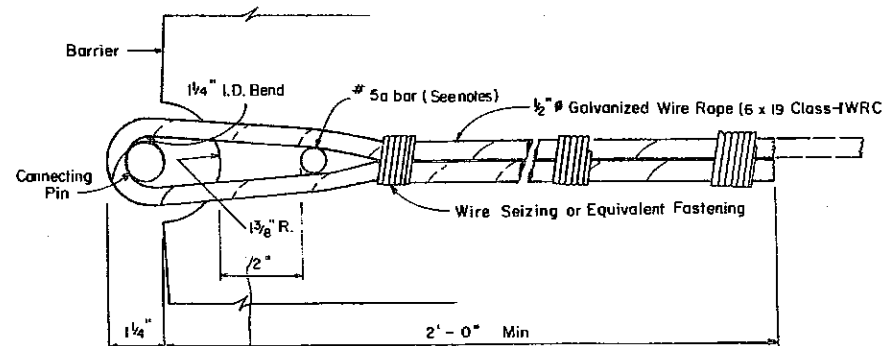

**WIRE ROPE LOOP DETAIL**  
(20,000 lbs. min. breaking strength)

Design Notes will not appear in the contract plans.

**GENERAL NOTES**

Barrier units shall be pinned one to another in continuous smooth line at the exact locations provided by the Engineer.

The wall units shall be reinforced with either bar reinforcement or welded wire fabric. Welded Wire Fabric shall be 6x6-W4 x W4, weighing approximately 58lbs. per 100 sq.ft., conforming to the requirements of AASHTO M-55.

Barrier units placed on rigid pavement or median surfaces shall be seated with styrofoam pads. Units placed on flexible pavement or shoulders shall be secured with dowel bars. Dowel bars shall be one inch in diameter, at least 12 inches long, shall be embedded at least 8 inches into base material, and shall not project above the outer surface of the barrier. After pin removal all holes in the base shall be grout filled.

Alternate lifting devices meeting the approval of the Engineer may be substituted for the lifting slots shown.

When the Terminal Section is used, the hex nut on the drift pin shall be threaded half way onto the pin and tack welded, or a coupling nut tightened sufficiently to prevent loosening may be used. Fill nut with grease to exclude contaminants.

Inserts for 1/2" Ø bolts shall be capable of 3000 lbs. pull out strength and shall be furnished with a galvanized ball and washer.

The #5 bar may be omitted if 2 continuous wire ropes are substituted for the 4 wire rope loops shown. The continuous ropes shall be looped and fastened on each end as shown in the wire rope loop detail.

The Contractor shall have the option to furnish Barrier with or without the longitudinal keyway unless otherwise specified.

Illinois Department of Transportation  
 PASSED Oct. 22 1991  
 John E. Bone Sr.  
 Engineer of Policy and Procedures  
 APPROVED Oct. 22 1991  
 The Illinois  
 Engineer of Design

ISSUED 6-18-79

Not to scale



**TEMPORARY CONCRETE BARRIER**

**STANDARD 2383 - 3**

(Full Size)

D.W.W. Sr.


E-7.05C

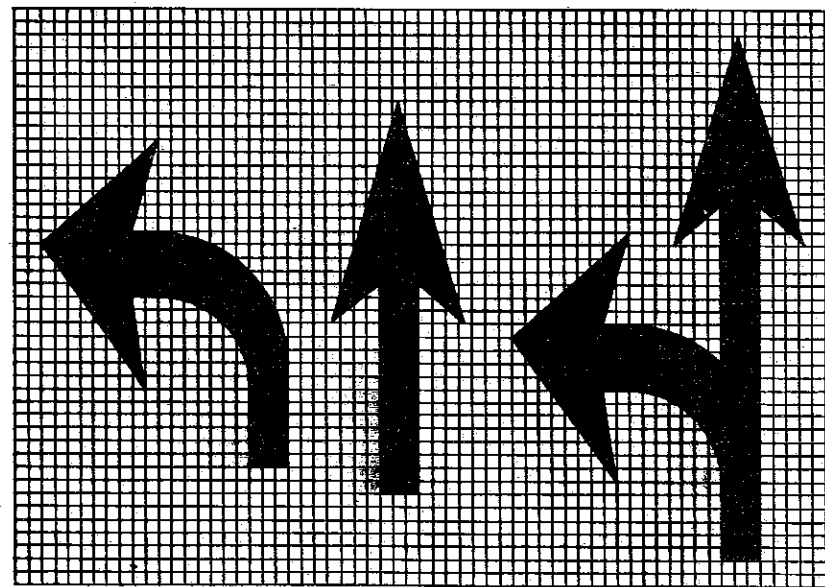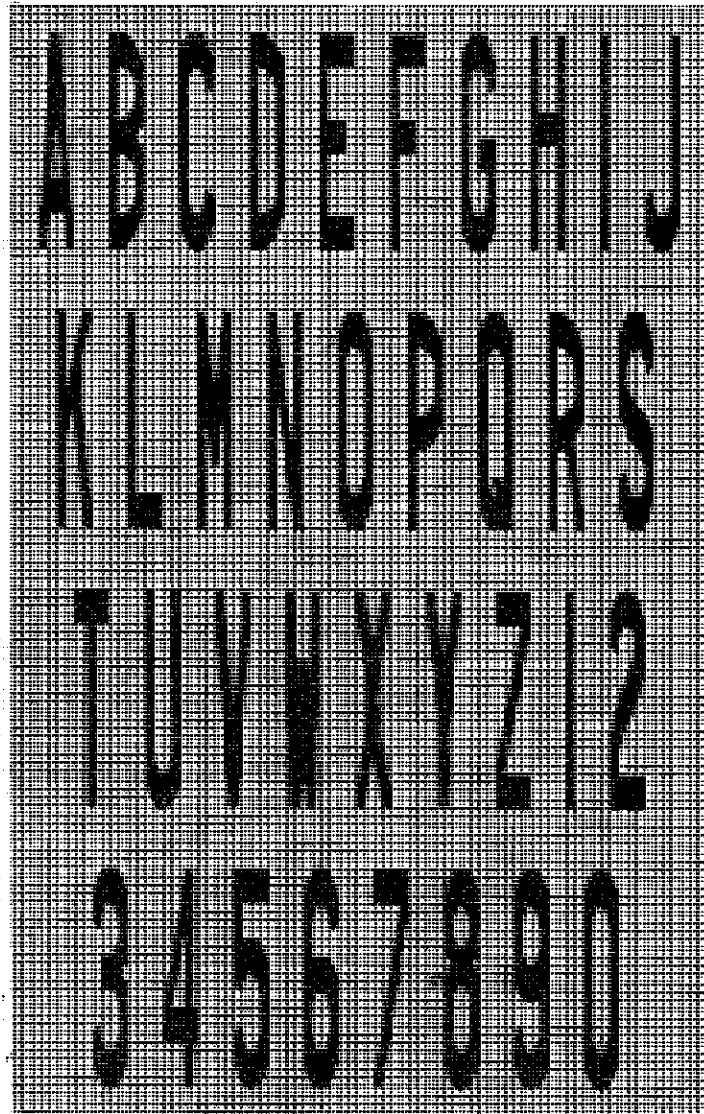

Legend Height	Arrow Size	"a"
6'	Small	2.9"
8'	Large	3.8"

The space between adjacent letters or numerals should be approximately 3 inches for 6 foot legend and 4 inches for 8-foot legend.


LETTER AND ARROW GRID SCALE

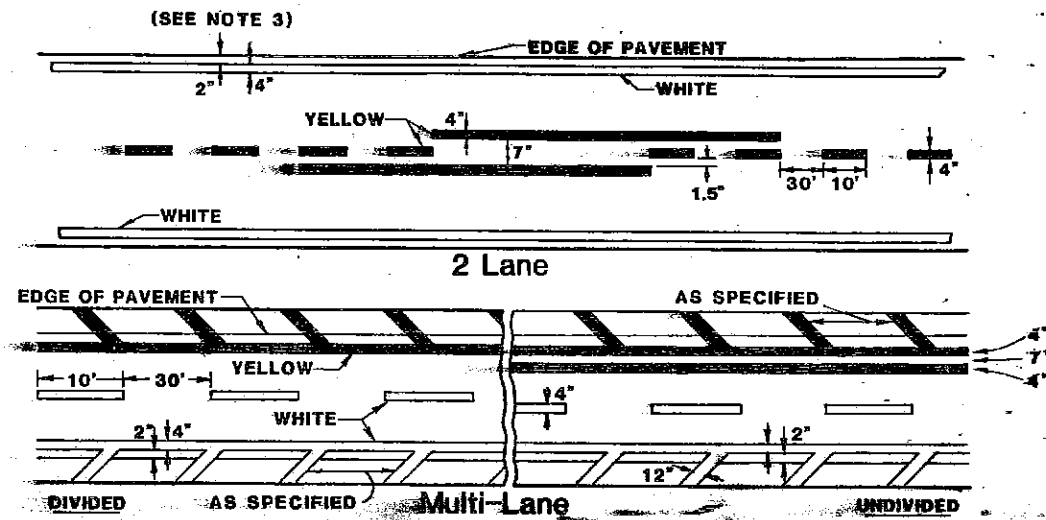

TYPICAL LANE AND EDGE LINES

NOTES:

1. Diagonals shall be used only where specified in the plans.
2. Unless directed by the Engineer, lines shall not be laid directly over a longitudinal crack or joint nor over a tar or asphalt painted line. The edge of a center line or lane line shall be offset a minimum of two inches from a longitudinal crack or joint.
3. Edge lines shall be placed on the shoulder, 2 inches from the edge of pavement when specified in the plans.

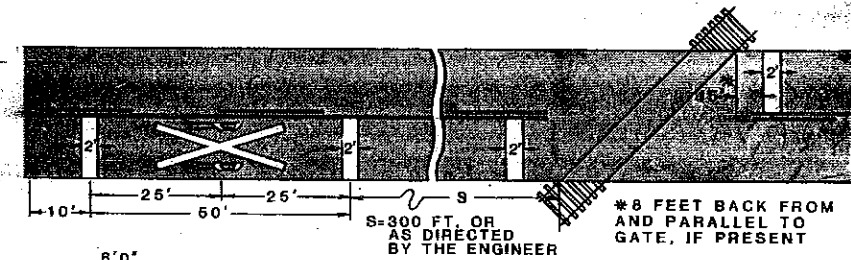


8'0" OR AS DIRECTED BY THE ENGINEER

THE TRANSVERSE SPREAD OF THE "X" MAY VARY ACCORDING TO LANE WIDTH.


On multi-lane roads, the stop lines shall extend across the right-hand lanes only to the center line, and separate RXR symbols shall be placed adjacent to each other in each lane.

STANDARD PAVEMENT MARKINGS AT RAILROAD-HIGHWAY GRADE CROSSING

TYPICAL WORD AND ARROW LAYOUT

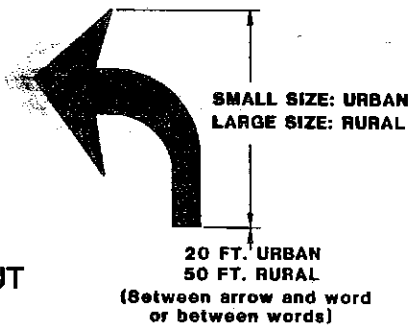


FREEWAY ARROW

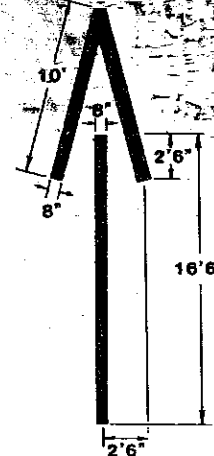

Illinois Department of Transportation  
 Approved 4-9-85  
 R. W. Jones  
 Engineer of Traffic  
 68-C-4-DRAWN

TYPICAL PAVEMENT MARKINGS  
 STANDARD 2396

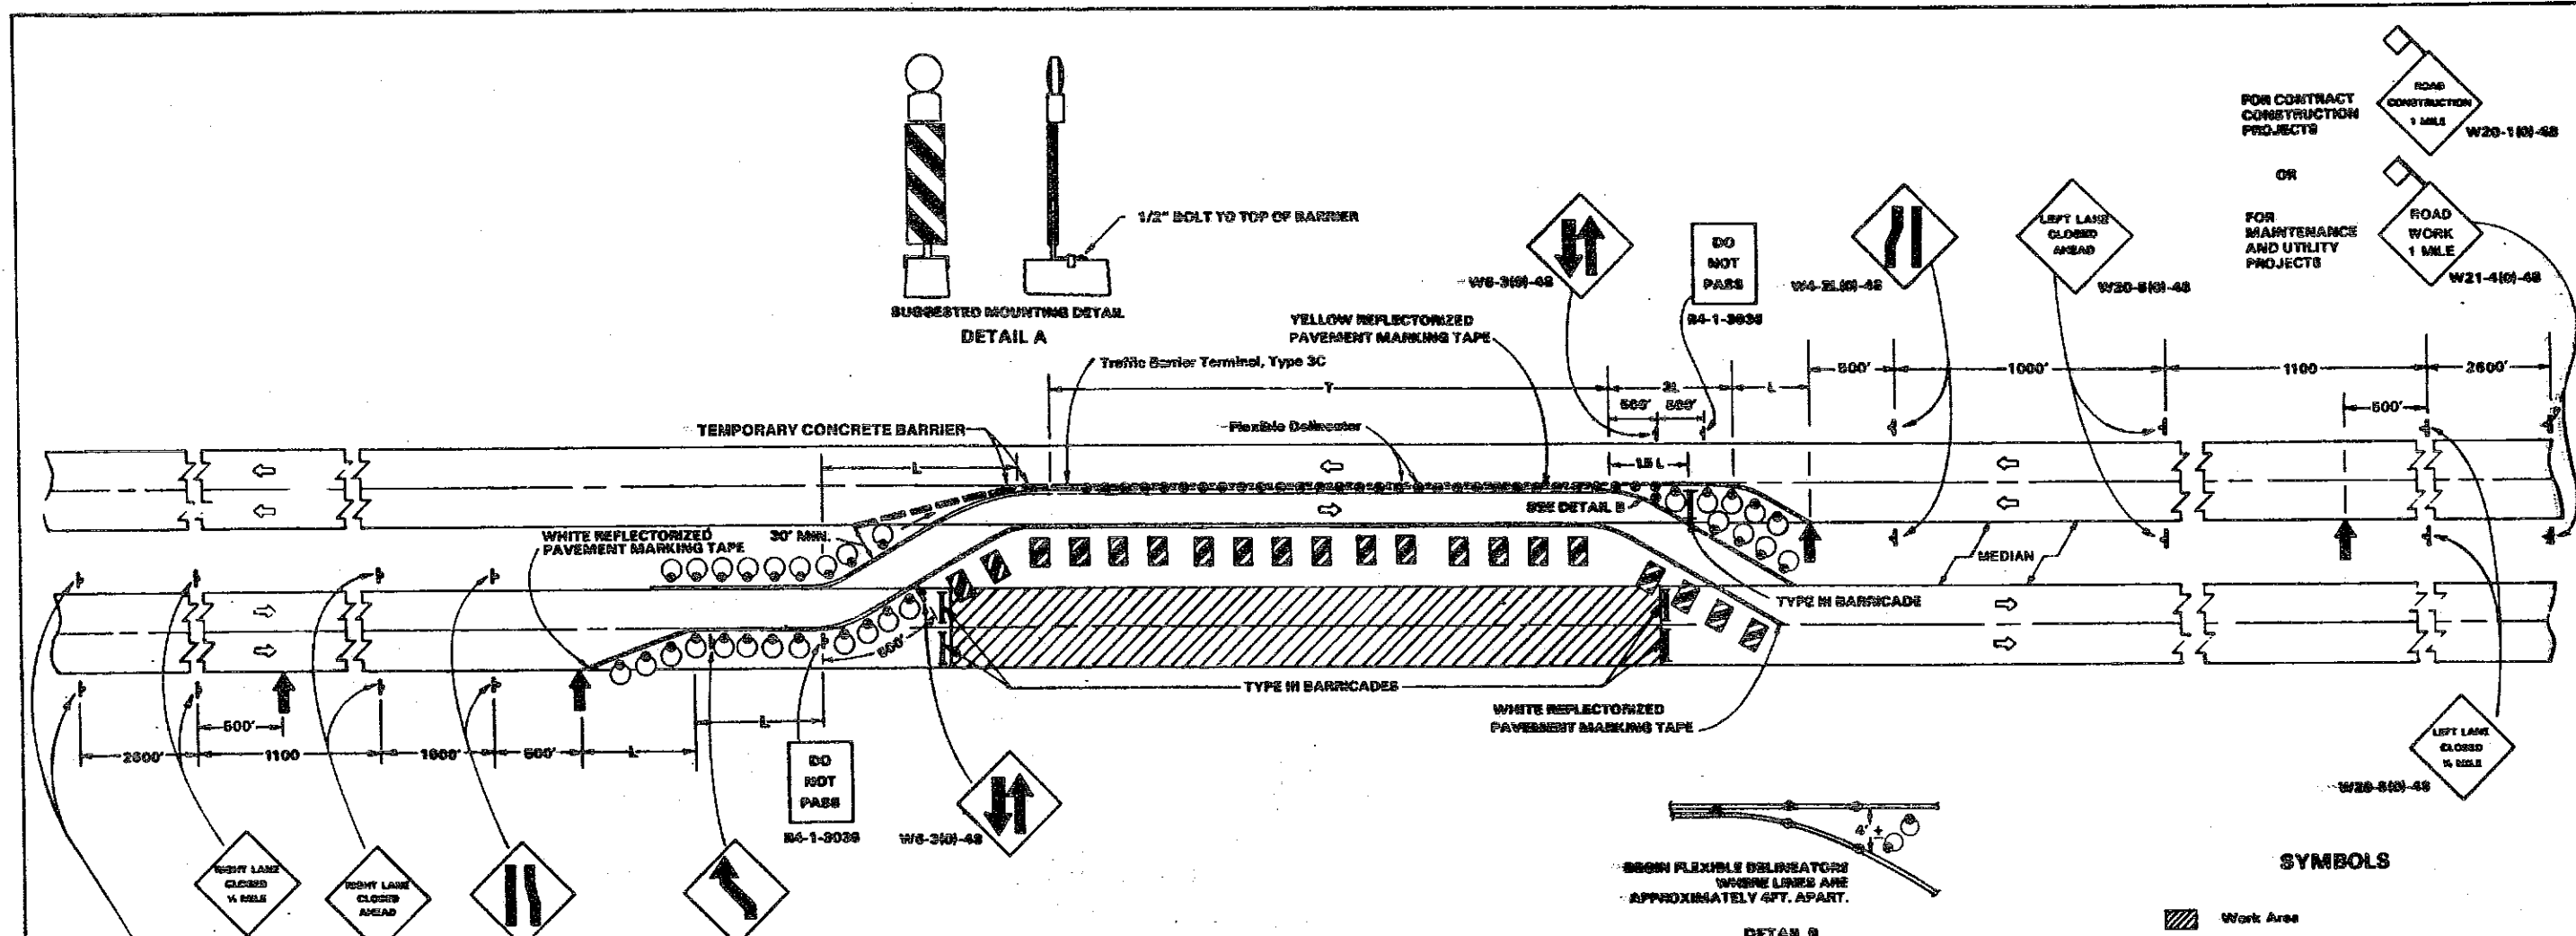

FOR CONTRACT CONSTRUCTION PROJECTS  
ROAD CONSTRUCTION 1 MILE W20-1101-48

OR

FOR MAINTENANCE AND UTILITY PROJECTS  
ROAD WORK 1 MILE W21-4101-48

**SYMBOLS**

- Work Area
- Sign on Portable or Permanent Support
- Barricade
- Drum with Steady Burning Light
- Vertical Panel
- Arrow Board
- 18 in. X 18 in. (minimum) Orange Flag
- Flexible Delineator
- Temporary Concrete Barrier

**GENERAL NOTES**

1. Reflective, solid edge lines and a double yellow center-line shall be used when the closure time exceeds four days or when the normal posted speed outside the area of operations exceeds 50 miles per hour. Reflectorized pavement marking tape shall be used for marking the edge lines and center line on existing pavement. Either tape or reflectorized pavement marking paint may be used for markings on the paved crossovers. Raised reflective pavement markers at 25 ft. centers shall also be installed to provide additional delineation. An existing pavement markings which conflict with the revised traffic pattern shall be removed.
2. Two-Way Traffic sign(s) shall be repeated every one-quarter mile in each direction through the tangent distance.
3. All drums and vertical panels shall be at 50 ft. centers. Where the tangent distance "T" on the temporary roadway exceeds 900 ft., steel delineators at 50 ft. centers may be substituted for the vertical panels, or spacing between vertical panels may be increased to 100 ft. within the limits of the tangent.
4. Cones may be substituted for drums or flexible delineators at half the spacing during day operations. On fully access-controlled facilities, cones shall be a minimum of 28 in. in height.
5. Reflectorized flexible delineators are to be attached to the pavement at 50 ft. centers for the first 250 feet at each end of "T", and at 100 ft. centers throughout the remainder of "T".
6. The impact attenuator shall be positioned so as not to encroach onto the outer lane. Vertical panels (see detail A) shall be attached to the concrete barriers where available space prohibits use of drums.
7. The speed limit to be shown on the advisory speed plate shall be 10 miles per hour below the normal posted speed limit or 45 MPH, whichever is less. The signs shall not be used where the normal posted speed limit is less than 45 miles per hour.
8. A curve sign will be required 500 ft. in advance of the exit end of the ramp/round if "T" is equal to or greater than 1,000 feet.
9. The "L" distance equals the lane width times the taper ratio.
 

Normal Posted Speed	Taper Ratio
m.p.h.	ft./ft.
65	65/1
55	55/1
50	50/1
45 or less	45/1
10. Signs mounted in the median may be omitted when the median is less than 10 feet wide. Arrow boards mounted in the median may be omitted when the median is less than 20 feet wide.
11. Steady burning lights will not be required on drums for day operations. All drum lights shall be monodirectional.
12. All signs shall be post mounted if the closure time exceeds four days.
13. Flashing lights shall be used on each approach in advance of the work area during hours of darkness and installed above the first two signs in each series.
14. Longitudinal dimensions may be adjusted to fit field conditions.
15. Form BT 725 is required.

Illinois Department of Transportation

Approved 21 March 1989

*R. H. Jones*  
Engineer of Traffic

**TYPICAL APPLICATION OF TRAFFIC CONTROL DEVICES  
HIGHWAY CONSTRUCTION AND CONTRACT MAINTENANCE**

**MULTILANE, DIVIDED, RURAL DAY OR NIGHT OPERATIONS**

Where at any time, any vehicle, equipment, workers or their activities require the closure of two adjacent lanes and a temporary crossover is provided by making use of one lane of pavement normally used by the opposing flow of traffic and positive barrier is used in the transition to separate the opposing traffic.

**STANDARD 2417-2**