

# As BUILT PLANS

FOR INDEX OF SHEETS, SEE SHEET NO.2  
FOR SUMMARY OF QUANTITIES, SEE SHEET NO.3-4

STATE OF ILLINOIS  
DEPARTMENT OF TRANSPORTATION  
DIVISION OF HIGHWAYS


## PLANS FOR PROPOSED FEDERAL AID HIGHWAY

F.A.I. ROUTE 57  
SECTION 28(5B-1,5B,2B,1B)D-1; 28(5VB,3VB-1)I-1  
FRANKLIN COUNTY  
PROJECT NO. IM-57-2(133)63  
C-99-007-91


F.A.I. RTE.	SECTION	COUNTY	TOTAL SHEETS	SHEET NO.
57	*	FRANKLIN	145	1

ILLINOIS PROJECT NO. 57-2(133)63  
\* 28(5B-1,5B,2B,1B)D-1; 28(5VB,3VB-1)I-1

D-99-036-90

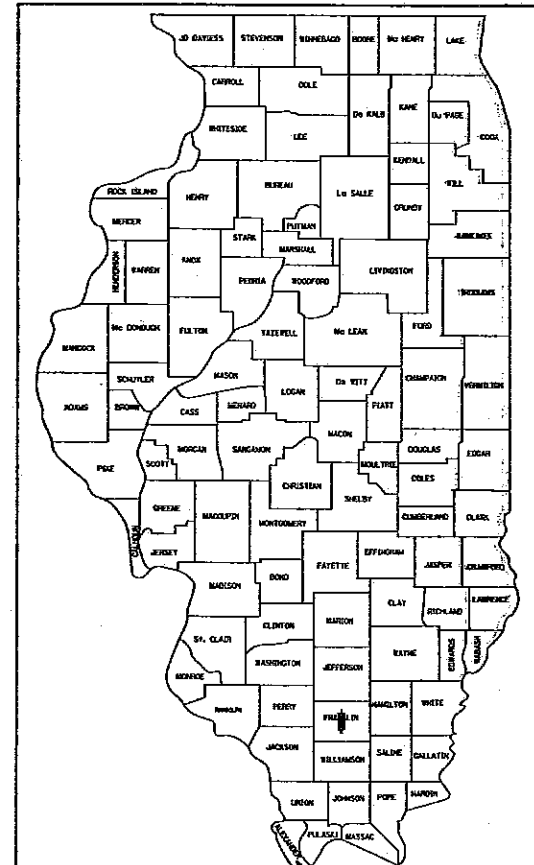

LOCATION OF SECTION INDICATED THUS: [Symbol]

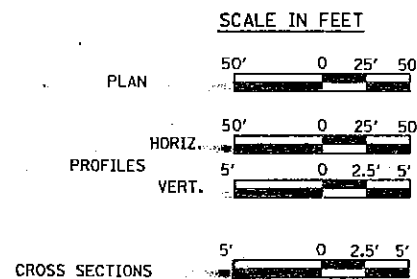

### SUMMARY OF PLAN CHANGES

SEE BACK OF SHEET NO. 5

GUN CREEK	25
MARCUM BRANCH	51
MO-PAC RR	70
MIDDLE FORK CREEK	88
C&E I RR	113
POND CREEK	128

GUN CREEK  
SECTION (28-1B)D-1  
STRUCTURE NO. 028-0014  
(S.B.)



MARCUM BRANCH  
SECTION (28-2B)D-1  
STRUCTURE NO. 028-0011  
(S.B.)

MO. PAC. RAILROAD  
SECTION (28-3VB-1)I-1  
STRUCTURE NO. 028-0008  
(S.B.)

MIDDLE FORK BIG MUDDY RIVER  
SECTION (28-5B)D-1  
STRUCTURE NO. 028-0007  
(S.B.)

ABANDONED RAILROAD & 7TH ST.  
SECTION (28-5VB)I-1  
STRUCTURE NO. 028-0005  
(S.B.)

POND CREEK  
SECTION (28-5B-1)D-1  
STRUCTURE NO. 028-0002  
(S.B.)

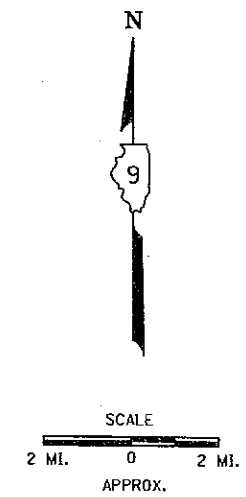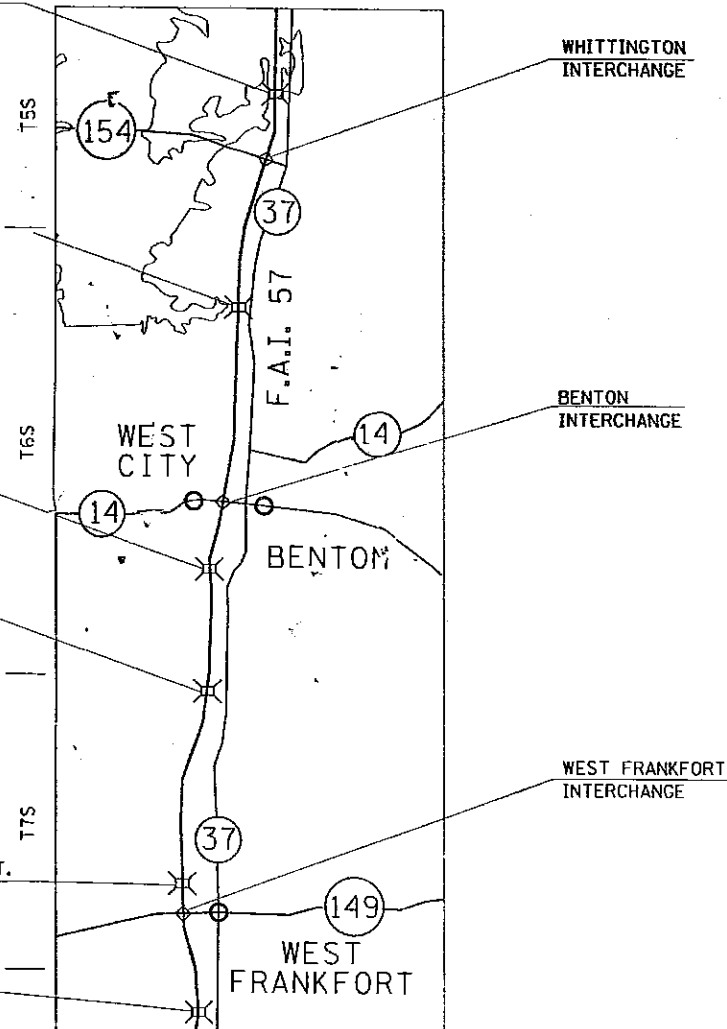

STATE OF ILLINOIS  
DEPARTMENT OF TRANSPORTATION  
DIVISION OF HIGHWAYS

SUBMITTED March 25 1993

EXAMINED \_\_\_\_\_ 19\_\_\_\_

PASSED JUNE 4 1993

APPROVED JUNE 4 1993

DISTRICT ENGINEER: *John D. Rutledge*

ENGINEER OF PLANS AND CONTRACTS: *Harry Gault*

ENGINEER OF DESIGN AND ENVIRONMENT: *Robert C. Weber*

DIRECTOR, DIVISION OF HIGHWAYS

CONTRACT NO. 98149

Sheets 1 Thru 100 (Set of 2)

COUNTY: FRANKLIN SECTION: 28(5B-1,5B,2B,1B)D-1; 28(5VB,3VB-1)I-1 ROUTE: F.A.I. RTE. 57

PROJECT ENGINEER: ED SVI, SQUAD LEADER: CENTREX 71

P. A. L. NO.	SECTION	COUNTY	TOTAL SHEETS	SHEET NO.
57	*	FRANKLIN	145	2
STA.		TO STA.		
FED. ROAD DIST. NO.		SUNDRY	FED. ROAD PROJECT	

\* 2845B-1,5B,2B,1B/D-1428(5VB,3VB)-1H-1

## GENERAL NOTES

THE THICKNESS OF BITUMINOUS MIXTURE SHOWN ON THE PLANS IS THE NOMINAL THICKNESS. DEVIATIONS FROM THE NOMINAL THICKNESS WILL BE PERMITTED WHEN SUCH DEVIATIONS OCCUR DUE TO IRREGULARITIES IN THE EXISTING SURFACE OR BASE ON WHICH THE BITUMINOUS MIXTURE IS PLACED.

FACTORS USED FOR QUANTITY CALCULATIONS ARE AS FOLLOWS:  
ALL BITUMINOUS CONCRETE - - - - - 2.016 TONS/CU. YD.

AT ALL LOCATIONS WHERE BITUMINOUS OR CONCRETE PAVEMENT JOINS AN EXISTING BITUMINOUS OR CONCRETE PAVEMENT, A SAWED JOINT SHALL BE CONSTRUCTED. THE COST OF THIS JOINT WILL BE INCIDENTAL TO THE TYPE OF PAVEMENT BEING CONSTRUCTED.

EXISTING PIPE UNDERDRAIN OUTLETS IN THE MEDIAN SHALL BE PRESERVED AND PROTECTED DURING CONSTRUCTION. ANY DAMAGE TO AN UNDERDRAIN OUTLET RESULTING FROM CONSTRUCTION ACTIVITY SHALL BE REPAIRED AT THE CONTRACTOR'S EXPENSE. IN AREAS WHERE MEDIAN SLOPES ARE TO BE FLATTENED, IT MAY BE NECESSARY TO LENGTHEN EXISTING PIPE DRAINS. IF THIS OCCURS, THE WORK SHALL BE DONE AS DIRECTED BY THE ENGINEER AND PAID FOR IN ACCORDANCE WITH ARTICLE 109.04 OF THE STANDARD SPECIFICATIONS.

UNLESS OTHERWISE NOTED IN THE PLANS, PROPOSED GUARDRAIL WILL BE TAPERED FROM THE BRIDGE PARAPETS AT A RATIO OF 30:1.

THE QUANTITIES FOR BITUMINOUS SHOULDER REMOVAL AND BITUMINOUS SHOULDERS SHOWN IN THE PLANS ARE ONLY ESTIMATES. THE ACTUAL QUANTITIES REQUIRED FOR REPAIR OF SHOULDERS DAMAGED DURING REMOVAL OF THE MEDIAN CROSS-OVER PAVEMENT, AND FOR REPAIR OF DAMAGE TO THE OUTSIDE SOUTHBOUND SHOULDER CAUSED BY TRAFFIC TO THE EXIT RAMP AT THE REST AREA NEAR GUN CREEK, SHALL BE AS DETERMINED BY THE ENGINEER.

A 4' WIDE STRIP OF CROSS-OVER PAVEMENT ADJACENT TO THE EXISTING MAINLINE PAVEMENT SHALL REMAIN IN PLACE AS BITUMINOUS SHOULDER AT EACH END OF EACH MEDIAN CROSS-OVER. SEE THE SPECIAL PROVISION FOR "CROSS-OVER PAVEMENT TO BE USED AS BITUMINOUS SHOULDER".

FOR THE PURPOSE OF THIS CONTRACT, EARTHWORK COMPACTION WILL BE TO THE SATISFACTION OF THE ENGINEER.

THERE ARE NO STUD SHEAR CONNECTORS IN THE EXISTING BRIDGE DECKS.

THE QUANTITY SHOWN IN THE PLANS FOR WOVEN WIRE FENCE TO BE REMOVED AND RE-ERECTED IS BASED ON AN ESTIMATED 5 LINE L FEET AT EACH OF THE WEST WINGWALLS AT EACH OF THE FOUR BRIDGE DECK REPLACEMENT LOCATIONS. THE ACTUAL QUANTITY WILL BE AS DIRECTED BY THE ENGINEER.

## INDEX OF SHEETS

SHEET NO.	ITEM DESCRIPTION
1	TITLE SHEET
2	GENERAL NOTES & INDEX OF SHEETS
3-4	SUMMARY OF QUANTITIES
5	SCHEDULES OF QUANTITIES
6-11	I-57 PLAN SHEETS (1"=200')
	<b>GUN CREEK</b>
12	PLAN SHEET (1"=50')
13-14	PLAN-PROFILE OF MEDIAN CROSS-OVERS
15-22	CROSS SECTIONS OF MEDIAN CROSS-OVERS & GRADING FOR GUARDRAIL
23-38	BRIDGE PLANS
	<b>MARCUM BRANCH</b>
39	PLAN SHEET (1"=50')
40-41	PLAN-PROFILE OF MEDIAN CROSS-OVERS
42-49	CROSS SECTIONS OF MEDIAN CROSS-OVERS & GRADING FOR GUARDRAIL
50-65	BRIDGE PLANS
	<b>MISSOURI PACIFIC RAILROAD</b>
66	PLAN SHEET (1"=50')
67-69	CROSS SECTIONS OF GRADING FOR GUARDRAIL
70-73	BRIDGE PLANS
	<b>MIDDLE FORK BIG MUDDY RIVER</b>
74	PLAN SHEET (1"=50')
75-76	PLAN-PROFILE OF MEDIAN CROSS-OVERS
77-83	CROSS SECTIONS OF MEDIAN CROSS-OVERS & GRADING FOR GUARDRAIL
84-108	BRIDGE PLANS
108A	SOIL BORINGS
	<b>C&amp;E RAILROAD &amp; 7TH STREET</b>
109	PLAN SHEET (1"=50')
110-112	CROSS SECTIONS OF GRADING FOR GUARDRAIL
113-114	BRIDGE PLANS
	<b>POND CREEK</b>
115	PLAN SHEET (1"=50')
116-117	PLAN-PROFILE OF MEDIAN CROSS-OVERS
118-126	CROSS SECTIONS OF MEDIAN CROSS-OVERS & GRADING FOR GUARDRAIL
127-142	BRIDGE PLANS
143	DETAILS: TYPICAL SECTION & TYPICAL PLAN OF MEDIAN CROSS-OVERS; TRAFFIC BARRIER TERMINAL, TY. 3C (PORTABLE)
144	DETAILS: SEEDING & MULCHING; INLET TO BE RECONSTRUCTED
145	DETAILS: TRAFFIC BARRIER TERMINAL, TYPE 7

## STANDARDS

2230-16	2326-3
2298-9	2336-4
2299-13	2337-2
2300-3	2339-2
2307-7	2340-4
2308-6	2341-5
2314-6	2383-3
2315-8	2396
2316-13	2417-2
2324-8	2361

Prepared By:	<i>Joseph L. Linn</i> DISTRICT STUDIES & PLANS ENGINEER
Examined By:	<i>James D. Linn</i> DISTRICT LAND ACQUISITION ENGINEER
Examined By:	<i>Don B. Powell</i> DISTRICT PROGRAM DEVELOPMENT ENGINEER
Examined By:	<i>Bill Stout, Jr.</i> DISTRICT OPERATIONS ENGINEER
Examined By:	<i>Bob Ziebra</i> DISTRICT CONSTRUCTION ENGINEER
Examined By:	<i>James N. Linn</i> DISTRICT MATERIALS ENGINEER
Examined By:	<i>W. P. Linn</i> DISTRICT PROJECT IMPLEMENTATION ENGINEER
Approved By:	<i>N. A. Bethany</i> DISTRICT ENGINEER
	March 25 1973 DATE

# SUMMARY OF QUANTITIES

P.A.L. FILE	SECTION	COUNTY	TOTAL SHEETS	SHEET NO.
57	*	FRANKLIN	145	3
STA.		TO STA.		
FED. ROAD DIST. NO.		BLANKS	FED. AID PROJECT	
* 2B15B-1,5B,2B,1B1D-1;2B15VB,3VB-1;11-1				

CODE NUMBER	ITEM	UNIT	CONSTRUCTION TYPE CODE		SFTY-3Q BRIDGE APPROACHES	SFTY-2c STRUCTURES: 028-0005 028-0008	X071-2A STRUCTURES: 028-0002 028-0007 028-0011 028-0014	S.B. STRUCTURE NUMBER AND NAME					
			PROJECT TOTAL QUANTITY					028-0014 GUN CREEK	028-0011 MARCUM BRANCH	028-0008 MO. PAC. R.R.	028-0007 MIDDLE FORK OF BIG MUDDY RIVER	028-0005 C. & E.L. R.R. & 7TH ST.	028-0002 POND CREEK
20200100	EARTH EXCAVATION	CU. YD.	7,746		7,746	-	-	2,471	2,102	-	1,821	-	1,352
21901000	BITUMINOUS SHOULDERS	TON	300		300	-	-	150	50	-	50	-	50
40801500	P.C. CONCRETE BRIDGE APPROACH SHOULDER PAYEMENT	SQ. YD.	29		29	-	-	-	-	-	29	-	-
50102400	CONCRETE REMOVAL	CU. YD.	70.6		-	31.6	39	9	9	21.4	12	10.2	9
50104720	REMOVAL OF EXISTING CONCRETE DECK	EACH	4		-	-	4	1	1	-	1	-	1
50200100	STRUCTURE EXCAVATION	CU. YD.	150		-	-	150	23	22	-	83	-	22
50200300	COFFERDAM EXCAVATION	CU. YD.	52		-	-	52	-	-	-	52	-	-
50200500	COFFERDAMS	EACH	2		-	-	2	-	-	-	2	-	-
50300100	FLOOR DRAINS	EACH	61		-	-	61	18	12	-	17	-	14
50300120	PREFORMED JOINT SEAL 2 1/2"	LIN. FT.	136		-	-	136	43	49	-	-	-	44
50300130	PREFORMED JOINT SEAL 4"	LIN. FT.	219		-	83	136	43	49	-	-	83	44
50300150	NEOPRENE EXPANSION JOINT 2"	LIN. FT.	125		-	125	42	-	-	125	42	-	-
50300160	NEOPRENE EXPANSION JOINT 4"	LIN. FT.	42		-	-	42	-	-	-	42	-	-
50300250	CLASS X CONCRETE SUPERSTRUCTURE	CU. YD.	1,044.1		-	-	1,044.1	215.4	177.6	-	464.0	-	187.1
50300300	PROTECTIVE COAT	SQ. YD.	3,864		-	-	3,864	852	672	-	1,920	-	690
50300310	ELASTOMERIC BEARING ASSEMBLY, TYPE I	EACH	70		-	-	70	21	14	-	21	-	14
50300320	ELASTOMERIC BEARING ASSEMBLY, TYPE II	EACH	28		-	-	28	-	7	-	14	-	7
50400300	CLASS X CONCRETE	CU. YD.	78.6		-	30.7	67.9	-	-	20.75	67.9	9.95	-
50700100	FURNISHING AND ERECTING STRUCTURAL STEEL	L. SUM	1		-	-	1	-	-	-	1	-	-
50700400	FURNISHING AND ERECTING STRUCTURAL STEEL	POUND	32,240		-	3180	29,060	10,300	9,230	-	-	3180	9,530
50700500	STUD SHEAR CONNECTORS	EACH	16,555		-	-	16,555	3,094	3,255	-	7,056	-	3,150
50700705	JACK AND REMOVE EXISTING BEARINGS	EACH	120		-	-	120	28	28	-	36	-	28
51200200	REINFORCEMENT BARS, EPOXY COATED	POUND	259,975		-	5,335	254,640	51,380	41,660	3930	117,450	1405	44,150
51301600	FURNISHING STEEL PILES HP 12X53	LIN. FT.	208		-	-	208	-	-	-	208	-	-
51301700	FURNISHING STEEL PILES HP 12X74	LIN. FT.	230		-	-	230	-	-	-	230	-	-
51302700	DRIVING STEEL PILES	LIN. FT.	438		-	-	438	-	-	-	438	-	-
51303600	TEST PILE STEEL HP 12X53	EACH	2		-	-	2	-	-	-	2	-	-
51400100	NAME PLATES	EACH	4		-	-	4	1	1	-	1	-	1
61701430	BITUMINOUS SHOULDER REMOVAL	SQ. YD.	697		697	-	-	305	152	-	112	-	128
61704800	SLOPE WALL REMOVAL	SQ. YD.	14		-	-	14	-	-	-	14	-	-

VIEW - SOUTH  
 DATE: Feb. 17, 1957  
 DRAWN BY: J. J. JAMES

△

# SUMMARY OF QUANTITIES

P. A. & P. E.	SECTION	COUNTY	TOTAL SHEETS	SHEET NO.
57	*	FRANKLIN	145	4
STA.		TO STA.		
FED. ROAD DIST. NO.		ALIGN.	TOTAL SHEETS	
* 2815B-1,5B,2B,1B,D-1;2815VB,3VB-111-1				

CODE NUMBER	ITEM	CONSTRUCTION TYPE CODE		SFTY-3Q	SFTY-2Q	X071-2A	S.B. STRUCTURE NUMBER AND NAME					
		UNIT	PROJECT TOTAL QUANTITY	BRIDGE APPROACHES	STRUCTURES: 028-0005 028-0008	STRUCTURES: 028-0002 028-0007 028-0011 028-0014	028-0014 GUN CREEK	028-0011 MARCLUM BRANCH	028-0008 MO. PAC. R.R.	028-0007 MIDDLE FORK OF BIG MUDDY RIVER	028-0005 C. & E.I. R.R. & 7TH ST.	028-0002 POND CREEK
61800300	SLOPE WALL 6 INCH	SQ. YD.	8	-	-	8	-	-	-	8	-	-
62800000	STEEL PLATE BEAM GUARD RAIL, TYPE A	LIN. FT.	2,900	2,900	-	-	200	512.5	437.5	787.5	312.5	650
62800035	TRAFFIC BARRIER TERMINAL, TYPE 1	EACH	8	8	-	-	-	1	2	2	1	2
62800045	TRAFFIC BARRIER TERMINAL, TYPE 2	EACH	3	3	-	-	1	1	1	-	-	-
62800065	TRAFFIC BARRIER TERMINAL, TYPE 4	EACH	2	2	-	-	1	1	-	-	-	-
62800070	TRAFFIC BARRIER TERMINAL, TYPE 5	EACH	3	3	-	-	1	1	-	1	-	-
62800085	TRAFFIC BARRIER TERMINAL, TYPE 6	EACH	8	8	-	-	2	2	-	2	-	2
62800090	TRAFFIC BARRIER TERMINAL, TYPE 7	EACH	4	4	-	-	-	-	2	-	2	-
62800105	TRAFFIC BARRIER TERMINAL, TYPE 10	EACH	1	1	-	-	-	-	1	-	-	-
62802800	TEMPORARY GUARD RAIL	LIN. FT.	537.5	537.5	-	-	150	137.5	-	137.5	-	112.5
63002400	WOVEN WIRE FENCE TO BE REMOVED AND RE ERCTED	LIN. FT.	40	40	-	-	10	10	-	10	-	10
63300300	STEEL PLATE BEAM GUARD RAIL REMOVAL	LIN. FT.	4,100	4,100	-	-	675	325	975	325	862.5	937.5
64200200	SEEDING CLASS 2	ACRE	11.8	11.8	-	-	3.2	3.2	-	3.0	-	2.4
64200400	NITROGEN FERTILIZER NUTRIENT	POUND	944	944	-	-	256	256	-	240	-	192
64200500	PHOSPHORUS FERTILIZER NUTRIENT	POUND	3,776	3,776	-	-	1,024	1,024	-	960	-	768
64200600	POTASSIUM FERTILIZER NUTRIENT	POUND	1,888	1,888	-	-	512	512	-	480	-	384
64200700	AGRICULTURAL GROUND LIMESTONE	TON	23.6	23.6	-	-	6.4	6.4	-	6	-	4.8
64300130	MULCH, METHOD 3	TON	23.6	23.6	-	-	6.4	6.4	-	6	-	4.8
64600401	ENGINEER'S FIELD OFFICE, TYPE A 1	CAL. MO.	14	14	-	-	3	3	1	3	1	3
64800410	TRAFFIC CONTROL AND PROTECTION STANDARD 2417	EACH	4	4	-	-	1	1	-	1	-	1
64800700	TRAFFIC CONTROL AND PROTECTION STANDARD 2315	L. SUM	1	1	-	-	-	-	-	1	-	-
64800800	TRAFFIC CONTROL AND PROTECTION STANDARD 2316	L. SUM	1	1	-	-	0.1	0.1	0.3	0.1	0.3	0.1
65601000	TEMPORARY CONCRETE BARRIER (STATE FURNISHED)	LIN. FT.	5,010	-	-	5,010	1,080	1,240	-	1,520	-	1,170
67100100	TEMPORARY LIGHTING SYSTEM	L. SUM	1	1	-	-	0.25	0.25	-	0.25	-	0.25
Z0006070	BRIDGE DECK GROOVING	SO. YD.	3281	-	-	3281	678	527	-	1521	-	555
X0557700	BRIDGE SEAT SEALER	SQ. FT.	680	-	-	680	147	189	-	167	-	177
Z0017900	DRAINAGE SCUPPERS	EACH	4	-	-	4	-	-	-	4	-	-
Z0048665	RAILROAD PROTECTIVE LIABILITY INSURANCE	L. SUM	1	-	1	-	-	-	1	-	-	-
Z0076600	TRAINEES	HOUR	500	-	100	400	100	100	50	100	50	100
T5020200	PAINT PAVEMENT MARKING - LINE 4"	LIN. FT.	1,779	-	-	1,779	367	287	-	827	-	298
TX003900	PORTABLE CHANGEABLE MESSAGE SIGN	EACH	4	-	0.8	3.2	0.8	0.8	0.4	0.8	0.4	0.8

0 CONSTRUCTION TYPE CODE - 4080

\*Specialty items




WES - CONSTRUCTION  
 Date: Mar 23 11:47:47 1993  
 Job: FRANKLIN/1111/0015003.DWG L111-03








ROUTE NO.	SEC.	COUNTY	TOTAL SHEETS	SHEET NO.
F.A. 57		FRANKLIN	145	6
FED. ROAD DIST. NO. 7	ILLINOIS	PROJECT		




SEC. 28 (5B-1, 5B-2, 1B) D-1  
28 (5VB, 3VB-1) F-1

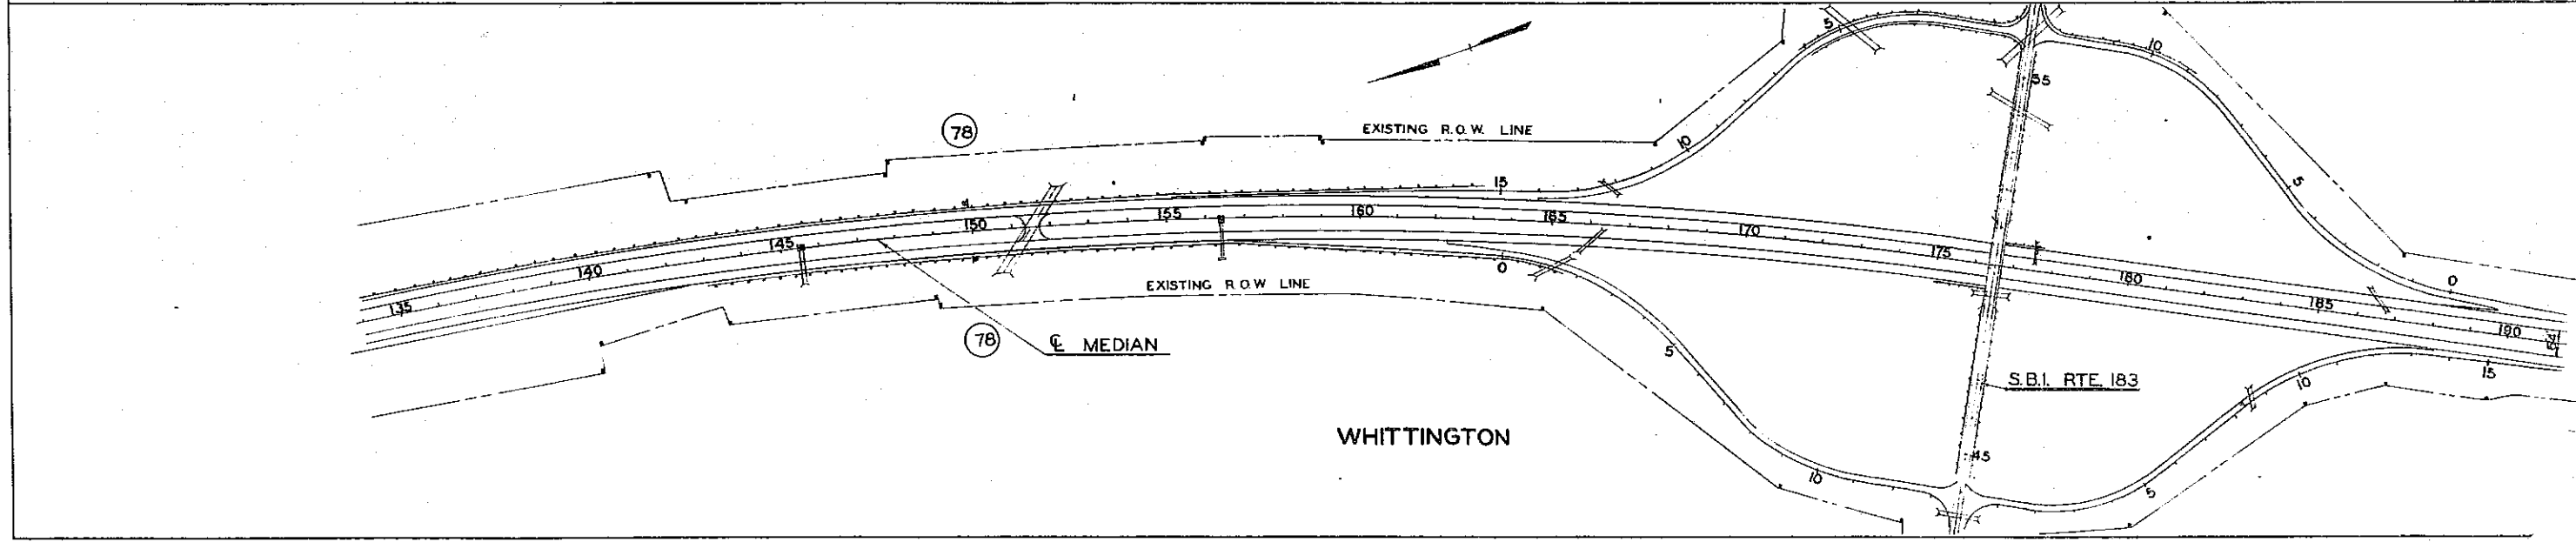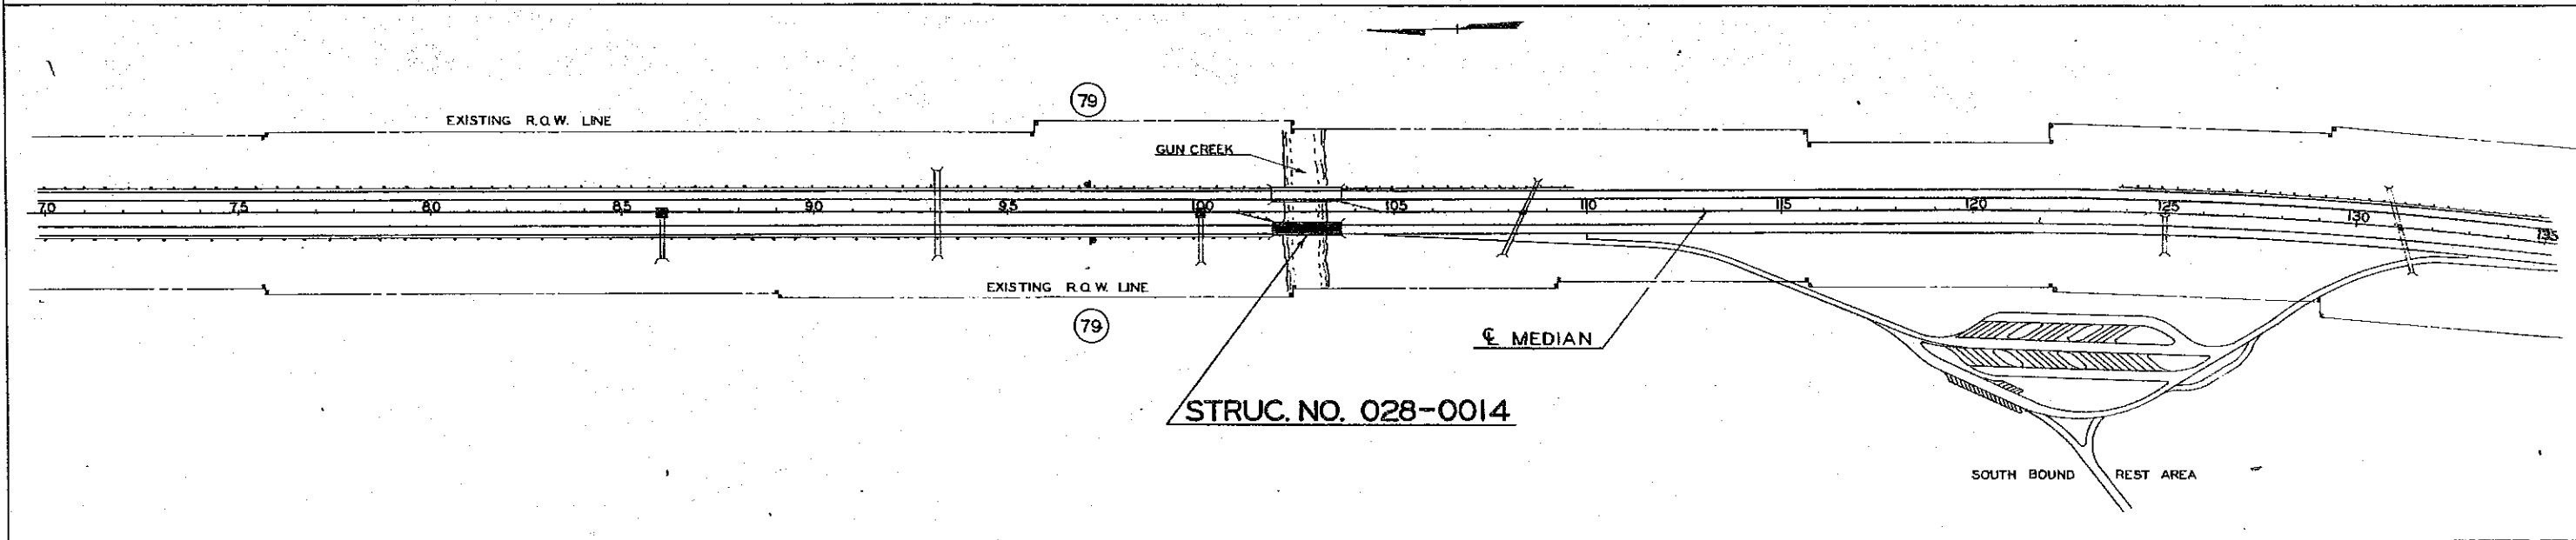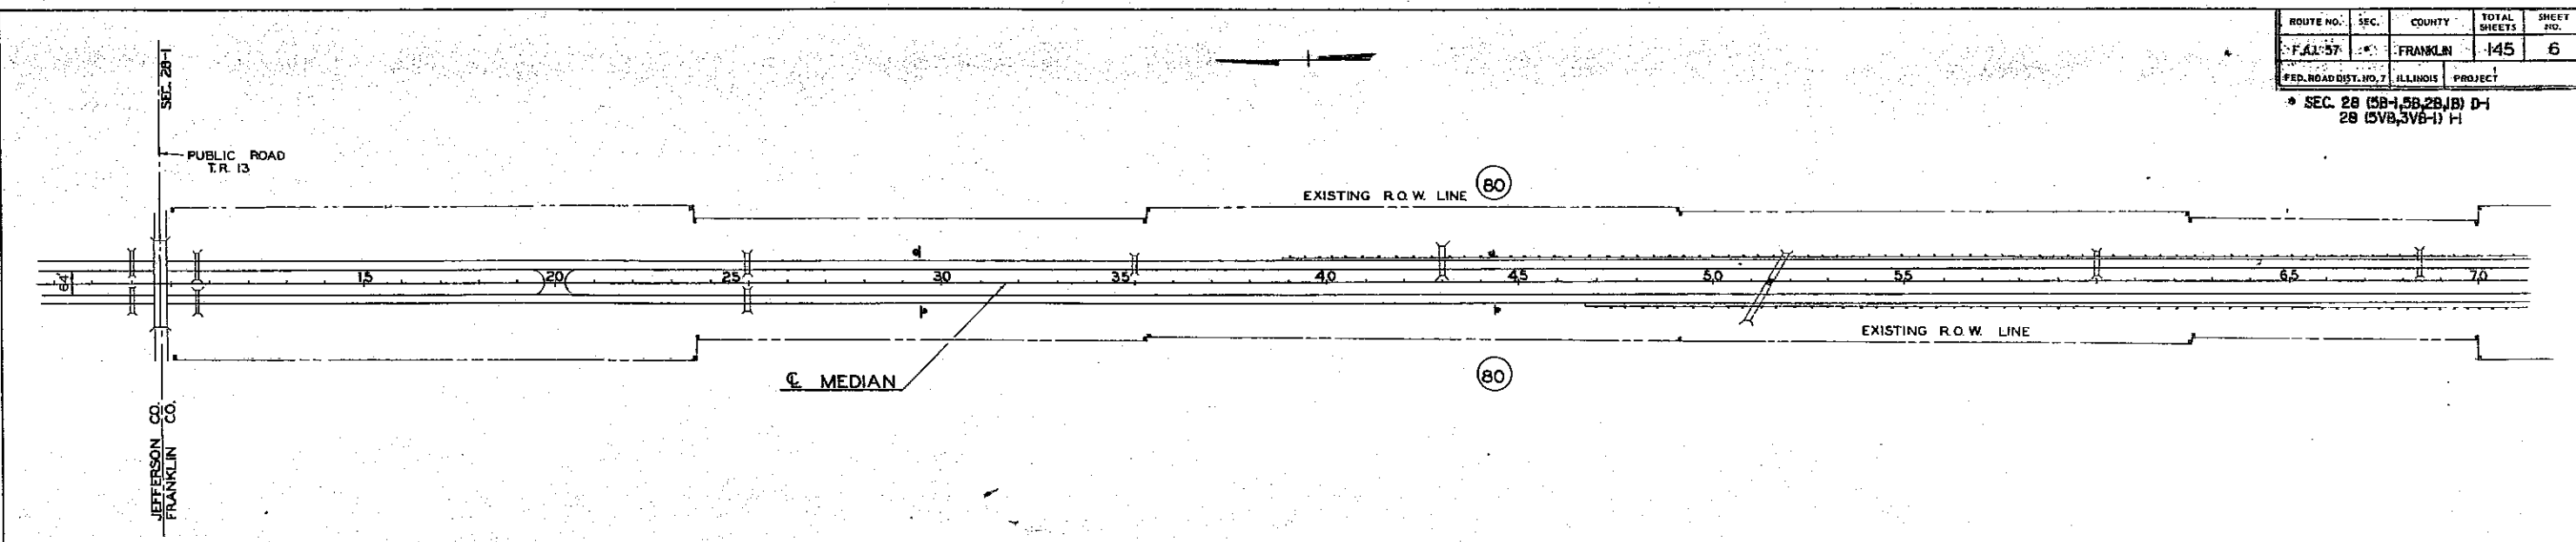




ROUTE NO.	SEC.	COUNTY	TOTAL SHEETS	SHEET NO.
FAI. 57		FRANKLIN	145	7
FED. ROAD DIST. NO. 7 ILLINOIS PROJECT:				
SEC. 28 (58-1, 58-2, 1B) D-1				
28 (58-1, 58-2, 1B) H				

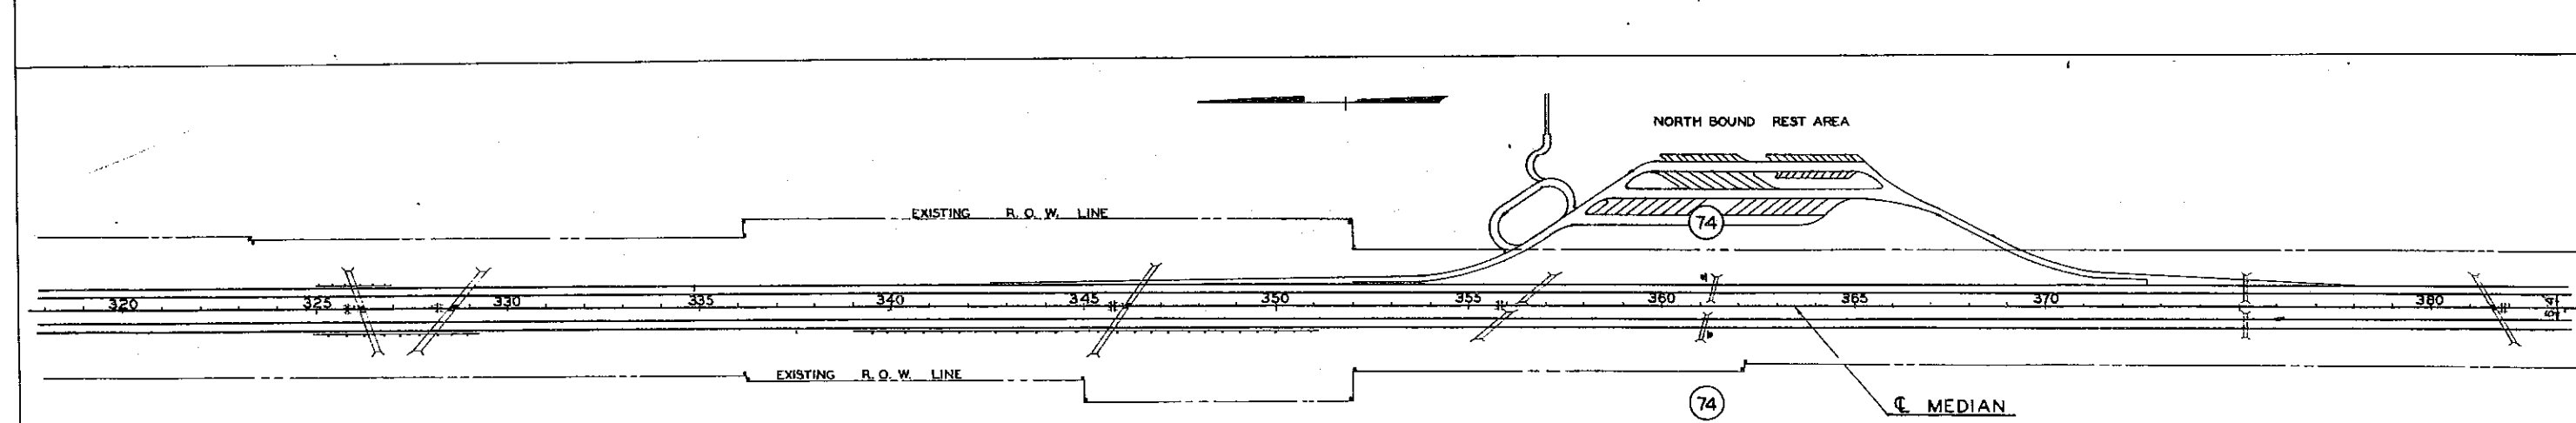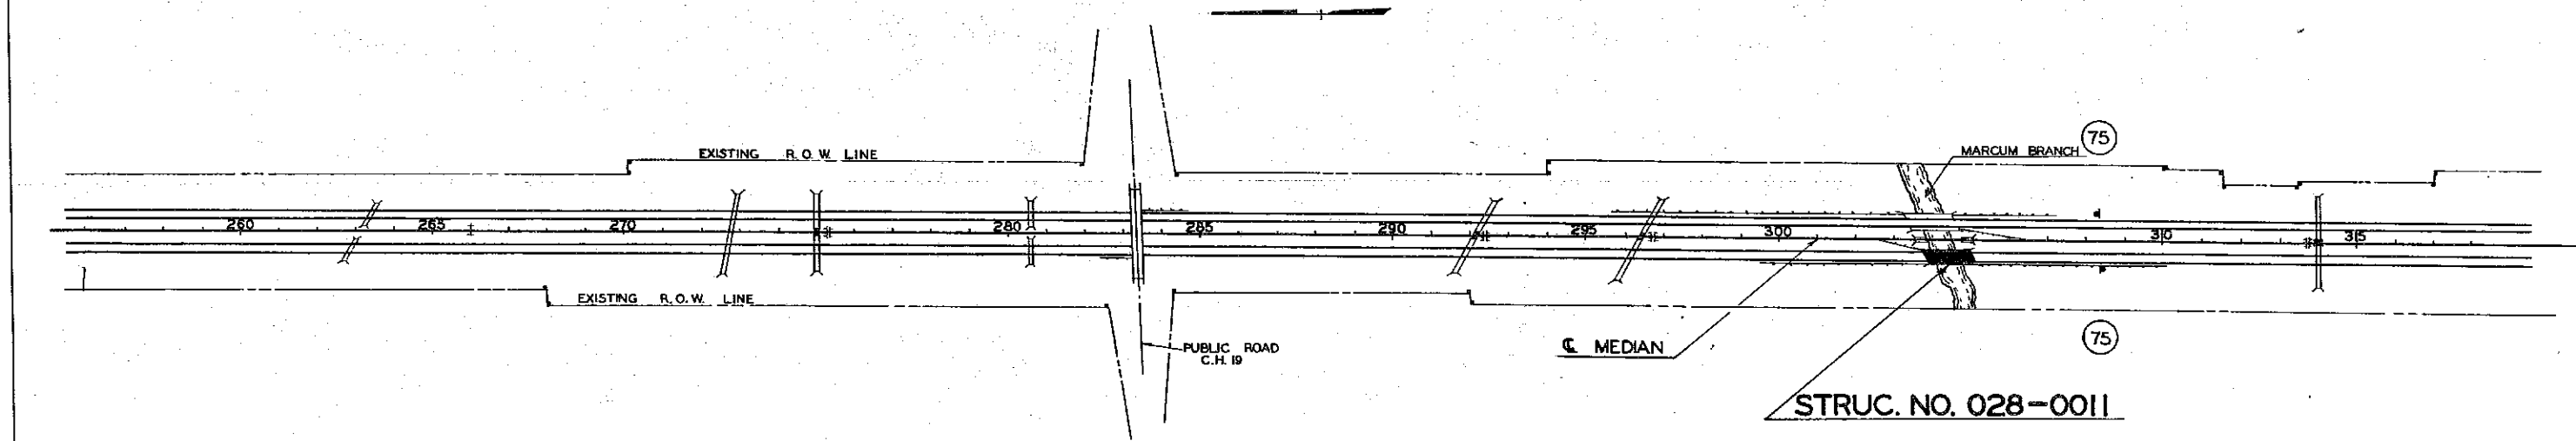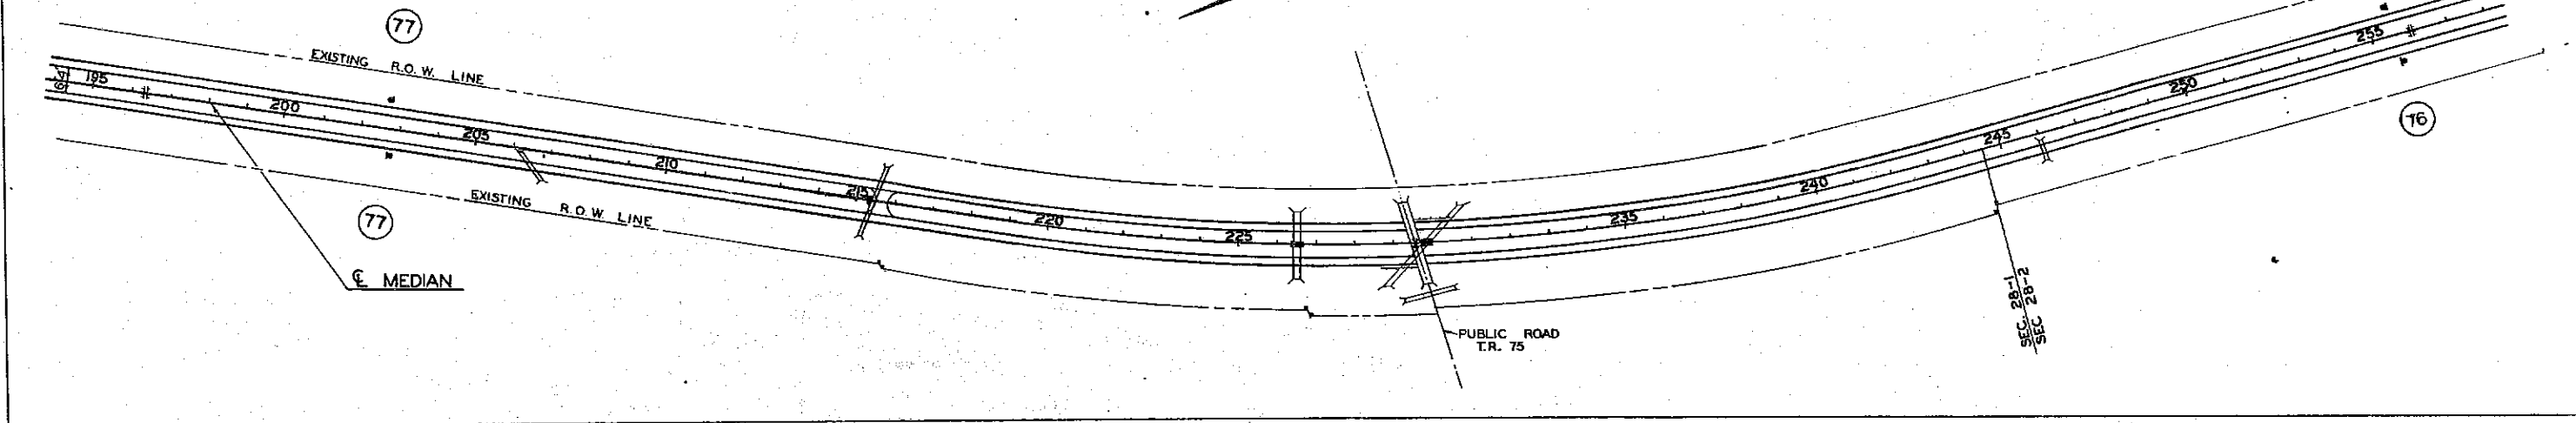


ROUTE NO.	SEC.	COUNTY	TOTAL SHEETS	SHEET NO.
F.A.I. 57	28	FRANKLIN	145	8
FED. ROAD DIST. NO. 7 ILLINOIS PROJECT				
* SEC. 28 (5B-1, 5B, 2B, 1B) D-1 28 (5VB, 3VB-1) H				

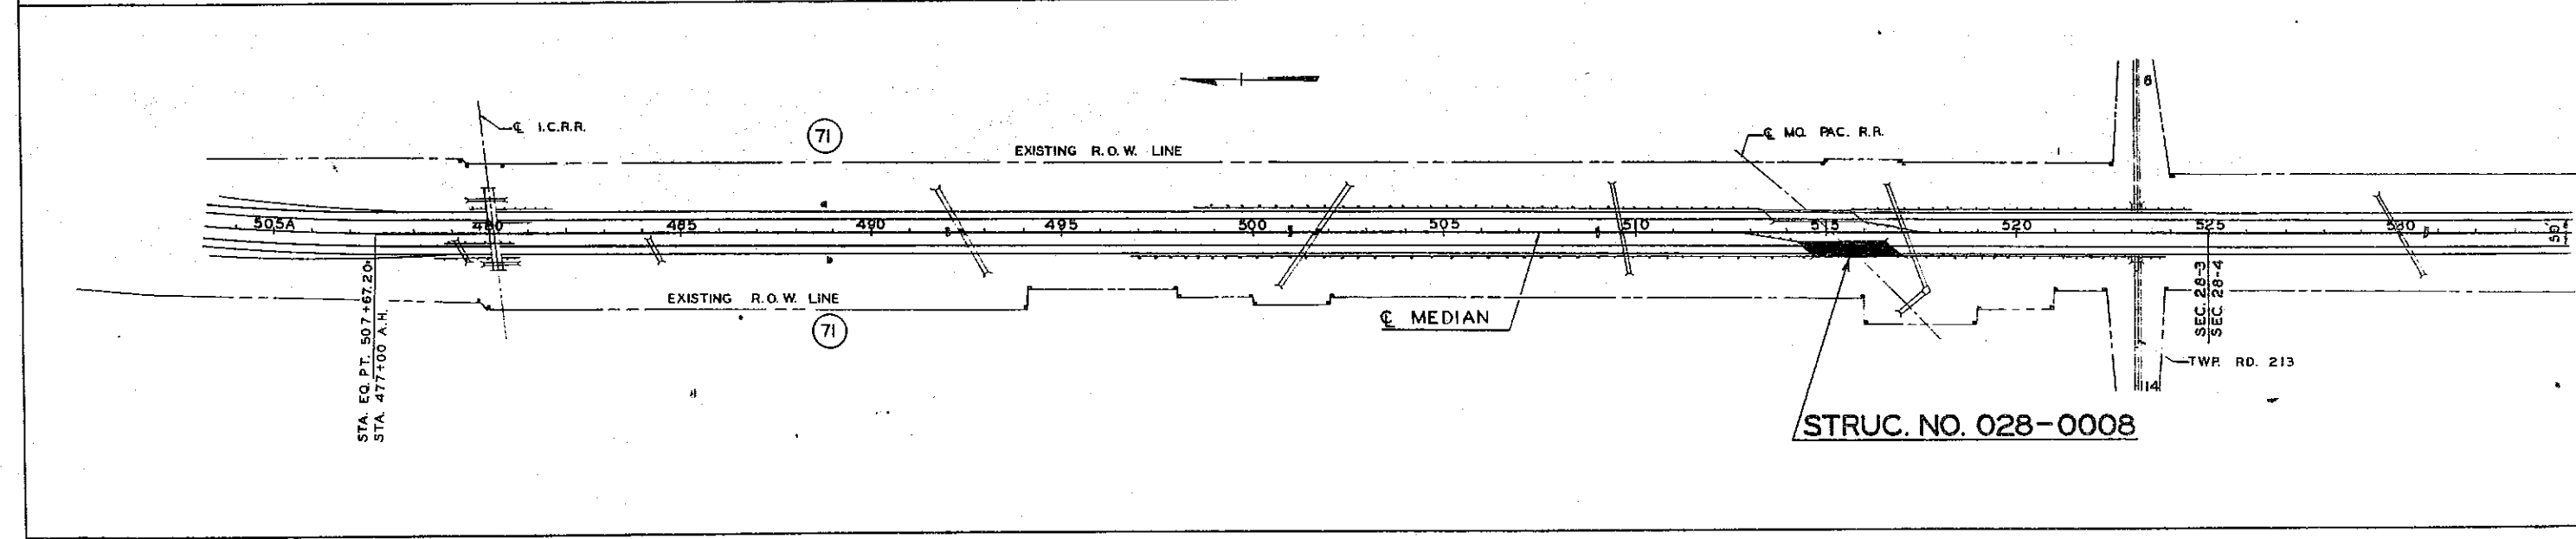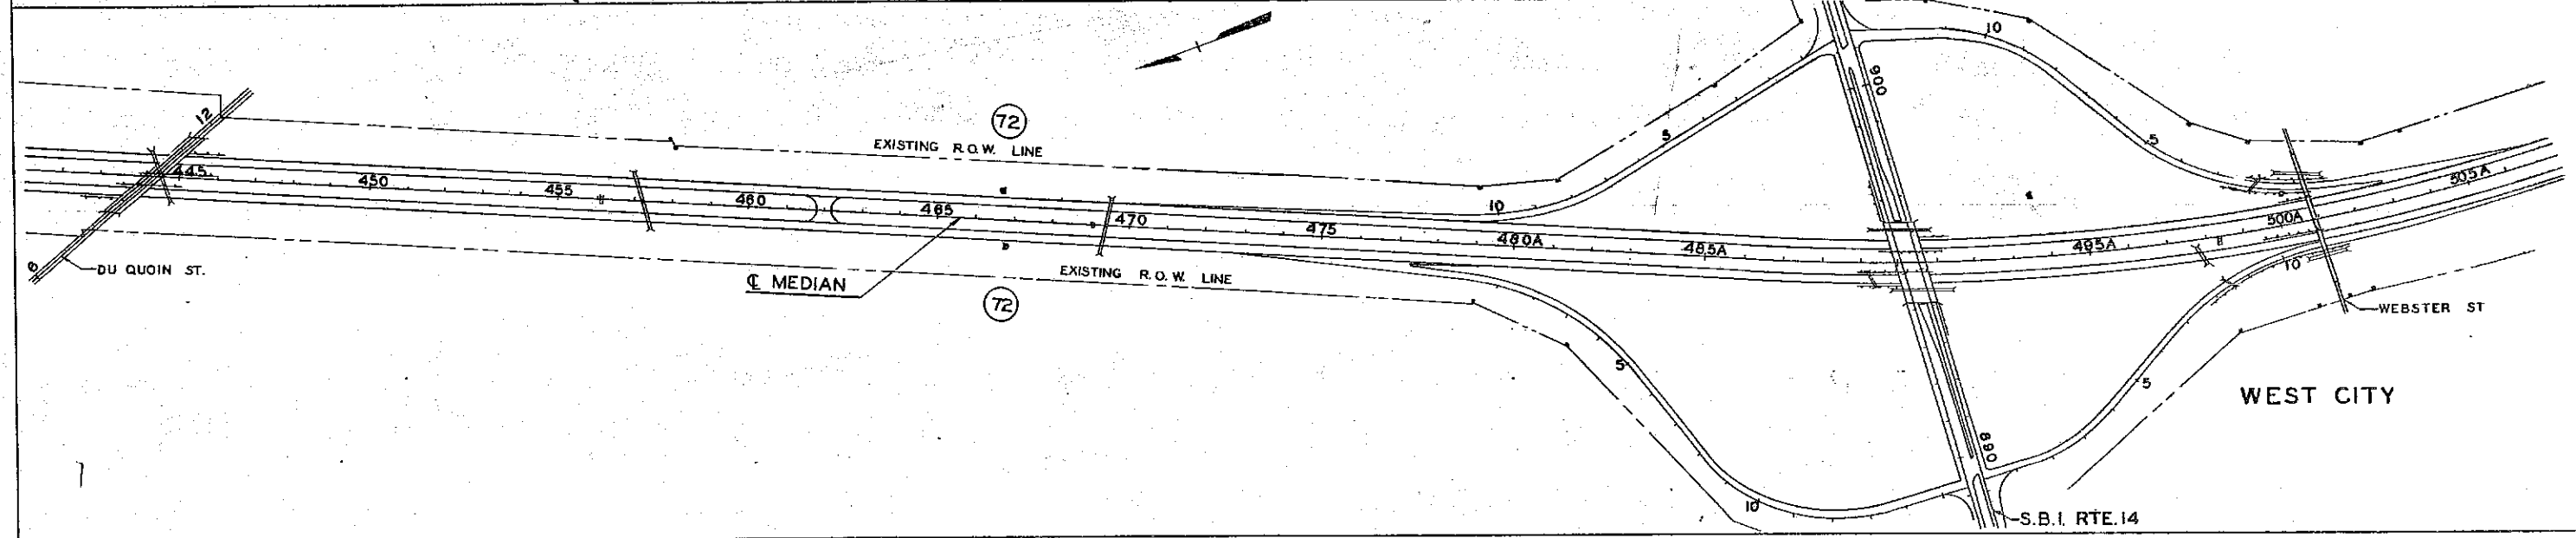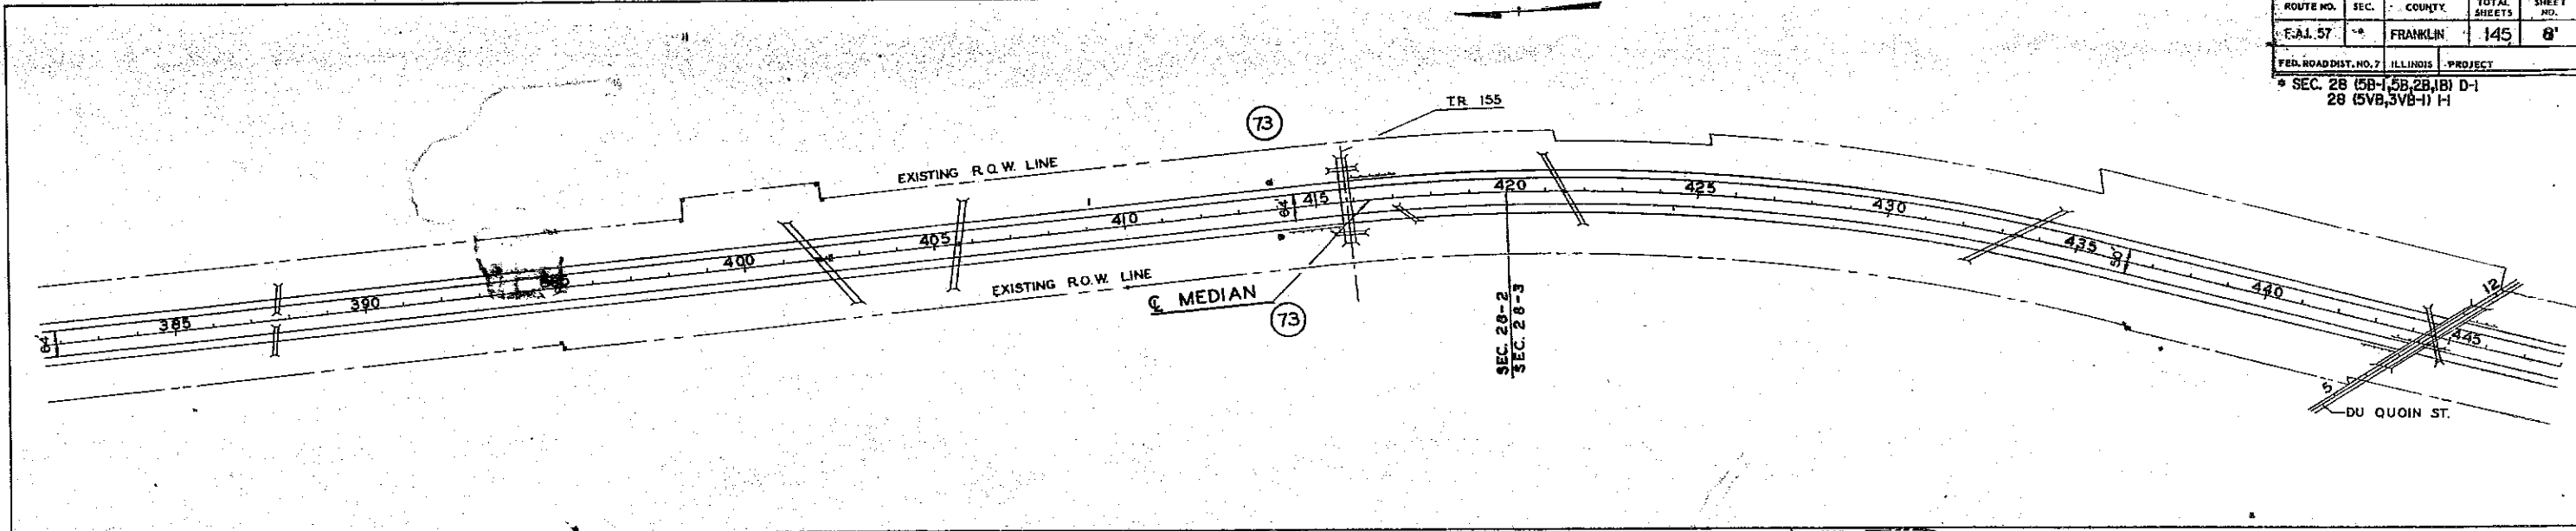


ROUTE NO.	SEC.	COUNTY	TOTAL SHEETS	SHEET NO.
F.A.I. 57	•	FRANKLIN	145	9
FED. ROAD DIST. NO. 7		ILLINOIS	PROJECT	

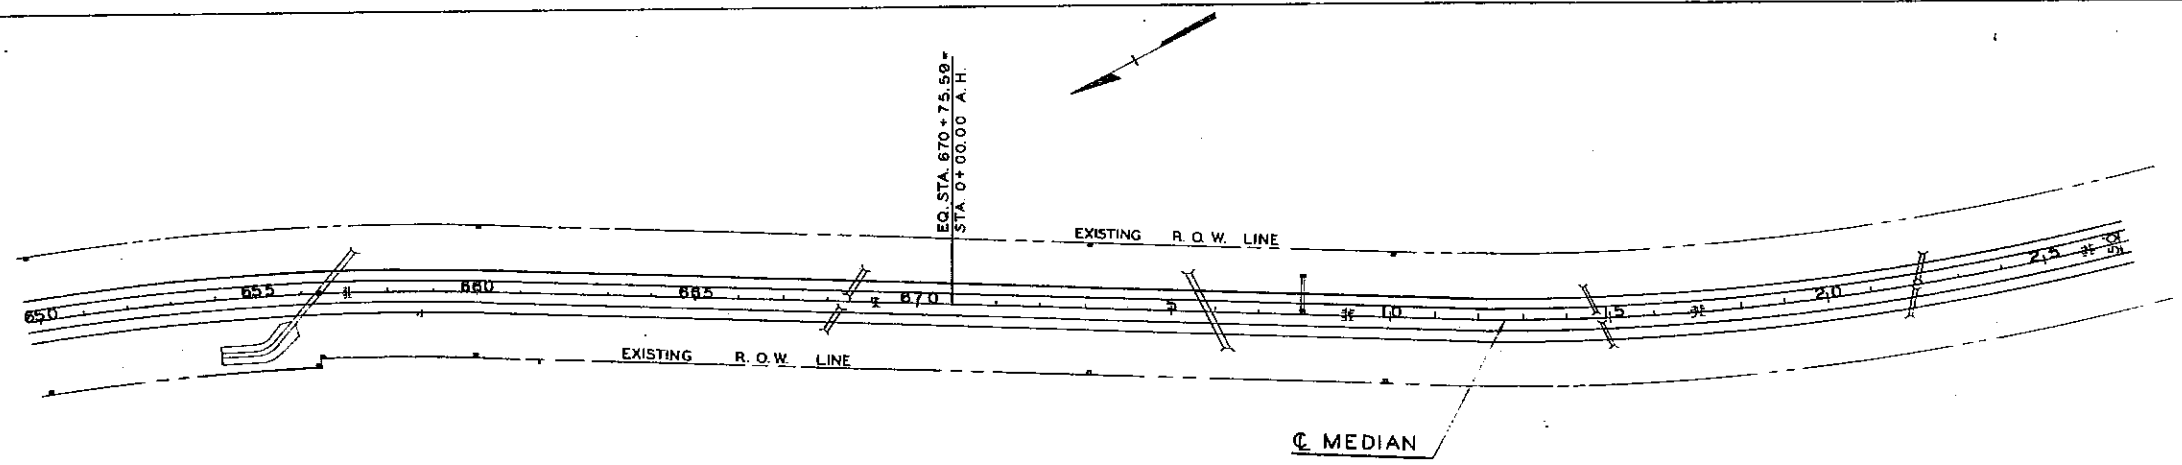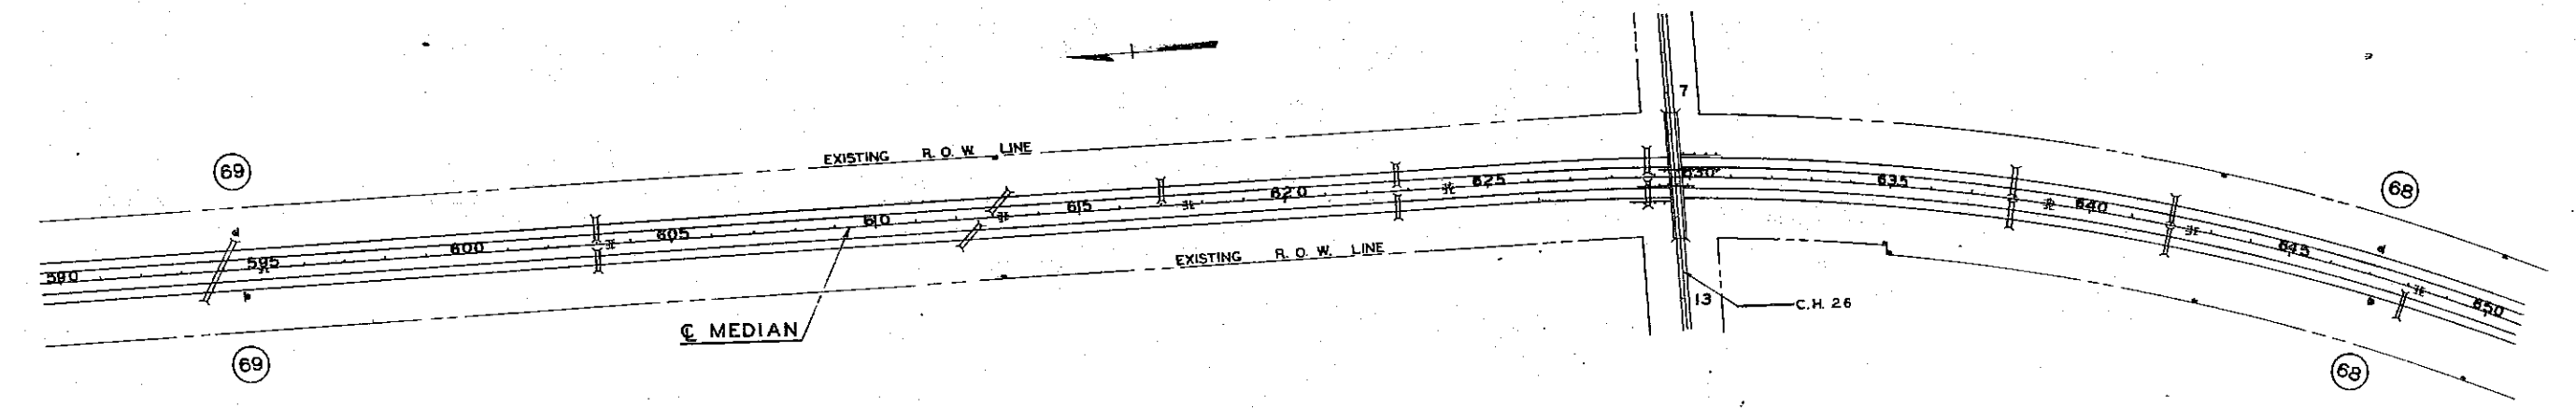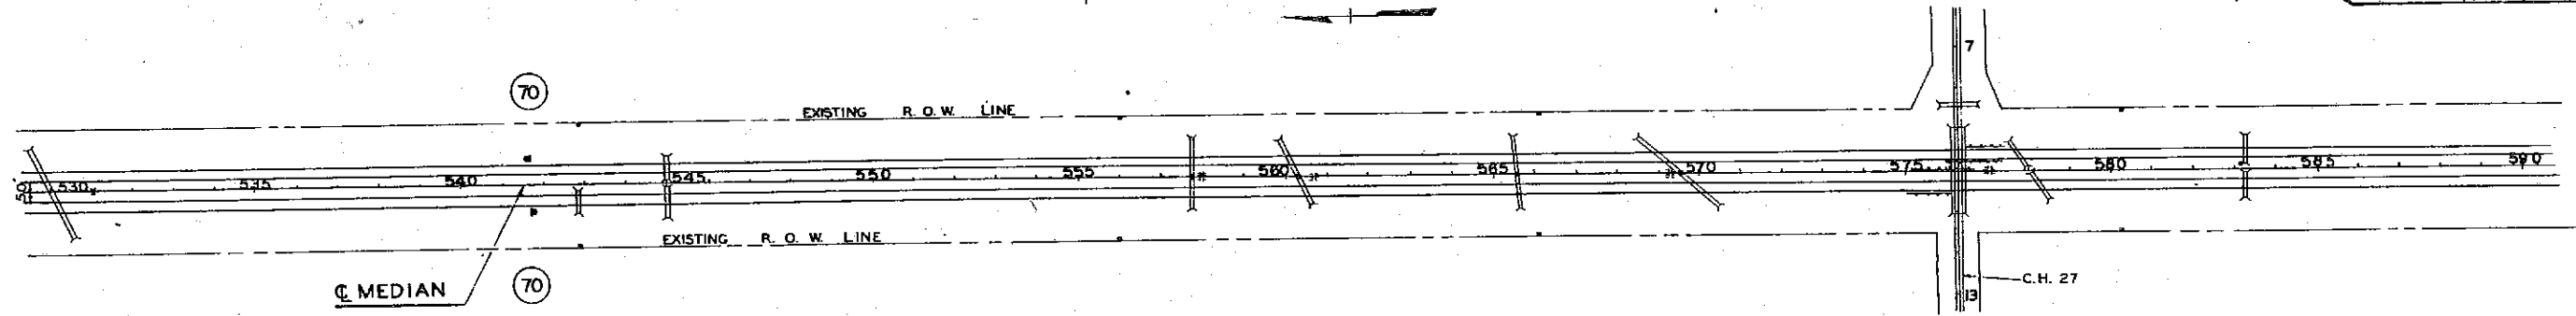


ROUTE NO.	SEC.	COUNTY	TOTAL SHEETS	SHEET NO.
F.A.I. 57	*	FRANKLIN	145	10
FED. ROAD DIST. NO. 7		ILLINOIS	PROJECT	
* SEC. 20156-1,58,180-1,28(SVB,3VB-1H)				

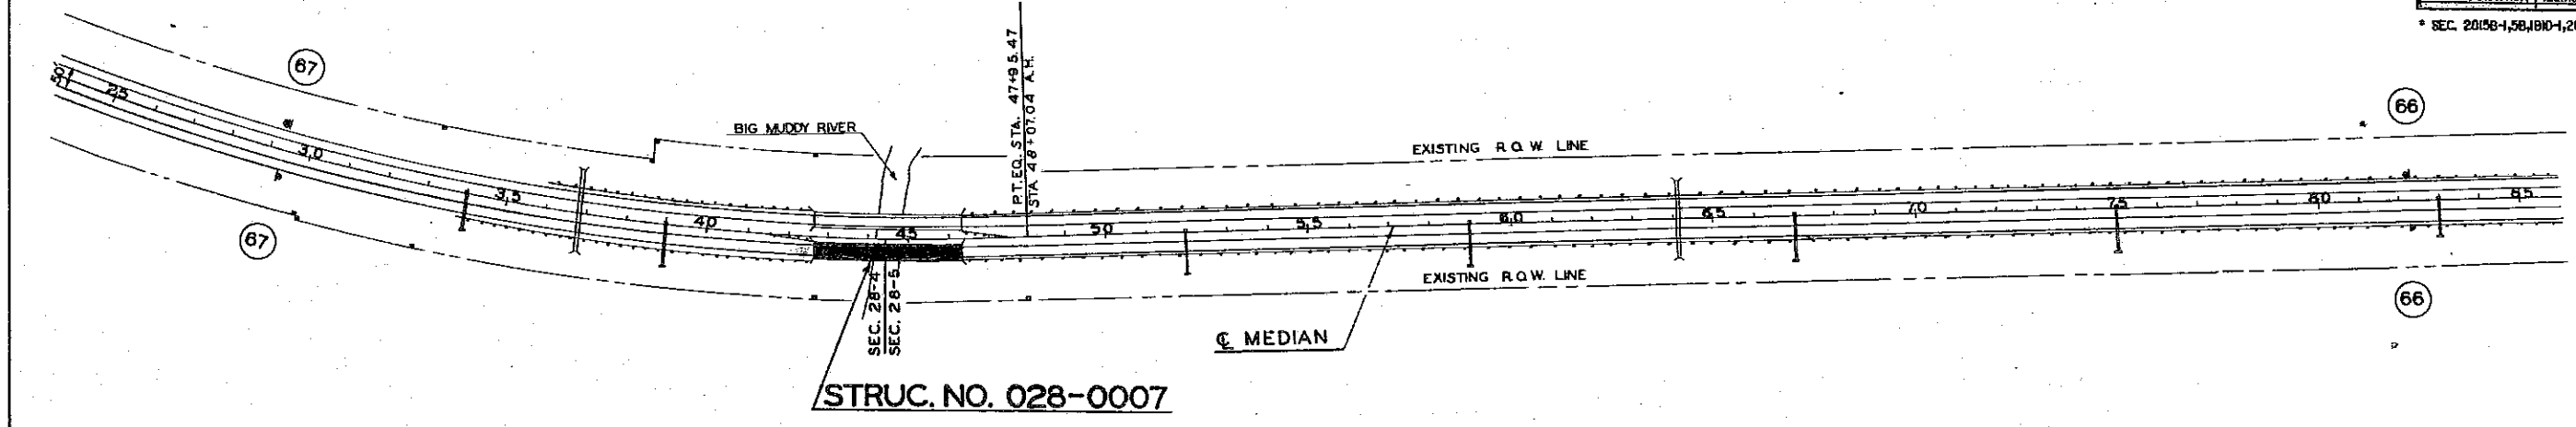

STRUC. NO. 028-0007

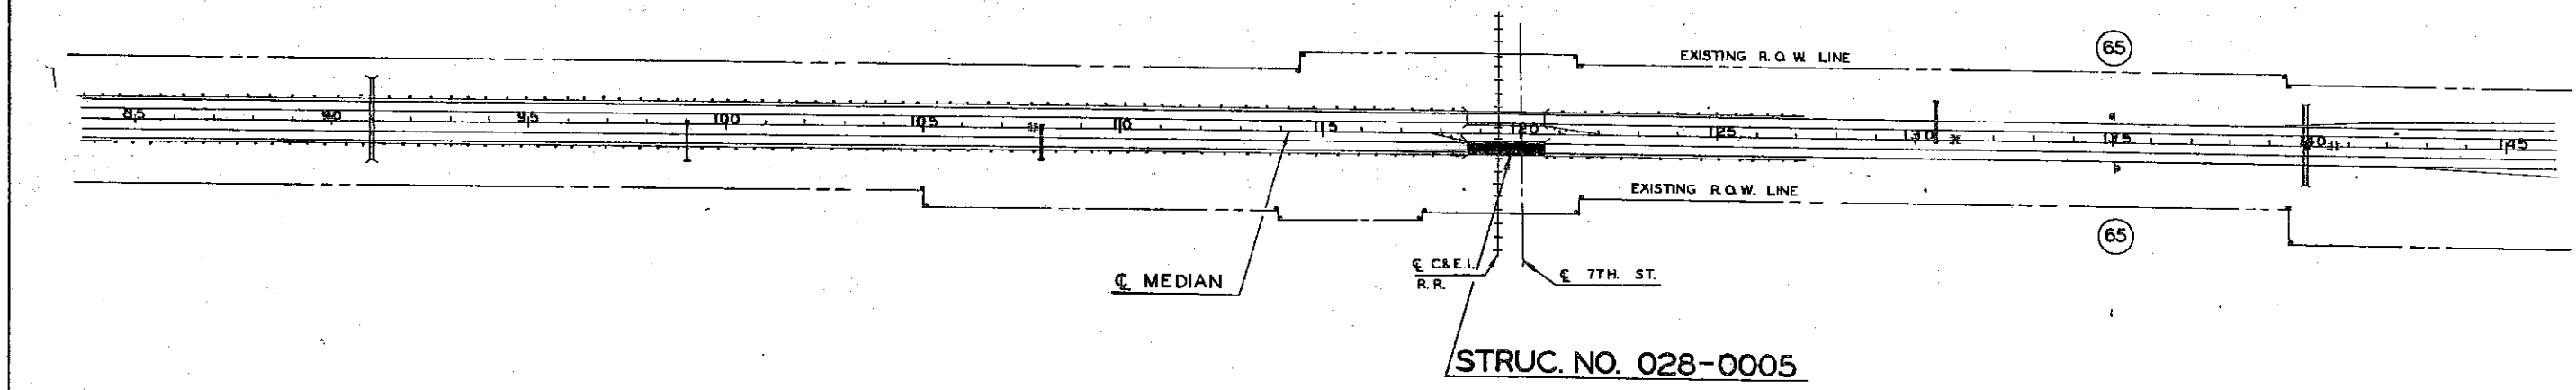




STRUC. NO. 028-0005

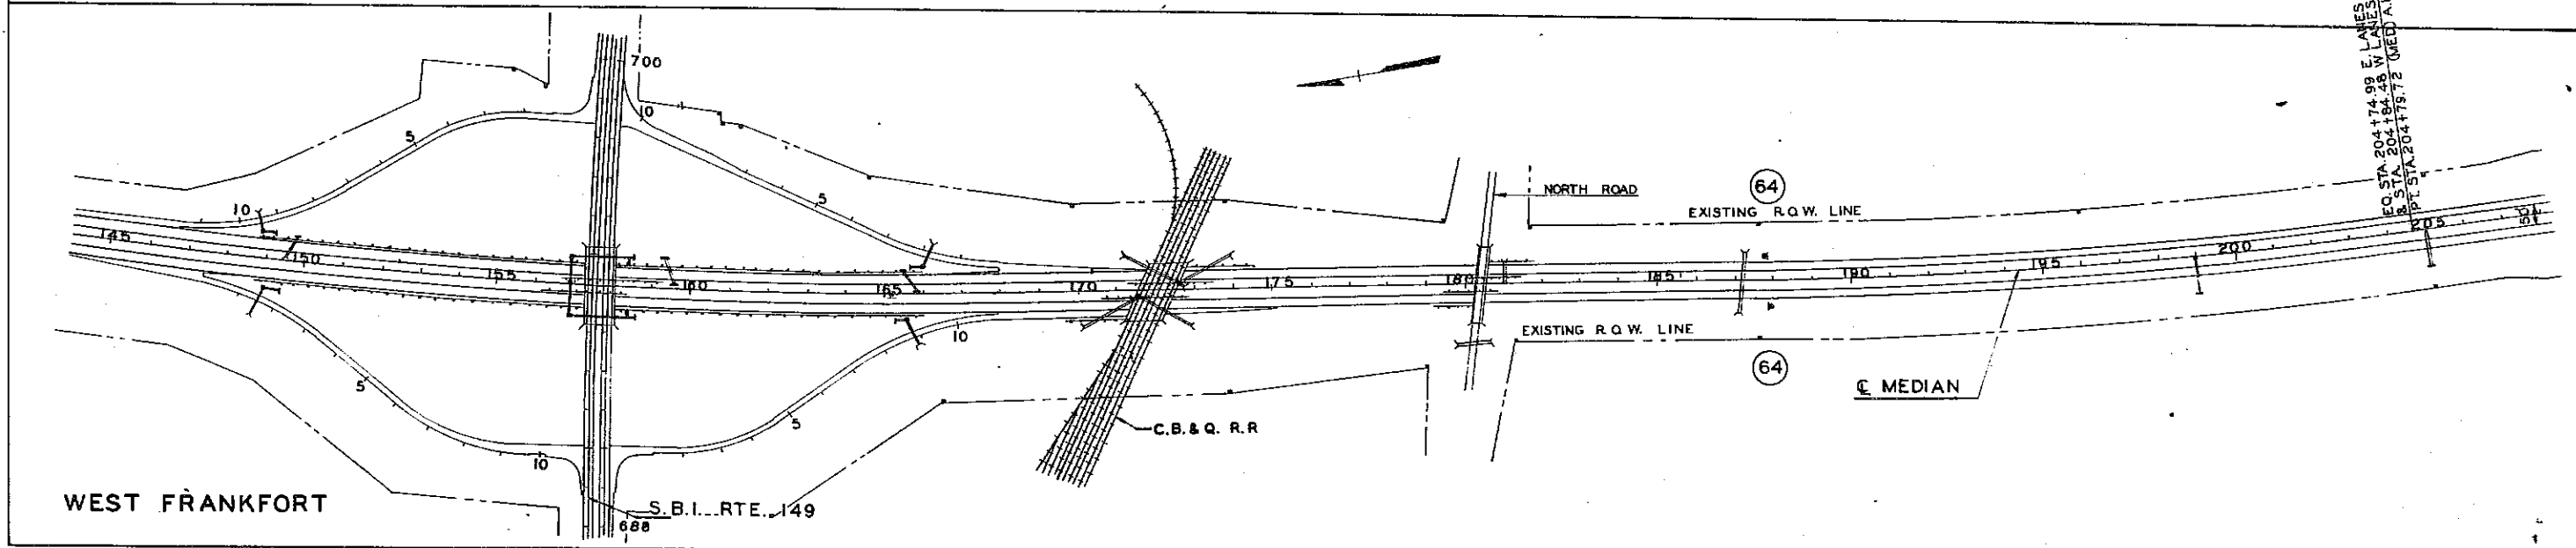

WEST FRANKFORT

ROUTE NO.	SEC.	COUNTY	TOTAL SHEETS	SHEET NO.
FAL 57		FRANKLIN	145	11
FED. ROAD DIST. NO. 7 ILLINOIS PROJECT				

\* SEC. 5B-1, 5B, 2B, 1B 1 D-1, 2B (5VB, 3VB-1H-1)

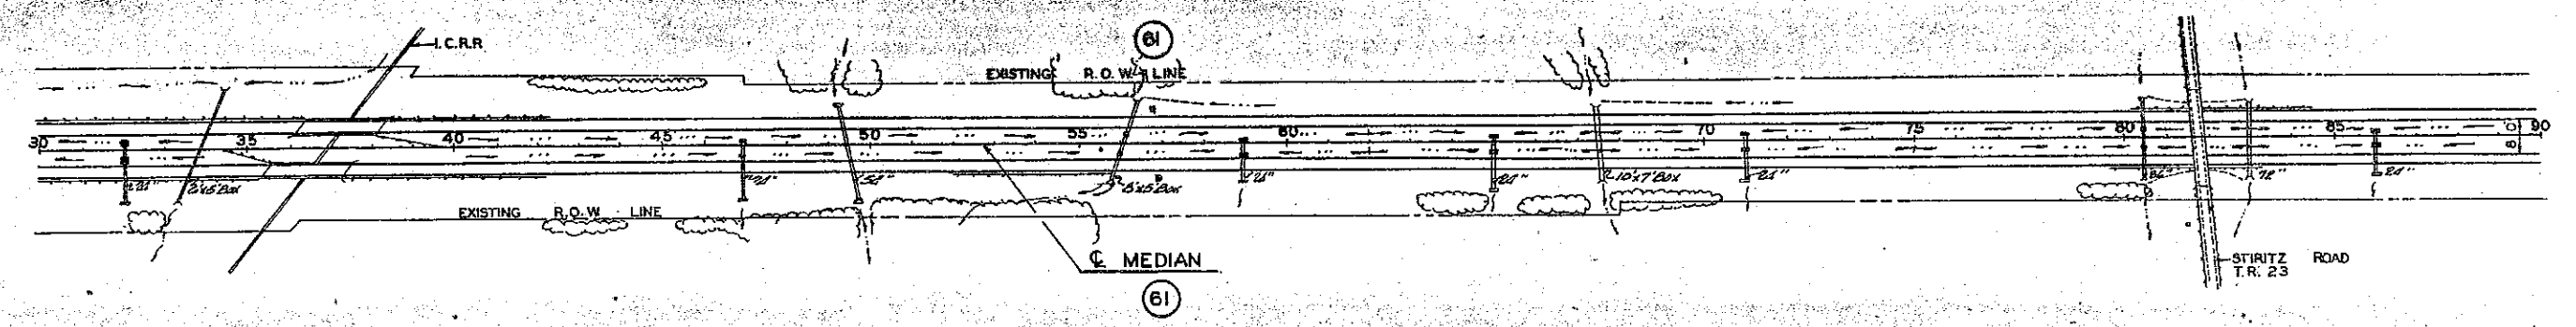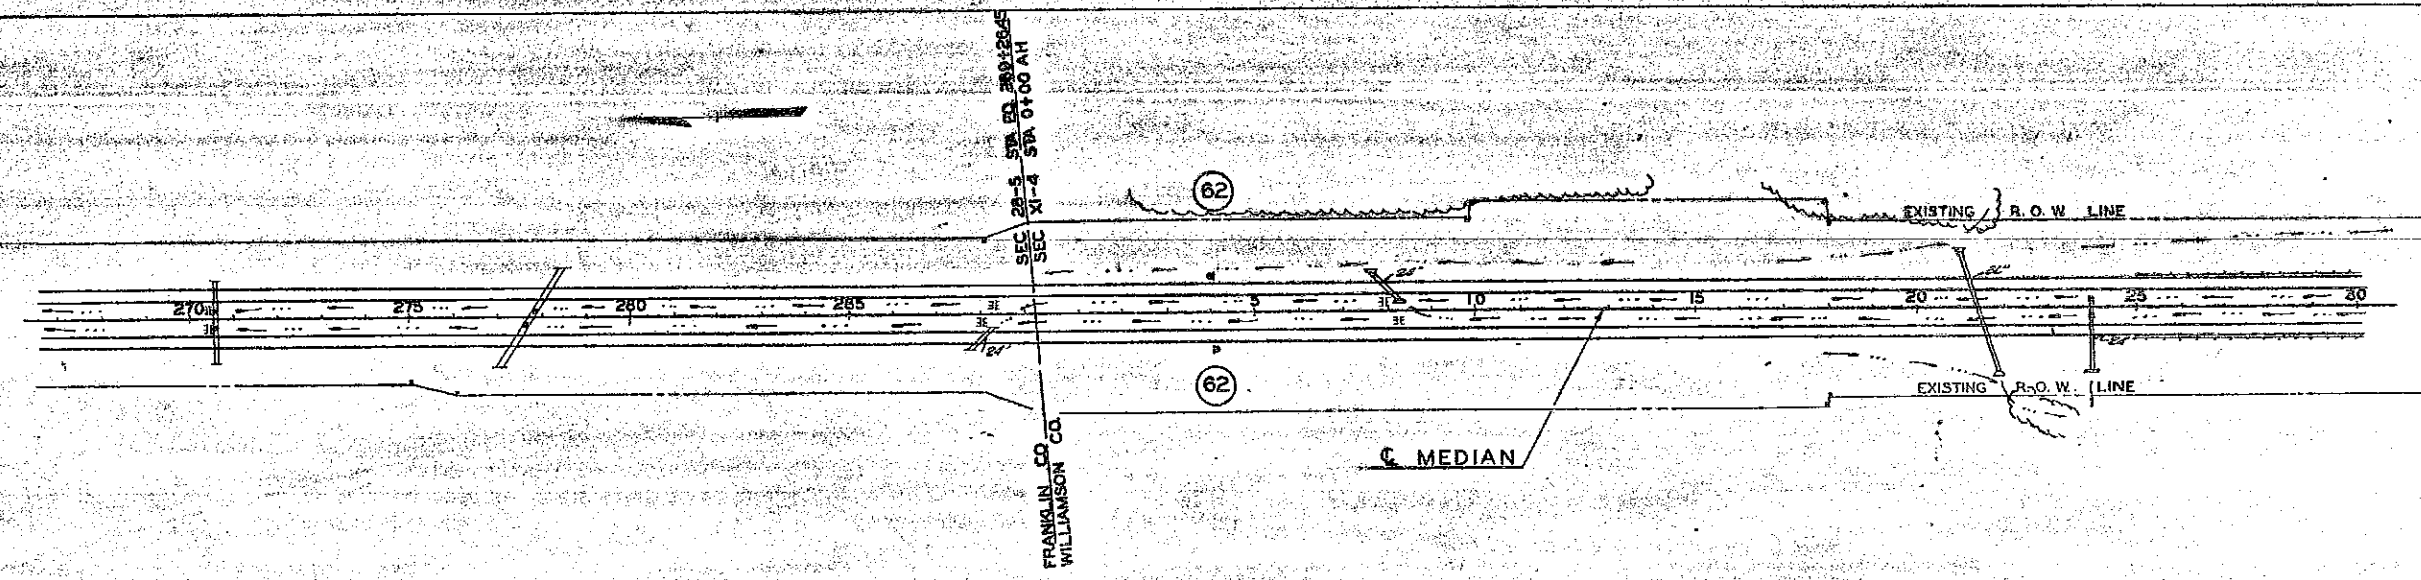
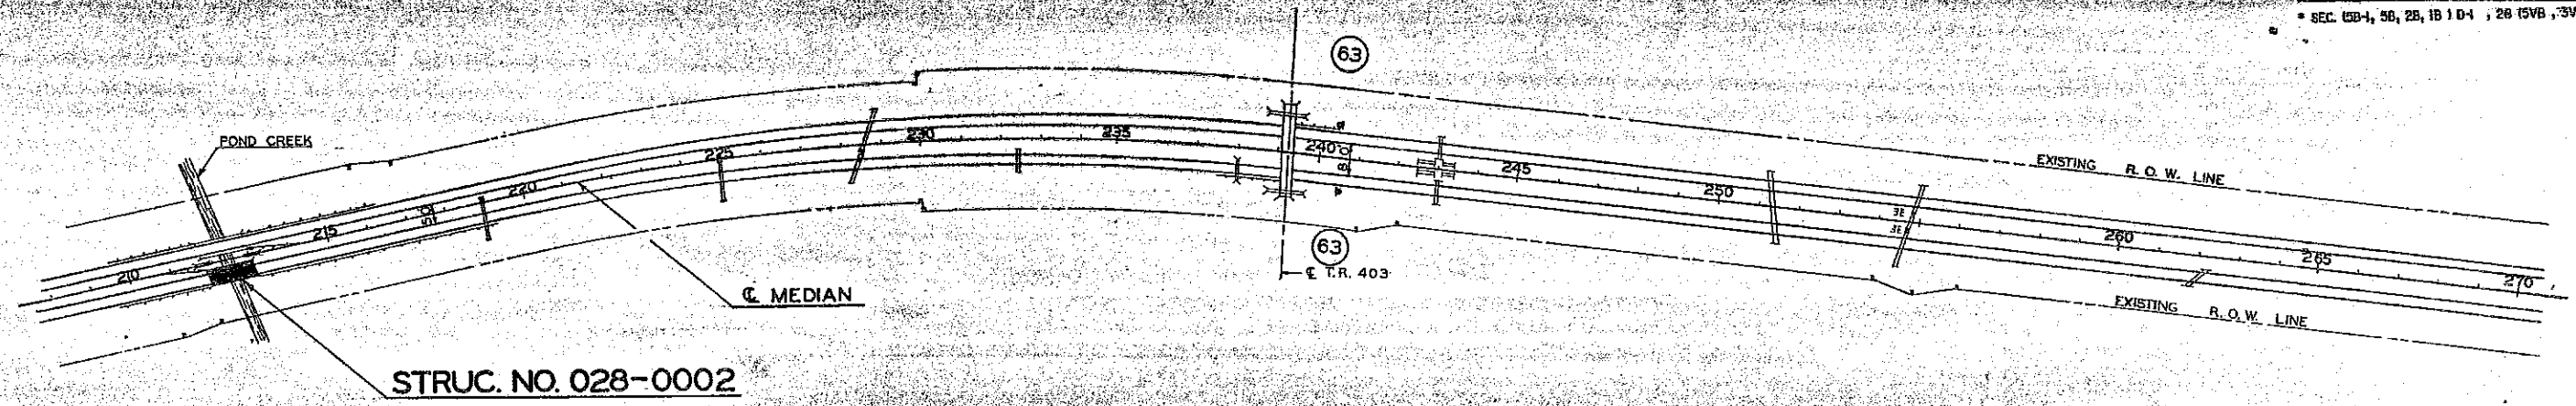






NO.	SECTION	COUNTY	TITLE	SHEET NO.
57	*	FRANKLIN	145	13
STA.		TO STA.		
FOOT AND DECI. IN.		ELEVATION		

\* 28 (58-1, 58, 28, 18) 0-1, 28 (58/8, 58/3) I-1  
 TEMP. GUARDRAIL  
 150 LIN. FT.  
 (INCLUDES ONE TY. 4 TERMINAL  
 & ONE TY. 5 TERMINAL)

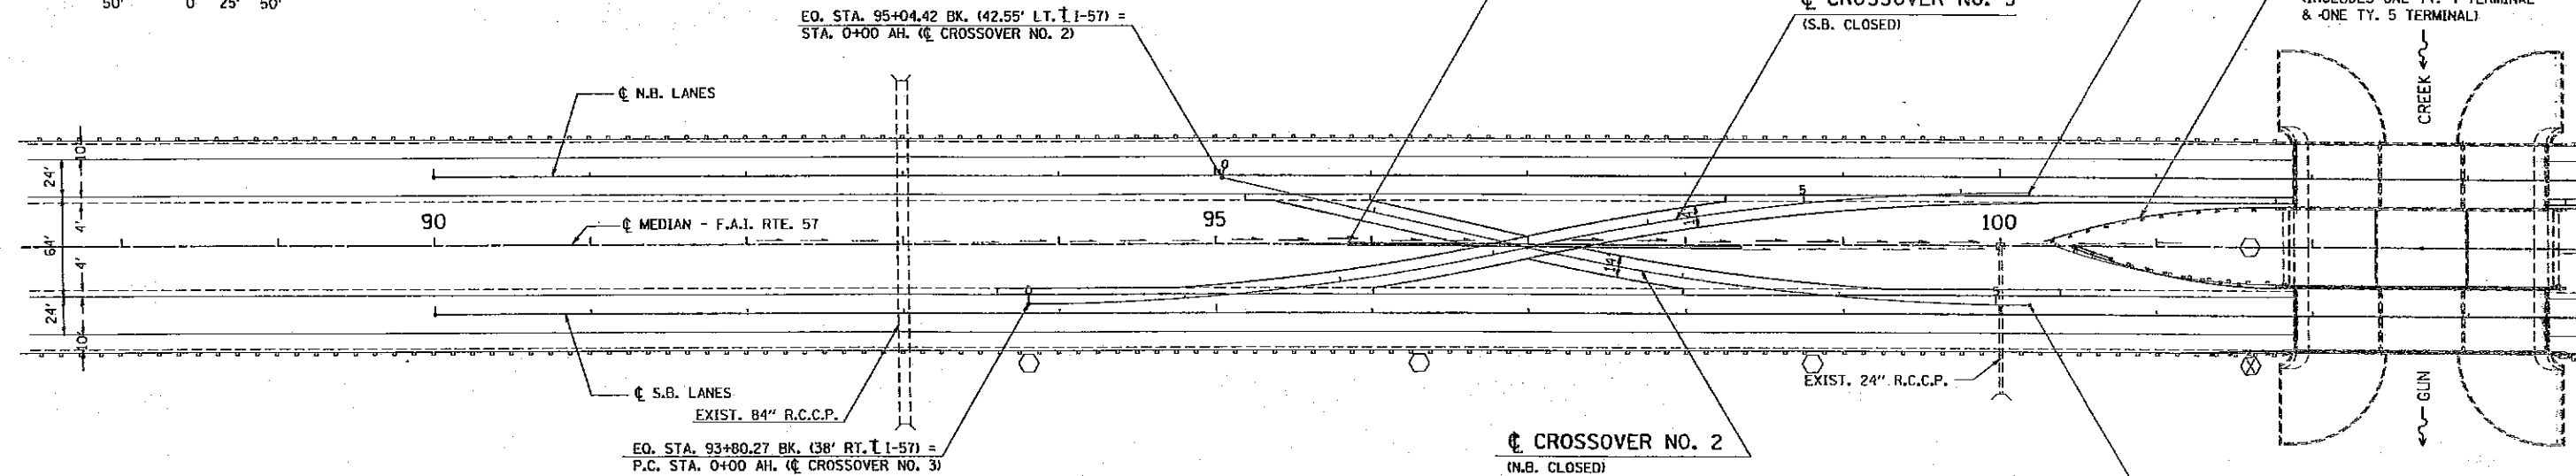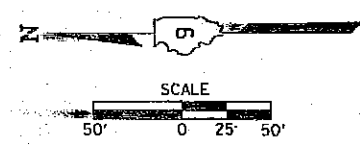


**LEGEND**  
 (TEMPORARY LIGHTING SYSTEM)

- ◊ EXISTING WOODEN POLE WITH 250 WATT LUMINAIRE
- ⊗ EXISTING WOODEN POLE

CURVE DATA CROSSOVER NO. 3		CURVE DATA CROSSOVER NO. 2	
P.I. STA= 1+61.59	Δ= 12° 52' 22"	P.I. STA= 4+83.41	Δ= 12° 52' 22"
D= 4° 00' 00"	R= 1432.39'	D= 4° 00' 00"	R= 1432.39'
T= 161.59'	L= 321.82'	T= 161.59'	L= 321.82'
E= 9.09'	P.C. STA= 0+00.00	E= 9.09'	P.C. STA= 2+00.00
P.T. STA= 3+21.82		P.T. STA= 6+43.64	

DATE	
BY	
REVISION	
NO. 1	
NO. 2	
NO. 3	
NO. 4	
NO. 5	
NO. 6	
NO. 7	
NO. 8	
NO. 9	
NO. 10	


DATE	
BY	
REVISION	
NO. 1	
NO. 2	
NO. 3	
NO. 4	
NO. 5	
NO. 6	
NO. 7	
NO. 8	
NO. 9	
NO. 10	

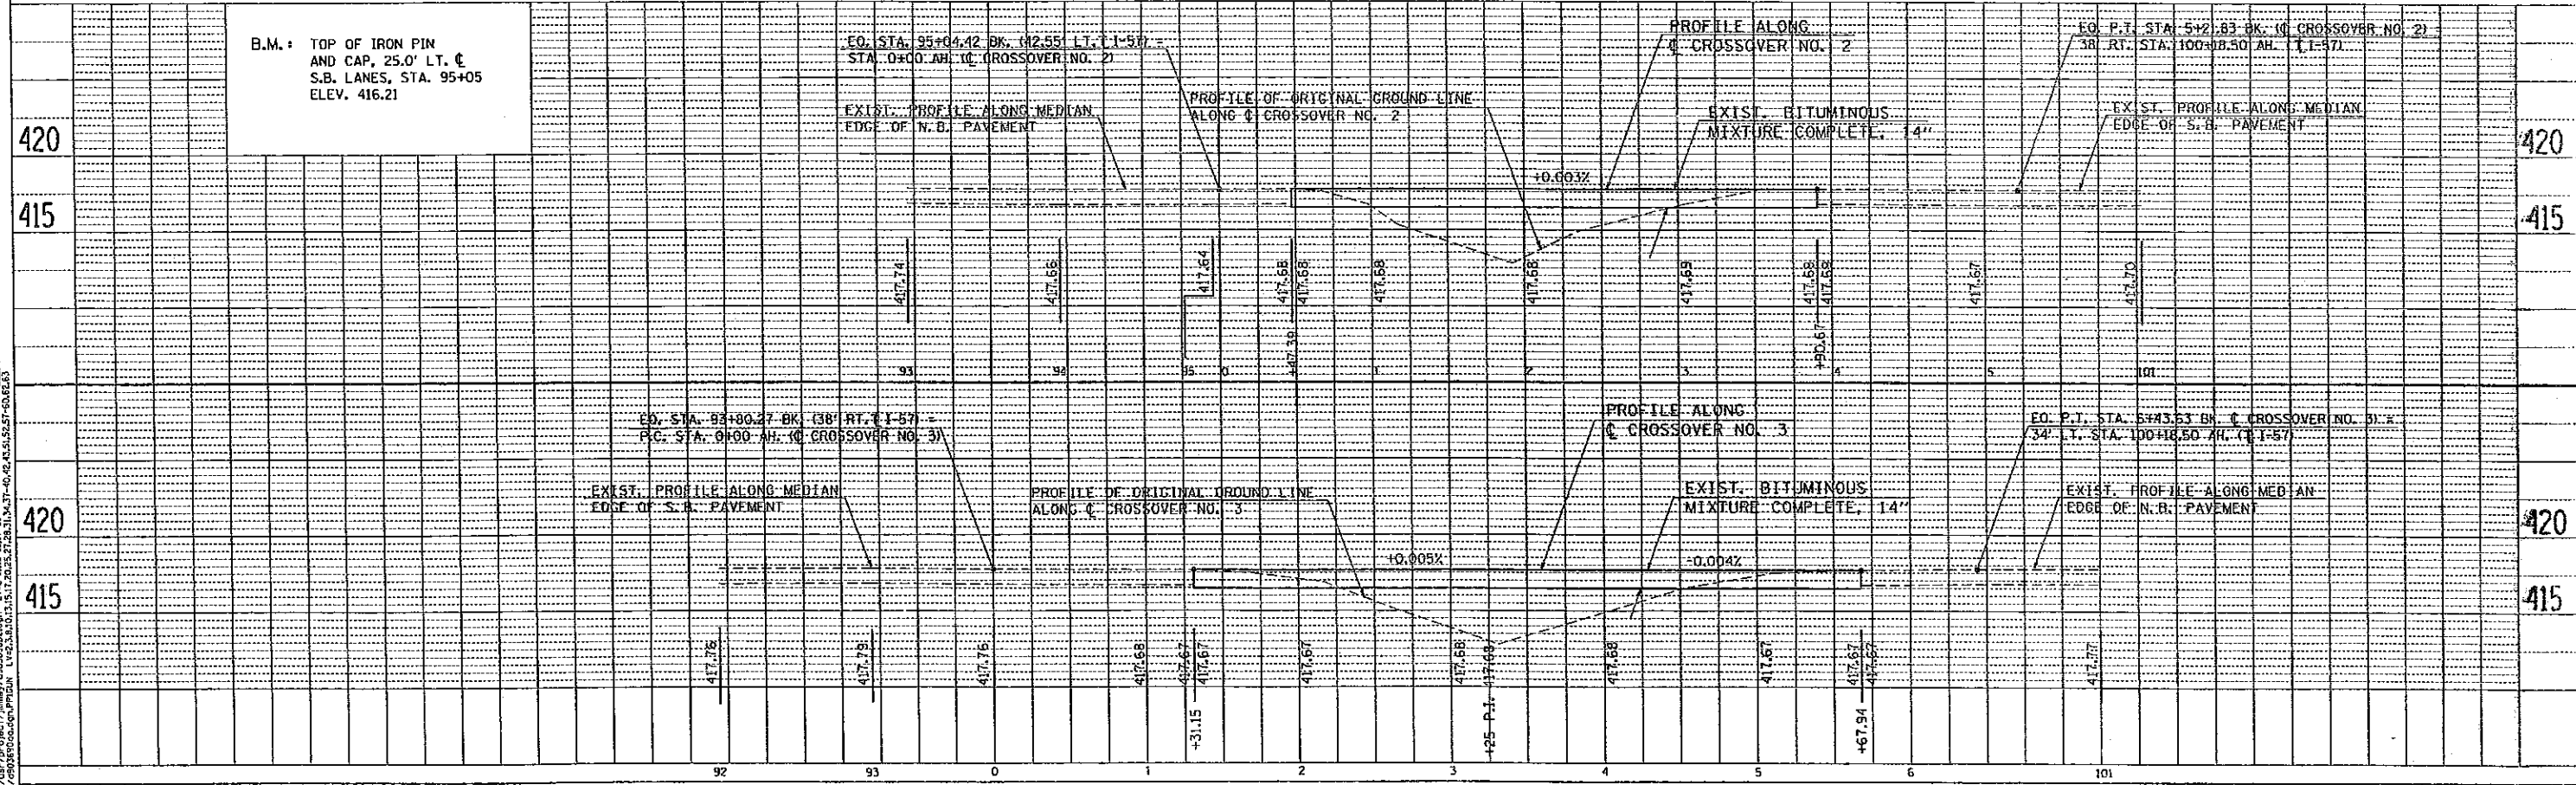

VIEW FROM SOUTH  
 P1: Mar 19 07:50:00 1953  
 /usr/pc/plot7/jimray/epd060602.dgn LVE=113 15 15 43  
 /usr/pc/plot7/jimray/epd060602.dgn LVE=113 15 15 43  
 /usr/pc/plot7/jimray/epd060602.dgn LVE=113 15 15 43

FILE NO.	SECTION	COUNTY	SHEET NO.	TOTAL SHEETS
57	*	FRANKLIN	145	14
STA.	TO STA.			
150	150			

\* 28 (58-1, 58, 28, 18) 0-1; 28 (58-1, 58, 28, 18) 0-1

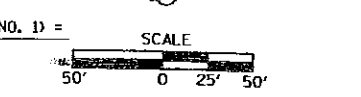

**CURVE DATA  
CROSSOVER NO. 4**  
 P.I. STA= 1+61.59  
 $\Delta = 12^\circ 52' 22''$   
 $D = 4^\circ 00' 00''$   
 $R = 1432.39'$   
 $T = 161.59'$   
 $L = 321.82'$   
 $E = 9.09'$   
 P.C. STA= 0+00.00  
 P.T. STA= 3+21.82

EXIST. 24" R.C.C.P.  
TO REMAIN IN PLACE


\* EXISTING GUARDRAIL ALONG X-OVERS IS TO BE REMOVED ONLY AFTER THE MAINLINE SOUTH BOUND LANES ARE RE-OPENED TO TRAFFIC.

EQ. P.T. STA. 6+43.64 BK. (C CROSSOVER NO. 1) =  
38' LT. STA. 113+39.73 (I-57)

EQ. P.I. STA. 5+28.29 BK. (C CROSSOVER NO. 4) =  
44' RT. STA. 109+21.91 AH. (I-57)


**CURVE DATA  
CROSSOVER NO. 1**  
 P.I. STA= 1+61.59  
 $\Delta = 12^\circ 52' 22''$   
 $D = 4^\circ 00' 00''$   
 $R = 1432.39'$   
 $T = 161.59'$   
 $L = 321.82'$   
 $E = 9.09'$   
 P.C. STA= 0+00.00  
 P.T. STA= 3+21.82

P.I. STA= 4+83.41  
 $\Delta = 12^\circ 52' 22''$   
 $D = 4^\circ 00' 00''$   
 $R = 1432.39'$   
 $T = 161.59'$   
 $L = 321.82'$   
 $E = 9.09'$   
 P.C. STA= 3+21.82  
 P.T. STA= 6+43.64

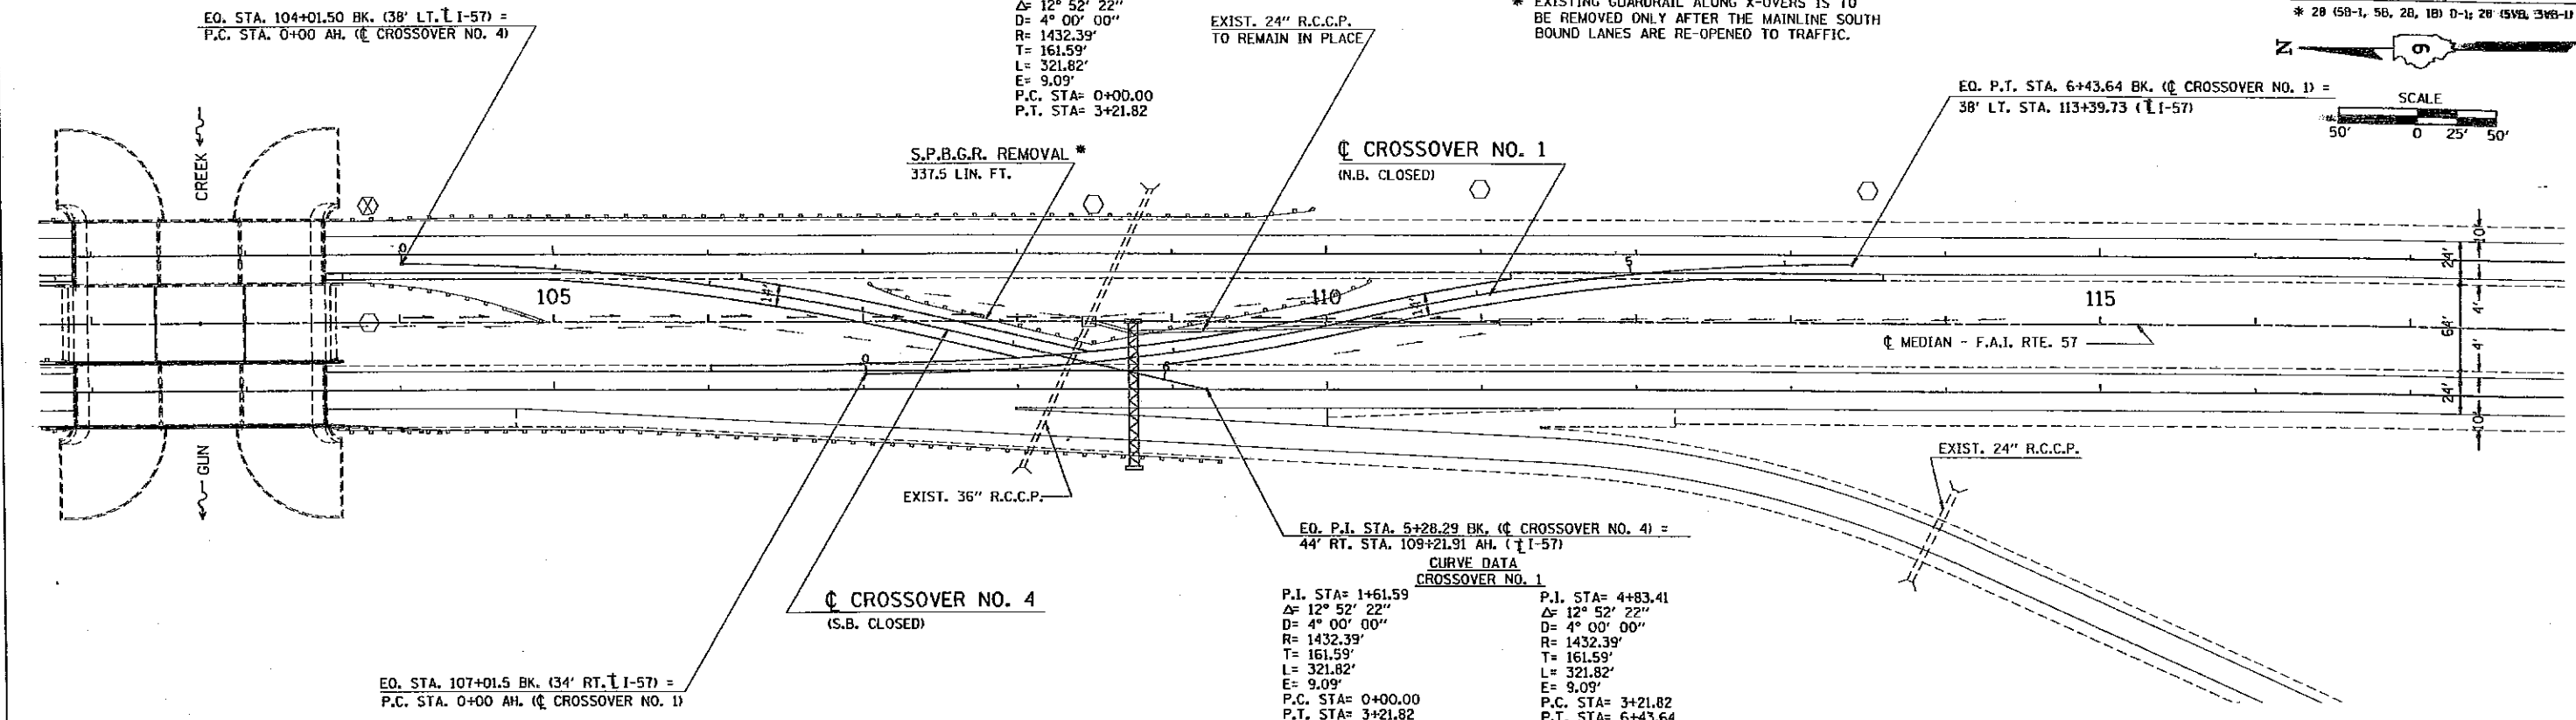

DATE	BY

DATE	BY

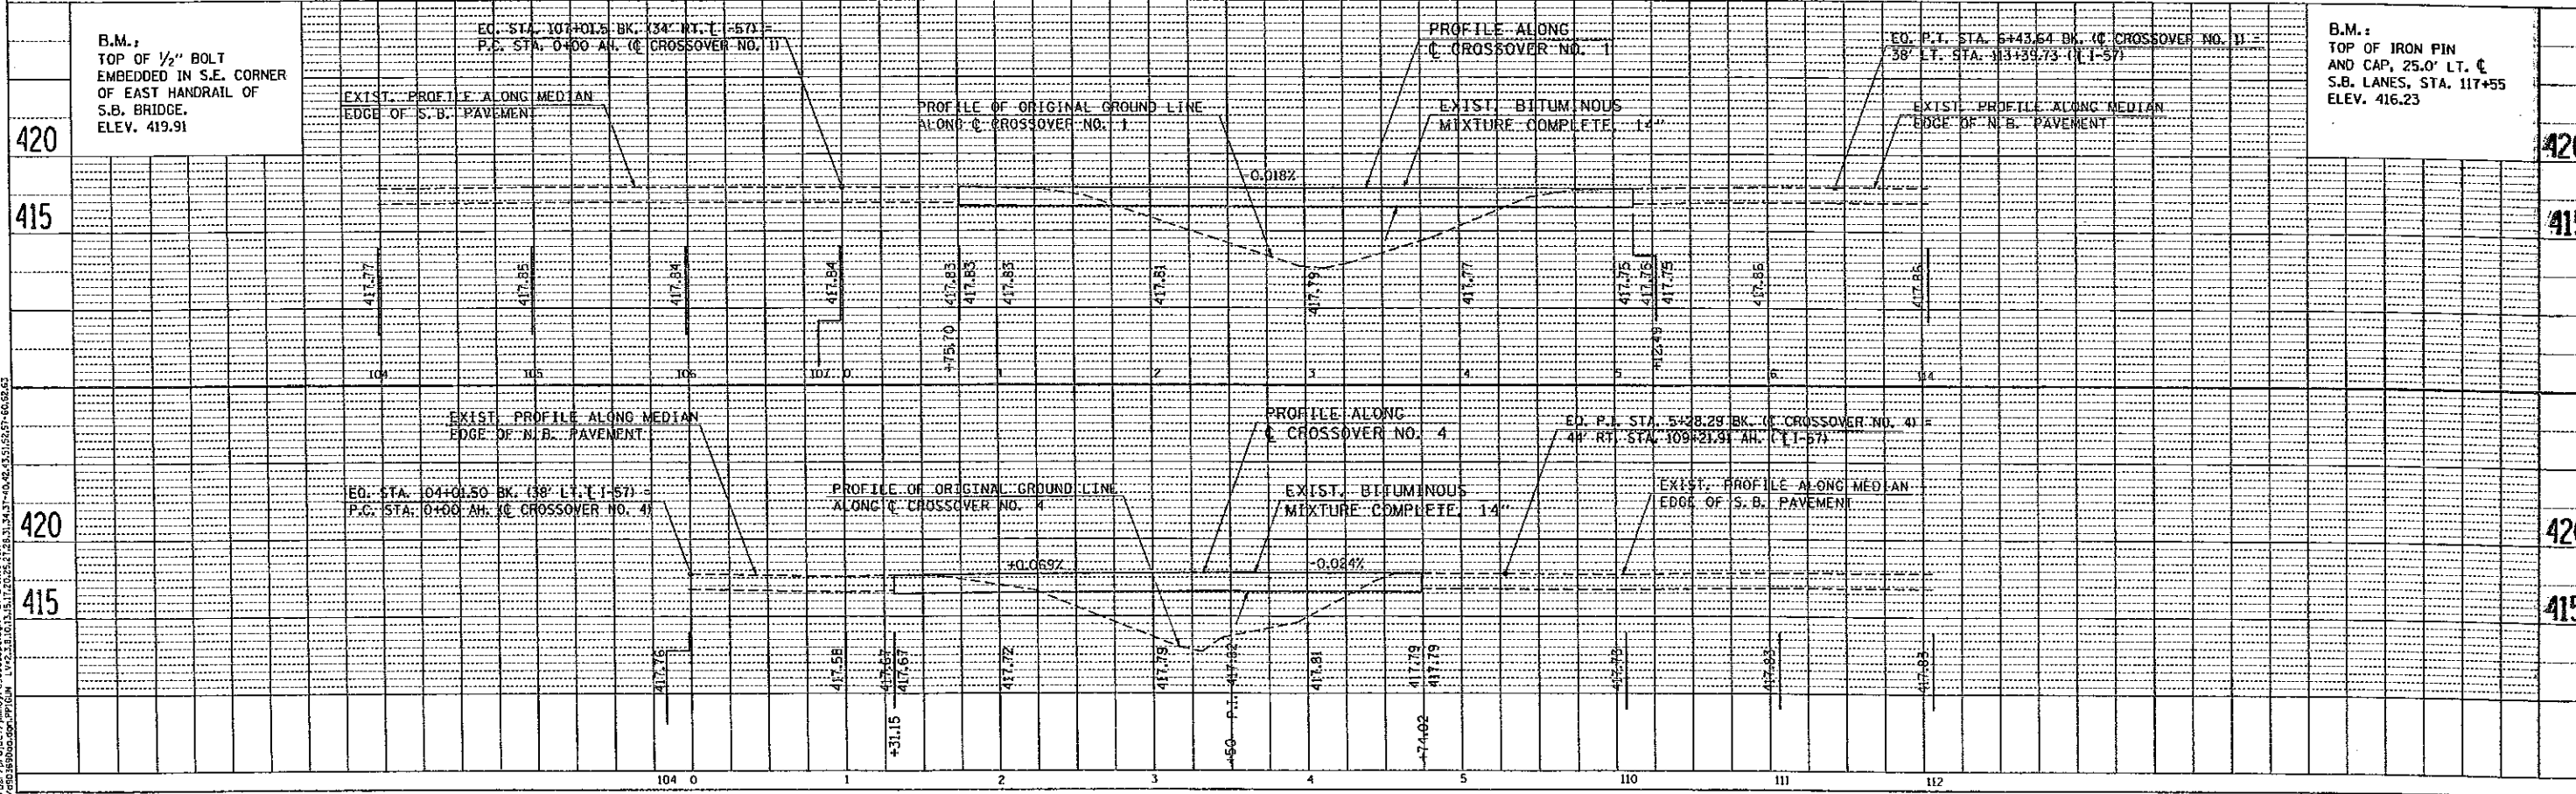

F.A.I. RTE. 57 OVER GUN CREEK



ROUTE NO.	SEC.	COUNTY	TOTAL SHEETS	SHEET NO.
F.A.J. 57	•	FRANKLIN	145	15

FED. ROAD DIST. 7 ILLINOIS PROJECT  
 SEC. 26 (N.B. & S.B. 1/2) D-1  
 26 (CONTRACT 1-1)

94  
1  
00

95  
1  
00


96  
1  
00

LEGEND:

NORTHBOUND CONTRACT	—————
SOUTHBOUND CONTRACT	—————
N.B. CONTRACT DITCH	~~~~~
S.B. CONTRACT DITCH	~~~~~

PLATE 3 CROSS SECTION O. P. R. & A. C. STANDARD  
 DEFZOSH CORPORATION

GUN CREEK

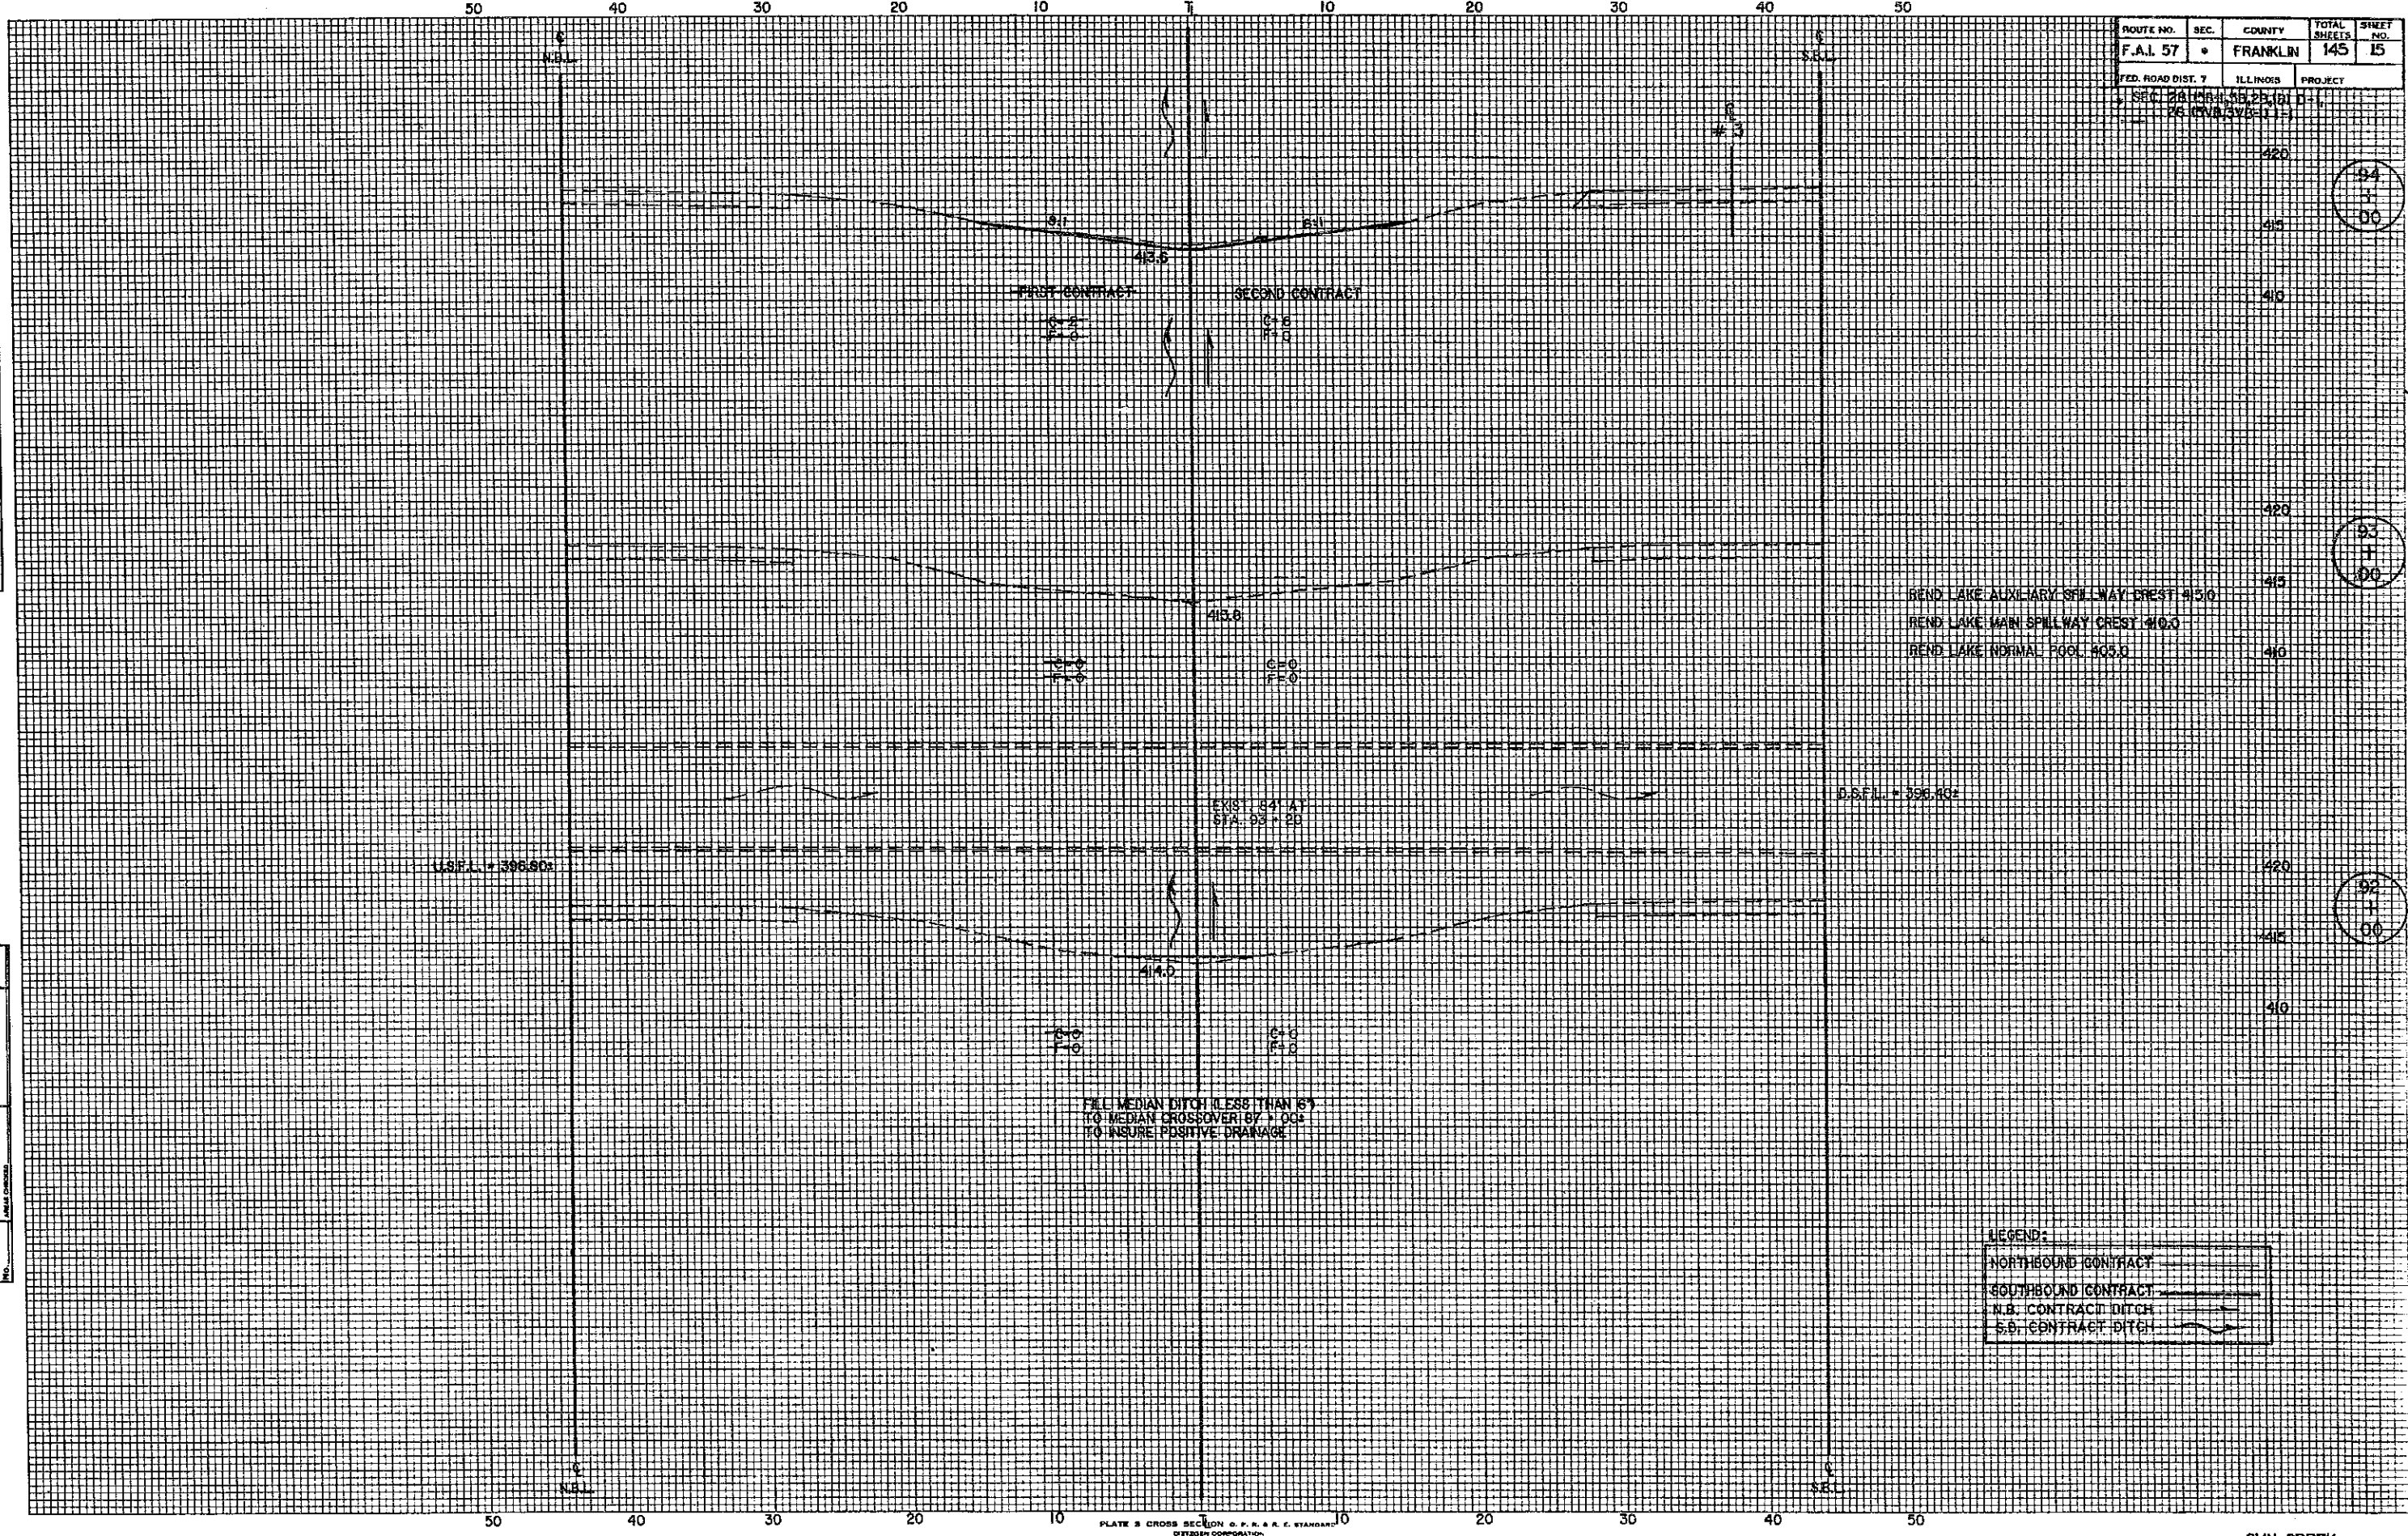

DATE \_\_\_\_\_ BY \_\_\_\_\_  
 ORIGINAL SURVEY NOTE BOOK No. \_\_\_\_\_  
 REVISIONS:  
 NO. DATE BY


DATE \_\_\_\_\_ BY \_\_\_\_\_  
 ORIGINAL SURVEY NOTE BOOK No. \_\_\_\_\_  
 REVISIONS:  
 NO. DATE BY



ROUTE NO.	SEC.	COUNTY	TOTAL SHEETS	SHEET NO.
F.A.I. 57	*	FRANKLIN	145	16
FED. ROAD DIST. 7		ILLINOIS	PROJECT	
* SEC. 10, 11, 12, 13, 14, 15, 16, 17, 18, 19, 20, 21, 22, 23, 24, 25, 26, 27, 28, 29, 30, 31, 32, 33, 34, 35, 36, 37, 38, 39, 40, 41, 42, 43, 44, 45, 46, 47, 48, 49, 50				

DATE	
BY	
REVISION	
PLotted	
TRIMMED	
INSTRUMENT	
NO.	

DATE	
BY	
REVISION	
PLotted	
TRIMMED	
INSTRUMENT	
NO.	

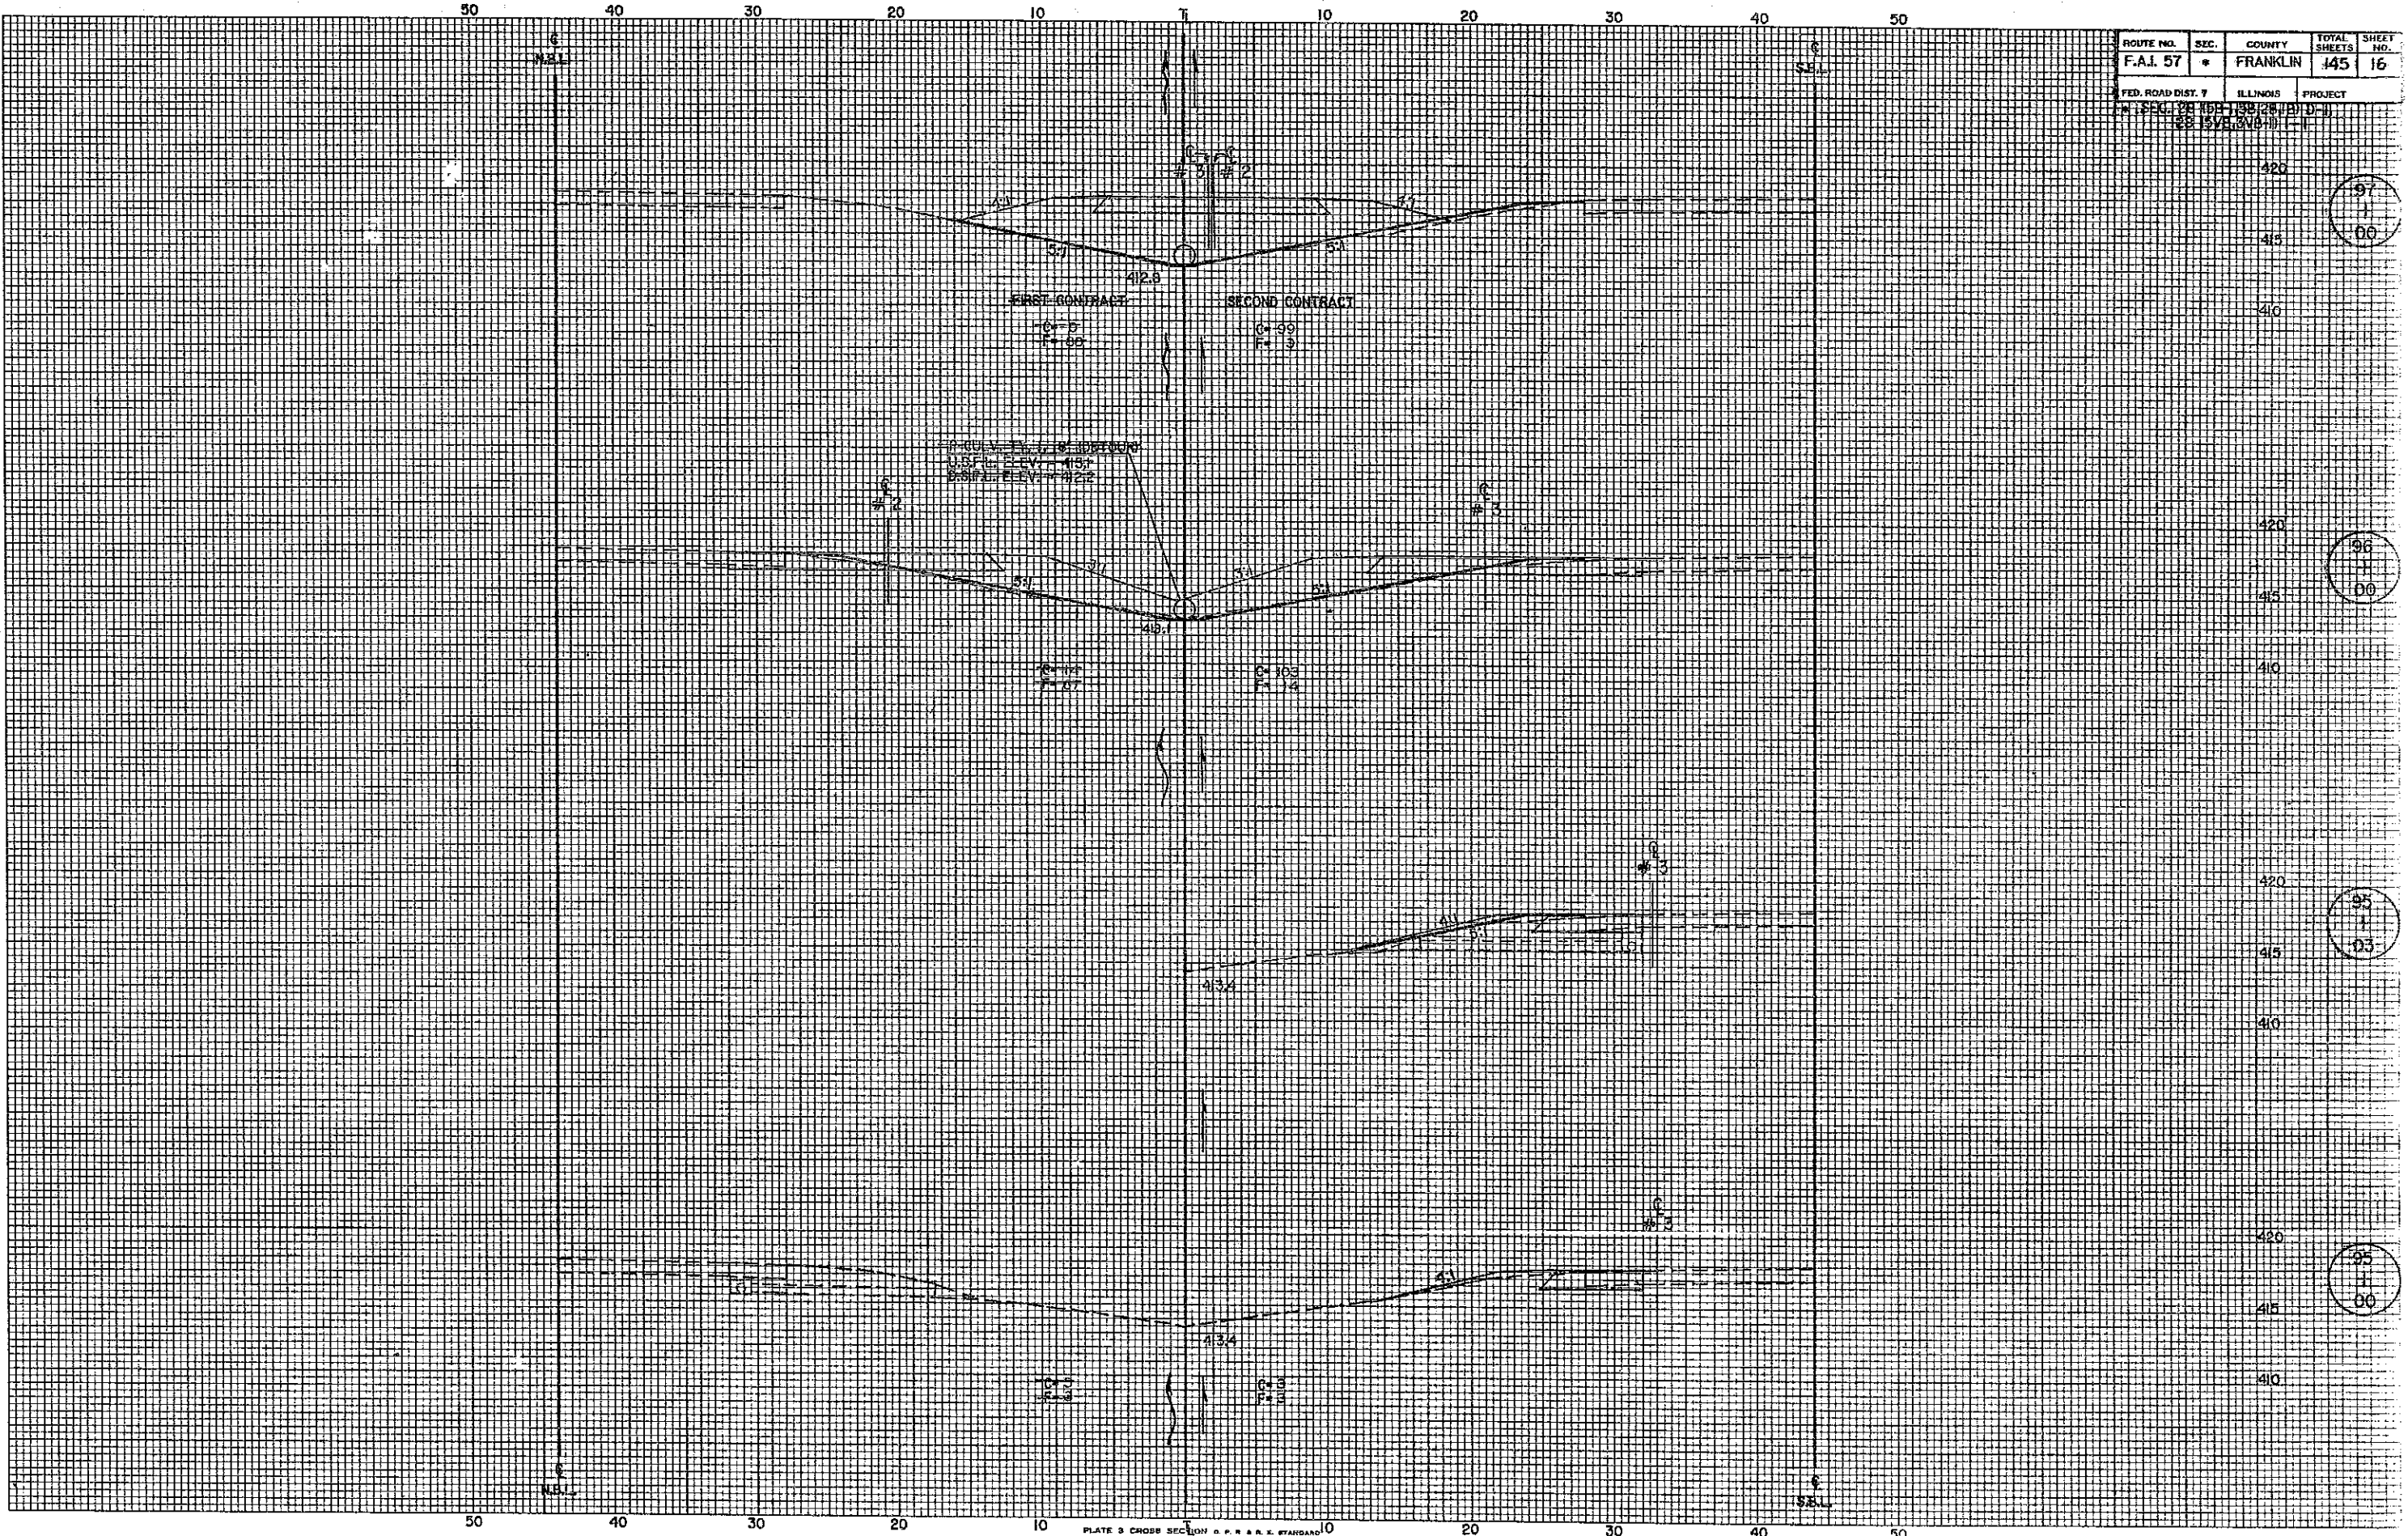



ROUTE NO.	SEC.	COUNTY	TOTAL SHEETS	SHEET NO.
F.A. 57	*	FRANKLIN	145	17
ROAD DIST. 7		ILLINOIS	PROJECT	
SEC. 28 T. 35 N. R. 10 E. S. 11				

DATE	
BY	
PROJECT	
PLANT	
NOTE BOOK	
NO.	

DATE	
BY	
PROJECT	
PLANT	
NOTE BOOK	
NO.	

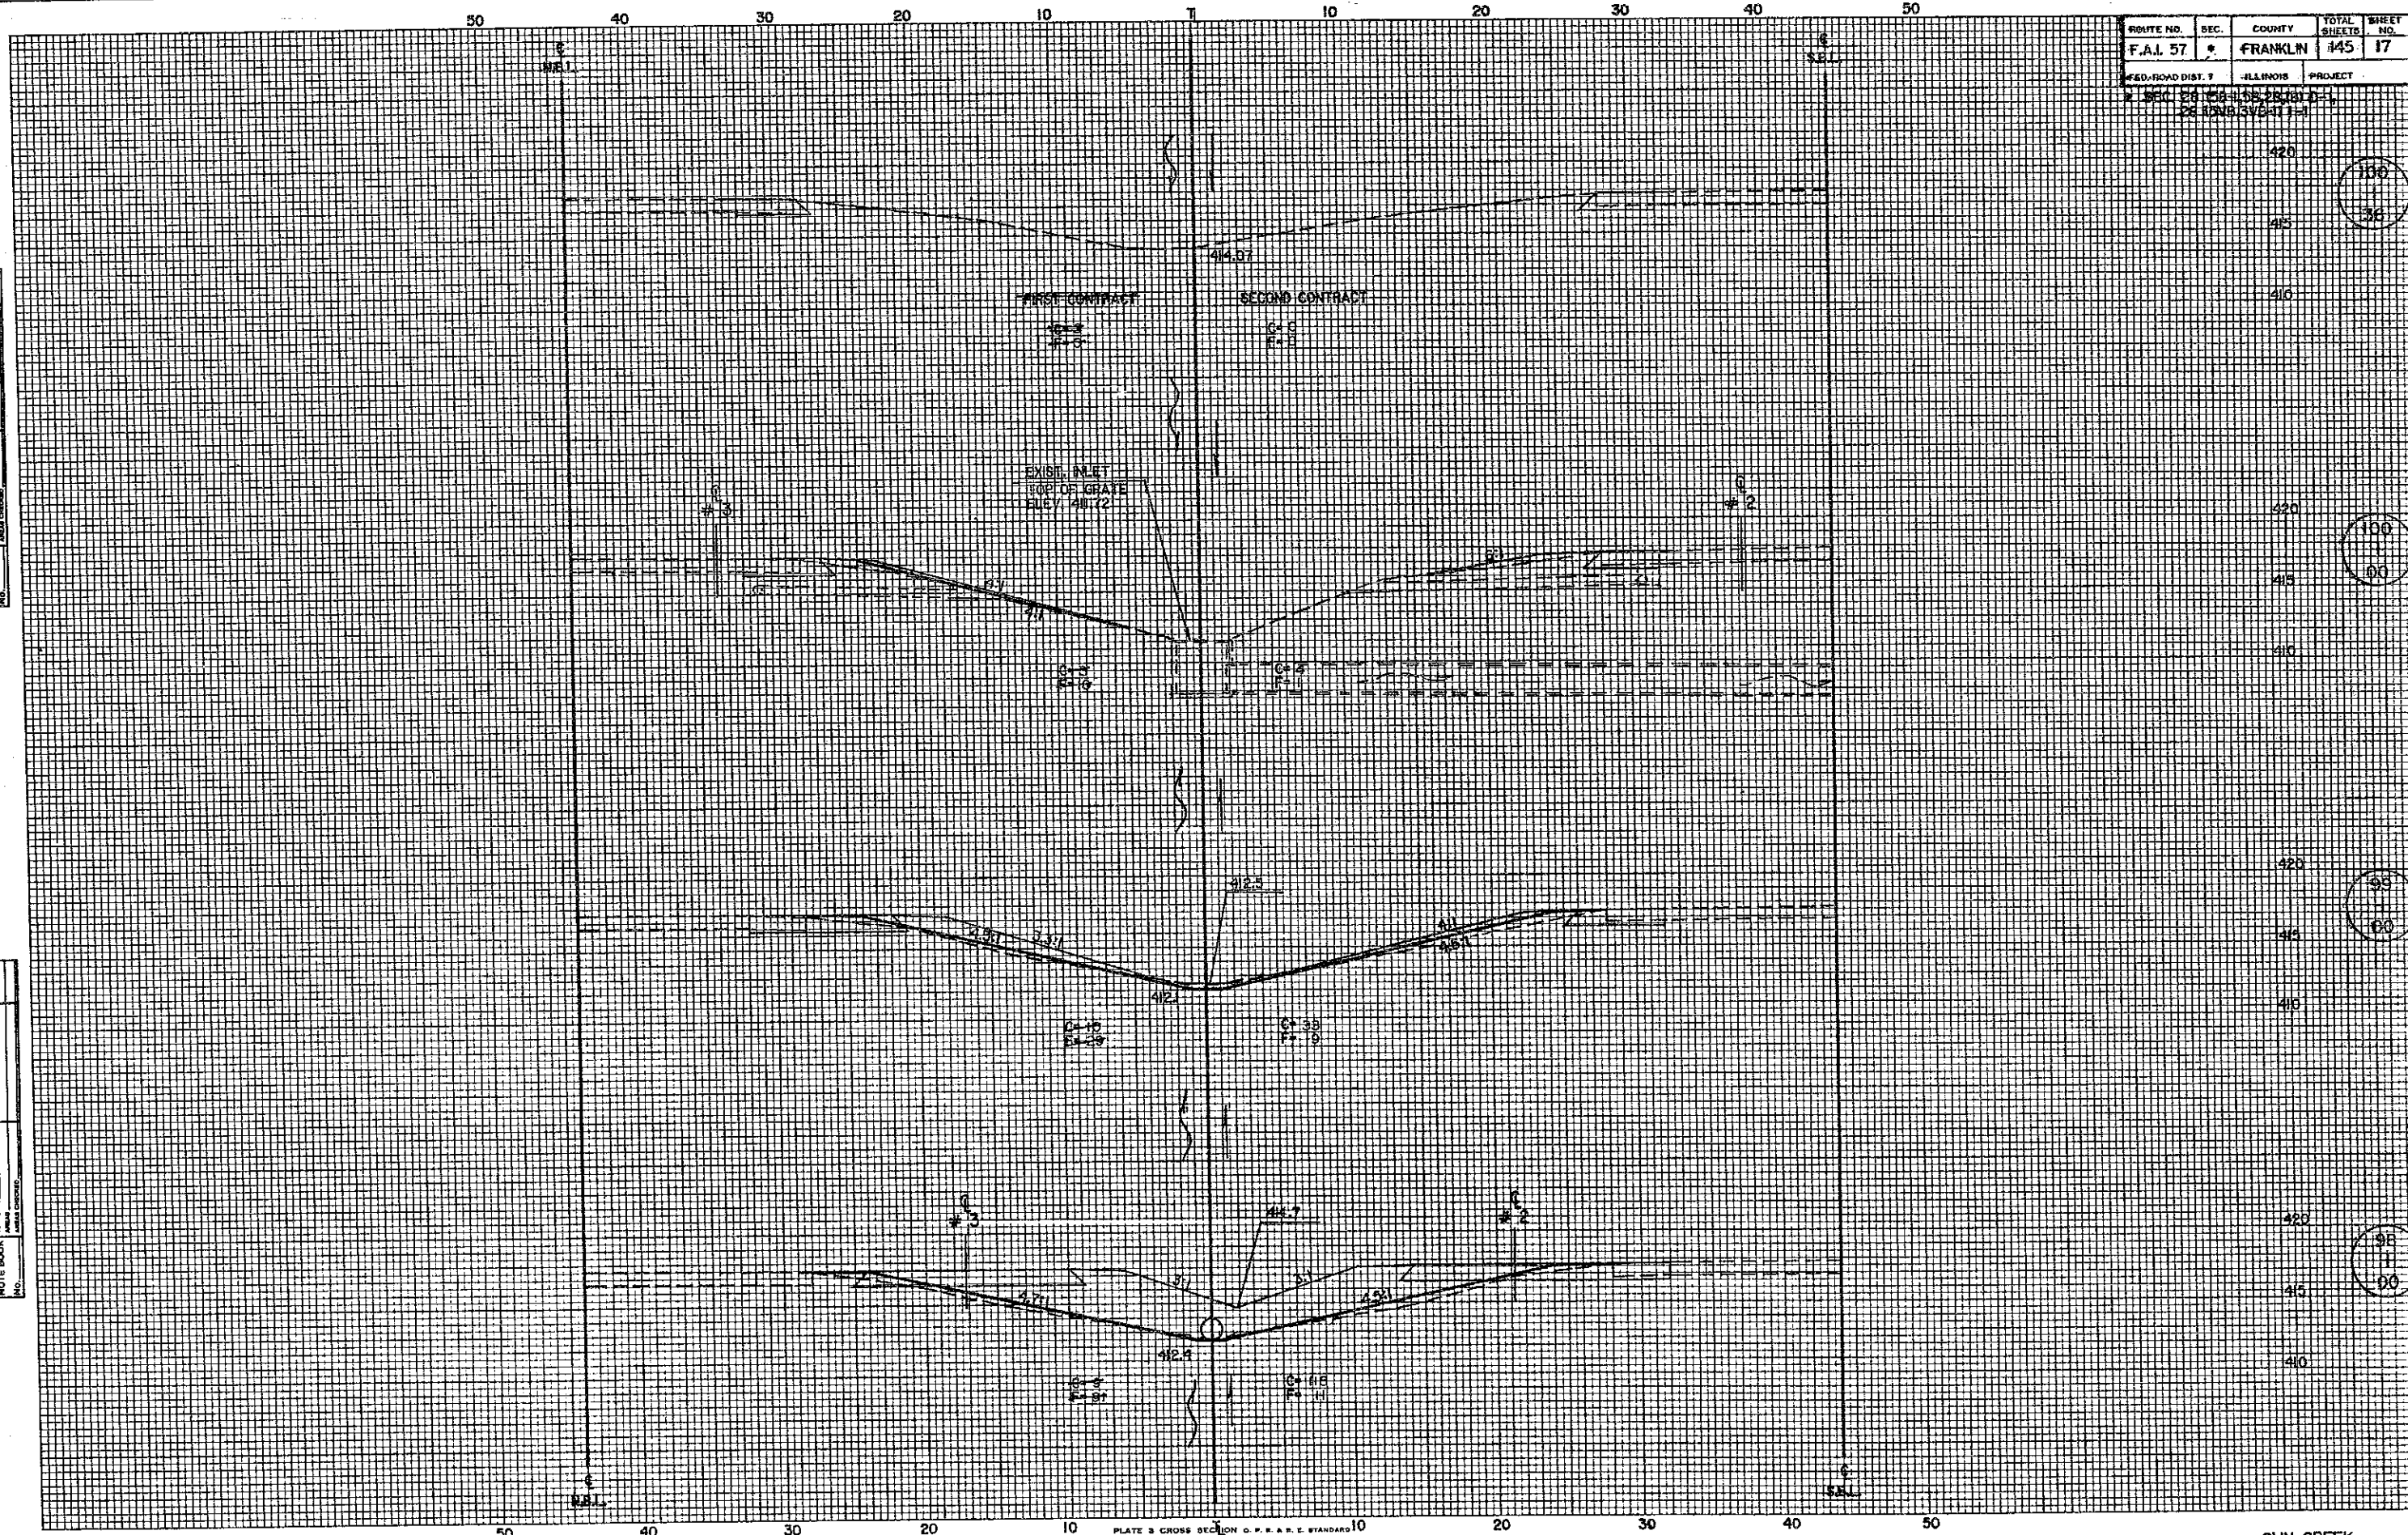


PLATE 3 CROSS SECTION D. P. & S. STANDARDS 10  
DETROIT CORPORATION







50 40 30 20 10 1 10 20 30 40 50

ROUTE NO.	SEC.	COUNTY	TOTAL SHEETS	SHEET NO.
F.A.I. 57	*	FRANKLIN	145	19
FED. ROAD DIST. 7		ILLINOIS	PROJECT	
# SEC. 26 1/4 1/4 20 1/4 1/4		21 1/4 1/4 1/4 1/4		

FINAL SURVEY NOTE BOOK NO.

DATE

BY

REVISOR

NOTED

REVISION

APPROVED

ORIGINAL SURVEY NOTE BOOK NO.

DATE


BY

REVISOR

NOTED

REVISION

APPROVED

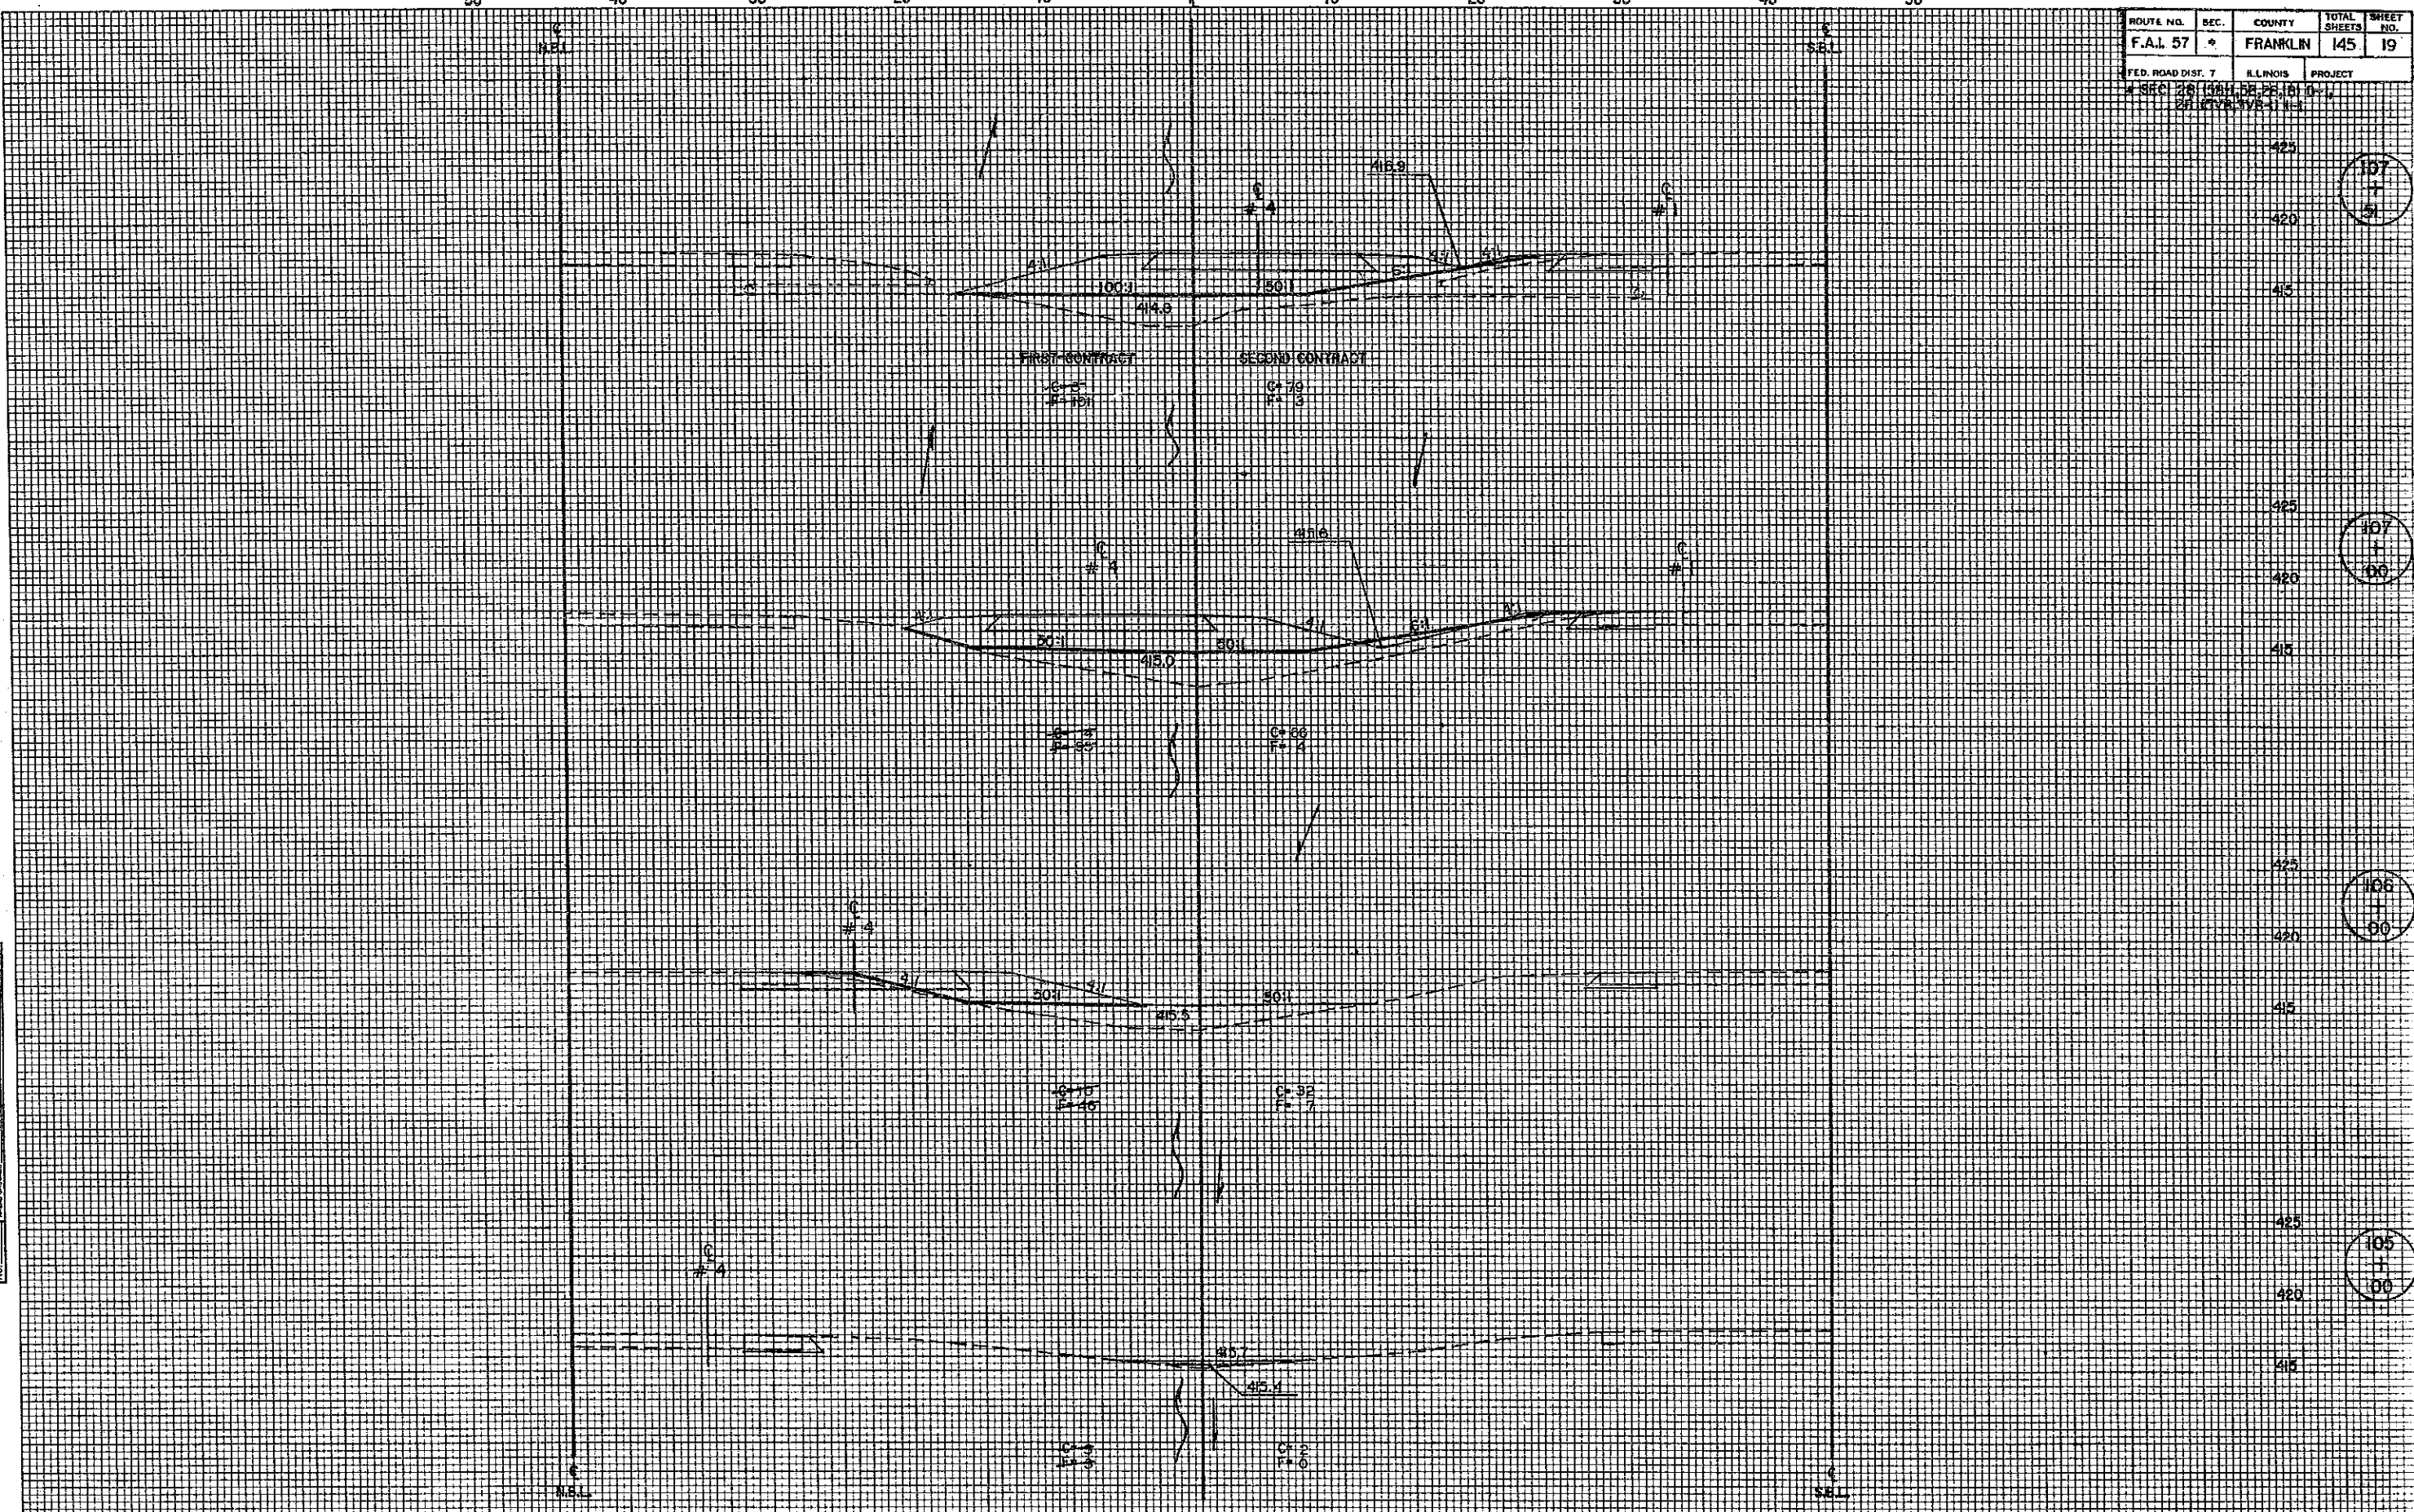

107  
1  
50

107  
1  
00

106  
1  
00

105  
1  
00

PLATE 3 CROSS SECTION O. P. R. & R. E. STANDARD  
DETROIT CORPORATION

50 40 30 20 10 1 10 20 30 40 50


GUN CREEK



ROUTE NO.	SEC.	COUNTY	TOTAL SHEETS	SHEET NO.
F.A.J. 57	*	FRANKLIN	145	20
FED. ROAD DIST. 7		ILLINOIS	PROJECT	
SEC. 28 1881 55 22 18 10-12 28 1881 55 22 18 10-12				

DATE \_\_\_\_\_ BY \_\_\_\_\_  
 SURVEYED \_\_\_\_\_  
 DRAWN \_\_\_\_\_  
 CHECKED \_\_\_\_\_  
 FINAL SURVEY NOTE BOOK NO. \_\_\_\_\_

DATE \_\_\_\_\_ BY \_\_\_\_\_  
 SURVEYED \_\_\_\_\_  
 DRAWN \_\_\_\_\_  
 CHECKED \_\_\_\_\_  
 ORIGINAL SURVEY NOTE BOOK NO. \_\_\_\_\_

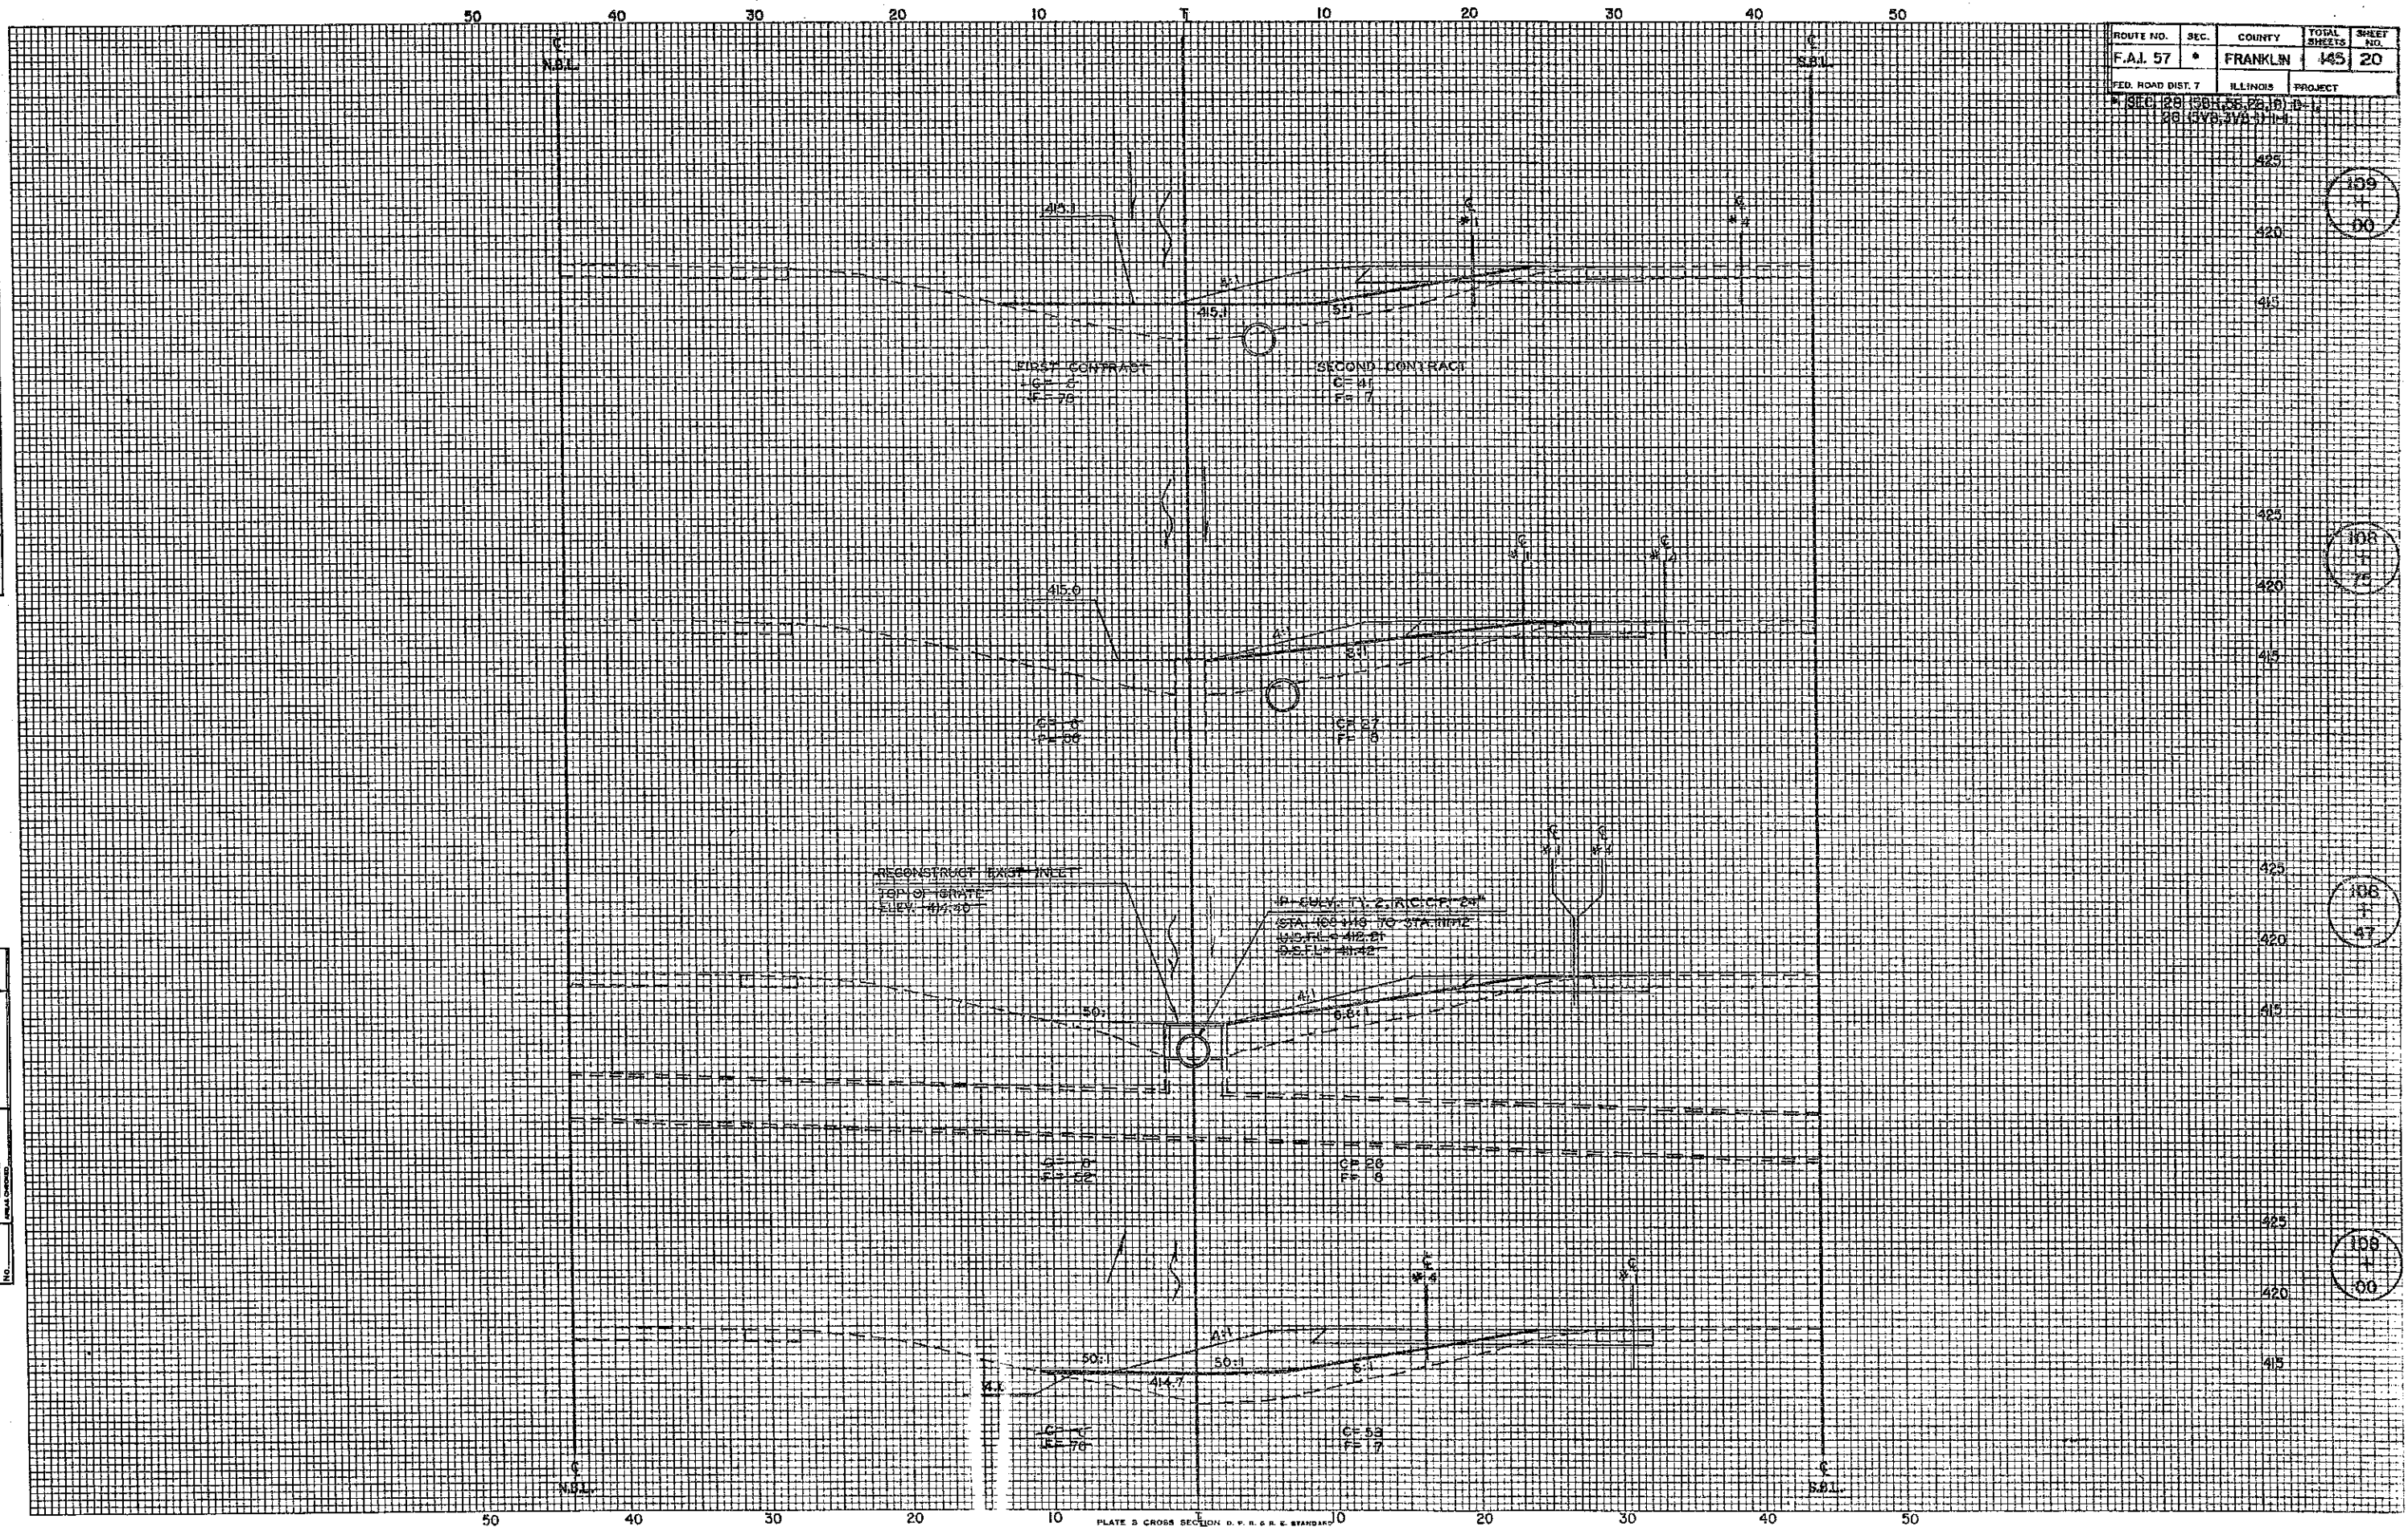

425  
 420  
 415  
 425  
 420  
 415  
 425  
 420  
 415  
 425  
 420  
 415

109  
 108  
 107  
 106  
 105  
 104  
 103  
 102  
 101  
 100

PLATE 3 CROSS SECTION D. P. R. & E. STANDARD  
 DETZORN CORPORATION



ROUTE NO.	SEC.	COUNTY	TOTAL SHEETS	SHEET NO.
F.A.I. 57	*	FRANKLIN	145	21
FED. ROAD DIST. 7		ILLINOIS	PROJECT	
* SEC. 27 15N 18E 28N D-1 28 37S 36E 11-11				

DATE	
BY	
REVISIONS	
NO.	DESCRIPTION
1	AS SHOWN
FINAL SURVEY NOTE BOOK No. _____	

DATE	
BY	
REVISIONS	
NO.	DESCRIPTION
1	AS SHOWN
FINAL SURVEY NOTE BOOK No. _____	

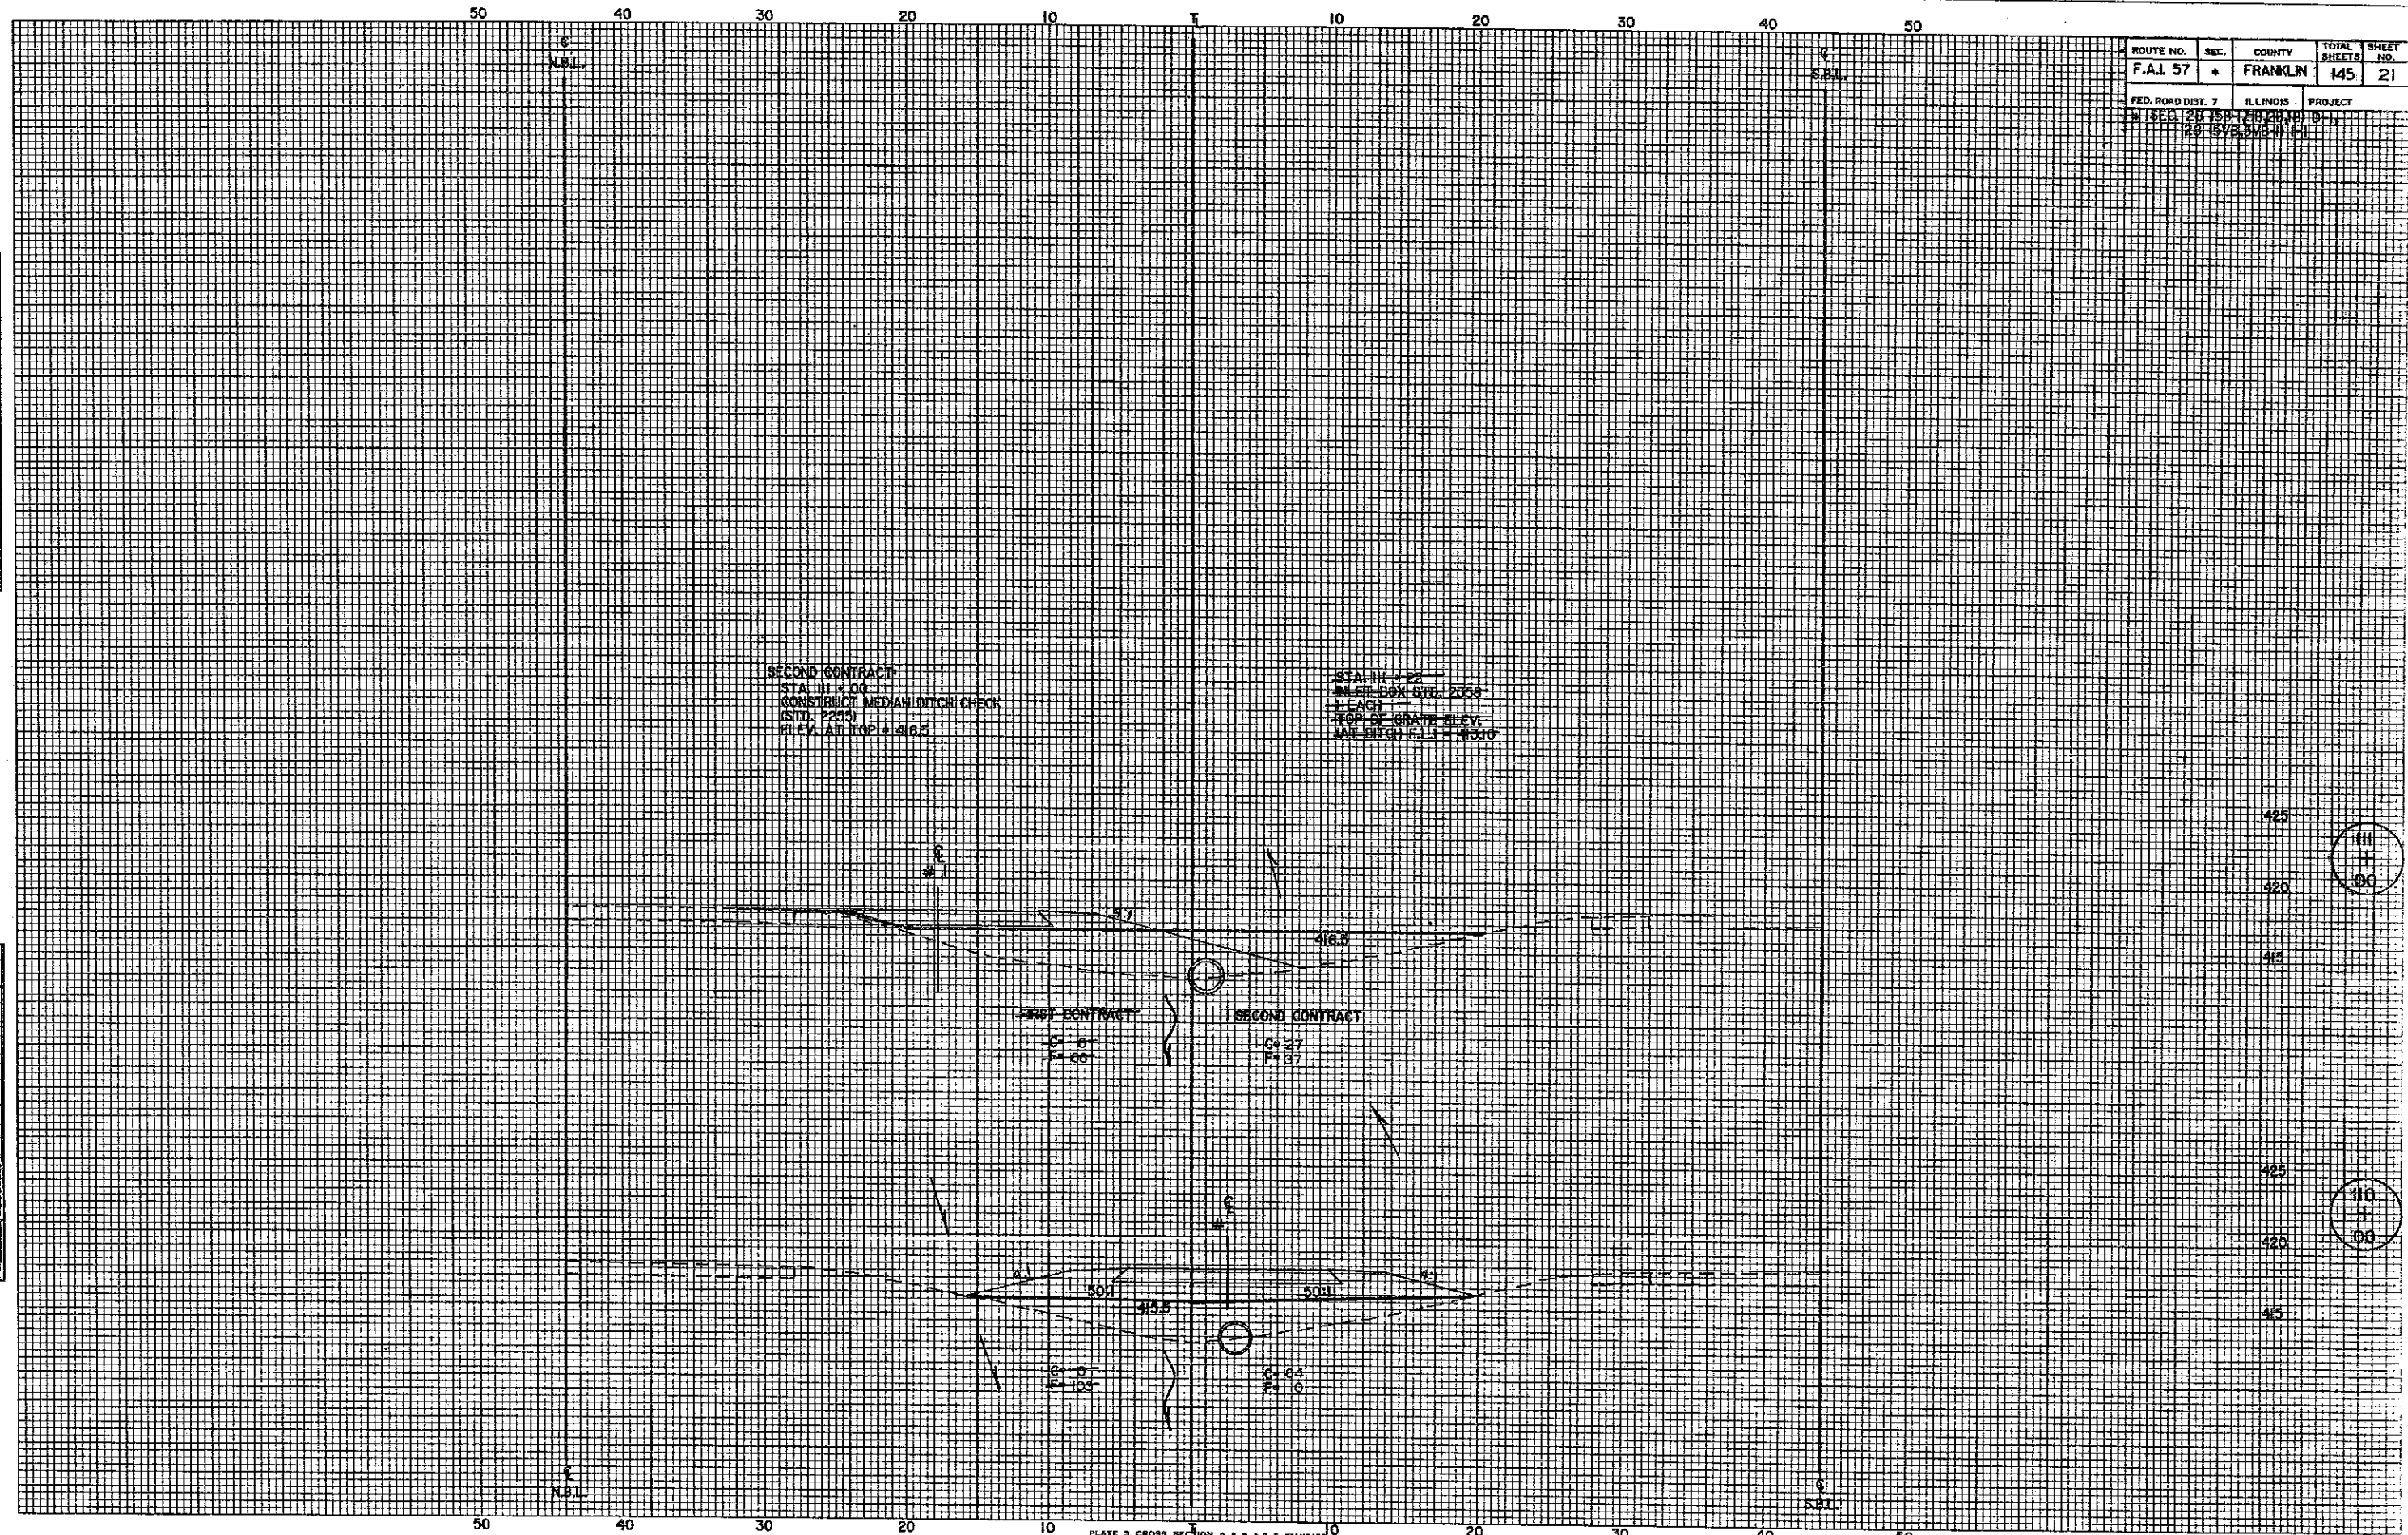


PLATE 3 CROSS SECTION S. P. R. & R. E. STANDARD  
DETROIT CORPORATION





STATE OF ILLINOIS  
DEPARTMENT OF TRANSPORTATION

SHEET NO.	SECTION	COUNTY	ROUTE	POST	SHEET NO.
23		FRANKLIN		23	16 SHEETS
PROJECT NO. 028-0013 N.B.					
SECTION 28-1B-D-1					

Bench Mark: Top of 1/2" bolt imbedded in the S.E. corner of the east handrail on the southbound lane of the Gun Creek Bridge. Elev. 419.91

Existing structure 028-0014 S.B. Built as F.A.I. Route 57 28-1B-F in 1962. The superstructure consists of R.C. deck supported on 3 span continuous W.F. beams. Temporary median cross-overs shall be utilized to divert traffic over adjacent bridge (028-0013 N.B.) during reconstruction.

GENERAL NOTES

Fasteners shall be high strength bolts. Bolts 3/4". Open holes 7/8". Unless otherwise noted.

Field welding of construction accessories will not be permitted to the bottom flange of beams nor to the top flange for a distance equal to one-fourth the span length each way from the pier supports. Field welding in other areas will be permitted only when approved by the Engineer.

Reinforcement bars shall conform to the requirements of AASHTO M-31 M-42 or M-53 Grade 60.


Plan dimensions and details relative to existing structure have been taken from existing plans and Field Survey Elevations and are subject to nominal construction variations. It shall be the Contractor's responsibility to verify such dimensions and details in the field and make necessary approved adjustments prior to construction or ordering of materials. Such variations shall not be cause for additional compensation for a change in the scope of the work, however, the contractor will be paid for the quantity actually furnished of the unit price bid for the work.

The Contractor will be required to mark on top of the concrete deck, the locations of the top flange of all the steel beams, prior to any removal of the bridge concrete deck. Saw cutting directly over the top of the beam flanges is not permitted.

All top surfaces of the abutment seat area shall receive "Bridge Seat Sealer."

The Zinc-Silicate Primer Paint System shall be used for shop painting of new structural steel. The color of the vinyl finish coat shall be Munsell Std. 10Y 7/1 light grey.

Prior to pouring the new concrete for the deck, all loose rust, loose mill scale, and all other foreign material shall be removed from the embedded portions of flanges of stringers. The removal shall be accomplished in accordance with the requirements of the SSPC Surface Preparation Specifications SP-3 for power tool cleaning or SP-2 for hand tool cleaning. Cost shall be incidental to Removal of Existing Concrete Deck.

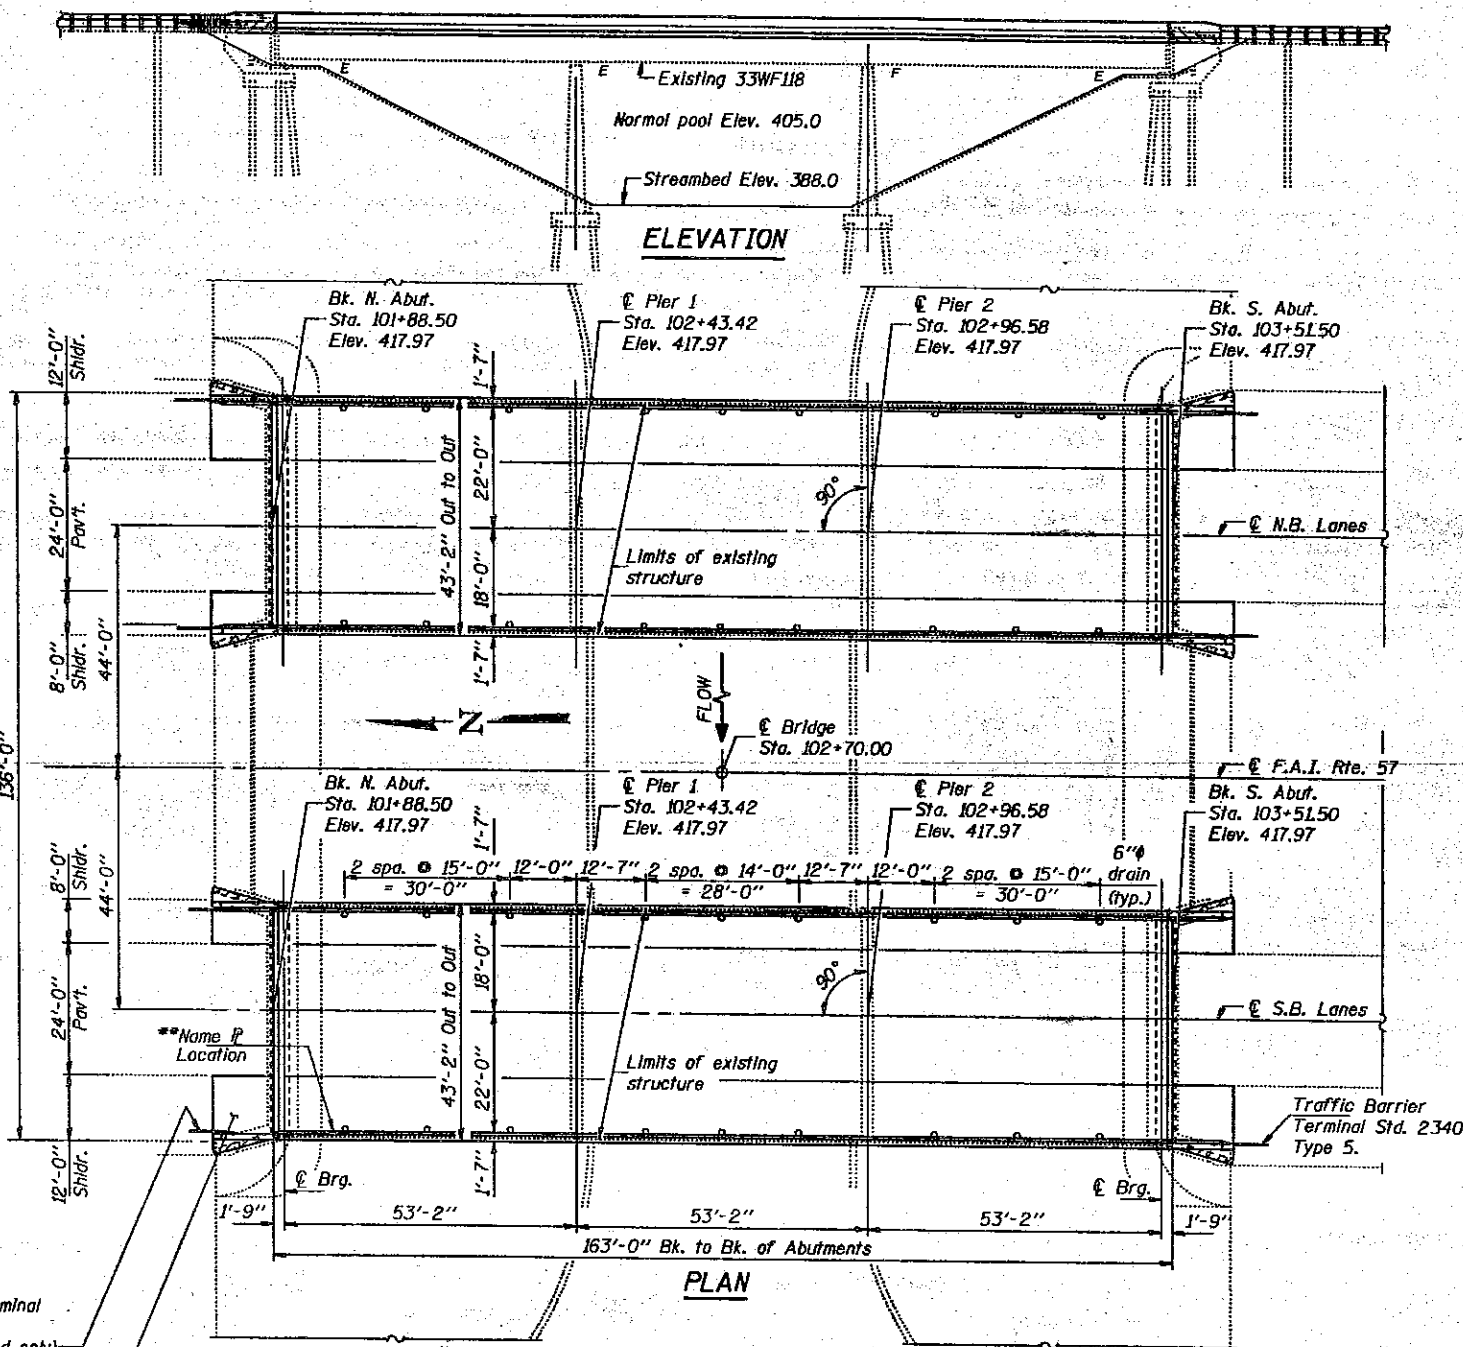

STATION 102 + 70.00  
BUILT 199 BY  
STATE OF ILLINOIS  
F.A.I. RT.57 SEC.(28-1B)D-1  
F.A. PROJ. \*  
LOADING HS20  
STR. NO. 028-0014  
\*IN-57-2(133)63

**NAME PLATE**  
See Std. 2113  
\*\*Existing Name Plate to be cleaned and relocated next to the new Name Plate on the New Parapet. Cost incidental to "Name Plates."

TOTAL BILL OF MATERIAL

ITEM	UNIT	SUPER	SUB	TOTAL
Concrete Removal	Cu. Yd.		9	9
Removal of Existing Concrete Deck	Each	1		1
Structure Excavation	Cu. Yd.		23	23
Floor Drains	Each	18		18
Preformed Joint Seal 2 1/2"	Lin. Ft.	43		43
Preformed Joint Seal 4"	Lin. Ft.	43		43
Class X Concrete Superstructure	Cu. Yd.	215.4		215.4
Protective Coat	Sq. Yd.	852		852
Elastomeric Bearing Assembly, Type I	Each	21		21
Structural Steel	Lbs.	10,300		10,300
Stud Shear Connectors	Each	3094		3094
Reinforcement Bars, Epoxy Coated	Pound	51,380		51,380
Name Plates	Each	1		1
Bridge Seat Sealer	Sq. Ft.		147	147
Jack and Remove Existing Brgs.	Each	28		28
Bridge Deck Grooving	Sq. Yd.	678		678


\*\*\* Includes deck & top and inside face of parapet.  
\* Includes removal of existing railing and expansion plates.

**DESIGN SPECIFICATIONS**  
1989 AASHTO, 1990 & 1991 Interim Specifications & Seismic Retrofitting Guidelines for Highway Bridges.


**LOADING HS 20-44 & ALT.**  
Allow 25#/ sq. ft. for future wearing surface.

**DESIGN STRESSES**

FIELD UNITS  
New Construction  
f<sub>c</sub> = 3,500 psi  
f<sub>y</sub> = 60,000 psi (Reinf.)  
f<sub>y</sub> = 36,000 psi (Str. Steel - M270 Gr. 36)  
Old Construction  
f<sub>s</sub> = 20,000 psi (Exist. Structural Steel)

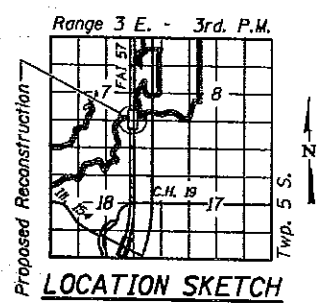

GENERAL PLAN  
F.A.I. ROUTE 57 OVER  
GUN CREEK  
F.A.I. ROUTE 57 SECTION (28-1B)D-1  
FRANKLIN COUNTY  
STATION 102+70.00  
STRUCTURE NUMBER 028-0014 (S.B.)

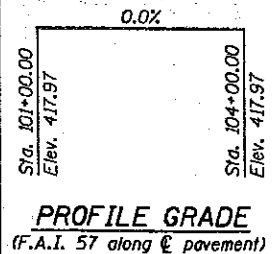

Traffic Barrier Terminal Std. 2341 Type 6 (typ. - approach end only)

Removal of Existing Bit. Appr. Shldr. Pav't. Included in Rdwy. Plan. (Typ. all locations)


NOTE: Only the Southbound Structure is Included in the Contract.

DESIGNED Michael A. Stolman  
CHECKED George A. Glavin  
DRAWN E. Vern Tauler  
CHECKED MAS GAG JAC


EXAMINED May 20 1993  
PASSED Ralph E. Anderson  
APPROVED  
DIRECTOR OF HIGHWAYS



STATE OF ILLINOIS  
DEPARTMENT OF TRANSPORTATION

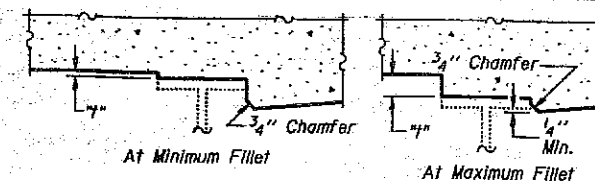

ROUTE NO.	SECTION	COUNTY	DATE	SHEET NO.
P.A.S. 57		FRANKLIN		2A
SHEET NO. 2				
16 SHEETS				

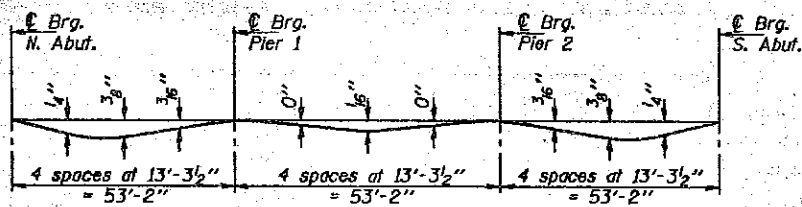


**DEAD LOAD DEFLECTION DIAGRAM**

(Includes weight of concrete only)

Note: The above deflections are not to be used in the field if the engineer is working from the grade elevations adjusted for dead load deflections as shown on Sheet #3 of 16.

To determine "f": After all structural steel has been erected, elevations of the top flanges of the beams shall be taken at intervals shown below. These elevations subtracted from the "Theoretical Grade Elevations Adjusted for Dead Load Deflection" shown on Sheet #3 of 16, minus slab thickness, equals the fillet heights "f" above top flange of beams.

**FILLET HEIGHTS**

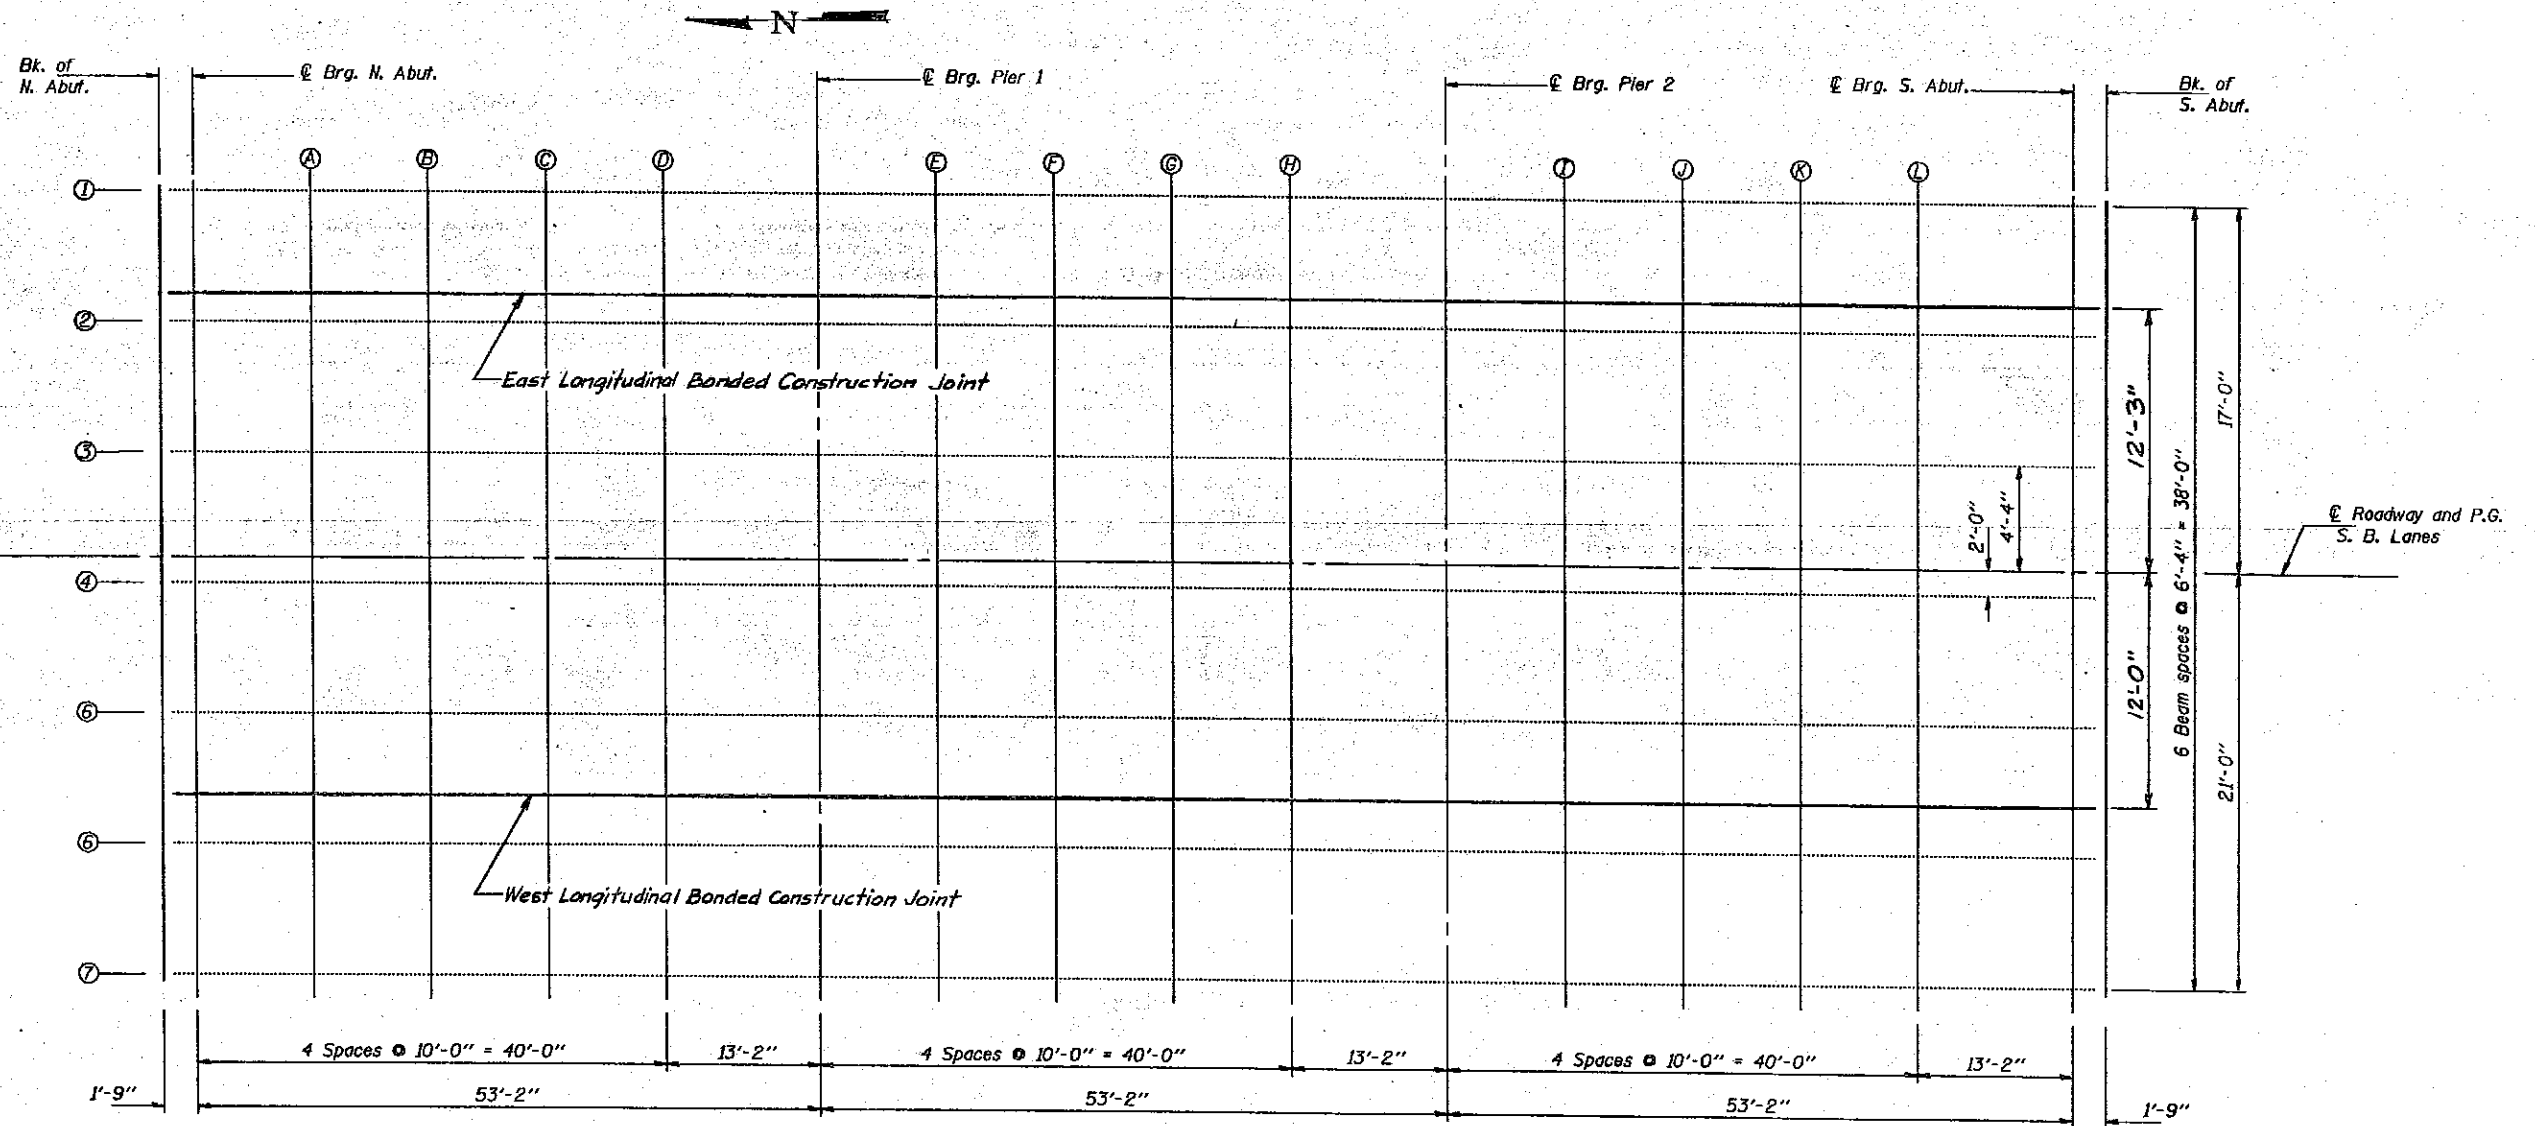

**PLAN**

DESIGNED *Michael A. Stephenson*  
CHECKED *George A. Hines*  
DRAWN *E. Vern Taylor*  
CHECKED *MAS GGG TAC*

May 20 1993  
EXAMINED *Gregory J. Kasper*  
PASSED *Ralph E. Anderson*  
APPROVED \_\_\_\_\_  
DIRECTOR OF HIGHWAYS

TOP OF SLAB ELEVATIONS  
F.A.I. RT. 57 SEC. (28-1B)D-1  
FRANKLIN COUNTY  
STATION 102+70.00



STATE OF ILLINOIS  
DEPARTMENT OF TRANSPORTATION

ROUTE NO.	SECTION	COPY	DATE	SHEET	SHEET NO. 3
A.L.L. 57		FRANKLIN		25	16 SHEETS
P.L.S. ROAD DIST. NO. 7					
ILLINOIS					
28-IBD-1					

☉ BEAM 1

Location	Station	Offset	Theoretical Grade Elevations	Theoretical Grade Elevations Adjusted For Dead Load Deflection
BK. N. ABUT.	10188.500	-17.000	417.741	417.741
☉ BRG. N. ABUT.	10190.250	-17.000	417.741	417.741
A	10200.250	-17.000	417.741	417.759
B	10210.250	-17.000	417.741	417.768
C	10220.250	-17.000	417.741	417.768
D	10230.250	-17.000	417.741	417.758
☉ BRG. PIER 1	10243.417	-17.000	417.741	417.741
E	10253.417	-17.000	417.741	417.741
F	10263.417	-17.000	417.741	417.743
G	10273.417	-17.000	417.741	417.743
H	10283.417	-17.000	417.741	417.741
☉ BRG. PIER 2	10296.583	-17.000	417.741	417.741
I	10306.583	-17.000	417.741	417.754
J	10316.583	-17.000	417.741	417.765
K	10326.583	-17.000	417.741	417.759
L	10336.583	-17.000	417.741	417.764
☉ BRG. S. ABUT.	10349.750	-17.000	417.741	417.741
BK. S. ABUT.	10351.500	-17.000	417.741	417.741

E. LONGITUDINAL BONDED CONSTRUCTION JOINT

Location	Station	Offset	Theoretical Grade Elevations	Theoretical Grade Elevations Adjusted For Dead Load Deflection
BK. N. ABUT.	10188.500	-12.250	417.840	417.840
☉ BRG. N. ABUT.	10190.250	-12.250	417.840	417.840
A	10200.250	-12.250	417.840	417.857
B	10210.250	-12.250	417.840	417.867
C	10220.250	-12.250	417.840	417.866
D	10230.250	-12.250	417.840	417.857
☉ BRG. PIER 1	10243.417	-12.250	417.840	417.840
E	10253.417	-12.250	417.840	417.840
F	10263.417	-12.250	417.840	417.841
G	10273.417	-12.250	417.840	417.842
H	10283.417	-12.250	417.840	417.840
☉ BRG. PIER 2	10296.583	-12.250	417.840	417.840
I	10306.583	-12.250	417.840	417.853
J	10316.583	-12.250	417.840	417.863
K	10326.583	-12.250	417.840	417.868
L	10336.583	-12.250	417.840	417.863
☉ BRG. S. ABUT.	10349.750	-12.250	417.840	417.840
BK. S. ABUT.	10351.500	-12.250	417.840	417.840

☉ BEAM 2

Location	Station	Offset	Theoretical Grade Elevations	Theoretical Grade Elevations Adjusted For Dead Load Deflection
BK. N. ABUT.	10188.500	-10.667	417.871	417.871
☉ BRG. N. ABUT.	10190.250	-10.667	417.871	417.871
A	10200.250	-10.667	417.871	417.889
B	10210.250	-10.667	417.871	417.898
C	10220.250	-10.667	417.871	417.898
D	10230.250	-10.667	417.871	417.888
☉ BRG. PIER 1	10243.417	-10.667	417.871	417.871
E	10253.417	-10.667	417.871	417.871
F	10263.417	-10.667	417.871	417.873
G	10273.417	-10.667	417.871	417.874
H	10283.417	-10.667	417.871	417.871
☉ BRG. PIER 2	10296.583	-10.667	417.871	417.871
I	10306.583	-10.667	417.871	417.884
J	10316.583	-10.667	417.871	417.895
K	10326.583	-10.667	417.871	417.900
L	10336.583	-10.667	417.871	417.894
☉ BRG. S. ABUT.	10349.750	-10.667	417.871	417.871
BK. S. ABUT.	10351.500	-10.667	417.871	417.871

☉ BEAM 3

Location	Station	Offset	Theoretical Grade Elevations	Theoretical Grade Elevations Adjusted For Dead Load Deflection
BK. N. ABUT.	10188.500	-4.333	417.954	417.954
☉ BRG. N. ABUT.	10190.250	-4.333	417.954	417.954
A	10200.250	-4.333	417.954	417.971
B	10210.250	-4.333	417.954	417.980
C	10220.250	-4.333	417.954	417.984
D	10230.250	-4.333	417.954	417.970
☉ BRG. PIER 1	10243.417	-4.333	417.954	417.954
E	10253.417	-4.333	417.954	417.954
F	10263.417	-4.333	417.954	417.955
G	10273.417	-4.333	417.954	417.956
H	10283.417	-4.333	417.954	417.954
☉ BRG. PIER 2	10296.583	-4.333	417.954	417.954
I	10306.583	-4.333	417.954	417.965
J	10316.583	-4.333	417.954	417.977
K	10326.583	-4.333	417.954	417.982
L	10336.583	-4.333	417.954	417.977
☉ BRG. S. ABUT.	10349.750	-4.333	417.954	417.954
BK. S. ABUT.	10351.500	-4.333	417.954	417.954

☉ ROADWAY AND P. G.

Location	Station	Offset	Theoretical Grade Elevations	Theoretical Grade Elevations Adjusted For Dead Load Deflection
BK. N. ABUT.	10188.500	0.000	417.970	417.970
☉ BRG. N. ABUT.	10190.250	0.000	417.970	417.970
A	10200.250	0.000	417.970	417.988
B	10210.250	0.000	417.970	417.997
C	10220.250	0.000	417.970	417.997
D	10230.250	0.000	417.970	417.967
☉ BRG. PIER 1	10243.417	0.000	417.970	417.970
E	10253.417	0.000	417.970	417.970
F	10263.417	0.000	417.970	417.972
G	10273.417	0.000	417.970	417.972
H	10283.417	0.000	417.970	417.970
☉ BRG. PIER 2	10296.583	0.000	417.970	417.970
I	10306.583	0.000	417.970	417.983
J	10316.583	0.000	417.970	417.994
K	10326.583	0.000	417.970	417.998
L	10336.583	0.000	417.970	417.993
☉ BRG. S. ABUT.	10349.750	0.000	417.970	417.970
BK. S. ABUT.	10351.500	0.000	417.970	417.970

☉ BEAM 4

Location	Station	Offset	Theoretical Grade Elevations	Theoretical Grade Elevations Adjusted For Dead Load Deflection
BK. N. ABUT.	10188.500	2.000	417.967	417.967
☉ BRG. N. ABUT.	10190.250	2.000	417.967	417.967
A	10200.250	2.000	417.967	417.984
B	10210.250	2.000	417.967	417.993
C	10220.250	2.000	417.967	417.993
D	10230.250	2.000	417.967	417.967
☉ BRG. PIER 1	10243.417	2.000	417.967	417.967
E	10253.417	2.000	417.967	417.967
F	10263.417	2.000	417.967	417.968
G	10273.417	2.000	417.967	417.969
H	10283.417	2.000	417.967	417.967
☉ BRG. PIER 2	10296.583	2.000	417.967	417.967
I	10306.583	2.000	417.967	417.979
J	10316.583	2.000	417.967	417.990
K	10326.583	2.000	417.967	417.995
L	10336.583	2.000	417.967	417.990
☉ BRG. S. ABUT.	10349.750	2.000	417.967	417.967
BK. S. ABUT.	10351.500	2.000	417.967	417.967

☉ BEAM 5

Location	Station	Offset	Theoretical Grade Elevations	Elevations Adjusted For Dead Load Deflection
BK. N. ABUT.	10188.500	8.333	417.910	417.910
☉ BRG. N. ABUT.	10190.250	8.333	417.910	417.910
A	10200.250	8.333	417.910	417.927
B	10210.250	8.333	417.910	417.936
C	10220.250	8.333	417.910	417.936
D	10230.250	8.333	417.910	417.926
☉ BRG. PIER 1	10243.417	8.333	417.910	417.910
E	10253.417	8.333	417.910	417.910
F	10263.417	8.333	417.910	417.911
G	10273.417	8.333	417.910	417.912
H	10283.417	8.333	417.910	417.910
☉ BRG. PIER 2	10296.583	8.333	417.910	417.910
I	10306.583	8.333	417.910	417.922
J	10316.583	8.333	417.910	417.933
K	10326.583	8.333	417.910	417.938
L	10336.583	8.333	417.910	417.933
☉ BRG. S. ABUT.	10349.750	8.333	417.910	417.910
BK. S. ABUT.	10351.500	8.333	417.910	417.910

W. LONGITUDINAL BONDED CONSTRUCTION JOINT

Location	Station	Offset	Theoretical Grade Elevations	Theoretical Grade Elevations Adjusted For Dead Load Deflection
BK. N. ABUT.	10188.500	12.000	417.845	417.845
☉ BRG. N. ABUT.	10190.250	12.000	417.845	417.845
A	10200.250	12.000	417.845	417.863
B	10210.250	12.000	417.845	417.872
C	10220.250	12.000	417.845	417.872
D	10230.250	12.000	417.845	417.862
☉ BRG. PIER 1	10243.417	12.000	417.845	417.845
E	10253.417	12.000	417.845	417.845
F	10263.417	12.000	417.845	417.847
G	10273.417	12.000	417.845	417.847
H	10283.417	12.000	417.845	417.845
☉ BRG. PIER 2	10296.583	12.000	417.845	417.845
I	10306.583	12.000	417.845	417.858
J	10316.583	12.000	417.845	417.869
K	10326.583	12.000	417.845	417.873
L	10336.583	12.000	417.845	417.858
☉ BRG. S. ABUT.	10349.750	12.000	417.845	417.845
BK. S. ABUT.	10351.500	12.000	417.845	417.845

☉ BEAM 6


Location	Station	Offset	Theoretical Grade Elevations	Theoretical Grade Elevations Adjusted For Dead Load Deflection
BK. N. ABUT.	10188.500	14.666	417.790	417.790
☉ BRG. N. ABUT.	10190.250	14.666	417.790	417.790
A	10200.250	14.666	417.790	417.807
B	10210.250	14.666	417.790	417.816
C	10220.250	14.666	417.790	417.816
D	10230.250	14.666	417.790	417.806
☉ BRG. PIER 1	10243.417	14.666	417.790	417.790
E	10253.417	14.666	417.790	417.790
F	10263.417	14.666	417.790	417.791
G	10273.417	14.666	417.790	417.792
H	10283.417	14.666	417.790	417.790
☉ BRG. PIER 2	10296.583	14.666	417.790	417.790
I	10306.583	14.666	417.790	417.802
J	10316.583	14.666	417.790	417.813
K	10326.583	14.666	417.790	417.818
L	10336.583	14.666	417.790	417.813
☉ BRG. S. ABUT.	10349.750	14.666	417.790	417.790
BK. S. ABUT.	10351.500	14.666	417.790	417.790

☉ BEAM 7


Location	Station	Offset	Theoretical Grade Elevations	Theoretical Grade Elevations Adjusted For Dead Load Deflection
BK. N. ABUT.	10188.500	21.000	417.658	417.658
☉ BRG. N. ABUT.	10190.250	21.000	417.658	417.658
A	10200.250	21.000	417.658	417.675
B	10210.250	21.000	417.658	417.685
C	10220.250	21.000	417.658	417.685
D	10230.250	21.000	417.658	417.675
☉ BRG. PIER 1	10243.417	21.000	417.658	417.658
E	10253.417	21.000	417.658	417.658
F	10263.417	21.000	417.658	417.659
G	10273.417	21.000	417.658	417.660
H	1028			

STATE OF ILLINOIS  
DEPARTMENT OF TRANSPORTATION

ROUTE NO.	SECTION	COUNTY	MILE	POST	SHEET NO. 4
P.A.L. 57	*	FRANKLIN		26	16 SHEETS
DESIGNED BY		DRAWN BY		CHECKED BY	
E.L.S.		E.L.S.		E.L.S.	

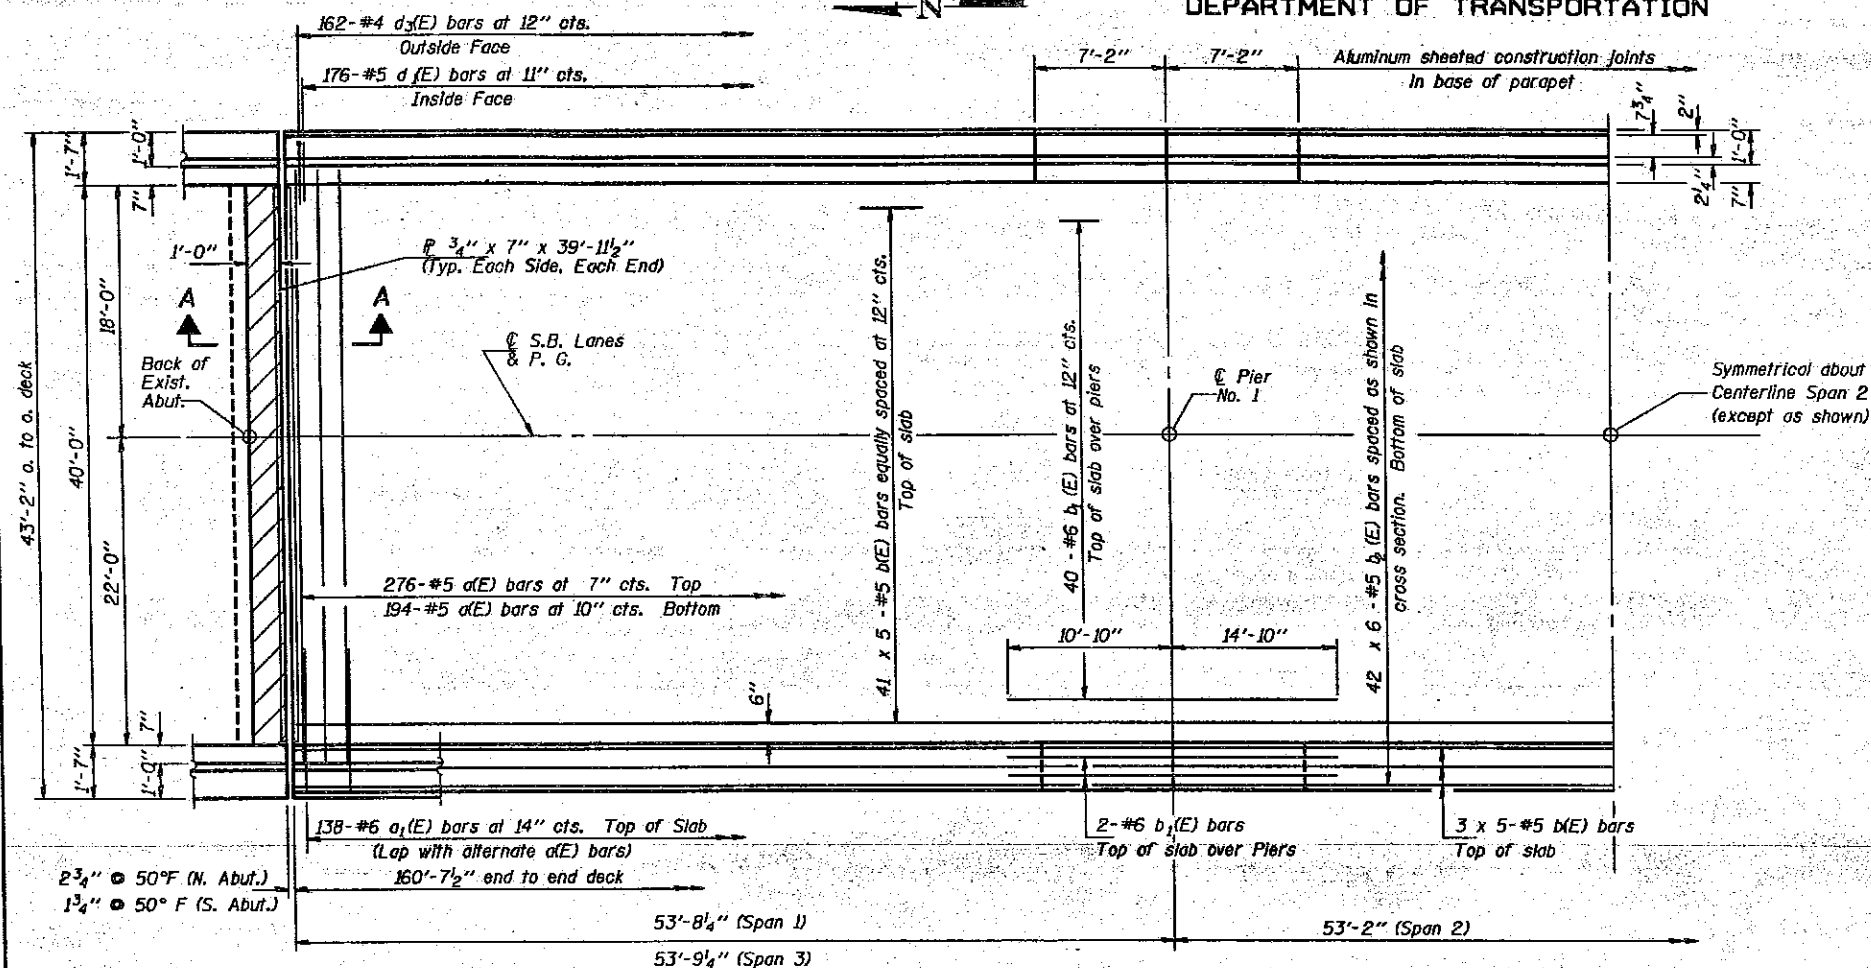

HALF PLAN

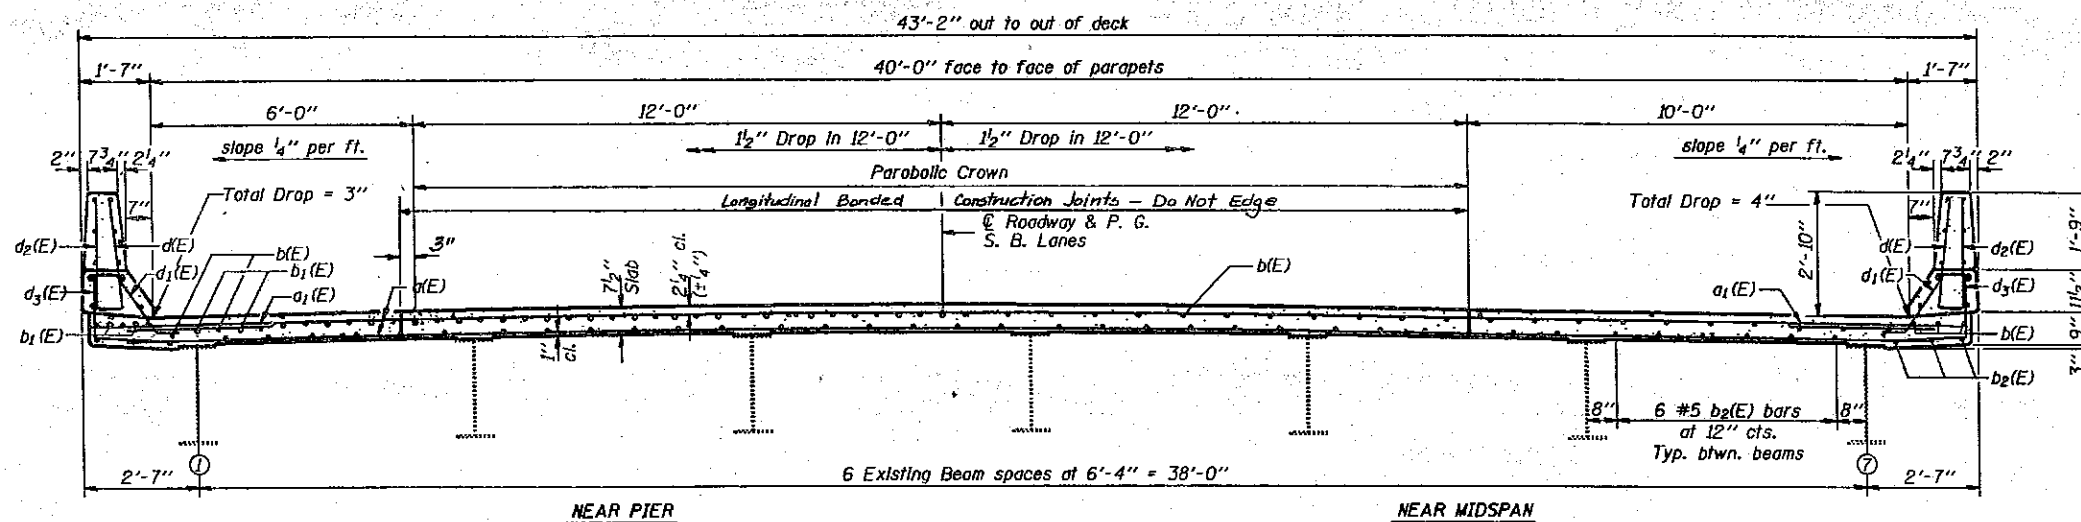

CROSS SECTION  
(Looking South)

Notes: See sheets #5 and #6 of 16 for superstructure details, parapet reinforcement and Bill of Material.  
Reinforcement bars designated (E) shall be epoxy coated.  
Reinforcement bars indicated thus 40 x 4 #5 etc. indicates 40 lines of bars with 4 lengths per line.  
See sheet #1 of 16 for drain locations and sheet #5 of 16 for details.  
Hatched area to be poured after superstructure forms have been removed. Quantity of concrete to be included with Class X Concrete Superstructure.  
For Sec. A-A See Sht. 6 of 16.

MIN. BAR LAPS  
#5 bars = 1'-8"


DESIGNED <i>Michael A. Stephens</i>	EXAMINED <i>Greg J. Kaspa</i>
CHECKED <i>Thomas A. Graw</i>	PASSED <i>Ralph E. Anderson</i>
DRAWN E. Vern Taylor	APPROVED _____
CHECKED MAS GAG JAC	DIRECTOR OF HIGHWAYS

May 20 1993

SUPERSTRUCTURE  
F.A.I. RT. 57 SEC. (28-1B)D-1  
FRANKLIN COUNTY  
STATION 102+70.00


STATE OF ILLINOIS  
DEPARTMENT OF TRANSPORTATION

ROUTE NO.	DISTRICT	COUNTY	SECT.	SHEET	SHEET NO. 5
F.A.I. 57		FRANKLIN		27	16 SHEETS
PROJECT EST. NO. 7					
*28-1B/D-1					

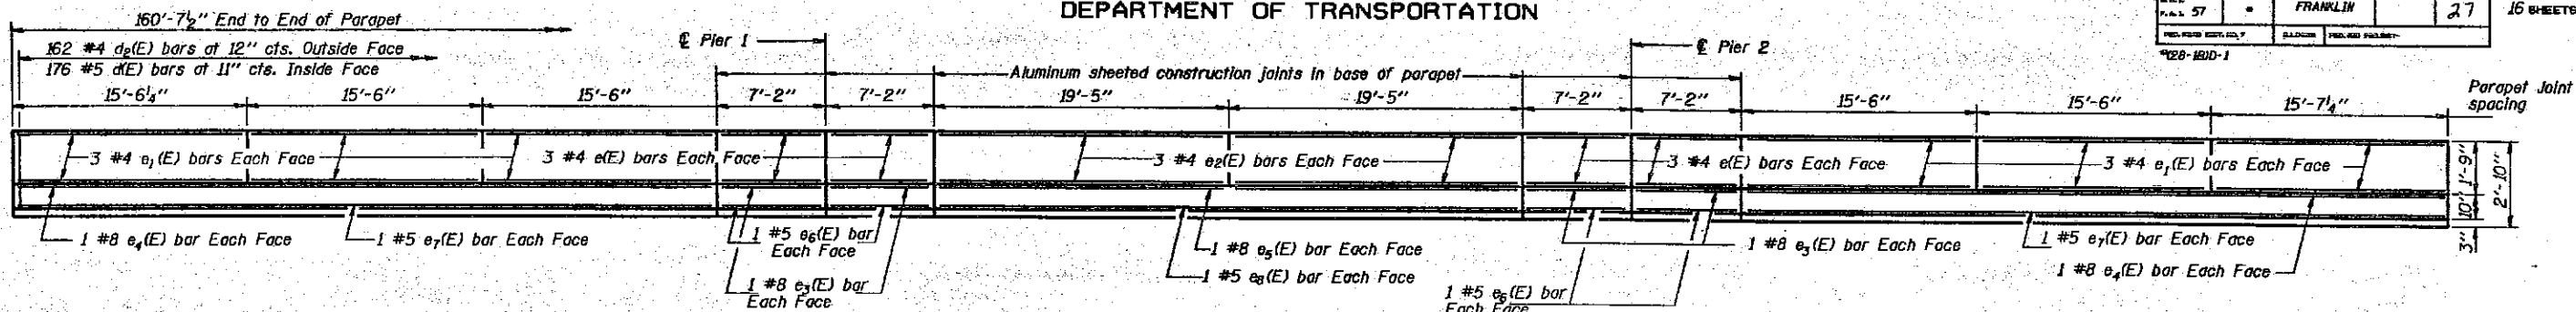


**EAST PARAPET ELEVATION**

(Looking East - East Parapet So. Bd. Lanes)

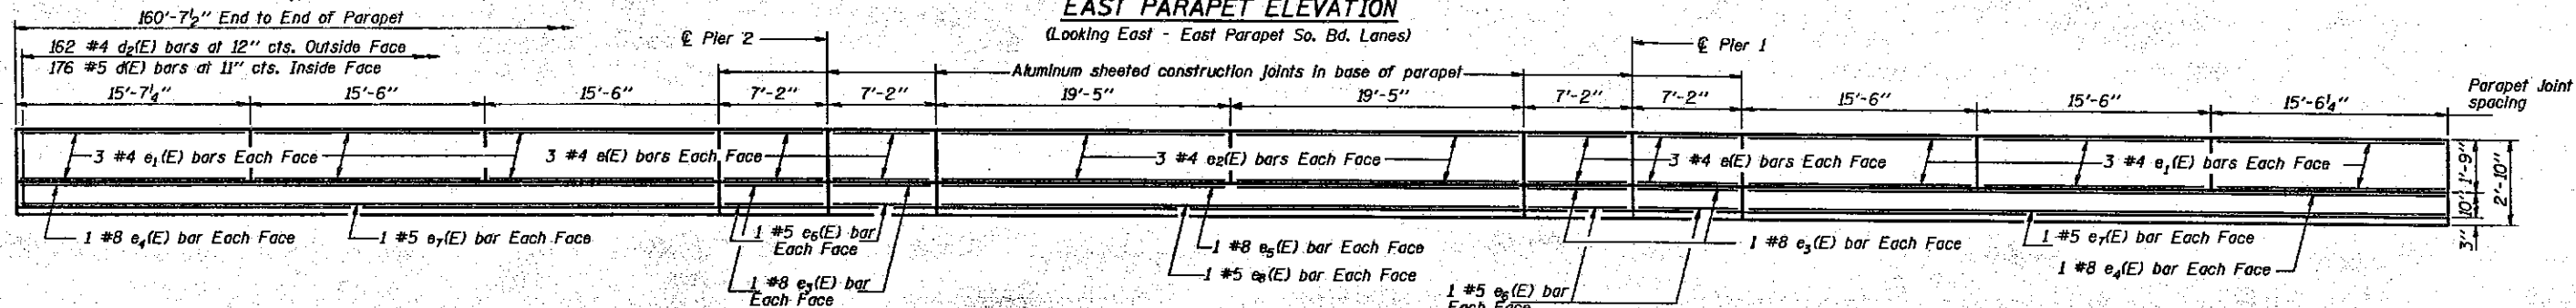


**WEST PARAPET ELEVATION**

(Looking West - West Parapet So. Bd. Lanes)

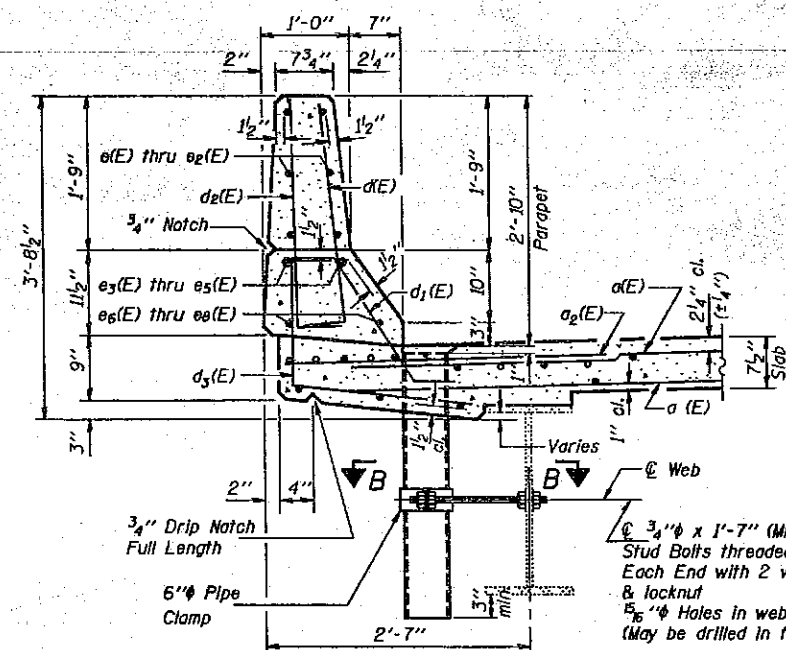

**SECTION THRU PARAPET**


See Plan view for Location of 6" drain.

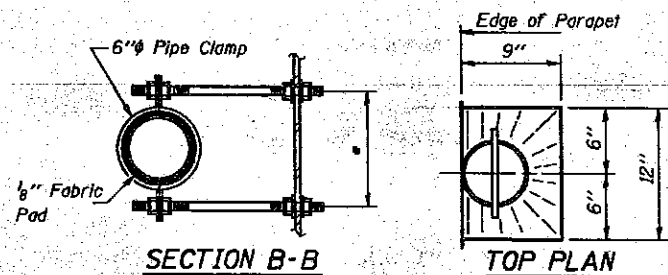


**SECTION B-B**

**TOP PLAN**


\* Dimension as required by Pipe Clamp

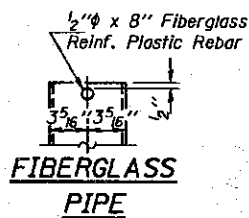

**FIBERGLASS PIPE**

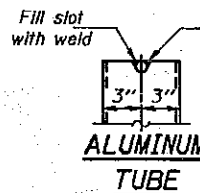


**ALUMINUM TUBE**

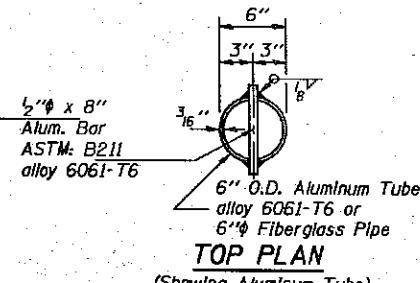

**TOP PLAN**

(Showing Aluminum Tube)

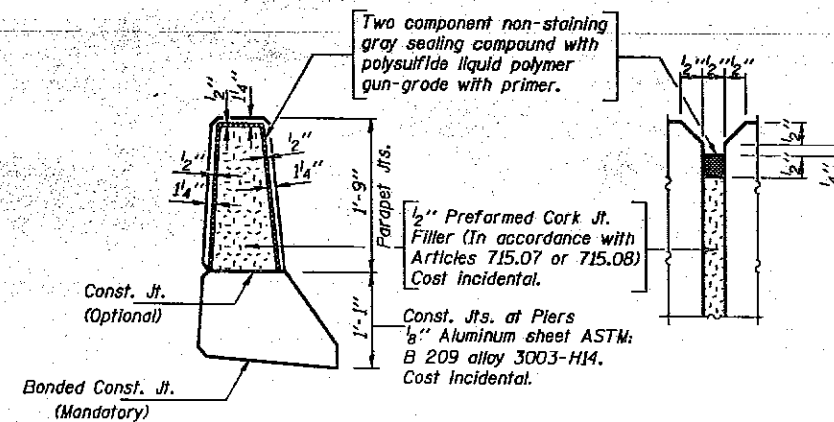

**PARAPET JOINT DETAILS**

**Notes:**

The exterior surfaces of the Floor Drain shall be painted with the vinyl enamel paint as specified in the Standard Specifications. The exterior surface of the drain shall be cleaned and given a washcoat pretreatment in accordance with Steel Structural Painting Council's Spec. SSPC-SP1 & SSPC-Paint 27 prior to painting.


Fiberglass pipe shall conform to ASTM: D2996, with short-time rupture strength hoop tensile stress of 30,000 p.s.i. minimum. The surface of the Fiberglass pipe shall be free of bond inhibiting agents.

DESIGNED <i>Michael A. Stegeman</i>	EXAMINED <i>Orin J. Kaspar</i>
CHECKED <i>George A. ...</i>	PASSED <i>Ralph E. ...</i>
DRAWN <i>E. Vern Taylor</i>	APPROVED _____
CHECKED <i>M.S. GAG</i>	DIRECTOR OF HIGHWAYS


**SOUTH BOUND LANES  
SUPERSTRUCTURE DETAILS  
F.A.I. RT. 57 SEC. (28-1B/D)-1  
FRANKLIN COUNTY  
STATION 102+70.00**

STATE OF ILLINOIS  
DEPARTMENT OF TRANSPORTATION


DATE	DESIGN	CONTRACT	SECTION	SHEET NO.
MAY 20 1993		FRANKLIN		29
SHEET NO. 6 OF 26 SHEETS				

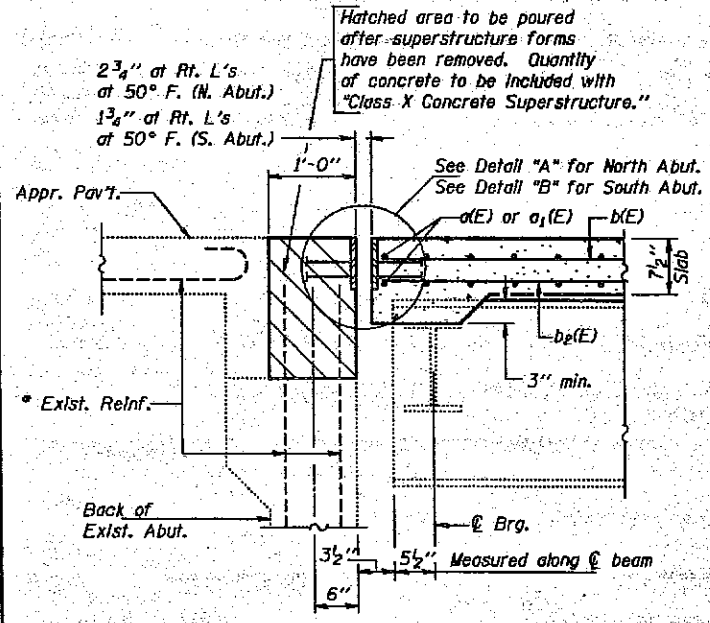

SECTION A-A

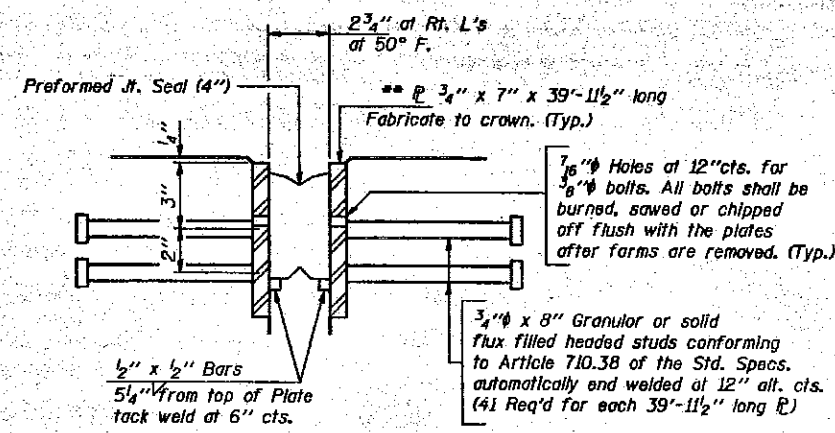

DETAIL "A"

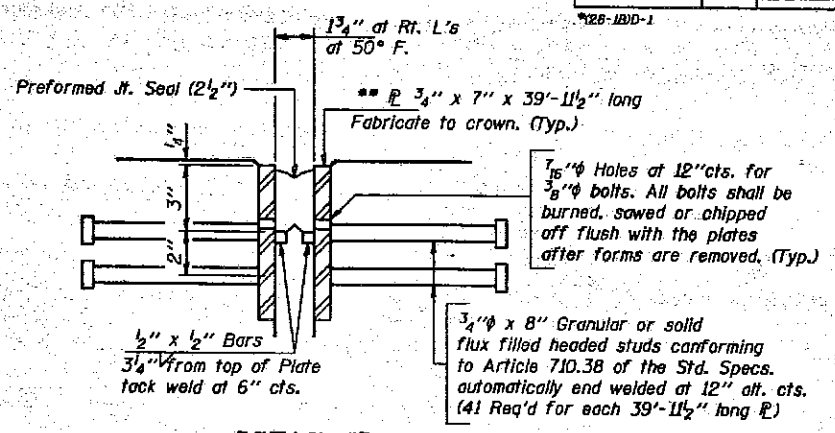


DETAIL "B"


\*\* Furnish in segments of 20 ft. maximum length. Maximum space between installed segments shall be 1/8". Seal space with Silicone Sealant suitable for Structural Steel.

Notes: After fabrication all surfaces of the steel plates shall be given one shop coat of paint specified for Structural Steel. No field painting required.


\* Existing vertical Reinforcement in the back wall and the longitudinal reinforcement in the approach slab shall be cleaned and straightened and incorporated into new construction. Cost incidental to "Concrete Removal."

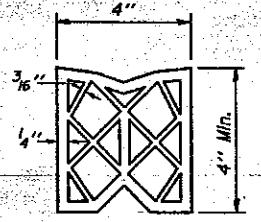


PREFORMED JOINT SEAL (4")  
North Abutment

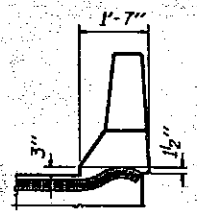


END TREATMENT  
Typ. for (4") and (2 1/2").

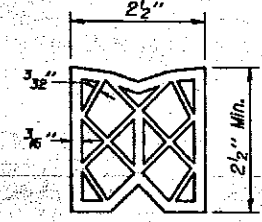


PREFORMED JOINT SEAL (2 1/2")  
South Abutment

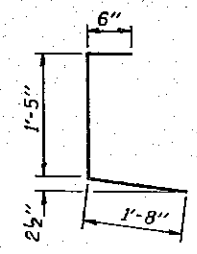

BAR d3(E)

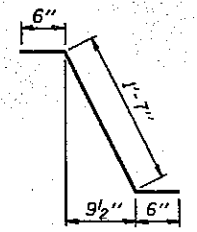

BAR d1(E)

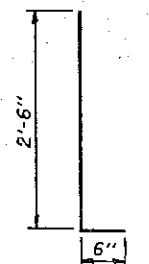

BARS d(E) & d2(E)

SUPERSTRUCTURE  
BILL OF MATERIAL

Bar	No.	Size	Length	Shape
d(E)	470	#5	41'-2"	—
a1(E)	276	#6	4'-0"	—
b(E)	235	#5	33'-5"	—
b1(E)	88	#6	25'-8"	—
b2(E)	252	#5	28'-2"	—
d(E)	352	#5	3'-0"	L
d1(E)	352	#5	2'-7"	L
d2(E)	324	#4	3'-0"	L
d3(E)	324	#4	3'-7"	L
e(E)	48	#4	6'-11"	—
e1(E)	72	#4	15'-3"	—
e2(E)	24	#4	19'-2"	—
e3(E)	16	#8	6'-11"	—
e4(E)	8	#8	46'-3"	—
e5(E)	4	#8	38'-7"	—
e6(E)	16	#5	6'-11"	—
e7(E)	8	#5	46'-3"	—
e8(E)	4	#5	38'-7"	—

Reinforcement Bars, Epoxy Coated	Lbs.	47,920
** Class X Concrete Superstructure	Cu. Yd.	215.4

Reinforcement bars designated (E) shall be epoxy coated.

\*\* Includes 17.2 cu. yds. for Abutments and approaches.

SUPERSTRUCTURE DETAILS  
F.A.I. RT. 57 SEC. (28-1B)D-1  
FRANKLIN COUNTY  
STATION 102+70.00

DESIGNED Michael A. Steinhilber  
CHECKED George A. Janicek  
DRAWN E. Vern Taylor  
CHECKED MAS GAG TAC

EXAMINED Gregory J. Kaspar  
PASSED Ronald E. Anderson  
APPROVED \_\_\_\_\_

MAY 20 1993

ENGINEER OF BRIDGES AND STRUCTURES  
DIRECTOR OF HIGHWAYS



STATE OF ILLINOIS  
DEPARTMENT OF TRANSPORTATION

STATE NO.	SECTION	QUANTITY	DATE	BY	SHEET NO. 7
F.A.S. 57	FRANKLIN			29	16 SHEETS
DESIGNER'S CERT. NO. 128-1B10-1					

**\* INTERIOR BEAM MOMENT TABLE**

	0.4 Sp. 1 or 0.6 Sp. 3	Pier 1 or Pier 2	0.5 Sp. 2
$I_s$ (in <sup>4</sup> )	5900	5900	5900
$I_c$ (in <sup>4</sup> )	15782		15782
$S_s$ (in <sup>3</sup> )	359	359	359
$S_c$ (in <sup>3</sup> )	530		530
$\rho$ (K/ft.)	.75	1.03	.75
$M_P$ (K)	169	271	53
$f_s \rho$ non-comp (k.s.i.)	5.6	9.1	1.8
$s \rho$ (K/ft.)	.276		.276
$M_s \rho$ (K)	69		37
$M_L$ (K)	329	160	267
$M$ (Imp) (K)	92	45	75
$M$ (Total) (K)	490	205	379
$f_s$ (Comp) (k.s.i.)	11.1	6.9	8.6
$f_s$ (Total) (k.s.i.)	16.7	16.0	10.4
$VR$ (K)	41		40

**\* INTERIOR BEAM REACTION TABLE**

	Abuts.	Piers
$R_P$ (K)	22.2	59.7
$R_L$ (K)	32.8	38.4
$Imp.$ (K)	9.2	10.8
$R$ (Total) (K)	64.2	108.9

**\* Service Load Values.**

$I_s$  and  $S_s$  are the moment of inertia and section modulus of the steel section used in computing  $f_s$  (Total).

$I_c$  and  $S_c$  are the moment of inertia and section modulus of the composite section used in computing  $f_s$  (Total).

$VR$  is the maximum live load + impact shear range in span.

$M$  (Total) =  $M_s \rho + (M_L + I)$






$f_s$  (Total) is the sum of the stresses due to  $[M_P + M_s \rho + (M_L + I)]$ .

$M_P$  is the Moment due to Dead Loads on non-composite section.

$M_s \rho$  is the Moment due to Dead Loads on composite section.

$M_L$  is the Moment due to Live Loads on non-composite or composite section.

$I$  is the Live Load Impact.

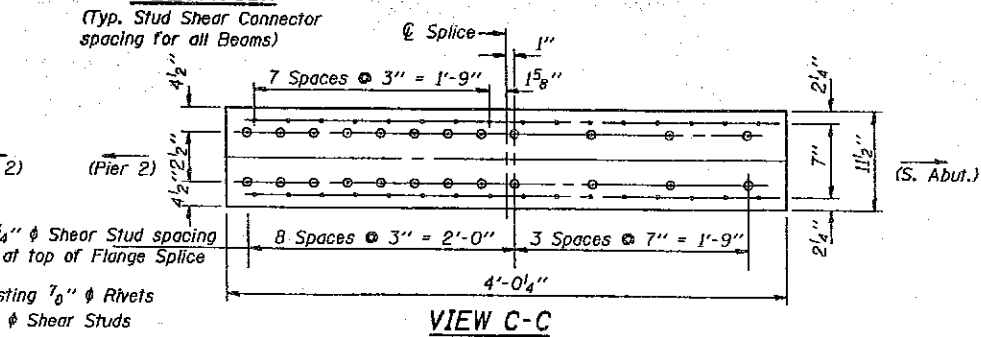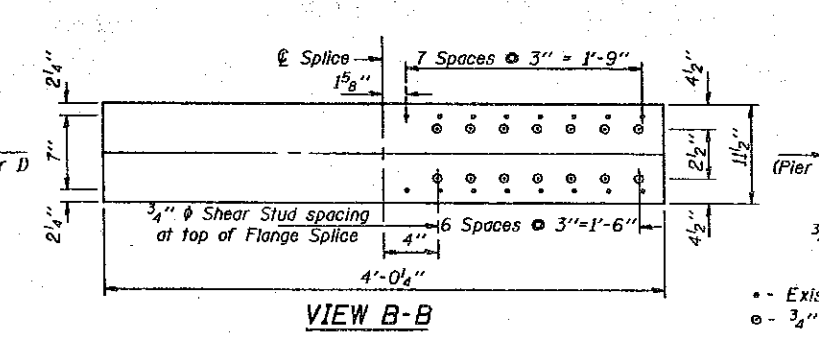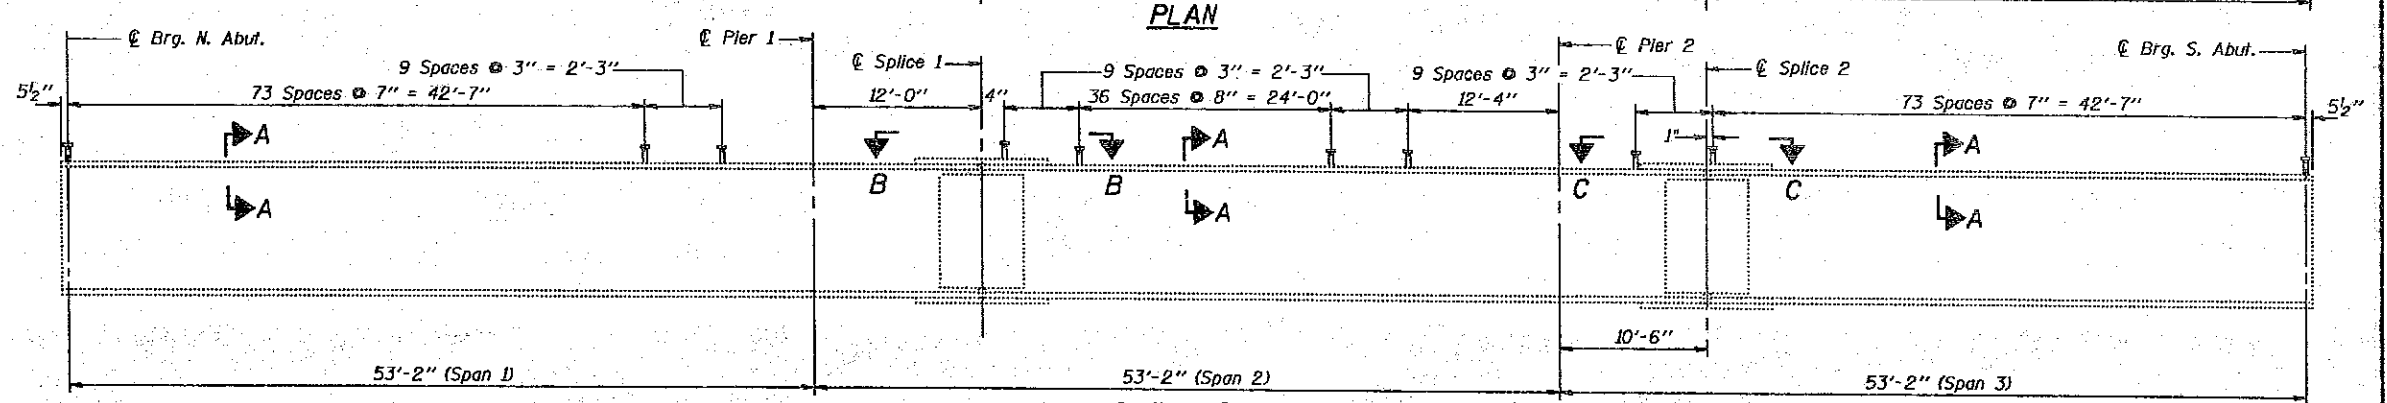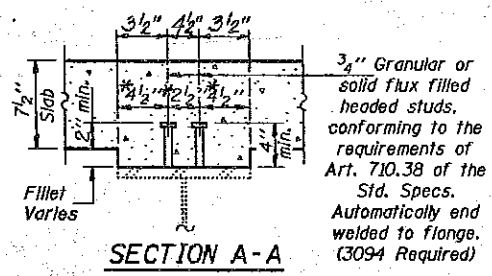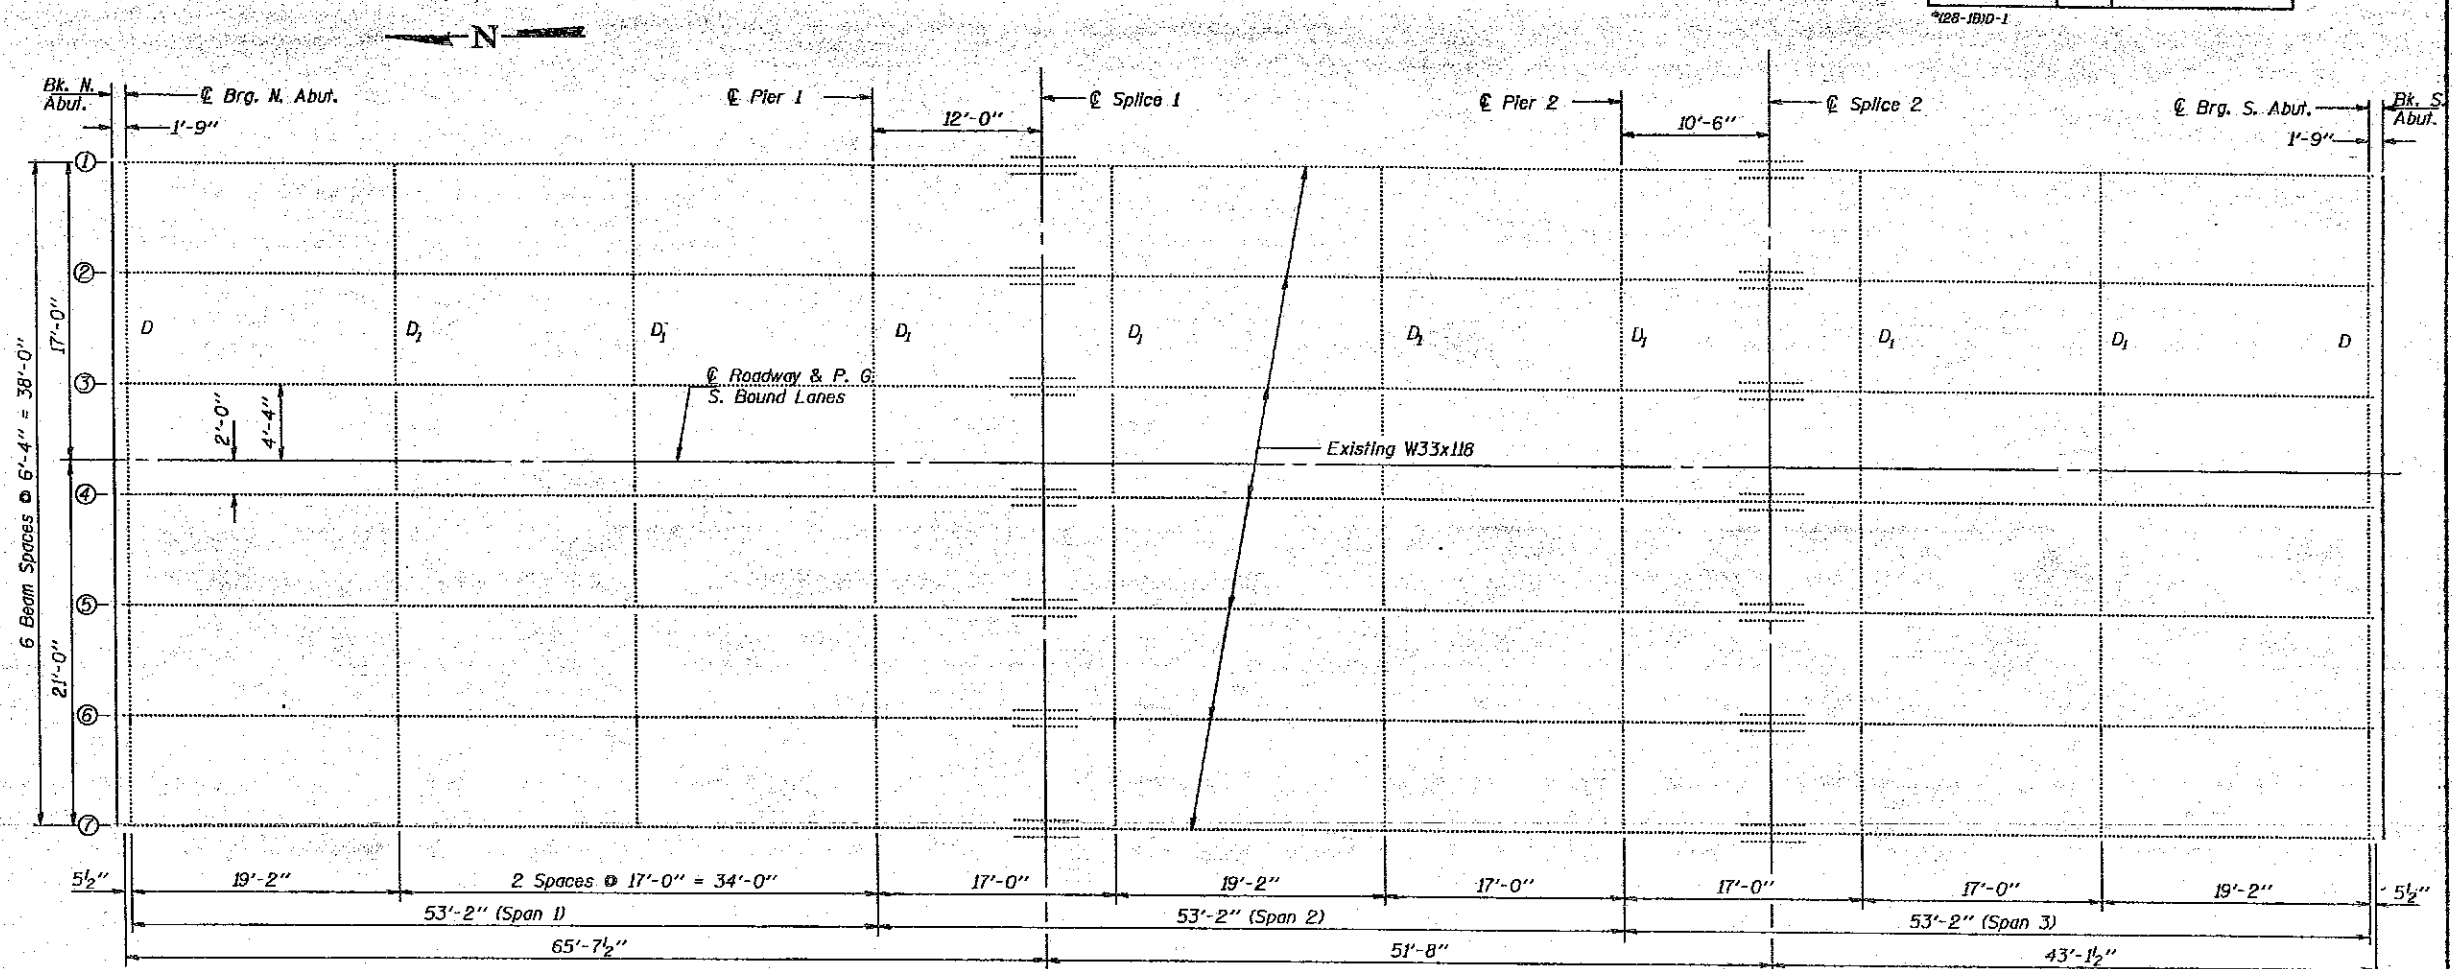

DESIGNED: Michael A. Stegeman  
 CHECKED: Thomas A. Lawrence  
 DRAWN: E. Vern Taylor  
 CHECKED: M.A.S. Glas, TAC

EXAMINED: Orji O. Kapan  
 PASSED: Ralph E. Anderson  
 APPROVED: [Signature]


MAY 20 1993

STRUCTURAL STEEL DETAILS  
 F.A.I. RT. 57 SEC. (28-1B)D-1  
 FRANKLIN COUNTY  
 STATION 102+70.00




STATE OF ILLINOIS  
DEPARTMENT OF TRANSPORTATION

PROJECT NO.	SECTION	DATE	JOB NO.	SHEET NO.
F.A.I. 57	FRANKLIN		31	16 SHEETS

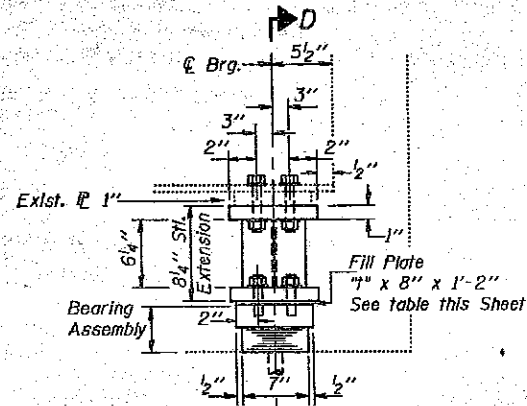


ELEVATION AT SOUTH ABUT.

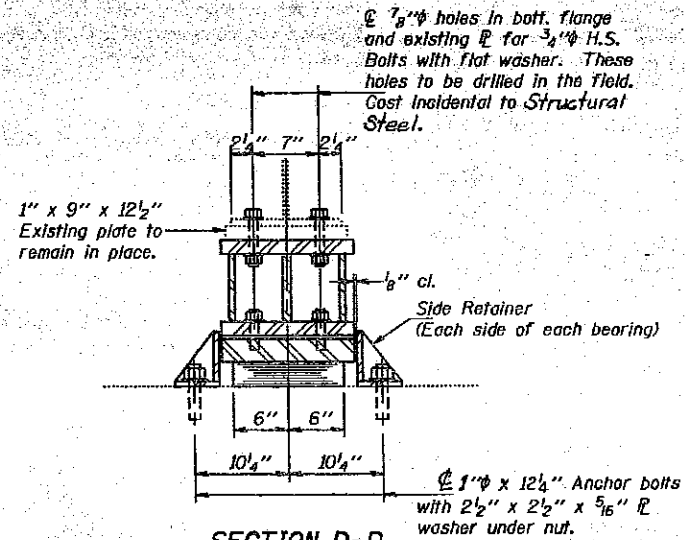


SECTION D-D

TYPE I ELASTOMERIC EXP. BRG.

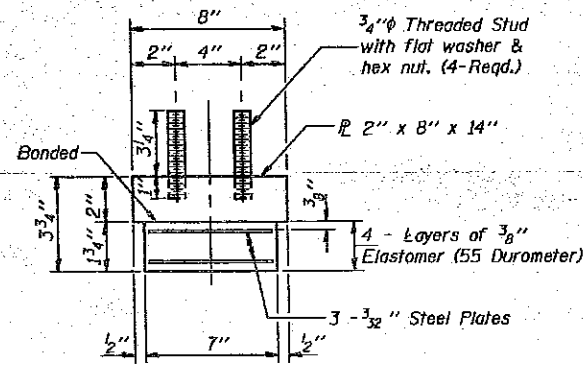

BEARING ASSEMBLY

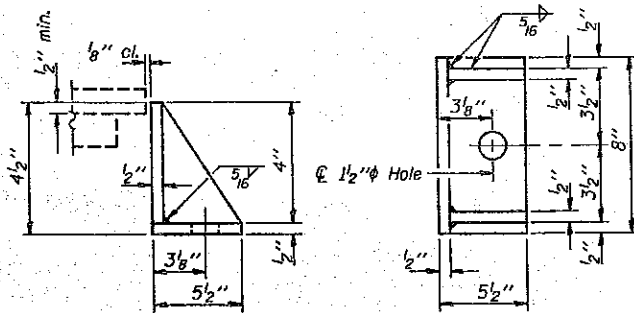

SIDE RETAINER

Equivalent rolled angle with stiffeners will be allowed in lieu of welded plates.

**BILL OF MATERIAL**

Item	Unit	Total
Elastomeric Bearing Assembly Type I	Each	7
*** Jack and Remove Existing Bearings	Each	7


\*\*\*See Sheet #11 of 16 for the Jacking locations.

Notes: For anchor bolt installation details see sheet #12 of 16. Existing anchor bolts which are not under side retainer shall be covered with a 2" thick layer of cement mortar. Cost incidental to "Jack and Remove Existing Bearing". For anchor bolt location see sheets #13 and #14 of 16.


\* Based on the existing elevations shown on sheet #11 of 16. The Contractor shall verify these elevations and make adjustments if necessary.

Dimension / Location	Bm. #1	Bm. #2	Bm. #3	Bm. #4	Bm. #6
≈ Dim. "1"	3/8"	5/8"	7/8"	7/8"	1/2"

Beams #5 & #7, No Fill R Required.

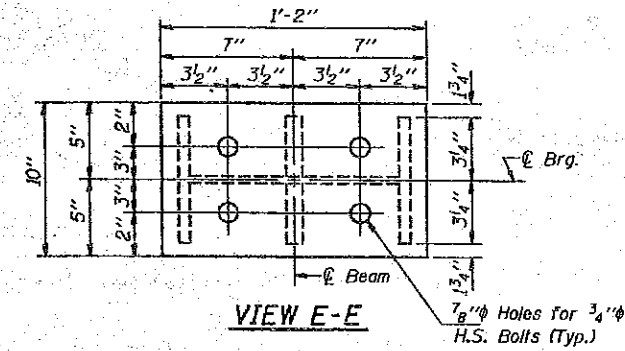


VIEW E-E

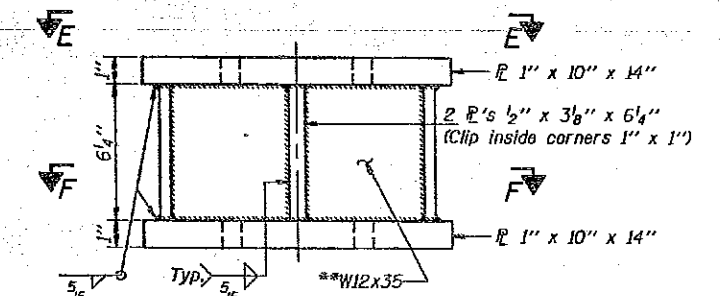

STEEL EXTENSION AT SOUTH ABUT.

\*\*Equivalent welded plates will be allowed in lieu of W12x35 section.

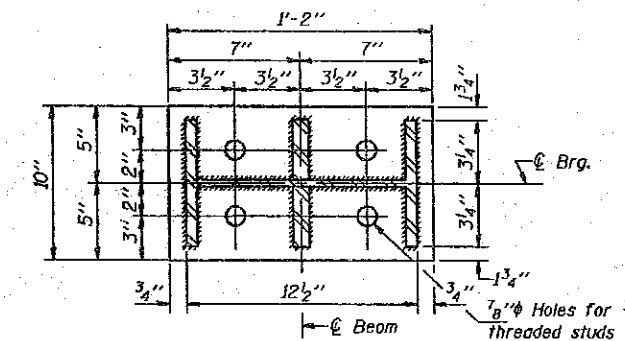

SECTION F-F


SOUTH ABUTMENT  
BEARING DETAILS  
F.A.I. RT. 57 SEC. (28-1B)D-1  
FRANKLIN COUNTY  
STATION 102+70.00

DESIGNED Michael A. Stephenson  
George A. Schmitt  
CHECKED Kenneth A. Cannon  
DRAWN E. Vern Taylor  
CHECKED MAS GMS TAC


May 20 1993  
EXAMINED [Signature]  
PASSED [Signature]  
APPROVED [Signature]

STATE OF ILLINOIS  
DEPARTMENT OF TRANSPORTATION

PROJECT NO.	DESIGN	DATE	SHEET NO.
F.A.I. 57	FRANKLIN		32
SHEET NO. 10			
16 SHEETS			

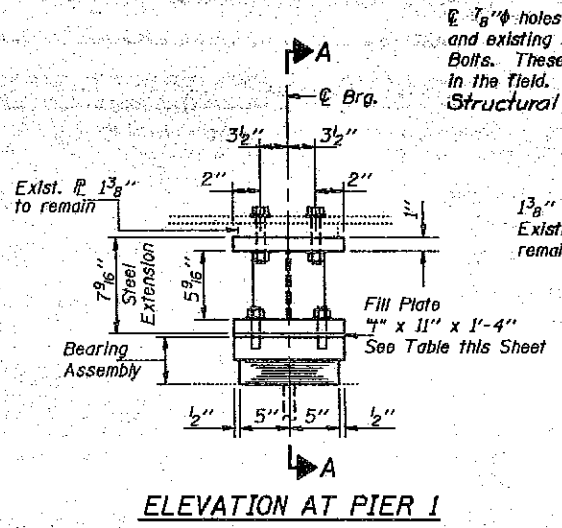


$\varnothing 7/8$ " holes in existing flange and existing R for  $3/4$ " H.S. Bolts. These holes to be drilled in the field. Cost incidental to Structural Steel.

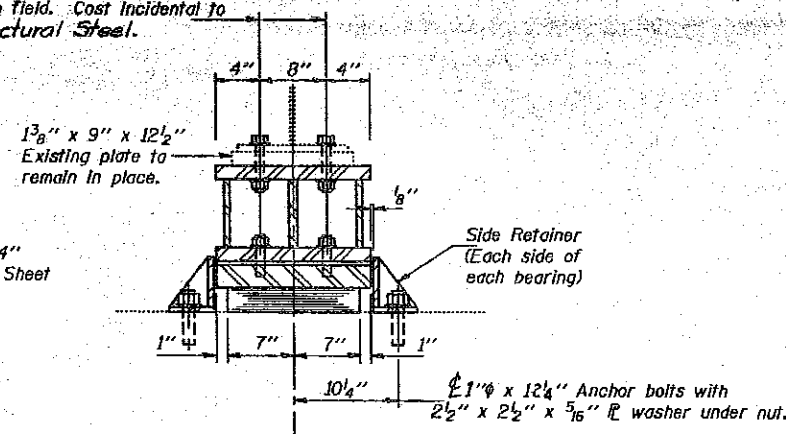

ELEVATION AT PIER 1

SECTION A-A

TYPE I ELASTOMERIC EXP. BRG.

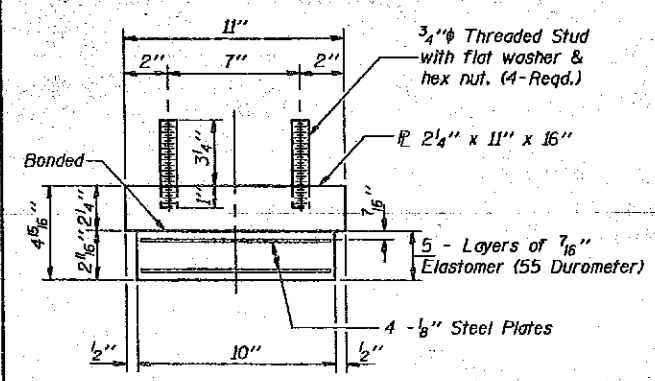

BEARING ASSEMBLY

Note: Shim Plates shall not be placed under Bearing Assembly.

\* Based on the existing elevations shown on Sheet #11 of 16. The Contractor shall verify these elevations and make adjustments if necessary.


Dimension / Location	Bm. #2	Bm. #3	Bm. #4	Bm. #5	Bm. #6	Bm. #7
Dim. 7"	9/16"	1/2"	13/16"	3/16"	1/4"	3/16"

Beam #1, No Fill R Required.


BILL OF MATERIAL

Item	Unit	Total
Elastomeric Bearing Assembly Type I	Each	7
*** Jack and Remove Existing Bearings	Each	7

\*\*\* See Sheet #11 of 16 for the Jacking locations.

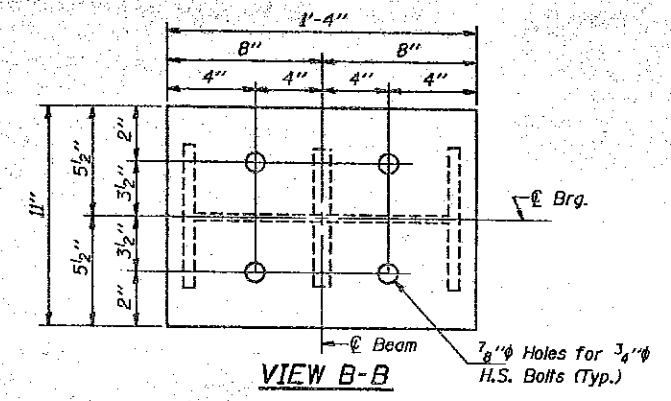


VIEW B-B

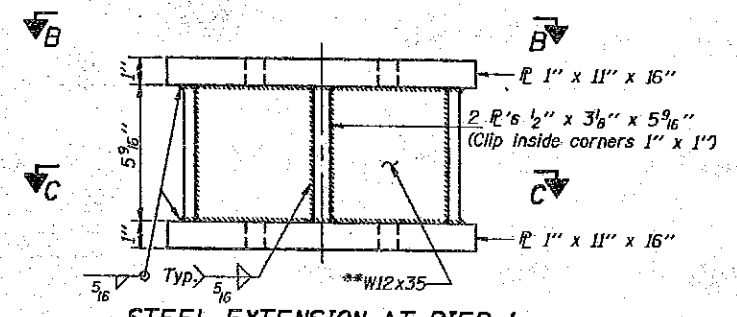


STEEL EXTENSION AT PIER 1

\*\*Equivalent welded plates will be allowed in lieu of W12x35 section.

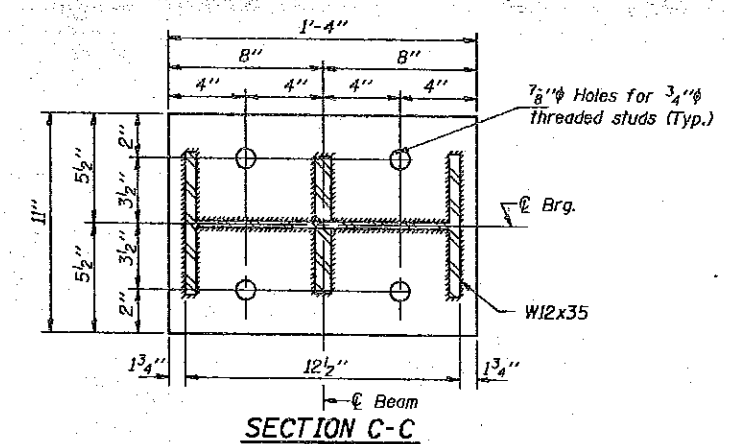

SECTION C-C

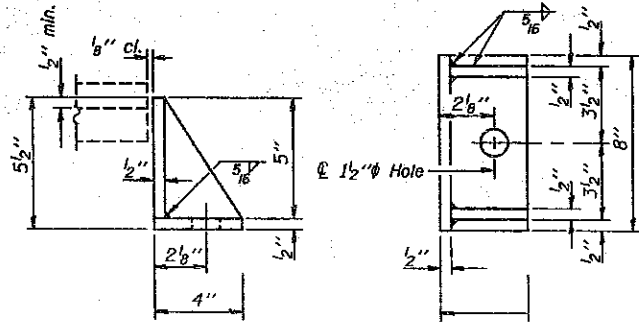

SIDE RETAINER

Equivalent rolled angle with stiffeners will be allowed in lieu of welded plates.

Notes: For anchor bolt installation details see sheet #12 of 16. Existing anchor bolts which are not under side retainer shall be covered with a 2" thick layer of cement mortar. Cost incidental to "Jack and Remove Existing Bearing". For anchor bolt location see sheets #13 and #14 of 16.

PIER 1  
BEARING DETAILS  
F.A.I. RT. 57 SEC. (28-1B)D-1  
FRANKLIN COUNTY  
STATION 102+70.00

DESIGNED *Michael A. Stephenson*  
CHECKED *George A. Johnson*  
DRAWN *E. Vern Taylor*  
CHECKED *MAS*

EXAMINED *Orsi J. Kapor*  
PASSED *Ralph E. Anderson*  
APPROVED \_\_\_\_\_

May 20 1993

ENGINEER OF BRIDGE DESIGN  
ENGINEER OF BRIDGES AND STRUCTURES  
DIRECTOR OF HIGHWAYS





STATE OF ILLINOIS  
DEPARTMENT OF TRANSPORTATION

ROUTE NO.	SECTION	COUNTY	SERIAL	"ET"	SHEET NO. 12
F.A.I. 57	28	FRANKLIN		34	16 SHEETS
FED. ROAD DIST. NO. 7		ALLOYS		FED. AID PROJECT	
*28-1B1D-1					

The Illinois Coil-Lock Anchor Bolt is a proprietary item which is the property of the Illinois Department of Transportation. Use, reproduction or disclosure without express written permission is prohibited and protected under Federal copyright laws. The production and the fabrication of this bolt for use on highway projects in the State of Illinois shall be permitted and there shall be no incurred charges or fees to the manufacturer or the fabricator for producing or fabricating this bolt.

D	E	H	K	"d"
1"	1 1/8"	1 1/16"	1 3/4"	1/4"
1 1/4"	1 3/8"	1 1/16"	2"	3/8"
1 1/2"	1 5/8"	1 5/16"	2 1/8"	1/2"
2"	2 1/8"	1 5/16"	2 7/8"	1/2"
2 1/2"	2 5/8"	2 5/16"	3 3/8"	1"

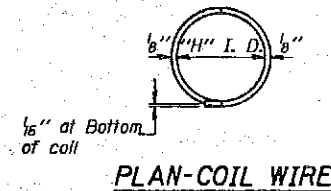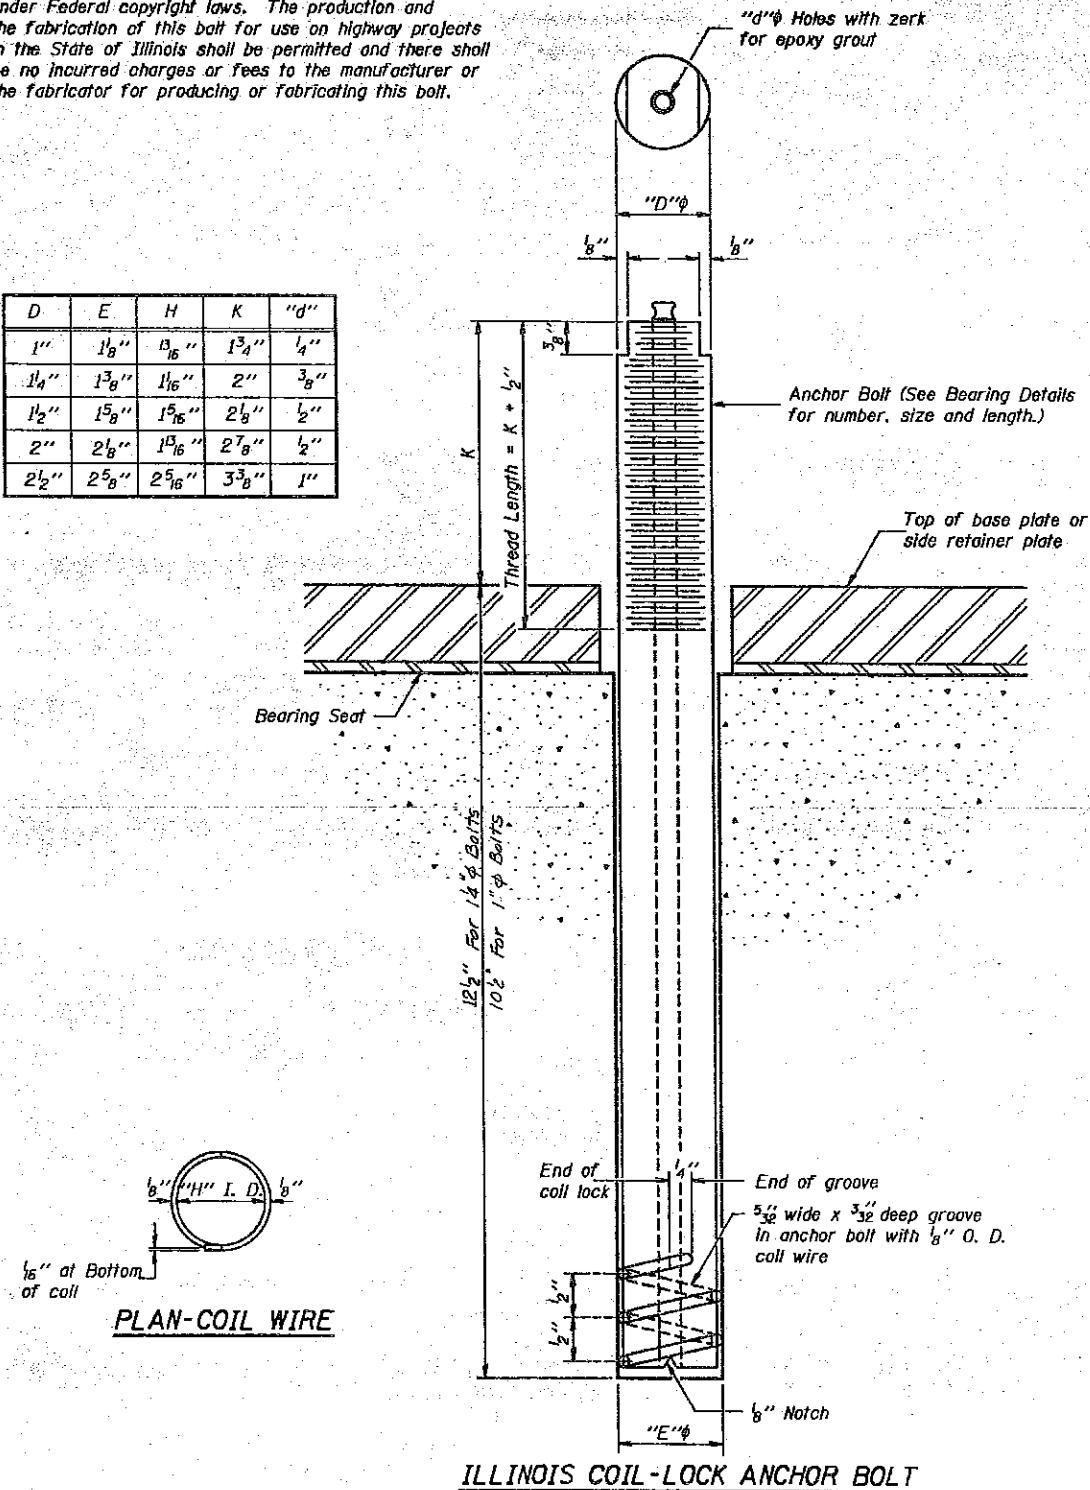

MATERIALS FOR ILLINOIS COIL-LOCK ANCHOR BOLT

The anchor bolt shall be fabricated from cold drawn or hot finished seamless carbon steel mechanical tubing conforming to ASTM A519, Grade 1026 and supplied with hexagonal nuts and cut washers.  
The coil wire shall be made of any suitable soft steel wire.  
The finished anchor bolt shall be cleaned of rust and other foreign materials and wrapped or packaged to prevent contamination until they are installed.  
The epoxy grout shall be a two-component, epoxy resin bonding system conforming to ASTM C881, Type I, Grade 1 and of a Class suitable for the temperature at installation.

INSTALLATION PROCEDURE for the ILLINOIS COIL-LOCK ANCHOR BOLT

1. With the coil wire in place, the bolt shall be inserted into the hole and turned clockwise to a snug fit in the hole. Nut and washer shall be placed on the bolt. The nut shall be tensioned until the steel base plates are held securely to the concrete bearing seat.
2. Epoxy grout shall be pumped through the zerk fitting with a pressure gun. Pumping shall continue until the epoxy overflows the hole around the bolt shank. After pumping is discontinued, excess epoxy shall be immediately wiped off.

ALTERNATE ANCHOR BOLTS

The Contractor may use, at his option, the capsule or the adhesive cartridge type anchor rods that have been previously tested and given a prior approval by the Department. The Contractor shall install these anchor rods in pre-drilled holes in accordance with the manufacturer's recommendations and procedures.  
The capsule or the adhesive cartridge type anchor rods shall be a two part system composed of:  
1. A threaded rod stud with nut and washer conforming to ASTM A307.  
2. A sealed glass capsule or a sealed glass adhesive cartridge containing premeasured amounts of the adhesive chemical.

GENERAL NOTES

Holes in the masonry for anchor bolts shall be drilled through the base plates to the diameter and depth shown or in accordance with the manufacturer's recommendation after beams or girders have been erected and adjusted.  
Prior to setting the bolts, the holes shall be dry and all dust and loose particles shall be removed by the use of compressed air or vacuuming.  
The anchor bolts, furnished and installed and including the epoxy grout or capsules shall not be paid for separately but shall be included in the unit bid price for "Furnishing and Erecting Structural Steel".

DESIGNED Michael A. Stephenson  
 CHECKED George A. Althouse  
 DRAWN E. Vern Taylor  
 CHECKED MAS GAG TAC

EXAMINED Greg J. Kaspa  
 PASSED Ralph E. Anderson  
 APPROVED \_\_\_\_\_

May 20 1993  
 ENGINEER OF RECORD DESIGN  
 ENGINEER OF BRIDGES AND STRUCTURES  
 DIRECTOR OF HIGHWAYS


ABB-1 12-1-83

ANCHOR BOLT DETAILS  
FOR BEARINGS  
F.A.I. RT. 57 SEC. (28-1B1D-1)  
FRANKLIN COUNTY  
STATION 102+70.00




STATE OF ILLINOIS  
DEPARTMENT OF TRANSPORTATION

ROUTE NO.	SECTION	COUNTY	SPR.	SHEET NO.
F.A.I.	57	FRANKLIN		35
PROJECT NO. (28-1B)D-1				16 SHEETS

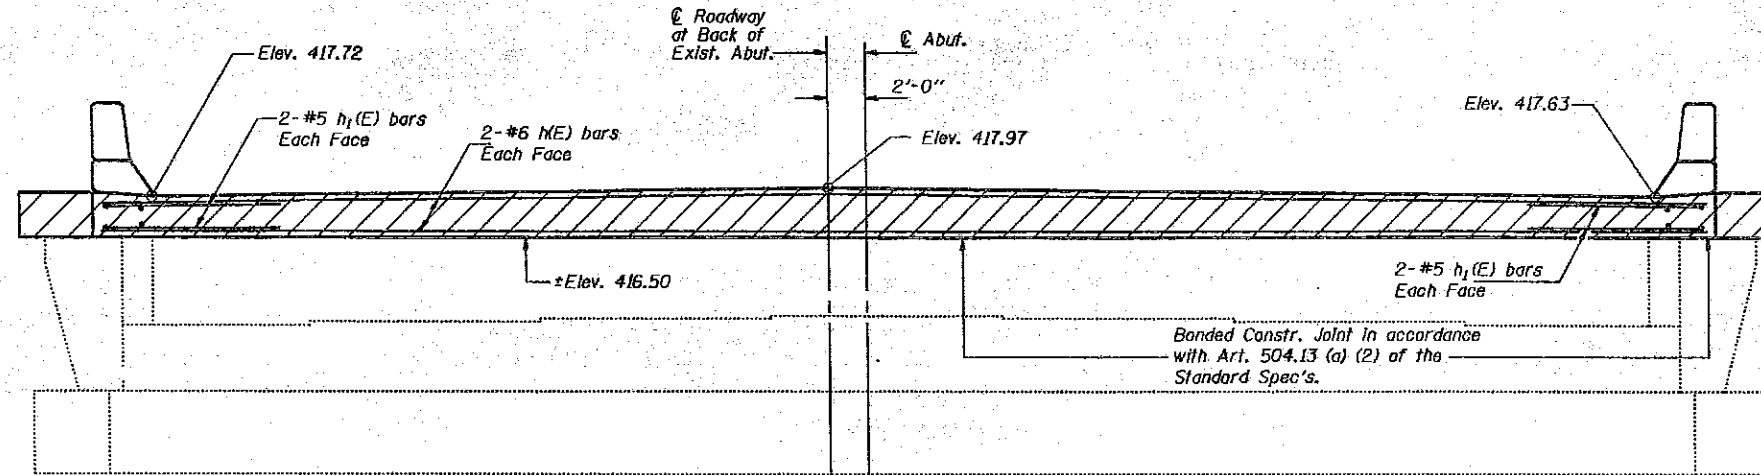

ELEVATION  
(Looking South)

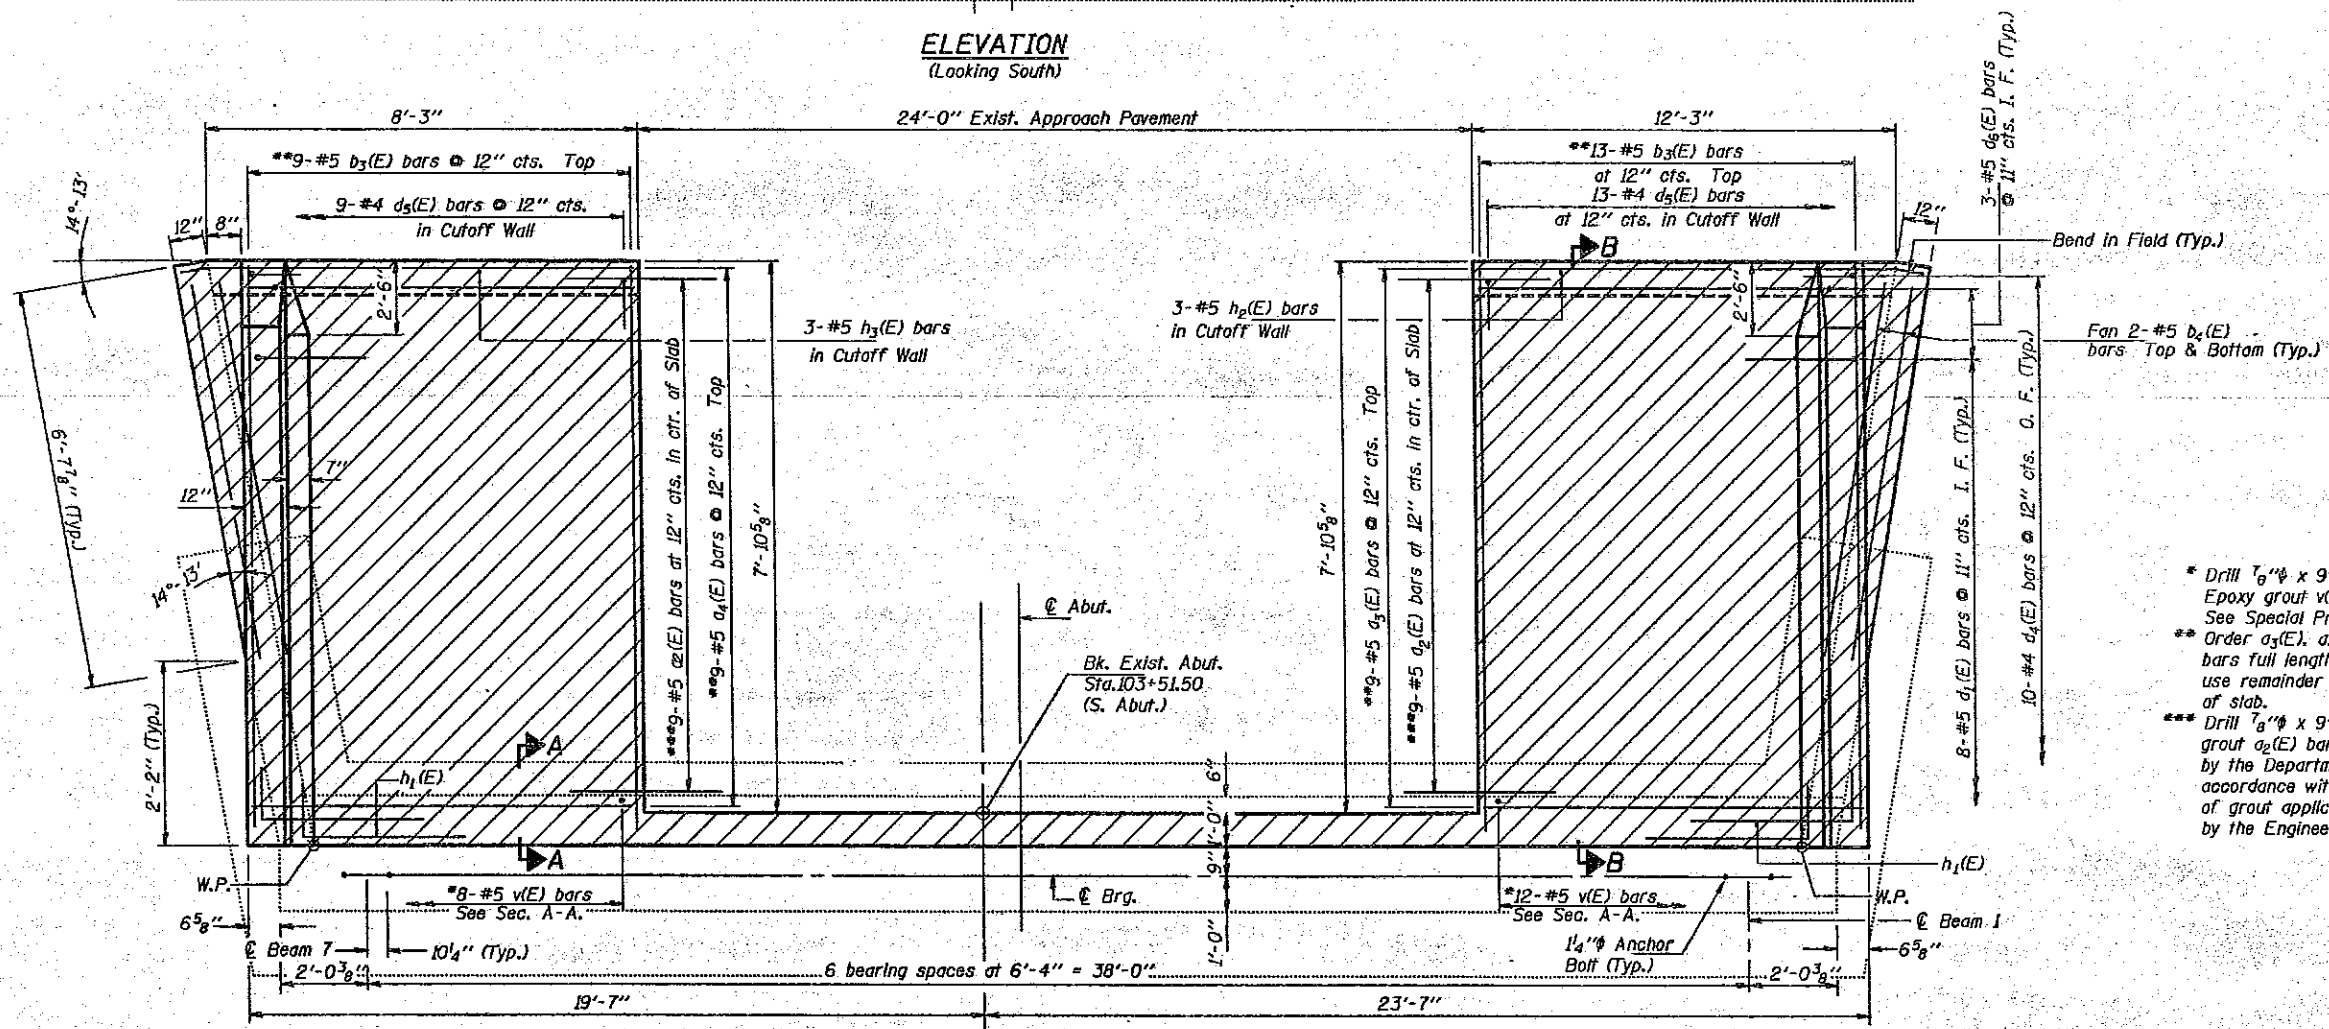

PLAN

- \* Drill  $\frac{1}{8}$ " x 9" Min. hole. Epoxy grout v(E) bars. See Special Provisions.
- \*\* Order  $a_3(E)$ ,  $a_4(E)$  and  $b_3(E)$  bars full length. Cut to fit and use remainder of bars in bottom of slab.
- \*\*\* Drill  $\frac{1}{8}$ " x 9" Min. hole. Epoxy grout  $a_2(E)$  bars. Use a grout approved by the Department or epoxy grout in accordance with BSP-11. The method of grout application shall be approved by the Engineer. See Special Provisions.

Notes: Hatched area to be poured after superstructure forms have been removed. Quantity of concrete included with "Class X Concrete Superstructure" on sheet #6 of 16. Quantity for End Post is billed with "Class X Conc. Superstr." Existing reinforcement extending into removed area shall be cleaned, straightened and incorporated into the new construction. Reinforcement bars designated (E) shall be epoxy coated. Bars indicated thus 2 x 2-#6 etc. indicates 2 lines of bars with 2 lengths per line. For anchor bolt installation details see sheet #12 of 16. All edges shall have Standard  $\frac{3}{4}$ " chamfer. Work this sheet with sheet #15 of 16.

DESIGNED: Michael A. Stephenson  
 CHECKED: George A. Schmitt  
 DRAWN: E. Vera Taylor  
 CHECKED: MAS GAG, Inc.

EXAMINED: [Signature]  
 PASSED: [Signature]  
 APPROVED: [Signature]

May 20, 1993

SOUTH ABUTMENT  
 F.A.I. RT. 57 SEC. (28-1B)D-1  
 FRANKLIN COUNTY  
 STATION 102+70.00







STATE OF ILLINOIS  
DEPARTMENT OF TRANSPORTATION

ROUTE NO.	DISTRICT	COUNTY	SECTION	SHEET
F.A.I. 57		FRANKLIN		37
SHEET NO. 15				
16 SHEETS				

Approach Parapet shall be poured after bridge parapet is in place. Form top surface to match parapet grade.

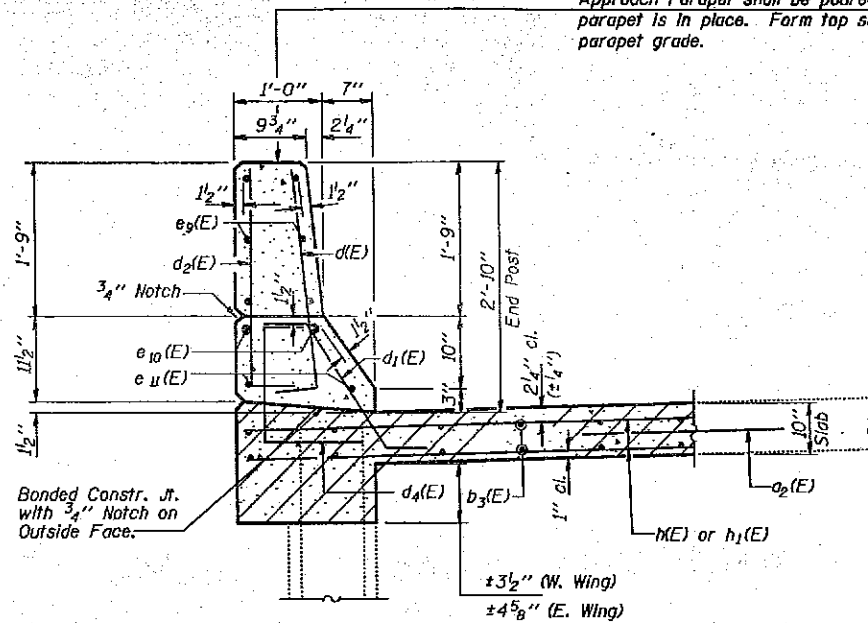


SECTION E-E

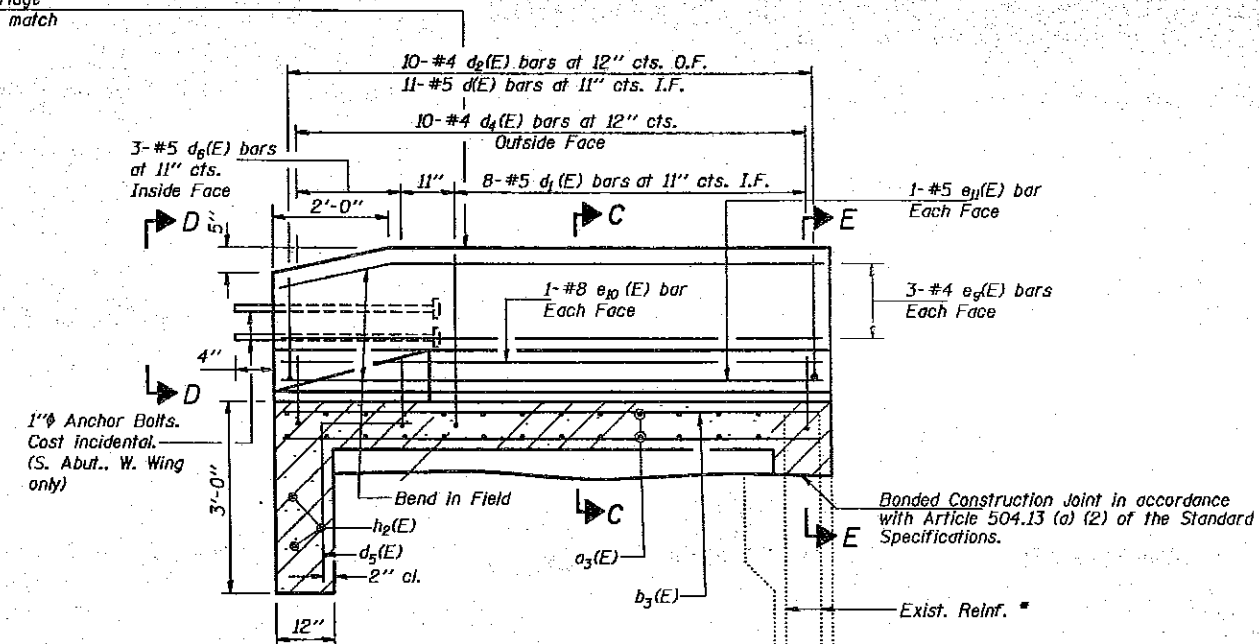


SECTION B-B

\* Existing Reinforcement extending into new Construction shall be cleaned, straightened and incorporated into new Construction. Cost is incidental to "Concrete Removal."

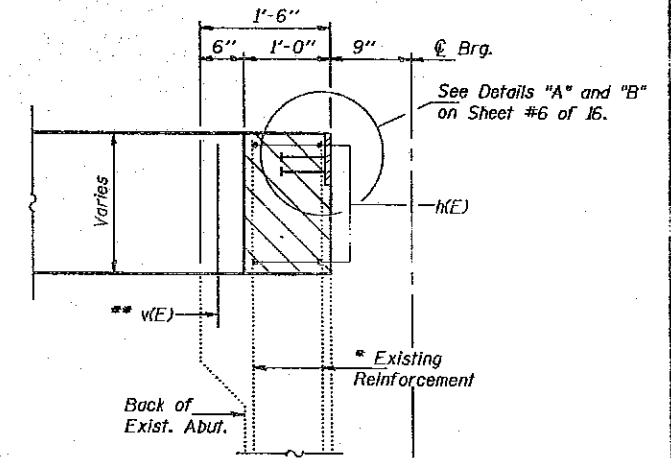

SECTION A-A



\*\* Drill 7/8"φ x 9" min. holes and epoxy grout v(E) bars in accordance with Special Provision BSP-11 or grout approved by the Department. Cost shall be incidental to "Reinforcement Bars (Epoxy Coated)".

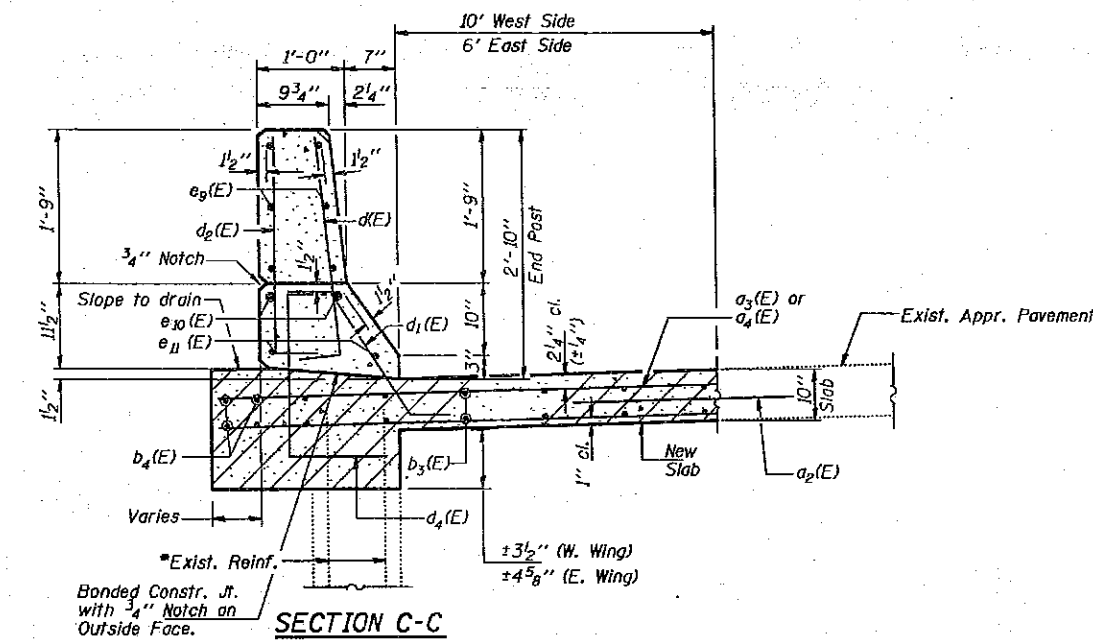

SECTION C-C

Notes: Area to be poured after Superstructure forms have been removed.  
Concrete quantity to be billed with "Class X Concrete Superstructure." See Sheet #6 of 16.  
Reinforcement bars designated (E) shall be Epoxy coated.

DESIGNED <i>Michael A. Stogdeman</i>	EXAMINED <i>Gregory J. Kaspar</i>
CHECKED <i>Joseph A. Johnson</i>	PASSED <i>Ralph E. Anderson</i>
DRAWN <i>E. Vern Taylor</i>	APPROVED _____
CHECKED <i>MAS GAG</i>	DIRECTOR OF HIGHWAYS

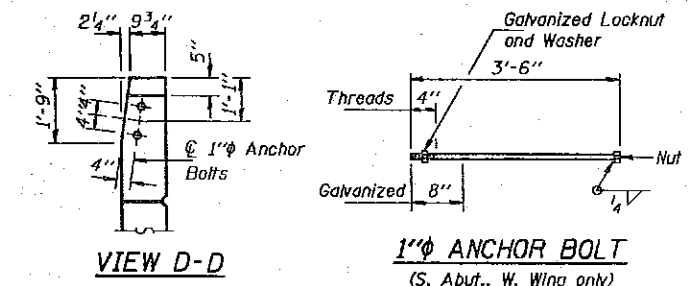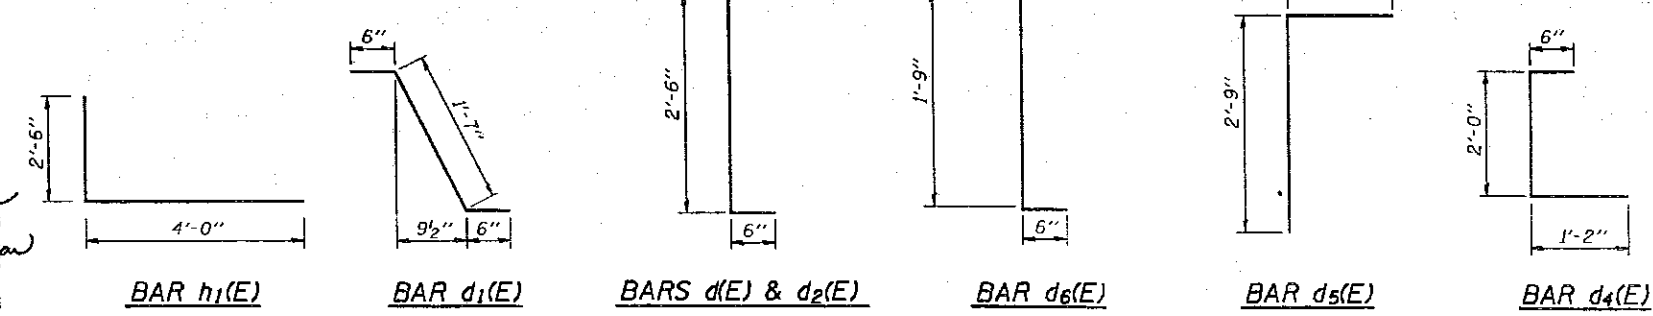

VIEW D-D

1"φ ANCHOR BOLT  
(S. Abut., W. Wing only)

ABUTMENTS & APPROACHES  
BILL OF MATERIAL

Bar	No.	Size	Length	Shape
d2(E)	36	#5	3'-0"	—
d3(E)	18	#5	26'-0"	—
d4(E)	18	#5	18'-0"	—
b3(E)	44	#5	17'-2"	—
b4(E)	16	#5	7'-6"	—
d(E)	44	#5	3'-0"	L
d1(E)	32	#5	2'-7"	L
d2(E)	40	#4	3'-0"	L
d4(E)	40	#4	3'-8"	L
d5(E)	44	#4	4'-6"	L
d6(E)	12	#5	2'-9"	L
e9(E)	24	#4	8'-7"	—
e10(E)	8	#8	8'-7"	—
e11(E)	8	#5	8'-7"	—
h(E)	8	#6	39'-9"	—
h1(E)	16	#5	6'-6"	L
h2(E)	6	#5	12'-0"	—
h3(E)	6	#5	8'-0"	—
v(E)	40	#5	2'-0"	—
Reinforcement Bars, Epoxy Coated		Lbs.	3,460	

Reinforcement bars designated (E) shall be epoxy coated.


Notes: Work this sheet with Sheets #13 & #14 of 16.

NORTH AND SOUTH ABUTMENT DETAILS  
F.A.I. RT. 57 SEC. (28-1B)D-1  
FRANKLIN COUNTY  
STATION 102+70.00


STATE OF ILLINOIS  
DEPARTMENT OF TRANSPORTATION

ROUTE NO.	SECTION	COUNTY	MILE	SHEET NO.
57		FRANKLIN	38	16
PROJECT NO. 28-1B1D-1				


\* These dimensions are along front face of hatched area.

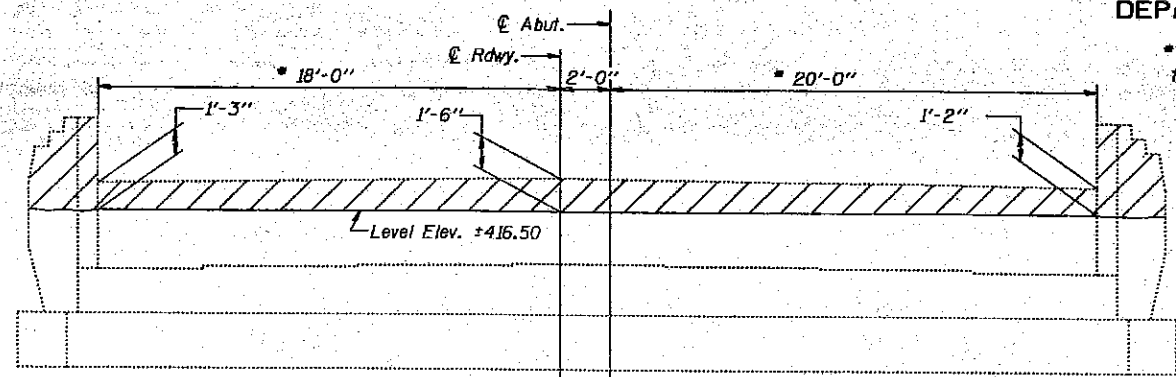


ELEVATION  
(Looking South)

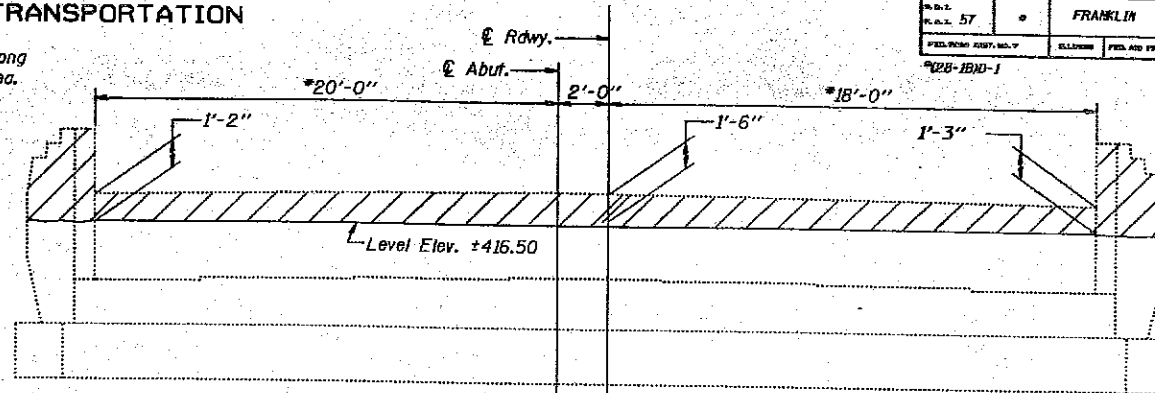


ELEVATION  
(Looking North)

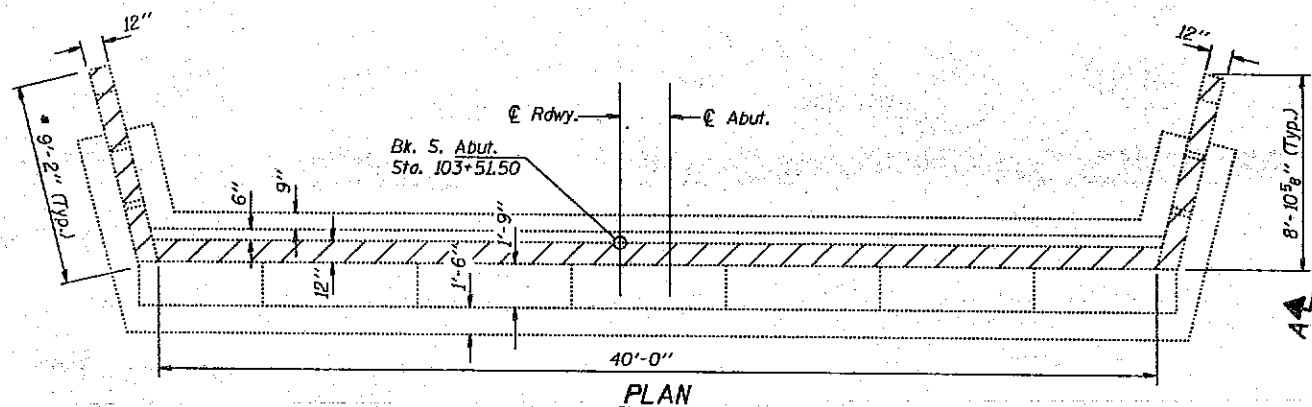

PLAN

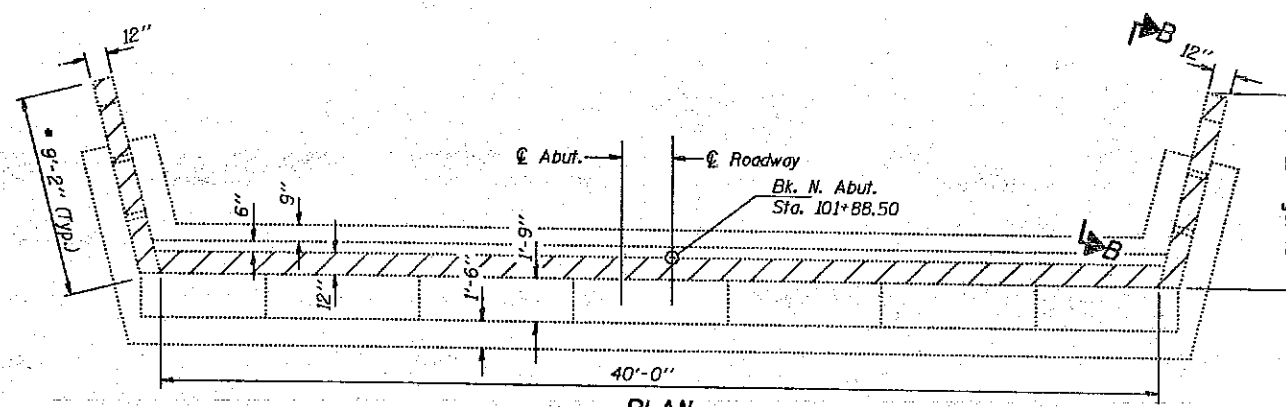


PLAN

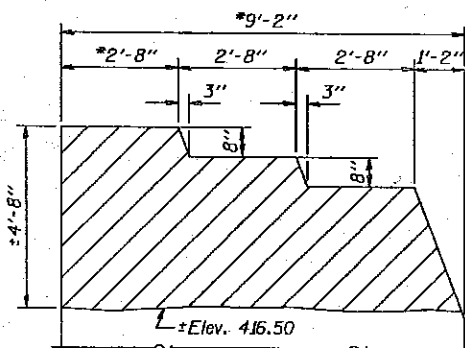

VIEW A-A

\* Inside Face of wing

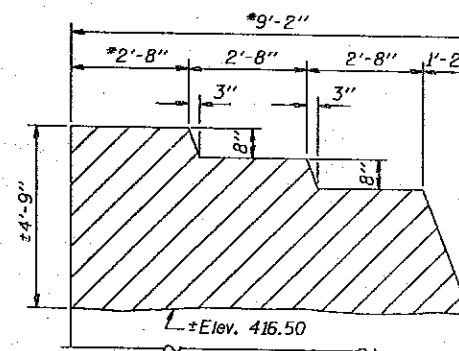

VIEW B-B

SOUTH ABUTMENT DETAILS

NORTH ABUTMENT DETAILS

Notes: Hatched area indicates Concrete Removal.  
For existing shoulder pavement removal see Roadway Plans.

TWO ABUTMENTS  
BILL OF MATERIAL

Item	Unit	Total
Concrete Removal	Cu. Yd.	9

CONCRETE REMOVAL DETAILS  
FOR EXISTING ABUTMENTS  
F.A.I. RT. 57 SEC. (28-1B1D)-1  
FRANKLIN COUNTY  
STATION 102+70.00

DESIGNED <i>Michael A. Stephenson</i>	EXAMINED <i>Raj D. Kasar</i>
CHECKED <i>George A. Howard</i>	PASSED <i>Ralph E. Anderson</i>
DRAWN <i>E. Vern Teulor</i>	APPROVED _____
CHECKED <i>MAS GAG</i>	DIRECTOR OF HIGHWAYS

May 20 1993










ROUTE NO.	SEC.	COUNTY	TOTAL SHEETS	SHEET NO.
F.A.I. 57	*	FRANKLIN	145	42
FED. ROAD DIST. 7		ILLINOIS	PROJECT	
SEC. 20 (S&B) (S&B) (S&B)		BB (S&B) (S&B) (S&B)		

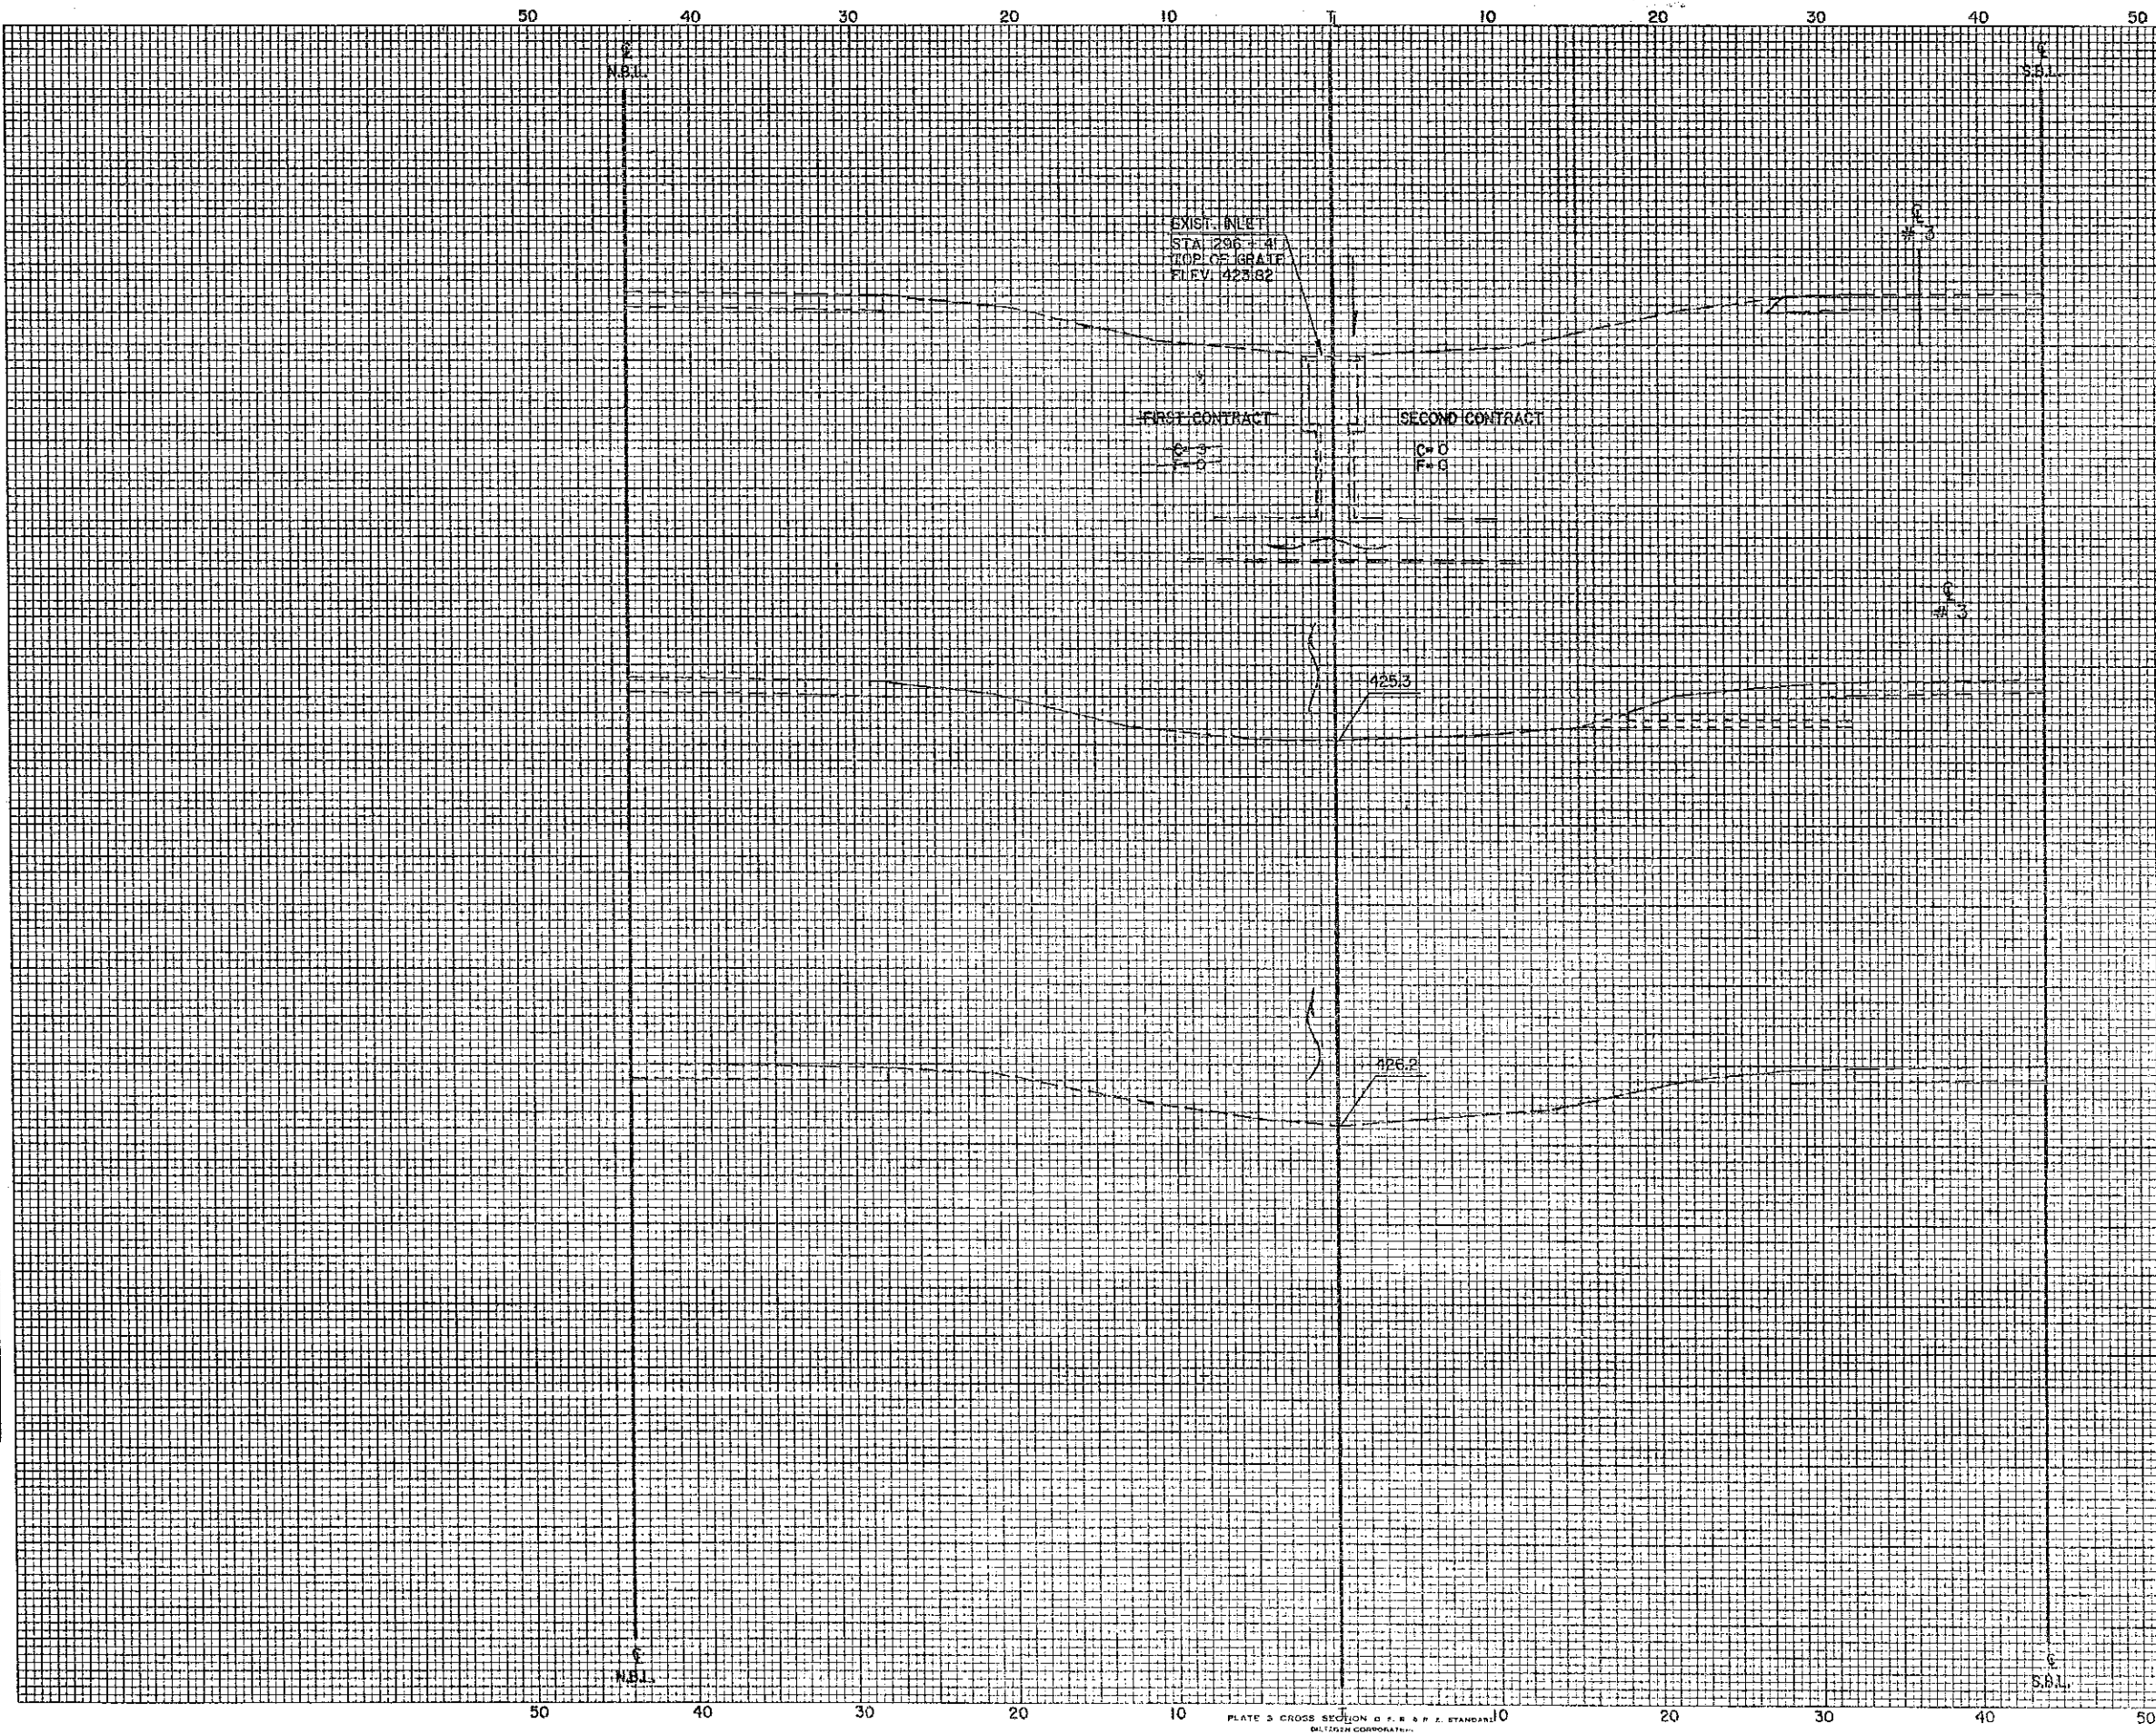

286  
00

293  
00

294  
00

LEGEND:

NORTHBOUND CONTRACT	
SOUTHBOUND CONTRACT	
N.B. CONTRACT DITCH	
S.B. CONTRACT DITCH	

DATE: \_\_\_\_\_ BY: \_\_\_\_\_

REVIEWED: \_\_\_\_\_

DESIGNED: \_\_\_\_\_

DRAWN: \_\_\_\_\_

CHECKED: \_\_\_\_\_

APPROVED: \_\_\_\_\_

NO. \_\_\_\_\_

DATE: \_\_\_\_\_ BY: \_\_\_\_\_

REVIEWED: \_\_\_\_\_

DESIGNED: \_\_\_\_\_

DRAWN: \_\_\_\_\_

CHECKED: \_\_\_\_\_

APPROVED: \_\_\_\_\_

NO. \_\_\_\_\_







50 40 40 30 20 10 10 20 30 40 50

ROUTE NO.	SEC.	COUNTY	TOTAL SHEETS	SHEET NO.
F.A. 57	*	FRANKLIN	45	44
FED. ROAD DIST. 7	ILLINOIS	PROJECT		
SEC. 28 155 150 201 B D		(28 155 150 201 B D)		

430  
425  
420

430  
425  
420

300  
1  
74

300  
1  
66

300  
1  
50

300  
1  
30

EXIST. MEDIAN  
SLOPED INLET  
TOP OF GRATE  
ELEV. 419.21

FIRST CONTRACT

SECOND CONTRACT

C# 2  
F# 0

C# 0  
F# 0

419.4

419.7

420.0

C# 44  
F# 45

C# 65  
F# 10

PLATE 8 CROSS SECTION OF R.R. E. STANDARD  
DIETZEN CORPORATION.

50 40 30 20 10 20 30 40 50

MARCUM BRANCH

DATE	
BY	
APPROVED	
SURVEY	
NOTE BOOK	
NO.	

DATE	
BY	
APPROVED	
SURVEY	
NOTE BOOK	
NO.	











ROUTE NO.	SEC.	COUNTY	TOTAL SHEETS	SHEET NO.
F.A. 57	*	FRANKLIN	145	47
FED. ROAD DIST. 7		ILLINOIS	PROJECT	
* SEC. 28, 35, 36, 37, 38, 39, 40, 41, 42, 43, 44, 45, 46, 47				

DATE	
BY	
REVISION	
PLOTTED	
DATE	
NO.	

DATE	
BY	
REVISION	
PLOTTED	
DATE	
NO.	

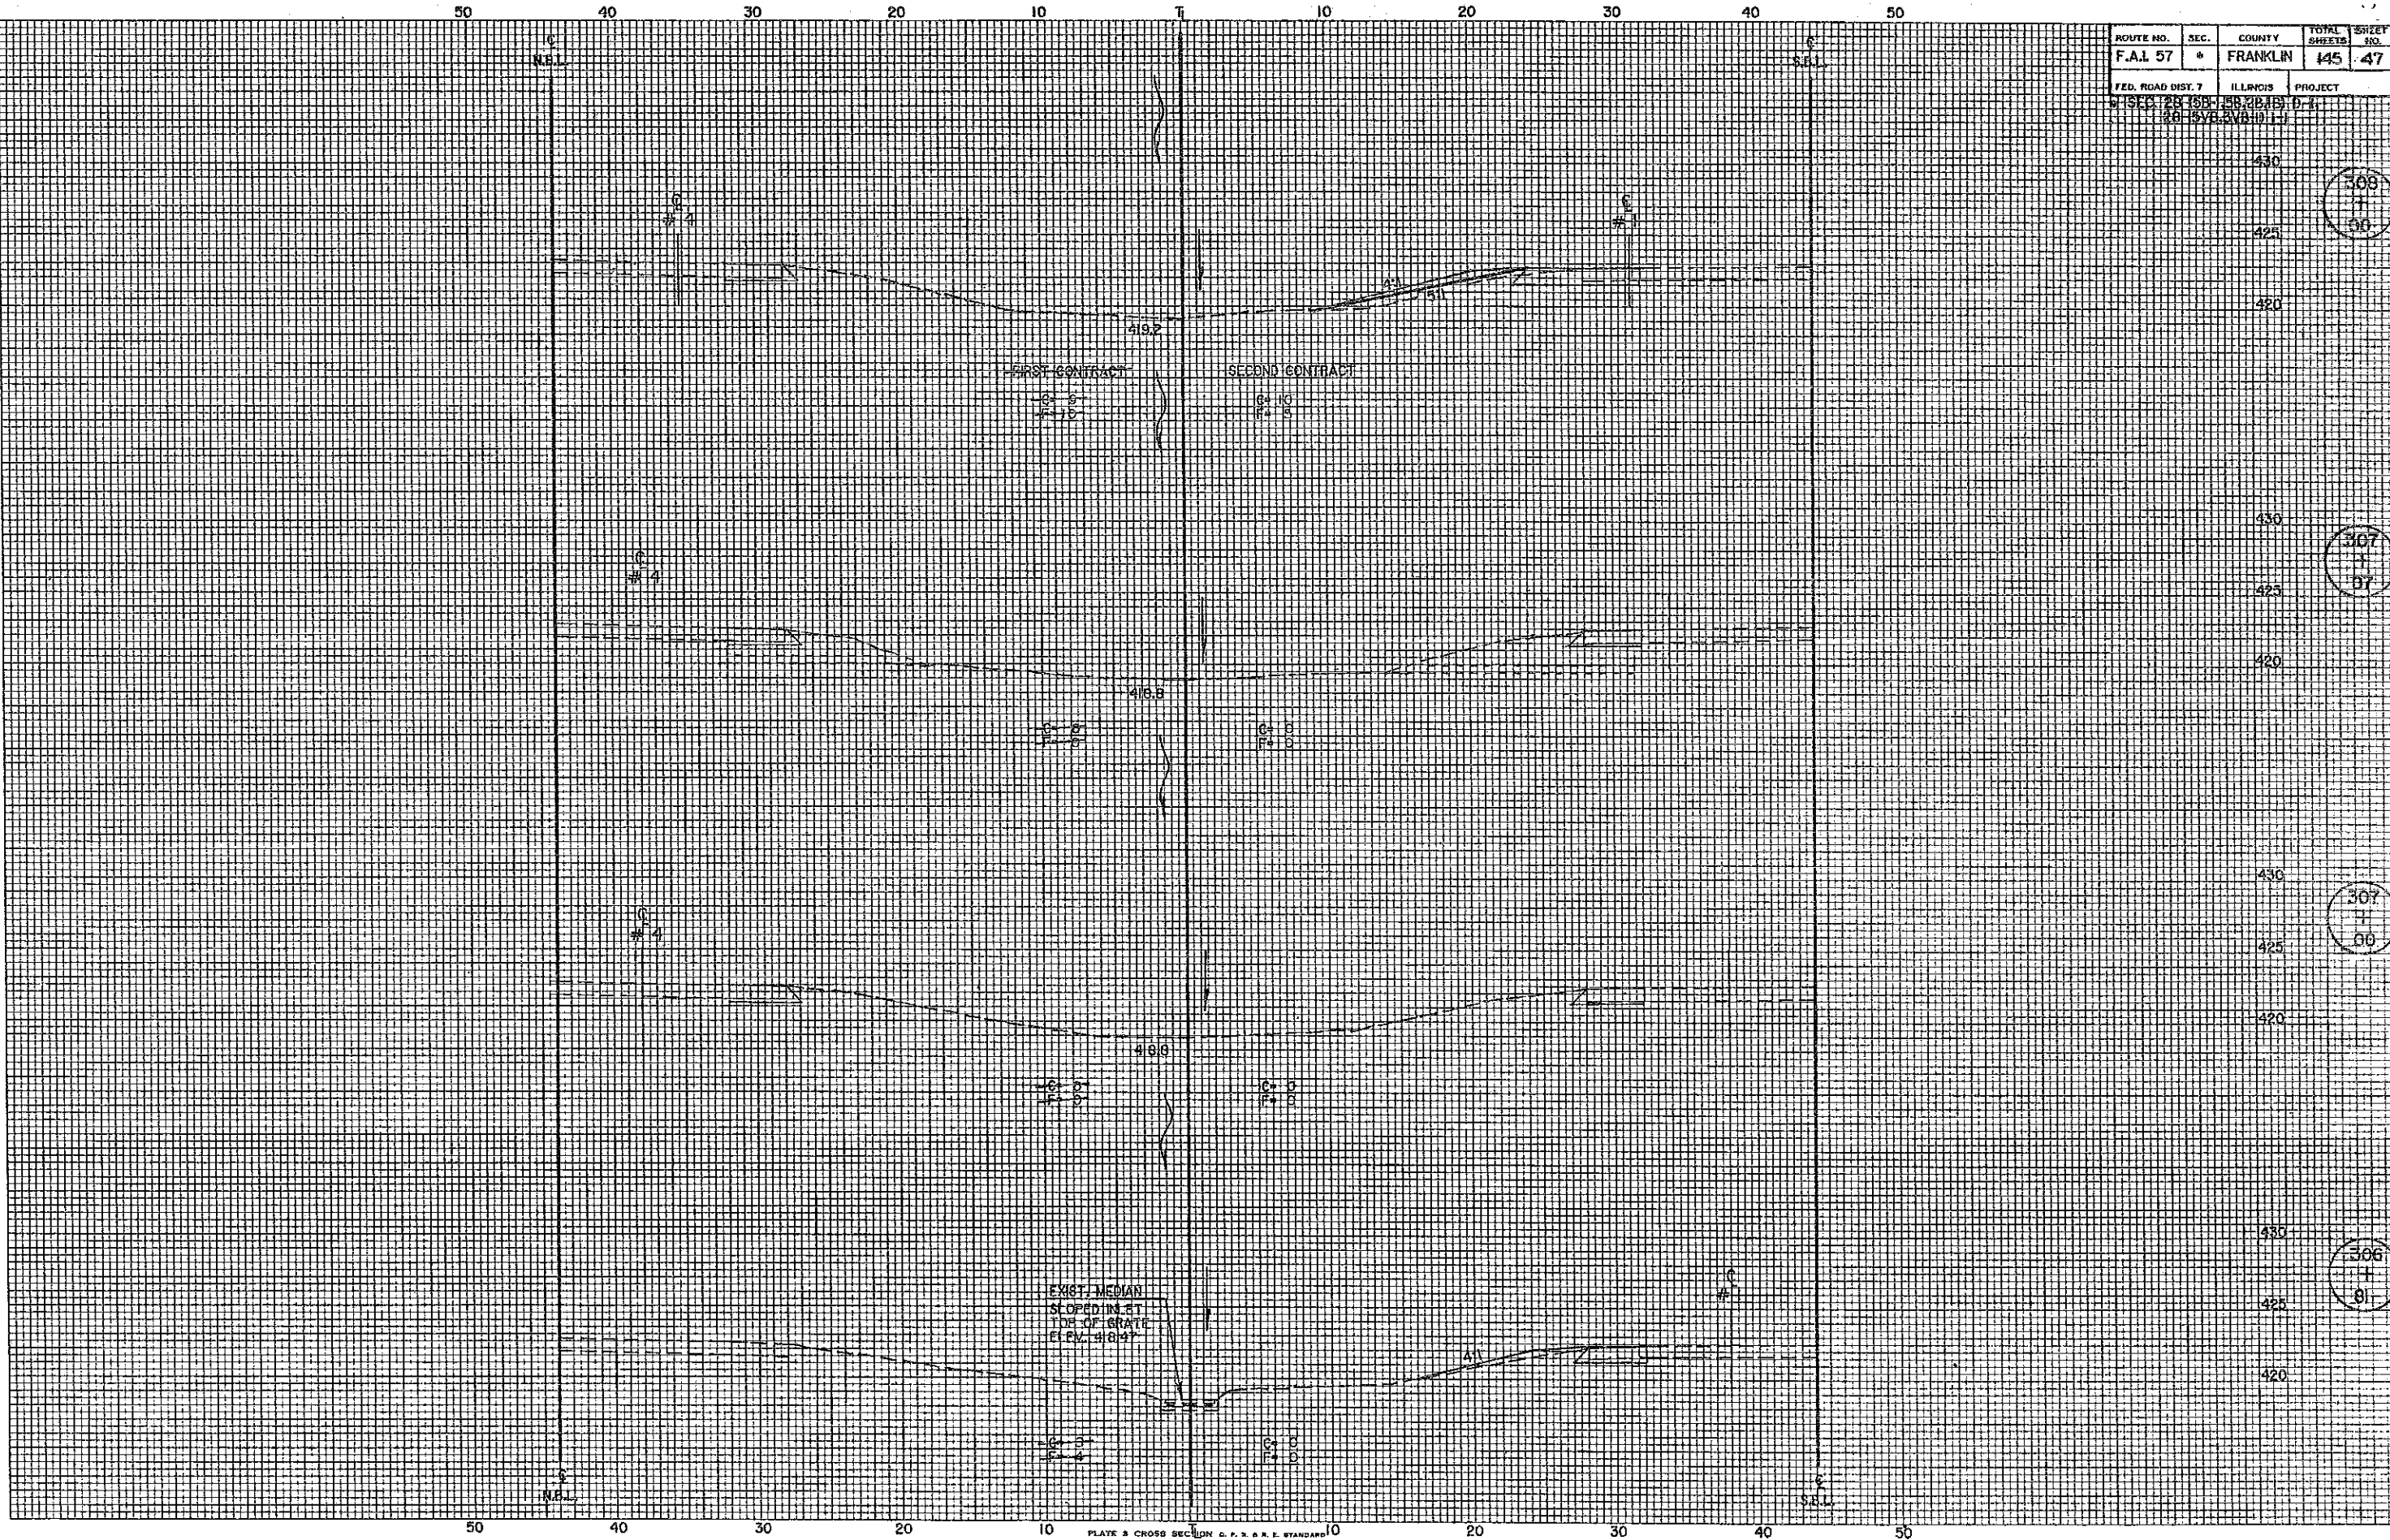


PLATE 2 CROSS SECTION D. P. S. & E. STANDARD 10  
METZGER CORPORATION




50 40 30 20 10 10 20 30 40 50

ROUTE NO.	SEC.	COUNTY	TOTAL SHEETS	SHEET NO.
F.A.L 57	0	FRANKLIN	145	48
FED. ROAD DIST. 7		1.1 LINES	PROJECT	
SEC. 128 150 160 170 180 190		40' 5/8" 3/8" 1/4"		

DATE	
BY	
REVISION	
APPROVED	
DATE	
NO. 1	
NO. 2	
NO. 3	
NO. 100	

DATE	
BY	
REVISION	
APPROVED	
DATE	
NO. 1	
NO. 2	
NO. 3	
NO. 100	

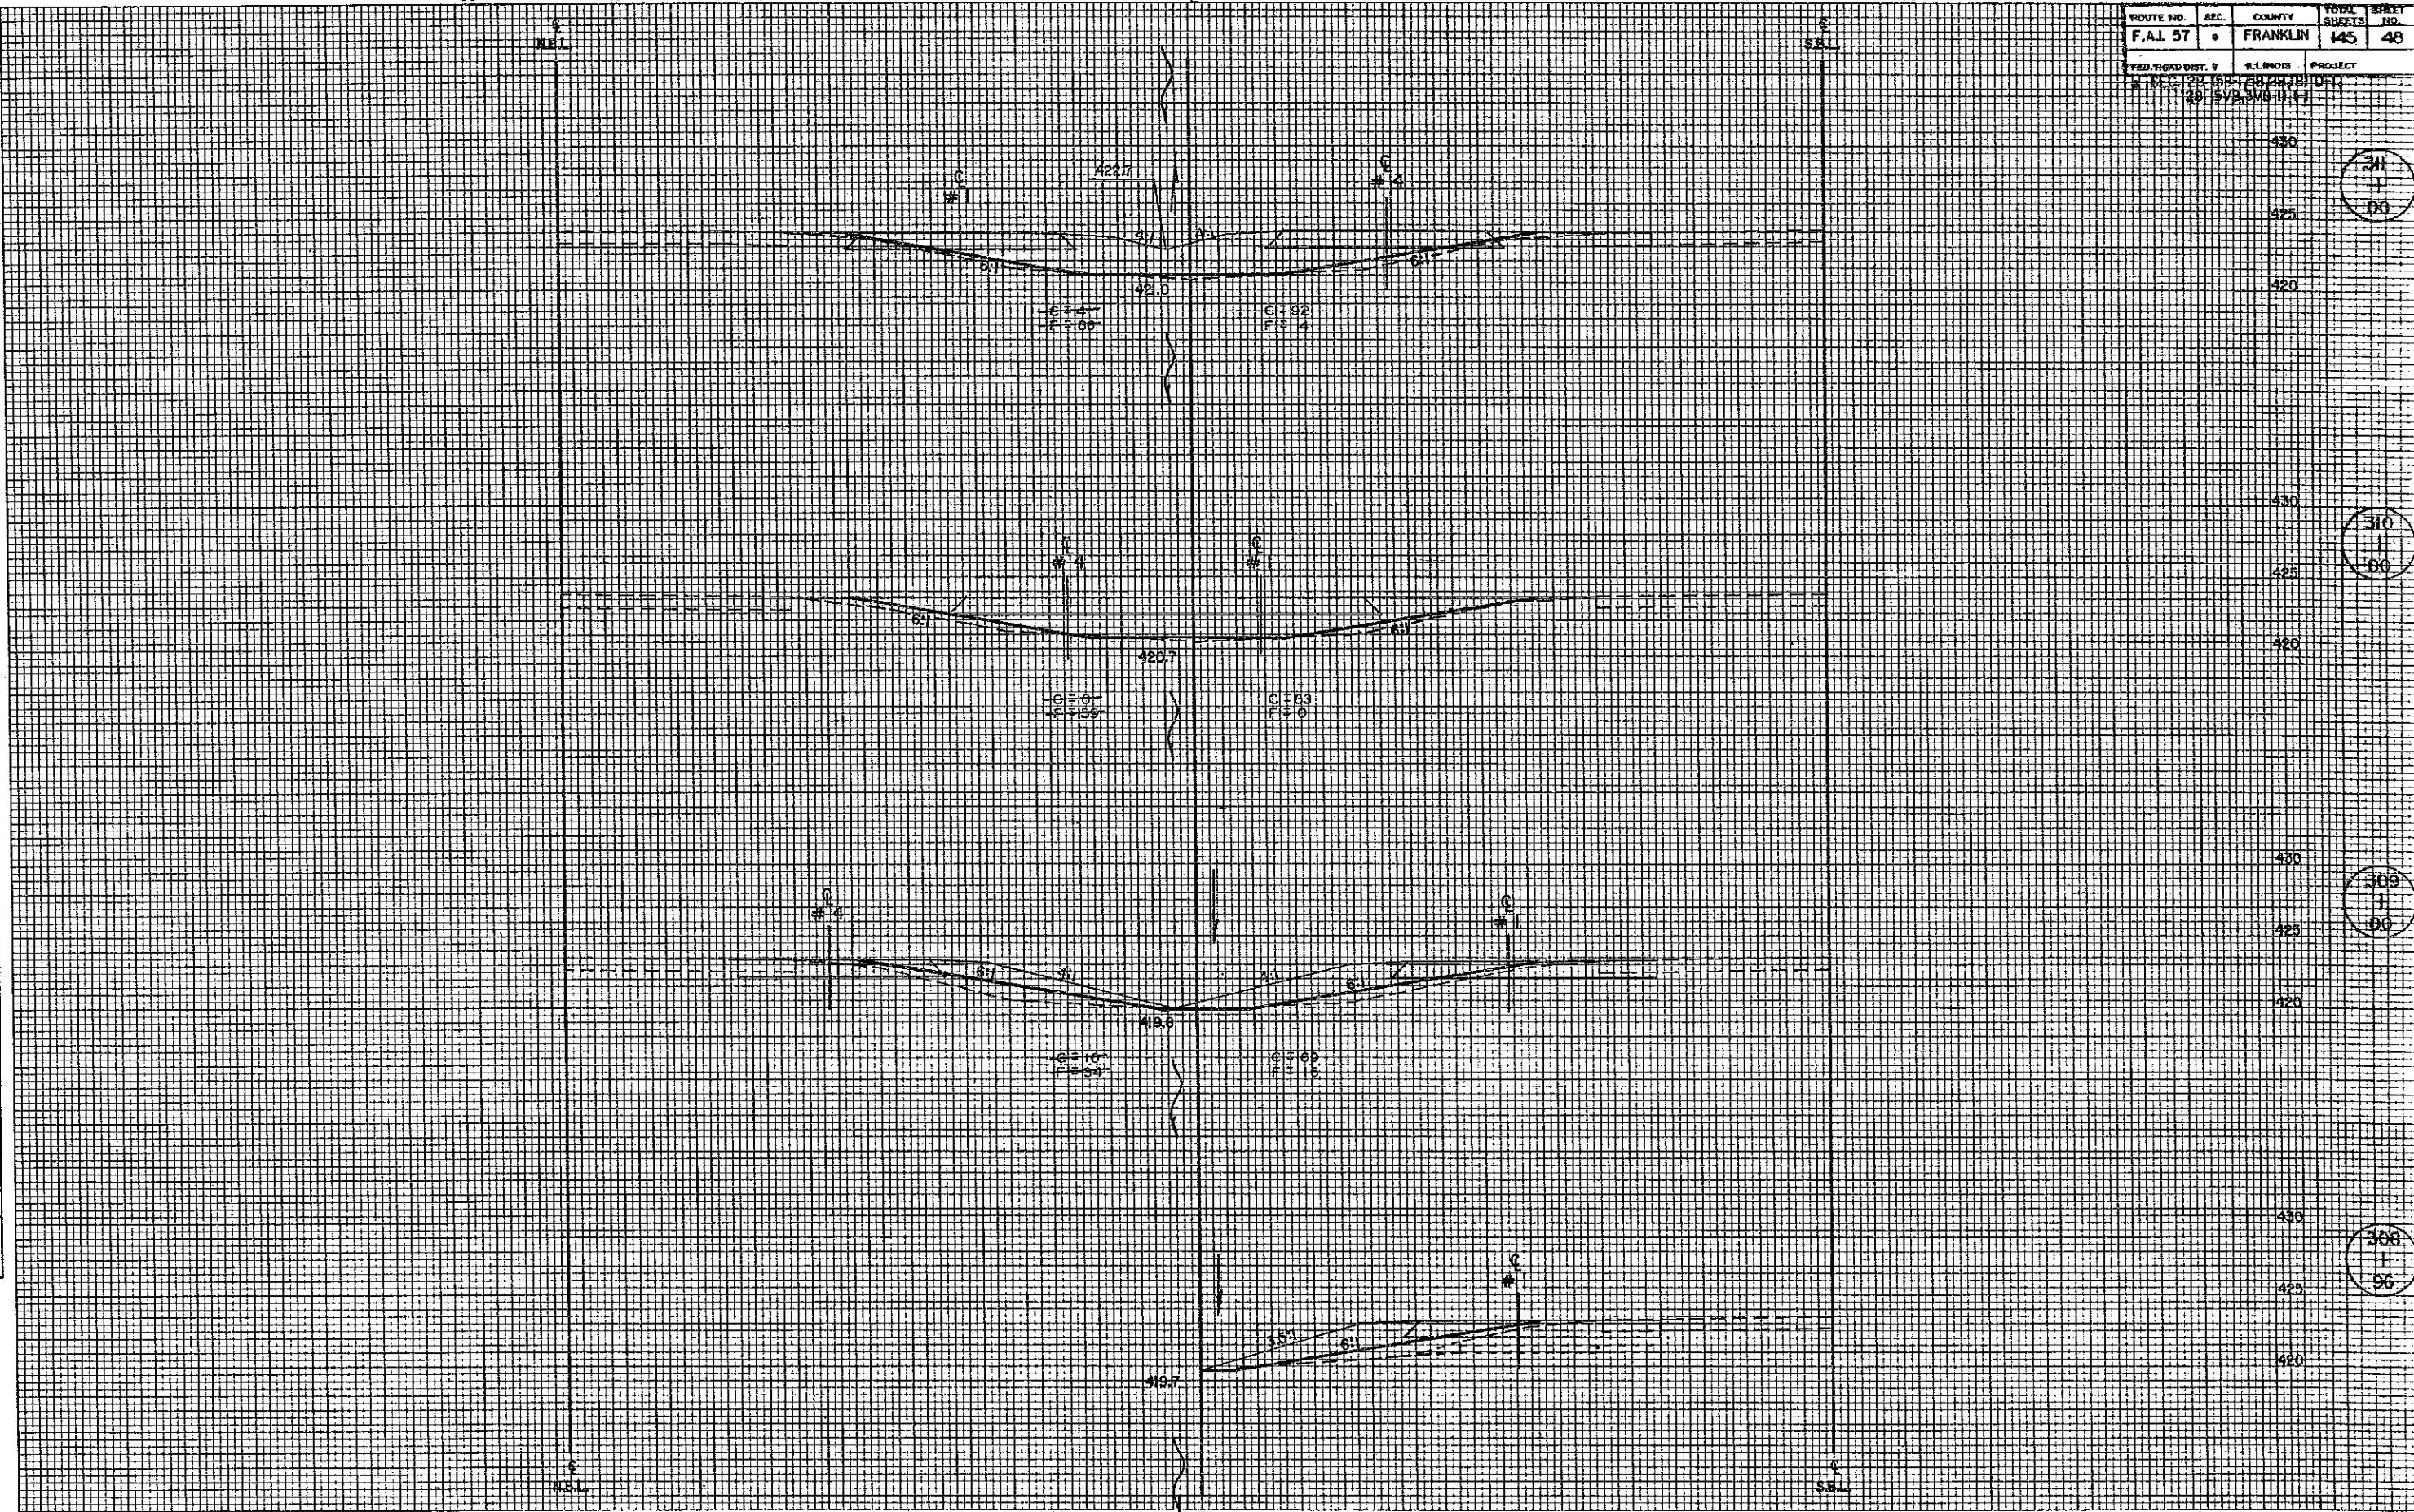

311  
1  
00

310  
1  
00

309  
1  
00

308  
1  
00

PLATE 3 CROSS SECTION ON O. R. R. E. STANDARD  
GLEZDEN CORPORATION

MARCUM BRANCH



50 40 30 20 10 10 20 30 40 50

ROUTE NO.	SEC.	COUNTY	TOTAL SHEETS	SHEET NO.
F.A.I. 57	*	FRANKLIN	145	49
FED. ROAD DIST. 7		ILLINOIS	PROJECT	
* SEC. 29 1881, 25, 28, 181, 184, 26 (3VB, 3VB-1)				

DATE \_\_\_\_\_ BY \_\_\_\_\_

DESIGNED BY \_\_\_\_\_

PLANNED BY \_\_\_\_\_

NOTED BY \_\_\_\_\_

NO. \_\_\_\_\_

FINAL SURVEY NOTE BOOK

DATE \_\_\_\_\_ BY \_\_\_\_\_

DESIGNED BY \_\_\_\_\_

PLANNED BY \_\_\_\_\_

NOTED BY \_\_\_\_\_

NO. \_\_\_\_\_

FINAL SURVEY NOTE BOOK

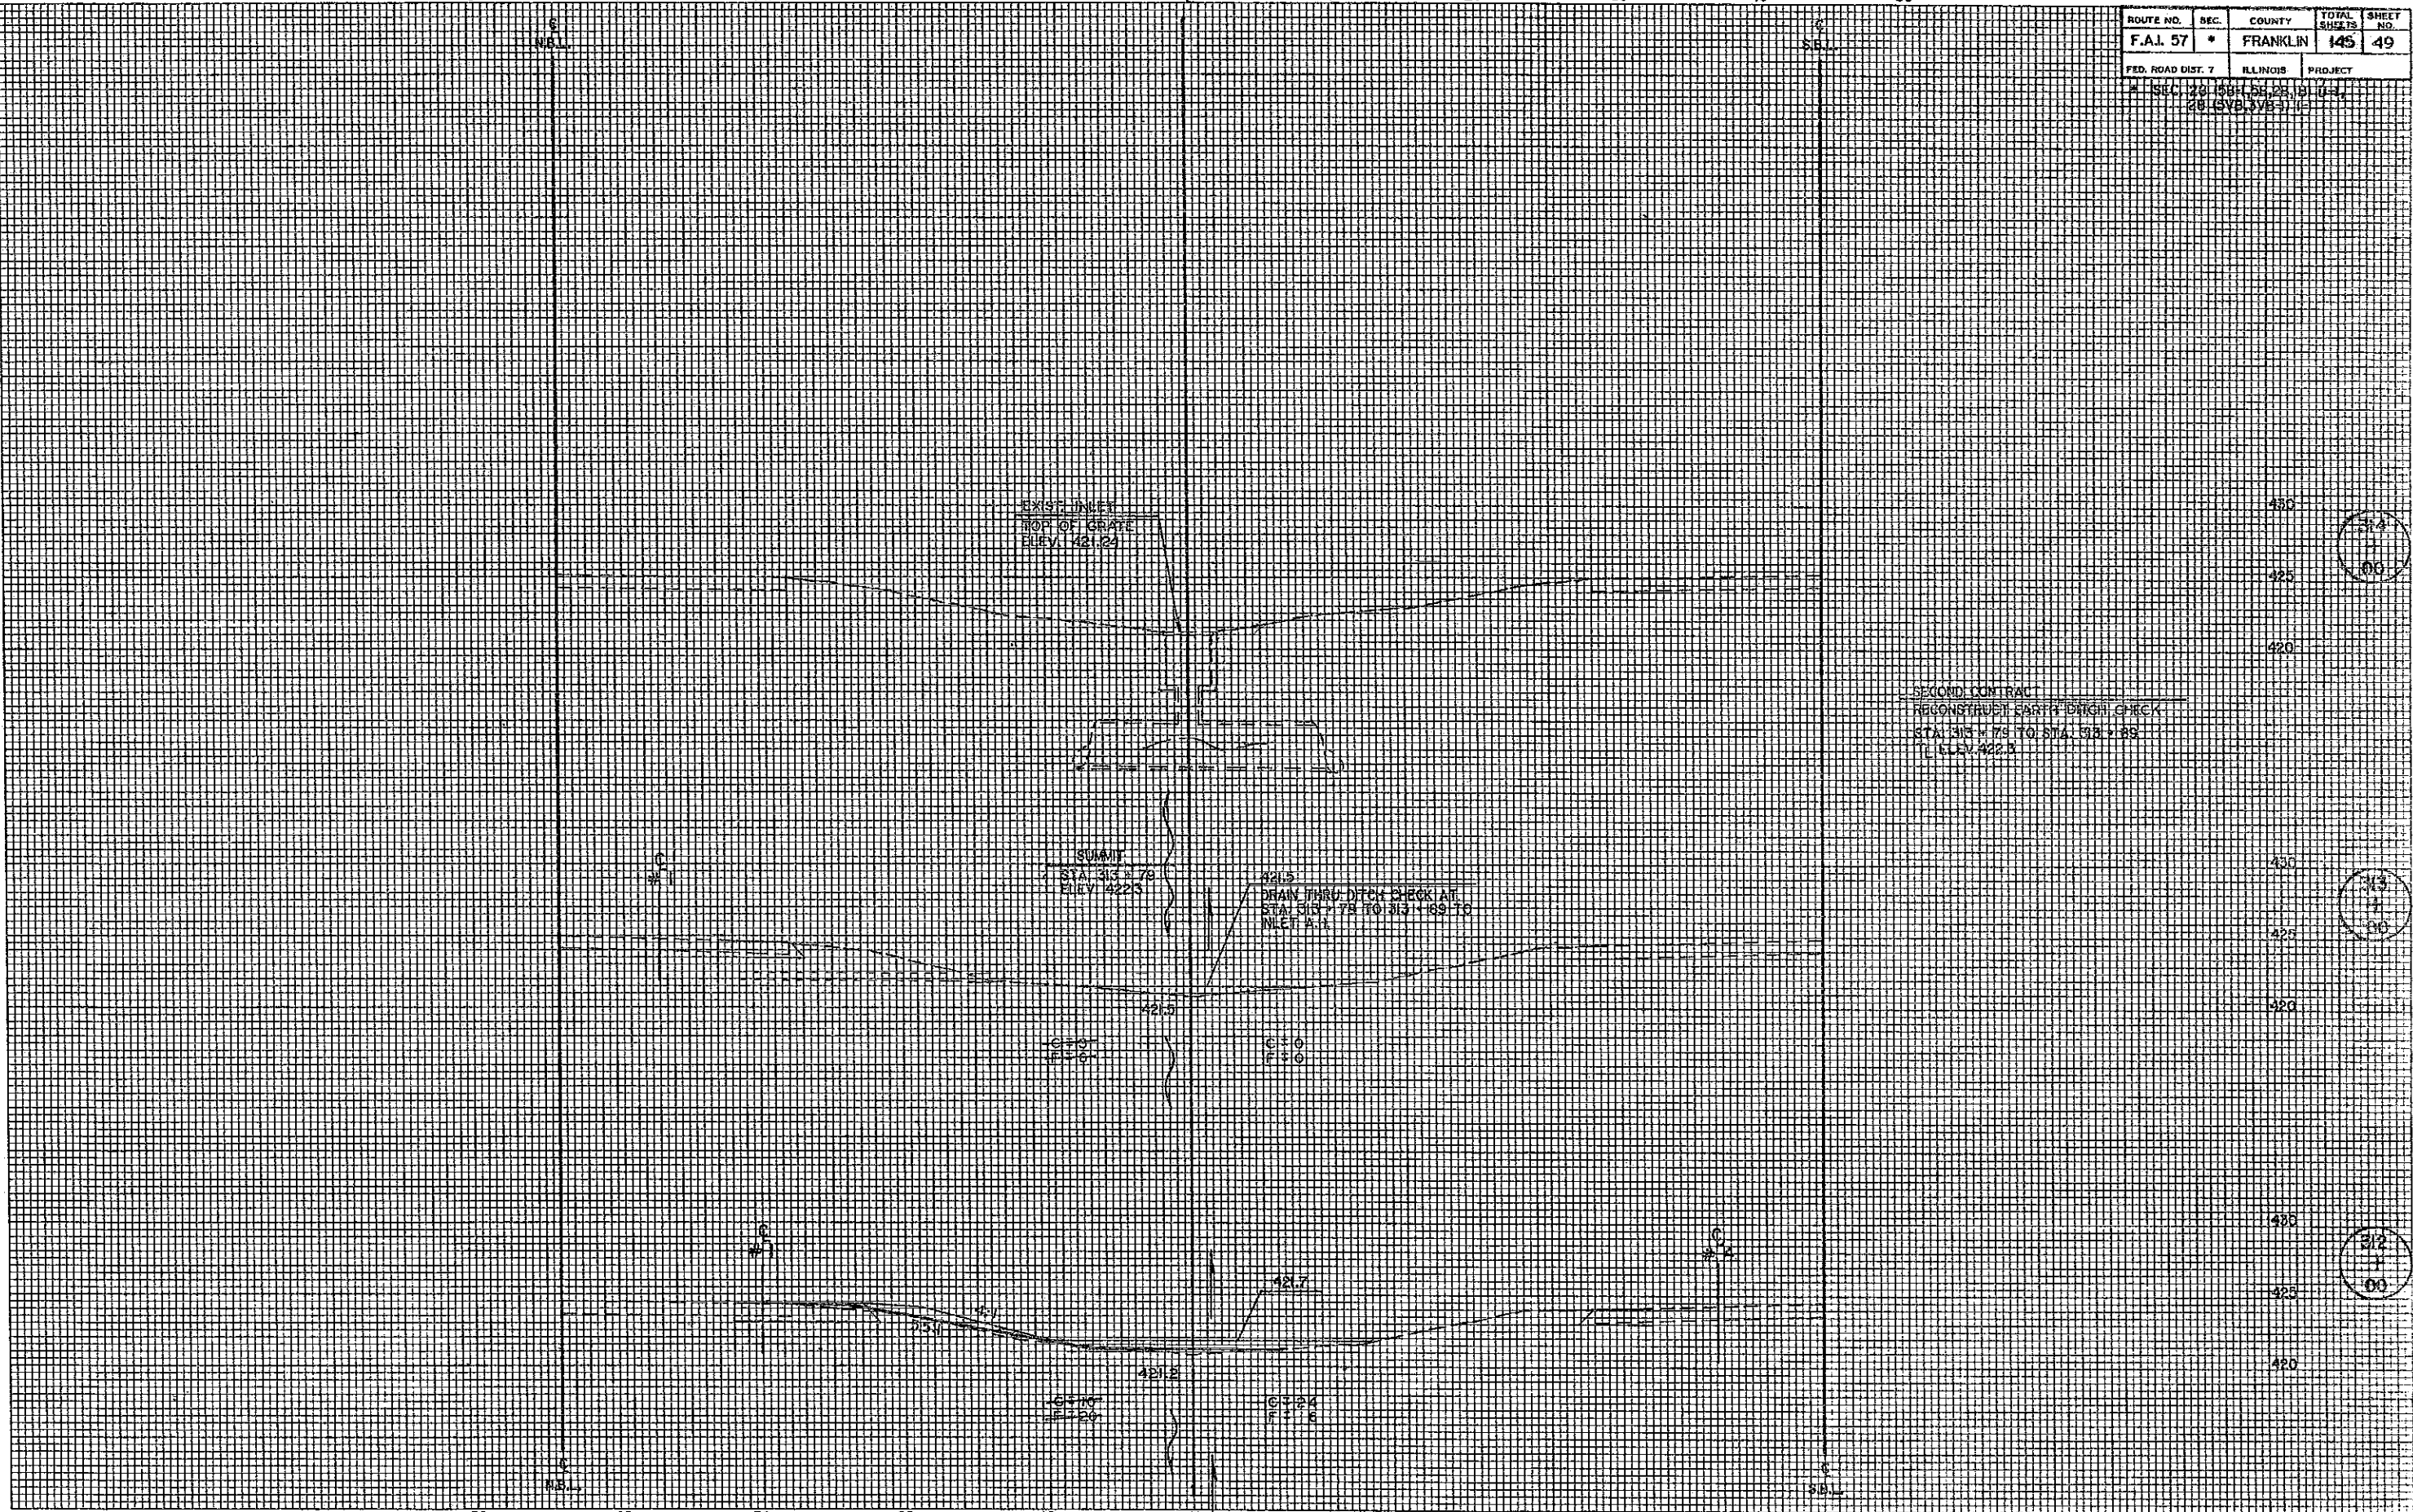


PLATE 3 CROSS SECTION O.P.R. & P.E. STANDARD  
BETZDEI CORPORATION



STATE OF ILLINOIS  
DEPARTMENT OF TRANSPORTATION

PROJECT NO.	028-0011 (S.B.)	SHEET NO.	50
SECTION	28-2B(1)-1	TOTAL SHEETS	50

Existing Structures: #028-0011 (S.B.) & #028-0012 (N.B.) are each 127'-6" long and 42'-0" wide. Built as F.A.I. Rte. 57, Section 28-2B at Sta. 304+25 in 1962 consists of RC Deck supported on 3 span continuous wide flange beams. Temporary median crossovers shall be utilized to divert traffic over adjacent bridge during reconstruction. Bench Mark: 13' high on top of N.E. end of West handrail of Southbound Lane of bridge over Marcum Branch. Elevation #24.81. No Damage.



STATION 304+25.00  
REBUILT IN 61  
STATE OF ILLINOIS  
F.A.I. RT. 57 SEC. (28-2B)D-1  
F.A.I. PROJECT # 51-215965  
LOADING HS20 & ALT.  
STR. NO. 028-0011

NAME PLATE  
See Std. 2113



GENERAL NOTES

Fasteners shall be high strength bolts. Bolts 1/2" open holes 5/8" unless otherwise noted.  
Field welding of construction accessories will not be permitted to the bottom flange of beams nor to the top flange for a distance equal to one-fourth the span length each way from the pier supports. Field welding in other areas will be permitted only when approved by the Engineer.  
Reinforcement bars shall conform to the requirements of AASHTO M-31, #3 or #4 Grade 60.  
Dimensions and details relative to existing structure have been taken from existing plans and field survey and are subject to nominal construction variations. It shall be the Contractor's responsibility to verify such dimensions and details in the field and make necessary approved adjustments prior to construction or ordering of materials. Such variations shall not be cause for additional compensation for a change in the scope of the work, however, the Contractor will be paid for the quantity actually furnished at the unit prices bid for the work.  
Two 1/2" adjusting shims, of the dimensions of the bottom bearing plate, shall be provided for each bearing in addition to all other plates or shims. For Type I Elastomeric Bearings, shims of the dimensions of the top plate shall be provided and placed as detailed.  
The Contractor will be required to mark, on top of the concrete deck, the locations of the top flange of all the steel beams, prior to any removal of the bridge concrete deck. Saw cutting directly over the top of the beam flanges is not permitted.  
Bearing seat surfaces of the abutments shall receive Bridge Seat Sealer. The zinc-silicate primer shall be used for shop painting of new structural steel.  
Prior to pouring the new concrete for the deck, all loose rust, loose mill scale and all other foreign material shall be removed from the embedded portions of flanges of stringers. The removal shall be accomplished in accordance with the requirements of the SSPC Surface Preparation Specifications SP-3 for power tool cleaning or SP-2 for hand tool cleaning. Cost shall be incidental to "Removal of Existing Concrete Deck".  
For pileover forming brackets see Special Provisions.

TOTAL BILL OF MATERIAL

ITEM	UNIT	SUPER	SUB	TOTAL
Concrete Removal	Cu. Yd.		9	9
Structure Excavation	Cu. Yd.		22	22
Removal of Existing Concrete Deck	Each	1		1
Floor Drains	Each	12		12
Preformed Joint Seal 2 1/2"	Lin. Ft.	49		49
Preformed Joint Seal 4"	Lin. Ft.	49		49
Class X Concrete Superstructure	Cu. Yd.	177.6		177.6
Protective Coat	Sq. Yd.	672		672
Elastomeric Bearing Assembly, Type I	Each	14		14
Elastomeric Bearing Assembly, Type II	Each	7		7
Structural Steel	Lbs.	9230		9230
Stud Shear Connectors	Each	3255		3255
Reinforcement Bars, Epoxy Coated	Pound	38060	4600	42660
Name Plates	Each	1		1
Bridge Seat Sealer	Sq. Ft.		109	109
Jack and Remove Existing Bearings	Each	28		28
Bridge Deck Grooving	Sq. Yd.	527		527

\*\* Includes the removal of existing steel railing.  
\*\*\* Quantity includes bridge deck surface.

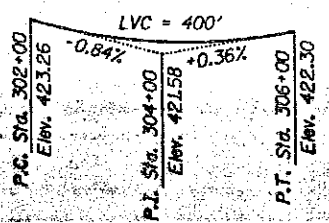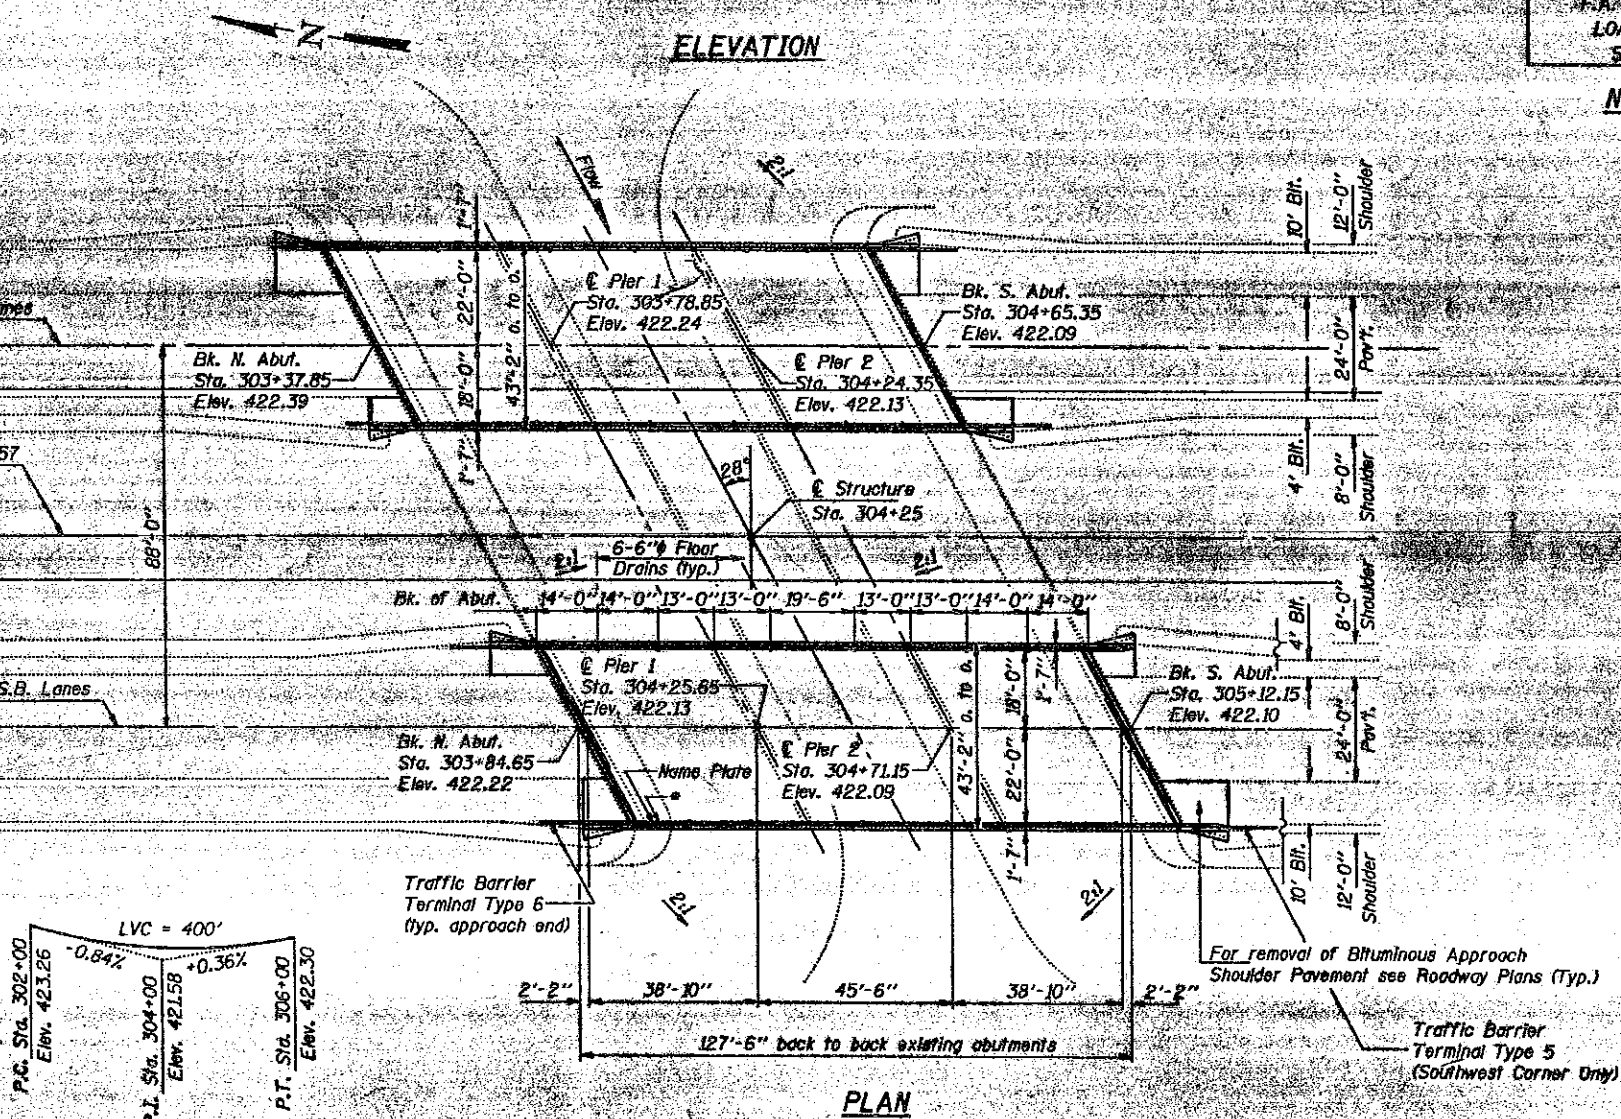

PROFILE GRADE  
F.A. Route 57 (along E pavement)


Note: Only the Southbound structure is included in this contract.

DESIGN SPECIFICATIONS

1989 AASHTO, 1990 & 1991 Interim Specifications  
and Seismic Retrofitting Guidelines for Highway Bridges  
LOADING HS 20-44 & Alt.  
Allow 25# sq. ft. for future wearing surface.

DESIGN STRESSES

FIELD UNITS  
New Construction  
f<sub>c</sub> = 3,500 psi  
f<sub>y</sub> = 60,000 psi (Reinf.)  
f<sub>y</sub> = 36,000 psi (A270 Gr. 36)  
Old Construction  
f<sub>s</sub> = 20,000 psi (Structural Steel)

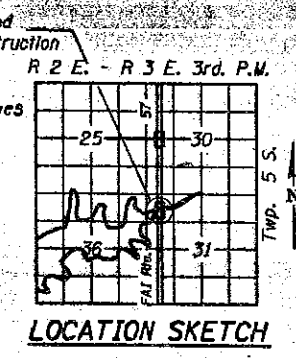

LOCATION SKETCH

GENERAL PLAN  
F.A.I. ROUTE 57 OVER  
MARCUM BRANCH  
F.A.I. ROUTE 57 SECTION (28-2B)D-1  
FRANKLIN COUNTY  
STATION 304+25.00  
STRUCTURE NUMBER 028-0011 (S.B.)

DESIGNED John Ciccone  
CHECKED Anthony J. V... RD  
DRAWN Paul W. Sweet  
CHECKED JLC. AYY


EXAMINED Craig J. Kasper  
PASSED Ralph E. Anderson  
APPROVED [Signature]

May 20 1992




\* Existing Name Plate to be cleaned and relocated. Cost incidental to "Name Plates".

STATE OF ILLINOIS  
DEPARTMENT OF TRANSPORTATION

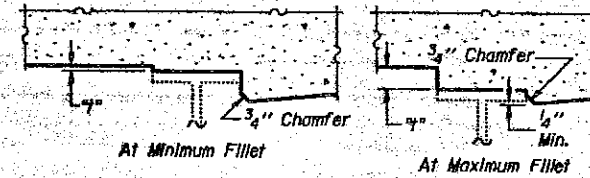

PROJECT NO.	SECTION	SHEET NO.	TOTAL SHEETS
51		51	16 SHEETS

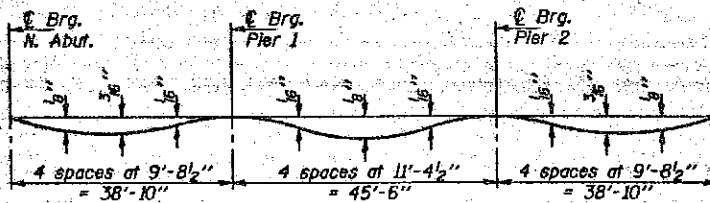

**DEAD LOAD DEFLECTION DIAGRAM**

(Includes weight of concrete only)

Note: The above deflections are not to be used in the field if the engineer is working from the grade elevations adjusted for dead load deflections as shown below.

**BEAM 8**

Location	Station	Offset	Theoretical Grade Elevations	Theoretical Grade Elevations Adjusted For Dead Load Deflection
Bk. N. Abut.	30375.611	-17.000	422.018	422.018
Br. N. Abut.	30377.778	-17.000	422.012	422.012
A	30387.778	-17.000	421.983	421.993
B	30397.778	-17.000	421.956	421.970
C	30407.778	-17.000	421.933	421.939
Br. Pier 1	30416.611	-17.000	421.915	421.915
D	30426.611	-17.000	421.898	421.902
E	30436.611	-17.000	421.883	421.892
F	30446.611	-17.000	421.872	421.879
G	30456.611	-17.000	421.863	421.866
Br. Pier 2	30462.111	-17.000	421.860	421.860
H	30472.111	-17.000	421.856	421.863
I	30482.111	-17.000	421.855	421.868
J	30492.111	-17.000	421.857	421.867
Br. S. Abut.	30500.944	-17.000	421.862	421.862
Bk. S. Abut.	30503.111	-17.000	421.863	421.863

**EAST LONGITUDINAL BONDED CONSTRUCTION JOINT**

Location	Station	Offset	Theoretical Grade Elevations	Theoretical Grade Elevations Adjusted For Dead Load Deflection
Bk. N. Abut.	30378.137	-12.250	422.109	422.109
Br. N. Abut.	30380.303	-12.250	422.103	422.103
A	30390.303	-12.250	422.074	422.085
B	30400.303	-12.250	422.049	422.062
C	30410.303	-12.250	422.027	422.033
Br. Pier 1	30419.137	-12.250	422.009	422.009
D	30429.137	-12.250	421.993	421.997
E	30439.137	-12.250	421.979	421.988
F	30449.137	-12.250	421.968	421.975
G	30459.137	-12.250	421.960	421.963
Br. Pier 2	30464.637	-12.250	421.957	421.957
H	30474.637	-12.250	421.954	421.961
I	30484.637	-12.250	421.954	421.967
J	30494.637	-12.250	421.957	421.967
Br. S. Abut.	30503.470	-12.250	421.962	421.962
Bk. S. Abut.	30505.637	-12.250	421.964	421.964

**BEAM 9**

Location	Station	Offset	Theoretical Grade Elevations	Theoretical Grade Elevations Adjusted For Dead Load Deflection
Bk. N. Abut.	30378.978	-10.667	422.138	422.138
Br. N. Abut.	30381.145	-10.667	422.132	422.132
A	30391.145	-10.667	422.104	422.114
B	30401.145	-10.667	422.078	422.092
C	30411.145	-10.667	422.056	422.062
Br. Pier 1	30419.978	-10.667	422.039	422.039
D	30429.978	-10.667	422.023	422.027
E	30439.978	-10.667	422.009	422.018
F	30449.978	-10.667	421.999	422.006
G	30459.978	-10.667	421.991	421.994
Br. Pier 2	30465.478	-10.667	421.988	421.988
H	30475.478	-10.667	421.986	421.992
I	30485.478	-10.667	421.986	421.999
J	30495.478	-10.667	421.989	421.999
Br. S. Abut.	30504.312	-10.667	421.994	421.994
Bk. S. Abut.	30506.478	-10.667	421.996	421.996

**BEAM 10**

Location	Station	Offset	Theoretical Grade Elevations	Theoretical Grade Elevations Adjusted For Dead Load Deflection
Bk. N. Abut.	30382.346	-4.333	422.211	422.211
Br. N. Abut.	30384.513	-4.333	422.204	422.204
A	30394.513	-4.333	422.177	422.188
B	30404.513	-4.333	422.153	422.166
C	30414.513	-4.333	422.132	422.138
Br. Pier 1	30423.346	-4.333	422.116	422.116
D	30433.346	-4.333	422.100	422.105
E	30443.346	-4.333	422.088	422.097
F	30453.346	-4.333	422.078	422.085
G	30463.346	-4.333	422.072	422.074
Br. Pier 2	30468.846	-4.333	422.069	422.069
H	30478.846	-4.333	422.068	422.075
I	30488.846	-4.333	422.069	422.082
J	30498.846	-4.333	422.073	422.083
Br. S. Abut.	30507.679	-4.333	422.079	422.079
Bk. S. Abut.	30509.846	-4.333	422.081	422.081

**ROADWAY AND P. G.**

Location	Station	Offset	Theoretical Grade Elevations	Theoretical Grade Elevations Adjusted For Dead Load Deflection
Bk. N. Abut.	30384.650	0.000	422.220	422.220
Br. N. Abut.	30386.817	0.000	422.214	422.214
A	30396.817	0.000	422.188	422.199
B	30406.817	0.000	422.164	422.178
C	30416.817	0.000	422.144	422.150
Br. Pier 1	30425.650	0.000	422.128	422.128
D	30435.650	0.000	422.114	422.118
E	30445.650	0.000	422.102	422.111
F	30455.650	0.000	422.093	422.100
G	30465.650	0.000	422.087	422.090
Br. Pier 2	30471.150	0.000	422.085	422.085
H	30481.150	0.000	422.084	422.091
I	30491.150	0.000	422.086	422.099
J	30501.150	0.000	422.091	422.100
Br. S. Abut.	30509.983	0.000	422.097	422.097
Bk. S. Abut.	30512.150	0.000	422.100	422.100

**BEAM 11**

Location	Station	Offset	Theoretical Grade Elevations	Theoretical Grade Elevations Adjusted For Dead Load Deflection
Bk. N. Abut.	30385.713	2.000	422.214	422.214
Br. N. Abut.	30387.880	2.000	422.208	422.208
A	30397.880	2.000	422.182	422.193
B	30407.880	2.000	422.159	422.172
C	30417.880	2.000	422.138	422.145
Br. Pier 1	30426.713	2.000	422.123	422.123
D	30436.713	2.000	422.109	422.113
E	30446.713	2.000	422.097	422.106
F	30456.713	2.000	422.089	422.096
G	30466.713	2.000	422.083	422.086
Br. Pier 2	30472.213	2.000	422.082	422.082
H	30482.213	2.000	422.081	422.088
I	30492.213	2.000	422.083	422.096
J	30502.213	2.000	422.088	422.098
Br. S. Abut.	30511.047	2.000	422.095	422.095
Bk. S. Abut.	30513.213	2.000	422.097	422.097

**BEAM 12**

Location	Station	Offset	Theoretical Grade Elevations	Theoretical Grade Elevations Adjusted For Dead Load Deflection
Bk. N. Abut.	30389.081	8.333	422.148	422.148
Br. N. Abut.	30391.248	8.333	422.142	422.142
A	30401.248	8.333	422.117	422.127
B	30411.248	8.333	422.095	422.108
C	30421.248	8.333	422.075	422.082
Br. Pier 1	30430.081	8.333	422.061	422.061
D	30440.081	8.333	422.048	422.052
E	30450.081	8.333	422.037	422.046
F	30460.081	8.333	422.030	422.037
G	30470.081	8.333	422.025	422.028
Br. Pier 2	30475.581	8.333	422.024	422.024
H	30485.581	8.333	422.024	422.031
I	30495.581	8.333	422.027	422.041
J	30505.581	8.333	422.033	422.043
Br. S. Abut.	30514.414	8.333	422.041	422.041
Bk. S. Abut.	30516.581	8.333	422.044	422.044

**WEST LONGITUDINAL BONDED CONSTRUCTION JOINT**

Location	Station	Offset	Theoretical Grade Elevations	Theoretical Grade Elevations Adjusted For Dead Load Deflection
Bk. N. Abut.	30391.030	12.000	422.077	422.077
Br. N. Abut.	30393.197	12.000	422.072	422.072
A	30403.197	12.000	422.047	422.058
B	30413.197	12.000	422.026	422.039
C	30423.197	12.000	422.007	422.013
Br. Pier 1	30432.030	12.000	421.993	421.993
D	30442.030	12.000	421.980	421.985
E	30452.030	12.000	421.970	421.979
F	30462.030	12.000	421.964	421.971
G	30472.030	12.000	421.960	421.962
Br. Pier 2	30477.530	12.000	421.959	421.959
H	30487.530	12.000	421.960	421.967
I	30497.530	12.000	421.963	421.977
J	30507.530	12.000	421.970	421.980
Br. S. Abut.	30516.364	12.000	421.979	421.979
Bk. S. Abut.	30518.530	12.000	421.981	421.981

**BEAM 13**

Location	Station	Offset	Theoretical Grade Elevations	Theoretical Grade Elevations Adjusted For Dead Load Deflection
Bk. N. Abut.	30392.448	14.667	422.018	422.018
Br. N. Abut.	30394.615	14.667	422.013	422.013
A	30404.615	14.667	421.988	421.998
B	30414.615	14.667	421.967	421.981
C	30424.615	14.667	421.949	421.955
Br. Pier 1	30433.448	14.667	421.936	421.936
D	30443.448	14.667	421.923	421.928
E	30453.448	14.667	421.914	421.923
F	30463.448	14.667	421.907	421.914
G	30473.448	14.667	421.904	421.906
Br. Pier 2	30478.948	14.667	421.903	421.903
H	30488.948	14.667	421.904	421.911
I	30498.948	14.667	421.909	421.922
J	30508.948	14.667	421.916	421.926
Br. S. Abut.	30517.782	14.667	421.925	421.925
Bk. S. Abut.	30519.948	14.667	421.927	421.927


**BEAM 14**

Location	Station	Offset	Theoretical Grade Elevations	Theoretical Grade Elevations Adjusted For Dead Load Deflection
Bk. N. Abut.	30395.816	21.000	421.878	421.878
Br. N. Abut.	30397.983	21.000	421.872	421.872
A	30407.983	21.000	421.848	421.860
B	30417.983	21.000	421.829	421.842
C	30427.983	21.000	421.812	421.818
Br. Pier 1	30436.816	21.000	421.799	421.799
D	30446.816	21.000	421.788	421.793
E	30456.816	21.000	421.780	421.788
F				



STATE OF ILLINOIS  
DEPARTMENT OF TRANSPORTATION

ROUTE NO.	SECTION	DISTRICT	DATE	SCALE	SHEET NO. 3
				5/2	16 SHEETS
DESIGNED BY	DESIGNED-TO	DESIGNED BY			
DESIGNED BY	DESIGNED-TO	DESIGNED BY			

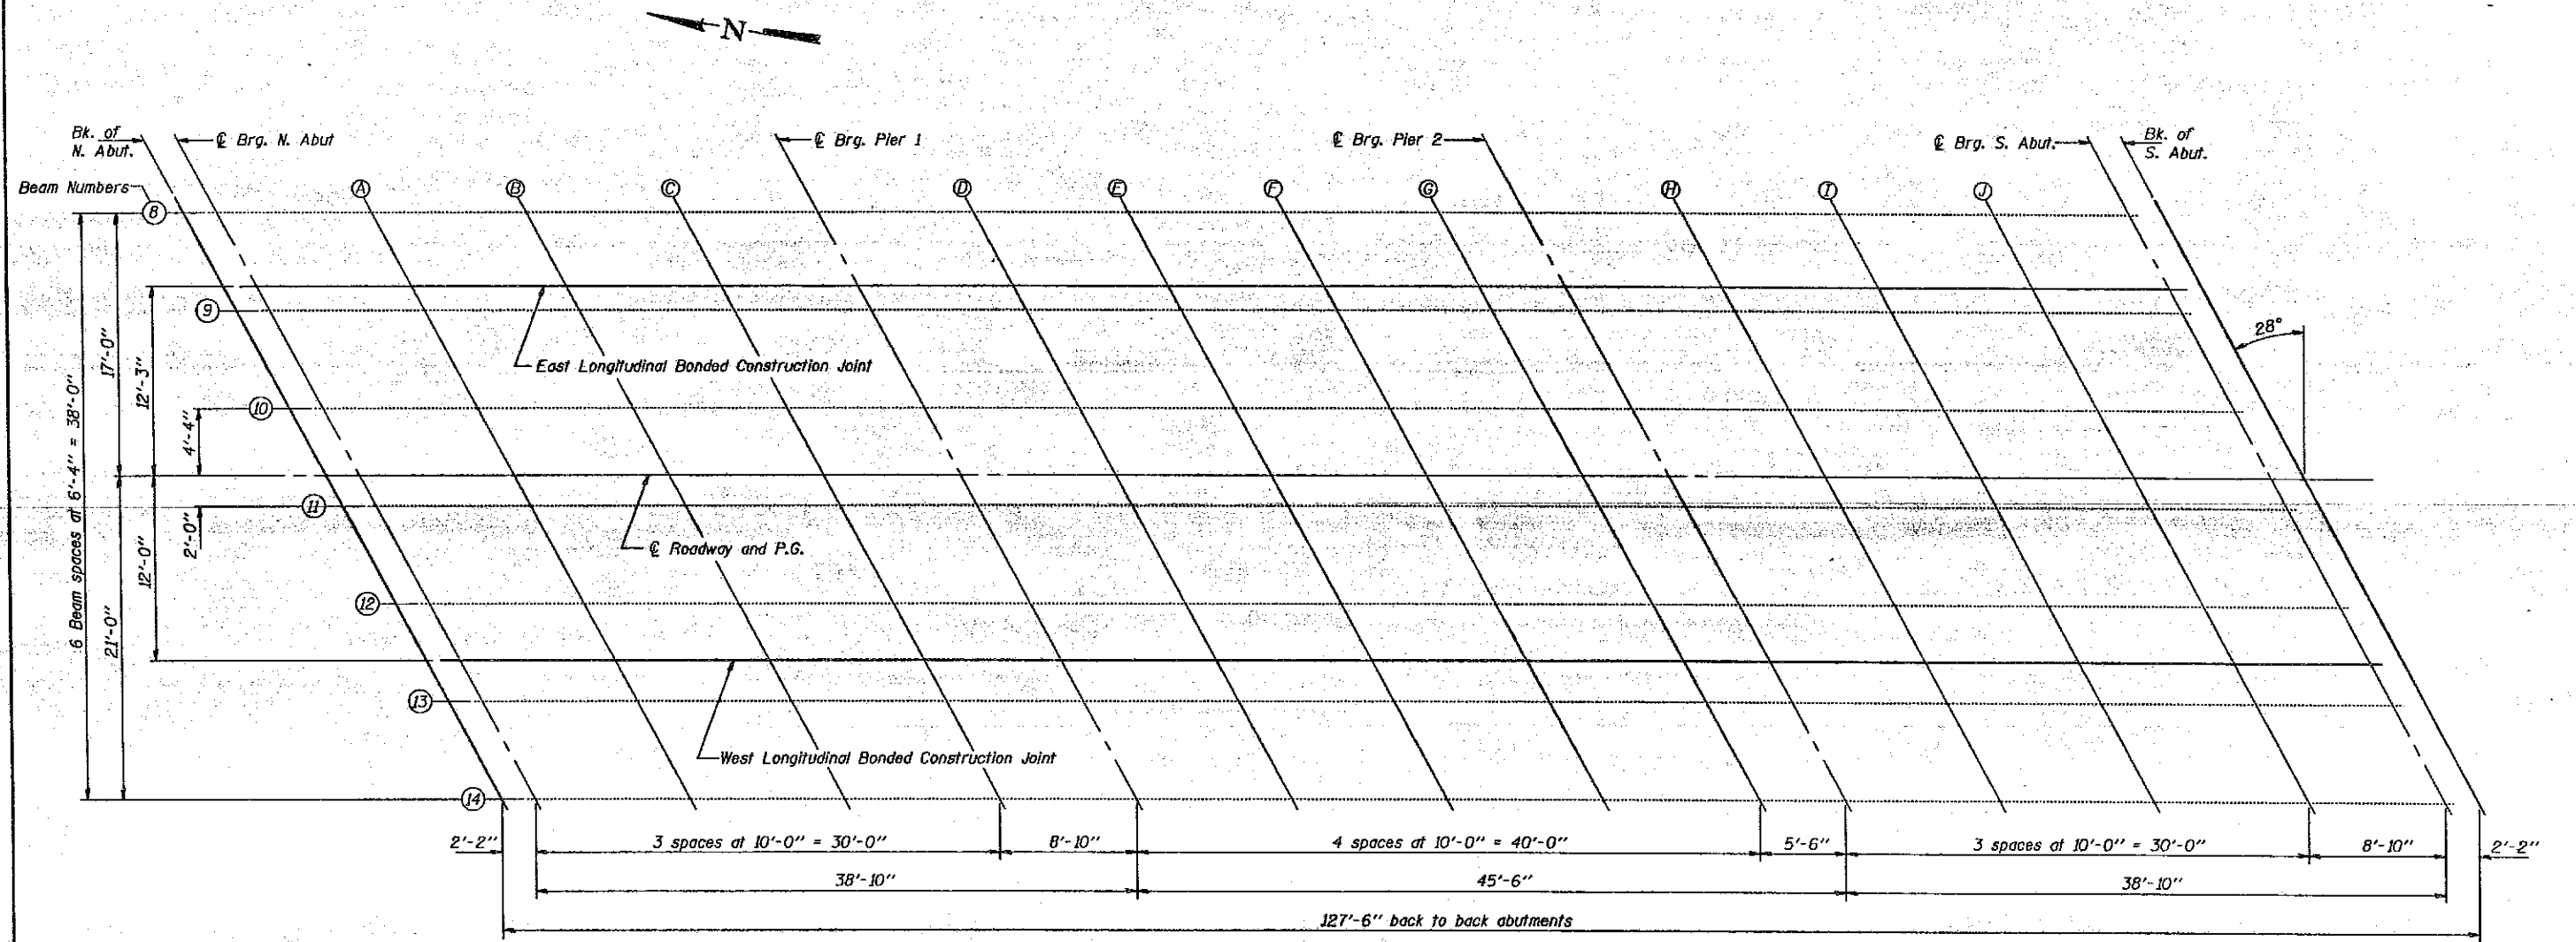

PLAN


DESIGNED <i>John Ciccone</i>	EXAMINED <i>Origi J. Kaspar</i>
CHECKED <i>Anthony J. Williams</i>	PASSED <i>Ralph E. Anderson</i>
DRAWN <i>R. Dory</i>	APPROVED _____
CHECKED <i>J.C., A.P.V.</i>	DIRECTOR OF HIGHWAYS

May 20 1933


TOP OF SLAB ELEVATIONS  
F.A.I. RT. 57 SEC. (28-2B)D-1  
FRANKLIN COUNTY  
STATION 304+25.00

STATE OF ILLINOIS  
DEPARTMENT OF TRANSPORTATION

DATE	DESIGNED	CHECKED	BY	NO.	SHEET NO. 4
	John Ciccone	Anthony J. ...	R. Dofy	J.L.C., R.V.V.	16 SHEETS
P.A.S. #	PROJECT	FRANKLIN		SS	
DESIGNED	EXAMINED	APPROVED			

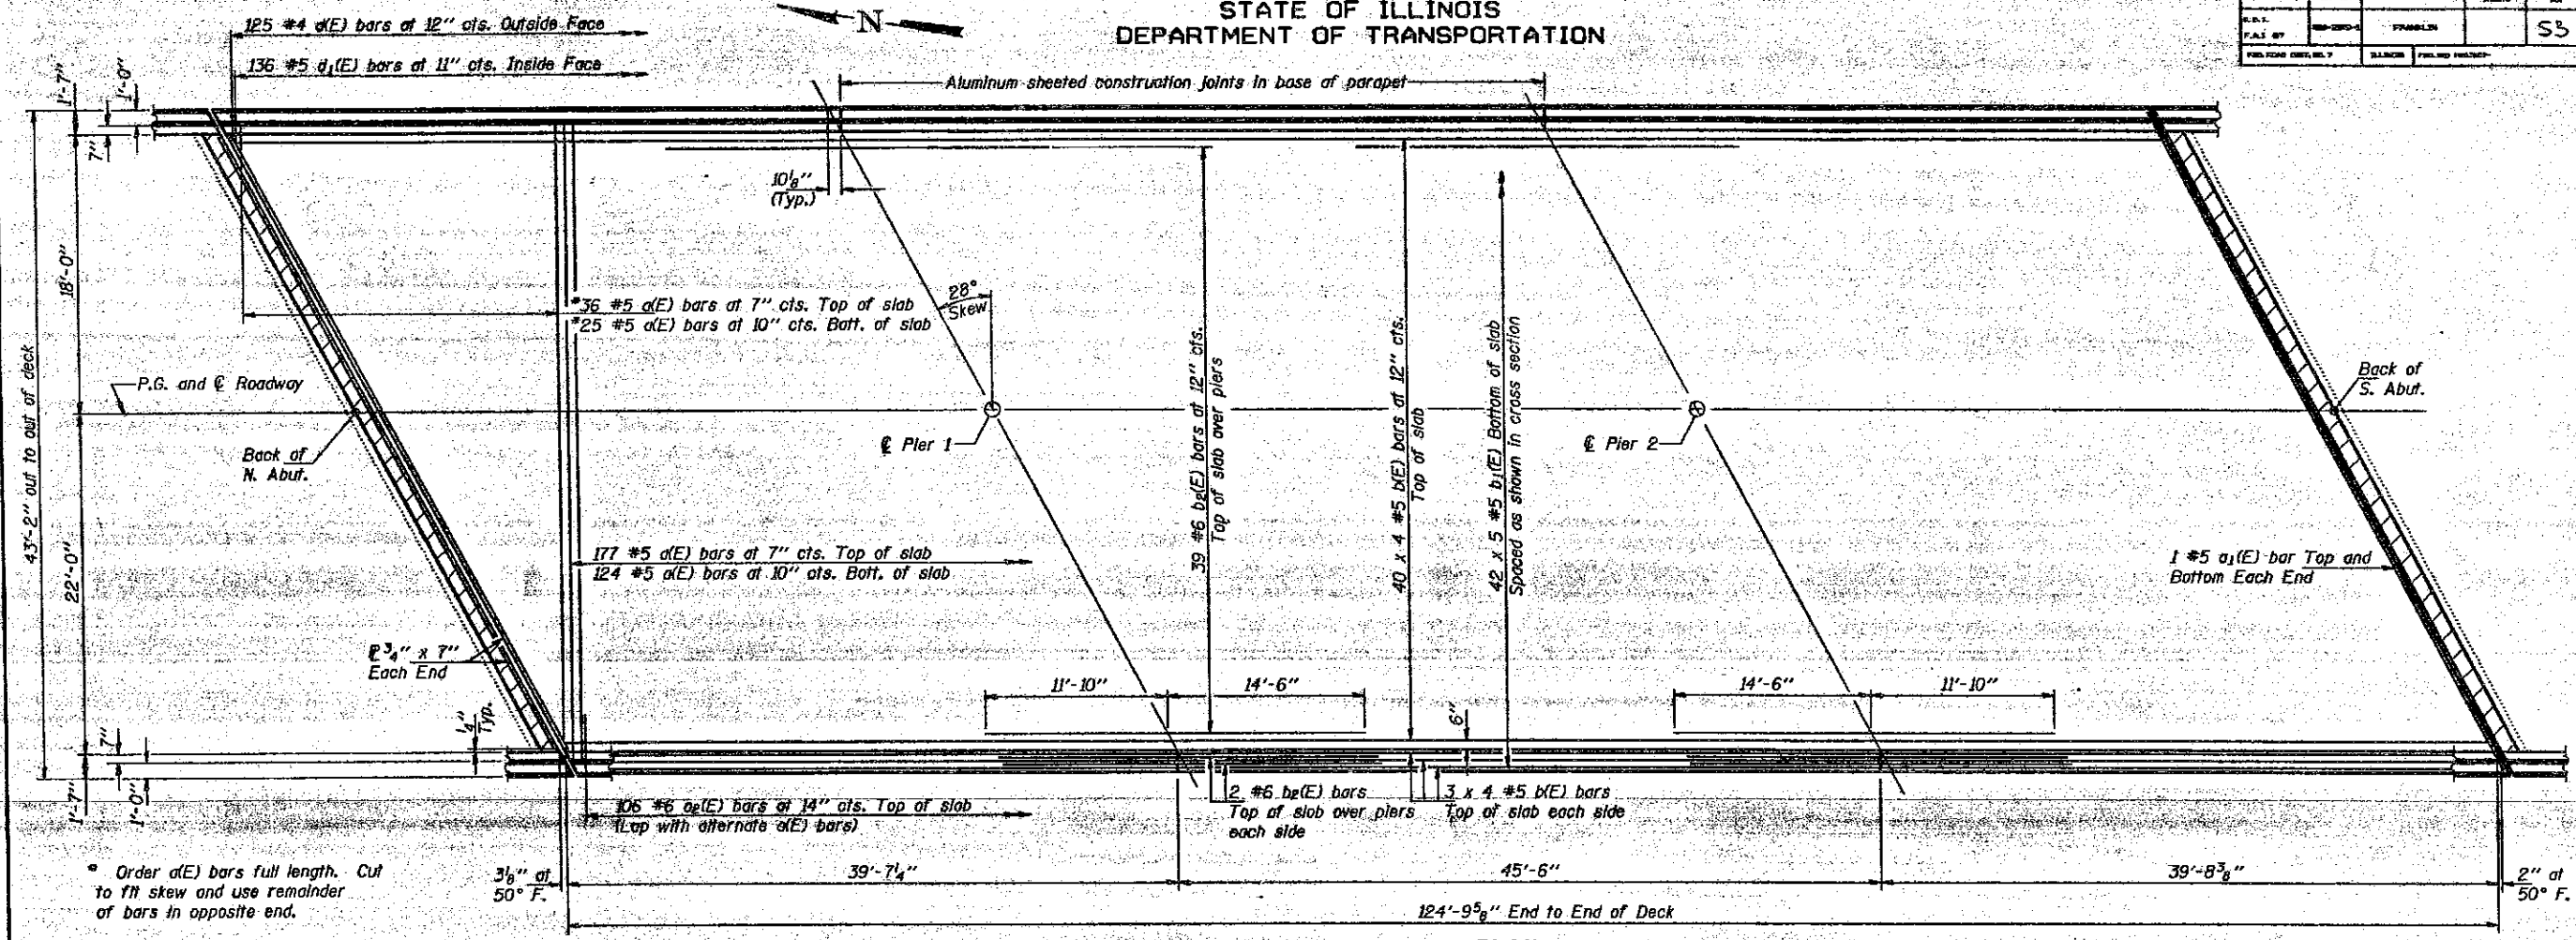

PLAN

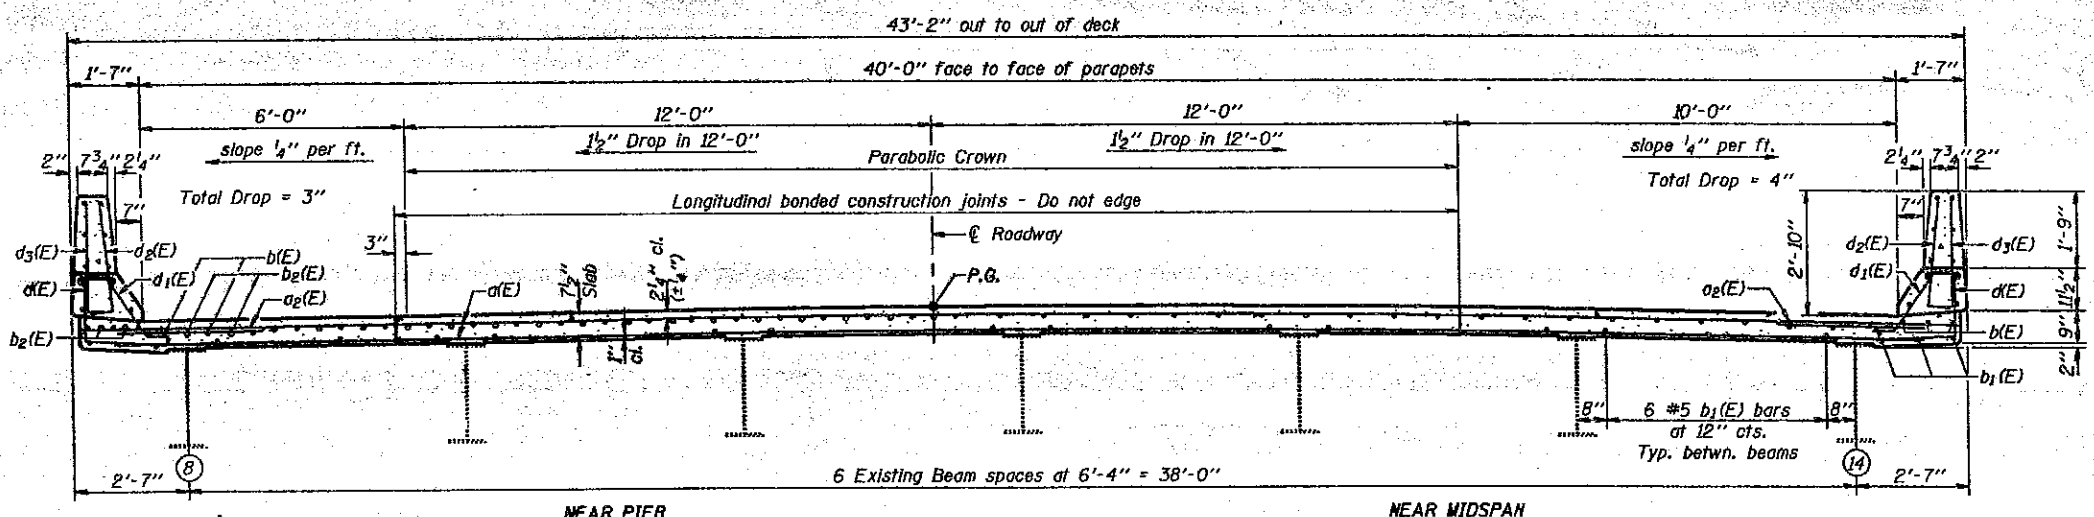

CROSS SECTION  
(Looking South)

Notes: See sheets #5 and #6 of 16 for superstructure details, parapet reinforcement and Bill of Material.  
Reinforcement bars designated (E) shall be epoxy coated.  
Reinforcement bars indicated thus 40 x 4 #5 etc. indicates 40 lines of bars with 4 lengths per line.  
See sheet #1 of 16 for drain locations and sheet #5 of 16 for details.  
Hatched area to be poured after superstructure forms have been removed. Quantity of concrete to be included with Class X Concrete Superstructure.

MIN. BAR LAPS  
#5 bars = 1'-8"

DESIGNED John Ciccone  
CHECKED Anthony J. ...  
DRAWN R. Dofy  
CHECKED J.L.C., R.V.V.

EXAMINED [Signature]  
PASSED Ralph E. ...  
APPROVED [Signature]

May 20 1993


SUPERSTRUCTURE  
F.A.I. RT. 57 SEC. (28-2B)D-1  
FRANKLIN COUNTY  
STATION 304+25.00






STATE OF ILLINOIS  
DEPARTMENT OF TRANSPORTATION

DATE	BY	CHKD	APP'D	SHEET NO. 6
55				16 SHEETS

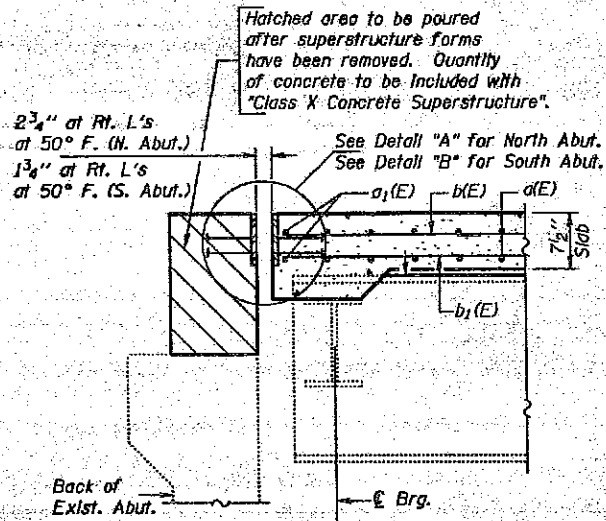


SECTION THRU ABUTMENTS

North Abut. Looking East  
South Abut. Looking West

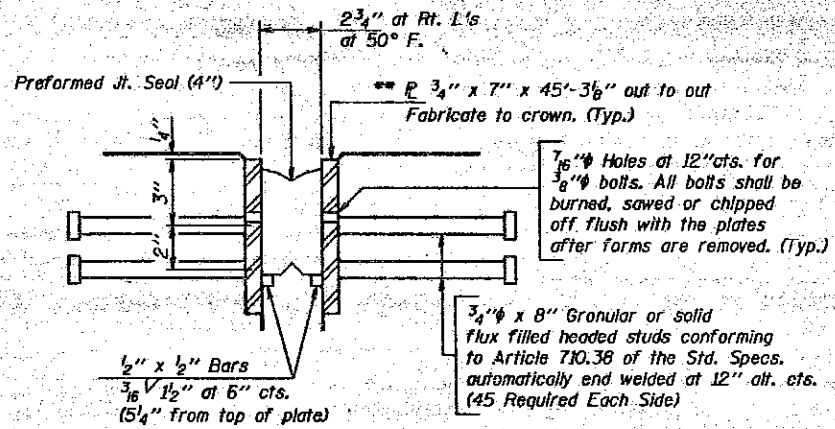


DETAIL "A"

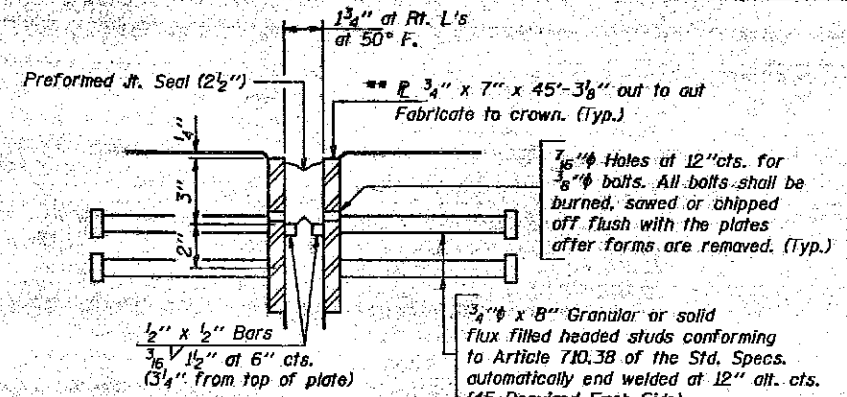


DETAIL "B"

\*\* Furnish in segments of 20 ft. maximum length. Maximum space between installed segments shall be 1/16\"/>


Note: After fabrication all surfaces of the steel plates shall be given one shop coat of paint specified for Structural Steel. No field painting required.

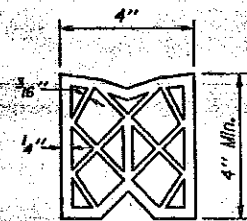

PREFORMED JOINT SEAL (4")

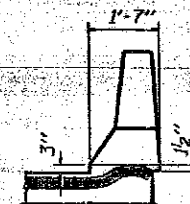

END TREATMENT  
Typ. for (4") and (2 1/2")

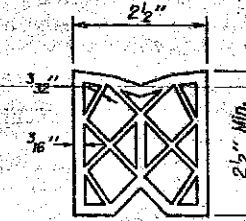


PREFORMED JOINT SEAL (2 1/2")


BILL OF MATERIAL

Bar	No.	Size	Length	Shape
a(E)	362	#5	41'-2"	
a1(E)	4	#5	48'-2"	
a2(E)	212	#6	4'-0"	
b(E)	184	#5	32'-5"	
b1(E)	210	#5	26'-3"	
b2(E)	86	#6	26'-4"	
d(E)	250	#4	3'-8"	C
d1(E)	272	#5	2'-7"	L
d2(E)	272	#5	3'-0"	L
d3(E)	250	#4	3'-0"	L
e(E)	24	#4	19'-7"	
e1(E)	12	#4	20'-4"	
e2(E)	36	#4	14'-11"	
e3(E)	12	#4	19'-3"	
e4(E)	16	#8	22'-4"	
e5(E)	4	#8	45'-3"	
e6(E)	16	#5	21'-2"	
e7(E)	4	#5	45'-3"	
Reinforcement Bars, Epoxy Coated			Lbs.	38060
Class X Concrete Superstructure			Cu. Yd.	177.6


Reinforcement bars designated (E) shall be epoxy coated.

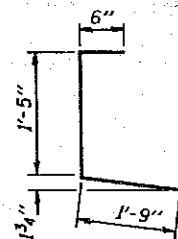

BAR a(E)

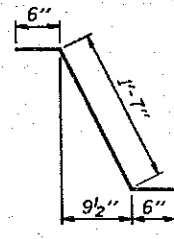

BAR d1(E)

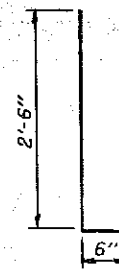

BARS d2(E) & d3(E)


DESIGNED	John Ciccone
CHECKED	Anthony J. ...
DRAWN	R. Doty
CHECKED	JCC AYV

EXAMINED	May 20 1993
PASSED	Ralph E. ...
APPROVED	...


SUPERSTRUCTURE DETAILS  
F.A.I. RT. 57 SEC. (28-2B)D-1  
FRANKLIN COUNTY  
STATION 304+25.00

STATE OF ILLINOIS  
DEPARTMENT OF TRANSPORTATION

ROUTE NO.	SECTION	LENGTH	PIERS	ABUT.	SHEET NO. 7
F.A.I. 57	28-2B(1)	FRANKLIN		56	16 SHEETS
FED. ROAD DIST. NO. 7	ILLINOIS	FED. ROAD PROJECT			

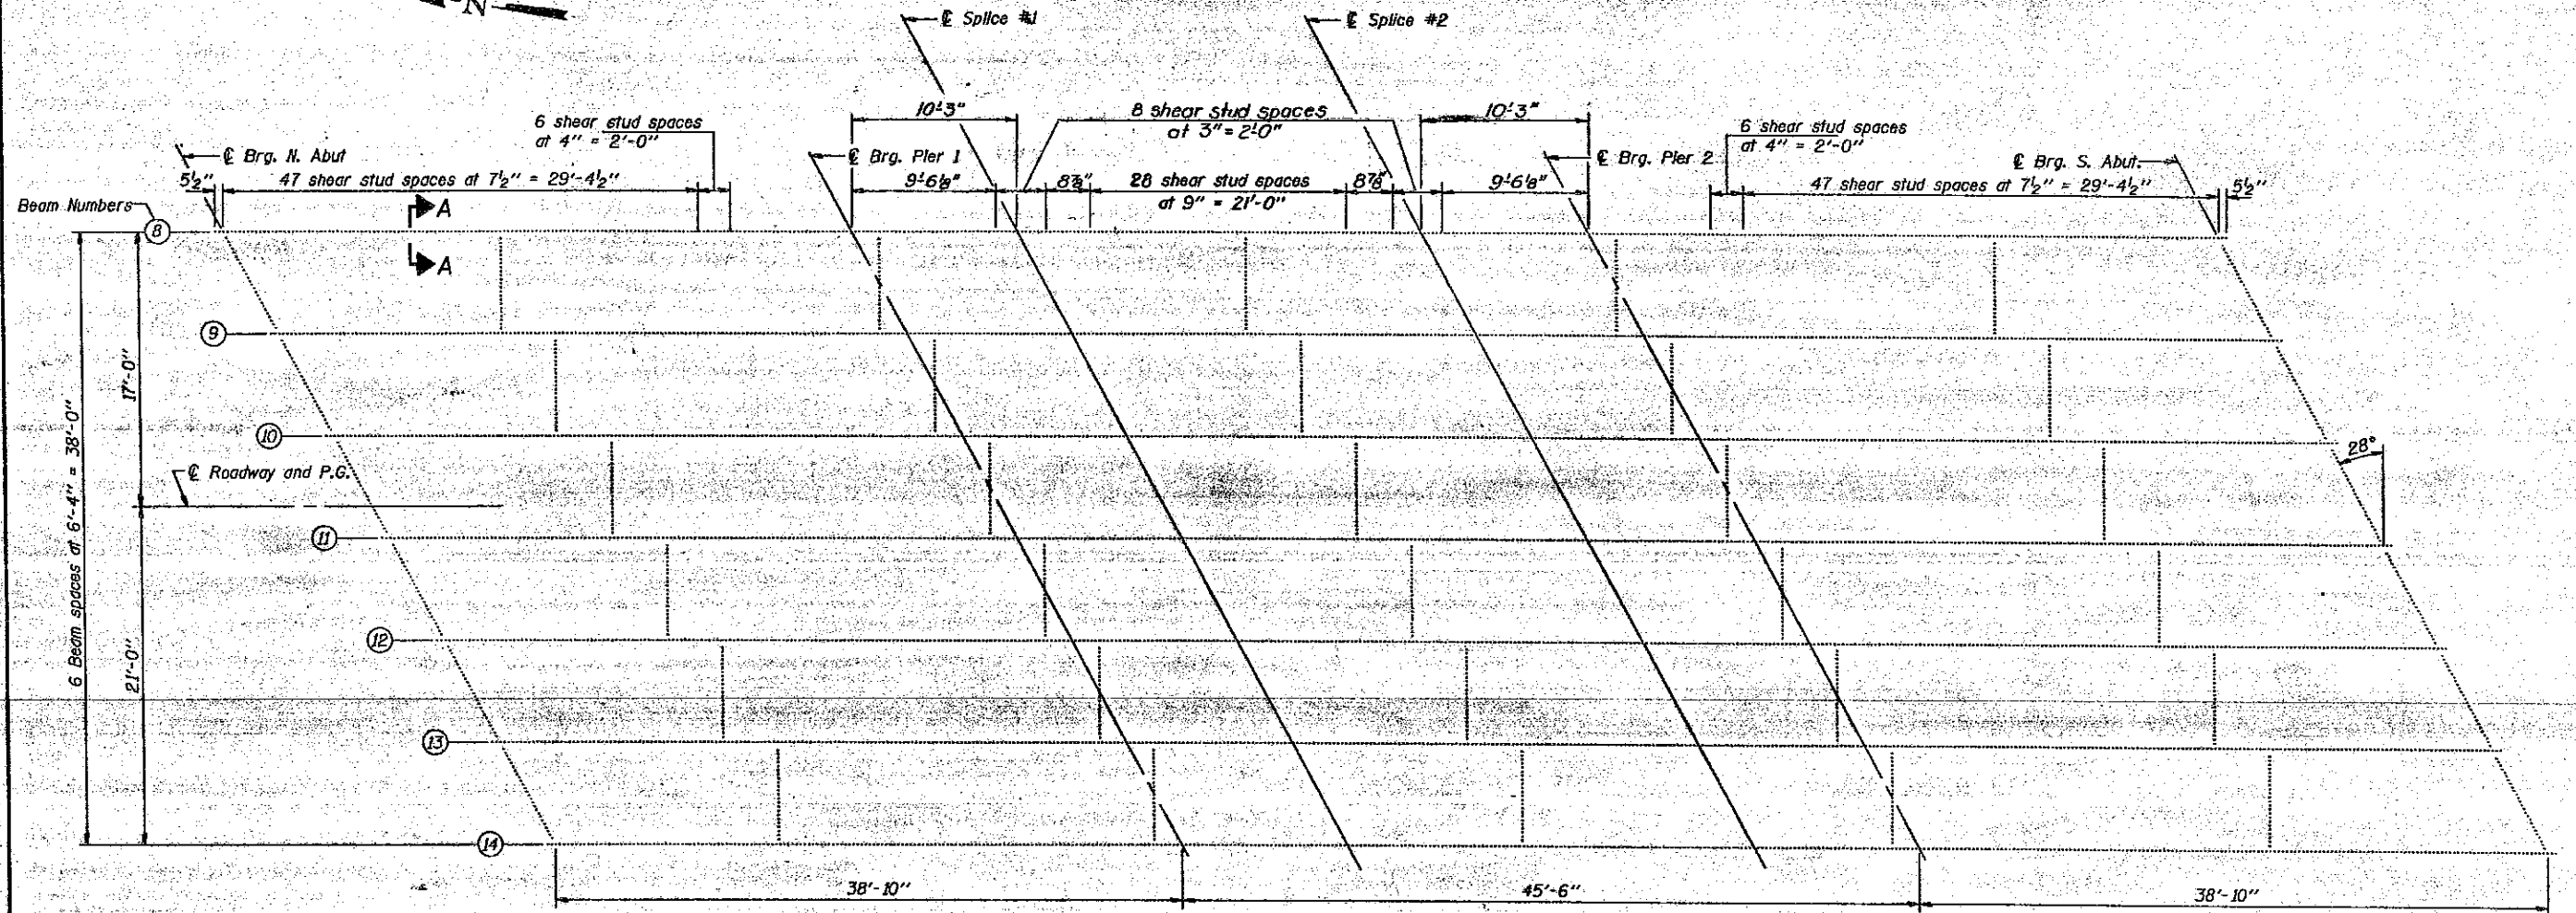

**PLAN**  
(Shear Studs Typ. All Beams)

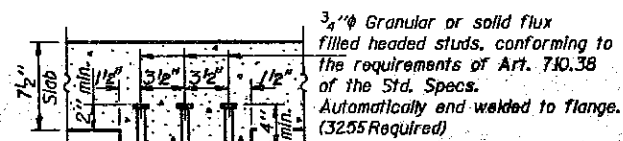









**SECTION A-A**

DESIGNED <i>John C. Cason</i>	EXAMINED <i>Dr. J. D. Kasper</i>
CHECKED <i>Anthony J. G. G. G.</i>	PASSED <i>Ralph E. Anderson</i>
DRAWN <i>R. Doty</i>	APPROVED _____
CHECKED <i>JLC, R.V.V.</i>	DIRECTOR OF HIGHWAYS

STRUCTURAL STEEL DETAILS  
F.A.I. RT. 57 SEC. (28-2B)D-1  
FRANKLIN COUNTY  
STATION 304+25.00

STATE OF ILLINOIS  
DEPARTMENT OF TRANSPORTATION



ROUTE NO.	SECTION	COUNTY	DATE	SHEET NO.
57			57	16 SHEETS

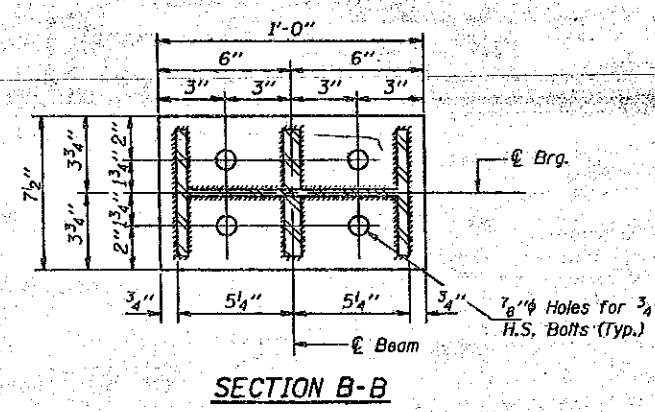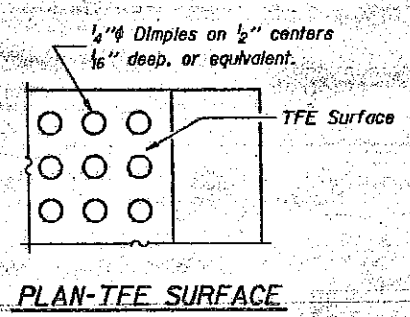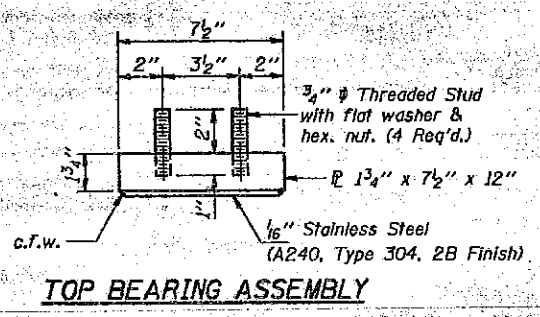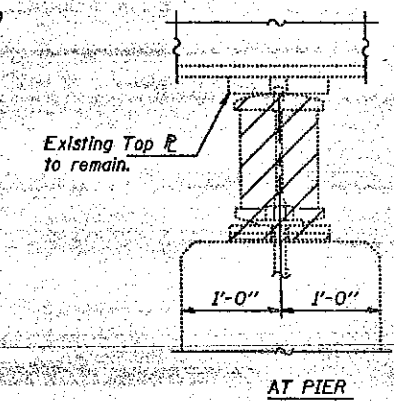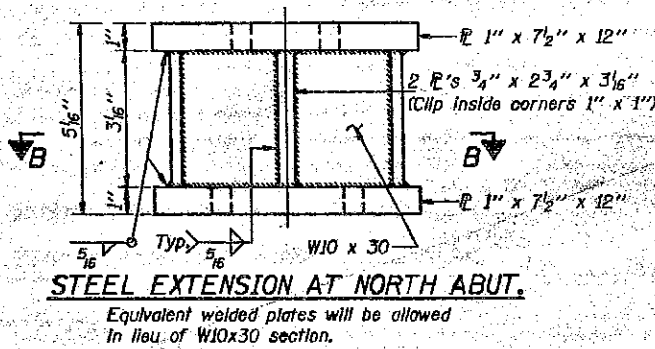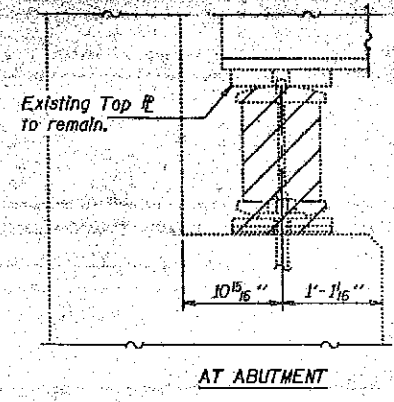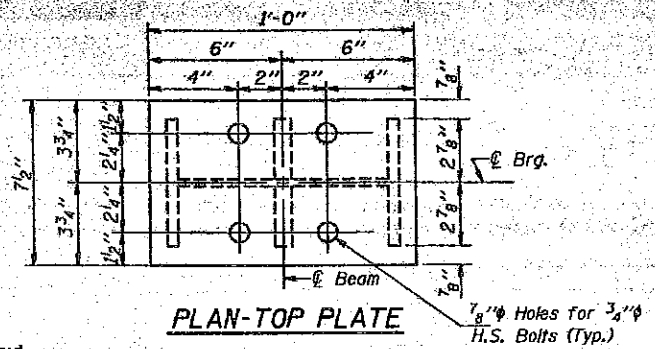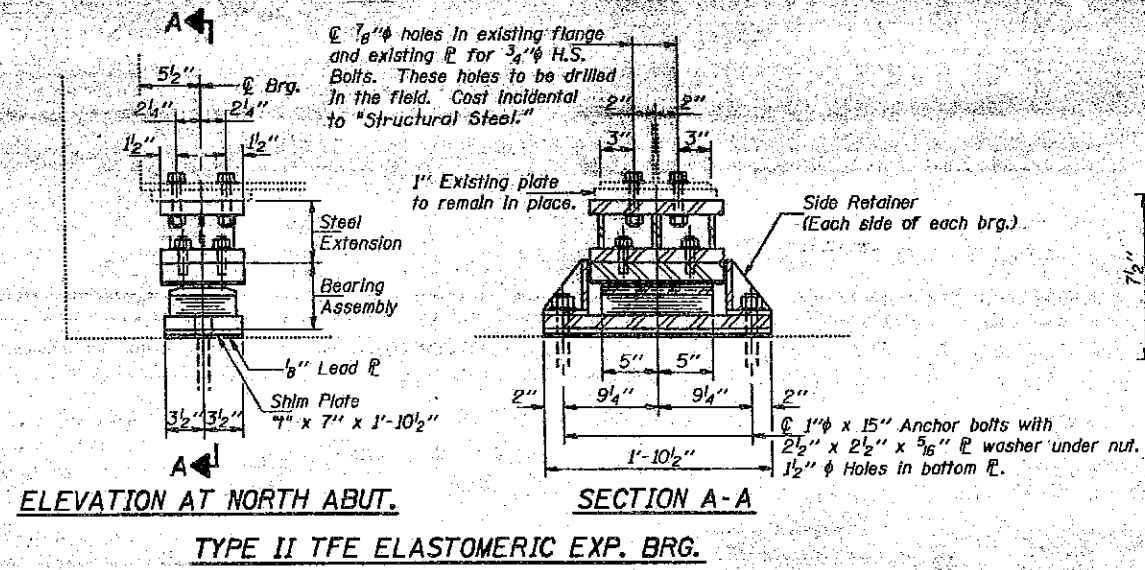

**JACK AND REMOVE EXISTING BEARING**  
Hatched areas indicate Removal of Existing Bearing. See sheets #8, #9 & #10 of 16 for new brg. details.


**JACK AND REMOVE EXISTING BEARING PROCEDURE**

- The Contractor shall submit for approval by the Engineer, plans for jacking prior to commencing any work at the bearings. Dead Load = 3.0K at each beam at abutments and 6.0K at each beam at piers without concrete. Min. Jack Capacity at each beam shall be 5 Tons.
- Jacking and removing existing bearings shall be done after deck removal is completed and before the new deck is poured.
- All beams at one abutment or at one pier shall be lifted simultaneously.
- Jacking shall be limited to a maximum of 1/4".
- Remove the existing anchor bolts flush with the concrete surface and grind smooth. The rockers and bottom plates shall be removed, leaving the existing top plate intact.
- The new bearings and steel extensions shall be installed in place and the jacks shall be lowered before the new deck is poured.

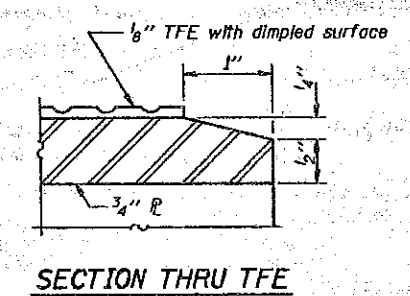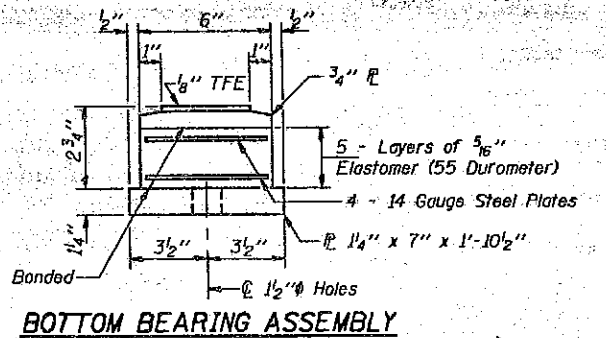


Note: The 1/8" TFE sheet shall be bonded directly to the top steel plate with a two-component, medium viscosity epoxy resin, conforming to the requirements of the Federal Specification MMM-A-134, Type I. The bond agent shall be applied on the full area of the contact surfaces.

Bonding of 1/8" TFE sheet during vulcanizing process will be permitted provided the process and method of adjusting assembly height is approved by the Engineer.

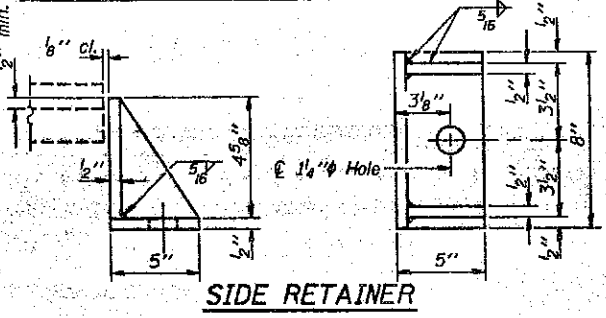

Equivalent rolled angle with stiffeners will be allowed in lieu of welded plates. Weight included with Structural Steel.

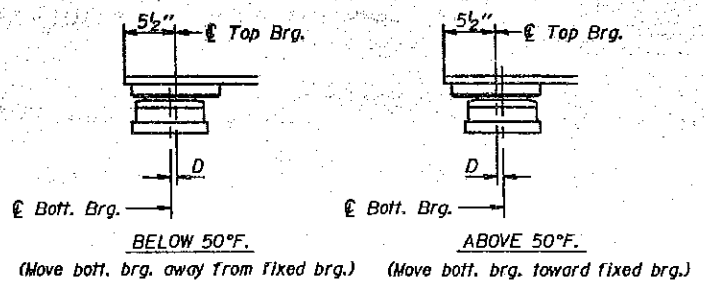

**SETTING ANCHOR BOLTS AT EXP. BRG.**

D=1/8" per each 100' of expansion for every 15° temp. change from the normal temp. of 50°F.

**INTERIOR BEAM MOMENT TABLE**

	0.4 Sp. 1 or 0.6 Sp. 3	Pier 1 or Pier 2	0.5 Sp. 2
Is (in <sup>4</sup> )	2850	2850	2850
Ic (n=9) (in <sup>4</sup> )	8361	8361	8361
Ic (n=27) (in <sup>4</sup> )	6285	6285	6285
Ss (in <sup>3</sup> )	213	213	213
Sc (n=9) (in <sup>3</sup> )	326	326	326
Sc (n=27) (in <sup>3</sup> )	296	296	296
Q (K/ft.)	.705	.980	.705
M $\phi$ (K)	77.3	163	56.7
fs $\phi$ non-comp (k.s.i.)	4.4	9.2	3.2
s $\phi$ (K/ft.)	.275	---	.275
M $\phi$ (K)	34.8	---	33.9
fs $\phi$ (comp) (k.s.i.)	1.4	---	1.4
M $\phi$ (K)	213	110	219.7
M (Imp) (K)	63.2	32.6	65.2
(Total) (K)	276.2	142.6	284.9
fs (k+1) (k.s.i.)	10.2	8.0	10.5
fs (Total) (k.s.i.)	16.0	17.2	15.1
VR (K)	43.2	---	45.9

\*\* For n = 27.

**INTERIOR BEAM REACTION TABLE**

	Abutts.	Piers
R $\phi$ (K)	10.5	33.0
R $\phi$ (K)	30.3	37.3
Imp. (K)	9.0	11.1
R (Total) (K)	49.8	81.4

Is and Ss are the moment of inertia and section modulus of the steel section used in computing fs (Total).  
Ic and Sc are the moment of inertia and section modulus of the composite section used in computing fs (Total).  
VR is the maximum live Load + Impact shear range in span.

**BILL OF MATERIAL**

Item	Unit	Total
Elastomeric Bearing Assembly Type II	Each	7
Jack and Remove Existing Bearings	Each	7

**NORTH ABUTMENT BEARING DETAILS**  
F.A.I. RT. 57 SEC. (28-2B)D-1  
FRANKLIN COUNTY  
STATION 304+25.00

DESIGNED John C. Adams  
CHECKED Anthony J. Vanecko  
DRAWN Joe Sutherland R.D.  
CHECKED JLC, RYV

EXAMINED Craig J. Kasper  
PAIRED Robert E. Anderson  
APPROVED [Signature]





May 20, 1993

Notes: For anchor bolt installation details see sheet #16 of 16.  
For anchor bolt location see sheet #10 of 16.  
For shim plate thickness see sheet #10 of 16.













STATE OF ILLINOIS  
DEPARTMENT OF TRANSPORTATION

PROJECT NO.	DATE	SCALE	SHEET NO.
100-250-0	1993	AS SHOWN	58
PROJECT NAME			TOTAL SHEETS
FRANKLIN COUNTY			16 SHEETS

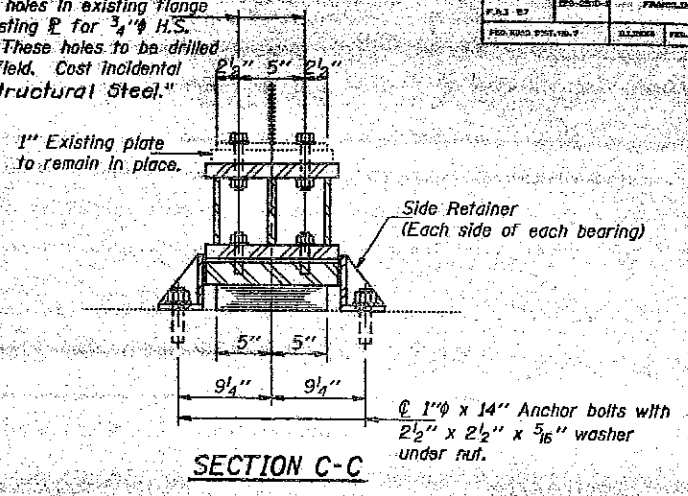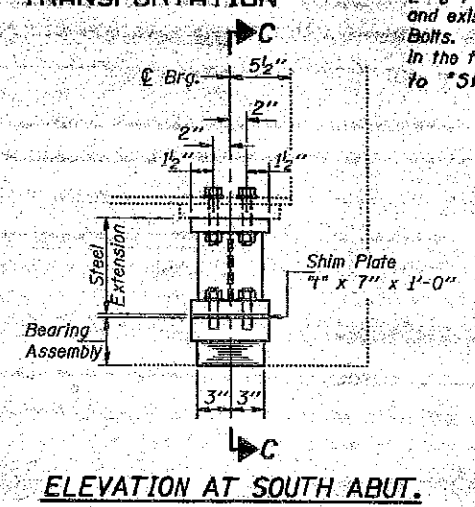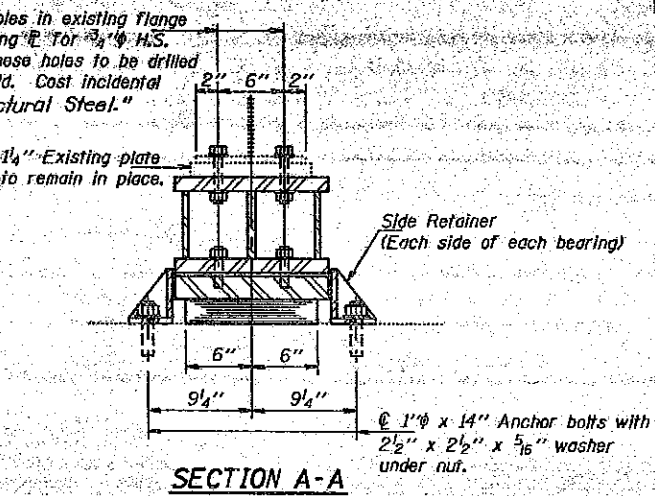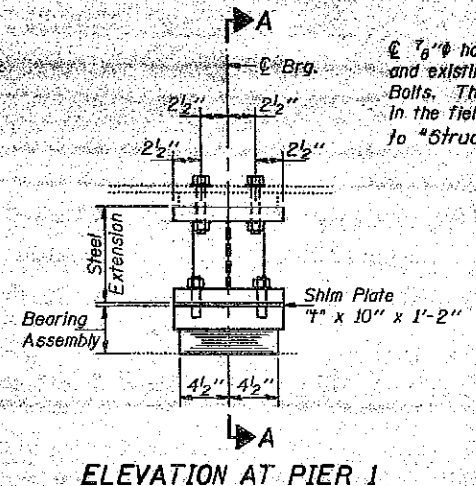

TYPE I ELASTOMERIC EXP. BRG.

TYPE I ELASTOMERIC EXP. BRG.

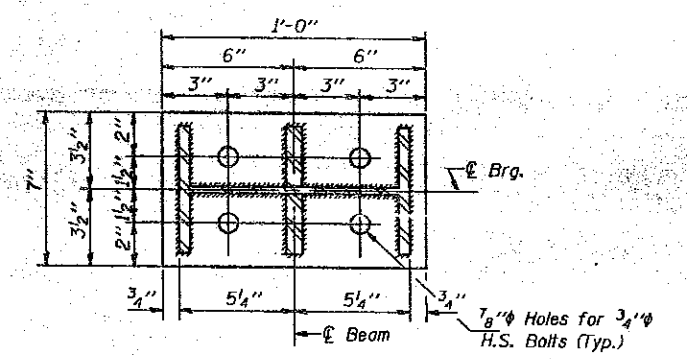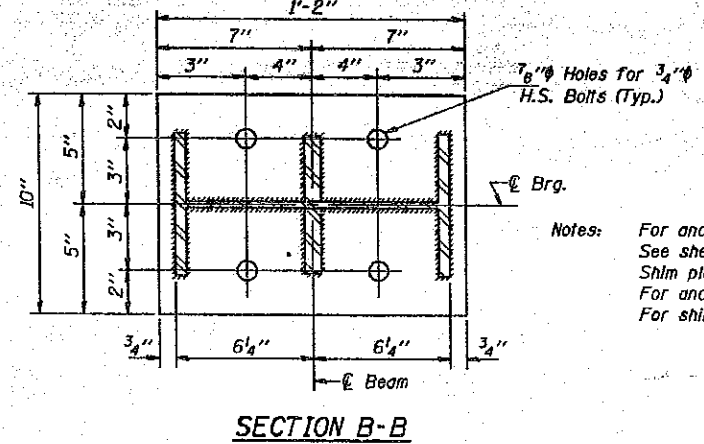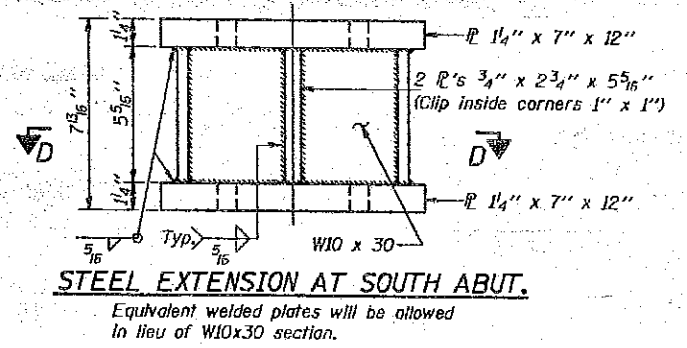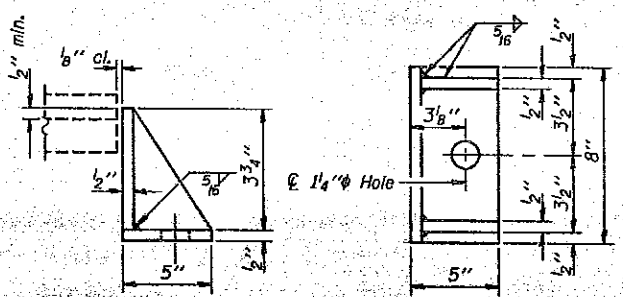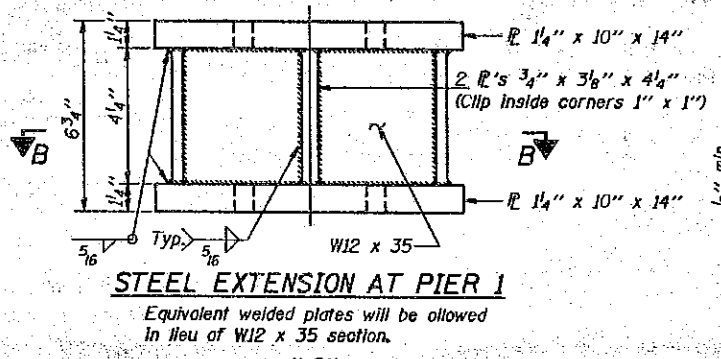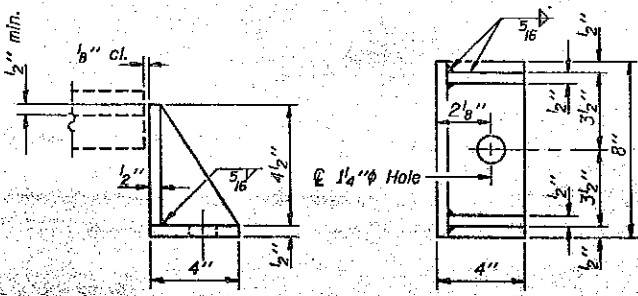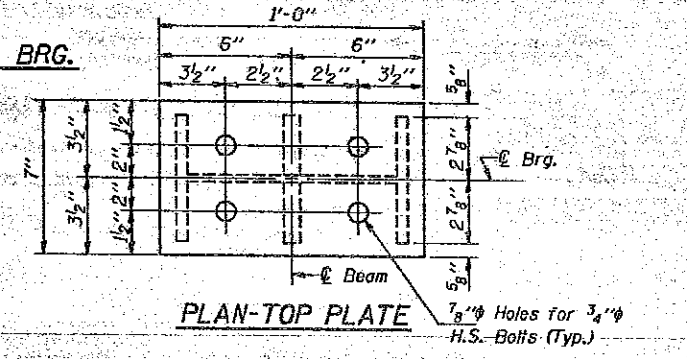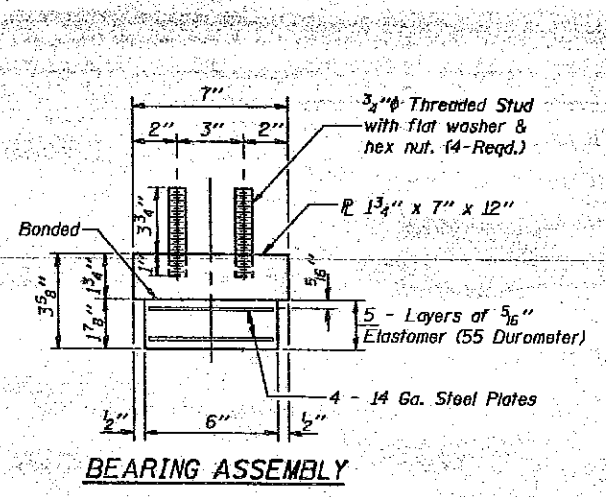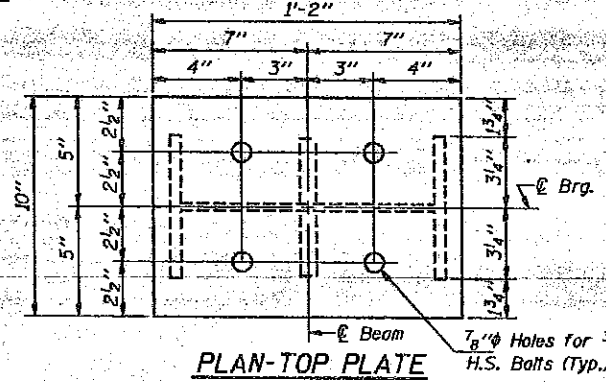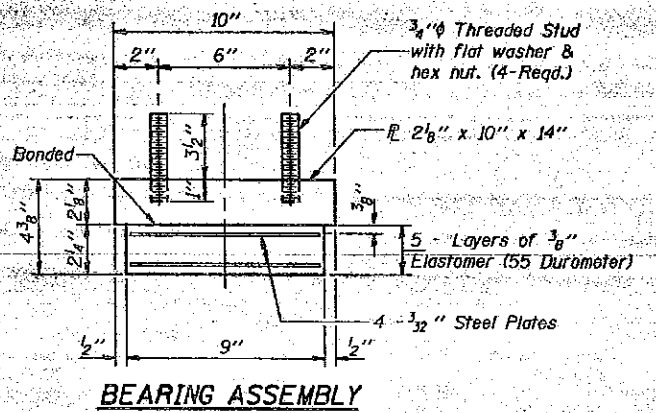

Notes: For anchor bolt installation details see sheet #16 of 16. See sheet #8 of 16 for Jack and Remove Existing Bearing Procedure. Shim plates shall not be placed under Bearing Assembly. For anchor bolt location see sheet #10 of 16. For shim plate thickness see sheet #10 of 16.

BILL OF MATERIAL

Item	Unit	Total
Elastomeric Bearing Assembly Type I	Each	14
Jack and Remove Existing Bearings	Each	14


PIER 1 AND SOUTH ABUTMENT  
BEARING DETAILS  
F.A.I. RT. 57 SEC. (28-2B)D-1  
FRANKLIN COUNTY  
STATION 304+25.00

DESIGNED John Ciccone	EXAMINED [Signature]
CHECKED Anthony J. Vinton	PASSED [Signature]
DRAWN Joe Sutherland R.D.	APPROVED [Signature]
CHECKED JCC, RYV	



STATE OF ILLINOIS  
DEPARTMENT OF TRANSPORTATION


ROUTE NO.	DISTRICT	COUNTY	SECTION	SHEET NO.	SHEET NO. 10 16 SHEETS
F.A.I. RT. 57	28-2B	FRANKLIN		59	
PROJ. DIST. NO. 7	ILLINOIS	FRANKLIN			

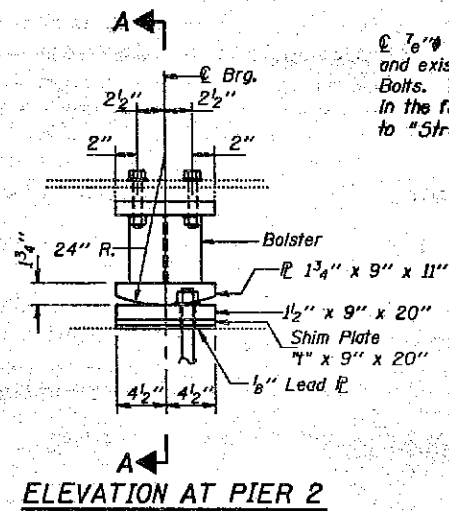


ELEVATION AT PIER 2

7/8" holes in existing flange and existing flange for 3/4" H.S. Bolts. These holes to be drilled in the field. Cast incidental to "Structural Steel."


1/4" Existing plate to remain in place.

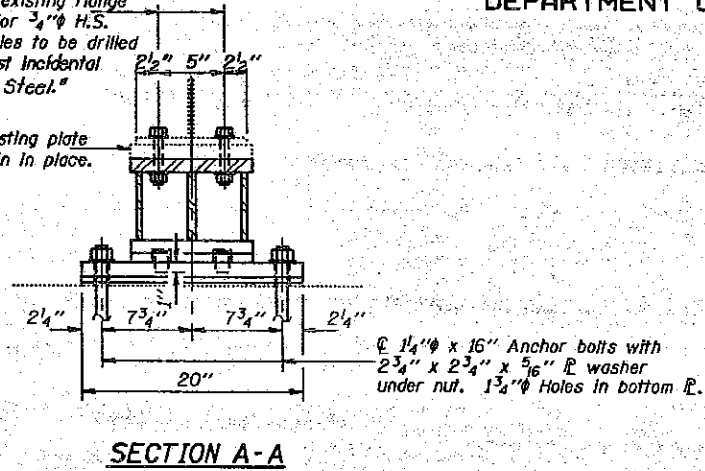

SECTION A-A

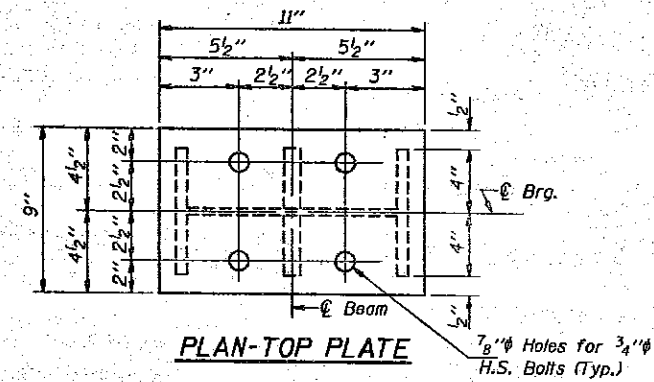


PLAN-TOP PLATE

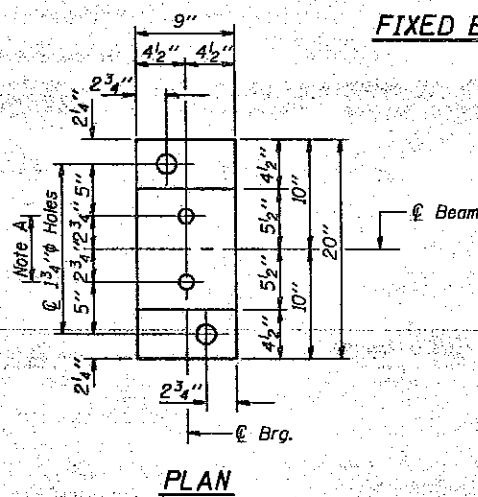


PLAN

FIXED BEARING

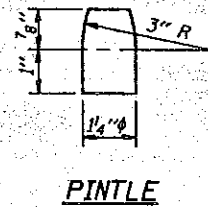


PINTLE

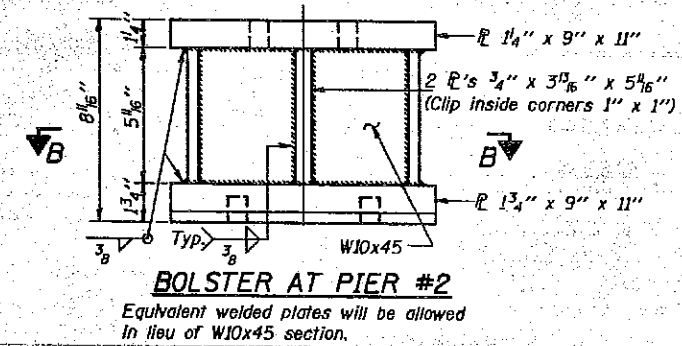

BOLSTER AT PIER #2

Equivalent welded plates will be allowed in lieu of W10x45 section.

Note A:  
1 3/8" holes 1" deep in bolster for 1 1/4" pintles. Thread or press fit in bottom flange.

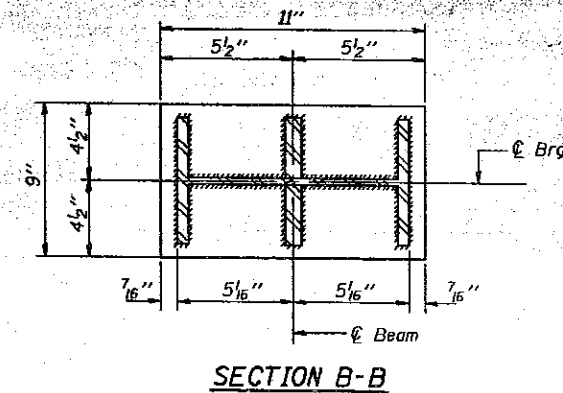

SECTION B-B

\* TABLE OF "T" DIMENSIONS

Location	N. Abut.	Pier #1	Pier #2	S. Abut.
Beam #8	1/2"	1/2"	1/2"	1/2"
Beam #9	1/8"	3/8"	7/16"	7/8"
Beam #10	1"	1"	1"	5/8"
Beam #11	1 1/8"	5/8"	1 1/8"	1 1/8"
Beam #12	1 1/8"	1 1/8"	1 1/8"	1 1/8"
Beam #13	1 1/8"	1"	1"	1 1/8"
Beam #14	1 1/8"	1"	1"	1 1/8"

FIELD SURVEY SEAT ELEVATIONS


Location	N. Abut.	Pier #1	Pier #2	S. Abut.
Beam #8	418.08	417.91	417.92	417.89
Beam #9	418.17	418.01	418.02	417.99
Beam #10	418.23	418.08	418.09	418.07
Beam #11	418.22	418.08	418.09	418.07
Beam #12	418.13	418.00	418.02	418.00
Beam #13	418.02	417.90	417.92	417.91
Beam #14	417.87	417.76	417.78	417.77

\* Based on the field survey seat elevations shown on this sheet. The Contractor shall verify these elevations in the field and make adjustments if necessary.


Notes: For anchor bolt installation details see sheet #16 of 16. See sheet #8 of 16 for Jack and Remove Existing Bearing Procedure.

DESIGNED John Ciccone  
CHECKED Anthony J. Wilson  
DRAWN Joe Sutherland R.D.  
CHECKED JLC, R.V.V.

EXAMINED May 20 1993  
PASSED Ralph E. Anderson  
APPROVED

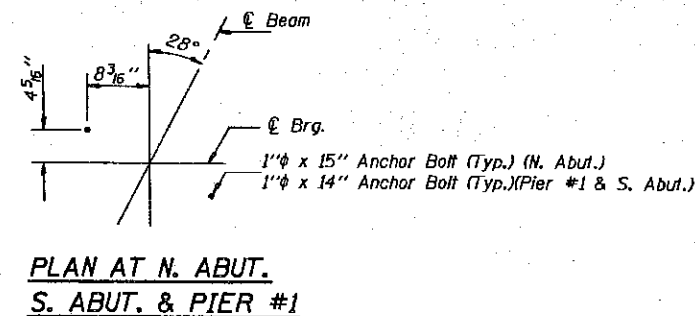

PLAN AT N. ABUT.  
S. ABUT. & PIER #1

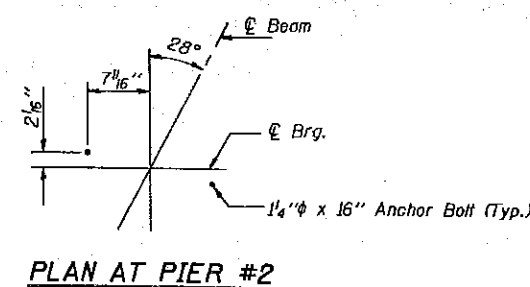


PLAN AT PIER #2

PIER 2  
BEARING DETAILS  
F.A.I. RT. 57 SEC. (28-2B)D-1  
FRANKLIN COUNTY  
STATION 304+25.00


STATE OF ILLINOIS  
DEPARTMENT OF TRANSPORTATION

ROUTE NO.	SECTION	COUNT	DATE	SHEET NO. 11
F.A.I. BY	DESIGNED BY	FRANKLIN	60	16 SHEETS
FED. ROAD DIST. NO. 7	BUILDING	FED. ROAD PROJECT		


\* These dimensions are along front face of hatched area.

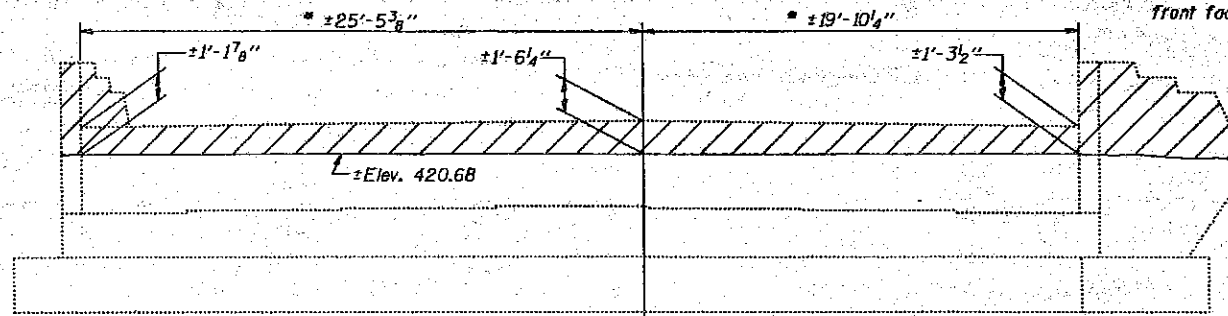


ELEVATION  
(Looking North)

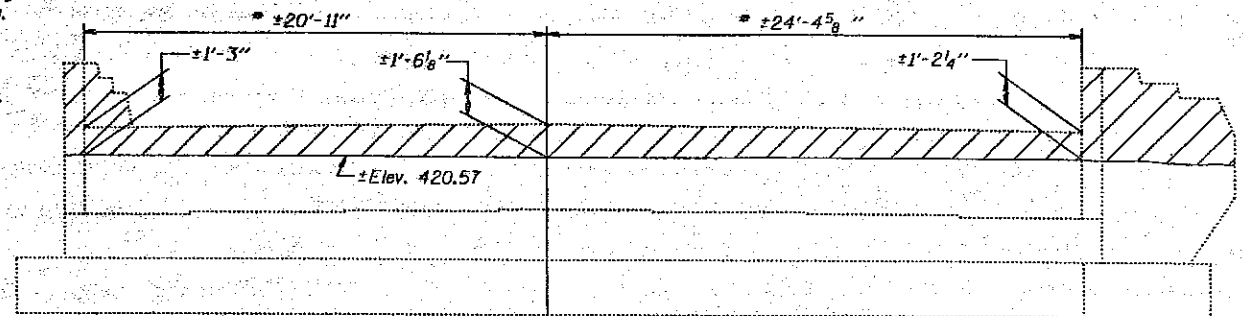


ELEVATION  
(Looking South)

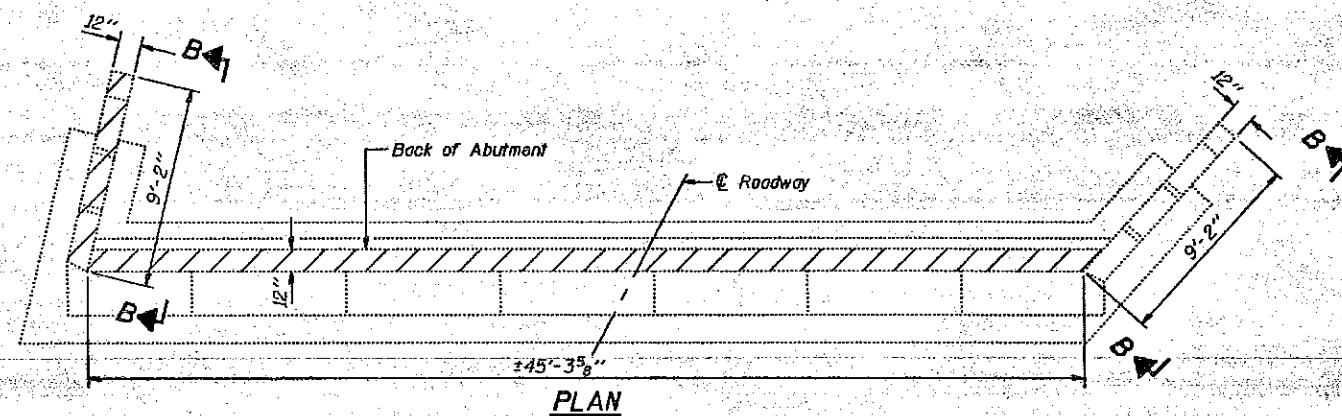

PLAN

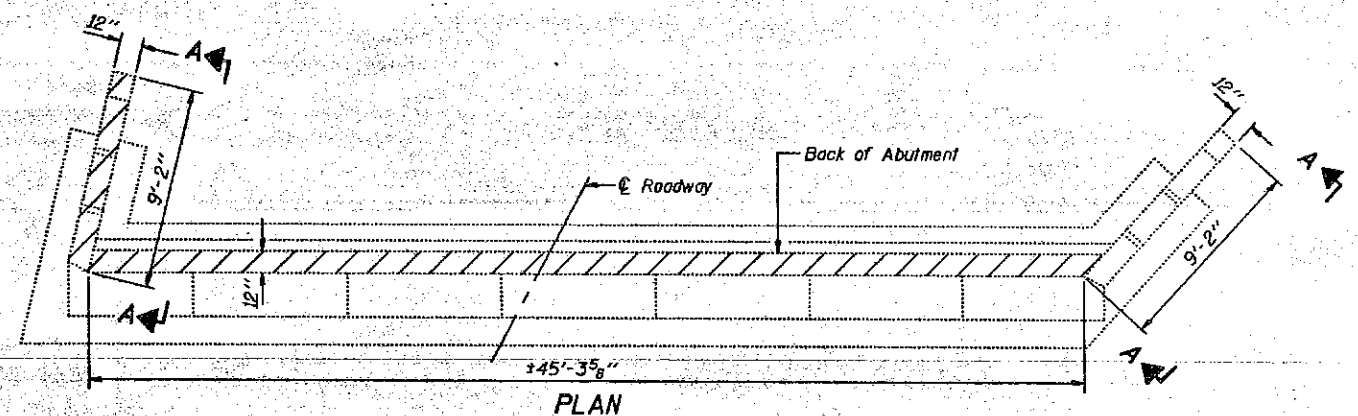


PLAN

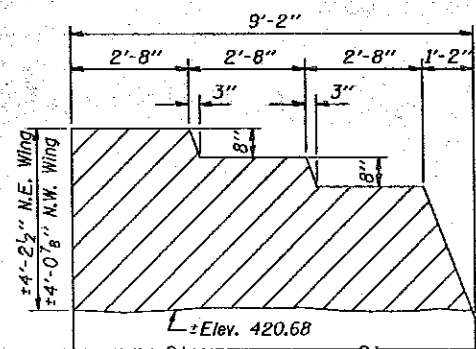

VIEW B-B

NORTH ABUTMENT DETAILS

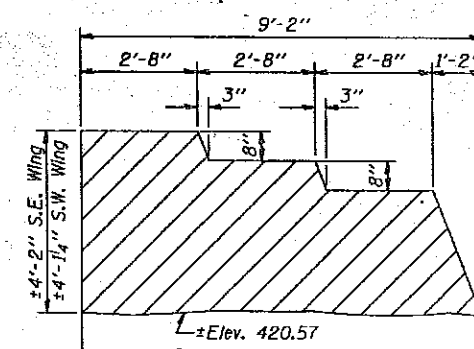

VIEW A-A

SOUTH ABUTMENT DETAILS

Notes: Hatched area indicates Concrete Removal.  
For existing shoulder pavement removal see Roadway Plans.  
Existing reinforcement extending into removed area shall be cleaned, straightened and incorporated into the new construction.

DESIGNED <i>John Ciccone</i>	EXAMINED <i>May 20 1993</i>
CHECKED <i>Anthony J. Vanzo</i>	PASSED <i>Ralph E. Anderson</i>
DRAWN <i>R. Dory</i>	APPROVED
CHECKED <i>J.C. Alv</i>	DIRECTOR OF HIGHWAYS


TWO ABUTMENTS  
BILL OF MATERIAL

Item	Unit	Total
Concrete Removal	Cu. Yd.	9

CONCRETE REMOVAL DETAILS  
FOR EXISTING ABUTMENTS  
F.A.I. RT. 57 SEC. (28-2B)D-1  
FRANKLIN COUNTY  
STATION 304+25.00


STATE OF ILLINOIS  
DEPARTMENT OF TRANSPORTATION

ROUTE NO.	DISTRICT	COUNTY	JOB NO.	SHEET NO.
F.A.I. RT.	28-2B-D	FRANKLIN	61	16 SHEETS
FED. ROAD DIST. NO. 7	ILLINOIS	FED. ROAD PROJECT		

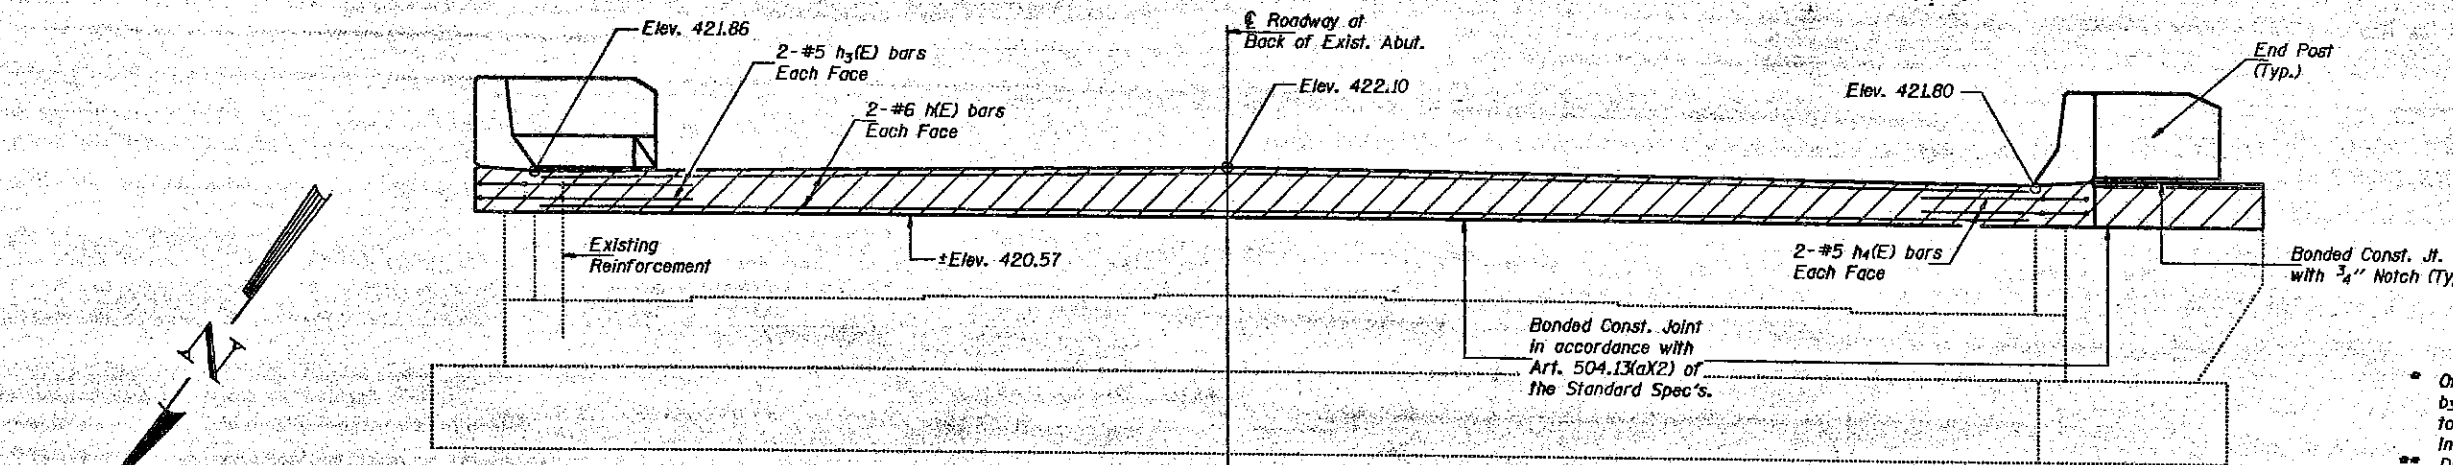

ELEVATION  
(Looking South)

- \* Order  $a_3(E)$ ,  $a_4(E)$ ,  $a_6(E)$ ,  $a_7(E)$ ,  $b_3(E)$  and  $b_5(E)$  bars full length. Cut to fit and use remainder of bars in bottom of slab.
- \*\* Drill  $7/8"$   $\phi$  x 9" Min. hole. Epoxy grout  $a_5(E)$  bars. Use a grout approved by the Department or epoxy grout in accordance with BSP-II. The method of grout application shall be approved by the Engineer. See Special Provisions.

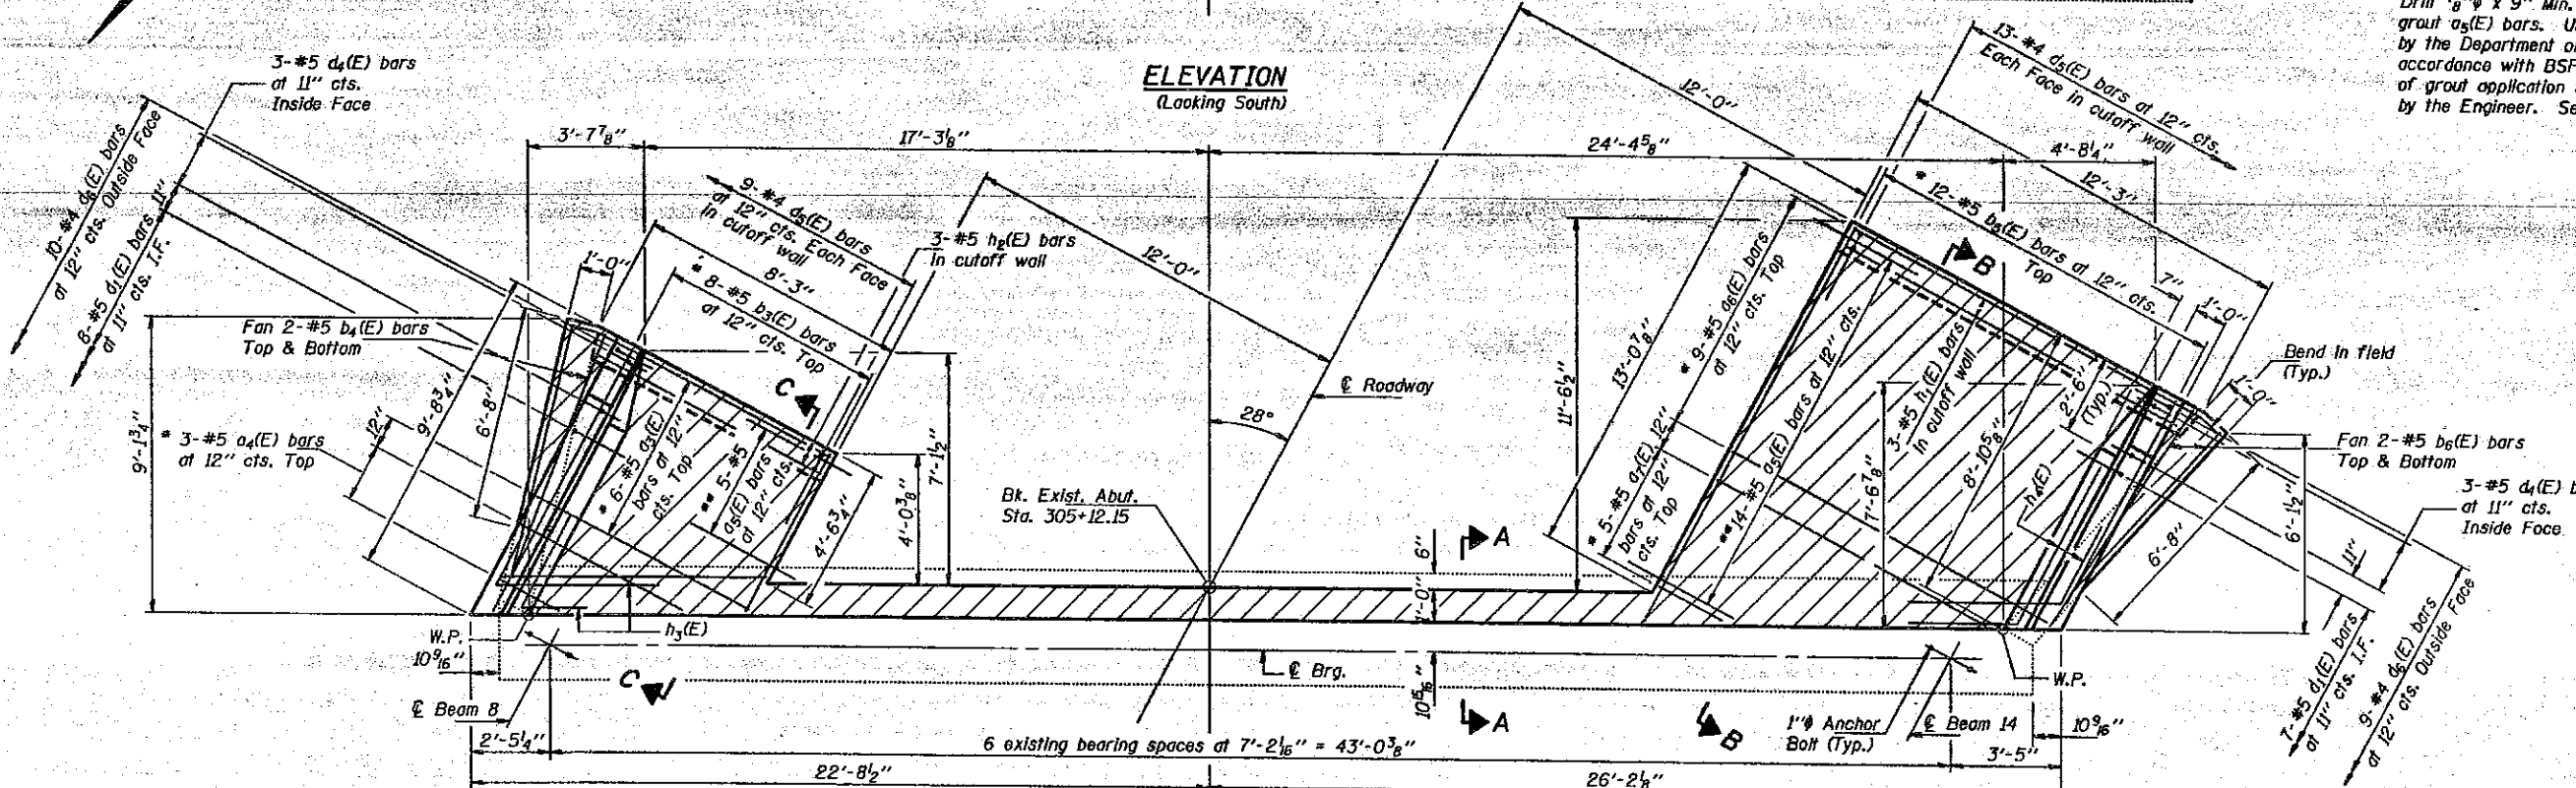

PLAN

Notes: Hatched area to be poured after superstructure forms have been removed. Quantity of concrete for hatched area and end post is included with "Class X Concrete Superstructure" on sheet #6 of 16. Existing reinforcement extending into removed area shall be cleaned, straightened and incorporated into the new construction. Reinforcement bars designated (E) shall be epoxy coated. For anchor bolt installation details see sheet #16 of 16. For anchor bolt location detail see sheet #10 of 16. All edges shall have standard  $3/4"$  chamfer. Work this sheet with sheet #13 of 16.





DESIGNED <i>John Ciesne</i>	EXAMINED <i>Logi O. Kasco</i>
CHECKED <i>Anthony J. Vernon</i>	PASSED <i>Ralph E. Anderson</i>
DRAWN <i>R. Doy</i>	APPROVED _____
CHECKED <i>JLC, RYV</i>	DIRECTOR OF HIGHWAYS

SOUTH ABUTMENT  
F.A.I. RT. 57 SEC. (28-2B)D-1  
FRANKLIN COUNTY  
STATION 304+25.00













STATE OF ILLINOIS  
DEPARTMENT OF TRANSPORTATION

ROUTE NO.	DISTRICT	COUNTY	SECTION	SHEET NO.
F.A.I. RT. 57	(28-2B)-1	FRANKLIN	62	16 SHEETS
FED. ROAD DIST. NO. 7	ILLINOIS	FRANKLIN		

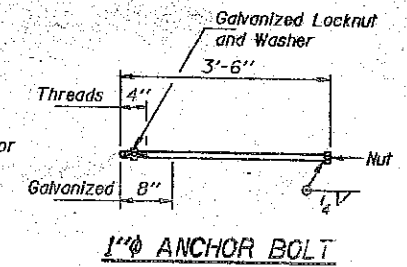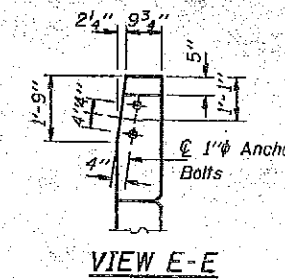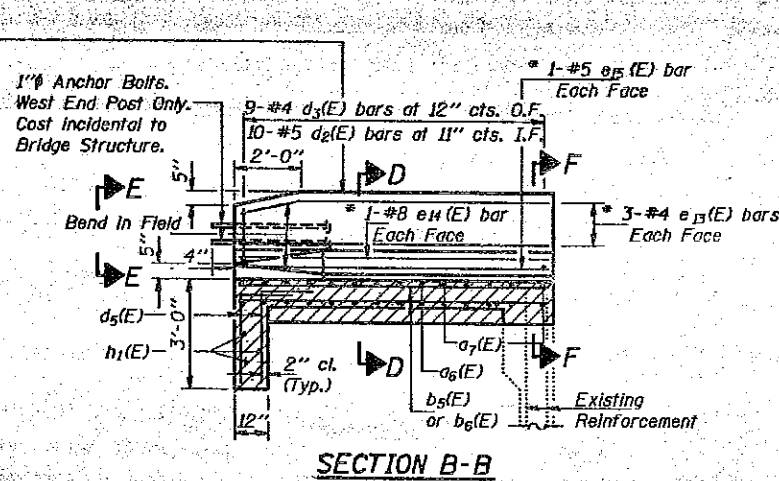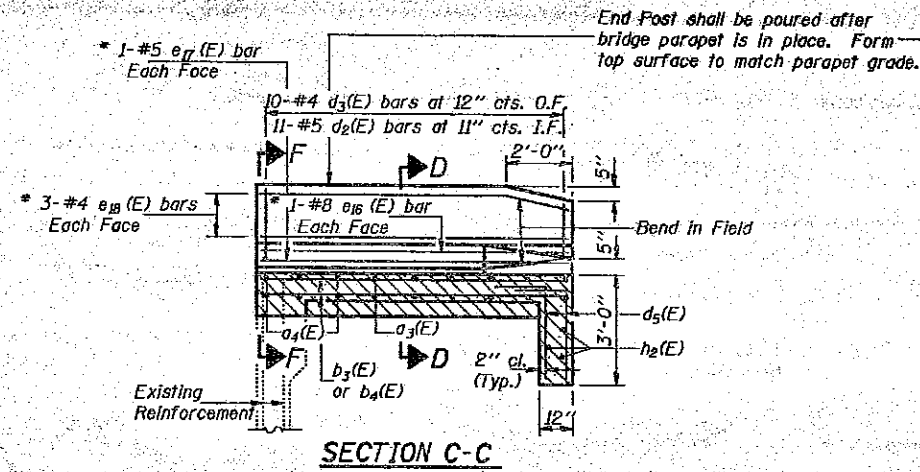

\* Cut to fit. Cost incidental.

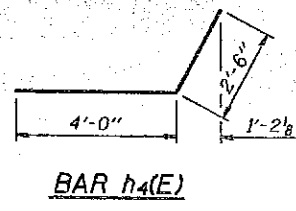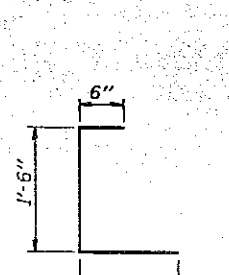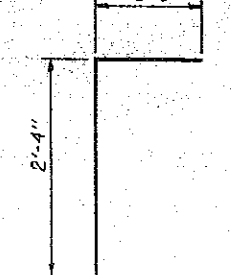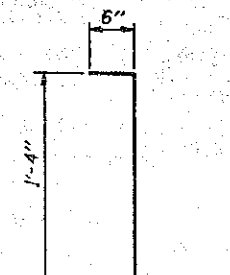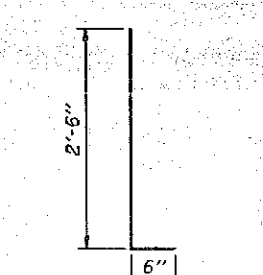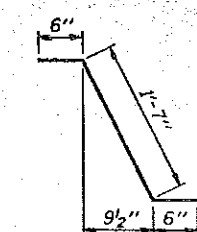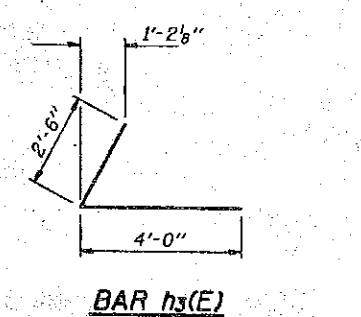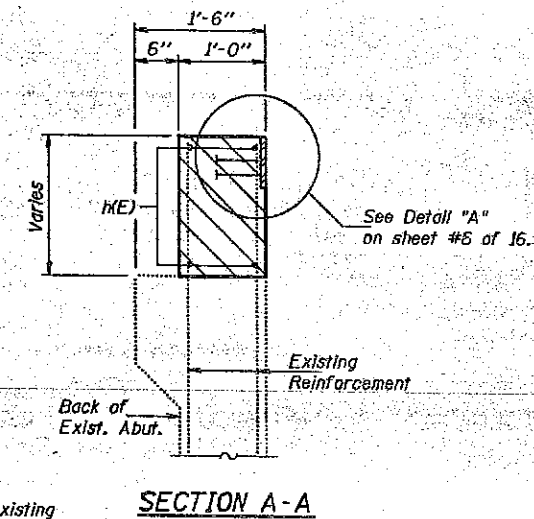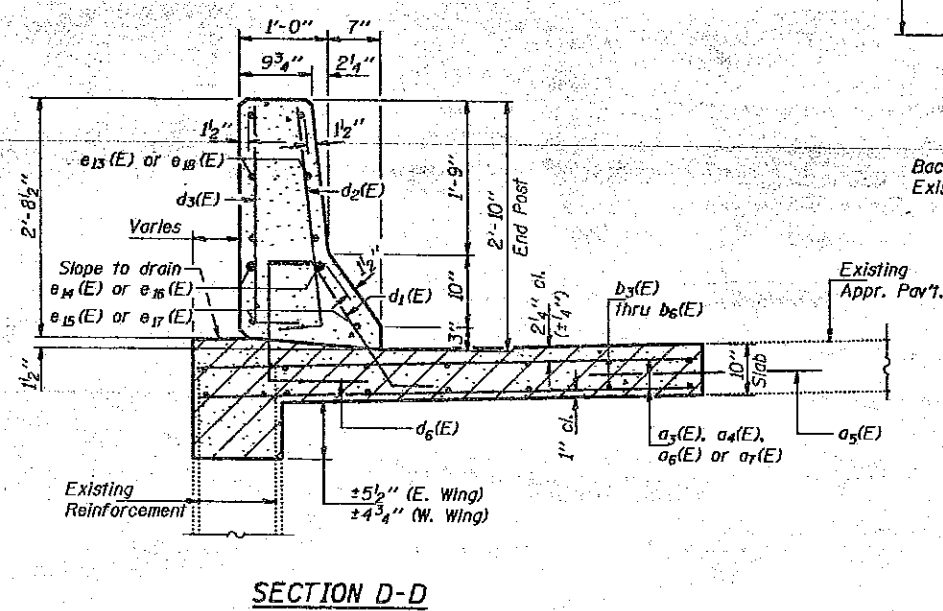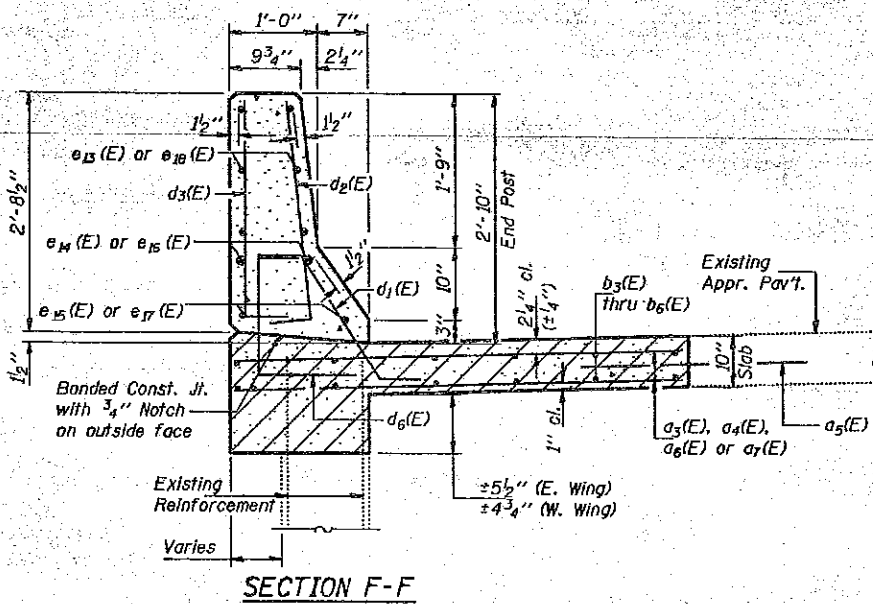

BILL OF MATERIAL

Bar	No.	Size	Length	Shape
a3(E)	6	#5	16'-4"	
a4(E)	3	#5	7'-4"	
a5(E)	19	#5	3'-0"	
a6(E)	9	#5	24'-2"	
a7(E)	5	#5	10'-4"	
b3(E)	8	#5	14'-10"	
b4(E)	4	#5	8'-2"	
b5(E)	12	#5	21'-9"	
b6(E)	4	#5	7'-9"	
d1(E)	15	#5	2'-7"	
d2(E)	21	#5	3'-0"	
d3(E)	19	#4	3'-0"	
d4(E)	6	#5	2'-4"	
d5(E)	44	#4	4'-1"	
d6(E)	19	#4	4'-0"	
e13(E)	6	#4	8'-3"	
e14(E)	2	#8	8'-3"	
e15(E)	2	#5	8'-6"	
e16(E)	2	#8	9'-5"	
e17(E)	2	#5	9'-5"	
e18(E)	6	#4	9'-5"	
h1(E)	4	#6	48'-7"	
h2(E)	3	#5	11'-9"	
h3(E)	4	#5	6'-6"	
h4(E)	4	#5	6'-6"	
Reinforcement Bars, Epoxy Coated		Lbs.	1870	
Structure Excavation		Cu. Yd.	11	

Reinforcement bars designated (E) shall be epoxy coated.

DESIGNED *John C. Lyons*  
CHECKED *Anthony J. Plonka*  
DRAWN *R. Doty*  
CHECKED *J.C. RLV*


EXAMINED *Draj D. Kaspar*  
PASSED *Ralph E. Anderson*  
APPROVED \_\_\_\_\_  
DIRECTOR OF HIGHWAYS

May 20 1993

SOUTH ABUTMENT DETAILS  
F.A.I. RT. 57 SEC. (28-2B)D-1  
FRANKLIN COUNTY  
STATION 304+25.00


STATE OF ILLINOIS  
DEPARTMENT OF TRANSPORTATION

DATE	BY	CHKD	APP'D	SHEET NO.
6/23				14
PROJECT NO.				16 SHEETS

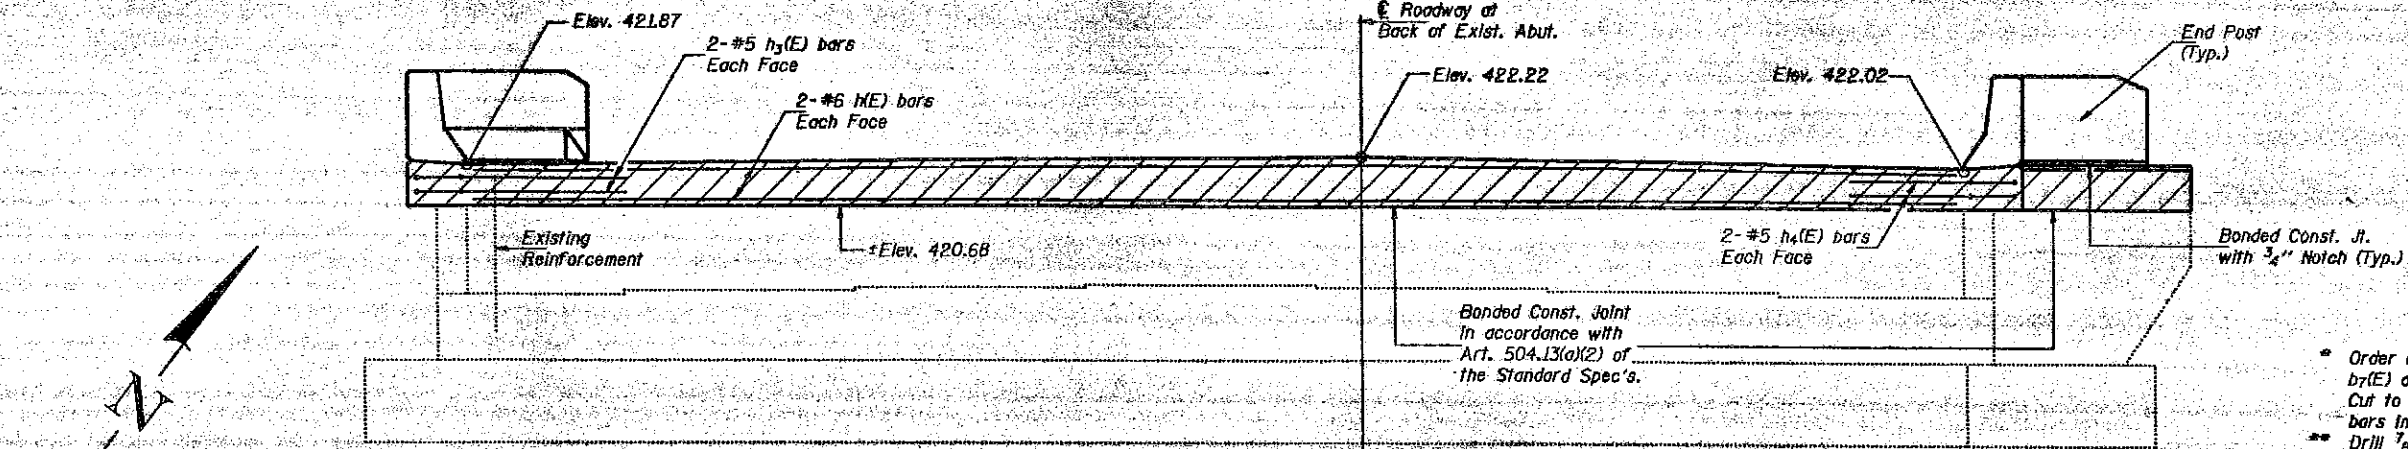

ELEVATION  
(Looking North)

- \* Order  $a_3(E)$ ,  $a_9(E)$ ,  $a_{10}(E)$ ,  $a_{11}(E)$ ,  $b_7(E)$  and  $b_8(E)$  bars full length. Cut to fit and use remainder of bars in bottom of slab.
- \*\* Drill  $3/8"$  x  $9"$  Min. hole. Epoxy grout  $a_5(E)$  bars. Use a grout approved by the Department or epoxy grout in accordance with BSP-11. The method of grout application shall be approved by the Engineer. See Special Provisions.

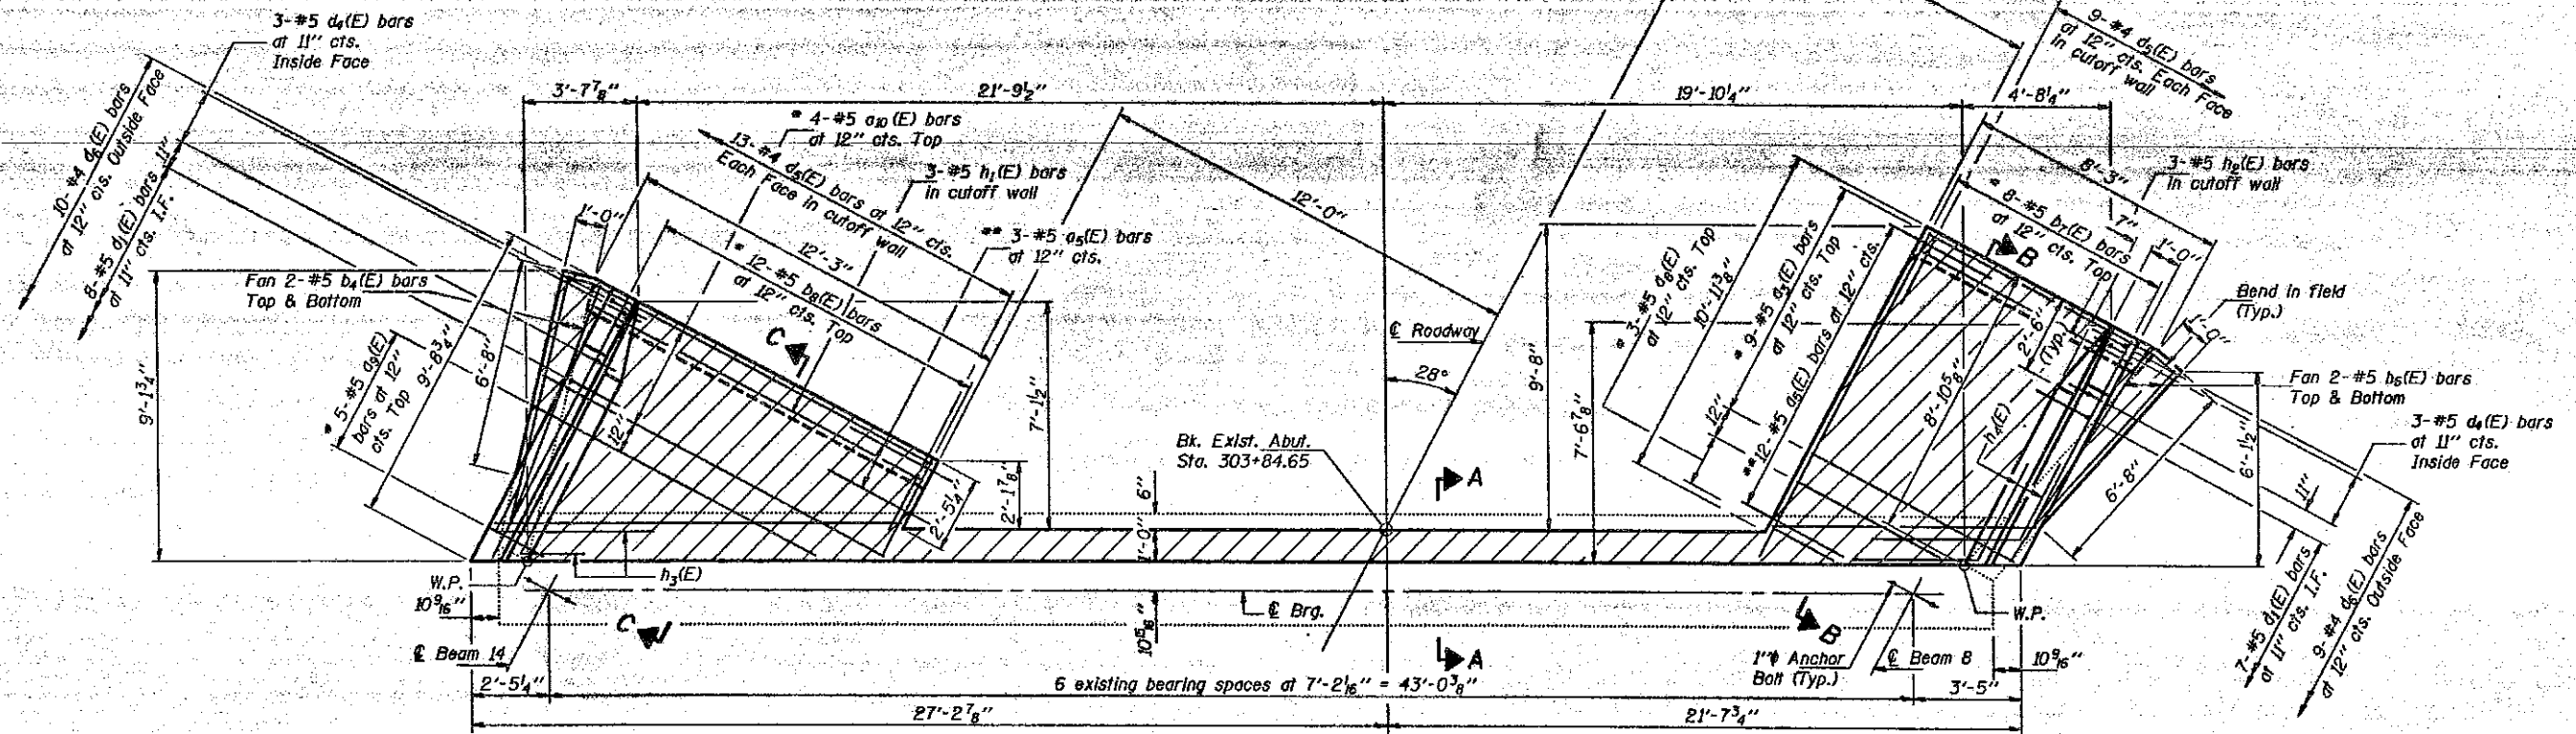

PLAN

Notes: Hatched area to be poured after superstructure forms have been removed. Quantity of concrete for hatched area and end post is included with "Class X Concrete Superstructure" on sheet #6 of 16. Existing reinforcement extending into removed area shall be cleaned, straightened and incorporated into the new construction. Reinforcement bars designated (E) shall be epoxy coated. For anchor bolt installation details see sheet #16 of 16. For anchor bolt location detail see sheet #10 of 16. All edges shall have standard  $3/4"$  chamfer. Work this sheet with sheet #15 of 16.






DESIGNED <i>John Ciccone</i>	EXAMINED <i>Rajiv D. Kaspar</i>
CHECKED <i>Anthony J. Amico</i>	ENGINEER OF BRIDGE DESIGN
DRAWN <i>R. Doty</i>	PASSED <i>Ralph E. Anderson</i>
CHECKED <i>J.C.C., N.V.</i>	ENGINEER OF BRIDGES AND STRUCTURES
	APPROVED _____
	DIRECTOR OF HIGHWAYS

MAY 20 1993

NORTH ABUTMENT  
F.A.I. RT. 57 SEC. (28-2B)D-1  
FRANKLIN COUNTY  
STATION 304+25.00


STATE OF ILLINOIS  
DEPARTMENT OF TRANSPORTATION

PROJECT NO.	SECTION	DATE	JOB NO.	SHEET NO. 15
P.A.S. 57	28-28D-1		64	16 SHEETS
DESIGNED BY	DRAWN BY	CHECKED BY	APPROVED BY	

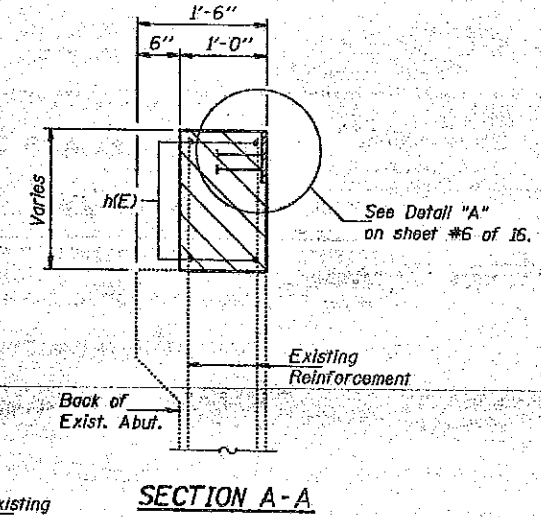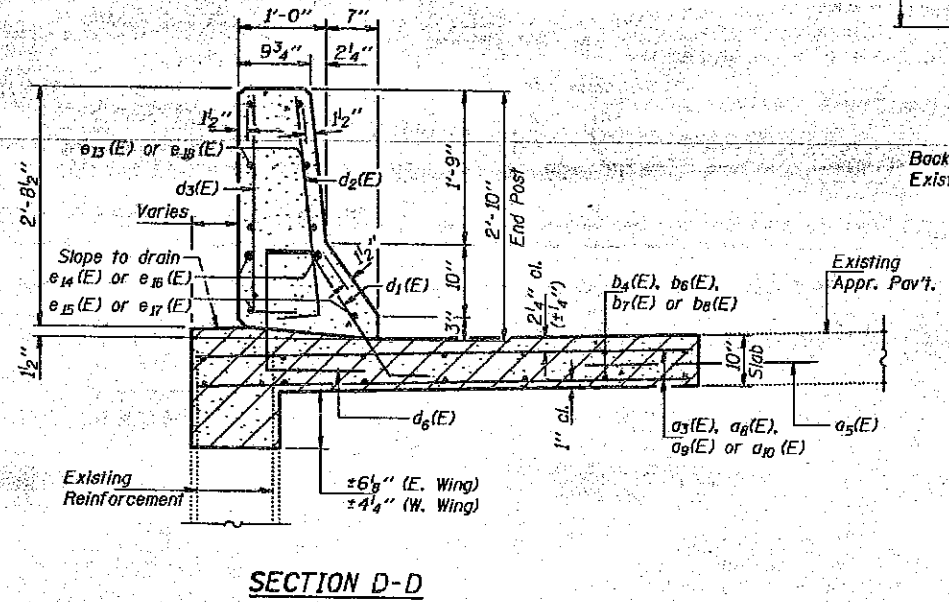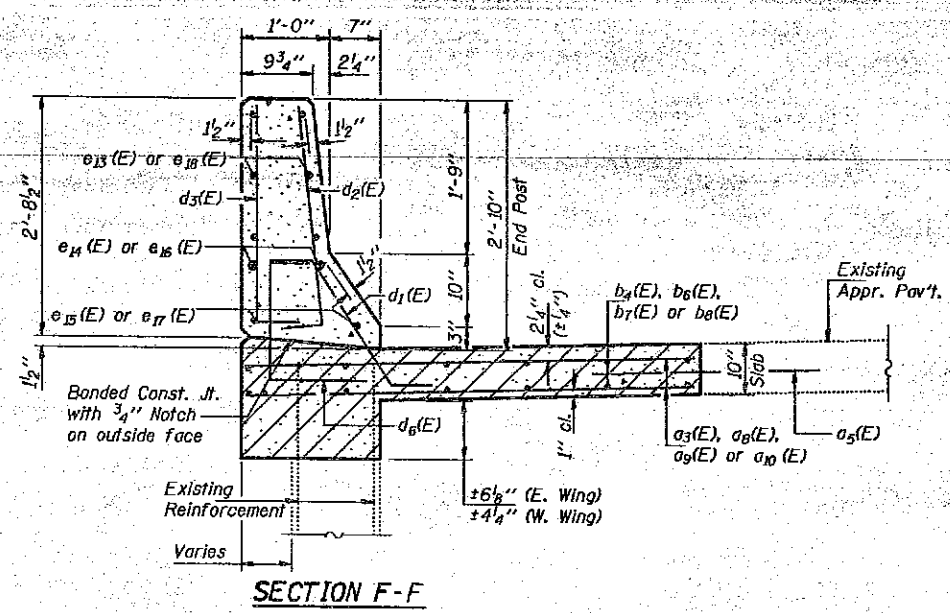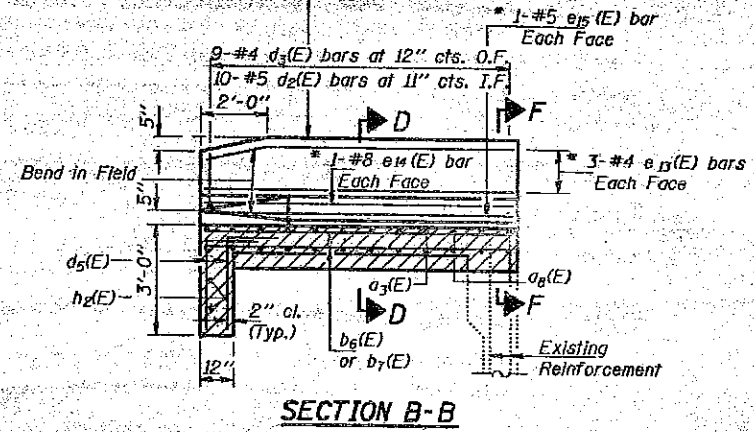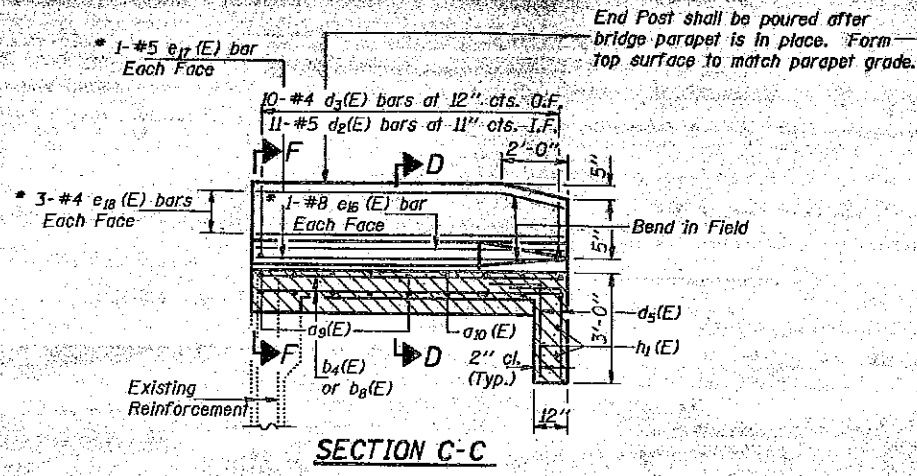


BILL OF MATERIAL


Bar	No.	Size	Length	Shape
d3(E)	9	#5	16'-4"	
d5(E)	15	#5	3'-0"	
a8(E)	3	#5	7'-0"	
a9(E)	5	#5	13'-6"	
a10(E)	4	#5	25'-2"	
b4(E)	4	#5	8'-2"	
b6(E)	4	#5	7'-9"	
b7(E)	8	#5	19'-6"	
b8(E)	12	#5	12'-9"	
d1(E)	15	#5	2'-7"	
d2(E)	21	#5	3'-0"	
d3(E)	19	#4	3'-0"	
d4(E)	6	#5	2'-4"	
d5(E)	44	#4	4'-1"	
d6(E)	19	#4	4'-0"	
e13(E)	6	#4	8'-3"	
e14(E)	2	#8	8'-3"	
e15(E)	2	#5	8'-6"	
e16(E)	2	#8	9'-5"	
e17(E)	2	#5	9'-5"	
e18(E)	6	#4	9'-5"	
h1(E)	4	#6	48'-7"	
h2(E)	3	#5	11'-9"	
h3(E)	3	#5	7'-9"	
h4(E)	4	#5	6'-6"	
h4(E)	4	#5	6'-6"	
Reinforcement Bars, Epoxy Coated		Lbs.	1730	
Structure Excavation		Cu. Yd.	11	

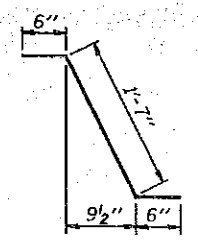


BAR d1(E)

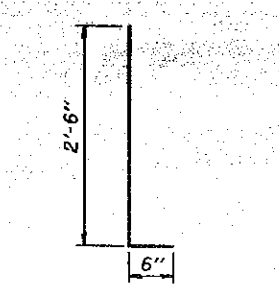


BARS d2(E) & d3(E)

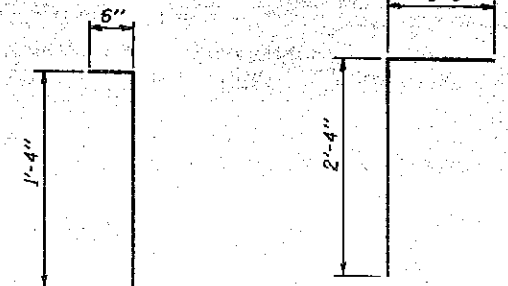


BAR d4(E)

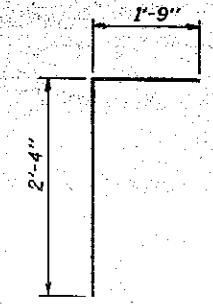


BAR d5(E)

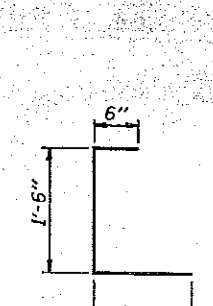

BAR d6(E)

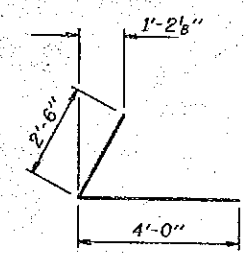

BAR h3(E)

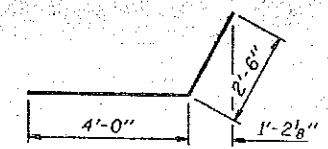

BAR h4(E)

DESIGNED *John Ciccone*  
CHECKED *Anthony G. Gibson*  
DRAWN *R. Doty*  
CHECKED *JLC, A.V.V.*

EXAMINED *Greg J. Kaspar*  
PASSED *Ralph E. Anderson*  
APPROVED \_\_\_\_\_

May 20 1993

ENGINEER OF BRIDGE DESIGN  
ENGINEER OF BRIDGE AND STRUCTURES  
DIRECTOR OF HIGHWAYS

NORTH ABUTMENT DETAILS  
F.A.I. RT. 57 SEC. (28-28)D-1  
FRANKLIN COUNTY  
STATION 304+25.00





STATE OF ILLINOIS  
DEPARTMENT OF TRANSPORTATION

DESIGN NO.	SECTION	DATE	SCALE	SHEET NO.
F.A.I. RT. 57	SEC. 28-2B	1983	1/2"	16
TOTAL SHEETS				10

The Illinois Coil-Lock Anchor Bolt is a proprietary item which is the property of the Illinois Department of Transportation. Use, reproduction or disclosure without express written permission is prohibited and protected under Federal copyright laws. The production and the fabrication of this bolt for use on highway projects in the State of Illinois shall be permitted and there shall be no incurred charges or fees to the manufacturer or the fabricator for producing or fabricating this bolt.

D	E	H	K	"d"
1"	1 1/8"	1 1/16"	1 3/4"	1/4"
1 1/4"	1 3/8"	1 1/16"	2"	3/8"
1 1/2"	1 5/8"	1 5/16"	2 1/8"	1/2"
2"	2 1/8"	1 3/16"	2 7/8"	1/2"
2 1/2"	2 5/8"	2 5/16"	3 3/8"	1"

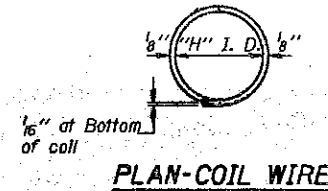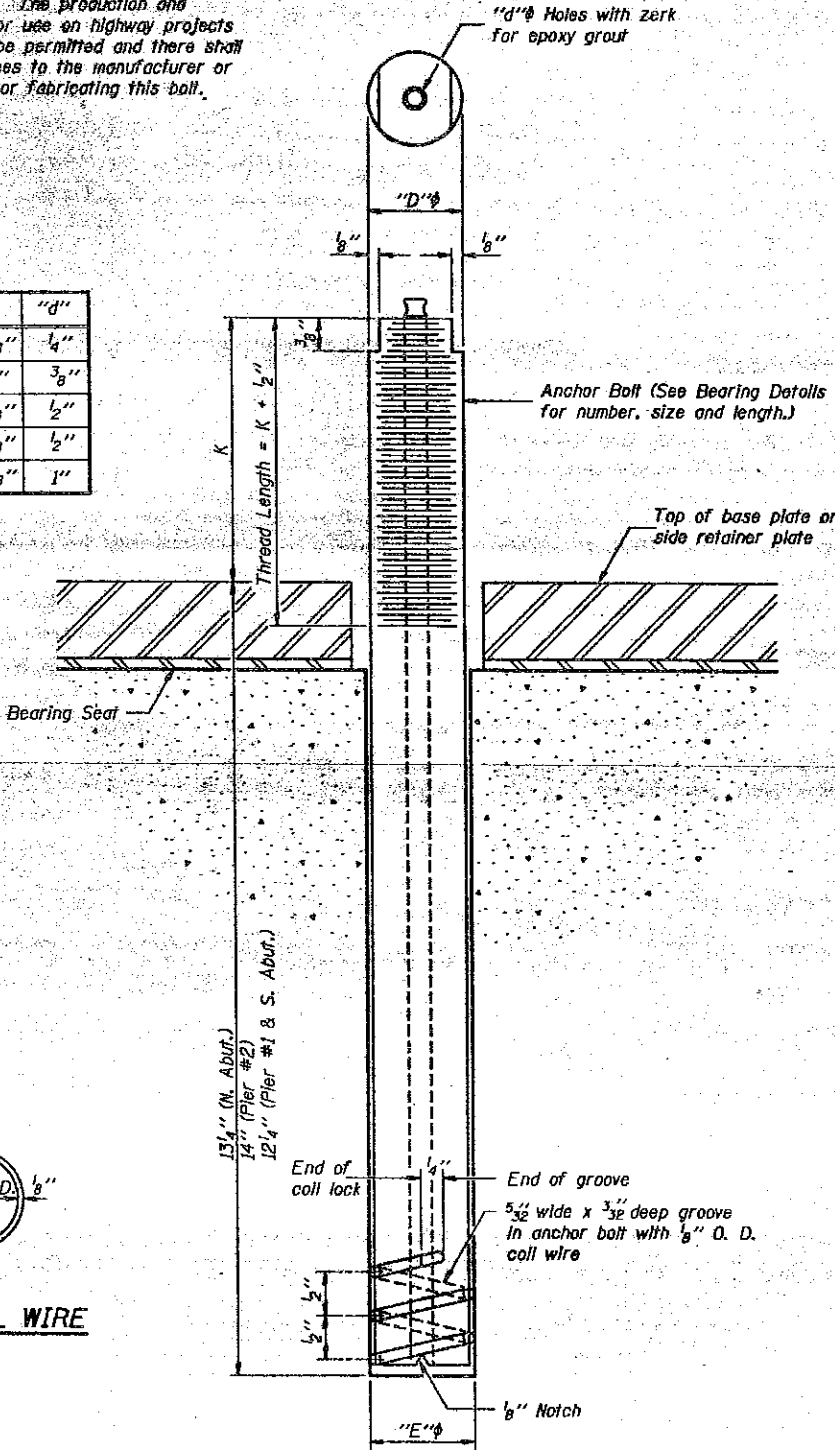

ILLINOIS COIL-LOCK ANCHOR BOLT

MATERIALS FOR ILLINOIS COIL-LOCK ANCHOR BOLT

The anchor bolt shall be fabricated from cold drawn or hot finished seamless carbon steel mechanical tubing conforming to ASTM A519, Grade 1026 and supplied with hexagonal nuts and cut washers.  
The coil wire shall be made of any suitable soft steel wire.  
The finished anchor bolt shall be cleaned of rust and other foreign materials and wrapped or packaged to prevent contamination until they are installed.  
The epoxy grout shall be a two-component, epoxy resin bonding system conforming to ASTM C881, Type 1, Grade 1 and of a Class suitable for the temperature at installation.

INSTALLATION PROCEDURE for the ILLINOIS COIL-LOCK ANCHOR BOLT

1. With the coil wire in place, the bolt shall be inserted into the hole and turned clockwise to a snug fit in the hole. Nut and washer shall be placed on the bolt. The nut shall be tensioned until the steel base plates are held securely to the concrete bearing seat.
2. Epoxy grout shall be pumped through the zerk fitting with a pressure gun. Pumping shall continue until the epoxy overflows the hole around the bolt shank. After pumping is discontinued, excess epoxy shall be immediately wiped off.

ALTERNATE ANCHOR BOLTS

The Contractor may use, at his option, the capsule or the adhesive cartridge type anchor rods that have been previously tested and given a prior approval by the Department. The Contractor shall install these anchor rods in pre-drilled holes in accordance with the manufacturer's recommendations and procedures.  
The capsule or the adhesive cartridge type anchor rods shall be a two part system composed of:  
1. A threaded rod stud with nut and washer conforming to ASTM A307.  
2. A sealed glass capsule or a sealed glass adhesive cartridge containing premeasured amounts of the adhesive chemical.

GENERAL NOTES

Holes in the masonry for anchor bolts shall be drilled through the base plates to the diameter and depth shown or in accordance with the manufacturer's recommendation after beams or girders have been erected and adjusted.  
Prior to setting the bolts, the holes shall be dry and all dust and loose particles shall be removed by the use of compressed air or vacuuming.  
The anchor bolts, furnished and installed and including the epoxy grout or capsules shall not be paid for separately but shall be included in the unit bid price for "Furnishing and Erecting Structural Steel".

DESIGNED <i>John Casano</i>	EXAMINED <i>Greg J. Kaspar</i>
CHECKED <i>Anthony J. Vinson</i>	PASSED <i>Ralph E. Anderson</i>
DRAWN <i>R. Doty</i>	APPROVED _____
CHECKED <i>J.C. RVV</i>	DIRECTOR OF HIGHWAYS

May 10 1983

ABB-1 12-1-83

ANCHOR BOLT DETAILS  
FOR BEARINGS  
F.A.I. RT. 57 SEC. (28-2B)D-1  
FRANKLIN COUNTY  
STATION 304+25.00











ROUTE NO.	SEC.	COUNTY	TOTAL SHEETS	SHEET NO.
F.A.I. 57	*	FRANKLIN	145	69
FED. ROAD DIST. 7	ILLINOIS	PROJECT		
SEC. 26 156-158 2010 10 20 (V.V.B.V.B.)				

DATE \_\_\_\_\_

BY \_\_\_\_\_

NO. \_\_\_\_\_

APPROVED \_\_\_\_\_

PLATTED \_\_\_\_\_

REPLANT \_\_\_\_\_

FIELD CHECKED \_\_\_\_\_

PRIAL SURVEY NOTE BOOK

DATE \_\_\_\_\_

BY \_\_\_\_\_

NO. \_\_\_\_\_

APPROVED \_\_\_\_\_

PLATTED \_\_\_\_\_

REPLANT \_\_\_\_\_

FIELD CHECKED \_\_\_\_\_

ORIAL SURVEY NOTE BOOK

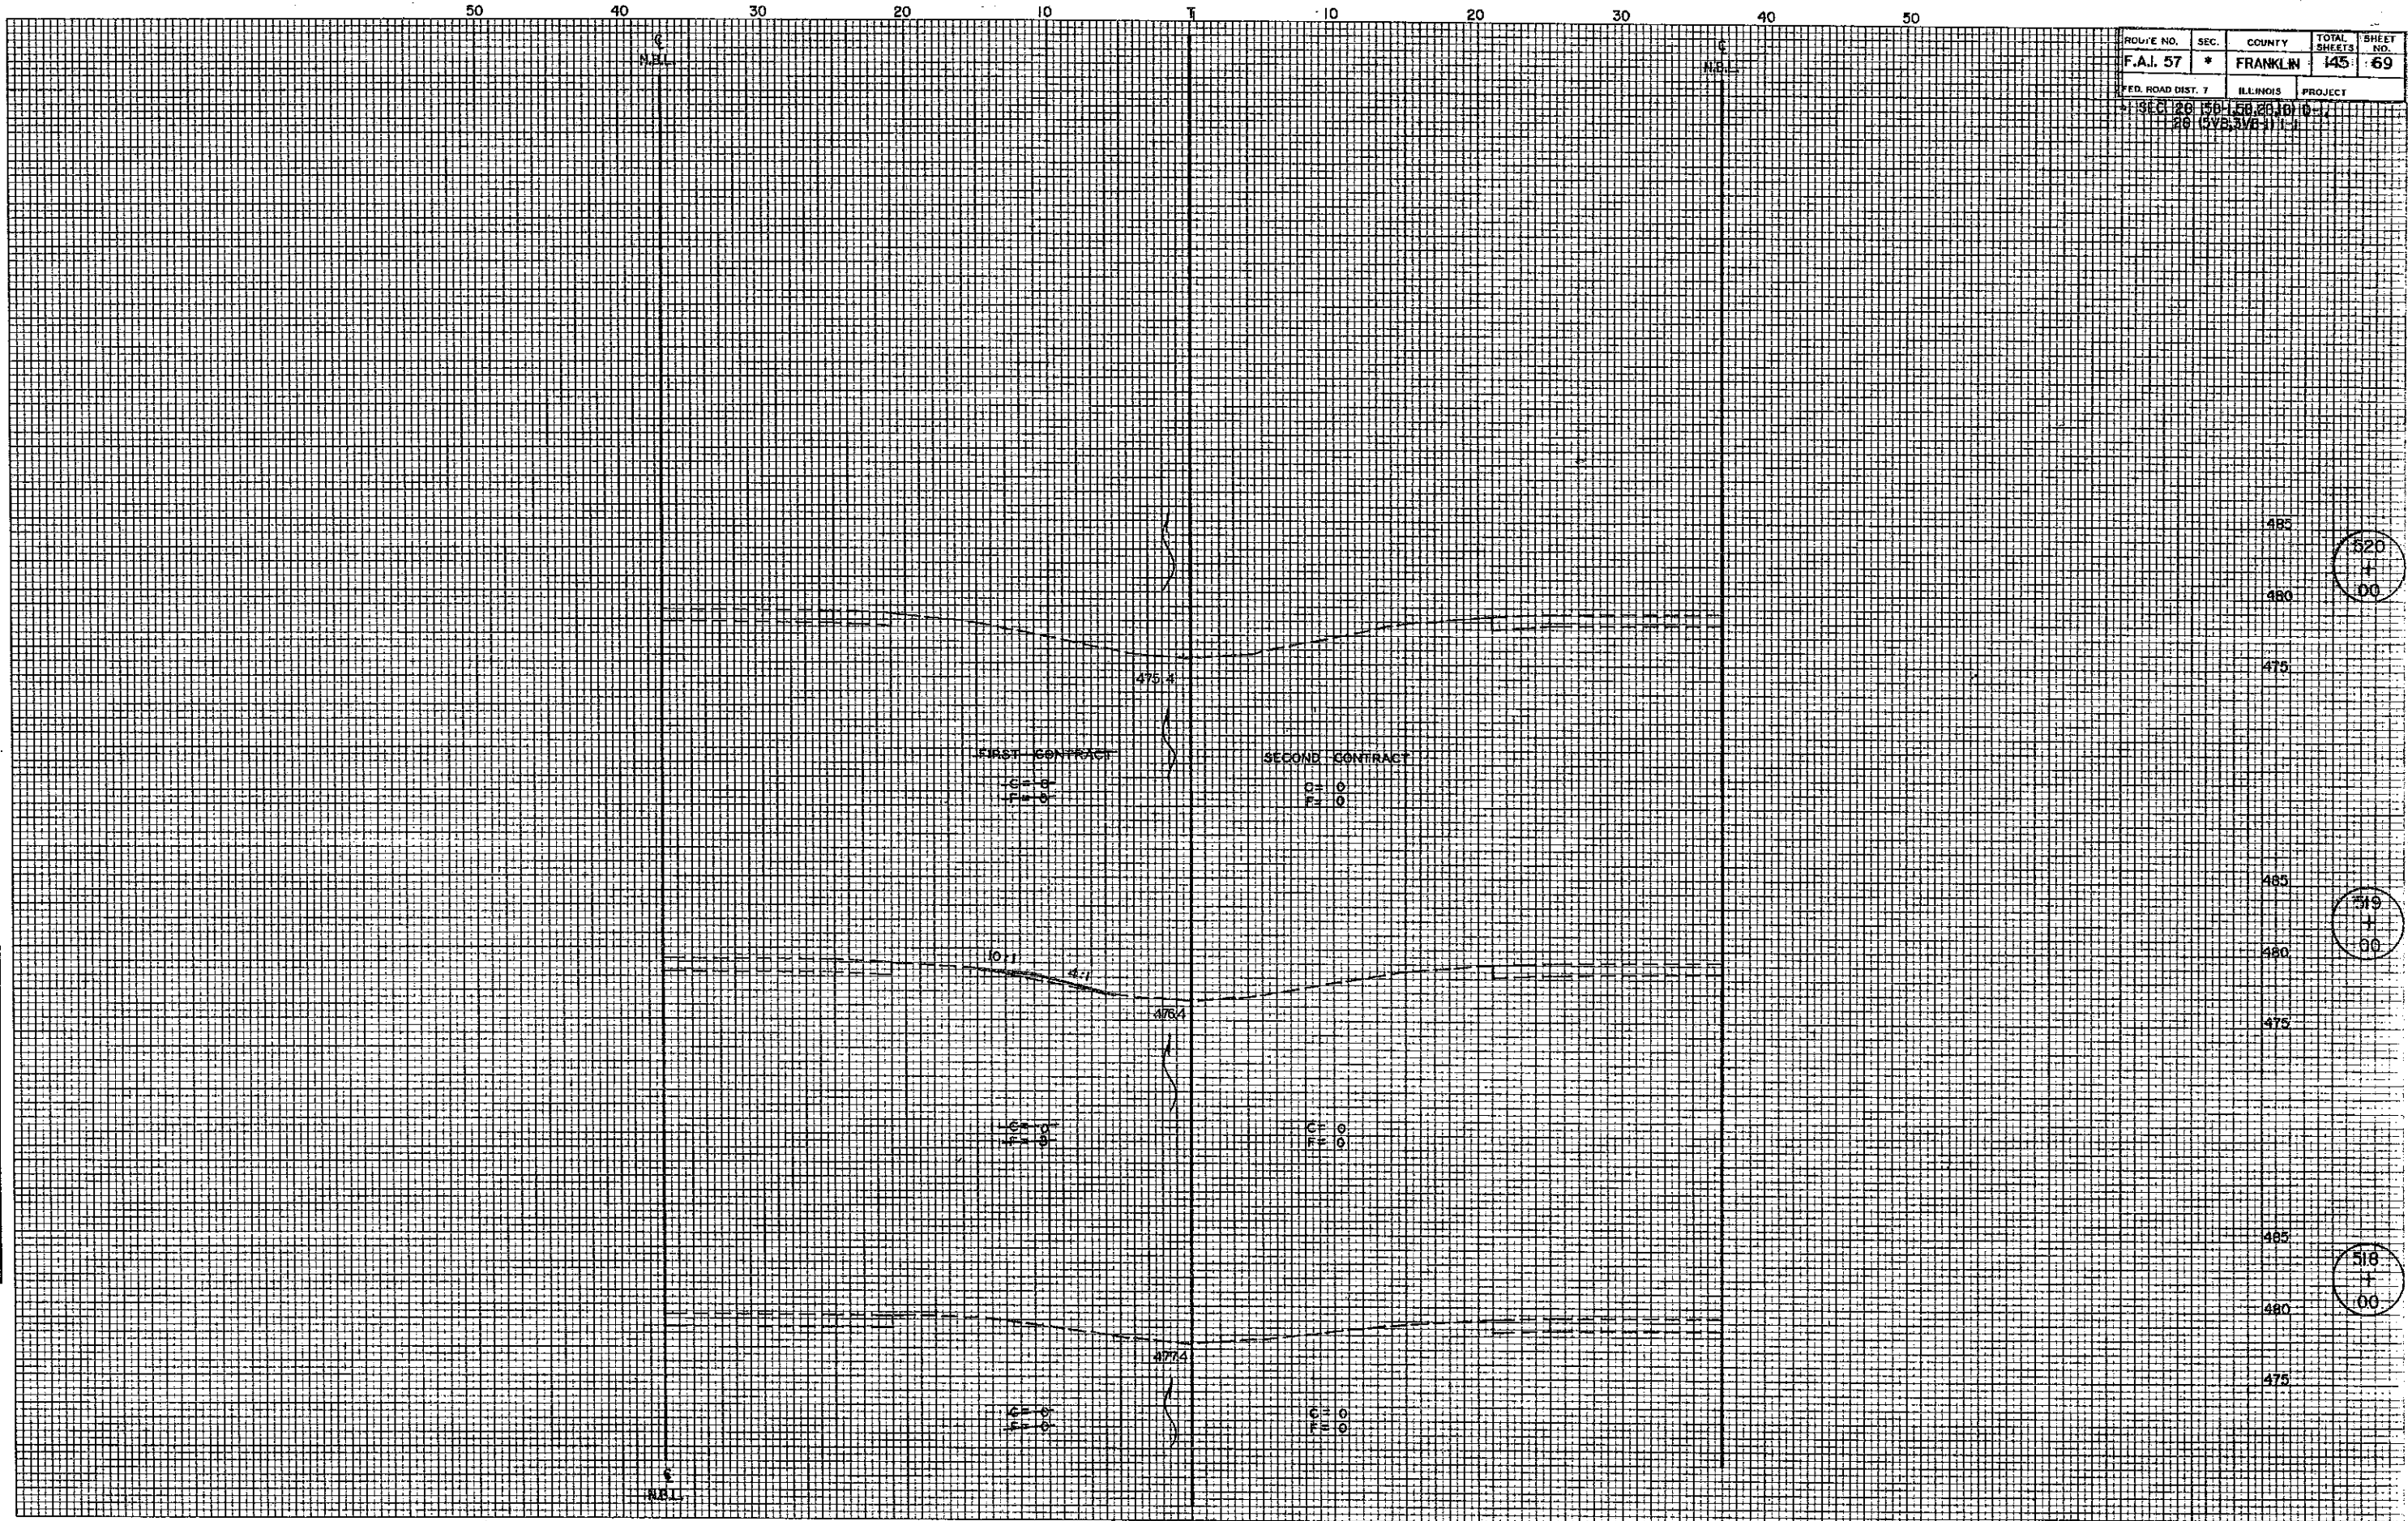




PLATE 3 CROSS SECTION O.P.R. & E. STANDARD  
DETZEN CORPORATION.

STATE OF ILLINOIS  
DEPARTMENT OF TRANSPORTATION

ROUTE NO.	SECTION	COUNTY	SHEETS	"SET"	SHEET NO. 1
F.A.I. 57		FRANKLIN	145	70	4 SHEETS
FED. ROAD DIST. NO. 7	ALIGNMENT	FED. AID PROJECT:			

**GENERAL NOTES**

Reinforcement bars shall conform to the requirements of AASHTO M-31, M-42 or M-53 Grade 60.  
Traffic control shall be determined by the District.  
Prior to pouring the new concrete for the deck, all loose rust, loose mill scale, and all other foreign material shall be removed from the embedded portions of flanges of girders. The removal shall be accomplished in accordance with the requirements of the SSPC Surface Preparation Specifications SP-3 for Power Tool Cleaning or SP-2 for Hand Tool Cleaning. Cost shall be incidental to Concrete Removal.  
Plan dimensions and details relative to existing structure have been taken from existing plans and are subject to nominal construction variations. It shall be the Contractor's responsibility to verify such dimensions and details in the field and make necessary approved adjustments prior to construction or ordering of materials. Such variations shall not be cause for additional compensation for a change in the scope of the work, however, the Contractor will be paid for the quantity actually furnished at the unit price bid for the work.  
The first bridge Post and Insert at each corner shall be removed, cleaned and reinstalled in new construction. Cost incidental to "Concrete Removal".

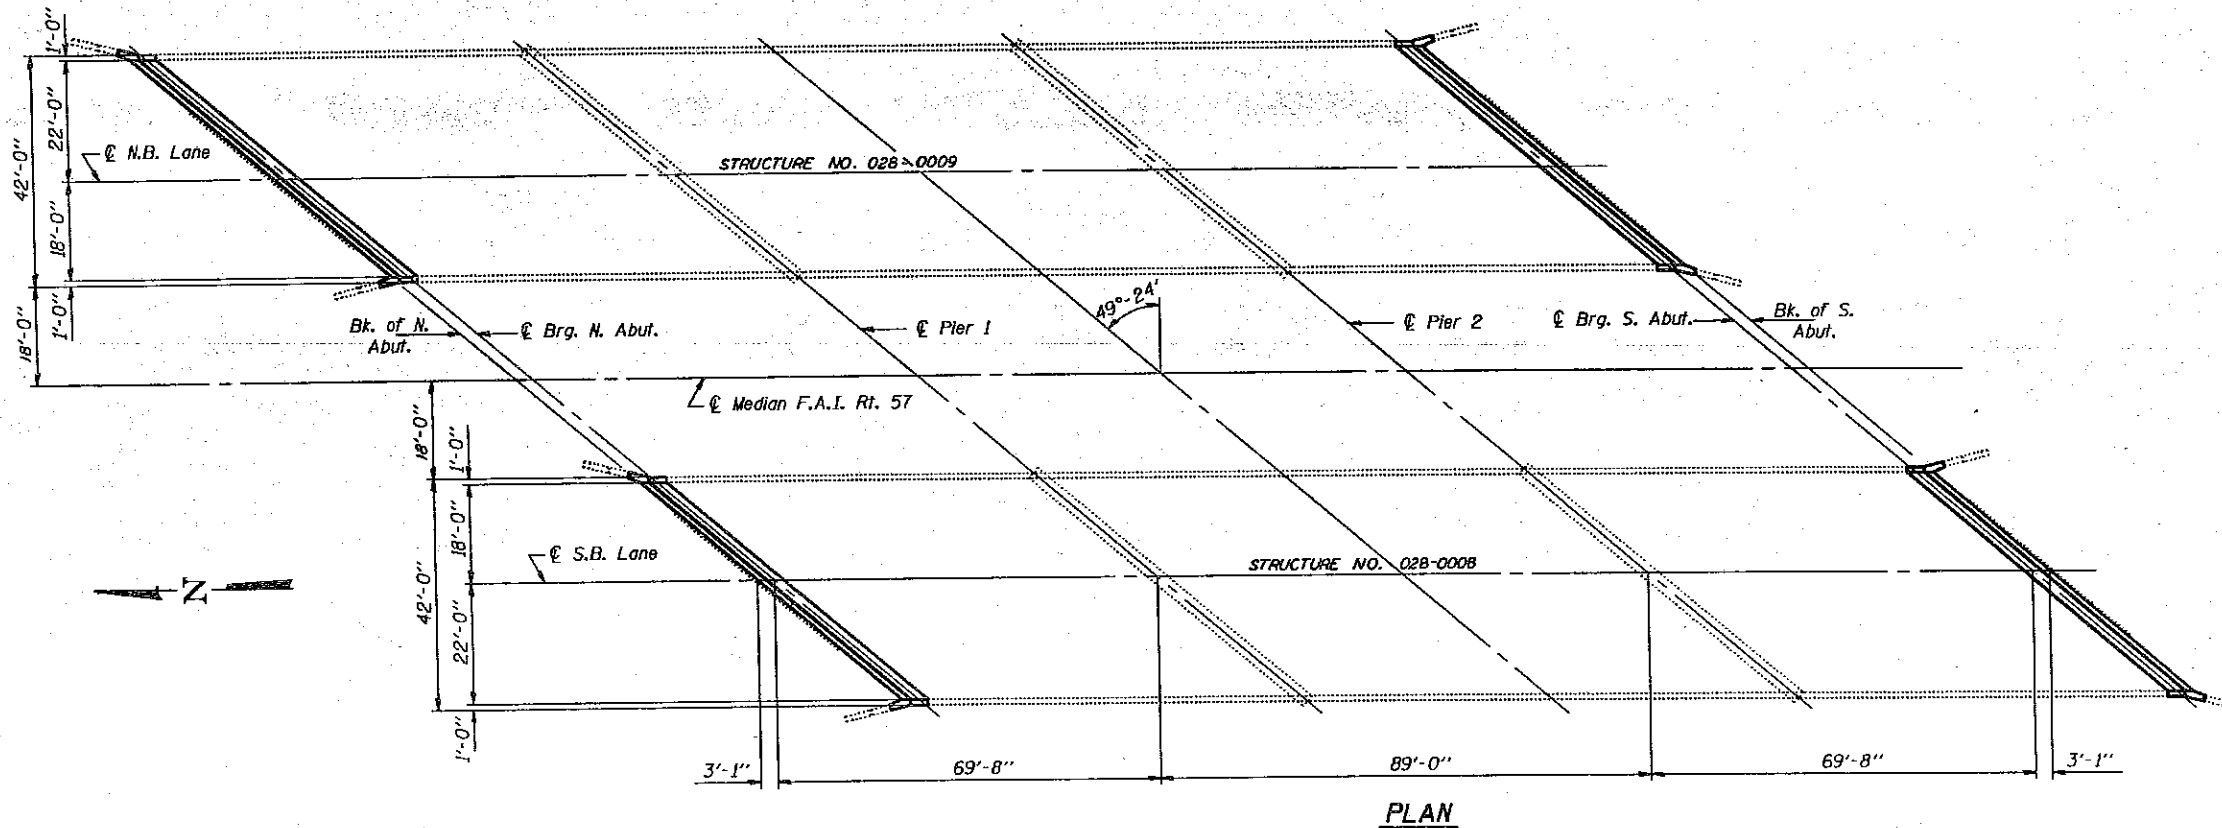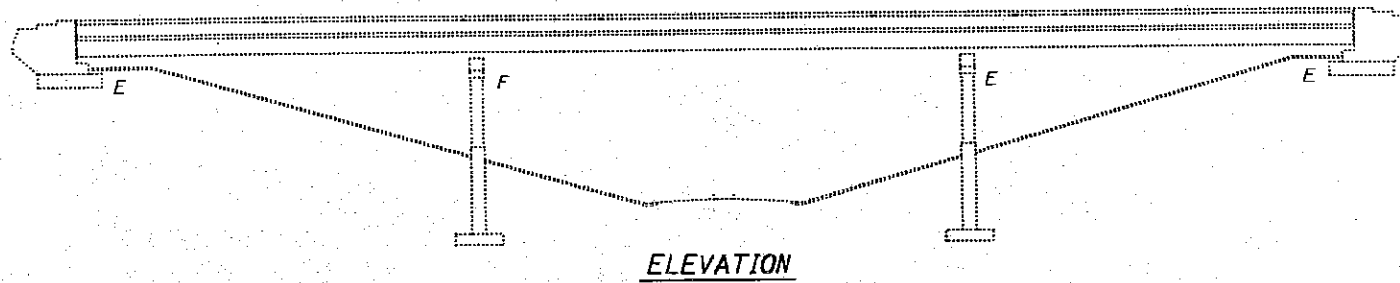

**TOTAL BILL OF MATERIAL**

ITEM	UNIT	QUANTITY
Concrete Removal	Cu. Yd.	42.8
Class X Concrete	Cu. Yd.	41.5
Reinforcement Bars, Epoxy Coated	Pound	7860
Neoprene Expansion Joint 2"	Lin. Ft.	250

NOTE: QUANTITIES IN THE ABOVE BILL OF MATERIAL ARE FOR BOTH BRIDGES.

DESIGNED *Paul Summer*  
CHECKED *BRT*  
DRAWN *Paul Summer*  
CHECKED *BRT*

February 7 19 92  
EXAMINED *John E. H...*  
PASSED  
APPROVED


JOINT REPLACEMENT DETAILS  
F.A.I. RT. 57 SEC. (28-3VB-1) I-1  
FRANKLIN COUNTY  
STA. 515+16.08  
STR. No. 028-0008 & 028-0009




STATE OF ILLINOIS  
DEPARTMENT OF TRANSPORTATION

ROUTE NO.	SECTION	DISTRICT	SHEET	SHEET NO.
F.A.I. 57		FRANKLIN	145	71
FED. ROAD DIST. NO. 7	DATE	PROJECT		


SHEET NO. 2  
4 SHEETS

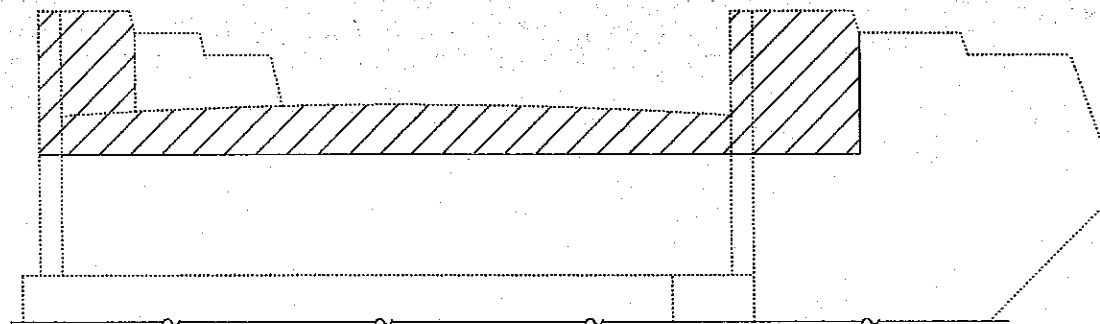


EXISTING ELEVATION

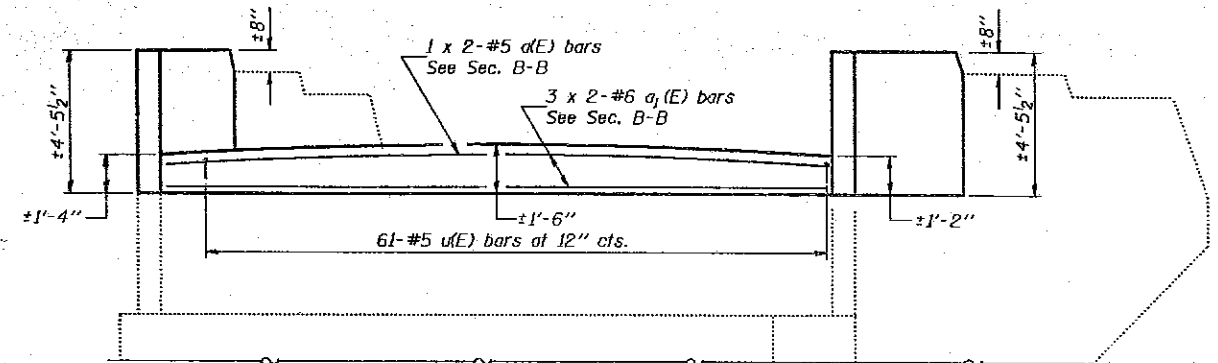


PROPOSED ELEVATION

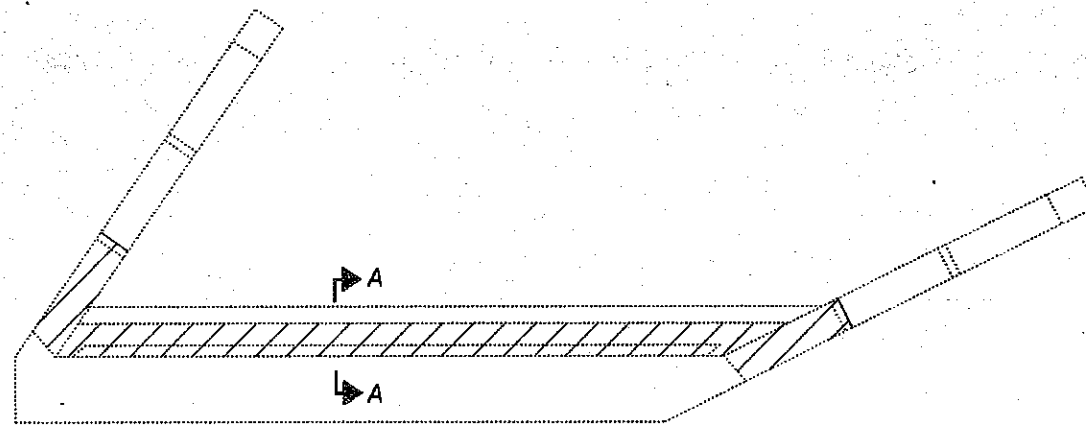

EXISTING PLAN

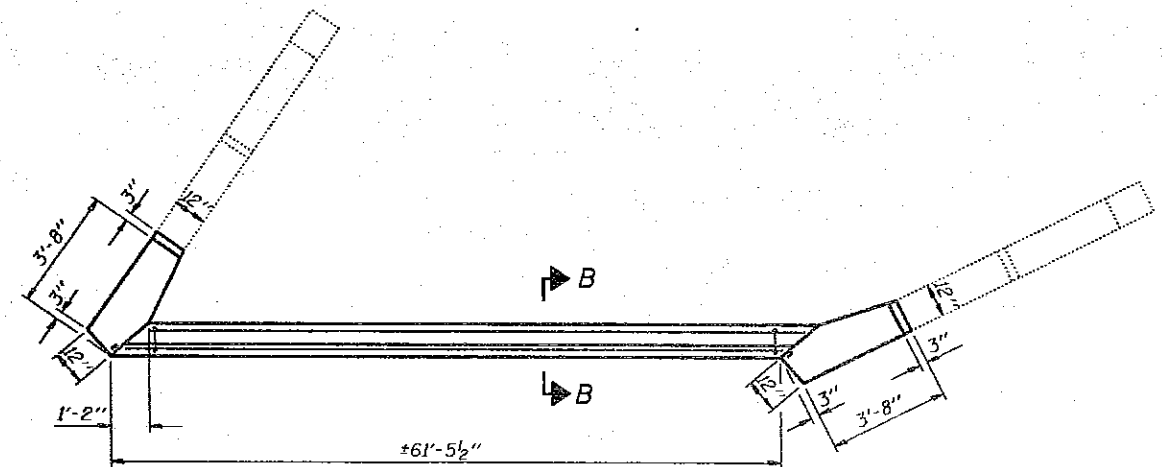


PROPOSED PLAN

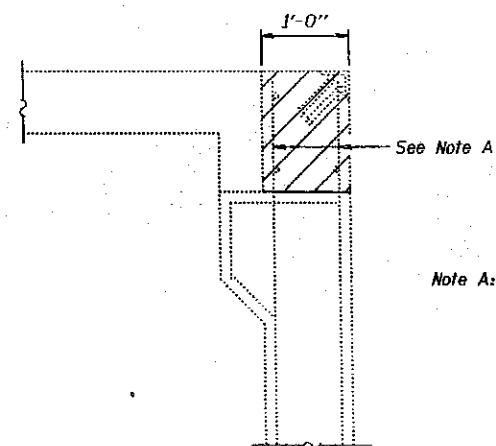

SECTION A-A

Note A: Existing Reinforcement shall be cleaned, straightened and incorporated into the new construction. Cost incidental to "Concrete Removal."

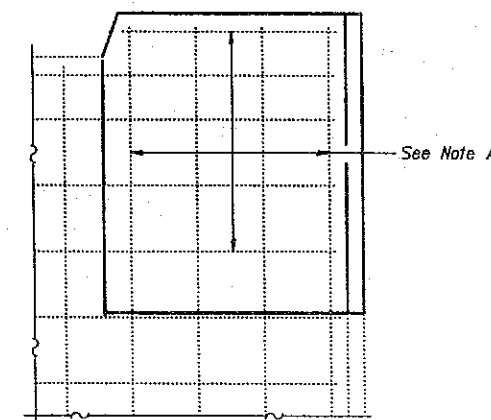

WING WALL ELEVATION

Notes: For Section A-A and B-B see Sheet 3.  
For bar details and Bill of Material see Sheet 3.  
Bars indicated thus 3 x 2-#6 ect. indicates 3 lines of bars with 2 lengths per line.  
Reinforcement bars designated (E) shall be epoxy coated.  
Hatched area indicates Concrete Removal.


DESIGNED <i>Paul Sumner</i>	EXAMINED <i>Joseph E. Ahern</i>
CHECKED <i>BRT</i>	PASSED
DRAWN <i>Paul Sumner</i>	APPROVED
CHECKED <i>BRT</i>	

February 7 19 92  
ENGINEER OF STRUCTURAL SERVICES  
DIRECTOR OF BRIDGES AND STRUCTURES  
DIRECTOR OF HIGHWAYS


JOINT REPLACEMENT DETAILS  
F.A.I. RT. 57 SEC. (28-3VB-1) I-1  
FRANKLIN COUNTY  
STA. 515+16.08  
STR. No. 028-0008 & 028-0009

STATE OF ILLINOIS  
DEPARTMENT OF TRANSPORTATION

ROUTE NO.	SECTION	COUNTY	STA.	POST	SHEET NO. 3
F.A.I. 57		FRANKLIN	145	72	4 SHEETS
FED. ROAD DIST. DIST. 1		ALLIANCE		FED. AID PROJECT	

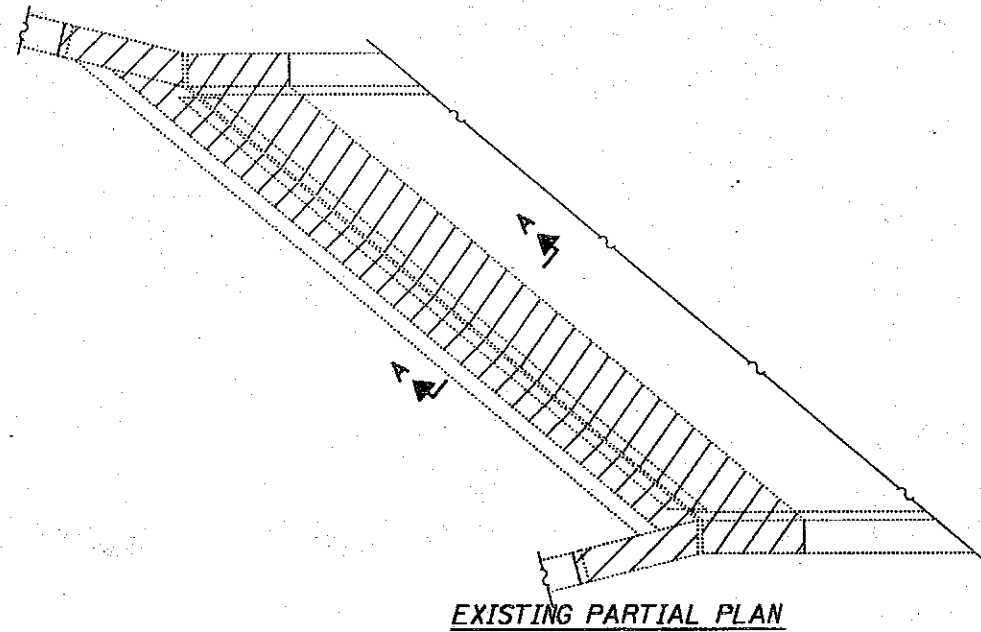


EXISTING PARTIAL PLAN

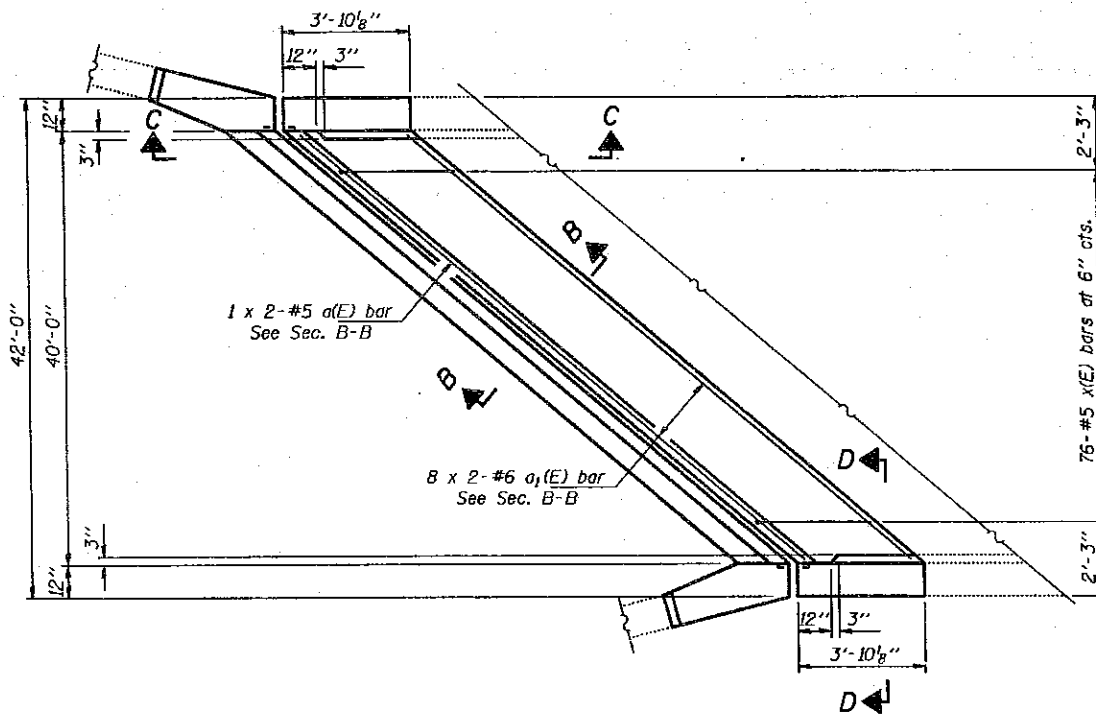


PROPOSED PARTIAL PLAN

DESIGNED <i>Paul Sumner</i>	EXAMINED <i>Todd E. Adams</i>	February 7 1992
CHECKED <i>BRT</i>	PABBED	DIRECTOR OF STRUCTURAL SERVICES
DRAWN <i>Paul Sumner</i>	APPROVED	ENGINEER OF BRIDGES AND STRUCTURES
CHECKED <i>BRT</i>		DIRECTOR OF HIGHWAYS

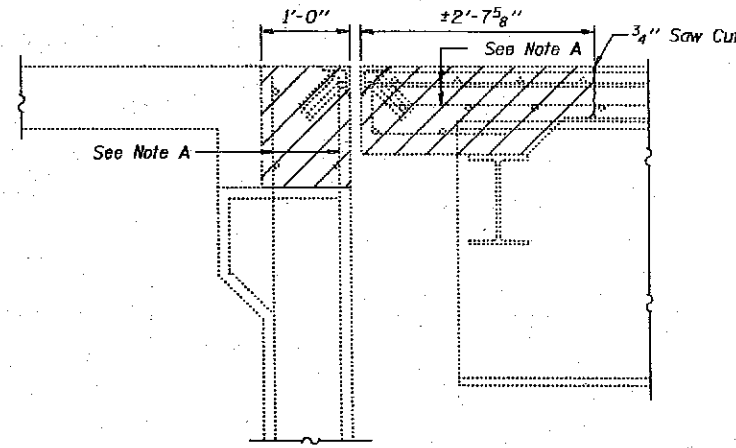


SECTION A-A

Note A: Existing Reinforcement shall be cleaned, straightened and incorporated into the new construction. Cost incidental to "Concrete Removal."

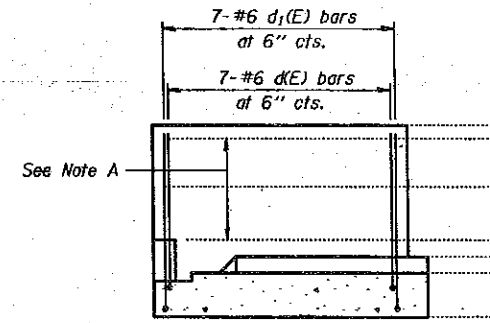


SECTION C-C

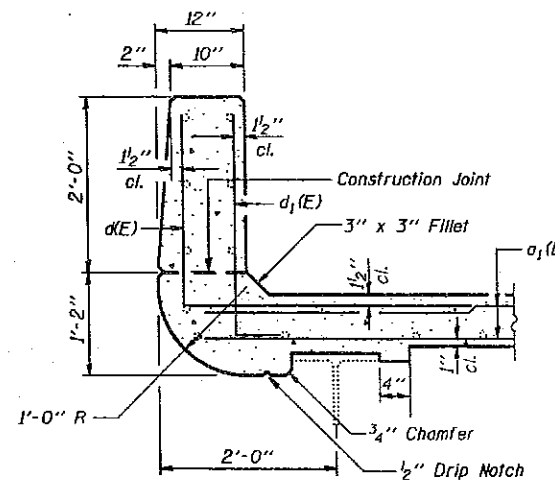


SECTION D-D


\*Place a(E) bars in back of anchor bolts as shown if required to maintain 1" cl. (+0-1/8"). Anchor bolts should be tied to a(E) and h(E) bars.

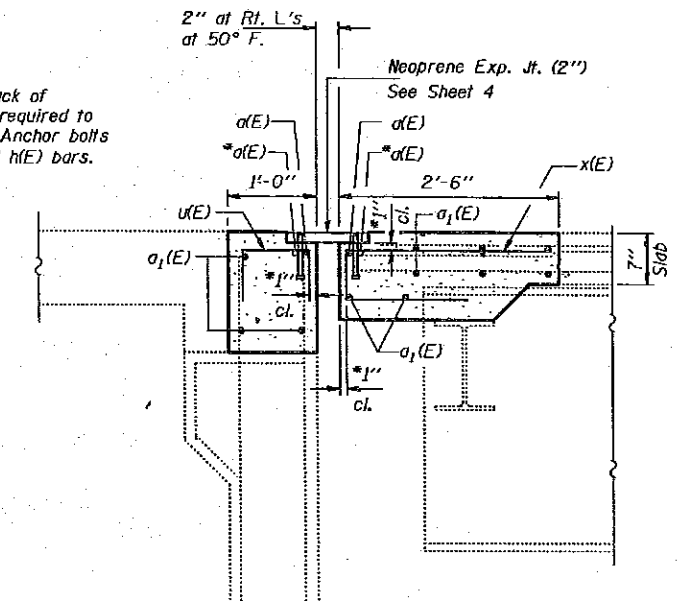


SECTION B-B

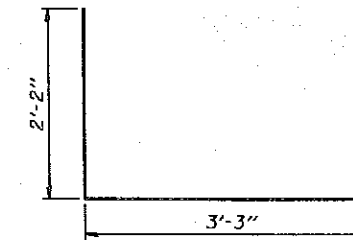


BAR d(E)

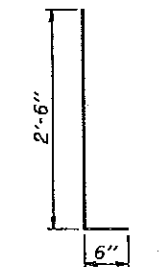

BAR d1(E)

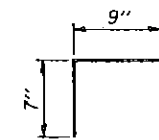

BAR u(E)

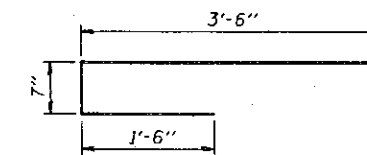

BAR x(E)

BILL OF MATERIAL

Bar	No.	Size	Length	Shape
a(E)	16	#5	32'-7"	—
a1(E)	88	#6	32'-10"	—
d(E)	56	#6	5'-6"	—
d1(E)	56	#6	3'-0"	—
u(E)	244	#5	1'-11"	□
x(E)	304	#5	5'-7"	□
Concrete Removal		Cu. Yd.	42.8	
Class X Concrete		Cu. Yd.	41.5	
Reinforcement Bars, Epoxy Coated		Lbs.	7860	

Notes: Bars indicated thus 3 x 2-#6 ect. indicates 3 lines of bars with 2 lengths per line. Reinforcement bars designated (E) shall be epoxy coated. Hatched area indicates Concrete Removal. QUANTITIES IN THE ABOVE BILL OF MATERIAL ARE FOR BOTH BRIDGES.

JOINT REPLACEMENT DETAILS  
F.A.I. RT. 57 SEC. (28-3VB-D) I-1  
FRANKLIN COUNTY  
STA. 515+16.08  
STR. No. 028-0008 & 028-0009

STATE OF ILLINOIS  
DEPARTMENT OF TRANSPORTATION

ROUTE NO.	PROJECT	COUNTY	SECTION	SHEET NO.
F.A.I. 57		FRANKLIN	145 73	4 SHEETS
FED. ROAD DIST. NO. 7	ILLINOIS	FED. AID PROJECT		

Joint Size	"C" at 50°F	"D" at 50°F
2"	2"	1 1/2" Min.
2 1/2"	2 1/2"	1 3/4" Min.
4"	3"	2 1/2" Min.



**INSTALLATION NOTES**

- 1 Install sponge mandrels into positions shown to form flap convolution.
- 2 Install parapet or sidewalk piece (trim roadway flap to fit before applying epoxy).
- 3 Install continuous seal in roadway.
- 4 Install anchor blocks as indicated.


NOTE A: Maximum spacing of anchor bolts shall be 12" centers.

**SKEW LIMITATIONS**

The details of the anchor blocks and the elastomeric membrane in the parapet, as shown, are for up to 50° skews. For skews greater than 50°, the anchor blocks and the elastomeric membrane, installed in accordance with dimension "D", might require modifications to insure a minimum clearance of 1/2" from centerline of anchor studs to edge of parapet opening. The anchor blocks and the elastomeric membrane shall also be installed to the top of the parapet with the anchor studs spaced of ±12" cts.

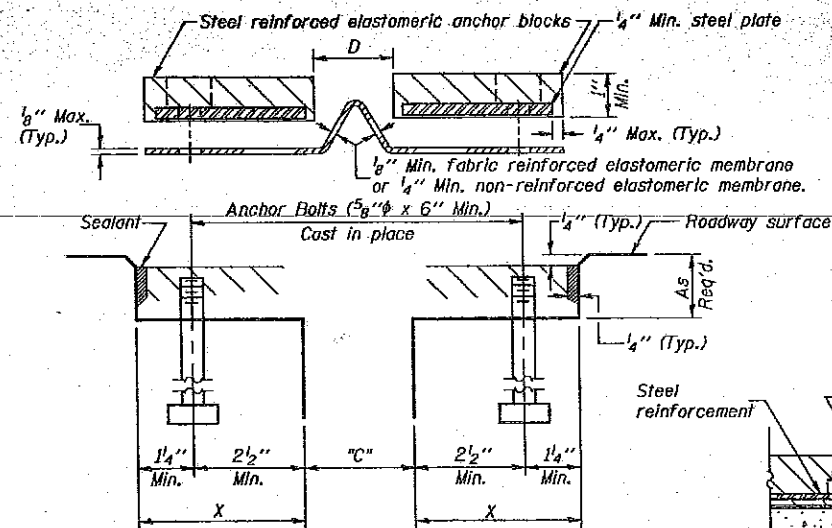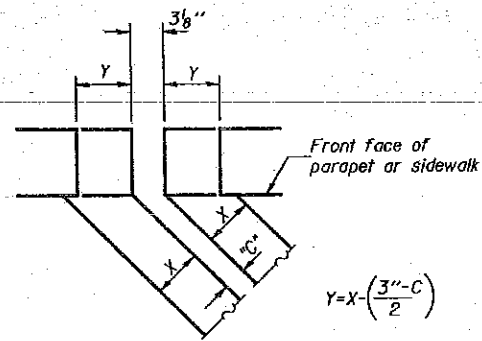

**ANCHOR BLOCK REINFORCEMENT WITH ASPHALT SURFACE**

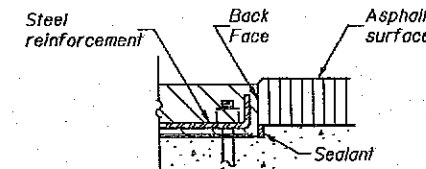

**GENERAL NOTES**

Continuous Seal Neoprene Expansion Joint shall consist of molded anchor blocks of elastomer and steel, field assembled over continuous lengths of elastomeric membrane.








The elastomeric membrane shall be premolded with a single or a double upward convolution that will have a "memory" to return to its molded position upon joint closure.

The steel reinforcement must extend up the back face of anchor blocks when asphalt surfaces are used but is optional in concrete blockout.

The convolution length shall be such that the extended length will not be greater than the manufactured length when the joint is fully expanded in its design range and will not protrude above the anchor blocks when the joint is fully compressed.

Joint openings shall be adjusted in accordance with Article 503.07(c) of the Standard Specifications when the deck is poured at an ambient temperature other than 50° F.

The parapet and sidewalk flaps may be furnished factory vulcanized to the roadway membrane provided the centerline of the convolution is maintained and the process and method meet the approval of the Engineer.

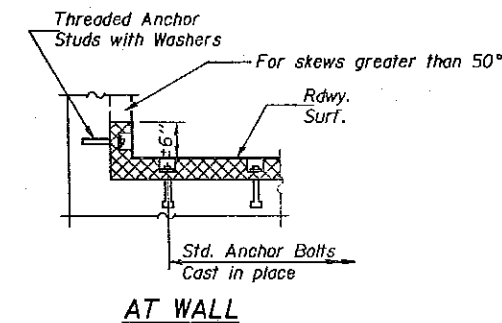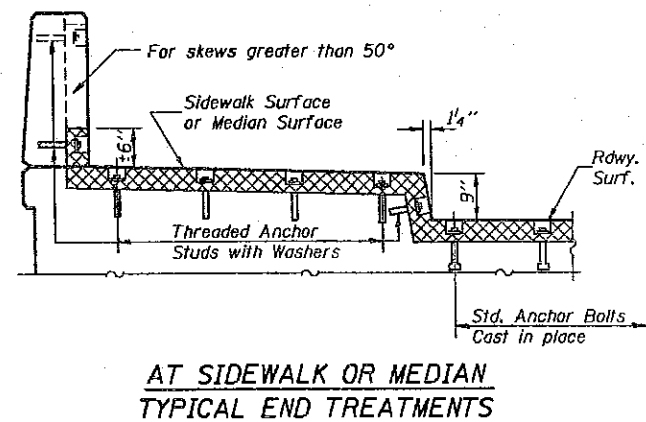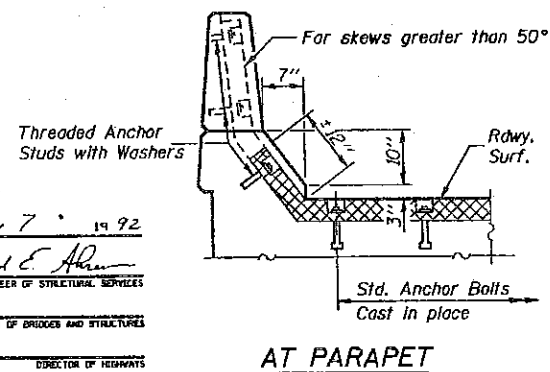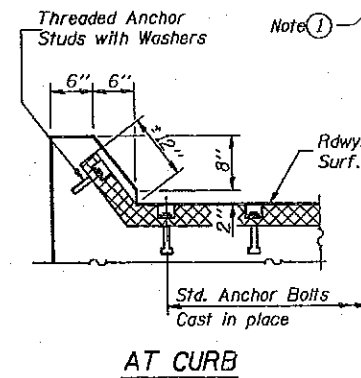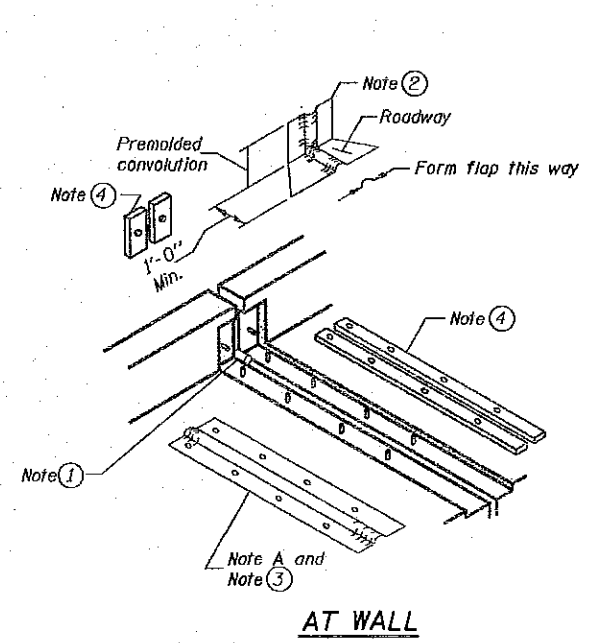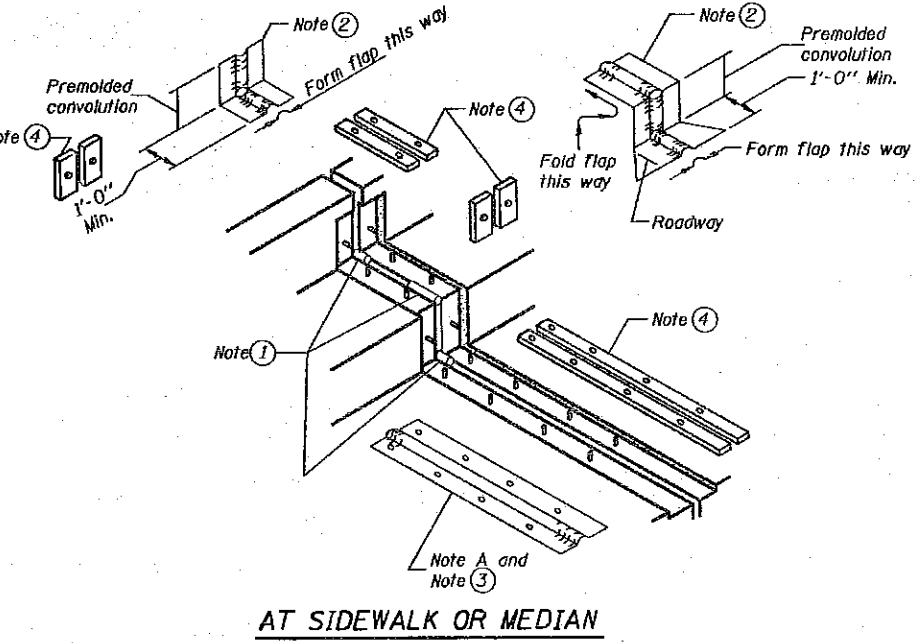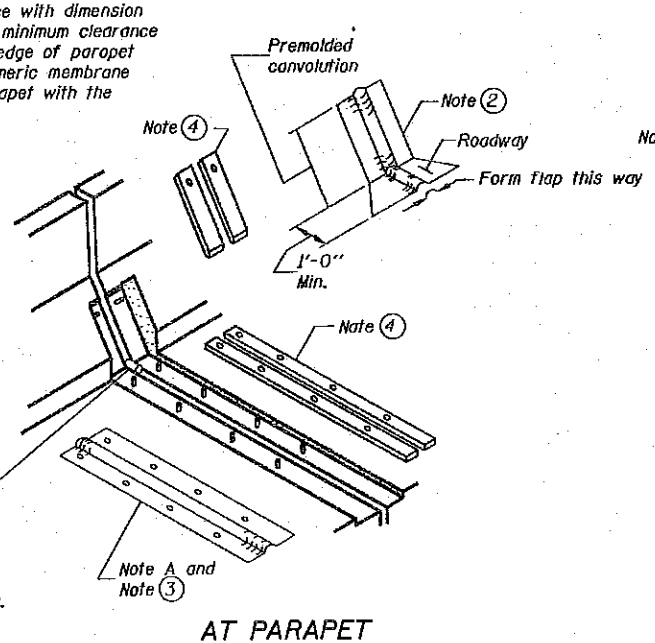

DESIGNED Paul Summer  
CHECKED BRT  
DRAWN Paul Summer  
CHECKED BRT  
EJ-CS 6-1-89

February 7, 1992  
EXAMINED Jerald E. Allen  
PASSED  
APPROVED  
ENGINEER OF STRUCTURAL SERVICES  
ENGINEER OF BRIDGES AND STRUCTURES  
DIRECTOR OF HIGHWAYS



CONTINUOUS SEAL TYPE  
NEOPRENE EXPANSION JOINTS  
For 2", 2 1/2" and 4" Movement

JOINT REPLACEMENT DETAILS  
F.A.I. RT. 57 SEC. (28-3VB-1) I-1  
FRANKLIN COUNTY  
STA. 515+16.08  
STR. No. 028-0008 & 028-0009




SHEET NO.	SECTION	COUNTY	TOTAL SHEETS	SHEET NO.
57	#	FRANKLIN	145	74
STA.	TO STA.			
FED. ROAD DIST. NO.	BLDG. NO.	FED. AID PROJECT		

\* 28 (5B-1, 5B, 26, 1B) D-1; 28 (5VB, 3VB-3) 1-1

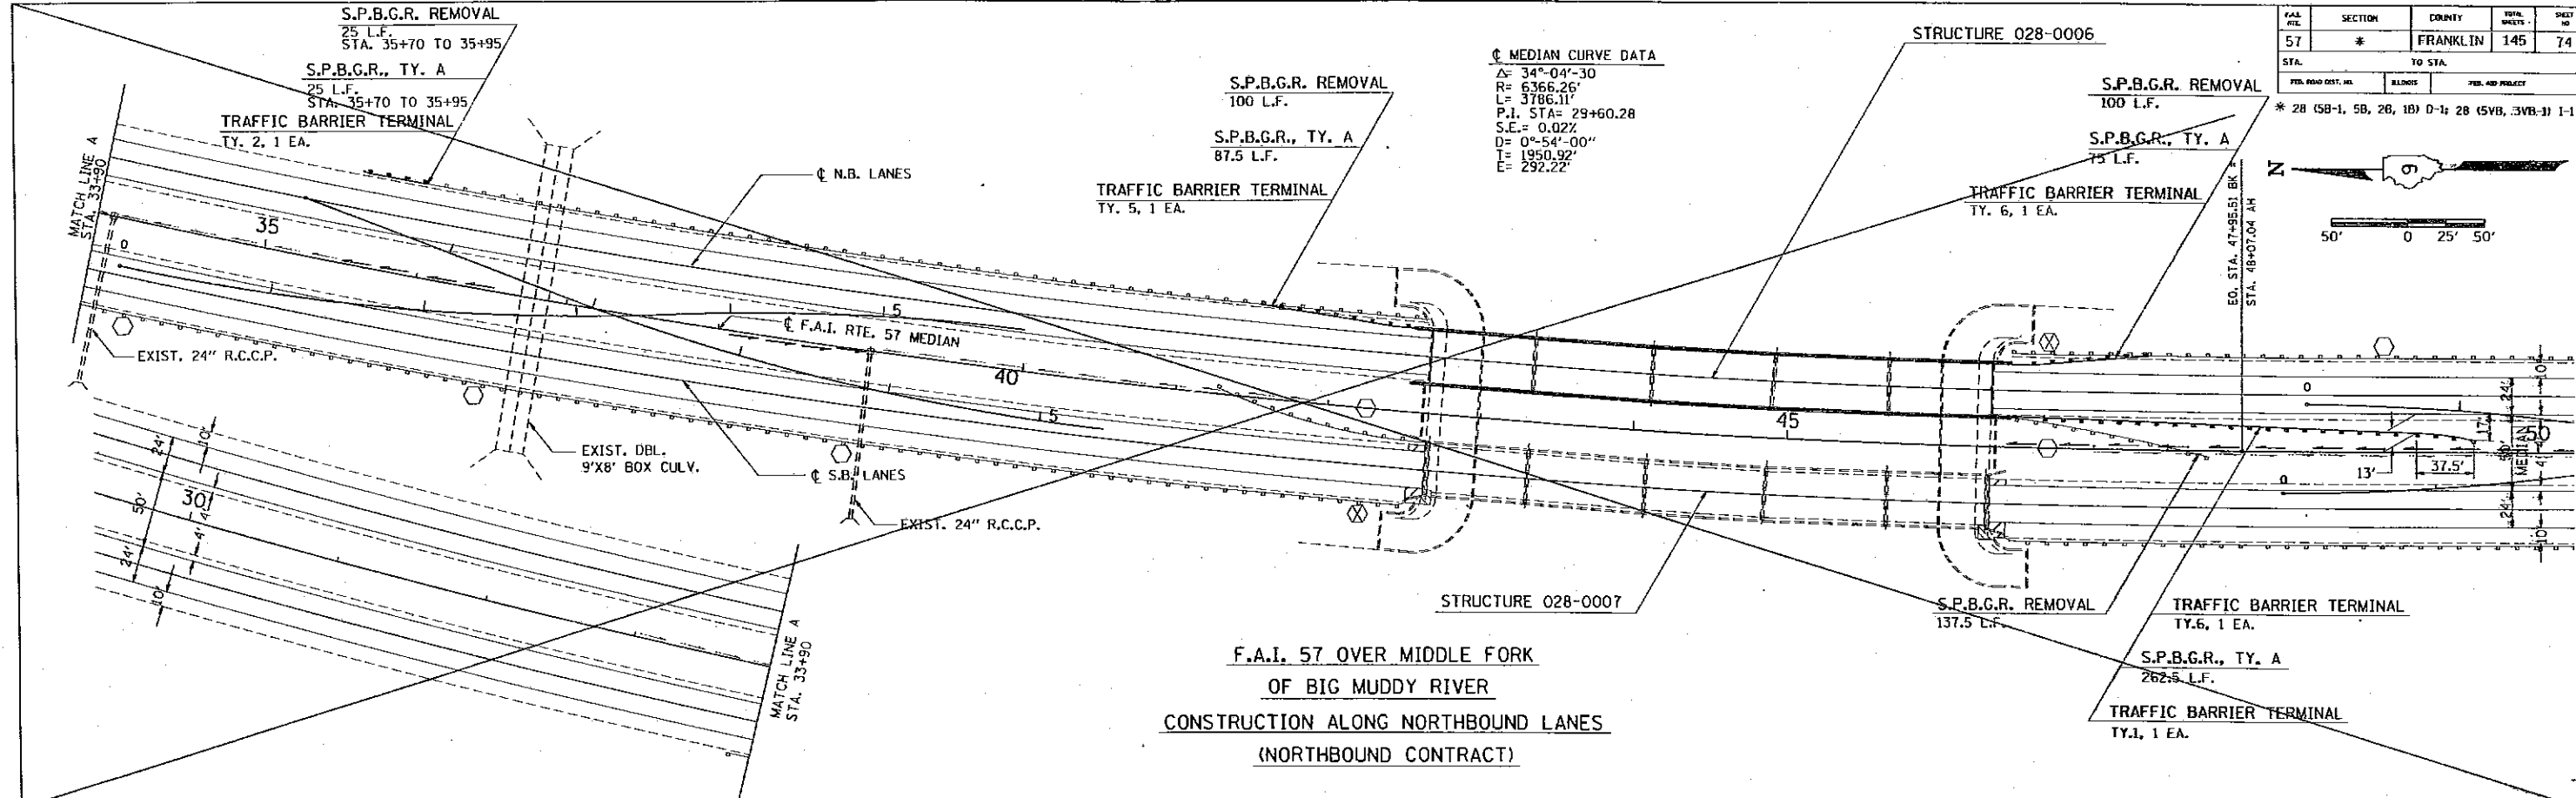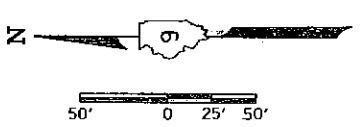

**F.A.I. 57 OVER MIDDLE FORK  
OF BIG MUDDY RIVER  
CONSTRUCTION ALONG NORTHBOUND LANES  
(NORTHBOUND CONTRACT)**

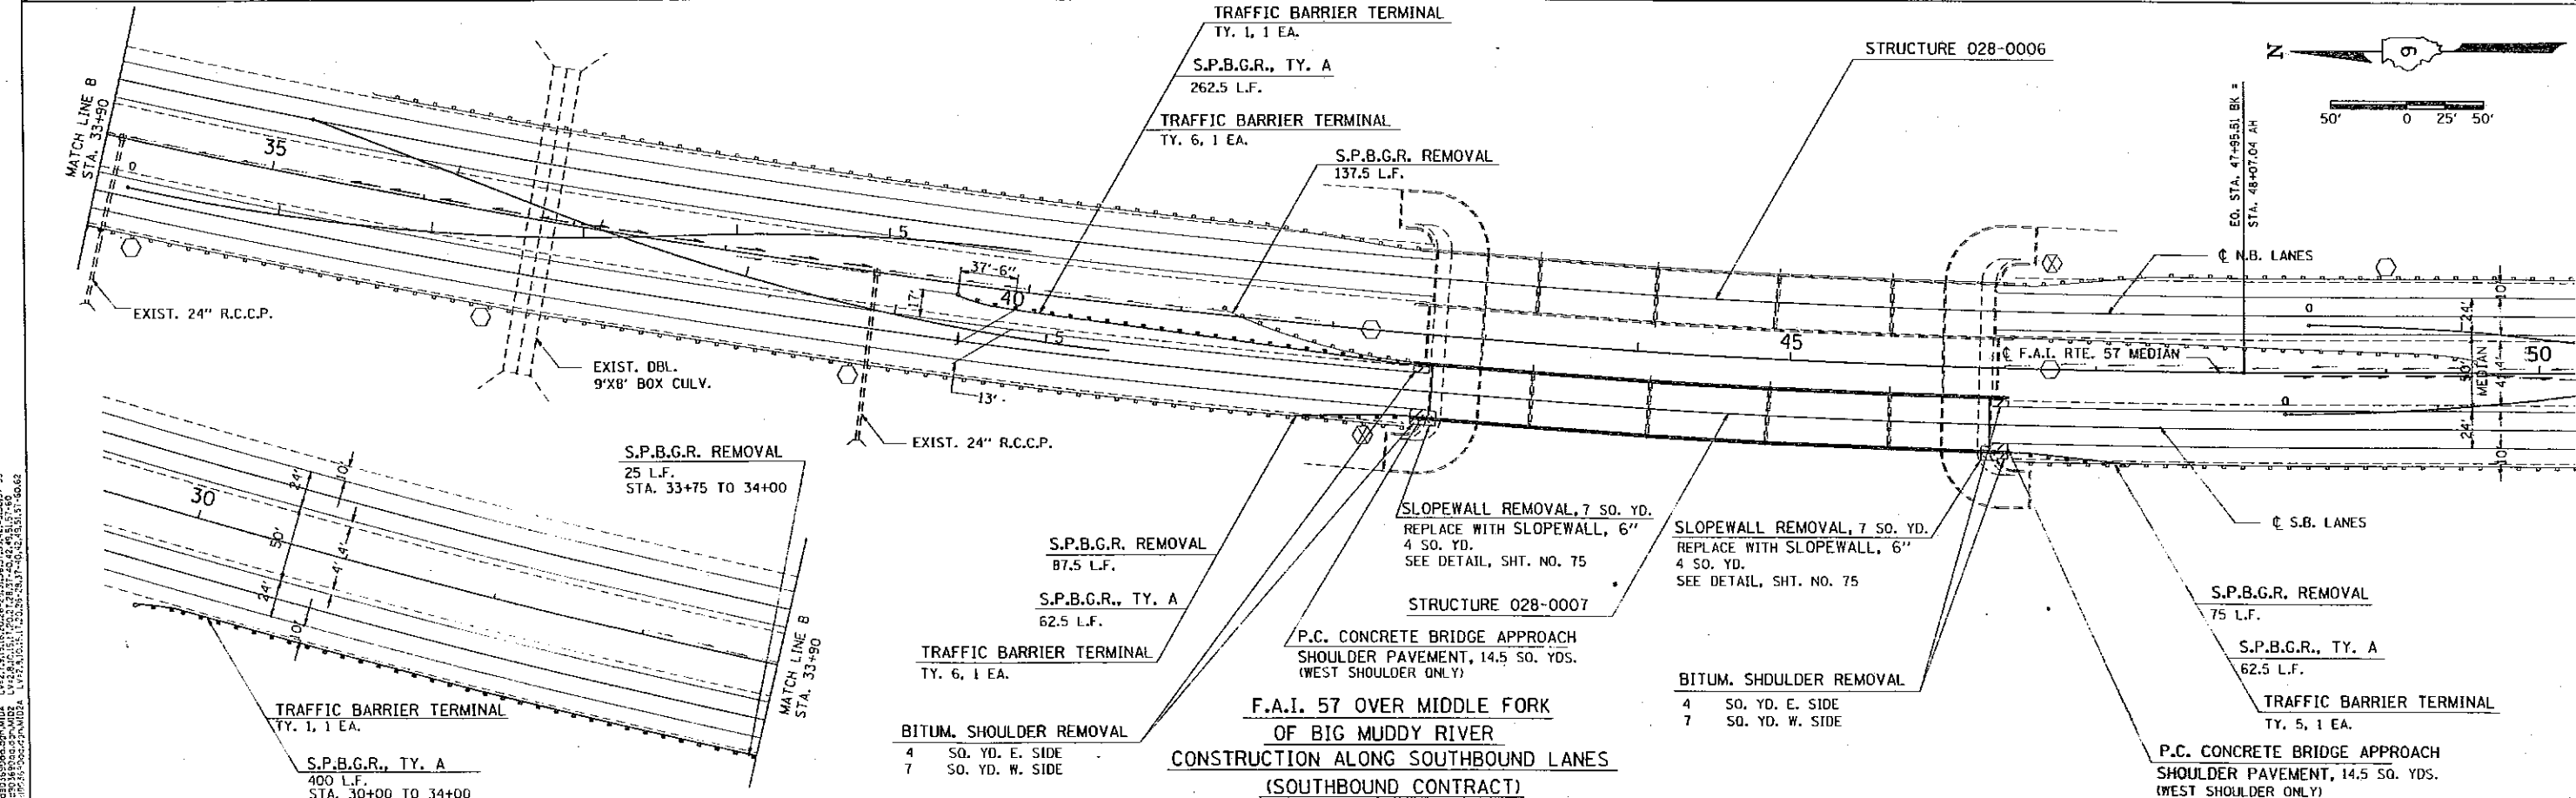

**F.A.I. 57 OVER MIDDLE FORK  
OF BIG MUDDY RIVER  
CONSTRUCTION ALONG SOUTHBOUND LANES  
(SOUTHBOUND CONTRACT)**

VIEW BIDDING  
 Proj No: 18 003641 1993  
 User: jacob77/jimney.dms@nd.gov  
 Date: 11/16/2018 10:28:53 AM  
 Path: \\snp01\proj\18 003641 1993\18 003641 1993.dwg  
 Plot: 11/16/2018 10:28:53 AM  
 Plot Device: HP DesignJet 500  
 Plotter Driver: HPGL-2  
 Plot Scale: 1:1  
 Plot Range: All in View  
 Plot Orientation: Landscape  
 Plot Color: Black  
 Plot Lineweight: 0.25  
 Plot Linetype: Solid  
 Plot Font: Arial, 10  
 Plot Title: 18 003641 1993.dwg








ROUTE NO.	SEC.	COUNTY	TOTAL SHEETS	SHEET NO.
F.A.I. 57		FRANKLIN	145	77
FED. ROAD DIST. 7		ILLINOIS	PROJECT	
SEC. 28 (S&H, S&P, B) 0-1,		08 (S&H, S&P, B) 1-1		

DATE	
BY	
APPROVED	
ENGINEER	
NOTE BOOK	
NO.	

DATE	
BY	
APPROVED	
ENGINEER	
NOTE BOOK	
NO.	

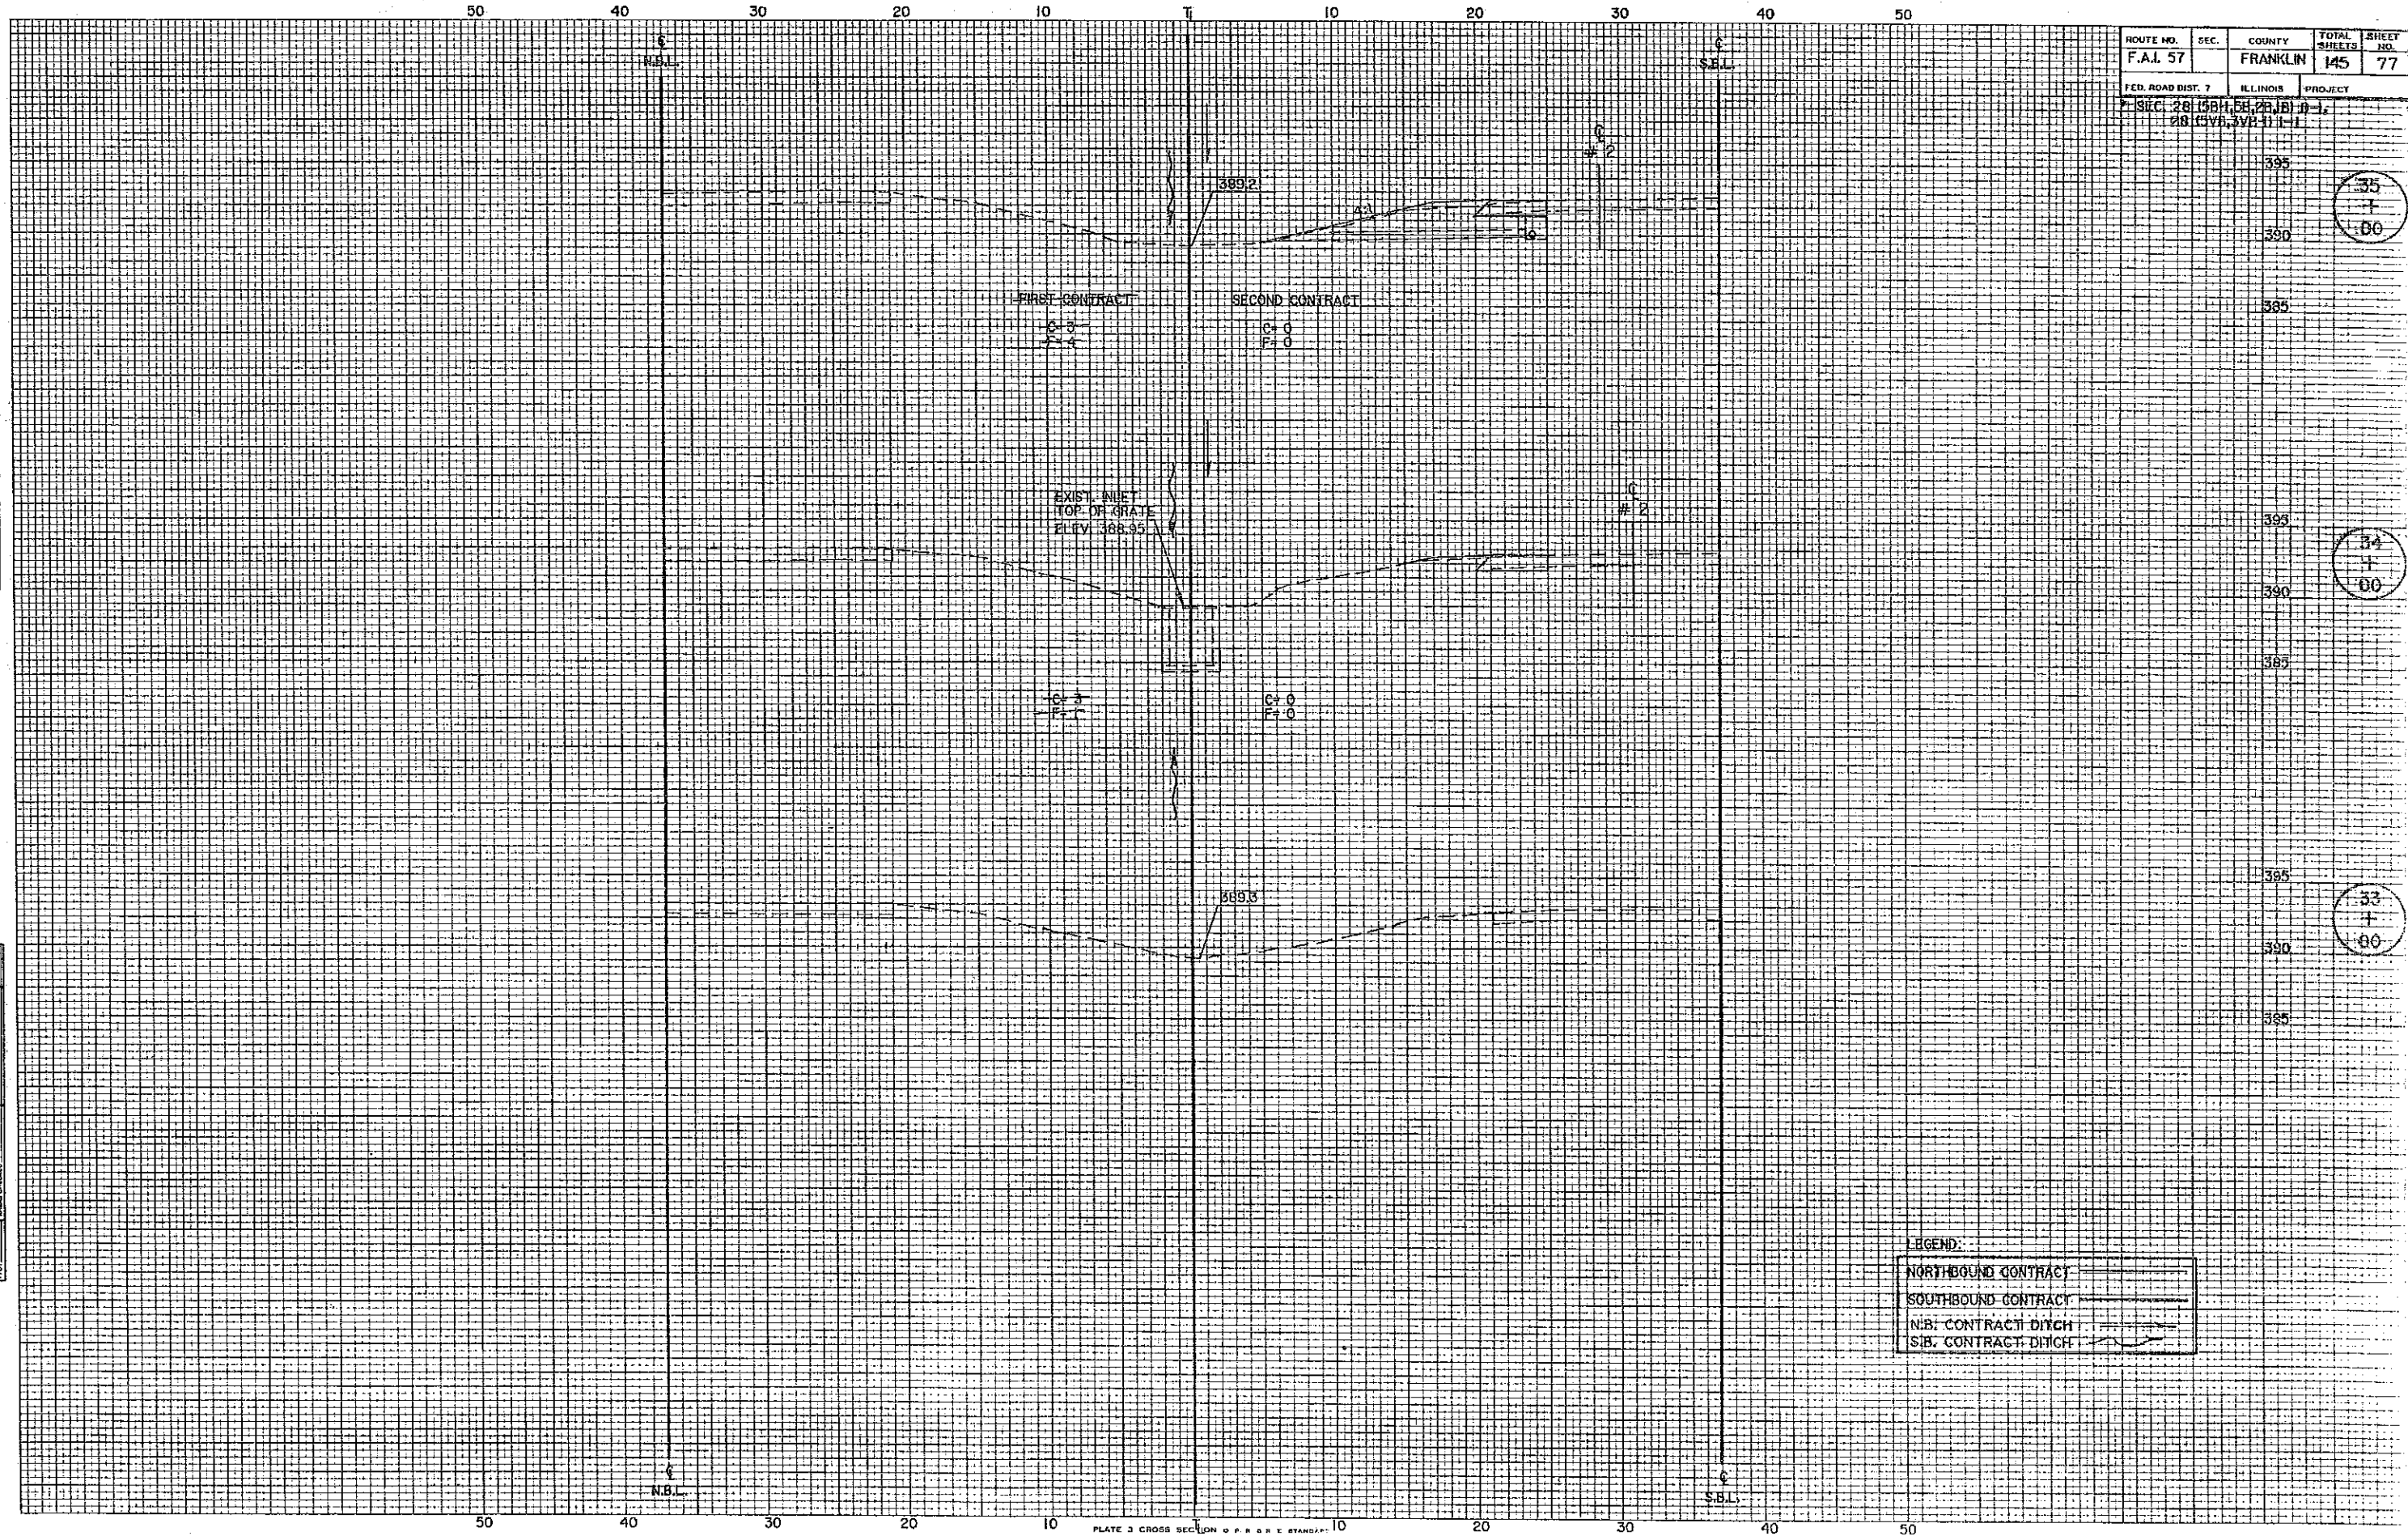

35  
+

34  
+

33  
+

PLATE 3 CROSS SECTION OF R.R. STANDARDS  
DETZEN CORPORATION













ROUTE NO.	SEC.	COUNTY	TOTAL SHEETS	SHEET NO.
F.A.I. 57	2	FRANKLIN	145	81
FED. ROAD DIST. 7	ILLINOIS	PROJECT		
SEC. 28 168-180 28180 D-1 28 1578, 158-171 F-1				

DATE	
BY	
REVISION	
NO.	
DATE	
BY	
REVISION	
NO.	

DATE	
BY	
REVISION	
NO.	
DATE	
BY	
REVISION	
NO.	

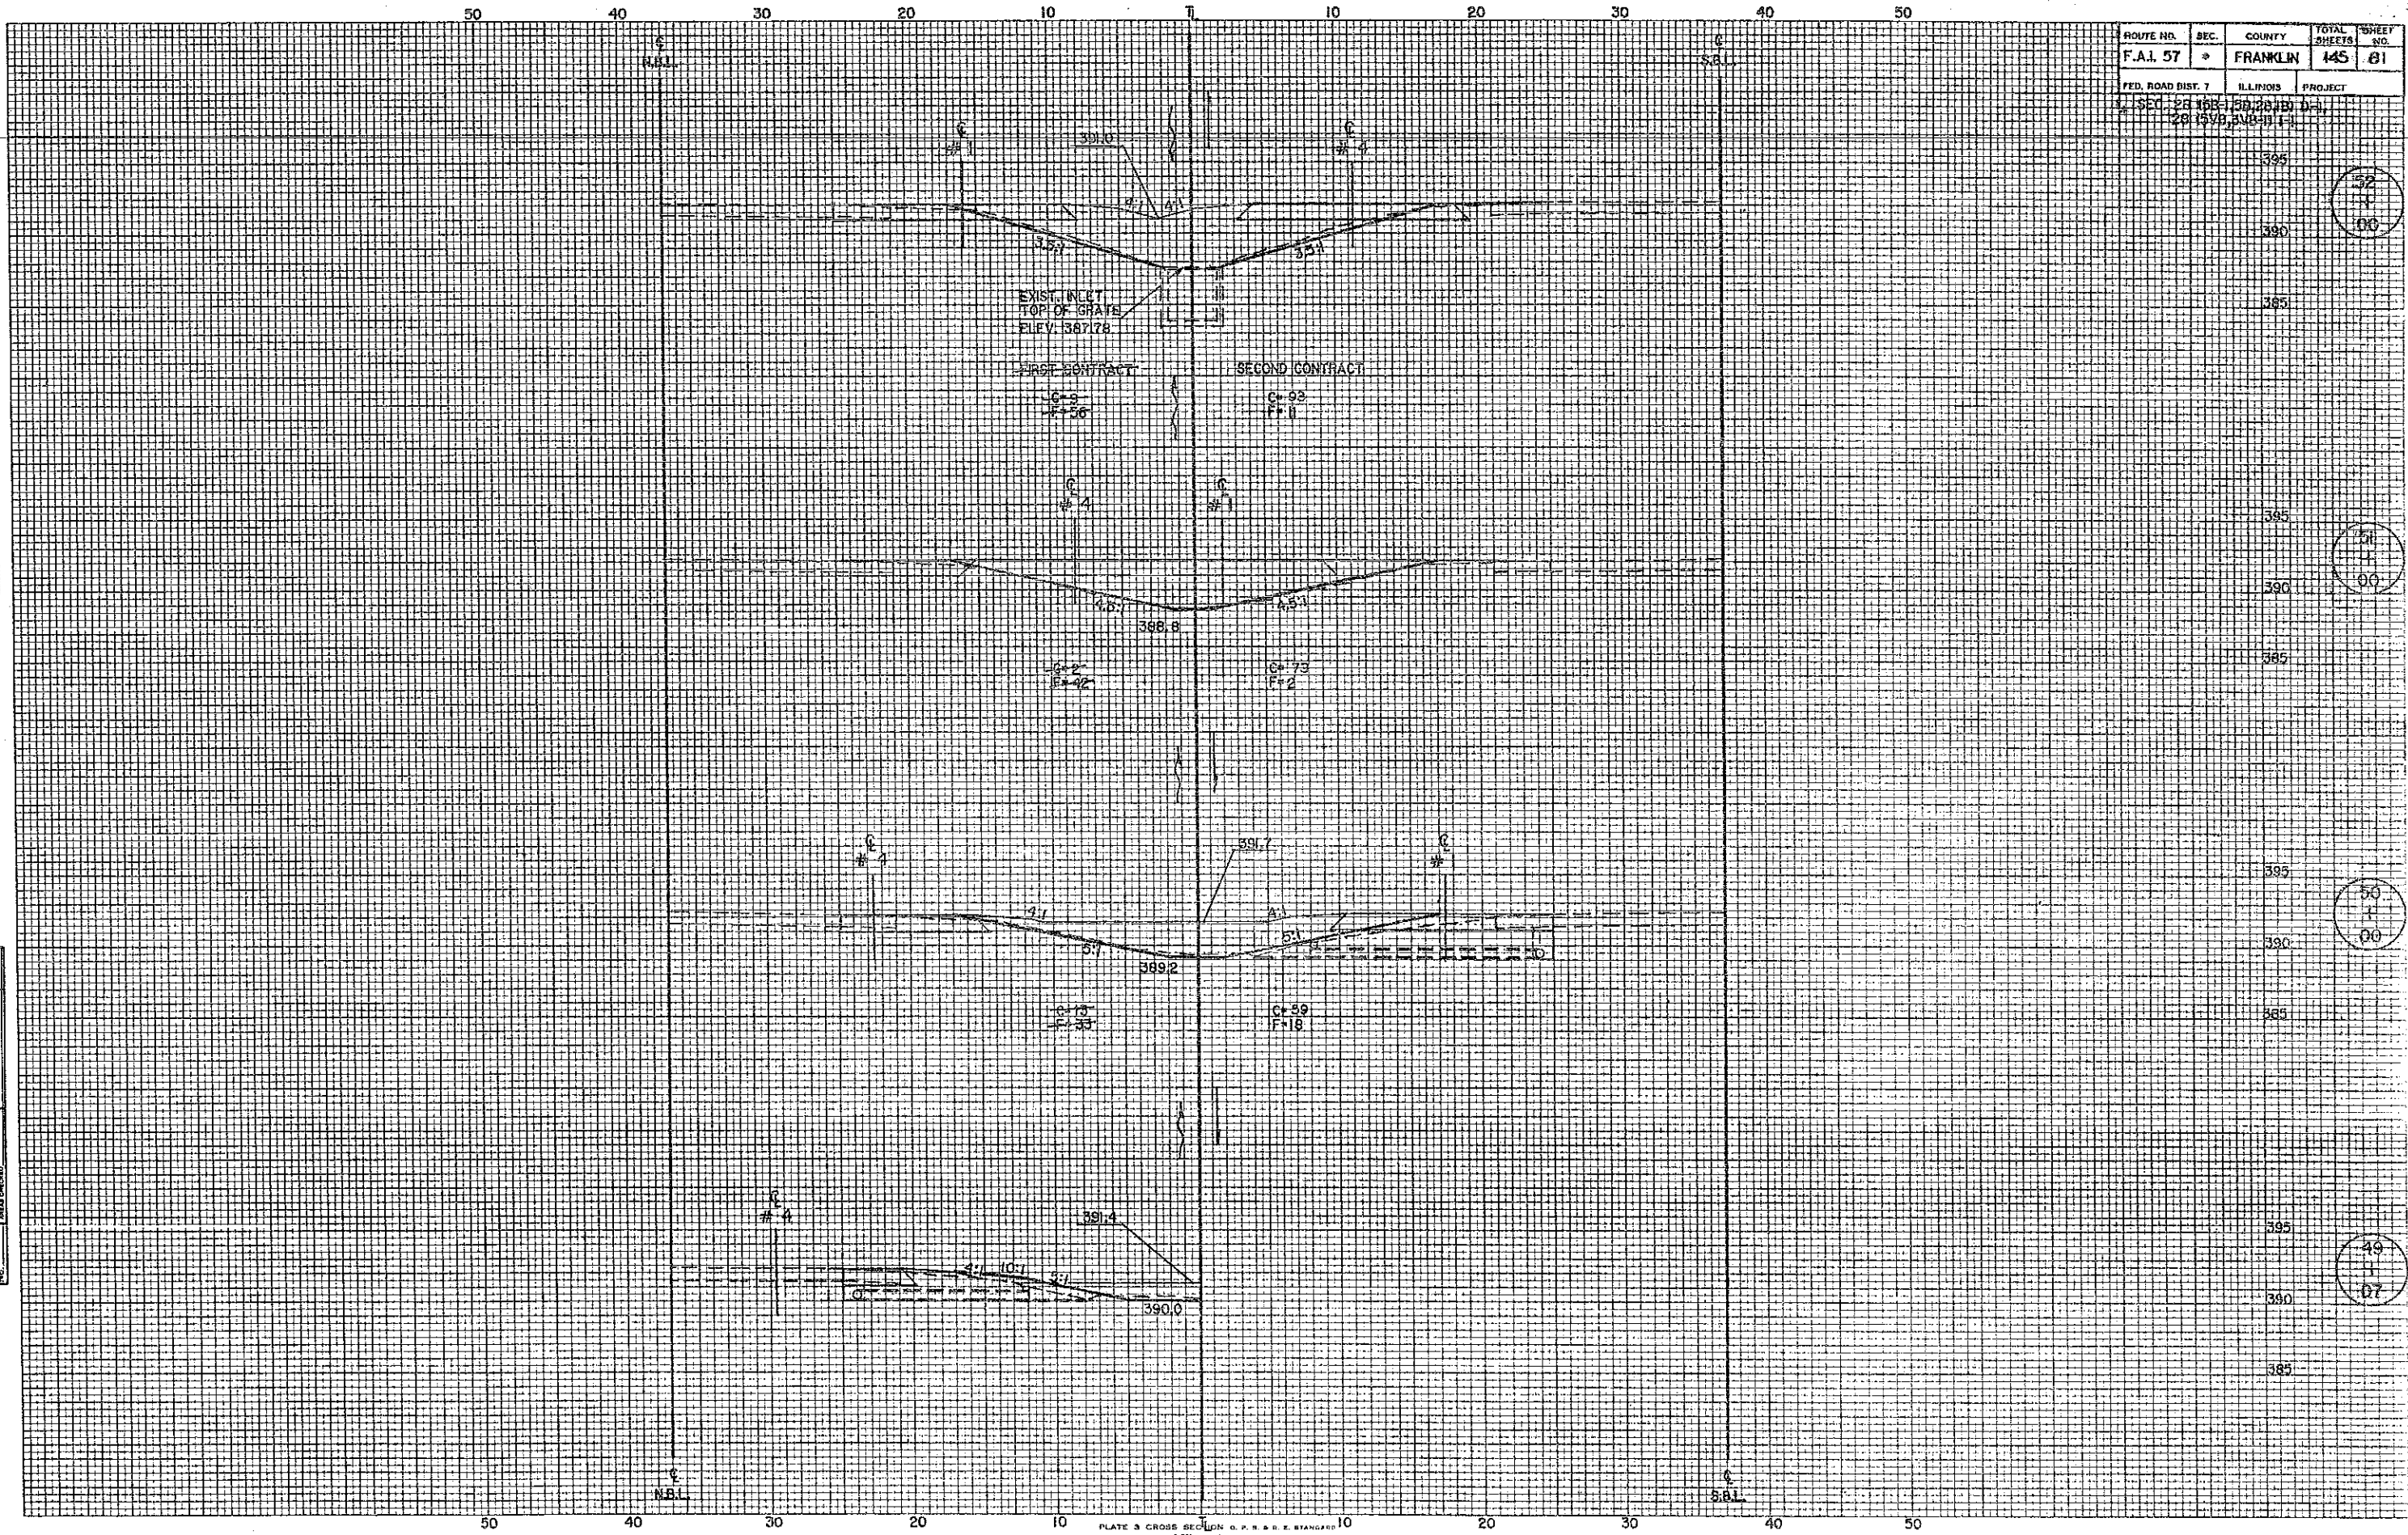


PLATE 3 CROSS SECTION D. P. R. & E. STANGOR, 10  
DETZEN CORPORATION




50 40 30 20 10 10 20 30 40 50

ROUTE NO.	SEC.	COUNTY	TOTAL SHEETS	SHEET NO.
F.A.I. 57	9	FRANKLIN	145	82
FED. ROAD DIST. 7	ILLINOIS	PROJECT		
* SEC. 26 T8N R5E S181 D-1, 2E 1158346-117				

DATE	
BY	
APPROVED	
PROJECT	
TEMP. DATE	
FIELD BOOK	
NO.	

DATE	
BY	
APPROVED	
PROJECT	
TEMP. DATE	
FIELD BOOK	
NO.	

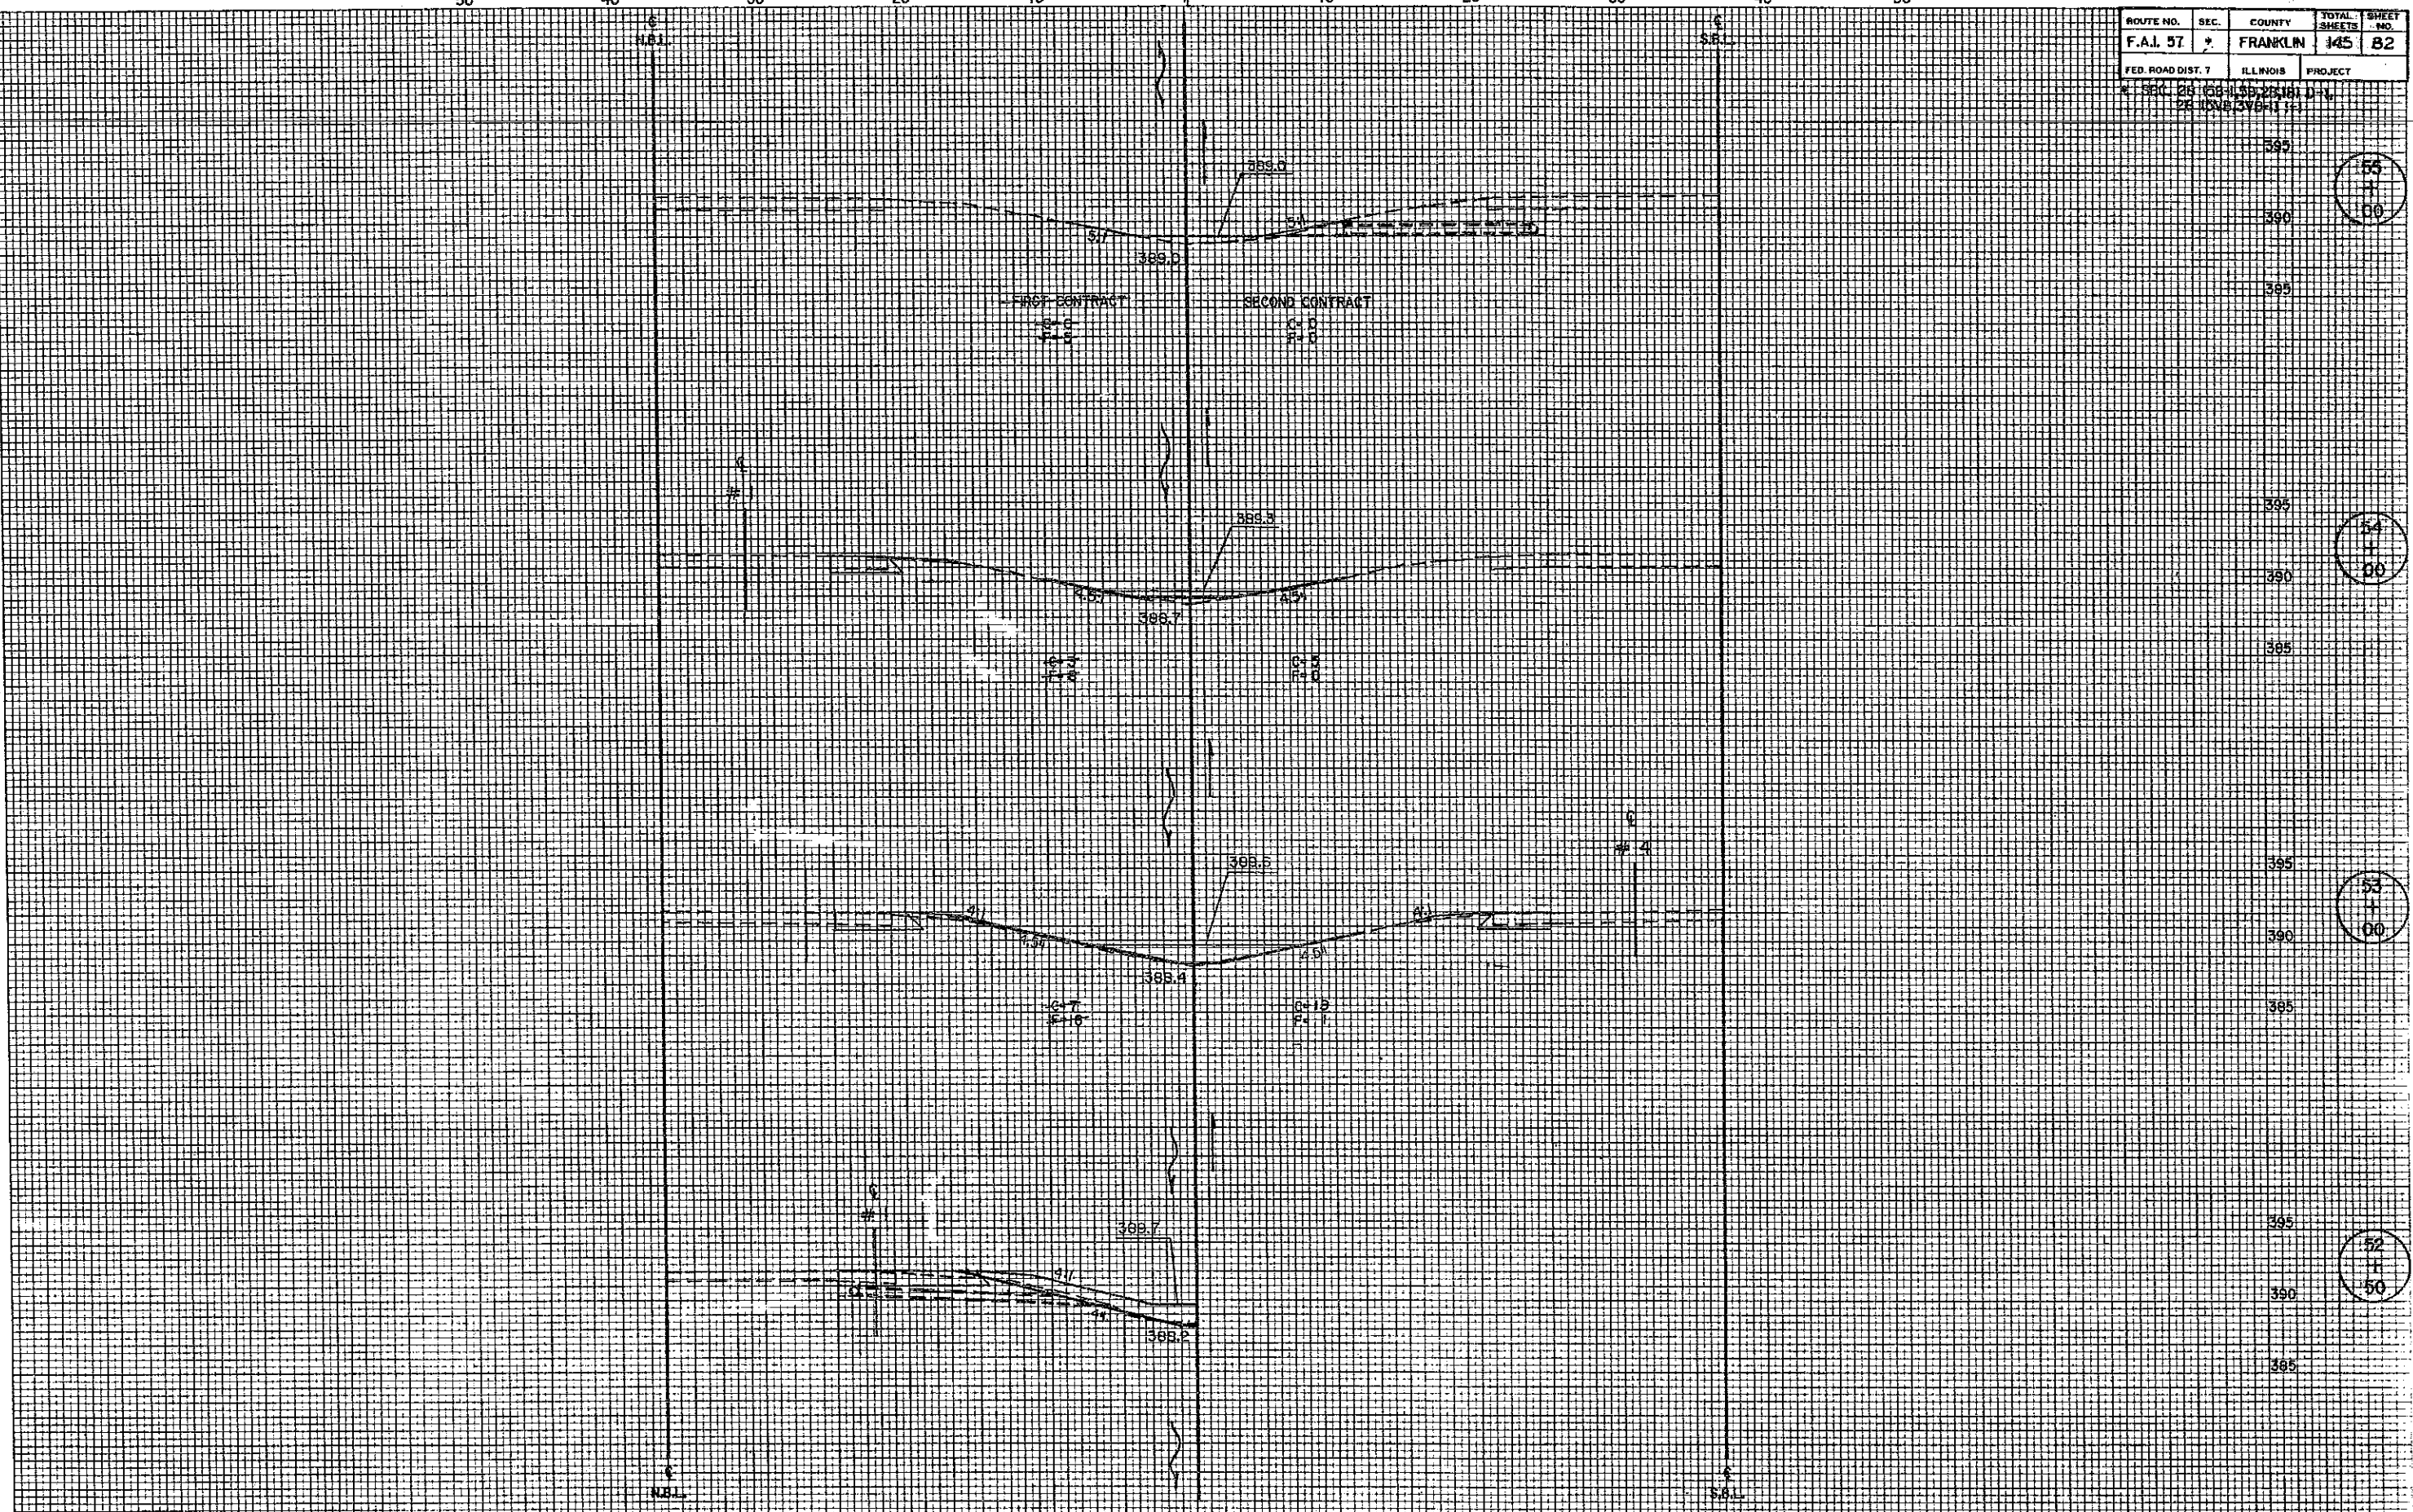

55  
1  
00

54  
1  
00

53  
1  
00

52  
1  
50







ROUTE NO.	SECTION	COUNTY	DATE	SHEET NO.
F.A.I. 57	(28-5B) D-1	FRANKLIN	84	25 SHEETS
FED. ROAD DIST. NO. 7	BRIDGE	FED. AID PROJECT		

STATE OF ILLINOIS  
DEPARTMENT OF TRANSPORTATION

Bench Mark: "□" Cut in N.E. handrail on the N.E. corner of Middle Fork of Big Muddy River bridge - Southbound Lanes. Sta. 44+49.00 Elevation 395.13.  
Existing Structure: 028-0007 (SB). Built as F.A.I. Route 57, Sec. 28-5(B-F) in 1962. The superstructure consists of 5 spans of continuous WF beams with an R.C. deck. The bridge will be rehabilitated in accordance with the scope of work shown below.  
Temporary median crossovers shall be utilized to divert traffic over adjacent bridge (028-0006 N.B.) during reconstruction. No salvage.

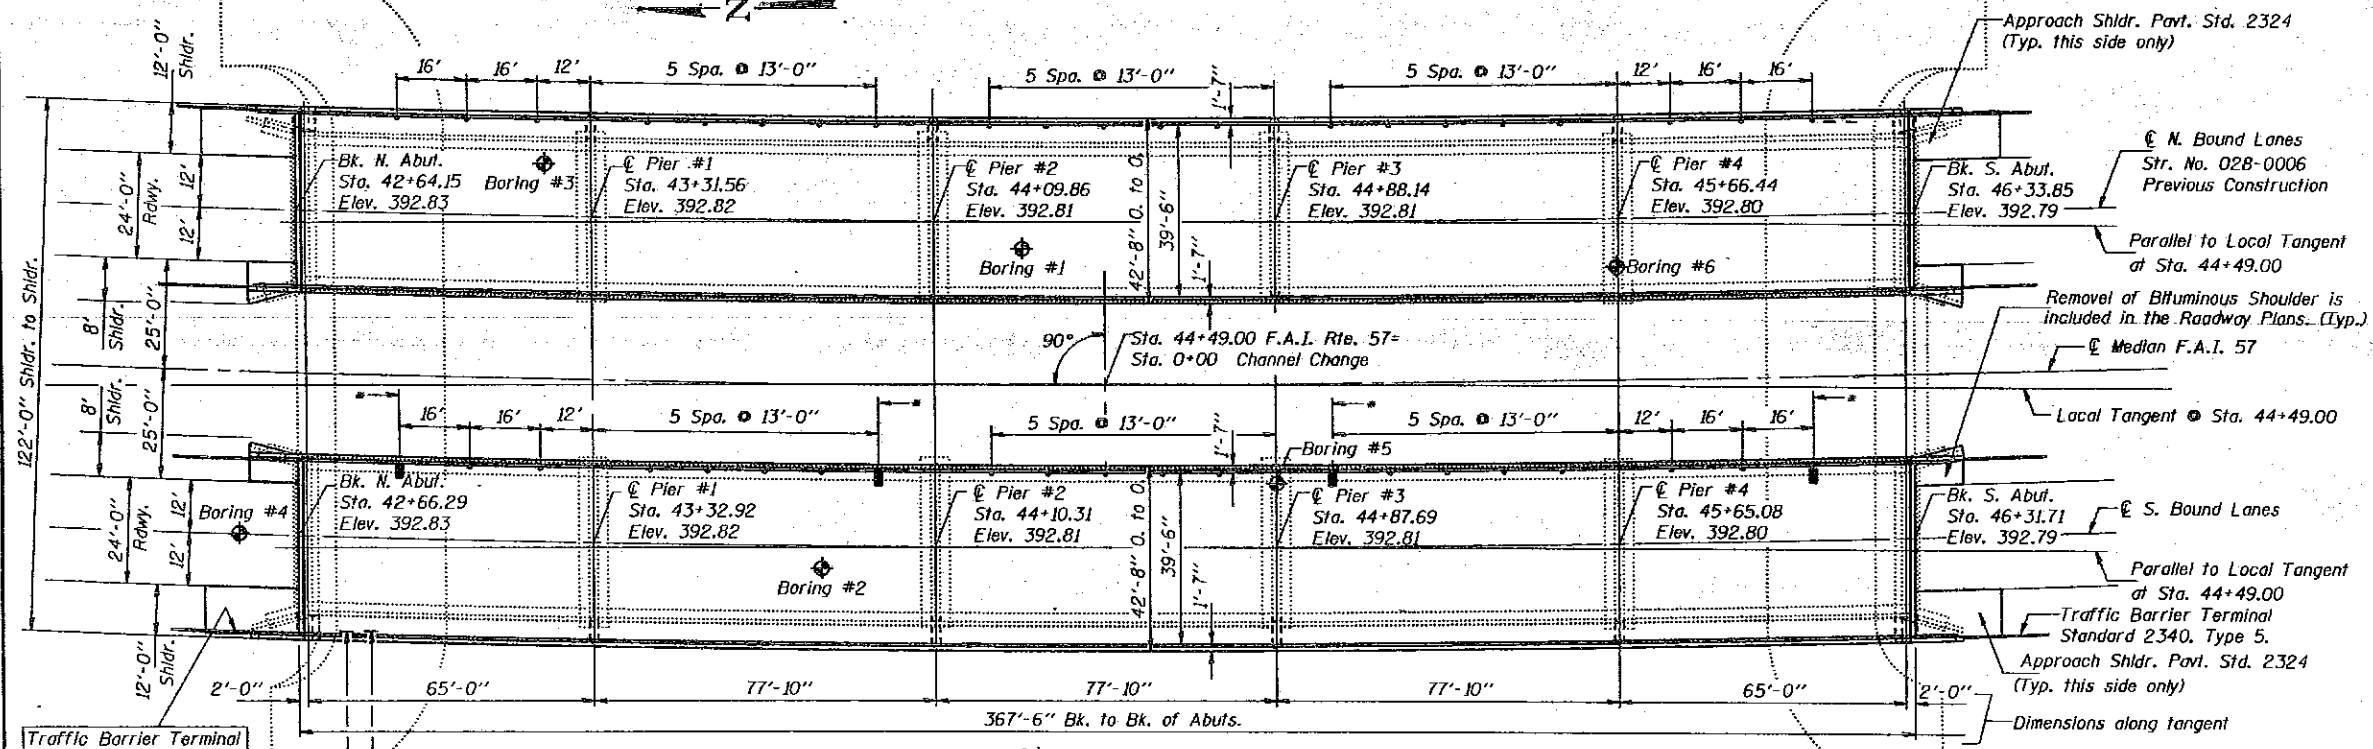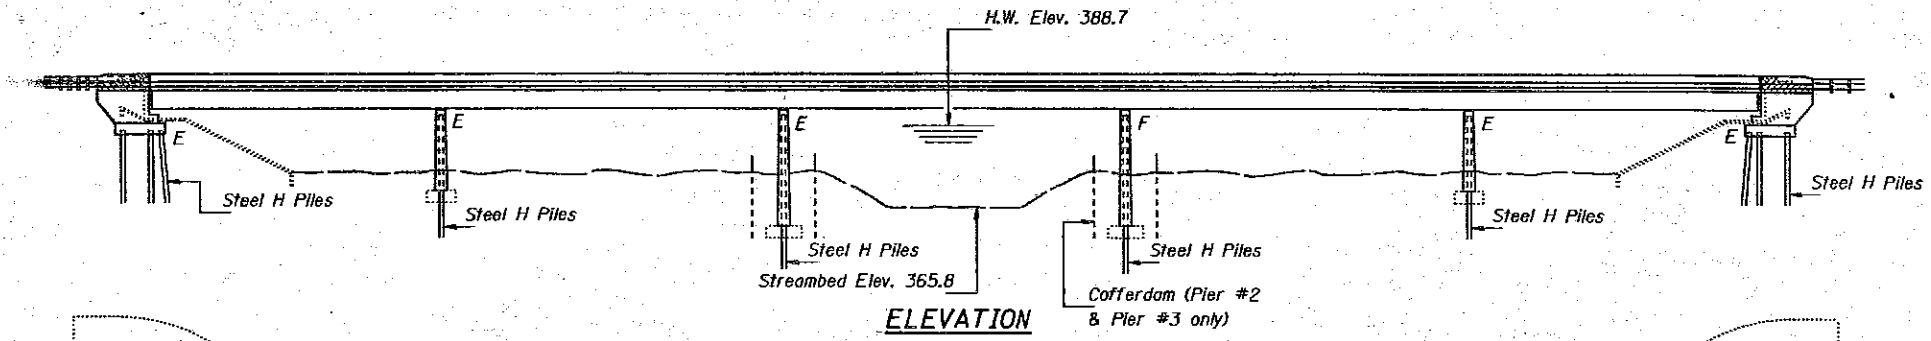


PLAN

Notes:  
Only the South Bound Structure is included in the Contract.

\* Indicates specific locations of Drainage Scupper.  
(All other locations shall be 6"Ø Drains.)

For quantities of Slope Wall Removal and Replacement see Roadway Plans

PROPOSED PROFILE GRADE  
F.A. Route 57 (along & pavement)

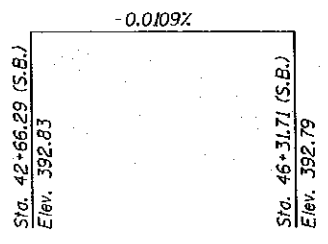

CURVE DATA

Δ = 34°-04'-30"  
D = 0°-54'  
T = 1950.92'  
L = 3786.11'  
E = 292.22'  
R = 6366.26'  
S.E. = 0.020'

STATION 44+49.00  
REBUILT 199 BY  
STATE OF ILLINOIS  
F.A.I. RT. 57 SEC. (28-5B)D-1  
F.A. PROJ.  
LOADING HS20 & ALT.  
STR. NO. 028-0007


NAME PLATE  
(South Bound Lanes)  
See Std. 2113

DESIGN SPECIFICATIONS  
1989 AASHTO, 1990, 1991 Interim Specifications & Seismic Retrofitting Guidelines for Highway Bridges

LOADING HS 20-44 & Alt.  
Allow 25# / sq. ft. for future wearing surface.

DESIGN STRESSES

FIELD UNITS  
New Construction  
f'c = 3,500 psi  
fy = 60,000 psi (Reinf.)  
fs = 27,000 psi (Structural Steel M270 Gr. 50)  
fs = 20,000 psi (Structural Steel M270 Gr. 36)  
Old Construction  
fs = 20,000 psi (Structural Steel)

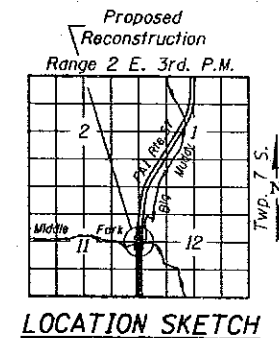

GENERAL PLAN  
F.A.I. ROUTE 57 OVER  
MIDDLE FORK OF BIG MUDDY RIVER  
F.A.I. ROUTE 57 SECTION (28-5B)D-1  
FRANKLIN COUNTY  
STATION 44+49.00  
STRUCTURE NUMBER 028-0007 (S.B.)

DESIGNED: Steven Neumann  
CHECKED: Paul W. Sweet, W.D.C.  
DRAWN: John F. Schneller Jr.  
CHECKED: SPA, SIB

EXAMINED: Joseph J. Kasper  
PASSED: Ralph E. Anderson  
APPROVED: [Signature]



May 20 1993

DIRECTOR OF HIGHWAYS

STATE OF ILLINOIS  
DEPARTMENT OF TRANSPORTATION

PROJECT NO.	DISTRICT	COUNTY	SECTION	SHEET	SHEET NO. 2 25 SHEETS
F.A.I. 57	(28-5B) D-1	FRANKLIN		85	
PRELIMINARY DATE	DATE	DATE	DATE	DATE	

GENERAL NOTES

Fasteners shall be high strength bolts. Bolts  $\frac{7}{8}$ " $\phi$ , open holes  $\frac{5}{8}$ " $\phi$ , unless otherwise noted.

Calculated weight of Structural Steel M270 Gr. 50 = 51,230 Lbs.  
Calculated weight of Structural Steel M270 Gr. 36 = 18,210 Lbs.

Field welding of construction accessories will not be permitted to the bottom flange of beams nor to the top flange for a distance equal to one-fourth the span length each way from the pier supports. Field welding in other areas will be permitted only when approved by the Engineer.

Anchor bolts shall be set before bolting diaphragms over supports.

The main load carrying member components subject to tensile stress shall conform to the Supplemental Requirements for Notch Toughness Zone 2. These components are the wide flange beams and all splice plate material of the wide flange beams.

Reinforcement bars shall conform to the requirements of AASHTO M-31, M-42 or M-53 Grade 60.

All top surfaces of the Abutments shall receive "Bridge Seat Sealer".

The contractor shall drive 2 (two) Steel HP12 x 53 test piles in permanent locations 1 (one) at the North Abutment and 1 (one) at South Abutment as directed by the Engineer before ordering the remainder of the piles.

The Zinc-silicate and vinyl paint system shall be used for shop and field painting of New Structural Steel. The color of the vinyl finish coat shall be Munsell No. 7.5 G 4/8, Interstate Green.

Plan dimensions and details relative to existing structure have been taken from existing plans and field survey elevations and are subject to nominal construction variations. It shall be the Contractor's responsibility to verify such dimensions and details in the field and make necessary approved adjustments prior to construction or ordering of materials. Such variations shall not be cause for additional compensation for a change in the scope of the work, however, the contractor will be paid for the quantity actually furnished at the unit price bid for the work.


Bearing seat surfaces shall be constructed or adjusted to the designated elevations within a tolerance of  $\frac{1}{8}$  inch. Adjustment shall be made either by grinding the surface or by shimming the bearing. Two  $\frac{1}{8}$ " adjusting shims, of the dimensions of the bottom bearing plate, shall be provided for each bearing in addition to all other plates or shims. For Type I Elastomeric Bearings, shims of the dimensions of top plate shall be provided and placed as detailed.

The Contractor will be required to mark, on top of the concrete deck, the locations of the top flange of all the steel beams, prior to any removal of the bridge concrete deck. Saw cutting directly over the top of the beam flanges is not permitted.

Prior to pouring the new concrete for the deck, all loose rust, loose mill scale and all other foreign material shall be removed from the embedded portions of flanges of stringers. The removal shall be accomplished in accordance with the requirements of the SSPC Surface Preparation Specifications SP-3 for Power Tool Cleaning or SP-2 for hand tool cleaning. Cost shall be incidental to "Removal of Existing Concrete Deck".

TOTAL BILL OF MATERIAL

ITEM	UNIT	SUPER	SUB	TOTAL
Concrete Removal	Cu. Yd.		12	12
Removal of Existing Concrete Deck	Each	1		1
Structure Excavation	Cu. Yd.		83	83
Floor Drains	Each	17		17
Class X Concrete Superstructure	Cu. Yd.	464.0		464.0
Protective Coat	Sq. Yd.	1,920		1,920
Elastomeric Bearing Assembly Type I	Each		21	21
Elastomeric Bearing Assembly Type II	Each		14	14
Class X Concrete	Cu. Yd.		67.9	67.9
Structural Steel	L.S.	1		1
Slud Shear Connectors	Each	7,056		7,056
Reinforcement Bars, Epoxy Coated	Pound	109,380	8,070	117,450
Steel Piles HP12 x 53	Lin. Ft.		208	208
Steel Piles HP12 x 74	Lin. Ft.		230	230
Test Pile Steel HP12 x 53	Each		2	2
Name Plates	Each	1		1
Bridge Seat Sealer	Sq. Ft.		167	167
Neoprene Expansion Joint 2"	Lin. Ft.	42		42
Neoprene Expansion Joint 4"	Lin. Ft.	42		42
Jack and Remove Existing Bearings	Each		36	36
Cofferdams	Each		2	2
Cofferdam Excavation	Cu. Yd.		52	52
Bridge Deck Grooving	Sq. Yd.	1,521		1,521
Drainage Scuppers	Each	4		4

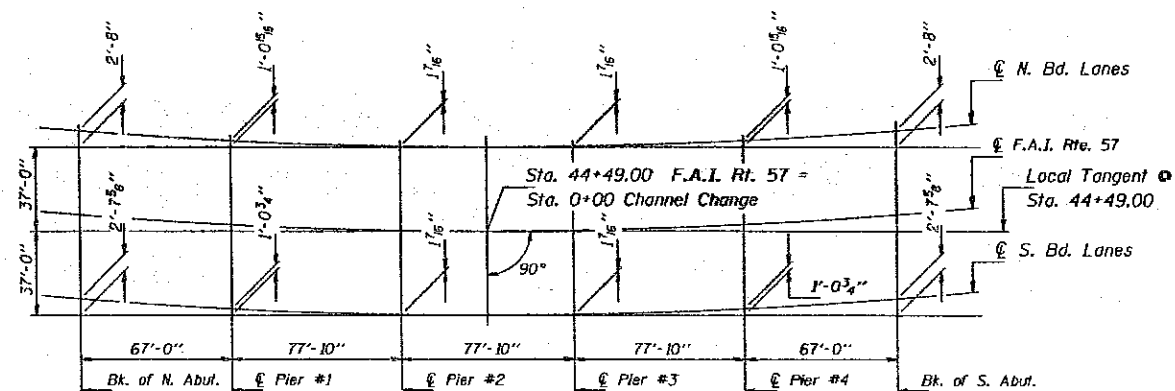

OFFSET SKETCH

DESIGNED <i>John F. Schneller Jr.</i>	EXAMINED <i>Ralph E. Anderson</i>
CHECKED <i>John F. Schneller Jr.</i>	PASSED <i>Ralph E. Anderson</i>
DRAWN <i>John F. Schneller Jr.</i>	APPROVED <i>Ralph E. Anderson</i>
CHECKED <i>John F. Schneller Jr.</i>	DIRECTOR OF HIGHWAYS

May 20 1973


GENERAL PLAN DETAILS  
F.A.I. RT 57 SEC. (28-5B)D-1  
FRANKLIN COUNTY  
STATION 44+49.00



STATE OF ILLINOIS  
DEPARTMENT OF TRANSPORTATION

SECTION NO.	SECTION	COUNTY	DATE	SHEET NO.
F.A.I. 57	(28-5B) D-1	FRANKLIN	8/6	25 SHEETS
DESIGNED BY	CHECKED BY	DRAWN BY	DATE	

BEAM #1					EAST LONGITUDINAL BONDED CONSTRUCTION JOINT					BEAM #2					BEAM #3				
Location	Station	Offset	Theoretical Grade Elevations	Theoretical Grade Elevations Adjusted For Dead Load Deflection	Location	Station	Offset	Theoretical Grade Elevations	Theoretical Grade Elevations Adjusted For Dead Load Deflection	Location	Station	Offset	Theoretical Grade Elevations	Theoretical Grade Elevations Adjusted For Dead Load Deflection	Location	Station	Offset	Theoretical Grade Elevations	Theoretical Grade Elevations Adjusted For Dead Load Deflection
Bk. No. Abut.	4265.830	-15.977	392.510	392.510	Bk. No. Abut.	4265.944	-12.000	392.590	392.590	Bk. No. Abut.	4266.013	-9.561	392.639	392.639	Bk. No. Abut.	4266.197	-3.144	392.767	392.767
Br. No. Abut.	4267.824	-15.982	392.510	392.510	Br. No. Abut.	4267.937	-12.000	392.590	392.590	Br. No. Abut.	4268.006	-9.566	392.639	392.639	Br. No. Abut.	4268.187	-3.149	392.767	392.767
A	4277.794	-15.996	392.509	392.527	A	4277.897	-12.000	392.589	392.605	A	4277.966	-9.580	392.637	392.655	A	4278.138	-3.163	392.766	392.784
B	4287.765	-15.996	392.508	392.538	B	4287.898	-12.000	392.588	392.615	B	4287.927	-9.580	392.636	392.666	B	4288.088	-3.163	392.765	392.795
C	4297.735	-15.979	392.507	392.539	C	4297.819	-12.000	392.587	392.617	C	4297.887	-9.563	392.636	392.668	C	4298.039	-3.146	392.764	392.796
D	4307.706	-15.946	392.506	392.532	D	4307.780	-12.000	392.585	392.609	D	4307.847	-9.530	392.634	392.660	D	4307.989	-3.113	392.763	392.789
E	4317.676	-15.897	392.506	392.520	E	4317.741	-12.000	392.584	392.599	E	4317.808	-9.481	392.634	392.648	E	4317.939	-3.064	392.763	392.777
F	4327.646	-15.834	392.506	392.509	F	4327.702	-12.000	392.583	392.588	F	4327.768	-9.418	392.635	392.638	F	4327.889	-3.001	392.763	392.766
Pier #1	4332.631	-15.797	392.507	392.507	Pier #1	4332.700	-12.000	392.583	392.583	Pier #1	4332.748	-9.381	392.635	392.635	Pier #1	4332.864	-2.964	392.764	392.764
G	4342.601	-15.709	392.508	392.514	G	4342.661	-12.000	392.582	392.591	G	4342.708	-9.293	392.636	392.642	G	4342.814	-2.874	392.765	392.771
H	4349.579	-15.639	392.508	392.522	H	4349.636	-12.000	392.581	392.596	H	4349.679	-9.223	392.637	392.651	H	4349.779	-2.806	392.765	392.779
I	4362.535	-15.828	392.503	392.528	I	4362.583	-12.000	392.580	392.604	I	4362.622	-9.411	392.631	392.656	I	4362.708	-2.995	392.760	392.784
J	4372.501	-15.956	392.499	392.530	J	4372.544	-12.000	392.578	392.609	J	4372.578	-9.539	392.628	392.658	J	4372.654	-3.123	392.756	392.786
K	4382.468	-16.068	392.496	392.519	K	4382.505	-12.000	392.577	392.601	K	4382.534	-9.652	392.624	392.648	K	4382.601	-3.235	392.753	392.776
L	4392.434	-16.165	392.493	392.509	L	4392.466	-12.000	392.576	392.592	L	4392.491	-9.748	392.621	392.637	L	4392.548	-3.332	392.750	392.766
M	4402.401	-16.246	392.490	392.497	M	4402.426	-12.000	392.575	392.582	M	4402.448	-9.829	392.619	392.626	M	4402.495	-3.413	392.747	392.754
Pier #2	4410.209	-16.298	392.488	392.488	Pier #2	4410.235	-12.000	392.574	392.574	Pier #2	4410.248	-9.882	392.617	392.617	Pier #2	4410.287	-3.465	392.745	392.745
N	4420.177	-16.351	392.486	392.496	N	4420.196	-12.000	392.573	392.583	N	4420.206	-9.935	392.615	392.624	N	4420.234	-3.518	392.743	392.752
O	4430.144	-16.389	392.484	392.503	O	4430.157	-12.000	392.572	392.591	O	4430.163	-9.972	392.613	392.632	O	4430.182	-3.555	392.741	392.760
P	4440.112	-16.410	392.483	392.509	P	4440.118	-12.000	392.571	392.597	P	4440.121	-9.994	392.611	392.637	P	4440.130	-3.577	392.740	392.765
Q	4450.080	-16.417	392.482	392.513	Q	4450.079	-12.000	392.570	392.601	Q	4450.079	-10.000	392.610	392.641	Q	4450.078	-3.583	392.738	392.770
R	4460.048	-16.407	392.481	392.505	R	4460.040	-12.000	392.569	392.593	R	4460.036	-9.990	392.609	392.633	R	4460.025	-3.574	392.737	392.762
S	4470.015	-16.382	392.480	392.497	S	4470.001	-12.000	392.568	392.595	S	4469.994	-9.965	392.608	392.625	S	4469.973	-3.549	392.737	392.754
T	4479.983	-16.341	392.480	392.487	T	4479.961	-12.000	392.567	392.574	T	4479.952	-9.924	392.608	392.616	T	4479.921	-3.508	392.737	392.744
Pier #3	4487.791	-16.298	392.480	392.480	Pier #3	4487.765	-12.000	392.566	392.566	Pier #3	4487.752	-9.882	392.608	392.608	Pier #3	4487.713	-3.465	392.737	392.737
U	4497.758	-16.229	392.480	392.489	U	4497.725	-12.000	392.565	392.574	U	4497.709	-9.813	392.609	392.618	U	4497.660	-3.396	392.737	392.746
V	4507.725	-16.145	392.481	392.499	V	4507.686	-12.000	392.564	392.582	V	4507.666	-9.729	392.609	392.627	V	4507.607	-3.312	392.737	392.755
W	4517.692	-16.045	392.482	392.507	W	4517.647	-12.000	392.563	392.588	W	4517.623	-9.629	392.610	392.635	W	4517.554	-3.212	392.738	392.763
X	4527.658	-15.929	392.483	392.513	X	4527.608	-12.000	392.562	392.592	X	4527.579	-9.513	392.611	392.642	X	4527.501	-3.097	392.740	392.770
Y	4537.624	-15.798	392.484	392.508	Y	4537.569	-12.000	392.560	392.584	Y	4537.539	-9.392	392.613	392.636	Y	4537.447	-2.966	392.741	392.764
Z	4547.590	-15.639	392.486	392.500	Z	4547.534	-12.000	392.559	392.575	Z	4547.502	-9.223	392.615	392.629	Z	4547.421	-2.806	392.743	392.757
AI	4557.556	-15.479	392.484	392.490	AI	4557.537	-12.000	392.558	392.565	AI	4557.502	-9.293	392.612	392.618	AI	4557.486	-2.874	392.742	392.748
Pier #4	4565.369	-15.797	392.481	392.481	Pier #4	4565.300	-12.000	392.557	392.557	Pier #4	4565.252	-9.381	392.609	392.609	Pier #4	4565.136	-2.964	392.738	392.738
BI	4570.354	-15.634	392.480	392.483	BI	4570.281	-12.000	392.556	392.561	BI	4570.232	-9.418	392.609	392.612	BI	4570.111	-3.001	392.737	392.740
CI	4580.324	-15.897	392.478	392.492	CI	4580.244	-12.000	392.555	392.570	CI	4580.192	-9.481	392.606	392.620	CI	4580.061	-3.064	392.735	392.749
DI	4590.294	-15.946	392.476	392.502	DI	4590.207	-12.000	392.554	392.579	DI	4590.153	-9.530	392.604	392.630	DI	4590.011	-3.113	392.733	392.759
EI	4600.265	-15.979	392.474	392.506	EI	4600.171	-12.000	392.553	392.584	EI	4600.113	-9.563	392.603	392.635	EI	4599.961	-3.146	392.731	392.763
FI	4610.235	-15.996	392.473	392.503	FI	4610.135	-12.000	392.552	392.579	FI	4610.073	-9.580	392.601	392.631	FI	4609.912	-3.163	392.730	392.760
GI	4620.206	-15.996	392.471	392.489	GI	4620.099	-12.000	392.551	392.567	GI	4620.034	-9.580	392.599	392.617	GI	4619.862	-3.163	392.728	392.746
Br. So. Abut.	4630.176	-15.982	392.470	392.470	Br. So. Abut.	4630.063	-12.000	392.550	392.550	Br. So. Abut.	4629.994	-9.566	392.599	392.599	Br. So. Abut.	4629.813	-3.149	392.727	392.727
Bk. So. Abut.	4632.170	-15.977	392.470	392.470	Bk. So. Abut.	4632.056	-12.000	392.550	392.550	Bk. So. Abut.	4631.987	-9.561	392.599	392.599	Bk. So. Abut.	4631.803	-3.144	392.727	392.727

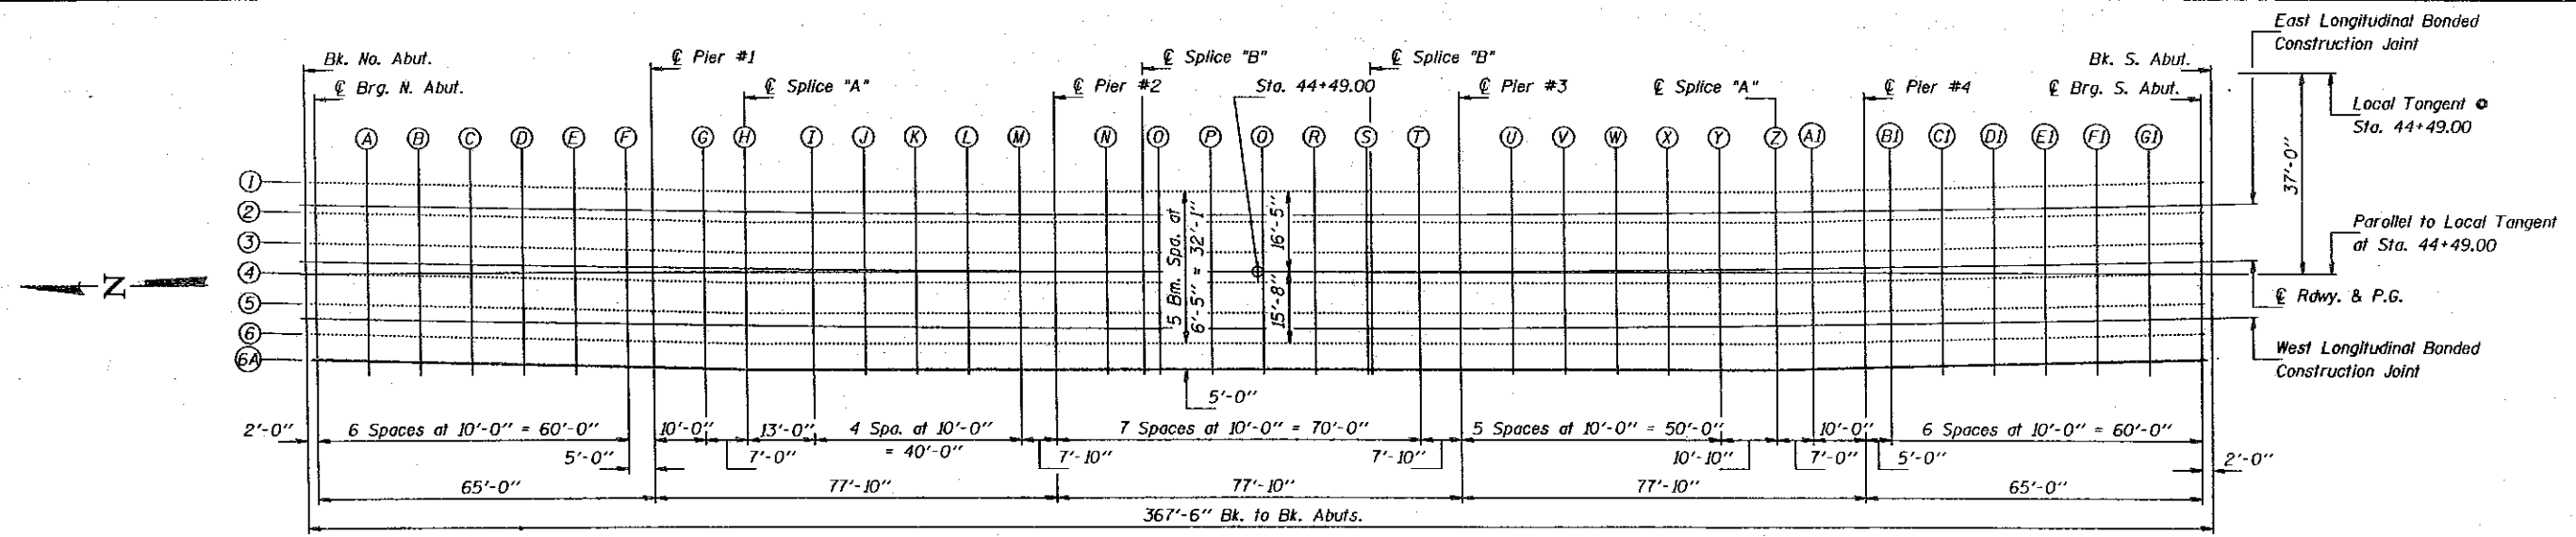


DESIGNED *Steven Hageman*  
 CHECKED *John F. Schneller Jr.*  
 DRAWN *John F. Schneller Jr.*  
 EXAMINED *Raj D. Kasper*  
 PASSED *Raj D. Kasper*  
 APPROVED *Raj D. Kasper*  
 May 20 1993

PLAN  
 NOTE:  
 Work this sheet with sheets #4 & #5 of 25.

TOP OF SLAB ELEVATIONS  
 F.A.I. RT 57 SEC. (28-5B)D-1  
 FRANKLIN COUNTY  
 STATION 44+49.00

STATE OF ILLINOIS  
DEPARTMENT OF TRANSPORTATION


ROUTE NO.	SECTION	COUNTY	DATE	SHEET NO.
F.A.I. 57	(28-5B) D-1	FRANKLIN		25 SHEETS
FED. ROAD DIST. NO. 7	BLANCK	FED. AID PROJECT		

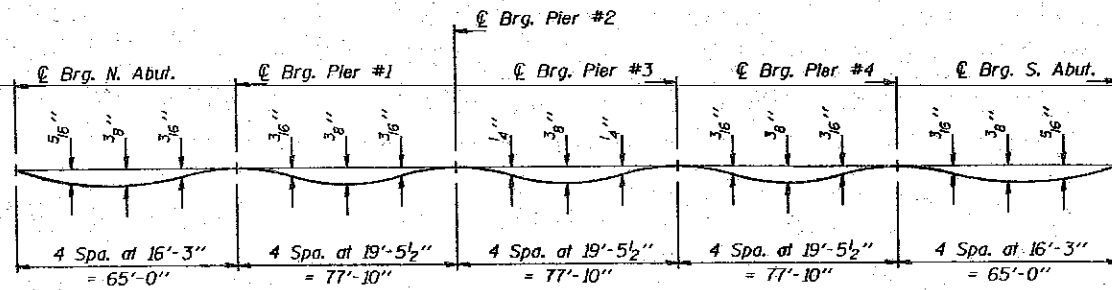

DEAD LOAD DEFLECTION DIAGRAM

(Includes weight of concrete only)

Note: The above deflections are not to be used in the field if the engineer is working from the grade elevations adjusted for dead load deflections as shown below and on sheets #3 & #5 of 25.

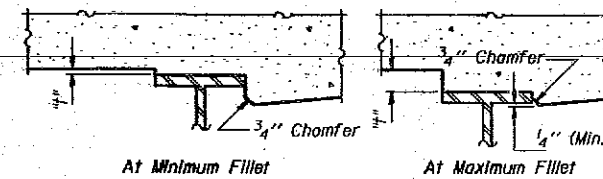

To determine "f": After all structural steel has been erected, elevations of the top flanges of the beams shall be taken at intervals shown on sheets #3, #4 & #5 of 25. These elevations subtracted from the "Theoretical Grade Elevations Adjusted for Dead Load Deflection" shown on sheets #3, #4 & #5 of 25, minus slab thickness, equals the fillet heights "f" above top flange of beams.

FILLET HEIGHTS

RDWY. & P.G.

Location	Station	Offset	Theoretical Grade Elevations	Theoretical Grade Elevations Adjusted For Dead Load Deflection
Bk. No. Abut.	4266.287	0.000	392.830	392.830
Brg. No. Abut.	4268.276	0.000	392.830	392.830
A	4278.222	0.000	392.829	392.847
B	4288.168	0.000	392.827	392.857
C	4298.113	0.000	392.826	392.858
D	4308.058	0.000	392.825	392.851
E	4318.002	0.000	392.824	392.838
F	4327.946	0.000	392.823	392.825
Pier #1	4332.918	0.000	392.823	392.823
G	4342.862	0.000	392.821	392.827
H	4349.822	0.000	392.821	392.835
I	4362.749	0.000	392.819	392.844
J	4372.692	0.000	392.818	392.848
K	4392.634	0.000	392.817	392.840
L	4392.577	0.000	392.816	392.832
M	4402.520	0.000	392.815	392.823
Pier #2	4410.308	0.000	392.814	392.814
N	4420.250	0.000	392.813	392.823
O	4430.193	0.000	392.812	392.831
P	4440.135	0.000	392.811	392.837
Q	4450.077	0.000	392.810	392.841
R	4460.019	0.000	392.809	392.833
S	4469.962	0.000	392.807	392.825
T	4479.904	0.000	392.806	392.813
Pier #3	4487.692	0.000	392.805	392.805
U	4497.634	0.000	392.804	392.813
V	4507.577	0.000	392.803	392.821
W	4517.520	0.000	392.802	392.826
X	4527.463	0.000	392.801	392.831
Y	4537.406	0.000	392.800	392.823
Z	4548.349	0.000	392.799	392.813
AI	4556.138	0.000	392.798	392.804
Pier #4	4565.082	0.000	392.797	392.797
BI	4570.054	0.000	392.796	392.800
CI	4579.998	0.000	392.795	392.809
DI	4589.942	0.000	392.794	392.820
EI	4599.887	0.000	392.793	392.825
FI	4609.832	0.000	392.792	392.822
GI	4619.778	0.000	392.791	392.809
Brg. So. Abut.	4629.724	0.000	392.790	392.790
Bk. So. Abut.	4631.713	0.000	392.790	392.790

BEAM #4

Location	Station	Offset	Theoretical Grade Elevations	Theoretical Grade Elevations Adjusted For Dead Load Deflection
Bk. No. Abut.	4266.380	3.273	392.895	392.895
Brg. No. Abut.	4268.368	3.268	392.895	392.895
A	4278.309	3.254	392.894	392.912
B	4288.249	3.254	392.893	392.921
C	4298.190	3.271	392.892	392.924
D	4308.130	3.304	392.891	392.917
E	4318.071	3.353	392.891	392.905
F	4328.011	3.416	392.891	392.894
Pier #1	4332.981	3.453	392.892	392.892
G	4342.921	3.541	392.893	392.899
H	4349.878	3.611	392.893	392.907
I	4362.795	3.421	392.888	392.913
J	4372.731	3.293	392.884	392.915
K	4382.667	3.181	392.881	392.904
L	4392.604	3.085	392.878	392.894
M	4402.542	3.004	392.875	392.882
Pier #2	4410.326	2.952	392.873	392.873
N	4420.263	2.899	392.871	392.881
O	4430.201	2.861	392.869	392.888
P	4440.139	2.840	392.868	392.894
Q	4450.077	2.833	392.867	392.898
R	4460.014	2.843	392.866	392.890
S	4469.952	2.868	392.865	392.882
T	4479.890	2.909	392.865	392.872
Pier #3	4487.674	2.952	392.865	392.865
U	4497.611	3.020	392.865	392.874
V	4507.549	3.104	392.866	392.884
W	4517.485	3.204	392.867	392.892
X	4527.422	3.319	392.868	392.898
Y	4537.358	3.450	392.869	392.893
Z	4548.292	3.611	392.871	392.885
AI	4555.079	3.541	392.870	392.876
Pier #4	4565.019	3.453	392.866	392.866
BI	4569.989	3.416	392.865	392.868
CI	4579.929	3.353	392.863	392.877
DI	4589.870	3.304	392.861	392.887
EI	4599.810	3.271	392.859	392.891
FI	4609.751	3.254	392.858	392.888
GI	4619.691	3.254	392.856	392.874
Brg. So. Abut.	4629.632	3.268	392.855	392.855
Bk. So. Abut.	4631.620	3.273	392.855	392.855

BEAM #5

Location	Station	Offset	Theoretical Grade Elevations	Theoretical Grade Elevations Adjusted For Dead Load Deflection
Bk. No. Abut.	4266.563	9.689	393.024	393.024
Brg. No. Abut.	4268.549	9.684	393.024	393.024
A	4278.479	9.670	393.022	393.040
B	4288.410	9.670	393.021	393.051
C	4298.341	9.667	393.021	393.053
D	4308.271	9.720	393.019	393.045
E	4318.202	9.769	393.019	393.033
F	4328.132	9.832	393.020	393.023
Pier #1	4333.097	9.869	393.020	393.020
G	4343.027	9.957	393.021	393.027
H	4349.977	10.027	393.022	393.036
I	4362.881	9.837	393.016	393.041
J	4372.807	9.709	393.013	393.043
K	4382.734	9.598	393.009	393.033
L	4392.661	9.501	393.006	393.022
M	4402.588	9.421	393.004	393.011
Pier #2	4410.364	9.368	393.002	393.002
N	4420.292	9.315	393.000	393.009
O	4430.220	9.278	392.998	393.017
P	4440.148	9.256	392.996	393.022
Q	4450.075	9.250	392.995	393.026
R	4460.003	9.260	392.994	393.018
S	4469.931	9.295	392.993	393.010
T	4479.859	9.325	392.993	393.001
Pier #3	4487.635	9.368	392.993	392.993
U	4497.563	9.437	392.994	393.003
V	4507.490	9.521	392.994	393.012
W	4517.417	9.620	392.995	393.021
X	4527.343	9.736	392.996	393.027
Y	4537.270	9.867	392.998	393.021
Z	4548.202	10.027	393.000	393.014
AI	4554.970	9.957	392.998	393.004
Pier #4	4564.900	9.869	392.994	392.994
BI	4569.870	9.832	392.994	392.997
CI	4579.800	9.769	392.991	393.005
DI	4589.730	9.720	392.989	393.015
EI	4599.660	9.687	392.988	393.020
FI	4609.590	9.670	392.986	393.016
GI	4619.520	9.670	392.984	393.002
Brg. So. Abut.	4629.450	9.684	392.984	392.984
Bk. So. Abut.	4631.440	9.689	392.984	392.984

WEST LONGITUDINAL BONDED CONSTRUCTION JOINT

Location	Station	Offset	Theoretical Grade Elevations	Theoretical Grade Elevations Adjusted For Dead Load Deflection
Bk. No. Abut.	4266.629	12.000	393.070	393.070
Brg. No. Abut.	4268.614	12.000	393.070	393.070
A	4278.538	12.000	393.069	393.085
B	4288.461	12.000	393.068	393.095
C	4298.385	12.000	393.067	393.087
D	4308.309	12.000	393.065	393.089
E	4318.232	12.000	393.064	393.079
F	4328.156	12.000	393.063	393.068
Pier #1	4333.135	12.000	393.063	393.063
G	4343.059	12.000	393.062	393.070
H	4349.988	12.000	393.061	393.078
I	4362.906	12.000	393.059	393.084
J	4372.830	12.000	393.058	393.089
K	4382.753	12.000	393.057	393.081
L	4392.677	12.000	393.056	393.072
M	4402.601	12.000	393.055	393.062
Pier #2	4410.380	12.000	393.054	393.054
N	4420.304	12.000	393.053	393.063
O	4430.228	12.000	393.052	393.071
P	4440.151	12.000	393.051	393.077
Q	4450.075	12.000	393.050	393.081
R	4460.003	12.000	393.049	393.073
S	4469.927	12.000	393.048	393.065
T	4479.846	12.000	393.047	393.054
Pier #3	4487.620	12.000	393.046	393.046
U	4497.543	12.000	393.045	393.054
V	4507.467	12.000	393.044	393.062
W	4517.390	12.000	393.043	393.068
X	4527.314	12.000	393.042	393.072
Y	4537.238	12.000	393.040	393.064
Z	4547.162	12.000	393.039	393.054
AI	4554.940	12.000	393.038	393.047
Pier #4	4564.865	12.000	393.037	393.037
BI	4569.827	12.000	393.036	393.041
CI	4579.753	12.000	393.035	393.050
DI	4589.679	12.000	393.034	393.059
EI	4599.605	12.000	393.033	393.064
FI	4609.532	12.000	393.032	393.059
GI	4619.459	12.000	393.031	393.047
Brg. So. Abut.	4629.386	12.000	393.030	393.030
Bk. So. Abut.	4631.371	12.000	393.030	393.030

DESIGNED *Steven Hageman*  
CHECKED *John F. Schneller Jr.*  
DRAWN *John F. Schneller Jr.*  
CHECKED *SPV LHB*

EXAMINED *Greg J. Kaspar*  
PASSED *Ralph E. Carlson*  
APPROVED \_\_\_\_\_  
DIRECTOR OF HIGHWAYS

May 20 1993

NOTE:  
Work this sheet with sheets #3 & #5 of 25.

TOP OF SLAB ELEVATIONS  
F.A.I. RT 57 SEC. (28-5B)D-1  
FRANKLIN COUNTY  
STATION 44+49.00

STATE OF ILLINOIS  
DEPARTMENT OF TRANSPORTATION

ROUTE NO.	SECTION	COUNTY	DATE	SHEET NO.
F.A.I. 57	(28-5B) D-1	FRANKLIN	88	25 SHEETS
FEDERAL DIST. NO.	ILLINOIS	FED. AID PROJECT		

BEAM #6

Location	Station	Offset	Theoretical Grade Elevations	Theoretical Grade Elevations Adjusted For Dead Load Deflection
Bk. No. Abut.	4266.745	16.106	393.152	393.152
€ Brg. No. Abut.	4268.729	16.101	393.152	393.152
A	4278.650	16.087	393.151	393.169
B	4288.571	16.087	393.150	393.180
C	4298.491	16.104	393.148	393.180
D	4308.412	16.137	393.148	393.174
E	4318.332	16.186	393.148	393.162
F	4328.253	16.249	393.148	393.151
€ Pier #1	4333.213	16.286	393.149	393.149
G	4343.133	16.374	393.149	393.155
H	4350.076	16.444	393.150	393.164
I	4362.967	16.253	393.145	393.169
J	4372.883	16.125	393.141	393.171
K	4382.800	16.014	393.138	393.161
L	4392.717	15.918	393.135	393.151
M	4402.634	15.837	393.132	393.139
€ Pier #2	4410.403	15.785	393.130	393.130
N	4420.321	15.732	393.128	393.137
O	4430.239	15.695	393.126	393.145
P	4440.156	15.673	393.125	393.150
Q	4450.074	15.667	393.123	393.155
R	4459.992	15.676	393.122	393.147
S	4469.910	15.701	393.122	393.139
T	4479.828	15.742	393.122	393.129
€ Pier #3	4487.597	15.785	393.122	393.122
U	4497.514	15.853	393.122	393.131
V	4507.432	15.937	393.122	393.140
W	4517.349	16.037	393.123	393.148
X	4527.265	16.152	393.125	393.155
Y	4537.181	16.283	393.126	393.149
Z	4547.098	16.444	393.128	393.142
AI	4554.870	16.374	393.126	393.132
€ Pier #4	4564.790	16.286	393.123	393.123
BI	4569.750	16.249	393.122	393.125
CJ	4579.670	16.186	393.120	393.134
DI	4589.590	16.137	393.118	393.144
EJ	4599.510	16.104	393.116	393.148
FJ	4609.430	16.087	393.115	393.145
GI	4619.350	16.087	393.114	393.132
€ Brg. So. Abut.	4629.270	16.101	393.112	393.112
Bk. So. Abut.	4631.260	16.106	393.112	393.112

BEAM #6A

Location	Station	Offset	Theoretical Grade Elevations	Theoretical Grade Elevations Adjusted For Dead Load Deflection
Bk. No. Abut.	4266.885	21.106	393.252	393.252
€ Brg. No. Abut.	4268.867	21.101	393.252	393.252
A	4278.780	21.087	393.251	393.269
B	4288.693	21.087	393.250	393.280
C	4298.606	21.104	393.248	393.280
D	4308.519	21.137	393.248	393.274
E	4318.432	21.186	393.248	393.262
F	4328.345	21.249	393.248	393.251
€ Pier #1	4333.301	21.286	393.249	393.249
G	4343.214	21.374	393.249	393.255
H	4350.152	21.444	393.250	393.264
I	4362.034	21.253	393.245	393.269
J	4372.943	21.125	393.241	393.271
K	4382.852	21.014	393.238	393.261
L	4392.761	20.917	393.235	393.251
M	4402.670	20.837	393.232	393.239
€ Pier #2	4410.433	20.785	393.230	393.230
N	4420.343	20.732	393.228	393.237
O	4430.253	20.695	393.226	393.245
P	4440.163	20.673	393.225	393.250
Q	4450.074	20.667	393.223	393.255
R	4459.984	20.676	393.222	393.247
S	4469.894	20.701	393.222	393.239
T	4479.804	20.742	393.222	393.229
€ Pier #3	4487.567	20.785	393.222	393.222
U	4497.477	20.853	393.222	393.231
V	4507.386	20.937	393.222	393.240
W	4517.295	21.036	393.223	393.248
X	4527.204	21.152	393.225	393.255
Y	4537.113	21.282	393.226	393.249
Z	4547.028	21.444	393.228	393.242
AI	4554.786	21.374	393.226	393.232
€ Pier #4	4564.699	21.286	393.223	393.223
BI	4569.655	21.249	393.222	393.225
CJ	4579.568	21.186	393.222	393.234
DI	4589.481	21.137	393.218	393.244
EJ	4599.394	21.104	393.216	393.248
FJ	4609.307	21.087	393.215	393.245
GI	4619.220	21.087	393.214	393.232
€ Brg. So. Abut.	4629.130	21.101	393.212	393.212
Bk. So. Abut.	4631.120	21.106	393.212	393.212

DESIGNED *Steven M. Johnson*  
CHECKED *John P. Schneller Jr.*  
DRAWN *John P. Schneller Jr.*  
CHECKED *John P. Schneller Jr.*

EXAMINED *Gregory D. Kasper*  
PASSED *Ralph E. Anderson*  
APPROVED \_\_\_\_\_

May 20 1993

ENGINEER OF BRIDGE DESIGN  
ENGINEER OF BRIDGES AND STRUCTURES  
DIRECTOR OF HIGHWAYS


NOTE:  
Work this sheet with sheets  
#3 & #4 of 25.

TOP OF SLAB ELEVATIONS  
F.A.I. RT 57 SEC. (28-5B)D-1  
FRANKLIN COUNTY  
STATION 44+49.00




STATE OF ILLINOIS  
DEPARTMENT OF TRANSPORTATION

ROUTE NO.	SECTION	COUNTY	DATE	SCALE	SHEET NO. 5
F.A.I. 57	(28-5B) D-1	FRANKLIN		1/4"	25 SHEETS
FED. ROAD DIST. NO. 7	ALIGNED	FED. AID PROJECT			

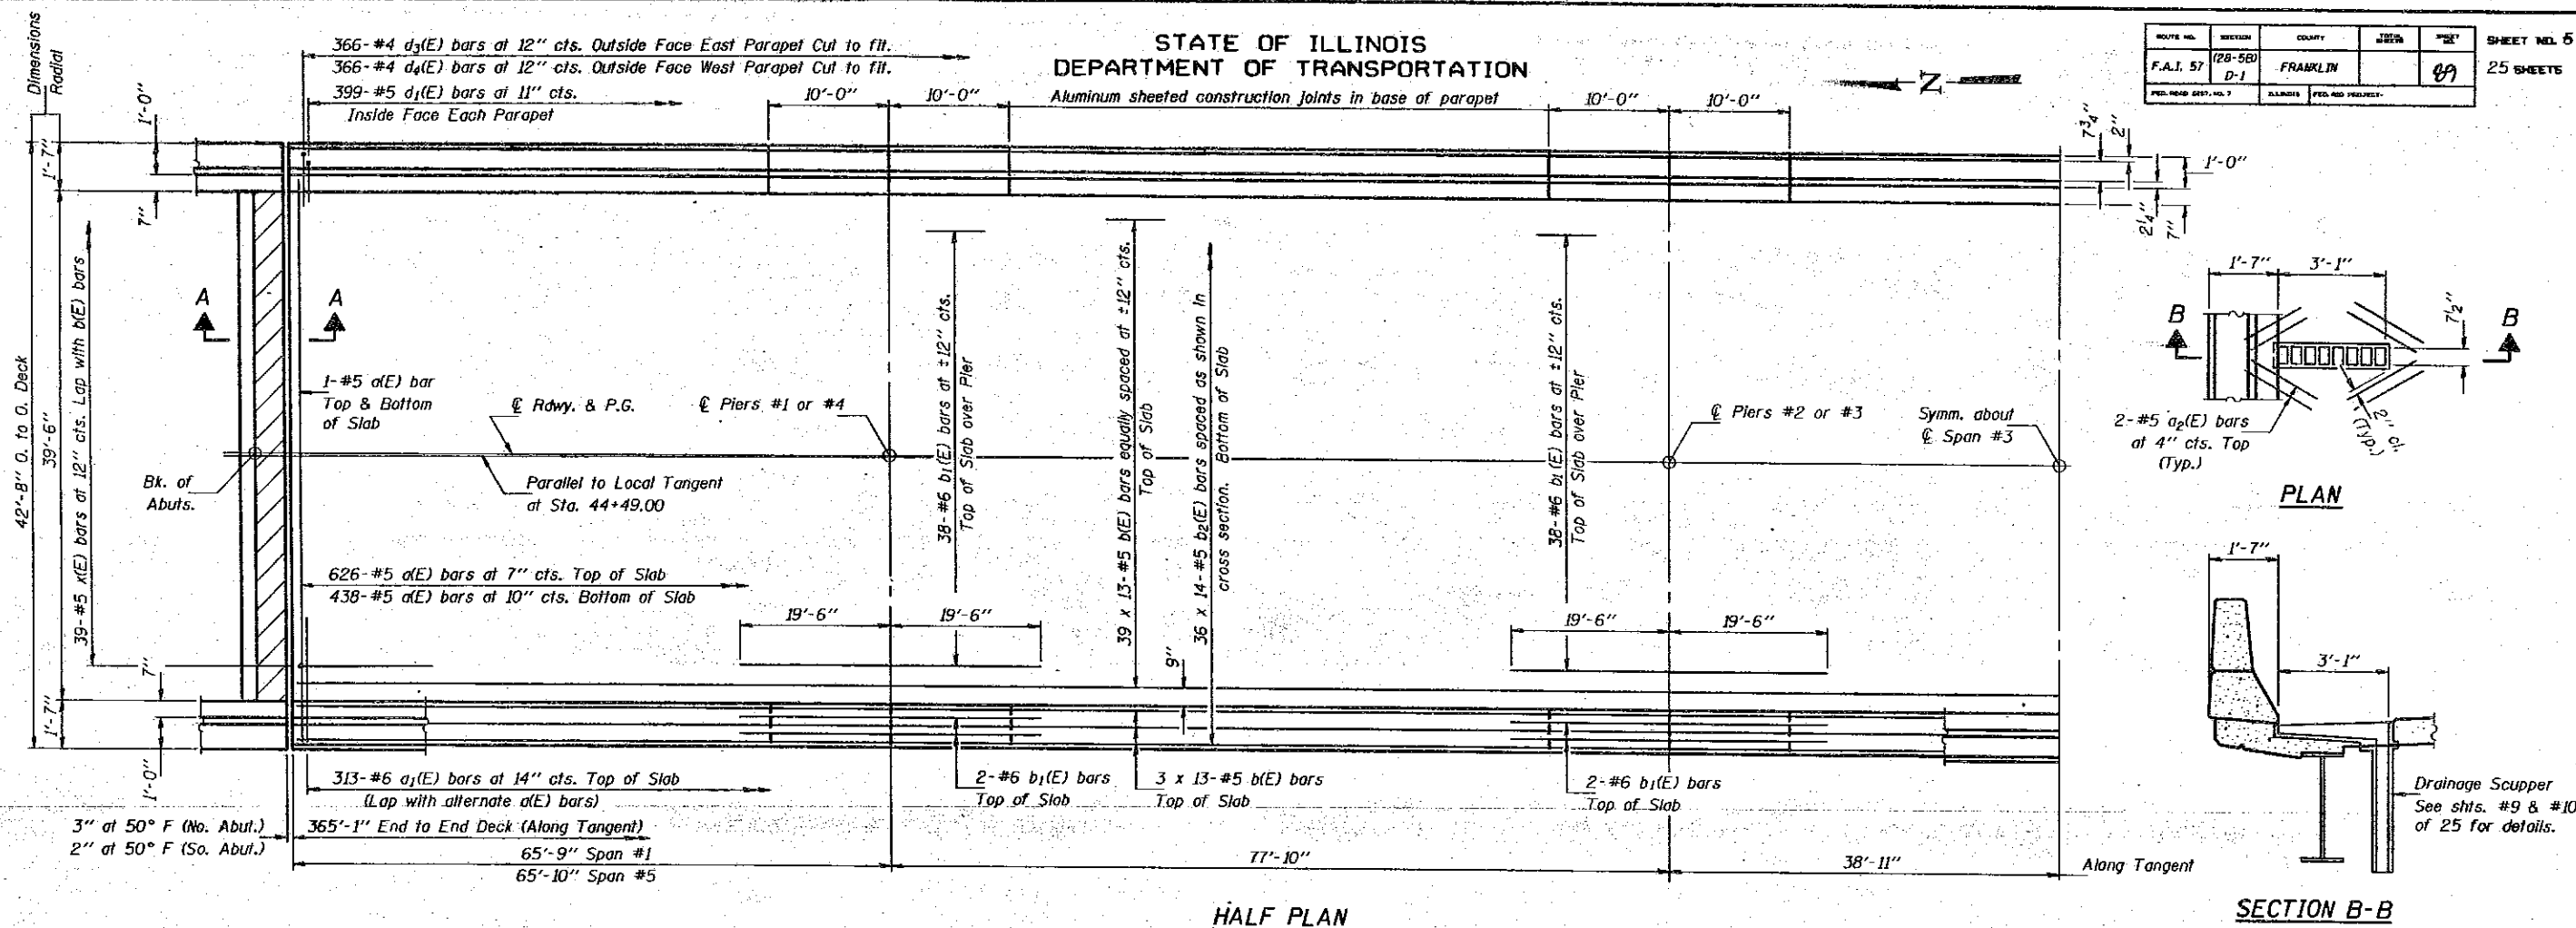

**MIN. BAR LAPS**  
#5 (E) bar = 2'-2"

Notes: See Sheet #7 of 25 for superstructure details and Bill of Material.  
Reinforcement bars designated (E) shall be epoxy coated.  
Bars indicated thus 20 x 3-#5 etc. indicates 20 lines of bars with 3 lengths per line.  
See Sheet #7 of 25 for parapet reinforcement.

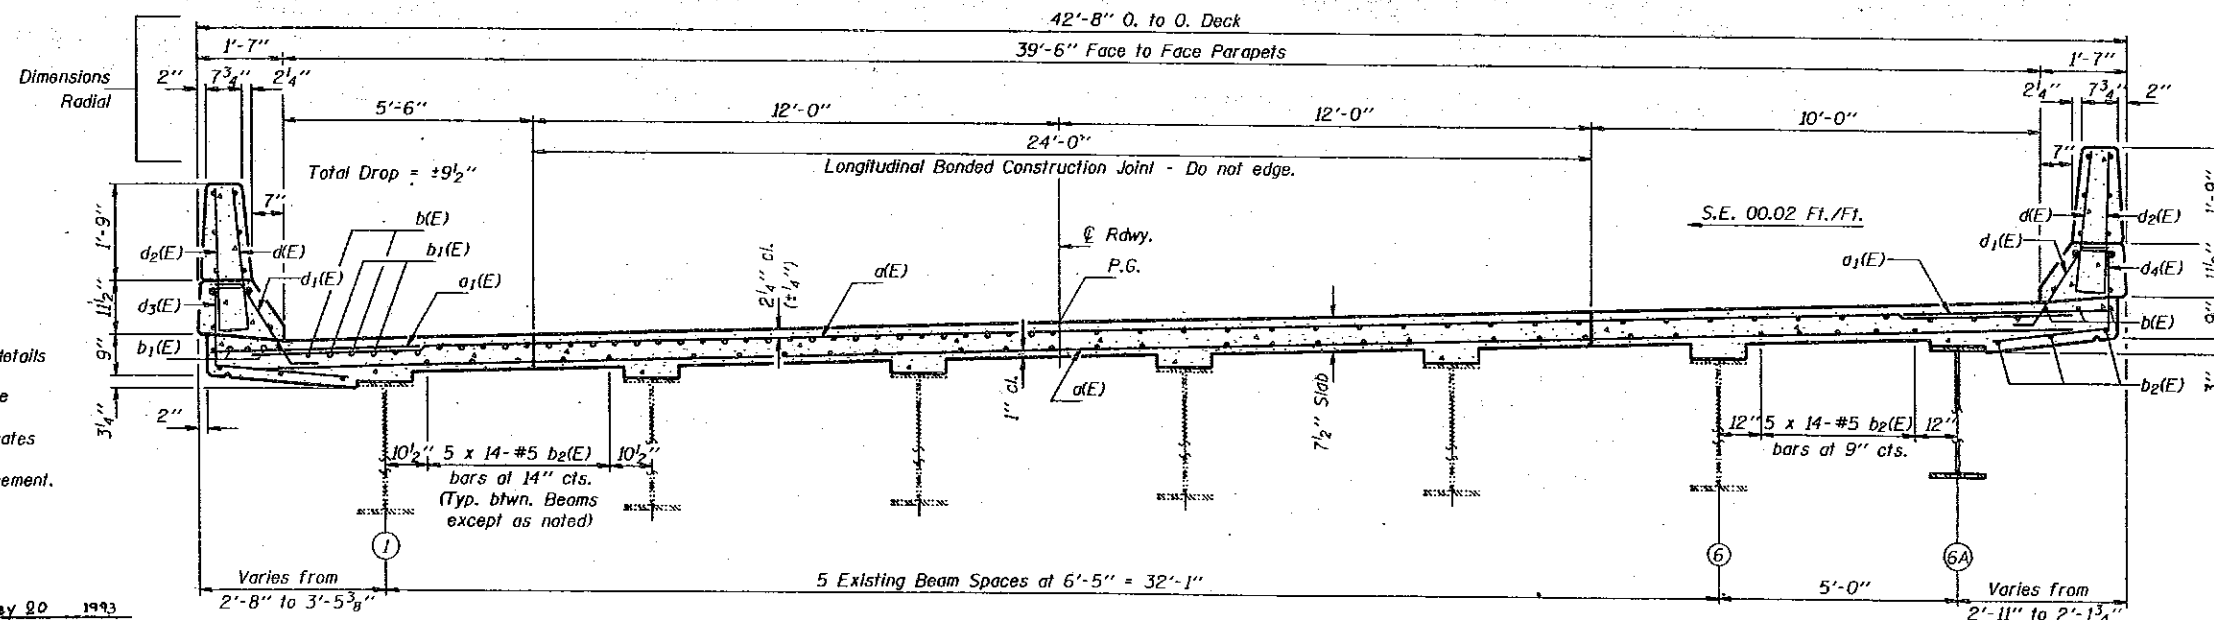

DESIGNED *Steven Negandhi*  
CHECKED *AD*  
DRAWN *John F. Schneller Jr.*  
CHECKED *SPN*

EXAMINED *Gregory J. Kaspar*  
PASSED *Ralph E. Anderson*  
APPROVED


May 20 1993

ENGINEER OF BRIDGE DESIGN  
ENGINEER OF BRIDGES AND STRUCTURES  
DIRECTOR OF HIGHWAYS


**SUPERSTRUCTURE**  
F.A.I. RT. 57 SEC. (28-5B)D-1  
FRANKLIN COUNTY  
STA. 44+49.00

STATE OF ILLINOIS  
DEPARTMENT OF TRANSPORTATION



PROJECT NO.	SECTION	COUNT	DATE	REV.	SHEET NO.
F.A.I. 57	(28-5B)	FRANKLIN		00	25 SHEETS
FED. ROAD DIST. NO. 7	ROADS	FED. AID PROJECT			

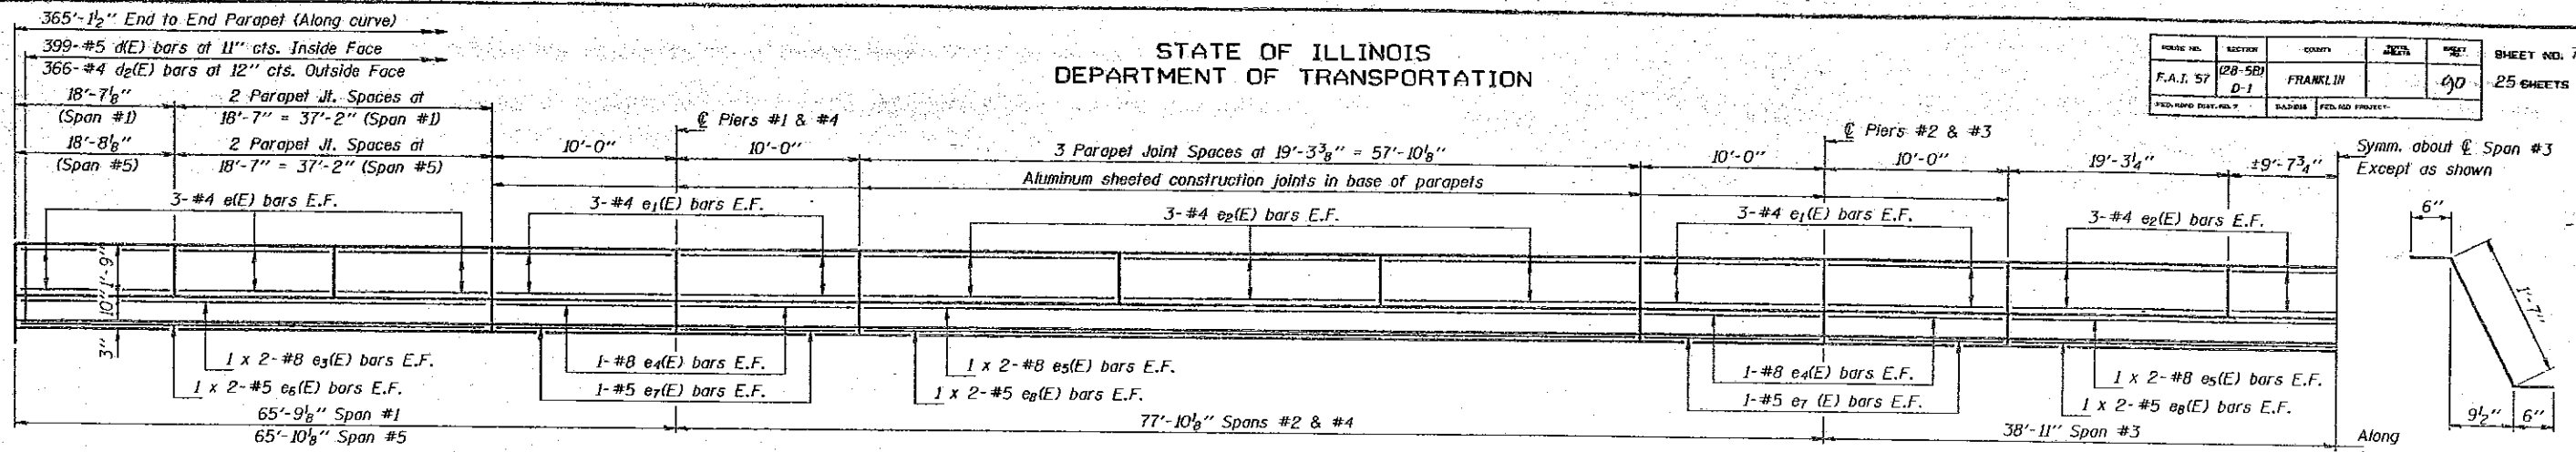

INSIDE ELEVATION OF PARAPET

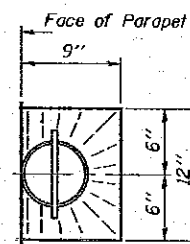

TOP PLAN

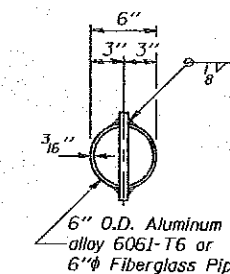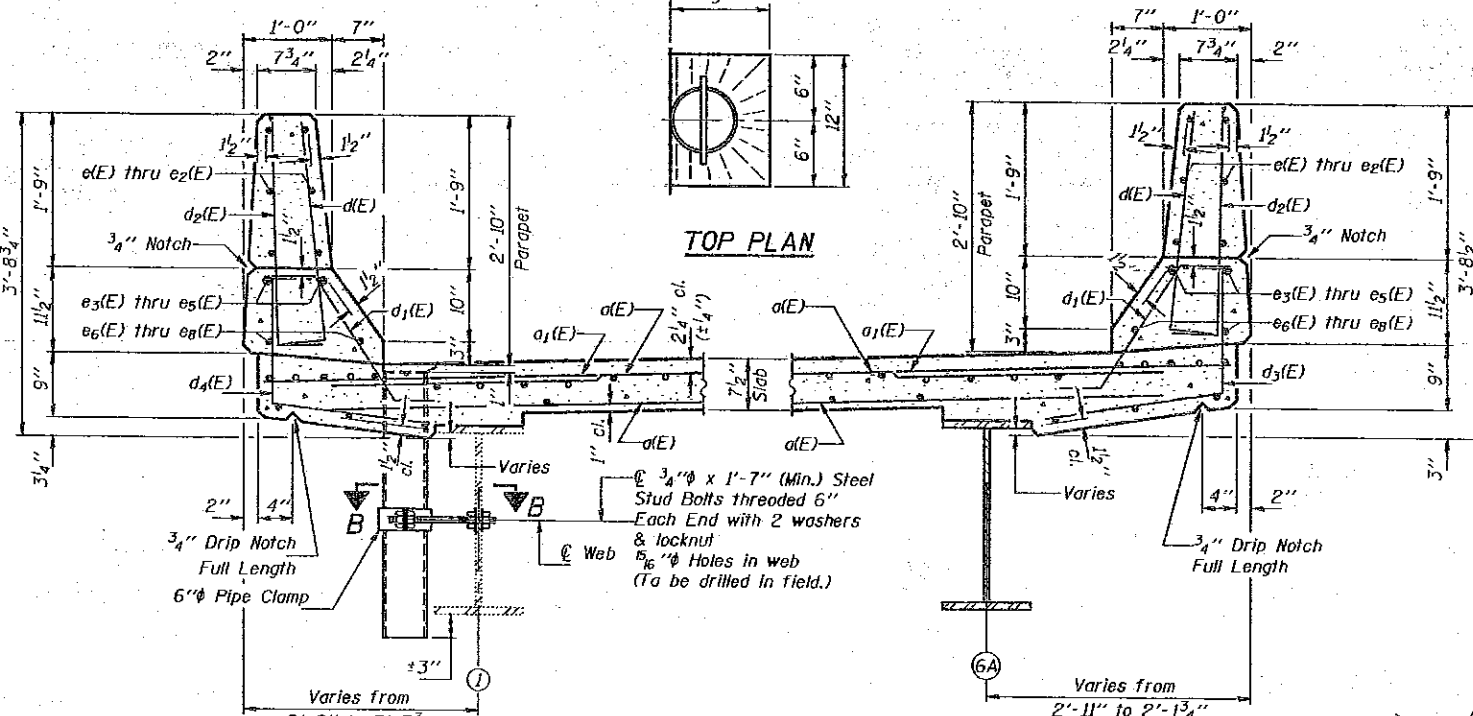






MIN. BAR LAPS  
#5 (E) bar = 2'-2"  
#8 (E) bar = 4'-6"

SUPERSTRUCTURE  
BILL OF MATERIAL

Bar	No.	Size	Length	Shape
a(E)	1068	#5	40'-6"	—
a1(E)	626	#6	4'-6"	—
a2(E)	32	#5	2'-0"	—
b(E)	585	#5	30'-1"	—
b1(E)	168	#6	39'-0"	—
b2(E)	504	#5	28'-1"	—
d(E)	798	#5	3'-0"	—
d1(E)	798	#5	2'-7"	—
d2(E)	732	#4	3'-0"	—
d3(E)	366	#4	3'-11"	—
d4(E)	366	#4	4'-4"	—
e(E)	72	#4	18'-4"	—
e1(E)	96	#4	9'-9"	—
e2(E)	108	#4	19'-0"	—
e3(E)	16	#8	30'-0"	—
e4(E)	32	#8	9'-9"	—
e5(E)	24	#8	31'-1"	—
e6(E)	16	#5	28'-10"	—
e7(E)	32	#5	9'-9"	—
e8(E)	24	#5	30'-0"	—
x(E)	78	#5	4'-1"	—
Reinforcement Bars (Epoxy Coated)		Lbs.	109,380	
Class X Concrete Superstructure		Cu. Yds.	464.0	

SECTION THRU EAST PARAPET

SECTION THRU WEST PARAPET

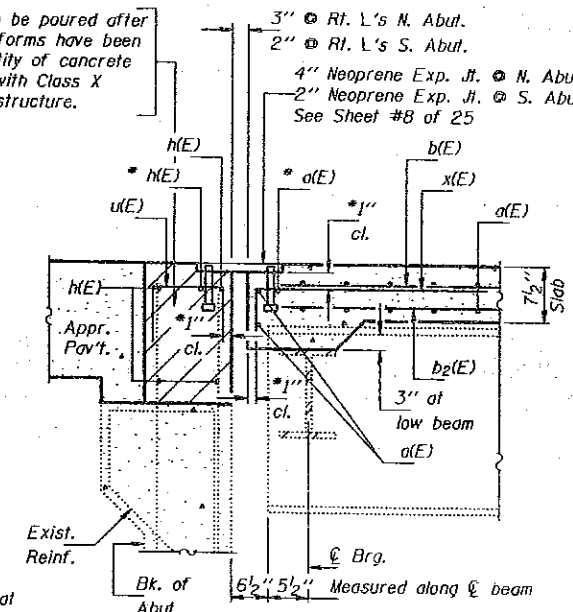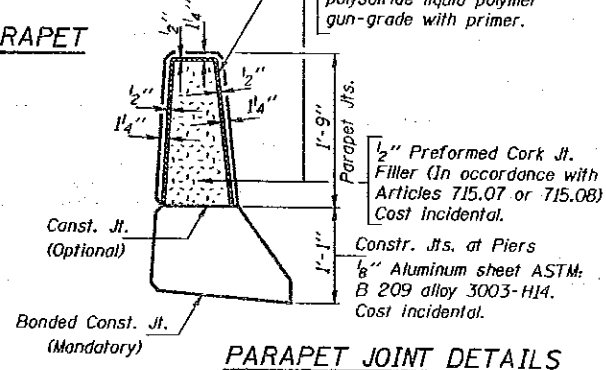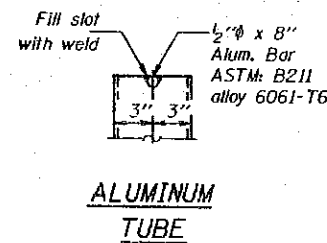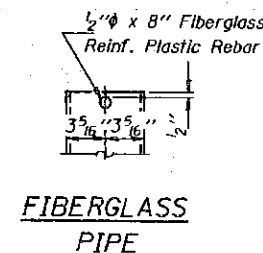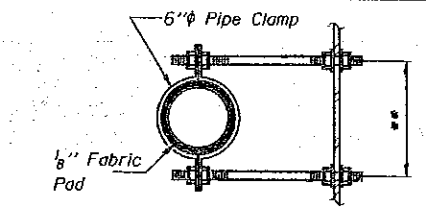

DESIGNED *Steve Thompson*  
CHECKED *John F. Schneller Jr.*  
DRAWN *John F. Schneller Jr.*  
MAY 20 1993  
EXAMINED *Ralph E. Anderson*  
PASSED *Ralph E. Anderson*  
APPROVED *Ralph E. Anderson*  
DIRECTOR OF HIGHWAYS

Notes:  
The exterior surfaces of the Floor Drain shall be painted with the vinyl enamel coat painting specified for Structural Steel. The exterior surfaces of the Drain shall be cleaned and given a washcoat pretreatment in accordance with Steel Structures Painting Council's Spec. SSPC-SPI & SSPC-Paint 27 prior to painting.  
Fiberglass pipe shall conform to ASTM: D2996, with short-time rupture strength hoop tensile stress of 30,000 p.s.i. minimum. The surface of the Fiberglass pipe shall be free of bond inhibiting agents.

SECTION A-A  
Place a(E) bars and h(E) bars in back of anchor bolts as shown if required to maintain 1" cl. (+0-1/8"). Anchor bolts should be tied to a(E) and h(E)

SUPERSTRUCTURE  
F.A.I. RT. 57 SEC. (28-5B)D-1  
FRANKLIN COUNTY  
STA. 44+49.00

STATE OF ILLINOIS  
DEPARTMENT OF TRANSPORTATION

PROJECT NO.	SECTION	CONTRACT	DATE	SHEET NO.
F.A.I. 57	(28-5B) D-1	FRANKLIN		25 SHEETS
P.O. NO. DIST. NO. 7	BAIDEN	PER. AND PROJECT		

Joint Size	"C" at 50°F	"D" at 50°F
2"	2"	1 1/2" Min.
2 1/2"	2 1/2"	1 3/4" Min.
4"	3"	2 1/2" Min.



**INSTALLATION NOTES**

- Install sponge mandrels into positions shown to form flap convolution.
- Install parapet or sidewalk piece (trim roadway flap to fit before applying epoxy).
- Install continuous seal in roadway.
- Install anchor blocks as indicated.

NOTE A: Maximum spacing of anchor bolts shall be 12" centers.

**SKEW LIMITATIONS**






The details of the anchor blocks and the elastomeric membrane in the parapet, as shown, are for up to 50° skews. For skews greater than 50°, the anchor blocks and the elastomeric membrane, installed in accordance with dimension "D", might require modifications to insure a minimum clearance of 1/2" from centerline of anchor studs to edge of parapet opening. The anchor blocks and the elastomeric membrane shall also be installed to the top of the parapet with the anchor studs spaced at ±12" cts.

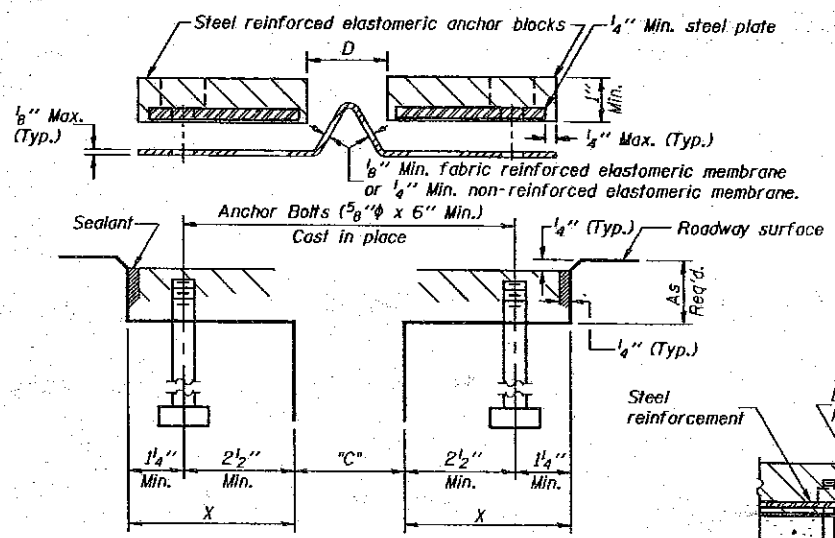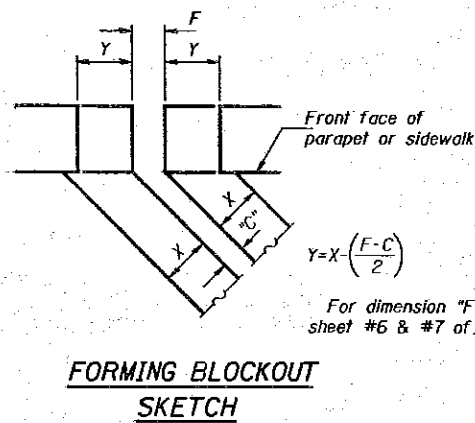

**ANCHOR BLOCK REINFORCEMENT WITH ASPHALT SURFACE**

**GENERAL NOTES**

Continuous Seal Neoprene Expansion Joint shall consist of molded anchor blocks of elastomer and steel, field assembled over continuous lengths of elastomeric membrane.  
The elastomeric membrane shall be premolded with a single or a double upward convolution that will have a "memory" to return to its molded position upon joint closure.  
The steel reinforcement must extend up the back face of anchor blocks when asphalt surfaces are used but is optional in concrete blockout.  
The convolution length shall be such that the extended length will not be greater than the manufactured length when the joint is fully expanded in its design range and will not protrude above the anchor blocks when the joint is fully compressed.  
Joint openings shall be adjusted in accordance with Article 503.07(c) of the Standard Specifications when the deck is poured at an ambient temperature other than 50° F.  
The parapet and sidewalk flaps may be furnished factory vulcanized to the roadway membrane provided the centerline of the convolution is maintained and the process and method meet the approval of the Engineer.

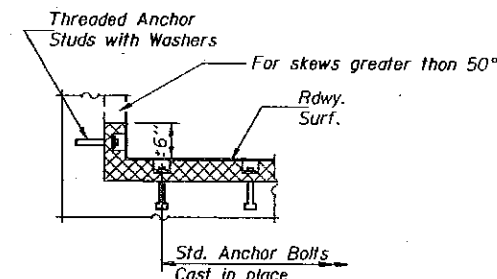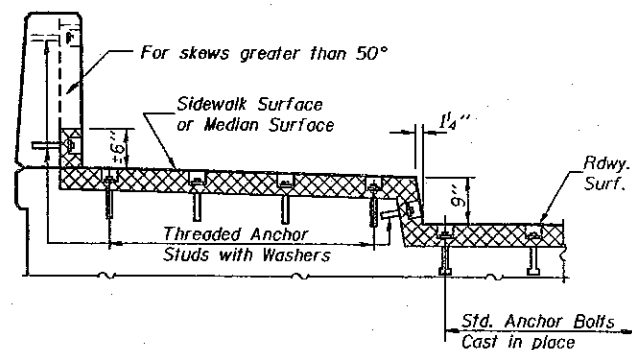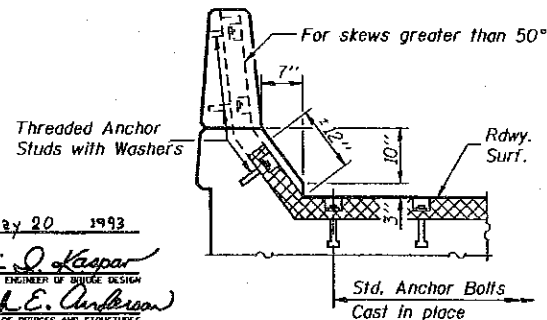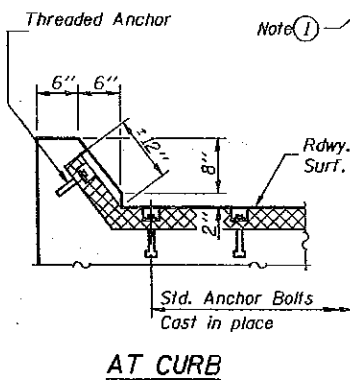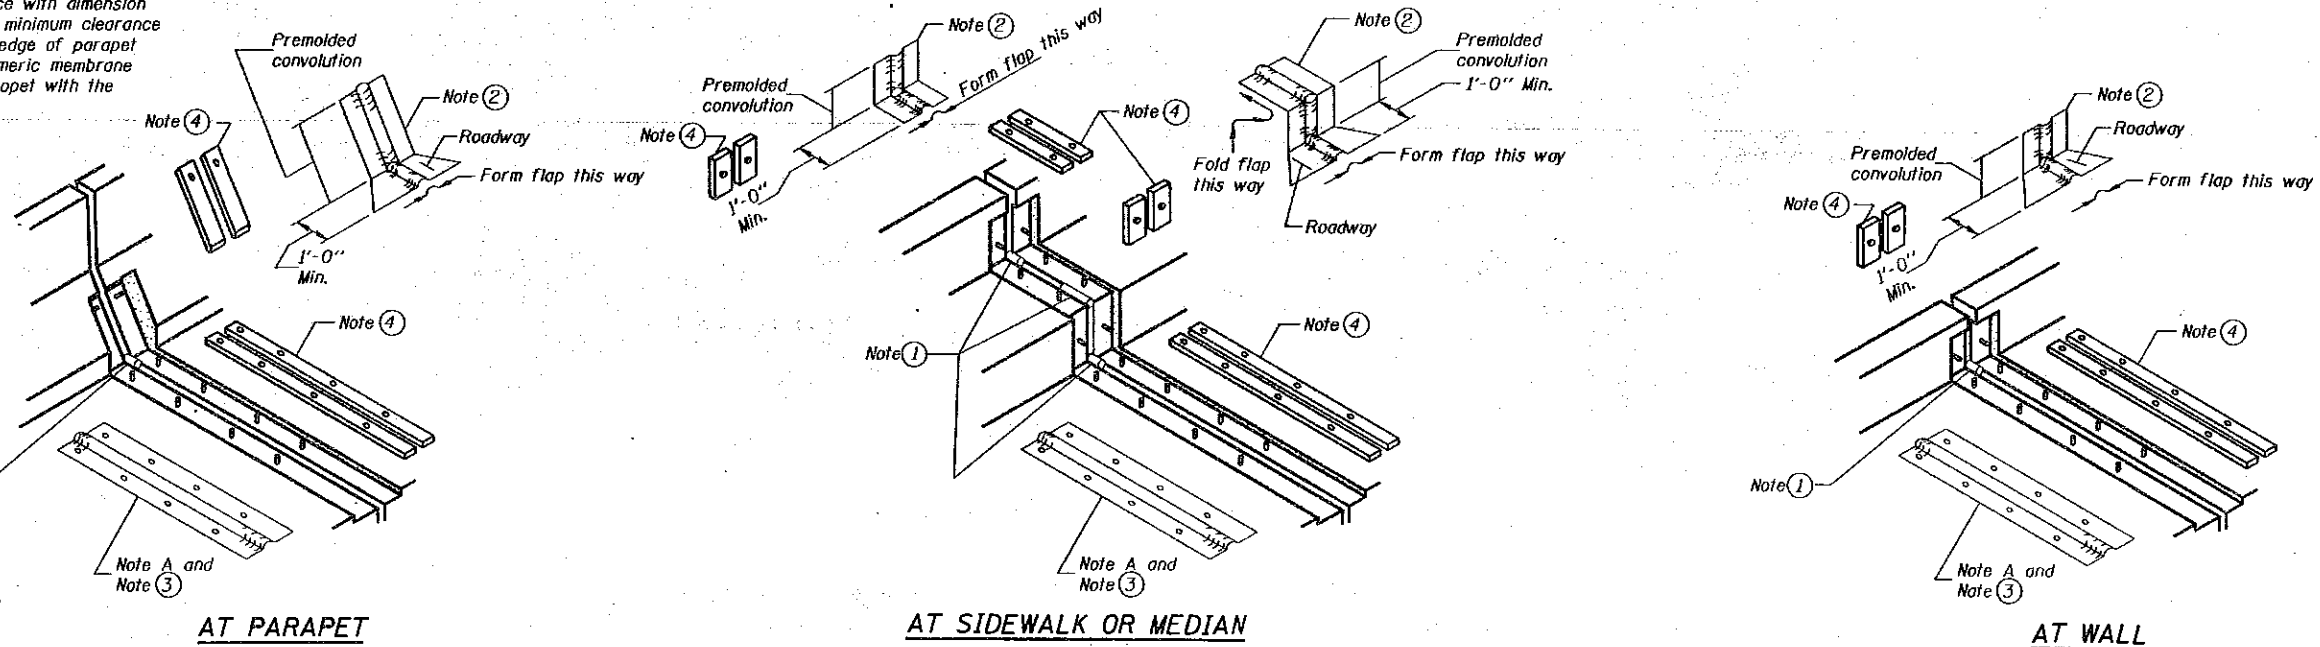

**AT SIDEWALK OR MEDIAN  
TYPICAL END TREATMENTS**

DESIGNED *Steve Nagay*  
CHECKED *AD*  
DRAWN *John F. Schneller Jr.*  
CHECKED *APN*

EXAMINED *Dr. J. Kaspar*  
PASSED *Ralph E. Anderson*  
APPROVED \_\_\_\_\_  
DIRECTOR OF HIGHWAYS

EJ-CS

CONTINUOUS SEAL TYPE  
NEOPRENE EXPANSION JOINTS  
For 2", 2 1/2" and 4" Movement

F.A.I. RT. 57 SEC. (28-5B)D-1  
FRANKLIN COUNTY  
STA. 44+49.00
















STATE OF ILLINOIS  
DEPARTMENT OF TRANSPORTATION

ROUTE NO.	SECTION	COUNTY	DATE	REV.	SHEET NO. II
F.A.I. 57	(28-5B) D-1	FRANKLIN		04	25 SHEETS
PREPARED BY:	DRAWN BY:	CHECKED BY:	DATE:		

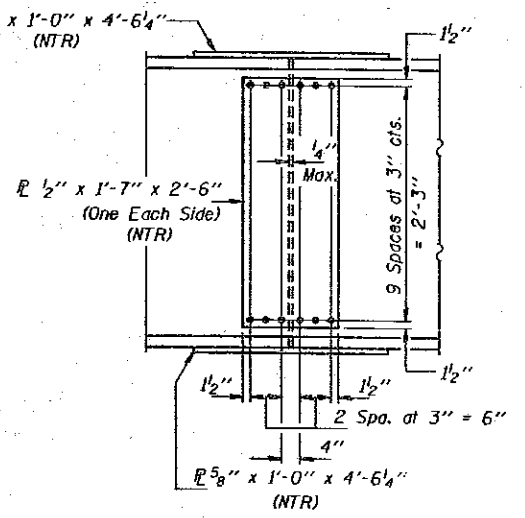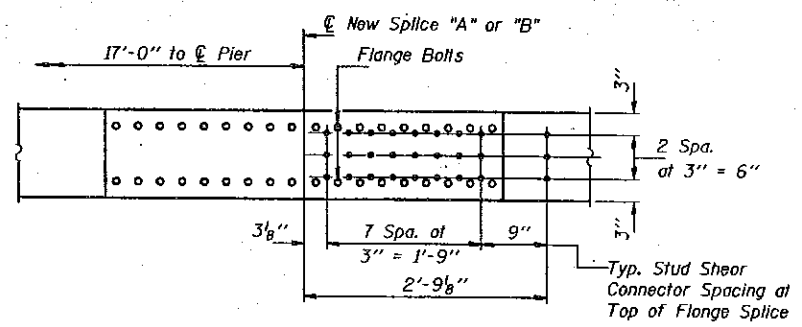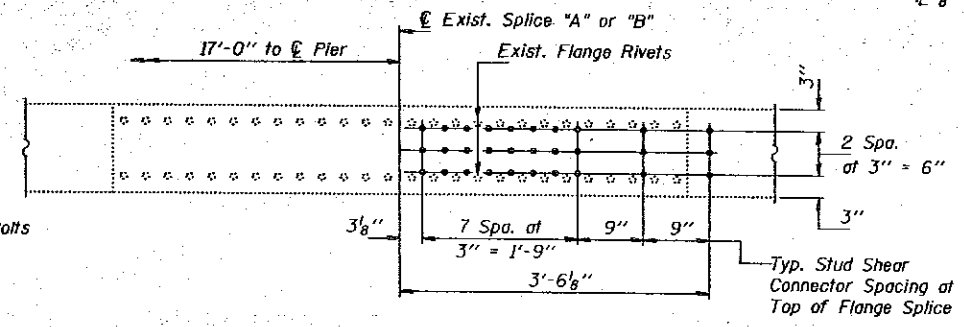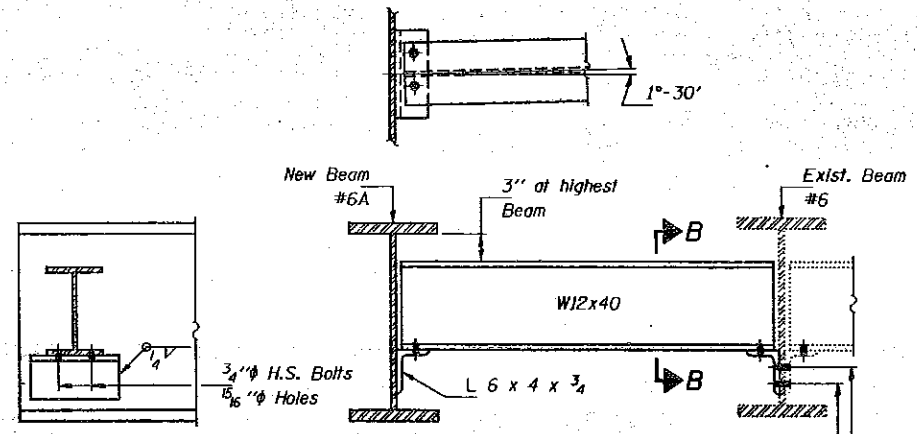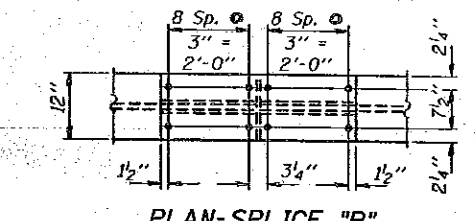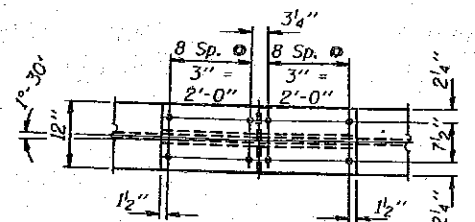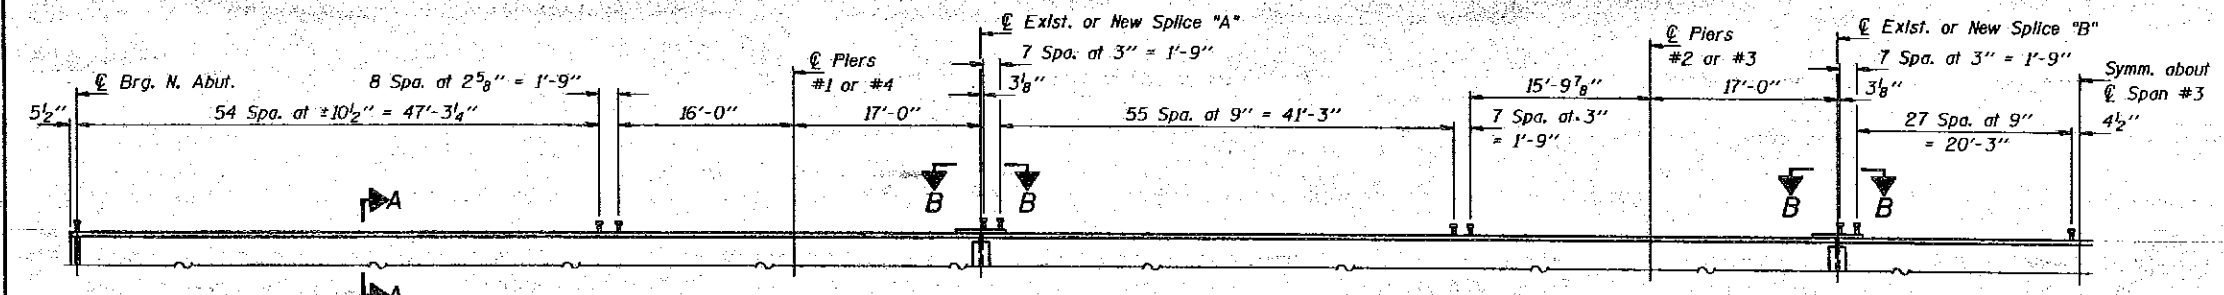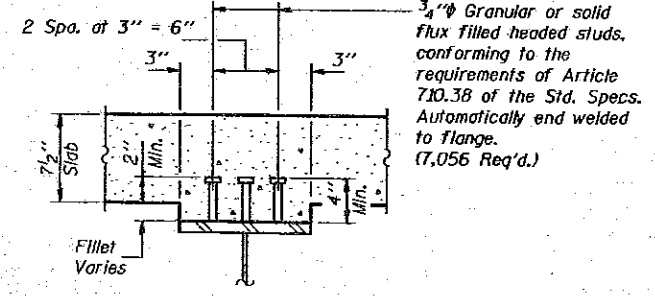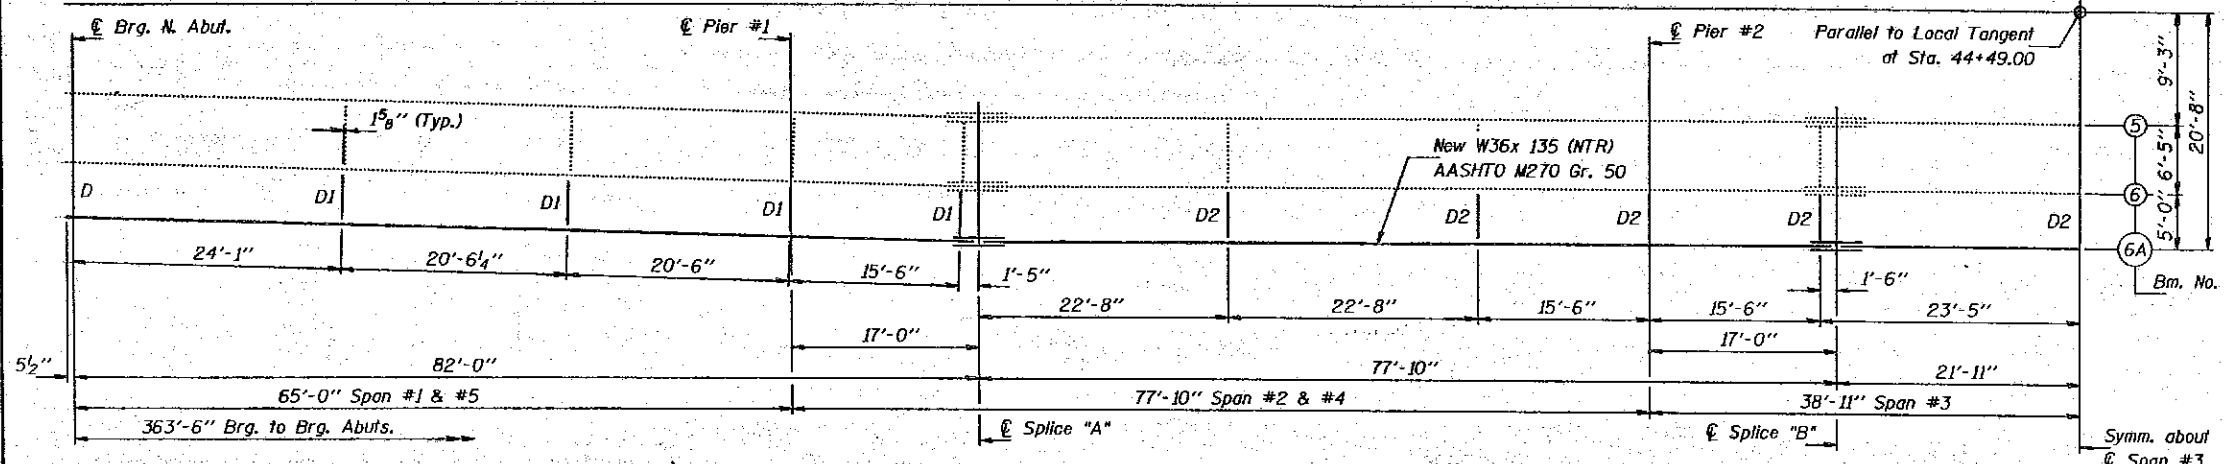

DESIGNED: *John F. Schneller Jr.*  
CHECKED: *John F. Schneller Jr.*  
DRAWN: *John F. Schneller Jr.*  
CHECKED: *John F. Schneller Jr.*

EXAMINED: *John F. Schneller Jr.*  
PASSED: *John F. Schneller Jr.*  
APPROVED: *John F. Schneller Jr.*

May 20 1993

DIRECTOR OF HIGHWAYS


Note: Two hardened washers shall be required over all 5/16" holes. "NTR" denotes Notch Toughness Requirements.

STRUCTURAL STEEL  
F.A.I. RT. 57 SEC. (28-5B)D-1  
FRANKLIN COUNTY  
STA. 44+49.00




STATE OF ILLINOIS  
DEPARTMENT OF TRANSPORTATION

PROJECT NO.	SECTION	LENGTH	NO. SHEETS	SHEET NO.
F.A.I. 57	(28-5B) D-1	FRANKLIN	95	25 SHEETS
FED. ROAD DIST. NO. 7	ILLINOIS	FED. AID PROJECT		

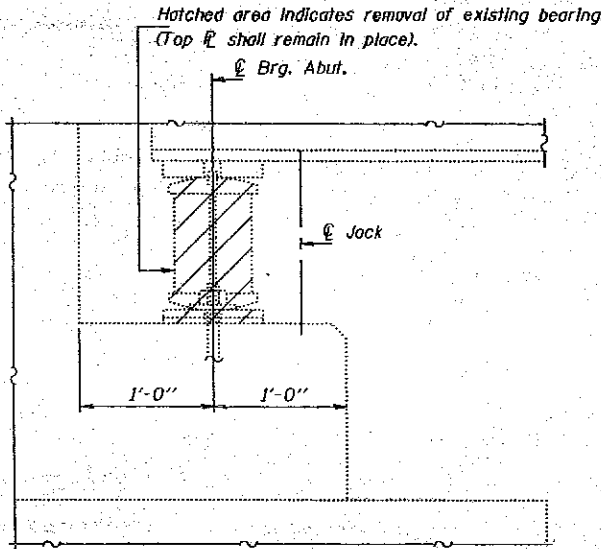

**JACK AND REMOVE EXISTING BEARINGS**  
(Dimensions are at Rt. L's)  
(Typ. for all Abutments)

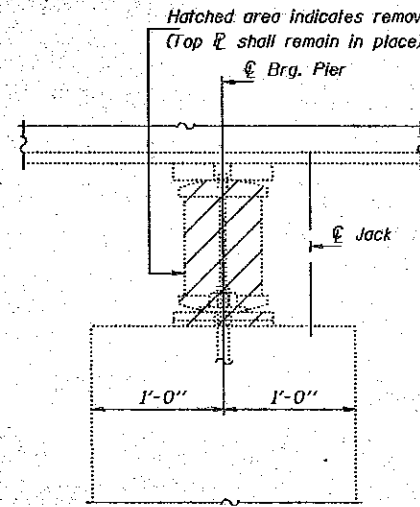

**JACK AND REMOVE EXISTING BEARINGS**  
(Dimensions are at Rt. L's)  
(Typ. for all Piers)

	0.4 Sp. #1 or 0.6 Sp. #5	Pier #1 or Pier #4	0.5 Sp. #2 or 0.5 Sp. #4	Pier #2 or Pier #3	0.5 Sp. #3
Is (in <sup>4</sup> )	10500	10500	10500	10500	10500
Ic (in <sup>4</sup> )	24819	24819	24819	24819	24819
Ss (in <sup>3</sup> )	580	580	580	580	580
Sc (in <sup>3</sup> )	810	810	810	810	810
φ (K/ft.)	.82	1.116	.82	1.116	.82
M <sub>R</sub> (K)	247	545	203	537	209
fs-non-comp (k.s.i.)	5.1	11.3	4.2	11.1	4.3
s <sub>φ</sub> (K/ft.)	.296	.296	.296	.296	.296
M <sub>s<sub>φ</sub></sub> (K)	102	101	101	99	101
M <sub>t</sub> (K)	447	276	469	296	472
M (Imp) (K)	118	70	115	73	116
Total (K)	667	346	685	369	687
fs-comp (k.s.i.)	9.9	7.2	10.1	7.6	10.2
fs (Total) (k.s.i.)	15.0	18.5	14.3	18.7	14.5
VR (K)	48.3	41.4	41.4	41.2	41.2

	0.4 Sp. #1 or 0.6 Sp. #5	Pier #1 or Pier #4	0.5 Sp. #2 or 0.5 Sp. #4	Pier #2 or Pier #3	0.5 Sp. #3
Is (in <sup>4</sup> )	7800	7800	7800	7800	7800
Ic (in <sup>4</sup> )	19426	19426	19426	19426	19426
Ss (in <sup>3</sup> )	439	439	439	439	439
Sc (in <sup>3</sup> )	631	631	631	631	631
φ (K/ft.)	.82	1.116	.82	1.116	.82
M <sub>R</sub> (K)	247	543	203	536	209
fs-non-comp (k.s.i.)	6.8	14.8	5.5	14.6	5.7
s <sub>φ</sub> (K/ft.)	.296	.296	.296	.296	.296
M <sub>s<sub>φ</sub></sub> (K)	102	102	102	101	101
M <sub>t</sub> (K)	449	271	470	291	475
M (Imp) (K)	117	69	118	72	117
Total (K)	668	340	690	363	693
fs-comp (k.s.i.)	12.7	9.3	13.1	9.9	13.2
fs (Total) (k.s.i.)	19.5	24.1	18.6	24.5	18.9
VR (K)	48.3	41.4	41.4	41.2	41.2



	Abutments	Pier #1 & #4	Pier #2 & #3
RP (K)	27.9	88.1	86.8
R <sub>t</sub> (K)	35.1	45.9	47.3
Imp. (K)	9.3	11.7	11.7
R (Total) (K)	72.3	145.7	145.8

Is and Ss are the moment of inertia and section modulus of the steel section used in computing fs (Total).  
Ic and Sc are the moment of inertia and section modulus of the composite section used in computing fs (Total).  
VR is the maximum live Load + Impact shear range in span.

**PROCEDURE FOR JACKING AND REMOVING OF EXISTING BEARINGS**

The Contractor shall submit plans for Jacking and Cribbing, to the Engineer for approval, prior to commencing any work at the Bearings.  
Jacking and Removing Existing Bearings shall be done after existing deck removal is completed and before new deck is poured.  
All Beams all locations to be lifted simultaneously.  
The maximum dead load reaction with deck removed (per bearing) at each Abutment is 5.0 kips and 16.5 kips at each Pier.  
Jacking shall be limited to a maximum 1/4" lift to remove the Existing Bearing Assembly.  
The Jack capacity for each beam is 5 Tons at Abutments and 20 Tons at Piers. Set Jacks so that Beams can be lowered up to 2" from original position.  
The bottom flange area of the Beam and Existing Top Plate shall be cleaned and pointed as required and specified for Structural Steel.  
The new Bearings and Steel Extensions shall be in place and the Jacks shall be lowered before the new concrete Deck is poured. Lower all Beams simultaneously in 1/4" increments.  
The new Beam shall be installed after the replacement of the existing bearings.

Note: Two hardened washers shall be required over all 5/16" φ holes.

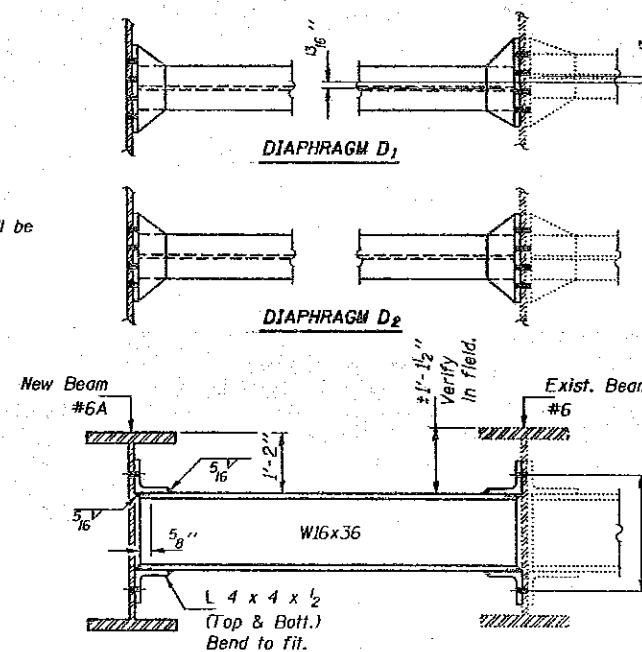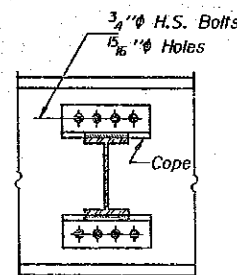

**DIAPHRAGM D<sub>1</sub> & D<sub>2</sub>**  
(D<sub>1</sub> = 8 Required)  
(D<sub>2</sub> = 9 Required)

Remove existing rivets or bolts. Field drill 5/16" φ holes in new angles using holes in existing beams as a template. Existing bolts and rivets are to be replaced by 3/4" φ H.S. Bolt. Cost of Rivet and Bolt Removal and Field Drilling is incidental to "Structural Steel".

**\* TOP OF BEAM ELEVATIONS**

Loc.	Clr.	Beam #6A
⊕ Brg. N. Abut.		392.53
⊕ Brg. Pier #1		392.53
⊕ Splice "A"		392.53
⊕ Brg. Pier #2		392.51
⊕ Splice "B"		392.51
⊕ Splice "B"		392.50
⊕ Brg. Pier #3		392.50
⊕ Splice "A"		392.50
⊕ Brg. Pier #4		392.50
⊕ Brg. S. Abut.		392.49

\* For Fabrication only.

DESIGNED *Steven W. Johnson*  
CHECKED *John F. Schneller Jr.*  
DRAWN *John F. Schneller Jr.*  
CHECKED *John F. Schneller Jr.*

EXAMINED *Gregory J. Kaspar*  
PASSED *Ralph E. Anderson*  
APPROVED \_\_\_\_\_

May 20 1993  
DIRECTOR OF HIGHWAYS


STRUCTURAL STEEL  
F.A.I. RT. 57 SEC. (28-5B)D-1  
FRANKLIN COUNTY  
STA. 44+49.00

STATE OF ILLINOIS  
DEPARTMENT OF TRANSPORTATION

ROUTE NO.	SECTION	COUNTY	DATE	SHEET NO.
F.A.I. 57	(28-5B) D-1	FRANKLIN		90
FED. ROAD DIST. NO. 7		ILLINOIS	FED. AID PROJECT	

SHEET NO. 13  
25 SHEETS


\* Cost of drilling holes in existing bottom flanges and existing 1" plate in field is incidental to "Structural Steel".

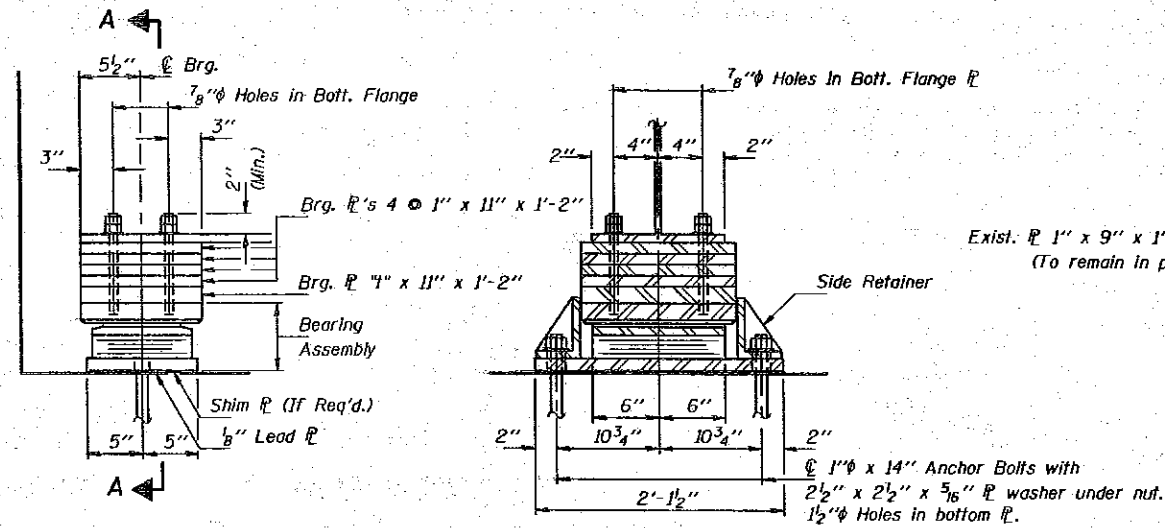

ELEVATION AT N. ABUT.

SECTION A-A


TYPE II TFE ELASTOMERIC EXP. BRG. BEAM #6A  
(1 Required)

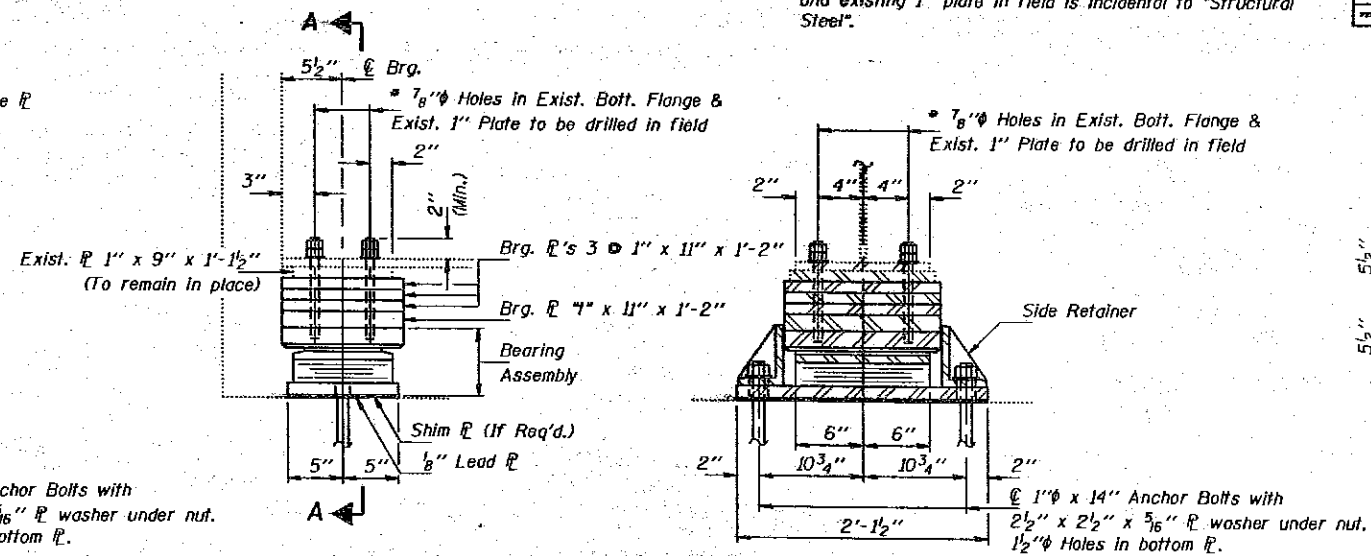


ELEVATION AT N. ABUT.

SECTION A-A

TYPE II TFE ELASTOMERIC EXP. BRG. BEAMS #1 THRU #6  
(6 Required)

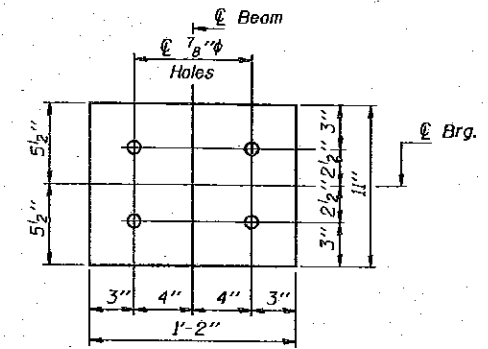


BEARING PLATE

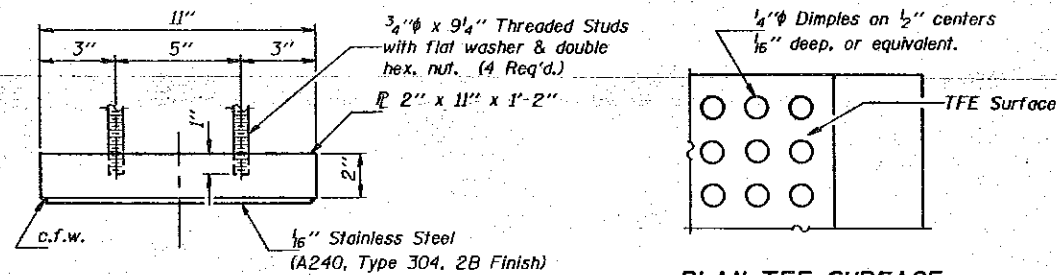


TOP BEARING ASSEMBLY


PLAN-TFE SURFACE

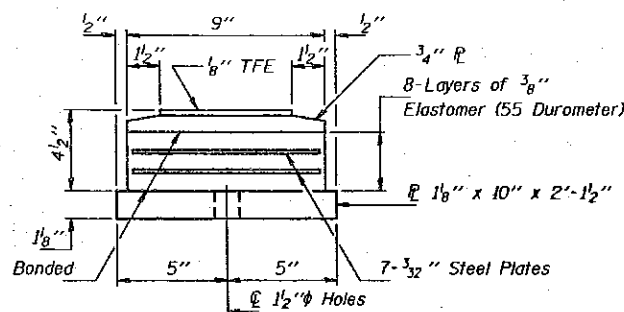

BOTTOM BEARING ASSEMBLY

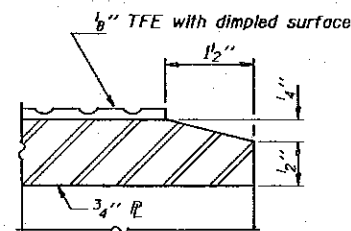

SECTION THRU TFE

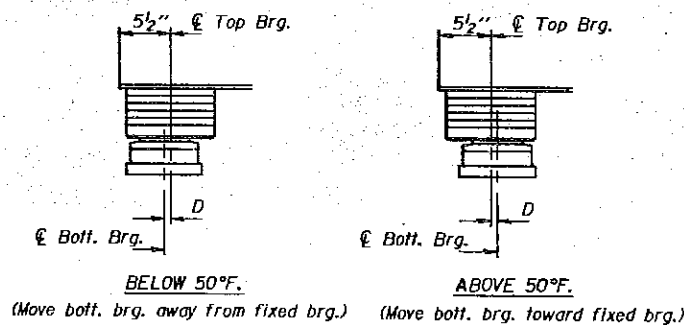

SETTING ANCHOR BOLTS AT EXP. BRG.

$D = \frac{1}{8}$ " per each 100' of expansion for every 15° temp. change from the normal temp. of 50°F.

BEARING PLATE "4" DIMENSIONS

Dim.	#1	#2	#3	#4	#5	#6	#6A
"4"	7/8"	7/8"	7/8"	3/4"	3/4"	3/4"	5/8"

\*\* Based on the survey elevations. The contractor shall verify and make adjustments if necessary.

Notes: See sheet #19 of 25 for Anchor Bolt installation. Existing Anchor Bolts to be cut off flush with top of cap and ground smooth. Cost incidental to "Jack and Remove Existing Bearing." Weight of Steel Shim Plates, Lead Plates, Anchor Bolts, nuts and washers and Side Retainers is included in "Structural Steel".

BILL OF MATERIAL


Item	Unit	Total
Elastomeric Bearing Assembly Type II	Each	7
Jack and Remove Existing Bearings	Each	6

BEARING DETAILS  
NORTH ABUTMENT  
F.A.I. RT. 57 SEC. (28-5B)D-1  
FRANKLIN COUNTY  
STA. 44+49.00

DESIGNED: *John F. Schneller Jr.*  
CHECKED: *John F. Schneller Jr.*  
DRAWN: *John F. Schneller Jr.*  
CHECKED: *John F. Schneller Jr.*

EXAMINED: *Dr. J. Q. Kaspar*  
PASSED: *Patrick E. Anderson*  
APPROVED: *Patrick E. Anderson*

Note: The 1/8" TFE sheet shall be bonded directly to the top steel plate with a two-component, medium viscosity epoxy resin, conforming to the requirements of the Federal Specification MMM-A-134, Type I. The bond agent shall be applied on the full area of the contact surfaces. Bonding of 1/8" TFE sheet during vulcanizing process will be permitted provided the process and method of adjusting assembly height is approved by the Engineer.

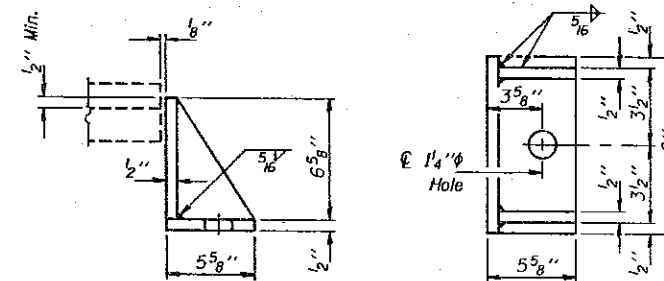


SIDE RETAINER-N. ABUT.  
Equivalent rolled angle with stiffeners will be allowed in lieu of welded plates.

STATE OF ILLINOIS  
DEPARTMENT OF TRANSPORTATION

STATE NO.	SECTION	COUNTY	JOB#	"RT"	SHEET NO. 14
F.A.I. 57	(28-5B) D-1	FRANKLIN		97	25 SHEETS
FED. PROJ. DIST. NO. 7	ALIGNED	FIELD PROJECT			


\* Cost of drilling holes in existing bottom flanges and existing 1" plate in field is incidental to "Structural Steel".

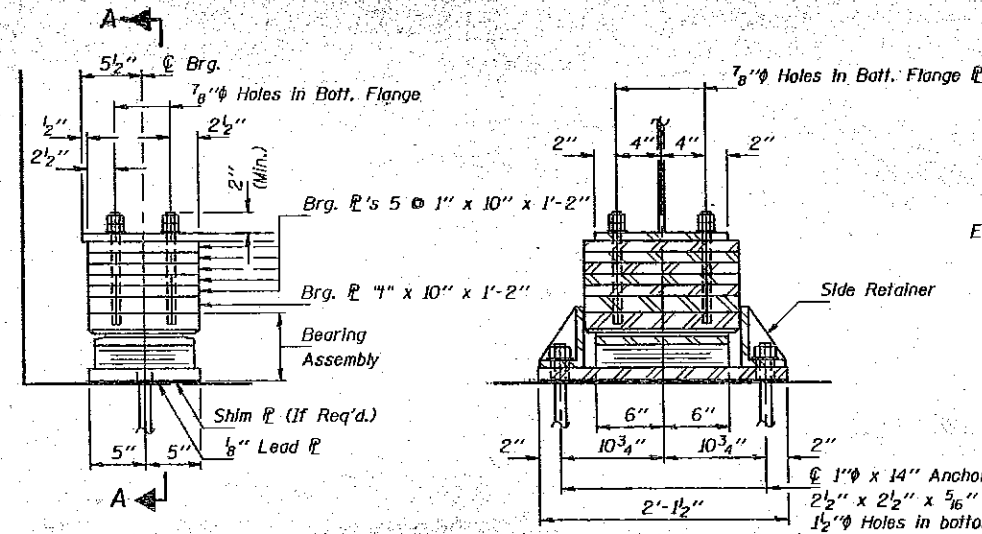

ELEVATION AT S. ABUT.

SECTION A-A


TYPE II TFE ELASTOMERIC EXP. BRG. BEAM #6A  
(1 Required)

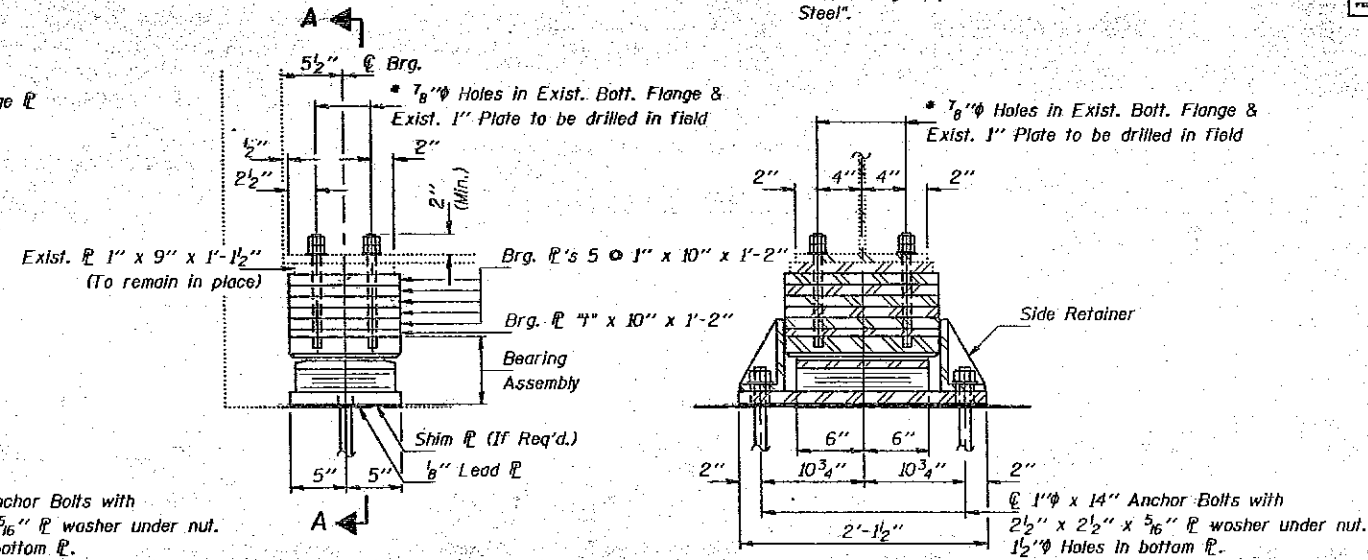

ELEVATION AT S. ABUT.

SECTION A-A

TYPE II TFE ELASTOMERIC EXP. BRG. BEAMS #1 THRU #6  
(6 Required)

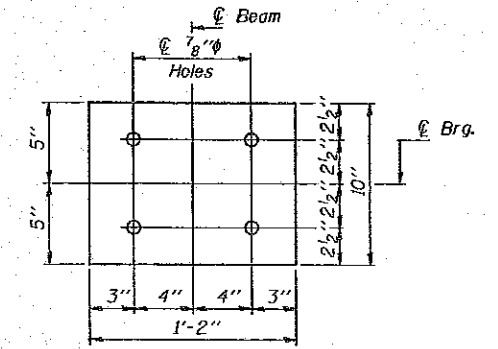


BEARING PLATE


\*\* BEARING PLATE "H" DIMENSIONS

Dim.	Beam	#1	#2	#3	#4	#5	#6	#6A
"H"		0	0	0	1/8"	1/8"	1/8"	5/8"


\*\* Based on the survey elevations. The contractor shall verify and make adjustments if necessary.

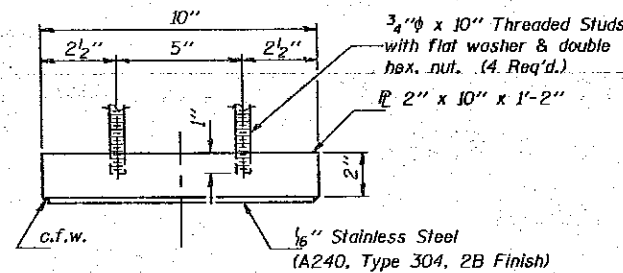


TOP BEARING ASSEMBLY

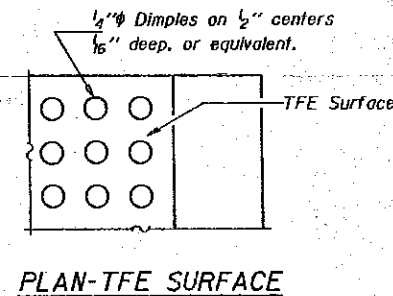


PLAN-TFE SURFACE

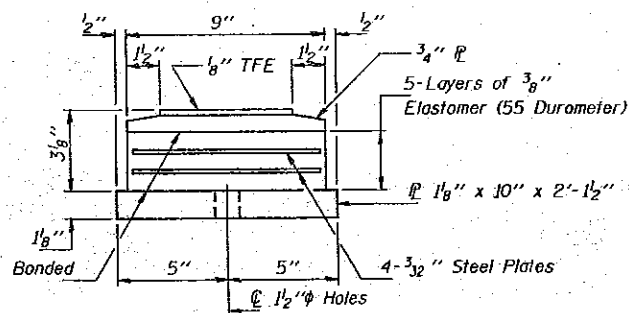

BOTTOM BEARING ASSEMBLY

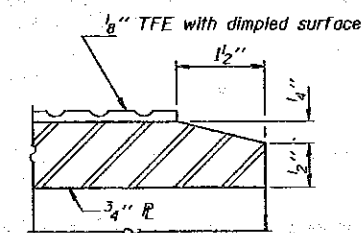


SECTION THRU TFE

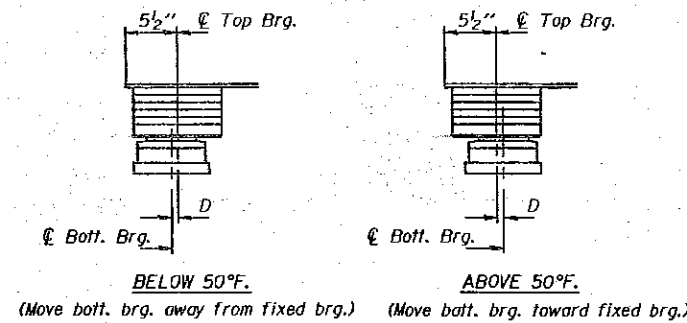

SETTING ANCHOR BOLTS AT EXP. BRG.

D=1/8" per each 100' of expansion for every 15° temp. change from the normal temp. of 50°F.

Notes: See sheet #19 of 25 for Anchor Bolt Installation. Existing Anchor Bolts to be cut off flush with top of cap and ground smooth. Cost incidental to "Jack and Remove Existing Bearing." Weight of Steel Shim Plates, Lead Plates, Anchor Bolts, nuts and washers and Side Retainers is included in "Structural Steel".

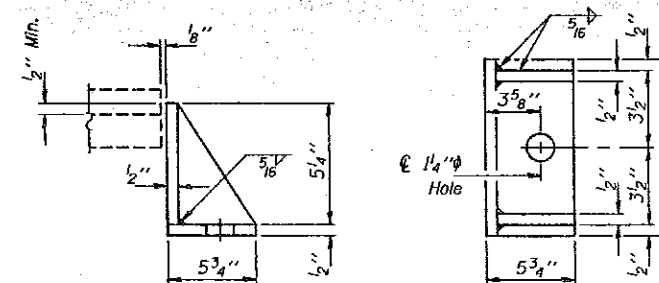

SIDE RETAINER-S. ABUT.

Equivalent rolled angle with stiffeners will be allowed in lieu of welded plates.

BILL OF MATERIAL

Item	Unit	Total
Elastomeric Bearing Assembly Type II	Each	7
Jack and Remove Existing Bearings	Each	6

BEARING DETAILS

SOUTH ABUTMENT

F.A.I. RT. 57 SEC. (28-5B)D-1

FRANKLIN COUNTY

STA. 44+49.00

DESIGNED	DATE	EXAMINED	DATE
<i>[Signature]</i>	May 20 1993	<i>[Signature]</i>	
CHECKED		PASSED	
<i>[Signature]</i>		<i>[Signature]</i>	
DRAWN		APPROVED	
John F. Schneller Jr.		<i>[Signature]</i>	
CHECKED		DIRECTOR OF HIGHWAYS	
<i>[Signature]</i>			


Note: The 1/8" TFE sheet shall be bonded directly to the top steel plate with a two-component, medium viscosity epoxy resin, conforming to the requirements of the Federal Specification MMM-A-134, Type I. The bond agent shall be applied on the full area of the contact surfaces. Bonding of 1/8" TFE sheet during vulcanizing process will be permitted provided the process and method of adjusting assembly height is approved by the Engineer.




STATE OF ILLINOIS  
DEPARTMENT OF TRANSPORTATION

\* Cost of drilling holes in existing bottom flanges and existing 1 3/8" plate in field is incidental to "Structural Steel".

PROJECT NO.	SHEET	COUNTY	DATE	REV.	SHEET NO. 15
F.A.I. 57	(28-5B) D-1	FRANKLIN		98	25 SHEETS
PREPARED BY: J.P.F.	DRAWN BY: J.P.F.	CHECKED BY: J.P.F.	DATE: 5/20/93		

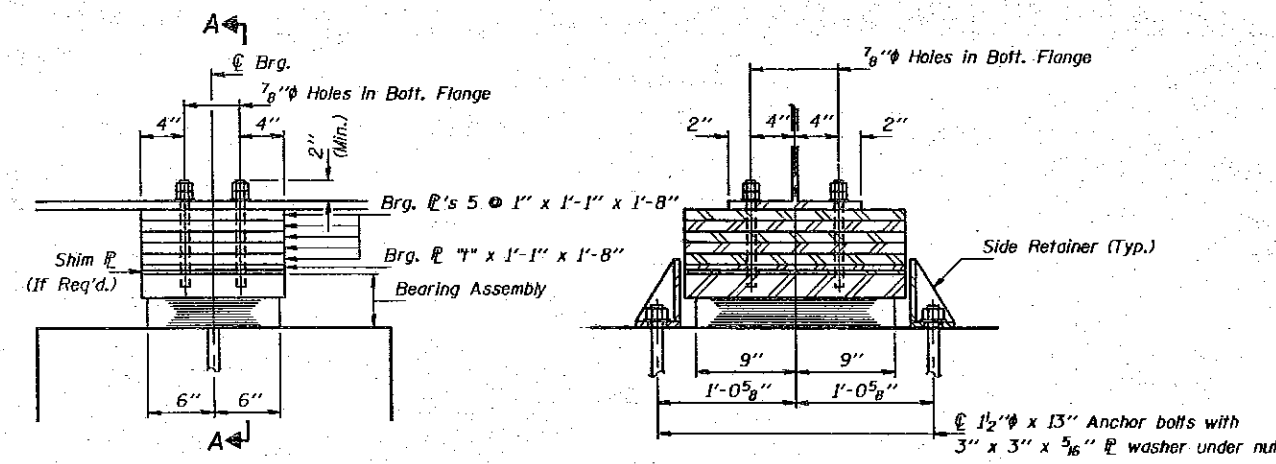

**ELEVATION AT PIER #1**  
**SECTION A-A**  
**TYPE I ELASTOMERIC EXP. BRG. BEAM #6A**  
(1 Required)

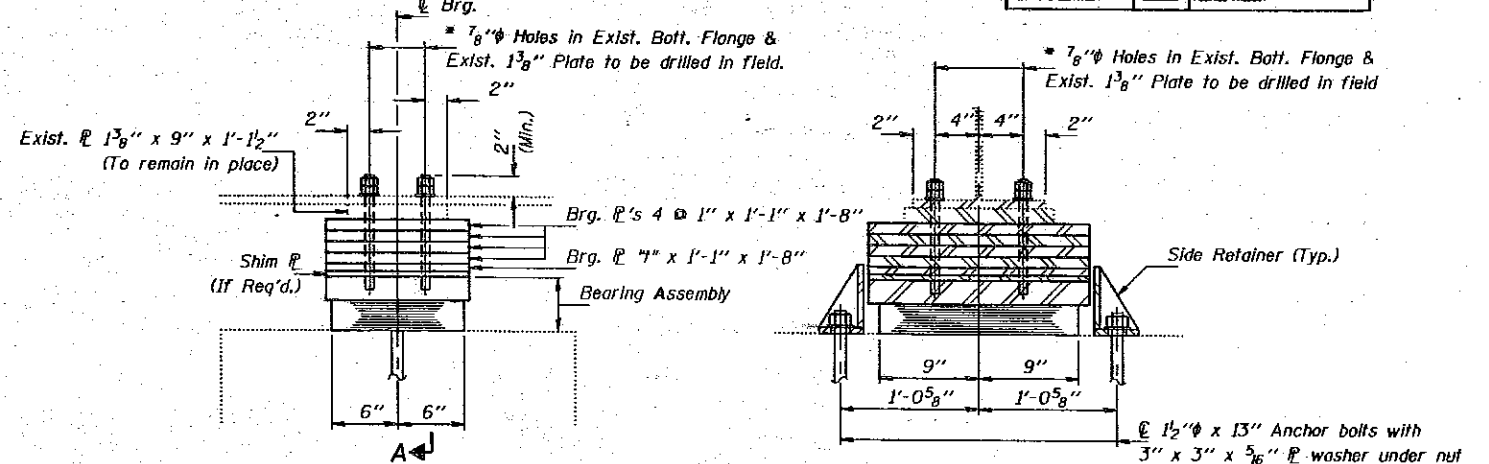


**ELEVATION AT PIER #1**  
**SECTION A-A**  
**TYPE I ELASTOMERIC EXP. BRG. BEAMS #1 THRU #6**  
(6 Required)


**\*\* BEARING PLATE "I" DIMENSIONS**

Dim.	Beam	#1	#2	#3	#4	#5	#6	#6A
"I"		1/2"	3/8"	1/4"	1/8"	0	0	1/8"

\*\* Based on the survey elevations. The contractor shall verify and make adjustments if necessary.

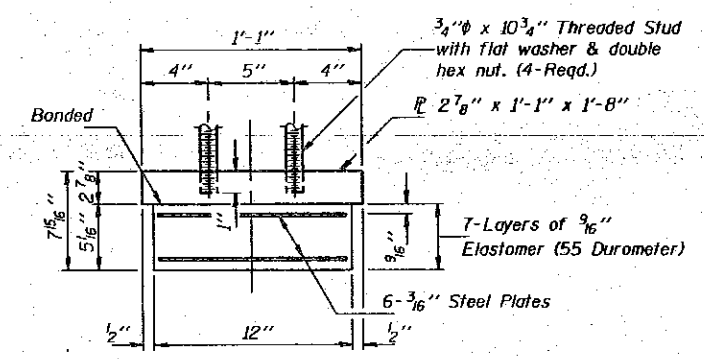


**BEARING ASSEMBLY**  
Note: Shim plates shall not be placed under Bearing Assembly.

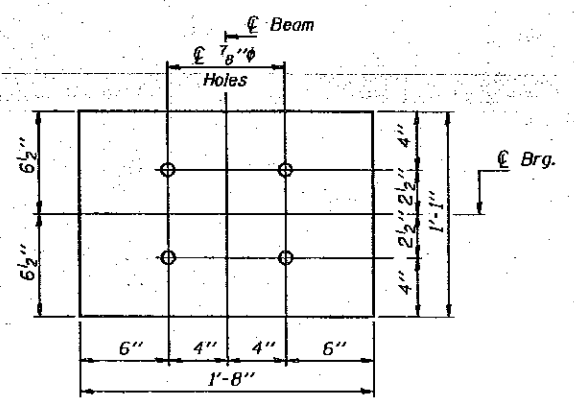

**BEARING PLATE**

Notes: See sheet #19 of 25 for Anchor Bolt Installation. Existing Anchor Bolts to be cut off flush with top of cap and ground smooth. Cost incidental to "Jack and Remove Existing Bearing." Weight of Steel Shim Plates, Anchor Bolts, nuts and washers and Side Retainers is included in "Structural Steel".

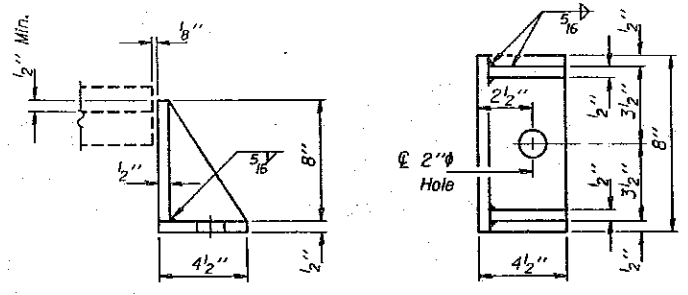

**SIDE RETAINER-PIER #1**  
Equivalent rolled angle with stiffeners will be allowed in lieu of welded plates.

DESIGNED *John F. Schnoller Jr.*  
CHECKED *John F. Schnoller Jr.*  
DRAWN *John F. Schnoller Jr.*  
CHECKED *SPW*

May 20 1993  
EXAMINED *Greg D. Kaspar*  
PASSED *Ralph E. Anderson*  
APPROVED \_\_\_\_\_  
DIRECTOR OF HIGHWAYS

**BILL OF MATERIAL**


Item	Unit	Total
Elastomeric Bearing Assembly Type 1	Each	7
Jack and Remove Existing Bearings	Each	6

**BEARING DETAILS - PIER #1**  
**F.A.I. RT. 57 SEC. (28-5B)D-1**  
**FRANKLIN COUNTY**  
**STA. 44+49.00**


STATE OF ILLINOIS  
DEPARTMENT OF TRANSPORTATION

\* Cost of drilling holes in existing bottom flanges and existing 1 3/8" plate in field is incidental to "Structural Steel".


ROUTE NO.	DISTRICT	COUNTY	SECTION	"RE"	SHEET NO. 16
F.A.I. 57	(28-5B) D-1	FRANKLIN		09	25 SHEETS
FED. ROAD DIST. NO. 7					

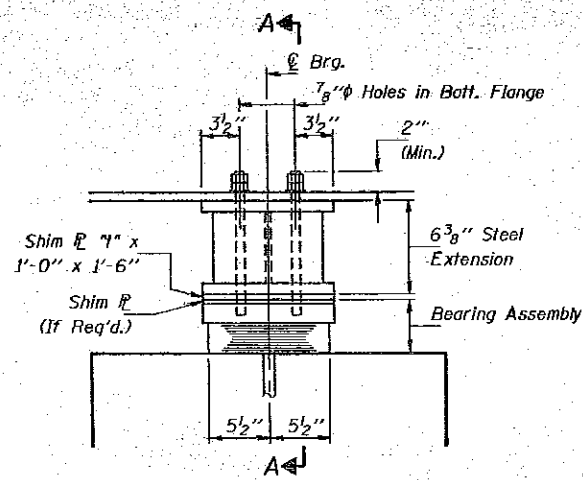


ELEVATION AT PIER #2

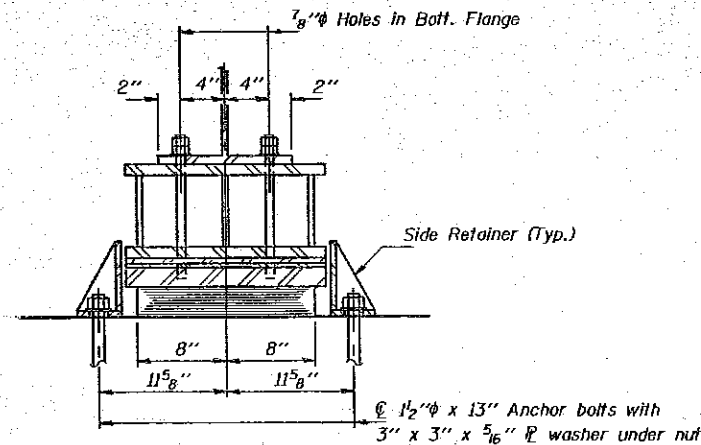

SECTION A-A

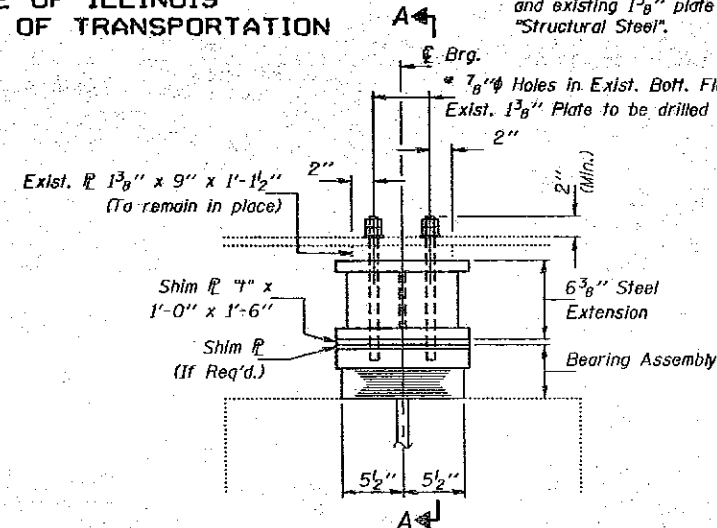


ELEVATION AT PIER #2

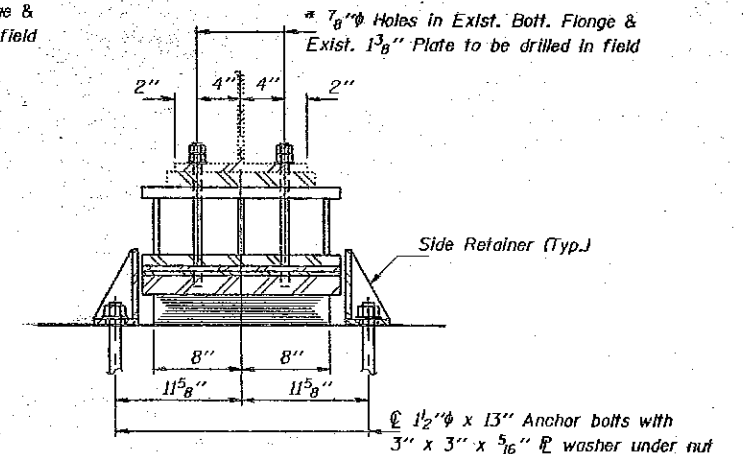


SECTION A-A

TYPE I ELASTOMERIC EXP. BRG. BEAM #6A  
(1 Required)

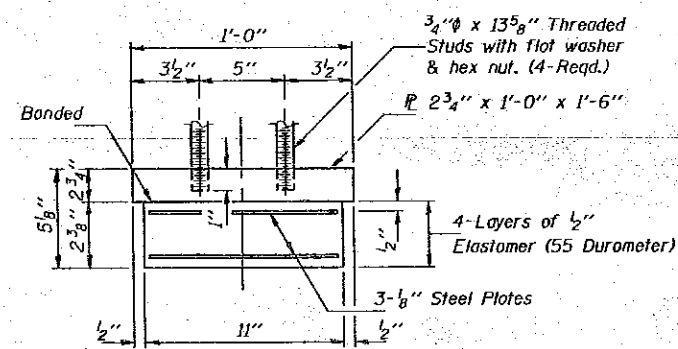


BEARING ASSEMBLY

Note: Shim plates shall not be placed under Bearing Assembly.

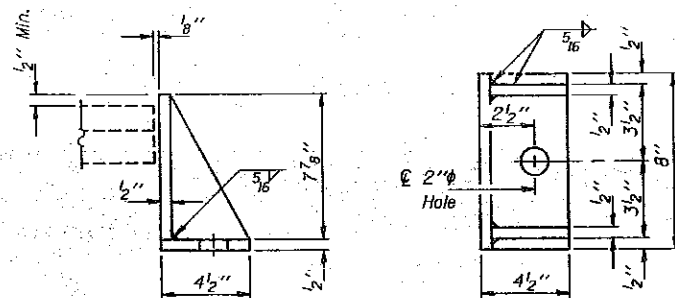


SIDE RETAINER-PIER #2

Equivalent rolled angle with stiffeners will be allowed in lieu of welded plates.

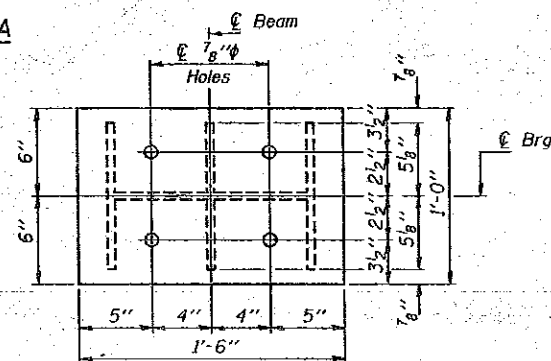


TOP PLATE

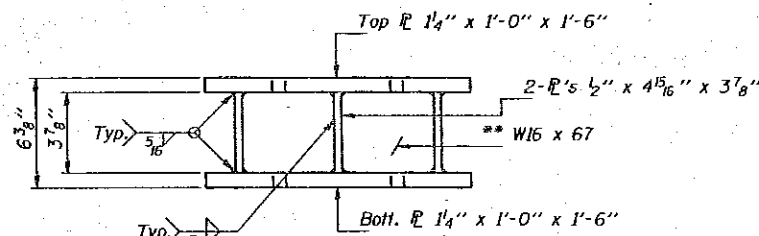

ELEVATION

\*\* Equivalent welded plates will be allowed in lieu of W16 x 67.

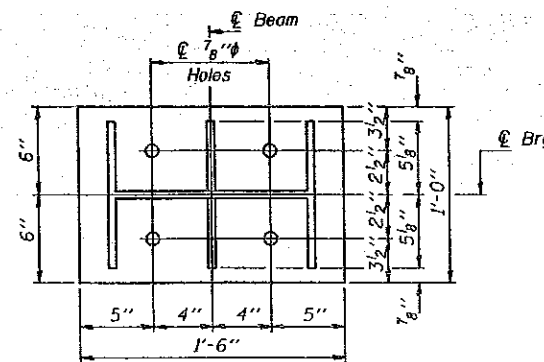

BOTTOM PLATE

STEEL EXTENSION

TYPE I ELASTOMERIC EXP. BRG. BEAMS #1 THRU #6  
(6 Required)

\*\* SHIM PLATE "I" DIMENSIONS

Dim.	Item	#1	#2	#3	#4	#5	#6	#6A
"I"		0	3/8"	5/8"	1"	1 1/4"	1 5/8"	2 5/8"

\*\* Based on the survey elevations. The contractor shall verify and make adjustments if necessary.

Notes: See sheet #19 of 25 for Anchor Bolt installation. Existing Anchor Bolts to be cut off flush with top of cap and ground smooth. Cost incidental to "Jack and Remove Existing Bearing." Weight of Steel Shim Plates, Steel Extensions, Anchor Bolts, nuts and washers and Side Retainers is included in "Structural Steel".

BILL OF MATERIAL

Item	Unit	Total
Elastomeric Bearing Assembly Type I	Each	7
Jack and Remove Existing Bearings	Each	6

BEARING DETAILS - PIER #2  
F.A.I. RT. 57 SEC. (28-5B)D-1  
FRANKLIN COUNTY  
STA. 44+49.00


DESIGNED <i>Steve Hagan</i>	EXAMINED <i>Greg J. Kaspar</i>
CHECKED <i>Bob Wren</i>	PASSED <i>Ralph E. Anderson</i>
DRAWN <i>John F. Schneller Jr.</i>	APPROVED _____
CHECKED <i>SPW</i>	DIRECTOR OF HIGHWAYS

May 20 1993


STATE OF ILLINOIS  
DEPARTMENT OF TRANSPORTATION

\*\*\* Cost of drilling holes in existing bottom flanges and existing 1 3/8" plate in field is incidental to "Structural Steel".

PROJECT NO.	DISTRICT	COUNTY	SECTION	SHEET	SHEET NO. OF
F.A.I. 57	(28-5B)	FRANKLIN		100	25 SHEETS
FED. ROAD DIST. NO. 7					

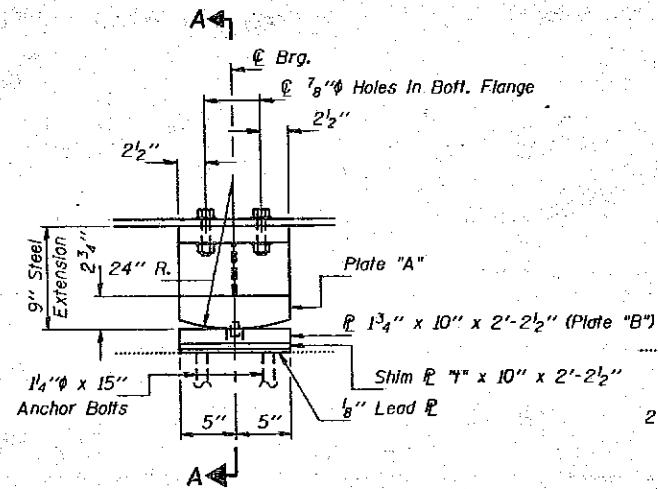


ELEVATION AT PIER 3

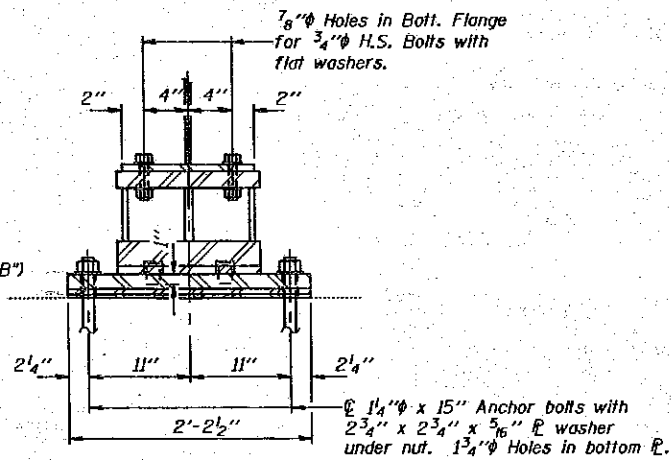


SECTION A-A

FIXED BEARING BEAM #6A  
(1 Required)

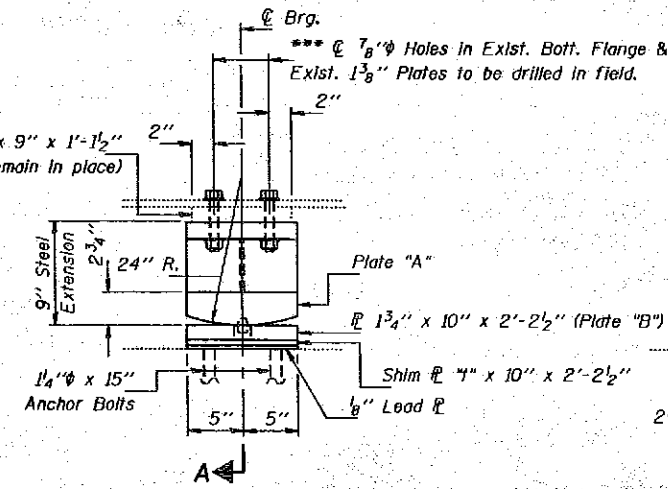


ELEVATION AT PIER 3

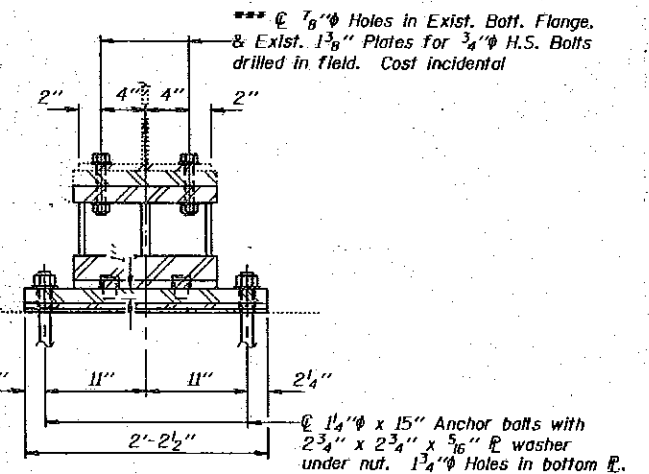

SECTION A-A


FIXED BEARING BEAMS #1 THRU #6  
(6 Required)

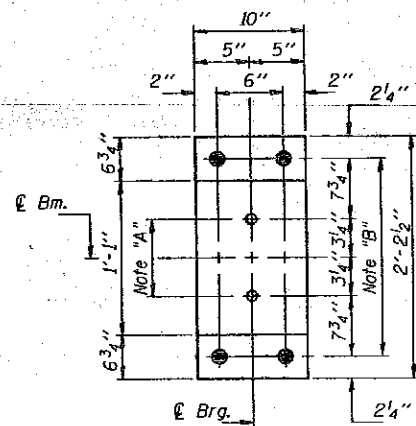


PLAN-BOTTOM PLATE "B"

Note "A"  
1 3/8" Holes 1" deep in Bottom of Plate "A" for 1 1/2" Pintles. Thread or press fit pintles in Top of Plate "B".


Note "B"  
1 3/4" Holes for 1 1/4" Anchor Bolts 2 3/4" x 2 3/4" x 5/16" R washer under nut.

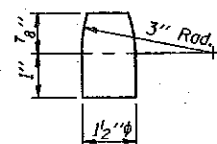

PINTLE

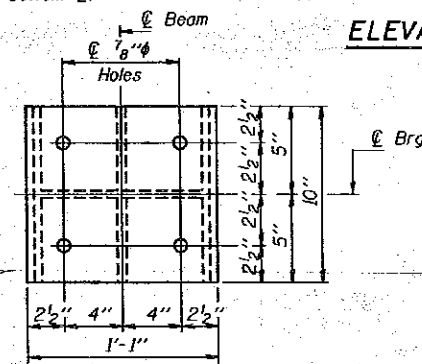


TOP PLATE

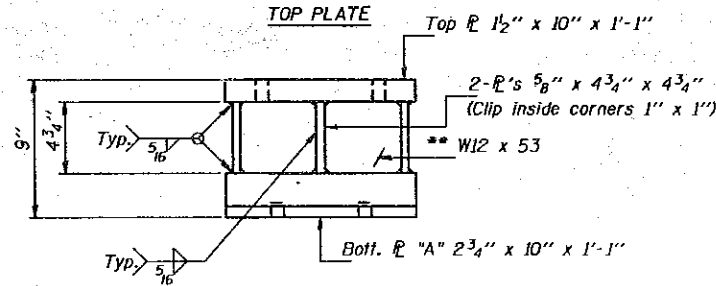

ELEVATION

\*\* Equivalent welded plates will be allowed in lieu of W12 x 53.

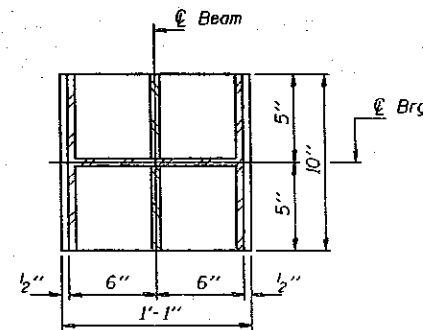

BOTTOM PLATE "A"

STEEL EXTENSION

\* SHIM PLATE "4" DIMENSIONS

Dim.	Bm	#1	#2	#3	#4	#5	#6	#6A
4"		0	1/4"	1/2"	3/4"	7/8"	1 1/8"	1 3/4"

\* Based on the survey elevations. The contractor shall verify and make adjustments if necessary.

Notes: See sheet #19 of 25 for Anchor Bolt Installation. Existing Anchor Bolts to be cut off flush with top of cap and ground smooth. Cost incidental to "Jack and Remove Existing Bearing." Weight of Steel Shim Plates, Lead Plates, Anchor Bolts, nuts and washers, 3/4" H.S. Bolts, nuts and flat washers and Steel Extensions is included in "Structural Steel".

DESIGNED <i>John F. Schneller Jr.</i>	EXAMINED <i>Ralph E. Anderson</i>
CHECKED <i>John F. Schneller Jr.</i>	PASSED <i>Ralph E. Anderson</i>
DRAWN <i>John F. Schneller Jr.</i>	APPROVED _____
CHECKED <i>John F. Schneller Jr.</i>	DIRECTOR OF HIGHWAYS

Nov 20 1993


BEARING DETAILS - PIER #3  
F.A.I. RT. 57 SEC. (28-5B)D-1  
FRANKLIN COUNTY  
STA. 44+49.00




STATE OF ILLINOIS  
DEPARTMENT OF TRANSPORTATION

\* Cost of drilling holes in existing bottom flanges and existing 1 3/8" plate in field is incidental to "Structural Steel".


PROJECT NO.	SECTION	COUNTY	DATE	"REV"	SHEET NO. 18
F.A.I. 57	(28-5B) D-1	FRANKLIN		101	25 SHEETS
DESIGNED BY	CHECKED BY	APPROVED BY			

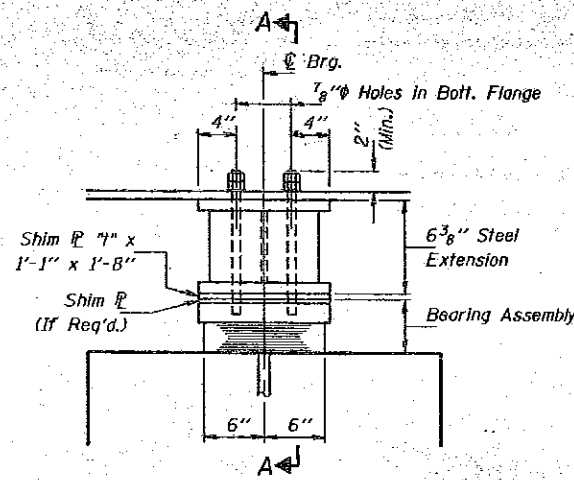


ELEVATION AT PIER #4

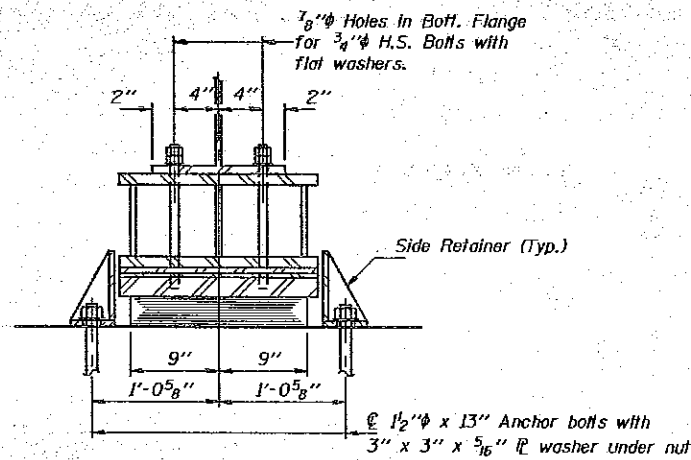

SECTION A-A

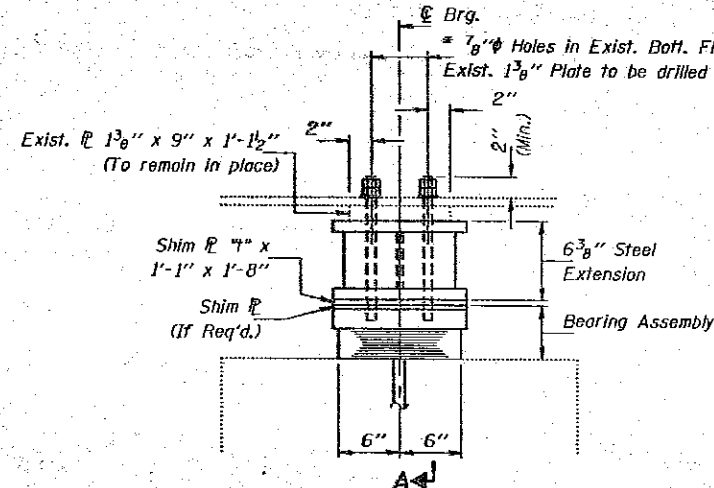


ELEVATION AT PIER #4

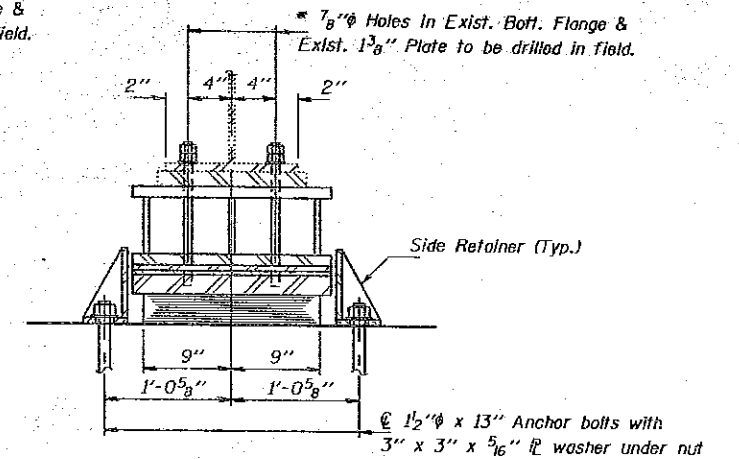


SECTION A-A

TYPE I ELASTOMERIC EXP. BRG. BEAM #6A  
(1 Required)

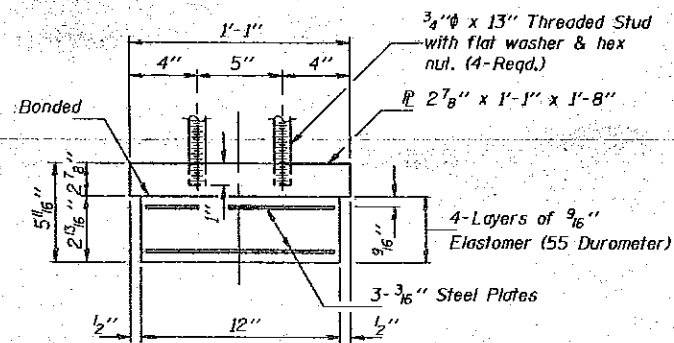


BEARING ASSEMBLY

Note: Shim plates shall not be placed under Bearing Assembly.

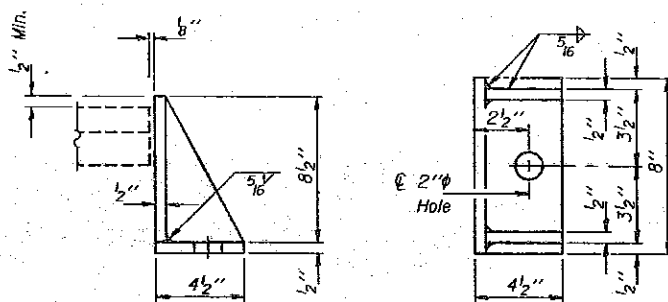


SIDE RETAINER-PIER #4

Equivalent rolled angle with stiffeners will be allowed in lieu of welded plates.

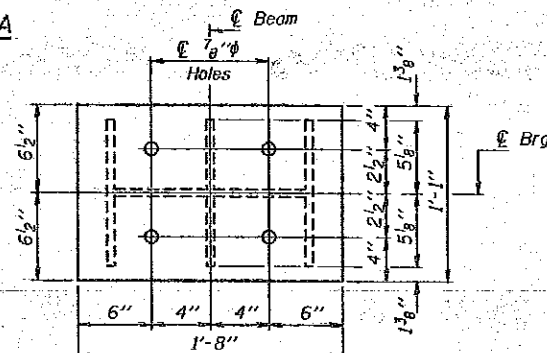


TOP PLATE

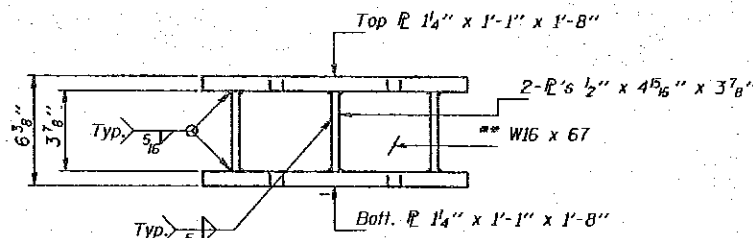

ELEVATION

\*\* Equivalent welded plates will be allowed in lieu of W16 x 67.

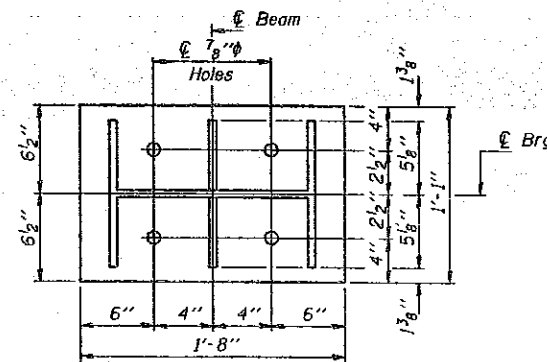

BOTTOM PLATE

STEEL EXTENSION

TYPE I ELASTOMERIC EXP. BRG. BEAMS #1 THRU #6  
(6 Required)

\*\* SHIM PLATE "I" DIMENSIONS

Dim.	Bm	#1	#2	#3	#4	#5	#6	#6A
4"	1"	7/8"	5/8"	3/8"	1/4"	0	2 1/8"	

\*\* Based on the survey elevations. The contractor shall verify and make adjustments if necessary.

Notes: See sheet #19 of 25 for Anchor Bolt Installation. Existing Anchor Bolts to be cut off flush with top of cap and ground smooth. Cost incidental to "Jack and Remove Existing Bearing." Weight of Steel Shim Plates, Steel Extensions, Anchor Bolts, nuts and washers and Side Retainers is included in "Structural Steel".

BILL OF MATERIAL

Item	Unit	Total
Elastomeric Bearing Assembly Type I	Each	7
Jack and Remove Existing Bearings	Each	6

BEARING DETAILS - PIER #4  
F.A.I. RT. 57 SEC. (28-5B)D-1  
FRANKLIN COUNTY  
STA. 44+49.00

DESIGNED <i>Steven Raymond</i>	EXAMINED <i>Greg J. Kaspar</i>
CHECKED <i>STW</i>	PASSED <i>Ralph E. Anderson</i>
DRAWN <i>John F. Schellor Jr.</i>	APPROVED _____
CHECKED <i>SPM</i>	DIRECTOR OF HIGHWAYS


May 20 1993

STATE OF ILLINOIS  
DEPARTMENT OF TRANSPORTATION


ROUTE NO.	DISTRICT	COUNTY	SECTION	SHEET	SHEET NO. 19 25 SHEETS
F.A.I. 57	(28-5B) D-1	FRANKLIN		102	
FED. ROAD DIST. NO. 7		ILLINOIS			

The Illinois Coil-Lock Anchor Bolt is a proprietary item which is the property of the Illinois Department of Transportation. Use, reproduction or disclosure without express written permission is prohibited and protected under Federal copyright laws. The production and the fabrication of this bolt for use on highway projects in the State of Illinois shall be permitted and there shall be no incurred charges or fees to the manufacturer or the fabricator for producing or fabricating this bolt.

D	E	H	K	"d"
1"	1 1/8"	1 3/16"	1 3/4"	1/4"
1 1/4"	1 3/8"	1 1/16"	2"	3/8"
1 1/2"	1 5/8"	1 5/16"	2 1/8"	1/2"
2"	2 1/8"	1 13/16"	2 7/8"	1/2"
2 1/2"	2 5/8"	2 5/16"	3 3/8"	1"

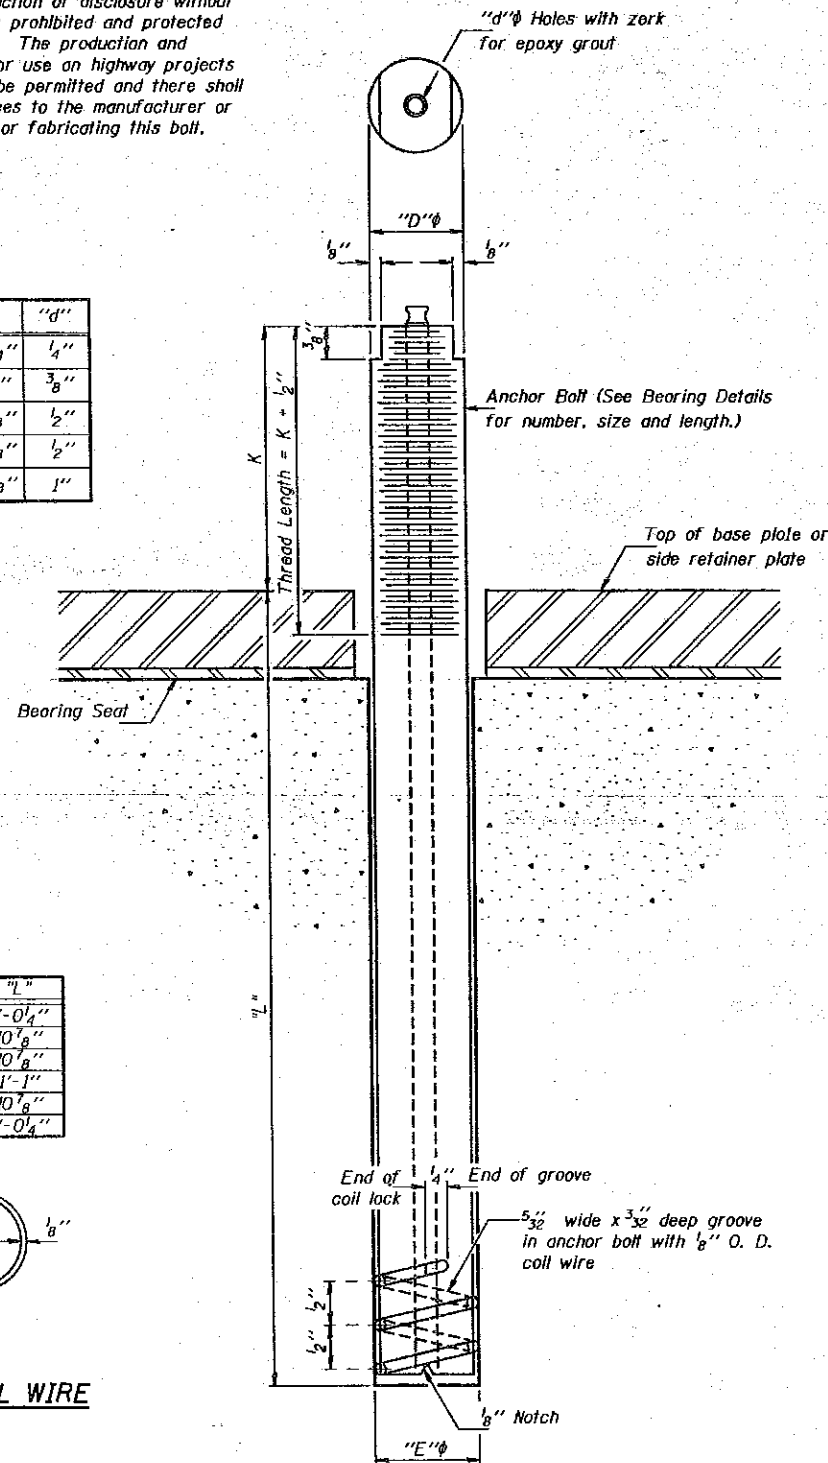

LOCATION	"L"
No. Abutment	1'-0 1/4"
Pier #1	10' 8"
Pier #2	10' 8"
Pier #3	1'-1"
Pier #4	10' 8"
So. Abutment	1'-0 1/4"

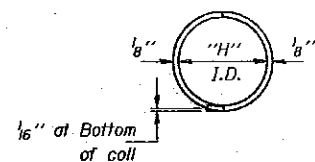

PLAN-COIL WIRE

ILLINOIS COIL-LOCK ANCHOR BOLT

MATERIALS FOR ILLINOIS COIL-LOCK ANCHOR BOLT

The anchor bolt shall be fabricated from cold drawn or hot finished seamless carbon steel mechanical tubing conforming to ASTM A519, Grade 1026 and supplied with hexagonal nuts and cut washers.  
The coil wire shall be made of any suitable soft steel wire.  
The finished anchor bolt shall be cleaned of rust and other foreign materials and wrapped or packaged to prevent contamination until they are installed.  
The epoxy grout shall be a two-component, epoxy resin bonding system conforming to ASTM C881, Type I, Grade 1 and of a Class suitable for the temperature at installation.

INSTALLATION PROCEDURE for the ILLINOIS COIL-LOCK ANCHOR BOLT

1. With the coil wire in place, the bolt shall be inserted into the hole and turned clockwise to a snug fit in the hole. Nut and washer shall be placed on the bolt. The nut shall be tensioned until the steel base plates are held securely to the concrete bearing seat.
2. Epoxy grout shall be pumped through the zerk fitting with a pressure gun. Pumping shall continue until the epoxy overflows the hole around the bolt shank. After pumping is discontinued, excess epoxy shall be immediately wiped off.

ALTERNATE ANCHOR BOLTS

The Contractor may use, at his option, the capsule or the adhesive cartridge type anchor rods that have been previously tested and given a prior approval by the Department. The Contractor shall install these anchor rods in pre-drilled holes in accordance with the manufacturer's recommendations and procedures.  
The capsule or the adhesive-cartridge-type anchor rods shall be a two-part system composed of:  
1. A threaded rod stud with nut and washer conforming to ASTM A307.  
2. A sealed glass capsule or a sealed glass adhesive cartridge containing premeasured amounts of the adhesive chemical.

GENERAL NOTES

Holes in the masonry for anchor bolts shall be drilled through the base plates to the diameter and depth shown or in accordance with the manufacturer's recommendation after beams or girders have been erected and adjusted.  
Prior to setting the bolts, the holes shall be dry and all dust and loose particles shall be removed by the use of compressed air or vacuuming.  
The anchor bolts, furnished and installed including the epoxy grout or capsules shall not be paid for separately but shall be included in the unit bid price for "Furnishing and Erecting Structural Steel".

DESIGNED <i>Steve Hegarty</i>	EXAMINED <i>Prof. J. Kaspar</i>
CHECKED <i>SP</i>	PASSED <i>Ralph E. Anderson</i>
DRAWN <i>John F. Schneller Jr.</i>	APPROVED _____
CHECKED <i>SP</i>	DIRECTOR OF HIGHWAYS




ABB-1 12-1-83 Sheets 101 Thru 145 (Set 2 of 2)

ANCHOR BOLT DETAILS  
FOR BEARINGS  
F.A.I. RT. 57 SEC. (28-5B)D-1  
FRANKLIN COUNTY  
STA. 44+49.00



STATE OF ILLINOIS  
DEPARTMENT OF TRANSPORTATION  
40-#5 u(E) bars at 12" cts.

ROUTE NO.	SECTION	COUNTY	MILE MARK	SHEET NO.
F.A.I. 57	(28-5B) D-1	FRANKLIN		103
FED. ROAD DIST. NO. 7	NUMBER	FED. AID PROJECT		

SHEET NO. 20  
25 SHEETS

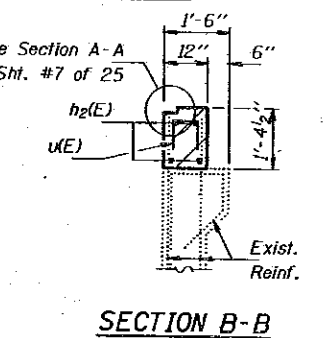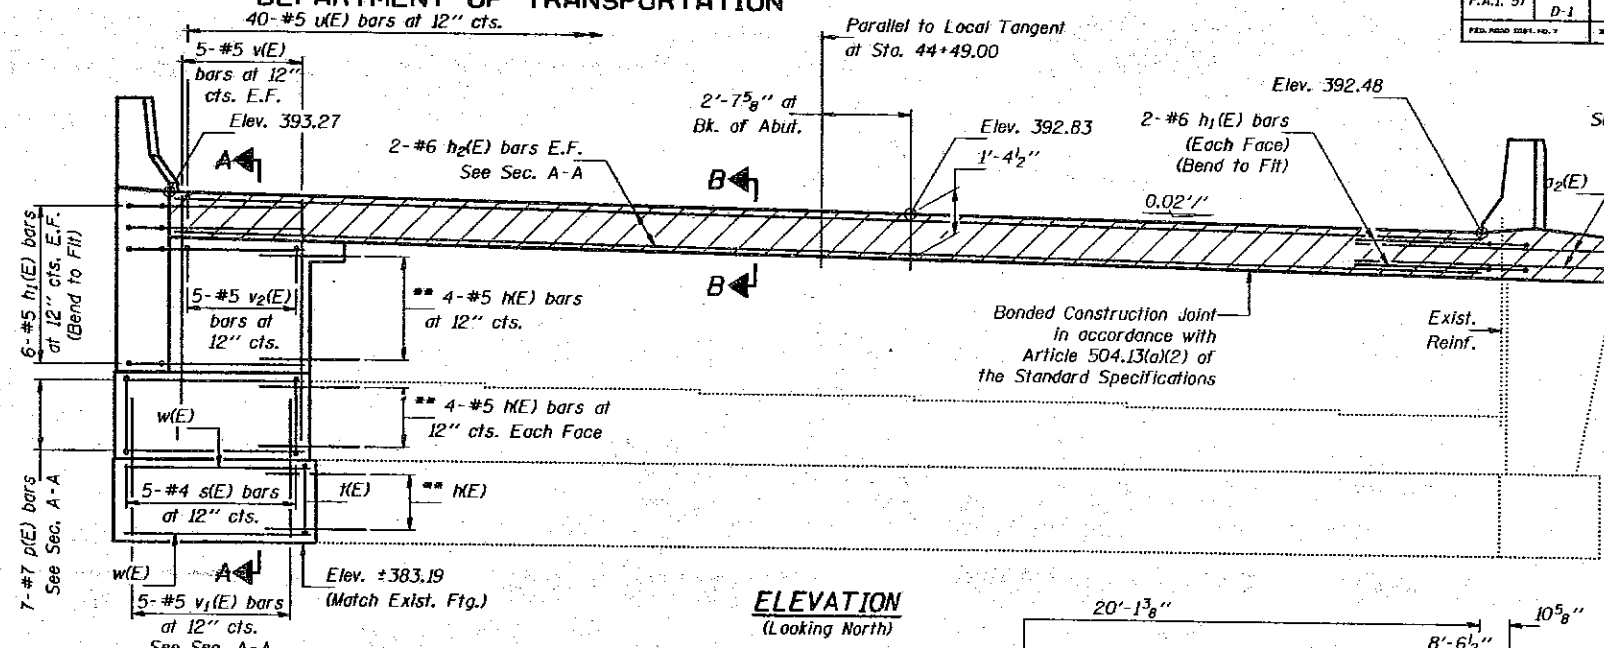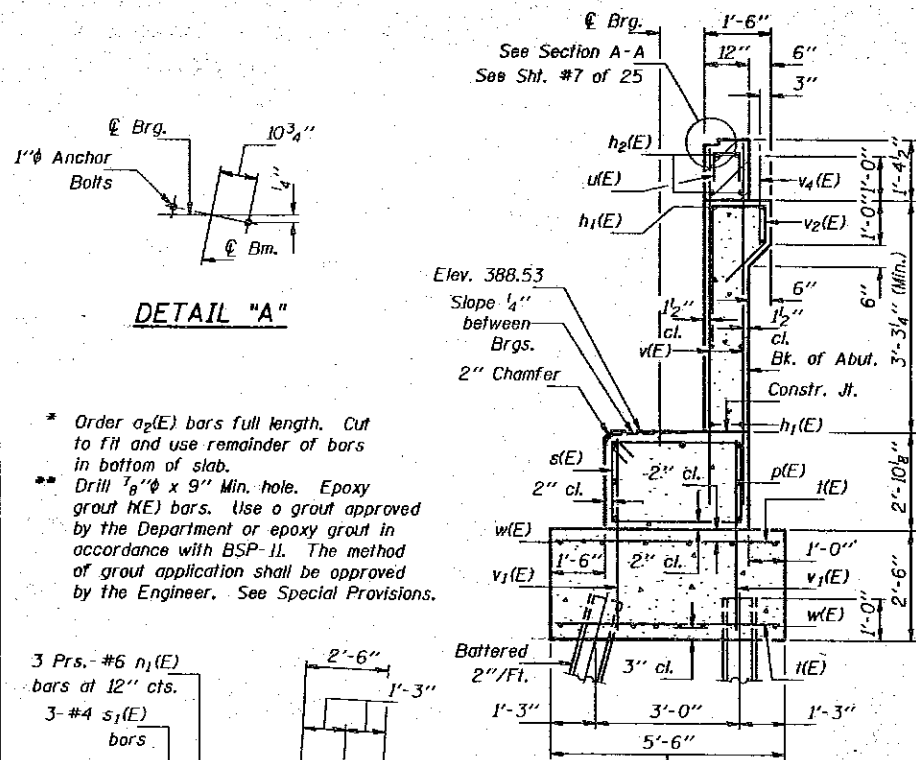

\* Order w(E) bars full length. Cut to fit and use remainder of bars in bottom of slab.  
\*\* Drill 3/8" x 9" Min. hole. Epoxy grout h(E) bars. Use a grout approved by the Department or epoxy grout in accordance with BSP-11. The method of grout application shall be approved by the Engineer. See Special Provisions.

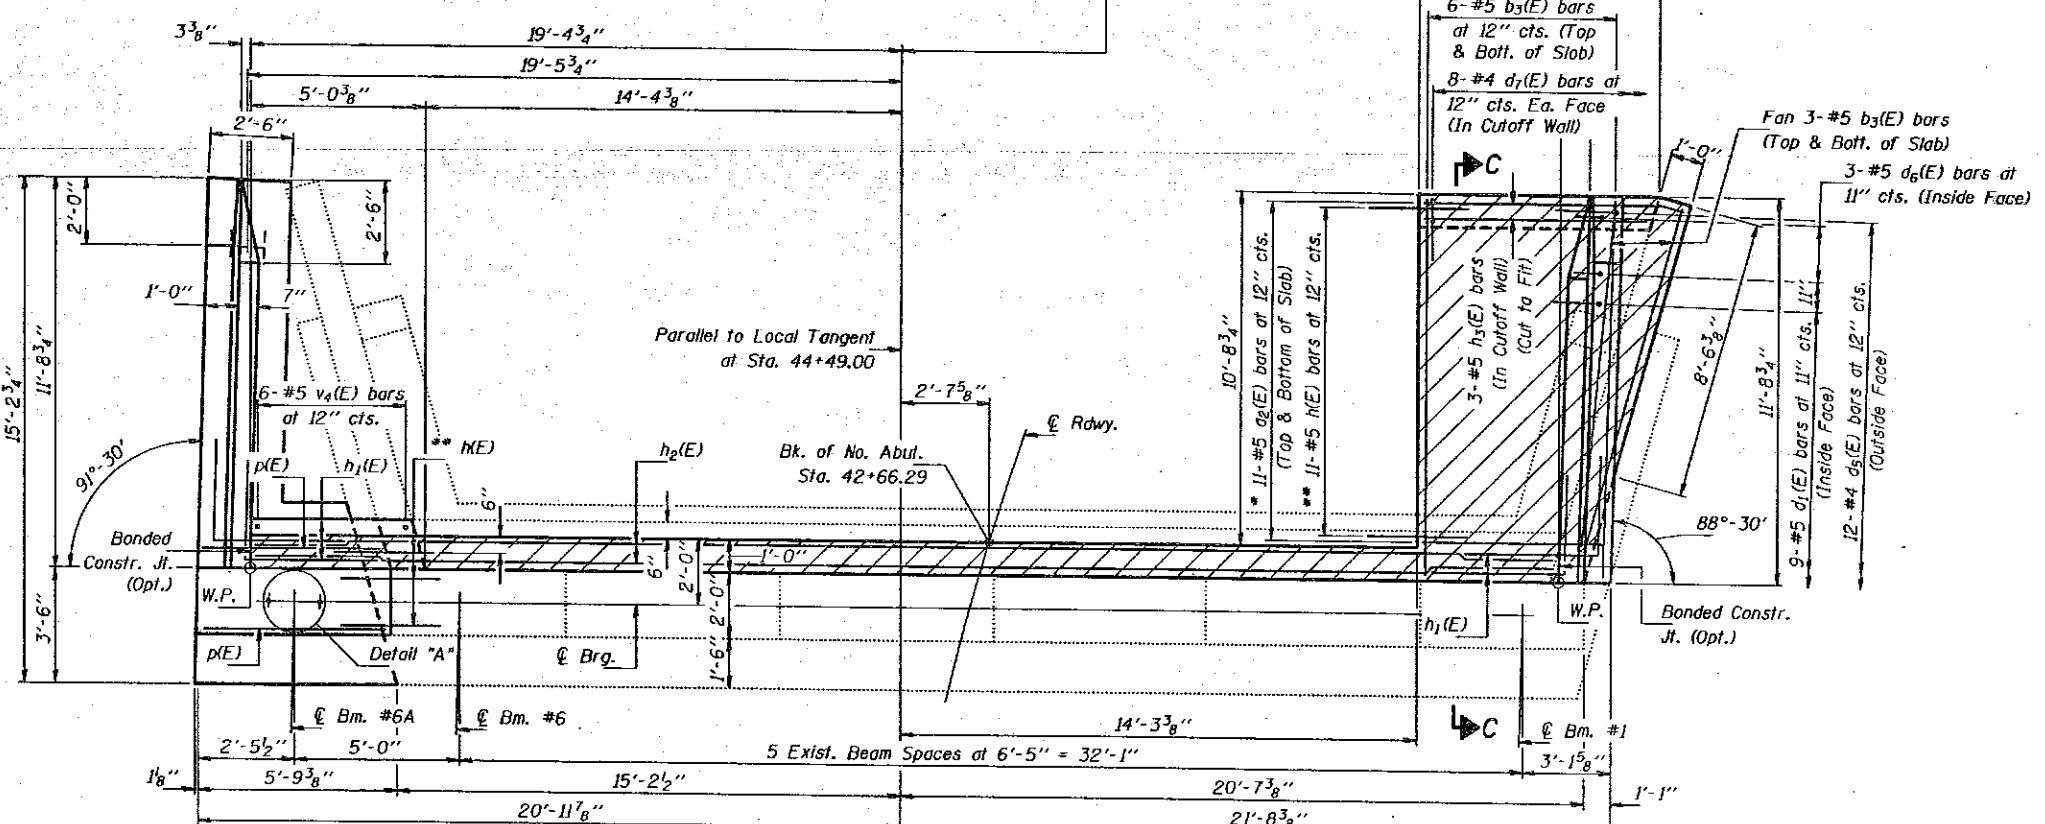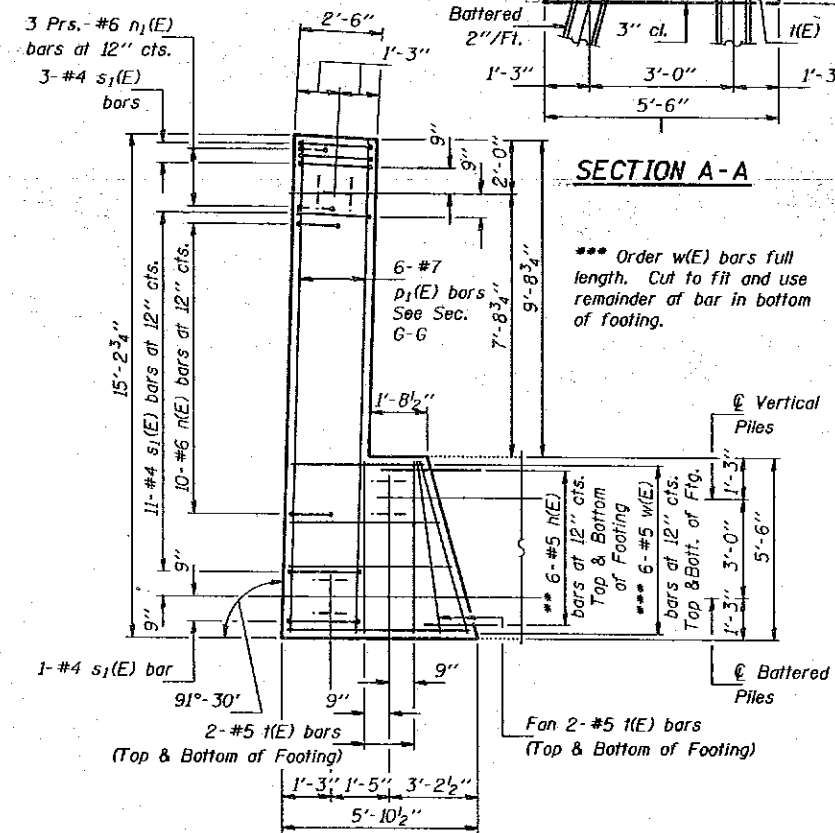

FOOTING PLAN

PLAN

PILE DATA

DESIGNED *Steve Thompson*  
CHECKED *John F. Schneller Jr.*  
DRAWN *John F. Schneller Jr.*  
CHECKED *SPM*

EXAMINED *Raj D. Kasper*  
PASSED *Ralph E. Anderson*  
APPROVED \_\_\_\_\_  
DIRECTOR OF HIGHWAYS

May 20 1993

Notes:  
Hatched area to be poured after Superstructure forms have been removed. Form top surface to match superstructure. Concrete quantity is billed with "Class X Concrete Superstructure" see sheet #7 of 25.  
Concrete quantity for End Posts is billed with "Class X Concrete Superstructure" see sheet #7 of 25.  
Existing vertical reinforcement extending into new construction shall be cleaned, straightened, and incorporated into new construction. Cost is incidental to "Concrete Removal".

Notes:  
Space reinforcement in cap to miss anchor bolts. Existing reinforcement not extending into new construction shall be cut off and covered with a 2" layer of cement grout. Cost incidental to "Concrete Removal".  
Reinforcement bars designated (E) shall be epoxy coated. For Wingwall Details and Bill of Material see sheet #22 of 25. For Anchor Bolt installation details see sheet #19 of 25. All edges shall have standard 3/4" chamfer except as noted. See sheet #25 of 25 for locations of Concrete Removal.

Type: Steel HP12 x 53  
Capacity: Drive to Refusal  
Est. Length: 44 Ft.  
No. Required: 2 + 1 Test Pile

MIN. BAR LAPS  
#5 (E) bars = 2'-2"


NORTH ABUTMENT  
F.A.I. RT. 57 SEC. (28-5B)D-1  
FRANKLIN COUNTY  
STA. 44+49.00






STATE OF ILLINOIS  
DEPARTMENT OF TRANSPORTATION


NOTE NO.	SECTION	COUNTY	LEVEE	FEET	SHEET NO.
F.A.I. 57	(28-5B)	FRANKLIN		105	25 SHEETS
FED. ROAD DIST. NO. 7		MAINTENANCE		FED. AID PROJECT	

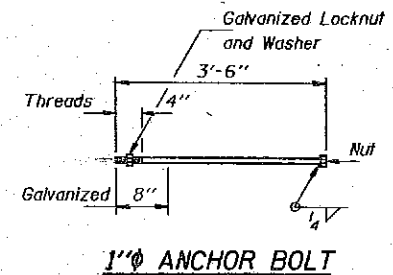


1" ANCHOR BOLT

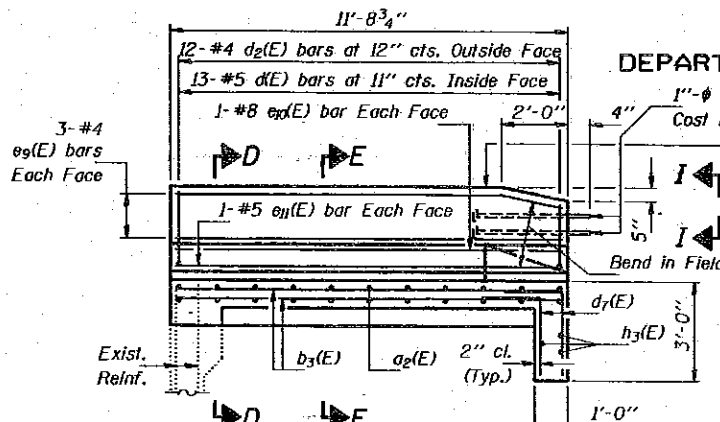


SECTION C-C

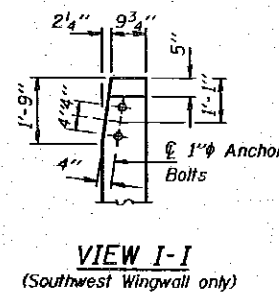


VIEW I-I  
(Southwest Wingwall only)

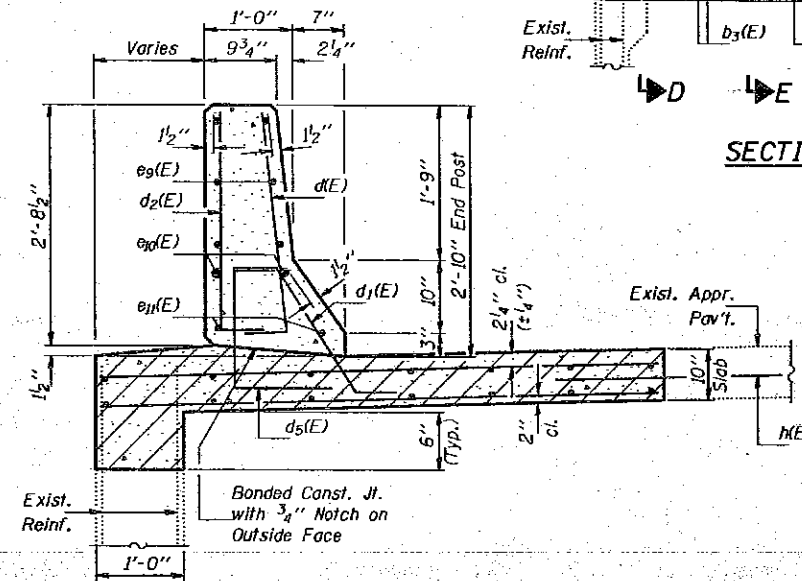


SECTION E-E

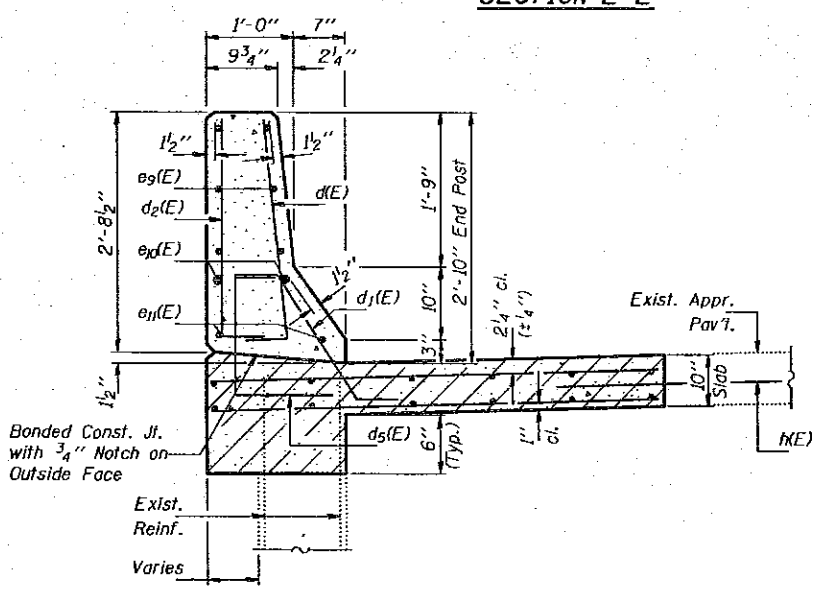


SECTION D-D

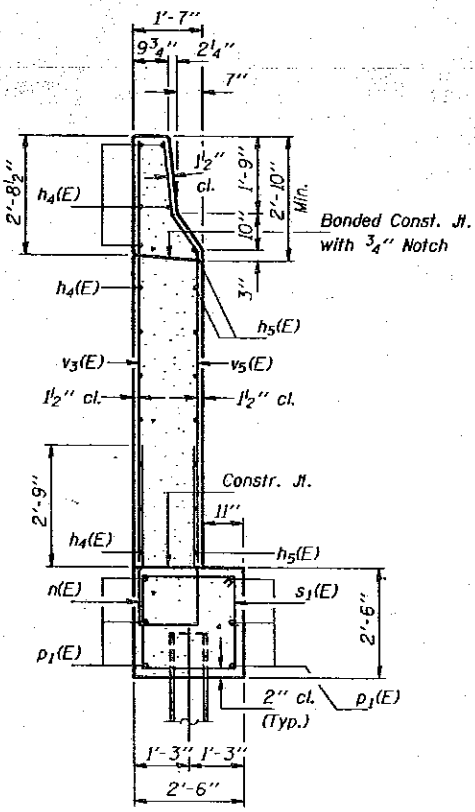


SECTION G-G

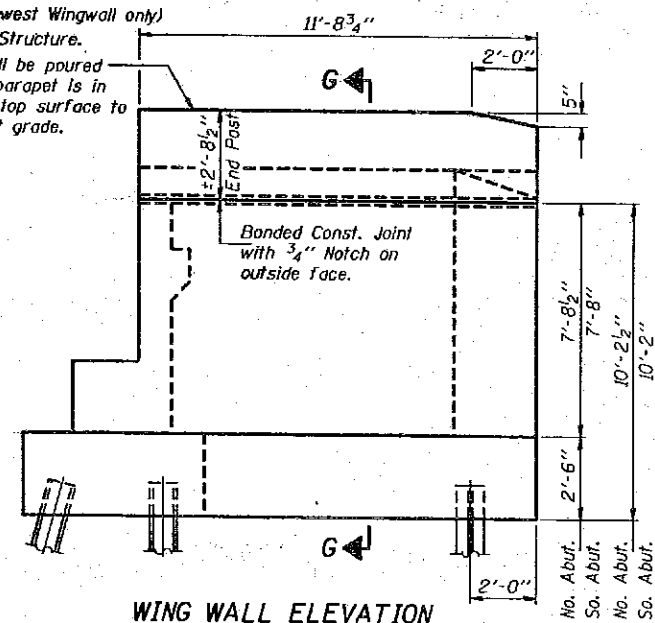

WING WALL ELEVATION

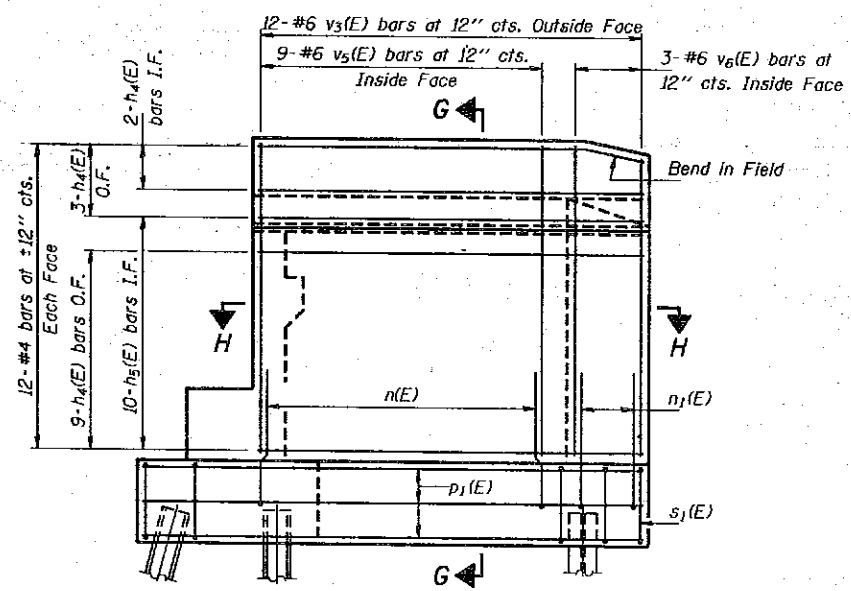


WING WALL ELEVATION  
Reinforcement

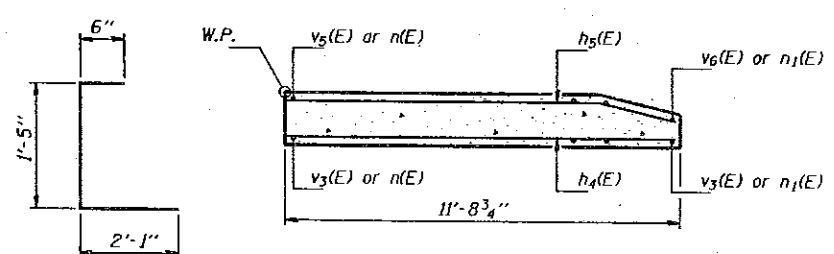

SECTION H-H

BAR d5(E)

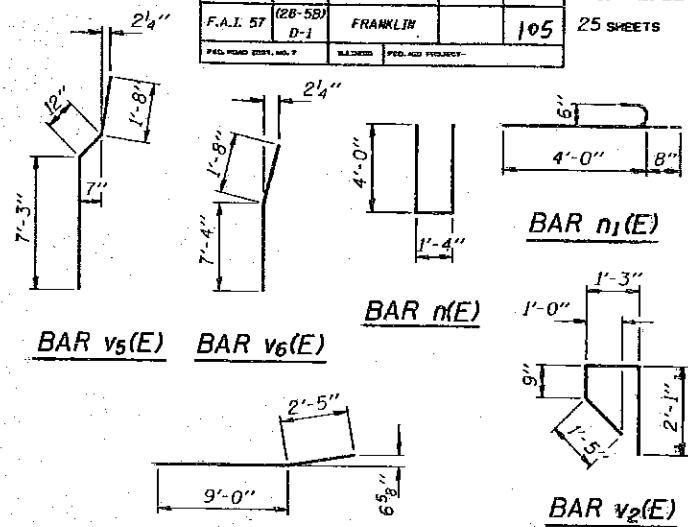


BAR n1(E)  
BAR v5(E) BAR v6(E)  
BAR n(E)  
BAR v2(E)

**TWO ABUTMENTS  
BILL OF MATERIAL**

Bar	No.	Size	Length	Shape
d2(E)	22	#5	15'-6"	
b3(E)	36	#5	11'-5"	
d(E)	26	#5	3'-0"	
d1(E)	18	#5	2'-7"	
d2(E)	24	#4	3'-0"	
d5(E)	24	#4	4'-0"	
d6(E)	6	#5	2'-7"	
d7(E)	32	#4	4'-0"	
e9(E)	12	#4	11'-5"	
e11(E)	4	#8	11'-5"	
e11(E)	4	#5	11'-5"	
n(E)	70	#5	3'-0"	
h1(E)	32	#5	6'-7"	
h2(E)	8	#6	39'-3"	
h3(E)	6	#5	8'-3"	
h4(E)	28	#4	11'-5"	
h5(E)	20	#4	11'-5"	
n(E)	20	#6	9'-4"	
n1(E)	12	#6	4'-8"	
p(E)	14	#7	5'-5"	
p1(E)	12	#7	15'-0"	
s(E)	10	#4	11'-1"	
s1(E)	30	#4	9'-5"	
n(E)	16	#5	5'-3"	
u(E)	80	#5	1'-11"	
v(E)	20	#5	6'-9"	
v1(E)	20	#5	4'-10"	
v2(E)	10	#5	5'-6"	
v3(E)	24	#6	9'-11"	
v4(E)	12	#5	2'-0"	
v5(E)	18	#6	9'-11"	
v6(E)	6	#6	9'-0"	
w(E)	12	#5	9'-4"	
Class X Concrete		Cu. Yds.	30.0	
Reinforcement Bars (Epoxy Coated)		Lbs.	5,270	
Steel Piles HP12 x 53		Lin. Ft.	208	
Test Piles		Each	2	
Steel HP12 x 53		Each	2	
Structure Excavation		Cu. Yds.	70	

BARs s(E) & s1(E)

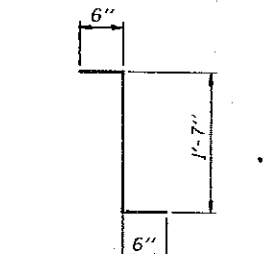

BAR d6(E)

DESIGNED *Steve Hagen*  
CHECKED *Bob Mc...*  
DRAWN *John F. Schneller Jr.*  
CHECKED *BM BM*

EXAMINED *Greg J. Kaspar*  
PASSED *Ralph E. Anderson*  
APPROVED \_\_\_\_\_

May 20 1992  
DIRECTOR OF HIGHWAYS

For details of bars d(E) thru d2(E) see sheet #7 of 25.  
Reinforcement bars designated (E) shall be epoxy coated.


**ABUTMENT DETAILS**  
F.A.I. RT. 57 SEC. (28-5B)D-1  
FRANKLIN COUNTY  
STA. 44+49.00

STATE OF ILLINOIS  
DEPARTMENT OF TRANSPORTATION


PROJECT NO.	SECTION	DATE	SHEET NO.	SHEET NO. 23
F.A.I. 57	(28-5B) D-1	FRANKLIN	106	25 SHEETS
FED. ROAD DIST. NO. 7	ILLINOIS	FED. AID PROJECT		

Notes: For Anchor Bolt installation details see sheet #19 of 25.

\* Drill  $7/8"$   $\phi$  x 9" Min. hole. Epoxy grout  $h_6(E)$  bars. Use a grout approved by the Department or epoxy grout in accordance with BSP-11. The method of grout application shall be approved by the Engineer. See Special Provisions.

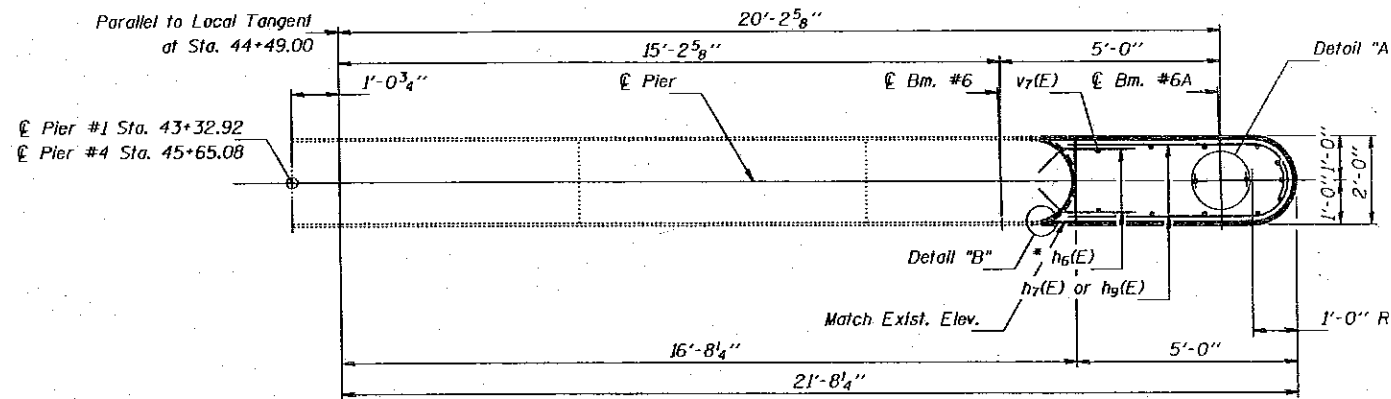


PLAN

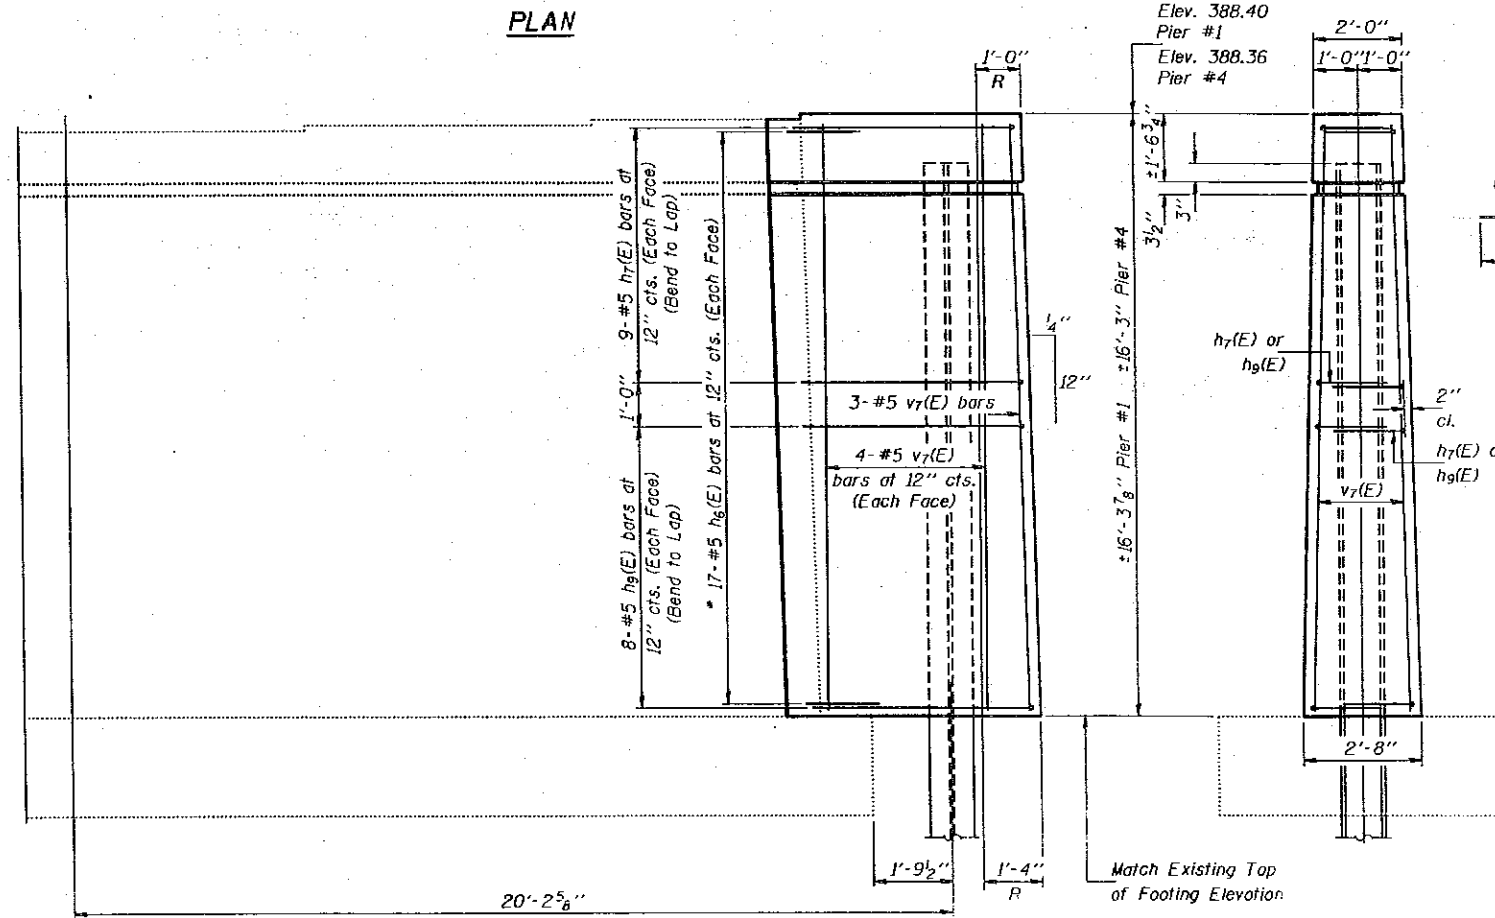


ELEVATION  
(Looking South)


END VIEW

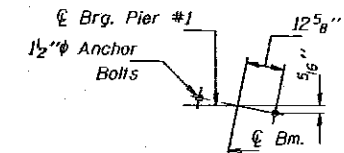


DETAIL "A"  
(Pier #1)

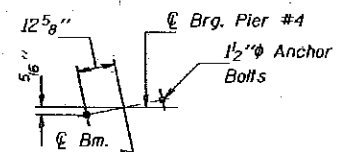

DETAIL "A"  
(Pier #4)

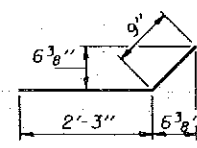


BAR  $h_6(E)$

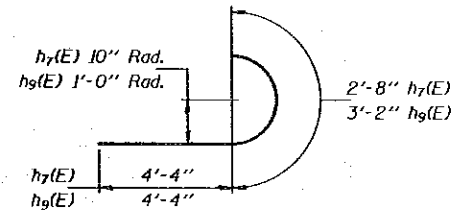


BARS  $h_7(E)$  &  $h_9(E)$

PILE DATA

Type: Steel (HP12 x 74)  
Capacity: Drive to Refusal  
Est. Length: 47 Ft. Pier #1  
Est. Length: 61 Ft. Pier #4  
No. Req'd: 1 Each Pier

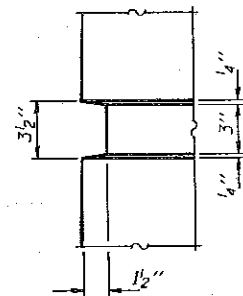

NOTCH DETAIL

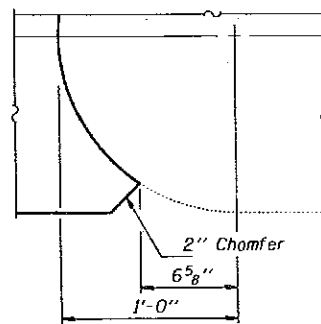

DETAIL "B"

BILL OF MATERIAL

Bar	No.	Size	Length	Shape
$h_6(E)$	68	#5	3'-0"	—
$h_7(E)$	36	#5	7'-0"	—
$h_9(E)$	32	#5	7'-6"	—
$v_7(E)$	22	#5	15'-11"	—
Class X Concrete		Cu. Yd.	14.1	
Reinforcement Bars, Epoxy Coated		Lbs.	1,090	
Structure Excavation		Cu. Yd.	13	
Steel Piles HP12 x 74		Lin. Ft.	108	

Reinforcement Bars designated (E) shall be epoxy coated.

DESIGNED: Steve Neumann  
CHECKED: [Signature]  
DRAWN: John F. Schneller Jr.  
CHECKED: [Signature]

EXAMINED: [Signature]  
PASSED: Ralph E. Anderson  
APPROVED: [Signature]

May 20 1993

PIERS #1 & #4  
F.A.I. RT. 57 SEC. (28-5B)D-1  
FRANKLIN COUNTY  
STA. 44+49.00



STATE OF ILLINOIS  
DEPARTMENT OF TRANSPORTATION

PROJECT NO.	SECTION	COUNTY	JOB NO.	SHEET NO.
F.A.I. 57	(28-5B) D-3	FRANKLIN		107
SHEET NO. 24				25 SHEETS

Notes: For Anchor Bolt installation details see sheet #19 of 25.


\* Drill  $\frac{1}{8}$ " x 9" Min. hole. Epoxy grout  $\frac{1}{8}$ "(E) bars. Use a grout approved by the Department or epoxy grout in accordance with BSP-11. The method of grout application shall be approved by the Engineer. See Special Provisions.

PILE DATA


Type: Steel (HP12 x 74)  
Capacity: Drive to Refusal  
Est. Length: 60 Ft. Pier #2  
Est. Length: 62 Ft. Pier #3  
No. Req'd: 1 Each Pier




NOTCH DETAIL

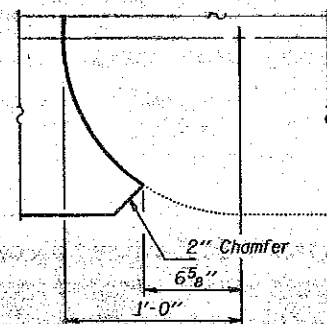

DETAIL "B"

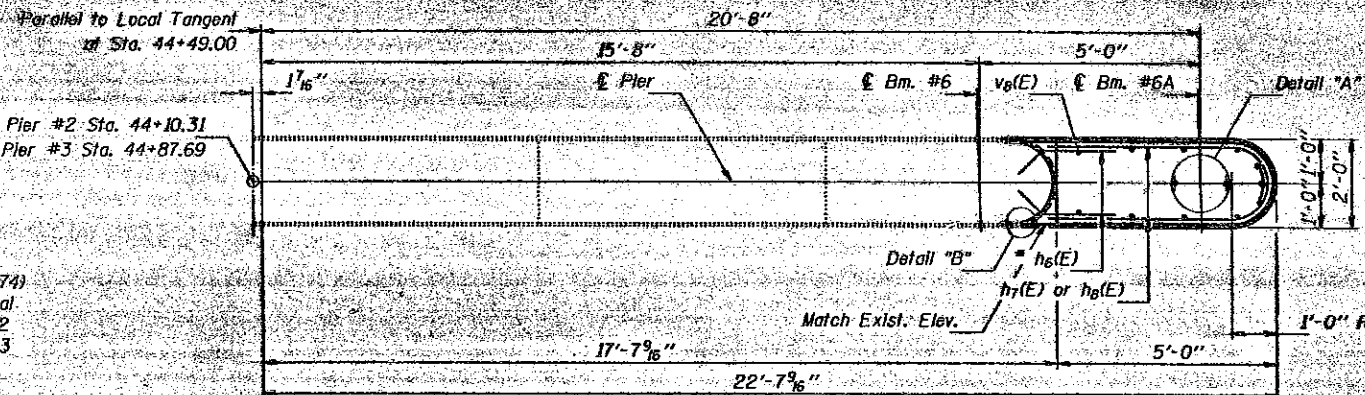


PLAN

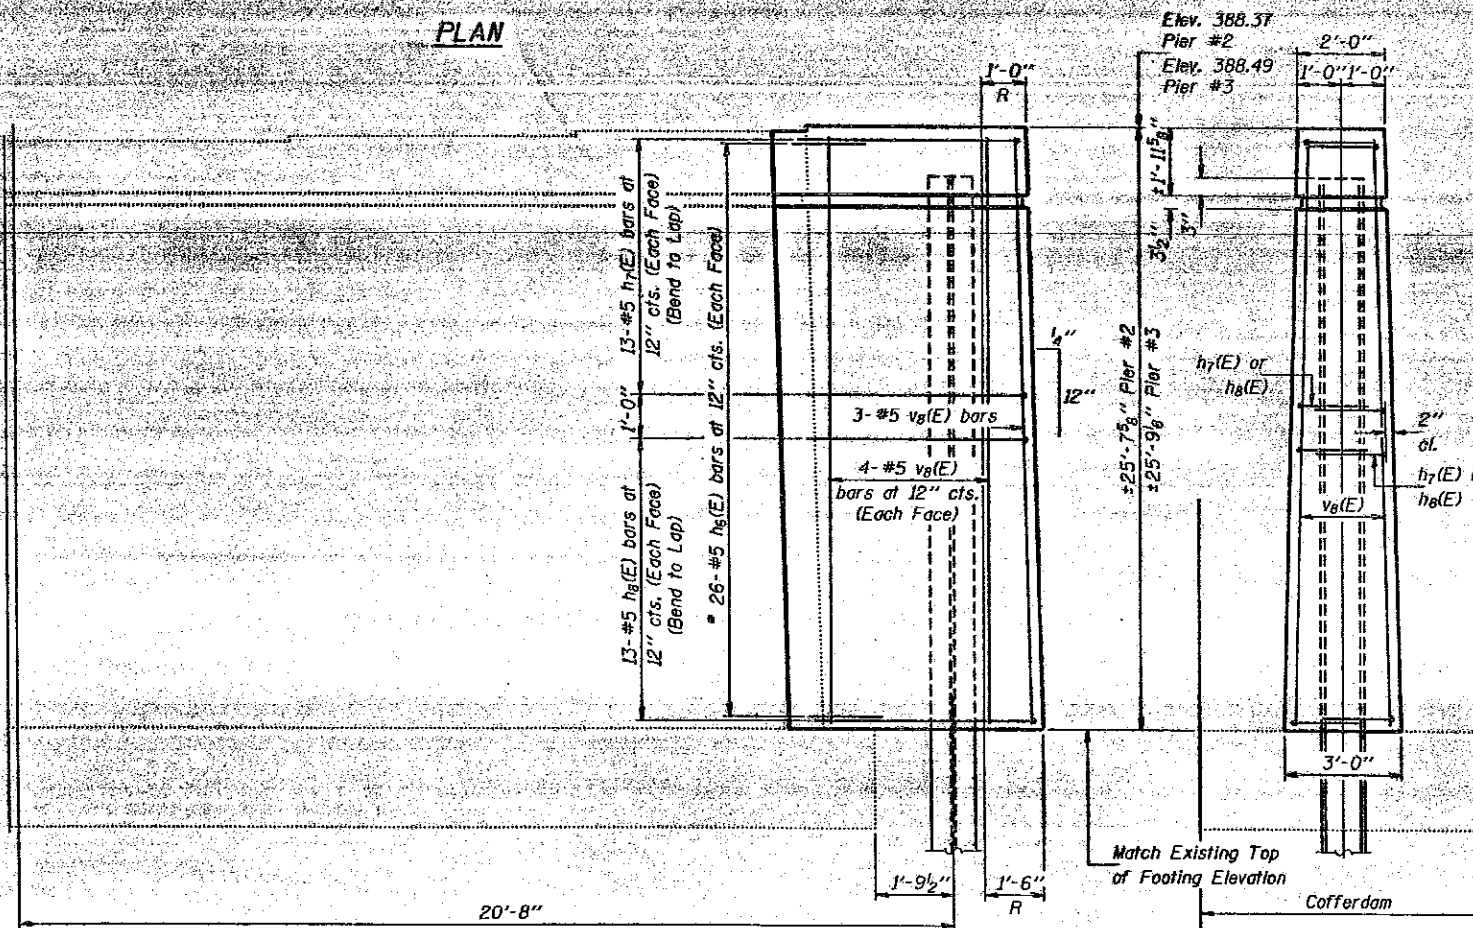


ELEVATION  
(Looking South)


END VIEW

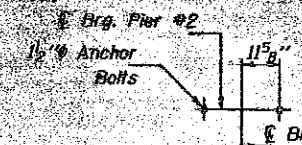


DETAIL "A"  
(Pier #2)

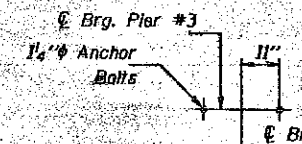

DETAIL "A"  
(Pier #3)

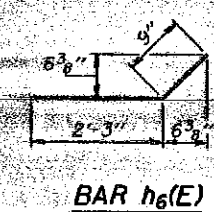

BAR h6(E)

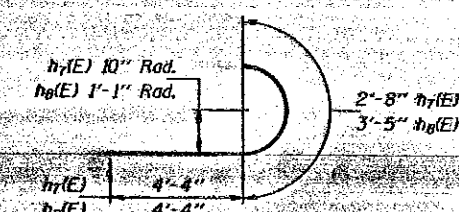

BARS h7(E) & h8(E)

BILL OF MATERIAL

Bar	No.	Size	Length	Shape
h6(E)	104	#5	3'-0"	┌
h7(E)	52	#5	7'-0"	┌
h8(E)	52	#5	7'-9"	┌
v6(E)	22	#5	25'-4"	—
Class X Concrete			Cu. Yd.	23.8
Reinforcement Bars, Epoxy Coated			Lbs.	1,710
Cofferdams			Each	2
Cofferdam Excavation			Cu. Yd.	52
Steel Piles HP12 x 74			Lin. Ft.	122

Reinforcement Bars designated (E) shall be epoxy coated.


DESIGNED *Stewart Hays*  
CHECKED *AD*  
DRAWN John F. Schneller Jr.  
CHECKED *BPH*

May 20 1993  
EXAMINED *Dr. J. O. Kaspar*  
PASSED *Robert E. Anderson*  
APPROVED \_\_\_\_\_


PIERS #2 & #3  
F.A.I. RT. 57 SEC. (28-5B)D-1  
FRANKLIN COUNTY  
STA. 44+49.00

STATE OF ILLINOIS  
DEPARTMENT OF TRANSPORTATION


ROAD NO.	DISTRICT	TOWNSHIP	RANGE	SHEET NO.
F.A.I. 57	(28-5B)	FRANKLIN		25
SECTION				25 SHEETS
DRAWN BY				100
CHECKED BY				

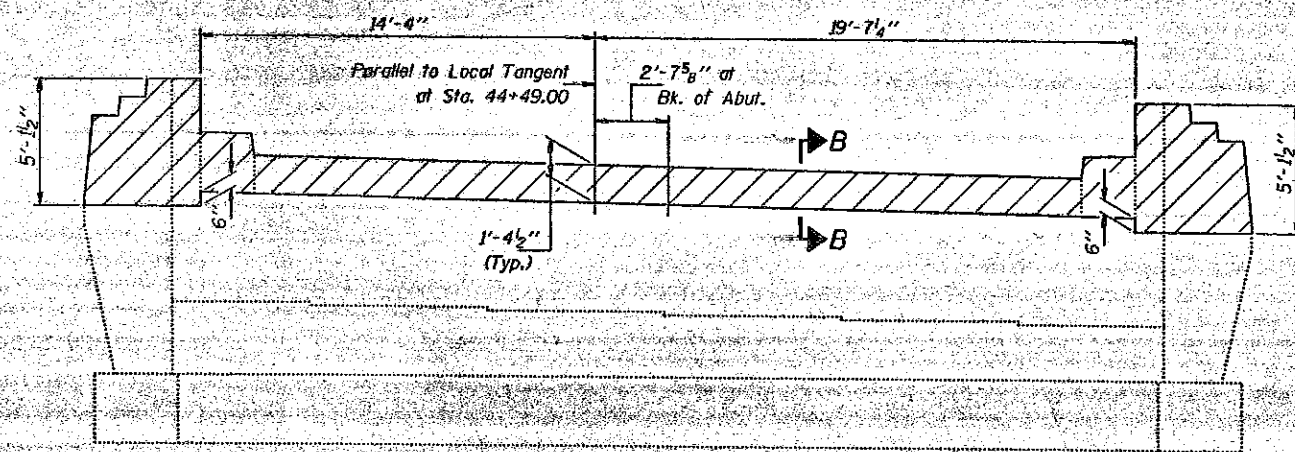


ELEVATION  
(Looking North)

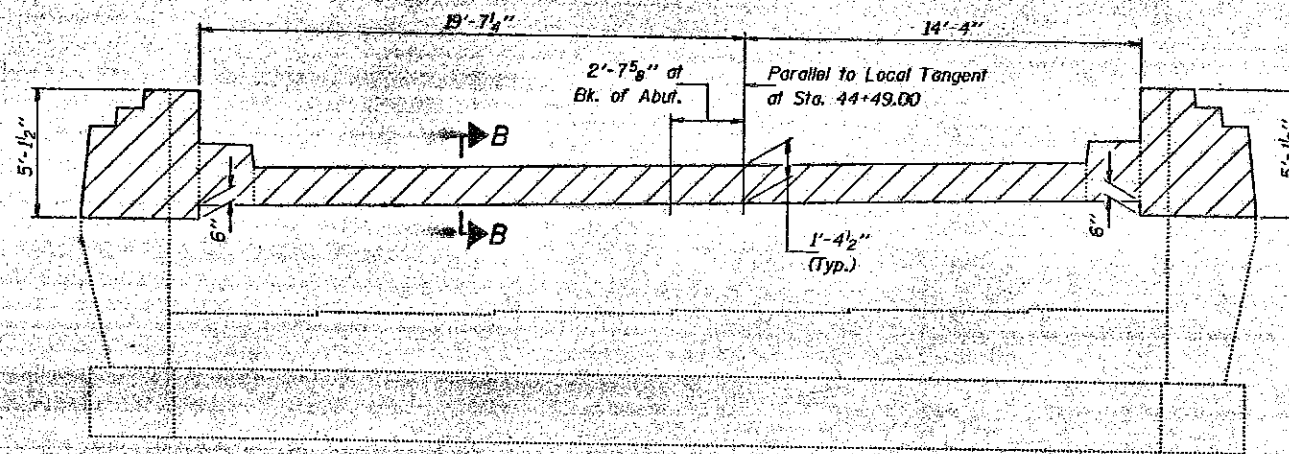


ELEVATION  
(Looking South)

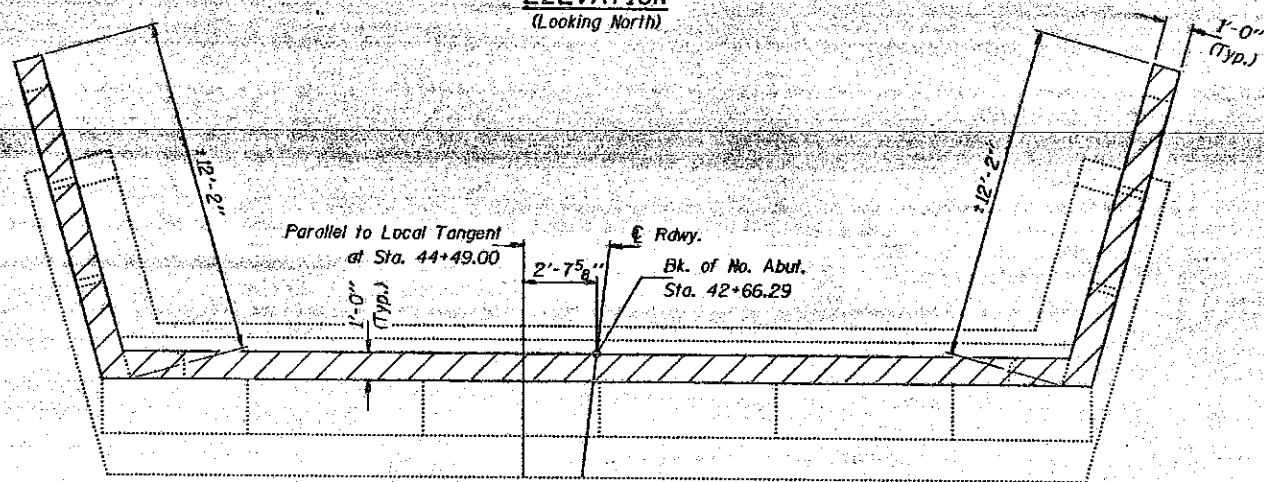

PLAN  
(North Abutment)

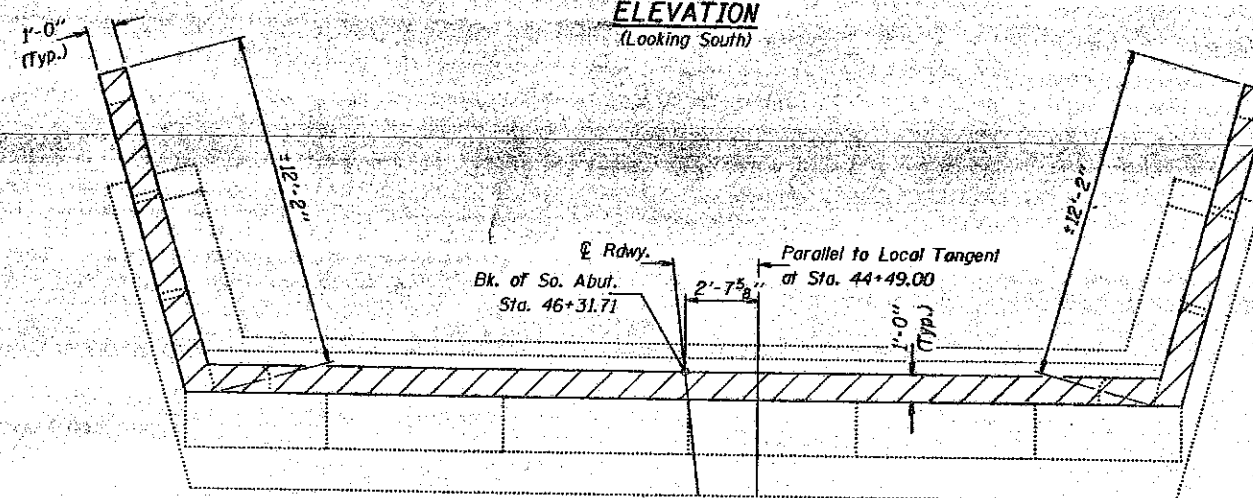

PLAN  
(South Abutment)

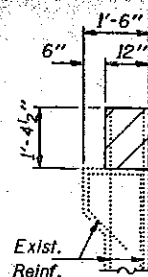

SECTION B-B

Notes: Hatched area indicates "Concrete Removal".  
Existing reinforcement extending into new construction shall be cleaned, straightened, and incorporated into new construction. Cost incidental to "Concrete Removal".  
Existing reinforcement not extending into new construction shall be cut off flush and covered with a 2" layer of cement grout. Cost incidental to "Concrete Removal".  
For existing shoulder pavement removal see Roadway Plans.

BILL OF MATERIAL

ITEM	UNIT	TOTAL
Concrete Removal	Cu. Yd.	12

DESIGNED *Steve Nyquist*  
CHECKED *W.D. Mc...*  
DRAWN *John F. Schneller Jr.*  
CHECKED *W.P. Mc...*

EXAMINED *Craig J. Kasper*  
PASSED *Ralph E. Anderson*  
APPROVED \_\_\_\_\_  
MAY 20 1993  
DIRECTOR OF HIGHWAYS

CONCRETE REMOVAL  
F.A.I. RT. 57 SEC. (28-5B)D-1  
FRANKLIN COUNTY  
STA. 44+49.00



STATE OF ILLINOIS  
DEPARTMENT OF PUBLIC WORKS & BUILDINGS  
DIVISION OF HIGHWAYS

PROJECT NO. 28-5B  
SHEET NO. 108  
FRANKLIN CO.  
STATION 44+49

Boring No. 1 Cont.

Elevation	Soils	Notes
374.6	Ground Surface	Soft and very moist brown silty clay to silty clay-loam A-6(10)
370.6		Medium to stiff and moist tan clay A-7-6(15)
369.6		Stiff and moist tan mottled brown clay A-7-6(13-14)
363.6		Stiff and moist grey mottled brown silty clay to silty clay loam A-6(9-10)
360.1		Stiff and moist grey mottled brown silty clay to clay A-6(11-12)
357.6		Medium to stiff and moist grey silty clay A-6(10)
355.2		Medium and moist grey silt loam A-6(8)
353.6		Stiff and moist grey silty clay to clay A-6(12)
350.1		Very stiff and moist brown clay A-7-6(14-15)
345.1		Stiff and moist brown clay A-7-6(14-15)
342.6		Medium to stiff and moist brown silty clay to clay A-6(10-11)
341.1		Medium and moist grey clay loam A-6(8)
338.6		Soft and moist grey sandy loam
336.1		Loose and very moist grey medium graded fine sand
332.6		

Boring No. 2 Cont.

(See previous column)

Elevation	Soils	Notes
332.6		Loose and wet grey medium graded fine sand
328.6		Medium to hard and dry clay shale
323.1		Medium to hard and dry black bituminous coal
322.1		Bottom of Hole = 32.5 feet
320.7		Very stiff and moist tan mottled brown and black clay A-7-6(13)
319.2		Very stiff and moist tan mottled brown and black clay A-7-6(14)
316.2		Very stiff and moist tan mottled brown and black clay A-7-6(13)
312.7		Stiff and moist tan mottled brown and black clay A-7-6(13-14)
309.2		Stiff and moist red with grey & black streak silty clay A-6(11-12)
305.2		Soft and wet brown sandy clay loam
301.2		Stiff and moist brown silty clay A-7-6(13-14)
297.7		Very stiff and moist brown silty clay A-7-6(13-14)
294.2		Stiff and moist brown clay to clay loam A-6(10)
290.7		Medium to stiff and moist tan mottled grey clay to clay loam A-6(10)
287.2		Stiff and moist greenish grey clay to clay loam A-6(10)
283.7		Stiff and moist greenish grey clay to clay loam A-6(11-12)
280.2		Hard and dry grey clay shale
276.7		Hard and dry grey clay shale
273.2		Bottom of Hole 40.1 feet
269.7		During drilling operations, it appeared that free water was encountered at 15.0 feet
266.2		Bottom of Hole 43.6 feet

Boring No. 3 Cont.

Elevation	Soils	Notes
374.4	Ground Surface	Medium and moist tan silty clay A-6(12-12)
369.9		Hard and moist grey mottled tan silty clay to clay A-7-6(13)
366.9		Stiff and moist tan clay A-7-6(15)
361.1		Stiff and moist grey mottled brown silty clay A-6(11-12)
359.9		Very stiff and moist grey mottled brown silty clay A-7-6(13)
357.9		Medium and moist brown clay loam A-6(11-12)
355.4		Medium and wet brown sandy loam to sand
352.0		Medium and moist grey silt loam A-6(8)
349.4		Medium and wet brown medium graded fine sand
345.9		Medium and wet brown gravelly sand
342.9		Hard and dry grey clay shale
340.5		Very stiff and moist grey clay to clay loam A-6(10-11)
337.0		Hard and moist grey clay shale
334.3		Hard and dry grey clay shale
331.3		Bottom of Hole 39.7 feet
329.7		Medium and wet grey clay loam A-6(7)
327.7		Medium and wet well graded medium sand
321.2		Medium and dry grey clay shale
317.7		Bottom of Hole = 37.5 feet

Boring No. 4 Cont.

Elevation	Soils	Notes
374.4	Ground Surface	Medium and moist tan silty clay A-6(12-12)
369.9		Hard and moist grey mottled tan silty clay to clay A-7-6(13)
366.9		Stiff and moist tan clay A-7-6(15)
361.1		Stiff and moist grey mottled brown silty clay A-6(11-12)
359.9		Very stiff and moist grey mottled brown silty clay A-7-6(13)
357.9		Medium and moist brown clay loam A-6(11-12)
355.4		Medium and wet brown sandy loam to sand
352.0		Medium and moist grey silt loam A-6(8)
349.4		Medium and wet brown medium graded fine sand
345.9		Medium and wet brown gravelly sand
342.9		Hard and dry grey clay shale
340.5		Very stiff and moist grey clay to clay loam A-6(10-11)
337.0		Hard and moist grey clay shale
334.3		Hard and dry grey clay shale
331.3		Bottom of Hole 39.7 feet
329.7		Medium and wet grey clay loam A-6(7)
327.7		Medium and wet well graded medium sand
321.2		Medium and dry grey clay shale
317.7		Bottom of Hole = 37.5 feet

Boring No. 5 Cont.

Elevation	Soils	Notes
375.2	Ground Surface	Soft and very moist tan silty loam A-6(8)
370.0		Medium and moist tan silty clay loam to silty clay A-6(10-11)
368.0		Stiff and moist tan clay A-7-6(15)
364.2		Stiff and moist tan mottled grey clay A-7-6(15)
361.7		Soft to medium and moist bluish grey silty clay A-6(11-12)
359.5		Medium to stiff and moist grey mottled tan silty clay A-6(12-13)
357.0		Stiff and moist grey mottled tan clay A-7-6(15)
354.5		Medium to stiff and moist tan silty clay (11-12)
353.0		Very stiff and moist brown clay A-7-6(20)
347.2		Stiff and moist grey mottled brown clay A-7-6(20)
342.0		Medium and very moist grey clay to clay loam A-6(10-11)
340.5		Very stiff and moist grey clay to clay loam A-6(10-11)
337.0		Hard and dry grey clay shale
334.3		Bottom of Hole 39.7 feet
329.7		Medium and wet well graded medium sand
327.7		Hard and moist grey clay A-7-6(15) near clay shale
321.2		Medium and dry grey clay shale
317.7		Bottom of Hole = 37.5 feet

Boring No. 6 Cont.

Elevation	Soils	Notes
375.6	Ground Surface	Loose and wet grey poorly graded fine sand
371.1		Medium and wet grey well graded coarse sand
369.6		Stiff to hard and slightly moist to moist grey clay A-7-6(15) near clay shale
365.6		Medium and very moist grey mottled brown silty clay A-6(11-12)
363.6		Stiff and moist grey mottled brown silty loam A-6(8)
361.7		Medium and very moist grey mottled brown silty clay A-6(11-12)
359.6		Soft to medium and moist bluish grey silty clay A-6(9-10)
357.6		Soft and very moist bluish grey silty clay A-6(10)
354.6		Stiff and moist bluish grey clay A-7-6(15)
352.1		Very stiff and moist brown clay A-7-6(20)
347.2		Stiff and moist grey mottled brown clay A-7-6(20)
342.2		Stiff and moist bluish grey clay A-7-6(20)
339.2		Medium and wet grey sandy clay loam
337.1		Stiff and moist grey clay A-7-6(17-20)
333.1		Medium and wet grey sandy clay loam
331.1		Bottom of Hole = 56.0 feet

DESIGNED R. Kowert  
CHECKED  
DRAWN  
CHECKED

EXAMINED H.C. Burmann  
PASSED E.L. Shurt  
APPROVED M. J. ...

N - Standard Penetration Test - Blows per foot to drive 2" O.D. Split Spoon Sampler with 140# hammer.  
Qu - Unconfined Compressive Strength - T<sub>u</sub>  
w - Water Content - percentage of oven dry weight %  
Type Failure  
E - Edge Failure  
S - Shear Failure  
P - Penetration Value

BORINGS  
FAI RT 57 SEC 28-5B  
FRANKLIN CO.  
STATION 44+49





ROUTE NO.	SEC.	COUNTY	TOTAL SHEETS	SHEET NO.
F.A.I. 57	*	FRANKLIN	145	110
FED. ROAD DIST. 7		ILLINOIS	PROJECT	
* SEC. 26 (SOUTH) PL. 101		28 (SOUTH) PL. 111		

FINAL SURVEY NOTE BOOK


DATE: \_\_\_\_\_ BY: \_\_\_\_\_

NO. \_\_\_\_\_

ORIG. SURVEY NOTE BOOK

DATE: \_\_\_\_\_ BY: \_\_\_\_\_

NO. \_\_\_\_\_

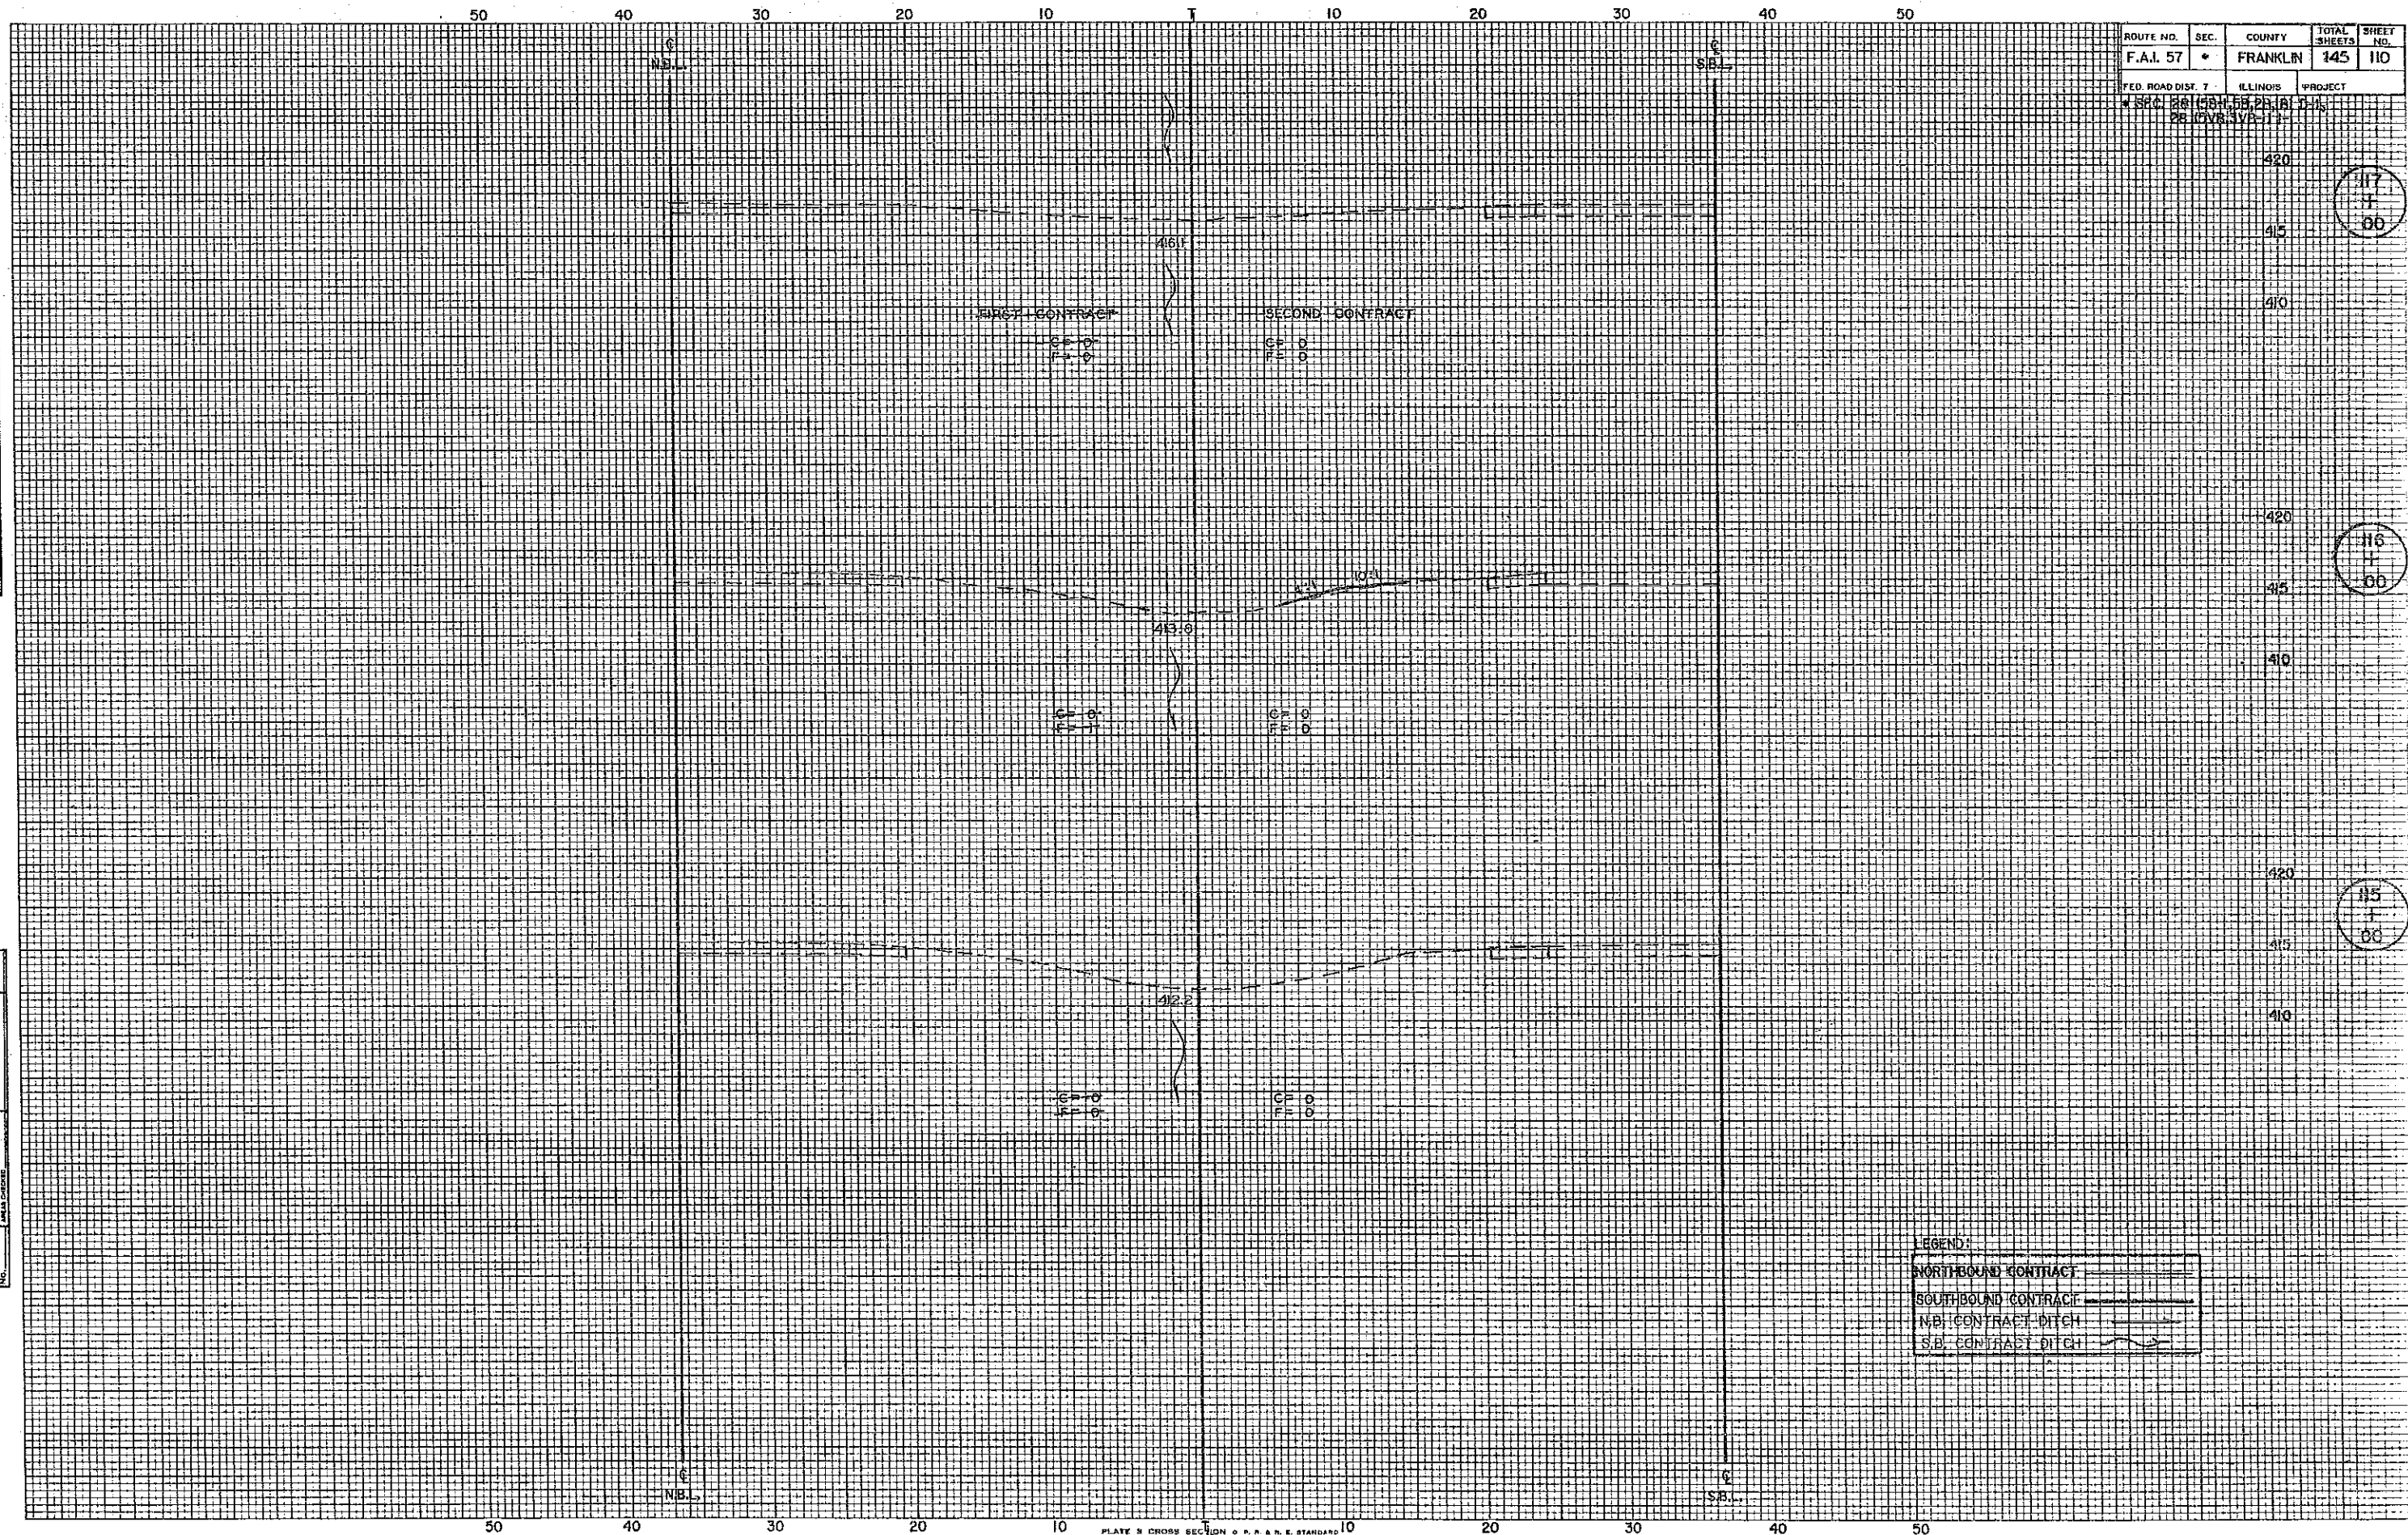

117  
T  
00

116  
T  
00

115  
T  
00

LEGEND:

NORTHBOUND CONTRACT	---
SOUTHBOUND CONTRACT	---
N.B. CONTRACT DITCH	---
S.B. CONTRACT DITCH	---







ROUTE NO.	SEC.	COUNTY	TOTAL SHEETS	SHEET NO.
F.A.I. 57	*	FRANKLIN	145	112
FED. ROAD DIST. 7	ILLINOIS	PROJECT		
SEC. 28 34 50 28 18 11				
28 13 18 3 11 11				

FINAL SURVEY NOTE BOOK

DATE: \_\_\_\_\_ BY: \_\_\_\_\_

REVIEWED: \_\_\_\_\_

PLOTTED: \_\_\_\_\_

DATE: \_\_\_\_\_

NO. \_\_\_\_\_

ORIG SURVEY NOTE BOOK

DATE: \_\_\_\_\_ BY: \_\_\_\_\_

REVIEWED: \_\_\_\_\_

PLOTTED: \_\_\_\_\_

DATE: \_\_\_\_\_

NO. \_\_\_\_\_

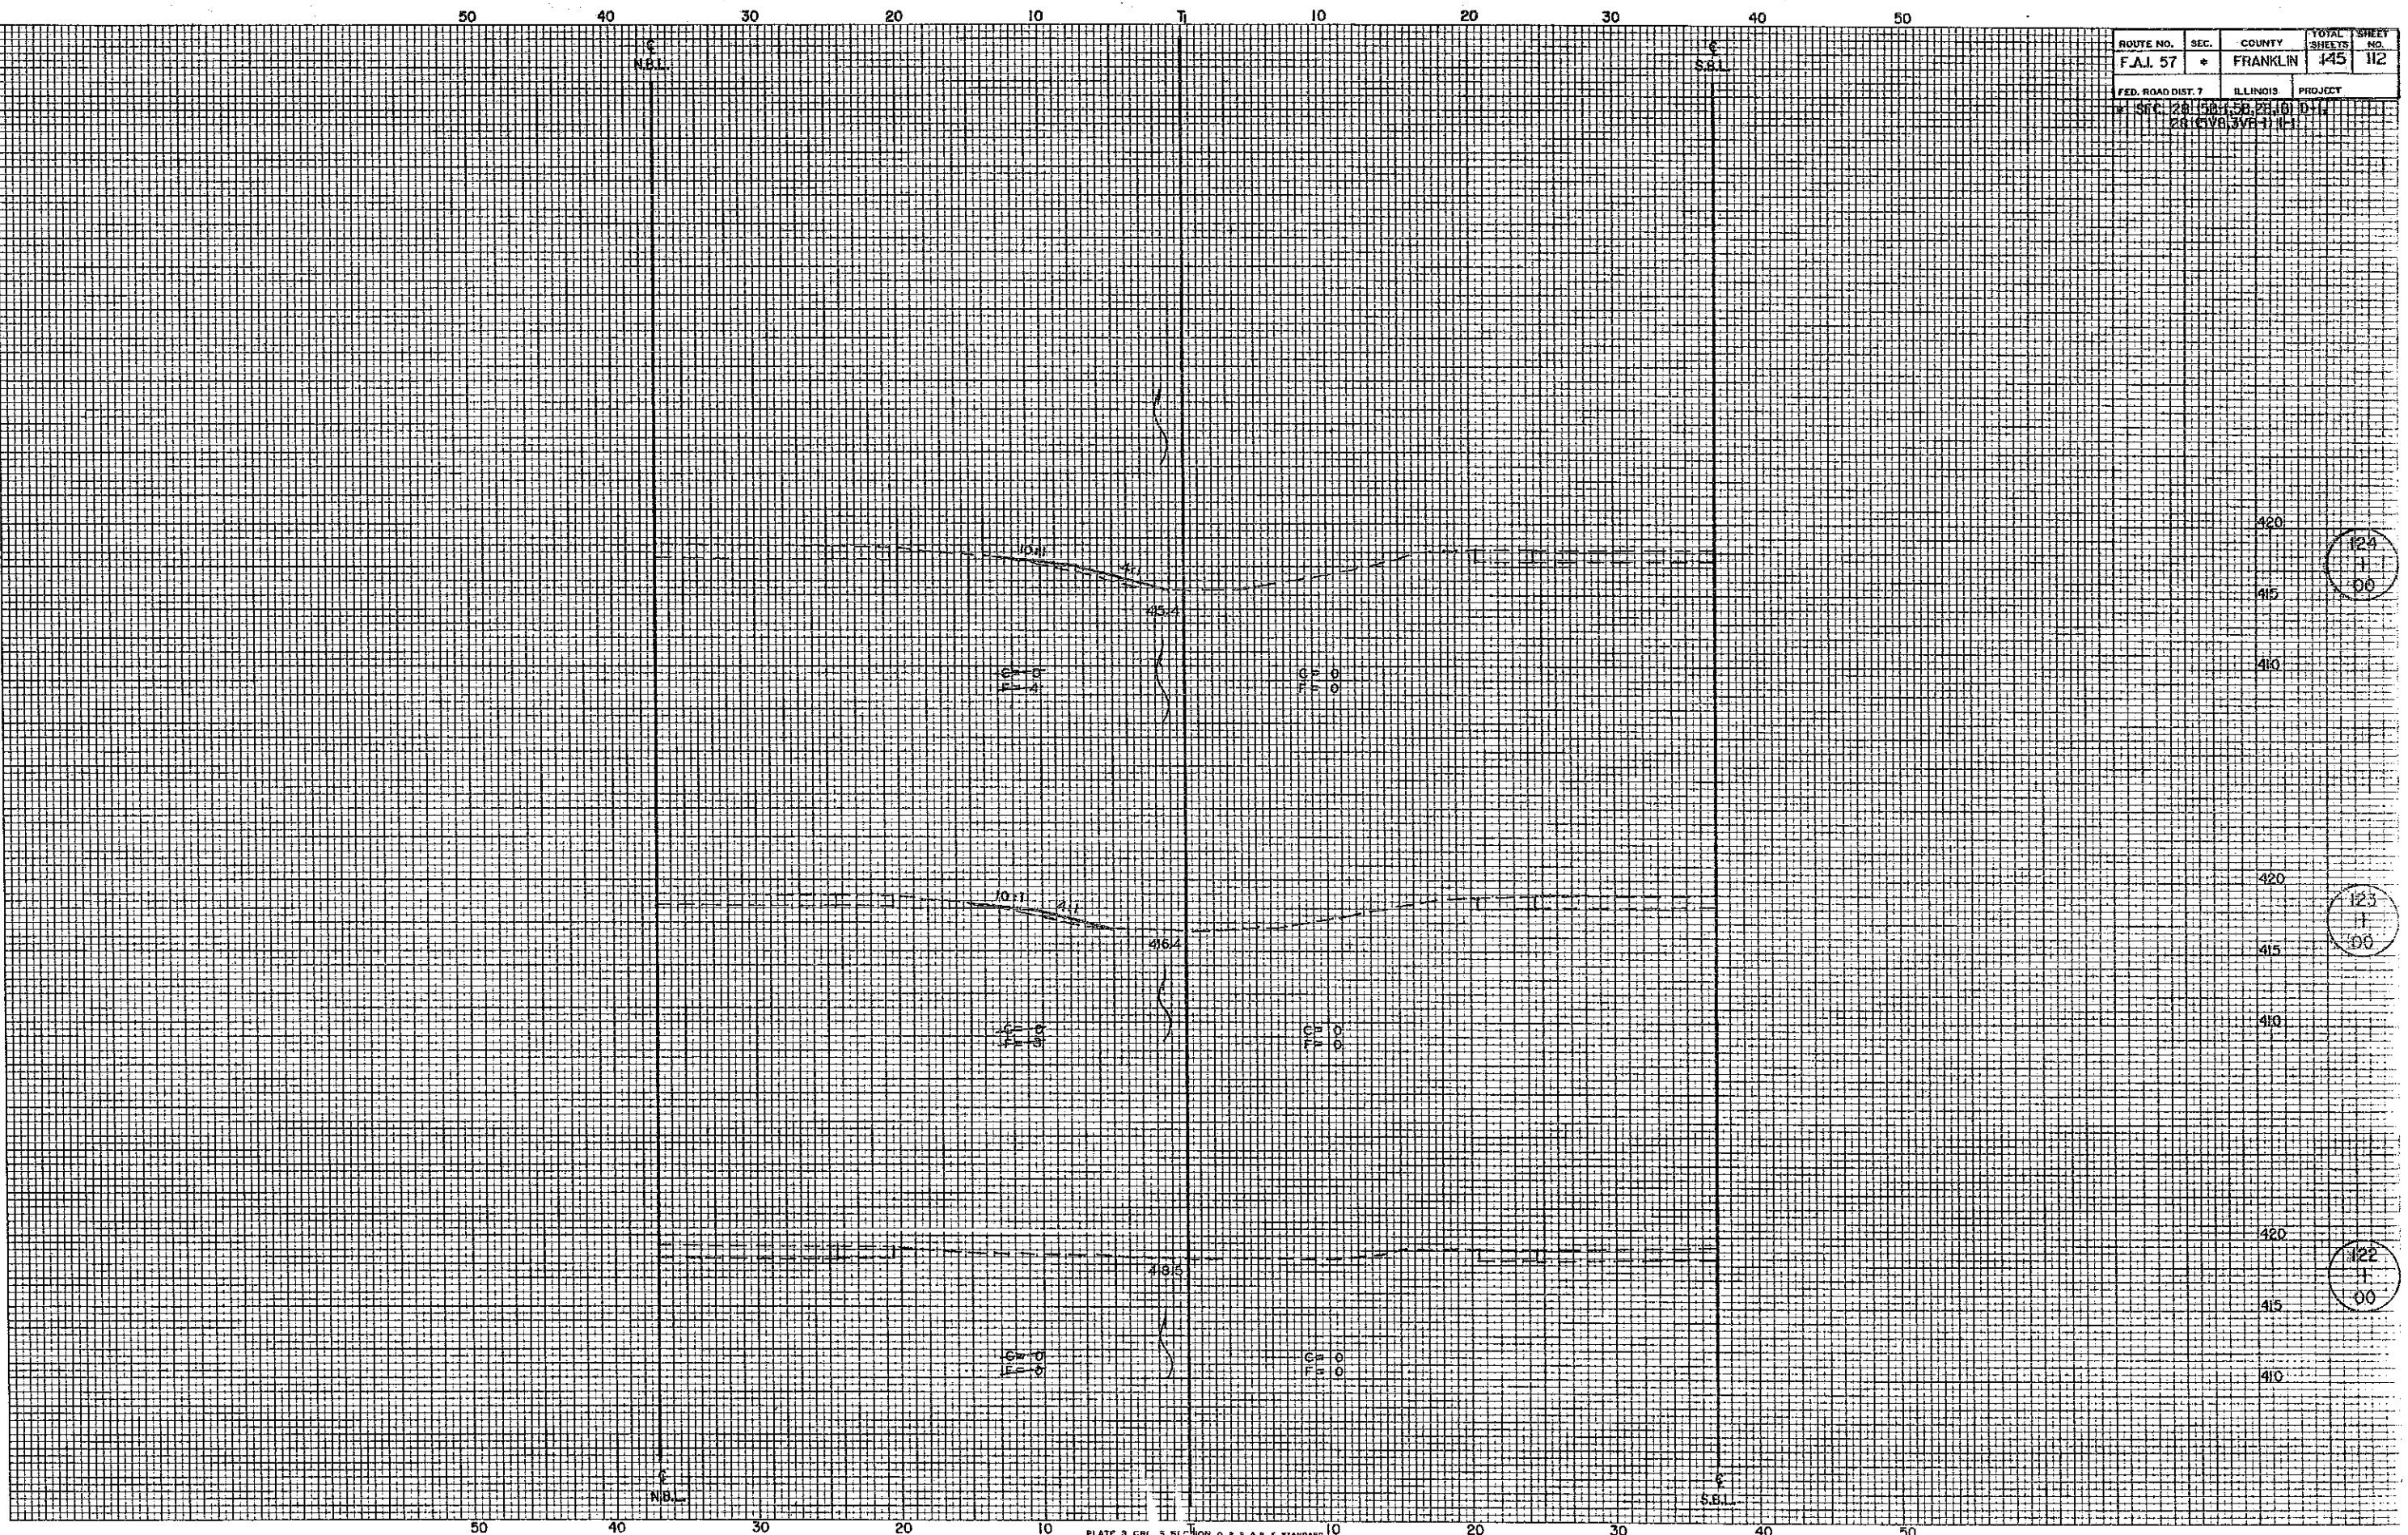



PLATE 3 CR. 5 SECTION OF P. & R. E. STANDARD 10  
 DEW-LIN CORPORATION

STATE OF ILLINOIS  
DEPARTMENT OF TRANSPORTATION


ROUTE NO.	SECTION	COUNTY	SPAN	PIERS	SHEET NO. /
F.A.I. 57		FRANKLIN	145	113	2 SHEETS
FED. ROAD DIST. NO. 7	SLAB NO.	FED. AID PROJECT			

**GENERAL NOTES**


Reinforcement bars shall conform to the requirements of AASHTO M-31, M-42 or M-53 Grade 60.  
 Traffic control shall be determined by the District.  
 Prior to pouring the new concrete for the deck, all loose rust, loose mill scale, and all other foreign material shall be removed from the embedded portions of flanges of girders. The removal shall be accomplished in accordance with the requirements of the SSPC Surface Preparation Specifications SP3 for Power Tool Cleaning or SP2 for Hand Tool Cleaning. Cost shall be incidental to Concrete Removal.  
 Plan dimensions and details relative to existing structure have been taken from existing plans and are subject to nominal construction variations. It shall be the Contractor's responsibility to verify such dimensions and details in the field and make necessary approved adjustments prior to construction or ordering of materials. Such variations shall not be cause for additional compensation for a change in the scope of the work, however, the Contractor will be paid for the quantity actually furnished at the unit price bid for the work.  
 The first bridge Post and Insert at each corner shall be removed, cleaned and reinstalled in new construction. Cost incidental to "Concrete Removal".  
 After fabrication all surfaces of the steel plates shall be given one shop coat of the zinc-silicate and vinyl paint system. Cost incidental to "Furnishing and Erecting Structural Steel".

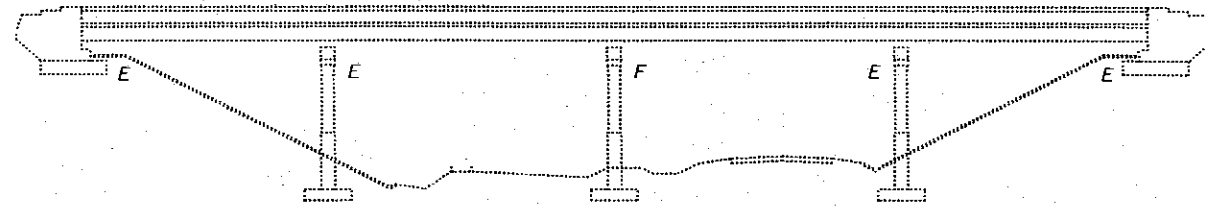

**ELEVATION**

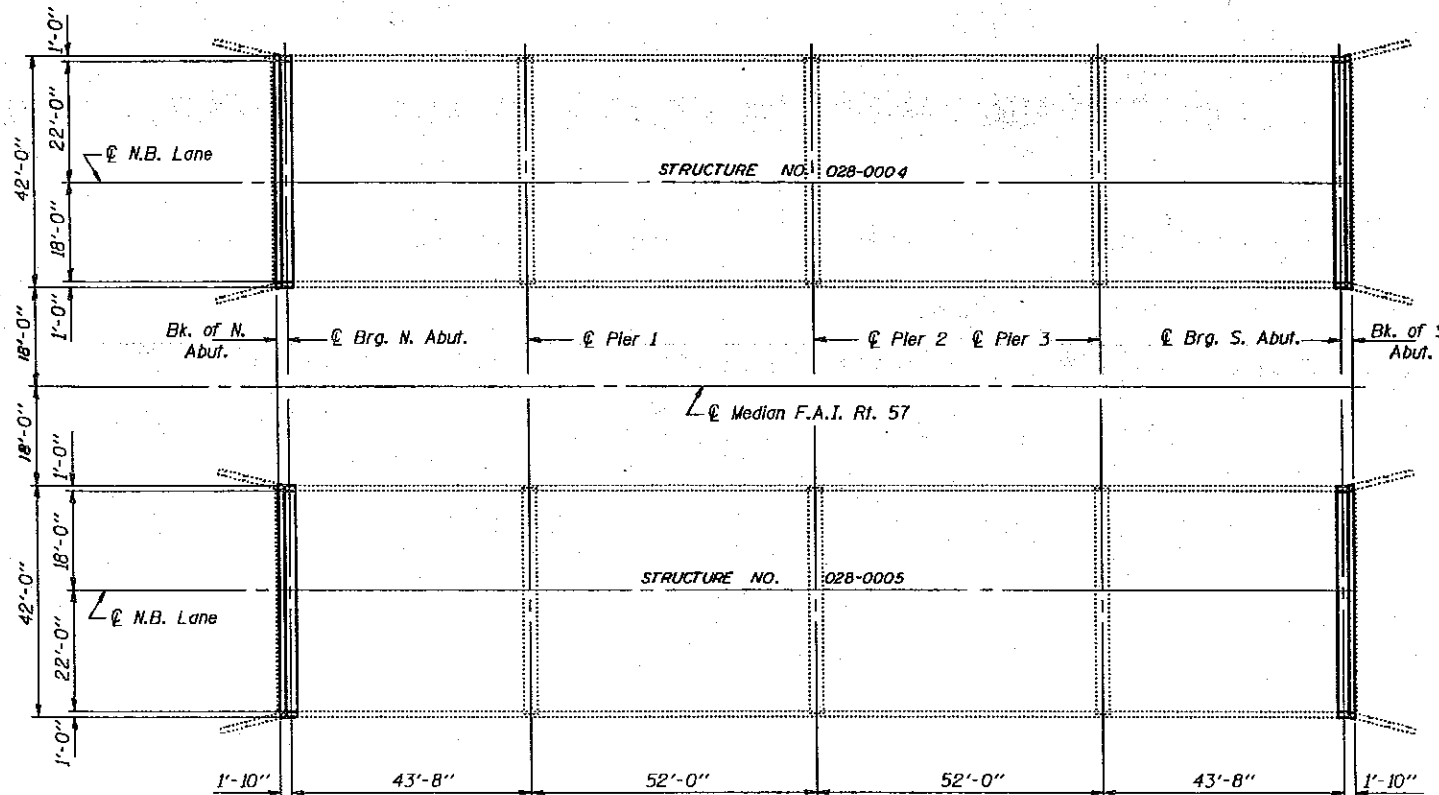

**PLAN**

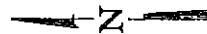

**TOTAL BILL OF MATERIAL**

ITEM	UNIT	QUANTITY
Concrete Removal	Cu. Yd.	20.4
Class X Concrete	Cu. Yd.	19.9
Reinforcement Bars, Epoxy Coated	Pound	2810
Preformed Joint Seal 4"	Lin. Ft.	165
Furnishing and Erecting Structural Steel	Pound	6360

NOTE: QUANTITIES IN THE ABOVE BILL OF MATERIAL ARE FOR BOTH BRIDGES.

DESIGNED <i>Paul Summer</i>	February 7 19 92
CHECKED <i>BRT</i>	EXAMINED <i>John E. Alton</i>
DRAWN <i>Paul Summer</i>	PAGESD
CHECKED <i>BRT</i>	APPROVED


JOINT REPLACEMENT DETAILS  
 F.A.I. RT. 57 SEC. (28-5VB) I-1  
 FRANKLIN COUNTY  
 STA. 119+71.94  
 STR. No. ~~028-0004~~ & 028-0005






F.A.I. NO.	SECTION	COUNTY	TOTAL SHEETS	SHEET NO.
57	*	FRANKLIN	145	115
STA.		TO STA.		
FUEL ROAD DIST. NO.		BLANKET	FUEL ROAD PRODUCT	

\*28 (5B-1, 5B, 2B, 1B) D-1; 28 (5VB, 3VB-1) I-1

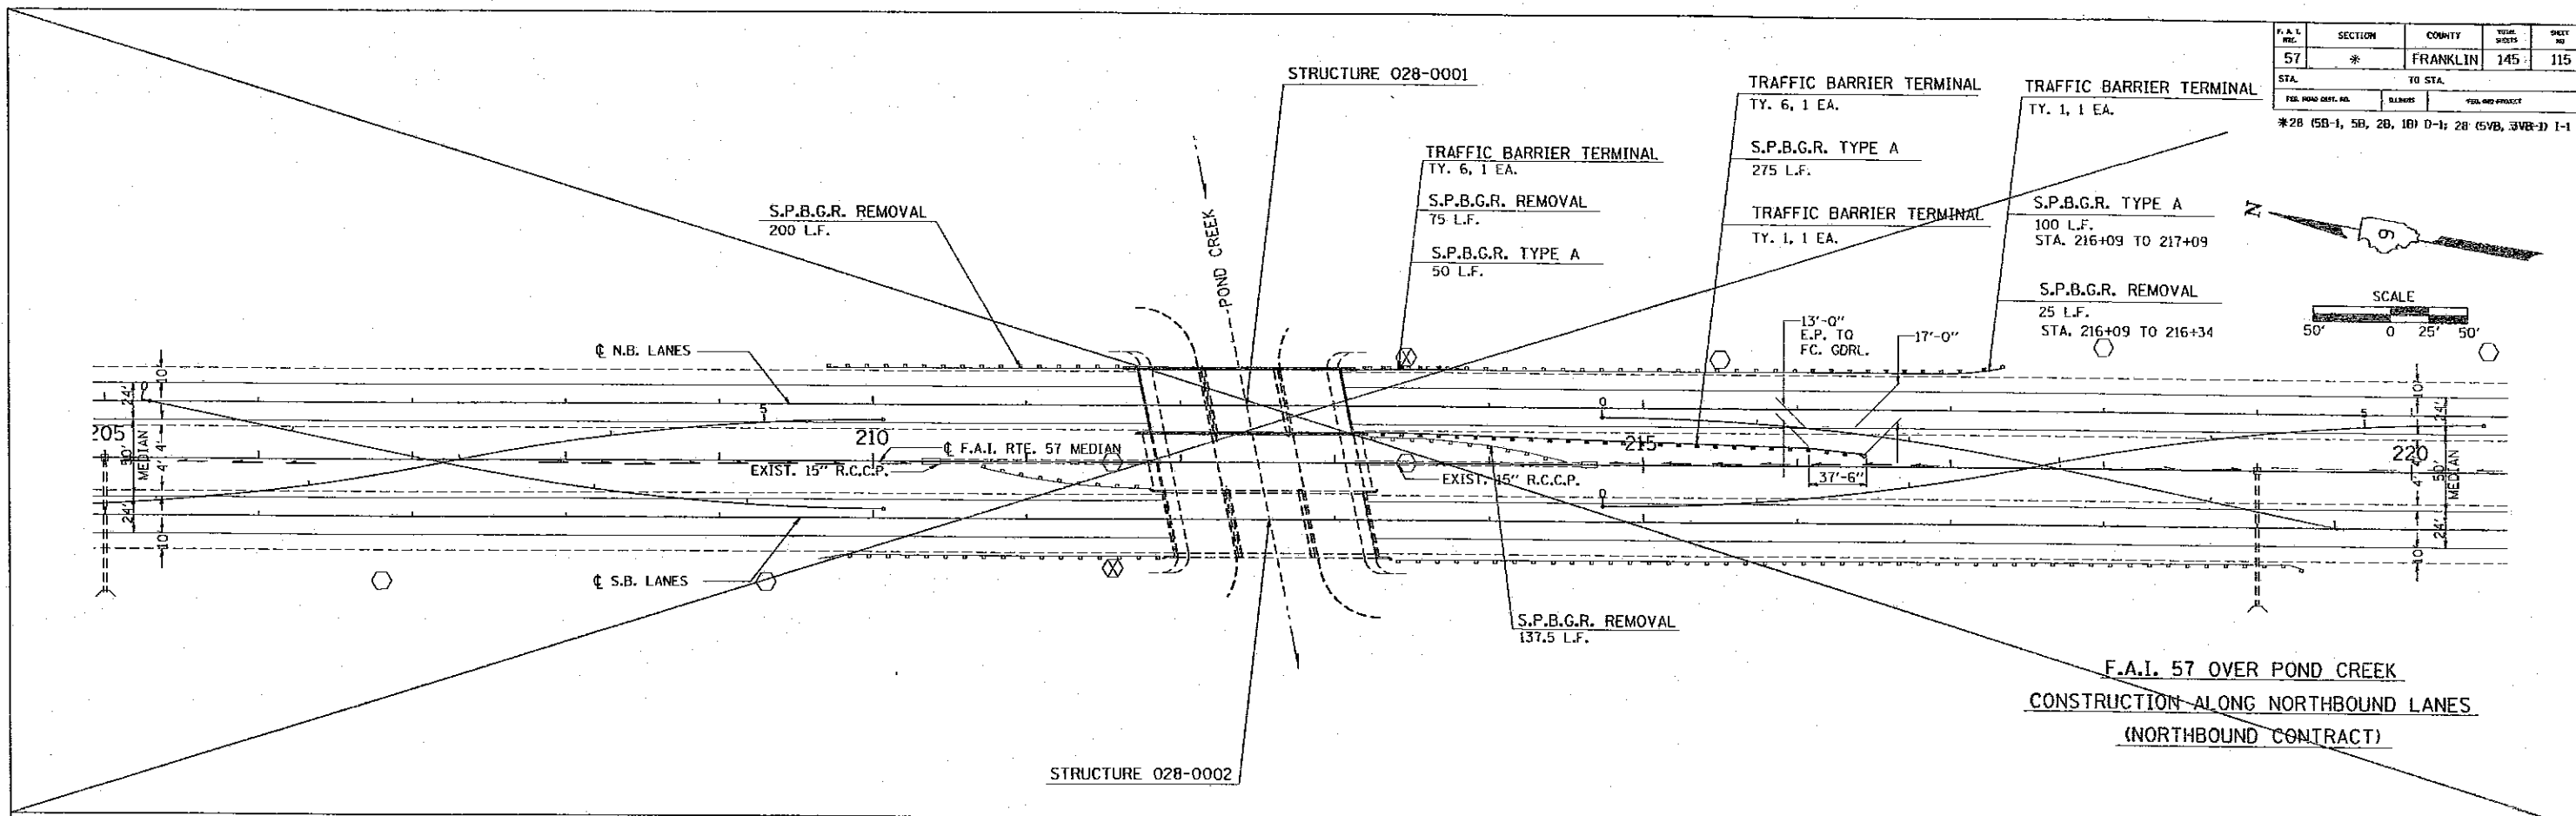

F.A.I. 57 OVER POND CREEK  
CONSTRUCTION ALONG NORTHBOUND LANES  
(NORTHBOUND CONTRACT)

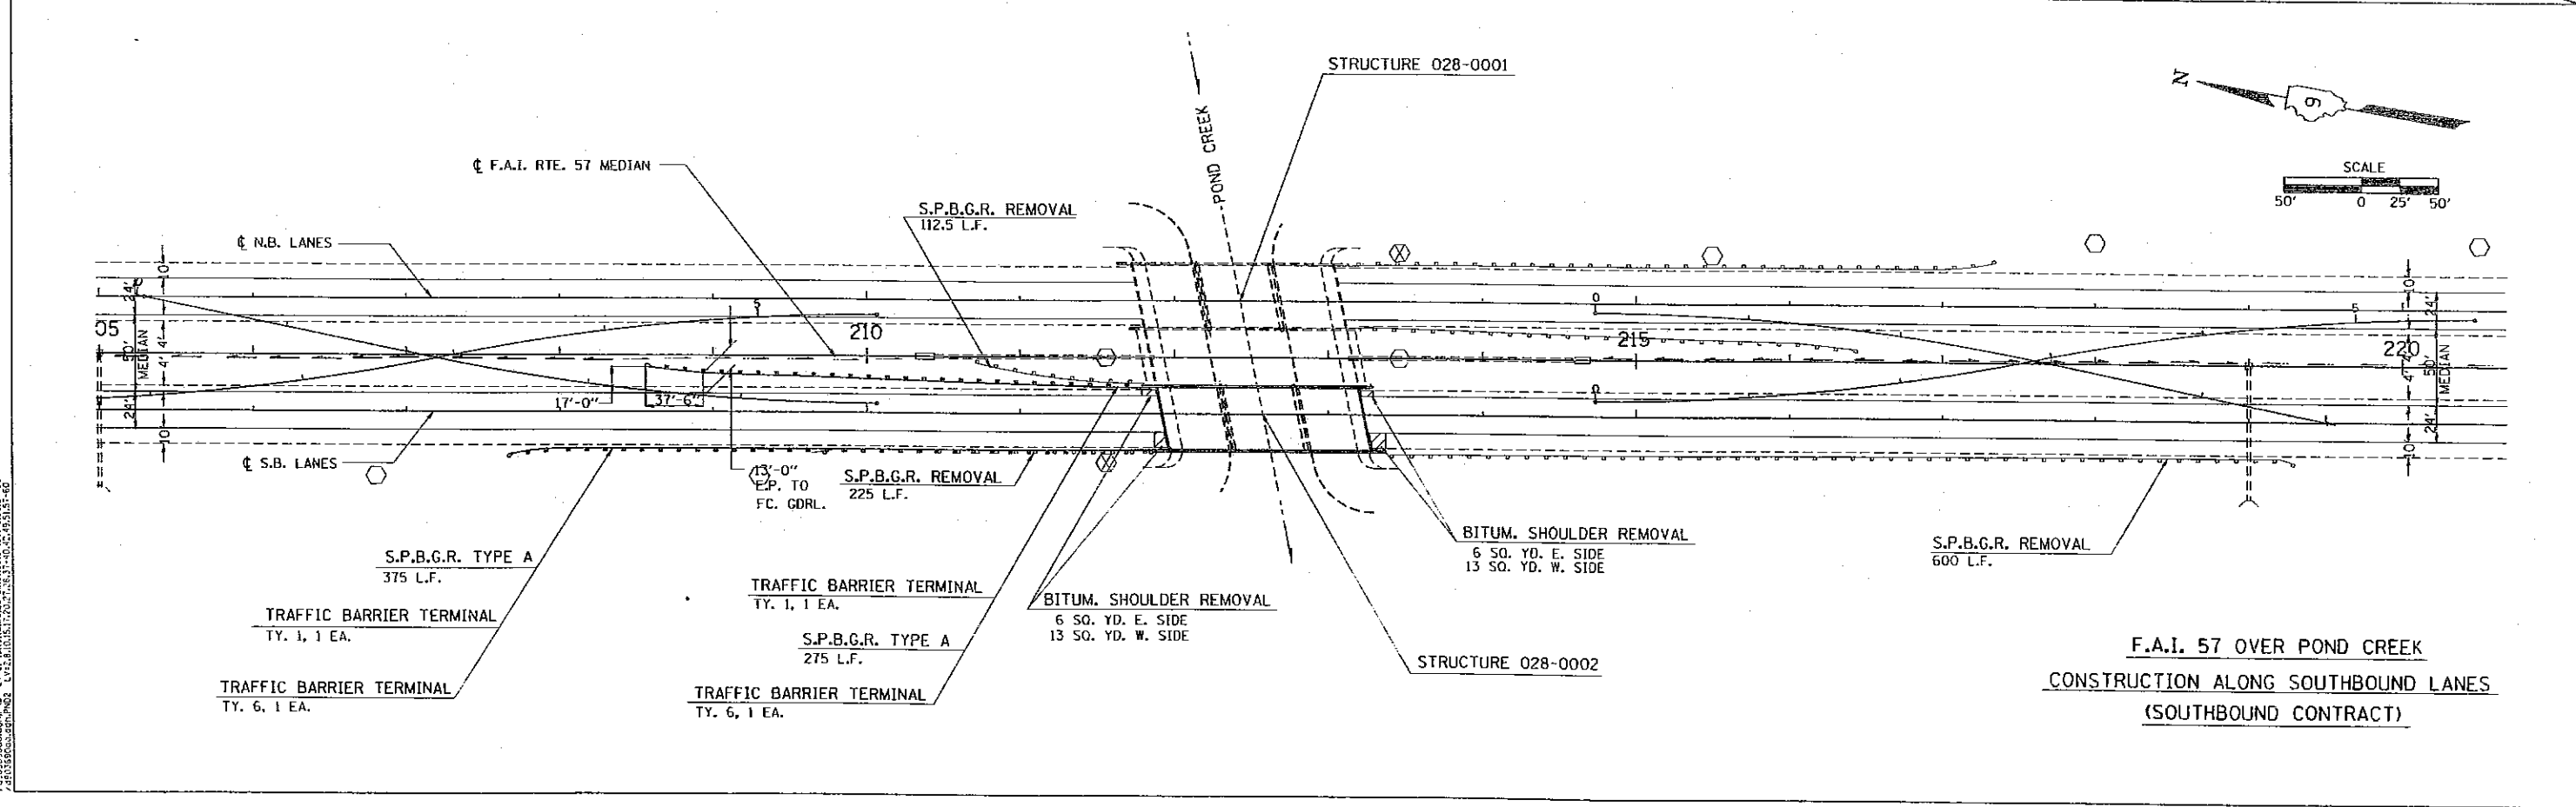

F.A.I. 57 OVER POND CREEK  
CONSTRUCTION ALONG SOUTHBOUND LANES  
(SOUTHBOUND CONTRACT)



VIEW INDEX  
 P1: 100 10 000000 1000  
 P2: 100 10 000000 1000  
 P3: 100 10 000000 1000  
 P4: 100 10 000000 1000  
 P5: 100 10 000000 1000  
 P6: 100 10 000000 1000  
 P7: 100 10 000000 1000  
 P8: 100 10 000000 1000  
 P9: 100 10 000000 1000  
 P10: 100 10 000000 1000

SECTION	COUNTY	TOTAL SHEETS	SHEET NO.
57	FRANKLIN	145	116


**CURVE DATA  
CROSSOVER NO. 2**  
P.I. STA= 3+44.85  
Δ= 11° 32' 56"  
D= 4° 00' 00"  
R= 1432.39'  
T= 144.85'  
L= 288.72'  
E= 7.31'  
P.C. STA= 2+00.00  
P.T. STA= 4+88.72

**CURVE DATA  
CROSSOVER NO. 3**  
P.I. STA= 1+44.85  
Δ= 11° 32' 56"  
D= 4° 00' 00"  
R= 1432.39'  
T= 144.85'  
L= 288.72'  
E= 7.31'  
P.C. STA= 0+00.00  
P.T. STA= 2+88.72

P.I. STA= 4+33.57  
Δ= 11° 32' 56"  
D= 4° 00' 00"  
R= 1432.39'  
T= 144.85'  
L= 288.72'  
E= 7.31'  
P.C. STA= 2+88.72  
P.T. STA= 5+77.44

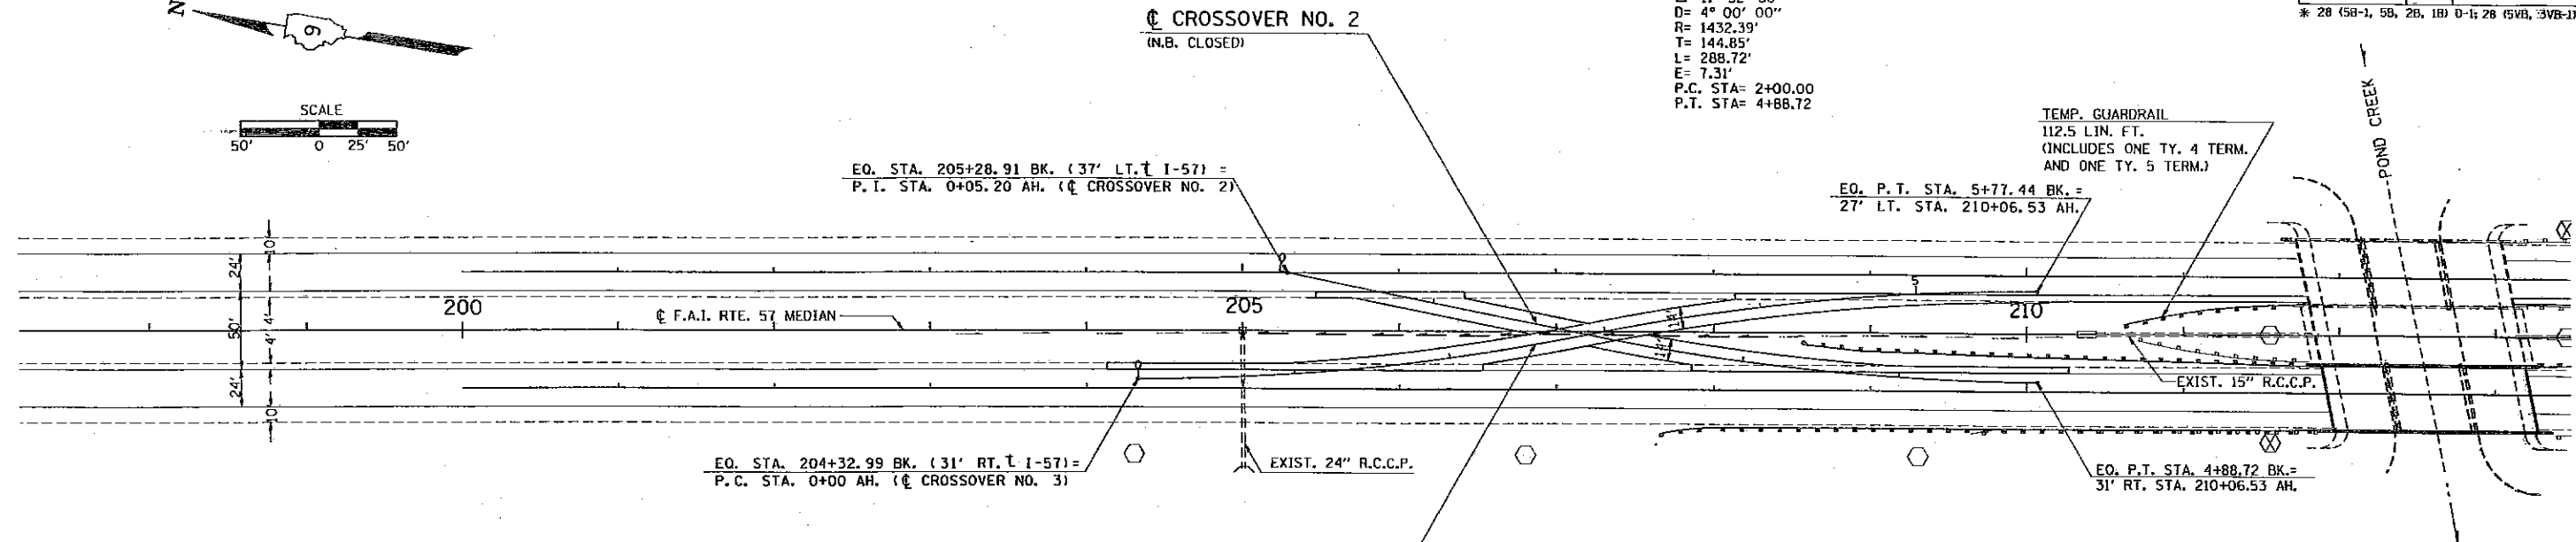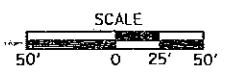

- LEGEND**  
(TEMPORARY LIGHTING SYSTEM)
- EXISTING WOODEN POLE WITH 250 WATT LUMINAIRE
  - ⊗ EXISTING WOODEN POLE

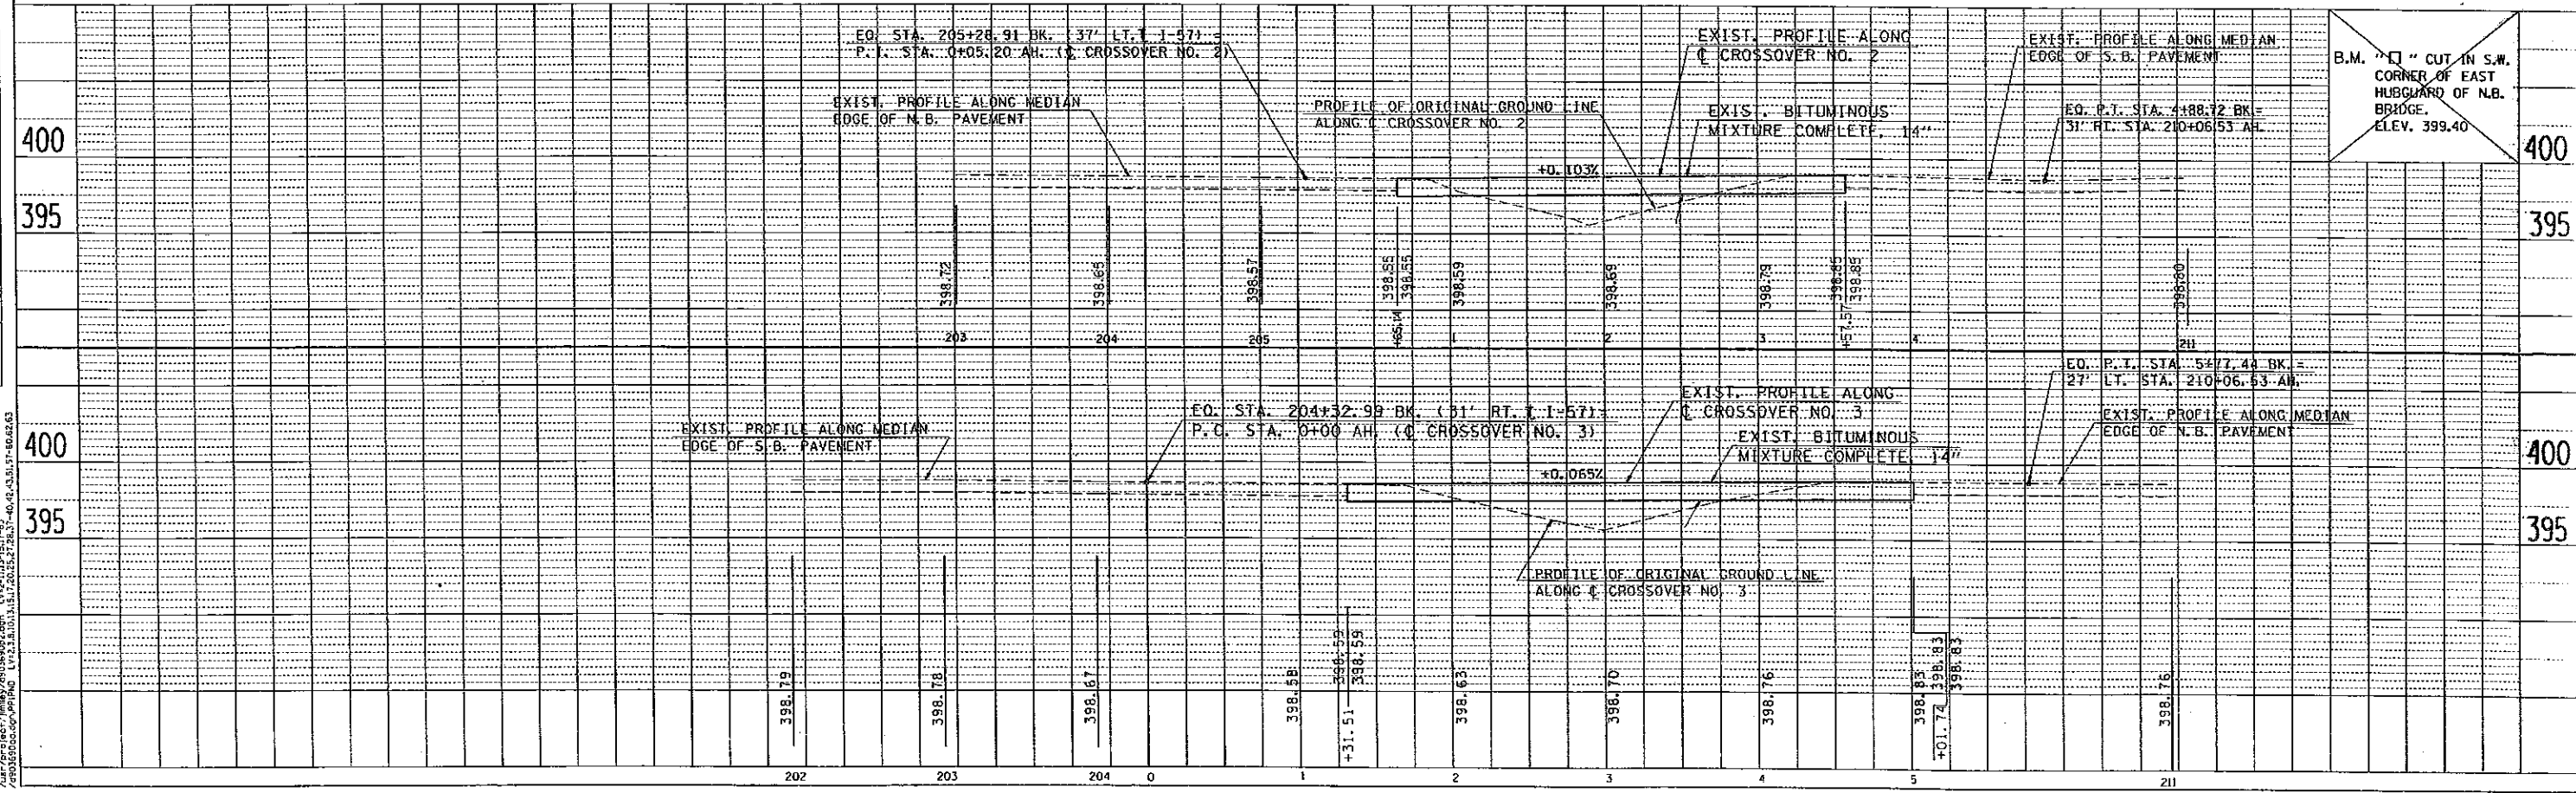


DATE	
BY	
DESIGNED	
PLANNED	
NOTED	
CHECKED	
IN CHARGE	
NO.	

DATE	
BY	
DESIGNED	
PLANNED	
NOTED	
CHECKED	
IN CHARGE	
NO.	



VIEW P.P. 110  
P1: 10/10/1983  
P2: 10/10/1983  
P3: 10/10/1983  
P4: 10/10/1983  
P5: 10/10/1983  
P6: 10/10/1983  
P7: 10/10/1983  
P8: 10/10/1983  
P9: 10/10/1983  
P10: 10/10/1983

FILE NO.	SECTION	COUNTY	SHEET NO.	TOTAL SHEETS
57	*	FRANKLIN	145	117
STA. TO STA.		FILED PROJECT		
* 28 (5B-1, 5B, 2B, 1B) 0-1:28 (5VB, 3VB-1) 1-1				

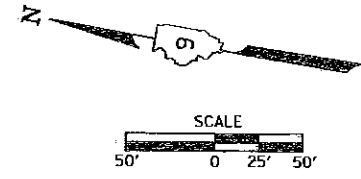

PLAN	DATE
BY	
REVISIONS	
NO.	

PROFILE	DATE
BY	
REVISIONS	
NO.	

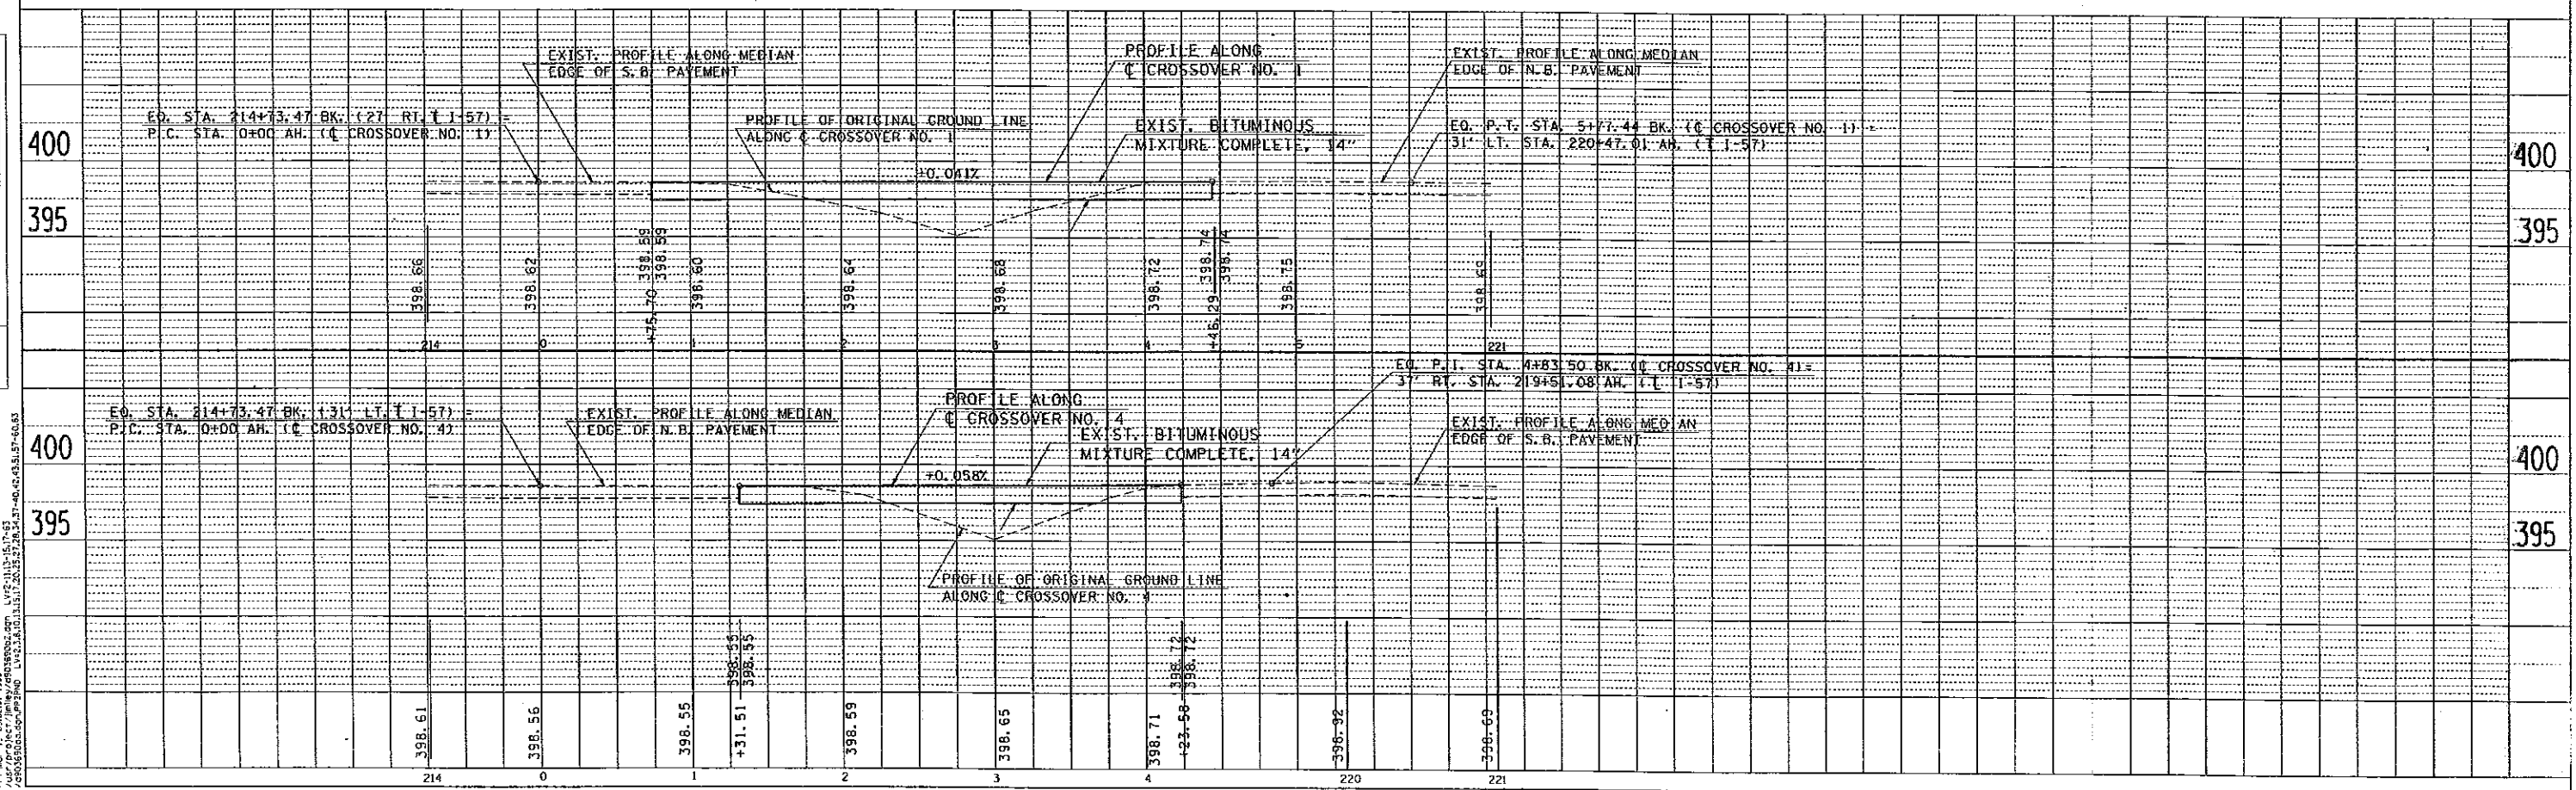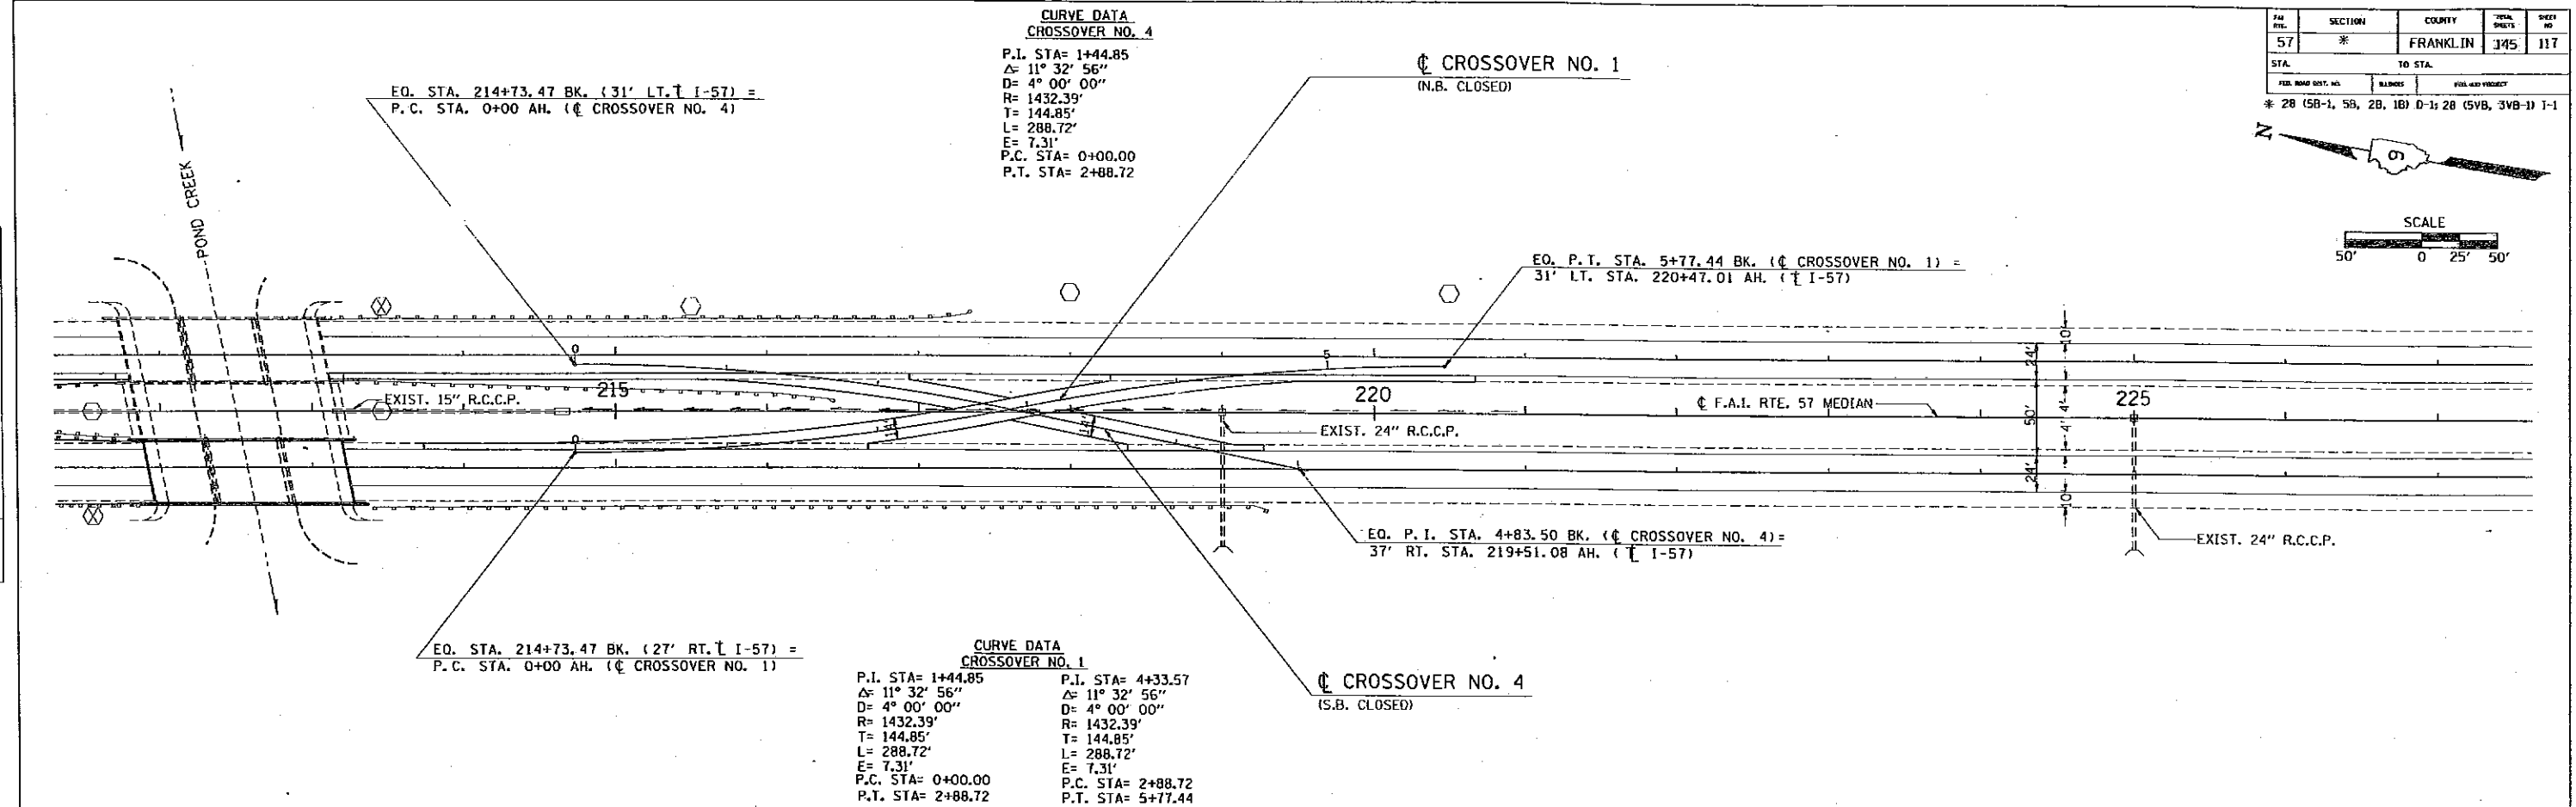












ROUTE NO.	SEC.	COUNTY	TOTAL SHEETS	SHEET NO.
F.A.I. 57	*	FRANKLIN	145	120
FED. ROAD DIST. 7		ILLINOIS	PROJECT	
SEC. 28 158 28 159 10 11		20 5V8 5V8 II (1)		

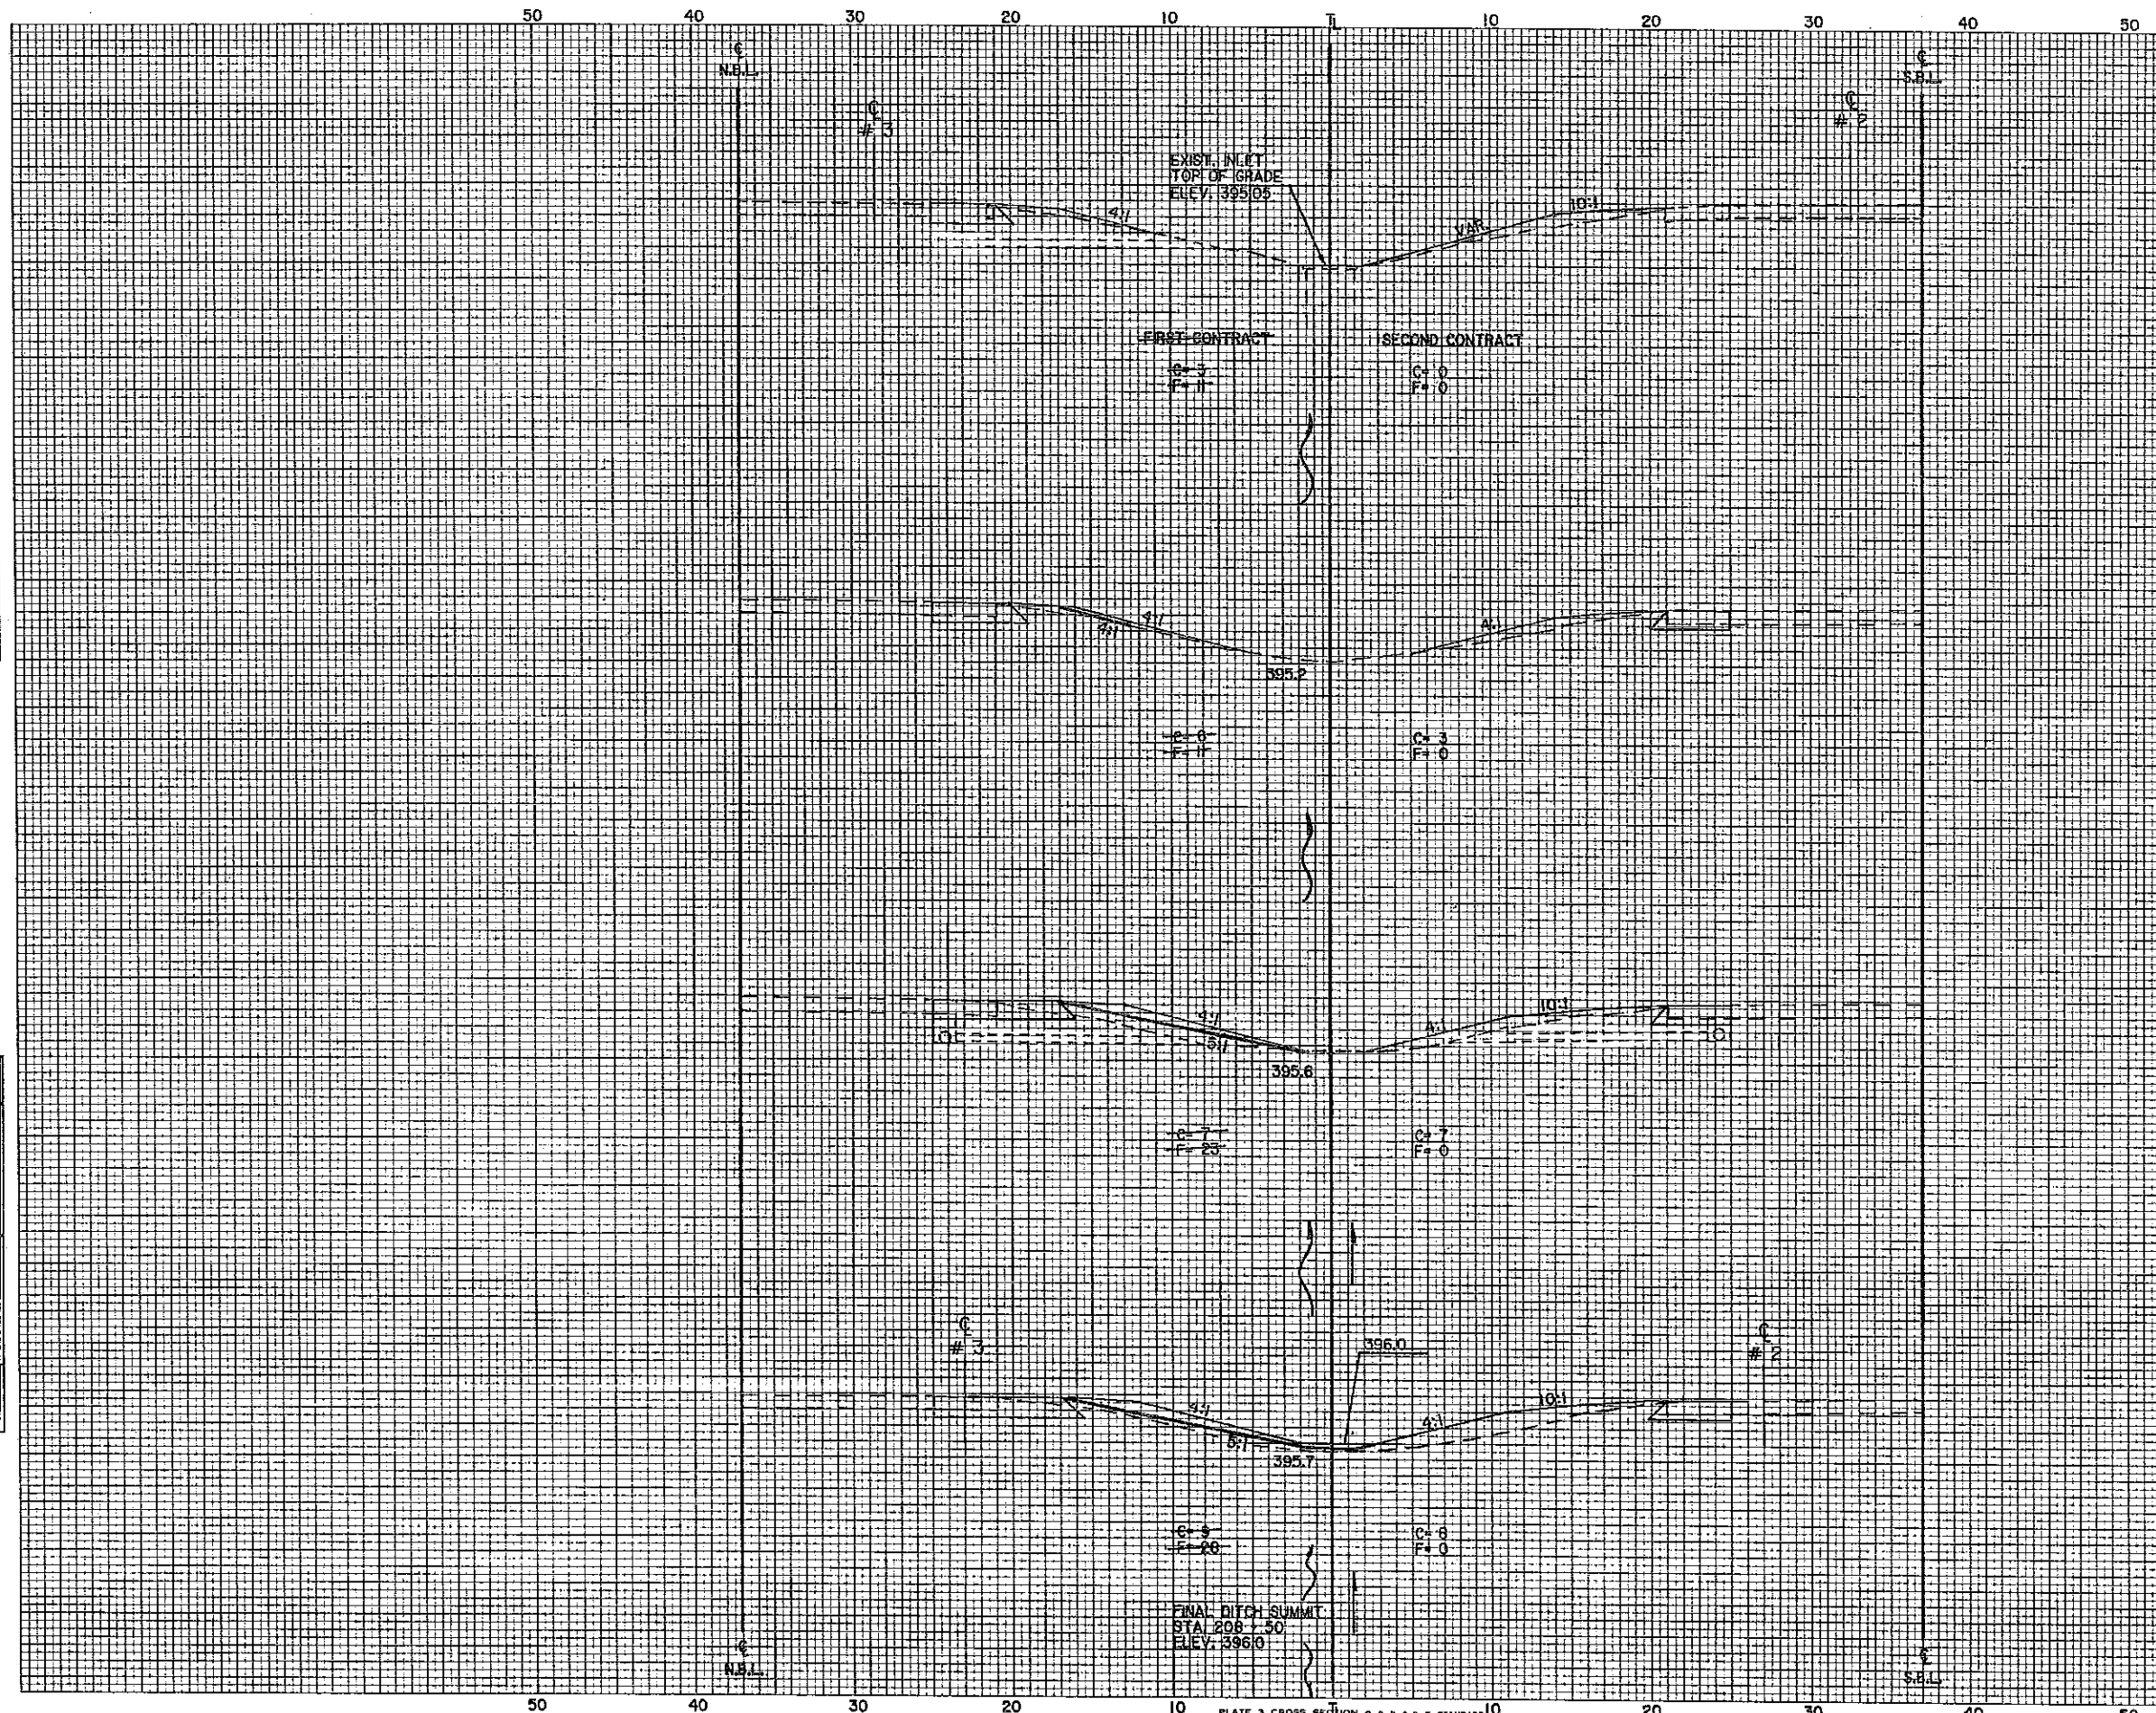

210  
+  
32

210  
+  
00

209  
+  
19

209  
+  
00

DATE  
BY  
REVISIONS  
NOTED  
FINAL SURVEY  
NOTE BOOK  
NO.


DATE  
BY  
REVISIONS  
NOTED  
CHECK SURVEY  
NOTE BOOK  
NO.



ROUTE NO.	SEC.	COUNTY	TOTAL SHEETS	SHEET NO.
F.A.I. 57	*	FRANKLIN	145	121
FED. ROAD DIST. 7		ILLINOIS	PROJECT	
SEC. 28 (50+55.25) (S) P.L. PR. 15V8.3V8.1.11				

DATE	
BY	
REVISION	
NO.	
DATE	
BY	
REVISION	
NO.	
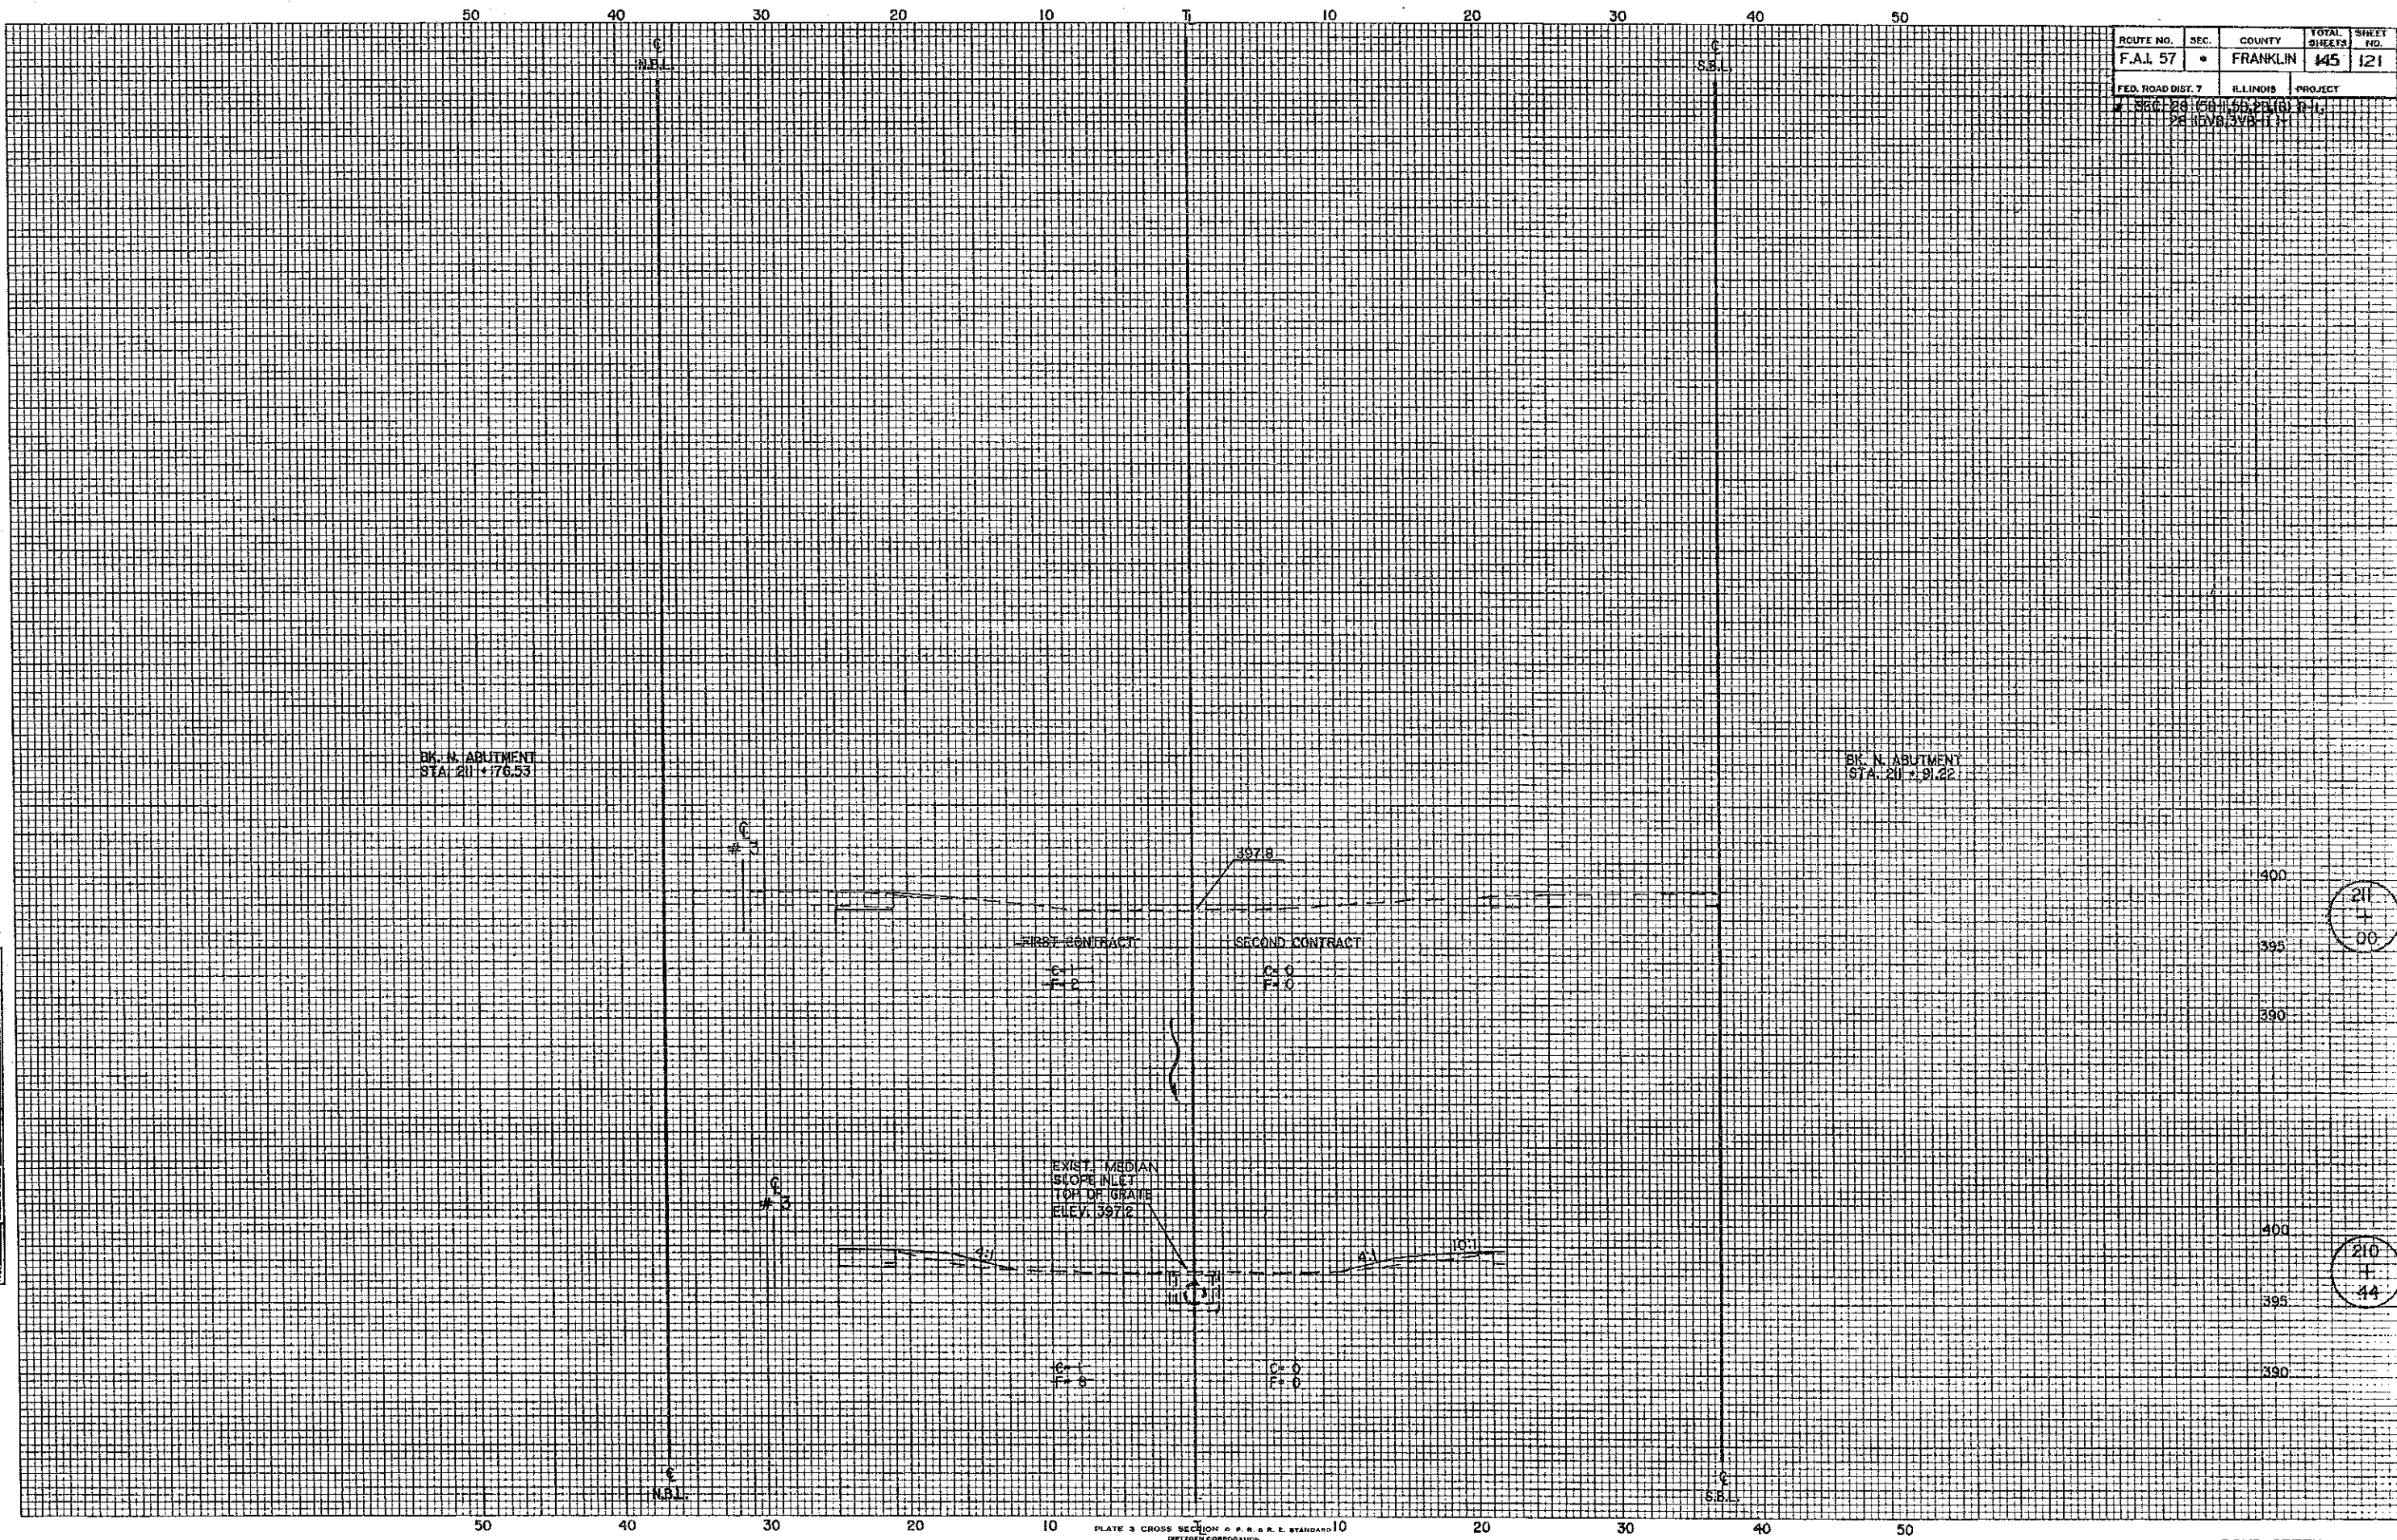

211  
+  
00

211  
+  
44

PLATE 3 CROSS SECTION OF P. R. & R. E. STANDARD 10  
DETROIT CORPORATION



ROUTE NO.	SEC.	COUNTY	TOTAL SHEETS	SHEET NO.
F.A.L 57	*	FRANKLIN	145	122
FED. ROAD DIST. 7		ILLINOIS	PROJECT	
SEC. 28 1951-58 2310		U-1	26 (CVB 398-41)	

FINAL SURVEY NOTE BOOK


DATE: \_\_\_\_\_ BY: \_\_\_\_\_

NO. \_\_\_\_\_

FINAL SURVEY NOTE BOOK

DATE: \_\_\_\_\_ BY: \_\_\_\_\_

NO. \_\_\_\_\_

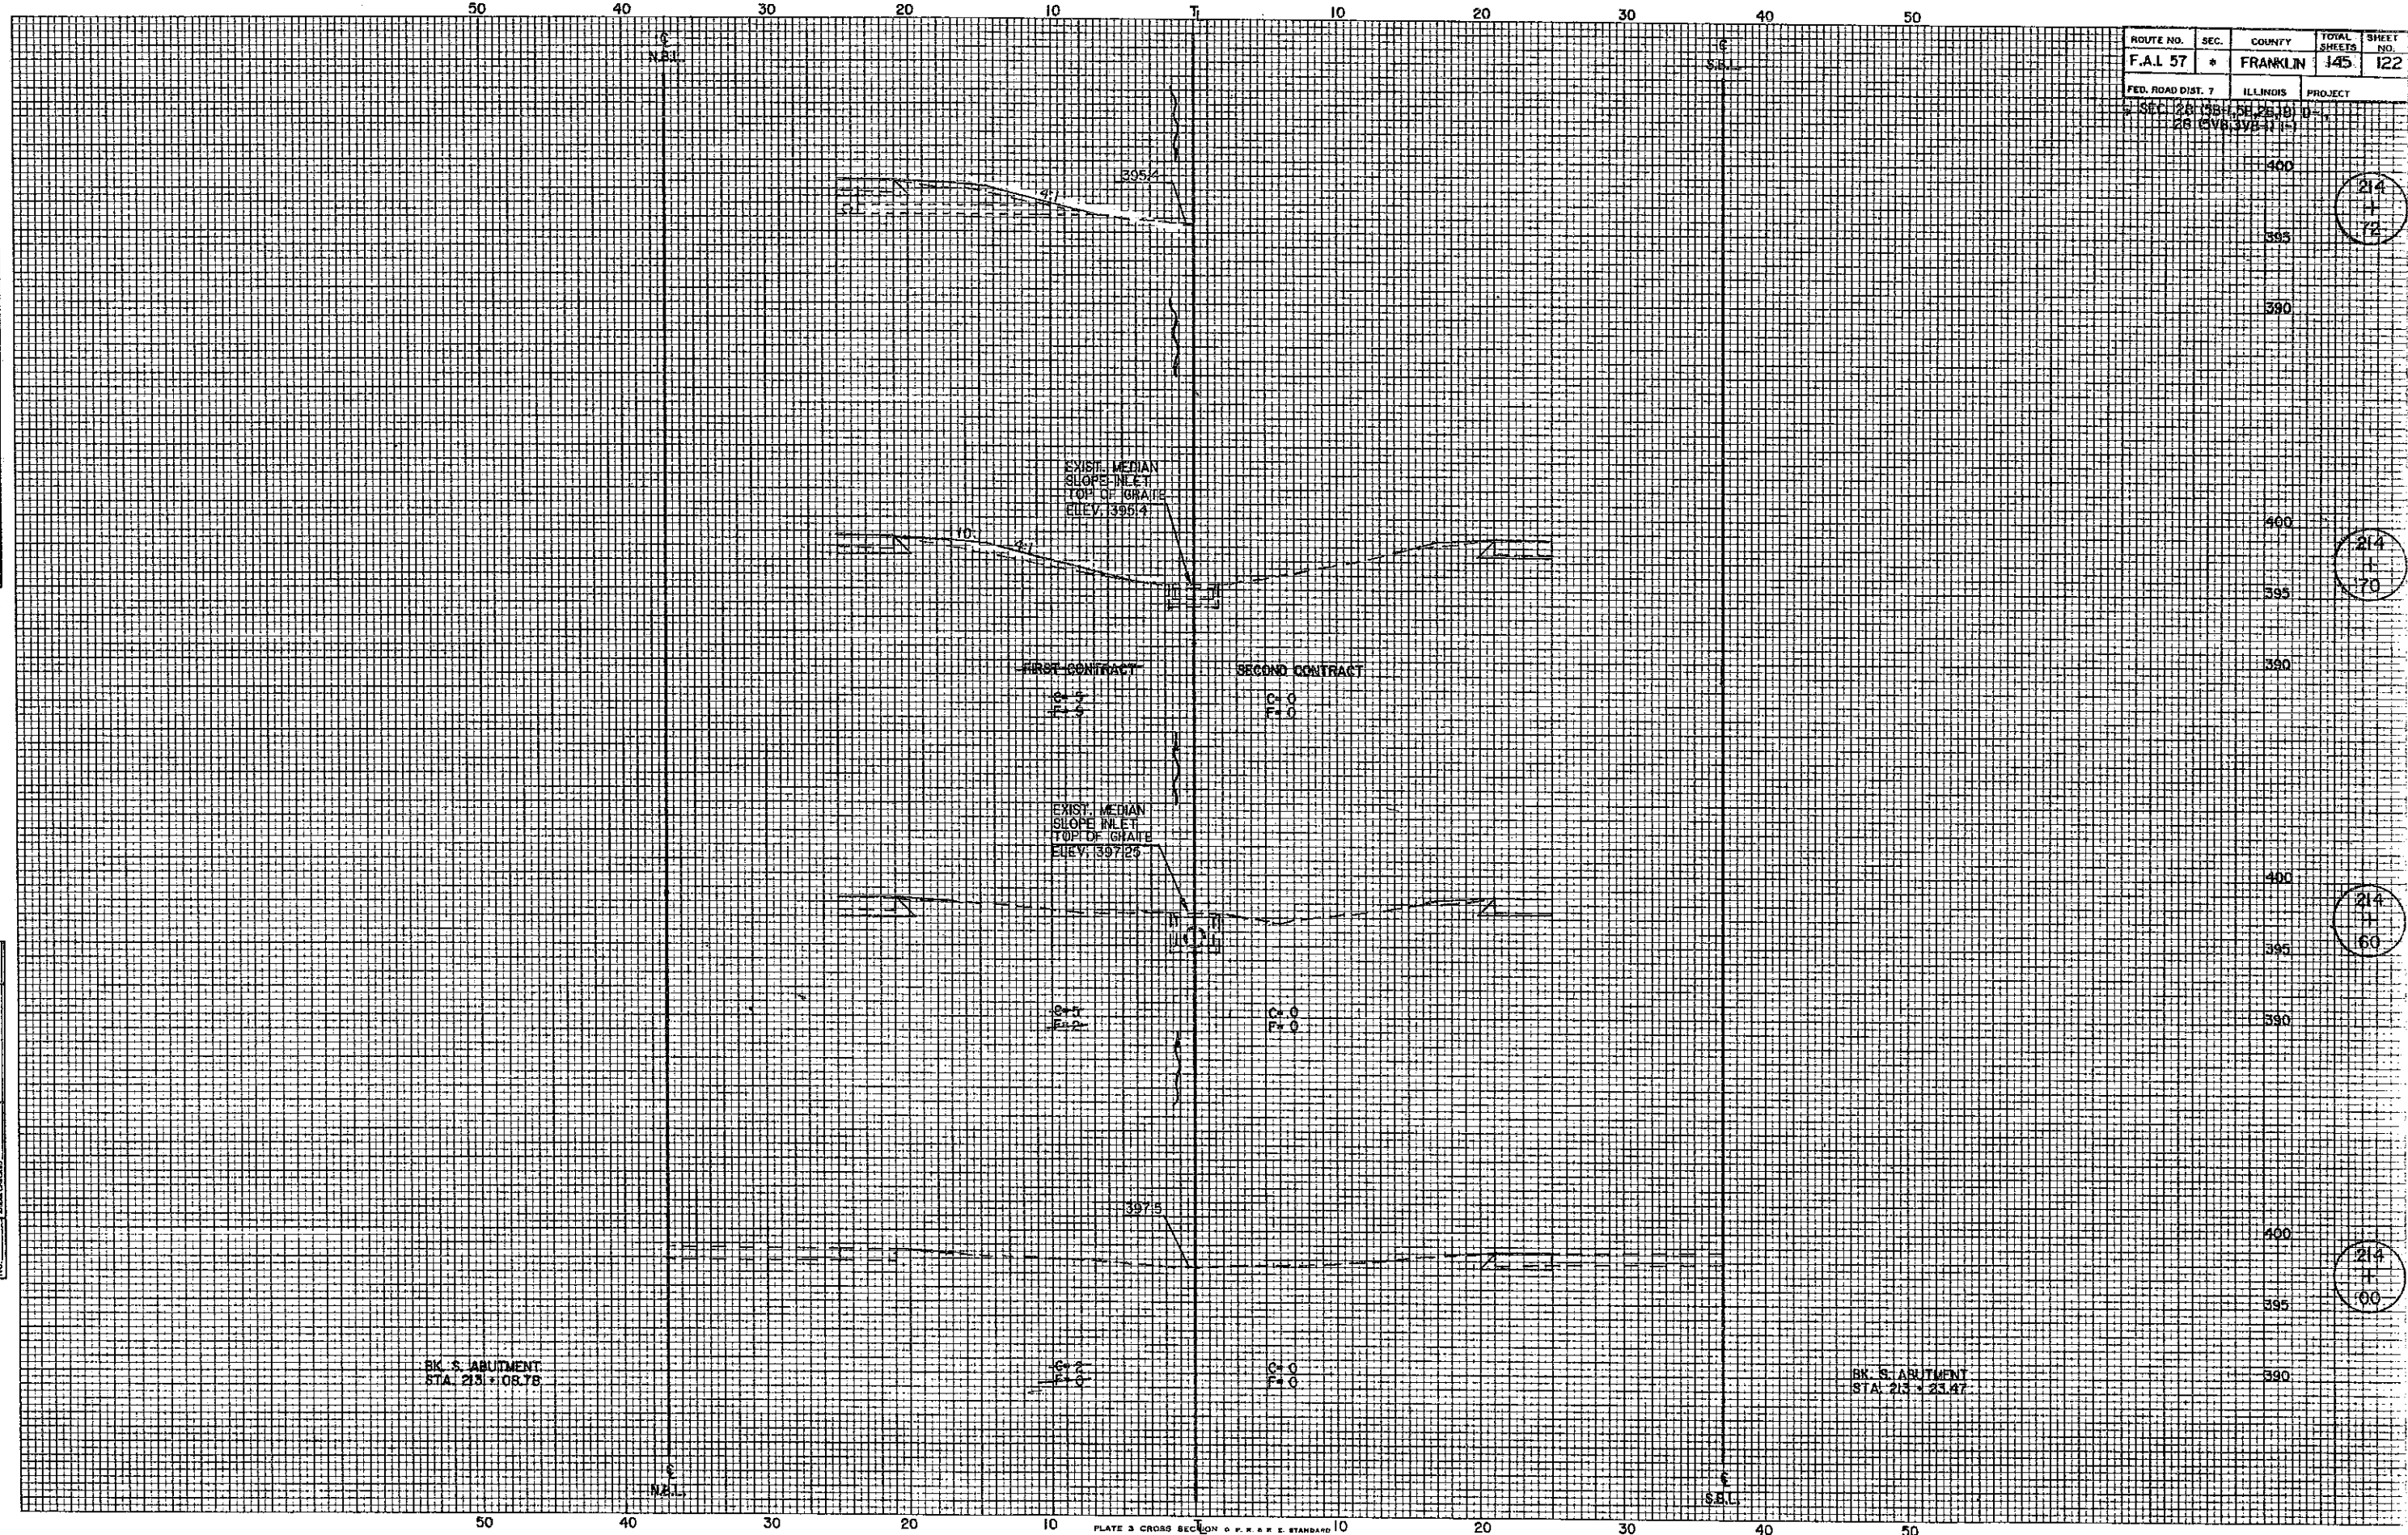

214  
1  
72

214  
1  
70

214  
1  
60


214  
1  
00



ROUTE NO.	SEC.	COUNTY	TOTAL SHEETS	SHEET NO.
F.A.I. 57	*	FRANKLIN	145	123
FED. ROAD DIST. 7		ILLINOIS	PROJECT	
SEC 10B 15B 16B 20B 10 11		100 (5V) 3/4" THICK		

DATE	
BY	
REVISIONS	
PLUTED	
REVISIONS	
PLUTED	
REVISIONS	
PLUTED	
NO.	

DATE	
BY	
REVISIONS	
PLUTED	
REVISIONS	
PLUTED	
REVISIONS	
PLUTED	
NO.	

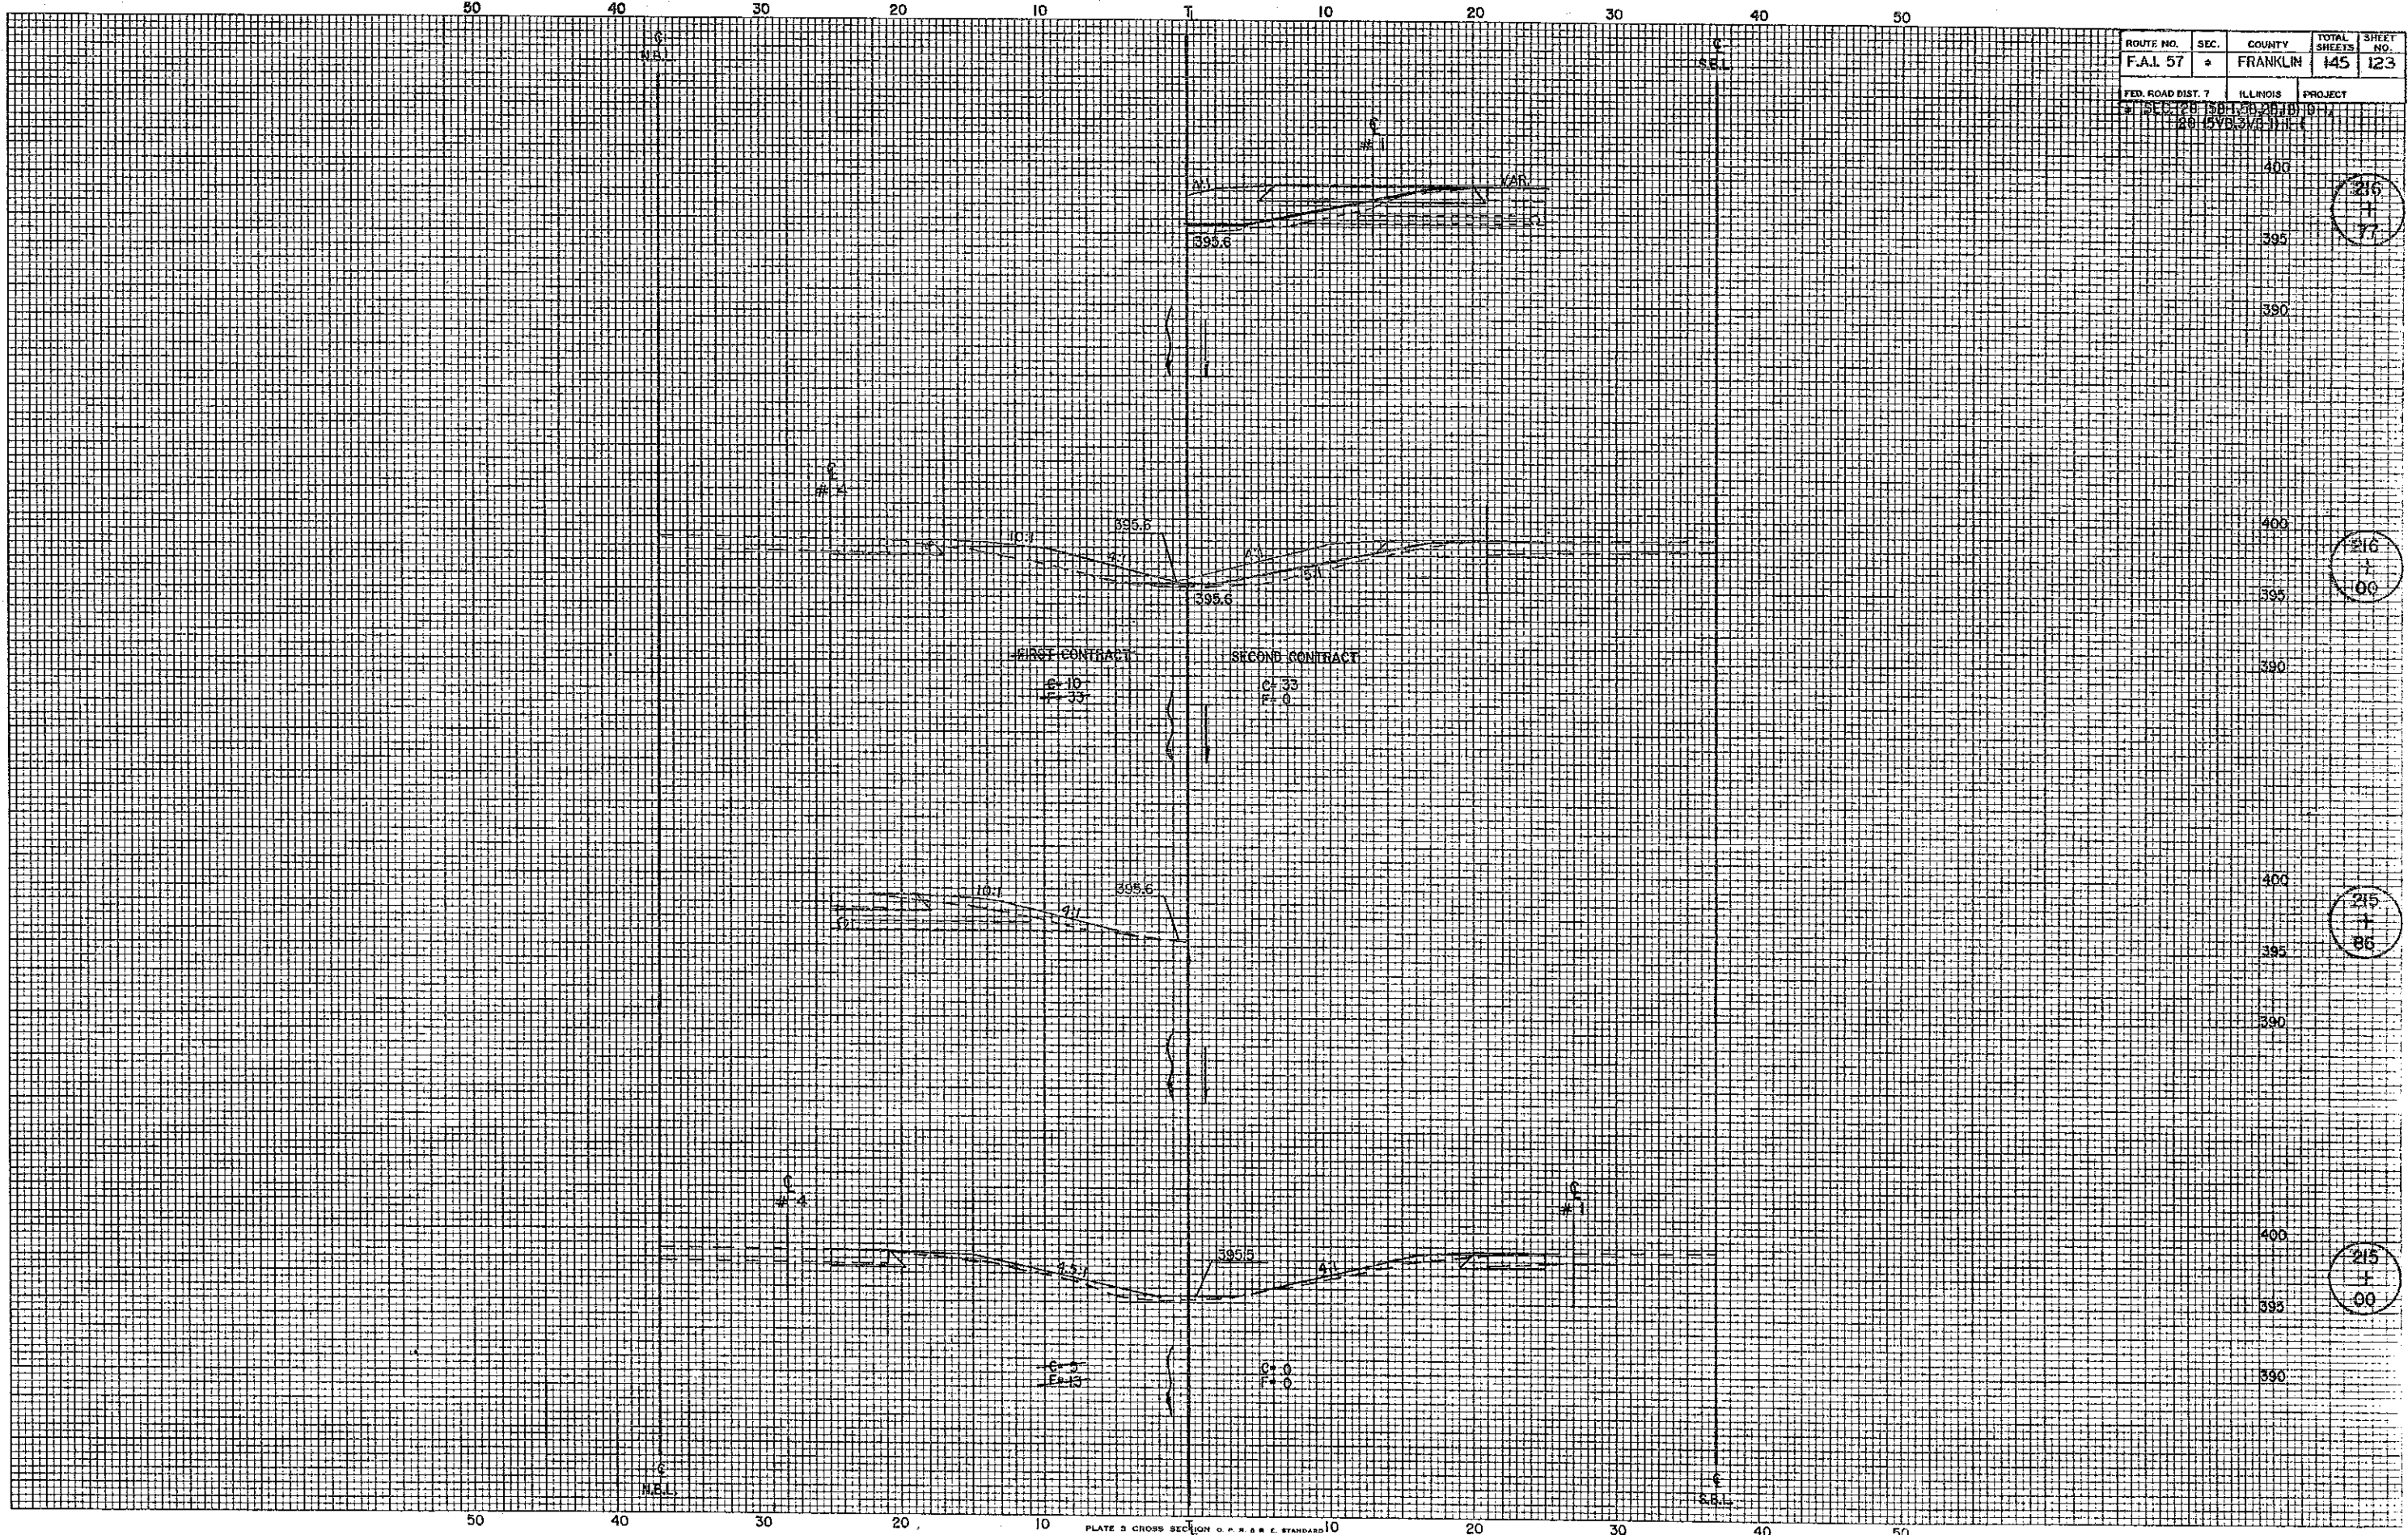

216  
+  
77

216  
+  
00

215  
+  
86

215  
+  
00







ROUTE NO.	SEC.	COUNTY	TOTAL SHEETS	SHEET NO.
F.A.I. 57	*	FRANKLIN	145	125
FED. ROAD DIST. 7		ILLINOIS	PROJECT	
* SEC. 28 1961, 26 25, 27 1-1,		28 (EVS, SW-1) 1-1		

ORIGINAL SURVEY NOTE BOOK No. \_\_\_\_\_

DATE \_\_\_\_\_

BY \_\_\_\_\_

REVISIONS:

NO.	DATE	DESCRIPTION

ORIGINAL SURVEY NOTE BOOK No. \_\_\_\_\_

DATE \_\_\_\_\_

BY \_\_\_\_\_

REVISIONS:

NO.	DATE	DESCRIPTION

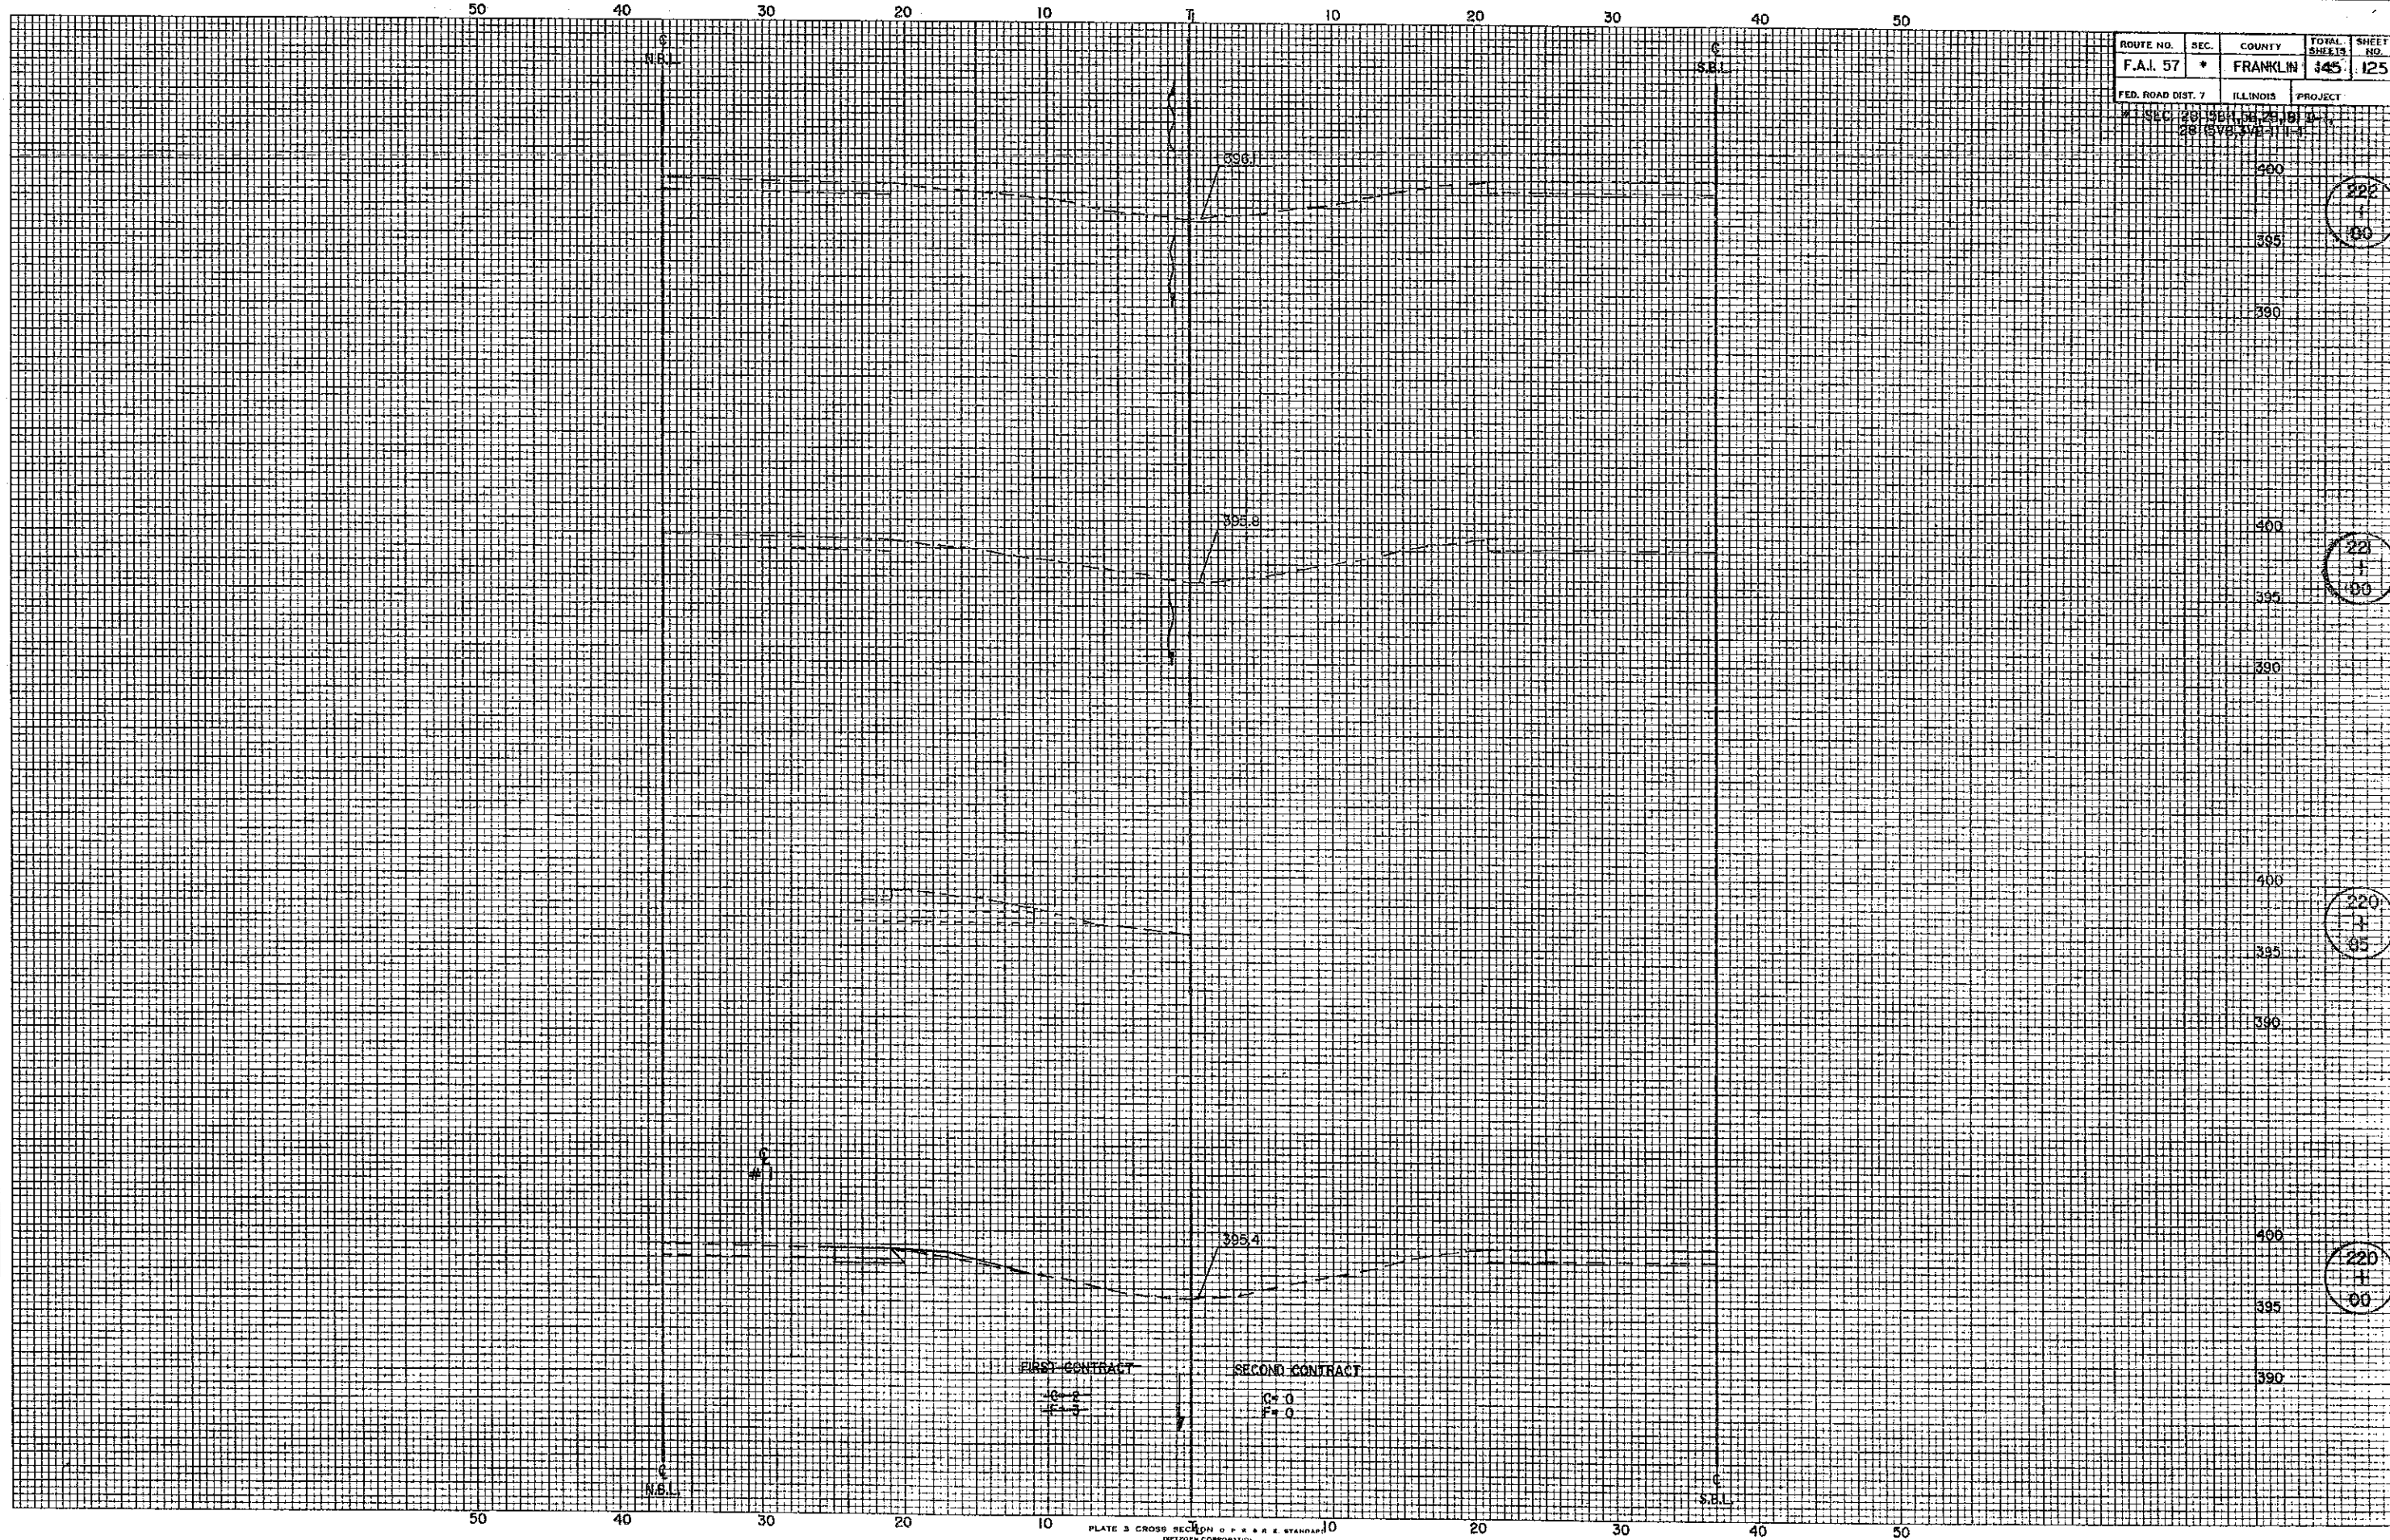


PLATE 3 CROSS SECTION OF P & R E STANDARD  
DETROIT CORPORATION



50 40 30 20 10 10 20 30 40 50

ROUTE NO.	SEC.	COUNTY	TOTAL SHEETS	SHEET NO.
F.A.I. 57	*	FRANKLIN	145	126
FED. ROAD DIST. 7		ILLINOIS	PROJECT	
SBC 26 (158, 25, 10) D-1		PB HWB, SVS-11		

DATE	
BY	
REVISIONS	
NOTED	
TEMP	
ADJ. CHECKED	
FINAL SURVEY NOTE BOOK No.	

DATE	
BY	
REVISIONS	
NOTED	
TEMP	
ADJ. CHECKED	
ORIG. SURVEY NOTE BOOK No.	

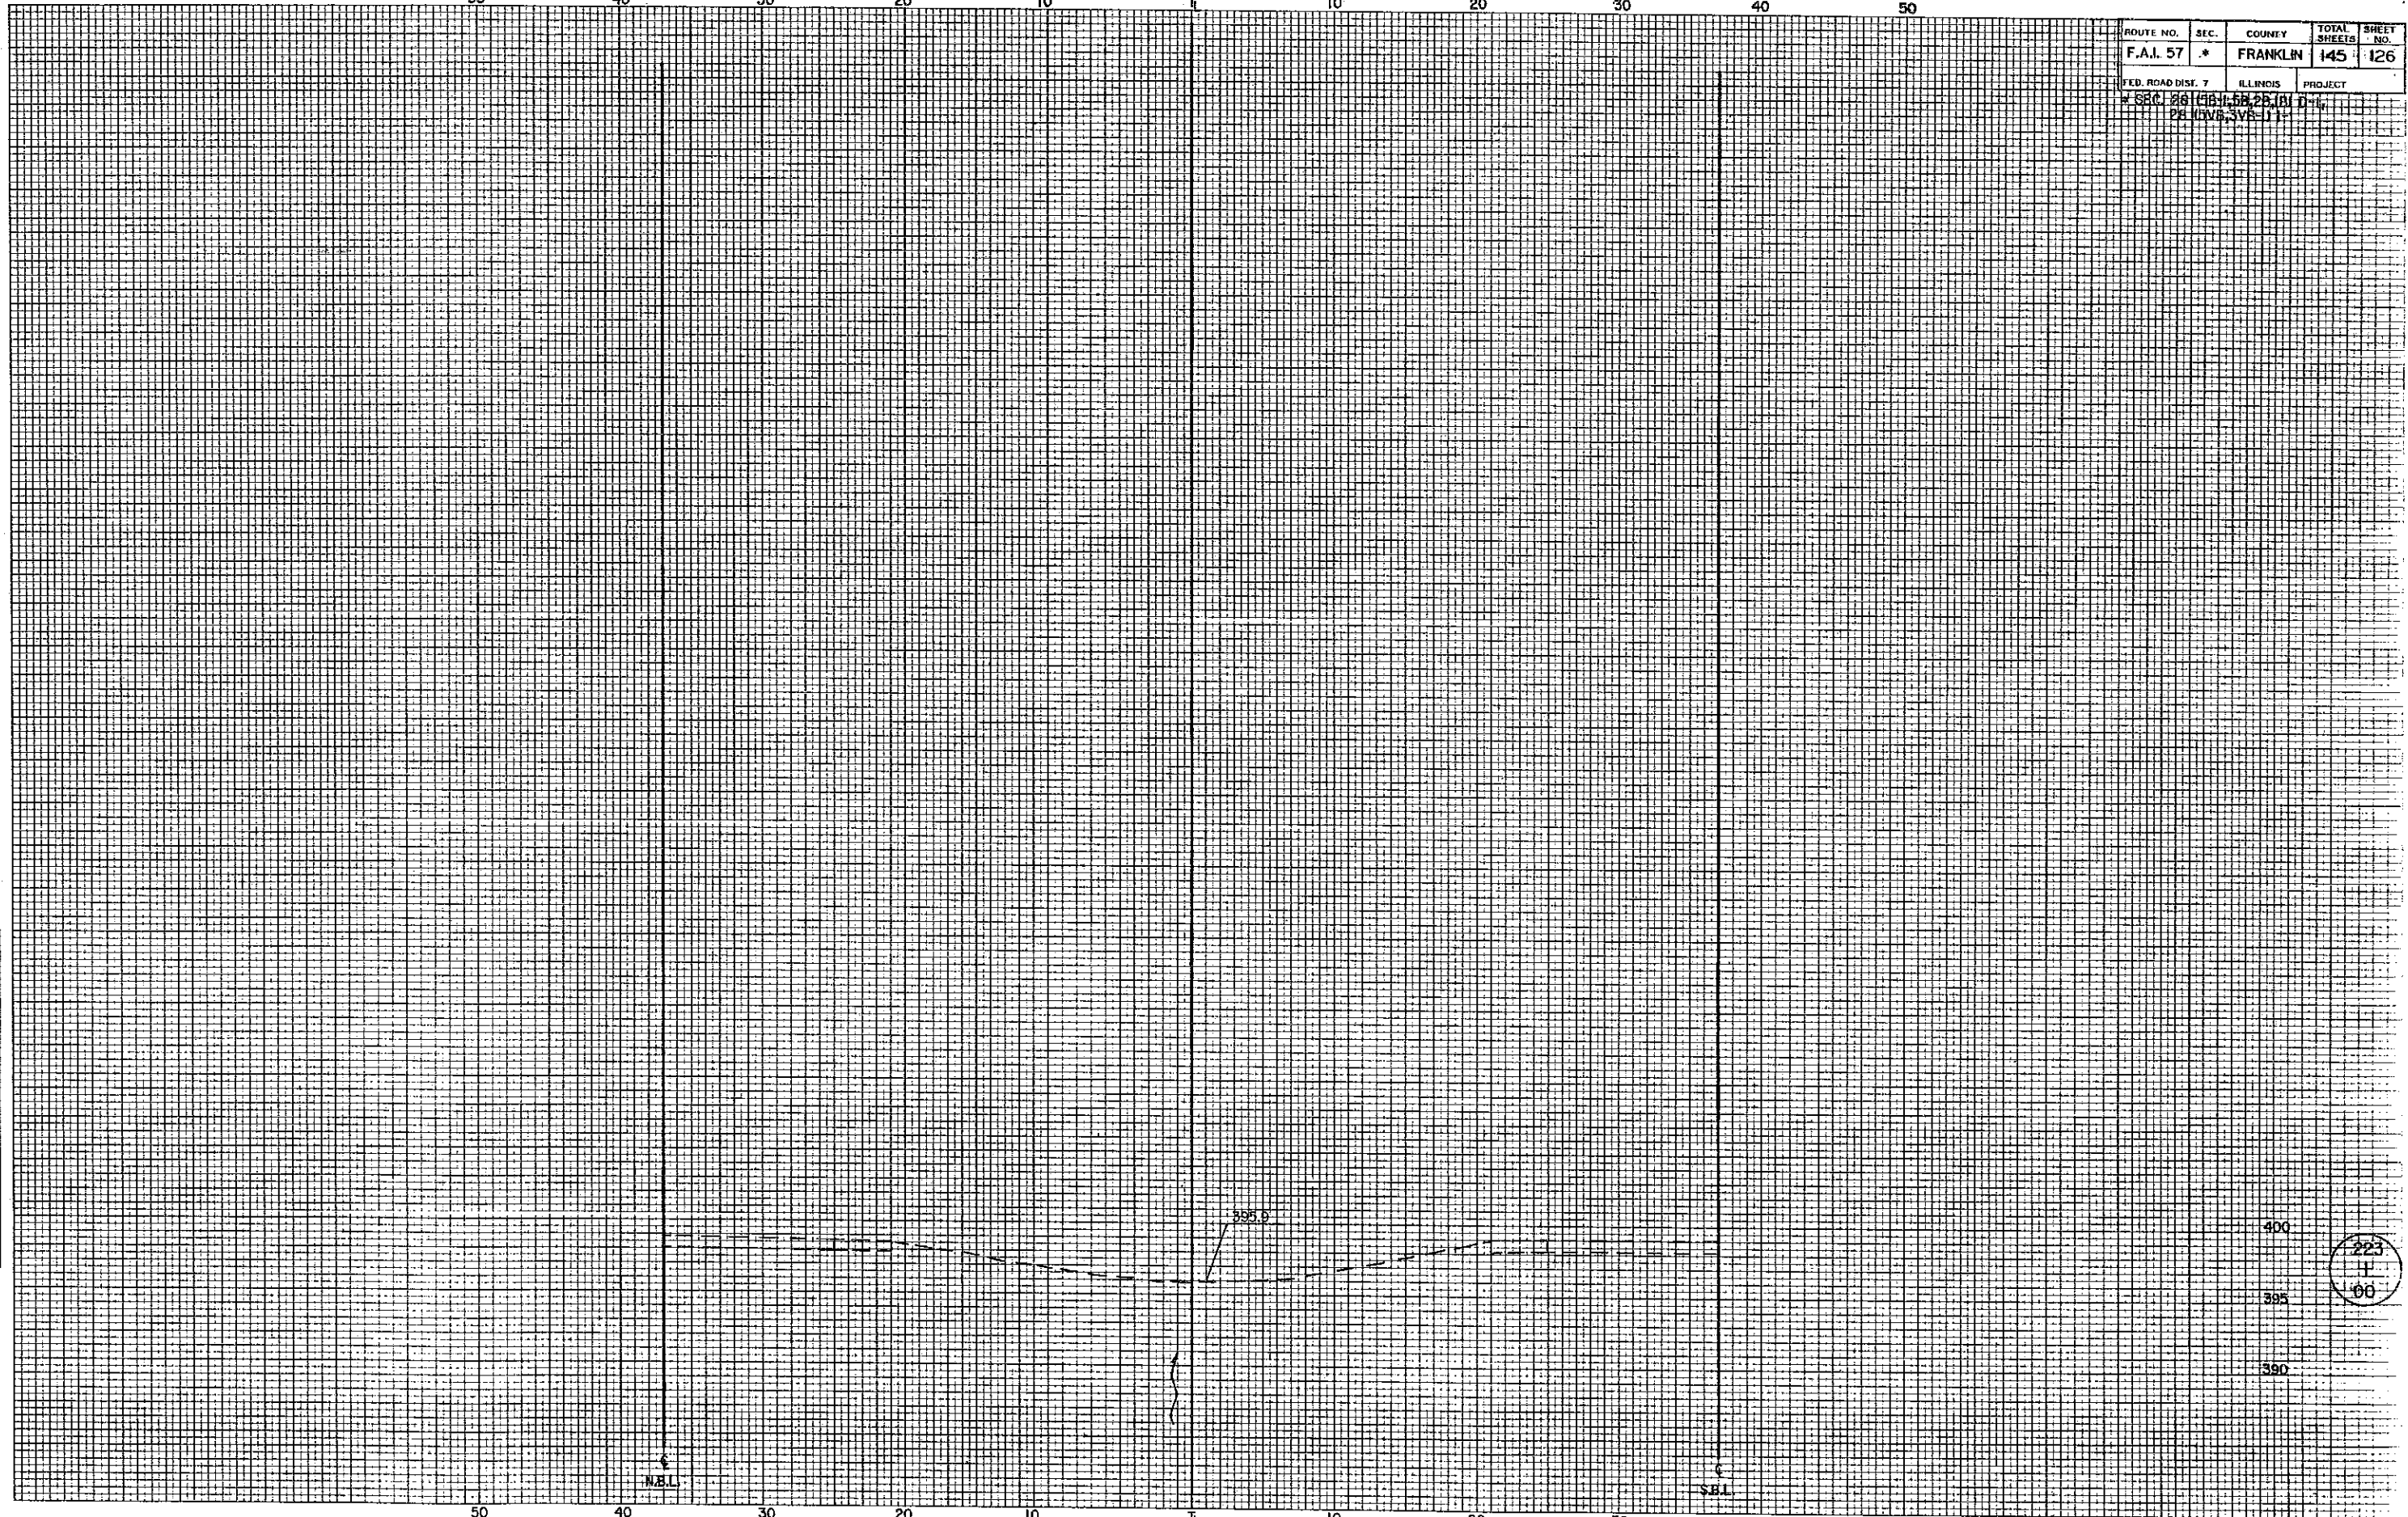


PLATE 3 CROSS SECTION ON O.P.R. & STANDARD  
METZGER CORPORATION

POND CREEK



Bench Mark: "C" Cut in S.W. corner of East Abutment of Pond Creek Bridge  
 Northbound Lane, Sta. 212+50.00 Elevation 399.40  
 Existing Structure: 028-0002 (S.B.) Built on F.A.I. Route 57, Sec. 28-5B-1 in 1961. Superstructure consists of P.C. deck supported on a 3 span continuous W.F. beams. Temporary median cross-overs shall be utilized to divert traffic over adjacent bridge 028-0001 (N.B.) during reconstruction.


STATE OF ILLINOIS  
 DEPARTMENT OF TRANSPORTATION

PROJECT NO.	DISTRICT	SECTION	SHEET NO.	TOTAL SHEETS
028-0002	12	12	12	12

GENERAL NOTES

Field welding of construction accessories will not be permitted to the bottom flange of beams nor to the top flange for a distance equal to one-fourth the span length each way from the pier supports. Field welding in other areas will be permitted only when approved by the Engineer.  
 For cantilever forming bracket. See Special Provisions.  
 Reinforcement bars shall conform to the requirements of AASHTO M-31, M-42 or M-53 Grade 60.  
 Plan dimensions and details relative to existing structure have been taken from existing plans and field survey and are subject to nominal construction variations. It shall be the Contractor's responsibility to verify such dimensions and details in the field and make necessary approved adjustments prior to construction or ordering of materials. Such variations shall not be cause for additional compensation for a change in the scope of the work, however, the Contractor will be paid for the quantity actually furnished at the unit price bid for the work.  
 All beams shall be lowered 2 1/2" from original position. (See Sht. #8 of 16)  
 Two 1/2" adjusting shims, of the dimensions of the dimensions of the bottom bearing plate, shall be provided for each bearing in addition to all other plates or shims. For Type I Elastomeric Bearings, shims of the dimensions of top plate shall be provided and placed as detailed.  
 The Contractor will be required to mark, on top of the concrete deck, the locations of the top flange of all the steel beams, prior to any removal of the existing concrete deck. Saw cutting directly over the top of the beam flanges is not permitted.  
 All top surfaces of the abutments shall receive Bridge Seat Sealer.  
 The zinc-silicate primer shall be used for shop painting of new Structural Steel. Prior to Welding Studs and pouring the new concrete for the deck, all loose rust, loose mill scale and all other foreign material shall be removed from the embedded portions of flanges of stringers. The removal shall be accomplished in accordance with the requirements of the SSPC Surface Preparation Specifications SP-3 for power tool cleaning or SP-2 for hand tool cleaning. Cost shall be incidental to "Removal of Existing Concrete Deck".

STATION 212+50.00  
 REBUILT BY  
 STATE OF ILLINOIS  
 F.A.I. RT. 57 SEC. 28-5B-1D-1  
 F.A. PROJECT: EN-57-2(1993) 6<sup>th</sup>  
 LOADING HS20 & ALT.  
 STR. NO. 028-0002  
 NAME PLATE  
 See Sht. 2113

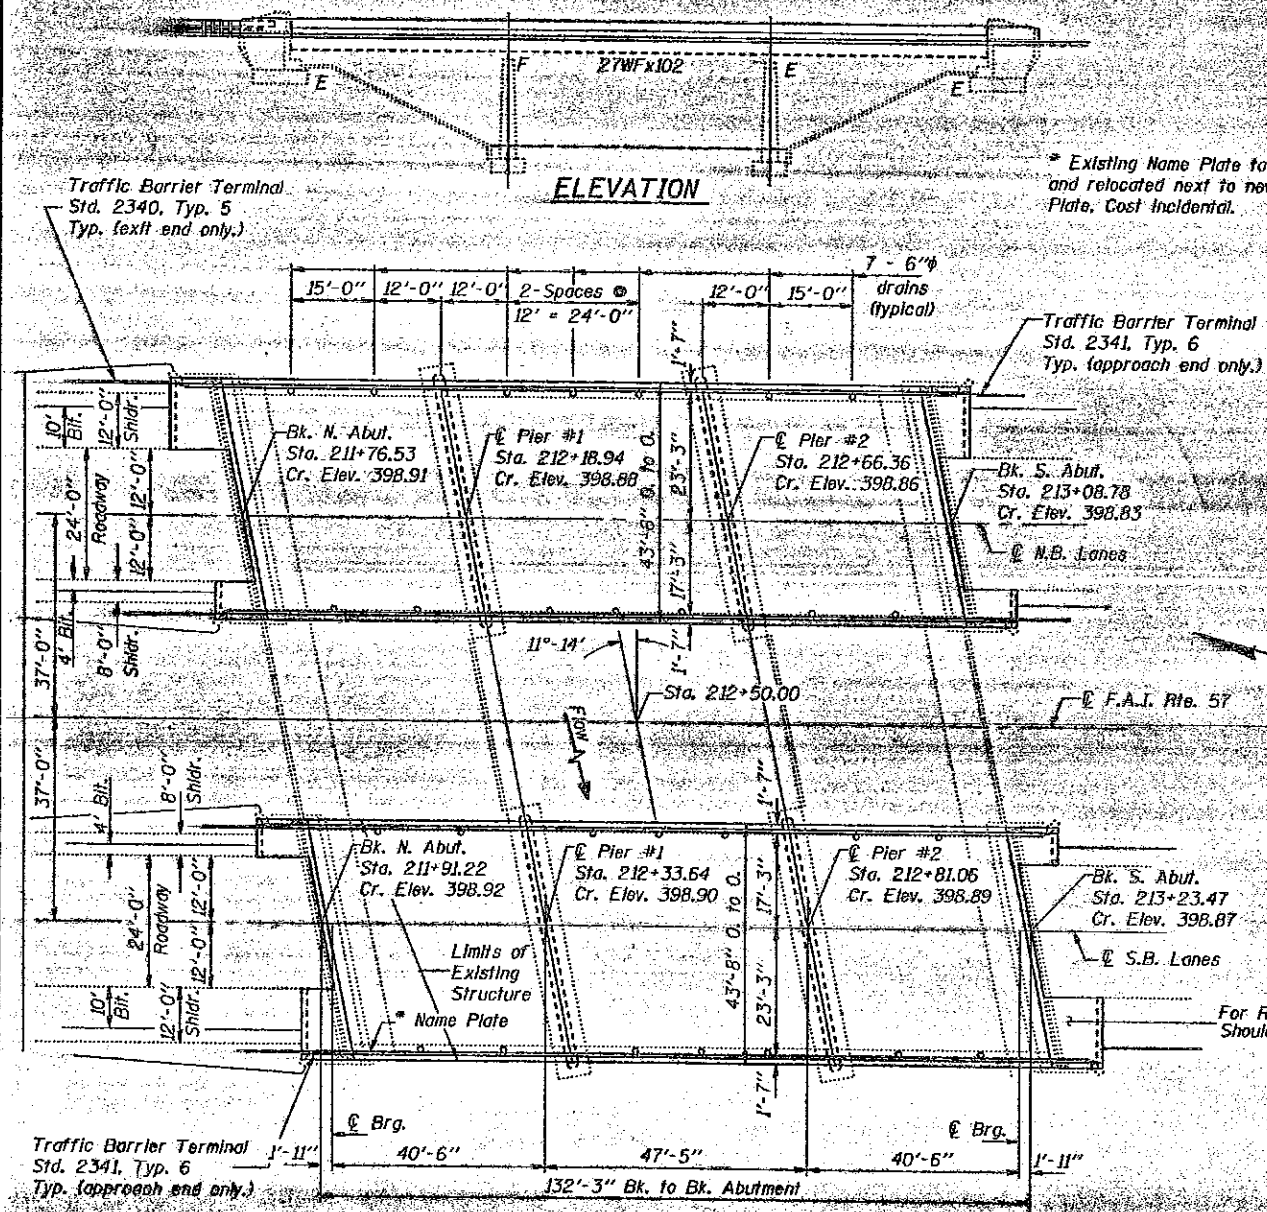

TOTAL BILL OF MATERIAL

ITEM	UNIT	SUB	SUPER	TOTAL
Concrete Removal	Cu. Yd.		9	9
Removal of Existing Concrete Deck	Each	1		1
Floor Drains	Each	14		14
Preformed Joint Seal 2 1/2"	Lin. Ft.	44		44
Preformed Joint Seal 4"	Lin. Ft.	44		44
Class X Concrete Superstructure	Cu. Yd.	187.1		187.1
Protective Coat	Sq. Yd.	690		690
Elastomeric Bearing Assembly, Type I	Each	14		14
Elastomeric Bearing Assembly, Type II	Each	7		7
Structural Steel	Lbs.	9,530		9,530
Stud Shear Connectors	Each	3,150		3,150
Reinforcement Bars, Epoxy Coated	Pound	44,150		44,150
Name Plates	Each	1		1
Bridge Seat Sealer	Sq. Ft.	177		177
Jack and Remove Existing Bearings	Each	28		28
Bridge Deck Grooving	Sq. Yd.	555		555
Structure Excavation	Cu. Yd.		22.0	22.0

DESIGN SPECIFICATIONS


1989 AASHTO with 1990 & 1991 Interims & Seismic Retrofitting Guidelines for Highway Bridges.

LOADING HS 20-44 & AH.

Allow 25# / sq. ft. for future wearing surface.


DESIGN STRESSES

FIELD UNITS  
 New Construction  
 $f_c = 3,500$  psi  
 $f_y = 60,000$  psi (Reinf.)  
 $f_y = 33,000$  psi (Existing Structural Steel)  
 $f_y = 36,000$  psi (New Structural Steel)

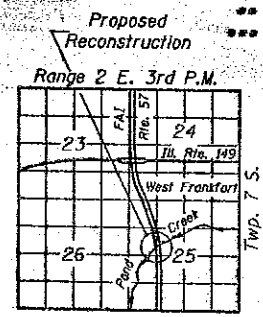

LOCATION SKETCH

GENERAL PLAN  
 F.A.I. ROUTE 57 OVER  
 POND CREEK  
 F.A.I. ROUTE 57 SECTION (28-5B-1D-1)  
 FRANKLIN COUNTY  
 STATION 212+50.00  
 STRUCTURE NUMBER 028-0002 (S.B.)

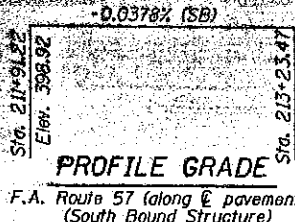


PROFILE GRADE  
 F.A. Route 57 (along E. pavement)  
 (South Bound Structure)

Note:  
 Only the South bound structure is included in this contract. North bound structure shown for information only.


DESIGNED: Richard J. Gagnier  
 CHECKED: Paul W. Sweet  
 DRAWN: Paul W. Sweet  
 EXAMINED: [Signature]  
 PREPARED: [Signature]  
 APPROVED: [Signature]  
 DATE: May 20, 1993



STATE OF ILLINOIS  
DEPARTMENT OF TRANSPORTATION

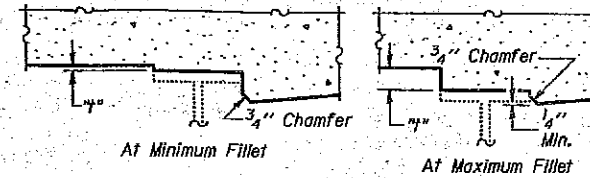

ROUTE NO.	SECTION	COUNTY	SHEET NO.	16 SHEETS
P.A.I. BY	FRANKLIN		128	
FED. ROAD DIST. NO.	FRANKLIN			

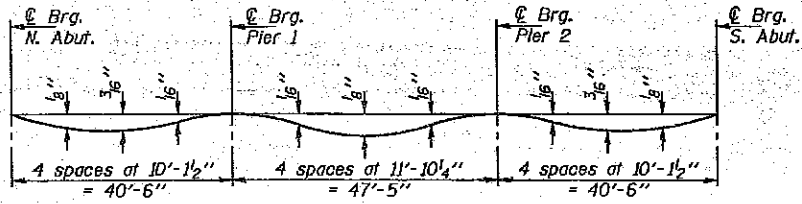

**DEAD LOAD DEFLECTION DIAGRAM**  
(Includes weight of concrete only)  
Note: The above deflections are not to be used in the field if the engineer is working from the grade elevations adjusted for dead load deflections as shown below.

To determine "f": After all structural steel has been erected, elevations of the top flanges of the beams shall be taken at intervals shown below. These elevations subtracted from the "Theoretical Grade Elevations Adjusted for Dead Load Deflection" shown below, minus slab thickness, equals the fillet heights "f" above top flange of beams.

**FILLET HEIGHTS**

**BEAM 1**

Location	Station	Offset	Theoretical Grade Elevations	Theoretical Grade Elevations Adjusted For Dead Load Deflection
BK. OF N. ABUT.	21187.868	-16.875	398.695	398.695
BEAM N. ABUT.	21189.785	-16.875	398.694	398.694
A	21199.785	-16.875	398.690	398.702
B	21209.785	-16.875	398.687	398.701
C	21219.785	-16.875	398.683	398.690
BEAM PIER 1	21230.285	-16.875	398.679	398.679
D	21240.285	-16.875	398.675	398.680
E	21250.285	-16.875	398.671	398.681
F	21260.285	-16.875	398.667	398.676
G	21270.285	-16.875	398.664	398.668
BEAM PIER 2	21277.702	-16.875	398.661	398.661
H	21287.702	-16.875	398.657	398.664
I	21297.702	-16.875	398.653	398.668
J	21307.702	-16.875	398.650	398.661
BEAM S. ABUT.	21318.202	-16.875	398.646	398.646
BK. OF S. ABUT.	21320.119	-16.875	398.645	398.645

**EAST LONGITUDINAL BONDED CONSTRUCTION JOINT**

Location	Station	Offset	Theoretical Grade Elevations	Theoretical Grade Elevations Adjusted For Dead Load Deflection
BK. OF N. ABUT.	21188.837	-12.000	398.796	398.796
BEAM N. ABUT.	21190.754	-12.000	398.795	398.795
A	21200.754	-12.000	398.791	398.803
B	21210.754	-12.000	398.788	398.802
C	21220.754	-12.000	398.784	398.791
BEAM PIER 1	21231.254	-12.000	398.780	398.780
D	21241.254	-12.000	398.776	398.781
E	21251.254	-12.000	398.772	398.782
F	21261.254	-12.000	398.769	398.777
G	21271.254	-12.000	398.765	398.769
BEAM PIER 2	21279.671	-12.000	398.762	398.762
H	21286.671	-12.000	398.758	398.765
I	21296.671	-12.000	398.754	398.769
J	21306.671	-12.000	398.751	398.762
BEAM S. ABUT.	21319.171	-12.000	398.747	398.747
BK. OF S. ABUT.	21321.088	-12.000	398.746	398.746

**BEAM 2**

Location	Station	Offset	Theoretical Grade Elevations	Theoretical Grade Elevations Adjusted For Dead Load Deflection
BK. OF N. ABUT.	21189.184	-10.250	398.830	398.830
BEAM N. ABUT.	21191.101	-10.250	398.829	398.829
A	21201.101	-10.250	398.825	398.836
B	21211.101	-10.250	398.821	398.836
C	21221.101	-10.250	398.818	398.825
BEAM PIER 1	21231.601	-10.250	398.814	398.814
D	21241.601	-10.250	398.810	398.815
E	21251.601	-10.250	398.806	398.815
F	21261.601	-10.250	398.802	398.811
G	21271.601	-10.250	398.798	398.802
BEAM PIER 2	21279.018	-10.250	398.796	398.796
H	21289.018	-10.250	398.792	398.799
I	21299.018	-10.250	398.788	398.802
J	21309.018	-10.250	398.784	398.796
BEAM S. ABUT.	21319.518	-10.250	398.780	398.780
BK. OF S. ABUT.	21321.435	-10.250	398.780	398.780

**BEAM 3**

Location	Station	Offset	Theoretical Grade Elevations	Theoretical Grade Elevations Adjusted For Dead Load Deflection
BK. OF N. ABUT.	21190.500	-3.625	398.909	398.909
BEAM N. ABUT.	21192.417	-3.625	398.908	398.908
A	21202.417	-3.625	398.904	398.916
B	21212.417	-3.625	398.901	398.915
C	21222.417	-3.625	398.897	398.904
BEAM PIER 1	21232.917	-3.625	398.893	398.893
D	21242.917	-3.625	398.889	398.894
E	21252.917	-3.625	398.885	398.895
F	21262.917	-3.625	398.881	398.890
G	21272.917	-3.625	398.878	398.882
BEAM PIER 2	21280.334	-3.625	398.875	398.875
H	21290.334	-3.625	398.871	398.878
I	21300.334	-3.625	398.867	398.882
J	21310.334	-3.625	398.864	398.875
BEAM S. ABUT.	21320.834	-3.625	398.860	398.860
BK. OF S. ABUT.	21322.751	-3.625	398.859	398.859

**ROADWAY AND P. G.**

Location	Station	Offset	Theoretical Grade Elevations	Theoretical Grade Elevations Adjusted For Dead Load Deflection
BK. OF N. ABUT.	21191.220	0.000	398.920	398.920
BEAM N. ABUT.	21193.137	0.000	398.919	398.919
A	21203.137	0.000	398.915	398.927
B	21213.137	0.000	398.912	398.926
C	21223.137	0.000	398.908	398.915
BEAM PIER 1	21233.637	0.000	398.904	398.904
D	21243.637	0.000	398.900	398.905
E	21253.637	0.000	398.896	398.906
F	21263.637	0.000	398.893	398.901
G	21273.637	0.000	398.889	398.893
BEAM PIER 2	21281.054	0.000	398.886	398.886
H	21291.054	0.000	398.882	398.889
I	21301.054	0.000	398.878	398.893
J	21311.054	0.000	398.875	398.886
BEAM S. ABUT.	21321.554	0.000	398.871	398.871
BK. OF S. ABUT.	21323.471	0.000	398.870	398.870

**BEAM 4**

Location	Station	Offset	Theoretical Grade Elevations	Theoretical Grade Elevations Adjusted For Dead Load Deflection
BK. OF N. ABUT.	21191.816	3.000	398.912	398.912
BEAM N. ABUT.	21193.733	3.000	398.911	398.911
A	21203.733	3.000	398.907	398.919
B	21213.733	3.000	398.904	398.918
C	21223.733	3.000	398.900	398.907
BEAM PIER 1	21234.233	3.000	398.896	398.896
D	21244.233	3.000	398.892	398.897
E	21254.233	3.000	398.888	398.898
F	21264.233	3.000	398.885	398.893
G	21274.233	3.000	398.881	398.885
BEAM PIER 2	21281.650	3.000	398.878	398.878
H	21291.650	3.000	398.874	398.881
I	21301.650	3.000	398.870	398.885
J	21311.650	3.000	398.867	398.878
BEAM S. ABUT.	21322.150	3.000	398.863	398.863
BK. OF S. ABUT.	21324.067	3.000	398.862	398.862

**BEAM 5**

Location	Station	Offset	Theoretical Grade Elevations	Theoretical Grade Elevations Adjusted For Dead Load Deflection
BK. OF N. ABUT.	21193.132	9.625	398.839	398.839
BEAM N. ABUT.	21195.049	9.625	398.838	398.838
A	21205.049	9.625	398.834	398.846
B	21215.049	9.625	398.831	398.845
C	21225.049	9.625	398.827	398.834
BEAM PIER 1	21235.549	9.625	398.823	398.823
D	21245.549	9.625	398.819	398.824
E	21255.549	9.625	398.815	398.825
F	21265.549	9.625	398.811	398.820
G	21275.549	9.625	398.808	398.812
BEAM PIER 2	21282.966	9.625	398.805	398.805
H	21292.966	9.625	398.801	398.808
I	21302.966	9.625	398.797	398.811
J	21312.966	9.625	398.794	398.805
BEAM S. ABUT.	21323.466	9.625	398.790	398.790
BK. OF S. ABUT.	21325.383	9.625	398.789	398.789

**WEST LONGITUDINAL BONDED CONSTRUCTION JOINT**

Location	Station	Offset	Theoretical Grade Elevations	Theoretical Grade Elevations Adjusted For Dead Load Deflection
BK. OF N. ABUT.	21193.603	12.000	398.794	398.794
BEAM N. ABUT.	21195.520	12.000	398.793	398.793
A	21205.520	12.000	398.789	398.801
B	21215.520	12.000	398.786	398.800
C	21225.520	12.000	398.782	398.799
BEAM PIER 1	21236.020	12.000	398.778	398.778
D	21246.020	12.000	398.774	398.779
E	21256.020	12.000	398.771	398.780
F	21266.020	12.000	398.767	398.775
G	21276.020	12.000	398.763	398.767
BEAM PIER 2	21283.437	12.000	398.760	398.760
H	21293.437	12.000	398.756	398.763
I	21303.437	12.000	398.753	398.767
J	21313.437	12.000	398.749	398.760
BEAM S. ABUT.	21323.937	12.000	398.745	398.745
BK. OF S. ABUT.	21325.854	12.000	398.744	398.744

**BEAM 6**

Location	Station	Offset	Theoretical Grade Elevations	Theoretical Grade Elevations Adjusted For Dead Load Deflection
BK. OF N. ABUT.	21194.447	16.250	398.705	398.705
BEAM N. ABUT.	21196.364	16.250	398.705	398.705
A	21206.364	16.250	398.701	398.712
B	21216.364	16.250	398.697	398.711
C	21226.364	16.250	398.693	398.701
BEAM PIER 1	21236.864	16.250	398.689	398.689
D	21246.864	16.250	398.685	398.691
E	21256.864	16.250	398.682	398.691
F	21266.864	16.250	398.678	398.686
G	21276.864	16.250	398.674	398.678
BEAM PIER 2	21284.281	16.250	398.671	398.671
H	21294.281	16.250	398.668	398.675
I	21304.281	16.250	398.664	398.679
J	21314.281	16.250	398.660	398.672
BEAM S. ABUT.	21324.781	16.250	398.656	398.656
BK. OF S. ABUT.	21326.698	16.250	398.655	398.655

**BEAM 7**

Location	Station	Offset	Theoretical Grade Elevations	Theoretical Grade Elevations Adjusted For Dead Load Deflection
BK. OF N. ABUT.	21195.763	22.875	398.567	398.567
BEAM N. ABUT.	21197.680	22.875	398.566	398.566
A	21207.680	22.875	398.563	398.574
B	21217.680	22.875	398.559	398.573
C	21227.680	22.875	398.555	398.562
BEAM PIER 1	21238.180	22.875	398.551	398.551
D	21248.180	22.875	398.547	398.552
E	21258.180	22.875	398.543	398.553
F	21268.180	22.875	398.540	398.548
G	21278.180	22.875	398.536	398.540
BEAM PIER 2	21285.597	22.875	398.533	398.533
H	21295.597	22.875	398.529	398.536
I	21305.597	22.875	398.526	398.540
J	21315.597	22.875	398.522	398.533
BEAM S. ABUT.	21326.097	22.875	398.518	398.518
BK. OF S. ABUT.	21328.014	22.875	398.517	398.517

DESIGNED *Clark Verhulst*  
CHECKED *Richard J. Chaput*  
DRAWN *Paul W. Sweet*  
CHECKED *RJL DGV RFB*

EXAMINED *Ray J. Kaspar*  
PASSED *Ralph E. Anderson*  
APPROVED \_\_\_\_\_


May 20 1993

Note: Work this sheet with sheet #3 of 16.

TOP OF SLAB ELEVATIONS  
F.A.I. RT. 57 SEC. (28-5B-1)D-1  
FRANKLIN COUNTY  
STATION 212+50.00

STATE OF ILLINOIS  
DEPARTMENT OF TRANSPORTATION

SECTION NO.	SECTION	COUNTY	DATE	SHEET	SHEET NO. 3
F.A.I. RT.	28-5B-1D-1	FRANKLIN		129	16 SHEETS
FED. ROAD DIST. NO. 7	ILLINOIS	FED. ROAD PROJECT			

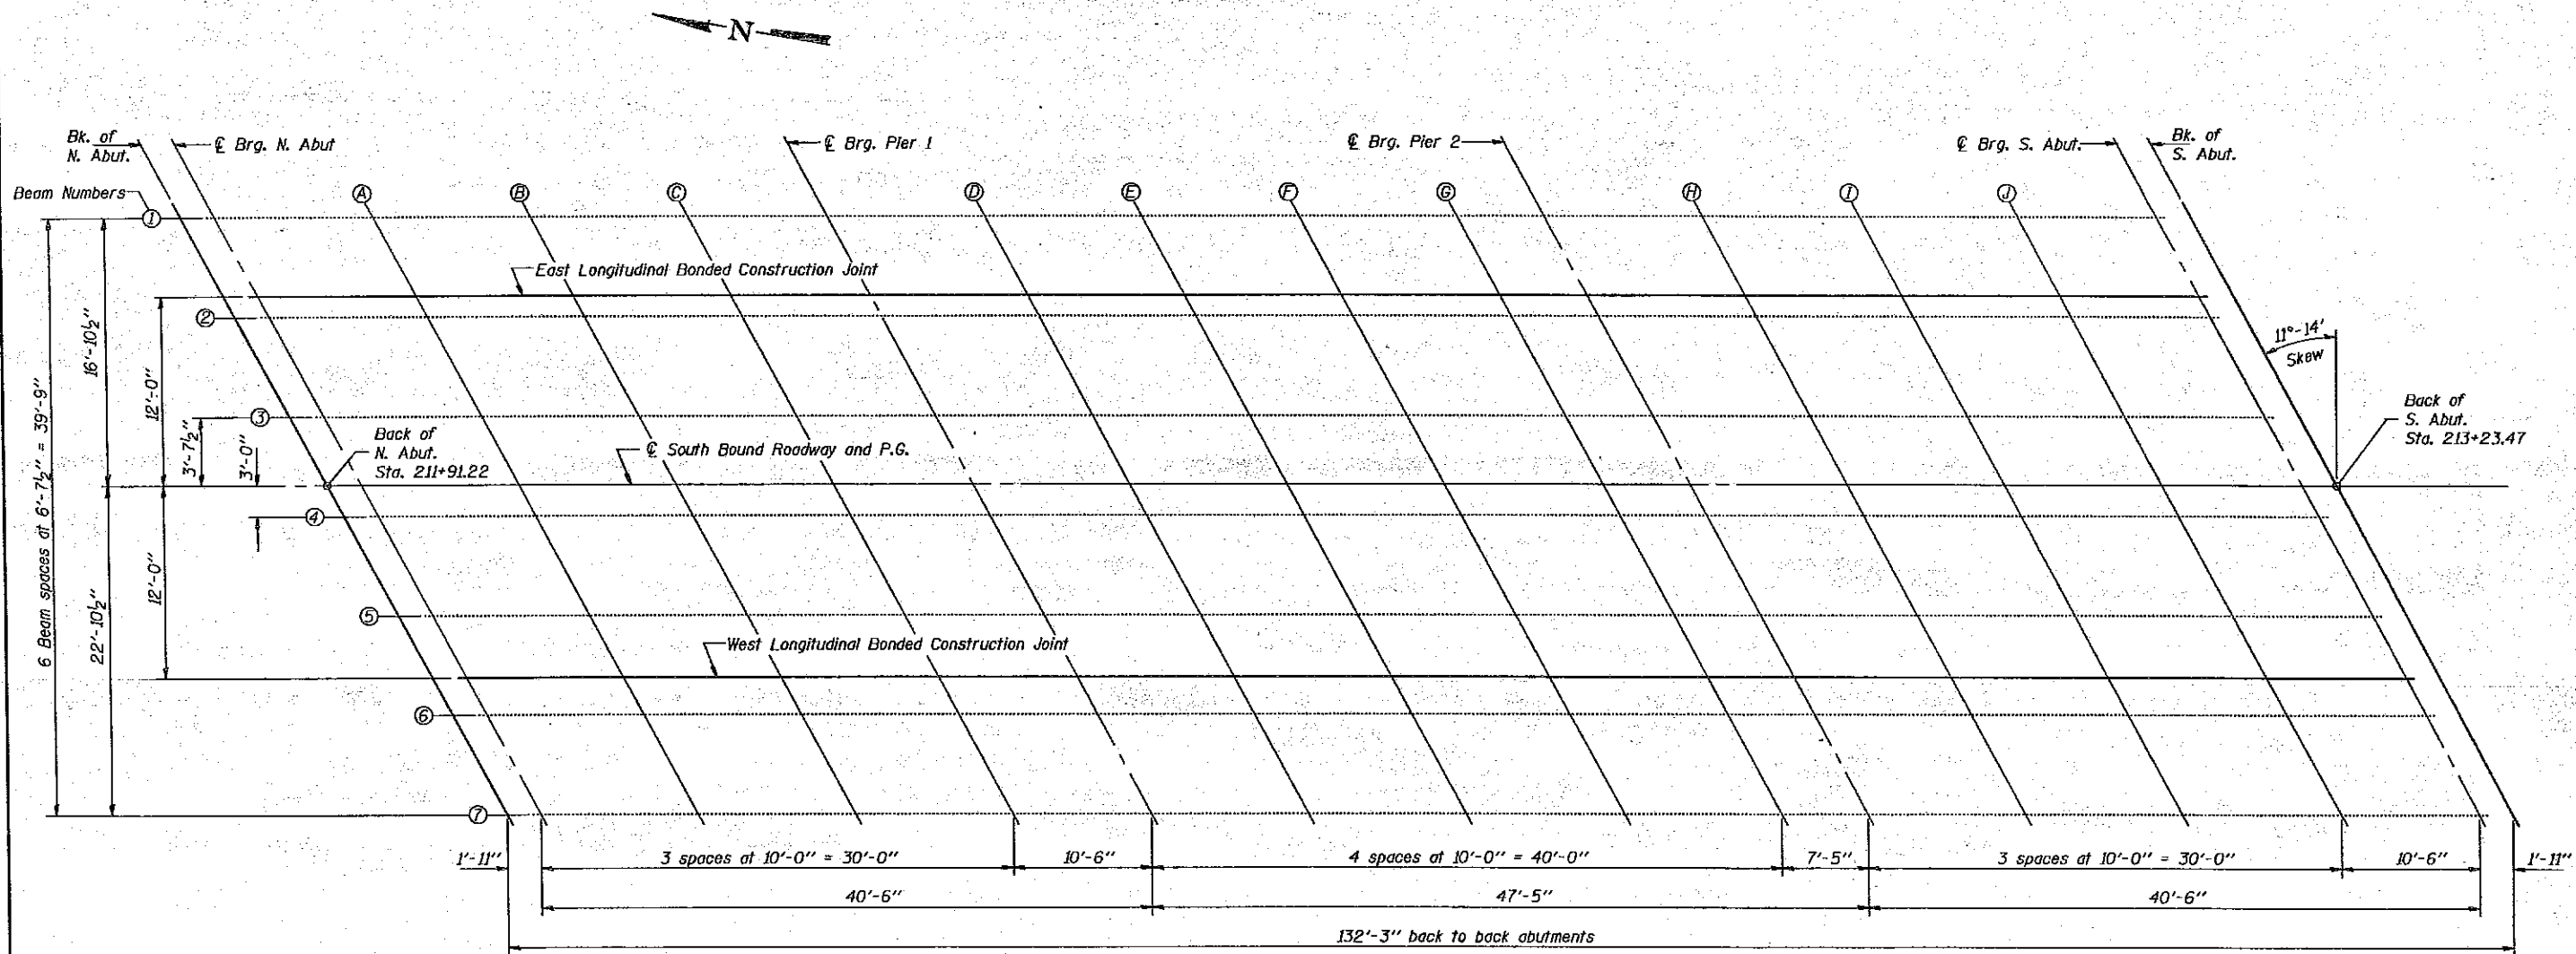

PLAN

Work this sheet with sheet #2 of 16.

DESIGNED *Richard J. Chopt*  
CHECKED *Dennis P. Rasicki*  
DRAWN *Paul W. Sweet*  
CHECKED *RJC DGV RJB*

EXAMINED *Greg J. Kasper*  
PASSED *Ralph E. Anderson*  
APPROVED \_\_\_\_\_  
DIRECTOR OF HIGHWAYS

May 20 1993

TOP OF SLAB ELEVATIONS  
F.A.I. RT. 57 SEC. (28-5B-1D-1  
FRANKLIN COUNTY  
STATION 212+50.00









STATE OF ILLINOIS  
DEPARTMENT OF TRANSPORTATION

ROUTE NO.	DISTRICT	COUNTY	SECTION	SHEET NO.
F.A.I. 57	28-5B-1D-1	FRANKLIN	132	16 SHEETS
FED. ROAD DIST. NO.		PROJECT		


Hatched area to be poured after superstructure forms have been removed. Quantity of concrete to be included with "Class X Concrete Superstructure" that is shown on this Sheet.

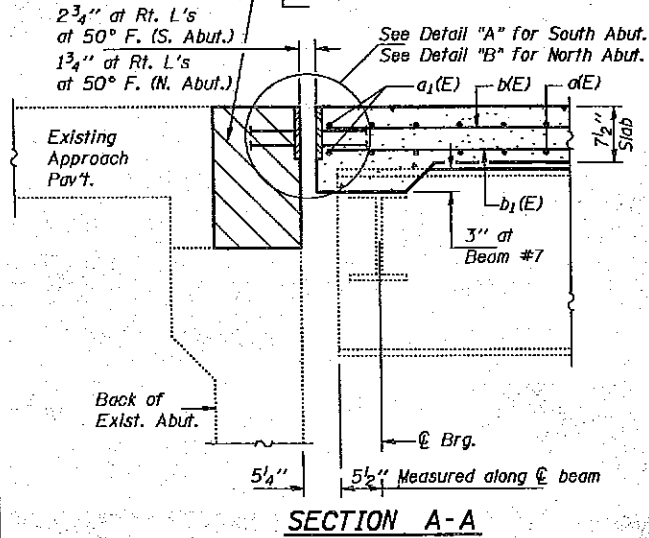

SECTION A-A

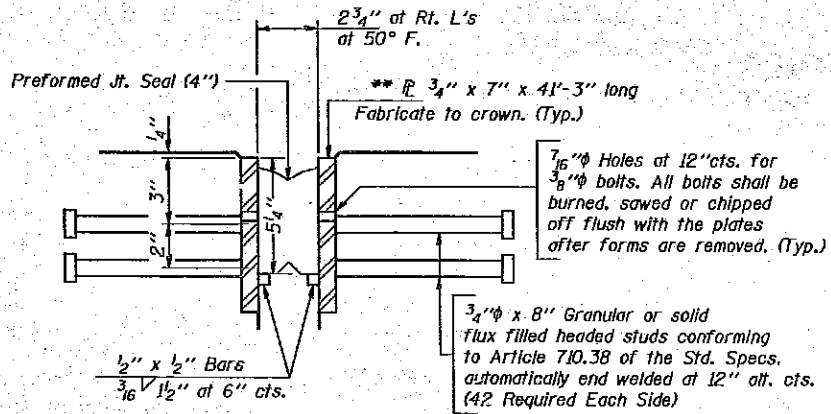


DETAIL "A"

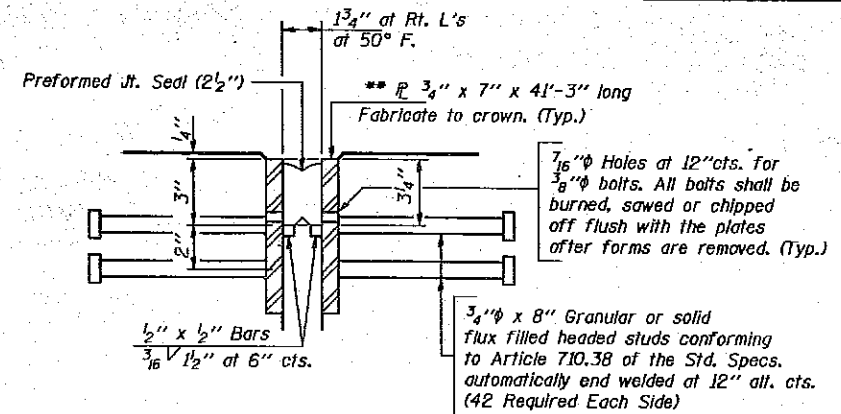


DETAIL "B"


\*\* Furnish in segments of 20 ft. maximum length. Maximum space between installed segments shall be 3/16". Seal space with Silicone Sealant suitable for Structural Steel. After fabrication all surfaces of the steel plates shall be given one shop coat of paint specified for New Structural Steel. No field painting required.

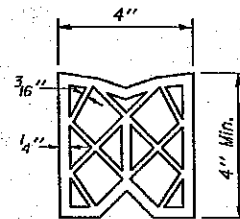

PREFORMED JOINT SEAL (4")

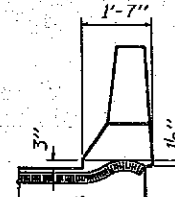

END TREATMENT  
Typ. for (4") and (2 1/2").

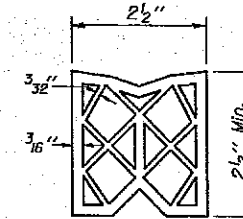


PREFORMED JOINT SEAL (2 1/2")


BILL OF MATERIAL

Bar	No.	Size	Length	Shape
a(E)	401	#5	41'-8"	
a1(E)	4	#5	42'-6"	
a2(E)	226	#6	4'-0"	
b(E)	188	#5	33'-8"	
b1(E)	210	#5	27'-3"	
b2(E)	88	#6	25'-6"	
d(E)	260	#4	3'-0"	L
d1(E)	284	#5	2'-7"	L
d2(E)	284	#5	3'-0"	L
d3(E)	260	#4	3'-0"	L
e(E)	48	#4	20'-4"	
e1(E)	36	#4	15'-6"	
e2(E)	8	#8	40'-10"	
e3(E)	4	#8	47'-1"	
e4(E)	8	#5	40'-10"	
e5(E)	4	#5	47'-1"	
Reinforcement Bars, Epoxy Coated		Lbs.	40,540	
Class X Concrete Superstructure		Cu. Yd.	187.1	


Reinforcement bars designated (E) shall be epoxy coated.

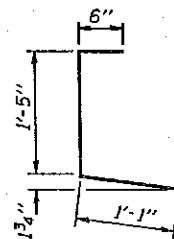

BAR d(E)

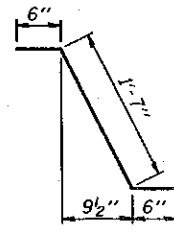

BAR d1(E)

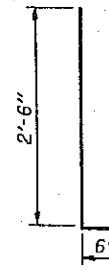

BARS d2(E) & d3(E)

DESIGNED *Richard J. Chast*  
CHECKED *James P. Ariston*  
DRAWN *Paul W. Sweet*  
CHECKED *RJC DGV RJB*

EXAMINED *Greg J. Kaspar*  
PASSED *Ralph E. Anderson*  
APPROVED \_\_\_\_\_  
DIRECTOR OF HIGHWAYS


May 20 1993

SUPERSTRUCTURE DETAILS  
F.A.I. RT. 57 SEC. (28-5B-1D-1  
FRANKLIN COUNTY  
STATION 212+50.00




STATE OF ILLINOIS  
DEPARTMENT OF TRANSPORTATION

ROUTE NO.	SECTION	BRIDGE	SPAN	SHEET NO.
				133
F.A.I. RT. 57 SEC. 28-5B-1D-1				16 SHEETS

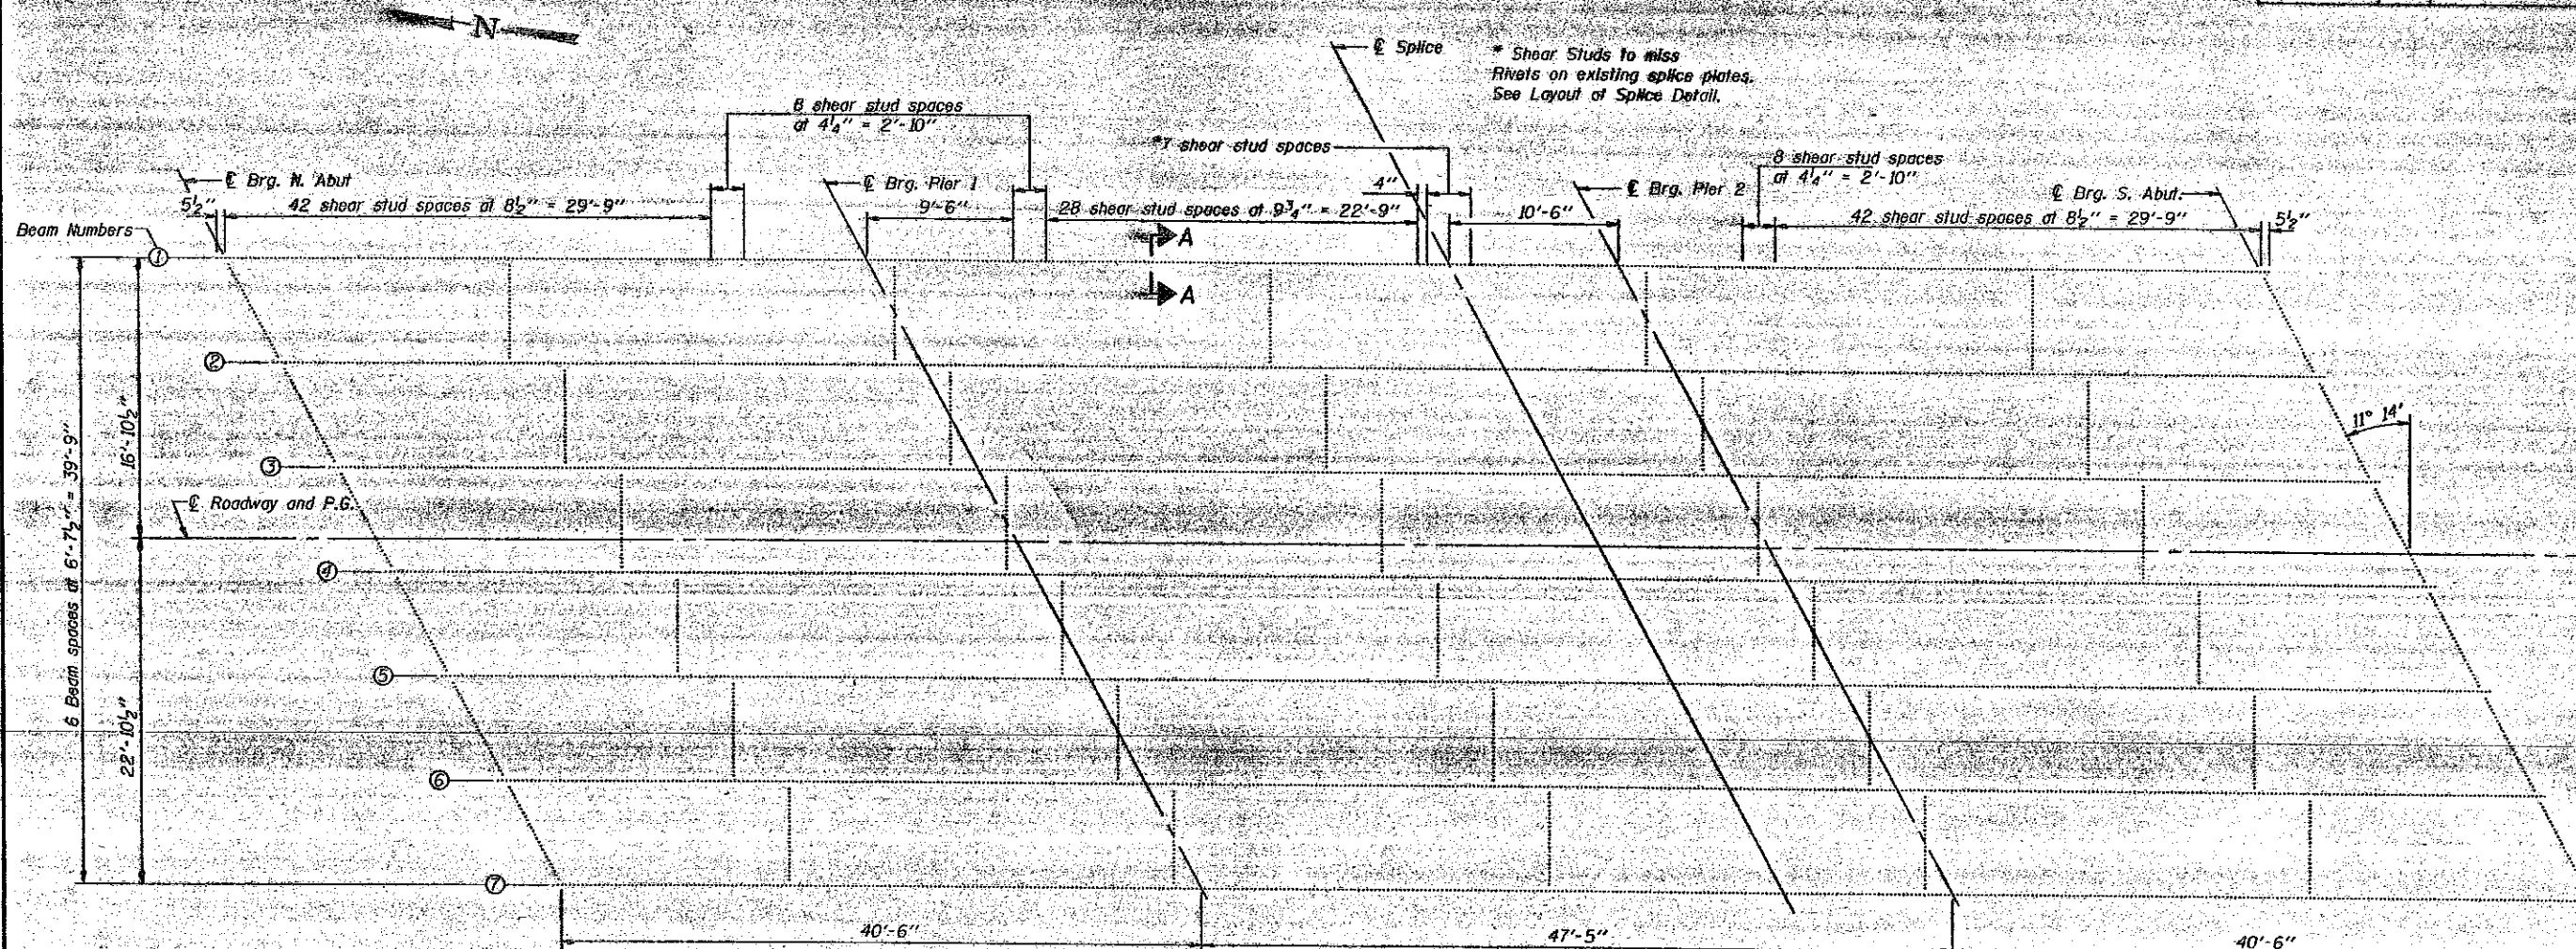

All existing beams are 27WF102

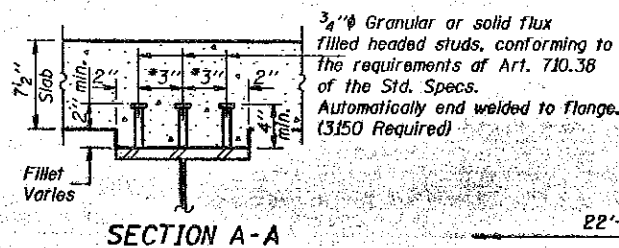

**PLAN**


**INTERIOR BEAM REACTION TABLE**

	Abuts.	Piers
RP (K)	15.9	49.0
Rt (K)	32.2	39.3
Imp. (K)	9.7	11.6
R (Total) (K)	57.8	99.9

**INTERIOR BEAM MOMENT TABLE**

	0.4 Sp. 1 or 0.6 Sp. 3	Pier 1 or Pier 2	0.5 Sp. 2
Is (in <sup>4</sup> )	3604	3604	3604
Ic (n=9) (in <sup>4</sup> )	10448	10448	10448
Ic (n=27) (in <sup>4</sup> )	7732	7732	7732
Ss (in <sup>3</sup> )	266	266	266
Sc (n=9) (in <sup>3</sup> )	405	405	405
Sc (n=27) (in <sup>3</sup> )	367	367	367
Q (K/ft.)	748	101	748
Mp (K)	89.3	183.6	65.3
Ms (non-comp) (k.s.i.)	4.0	8.3	2.9
sr (K/ft.)	262	262	262
Msp (K)	36.1	34.9	34.9
Ms (comp) (k.s.i.)	1.2	1.1	1.1
Mt (K)	237.3	122.9	245.1
M (Imp) (K)	71.2	36.2	70.8
S <sub>3</sub> (M <sub>t</sub> +I) (K)	514.2	265.2	526.5
fs S <sub>3</sub> (I+I) (k.s.i.)	15.2	11.9	15.6
Ma (K)	831.0	583.0	815.0
fs (Overload) (k.s.i.)	20.4	20.2	19.6
fs (Total) (k.s.i.)	26.5	26.3	25.5
VR (K)	45.4	48.5	48.5

Is and Ss are the moment of inertia and section modulus of the steel section used in computing fs (Total and Overload).  
Ic and Sc are the moment of inertia and section modulus of the composite section used in computing fs (Total and Overload).  
VR is the maximum Live Load + Impact shear range in span.  
Ma (Applied Moment) = 1.3 [Mp + Ms + S<sub>3</sub>(M<sub>t</sub> + I)]  
fs (Overload) is the sum of the stresses due to [Mp + Ms + S<sub>3</sub>(M<sub>t</sub> + I)]  
fs (Total) is the sum of the stresses due to 1.3 [Mp + Ms + S<sub>3</sub>(M<sub>t</sub> + I)], at unbraced, Non-compact, section.  
Mp - Moment due to dead load on non-composite section.  
Ms - Moment due to dead load on composite section.  
M<sub>t</sub> - Moment due to live load on non-composite section.  
I - Live load impact.

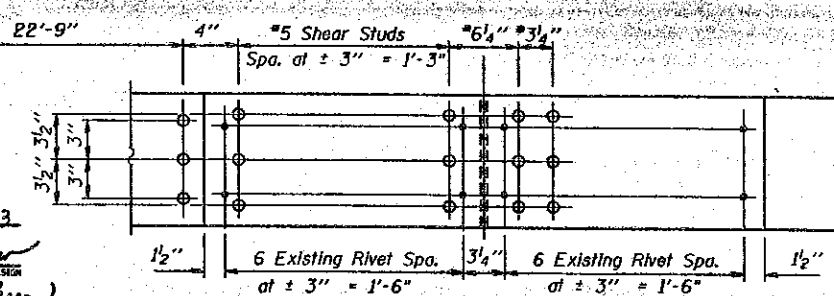

LAYOUT AT SPLICE

DESIGNED *Richard J. Chapt*  
CHECKED *Paul W. Sweet*  
DRAWN *Paul W. Sweet*  
CHECKED *RSE RFB*

EXAMINED *Orin J. Kasper*  
PASSED *Robert E. Anderson*  
APPROVED

May 20 1993  
DIRECTOR OF HIGHWAYS

For n = 27.

**STRUCTURAL STEEL DETAILS**  
F.A.I. RT. 57 SEC. (28-5B-1D-1)  
FRANKLIN COUNTY  
STATION 212+50.00

















STATE OF ILLINOIS  
DEPARTMENT OF TRANSPORTATION

ROUTE NO.	SHEET	COUNTY	DATE	POST	SHEET NO. 11 16 SHEETS
A.B.L.	128-58-11	FRANKLIN		137	
P.A.I. 57	D-1				
FED. ROAD DIST. NO. 7					

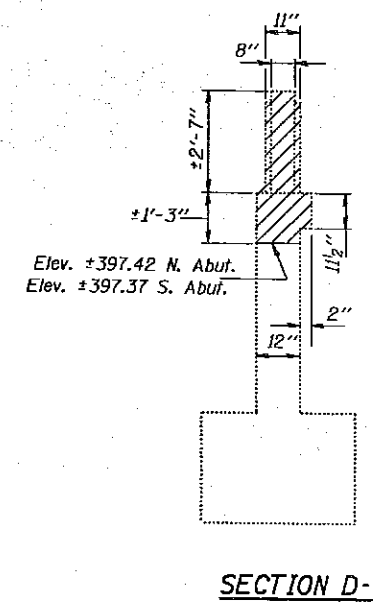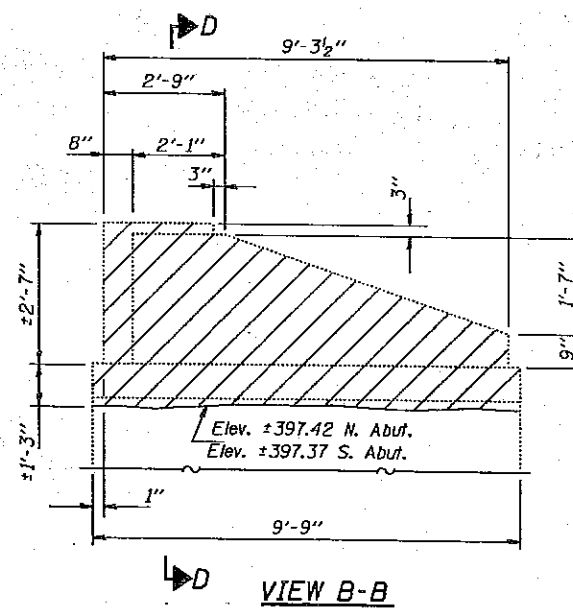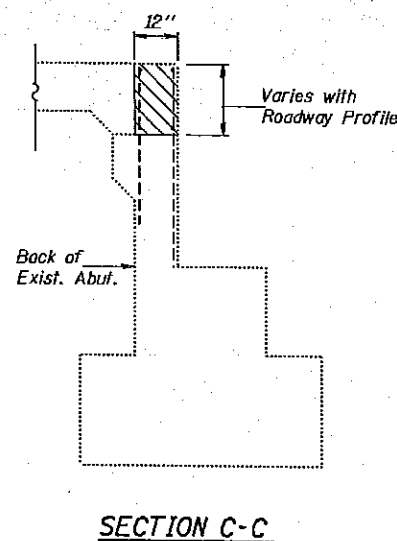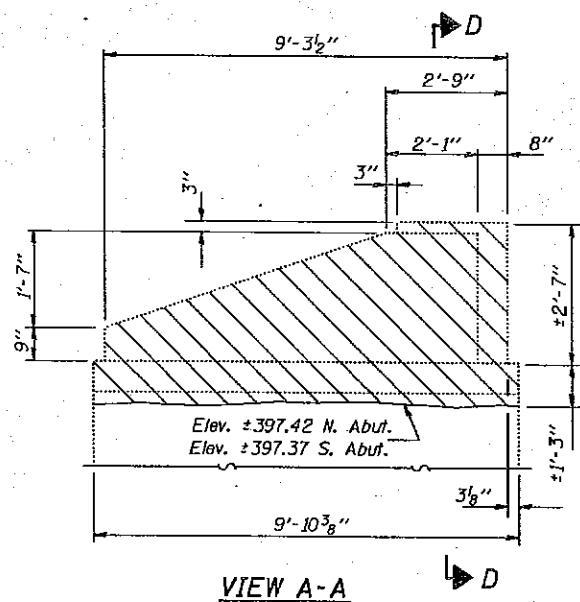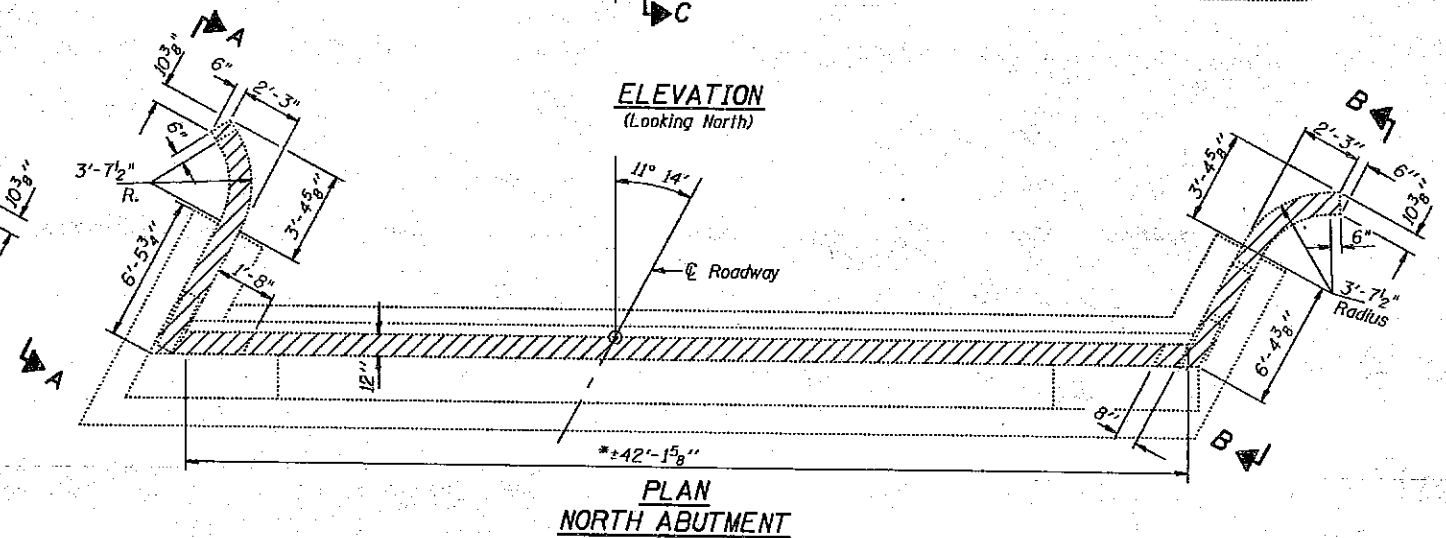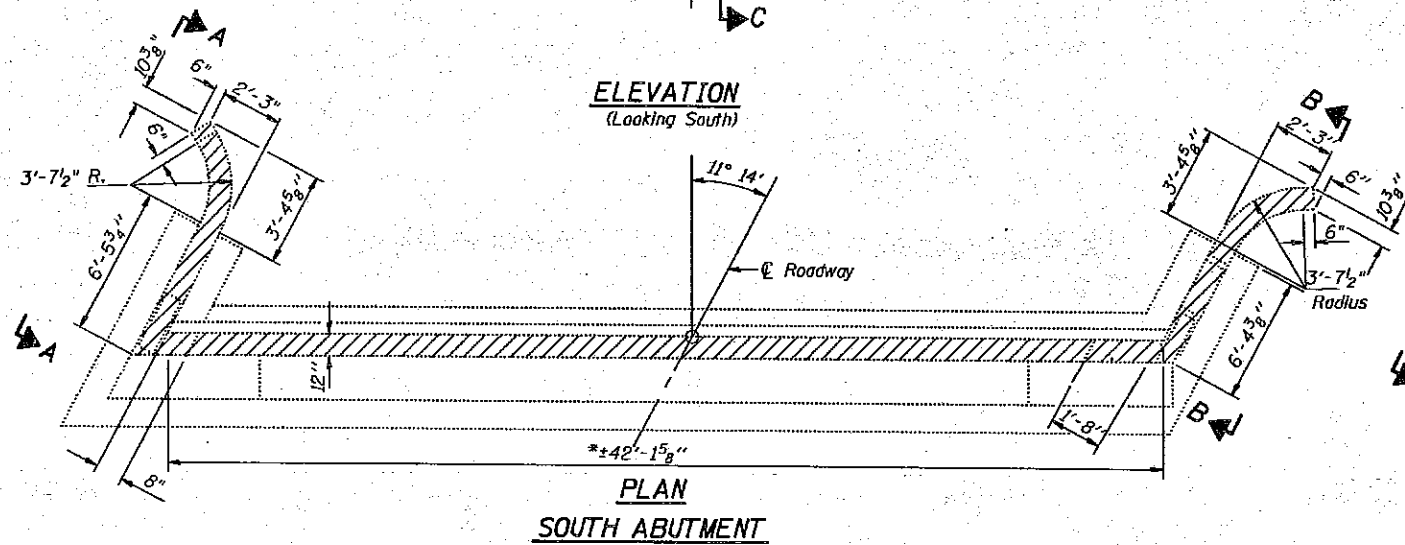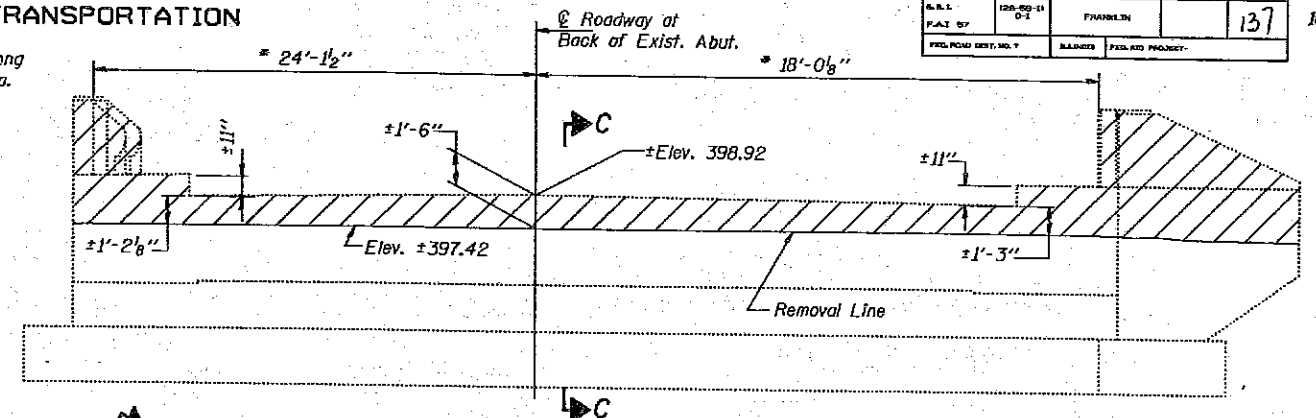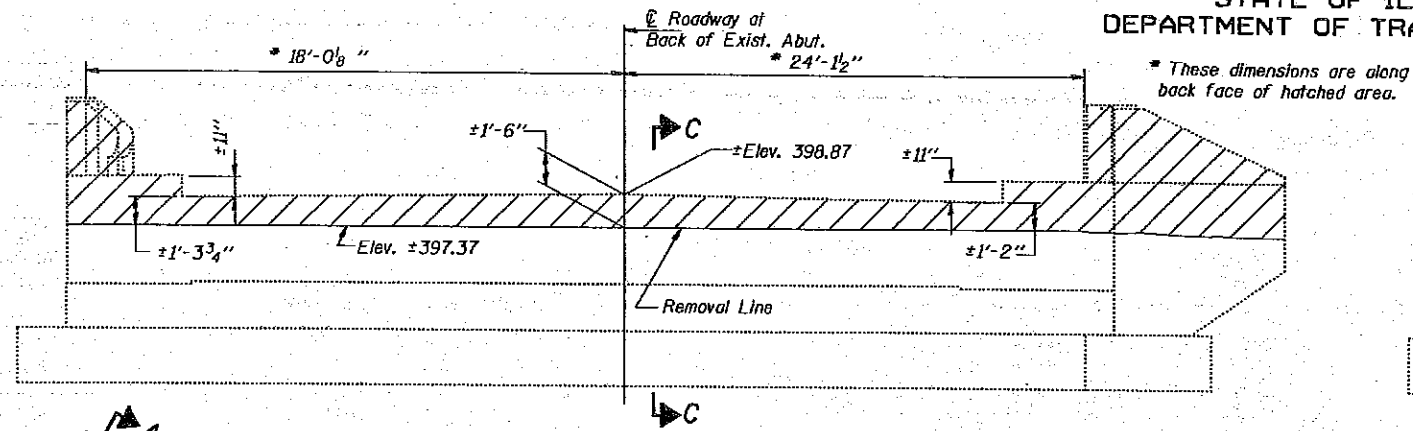

TWO ABUTMENTS  
BILL OF MATERIAL

Item	Unit	Total
Concrete Removal	Cu. Yd.	9

CONCRETE REMOVAL DETAILS  
FOR EXISTING ABUTMENTS  
F.A.I. RT. 57 SEC. (28-5B-1)D-1  
FRANKLIN COUNTY  
STATION 212+50.00

DESIGNED *Richard J. Chaput*  
CHECKED *Edward P. Nardiswahn*  
DRAWN *Paul W. Sweet*  
CHECKED *RJC DGV RTB*

EXAMINED *Ray J. Kaspar*  
PASSED *Ralph E. Anderson*  
APPROVED \_\_\_\_\_  
MAY 20 1993  
DIRECTOR OF HIGHWAYS

Notes: Hatched area indicates "Concrete Removal".  
For existing shoulder pavement removal see Roadway Plans.  
Existing vertical reinforcement shall be cleaned,  
straightened and incorporated into the new construction  
Cost incidental to "Concrete Removal".






STATE OF ILLINOIS  
DEPARTMENT OF TRANSPORTATION

ROUTE NO.	ACTION	COUNTY	SHEET	DATE
139	28-5B-11	FRANKLIN	139	1993
F.A.I. BY	DESIGNED BY	ENGINEER	FED. AID PROJECT NO.	

SHEET NO. 13  
16 SHEETS










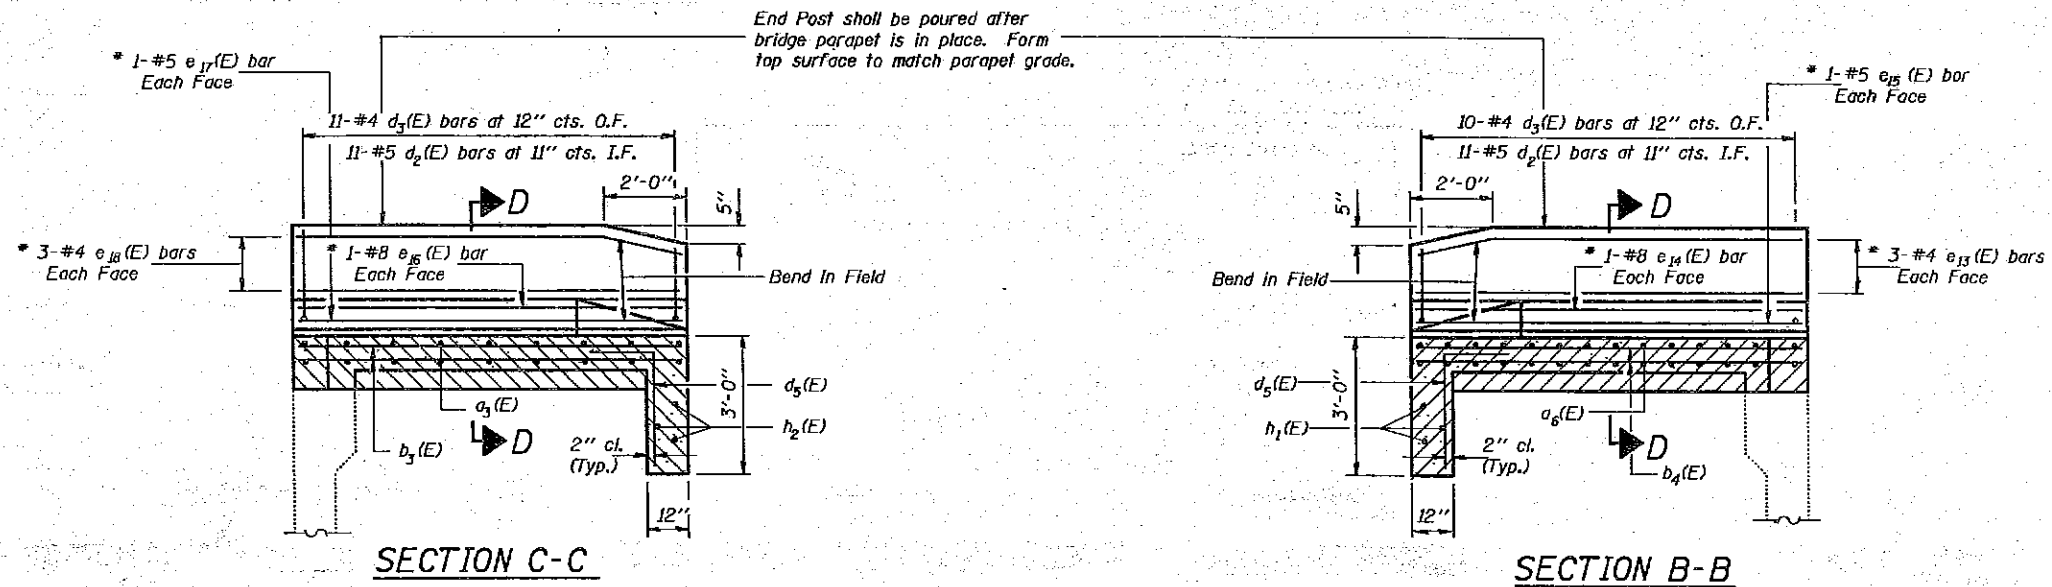


\* Order End Post  $e_3(E)$  thru  $e_{11}(E)$  bars full length, cut to fit skew in the field.

BILL OF MATERIAL

Bar	No.	Size	Length	Shape
$a_3(E)$	20	#5	6'-7"	
$a_5(E)$	20	#5	3'-0"	
$a_6(E)$	23	#5	12'-7"	
$b_3(E)$	7	#5	17'-9"	
$b_4(E)$	14	#5	21'-6"	
$d_1(E)$	16	#5	2'-7"	L
$d_2(E)$	22	#5	3'-0"	L
$d_3(E)$	21	#4	3'-0"	L
$d_4(E)$	6	#5	2'-11"	L
$d_5(E)$	21	#4	4'-1"	L
$d_6(E)$	21	#4	4'-0"	L
$e_{13}(E)$	6	#4	9'-9"	
$e_{14}(E)$	2	#8	9'-9"	
$e_{15}(E)$	2	#5	9'-9"	
$e_{16}(E)$	2	#8	9'-7"	
$e_{17}(E)$	2	#5	9'-7"	
$e_{18}(E)$	6	#4	9'-7"	
$h(E)$	4	#6	43'-6"	
$h_1(E)$	3	#5	12'-7"	
$h_2(E)$	3	#5	6'-7"	
$h_3(E)$	4	#5	6'-6"	L
$h_4(E)$	4	#5	6'-6"	L
Reinforcement Bars, Epoxy Coated			Lbs.	1,870
Structure Excavation			Cu. Yd.	11.0

Reinforcement bars designated (E) shall be epoxy coated.

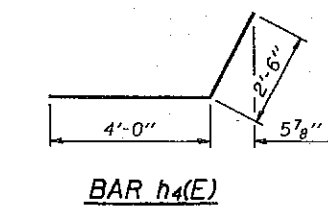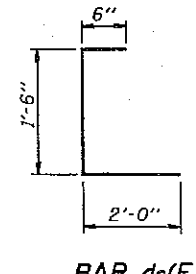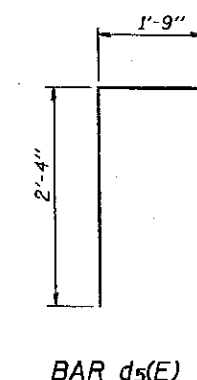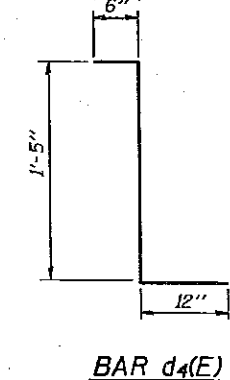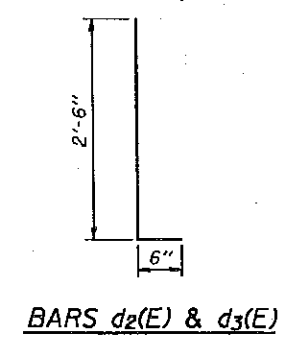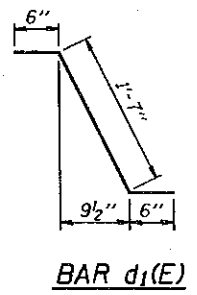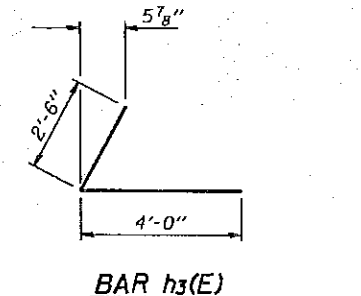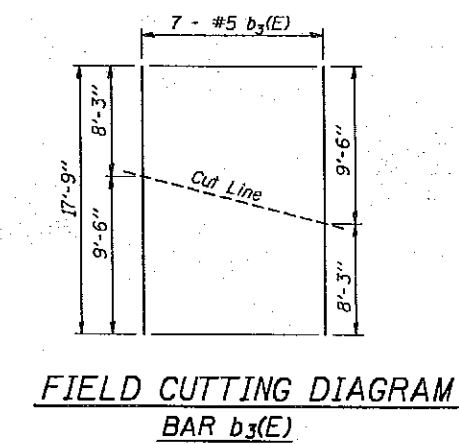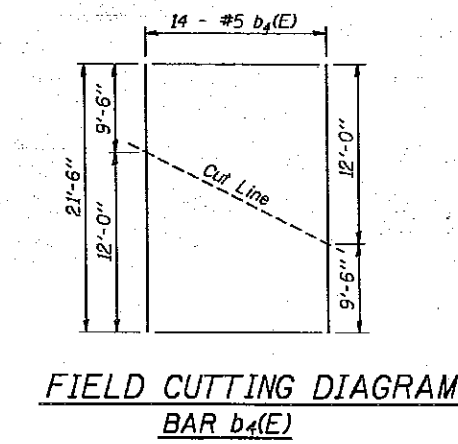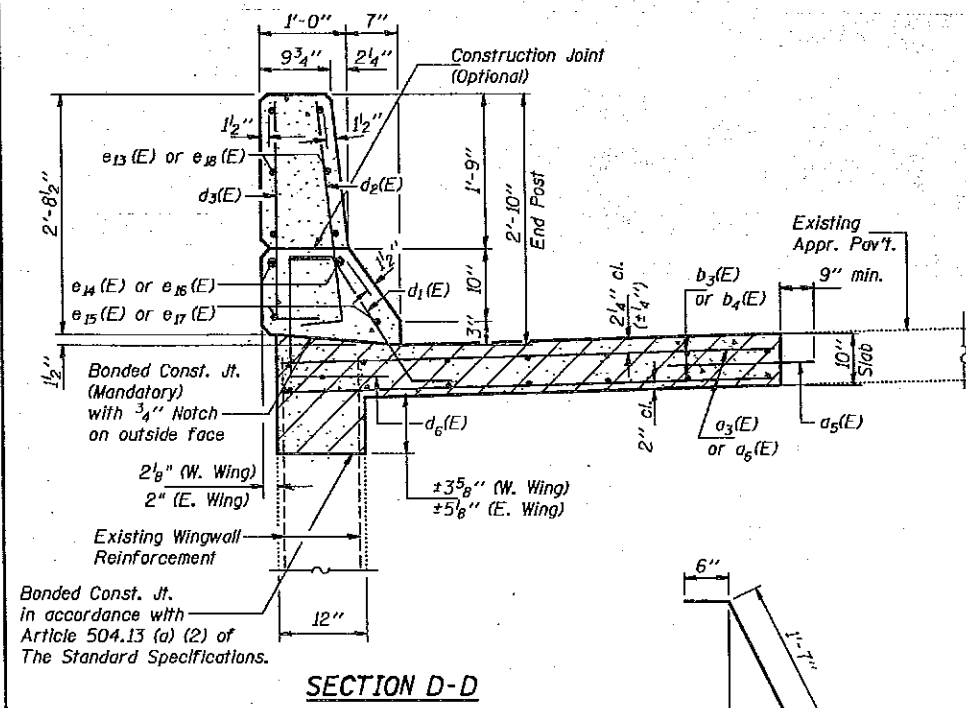

DESIGNED *Richard J. Chaput*  
 CHECKED *Thomas P. Nischholz*  
 DRAWN *Paul W. Sweet*  
 CHECKED *RSC DGV RYB*


EXAMINED *Greg J. Kaspar*  
 PASSED *Ralph E. Anderson*  
 APPROVED \_\_\_\_\_  
 DIRECTOR OF HIGHWAYS

May 20 1993

SOUTH ABUTMENT DETAILS  
 F.A.I. RT. 57 SEC. (28-5B-11)D-1  
 FRANKLIN COUNTY  
 STATION 212+50.00

STATE OF ILLINOIS  
DEPARTMENT OF TRANSPORTATION


DATE	SECTION	DESIGNER	CHECKER	SCALE	SHEET NO. 14
10-1-93	28-5B-1D-1	FRANKLIN		1/40	16 SHEETS
PROJECT NO. 212+50.00		ILLINOIS PROJECT NO.			

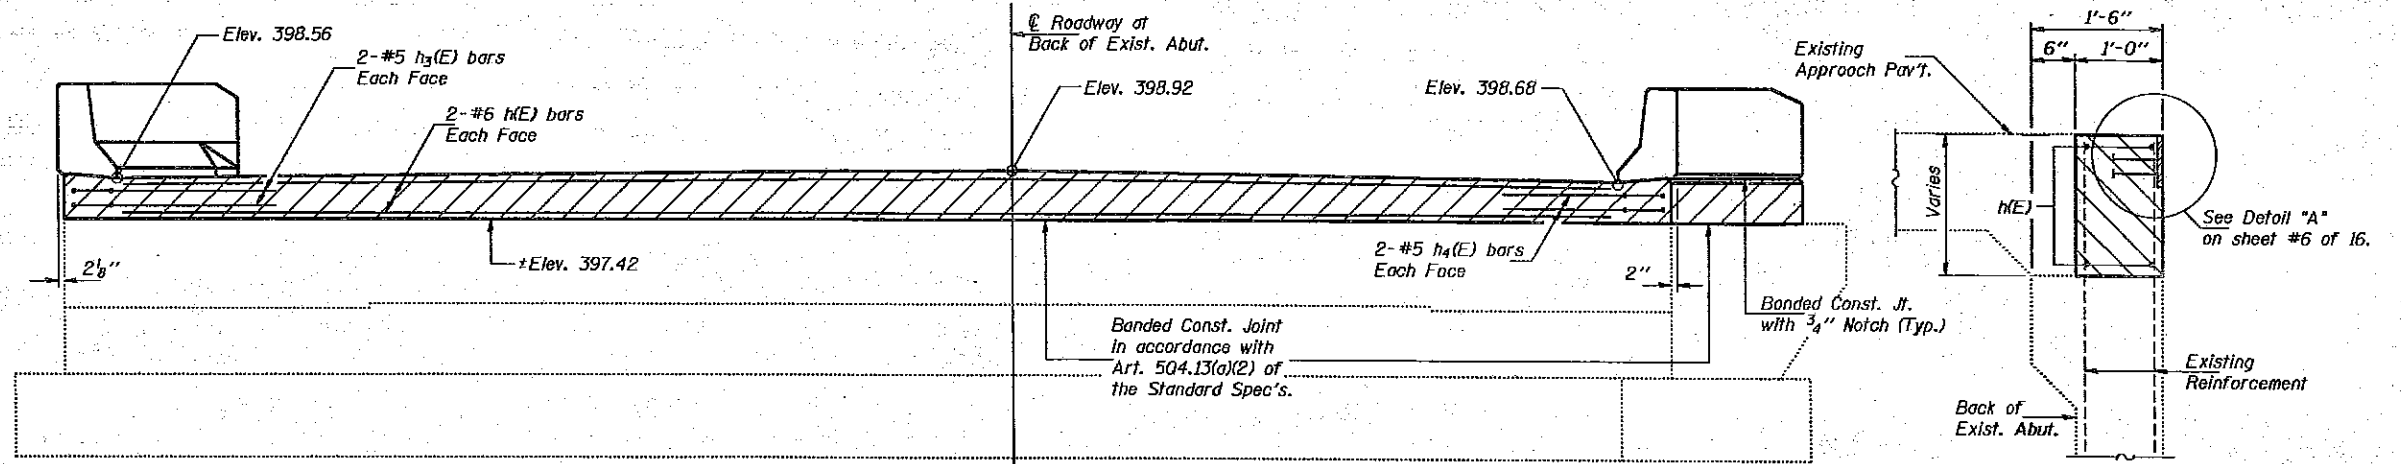

ELEVATION  
(Looking North)

SECTION A-A

- Order  $a_3(E)$  and  $a_6(E)$  bars full length. Cut to fit and use remainder of bars in bottom of slab.
- Drill  $1/8"$  x  $9"$  Min. hole in existing approach pavement epoxy grout  $a_3(E)$  bars. Use a grout approved by the Department or epoxy grout in accordance with BSP-11. The method of grout application shall be approved by the Engineer. See Special Provisions.

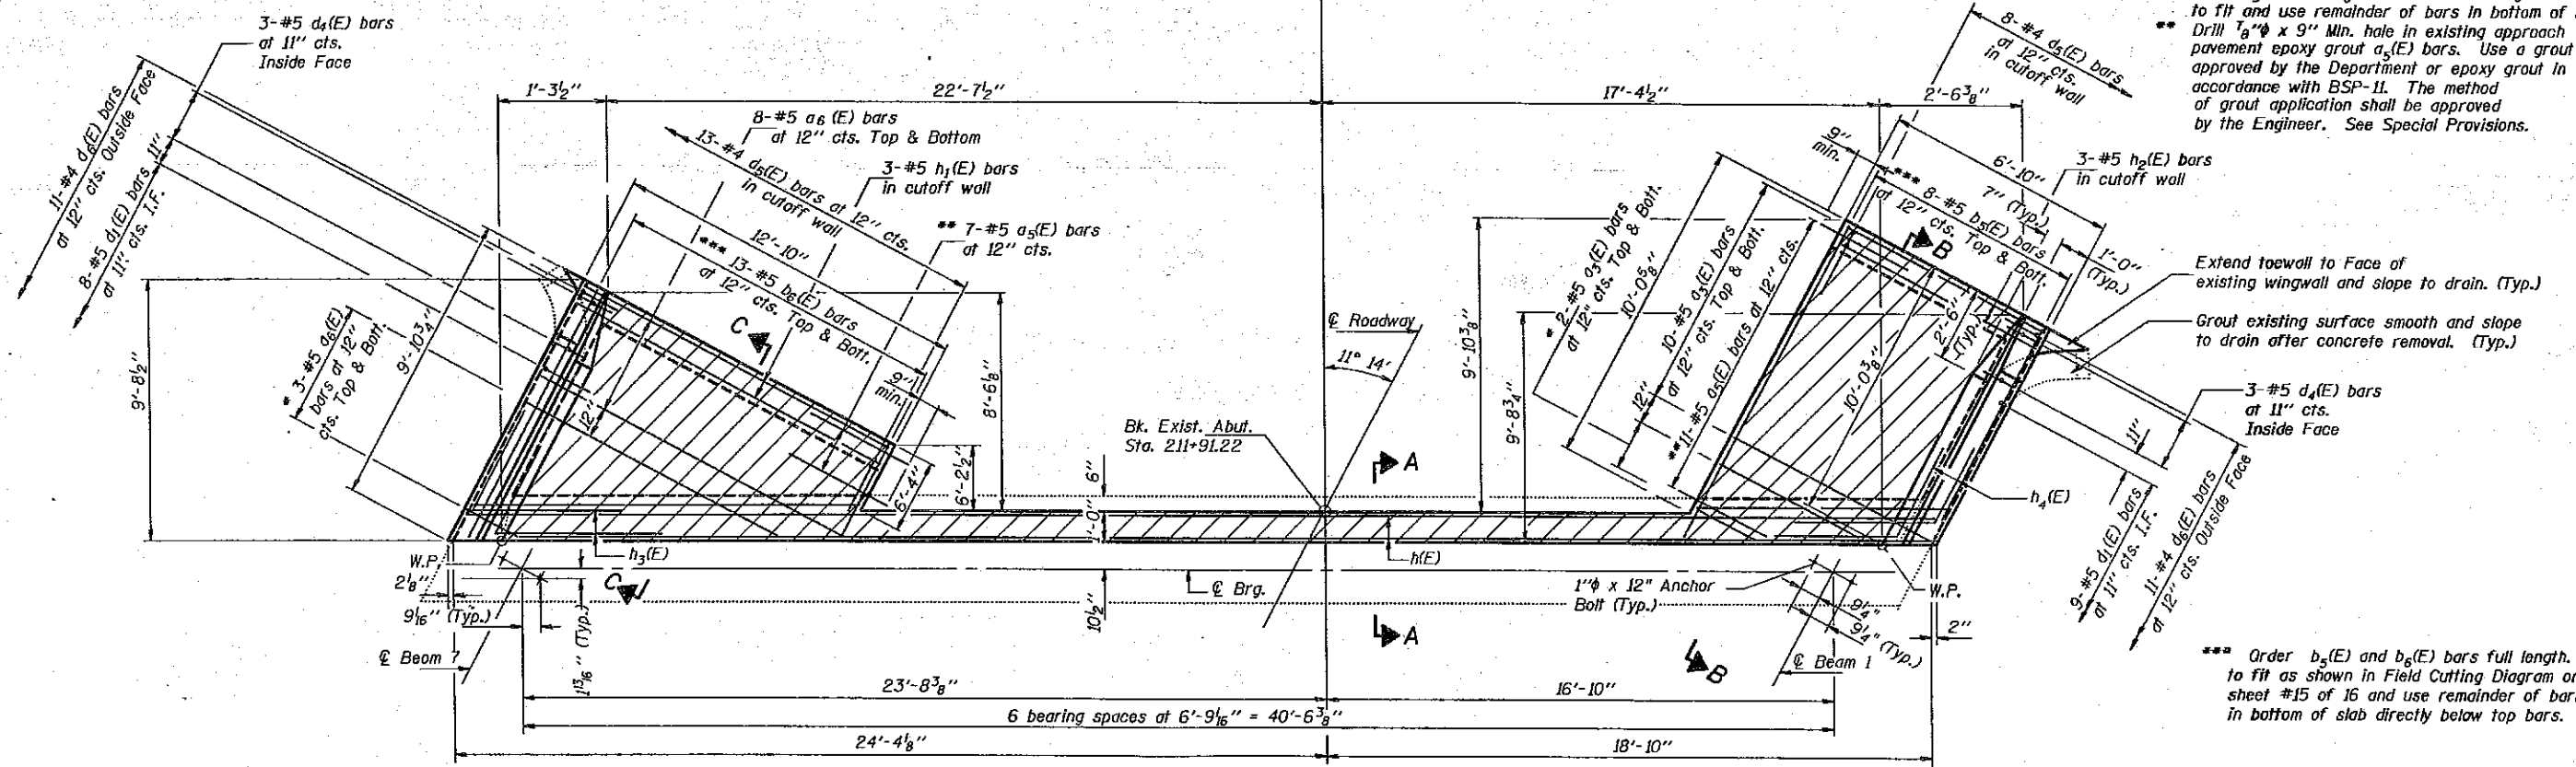

PLAN

- Notes:
- Hatched area to be poured after superstructure forms have been removed. Quantity of concrete included with "Class X Concrete Superstructure" on sheet #6 of 16.
  - Existing reinforcement extending into removed area shall be cleaned, straightened and incorporated into the new construction.
  - Reinforcement bars designated (E) shall be epoxy coated.
  - For anchor bolt installation details see sheet #16 of 16.
  - Concrete Quantity for End Posts is included in "Class X Concrete Superstructure". All edges shall have standard  $3/4"$  chamfer.

NORTH ABUTMENT  
F.A.I. RT. 57 SEC. (28-5B-1D-1)  
FRANKLIN COUNTY  
STATION 212+50.00

DESIGNED *Richard J. Chipt*  
CHECKED *Shirley P. Nishenko*  
DRAWN *Paul W. Sweet*  
CHECKED *RJC DGV RJB*

May 20 1993


EXAMINED *David J. Kasper*  
ENGINEER OF GEODIC DESIGN

PASSED *Ralph E. Anderson*  
ENGINEER OF BRIDGES AND STRUCTURES

APPROVED \_\_\_\_\_  
DIRECTOR OF HIGHWAYS


STATE OF ILLINOIS  
DEPARTMENT OF TRANSPORTATION

ROUTE NO.	SECTION	DRAWN	DATE	SHEET NO. 15
F.A.I.	28-5B-11	FRANKLIN		16 SHEETS
FILED BY				141
PRELIMINARY	BLANK	PRELIMINARY		

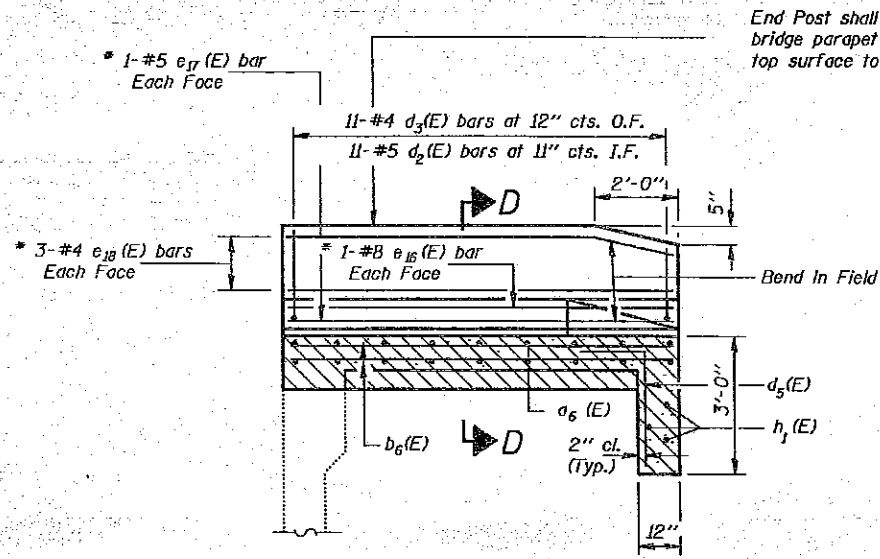


SECTION C-C

End Post shall be poured after bridge parapet is in place. Form top surface to match parapet grade.

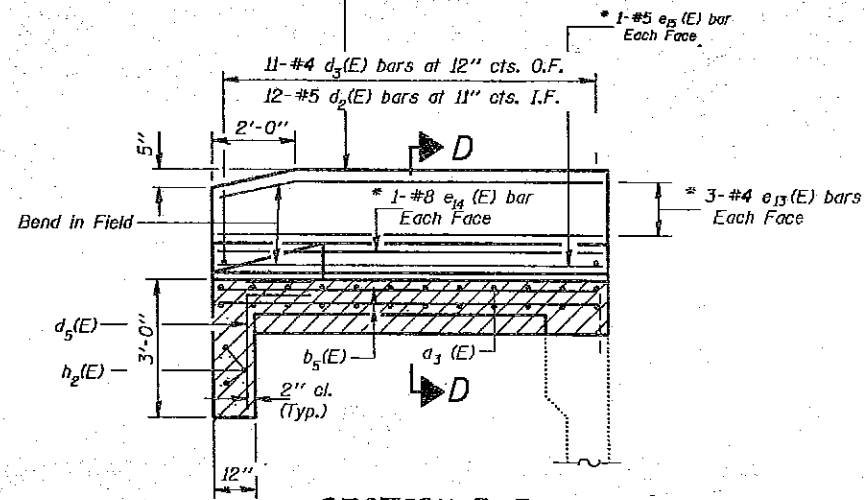


SECTION B-B


\* Order End Post e23 (E) thru e24 (E) bars full length, cut to fit skew in the field.

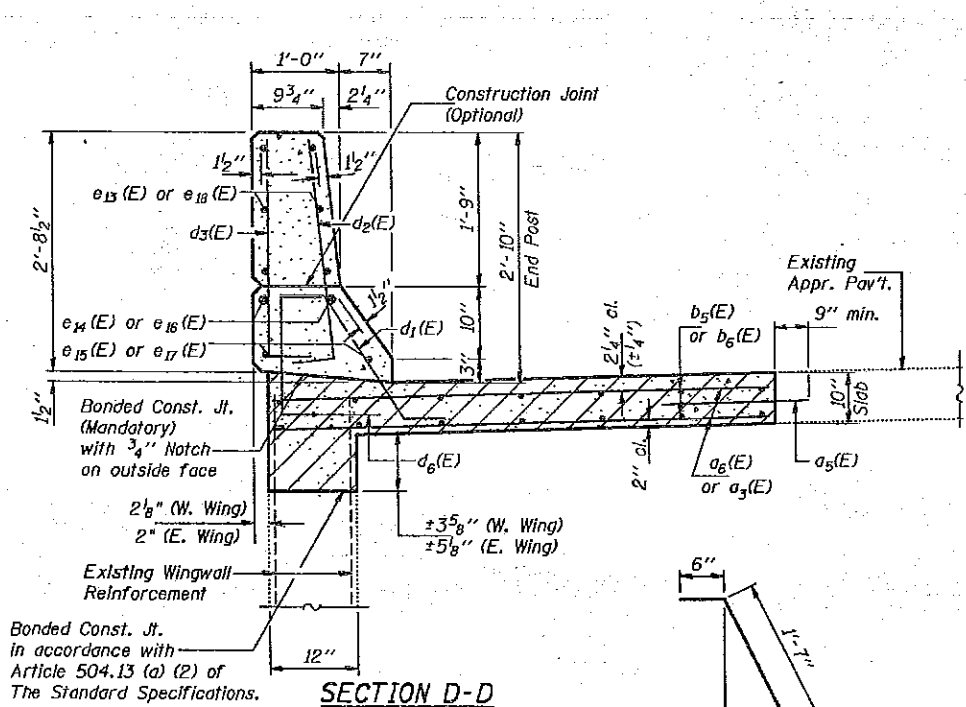


SECTION D-D

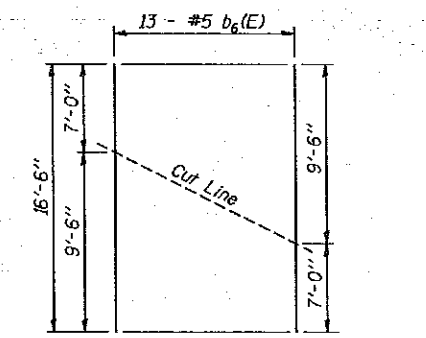


FIELD CUTTING DIAGRAM  
BAR b6 (E)

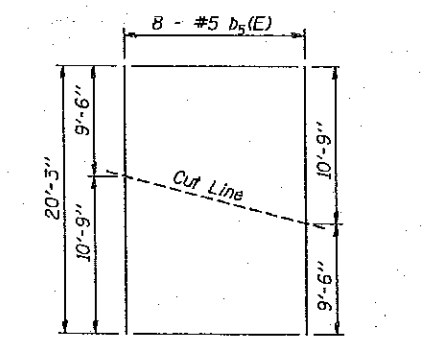


FIELD CUTTING DIAGRAM  
BAR b5 (E)

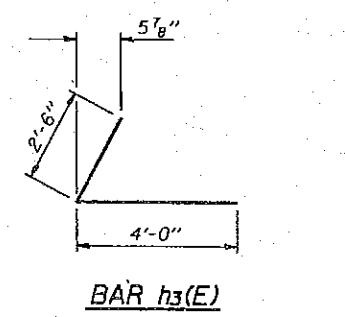


BAR h3 (E)

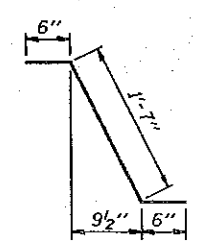


BAR d1 (E)

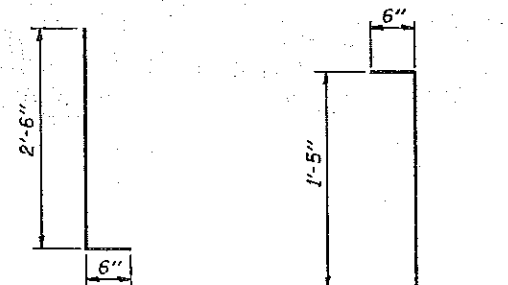


BARS d2 (E) & d3 (E)

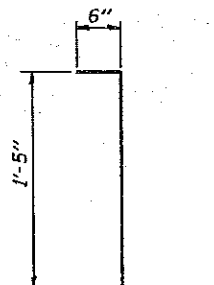


BAR d4 (E)

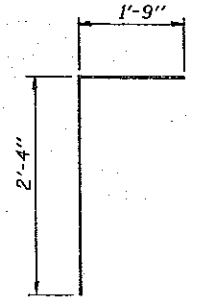

BAR d5 (E)

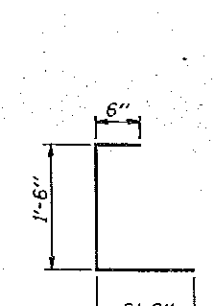

BAR d6 (E)

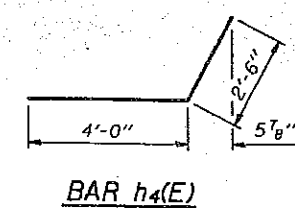

BAR h4 (E)

BILL OF MATERIAL

Bar	No.	Size	Length	Shape
a3 (E)	22	#5	6'-7"	—
a5 (E)	18	#5	3'-0"	—
a6 (E)	19	#5	12'-7"	—
b2 (E)	8	#5	20'-3"	—
b6 (E)	13	#5	16'-6"	—
d1 (E)	17	#5	2'-7"	L
d2 (E)	23	#5	3'-0"	L
d3 (E)	22	#4	3'-0"	L
d4 (E)	6	#5	2'-11"	L
d5 (E)	21	#4	4'-1"	L
d6 (E)	22	#4	4'-0"	L
e13 (E)	6	#4	9'-9"	—
e14 (E)	2	#8	9'-9"	—
e15 (E)	2	#5	9'-9"	—
e16 (E)	2	#8	9'-7"	—
e17 (E)	2	#5	9'-7"	—
e18 (E)	6	#4	9'-7"	—
h1 (E)	4	#6	43'-6"	—
h2 (E)	3	#5	12'-7"	—
h3 (E)	3	#5	6'-7"	—
h4 (E)	4	#5	6'-6"	L
h4 (E)	4	#5	6'-6"	L
Reinforcement Bars, Epoxy Coated			Lbs.	1,740
Structure Excavation			Cu. Yd.	11.0

Reinforcement bars designated (E) shall be epoxy coated.

NORTH ABUTMENT DETAILS  
F.A.I. RT. 57 SEC. (28-5B-11D-1)  
FRANKLIN COUNTY  
STATION 212+50.00

DESIGNED <i>Richard J. Christ</i>	EXAMINED <i>Greg J. Kasper</i>
CHECKED <i>Paul W. Sweet</i>	PASSED <i>Ralph E. Carlson</i>
DRAWN <i>Paul W. Sweet</i>	APPROVED
CHECKED <i>RJC DGV RJB</i>	




STATE OF ILLINOIS  
DEPARTMENT OF TRANSPORTATION

ROUTE NO.	SECTION	COUNTY	SHEETS	PART	SHEET NO. 16
F.A.I. 57	28-5B-11	FRANKLIN	142		16 SHEETS
FED. ROAD DIST. NO. 7	BLANK	FED. AID PROJECT			

The Illinois Coil-Lock Anchor Bolt is a proprietary item which is the property of the Illinois Department of Transportation. Use, reproduction or disclosure without express written permission is prohibited and protected under Federal copyright laws. The production and the fabrication of this bolt for use on highway projects in the State of Illinois shall be permitted and there shall be no incurred charges or fees to the manufacturer or the fabricator for producing or fabricating this bolt.

D	E	H	K	"d"
1"	1 1/8"	1 3/16"	1 3/4"	1/4"
1 1/4"	1 3/8"	1 1/16"	2"	3/8"
1 1/2"	1 5/8"	1 5/16"	2 1/8"	1/2"
2"	2 1/8"	1 13/16"	2 7/8"	1/2"
2 1/2"	2 5/8"	2 5/16"	3 3/8"	1"

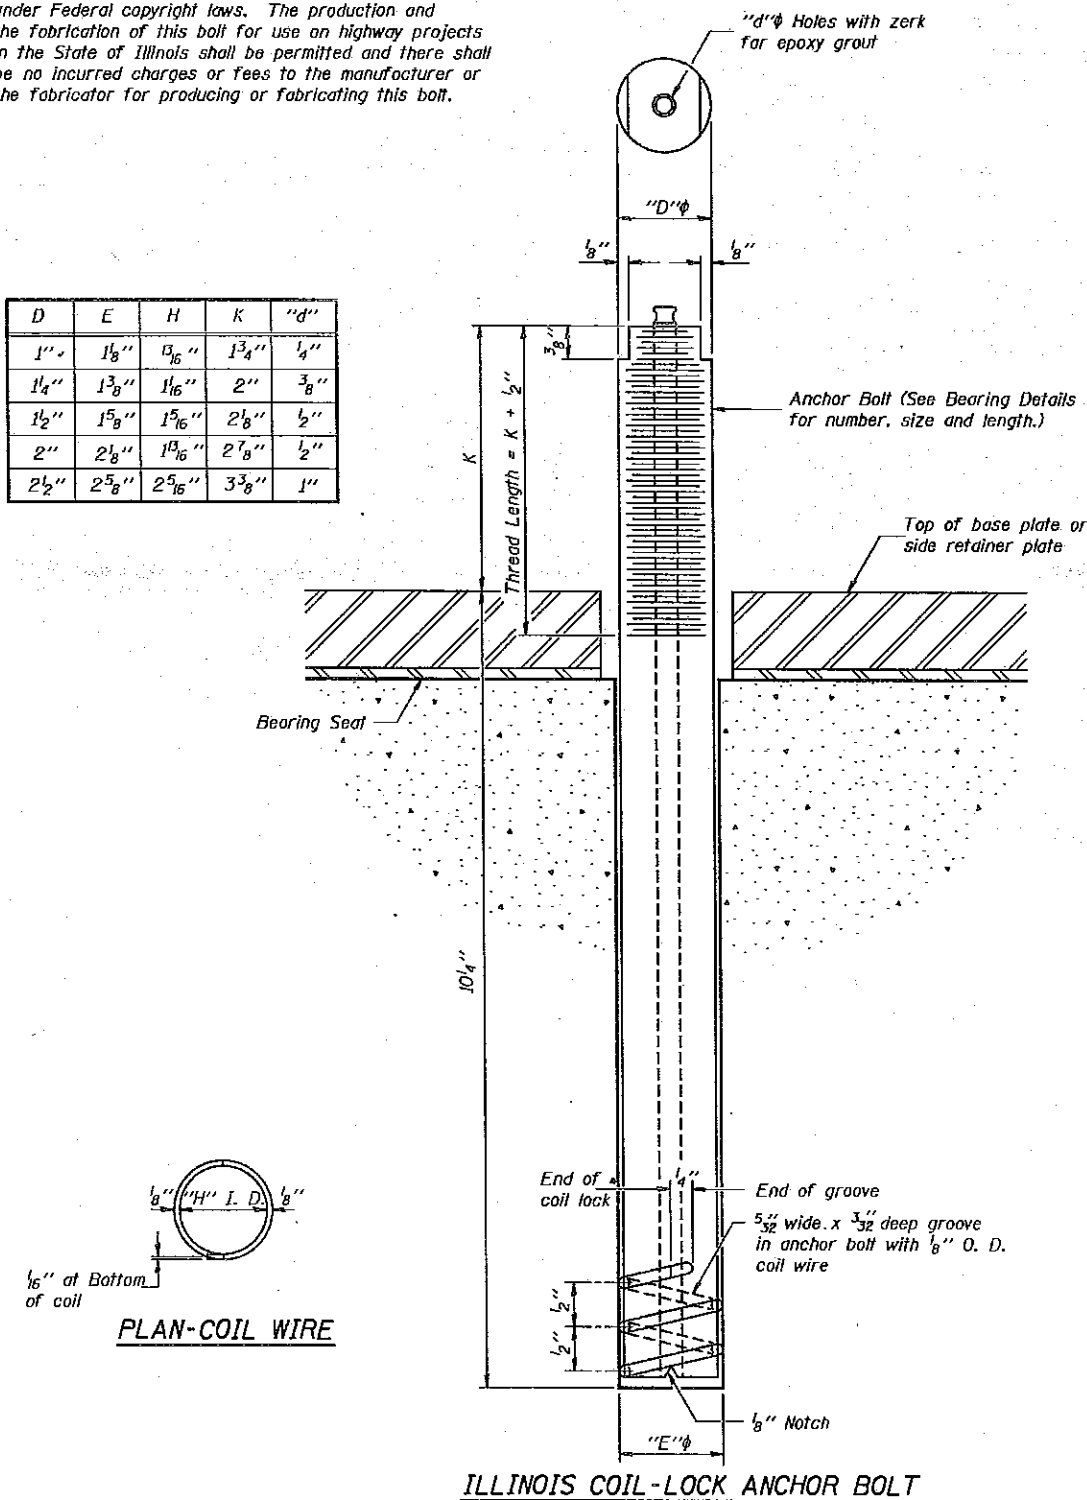

**MATERIALS FOR ILLINOIS COIL-LOCK ANCHOR BOLT**

The anchor bolt shall be fabricated from cold drawn or hot finished seamless carbon steel mechanical tubing conforming to ASTM A519, Grade 1026 and supplied with hexagonal nuts and cut washers.  
The coil wire shall be made of any suitable soft steel wire.  
The finished anchor bolt shall be cleaned of rust and other foreign materials and wrapped or packaged to prevent contamination until they are installed.  
The epoxy grout shall be a two-component, epoxy resin bonding system conforming to ASTM C881, Type I, Grade 1 and of a Class suitable for the temperature of installation.

**INSTALLATION PROCEDURE for the ILLINOIS COIL-LOCK ANCHOR BOLT**

1. With the coil wire in place, the bolt shall be inserted into the hole and turned clockwise to a snug fit in the hole. Nut and washer shall be placed on the bolt. The nut shall be tensioned until the steel base plates are held securely to the concrete bearing seat.
2. Epoxy grout shall be pumped through the zerk fitting with a pressure gun. Pumping shall continue until the epoxy overflows the hole around the bolt shank. After pumping is discontinued, excess epoxy shall be immediately wiped off.

**ALTERNATE ANCHOR BOLTS**

The Contractor may use, at his option, the capsule or the adhesive cartridge type anchor rods that have been previously tested and given a prior approval by the Department. The Contractor shall install these anchor rods in pre-drilled holes in accordance with the manufacturer's recommendations and procedures.  
The capsule or the adhesive cartridge type anchor rods shall be a two part system composed of:  
1. A threaded rod stud with nut and washer conforming to ASTM A307.  
2. A sealed glass capsule or a sealed glass adhesive cartridge containing premeasured amounts of the adhesive chemical.

**GENERAL NOTES**

Holes in the masonry for anchor bolts shall be drilled through the base plates to the diameter and depth shown or in accordance with the manufacturer's recommendation after beams or girders have been erected and adjusted.  
Prior to setting the bolts, the holes shall be dry and all dust and loose particles shall be removed by the use of compressed air or vacuuming.  
The anchor bolts, furnished and installed and including the epoxy grout or capsules shall not be paid for separately but shall be included in the unit bid price for "Furnishing and Erecting Structural Steel".

**ANCHOR BOLT DETAILS  
FOR BEARINGS  
F.A.I. RT. 57 SEC. (28-5B-11D-1  
FRANKLIN COUNTY  
STATION 212+50.00**

DESIGNED <i>Richard A. Chaput</i>	EXAMINED <i>Greg J. Kaspar</i> ENGINEER OF BRIDGE DESIGN
CHECKED <i>Chas. P. Naisel</i>	PASSED <i>Ralph E. Anderson</i> ENGINEER OF BRIDGES AND STRUCTURES
DRAWN <i>Paul W. Sweet</i>	APPROVED _____ DIRECTOR OF HIGHWAYS
CHECKED <i>RJC DGV RJB</i>	


ABB-1 12-1-83

May 20 1993

# DETAILS OF MEDIAN CROSSOVERS

(USE SOUTH BOUND CROSSOVERS FOR THIS CONTRACT)

P. A. L. NO.	SECTION	COUNTY	TOTAL SHEETS	SHEET NO.
57	*	FRANKLIN	145	143
STA.		TO STA.		
FILE NO. OR DET. NO.		SCALE	FILE NO. PROJECT	
* 28(5B)-1,5B,2B,1B(D)-1;28(5VB,3VB)-1(I)-1				

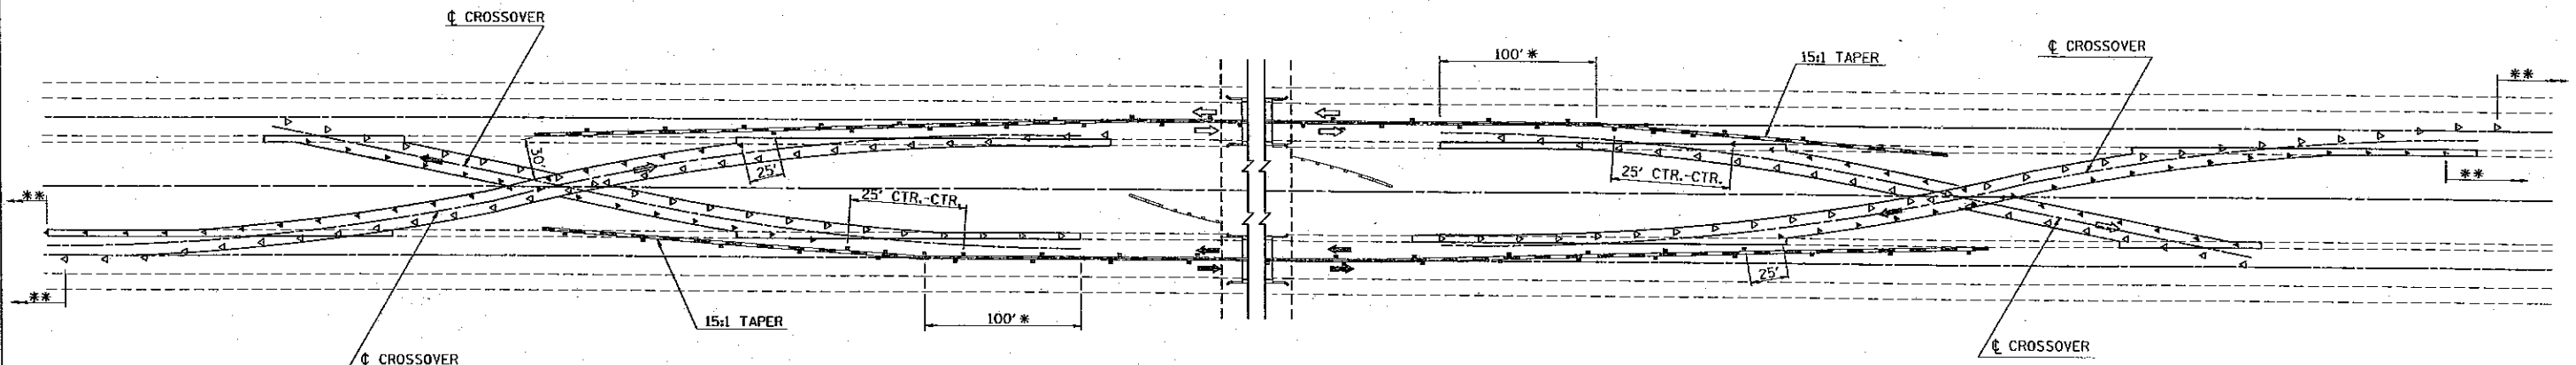

PLAN VIEW

\* THE CONCRETE BARRIER SHALL CONTINUE ALONG THE CENTERLINE OF THE MAINLINE PAVEMENT FOR 100' BEYOND THE END OF THE CROSSOVER BEFORE BEGINNING THE TAPER UNLESS OTHERWISE NOTED IN THE PLANS.

\*\* CONTINUE TEMPORARY RAISED PAVEMENT MARKERS THRU LIMITS OF TEMPORARY PAVEMENT MARKING TAPE SHOWN ON STANDARD 2417.

NOTE: WHEN NOT IN USE MEDIAN CROSSOVERS SHALL BE CLOSED TO TRAFFIC BY PLACING TYPE III BARRICADES AT EACH END OF THE CROSSOVER.

**LEGEND**


- TEMPORARY CONCRETE BARRIER
- ◁ ONE-WAY CRYSTAL TEMPORARY RAISED REFLECTIVE PAVEMENT MARKERS AT 25' CENTER TO CENTER
- ◄ ONE-WAY AMBER TEMPORARY RAISED REFLECTIVE PAVEMENT MARKERS AT 25' CENTER TO CENTER
- AMBER MONODIRECTIONAL PRISMATIC BARRIER REFLECTORS. TO BE SPACED 50' CENTER TO CENTER EXCEPT WHERE OTHERWISE SHOWN ON DETAIL.

**GENERAL NOTES**

THIS DETAIL SHALL BE USED IN CONJUNCTION WITH STANDARD 2417.

THE PRISMATIC BARRIER REFLECTORS SHALL BE MOUNTED HALF-WAY UP THE NEARLY VERTICAL FACE OF THE TEMPORARY CONCRETE BARRIER, OR 1'-10 1/2" FROM THE PAVEMENT TO THE CENTER OF THE REFLECTOR.

THE COST TO PROVIDE, INSTALL, AND MAINTAIN TEMPORARY RAISED REFLECTIVE PAVEMENT MARKERS AND PRISMATIC BARRIER REFLECTORS SHALL BE INCLUDED IN THE CONTRACT UNIT PRICE EACH FOR TRAFFIC CONTROL AND PROTECTION, STANDARD 2417.

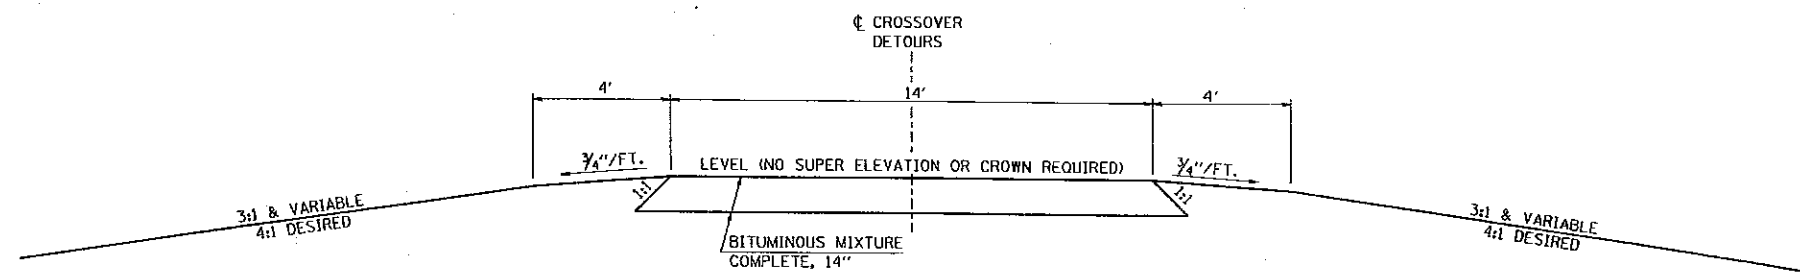


TYPICAL SECTION MEDIAN CROSSOVER DETOURS

VIEW \* CROSS SOUTH  
201 Feb 19 09:00:20 1993  
C:\p2\reflect\p2\93035826.dgn L:\p2\113-03

# SEEDING & MULCHING

P. A. & DIST.	SECTION	COUNTY	TOTAL SHEETS	SHEET NO.
57	*	FRANKLIN	145	144
STA. TO STA.				
FED. ROAD DIST. NO.		PROJECT	FED. AID PROJECT	

\* 2815B-1,5B,2B,1B1D-1;2815VB,3VB-111-1

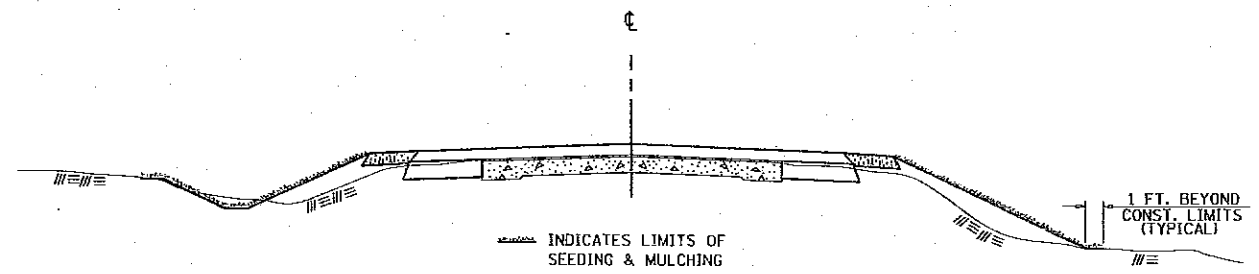

## GENERAL NOTES

IN GENERAL, ALL EARTH SURFACES DISTURBED DURING CONSTRUCTION OPERATIONS SHALL BE SEEDED AND MULCHED UPON COMPLETION OF ALL GRADING OPERATIONS.

FERTILIZER NUTRIENTS AND LIMESTONE SHALL BE APPLIED TO ALL SEEDED AREAS.

THE RATES OF APPLICATION OF FERTILIZER, MULCH AND LIMESTONE SHALL BE AS SPECIFIED IN THE SPECIAL PROVISIONS.


SECTIONS 642 AND 643 OF THE STANDARD SPECIFICATIONS SHALL GOVERN THIS WORK EXCEPT AS SPECIFIED HEREIN OR AS NOTED IN THE SPECIAL PROVISIONS.

REVISIONS	
REDRAWN	2-15-89


STD. 9-12






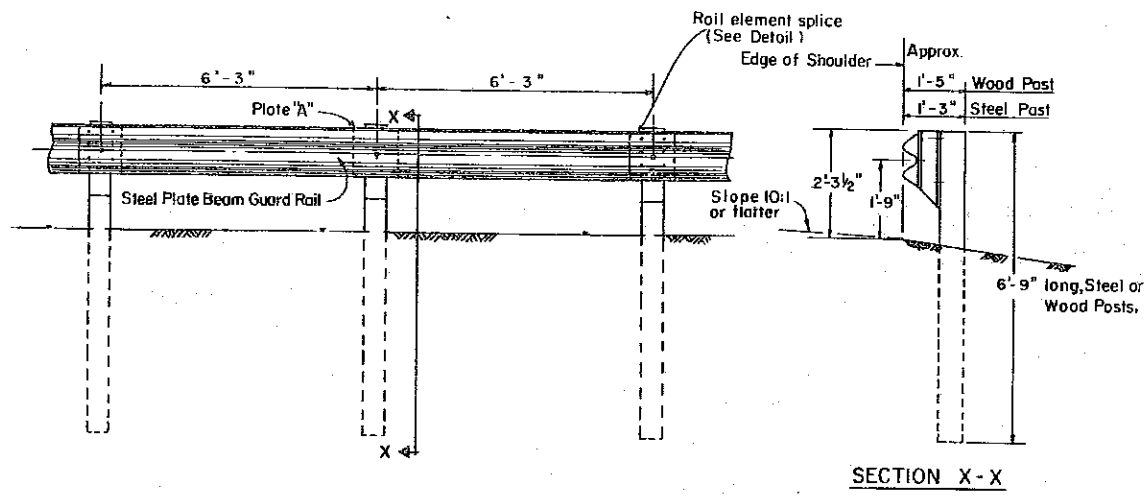


**TYPE A**  
(6'-3" Typical Post Spacing)

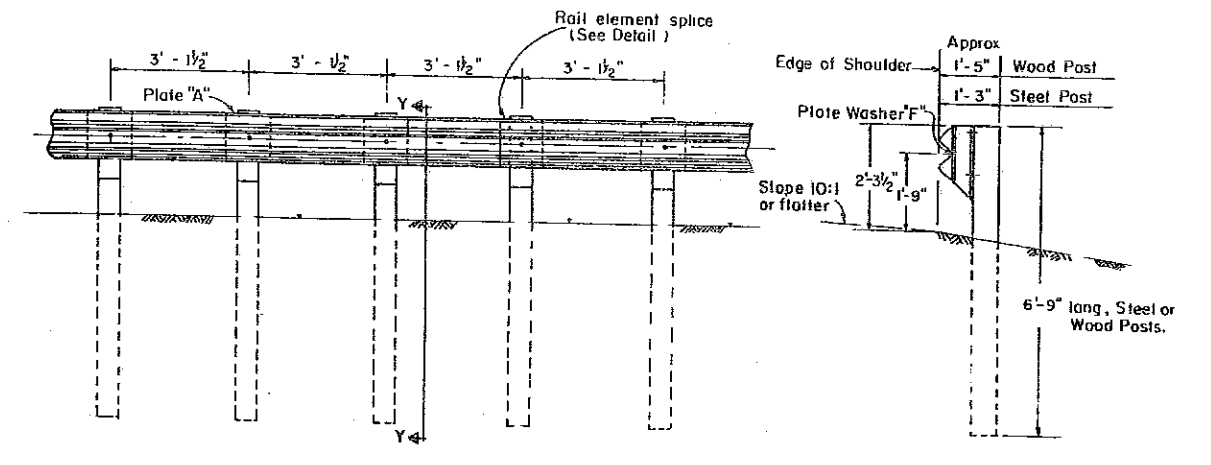

**TYPE B**  
(3'-1/2" Closed Post Spacing)

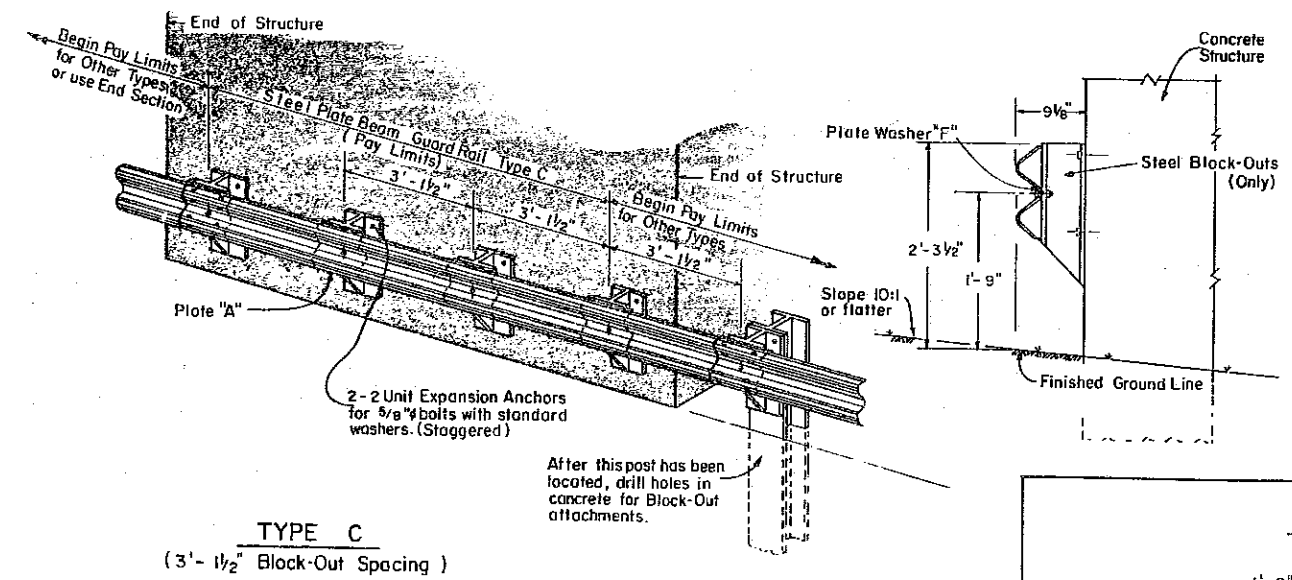


**TYPE C**  
(3'-1/2" Block-Out Spacing)

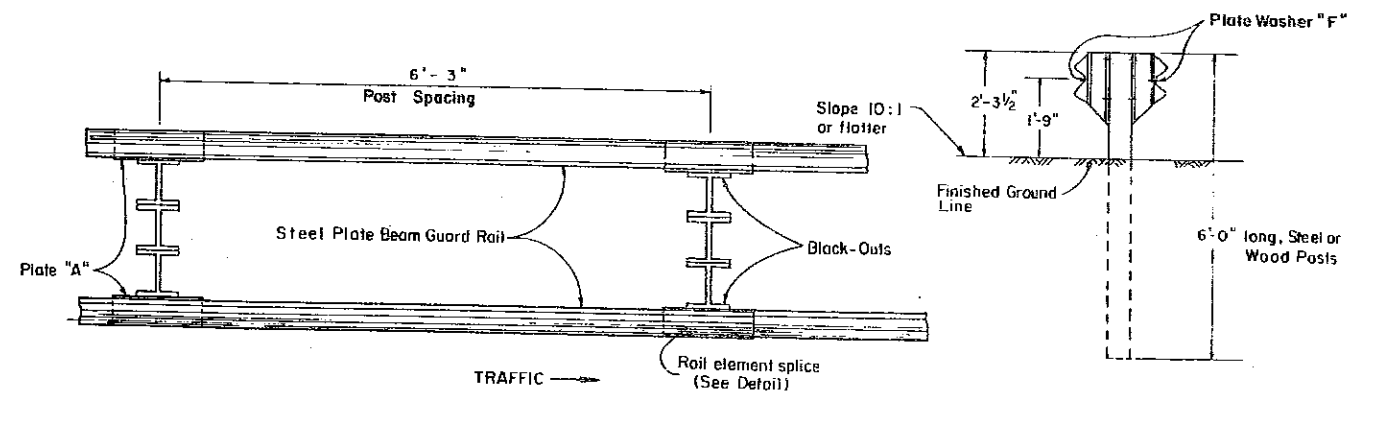

**TYPE D**  
(Double Steel Plate Beam Guard Rail, with 6'-3" Typical Post Spacing)

**NOTE:** Rail element lap in direction of traffic of the adjacent lane for all types

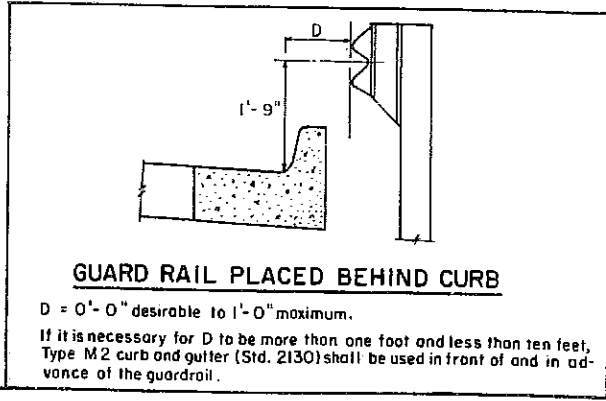


Illinois Department of Transportation  
 PASSED April 9, 1990  
 John E. ...  
 Engineer of Policy and Procedures  
 APPROVED April 9, 1990  
 ...  
 Engineer of Design  
 ISSUED 2-11-86

**STEEL PLATE BEAM GUARD RAIL**  
**TYPES A, B, C & D**  
 Sheet 1 of 2 Sheets  
**STANDARD 2230-16**


F-301N

**TYPICAL APPLICATIONS OF TYPE III BARRICADES CLOSING A ROAD**

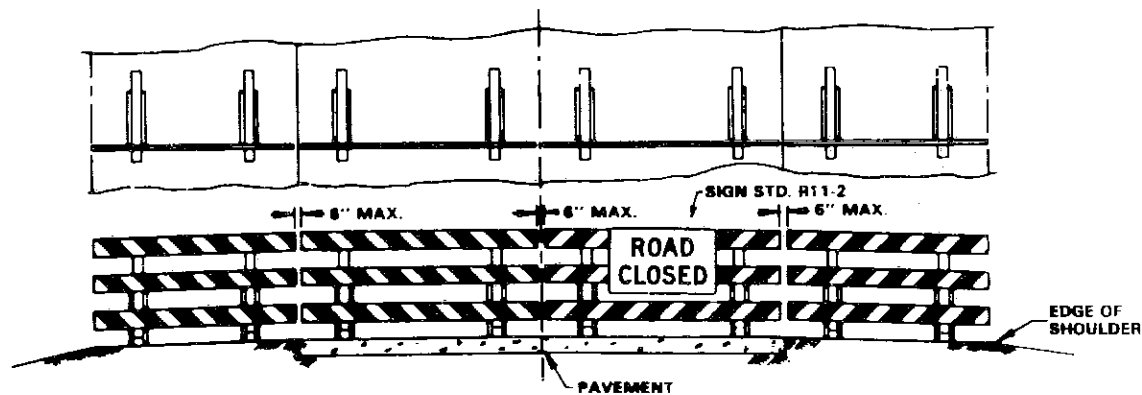

ROAD CLOSED TO ALL TRAFFIC


Reflectorized striping may be omitted on the back side of the barricades. The barricades shall be to the edge of the shoulders except when otherwise directed by the Engineer or shown on the detailed construction plans.

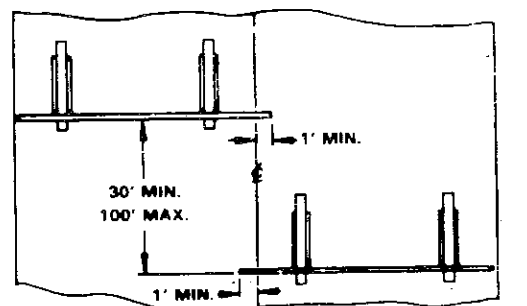

ROAD CLOSED TO ALL THRU TRAFFIC


Reflectorized striping shall appear on both sides of barricades. The barricades shall be to the edge of the pavement, except when otherwise directed by the Engineer or shown on the detailed construction plans.

**ARROW BOARDS**

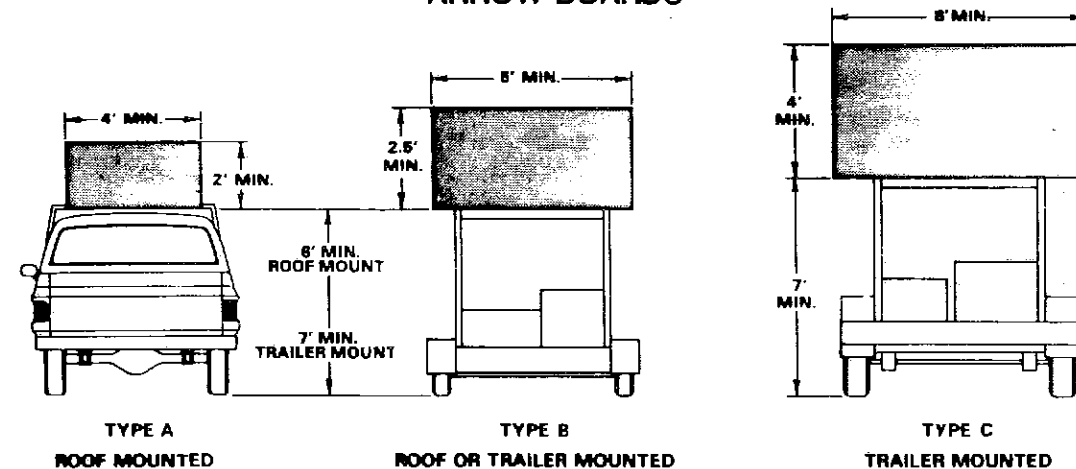


Arrow boards shall conform to Article 718.22 of the Standard Specifications. On roads with speeds of 45 miles per hour and above, Type C units are to be used for all operations 24 hours or more in duration and Type B units may be used for operations less than 24 hours in duration. Type A, B or C units may be used for all operations on roads with speeds less than 45 miles per hour. Arrow boards shall not be used to direct passing moves into lanes used by opposing traffic.

**WORK LIMIT SIGNING**

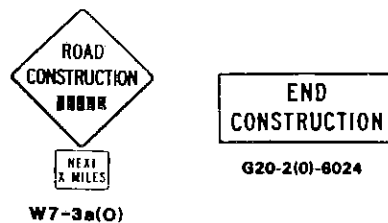

The NEXT X MILES supplemental plate shall be installed below the first warning sign in the series of all projects over two miles in length. The END CONSTRUCTION sign shall also be erected near the end of these projects, unless another project is within 2 miles beyond the end of the job.

**TYPICAL SIGN INSTALLATIONS**

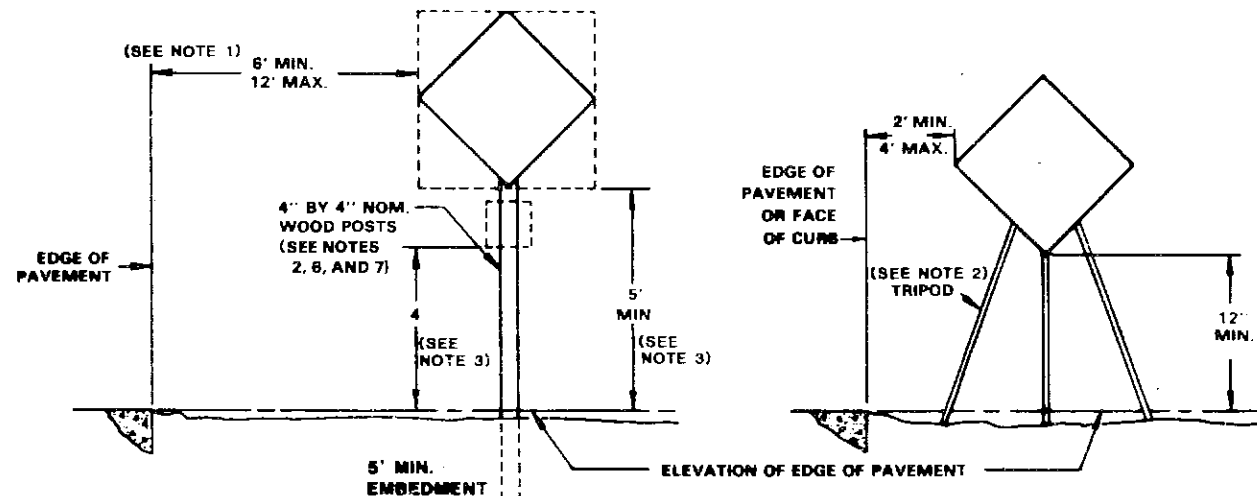

- 2 ft. minimum to face of curb.
- Alternate designs and or materials may be permitted when authorized by the Engineer. All materials shall be substantial and durable.
- Add 2 ft. if parking exists within 200 ft. in advance of the sign location or if pedestrian movement is likely to occur at any time during the project.
- Signs on temporary supports shall be within 20° of a vertical position.
- Weights of concrete, stone, or brick will not be allowed and all weights used to stabilize signs other than sand-bags must be rigidly attached to the sign support as close to the ground as possible.
- Two posts shall be used for signs greater than 16 sq. ft. in area or where the height between the sign and the ground exceeds 7 ft. Bracing no heavier than 2" x 4" wood may be used for added support. Any brace placed parallel to the road shall be sloped down toward approaching traffic.
- If approved by the Engineer, skids may be used to support signs where posts are impractical. If used, they shall not exceed the structural design of Type III barricades and shall be no greater than 4 ft. in length.

**TYPICAL APPLICATION OF TRAFFIC CONTROL DEVICES  
HIGHWAY CONSTRUCTION AND CONTRACT MAINTENANCE**

SHEET 1 OF 2  
**STANDARD 2298-9**

Illinois Department of Transportation



Approved: 2/14/92

*W. Jones*  
Engineer of Traffic


08/17/92



**TYPE I BARRICADES**

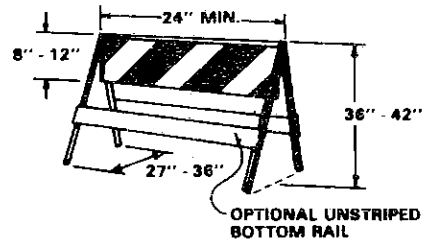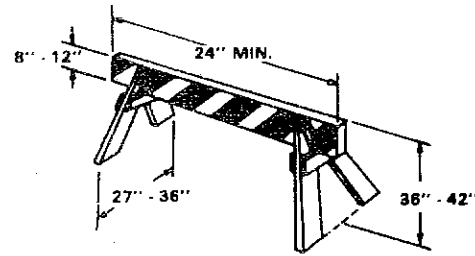



**TYPE II BARRICADES**

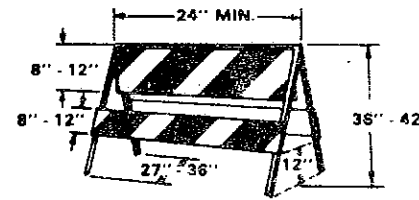


**GENERAL NOTES**

1. Type I Barricades are intended for use on lower speed roads and shall not be used where normal speeds are greater than 40 MPH unless the reflective area of the upper rail is at least 288 square inches.
2. Type I and Type II Barricades shall not be intermixed within an individual string of barricades.
3. Type III Barricades are intended for road and lane closures and shall not be used for channelization or delineation.
4. All heights shown shall be measured above the pavement surface.
5. Unless otherwise noted, the reflective sheeting used for barricades, drums, and vertical panels shall meet the requirements of Article 718.17 and 718.18 of the Standard Specifications for Road and Bridge Construction.
6. All barricades and vertical panels shall have alternating reflectorized white and reflectorized orange stripes sloping downward at 45° toward the side on which traffic will pass. Barricade stripes shall be 8 inches in width on barricades 36 inches or greater in length and 4 inches in width on barricades less than 36 inches in length. Type I and Type II Barricades shall be striped on both sides. Type III Barricades shall be striped on both sides where traffic approaches from either direction. Vertical panels placed on the outside of curves shall be striped on both sides. The predominant color for other barricade components shall be white or silver, except that unpainted galvanized metal or aluminum components may be used.
7. Drums shall be non-metallic and have alternating reflectorized orange and reflectorized white horizontal, circumferential stripes 4 inches to 8 inches in width. There shall be at least two orange and at least two white stripes on each drum. If nonreflective spaces are left between the orange and white stripes, they shall be no more than 2 inches in width. All nonreflective portions of the drums shall be orange or white. Drums may be slightly conical in shape and may have one or more flat surfaces to minimize rolling when hit.
8. Frames for Type I and Type II Barricades shall be designed so as to provide a stable support and should be constructed of light weight steel or aluminum angles or tubing, wood, plastic, or rubber and have no rigid stay bracing for "A" frame designs. As Type III Barricades are only used at closures, they may be constructed of heavier materials than Type I or Type II Barricades. However, they should not have any vertical or sloping supports heavier than 4-inch by 4-inch lumber, 2-inch by 2-inch by 1/8-inch steel tubing, or 2-inch by 2-inch by 3/16-inch steel angles.
9. Barricade rails shall be no heavier than 1-inch thick lumber or plywood except for the "sawhorse" design Type I Barricade which may have a rail no heavier than 2-inch thick lumber. Other light weight weather resistant materials such as plastic, fiberglass or sheet aluminum may be used. Barricade rails may be sloping or vertical. Nominal lumber dimensions may be used to satisfy wooden barricade component dimensions.
10. The name and phone number only of an agency, contractor, or supplier may be shown on the nonreflective surface of the face part of a barricade. Such identification shall be in one color and nonreflective with letters not to exceed 1-inch in height.
11. When used, warning lights on barricades, drums, or vertical panels shall be mounted above the top of the device to the side on which traffic will pass and shall not obscure any reflectorized portion of the device.
12. Weights of concrete, stone, or brick will not be allowed and all weights used to stabilize barricades other than sandbags must be rigidly attached to the legs of the barricades as close to the ground as possible. No sandbags will be allowed on the top rail of barricades. Sandbags may be placed on barricade legs, over striped bottom rails not facing traffic, over unstriped bottom rails, or suspended from the barricade rail or frame in such a manner so that the bulk of the sand is at least 18 inches below the top of the barricade. Drums may be weighted internally with just enough sand, water, or other material to provide stability.
13. Cones shall be constructed of durable material able to withstand abuse by vehicular traffic. Minimum weights shall be 4 pounds for 18 inch, 7 pounds for 28 inch, and 10 pounds for 36 inch cones with a minimum of 60 percent of the total weight in the base. On fully access-controlled facilities, cones shall be a minimum of 28 inches in height. Reflectorized cones shall only be used as specified on the plans or as approved by the Engineer. When used, reflectorized cones shall be a minimum 28 inches in height and shall have two reflective bands: one a minimum of six inches wide placed three inches from the top of the cone and the other a minimum of four inches placed two inches below the six inch band.
14. Vertical panels may be either post mounted, frame supported or attached to the top of a barrier. Post mounted vertical panels shall be firmly attached to light weight wood or metal posts with the top a minimum height of 48 inches above the pavement surface. Frame supported vertical panels shall conform to General Notes 8, 9, 10 and 12 of this Standard and shall only be used where normal speeds are 40 MPH or less, with the top a minimum height of 36 inches above the pavement surface.

**TYPE III BARRICADES**

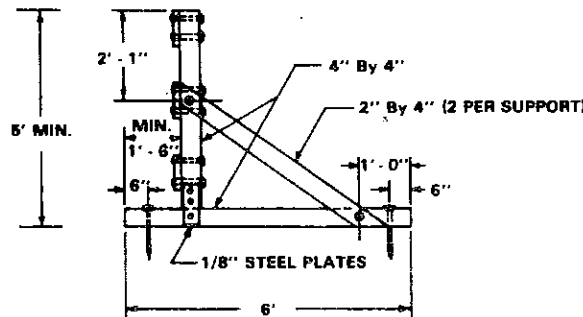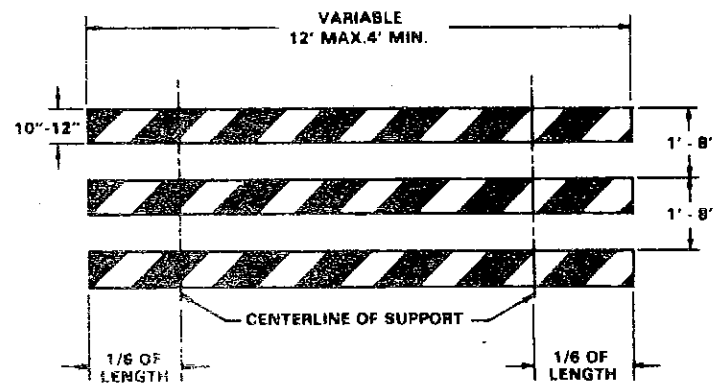


TYPICAL WOOD SUPPORT

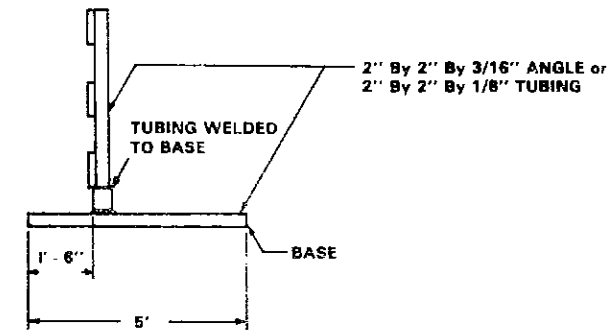


TYPICAL STEEL SUPPORT


**HIGH LEVEL WARNING DEVICE**

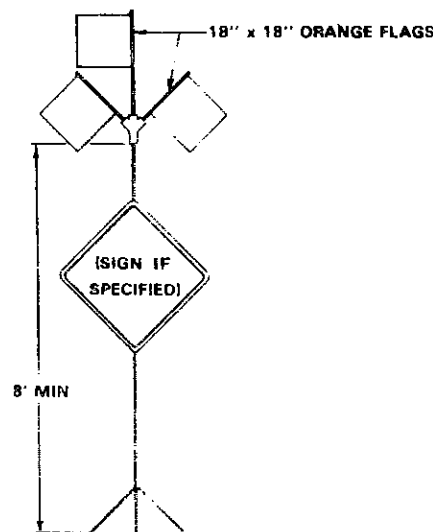


**DRUMS**

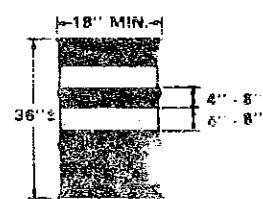

**CONES**

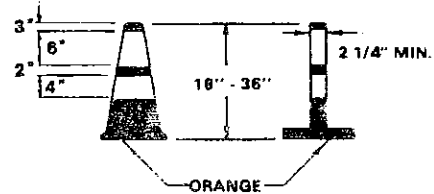


**VERTICAL PANELS**

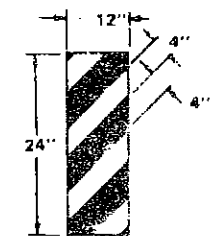


SEE NOTE 14 FOR SUPPORT OR MOUNTING REQUIREMENTS

Illinois Department of Transportation  
 Approved: 2/4/82  
 [Signature]  
 Engineer of Traffic


DESIGN OF TRAFFIC CONTROL DEVICES FOR  
 HIGHWAY CONSTRUCTION AND CONTRACT MAINTENANCE  
**STANDARD 2299-13**

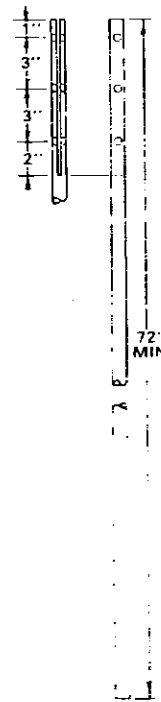

STAFF

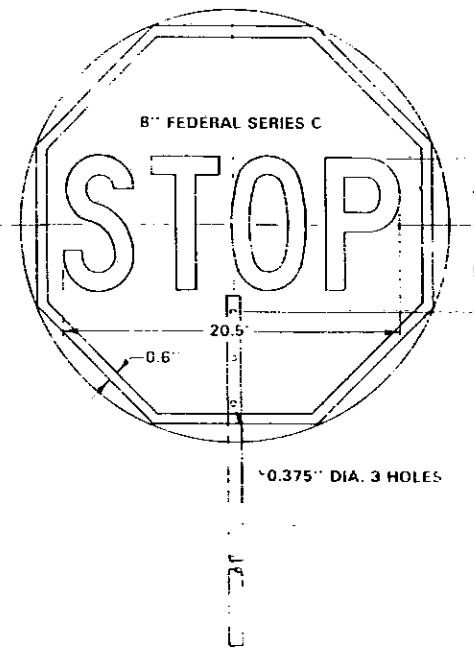

FRONT SIDE

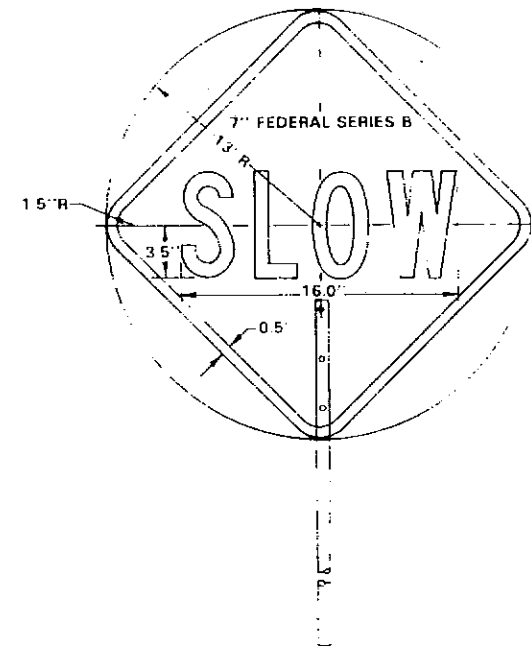


REVERSE SIDE


GENERAL NOTES

1. The "STOP" face shall consist of white letters and border on a red reflectorized background.
2. The "SLOW" face shall consist of black letters and border on an orange reflectorized background.
3. Areas outside sign borders shall be light blue or black.
4. The sign blank may be octagonal in shape in lieu of circular.
5. The portion of the staff within the sign face shall match the sign colors.
6. All colors and letters shall meet applicable federal standard.
7. The staff shall consist of two sections joined by a coupling located 60 in. from the bottom of the staff. Alternate designs may be used when approved by the Engineer. All materials shall be substantial and durable.
8. This sign shall be furnished by the contractor and shall be used by the flagger in lieu of flags or other signaling devices. The cost of furnishing and maintaining the sign shall be considered incidental to the contract and no additional compensation will be allowed.


A. FOR ANY OPERATION THAT ENEROACHES IN THE AREA BETWEEN THE CENTER LINE AND A LINE 2 FT. OUTSIDE THE EDGE OF THE PAVEMENT FOR A PERIOD OF LESS THAN 15 MINUTES.

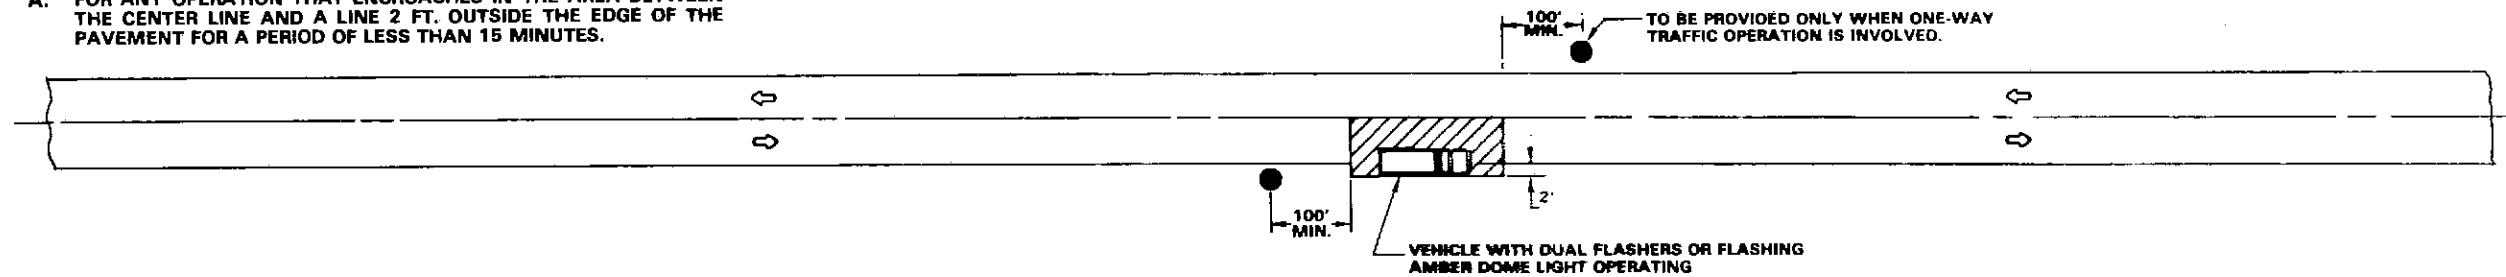

B. FOR ANY OPERATION THAT ENEROACHES IN THE AREA BETWEEN THE CENTER LINE AND A LINE 2 FT. OUTSIDE THE EDGE OF THE PAVEMENT FOR A PERIOD IN EXCESS OF 15 MINUTES BUT LESS THAN 60 MINUTES.

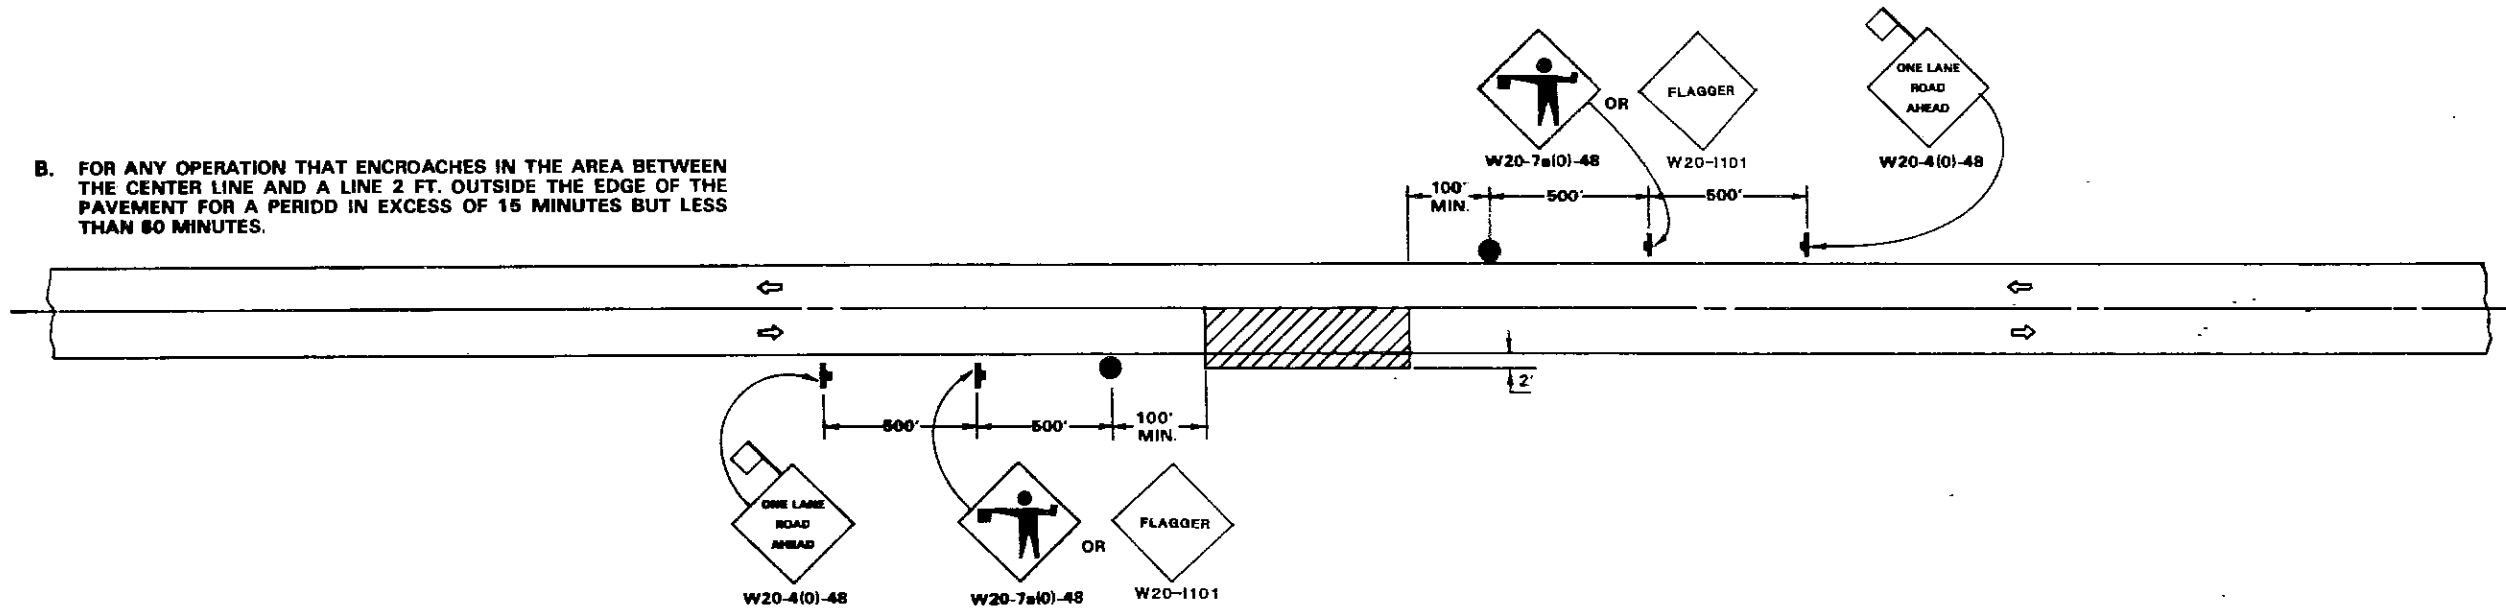

C. FOR ANY OPERATION THAT IS MORE THAN 2 FT. OUTSIDE THE EDGE OF THE PAVEMENT FOR A PERIOD OF LESS THAN 60 MINUTES.

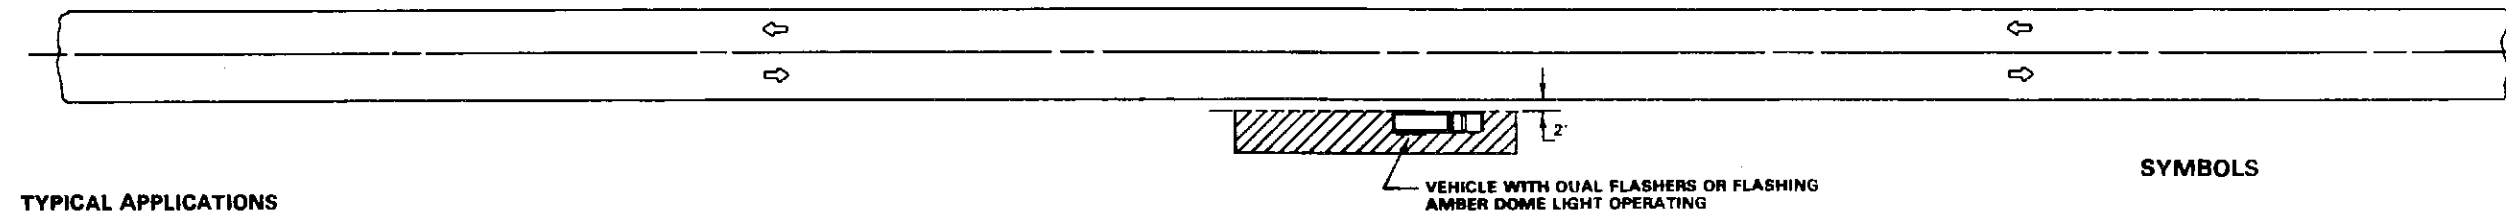

**TYPICAL APPLICATIONS**

- Marking Patches
- Field Survey
- String Line
- Utility Operation
- Cleaning Up Debris on Pavement

**GENERAL NOTES**

1. Construction operations shall be confined to one traffic lane. On two-lane roads, at least 500 ft. of both traffic lanes shall be available for traffic movement at intervals not greater than 1,000 ft. and a complete traffic control plan must be approved for any project expected to exceed 1,000 ft. in length.
2. The flaggers shall be in sight of each other or in direct communication at all times.
3. All signs are to be removed at completion of each operation.
4. For multilane roadways the flagger shown for traffic approaching from the opposite direction will be positioned as directed by the Engineer, the advance warning signs for traffic approaching from the opposite direction omitted, and the ONE LANE ROAD AHEAD sign changed to RIGHT (LEFT) LANE CLOSED AHEAD.
5. Longitudinal dimensions may be adjusted to fit field conditions. The lateral placement of the flaggers may be varied from that shown.

**SYMBOLS**

- Work Area
- 18 in. X 18 in. (minimum) Orange Flag
- Sign on Portable or Permanent Support
- Flagger with Traffic Control Sign

Illinois Department of Transportation

Approved: 8/4/82

*R.W. Jones*  
Engineer of Traffic

ISSUED PERMITS

**TYPICAL APPLICATION OF TRAFFIC CONTROL DEVICES  
HIGHWAY CONSTRUCTION AND CONTRACT MAINTENANCE**


SHORT-TIME OPERATIONS  
DAY OR NIGHT OPERATIONS

**STANDARD 2307-7**


T  
I  
C  
I  
N  
G



DETAIL A

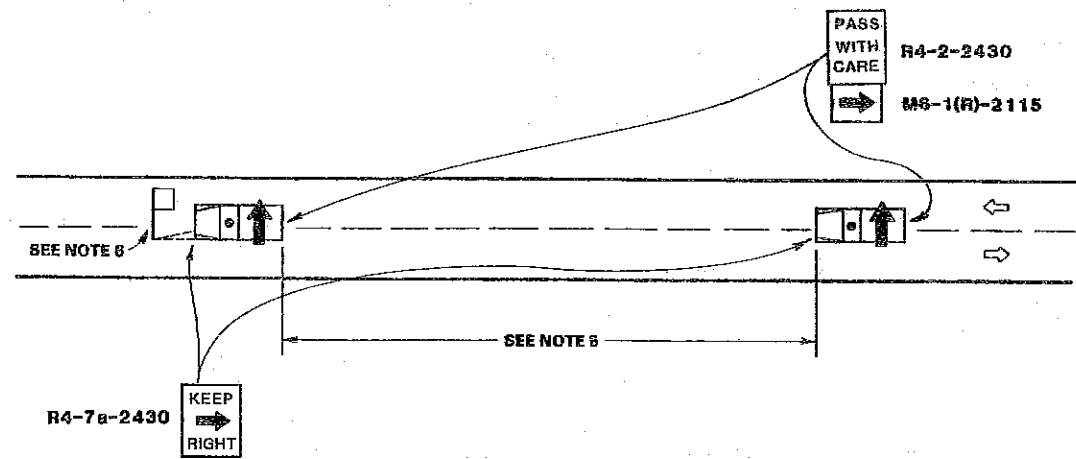

DETAIL B

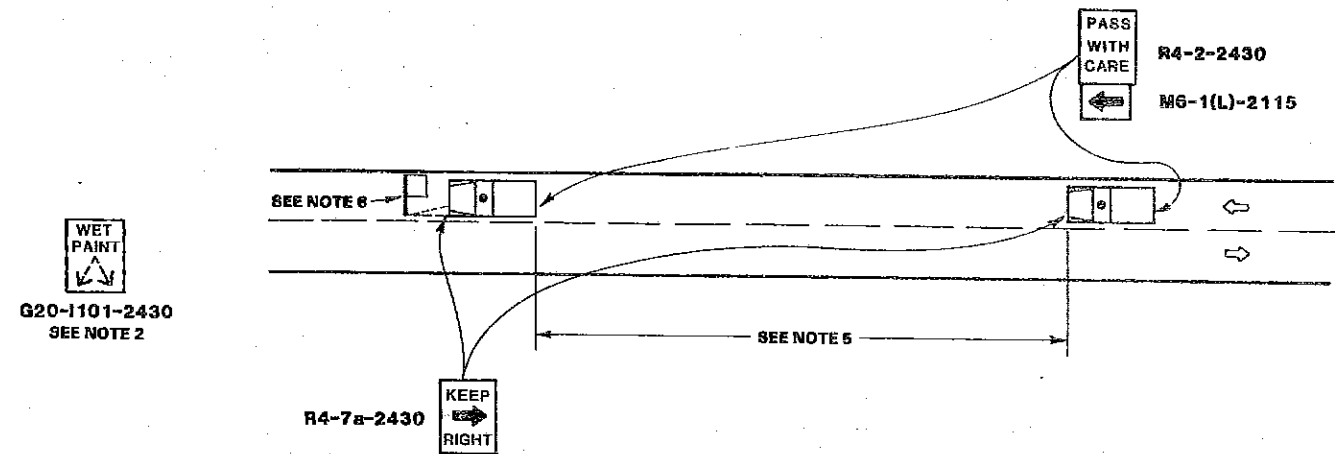


GENERAL NOTES

1. For shoulder operations not encroaching on the pavement, use DETAIL A, Sheet 2.
2. During pavement marking operations, WET PAINT signs with appropriate arrow(s) shall be mounted on the back of the striper and following vehicle where necessary to reduce tracking.
3. In areas where the shoulder is inadequate for motorists to pass the convoy, the arrow boards shall be changed from the flashing arrow mode to a flashing hazard mode. In no case shall the arrow boards be visible to traffic approaching the front of the convoy in the open lane. Arrow boards shall never flash to indicate passing on the left on a two-lane, two-way roadway.
4. All vehicles shall have headlights and emergency flashers operating and shall display an amber colored oscillating, rotating or flashing light(s). At least one amber light is to be visible from any direction.
5. Trailing vehicles shall be at least 200 feet behind the lead vehicles with the distance varying depending upon the terrain and susceptibility of any pavement marking to wheel tracking.
6. If a guide wheel is used in pavement marking operations, it shall be equipped with a flag as shown.

TYPICAL APPLICATIONS

- Landscaping work
- Utility work
- Pavement marking
- Weed spraying
- Rodometer measurements
- Debris clean-up
- Crack pouring

SYMBOLS

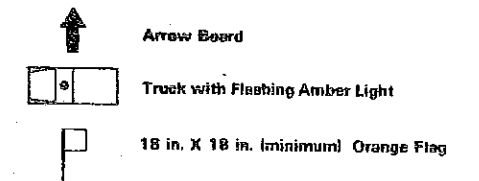

TYPICAL APPLICATION OF TRAFFIC CONTROL DEVICES  
HIGHWAY CONSTRUCTION AND CONTRACT MAINTENANCE

RURAL, DAY OR NIGHT MOVING OPERATIONS

Where, at any time, any vehicle, equipment, workers or their activities will require a continuous or intermittent moving operation where the average speed of movement is greater than 1 MPH.


SHEET 1 OF 2  
**STANDARD 2308-6**

Illinois Department of Transportation

Approved: 8/4/82

R.W. Long  
Engineer of Traffic

ISSUED  
8/2/82

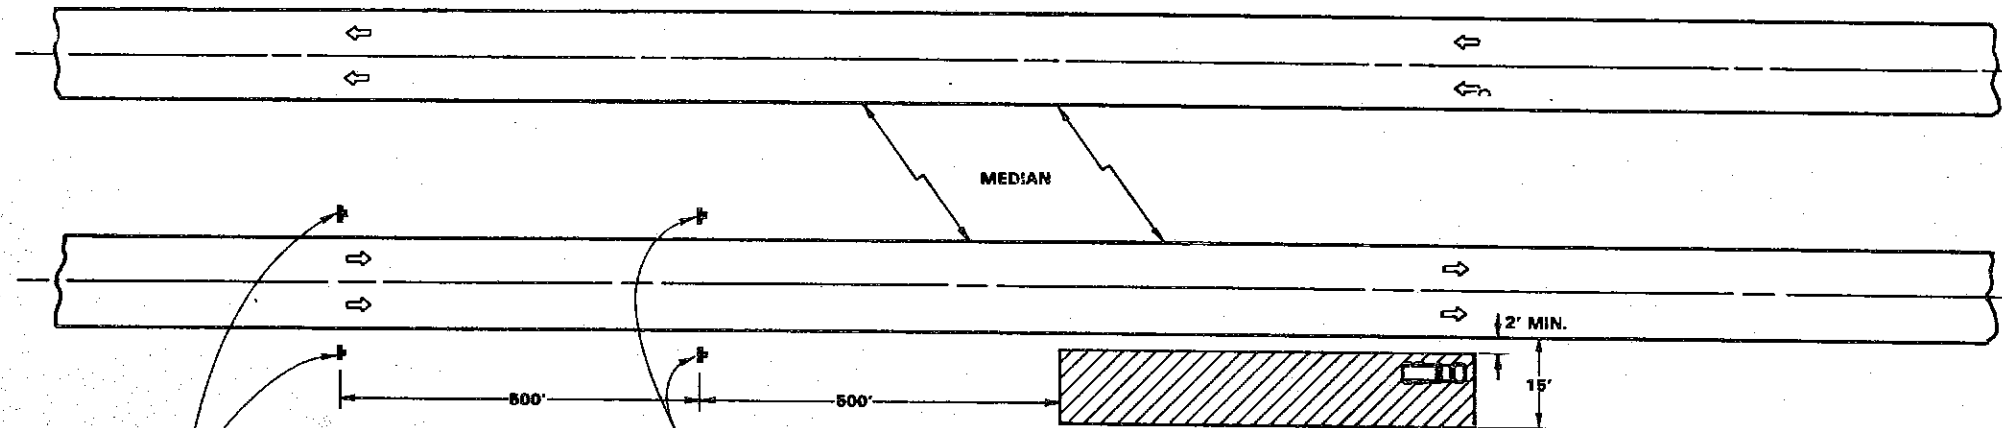

FOR CONTRACT  
CONSTRUCTION  
PROJECTS



W20-1(0)-48

FOR MAINTENANCE  
AND UTILITY  
PROJECTS



W21-4(0)-48



W21-1a(0)-48

OR



W20-1110

### TYPICAL APPLICATIONS

Utility Operations

Culvert Extensions

Side Slope Changes

Guard Rail Installation and Maintenance

Delineator Installation

Landscaping Operations

Sign Installation and Maintenance

Shoulder Repair

### GENERAL NOTES

1. If the work operation does not exceed 60 minutes, traffic control may be in conformance with STANDARD 2307.
2. Worker signs are to be removed when no work is being performed. Any unattended obstacle or excavation in the work area which in the opinion of the Engineer constitutes a hazard shall be protected by barricades at 80 ft. centers, with flashing lights at night. If the hazard exceeds 100 ft. in length, steady burning lights shall be substituted for flashing lights. When the distance is greater than 250 ft., barricade spacing may be increased to 100 ft.
3. If the work operation requires that four or more work vehicles enter through traffic lanes in a one hour period, a flagger shall be provided and a Flagger sign shall be substituted for the Worker sign.
4. Signs mounted in the median may be omitted when the median is less than 10 feet wide.
5. This standard also applies when work is being performed on a multilane undivided highway. Under these conditions the signs normally mounted in the median shall be omitted.
6. Longitudinal dimensions may be adjusted to fit field conditions.

### SYMBOLS

Work Area

18 in. X 18 in. (minimum) Orange Flag

Sign on Portable or Permanent Support

### TYPICAL APPLICATION OF TRAFFIC CONTROL DEVICES HIGHWAY CONSTRUCTION AND CONTRACT MAINTENANCE

MULTILANE, DIVIDED AND UNDIVIDED,  
RURAL DAY OR NIGHT OPERATIONS.

Where at any time, any vehicle, equipment,  
workers or their activities will encroach in the  
area closer than 15 ft. but not closer than 2 ft.  
to the edge of pavement.



**STANDARD 2314-6**

Illinois Department of Transportation

Approved: 2/4/92

*RW Jones*  
Engineer of Traffic

Issued 6/3/88

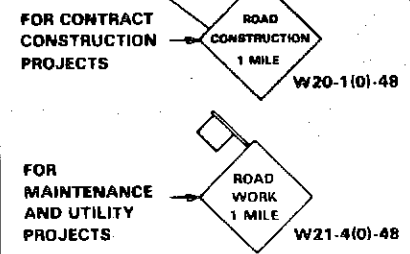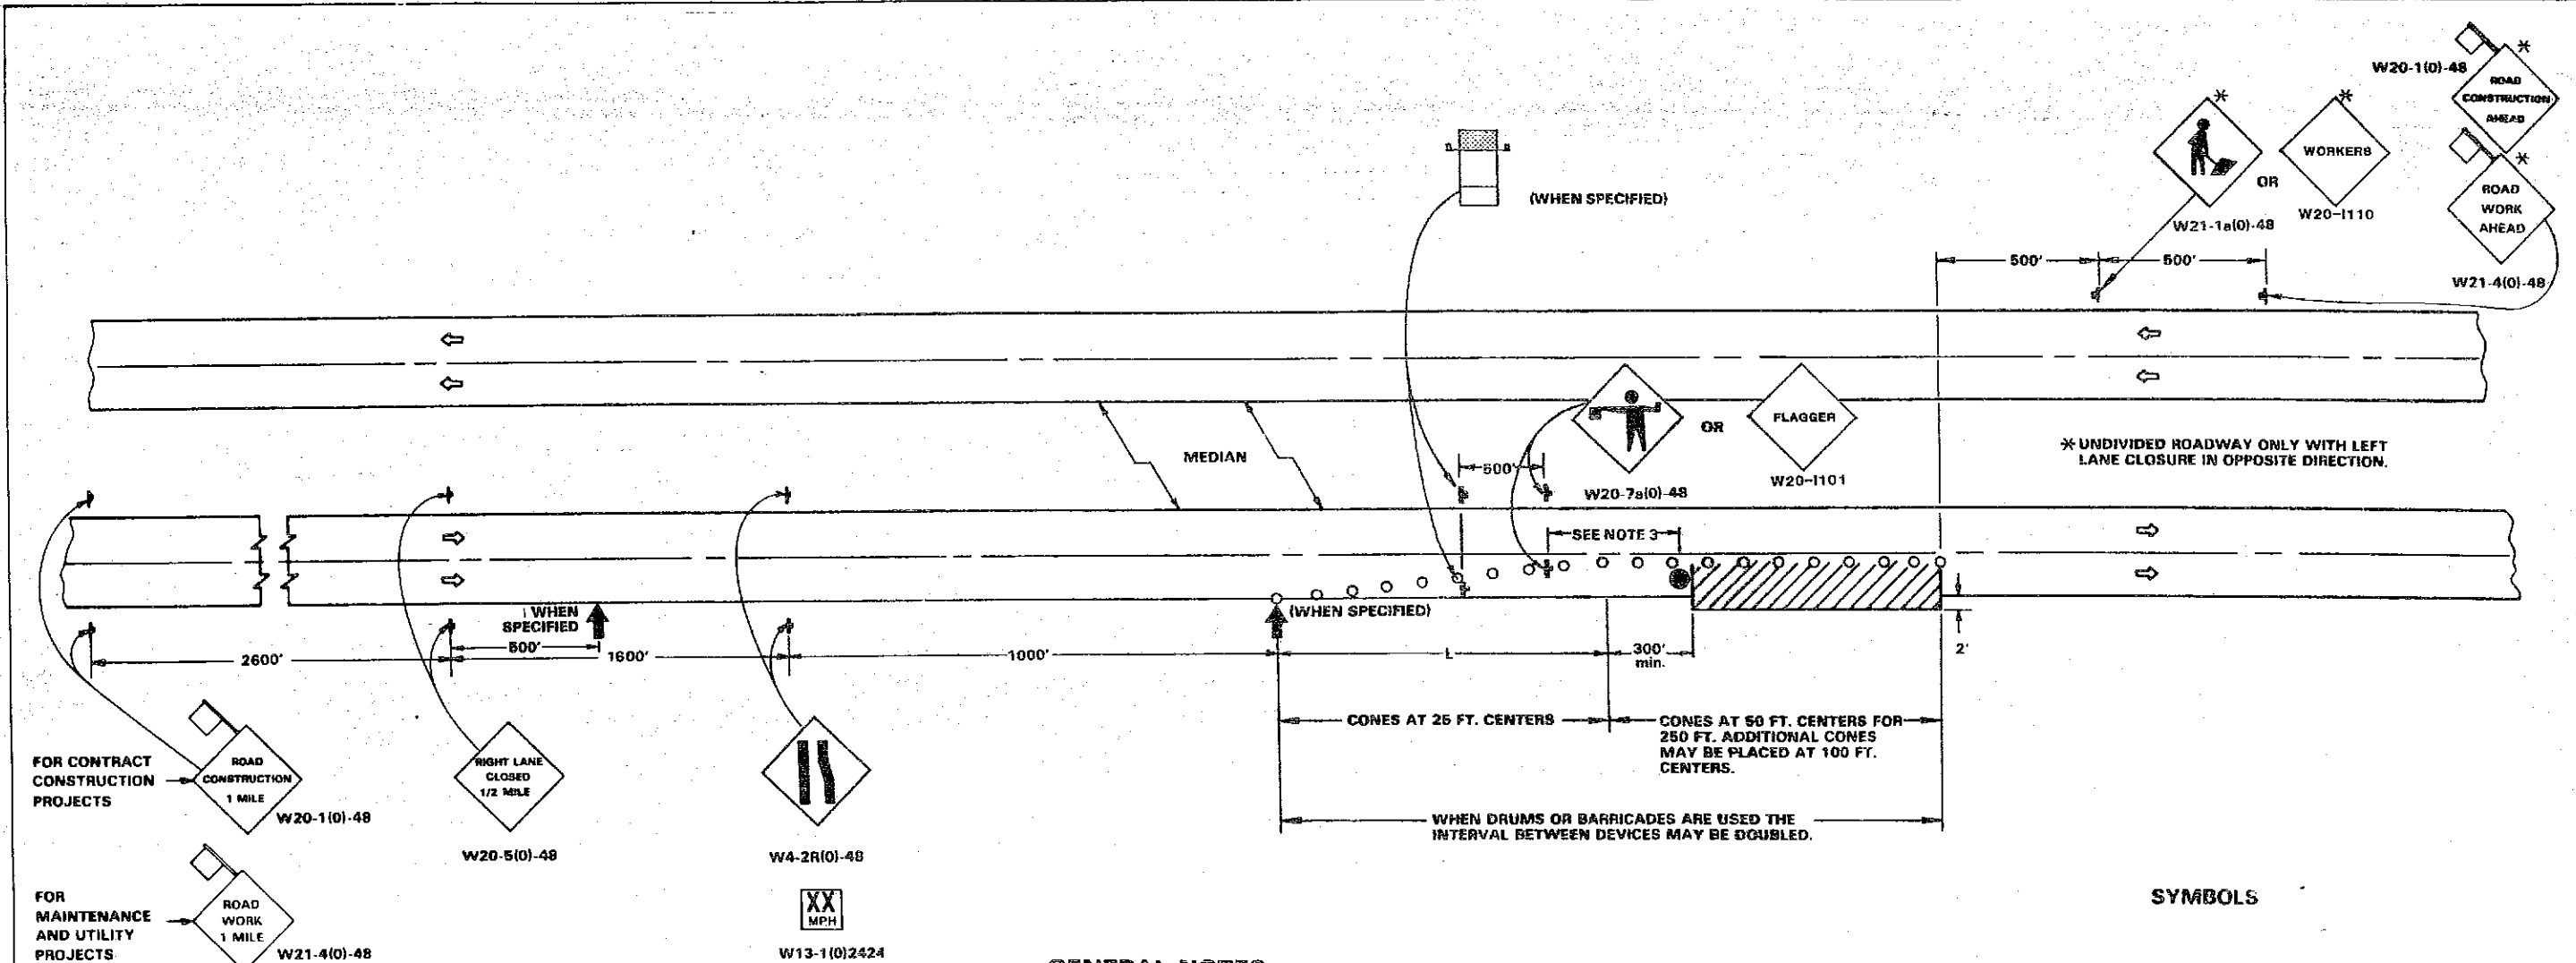

**GENERAL NOTES**


- The "L" distance equals the lane width times the taper ratio.
 

Normal Posted Speed m.p.h.	Taper Ratio ft./ft.
65	85/1
60	80/1
55	55/1
50	50/1
45 or less	45/1
- When no work is being performed, the flagger will not be required. If the flagger is not present, the Flagger and Worker signs shall be removed or covered.
- The Construction Speed Limit signs (when specified) and the Flagger signs shall be moved as necessary to maintain a spacing of 500 feet to 1.5 miles between the Flagger and Flagger signs.
- This standard also applies when work is being performed in the left lane. Under these conditions, LEFT LANE CLOSED signs shall be substituted for RIGHT LANE CLOSED signs. On undivided highways, signs shall be added in the opposite direction as shown and cones shall be placed along the center line throughout the taper and work area. On left lane closures with narrow medians, the arrow board at the beginning of the lane closure (when specified) shall be relocated behind the taper as necessary so that a clearance of at least 4 ft. can be maintained from the opposing traffic.
- The speed limit to be shown on the Construction Speed Limit signs and Advisory Speed plates shall be 10 miles per hour less than the normal posted speed limit or 45 MPH, whichever is less. The signs shall not be used where the normal posted speed limit is below 45 miles per hour.
- The flashing lights on the Construction Speed Limit signs shall be activated only when workers are present in a lane adjacent to one open to traffic. At all other times, the flashing lights shall be turned off and the signs may be removed.
- All signs, cones, barricades and drums are to be removed at completion of the day's operations and the work area opened to traffic.
- Median signs may be omitted when the median is less than 10 feet wide.
- This standard does not apply when work is being performed in the middle lane(s) of a six or more lane highway. Special plans approved by the Engineer will be required.
- On fully access-controlled facilities, cones shall be a minimum of 28 in. in height.
- Longitudinal dimensions may be adjusted to fit field conditions. The lateral placement of the flagger may be varied from that shown. The flagger shown at the beginning of the work area shall be stationed approximately 200 feet in advance of the work party.
- At all times when workers are present, a flagger shall be positioned in advance of the first work operation as shown. (See Note 2) An additional flagger, as required by Paragraph 10 of Article 107.14 of the Standard Specifications, shall be positioned in advance of each separate activity of the operation that requires frequent encroachment into a lane open to traffic.
- Form BT 725 may be required.

**TYPICAL APPLICATIONS**

- Pavement Patch
- Utility Operations
- Bituminous Resurfacing

**SYMBOLS**

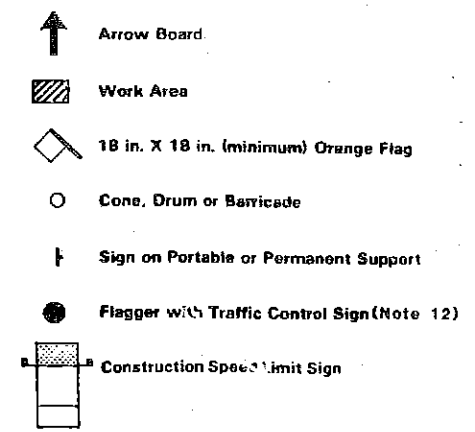

**TYPICAL APPLICATION OF TRAFFIC CONTROL DEVICES HIGHWAY CONSTRUCTION AND CONTRACT MAINTENANCE**

MULTILANE, DIVIDED AND UNDIVIDED, RURAL DAY OPERATIONS ONLY

Where, at any time, any vehicle, equipment, workers or their activities will encroach on any portion of the lane immediately adjacent to the shoulder or on the shoulder within 2 ft. of the edge of pavement.

**STANDARD 2315-8**


Illinois Department of Transportation

Approved: 2/4/82

*R. W. Jones*  
Engineer of Traffic

Issued: 4/3/88



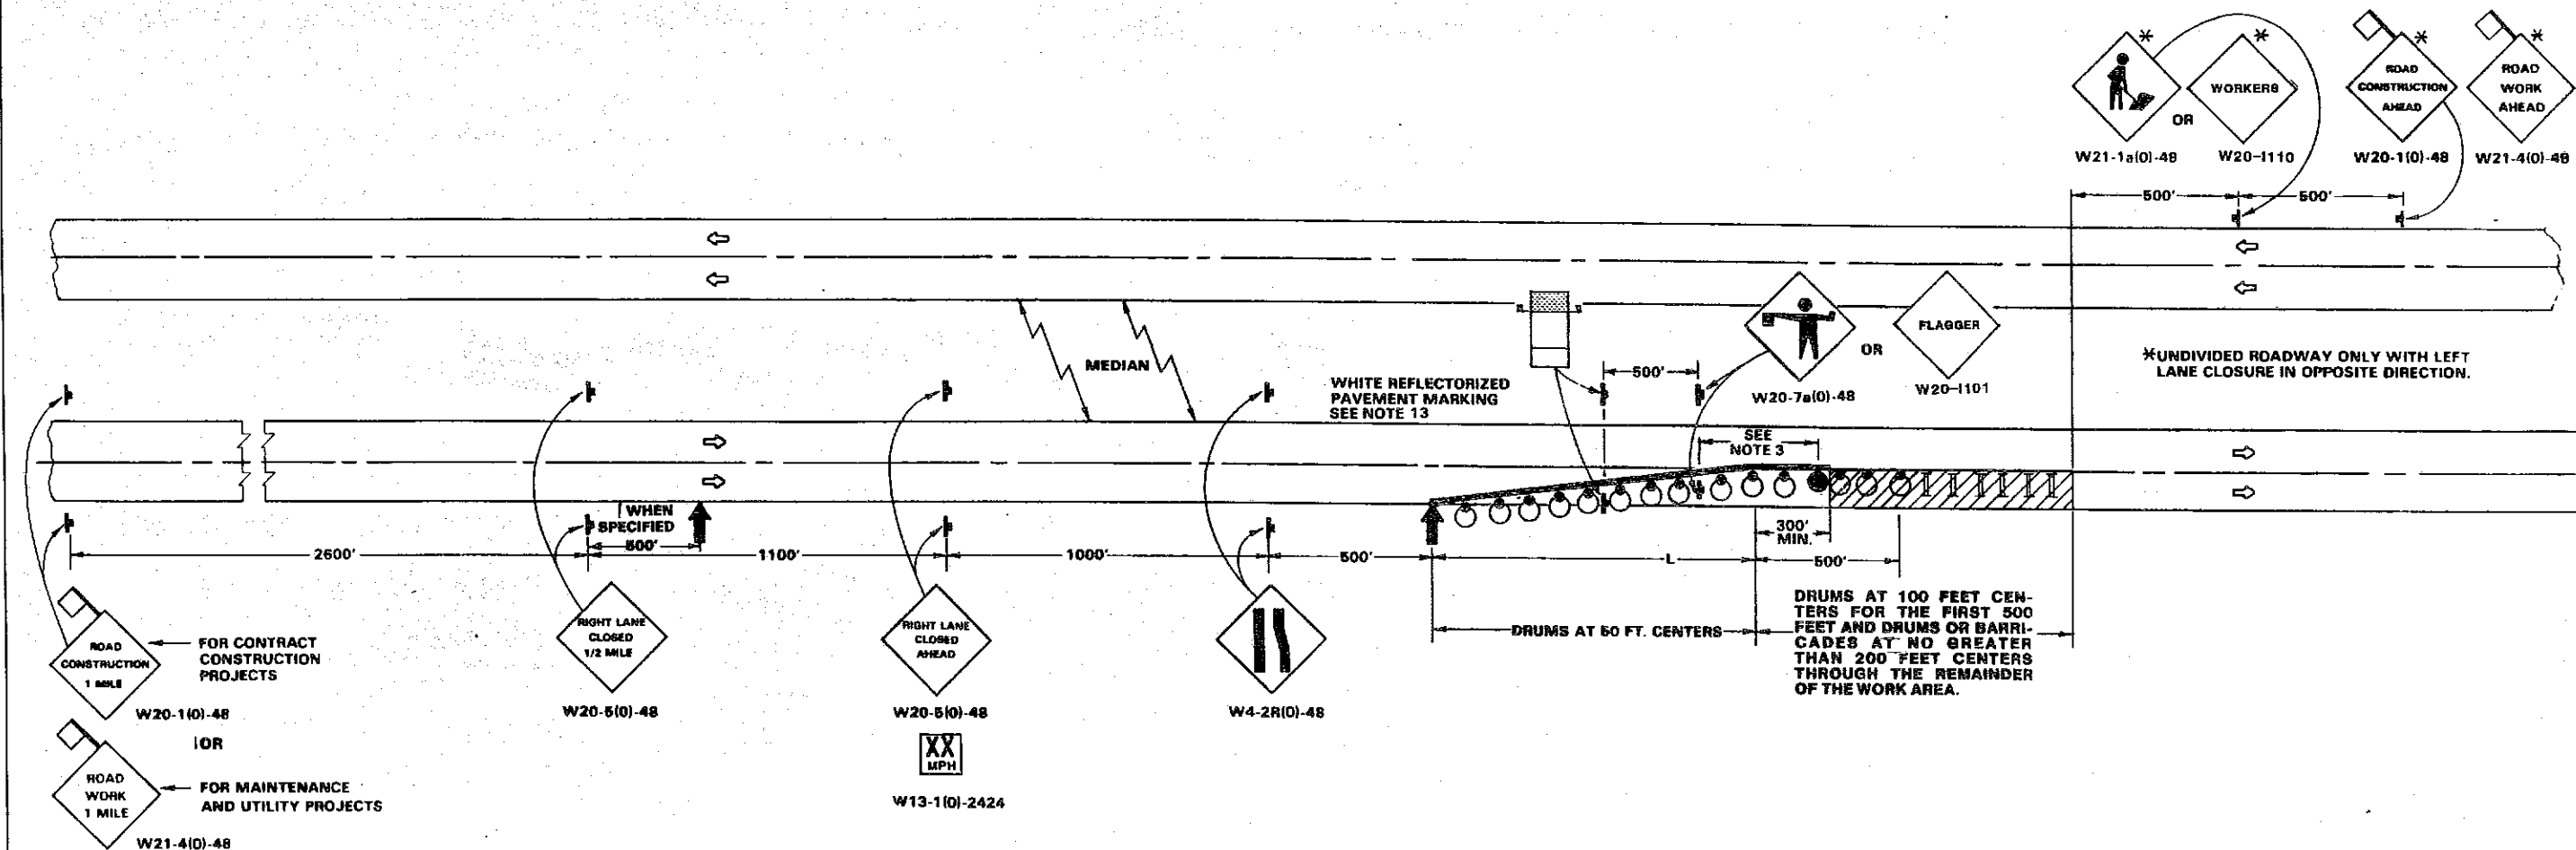

### GENERAL NOTES

- The "L" distance equals the lane width times the taper ratio.

Normal Posted Speed m.p.h.	Taper Ratio ft./ft.
65	65/1
60	60/1
55	55/1
50	50/1
45 or less	45/1
- When no work is being performed, the flagger will not be required. If the flagger is not present, the Flagger and Worker signs shall be removed or covered.
- The Construction Speed Limit sign and the Flagger sign shall be moved as necessary to maintain a spacing of 500 feet to 1.5 miles between the flagger and the Flagger sign.
- This standard also applies when work is being performed in the left lane. Under these conditions, LEFT LANE CLOSED signs shall be substituted for RIGHT LANE CLOSED signs. On undivided highways, signs shall be added in the opposite direction as shown. On left lane closures with narrow medians, the arrow board at the beginning of the lane closure shall be relocated behind the taper as necessary so that a clearance of at least 4 ft. can be maintained from the opposing traffic.
- The speed limit to be shown on the Construction Speed Limit signs and Advisory Speed plates shall be 10 miles per hour less than the normal posted speed limit or 45 MPH, whichever is less. The signs shall not be used where the normal posted speed limit is below 45 miles per hour.
- The flashing lights on the Construction Speed Limit signs shall be activated only when workers are present in a lane adjacent to one open to traffic. At all other times, the flashing lights shall be turned off and the signs may be removed.

- Median signs may be omitted when the median is less than 10 feet wide.
- This standard does not apply when work is being performed in the middle lane(s) of a six or more lane highway. Special plans approved by the Engineer will be required.
- Cones may be substituted for barricades or drums at half the spacing during day operations. On fully access-controlled facilities, cones shall be a minimum of 28 in. in height.
- Steady burning lights will not be required on drums for day operations. All drum lights shall be monodirectional.
- All signs shall be post-mounted if the closure time exceeds four days.
- Flashing lights shall be used on each approach in advance of the work area during hours of darkness and installed above the first two signs in each series.
- ReflectORIZED temporary pavement marking tape shall be placed throughout the taper and for 300 feet along-side the work area where the closure time is greater than fourteen days. The edge line shall be yellow for left lane closures. Raised reflectORIZED pavement markers at 25 ft. centers may be used to supplement the pavement marking tape.
- Longitudinal dimensions may be adjusted to fit field conditions. The lateral placement of the flagger may be varied from that shown. The flagger shown at the beginning of the work area shall be stationed approximately 200 feet in advance of the work party.
- At all times when workers are present, a flagger shall be positioned in advance of the first work operation as shown. (See Note 2) An additional flagger, as required by Paragraph 10 of Article 107.14 of the Standard Specifications, shall be positioned in advance of each separate activity of the operation that requires frequent encroachment into a lane open to traffic.
- Form BT 725 is required.

### SYMBOLS

- Construction Speed Limit Sign
- Work Area
- Arrow Board
- Sign on Portable or Permanent Support
- Flagger with Traffic Control Sign (Note 15)
- Barricade or Drum
- Drum with Steady Burning Light
- 18 in. X 18 in. (minimum) Orange Flag

Illinois Department of Transportation

Approved: 2/4/92

*R.W. Jones*  
Engineer of Traffic


Issued: 4/3/88

### TYPICAL APPLICATION OF TRAFFIC CONTROL DEVICES HIGHWAY CONSTRUCTION AND CONTRACT MAINTENANCE

#### MULTILANE, DIVIDED AND UNDIVIDED, RURAL OPERATIONS EXCEEDING ONE DAYLIGHT OPERATION


Where, at any time, any vehicle, equipment, workers or their activities will encroach on any portion of the lane immediately adjacent to the shoulder or on the shoulder within 2 feet of the edge of pavement.

### STANDARD 2316-13

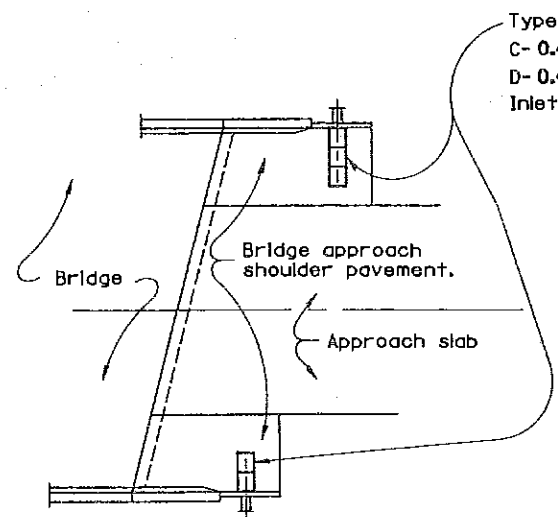


GENERAL PLAN

Type B- 0.457 x 0.559 m (1'-6" x 1'-10"),  
 C- 0.457 x 1.194 m (1'-6" x 3'-11") or  
 D- 0.457 x 1.829 m (1'-6" x 6'-0")  
 Inlet Box as required.

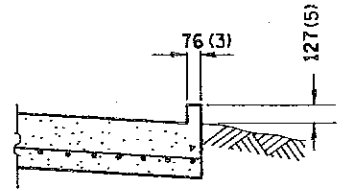

SEC. C-C

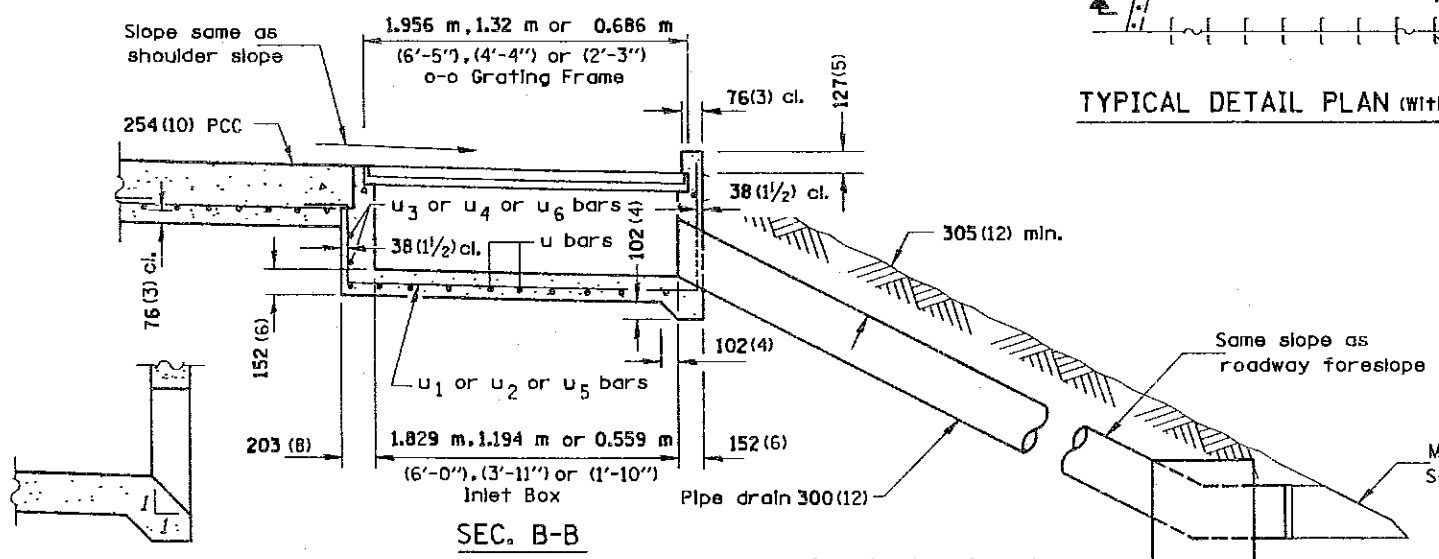


SEC. B-B

BOX OUTLET  
 WHEN PRECAST

Cast in place Class X  
 Concrete Thrust Block  
 610 x 610 x 610  
 (2'-0" x 2'-0" x 2'-0").

TYPICAL DETAIL PLAN (W/O Wingwall)

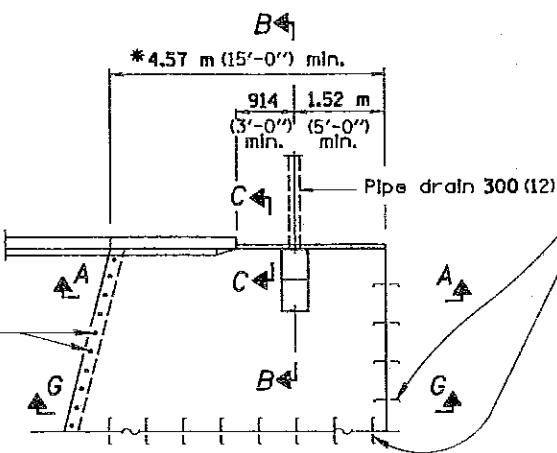


TYPICAL DETAIL PLAN (With Wingwall)

\* Increase this dimension as  
 needed to position the Inlet Box  
 and Pipe Drain between the  
 proposed approach guardrail  
 posts.


64 x 64 x 12.7  
 (2 1/2 x 2 1/2 x 1/2)  
 angle frame

#15(#5) tie bars as detailed  
 for Bulkhead Construction  
 Joint on Standard 2323 (typ.).

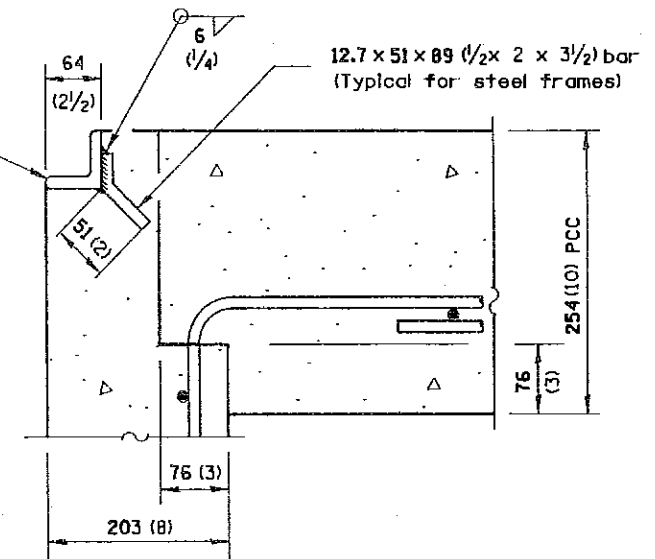


DETAIL A

#15(#4) bars on 178 (7)  
 cts. each direction

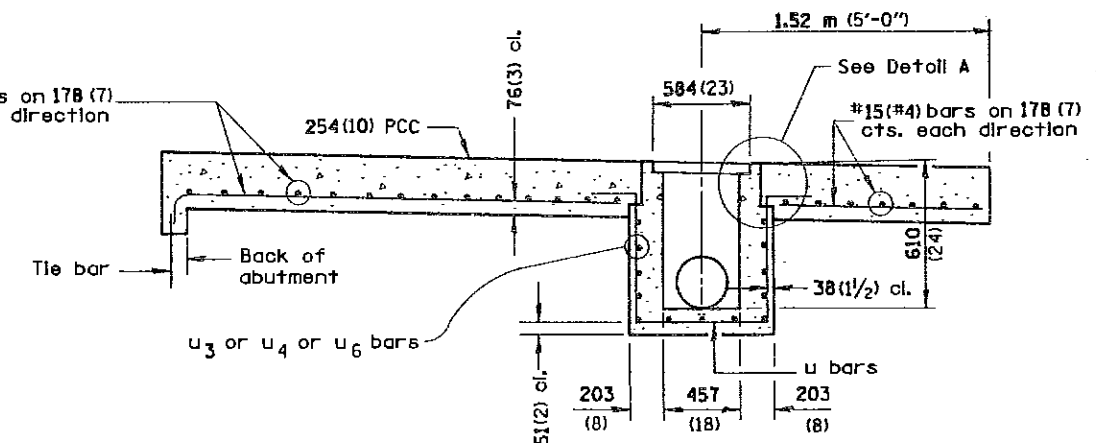

SEC. A-A

#15(#4) bars on 178 (7)  
 cts. each direction

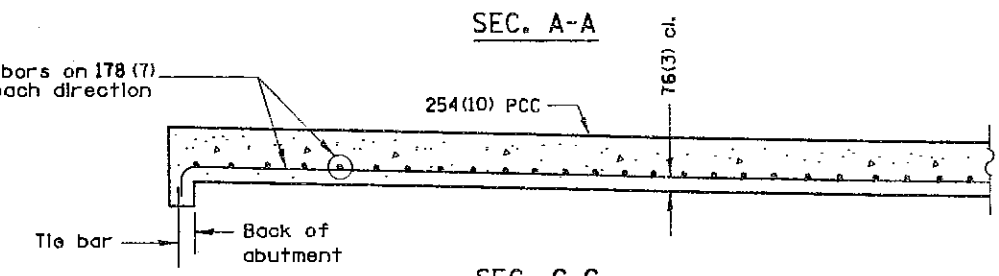

SEC. G-G

GENERAL NOTES

All exposed edges of the inlet, except the upper perimeter, shall be beveled 19 mm (3/4).

For placement of approach shoulder pavement on existing construction substitute expansion anchor ties for tie bars. Omit tie bars for flexible approaches or Bridge Approach Shoulder Pavement constructed monolithically with shoulder pavement.

INLET TYPE	SHOULDER WIDTH
Type B	Less than 1.52 m (5')
Type C	1.52 m (5') 1.83 m (6')
Type D	Greater than 1.83 m (6')


All dimensions are in millimeters (Inches) unless otherwise shown.

BRIDGE APPROACH SHOULDER  
 PAVEMENT AND DRAIN


STANDARD 2324-8

Sheet 1 of 2

Illinois Department of Transportation  
 PASSED August 17 1992  
 ENGINEER OF POLICY AND PROCEDURES  
 APPROVED August 13 1992  
 ENGINEER OF DESIGN AND ENVIRONMENT

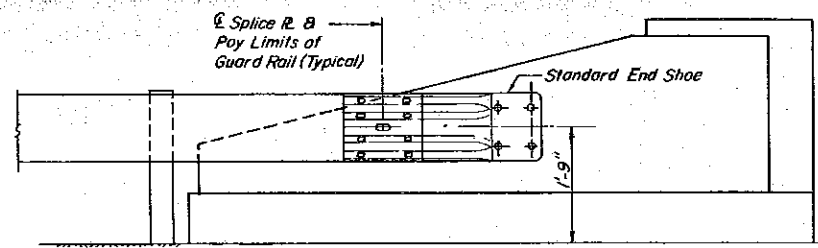


ELEVATION

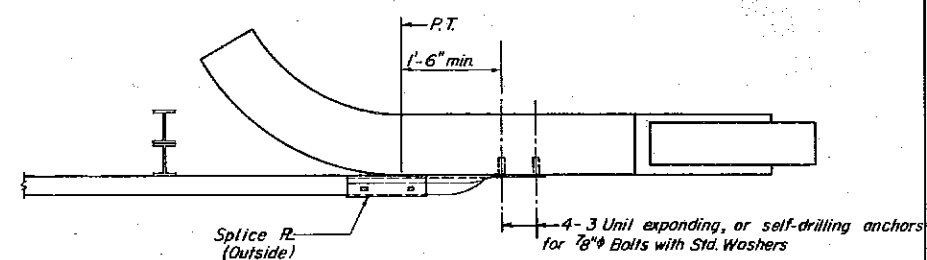


PLAN

CURVED WING

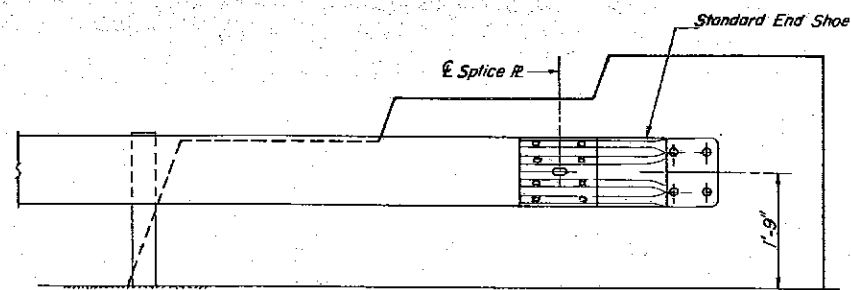


ELEVATION

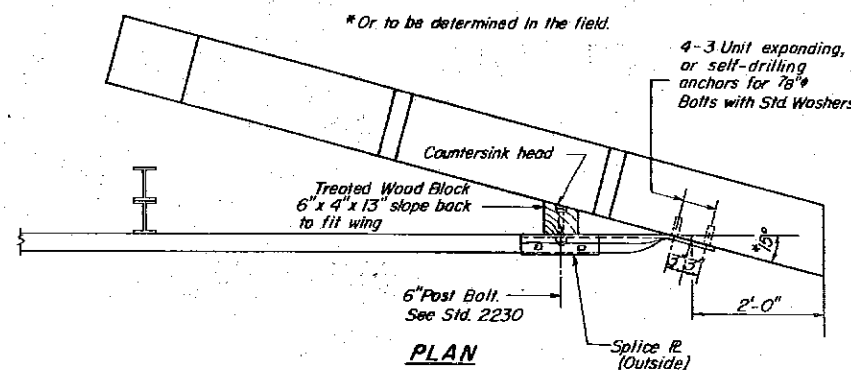


PLAN


FLARED WING

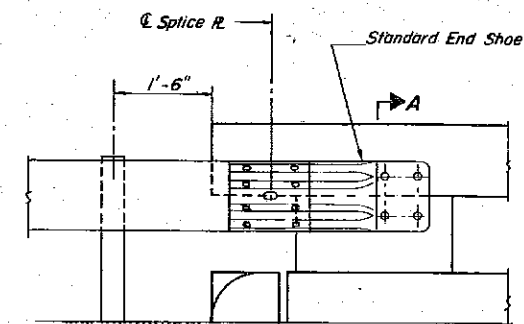


ELEVATION

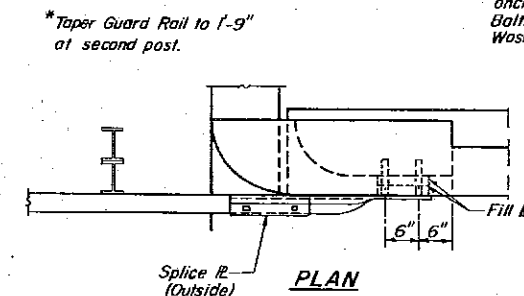

PLAN

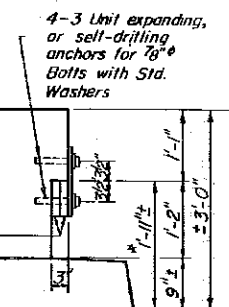


SECTION A-A  
(High Rail)

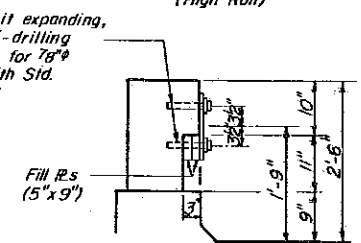


SECTION A-A  
(Low Rail)

R.C. HANDRAIL

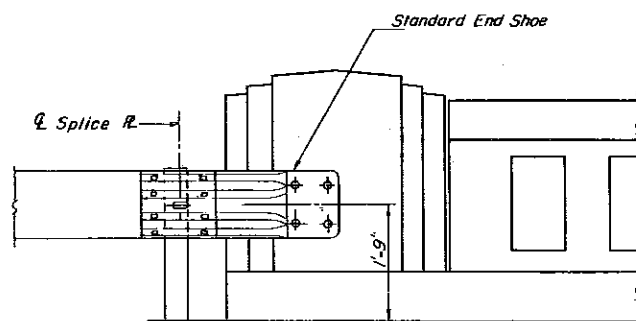

ELEVATION

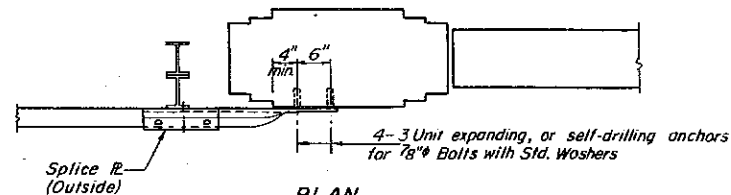

PLAN

CONCRETE HANDRAIL

NOTES

For details of guardrail not shown see Standard 2230.

The Standard End Shoe shall be attached to the existing concrete with Pre-drilled or Self-drilling anchor bolts. The anchor cone shall be set flush with the surface of the concrete. Externally threaded studs protruding from the surface of the concrete will not be permitted.

The Standard End Shoe shall be placed between the splice plate and the rail element.

The minimum edge distance (distance from any anchor to edge of existing concrete) shall be six (6) inches unless otherwise shown.

If the existing name plate is covered completely or partially by the end shoe, the name plate shall be moved to an adjacent area along the rail or end post. The cost of moving the name plate shall be included in the cost of TRAFFIC BARRIER TERMINAL, TYPE 10.

Pay limits of guardrail shall be at center of end shoe splice.

The cost of the Standard End Shoes, Splice Plate, any required blocks and plates, and all fasteners shall be included in the cost of TRAFFIC BARRIER TERMINAL, TYPE 10 (One Each).

When a bridge expansion joint exists between the End Shoe and the first post, all splice bolts at the End Shoe shall be fitted with a locknut or double nuts tightened only to a point that will allow guardrail movement.







Missouri Department of Transportation	
PASSED	AUG 31 1979
Engineer of Bridge and Traffic Structures	
APPROVED	AUG 31 1979
Engineer of Design	
ISSUED	9-23-70

TRAFFIC BARRIER TERMINAL  
TYPE 10  
STANDARD 2326-3

Full Size



OFFSETS TO FACE OF RAIL (Feet)				
Post	TYPE 1		TYPE 1A	
	X	Y (4')	Y (3')	Y (2')
①	37.22	4.00	3.00	2.00
②	31.09	2.79	2.09	1.40
③	24.92	1.79	1.34	0.90
④	20.79	1.25	0.94	0.62
⑤	16.64	0.80	0.60	0.40
⑥	12.49	0.45	0.34	0.23
⑦	6.25	0.11	0.08	0.06
⑧	0.00	0.00	0.00	0.00

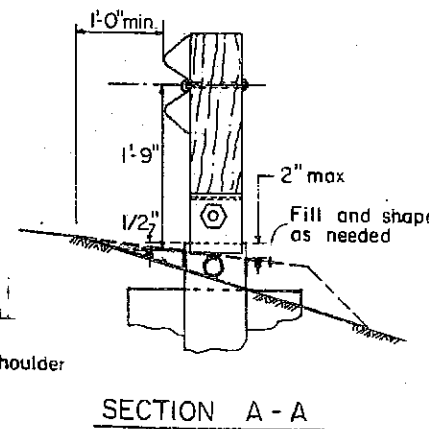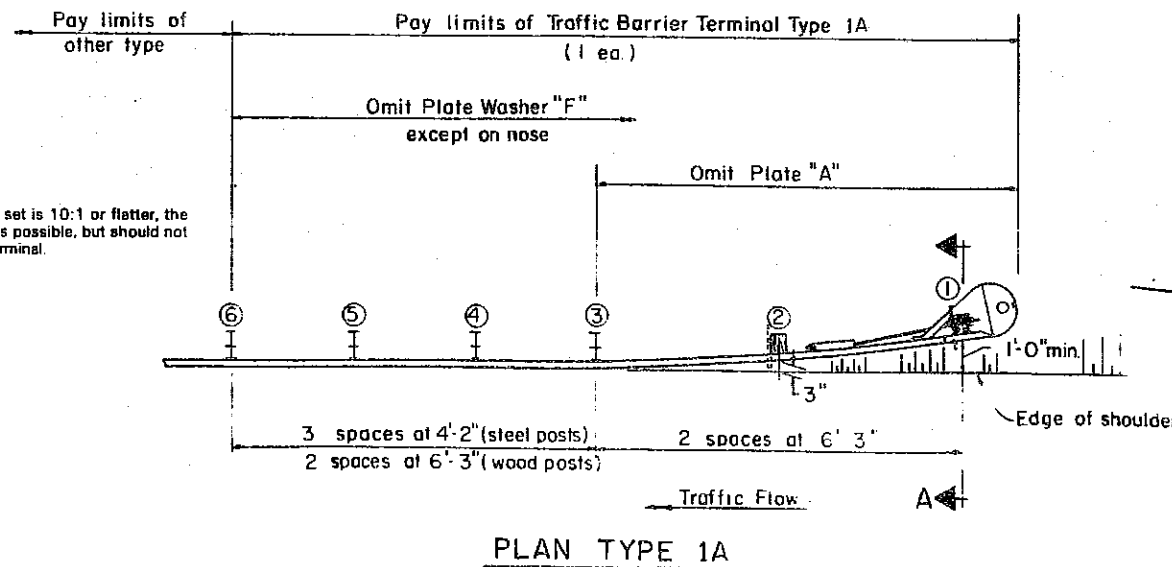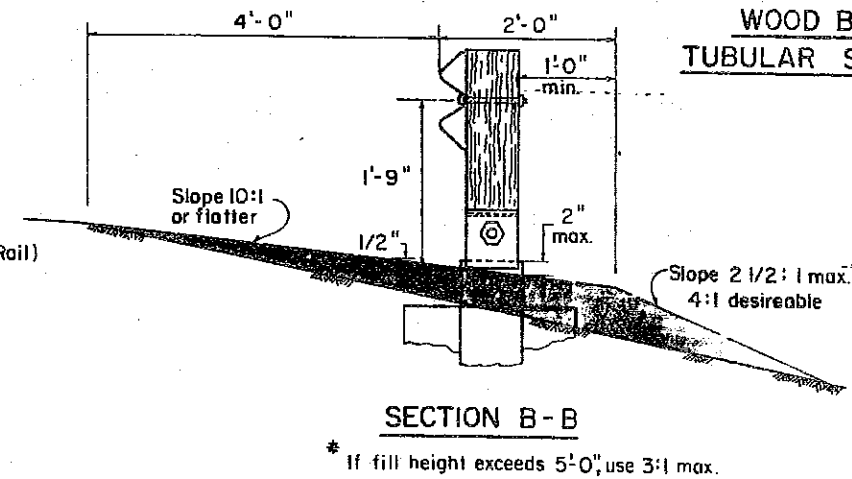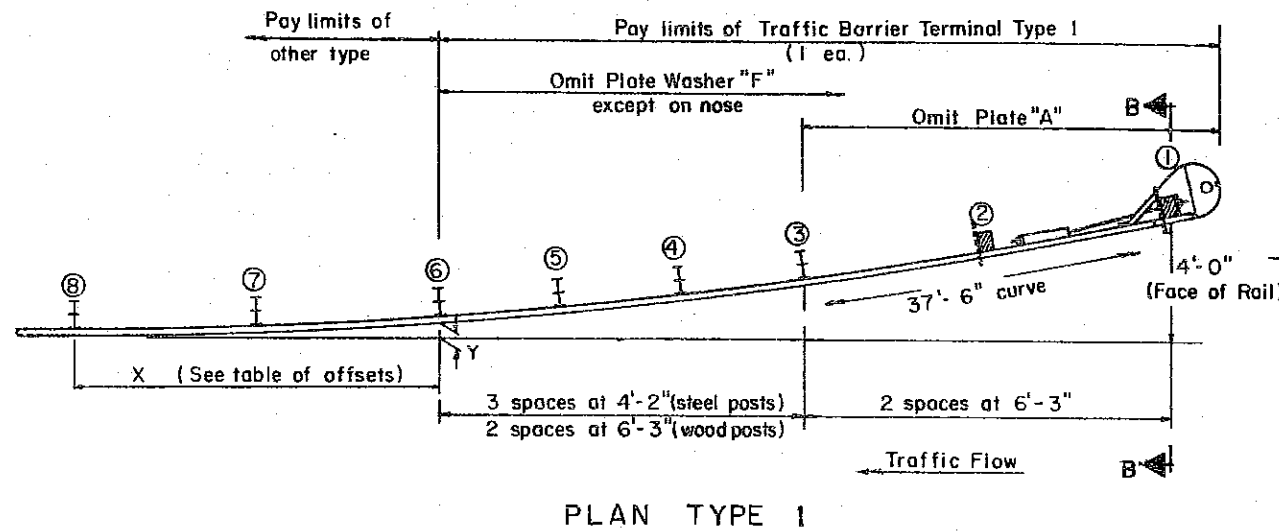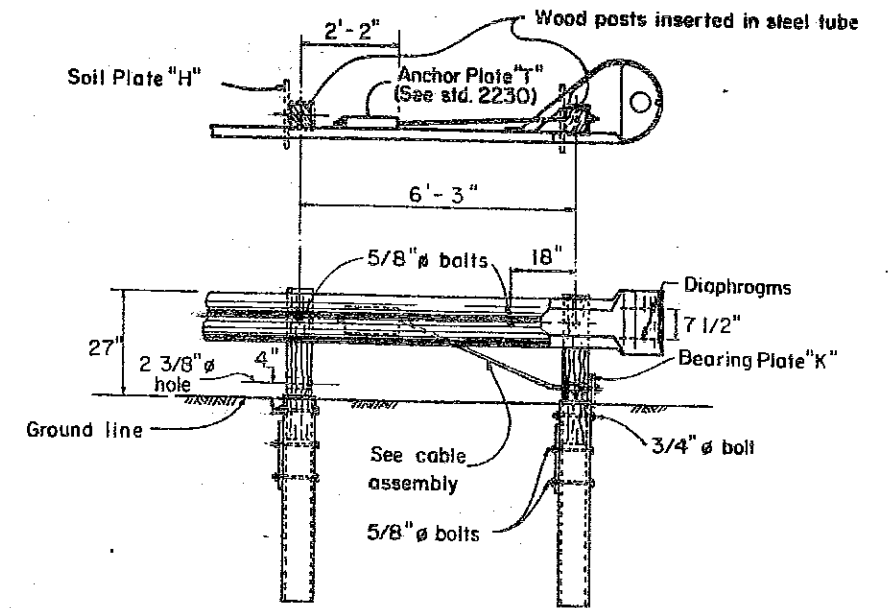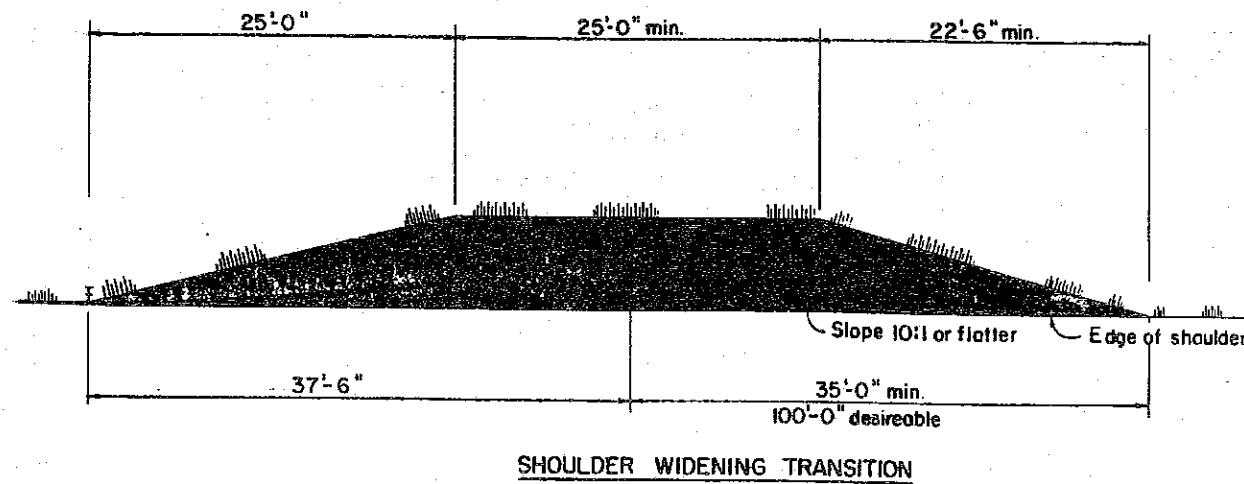

**NOTE**

If the surface upon which the barrier is to be set is 10:1 or flatter, the Type 1A Terminal should be flared as much as possible, but should not exceed the offsets provided for the Type 1 Terminal.

**GENERAL NOTES**

See Standard 2230 for details of guard rail not shown.

All steel parts shall be galvanized after fabrication.

Posts at locations 1 & 2 shall be wood breakaway posts. Posts other than 1 & 2 may be either standard wood posts or steel posts, at the option of the Contractor. If standard wood posts are used, one post shall be located midway between and in lieu of posts 4 & 5. For Terminal Type 1, the offset (Y) for this post shall be 1.00 foot.

The wood breakaway posts shall be treated and conform to the requirements of Art. 711.06 of the Standard Specifications.

A two-piece assembly may be substituted for the one-piece nose shown above.

Hollow structural tubing shall conform to the requirements of ASTM A-500 grade B or A-501.

The Bearing Plate "K" shall be held in position by (2) two eightpenny nails driven into the post and bent over the top of the plate.


Illinois Department of Transportation

PASSED *J. Edgar* Mar 30 1987  
 Engineer of Policy and Procedures


APPROVED *J. Edgar* Mar 30 1987  
 Engineer of Design

ISSUED 4-3-78


**TRAFFIC BARRIER  
 TERMINAL TYPE 1 & 1A**  
 (Sheet 1 of 2)  
**STANDARD 2336-4**

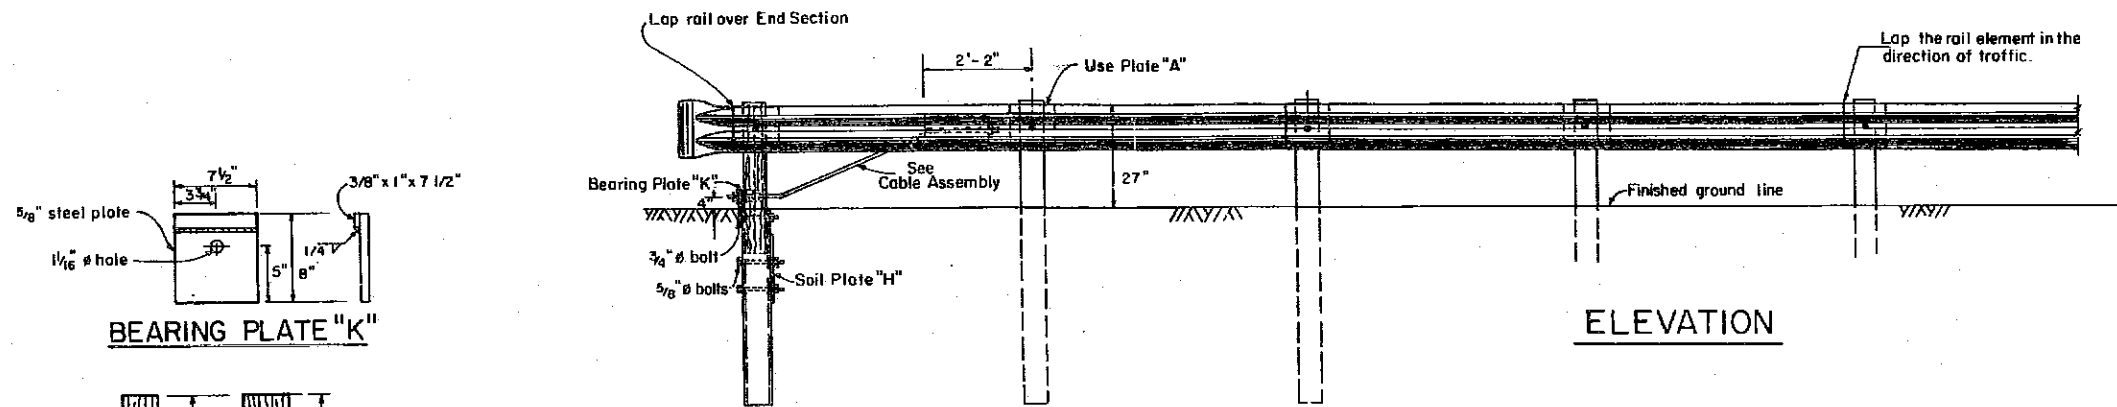


ELEVATION

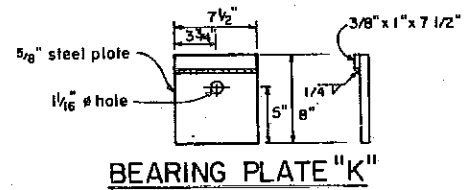


BEARING PLATE "K"

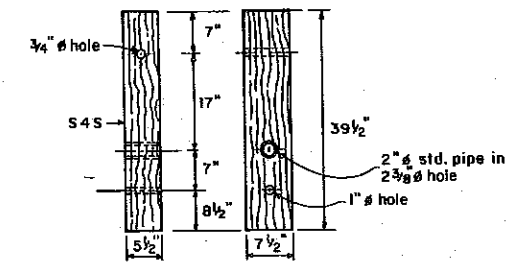


WOOD POST

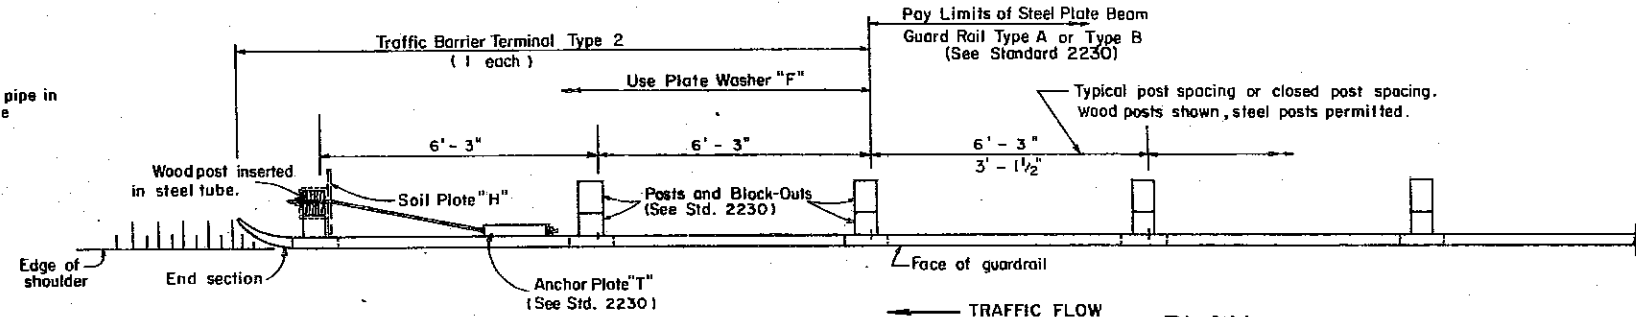


PLAN

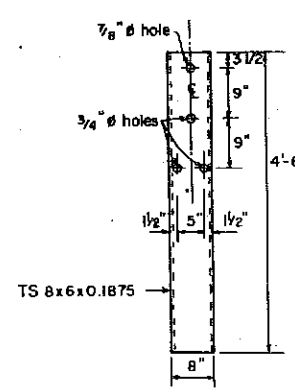


STEEL TUBE

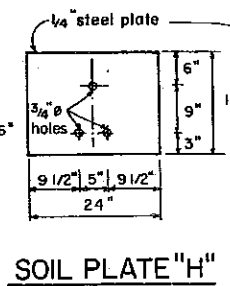

SOIL PLATE "H"

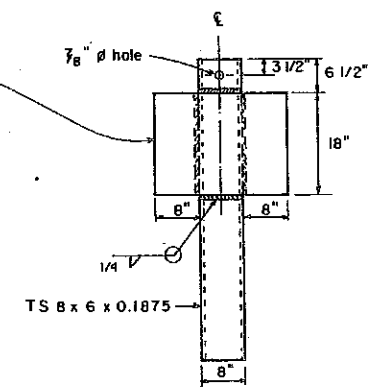


ALTERNATE SOIL PLATE CONNECTION

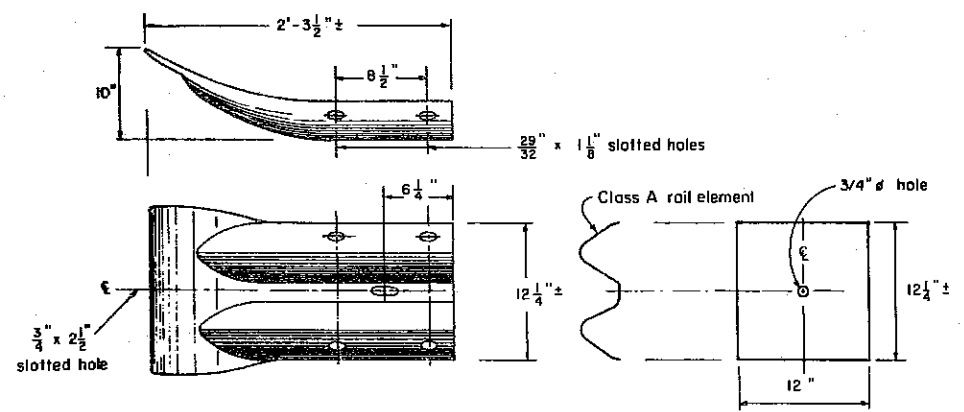

END SECTION

PLATE A

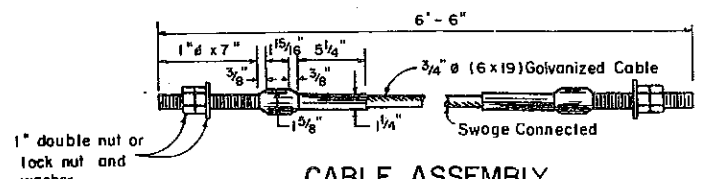

CABLE ASSEMBLY  
(40,000 lbs. min. breaking strength)  
Tighten cable to full tension.

NOTES:

See Standard 2230 for details of Guardrail not shown.  
The wood posts shall be treated and conform to the requirements of Article 711.06 of the Standard Specifications.  
All steel parts shall be galvanized after fabrication.  
Use Plate Washer "F" at all posts (See Std. 2230)

Illinois Department of Transportation

PASSED: Feb. 3, 1981  
Engineer of Design Operations

APPROVED: Feb. 3, 1981  
Engineer of Design





ISSUED 8-1-77

TRAFFIC BARRIER  
TERMINAL TYPE 2

STANDARD 2337-2







Full Size

F-326 b

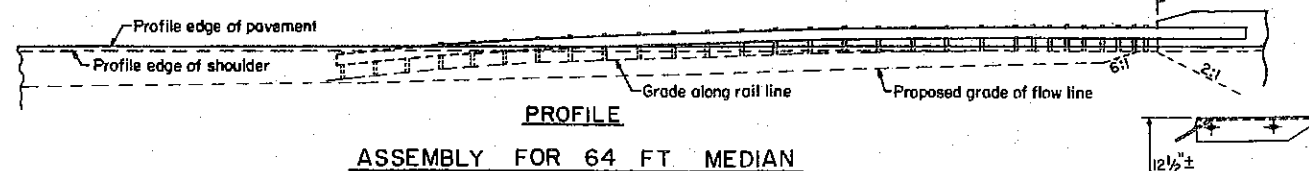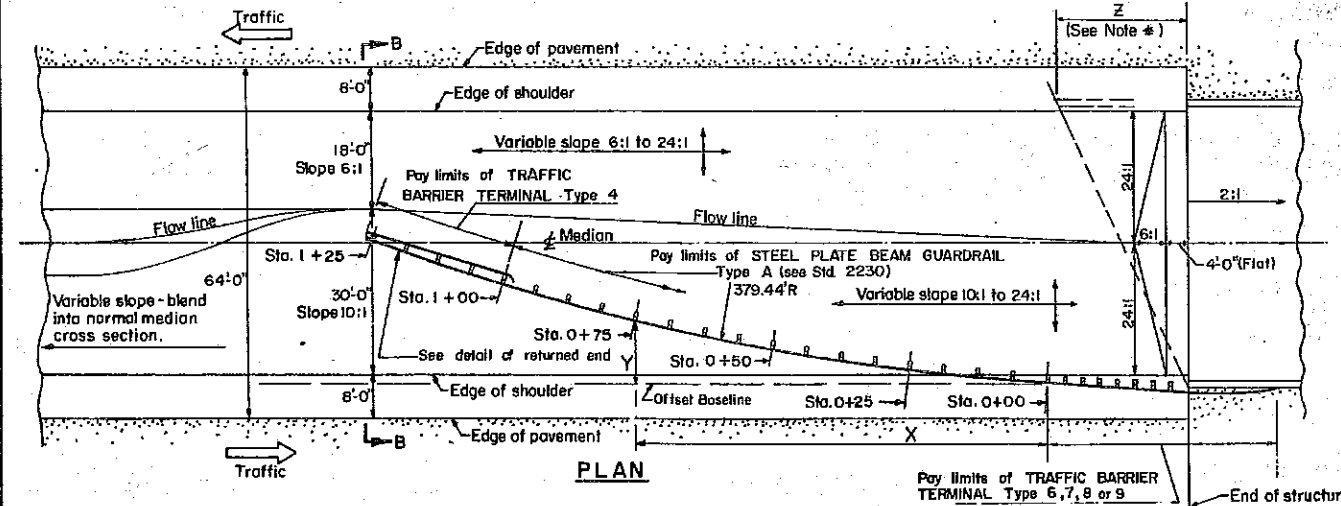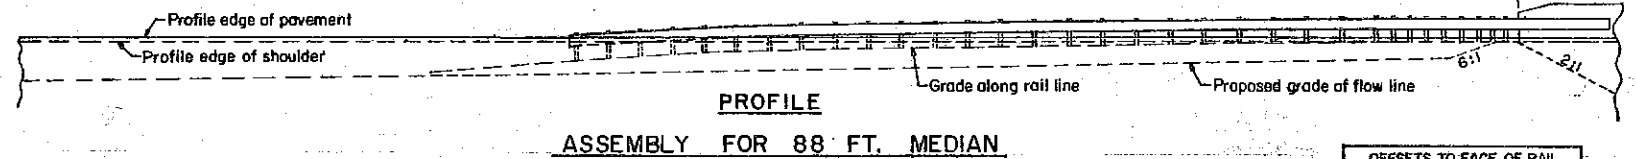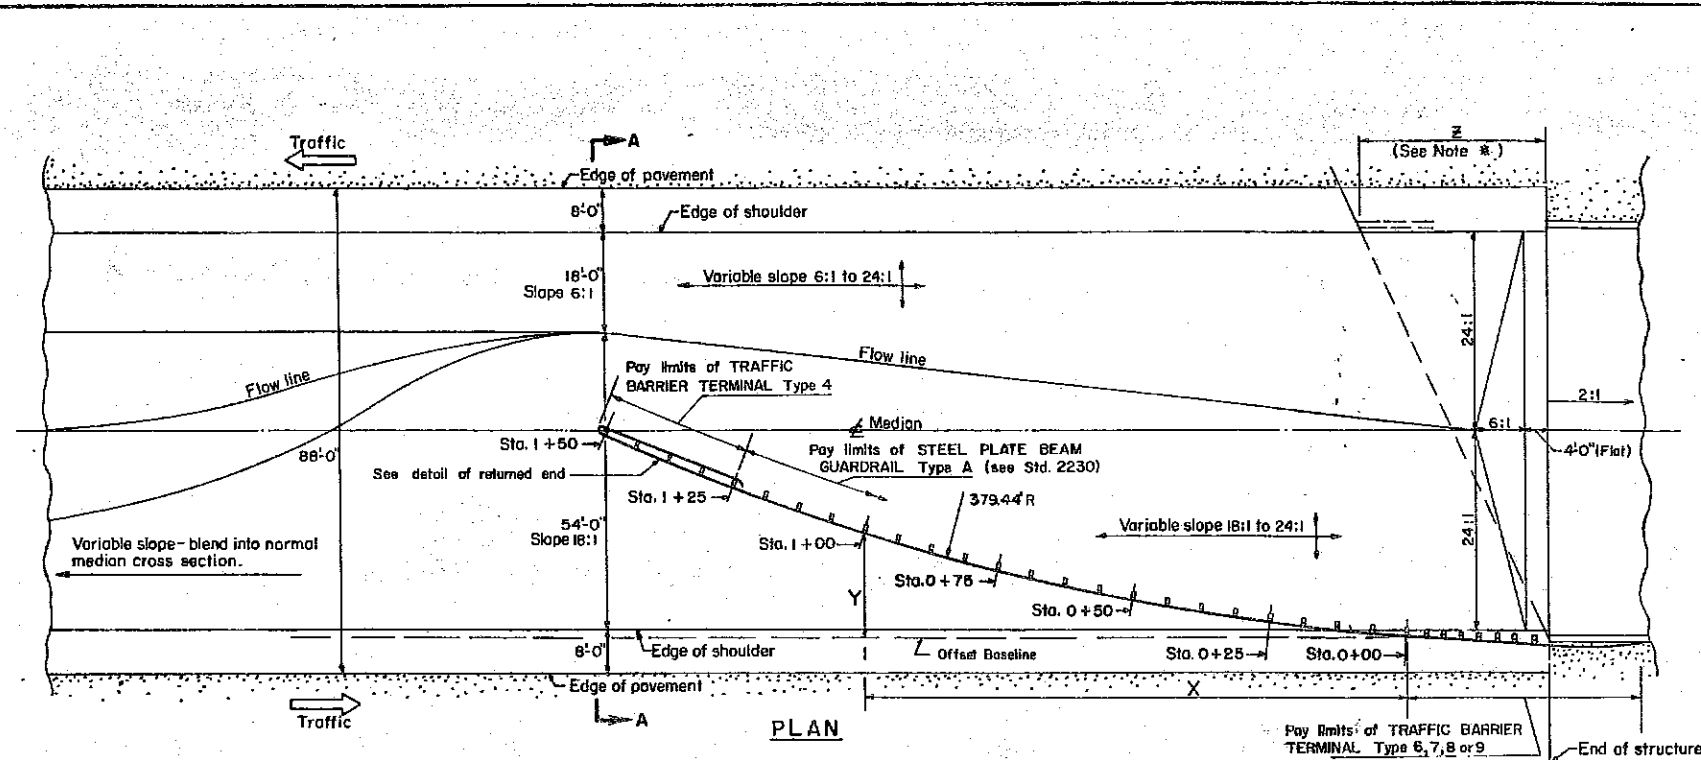

STATION	Distance	Offset
0+00	0.00'	0.00'
0+25	24.95'	1.83'
0+50	49.68'	5.28'
0+75	74.16'	10.37'
1+00	98.24'	17.05'
1+25	121.83'	25.30'
1+50	144.83'	35.09'

Offsets (Y) are measured between the face of rail and the Offset Baseline, which is parallel to the pavement edge and passes through Sta. 0+00. The location of Sta. 0+00 will vary, being dependent on structure details and the type of Traffic Barrier Terminal utilized.

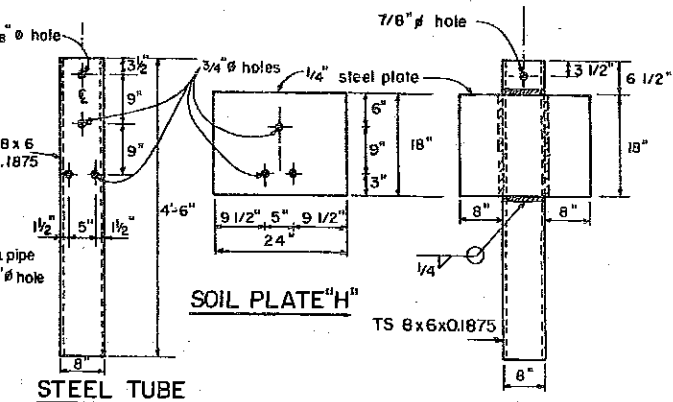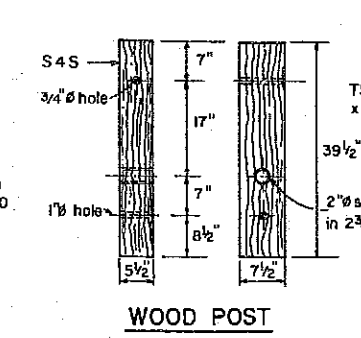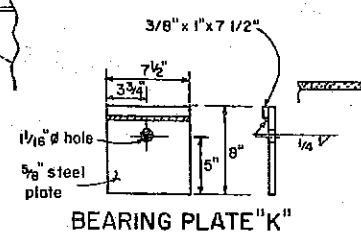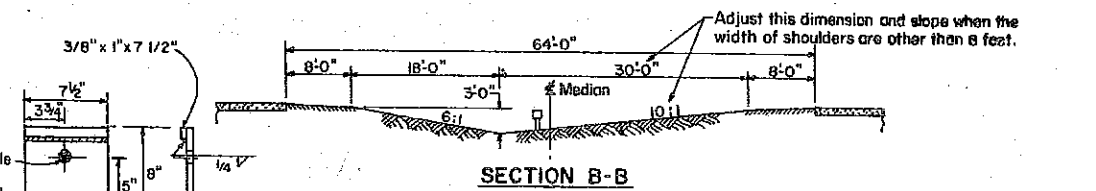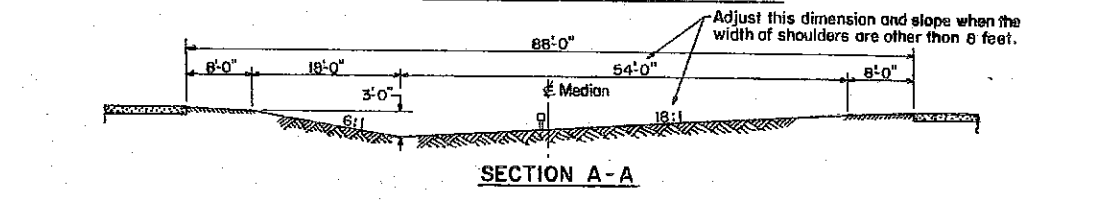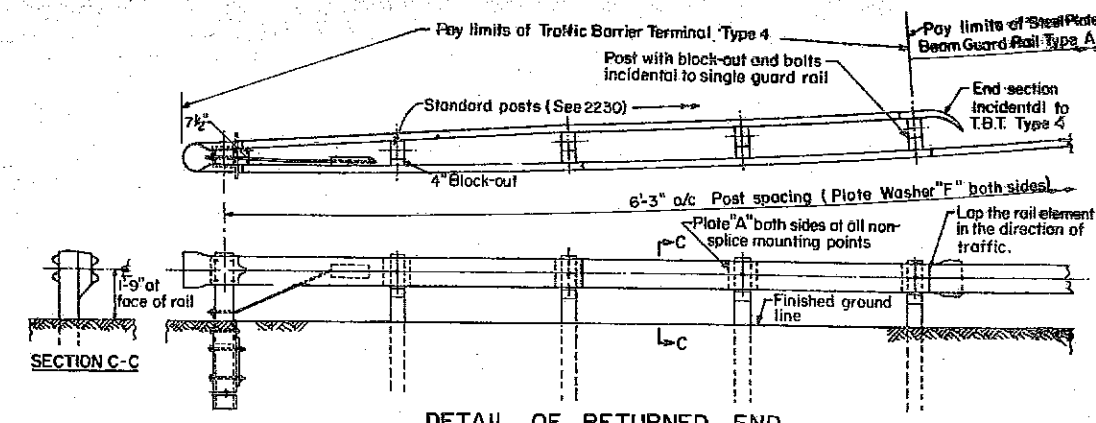

**GENERAL NOTES**

For details of Guardrail not shown, see Standard 2230.




When pavement is on a curved alignment, guardrail shall be approximately curved to match the alignment.

For dual structures that are 90°, or skewed left forward, the length of guardrail shown is appropriate.

\* For dual structures skewed right forward the structures for a distance equal to dimension Z. Appropriate adjustments to the length of the Type A Guardrail and its offsets (Y) shall be calculated and used. All additional lengths of guardrail shall be in increments of 12'-6".

All steel parts shall be galvanized after fabrication.

The wood posts shall be treated and conform to the requirements of Article 711.06 of the Standard Specifications.

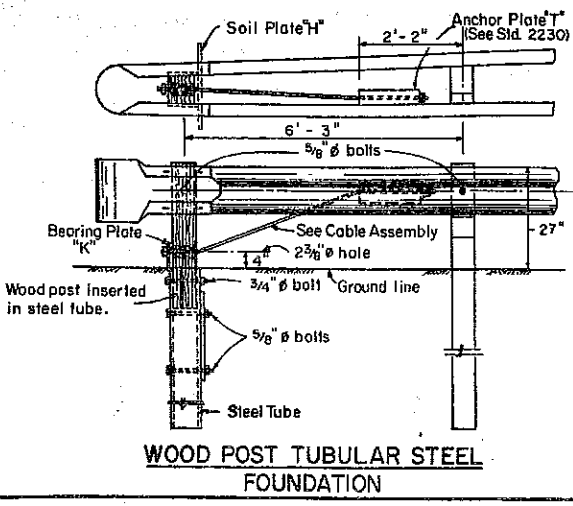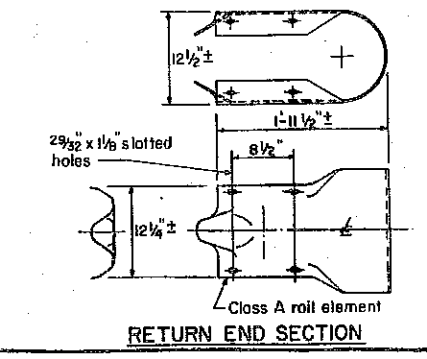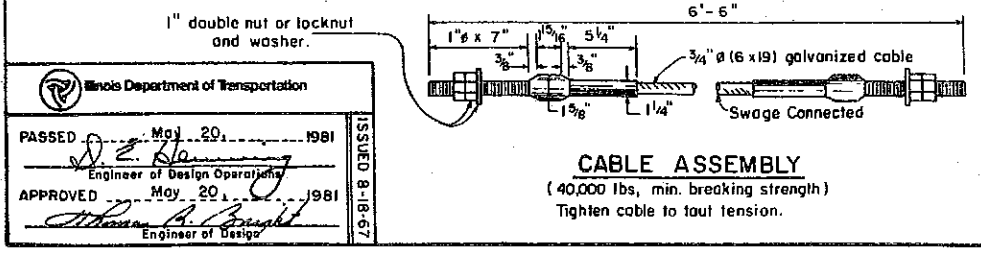

**TRAFFIC BARRIER TERMINAL TYPE 4**

**STANDARD 2339-2**

(Full Size)

Illinois Department of Transportation


PASSED May 20, 1981

APPROVED May 20, 1981


ISSUED 8-18-67

Engineer of Design




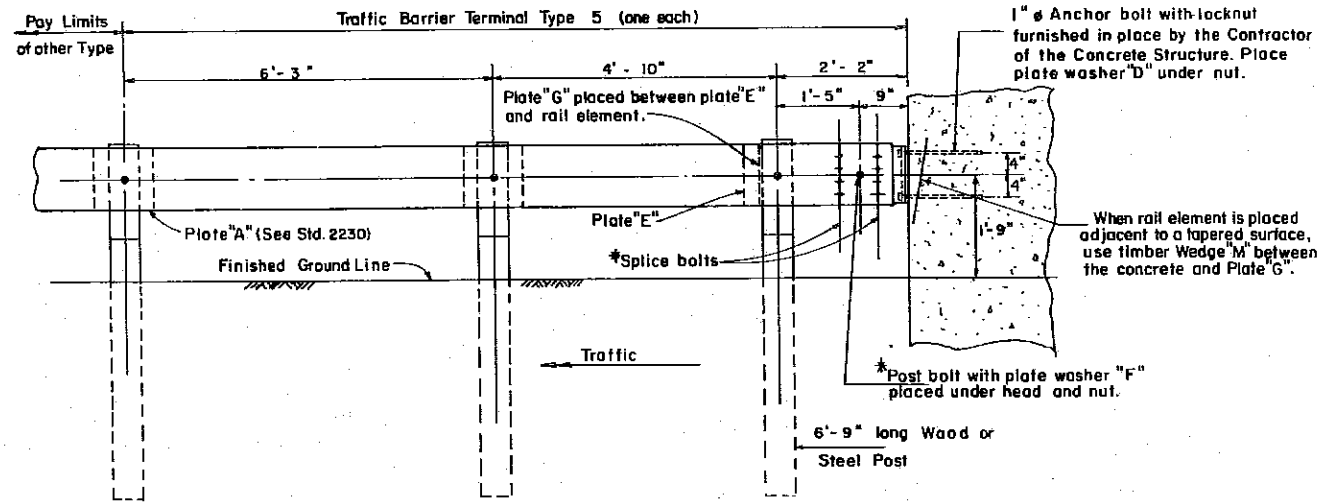


**TRAFFIC BARRIER TERMINAL TYPE 5**  
**ANCHORING RAIL ELEMENT TO CONCRETE BRIDGE PARAPET**

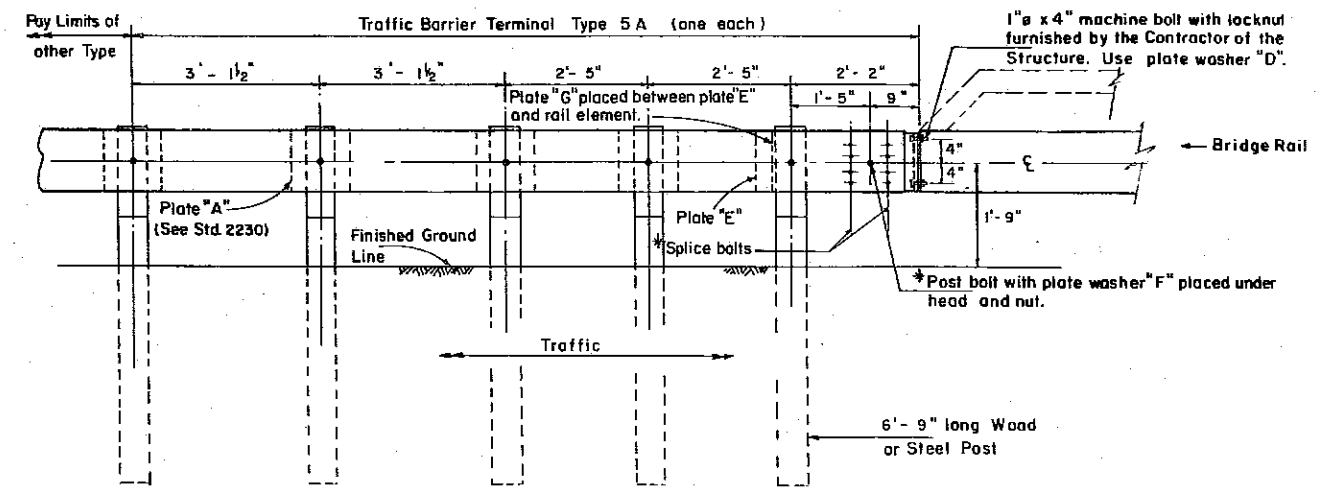


**TRAFFIC BARRIER TERMINAL TYPE 5A**  
**ANCHORING RAIL ELEMENT TO TYPE "S", "S-I", "T" or "T-I" BRIDGE RAIL**

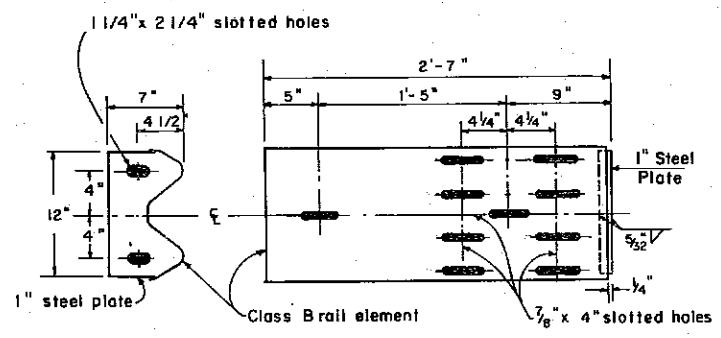


**PLATE "G"**

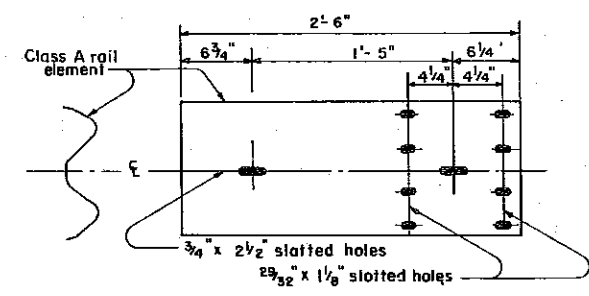



**PLATE "E"**

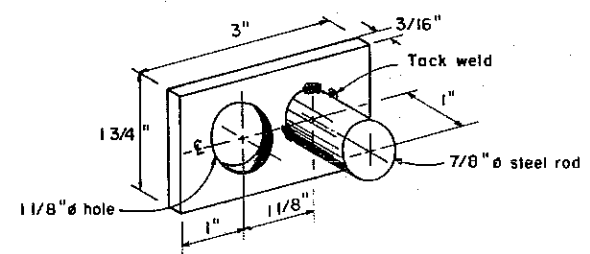

**PLATE WASHER "D"**

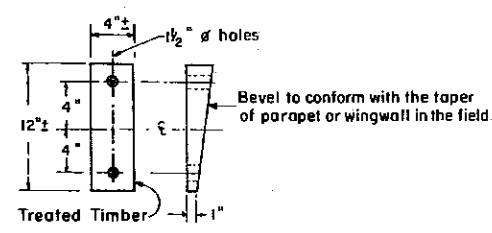

**WEDGE "M"**

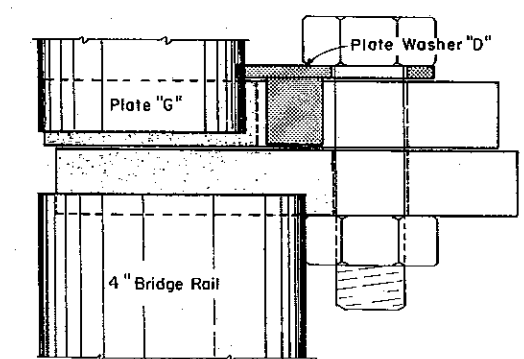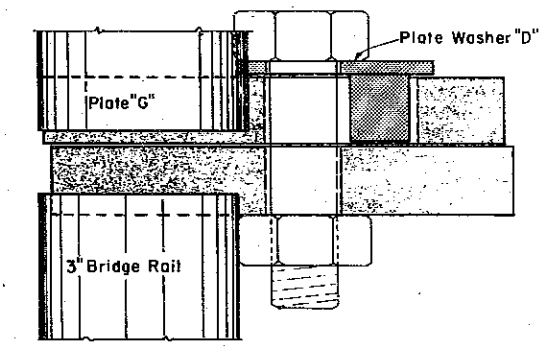

**ORIENTATION OF PLATE WASHER "D"**  
 ( Top View )

**NOTES:**

Install the face of the guardrail flush with the face of the bridge rail or parapet. Install plate washer "D" so that the 1" projection fills the remainder of the slotted holes in the 1" end plate on plate "G" after the 1" diameter bolts are in place.

\*Bolts shall be provided with lock nut or double nut and shall be tightened only to a point that will allow plate "G" to be free to move when an expansion joint exists below the connector.

See Standard 2230 for details of guardrail not shown.




Illinois Department of Transportation

PASSED June 20, 1984  
*John Ebersole*  
 Engineer of Policy and Procedures

APPROVED June 20, 1984  
*John Ebersole*  
 Engineer of Design

**TRAFFIC BARRIER TERMINAL**  
**TYPE 5 & 5A**

**STANDARD 2340 - 4**

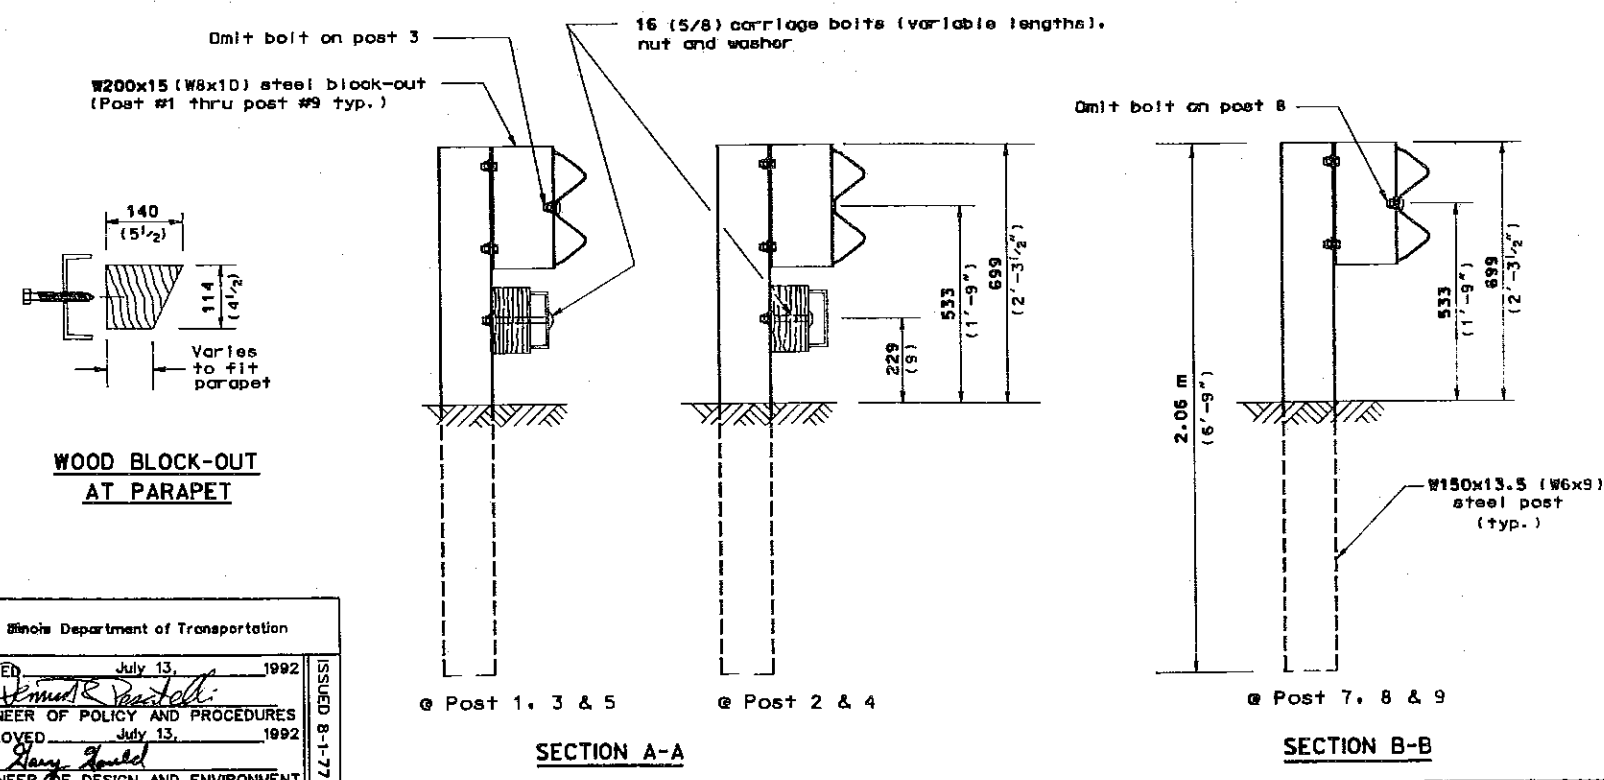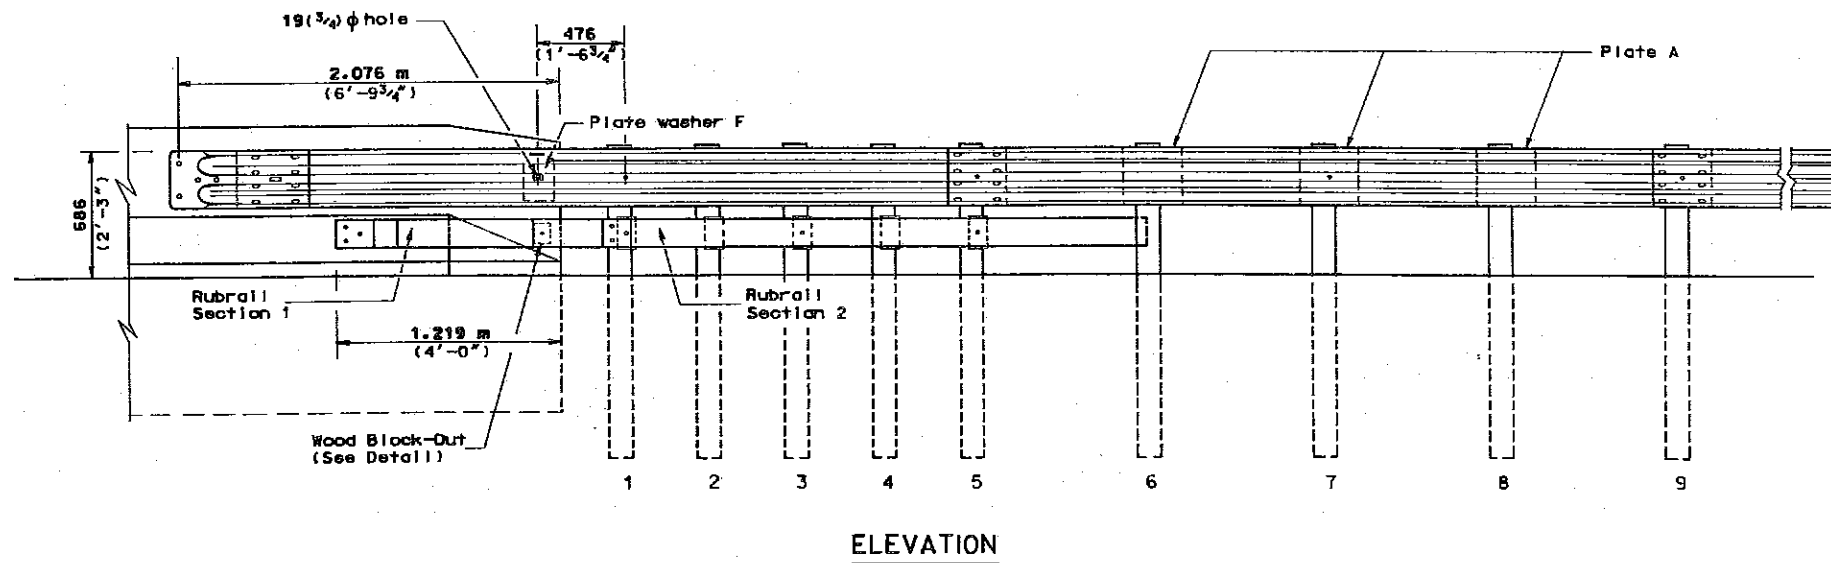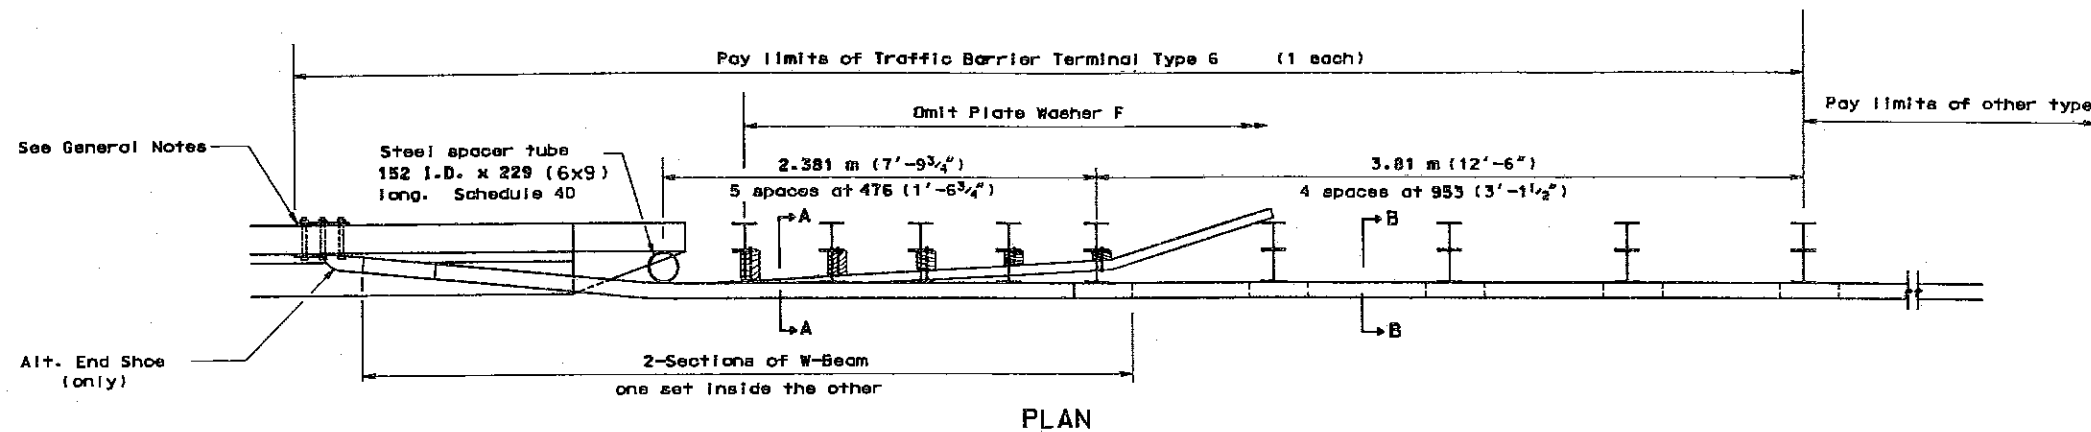

**GENERAL NOTES**

See Standard 2230 for details of guardrail not shown.

Rubrail Sections and the Bearing Plate shall conform to the requirements of AASHTO M-183. They shall be galvanized after fabrication in accordance with AASHTO M-111.

The Rubrail shall be fastened to the parapet/support by three 16x152 mm (5/8"x6") long hex bolts with 16 mm (5/8") expansion anchors or other approved cast-in-place insert devices.

The End Shoe shall be fastened to the parapet/support by four 22x152 mm (7/8"x6") long hex bolts conforming to AASHTO M164M or M164 with approved 22 mm (7/8") cast-in-place insert devices. An alternate method which uses thru-drilled holes with 16 mm (5/8") bearing plate may also be used.

Steel Spacer Tube shall be galvanized in accordance with Article 710.33(b)(1) of the Standard Specifications.

The Wood Block-Out shall be treated in accordance with Article 711.12 of the Standard Specifications.

All dimensions are in millimeters (inches) unless otherwise noted.

Illinois Department of Transportation

PASSED July 13, 1992

ENGINEER OF POLICY AND PROCEDURES

APPROVED July 13, 1992


ENGINEER OF DESIGN AND ENVIRONMENT

ISSUED 8-1-77


TRAFFIC BARRIER  
TERMINAL TYPE 6

Sheet 1 of 2


STANDARD 234I-5

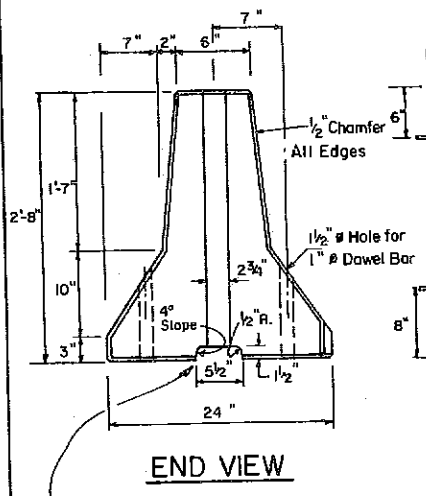


**END VIEW**

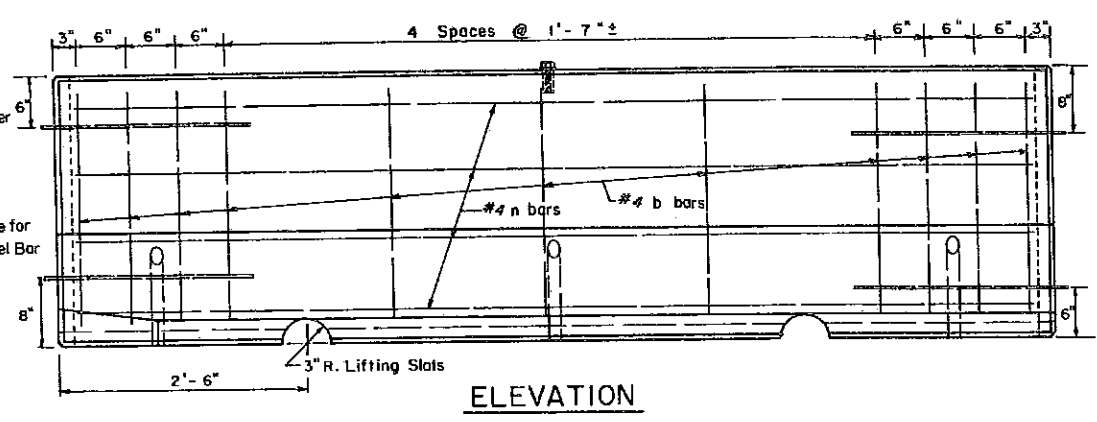


**ELEVATION**

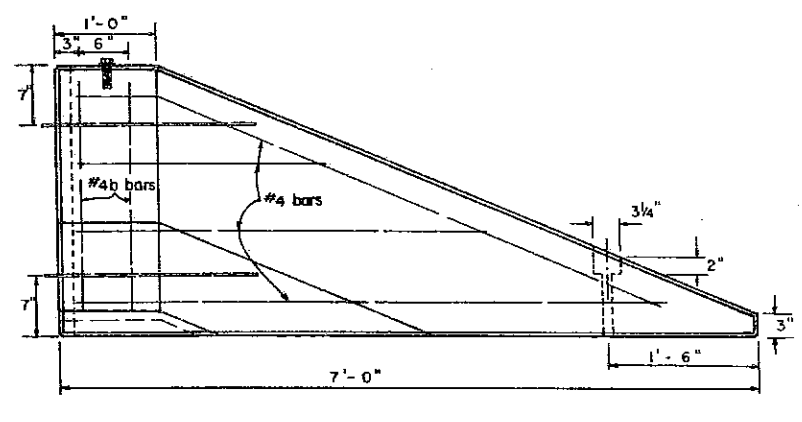


**TERMINAL SECTION**

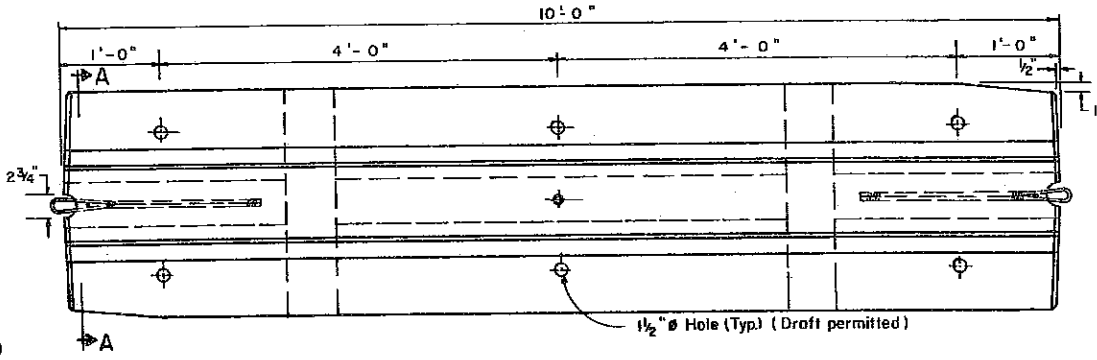


**PLAN**

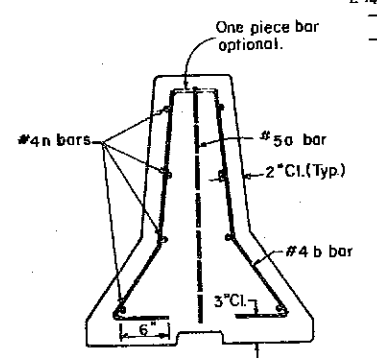


**SECTION A-A**  
(Showing Bar Reinforcement)

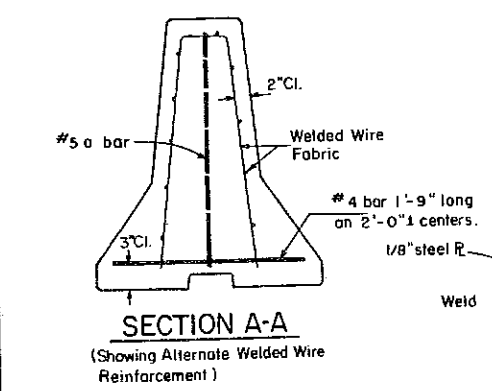


**SECTION A-A**  
(Showing Alternate Welded Wire Reinforcement)

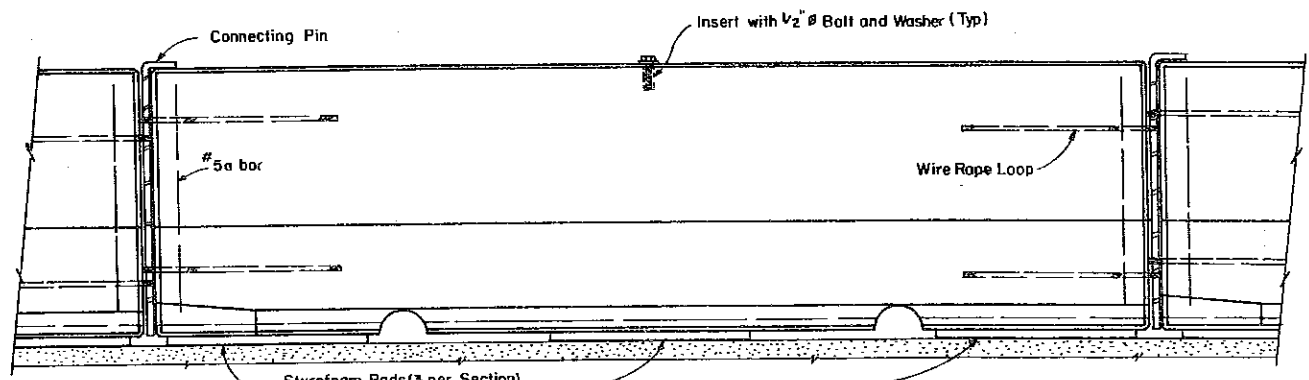


**TYPICAL INSTALLATION WITH STYROFOAM PADS**

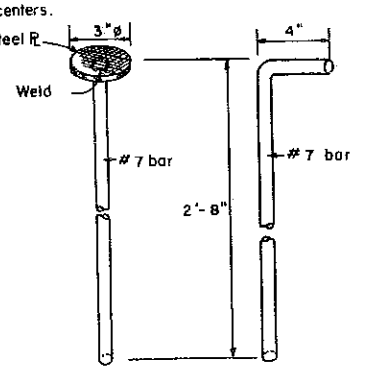

**ALTERNATE CONNECTING PINS**

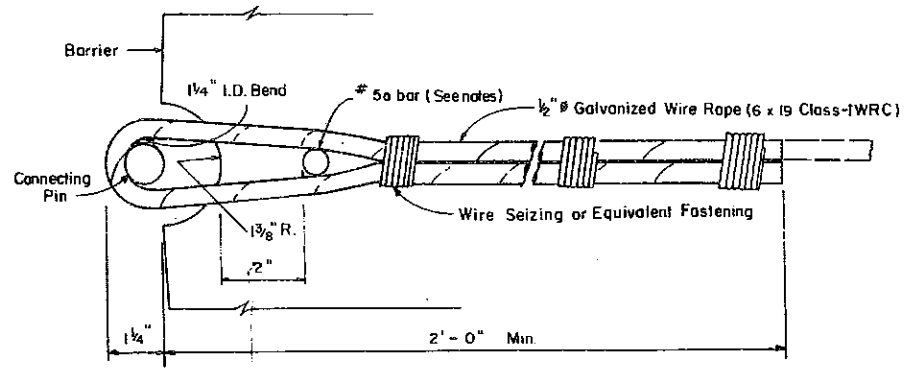

**WIRE ROPE LOOP DETAIL**  
(20,000 lbs. min. breaking strength)

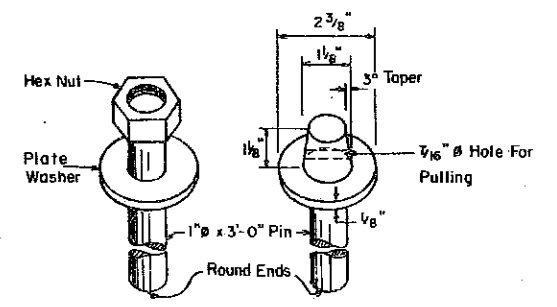

**ALTERNATE DRIFT PINS**

*Design Notes will not appear in the contract plans.*

**GENERAL NOTES**

Barrier units shall be pinned one to another in continuous smooth line at the exact locations provided by the Engineer.

The wall units shall be reinforced with either bar reinforcement or welded wire fabric. Welded Wire Fabric shall be 6x6-W4xW4, weighing approximately 58lbs. per 100 sq. ft., conforming to the requirements of AASHTO M-55.

Barrier units placed on rigid pavement or median surfaces shall be seated with styrofoam pads. Units placed on flexible pavement or shoulders shall be secured with dowel bars. Dowel bars shall be one inch in diameter, at least 12 inches long, shall be embedded at least 8 inches into base material, and shall not project above the outer surface of the barrier. After pin removal all holes in the base shall be grout filled.

Alternate lifting devices meeting the approval of the Engineer may be substituted for the lifting slats shown.

When the Terminal Section is used, the hex nut on the drift pin shall be threaded half way onto the pin and tack welded, or a coupling nut tightened sufficiently to prevent loosening may be used. Fill nut with grease to exclude contaminants.

Inserts for 1/2 inch bolts shall be capable of 3000 lbs. pull out strength and shall be furnished with a galvanized bolt and washer.

The #5 bar may be omitted if 2 continuous wire ropes are substituted for the 4 wire rope loops shown. The continuous ropes shall be looped and fastened on each end as shown in the wire rope loop detail.



The Contractor shall have the option to furnish Barrier with or without the longitudinal keyway unless otherwise specified.

Illinois Department of Transportation  
 PASSED Oct. 22 1991  
 John E. ...  
 Engineer of Policy and Procedures  
 APPROVED Oct. 22 1991  
 ...  
 Engineer of Design

**TEMPORARY CONCRETE BARRIER**  
**STANDARD 2383 - 3**  
 (Full Size) D.W.W. Sr.

Not to scale



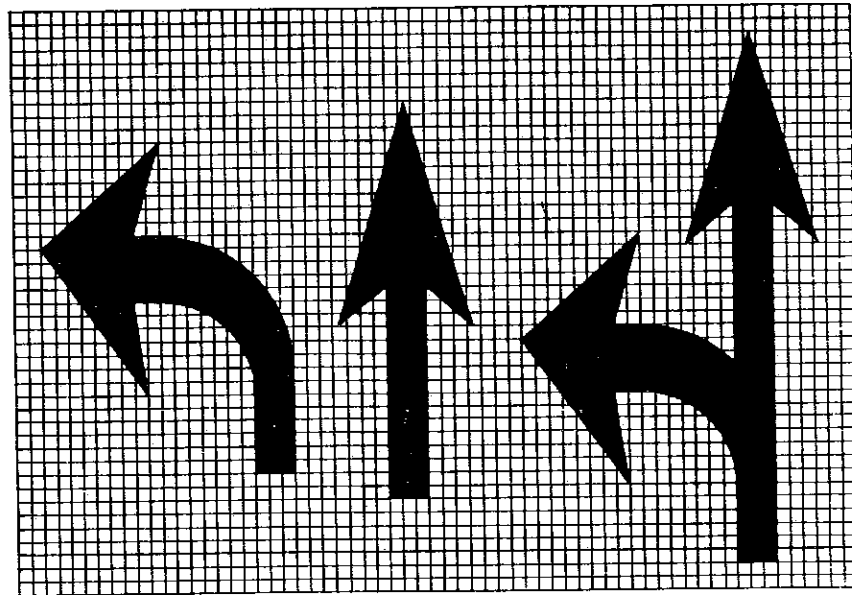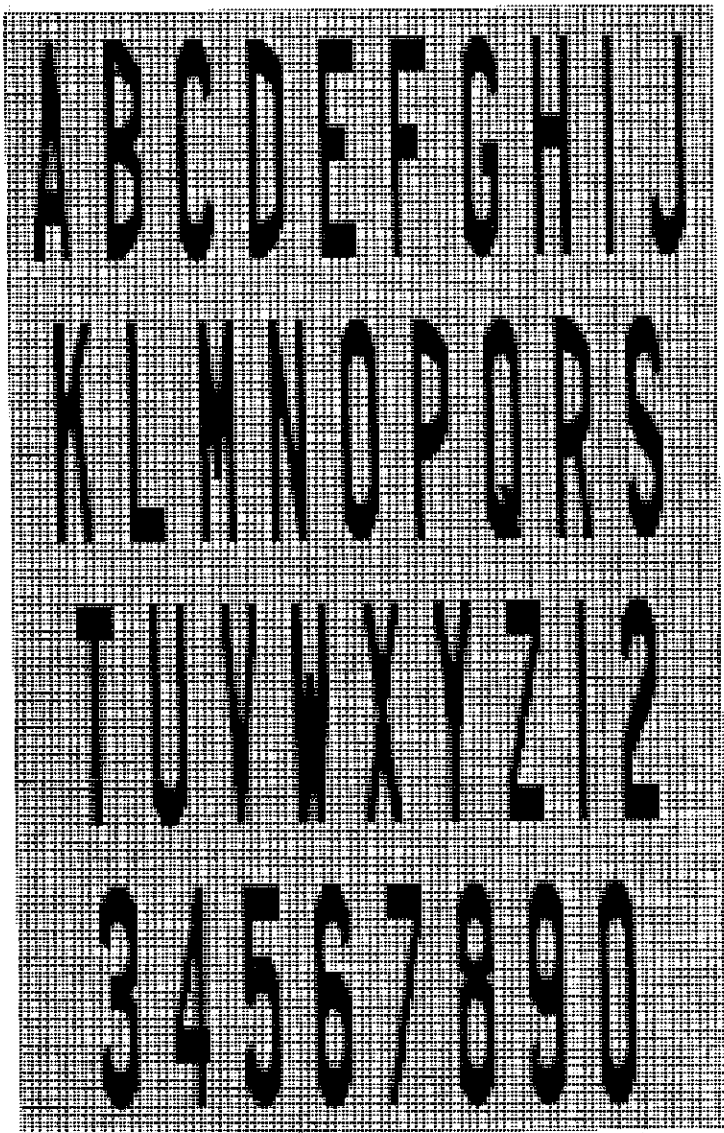


Legend Height	Arrow Size	a
6'	Small	2.9'
8'	Large	3.8"



The space between adjacent letters or numerals should be approximately 3 inches for 6 foot legend and 4 inches for 8 foot legend.

LETTER AND ARROW GRID SCALE

TYPICAL WORD AND ARROW LAYOUT

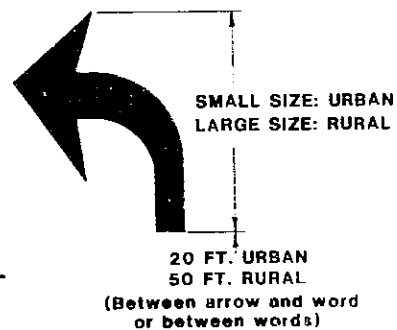


FREEWAY ARROW

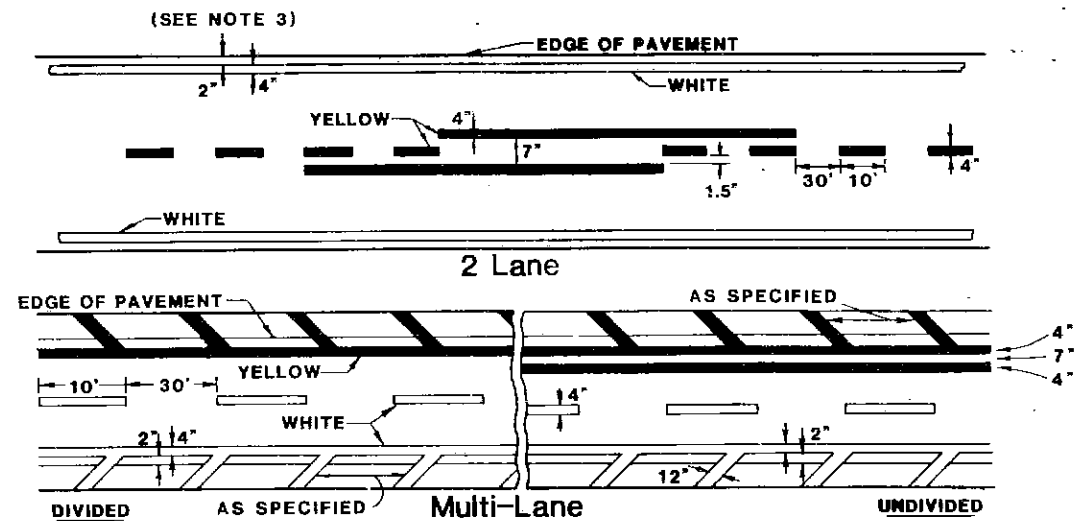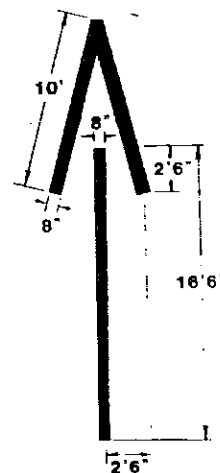


TYPICAL LANE AND EDGE LINES

NOTES:

1. Diagonals shall be used only where specified in the plans.
2. Unless directed by the Engineer, lines shall not be laid directly over a longitudinal crack or joint nor over a tar or asphalt painted line. The edge of a center line or lane line shall be offset a minimum of two inches from a longitudinal crack or joint.
3. Edge lines shall be placed on the shoulder, 2 inches from the edge of pavement when specified in the plans.

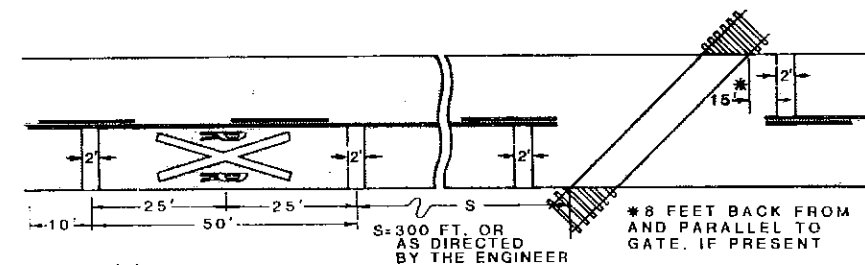

8' 0" OR AS DIRECTED BY THE ENGINEER

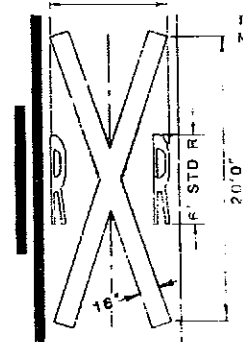


THE TRANSVERSE SPREAD OF THE 'X' MAY VARY ACCORDING TO LANE WIDTH.

On multi-lane roads, the stop lines shall extend across the right-hand lanes only to the center line and separate RXR symbols shall be placed adjacent to each other in each lane.

STANDARD PAVEMENT MARKINGS AT RAILROAD-HIGHWAY GRADE CROSSING

TYPICAL PAVEMENT MARKINGS  
STANDARD 2396

Illinois Department of Transportation  
Approved 4-3-85  
R. W. Jones  
Engineer of Traffic  
Issued 4-3-85

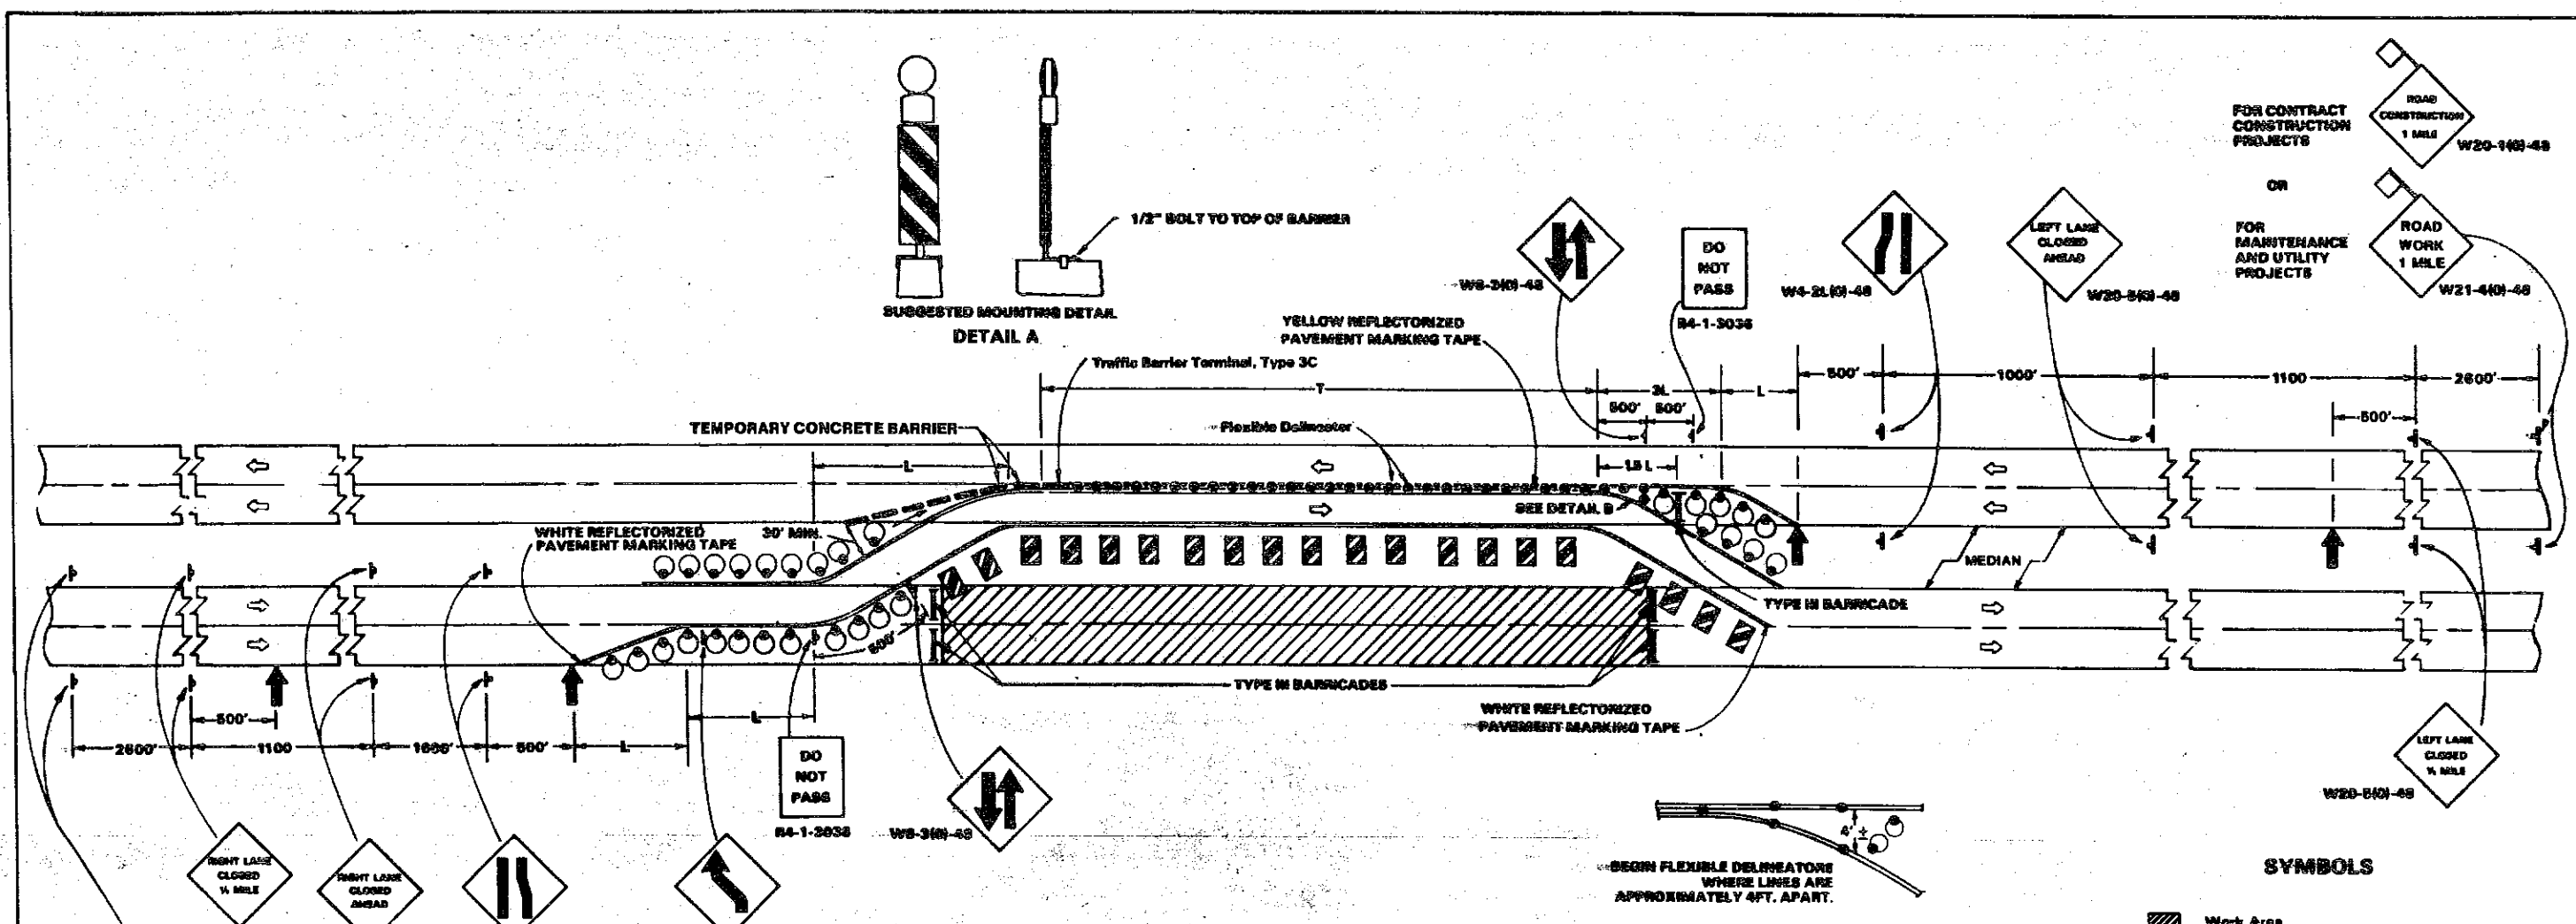

FOR CONTRACT CONSTRUCTION PROJECTS  
ROAD CONSTRUCTION 1 MILE W20-140-48

OR

FOR MAINTENANCE AND UTILITY PROJECTS  
ROAD WORK 1 MILE W21-410-48

RIGHT LANE CLOSED 1/4 MILE W20-510-48

RIGHT LANE CLOSED AHEAD W20-510-48

W4-2R0-48

DO NOT PASS R4-1-3038

WS-310-48

W1-410-48

XX 55 MPH W13-100-2424

W21-410-48 ROAD WORK 1 MILE FOR MAINTENANCE AND UTILITY PROJECTS

OR

W20-110-48 ROAD CONSTRUCTION 1 MILE FOR CONTRACT CONSTRUCTION PROJECTS


**GENERAL NOTES**

1. Reflective, solid edge lines and a double yellow center-line shall be used when the closure time exceeds four days or when the normal posted speed outside the area of operations exceeds 50 miles per hour. ReflectORIZED pavement marking tape shall be used for marking the edge lines and center line on existing pavement. Either tape or reflectORIZED pavement markers at 25 ft. centers shall also be installed to provide additional delineation. All existing pavement markings which conflict with the revised traffic pattern shall be removed.
2. Two-Way Traffic sign(s) shall be repeated every one-quarter mile in each direction through the tangent distance.
3. All drums and vertical panels shall be at 50 ft. centers. Where the tangent distance "T" on the temporary runaround exceeds 800 ft., clear delineators at 50 ft. centers may be substituted for the vertical panels, or spacing between vertical panels may be increased to 100 ft. within the limits of the tangent.
4. Cones may be substituted for drums or flexible delineators at half the spacing during day operations. On fully access-controlled facilities, cones shall be a minimum of 28 in. in height.
5. ReflectORIZED flexible delineators are to be attached to the pavement at 50 ft. centers for the first 250 feet at each end of "T", and at 100 ft. centers throughout the remainder of "T".
6. The impact attenuator shall be positioned so as not to encroach onto the outer lane. Vertical panels (See detail A) shall be attached to the concrete barriers where available space prohibits use of drums.

7. The speed limit to be shown on the advisory speed plate shall be 10 miles per hour below the normal posted speed limit or 45 MPH, whichever is less. The signs shall not be used where the normal posted speed limit is less than 45 miles per hour.
8. A curve sign will be required 500 ft. in advance of the exit and of the runarounds if "T" is equal to or greater than 1,000 feet.
9. The "L" distance equals the lane width times the taper ratio.

Normal Posted Speed	Taper Ratio
m.p.h.	ft./ft.
65	65/1
55	55/1
50	50/1
45 or less	45/1

10. Signs mounted in the median may be omitted when the median is less than 10 feet wide. Arrow boards mounted in the median may be omitted when the median is less than 20 feet wide.
11. Steady burning lights will not be required on drums for day operations. All drum lights shall be monodirectional.
12. All signs shall be post mounted if the closure time exceeds four days.
13. Flashing lights shall be used on each approach in advance of the work area during hours of darkness and installed above the first two signs in each series.
14. Longitudinal dimensions may be adjusted to fit field conditions.
15. Form BT 725 is required.

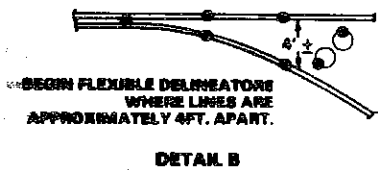

**SYMBOLS**

- Work Area
- Sign on Portable or Permanent Support
- Barricade
- Drum with Steady Burning Light
- Vertical Panel
- Arrow Board
- 18 in. X 18 in. (minimum) Orange Flag
- Flexible Delineator
- Temporary Concrete Barrier

**TYPICAL APPLICATION OF TRAFFIC CONTROL DEVICES  
HIGHWAY CONSTRUCTION AND CONTRACT MAINTENANCE**

**MULTILANE, DIVIDED, RURAL DAY OR NIGHT OPERATIONS**

Where at any time, any vehicle, equipment, workers or their activities require the closure of two adjacent lanes and a temporary crossover is provided by making use of one lane of pavement normally used by the opposing flow of traffic and positive barrier is used in the transition to separate the opposing traffic.

**STANDARD 2417-2**


Illinois Department of Transportation

Approved 21 March 1989


*R. H. Jones*  
Engineer of Traffic

DESIGN PRINTS

### SEDIMENT BASIN

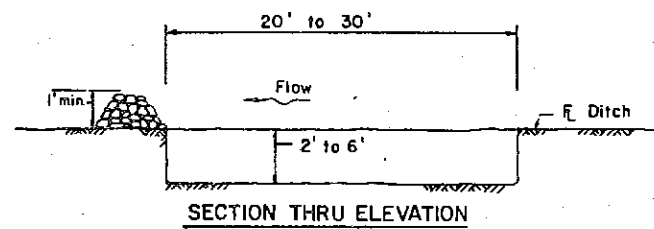



The performance of the basin will improve if put into a series.

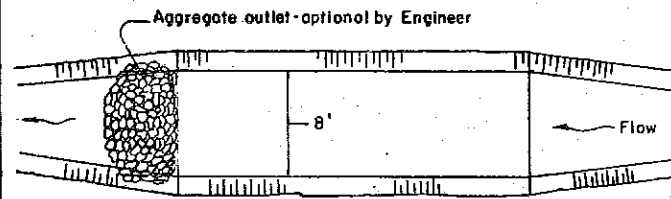

PLAN VIEW


The long dimension should be parallel with the direction of the flow. Accumulated silt shall be removed anytime the basins become 75% filled.

### HAY OR STRAW DITCH CHECK

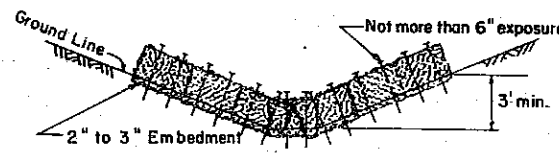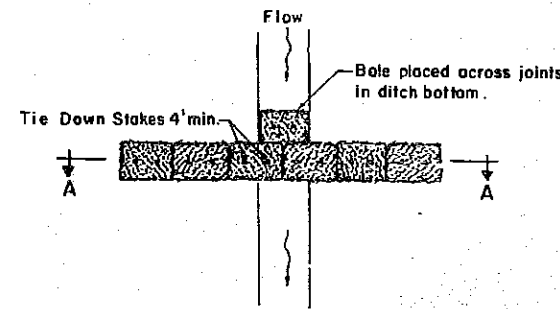


SECTION A-A

### HAY OR STRAW DITCH CHECK - TWO BALES HIGH

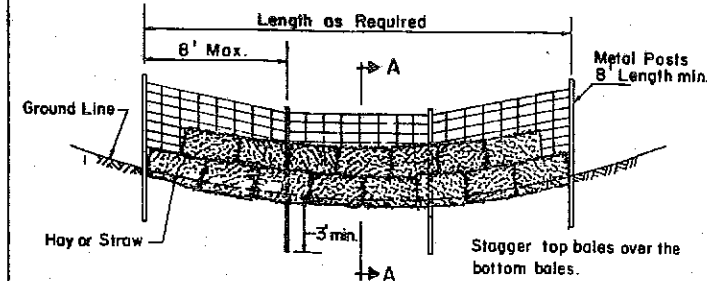


ELEVATION VIEW

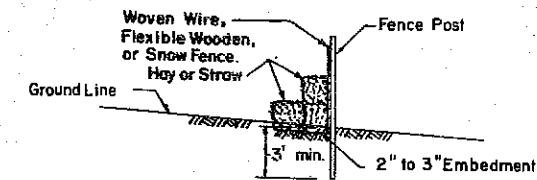


SECTION A-A

### HAY OR STRAW EROSION CHECK STONE OUTLETS

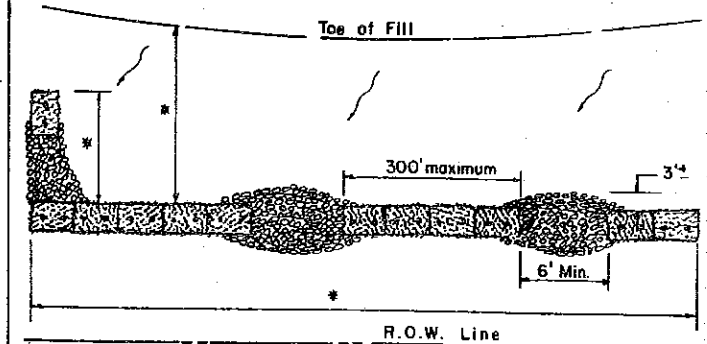


PLAN VIEW

\* To be constructed as required

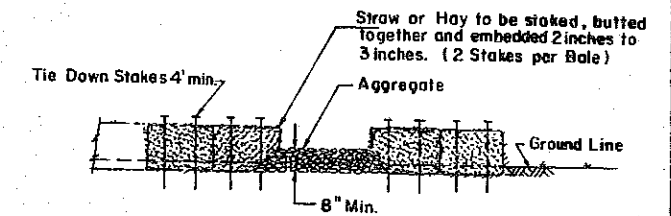


ELEVATION

### TEMPORARY DITCHES FOR CUT & FILL SECTIONS

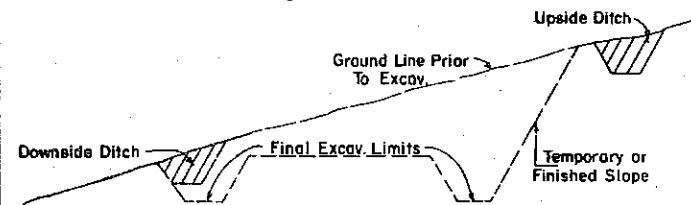

TYPICAL CUT CROSS SECTION

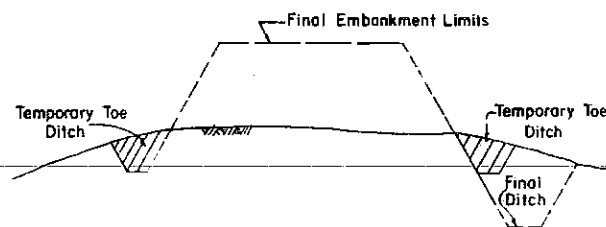

TYPICAL FILL CROSS SECTION

Temporary Ditches or the final ditch grades included in the plans shall be excavated at the earliest opportunity during construction in order to control runoff from the embankment or cut section per Art. 202.06 of the Standard Specifications. Some means of trapping siltation should be provided at the outflow of these ditch systems.


Missouri Department of Transportation

PASSED *[Signature]* May 6, 1979  
 Engineer of Design Operations

APPROVED *[Signature]* May 6, 1979  
 Engineer of Design


ISSUED 3-6-79

### AGGREGATE DITCH CHECK

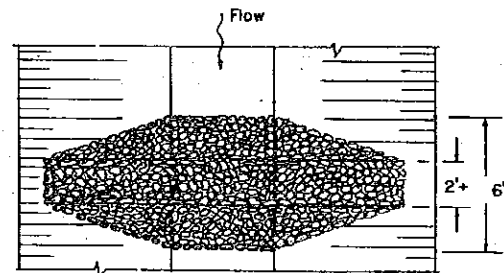


To be constructed by depositing material and shaping in a manner approved by the Engineer. If the ditch check is within the clear zone and the road is open to traffic, the traffic approach slope of the aggregate shall be graded to 4:1.

### MULCH BARRIER

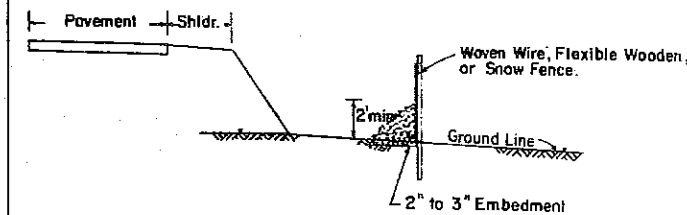

SIDE ELEVATION VIEW

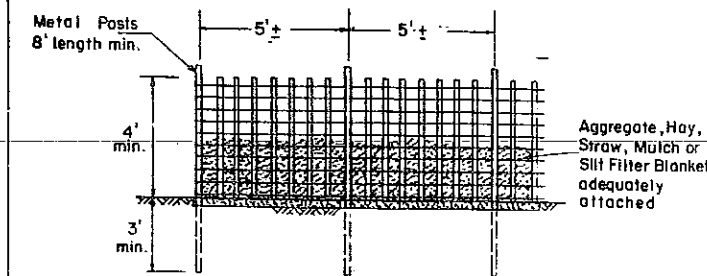

FRONT ELEVATION VIEW

### GENERAL NOTES

Actual configuration and location of Temporary Erosion Control Systems shall be as shown on the plans or as directed by the Engineer.

Ditch Checks and Sediment Basins should be constructed at appropriate intervals along the waterway to be effective.

Where more than one row of bales are used, stagger bales to cover joints.

Where bales are shown staked, a minimum of two stakes per bale shall be used.

The Temporary Erosion Control Systems installed by the Contractor shall be properly maintained as directed by the Engineer to control siltation at all times during the life of the contract.

All salvageable temporary erosion control items shall be removed and become the property of the Contractor at the completion of the contract.

Existing R.O.W. fence may be utilized if such location is desired with use of Mulch Barrier or Hay or Straw Ditch Check - Two Bales High.

## TEMPORARY EROSION CONTROL SYSTEMS

## STANDARD 2381