	CODE NUMBER	PAY ITEM	UNIT	TOTAL QUANTITY	I 000 - 2A 100% STATE
	31100100	SUB-BASE GRANULAR MATERIAL, TYPE A	TON	294.00	294.00
	~~~~		. ,	9 194	
$\triangle$	(40600200	BITUMINOUS MATERIALS (PRIME COAT)	TON	21.50	21.50
	40600300	AGGREGATE (PRIME COAT)	TON	57.00	57.00
-	40600555	LEVELING BINDER (HAND METHOD), N105	TON	208. 10	208.10
$\triangle$	40600 <b>6</b> 55	LEVELING BINDER (MACHINE METHOD), N105	TON	2, 144. 00	2, 144. 00
	40600895	CONSTRUCTING TEST STRIP	EACH	1.00	1.00
	40600982	HOT-MIX ASPHALT SURFACE REMOVAL - BUTT JOINT	SQ YD	432.00	432.00
_	40600985	PORTLAND CEMENT CONCRETE SURFACE REMOVAL - BUTT JOINT	SQ YD	134.00	134.00
-	40600990	TEMPORARY RAMP	SQ YD	2173.00	2,173.00
$\triangle$	40603375	- 3HOT-MIX ASPHALT SURFACE COURSE, MIX "E", N105	TON	3,441.0	3, 441. 0
	44000155	HOT-MIX ASPHALT SURFACE REMOVAL, 1 1/2"	SQ YD	4,879.00	4,879.00
-	44201843	CLASS D PATCHES, TYPE III, 16 INCH	SQ YD	100.00	100.00
	44201845	CLASS D PATCHES, TYPE IV, 16 INCH	SQ YD	331.00	331.00
				7	
	60300105	FRAMES AND GRATES TO BE ADJUSTED	EACH	1.00	1.00
-	64200105	SHOULDER RUMBLE STRIP	FOOT	13, 245, 00	13, 245. 00
	67100100	MOBILIZATION	L SUM	1.00	1.00
	70100420	TRAFFIC CONTROL AND PROTECTION, STANDARD 701411	EACH	7.00	7.00

A REVISED 7-23-08

FILE NAME =	USER NAME = grantpm	DESIGNED -	REVISED -								F.A.I. RTE.	SECTION	COUNTY	TOTAL SHEET SHEETS NO.
P:\1-80 resurfovr.dgn		DRAWN -	REVISED -	STATE OF ILLINOIS		S	UMMAF	RY OF O	UANTITIES		80	*	ROCK ISLAN	VD 31 3
	PLOT SCALE = 50.000 ' / IN.	CHECKED -	REVISED -	DEPARTMENT OF TRANSPORTATION										T NO. 64D34
	PLOT DATE = Thu May 15 11:05:58 2008	DATE -	REVISED -		SCALE:	SHEET NO.	OF	SHEETS	STA.	TO STA.	FED. ROAD DIST.	NO. ILLINOIS FED.		- 1101 0 100 1

### **GENERAL NOTES**

All Borrow/Waste/Use sites must be approved by the Department prior to removing any material from the project or initiating any earthmoving activities, including temporary stockpiling outside the limits of construction.

Previously pugmilled stockpiles of "Type A" older than 1 month will not be approved for use until a moisture check is run to verify moisture content. Material shipped to projects without being tested will not be accepted.

When laying out for patching, the minimum distance between new patches (saw cut to saw cut) shall be 4.6 m (15 feet). When patch spacing is less than 4.6 m (15 feet), the pavement between patches shall also be removed and replaced.

Milling machines on this project shall be capable of removing a layer of bituminous a minimum 6' wide and 1-1/2 inches in depth in a single pass.

The following Mixture Requirements are applicable for this project:

Mixture Uses(s):		LEVEL	Partial Depth	
	SURFACE	BINDER	Patch	
PG:	PG 64-22	PG 64-22	PG 64-22	} <b>/</b>
Design Air Voids	4.0% @ N105	4.0% @ N105	4.0% @ N105	Canimati
Mixture Composition (Gradation Mixture)	IL 9.5 or 12.5	IL 9.5	IL 19.0	
Friction Aggregate	E	N/A	D	
20 Year ESAL	37.7	37.7	37.7	

The Contractor will be required to furnish 140 mm (5 1/2") high brass stencils as approved by the Engineer and install stationing at 250' intervals. Stationing shall be placed on both lanes of 2-lane highways and on the outside lanes in both directions on 4-lane highways. The stations shall be placed 150 mm (6") inside the pavement marking edge so they can be read from the shoulder. This work will be included in the cost of the final pavement surface.

Install rumble strips in all shoulders in accordance with State Standard 642001. Rumble Strips shall be placed on shoulders on both sides of the pavement.

Pavement Marking shall be done according to Standard 780001, except as follows:

- 1. All words, such as ONLY, shall be 2.4 m (8 feet) high.
- 2. All non-freeway arrows shall be the large size.
- 3. The distance between yellow no-passing lines shall be 200 mm (8"), not 180 mm (7") as shown in the detail of Typical Lane and Edge Lines.


Work on this project will be in progress at the same time as work on two adjacent projects (see Provisions). Work on these projects shall be scheduled to keep interference between all the projects to a minimum. The contractors shall inform each other of progress of the projects and give fair warning to the other contractors when a problem might be encountered.

CADD data will be available to Contractors and Consultants working on this project. This information will be provided upon request as MicroStation CADD files and Geopak coordinate geometry files <u>ONLY</u>. If data is required in other formats it will be your responsibility to make these conversions. If any discrepancy or inconsistency arises between the electronic data and the information on the hard copy, the information on the hard copy should be used. Contact the District's Project Engineer to request these files.

A REVISED 7-23-08

FILE NAME =	USER NAME = grontpm	DESIGNED -	REVISED -								F.A.I.	SECTION	COUNTY	TOTAL   SHEET
P:\1-80 resurfovr.dgn		DRAWN -	REVISED -	STATE OF ILLINOIS			GE	NERAL N	OTES		RTE.	3EC110H	DOCK TOLAN	SHEETS NO.
	PLOT SCALE = 50.000 ' / IN.	CHECKED -	REVISED -	DEPARTMENT OF TRANSPORTATION			<b>J.</b>				80	*	CONTRAC	T NO. 64D34
	PLOT DATE = Tue May 13 14:15:46 2008	DATE -	REVISED -		SCALE:	SHEET NO.	OF	SHEETS	STA.	TO STA.	FED. ROAD DIST.	NO. ILLINOIS FED.	AID PROJECT	1 110. 04054

STA 59+48 TO 89+25

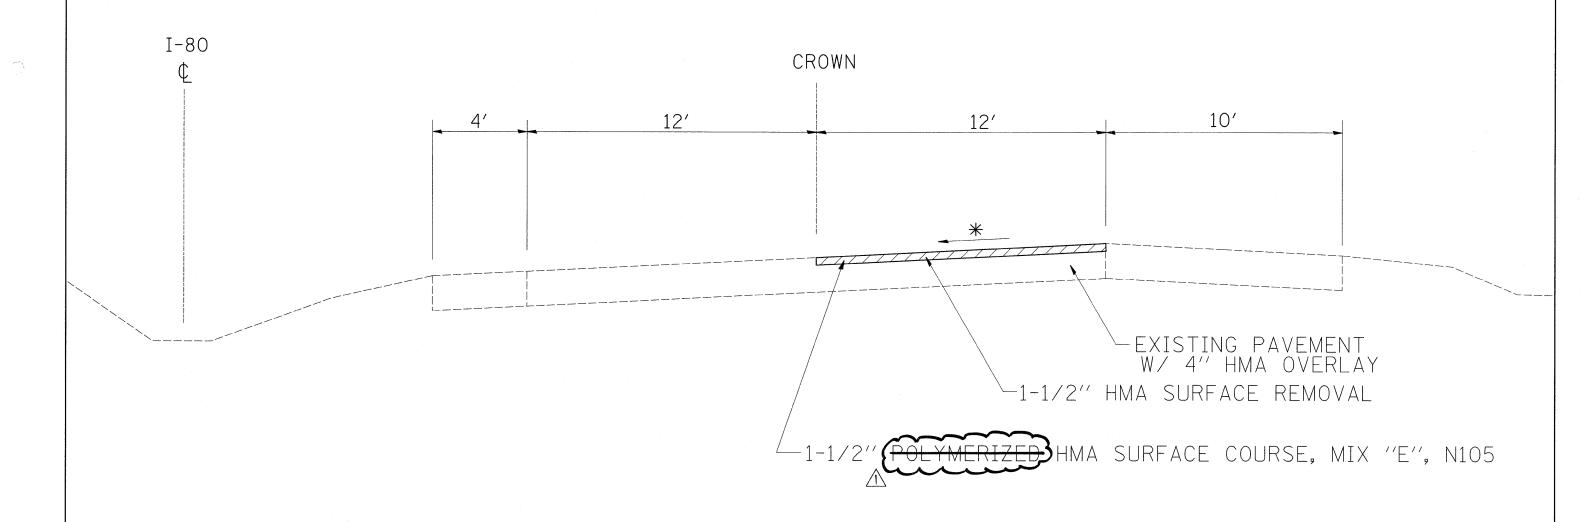

### BITUMINOUS APPLICATION RATES


SURFACE MIXTURES: 119 LB/SY-IN
OTHER BITUMINOUS MIXTURES: 112 LB/SY-IN
BITUMINOUS MATERIAL (PRIME COAT): 0.000286 TON/SY
AGGREGATE (PRIME COAT): 0.0015 TON/SY

* MAINTAIN EXISTING X-SLOPE

A REVISED 7-23-08

FILE NAME =	USER NAME = grantpm	DESIGNED -	REVISED -								F.A.I.	SECTION	COUNTY	TOTAL	SHEET
P:\1-80 resurfovr.dgn		DRAWN -	REVISED -	STATE OF ILLINOIS			TYPIC	CAL SEC	TIONS		RIE.	Ψ	DOCK TOLA	SHEETS	NO.
	PLOT SCALE = 50.000 ' / IN.	CHECKED ~	REVISED -	DEPARTMENT OF TRANSPORTATION							80	<b>*</b>	CONTRAC	CT NO. 64	4DZ4
	PLOT DATE = Thu May 15 11:03:28 2008	DATE -	REVISED -		SCALE:	SHEET NO.	OF	SHEETS	STA.	TO STA.	FED. ROAD DIS	T. NO. ILLINOIS F	D. AID PROJECT	CT NO. 64	4034

STA 89+25 TO 92+00

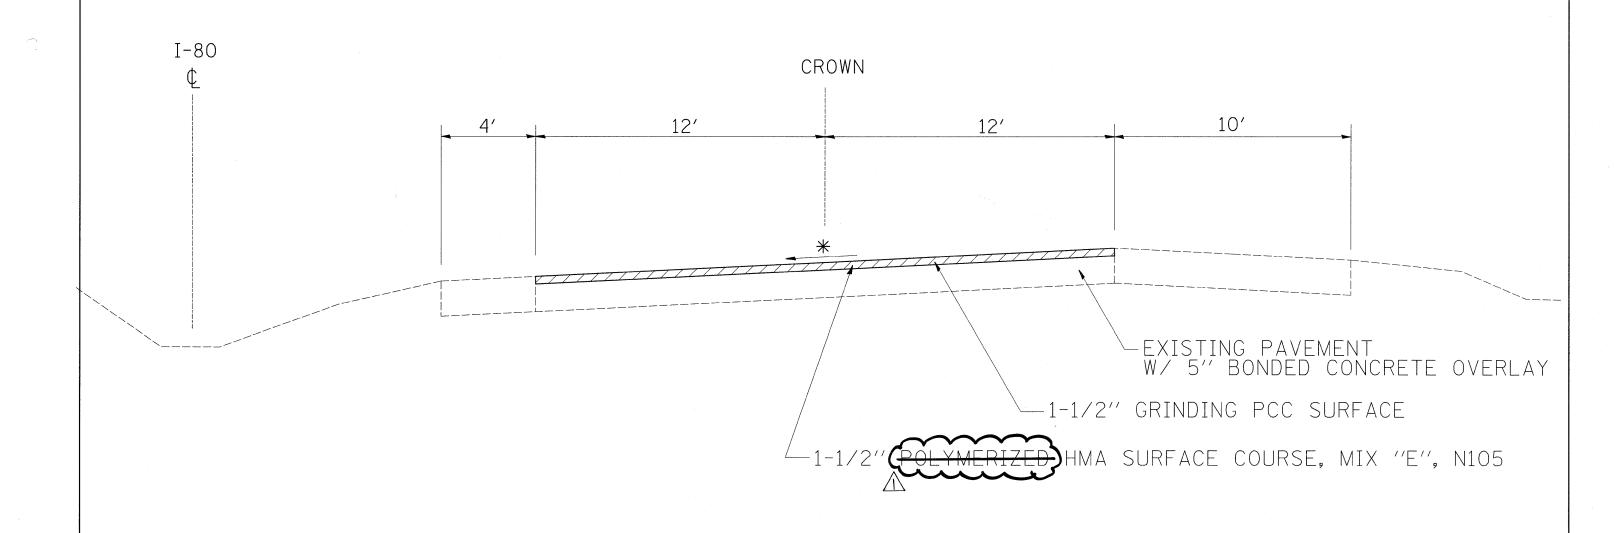

### BITUMINOUS APPLICATION RATES

SURFACE MIXTURES: 119 LB/SY-IN
OTHER BITUMINOUS MIXTURES: 112 LB/SY-IN
BITUMINOUS MATERIAL (PRIME COAT): 0.000286 TON/SY
AGGREGATE (PRIME COAT): 0.0015 TON/SY


* MAINTAIN EXISTING X-SLOPE X-SLOPE DESIRED 3/16 "/FT. MINIMUM 1/8 "/FT.

* D2 SPRING PATCHING 2007-2

A REVISED 7-23-08

FILE NAME = USER NAME = grantpm DESIGNED -REVISED REVISED STATE OF ILLINOIS TYPICAL SECTIONS P:\1-80 resurfovr.dgn DRAWN ROCK ISLAND 31 PLOT SCALE = 50.000 ' / IN. CHECKED -REVISED -**DEPARTMENT OF TRANSPORTATION** CONTRACT NO. 64D34 DATE REVISED SHEET NO. OF SHEETS STA.

STA 96+25 TO 177+75

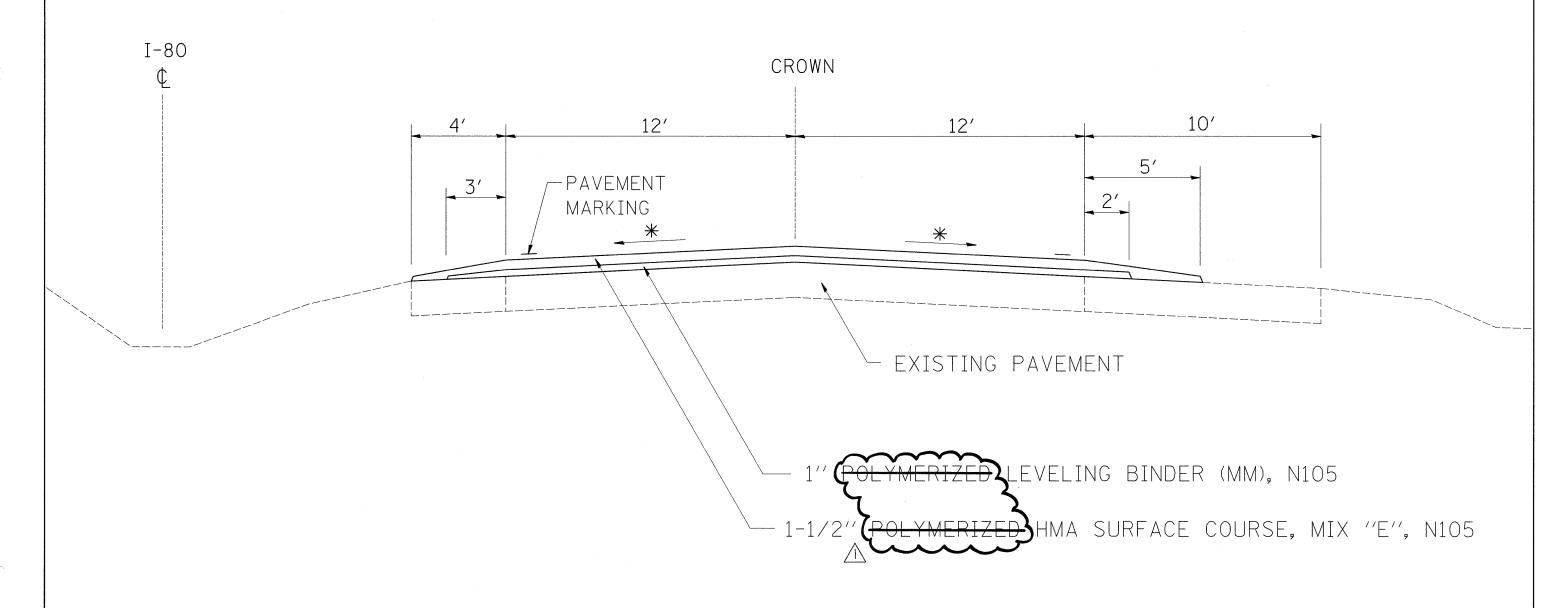

### BITUMINOUS APPLICATION RATES

SURFACE MIXTURES: 119 LB/SY-IN
OTHER BITUMINOUS MIXTURES: 112 LB/SY-IN
BITUMINOUS MATERIAL (PRIME COAT): 0.000286 TON/SY
AGGREGATE (PRIME COAT): 0.0015 TON/SY

* MAINTAIN EXISTING X-SLOPE X-SLOPE DESIRED 3/16 "/FT. MINIMUM 1/8 "/FT.

A REVISED 7-23-08

* D2 SPRING PATCHING 2007-2

FILE NAME =	USER NAME = grantpm	DESIGNED -	REVISED -	
P:\1-80 resurfovr.dgn		DRAWN -	REVISED -	
	PLOT SCALE = 50.000 ' / IN.	CHECKED -	REVISED -	
	PLOT DATE = Thu May 15 11:03:28 2008	DATE -	REVISED -	

STATE OF ILLINOIS DEPARTMENT OF TRANSPORTATION


 TYPICAL SECTIONS
 F.A.I. RECTION

 80
 *

 SCALE:
 SHEET NO. OF SHEETS STA. TO STA. FED. ROAD DIST. NO. | ILLINOIS FED. AI

### TYPICAL TAPER

STA 95+25 TO 96+25 STA 177+75 TO 178+75 (INTERSTATE)

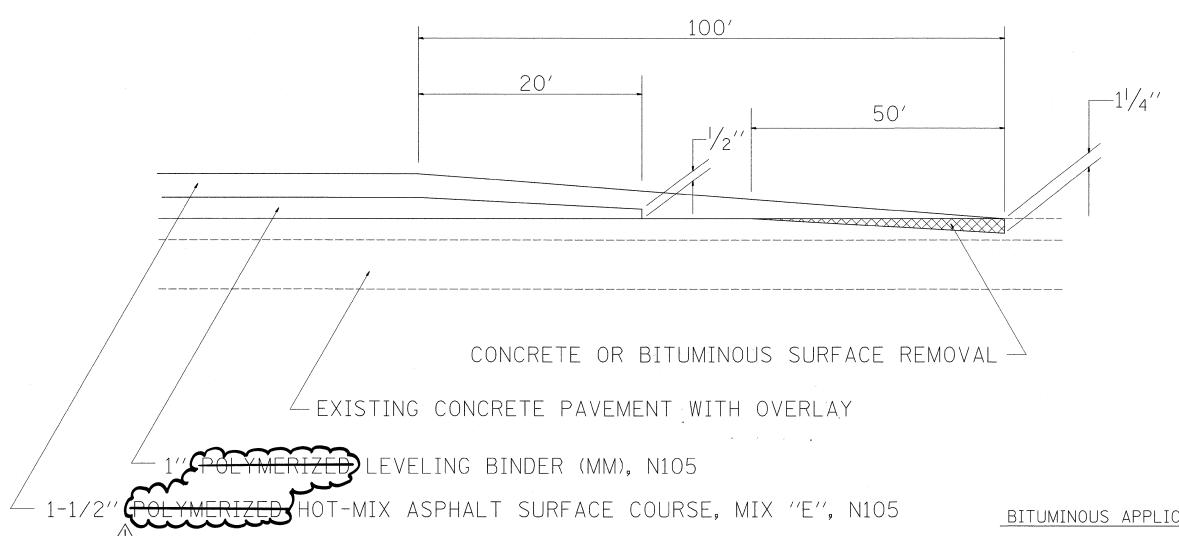

#### BITUMINOUS APPLICATION RATES


SURFACE MIXTURES: 119 LB/SY-IN OTHER BITUMINOUS MIXTURES: 112 LB/SY-IN BITUMINOUS MATERIAL (PRIME COAT): 0.000286 TON/SY AGGREGATE (PRIME COAT): 0.0015 TON/SY

↑ REVISED 7-23-08

Γ	FILE NAME =	USER NAME = grantpm	DESIGNED -	REVISED -					F.A.I.	SECTION	COUNTY	TOTAL SHEE	.T
- 1	P:\1-80 resurfovr.dgn		DRAWN	REVISED ~	STATE OF ILLINOIS		TYPICAL SECTIONS		80	*	ROCK ISLAND	31 9	-
- 1		PLOT SCALE = 50.000 ' / IN.	CHECKED -	REVISED -	DEPARTMENT OF TRANSPORTATION				J		CONTRACT	T NO. 64D34	4
Ĺ		PLOT DATE = Thu May 15 11:03:28 2008	DATE -	REVISED -		SCALE: SHEET NO.	OF SHEETS STA.	TO STA.	FED. ROAD DIST	. NO.   ILLINOIS   FEE			_

### TYPICAL TAPER

STA 130+49.24 TO 131+35.67 (WEIGH SCALE EXIT)

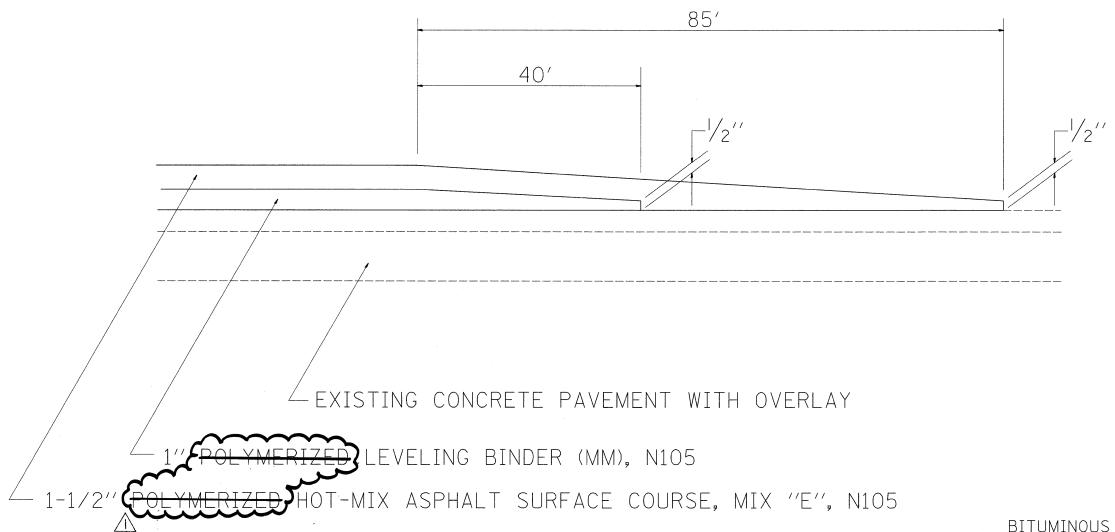

### BITUMINOUS APPLICATION RATES

SURFACE MIXTURES: 119 LB/SY-IN
OTHER BITUMINOUS MIXTURES: 112 LB/SY-IN
BITUMINOUS MATERIAL (PRIME COAT): 0.000286 TON/SY
AGGREGATE (PRIME COAT): 0.0015 TON/SY

AREVISED 7-23-08

* D2 SPRING PATCHING 2007-2

FILE NAME =	USER NAME = grantpm	DESIGNED -	REVISED -
P:\1-80 resurfovr.dgn		DRAWN -	REVISED -
	PLOT SCALE = 50.000 ' / IN.	CHECKED -	REVISĖD -
	PLOT DATE = Thu May 15 11:03:28 2008	DATE -	REVISED -


STATE OF ILLINOIS
DEPARTMENT OF TRANSPORTATION

 TYPICAL SECTIONS
 F.A.I. RTE.
 80

 SCALE:
 SHEET NO. OF SHEETS STA. TO STA. FED. ROAD DI.
 FED. ROAD DI.

### TYPICAL RAMP TAPER

STA 99+20 TO 99+70.10 STA 162+50 TO 163+00

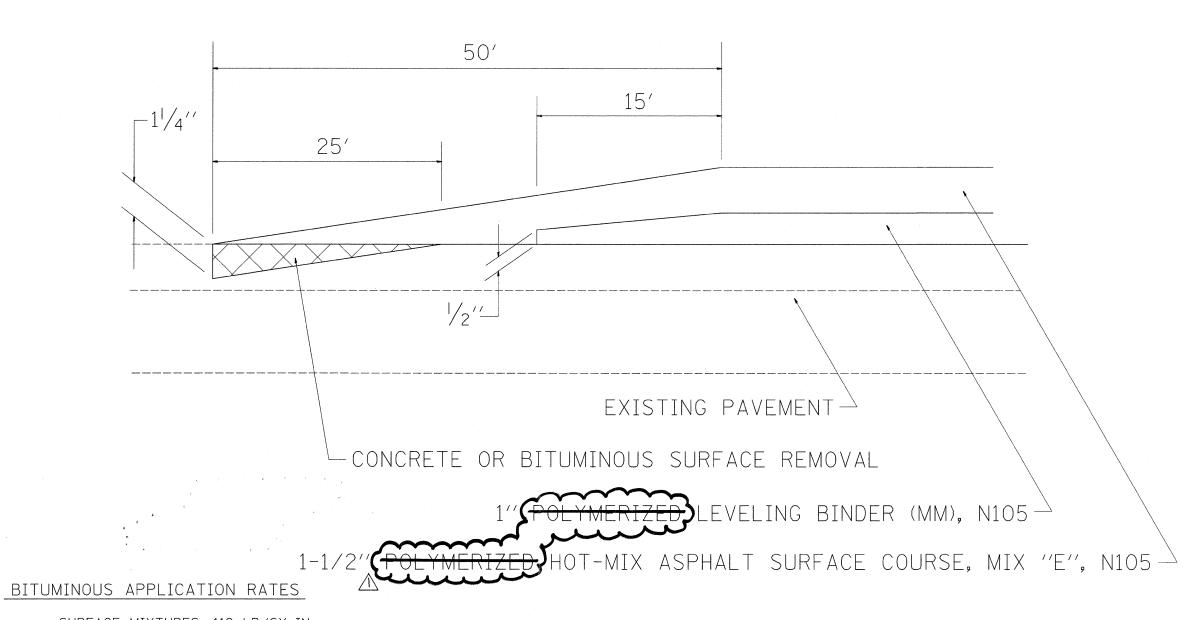

SURFACE MIXTURES: 119 LB/SY-IN
OTHER BITUMINOUS MIXTURES: 112 LB/SY-IN
BITUMINOUS MATERIAL (PRIME COAT): 0.000286 TON/SY

AGGREGATE (PRIME COAT): 0.0015 TON/SY

AREVISED 7-23-08

SCALE:

* D2 SPRING PATCHING 2007-2

ROCK ISLAND 31 11

CONTRACT NO. 64D34

STATE OF ILLINOIS
DEPARTMENT OF TRANSPORTATION


 TYPICAL SECTIONS
 F.A.I. SECTION

 80
 **

 SHEET NO. OF SHEETS STA. TO STA.
 FED. ROAD DIST. NO. | ILLINOIS| FED.

### TYPICAL LEFT SHOULDER

STA 96+25 TO 178+75

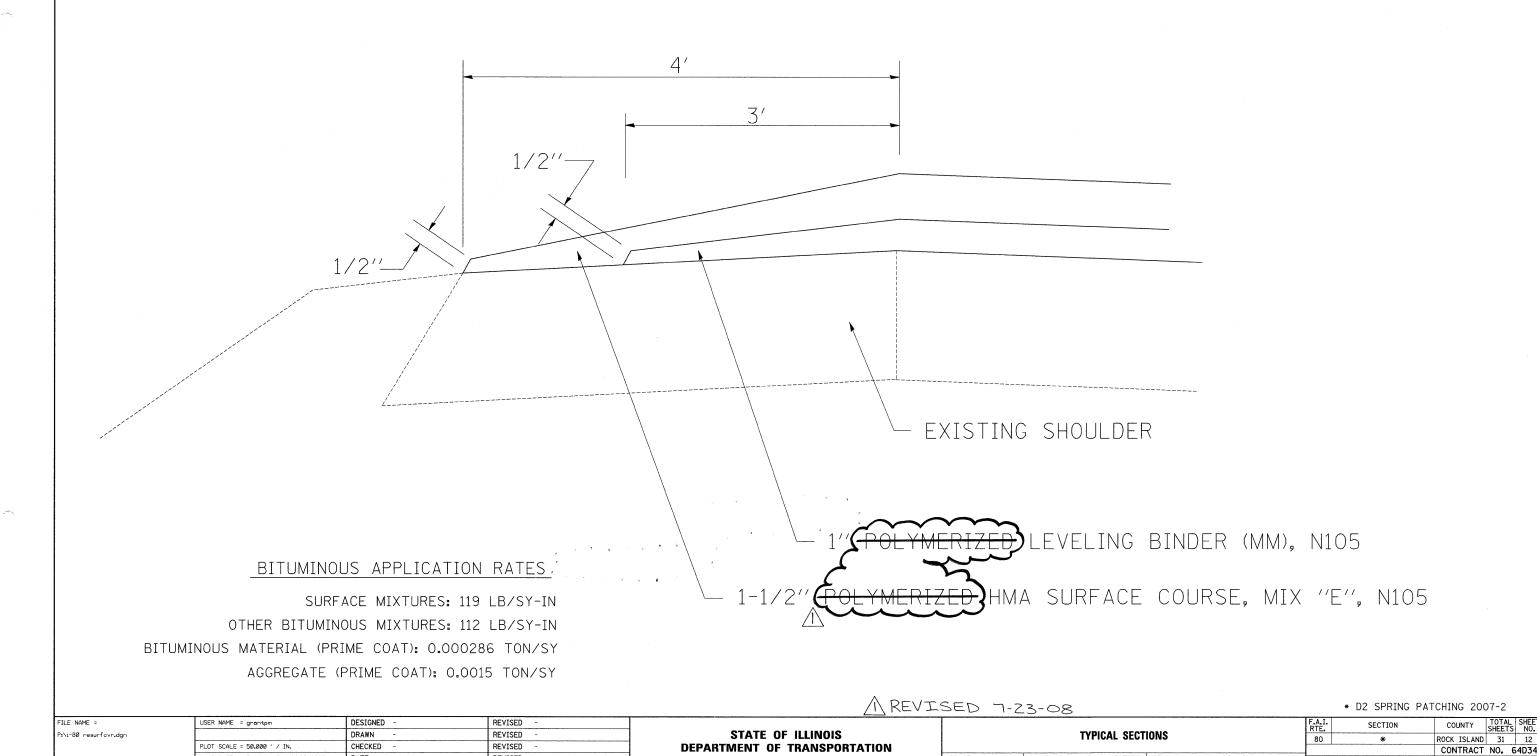

SCALE:

SHEET NO. OF SHEETS STA.

FED. ROAD DIST. NO. ILLINOIS FED. AID PROJECT


PLOT DATE = Thu May 15 11:03:29 2008

DATE

REVISED

# TYPICAL RIGHT SHOULDER

STA 108+00 TO 123+37 STA 131+33 TO 162+50 STA 169+85 TO 178+75

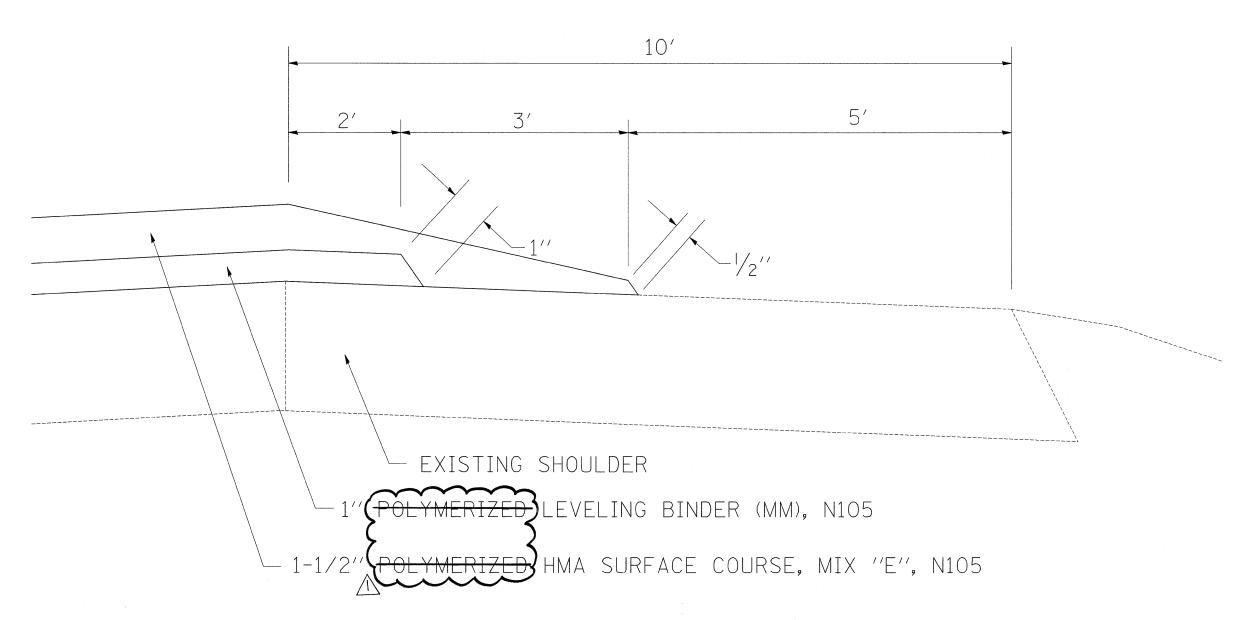

#### BITUMINOUS APPLICATION RATES


SURFACE MIXTURES: 119 LB/SY-IN
OTHER BITUMINOUS MIXTURES: 112 LB/SY-IN
BITUMINOUS MATERIAL (PRIME COAT): 0.000286 TON/SY
AGGREGATE (PRIME COAT): 0.0015 TON/SY

NOTE: TAPER SURFACE COURSE FROM 1-1/2" TO  $\frac{1}{2}$ " IN 5 FT.

AREVISED 7-23-08

FILE NAME =	USER NAME = grantpm	DESIGNED -	REVISED -							F.A.I.	SECTION	COUNTY TOTAL SHEET NO.
P:\1-8Ø resurfovr.dgn		DRAWN	REVISED -	STATE OF ILLINOIS		TYP	PICAL SECT	IONS		80	*	ROCK ISLAND 31 13
	PLOT SCALE = 50.000 ' / IN.	CHECKED -	REVISED -	DEPARTMENT OF TRANSPORTATION								CONTRACT NO. 64D34
	PLOT DATE = Thu May 15 11:03:29 2008	DATE -	REVISED -		SCALE:	SHEET NO. OF	SHEETS	STA.	TO STA.	FED. ROAD DIST.	NO. ILLINOIS	FED. AID PROJECT

STA 99+20 TO 108+00 STA 123+37 TO 131+33

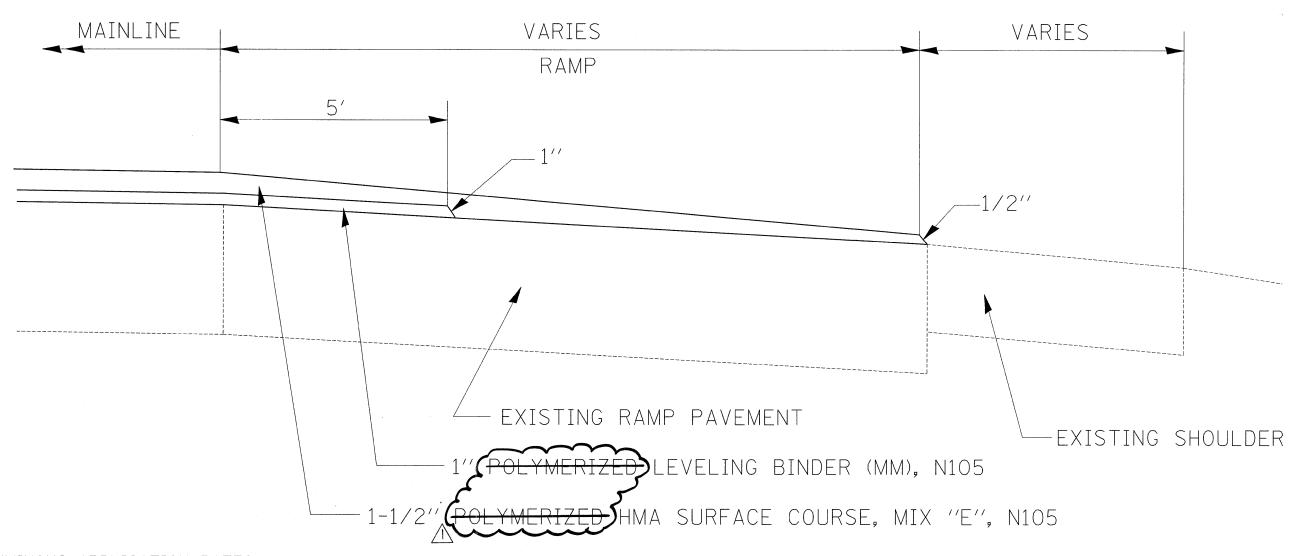


#### BITUMINOUS APPLICATION RATES

SURFACE MIXTURES: 119 LB/SY-IN
OTHER BITUMINOUS MIXTURES: 112 LB/SY-IN
BITUMINOUS MATERIAL (PRIME COAT): 0.000286 TON/SY
AGGREGATE (PRIME COAT): 0.0015 TON/SY

A REVISI	ED 7-	Z	3-	80
----------	-------	---	----	----

FILE NAME =	USER NAME = grantpm	DESIGNED -	REVISED -								F.A.I.	SECTION	COUNTY	TOTAL SI	EET
0:\Projects\Rock_Island\64D34_I-80_Sprin	_Patch_2007-2\1-80 resurfcvr.dgn	DRAWN	REVISED -	STATE OF ILLINOIS			TYPI	CAL SEC	TIONS		KIE.	- w	DOCK TO AN	SHEE IS I	10.
	PLOT SCALE = 50.000 ' / IN.	CHECKED -	REVISED -	DEPARTMENT OF TRANSPORTATION							80	不	CONTRAC	T NO. 64D	14
	PLOT DATE = Thu May 15 13:45:14 2008	DATE -	REVISED ~		SCALE:	SHEET NO.	OF	SHEET	STA.	TO STA.	FED. ROAD DIS	T. NO. ILLINO	S FED. AID PROJECT	1 100. 040	34

STA 162+50 TO 169+84.46

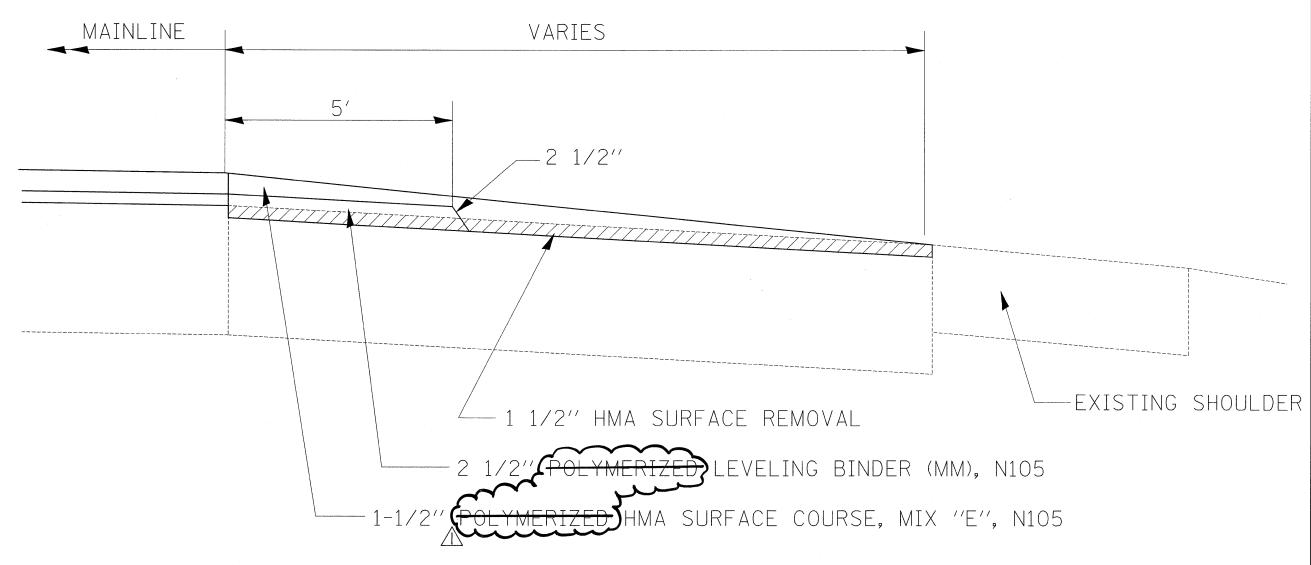

#### BITUMINOUS APPLICATION RATES

SURFACE MIXTURES: 119 LB/SY-IN
OTHER BITUMINOUS MIXTURES: 112 LB/SY-IN
BITUMINOUS MATERIAL (PRIME COAT): 0.000286 TON/SY
AGGREGATE (PRIME COAT): 0.0015 TON/SY

AREVISED 7-23-08

FILE NAME =	USER NAME = grantpm	DESIGNED	REVISED -								F.A.I.	SECTION	COUNTY	TOTAL	SHEET
Oi\Projects\Rock_Island\64D34_I-80_Spring	_Patch_2007-2\1-80 resurfovr.dgn	DRAWN -	REVISED -	STATE OF ILLINOIS			TYPIC	CAL SECT	IONS		80	*	DOOK TOLAN	JD 31	15
	PLOT SCALE = 50.000 ' / IN.	CHECKED ~	REVISED -	DEPARTMENT OF TRANSPORTATION								75	CONTRAC		4D34
	PLOT DATE = Thu May 15 13:45:14 2008	DATE	REVISED -		SCALE:	SHEET NO.	OF	SHEETS	STA.	TO STA.	FED. ROAD DIST. NO	. ILLINOIS FED.	AID PROJECT		

#### 40600200 BITUMINOUS MATERIALS (PRIME COAT) LOCATION STA to SIA 0.34 59 + 4863 + 90RESURFACING DRIVING LANE 2 APPLICATION RESURFACING DRIVING LANE 2 APPLICATION 1.91 64 + 15 89 + 25 EB MAINLINE, 2 APPLICATION 0.42 89 + 2592 + 0012.78 95 + 25179 + 05 EB MAINLINE, 2 APPLICATION 0.16 89 + 25 92 + 00EB SHOULDERS, 2 APPLICATIONS 4.79 95 + 25179 + 05 EB SHOULDERS, 2 APPLICATIONS 0.04 ALONG EDGE OF VISITOR CENTER OFF RAMP, 2 APPLICATION 0.05 ALONG EDGE OF VISITOR CENTER ON RAMP, 2 APPLICATION 0.48 EB WEIGH SCALE OFF RAMP EB WEIGH SCALE ON RAMP 0.43 TOTAL = 21.40 40600300 AGGREGATE (PRIME COAT) TON LOCATION SIA REMARKS SIA to 0.88 59 + 4863 + 90DRIVING LANE ONLY 5.02 64 + 15 89 + 25 DRIVING LANE ONLY 89 + 25 1.10 92 + 00MAINLINE 33.52 95 + 25179 + 05**MAINLINE** 0.41 89 + 2592 + 00SHOULDERS SHOULDERS 12.57 179 + 05 95 + 25 0.11 ALONG EDGE OF VISITOR CENTER OFF RAMP, 2 APPLICATION 0.13 ALONG EDGE OF VISITOR CENTER ON RAMP, 2 APPLICATION 1.26 EB WEIGH SCALE OFF RAMP 1.13 EB WEIGH SCALE ON RAMP TOTAL = **56.14** 40600555 LEVELING BINDER (HAND METHOD), N105 TON LOCATION SIA to SIA REMARKS 52.02 ENGINEERS DISCRESSION --- LEFT PAVEMENT EDGE 95 + 15 178 + 75 ENGINEERS DISCRESSION --- RIGHT PAVEMENT EDGE 156.05 178 + 75 95 + 15 TOTAL = 208.07 40600655 LEVELING BINDER (MACHINE METHOD), N105 LOCATION STA to STA 1,525.07 96 + 05 177 + 75 MAINLINE 2.49 177 + 75 177 + 95 EAST BUTT JOINT, MAILINE 177 + 75 4' LEFT SHOULDER 254.18 96 + 054' LEFT SHOULDER 0.41 177 + 75 177 + 95 15.15 96 + 0599 + 20 2' RIGHT SHOULDER 5' RIGHT SHOULDER 34.22 99 + 20108 + 0023.91 108 + 00123 + 372' RIGHT SHOULDER 30.96 123 + 37131 + 33 5' RIGHT SHOULDER 72.21 131 + 33 177 + 75 2' RIGHT SHOULDER 0.21 177 + 75 177 + 95 2' RIGHT SHOULDER 58.24 VISITOR CENTER ON RAMP 1.23 BUTT JOINT, VISITOR CENTER 59.27 WEIGH SCALE OFF RAMP 1.23 TAPER, WEIGH SCALE OFF RAMP 62.84 162 + 50WEIGH SCALE ON RAMP WEIGH SCALE BUTT JOINT, OFF RAMP 2.12 TOTAL = 2,143.72

	6011	FRUIT OF	OLIANITITICO	F	RTE. SEC	TION	
TOTAL	= 4,878.67						
	942.67	162 + 50	169 + 85	SCALE ON RAMP			
	3346.67		89 + 25	DRIVING LANE ONLY			
	OMISSION		64 + 15	WEATHER SENSOR C	TIMC		
	589. 33	59 + 48	63 + 90	DRIVING LANE ONLY			
			to <u>SIA</u>				
	SQ YD	LOCATION					
44000155			ACE REMOVAL	., 1 1/2"			
TOTAL	= 3,440.36						
	94.68	162 + 50	169 + 84	WEIGH SCALE ON RAMI	P		
	24.23	butt jt		WEIGH SCALE ON RAMI	P BUTT JOINT	Г	
	10.90	taper		WEIGH SCALE OFF RAN	IP TAPER		
	8.32			VISITOR CENTER ON RA	AMP BUTT JOI	NT	
	4.30	177 + 75	179 + 05	5' RIGHT SHOULDER			
	230.17	131 + 33	177 + 75	5' RIGHT SHOULDER			
	110.51	123 + 37	131 + 33	WEIGH SCALE OFF RAM	<b>NP</b>		
	76.21	108 + 00	123 + 37	5' RIGHT SHOULDER			
	122.17	99 + 20	108 + 00	VISITOR CENTER ON RA	AMP		
	19.59	95 + 25	99 + 20	5' RIGHT SHOULDER			
	3.44	177 + 75	179 + 05	4' LEFT SHOULDER			
	327.25	95 + 25	177 + 75	4' LEFT SHOULDER			
	28.36	177 + 75	179 + 05	EAST BUTT JOINT, MAIL	INE		
	1,963.50	95 + 25	177 + 75	MAINLINE			
	OMISSION	92 + 00	95 + 25	WEIGH-IN-MOTION SCALE OMIT			
	65.45	89 + 25	92 + 00	1 1/2" MAINLINE RESUR	FACING, BOTH LA	ANES	
	298.69	64 + 15	89 + 25	1 1/2" RESURFACE ONL	Υ		
	OMISSION	63 + 90	64 + 15	WEATHER SENSOR C	ТІМС		
	52.598	59 + 48	63 + 90	1 1/2" RESURFACE ONL	Υ		
$\sim$	$\sim \sim$	SIA -	to <u>SIA</u>				
4.	TON	LOCATION	~~~	~~~~	~~		
40603375		HOT-MIX	ASPHALT SUR	FACE COURSE, MIX "E", N	1105		
$\sim$	~~~	~~~		\\\\\\\\\\\\\\\\\\\\\\\\\\\\\\\\\\\\\\	7	•	
			_	<i> </i>	}_		
(_TOTAL	= 2,172.33	)		<i>&gt;</i>	1,	۸	
\	73.33	178 + 25	178 + 75	5	7		
$\langle 1 \rangle$	1,392.00	)	.=a ==	EB WEIGH SCALE	~ ~ <u>~</u>		
$\wedge$	707.00	\ \		VISITOR CENTER ON RA	AMP		
		SIA -	to <u>STA</u>	VIOLENCE OFFICE CO.	A.A.D.		
	Su. YD.	LOCATION	to CT:				
40600990	TEMPORAR						
4000000	whitever.	V DAW5					
TOTAL	= 133.33						
	133.33	95 + 25	95 + 75	BOTH LANES			
			to <u>STA</u>				
	SQ. YD.	LOCATION					
40600985	PORTLAND	CEMENT CO	NCRETE SURF	ACE REMOVAL - BUTT JO	INT		
TOTAL							
TOTAL		. 110 - 20	1,0.70	J. IOOLDLIN, INDIII OLL			
	50.00	178 + 25	178 + 75	SHOULDER, RIGHT & LE	EFT		
	133.33	178 + 25	178 + 75	MAINLINE			
	72.8			EB WEIGH SCALE ON R			
	38.89			EB WEIGH SCALE RAMP	<b>o</b>		

HOT-MIX ASPHALT SURFACE REMOVAL - BUTT JOINT

95 + 75

SHOULDER, RIGHT & LEFT

VISITOR CENTER ON RAMP

ER WEIGH SCALE RAMP

TAPER, NO GRINDING --- EB WEIGH SCALE OFF RAMP

STA to STA

SQ. YD. LOCATION

50.00

86.1

n

38 89

95 + 25

AREVISED 7-23-08

	USER NAME = grantpm	DESIGNED -	REVISED -
fovradgn		DRAWN -	REVISED -
	PLOT SCALE = 50.000 ' / IN.	CHECKED -	REVISED -
	PLOT DATE = Thu May 15 11:03:26 2008	DATE	REVISED -

FILE NAME =

P:\1-80 resurfo

SCALE: