
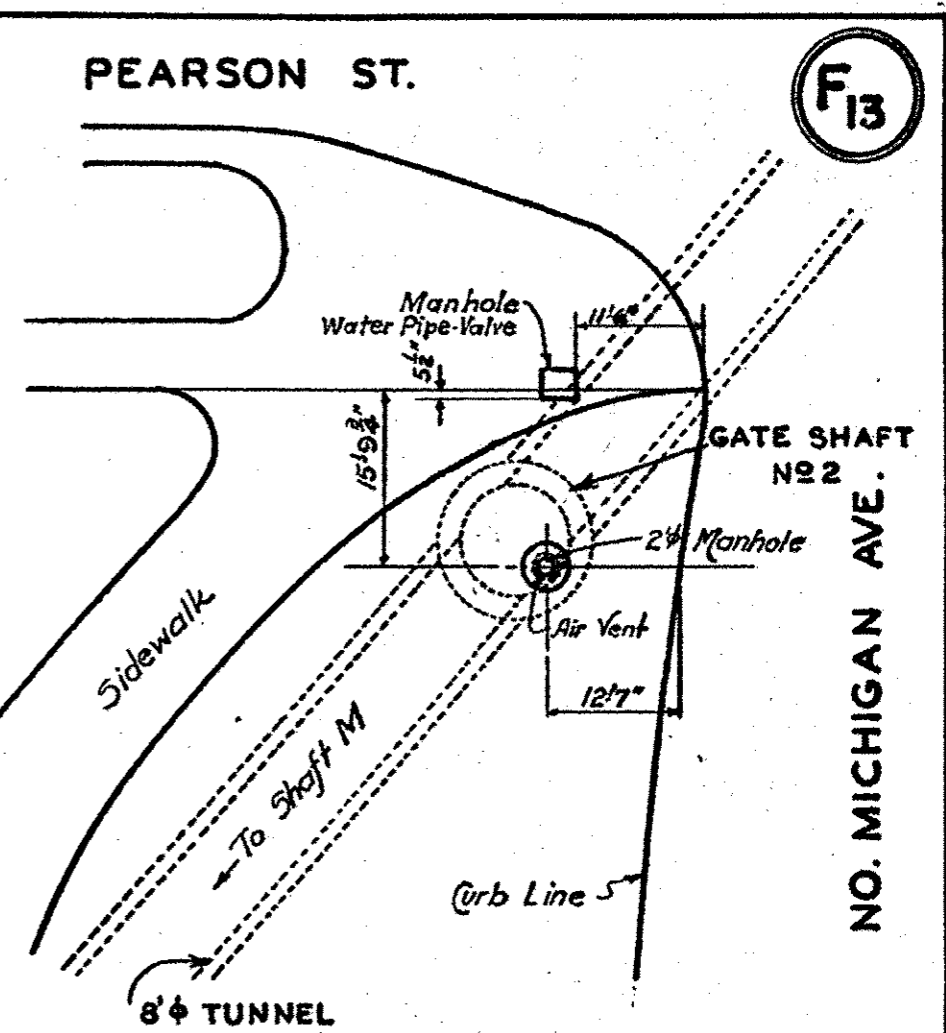
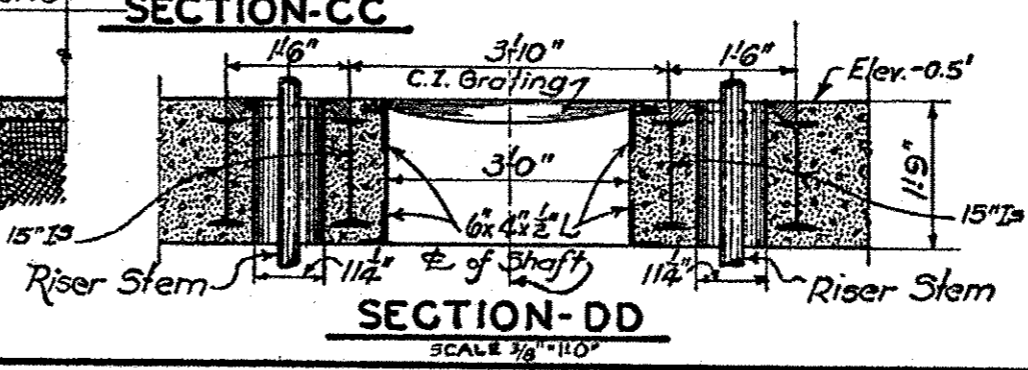
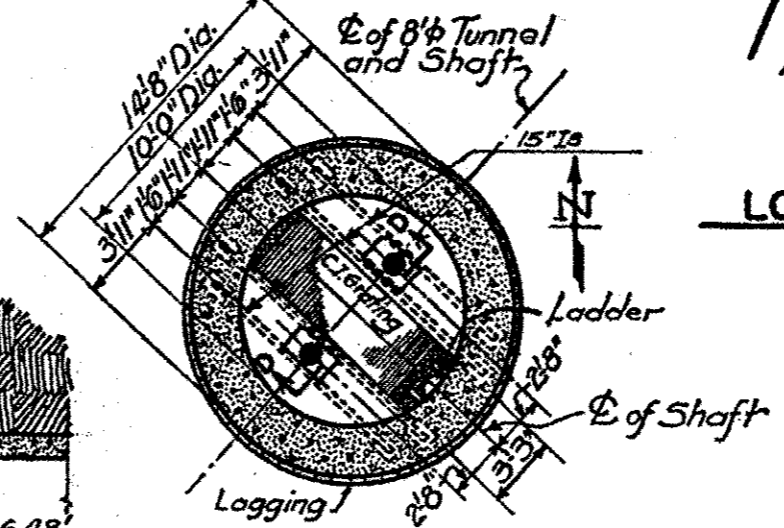
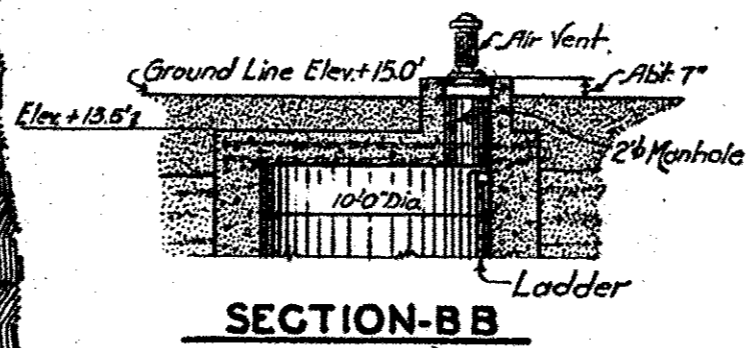
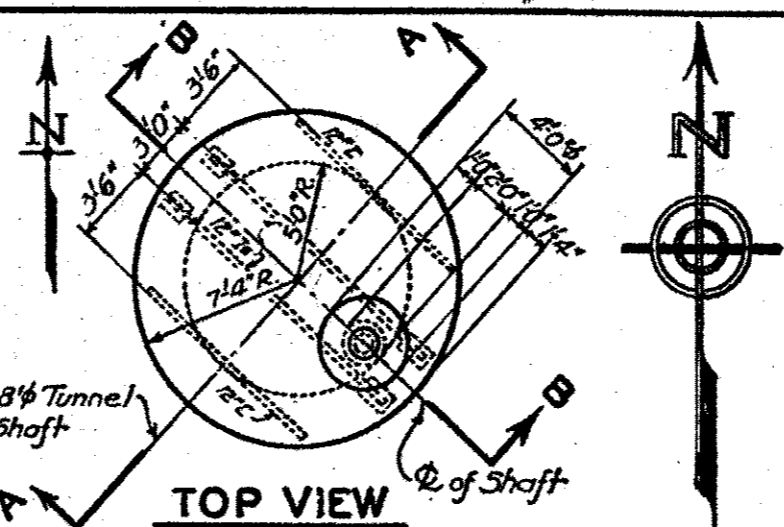


F13

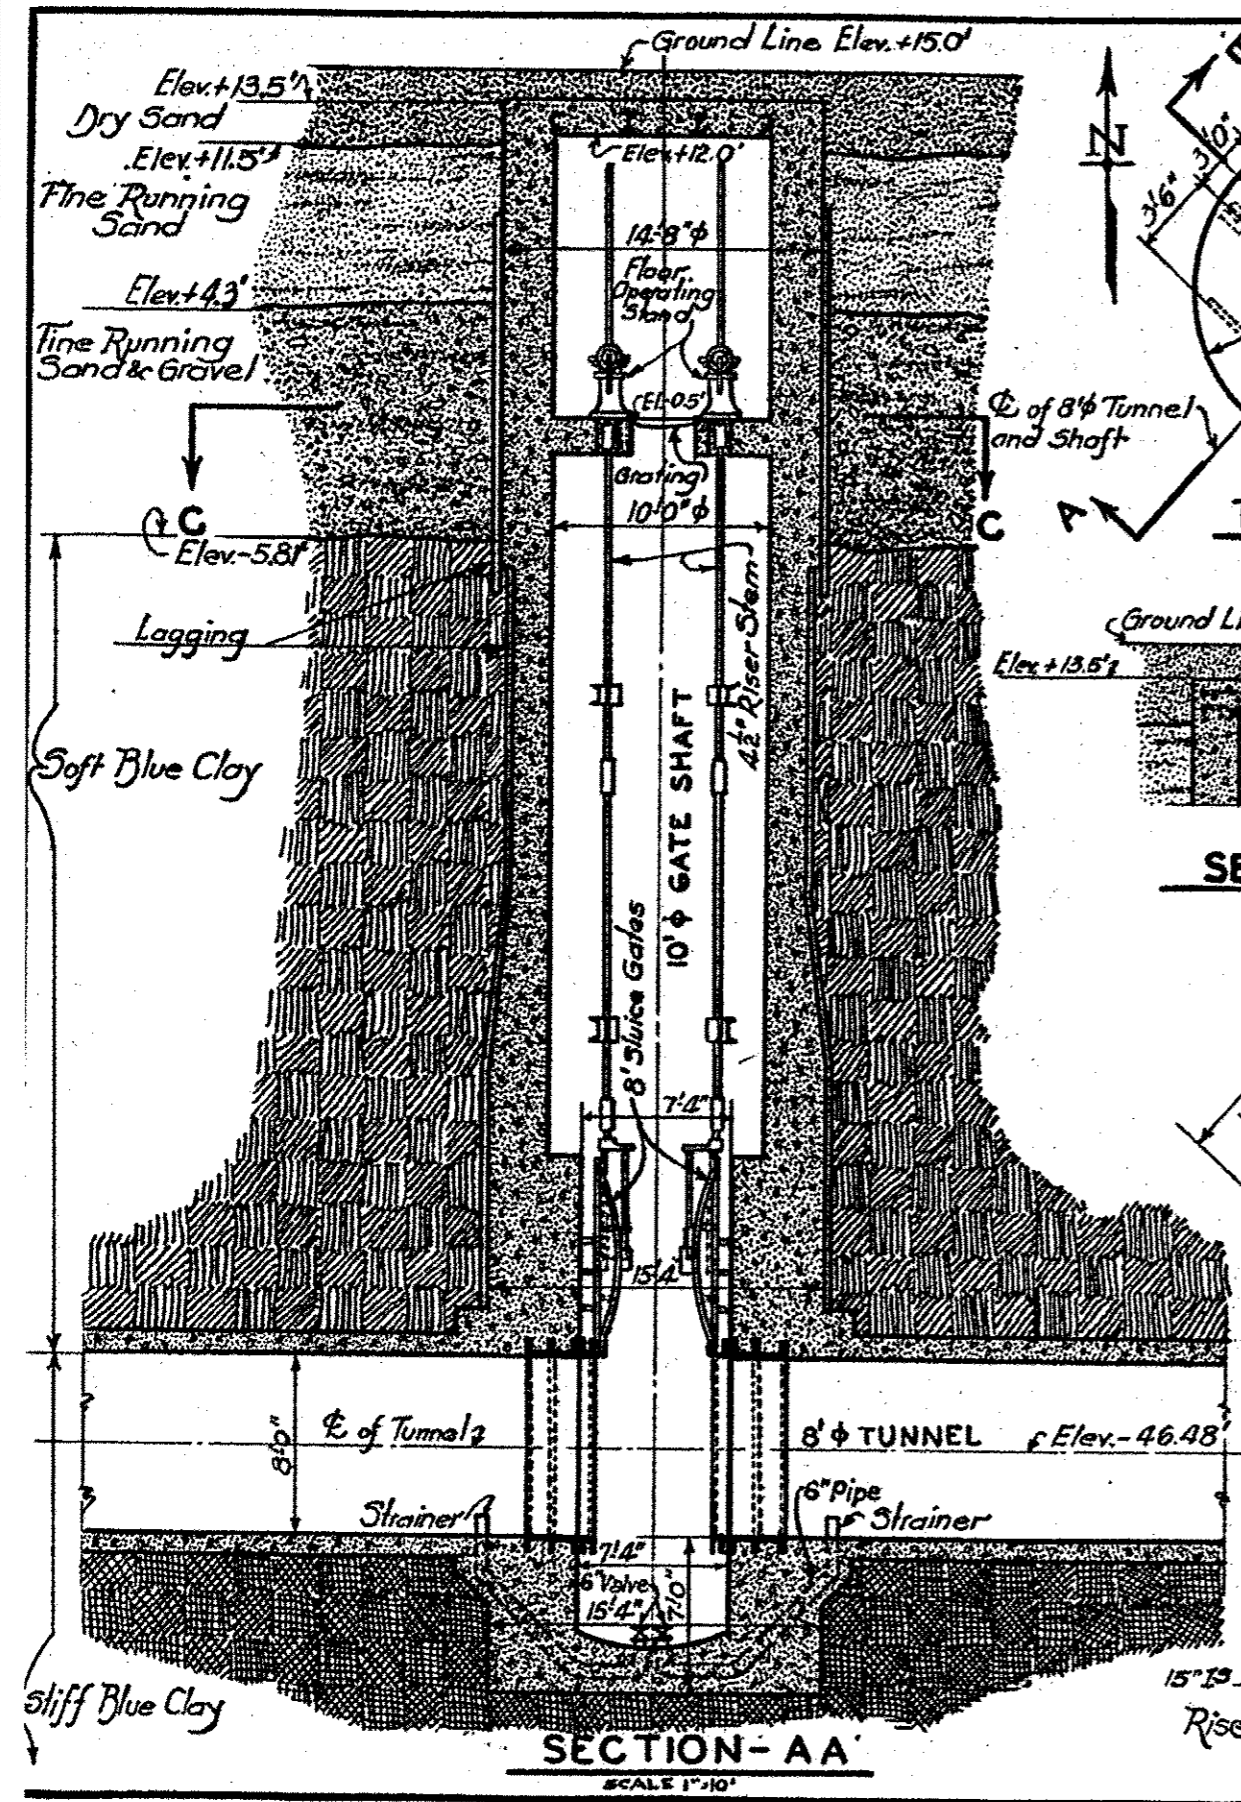

LOCATION DIAGRAM
SCALE 1"=20'

FOR INFORMATION ONLY

CITY OF CHICAGO
DEPARTMENT OF PUBLIC WORKS
BUREAU OF ENGINEERING
DIVISION OF WATER WORKS DESIGN

BLUE ISLAND AVE. TUNNEL
GATE SHAFT No. 2
N. MICHIGAN AVE. & PEARSON ST.

October, 1944
FILE 3-N

COLLINS ENGINEERS

USER NAME: mmp/ler	DESIGNED: -	REVISED: -
PLOT SCALE: 20,0000 1/2 in.	DRAWN: -	REVISED: -
PLOT DATE: 7/11/2013	CHECKED: -	REVISED: -
	DATE: -	REVISED: -

STATE OF ILLINOIS
DEPARTMENT OF TRANSPORTATION

RECORD DRAWING

SCALE:	SHEET NO. OF SHEETS	STA. TO STA.
--------	---------------------	--------------

F.A.I. RTE.	SECTION	COUNTY	TOTAL SHEETS	SHEET NO.
90/94	0101.6-2P-1-3 (13)	COOK	37	176
FED. ROAD DIST. NO. 1 ILLINOIS FED. AID PROJECT			CONTRACT NO. 60W36	