	SUMMARY OF QUANTITIES			
PAY ITEM NO.	PAY ITEM NAME	UNIT	QUANTITY	
20200100	EARTH EXCAVATION	CU YD	1410	1
20800150	TRENCH BACKFILL	CU YD	607	3
25000100	SEEDING, CLASS 1	ACRE	0.9	
25000400	NITROGEN FERTILIZER NUTRIENT	POUND	81	
25000500	PHOSPHORUS FERTILIZER NUTRIENT	POUND	81	
25000600	POTASSIUM FERTILIZER NUTRIENT	POUND	81	3 8
25100115	MULCH, METHOD 2	ACRE	0.9	£ 8
28000250	TEMPORARY EROSION CONTROL SEEDING	POUND	90	
28000400	PERIMETER EROSION BARRIER	FOOT	1768	
28000500	INLET AND PIPE PROTECTION	EACH	23	
28001100	TEMPORARY EROSION CONTROL BLANKET	SQ YD	731	
31100910	SUBBASE GRANULAR MATERIAL, TYPE A 12"	SQ YD	1775	
31101191	SUBBASE GRANULAR MATERIAL, TYPE B 3"	SQ YD	698	
31101200	SUBBASE GRANULAR MATERIAL, TYPE B 4"	SQ YD	2221	3/1
35100300	AGGREGATE BASE COURSE, TYPE A 4"	SQ YD	240	
35101600	AGGREGATE BASE COURSE, TYPE B 4"	SQ YD	421	
35102000	AGGREGATE BASE COURSE, TYPE B 8"	SQ YD	116	
35400100	PORTLAND CEMENT CONCRETE BASE COURSE WIDENING 6"	SQ YD	1397	$\frac{\sqrt{1}}{3}$
40200500	AGGREGATE SURFACE COURSE, TYPE B 6"	SQ YD	14	
40201000	AGGREGATE FOR TEMPORARY ACCESS	TON	200	
40600275	BITUMINOUS MATERIALS (PRIME COAT)	POUND	5496	
40600290	BITUMINOUS MATERIALS (TACK COAT)	POUND	1355	

PAY ITEM NO.	PAY ITEM NAME	UNIT	QUANTITY
40600990	TEMPORARY RAMP	SQ YD	131
40603080	HOT-MIX ASPHALT BINDER COURSE, IL-19.0, N50	TON	506
40604050	HOT-MIX ASPHALT SURFACE COURSE, IL-9.5, MIX "C", N50	TON	827
40800050	INCIDENTAL HOT-MIX ASPHALT SURFACING	TON	14
42000200	PORTLAND CEMENT CONCRETE PAVEMENT 7"	SQ YD	240
42300200	PORTLAND CEMENT CONCRETE DRIVEWAY PAVEMENT, 6 INCH	SQ YD	421
42400100	PORTLAND CEMENT CONCRETE SIDEWALK 4 INCH	SQ FT	7027
42400800	DETECTABLE WARNINGS	SQ FT	98
44000100	PAVEMENT REMOVAL	SQ YD	1178
44000200	DRIVEWAY PAVEMENT REMOVAL	SQ YD	507
44000500	COMBINATION CURB AND GUTTER REMOVAL	FOOT	1406
44000600	SIDEWALK REMOVAL	SQ FT	3925
44200120 50105220	PIPE CULVERT REMOVAL	SQ YD FOOT	124 333
550A2320	STORM SEWERS, RUBBER GASKET, CLASS A, TYPE 1 12"	FOOT	309
550A2330	STORM SEWERS, RUBBER GASKET, CLASS A, TYPE 1 15"	FOOT	1031
550A2340	STORM SEWERS, RUBBER GASKET, CLASS A, TYPE 1 18"	FOOT	703
60221200	MANHOLES, TYPE A, 5'-DIAMETER, TYPE 3 FRAME AND GRATE	EACH	1
60234200	INLETS, TYPE A, TYPE 1 FRAME, OPEN LID	EACH	2
60235700	INLETS, TYPE A, TYPE 3 FRAME AND GRATE	EACH	8
60236200	INLETS, TYPE A, TYPE 8 GRATE	EACH	, 1

INLETS, TYPE B, TYPE 3 FRAME AND GRATE

MANHOLES TO BE ADJUSTED

REMOVING INLETS

^{* =} SPECIALTY ITEMS



GONZALEZ COMPANIES, LLC 525 WEST MAIN STREET BELLEVILLE, IL 62220 PHONE (618-222-2221)

REVISED 7/19/2023 **⚠**REVISED — DESIGNED — TH CHECKED - TS REVISED -DATE - 3/31/2023

STATE OF ILLINOIS DEPARTMENT OF TRANSPORTATION

60240220

60255500

60500060

SUMMARY OF QUANTITIES

ROUTE	SECTION	COUNTY	TOTAL SHEETS	SHEE NO.
FAU 9310	16-00053-00-PV	MONROE	57	3
CONTRAC	CT NO. 97810	_		

EACH


EACH

EACH

12

2

2

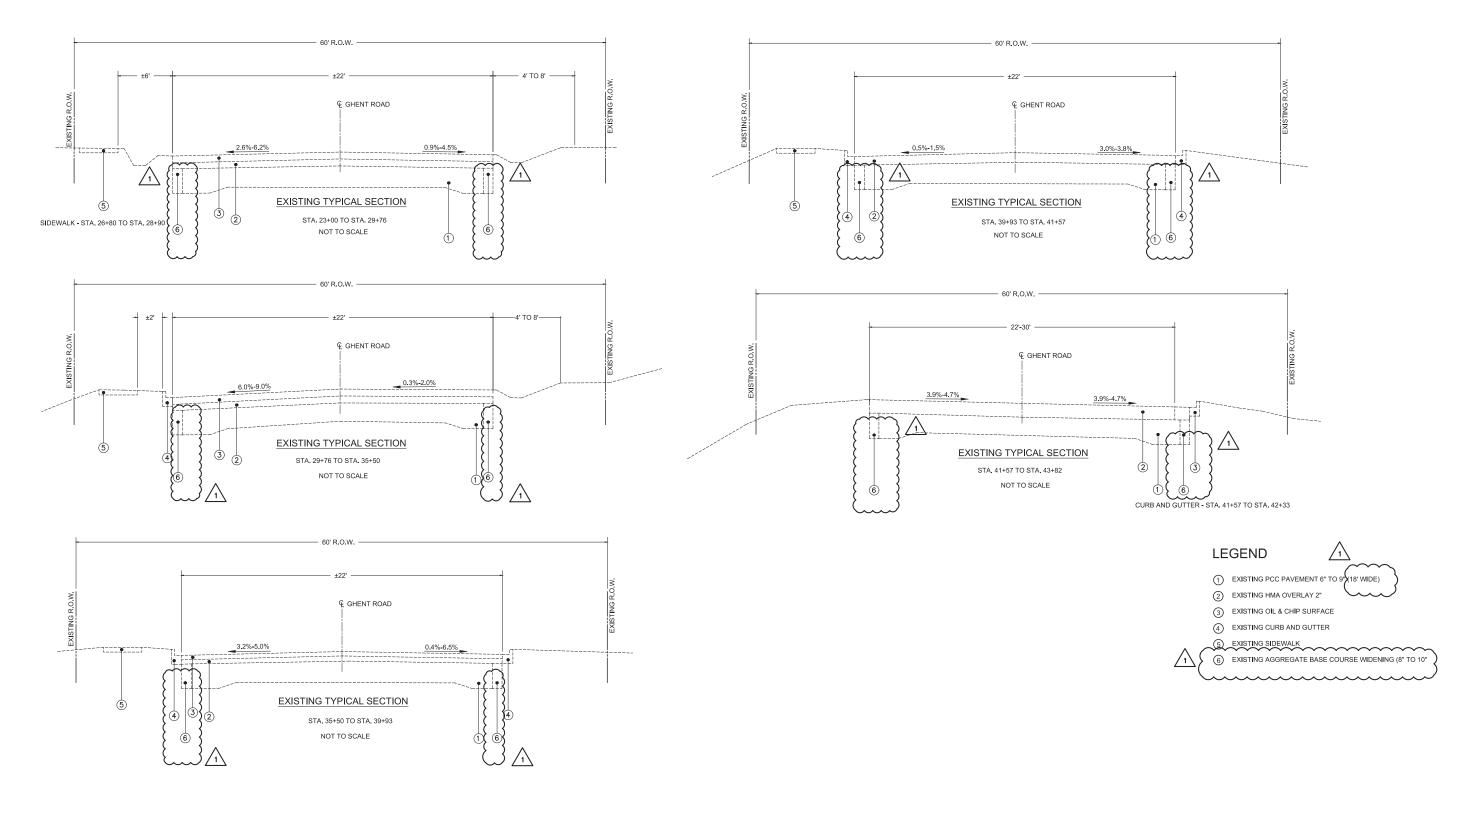

_gonzalez

GONZALEZ COMPANIES, LLC
525 WEST MAIN STREET
BELLEVILLE, IL 62220
PHONE (618-222-2221)
www.gpnzalezcos.com
www.gpnzalezcos.com

 DESIGNED
 ─ TH
 REVISED
 7/19/2023
 ⚠

 DRAWN
 ─ TH
 REVISED
 ─


 CHECKED
 ─ TS
 REVISED
 ─

 DATE
 ─ 3/31/2023
 REVISED
 ─

STATE OF ILLINOIS
DEPARTMENT OF TRANSPORTATION

EXISTING TYPICAL SECTIONS

ROUTE	SECTION	COUNTY	TOTAL SHEETS	SHEET NO.
FAU 9310	16-00053-00-PV	MONROE	57	5
CONTRAC	T NO 07810			

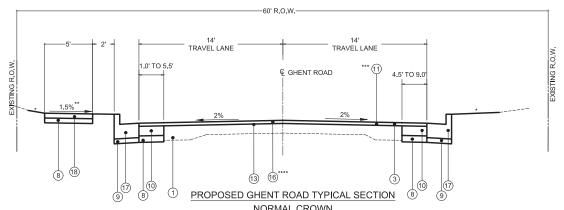


NORMAL CROWN

STA. 23+12 TO STA. 28+34 STA. 36+88 TO STA. 40+53 NOT TO SCALE *1:50 TO 1:3

** SIDEWALK SLOPES TOWARDS ROADWAY STA. 23+12 TO STA. 28+34 STA. 36+88 TO STA. 39+50 SIDEWALK SLOPES AWAY FROM ROADWAY

STA. 39+50 TO STA. 39+93 *** OIL AND CHIP ENDS STA. 39+93 **** ADDITIONAL HMA SURFACE COURSE TO BE PLACED TO ACCOUNT FOR DEVIATIONS BETWEEN EXISTING AND PROPOSED SURFACE

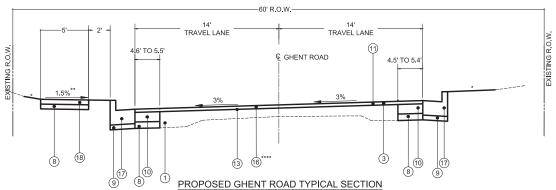


SUPERELEVATION

STA. 28+34 TO STA. 28+86 & STA. 36+36 TO 36+88 TANGENT RUNOUT STA. 28+86 TO STA. 29+64 & STA. 35+59 TO STA. 36+36 TANGENT RUNOFF STA. 29+64 TO STA. 30+75 SUPERELEVATION NOT TO SCALE *1:50 TO 1:3

> ** SIDEWALK SLOPES TOWARDS ROADWAY STA. 28+34 TO STA. 29+00 STA. 35+59 TO STA. 36+88 SIDEWALK SLOPES AWAY FROM ROADWAY STA. 29+00 TO STA. 30+75

**** ADDITIONAL HMA SURFACE COURSE TO BE PLACED TO ACCOUNT FOR DEVIATIONS BETWEEN EXISTING AND PROPOSED SURFACE

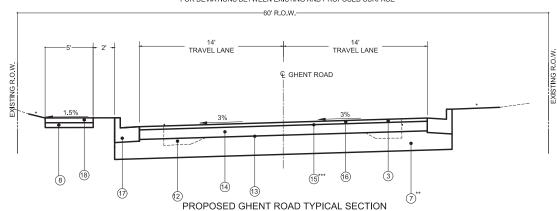

SUPERELEVATION STA. 30+75 TO STA. 35+59 SUPERELEVATION

NOT TO SCALE *1:50 TO 1:3

** NO DEDUCTION IN QUANTITY WILL BE MADE FOR TRIMMING SUB-BASE FOR INSTALLATION OF CURB AND GUTTER *** BITUMINOUS MATERIALS (TACK COAT) SHALL BE APPLIED BETWEEN EACH LIFT OF HMA SURFACE AND BINDER

REVISED 7/19/2023 🛕 DESIGNED - TH DRAWN REVISED CHECKED - TS **—** 3/31/2023 REVISED -

STATE OF ILLINOIS DEPARTMENT OF TRANSPORTATION

PROPOSED TYPICAL SECTIONS

ROUTE SECTION COUNTY SHEETS FAU 9310 16-00053-00-PV MONROE CONTRACT NO. 97810

PROPOSED GHENT ROAD TYPICAL SECTION

-60' R.O.W.

28'-30'

€ GHENT ROAD

STA. 40+53 TO STA. 40+77 TANGENT RUNOUT STA. 40+77 TO STA. 41+44 TANGENT RUNOFF STA. 41+44 TO STA. 43+82 SUPERELEVATION

* EXISTING SIDEWALK ENDS STA, 41+57

** EXISTING CURB AND GUTTER ENDS STA. 41+57, LT. AND 42+33 RT.

STRUCTURAL PAVEMENT DESIGN INFORMATION TOTAL: 1,835 VEHICLES YEAR: 2033 STRUCTURAL DESIGN TRAFFIC PV:1780 (97%) SU: 37 (2%) MU: 18 (1%) CLASS III ROADWAY MAJOR COLLECTOR ROAD/STREET CLASSIFICATION TRAFFIC FACTOR 0.113 SUBGRADE SUPPORT RATING ASSUMED POOR RATING

LEGEND

- (1) EXISTING PCC PAVEMENT 6" TO 9" (18' WIDE) ② EXISTING HMA OVERLAY AND WIDENING 2" TO
- 3 EXISTING OIL & CHIP SURFACE
- 4 EXISTING CURB AND GUTTER
- 5 EXISTING SIDEWALK
- 6 EXISTING AGGREGATE BASE
- 7 PROPOSED SUBBASE GRANULAR MATERIAL, TYPE A 12"
- 8 PROPOSED SUBBASE GRANULAR MATERIAL, TYPE B 4"
- 9 PROPOSED SUBBASE GRANULAR MATERIAL, TYPE B 3"
- 10 PROPOSED PCC BASE COURSE WIDENING 6'
- 11 PROPOSED HMA SURFACE REMOVAL (VARIABLE DEPTH)
- 12 PROPOSED PAVEMENT REMOVAL
- (13) PROPOSED BITUMINOUS MATERIALS (PRIME COAT)
- 14) PROPOSED HMA BINDER COURSE, IL-19.0, N50, 6"
- 15) PROPOSED BITUMINOUS MATERIALS (TACK COAT)
- 16 PROPOSED HMA SURFACE COURSE, IL-9.5, MIX "C", N50, 2"
- 77 PROPOSED COMBINATION CONCRETE CURB AND GUTTER TYPE B-6.24
- (18) PROPOSED PCC SIDEWALK 4"



GONZALEZ COMPANIES, LLC 525 WEST MAIN STREET BELLEVILLE, IL 62220 PHONE (618-222-2221)

DRAINAGE STRUCTURE SCHEDULE					
PT	LOCATION STATION / OFFSET	DESCRIPTION	RIM	INVERTS	
S-1	40+49.66 14.42'LT.	Manholes, Type A, 5'-Dia., with Type 3 Frame and Grate (Open Back)	432.77	428.16 SE 426.54 NE 425.70 NW	
S-2	37+90.01 15.58'LT.	Inlets, Type B, with Type 3 Frame and Grate (Open Back)	445.31	441.14 NW 441.34 SE 441.84 NE	
S-3	35+15.19 15.14'LT.	Inlets, Type B, with Type 3 Frame and Grate (Open Back)	456.46	452.84 SE 452.64 NW 453.22 NE	
S-4	34+15.75 15.13'LT.	Inlets, Type B, with Type 3 Frame and Grate (Open Back)	460.04	456.46 SE 456.26 NW	
S - 5	33+43.56 15.13'LT.	Inlets, Type B, with Type 3 Frame and Grate (Open Back)	462.73	459.18 SE 458.98 NW 459.51 NE	
S-6	31+86.95 15.11'LT.	Inlets, Type B, with Type 3 Frame and Grate (Open Back)	468.80	465.57 NE 465.25 S 465.05 NW	
S-7	30+23.52 15.09'LT.	Inlets, Type B, with Type 3 Frame and Grate (Open Back)	474.92	471.62 S 471.42 N	
S-8	28+62.03 15.08'LT.	Inlets Type B, with Type 3 Frame and Grate (Open Back)	479.35	475.83 N 475.93 E 476.03 S	
S-9	27+82.58 15.03'LT.	Inlets, Type B, with Type 3 Frame and Grate (Open Back)	481.61	478.25 S 478.05 N 478.15 W 478.15 E	
S-10	25+93.71 15.29'LT.	Inlets, Type B, with Type 3 Frame and Grate (Open Back)	486.95	483.50 E 483.40 N 483.60 S	
S-11	23+70.16 15.29'LT.	Inlets, Type B, with Type 3 Frame and Grate (Open Back)	491.69	488.30 S 488.20 N 488.50 W	
S-12	23+16.07 14.69'LT.	Inlets, Type B, with Type 3 Frame and Grate (Open Back)	492.47	489.01 E 488.91 N 489.11 S	
S-13	37+89.89 15.58'RT.	Inlets, Type A, with Type 3 Frame and Grate (Open Back)	445.31	442.15 SW	_
S-14	35+15.20 15.52'RT.	Inlets, Type B, with Type 3 Frame and Grate (Open Back)	457.30	454.06 SW 454.07 NE	}
S-15	33+43.56 15.53'RT.	Inlets, Type A, with Type 3 Frame and Grate (Open Back)	463.57	460.34 SW	
S-16	31+86.95 15.55'RT.	Inlets, Type A, with Type 3 Frame and Grate (Open Back)	469.64	466.41 SW	
S-17	28+62.03 15.58'RT.	Inlets, Type A, with Type 3 Frame and Grate (Open Back)	479.36	476.34 N 476.24 W	
S-18	28+80.00 15.58'RT.	Inlets, Type A, with Type 3 Frame and Grate (Open Back)	479.11	476.52 S	
S-19	27+82.59 30.49'LT.	Inlets, Type A, with Type 1 Frame and Lid (Open)	480.62	478.38 E	
S-20	27+82.58 15.58'RT.	Inlets, Type A, with Type 3 Frame and Grate (Open Back)	481.61	478.46 W	
S-21	25+93.71 15.58'RT.	Inlets, Type A, with Type 3 Frame and Grate (Open Back)	486.95	483.81 W	
S-22	23+70.15 30.55'LT.	Inlets, Type A, with Type 1 Frame and Lid (open)	490.84	488.65 E	
S-23	23+16.07 15.58'RT.	Inlets, Type A, with Type 3 Frame and Grate (Open Back)	492.47	489.31 W 489.78 SE	/
S-24	35+15.20 21.76'RT.	Inlets, Type A, with Type 8 Grate	456.38	454.13 SW	}
X-1	42+36.57 33.36'LT.	EXISTING FES- 24"	424.18	421.85 SE)
X-4	40+49.26 19.14'RT.	EXISTING INLET	432.57	427.72 SW	

NOTE:	
NOIL.	

RIM ELEVATION REFERS TO THE ELEVATION AT THE CENTER OF LID.
STATION/OFFSETS ARE GIVEN TO THE CENTER OF THE DRAINAGE STRUCTURE.
USE PRECAST FLAT SLAB TOP WHEN REQUIRED.
EXISTING STRUCTURES SHOWN IN SCHEDULE TO PROVIDE CONNECTION INFORMATION.

PIPE NO.	START PIPE STRUCTURE	END PIPE STRUCTURE	PIPE DESCRIPTION	PIPE LENGTH	UPSTREAM INVERT ELEV.	DOWNSTREAM INVERT ELEV.	PIPE SLOPE	TRENCH BACKFILL (CU YD)
P-1	S-2	S-1	Storm Sewers, Rubber Gasket, Class A, Type 1 - 18"	260	441.14	428.16	5.00%	82
P-2	S-3	S-2	Storm Sewers, Rubber Gasket, Class A, Type 1 - 18"	274	452.64	441.34	4.12%	91
P-3	S-4	S-3	Storm Sewers, Rubber Gasket, Class A, Type 1 - 18"	98	456.26	452.84	3.49%	34
P-4	S-5	S-4	Storm Sewers, Rubber Gasket, Class A, Type 1 - 18"	71	458.98	456.46	3.54%	20
P-5	S-6	S-5	Storm Sewers, Rubber Gasket, Class A, Type 1 - 15"	154	465.05	459.18	3.81%	49
P-6	S-7	S-6	Storm Sewers, Rubber Gasket, Class A, Type 1 - 15"	161	471.42	465.25	3.83%	51
P-7	S-8	S-7	Storm Sewers, Rubber Gasket, Class A, Type 1 - 15"	161	475.83	471.62	2.62%	44
P-8	S-9	S-8	Storm Sewers, Rubber Gasket, Class A, Type 1 - 15"	80	478.05	476.03	2.53%	21
P-9	S-10	S-9	Storm Sewers, Rubber Gasket, Class A, Type 1 - 15"	189	483.40	478.25	2.73%	51
P-10	S-11	S-10	Storm Sewers, Rubber Gasket, Class A, Type 1 - 15"	224	488.20	483.60	2.06%	66
P-11	S-12	S-11	Storm Sewers, Rubber Gasket, Class A, Type 1 - 15"	54	488.91	488.30	1.13%	15
P-12	OPEN DITCH	S-12	Storm Sewers, Rubber Gasket, Class A, Type 1 - 15"	8	489.19	489.11	1.00%	3
P-13	S-13	S-2	Storm Sewers, Rubber Gasket, Class A, Type 1 - 12"	31	442.15	441.84	1.00%	8
P-14	S-14	S-3	Storm Sewers, Rubber Gasket, Class A, Type 1 - 12"	31	454.06	453.22	2.74%	8
P-15	S-15	S-5	Storm Sewers, Rubber Gasket, Class A, Type 1 - 12"	31	460.34	459.51	2.69%	8
P-16	S-16	S-6	Storm Sewers, Rubber Gasket, Class A, Type 1 - 12"	31	466.41	465.57	2.75%	8
P-17	S-17	S-8	Storm Sewers, Rubber Gasket, Class A, Type 1 - 12"	31	476.24	475.93	1.00%	8
P-18	S-18	S-17	Storm Sewers, Rubber Gasket, Class A, Type 1 - 12"	18	476.52	476.34	1.00%	3
P-19	S-19	S-9	Storm Sewers, Rubber Gasket, Class A, Type 1 - 12"	15	478.38	478.15	1.50%	4
P-20	S-20	S-9	Storm Sewers, Rubber Gasket, Class A, Type 1 - 12"	31	478.46	478.15	1.00%	10
P-21	S-21	S-10	Storm Sewers, Rubber Gasket, Class A, Type 1 - 12"	31	483.81	483.50	1.00%	9
P-22	S-22	S-11	Storm Sewers, Rubber Gasiket, Class A, Type 1 - 12"	15	488.65	488.50	1.00%	4
P-23	S-23	S-12	Storm Sewers, Rubber Gasket, Class A, Type 1 - 12"	30	489.31	489.01	1.00%	8
P-24	OPEN DITCH	S-23	Storm Sewers, Rubber Gasket, Class A, Type 1 - 12"	8	490.54	489.78	9.50%	2
P-25	S-24	S-14	Storm Sewers, Rubber Gasket, Class A, Type 1 - 12"	6	454.13	454.07	1.00%	2
X-2	S-1	X-1	EXISTING RCP - 24'	197	425.70	421.85	1.96%	}
X-3	X-4	S-1	EXISTING RCP - 15"	34	427.72	426.54	3.52%	(

NOTE:

STORM SEWERS CLASS A SHALL BE REINFORCED CONCRETE PIPE (RCP).
PIPE LENGTHS SHOWN IN SCHEDULE ARE MEASURED CENTER TO CENTER OF STRUCTURE.
PAYMENT SHALL BE ACCORDING TO SECTION 550 OF THE IDOT STANDARD SPECIFICATIONS.




GONZALEZ COMPANIES, LLC
525 WEST MAIN STREET
BELLEVILLE, IL 62220
PHONE (618-222-2221)
www.gonralezos.com

DESIGNED	— тн	REVISED	7/19/2023 🛕
DRAWN	— тн	REVISED	-
CHECKED	— TS	REVISED	-
DATE	— 3/31/2023	REVISED	_

STATE OF ILLINOIS
DEPARTMENT OF TRANSPORTATION

	ROUTE	SECTION	COUNTY	TOTAL SHEETS	SHEE
DULES	FAU 9310	16-00053-00-PV	MONROE	57	7
	CONTRAC	CT NO. 97810			

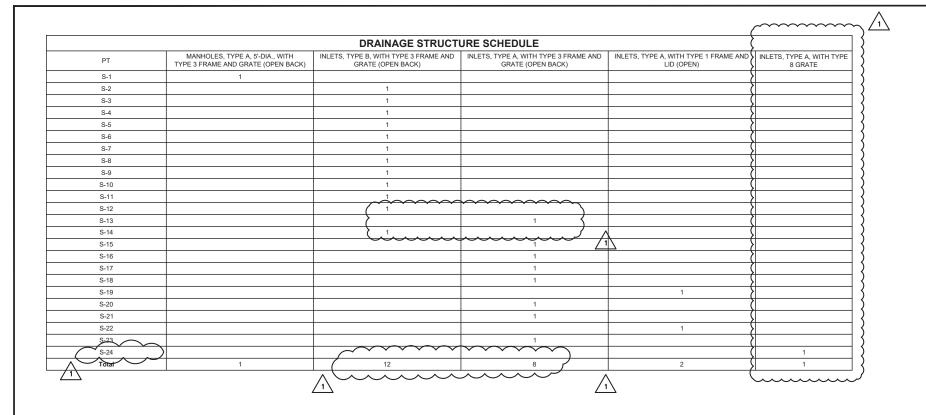

STORM SEWER SCHEDULE			
PIPE NO.	STORM SEWERS, RUBBER GASKET, CLASS A, TYPE 1 - 18"	STORM SEWERS, RUBBER GASKET, CLASS A, TYPE 1 - 15"	STORM SEWERS, RUBBER GASKET CLASS A, TYPE 1 - 12"
P-1	260		
P-2	274		
P-3	98		
P-4	71		
P-5		154	
P-6		161	
P-7		161	
P-8		80	
P-9		189	
P-10		224	
P-11		54	
P-12		8	
P-13			31
P-14			31
P-15			31
P-16			31
P-17			31
P-18			18
P-19			15
P-20			31
P-21			31
P-22			15
P-23			30
P-24			8000
P-25	<u> </u>		6
Total		1031	309

GONZALEZ COMPANIES, LLC
525 WEST MAIN STREET
BELLEVILLE, IL 62220
PHONE (618-222-2221)
www.oproalezons.com

REVISED 7/19/2023 🛕 DESIGNED - TH DRAWN - TH REVISED -CHECKED - TS REVISED -REVISED -

STATE OF ILLINOIS DEPARTMENT OF TRANSPORTATION

TOTAL SHEET NO. ROUTE SECTION COUNTY FAU 9310 16-00053-00-PV MONROE CONTRACT NO. 97810



STA. 35+84 to STA. 36+14
STA. 37+88 to STA. 37+92

124

PAVEMENT REMOVAL SCHEDULE			
LOCATION	PAVEMENT REMOVAL	HMA SURFACE REMOVAL (VARIABLE DEPTH)	
	(SQ YD)	(SQ YD)	
CHRISTINA COURT TO ASHLEE LANE			
STA. 23+12 TO STA. 28+68		1334	
ASHLEE LANE TO WOODLAND TERRACE			
STA. 28+68 TO STA. 35+59	1178	512	
WOODLAND TERRACE TO END OF WIDENING			
STA. 35+59 TO STA. 40+53		1185	
MILLING AND RESURFACING			
STA. 40+53 TO STA. 43+82		1043	
Total	1178	4074	

CURB AND GU	ITTER SCHEDULE
LOCATION	COMBINATION CONCRETE CURB AND GUTTER, TYPE B-6.24
	(FOOT)
STA. 23+12 TO STA. 23+34 RT	20
STA. 23+12 TO STA. 28+97 LT	607
STA. 23+83 TO STA. 35+66 RT	1202
STA. 29+21 TO STA. 35+76 LT	680
STA. 35+97 TO STA. 40+56 RT	467
STA. 36+02 TO STA. 40+55 LT	494
TOTAL	3470

SIDEWALK REMOV	VAL SCHEDULE
	SIDEWALK REMOVAL
LOCATION - LT.	(SQ FT)
STA. 26+80 TO STA. 27+14	134
STA. 27+34 TO STA. 27+98	250
STA. 28+16 TO STA. 28+95	462
STA. 30+77 TO STA. 31+44	260
STA. 31+65 TO STA. 32+06	157
STA. 32+34 TO STA. 33+54	457
STA. 33+76 TO STA. 34+32	215
STA. 34+50 TO STA. 35+52	380
STA. 36+07 TO STA. 38+04	816
STA. 38+29 TO STA. 39+53	518
STA. 39+78 TO STA. 40+52	276
TOTAL	3925

LOCATION	COMBINATION CURB AND GUTTER REMOVAL
LOCATION	(FOOT)
TA. 23+06 TO STA. 23+30 RT	29
TA. 23+84 TO STA. 24+07 RT	27
TA. 28+77 TO STA. 28+97 LT	45
TA. 29+21 TO STA. 29+42 LT	43
TA. 30+23 TO STA. 31+44 LT	120
TA. 31+65 TO STA. 32+03 LT	37
TA. 32+38 TO STA. 33+49 LT	110
TA. 33+79 TO STA. 34+28 LT	49
TA. 34+52 TO STA. 35+59 LT	108
TA. 35+80 TO STA. 40+56 RT	477
TA. 36+33 TO STA. 37+84 LT	151
TA. 38+39 TO STA. 40+48 LT	210
OTAL	1406

EARTHWORK SCHEDULE					
LOCATION	EARTH EXCAVATION	EARTH EXCAVATION ADJUSTED FOR SHRINKAGE (25%)	EMBANKMENT	STORM SEWER SPOILS	WASTE (+) SHORTAGE (-)
	CU YD	CU YD	CU YD	CU YD	CU YD
STA. 23+12 TO STA. 40+50	1410	1058	1022	465	501
·					
TOTALS	1410				501

		į						
			STA. 24+18 TO STA. 24+6	7	271		30)
276	22							
			STA. 24+98 TO STA. 26+2	4	654		73	3
117	44		STA. 26+50 TO STA. 27+0	9	320)	36	3
827	131							
627	131		STA. 27+39 TO STA. 27+9	3	297	·	33	3
			STA. 28+21 TO STA. 28+9	15	568	3	63	3
\		-						
_		-	STA. 29+40 TO STA. 31+4	-3	1033	3	11:	5
	~~~~~	$\sim$	STA. 31+68 TO STA. 32+0	12	190		2.	1
PATCHING	SCHEDULE	\	31A. 31100 TO 31A. 3270		190	'		'
	PAVEMENT PATCHING,	1 }	STA. 32+37 TO STA. 33+5	3	590	)	66	3
LOCATION	TYPE II, 10 INCH (SQ YD)	-		-		·		<u>-                                      </u>
	(5Q 1D)	-	STA. 33+81 TO STA. 34+2	7	249	)	28	3
CTA 22:44 to CTA 22:40	44	-						
STA. 23+14 to STA. 23+18	11	1 }	STA. 34+54 TO STA. 35+6	i1	555	i	62	2
STA. 23+28 to STA. 23+57	13	-						
31A. 23120 to 31A. 23131	10	┧	STA. 36+17 TO STA. 38+0	2	954		10	6
STA, 23+57 to STA, 23+87	13	<del> </del>						
017.1.20.01.10.017.1.20.01	10	1 }	STA. 38+31 TO STA. 39+5	1	610	)	68	3
STA, 25+92 to STA, 25+96	10	┧						
		1	STA. 39+80 TO STA. 40+6	4	420	)	47	7
STA. 27+80 to STA. 27+84	9	] {						
		] }	TOTAL		702	7	78	3
STA. 28+60 to STA. 28+64	10	] }						
		] }						
STA. 28+77 to STA. 29+10	13	լ {	חם	AINAGE	REMO	/ΔΙ 9	SCHEDUI	F
		<b>」                                    </b>	שט	AINAGE	KLIVIO		CULVERT	
STA. 29+10 to STA. 29+42	13	↓	LOCATION	DESCRI	PTION		EMOVAL	REMOVII
		<b>↓ }</b>				(	FOOT)	(E/
STA. 35+61 to STA. 35+84	9	↓						

LOCATION - LT.

STA. 23+02 TO STA. 23+28

STA. 23+50 TO STA. 23+90

DR	RAINAGE REMO		LE
LOCATION	DESCRIPTION	PIPE CULVERT REMOVAL	REMOVING INLET
		(FOOT)	(EACH)
STA. 23+26 RT.	12" RCP	63	
STA. 23+94 LT.	12" RCP	20	
STA. 24+69 LT.	15" VCP	28	
STA. 25+34 RT.	12" CMP	28	
STA. 26+25 RT.	12" CMP	22	
STA. 26+85 RT.	12" CMP	27	
STA. 27+14 LT.	15" CMP	20	
STA. 27+67 RT.	15" VCP	17	
STA. 27+97 LT.	15" CMP	20	
STA. 28+66 LT.	EX INLET		1
STA. 29+65 RT.	15" VCP	24	
STA. 32+48 RT.	18" CMP	22	
STA. 35+24 RT.	12" RCP	42	
STA. 40+50 LT.	EX INLET		1
TOT	AL:	333	2

SIDEWALK SCHEDULE

SUBBASE GRANULAR MATERIAL, TYPE B 4"

(SQ YD)

10

25

(SQ FT)


PCC SIDEWALK, 4"

(SQ FT)

94


222

DESIGNED	— тн	REVISED	7/19/2023
DRAWN	— тн	REVISED	-
CHECKED	— TS	REVISED	-
DATE	<b>—</b> 3/31/2023	REVISED	-

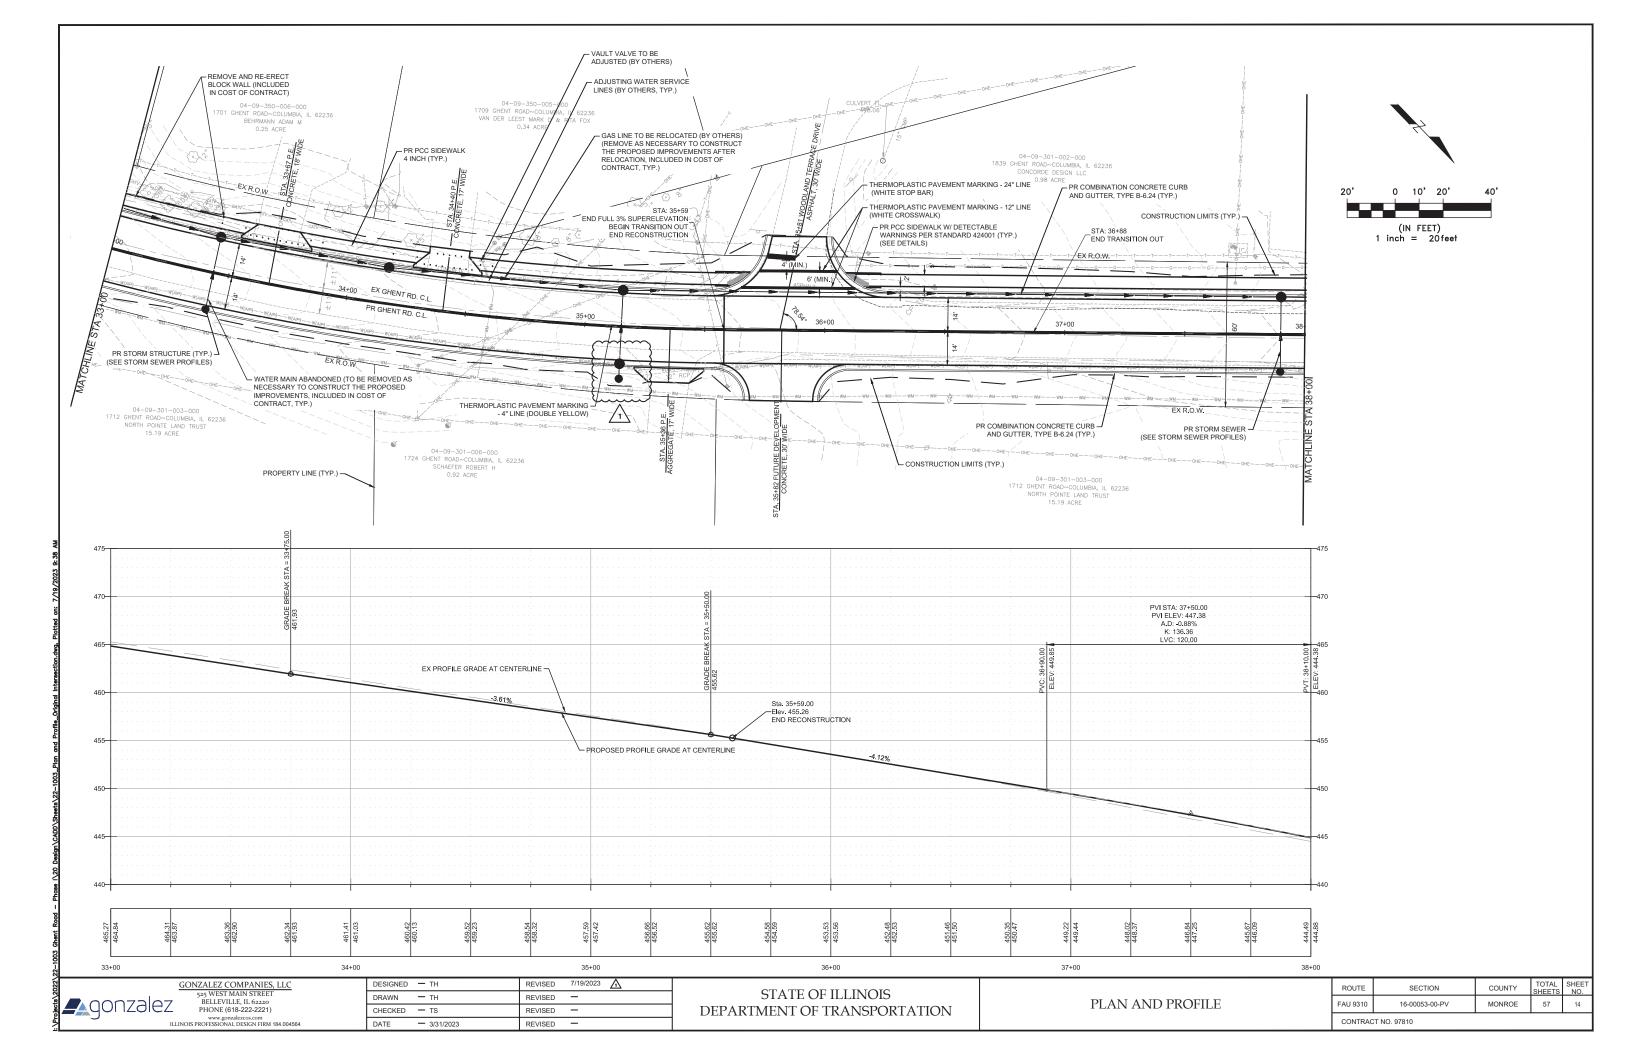




20' 20'

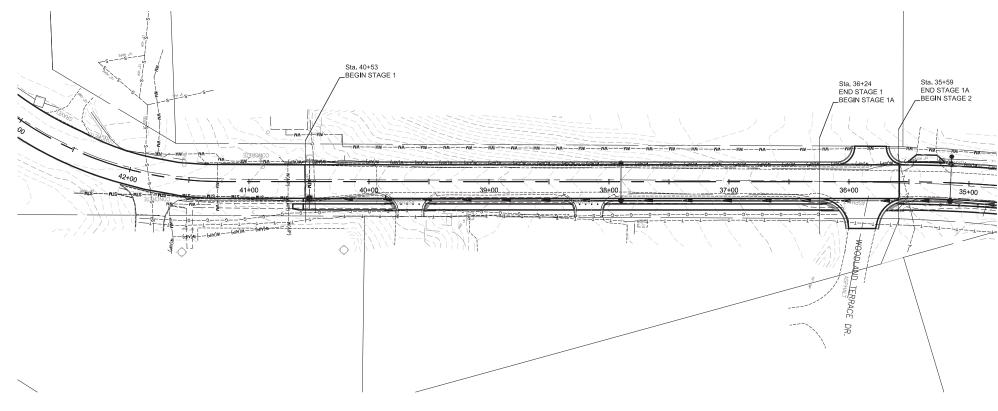

## NOTES:

- 1. TYPE III BARRICADES AND ROAD CLOSURE SIGNS SHALL BE POSITIONED ACCORDING TO HIGHWAY STANDARD B.L.R. 22-7
- 2. ALL TRAFFIC CONTROL SIGNS, BARRICADES, AND MAINTENANCE TO BE INCLUDED IN THE COST OF TRAFFIC CONTROL AND PROTECTION, (SPECIAL)
- 3. ACCESS TO ENTRANCES SHALL BE MAINTAINED AT ALL TIMES.
- 4. THE CONTRACTOR SHALL MAINTAIN DRAINAGE THROUGH CONSTRUCTION.
- 5. TYPE A LOW INTENSITY FLASHING LIGHTS SHALL BE USED ON THE FIRST SIGN IN ADVANCE OF THE WORK SITE AND ON ALL TYPE III BARRICADES DURING HOURS OF DARKNESS.
- 6. BARRICADES AND SIGNS SHALL BE POSITIONED ACCORDING TO HIGHWAY STANDARDS, THE MANUAL ON UNIFORM TRAFFIC CONTROL DEVICES, AND AS
- 7. ALL SERVICES AND PROPERTY OWNERS ALONG THE PROJECT SHALL BE NOTIFIED OF THE WORK AT LEAST 48 HOURS PRIOR TO CONSTRUCTION OPERATIONS.
- 8. THE STAGES OF CONSTRUCTION DESCRIBED MAY BE ADJUSTED WITH THE APPROVAL OF THE ENGINEER TO ACCOMMODATE SCHEDULES AND/OR EXPEDITE CONSTRUCTION. THE CONTRACTOR MAY SUBMIT AN ALTERNATE SEQUENCE ON CONSTRUCTION FOR CONSIDERATION WHICH MAINTAINS COMPARABLE ACCESS. NO ADDITIONAL PAYMENT WILL BE MADE FOR ACCEPTANCE OF AN ALTERNATE SEQUENCE OF CONSTRUCTION.

### STAGING NOTES:

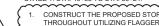

CONSTRUCT THE PROPOSED STORM SEWER SYSTEM FOR THE LENGTH OF THE STAGE. ENSURE ONE LANE AT LEAST 10" WIDE IS MAINTAINED FOR ACCESS THROUGHOUT UTILIZING FLAGGERS FOR LOCAL TRAFFIC. USE TRENCH BACKFILL TO FILL STORM SEWER TRENCHES TO THE BOTTOM OF THE PROPOSED PAVEMENT STRUCTURE AND PAVEMENT PATCHING TO FILL TRENCHES THE REMAINDER OF THE WAY UP TO MATCH THE EXISTING ROADWAY SURFACE. AT THE ENTRANCES CONSTRUCT ONE HALF AT A TIME TO MAINTAIN ACCESS.

- REMOVE EXISTING CURB THAT HAS NOT ALREADY BEEN REMOVED IN THE CONSTRUCTION OF THE PROPOSED STORM SEWER.
- CONSTRUCT CURB AND GUTTER AND BASE COURSE WIDENING ALONG BOTH SIDES OF THE ROADWAY, BARRICADES OR CONES SHALL BE PLACED AT INTERVALS REQUIRED TO SUFFICIENTLY DELINEATE DROP-OFFS AT THE EDGE OF PAVEMENT. USE AGGREGATE FOR TEMPORARY ACCESS TO MAINTAIN ACCESS TO DRIVEWAYS AT ALL TIMES. IN ORDER TO MAINTAIN ACCESS TO ENTRANCES CONSTRUCT HALF THE CURB AND GUTTER AND BASE WIDENING AT A TIME AT THE
- 4. CONSTRUCT ALL SIDEWALK AND ENTRANCES. PROVIDE ANY REQUIRED BACKFILL AND/OR GRADING BEHIND THE CURB AND GUTTER PRIOR TO SEEDING FERTILIZING AND MULCHING.
- 5. MILLING AND HMA SURFACE COURSE WILL BE COMPLETED IN A LATER STAGE.

#### STAGE 1A: STA. 36+24 TO STA. 35+52.

- 1. CONSTRUCT THE PROPOSED STORM SEWER SYSTEM ACROSS WOODLAND TERRACE DRIVE. ENSURE ONE LANE AT LEAST 10' WIDE IS MAINTAINED FOR ACCESS. USE TRENCH BACKFILL TO FILL STORM SEWER TRENCHES TO THE BOTTOM OF THE PROPOSED PAVEMENT STRUCTURE AND AGGREGATE FOR TEMPORARY ACCESS TO FILL TRENCHES THE REMAINDER OF THE WAY UP TO MATCH THE EXISTING ROADWAY SURFACE.
- 2. REMOVE EXISTING CURB THAT HAS NOT ALREADY BEEN REMOVED IN THE CONSTRUCTION OF THE PROPOSED STORM SEWER.
- 3. CONSTRUCT CURB AND GUTTER AND BASE COURSE WIDENING ALONG BOTH SIDES OF THE ROADWAY. BARRICADES OR CONES SHALL BE PLACED AT INTERVALS REQUIRED TO SUFFICIENTLY DELINEATE DROP-OFFS AT THE EDGE OF PAVEMENT.
- 4. REMOVE PAVEMENT FOR WOODLAND TERRACE DRIVE ONE HALF AT A TIME, AND CONSTRUCT AGGREGATE BASE COURSE. PROVIDE AGGREGATE FOR TEMPORARY ACCESS UNTIL HMA BINDER AND SURFACE COURSE IS PAVED IN LATER STAGES.
- 5. CONSTRUCT ALL SIDEWALK. PROVIDE ANY REQUIRED BACKFILL AND/OR GRADING BEHIND THE CURB AND GUTTER PRIOR TO SEEDING FERTILIZING AND
- 6. MILLING AND HMA SURFACE COURSE WILL BE COMPLETED IN A LATER STAGE



GONZALEZ COMPANIES, LLC 525 WEST MAIN STREET BELLEVILLE, IL 62220 PHONE (618-222-2221)

DESIGNED - TH	REVISED 7/19/2023 🛕
DRAWN - TH	REVISED -
CHECKED — TS	REVISED —
DATE - 3/31/2023	REVISED -

ROUTE	SECTION	COUNTY	TOTAL SHEETS	SHEET NO.
FAU 9310	16-00053-00-PV	MONROE	57	17
CONTRAC	T NO. 97810			



- 1. TYPE III BARRICADES AND ROAD CLOSURE SIGNS SHALL BE POSITIONED ACCORDING TO HIGHWAY STANDARD B.L.R. 22-7.
- 2. ALL TRAFFIC CONTROL SIGNS, BARRICADES, AND MAINTENANCE TO BE INCLUDED IN THE COST OF TRAFFIC CONTROL AND PROTECTION, (SPECIAL)
- 3. ACCESS TO ENTRANCES SHALL BE MAINTAINED AT ALL TIMES.
- 4. THE CONTRACTOR SHALL MAINTAIN DRAINAGE THROUGH CONSTRUCTION
- 5. TYPE A LOW INTENSITY FLASHING LIGHTS SHALL BE USED ON THE FIRST SIGN IN ADVANCE OF THE WORK SITE AND ON ALL TYPE III BARRICADES DURING HOURS
- 6. BARRICADES AND SIGNS SHALL BE POSITIONED AS SHOWN, ACCORDING TO HIGHWAY STANDARDS, THE MANUAL ON UNIFORM TRAFFIC CONTROL DEVICES, AND AS DIRECTED BY THE ENGINEER.
- 7. ALL SERVICES AND PROPERTY OWNERS ALONG THE PROJECT SHALL BE NOTIFIED OF THE WORK AT LEAST 48 HOURS PRIOR TO CONSTRUCTION OPERATIONS.
- 8. THE STAGES OF CONSTRUCTION DESCRIBED MAY BE ADJUSTED WITH THE APPROVAL OF THE ENGINEER TO ACCOMMODATE SCHEDULES AND/OR EXPEDITE CONSTRUCTION. THE CONTRACTOR MAY SUBMIT AN ALTERNATE SEQUENCE ON CONSTRUCTION FOR CONSIDERATION WHICH MAINTAINS COMPARABLE ACCESS. NO ADDITIONAL PAYMENT WILL BE MADE FOR ACCEPTANCE OF AN ALTERNATE SEQUENCE OF CONSTRUCTION.

#### STAGING NOTES:

STAGE 2: STA. 35+59 TO STA. 29+53.



- CONSTRUCT THE PROPOSED STORM SEWER SYSTEM FOR THE LENGTH OF THE STAGE. ENSURE ONE LANE AT LEAST 10' WIDE IS MAINTAINED FOR ACCESS THROUGHOUT, UTILIZING FLAGGERS FOR LOCAL TRAFFIC. USE TRENCH BACKFILL TO FILL STORM SEWER TRENCHES TO THE BOTTOM OF THE PROPOSED PAYEMENT STRUCTURE AND AGGREGATE FOR TEMPORARY ACCESS TO FILL TRENCHES THE REMAINDER OF THE WAY UP TO MATCH THE EXISTING ROADWAY
- URFACE. CONSTRUCT CURB AND GUTTER THE LENGTH OF THE STAGE. BARRICADES OR CONES SHALL BE PLACED AT INTERVALS REQUIRED TO SUFFICIENTLY DELINEATE DROP-OFFS AT THE EDGE OF PAVEMENT. USE AGGREGATE FOR TEMPORARY ACCESS TO MAINTAIN ACCESS TO DRIVEWAYS AT ALL TIMES.
- 3. CONSTRUCT BASE COURSE WIDENING ALONG BOTH SIDES OF THE ROADWAY FROM STA, 30+75.TO STA, STA, 29+53.
- 4. REMOVE PAVEMENT IN GHENT ROAD FROM STA. 35+59 TO STA. 30+75, ONE LANE AT A TIME UTILIZING FLAGGERS FOR LOCAL TRAFFIC.
- 5. CONSTRUCT SUBBASE GRANULAR AND HMA BINDER COURSE FROM STA. 35+59 TO STA. 30+75. A TEMPORARY RAMP SHALL BE PROVIDED AT BOTH STA. 35+59 AND STA. 30+75. ENSURE ONE LANE AT LEAST 10' WIDE IS MAINTAINED FOR ACCESS THROUGHOUT.
- 6. PAVE HMA BINDER COURSE AT WOODLAND TERRACE DRIVE. A TEMPORARY RAMP SHALL BE PROVIDED UNTIL HMA SURFACE COURSE IS PAVED AT A LATER
- CONSTRUCT SIDEWALK ALONG THE ENTIRE STAGE FOR DRIVEWAYS AND ENTRANCES CONSTRUCT ONE HALF AT A TIME TO MAINTAIN ACCESS AT ALL TIMES.
  PROVIDE ANY REQUIRED BACKFILL AND/OR GRADING BEHIND THE CURB AND GUTTER PRIOR TO SEEDING, FERTILIZING, AND MULCHING.
- 8. MILLING AND HMA SURFACE COURSE WILL BE COMPLETED IN A LATER STAGE.

#### STAGE 2A: STA. 29+53 TO STA. 28+60

- CONSTRUCT THE PROPOSED STORM SEWER SYSTEM ACROSS ASHLEE LANE ONE HALF AT A TIME. ENSURE ONE LANE AT LEAST 10' WIDE IS MAINTAINED FOR ACCESS, UTILIZING FLAGGERS FOR LOCAL TRAFFIC. USE TRENCH BACKFILL TO FILL STORM SEWER TRENCHES TO THE BOTTOM OF THE PROPOSED PAVEMENT STRUCTURE AND AGGREGATE FOR TEMPORARY ACCESS TO FILL TRENCHES THE REMAINDER OF THE WAY UP TO MATCH THE EXISTING ROADWAY SURFACE.
- 2. REMOVE PAVEMENT AT ASHLEE LANE ONE HALF AT A TIME AND CONSTRUCT CURB AND GUTTER AND PCC PAVEMENT ACCORDING TO THE CROSS SECTIONS. PROVIDE A TEMPORARY RAMP UNTIL SURFACE COURSE IS PAVED ON GHENT ROAD IN A LATER STAGE.
- 3. CONSTRUCT ALL SIDEWALK. PROVIDE ANY REQUIRED BACKFILL AND/OR GRADING BEHIND THE CURB AND GUTTER PRIOR TO SEEDING, FERTILIZING, AND MULCHING.



GONZALEZ COMPANIES, LLC 525 WEST MAIN STREET BELLEVILLE, IL 62220 PHONE (618-222-2221)

REVISED 7/19/2023 🔨 DESIGNED - TH DRAWN REVISED CHECKED - TS **—** 3/31/2023 REVISED -

STATE OF ILLINOIS DEPARTMENT OF TRANSPORTATION STAGING PLAN

ROUTE	SECTION	COUNTY	TOTAL SHEETS	SHEET NO.
FAU 9310	16-00053-00-PV	MONROE	57	18
CONTRAC	T NO 97810			



- 1. TYPE III BARRICADES AND ROAD CLOSURE SIGNS SHALL BE POSITIONED ACCORDING TO HIGHWAY STANDARD B.L.R. 22-7.
- 2. ALL TRAFFIC CONTROL SIGNS, BARRICADES, AND MAINTENANCE TO BE INCLUDED IN THE COST OF TRAFFIC CONTROL AND PROTECTION, (SPECIAL)
- 3. ACCESS TO ENTRANCES SHALL BE MAINTAINED AT ALL TIMES.
- 4. THE CONTRACTOR SHALL MAINTAIN DRAINAGE THROUGH CONSTRUCTION
- 5. TYPE A LOW INTENSITY FLASHING LIGHTS SHALL BE USED ON THE FIRST SIGN IN ADVANCE OF THE WORK SITE AND ON ALL TYPE III BARRICADES DURING HOURS
- 6. BARRICADES AND SIGNS SHALL BE POSITIONED AS SHOWN, ACCORDING TO HIGHWAY STANDARDS, THE MANUAL ON UNIFORM TRAFFIC CONTROL DEVICES, AND AS DIRECTED BY THE ENGINEER.
- 7. ALL SERVICES AND PROPERTY OWNERS ALONG THE PROJECT SHALL BE NOTIFIED OF THE WORK AT LEAST 48 HOURS PRIOR TO CONSTRUCTION OPERATIONS.
- 8. THE STAGES OF CONSTRUCTION DESCRIBED MAY BE ADJUSTED WITH THE APPROVAL OF THE ENGINEER TO ACCOMMODATE SCHEDULES AND/OR EXPEDITE CONSTRUCTION. THE CONTRACTOR MAY SUBMIT AN ALTERNATE SEQUENCE ON CONSTRUCTION FOR CONSIDERATION WHICH MAINTAINS COMPARABLE ACCESS. NO ADDITIONAL PAYMENT WILL BE MADE FOR ACCEPTANCE OF AN ALTERNATE SEQUENCE OF CONSTRUCTION.

STAGE 3: STA. 28+60. TO STA. 24+20



- CONSTRUCT THE PROPOSED STORM SEWER SYSTEM FOR THE LENGTH OF THE STAGE. ENSURE ONE LANE AT LEAST 10' WIDE IS MAINTAINED FOR ACCESS THROUGHOUT, UTILIZING FLAGGERS FOR LOCAL TRAFFIC. USE TRENCH BACKFILL TO FILL STORM SEWER TRENCHES TO THE BOTTOM OF THE PROPOSED PAVEMENT STRUCTURE AND PAVEMENT PATCHING TO FILL TRENCHES THE REMAINDER OF THE WAY UP TO MATCH THE EXISTING ROADWAY SURFACE.
- CONSTRUCT CURB AND GUTTER THE LENGTH OF THE STAGE. BARRICADES OR CONES SHALL BE PLACED AT INTERVALS REQUIRED TO SUFFICIENTLY DELINEATE DROP-OFFS AT THE EDGE OF PAVEMENT. USE AGGREGATE FOR TEMPORARY ACCESS TO MAINTAIN ACCESS TO DRIVEWAYS AT ALL TIMES.
- 3. CONSTRUCT SIDEWALK ALONG THE ENTIRE STAGE, FOR DRIVEWAYS AND ENTRANCES CONSTRUCT ONE HALF AT A TIME TO MAINTAIN ACCESS AT ALL TIMES. PROVIDE ANY REQUIRED BACKFILL AND/OR GRADING BEHIND THE CURB AND GUTTER PRIOR TO SEEDING, FERTILIZING AND MULCHING.
- 4. MILLING AND HMA SURFACE COURSE WILL BE COMPLETED AT A LATER STAGE.


#### STAGE 3A: STA, 24+20 TO STA, 23+12

- 1. CONSTRUCT THE PROPOSED STORM SEWER SYSTEM FOR THE REMAINDER OF THE PROJECT. ENSURE ONE LANE AT LEAST 10' WIDE IS MAINTAINED FOR ACCESS THROUGHOUT, UTILIZING FLAGGERS FOR LOCAL TRAFFIC. USE TRENCH BACKFILL TO FILL STORM SEWER TRENCHES TO THE BOTTOM OF THE PROPOSED PAYEMENT STRUCTURE AND AGGREGATE FOR TEMPORARY ACCESS TO FILL TRENCHES THE REMAINDER OF THE WAY UP TO MATCH THE EXISTING ROADWAY
- 2. REMOVE PAVEMENT AND CONSTRUCT CHRISTINA COURT ONE HALF AT A TIME TO MAINTAIN ACCESS AT ALL TIMES ACCORDING TO THE CROSS SECTIONS. PROVIDE A TEMPORARY RAMP UNTIL SURFACE COURSE IS PAVED ON GHENT ROAD IN A LATER STAGE.
- 3. CONSTRUCT BASE COURSE WIDENING ALONG BOTH SIDES OF THE ROADWAY THE LENGTH OF THE STAGE.
- CONSTRUCT SIDEWALK ALONG THE ENTIRE STAGE, FOR DRIVEWAYS AND ENTRANCES CONSTRUCT ONE HALF AT A TIME TO MAINTAIN ACCESS AT ALL TIMES.
  PROVIDE ANY REQUIRED BACKFILL AND/OR GRADING BEHIND THE CURB AND GUTTER PRIOR TO SEEDING FERTILIZING AND MULCHING.
- 5. MILLING AND HMA SURFACE COURSE WILL BE COMPLETED IN A LATER STAGE.




GONZALEZ COMPANIES, LLC 525 WEST MAIN STREET BELLEVILLE, IL 62220 PHONE (618-222-2221)


DESIGNED	— тн	REVISED	7/19/2023 🛕
DRAWN	— тн	REVISED	-
CHECKED	<b>—</b> TS	REVISED	-
DATE	<b>—</b> 3/31/2023	REVISED	_

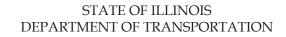





ROUTE	SECTION	COUNTY	TOTAL SHEETS	SHEE'
FAU 9310	16-00053-00-PV	MONROE	57	19
CONTRAC	T NO. 97810			

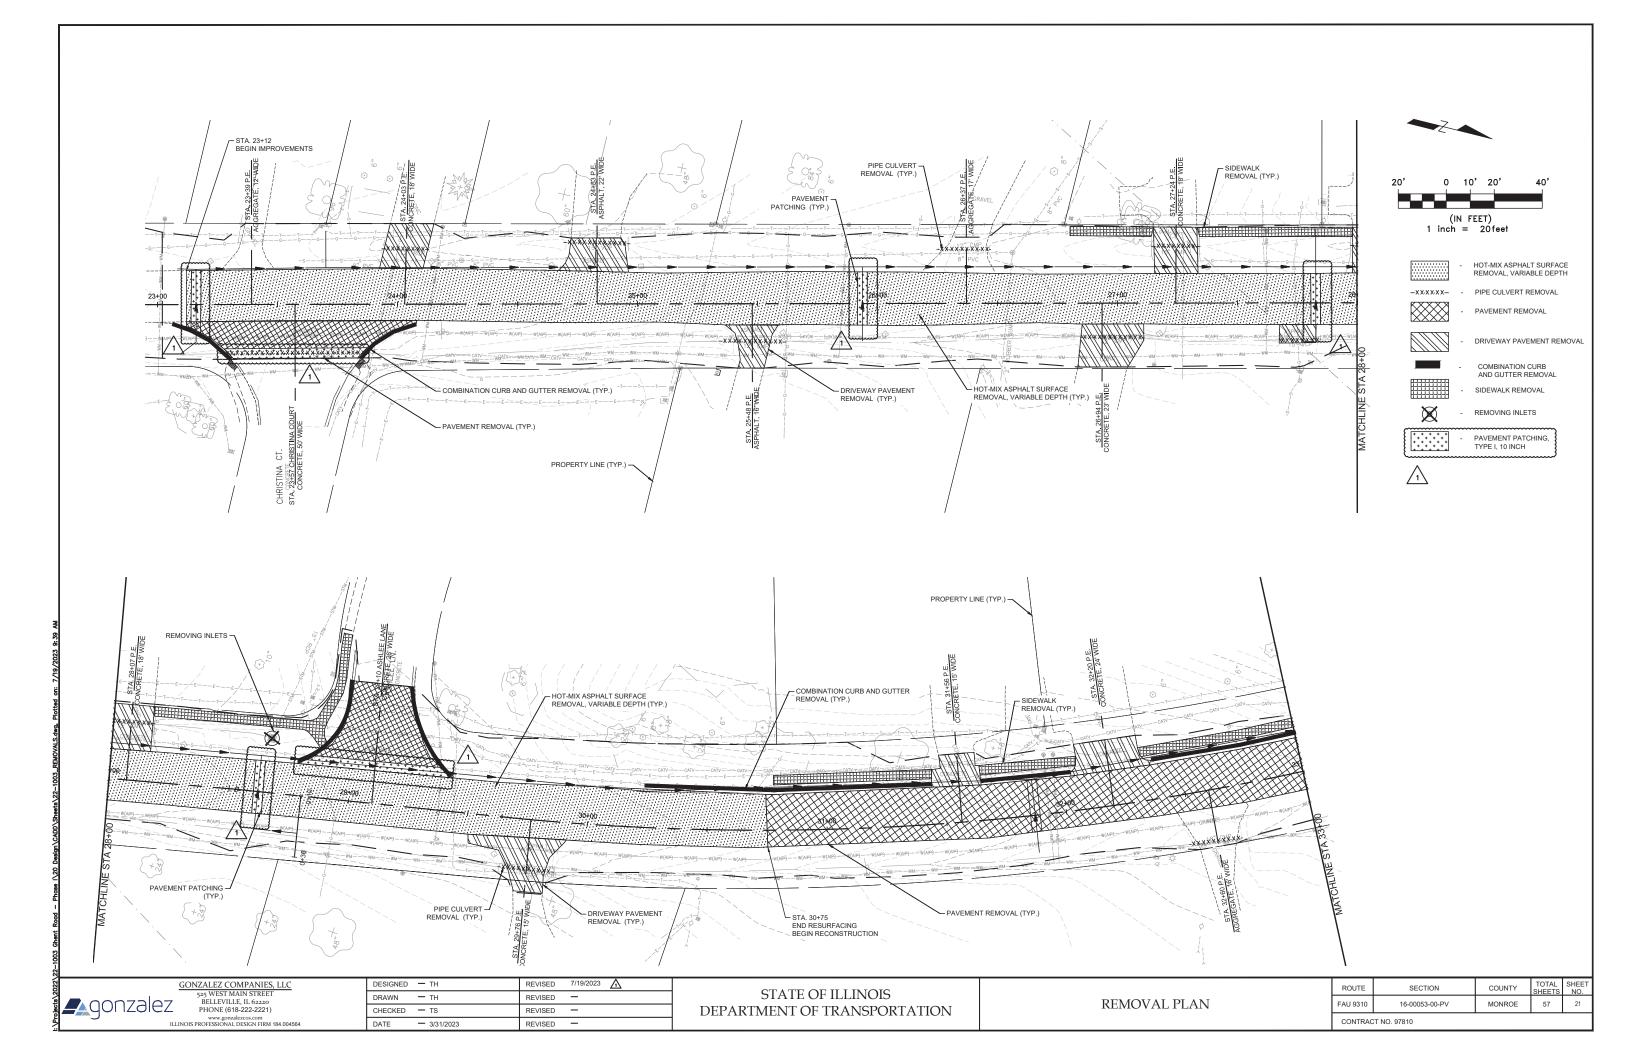

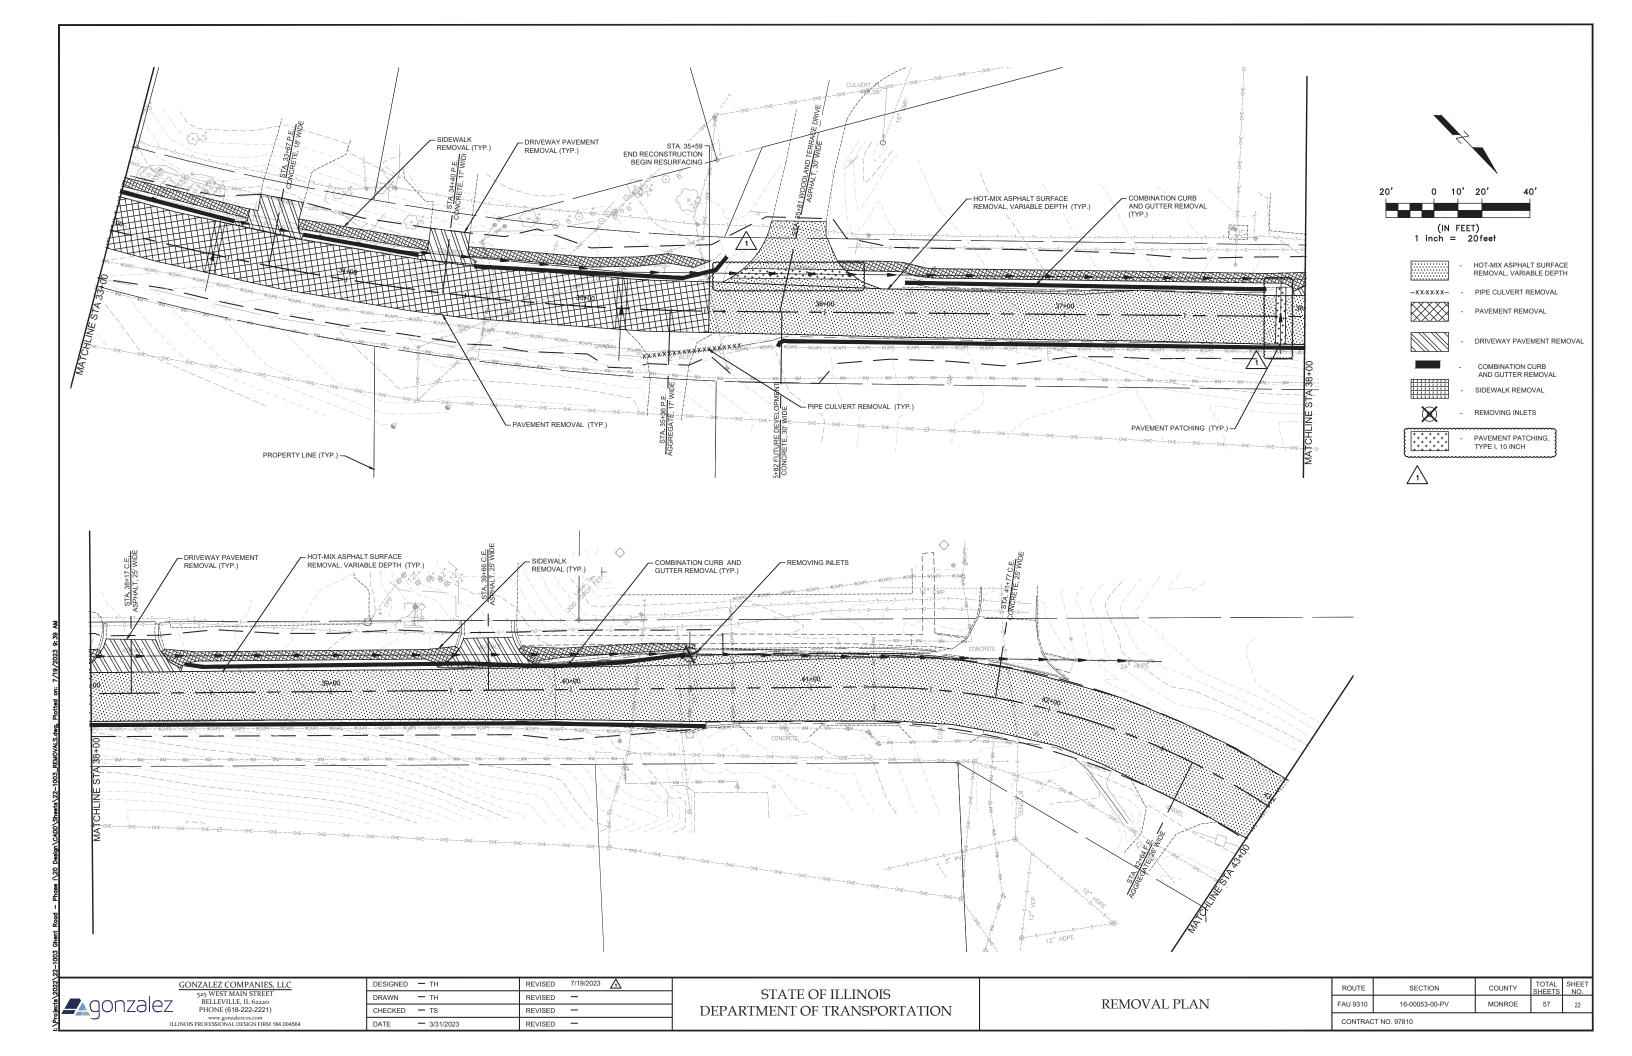

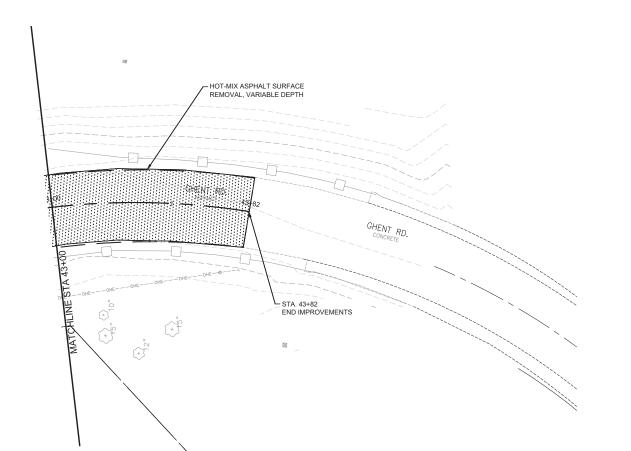



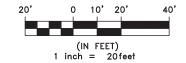

.....

- HOT-MIX ASPHALT SURFACE REMOVAL, VARIABLE DEPTH

PIPE CULVERT REMOVALPAVEMENT REMOVAL



- DRIVEWAY PAVEMENT REMOVAL



- COMBINATION CURB AND GUTTER REMOVAL



- SIDEWALK REMOVAL



- REMOVING INLETS



- PAVEMENT PATCHING, TYPE I, 10 INCH



			-
<b>_</b> gor	nza	lez	

GONZALEZ COMPANIES, LLC
525 WEST MAIN STREET
BELLEVILLE, IL 62220
PHONE (618-222-2221)
www.gonzalezcos.com
ILLINOIS PROFESSIONAL DESIGN FIRM 184 004564

 DESIGNED
 ─ TH
 REVISED
 7/19/2023
 ⚠

 DRAWN
 ─ TH
 REVISED
 ─

 CHECKED
 ─ TS
 REVISED
 ─

 DATE
 ─ 3/31/2023
 REVISED
 ─


STATE OF ILLINOIS
DEPARTMENT OF TRANSPORTATION


REMOVAL PLAN


 ROUTE
 SECTION
 COUNTY
 TOTAL SHEETS NO.


 FAU 9310
 16-00053-00-PV
 MONROE
 57
 23


 CONTRACT NO. 97810

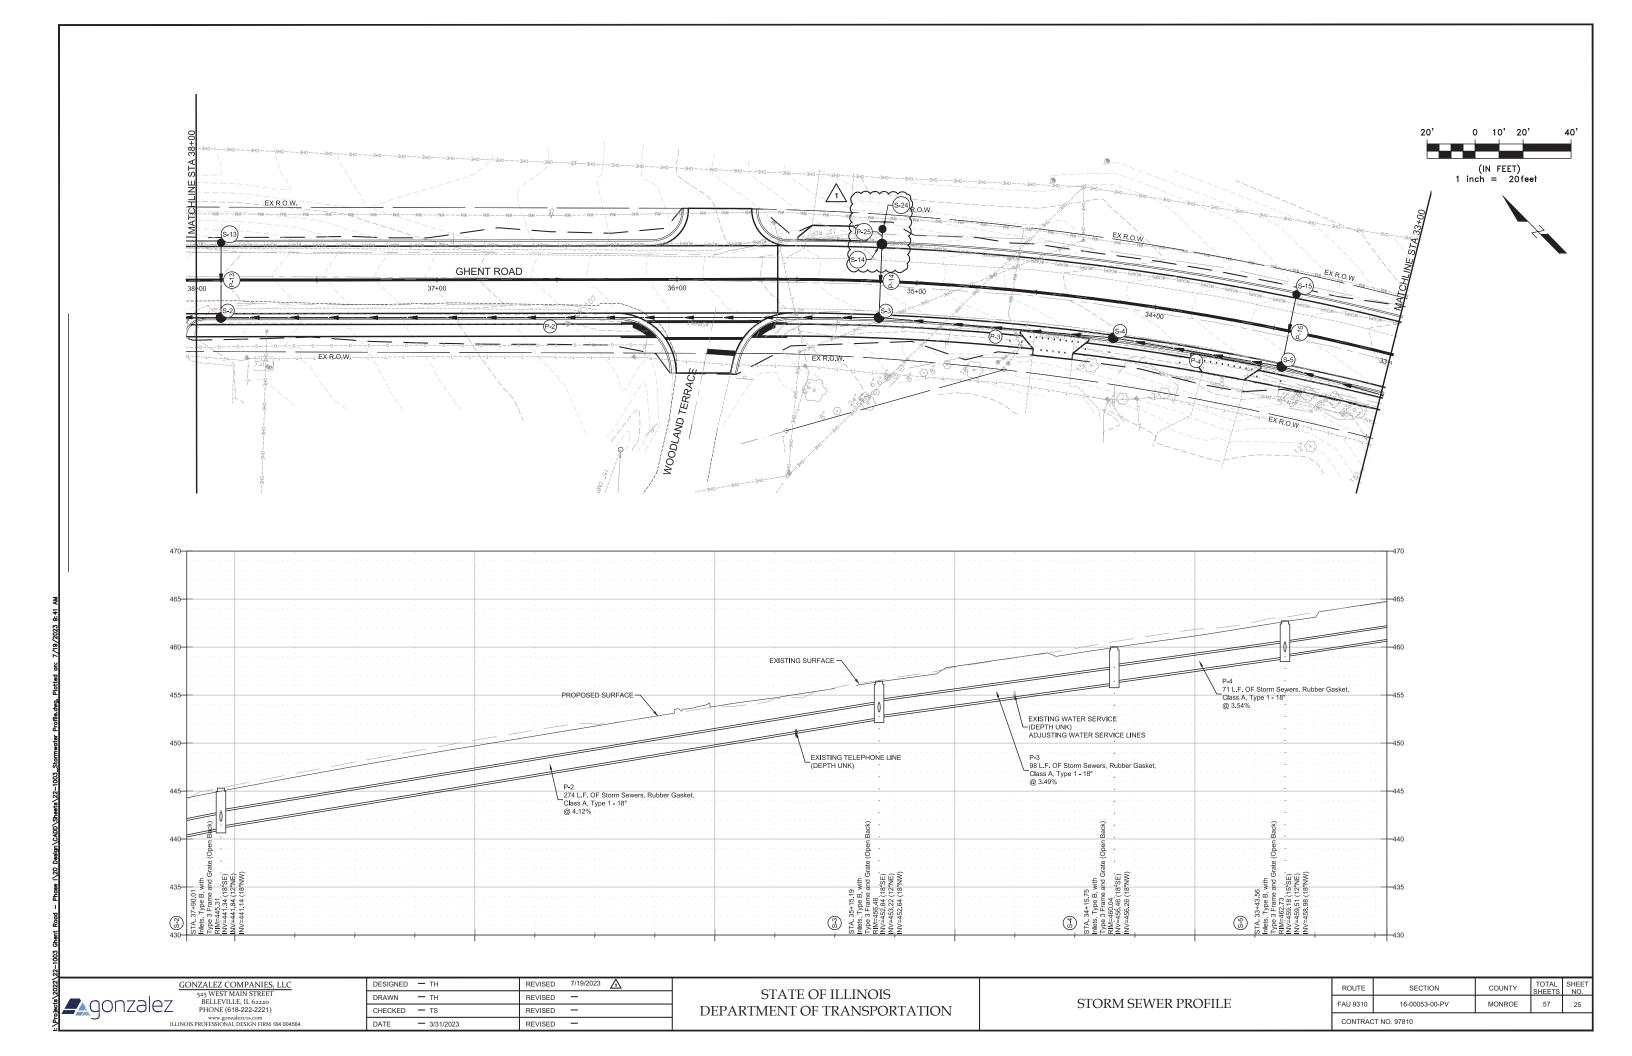


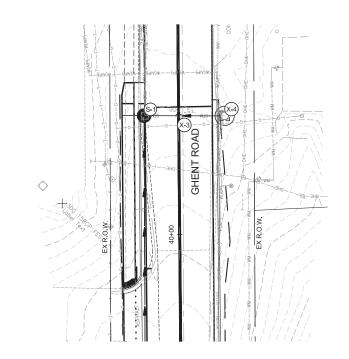


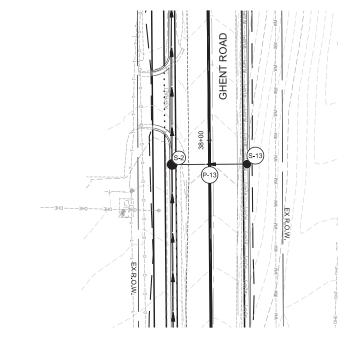


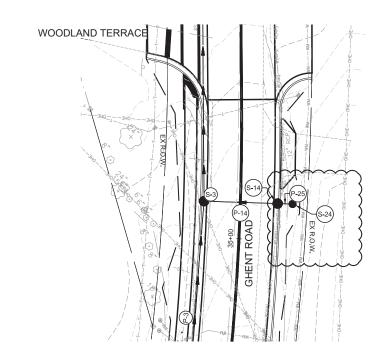

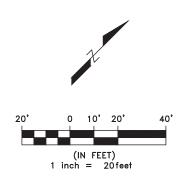

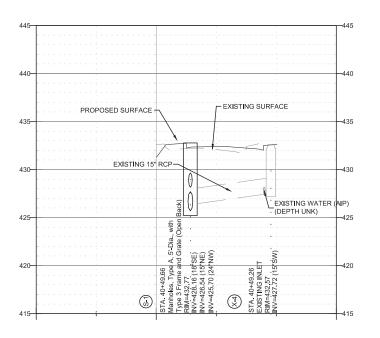

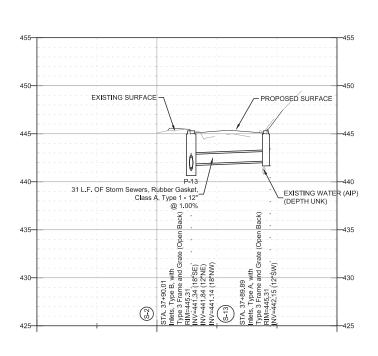

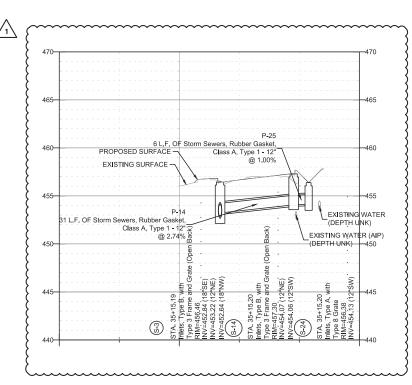

**_**gonzalez

GONZALEZ COMPANIES, LLC
525 WEST MAIN STREET
BELLEVILLE, IL 62220
PHONE (618-222-2221)
www.gonzalezcos.com
ILLINOIS PROFESSIONAL DESIGN FIEM 184.004564

DESIGNED	— тн	REVISED	7/19/2023
DRAWN	— тн	REVISED	-
CHECKED	— TS	REVISED	_
DATE	<b>—</b> 3/31/2023	REVISED	-
DATE	<del>- 3/31/2023</del>	REVISED	

STATE OF ILLINOIS
DEPARTMENT OF TRANSPORTATION

	ROUTE	SECTION	COUNTY	TOTAL SHEETS	SHEE NO.
STORM SEWER PROFILE	FAU 9310	16-00053-00-PV	MONROE	57	28
	CONTRACT NO 97810				