



F.A.I.	SECTION	COUNTY	TOTAL SHEETS	SHEET NO.
94/90	2005-008F	COOK	93	9
STA.		TO STA.		
FED. ROAD DIST. NO.	ILLINOIS	FED. AID PROJECT		
62919				

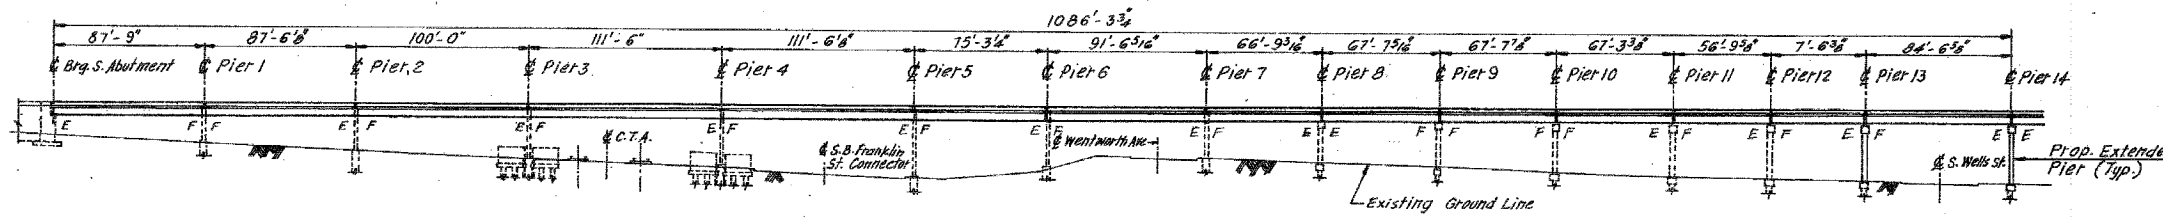

ELEVATION

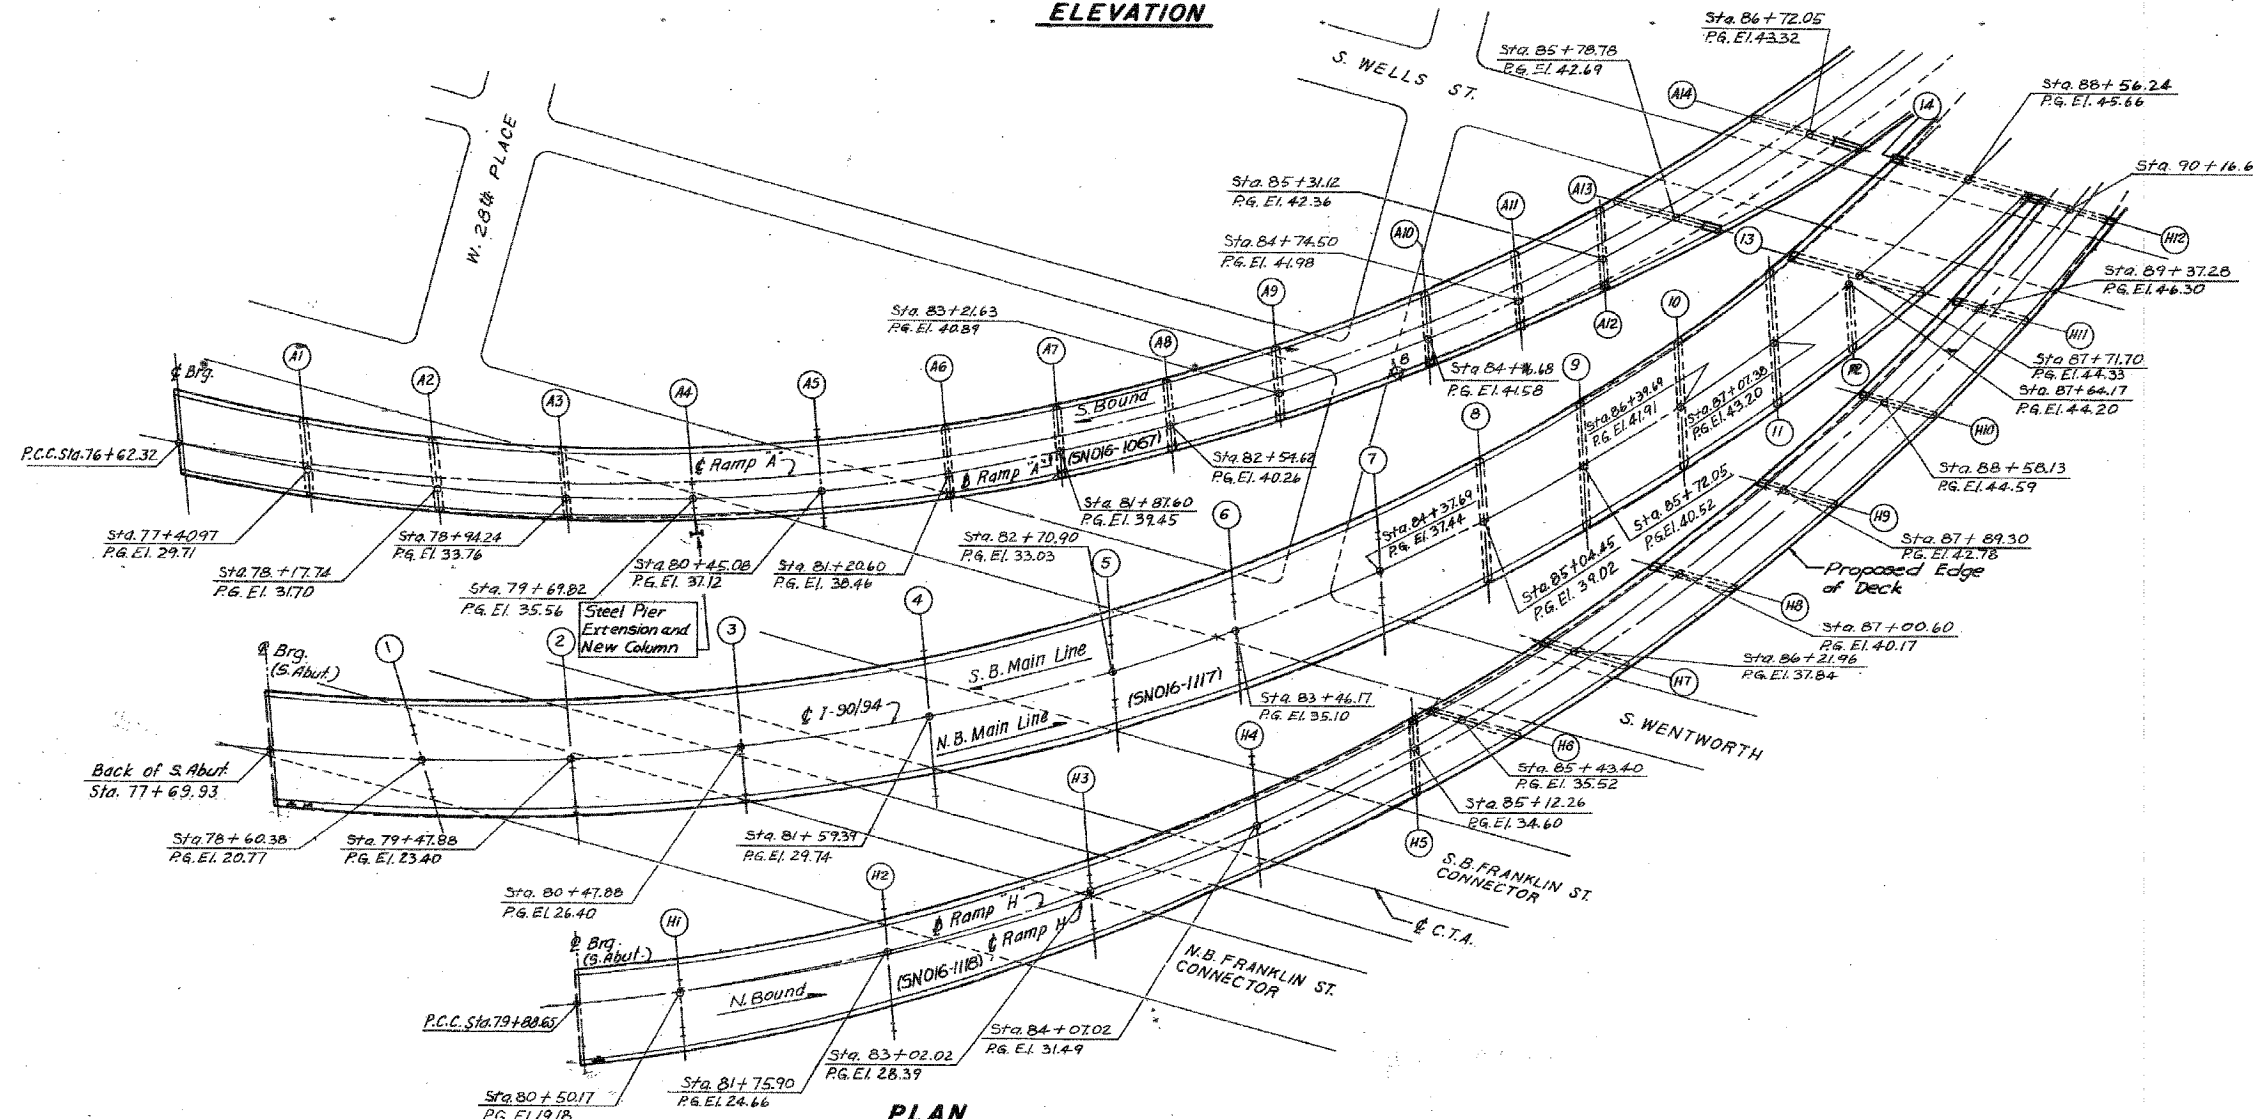

PLAN

BOWMAN, BARRETT & ASSOCIATES INC.
CONSULTING ENGINEERS
110 EAST RANDOLPH STREET SUITE 2650 CHICAGO, ILLINOIS 60601
312.467.1100

Note:
This sheet created from original 1988-89 reconstruction as-builts. These are provided for general reference to structure number, span lengths, etc. Work Items for this contract are identified on the partial framing plans and detail sheets that follow.

REVISIONS	
NAME	DATE

ILLINOIS DEPARTMENT OF TRANSPORTATION
F.A.I. 94/90 (DAN RYAN EXPRESSWAY)
FABRICATION CONTRACT
NB DAN RYAN ELEVATED BRIDGE
REPAIR FROM 15TH TO 28TH STREETS
GENERAL PLAN AND ELEVATION SN 016-1117
SCALE: NTS
DATE: 5/23/2005
DRAWN BY: BDC
CHECKED BY: BLU

5/23/2005 9:28:00 AM