# <u>GENERAL NOTES</u>

THE CONTRACTOR SHALL CONTACT JULIE (1-800-892-0123) BEFORE COMMENCING WORK. UNDERGROUND AND VISIBLE OVERHEAD UTILITIES SHOWN ON THE PLAN SHEETS WERE OBTAINED FROM LOCAL UTILITY COMPANIES AND OTHER AVAILABLE SOURCES. LOCATIONS, SIZE, MATERIAL, DESCRIPTION, OR TYPE OF EXISTING UTILITIES INDICATED ON THE PLANS ARE NOT REPRESENTED AS BEING ACCURATE, SUFFICIENT, OR COMPLETE AND SHALL BE CONSIDERED APPROXIMATE. ABOVE GROUND UTILITY LOCATIONS ARE SHOWN AS FOUND DURING THE INITIAL SURVEY FIELD WORK AND MAY NOT REFLECT CURRENT CONDITIONS. THE CONTRACTOR IS RESPONSIBLE FOR MAKING HIS OR HER OWN DETERMINATION AS TO THE TYPE, LOCATION, AND DEPTH OF UNDERGROUND AND OTHER UTILITIES AS MAY BE NECESSARY TO AVOID DAMAGE THERETO. THE CONTRACTOR SHALL BE RESPONSIBLE FOR LOCATING ALL UNDERGROUND UTILITIES AND COORDINATION WITH UTILITY COMPANIES.

THE CONTRACTOR SHALL COORDINATE ALL CONSTRUCTION ACTIVITIES WITH UTILITY COMPANIES AND THE RICHLAND COUNTY HIGHWAY DEPARTMENT.

THE	FOLLOWING RATES HAVE BEEN USED TO CALCULATE PLAY
	BITUMINOUS MATERIALS (HFRS-2P)
	SEAL COAT AGGREGATE
	AGGREGATE SURFACE COURSE, TYPE-B
	BITUMINOUS MATERIALS (PRIME COAT)
	BITUMINOUS MATERIALS (TACK COAT ON SOIL-CEMENT)
	BITUMINOUS MATERIALS (TACK COAT ON NEW H.M.A.)
	HOT-MIX ASPHALT
	AGGREGATE WEDGE SHOULDER, TYPE-B

### SCHEDULE OF KNOWN UTILITIES

DESIGN STAGE JULIE NO. A2793974 JULIE NO. A220701181

UTILITY COMPANY AMEREN ILLINOIS NORRIS ELECTRIC CO-OP FRONTIER COMMUNICATIONS ILLINOIS GAS COMPANY SPARKLIGHT WEST LIBERTY-DUNDAS WATER DISTRICT WATER LINE WEST LIBERTY-DUNDAS WATER DISTRICT SEWER LINE

<u>TYPE</u> ELECTRIC ELECTRIC COMMUNICATIONS GAS COMMUNICATIONS

CONTACT NAME NATE HILL TIM HUBER BRIAN VANGUNDY JORDAN KOCHER, P.E. 618-395-8588 JOEL HARRELSON ERIC MAY ERIC MAY

PHONE NUMBER 618-301-5327 618-783-8765 618-395-6189 618-383-2650 618-754-3576 618-754-3576

CHARLESTON ENGINEERING, INC.	DESIGNED – BMB	REVISED – 7–19–2022 🚹	
CONSULTING ENGINEERS - LAND SURVEYORS	DRAWN – BMB	REVISED –	
105 NORTH KITCHELL AVENUE OLNEY, ILLINOIS 62450 P.O. BOX 397 (618) 392-0736	CHECKED – BMB	REVISED -	
P.O. BOX 397 (618) 392-0736 ILLINOIS DEPARTMENT OF PROFESSIONAL REGULATION REGISTRATION #184.003513	DATE – 1–2022	REVISED -	

AN QUANTITIES: 2.92 LB/SY=(0.35 GAL/SY)\*(8.35 LB/GAL) 25 POUNDS/SQ YD 2.0 TONS/CU YD 0.25 POUNDS/SQ FT 0.05 POUNDS/SQ FT 0.025 POUNDS/SQ FT 112.0 POUNDS/SQ YD/INCH THICKNESS 2.0 TONS/CU YD

<u>E-MAIL ADDRESS</u> nhill2@ameren.com thuber@norriselectric.com brian.vangundy@ftr.com jkocher@ilgas.com eric@ericsaccounting.com eric@ericsaccounting.com

MAILING ADDRESS #6 EXECUTIVE DRIVE, COLLINSVILLE, IL 62234 8543 N. IL. 130, NEWTON, IL 62448 225 E. CHESTNUT ST, OLNEY, IL 62450 1927 MILLER DRIVE, OLNEY, IL 62450 joel.harrelson@sparklight.biz 113 W 9TH ST, MT. CARMEL, IL 62863

<b></b>					
	SUMMARY OF QUANTITIES				
			TOTAL		
CODE NO.	ITEM	UNIT	QUANTITY		
LR403400	BITUMINOUS MATERIALS (COVER AND SEAL COATS)	TON	24.5		
LR403600	SEAL COAT AGGREGATE	TON	211	_	
				$\bigcirc$	$\wedge$
X0326440	SURFACE REMOVAL, VARIABLE DEPTH (SPECIAL)	SQ YD	9,870	)	$\sum I \sum$
X7010216	TRAFFIC CONTROL AND PROTECTION, (SPECIAL)	L SUM	1		
7/010210			<b>T</b>		
Z0055300	RUMBLE STRIP	EACH	2		
35200410	PROCESSING SOIL-CEMENT BASE COURSE 10"	SQ YD	16,468		
35200500	CEMENT	100 WT	13,030		
				$\mathbf{i}$	$\wedge$
40200800	AGGREGATE SURFACE COURSE, TYPE B	TON	111	)	1
40600275	BITUMINOUS MATERIALS (PRIME COAT)	POUND	20		
40000275		FOOND	20		
40600290	BITUMINOUS MATERIALS (TACK COAT)	POUND	10,050		
		(			$\wedge$
40600990	TEMPORARY RAMP	SQ YD 🗸	2,160	3	/1\
40604152	POLYMERIZED HOT-MIX ASPHALT SURFACE COURSE, IL-9.5, MIX "C", N70	TON	2,252		
48102100	AGGREGATE WEDGE SHOULDER, TYPE B	TON	125		
67100100	MOBILIZATION	L SUM	1		
01100100			1		

APPLICATION	

POLYMERIZED HOT-MIX ASPHALT SURFAC COURSE, IL-9.5, MIX "C", N70

STATE OF ILLINOIS	SUMMARY OF QUANTITIES AND
DEPARTMENT OF TRANSPORTATION	GENERAL NOTES

SUMMARY OF BITUMINOUS MATERIALS (TACK COAT)			
QUANTITY (POUNDS)			
8,685			
1,365			
10,050			

	SUMMARY OF TEMPORARY RAMPS					
	LOCATION	QUANTITY (SQ YD)				
	MAINLINE BUTT JOINT, STA. 0+14.60	150				
	MAINLINE TRANSITION, STA. 16+00.00	42				
	MAINLINE TRANSITION, STA. 40+00.00	27				
$\frown$	MAINLINE, STA, 43+00.00	~~~~~~~~~~~~~~~~~~~~~~~~~~~~~~~~~~~~~~~				
	SIDE ROADS	1,871				
	TOTAL TEMPORARY RAMP =	2,160				
i						


\_\_\_\_\_

SUMMARY OF HOT-MIX ASPHALT			
OPERATION	QUANTITY (TONS)		
MAINLINE PAVING	2,170		
SIDEROADS AND PRIVATE ENTRANCES	76		
MAILBOX TURNOUTS	6		
TOTAL HMA SURFACE COURSE =	2,252		


	HOT-MIX ASPHALT MIXTURE REQUIREMENTS						
	PERFORMANCE GRADE	DESIGN AIR VOIDS	MIXTURE COMPOSITION	FRICTION AGGREGATE	MIXTURE UNIT WEIGHT	QUALITY MANAGEMENT PROGRAM	
ACE	PG 70-22	4% @ N=70 Gyrations	IL - 9.5	MIXTURE "C"	112 LB/SQ YD/IN	QC/QA	

ROUTE	SECTION	COUNTY		TOTAL SHEETS	SHEET NO.
FAS 801	21-00128-00-FP	RICHL	AND	11	2
CONTRACT 95925		ILLINOIS	PROJEC	「SDE2(930)	



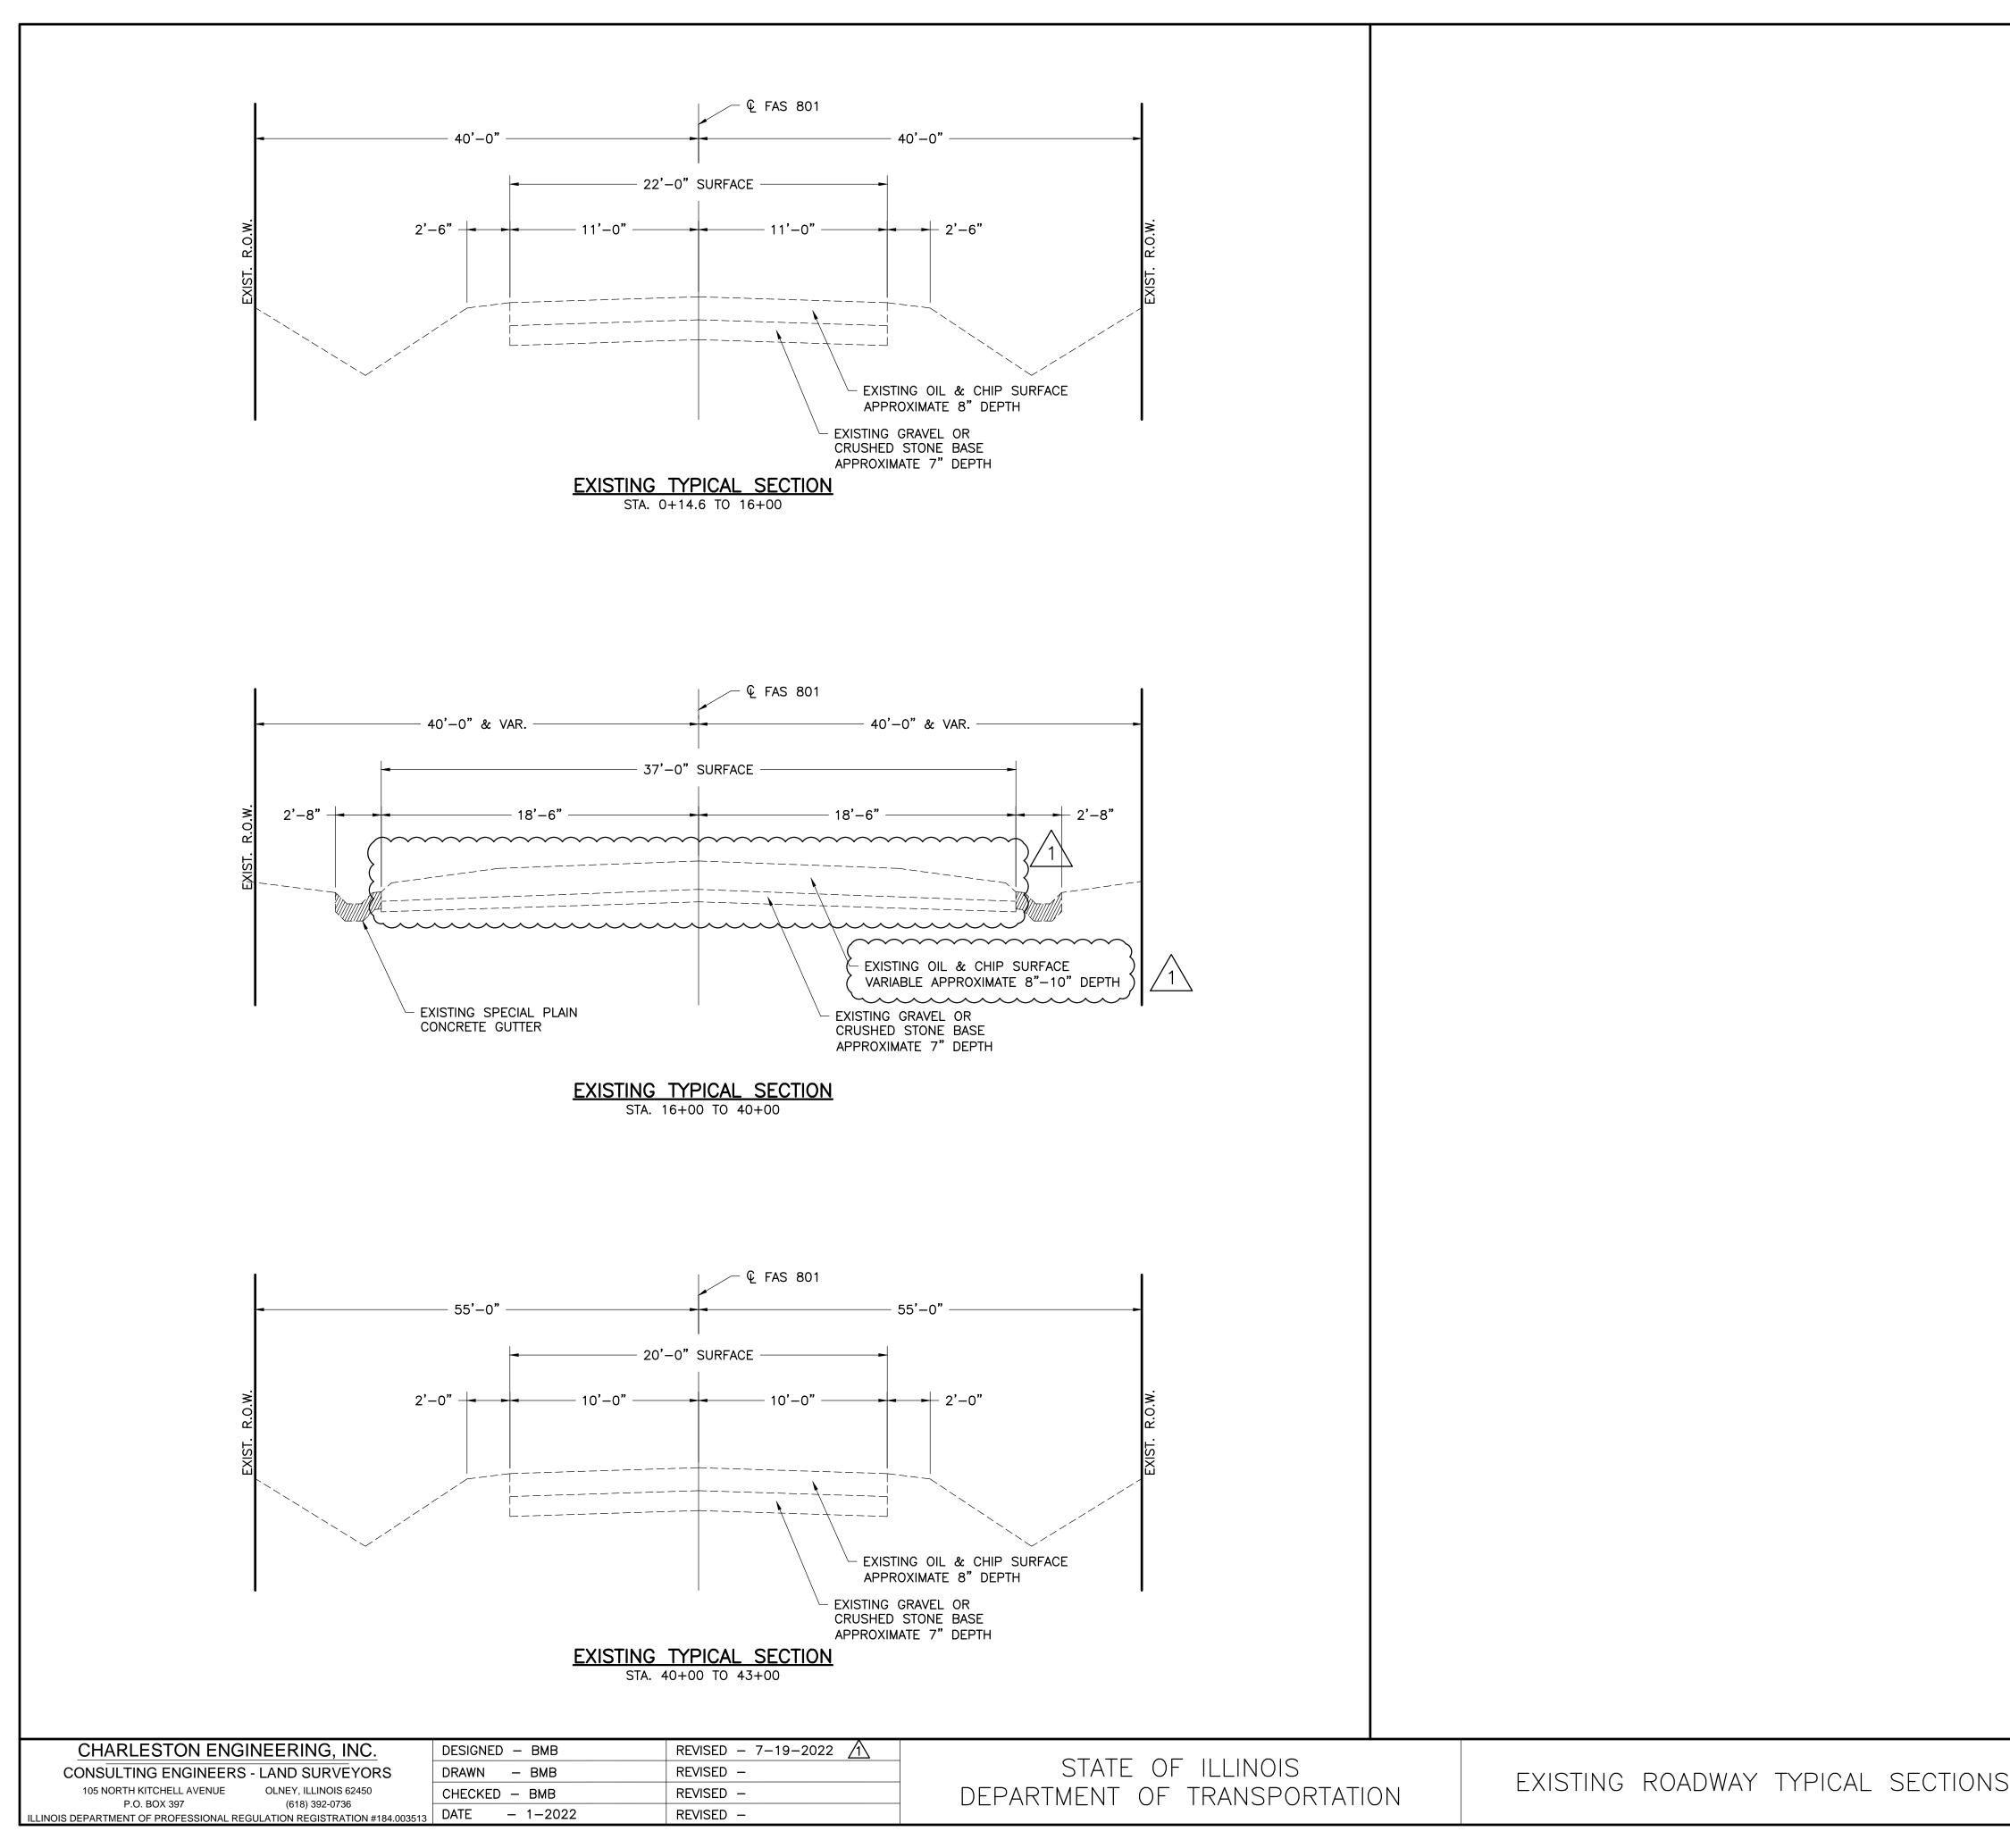

	ROUTE	SECTION	1000	NTY	TOTAL SHEETS	SHEET NO.
S	FAS 801	21-00128-00-FP	RICHL	AND	11	3
	CONTRACT 95925		ILLINOIS	PROJEC	「SDE2(930)	

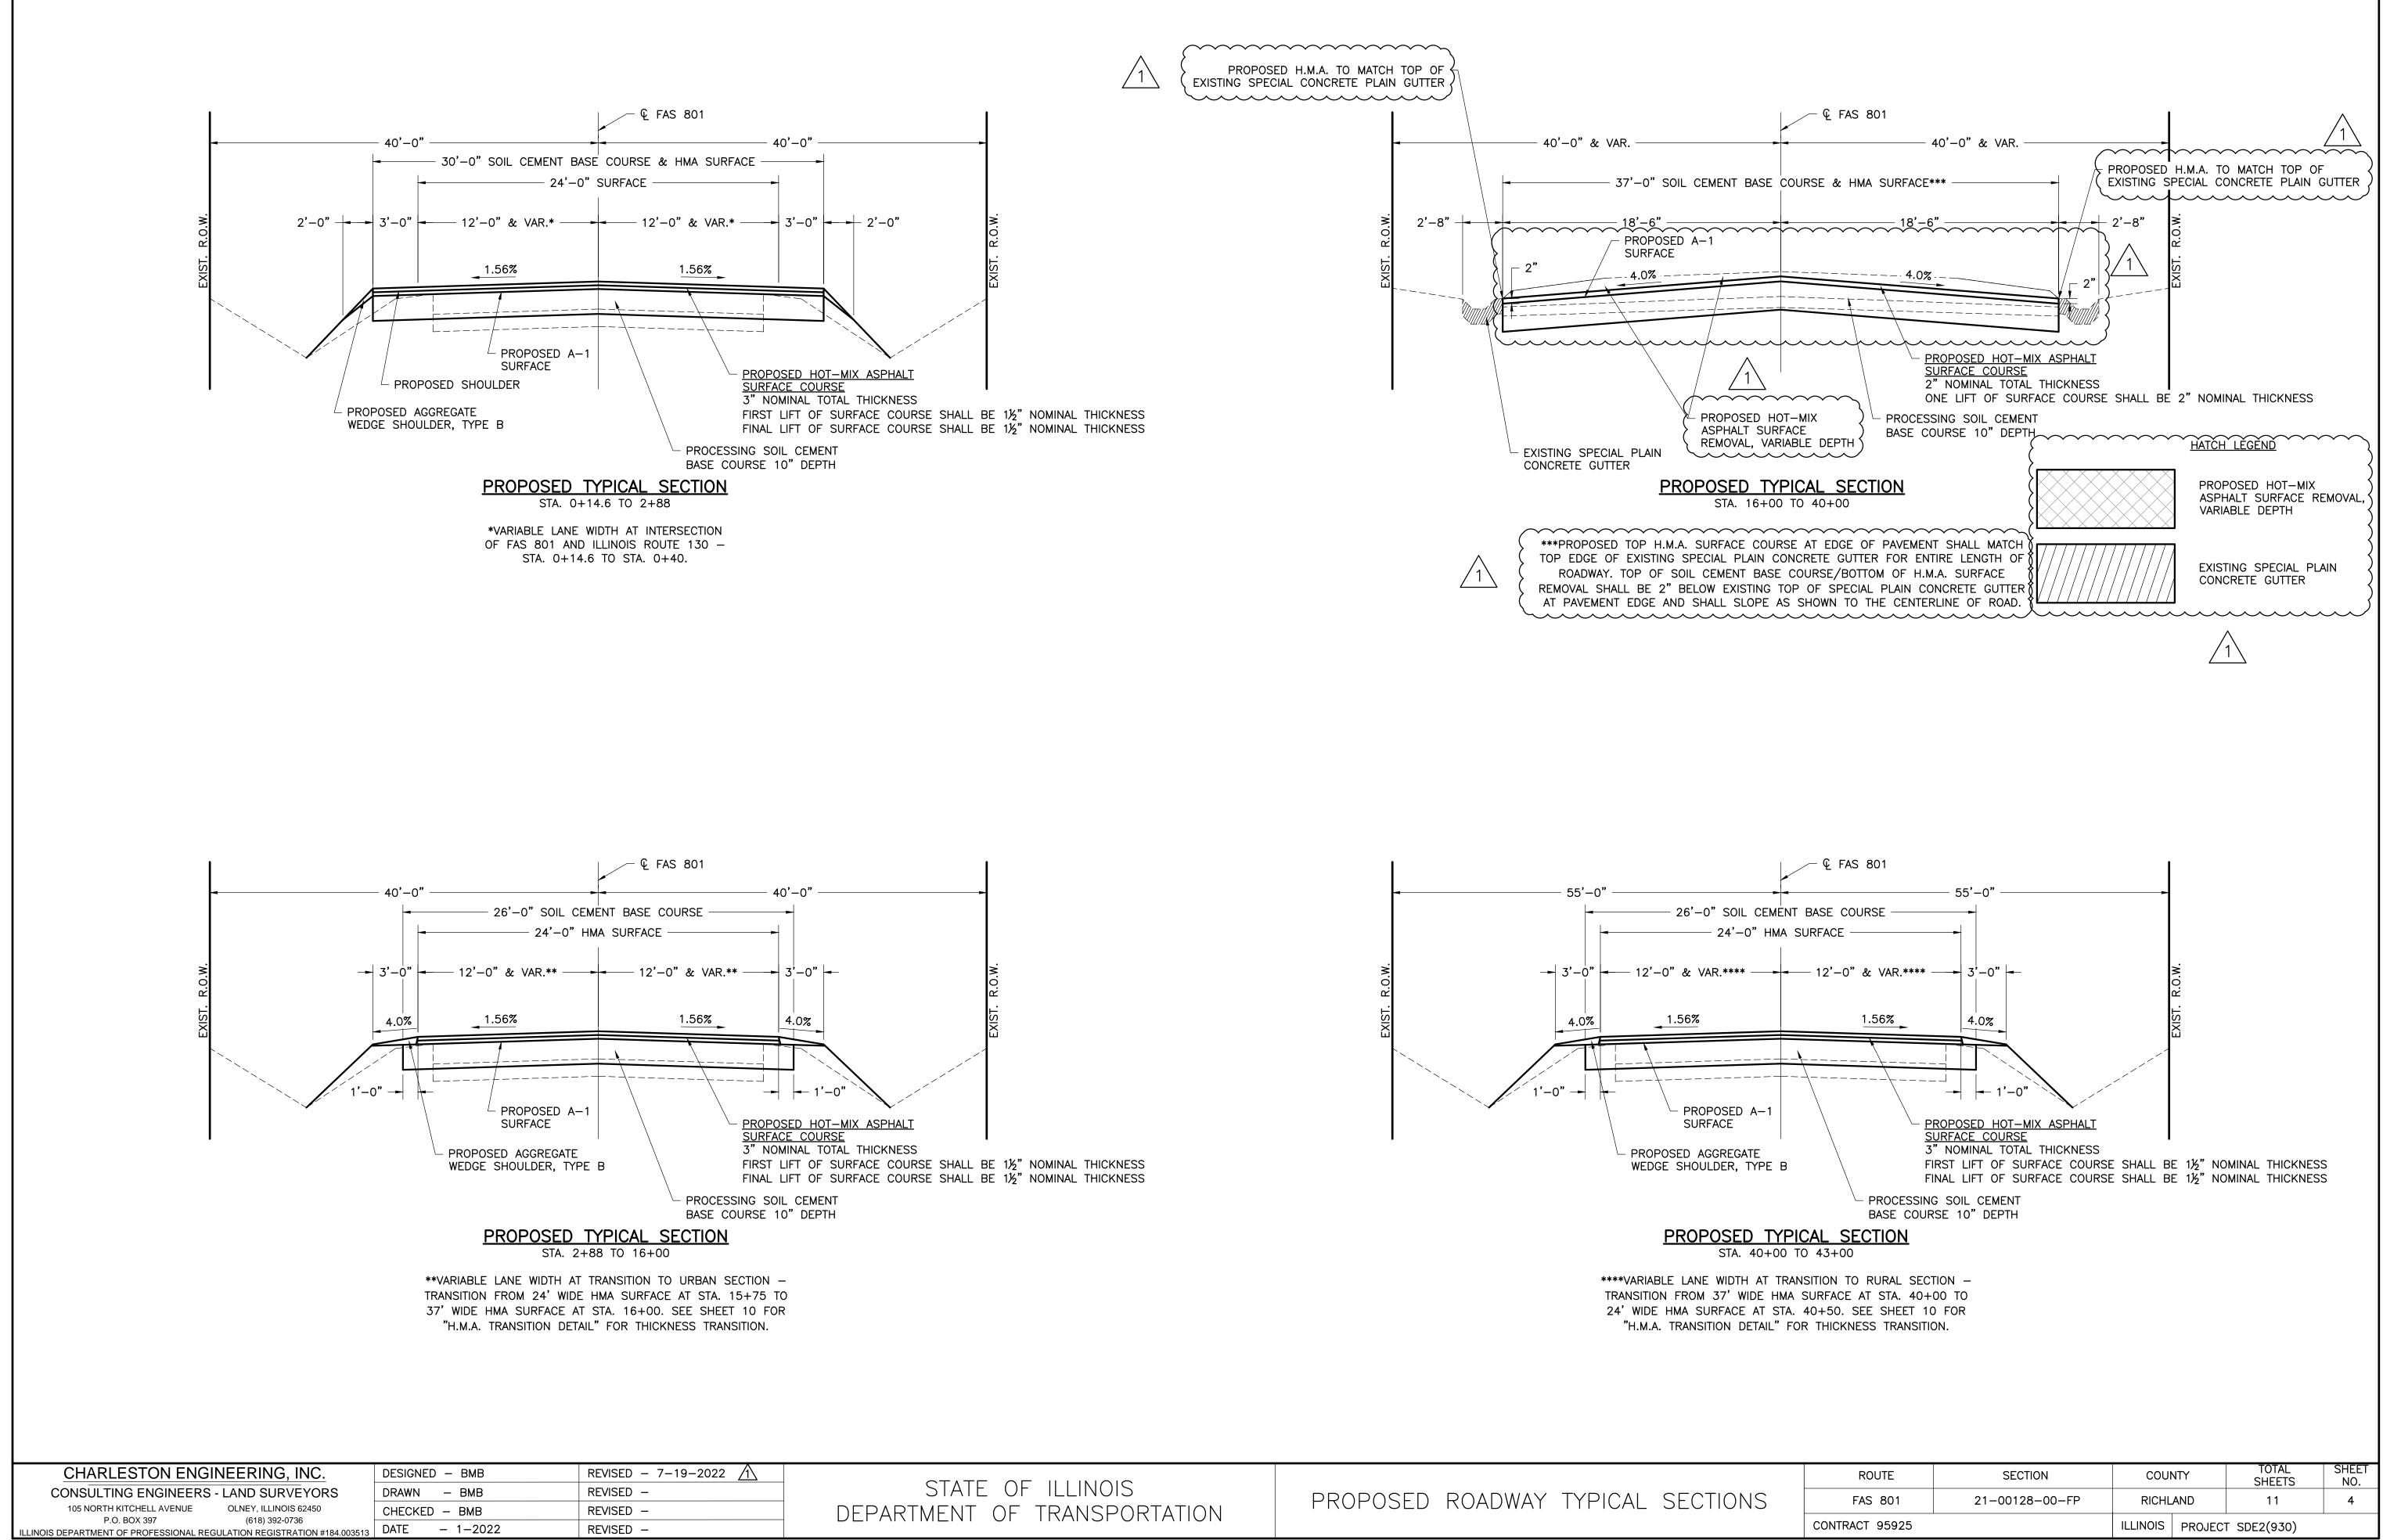

STATE OF ILLINOIS	PROPOSED	
DEPARTMENT OF TRANSPORTATION	PROPUSED	RUADWAT


No.         No. <th></th> <th></th> <th><math>\sim</math></th> <th><u> </u></th> <th><u> </u></th> <th></th> <th></th> <th>Þ∩</th> <th></th> <th></th> <th></th> <th>VING SCH</th> <th></th>			$\sim$	<u> </u>	<u> </u>			Þ∩				VING SCH										
NAME         VI-VI-VI         Parte         Parte        Parte        Parte <th< th=""><th>IENT STRUC</th><th></th><th>SURFACE F</th><th>REM., VAR. DI</th><th>EPTH (SPL)</th><th></th><th>BASE COURSI</th><th></th><th></th><th></th><th></th><th></th><th></th><th><u>vliivl</u></th><th></th><th></th><th>PAVING</th><th></th><th></th><th></th><th></th><th></th></th<>	IENT STRUC		SURFACE F	REM., VAR. DI	EPTH (SPL)		BASE COURSI							<u>vliivl</u>			PAVING					
Normal         Normal<					\$				0							40600990	-	40600290		40604152	Z00	955300 48
N         N		A N			SURFACE	SOIL																
Image         Image <t< td=""><td></td><td>۲ ۲</td><td>-</td><td>-</td><td>· V</td><td></td><td></td><td></td><td>BI</td><td>ruminous</td><td></td><td></td><td></td><td>,</td><td></td><td></td><td></td><td></td><td>TOTAL HM</td><td></td><td></td><td>AGO</td></t<>		۲ ۲	-	-	· V				BI	ruminous				,					TOTAL HM			AGO
N matrix         Partial		Ś			J J											• •						
bit         bit <td>ON TO STA<sup>-</sup></td> <td>TION (</td> <td></td> <td></td> <td>(SPECIAL)</td> <td></td> <td></td> <td></td> <td>· ·</td> <td></td>	ON TO STA <sup>-</sup>	TION (			(SPECIAL)				· ·													
b)         b)         ·		)	(FT)	(FT)	(SQ YD)			(PCF) (% MASS			, ,						- -		. ,	(T		ACH) (
M         M		/>	-		- {										90 0	60	0 1 0					0
mainma	288 to	1575	-	-	- }	1,287 26	3,718		2,940	5.5	47	24	3,432		0	(	0	0 2,320			580	2
DegDe		/			)			132 8%							0	42	2					0
NUMA         LADE         LADE         RA         AL         DAD         DAD <thdad< th=""> <thdad< th=""></thdad<></thdad<>	000 to	4050		-	Į	50 37 TO 26	175		140	0.3	3		170		0		_	27 120			30	0
INTERCISAND SOLEMADS OF LEADS O		/	-	-	9.870	250 26							667		40 130				3			<u> </u>
Lettence         Cuthomes and solid books solid booksolid booksolid books solid books solid books solid books solid b		··								I		1					1	· · ·				
U         U	[						(							• • • •	• • • •	$\rightarrow$		• • • • •	<u>}</u>			
Image: serie							<u> </u>	T	EN	RANCES A			HEDULE				{				Ι	
		CC	יטיב NUMBE	<u>к</u> 	4060029	J 40600275	40604152	TEMPORARY	TAPER LENG	STH		40600990				<u> </u> }_		40200800	<b> </b> {} −			
							{	RAMP (AFTER	(AFTER							$ \langle$	}		}			
							ζ										A SURFACF		$ \lambda $			
Normal         Normal<							1 (	VARIABLE	VARIABL	<i>'</i>						<b>{</b> re	EMOVAL, 👌		<u> </u> }			
Image:         Norma         Number of Mathics         Number of Mathic											ORARY		TEMPORARY				N N		$ \rangle$		FINAL	
symbol         ymbol         <							SURFACE	HMA SURFACE		CE RAMP	(AFTER TA		RAMP (AFTER		GTH RAMP,	SIDE (SPE			3		DISTANCE	
NO         NO         NON         NON         NO         N	STATION	ΙΟCΑΤΙΟ								-							<b>X</b>		17 1			_
1925       0ff       M       AGG					•		$\rightarrow$			,					· ·		<u> </u>		+			
3100     17     17     1    1 <th< td=""><td>1+72</td><td>RT</td><td>PE</td><td>AGG</td><td></td><td></td><td></td><td></td><td></td><td></td><td></td><td></td><td></td><td></td><td></td><td></td><td>- (</td><td></td><td></td><td></td><td>8</td><td>4 'FLARE</td></th<>	1+72	RT	PE	AGG													- (				8	4 'FLARE
DAD         UI         PE         ACC         I.         I						-	- }	-	-		-	-	-	-	-		-				8	4 'FLARE
1970     1971     1970							$ \rightarrow $									-++					8	
1996     U     PR     AGG						-	- (	-	-		-	-	-	-	-		- }				8	-
111         111         112         1 </td <td></td> <td></td> <td></td> <td></td> <td></td> <td>20</td> <td></td> <td>0</td> <td></td> <td></td> <td></td> <td>-</td> <td></td> <td></td> <td></td> <td></td> <td>67.9</td> <td></td> <td></td> <td></td> <td>30</td> <td></td>						20		0				-					67.9				30	
bees         PE         AGC          I <thi< th="">         I         I</thi<>						-	- >	-								-	- {				8	
1/177     III     PE     AGG		LT	SIDE RC			0	4		7		0	-	0	-		/	28.4				11	-
1770       II       PE       ASS.							<u> </u>		/								- (				8	
1988       1T       PF       AGG        MAA       90        90        90        90        80       0       80       0       80       0       80       0       100       100        90       100 <th1< td=""><td></td><td></td><td></td><td></td><td></td><td></td><td><math>  \longrightarrow</math></td><td></td><td></td><td></td><td>-</td><td></td><td></td><td></td><td></td><td></td><td></td><td></td><td></td><td></td><td>8</td><td>4 'FLARE</td></th1<>							$  \longrightarrow$				-										8	4 'FLARE
9988         11         SUP MOM         99A         99A         90A         97A         99A         100							$\mid \longrightarrow$		-										+		8	4 'FLARE
11-00         11-00         12-00 <th< td=""><td></td><td></td><td></td><td></td><td></td><td></td><td>┼────</td><td></td><td>/</td><td></td><td></td><td></td><td></td><td></td><td></td><td></td><td></td><td></td><td></td><td></td><td>8 17</td><td></td></th<>							┼────		/												8 17	
12383         111         SDE NOA         HMAA         95         0         5         877         97         0          0          877         9         4.2         7         0          0          877         9         10     <		LT				-	- }	32	7		0	-	0	-			- }	2.5	20		8	4 ' FLARE
139-39       RT       PF       MAA AGG       15       1.0       32.0       7.0       0.0       0.0       0.0       32.0       7.0       2.5       2.0       0.0     <							- >					-		-			{				8	
1239         17         17         1 <td></td> <td></td> <td></td> <td></td> <td></td> <td></td> <td></td> <td>1</td> <td>7</td> <td></td> <td></td> <td>_</td> <td></td> <td>-</td> <td></td> <td>/</td> <td></td> <td></td> <td></td> <td></td> <td></td> <td></td>								1	7			_		-		/						
24468       RT       PE       AGG.         36        36        36        36        36        36        36        36        36        36        36        36       0        36       0        36       0        36       0        36       0       0       0        36       0       1.0       1.5       8       0<'tARR         25+95       IT       StDE KOAD       HMA       35       0        1.0       0        0       0        0.4       1.0       1.5       8       0'tARR         27+35       RT       PE       AGG.        0       1.0       0       0       0       0       0       0       2.0       2.0       12       12       14		LT					$  \longrightarrow$	1	,		-										8	2 'FLARE
2570       RT       PE       HMA & AGG       5       I       1       244       7       0       I       0       I       244       246       16       16       10       15       16       16       16       16       16       16       16       16       16       16       16       16       16							$\mapsto$									+	<u> </u>				8	4 'FLARE 4 'FLARE
26-57       RT       PE       AGG.       -       -       -       19       7       0       -       0       -       19       2       2.0       12	25+70		PE	HMA & A	AGG. 5		1	24	/		0	-	0	-	24		(		2 15	15	8	0 ' FLARE
27435       LT       SIDE RAD       HMA       320       0       16       189       7       0       -       0       189       141.2       141.2       1       81       32       2020         2765       RT       PE       AGG.       -       -       -       222       7       0       -       0       -       220       -       2.5       14       14       80       0'FLARE         28422       I.T       PE       AGG.       -       -       -       6       0       -       0       -       200       -       7.5       52       44       80       0'FLARE         28422       I.T       SIDE ROAD       HMA       200       0       120       1164       7       0       -       0       -       164       164       98.9       106.7       7.0       18       20/20         3040       RT       PE       AGG.       -       -       122       164       7       0       -       0       -       164       98.9       1.5       1.6       1.6       8       0/70         3141       RT       PE       AGG.       -       -       <							- (		,		-											-
2742       RT       PE       AGG.          22       7       0        0        22       1       25.5       14       14       8       0 'FARE         28+22       LT       PE       AGG.          81       7       00        00        81       5.0       7.5       52       44       8       4 'FARE         3040       LT       SDE ROA       HMA       240       0       12       164       7       0        0.6        164       98.9        70       30       20       20/0         3040       KT       SDE ROA       HMA       225       0       122       7       0        164       98.9        70       30       20       20/0         31450       KT       PE       AGG.         2.5       14       14       8       0 'FLARE         31451       KT       PE       AGG.         2.5       14       14       8       0 'FLARE         31451       KT       PE <td< td=""><td></td><td>LT</td><td></td><td></td><td></td><td></td><td>(</td><td></td><td></td><td></td><td></td><td></td><td>-</td><td></td><td></td><td></td><td></td><td></td><td></td><td></td><td><u> </u></td><td></td></td<>		LT					(						-								<u> </u>	
30+40       LT       SIDE ROAD       HMA       240       0       164       7       0       1       0       1		RT	PE	AGG		-	- {		/		-	-		-		3			5 14	14	8	0 ' FLARE
30+40       RT       SIDE ROAD       HMA       225       0       12       164       7       0       -       0       -       164       98.9       -       70       30       20       20/20         31+60       RT       PE       AGG.       -       -       -       22       7       00       -       00       -       22       -       2.5       14       14       8       0 'FLARE         31+85       RT       PE       AGG.       -       -       -       25       7       00       -       00       -       22       -       2.5       14       14       8       0 'FLARE         31+85       RT       PE       AGG.       -       -       -       25       7       00       -       00       -       25       2.5       16       16       8       0 'FLARE         36+69       IT       PE       AGG.       -       -       -       44       7       00       -       00       -       44       -       40.0       28       20       8       4 'FLARE         37+28       RT       PE       AGG.       -       -		LT 1 T					$\rightarrow$		,		-					-	X		<del> /  </del>		8	
31+85       RT       PE       AGG.        1       2.5       7       0        0        2.5       1.6       1.6       8       0 'FLARE         35+01       RT       SIDE ROAD       HMA       120       0       6       56       7       0        0        56.0       53.4        2.4       20       2.4       4 'FLARE         36469       LT       PE       AGG.         4.4       7       0.0        0.4       4.0       2.4       20       2.4       4 'FLARE         37+28       RT       PE       AGG.         5.3       7       0.0        0.1       4.4       7       0.1        0.1       4.4       7       0.1       0.1       0.1       4.4       7       0.1       0.1       0.1       3.1       4.5       3.4       2.6       8.4       4'FLARE         38+20       LT       PE       AGG.         3.2       7       0.1       0.1       0.1       3.0       2.2       1.2       8.4       4'FLARE         <		RT					$+ \rightarrow$	1	+ '		-					<del>`</del>	/					
SH2       NT       SIDE ROAD       HMA       120       0       66       56       7       0       -       0       -       56       53.4       -       24       20       24       4'FLARE         36469       LT       PE       AGG.       -       -       -       -       44       7       0       -       0       -       44       -       4'FLARE         37428       RT       PE       AGG.       -       -       -       -       -       -       -       4'FLARE         38420       LT       PE       AGG.       -							- }		,		-					$\rightarrow$	(				8	
36+69       IT       PE       AGG.							- > 6 >		· · ·		-		-				(				× 24	
38+20       LT       PE       AGG.       -       -       32       7       0       -       0       -       32       7       0       -       32       7       0       -       32       7       0       -       32       7       0       -       32       7       0       -       0       -       32       7       0       -       0       -       32       7       0       -       0       -       35       7       0       -       0       -       35       7       0       -       0       -       35       7       0       -       0       -       35       7       0       -       0       -       35       7       0       -       0       -       35       7       0       -       0       -       35       7       0       -       0       -       46       7       0       -       0       -       46       7       0       -       0       -       46       7       0       0       -       0       -       46       7       0       0       -       0       0       0       0       0 <t< td=""><td>36+69</td><td></td><td></td><td>AGG</td><td></td><td></td><td>  (</td><td>44</td><td>-</td><td></td><td>0</td><td>-</td><td></td><td>-</td><td>44</td><td>3</td><td><u> </u></td><td></td><td>3 28</td><td>20</td><td>8</td><td>4 ' FLARE</td></t<>	36+69			AGG			(	44	-		0	-		-	44	3	<u> </u>		3 28	20	8	4 ' FLARE
38+94       LT       PE       AGG.         35       7       0        0        35       7       0        0        35       7       0        0        35       7       0        0        35       7       0        0        35       7       0        0        35       7       0        0        35       7       0        0        35       7       0        0        35       7       0        0        35       7       0        0        46       7       0        0        46       7       0        0        46       7       0        0        46       7       0       0       0        0        46       7       0       0       0       0       0       0       0       0       0       0       0       0       0       0       0       0 </td <td></td> <td>RT</td> <td></td> <td></td> <td></td> <td></td> <td><u> </u></td> <td></td> <td></td> <td></td> <td>-</td> <td></td> <td></td> <td></td> <td></td> <td>/</td> <td><u>}</u></td> <td></td> <td></td> <td></td> <td>8</td> <td>4 'FLARE</td>		RT					<u> </u>				-					/	<u>}</u>				8	4 'FLARE
39+80       LT       PE       AGG.       -       -       -       28       7       0       -       0       -       28       7       2.5       18       10       8       4 'FLARE         40+25       LT       PE       AGG.       -       -       0       0       -       -       -       2.5       18       10       8       4 'FLARE         40+25       LT       PE       AGG.       -       -       0       0       -       -       -       2.5       18       10       8       4 'FLARE         40+69       LT       PE       AGG.       -       -       0       0       -       -       -       2.5       18       10       8       4 'FLARE         40+69       LT       PE       AGG.       -       -       0       0       -       -       -       2.0       27       19       8       4 'FLARE         40+69       RT       PE       AGG.       -       -       0       0       -       -       -       18.0       14       14       4 'FLARE         40+69       RT       PE       AGG.       -       -		LT					$+ \rightarrow$		,		-										8	
40+25       LT       PE       AGG.       -       -       -       0       0       -       -       -       2.0       19       11       12       4 'FLARE         40+69       LT       PE       AGG.       -       -       -       -       -       -       2.0       19       11       12       4 'FLARE         40+69       LT       PE       AGG.       -       -       -       -       -       2.0       27       19       8       4 'FLARE         40+69       RT       PE       AGG.       -       -       -       -       -       -       -       2.0       27       19       8       4 'FLARE         40+69       RT       PE       AGG.       -       -       -       -       -       -       -       2.0       27       19       8       4 'FLARE         40+69       RT       PE       AGG.       -       -       -       -       -       -       -       18.0       142       14       14       'FLARE						-			· · · ·		-			-		+	- }				8	
40+69       LT       PE       AGG.       -       -       0       0       -       -       -       2.0       27       19       8       4 'FLARE         40+69       RT       PE       AGG.       -       -       0       0       -       -       -       -       2.0       27       19       8       4 'FLARE		LT LT					$\mapsto$		· · ·												8	
	40+69	LT	PE	AGG			+	-	-								(	2.0	27	19	8	4 ' FLARE
$\mathbf{x} = \mathbf{x} + $	40+69	RT				-	- }	Ť	0			-		-			- >		/ 142	134	14	4 'FLARE

MAILBOX TURNO					
STATION	LOCATION				
9+78	LT				
40+45	LT				
	TOTAL				

CHARLESTON ENGINEERING, INC.	DESIGNED – BMB	REVISED – 7–19–2022 🕂	
CONSULTING ENGINEERS - LAND SURVEYORS	DRAWN – BMB	REVISED -	
105 NORTH KITCHELL AVENUE OLNEY, ILLINOIS 62450	CHECKED – BMB	REVISED -	
P.O. BOX 397 (618) 392-0736 ILLINOIS DEPARTMENT OF PROFESSIONAL REGULATION REGISTRATION #184.003513	DATE – 1–2022	REVISED -	

NO.	\$
1 2 3 4 5 6 7 8	2
З	2
4	2
5	2
6	3
7	3
8	3
9	3
10	3
11	3
11 12	3
13 14	3
14	3
	_

	SCHEDULE OF EXISTING STORM SEWER PIPES													
L	OCATIO	N	SIDE	MATERIAL	TY-1, 12"	TY-1, 15"	TY-1, 18"	TY-1, 24"	TY-1, 30"					
1	то	2	A.R.	RCCP			Х							
3	то	5	A.R.	RCCP	Х									
4	то	5	A.R.	RCCP	Х									
5	то	6	RT	RCCP		Х								
7	то	6	RT	RCCP	Х									
8	то	6	A.R.	RCCP	Х									
6	то	9	RT	RCCP			Х							
10	то	9	RT	RCCP	Х									
11	то	9	A.R.	RCCP	Х									
9	то	14	RT	RCCP			Х							
12	то	13	A.R.	RCCP				Х						
13	то	14	RT	RCCP				Х						
14	то	15	RT	RCCP					Х					
L			1		1	1	1	1	1					

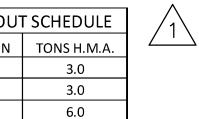

HOT-MIX ASPHALT AT MAILBOX TURNOUT LOCATIONS

PAID FOR AS POLYMERIZED HOT-MIX ASPHALT

SURFACE COURSE, IL-9.5, MIX "C", N70

SCHEDULES OF PROPOSED QUANTITIES EXISTING STORM SEWERS

STATE OF ILLINOIS DEPARTMENT OF TRANSPORTATION

	SCHEDULE OF EXISTING STORM SEWER DRAINAGE STRUCTURES											
STA.	SIDE	ITEM	GRATE	INVERT	TOP ELEV.							
5+86	LT	SPECIAL CATCH BASINS, TYPE 1 WITH TYPE 3 GRATE	475.79	473.34	-							
5+84	RT	SPECIAL CATCH BASINS, TYPE 1 WITH TYPE 3 GRATE	475.99	473.41	-							
6+95	LT	SPECIAL CATCH BASINS, TYPE 1 WITH TYPE 3 GRATE	475.51	473.99	-							
7+73	LT	SPECIAL CATCH BASINS, TYPE 1 WITH TYPE 3 GRATE	474.58	472.53	-							
7+91	RT	MANHOLES, TYPE A-1-C, 3' DIAMETER	-	471.71	474.92							
0+16	RT	MANHOLES, TYPE A-1-C, 3' DIAMETER	-	469.42	472.57							
0+03	RT	SPECIAL CATCH BASINS, TYPE 1 WITH TYPE 3 GRATE	472.00	470.28	-							
0+03	LT	SPECIAL CATCH BASINS, TYPE 1 WITH TYPE 3 GRATE	471.94	470.14	-							
0+87	RT	MANHOLES, TYPE A-1-C, 3' DIAMETER	-	468.77	472.28							
0+79	RT	SPECIAL CATCH BASINS, TYPE 1 WITH TYPE 3 GRATE	471.01	469.18	-							
0+79	LT	SPECIAL CATCH BASINS, TYPE 1 WITH TYPE 3 GRATE	471.50	470.04	-							
4+47	LT	SPECIAL CATCH BASINS, TYPE 2	466.04	463.14	_							
4+69	RT	SPECIAL CATCH BASINS, TYPE 2	466.04	462.99	-							
4+72	RT	MANHOLES, TYPE A-1-C, 3' DIAMETER	-	462.91	466.56							

S	SCHED	OULE	OF	EXIS	STI	NG	STO	RM	SEWE	R PIPES	5

## <u>NOTES</u>

LOCATIONS, SIZE, MATERIAL, DESCRIPTION, OR TYPE OF EXISTING STORM SEWERS INDICATED ON THE PLANS ARE NOT REPRESENTED AS BEING ACCURATE, SUFFICIENT, OR COMPLETE AND SHALL BE CONSIDERED APPROXIMATE. EXISTING STORM SEWER INFORMATION WAS OBTAINED FROM ORIGINAL CONSTRUCTION PLANS FOR SEC. 100G AND SEC 100B - F.A.S. PROJECT 562B, AND ELEVATIONS OF DRAINAGE STRUCTURES SHOWN WERE FIELD MEASURED, BUT SHALL STILL BE CONSIDERED APPROXIMATE. DEPTHS OF EXISTING STORM SEWER PIPES BETWEEN DRAINAGE STRUCTURES WERE NOT OBTAINED AND SHALL BE VERIFIED BY THE CONTRACTOR. THE CONTRACTOR IS STILL RESPONSIBLE FOR MAKING HIS OR HER OWN DETERMINATION AS TO THE TYPE, LOCATION, AND DEPTH OF UNDERGROUND AND OTHER UTILITIES AS MAY BE NECESSARY TO AVOID DAMAGE THERETO. THE CONTRACTOR SHALL BE RESPONSIBLE TO REPAIR OR REPLACE AT HIS OR HER OWN EXPENSE, OR BEAR THE COST, TO REPAIR OR REPLACE ALL STORM SEWERS WHICH HAVE BEEN DAMAGED THROUGH HIS OR HER OWN NEGLIGENCE.

	ROUTE	SECTION	COUNTY		TOTAL SHEETS	SHEET NO.
AND	FAS 801	21-00128-00-FP	RICHL	AND	11	5
	CONTRACT 95925		ILLINOIS	PROJEC	T SDE2(930)	

