

**IDOT HIGHWAY STANDARDS**

280001-05 TEMPORARY EROSION CONTROL SYSTEMS  
 420001-07 PAVEMENT JOINTS  
 420101-04 24" (7.2M) JOINTED PCC PAVEMENT  
 420401-08 BRIDGE APPROACH PAVEMENT CONNECTOR  
 420601-05 24" (7.2M) PCC PAVEMENT  
 420701-02 PAVEMENT FABRIC  
 424001-05 CURB RAMPS FOR SIDEWALKS  
 482006-03 HMA SHOULDER ADJACENT TO RIGID PAVEMENT  
 515001-03 NAME PLATE FOR BRIDGES  
 542201-02 REINFORCED CONCRETE END SECTIONS FOR PIPE CULVERTS 15" (375 mm)  
 542301-02 THROUGH 36" (900 mm) DIAMETER SKEWED WITH ROADWAY  
 542401-01 PRECAST REINFORCED CONCRETE FLARED END SECTION  
 542401-01 METAL END SECTION FOR PIPE CULVERTS  
 542601-02 REINFORCED CONCRETE PIPE ELBOW  
 601001-03 SUB-SURFACE DRAINS  
 601101-01 CONCRETE HEADWALL FOR PIPE DRAIN  
 602301-02 INLET - TYPE A  
 602306-02 INLET - TYPE B  
 602401-02 MANHOLE TYPE A  
 602406-03 MANHOLE, TYPE A, 1.8m (6') DIAMETER  
 602601-02 PRECAST REINFORCED CONCRETE FLAT SLAB TOP  
 602701-02 MANHOLE STEPS  
 604001-03 FRAMES AND LIDS TYPE 1  
 604006-04 FRAME AND GRATE TYPE 3  
 604011-04 FRAME AND GRATE TYPE 3V  
 604036-02 GRATE TYPE 8  
 604066-02 FRAME AND LID, TYPE 15  
 604071-04 FRAME AND GRATE TYPE 20  
 606001-04 CONCRETE CURB TYPE B AND COMBINATION CONCRETE CURB AND GUTTER  
 606301-04 PC CONCRETE ISLANDS AND MEDIANS  
 606306-03 CORRUGATED PC CONCRETE MEDIANS  
 630001-08 STEEL PLATE BEAM GUARDRAIL  
 630301-05 SHOULDER WIDENING FOR TYPE 1 (SPECIAL) GUARDRAIL TERMINALS  
 631011-06 TRAFFIC BARRIER TERMINAL, TYPE 2  
 631031-08 TRAFFIC BARRIER TERMINAL, TYPE 6  
 635001-01 DELINEATORS  
 635006-03 REFLECTOR AND TERMINAL MARKER PLACEMENT  
 635011-02 REFLECTOR MARKER AND MOUNTING DETAILS  
 642001-01 SHOULDER RUMBLE STRIPS  
 664001-02 CHAIN LINK FENCE  
 665001-02 WOVEN WIRE FENCE

667101-01 PERMANENT SURVEY MARKERS  
 701001-02 OFF-ROAD OPERATIONS, 2L, 2W, MORE THAN 15' (4.5 m) AWAY  
 701006-03 OFF-ROAD OPERATIONS, 2L, 2W, 15' (4.5 m) TO 24" (600 mm) FROM PAVEMENT EDGE  
 701101-02 OFF-ROAD OPERATIONS, MULTILANE, 4.5 m (15') TO 600 mm (24") FROM PAVEMENT EDGE  
 701106-02 OFF-ROAD OPERATIONS, MULTILANE, MORE THAN 4.5 m (15') AWAY  
 701301-03 LANE CLOSURE, 2L, 2W, SHORT TERM OPERATIONS  
 701400-04 APPROACH TO LANE CLOSURE, FREEWAY/EXPRESSWAY  
 701401-05 LANE CLOSURE, FREEWAY/EXPRESSWAY  
 701402-07 LANE CLOSURE, FREEWAY/EXPRESSWAY, WITH BARRIER  
 701406-05 LANE CLOSURE, FREEWAY/EXPRESSWAY, DAY OPERATIONS ONLY  
 701411-06 LANE CLOSURE, MULTILANE, AT ENTRANCE OR EXIT RAMP, FOR SPEEDS > 45 MPH  
 701606-06 URBAN LANE CLOSURE, MULTILANE, 2W WITH MOUNTABLE MEDIAN  
 701901-01 TRAFFIC CONTROL DEVICES  
 704001-06 TEMPORARY CONCRETE BARRIER  
 720001-01 SIGN PANEL MOUNTING DETAILS  
 720006-02 SIGN PANEL ERECTION DETAILS  
 720011-01 METAL POSTS FOR SIGNS, MARKERS AND DELINEATORS  
 720016-02 MAST ARM MOUNTED STREET NAME SIGNS  
 720021-02 SIGN PANELS, EXTRUDED ALUMINUM TYPE  
 729001-01 APPLICATIONS OF TYPES A AND B METAL POSTS (FOR SIGNS AND MARKERS)  
 780001-02 TYPICAL PAVEMENT MARKINGS  
 781001-03 TYPICAL APPLICATIONS RAISED REFLECTIVE PAVEMENT MARKERS  
 805001-01 ELECTRICAL SERVICE INSTALLATION DETAILS  
 814001-02 HANDHOLES  
 814006-02 DOUBLE HANDHOLES  
 825026 LIGHTING CONTROLLER, 480V, BASE MOUNTED  
 836001 LIGHT POLE FOUNDATION  
 857001-01 STANDARD PHASE DESIGNATION DIAGRAMS AND PHASE SEQUENCES  
 862001-01 UNINTERRUPTABLE POWER SUPPLY  
 873001-02 TRAFFIC SIGNAL GROUNDING AND BONDING  
 876001-01 PEDESTRIAN PUSH BUTTON POST  
 877001-04 STEEL MAST ARM ASSEMBLY AND POLE 16' THROUGH 55'  
 877011-04 STEEL COMBINATION MAST ARM ASSEMBLY AND POLE 16' THROUGH 55'  
 878001-08 CONCRETE FOUNDATION DETAILS  
 880001-01 SPAN WIRE MOUNTED SIGNALS AND FLASHING BEACON INSTALLATION  
 880006-01 TRAFFIC SIGNAL MOUNTING DETAILS  
 886001-01 DETECTOR LOOP INSTALLATIONS  
 886006-01 TYPICAL LAYOUTS FOR DETECTION LOOPS  
 000001-05 STANDARD SYMBOLS, ABBREVIATIONS AND PATTERNS  
 001001-02 AREAS OF REINFORCEMENT BARS  
 001006 DECIMAL OF AN INCH AND OF A FOOT

**INDEX OF SHEETS**

1 COVER SHEET  
 2-3 GENERAL NOTES, INDEX OF SHEETS AND STANDARDS  
 4-7 SUMMARY OF QUANTITIES  
 8-11 TYPICAL SECTIONS - EXISTING FAYETTE AVE  
 12-15 TYPICAL SECTIONS - EXISTING RAMPS  
 16-23 TYPICAL SECTIONS - PROPOSED FAYETTE AVE  
 24 TYPICAL SECTIONS - I-57/70  
 25-28 TYPICAL SECTIONS - PROPOSED RAMPS  
 29 TYPICAL SECTIONS - PROPOSED FRONTAGE ROAD/ILLINI DRIVE  
 30 TYPICAL SECTIONS - BIKE TRAIL  
 31-36 SCHEDULE OF QUANTITIES  
 37-40 HORIZONTAL CONTROL AND TIES  
 41 SUPERELEVATION TABLES  
 42-49 PLAN AND PROFILE - FAYETTE AVE  
 50-57 PLAN AND PROFILE - I-57/70  
 58-69 PLAN AND PROFILE - FAYETTE AVE RAMPS  
 70 PLAN AND PROFILE - ILLINI DRIVE  
 71-74 PLAN AND PROFILE - BIKE TRAIL  
 75-146 MAINTENANCE OF TRAFFIC AND STAGE CONSTRUCTION DETAILS  
 147-154 EROSION AND SEDIMENT CONTROL PLANS  
 155-162 DRAINAGE PLAN  
 163-169 DRAINAGE PROFILE  
 170-181 DRAINAGE PLAN AND PROFILE - FAYETTE AVE RAMPS  
 182-185 CHANNELIZED APPROACHES  
 186-188 INTERSECTION DETAIL  
 189 INTERSECTION DETAIL - FAYETTE AVE RAMPS  
 190-192 PAVEMENT ELEVATION DETAIL  
 193 PAVEMENT ELEVATION DETAIL - FAYETTE AVE RAMPS  
 194-197 JOINTING DETAIL  
 198 JOINTING DETAIL - FAYETTE AVE RAMPS  
 199 INTERCHANGE LAYOUT - FAYETTE AVE.  
 200 INTERCHANGE ROADWAY PLAN - FAYETTE AVE.  
 201 INTERCHANGE GRADING - HORIZONTAL CONTROL.  
 202 INTERCHANGE SHEAR LINE DETAIL - FAYETTE AVE.  
 203 INTERCHANGE GRADING PLAN - FAYETTE AVE  
 204-216 PAVEMENT MARKING PLANS  
 217-226 SIGNING DETAILS  
 227-236 TEMPORARY TRAFFIC SIGNAL PLANS  
 237-262 TRAFFIC SIGNAL PLANS  
 263-286 LIGHTING PLANS  
 287-291 DETOUR SIGNING PLANS  
 292-304 DELETED  
 305-324 REMOVAL PLANS  
 325-326 ENTRANCE DETAILS  
 327 DELINEATOR DETAILS  
 328 MISCELLANEOUS DETAILS  
 329 BOX CULVERT DETAILS  
 330-358 STRUCTURE PLANS - FAYETTE AVE (SN 025-0106)  
 358A STRUCTURE PLANS - FAYETTE AVE (SN 025-0106)  
 359-360 STRUCTURE PLANS - FAYETTE AVE (SN 025-0106)  
 360A STRUCTURE PLANS - FAYETTE AVE (SN 025-0106)  
 330-367 STRUCTURE PLANS - FAYETTE AVE (SN 025-0106)  
 368-369 CULVERT PROFILES  
 370-412 CROSS SECTIONS - FAYETTE AVE.  
 413-445 CROSS SECTIONS - I-57/70  
 446-529 CROSS SECTIONS - FAYETTE AVE. RAMPS & GRADING  
 530-535 CROSS SECTIONS - SOUTH FRONTAGE RD & ILLINI DRIVE  
 536-537 CROSS SECTIONS - BIKE TRAIL  
 538-839 MOT CROSS SECTIONS

THE FOLLOWING RATES OF APPLICATION HAVE BEEN USED IN CALCULATING PLAN QUANTITIES:

NITROGEN FERTILIZER NUTRIENT	90	LBS / ACRE
PHOSPHORUS FERTILIZER NUTRIENT	90	LBS / ACRE
POTASSIUM FERTILIZER NUTRIENT	90	LBS / ACRE
AGRICULTURAL GROUND LIMESTONE	2	TONS / ACRE
MULCH, METHOD 2	2	TONS / ACRE
AGGREGATE (EROSION CONTROL)	1.9	TONS / CU YD
LIME	4.2	LBS / SQ YD / INCH
SLAG MODIFIED PORTLAND CEMENT	3.31	LBS / SQ YD / INCH
AGGREGATE FOR TEMPORARY ACCESS	2.0	TONS / CU YD
BITUMINOUS MATERIALS (PRIME COAT)	0.075	GAL / SQ YD
AGGREGATE (PRIME COAT)	0.0015	TONS / SQ YD
HOT-MIX ASPHALT SURFACE COURSE	0.056	TONS / SQ YD / INCH
BITUMINOUS MATERIALS (PRIME COAT)	0.375	GAL / SQ YD
AGGREGATE (PRIME COAT)	0.0015	TONS / SQ YD
INCIDENTAL HOT-MIX ASPHALT SURFACING	0.056	TONS / SQ YD / INCH
AGGREGATE SHOULDERS, TYPE B	2.0	TONS / CU YD

MIXTURE REQUIREMENTS  
 THE FOLLOWING MIXTURE REQUIREMENTS ARE APPLICABLE FOR THIS PROJECT

	HMA SURFACE COURSE	STABILIZED SUBBASE HMA (OPTION)	HMA SHOULDERS	INCIDENTAL HOT-MIX ASPHALT SURFACING		
PG GRADE	PG 70-22	PG 64-22	PG 64-22	PG 64-22		
DESIGN AIR VOIDS	4.0% @ Ndes=105	4.0% @ Ndes=30	4.0% @ Ndes=30	4.0% @ Ndes=70		
MIXTURE COMPOSITION	IL-9.5	IL-19.0L	IL-19.0L	IL-9.5		
FRICITION AGGREGATE	MIXTURE D	N/A	N/A	MIXTURE C		


**GENERAL NOTES**

1. THIS SECTION SHALL BE CONSTRUCTED IN ACCORDANCE WITH THE PLANS, THE "STANDARD SPECIFICATIONS FOR ROAD AND BRIDGE CONSTRUCTION" ADOPTED JANUARY 1, 2007; THE SUPPLEMENTAL SPECIFICATIONS AND THE RECURRING SPECIAL PROVISIONS, AND THE SPECIAL PROVISIONS INCLUDED IN THE PROPOSAL.
2. THE PROPOSED PROJECT IS LOCATED ON FAYETTE AVENUE IN EFFINGHAM COUNTY.
3. THE WORK INCLUDED IN SECTION (25-3)I-6 CONSISTS OF 0.68 MILES OF PAVEMENT RECONSTRUCTION TO FACILITATE THE INTERCHANGE RECONSTRUCTION ON FAYETTE AVENUE AT FAI ROUTES 57/70.
4. ALL ELEVATIONS REFER TO U.S.G.S. MEAN SEA LEVEL DATUM.
5. WHERE SECTION OR SUBSECTION MONUMENTS ARE ENCOUNTERED, THE ENGINEER SHALL BE NOTIFIED BEFORE SUCH MONUMENTS ARE REMOVED. THE CONTRACTOR SHALL PROTECT AND CAREFULLY PRESERVE ALL MONUMENTS UNTIL AN AUTHORIZED SURVEYOR OR AGENT HAS WITNESSED OR OTHERWISE REFERENCED THEIR LOCATION. THE CONTRACTOR WILL BE RESPONSIBLE FOR HAVING AN AUTHORIZED SURVEYOR RE-ESTABLISH ANY SECTION OR SUBSECTION MONUMENTS DESTROYED BY HIS/HER OPERATIONS.
6. ABANDONED UNDERGROUND UTILITIES THAT CONFLICT WITH CONSTRUCTION SHALL BE DISPOSED OF OUTSIDE THE LIMITS OF RIGHT OF WAY ACCORDING TO ARTICLE 202.03 OF THE STANDARD SPECIFICATIONS AND AS DIRECTED BY THE ENGINEER. THIS WORK WILL NOT BE PAID FOR SEPARATELY BUT SHALL BE INCLUDED IN THE COST OF EARTH EXCAVATION AND NO ADDITIONAL COMPENSATION WILL BE ALLOWED.
7. ILLINOIS STATE LAW REQUIRES A 48-HOUR NOTICE BE GIVEN TO ALL UTILITIES BEFORE DIGGING. FIELD MARKING OF FACILITIES MAY ALSO BE OBTAINED BY CALLING J.U.L.I.E. AND FOR NON-J.U.L.I.E. MEMBERS, THE UTILITY COMPANY DIRECTLY. AGENCIES KNOWN TO HAVE FACILITIES WITHIN THE PROJECT AREA ARE AS FOLLOWS.
  - AMEREN / CIPS                      GAS / ELECTRIC
  - ILLINOIS CONSOLIDATED            TELEPHONE
  - CITY OF EFFINGHAM                WATER / SEWER
  - IDOT                                    HIGHWAY LIGHTING/SIGN LIGHTING/TRAFFIC SIGNALS

(MEMBERS OF J.U.L.I.E. (800) 892-0123 ARE INDICATED BY \*  
NON-J.U.L.I.E. MEMBERS MUST BE NOTIFIED INDIVIDUALLY.)
8. CONTACT MIKE WORTHY OF IDOT THREE WORKING DAYS PRIOR TO CONSTRUCTION AT 217-342-8284 TO HAVE UNDERGROUND WIRING LOCATED FOR HIGHWAY LIGHTING/SIGN LIGHTING. IF DAMAGE OCCURS TO THE UNDERGROUND WIRING CAUSED BY THIS INSTALLATION, THE REPAIRS SHALL BE COMPLETED TO THE SATISFACTION OF THE DISTRICT. PLEASE CONTACT JOSH PORTER OF IDOT AT 217-342-8382 PRIOR TO CONSTRUCTION TO HAVE UNDERGROUND WIRING LOCATED FOR EXISTING TRAFFIC SIGNALS.
9. WHERE SMALL QUANTITIES OF LIME MODIFICATION ARE SHOWN IN THE PLANS, SUB-BASE GRANULAR MATERIAL, TYPE B CRUSHED STONE MAY BE SUBSTITUTED AND CONSTRUCTED ACCORDING TO THE APPLICABLE PORTIONS OF SECTION 311 OF THE STANDARD SPECIFICATIONS FOR ROAD AND BRIDGE CONSTRUCTION AS DIRECTED BY THE ENGINEER. THE DEPTH OF THE SUB-BASE GRANULAR MATERIAL, TYPE B SHALL BE THE SAME AS THE DEPTH OF THE LIME MODIFICATION. THIS WORK WILL BE PAID FOR AT THE CONTRACT UNIT PRICE PER SQUARE YARD FOR PROCESSING LIME MODIFIED SOILS OF THE DEPTH SPECIFIED, INCLUDING ALL NECESSARY MATERIAL, AND NO ADDITIONAL COMPENSATION WILL BE ALLOWED.
10. THE CONTRACTOR SHALL USE EITHER RC-70, SS1H OR SS1HP, APPLIED AT THE RATE DIRECTED BY THE ENGINEER, FOR THE PAY ITEM BITUMINOUS MATERIALS (PRIME COAT).
11. THE TREES LISTED IN THE TREE SCHEDULE SHALL BE APPROVED AND HAND PLANTED AT LOCATIONS AS DIRECTED BY THE ROADSIDE MAINTENANCE TECHNICIAN, PHIL NOSBISCH, (217)342-8249. THE CONTRACTOR SHALL BE REQUIRED TO GIVE TWO WEEKS NOTICE TO SCHEDULE A TIME FOR THE LOCATIONS TO BE STAKED AND ON THE SAME DAY THE TREES SHALL BE DELIVERED TO THE JOB SITE FOR ACCEPTANCE OF THE PLANTING MATERIAL BY THE ROADSIDE MAINTENANCE TECHNICIAN.
12. THE CONTRACTOR SHALL CONFINE HIS OPERATIONS TO THE AREA LOCATED INSIDE THE CONSTRUCTION LIMITS SHOWN ON THE PLANS. ANY AREA DISTURBED BEYOND THESE LIMITS SHALL BE RESTORED TO ITS ORIGINAL CONDITION AT THE CONTRACTORS EXPENSE.
13. ALL AREAS DISTURBED FOR ANY REASON SHALL BE SEEDED WITH CLASS 2 SEEDING AS DIRECTED BY THE ENGINEER. NUTRIENTS SHALL CONFORM TO ARTICLE 250.04 OF THE STANDARD SPECIFICATIONS. ANY SEEDING REQUIRED OUTSIDE THE CONSTRUCTION LIMITS OR RIGHT OF WAY FOR THIS CONTRACT SECTION WILL NOT BE PAID FOR SEPARATELY AND CONSIDERED AS A CONTRACTOR'S EXPENSE.
14. MULCH SHALL CONFORM TO SECTION 251 OF THE STANDARD SPECIFICATIONS. MULCH, UNLESS OTHERWISE PERMITTED BY THE ENGINEER, SHALL CONFORM TO METHOD 2, PROCEDURE 1 AS SPECIFIED IN ARTICLE 251.03.
15. IN ADDITION TO SURVEYS, SOME OF THE PLAN DIMENSIONS AND DETAILS RELATIVE TO EXISTING CONDITIONS HAVE BEEN TAKEN FROM EXISTING PLANS AND ARE SUBJECT TO NOMINAL CONSTRUCTION VARIATIONS. IT SHALL BE THE CONTRACTOR'S RESPONSIBILITY TO VERIFY SUCH DIMENSIONS IN THE FIELD. SUCH VARIATIONS SHALL NOT BE CAUSE FOR ADDITIONAL COMPENSATION DUE TO A CHANGE IN THE SCOPE OF THE WORK. THE CONTRACTOR WILL BE PAID FOR THE QUANTITY ACTUALLY FURNISHED AT THE UNIT PRICE BID FOR THE WORK.
16. THE THICKNESS OF HOT-MIX ASPHALT MIXTURE SHOWN ON THE PLANS IS THE NOMINAL THICKNESS. DEVIATIONS TO THE NOMINAL THICKNESS WILL BE PERMITTED WHEN SUCH DEVIATIONS OCCUR DUE TO IRREGULARITIES IN THE EXISTING SURFACE OR BASE ON WHICH THE HOT-MIX ASPHALT MIXTURE IS PLACED.
17. ANY EXCAVATION ADJACENT TO EDGE OF PAVEMENTS SHALL BE PROTECTED WITH EXTENDED LEG BARRICADES AND APPROPRIATE LIGHTS.
18. FULL DEPTH SAW CUTTING AT THE EDGE OF PAVEMENT WILL BE REQUIRED IN ORDER TO REMOVE EXISTING PAVEMENTS, SHOULDERS, CONCRETE CURB AND GUTTER, OR DRIVEWAY PAVEMENTS. THIS SAW CUTTING WILL NOT BE PAID FOR SEPARATELY BUT CONSIDERED AS INCLUDED IN THE COST OF THE RESPECTIVE REMOVAL ITEMS.
19. ANY FACILITIES OR APPURTENANCES WHICH ARE THE PROPERTY OF ANY PUBLIC UTILITY LOCATED WITHIN THE LIMITS OF CONSTRUCTION, SHALL BE RELOCATED OR ADJUSTED BY THEIR RESPECTIVE OWNERS. THE CONTRACTOR SHALL NOTIFY AND COOPERATE WITH THE OWNERS OF SUCH FACILITIES IN THEIR REMOVAL AND REARRANGEMENT OPERATIONS IN ORDER THAT THESE OPERATIONS AND THE CONSTRUCTION OF THIS PROJECT MAY PROGRESS IN A REASONABLE MANNER.
20. THE REMOVAL OF MISCELLANEOUS BITUMINOUS SURFACES PLACED ON SHOULDERS OR OTHER AREAS FOR MAINTENANCE OPERATIONS WILL NOT BE PAID FOR SEPARATELY BUT INCLUDED FOR PAYMENT AS EARTH EXCAVATION.
21. ALL CONFLICTING GROUND MOUNTED SIGNS AND SIGN SUPPORTS ARE TO BE REMOVED OR RELOCATED AS DIRECTED BY THE ENGINEER. THIS WORK SHALL BE DONE IN ACCORDANCE WITH SECTIONS 724 OF THE STANDARD SPECIFICATIONS EXCEPT THAT IT WILL NOT BE MEASURED FOR PAYMENT BUT CONSIDERED AS INCLUDED IN THE VARIOUS ITEMS OF WORK. SIGNS SHALL BE STORED AS DIRECTED BY THE ENGINEER AND CAREFULLY PROTECTED BY THE CONTRACTOR.
22. THE MATERIAL USED FOR AGGREGATE SHOULDERS, TYPE B SHALL BE CRUSHED STONE OR CRUSHED CONCRETE.
23. ALL WARNING SIGNS SHALL BE 48" FLUORESCENT ORANGE.
24. ACCESS SHALL BE MAINTAINED TO PUBLIC, PRIVATE AND COMMERCIAL PROPERTIES AT ALL TIMES. (SEE SPECIAL PROVISIONS)

25. CONNECTION OF PROPOSED STORM SEWERS AND/OR PIPE UNDERDRAINS TO DRAINAGE STRUCTURES OR CULVERTS SHALL BE DONE IN A MANNER MEETING THE APPROVAL OF THE ENGINEER AND SHALL CONFORM TO SECTION 501 OF THE STANDARD SPECIFICATIONS. THE COST OF THIS CONNECTION WILL NOT BE PAID FOR SEPARATELY, BUT CONSIDERED AS INCLUDED IN THE COST OF THE PROPOSED STORM SEWER OR PIPE UNDERDRAINS.
26. THE CONTRACTOR SHALL EXERCISE CARE IN TREE REMOVAL OPERATIONS AND TAKE WHATEVER PRECAUTIONS NECESSARY TO REMOVE ONLY THOSE TREES NECESSARY TO THE CONSTRUCTION OF THIS PROJECT AS DIRECTED BY THE ENGINEER.
27. EXCEPT AS NOTED ON THE PLANS, PAVEMENT GRADES SHOWN ARE AT THE TOP OF PAVEMENT SURFACES.
28. THE RESIDENT ENGINEER SHALL BE THE SOLE JUDGE CONCERNING CURING TIME FOR ALL HOT-MIX ASPHALT RESURFACING LIFTS.
29. FOR STABILIZATION, ALL TYPE III BARRICADES SHALL REQUIRE A MINIMUM OF FOUR SAND BAGS PER BARRICADE.
30. THE CONTRACTOR SHALL PROVIDE INTERNET ACCESSIBILITY TO THE HMA PLANT QUALITY CONTROL LAB SO THAT HMA PLANT REPORTS CAN BE E-MAILED TO THE DISTRICT HEADQUARTERS. THIS WORK SHALL BE INCLUDED IN THE COST OF HOT-MIX ASPHALT ITEMS.
31. STATION/OFFSETS FOR PROPOSED DRAINAGE STRUCTURES IS TO THE CENTER OF THE STRUCTURE. GRATE ELEVATIONS ARE TO THE FLOW LINE OF THE PROPOSED GRATE OR LID. (SEE MISCELLANEOUS DETAIL SHEETS)
32. SOME EXISTING STORM SEWER AND DRAINAGE STRUCTURE INFORMATION USED ON THESE PLANS WERE DEVELOPED FROM OFFICE RECORDS OR OTHERWISE HISTORICAL DATA. FINAL ELEVATIONS FOR INCORPORATING EXISTING DRAINAGE FACILITIES INTO THE PROPOSED SYSTEM SHALL BE DETERMINED BY THE ENGINEER. ALL SIZES AND DIMENSIONS OF THE EXISTING FACILITIES SHALL BE VERIFIED BEFORE ORDERING NEW MATERIALS.
33. END SECTIONS OR HEADWALLS MAY EXIST WHERE MISCELLANEOUS ENTRANCE PIPE CULVERTS ARE INDICATED TO BE REMOVED. PAYMENT FOR THE REMOVAL OF END SECTIONS OR HEADWALLS WILL NOT BE MADE SEPARATELY, BUT CONSIDERED AS INCLUDED IN THE COST OF REMOVING THE PIPE CULVERT.
34. EXISTING STORM SEWERS AND PIPE CULVERTS THAT ARE NOT BEING REMOVED UNDER THIS CONTRACT AND ARE NO LONGER REQUIRED OR IT IS INDICATED ON THE PLANS TO BE ABANDONED, SHALL BE FILLED WITH A CONTROLLED LOW STRENGTH MIXTURE AND THE ENDS PLUGGED. SEE SPECIAL PROVISIONS.
35. PROTECTIVE COAT SHALL BE APPLIED TO ALL CONCRETE CURB AND GUTTERS, MEDIANS AND MEDIAN SURFACES.
36. DELINEATOR REMOVAL IS INCIDENTAL TO EARTH EXCAVATION. NO ADDITIONAL COMPENSATION WILL BE PROVIDED FOR DELINEATOR REMOVAL.
37. ALL EXISTING PIPE UNDERDRAINS AND HEADWALLS SHALL BE REMOVED. PIPE UNDERDRAIN REMOVAL AND PIPE UNDERDRAIN HEADWALL REMOVAL SHALL BE INCLUDED IN THE COST OF EARTH EXCAVATION.
38. THE EXCAVATION AND BEDDING REQUIRED FOR RR 4 RIPRAP AS DESCRIBED IN ARTICLE 281.04 OF THE STANDARD SPECIFICATIONS WILL NOT BE PAID FOR SEPARATELY, BUT SHALL BE CONSIDERED INCLUDED IN THE PAY ITEM STONE RIPRAP, CLASS A4.
39. ANY REFERENCES TO STEEL PLATE BEAM GUARD RAIL, TYPE A SHOWN ON THE PLANS SHOULD BE INTERPRETED TO MEAN STEEL PLATE BEAM GUARD RAIL, TYPE A, 6 FOOT POSTS.
40. A QUANTITY OF 500 TONS AGGREGATE FOR TEMPORARY ACCESS HAS BEEN ESTIMATED TO MAINTAIN ACCESS ON FAYETTE AVENUE.
41. TRANSVERSE EXPANSION JOINTS SHALL BE CONSTRUCTED AT THE END OF ALL RECONSTRUCTED PAVEMENTS TIEING THEM TO EXISTING PAVEMENTS. THE EXPANSION JOINTS SHALL BE CONSTRUCTED IN ACCORDANCE WITH HIGHWAY STANDARD 420001 WITH THE DOWEL BARS EMBEDDED INTO THE EXISTING PAVEMENT. THIS WORK WILL NOT BE PAID FOR SEPARATELY, BUT CONSIDERED AS INCLUDED IN THE CONTRACT UNIT PRICE OF THE VARIOUS PAVEMENTS AND/OR SHOULDERS.
42. EXISTING SUBBASE GRANULAR MATERIAL AS DEPICTED ON EXISTING TYPICAL SECTIONS SHALL BE REMOVED AND COST IS INCLUDED IN PAVEMENT REMOVAL. THIS MATERIAL MAY BE USED IN EMBANKMENT CONSTRUCTION IN ACCORDANCE WITH ARTICLE 205.04 OR AS OTHERWISE DIRECTED BY THE ENGINEER.
43. IDOT D-7 TRAFFIC OFFICE SHALL BE NOTIFIED AT 217-342-8291 2 WEEKS PRIOR TO INSTALLING THE DETOUR TO ADJUST SIGNAL TIMINGS.

COMMITMENT - NONE

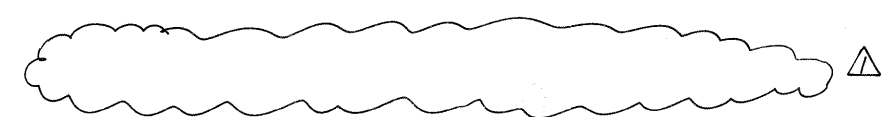

△ Rev. 8-31-10

FILE NAME =	USER NAME = paul	DESIGNED - JWS	REVISED -	<b>STATE OF ILLINOIS DEPARTMENT OF TRANSPORTATION</b>	<b>GENERAL NOTES, STANDARDS, AND INDEX OF SHEETS</b>			F.A.I. RTE.	SECTION	COUNTY	TOTAL SHEETS	SHEET NO.
S:\Projects\4003-00072-57-70\dgn\Fayette\gennotes.dgn		DRAWN - PDB	REVISED -					57/70	(25-3)I-6 & (25-3)HB-2)B	EFFINGHAM	839	3
		CHECKED - BRM	REVISED -		<b>CONTRACT NO. 74293</b>							
		DATE - 11-05-07	REVISED -		SCALE:	SHEET NO. 2 OF 2 SHEETS	STA.	TO STA.	FED. ROAD DIST. NO.	ILLINOIS FED. AID PROJECT		

SUMMARY OF QUANTITIES

CODED NO.	DESCRIPTION	UNIT	TOTAL QUANTITY	CONSTRUCTION CODE			
				(25-3) I-6			(25-3HB-2) B
				90% FED. 10% STATE ROADWAY J000-2A	90% FEDERAL 8% STATE 2% CITY BIKE PATH & SIDEWALK J000-2A	100% CITY TRAFFIC SIGNALS PREEMPTORS Y031-3D	90% FED. 10% STATE BRIDGE X271-2A
20100110	TREE REMOVAL (6 TO 15 UNITS DIAMETER)	UNIT	105	105			
20100210	TREE REMOVAL (OVER 15 UNITS DIAMETER)	UNIT	445	445			
20200100	EARTH EXCAVATION	CU YD	52390	52370	20		
20400800	FURNISHED EXCAVATION	CU YD	19860	19830	30		
X2090210	POROUS GRANULAR EMBANKMENT, SPECIAL	CU YD	384				384
20800150	TRENCH BACKFILL	CU YD	88	79	9		
21101615	TOPSOIL FURNISH AND PLACE, 4"	SQ YD	72465	72339	126		
25000200	SEEDING, CLASS 2	ACRE	25	25			
25000300	SEEDING, CLASS 3	ACRE	1	1			
25000350	SEEDING, CLASS 7	ACRE	26	26			
25000400	NITROGEN FERTILIZER NUTRIENT	POUND	2340	2340			
25000500	PHOSPHORUS FERTILIZER NUTRIENT	POUND	2340	2340			
25000600	POTASSIUM FERTILIZER NUTRIENT	POUND	2340	2340			
25000700	AGRICULTURAL GROUND LIMESTONE	TON	2	2			
A 25000750	MOWING	ACRE	26	26			
25100115	MULCH, METHOD 2	ACRE	26	26			
25100630	EROSION CONTROL BLANKET	SQ YD	1284	1284			
28000200	EARTH EXCAVATION FOR EROSION CONTROL	CU YD	9	9			
28000305	TEMPORARY DITCH CHECKS	FOOT	1629	1611	18		
28000400	PERIMETER EROSION BARRIER	FOOT	7044	7044			
28000500	INLET AND PIPE PROTECTION	EACH	80	78	2		
28001000	AGGREGATE (EROSION CONTROL)	TON	4	4			
28100105	STONE RIPRAP, CLASS A3	SQ YD	105	105			
28100107	STONE RIPRAP, CLASS A4	SQ YD	202	202			
28200200	FILTER FABRIC	SQ YD	202	202			
30200650	PROCESSING MODIFIED SOIL 12"	SQ YD	38665	38665			
30200950	PROCESSING MODIFIED SOIL 18"	SQ YD	1978	1978			
30201500	LIME	TON	1050	1050			
31200500	STABILIZED SUB-BASE - HOT-MIX ASPHALT, 4"	SQ YD	37427	37427			
<del>35100700</del>	<del>AGGREGATE BASE COURSE, TYPE A 8"</del>	<del>SQ YD</del>	<del>2220</del>	<del>25</del>	<del>2203</del>		
35102000	AGGREGATE BASE COURSE, TYPE B 8"	SQ YD	2395	192	2203		
40201000	AGGREGATE FOR TEMPORARY ACCESS	TON	500	500			
40600100	BITUMINOUS MATERIALS (PRIME COAT)	GALLON	23	23			
40600300	AGGREGATE (PRIME COAT)	TON	1	1			
40603350	HOT-MIX ASPHALT SURFACE COURSE, MIX "D", N105	TON	29	29			
40800010	BITUMINOUS MATERIALS (PRIME COAT)	GALLON	184	184			
40800030	AGGREGATE (PRIME COAT)	TON	3	3			
40800050	INCIDENTAL HOT-MIX ASPHALT SURFACING	TON	1079	1079			
A 42000506	PORTLAND CEMENT CONCRETE PAVEMENT 10 1/4" (JOINTED)	SQ YD	21416	21416			
42000511	PORTLAND CEMENT CONCRETE PAVEMENT 10 1/2" (JOINTED)	SQ YD	10264	10264			
42000540	PORTLAND CEMENT CONCRETE PAVEMENT 12"	SQ YD	11264	11264			
42001200	PAVEMENT FABRIC	SQ YD	11869	11869			
42001300	PROTECTIVE COAT	SQ YD	52575	52476	99		
42001420	BRIDGE APPROACH PAVEMENT CONNECTOR (PCC)	SQ YD	1337	1337			

*A - Non-participating Specialty Items*

CODED NO.	DESCRIPTION	UNIT	TOTAL QUANTITY	CONSTRUCTION CODE			
				(25-3) I-6			(25-3HB-2) B
				90% FED. 10% STATE ROADWAY J000-2A	90% FEDERAL 8% STATE 2% CITY BIKE PATH & SIDEWALK J000-2A	100% CITY TRAFFIC SIGNALS PREEMPTORS Y031-3D	90% FED. 10% STATE BRIDGE X271-2A
42300400	PORTLAND CEMENT CONCRETE DRIVEWAY PAVEMENT, 8 INCH	SQ YD	605	605			
42400100	PORTLAND CEMENT CONCRETE SIDEWALK 4 INCH	SQ FT	23639	6579	17060		
42400800	DETECTABLE WARNINGS	SQ FT	120	40	80		
44000100	PAVEMENT REMOVAL	SQ YD	31379	31379			
44000198	HOT-MIX ASPHALT SURFACE REMOVAL, VARIABLE DEPTH	SQ YD	292	292			
44000200	DRIVEWAY PAVEMENT REMOVAL	SQ YD	761	761			
44000400	GUTTER REMOVAL	FOOT	81	81			
44000500	COMBINATION CURB AND GUTTER REMOVAL	FOOT	8865	8865			
X0004552	APPROACH SLAB REMOVAL	SQ YD	461	461			
X4402805	ISLAND REMOVAL	SQ FT	271	271			
44003510	MEDIAN REMOVAL PARTIAL DEPTH	SQ FT	367	367			
X4403800	MEDIAN SURFACE REMOVAL	SQ FT	17342	17342			
44004000	PAVED DITCH REMOVAL	FOOT	249	249			
44004250	PAVED SHOULDER REMOVAL	SQ YD	14727	14727			
X4404400	PAVEMENT REMOVAL (SPECIAL)	SQ YD	5240	5240			
48101200	AGGREGATE SHOULDERS, TYPE B	TON	70		70		
48101500	AGGREGATE SHOULDERS, TYPE B 6"	SQ YD	1241	1241			
48203029	HOT-MIX ASPHALT SHOULDERS, 8"	SQ YD	203	203			
50100100	REMOVAL OF EXISTING STRUCTURES	EACH	1				1
50104400	CONCRETE HEADWALL REMOVAL	EACH	11	11			
50104650	SLOPE WALL REMOVAL	SQ YD	747	747			
50105220	PIPE CULVERT REMOVAL	FOOT	408	408			
50157300	PROTECTIVE SHIELD	SQ YD	1155				1155
50200100	STRUCTURE EXCAVATION	CU YD	864				864
50300100	FLOOR DRAINS	EACH	12				12
50300225	CONCRETE STRUCTURES	CU YD	394.4				394.4
50300255	CONCRETE SUPERSTRUCTURE	CU YD	982.9				982.9
50300260	BRIDGE DECK GROOVING	SQ YD	2342				2342
50300280	CONCRETE ENCASMENT	CU YD	12				12
50300300	PROTECTIVE COAT	SQ YD	2943				2943
50500105	FURNISHING AND ERECTING STRUCTURAL STEEL	L SUM	1				1
50500505	STUD SHEAR CONNECTORS	EACH	7740				7740
50800205	REINFORCEMENT BARS, EPOXY COATED	POUND	283365				283365
50800515	BAR SPLICERS	EACH	2308				2308
50901730	BRIDGE FENCE RAILING	FOOT	257				257
51100100	SLOPE WALL 4 INCH	SQ YD	898				898
51201610	FURNISHING STEEL PILES HP12X63	FOOT	2084				2084
51202305	DRIVING PILES	FOOT	2084				2084
51203610	TEST PILE STEEL HP12X63	EACH	6				6
51204650	PILE SHOES	EACH	56				56
X0026407	TEMPORARY SHEET PILING	SQ FT	1429				1429
51500100	NAME PLATES	EACH	1				1
52100520	ANCHOR BOLTS, 1"	EACH	40				40
52100530	ANCHOR BOLTS, 1 1/4"	EACH	20				20

*A Rev. 8-31-10*

SUMMARY OF QUANTITIES

CODED NO.	DESCRIPTION	UNIT	URBAN TOTAL QUANTITY	CONSTRUCTION CODE				(25-3HB-2)B 90% FED. 10% STATE BRIDGE X271-2A
				(25-3) I-6				
				90% FED. 10% STATE ROADWAY J000-2A	90% FEDERAL 8% STATE 2% CITY BIKE PATH & SIDEWALK J000-2A	100% CITY TRAFFIC SIGNALS PREEMPTORS Y031-3D		
54001001	BOX CULVERT END SECTIONS, CULVERT NO. 1	EACH	2	2				
54010502	PRECAST CONCRETE BOX CULVERTS 5' X 2'	FOOT	170	170				
542A0241	PIPE CULVERTS, CLASS A, TYPE 1 36"	FOOT	62	62				
542A1081	PIPE CULVERTS, CLASS A, TYPE 2 36"	FOOT	77	77				
542D0220	PIPE CULVERTS, CLASS D, TYPE 1 15"	FOOT	24		24			
54213660	PRECAST REINFORCED CONCRETE FLARED END SECTIONS 15"	EACH	1	1				
54213669	PRECAST REINFORCED CONCRETE FLARED END SECTIONS 24"	EACH	1	1				
54213681	PRECAST REINFORCED CONCRETE FLARED END SECTIONS 36"	EACH	2	2				
54213687	PRECAST REINFORCED CONCRETE FLARED END SECTIONS 42"	EACH	1	1				
54215436	CAST-IN-PLACE REINFORCED CONCRETE END SECTIONS 36"	EACH	2	2				
54215550	METAL END SECTIONS 15"	EACH	38	35	3			
54215973	REINFORCED CONCRETE PIPE ELBOW 18"	EACH	1	1				
54248510	CONCRETE COLLAR	CU YD	1.8	1.8				
54390310	INSERTION CULVERT LINER 60"	FOOT	137	137				
550A0070	STORM SEWERS, CLASS A, TYPE 1 15"	FOOT	390	390				
550A0090	STORM SEWERS, CLASS A, TYPE 1 18"	FOOT	6	6				
550A0160	STORM SEWERS, CLASS A, TYPE 1 36"	FOOT	59	59				
550A0180	STORM SEWERS, CLASS A, TYPE 1 42"	FOOT	134	134				
550A0360	STORM SEWERS, CLASS A, TYPE 2 15"	FOOT	98	98				
550A0380	STORM SEWERS, CLASS A, TYPE 2 18"	FOOT	10	10				
550A0410	STORM SEWERS, CLASS A, TYPE 2 24"	FOOT	327	327				
58700300	CONCRETE SEALER	SQ FT	2573				2573	
59100100	GEOCOMPOSITE WALL DRAIN	SQ YD	180				180	
60100060	CONCRETE HEADWALL FOR PIPE DRAINS	EACH	16	16				
60100955	PIPE DRAINS 15"	FOOT	777	708	69			
60107600	PIPE UNDERDRAINS 4"	FOOT	5796	5796				
60108100	PIPE UNDERDRAINS 4" (SPECIAL)	FOOT	254	254				
60109580	PIPE UNDERDRAINS FOR STRUCTURES 4"	FOOT	202				202	
60218400	MANHOLES, TYPE A, 4'-DIAMETER, TYPE 1 FRAME, CLOSED LID	EACH	4	4				
60221000	MANHOLES, TYPE A, 5'-DIAMETER, TYPE 1 FRAME, OPEN LID	EACH	1	1				
60221100	MANHOLES, TYPE A, 5'-DIAMETER, TYPE 1 FRAME, CLOSED LID	EACH	3	3				
60223800	MANHOLES, TYPE A, 6'-DIAMETER, TYPE 1 FRAME, CLOSED LID	EACH	1	1				
60224005	MANHOLES, TYPE A, 6'-DIAMETER, TYPE 8 GRATE	EACH	1	1				
60235700	INLETS, TYPE A, TYPE 3 FRAME AND GRATE	EACH	20	20				
60236200	INLETS, TYPE A, TYPE 8 GRATE	EACH	1	1				
60237000	INLETS, TYPE A, TYPE 15 FRAME AND LID	EACH	2	2				
60237420	INLETS, TYPE A, TYPE 20 FRAME AND GRATE	EACH	3	3				
60240220	INLETS, TYPE B, TYPE 3 FRAME AND GRATE	EACH	1	1				
60255500	MANHOLES TO BE ADJUSTED	EACH	1	1				
60260100	INLETS TO BE ADJUSTED	EACH	4	4				
60260400	INLETS TO BE ADJUSTED WITH NEW TYPE 1 FRAME, CLOSED LID	EACH	1	1				
60500040	REMOVING MANHOLES	EACH	1	1				
60500060	REMOVING INLETS	EACH	8	8				
60603500	COMBINATION CONCRETE CURB AND GUTTER, TYPE B-6.06	FOOT	437	437				
60603800	COMBINATION CONCRETE CURB AND GUTTER, TYPE B-6.12	FOOT	36	36				

CODED NO.	DESCRIPTION	UNIT	URBAN TOTAL QUANTITY	CONSTRUCTION CODE				(25-3HB-2)B 90% FED. 10% STATE BRIDGE X271-2A
				(25-3) I-6				
				90% FED. 10% STATE ROADWAY J000-2A	90% FEDERAL 8% STATE 2% CITY BIKE PATH & SIDEWALK J000-2A	100% CITY TRAFFIC SIGNALS PREEMPTORS Y031-3D		
60605000	COMBINATION CONCRETE CURB AND GUTTER, TYPE B-6.24	FOOT	10921	10921				
60618300	CONCRETE MEDIAN SURFACE, 4 INCH	SQ FT	25681	25681				
60619300	CONCRETE MEDIAN, TYPE SB-6.06 (DOWELLED)	SQ FT	230	230				
60624600	CORRUGATED MEDIAN	SQ FT	2401	2401				
60900515	CONCRETE THRUST BLOCKS	EACH	8	8				
* 63000001	STEEL PLATE BEAM GUARD RAIL, TYPE A, 6 FOOT POSTS	FOOT	275	275				
* 63100045	TRAFFIC BARRIER TERMINAL, TYPE 2	EACH	1	1				
* 63100085	TRAFFIC BARRIER TERMINAL, TYPE 6	EACH	3	3				
* 63100167	TRAFFIC BARRIER TERMINAL, TYPE 1 (SPECIAL) TANGENT	EACH	2	2				
63200310	GUARDRAIL REMOVAL	FOOT	537	537				
63301210	REMOVE AND REERECT STEEL PLATE BEAM GUARD RAIL, TYPE A	FOOT	292	292				
63500105	DELINEATORS	EACH	40	40				
64200105	SHOULDER RUMBLE STRIPS	FOOT	5573	5573				
66400305	CHAIN LINK FENCE, 6'	FOOT	1239	1239				
66700205	PERMANENT SURVEY MARKERS, TYPE I	EACH	16	16				
67000400	ENGINEER'S FIELD OFFICE, TYPE A	CAL MO	24	24				
67000600	ENGINEER'S FIELD LABORATORY	CAL MO	24	24				
67100100	MOBILIZATION	L SUM	1	1				
70100700	TRAFFIC CONTROL AND PROTECTION, STANDARD 701406	L SUM	1	1				
70101800	TRAFFIC CONTROL AND PROTECTION, (SPECIAL)	L SUM	1	1				
70102625	TRAFFIC CONTROL AND PROTECTION, STANDARD 701606	L SUM	1	1				
70103815	TRAFFIC CONTROL SURVEILLANCE	CAL DA	650	650				
70103820	TRAFFIC CONTROL TEMPORARY FREEWAY ENDING	EACH	14	14				
70106800	CHANGEABLE MESSAGE SIGN	CAL MO	96	96				
70300210	TEMPORARY PAVEMENT MARKING - LETTERS AND SYMBOLS	SQ FT	790	790				
70300220	TEMPORARY PAVEMENT MARKING - LINE 4"	FOOT	18437	18437				
70300240	TEMPORARY PAVEMENT MARKING - LINE 6"	FOOT	4197	4197				
70300250	TEMPORARY PAVEMENT MARKING - LINE 8"	FOOT	605	605				
70300260	TEMPORARY PAVEMENT MARKING - LINE 12"	FOOT	2848	2848				
70300280	TEMPORARY PAVEMENT MARKING - LINE 24"	FOOT	370	370				
70301000	WORK ZONE PAVEMENT MARKING REMOVAL	SQ FT	13023	13023				
70400100	TEMPORARY CONCRETE BARRIER	FOOT	1075	1075				
70400200	RELOCATE TEMPORARY CONCRETE BARRIER	FOOT	750	750				
* 72000100	SIGN PANEL - TYPE 1	SQ FT	514	514				
* 72000200	SIGN PANEL - TYPE 2	SQ FT	136	136				
* 72000300	SIGN PANEL - TYPE 3	SQ FT	2114	2114				
* 72400330	REMOVE SIGN PANEL - TYPE 3	SQ FT	1296	1296				
* 72700100	STRUCTURAL STEEL SIGN SUPPORT - BREAKAWAY	POUND	24248	24248				
* 72700200	TUBULAR STEEL SIGN SUPPORT - BREAKAWAY	POUND	926	926				
* 73000100	WOOD SIGN SUPPORT	FOOT	71	71				
* 73400100	CONCRETE FOUNDATIONS	CU YD	49.4	49.4				
* 73600200	REMOVE OVERHEAD SIGN STRUCTURE - CANTILEVER	EACH	1	1				
* 73700100	REMOVE GROUND-MOUNTED SIGN SUPPORT	EACH	20	20				

\* SPECIALTY ITEMS

Rev. B-31-10

Rev.

**SUMMARY OF QUANTITIES**

CODED NO.	DESCRIPTION	UNIT	URBAN TOTAL QUANTITY	CONSTRUCTION CODE				(25-3HB-2)B 90% FED. 10% STATE BRIDGE X271-2A
				(25-3)I-6				
				90% FED. 10% STATE ROADWAY J000-2A	90% FEDERAL 8% STATE 2% CITY BIKE PATH & SIDEWALK J000-2A	100% CITY TRAFFIC SIGNALS PREEMPTORS Y031-3D		
* 88200400	TRAFFIC SIGNAL BACKPLATE, FORMED PLASTIC	EACH	54	54				
* 88500100	INDUCTIVE LOOP DETECTOR	EACH	40	40				
* 88600100	DETECTOR LOOP, TYPE I	FOOT	3839	3839				
* 88700200	LIGHT DETECTOR	EACH	10		10			
* 88700300	LIGHT DETECTOR AMPLIFIER	EACH	3		3			
* 88800100	PEDESTRIAN PUSH-BUTTON	EACH	8	8				
* 89000100	TEMPORARY TRAFFIC SIGNAL INSTALLATION	EACH	4	4				
* 89502375	REMOVE EXISTING TRAFFIC SIGNAL EQUIPMENT	EACH	1	1				
* 89502380	REMOVE EXISTING HANDHOLE	EACH	9	9				
* 89502385	REMOVE EXISTING CONCRETE FOUNDATION	EACH	5	5				
Z0056610	STORM SEWER (WATER MAIN REQUIREMENTS) 15 INCH	FOOT	44	44				
X0322936	REMOVE EXISTING FLARED END SECTION	EACH	2	2				
X0323644	PAVEMENT MARKING GROOVING	FOOT	26455	26455				
Z0018002	DRAINAGE SCUPPERS, DS-11	EACH	8				8	
X0325605	PAVEMENT MARKING GROOVING	SQ FT	790	790				
X0325761	TRAFFIC CONTROL AND PROTECTION - STAGE 3	L SUM	1	1				
X0358300	REMOVE AND RELAY END SECTIONS	EACH	1	1				
X0696000	BRIDGE DRAINAGE SYSTEM	L SUM	1					
X5041800	CONCRETE ANCHORS	EACH	16	16				
X5510100	STORM SEWER REMOVAL	FOOT	179	179				
X6020074	INLETS, TYPE A, TYPE 3V FRAME AND GRATE	EACH	25	25				
X7011005	TRAFFIC CONTROL AND PROTECTION FOR TEMPORARY DETOUR	L SUM	1	1				
* X7800605	URETHANE PAVEMENT MARKING - LETTERS AND SYMBOLS	SQ FT	790	790				
* X7800610	URETHANE PAVEMENT MARKING - LINE 4"	FOOT	18791	18437	354			
* X7800630	URETHANE PAVEMENT MARKING - LINE 6"	FOOT	4197	4197				
* X7800640	URETHANE PAVEMENT MARKING - LINE 8"	FOOT	605	605				
* X7800650	URETHANE PAVEMENT MARKING - LINE 12"	FOOT	2848	2848				
* X7800680	URETHANE PAVEMENT MARKING - LINE 24"	FOOT	370	370				
* X8410102	TEMPORARY LIGHTING SYSTEM	L SUM	1	1				
* X8730027	ELECTRIC CABLE IN CONDUIT, GROUNDING, NO. 6 1C	FOOT	2089	2089				
* X8730250	ELECTRIC CABLE IN CONDUIT NO. 20 3/C, TWISTED, SHIELDED	FOOT	2249		2249			
Z0013798	CONSTRUCTION LAYOUT	L SUM	1	1				
Z0022800	FENCE REMOVAL	FOOT	1327	1327				
Z0030250	IMPACT ATTENUATORS, TEMPORARY (NON-REDIRECTIVE), TEST LEVEL 3	EACH	6	6				
Z0030350	IMPACT ATTENUATORS, RELOCATE (NON-REDIRECTIVE), TEST LEVEL 3	EACH	4	4				
© Z0076600	TRAINEES	HOUR	1000	1000				
* A2C05065	TREE, QUERCUS BICOLOR (SWAMP WHITE OAK), CONTAINER GROWN, 5-GALLON	EACH	2	2				
* A2C07063	TREE, TAXODIUM DISTICHUM (BALD CYPRESS), CONTAINER GROWN, 3-GALLON	EACH	2	2				
* B2001116	TREE, CERCIS CANADENSIS (EASTERN REDBUD), 2" CALIPER, TREE FORM, BALLED AND BURLAPPED	EACH	8	8				
* B2001464	TREE, CORNUS MAS (CORNELIAN CHERRY DOG WOOD), 5' HEIGHT, SHRUB FORM, BALLED AND BURLAPPED	EACH	8	8				

© YOBO \* SPECIALTY ITEMS

CODED NO.	DESCRIPTION	UNIT	URBAN TOTAL QUANTITY	CONSTRUCTION CODE				(25-3HB-2)B 90% FED. 10% STATE BRIDGE X271-2A
				(25-3)I-6				
				90% FED. 10% STATE ROADWAY J000-2A	90% FEDERAL 8% STATE 2% CITY BIKE PATH & SIDEWALK J000-2A	100% CITY TRAFFIC SIGNALS PREEMPTORS Y031-3D		
* B2006316	TREE, SYRINGA RETICULATA IVORY SILK (IVORY SILK JAPANESE TREE LILAC), 2" CALIPER, TREE FORM, BALLED AND BURLAPPED	EACH	8	8				
Z0018000	DRAINAGE SYSTEM	L SUM	1				1	
Z0073002	TEMPORARY SOIL RETENTION SYSTEM	SQ FT	687				687	
X5080600	MECHANICAL SPLICERS	EACH	482				482	
Z0073500	TEMPORARY SUPPORT SYSTEM	L SUM	1				1	

Rev. 8-31-10

**STRUCTURAL DESIGN INFORMATION  
FAYETTE AVENUE**

ROAD CLASSIFICATION: CLASS I


STRUCTURAL DESIGN TRAFFIC: 2030  
PV = 11,904 SU = 2,031 MU = 2,576

PERCENT OF STRUCTURAL DESIGN TRAFFIC IN DESIGN LANE  
P = 32% S = 45% M = 45%

MINIMUM SUBGRADE SUPPORT RATING: POOR


RIGID PAVEMENT DESIGN: MINIMUM  $T_F = 6.03$   
ACTUAL  $T_F = 18.79$

SELECTED DESIGN: 10.25 JRCPC

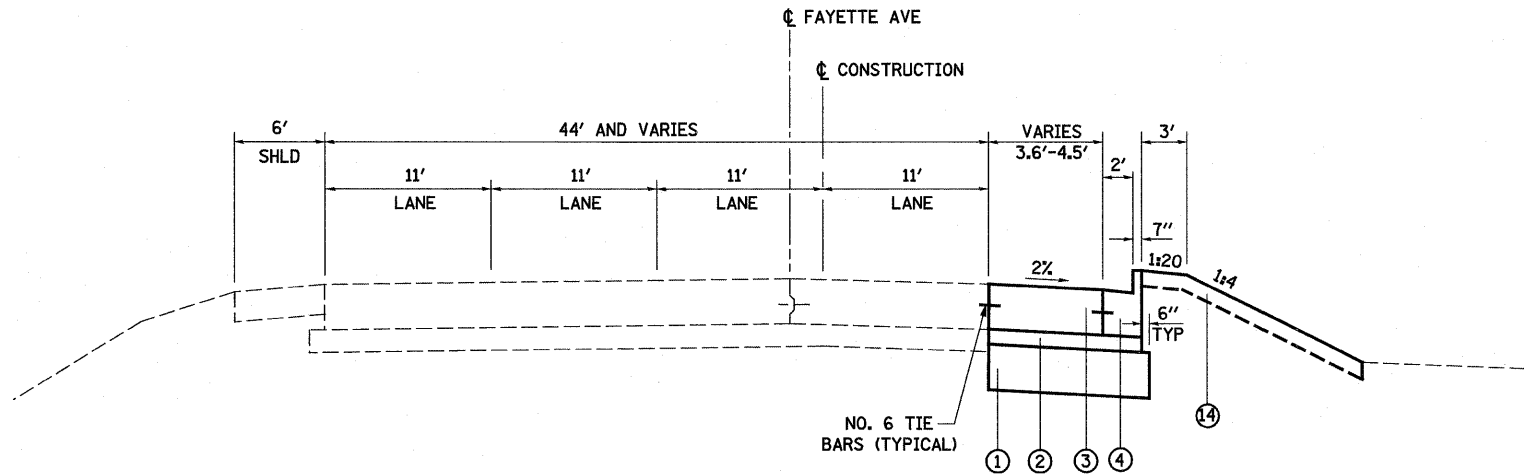

**EXISTING TANGENT SECTION**

STA 36+78.27 TO STA 37+85.10

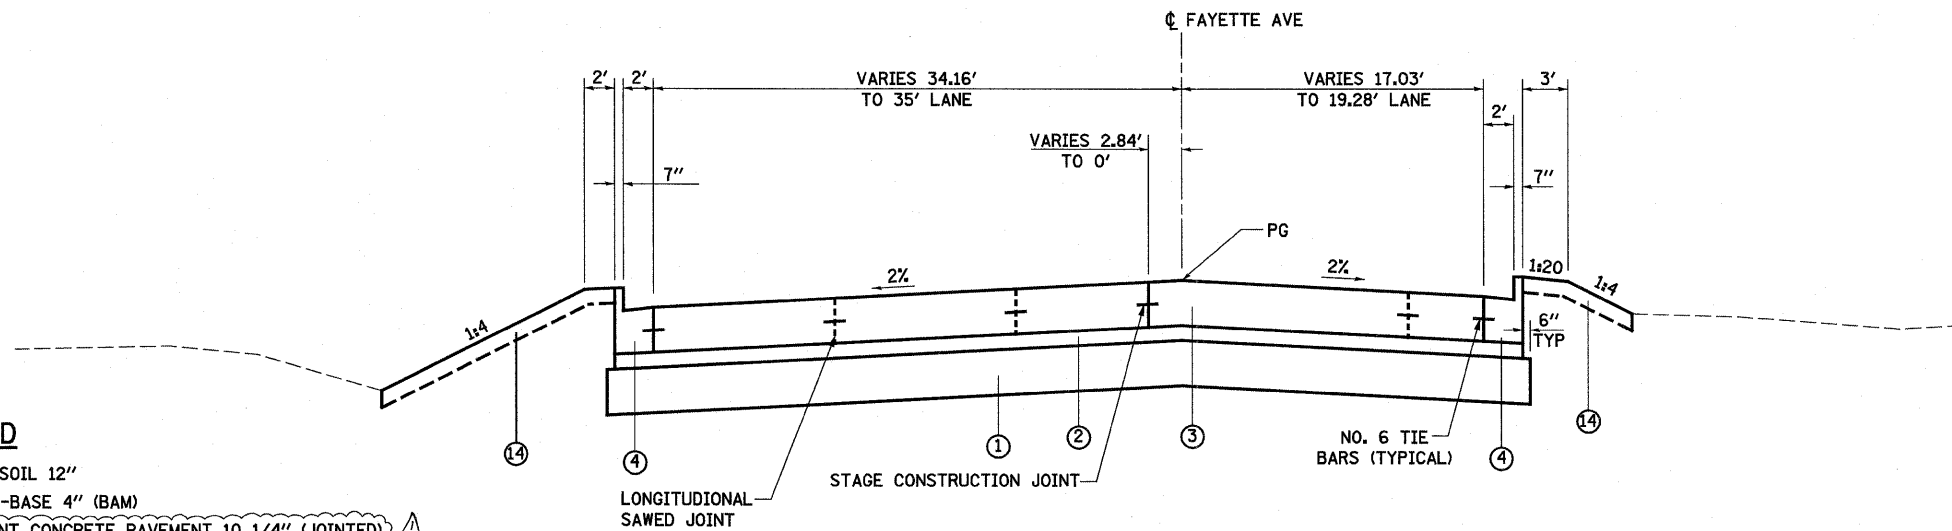

**PROPOSED TANGENT SECTION**


STA 37+85.10 TO STA 38+58.08

**LEGEND**

- ① PROPOSED LIME MODIFIED SOIL 12"
- ② PROPOSED STABILIZED SUB-BASE 4" (BAM)
- ③ PROPOSED PORTLAND CEMENT CONCRETE PAVEMENT 10 1/4" (JOINTED)
- ④ PROPOSED COMBINATION CONCRETE CURB AND GUTTER, TYPE B-6.24
- ⑤ PROPOSED PORTLAND CEMENT CONCRETE SIDEWALK 4"
- ⑥ PROPOSED CONCRETE MEDIAN SURFACE, 4"
- ⑦ PROPOSED CORRUGATED MEDIAN
- ⑧ PROPOSED COMBINATION CONCRETE CURB AND GUTTER, TYPE B-6.06
- ⑨ PROPOSED BRIDGE APPROACH SLAB (SEE STRUCTURE PLANS)
- ⑩ PROPOSED SUB-BASE GRANULAR MATERIAL, TYPE C
- ⑪ PROPOSED CONCRETE MEDIAN, TYPE SB (DOWELLED)
- ⑫ PROPOSED PORTLAND CEMENT CONCRETE PAVEMENT 10 1/2" (JOINTED)
- ⑬ PROPOSED AGGREGATE SHOULDERS, TYPE B 6"
- ⑭ PROPOSED TOPSOIL 4"
- ⑮ PROPOSED PIPE UNDERDRAINS 4"
- ⑯ PROPOSED PORTLAND CEMENT CONCRETE PAVEMENT, 12"
- ⑰ PROPOSED PAVEMENT FABRIC
- ⑱ PROPOSED AGGREGATE BASE COURSE, TYPE B, 8"
- ⑲ PROPOSED AGGREGATE SHOULDER TYPE B
- ⑳ PROPOSED LIME MODIFIED SOIL 18"

**PROPOSED FAYETTE AVE**

FILE NAME =	USER NAME = bctaj	DESIGNED - JWS	REVISED - 08-02-10	<b>STATE OF ILLINOIS DEPARTMENT OF TRANSPORTATION</b>	<b>PROPOSED TYPICAL SECTIONS - FAYETTE AVE</b>			F.A.I. RTE.	SECTION	COUNTY	TOTAL SHEETS	SHEET NO.
5:\P\Projects\403-00072-57-70\Drawn\Fayette\Addendum\1\addendum1.dgn	DRAWN - BOB	REVISED - (08-26-10)	57/70					(25-3)I-6	EFFINGHAM	839	16	
PLOT SCALE = 1/80.0000' / IN.	CHECKED - BRM	REVISED -	CONTRACT NO. 74293									
PLOT DATE = 8/27/2010	DATE - 11-05-07	REVISED -	SCALE: 1"=50'	SHEET NO. 1 OF 8 SHEETS	STA.	TO STA.	FED. ROAD DIST. NO.	ILLINOIS FED. AID PROJECT				

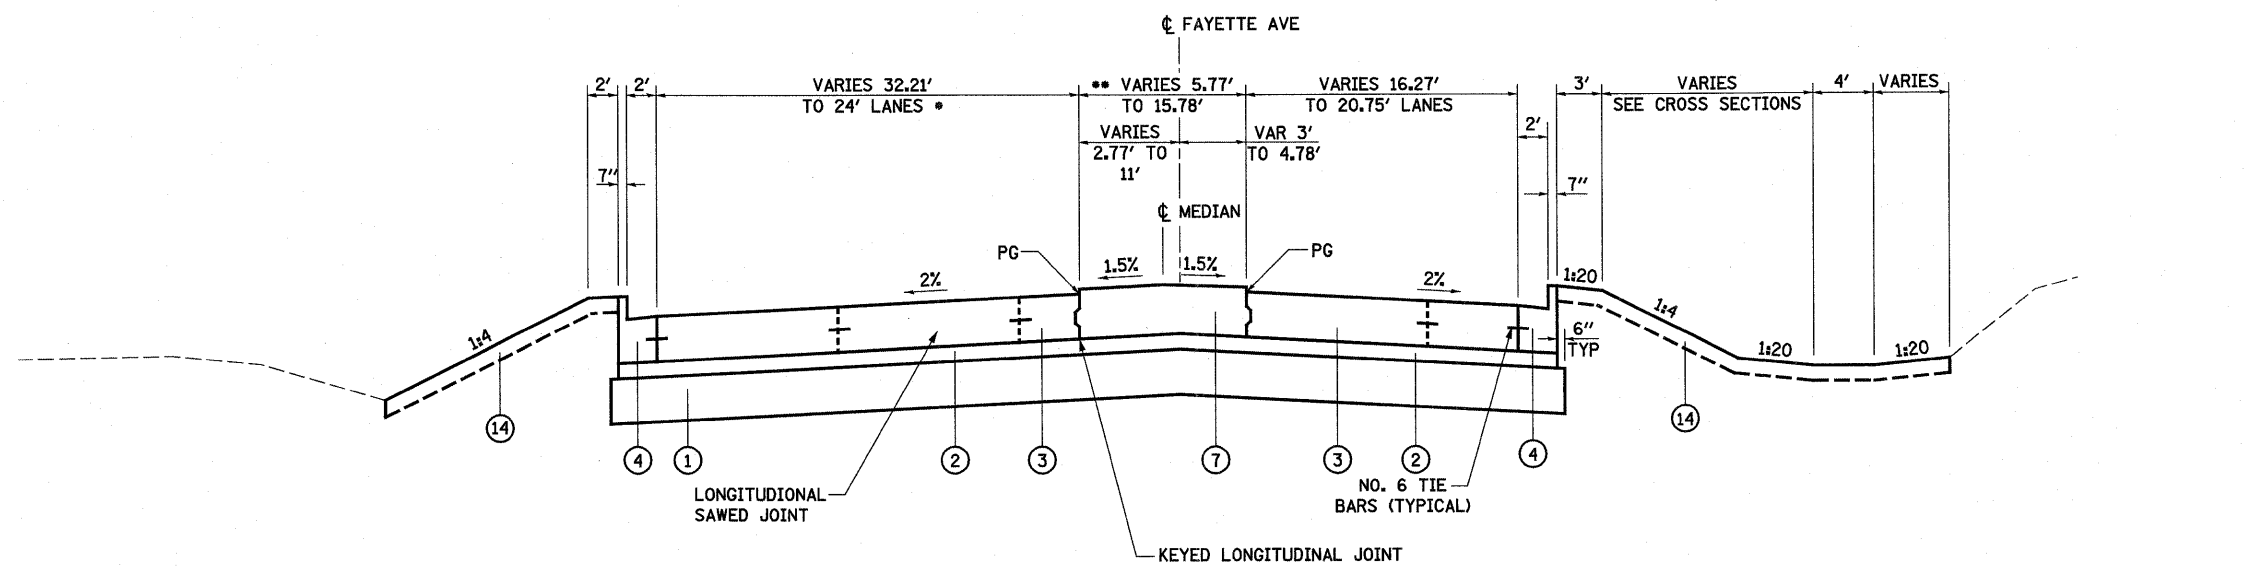


**PROPOSED TANGENT SECTION**

STA 38+58.08 TO STA 39+88.81

• 24' LANES BEGINS  
STA 39+85.75

• CORRUGATED MEDIAN BEGINS  
5' R NOSE, 0.03' RT STA 38+60.98  
ENDS 1' STUB, 11' RT STA 39+85.75  
ENDS 2' STUB, 4.78' RT STA 40+00.86

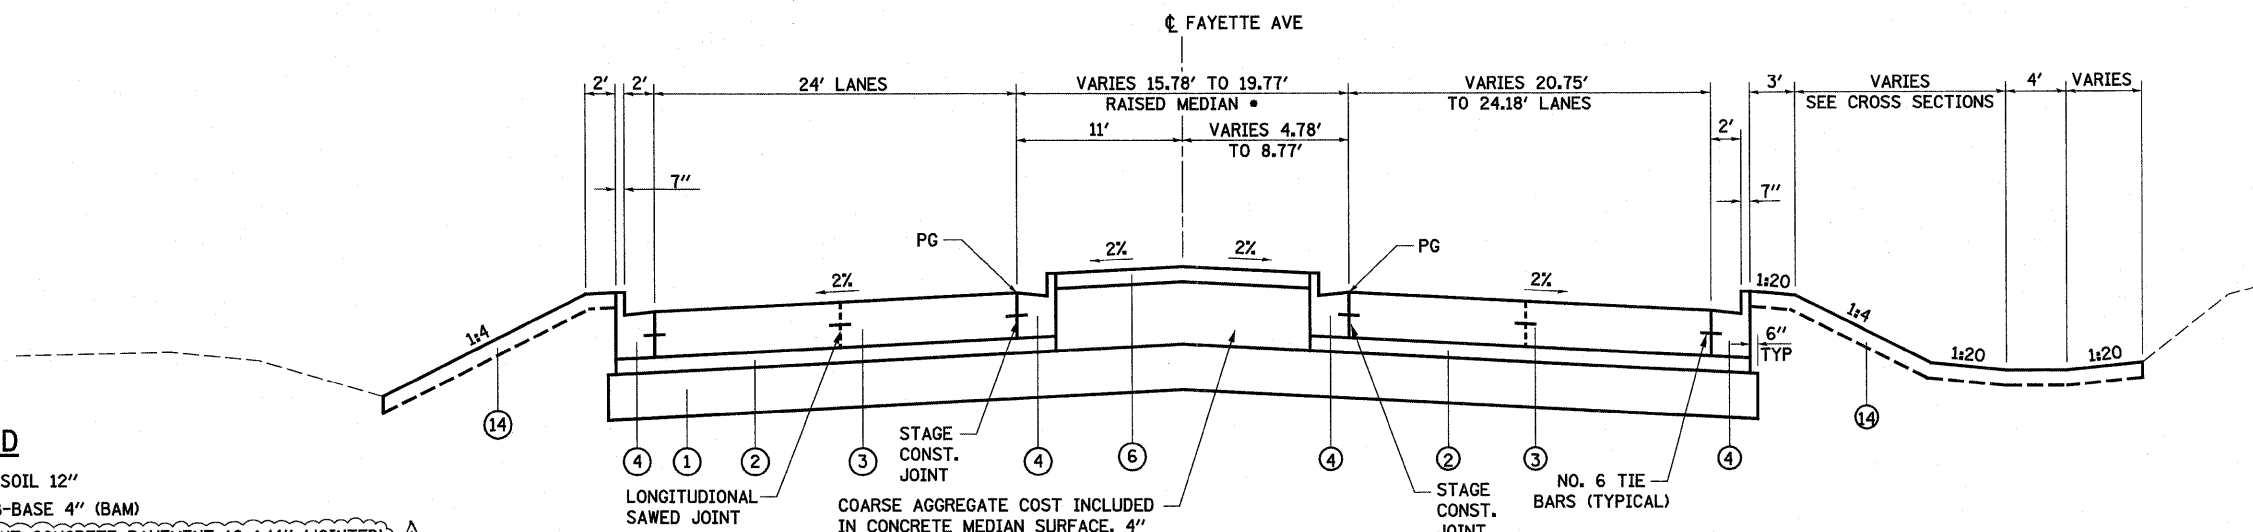

**PROPOSED TANGENT SECTION**

STA 39+88.81 TO STA 41+51.84


• RAISED MEDIAN BEGINS  
3' R NOSE, 6.0' LT  
STA 39+88.81

**LEGEND**

- ① PROPOSED LIME MODIFIED SOIL 12"
- ② PROPOSED STABILIZED SUB-BASE 4" (BAM)
- ③ PROPOSED PORTLAND CEMENT CONCRETE PAVEMENT 10 1/4" (JOINTED)
- ④ PROPOSED COMBINATION CONCRETE CURB AND GUTTER, TYPE B-6.24
- ⑤ PROPOSED PORTLAND CEMENT CONCRETE SIDEWALK 4"
- ⑥ PROPOSED CONCRETE MEDIAN SURFACE, 4"
- ⑦ PROPOSED CORRUGATED MEDIAN
- ⑧ PROPOSED COMBINATION CONCRETE CURB AND GUTTER, TYPE B-6.06
- ⑨ PROPOSED BRIDGE APPROACH SLAB (SEE STRUCTURE PLANS)
- ⑩ PROPOSED SUB-BASE GRANULAR MATERIAL, TYPE C
- ⑪ PROPOSED CONCRETE MEDIAN, TYPE SB (DOWELLED)
- ⑫ PROPOSED PORTLAND CEMENT CONCRETE PAVEMENT 10 1/2" (JOINTED)
- ⑬ PROPOSED AGGREGATE SHOULDERS, TYPE B 6"
- ⑭ PROPOSED TOPSOIL 4"
- ⑮ PROPOSED PIPE UNDERDRAINS 4"
- ⑯ PROPOSED PORTLAND CEMENT CONCRETE PAVEMENT, 12"
- ⑰ PROPOSED PAVEMENT FABRIC
- ⑱ PROPOSED AGGREGATE BASE COURSE, TYPE B, 8"
- ⑲ PROPOSED AGGREGATE SHOULDER TYPE B
- ⑳ PROPOSED LIME MODIFIED SOIL 18"

**PROPOSED FAYETTE AVE**

FILE NAME =	USER NAME = l1nde	DESIGNED - JWS	REVISED - 08-02-10	<b>STATE OF ILLINOIS DEPARTMENT OF TRANSPORTATION</b>	<b>PROPOSED TYPICAL SECTIONS - FAYETTE AVE</b>		F.A.I. RTE.	SECTION	COUNTY	TOTAL SHEETS	SHEET NO.
S:\Projects\403-00072-51-70\dgn\Fayette\Addendum\1\secfay.dgn	DRAWN - BOB	REVISOR - (08-26-10)	57/70				(25-3)-6	EFFINGHAM	839	17	
PLOT SCALE = 1/8" = 1' / IN.	CHECKED - BRM	REVISOR -	CONTRACT NO. 74293								
PLOT DATE = 8/26/2010	DATE - 11-05-07	REVISOR -	FED. ROAD DIST. NO. ILLINOIS FED. AID PROJECT								
				SCALE: 1"=50'		SHEET NO. 2 OF 8 SHEETS		STA. TO STA.			

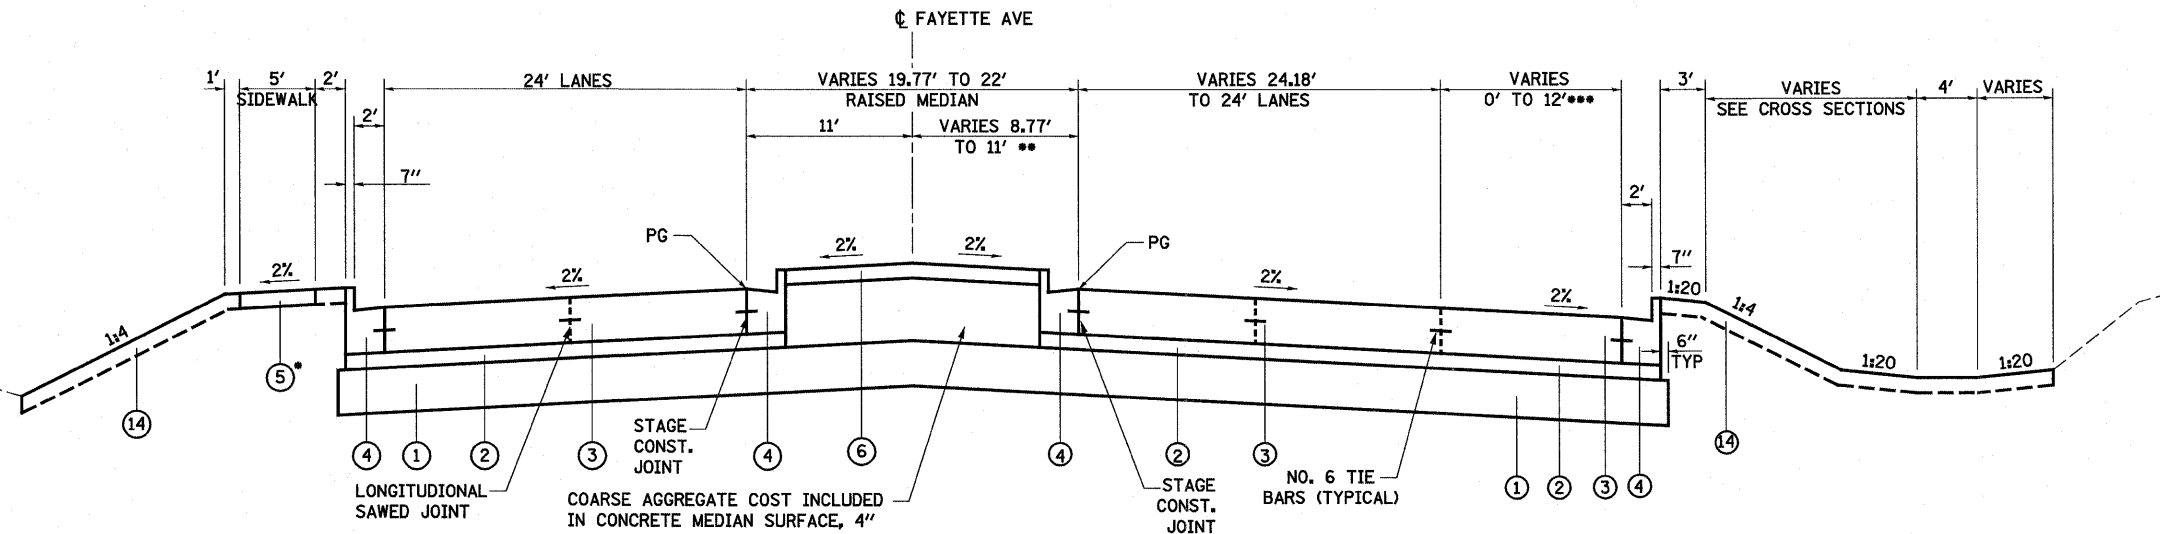


• PROPOSED SIDEWALK BEGINS STA 42+28.73

**PROPOSED TANGENT SECTION**  
STA 41+51.84 TO STA 46+25.00

•• 11' RAISED MEDIAN BEGINS STA 43+15.46  
RAISED MEDIAN ENDS 5' R NOSE, 6' RT STA 45+90.38

••• 12' RT TURN LANE BEGINS STA 43+34.79

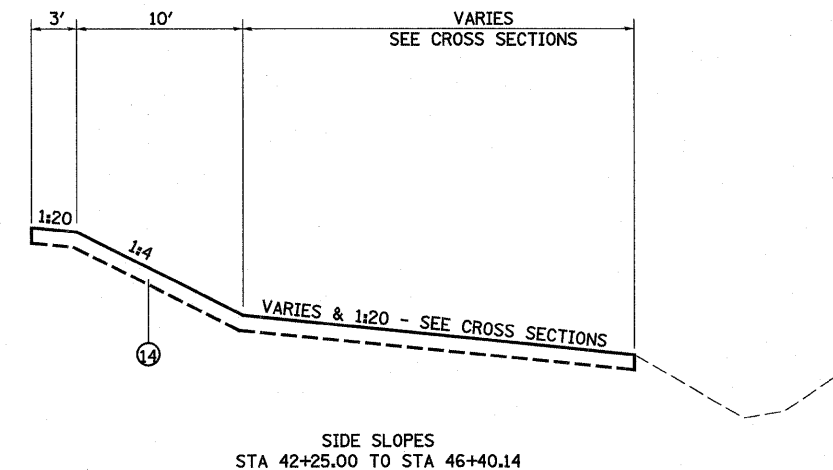


**LEGEND**

- ① PROPOSED LIME MODIFIED SOIL 12"
- ② PROPOSED STABILIZED SUB-BASE 4" (BAM)
- ③ PROPOSED PORTLAND CEMENT CONCRETE PAVEMENT 10 1/4" (JOINTED) △
- ④ PROPOSED COMBINATION CONCRETE CURB AND GUTTER, TYPE B-6.24
- ⑤ PROPOSED PORTLAND CEMENT CONCRETE SIDEWALK 4"
- ⑥ PROPOSED CONCRETE MEDIAN SURFACE, 4"
- ⑦ PROPOSED CORRUGATED MEDIAN
- ⑧ PROPOSED COMBINATION CONCRETE CURB AND GUTTER, TYPE B-6.06
- ⑨ PROPOSED BRIDGE APPROACH SLAB (SEE STRUCTURE PLANS)
- ⑩ PROPOSED SUB-BASE GRANULAR MATERIAL, TYPE C
- ⑪ PROPOSED CONCRETE MEDIAN, TYPE SB (DOWELLED)
- ⑫ PROPOSED PORTLAND CEMENT CONCRETE PAVEMENT 10 1/2" (JOINTED)
- ⑬ PROPOSED AGGREGATE SHOULDERS, TYPE B 6"
- ⑭ PROPOSED TOPSOIL 4"
- ⑮ PROPOSED PIPE UNDERDRAINS 4"
- ⑯ PROPOSED PORTLAND CEMENT CONCRETE PAVEMENT, 12"
- ⑰ PROPOSED PAVEMENT FABRIC
- ⑱ PROPOSED AGGREGATE BASE COURSE, TYPE B, 8"
- ⑲ PROPOSED AGGREGATE SHOULDER TYPE B
- ⑳ PROPOSED LIME MODIFIED SOIL 18"

**PROPOSED FAYETTE AVE**


FILE NAME =	USER NAME = lunde	DESIGNED - JWS	REVISED - 08-02-10	<b>STATE OF ILLINOIS DEPARTMENT OF TRANSPORTATION</b>	<b>PROPOSED TYPICAL SECTIONS - FAYETTE AVE</b>			F.A.I. RTE.	SECTION	COUNTY	TOTAL SHEETS	SHEET NO.
Plot Scale = 1/8" = 10' / IN.	CHECKED - BRM	REVISED - (08-26-10)	57/70					(25-3)I-6	EFFINGHAM	839	18	
Plot Date = 8/26/2010	DATE - 11-05-07	REVISED -	SCALE: 1"=50'			SHEET NO. 3 OF 8 SHEETS			CONTRACT NO. 74293			
					STA. TO STA.			FED. ROAD DIST. NO. ILLINOIS FED. AID PROJECT				



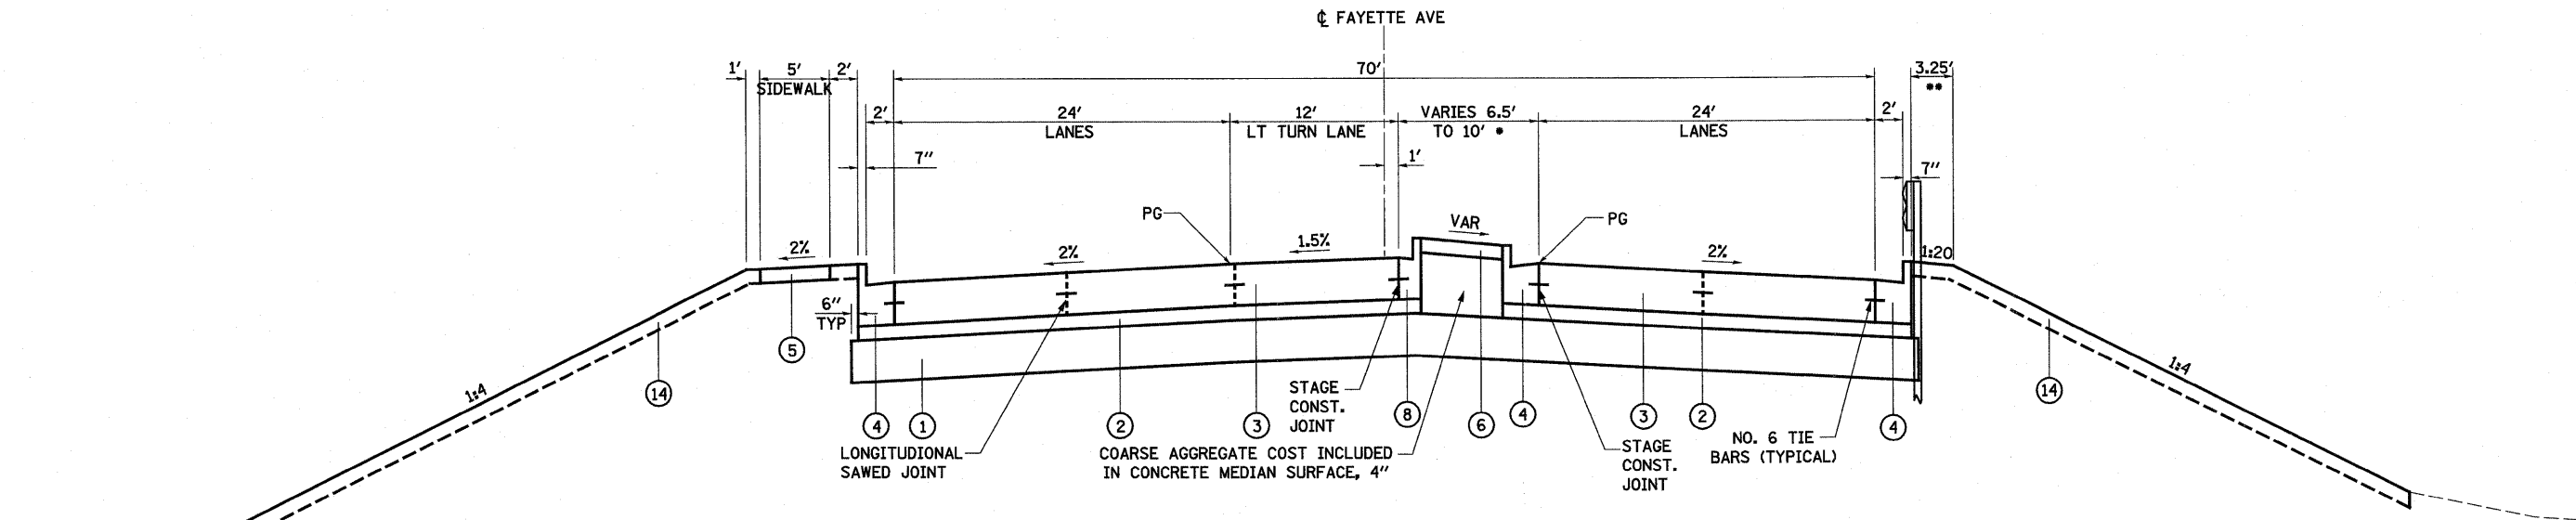

**PROPOSED TANGENT SECTION**  
STA 46+25.00 TO STA 47+56.16

• RAISED MEDIAN BEGINS 3.25' R NOSE, 4.25' RT STA 46+89.90  
 \*\* WIDEN SHOULDER TO 4' STA 46+24.38 TO STA 46+59.38

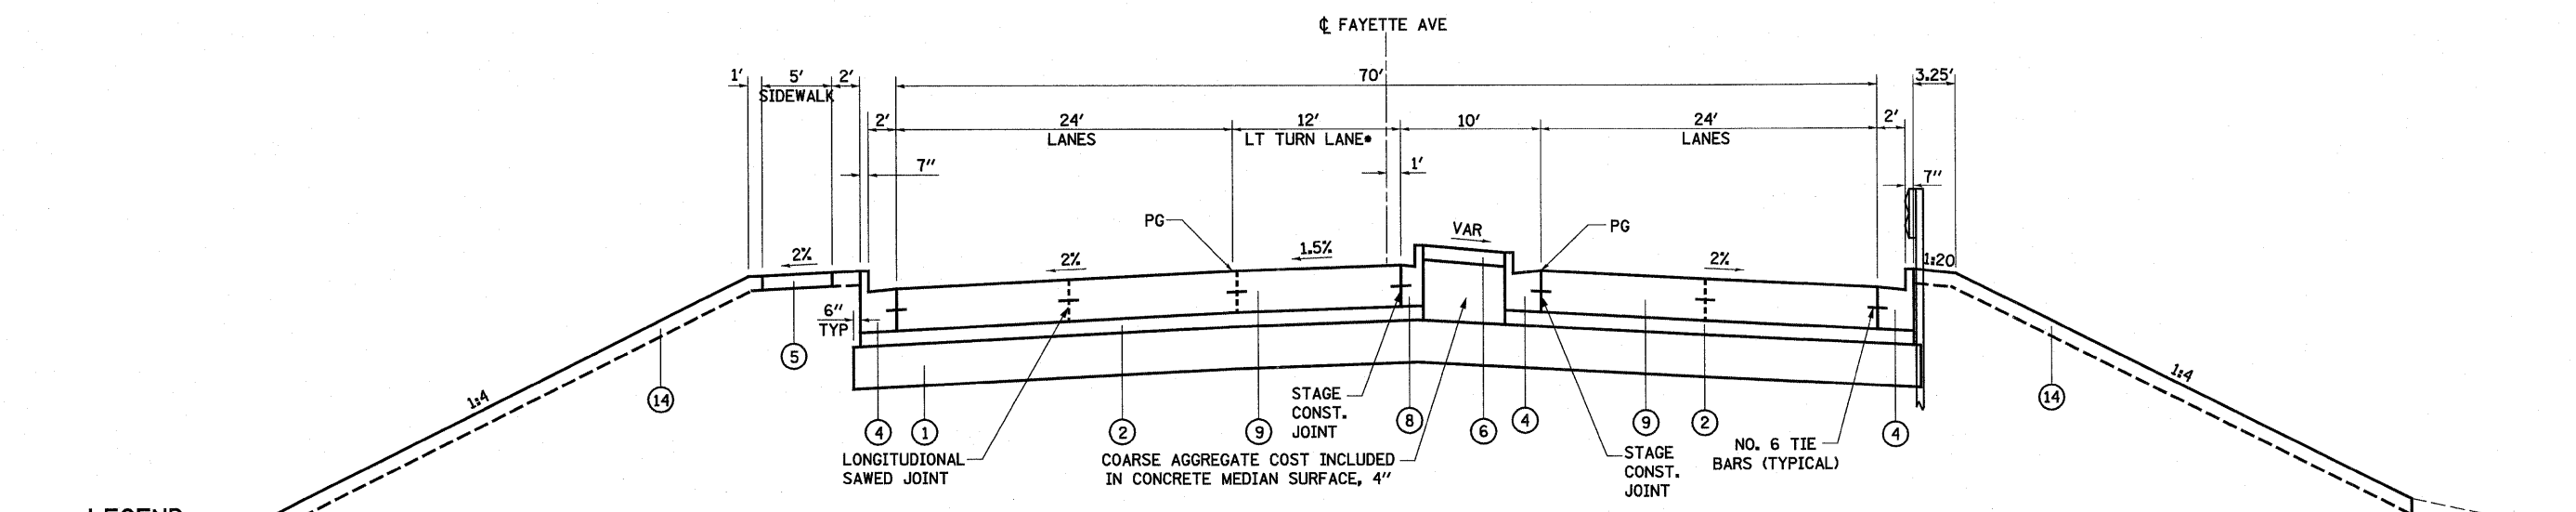

**PROPOSED TANGENT SECTION**  
STA 47+56.16 TO STA 48+56.16


• 12' LT TURN LANE ENDS STA 49+64.90  
 PAVING OMISSION - STA 48+56.16 TO STA 51+50.79

**LEGEND**


- ① PROPOSED LIME MODIFIED SOIL 12"
- ② PROPOSED STABILIZED SUB-BASE 4" (BAM)
- ③ PROPOSED PORTLAND CEMENT CONCRETE PAVEMENT 10 1/4" (JOINTED) ⚠
- ④ PROPOSED COMBINATION CONCRETE CURB AND GUTTER, TYPE B-6.24
- ⑤ PROPOSED PORTLAND CEMENT CONCRETE SIDEWALK 4"
- ⑥ PROPOSED CONCRETE MEDIAN SURFACE, 4"
- ⑦ PROPOSED CORRUGATED MEDIAN
- ⑧ PROPOSED COMBINATION CONCRETE CURB AND GUTTER, TYPE B-6.06
- ⑨ PROPOSED BRIDGE APPROACH SLAB (SEE STRUCTURE PLANS)
- ⑩ PROPOSED SUB-BASE GRANULAR MATERIAL, TYPE C
- ⑪ PROPOSED CONCRETE MEDIAN, TYPE SB (DOWELLED)
- ⑫ PROPOSED PORTLAND CEMENT CONCRETE PAVEMENT 10 1/2" (JOINTED)
- ⑬ PROPOSED AGGREGATE SHOULDERS, TYPE B 6"
- ⑭ PROPOSED TOPSOIL 4"
- ⑮ PROPOSED PIPE UNDERDRAINS 4"
- ⑯ PROPOSED PORTLAND CEMENT CONCRETE PAVEMENT, 12"
- ⑰ PROPOSED PAVEMENT FABRIC
- ⑱ PROPOSED AGGREGATE BASE COURSE, TYPE B, 8"
- ⑲ PROPOSED AGGREGATE SHOULDER TYPE B
- ⑳ PROPOSED LIME MODIFIED SOIL 18"

**PROPOSED FAYETTE AVE**

S:\Projects\403-00072-51-10\dgn\Fayette\Addendum\1\pawofay.dgn	DESIGNED - JWS	REVISED - 08-02-10	<b>STATE OF ILLINOIS DEPARTMENT OF TRANSPORTATION</b>	<b>PROPOSED TYPICAL SECTIONS - FAYETTE AVE</b>	F.A.I. RTE. 57/70	SECTION (25-3)1-6	COUNTY EFFINGHAM	TOTAL SHEETS 839	SHEET NO. 19		
PLOT SCALE = 1/8" = 10' / IN.	DRAWN - BOB	REVISED - (08-26-10) ⚠			SCALE: 1"=50'	SHEET NO. 4 OF 8 SHEETS	STA. TO STA.	FED. ROAD DIST. NO. ILLINOIS FED. AID PROJECT			
PLOT DATE = 8/26/2010	CHECKED - BRM	REVISED -									
	DATE - 11-05-07	REVISED -									

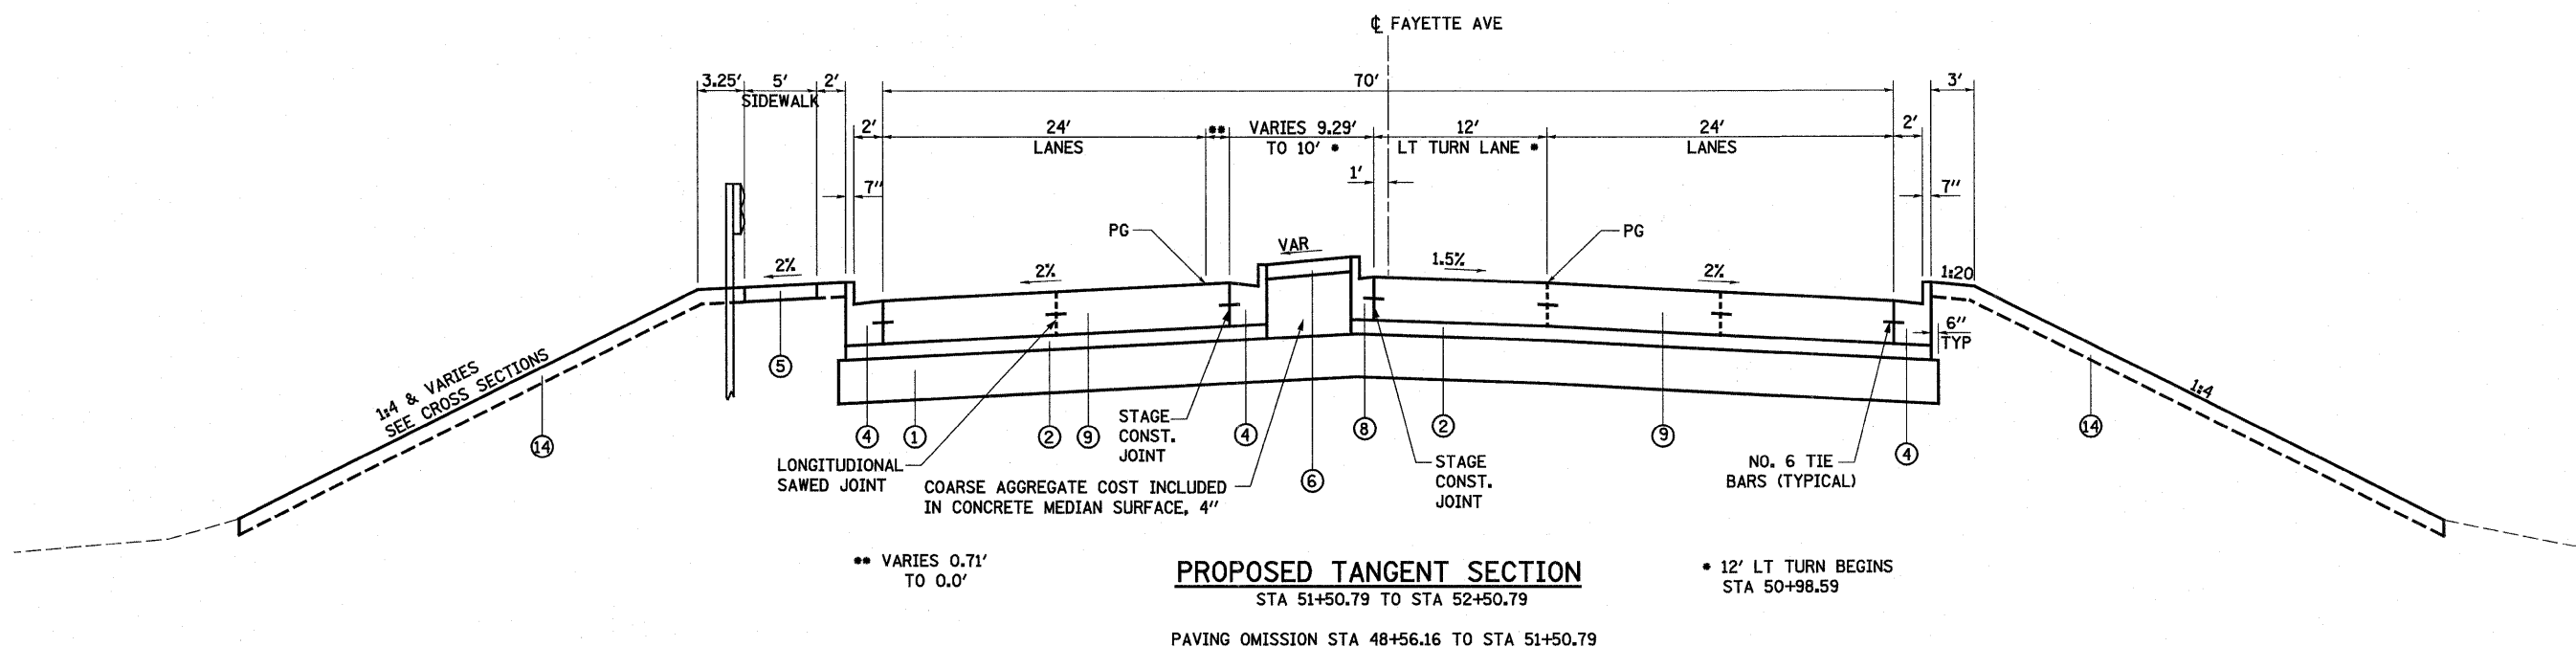

**PROPOSED TANGENT SECTION**  
 STA 51+50.79 TO STA 52+50.79  
 PAVING OMISSION STA 48+56.16 TO STA 51+50.79

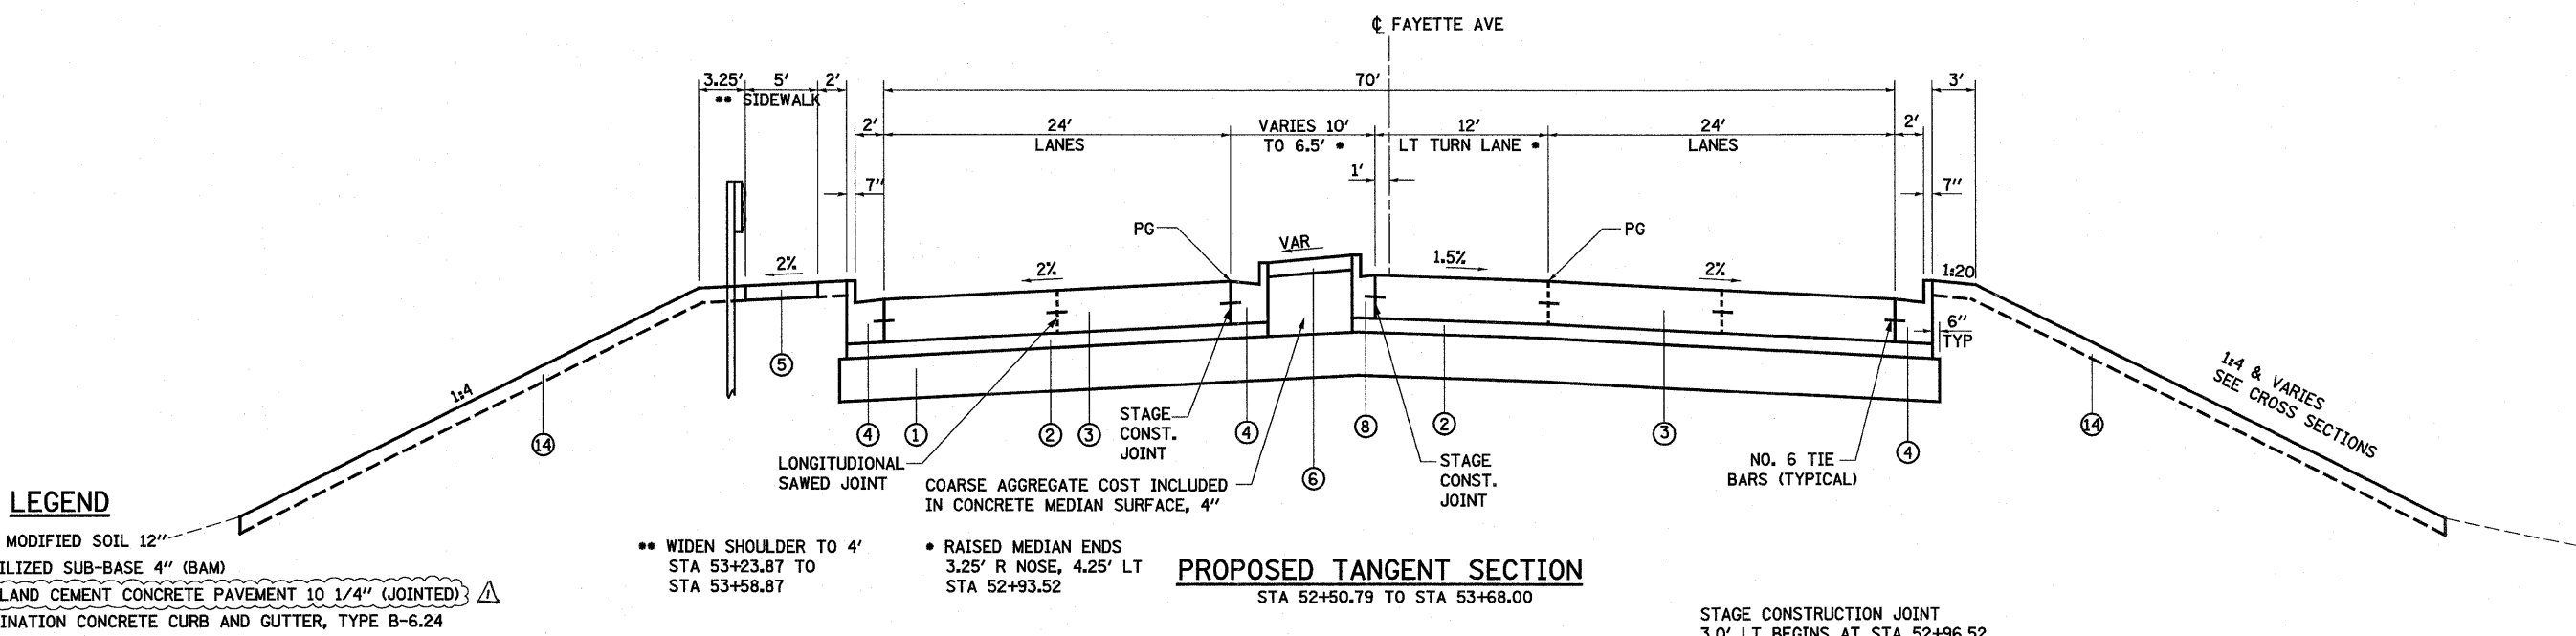

**PROPOSED TANGENT SECTION**  
 STA 52+50.79 TO STA 53+68.00  
 STAGE CONSTRUCTION JOINT  
 3.0' LT BEGINS AT STA 52+96.52

**PROPOSED FAYETTE AVE**


**LEGEND**

- ① PROPOSED LIME MODIFIED SOIL 12"
- ② PROPOSED STABILIZED SUB-BASE 4" (BAM)
- ③ PROPOSED PORTLAND CEMENT CONCRETE PAVEMENT 10 1/4" (JOINTED) ⚠
- ④ PROPOSED COMBINATION CONCRETE CURB AND GUTTER, TYPE B-6.24
- ⑤ PROPOSED PORTLAND CEMENT CONCRETE SIDEWALK 4"
- ⑥ PROPOSED CONCRETE MEDIAN SURFACE, 4"
- ⑦ PROPOSED CORRUGATED MEDIAN
- ⑧ PROPOSED COMBINATION CONCRETE CURB AND GUTTER, TYPE B-6.06
- ⑨ PROPOSED BRIDGE APPROACH SLAB (SEE STRUCTURE PLANS)
- ⑩ PROPOSED SUB-BASE GRANULAR MATERIAL, TYPE C
- ⑪ PROPOSED CONCRETE MEDIAN, TYPE SB (DOWELLED)
- ⑫ PROPOSED PORTLAND CEMENT CONCRETE PAVEMENT 10 1/2" (JOINTED)
- ⑬ PROPOSED AGGREGATE SHOULDERS, TYPE B 6"
- ⑭ PROPOSED TOPSOIL 4"
- ⑮ PROPOSED PIPE UNDERDRAINS 4"
- ⑯ PROPOSED PORTLAND CEMENT CONCRETE PAVEMENT, 12"
- ⑰ PROPOSED PAVEMENT FABRIC
- ⑱ PROPOSED AGGREGATE BASE COURSE, TYPE B, 8"
- ⑲ PROPOSED AGGREGATE SHOULDER TYPE B
- ⑳ PROPOSED LIME MODIFIED SOIL 18"

•• WIDEN SHOULDER TO 4'  
 STA 53+23.87 TO STA 53+58.87

• RAISED MEDIAN ENDS  
 3.25' R NOSE, 4.25' LT  
 STA 52+93.52


FILE NAME =	USER NAME = jinda	DESIGNED - JWS	REVISED - 08-02-10	<b>STATE OF ILLINOIS DEPARTMENT OF TRANSPORTATION</b>	<b>PROPOSED TYPICAL SECTIONS - FAYETTE AVE</b>	F.A.I. RTE.	SECTION	COUNTY	TOTAL SHEETS	SHEET NO.
S:\Projects\403-00072-51-70\dgn\Fayette\kiddendun\kiddendun.dgn		DRAWN - BOB	REVISED - 08-26-10 ⚠			57/70	(25-3)I-6	EFFINGHAM	839	20
PLOT SCALE = 1/8" = 1' / IN.		CHECKED - BRM	REVISED -			CONTRACT NO. 74293				
PLOT DATE = 8/26/2010		DATE - 11-05-07	REVISED -			FED. ROAD DIST. NO. ILLINOIS FED. AID PROJECT				

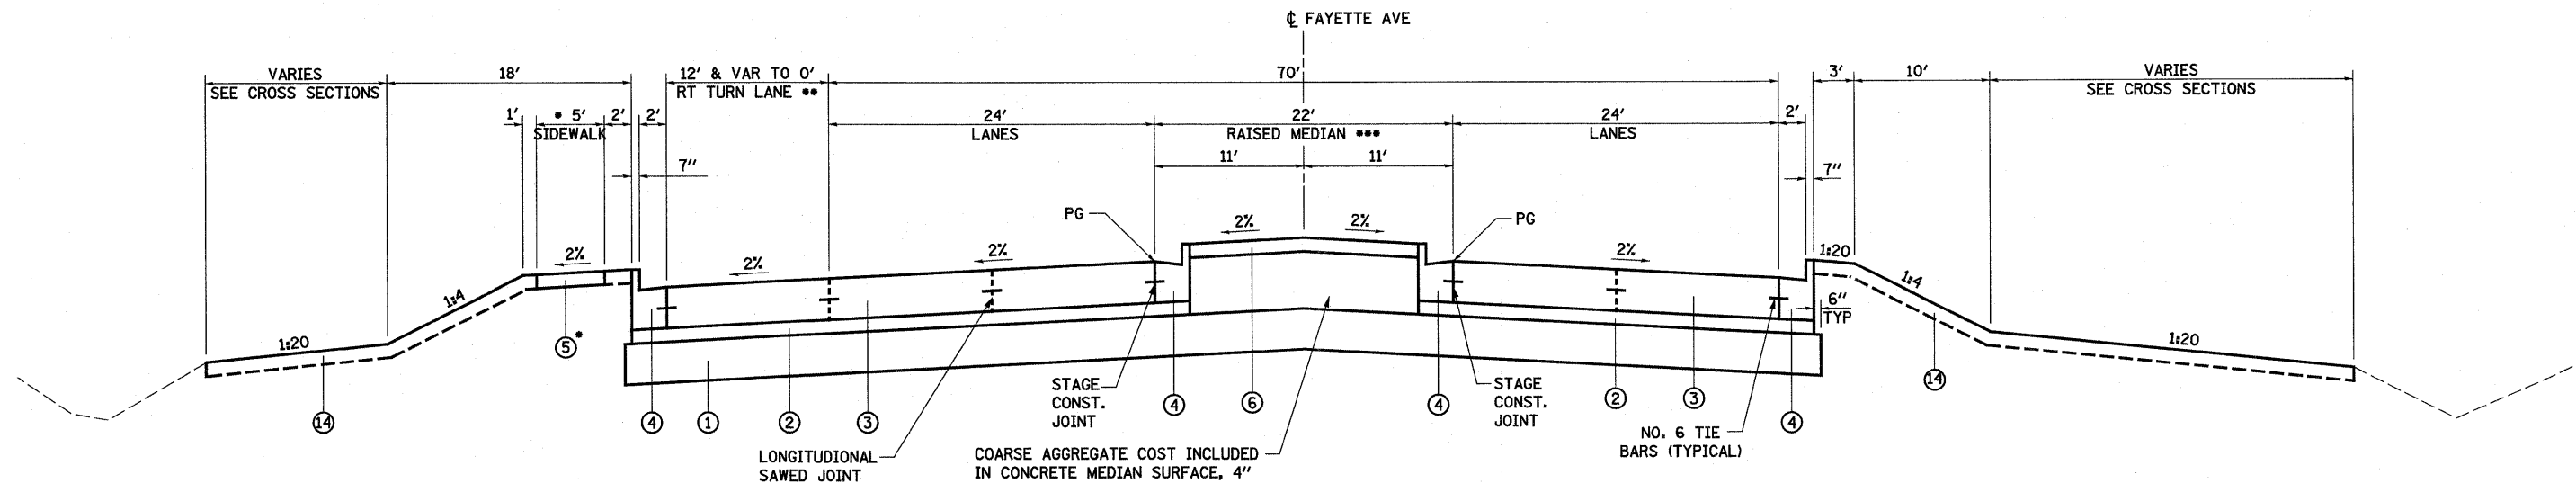

• PROPOSED SIDEWALK ENDS STA 57+24.20      •• 12' RT TURN LANE ENDS STA 57+30.00      \*\*\* RAISED MEDIAN BEGINS 5' R NOSE, 6' LT STA 53+91.34

**PROPOSED TANGENT SECTION**

STA 53+68.00 TO STA 59+30.00

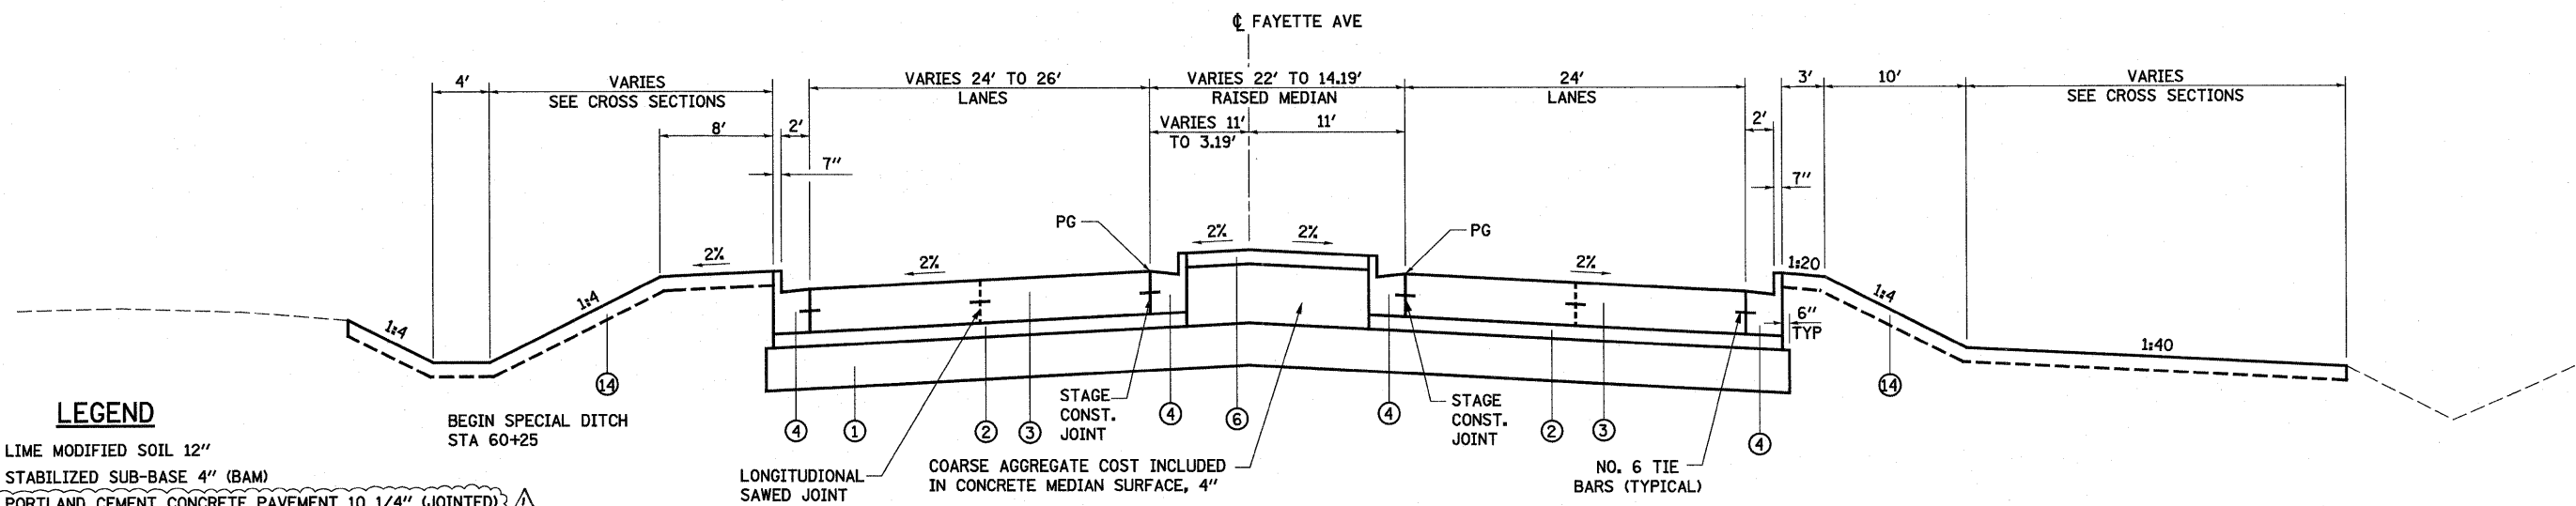

BEGIN SPECIAL DITCH STA 60+25

**PROPOSED TANGENT SECTION**


STA 59+30.00 TO STA 63+17.80

**PROPOSED FAYETTE AVE**

**LEGEND**

- ① PROPOSED LIME MODIFIED SOIL 12"
- ② PROPOSED STABILIZED SUB-BASE 4" (BAM)
- ③ PROPOSED PORTLAND CEMENT CONCRETE PAVEMENT 10 1/4" (JOINTED)
- ④ PROPOSED COMBINATION CONCRETE CURB AND GUTTER, TYPE B-6.24
- ⑤ PROPOSED PORTLAND CEMENT CONCRETE SIDEWALK 4"
- ⑥ PROPOSED CONCRETE MEDIAN SURFACE, 4"
- ⑦ PROPOSED CORRUGATED MEDIAN
- ⑧ PROPOSED COMBINATION CONCRETE CURB AND GUTTER, TYPE B-6.06
- ⑨ PROPOSED BRIDGE APPROACH SLAB (SEE STRUCTURE PLANS)
- ⑩ PROPOSED SUB-BASE GRANULAR MATERIAL, TYPE C
- ⑪ PROPOSED CONCRETE MEDIAN, TYPE SB (DOWELLED)
- ⑫ PROPOSED PORTLAND CEMENT CONCRETE PAVEMENT 10 1/2" (JOINTED)
- ⑬ PROPOSED AGGREGATE SHOULDERS, TYPE B 6"
- ⑭ PROPOSED TOPSOIL 4"
- ⑮ PROPOSED PIPE UNDERDRAINS 4"
- ⑯ PROPOSED PORTLAND CEMENT CONCRETE PAVEMENT, 12"
- ⑰ PROPOSED PAVEMENT FABRIC
- ⑱ PROPOSED AGGREGATE BASE COURSE, TYPE B, 8"
- ⑲ PROPOSED AGGREGATE SHOULDER TYPE B
- ⑳ PROPOSED LIME MODIFIED SOIL 18"

FILE NAME =	USER NAME = lunde	DESIGNED - JWS	REVISED - 08-02-10	<b>STATE OF ILLINOIS DEPARTMENT OF TRANSPORTATION</b>	<b>PROPOSED TYPICAL SECTIONS - FAYETTE AVE</b>			F.A.I. RTE.	SECTION	COUNTY	TOTAL SHEETS	SHEET NO.
5:\Projects\403-00072-57-70\dgn\FayetteAddendum\TYPICAL.dgn	DRAWN - BOB	REVISOR - (08-26-10)	57/70					(25-3)I-6	EFFINGHAM	839	21	
PLOT SCALE = 1/8"=50' / IN.	CHECKED - BRM	REVISOR -	CONTRACT NO. 74293									
PLOT DATE = 8/26/2010	DATE - 11-05-07	REVISOR -	ILLINOIS FED. AID PROJECT									

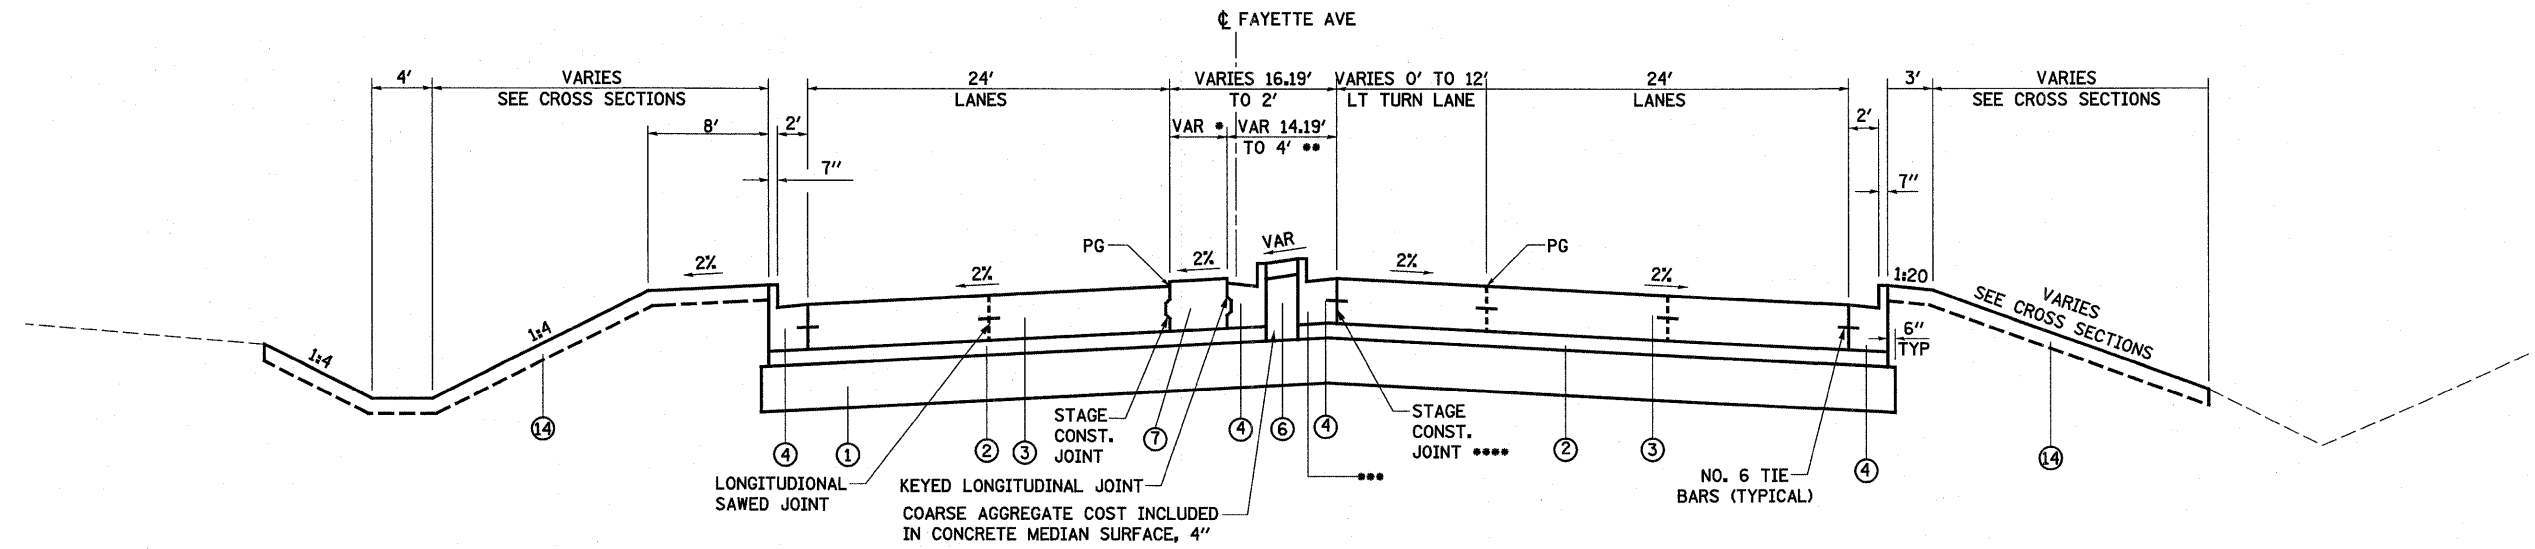


• CORRUGATED MEDIAN BEGINS  
2' STUB, 3.19' LT, STA 63+17.80  
9.50' WIDE STA 64+23.87  
1' R NOSE, 1' LT STA 65+31.00

**PROPOSED TANGENT SECTION**  
STA 63+17.80 TO STA 65+31.00

\*\* RAISED MEDIAN ENDS  
2' R NOSE, 4' RT STA 64+21.87

\*\*\* B-6.24 C&G TRANSITIONS  
TO B-6.06 AT STA 63+58.25  
\*\*\*\* STAGE CONSTRUCTION JOINT  
AT 11.00' RT BEGINNING AT  
STA 63+31.00

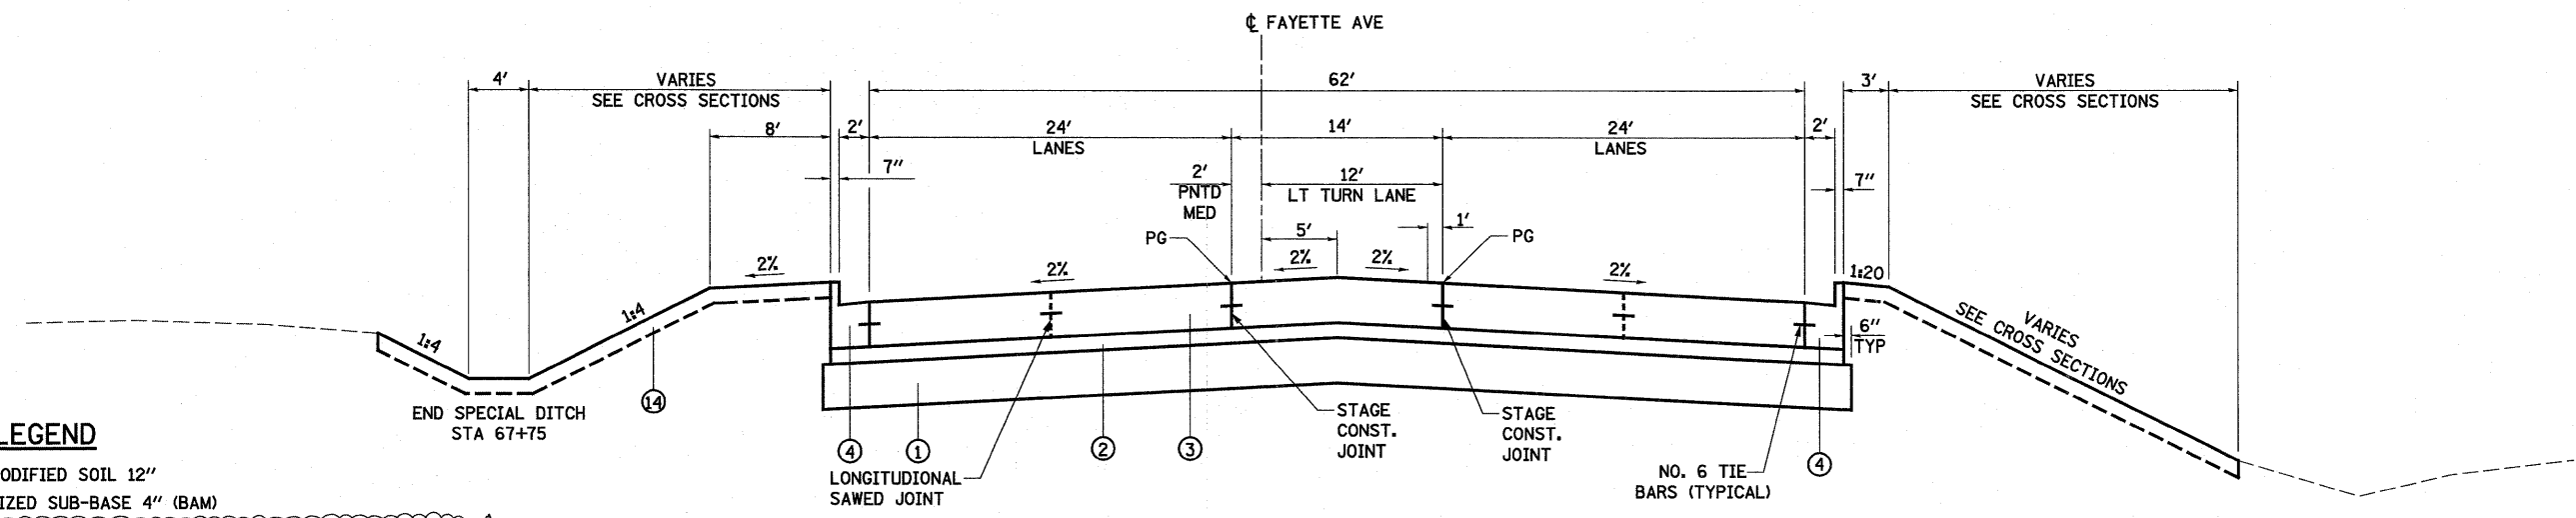


**PROPOSED TANGENT SECTION**  
STA 65+31.00 TO STA 67+67.50

**LEGEND**


- ① PROPOSED LIME MODIFIED SOIL 12"
- ② PROPOSED STABILIZED SUB-BASE 4" (BAM)
- ③ PROPOSED PORTLAND CEMENT CONCRETE PAVEMENT 10 1/4" (JOINTED)
- ④ PROPOSED COMBINATION CONCRETE CURB AND GUTTER, TYPE B-6.24
- ⑤ PROPOSED PORTLAND CEMENT CONCRETE SIDEWALK 4"
- ⑥ PROPOSED CONCRETE MEDIAN SURFACE, 4"
- ⑦ PROPOSED CORRUGATED MEDIAN
- ⑧ PROPOSED COMBINATION CONCRETE CURB AND GUTTER, TYPE B-6.06
- ⑨ PROPOSED BRIDGE APPROACH SLAB (SEE STRUCTURE PLANS)
- ⑩ PROPOSED SUB-BASE GRANULAR MATERIAL, TYPE C
- ⑪ PROPOSED CONCRETE MEDIAN, TYPE SB (DOWELLED)
- ⑫ PROPOSED PORTLAND CEMENT CONCRETE PAVEMENT 10 1/2" (JOINTED)
- ⑬ PROPOSED AGGREGATE SHOULDERS, TYPE B 6"
- ⑭ PROPOSED TOPSOIL 4"
- ⑮ PROPOSED PIPE UNDERDRAINS 4"
- ⑯ PROPOSED PORTLAND CEMENT CONCRETE PAVEMENT, 12"
- ⑰ PROPOSED PAVEMENT FABRIC
- ⑱ PROPOSED AGGREGATE BASE COURSE, TYPE B, 8"
- ⑲ PROPOSED AGGREGATE SHOULDER TYPE B
- ⑳ PROPOSED LIME MODIFIED SOIL 18"

**PROPOSED FAYETTE AVE**

FILE NAME =	USER NAME = llrnde	DESIGNED - JWS	REVISED - 08-02-10	<b>STATE OF ILLINOIS DEPARTMENT OF TRANSPORTATION</b>	<b>PROPOSED TYPICAL SECTIONS - FAYETTE AVE</b>			F.A.I. RTE.	SECTION	COUNTY	TOTAL SHEETS	SHEET NO.
57/70	(25-3)I-6	EFFINGHAM	839					22				
PLT SCALE = 1/8" = 1' / IN.	CHECKED - BRM	DATE - 11-05-07	REVISED -		SCALE: 1"=50'	SHEET NO. 7 OF 8 SHEETS	STA. TO STA.	CONTRACT NO. 74293				
PLT DATE = 8/26/2010	DATE - 11-05-07	REVISED -	REVISED -		FED. ROAD DIST. NO. ILLINOIS FED. AID PROJECT							

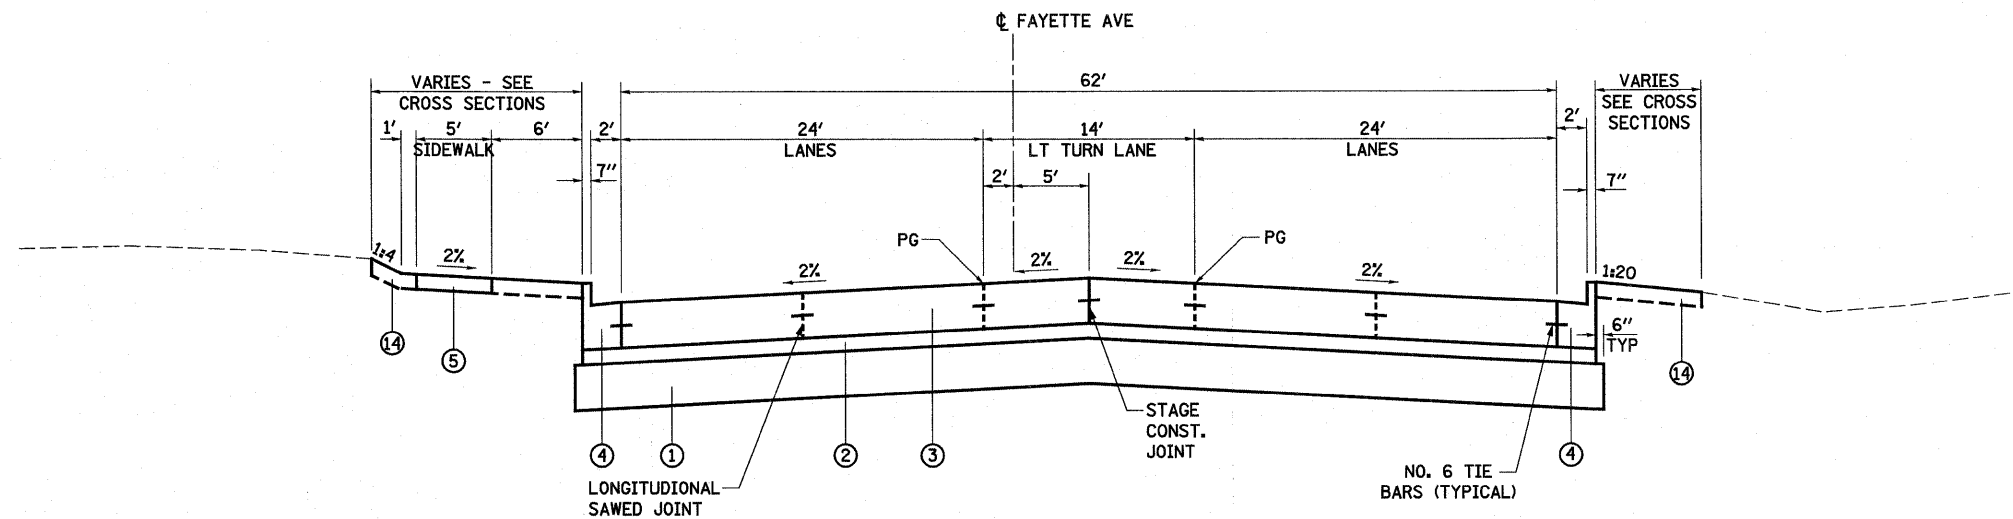

**PROPOSED TANGENT SECTION**  
STA 67+67.50 TO STA 71+68.00

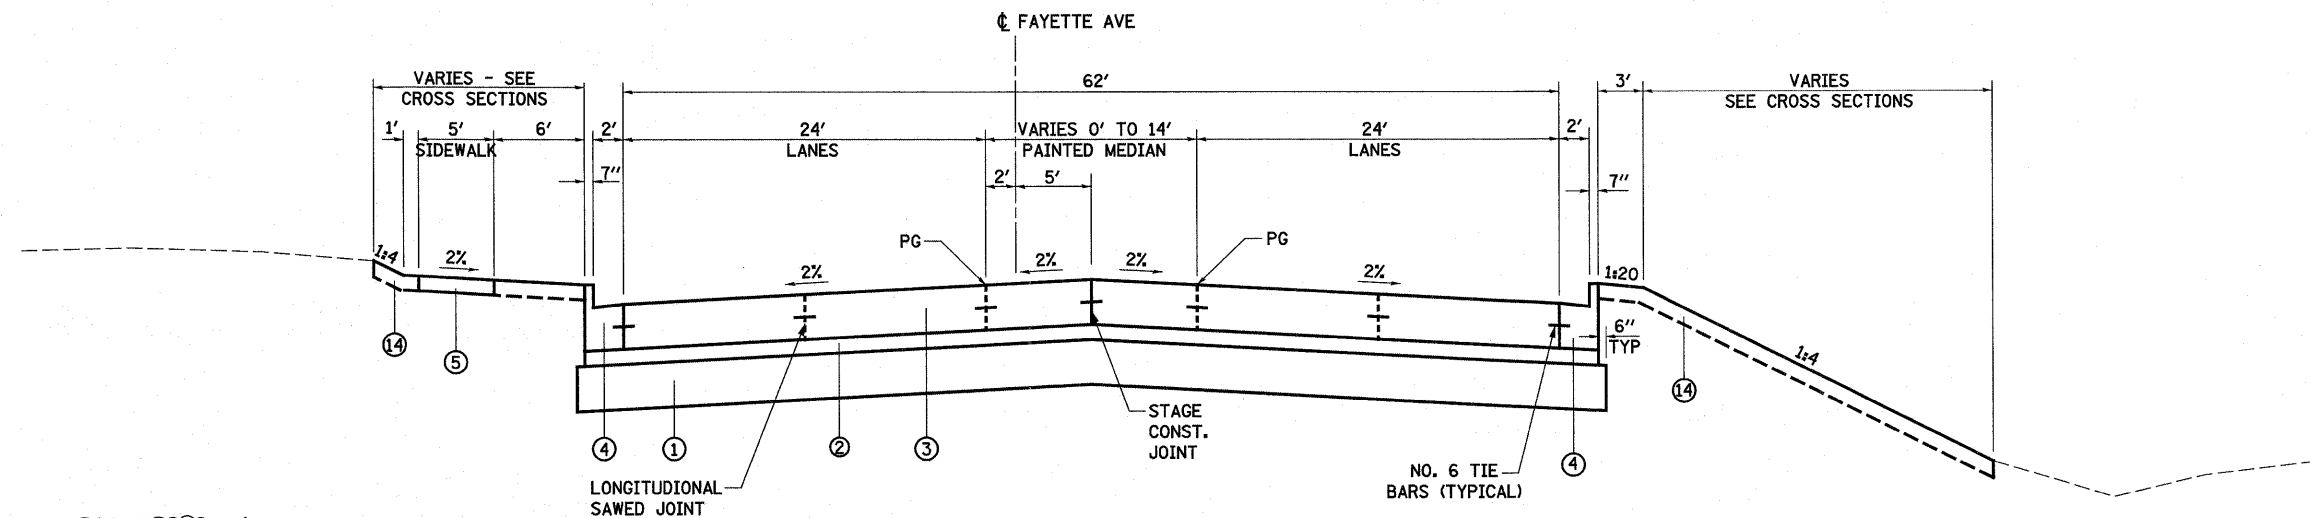


**PROPOSED TANGENT SECTION**  
STA 71+68.00 TO STA 73+81.75

**PROPOSED FAYETTE AVE**

**LEGEND**

- ① PROPOSED LIME MODIFIED SOIL 12"
- ② PROPOSED STABILIZED SUB-BASE 4" (BAM)
- ③ PROPOSED PORTLAND CEMENT CONCRETE PAVEMENT 10 1/4" (JOINTED) ⚠
- ④ PROPOSED COMBINATION CONCRETE CURB AND GUTTER, TYPE B-6.24
- ⑤ PROPOSED PORTLAND CEMENT CONCRETE SIDEWALK 4"
- ⑥ PROPOSED CONCRETE MEDIAN SURFACE, 4"
- ⑦ PROPOSED CORRUGATED MEDIAN
- ⑧ PROPOSED COMBINATION CONCRETE CURB AND GUTTER, TYPE B-6.06
- ⑨ PROPOSED BRIDGE APPROACH SLAB (SEE STRUCTURE PLANS)
- ⑩ PROPOSED SUB-BASE GRANULAR MATERIAL, TYPE C
- ⑪ PROPOSED CONCRETE MEDIAN, TYPE SB (DOWELLED)
- ⑫ PROPOSED PORTLAND CEMENT CONCRETE PAVEMENT 10 1/2 " (JOINTED)
- ⑬ PROPOSED AGGREGATE SHOULDERS, TYPE B 6"
- ⑭ PROPOSED TOPSOIL 4"
- ⑮ PROPOSED PIPE UNDERDRAINS 4"
- ⑯ PROPOSED PORTLAND CEMENT CONCRETE PAVEMENT, 12"
- ⑰ PROPOSED PAVEMENT FABRIC
- ⑱ PROPOSED AGGREGATE BASE COURSE, TYPE B, 8"
- ⑲ PROPOSED AGGREGATE SHOULDER TYPE B
- ⑳ PROPOSED LIME MODIFIED SOIL 18"

FILE NAME =	USER NAME = l1rldc	DESIGNED - JWS	REVISED - 08-02-10	<b>STATE OF ILLINOIS DEPARTMENT OF TRANSPORTATION</b>	<b>PROPOSED TYPICAL SECTIONS - FAYETTE AVE</b>	F.A.I. RTE.	SECTION	COUNTY	TOTAL SHEETS	SHEET NO.		
S:\Projects\403-00072-57-70\dgn\Fayette\Addendum\... PLOT SCALE = 100.0000' / IN.						DRAWN - BOB	REVISED - 08-26-10 ⚠	57/70	(25-3)I-6	EFFINGHAM	839	23
PLOT DATE = 8/26/2010						CHECKED - BRM	REVISED -	CONTRACT NO. 74293				
						DATE - 11-05-07	REVISED -	FED. ROAD DIST. NO. ILLINOIS FED. AID PROJECT				
						SCALE: 1"=50'		SHEET NO. 8 OF 8 SHEETS		STA. TO STA.		

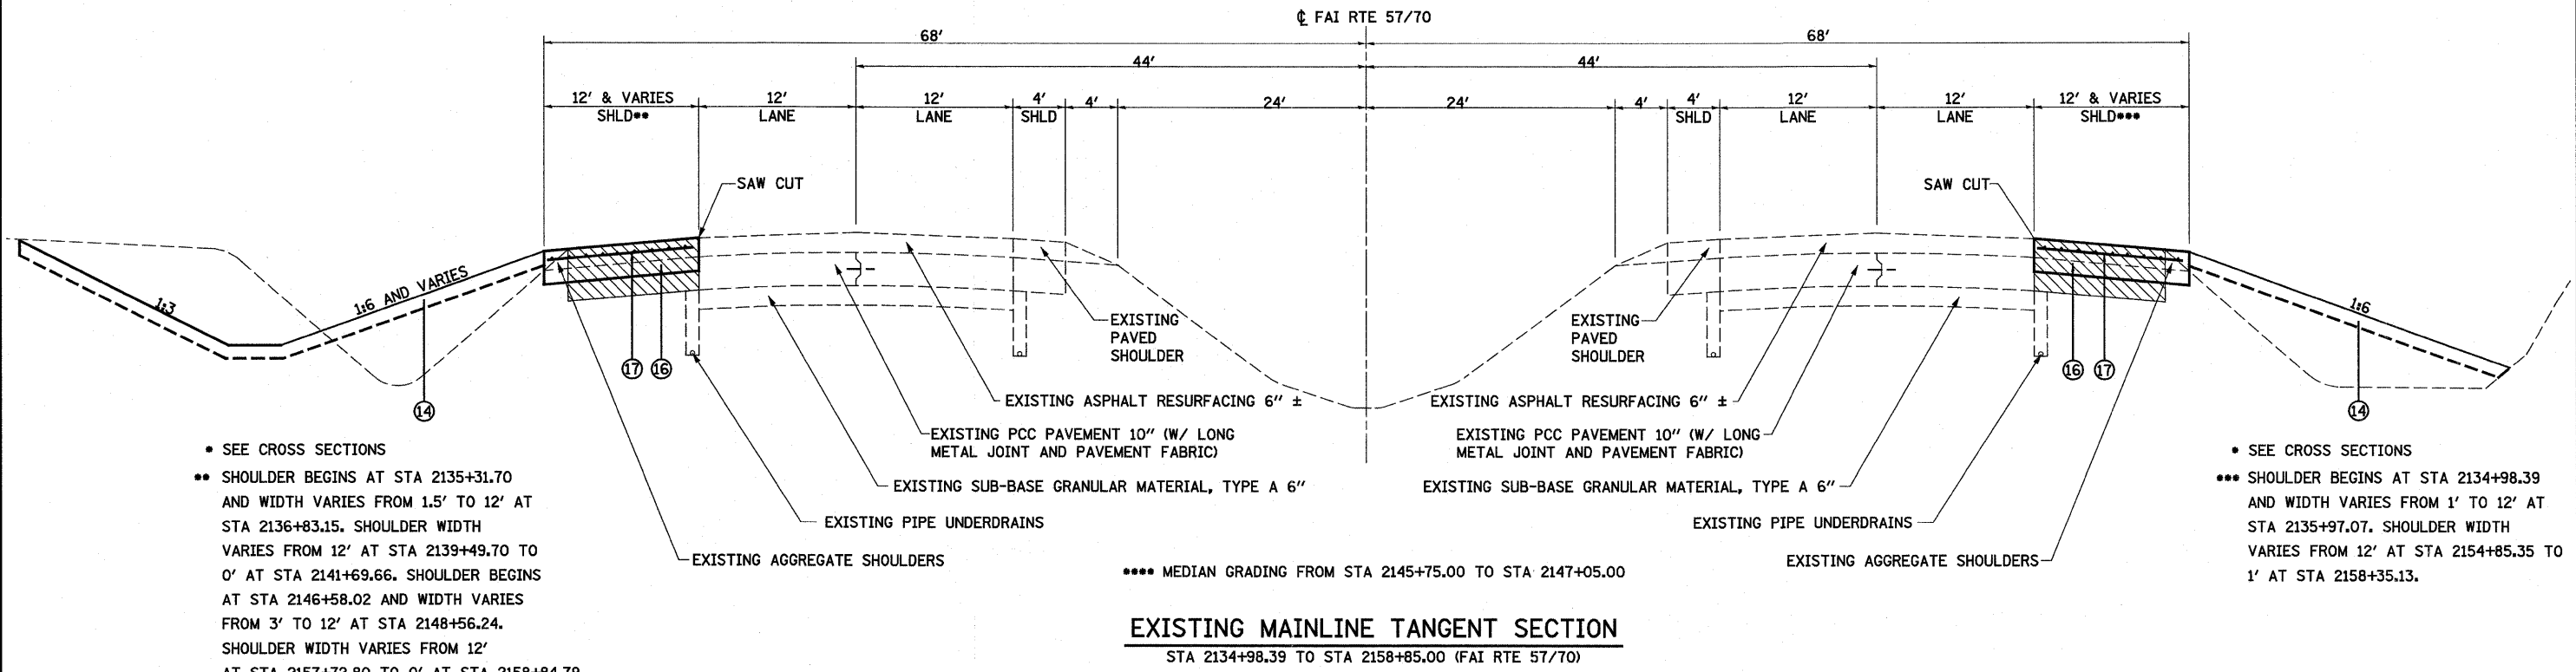

• SEE CROSS SECTIONS  
 \*\* SHOULDER BEGINS AT STA 2135+31.70 AND WIDTH VARIES FROM 1.5' TO 12' AT STA 2136+83.15. SHOULDER WIDTH VARIES FROM 12' AT STA 2139+49.70 TO 0' AT STA 2141+69.66. SHOULDER BEGINS AT STA 2146+58.02 AND WIDTH VARIES FROM 3' TO 12' AT STA 2148+56.24. SHOULDER WIDTH VARIES FROM 12' AT STA 2157+72.80 TO 0' AT STA 2158+84.79.

• SEE CROSS SECTIONS  
 \*\*\* SHOULDER BEGINS AT STA 2134+98.39 AND WIDTH VARIES FROM 1' TO 12' AT STA 2135+97.07. SHOULDER WIDTH VARIES FROM 12' AT STA 2154+85.35 TO 1' AT STA 2158+35.13.

\*\*\*\* MEDIAN GRADING FROM STA 2145+75.00 TO STA 2147+05.00  
**EXISTING MAINLINE TANGENT SECTION**  
 STA 2134+98.39 TO STA 2158+85.00 (FAI RTE 57/70)


PAVED SHOULDER REMOVAL

**LEGEND**

- ① PROPOSED LIME MODIFIED SOIL 12"
- ② PROPOSED STABILIZED SUB-BASE 4" (BAM)
- ③ PROPOSED PORTLAND CEMENT CONCRETE PAVEMENT 10 1/4" (JOINTED)
- ④ PROPOSED COMBINATION CONCRETE CURB AND GUTTER, TYPE B-6.24
- ⑤ PROPOSED PORTLAND CEMENT CONCRETE SIDEWALK 4"
- ⑥ PROPOSED CONCRETE MEDIAN SURFACE, 4"
- ⑦ PROPOSED CORRUGATED MEDIAN
- ⑧ PROPOSED COMBINATION CONCRETE CURB AND GUTTER, TYPE B-6.06
- ⑨ PROPOSED BRIDGE APPROACH SLAB (SEE STRUCTURE PLANS)
- ⑩ PROPOSED SUB-BASE GRANULAR MATERIAL, TYPE C
- ⑪ PROPOSED CONCRETE MEDIAN, TYPE SB (DOWELLED)
- ⑫ PROPOSED PORTLAND CEMENT CONCRETE PAVEMENT 10 1/2" (JOINTED)
- ⑬ PROPOSED AGGREGATE SHOULDERS, TYPE B 6"
- ⑭ PROPOSED TOPSOIL 4"
- ⑮ PROPOSED PIPE UNDERDRAINS 4"
- ⑯ PROPOSED PORTLAND CEMENT CONCRETE PAVEMENT, 12"
- ⑰ PROPOSED PAVEMENT FABRIC
- ⑱ PROPOSED AGGREGATE BASE COURSE, TYPE B, 8"
- ⑲ PROPOSED AGGREGATE SHOULDER TYPE B
- ⑳ PROPOSED LIME MODIFIED SOIL 18"

FILE NAME =	USER NAME = lnda	DESIGNED - JWS	REVISED - 08-02-10	<b>STATE OF ILLINOIS DEPARTMENT OF TRANSPORTATION</b>	<b>PROPOSED TYPICAL SECTIONS - MAINLINE</b>			F.A.I. RTE.	SECTION	COUNTY	TOTAL SHEETS	SHEET NO.
#FILEL#	PLOT SCALE = 100,0000' / IN.	DRAWN - PDB	REVISED - 08-26-10					57/70	(25-3)I-6	EFFINGHAM	839	24
	PLOT DATE = 8/26/2010	CHECKED - BRM	REVISED -		CONTRACT NO. 74293			FED. ROAD DIST. NO. ILLINOIS FED. AID PROJECT				
		DATE - 11-05-07	REVISED -		SCALE: 1"=50'	SHEET NO. 1 OF 1 SHEETS	STA.	TO STA.				



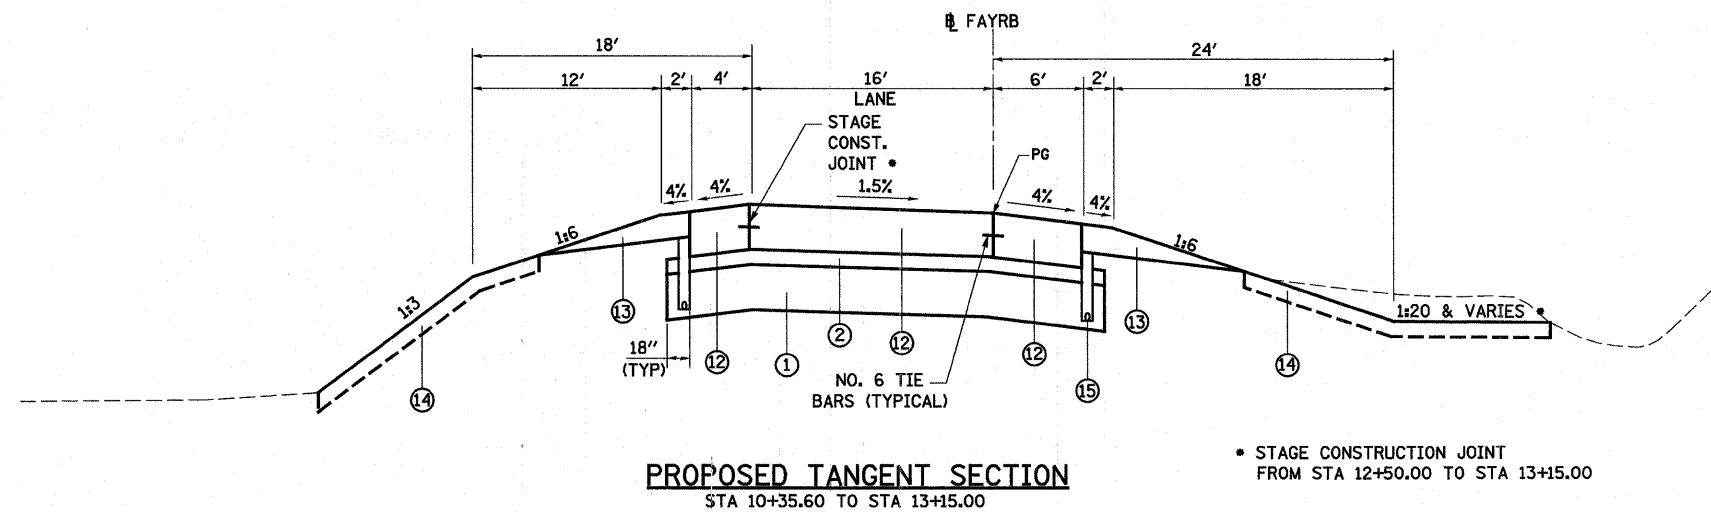


**LEGEND**

- ① PROPOSED LIME MODIFIED SOIL 12"
- ② PROPOSED STABILIZED SUB-BASE 4" (BAM)
- ③ PROPOSED PORTLAND CEMENT CONCRETE PAVEMENT 10 1/4" (JOINTED)
- ④ PROPOSED COMBINATION CONCRETE CURB AND GUTTER, TYPE B-6.24
- ⑤ PROPOSED PORTLAND CEMENT CONCRETE SIDEWALK 4"
- ⑥ PROPOSED CONCRETE MEDIAN SURFACE, 4"
- ⑦ PROPOSED CORRUGATED MEDIAN
- ⑧ PROPOSED COMBINATION CONCRETE CURB AND GUTTER, TYPE B-6.06
- ⑨ PROPOSED BRIDGE APPROACH SLAB (SEE STRUCTURE PLANS)
- ⑩ PROPOSED SUB-BASE GRANULAR MATERIAL, TYPE C
- ⑪ PROPOSED CONCRETE MEDIAN, TYPE SB (DOWELLED)
- ⑫ PROPOSED PORTLAND CEMENT CONCRETE PAVEMENT 10 1/2" (JOINTED)
- ⑬ PROPOSED AGGREGATE SHOULDERS, TYPE B 6"
- ⑭ PROPOSED TOPSOIL 4"
- ⑮ PROPOSED PIPE UNDERDRAINS 4"
- ⑯ PROPOSED PORTLAND CEMENT CONCRETE PAVEMENT, 12"
- ⑰ PROPOSED PAVEMENT FABRIC
- ⑱ PROPOSED AGGREGATE BASE COURSE, TYPE B, 8"
- ⑲ PROPOSED AGGREGATE SHOULDER TYPE B
- ⑳ PROPOSED LIME MODIFIED SOIL 18"

• SEE CROSS SECTIONS

FILE NAME =	USER NAME = linda	DESIGNED - JWS	REVISED - 08-02-10	<b>STATE OF ILLINOIS DEPARTMENT OF TRANSPORTATION</b>	<b>PROPOSED TYPICAL SECTIONS - FAYETTE AVE, RAMP B</b>	F.A.I. RTE.	SECTION	COUNTY	TOTAL SHEETS	SHEET NO.	
S:\Project\403-00072-57-70\dgn\Fayette\Addendum\FayRamp.dgn						57/70	(25-3)I-6	EFFINGHAM	839	26	
PLOT SCALE = 100.0000' / IN.						CONTRACT NO. 74293					
PLOT DATE = 8/26/2010						FED. ROAD DIST. NO. ILLINOIS FED. AID PROJECT					
		DRAWN - PDB	REVISED - 08-26-10	SCALE: 1"=50'		SHEET NO. 2 OF 4 SHEETS		STA. TO STA.			
		CHECKED - BRM	REVISED -								
		DATE - 11-05-07	REVISED -								




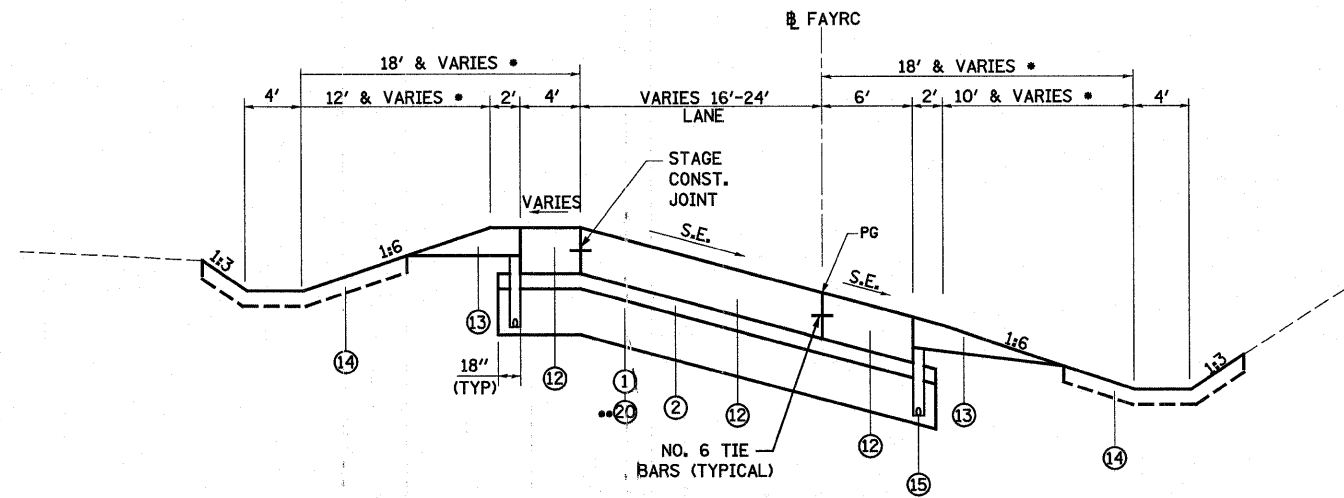

**PROPOSED SUPERELEVATED SECTION**

STA 11+00.00 TO STA 14+90.68  
STA 15+85.00 TO STA 19+72.08 (REVERSED)

\*\* PROPOSED LIME MODIFIED SOIL BEGINS AT STA 12+00.00 AND ENDS STA 18+00.00

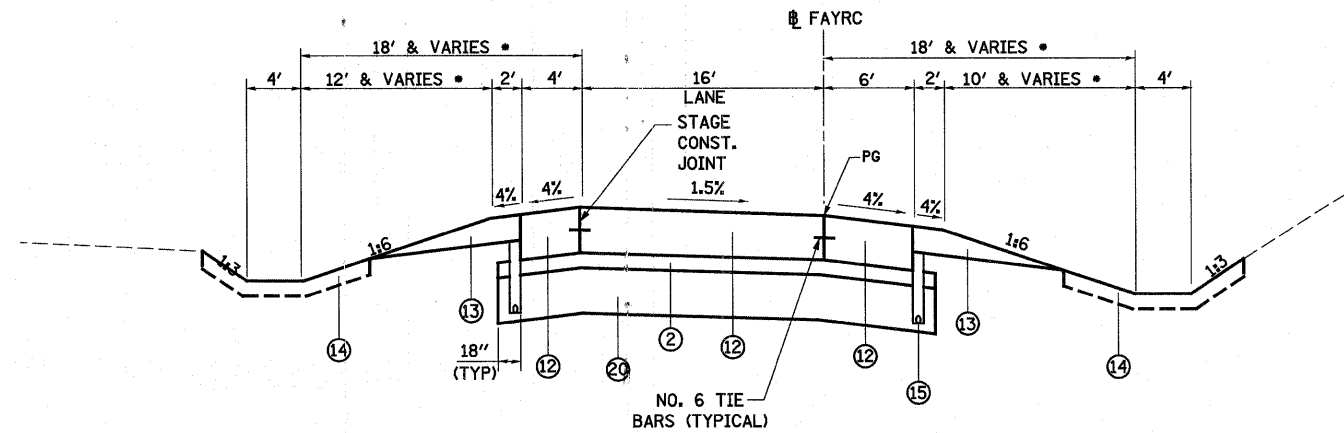


**PROPOSED TANGENT SECTION**

STA 14+90.68 TO STA 15+42.71

**LEGEND**

- ① PROPOSED LIME MODIFIED SOIL 12"
- ② PROPOSED STABILIZED SUB-BASE 4" (BAM)
- ③ PROPOSED PORTLAND CEMENT CONCRETE PAVEMENT 10 1/4" (JOINTED) △
- ④ PROPOSED COMBINATION CONCRETE CURB AND GUTTER, TYPE B-6.24
- ⑤ PROPOSED PORTLAND CEMENT CONCRETE SIDEWALK 4"
- ⑥ PROPOSED CONCRETE MEDIAN SURFACE, 4"
- ⑦ PROPOSED CORRUGATED MEDIAN
- ⑧ PROPOSED COMBINATION CONCRETE CURB AND GUTTER, TYPE B-6.06
- ⑨ PROPOSED BRIDGE APPROACH SLAB (SEE STRUCTURE PLANS)
- ⑩ PROPOSED SUB-BASE GRANULAR MATERIAL, TYPE C
- ⑪ PROPOSED CONCRETE MEDIAN, TYPE SB (DOWELLED)
- ⑫ PROPOSED PORTLAND CEMENT CONCRETE PAVEMENT 10 1/2" (JOINTED)
- ⑬ PROPOSED AGGREGATE SHOULDERS, TYPE B 6"
- ⑭ PROPOSED TOPSOIL 4"
- ⑮ PROPOSED PIPE UNDERDRAINS 4"
- ⑯ PROPOSED PORTLAND CEMENT CONCRETE PAVEMENT, 12"
- ⑰ PROPOSED PAVEMENT FABRIC
- ⑱ PROPOSED AGGREGATE BASE COURSE, TYPE B, 8"
- ⑲ PROPOSED AGGREGATE SHOULDER TYPE B
- ⑳ PROPOSED LIME MODIFIED SOIL 18"

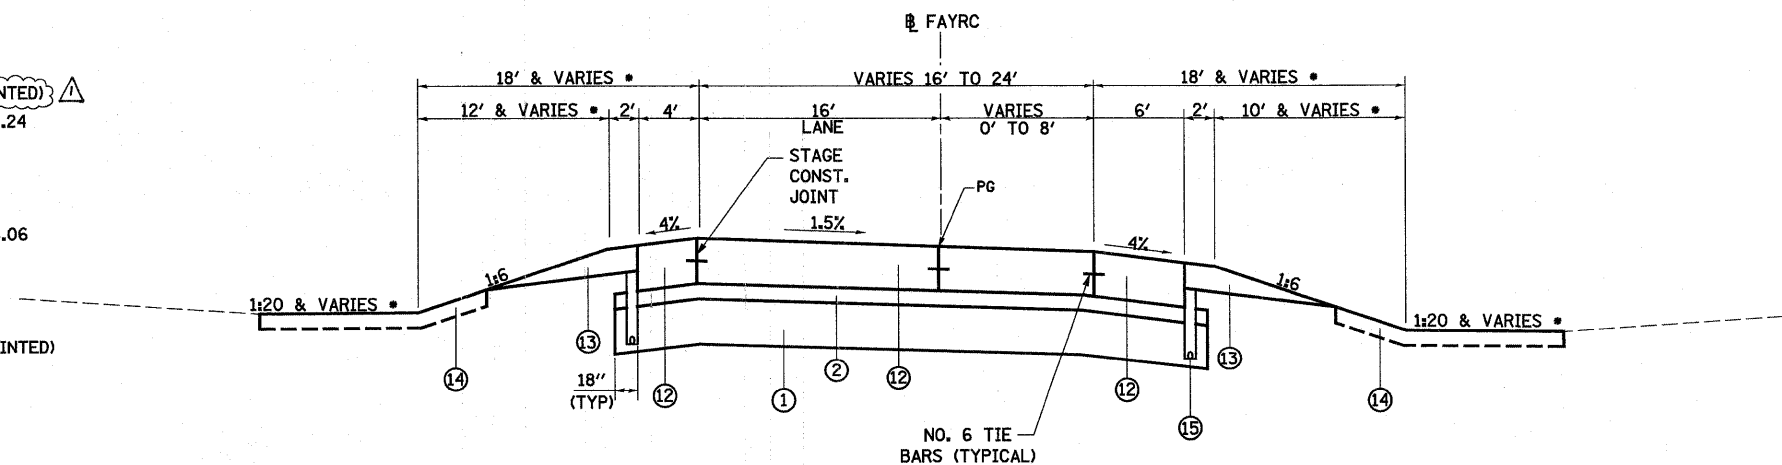




**PROPOSED TANGENT SECTION**

STA 19+72.08 TO STA 20+95.90

**PROPOSED FAYETTE AVE. RAMP C**

• SEE CROSS SECTIONS

FILE NAME =	USER NAME = lunde	DESIGNED - JWS	REVISED - 08-02-10	<b>STATE OF ILLINOIS DEPARTMENT OF TRANSPORTATION</b>	<b>PROPOSED TYPICAL SECTIONS - FAYETTE AVE, RAMP C</b>	F.A.I. RTE.	SECTION	COUNTY	TOTAL SHEETS	SHEET NO.
S:\Projects\1403-00072-57-70\Drawn\Fayette\Addendum\Drawings\FayetteRamp.dgn	DRAWN - PDB	REVISED - 08-26-10 △	57/70			(25-3)I-6	EFFINGHAM	839	27	
PLOT SCALE = 1/8"=1'-0" / IN.	CHECKED - BRM	REVISED -	CONTRACT NO. 74293							
PLOT DATE = 8/26/2010	DATE - 11-05-07	REVISED -	ILLINOIS FED. AID PROJECT							
					SCALE: 1"=50'	SHEET NO. 3 OF 4 SHEETS		STA. TO STA.		

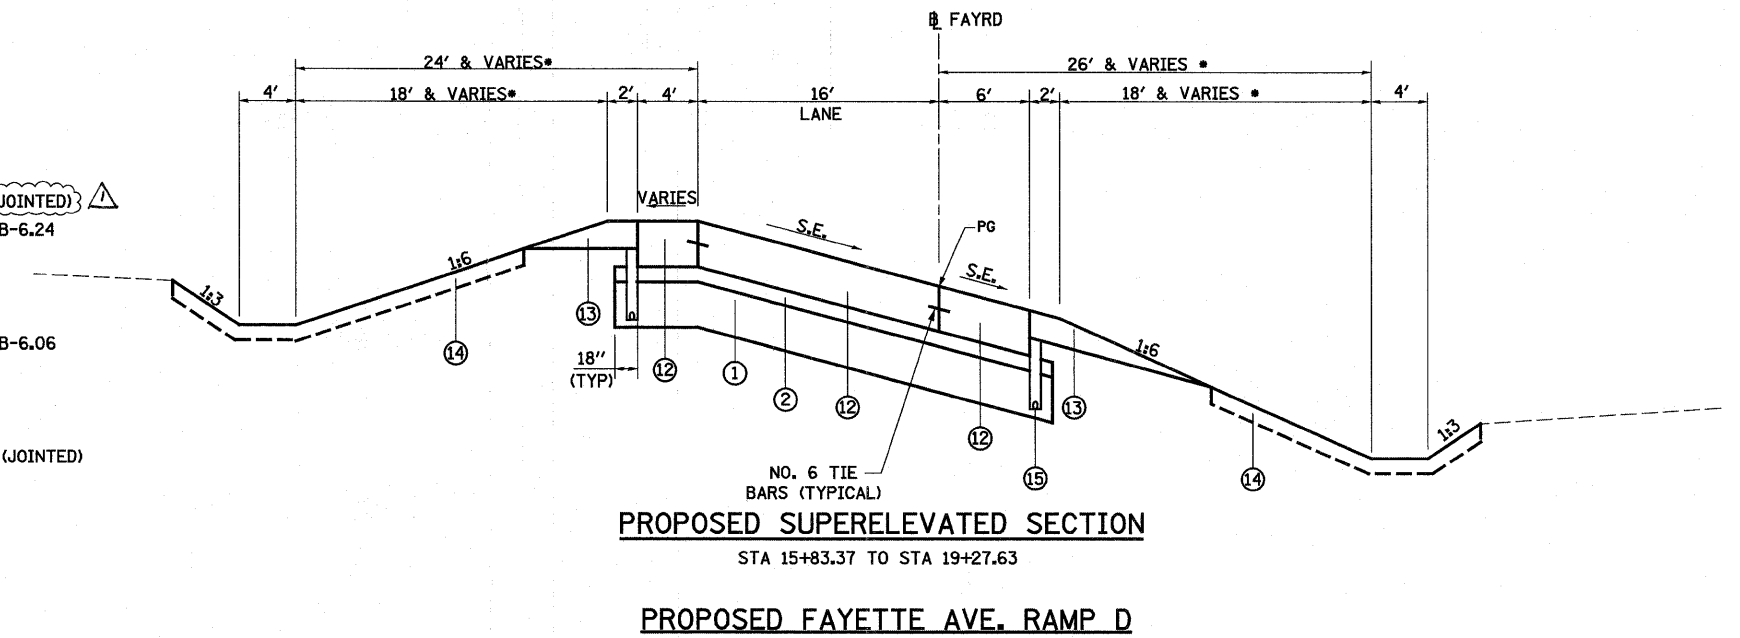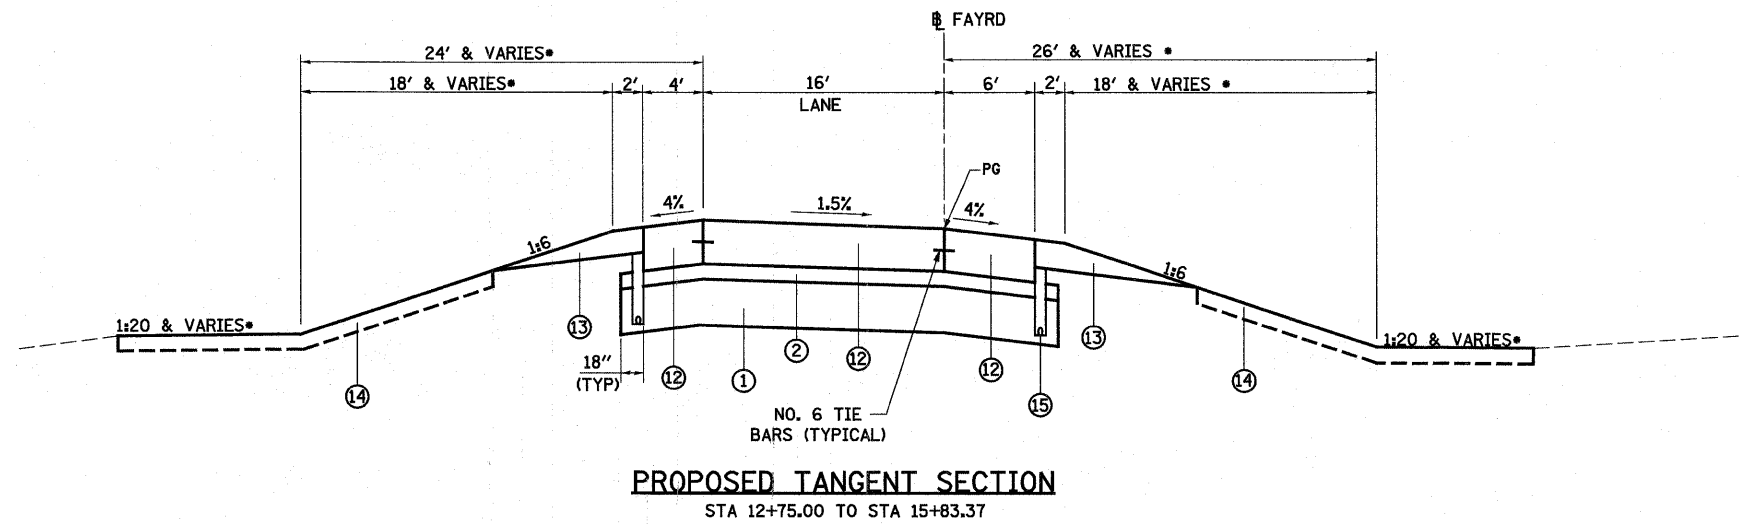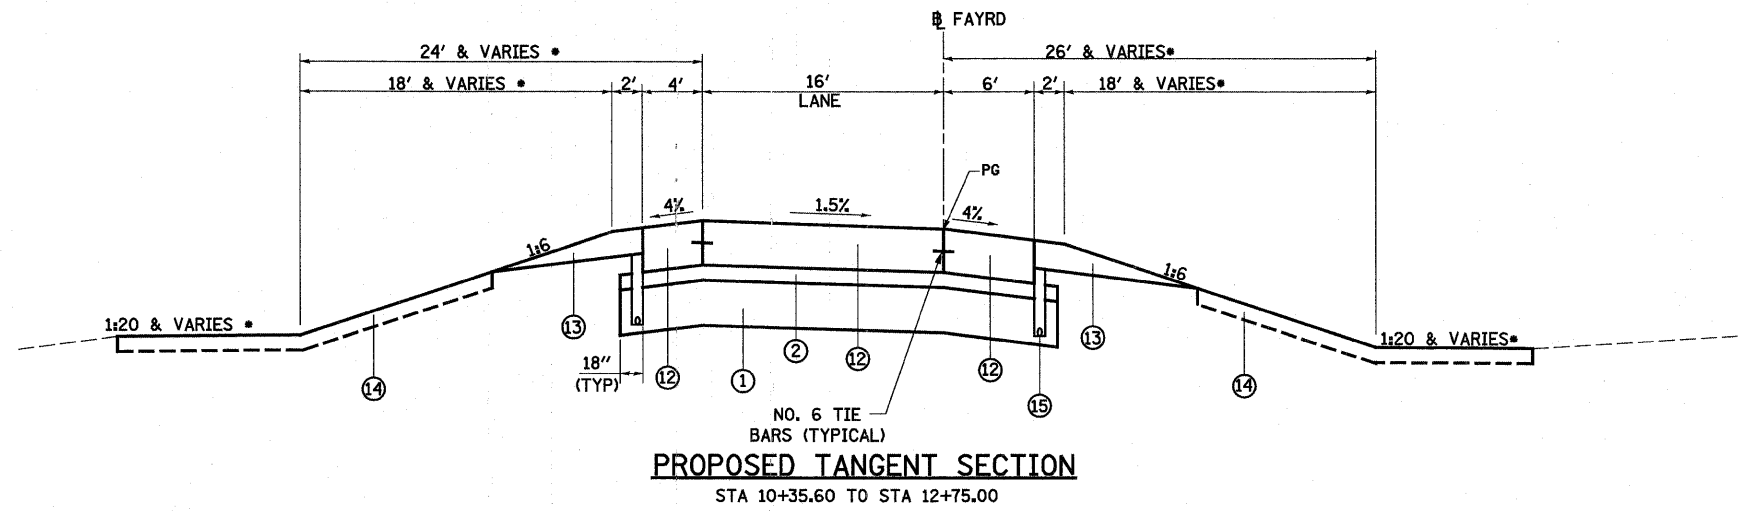


**LEGEND**

- ① PROPOSED LIME MODIFIED SOIL 12"
- ② PROPOSED STABILIZED SUB-BASE 4" (BAM)
- ③ PROPOSED PORTLAND CEMENT CONCRETE PAVEMENT 10 1/4" (JOINTED)
- ④ PROPOSED COMBINATION CONCRETE CURB AND GUTTER, TYPE B-6.24
- ⑤ PROPOSED PORTLAND CEMENT CONCRETE SIDEWALK 4"
- ⑥ PROPOSED CONCRETE MEDIAN SURFACE, 4"
- ⑦ PROPOSED CORRUGATED MEDIAN
- ⑧ PROPOSED COMBINATION CONCRETE CURB AND GUTTER, TYPE B-6.06
- ⑨ PROPOSED BRIDGE APPROACH SLAB (SEE STRUCTURE PLANS)
- ⑩ PROPOSED SUB-BASE GRANULAR MATERIAL, TYPE C
- ⑪ PROPOSED CONCRETE MEDIAN, TYPE SB (DOWELLED)
- ⑫ PROPOSED PORTLAND CEMENT CONCRETE PAVEMENT 10 1/2" (JOINTED)
- ⑬ PROPOSED AGGREGATE SHOULDERS, TYPE B 6"
- ⑭ PROPOSED TOPSOIL 4"
- ⑮ PROPOSED PIPE UNDERDRAINS 4"
- ⑯ PROPOSED PORTLAND CEMENT CONCRETE PAVEMENT, 12"
- ⑰ PROPOSED PAVEMENT FABRIC
- ⑱ PROPOSED AGGREGATE BASE COURSE, TYPE B, 8"
- ⑲ PROPOSED AGGREGATE SHOULDER TYPE B
- ⑳ PROPOSED LIME MODIFIED SOIL 18"


• SEE CROSS SECTIONS

FILE NAME =	USER NAME = lunde	DESIGNED - JWS	REVISED - 08-02-10	<b>STATE OF ILLINOIS DEPARTMENT OF TRANSPORTATION</b>	<b>PROPOSED TYPICAL SECTIONS - FAYETTE AVE, RAMP D</b>	F.A.I. RTE.	SECTION	COUNTY	TOTAL SHEETS	SHEET NO.		
S:\Projects\403-00072-57-70\dgn\FayetteAve\addendum\1\addendum.dgn						DRAWN - PDB	REVISED - 08-26-10	57/70	(25-3)I-6	EFFINGHAM	839	28
PLOT SCALE = 100.0000' / IN.						CHECKED - BRM	REVISED -	CONTRACT NO. 74293				
PLOT DATE = 8/25/2010						DATE - 11-05-07	REVISED -	FED. ROAD DIST. NO. ILLINOIS FED. AID PROJECT				
						SCALE: 1"=50'		SHEET NO. 4 OF 4 SHEETS		STA. TO STA.		

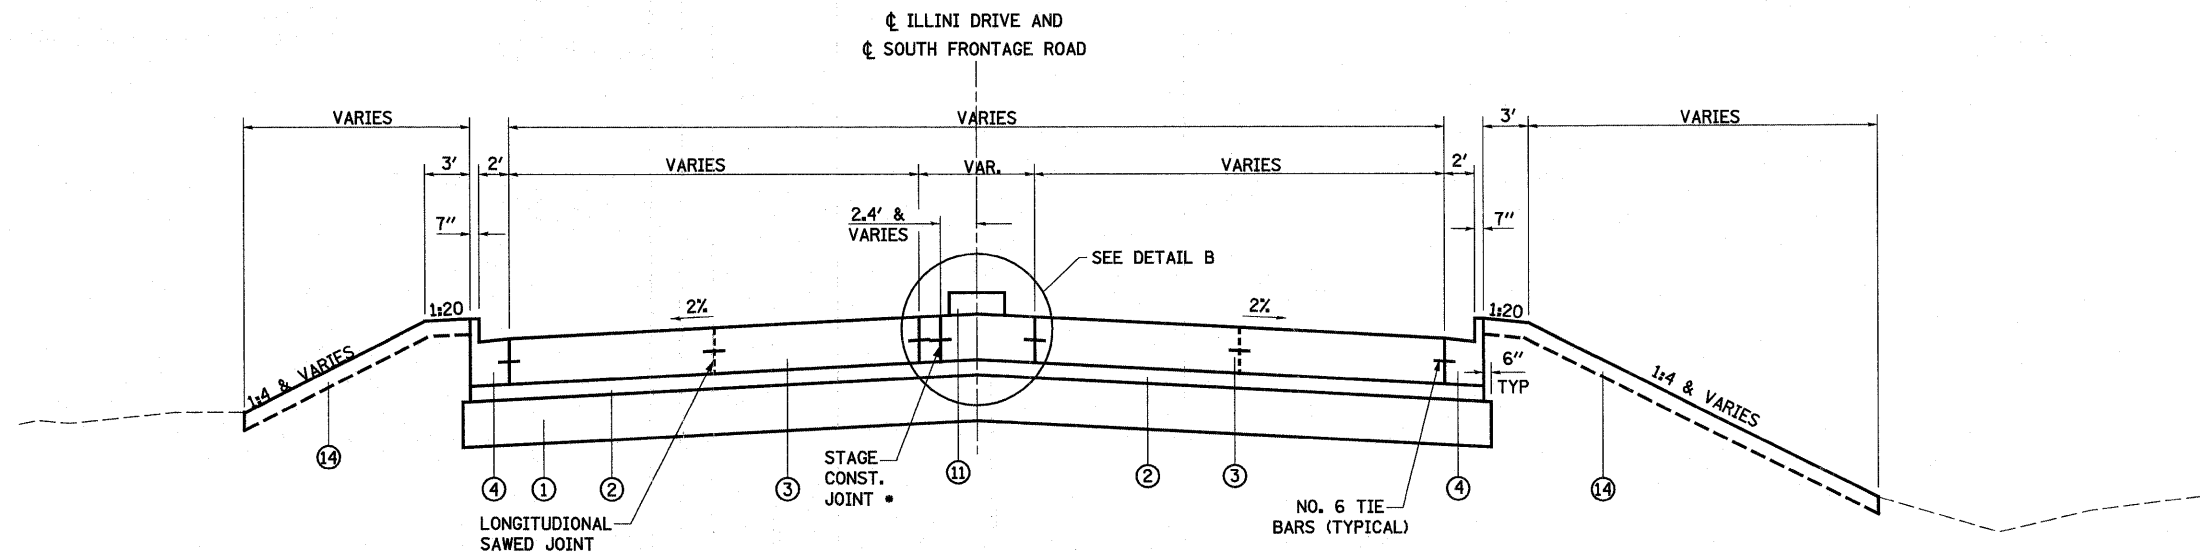

**PROPOSED TANGENT SECTION  
PROPOSED ILLINI DRIVE AND  
SOUTH FRONTAGE ROAD**


• STAGE CONSTRUCTION JOINT  
AT 2.4' LT AND VARIES ON SOUTH  
FRONTAGE ROAD AND AT 0.0'  
AND VARIES ON ILLINI DRIVE

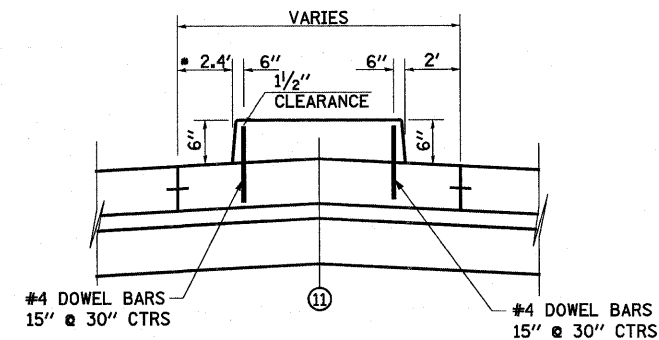

**DETAIL B**  
CONCRETE MEDIAN, TYPE SB-6.06 (DOWELLED)

**LEGEND**

- ① PROPOSED LIME MODIFIED SOIL 12"
- ② PROPOSED STABILIZED SUB-BASE 4" (BAM)
- ③ PROPOSED PORTLAND CEMENT CONCRETE PAVEMENT 10 1/4" (JOINTED)
- ④ PROPOSED COMBINATION CONCRETE CURB AND GUTTER, TYPE B-6.24
- ⑤ PROPOSED PORTLAND CEMENT CONCRETE SIDEWALK 4"
- ⑥ PROPOSED CONCRETE MEDIAN SURFACE, 4"
- ⑦ PROPOSED CORRUGATED MEDIAN
- ⑧ PROPOSED COMBINATION CONCRETE CURB AND GUTTER, TYPE B-6.06
- ⑨ PROPOSED BRIDGE APPROACH SLAB (SEE STRUCTURE PLANS)
- ⑩ PROPOSED SUB-BASE GRANULAR MATERIAL, TYPE C
- ⑪ PROPOSED CONCRETE MEDIAN, TYPE SB (DOWELLED)
- ⑫ PROPOSED PORTLAND CEMENT CONCRETE PAVEMENT 10 1/2" (JOINTED)
- ⑬ PROPOSED AGGREGATE SHOULDERS, TYPE B 6"
- ⑭ PROPOSED TOPSOIL 4"
- ⑮ PROPOSED PIPE UNDERDRAINS 4"
- ⑯ PROPOSED PORTLAND CEMENT CONCRETE PAVEMENT, 12"
- ⑰ PROPOSED PAVEMENT FABRIC
- ⑱ PROPOSED AGGREGATE BASE COURSE, TYPE B, 8"
- ⑲ PROPOSED AGGREGATE SHOULDER TYPE B
- ⑳ PROPOSED LIME MODIFIED SOIL 18"

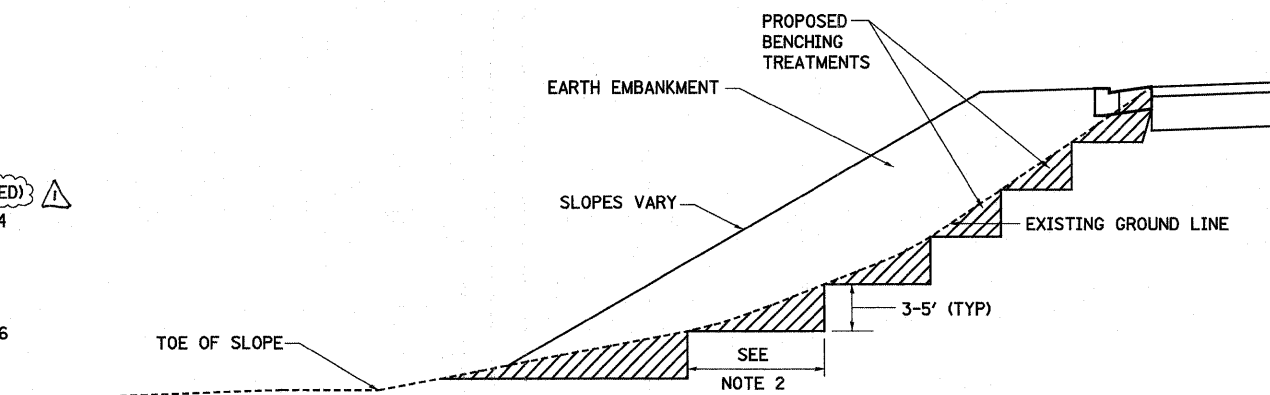


**TYPICAL**

**GENERAL NOTES:**


1. SLOPE STEPS WILL BE REQUIRED WHEN EMBANKMENTS ARE TO BE CONSTRUCTED ON HILLSIDES OR EXISTING EMBANKMENT SLOPES.
2. THE STEP WIDTH SHALL BE TWICE THE STEP DEPTH BUT NOT LESS THAN 6'.
3. REFER TO ARTICLE 205.03 FOR EMBANKMENT TO BE CONSTRUCTED ON HILLSIDE OR SLOPES, OR IF EXISTING EMBANKMENTS ARE TO BE WIDENED.
4. THIS WORK WILL NOT BE PAID FOR SEPARATELY BUT SHALL BE CONSIDERED AS INCLUDED IN THE VARIOUS ITEMS OF EXCAVATION, AND THEIR CONSTRUCTION SHALL BE INCLUDED IN THE UNIT PRICES FOR THESE ITEMS.

FILE NAME =	USER NAME = lunde	DESIGNED - JWS	REVISED - 08-02-10	<b>STATE OF ILLINOIS DEPARTMENT OF TRANSPORTATION</b>	<b>PROPOSED TYPICAL SECTIONS ILLINI DRIVE AND SOUTH FRONTAGE ROAD</b>			F.A.I. RTE.	SECTION	COUNTY	TOTAL SHEETS	SHEET NO.		
SN\Projects\403-00072-57-70\dgn\Foyette\kiddendun\ty	DESIGNED - BOB	REVISED - (08-26-10)	SCALE: 1"=50'		SHEET NO. 1	OF 1	SHEETS	STA.	TO STA.	57/70	(25-3)I-6	EFFINGHAM	839	29
PLOT SCALE = 100.0000' / IN.	CHECKED - BRM	REVISED -												
PLOT DATE = 8/26/2010	DATE - 11-05-07	REVISED -												
												<b>CONTRACT NO. 74293</b>		
												FED. ROAD DIST. NO. ILLINOIS FED. AID PROJECT		

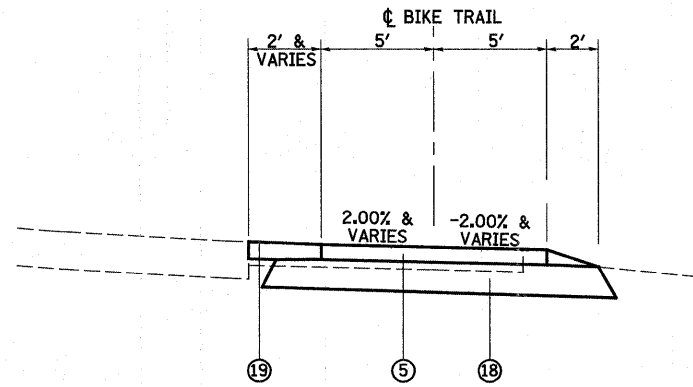

**PROPOSED TANGENT SECTION**

STA 7+82.60 TO STA 8+46.48

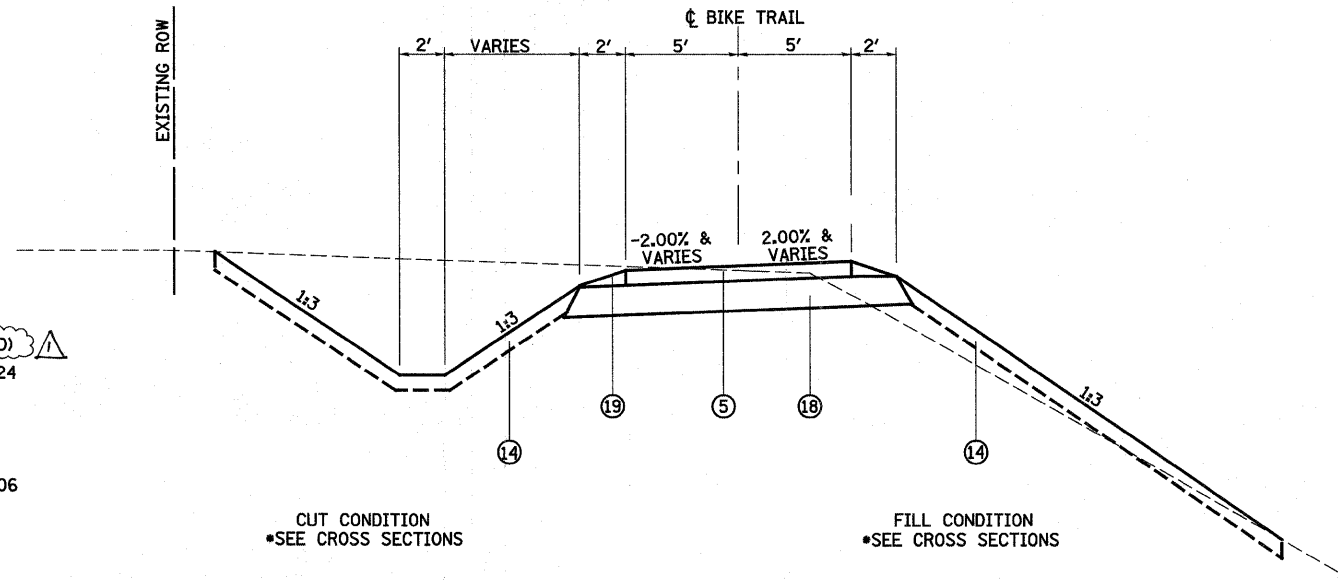

**PROPOSED TYPICAL SECTION**


STA 8+46.48 TO STA 11+50.00  
 STA 38+50.00 TO STA 49+40.20  
 BIKE TRAIL OMISSION STA 11+50.00 TO STA 38+50.00

**LEGEND**

- ① PROPOSED LIME MODIFIED SOIL 12"
- ② PROPOSED STABILIZED SUB-BASE 4" (BAM)
- ③ PROPOSED PORTLAND CEMENT CONCRETE PAVEMENT 10 1/4" (JOINTED) ⚠
- ④ PROPOSED COMBINATION CONCRETE CURB AND GUTTER, TYPE B-6.24
- ⑤ PROPOSED PORTLAND CEMENT CONCRETE SIDEWALK 4"
- ⑥ PROPOSED CONCRETE MEDIAN SURFACE, 4"
- ⑦ PROPOSED CORRUGATED MEDIAN
- ⑧ PROPOSED COMBINATION CONCRETE CURB AND GUTTER, TYPE B-6.06
- ⑨ PROPOSED BRIDGE APPROACH SLAB (SEE STRUCTURE PLANS)
- ⑩ PROPOSED SUB-BASE GRANULAR MATERIAL, TYPE C
- ⑪ PROPOSED CONCRETE MEDIAN, TYPE SB (DOWELLED)
- ⑫ PROPOSED PORTLAND CEMENT CONCRETE PAVEMENT 10 1/2" (JOINTED)
- ⑬ PROPOSED AGGREGATE SHOULDERS, TYPE B 6"
- ⑭ PROPOSED TOPSOIL 4"
- ⑮ PROPOSED PIPE UNDERDRAINS 4"
- ⑯ PROPOSED PORTLAND CEMENT CONCRETE PAVEMENT, 12"
- ⑰ PROPOSED PAVEMENT FABRIC
- ⑱ PROPOSED AGGREGATE BASE COURSE, TYPE B, 8"
- ⑲ PROPOSED AGGREGATE SHOULDER TYPE B
- ⑳ PROPOSED LIME MODIFIED SOIL 18"

FILE NAME =	USER NAME = lunde	DESIGNED - JWS	REVISED - 08-02-10	<b>STATE OF ILLINOIS DEPARTMENT OF TRANSPORTATION</b>	<b>TYPICAL SECTION, BIKE TRAIL</b>			F.A.I. RTE.	SECTION	COUNTY	TOTAL SHEETS	SHEET NO.
S:\Projects\403-00072-51-70\403-00072-51-70.dwg		DRAWN - PDB	REVISED - (08-26-10) ⚠					57/70	(25-3)I-6	EFFINGHAM	839	30
PLOT SCALE = 100.0000' / IN.		CHECKED - BRM	REVISED -		SCALE: 1"=50'	SHEET NO. 1 OF 1 SHEETS	STA.	TO STA.	FED. ROAD DIST. NO.	ILLINOIS FED. AID PROJECT	<b>CONTRACT NO. 74293</b>	
PLOT DATE = 8/26/2010		DATE - 11-25-09	REVISED -									




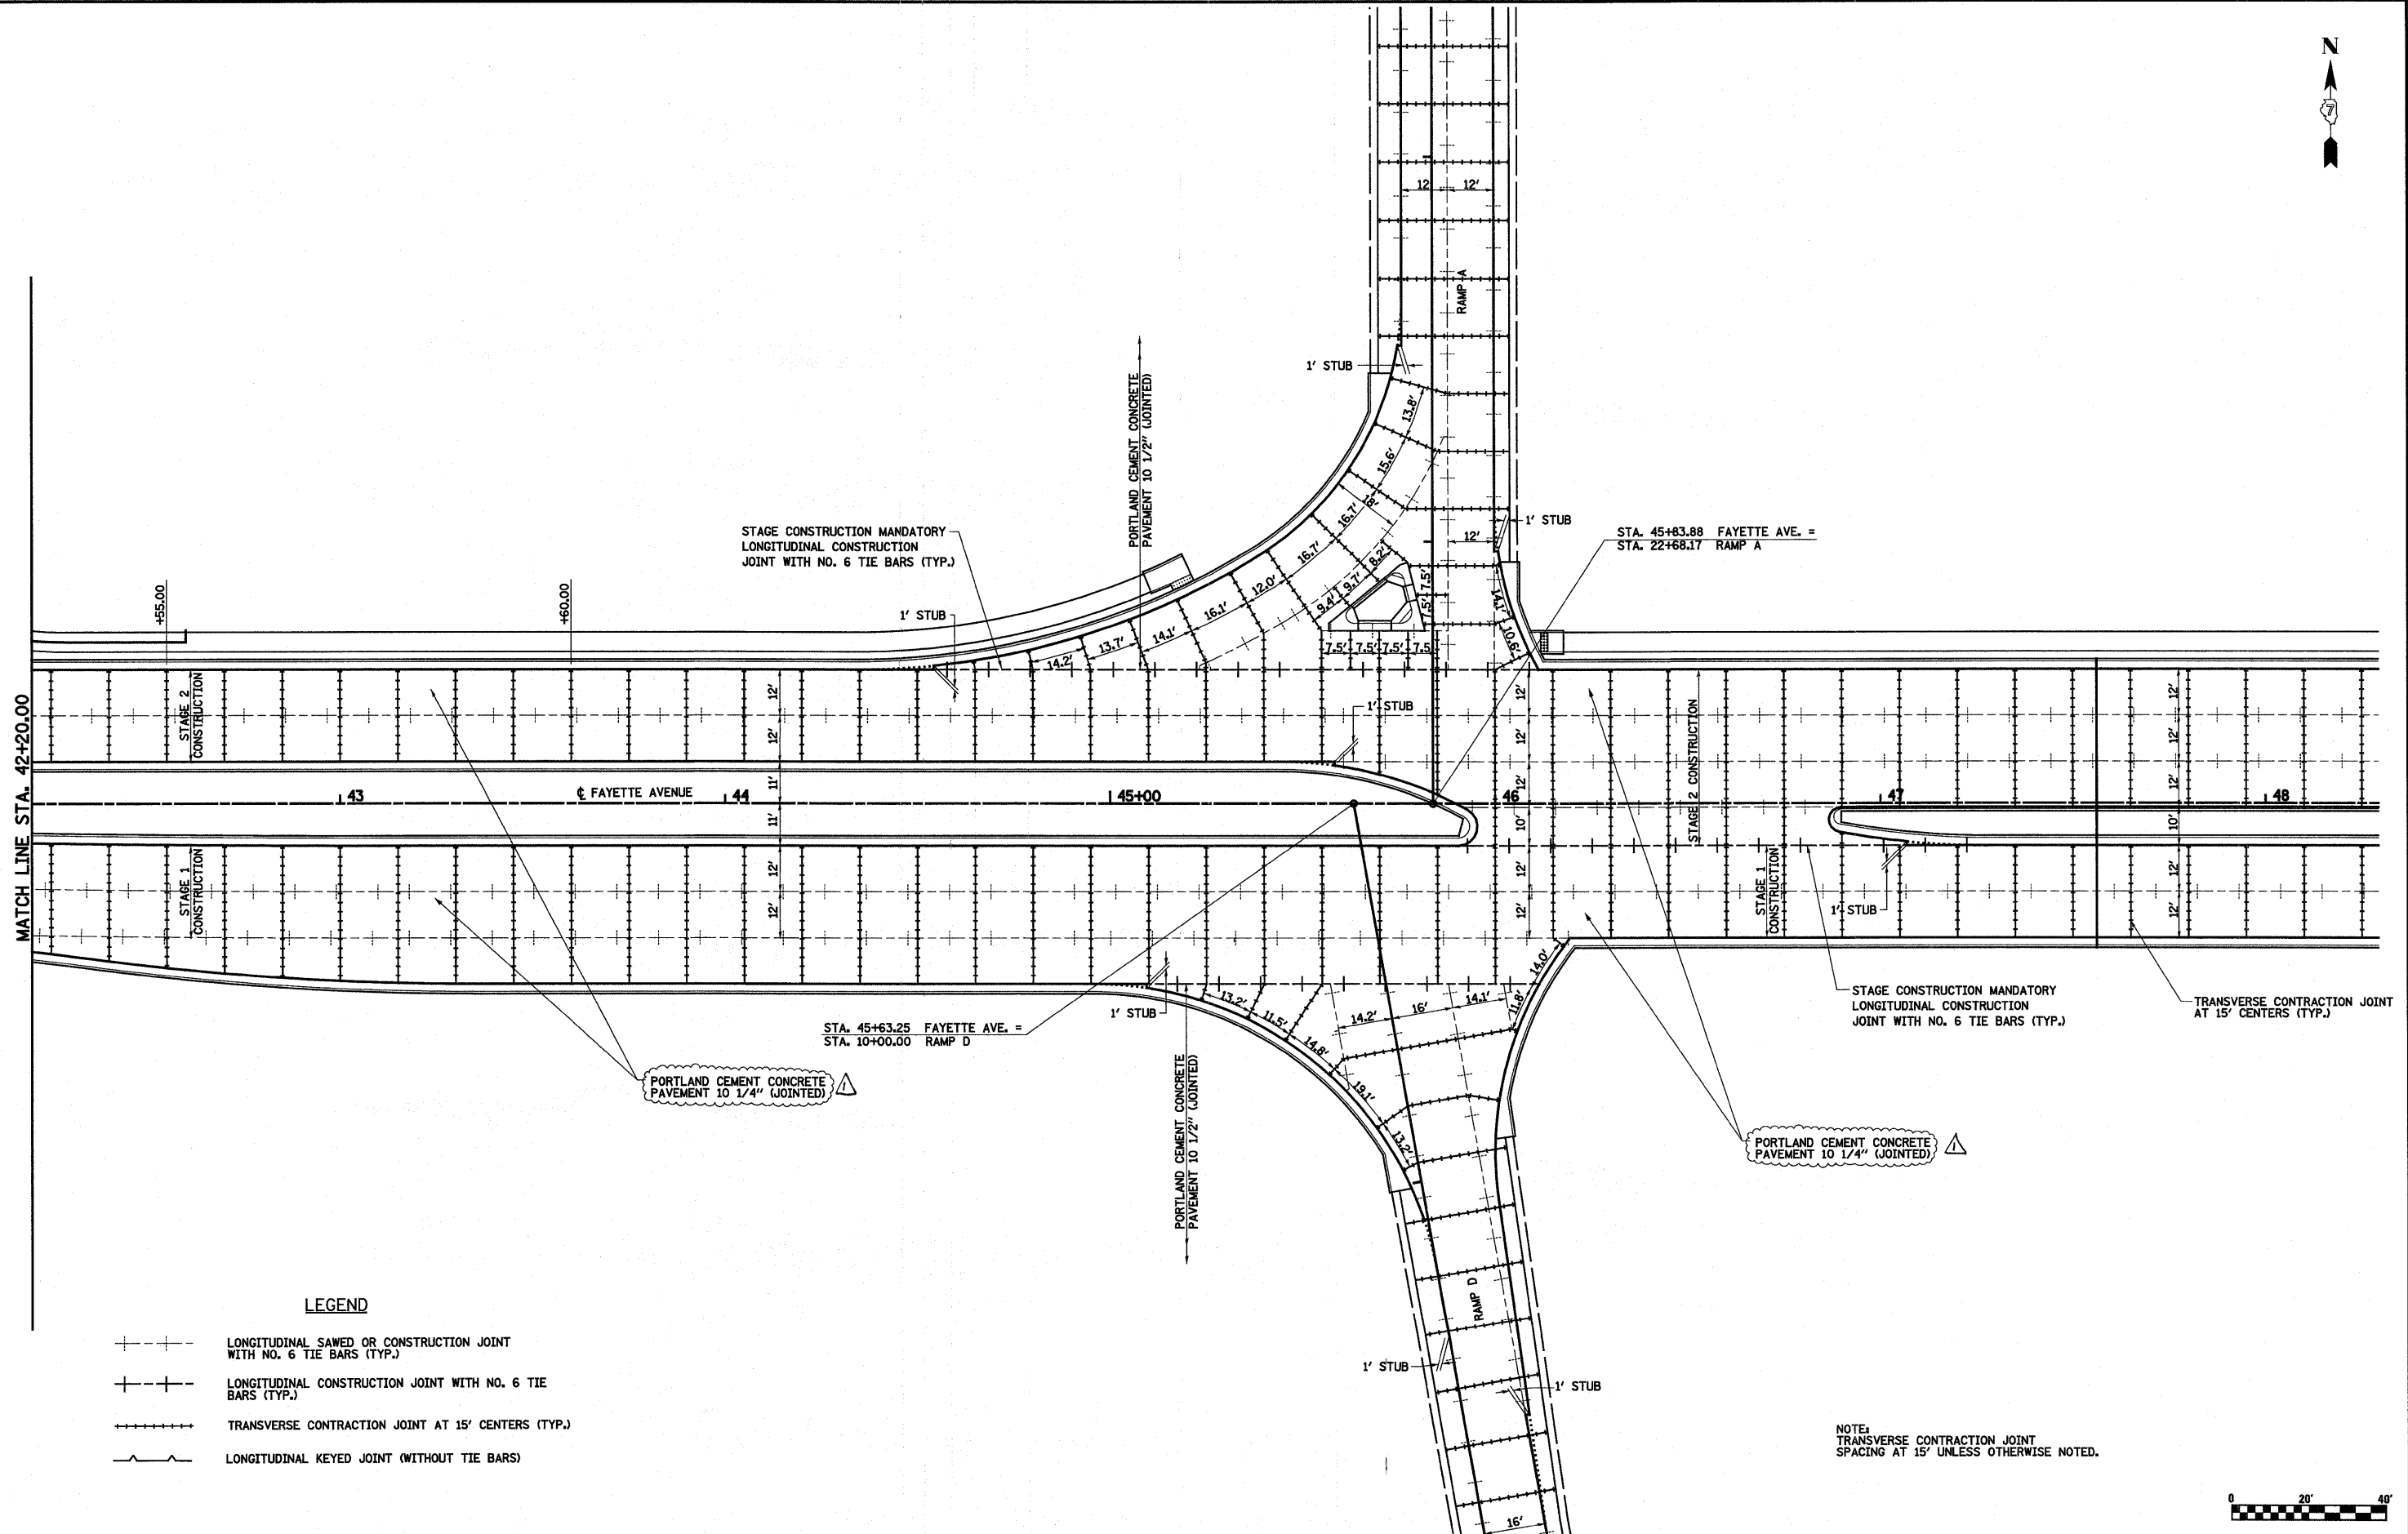


**LEGEND**

- +---+--- LONGITUDINAL SAWED OR CONSTRUCTION JOINT WITH NO. 6 TIE BARS (TYP.)
- +---+--- LONGITUDINAL CONSTRUCTION JOINT WITH NO. 6 TIE BARS (TYP.)
- +---+--- TRANSVERSE CONTRACTION JOINT AT 15' CENTERS (TYP.)
- +---+--- LONGITUDINAL KEYED JOINT (WITHOUT TIE BARS)

NOTE:  
TRANSVERSE CONTRACTION JOINT SPACING AT 15' UNLESS OTHERWISE NOTED.

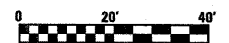

FILE NAME =	USER NAME = lunde	DESIGNED - JWS	REVISED - (08-26-10)	<b>STATE OF ILLINOIS DEPARTMENT OF TRANSPORTATION</b>	<b>JOINTING DETAIL, FAYETTE AVENUE</b>			F.A.I. RTE.	SECTION	COUNTY	TOTAL SHEETS	SHEET NO.
S:\Projects\403-00072-57-70\dgn\Fayette\Addendum\job1.dgn	DRAWN - PDB	CHECKED - BRM	REVISED -		57/70	(25-3)I-6	EFFINGHAM	839	195			
PLOT SCALE = 40,000.00' / IN.	DATE - 4-23-08	REVISED -	REVISED -		CONTRACT NO. 74293							
PLOT DATE = 8/26/2018					SCALE: 1"=20'			SHEET NO. 2 OF 4 SHEETS		STA. 42+20.00 TO STA. 48+30.00		FED. ROAD DIST. NO. ILLINOIS FED. AID PROJECT

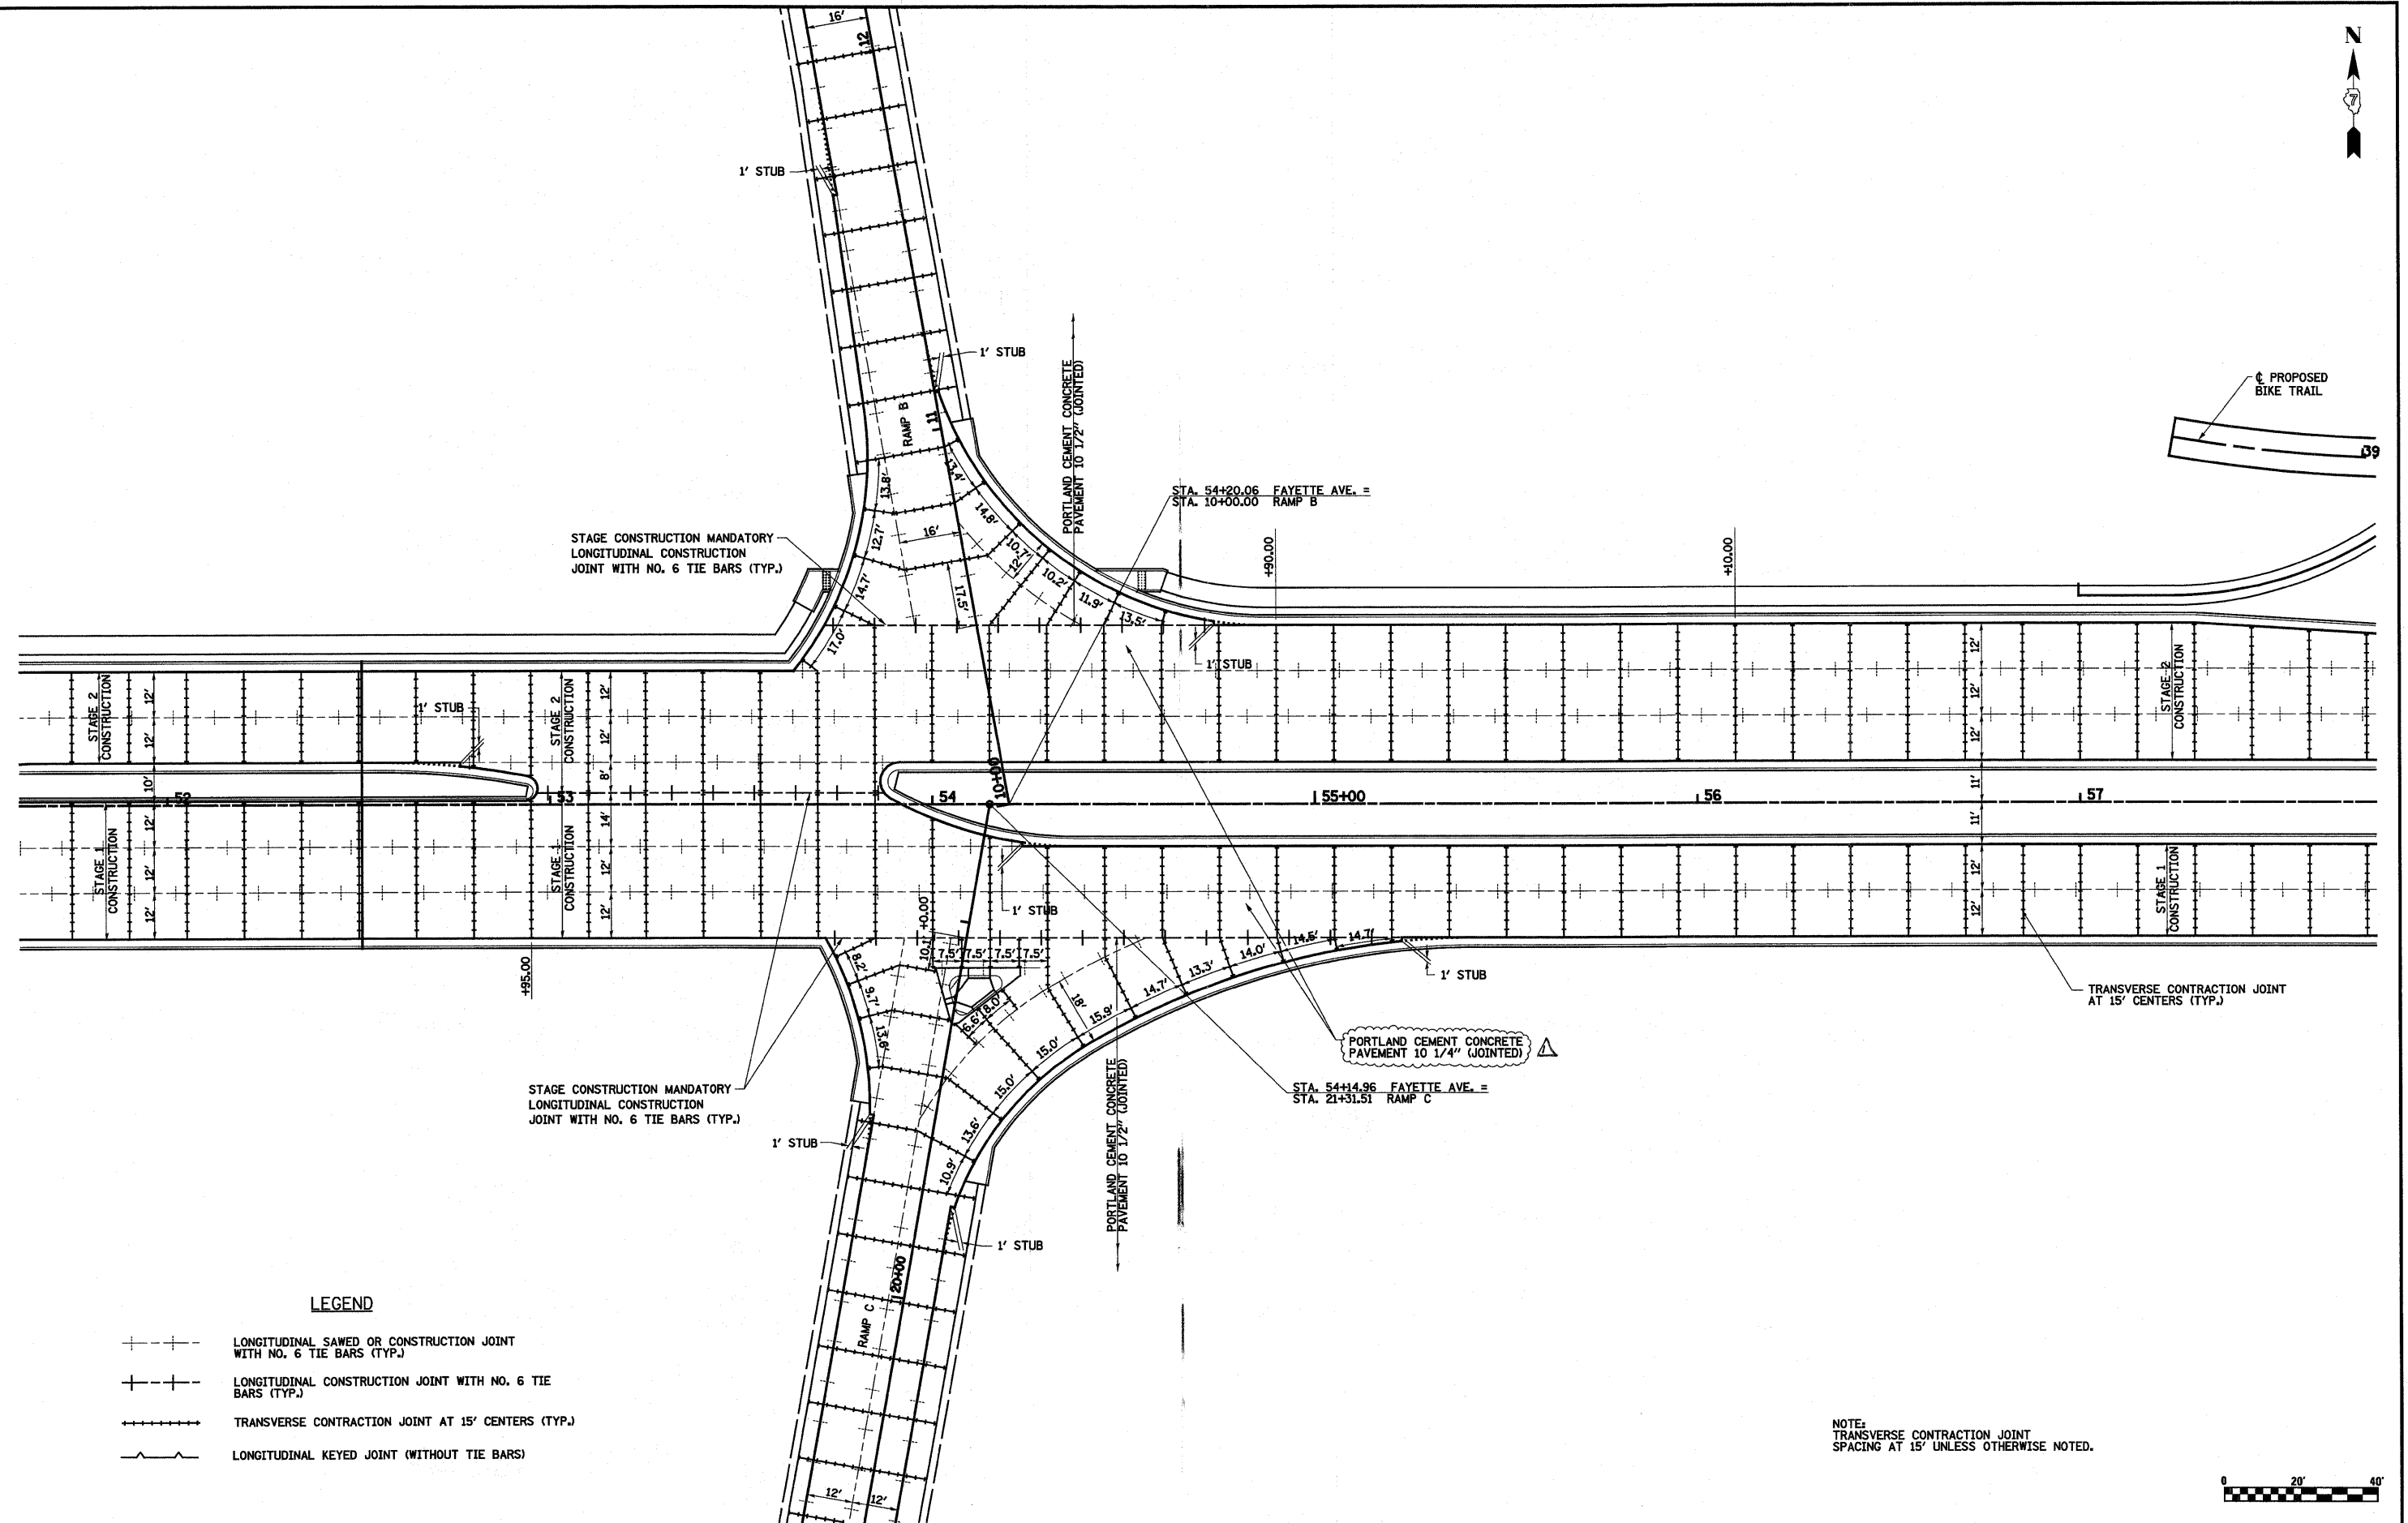

STAGE CONSTRUCTION MANDATORY LONGITUDINAL CONSTRUCTION JOINT WITH NO. 6 TIE BARS (TYP.)

STAGE CONSTRUCTION MANDATORY LONGITUDINAL CONSTRUCTION JOINT WITH NO. 6 TIE BARS (TYP.)


PORTLAND CEMENT CONCRETE PAVEMENT TO 1/4" (JOINTED)

TRANSVERSE CONTRACTION JOINT AT 15' CENTERS (TYP.)

**LEGEND**

- +---+--- LONGITUDINAL SAWED OR CONSTRUCTION JOINT WITH NO. 6 TIE BARS (TYP.)
- +---+--- LONGITUDINAL CONSTRUCTION JOINT WITH NO. 6 TIE BARS (TYP.)
- +---+--- TRANSVERSE CONTRACTION JOINT AT 15' CENTERS (TYP.)
- +---+--- LONGITUDINAL KEYED JOINT (WITHOUT TIE BARS)

NOTE: TRANSVERSE CONTRACTION JOINT SPACING AT 15' UNLESS OTHERWISE NOTED.

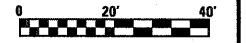


FILE NAME = S:\Projects\403-00072.57-70\dgn\Fayette\Addendum\Addendum.dgn	USER NAME = l1nde	DESIGNED - JWS	REVISED - (08-26-10)	<b>STATE OF ILLINOIS DEPARTMENT OF TRANSPORTATION</b>	<b>JOINTING DETAIL, FAYETTE AVENUE</b>			F.A.I. RTE. 57/70	SECTION (25-3)I-6	COUNTY EFFINGHAM	TOTAL SHEETS 839	SHEET NO. 196
	PLOT SCALE = 40,0000' / IN.	DRAWN - PDB	REVISED -		SCALE: 1"=20'	SHEET NO. 3 OF 4 SHEETS	STA. 51+60.00 TO STA. 57+70.00	<b>CONTRACT NO. 74293</b>				
	PLOT DATE = 8/26/2010	CHECKED - BRM	REVISED -									
		DATE - 4-23-08	REVISED -									


STATE OF ILLINOIS  
DEPARTMENT OF TRANSPORTATION

Notes:


Space reinforcement in cap to miss anchor bolts.  
Pour steps monolithically with cap.  
E.F. indicates Each Face.  
Clear cover noted to Mechanical Splicers, where applicable.  
Single Face Median Barriers (by others) on each face of Crashwall are not shown for clarity. See Section B-B on Sheet 1 of 38 for Crashwall and Median Barriers (by others).  
See Sheet 32B of 38 for Footing Plan, Crashwall Plan, Bar Bends and Bill of Materials.

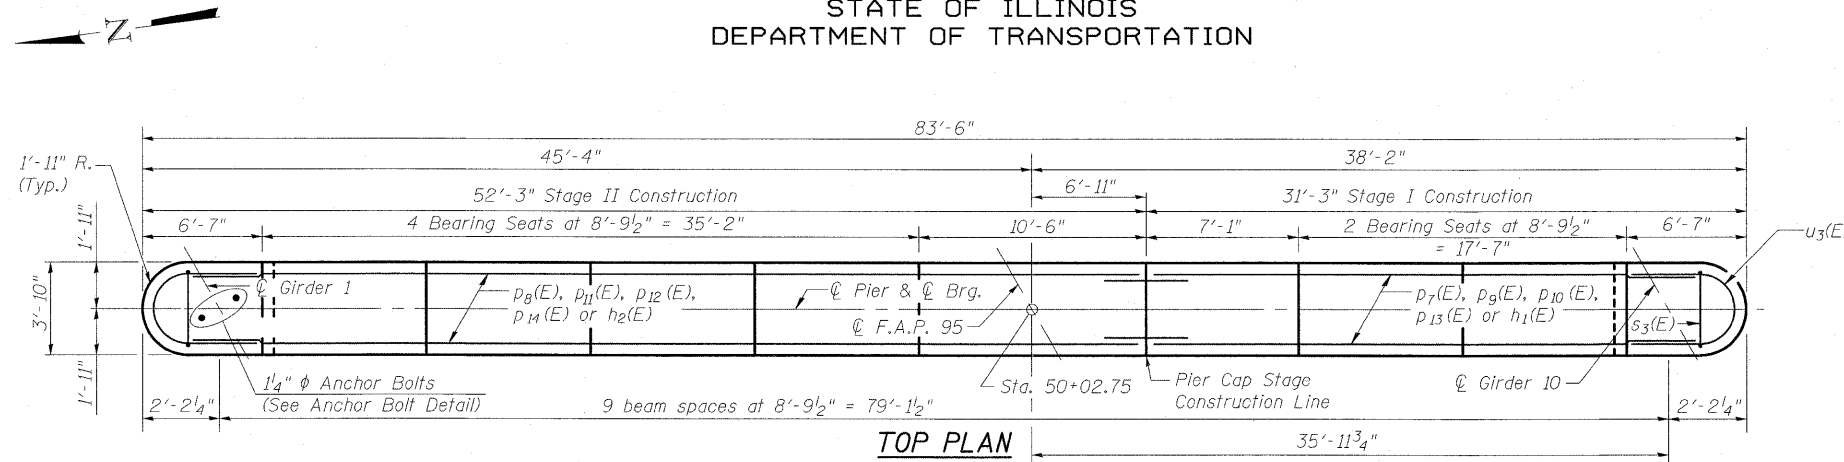

TOP PLAN

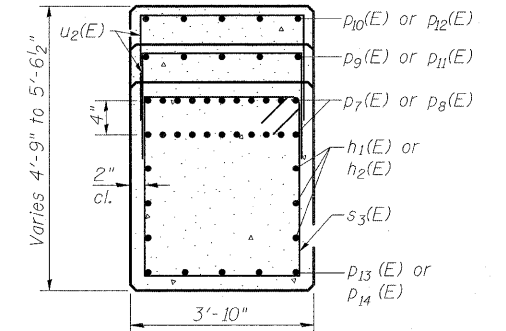


SEC. A-A

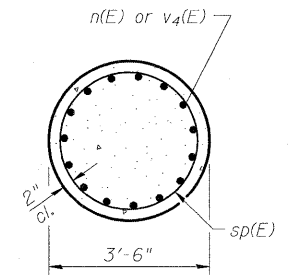

SEC. B-B


\* 16- #5 Bar Splicers (E) for h1(E), h2(E), p9(E), p10(E), p11(E) and p12(E)  
5 - #7 Bar Splicers (E) for p13(E) and p14(E)  
22 - #9 Bar Splicers (E) for p7(E) and p8(E)

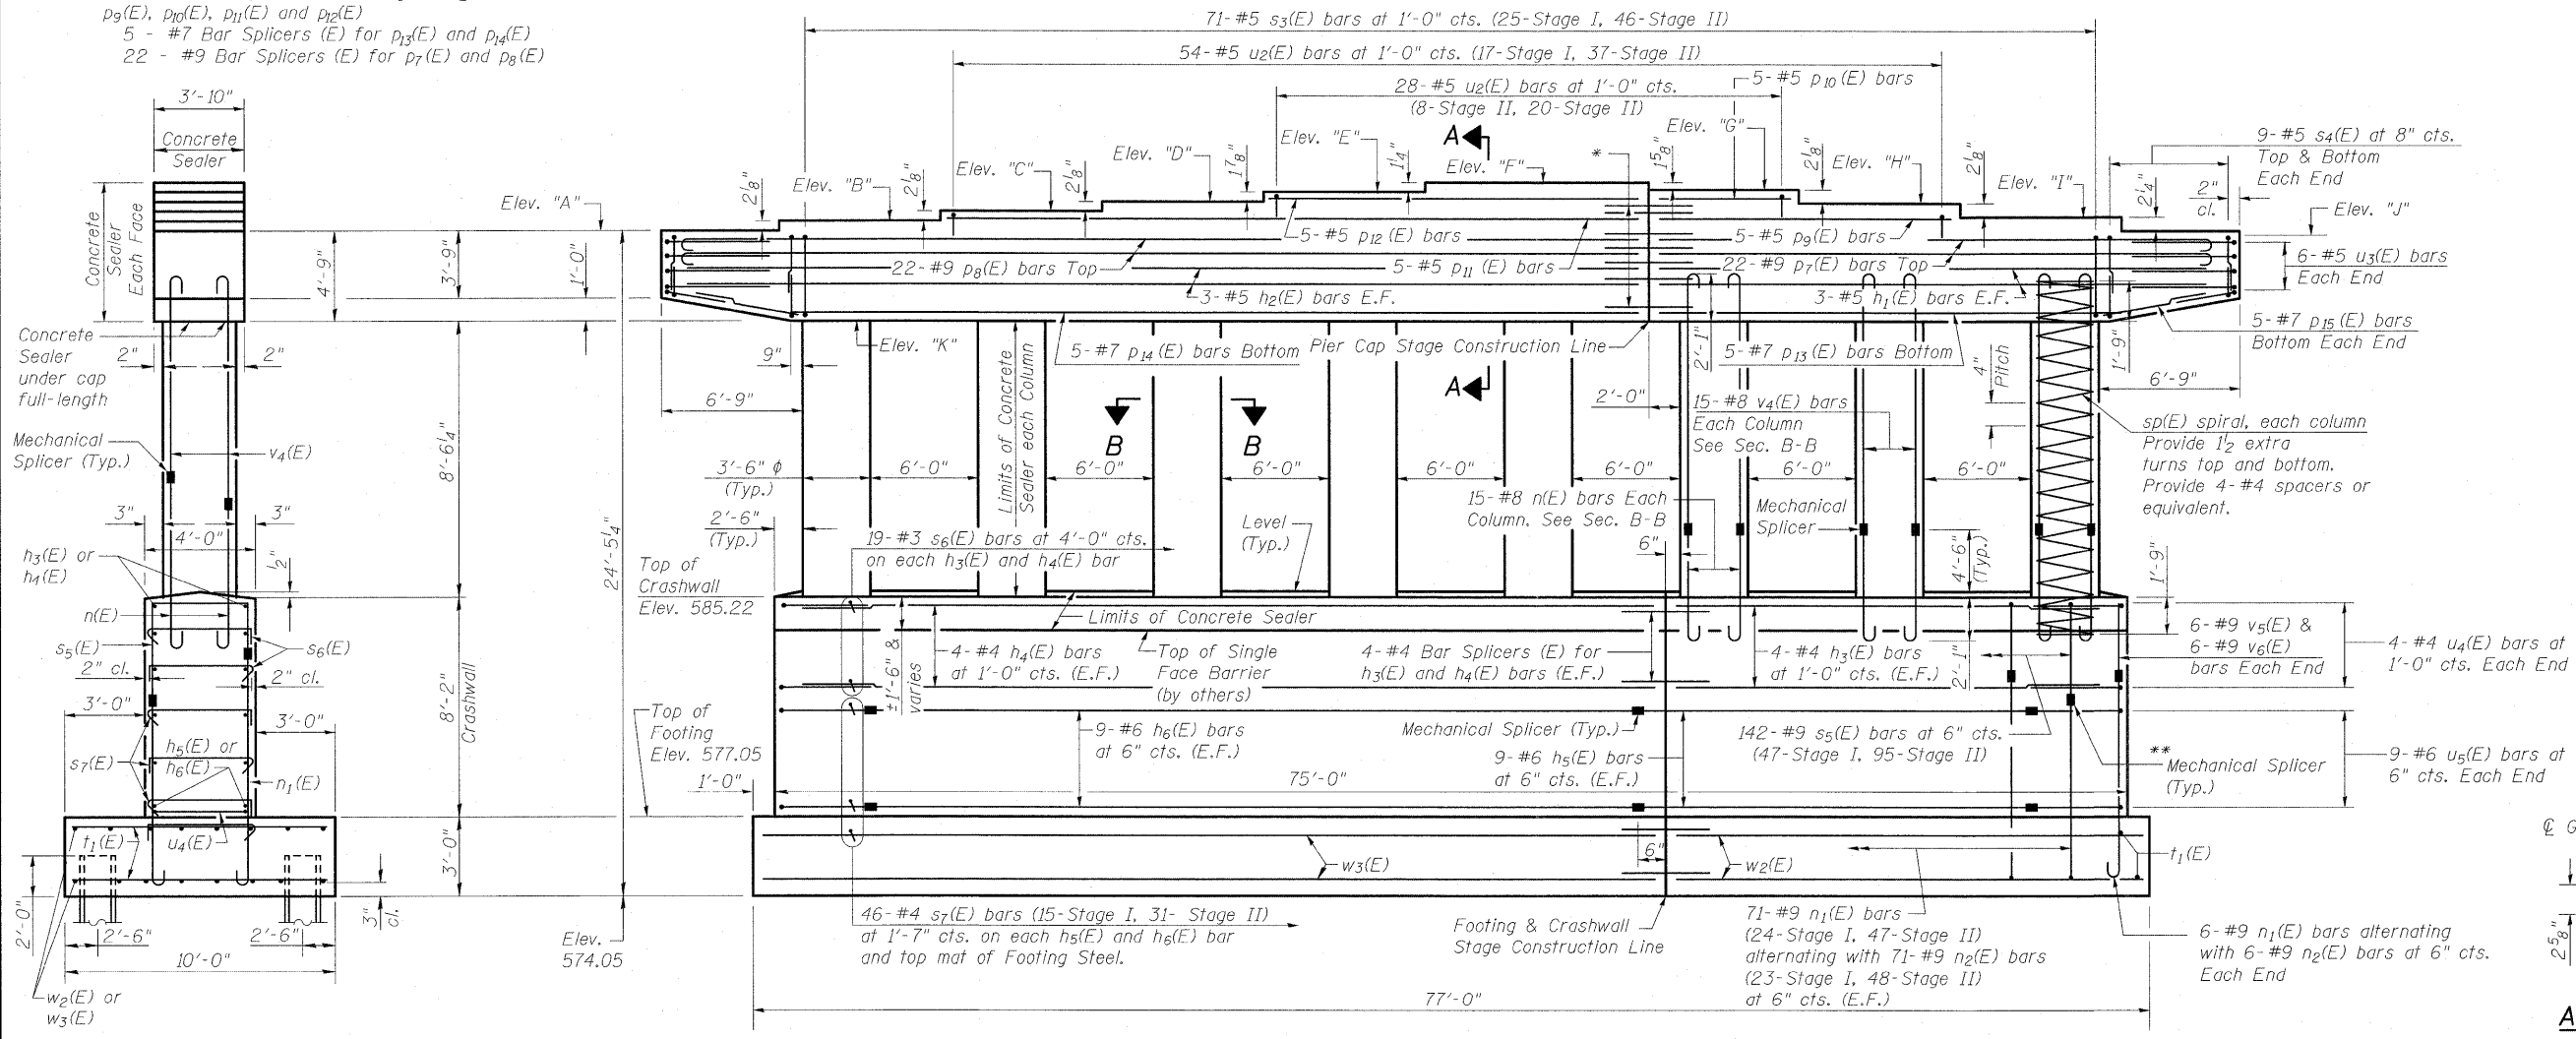

ELEVATION  
(Looking East)

ELEVATION DATA

Elev. A	598.50
Elev. B	598.67
Elev. C	598.84
Elev. D	599.02
Elev. E	599.18
Elev. F	599.28
Elev. G	599.15
Elev. H	598.98
Elev. I	598.79
Elev. J	598.61
Elev. K	593.75

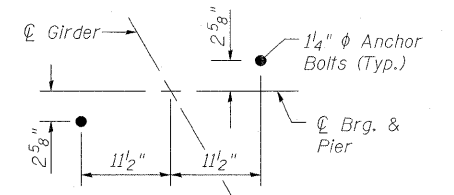

ANCHOR BOLT DETAIL

\*\* All Mechanical splicers for s5(E) & n1(E) bars shall be staggered.

END VIEW

DESIGNED	A.C.S.
CHECKED	B.B.
DRAWN	W.J.S.
CHECKED	C.J.F.

PIER DETAILS  
STRUCTURE NO. 025-0106

SHEET NO. 32 38 SHEETS	F.A.I. RTE.	SECTION	COUNTY	TOTAL SHEETS	SHEET NO.
	57/70	(25-3HB-2)B	EFFINGHAM	839	360A
SN 025-0106			CONTRACT NO. 74293		
FED. ROAD DIST. NO. 7 ILLINOIS FED. AID PROJECT					



BERNARDIN  
LOCHMUELLER &  
ASSOCIATES, INC.

3 Oak Drive  
Maryville, IL 62052-5685  
Local (618) 288-4666  
Fax 618-288-4666