



F.A. SITE	SECTION	EXPRESSWAYS	TOTAL SHEETS	SHEET NO.
132	0606-627 VB	SOUTHWEST		33A
STA.	TO STA.			
FED. ROAD DIST. NO. 7	ILLINOIS	FED. AID PROJECT		

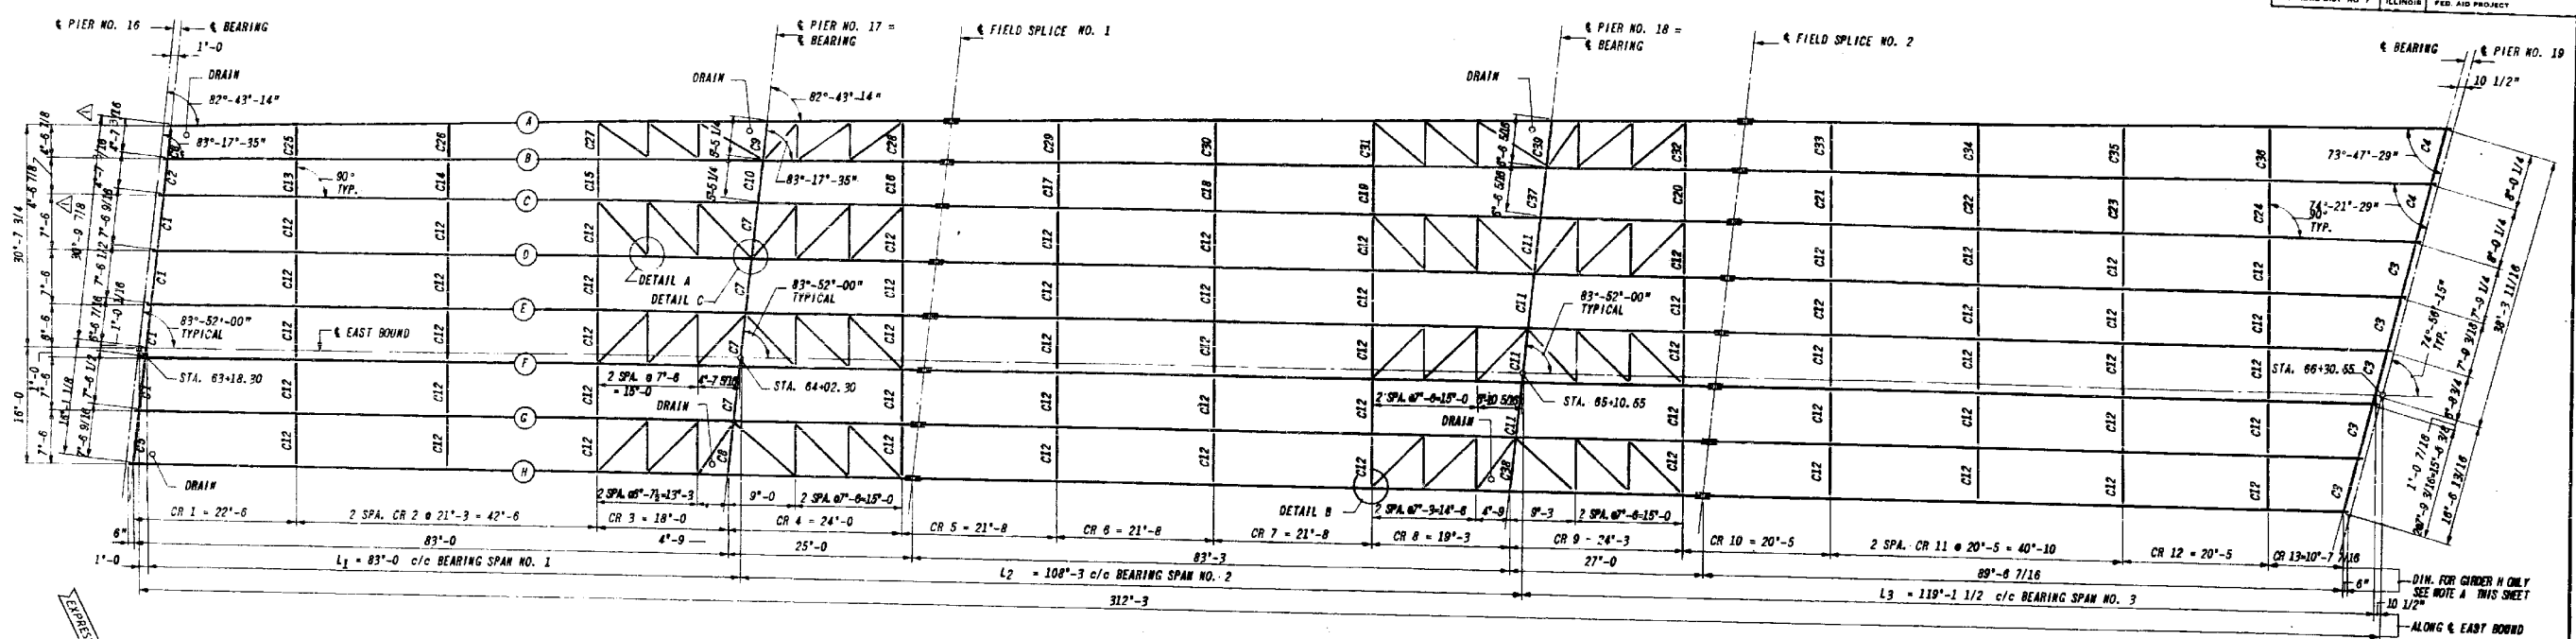

FRAMING PLAN SPAN NO. 1 THRU SPAN NO. 3 EAST BOUND

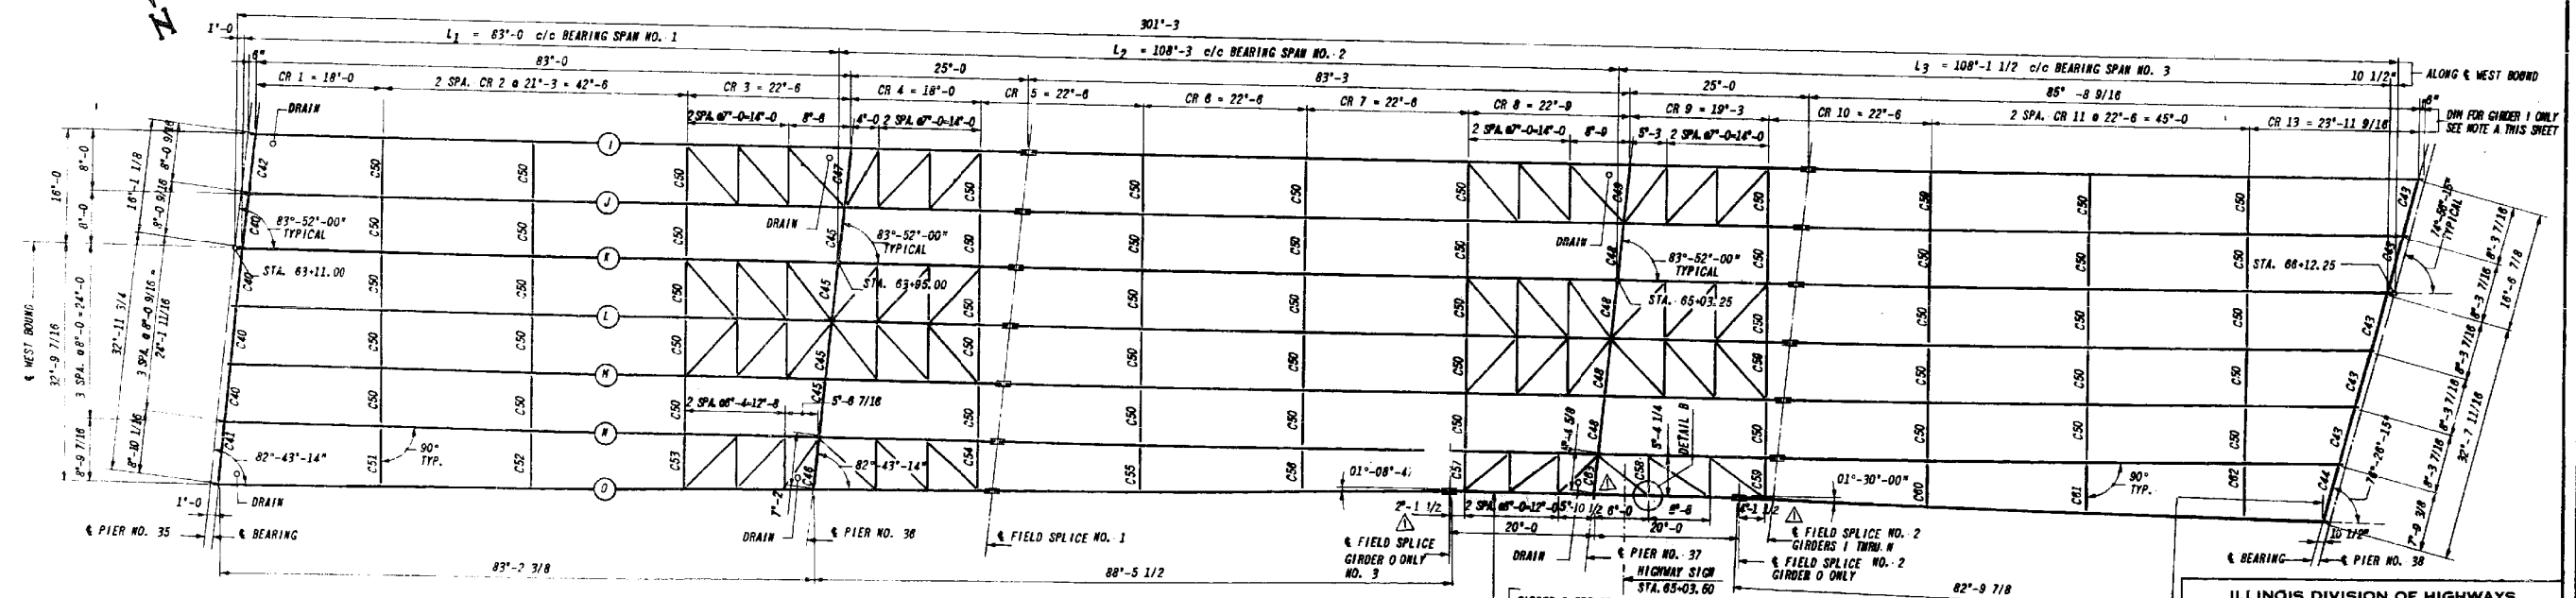

FRAMING PLAN SPAN NO. 1 THRU NO. 3 WEST BOUND

NOTE A:  
 FOR INDIVIDUAL CROSS FRAME AND INTERMEDIATE STIFFENER SPACINGS, FOR WEB PLATE AND FLANGE PLATE DIMENSIONS, FOR WEB PLATE AND FLANGE PLATE CUT OFFS, FOR BLOCKING OF EACH GIRDER SEE SWEETS:  
 (1) CONTINUOUS GIRDER  
 (2) SUMMARY OF CONTINUOUS GIRDERS

**AS BUILT**  
 This sheet (33A) replaces sheet (33) of the contract drawings. All revisions are made by the consultant RARE 5-29-64

REVISIONS	
NAME	DATE
REVISION	5-6-64
REVISION	PX-ST
REVISION	C.W.H.

ILLINOIS DIVISION OF HIGHWAYS  
 SOUTHWEST EXPRESSWAY  
 F.A.T. 133  
 LAWNDALE AVE. STRUCTURE OVER  
 A.T. & S.F. RR, C&W RR & B&OCT RR.  
 SECTION 0606-627 VB  
 FRAMING PLAN SPAN NO. 1 THRU NO. 3 E.B.&W.  
 SCALE: HORIZ. 3/8" = 1'-0"  
 DATE 11-20-63  
 DRAWN BY J.W.  
 CHECKED BY L.L.L.

**benesch**  
 engineers - scientists - planners  
 Alfred Benesch & Company  
 205 North Michigan Avenue, Suite 2400  
 Chicago, Illinois 60601  
 312-565-0450 Job No. 10093

FILE NAME =	USER NAME = tjenicke	DESIGNED - RDK	REVISED -
0162455.60J16.042.existplan.dgn		CHECKED - JDM	REVISED -
		DRAWN - MAK	REVISED -
		CHECKED - JDM	REVISED -

STATE OF ILLINOIS  
 DEPARTMENT OF TRANSPORTATION

EXISTING PLAN INFORMATION (7 OF 14)  
 STRUCTURE NO. 016-2455

FOR INFORMATION ONLY

F.A.P. RTE.	SECTION	COUNTY	TOTAL SHEETS	SHEET NO.
372	2013-038B-R	COOK	821	368
			CONTRACT NO. 60J16	
ILLINOIS FED. AID PROJECT				

SHEET NO. SCX7 OF SCX14 SHEETS

X:\100005\10093\Eng\_Docs\_Phase\_1\11\SN\_016\_2455\_1st\_Ave\_cover\_AT&SF\_PRR\Final\0162455-60J16\_042.existplan.dgn 2:38:19 PM 6/23/2014