

INDEX OF SHEETS


- S10-1 General Plan and Elevation
- S10-2 General Notes, Bill of Materials and Index of Sheets
- S10-3 Soil Borings

TOTAL BILL OF MATERIAL

ITEM DESCRIPTION	UNIT	TOTAL
Segmental Concrete Block Wall	Sq. Ft.	1,120

GENERAL NOTES:

1. The Contractor shall locate all existing utilities prior to construction. Any damage to utilities to be repaired at the Contractor's expense.
2. The segmental concrete block wall supplier shall design load transfer system to accommodate concrete pipes and catch basins.
3. The color of the blocks shall match the colors of natural limestone. The color mix shall also achieve the color variations present in natural limestone. This work shall be included in the pay item for Segmental Concrete Block Wall.
4. Final grading in front and behind the wall shall divert the surface run-off away from the wall. The cost of grading is included in the pay item for Segmental Concrete Block Wall. See civil plans for Landscaping details.
5. Column tube or pvc pipe shall be 6-inch min. in diameter greater than the post. The length shall be 3'-0" min. for guardrail Type A and 2'-0" min. for split rail fence.

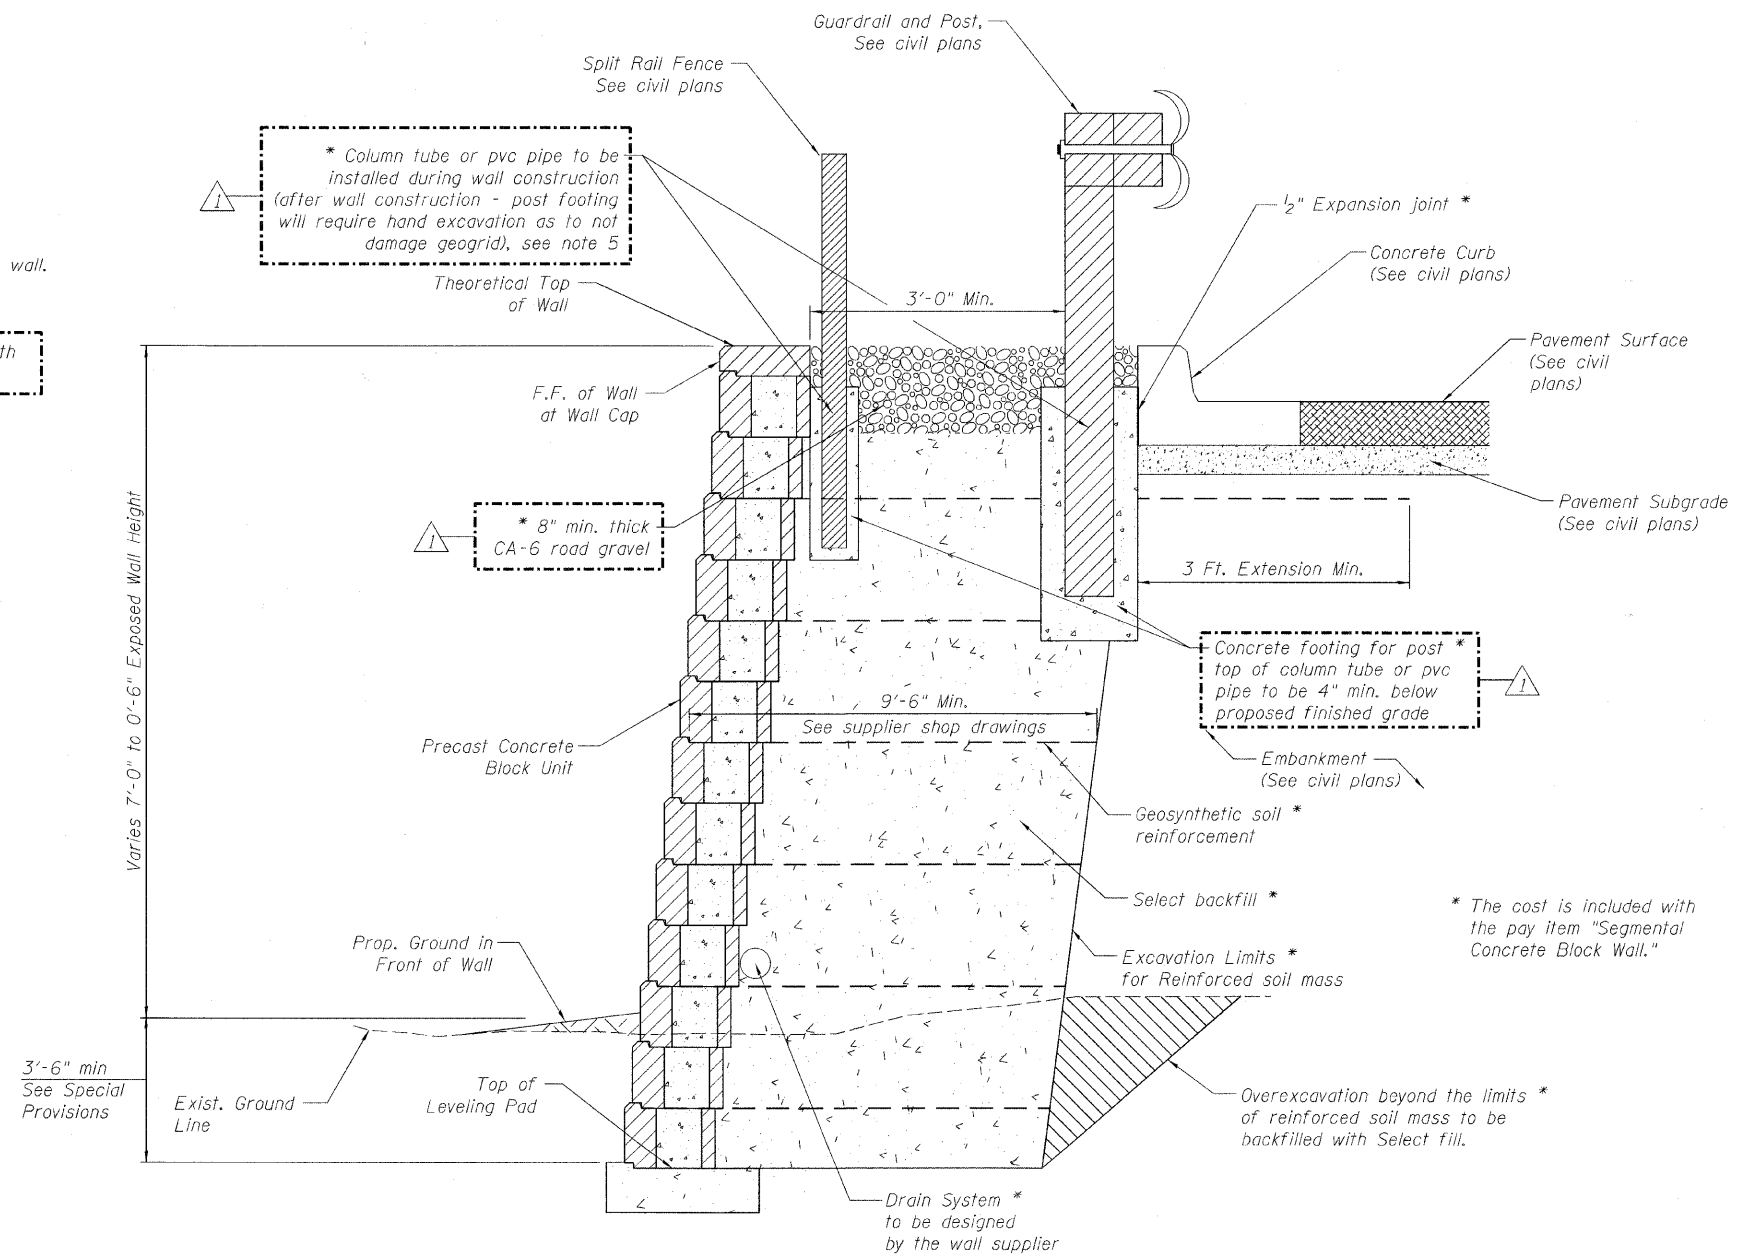

TYPICAL SECTION THRU CONCRETE BLOCK WALL

FILE NAME =	USER NAME =	DESIGNED - EM	REVISED Δ 8-26-2011 E.K.M	STATE OF ILLINOIS DEPARTMENT OF TRANSPORTATION	GENERAL NOTES, BILL OF MATERIALS AND INDEX OF SHEETS STRUCTURE NO. 000-0000	F.A.P. RTE. =	SECTION	COUNTY	TOTAL SHEETS	SHEET NO.	
	PLOT SCALE =	CHECKED - JMH	REVISED -			330	128R-3	LAKE	518	350	
	PLOT DATE =	DRAWN - DR	REVISED -			CONTRACT NO. 60953					
		CHECKED - JMH	REVISED -			ILLINOIS FED. AID PROJECT					