TRANSPORTATION BULLETIN



ADDENDUM NO. 1

Dated: September 2, 2011

For: Transportation Bulletin Volume 14, No. 33 Dated: August 19, 2011 Letting Date: September 23, 2011

Item No. 1A - Replace Navaids and Airfield Lighting

Fairfield Municipal Airport Fairfield, Illinois Wayne County Illinois Project No.: FWC-4105 Federal Project No. 3-17-0043-B12 Contract No. FA005

REASON FOR ADDENDUM:

Schedule of Prices Revised: AR108158 1/C #8 5KV UG CABLE IN UD changes in quantity from 1460 L.F. to 1630 L.F. Construction Plan Revisions

TO ALL PLAN HOLDERS:

Replace Schedule of Prices dated 08/11/11 with revised Schedule of Prices dated 8/30/11. <u>Return with bid</u>. Bidders are cautioned to verify the correct quantity if utilizing CBIDS.

CONSTRUCTION PLANS

Revised Plan Sheet 2 of 32.

The Quantity of Item AR108158 1/C #8 5KV UG CABLE IN UD changed from 1460 L.F. to 1630 L.F. Replace Plan Sheet 2 with the Revised Plan Sheet 2 dated 8/23/2011.

Revised Plan Sheet 9 of 32.

The Location of the Proposed L-806 Supplemental Wind Cone has changed from Station 126+24, 265' Right to Station 121+24, 280' Right. A note was added in regard to earth material to build up the area around the REIL slave unit. Replace Plan Sheet 9 with the Revised Plan Sheet 9 dated 8/23/2011.


Revised Plan Sheet 12 of 32.


The Location of the Proposed L-807 Primary Wind Cone has changed from Station 11+00, 215' Right to Station 11+00, 285' Right. Replace Plan Sheet 12 with the Revised Plan Sheet 12 dated 8/23/2011.

END OF ADDENDUM No. 1

	SUMMARY OF QUANTITIES			
ITEM NO.	DESCRIPTION	UNIT	TOTAL QUANTITIES	AS BUILT QUANTITIES
AR106930	REPLACE LIGHT FIXTURE	EACH	2	
AR107408	L-806 WIND CONE-8' LIGHTED	EACH	1	
AR107712	L-807 WIND CONE-12' LIGHTED	EACH	1	
AR107900	REMOVE WIND CONE	EACH	1	
AR108084	1/C #4 XLP-USE	L.F.	1,530	
AR108086	1/C #6 XLP-USE	L.F.	2,100	
AR108158	1/C #8 5 KV UG CABLE IN UD	L.F.	(1,630)	
AR108654	3/C #4 600V UG CABLE IN UD	L.F.	5,050	
AR108656	3/C #6 600V UG CABLE IN UD	L.F.	2,100	
AR109200	INSTALL ELECTRICAL EQUIPMENT	L.S.	1	
AR110014	4" DIRECTIONAL BORE	L.F.	1,000	
AR110610	ELECTRICAL HANDHOLE	EACH	4	
AR125540	MI THRESHOLD LIGHT STAKE MTD	EACH	8	
AR125565	SPLICE CAN	EACH	4	
AR125610	REILS	PAIR	1	
AR125901	REMOVE STAKE MOUNTED LIGHT	EACH	8	
AR125907	REMOVE REILS	PAIR	1	
AR125989	REFURBISH PLASI	EACH	2	
AR150510	ENGINEER'S FIELD OFFICE	L.S.	1	
AR150520	MOBILIZATION	L.S.	1	

	FAO		DATE REVISION \$/9/11 ART08189 0TY. UPDATE \$/23/11 ADDENDUM NO. 1	
	INDEX TO SHEETS		Fairfield Municipal Airport Fairfield, Illinois	
			Je construction	, , ,
SHEET NO.	DESCRIPTION		eld municipal aif Fairfield, Illinois	-
1	COVER SHEET		₽Ă.	Č
2	SUMMARY OF QUANTITIES AND INDEX TO SHEETS PROPOSED SAFETY PLAN		렷 그	-
3 4	EXISTING ELECTRICAL PLAN FOR RWY. 9–27 STA. 115+00 TO 129+00		S S S S S S S S S S S S S S S S S S S	-
5	EXISTING ELECTRICAL PLAN FOR RWY. 9–27 STA. 129+00 TO 142+50		ΞĒ	
6	EXISTING ELECTRICAL PLAN FOR RWY. 9-27 STA. 142+50 TO 156+75		ΣË	
7	EXISTING ELECTRICAL PLAN FOR RWY. 18-36 STA. 0+50 TO 14+50		JŘ	ļ
8 9	EXISTING ELECTRICAL PLAN FOR RWY. 18-36 STA. 14+50 TO 21+50 PROPOSED ELECTRICAL PLAN FOR RWY. 9-27 STA. 115+00 TO 129+00		朣ᅜ	
10	PROPOSED ELECTRICAL PLAN FOR RWY. 9–17 STA. 129+00 TO 142+50		цц.	
11	PROPOSED ELECTRICAL PLAN FOR RWY. 9–27 STA. 142+50 TO 156+75		FA	
12	PROPOSED ELECTRICAL PLAN FOR RWY. 18-36 STA. 0+50 TO 14+50		_	
13 14	PROPOSED ELECTRICAL PLAN FOR RWY. 18–36 STA. 14+50 TO 21+50 ELECTRICAL DETAILS SHEET 1			
15	ELECTRICAL DETAILS SHEET 2			
16	L-806 WIND CONE ELEVATION DETAIL			11
17	L-807 WIND CONE ELEVATION DETAIL		_	31/
18 19	REIL DETAILS REFURBISH PLASI WIRING DETAILS AND NOTES		Project No. 11A0016D 000 R-002FLP.DWG NOT TO SCALE 07/01/2011	05/31/ 05/31/
20	ELECTRICAL NOTES SHEET 1		Mo. 11A0016D C R-002FLP.DWG NOT TO SCALE 07/01/2011	
21	ELECTRICAL NOTES SHEET 2		No. 1140016E R-002FLP.DV NOT TO SCA 07/01/2011	KNL
22	ELECTRICAL LEGEND AND ABBREVIATIONS		No. 11A0C R-002FL NOT TO 07/01/2	. <u>Z</u> 8
23 24	VAULT FLOOR PLAN EXISTING ELECTRICAL ONE LINE DIAGRAM FOR VAULT AND AIRFIELD		O N N P	
25	PROPOSED ELECTRICAL ONE LINE FOR VAULT AND AIRFIELD - SHEET 1		ne Proje	LAYOUT DRAWN
26	PROPOSED ELECTRICAL ONE LINE FOR VAULT AND AIRFIELD – SHEET 2		<u>Hanson F</u> <u>Filename</u> Scale Date	LAYOU DRAWI
27	PROPOSED AIRFIELD LIGHTING CONTROL WIRING SCHEMATIC		1 1 0 0	
28 29	LIGHTING CONTACTOR PANEL DETAIL LIGHTING CONTACTOR PANEL SCHEMATIC		2 =	203
30	TRANSFORMER WIRING DIAGRAMS & LEGEND PLATE SCHEDULE		C 🖁	8 Inc
31	GROUNDING DETAILS			71, 77
32	GROUNDING NOTES			th Str (th Str 6270 x (21
			HANSON FOR Professional Services Inc. 2011	rotessiona 5 South Six eld, Illinois 8-2450 Fa w hanson-I
				Hanson Professional Services Inc. 1525 South Sixth Street Springfield, Illinois 62703-2886 Phi. (217) 788-2450 Fax: (217) 788-2503 www.hanson-Inc.com
			dr.	
			REPLACE NAVAIDS & AIRFIELD LIGHTING	SUMMARY OF QUANTITIES AND INDEX TO SHEETS
			₹ B	SH
			Z – I	٥p
			щР	ĺΣ
			Q⊟	ΥΥ ND
			<u>ا</u> بلاً ا	₹ P
			₩ E	AN SUN
			ш `	55
	ADDENDUM NO	. 1	2)

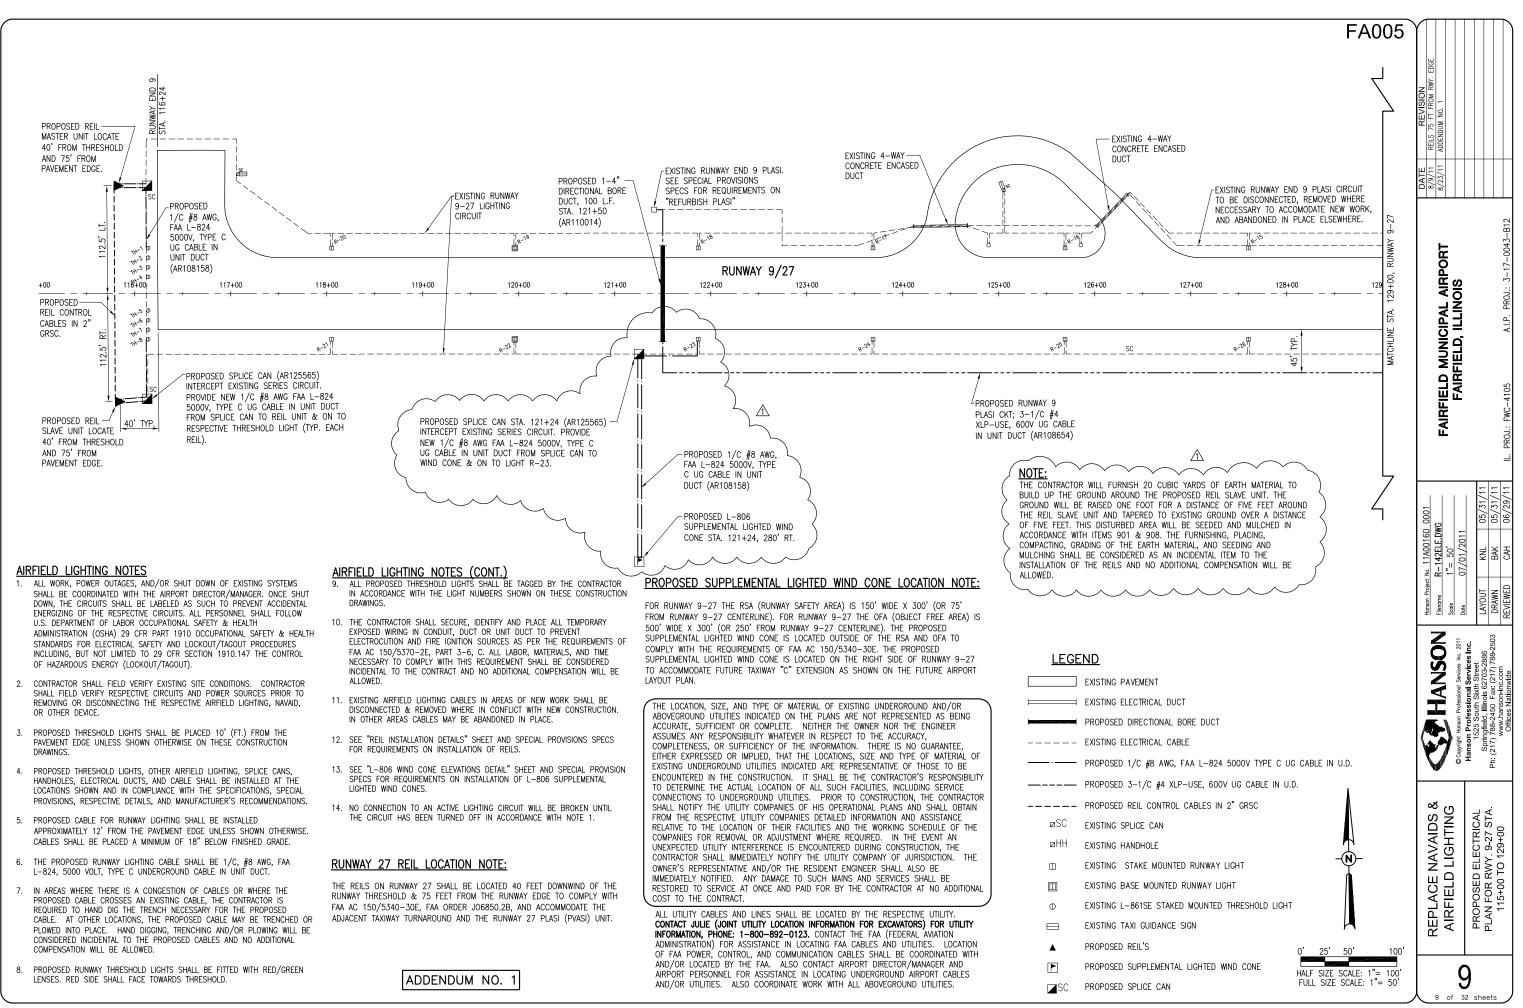

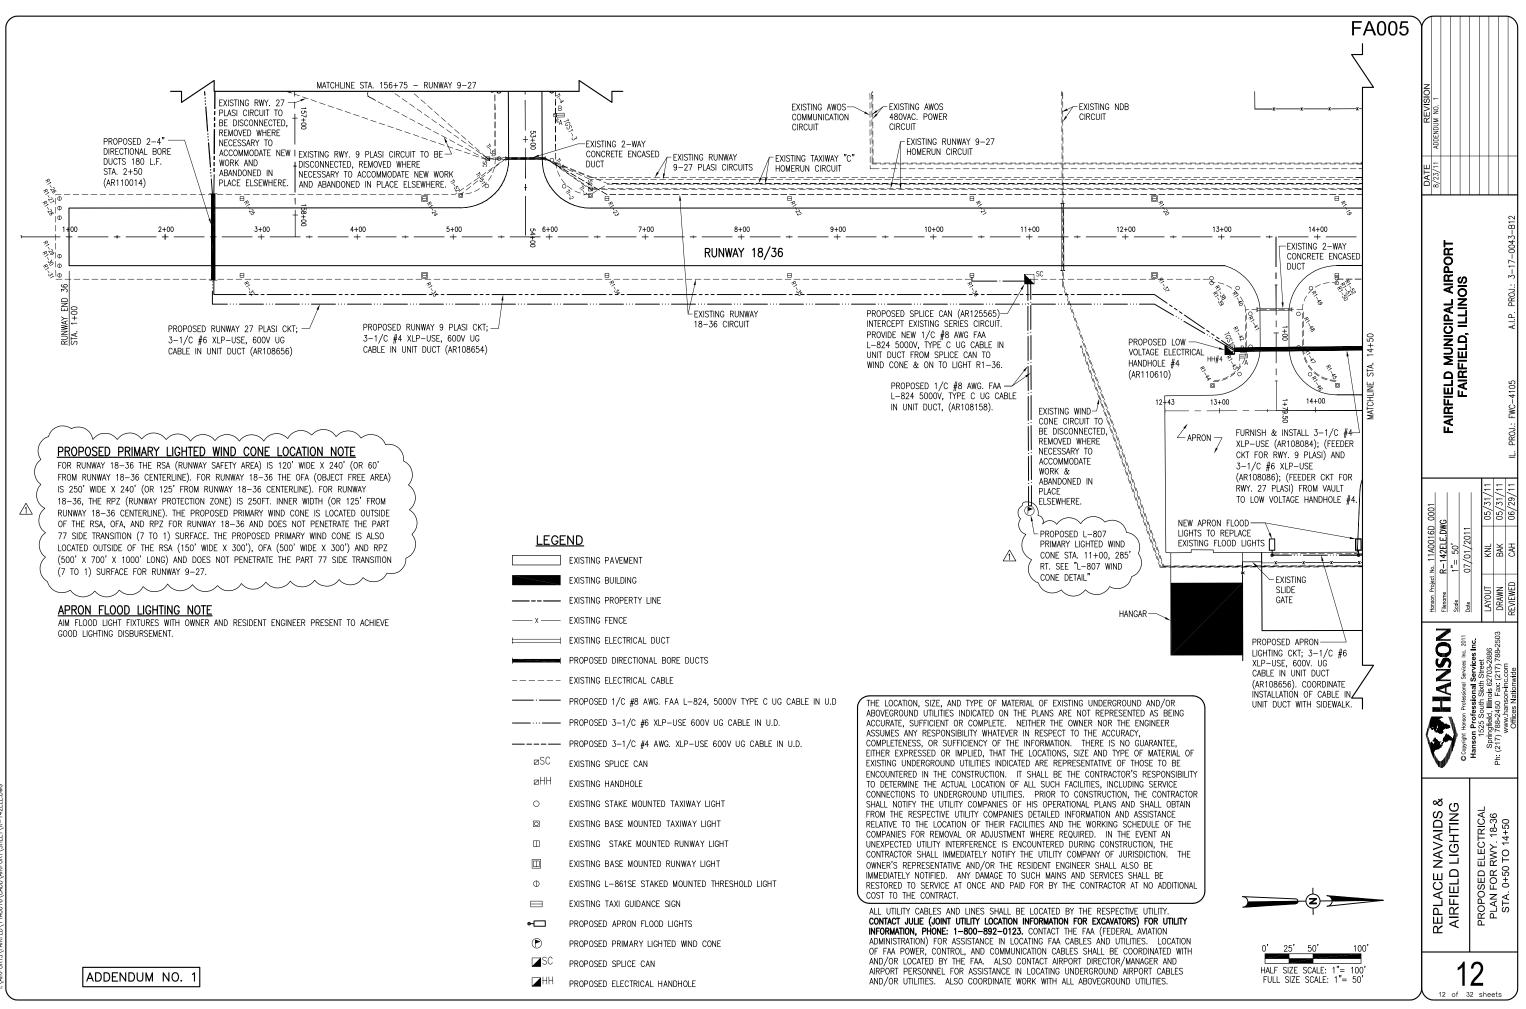

STATE JOB #-

ILLINOIS DEPARTMENT OF TRANSPORTATION ECMS002 DTGECM03 ECMR003 PAGE SCHEDULE OF PRICES CONTRACT NUMBER - FA005

RUN DATE - 08/30/11 RUN TIME - 190058

COUNTY N WAYNE				3-	FED PROJEC 17-0043-B12	T	ILL PROJECT FW-C -4105	
ITEM NUMBER	PAY ITEM DESCRIPTION	UNIT OF MEASURE	QUANTITY		UNIT PRICE DOLLARS CENTS		TOTAL PRICE DOLLARS CTS	
AR106930	REPLACE LIGHT FIXTURE	EACH	2	.000 ×		=		
AR107408	L-806 WIND CONE-8' LIGHTED	EACH	1	.000 ×		=====		
AR107712	L-807 WIND CONE-12' LIGHTED	EACH	1	.000 ×	(=		
AR107900	REMOVE WIND CONE	EACH	1	.000 X		=		
AR108084	1/C #4 XLP-USE	L.F.	1,530	.000 X		=		
AR108086	1/C #6 XLP-USE	L.F.	2,100	.000 X		=		
AR108158	1/C #8 5 KV UG CABLE IN UD	L.F.	1,630	.000 X		=		
AR108654	3/C #4 600 V UG CABLE IN UD	L.F.	5,050	.000 ×		=		
AR108656	3/C #6 600 V UG CABLE IN UD	L.F.	2,100	.000 X		=		
AR109200	INSTALL ELECTRICAL EQUIPMENT	L.S.	1	.000 X		=		
AR110014	4" DIRECTIONAL BORE	L.F.	1,000	.000 X		=		
AR110610	ELECTRICAL HANDHOLE	EACH	4	.000 X		=		
AR125540	MI THRESHOLD LIGHT STAKE MTD	EACH	8	.000 X		=		
AR125565	SPLICE CAN	EACH	4	.000 X		=		
AR125610	REILS	PAIR	1	.000 X		=		

1

FAIRFIELD MUNICIPAL WAYNE

ILLINOIS DEPARTMENT OF TRANSPORTATION ECMS002 DTGECM03 ECMR003 PAGE SCHEDULE OF PRICES CONTRACT NUMBER - FA005

2 RUN DATE - 08/30/11 RUN TIME - 190058

PAY ITEM DESCRIPTION			UNIT PRICE		TOTAL PRICE	
PAT TIEW DESCRIPTION	MEASURE	QUANTITY	DOLLARS	CENTS	DOLLARS	CTS
OVE STAKE MOUNTED LIGHT	EACH	8.000 X		=		
OVE REILS	PAIR	1.000 X		=		
URBISH PLASI	EACH	2.000 X		=		
INEER'S FIELD OFFICE	L.S.	1.000 X		=		
ILIZATION	L.S.	1.000 X		=		
(OVE STAKE MOUNTED LIGHT OVE REILS URBISH PLASI INEER'S FIELD OFFICE ILIZATION	OVE REILS PAIR URBISH PLASI EACH INEER'S FIELD OFFICE L.S.	OVE REILS PAIR 1.000 X URBISH PLASI EACH 2.000 X INEER'S FIELD OFFICE L.S. 1.000 X	OVE REILSPAIR1.000 XURBISH PLASIEACH2.000 XINEER'S FIELD OFFICEL.S.1.000 X	OVE REILSPAIR1.000 X=URBISH PLASIEACH2.000 X=INEER'S FIELD OFFICEL.S.1.000 X=	OVE REILSPAIR1.000 X=URBISH PLASIEACH2.000 X=INEER'S FIELD OFFICEL.S.1.000 X=

TOTAL

S

NOTE:

- 1. EACH PAY ITEM SHOULD HAVE A UNIT PRICE AND A TOTAL PRICE.
- 2. THE UNIT PRICE SHALL GOVERN IF NO TOTAL PRICE IS SHOWN OR IF THERE IS A DISCREPANCY BETWEEN THE PRODUCT OF THE UNIT PRICE MULTIPLIED BY THE QUANTITY.
- 3. IF A UNIT PRICE IS OMITTED, THE TOTAL PRICE WILL BE DIVIDED BY THE QUANTITY IN ORDER TO ESTABLISH A UNIT PRICE.
- 4. A BID MAY BE DECLARED UNACCEPTABLE IF NEITHER A UNIT PRICE NOR A TOTAL PRICE IS SHOWN.