



F.A.I.	SECTION	COUNTY	TOTAL SHEETS	SHEET NO.
94/90	*	COOK	598	226
STA.		TO STA.		
FED. ROAD DIST. NO.	ILLINOIS	FED. AID PROJECT		
62302		* (1818, ETC, 2324.6-1)R-9		

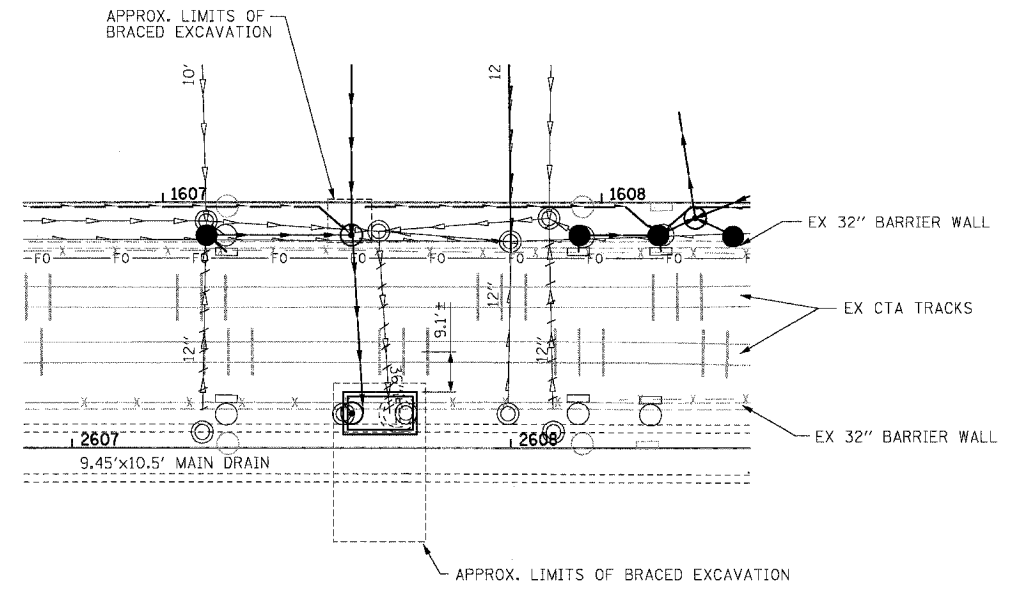

JUNCTION CHAMBER TYPE 2
NO. 41-01

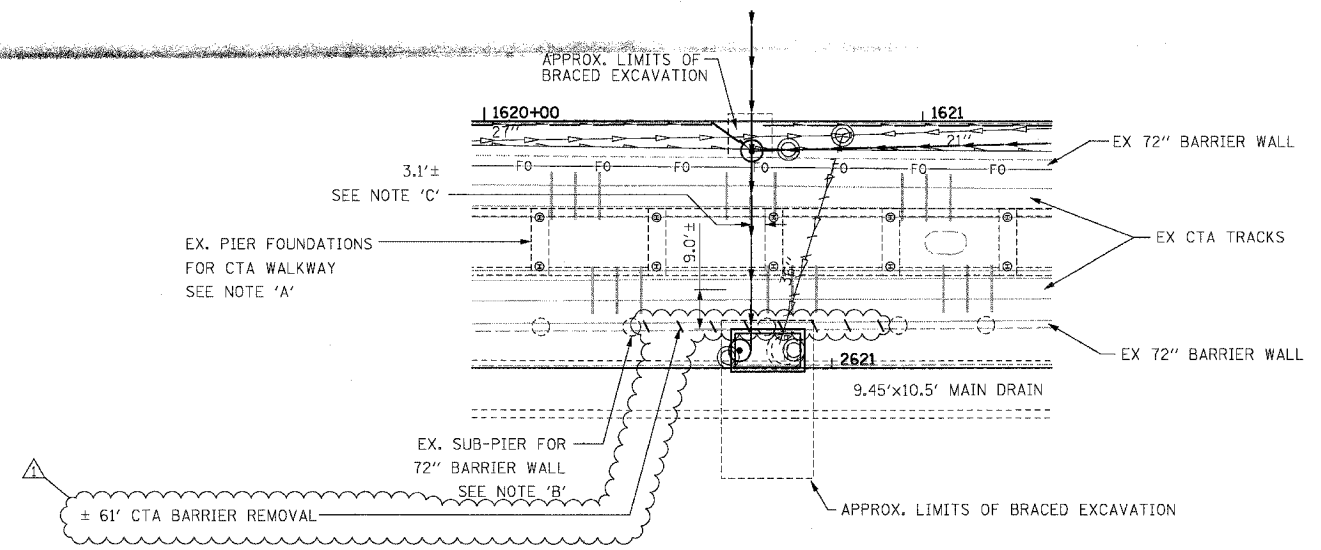

JUNCTION CHAMBER TYPE 2
NO. 44-01

- NOTES:
1. CONTRACTOR MUST FIELD VERIFY LOCATION OF EXISTING DROP MANHOLES AND ADJUST LOCATIONS OF JACKING PIT AND STORM SEWER JACKING AS REQUIRED.
 2. SEE SHEET 223 FOR DETAILS OF BRACED EXCAVATION
 3. SEE SHEETS 453 THROUGH 474 FOR DETAILS OF JUNCTION CHAMBER TYPE 2
 4. SEE DRAINAGE PLANS FOR DETAILS OF OTHER DRAINAGE STRUCTURES
 5. SEE SPECIAL PROVISIONS FOR REQUIREMENTS FOR WORK IN AND AROUND THE CTA OPERATING AREA.
 6. DIMENSIONS PROVIDED BETWEEN JUNCTION CHAMBER AND CENTERLINE OF NEAR CTA TRACK BASED ON LIMITED AVAILABLE INFORMATION. CONTRACTOR MUST FIELD VERIFY LOCATIONS AND ADJUST JACKING PIT AS NECESSARY.

- NOTES:
- A. SEE SHEET 227 TO 232 FOR DETAILS OF EXISTING CTA WALKWAY.
 - B. SEE SHEETS 425 THROUGH 434 FOR DETAILS OF EXISTING 72" BARRIER WALL. ALL SUB-PIER REMOVAL NECESSARY FOR CONSTRUCTION OF JACKING AND RECEIVING PITS MUST BE INCLUDED IN THE COST OF BRACED EXCAVATION.
 - C. PIER LOCATIONS FOR EX. CTA WALKWAY BASED ON RECORD DRAWINGS. CONTRACTOR MUST FIELD VERIFY PIER LOCATIONS AND ADJUST JACKING PIT AND STORM SEWER JACKING AS NECESSARY.

REVISIONS	
NAME	DATE
ADDENDUM 1	8/12/05

DDP03

ILLINOIS DEPARTMENT OF TRANSPORTATION
F.A.I. 94/90 (DAN RYAN EXPRESSWAY)
31ST STREET TO 71ST STREET
SB EXPRESS LANE RECONSTRUCTION
STORM SEWER JACKING AND
JUNCTION CHAMBER DETAIL PLANS

SCALE: 1"=20'
DATE: 07/07/05

DRAWN BY: RGR
CHECKED BY: DDM

BOWMAN, BARRETT & ASSOCIATES INC.
CONSULTING ENGINEERS
Chicago, Illinois
312.228.0100
www.bbandainc.com

PAGE 06 OF 07 VIEWS SHEETS 662-56040451
06/11/2005 06:03:19 PM