
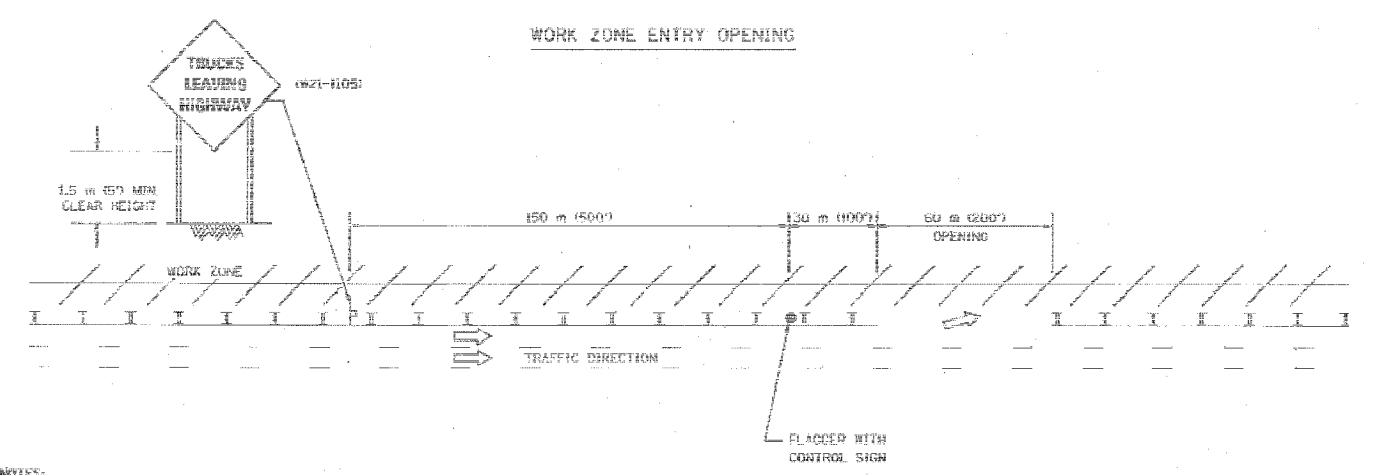


P.A. DIST.	SECTION	COUNTY	TOTAL SHEETS	SHEET NO.
			598	501
STA.		TO STA.		
FOR ROAD DIST. NO.		BARRIS FED. AID PROJECT		

SIGNING FOR FLAGGING OPERATIONS AT WORK ZONE OPENINGS

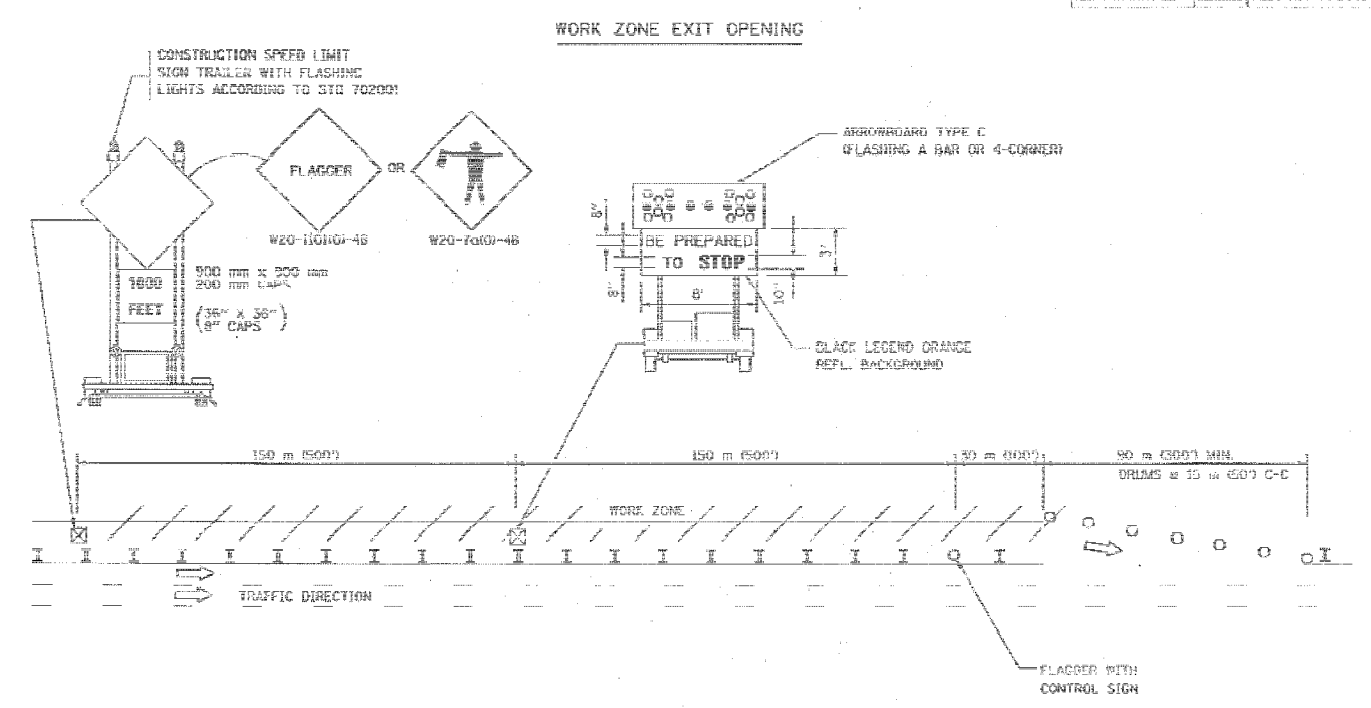

NOTES:

1. The Arrowboard, the Flagger Ahead trailer mounted sign, and the Trucks Leaving Highway sign shall be removed or turned away from traffic and the exit and entry openings shall be closed when the flagging operation ceases.
2. Work Zone Exit Openings should be a minimum of one half mile apart.
3. Exiting the work zone at any place other than at a Work Zone Exit Opening will be prohibited.
4. All vehicles shall enter the work zone at entry openings, using their turn signals to warn motorists.

ALL DIMENSIONS ARE IN MILLIMETERS (INCHES) UNLESS OTHERWISE SHOWN


ILLINOIS DEPARTMENT OF TRANSPORTATION

SIGNING FOR FLAGGING OPERATIONS AT WORK ZONE OPENINGS


REVISIONS	
NAME	DATE
DWS	8/98
JMF	4/03

SCALE: NONE
 DATE: 05/08/2003
 DRAWN BY: CADD
 CHECKED BY: TC-18

PROFILE SURVEYED BY DATE
 P. A. RICHARDSON
 NOTE BOOK NO. 1001
 STRUCTURE NO. 1001
 STRUCTURE MOTIVE CHRG.

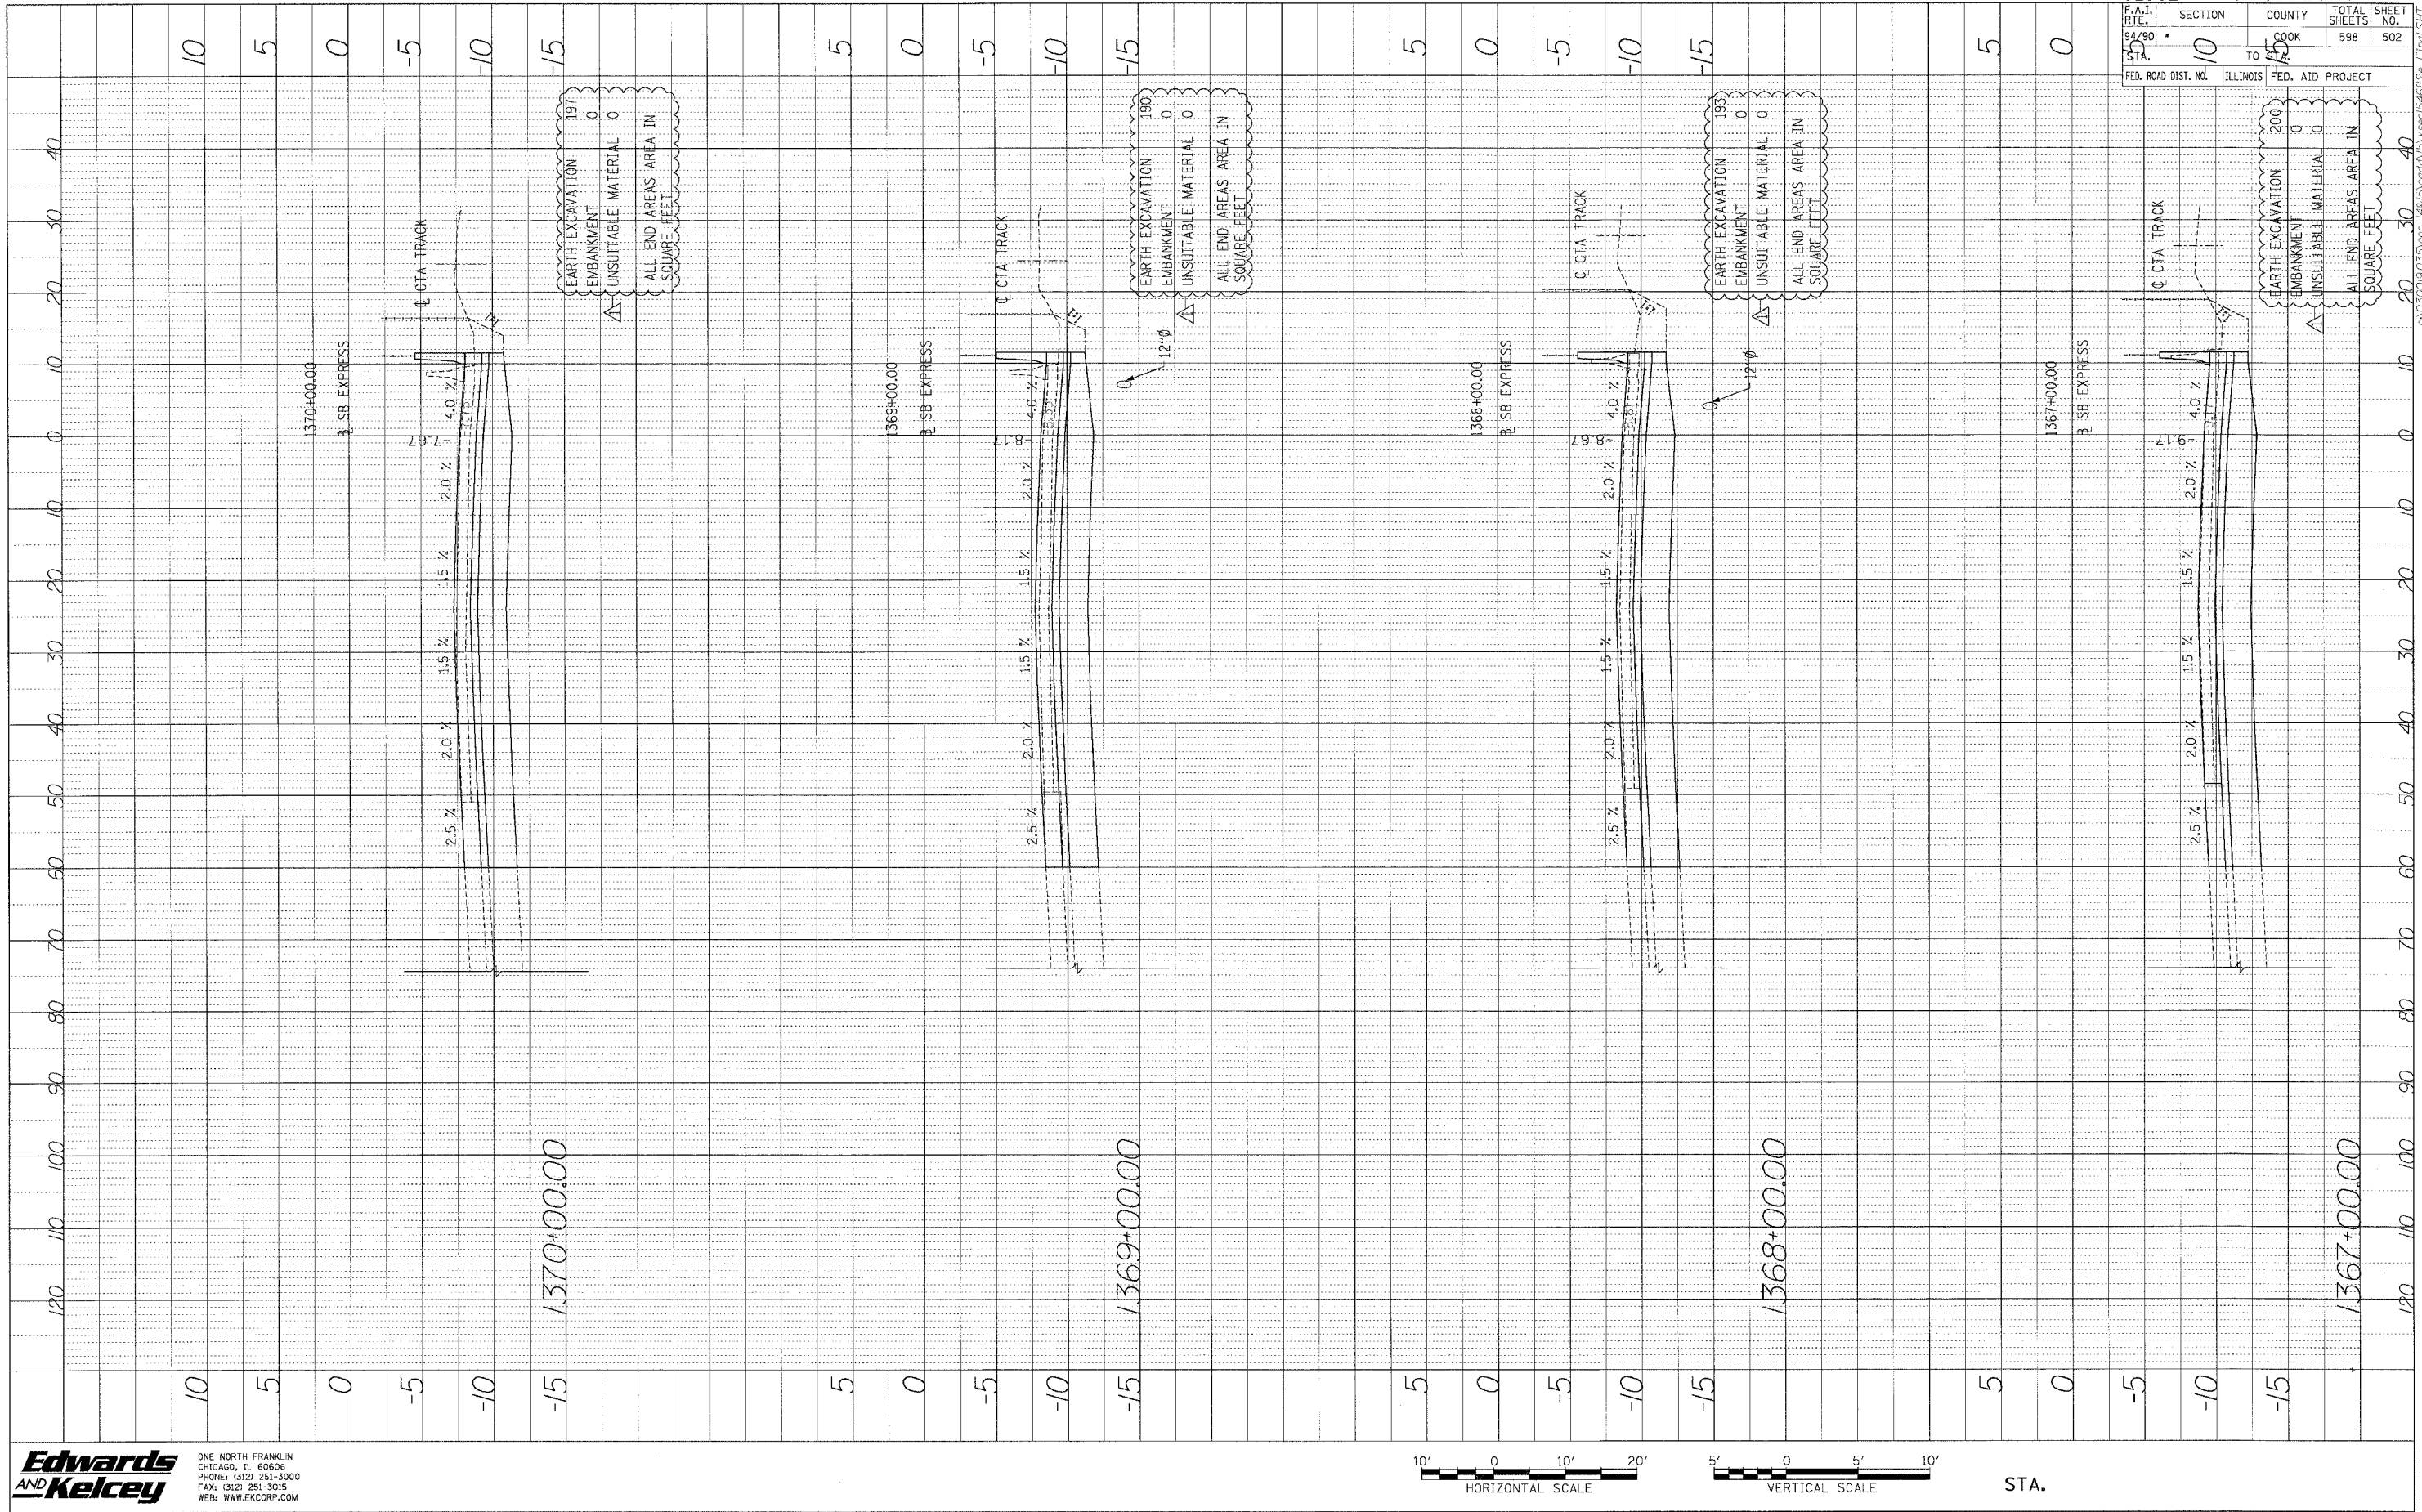

Edwards AND Kelcey
 ONE NORTH FRANKLIN
 CHICAGO, IL 60606
 PHONE: (312) 251-3000
 FAX: (312) 251-3015
 WEB: WWW.EDKCORP.COM

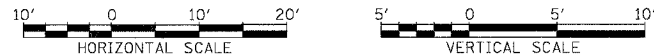


STA.

62302 • (1818, ETC, 2324.6-IPR-9	
FED. AID PROJECT NO. 10	SECTION COUNTY TOTAL SHEETS NO. 598 502
FED. ROAD DIST. NO. ILLINOIS	FED. AID PROJECT

P:\03\030303\0303\0303.dwg 14815\030303\0303.dwg 14815\030303\0303.dwg

PROFILE SUBMITTED BY	DATE
NO. 10	
NO. 5	
NO. 0	
NO. -5	
NO. -10	
NO. -15	

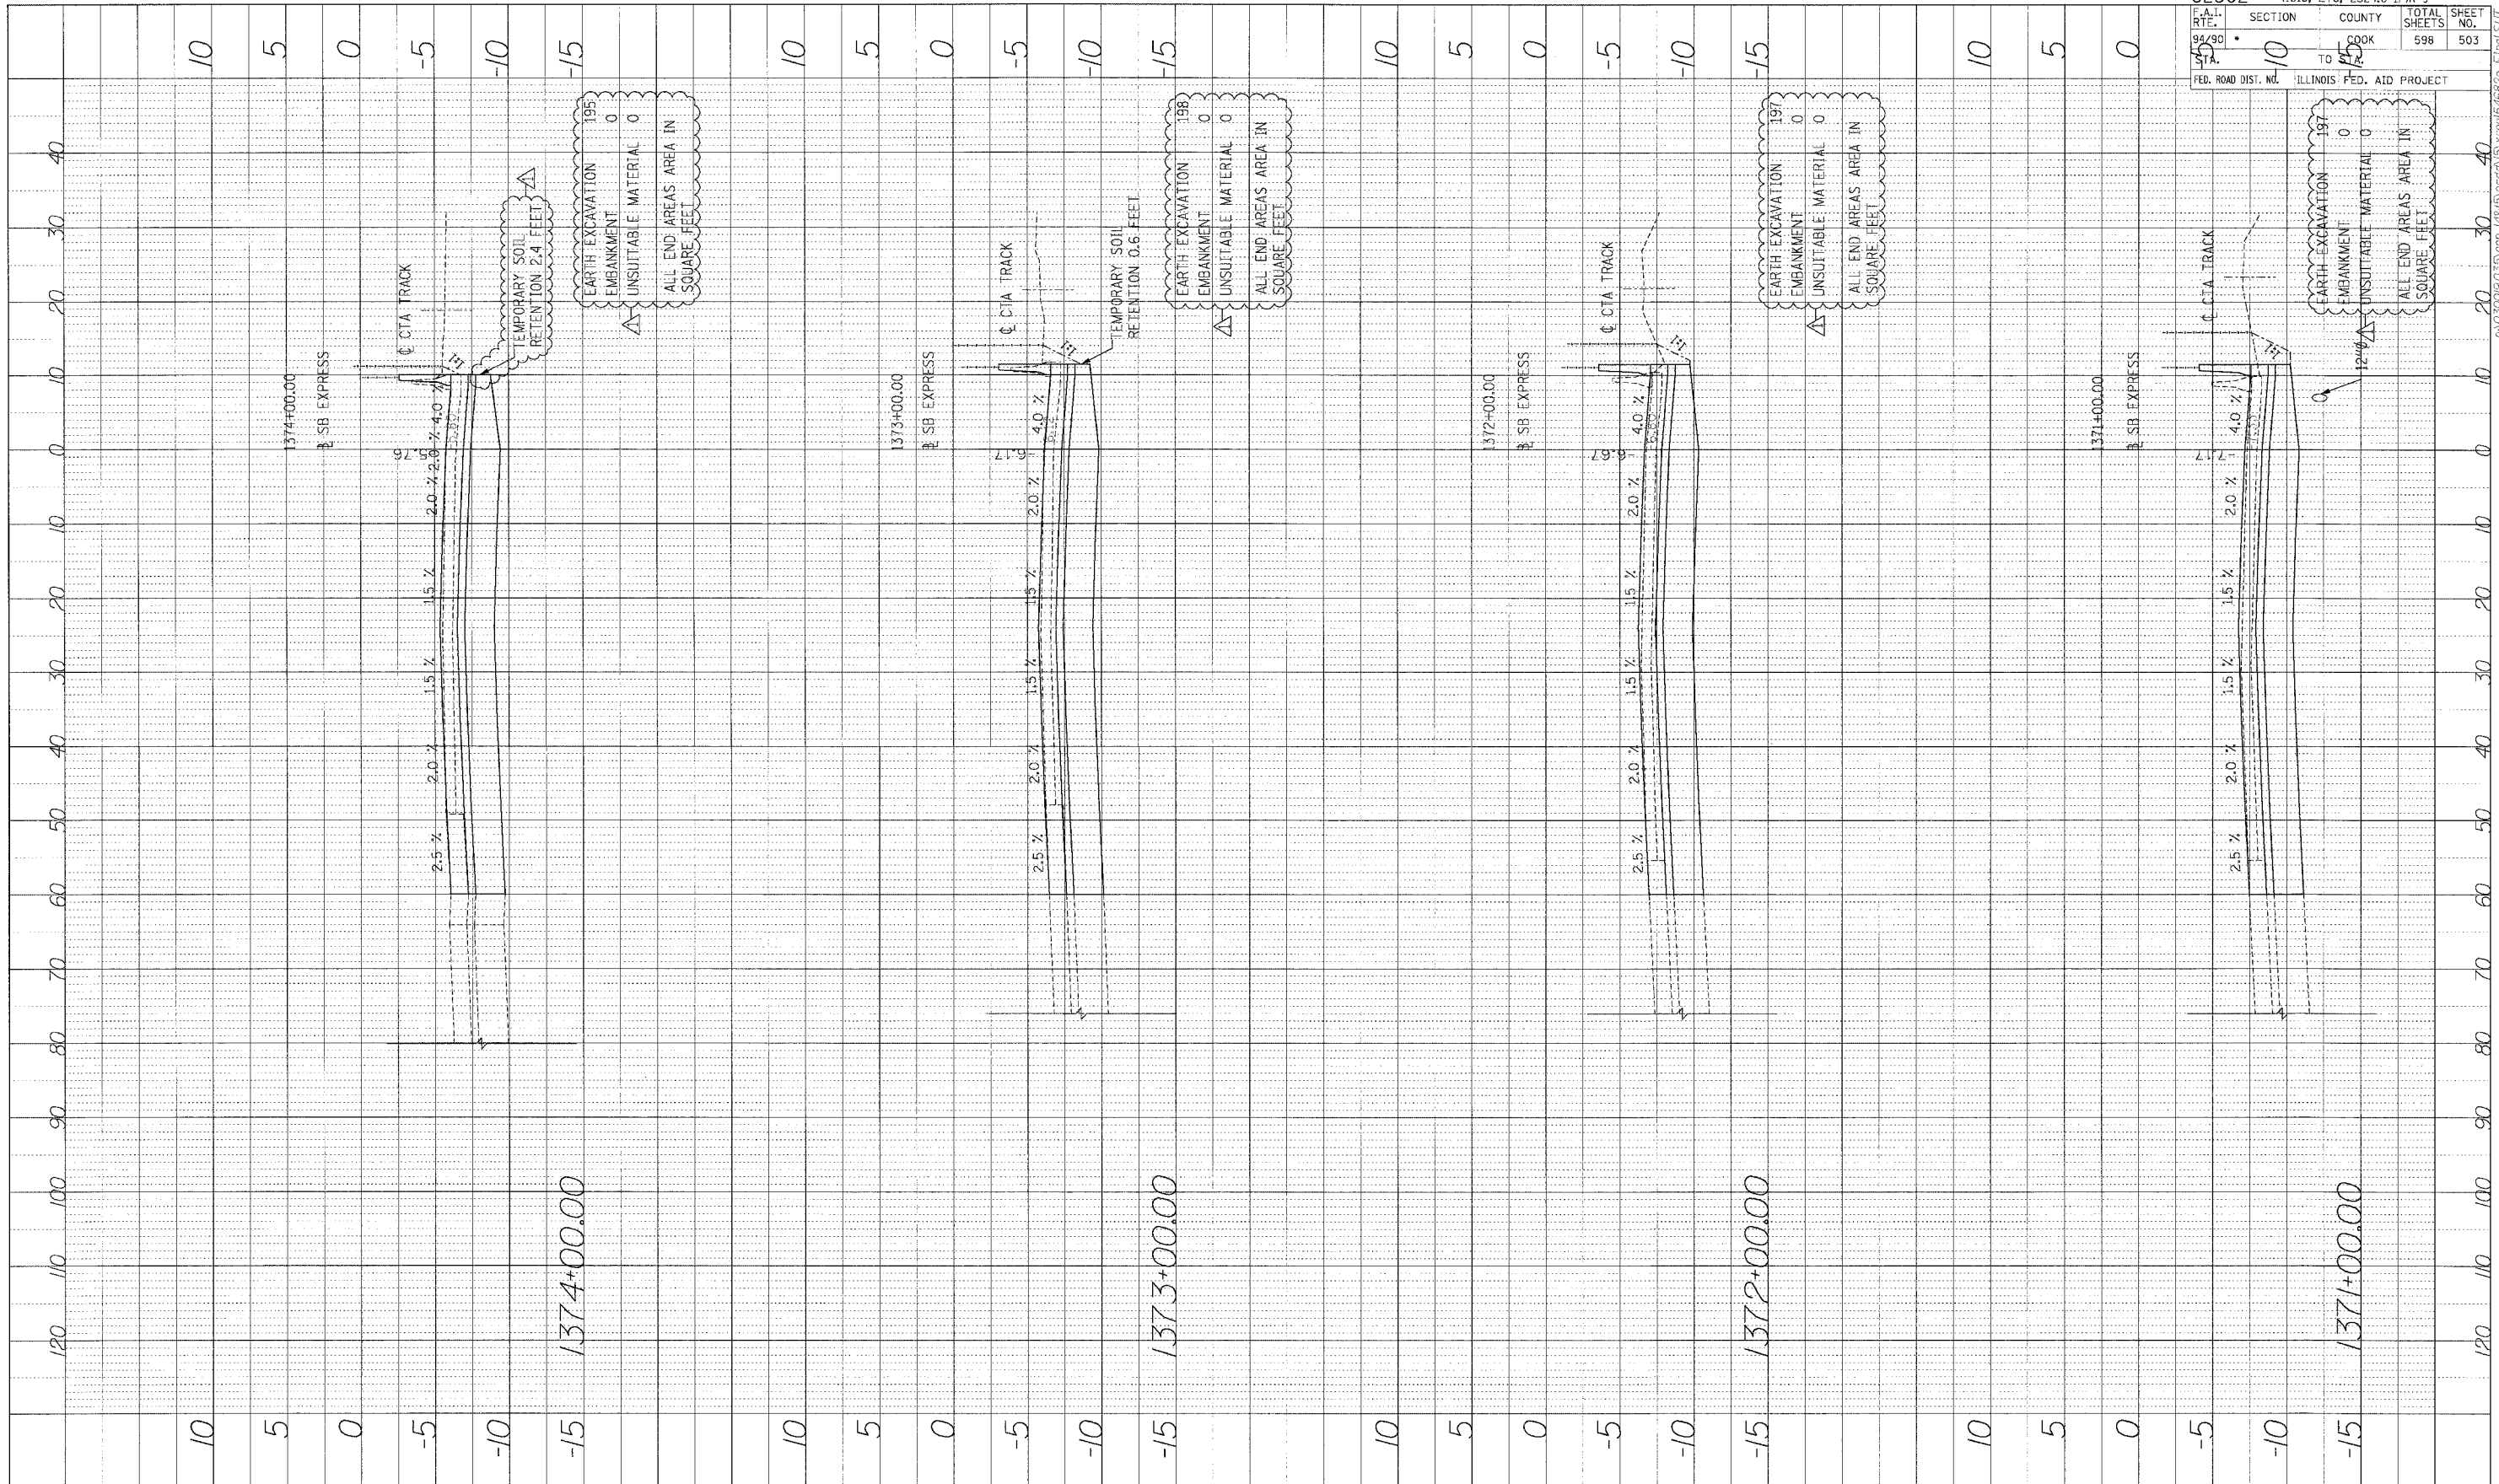

62302	SECTION	COUNTY	TOTAL SHEETS	SHEET NO.
92+90	10	COOK	598	503
STA.	TO	FROM		
	10	10		
ILLINOIS FED. AID PROJECT				


Edwards AND Kelcey
 ONE NORTH FRANKLIN
 CHICAGO, IL 60606
 PHONE: (312) 251-3000
 FAX: (312) 251-3015
 WEB: WWW.EKCORP.COM



STA.


P:\030019103\Drawings\1815\1815.dwg 1/15/03 10:58:28 AM

PROJECT: SURVEYED BY: DATE:
 NOTE BOOK: DRAWS CHECKED BY:
 NO. STRUCTURE INDICATING CHKS

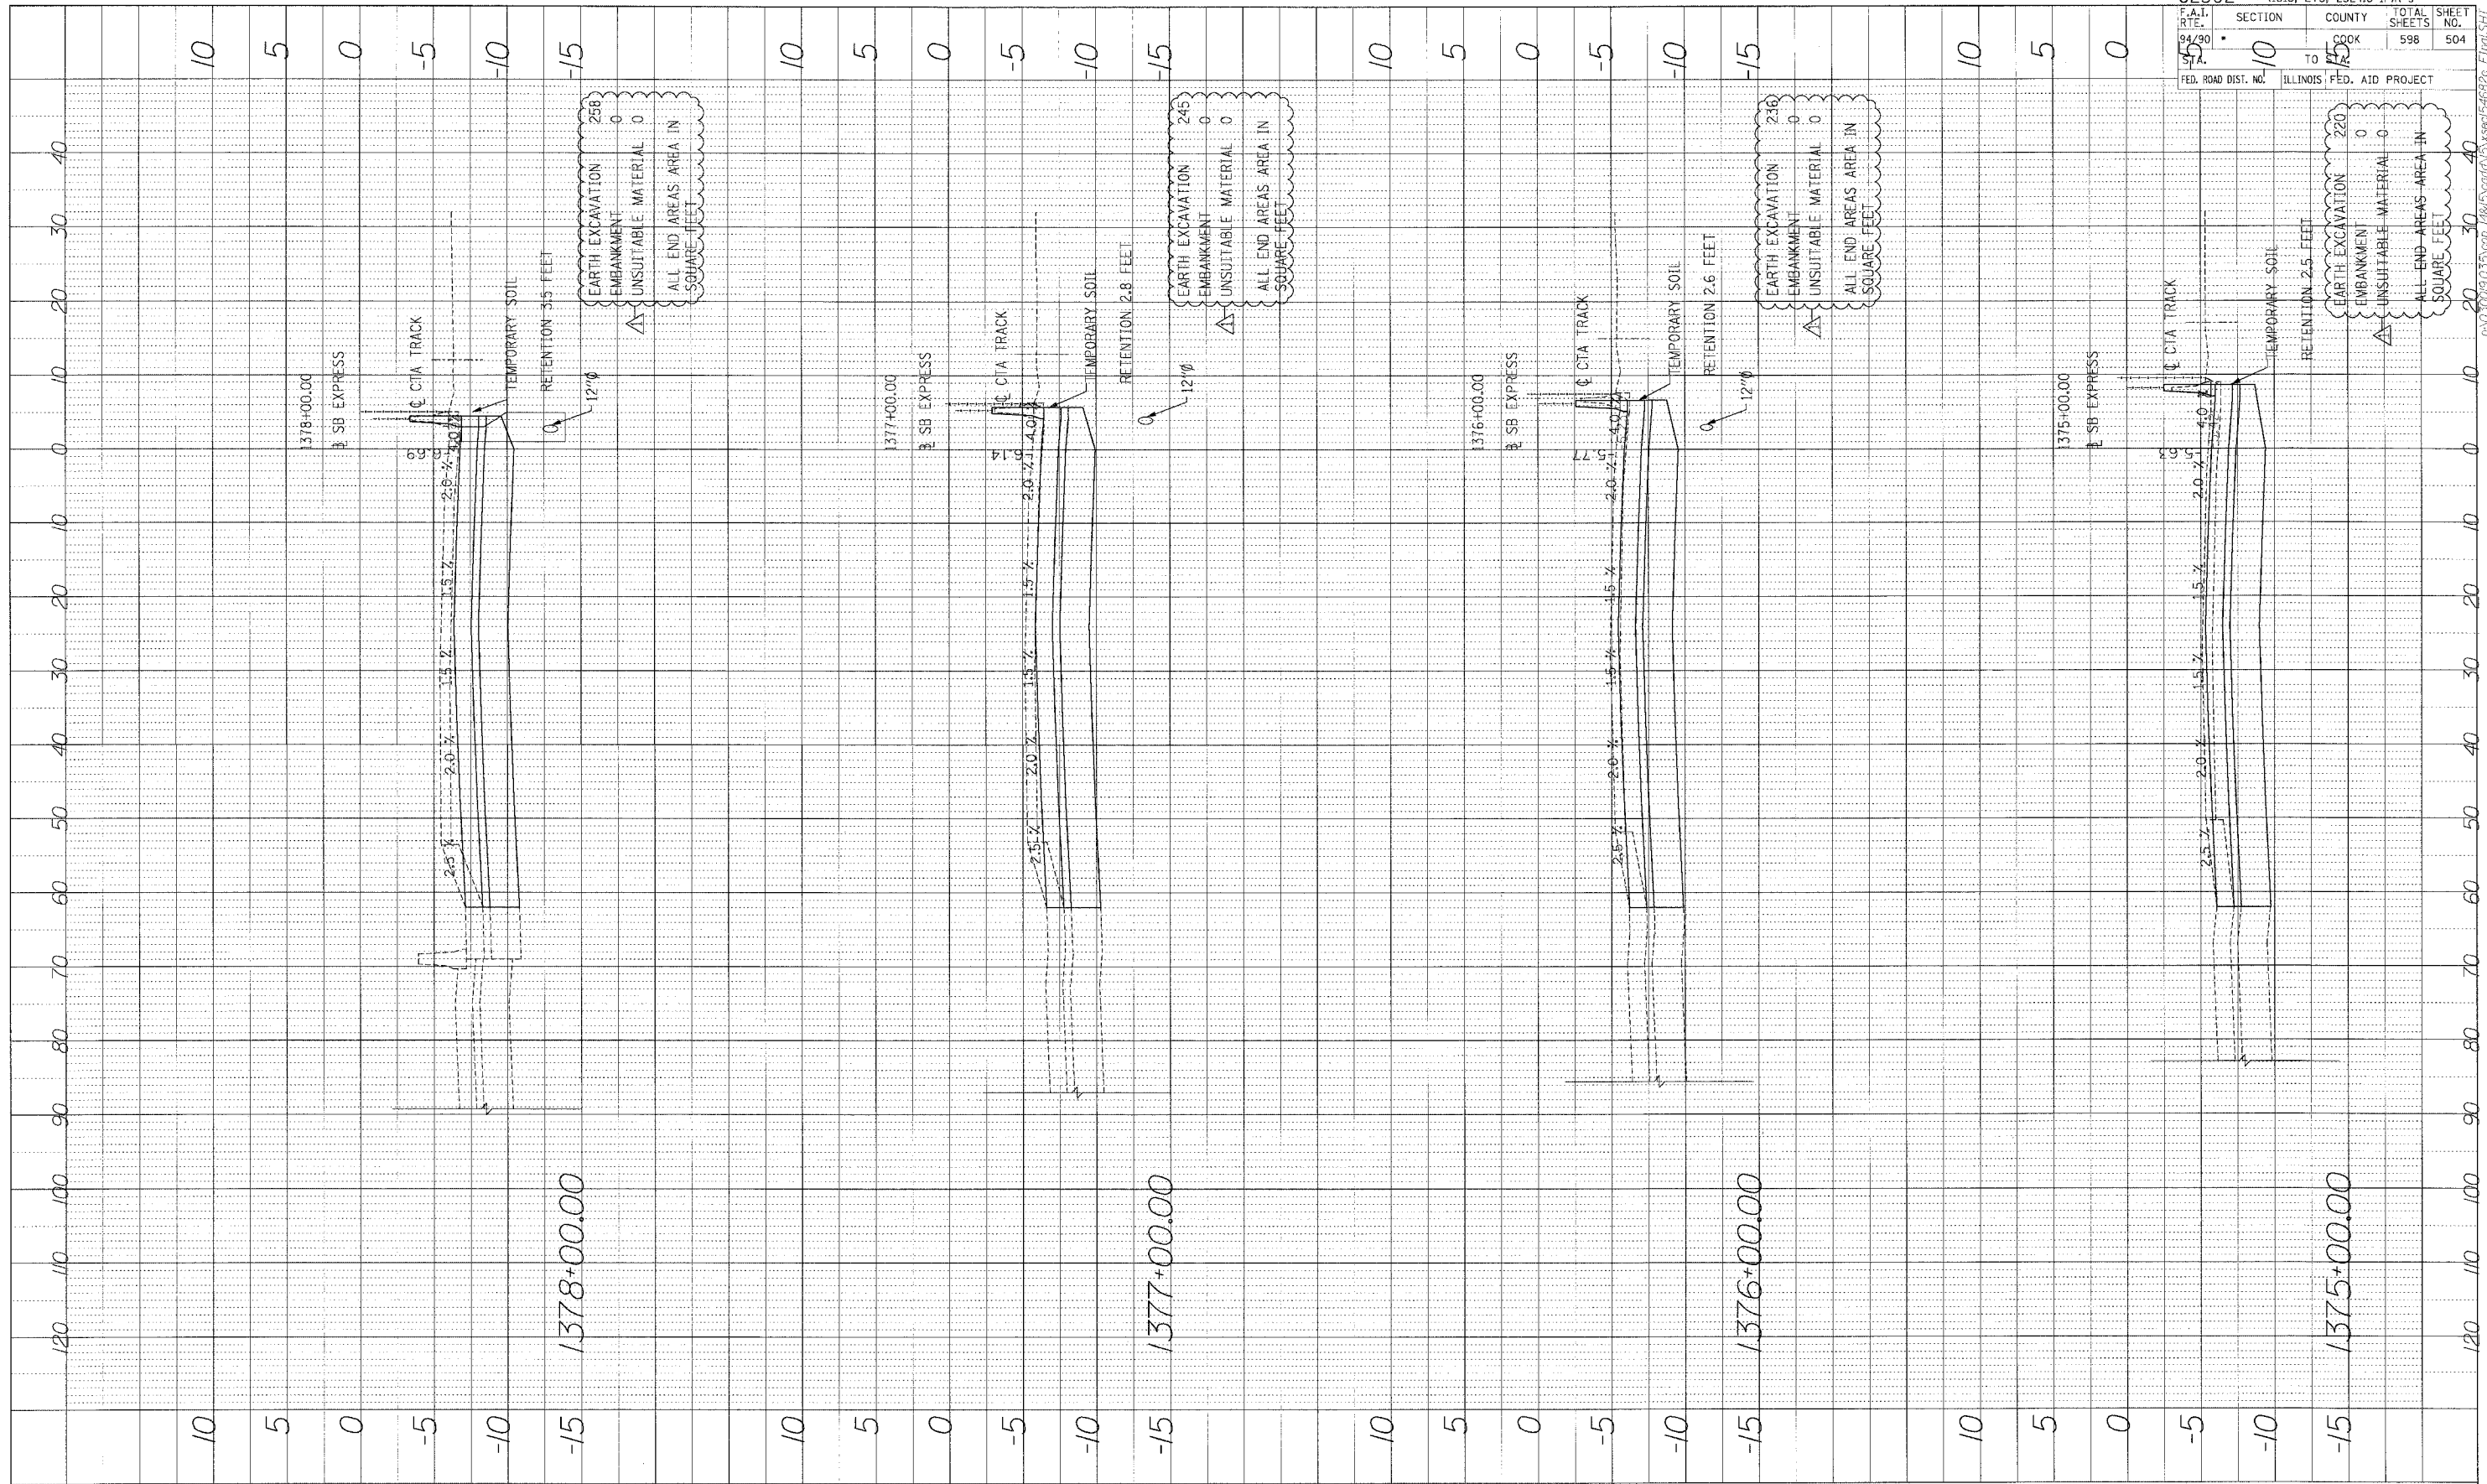

62302 • (1818, ETC, 2324.6-1PR-9	
F.A.T. R.T.E. 94/30	SECTION 10
TO 10	COUNTY COOK
FED. ROAD DIST. NO.	ILLINOIS FED. AID PROJECT
	TOTAL SHEETS 598
	SHEET NO. 504


Edwards AND Kelcey
 ONE NORTH FRANKLIN
 CHICAGO, IL 60606
 PHONE: (312) 251-3000
 FAX: (312) 251-3015
 WEB: WWW.EKCORP.COM

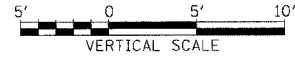

STA.


P:\030019\0305\com\%5\road\15\%504\54626.FXD\SHT

PROFILE SURVEYED BY DATE
 SCALE CHECKED BY DATE
 NOTE BOOK NO. AND SHEET NO. STRUCTURE (MATERIALS) OTHER

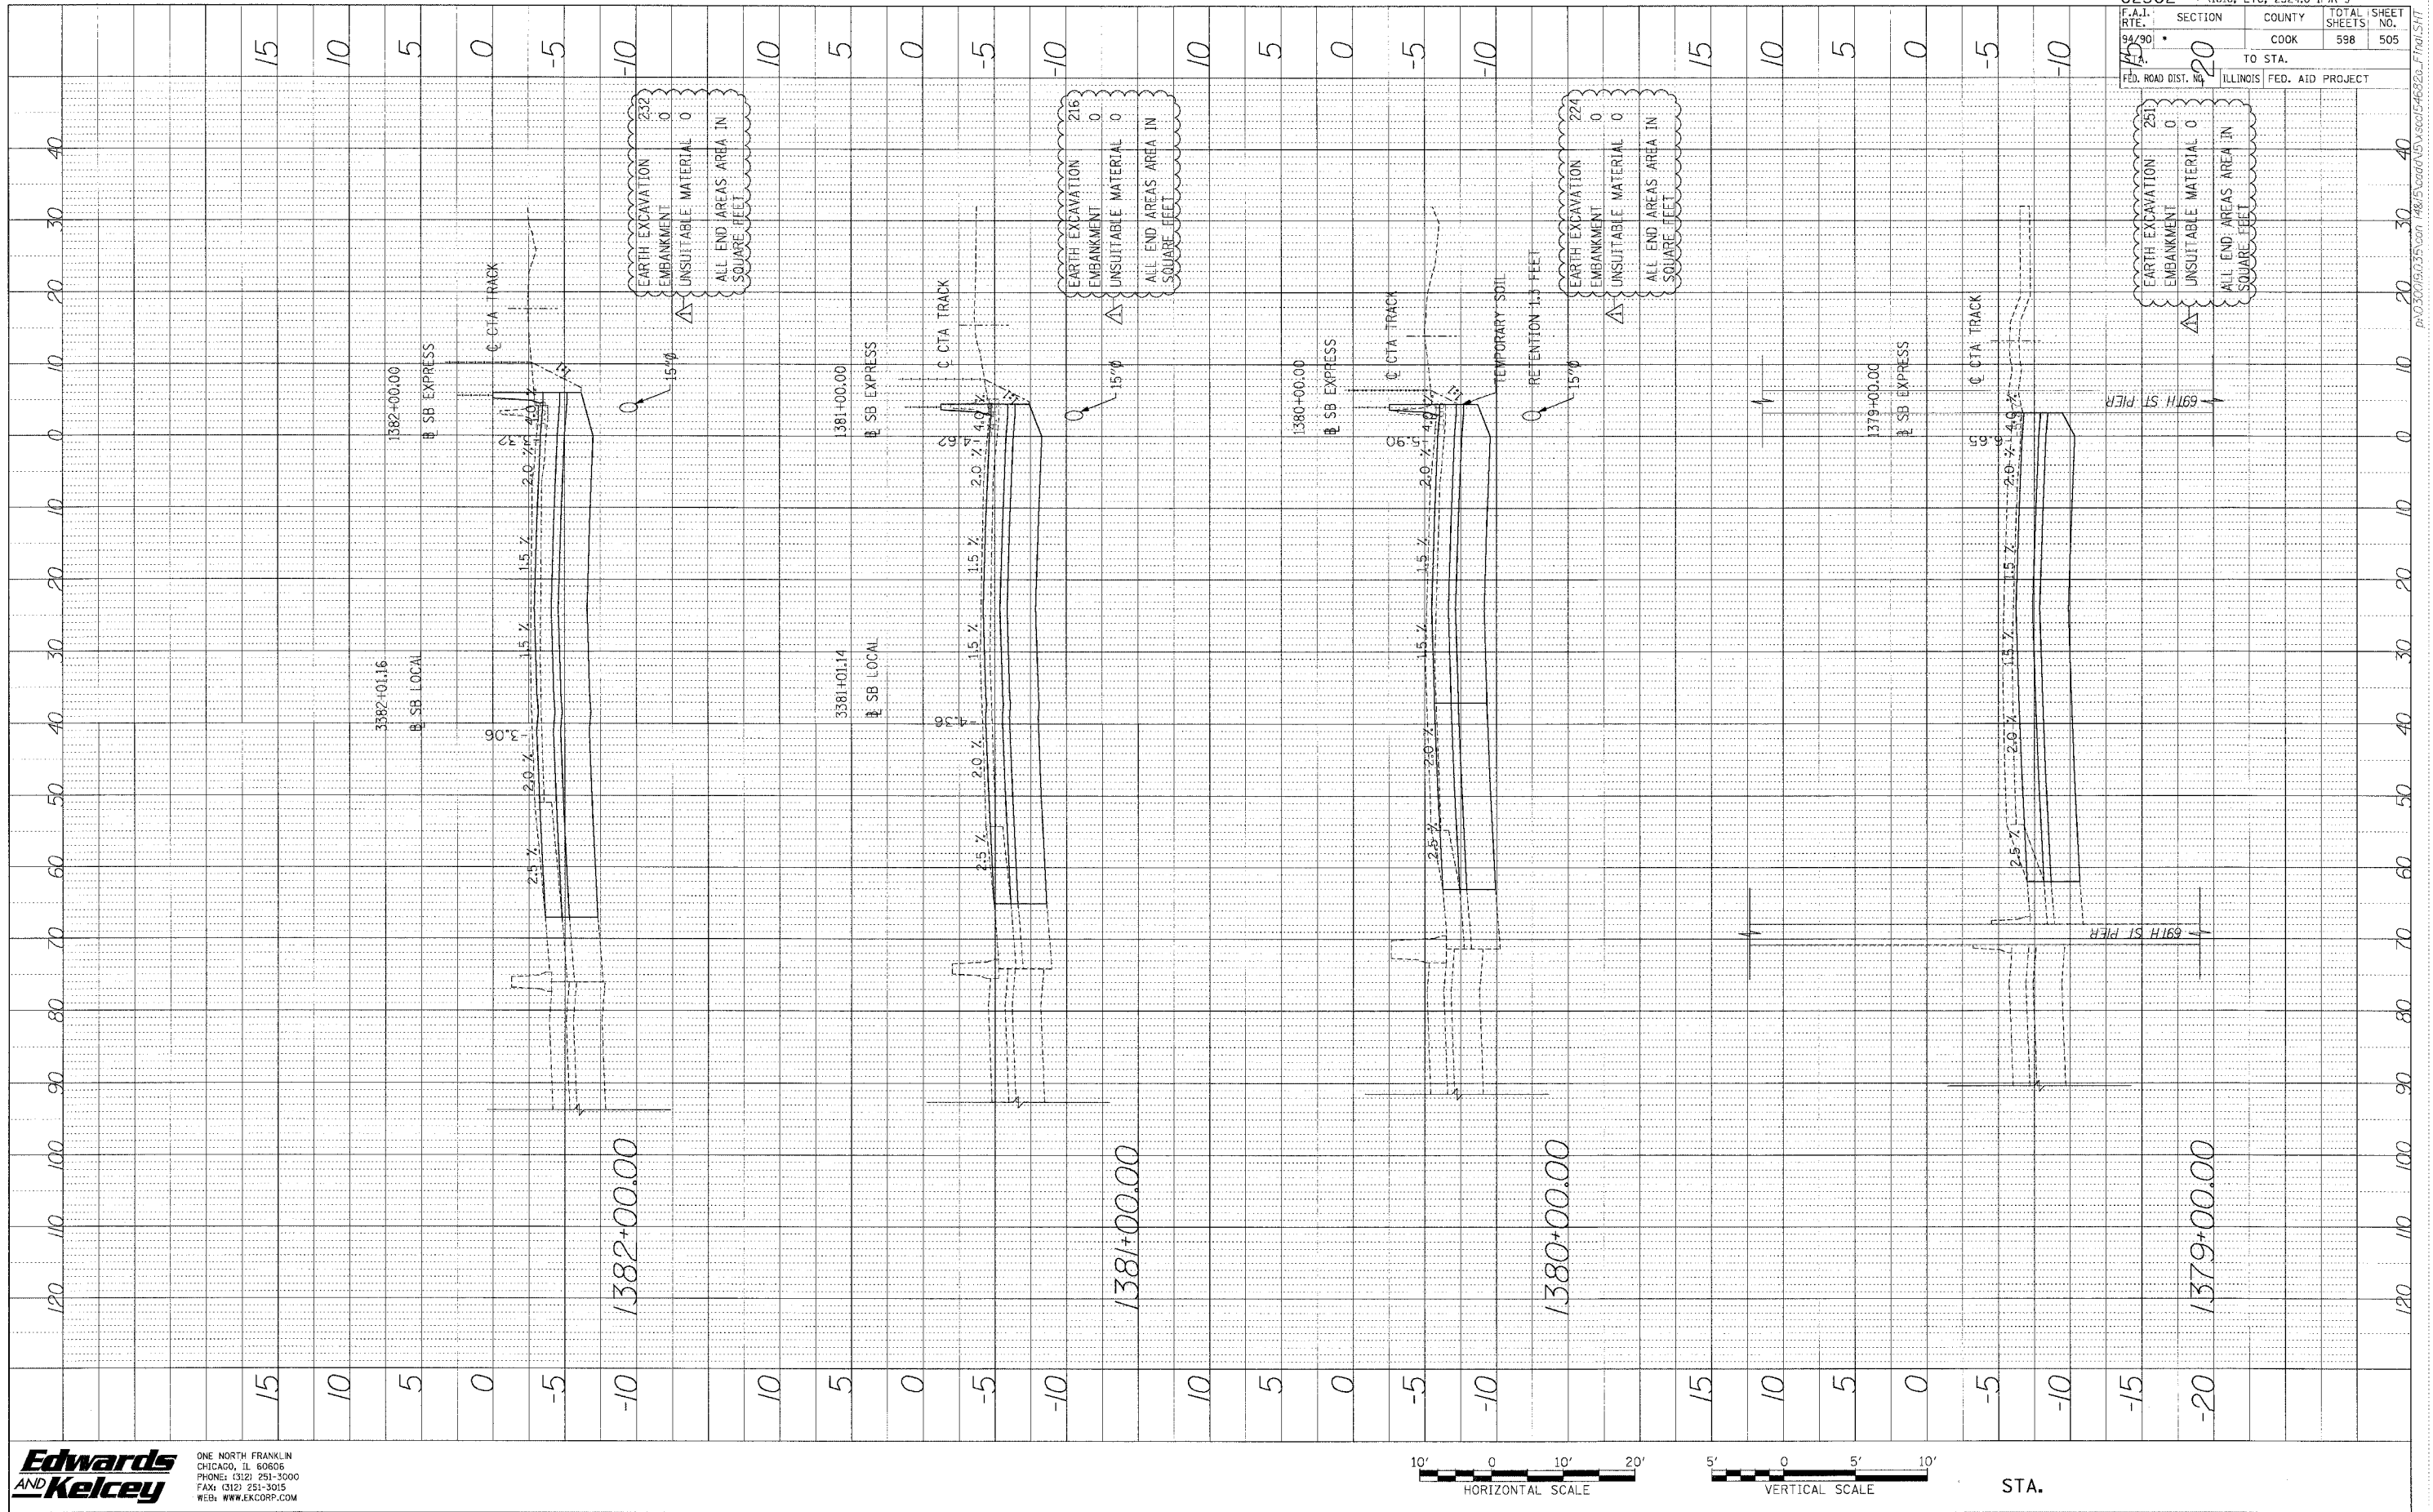

62302 • (1818, ETC. 2324.6-1PIR-9	
F.A.I. RTE. 94/90	SECTION COOK
TOTAL SHEETS 598	SHEET NO. 505
TO STA. ILLINOIS FED. AID PROJECT	


Edwards AND Kelcey
 ONE NORTH FRANKLIN
 CHICAGO, IL 60606
 PHONE: (312) 251-3000
 FAX: (312) 251-3015
 WEB: WWW.EKCORP.COM

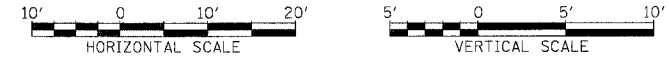

STA.


p:\03\07\05\05\cont\148\5\road\NS\5\sc03\546202_7\final.sht

PROFILE SURVEYED BY DATE
 WIRE BOOK NO. OF RECTANGULAR NOTING CIRCUIT
 DATE CHECKED BY DATE
 NO. OF RECTANGULAR NOTING CIRCUIT

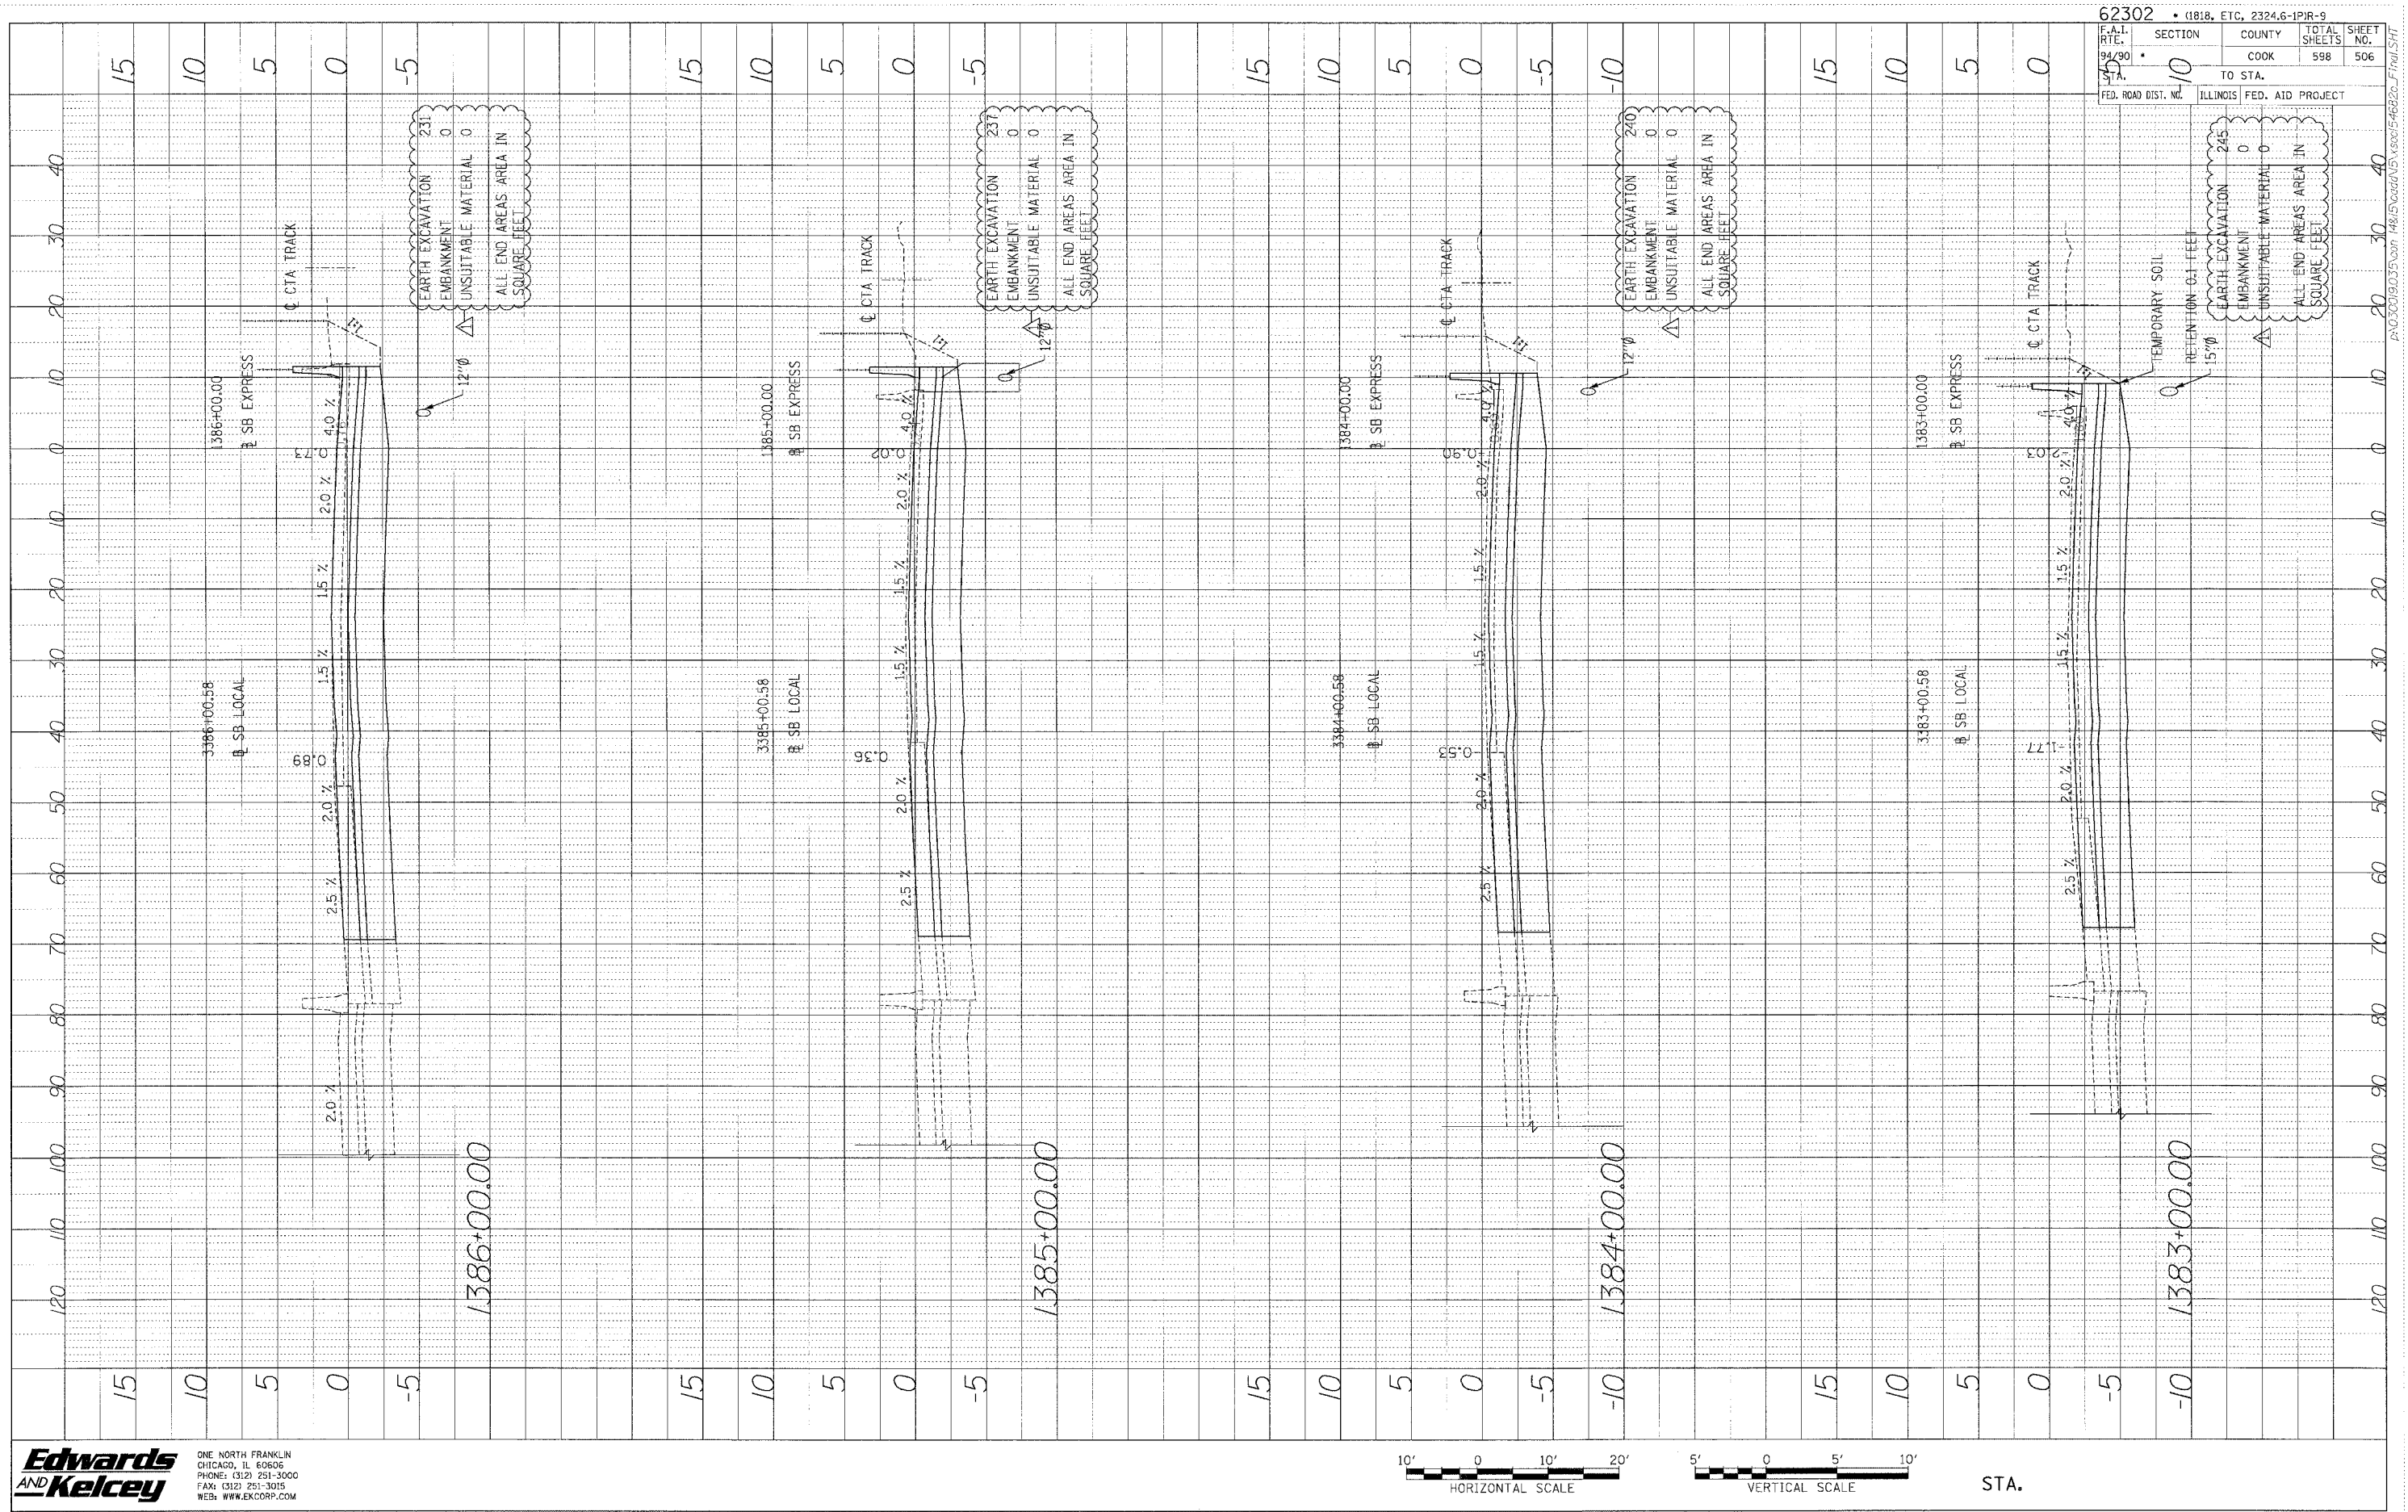

62302	(1818, ETC, 2324.6-IPR-9
F.A.I. R.T.E. 99/90	SECTION 10
COOK	COUNTY 598
TO STA.	SHEET NO. 506
FED. ROAD DIST. NO.	ILLINOIS FED. AID PROJECT


Edwards AND Kelcey
 ONE NORTH FRANKLIN
 CHICAGO, IL 60606
 PHONE: (312) 251-3000
 FAX: (312) 251-3015
 WEB: WWW.EKCORP.COM

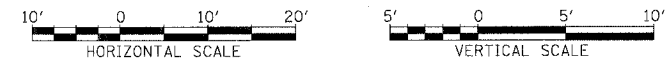

STA.


P:\03\0019\03\5\0017\1818\15\0015\4682c-Frail\SHR

PROFILE SURVEYED BY DATE
 NOTE BOOK DRAWN BY
 SIGNATURE OF SURVEYOR
 NO. SIGNATURE OF NOTARIES OFFICER

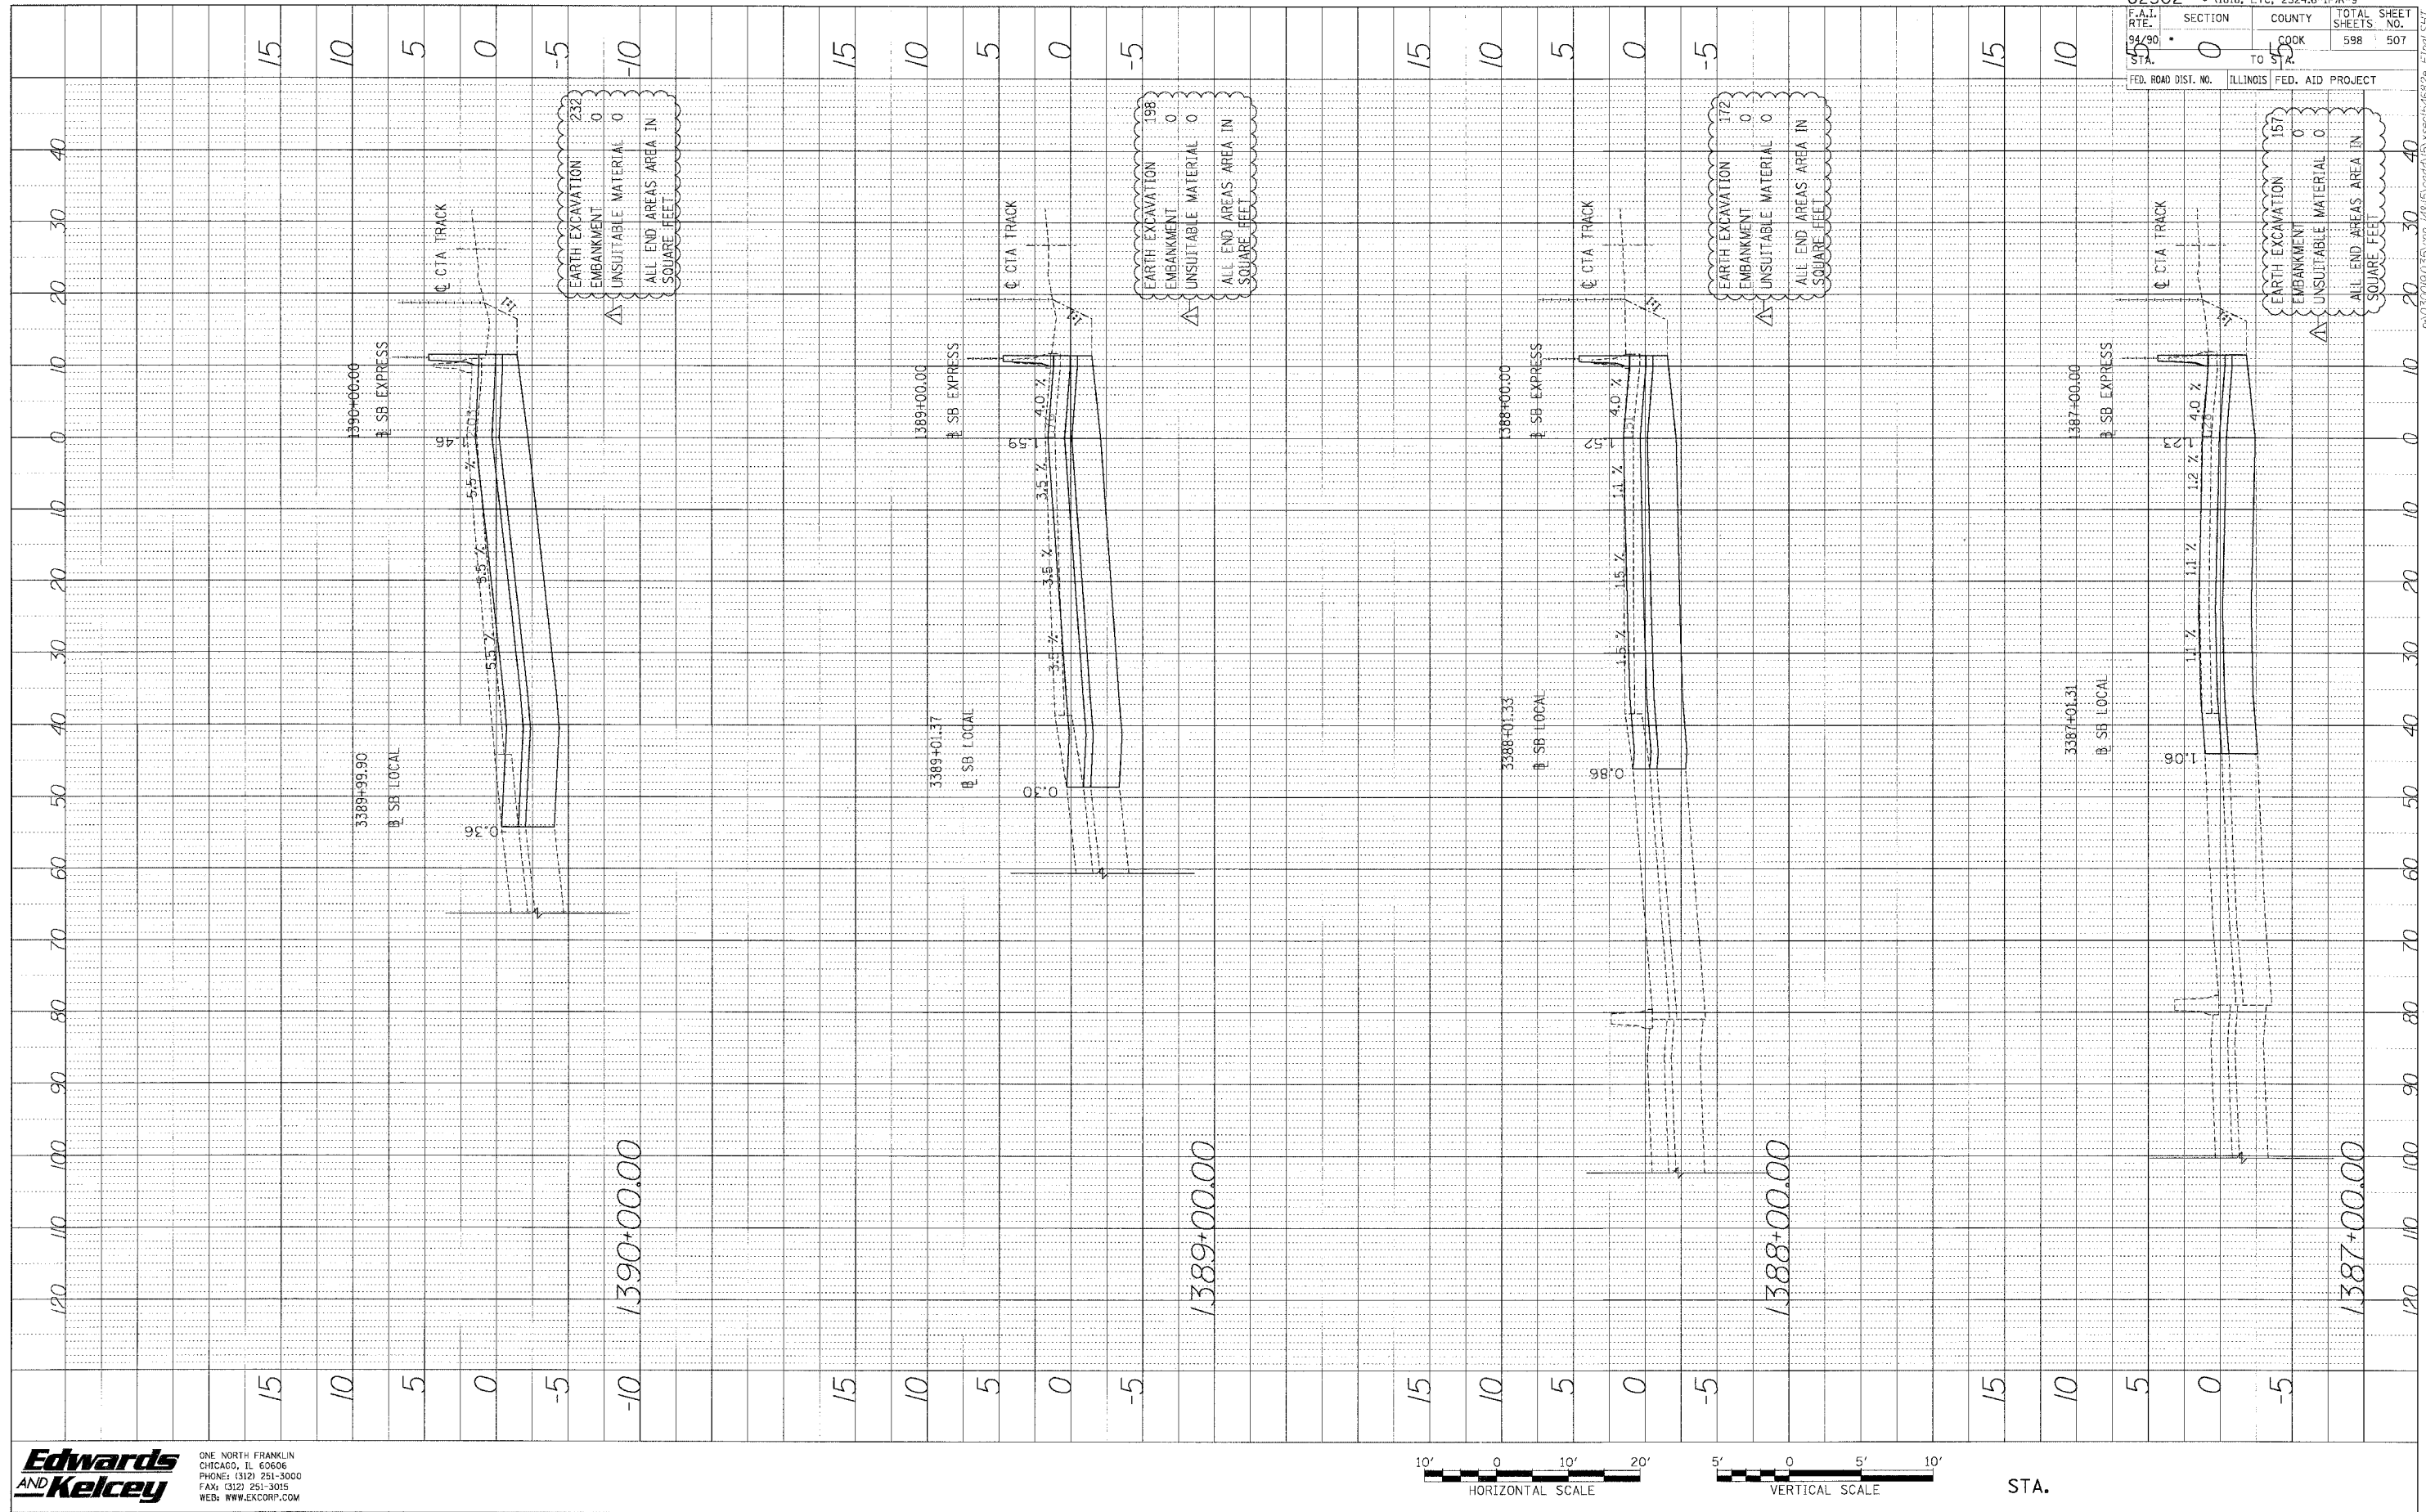

62302 • (1818, ETC, 2324.6-1PIR-9
 SECTION COUNTY TOTAL SHEET NO.
 94/80 COOK 598 507
 STA. TO 5
 FED. ROAD DIST. NO. ILLINOIS FED. AID PROJECT


Edwards AND Kelcey
 ONE NORTH FRANKLIN
 CHICAGO, IL 60606
 PHONE: (312) 251-3000
 FAX: (312) 251-3015
 WEB: WWW.EDKORP.COM

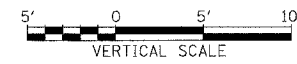

STA.


PA:03/09/03/35.dwg TRK/S:\cadd\13\1308015-46328-Final.dwg

PROFILE
 DRAWN BY: _____
 CHECKED BY: _____
 DATE: _____
 NOTE BOOK NO.: _____
 STRUCTURE NO.: _____

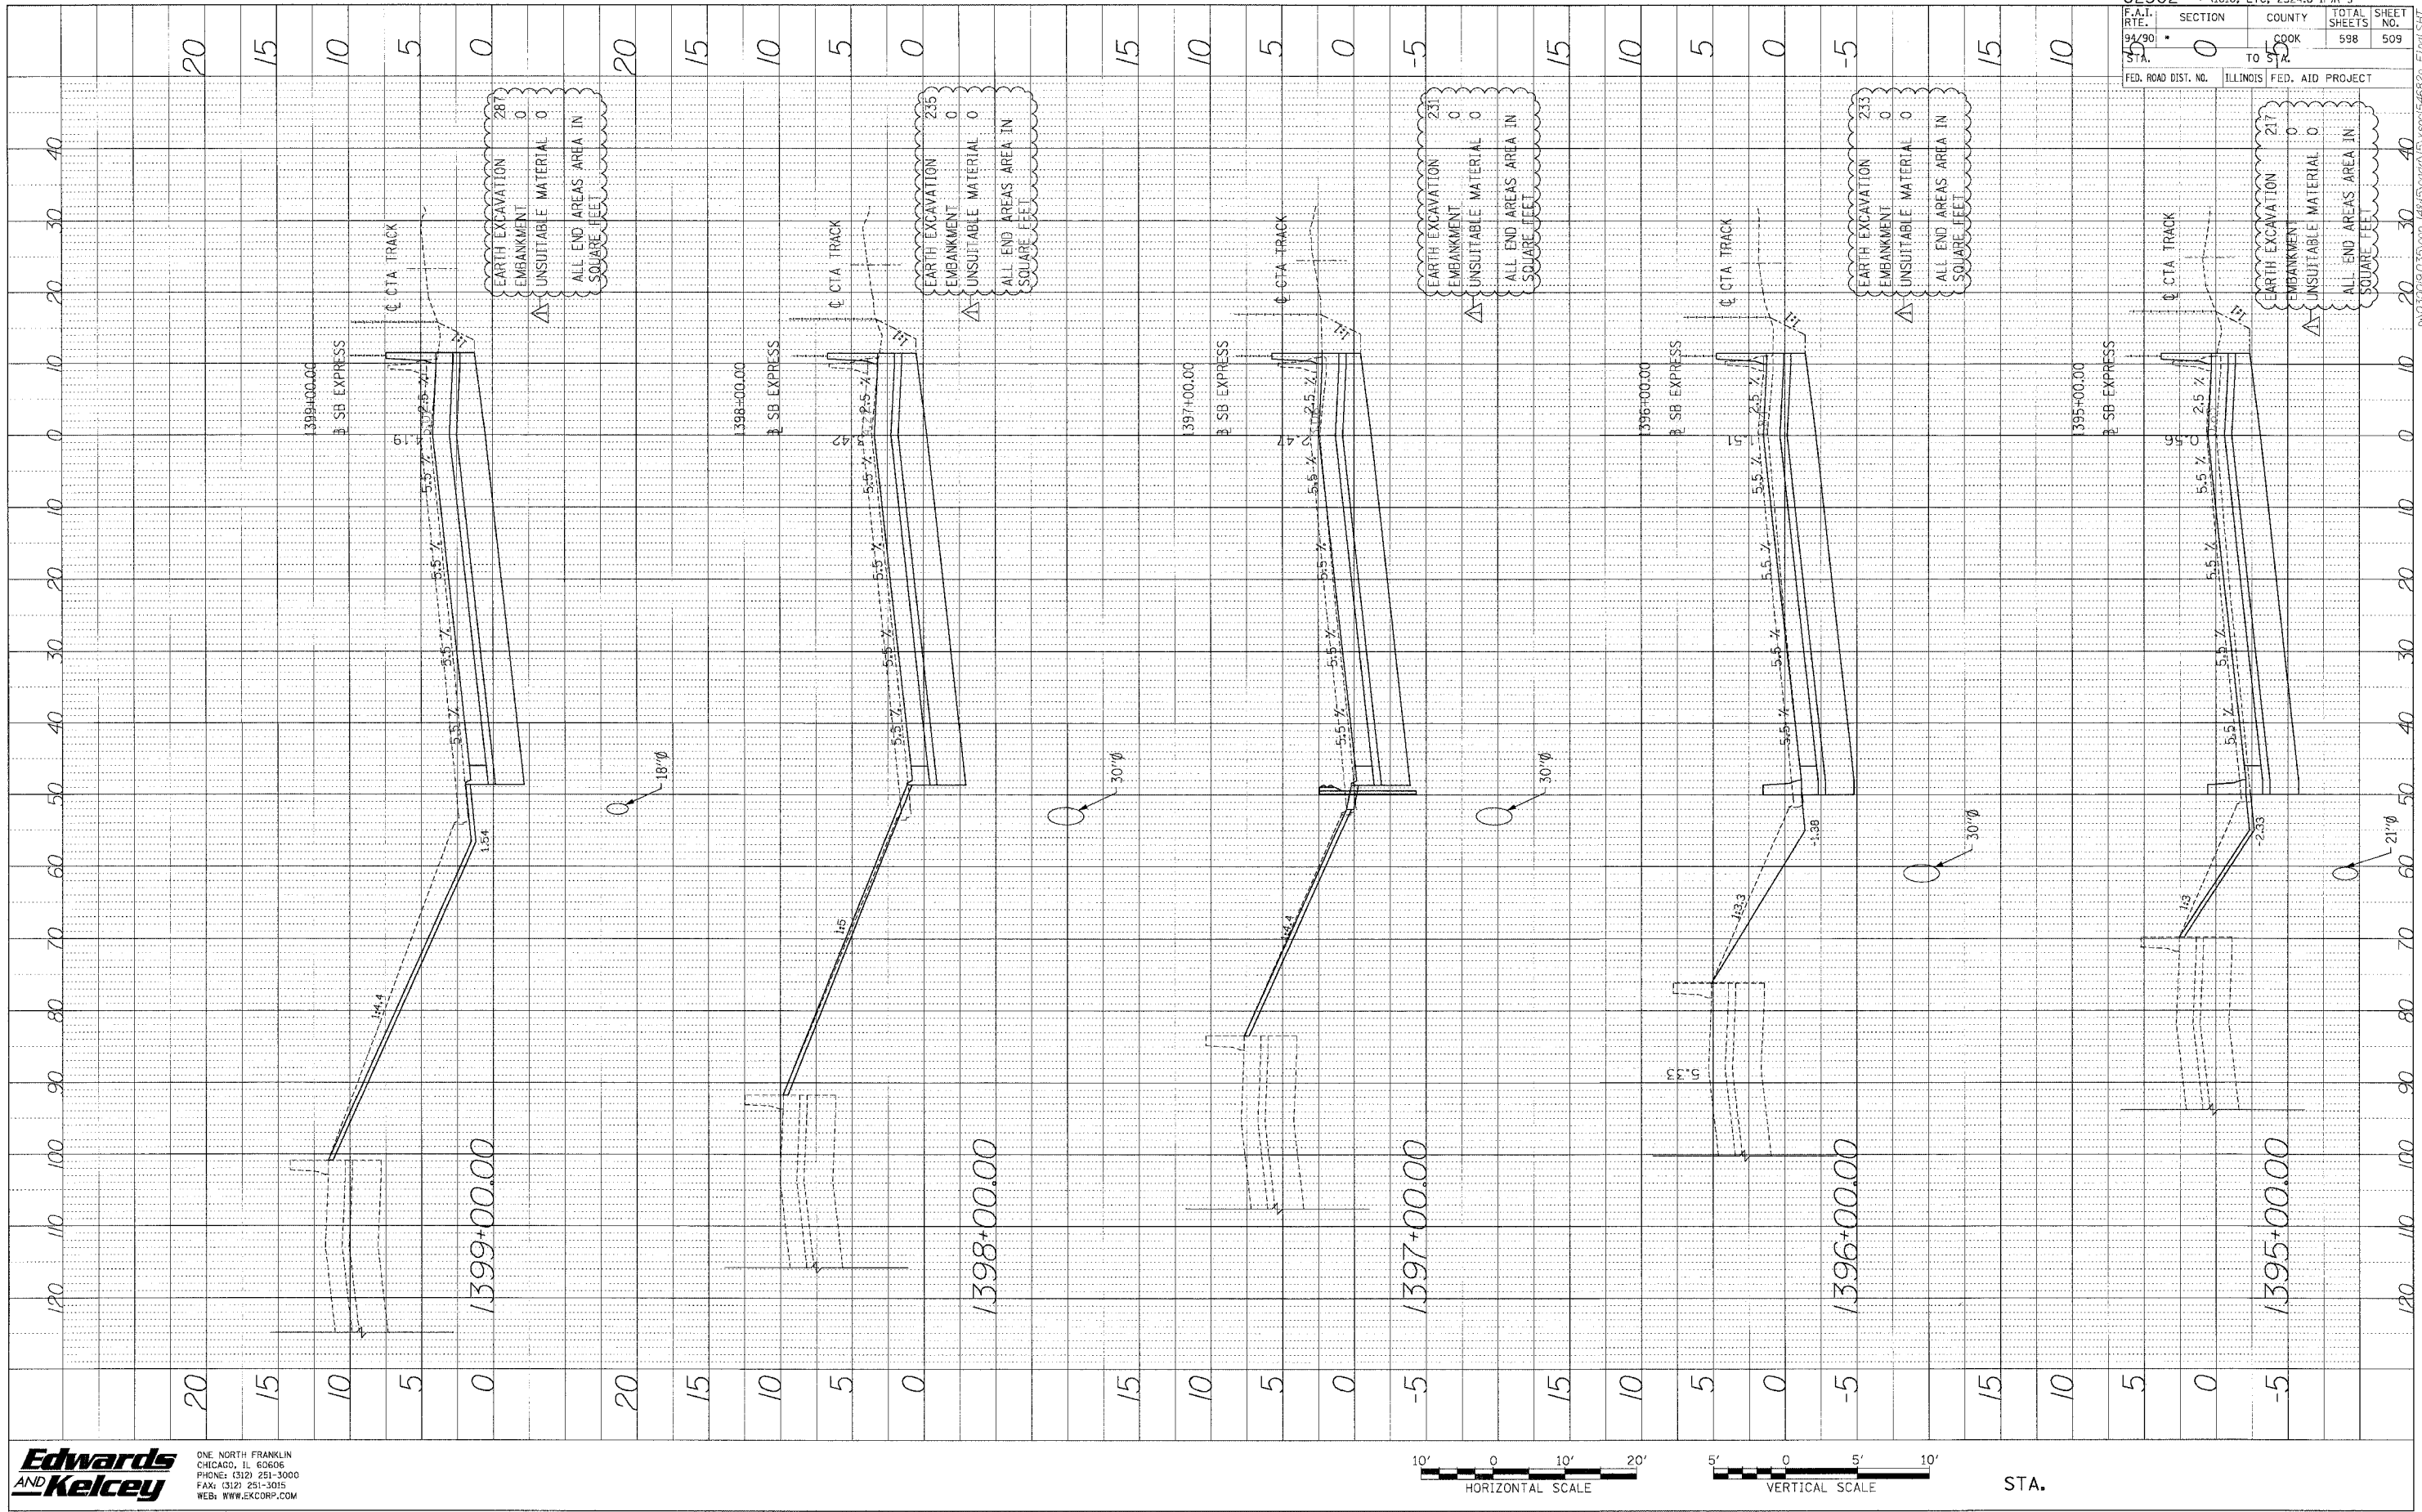

62302 • (1818, ETC. 2324.6-1PR-9)		TOTAL SHEETS		SHEET NO.	
F.A.I. RTE.	SECTION	COUNTY	598	599	
94/90	0	COOK			
TO	FROM	ILLINOIS FED. AID PROJECT			
0	0				
FED. ROAD DIST. NO.					


Edwards
AND Kelcey
 ONE NORTH FRANKLIN
 CHICAGO, IL 60606
 PHONE: (312) 261-3000
 FAX: (312) 261-3015
 WEB: WWW.EKCORP.COM

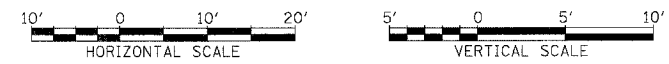

STA.

P:\03\0019\03\03\0019.dwg 11/15/00 11:50:00 AM 11/15/00 11:50:00 AM

PROJECT: SKWAWA BRIDGE
 DRAWING NO.: 1400-100-00
 DATE:

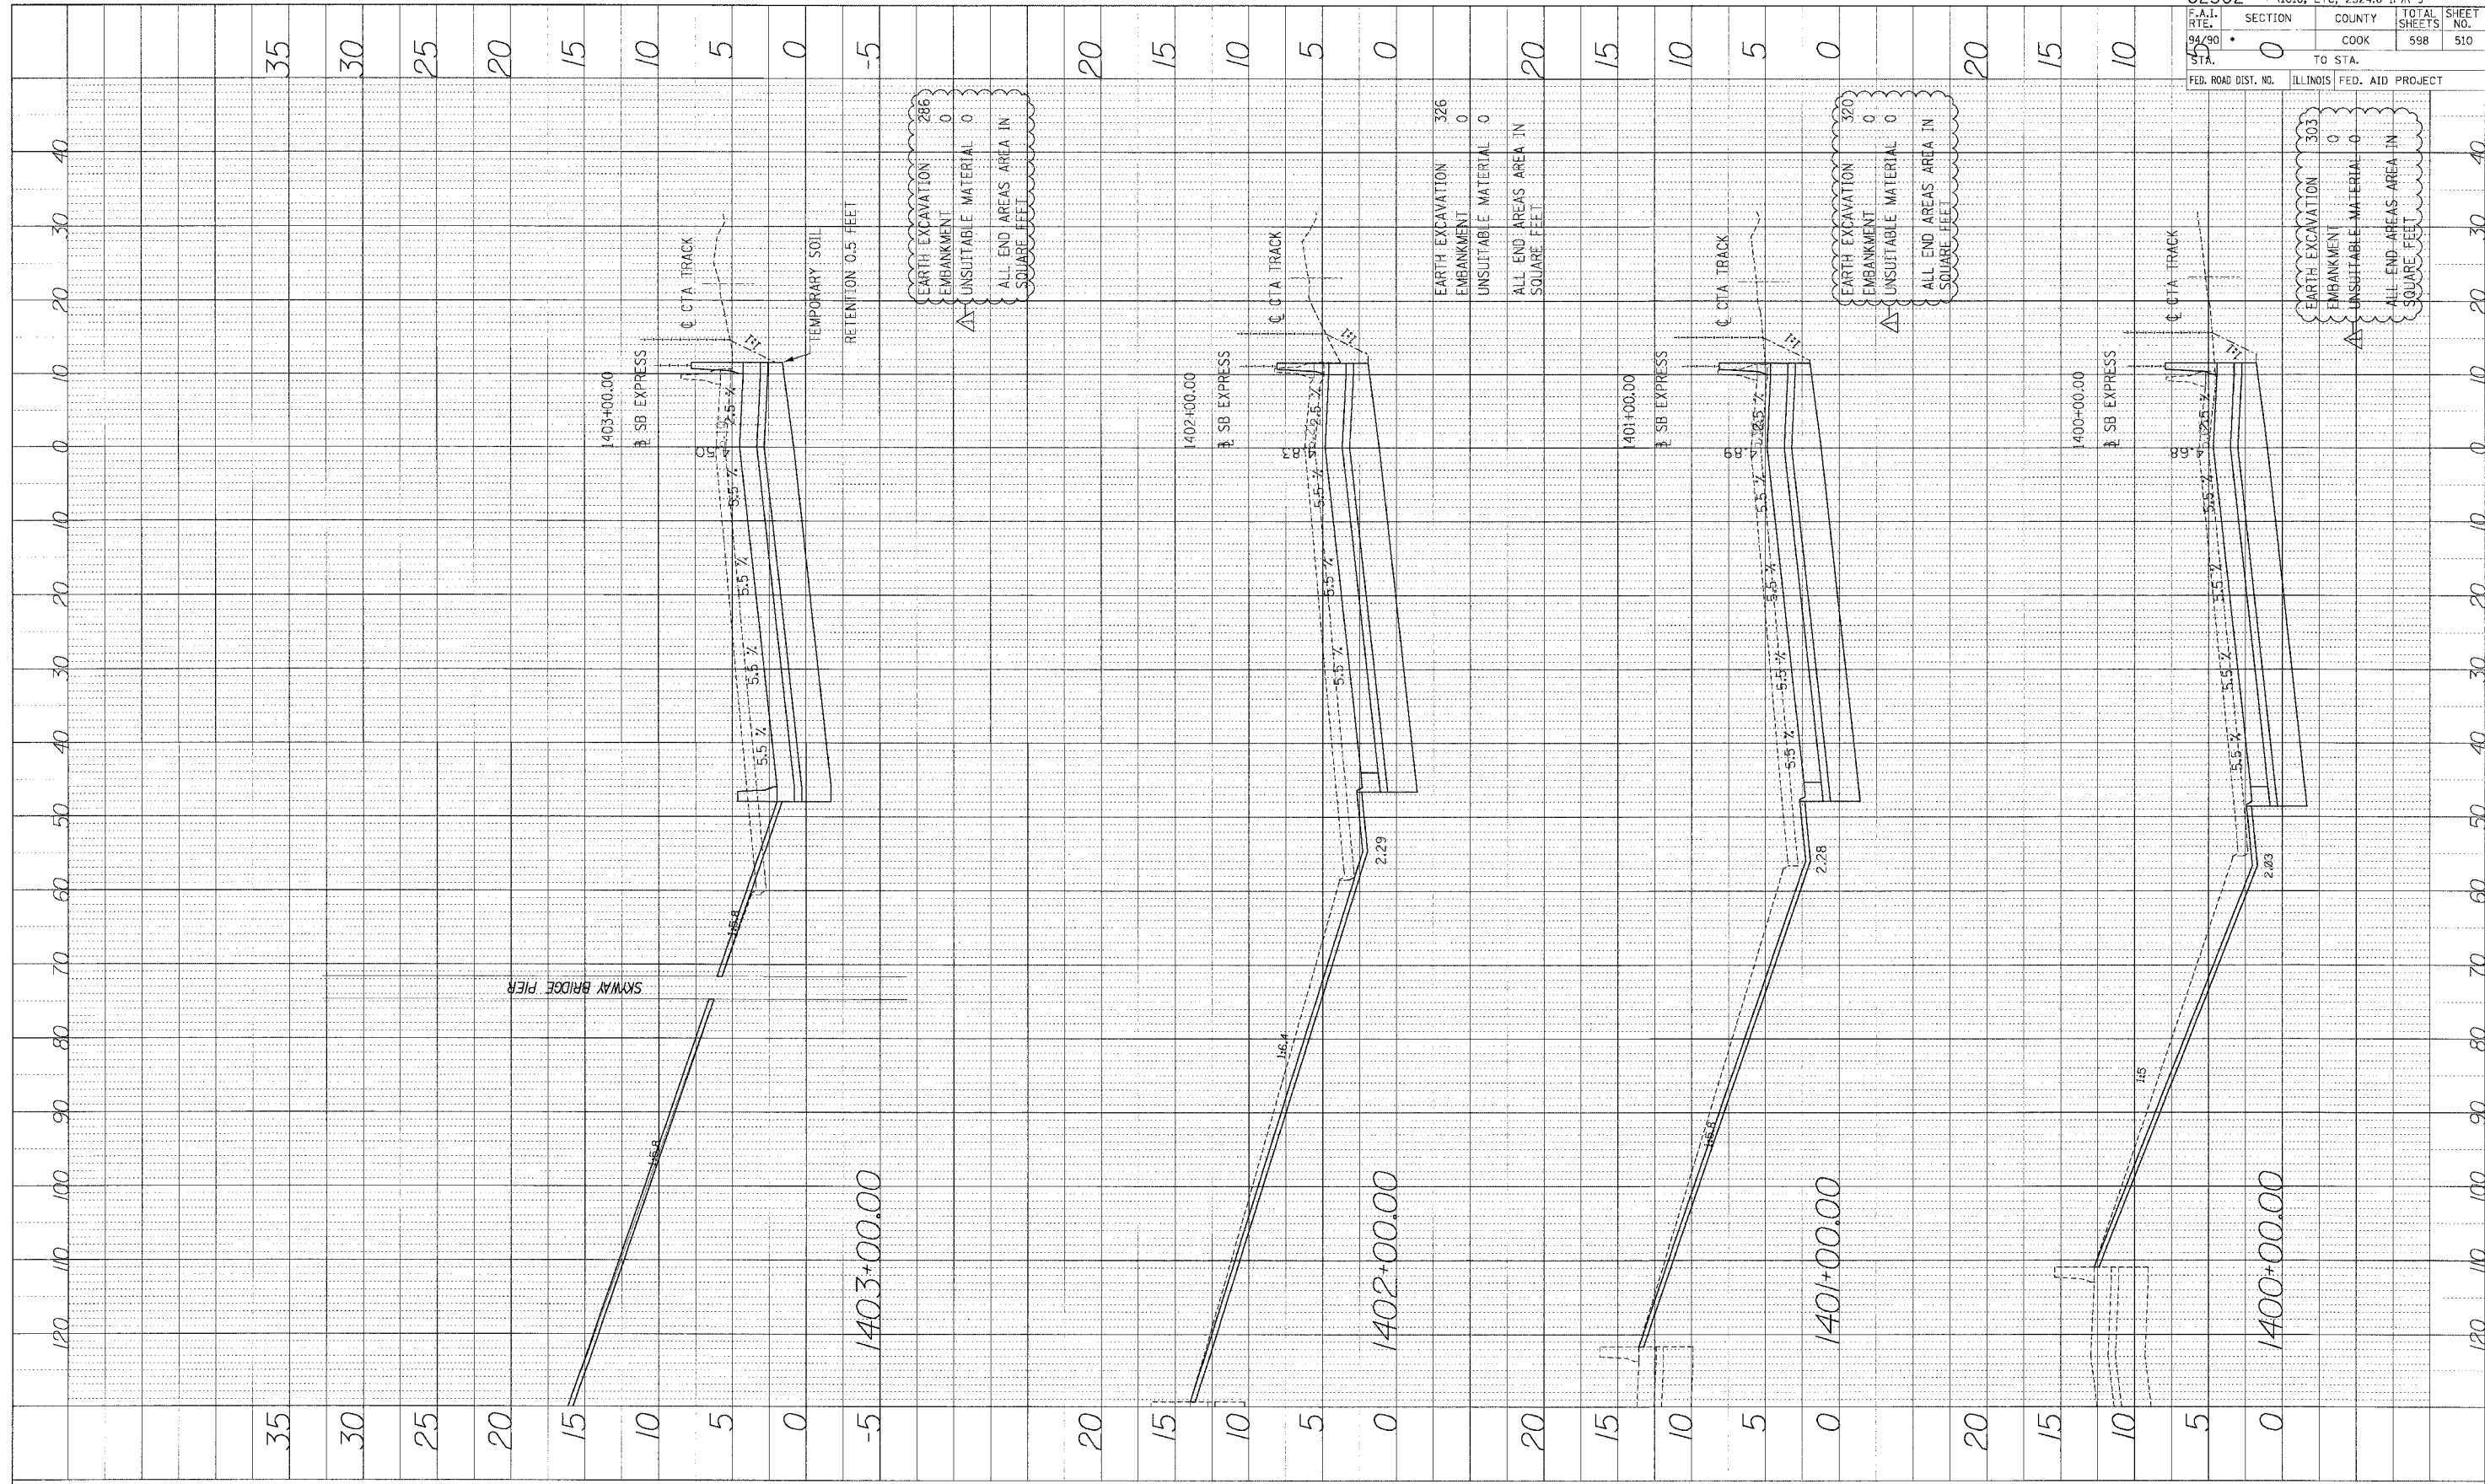

EARTH EXCAVATION 286
 EMBANKMENT 0
 UNSUITABLE MATERIAL 0
 ALL END AREAS AREA IN SQUARE FEET


EARTH EXCAVATION 326
 EMBANKMENT 0
 UNSUITABLE MATERIAL 0
 ALL END AREAS AREA IN SQUARE FEET

EARTH EXCAVATION 320
 EMBANKMENT 0
 UNSUITABLE MATERIAL 0
 ALL END AREAS AREA IN SQUARE FEET

EARTH EXCAVATION 303
 EMBANKMENT 0
 UNSUITABLE MATERIAL 0
 ALL END AREAS AREA IN SQUARE FEET

62302 • 11818, ETC, 2324.6-1PIR-9	
F.A.I. R.T.E. 94/90	SECTION 0
COUNTY COOK	TOTAL SHEETS 598
TO STA. 1400+00.00	SHEET NO. 510
FED. ROAD DIST. NO. ILLINOIS	FED. AID PROJECT


Edwards AND Kelcey
 ONE NORTH FRANKLIN CHICAGO, IL 60606
 PHONE: (312) 251-3000
 FAX: (312) 251-3015
 WEB: WWW.EKCORP.COM

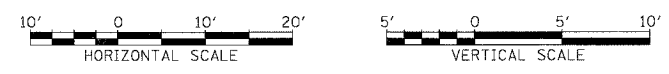

STA.


P:\030019\030019.dwg 1400-100-00.rvt 1400-100-00.rvt

PROFILE
 DRAWN BY: _____ DATE: _____
 CHECKED BY: _____
 SCALE: _____
 DATE: _____
 NO. _____
 STRUCTURE: METEORUS CHGD

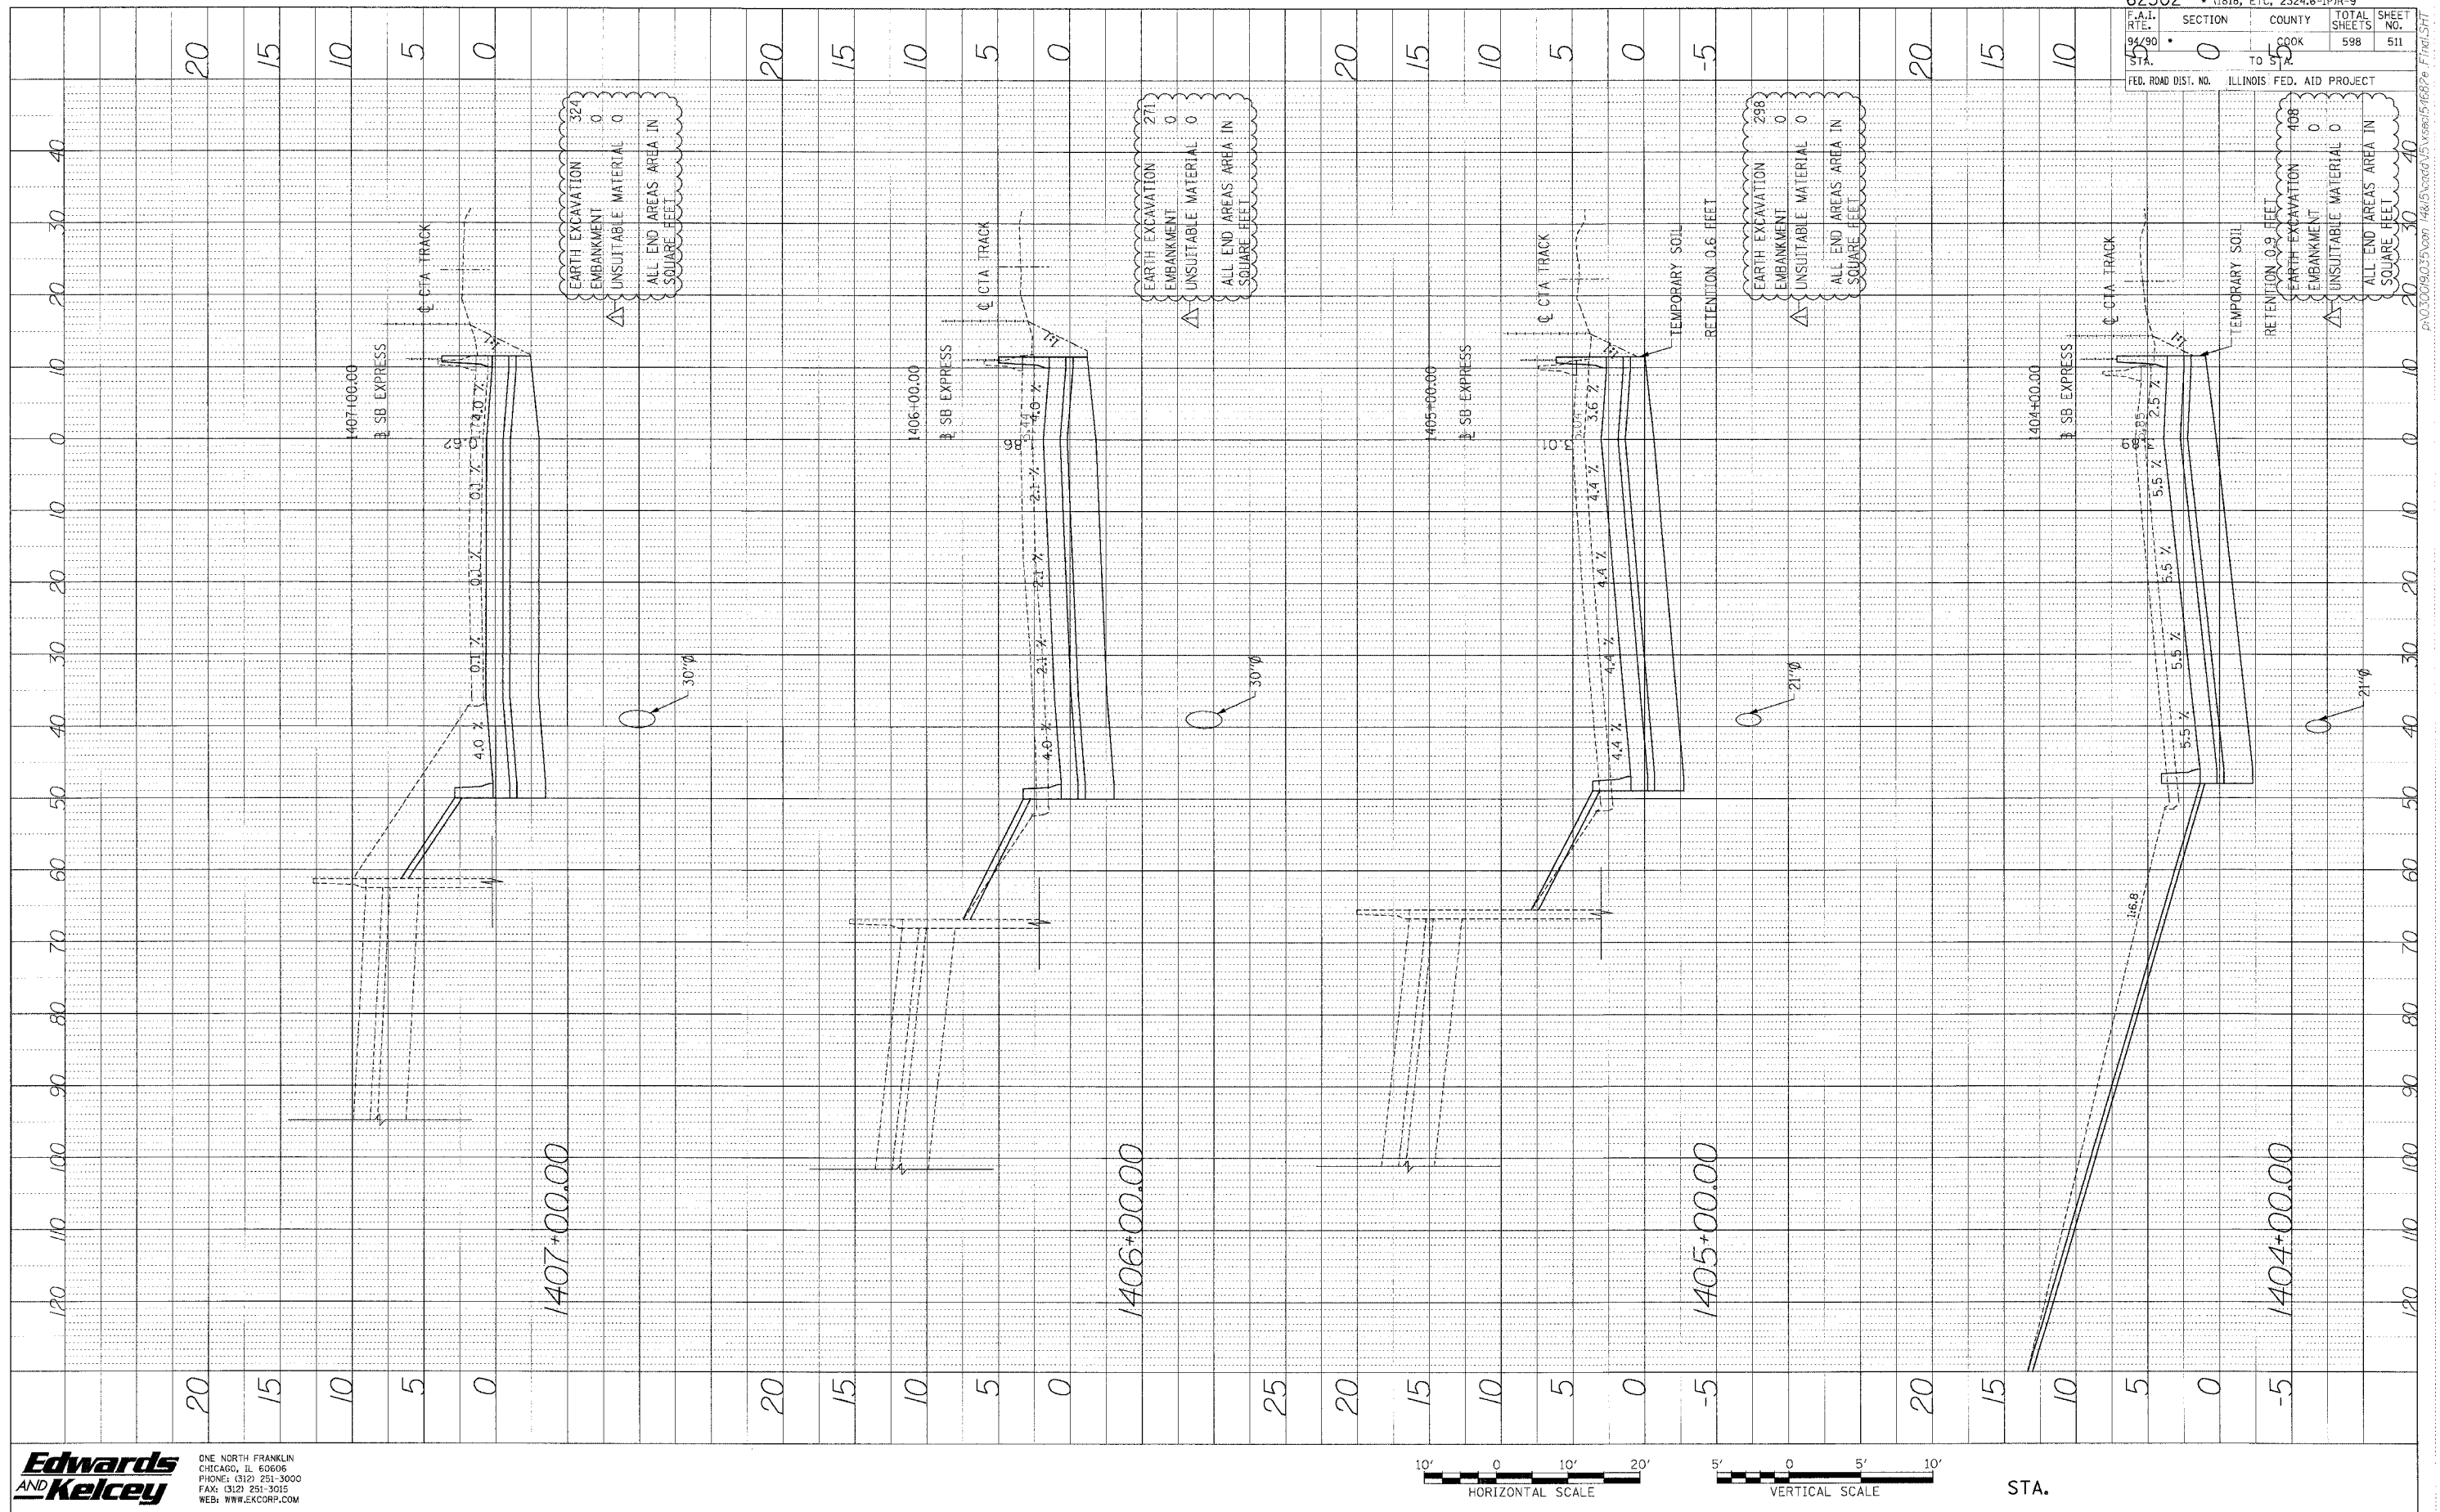

62302 • (1818, ETC, 2324.6-1PR-9	
F.A.I. NO. 90	SECTION 0
DATE 10/20/00	COUNTY COOK
	TOTAL SHEETS 598
	SHEET NO. 511
FED. ROAD DIST. NO. ILLINOIS FED. AID PROJECT	


Edwards AND Kelcey
 ONE NORTH FRANKLIN
 CHICAGO, IL 60606
 PHONE: (312) 251-3600
 FAX: (312) 251-3615
 WEB: WWW.EKCORP.COM

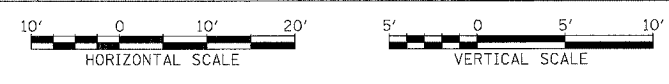

STA.


P:\03\0098\03\980917.dwg 14815\cadd\3\009815\9827e\Final\ST1

PROFIT I
 DATE
 BY
 CHECKED
 NO.

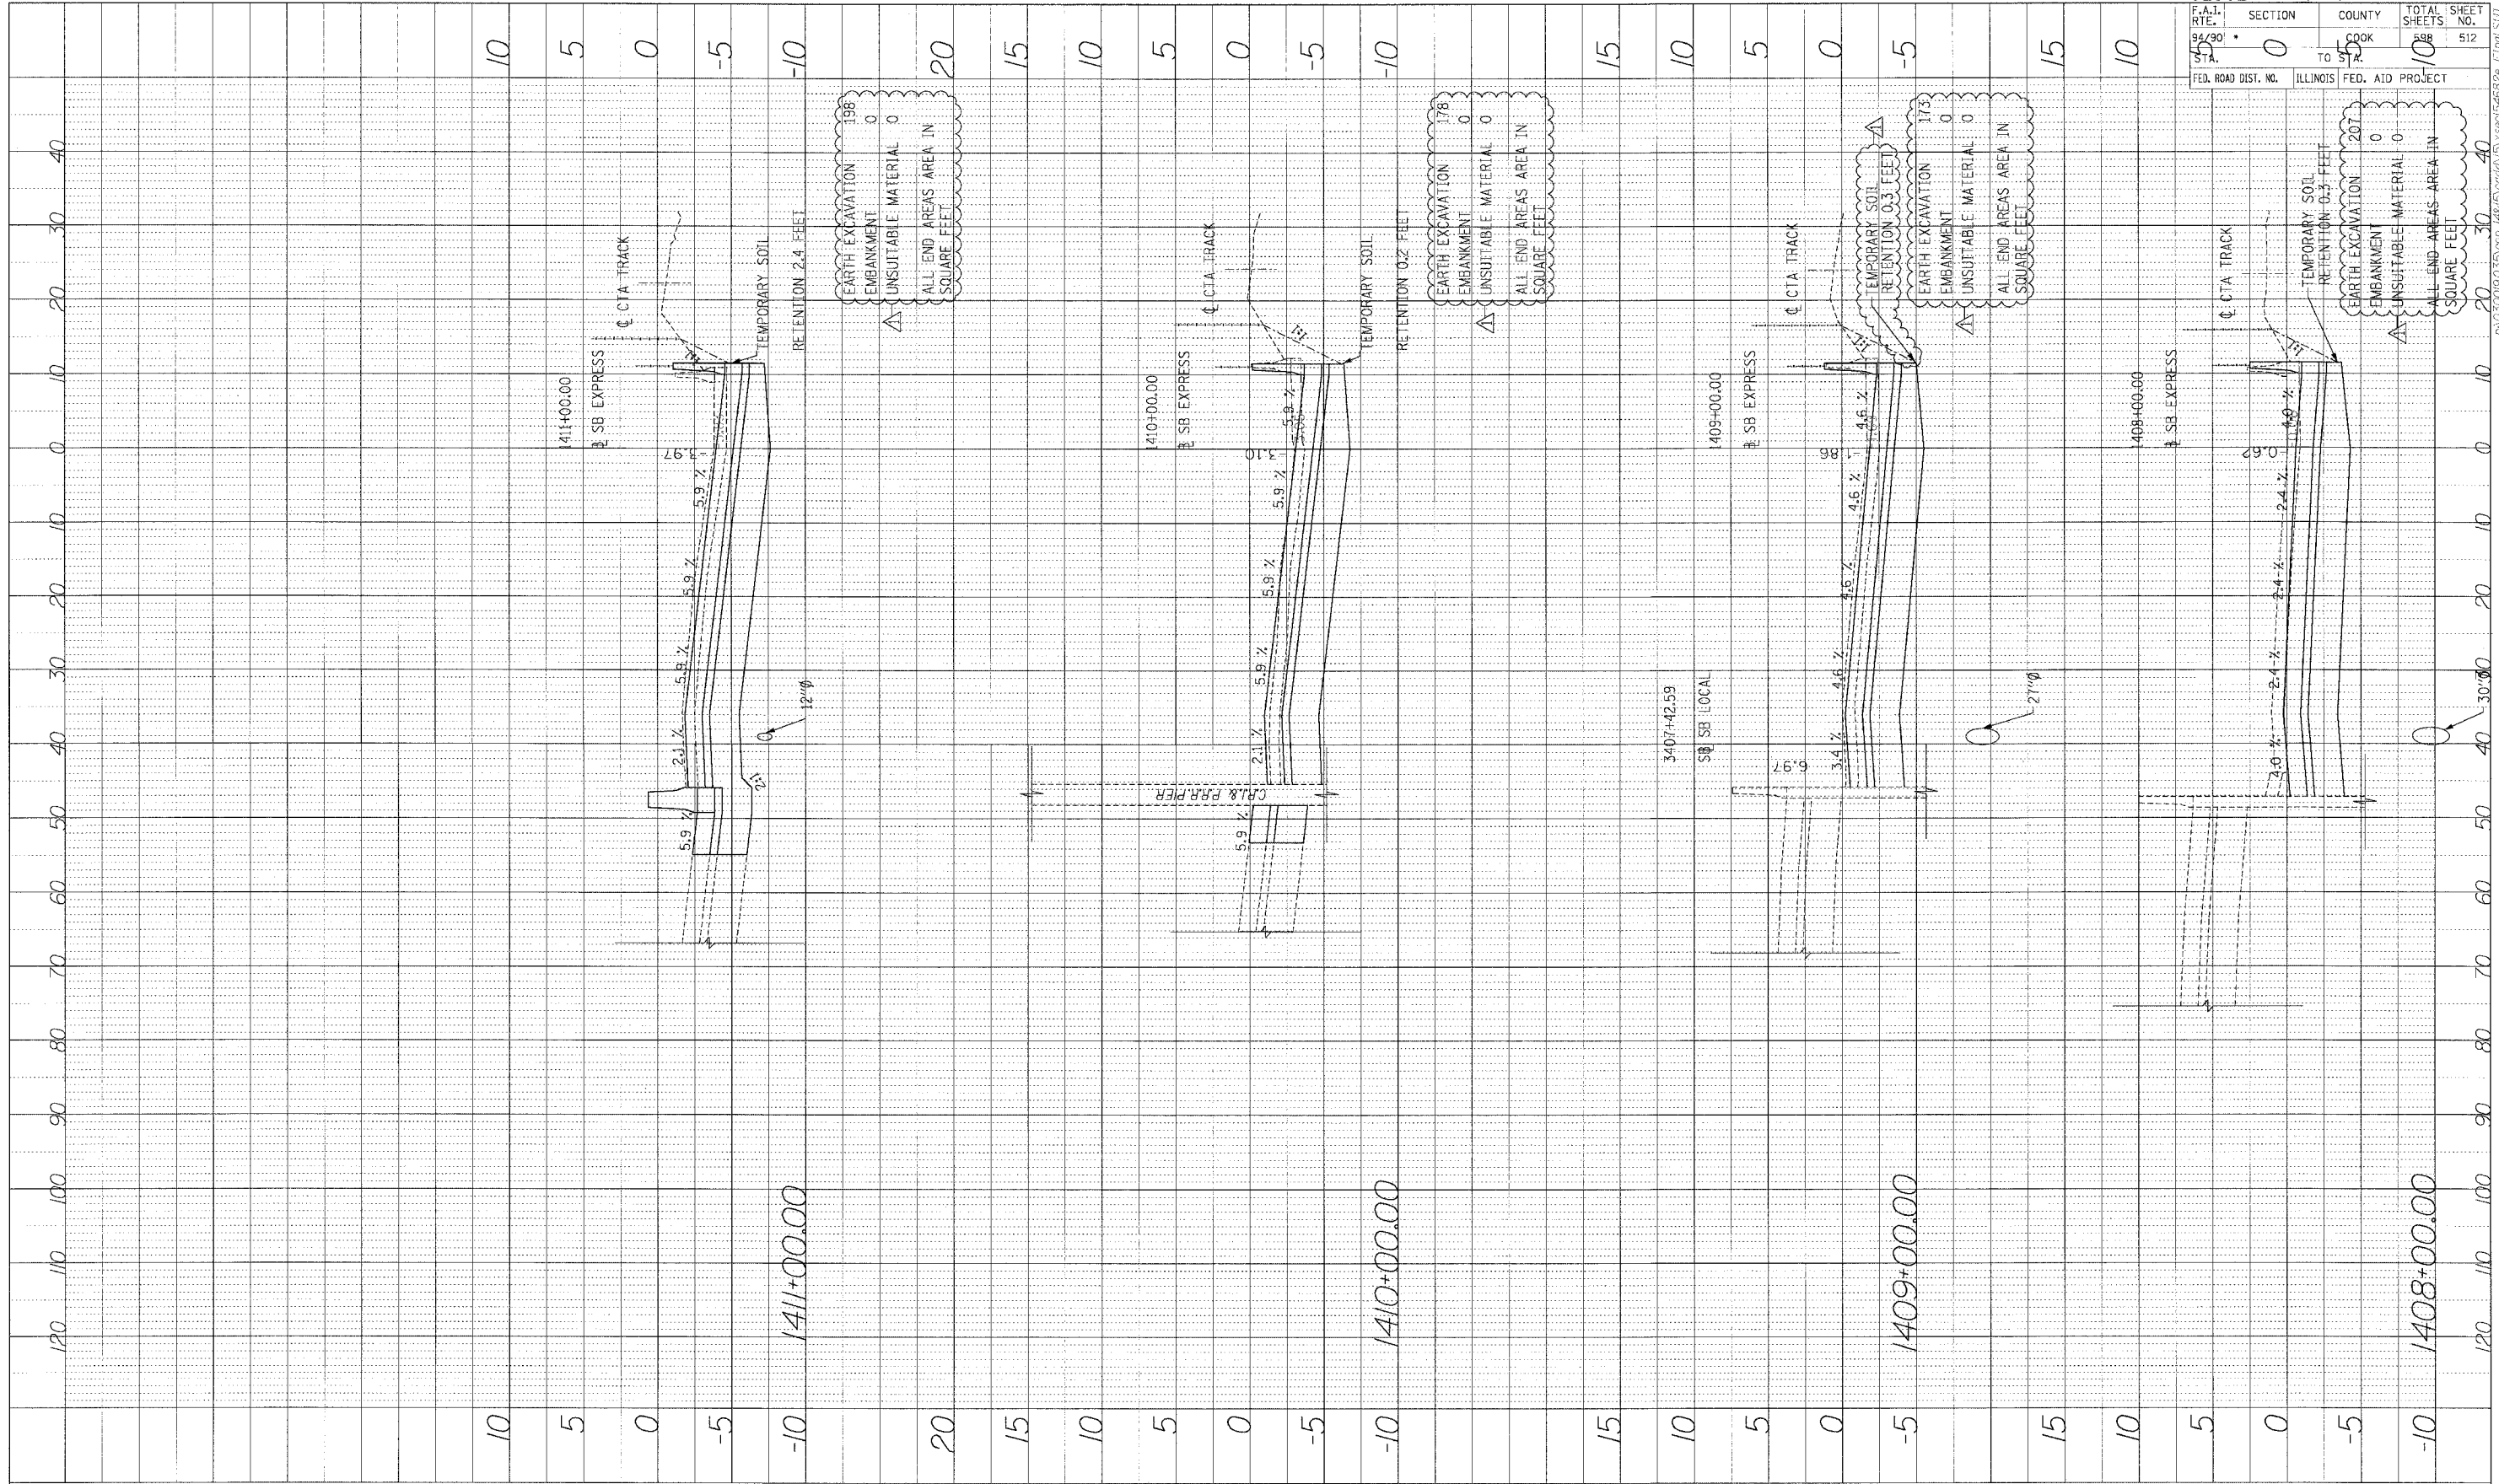

62302	SECTION	COUNTY	TOTAL SHEETS	SHEET NO.
9/90	0	COOK	10	512
FED. ROAD DIST. NO.	ILLINOIS	FED. AID PROJECT		


Edwards AND Kelcey
 ONE NORTH FRANKLIN
 CHICAGO, IL 60606
 PHONE: (312) 251-3000
 FAX: (312) 251-3015
 WEB: WWW.EKCORP.COM

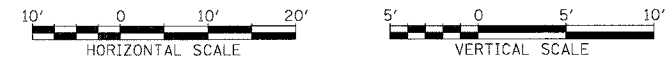

STA.


PA:03/09/03/5/03/178/5/22/03/5/00/5/46/82/-17/01/5/171

PROFILE SURVEYER: _____ DATE: _____
 NOTE BOOK: _____
 NO. _____

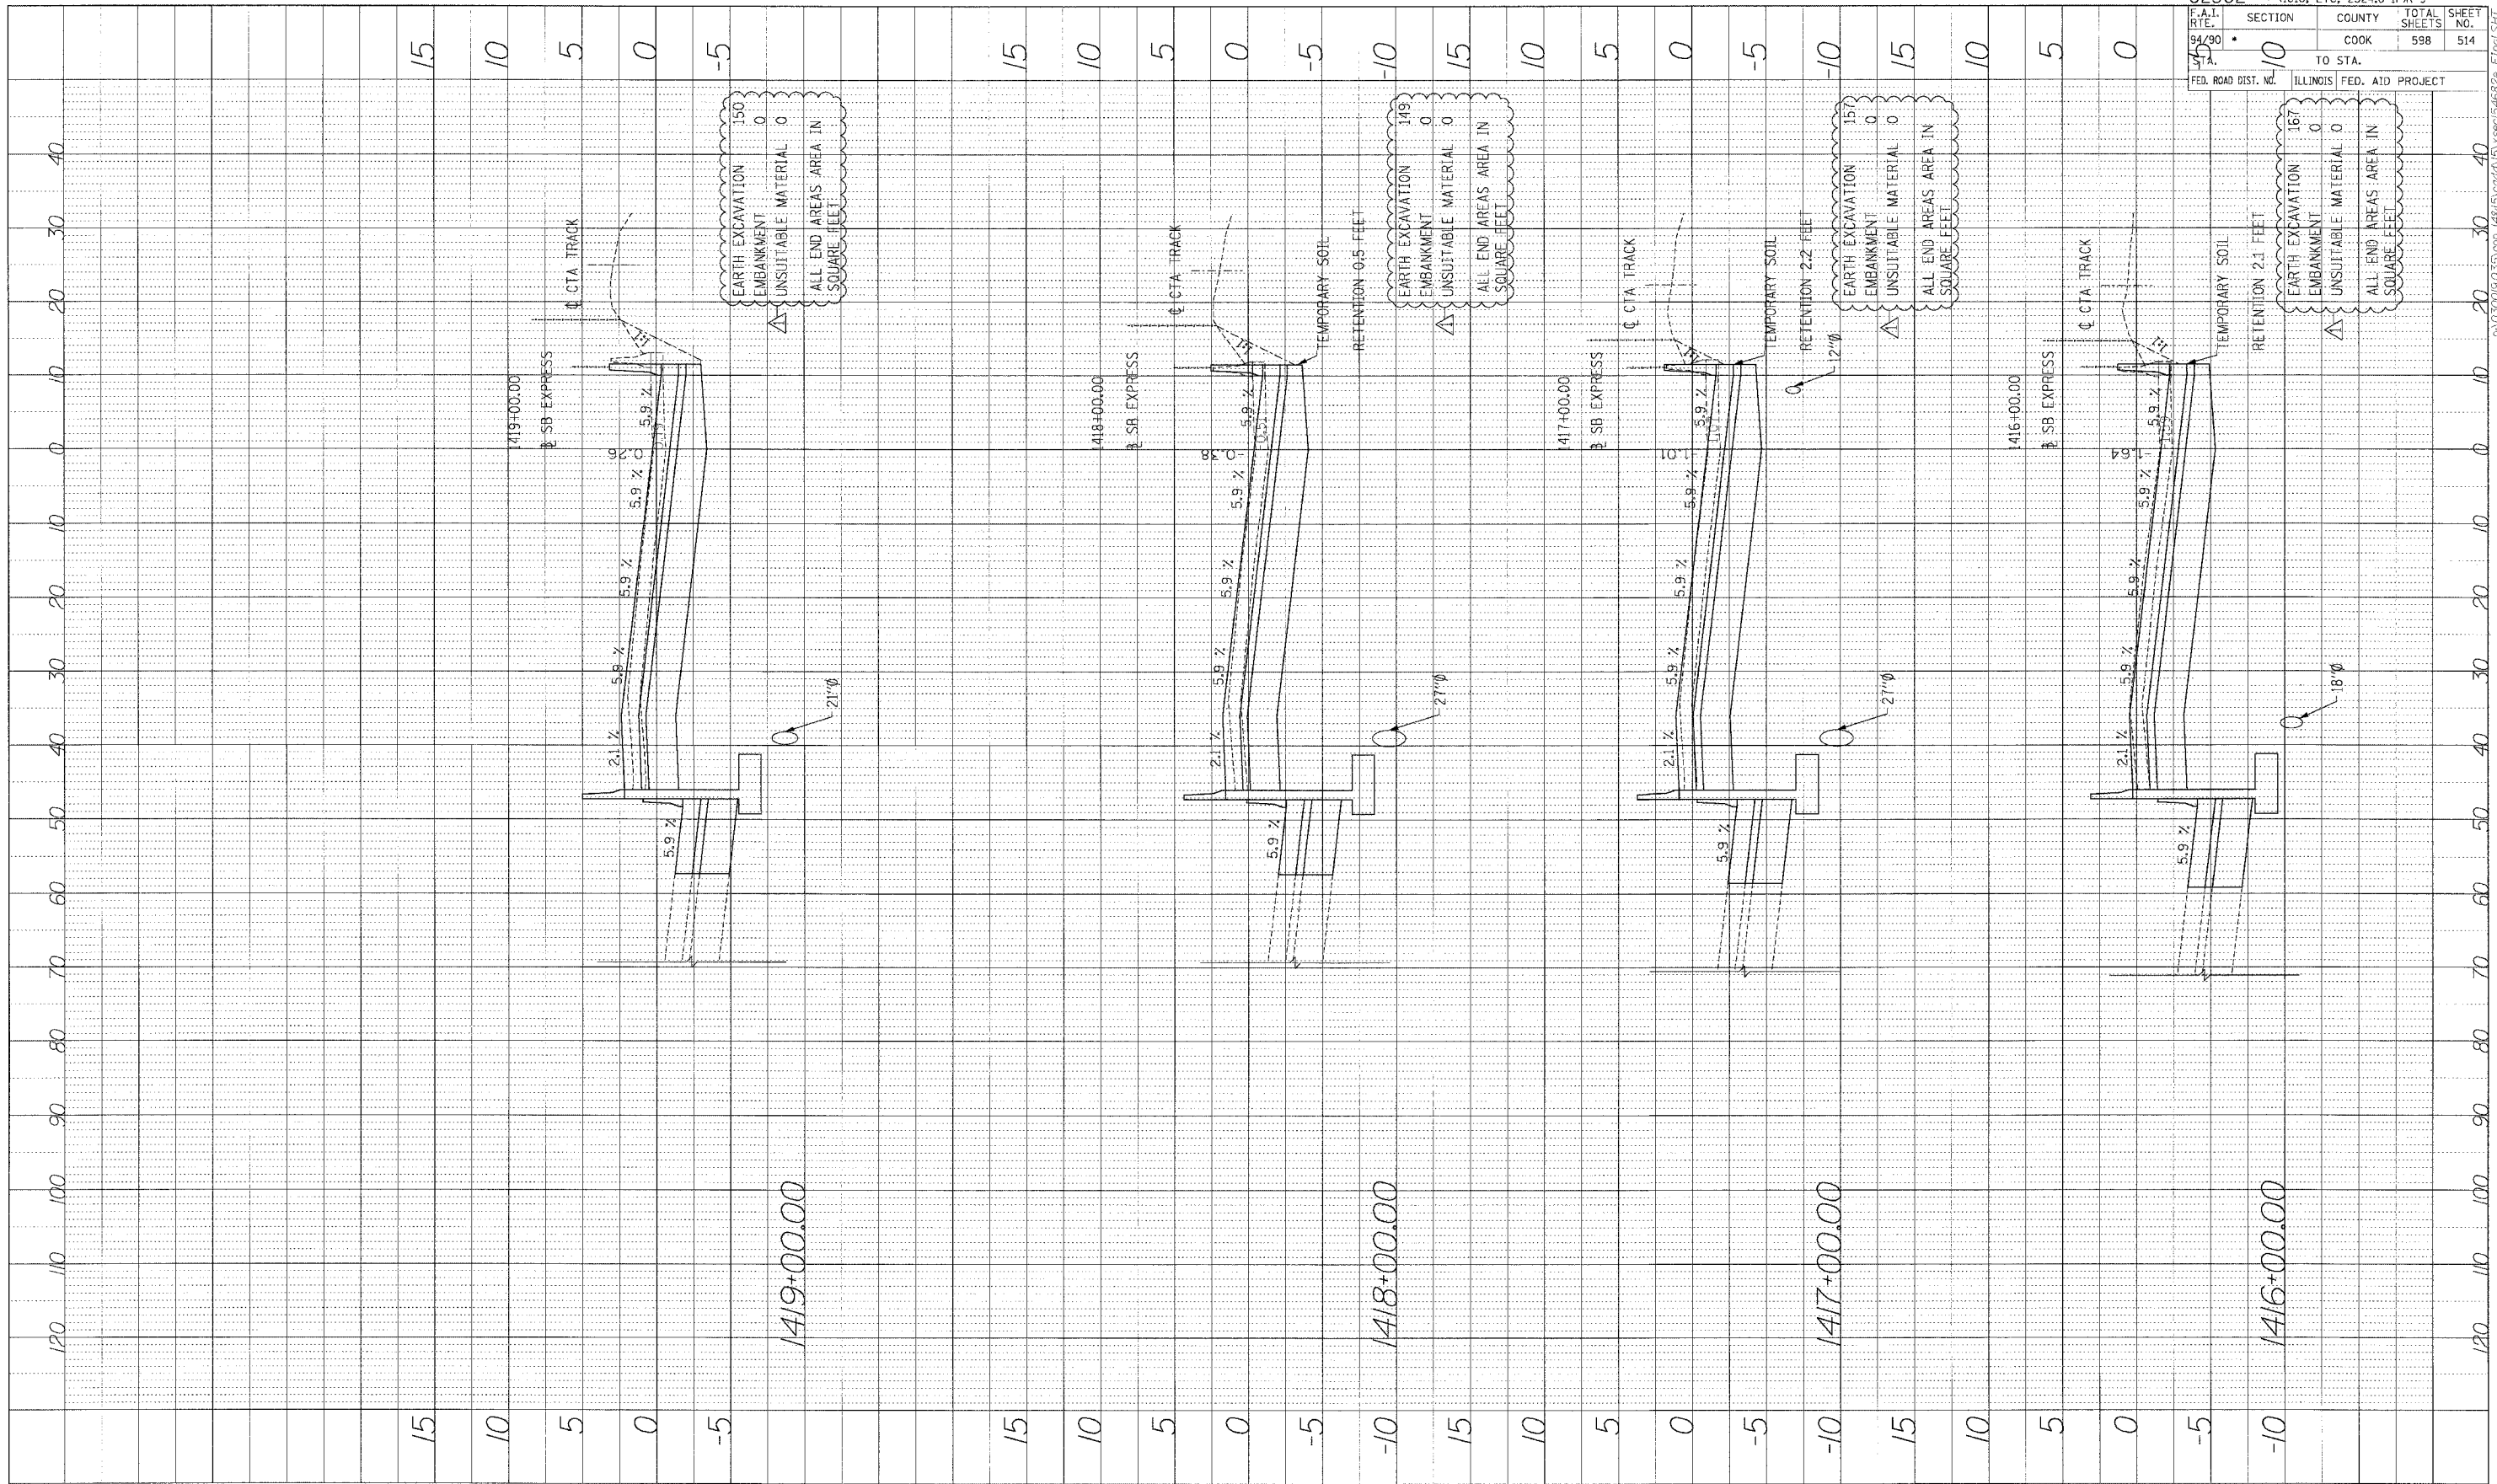

62302	• (1818, ETC, 2324.6-IPR-9		
SECTION	COUNTY	TOTAL SHEETS	SHEET NO.
10	COOK	598	514
TO STA.			
ILLINOIS FED. AID PROJECT			


Edwards AND Kelcey
 ONE NORTH FRANKLIN
 CHICAGO, IL 60606
 PHONE: (312) 251-3000
 FAX: (312) 251-3015
 WEB: WWW.EKCORP.COM

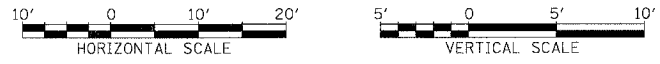

STA.


A:\030005\0355\con\14815\cadd\23\sect\54682c_f17d1\517

PROFILE
 DRAWN BY: _____ DATE: _____
 CHECKED BY: _____
 NO. _____
 STRUCTURE: NOTATION: CHRD

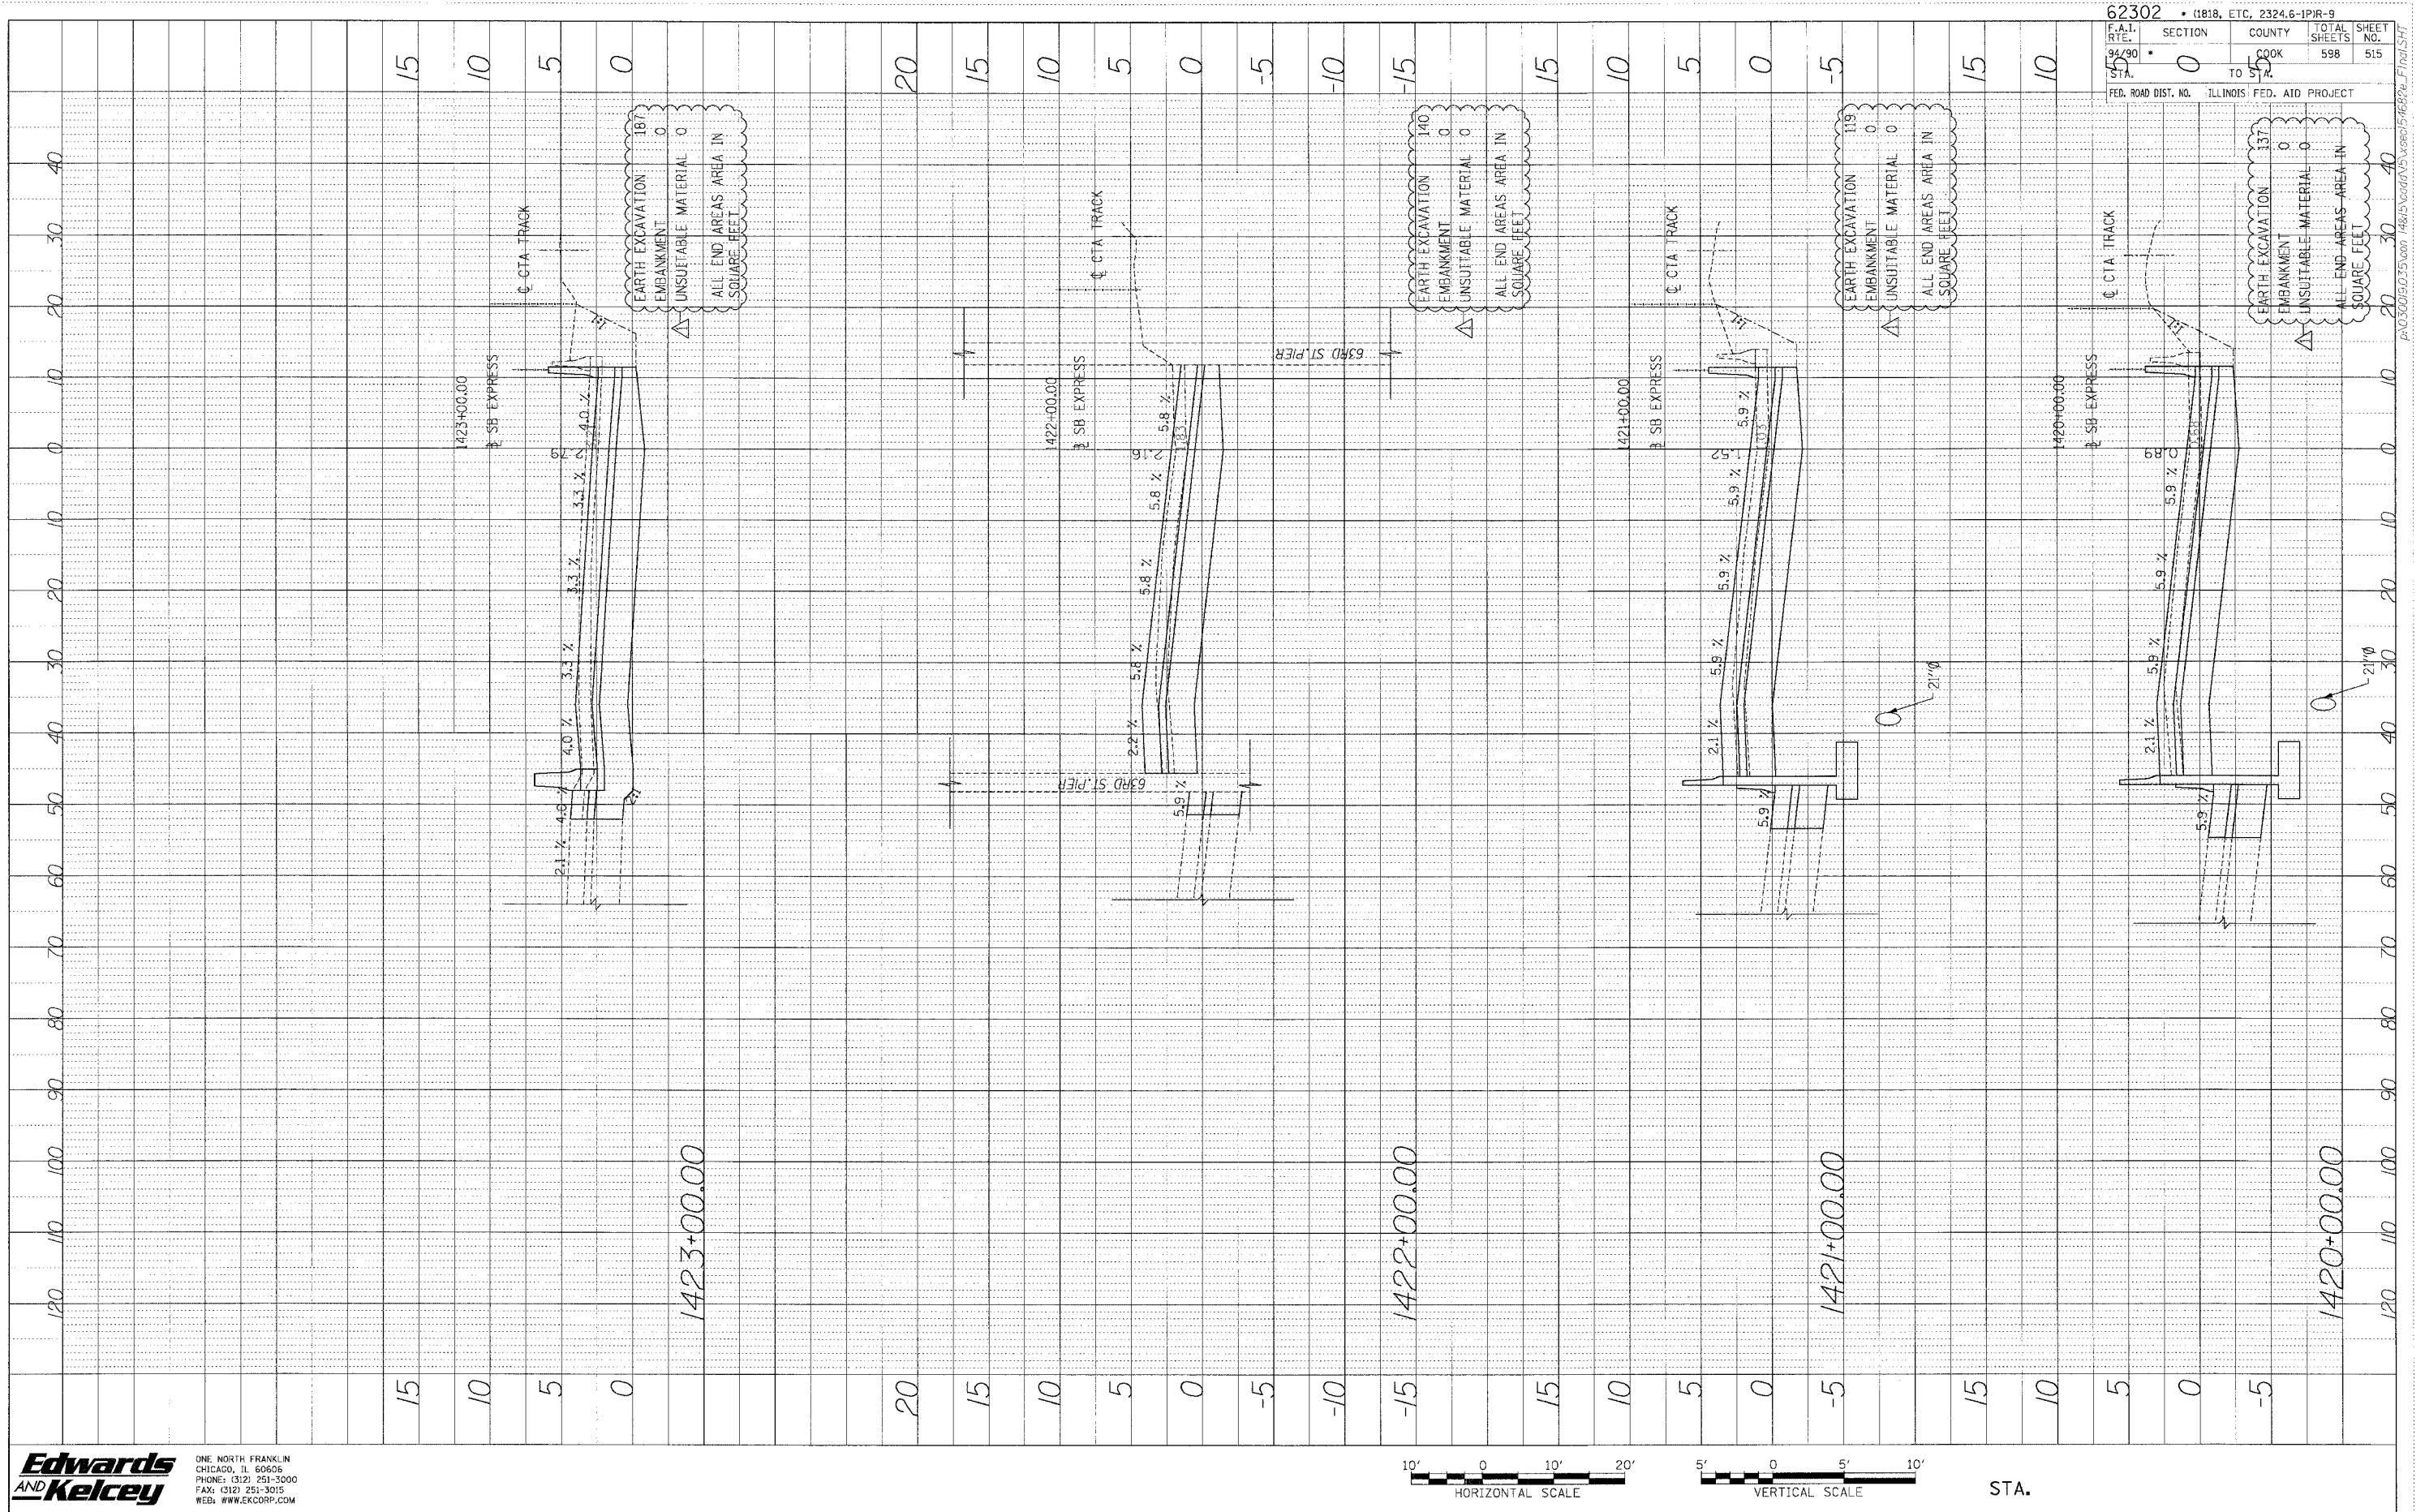

62302 • (1818, ETC, 2324.6-1PR-9	
F.A. I. NO. 94/90	SECTION 0
DATE 5/12	COUNTY COOK
	TOTAL SHEETS 598
	SHEET NO. 515
FED. ROAD DIST. NO.	ILLINOIS FED. AID PROJECT


Edwards AND Kelcey
 ONE NORTH FRANKLIN
 CHICAGO, IL 60606
 PHONE: (312) 251-3000
 FAX: (312) 251-3015
 WEB: WWW.EKCORP.COM

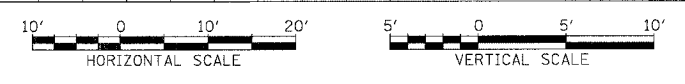


STA.

PA:030005.03:5:0007:14615:000005:0005:146829: F:\m\1517

PROFIT
 BY
 DATE
 NOTE BOOK
 DRAWING NO.
 PROJECT NAME

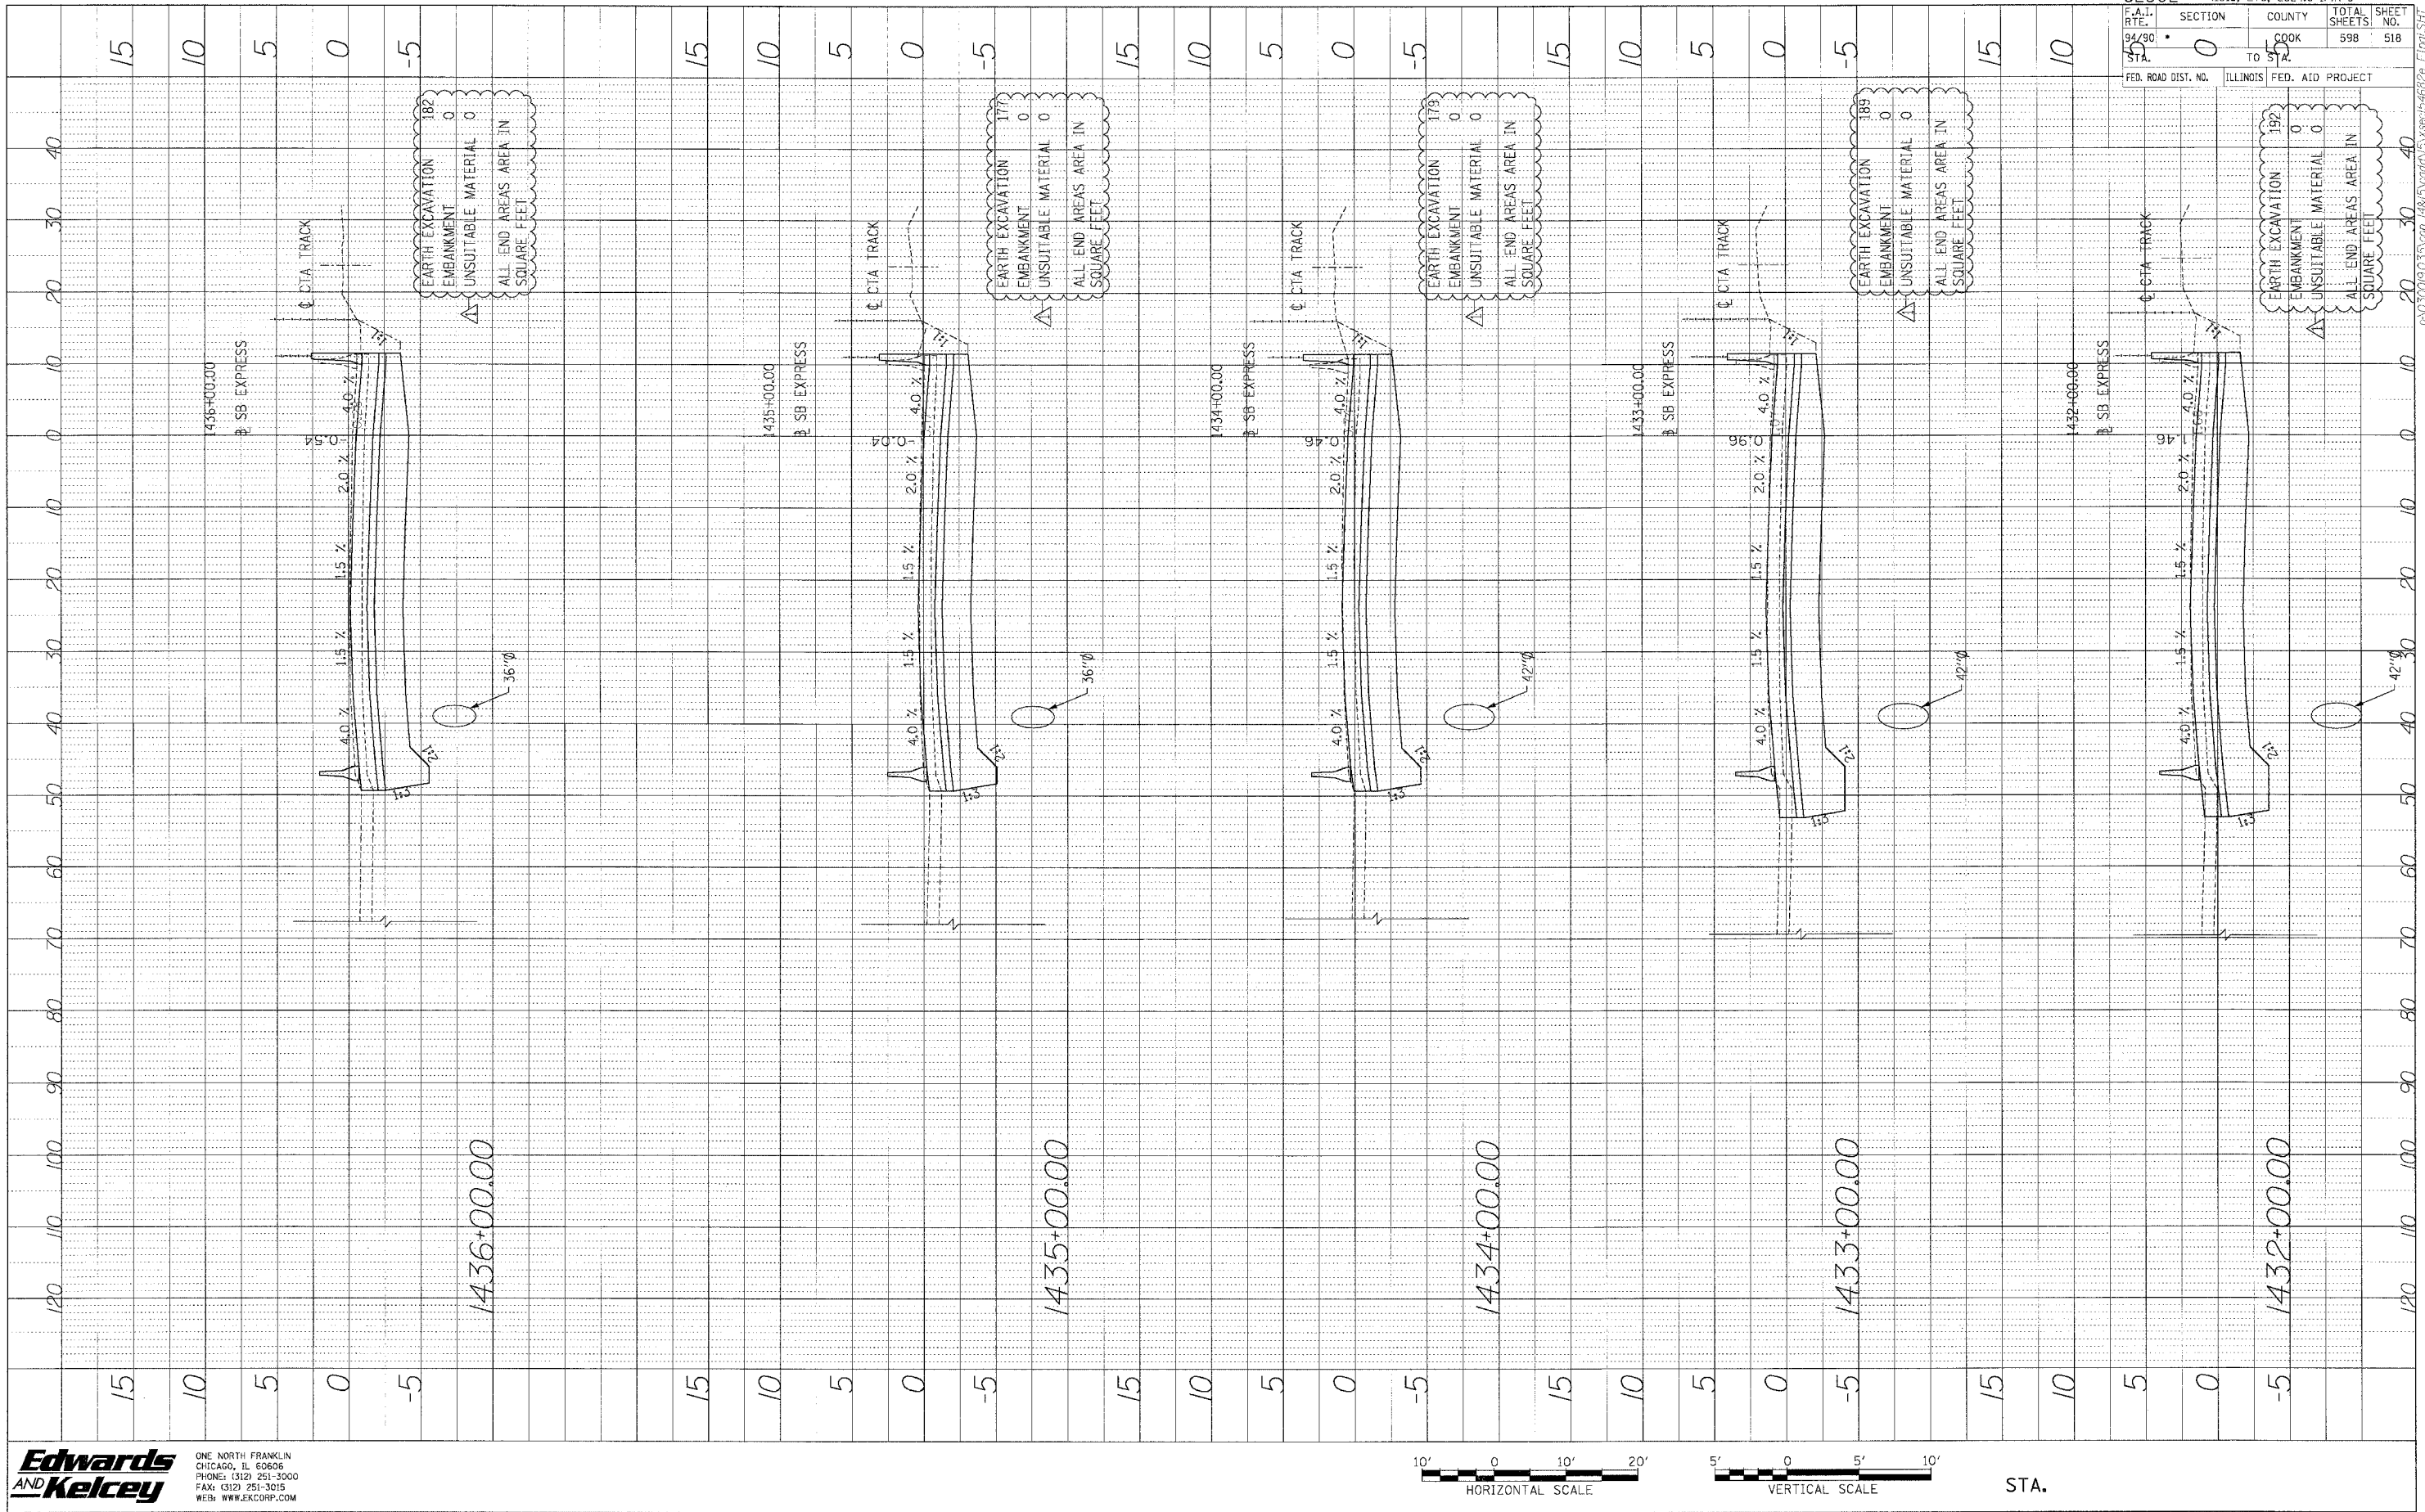

Edwards AND Kelcey
 ONE NORTH FRANKLIN
 CHICAGO, IL 60606
 PHONE: (312) 251-3000
 FAX: (312) 251-3015
 WEB: WWW.EKCORP.COM

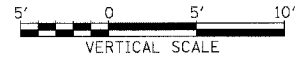

STA.

F.A.I. RTE.	SECTION	COUNTY	TOTAL SHEETS	SHEET NO.
94/90	0	COOK	598	518
DATA	TO STA.	FED. ROAD DIST. NO. ILLINOIS FED. AID PROJECT		

EARTH EXCAVATION 188
 EMBANKMENT 0
 UNSUITABLE MATERIAL 0
 ALL END AREAS AREA IN SQUARE FEET

EARTH EXCAVATION 177
 EMBANKMENT 0
 UNSUITABLE MATERIAL 0
 ALL END AREAS AREA IN SQUARE FEET


EARTH EXCAVATION 179
 EMBANKMENT 0
 UNSUITABLE MATERIAL 0
 ALL END AREAS AREA IN SQUARE FEET

EARTH EXCAVATION 185
 EMBANKMENT 0
 UNSUITABLE MATERIAL 0
 ALL END AREAS AREA IN SQUARE FEET

EARTH EXCAVATION 192
 EMBANKMENT 0
 UNSUITABLE MATERIAL 0
 ALL END AREAS AREA IN SQUARE FEET


PA05009.03 (Rev. 1/85) 1435 1436 1434 1433 1432 0

PROFILE SHEET
 DRAWN BY: _____ DATE: _____
 CHECKED BY: _____
 DATE: _____
 NO. _____

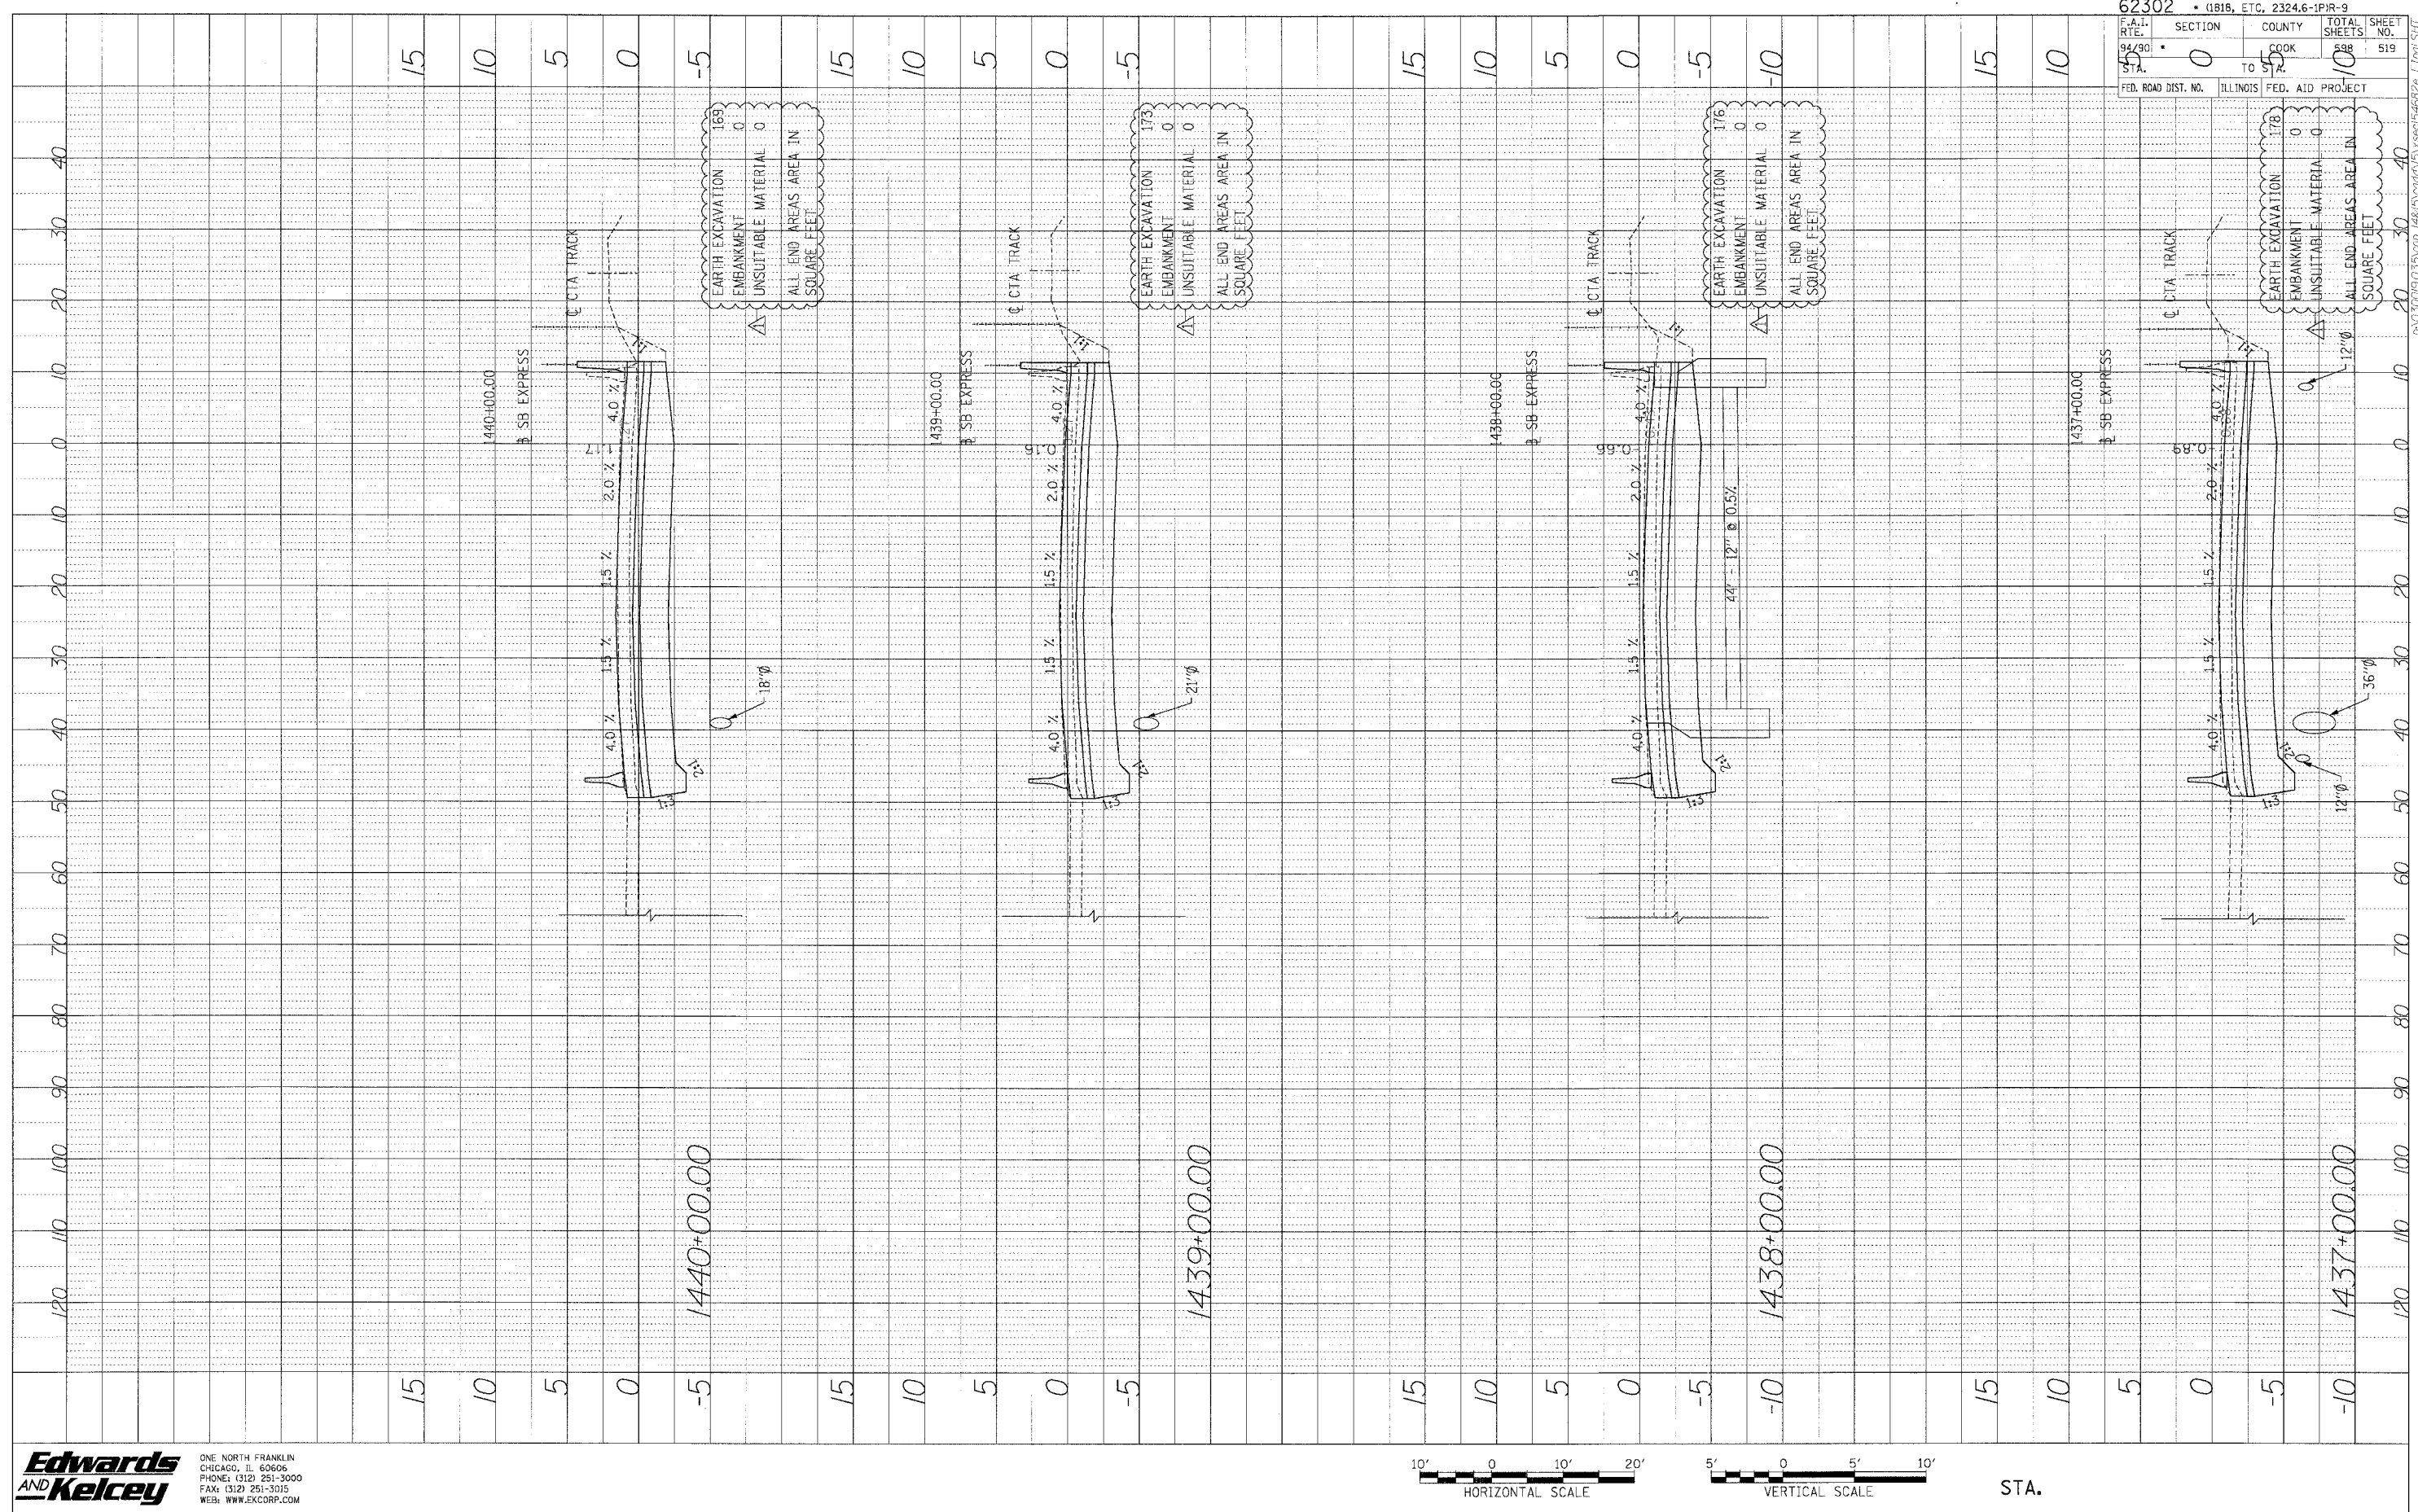

62302 • GB18, ETC. 2324.6-1PR-9	
F.A.I. DIST. NO. 99/90	SECTION 0
COUNTY COOK	TOTAL SHEETS 10
TO 52	SHEET NO. 519
FED. ROAD DIST. NO. ILLINOIS	FED. AID PROJECT


Edwards AND Kelcey
 ONE NORTH FRANKLIN CHICAGO, IL 60606
 PHONE: (312) 251-3000
 FAX: (312) 251-3015
 WEB: WWW.EKCORP.COM

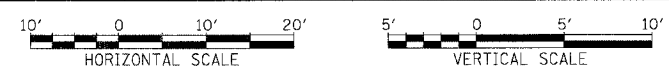

STA.

PA:02009.03/5/007 78/5/00015/3/005/46/22-1/10/1/11

PROJ ILL SURVEYED BY DATE
 NOTED CHECKED
 B.M. NOTED
 STRUCTURE NOTING ON/OFF

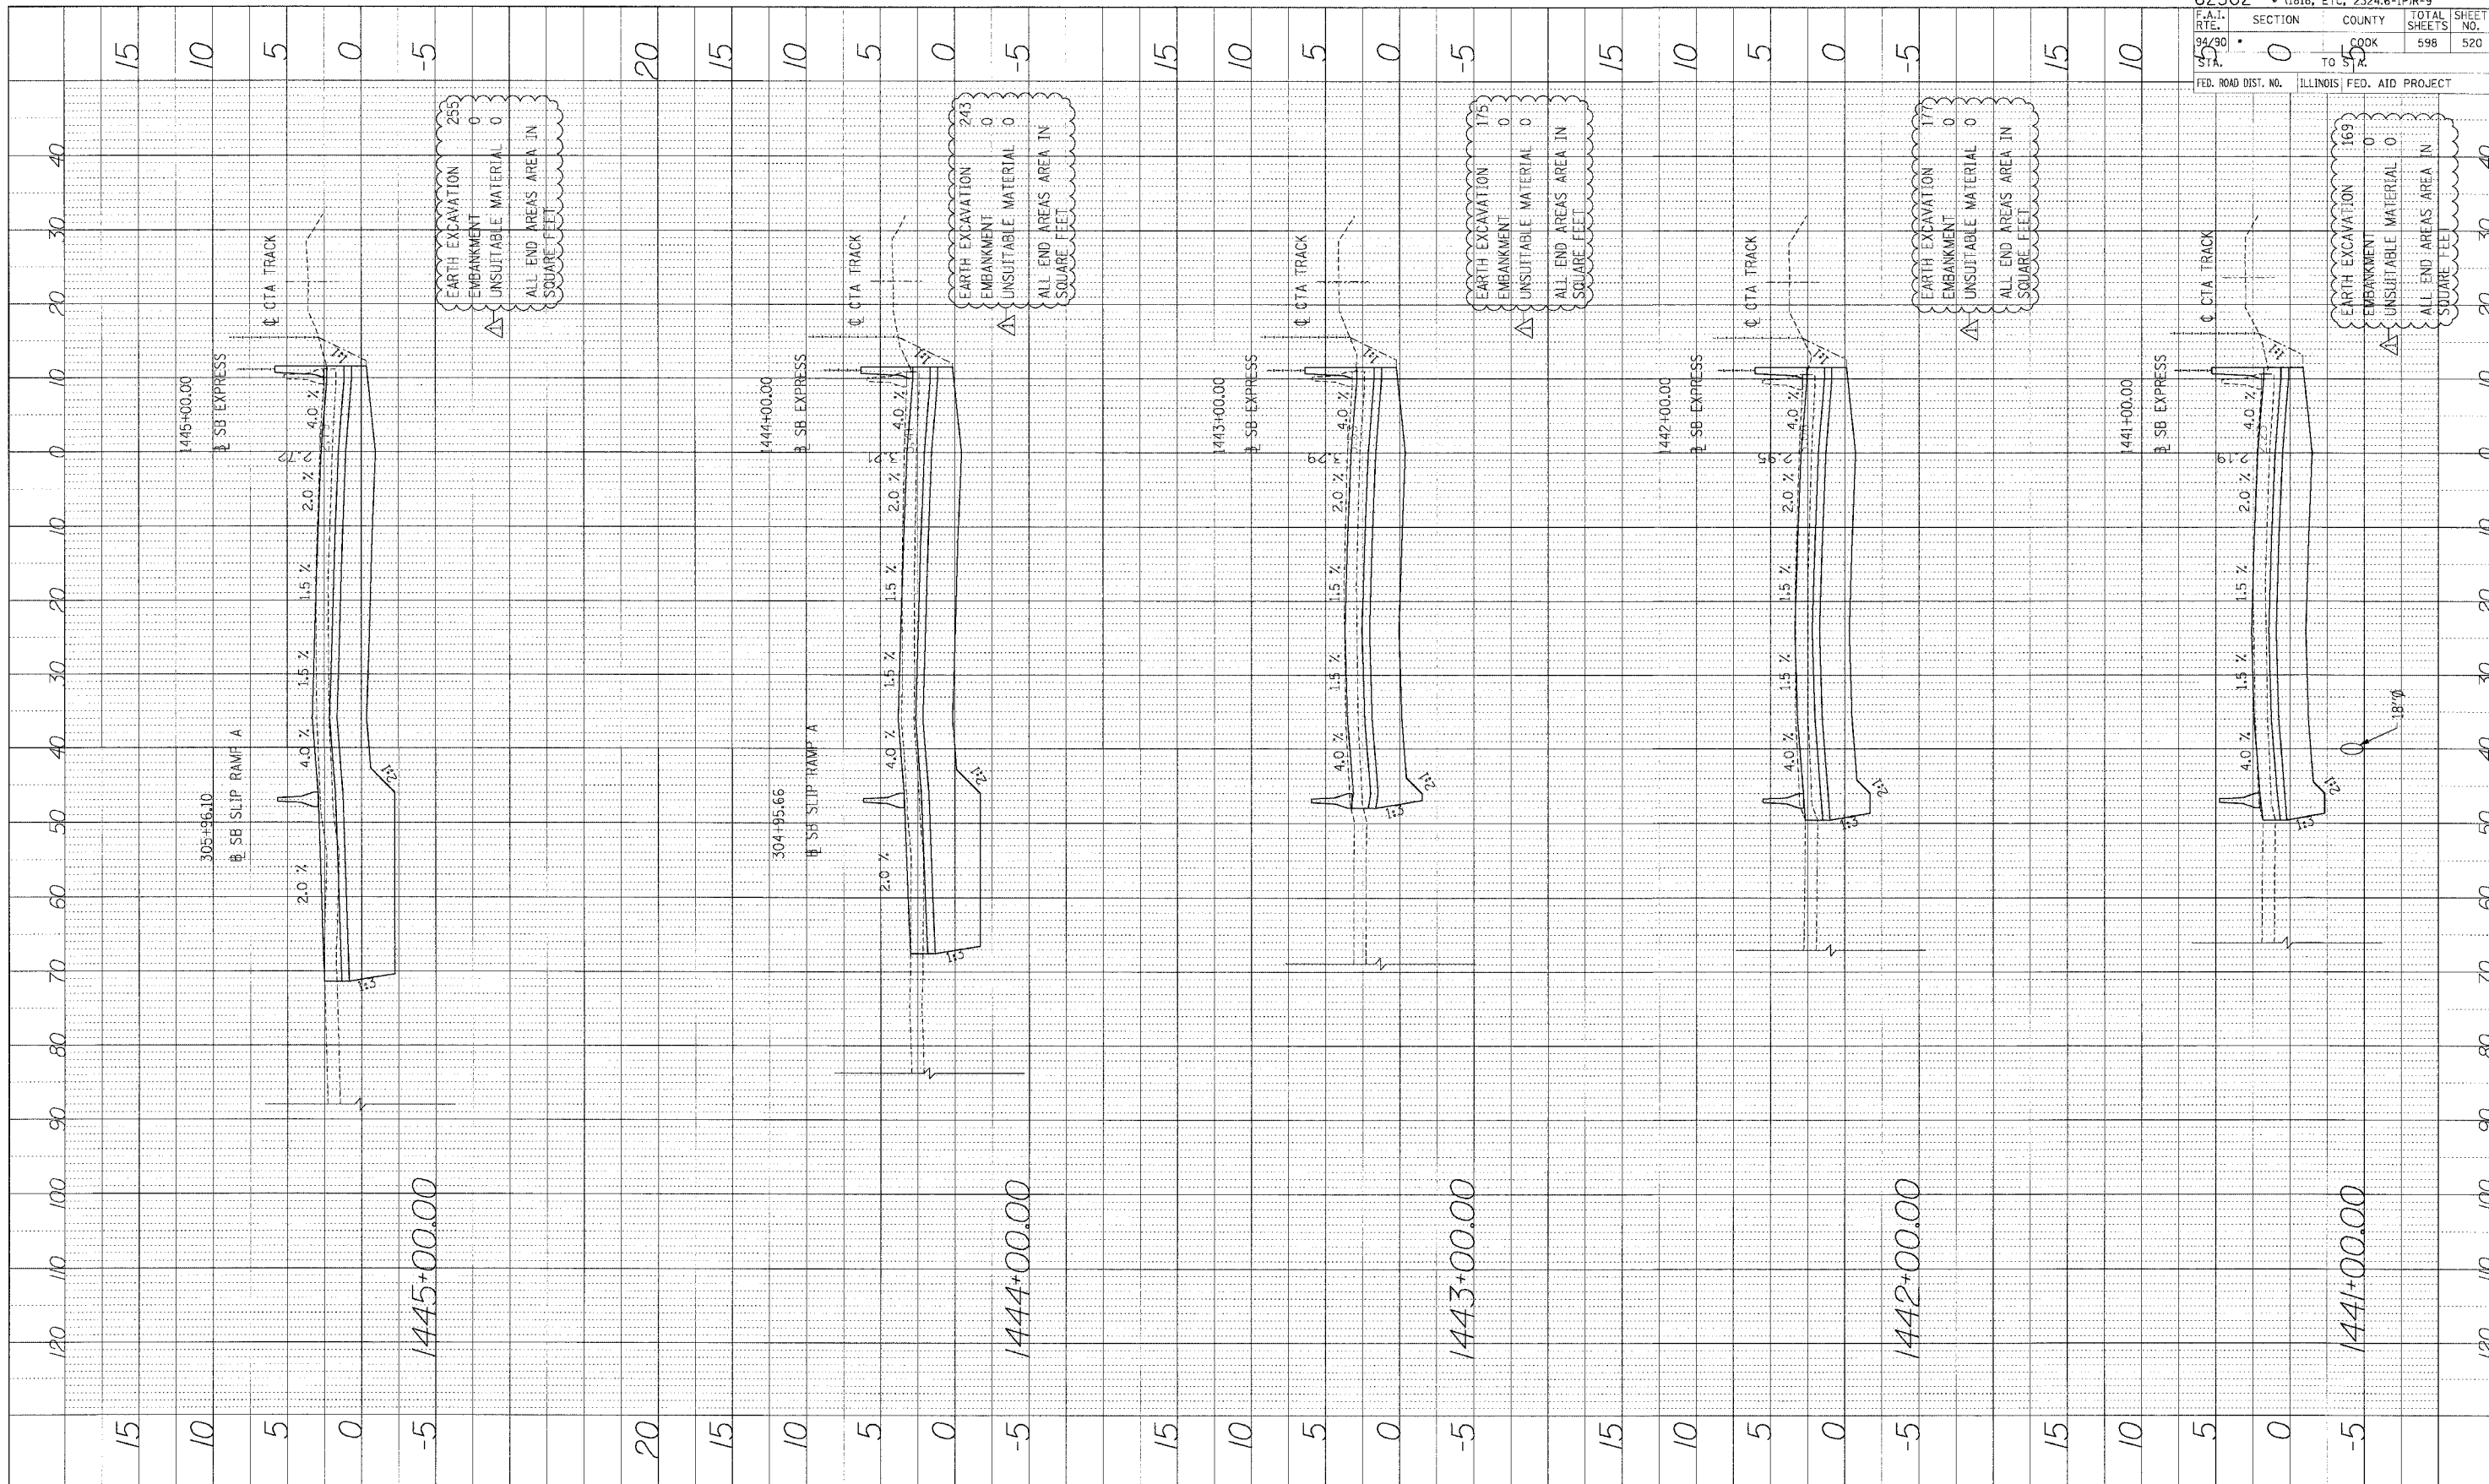

Edwards AND Kelcey
 ONE NORTH FRANKLIN
 CHICAGO, IL 60606
 PHONE: (312) 251-3000
 FAX: (312) 251-3015
 WEB: WWW.EDWARDS-AND-KELCEY.COM




STA.

62302	• (1818, ETC, 2324.6-IPR-9		
SECTION	COUNTY	TOTAL SHEETS	SHEET NO.
0	COOK	598	520
FED. ROAD DIST. NO.	ILLINOIS FED. AID PROJECT		


P:\03\05\03\5\com 148\15\000\025\sect5\sect54682b_17.mxd

PROFILE SURVEYED BY DATE
 NOTE BOOK GRADED BY CHECKED
 STA. NOTED BY
 NO. STRUCTURE NOTATION GRID

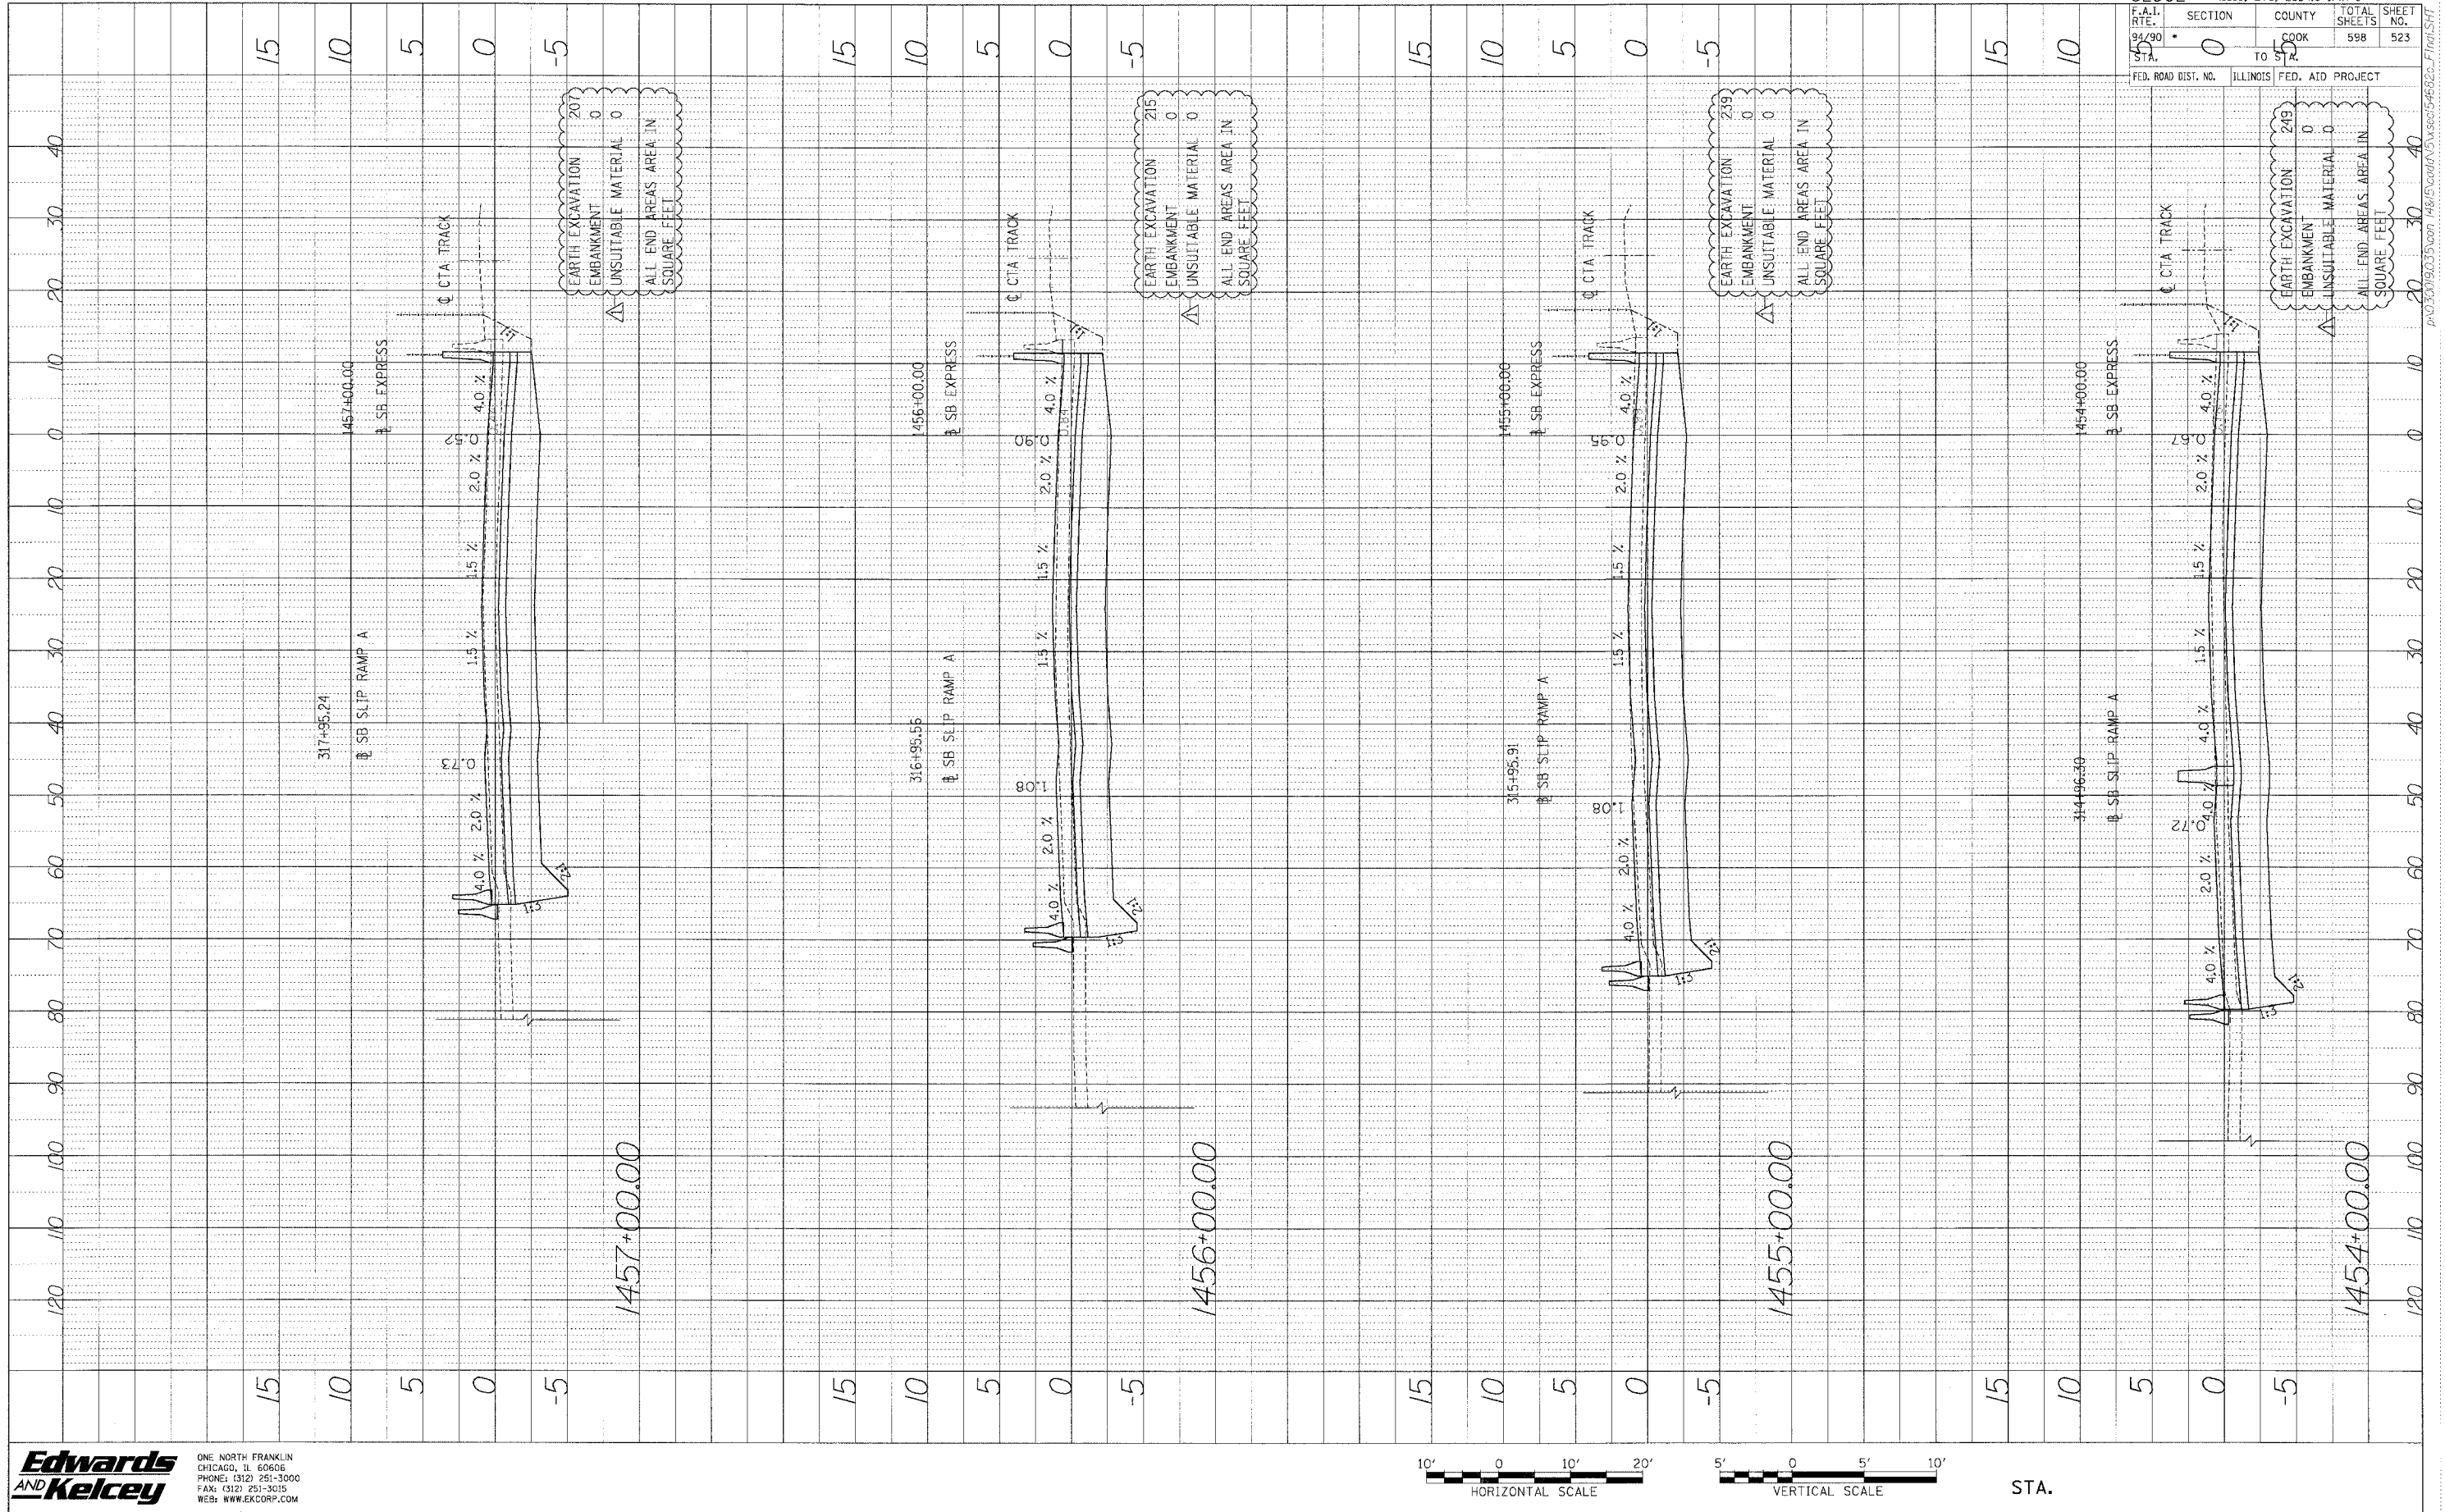

62302 • (1818, ETC., 2324.6-1PR-9	
F.A.I. R.T.E. 99/90	SECTION 0
TO 512	COUNTY COOK
FED. ROAD DIST. NO. ILLINOIS	FED. AID PROJECT
TOTAL SHEETS 598	SHEET NO. 523

Edwards AND Kelcey
 ONE NORTH FRANKLIN CHICAGO, IL 60606
 PHONE: (312) 251-3000
 FAX: (312) 251-3015
 WEB: WWW.EKCORP.COM

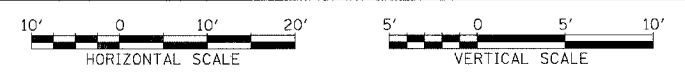


STA.


PA030090.00:5:007 1455+00.00:5:007 1454+00.00:5:007 1456+00.00:5:007 1455+00.00:5:007 1454+00.00:5:007

PHOTO ILL. SURVEYED BY DATE
 CHECKED
 DATE CHECKED
 NOTE BOOK NO. NOTED
 REVISIONS
 STRUCTURE NOTATION: CRFD

62302 • (1818, ETC. 2324.6-1PR-9
 F.A.I. SECTION COUNTY TOTAL SHEETS
 94-80 TO STA. 524
 STA. 10000
 FED. ROAD DIST. NO. ILLINOIS FED. AID PROJECT

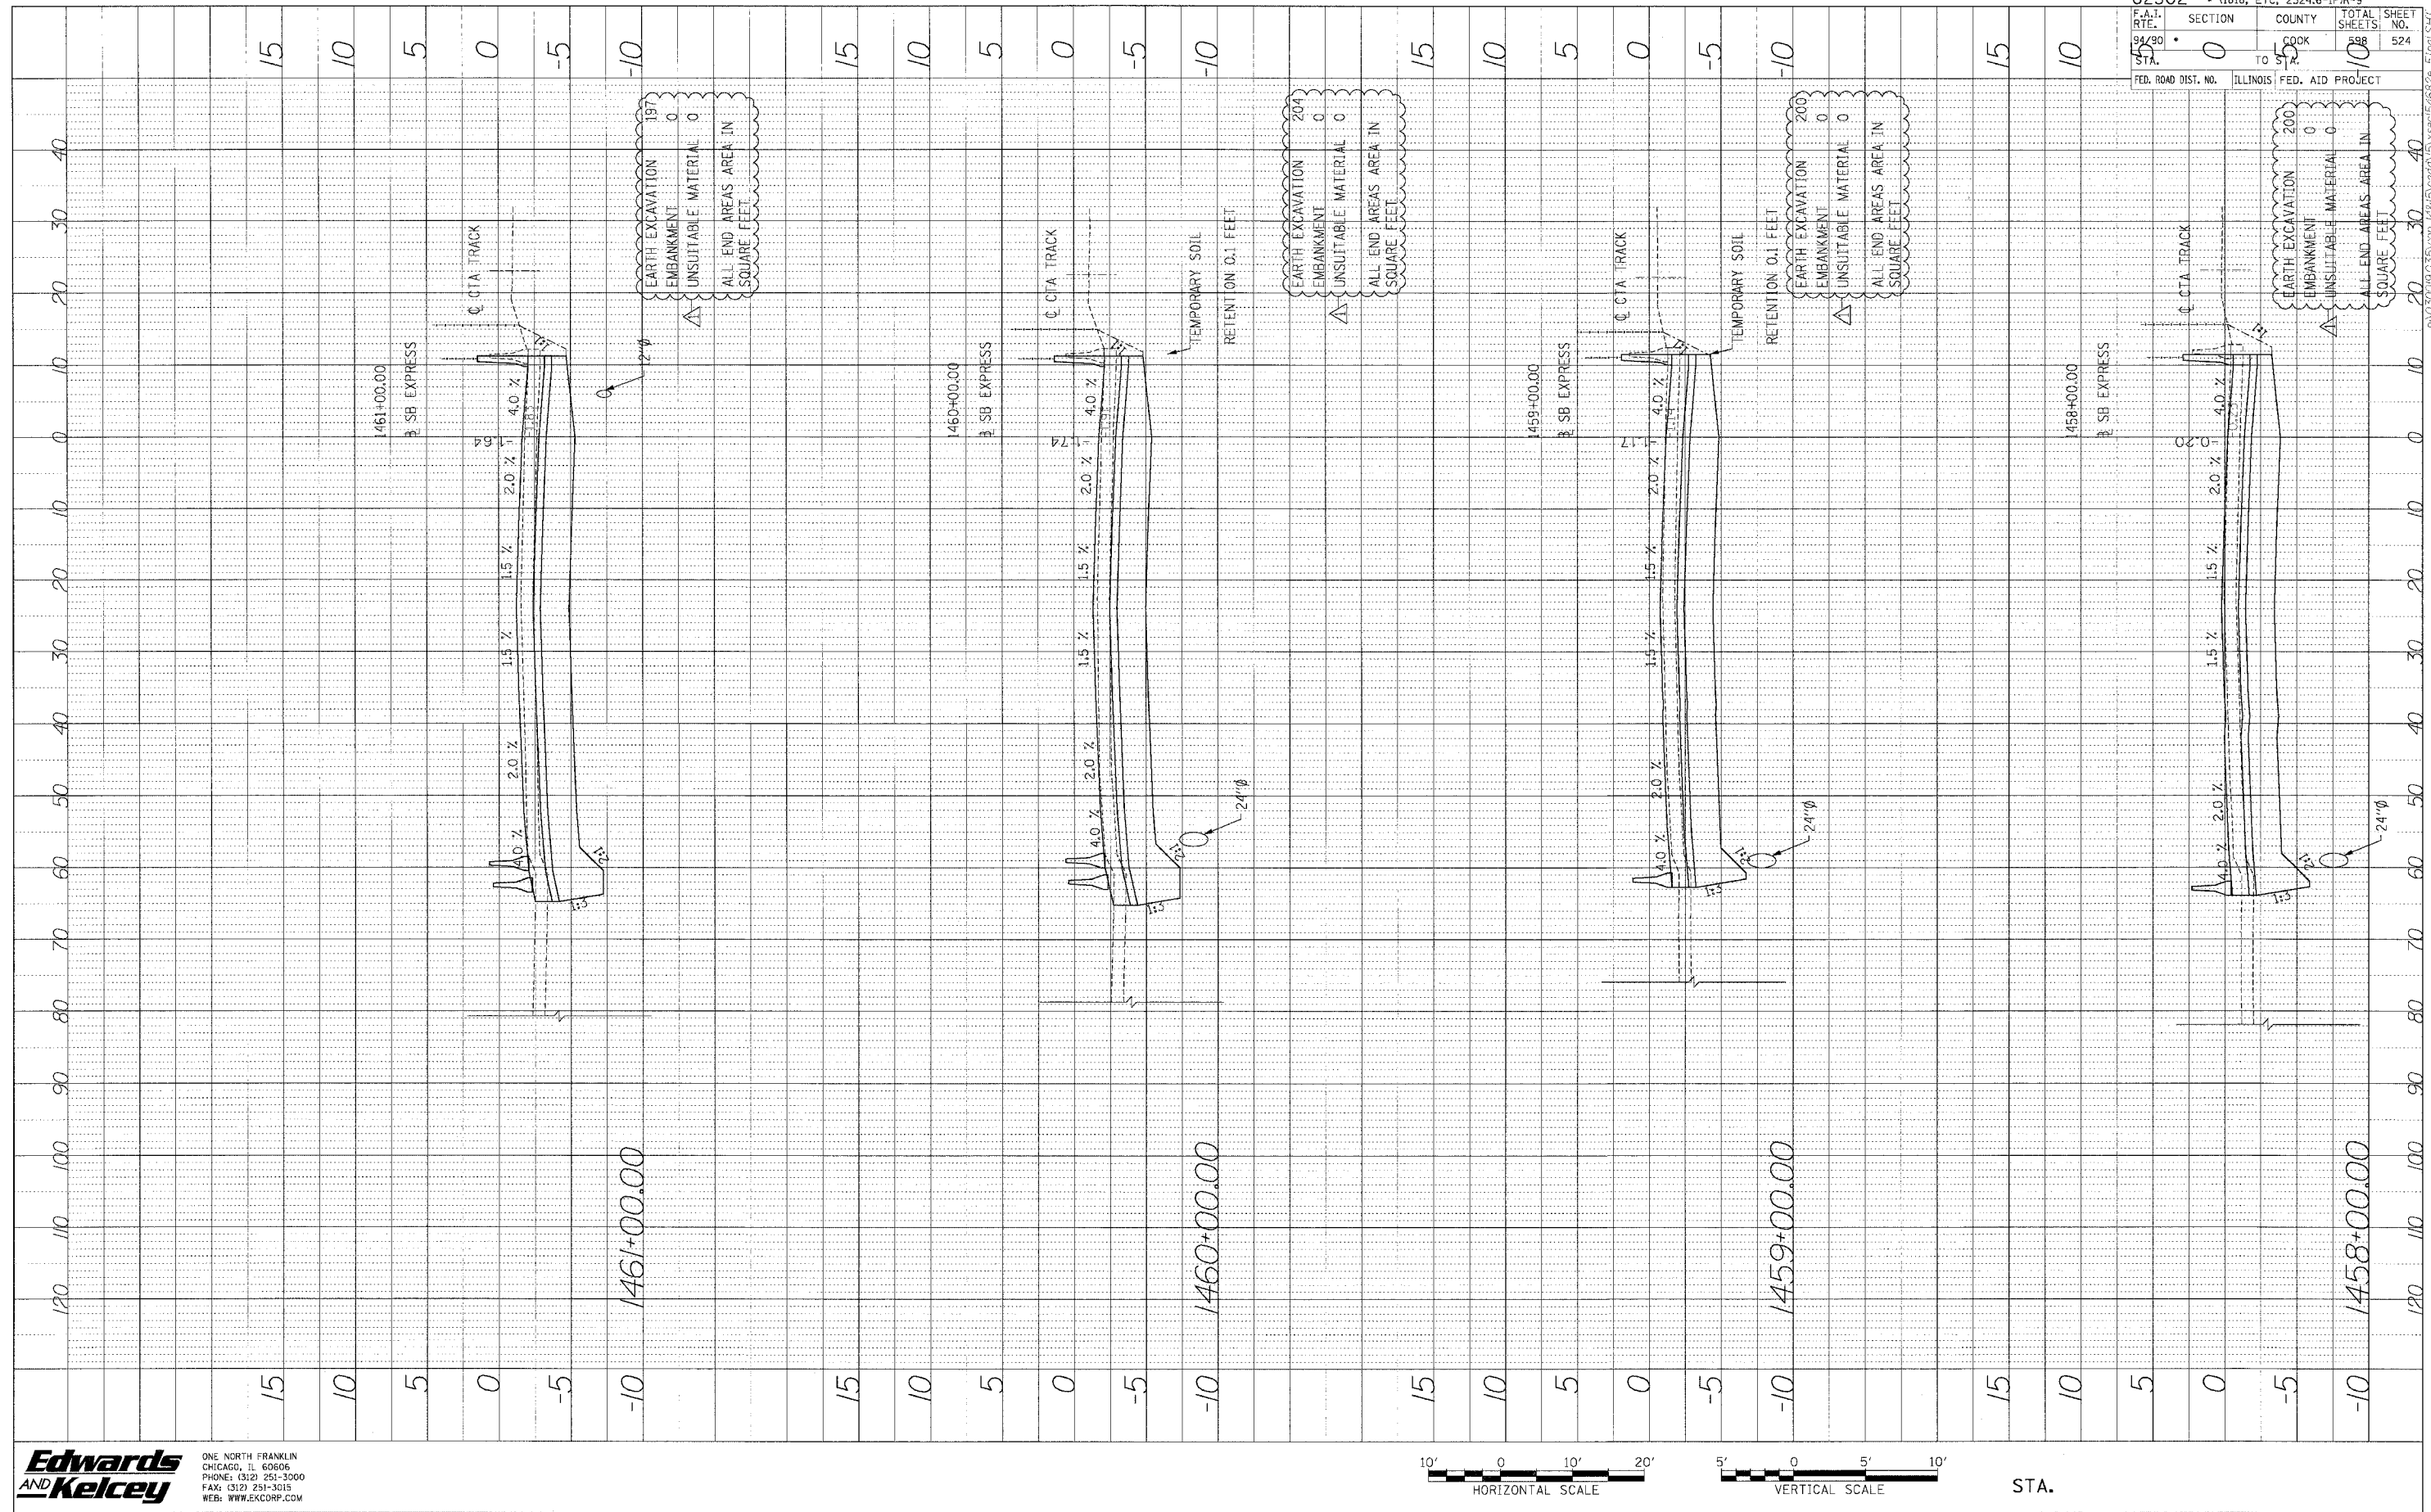


Edwards AND Kelcey
 ONE NORTH FRANKLIN
 CHICAGO, IL 60606
 PHONE: (312) 251-3000
 FAX: (312) 251-3015
 WEB: WWW.EKCORP.COM

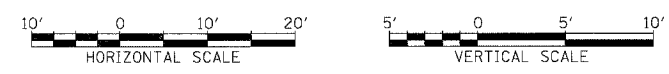

STA.


PA:030009.035 User: 1/18/15 cad00133\user1546876.Fred.S.H

PROFILE SURVEYED BY DATE
 CHECKED BY
 NOTE BOOK NO.
 STRUCTURE NO. DATE SURV.

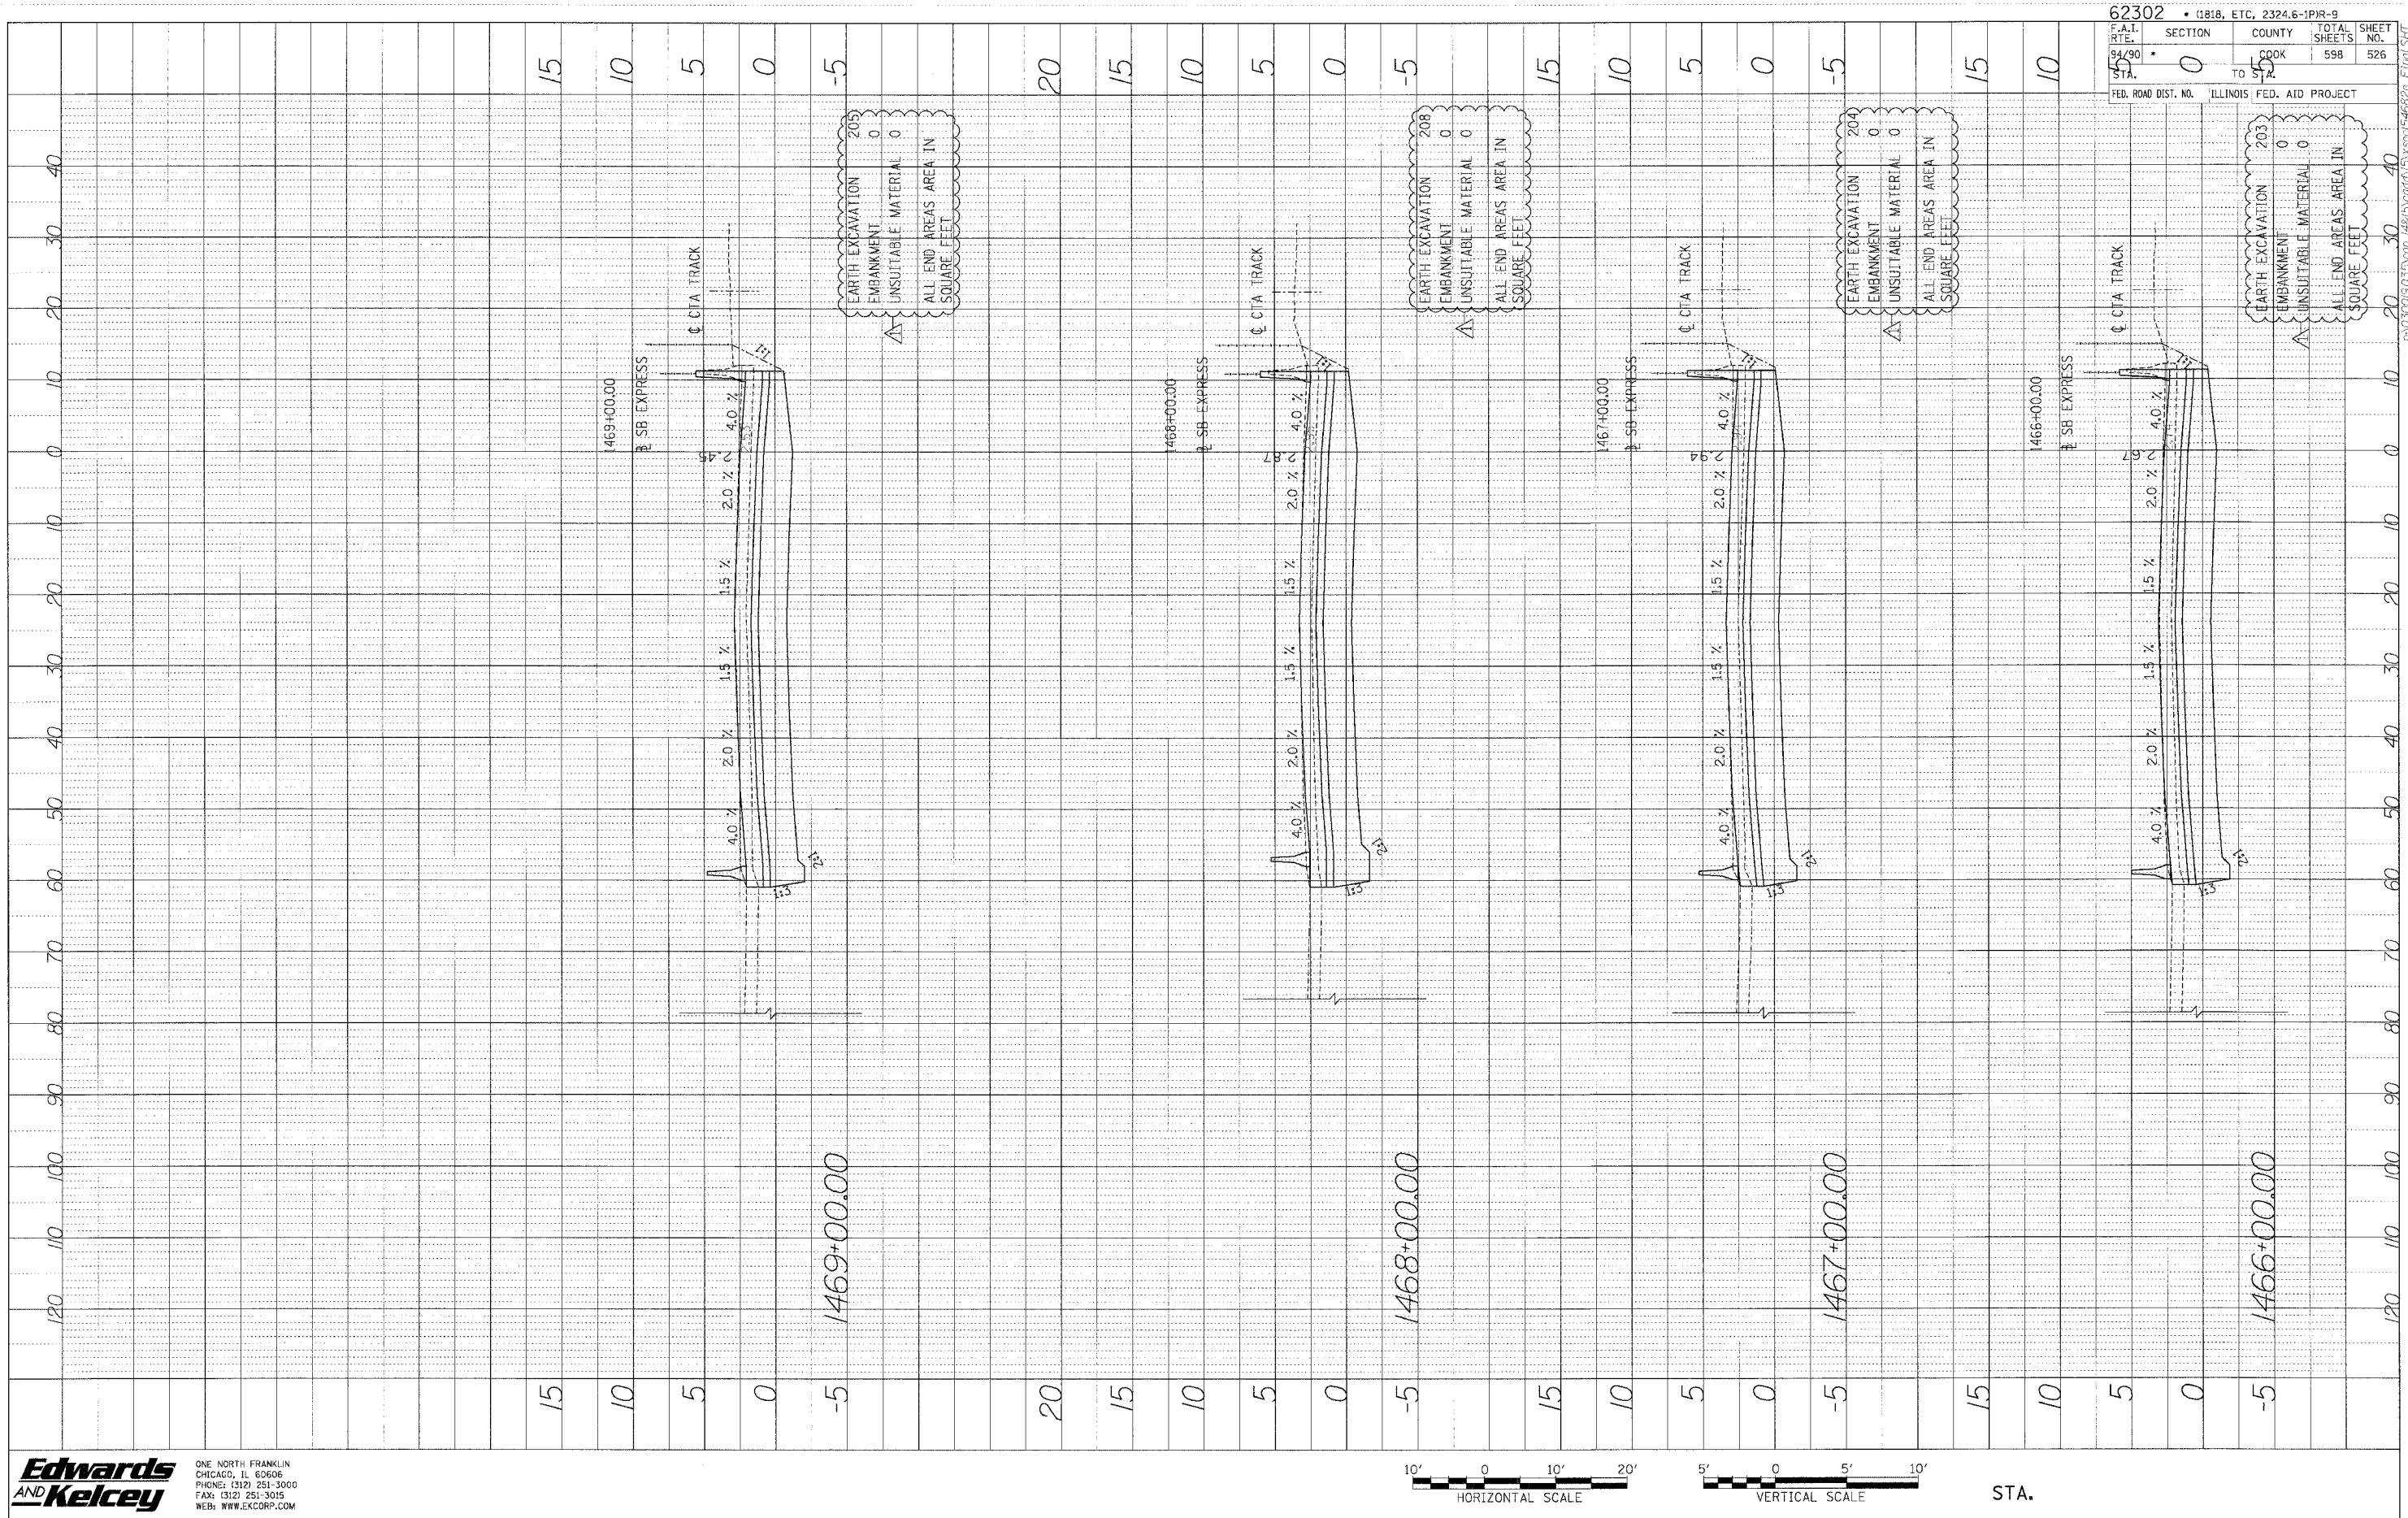

62302	1818, ETC, 2324.6-1P1R-9		
SECTION	COUNTY	TOTAL SHEETS	SHEET NO.
94/90	COOK	598	526
STA.	TO		
5	15		
ILLINOIS FED. AID PROJECT			


Edwards AND Kelcey
 ONE NORTH FRANKLIN
 CHICAGO, IL 60606
 PHONE: (312) 251-3000
 FAX: (312) 251-3015
 WEB: WWW.EKCORP.COM

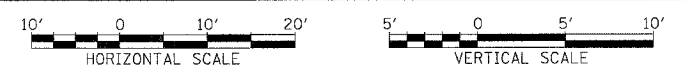

STA.


R:\030605\035\007\1465\corrd\3\cross\146676.F1a1.S17

PROFILE
 DRAWN BY: []
 CHECKED BY: []
 DATE: []
 NO. []

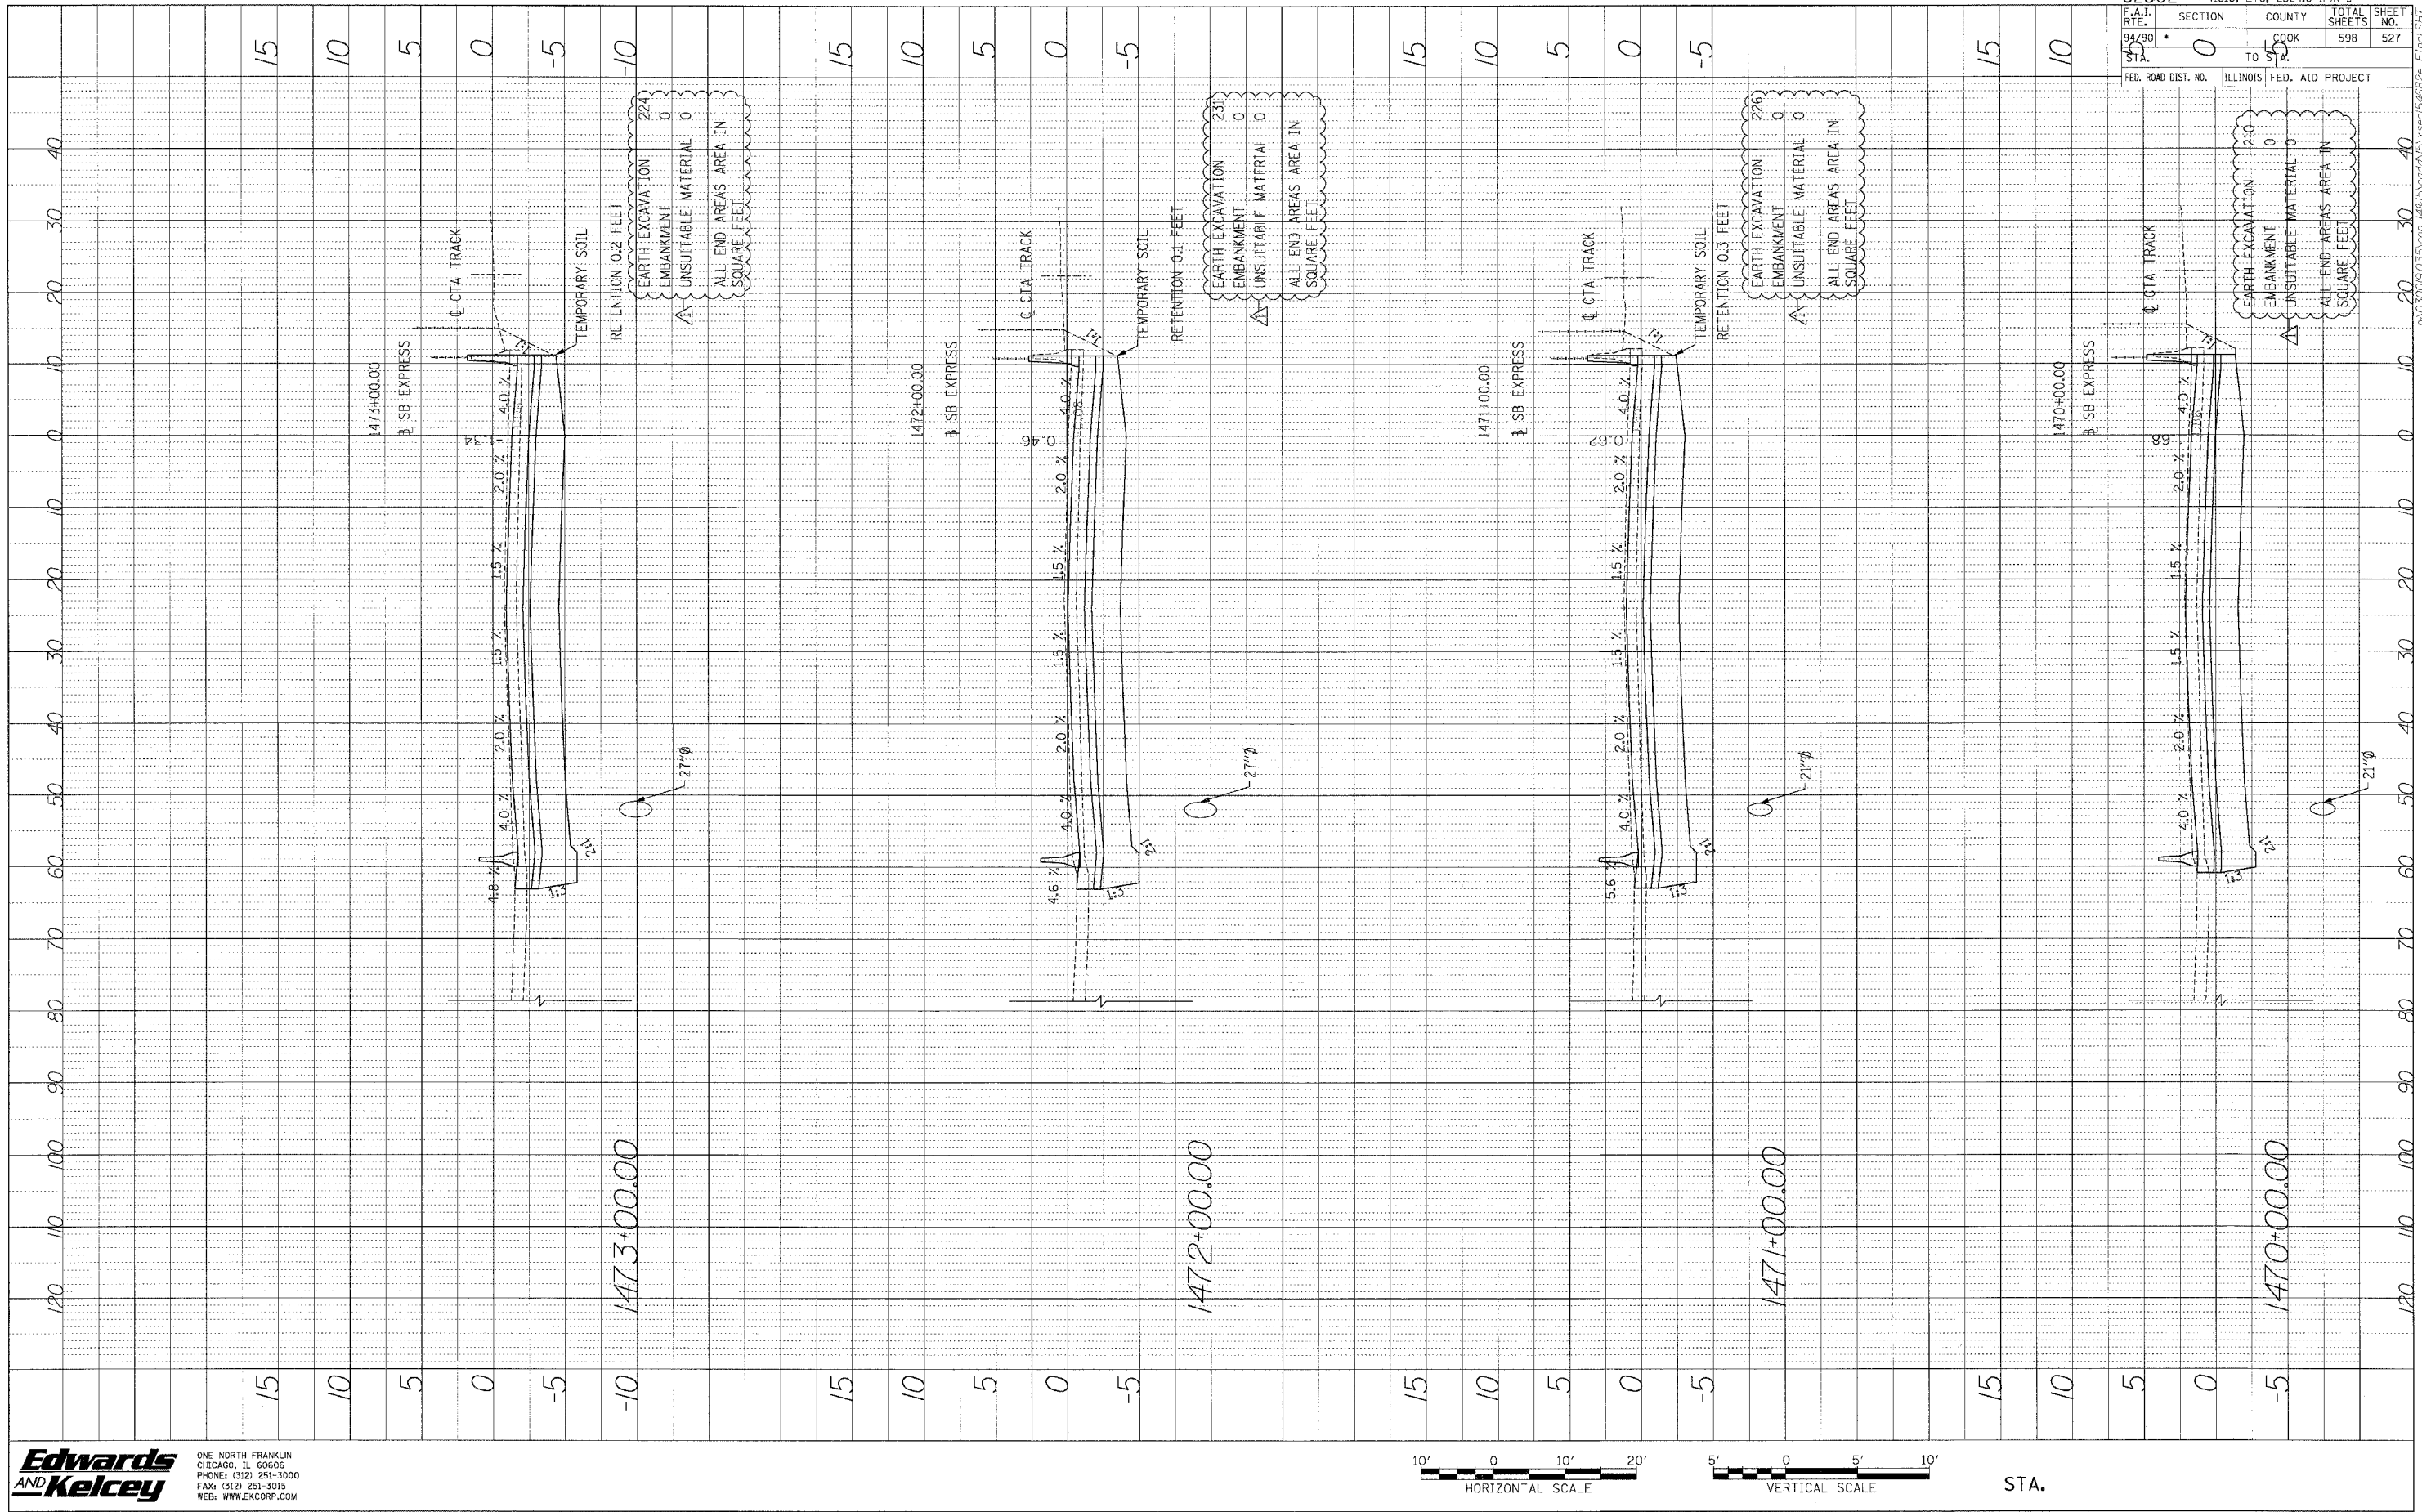

62302 • (1818, ETC, 2324.6-1PR-9	
F.A.I. NO. 94/30	SECTION 0
DATE 5/12	COUNTY COOK
	TOTAL SHEETS 598
	SHEET NO. 527
FED. ROAD DIST. NO.	ILLINOIS FED. AID PROJECT


Edwards AND Kelcey
 ONE NORTH FRANKLIN
 CHICAGO, IL 60606
 PHONE: (312) 251-3000
 FAX: (312) 251-3015
 WEB: WWW.EDKORP.COM

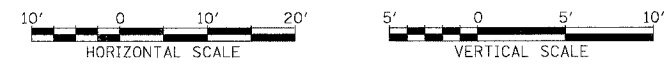

STA.


P:\030019\0305\007_148\15\road\15\15\62302\527.dwg

PROFILE SURVEYED BY DATE
 NO. L. BOOK DRAWN BY CHECKED
 REAM. NOTED BY ADJUSTED OFFICE
 NO. STATIONING DATE

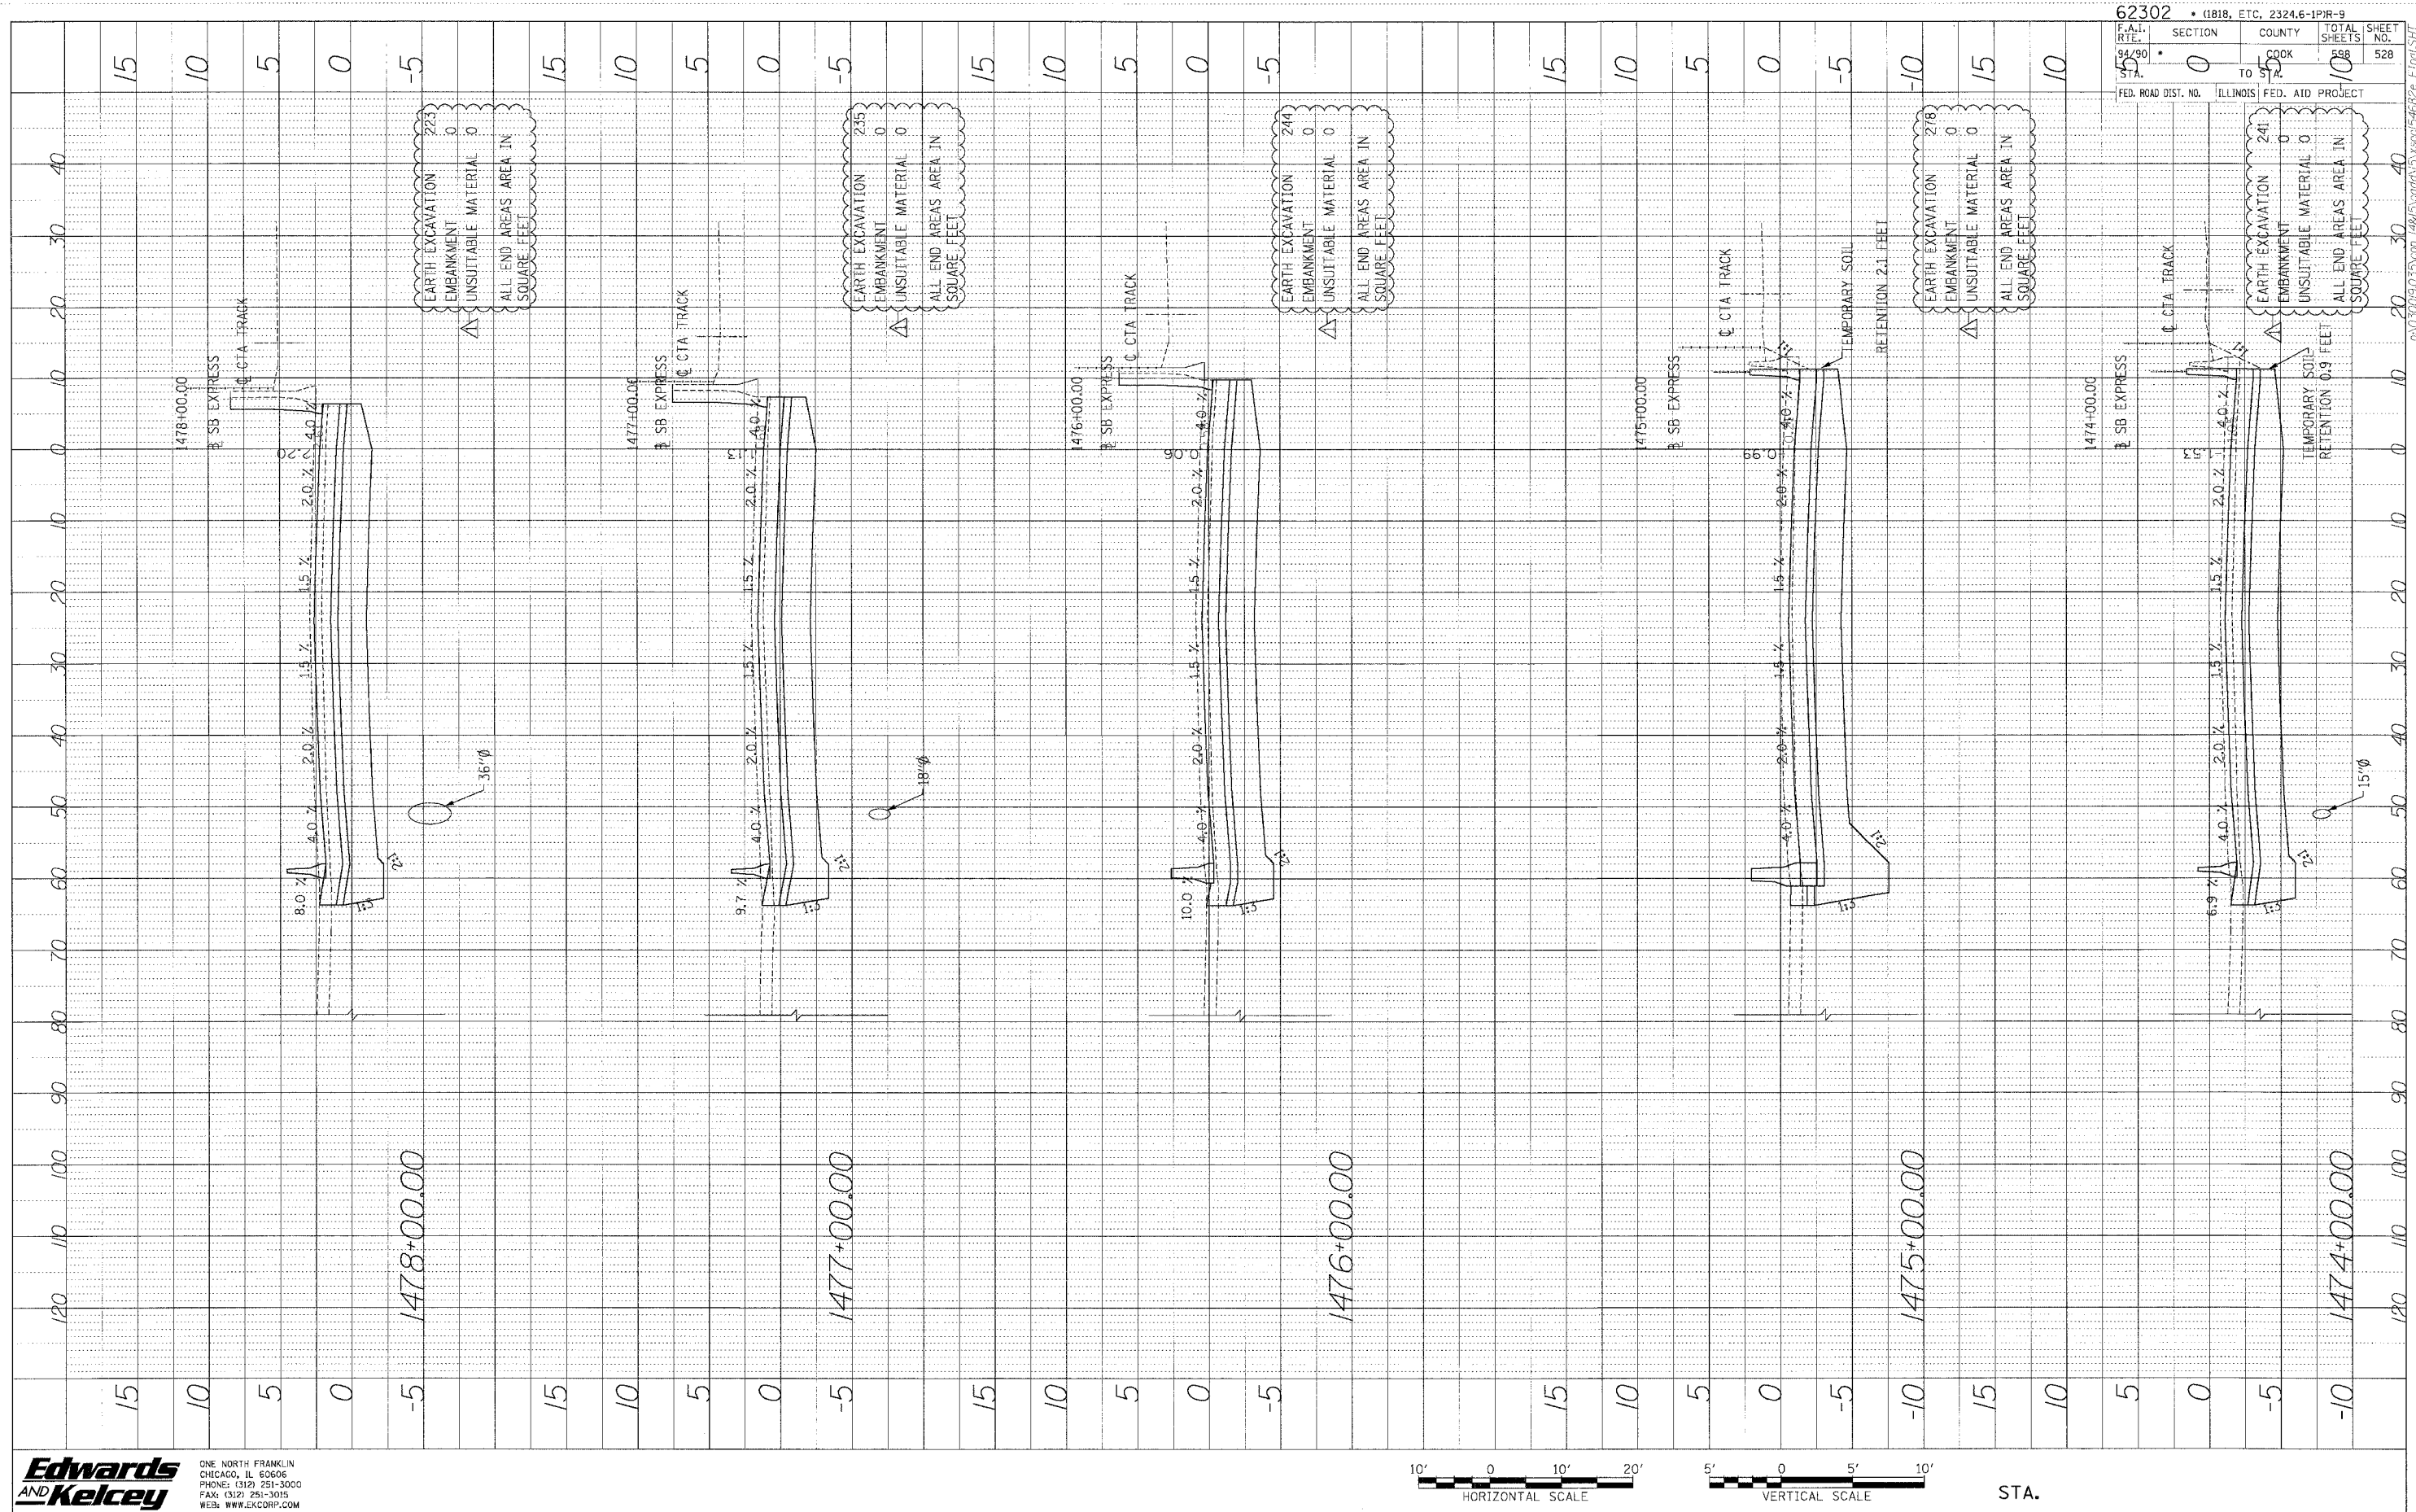

62302	(1818, ETC. 2324.6-1PR-9		
SECTION	COUNTY	TOTAL SHEETS	SHEET NO.
94/90	COOK	598	528
STA. 15	TO STA. 95		
FED. ROAD DIST. NO.		ILLINOIS FED. AID PROJECT	


Edwards AND Kelcey
 ONE NORTH FRANKLIN CHICAGO, IL 60606
 PHONE: (312) 251-3000
 FAX: (312) 251-3015
 WEB: WWW.EKCORP.COM

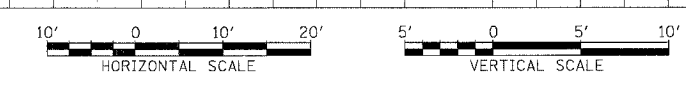

STA.


P:\070050.035\001\4615\0000\03\0000\4662217.msh

PROFILE SURVEYED BY DATE
 CHECKED BY
 NOTE BOOK NO. DATE
 STRUCTURE NO. DATE
 STRUCTURE ROTARY CHRG.

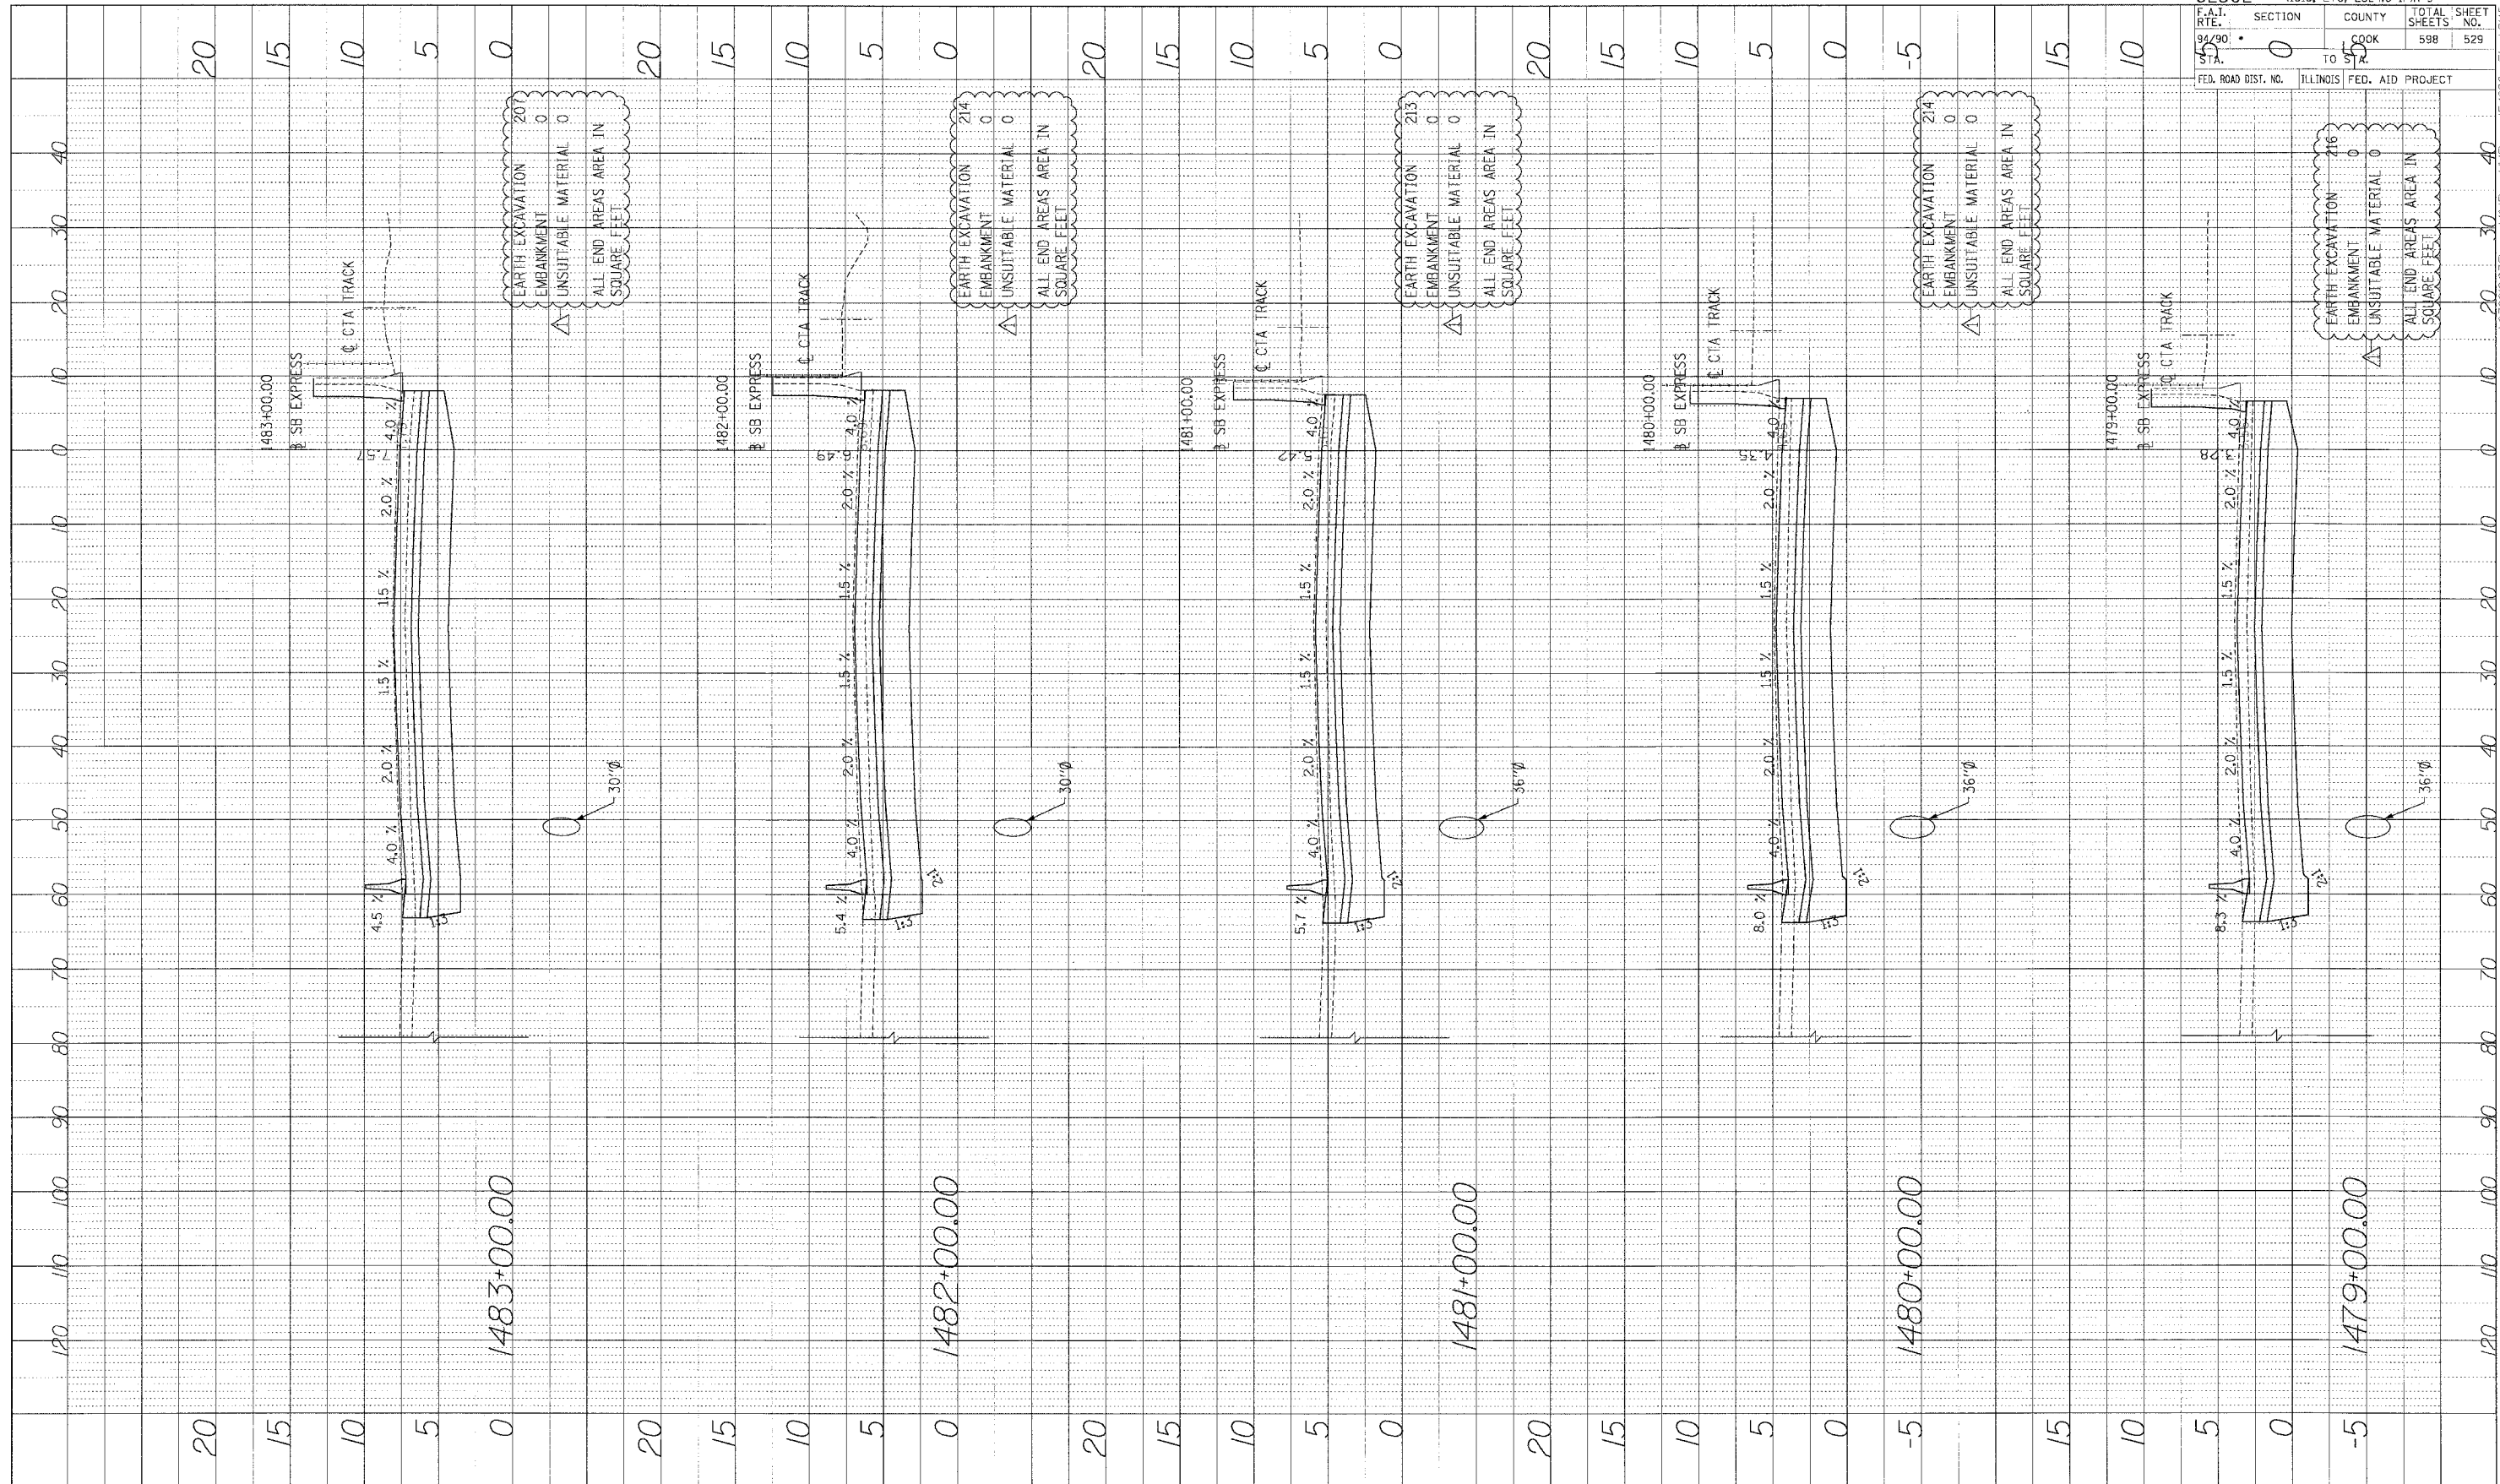

62302	• (1818, ETC. 2324.6-1PIR-9
F.A.I. RTE. 94/90	SECTION 0
STA. 55	COUNTY COOK
FED. ROAD DIST. NO.	ILLINOIS
	FED. AID PROJECT
TOTAL SHEETS 598	SHEET NO. 529


Edwards AND Kelcey
 ONE NORTH FRANKLIN
 CHICAGO, IL 60606
 PHONE: (312) 251-3000
 FAX: (312) 251-3015
 WEB: WWW.EKCORP.COM

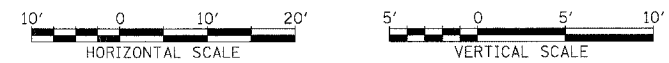


STA.

P:\03000\030035\con_1481\5\cadd\03\sect\05\sect05r682e.fvt.mtl:577

DRAWN BY: _____ DATE: _____
 CHECKED BY: _____
 DESIGNED BY: _____
 IN CHARGE BY: _____
 PROJECT NO.: _____
 SHEET NO.: _____
 TITLE: _____
 DATE: _____

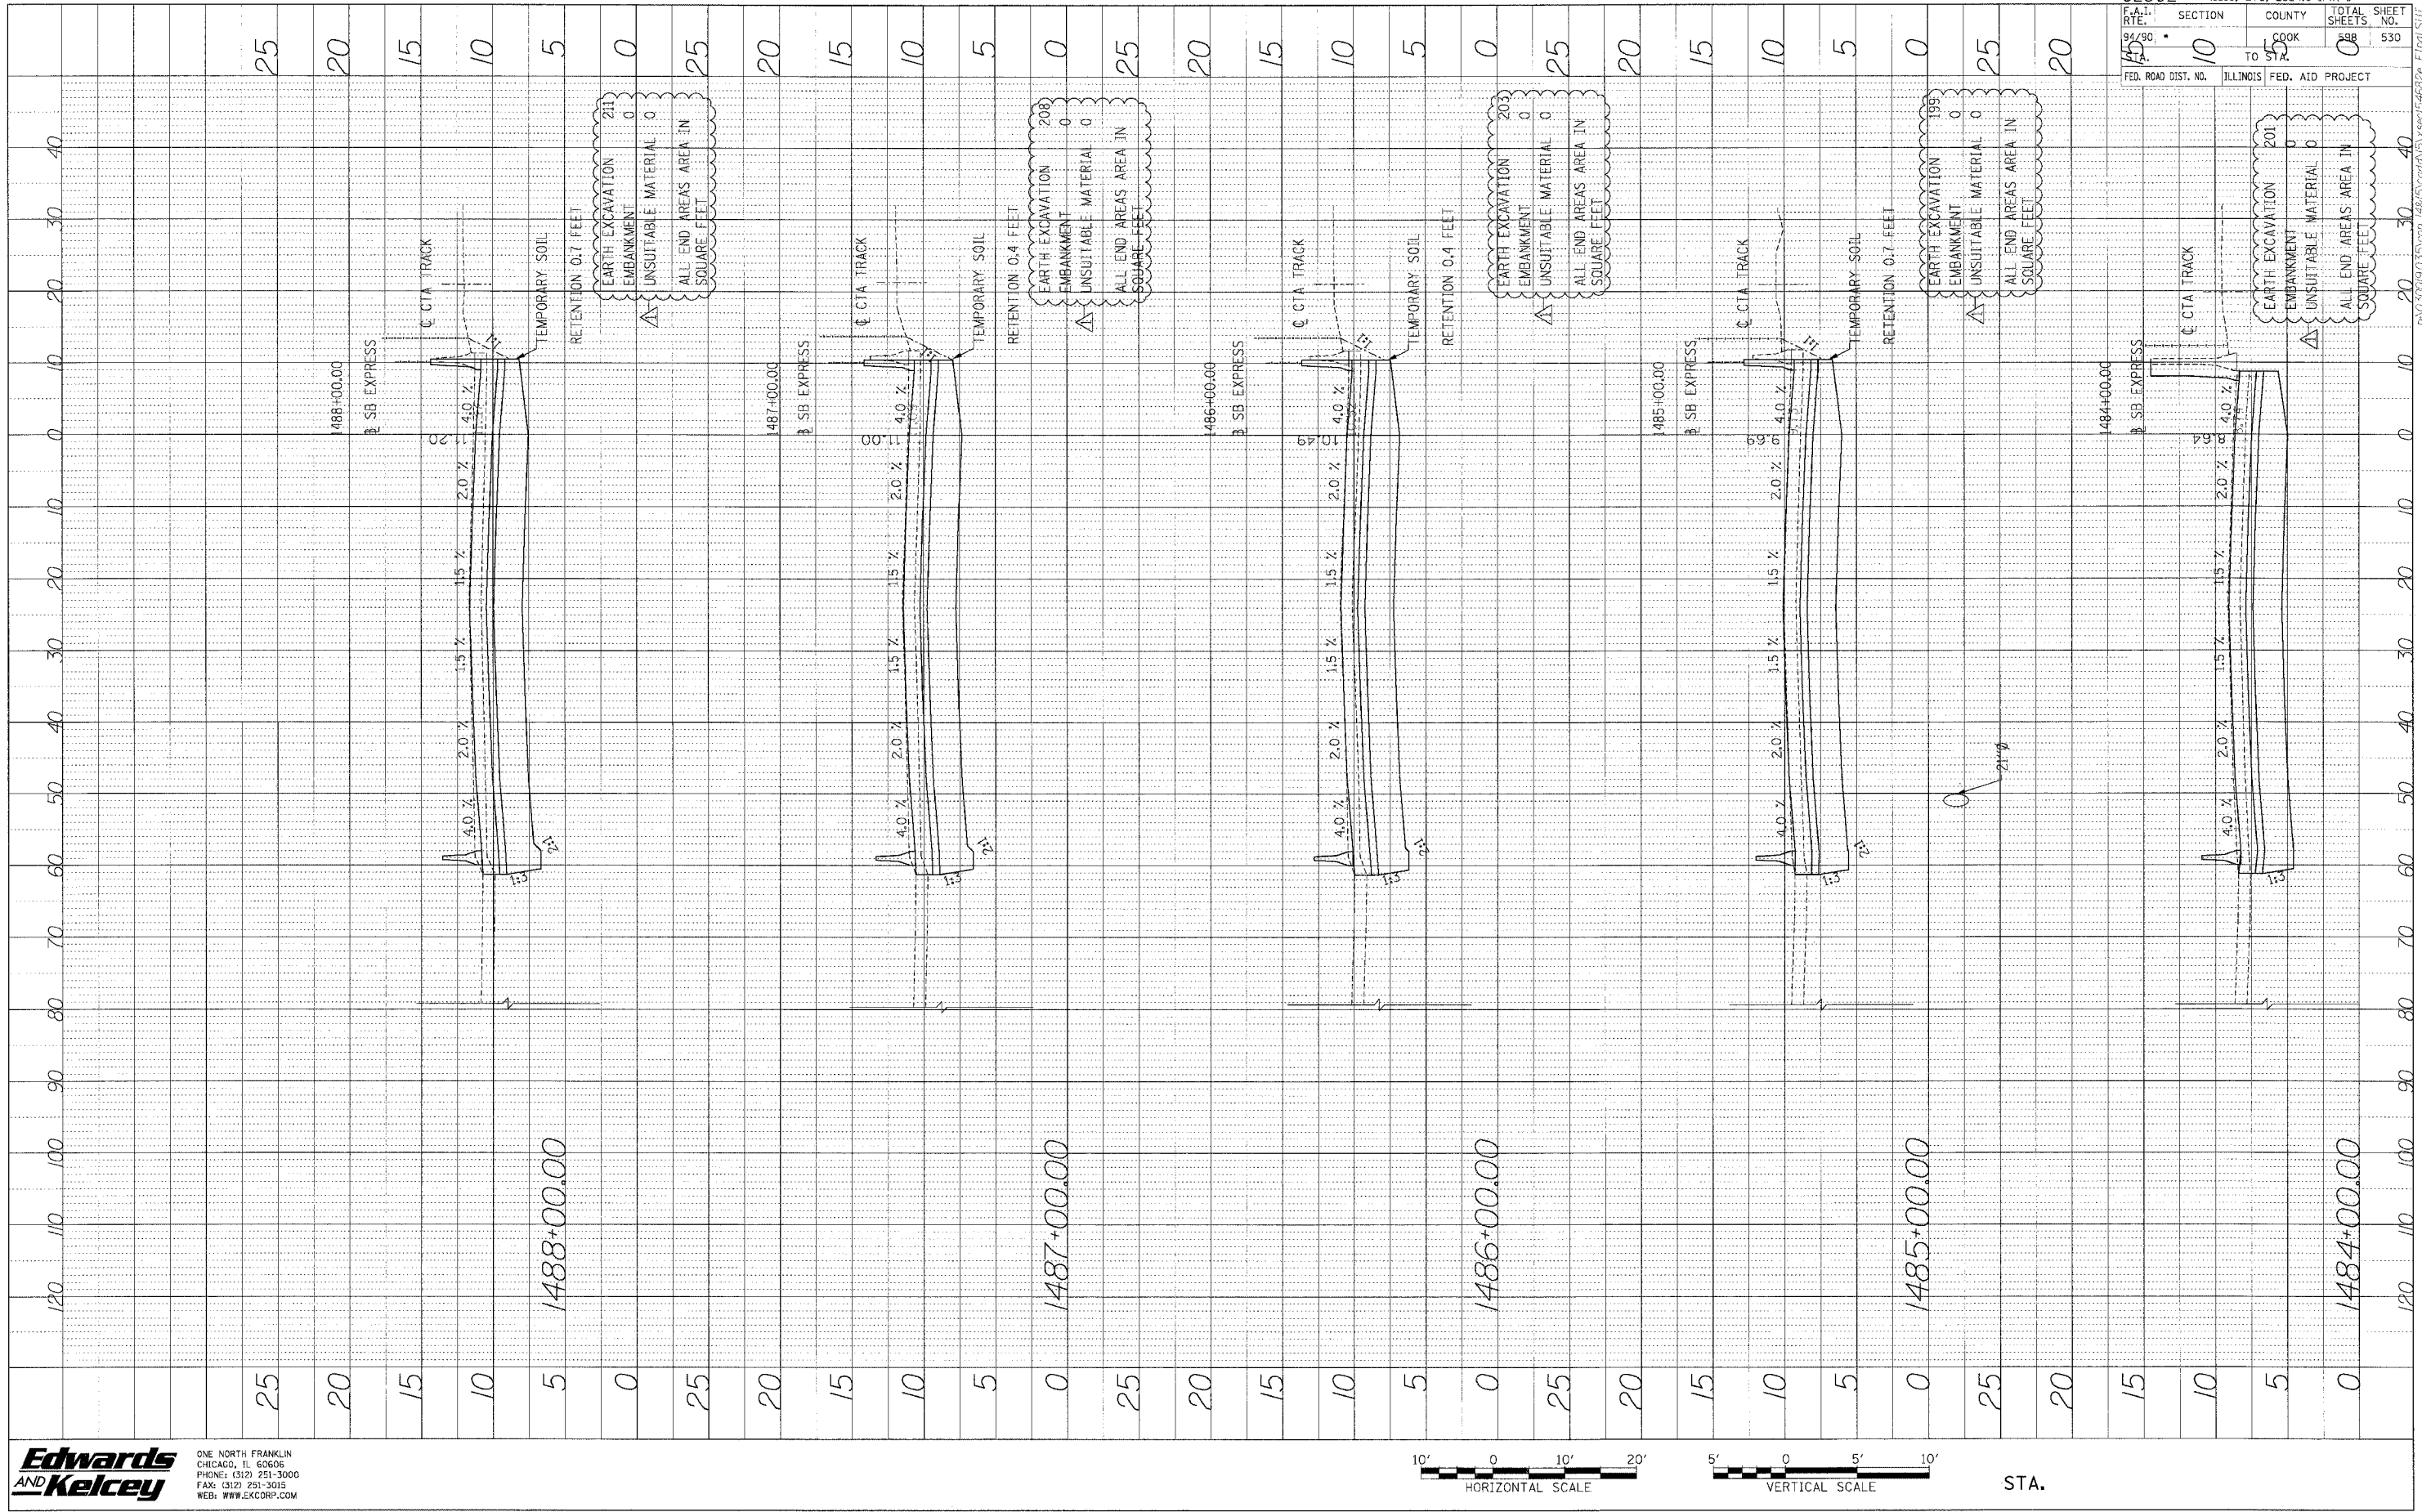

Edwards AND Kelcey
 ONE NORTH FRANKLIN CHICAGO, IL 60606
 PHONE: (312) 251-3000
 FAX: (312) 251-3015
 WEB: WWW.EKCORP.COM

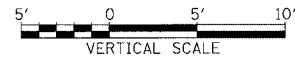


STA.

62302 • (1818, ETC. 2324.6-1PR-9)
 SECTION COUNTY TOTAL SHEETS SHEET NO. 10 COOK ILLINOIS 530
 FED. ROAD DIST. NO. ILLINOIS FED. AID PROJECT

P:\00000000\530007\1818\530007.dwg 1818\530007.dwg 1818\530007.dwg 1818\530007.dwg 1818\530007.dwg

PROFILE SURVEYED BY DATE
 PLOTTED BY
 NOTE BOOK NO. NOTED
 STRUCTURE INSTALLED BY

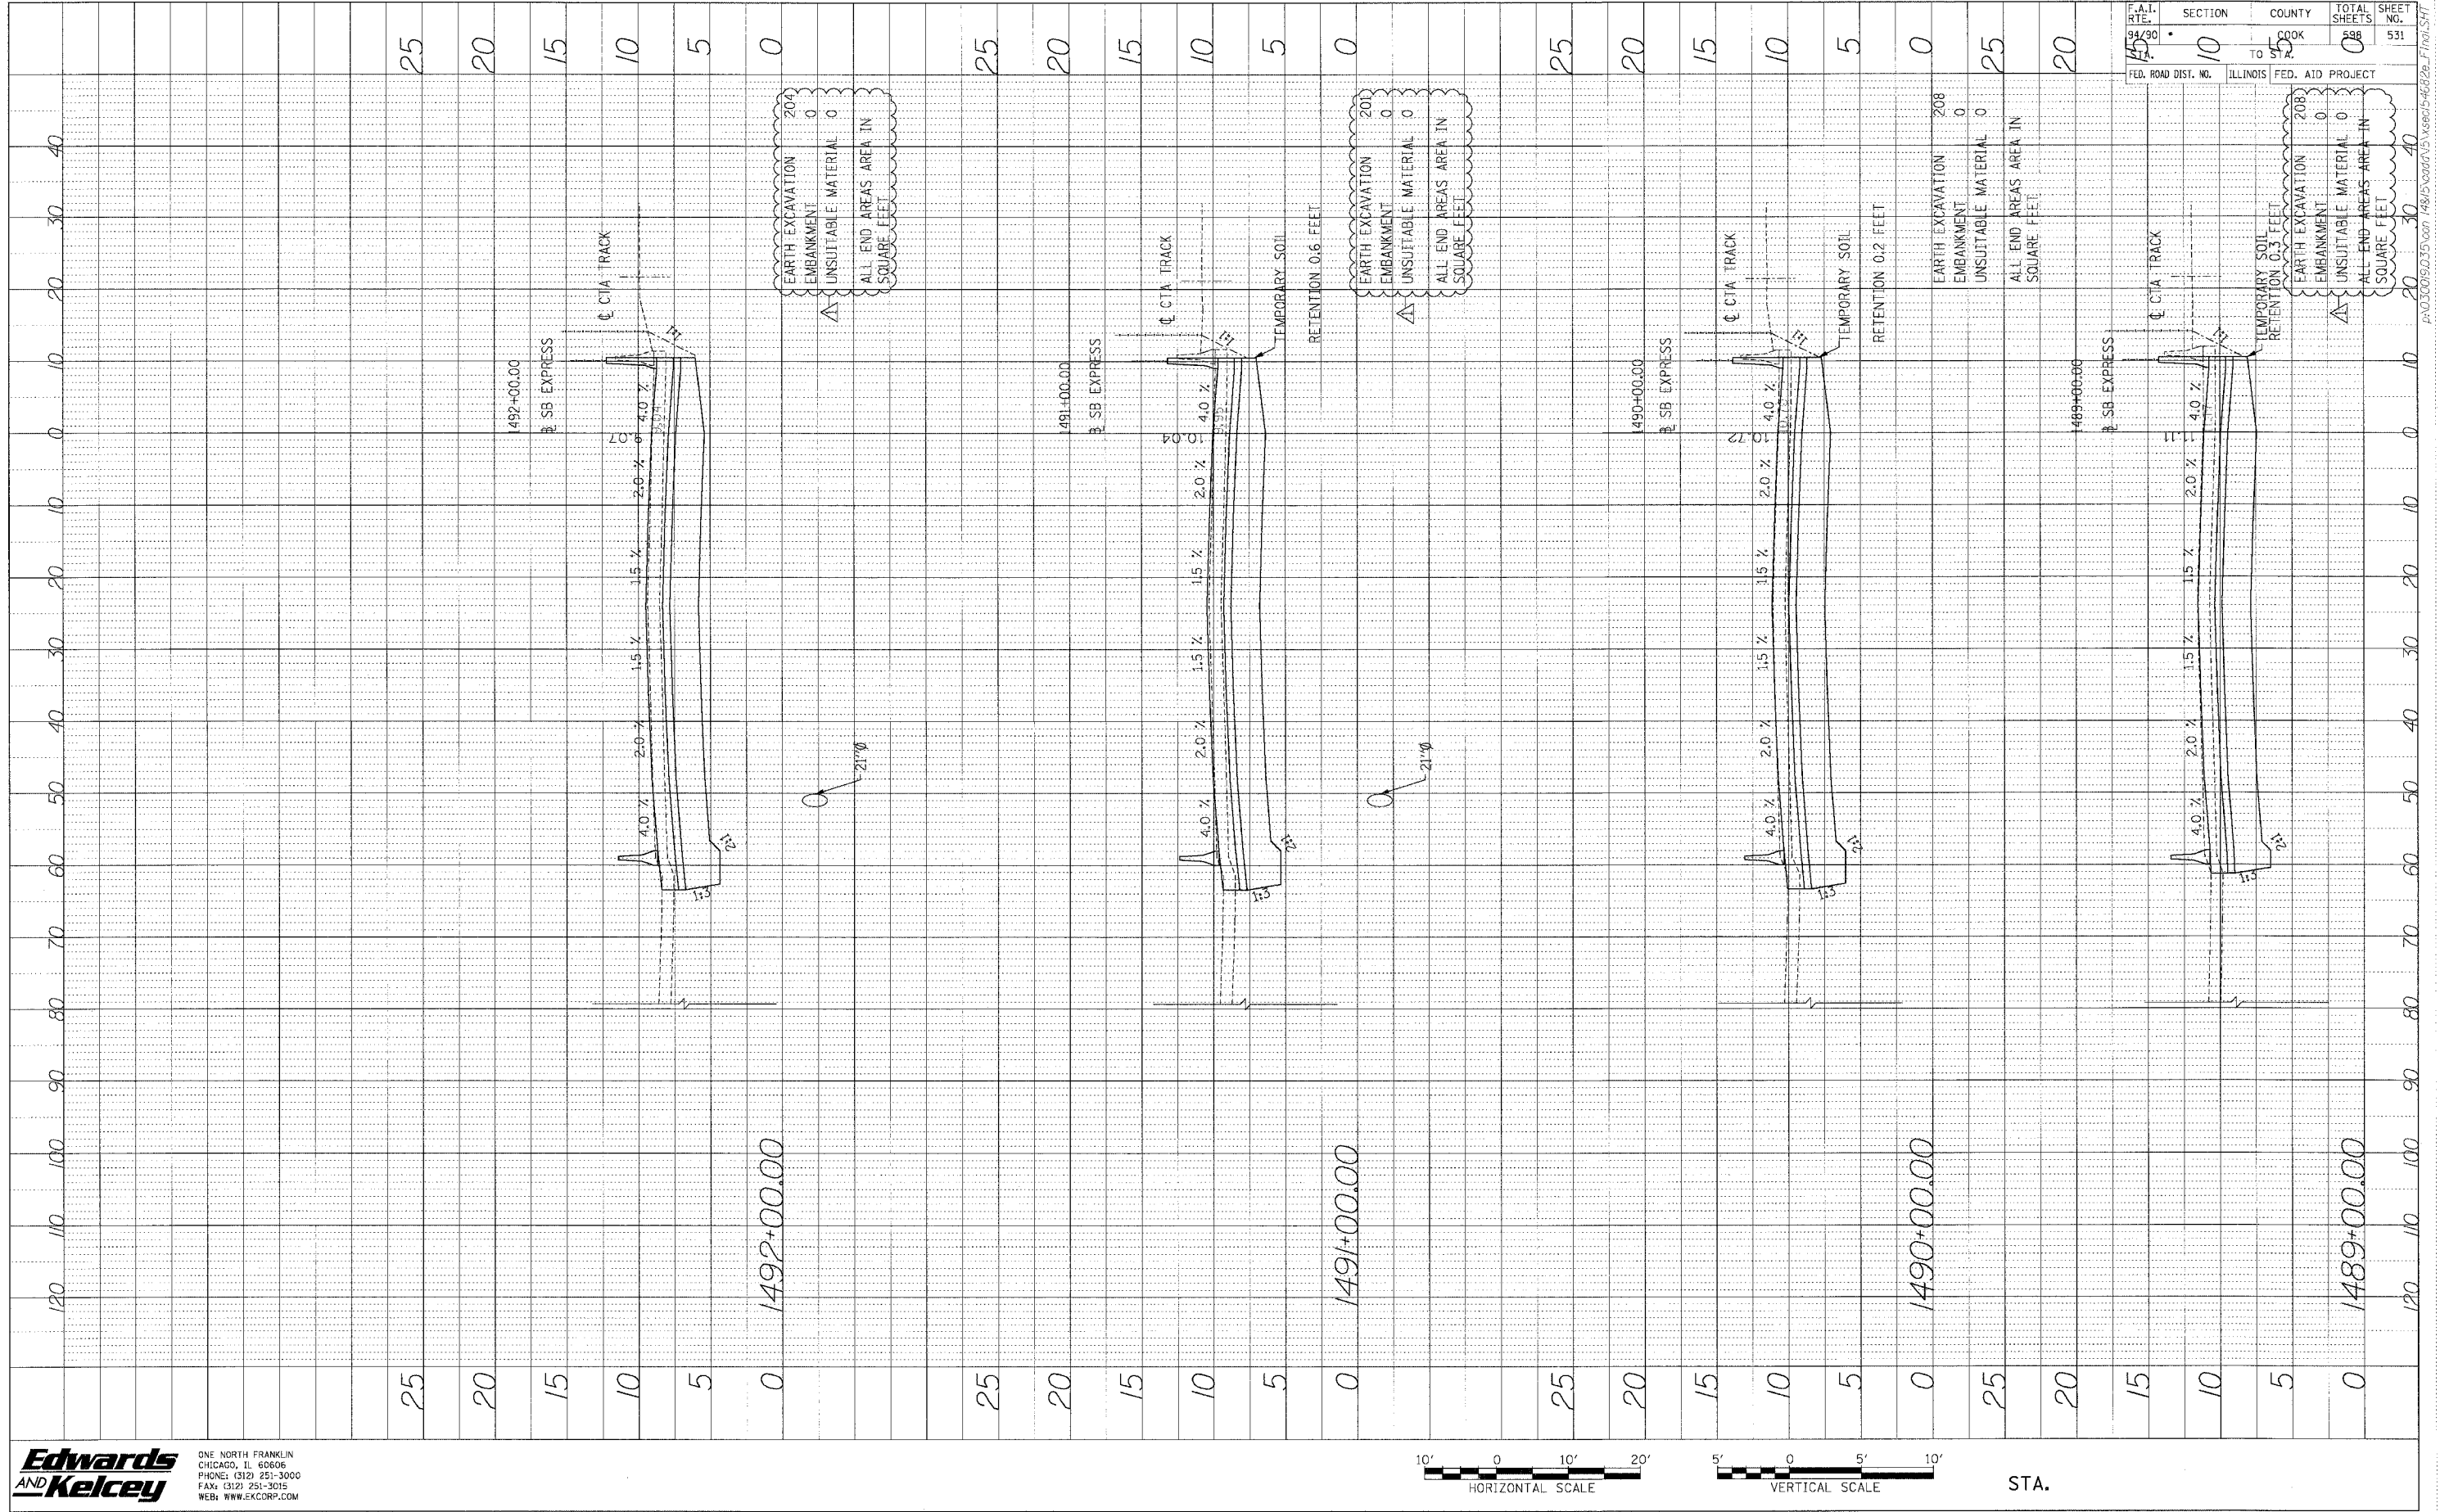


EARTH EXCAVATION 209
 EMBANKMENT 0
 UNSUITABLE MATERIAL 0
 ALL END AREAS AREA IN SQUARE FEET

EARTH EXCAVATION 208
 EMBANKMENT 0
 UNSUITABLE MATERIAL 0
 ALL END AREAS AREA IN SQUARE FEET

TEMPORARY SOIL RETENTION 0.3 FEET
 EARTH EXCAVATION 208
 EMBANKMENT 0
 UNSUITABLE MATERIAL 0
 ALL END AREAS AREA IN SQUARE FEET

62302 • (1818, ETC. 2324.6-1PR-9	
F.A.I. RTE. 99/30	SECTION TO
COOK	COUNTY
588	TOTAL SHEETS
531	SHEET NO.
FED. ROAD DIST. NO.	ILLINOIS FED. AID PROJECT


Edwards AND Kelcey
 ONE NORTH FRANKLIN CHICAGO, IL 60606
 PHONE: (312) 251-3000
 FAX: (312) 251-3015
 WEB: WWW.EKCORP.COM

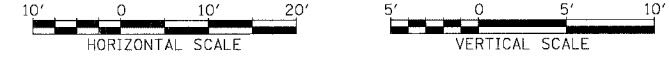

STA.

P:\03\0019\03\03\0019.dwg 148/15/2009 15:46:29 P:\19\15\19\15\19.dwg

PROFIT BY DATE
 NOTE BOOK NO. CHECKED BY
 NO. STRUCTURE NOTATION OF RD

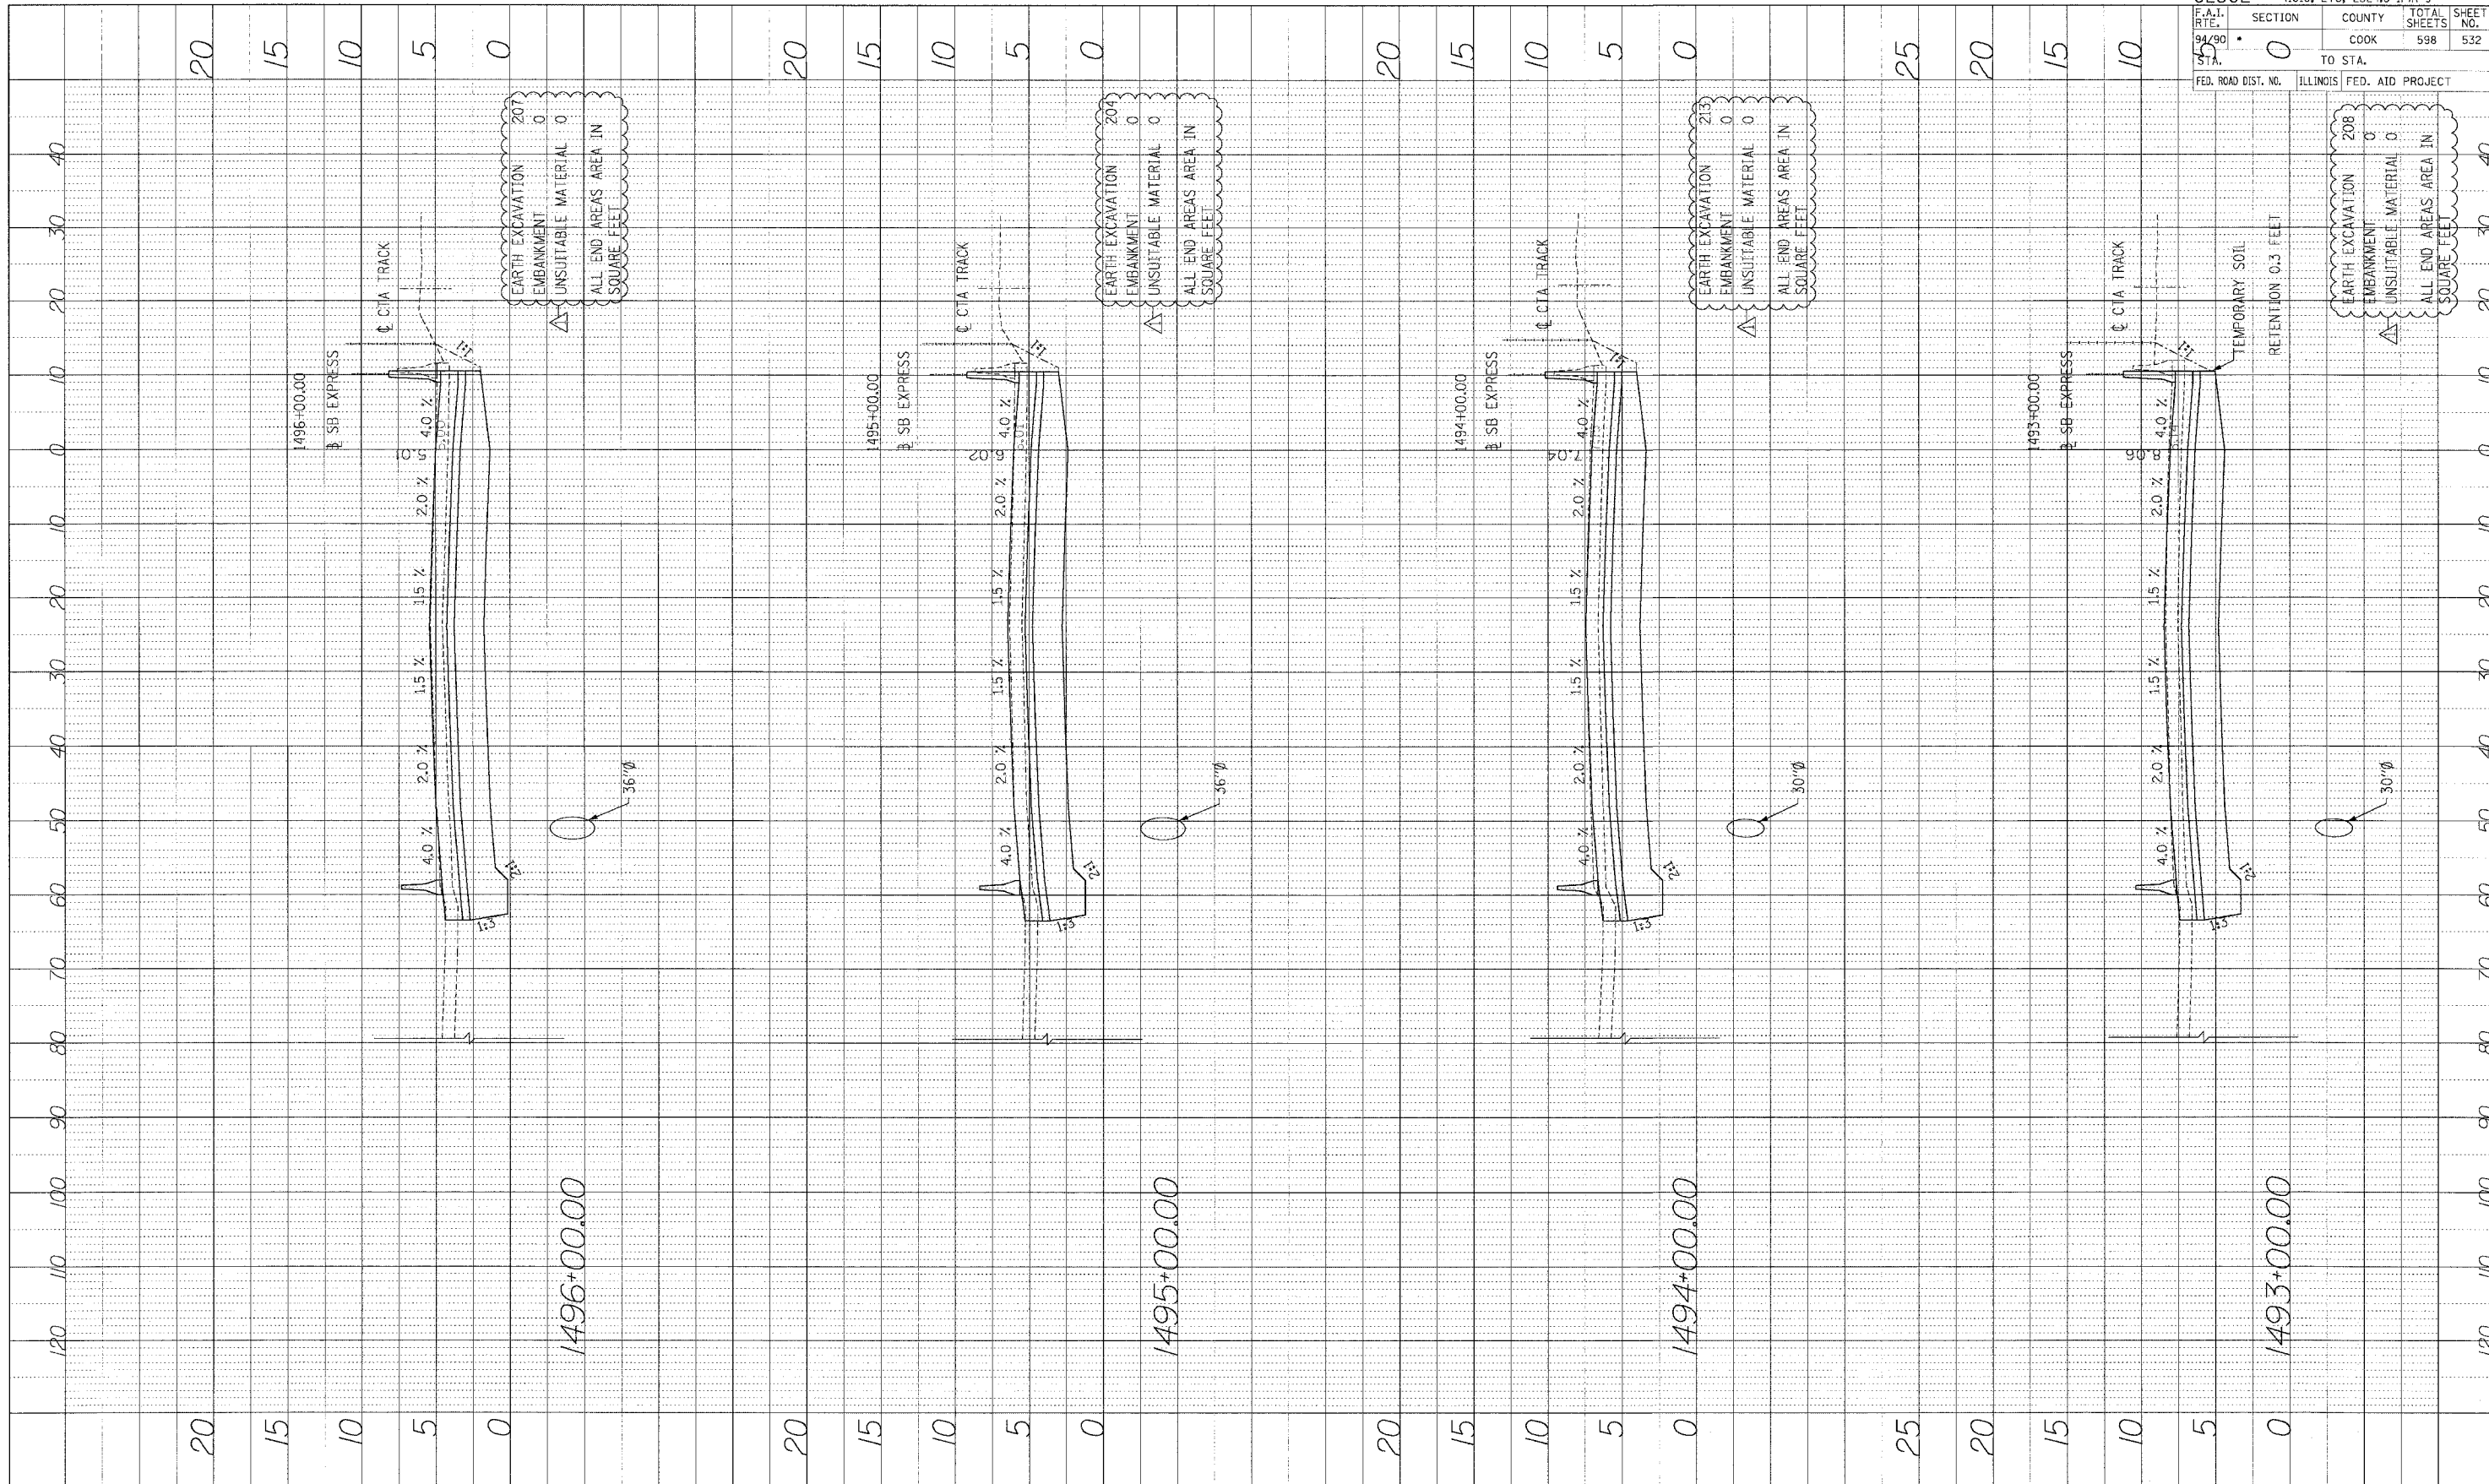

62302	(1818, ETC, 2324.6-1PIR-9
F.A.I. R.T.E. 94/90	SECTION 0
STA. 55	COUNTY COOK
FED. ROAD DIST. NO.	TO STA.
	ILLINOIS FED. AID PROJECT
	TOTAL SHEETS 598
	SHEET NO. 532


EARTH EXCAVATION 207
 EMBANKMENT 0
 UNSUITABLE MATERIAL 0
 ALL END AREAS AREA IN SQUARE FEET

EARTH EXCAVATION 204
 EMBANKMENT 0
 UNSUITABLE MATERIAL 0
 ALL END AREAS AREA IN SQUARE FEET

EARTH EXCAVATION 213
 EMBANKMENT 0
 UNSUITABLE MATERIAL 0
 ALL END AREAS AREA IN SQUARE FEET

EARTH EXCAVATION 208
 EMBANKMENT 0
 UNSUITABLE MATERIAL 0
 ALL END AREAS AREA IN SQUARE FEET


Edwards AND Kelcey
 ONE NORTH FRANKLIN CHICAGO, IL 60606
 PHONE: (312) 251-3000
 FAX: (312) 251-3015
 WEB: WWW.EKCORP.COM

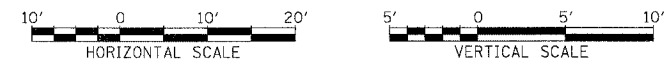

STA.

P:\030010\03015\con 1493+00\03015\vebes\54682a_F110115171

PROFILE
 DRAWN BY: _____ DATE: _____
 CHECKED BY: _____
 INCHES: _____
 FEET: _____

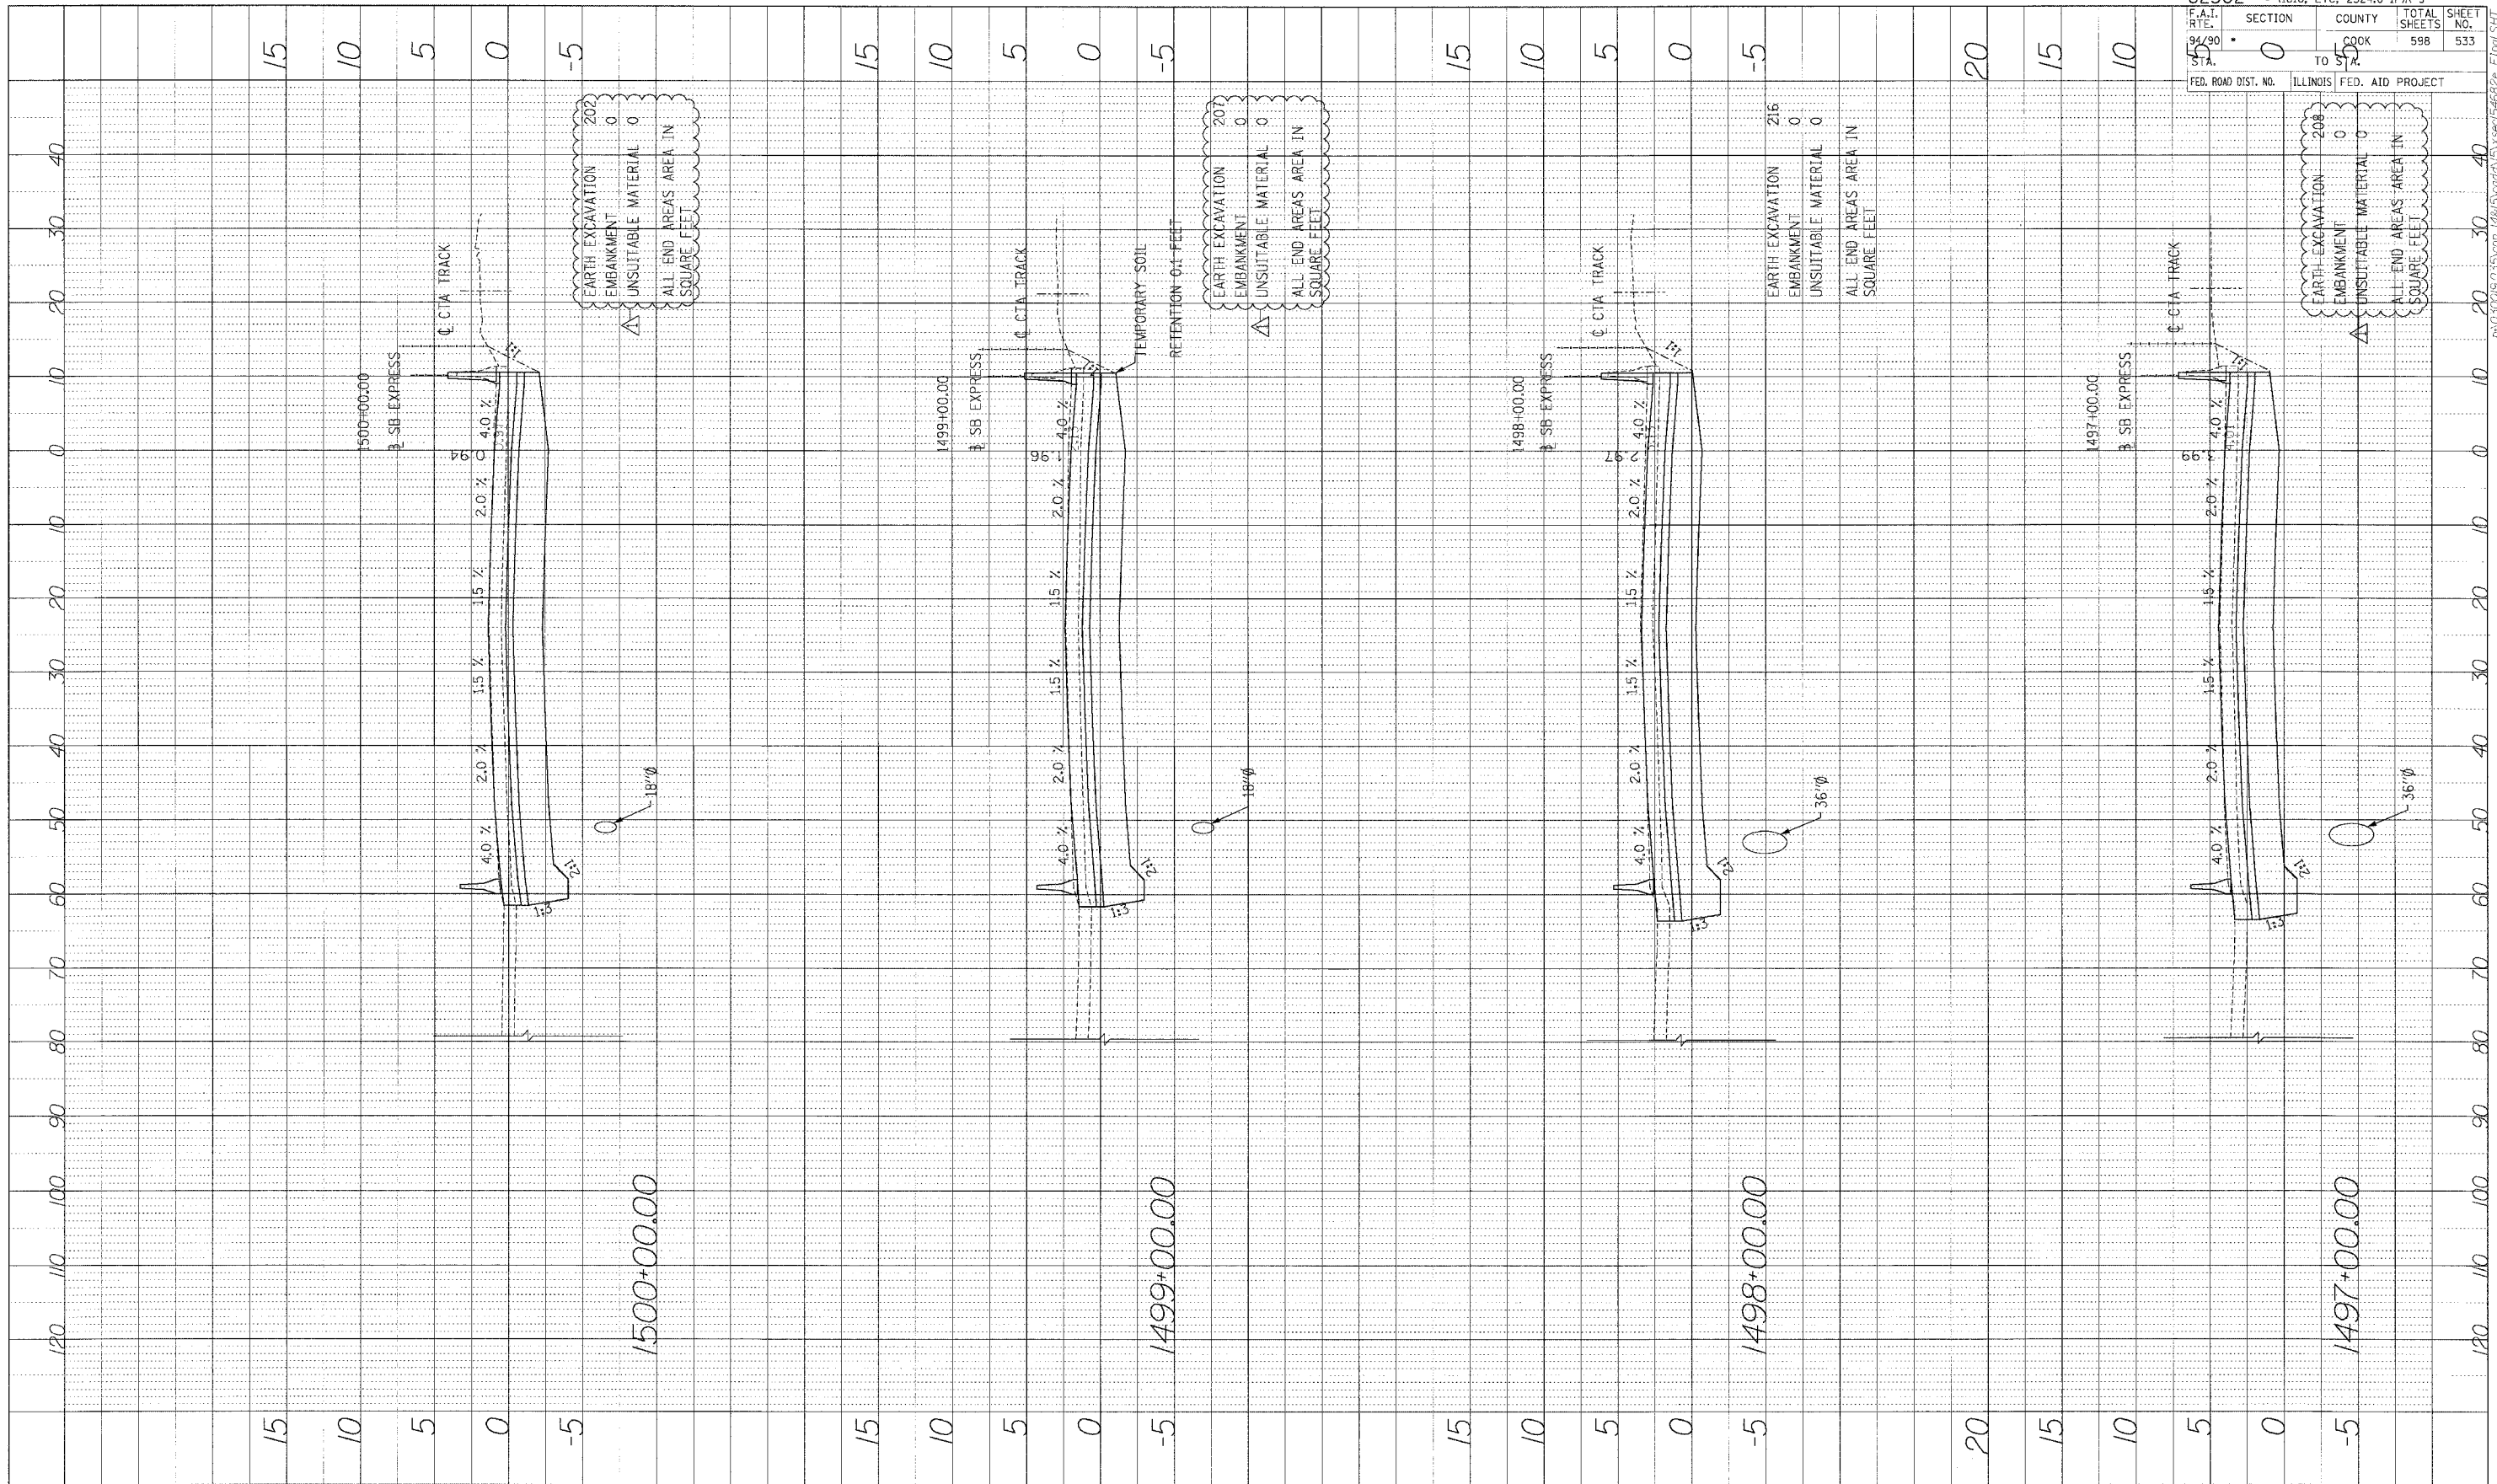

62302	11818, ETC. 2324.6-1P1R-9
F.A.T. NO. 94/90	SECTION 0
STA. 15	COUNTY COOK
	TOTAL SHEETS 598
	SHEET NO. 533
FED. ROAD DIST. NO.	ILLINOIS FED. AID PROJECT


Edwards AND Kelcey
 ONE NORTH FRANKLIN
 CHICAGO, IL 60606
 PHONE: (312) 251-3000
 FAX: (312) 251-3015
 WEB: WWW.EKCORP.COM



STA.


P:\03005\035\con\11818\15\road\15\used\54682e-f1.mxd

PROFILE SUBMITTED BY DATE
 NO. OF SHEETS TOTAL SHEETS
 DATE OF ISSUE
 DRAWN BY
 CHECKED BY
 STRUCTURE NO. DATE OF CONSTRUCTION

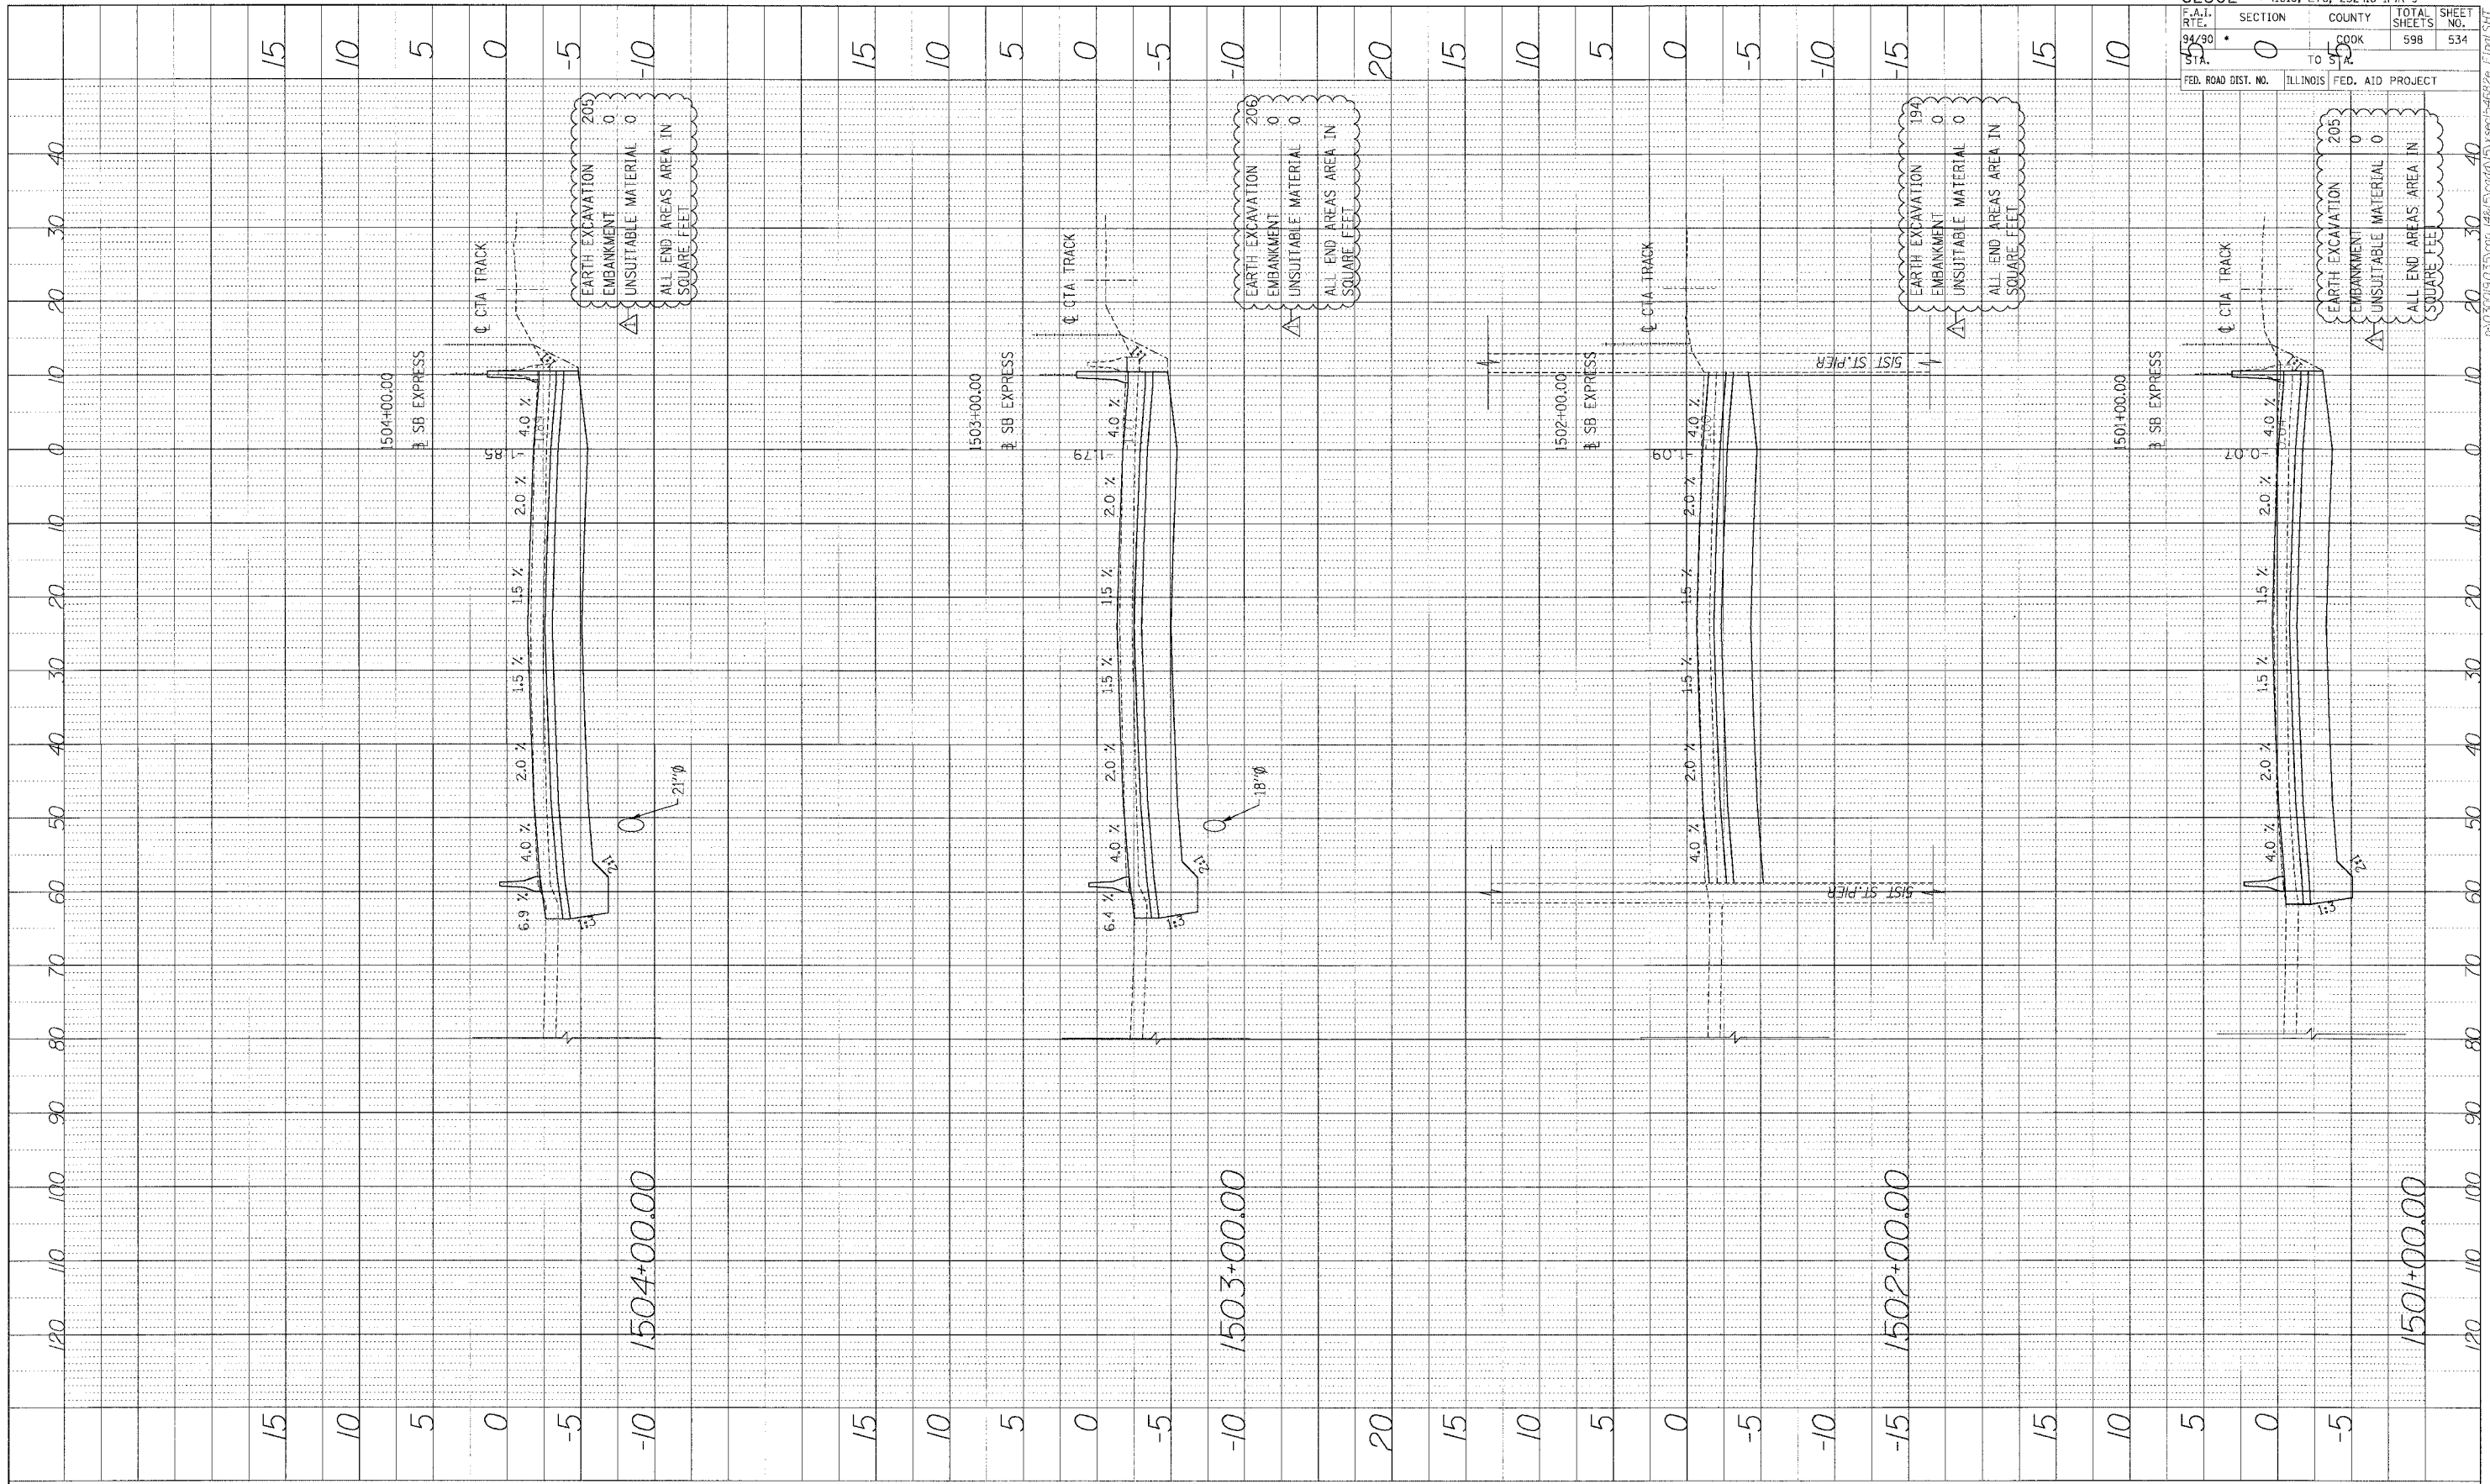

62302	11818, ETC, 2324.6-1PR-9
SECTION	COUNTY
94/90	COOK
STA.	TO
55	95
FED. ROAD DIST. NO.	ILLINOIS FED. AID PROJECT
TOTAL SHEETS	SHEET NO.
598	534


Edwards AND Kelcey
 ONE NORTH FRANKLIN
 CHICAGO, IL 60606
 PHONE: (312) 251-3000
 FAX: (312) 251-3015
 WEB: WWW.EKCORP.COM

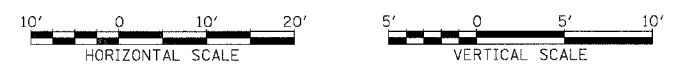

STA.

P:\05005\0505\007 748\5\000\0505.ecs\546826_17.mdi.SHT

PROFILE SHEET
 DRAWN BY: []
 CHECKED BY: []
 DATE: []

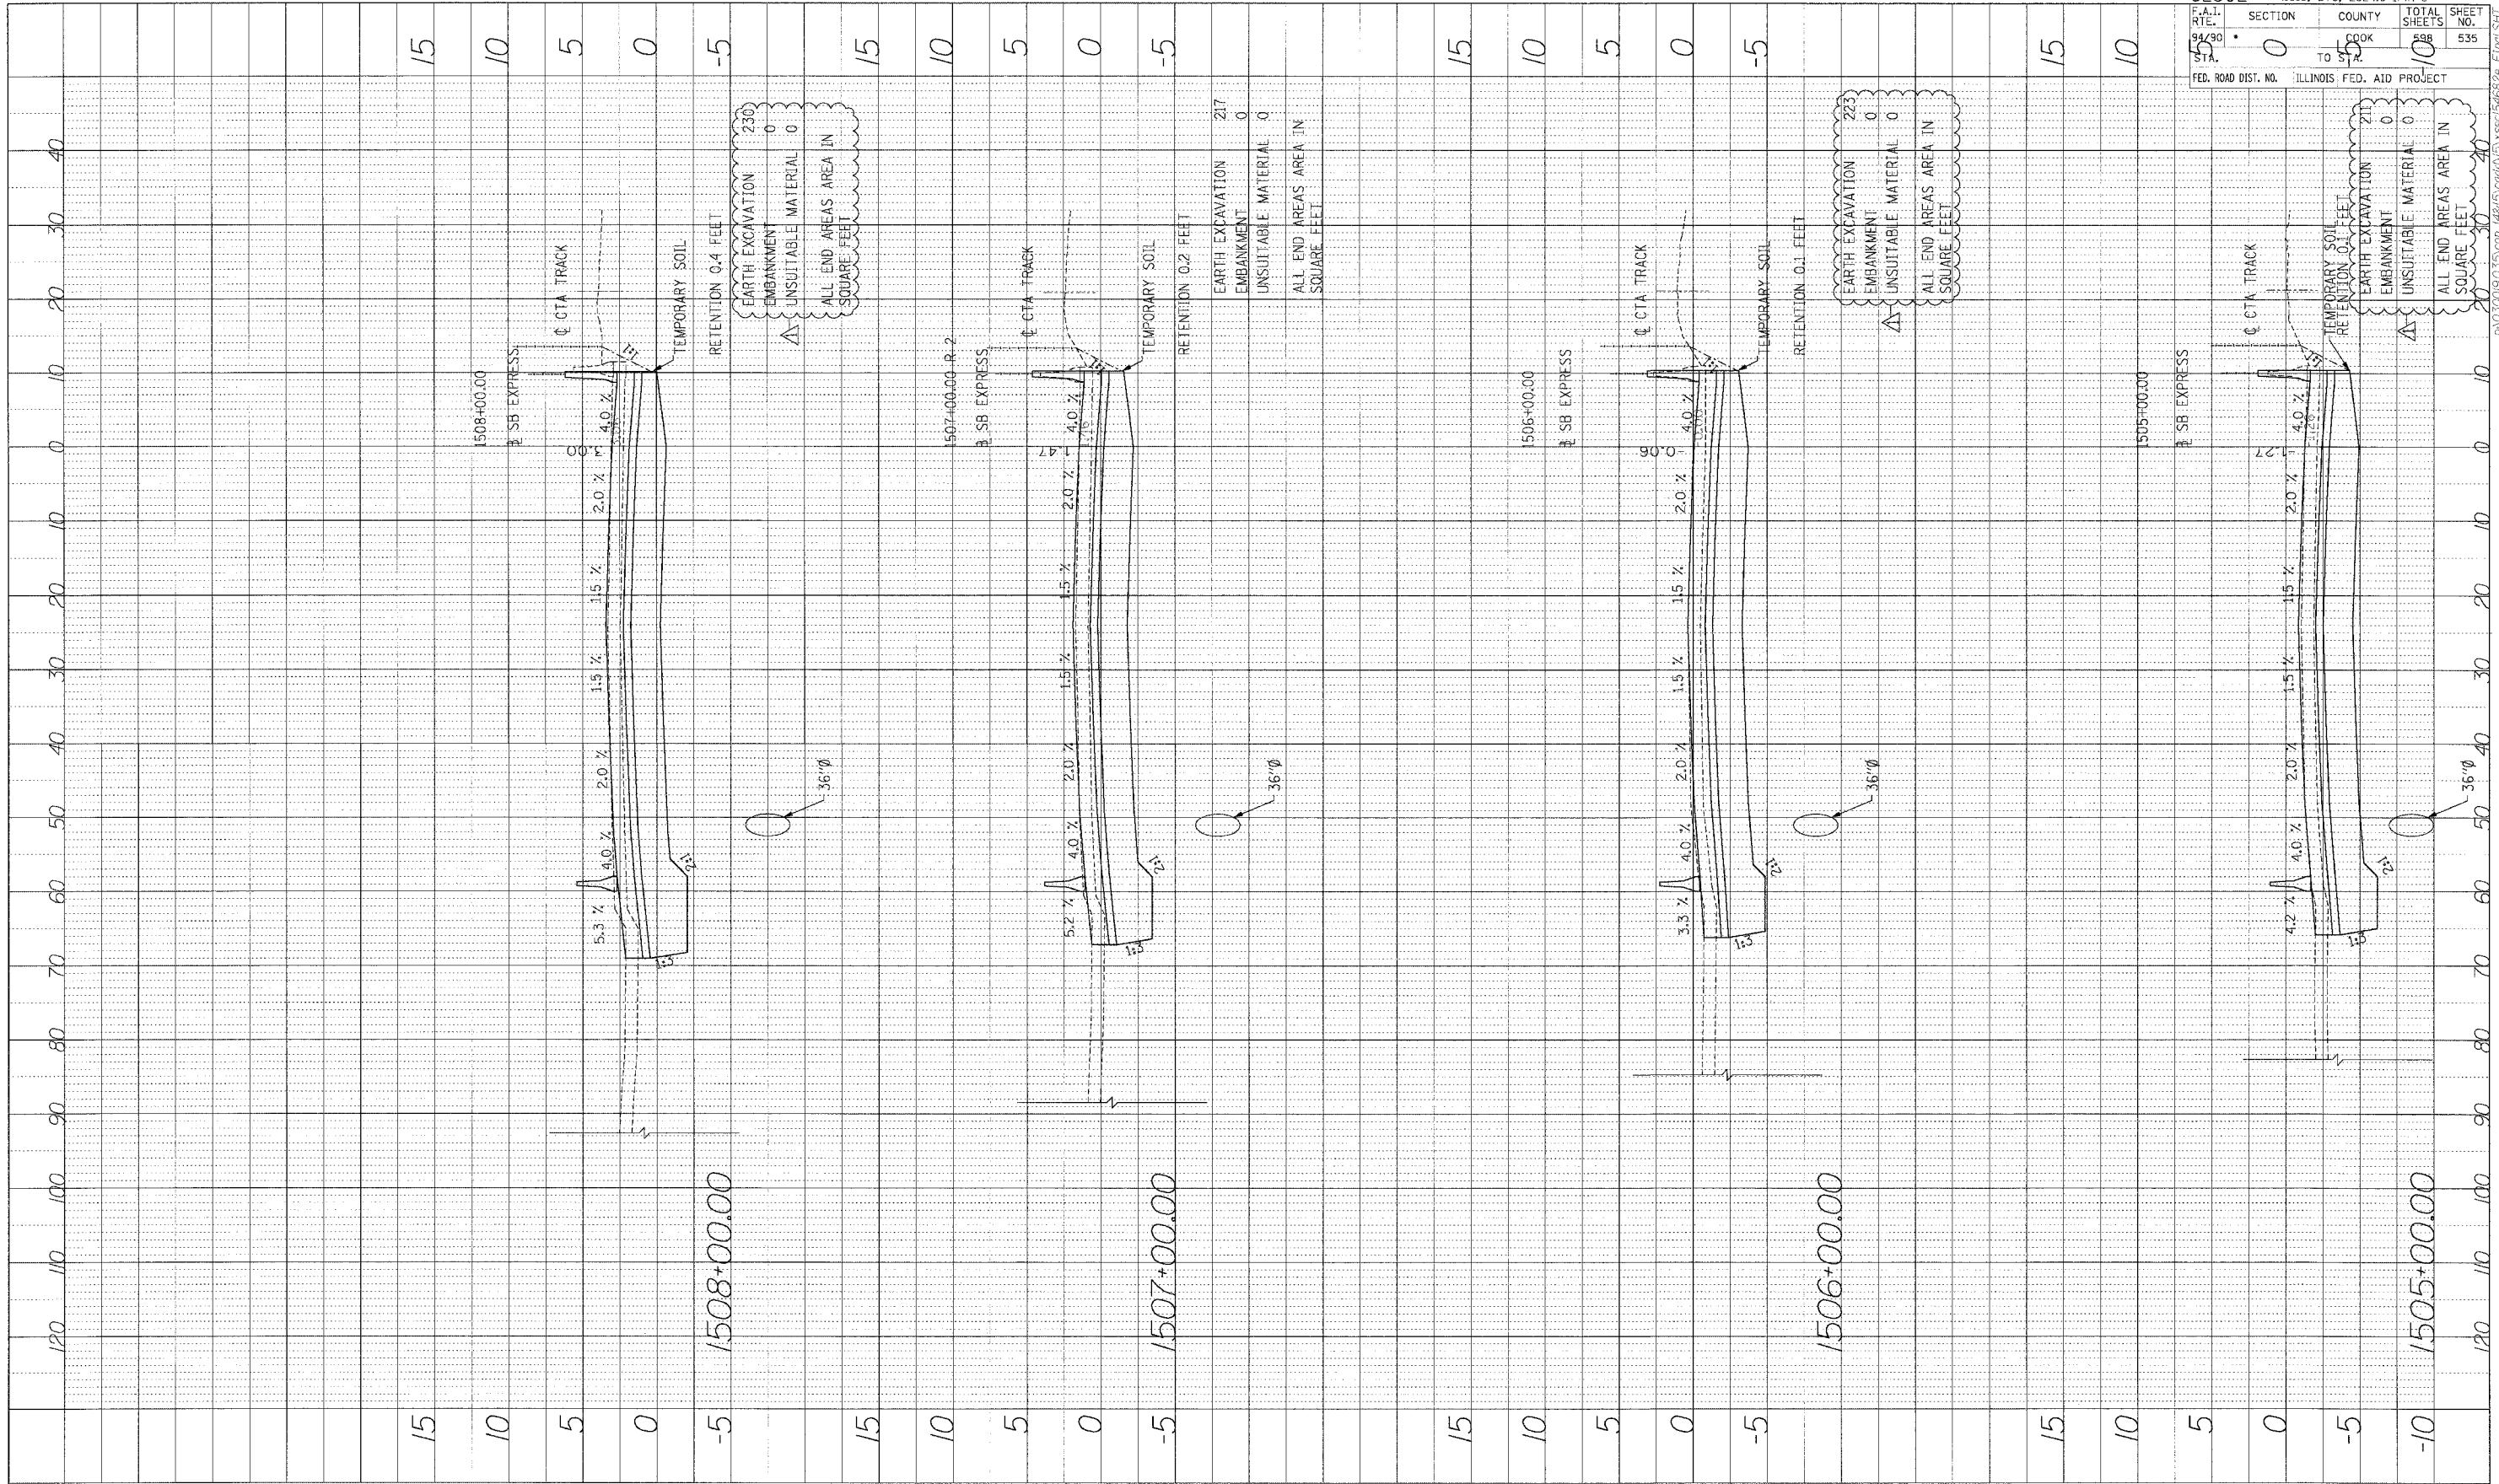

EARTH EXCAVATION 230
 EMBANKMENT 0
 UNSUITABLE MATERIAL 0
 ALL END AREAS AREA IN SQUARE FEET


EARTH EXCAVATION 217
 EMBANKMENT 0
 UNSUITABLE MATERIAL 0
 ALL END AREAS AREA IN SQUARE FEET

EARTH EXCAVATION 223
 EMBANKMENT 0
 UNSUITABLE MATERIAL 0
 ALL END AREAS AREA IN SQUARE FEET

EARTH EXCAVATION 211
 EMBANKMENT 0
 UNSUITABLE MATERIAL 0
 ALL END AREAS AREA IN SQUARE FEET

62302	SECTION 0	COUNTY COOK	TOTAL SHEETS 10	SHEET NO. 535
F.A.I. DIST. 90	TO 512	ILLINOIS FED. AID PROJECT		


Edwards AND Kelcey
 ONE NORTH FRANKLIN
 CHICAGO, IL 60606
 PHONE: (312) 251-3000
 FAX: (312) 251-3015
 WEB: WWW.EKCORP.COM

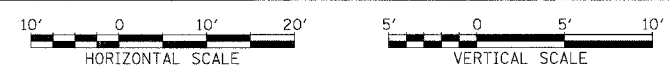

STA.

P:\02\009\02\5\cmr\148\5\add\23\uses\546826\Final.SHT

PROF ILL
 DRAWN BY: _____ DATE: _____
 CHECKED BY: _____
 IN CHARGE: _____
 STRUCTURE: HOTASTAS CRPO

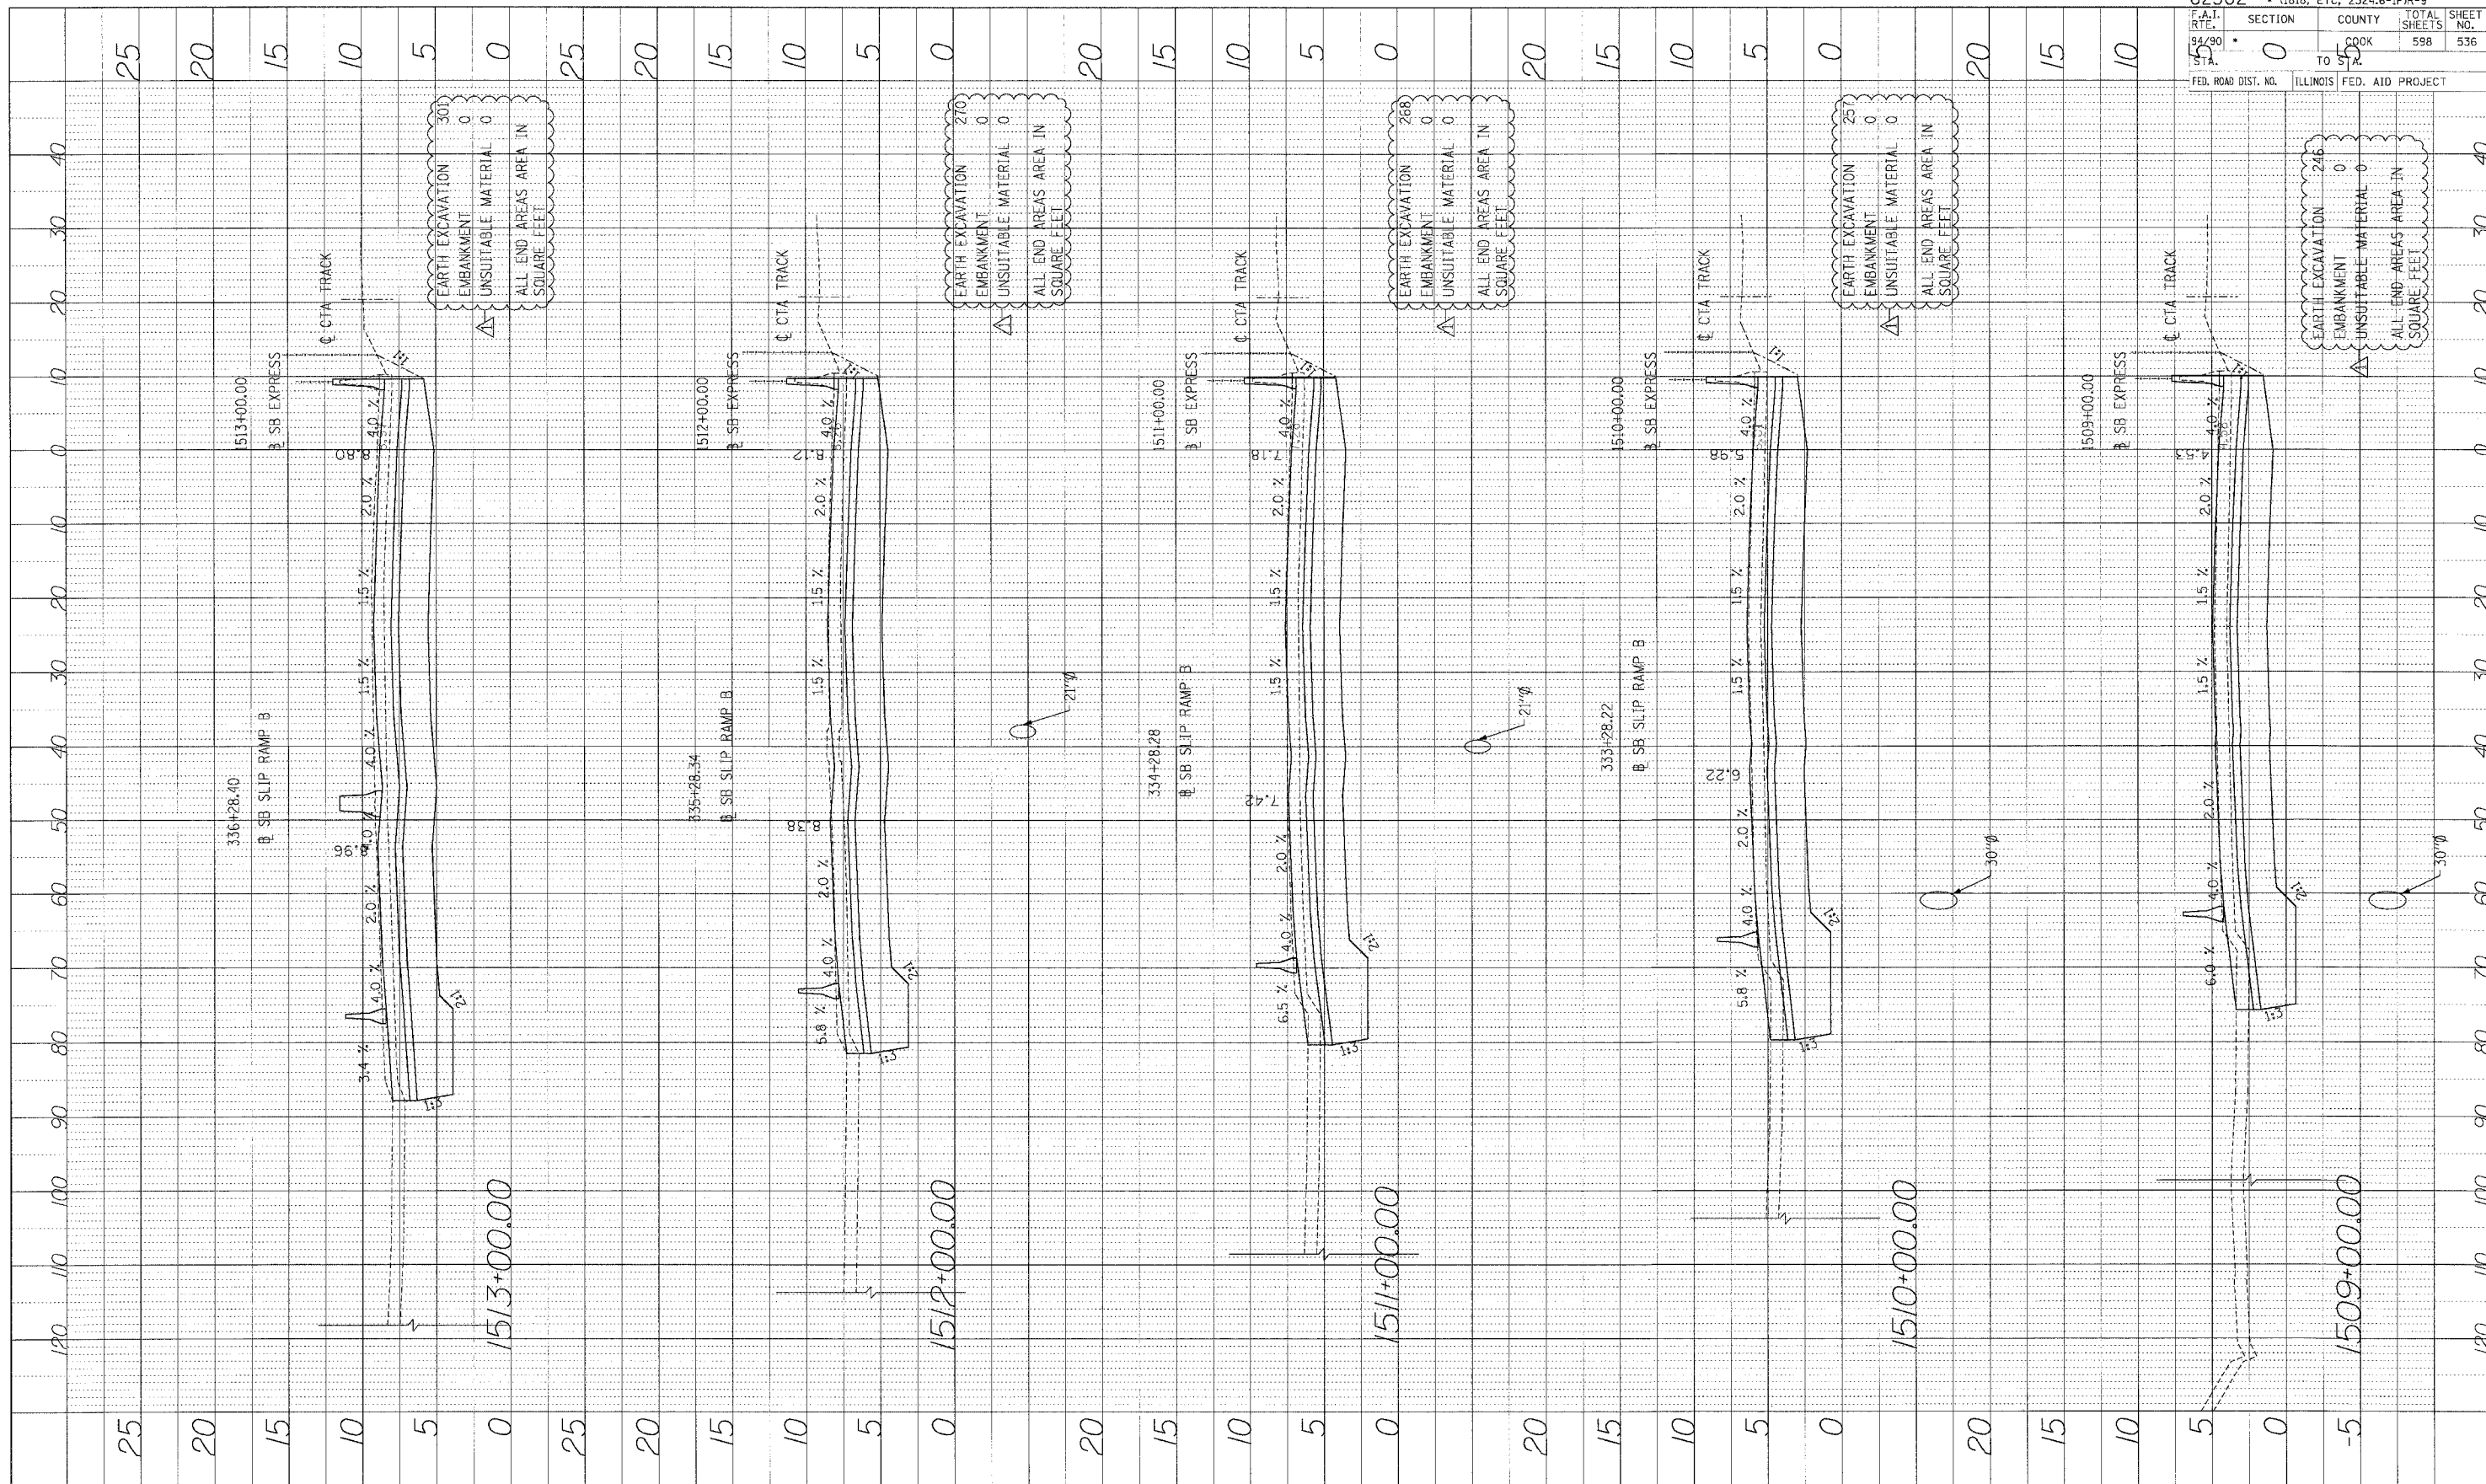

PROJECT NO.	SECTION	COUNTY	TOTAL SHEETS	SHEET NO.
62302	0	COOK	598	536
DATE	TO	FROM		
94/90	95	92		
FED. ROAD DIST. NO.	ILLINOIS	FED. AID PROJECT		

EARTH EXCAVATION 300
 EMBANKMENT 0
 UNSUITABLE MATERIAL 0
 ALL END AREAS AREA IN SQUARE FEET


EARTH EXCAVATION 270
 EMBANKMENT 0
 UNSUITABLE MATERIAL 0
 ALL END AREAS AREA IN SQUARE FEET

EARTH EXCAVATION 268
 EMBANKMENT 0
 UNSUITABLE MATERIAL 0
 ALL END AREAS AREA IN SQUARE FEET

EARTH EXCAVATION 257
 EMBANKMENT 0
 UNSUITABLE MATERIAL 0
 ALL END AREAS AREA IN SQUARE FEET

EARTH EXCAVATION 246
 EMBANKMENT 0
 UNSUITABLE MATERIAL 0
 ALL END AREAS AREA IN SQUARE FEET


Edwards AND Kelcey
 ONE NORTH FRANKLIN
 CHICAGO, IL 60606
 PHONE: (312) 251-3000
 FAX: (312) 251-3015
 WEB: WWW.EKCORP.COM

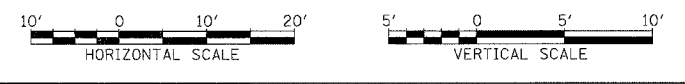


STA.

P:\0200\903035.corr\48155.corr\5\6682-F1701.SW

PROFILE	DATE
DRAWN BY	
CHECKED BY	
APPROVED BY	
NO.	

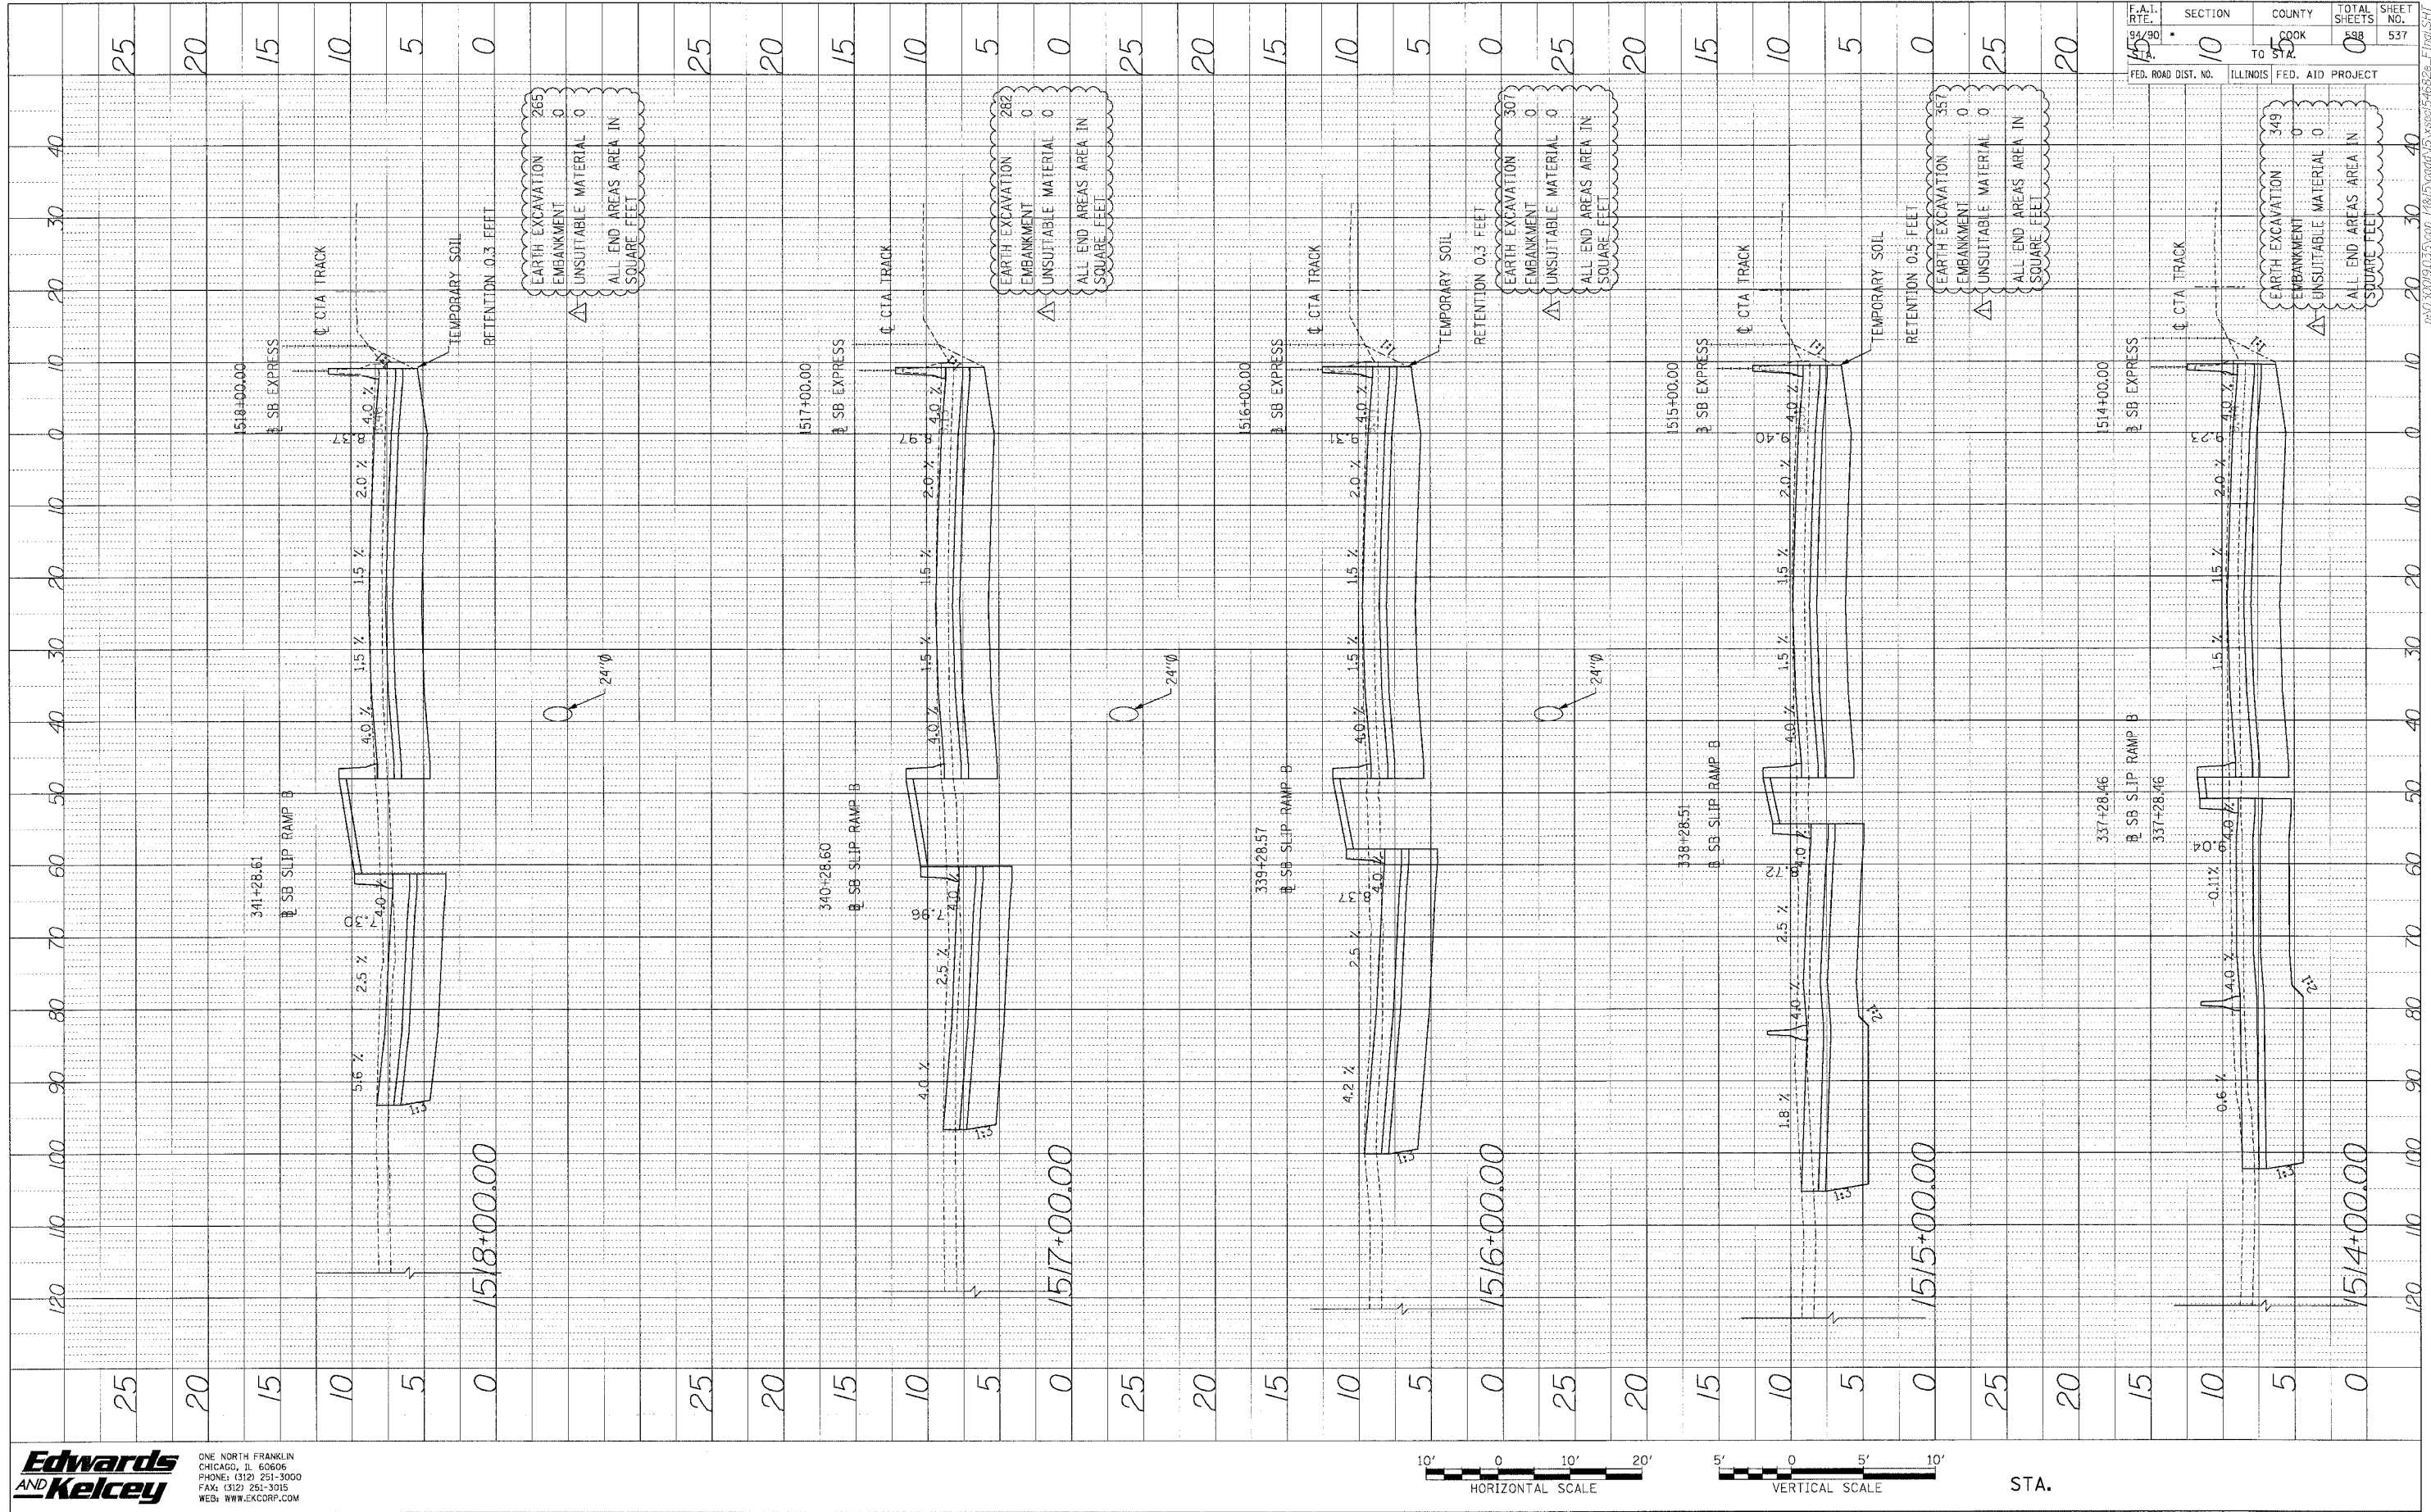

Edwards AND Kelcey
 ONE NORTH FRANKLIN
 CHICAGO, IL 60606
 PHONE: (312) 251-3000
 FAX: (312) 251-3015
 WEB: WWW.EKCORP.COM

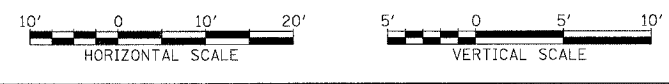


STA.

62302	(1818, ETC, 2324.6-1)PR-9
F.A.T. RTF.	SECTION COUNTY TOTAL SHEETS SHEET NO.
94/90	10 COOK 588 537
15	TO STA.
FED. ROAD DIST. NO.	ILLINOIS FED. AID PROJECT


P:\0500\09\035\00r\1818\5\car019\sect05\F6822-F1001.SW

PHOTO	BY	DATE
1		
2		
3		
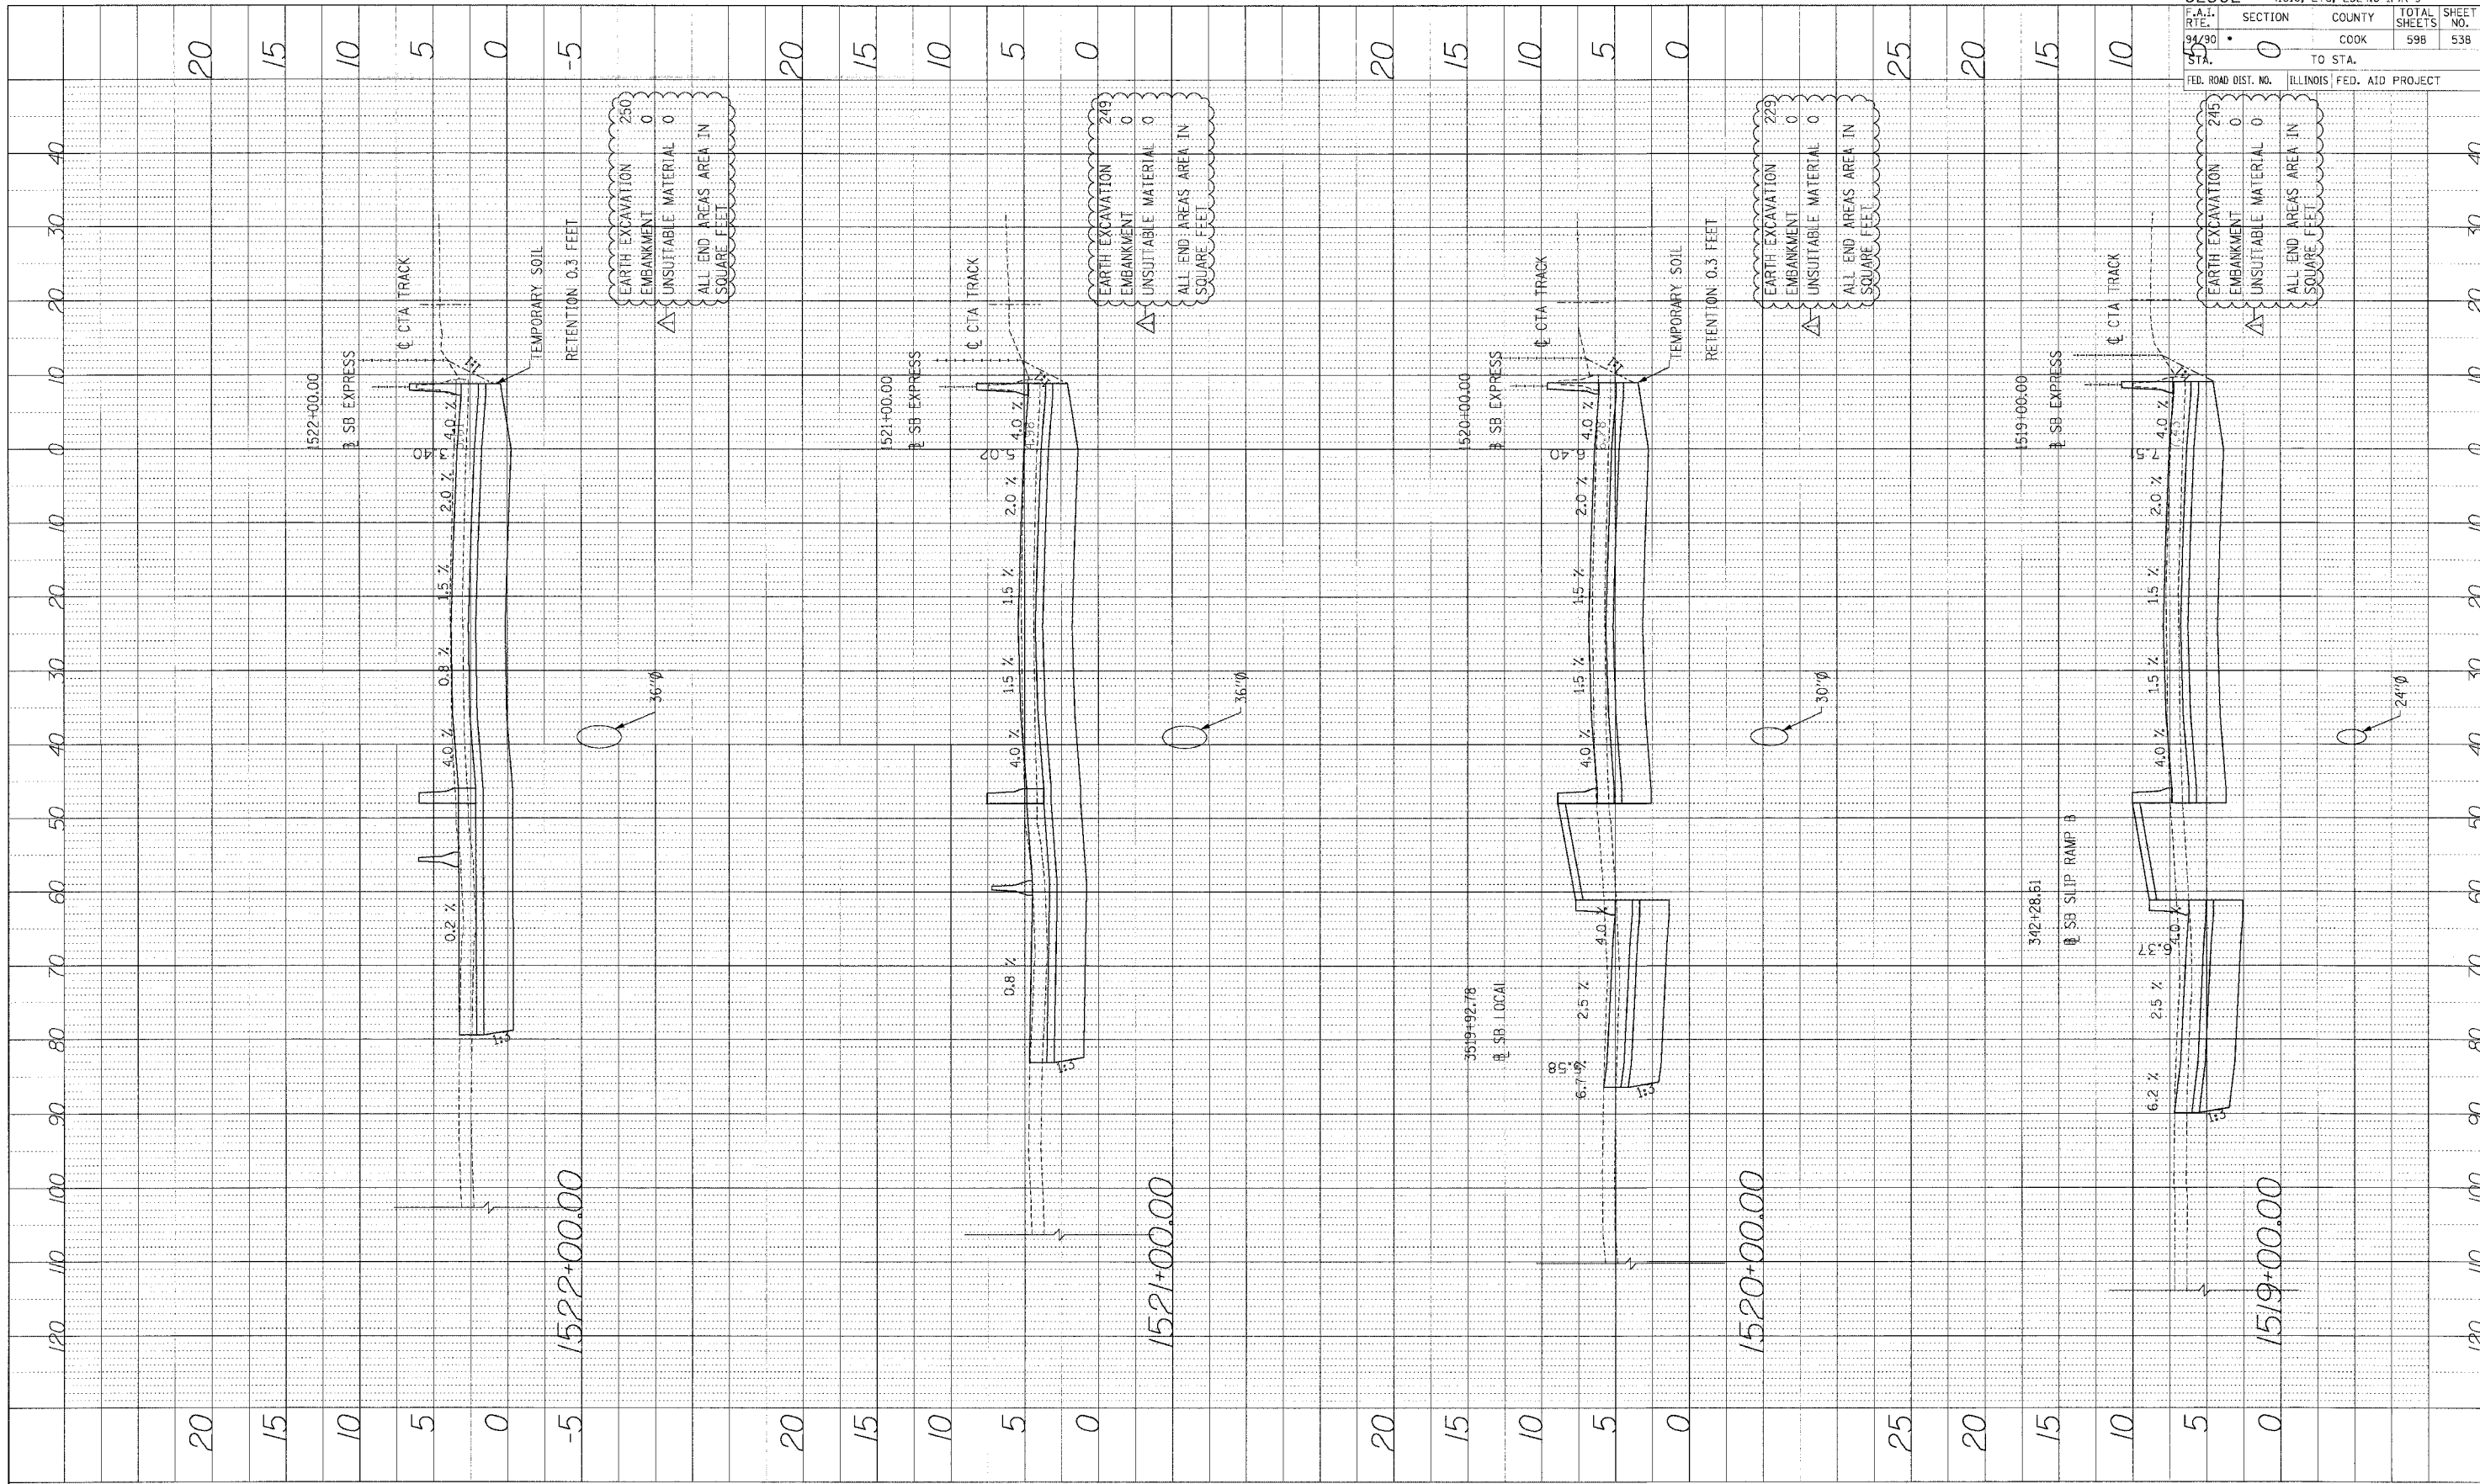

62302	• (1818, ETC, 2324.6-1PR-9		
SECTION	COUNTY	TOTAL SHEETS	SHEET NO.
0	COOK	598	538
TO STA.	ILLINOIS FED. AID PROJECT		


Edwards AND Kelcey
 ONE NORTH FRANKLIN
 CHICAGO, IL 60606
 PHONE: (312) 251-3000
 FAX: (312) 251-3015
 WEB: WWW.EKCORP.COM

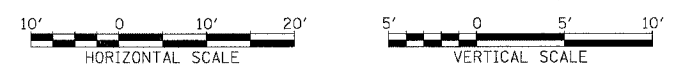

STA.


P:\03\005\035\com 148\5\000\PCS\00054829\Final.SHT

PROFILE: DRAWN BY: DATE:
 REVISIONS: BY: DATE:
 NOTE BOOK NO. STRUCTURE NOTATION: 0760

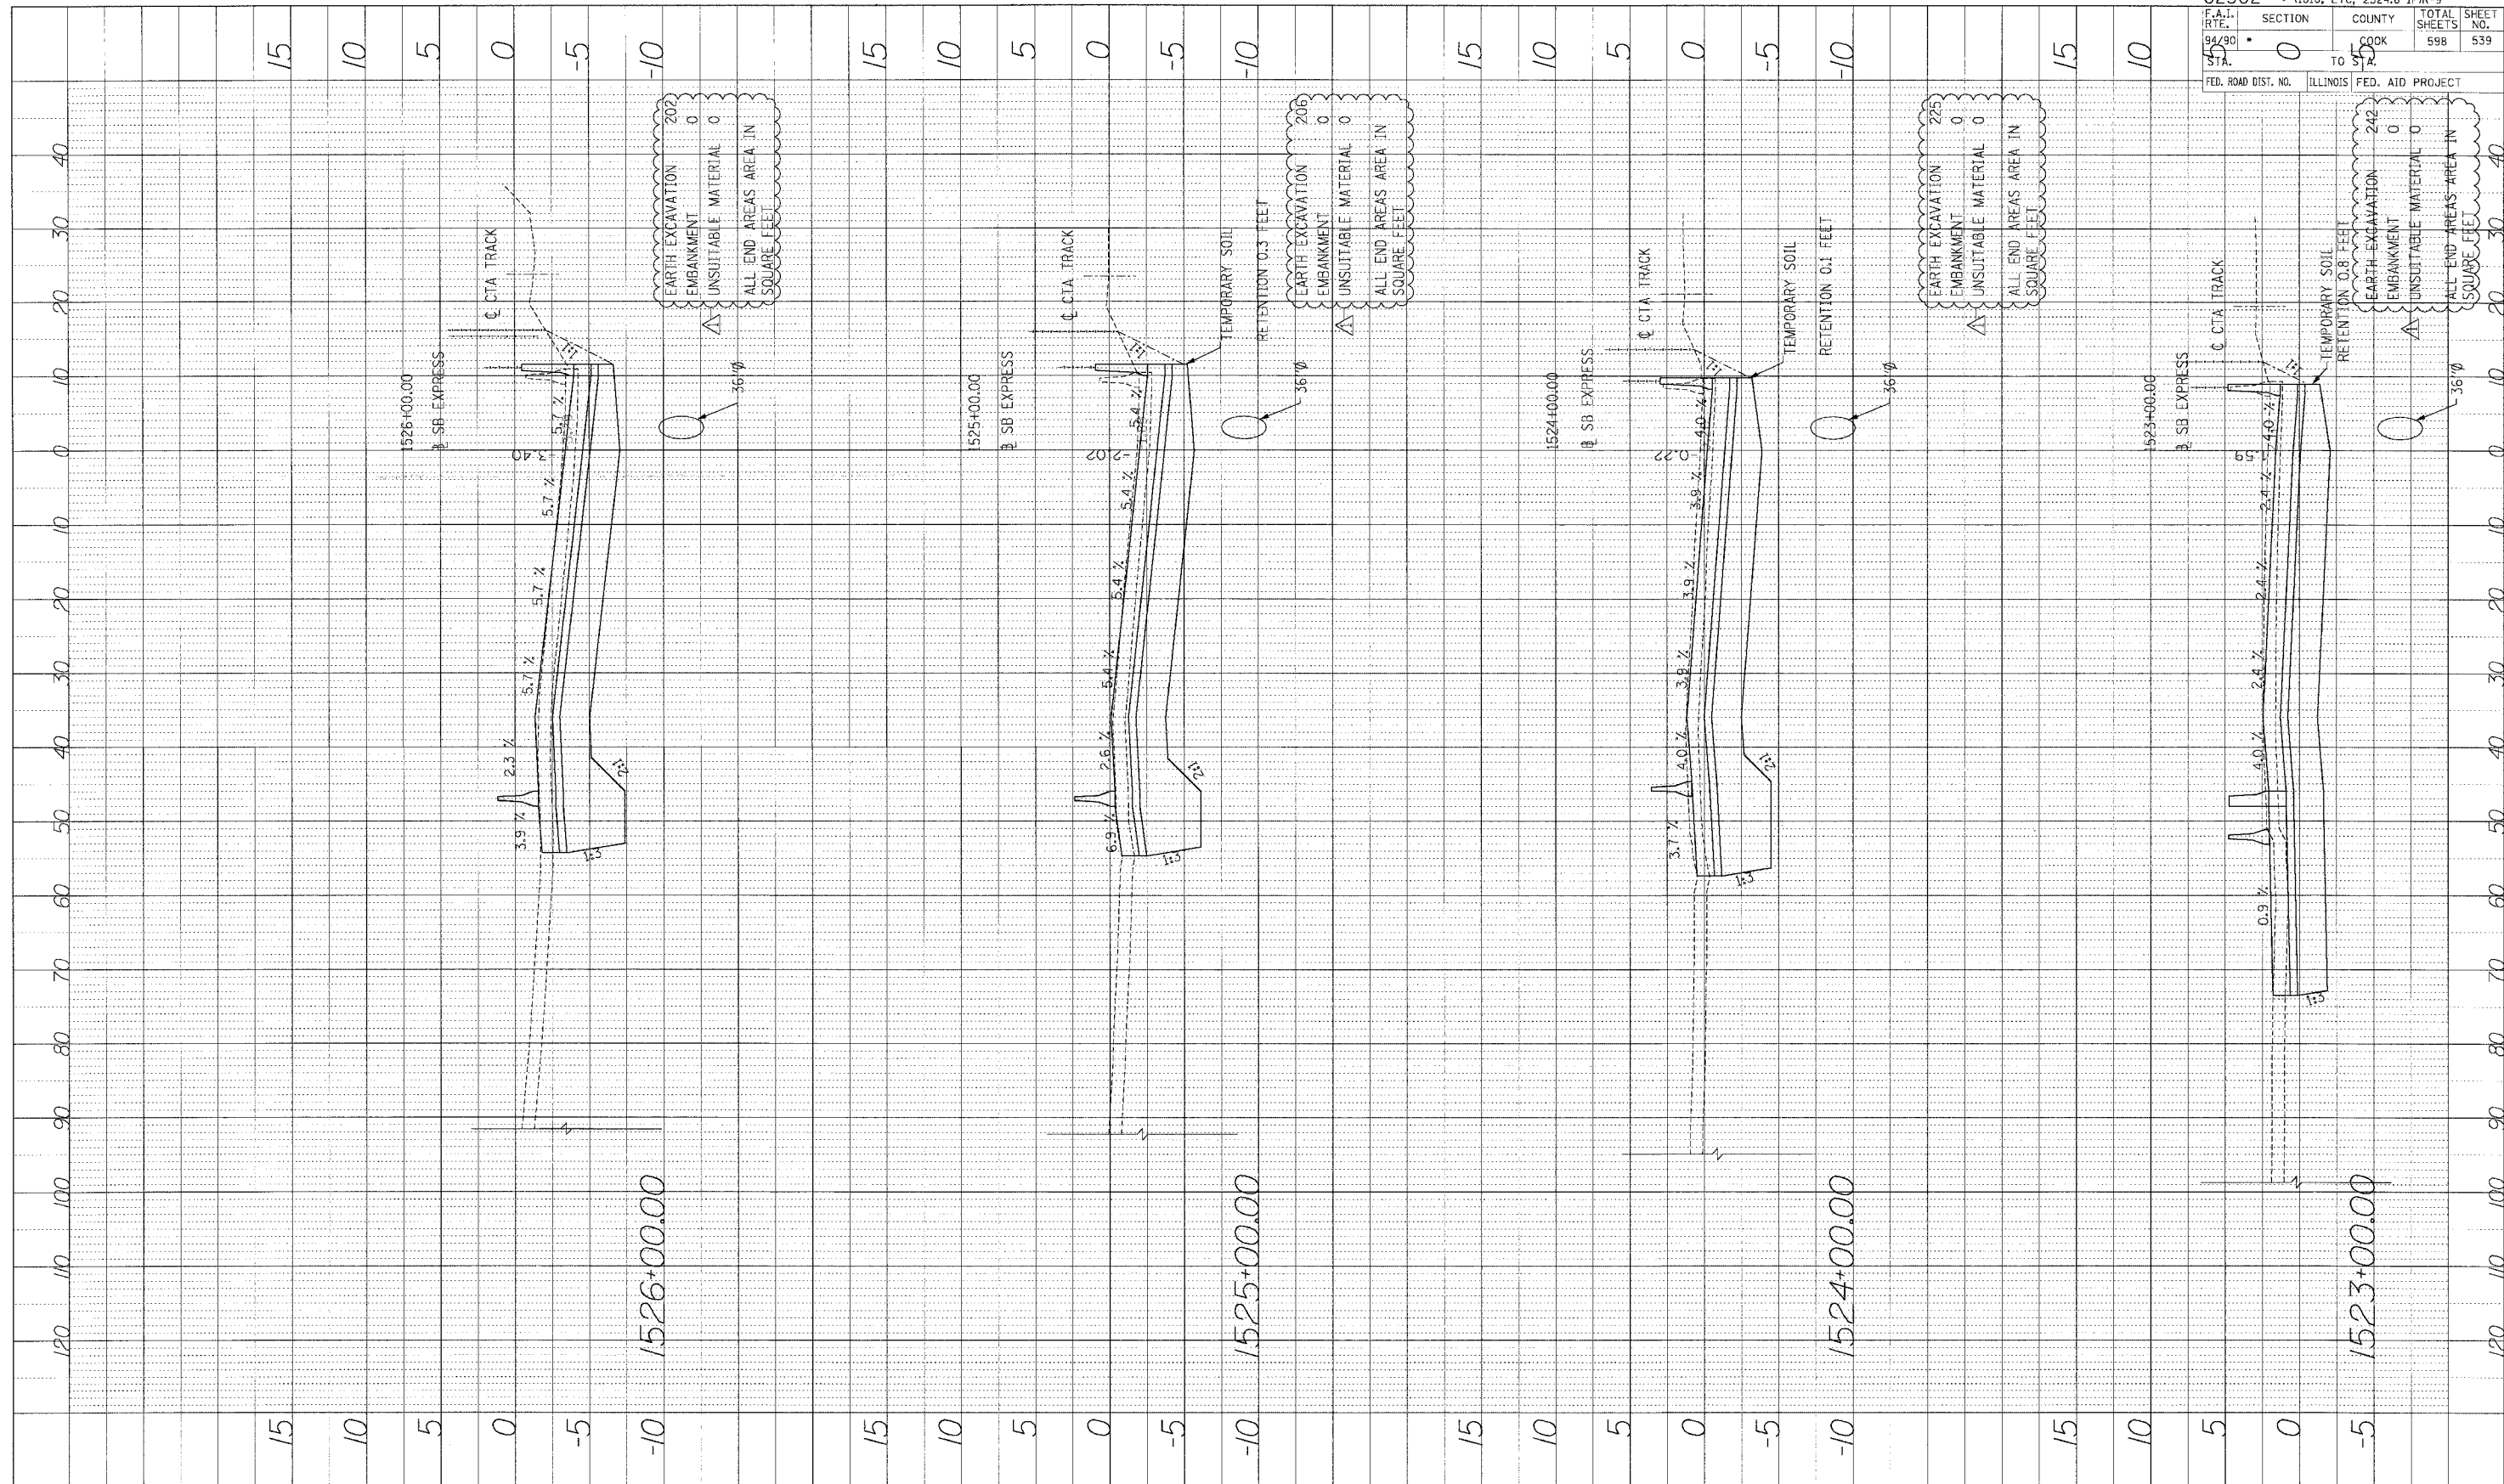

F.A.I. RTE. 94/90	SECTION 0	COUNTY COOK	TOTAL SHEETS 598	SHEET NO. 539
STA. 1523	TO STA. 1526	ILLINOIS FED. AID PROJECT		


Edwards AND Kelcey
 ONE NORTH FRANKLIN CHICAGO, IL 60606
 PHONE: (312) 251-3000
 FAX: (312) 251-3015
 WEB: WWW.EKCORP.COM

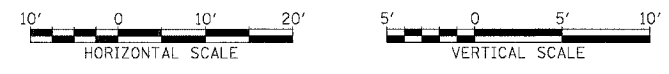

STA.

p:\03\09\035\035.dwg (46/5)cad\ANSYS\035.dwg 4/6/2003 11:51:15 AM


PROFILE SURVEYED BY DATE
 PLOTTED BY
 NOTE BOOK NO. AND SHEET NO.
 STRUCTURE NOTATION: CHND

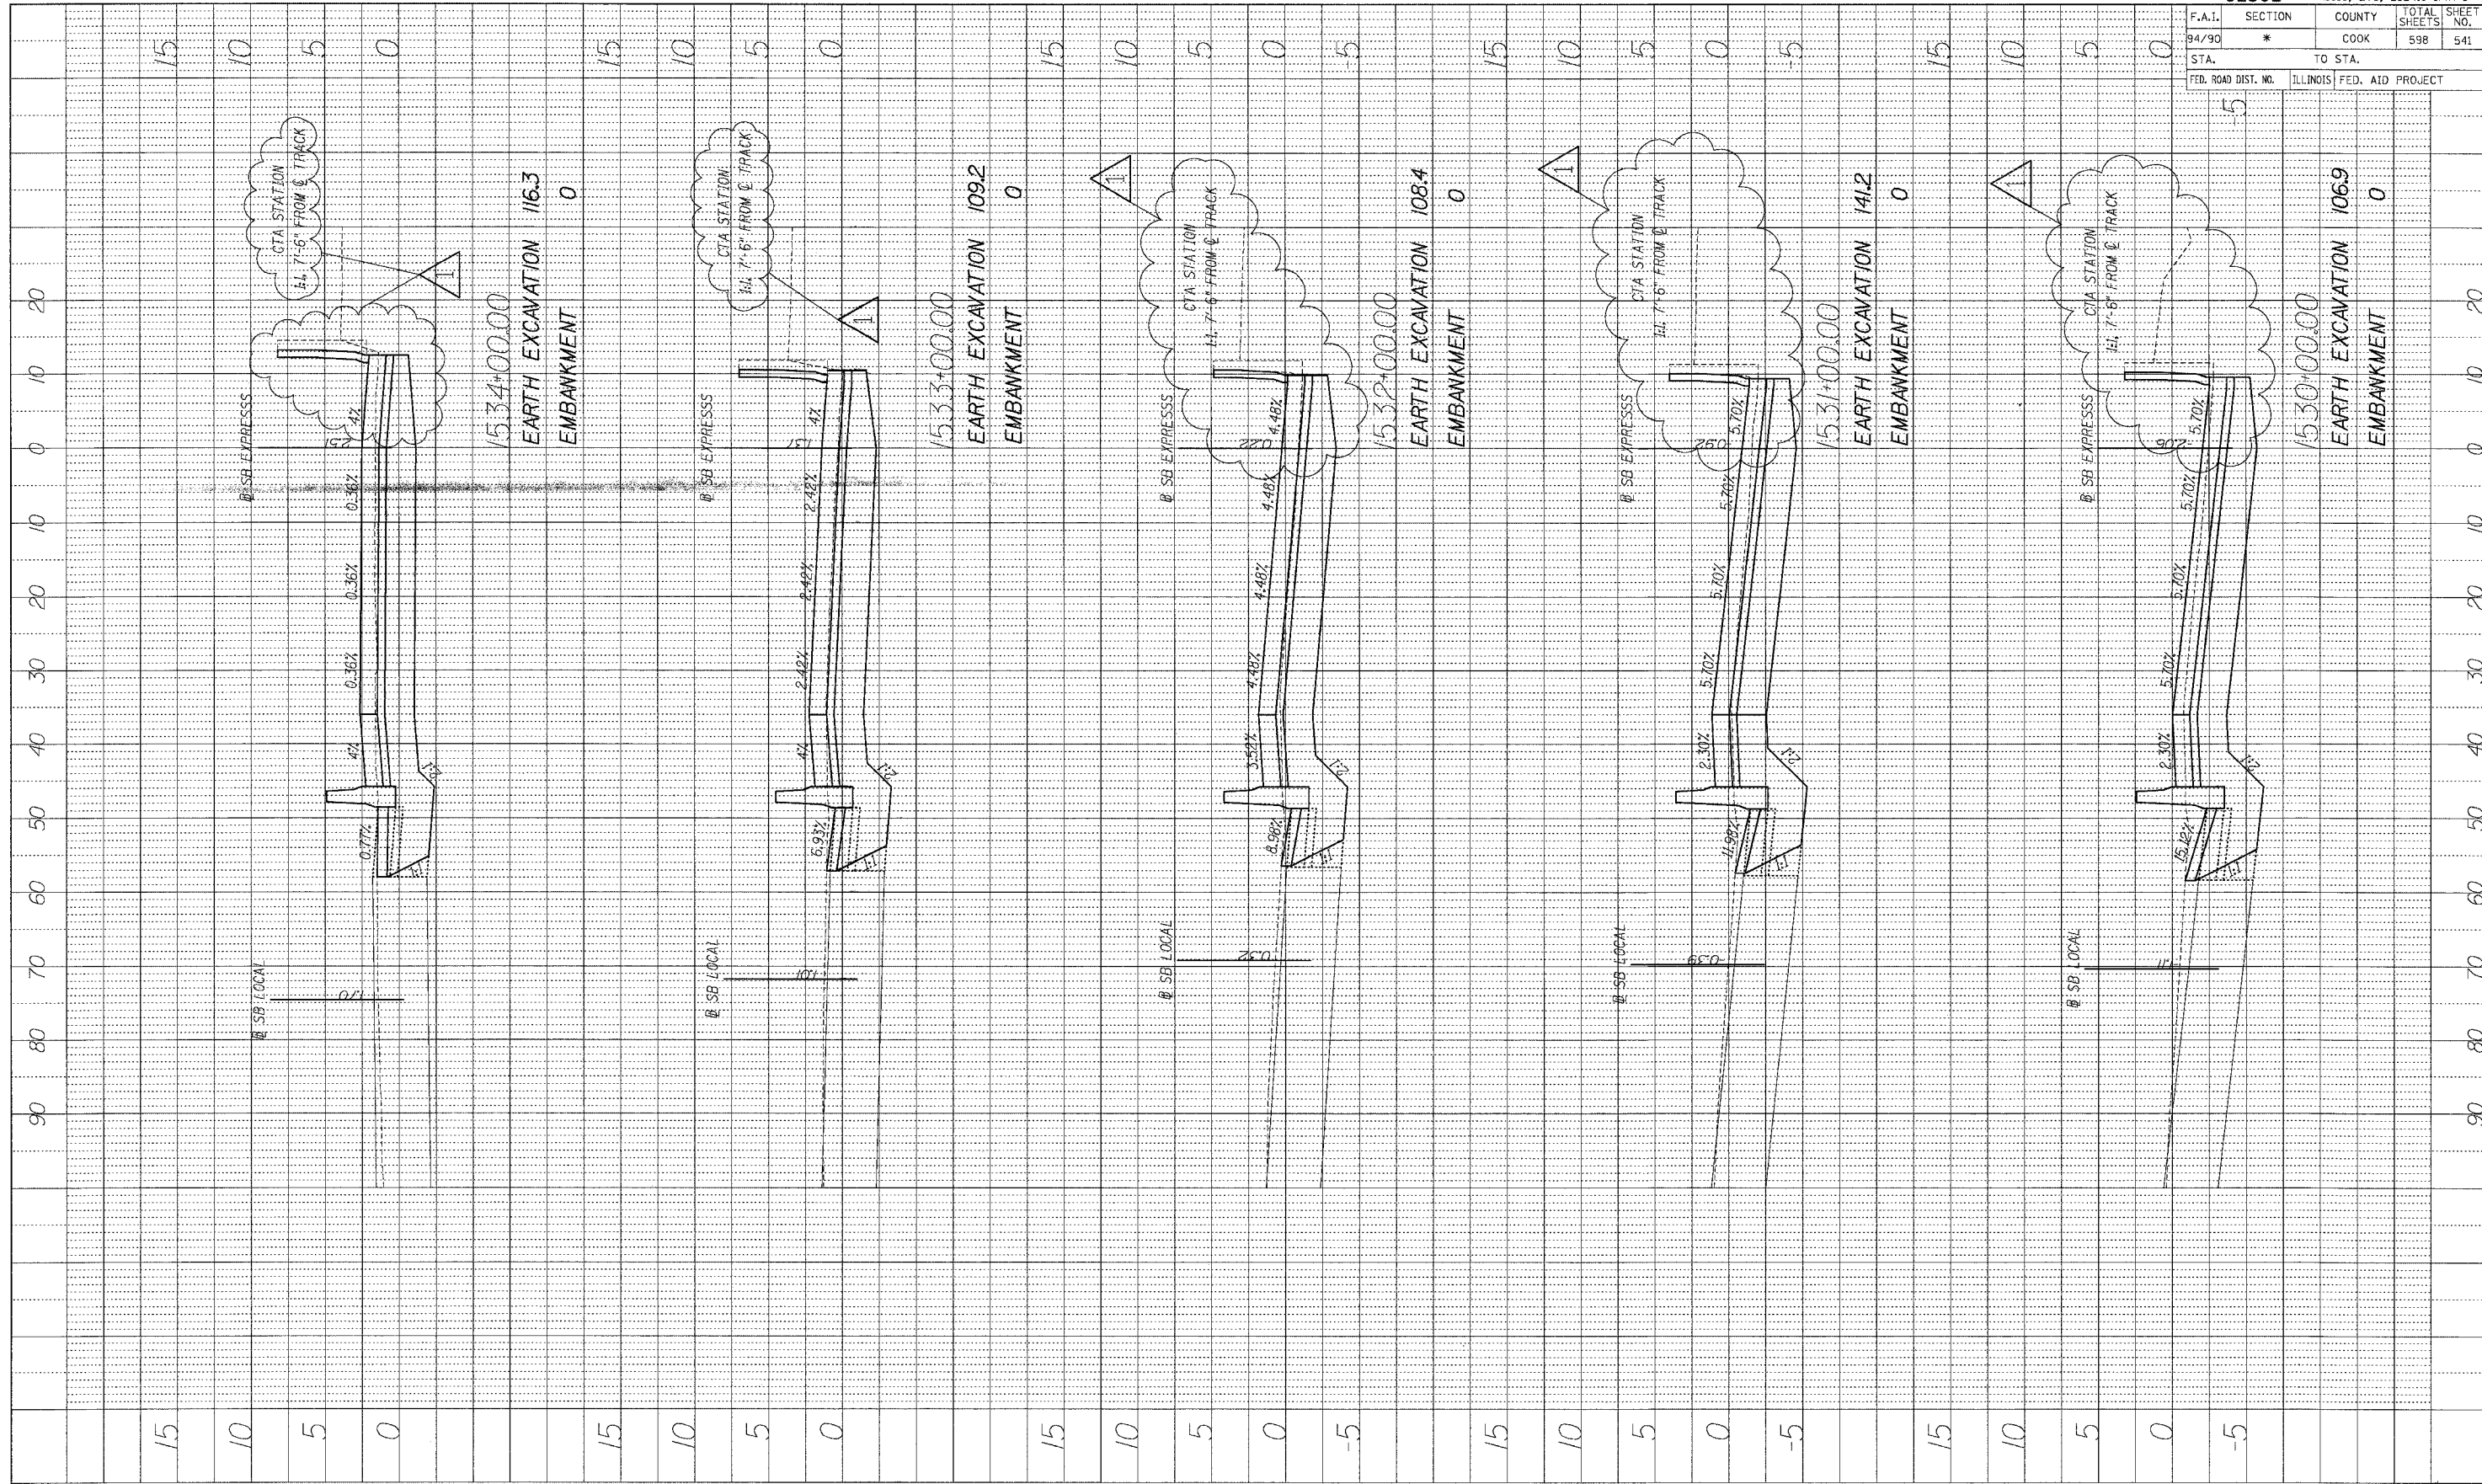

62302		*11818, ETC, 2324.6-1PIR-9	
F.A.I.	SECTION	COUNTY	TOTAL SHEET NO.
94/90	*	COOK	598
STA.	TO STA.		
FED. ROAD DIST. NO.	ILLINOIS	FED. AID PROJECT	

BOWMAN, BARRETT & ASSOCIATES INC.
 CONSULTING ENGINEERS
 Chicago, Illinois
 312.228.0100
 www.bbainc.com

ADDENDUM 1 8/12/05

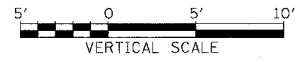


STA.+.. TO STA.+..

6-43-95 TM 8/11/2005


F.A.I.	SECTION	COUNTY	TOTAL SHEETS	SHEET NO.
94/90	*	COOK	598	542
STA.		TO STA.		
FED. ROAD DIST. NO.		ILLINOIS	FED. AID	PROJECT

PROFILE SURVEYED	BY	DATE
PLANTED		
NOTE BOOK NO.		
STRUCTURE NOTATION CIRCD		

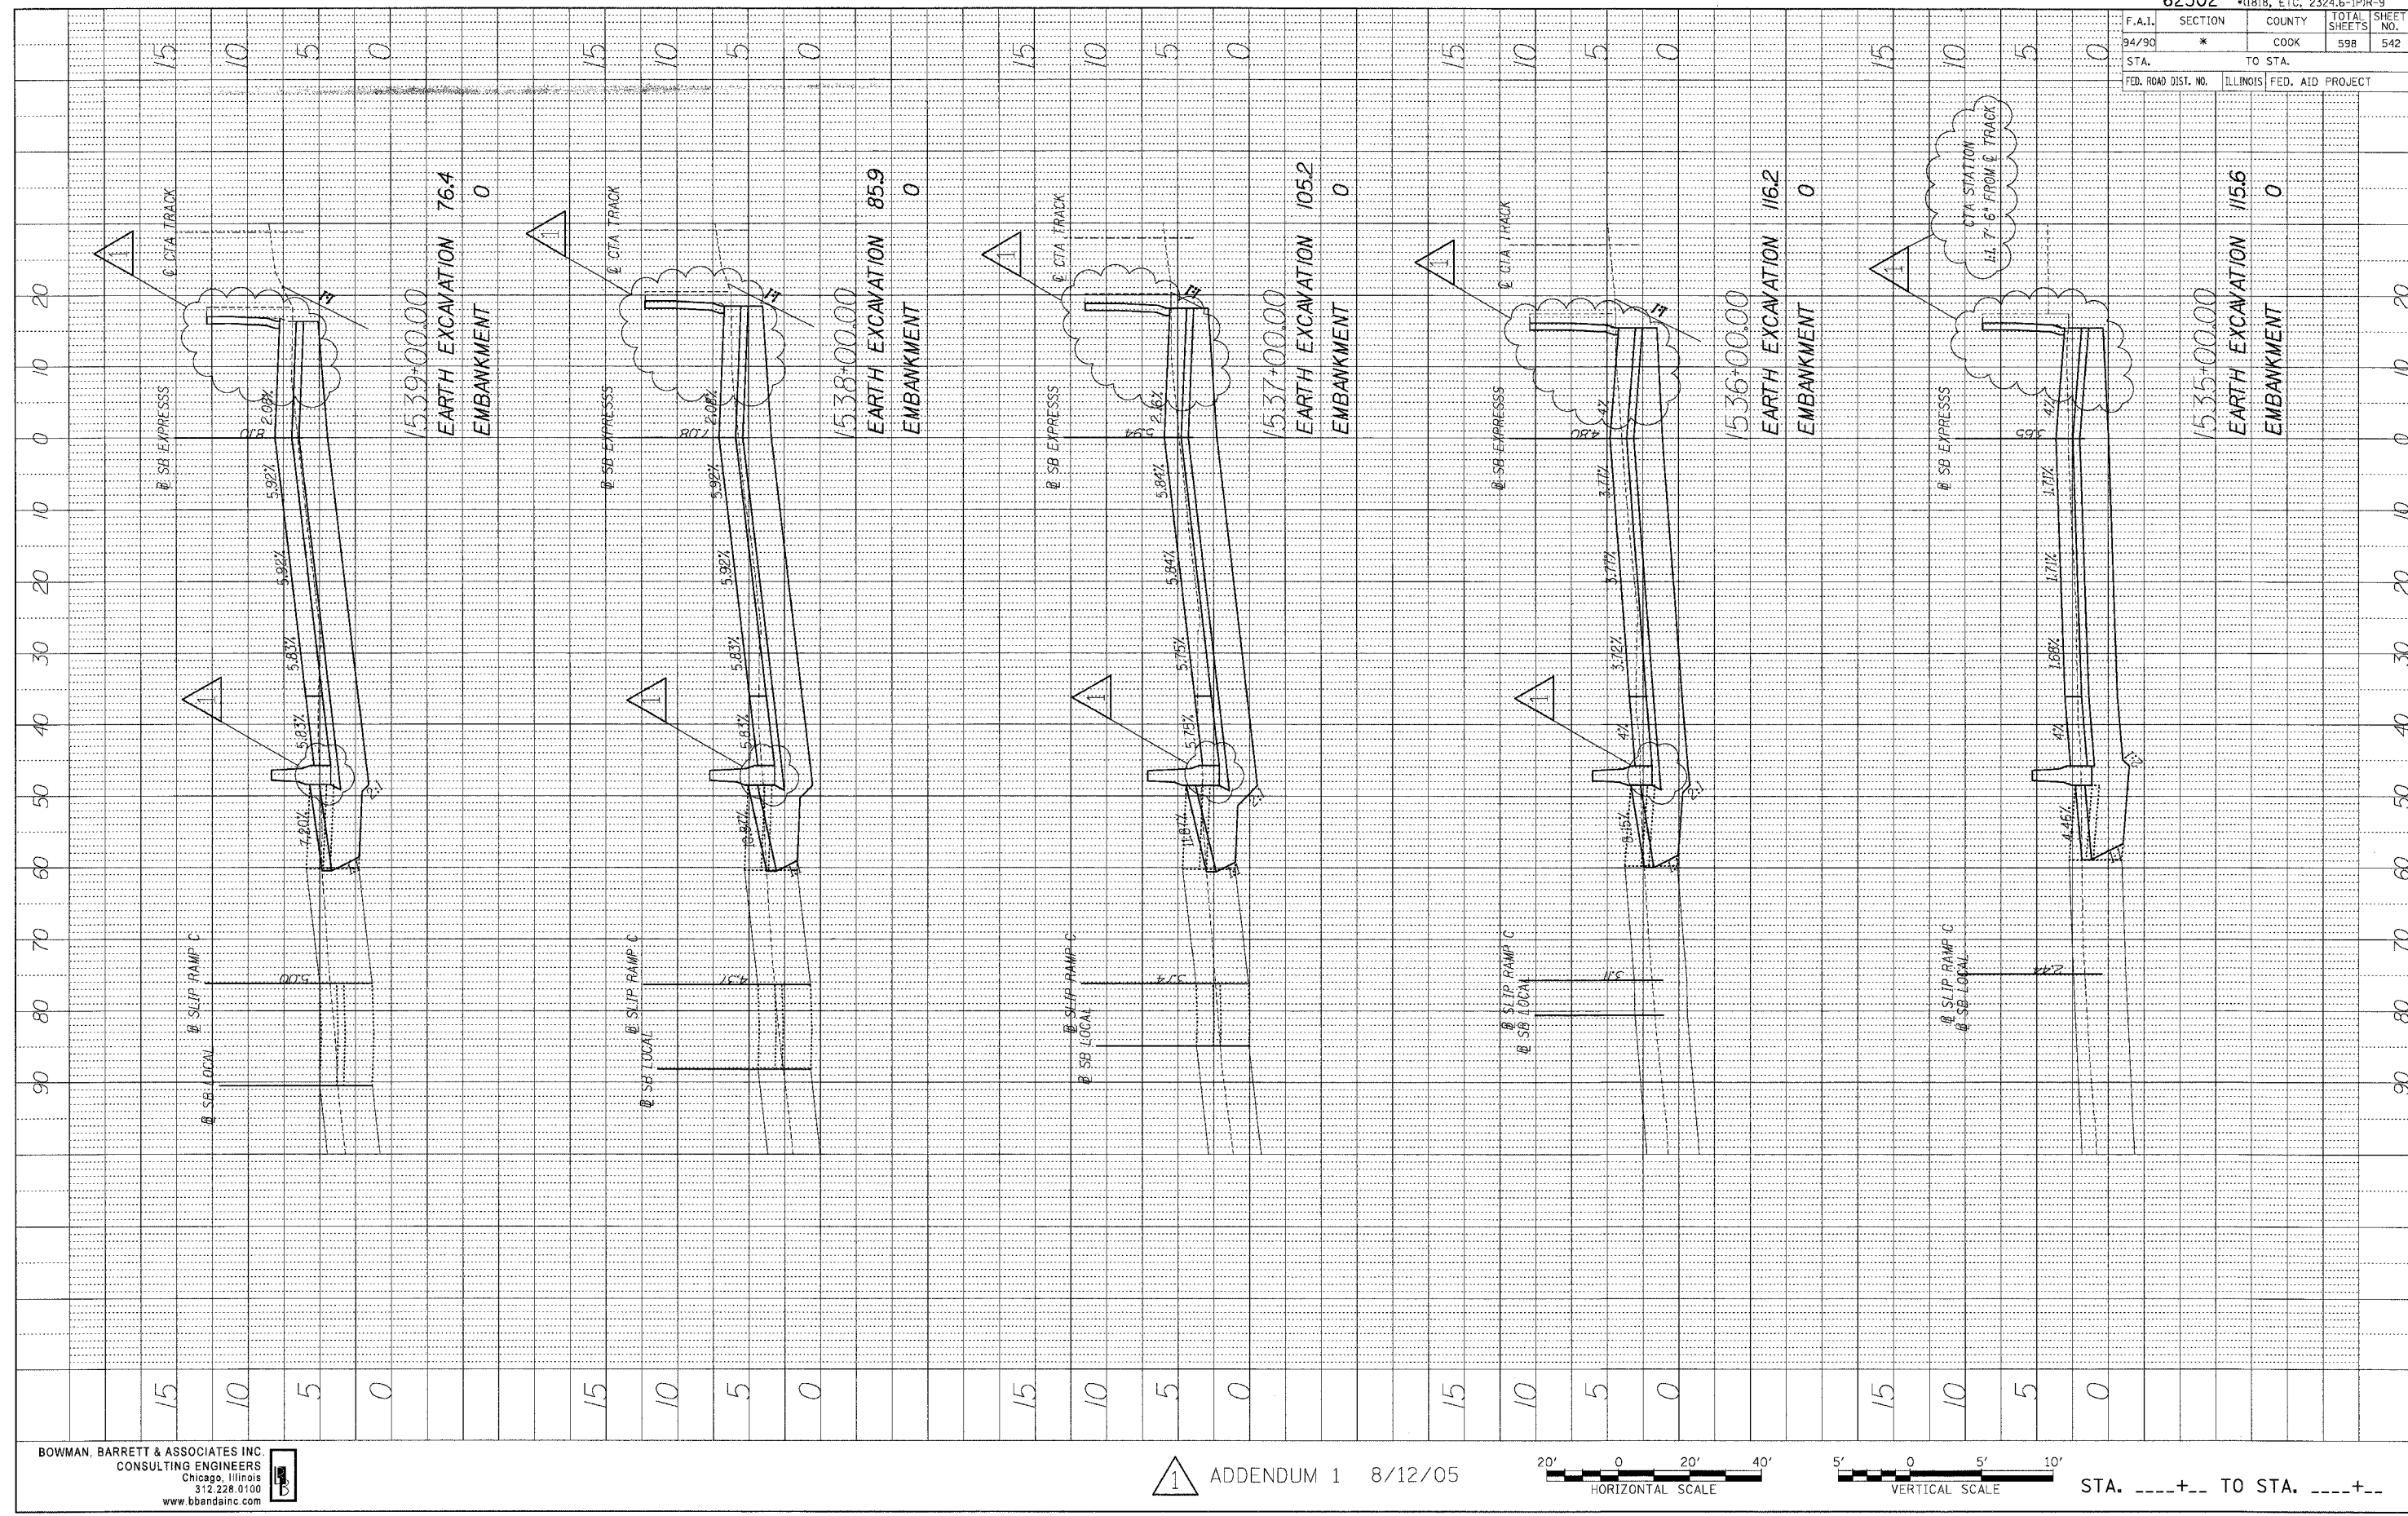

BOWMAN, BARRETT & ASSOCIATES INC
 CONSULTING ENGINEERS
 Chicago, Illinois
 312.228.0100
 www.bbainc.com


ADDENDUM 1 8/12/05

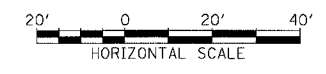

STA. ----+-- TO STA. ----+--

F.A.I.	SECTION	COUNTY	TOTAL SHEETS	SHEET NO.
84/90	*	COOK	598	543
STA.		TO STA.		
FED. ROAD DIST. NO.		ILLINOIS FED. AID PROJECT		

PROFILE	REVISION	BY	DATE
NOTE BOOK	FILED		
NO.	NO.		

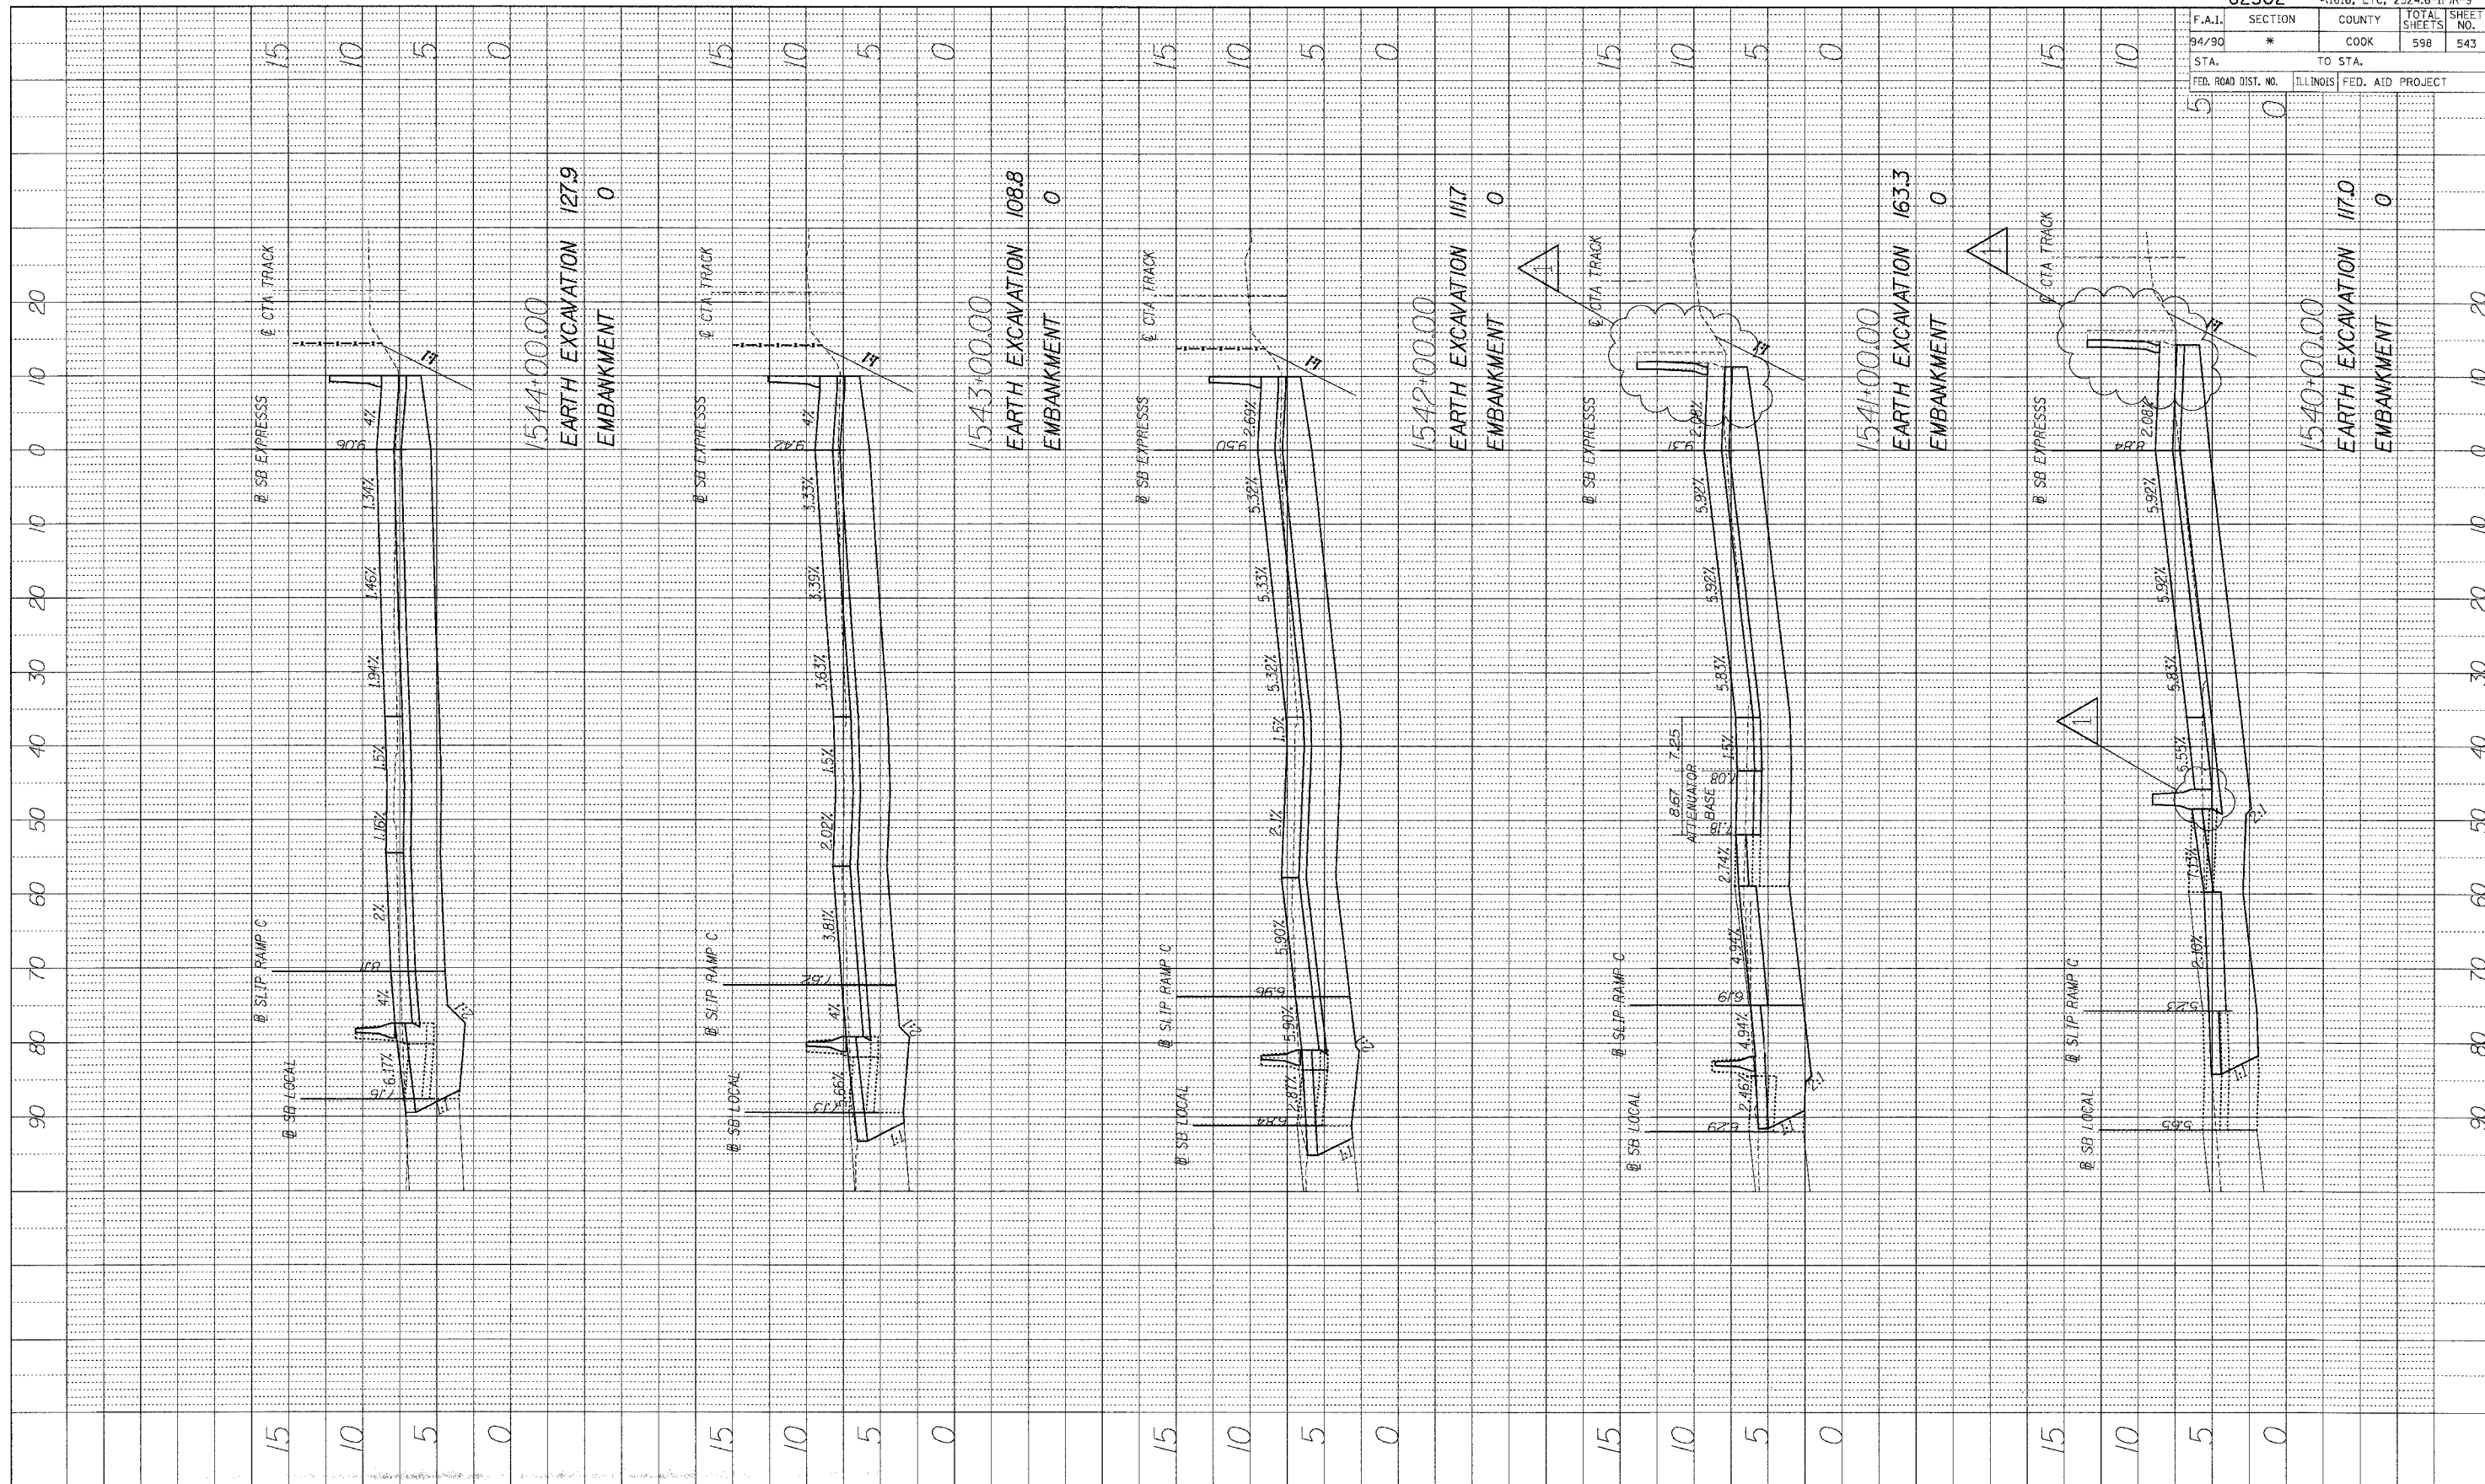

1544+00.00
EARTH EXCAVATION 127.9
EMBANKMENT 0

1543+00.00
EARTH EXCAVATION 108.8
EMBANKMENT 0


1542+00.00
EARTH EXCAVATION 111.7
EMBANKMENT 0

1541+00.00
EARTH EXCAVATION 163.3
EMBANKMENT 0

1540+00.00
EARTH EXCAVATION 170.0
EMBANKMENT 0

BOWMAN, BARRETT & ASSOCIATES INC.
CONSULTING ENGINEERS
Chicago, Illinois
312.228.0100
www.bbainc.com

ADDENDUM 1 8/12/05

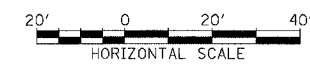

STA. ----+-- TO STA. ----+--


IN 6602 (04/04) (V) (S) SHEET 5 (6602) (5) (04/04)

6-4489 PM


8/11/2005

F.A.I.	SECTION	COUNTY	TOTAL SHEETS	SHEET NO.
94/90	*	COOK	598	544
STA.		TO STA.		
FED. ROAD DIST. NO.	ILLINOIS	FED. AID PROJECT		

PROFILE REVIEWED BY DATE
 GRADES CHECKED BY
 NOTE BOOK NO.
 STRUCTURE NOTATIONS OKWD

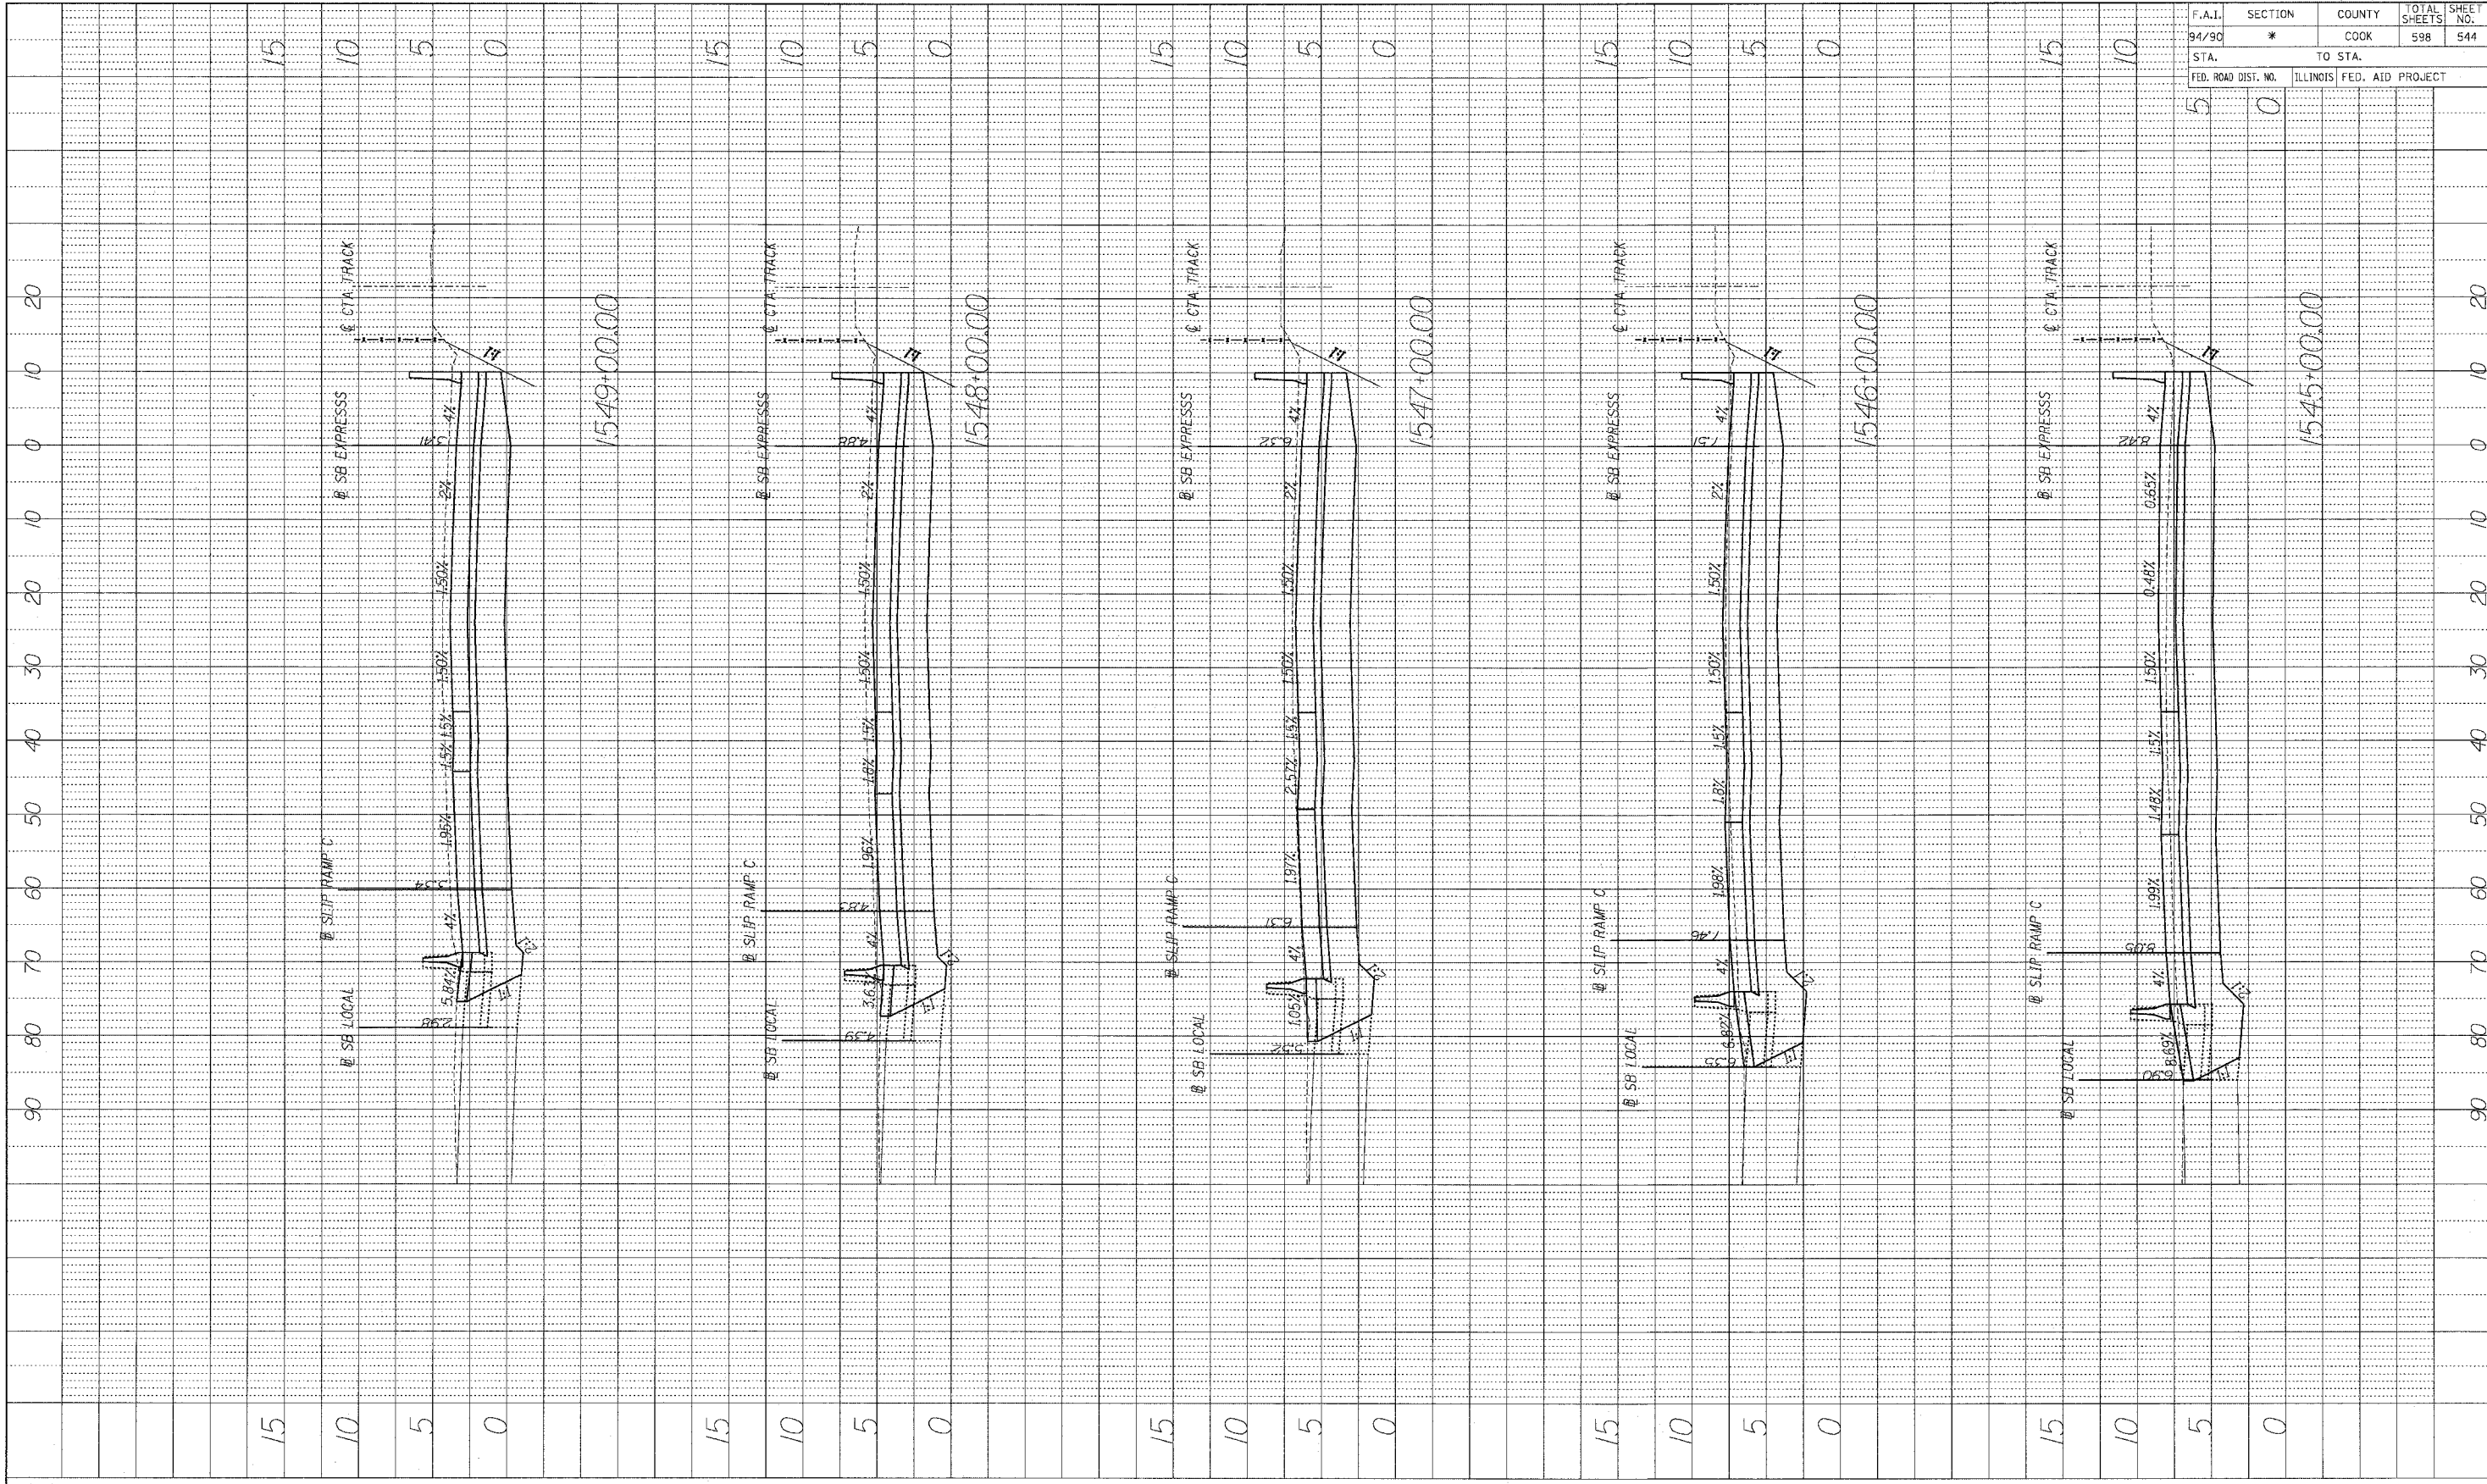


BOWMAN, BARRETT & ASSOCIATES INC
 CONSULTING ENGINEERS
 Chicago, Illinois
 312.228.0100
 www.bbandainc.com

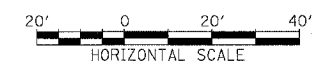

STA. ---+--- TO STA. ---+---

PROFILE SUBMITTED BY DATE
 PLotted BY
 NOTE BOOK NO. DATE NOTED
 STRUCTURE NOTATIONS CHRD

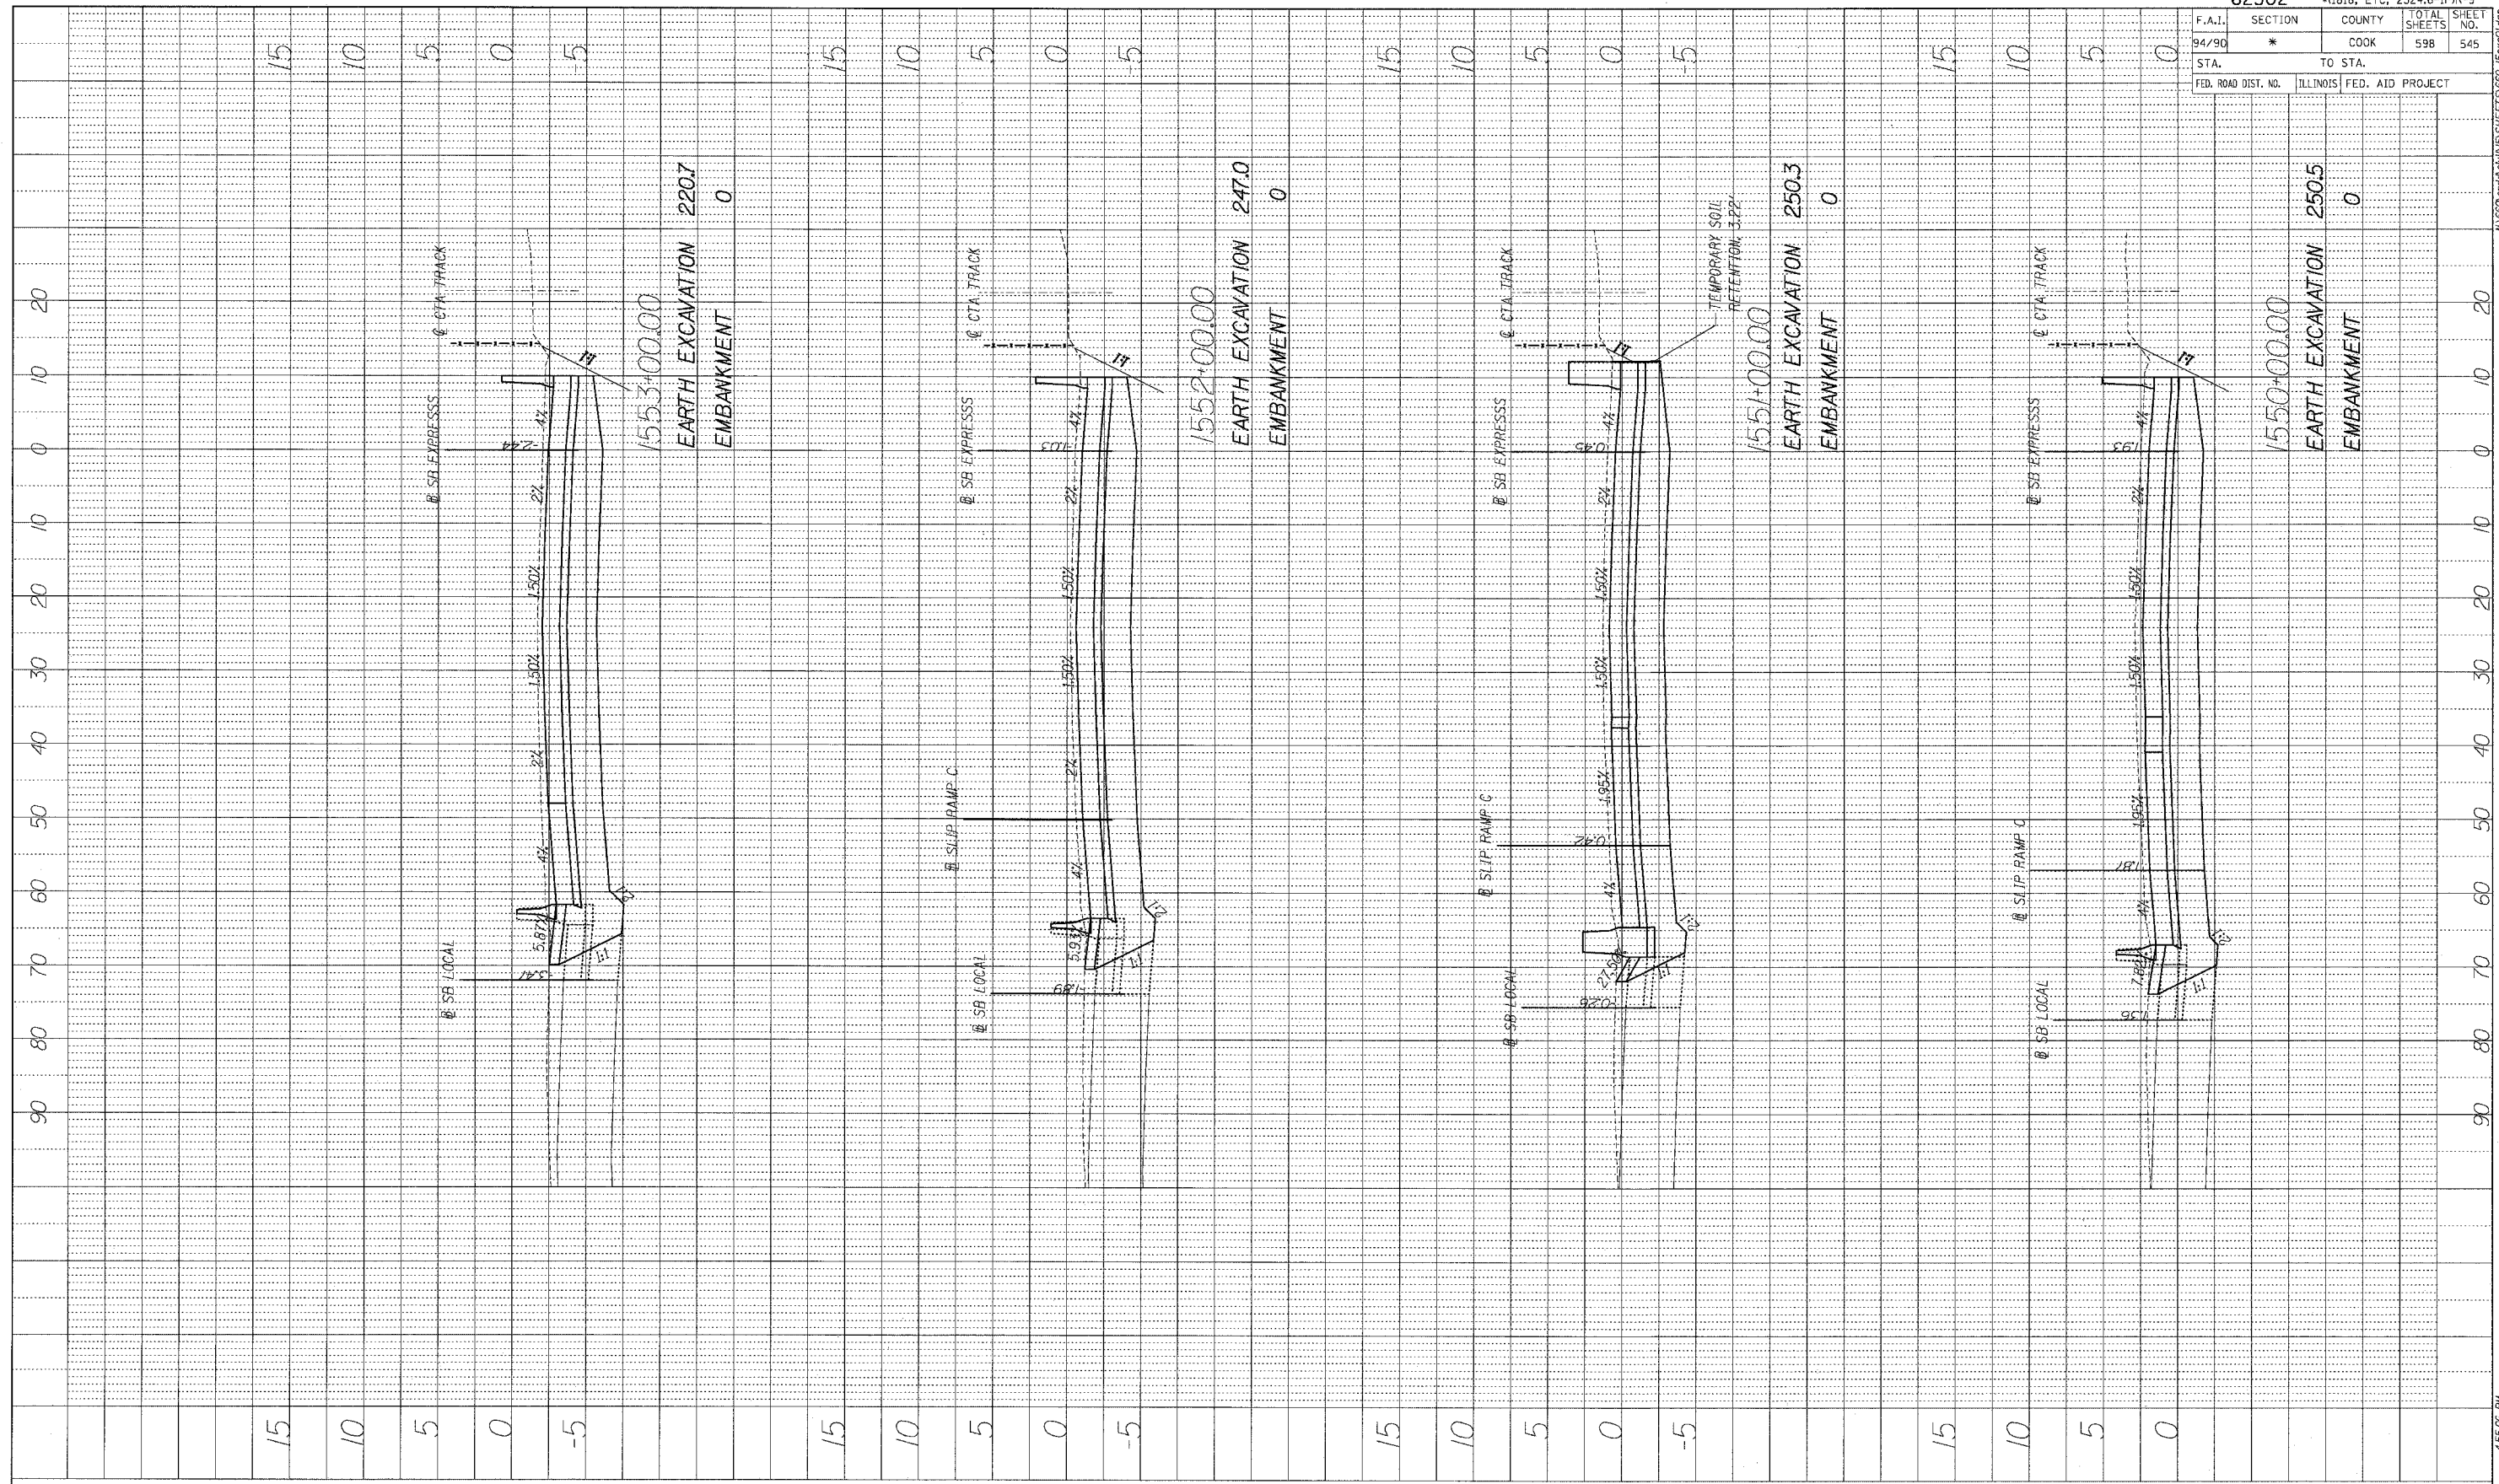

1553+00.00
 EARTH EXCAVATION 220.7
 EMBANKMENT 0



1552+00.00
 EARTH EXCAVATION 247.0
 EMBANKMENT 0

1551+00.00
 EARTH EXCAVATION 250.3
 EMBANKMENT 0

1550+00.00
 EARTH EXCAVATION 250.5
 EMBANKMENT 0

62302		* (1818, ETC, 2324.6-1PR-9	
F.A.I.	SECTION	COUNTY	TOTAL SHEETS
94/90	*	COOK	598
STA.	TO STA.		
FED. ROAD DIST. NO.	ILLINOIS	FED. AID PROJECT	


BOWMAN, BARRETT & ASSOCIATES INC.
 CONSULTING ENGINEERS
 Chicago, Illinois
 312.228.0100
 www.bbainc.com

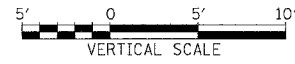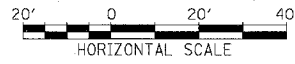


STA.+.. TO STA.+..

F.A.I.	SECTION	COUNTY	TOTAL SHEETS	SHEET NO.
94/90	*	COOK	598	546
STA.		TO STA.		
FED. ROAD DIST. NO.	ILLINOIS	FED. AID PROJECT		

PROFILE	SURVEYED	BY	DATE
	PLOTTED		
	CHECKED		
	REVISION		
	NO.		

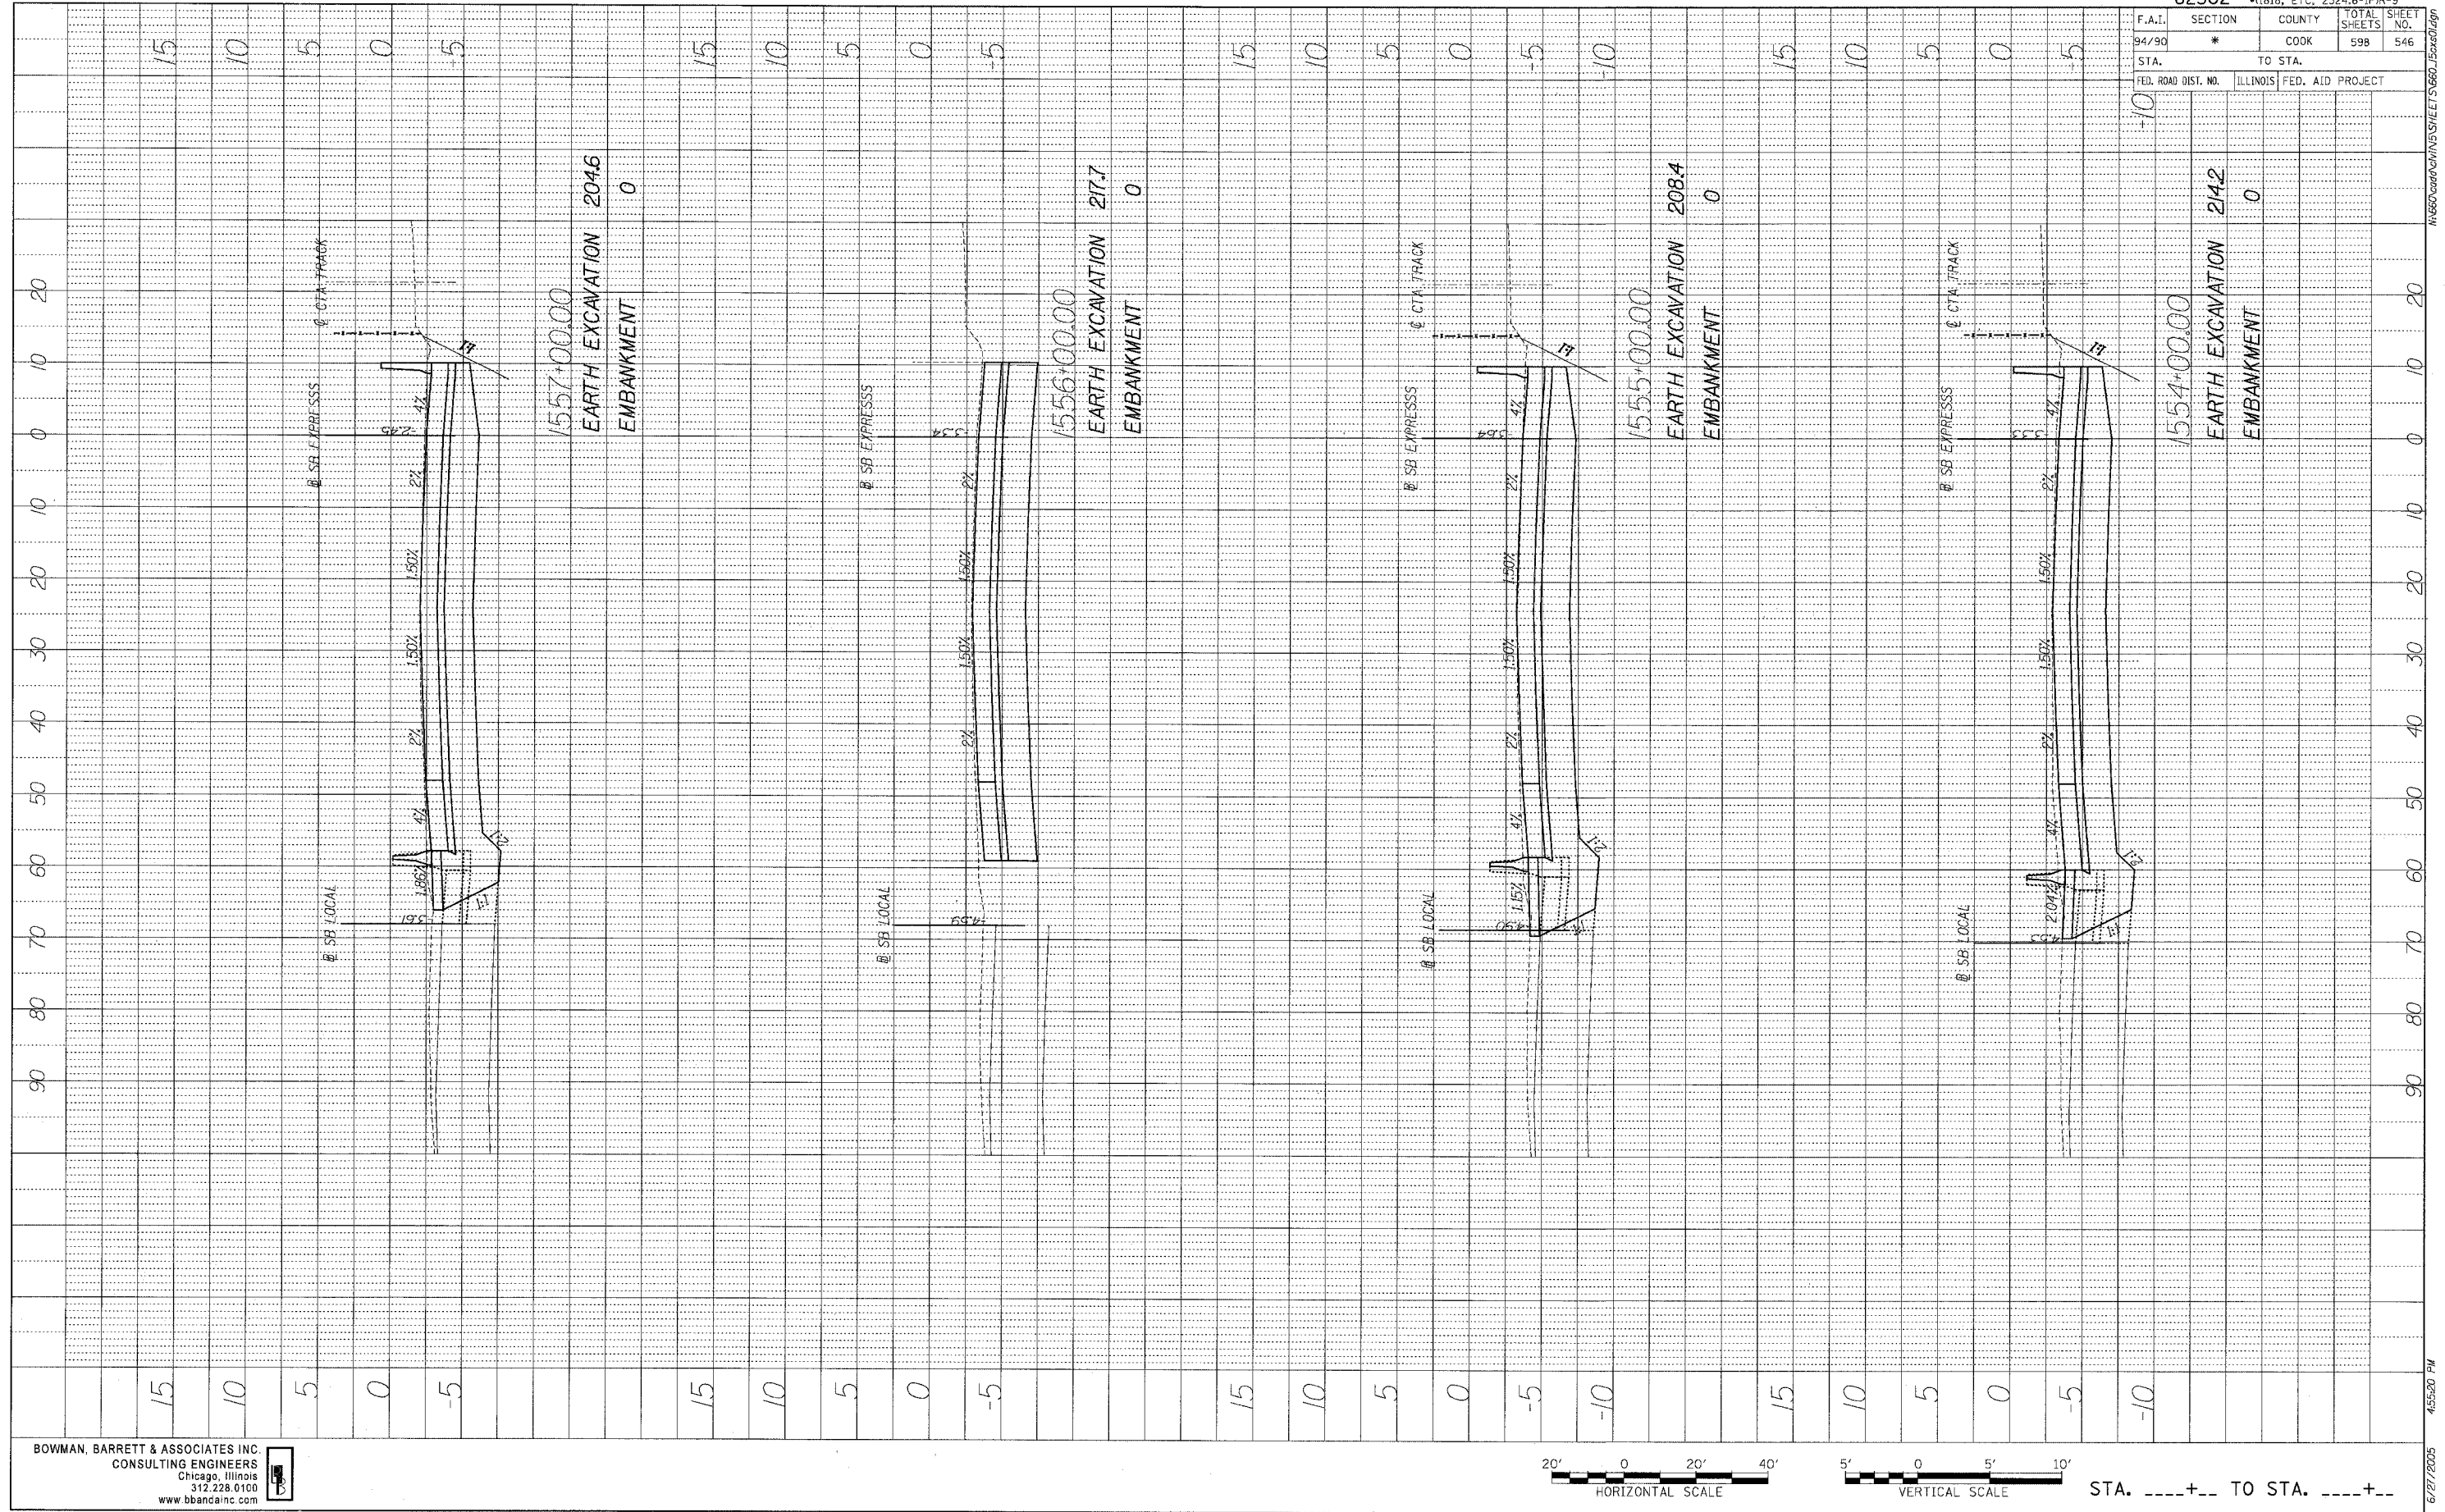


BOWMAN, BARRETT & ASSOCIATES INC.
 CONSULTING ENGINEERS
 Chicago, Illinois
 312.228.6100
 www.bbancinc.com

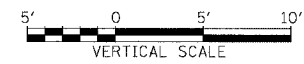


STA.+... TO STA.+...

PROFILE REVISIONS
 GRADES CHECKED
 STRUCTURE NO. / DATE
 NO. / DATE

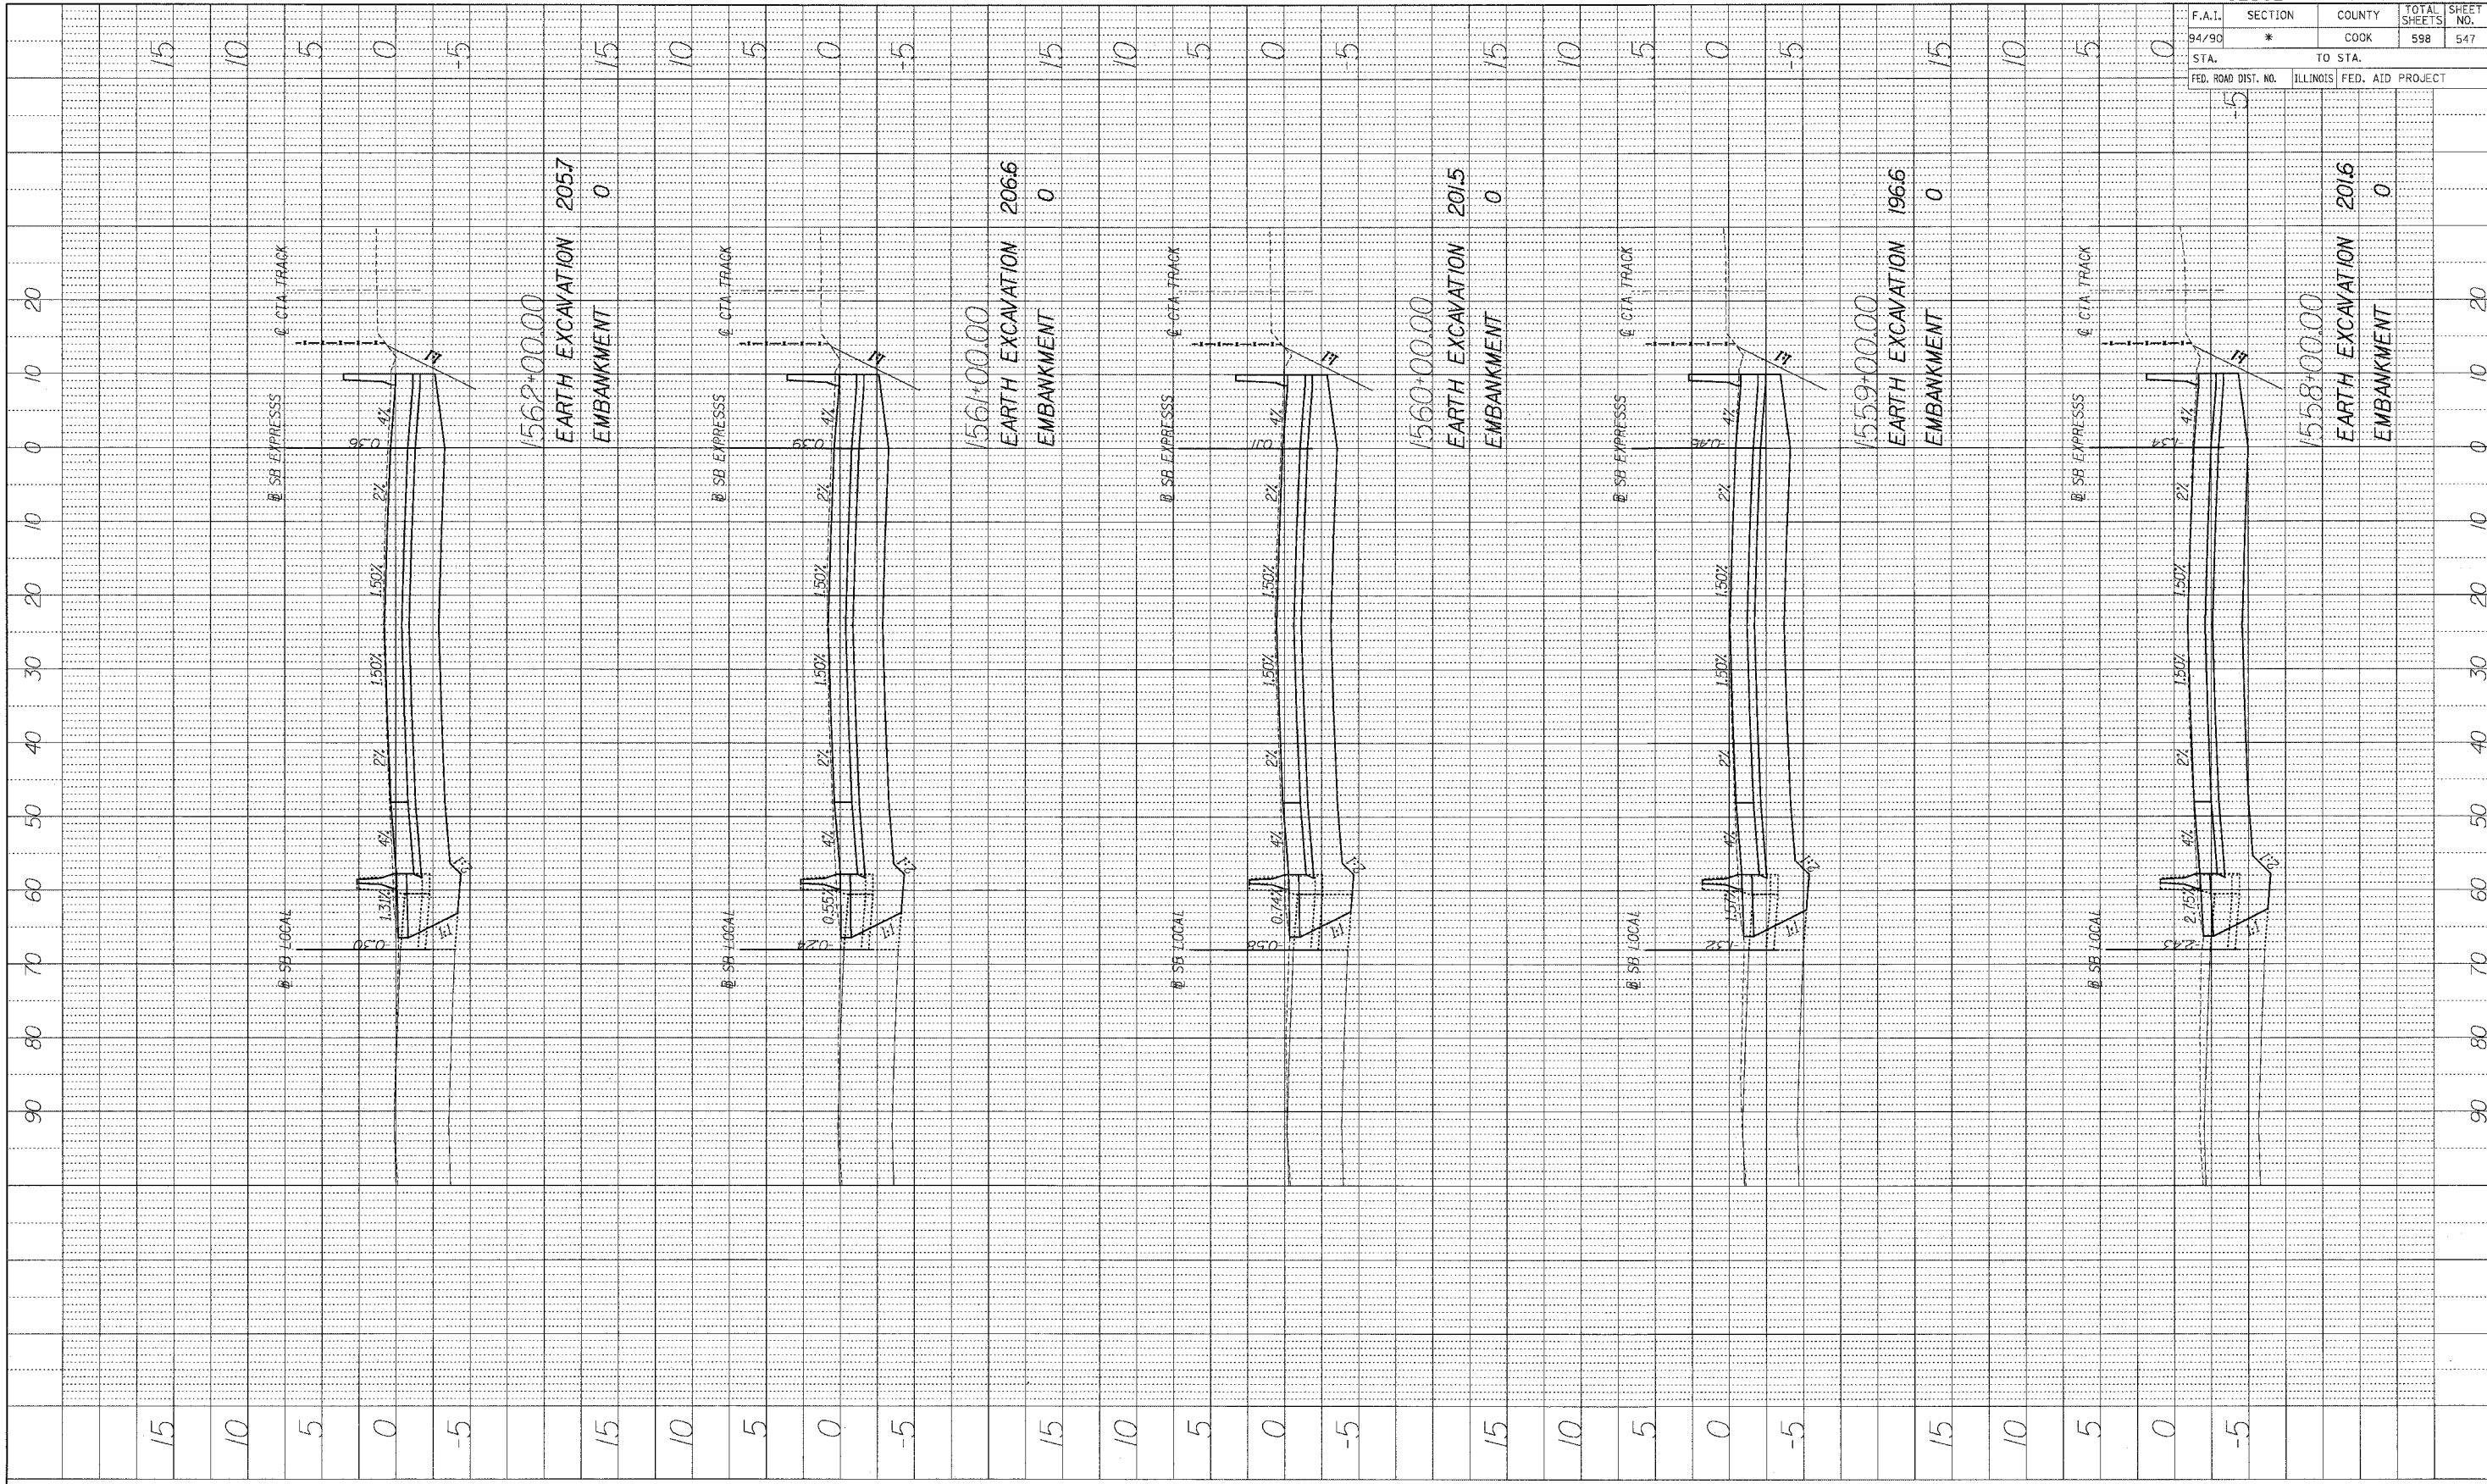

62302		*1818, ETC., 2324.6-1PIR-9	
F.A.I.	SECTION	COUNTY	TOTAL SHEETS
94/90	*	COOK	598
NO.			547
STA.		TO STA.	
FED. ROAD DIST. NO.	ILLINOIS	FED. AID PROJECT	


BOWMAN, BARRETT & ASSOCIATES INC
 CONSULTING ENGINEERS
 Chicago, Illinois
 312.228.9100
 www.bbancinc.com

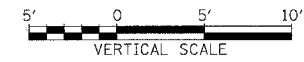

STA.+... TO STA.+...


4655.50 PM 6/27/2005

PROFILE	DESIGNED	BY	DATE
NOTE BOOK	PLOTTED		
NO.	NO.		
	STRUCTURE NOTATION	CPWD	

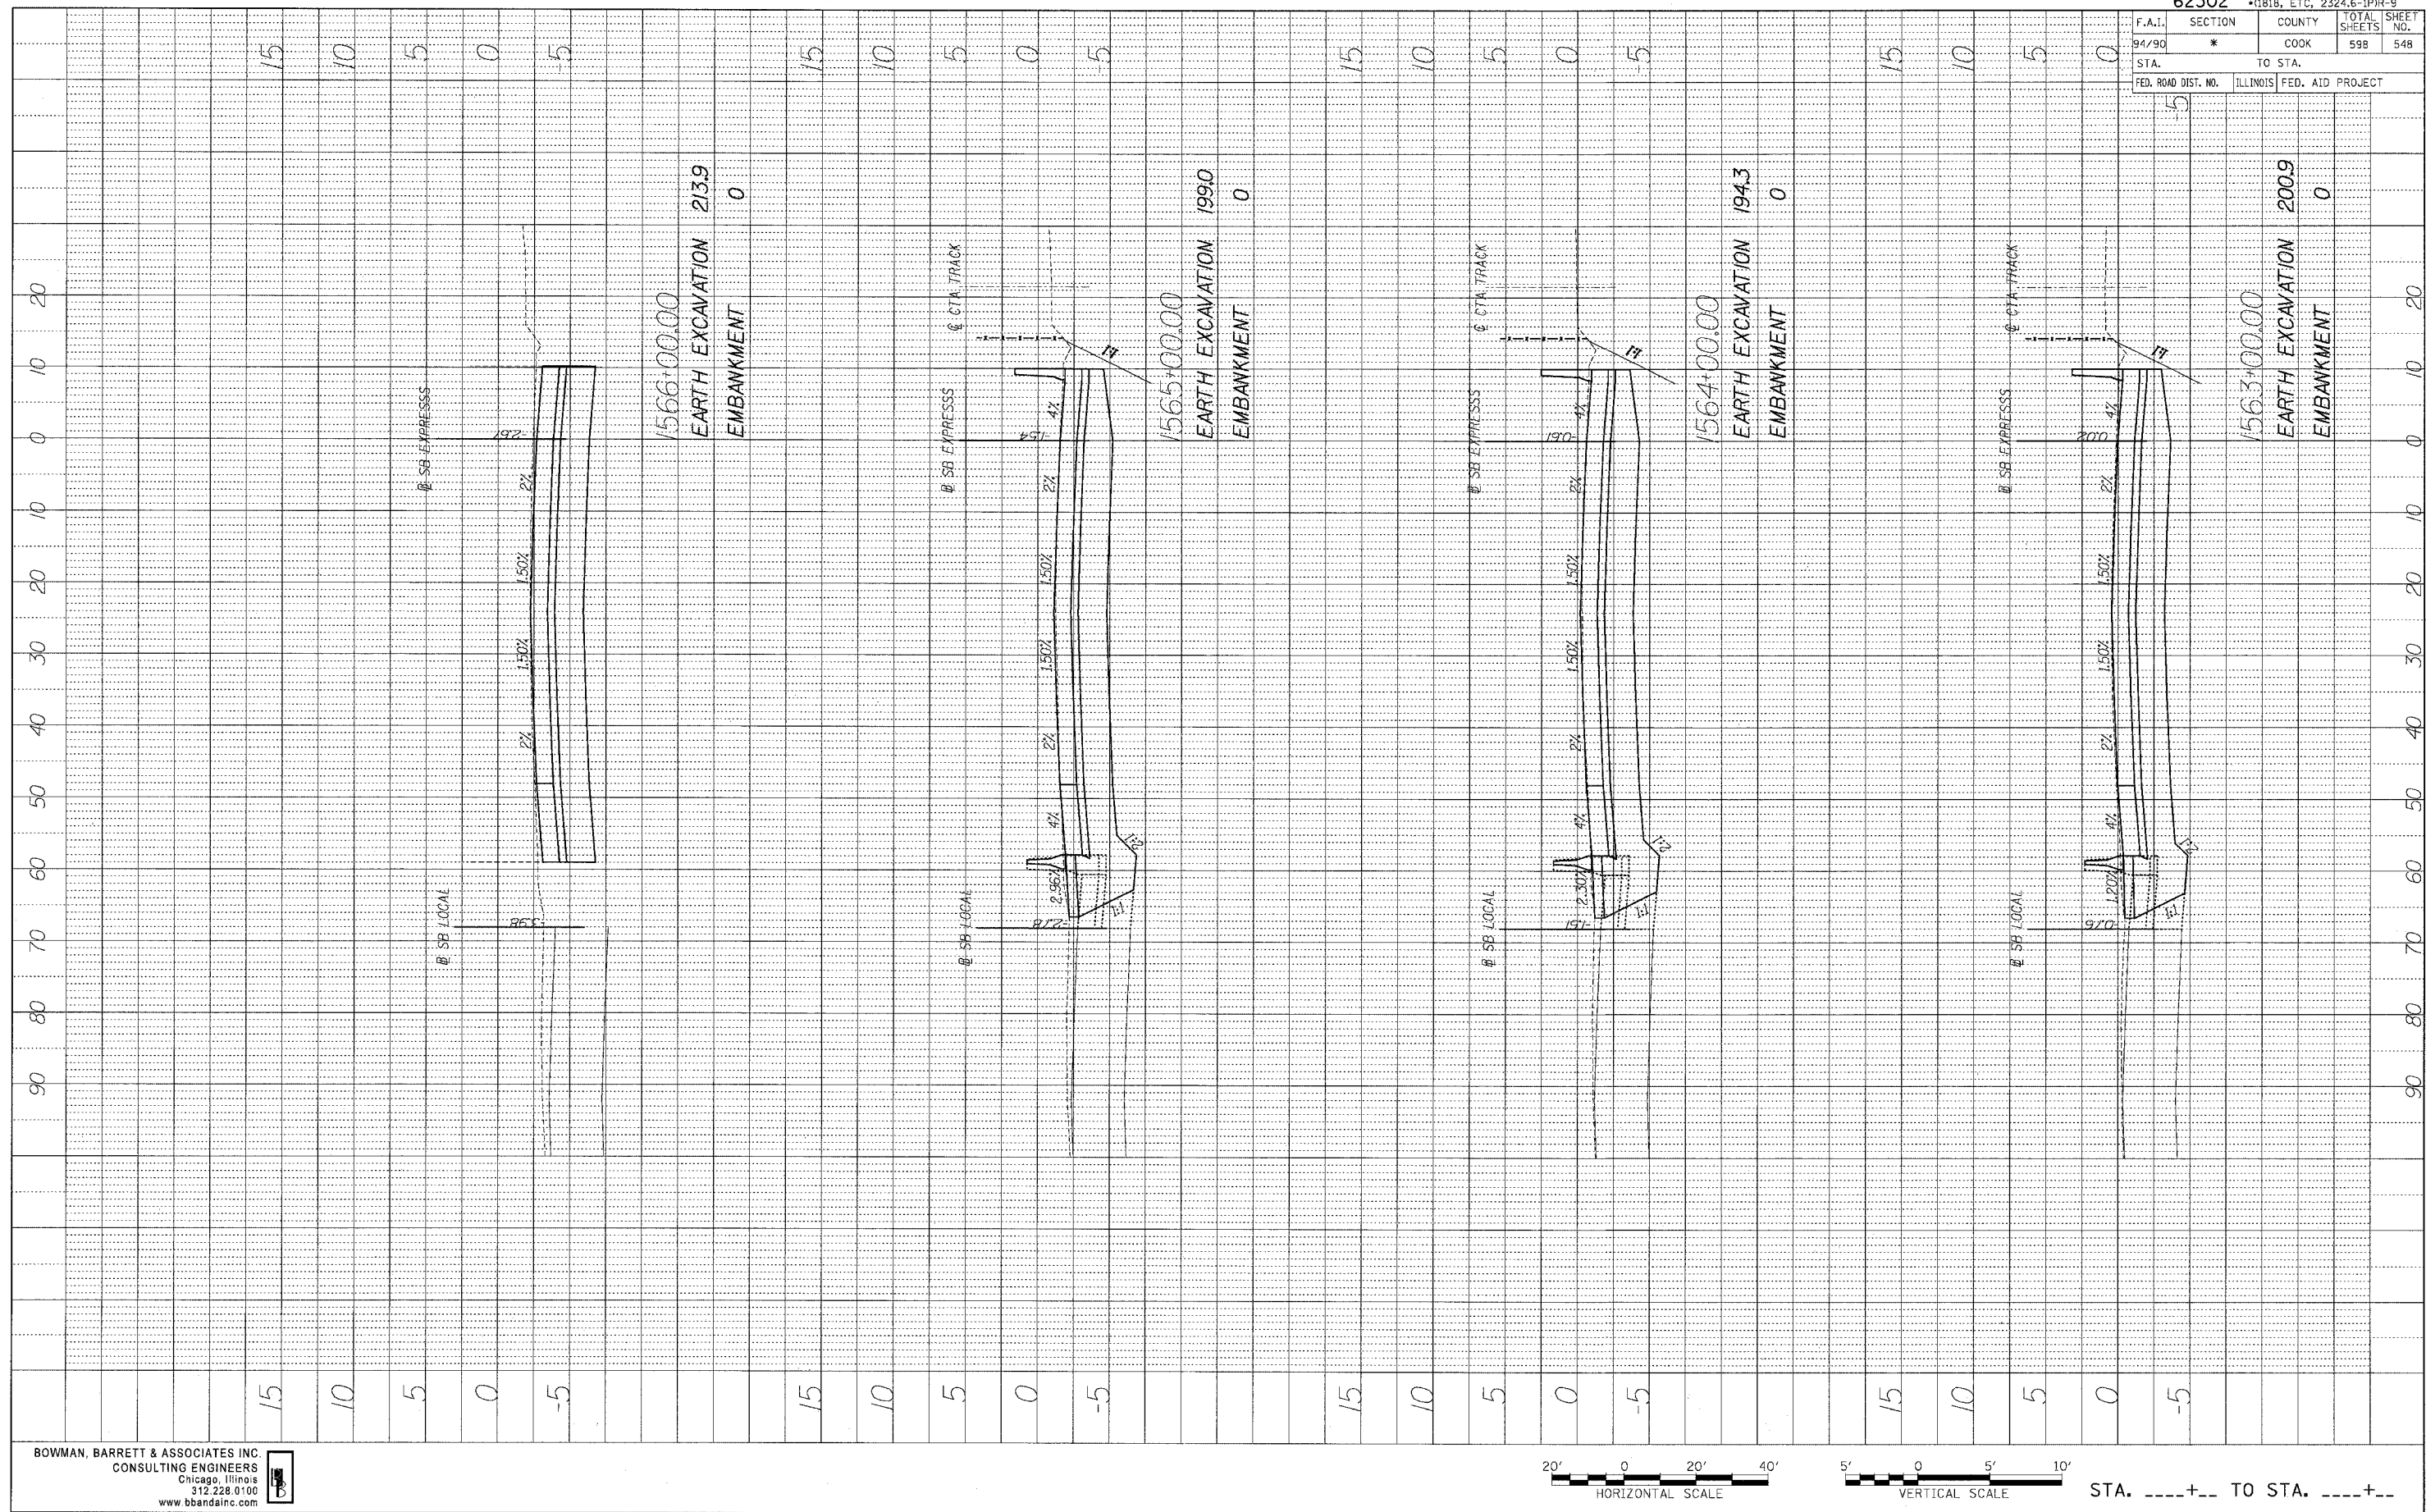

62302 • 1818, ETC, 2324.6-IPR-9				
F.A.I.	SECTION	COUNTY	TOTAL SHEETS	SHEET NO.
94/90	*	COOK	598	548
STA.		TO STA.		
FED. ROAD DIST. NO.	ILLINOIS	FED. AID PROJECT		

BOWMAN, BARRETT & ASSOCIATES INC.
CONSULTING ENGINEERS
Chicago, Illinois
312.228.0100
www.bbainc.com

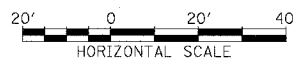


STA. ----+-- TO STA. ----+--

6/27/2005 4:55:43 PM

F.A.I.	SECTION	COUNTY	TOTAL SHEETS	SHEET NO.
94/90	*	COOK	598	549
STA.		TO STA.		
FED. ROAD DIST. NO.	ILLINOIS	FED. AID PROJECT		

PROFILE SURVEYED	BY	DATE
PLOTTED		
NOTE BOOK		
NO.		
STRUCTURE NOTATION: CPKD		


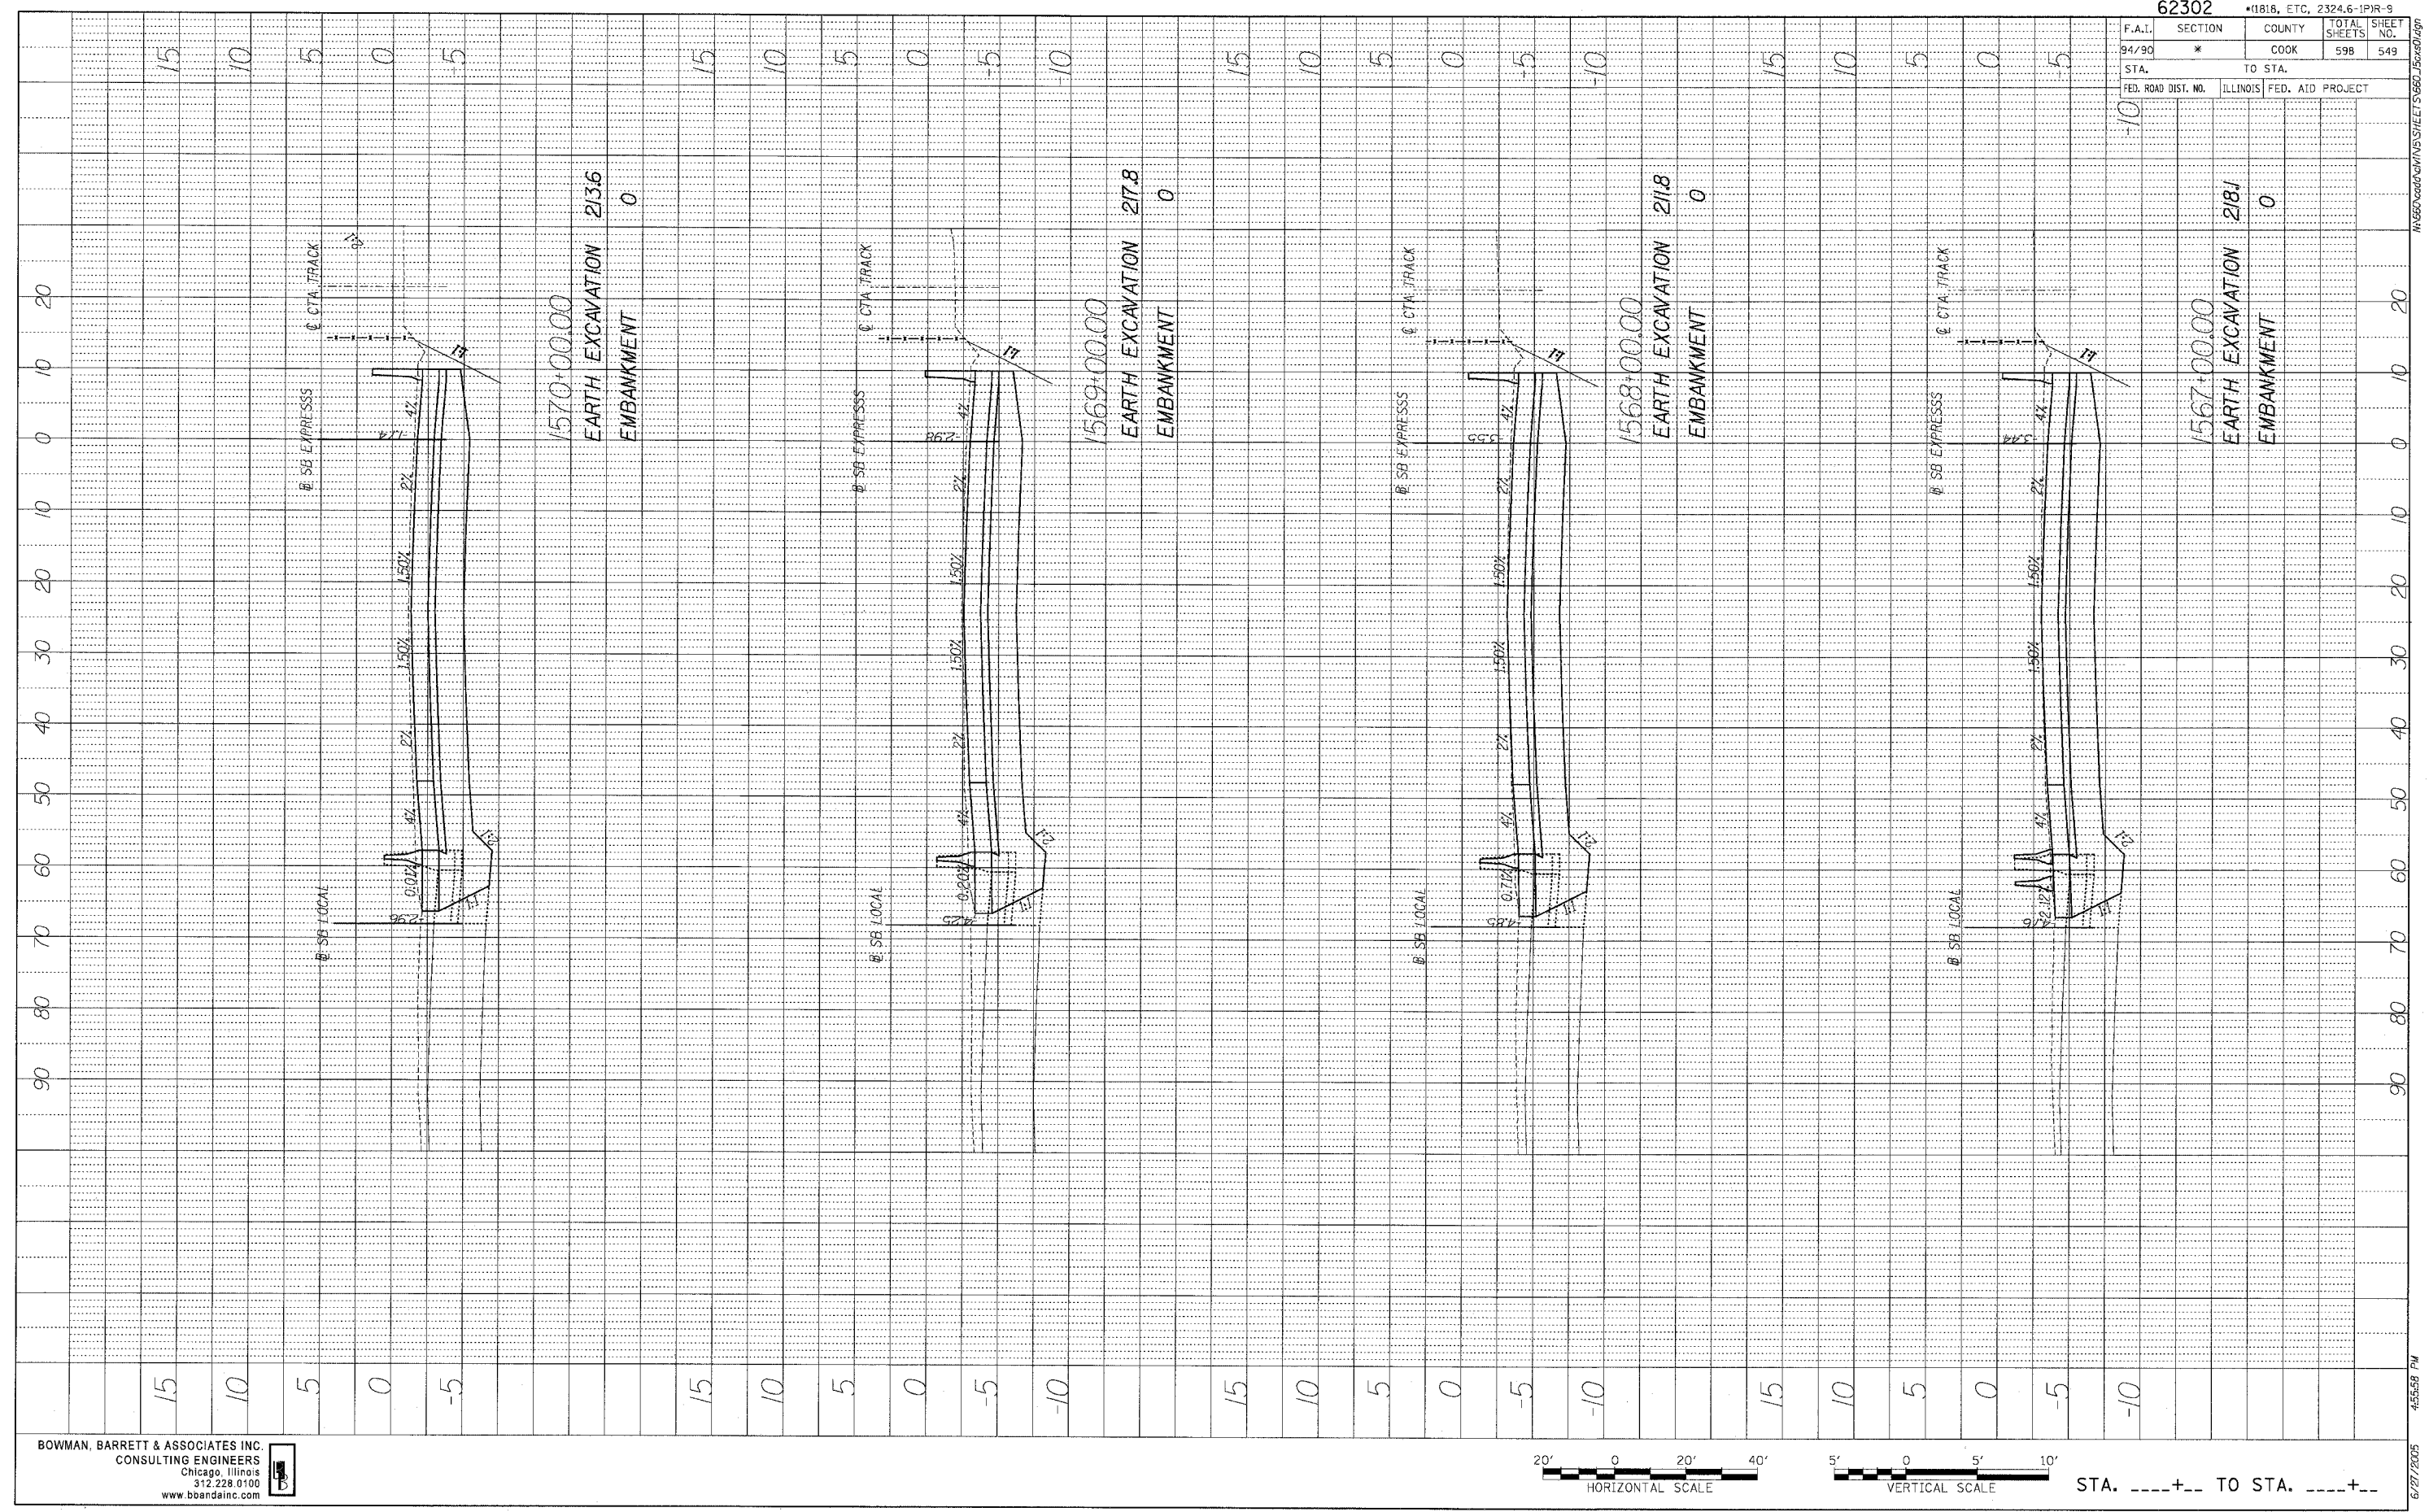


1570+00.00
EARTH EXCAVATION 2136
EMBANKMENT 0

1569+00.00
EARTH EXCAVATION 217.8
EMBANKMENT 0


1568+00.00
EARTH EXCAVATION 211.8
EMBANKMENT 0

1567+00.00
EARTH EXCAVATION 218.1
EMBANKMENT 0

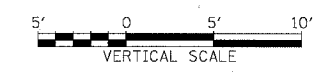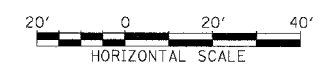



STA. ----+-- TO STA. ----+--

PROFILE SHEET
 DRAWING NO. _____ DATE _____
 CHECKED BY _____
 NOTE BOOK NO. _____
 STRUCTURE NO. _____
 DRAWING NO. _____

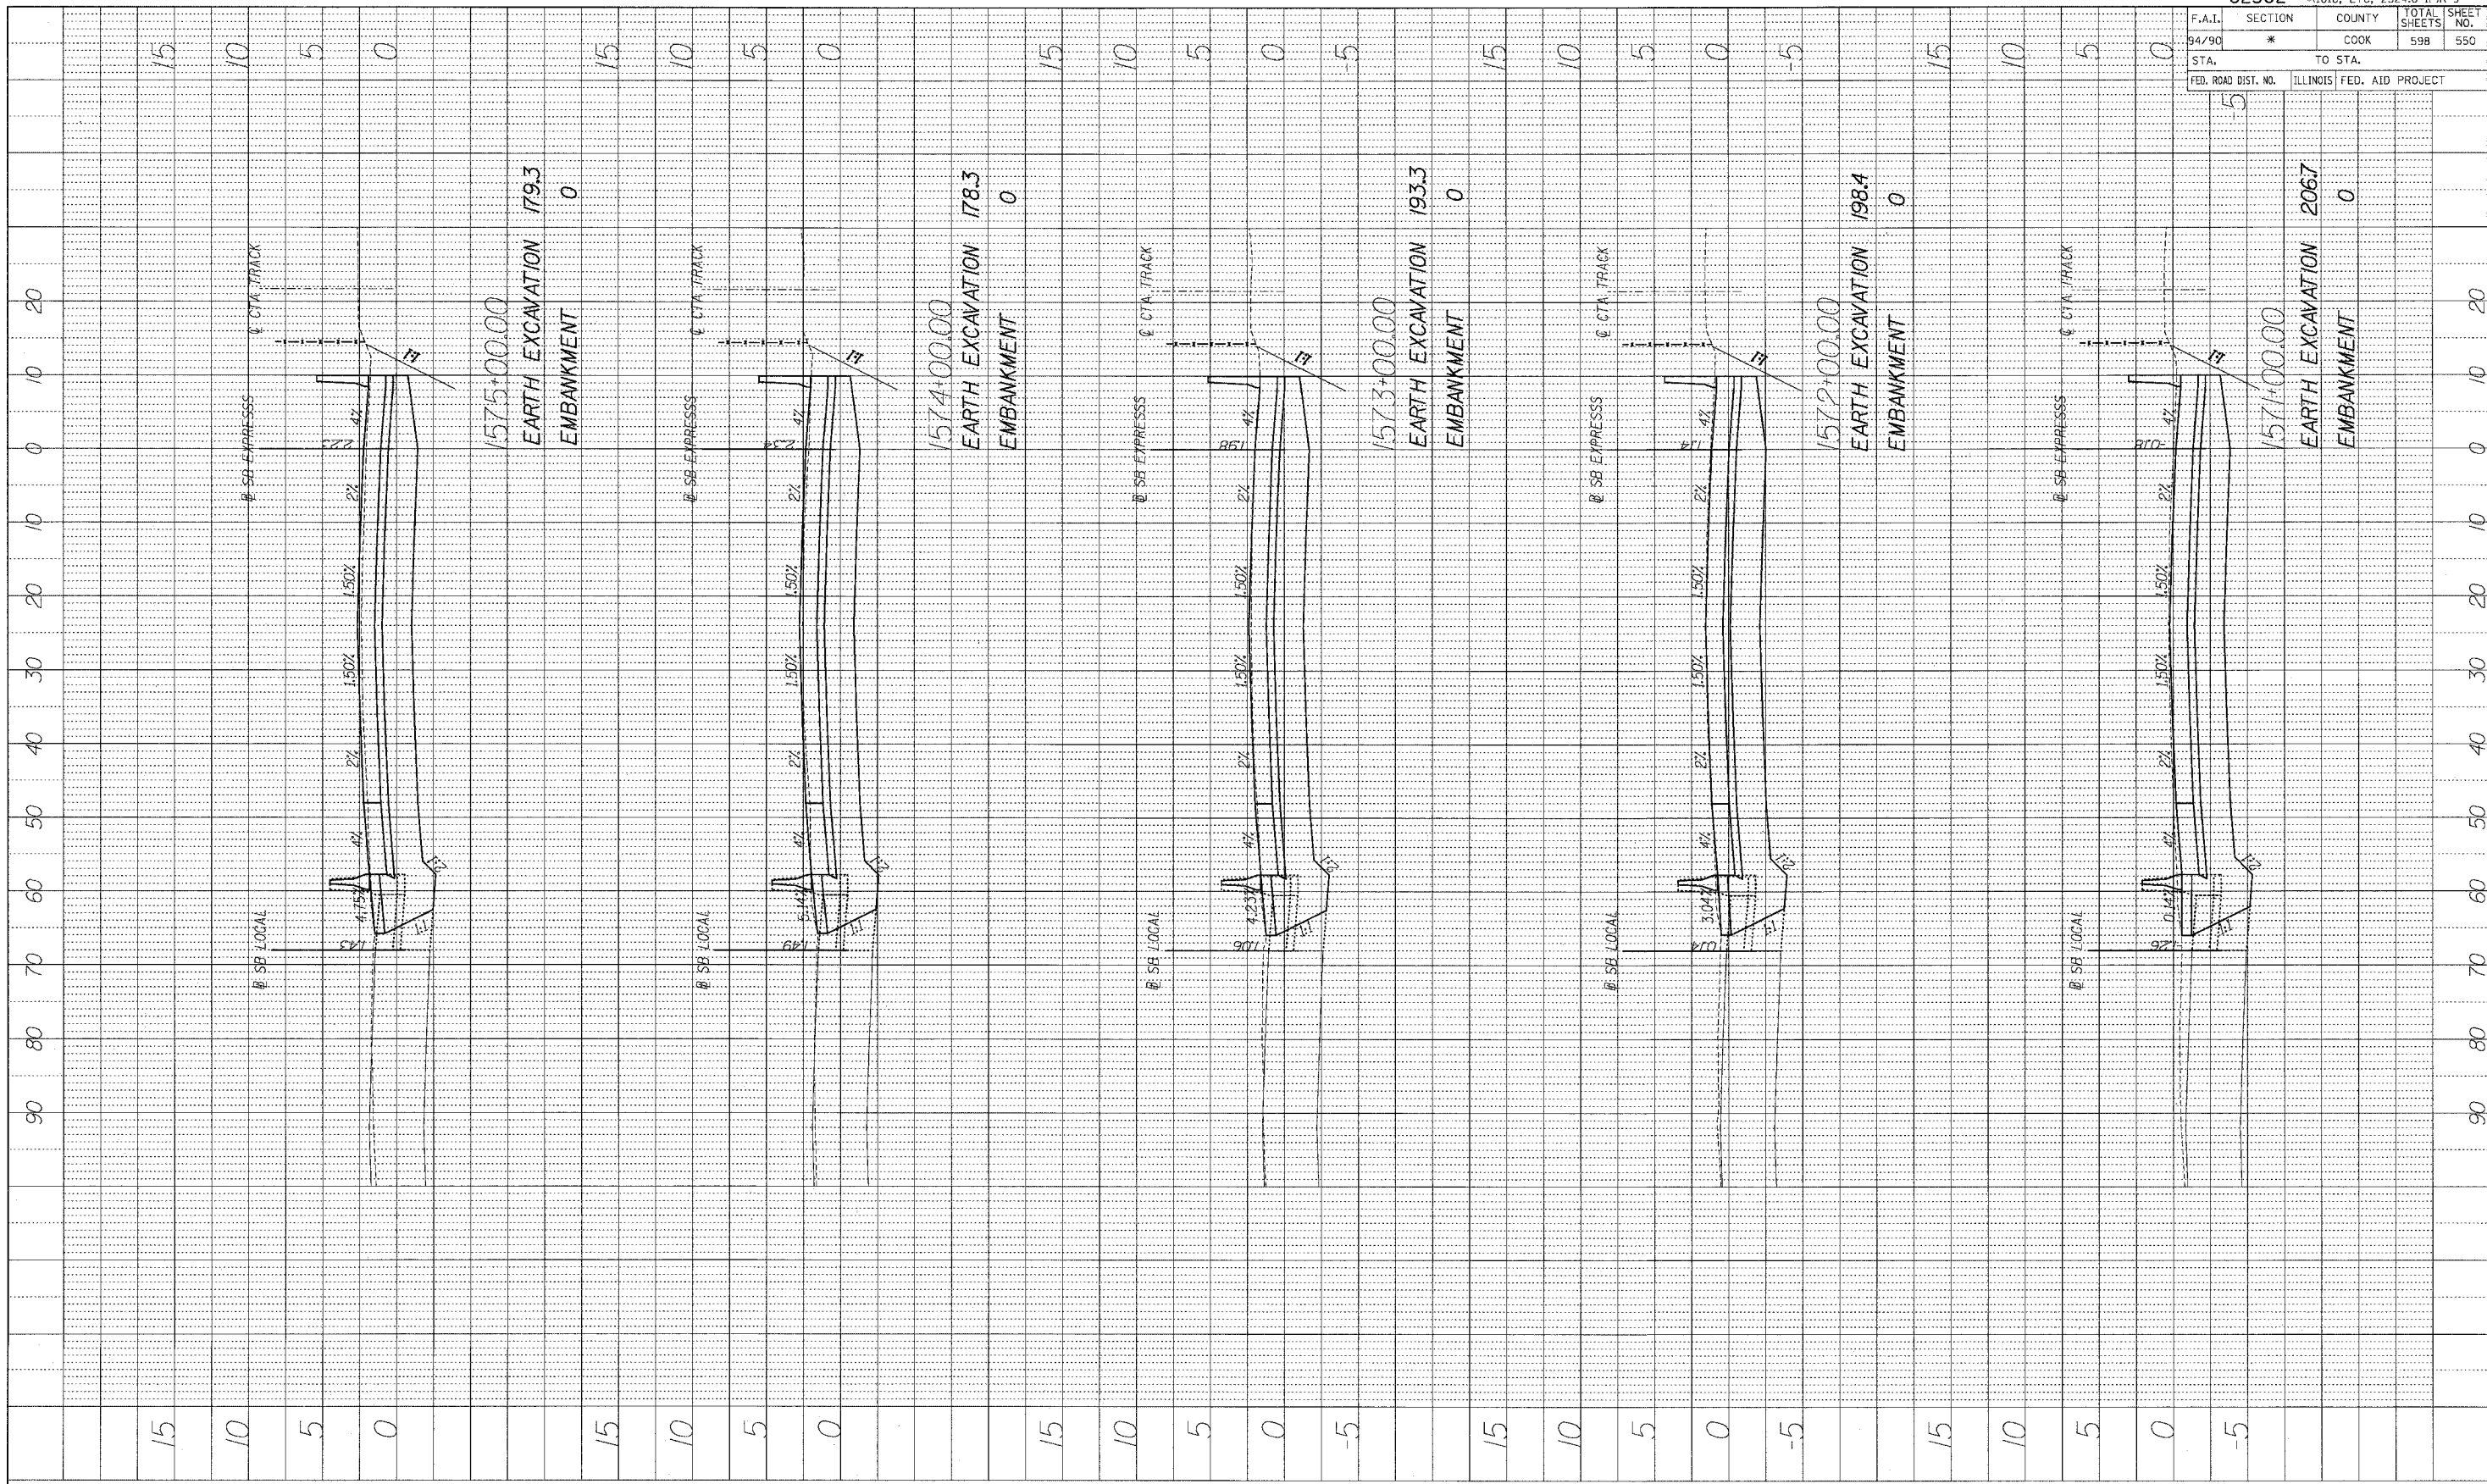

62302		*1818, ETC, 2324.6-1PR-9	
F.A.I.	SECTION	COUNTY	TOTAL SHEETS
94/90	*	COOK	598
STA.	TO STA.		SHEET NO.
			550
FED. ROAD DIST. NO.	ILLINOIS	FED. AID PROJECT	


BOWMAN, BARRETT & ASSOCIATES INC.
 CONSULTING ENGINEERS
 Chicago, Illinois
 312.228.0100
 www.bbainc.com

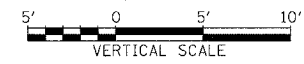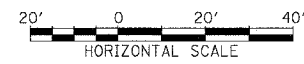

STA.+.. TO STA.+..



4:56:09 PM 6/27/2005

PROFILE
 DRAWN BY _____ DATE _____
 CHECKED BY _____
 PLANNED BY _____
 GRADES CHECKER _____
 NOTE BOOK NO. _____
 STRUCTURE NOTATIONS QPND

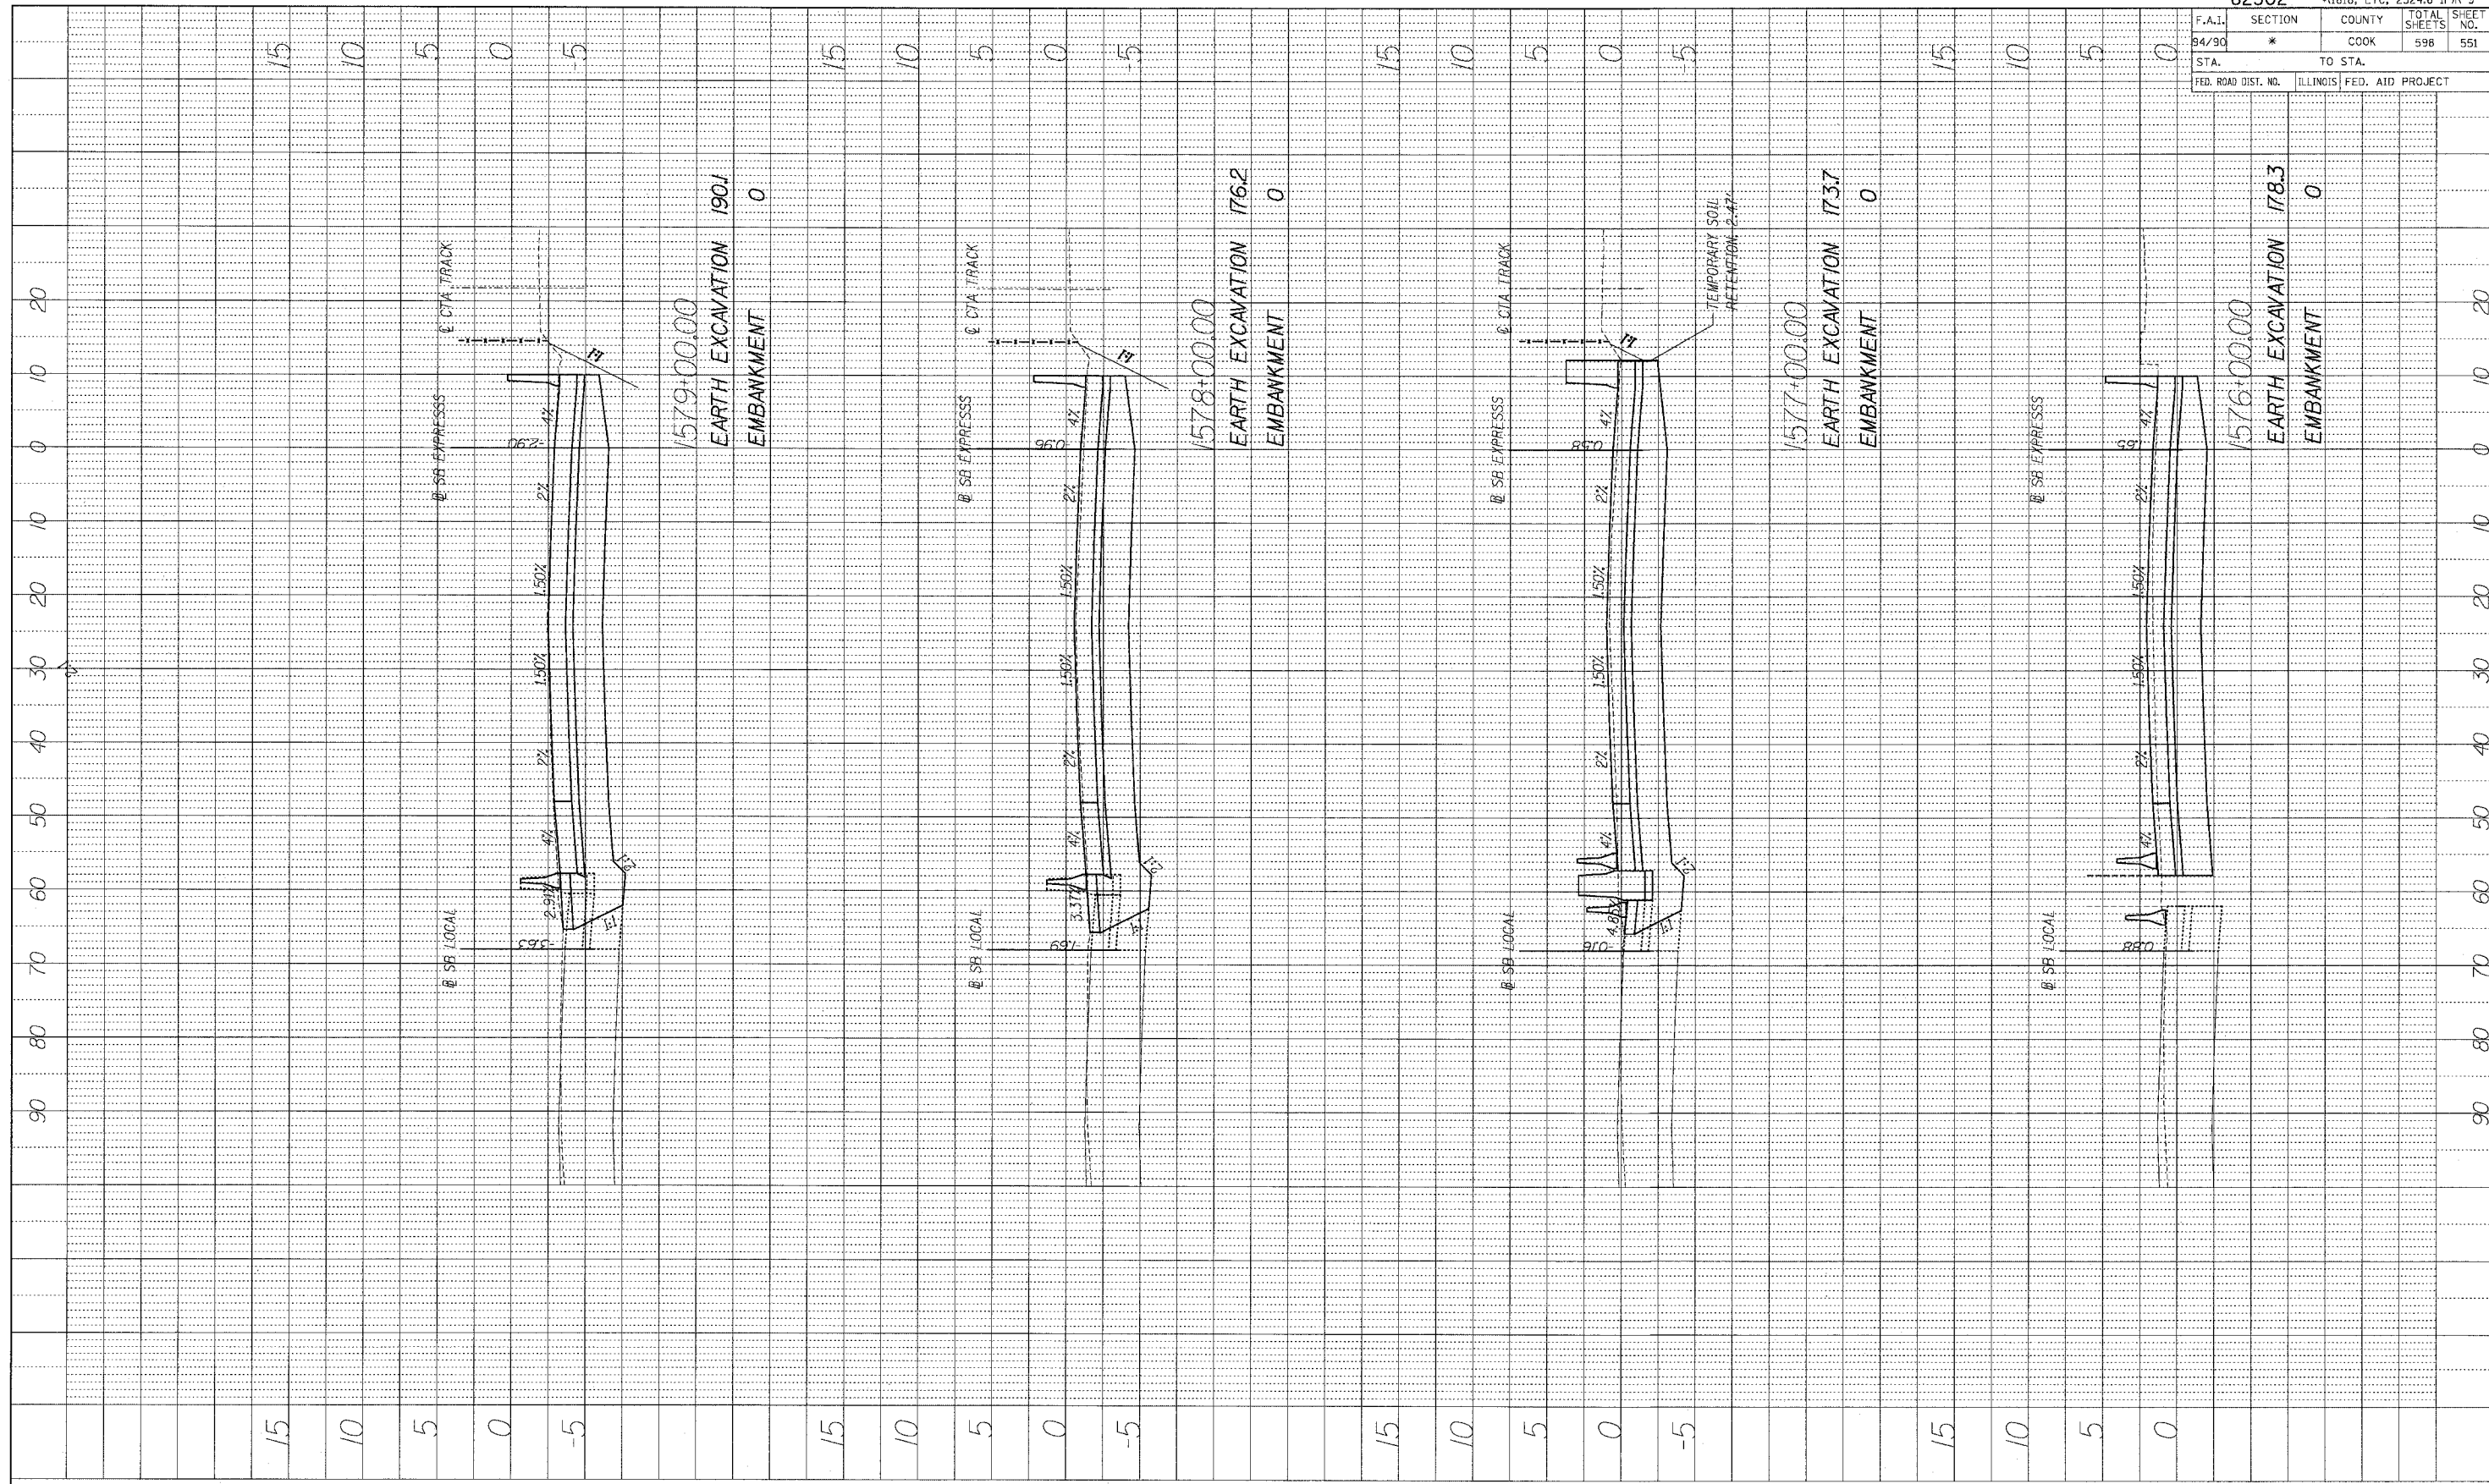

62302		•(1818, ETC. 2324.6-IPR-9	
F.A.I.	SECTION	COUNTY	TOTAL SHEETS
94/90	*	COOK	598
STA.	TO STA.		
FED. ROAD DIST. NO.	ILLINOIS	FED. AID PROJECT	

BOWMAN, BARRETT & ASSOCIATES INC
 CONSULTING ENGINEERS
 Chicago, Illinois
 312.228.9100
 www.bbandainc.com

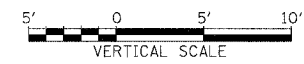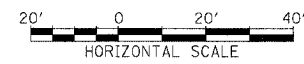


STA.+... TO STA.+...


4:56:27 PM 6/27/2005

F.A.I.	SECTION	COUNTY	TOTAL SHEETS	SHEET NO.
94/90	*	COOK	598	552
STA. _____		TO STA. _____		
FED. ROAD DIST. NO. _____		ILLINOIS FED. AID PROJECT _____		

PROFILE	DATE
DESIGNED BY	
CHECKED BY	
GRADES CHECKED	
STRUCTURE NOTATION CHVD	
NOTE BOOK NO.	

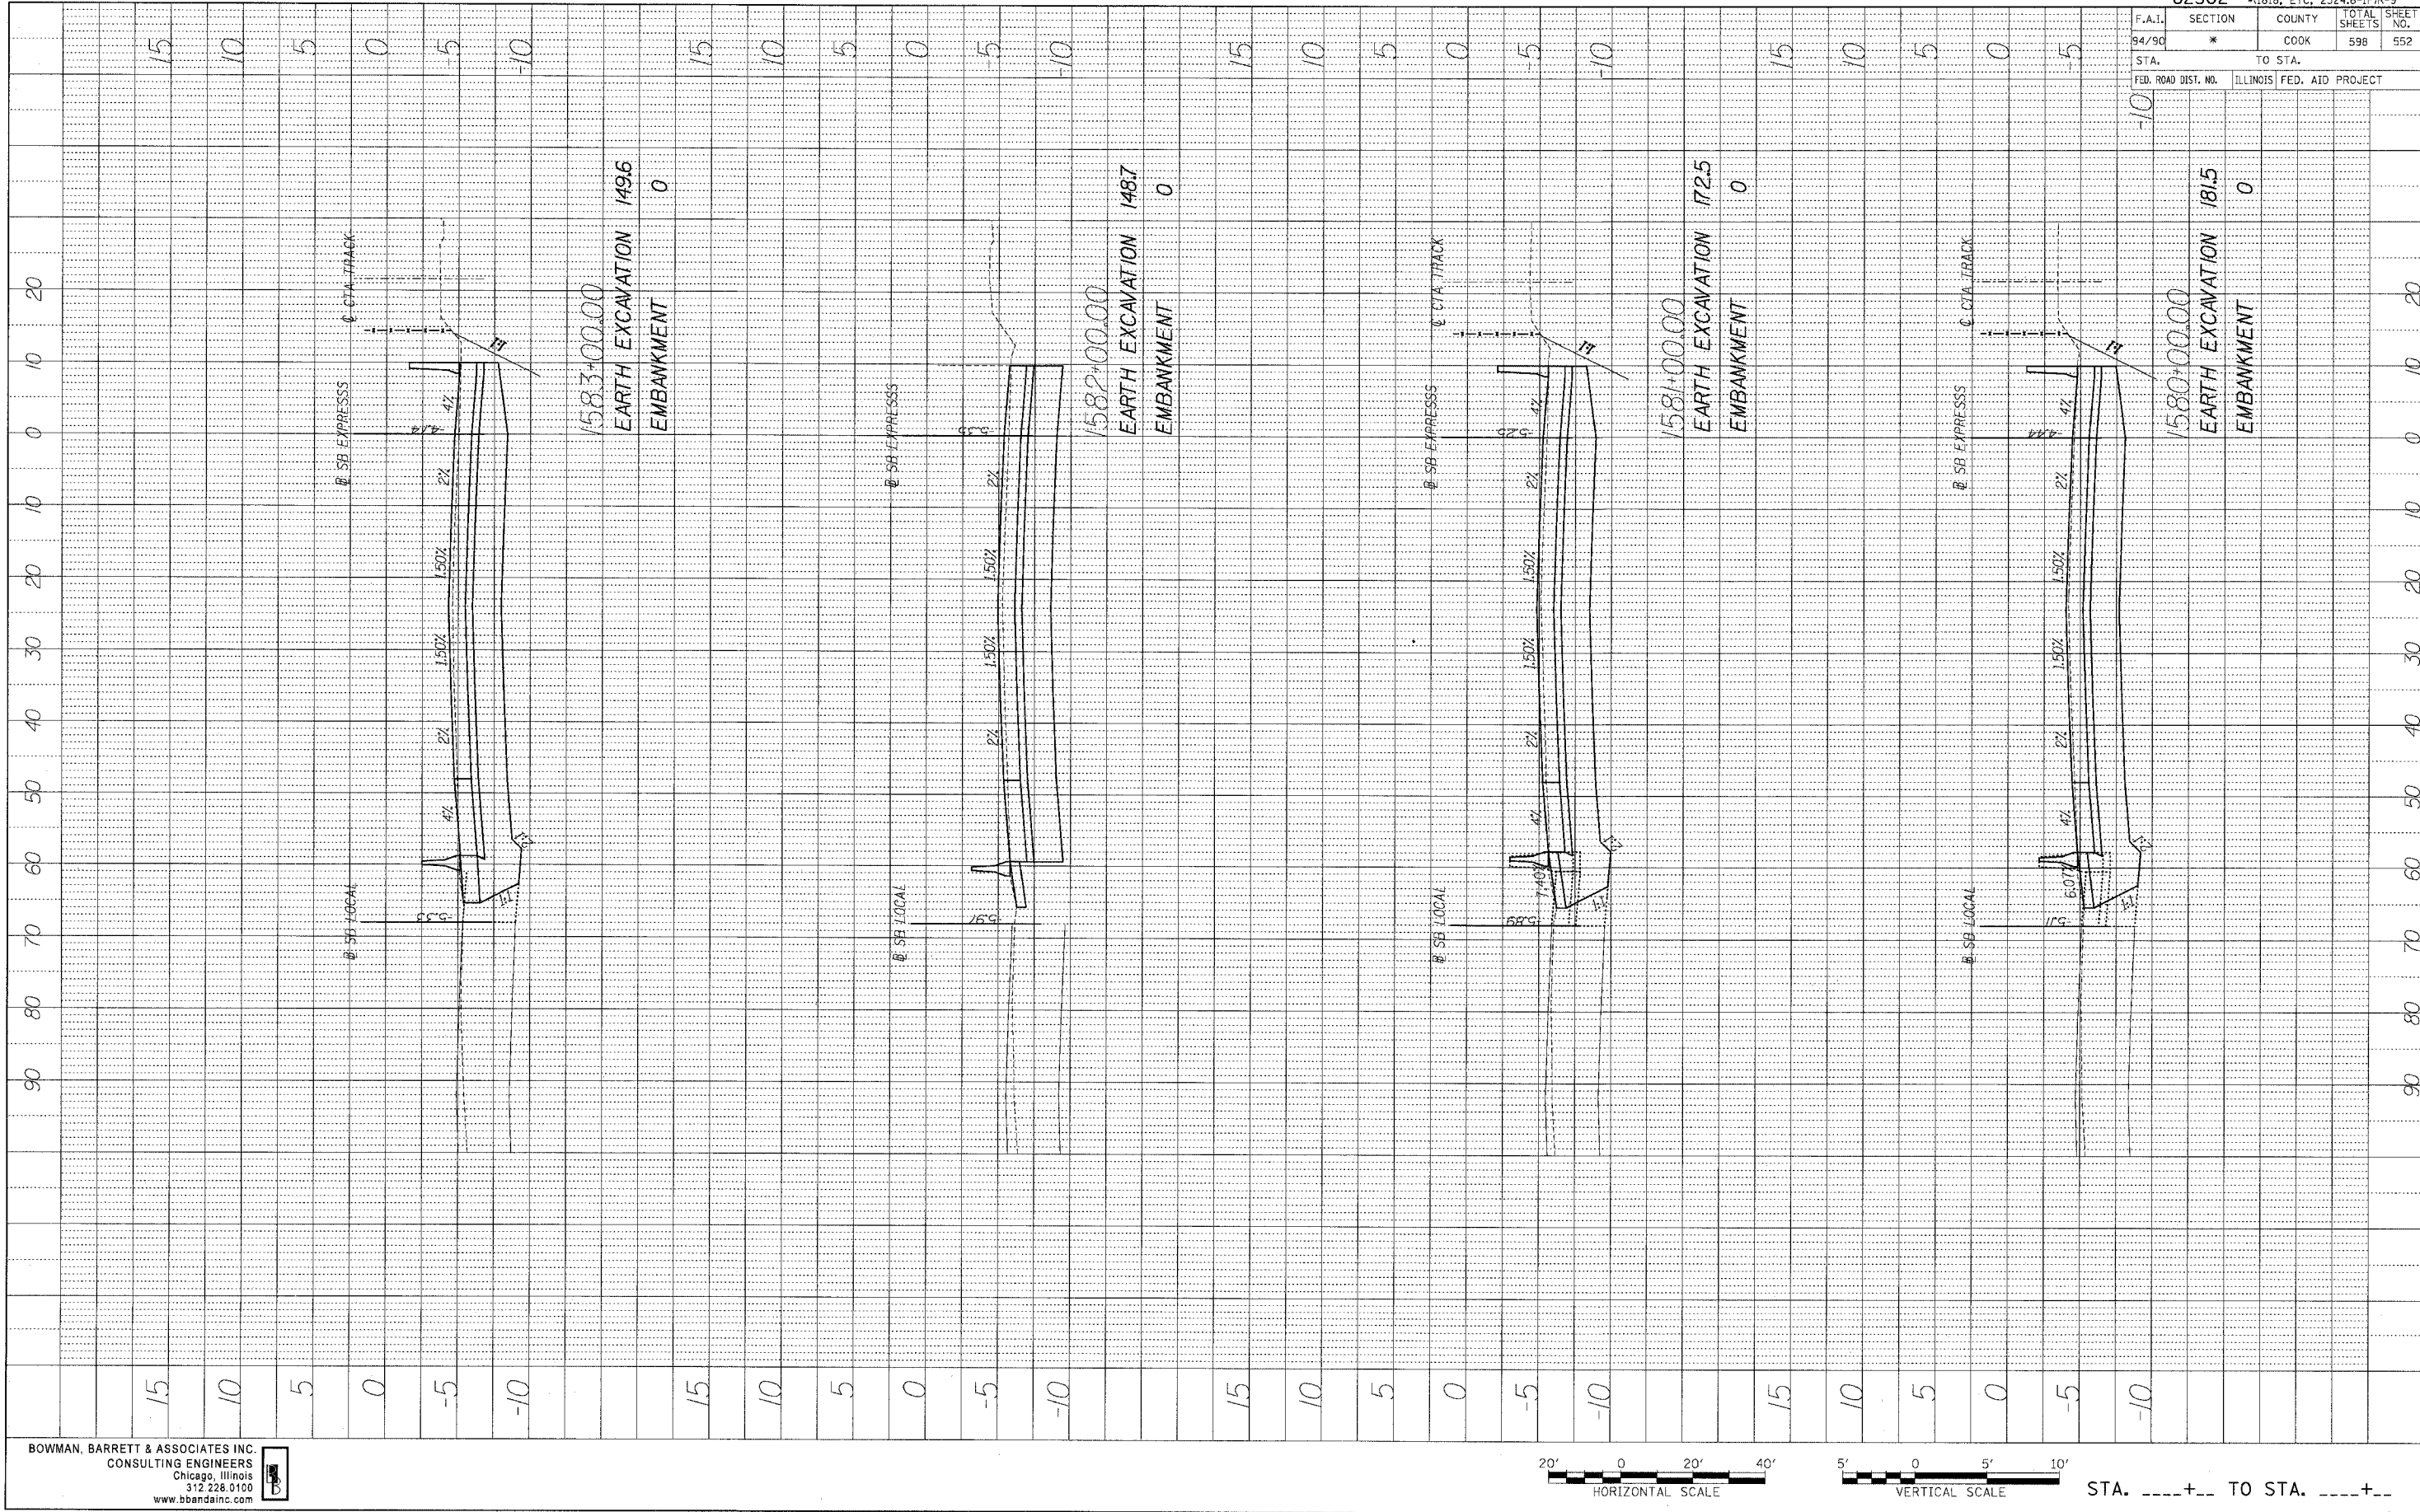


BOWMAN, BARRETT & ASSOCIATES INC.
 CONSULTING ENGINEERS
 Chicago, Illinois
 312.228.5100
 www.bbandainc.com

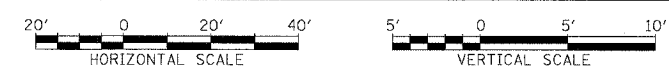

STA.+.. TO STA.+..

PROFILE REVIEWED BY: _____ DATE: _____
 GRADES CHECKED: _____
 NOTE BOOK NO.: _____
 STRUCTURE NOTATIONS OK/NO

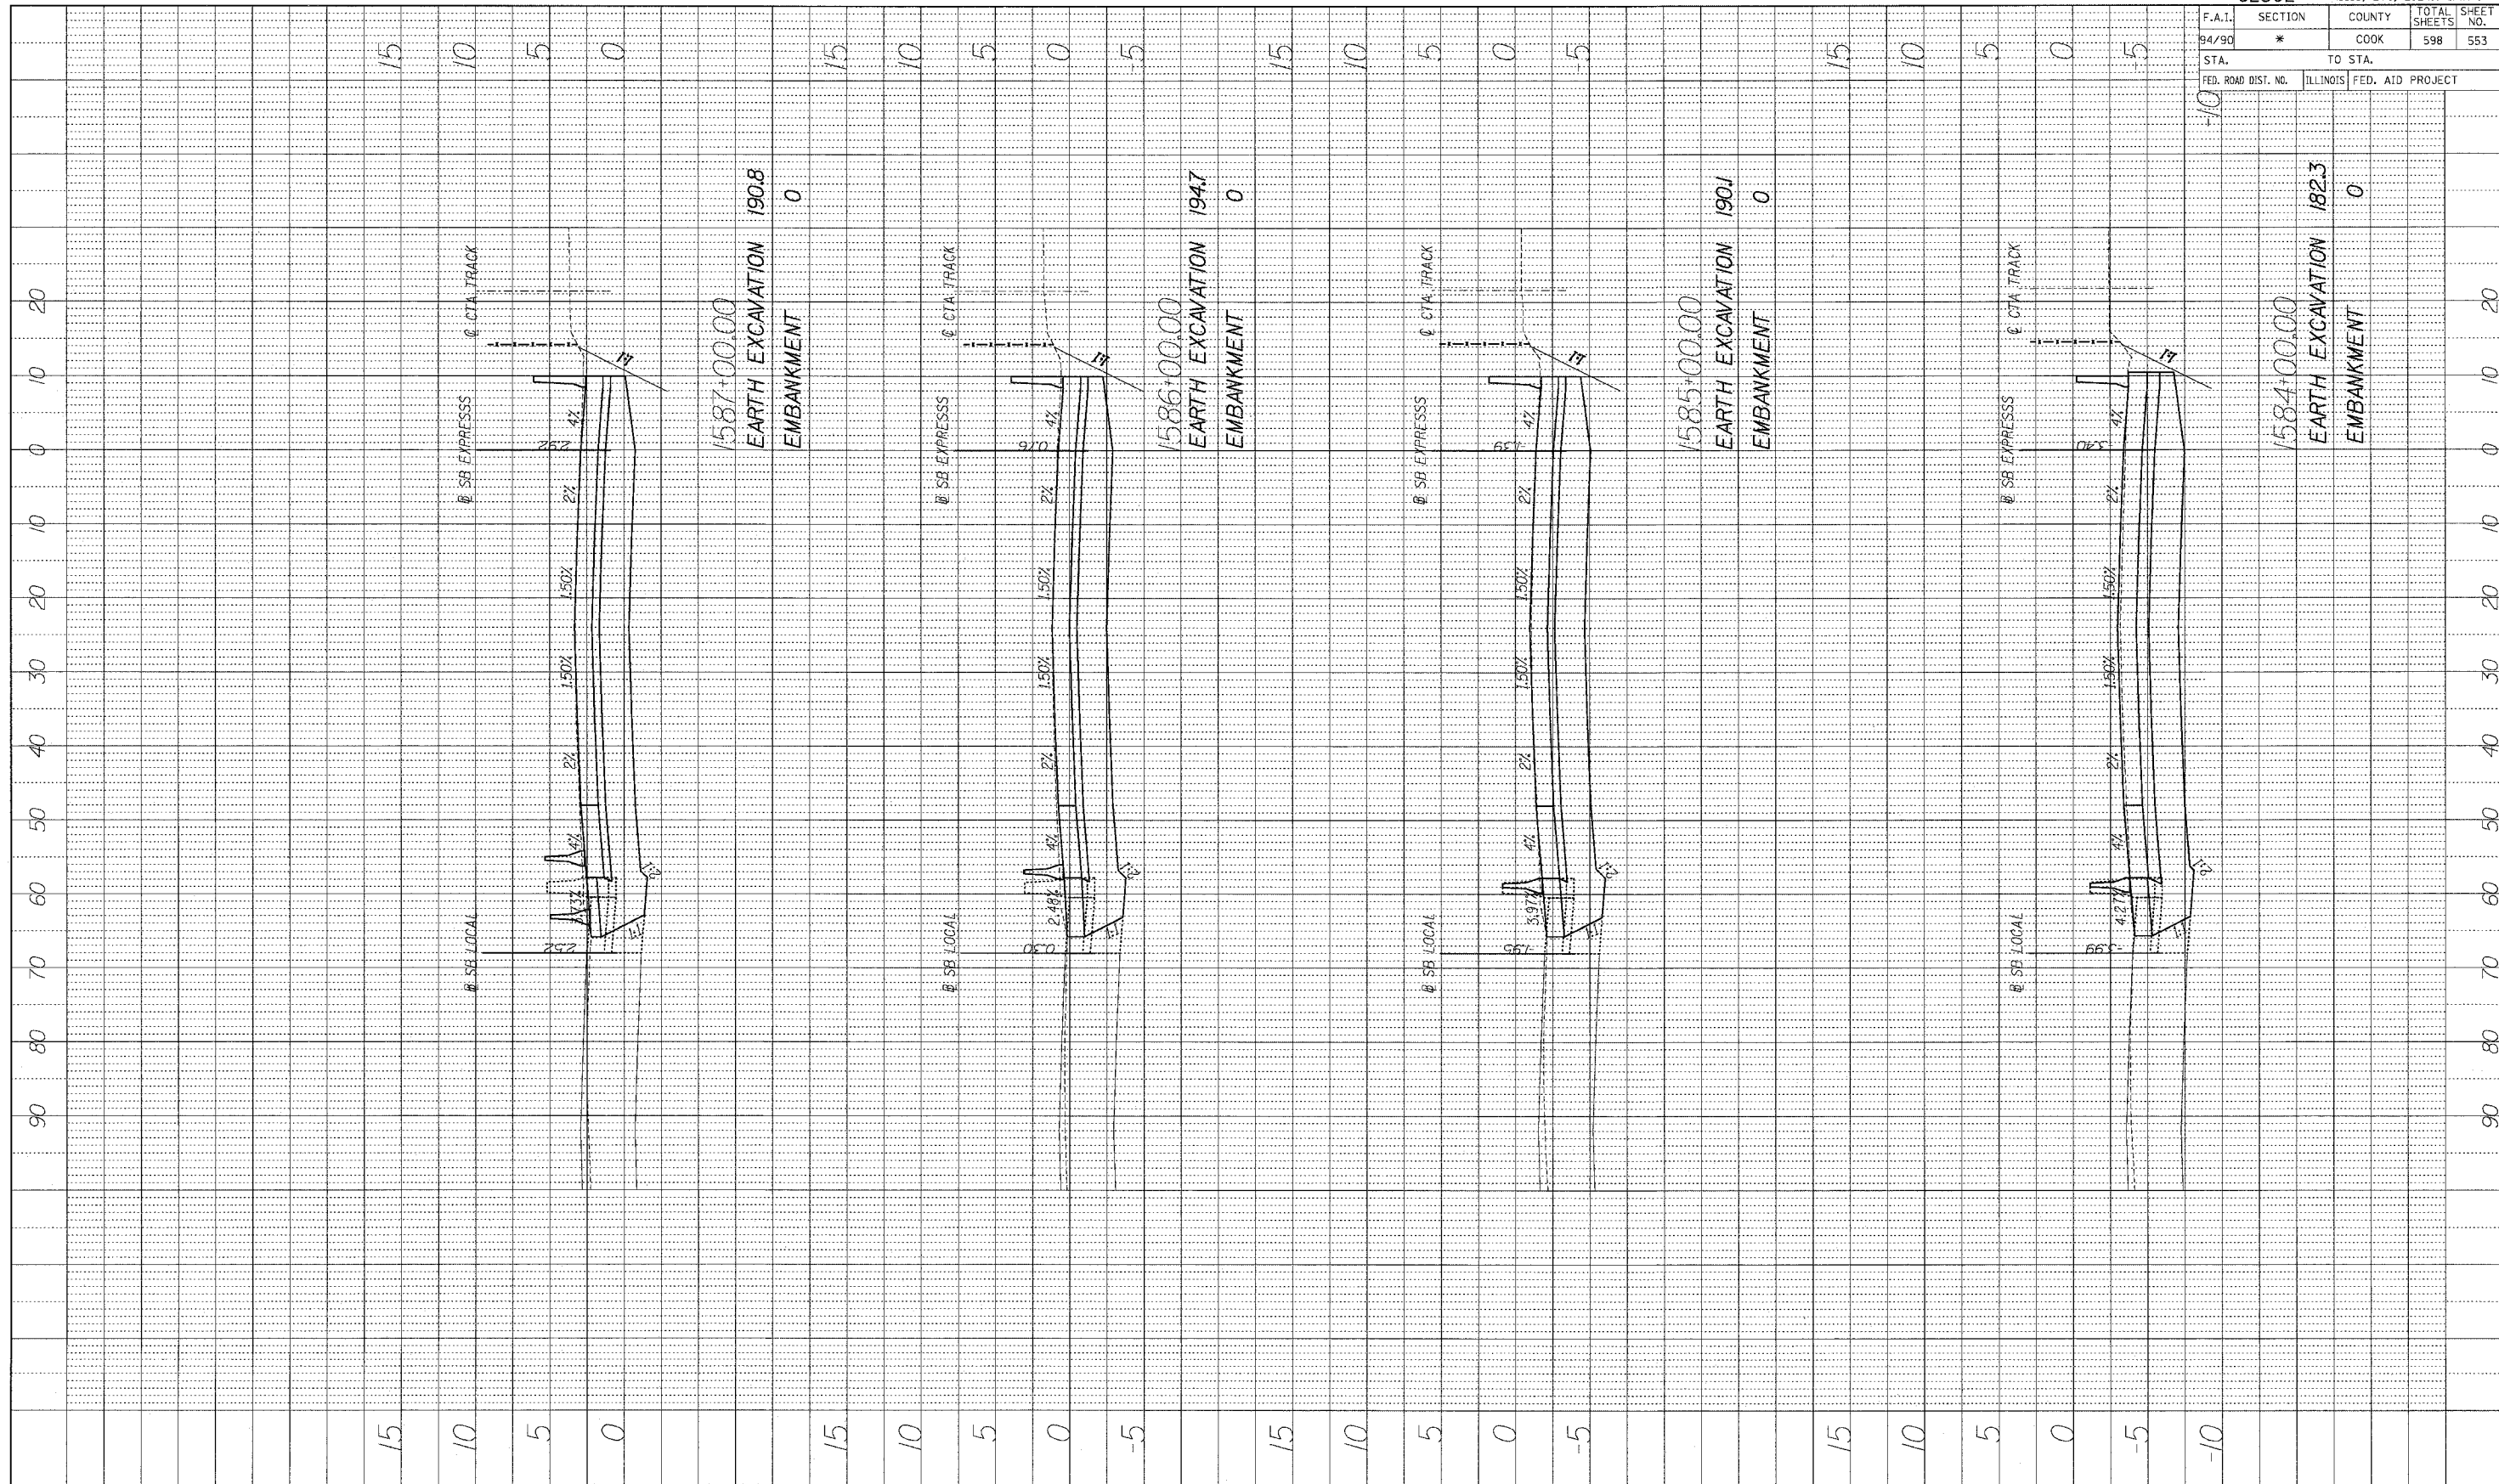


1587+00.00
 EARTH EXCAVATION 190.8
 EMBANKMENT 0

1586+00.00
 EARTH EXCAVATION 194.7
 EMBANKMENT 0

1585+00.00
 EARTH EXCAVATION 190.1
 EMBANKMENT 0

1584+00.00
 EARTH EXCAVATION 182.3
 EMBANKMENT 0

BOWMAN, BARRETT & ASSOCIATES INC
 CONSULTING ENGINEERS
 Chicago, Illinois
 312.228.0100
 www.bbainc.com

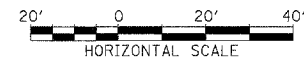


STA.+.. TO STA.+..

62302				*1818, ETC., 2324.6-1PIR-9	
F.A.I.	SECTION	COUNTY	TOTAL SHEETS	SHEET NO.	
94/90	*	COOK	598	553	
STA.			TO STA.		
FED. ROAD DIST. NO.	ILLINOIS	FED. AID PROJECT			


6/27/2005 4:58PM

F.A.I.	SECTION	COUNTY	TOTAL SHEETS	SHEET NO.
94/90	*	COOK	598	554
STA.		TO STA.		
FED. ROAD DIST. NO.	ILLINOIS FED. AID PROJECT			

PROFILE NUMBER	BY	DATE
PLANTED		
NOTE BOOK NO.		
STRUCTURE NOTATION		

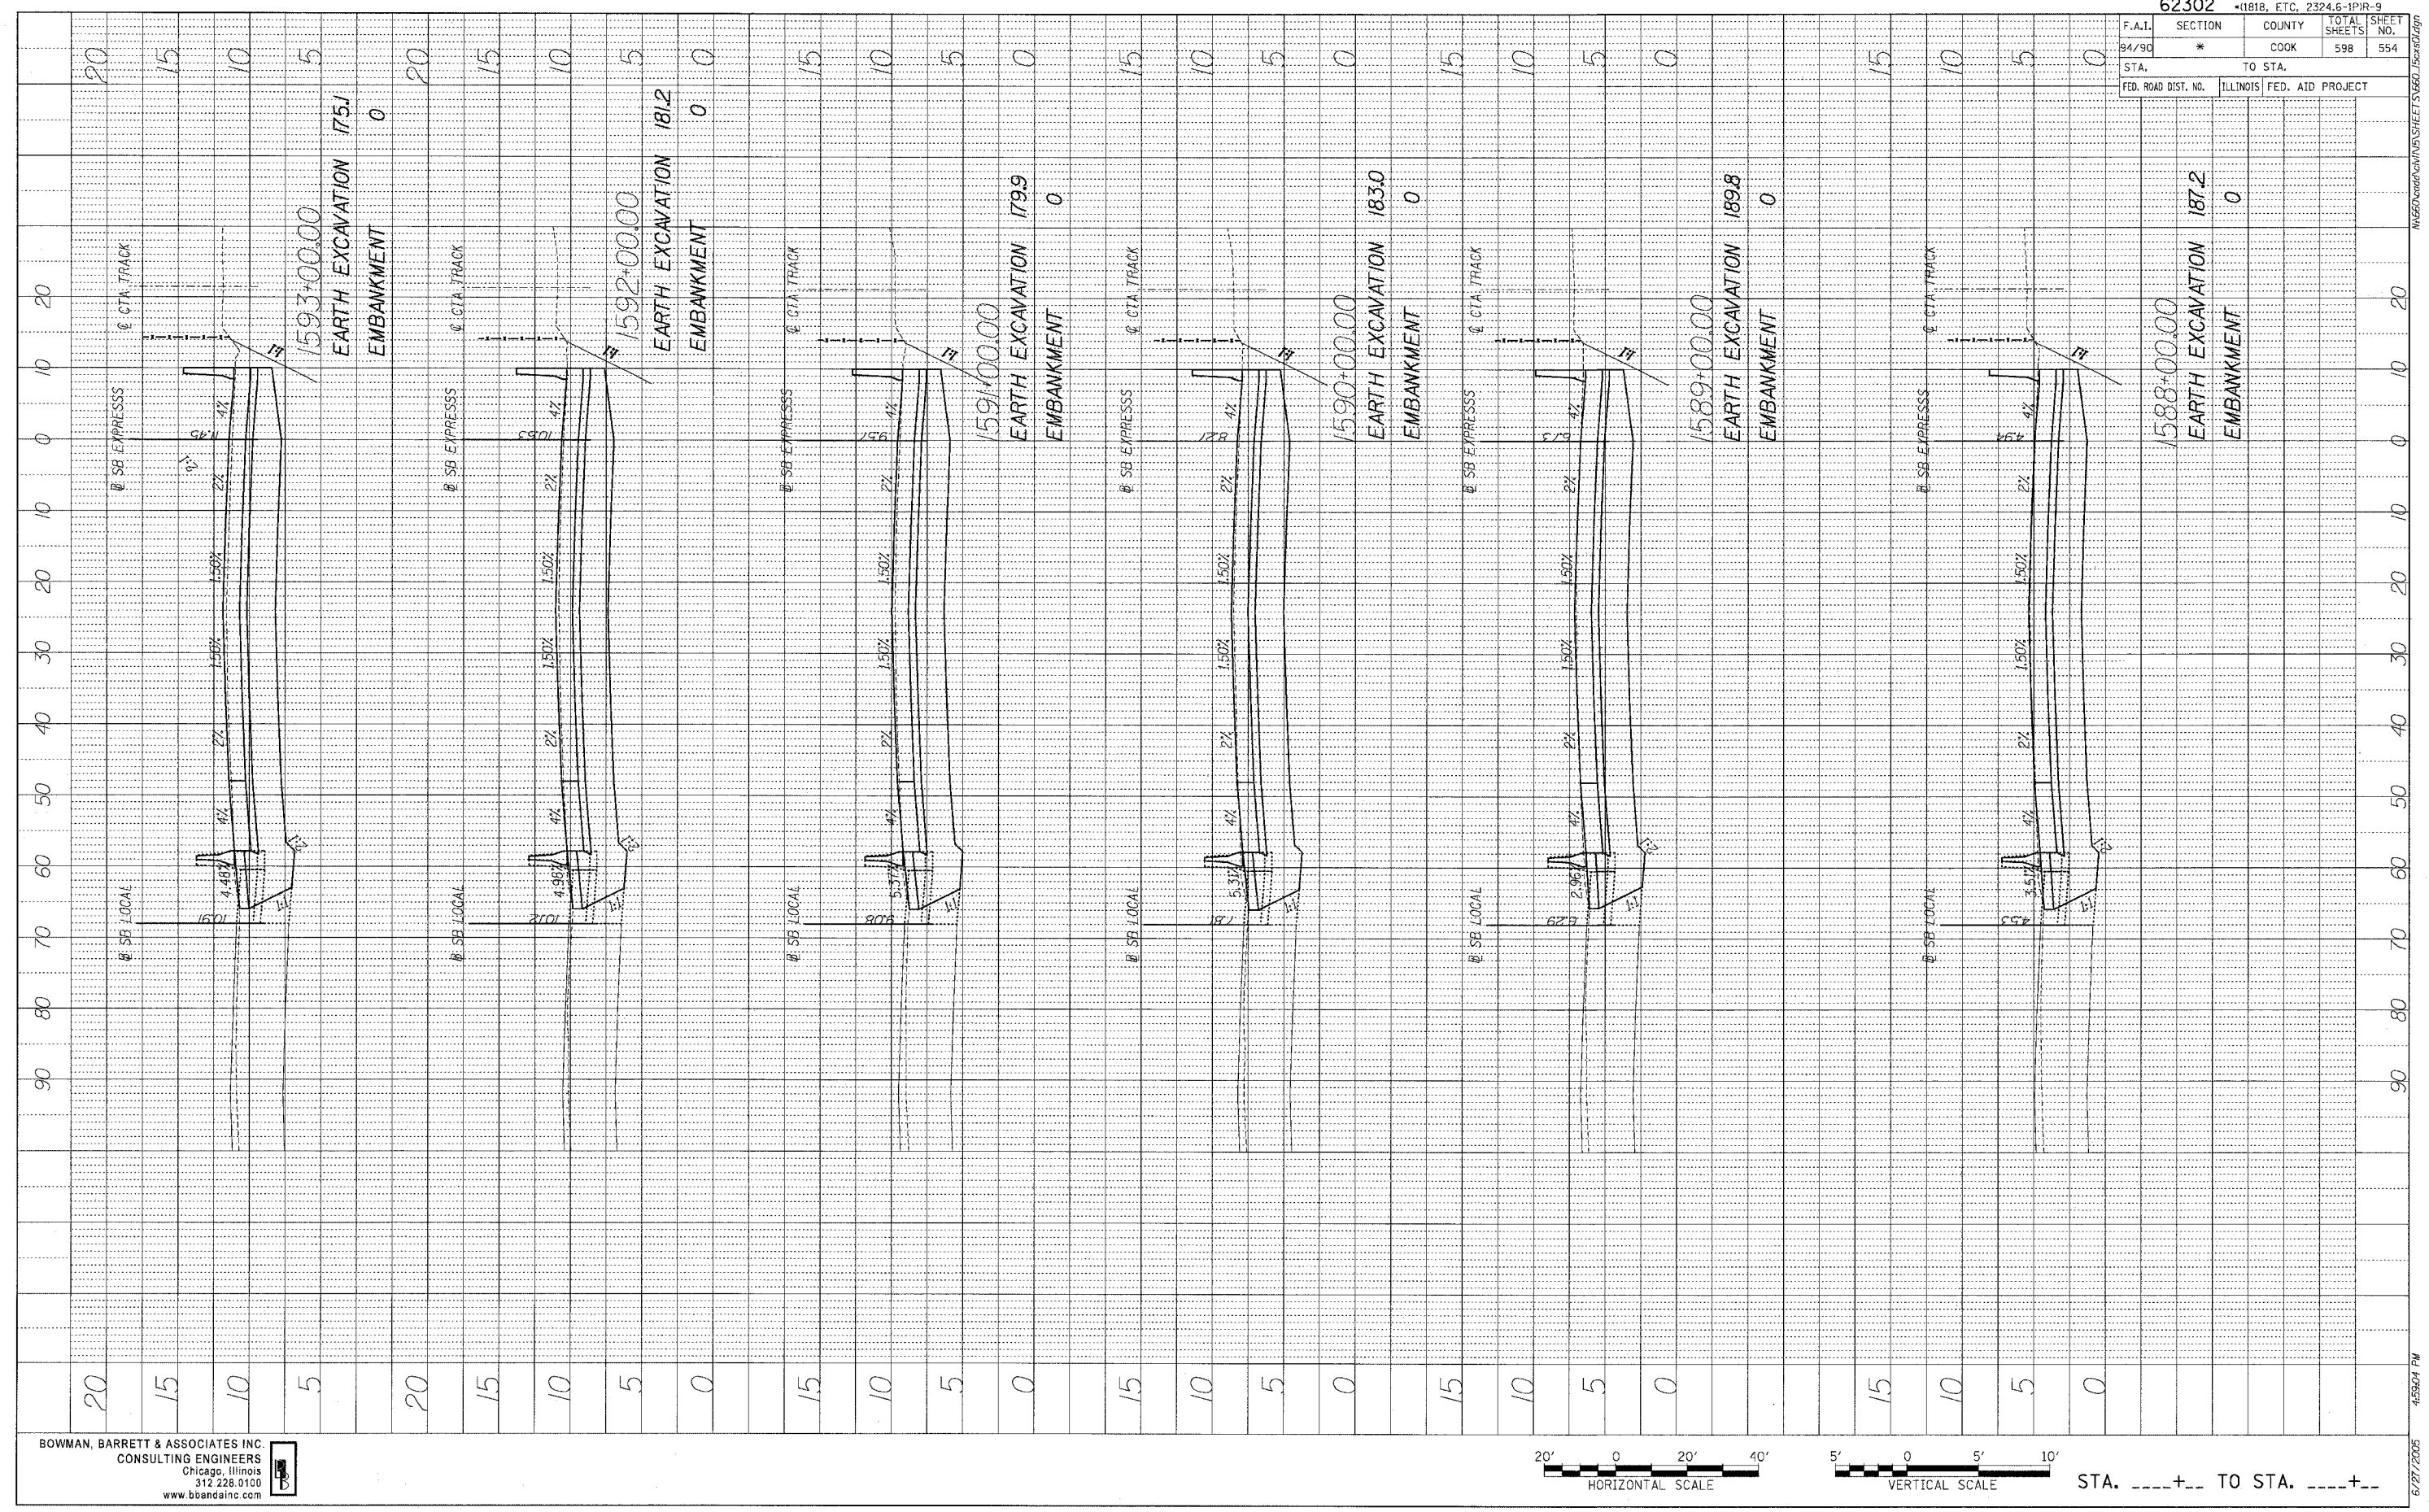


BOWMAN, BARRETT & ASSOCIATES INC.
 CONSULTING ENGINEERS
 Chicago, Illinois
 312 228-0100
 www.bbainc.com

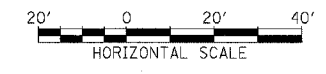

STA. ----+-- TO STA. ----+--

PROFILE SURVEYED BY DATE
 PLATTED BY
 NOTE BOOK NO. DRAWING NO.
 STRUCTURE NOTATION CIPKD

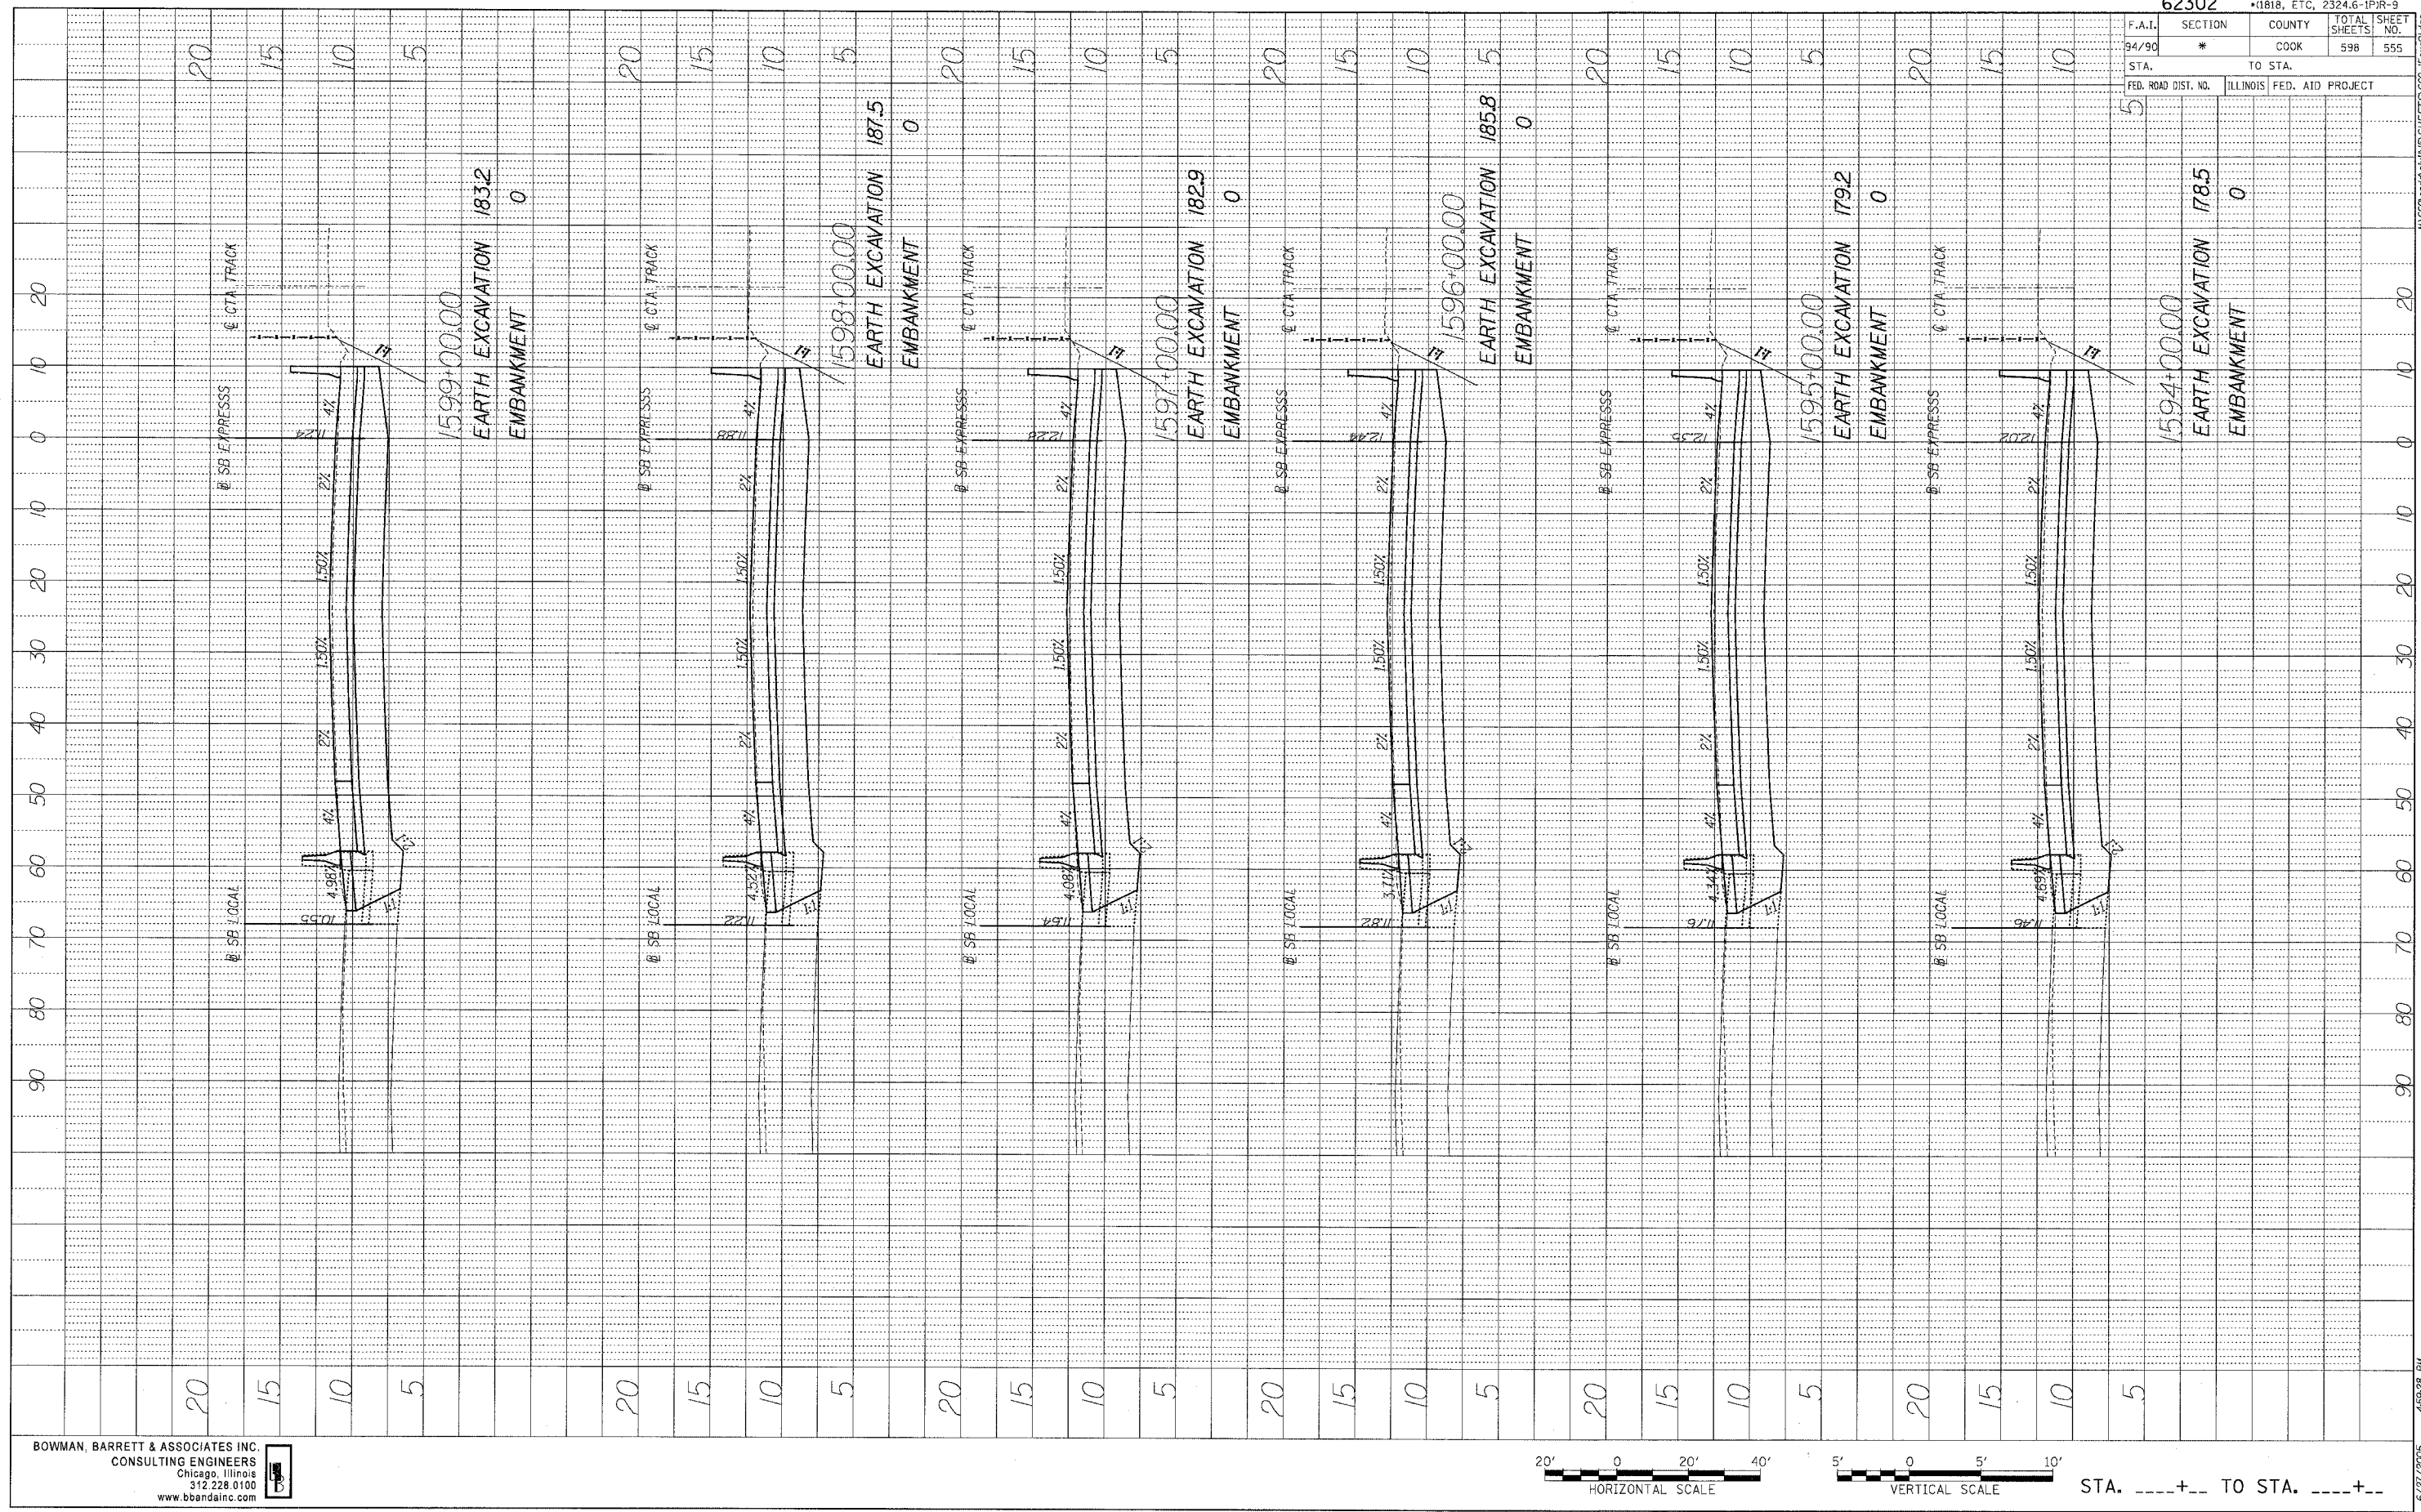

62302					*1818, ETC, 2324.6-1PJR-9				
F.A.I.	SECTION	COUNTY	TOTAL SHEETS	SHEET NO.					
94/90	*	COOK	598	555					
STA.		TO STA.							
FED. ROAD DIST. NO.	ILLINOIS	FED. AID PROJECT							

BOWMAN, BARRETT & ASSOCIATES INC.
 CONSULTING ENGINEERS
 Chicago, Illinois
 312.228.0100
 www.bbainc.com




STA. ----+-- TO STA. ----+--



6/27/2005 4:59:28 PM

F.A.I.	SECTION	COUNTY	TOTAL SHEETS	SHEET NO.
94/90	*	COOK	598	556
STA.		TO STA.		
FED. ROAD DIST. NO.		ILLINOIS	FED. AID PROJECT	

PROFILE	REVISIONS	BY	DATE
NOTE BOOK	PLOTTED		
NO.	GRADES CHECKED		
	STRUCTURE NOTATION CHECKED		

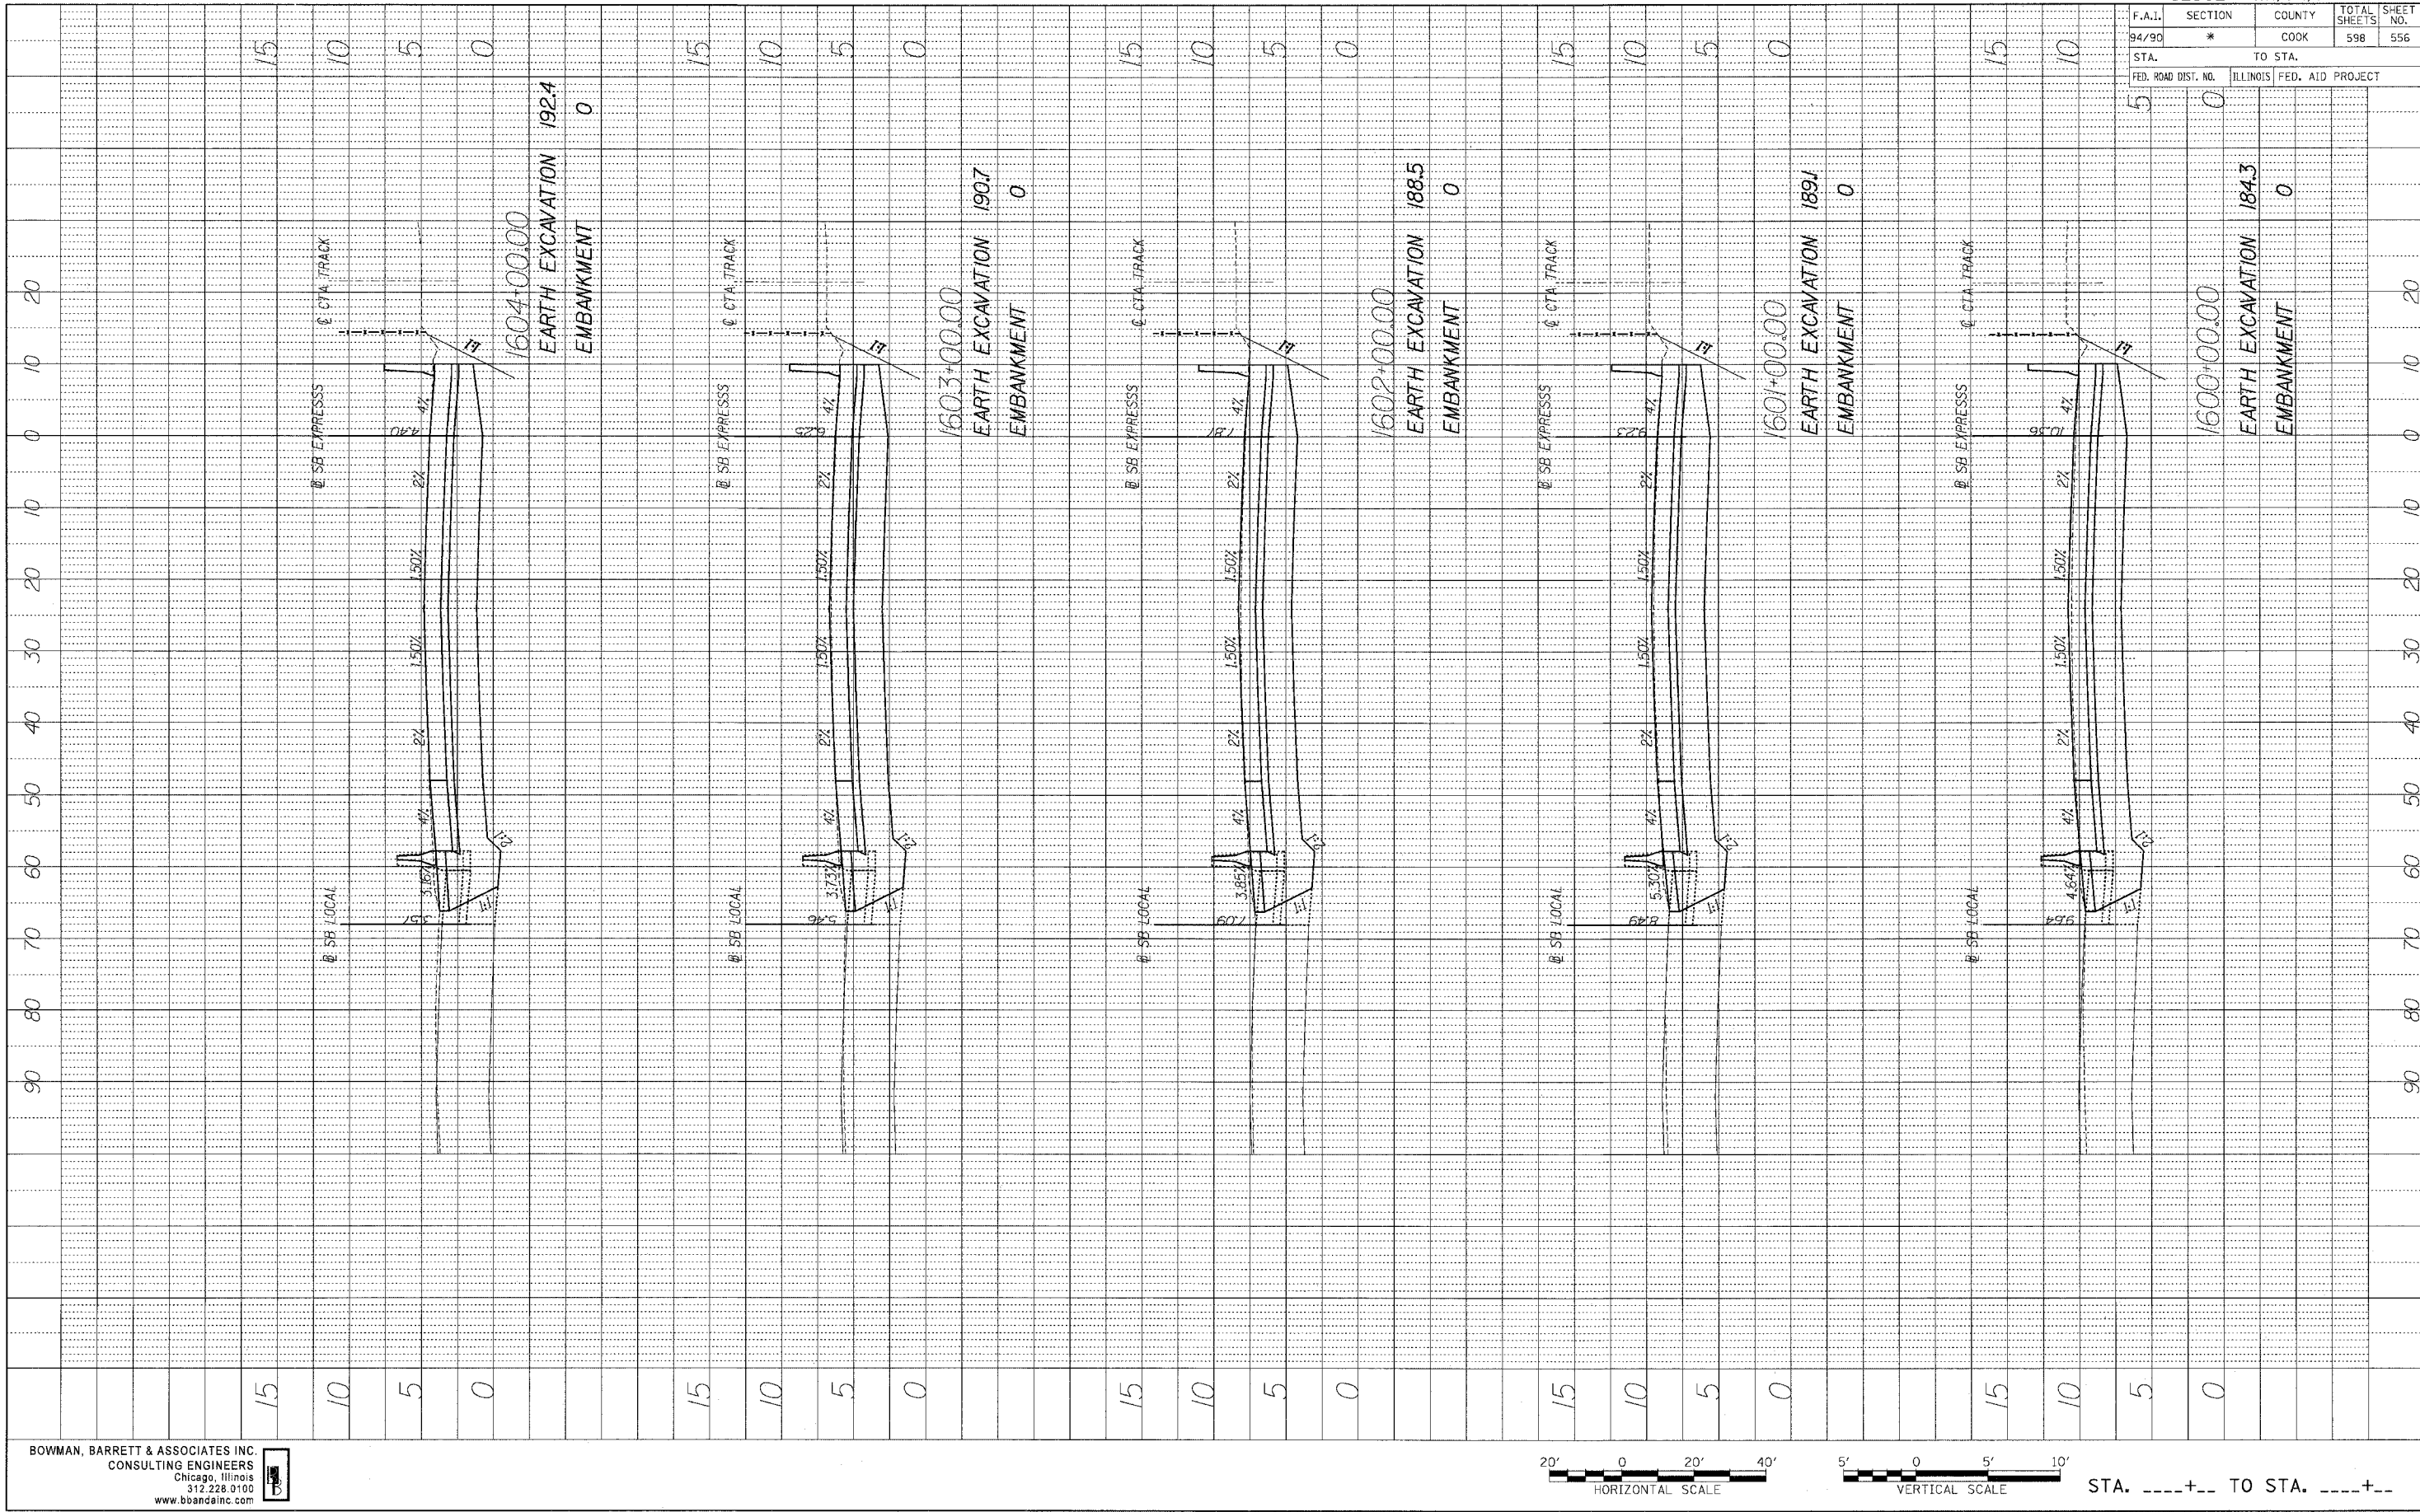


BOWMAN, BARRETT & ASSOCIATES INC.
 CONSULTING ENGINEERS
 Chicago, Illinois
 312.228.9100
 www.bbancinc.com

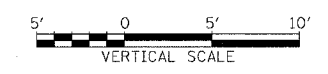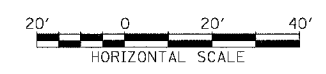

STA.+... TO STA.+...

PROFILE
 REVIEWED _____ BY _____ DATE _____
 GRADINGS CHECKED _____
 NOTE BOOK _____ PLOTTED _____
 NO. _____ STRUCTURE NOTATIONS OK'D _____

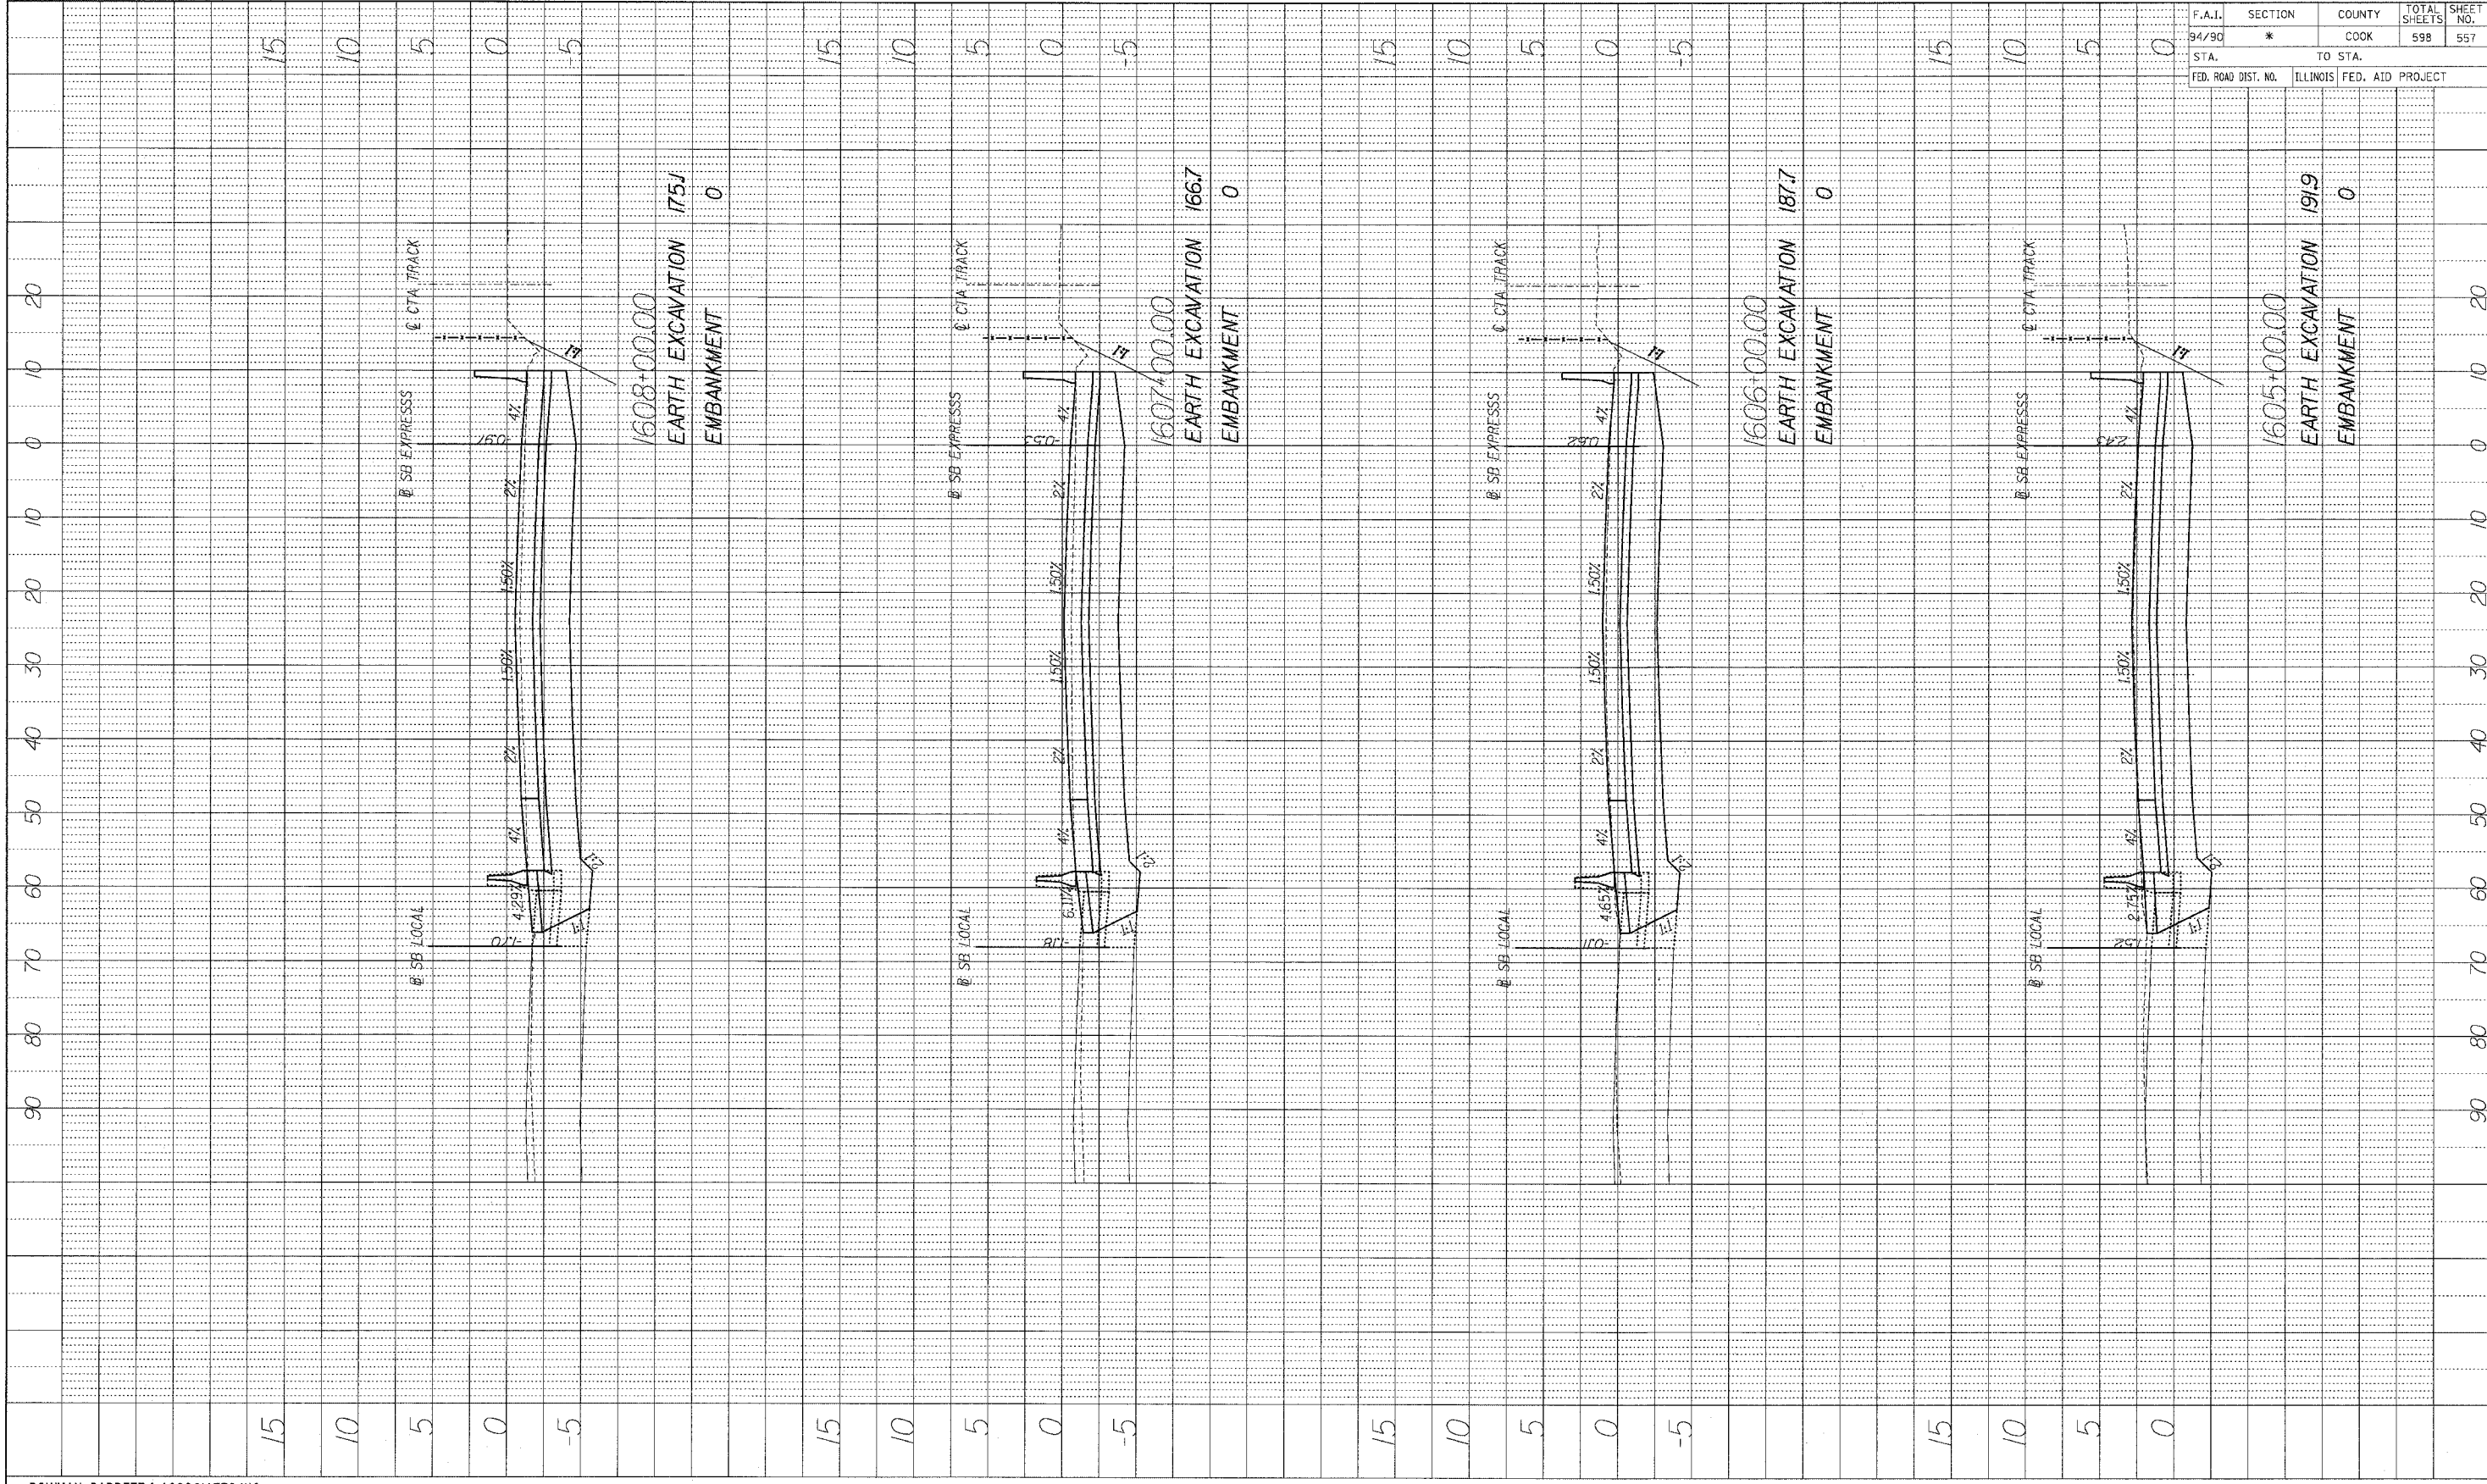

1608+00.00
 EARTH EXCAVATION 175J
 EMBANKMENT 0



1607+00.00
 EARTH EXCAVATION 166.7
 EMBANKMENT 0

1606+00.00
 EARTH EXCAVATION 187.7
 EMBANKMENT 0

1605+00.00
 EARTH EXCAVATION 191.9
 EMBANKMENT 0


62302		•(1818, ETC, 2324.6-1PIR-9	
F.A.I.	SECTION	COUNTY	TOTAL SHEETS
94/90	*	COOK	598
STA.	TO STA.		
FED. ROAD DIST. NO.	ILLINOIS	FED. AID PROJECT	

BOWMAN, BARRETT & ASSOCIATES INC.
 CONSULTING ENGINEERS
 Chicago, Illinois
 312.228.0100
 www.bbainc.com

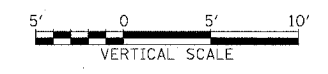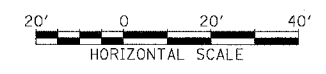

STA.+.. TO STA.+..

PROFILE SURVEYED BY DATE
 PLOTTED CHECKED
 NOTE BOOK B.M. NOTED
 NO. STRUCTURE NOTATION CHFD

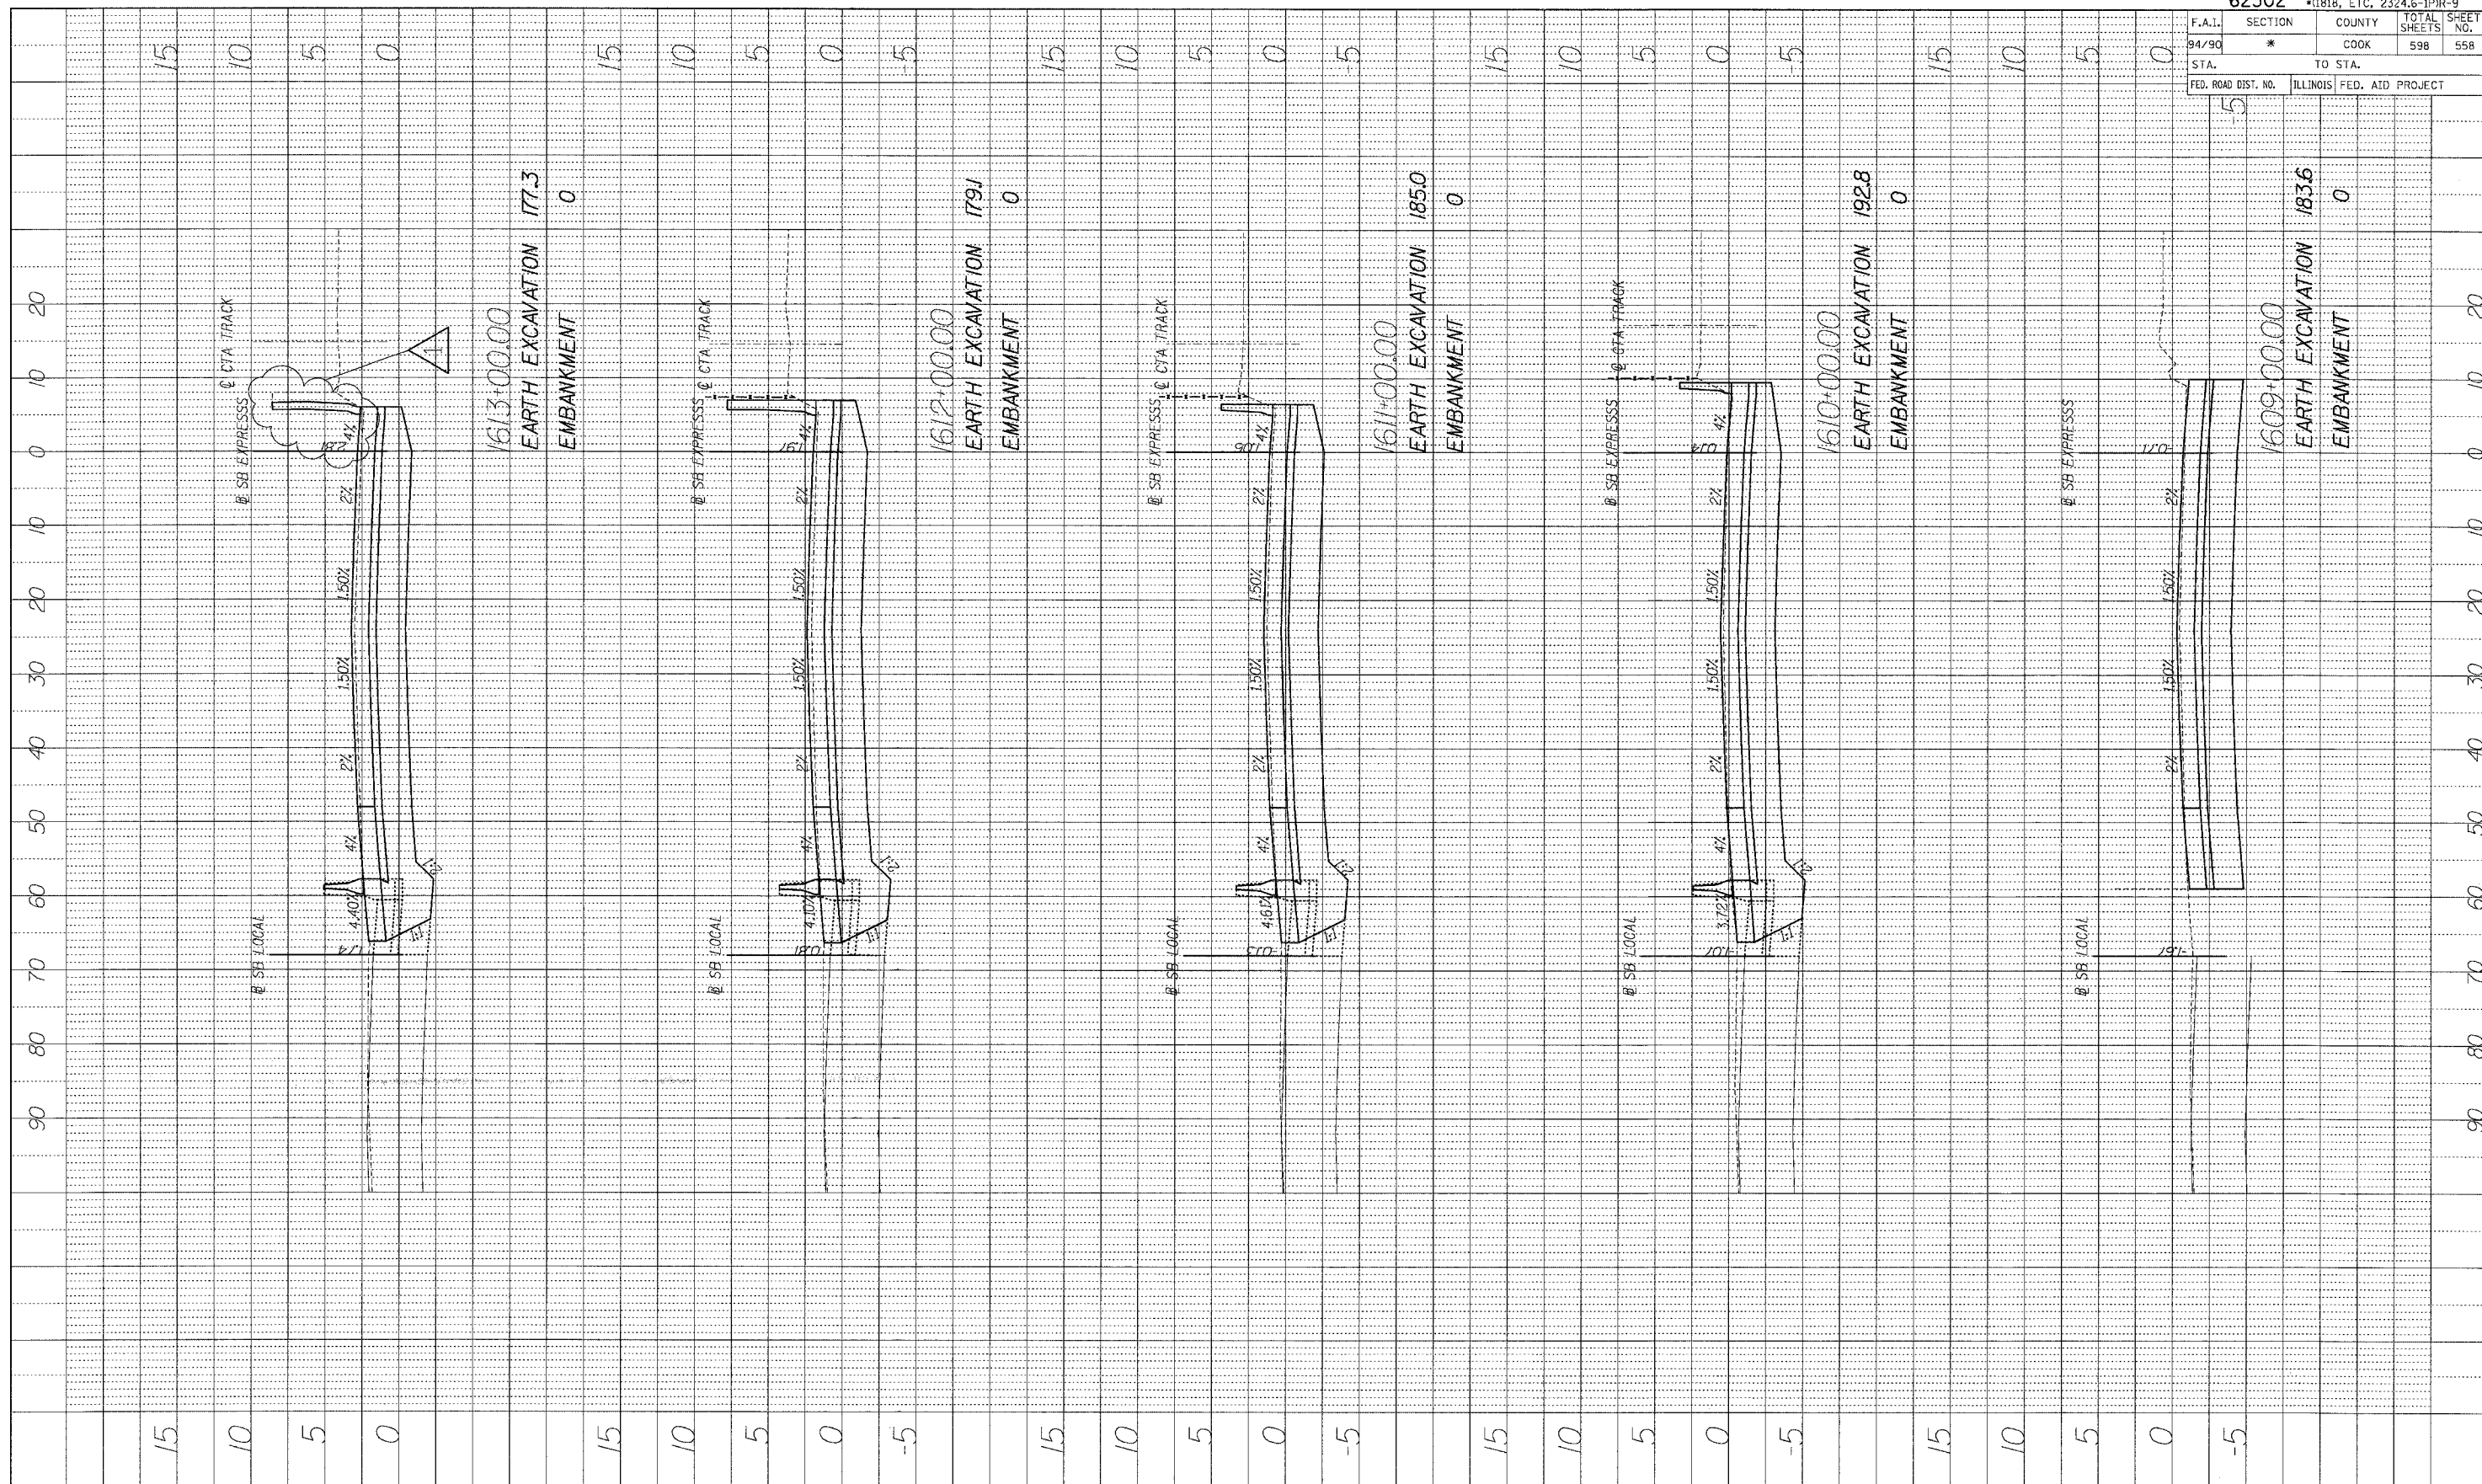

1613+00.00
 EARTH EXCAVATION 177.3
 EMBANKMENT 0

1612+00.00
 EARTH EXCAVATION 179J
 EMBANKMENT 0

1611+00.00
 EARTH EXCAVATION 185.0
 EMBANKMENT 0

1610+00.00
 EARTH EXCAVATION 192.8
 EMBANKMENT 0

1609+00.00
 EARTH EXCAVATION 183.6
 EMBANKMENT 0

62302		*0818, ETC, 2324.6-1PR-9	
F.A.I.	SECTION	COUNTY	TOTAL SHEETS
94/90	*	COOK	598
STA.	TO STA.		
FED. ROAD DIST. NO.	ILLINOIS	FED. AID PROJECT	

BOWMAN BARRETT & ASSOCIATES INC.
 CONSULTING ENGINEERS
 Chicago, Illinois
 312.228.0100
 www.bbainc.com

ADDENDUM 1 8/12/05




STA. ----+-- TO STA. ----+--

B:\11\2005 8-12-05 8:56:07 PM



F.A.I.	SECTION	COUNTY	TOTAL SHEETS	SHEET NO.
94/90	*	COOK	598	559
STA.		TO STA.		
FED. ROAD DIST. NO.	ILLINOIS	FED. AID PROJECT		

PROFILE SURVEYED	BY	DATE
PLotted		
NOTE BOOK		
NO.		

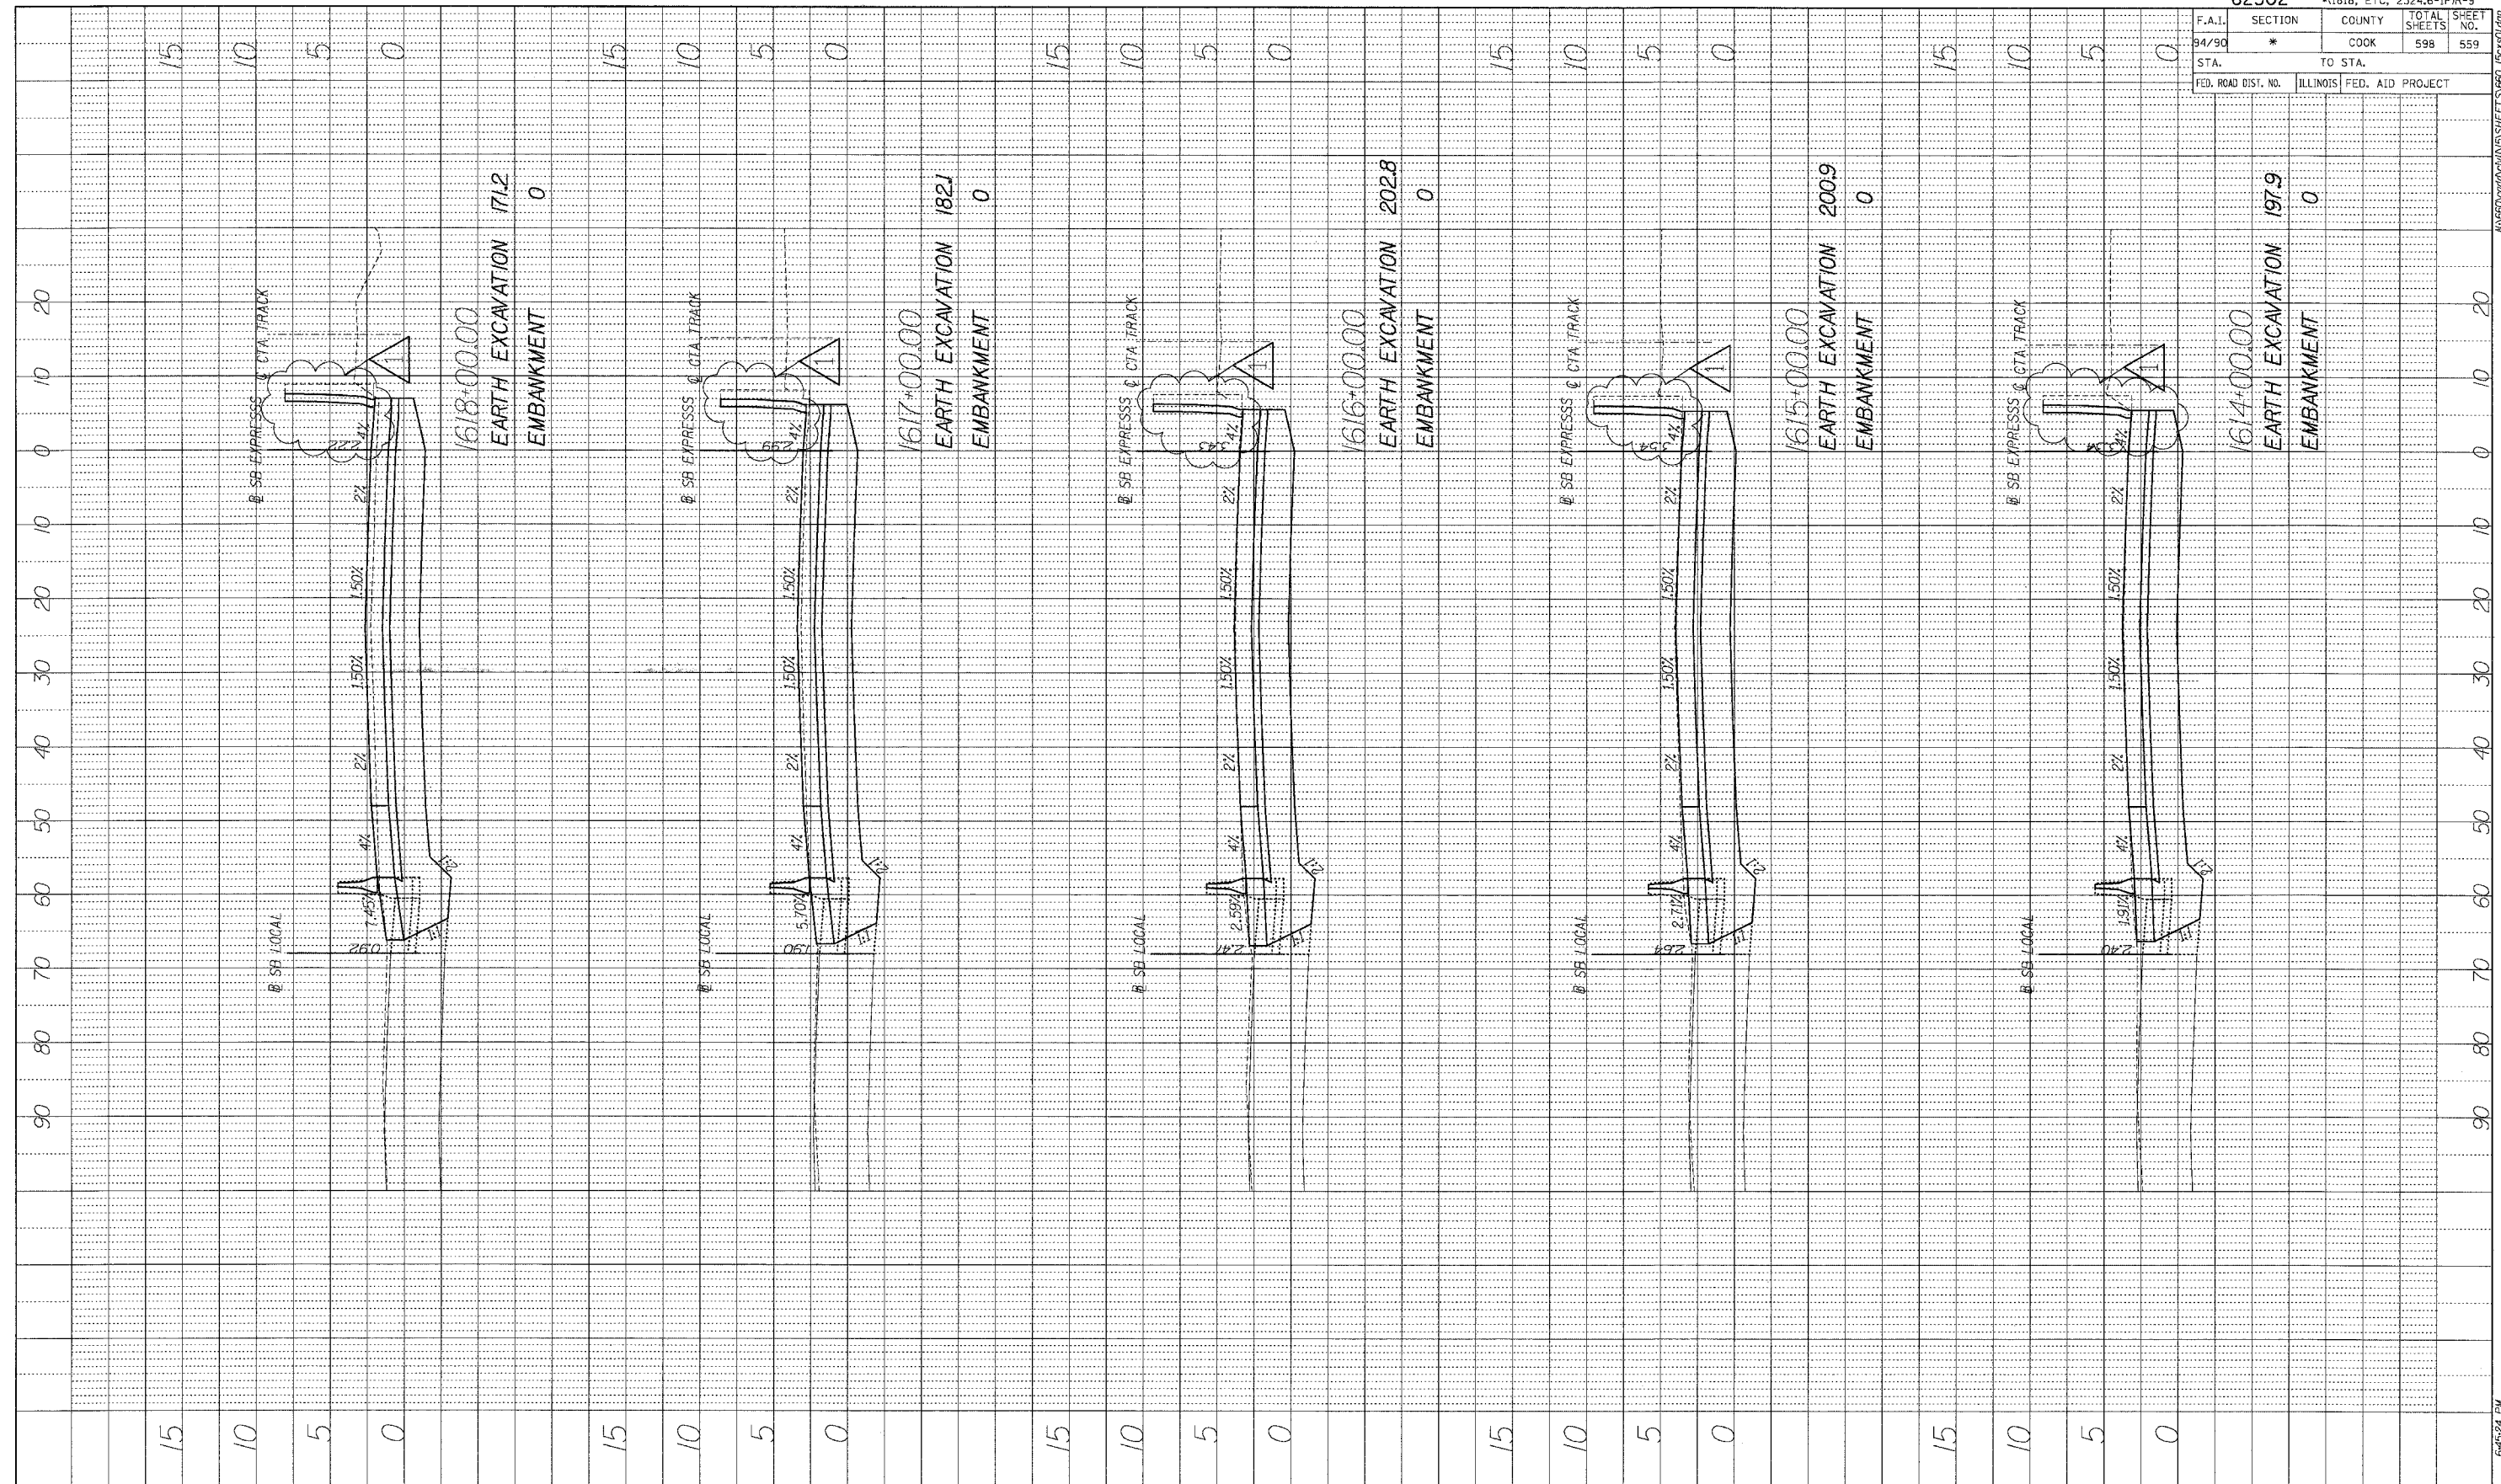

BOWMAN, BARRETT & ASSOCIATES INC.
 CONSULTING ENGINEERS
 Chicago, Illinois
 312.228.0100
 www.bbainc.com


1 ADDENDUM 1 8/12/05

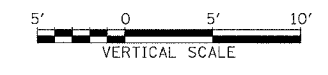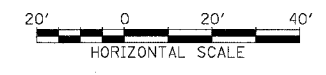

STA.+.. TO STA.+..

F.A.I.	SECTION	COUNTY	TOTAL SHEETS	SHEET NO.
94/90	*	COOK	598	560
STA.		TO STA.		
FED. ROAD DIST. NO.	ILLINOIS	FED. AID	PROJECT	



PROFILE SURVEYED BY _____ DATE _____
 PLOTTED CHECKED BY _____
 NOTE BOOK NO. _____
 STRUCTURE NOTATION CHFD

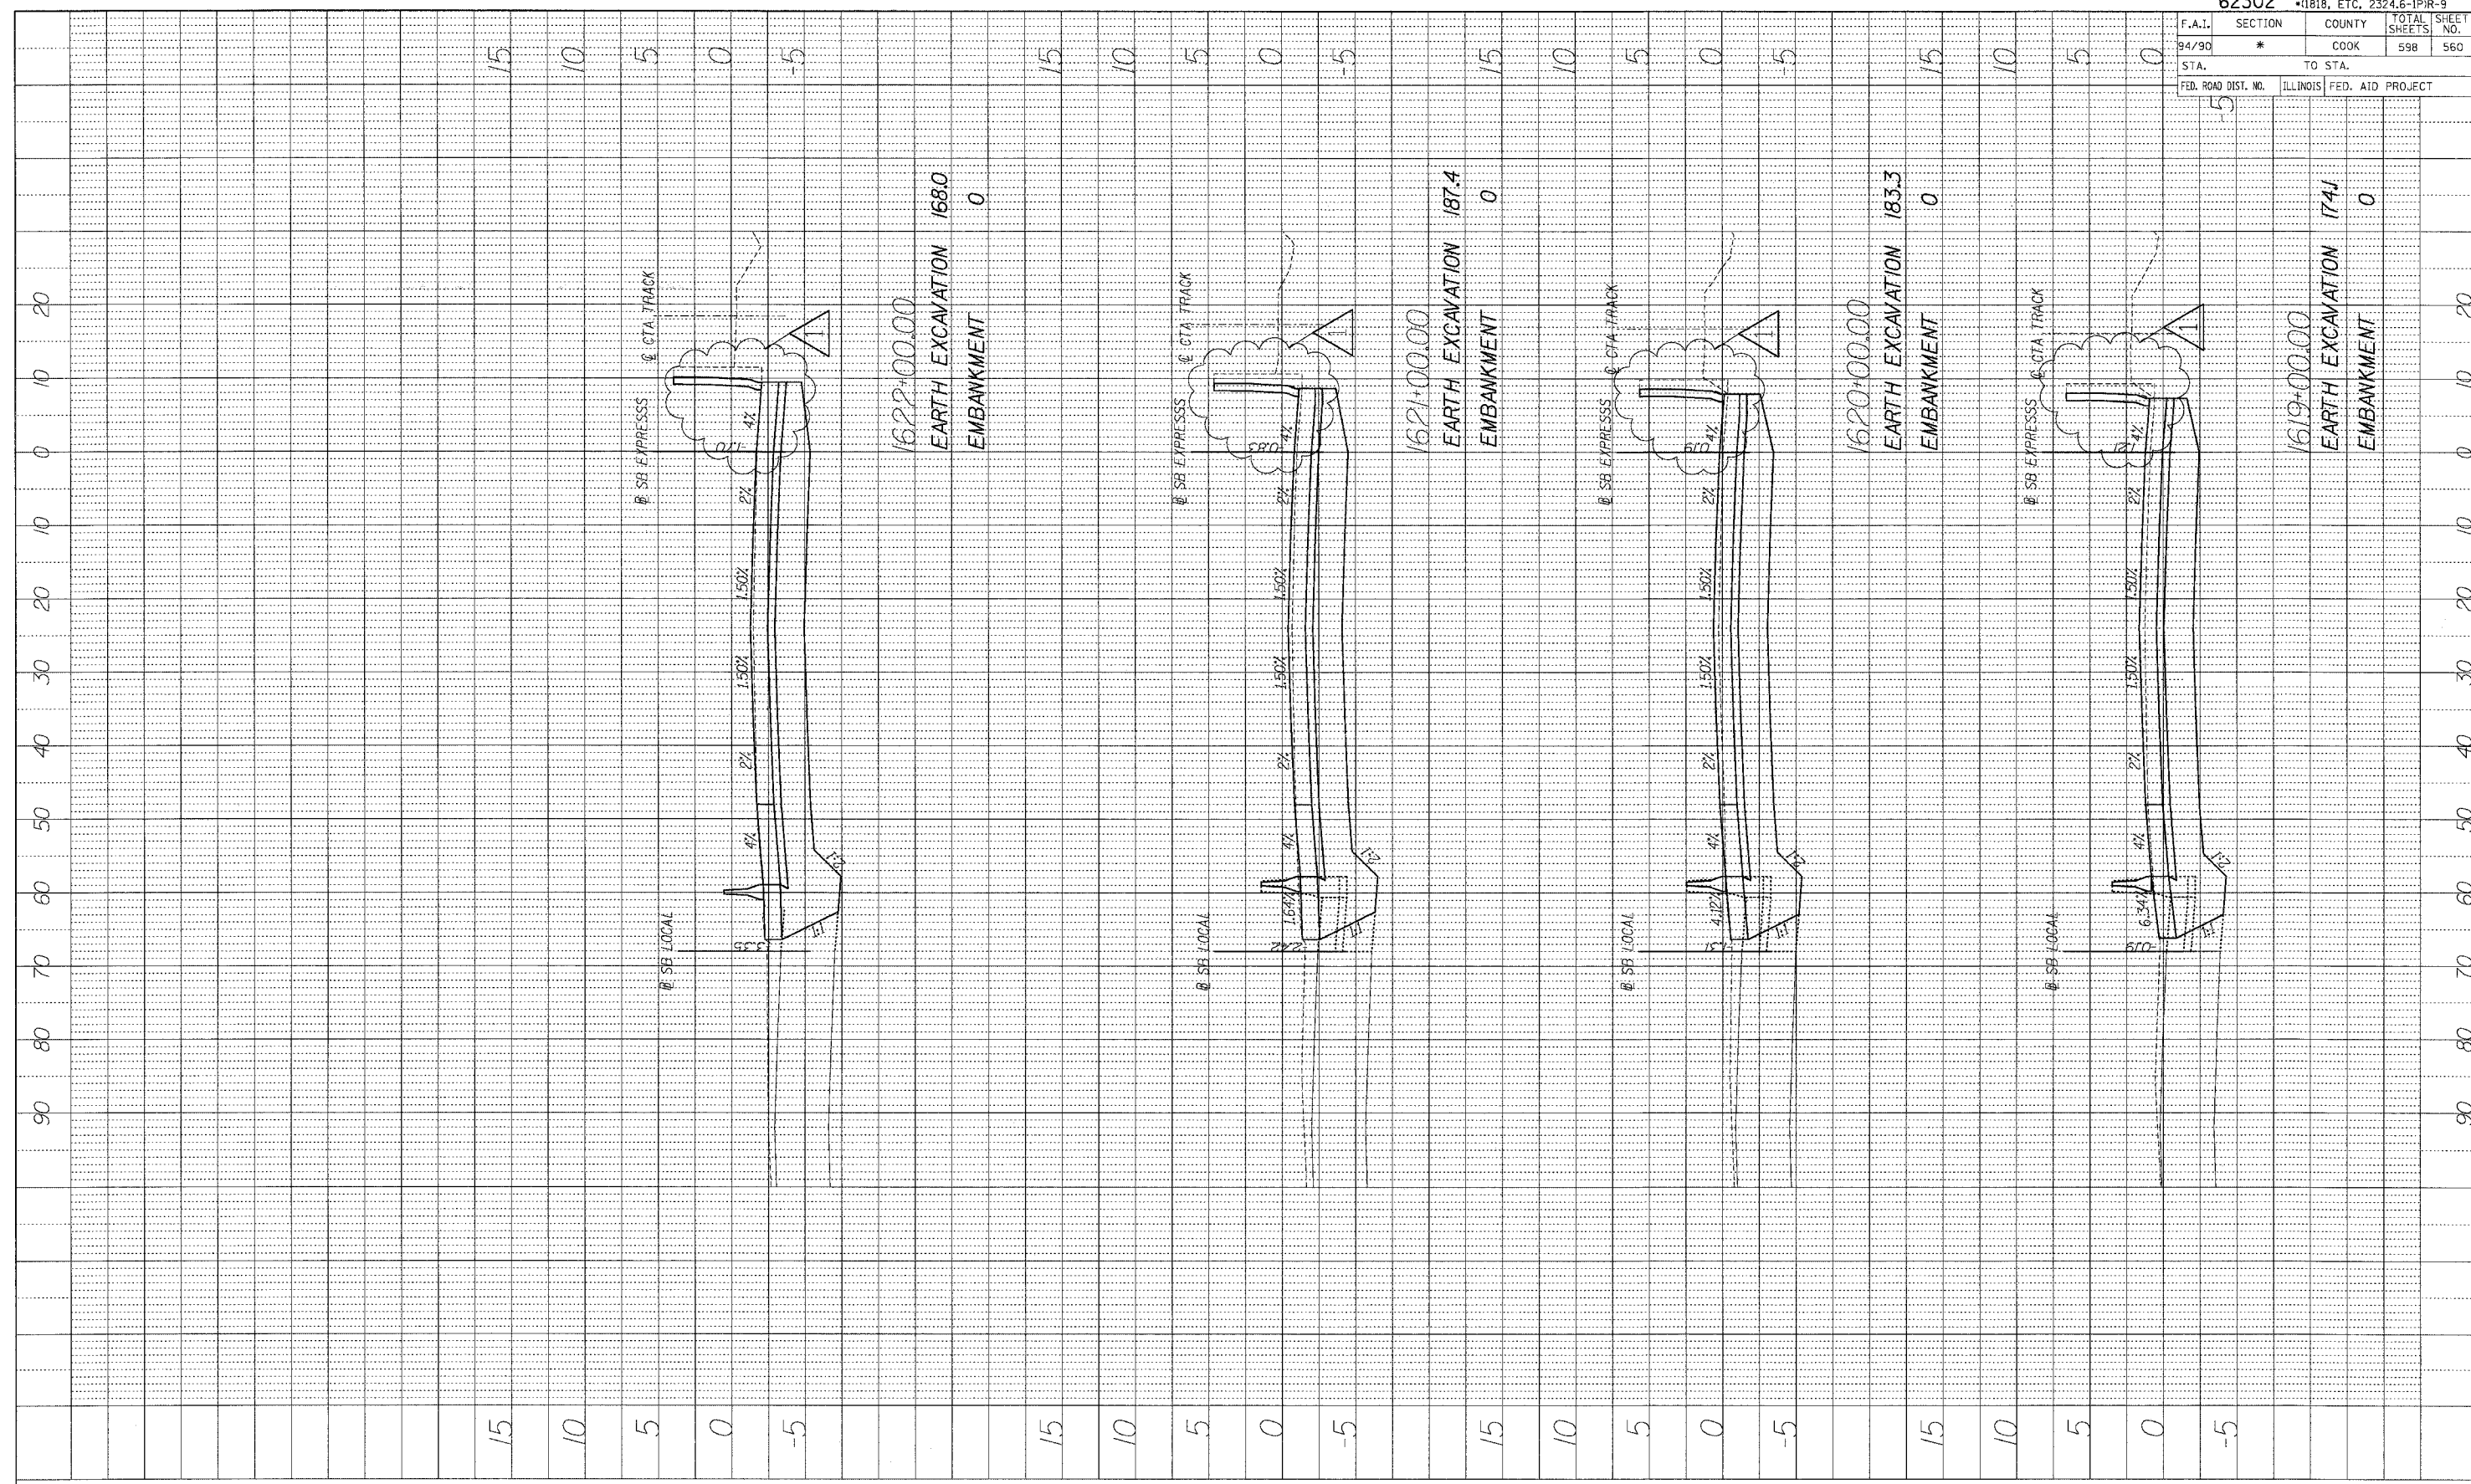

BOWMAN, BARRETT & ASSOCIATES INC
 CONSULTING ENGINEERS
 Chicago, Illinois
 312.228.0100
 www.bbainc.com




1 ADDENDUM 1 8/12/05

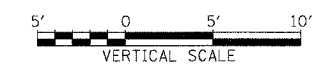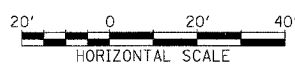

STA. ----+-- TO STA. ----+--

6/11/2005 6:56:47 PM

PROFILE SURVEYED BY DATE
 PLATED DRAWING NO. DATE
 NOTE BOOK NO. DATE
 STRUCTURE NOTATION CIRCD

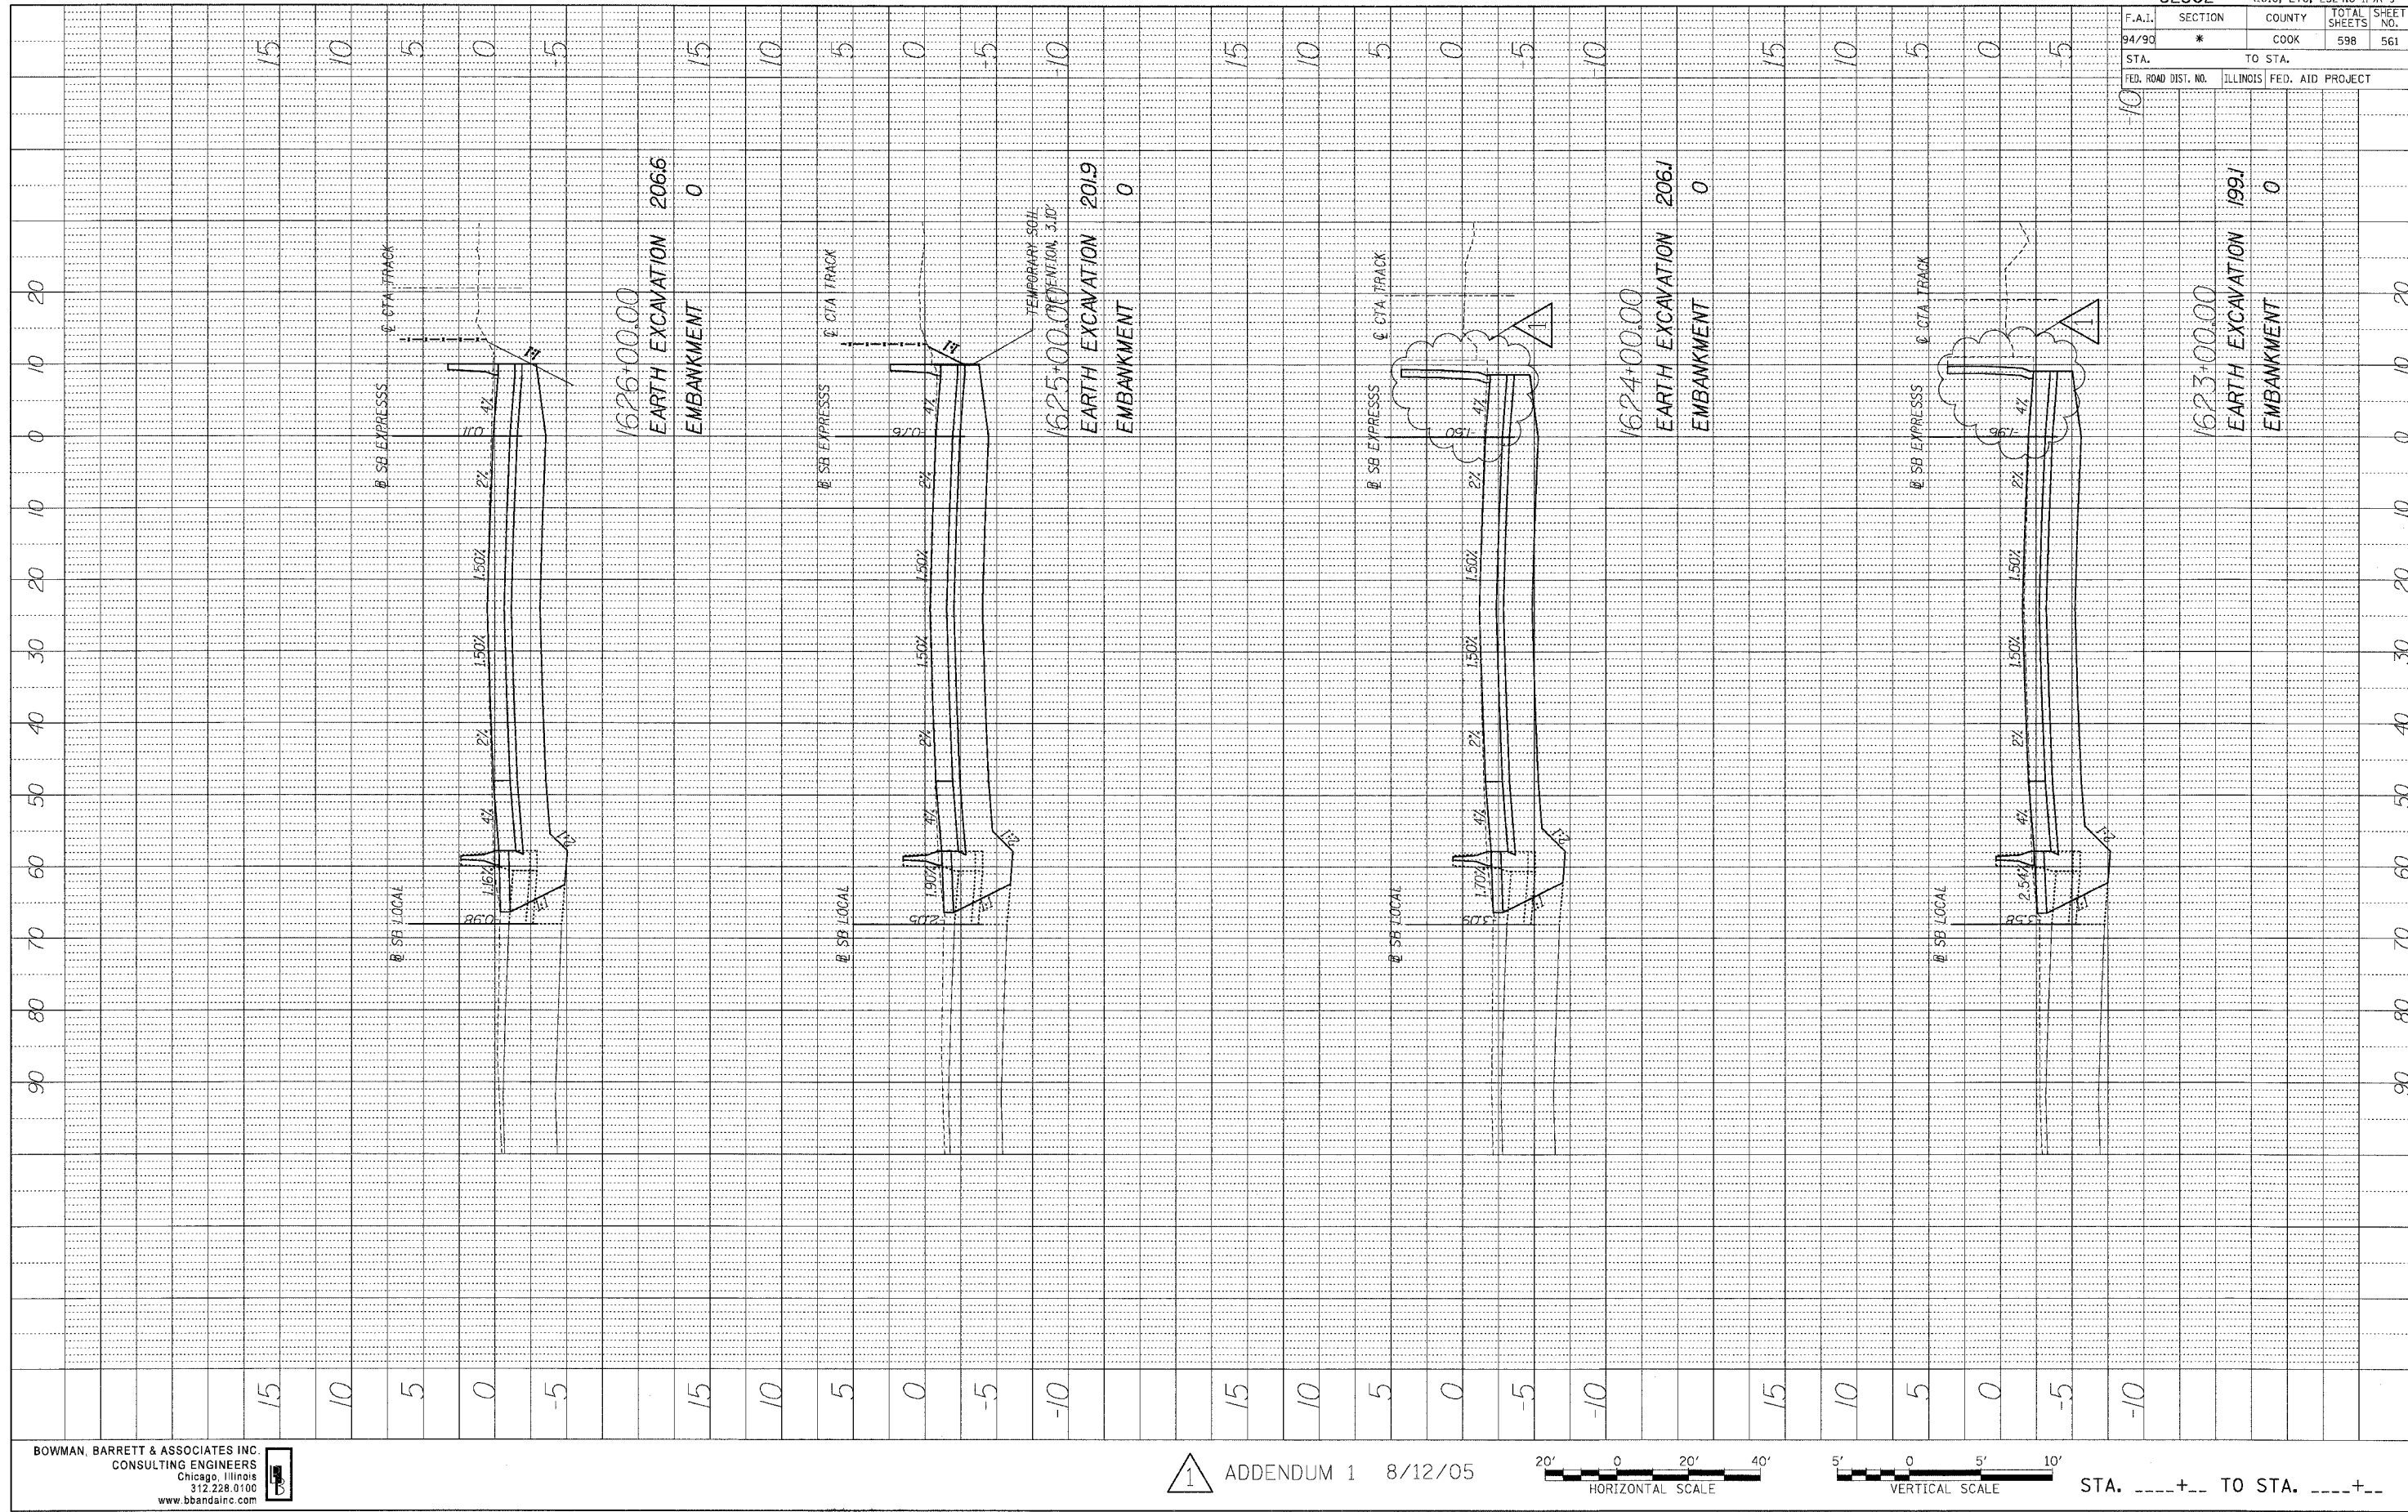

62302		* (1818, ETC, 2324.6-1PR-9	
F.A.I. SECTION	COUNTY	TOTAL SHEETS	SHEET NO.
94/90 *	COOK	598	561
STA.	TO STA.		
FED. ROAD DIST. NO.	ILLINOIS	FED. AID PROJECT	

BOWMAN, BARRETT & ASSOCIATES INC.
 CONSULTING ENGINEERS
 Chicago, Illinois
 312.228.0100
 www.bbainc.com


1 ADDENDUM 1 8/12/05



STA.+.. TO STA.+..



8/17/2005 6:46:28 PM

PROFILE
 DRAWINGS BY DATE
 PLANNED BY
 GRADES CHECKED
 NOTE BOOK NO.
 STRUCTURE NOTATION SHOWN

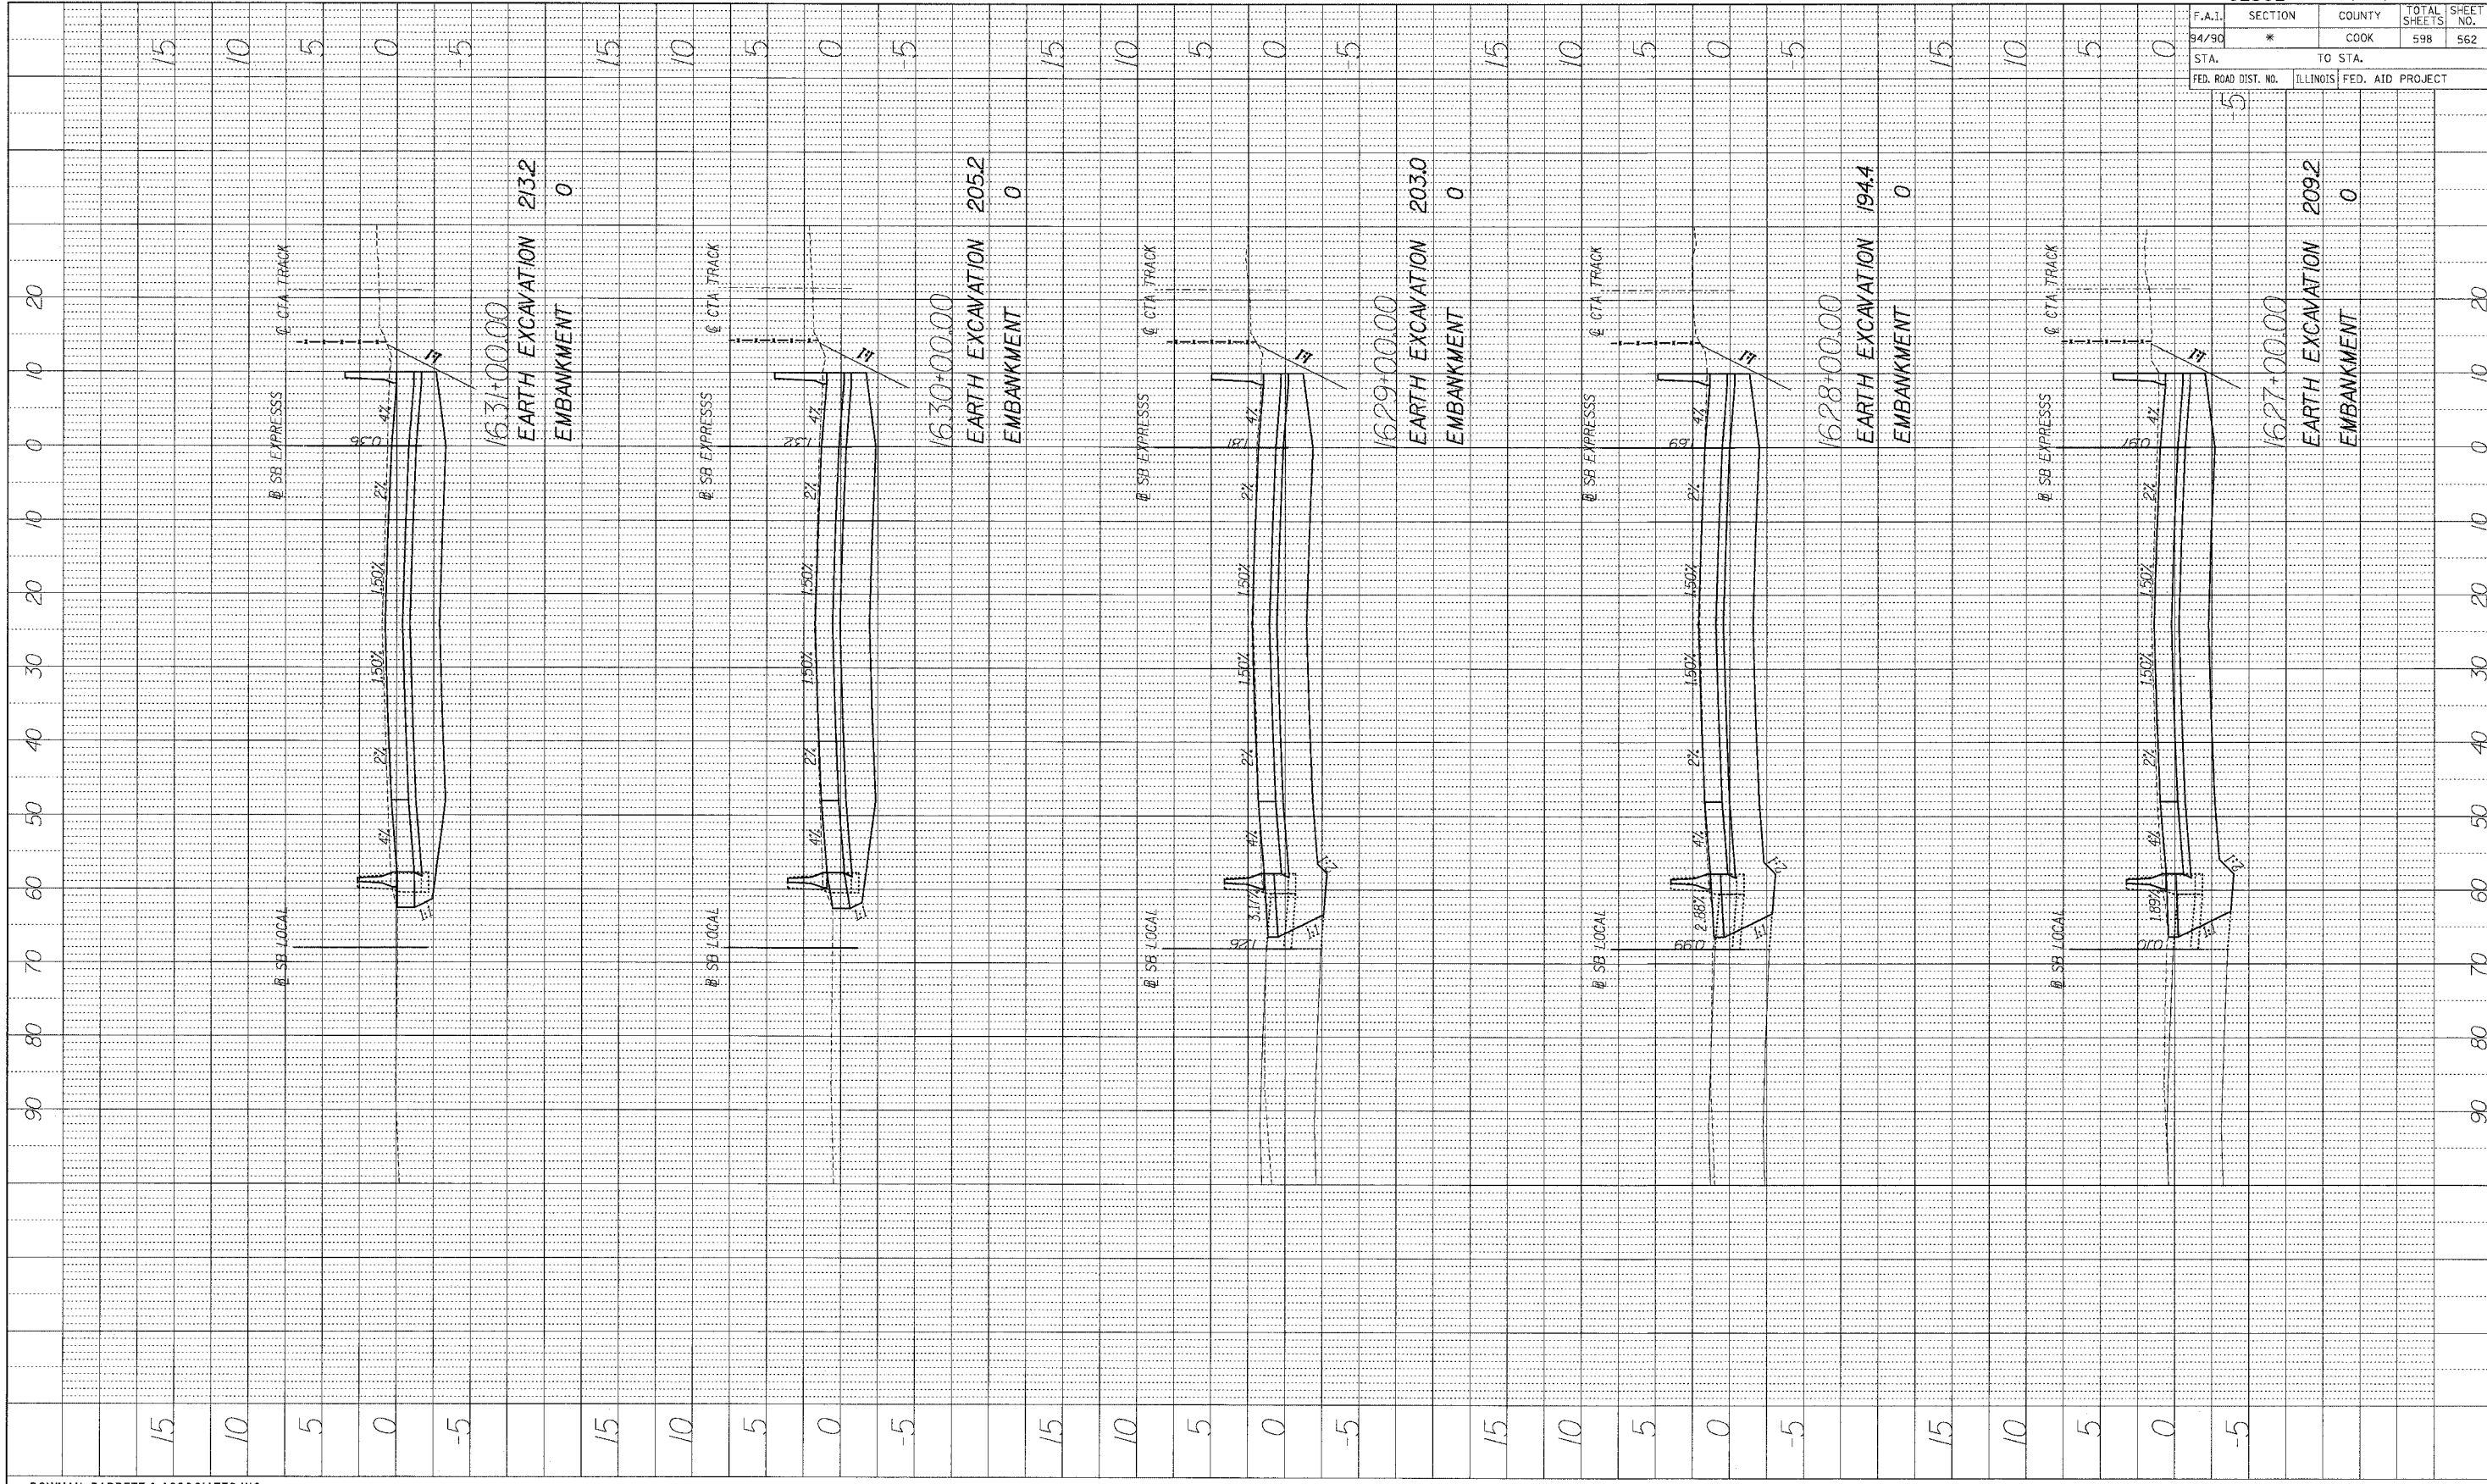

62302		*1818, ETC. 2324.6-1PIR-9	
F.A.I. SECTION	COUNTY	TOTAL SHEETS	SHEET NO.
94/90 *	COOK	598	562
STA. TO STA.		ILLINOIS FED. AID PROJECT	
FED. ROAD DIST. NO.			


BOWMAN, BARRETT & ASSOCIATES INC.
 CONSULTING ENGINEERS
 Chicago, Illinois
 312.228.0100
 www.bbainc.com

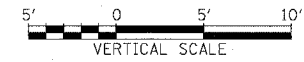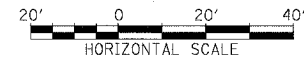

STA.+.. TO STA.+..

5:03:53 PM
 6/27/2005

PROFILE REVIEWED BY DATE
 GRADINGS CHECKED BY
 NOTE BOOK NO. STRUCTURE NOTATIONS CHKD

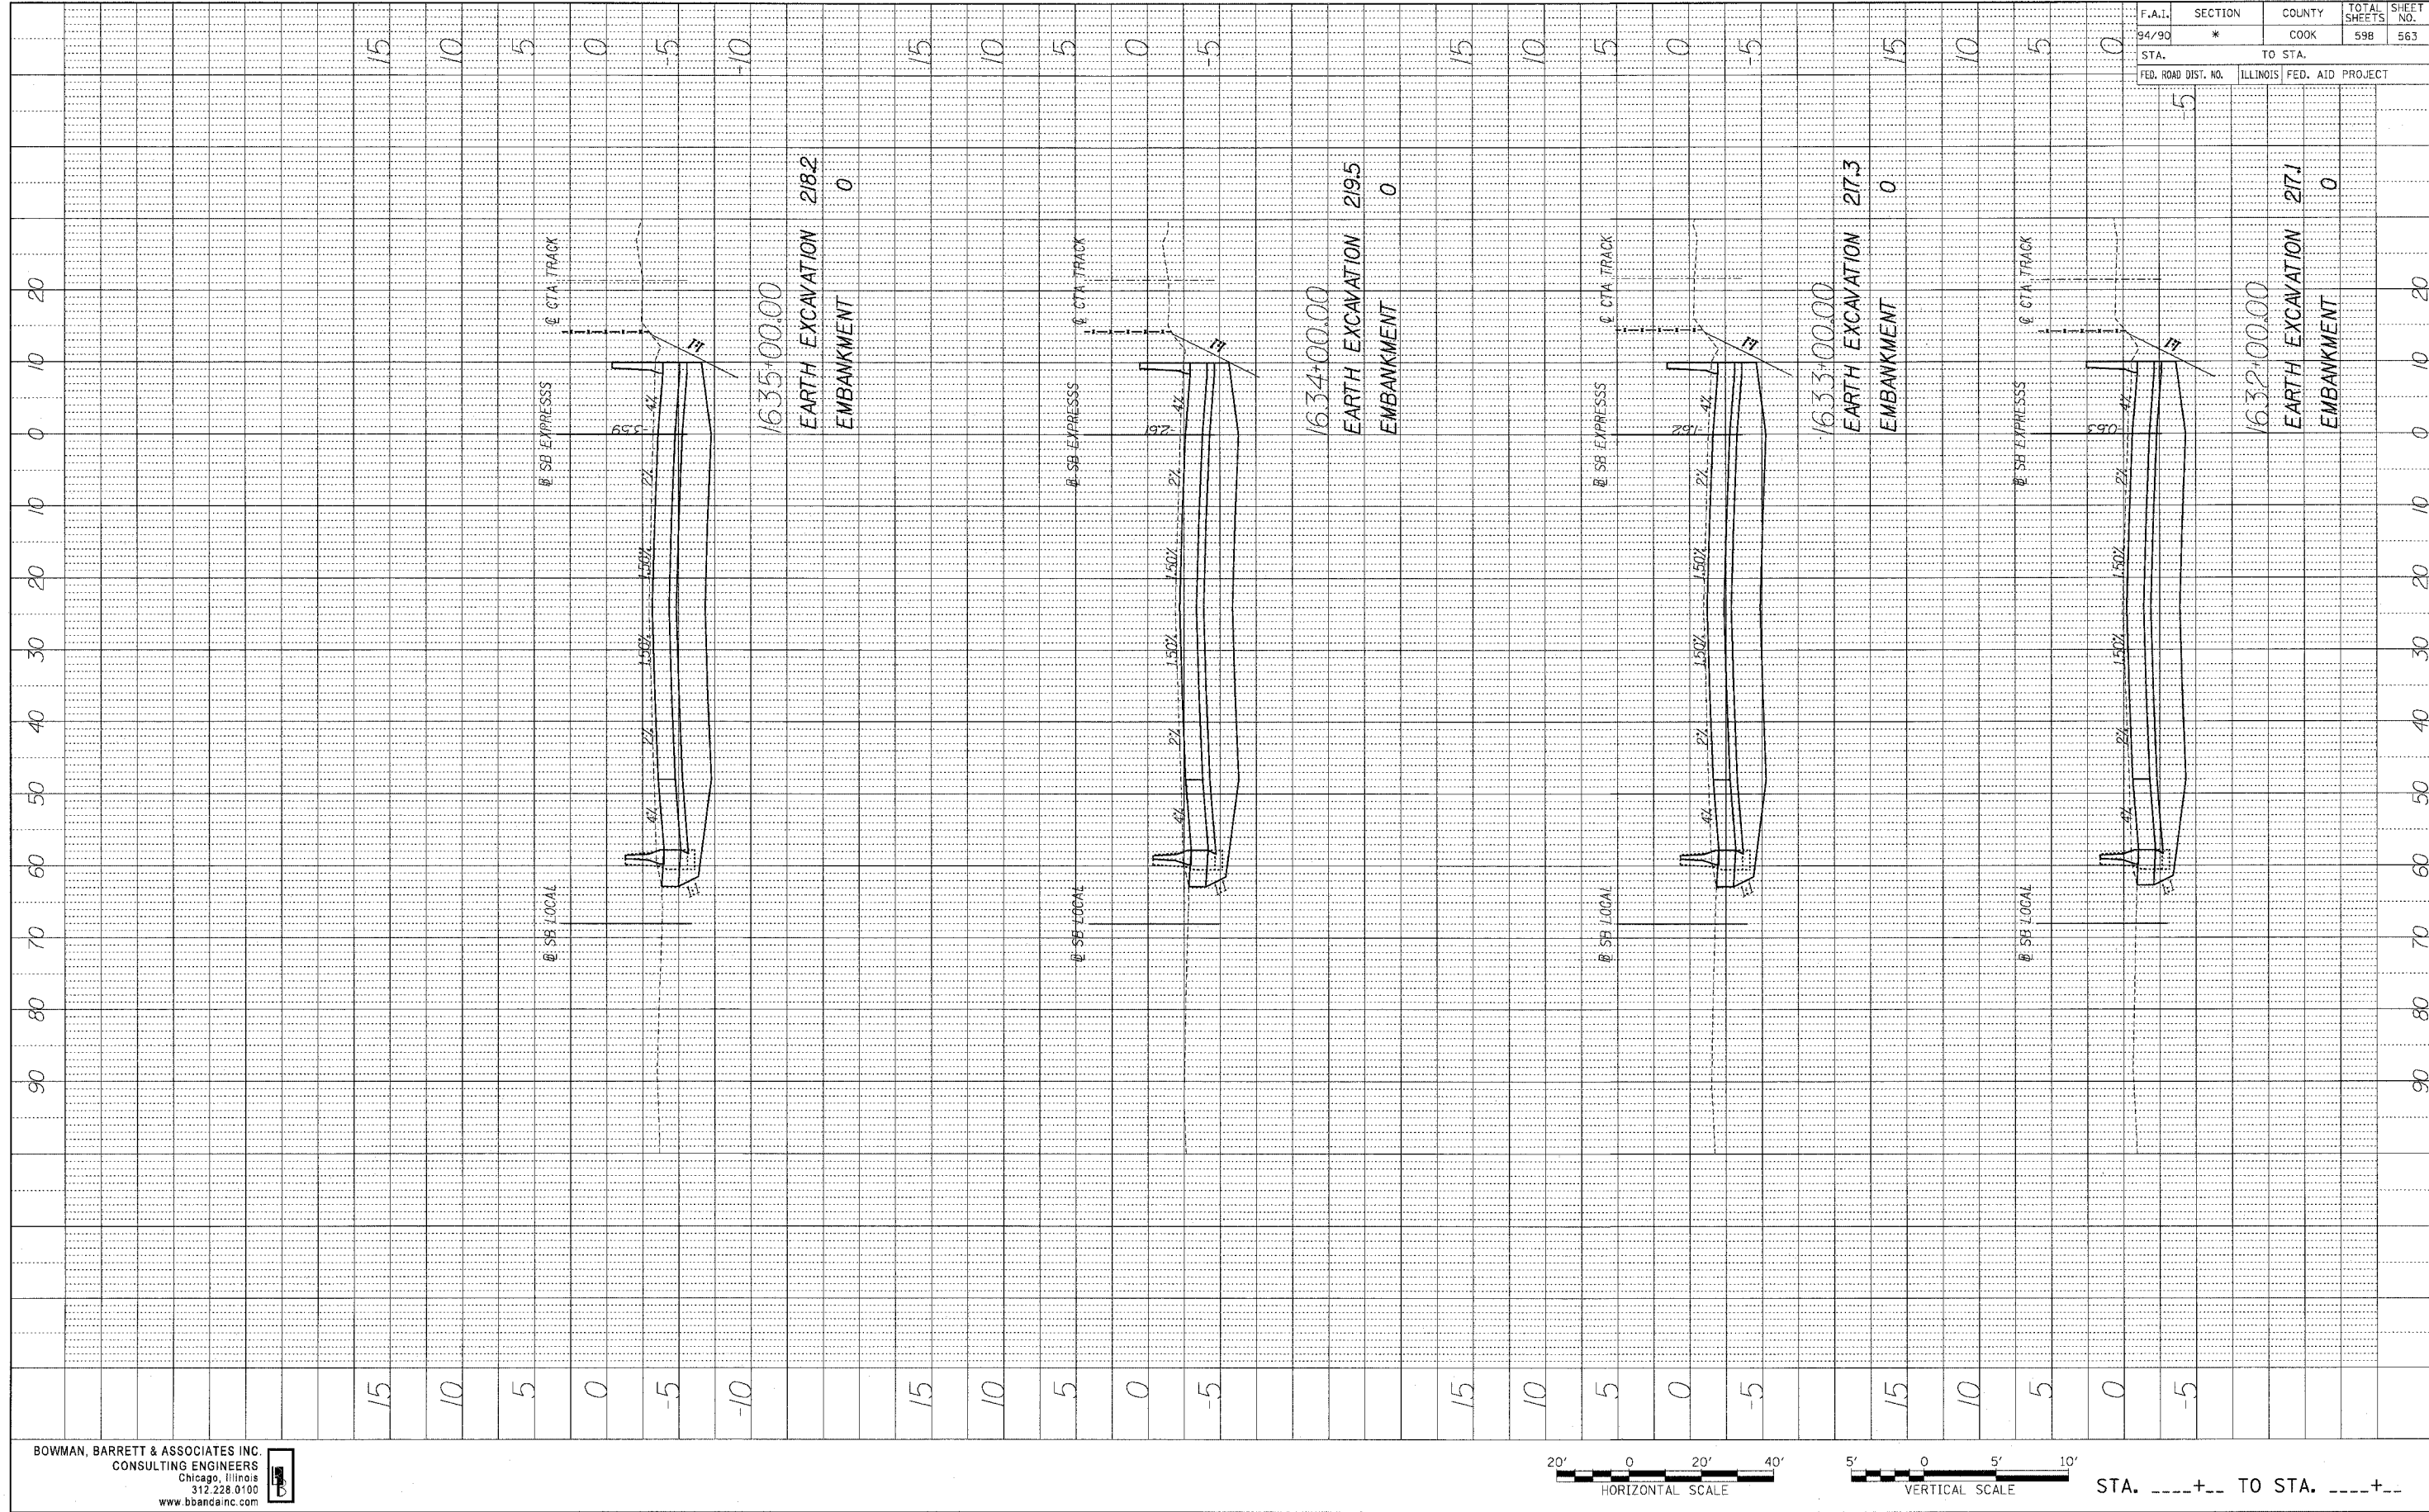

1635+00.00
 EARTH EXCAVATION 218.2
 EMBANKMENT 0

1634+00.00
 EARTH EXCAVATION 219.5
 EMBANKMENT 0

1633+00.00
 EARTH EXCAVATION 217.3
 EMBANKMENT 0

1632+00.00
 EARTH EXCAVATION 217.1
 EMBANKMENT 0

62302		*1818, ETC, 2324.6-1PJR-9	
F.A.I.	SECTION	COUNTY	TOTAL SHEETS
94/90	*	COOK	598
STA.	TO STA.		SHEET NO.
FED. ROAD DIST. NO.	ILLINOIS	FED. AID PROJECT	


BOWMAN, BARRETT & ASSOCIATES INC
 CONSULTING ENGINEERS
 Chicago, Illinois
 312.228.0100
 www.bbainc.com



STA.+... TO STA.+...


5/27/2005 5:00:03 PM

PROFILE DRAWING
 DATE
 BY
 CHECKED
 NO. OF SHEETS
 NO. OF SHEETS
 NO. OF SHEETS
 NO. OF SHEETS

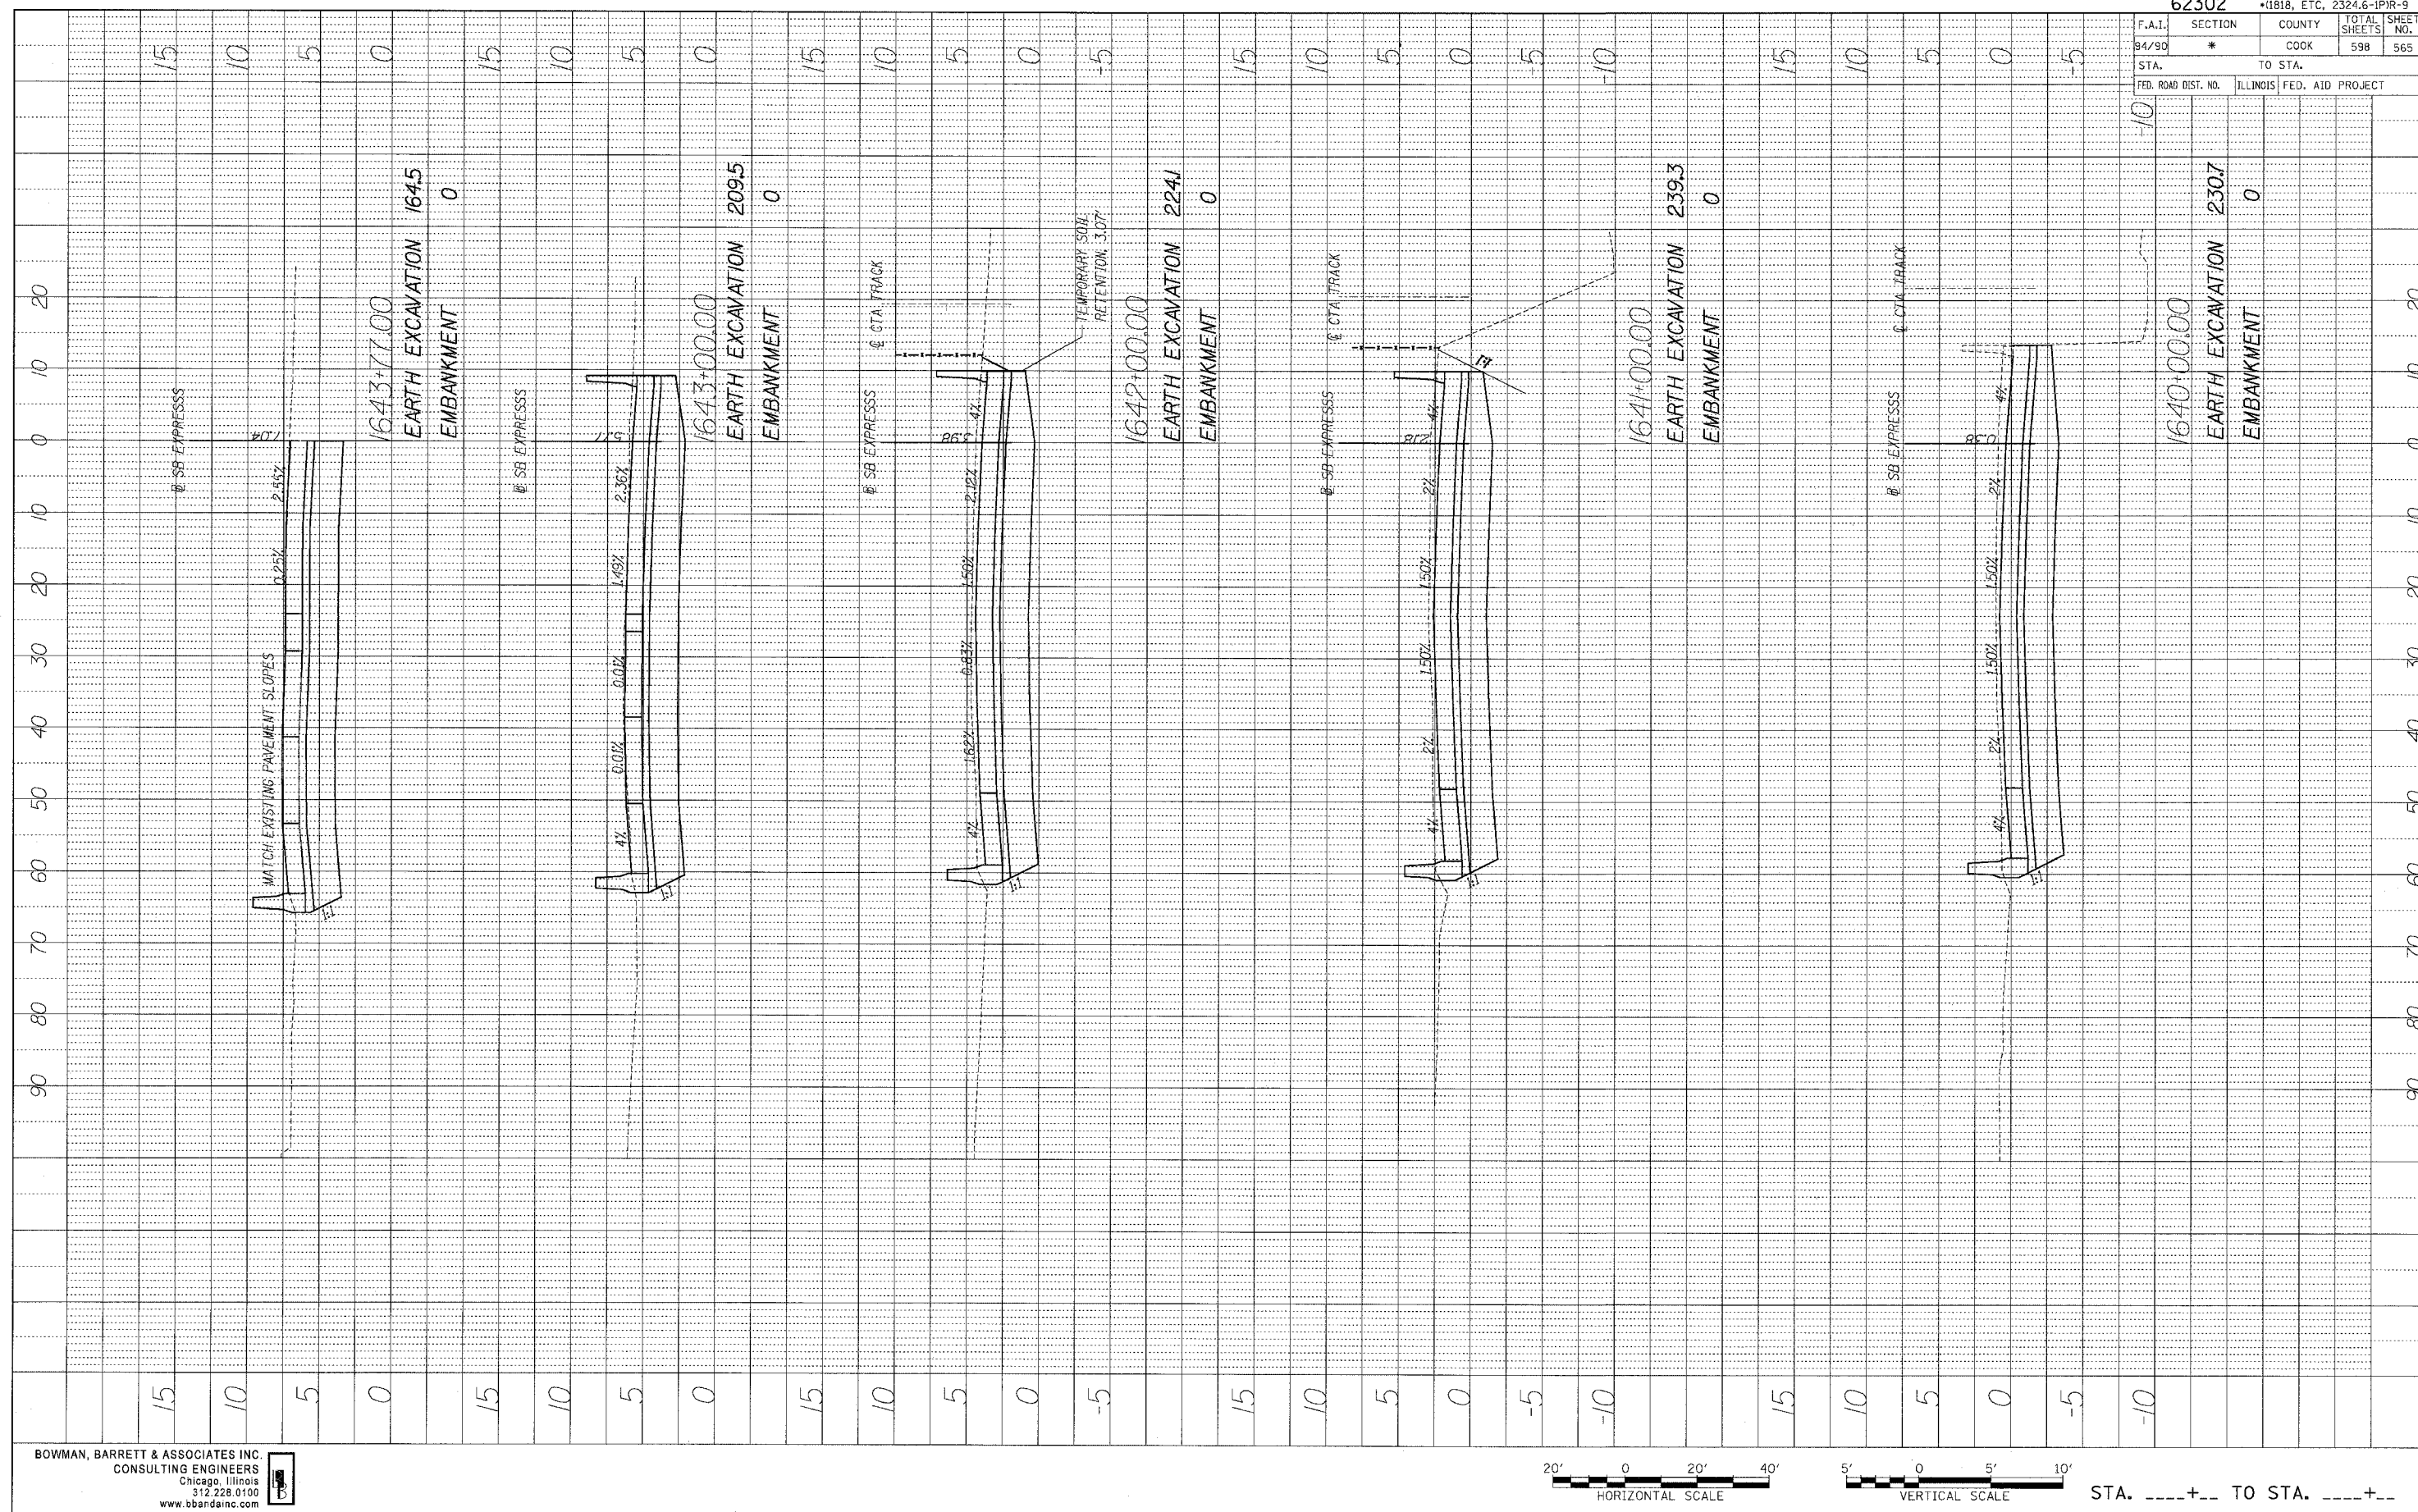

F.A.I.	SECTION	COUNTY	TOTAL SHEETS	SHEET NO.
84/90	*	COOK	598	565
STA.	TO STA.			
FED. ROAD DIST. NO.	ILLINOIS	FED. AID PROJECT		

BOWMAN, BARRETT & ASSOCIATES INC.
 CONSULTING ENGINEERS
 Chicago, Illinois
 312.228.0100
 www.bbainc.com

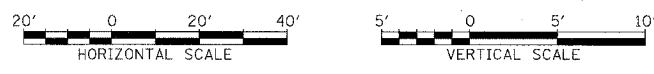

STA. ----+--- TO STA. ----+---


6/27/2005 50132 PW

F.A.I.	SECTION	COUNTY	TOTAL SHEETS	SHEET NO.
94/90	*	COOK	598	566

STA.	TO STA.
5	0

FED. ROAD DIST. NO.	ILLINOIS	FED. AID PROJECT

PROFILE
 DRAWN BY _____ DATE _____
 GRADES CHECKED _____
 NOTE BOOK NO. _____
 STRUCTURE NOTATION CHKD _____

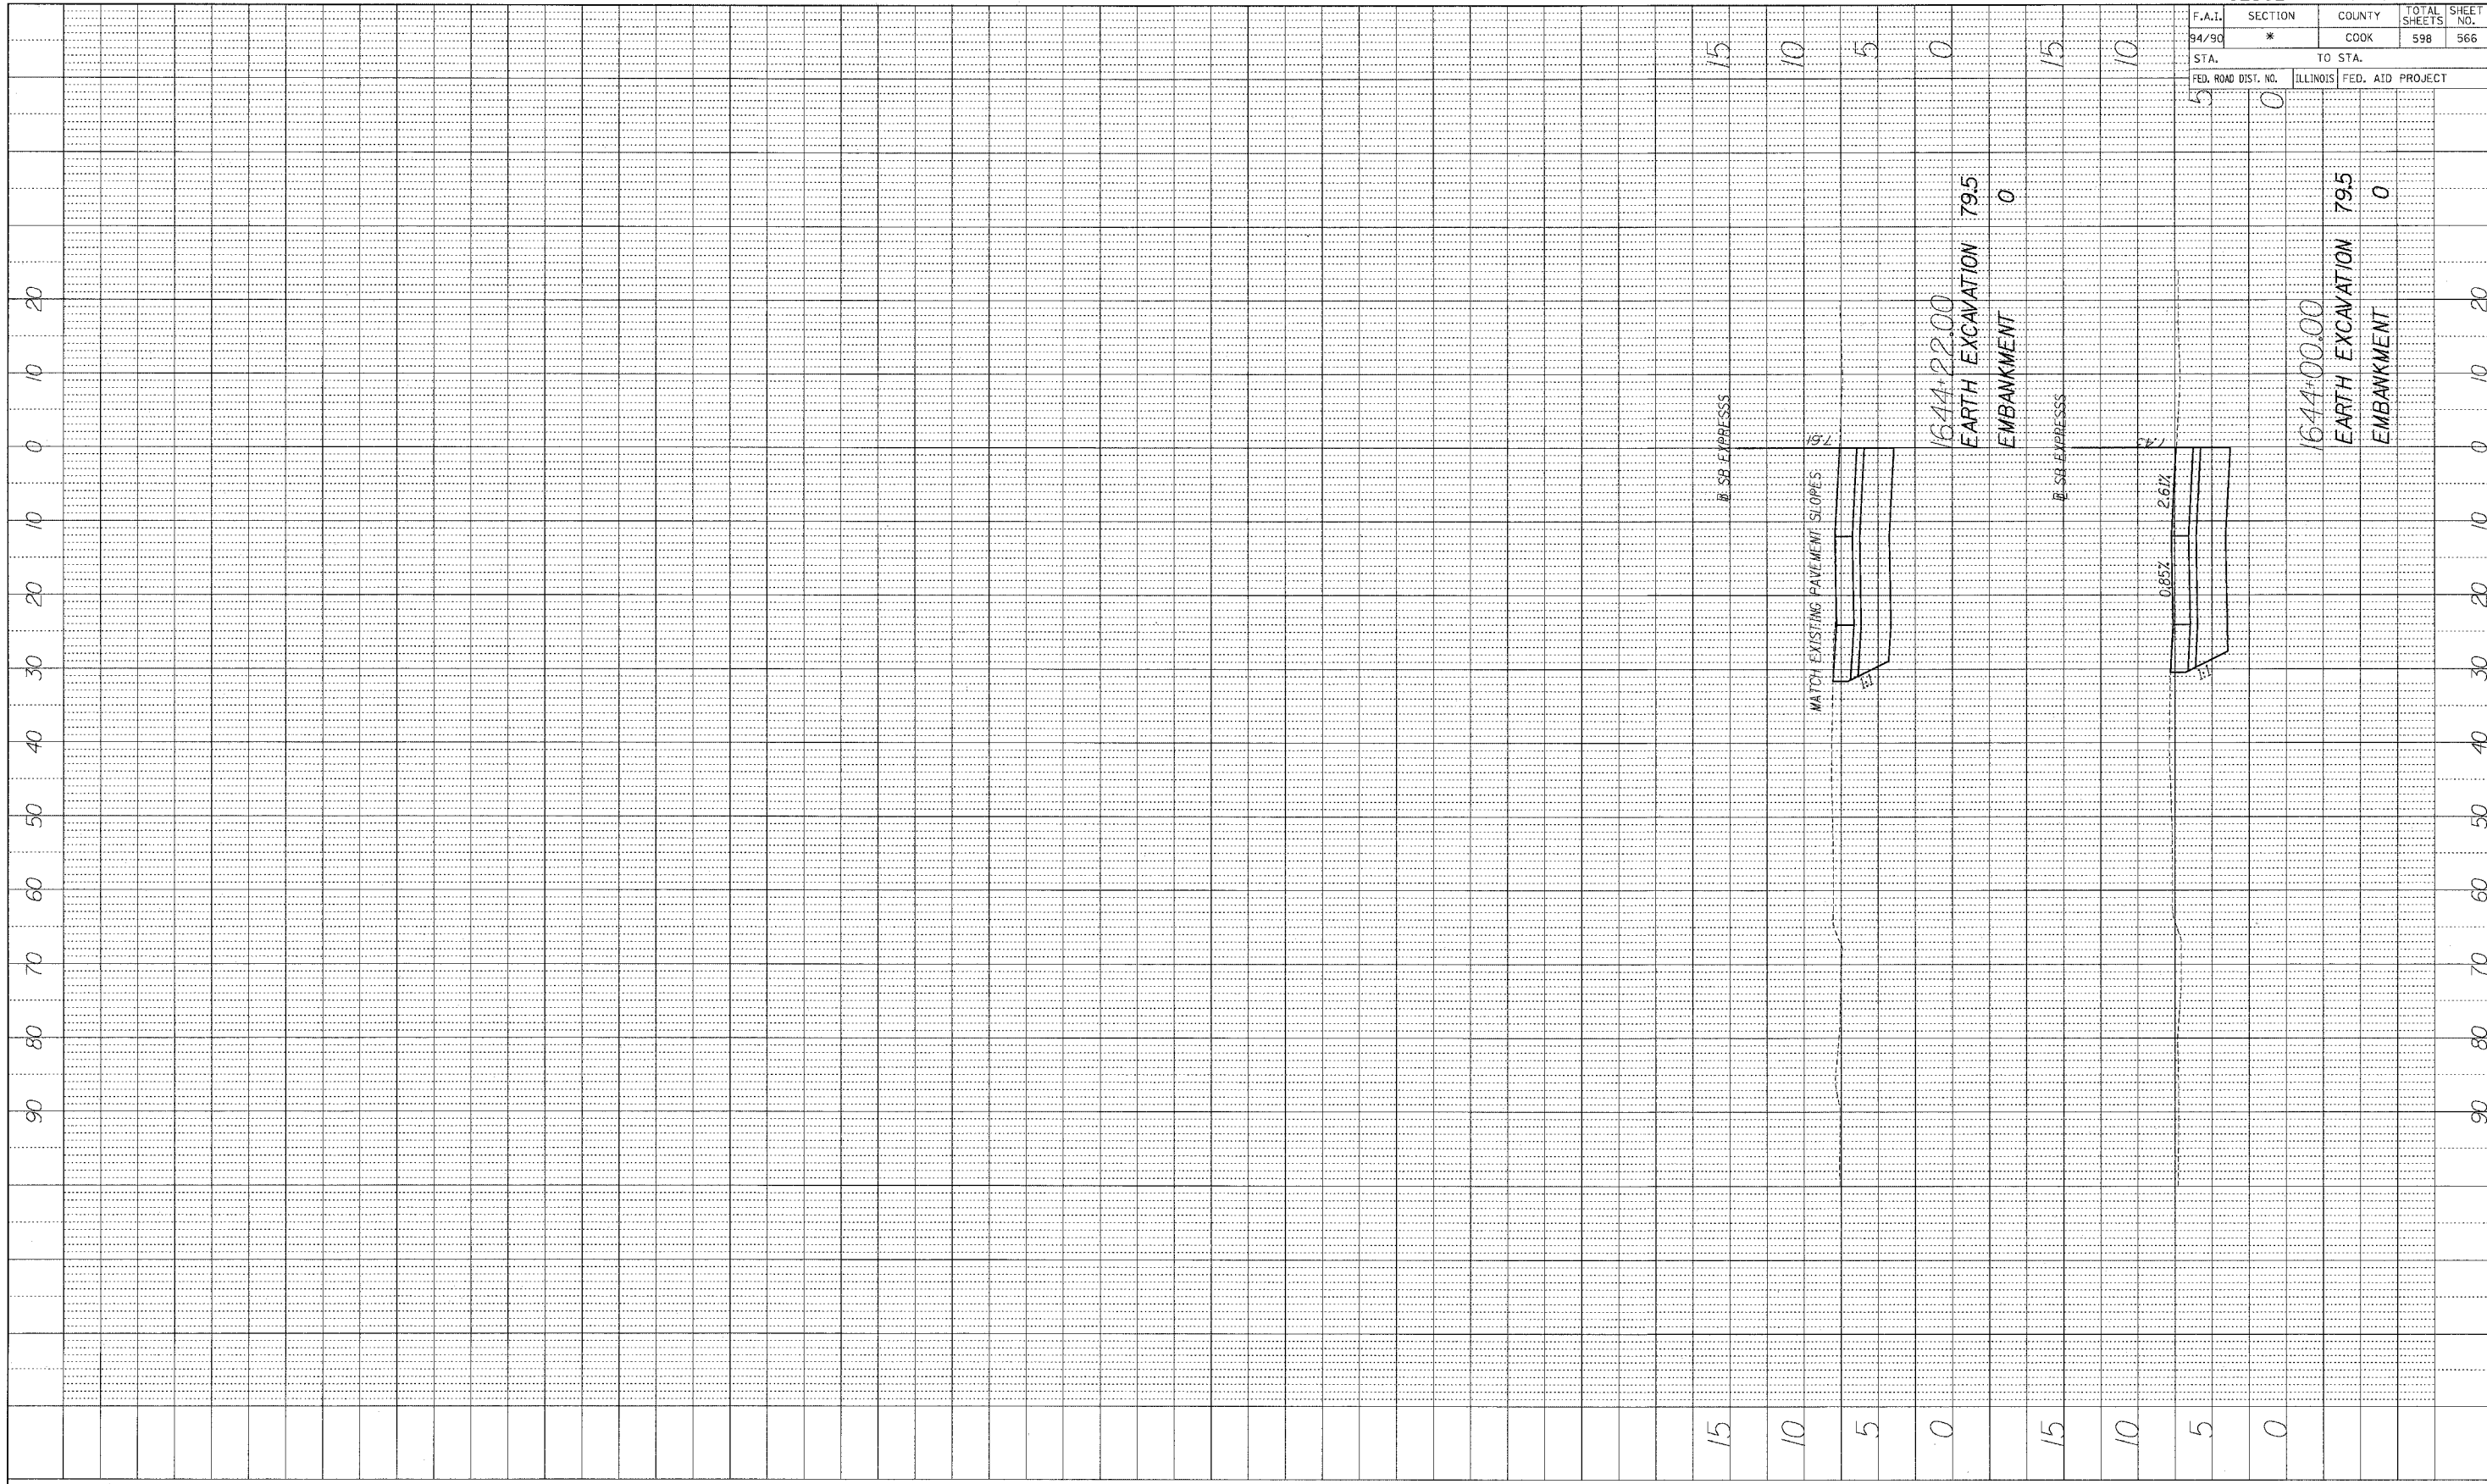

BOWMAN, BARRETT & ASSOCIATES INC
 CONSULTING ENGINEERS
 Chicago, Illinois
 312.228.0100
 www.bbainc.com




STA.+.. TO STA.+..

SECTION	COUNTY	TOTAL SHEETS
94/90	COOK	598

STATION	TO STA.
1372+00	1372+04.00

ILLINOIS FED. AID PROJECT

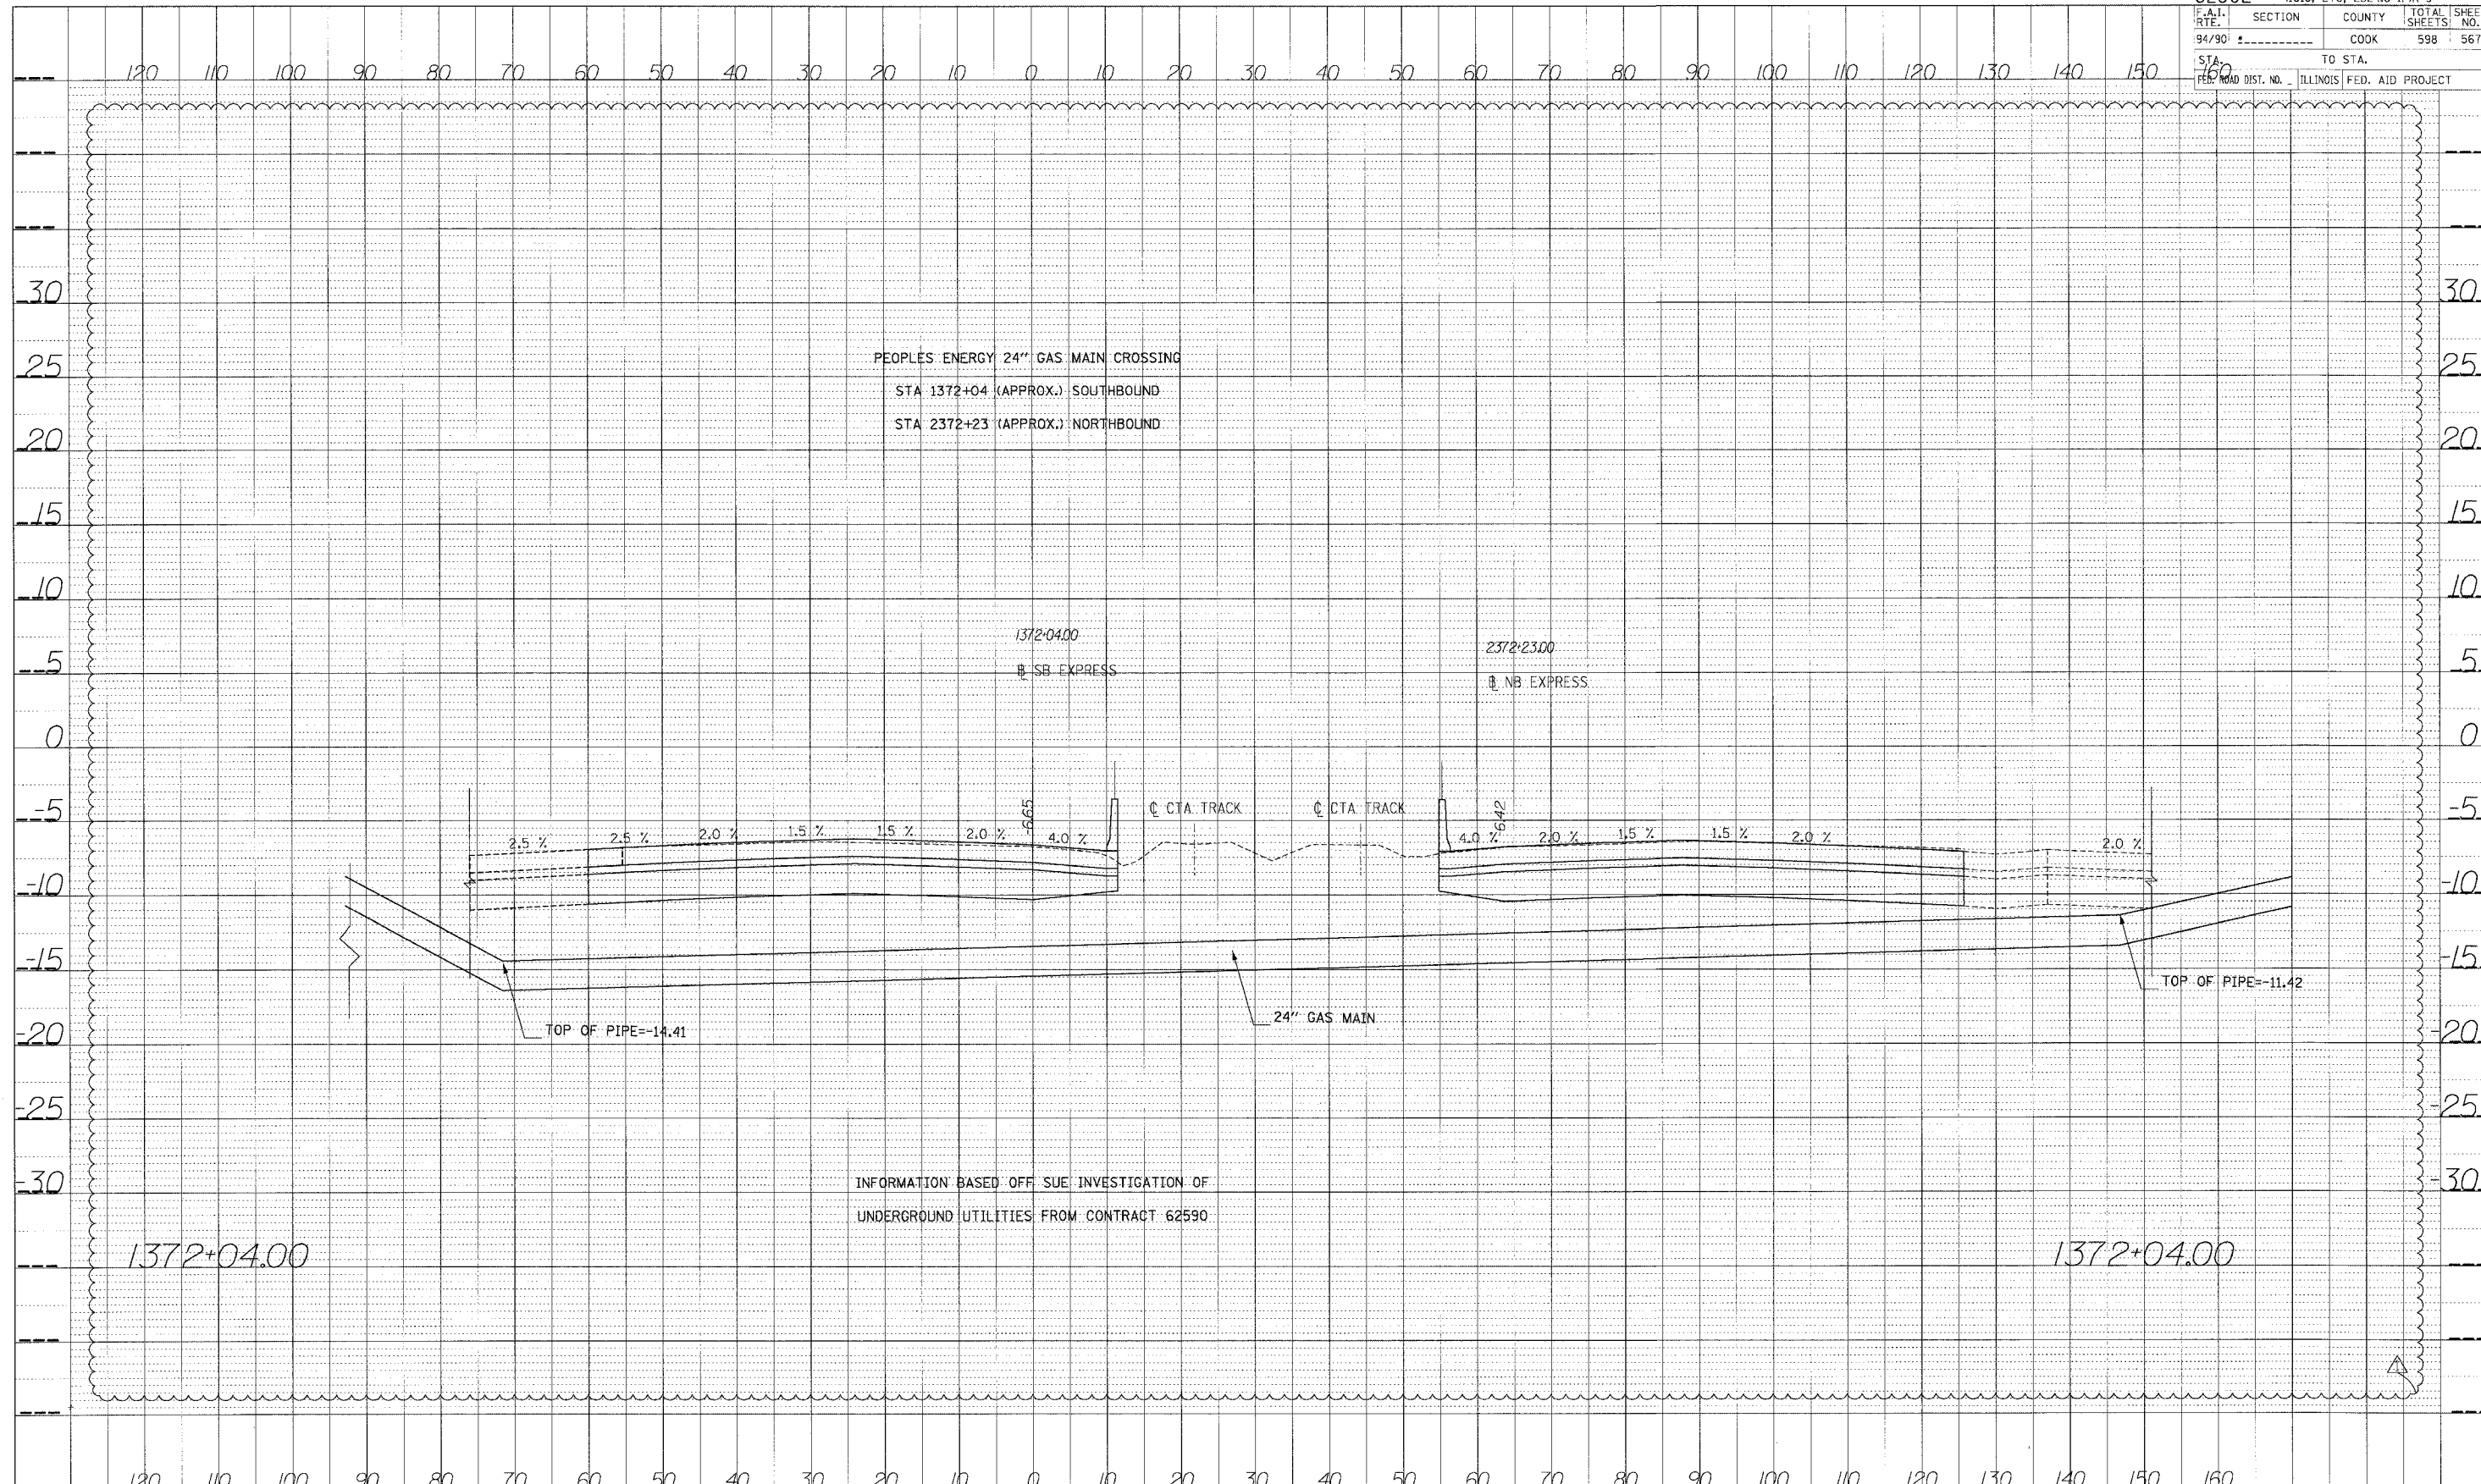

PEOPLES ENERGY 24" GAS MAIN CROSSING
 STA 1372+04 (APPROX.) SOUTHBOUND
 STA 2372+23 (APPROX.) NORTHBOUND

1372+04.00
 SB EXPRESS

2372+23.00
 NB EXPRESS

CTA TRACK

TOP OF PIPE=-14.41

24" GAS MAIN

TOP OF PIPE=-11.42

INFORMATION BASED OFF SUE INVESTIGATION OF
 UNDERGROUND UTILITIES FROM CONTRACT 62590

1372+04.00

1372+04.00

DATE	BY


Edwards AND Kelcey
 ONE NORTH FRANKLIN
 CHICAGO, IL 60606
 PHONE: (312) 251-3000
 FAX: (312) 251-3015
 WEB: WWW.EKCORP.COM



STA.

DATE PLOTTED: 10/15/03

PROFILE SUBMITTED BY DATE
 PLANS CHECKED
 NO. VE BOOK S.M. NO. DED
 NO. STRUCTURE MATERIALS CIPRO

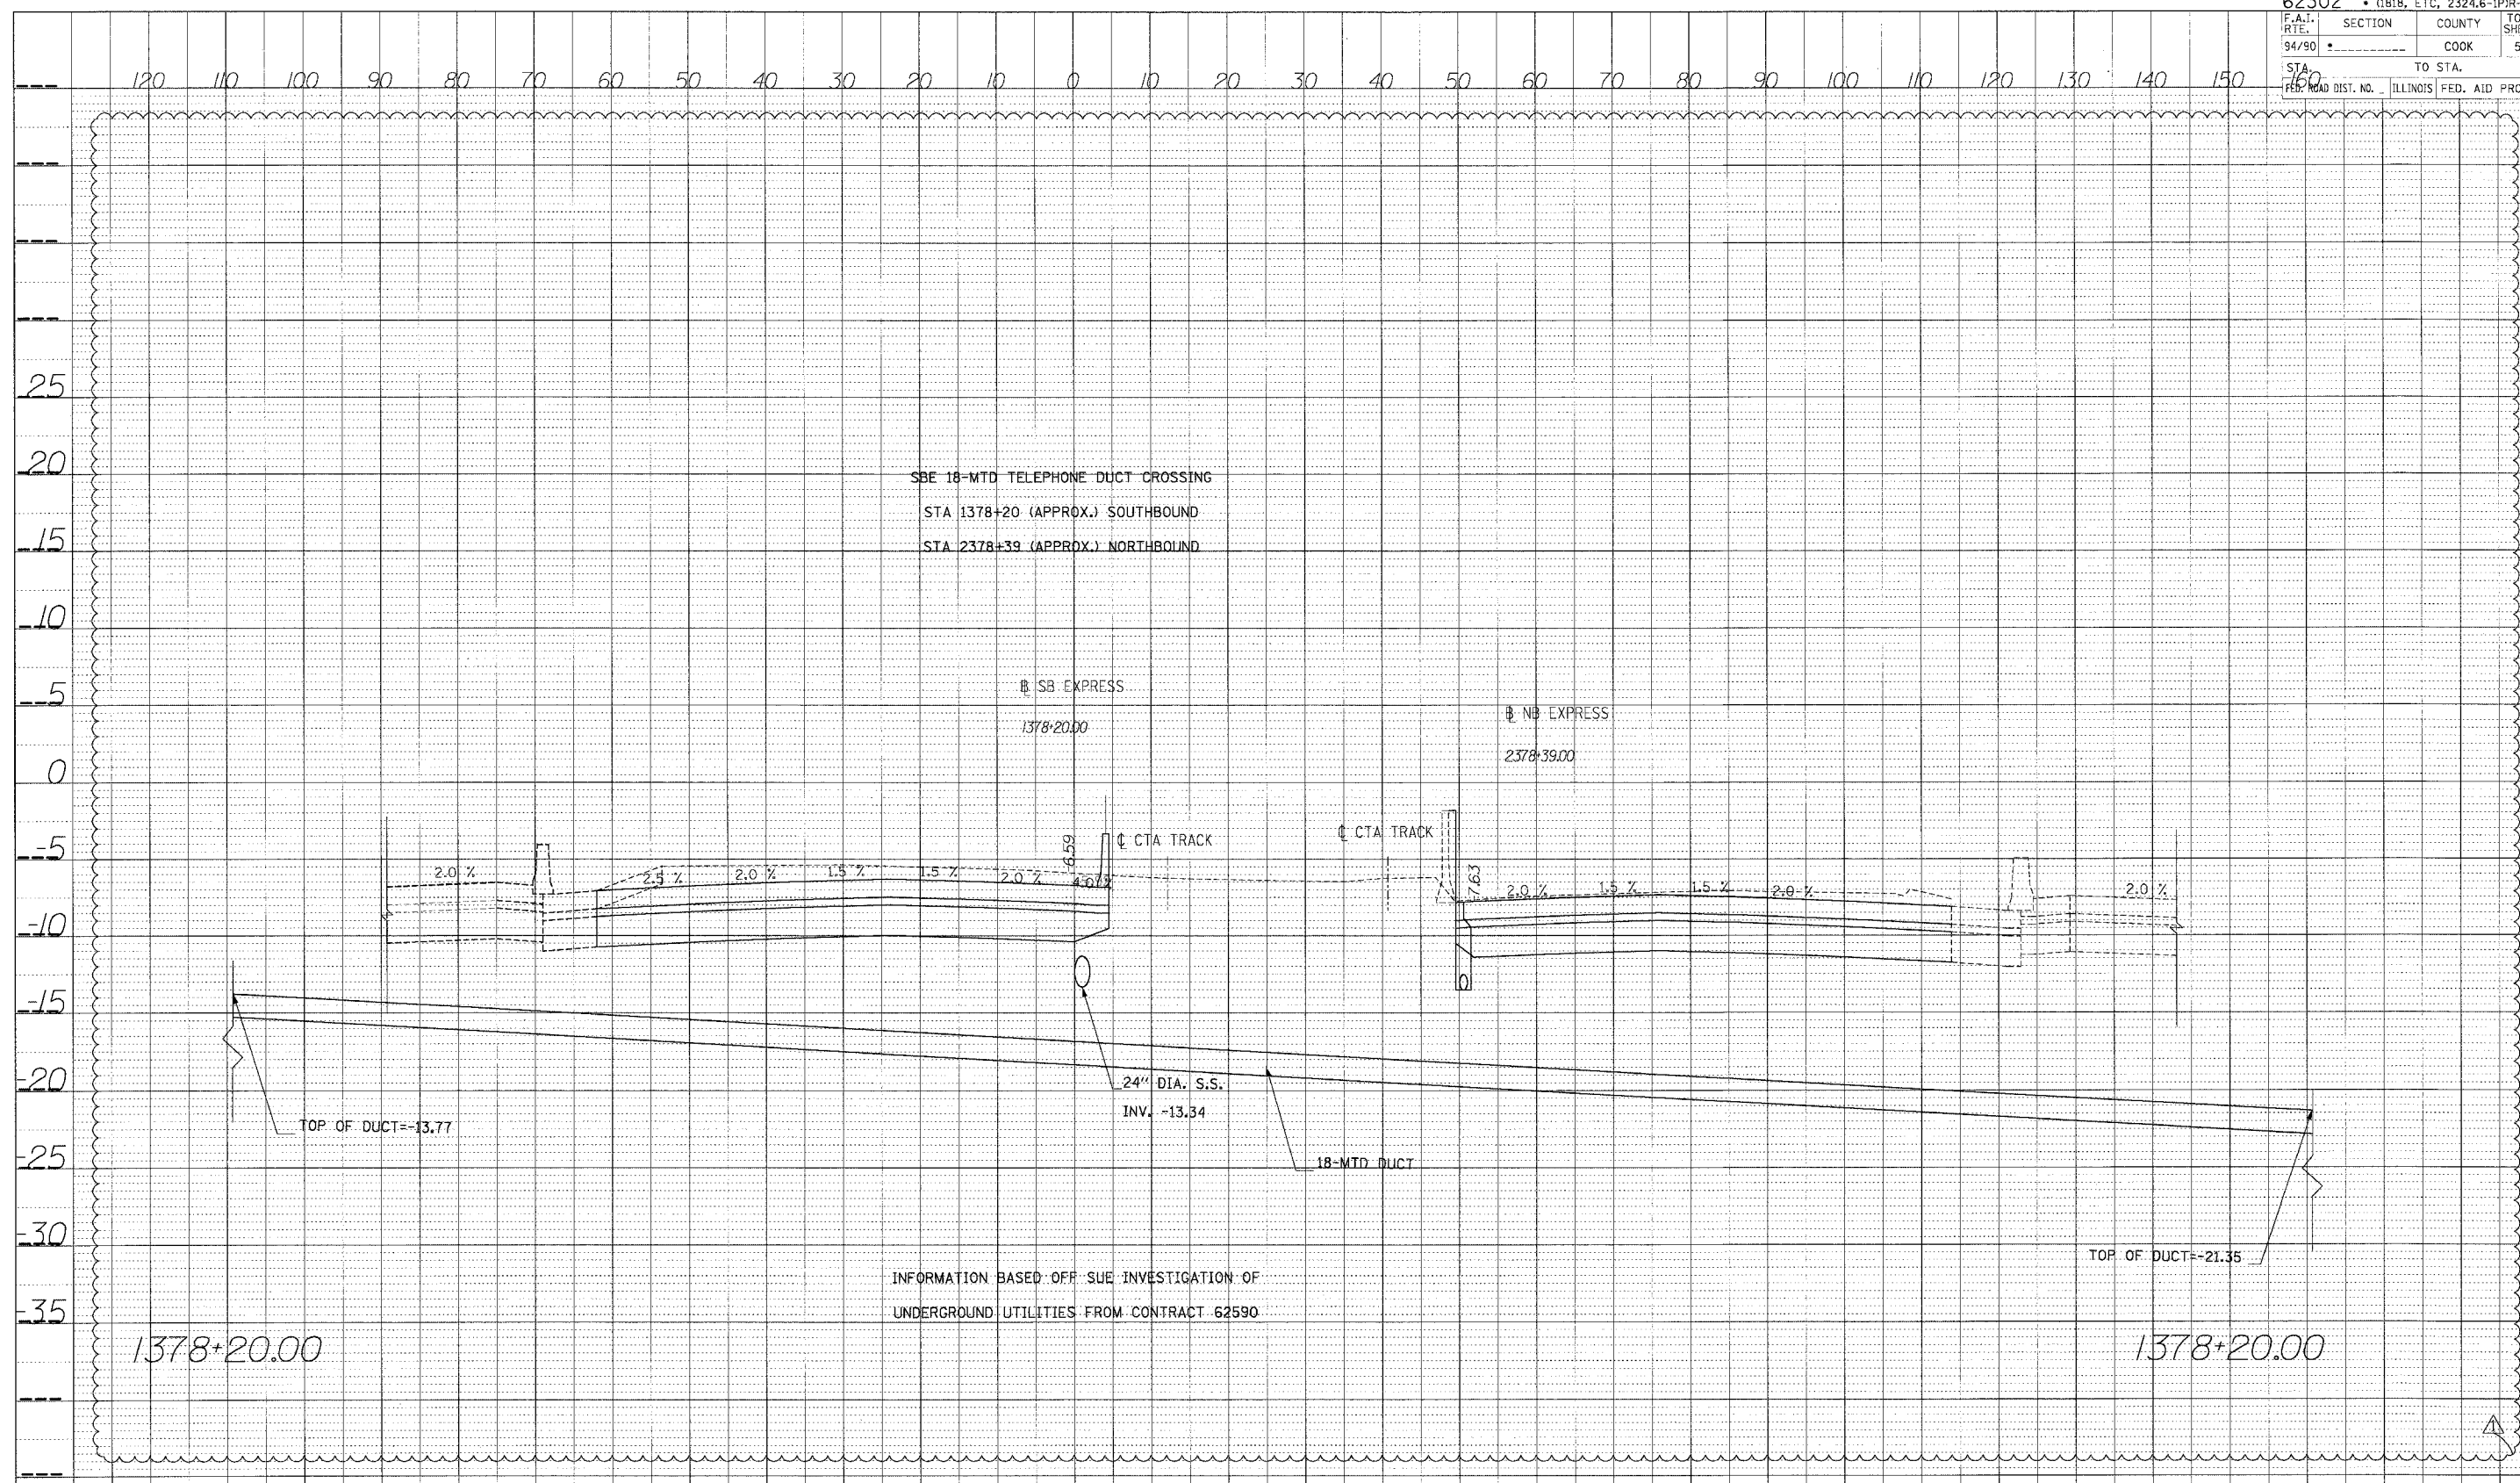


INFORMATION BASED OFF SUE INVESTIGATION OF
 UNDERGROUND UTILITIES FROM CONTRACT 62590




STA.


62302 • (1818, ETC, 2324.6-IPR-9)			
FILE NO.	SECTION	COUNTY	TOTAL SHEETS
94/90		COOK	598
STA. FROM	TO STA.	ILLINOIS FED. AID PROJECT	

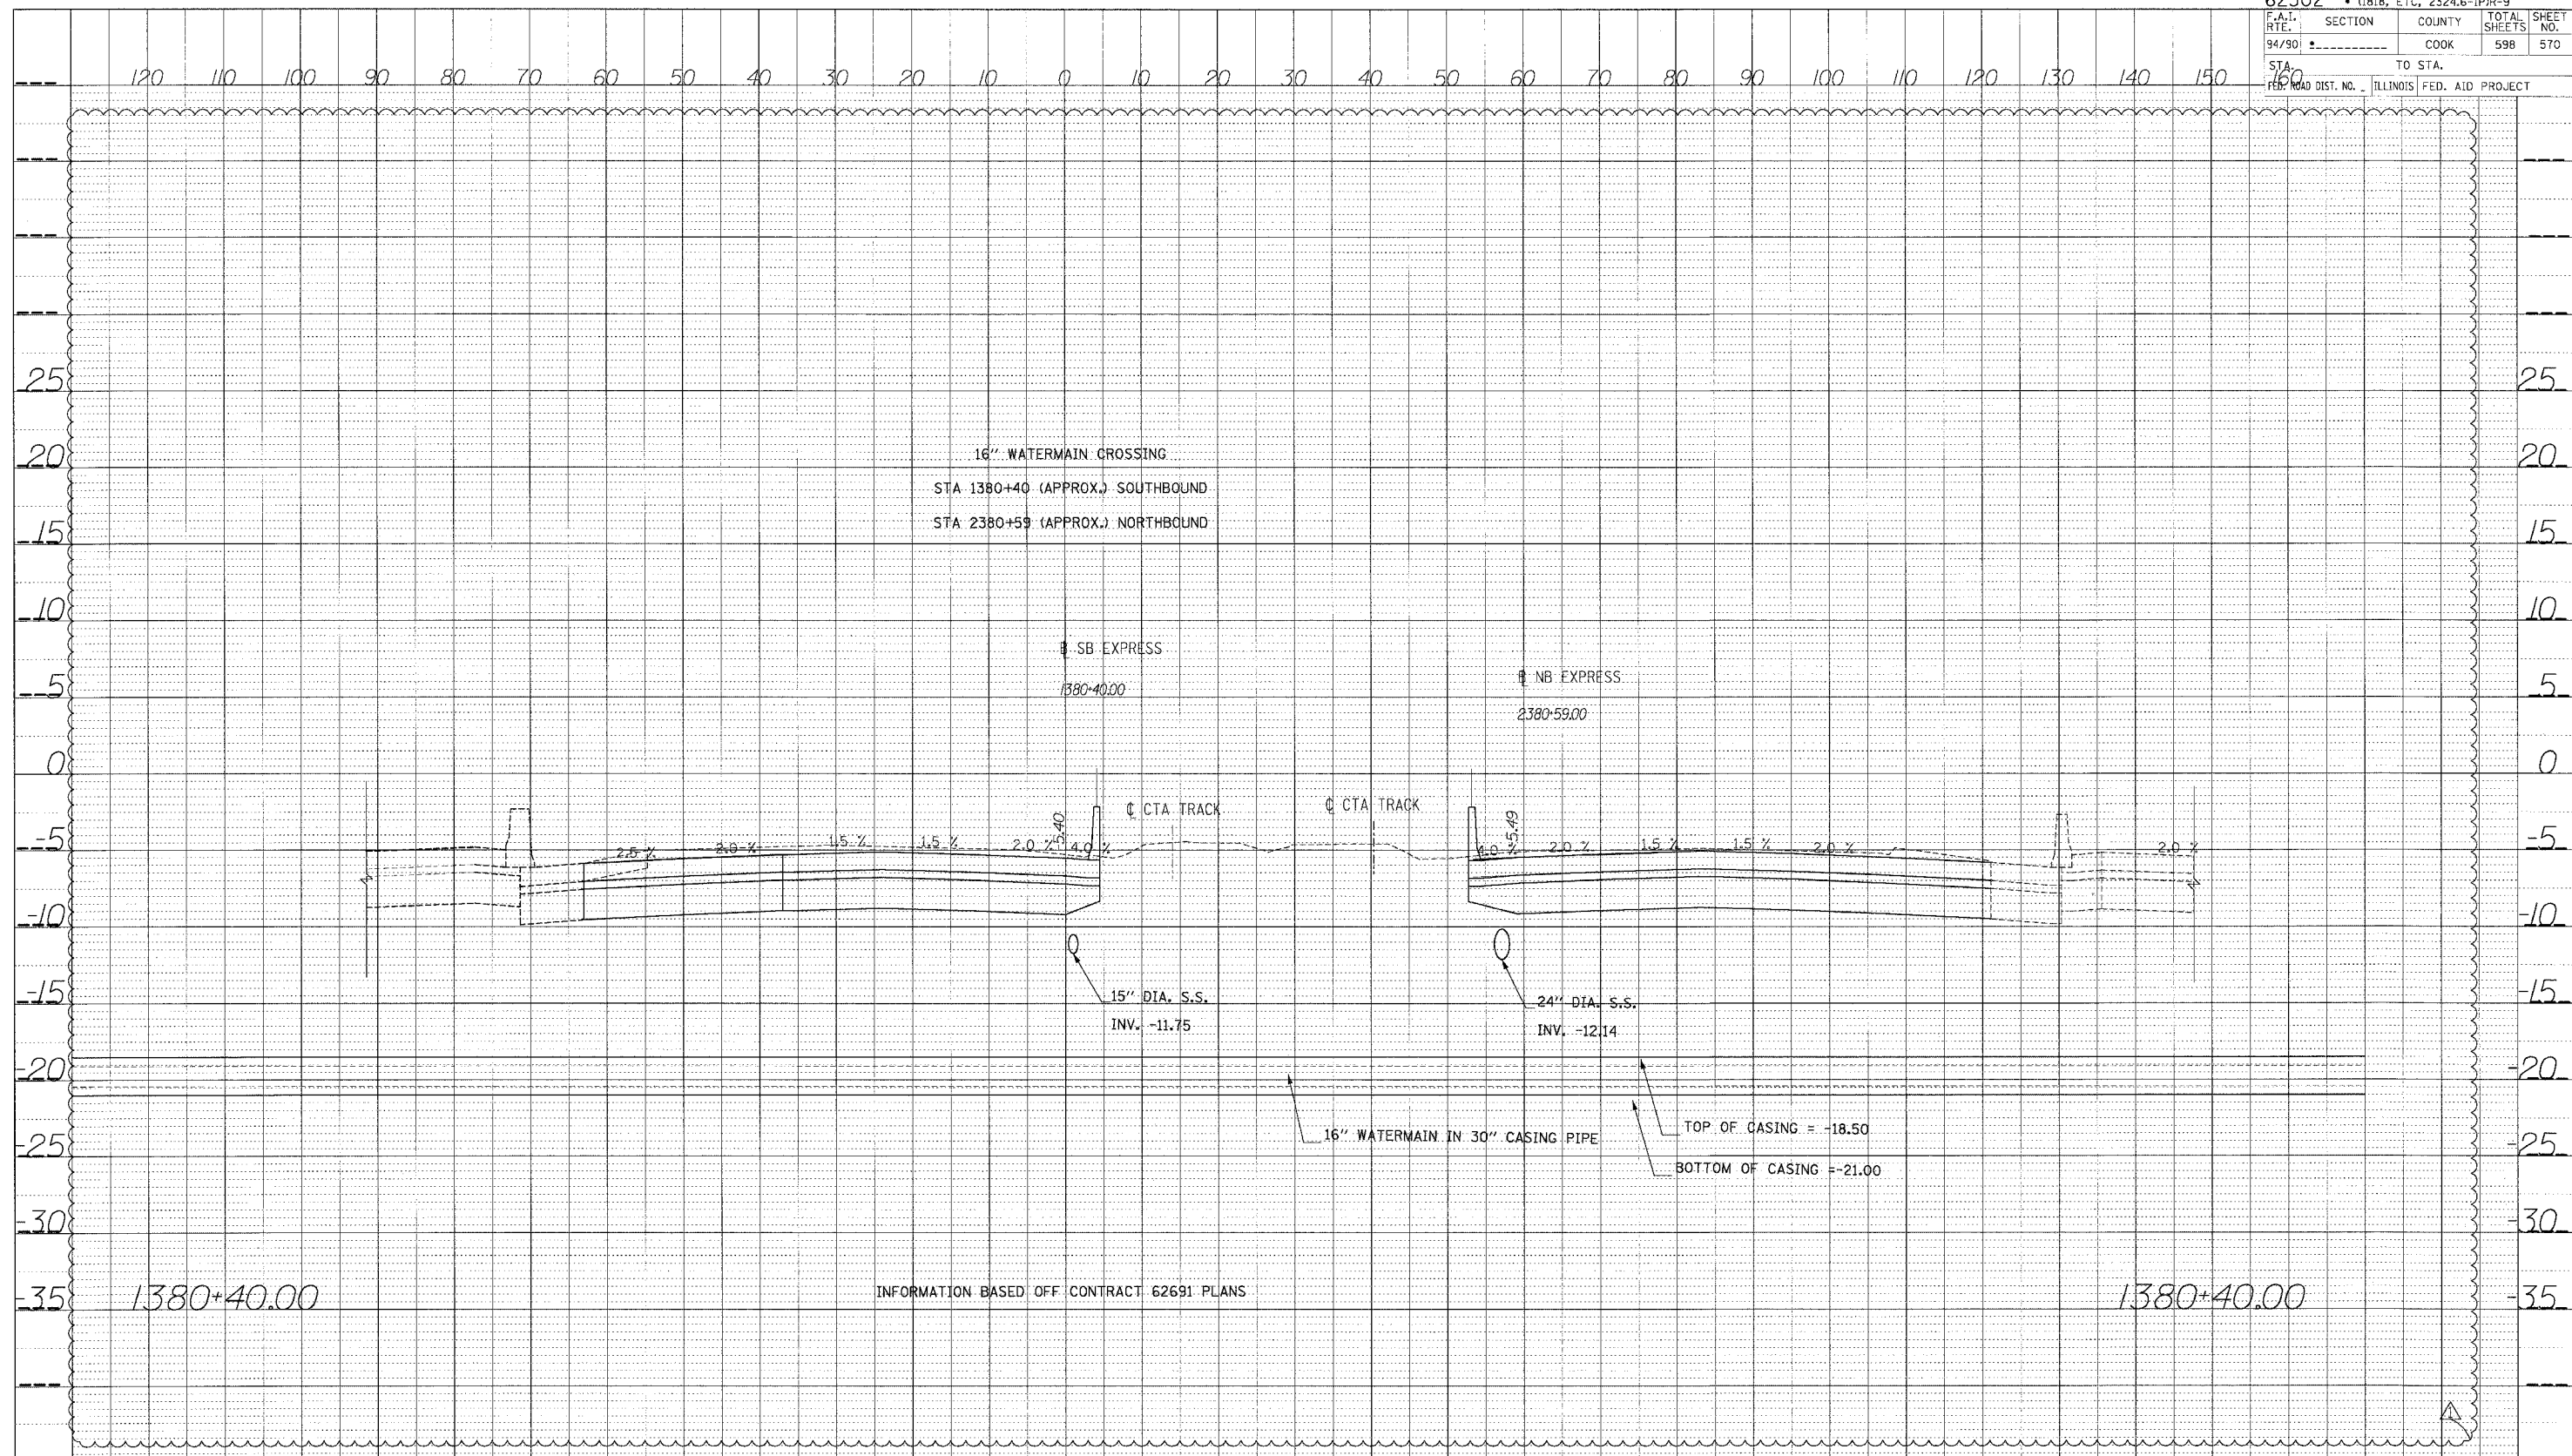


DATE	BY
PROF. ILL. SHEETED	
DESIGNED	
CHECKED	
SCALE	
NOTE BOOK	
NO.	
STRUCTURE	
NOTATION	
CHFD	

Edwards AND Kelcey
 ONE NORTH FRANKLIN
 CHICAGO, IL 60606
 PHONE: (312) 251-3000
 FAX: (312) 251-3015
 WEB: WWW.EKCORP.COM

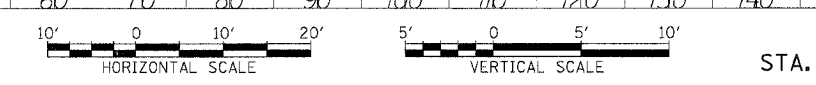

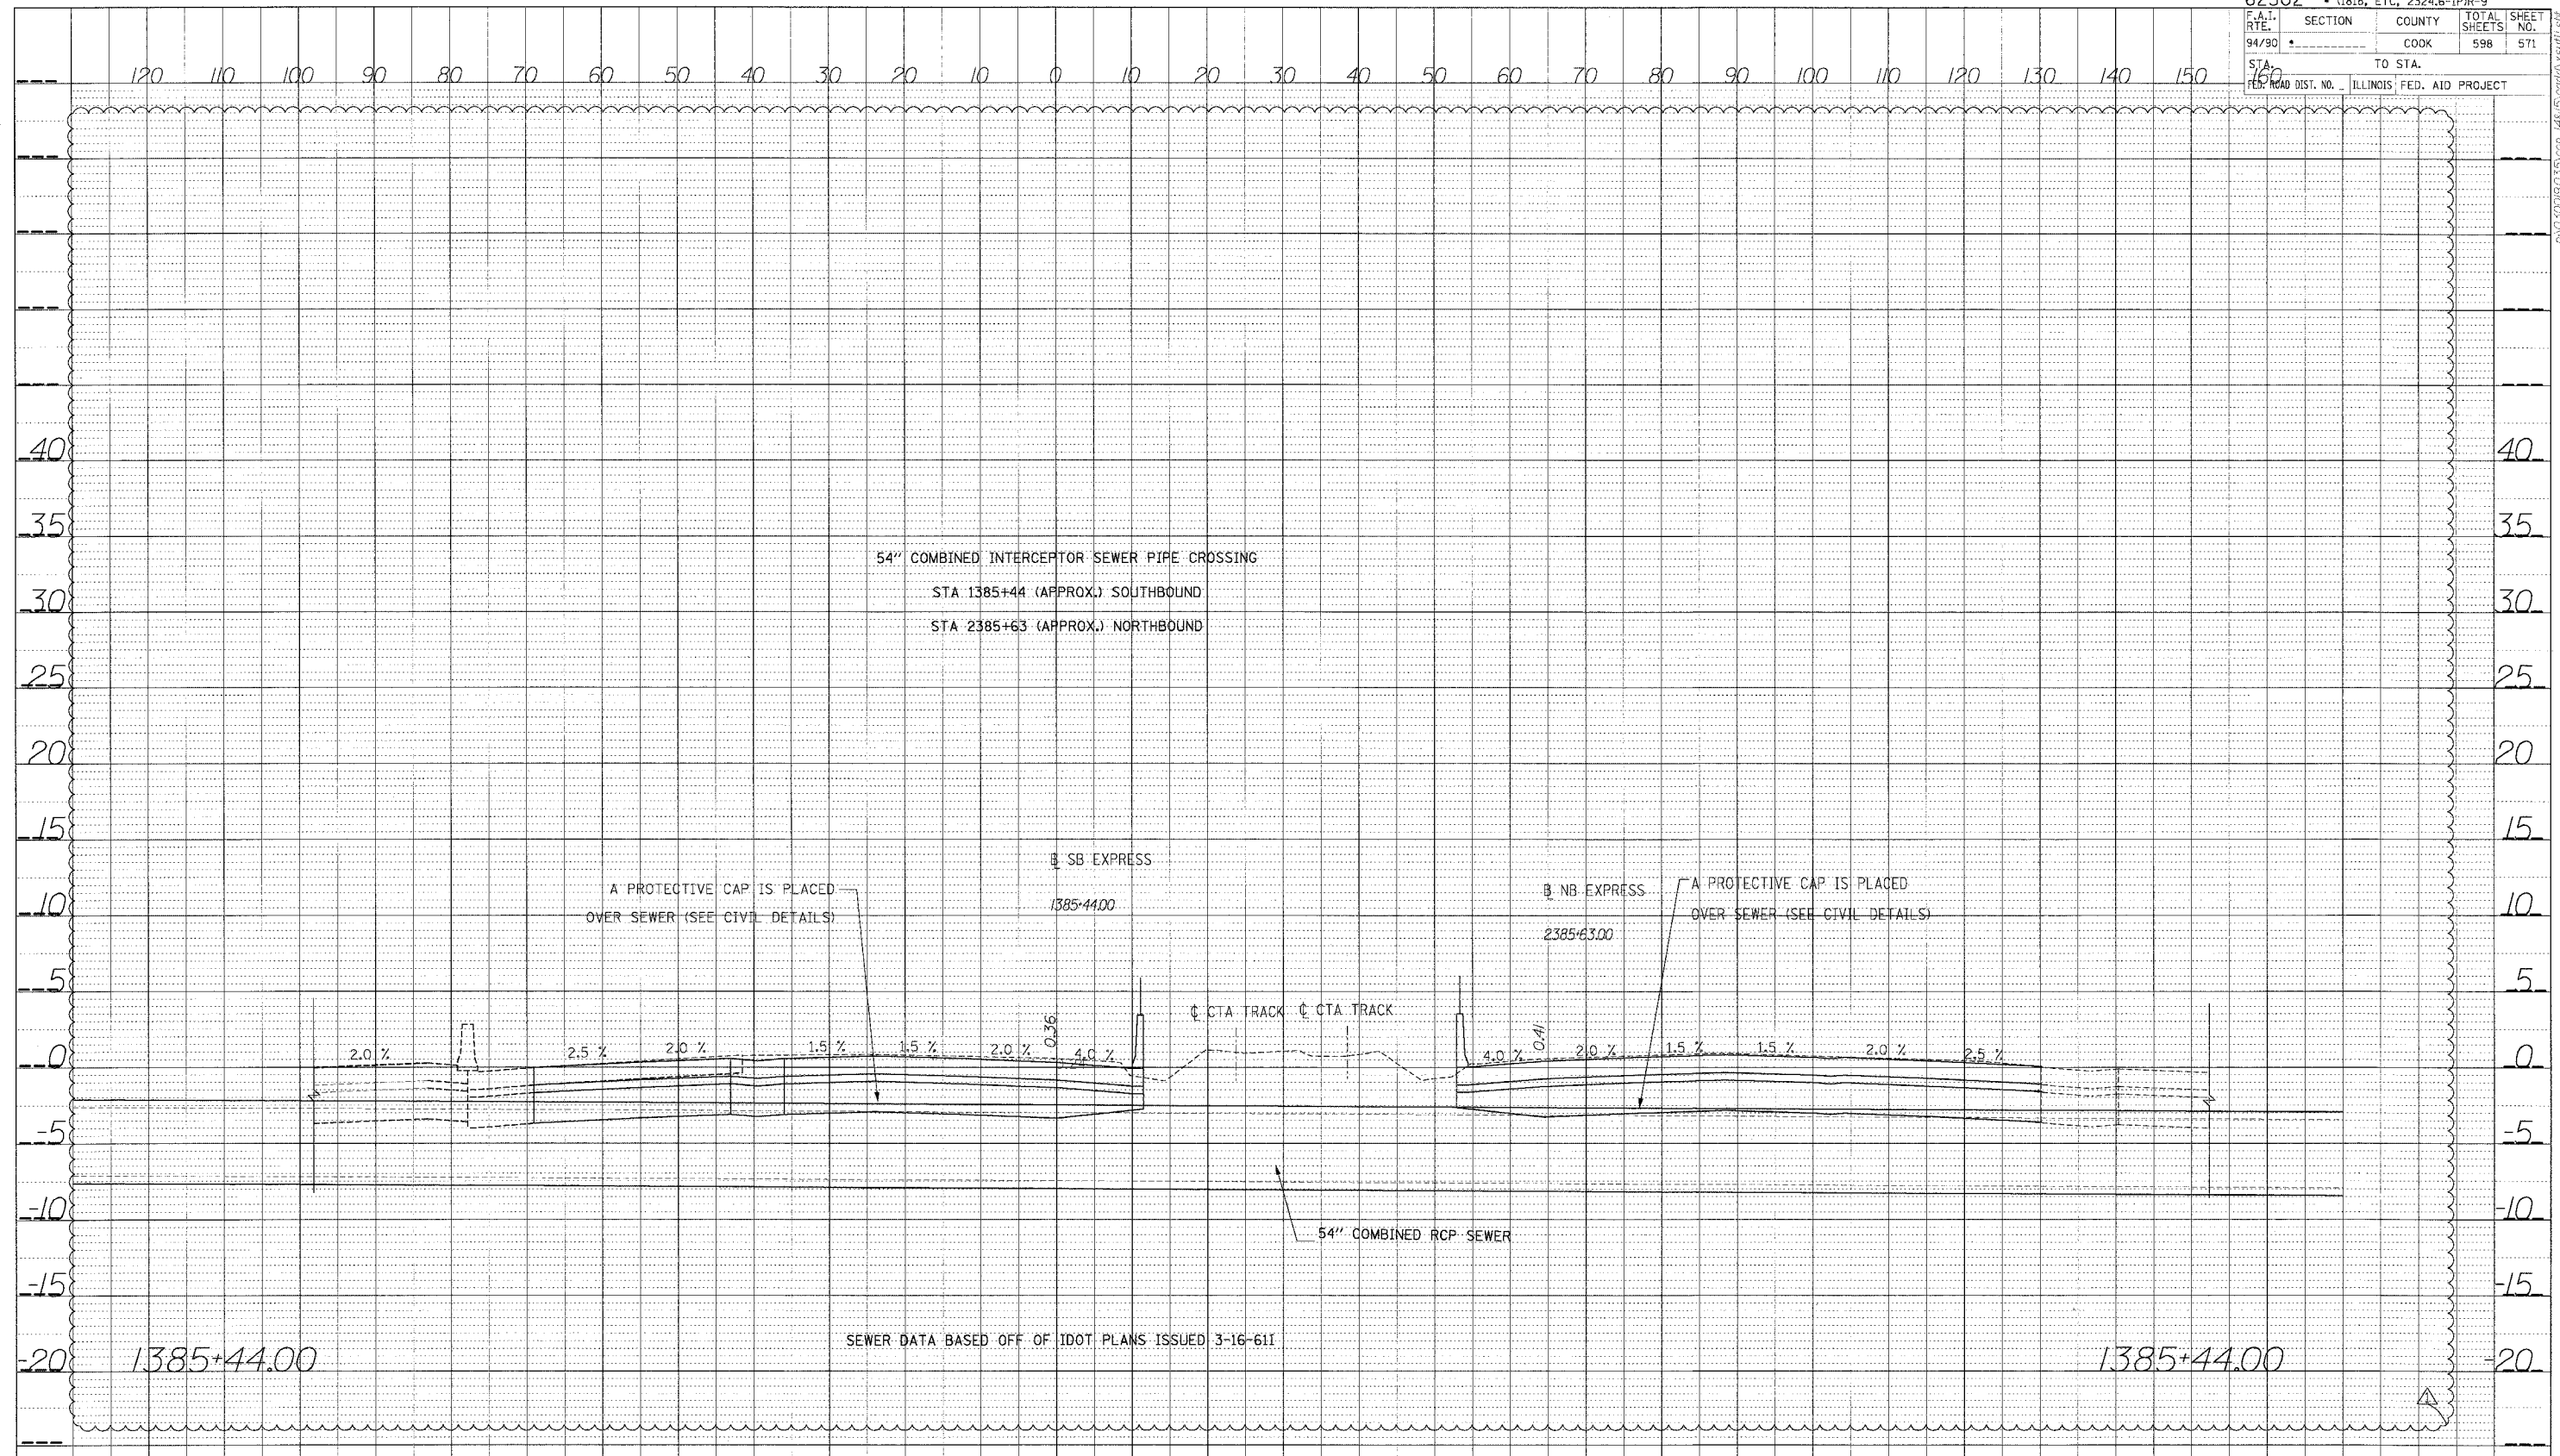


DATE	
BY	
PROJECT	
DESIGNED	
PLOTTED	
CHECKED	
IN CHARGE	
NOTE BOOK	
NO.	
STRUCTURE NOTATIONS	

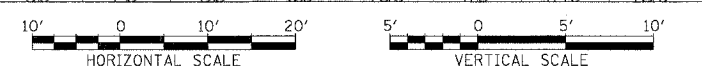


STA.

PROJ. ILL.	SUBMITTED	DATE
PLANT	CHECKED	
NOTE BOOK	BY	NOTED
NO.	STRUCTURE	NOTATION

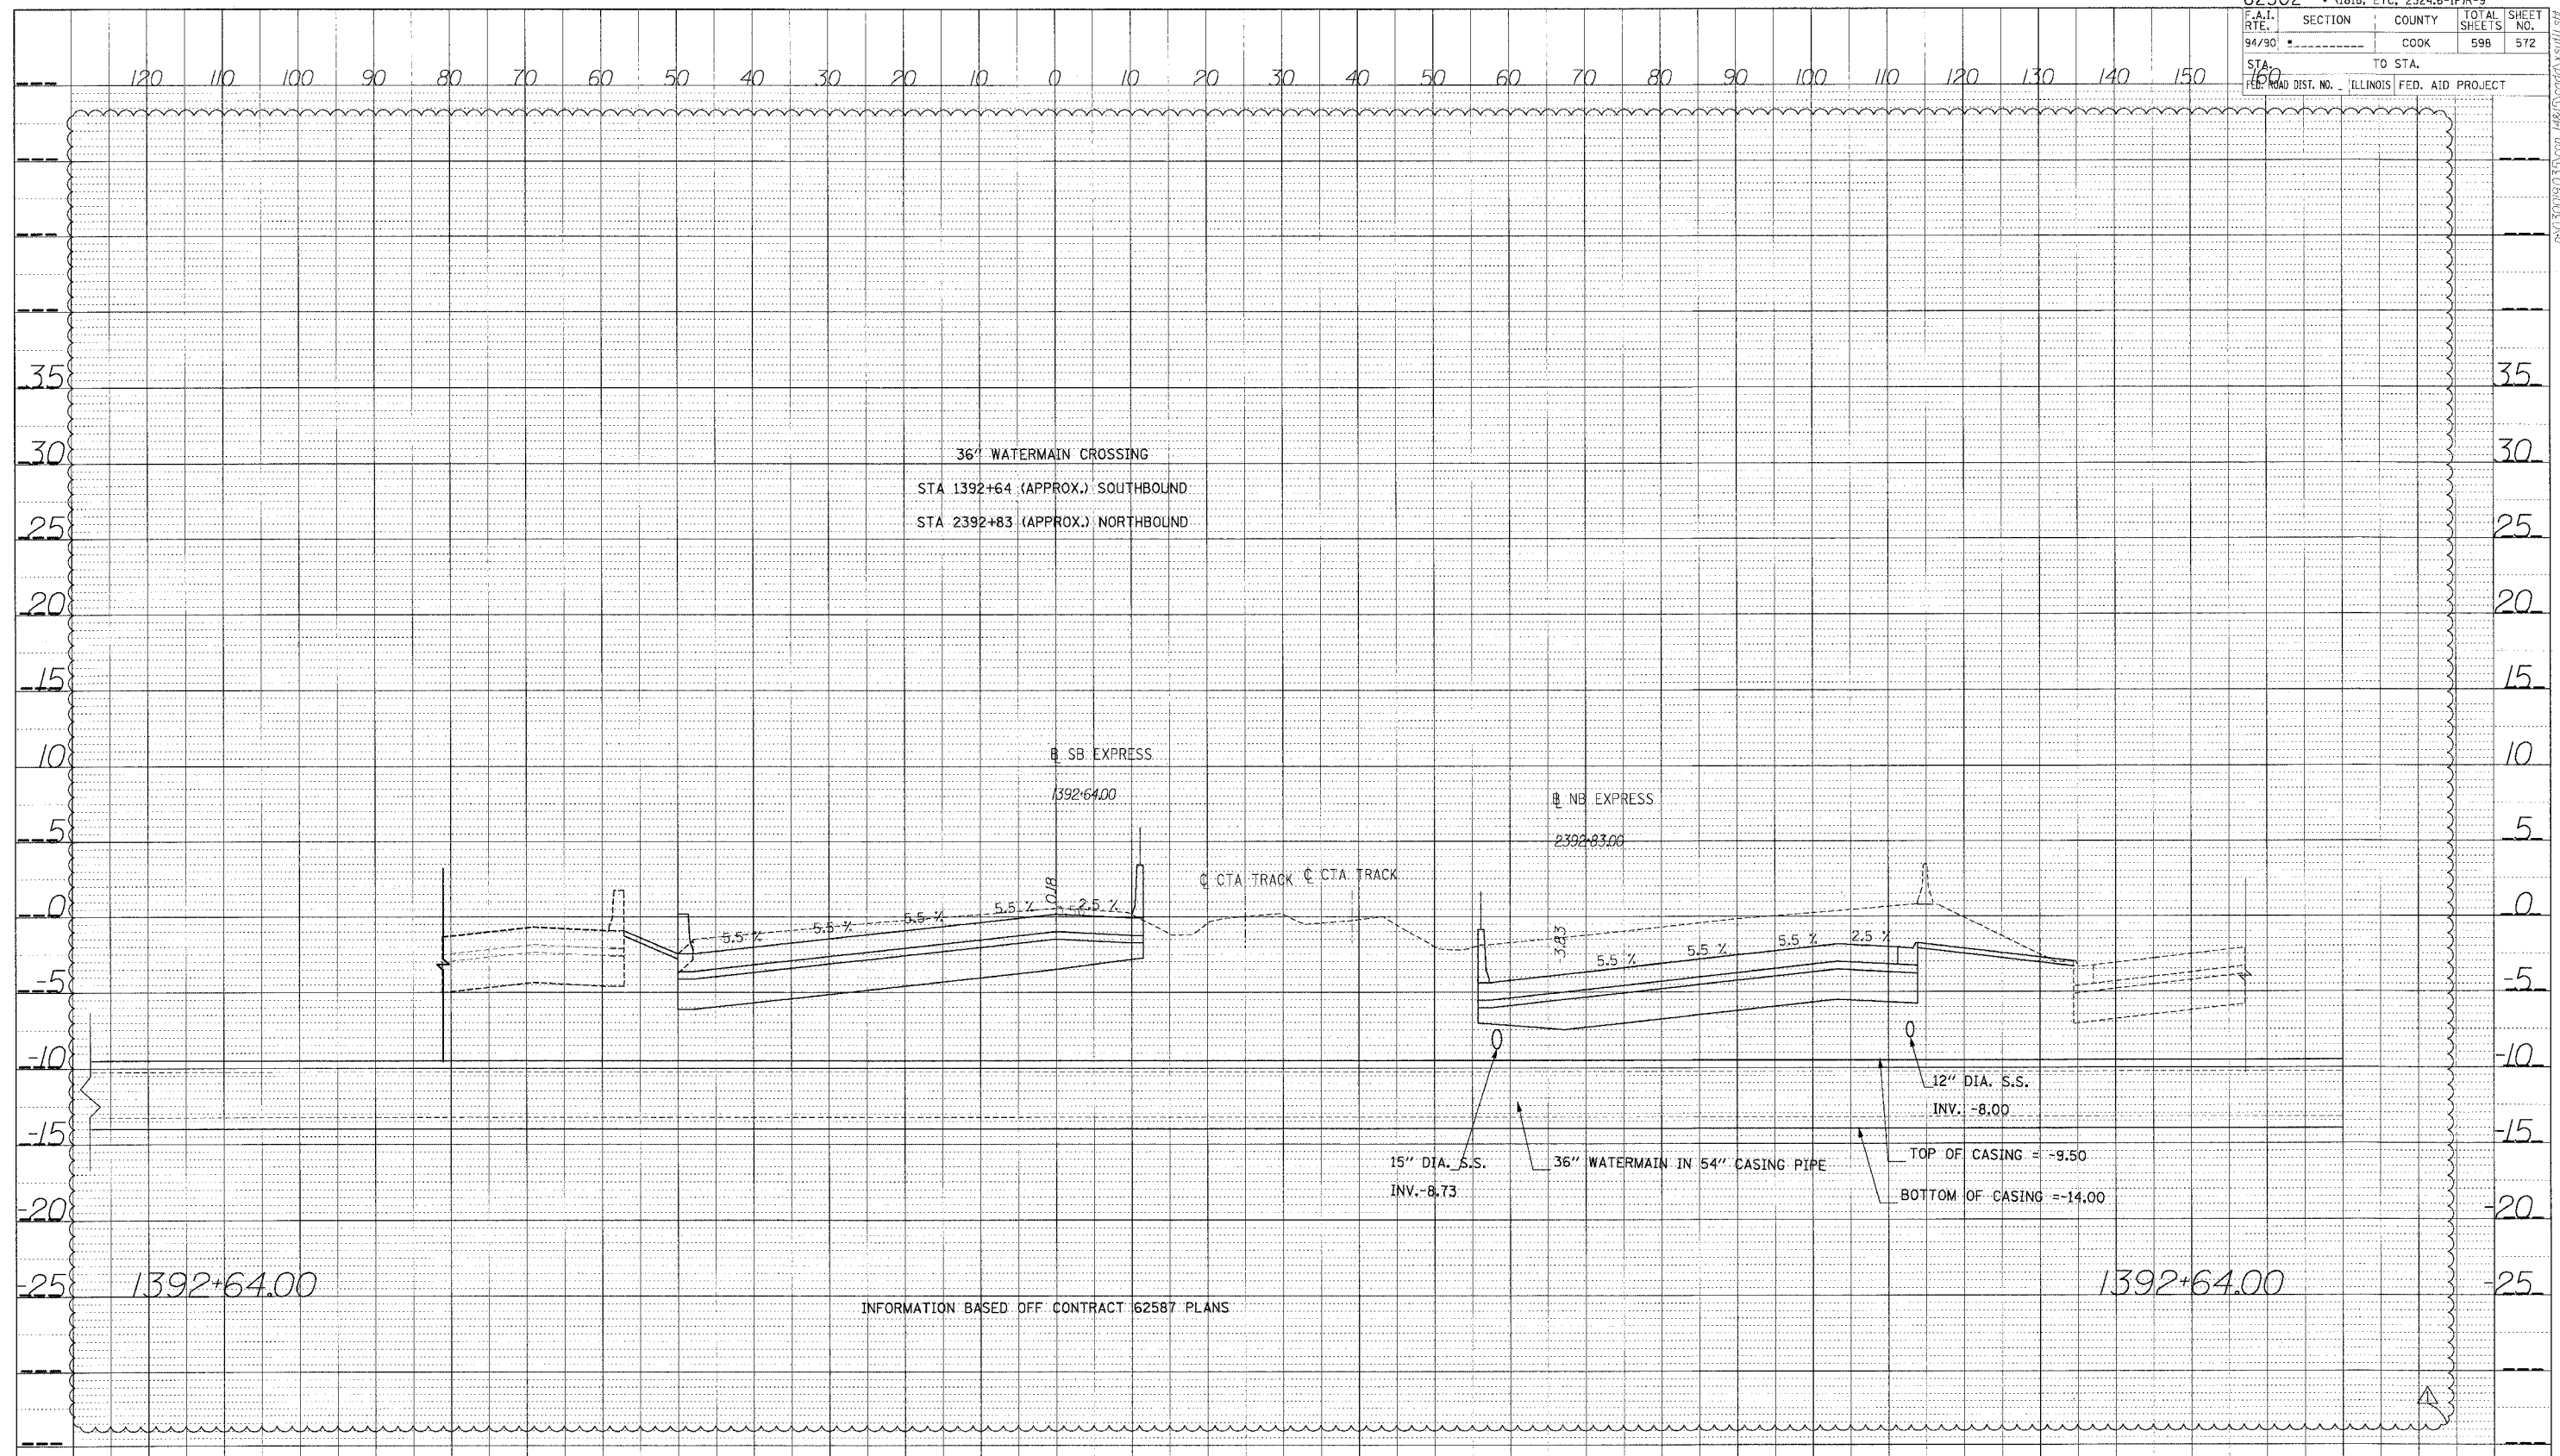


INFORMATION BASED OFF CONTRACT 62587 PLANS

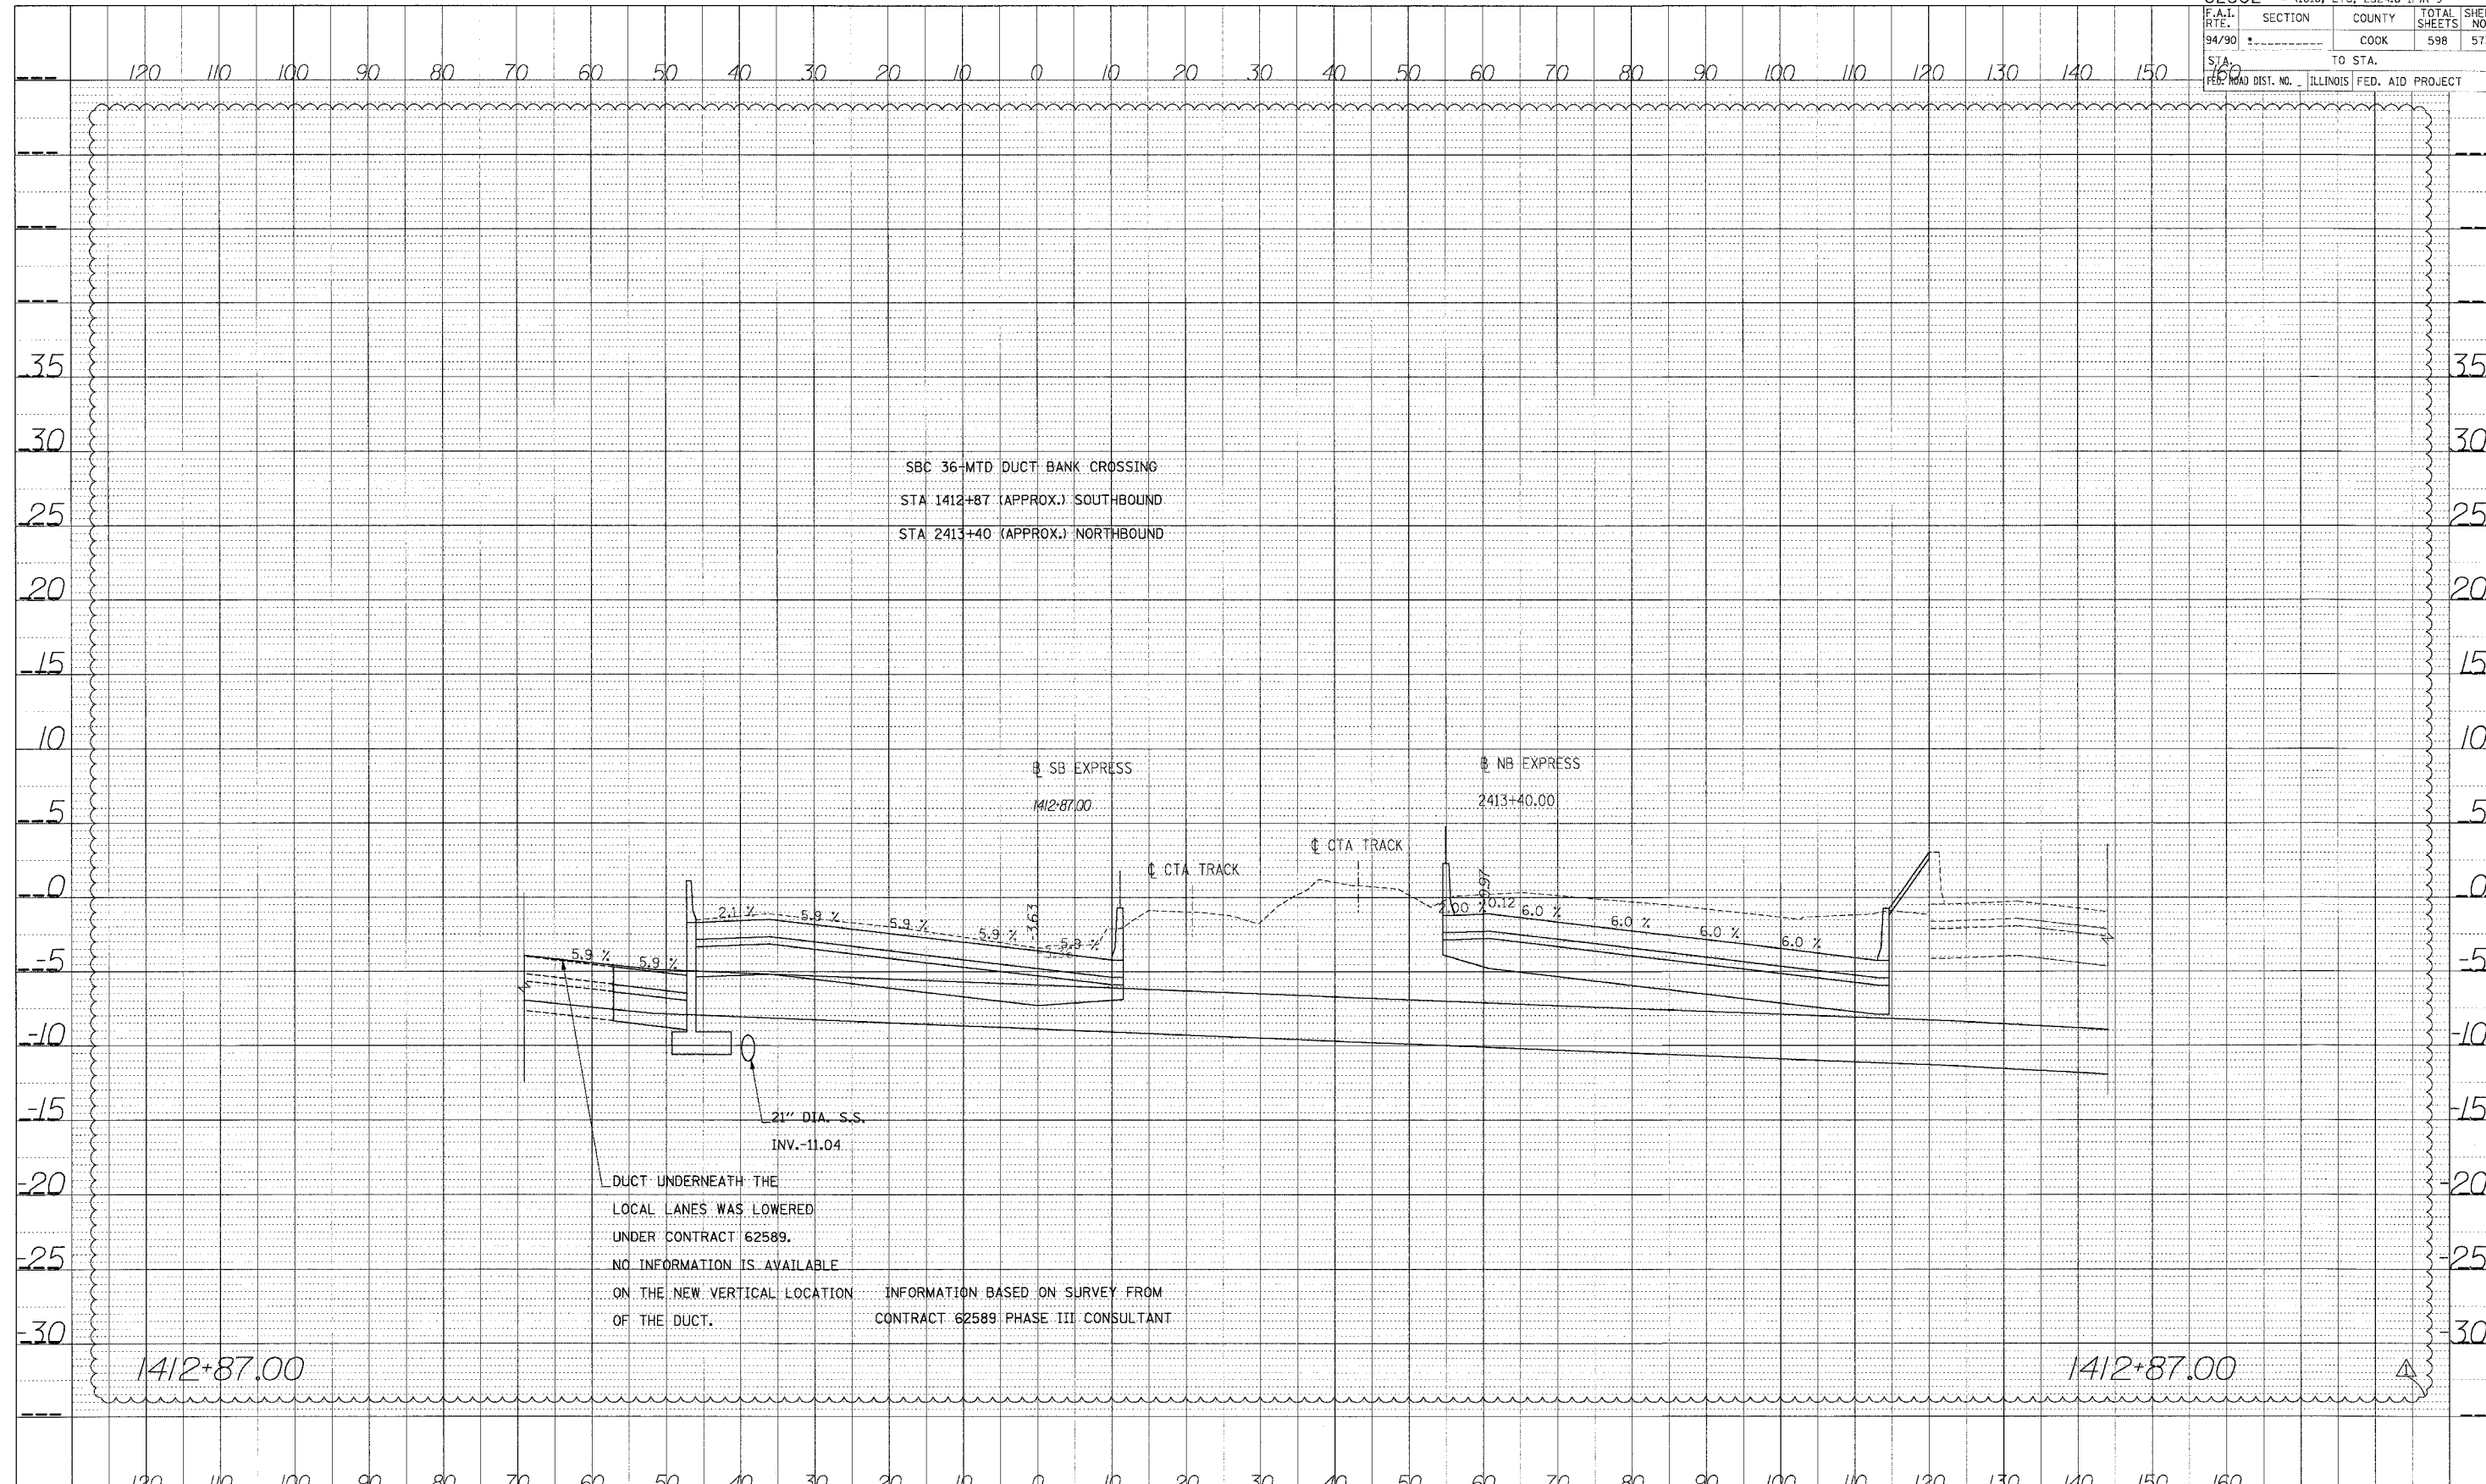


PROFILE	SEWER	DATE
NOTE BOOK	NO. 1	
STRUCTURE	NOTATION	CHFD

DUCT UNDERNEATH THE LOCAL LANES WAS LOWERED UNDER CONTRACT 62589. NO INFORMATION IS AVAILABLE ON THE NEW VERTICAL LOCATION OF THE DUCT. INFORMATION BASED ON SURVEY FROM CONTRACT 62589 PHASE III CONSULTANT

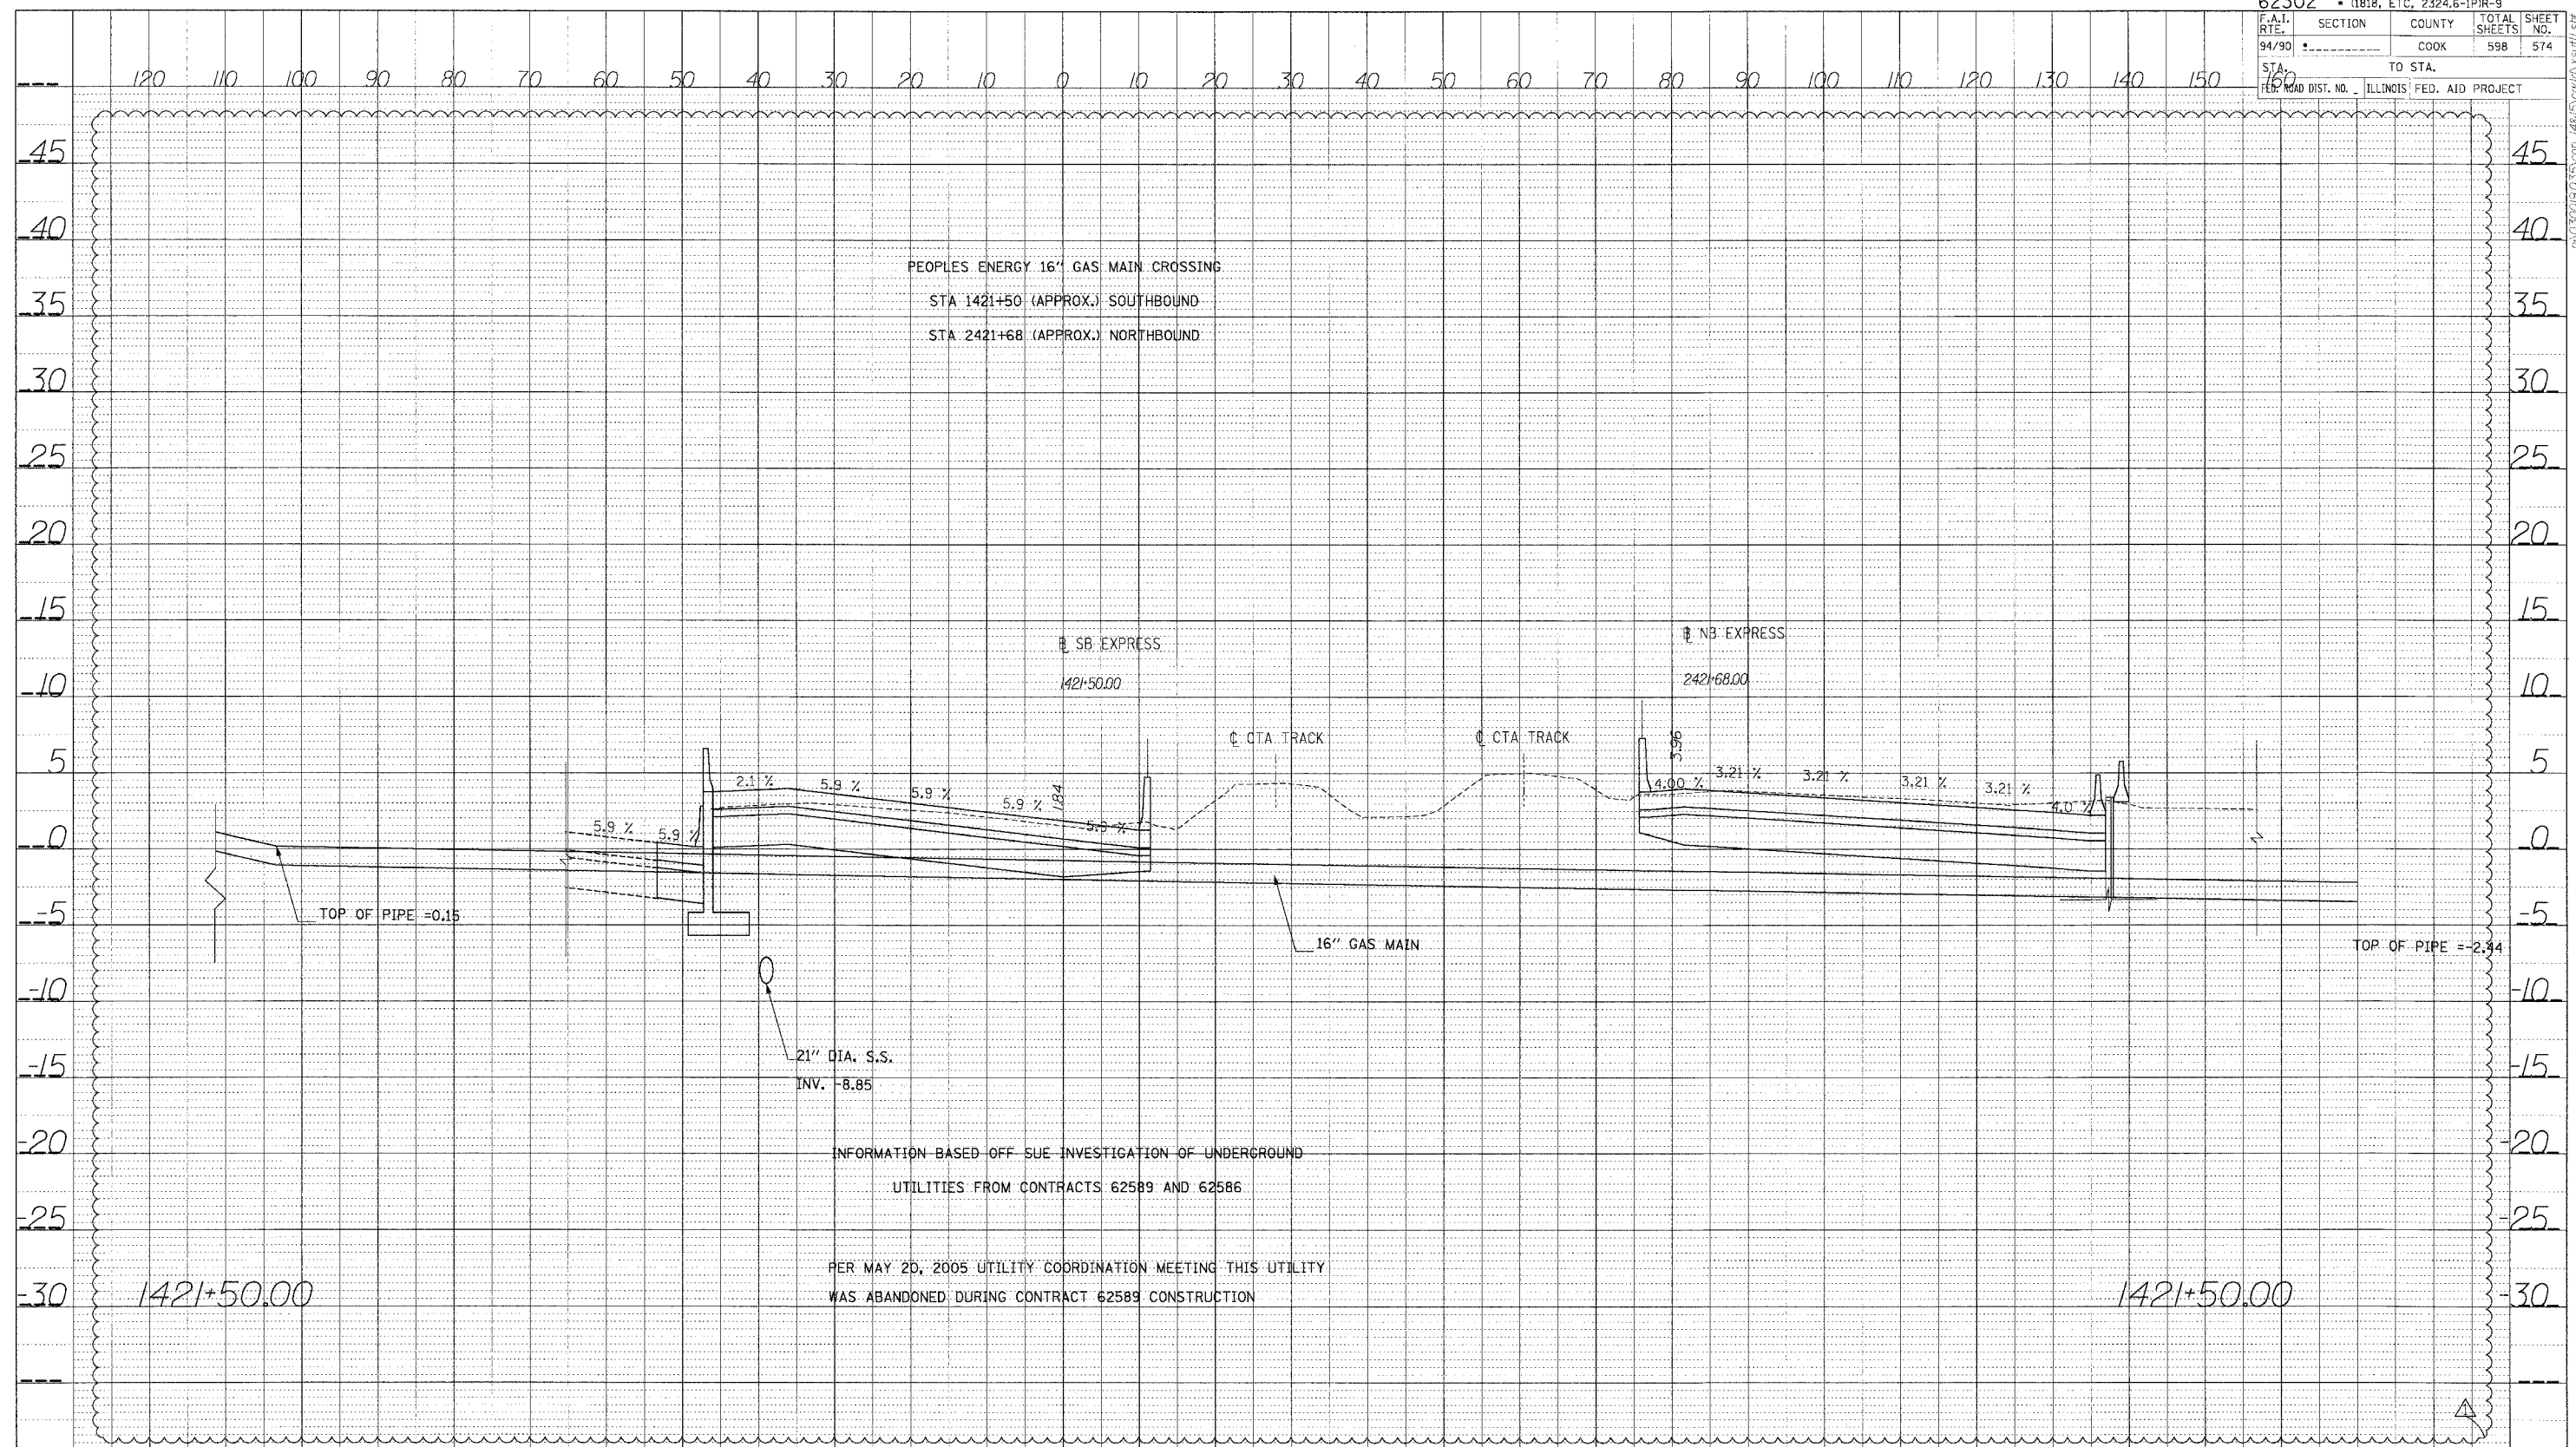


PROFILE	DATE
BY	
CHECKED	
NOTED	
NO.	


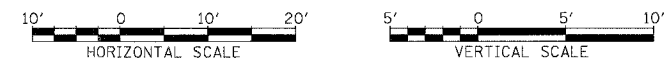


STA.

DATE	
BY	
PROF. E	
REVISED	
PLATTED	
NOTE BOOK	
NO.	
STRUCTURE NOTATING CODE	

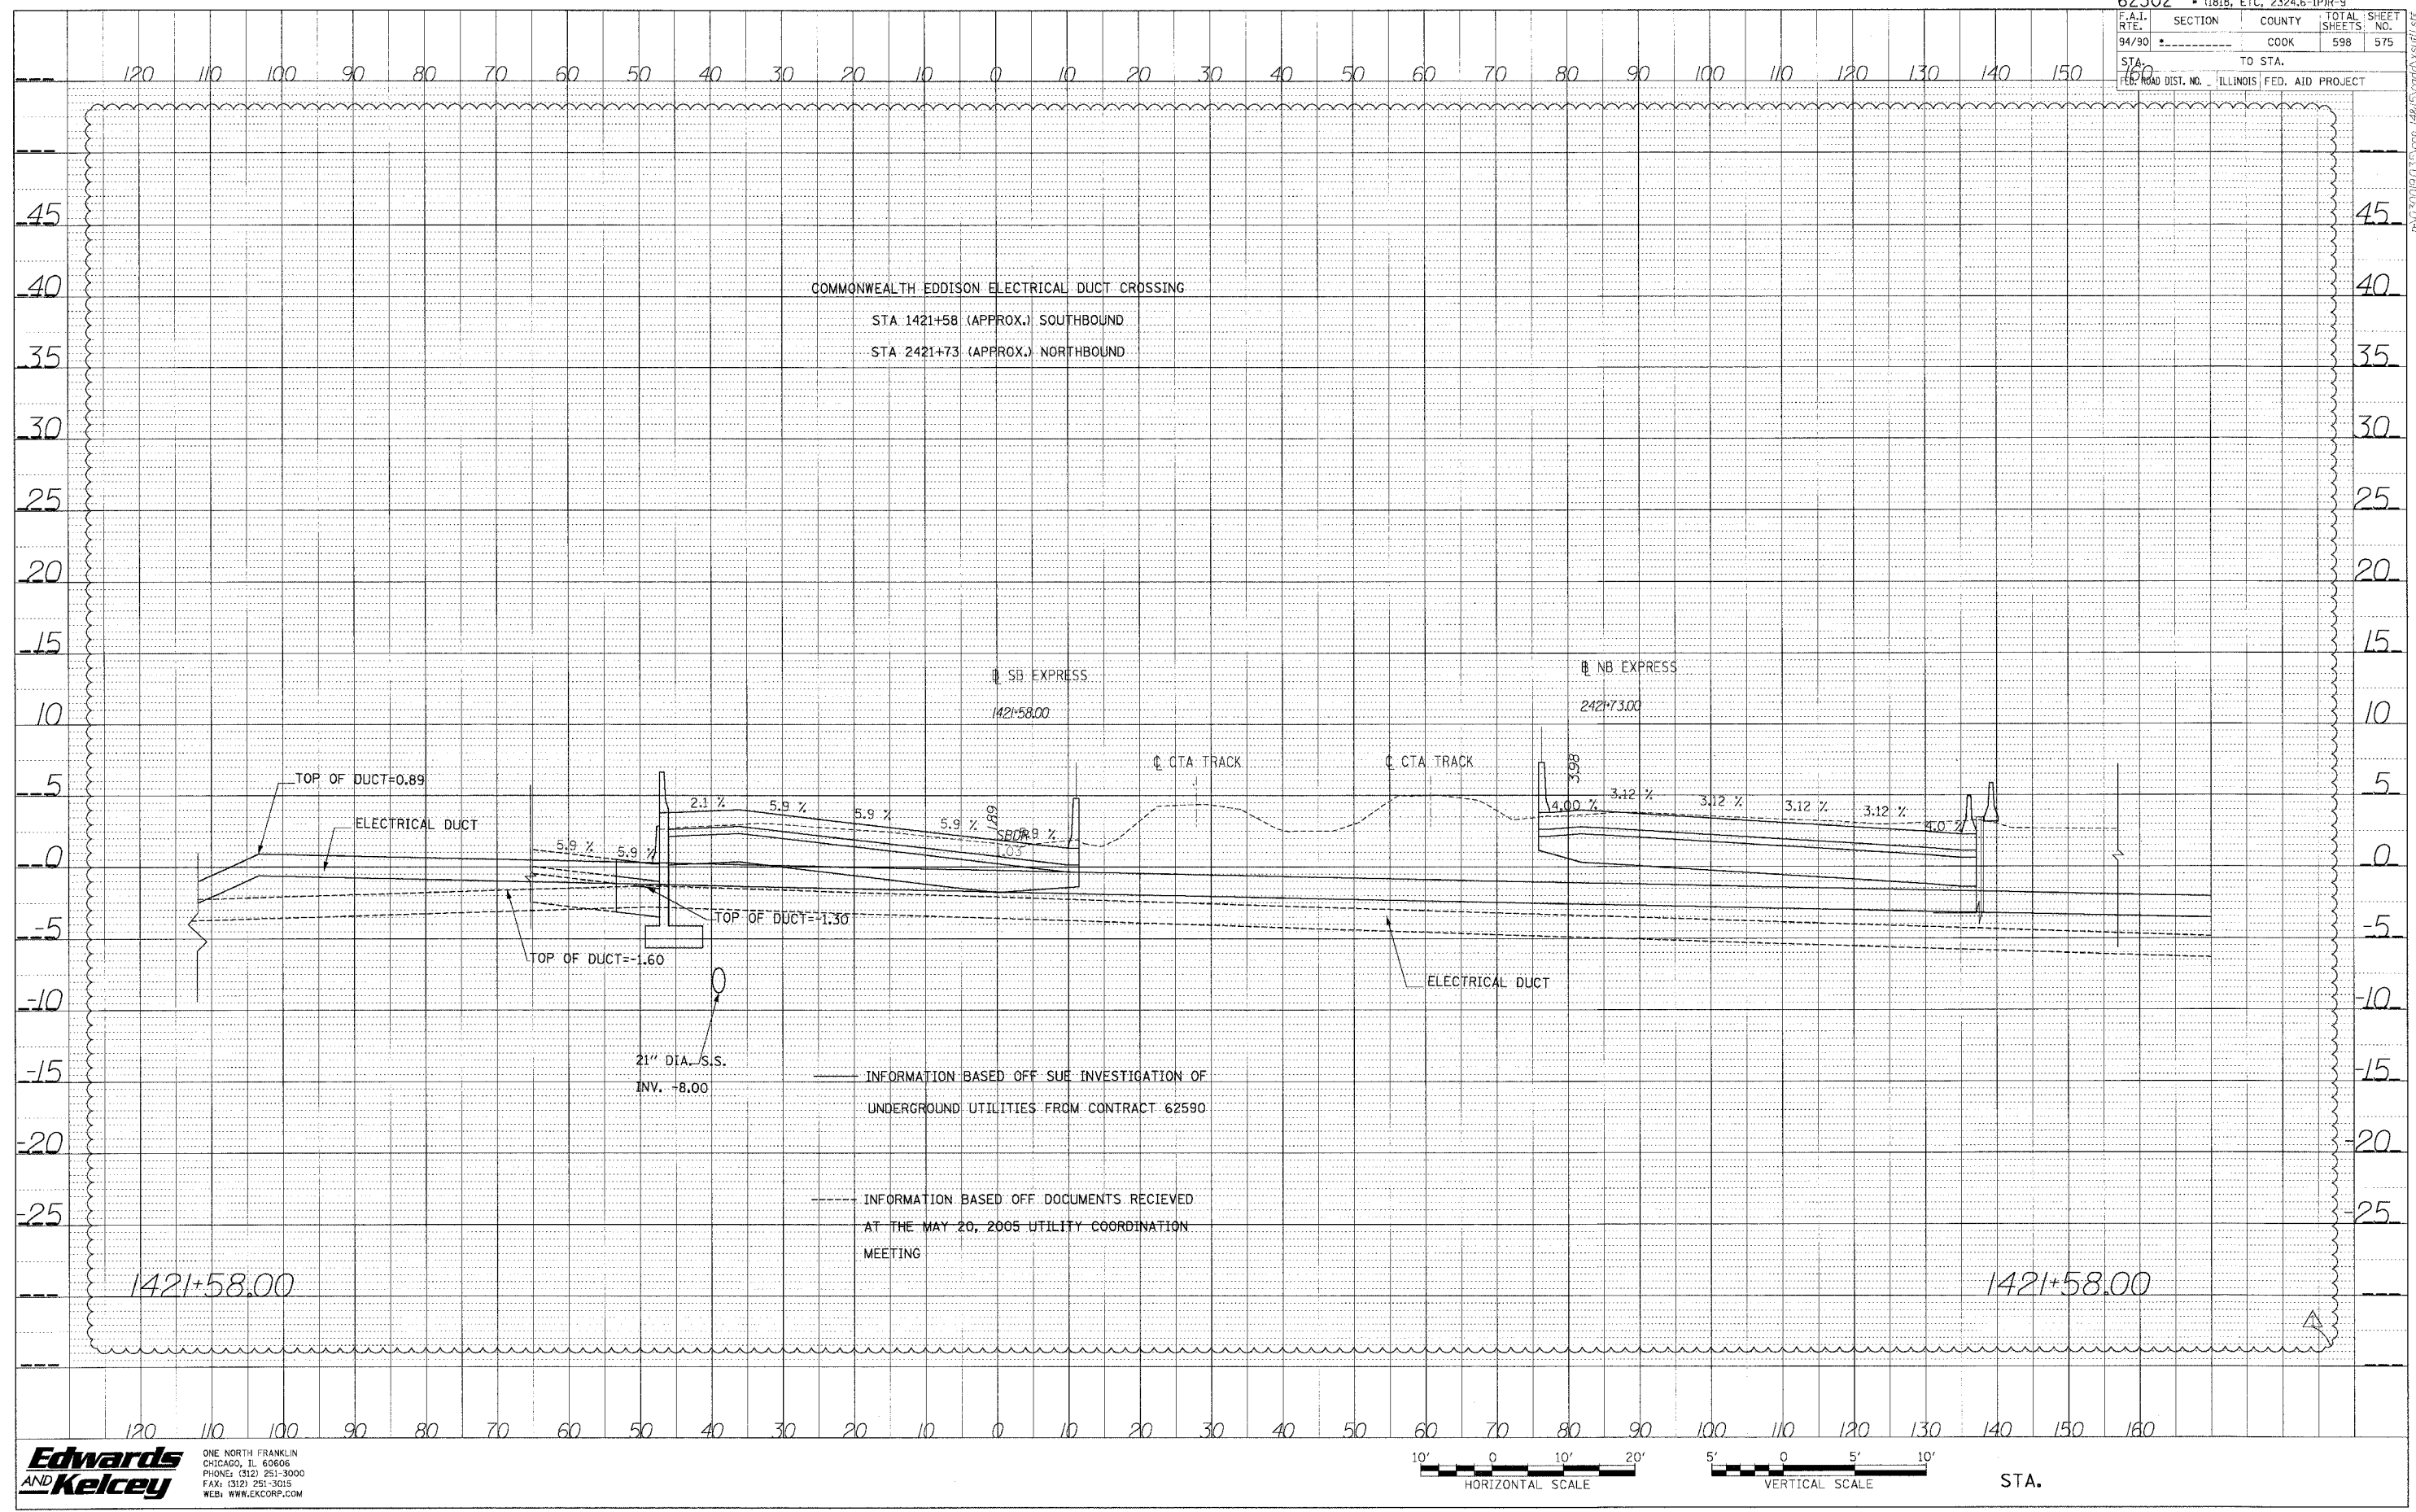


PROFILE SUBMITTED BY DATE
 DRAWN BY DATE
 CHECKED BY DATE
 IN CHARGE BY DATE
 NO. OF SHEETS TOTAL SHEETS

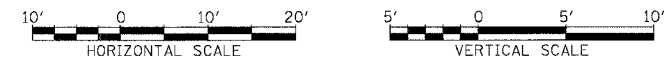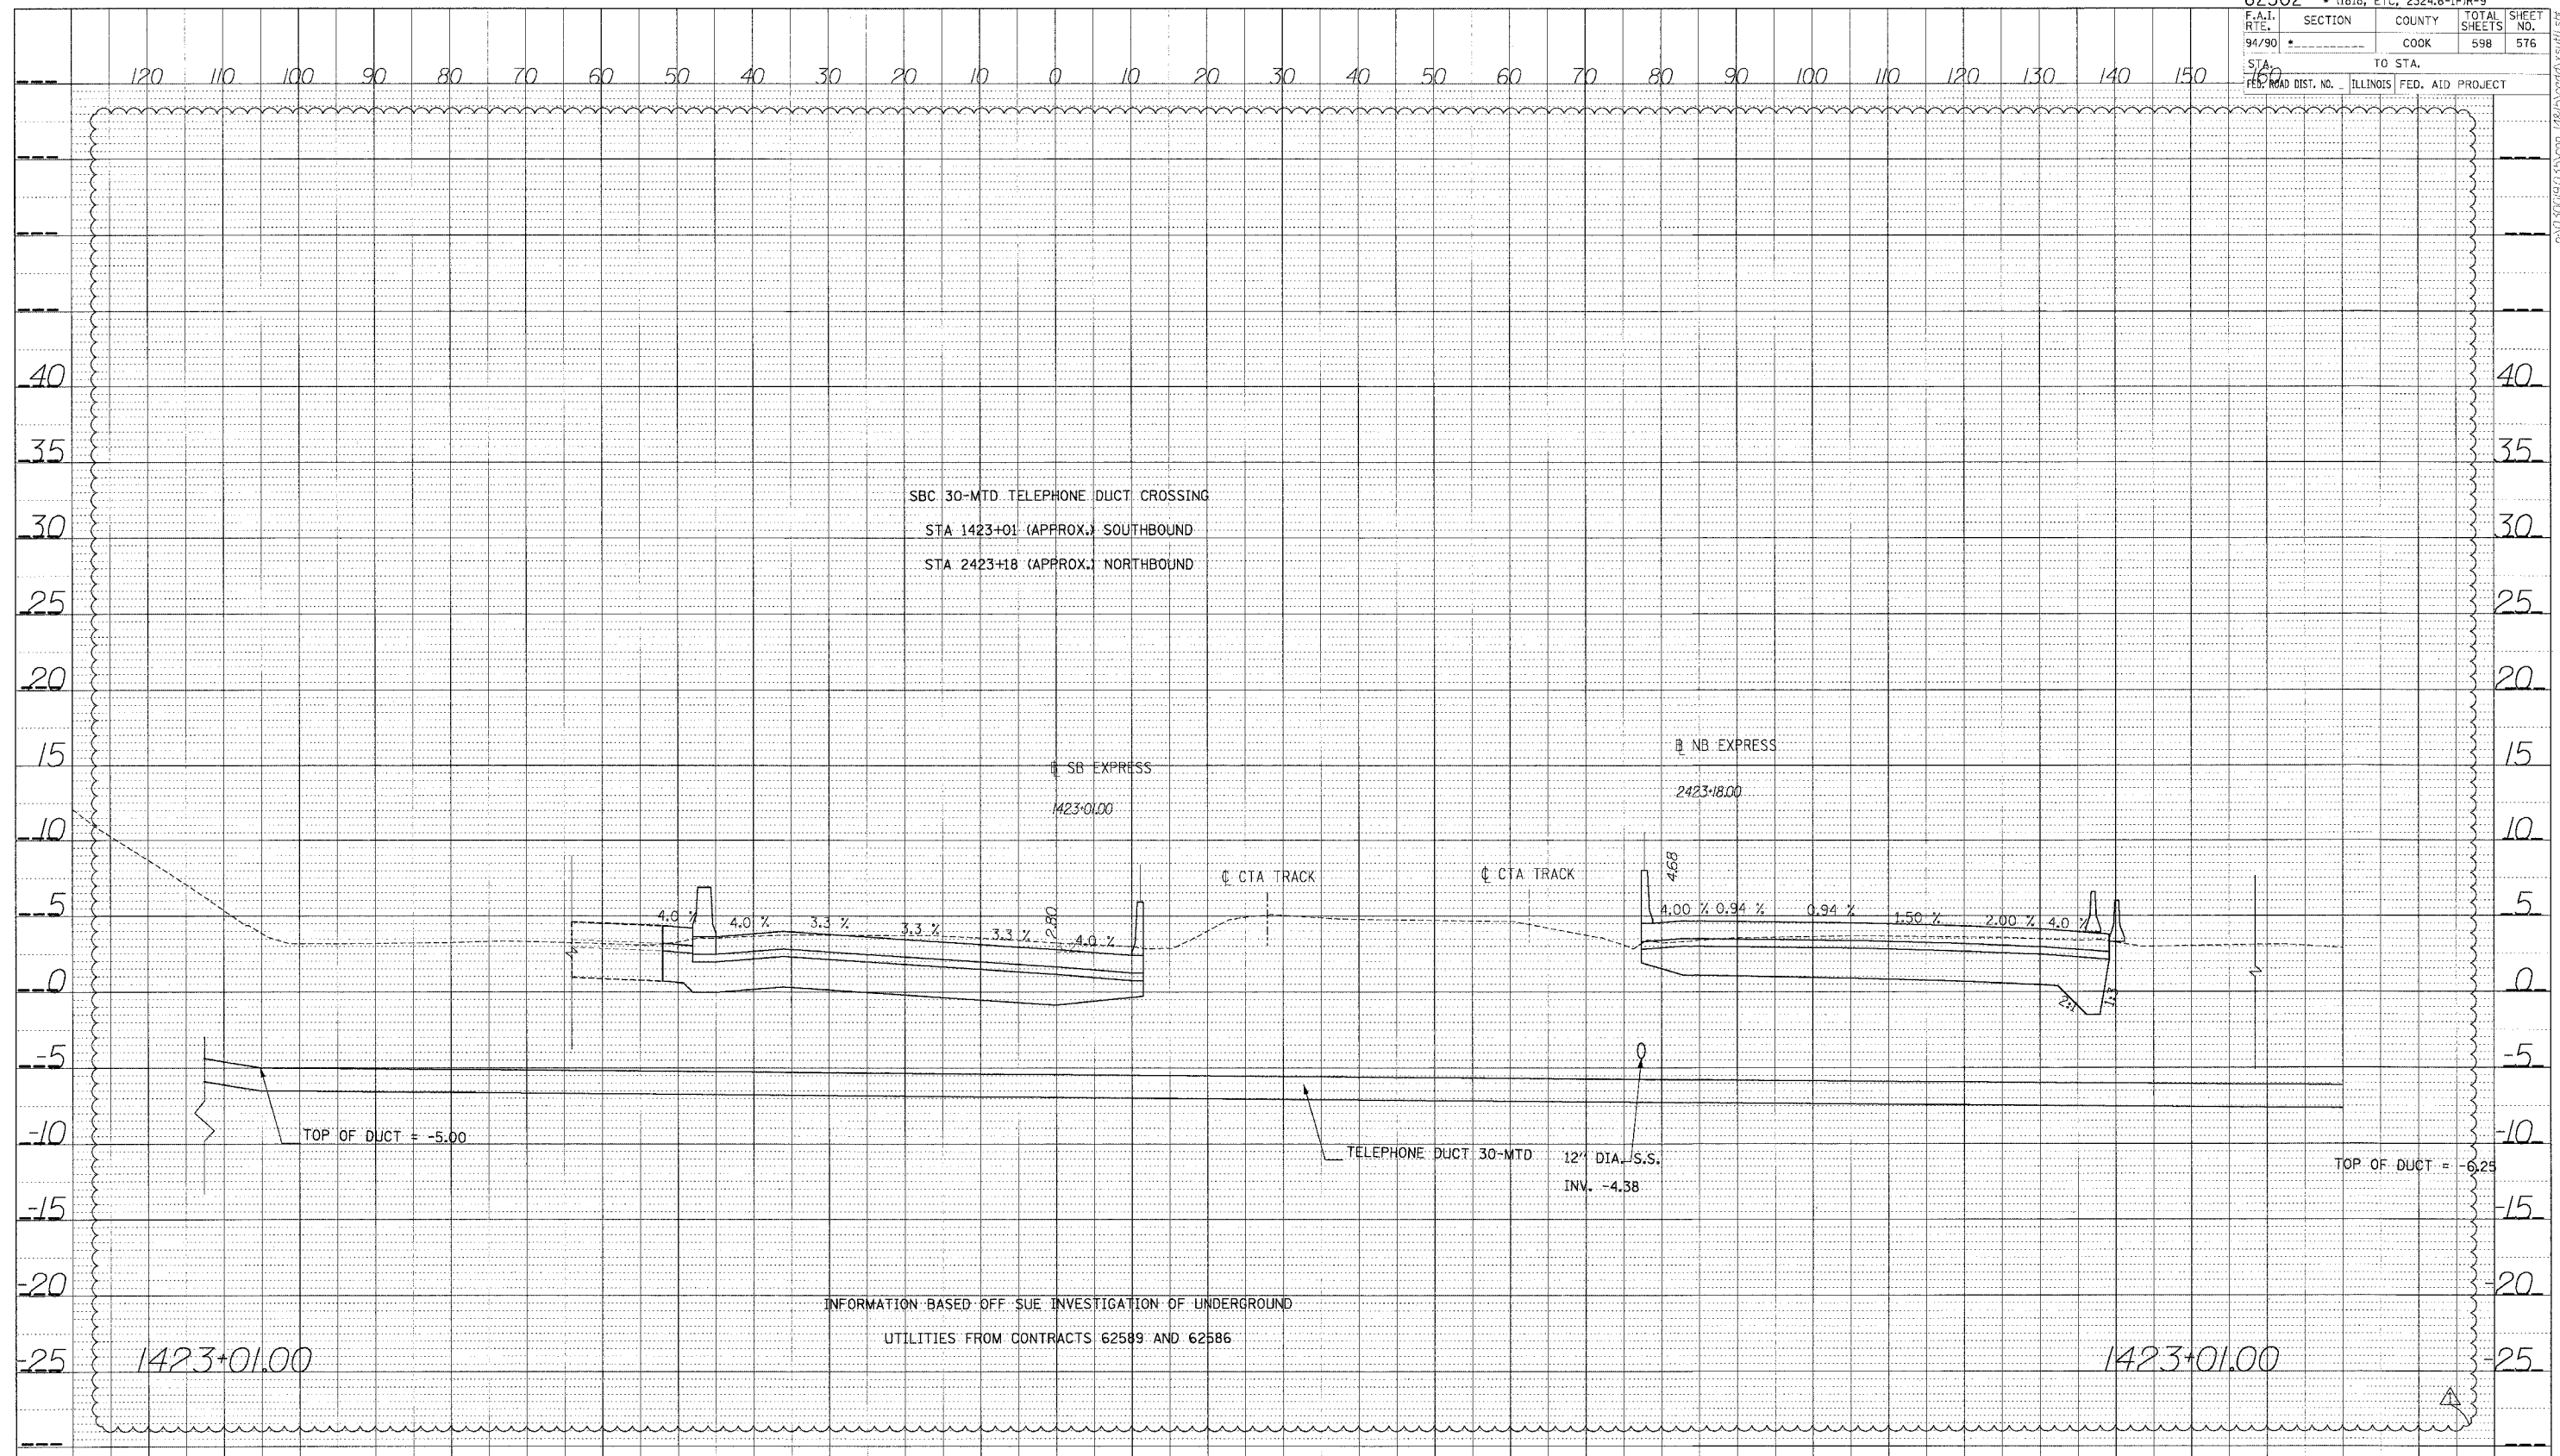


STA.

PROFIT: F SURVEYED BY DATE
 PLOTTED BY
 NOTE BOOK NO. AND U.S. NO.
 STRUCTURE NOTING CHFD

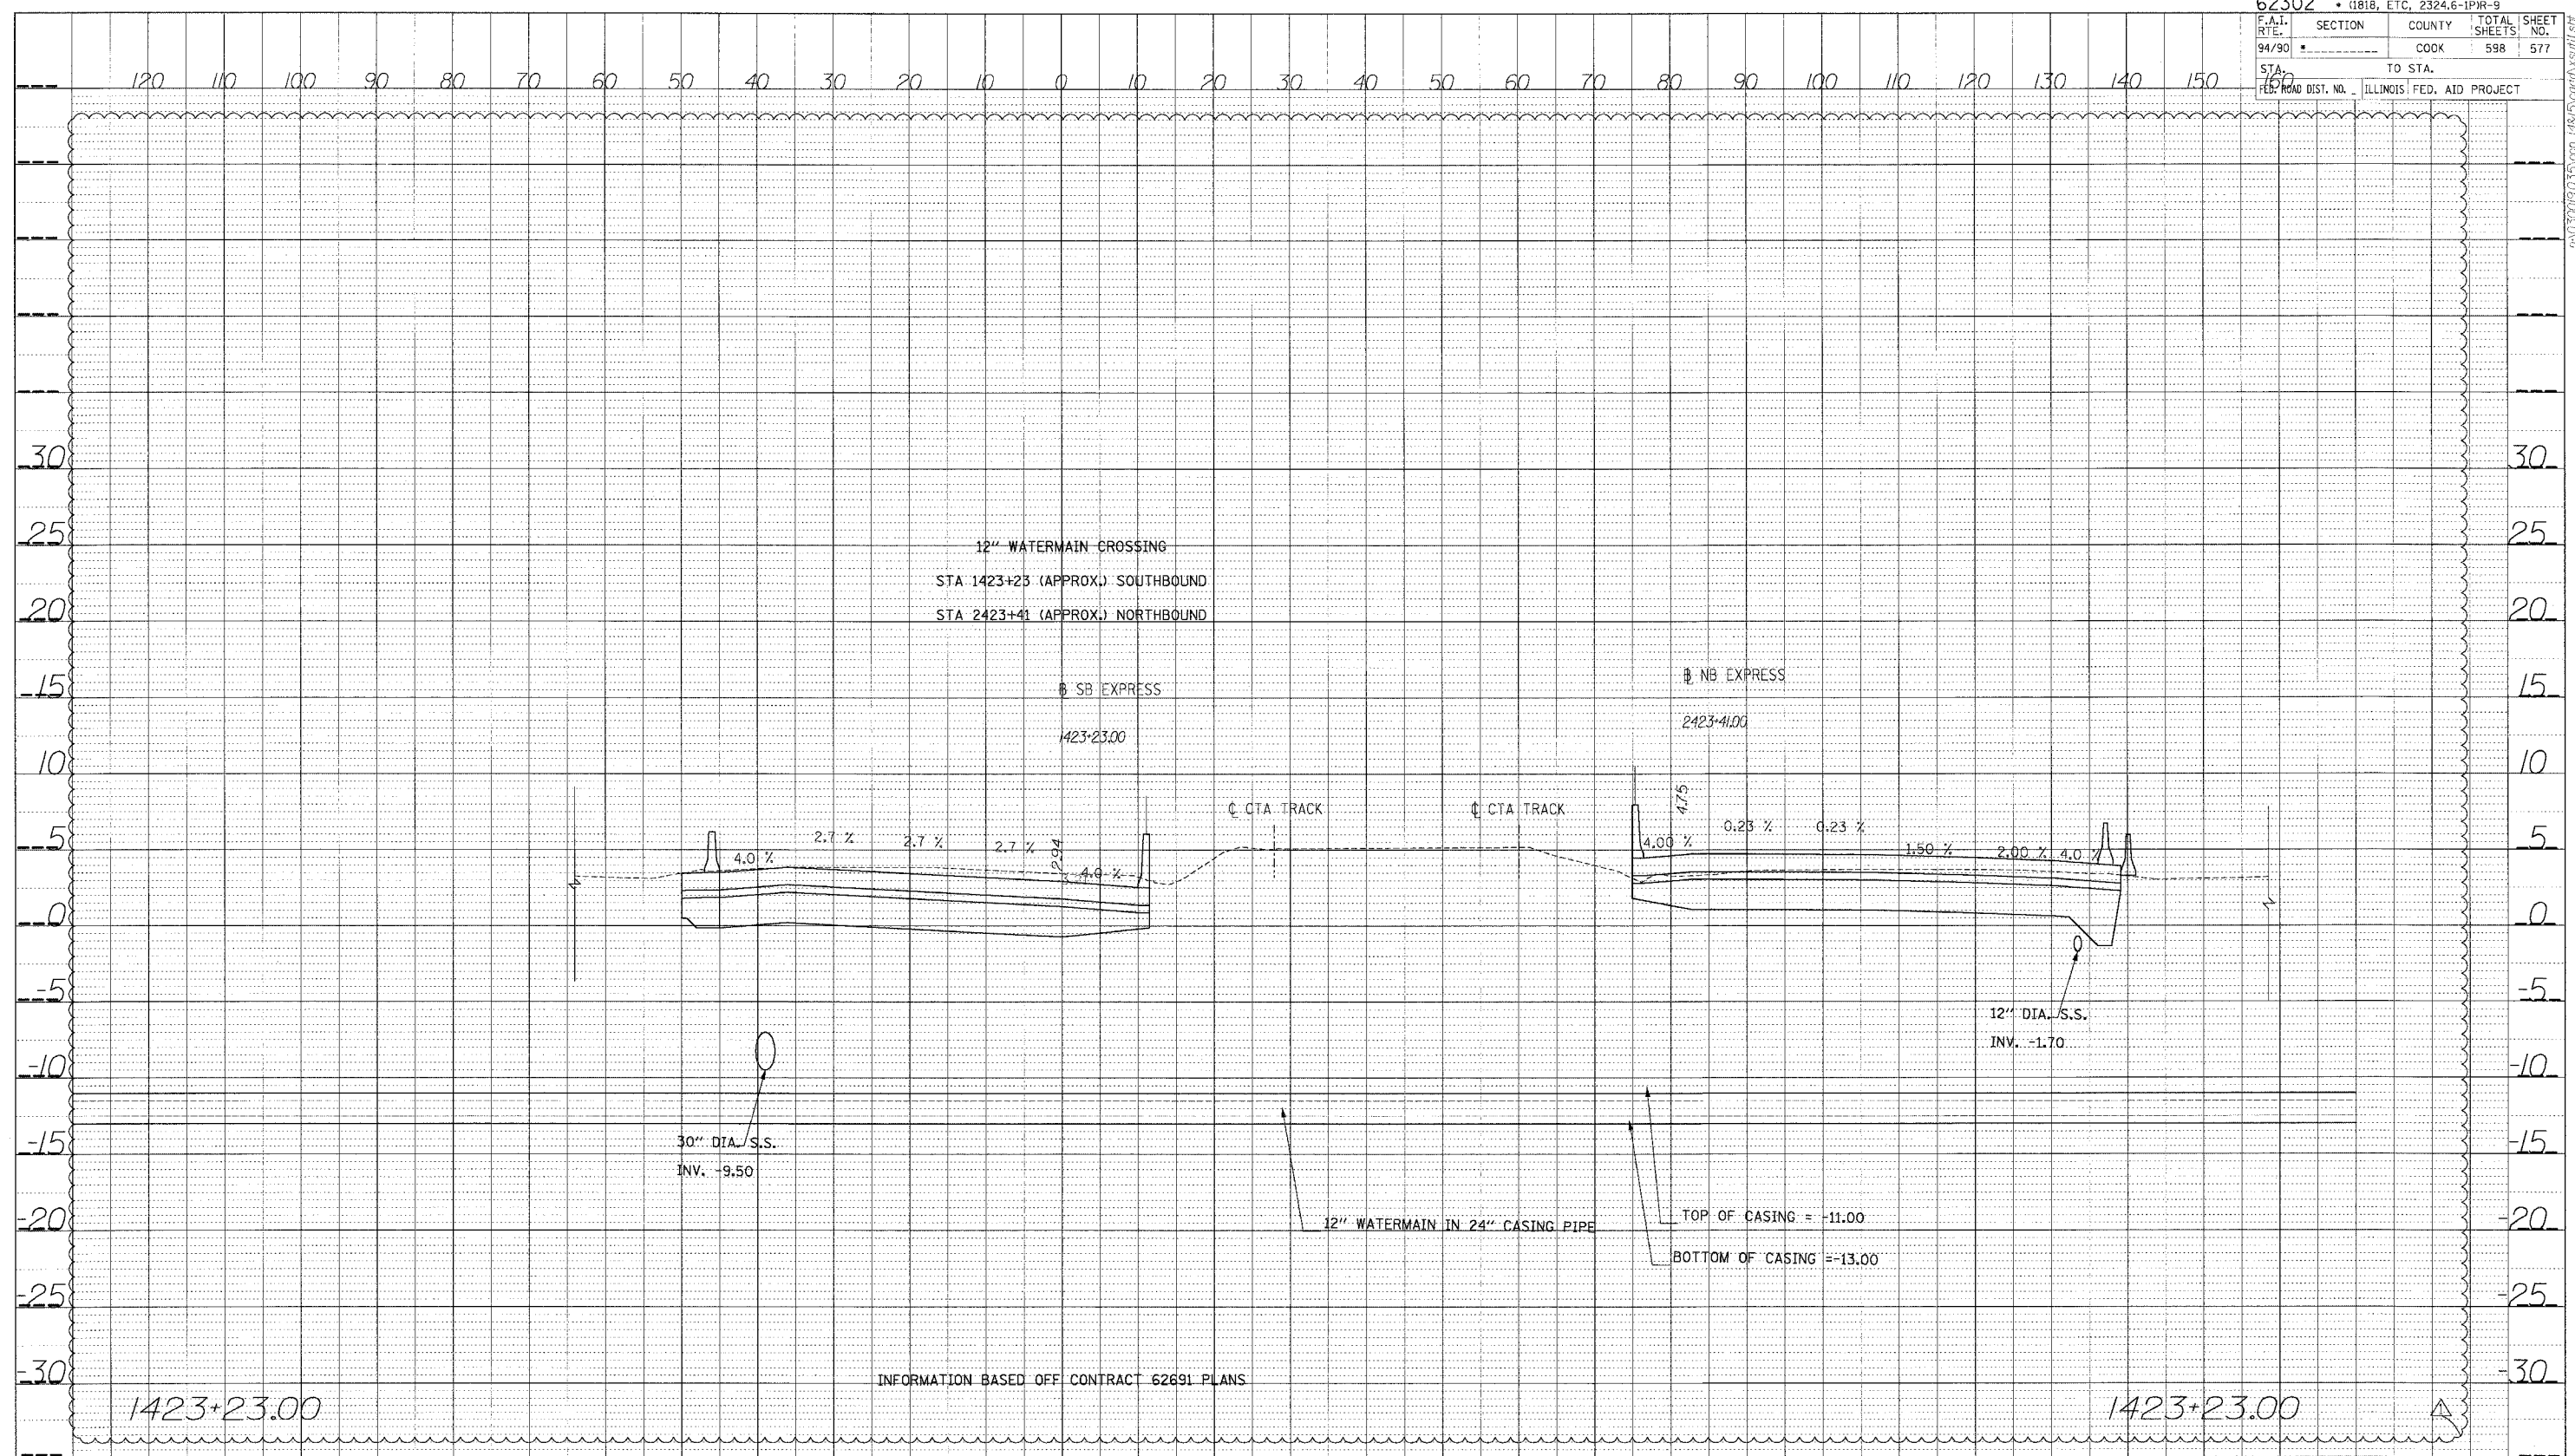


INFORMATION BASED OFF CONTRACT 62691 PLANS


PROFILE SUBMITTED BY DATE
 PLOTTED BY
 NOTE BOOK NO.
 STRUCTURE NOTATING SHEET NO.

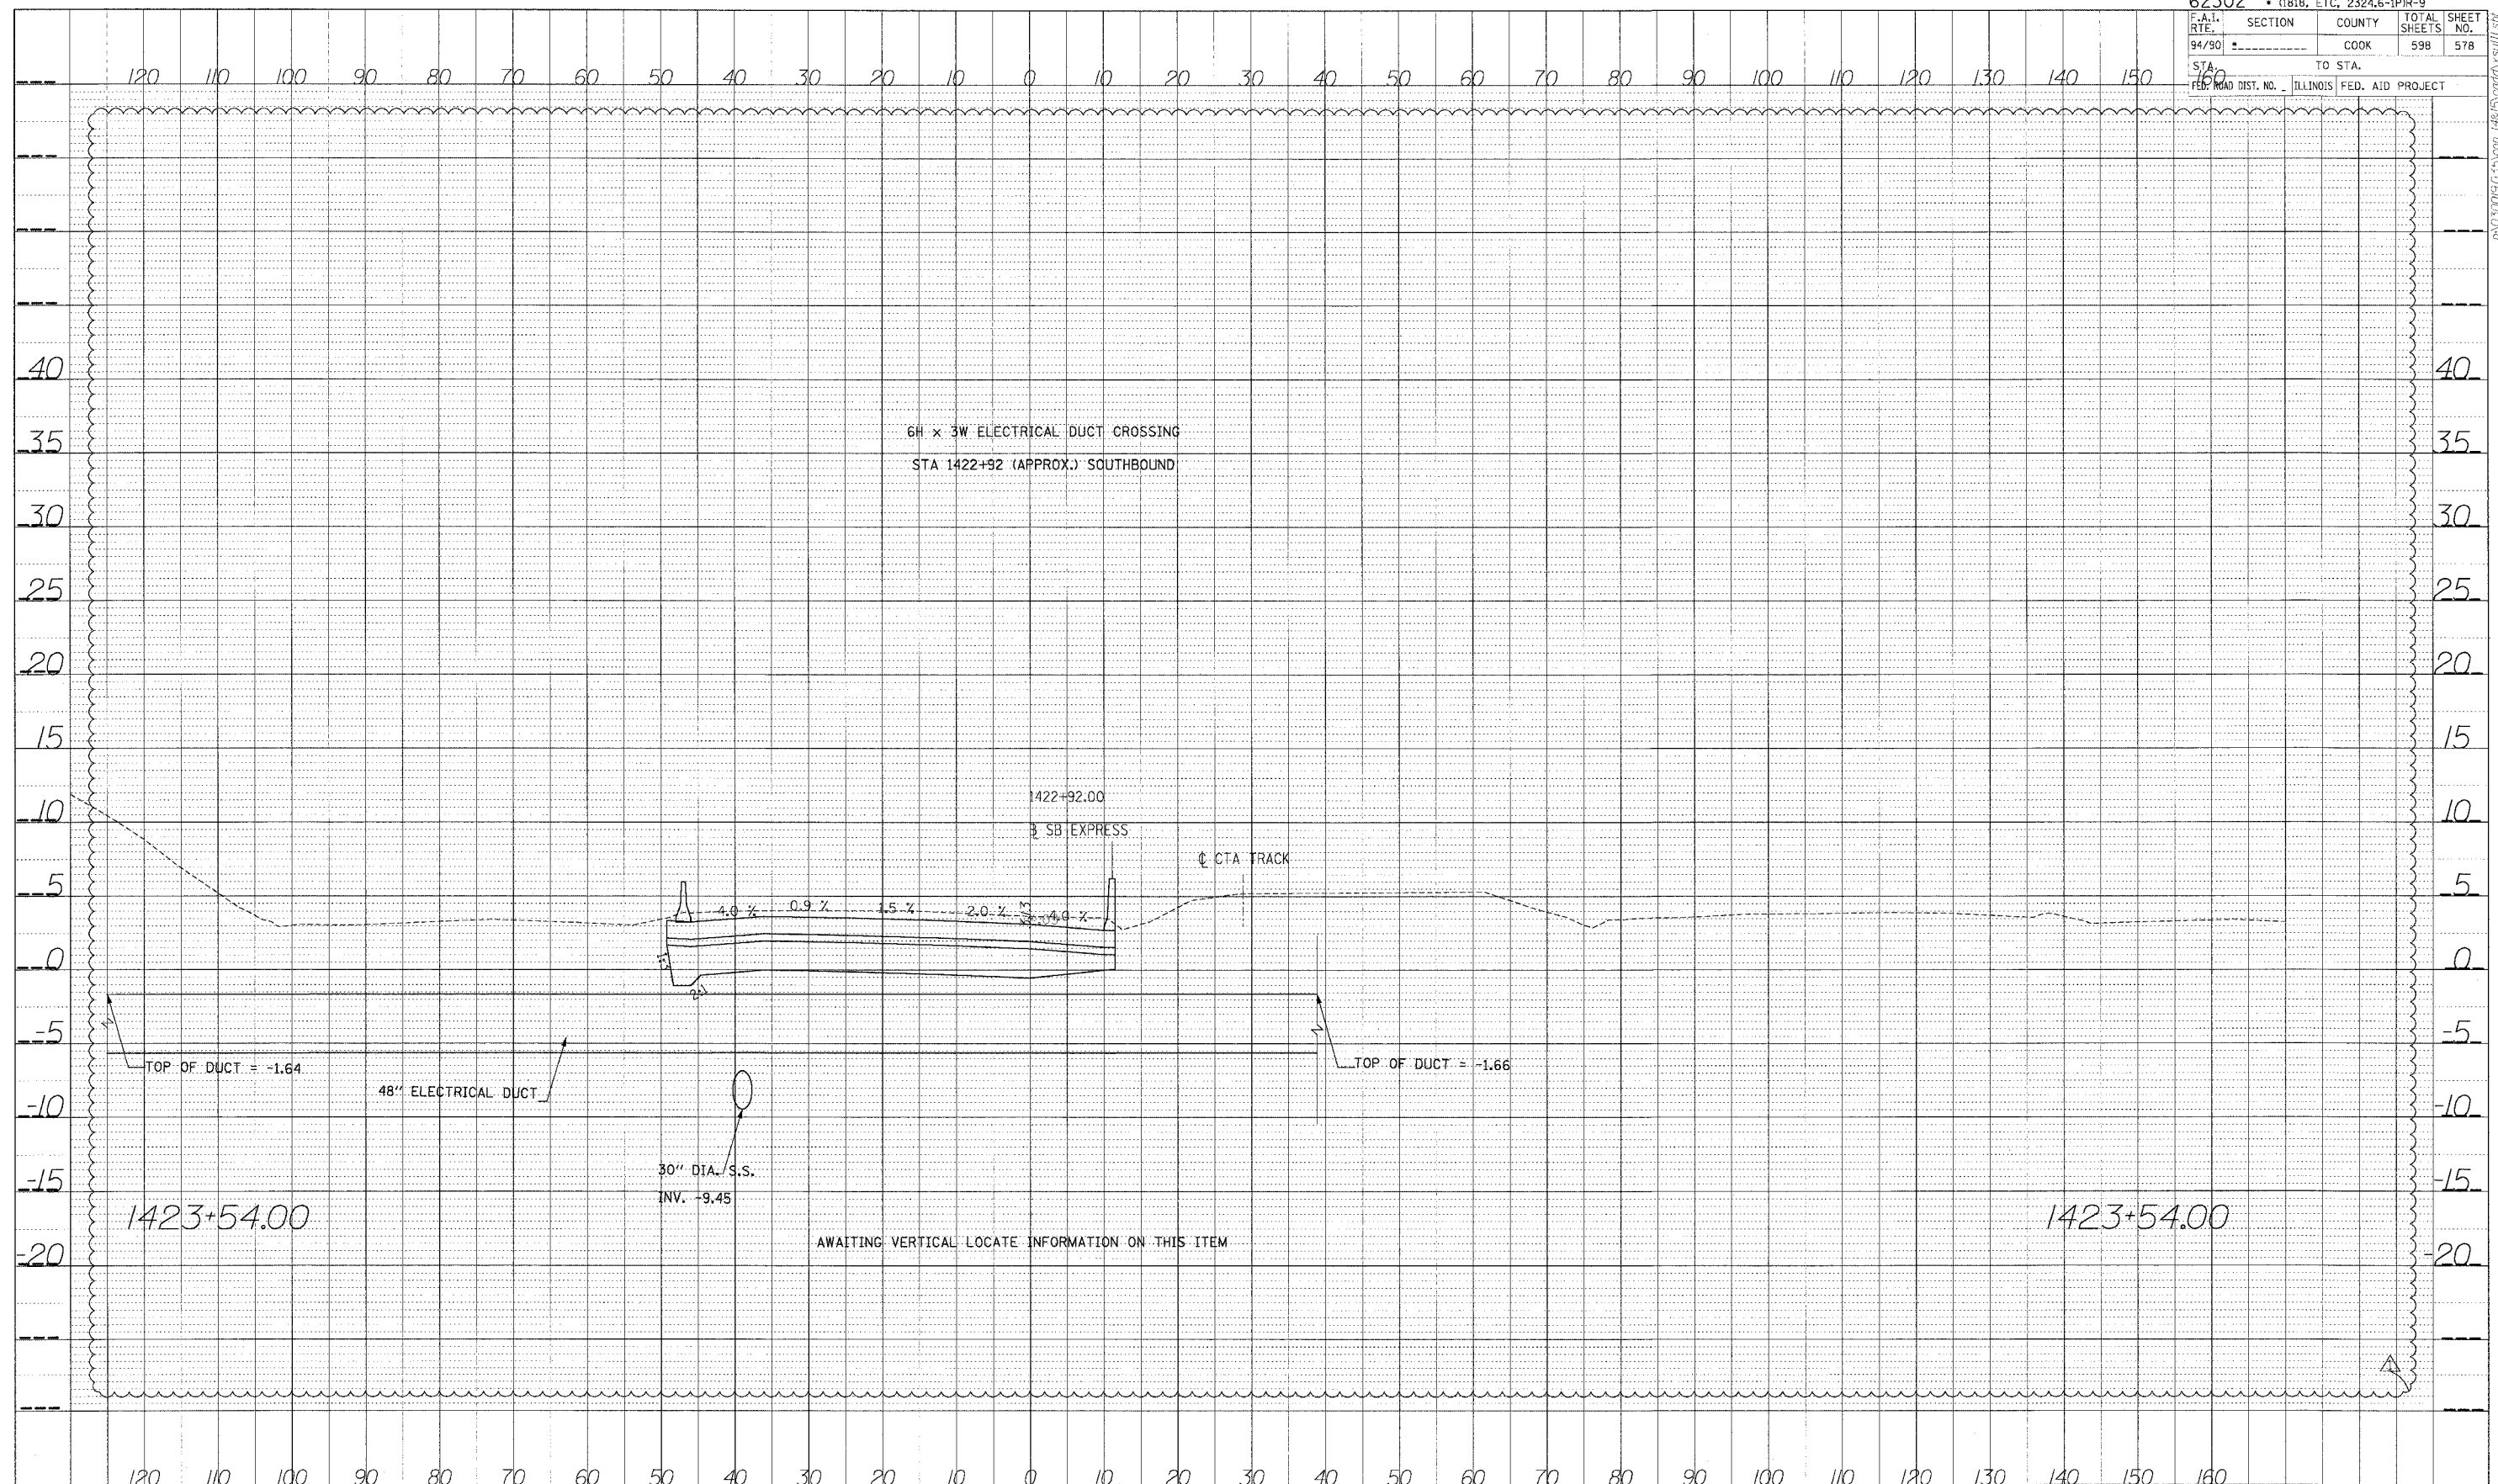

DATE
 BY
 SURVEYER
 PLOTTED
 CHECKED
 DATE
 NO. NOTED
 STRUCTURE NOTATIONS CHFD

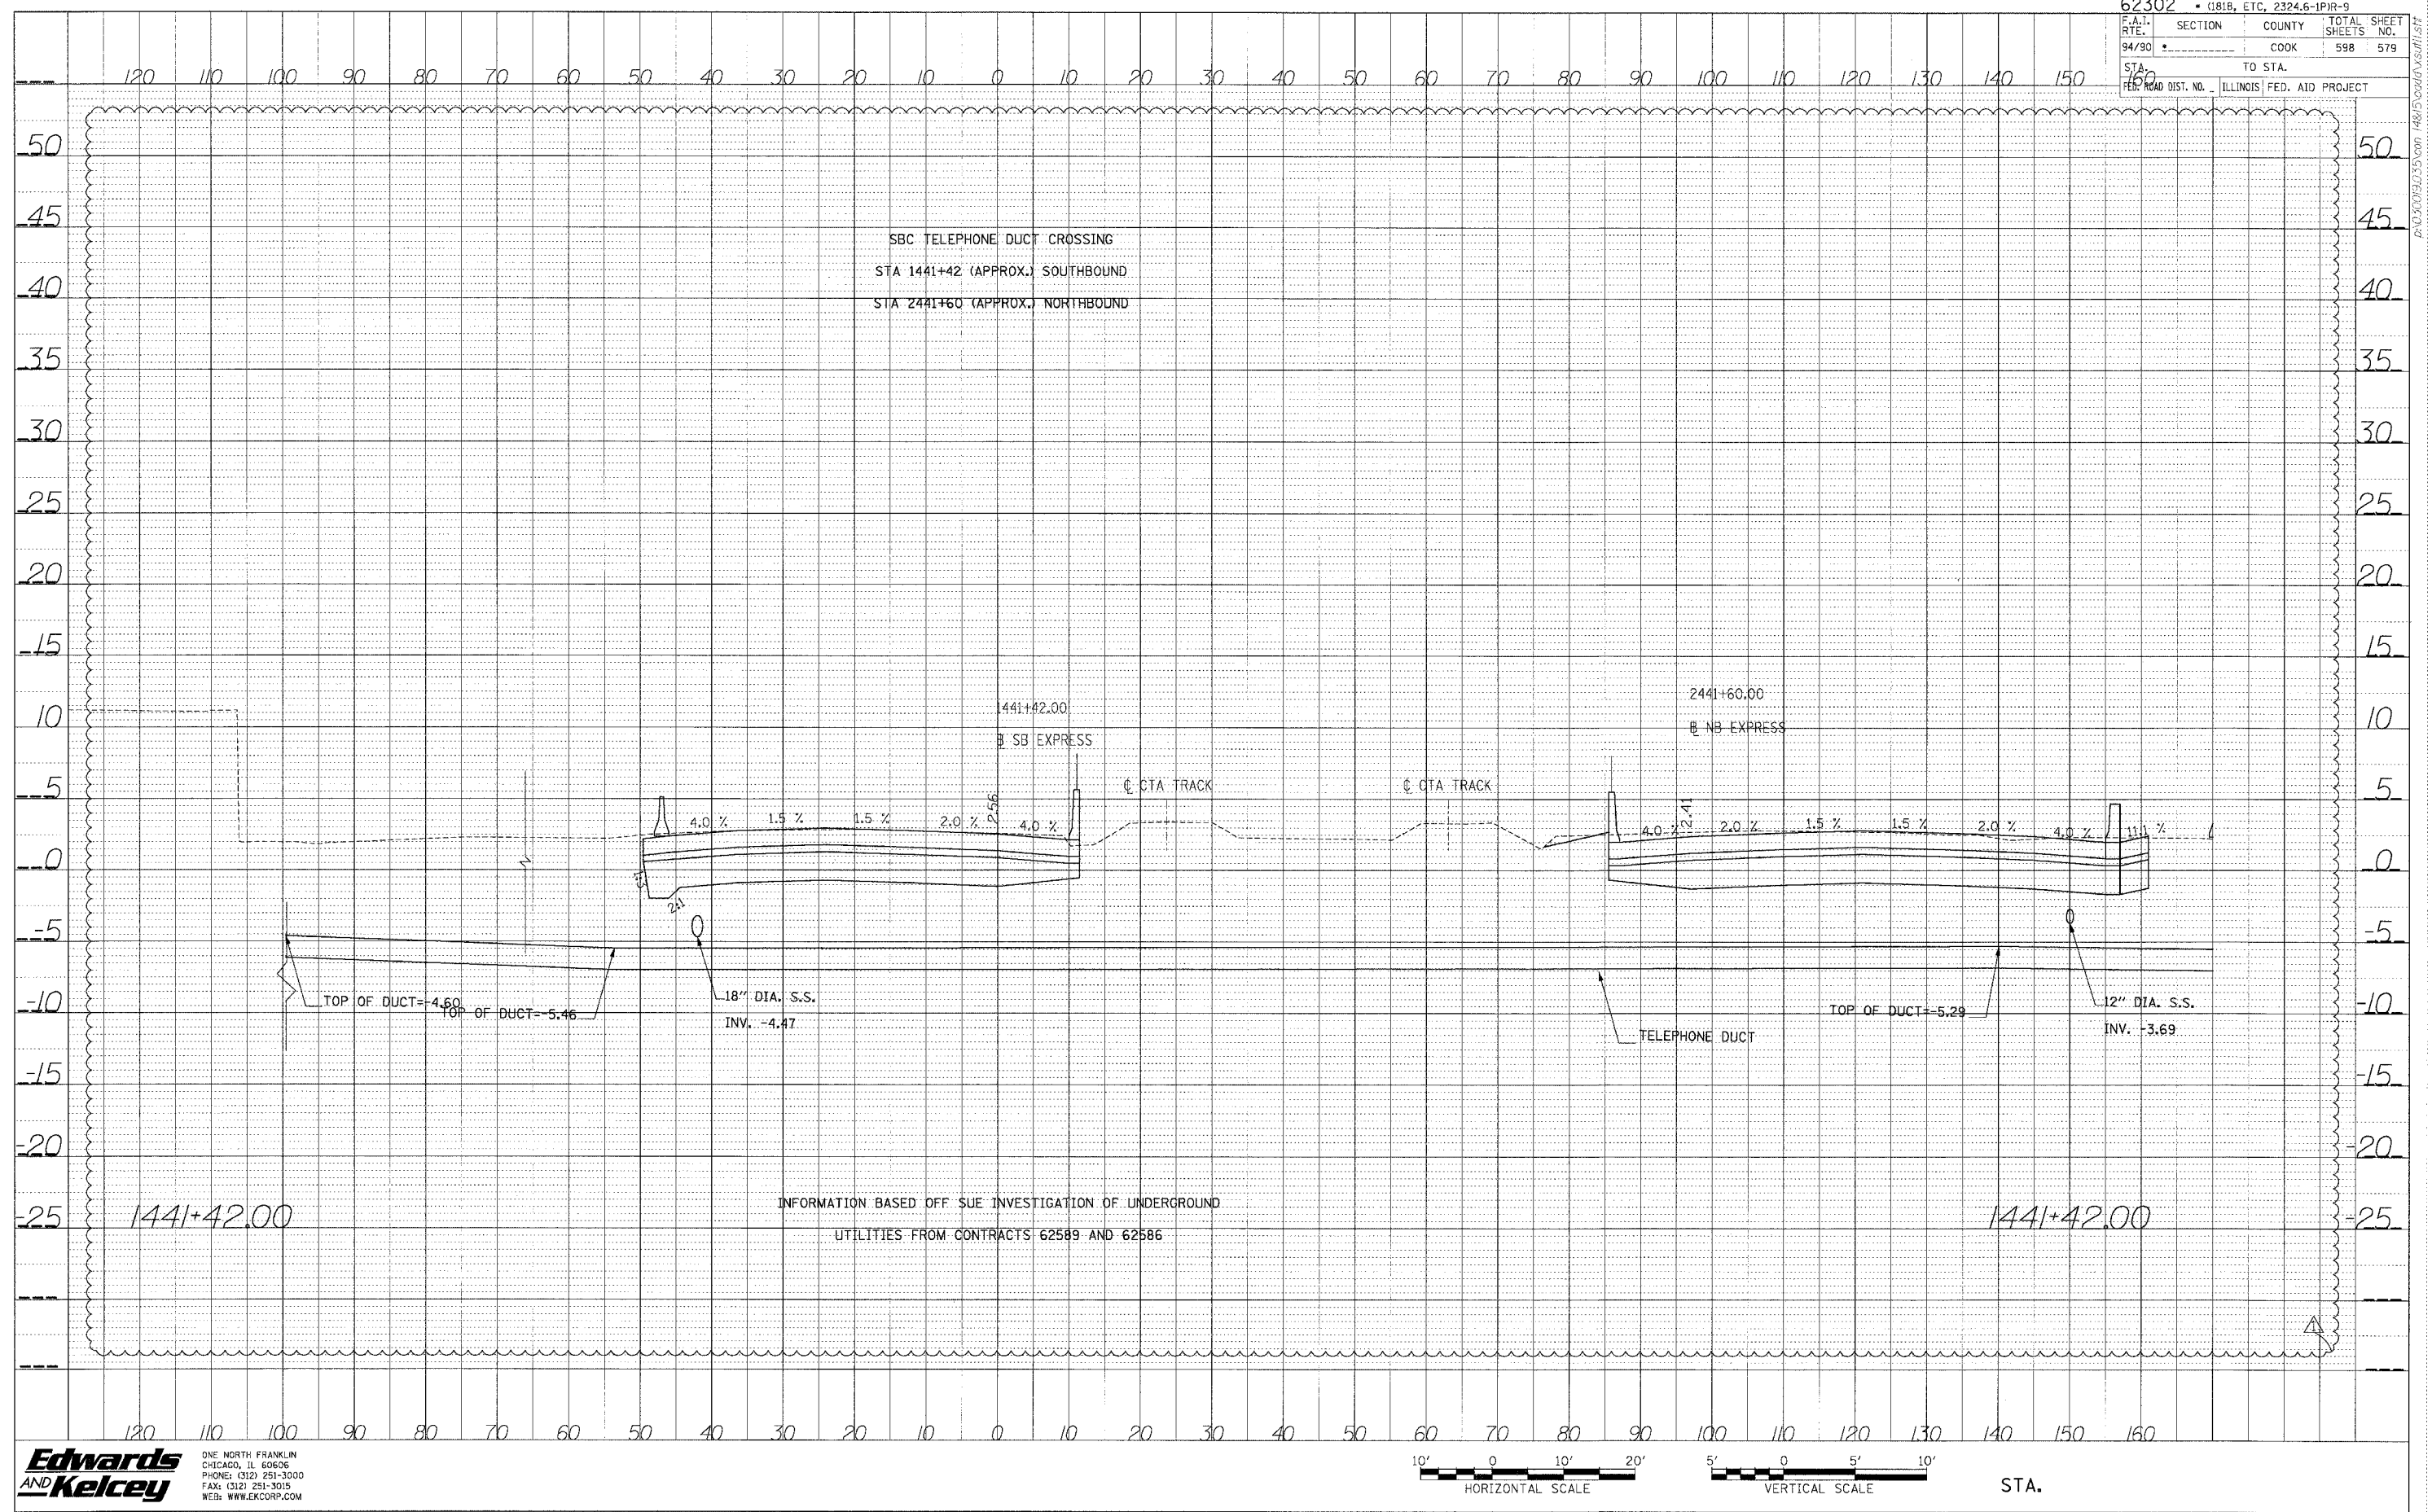

P:\030093\035 con 14815\030093.dwg

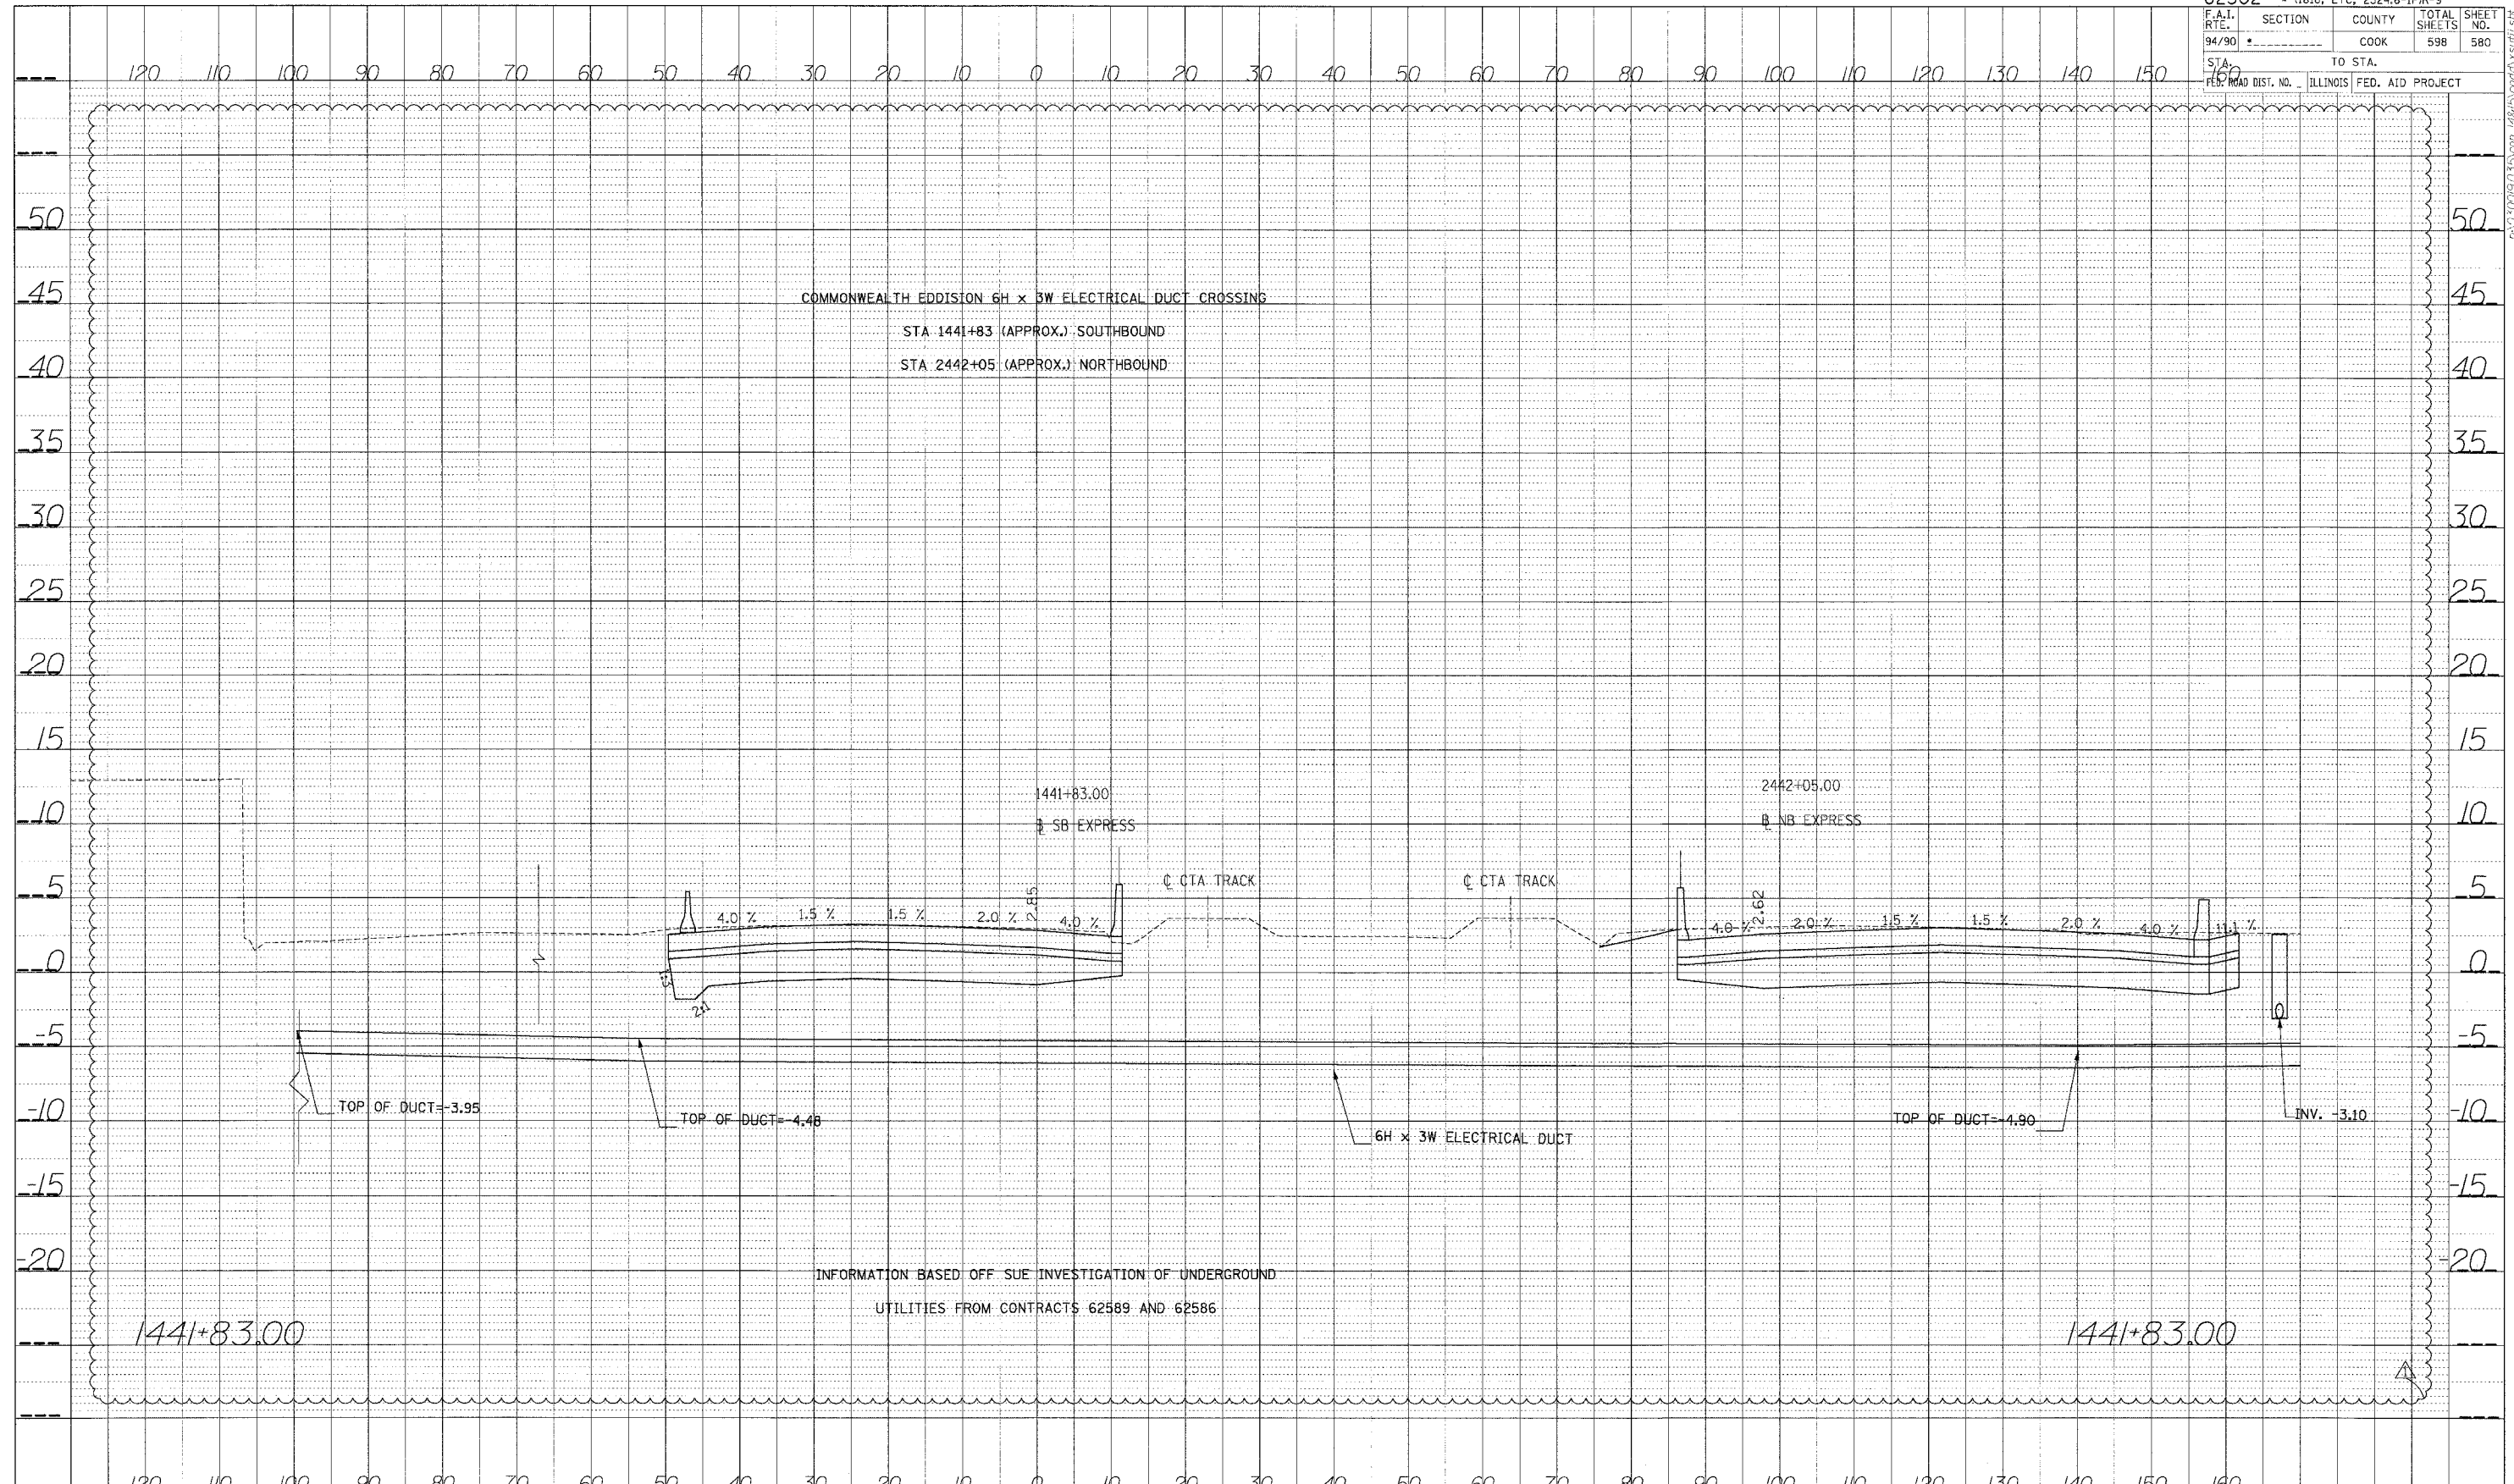


DATE	
BY	
PROJECT	
PROJ. NO.	
NO. OF SHEETS	
SHEET NO.	
DATE	
BY	
PROJECT	
PROJ. NO.	
NO. OF SHEETS	
SHEET NO.	




STA.

PROFILE SURVEYED BY DATE
 PLOTTED BY
 NOTE BOOK NO. DATE
 STRUCTURE NOTATION CARD

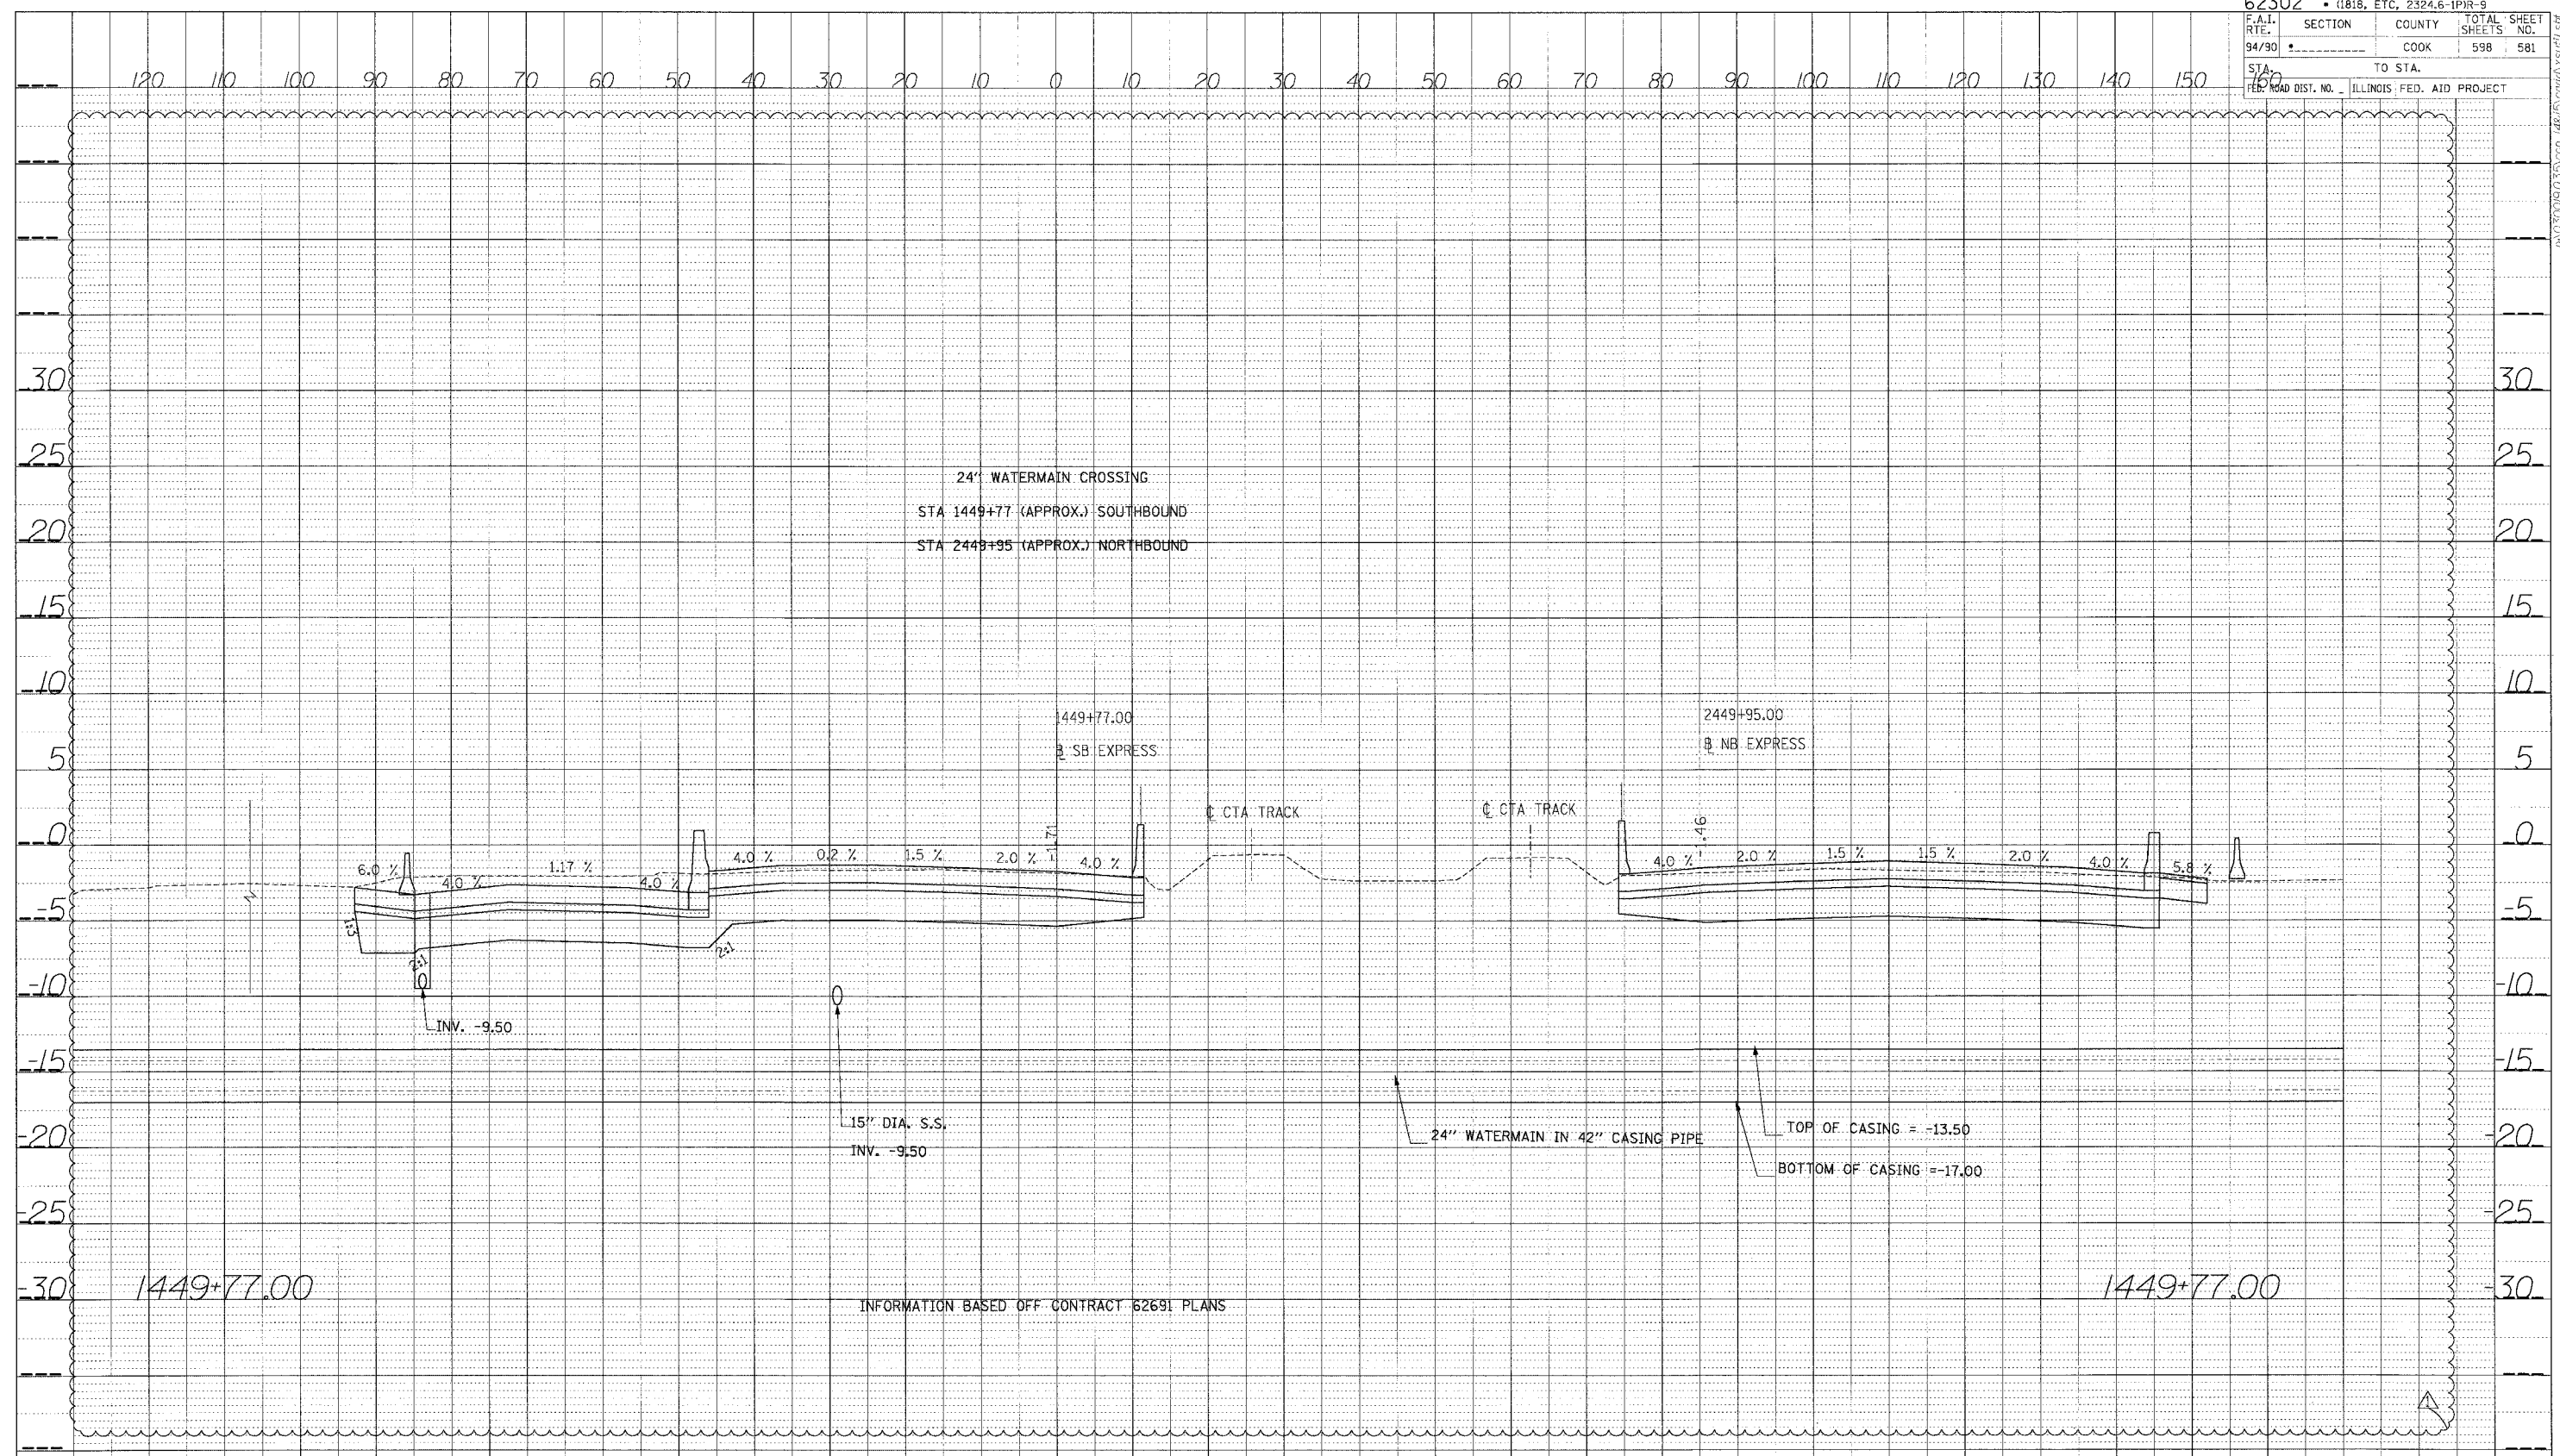

62302 • (1618, ETC, 2324.6-IPR-9)			
P.A.I. RITE	SECTION	COUNTY	TOTAL SHEETS
94/90		COOK	598
STA. FROM	TO STA.		SHEET NO.
1461+56.00	1461+56.00		582
ILLINOIS FED. AID PROJECT			


PROFILL	DATE
BY	
REVISION	
NO.	

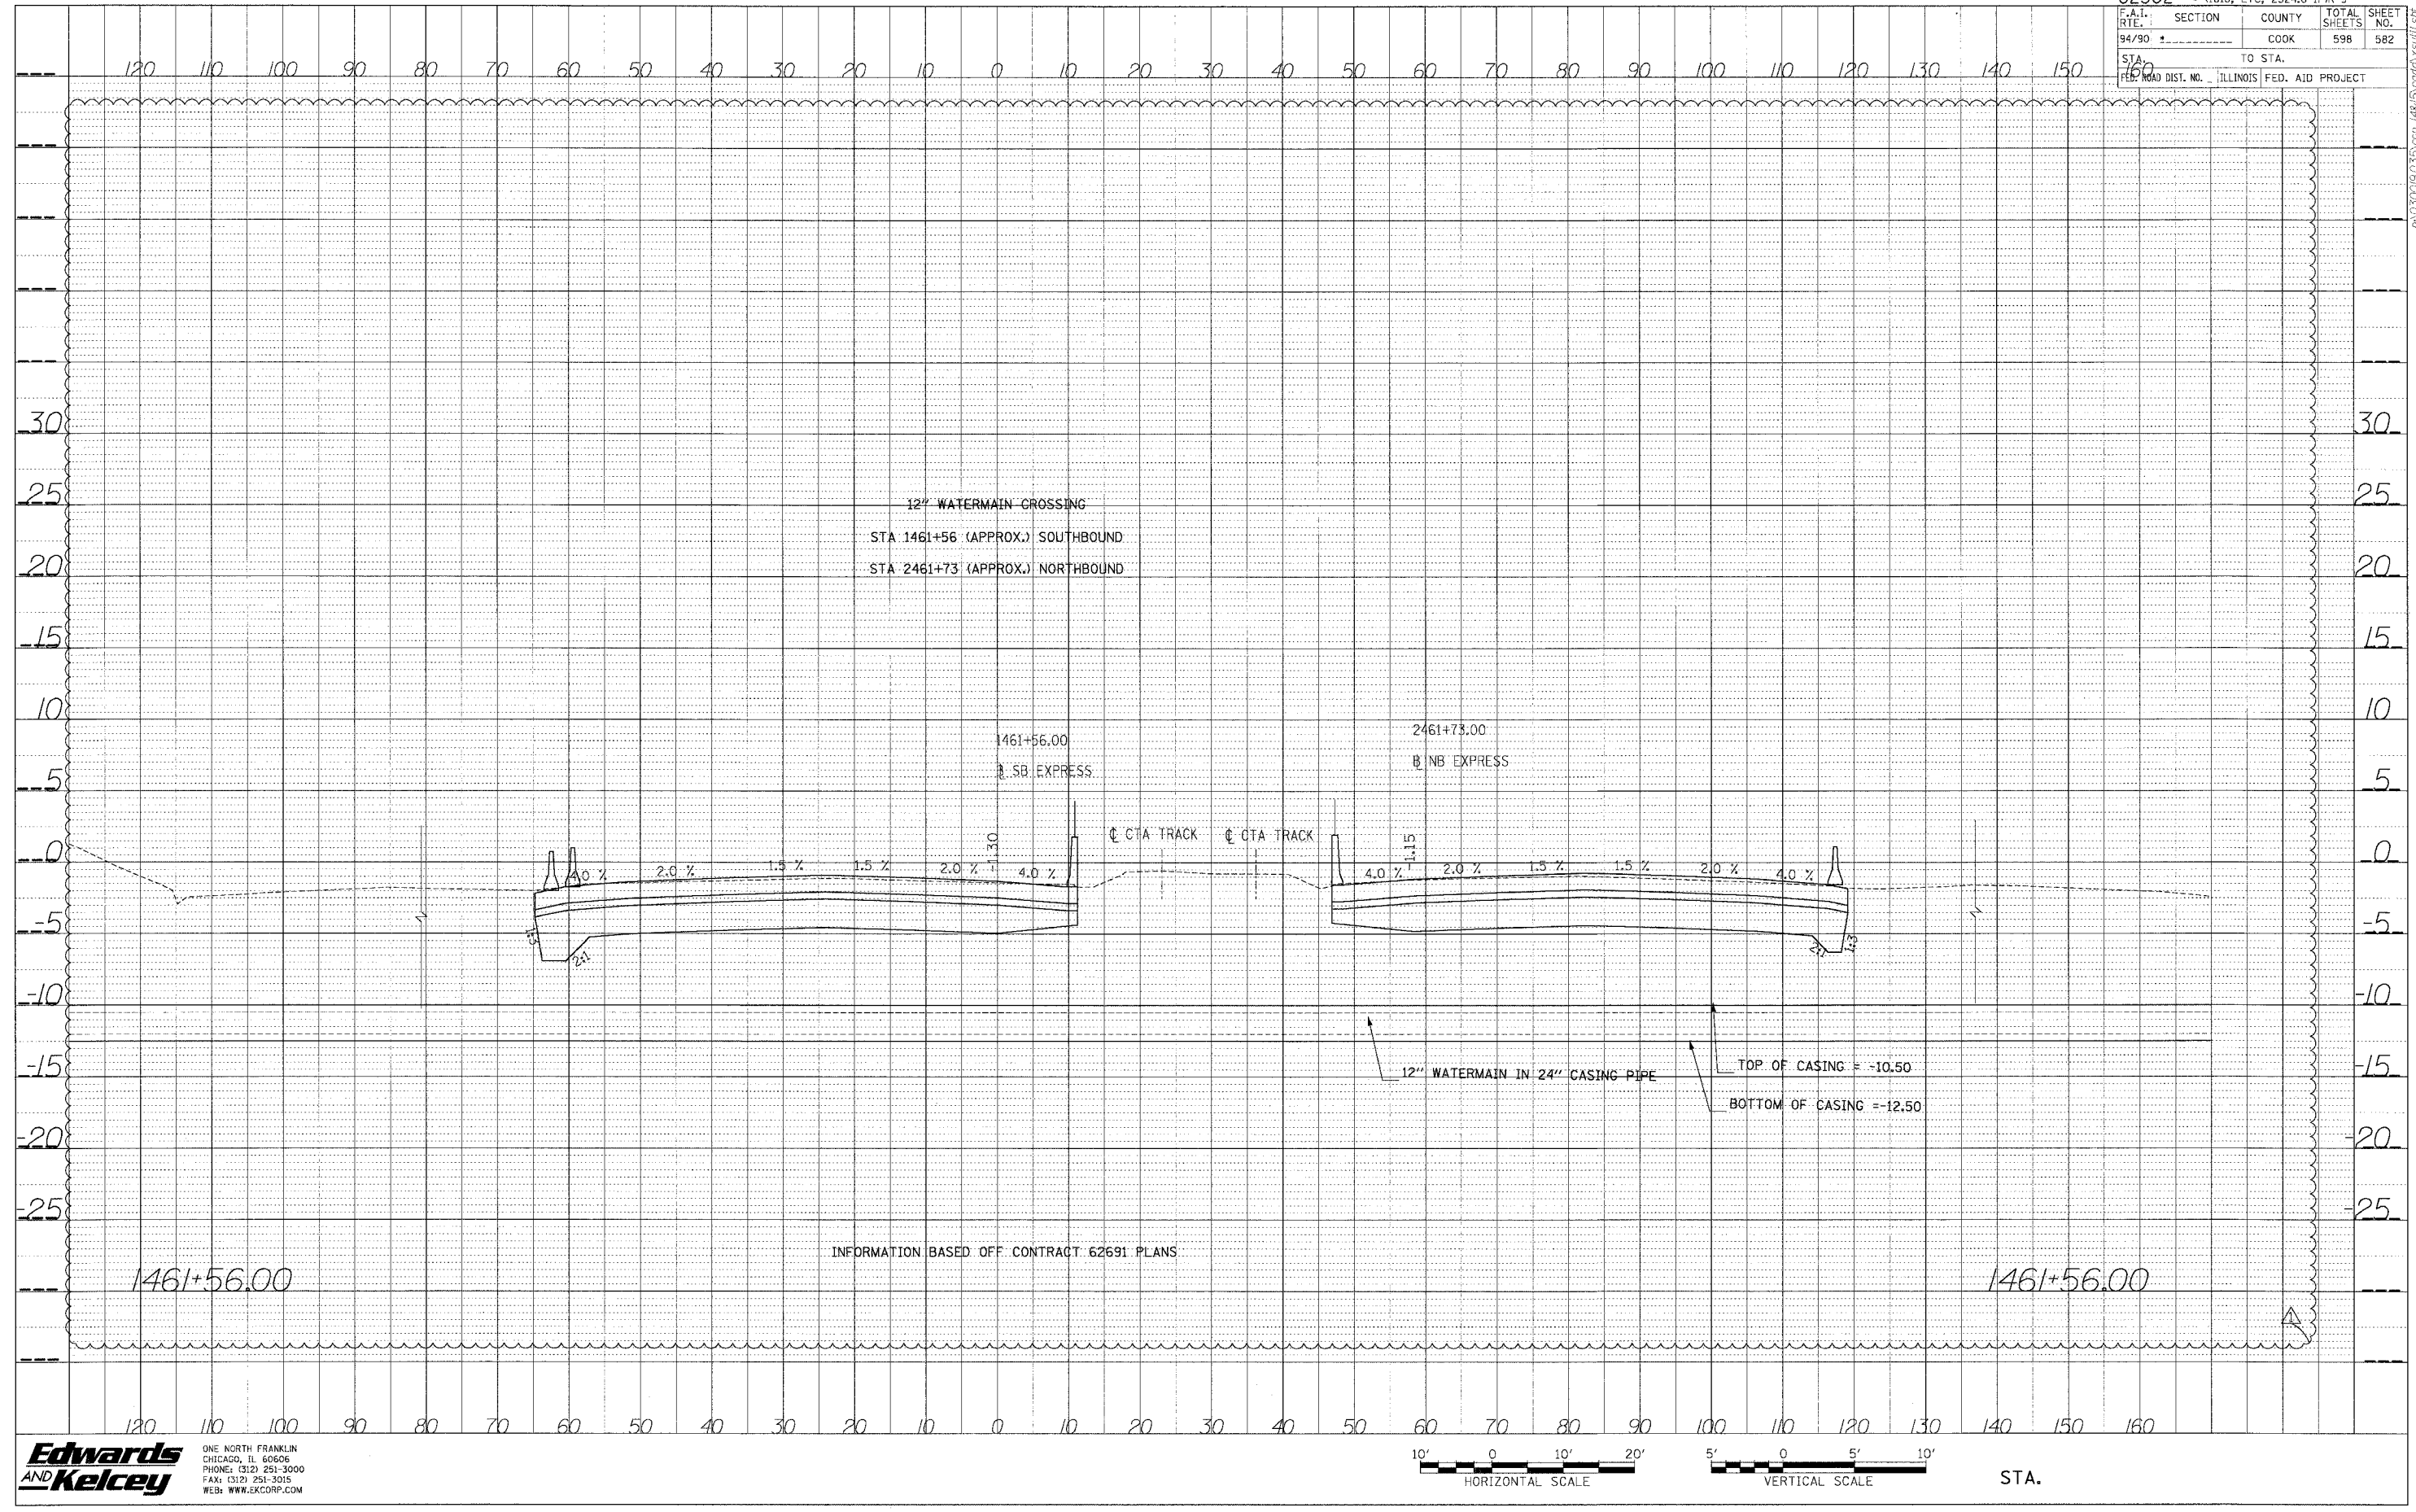


Edwards AND Kelcey
 ONE NORTH FRANKLIN
 CHICAGO, IL 60606
 PHONE: (312) 251-3000
 FAX: (312) 251-3015
 WEB: WWW.EKCORP.COM

62302 • (1818, ETC, 2324.6-1PIR-9			
F.A.I. RTE.	SECTION	COUNTY	TOTAL SHEETS
94/90		COOK	598
STA. 160	TO STA.		SHEET NO. 583
FED. ROAD DIST. NO.	ILLINOIS FED. AID PROJECT		

PROFILE
 SURVEYED BY _____ DATE _____
 PLotted _____
 CHECKED BY _____
 NOTE BOOK NO. _____
 STRUCTURE NOTATION CIND

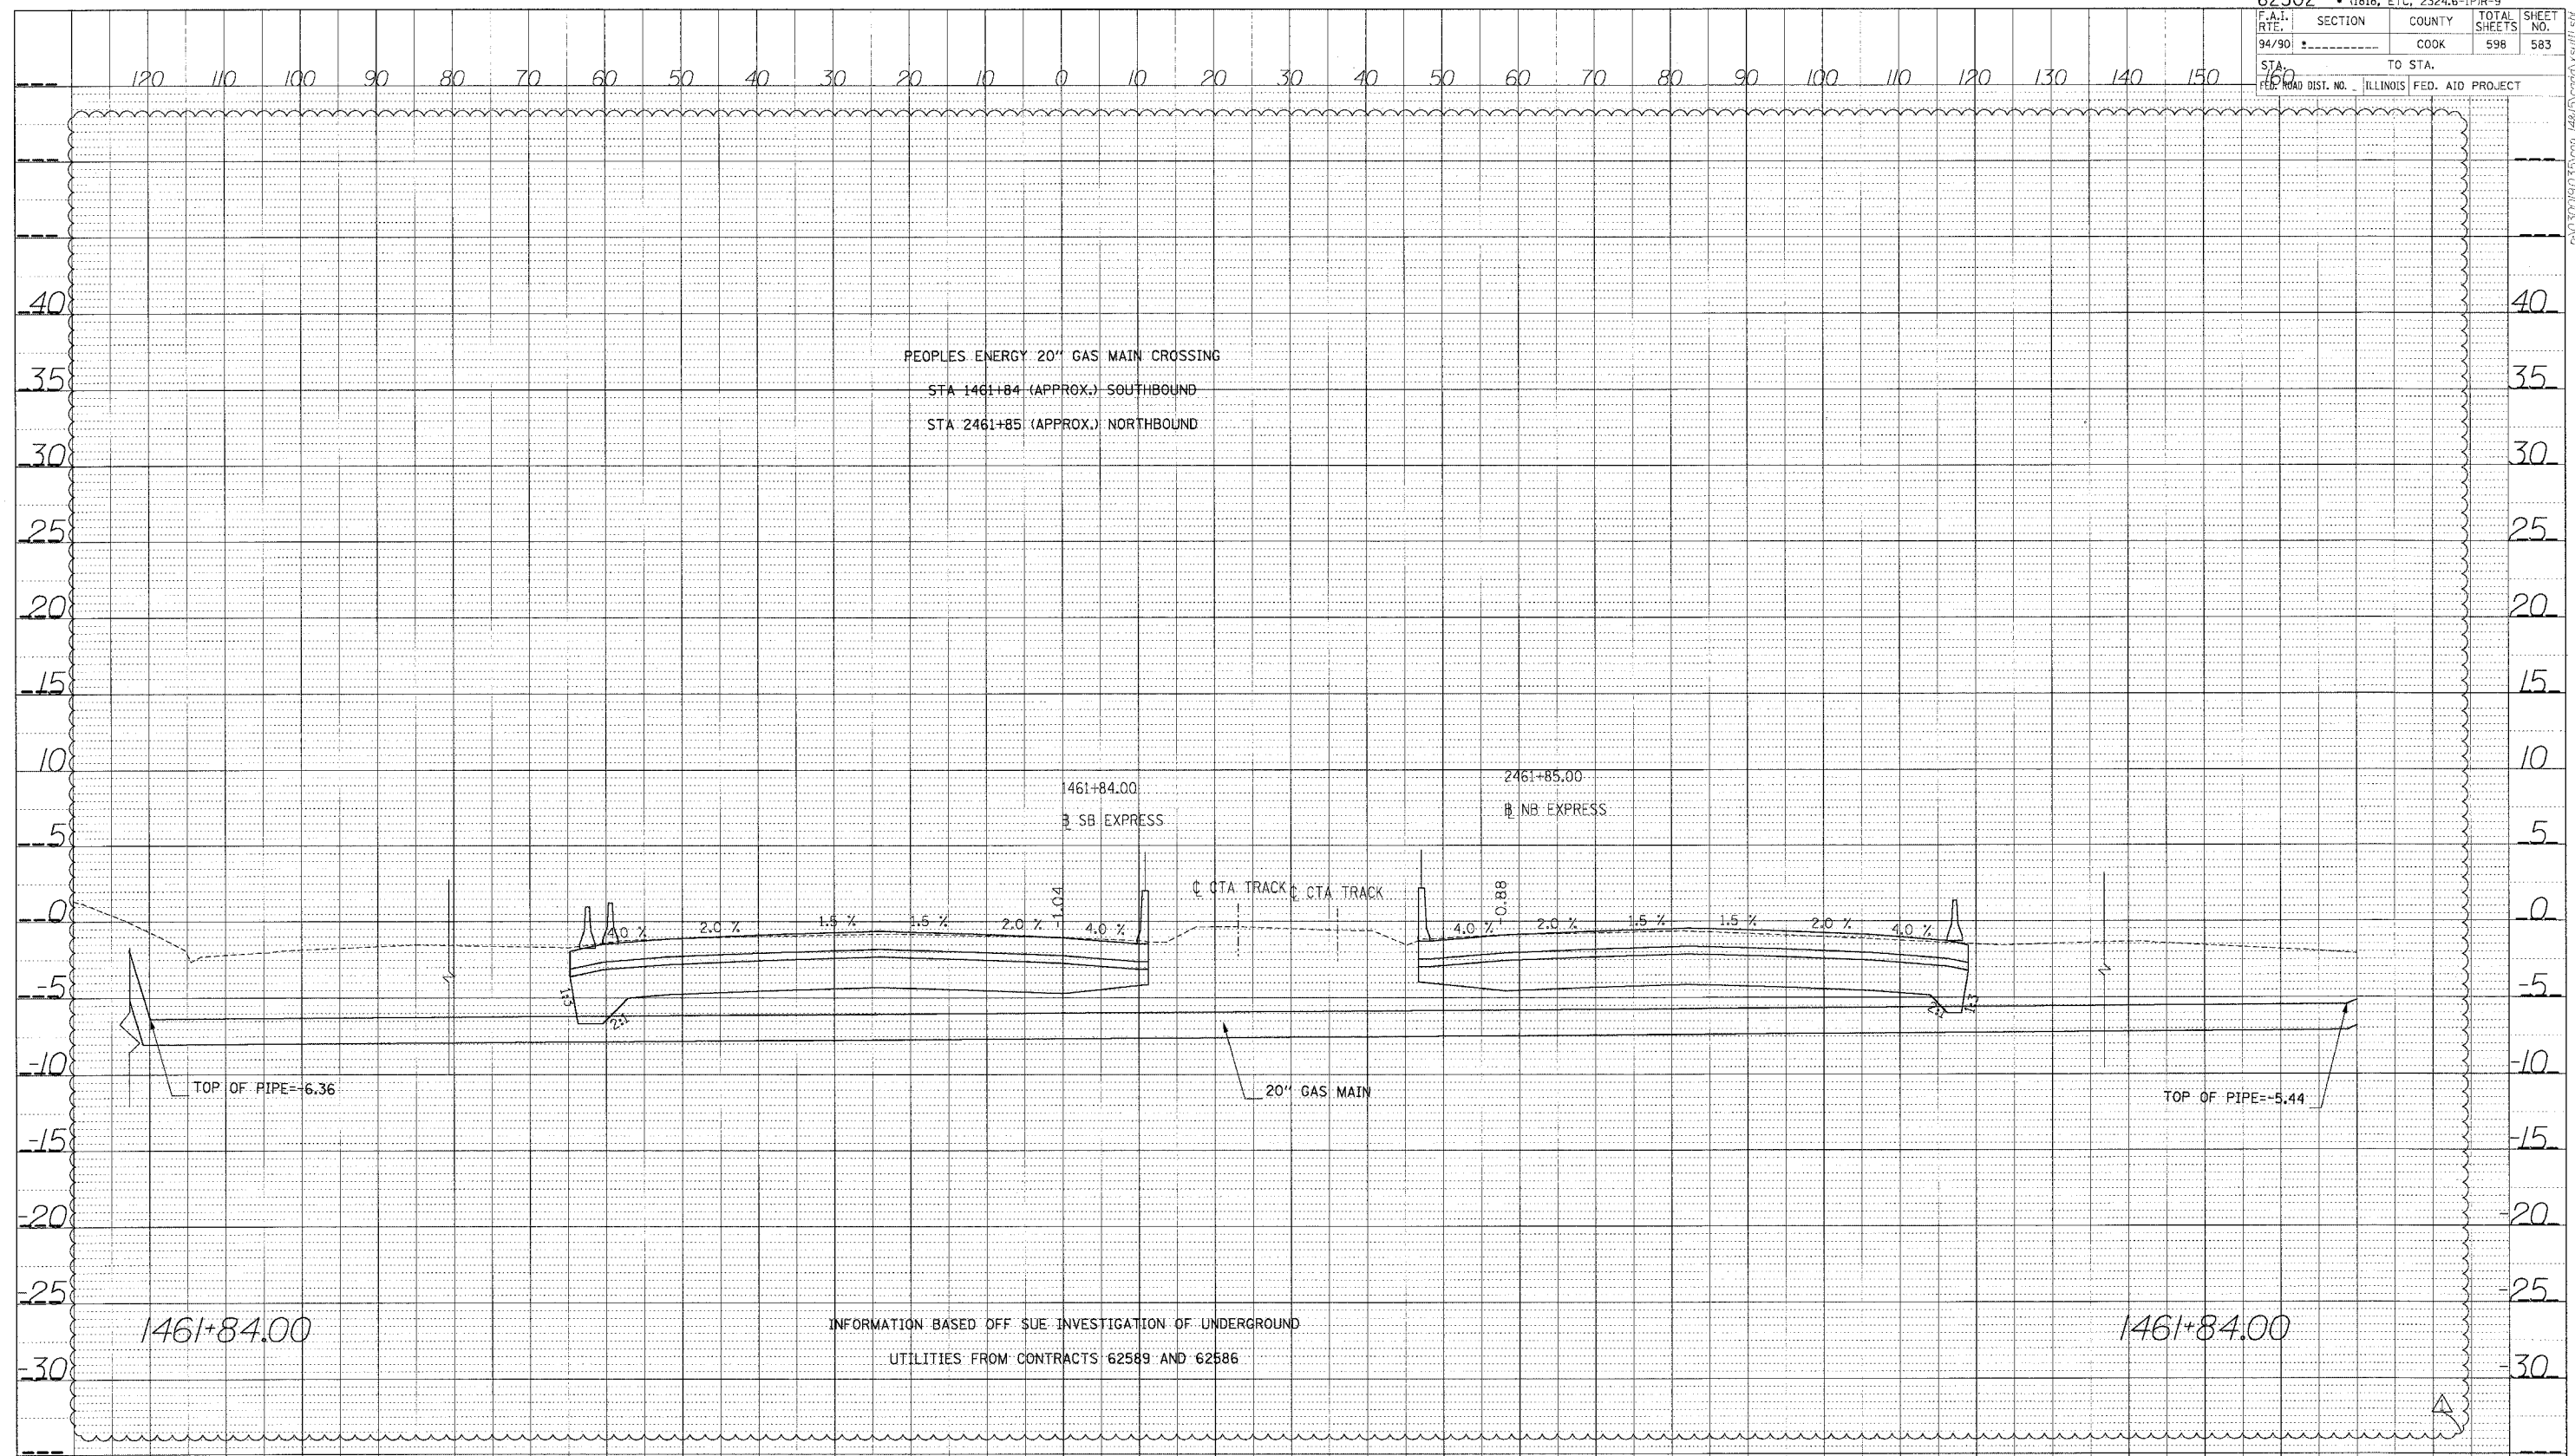


Edwards AND Kelcey
 ONE NORTH FRANKLIN
 CHICAGO, IL 60606
 PHONE: (312) 251-3000
 FAX: (312) 251-3015
 WEB: WWW.EKCORP.COM

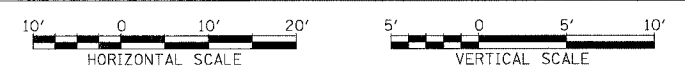


STA.

DATE	
BY	
PROF. CHECKED	
DATE	
NOTE BOOK	
NO.	

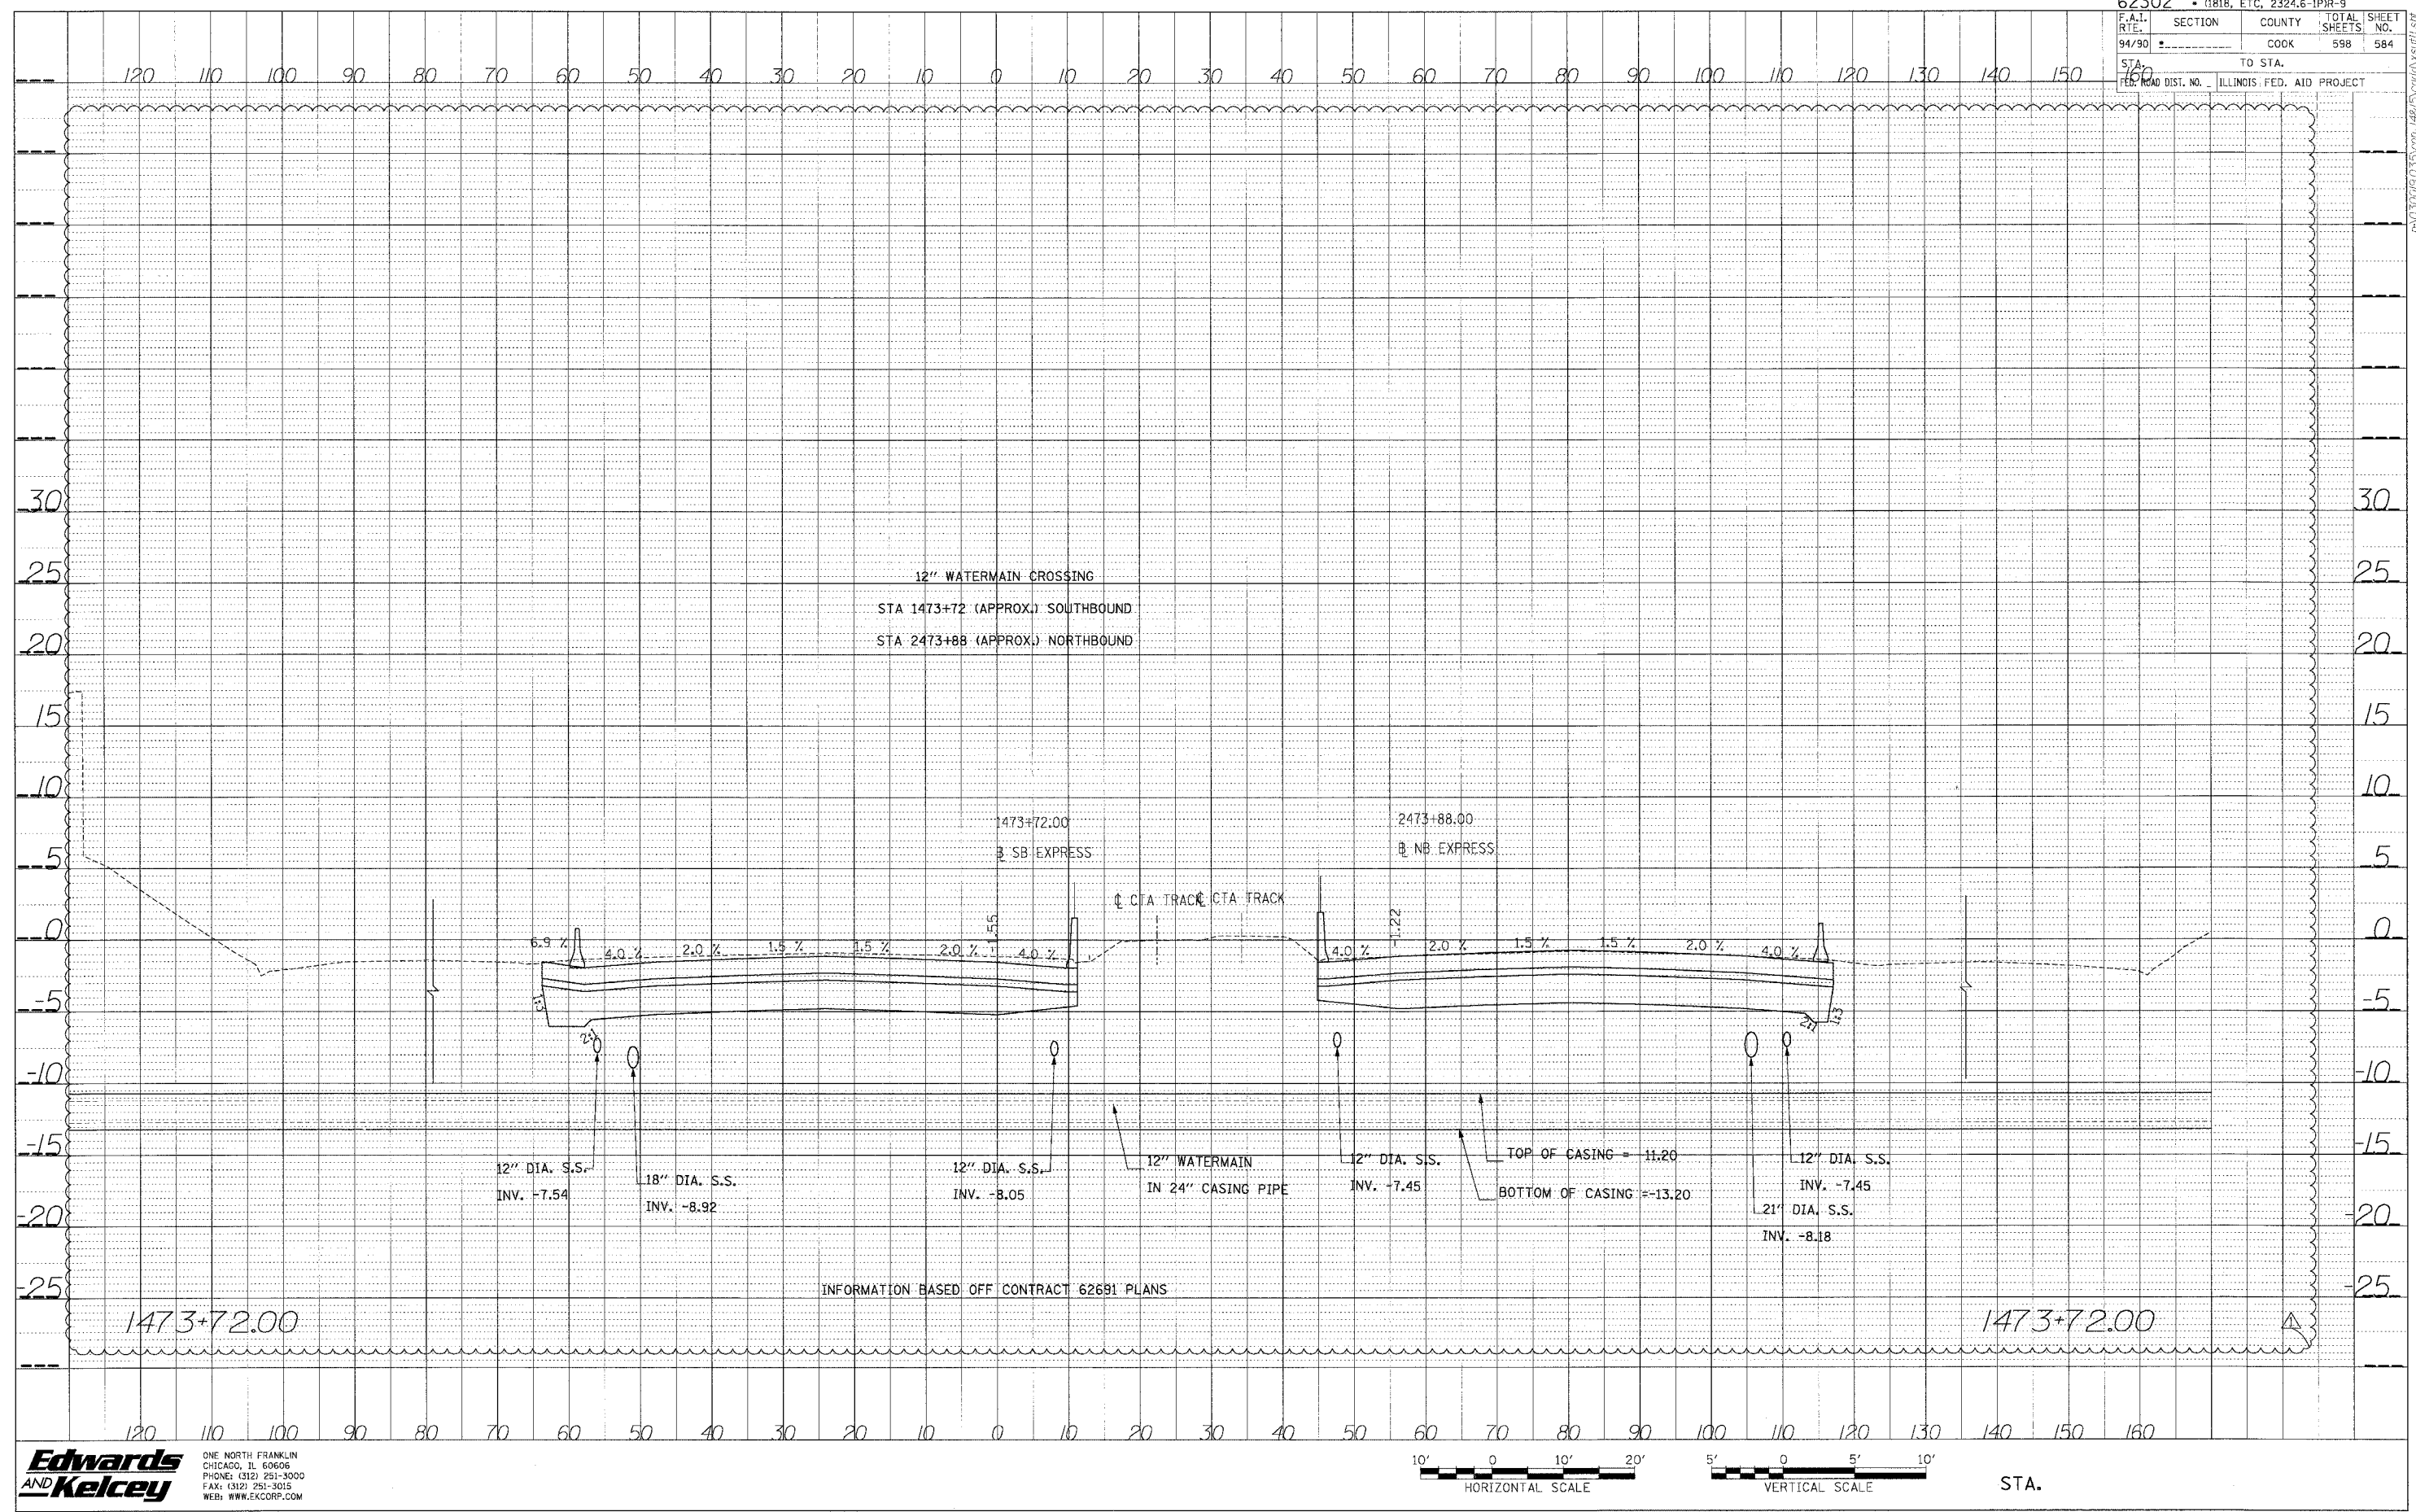


62302 • (1818, ETC, 2324.6-1PR-9			
F.A.I. SECTION	COUNTY	TOTAL SHEETS	SHEET NO.
94/90	COOK	598	585
STA. TO STA.		ILLINOIS FED. AID PROJECT	
160			

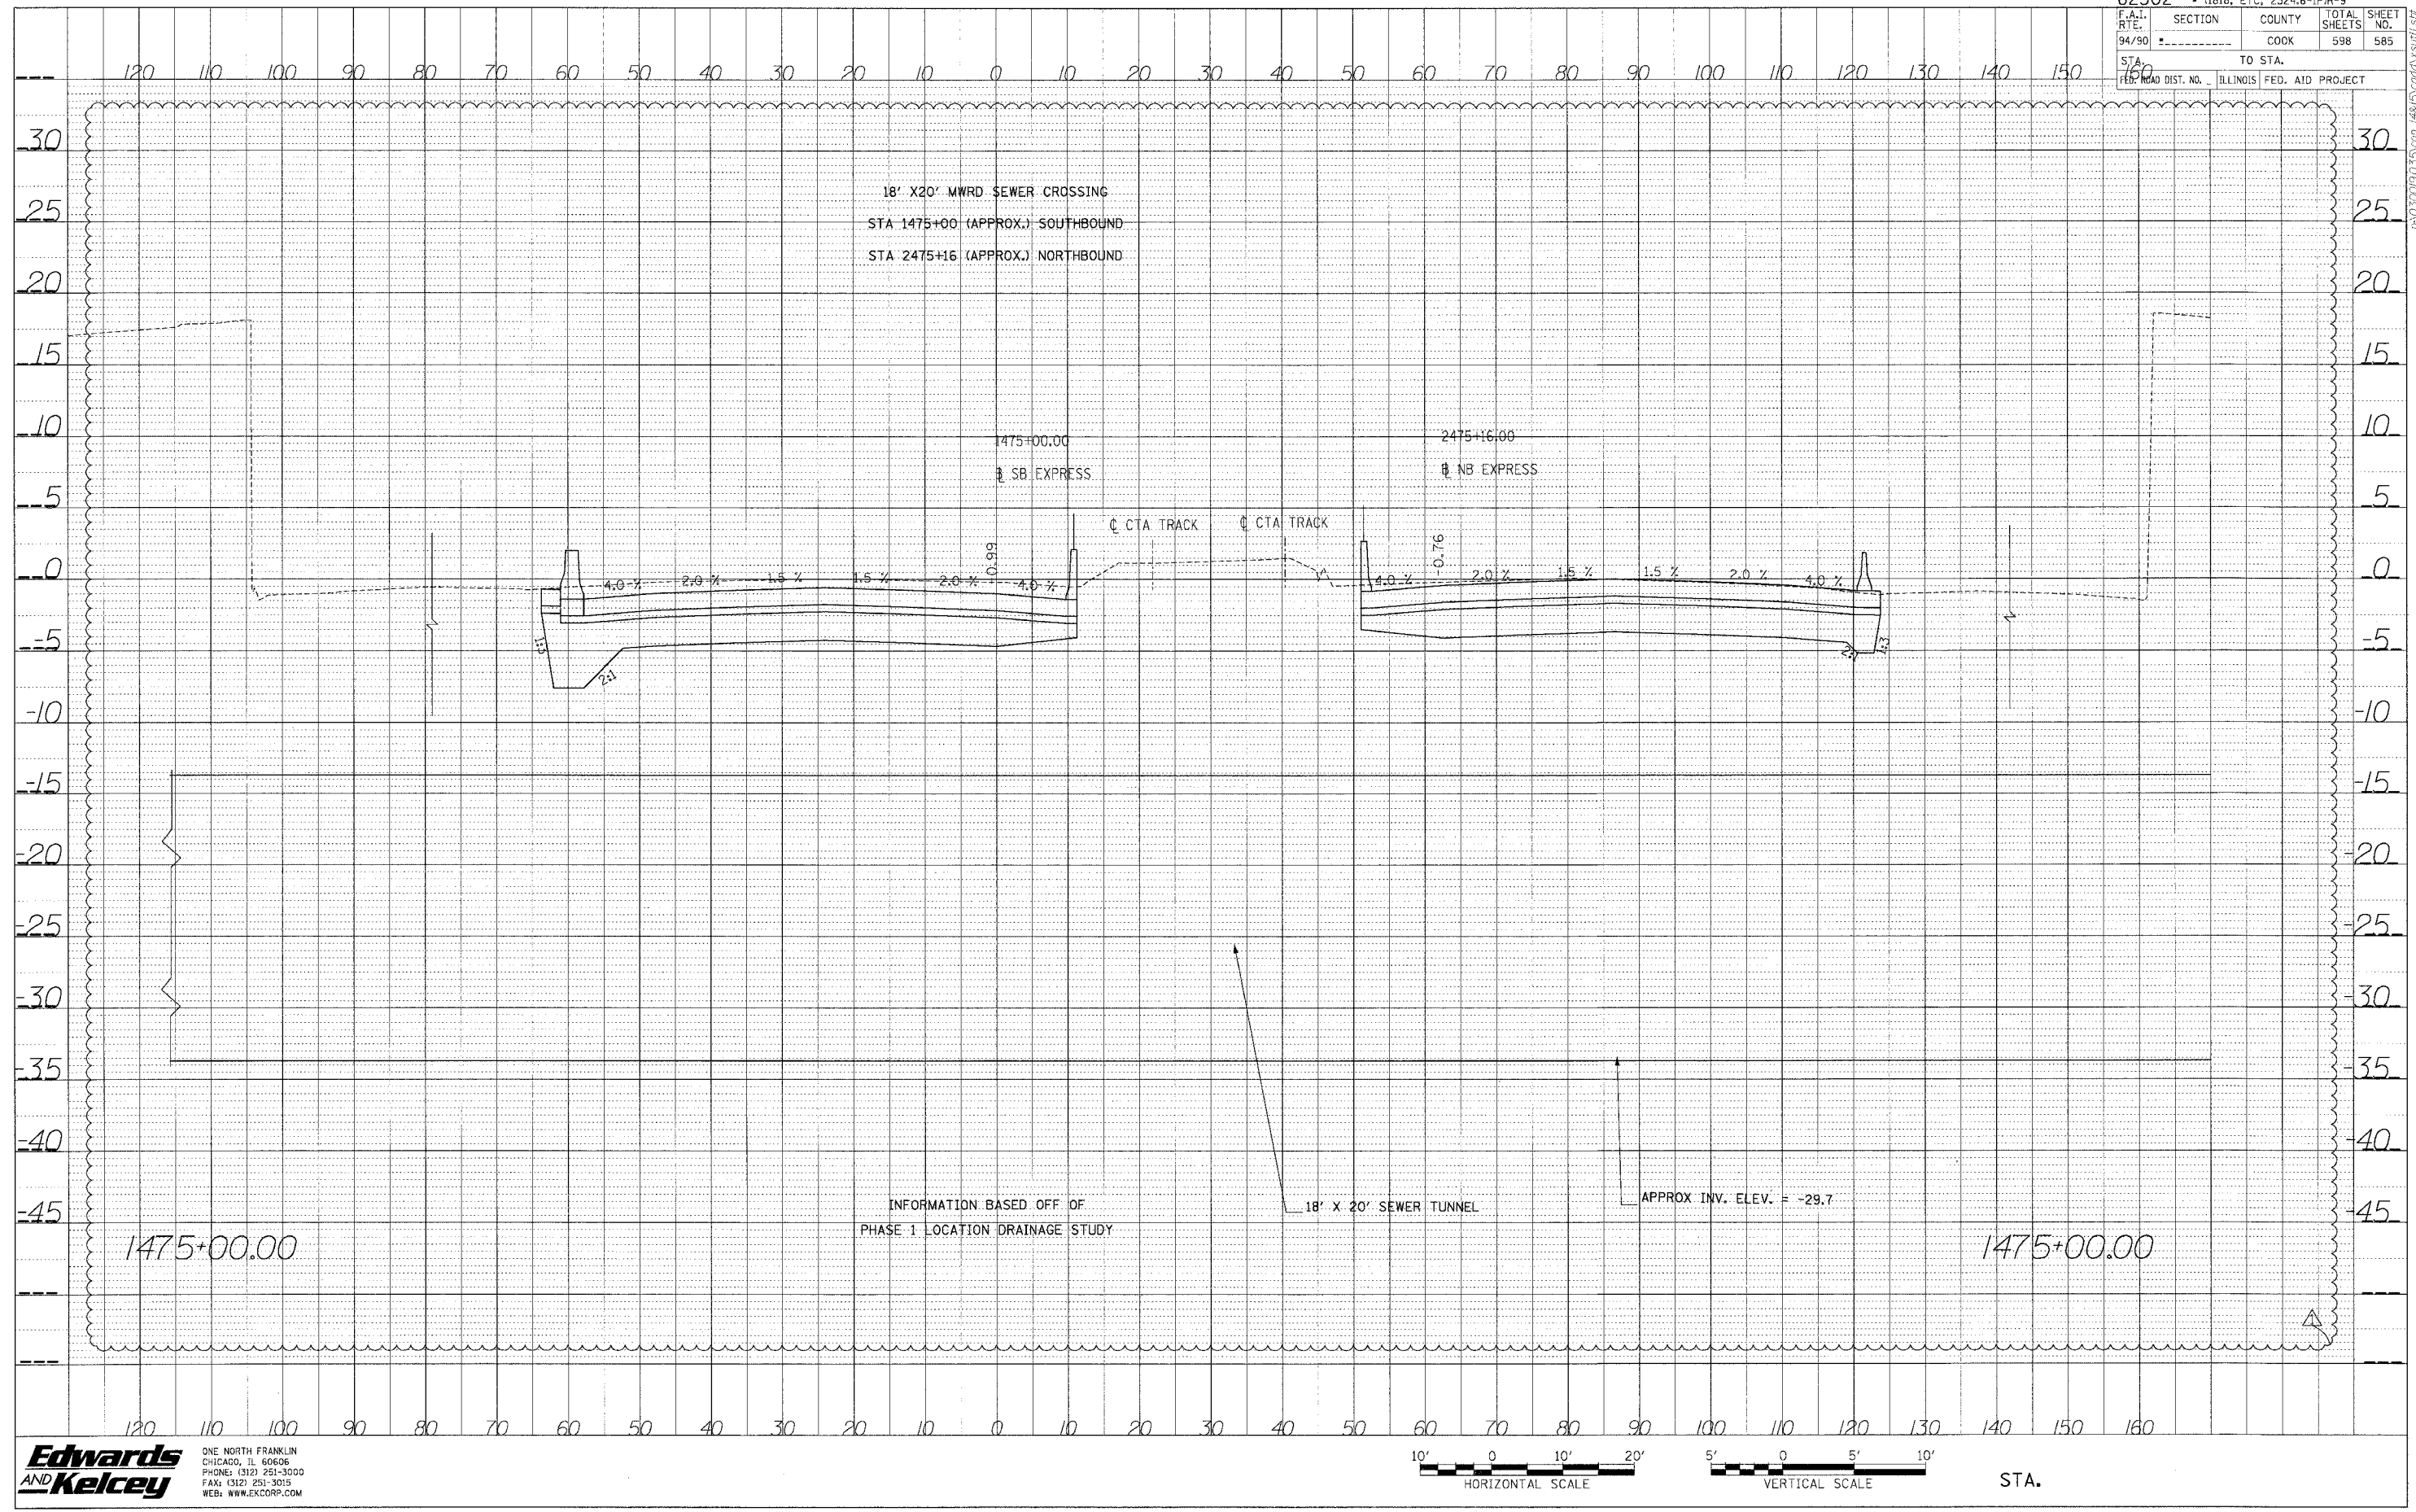


PROFILE	REVIEWED	DATE
NOTE BOOK	PLATED	
NO.	CHECKED	
	BY	
	DATE	
	NO.	
	NO.	
	NO.	
	NO.	

Edwards AND Kelcey
 ONE NORTH FRANKLIN
 CHICAGO, IL 60606
 PHONE: (312) 261-3000
 FAX: (312) 261-3015
 WEB: WWW.EKCORP.COM

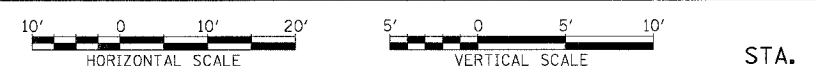


62302 • (1818, ETC, 2324.6-1PR-9				
FAA RTE.	SECTION	COUNTY	TOTAL SHEETS	SHEET NO.
94/30		COOK	598	586
STA.	TO STA.			
FED. ROAD DIST. NO.	ILLINOIS FED. AID PROJECT			

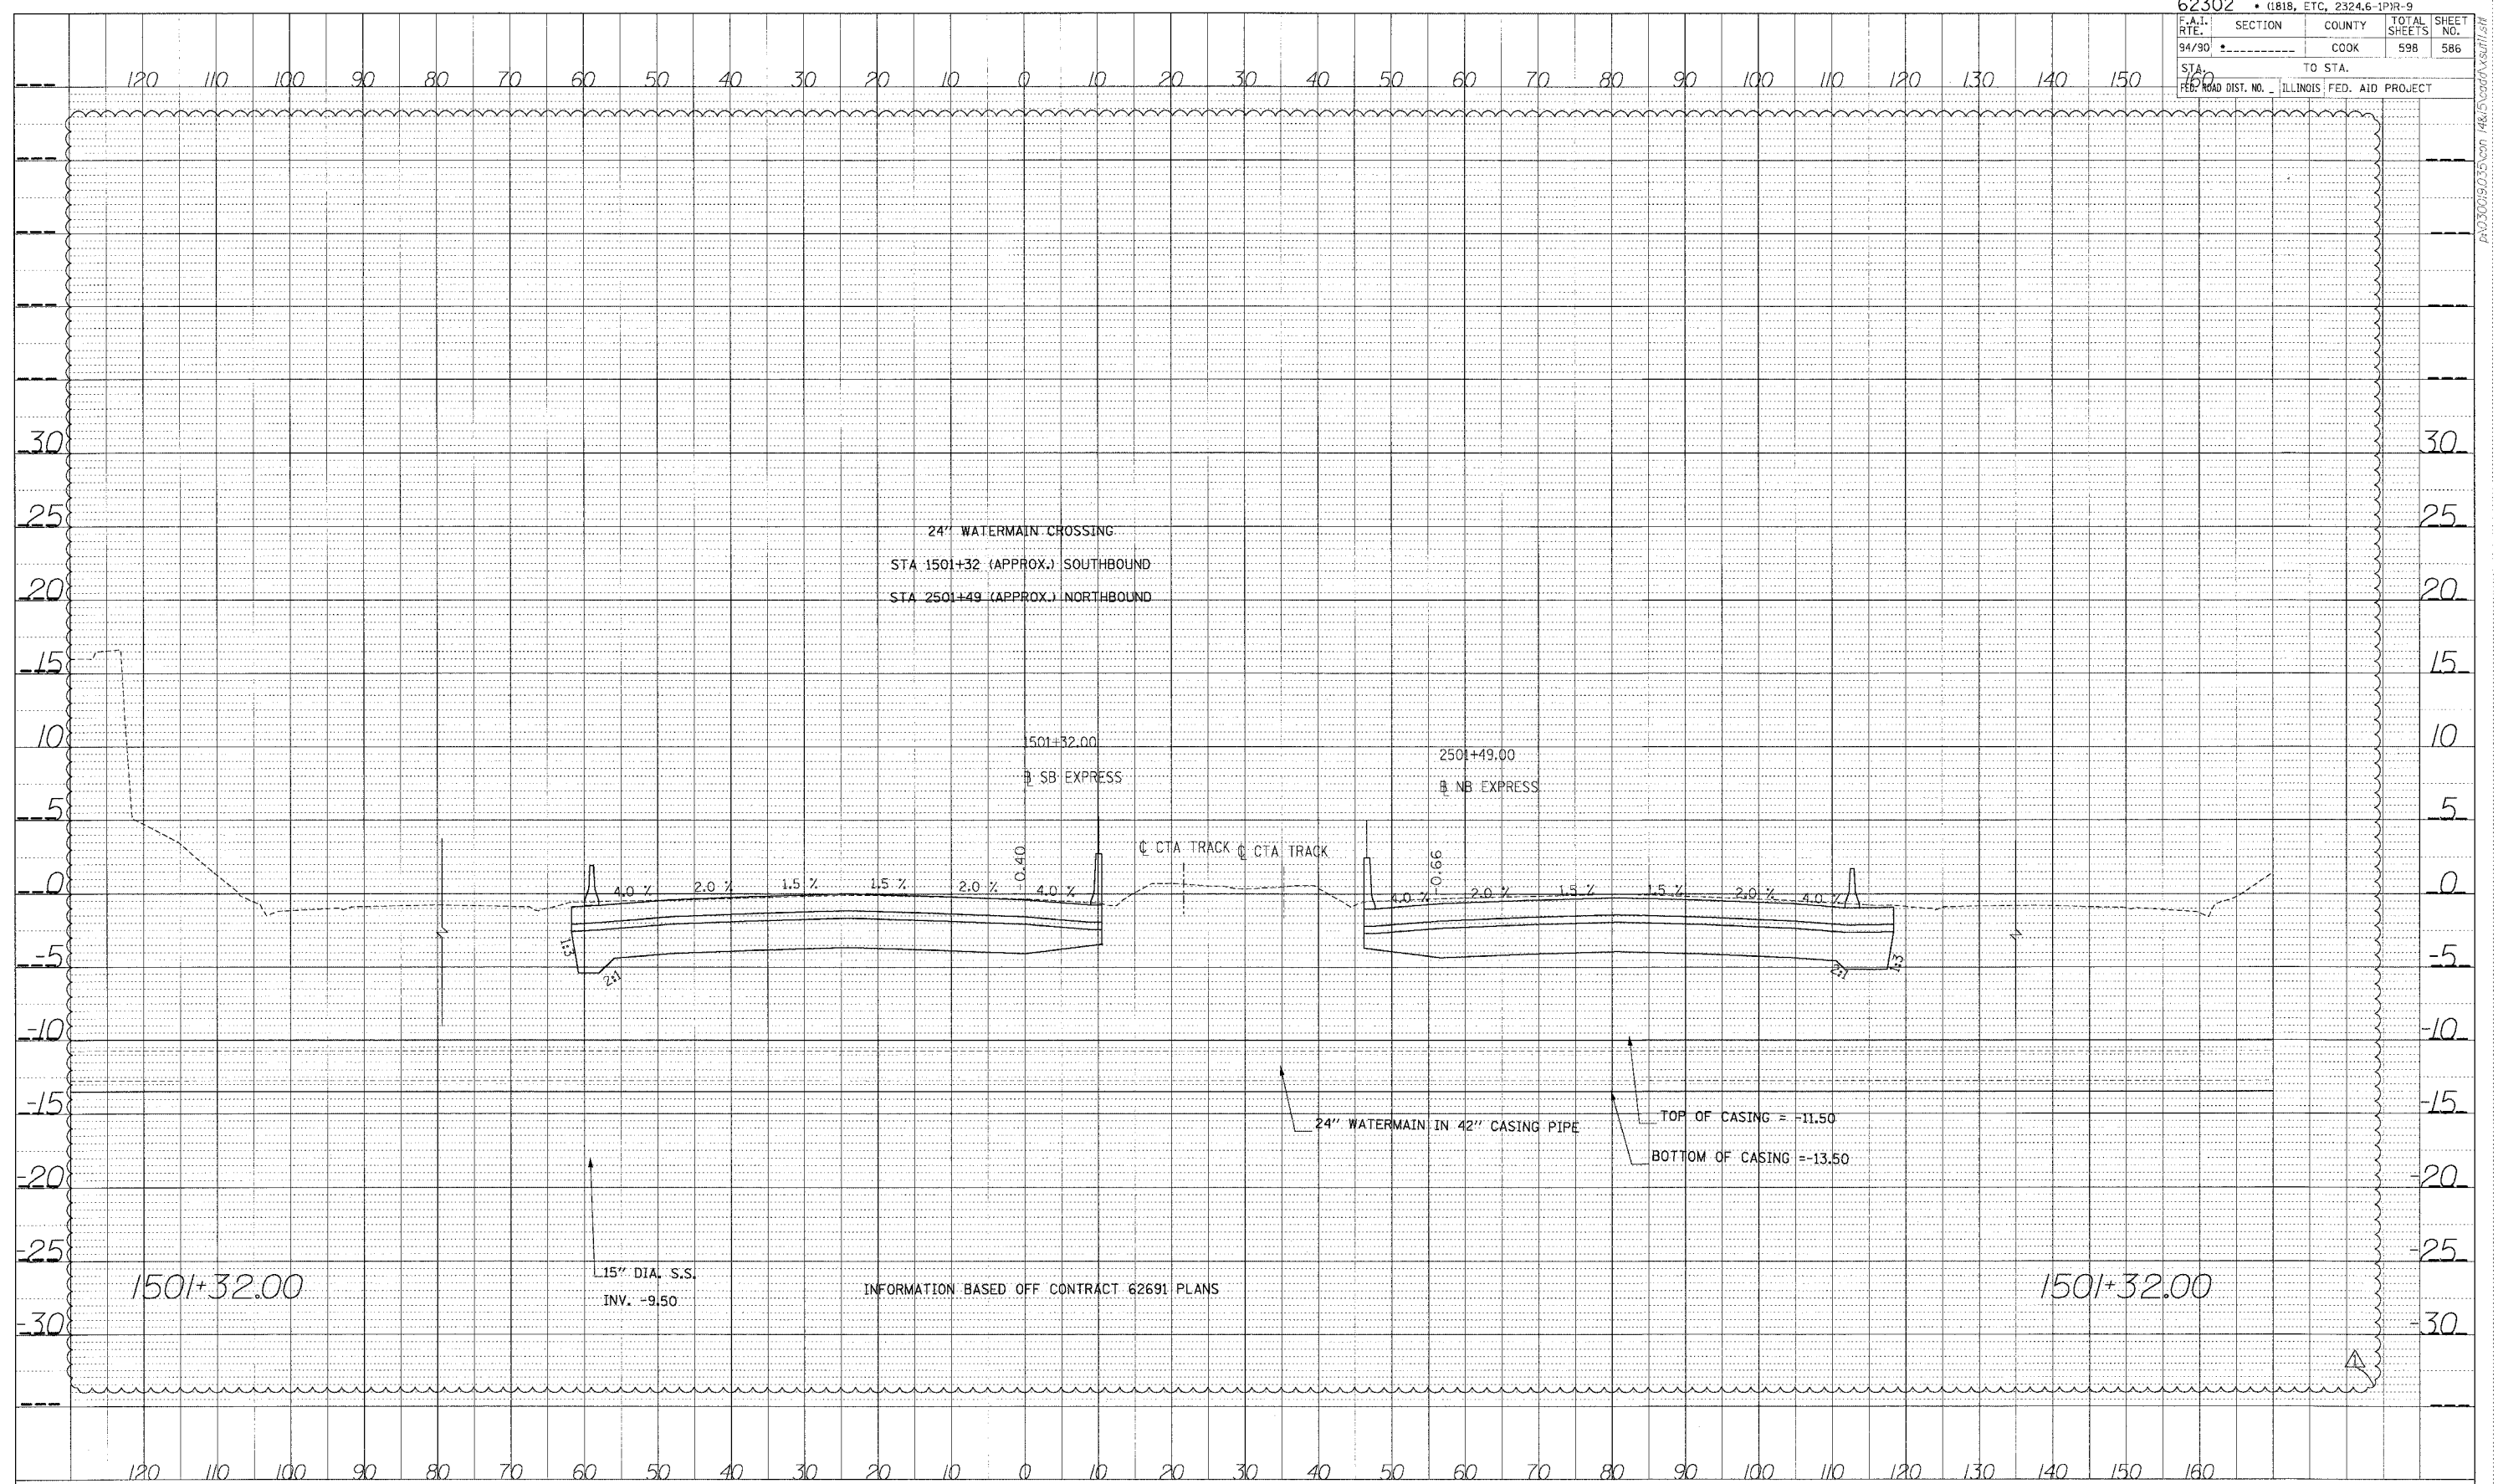

DATE	
BY	
PROJECT	SKANSKA
DESIGN	DESIGNED
CHECKED	CHECKED
DATE	
NOTE BOOK	NO. NOTED
NO.	NOTATION

Edwards AND Kelcey
 ONE NORTH FRANKLIN
 CHICAGO, IL 60606
 PHONE: (312) 251-3000
 FAX: (312) 251-3015
 WEB: WWW.EKCORP.COM

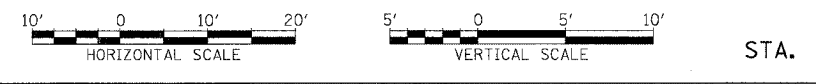

INFORMATION BASED OFF CONTRACT 62691 PLANS

1501+32.00

1501+32.00

15" DIA. S.S.
 INV. -9.50

24" WATERMAIN IN 42" CASING PIPE
 TOP OF CASING = -11.50
 BOTTOM OF CASING = -13.50

24" WATERMAIN CROSSING
 STA 1501+32 (APPROX.) SOUTHBOUND
 STA 2501+49 (APPROX.) NORTHBOUND

1501+32.00
 SB EXPRESS

2501+49.00
 NB EXPRESS


0.40%
 CTA TRACK CTA TRACK

4.0% 2.0% 1.5% 1.5% 2.0% 4.0%

4.0% 2.0% 1.5% 1.5% 2.0% 4.0%

A:\2000\90.05\con\4815\road\1501.dwg

62302 • (1818, ETC. 2324.6-1P1R-9			
F.A.T. RT.:	SECTION	COUNTY	TOTAL SHEETS
94/90		COOK	598
STA. 150	TO STA.		
FED. ROAD DIST. NO.	ILLINOIS FED. AID PROJECT		

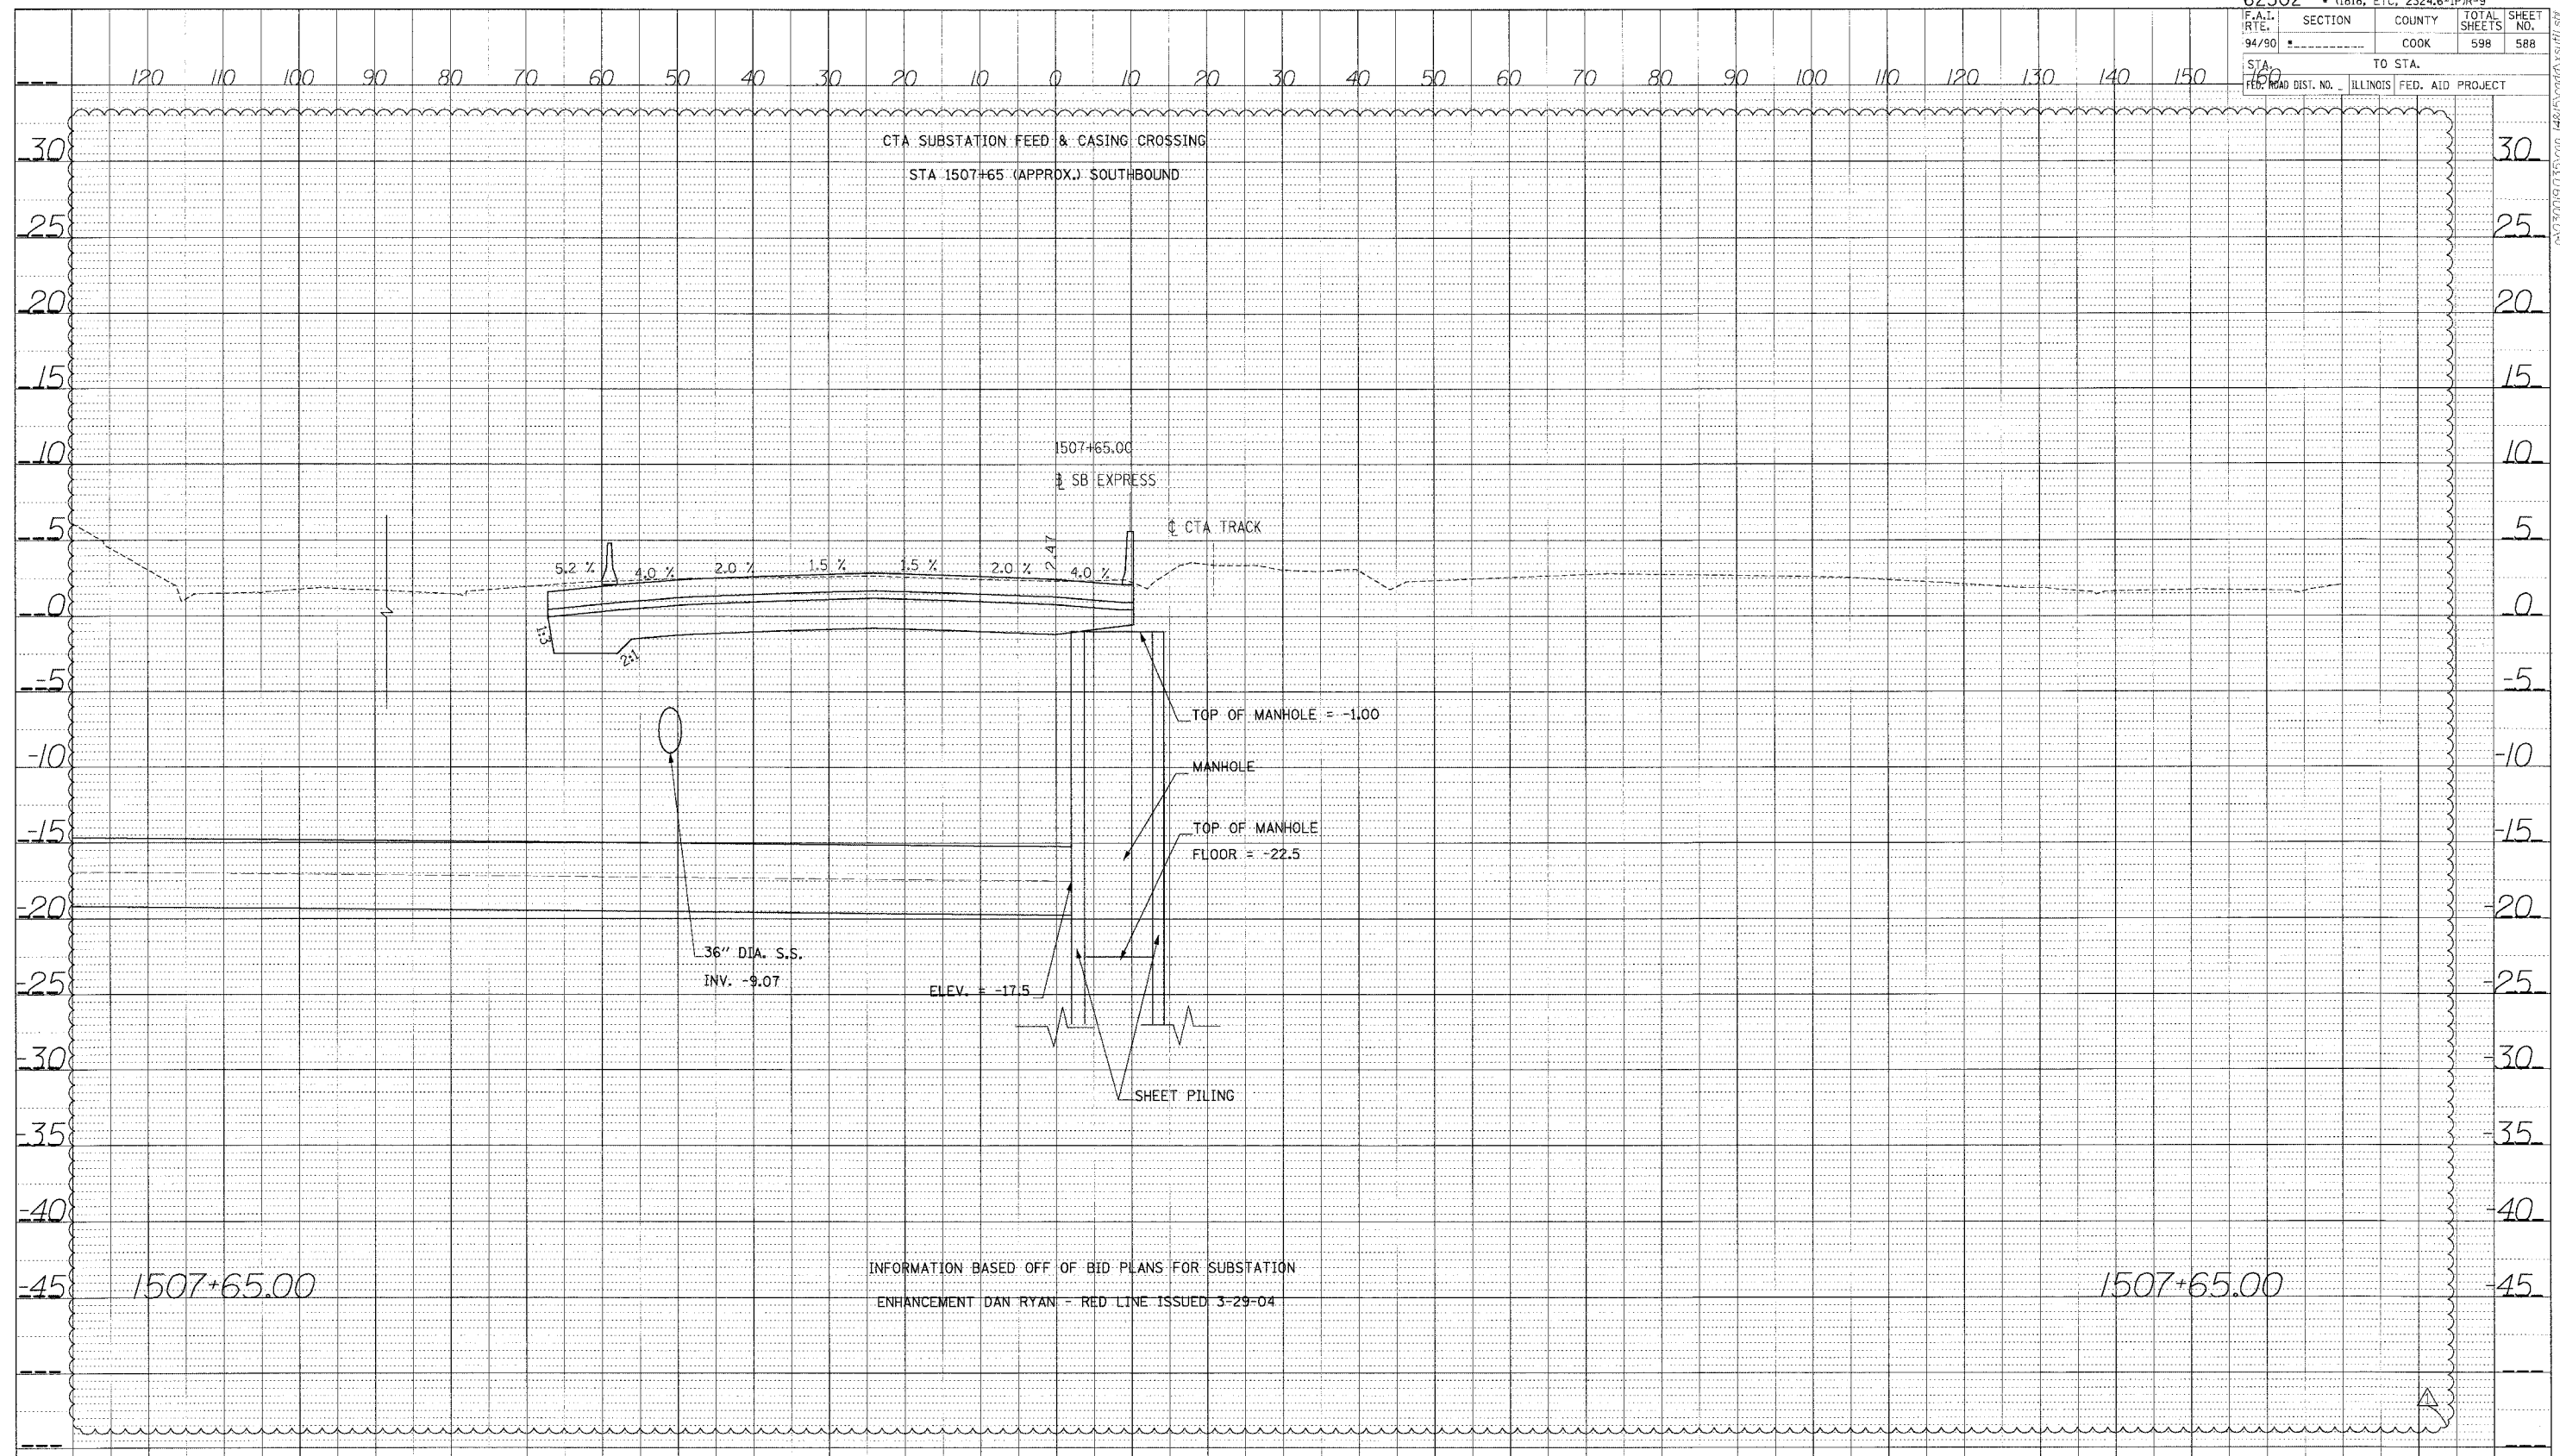

DATE	BY
PROFILL	SURVEYED
	P. LOTT
	CHECKED
	DAN RYAN
	NOTED
	STRUCTURE NOTATION
	CHRG


INFORMATION BASED OFF OF BID PLANS FOR SUBSTATION
 ENHANCEMENT DAN RYAN - RED LINE ISSUED 3-29-04

Edwards AND Kelcey
 ONE NORTH FRANKLIN
 CHICAGO, IL 60606
 PHONE: (312) 251-3000
 FAX: (312) 251-3015
 WEB: WWW.EKCORP.COM




STA.

PROFILE SURVEYED BY DATE
 PLOTTED CHECKED
 NOTED SAN. NOTED
 NO. STRUCTURE NOTATIONS CHVD

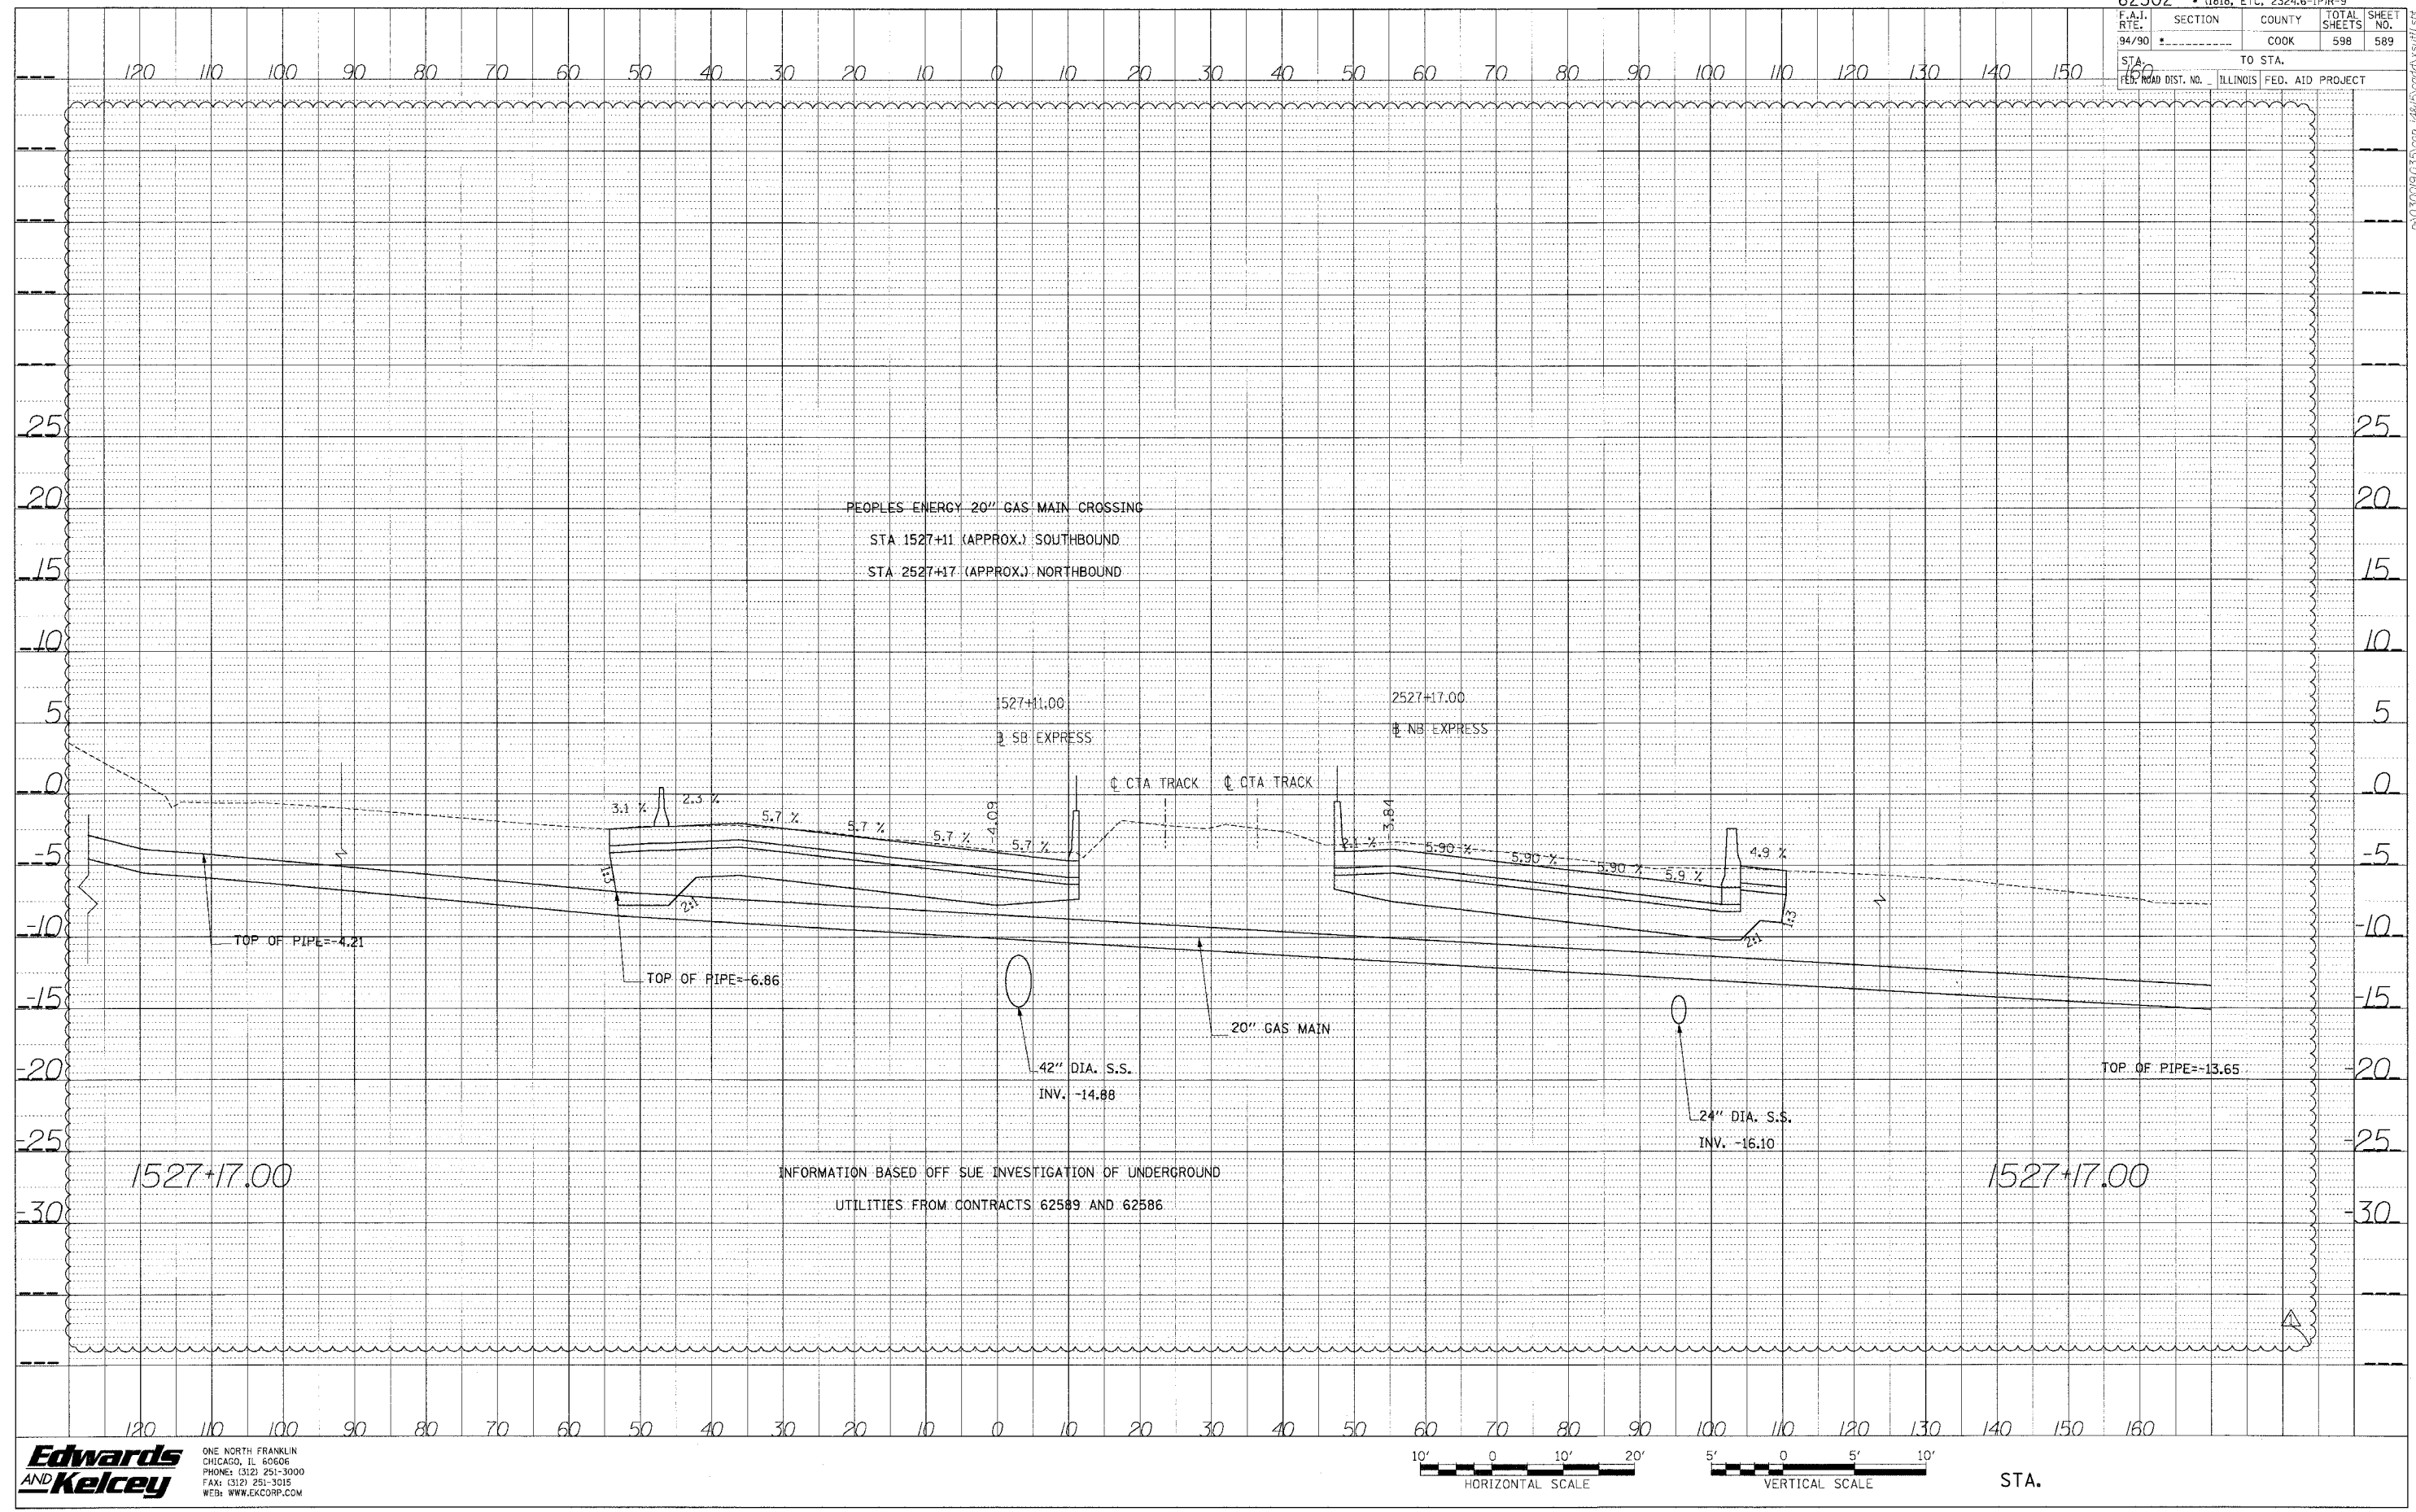

F.A.I.	SECTION	COUNTY	TOTAL SHEETS	SHEET NO.
94/90		COOK	598	590
STA.		TO STA.		
FED. ROAD DIST. NO.	ILLINOIS	FED. AID PROJECT		

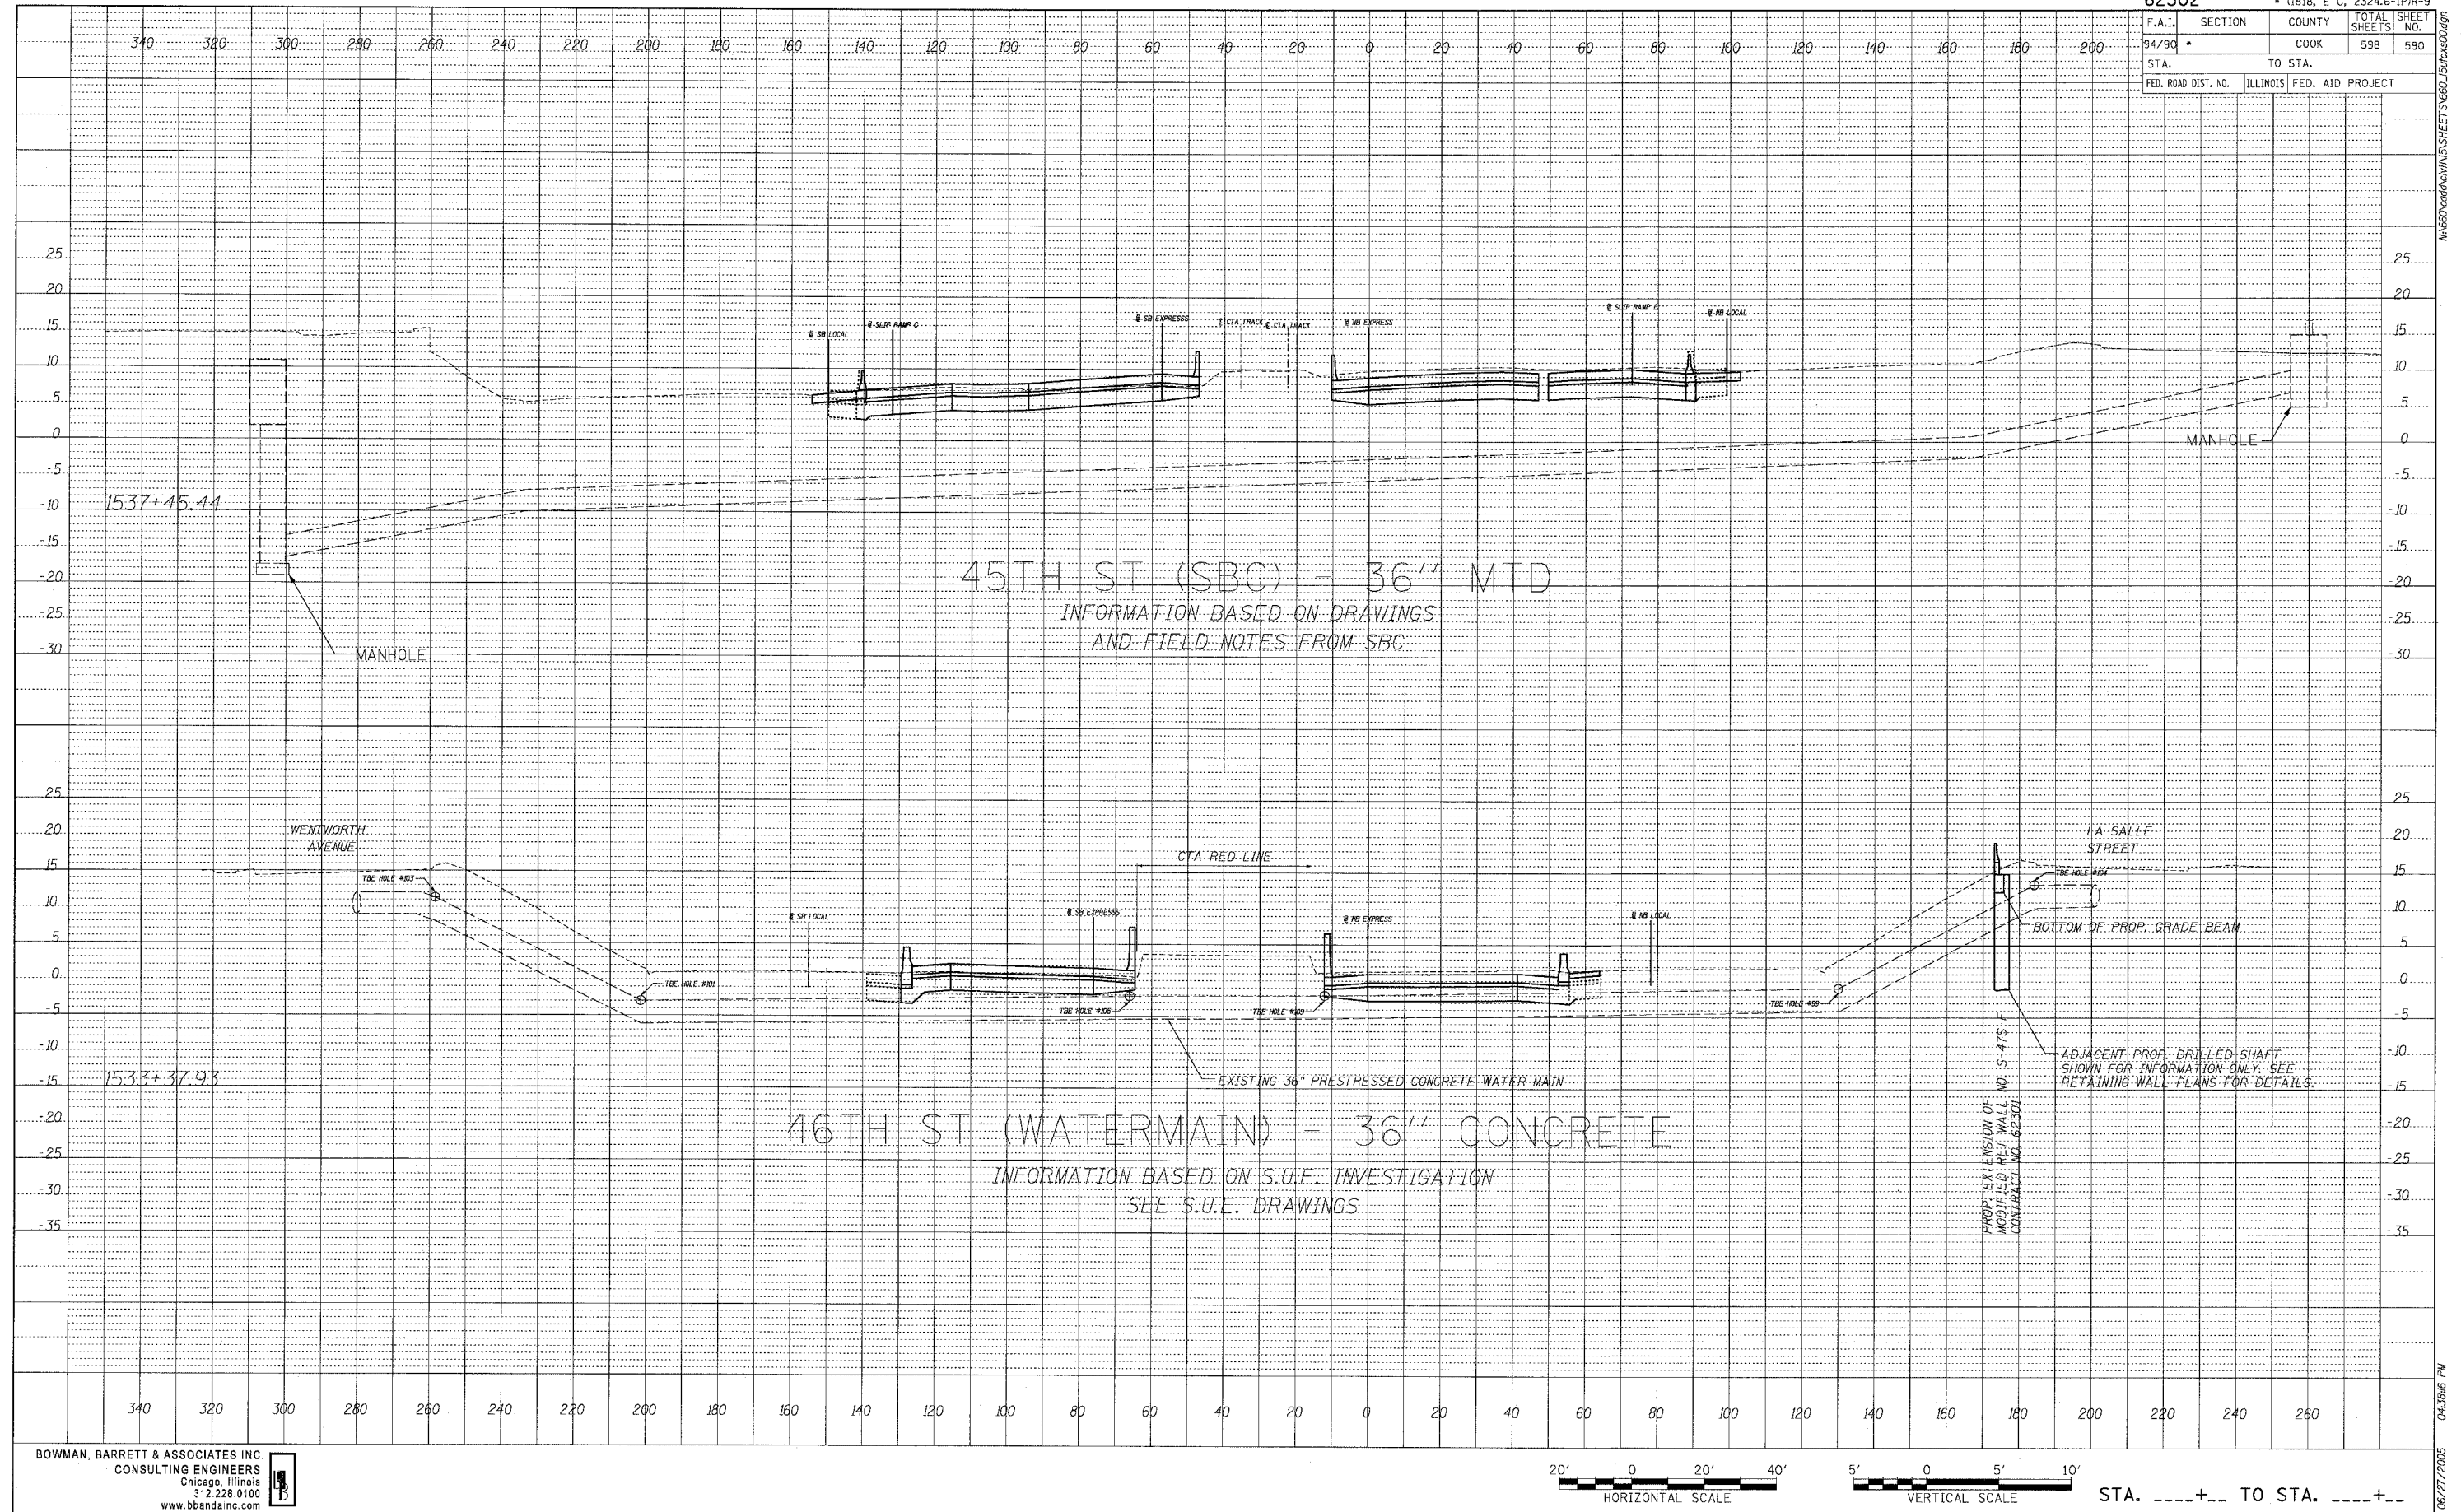


DATE	
BY	
PROFILE	
DESIGNED	
CHECKED	
NOTE BOOK	
NO.	
STRUCTURE	
NOTATION	
CHNO	

BOWMAN, BARRETT & ASSOCIATES INC.
 CONSULTING ENGINEERS
 Chicago, Illinois
 312.228.0100
 www.bbainc.com




F.A.I.	SECTION	COUNTY	TOTAL SHEETS	SHEET NO.
94/90		COOK	598	591
STA. _____		TO STA. _____		
FED. ROAD DIST. NO.	ILLINOIS	FED. AID PROJECT		

DATE	BY

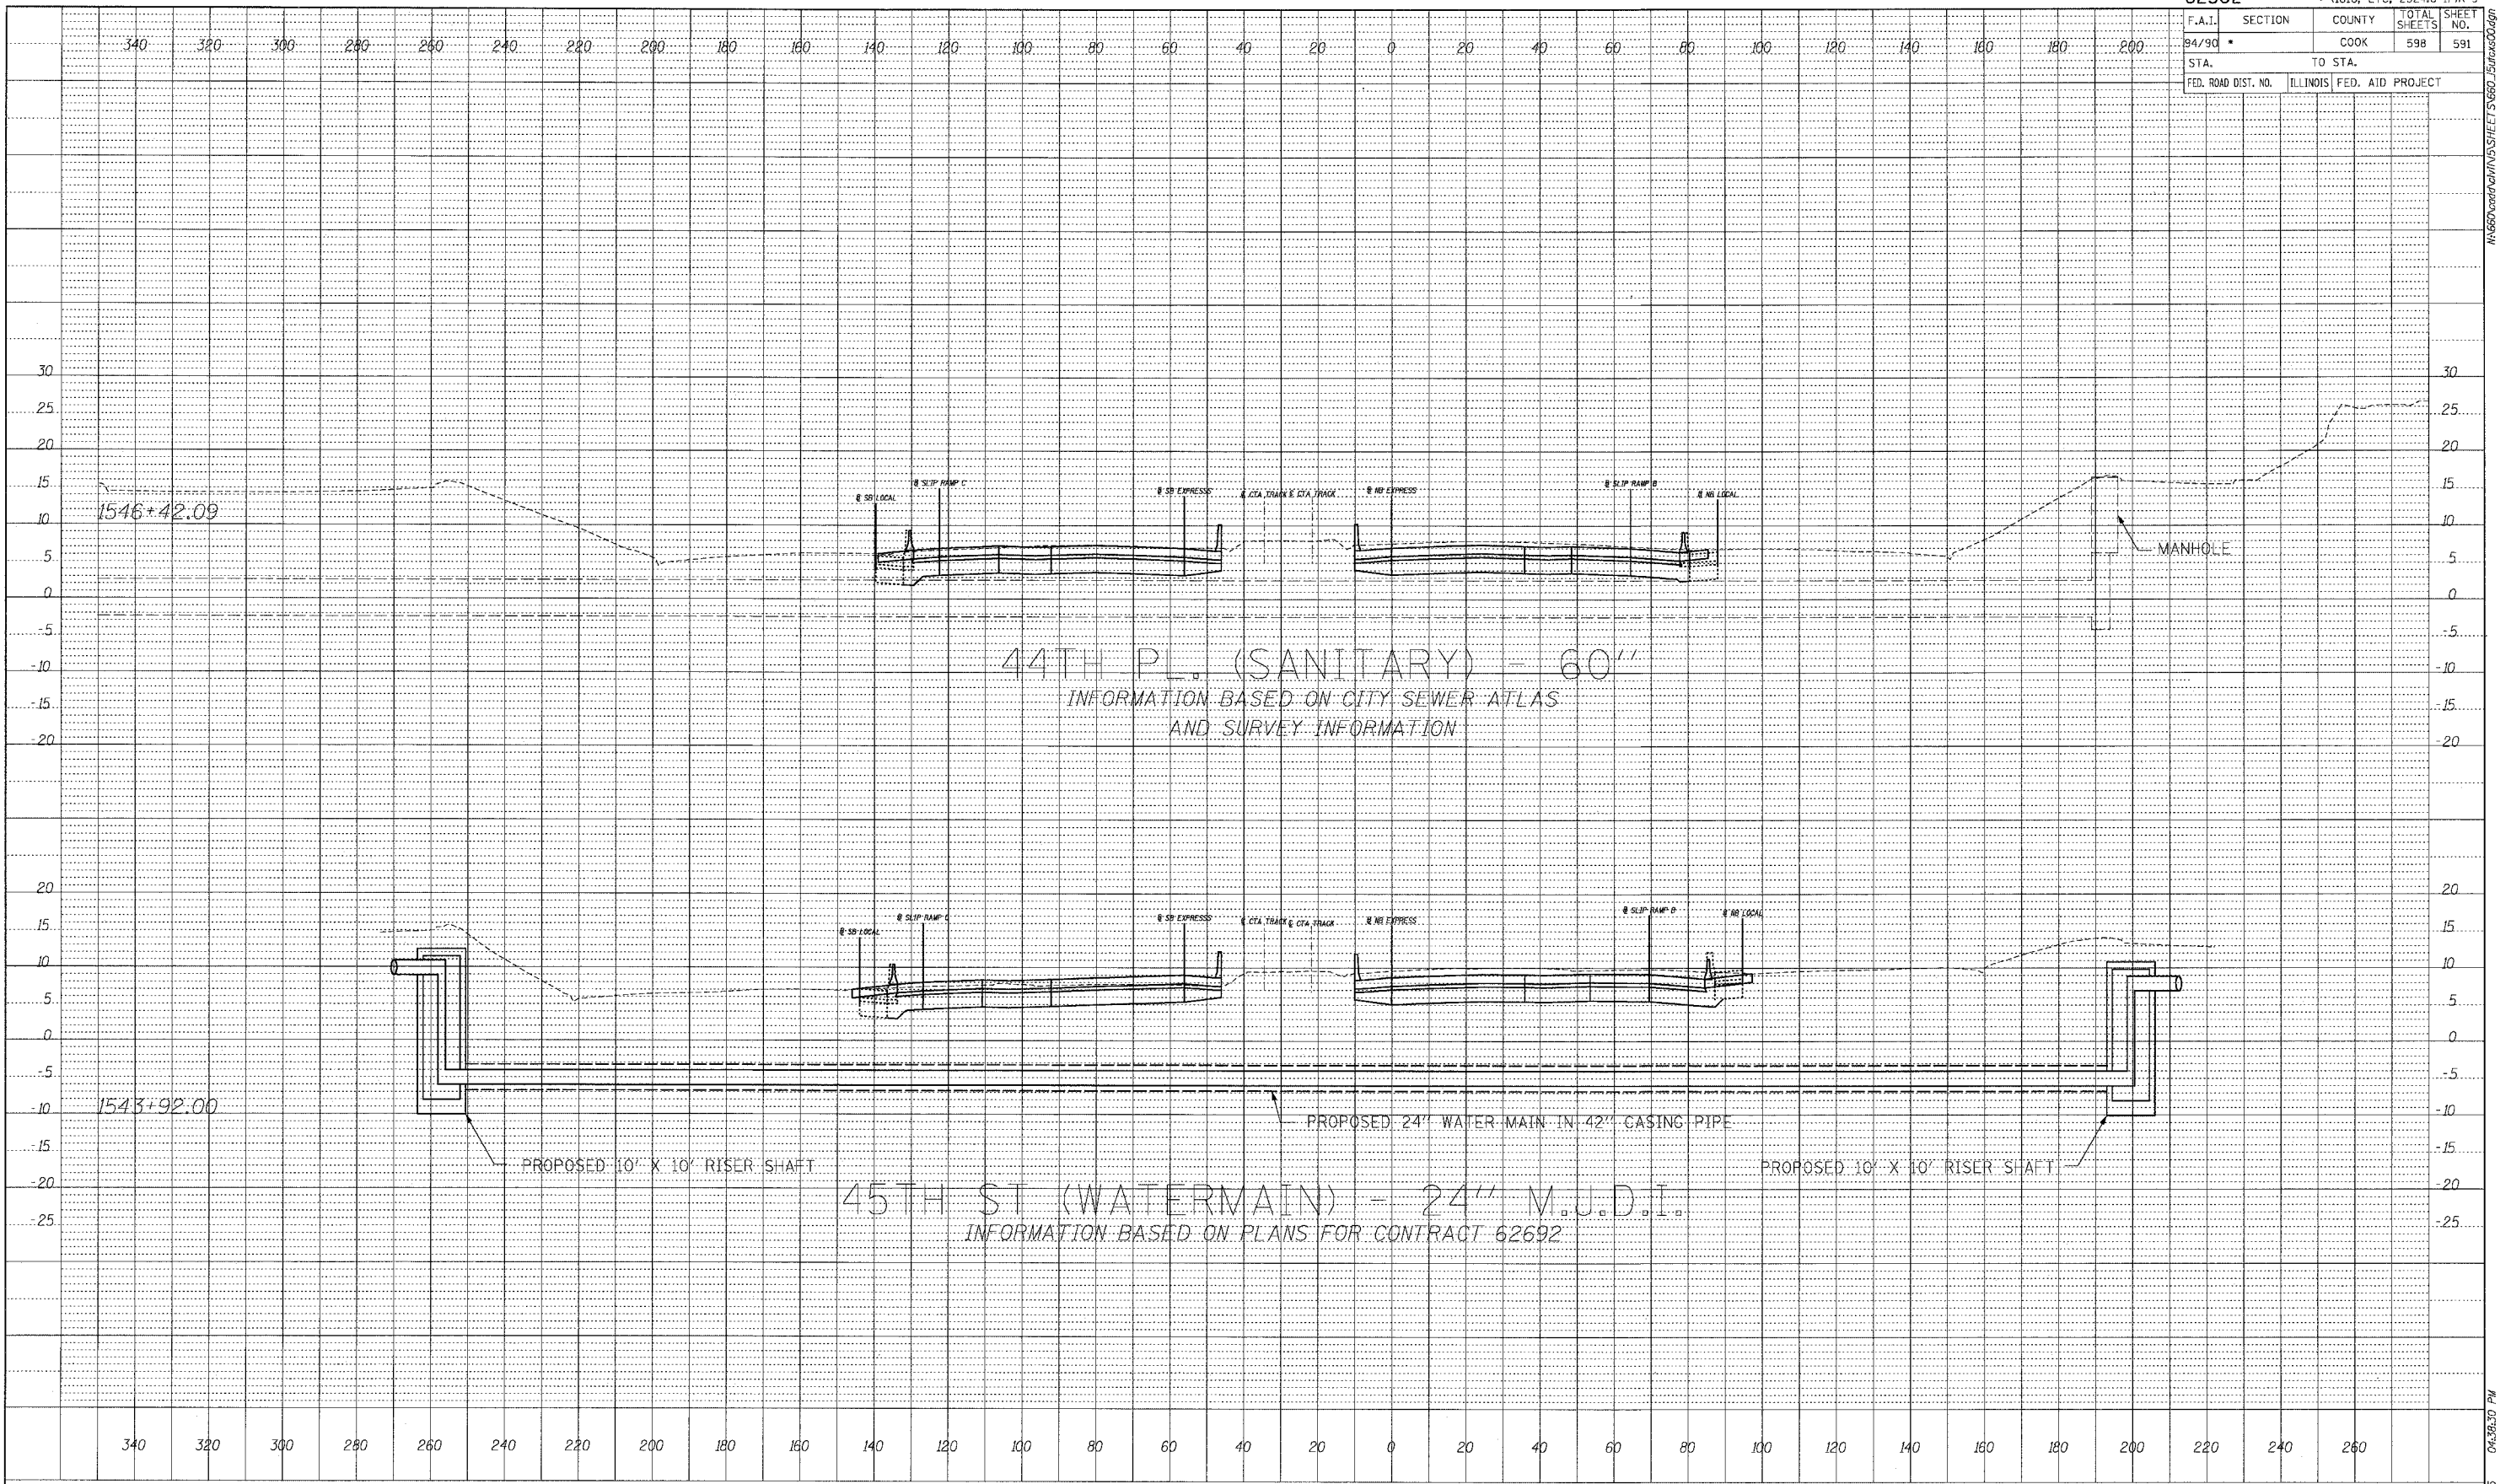


BOWMAN, BARRETT & ASSOCIATES INC.
 CONSULTING ENGINEERS
 Chicago, Illinois
 312.228.0100
 www.bbainc.com

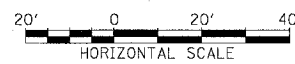


STA. ____+__ TO STA. ____+__

F.A.I.	SECTION	COUNTY	TOTAL SHEETS	SHEET NO.
94/90 *		COOK	598	593
STA.		TO STA.		
FED. ROAD DIST. NO.	ILLINOIS	FED. AID PROJECT		

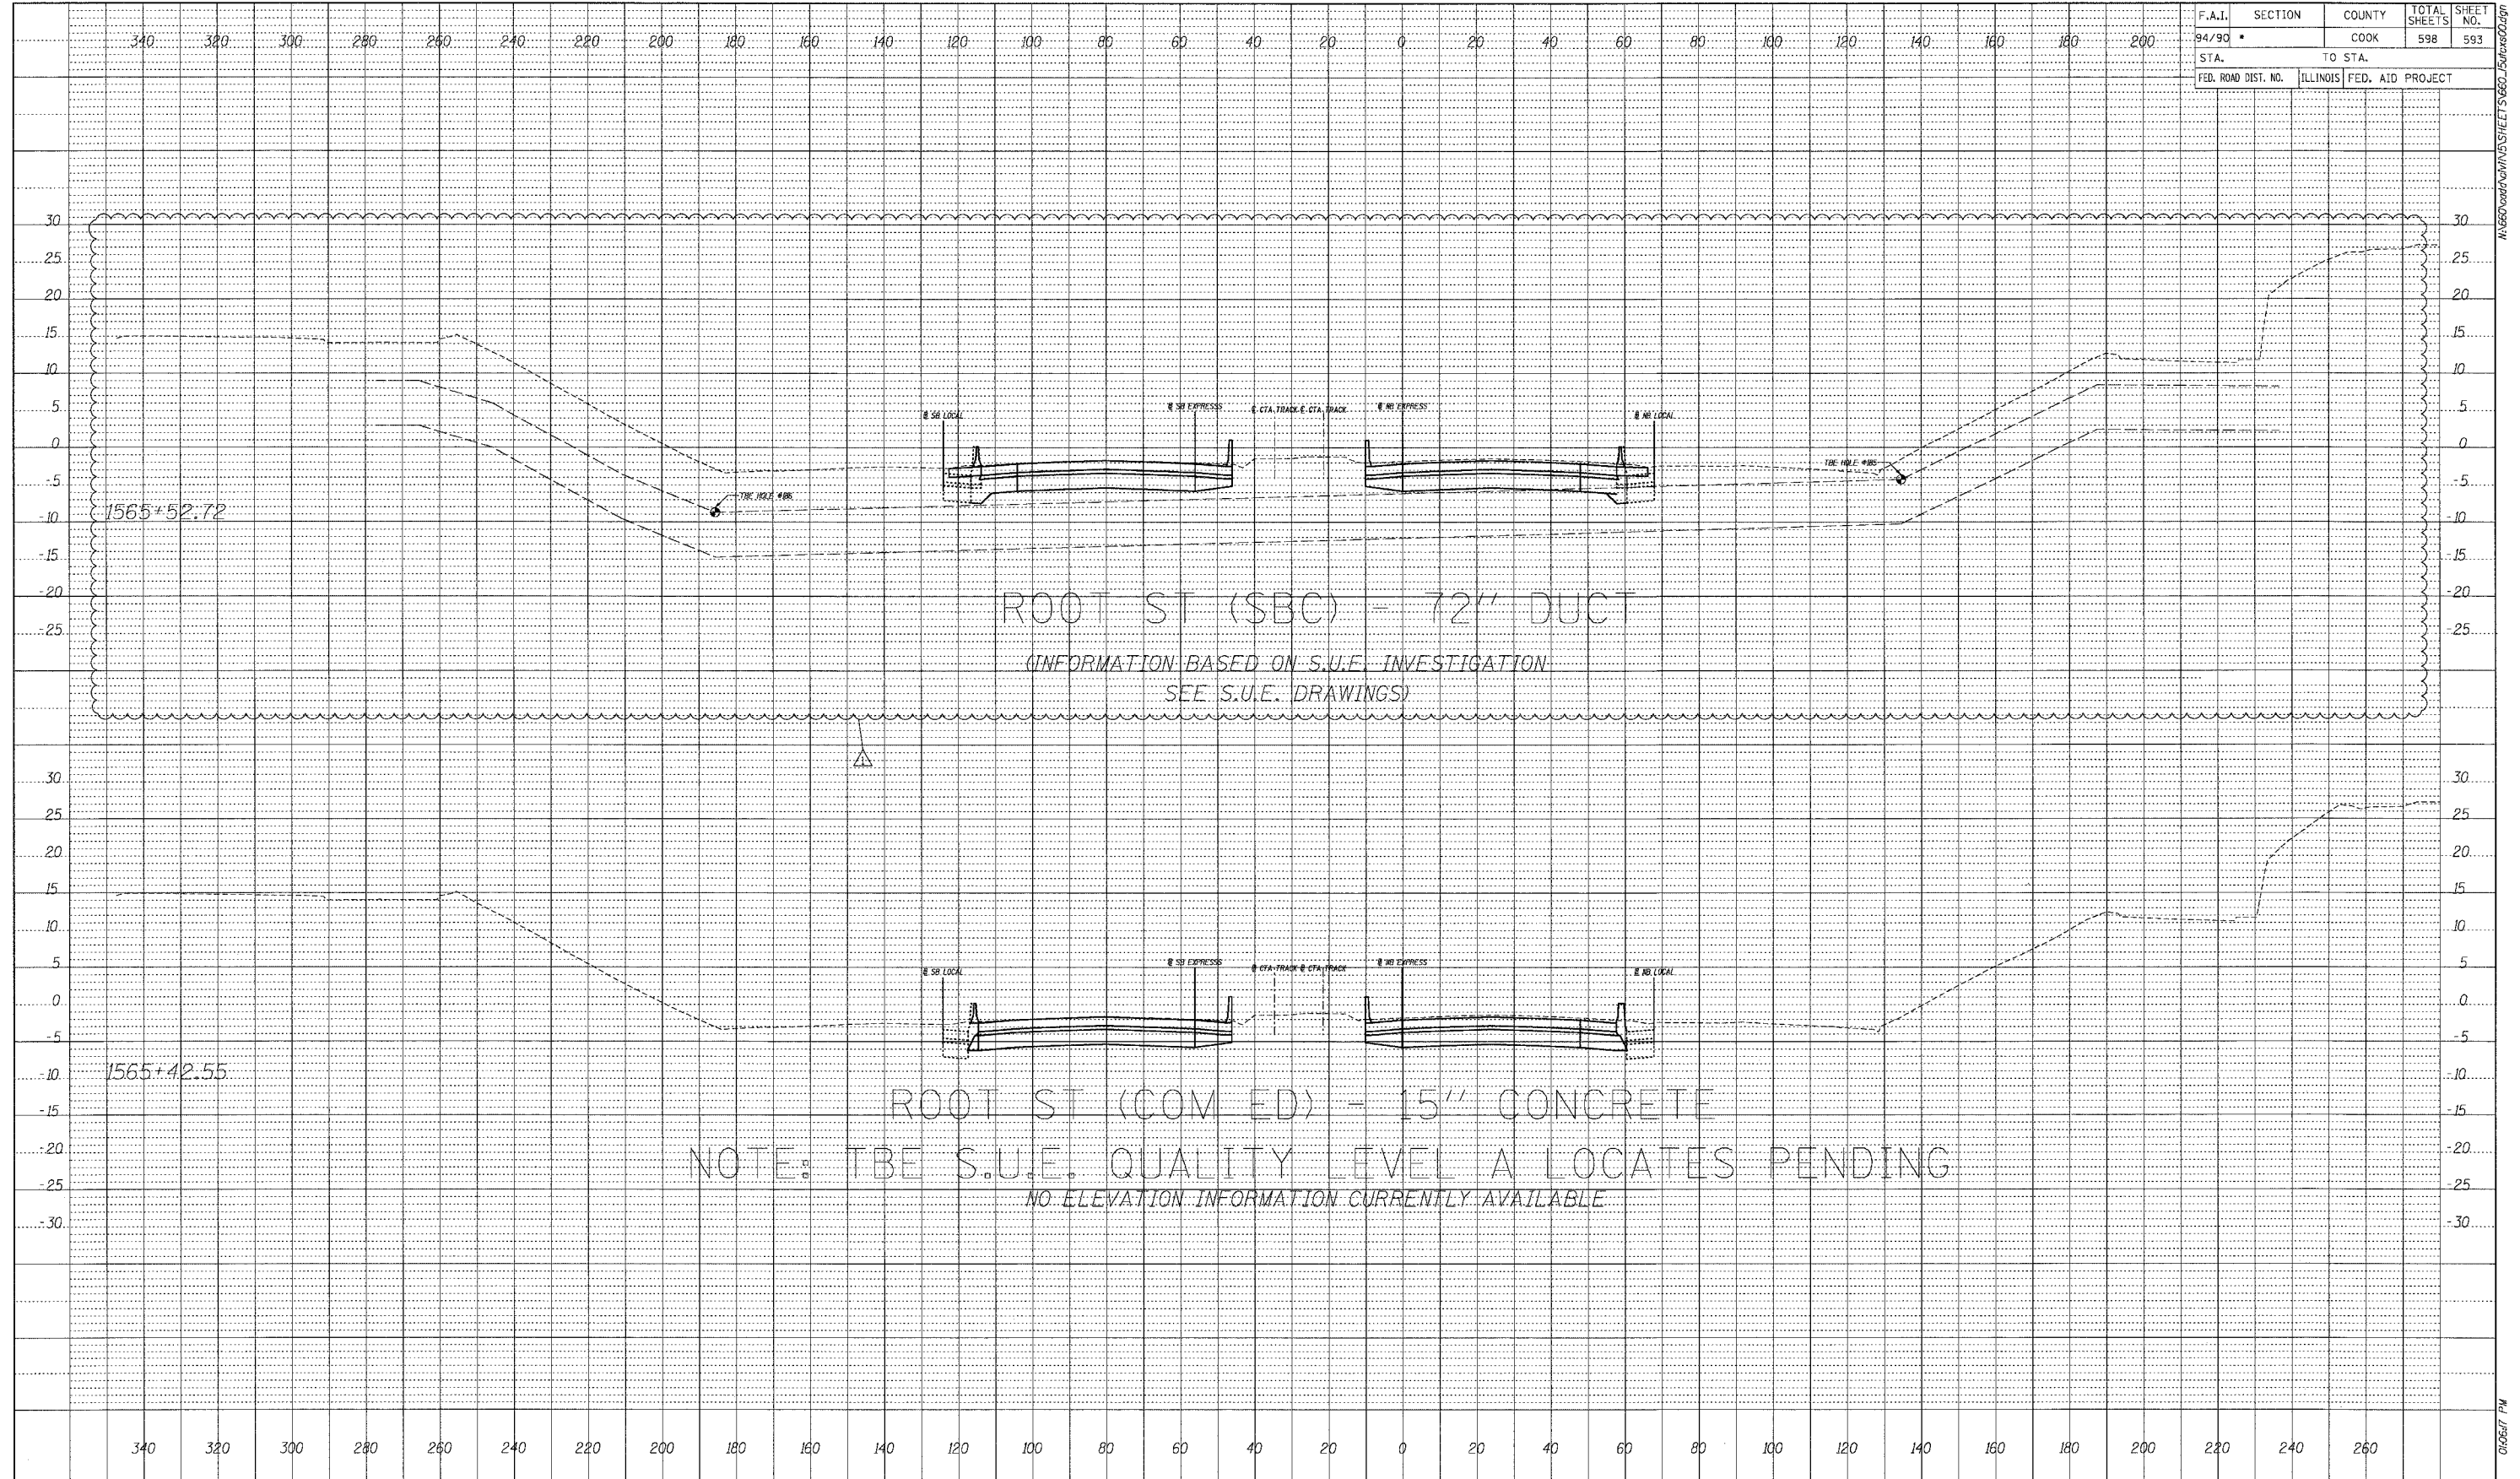


DATE	
BY	
PROF. NO.	
NO.	
STRUCTURE	
NOTATIONS	
CHECKED	
DATE	
NO.	

BOWMAN, BARRETT & ASSOCIATES INC.
CONSULTING ENGINEERS
Chicago, Illinois
312.228.0100
www.bbainc.com

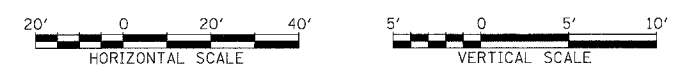

STA. ----+-- TO STA. ----+--


F.A.I.	SECTION	COUNTY	TOTAL SHEETS	SHEET NO.
94/90 *		COOK	598	594
STA.		TO STA.		
FED. ROAD DIST. NO.	ILLINOIS	FED. AID PROJECT		

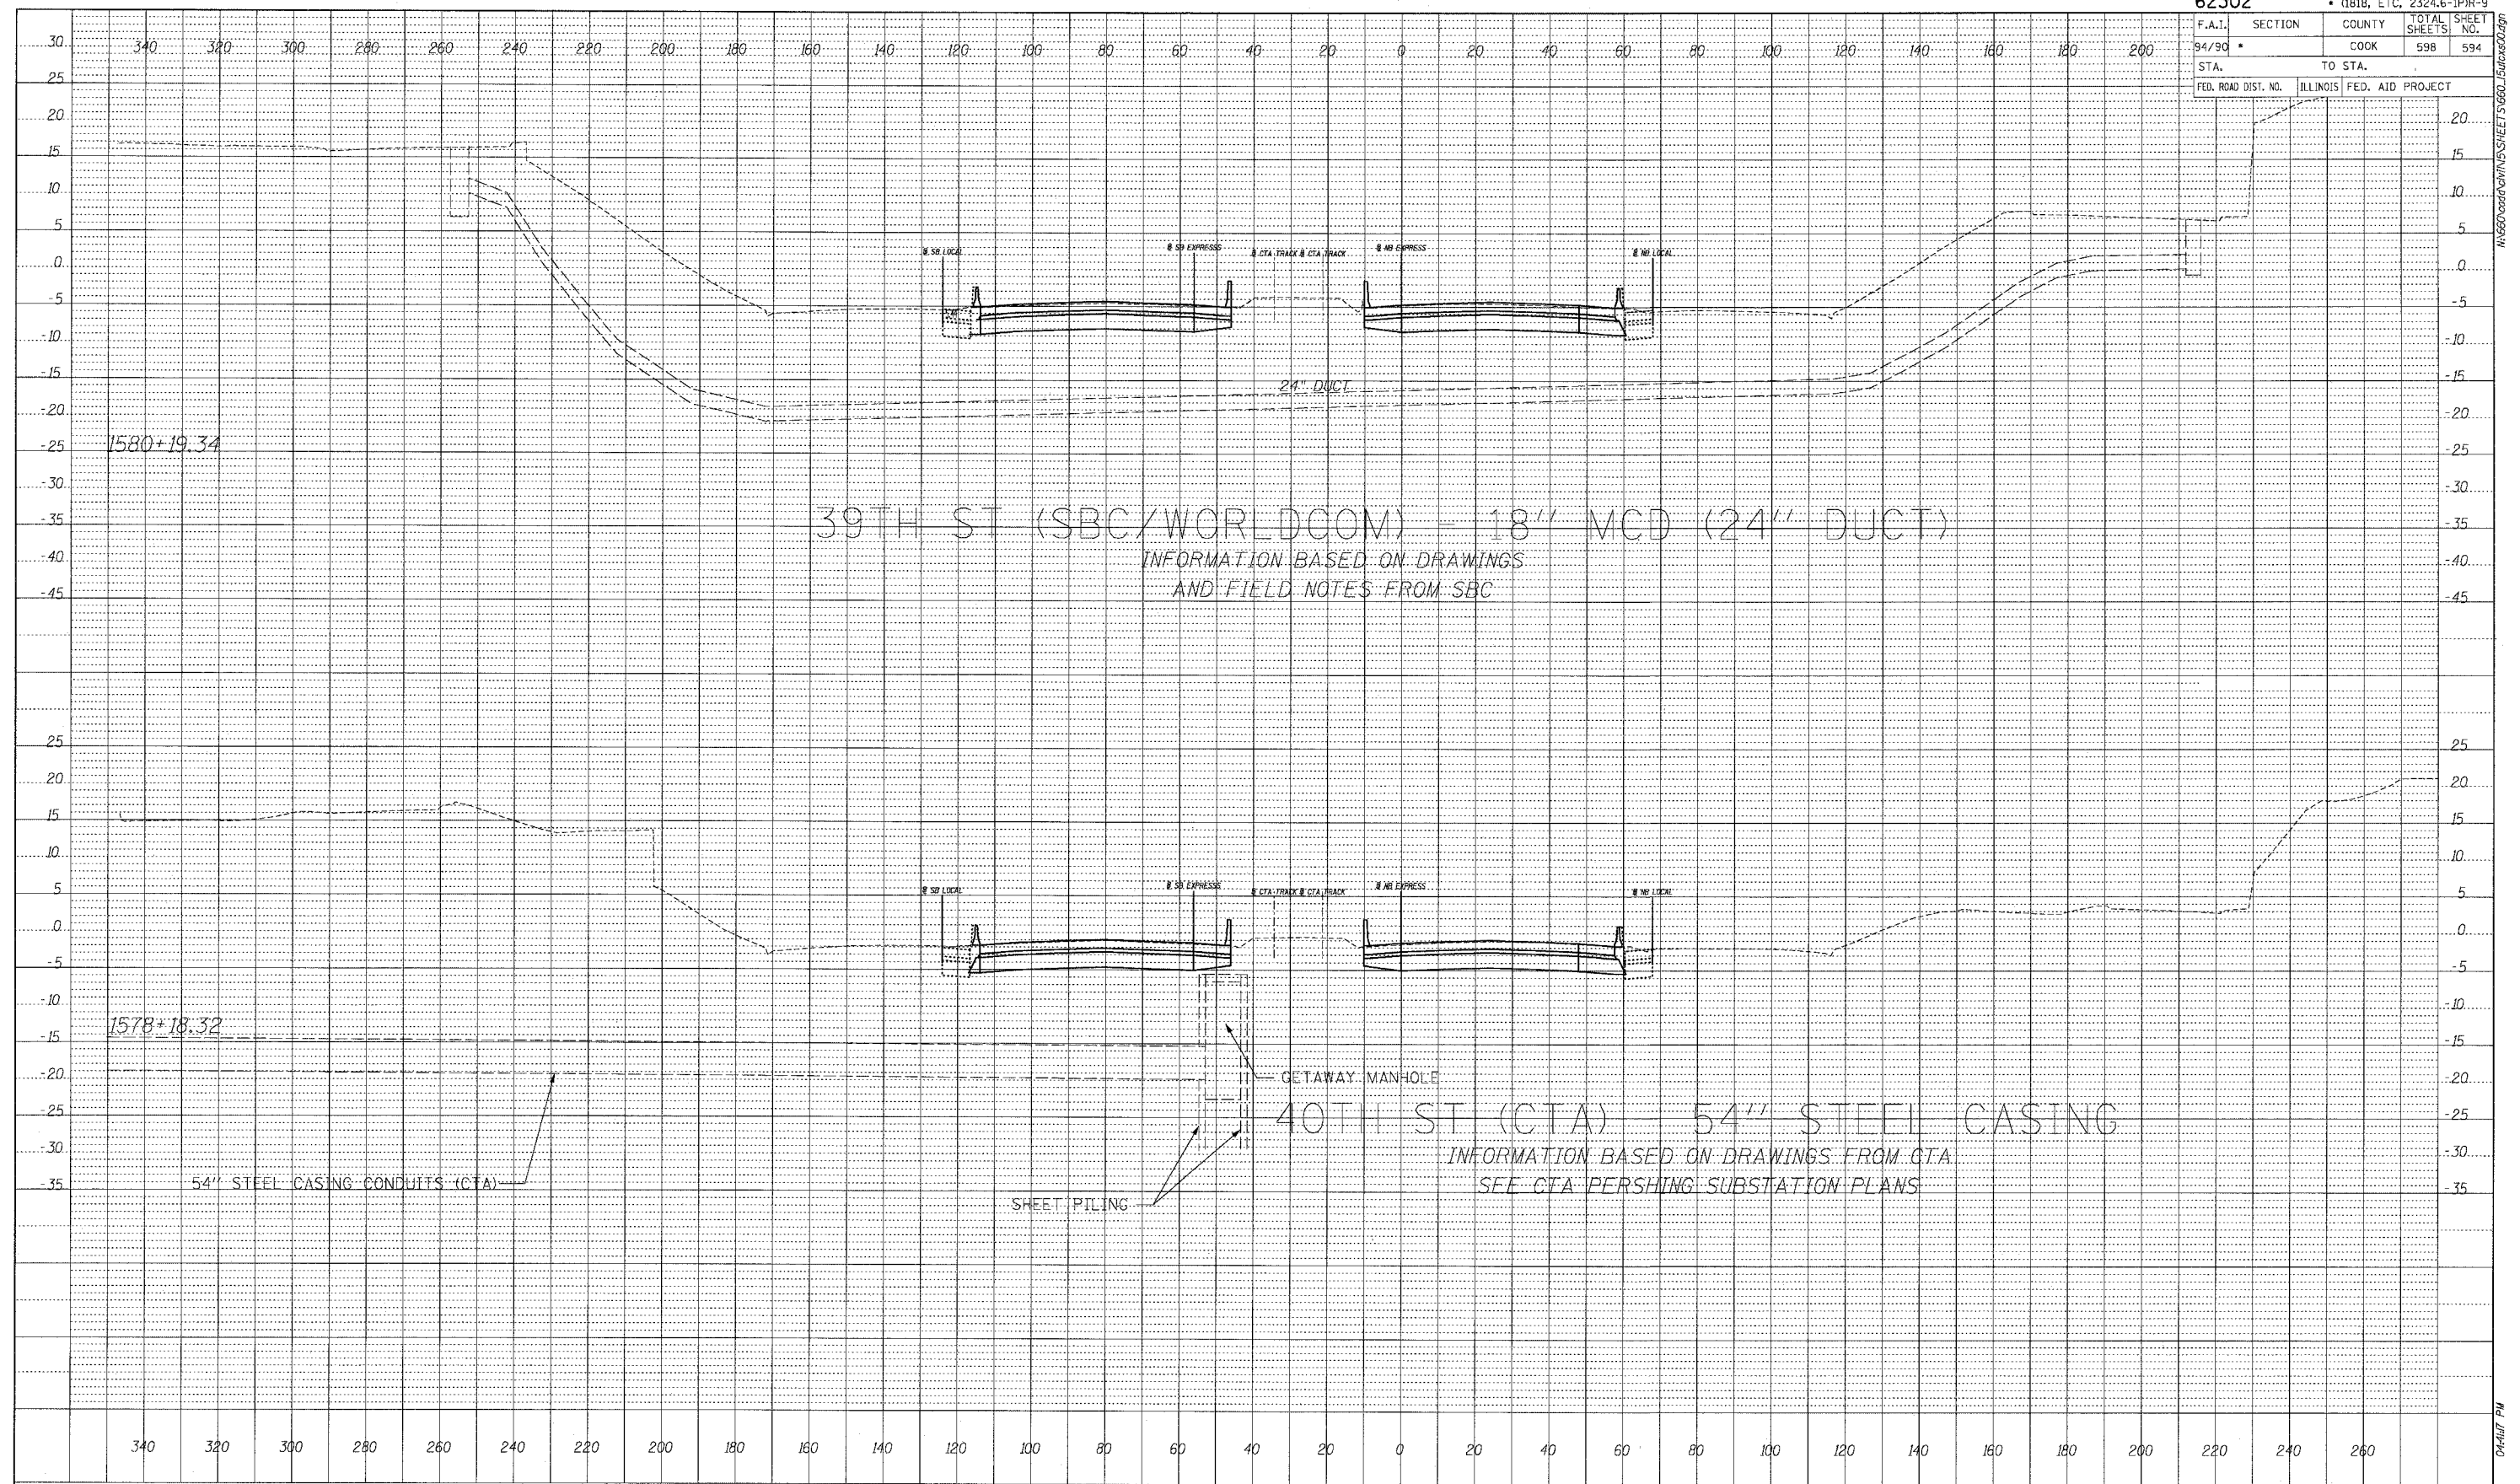

DATE	BY

PROFILE	REVISION


BOWMAN, BARRETT & ASSOCIATES INC.
 CONSULTING ENGINEERS
 Chicago, Illinois
 312.228.0100
 www.bbainc.com

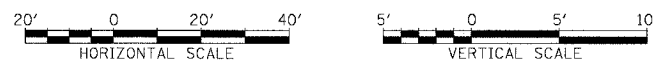


STA. ----+-- TO STA. ----+--

06/27/2005 04:41:17 PM

PROFILE SURVEYED BY DATE
 CHECKED BY
 NOTE BOOK NO.
 STRUCTURE NOTING OTHER

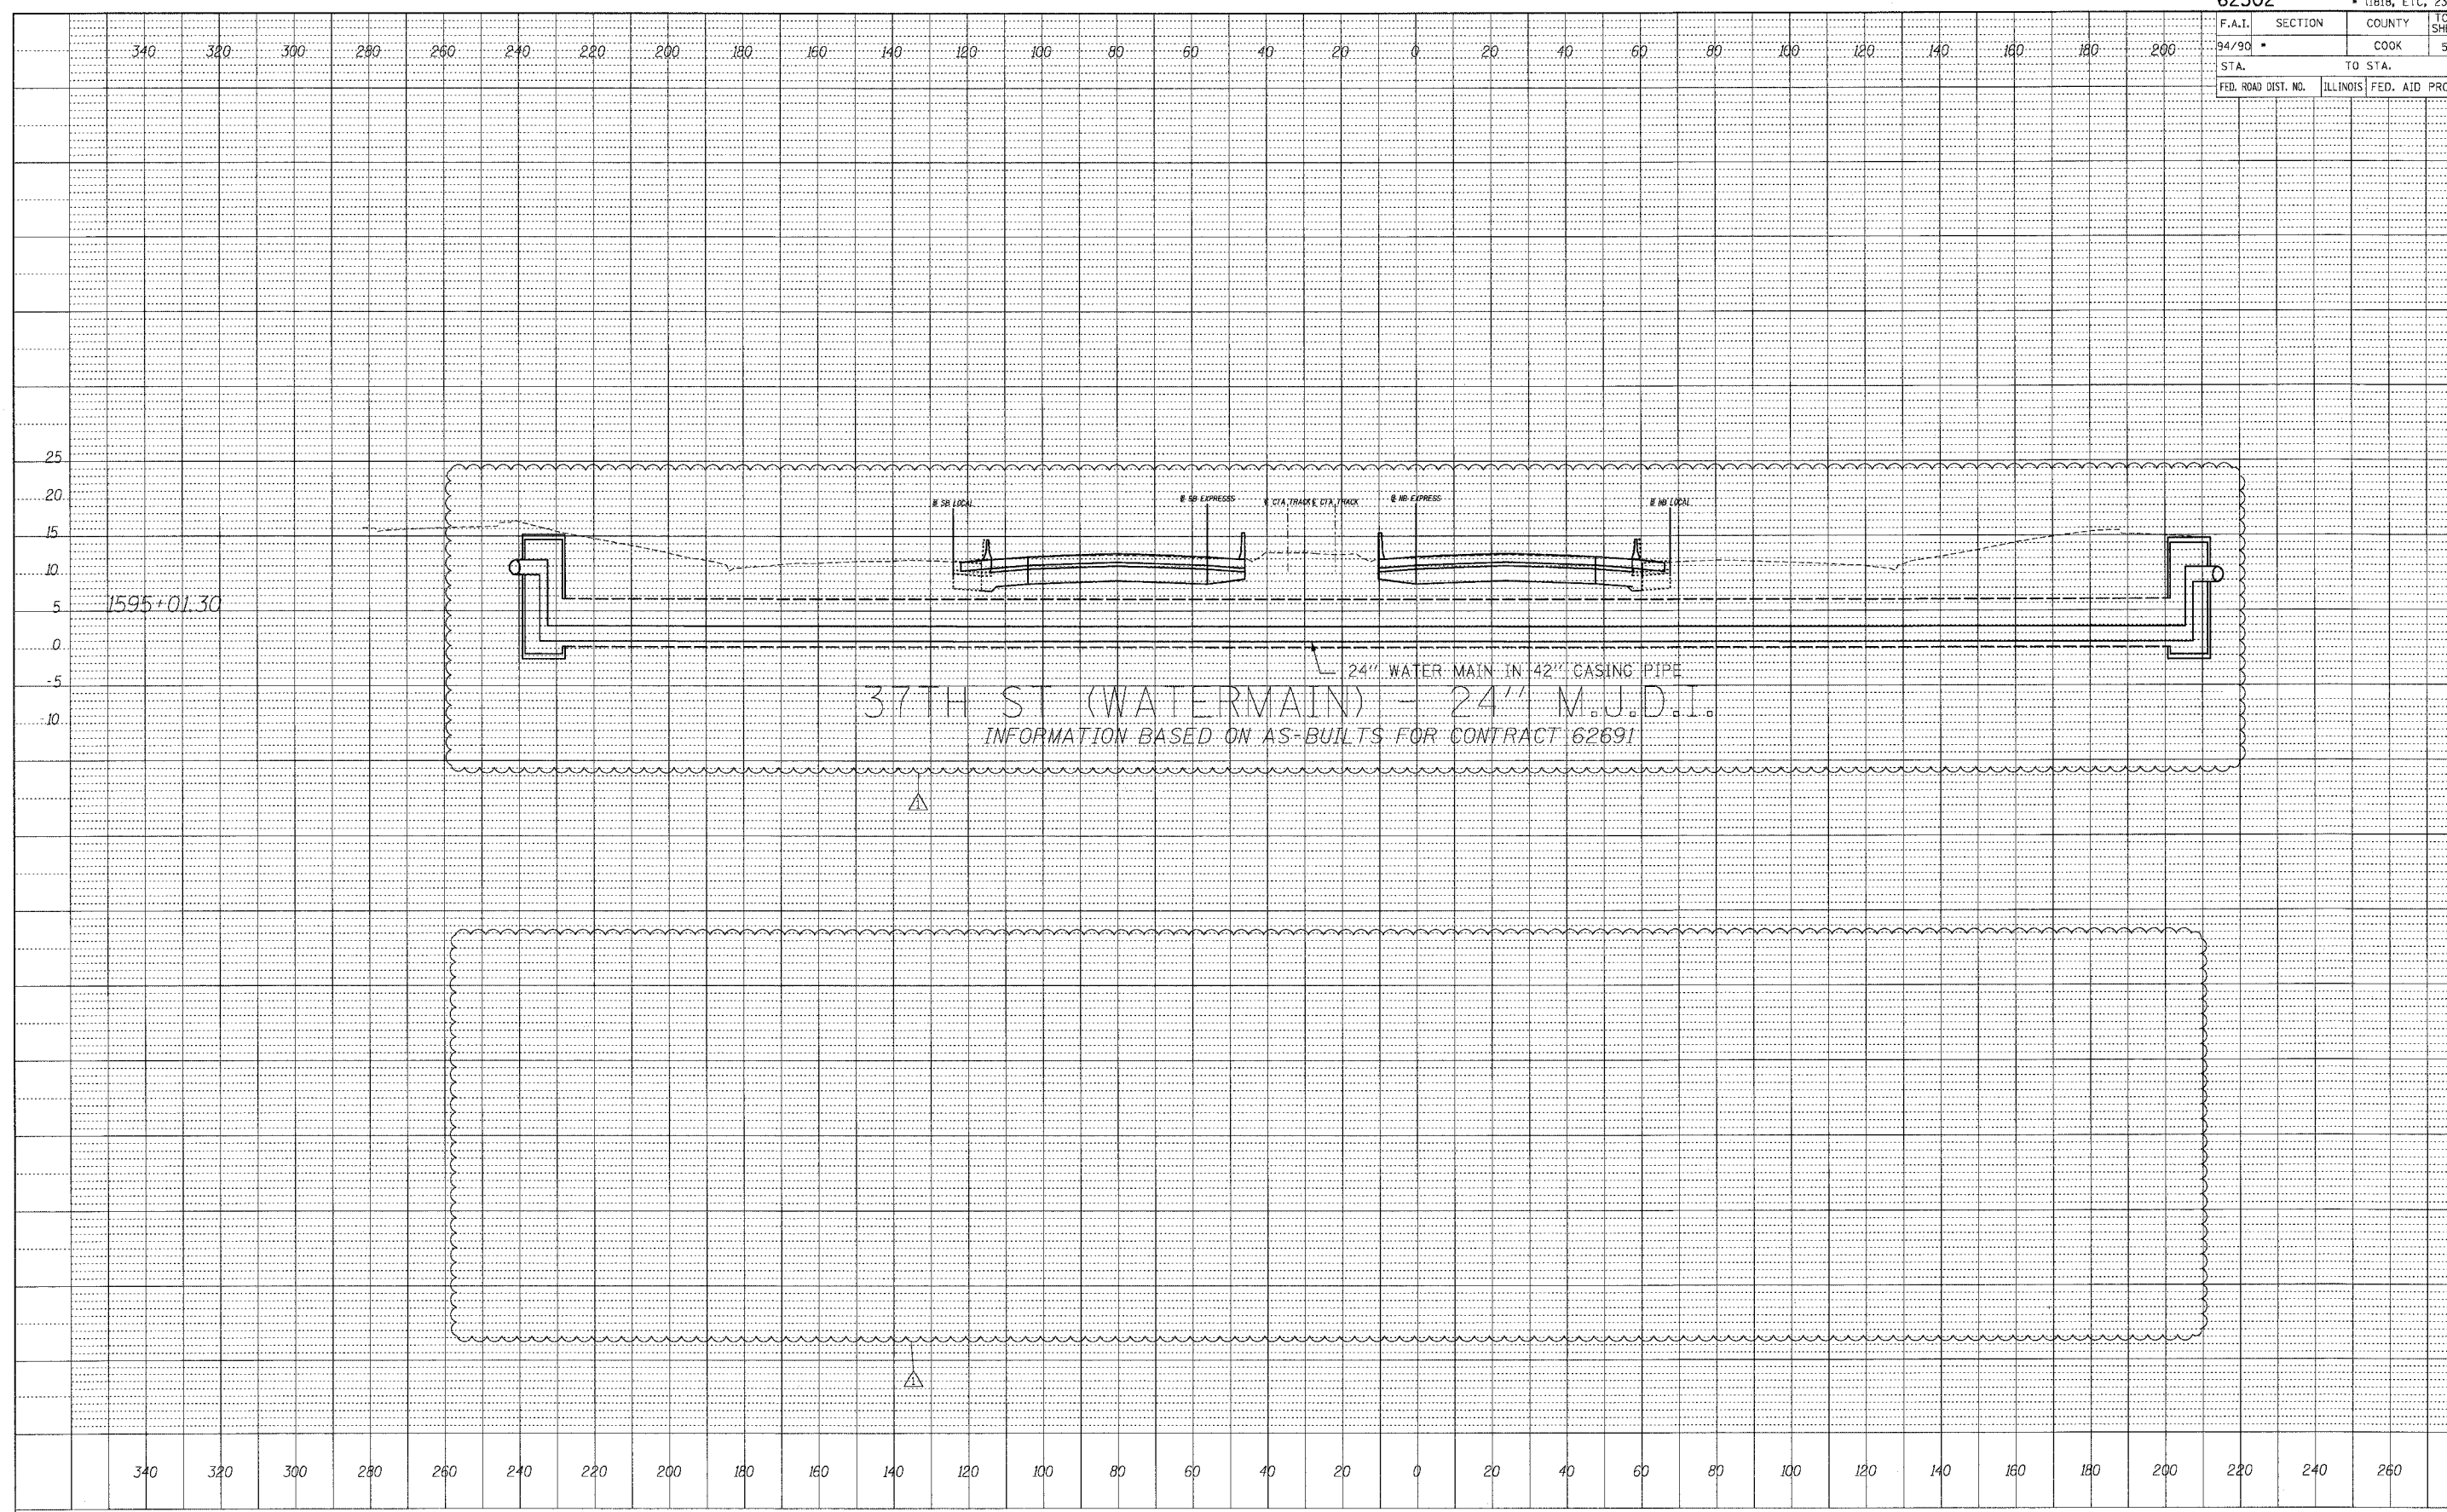


BOWMAN, BARRETT & ASSOCIATES INC
 CONSULTING ENGINEERS
 Chicago, Illinois
 312.228.0100
 www.bbainc.com

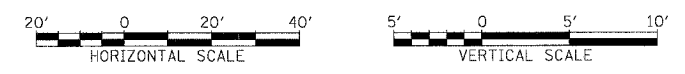


STA. ----+-- TO STA. ----+--

PROFILE
 DATE _____
 BY _____
 DRAWN BY _____
 CHECKED BY _____
 NOTE BOOK NO. _____
 SIGNATURE NOTATION CHRG

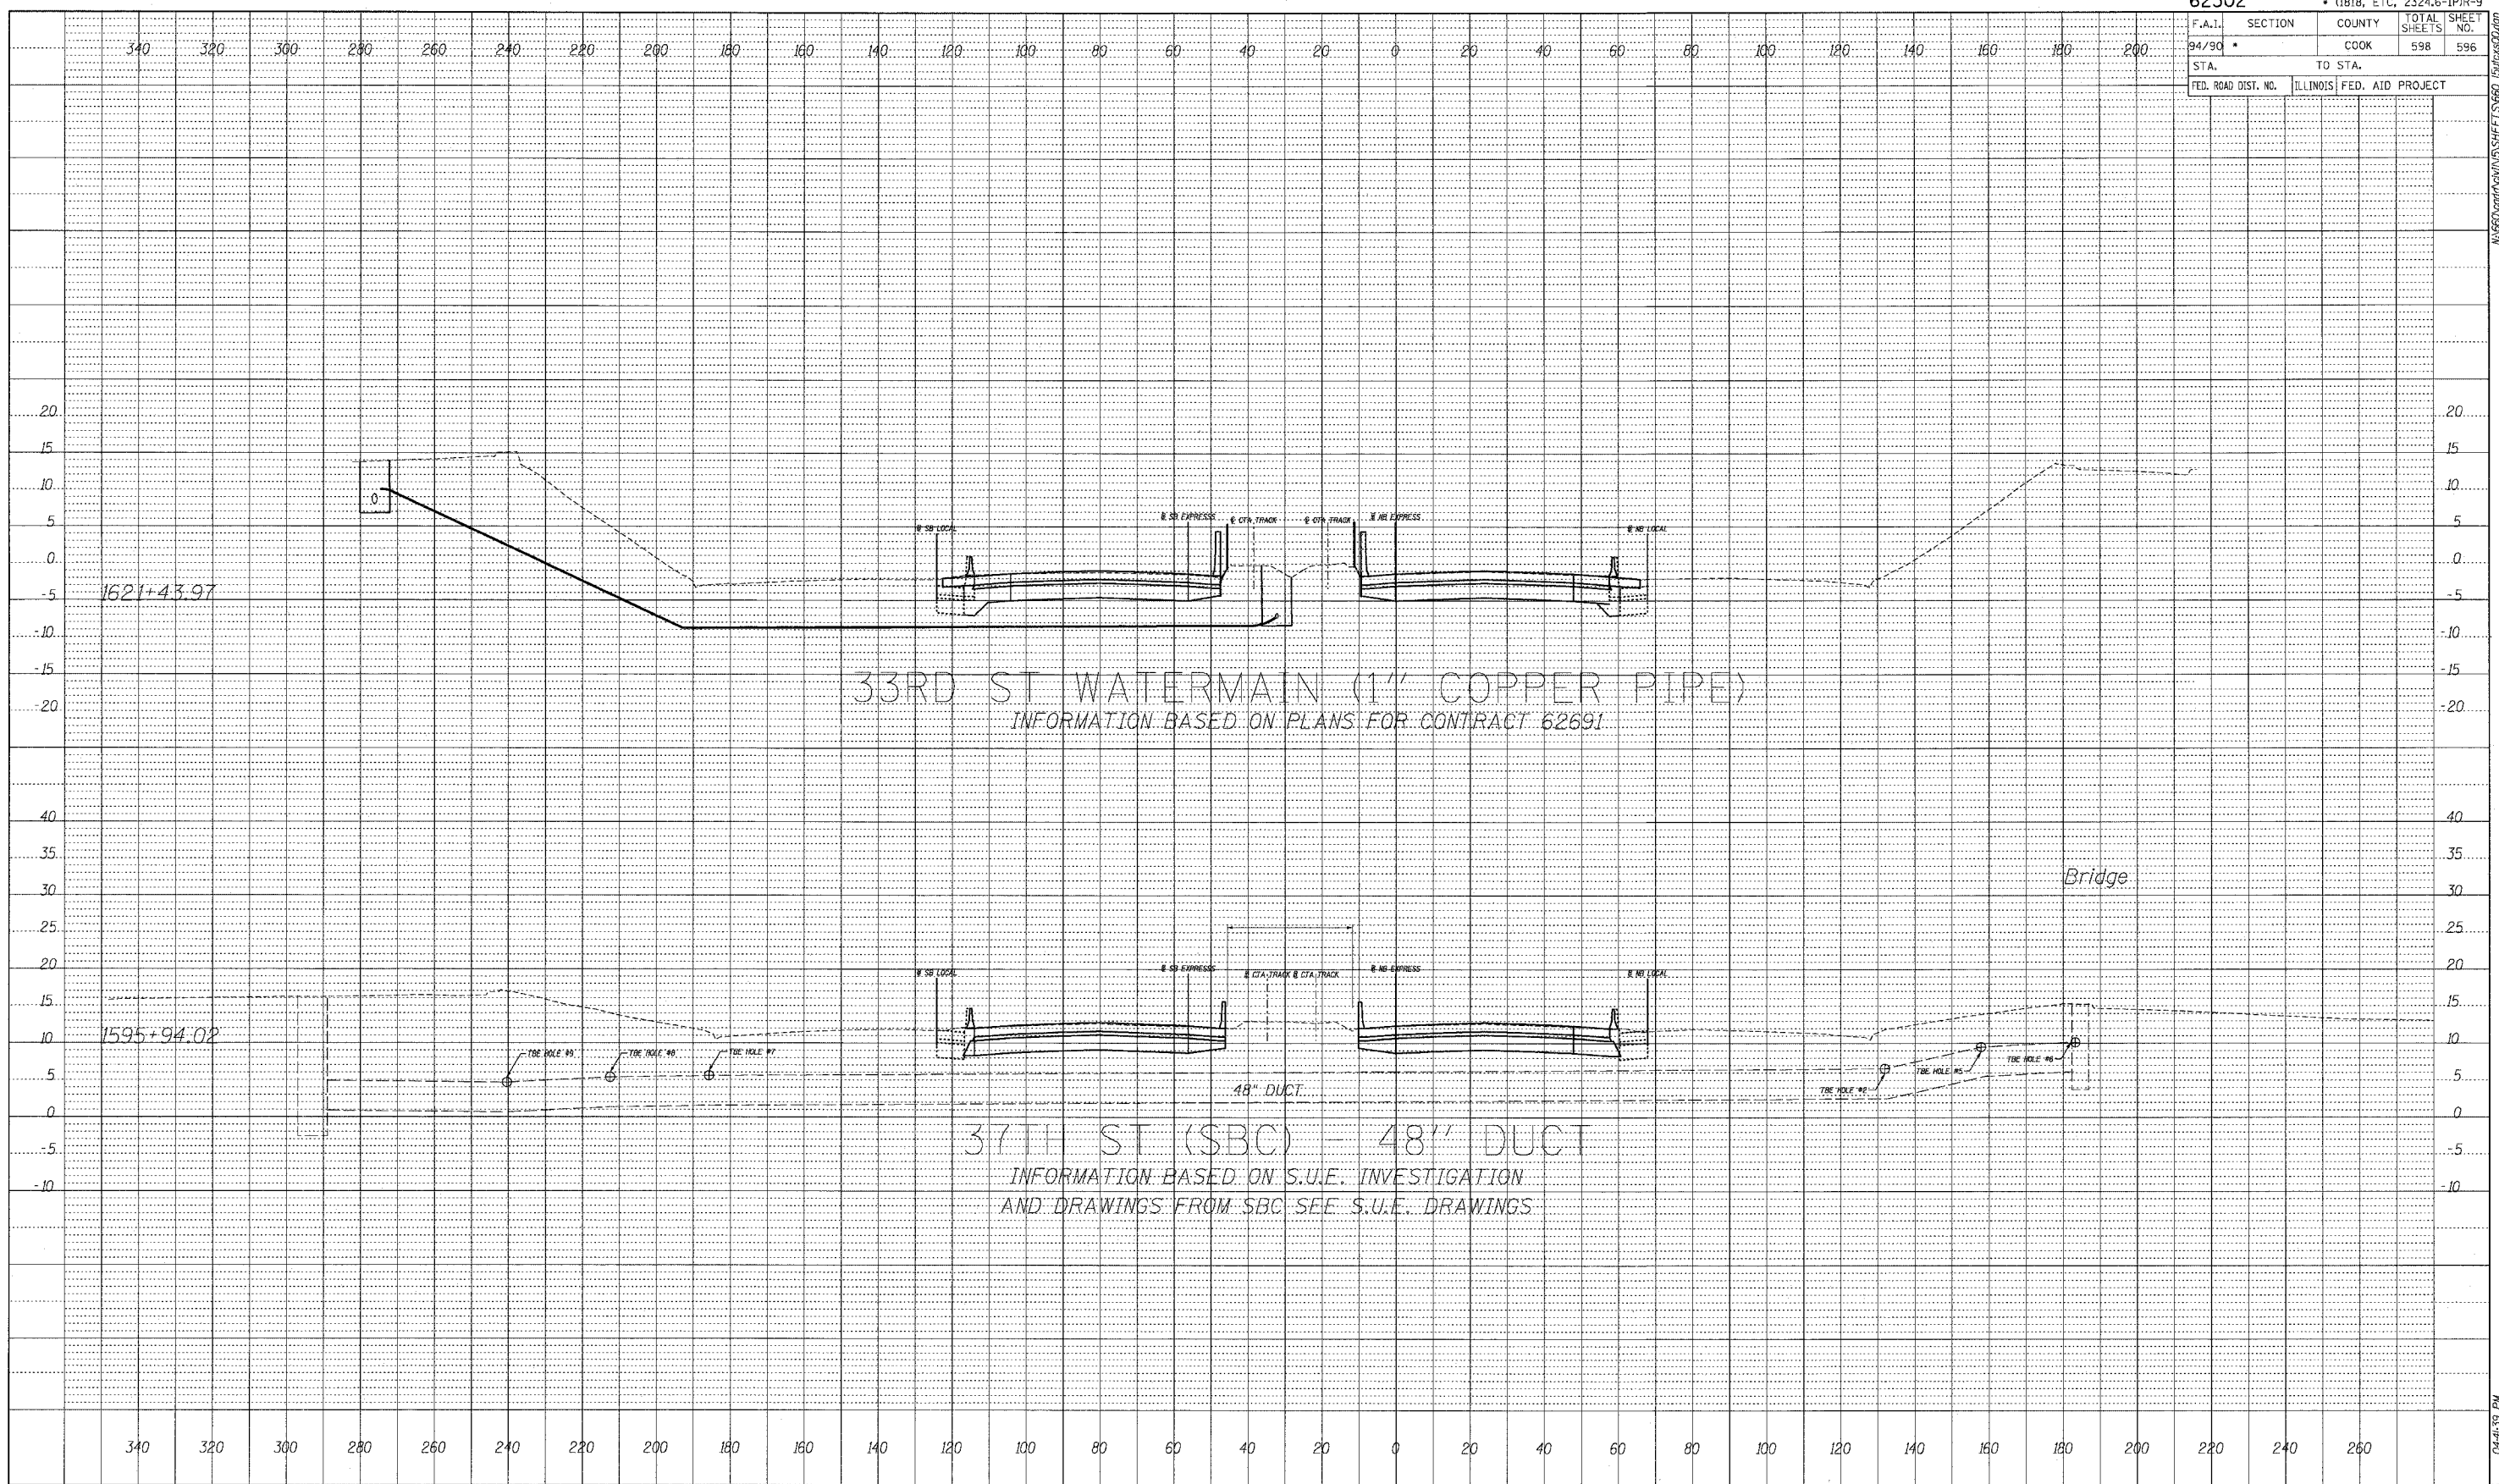


BOWMAN, BARRETT & ASSOCIATES INC
 CONSULTING ENGINEERS
 Chicago, Illinois
 312.228.0100
 www.bbandainc.com

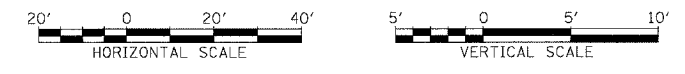

STA. ____+__ TO STA. ____+__

04/13/05 04:139 PM


F.A.I.	SECTION	COUNTY	TOTAL SHEETS	SHEET NO.
94/90	*	COOK	598	597
STA.		TO STA.		
FED. ROAD DIST. NO.	ILLINOIS	FED. AID PROJECT		

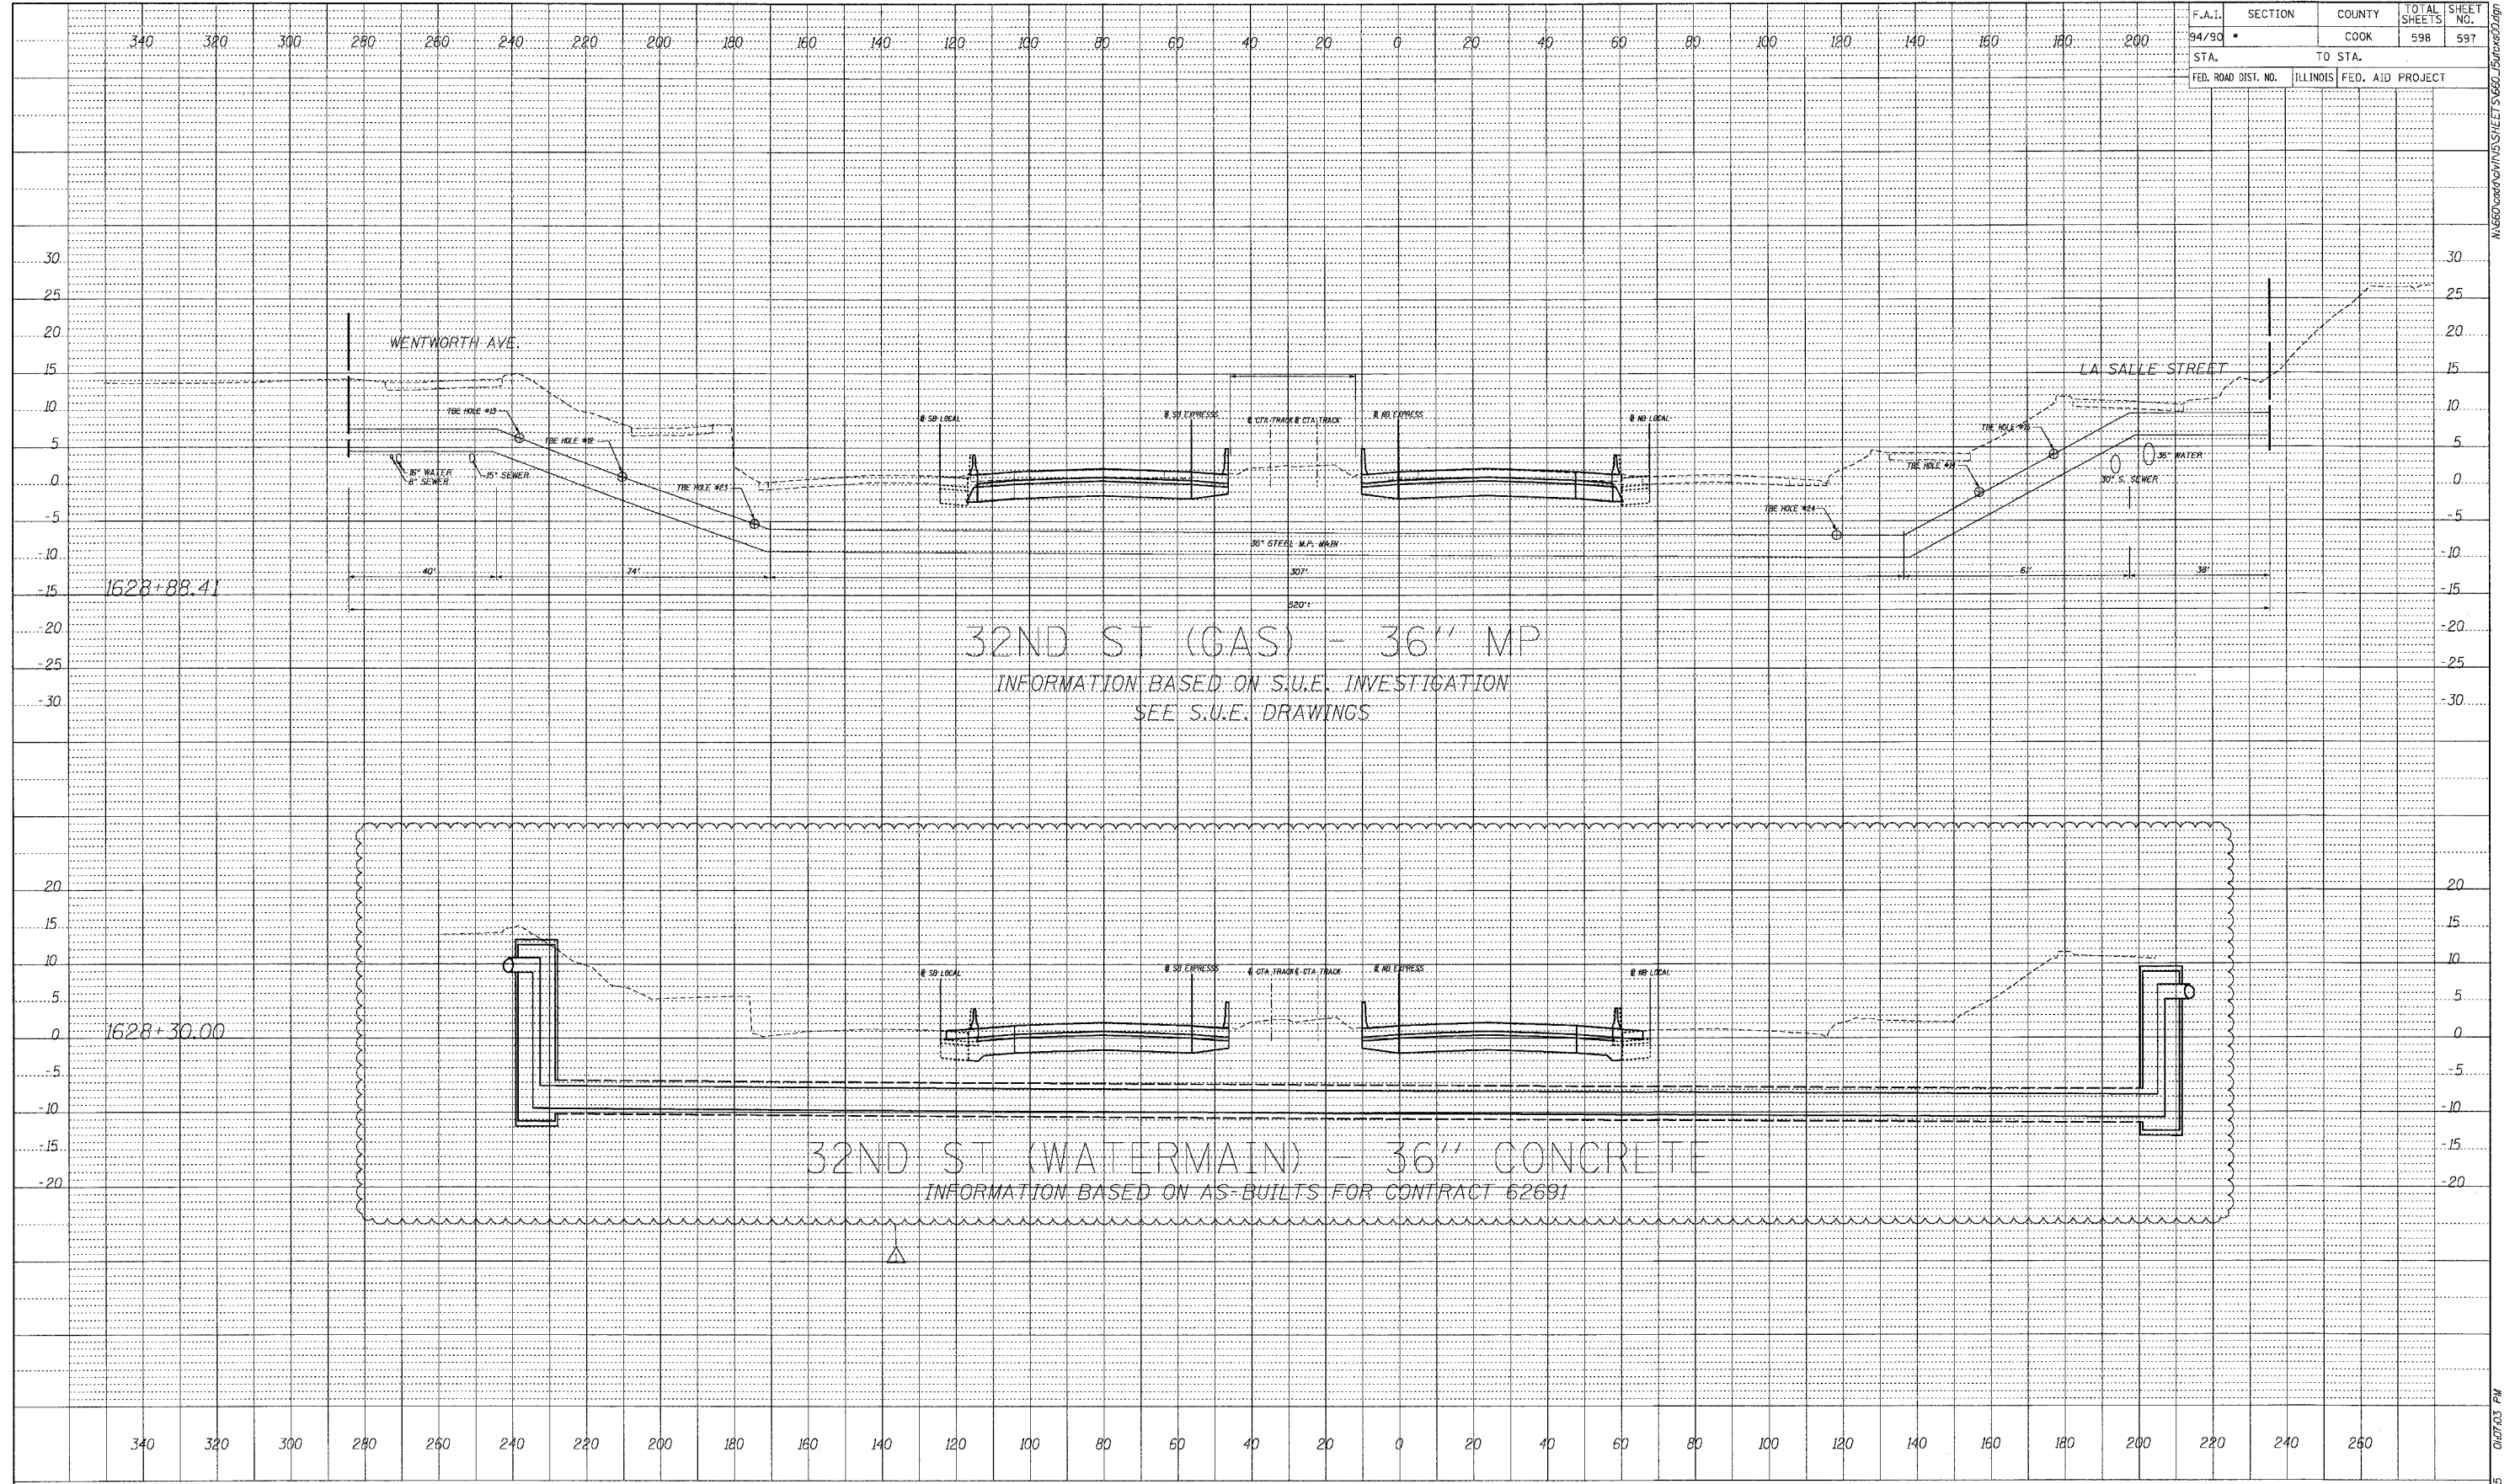

BY	DATE

PROFILE SURVEYED
 NOTE BOOK
 G.M. NOTED
 STRUCTURE NOTATIONS ON/D


BOWMAN, BARRETT & ASSOCIATES INC.
 CONSULTING ENGINEERS
 Chicago, Illinois
 312.228.0100
 www.bbainc.com

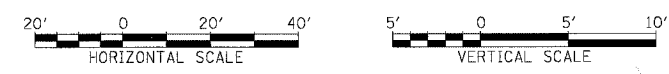

STA. ----- TO STA. -----

F.A.I.	SECTION	COUNTY	TOTAL SHEETS	SHEET NO.
94/90		COOK	598	598
STA.		TO STA.		
FED. ROAD DIST. NO.	ILLINOIS	FED. AID PROJECT		

PROFILE SURVEYED	DATE
BY	
DATE CHECKED	
BY	
DATE NOTED	
BY	
STRUCTURE	NOTATION
NO.	CHFD

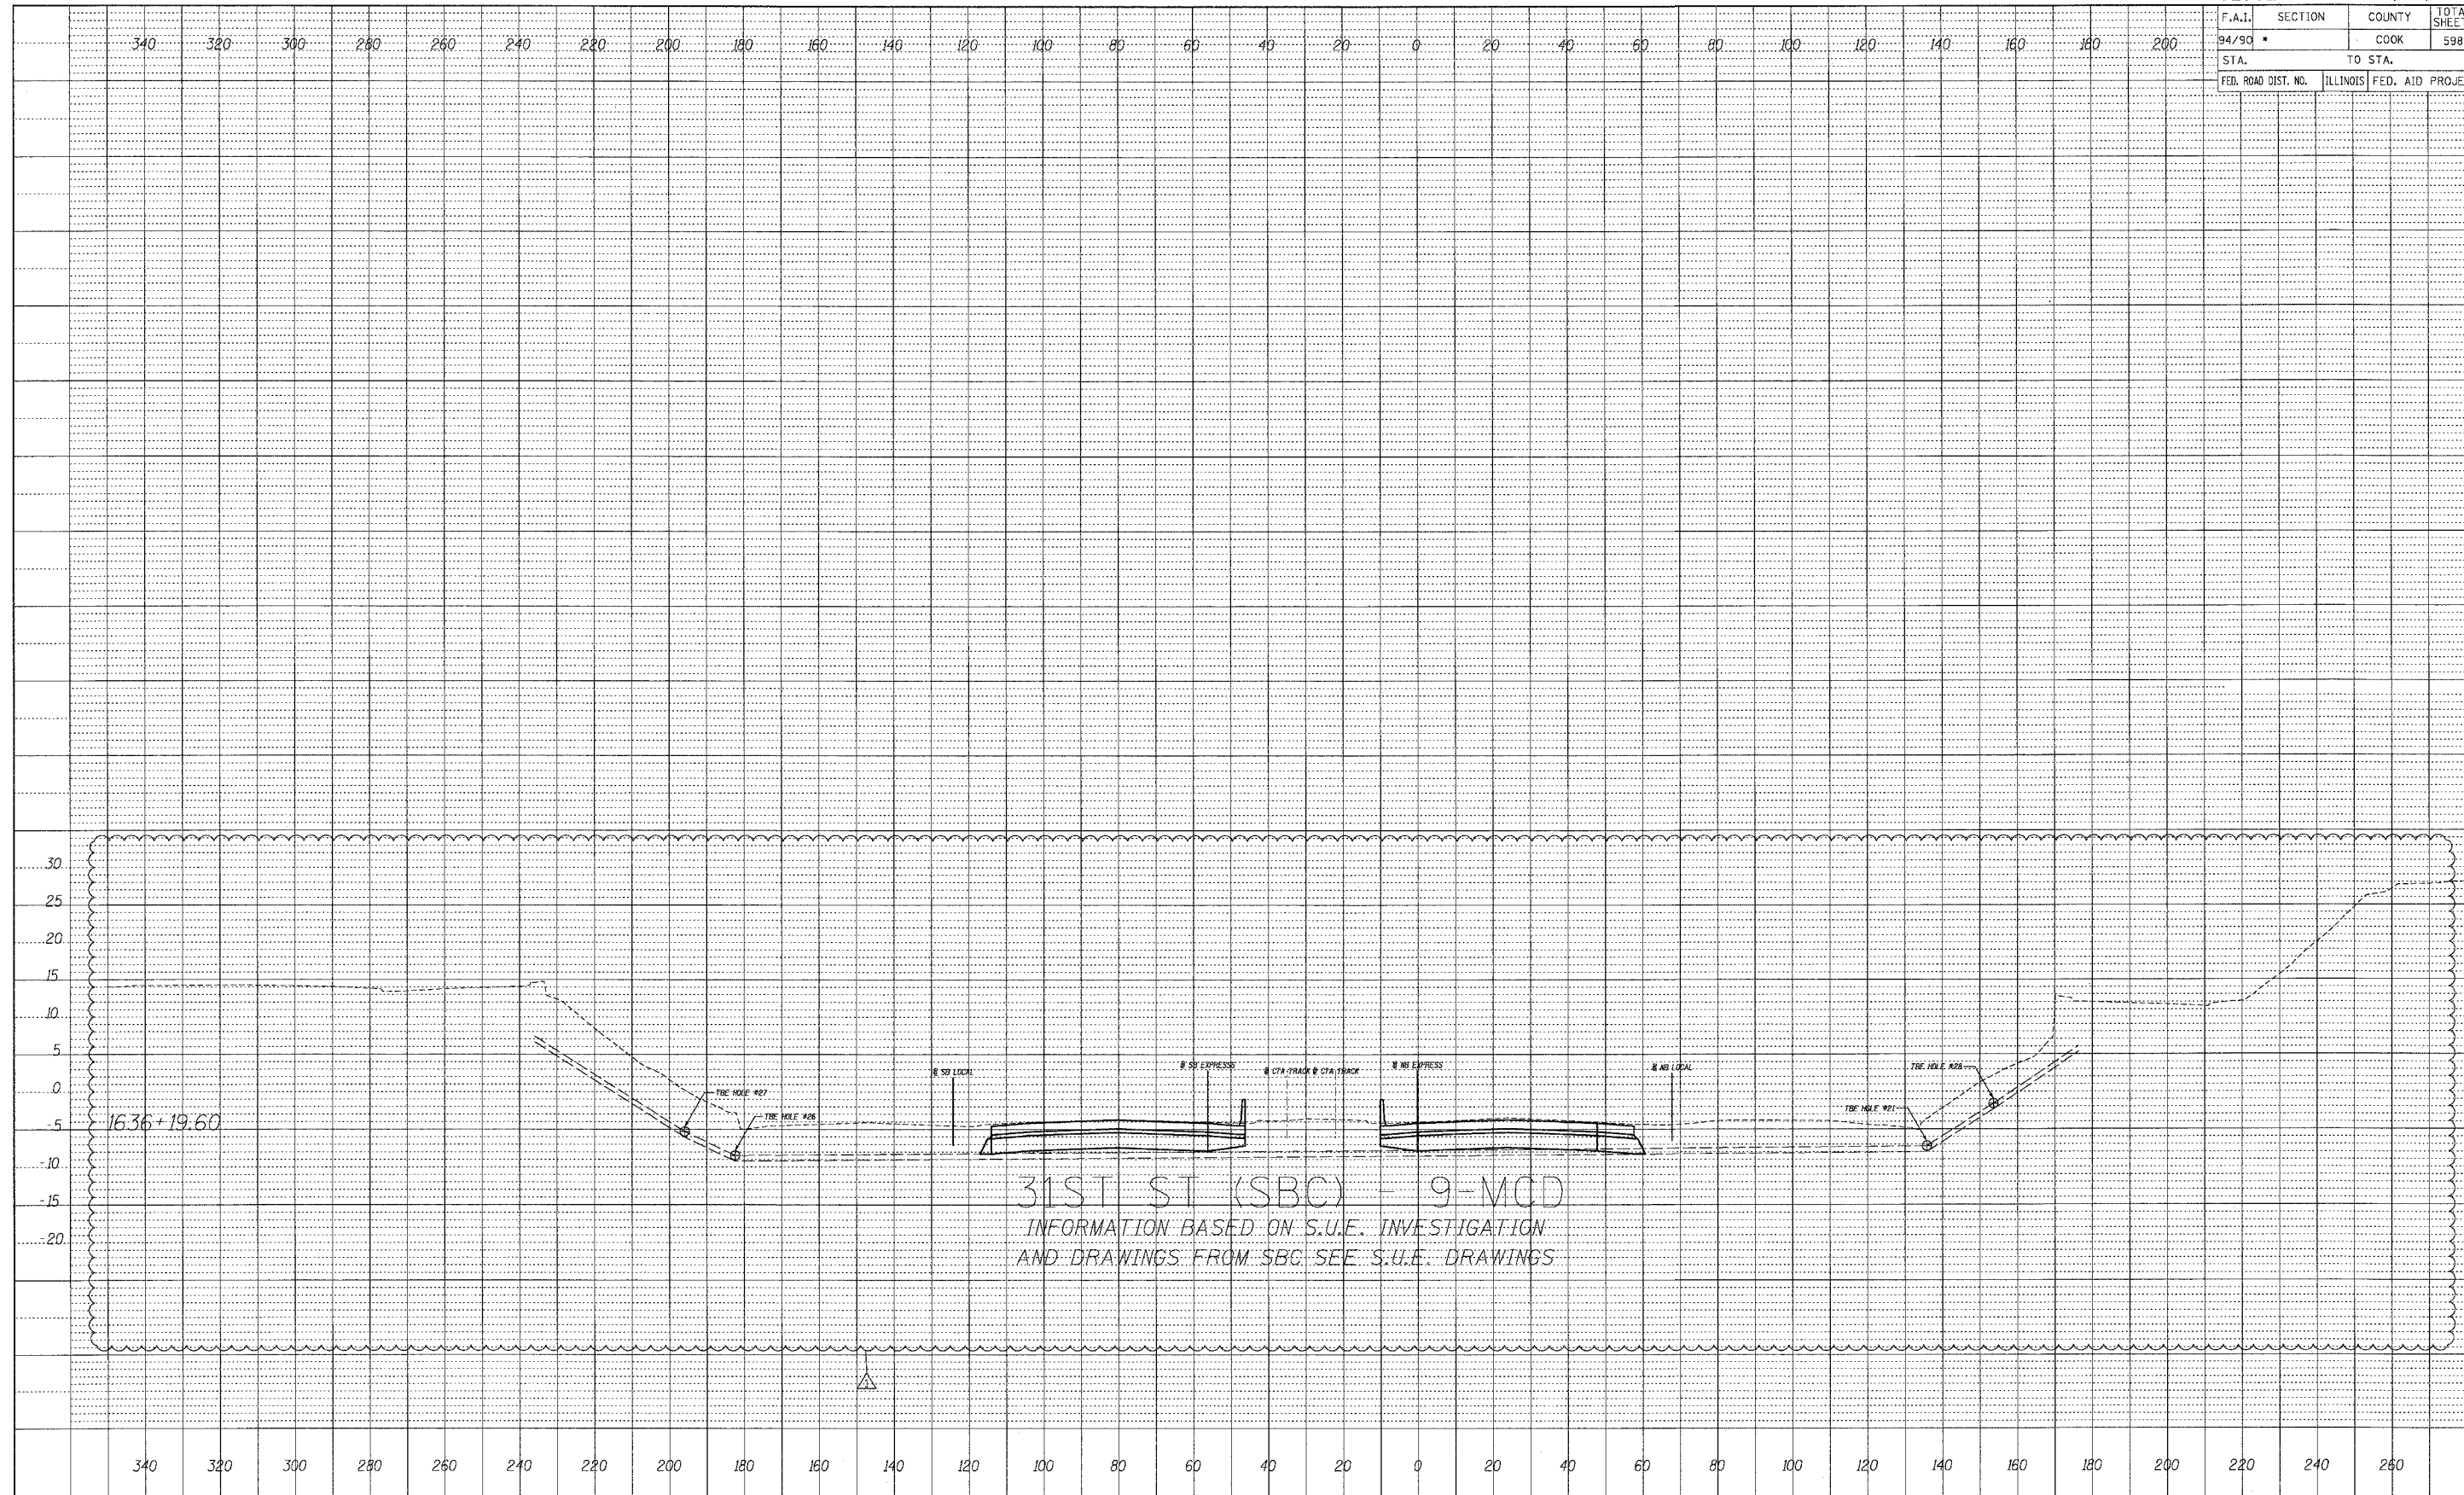

BOWMAN, BARRETT & ASSOCIATES INC.
 CONSULTING ENGINEERS
 Chicago, Illinois
 312.228.0100
 www.bbainc.com



STA. ----+-- TO STA. ----+--

08/05/2005 04:07:25 PM