

F.A.I. RTE.	SECTION	COUNTY	TOTAL SHEETS	SHEET NO.
74	(10-4,10-5)	CHAMPAIGN	74	1
		ILLINOIS	CONTRACT NO. 70B15	

STATE OF ILLINOIS  
DEPARTMENT OF TRANSPORTATION  
DIVISION OF HIGHWAYS  
**PROPOSED  
HIGHWAY PLANS**

FOR INDEX OF SHEETS, SEE SHEET NO. 2  
FOR SUMMARY OF QUANTITIES, SEE SHEET NO. 4-6

**CURRENT TRAFFIC DATA**

F.A.I. ROUTE 74

	LEG "A"	LEG "B"	LEG "C"
2013 ADT =	21,800	27,800	27,500
PV % =	67.6	73.5	75.3
SU % =	4.6	3.5	3.6
MU % =	27.8	23.0	21.1


TRAFFIC DATA LOCATIONS

LEG "A" = 0.5 MILES WEST OF IL 47 TO IL 47  
LEG "B" = IL 47 TO PRAIRIE VIEW RD  
LEG "C" = PRAIRIE VIEW RD TO 0.5 MILES WEST OF I-57

F.A.I. ROUTE 74 (I-74)  
SECTION (10-4,10-5)  
PROJECT ACNHPP-0074(319)  
THIN CONCRETE OVERLAY, BRIDGE JOINT  
REPAIR, BRIDGE DECK REPAIR  
CHAMPAIGN COUNTY



**DESIGN DESIGNATION**  
INTERSTATE

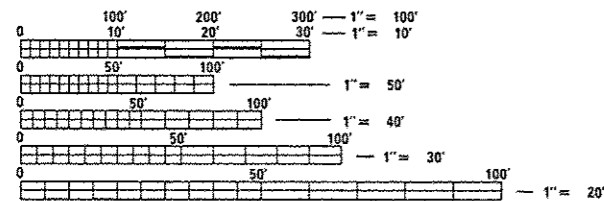


FULL SIZE PLANS HAVE BEEN PREPARED USING STANDARD ENGINEERING SCALES. REDUCED SIZED PLANS WILL NOT CONFORM TO STANDARD SCALES. IN MAKING MEASUREMENTS ON REDUCED PLANS, THE ABOVE SCALES MAY BE USED.

J.U.L.I.E.  
JOINT UTILITY LOCATION INFORMATION FOR EXCAVATION  
1-800-892-0123  
OR 811

PROJECT ENGINEER: TIM BRANDENBURG  
SQUAD LEADER: JEFF M. SHERER  
217-465-4181  
CONTRACT NO. 70B15

C-95-007-15

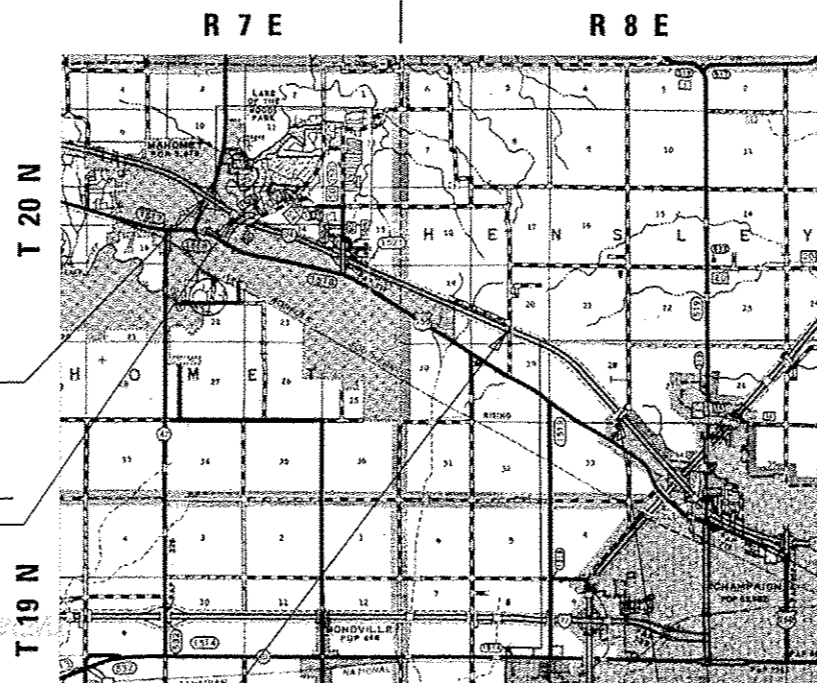

S.N. 010-0014 STA. 1518+66.10 (WB I-74)  
S.N. 010-0015 STA. 1518+84.25 (EB I-74)  
THIN CONCRETE OVERLAY

S.N. 010-0016 STA. 1539+94.80 (WB I-74)  
S.N. 010-0017 STA. 1539+94.80 (EB I-74)  
BRIDGE JOINT REPAIR

S.N. 010-0167 STA. 1747+74.26  
BRIDGE DECK REPAIR

S.N. 010-0169 STA. 1837+30.89  
THIN CONCRETE OVERLAY

GROSS LENGTH = 711.830 FT. = 0.135 MILE  
NET LENGTH = 711.830 FT. = 0.135 MILE

STATE OF ILLINOIS  
DEPARTMENT OF TRANSPORTATION  
DIVISION OF HIGHWAYS

SUBMITTED August 9 2016  
*James A. James*  
DEPUTY DIRECTOR OF HIGHWAYS, REGION 3 ENGINEER

Sept 30 2016  
*Muhammad M. Adib PE, Inc.*  
ENGINEER OF DESIGN AND ENVIRONMENT

Sept 30 2016  
*Omer Osman PE, Inc.*  
DIRECTOR OF HIGHWAYS, CHIEF ENGINEER

**PRINTED BY THE AUTHORITY  
OF THE STATE OF ILLINOIS**

# INDEX OF SHEETS

SHEET NO.	ITEM
1	COVER SHEET
2	INDEX OF SHEETS/ HIGHWAY STANDARDS
3	GENERAL NOTES
4-6	SUMMARY OF QUANTITIES
* 7-39	REPAIR PLANS S. N. 010-0014 & S. N. 010-0015
40-46	REPAIR PLANS S. N. 010-0016 & S. N. 010-0017
47-56	REPAIR PLANS S. N. 010-0167
57-68	REPAIR PLANS S. N. 010-0169
69-74	DESIGN DETAILS

\* INCLUDES SHEET 30A.

# LIST OF STANDARDS

STANDARD NO.	DESCRIPTION
000001-06	STANDARD SYMBOLS, ABBREVIATIONS AND PATTERNS
001001-02	AREAS OF REINFORCEMENT BARS
001006	DECIMAL OF AN INCH AND OF A FOOT
630001-10	STEEL PLATE BEAM GUARDRAIL
630301-06	SHOULDER WIDENING FOR TYPE 1 GUARDRAIL TERMINALS
701400-08	APPROACH TO LANE CLOSURE - FREEWAY/ EXPRESSWAY
701401-09	LANE CLOSURE FREEWAY/ EXPRESSWAY
701402-11	LANE CLOSURE FREEWAY/ EXPRESSWAY PLUS BARRIER
701411-09	LANE CLOSURE MULTILANE - ENTRANCE OR EXIT RAMP 45 MPH PLUS
701901-05	TRAFFIC CONTROL DEVICES
704001-08	TEMPORARY CONCRETE BARRIER
725001	OBJECT AND TERMINAL MARKERS
782006	GUARDRAIL AND BARRIER WALL REFLECTOR MOUNTING DETAILS
701101-05	OFF-RD OPERATIONS, MULTILANE, 15' (4.5 m) TO 24" (600 mm) FROM PAVEMENT EDGE

FILE NAME *	USER NAME = shoranjm	DESIGNED -	REVISED -	<b>STATE OF ILLINOIS DEPARTMENT OF TRANSPORTATION</b>	<b>INDEX OF SHEETS &amp; HIGHWAY STANDARDS</b>	F.A.L. RTE.	SECTION	COUNTY	TOTAL SHEETS	SHEET NO.
pu\\NL884EBIGINTEG.illinois.gov\1007\Documents\DOT Offices\District 5\Projects\057\Drawings\Structures\0570015-shr-Index		CHECKED -	REVISED -			74	(10-4,10-5)I	CHAMPAIGN	74	2
Default	PLOT SCALE = 40.0000' / in.	DATE -	REVISED -			CONTRACT NO. 70B15				
	PLOT DATE = 8/8/2016					SCALE:	SHEET 1	OF 1	SHEETS	STA.

G. N. -100

ENGLISH UNITS OF MEASUREMENT SHALL GOVERN OVER AND SUPERSEDE ANY METRIC UNITS SHOWN IN THIS CONTRACT. WHERE INCLUDED, METRIC UNITS ARE FOR INFORMATION ONLY.

G. N. -105.09A

ALL ELEVATIONS SHOWN IN THE PLANS ARE BASED ON NORTH AMERICAN VERTICAL DATUM OF 1988. (NAVD 88)

G. N. -406

THE QUANTITIES INCLUDED IN THE PLANS FOR HOT-MIX ASPHALT RESURFACING ARE INTENDED TO GIVE THE COVERAGE SHOWN ON THE TYPICAL CROSS SECTIONS. IT IS NOT INTENDED TO INCREASE THE THICKNESS OF THE HOT-MIX ASPHALT MIXTURE IN ORDER TO USE ALL OF THE QUANTITIES INCLUDED IN THE CONTRACT.

GN 406H Mixture Requirements

Location	TR 126 over I-74	I-74
Mixture Use	Surface	Surface
AC/PG	PG 64-22	SBS PG 70-22
Design Air Voids	4.0% @ Ndes=50	4.0% @ Ndes=90
Mix Comp(Gradation)	IL 9.5	IL 9.5
Friction Aggregate	Mix C	Mix D
Mixture Weight	112	112
Quality Management Program	QC/QA	QC/QA
Sublot Size	N. A.	N. A.

G. N. -442B -- PATCHING SCHEDULES

THE PATCHING SCHEDULES INCLUDED IN THE PLANS REPRESENT THE BEST INFORMATION AVAILABLE AT THE TIME OF COMPLETION OF THE PLANS FOR LETTING. VARIATIONS IN LOCATION AND SIZES OF BOTH FULL-DEPTH AND PARTIAL-DEPTH PATCHES MAY OCCUR.

G. N. -501A

THE EXISTING STRUCTURAL STEEL COATING CONTAINS LEAD. THE CONTRACTOR SHOULD FOLLOW THE GUIDE BRIDGE SPECIAL PROVISIONS FOR CONTAINMENT AND DISPOSAL OF LEAD PAINT CLEANING RESIDUES TO DEAL WITH THE PRESENCE OF LEAD ON THIS PROJECT.

G. N. -609

PRIOR TO ROUTING TRAFFIC ONTO THE SHOULDERS AS SHOWN IN THE STAGING PLANS, THE CONTRACTOR SHALL SECURE THE GRATINGS ON SHOULDER INLETS AS DIRECTED BY THE ENGINEER. THIS WORK WILL BE PAID FOR ACCORDING TO ARTICLE 109.04.

G. N. -631

IF THE CONTRACTOR ELECTS TO USE THE ALTERNATE MOUNTING METHOD OF THRU DRILLING THE MOUNTING HOLES FOR THE TRAFFIC BARRIER TERMINALS, TYPE 6, THE HOLES SHALL BE DRILLED USING A CORE DRILL. A HAMMER DRILL WILL NOT BE ALLOWED.

# GENERAL NOTES

THERE ARE NO COMMITMENTS ASSOCIATED WITH THIS PROJECT

PLAN NOTES:

QUANTITIES FOR SHOULDER WIDENING AT THE LOCATIONS OF THE TYPE ONE TERMINALS HAVE BEEN ESTIMATED AND ARE REPRESENTATIVE OF THE BEST INFORMATION AVAILABLE AT THE TIME OF THE COMPLETION OF THE PLANS FOR LETTING. THE AREAS SHALL BE VERIFIED BY THE ENGINEER IN THE FIELD.

EARTHWORK REQUIRED FOR WIDENING AT TYPE I TERMINAL LOCATIONS:

NW QUAD	8.0	CU YD
NE QUAD	8.0	CU YD
SW QUAD	8.0	CU YD
SE QUAD	8.0	CU YD

TOTAL = 32.0 CU YD

THIS WORK SHALL NOT BE PAID FOR SEPARATELY BUT SHALL BE INCLUDED IN THE COST FOR TRAFFIC BARRIER TERMINAL TYPE 1 (TANGENT).

## 63000001 STEEL PLATE BEAM GUARDRAIL, TYPE A, 6' POSTS

S. N. 010-0167 FOOT

NW QUAD	137.5
NE QUAD	137.5
SW QUAD	300.0
SE QUAD	312.5

TOTAL = 887.5

## 63100087 TRAFFIC BARRIER TERMINAL TYPE 6A

S. N. 010-0167 EACH

NW QUAD	1.0
NE QUAD	1.0
SW QUAD	1.0
SE QUAD	1.0

TOTAL = 8.0

S. N. 010-0169

NW QUAD	1.0
NE QUAD	1.0
SW QUAD	1.0
SE QUAD	1.0

TOTAL = 8.0

## 63301210 REMOVE AND REERECT STEEL PLATE BEAM GUARDRAIL, TYPE A

S. N. 010-0169

NW QUAD	12.5
NE QUAD	12.5
SW QUAD	12.5
SE QUAD	12.5

TOTAL = 50.0

## 63200310 GUARDRAIL REMOVAL

S. N. 010-0167 FOOT

NW QUAD	215.0
NE QUAD	253.0
SW QUAD	383.5
SE QUAD	365.0

S. N. 010-0169

NW QUAD	64.0
NE QUAD	64.0
SW QUAD	64.0
SE QUAD	64.0

S. N. 010-0014

NE QUAD	75.0
SE QUAD	75.0

S. N. 010-0015

NW QUAD	75.0
SW QUAD	75.0

TOTAL = 1772.5

USE = 1773.0

## 63100085 TRAFFIC BARRIER TERMINAL TYPE 6

S. N. 010-0014

NE QUAD	1.0
SE QUAD	1.0

S. N. 010-0015

NW QUAD	1.0
SW QUAD	1.0

TOTAL = 4.0

## 63100167 TRAFFIC BARRIER TERMINAL TYPE 1 SPECIAL (TANGENT)

S. N. 010-0167 EACH

NW QUAD	1.0
NE QUAD	1.0
SW QUAD	1.0
SE QUAD	1.0

TOTAL = 4.0

## 78200005 GUARDRAIL REFLECTORS, TYPE A

S. N. 010-0167 EACH

NW QUAD	2.0
NE QUAD	2.0
SW QUAD	4.0
SE QUAD	4.0

TOTAL = 12.0

FILE NAME *	USER NAME *	DESIGNED -	REVISED -	<b>STATE OF ILLINOIS DEPARTMENT OF TRANSPORTATION</b>	<b>GENERAL NOTES</b>			F.A.I. RTE.	SECTION	COUNTY	TOTAL SHEETS	SHEET NO.
Default		CHECKED -	REVISED -					74	(10-4,10-5)H	CHAMPAIGN	74	3
		DATE -	REVISED -					CONTRACT NO. 70B15			ILLINOIS FED. AID PROJECT	
								SCALE:	SHEET 1	OF 1 SHEETS	STA.	TO STA.

CONSTRUCTION CODE

URBAN

S.N. 010-0014 STA. 1518+66.10  
S.N. 010-0015 STA. 1518+84.25  
FAI-74  
100% STATE  
BRIDGE REHAB  
0014

S.N. 010-0016  
S.N. 010-0017  
STA. 1539+94.80  
FAI-74  
100% STATE  
BRIDGE REHAB  
0014

S.N. 010-0167  
STA. 50+00.00  
T.R. 104  
100% STATE  
BRIDGE REHAB  
0014

S.N. 010-0169  
STA. 89+80.58  
T.R. 126  
100% STATE  
BRIDGE REHAB  
0014

CODE NO.	ITEM	UNIT	TOTAL QUANTITY	S.N. 010-0014 STA. 1518+66.10 S.N. 010-0015 STA. 1518+84.25 FAI-74 100% STATE BRIDGE REHAB 0014	S.N. 010-0016 S.N. 010-0017 STA. 1539+94.80 FAI-74 100% STATE BRIDGE REHAB 0014	S.N. 010-0167 STA. 50+00.00 T.R. 104 100% STATE BRIDGE REHAB 0014	S.N. 010-0169 STA. 89+80.58 T.R. 126 100% STATE BRIDGE REHAB 0014
40600290	BITUMINOUS MATERIALS TACK COAT	POUND	374.0	328.0	0.0	0.0	45.0
40603310	HOT-MIX ASPHALT SURFACE COURSE, MIX "C", N50	TON	10.0	0.0	0.0	0.0	10.0
40603545	POLYMERIZED HOT-MIX ASPHALT SURFACE COURSE, MIX "D", N90	TON	62.0	62.0	0.0	0.0	0.0
50102400	CONCRETE REMOVAL	CU YD	19.7	19.7	0.0	0.0	0.0
50157300	PROTECTIVE SHIELD	SQ YD	849.0	410.0	0.0	175.0	264.0
50300100	FLOOR DRAINS	EACH	36.0	16.0	0.0	10.0	10.0
50300255	CONCRETE SUPERSTRUCTURE	CU YD	31.8	31.8	0.0	0.0	0.0
50300260	BRIDGE DECK GROOVING	SQ YD	1,791.0	1,286.0	0.0	0.0	505.0
50300300	PROTECTIVE COAT	SQ YD	140.0	140.0	0.0	0.0	0.0
50500405	FURNISHING AND ERECTING STRUCTURAL STEEL	POUND	4,210.0	4,210.0	0.0	0.0	0.0
50500505	STUD SHEAR CONNECTORS	EACH	224.0	224.0	0.0	0.0	0.0
50800205	REINFORCEMENT BARS, EPOXY COATED	POUND	4,910.0	4,910.0	0.0	0.0	0.0
50800515	BAR SPLICERS	EACH	64.0	64.0	0.0	0.0	0.0
50900200	STEEL RAILING, TYPE 2399	FOOT	911.0	0.0	0.0	491.0	420.0
52000110	PREFORMED JOINT STRIP SEAL	FOOT	180.0	180.0	0.0	0.0	0.0
52100010	ELASTOMERIC BEARING ASSEMBLY, TYPE I	EACH	28.0	28.0	0.0	0.0	0.0
52100520	ANCHOR BOLTS, 1"	EACH	56.0	56.0	0.0	0.0	0.0

\* SPECIALTY ITEM

CONSTRUCTION CODE

URBAN

S.N. 010-0014 STA. 1518+66.10  
S.N. 010-0015 STA. 1518+84.25  
FAI-74  
100% STATE  
BRIDGE REHAB  
0014

S.N. 010-0016  
S.N. 010-0017  
STA. 1539+94.80  
FAI-74  
100% STATE  
BRIDGE REHAB  
0014

S.N. 010-0167  
STA. 50+00.00  
T.R. 104  
100% STATE  
BRIDGE REHAB  
0014

S.N. 010-0169  
STA. 89+80.58  
T.R. 126  
100% STATE  
BRIDGE REHAB  
0014

CODE NO.	ITEM	UNIT	TOTAL QUANTITY	S.N. 010-0014 STA. 1518+66.10 S.N. 010-0015 STA. 1518+84.25 FAI-74 100% STATE BRIDGE REHAB 0014	S.N. 010-0016 S.N. 010-0017 STA. 1539+94.80 FAI-74 100% STATE BRIDGE REHAB 0014	S.N. 010-0167 STA. 50+00.00 T.R. 104 100% STATE BRIDGE REHAB 0014	S.N. 010-0169 STA. 89+80.58 T.R. 126 100% STATE BRIDGE REHAB 0014
* 63000001	STEEL PLATE BEAM GUARDRAIL, TYPE A, 6 FOOT POSTS	FOOT	887.5	0.0	0.0	887.5	0.0
* 63100085	TRAFFIC BARRIER TERMINAL, TYPE 6	EACH	4.0	4.0	0.0	0.0	0.0
* 63100087	TRAFFIC BARRIER TERMINAL, TYPE 6A	EACH	8.0	0.0	0.0	4.0	4.0
* 63100167	TRAFFIC BARRIER TERMINAL, TYPE 1 (SPECIAL) TANGENT	EACH	4.0	0.0	0.0	4.0	0.0
63200310	GUARDRAIL REMOVAL	FOOT	1,773.0	300.0	0.0	1,217.0	256.0
* 63301210	REMOVE AND REERECT STEEL PLATE BEAM GUARDRAIL, TYPE A	FOOT	50.0	0.0	0.0	0.0	50.0
67000400	ENGINEER FIELD OFFICE, TYPE A	CAL MO	8.0	2.0	2.0	2.0	2.0
67100100	MOBILIZATION	LSUM	1.0	0.3	0.3	0.4	0.0
70100207	TRAFFIC CONTROL AND PROTECTION, STANDARD 701402	EACH	2.0	2.0	0.0	0.0	0.0
70100420	TRAFFIC CONTROL AND PROTECTION, STANDARD 701411	EACH	4.0	4.0	0.0	0.0	0.0
70100800	TRAFFIC CONTROL AND PROTECTION, STANDARD 701401	L SUM	1.0	0.5	0.5	0.0	0.0
70400100	TEMPORARY CONCRETE BARRIER	FOOT	1,050.0	1,050.0	0.0	0.0	0.0
70400200	RELOCATE TEMPORARY CONCRETE BARRIER	FOOT	1,050.0	1,050.0	0.0	0.0	0.0
70600250	IMPACT ATTENUATORS, TEMPORARY (NON- REDIRECTIVE), TEST LEVEL 3	EACH	2.0	2.0	0.0	0.0	0.0
70600350	IMPACT ATTENUATORS, RELOCATE (NON- REDIRECTIVE), TEST LEVEL 3	EACH	2.0	2.0	0.0	0.0	0.0
* 72501000	TERMINAL MARKER - DIRECT APPLIED	EACH	4.0	0.0	0.0	4.0	0.0
* 78001110	PAINT PAVEMENT MARKING - LINE 4"	FOOT	9,120.0	9,120.0	0.0	0.0	0.0



\* SPECIALTY ITEM



Structures 010-0014 & 010-0015 were built in 1966 as FAI route 74, Section 10-4HB at station 1518+75.19 by the State of Illinois in Champaign County. In 1975, the structures received a waterproofing membrane with a Bitumious Concrete wearing surface as Section District 5 Waterproofing 1975-3.

The existing structures are two-span structures with back-to-back of abutment length of 113'-4". The structures measure 40'-0" from face-to-face of parapets and has an out-to-out width of 42'-0". The structures were built on a 10°-57' right-forward skew. The superstructures consist of seven WF steel girders supporting a 7" reinforced concrete deck. The superstructure is supported by two pile bent vaulted abutments and a pier on a spread footing. The slopes are protected with concrete slope walls.

**Method of Construction: STAGE CONSTRUCTION**

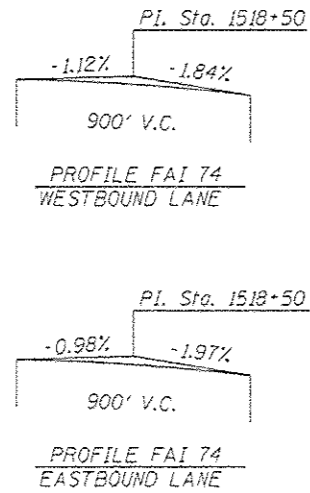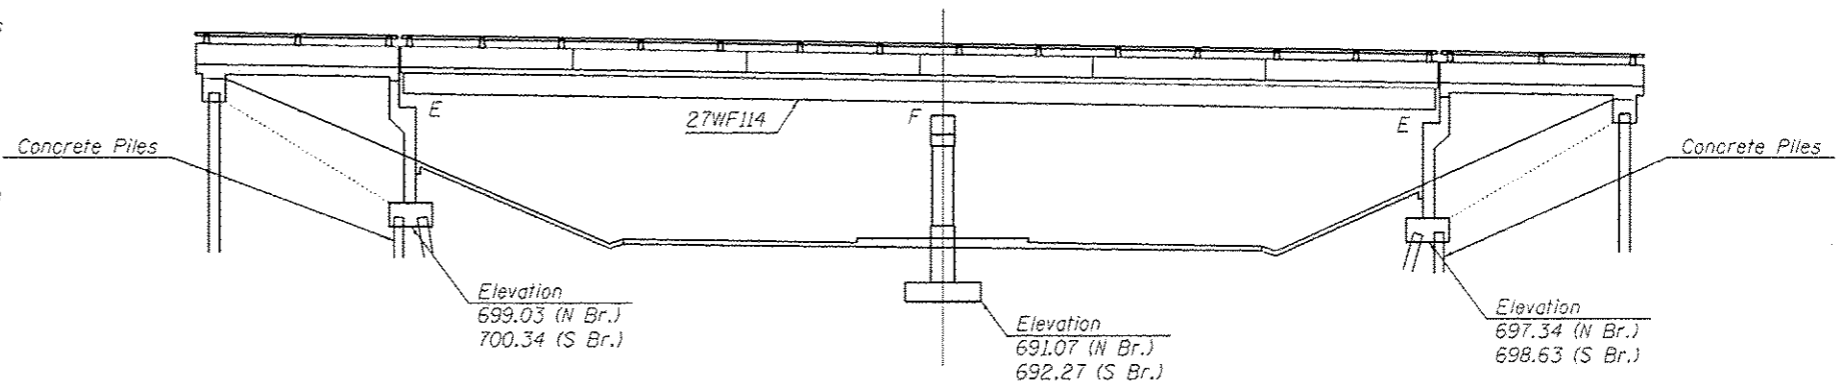

Bk. W. Appr.  
Sta. 1517+86.93  
Elev. 716.32

Stage II Construction  
Stage I Construction

Bk. W. Addr.  
Sta. 1518+05.11  
Elev. 717.63

Stage I Construction  
Stage II Construction

Bk. E. Appr.  
Sta. 1519+40.27  
Elev. 714.03


Bk. E. Abut.  
Sta. 1519+20.27  
Elev. 714.34

Bk. E. Addr.  
Sta. 1519+58.45  
Elev. 715.31

Bk. E. Abut.  
Sta. 1519+38.45  
Elev. 715.63



*David Carl Puzey* 7/26/16  
Expires 1/30/18

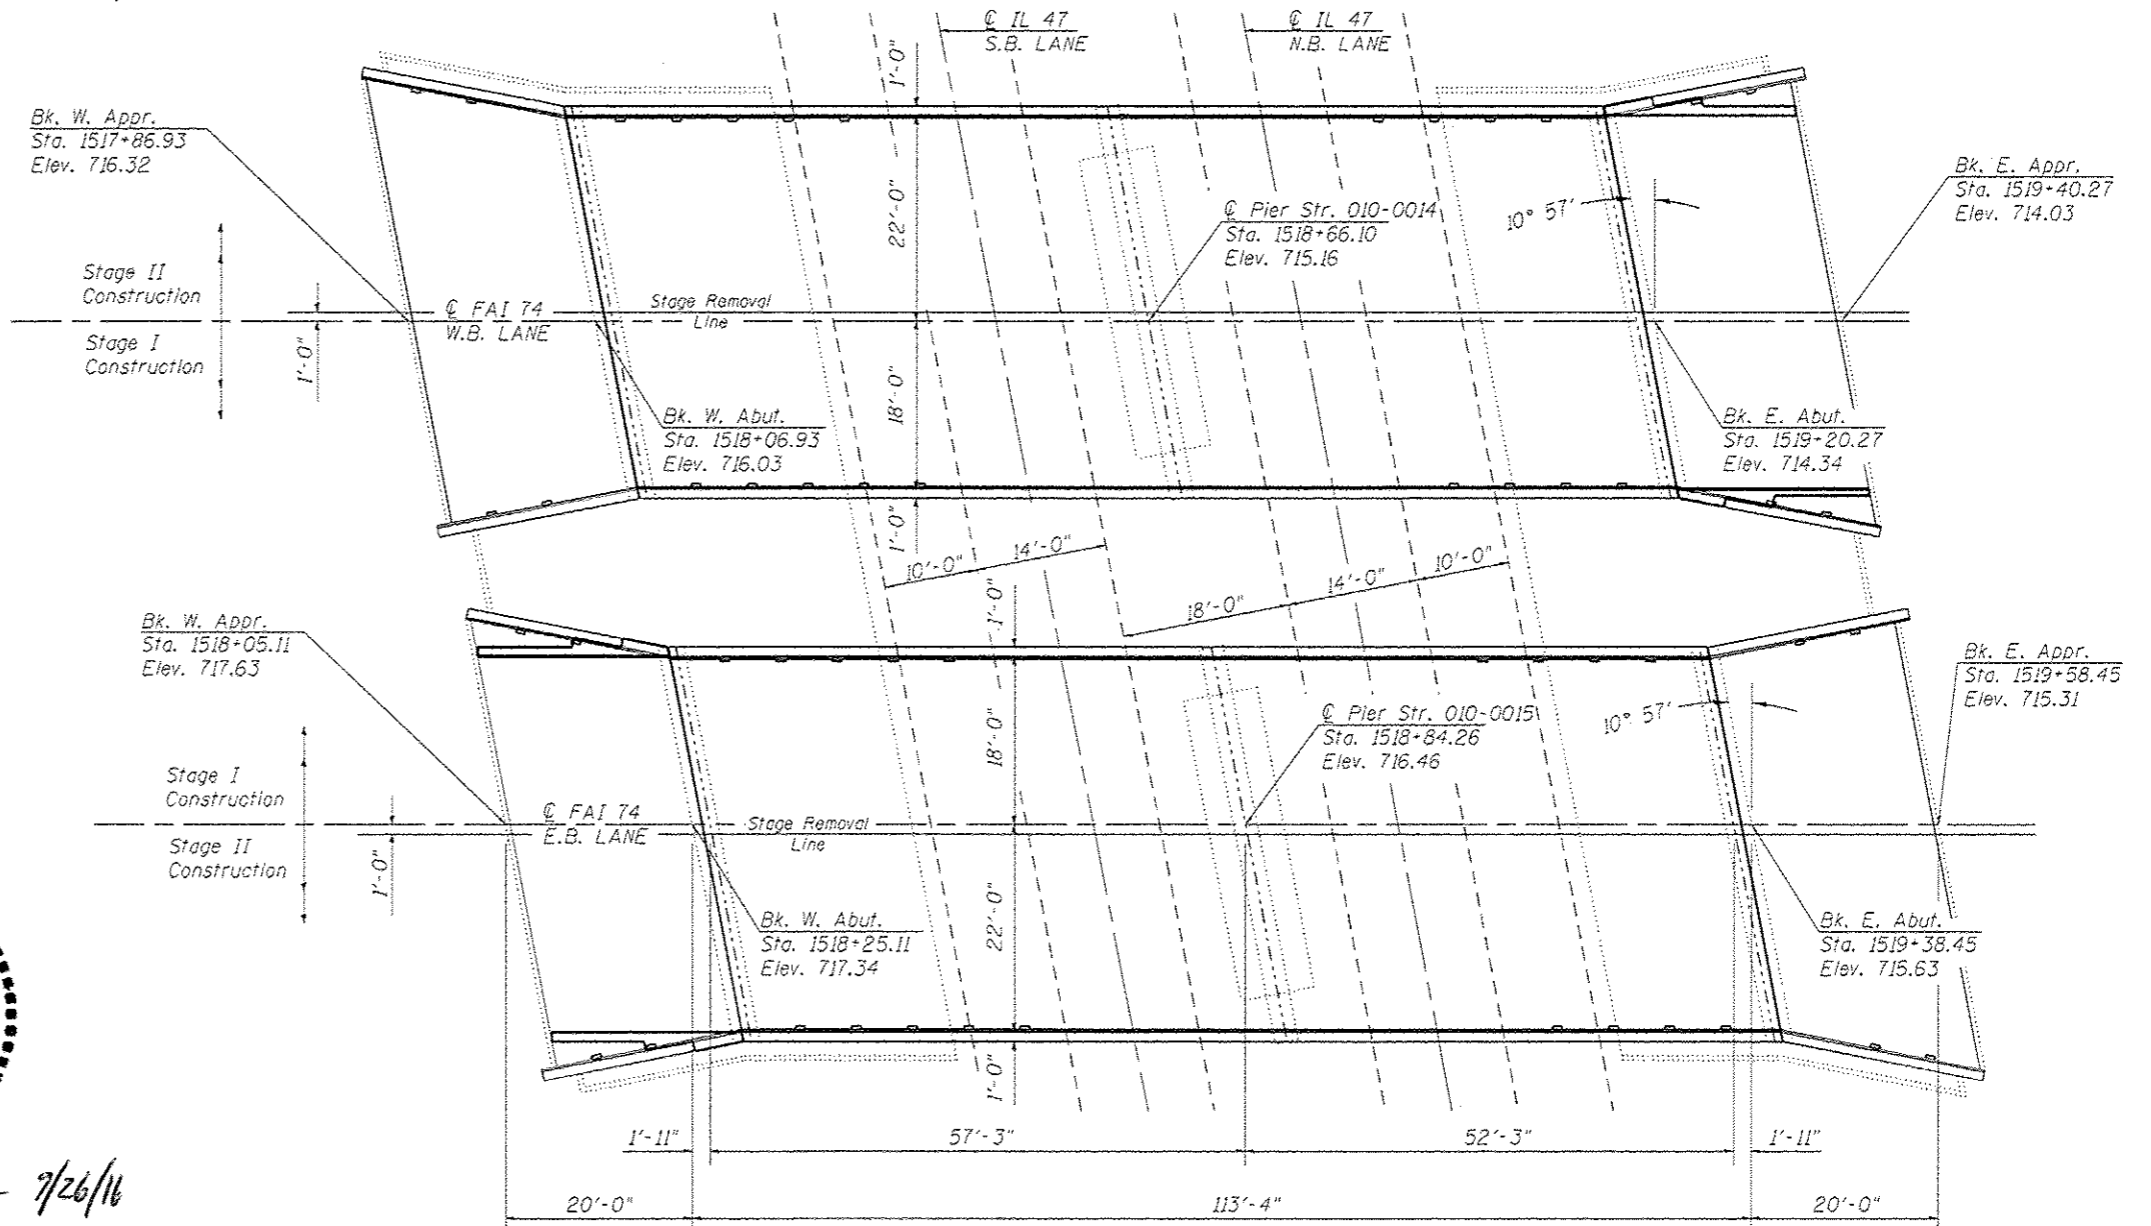

FILE NAME	USER NAME = shorer_j	DESIGNED - ESS	REVISED -	STATE OF ILLINOIS DEPARTMENT OF TRANSPORTATION	GENERAL PLAN AND ELEVATION S.N. 010-0014 (WB) & S.N. 010-0015 (EB)	F.A.I. RTE.	SECTION	COUNTY	TOTAL SHEETS	SHEET NO.	
PROJECT	PROJECT	CHECKED - <i>ATL</i>	REVISED -			74	(10-4,10-5H)	CHAMPAIGN	74	7	
PLOT SCALE = 48,000 / 1"	DATE - 11/7/2013	DATE - 11/7/2013	REVISED -			SCALE: SHEET 1 OF 33 SHEETS STA. TO STA.		CONTRACT NO. 70B15			
PLOT DATE = 8/9/2016						ILLINOIS FED. AID PROJECT					

**PROPOSED WORK**

1. Remove and Replace Stage I H.M.A. Wearing Surface Prior to Stage I Traffic.
2. Remove Existing Waterproofing Membrane System and H.M.A. Wearing Surface from Bridge Deck.
3. Remove Existing Waterproofing Membrane System and H.M.A. Wearing Surface from Approach Slabs.
4. Perform Bridge Deck Scarification on Bridge Deck and Approach Slabs.
5. Partial Removal of Deck Ends, Parapets, and Removal of Hatch Block.
6. Removal of Existing Joints.
7. Perform Full-Depth Patching.
8. Replace Existing Bearings with Elastomeric Bearings at Abutments.
9. Place Reinforcement Bars, Locking Edge Rail, and Studs.
10. Pour Deck Ends and Hatch Block.
11. Insert Rubber Strip Seal into Locking Edge Rails.
12. Pour Parapet Ends and Approach Bridge Rail Extensions.
13. Place Latex Concrete Overlay on Bridge Deck and Approach Slabs.
14. Repair Substructure Units- Abutments. Place Traffic Barrier Terminal, Type 6.

**TOTAL BILL OF MATERIALS S.N. 010-0014 & S.N. 010-0015**

ITEM	UNIT	QUANTITY
<b>BITUMINOUS MATERIAL (TACK COAT)</b>	<b>POUND</b>	<b>329.0</b>
<b>H.M.A. SURFACE COURSE MIX "D", N90</b>	<b>TON</b>	<b>62.0</b>
<b>HOT-MIX ASPHALT SURFACE REMOVAL (DECK)</b>	<b>SQ YD</b>	<b>2100.0</b>
<b>CONCRETE REMOVAL</b>	<b>CU YD</b>	<b>19.7</b>
<b>PROTECTIVE SHIELD</b>	<b>SQ YD</b>	<b>410.0</b>
<b>FLOOR DRAINS</b>	<b>EACH</b>	<b>16.0</b>
<b>CONCRETE SUPERSTRUCTURE</b>	<b>CU YD</b>	<b>31.8</b>
<b>BRIDGE DECK GROOVING</b>	<b>SQ YD</b>	<b>1286.0</b>
<b>PROTECTIVE COAT</b>	<b>SQ YD</b>	<b>140.0</b>
<b>FURNISHING AND ERECTING STRUCTURAL STEEL</b>	<b>POUND</b>	<b>4210.0</b>
<b>STUD SHEAR CONNECTORS</b>	<b>EACH</b>	<b>224.0</b>
<b>REINFORCEMENT BARS, EPOXY COATED</b>	<b>POUND</b>	<b>4910.0</b>
<b>BAR SPLICERS</b>	<b>EACH</b>	<b>64.0</b>
<b>PERFORMED JOINT STRIP SEAL</b>	<b>FOOT</b>	<b>180.0</b>
<b>ELASTOMERIC BEARING ASSEMBLY, TYPE I</b>	<b>EACH</b>	<b>28.0</b>
<b>ANCHOR BOLTS, 1"</b>	<b>EACH</b>	<b>56.0</b>
<b>TEMPORARY CONCRETE BARRIER</b>	<b>FOOT</b>	<b>1050.0</b>
<b>RELOCATE TEMPORARY CONCRETE BARRIER</b>	<b>FOOT</b>	<b>1050.0</b>
<b>IMPACT ATTENUATORS, TEMPORARY (NON-REDIRECTIVE), TEST LEVEL 3</b>	<b>EACH</b>	<b>2.0</b>
<b>IMPACT ATTENUATORS, RELOCATE (NON-REDIRECTIVE), TEST LEVEL 3</b>	<b>EACH</b>	<b>2.0</b>
<b>PAINT PAVEMENT MARKING - LINE 4 "</b>	<b>FOOT</b>	<b>9120.0</b>
<b>WIDTH RESTRICTION SIGNING</b>	<b>L SUM</b>	<b>1.0</b>
<b>JACK AND REMOVE EXISTING BEARINGS</b>	<b>EACH</b>	<b>28.0</b>
<b>BRIDGE DECK LATEX CONCRETE OVERLAY, 2 1/4 INCHES</b>	<b>SQ YD</b>	<b>1279.0</b>
<b>BRIDGE DECK SCARIFICATION 1/4 INCHES</b>	<b>SQ YD</b>	<b>1302.0</b>
<b>STRUCTURAL REPAIR OF CONCRETE (DEPTH EQUAL TO OR LESS THAN 5 INCHES)</b>	<b>SQ FT</b>	<b>138.0</b>
<b>DECK SLAB REPAIR (FULL DEPTH, TYPE I)</b>	<b>SQ YD</b>	<b>10.8</b>
<b>DECK SLAB REPAIR (FULL DEPTH, TYPE II)</b>	<b>SQ YD</b>	<b>62.3</b>
<b>POLYMER CONCRETE</b>	<b>CU FT</b>	<b>6.6</b>
<b>PLUG EXISTING DECK DRAINS</b>	<b>EACH</b>	<b>16.0</b>
<b>TEMPORARY SHORING AND CRIBBING</b>	<b>EACH</b>	<b>4.0</b>

**GENERAL NOTES**

The deck ends and hatch blocks shall have its final surface tined according to Article 420.09 (e) (1) of the Standard Specifications. Cost to be included with concrete superstructures.

Plan dimensions and details relative to existing plans are subject to nominal construction variations. The Contractor shall field verify existing dimensions and details affecting new construction and make necessary approved adjustments prior to construction or ordering of materials. Such variations shall not be cause for additional compensation for a change in scope of work. However, the Contractor will be paid for the quantity actually furnished at the unit price for the work.

The existing structural steel coating contains lead. The Contractor shall take appropriate precautions to deal with the presence of lead on this project.

All structural steel shall conform to AASHTO Classification M-270 Grade 36, unless otherwise noted.

Reinforcement bars designated (E) shall be epoxy coated.

Prior to pouring the new concrete deck, all heavy or loose rust, loose mill scale, and other loose or potentially detrimental foreign material shall be removed from the surfaces in contact with concrete. Tightly adhered paint may remain unless otherwise noted. Removal shall be accomplished by methods that will not damage the steel and the cost will be included in the pay item covering removal of the existing concrete.

Existing structural steel that will be in contact with new structural steel shall be cleaned and painted prior to erection as required by the Special Provision "Cleaning and Painting Contact Surface Areas of Existing Steel Structures".

Existing reinforcement bars extending into the removal area shall be cleaned, straightened and incorporated into the new construction. Any reinforcement bars that are damaged during concrete removal shall be replaced with an approved bar splicer or anchorage system. Cost included with Concrete Removal.

Joint openings shall be adjusted according to article 520.04 of the Std. Specs. when the deck is poured at an ambient temperature other than 50°F.

If the analysis submitted to the contractor for jacking/temporary support system to be used shows temporary stiffeners are required to prevent web crippling or buckling, the stiffeners shall be steel and bolted to the web. If stiffeners are not required, hard wood timbers shall be installed tightly between the top and bottom flange to prevent flange rotation.


S.N. 010-0014 & 0015 have been determined, through testing, not to involve asbestos in a bituminous bridge deck wearing surface or waterproofing membrane. As certified with BBS Form 2536, January 3, 2003.

Fibers are included in Bridge Deck Latex Concrete overlays.

FILE NAME =	USER NAME = shererjm	DESIGNED -	REVISED -	<b>STATE OF ILLINOIS DEPARTMENT OF TRANSPORTATION</b>	<b>SUMMARY OF QUANTITIES</b>				F.A.I. RTE.	SECTION	COUNTY	TOTAL SHEETS	SHEET NO.
Default		CHECKED -	REVISED -		<b>S.N. 010-0014 (WB) &amp; S.N. 010-0015 (EB)</b>				74	(10-4,10-5)I	CHAMPAIGN	74	8
	PLOT SCALE = 40.0000' / in.	DATE -	REVISED -						<b>CONTRACT NO. 70B15</b>				
	PLOT DATE = 8/8/2016	DATE -	REVISED -		SCALE:	SHEET 2	OF 33 SHEETS	STA.	TO STA.	ILLINOIS FED. AID PROJECT			




## EXISTING DECK CROSS SECTION

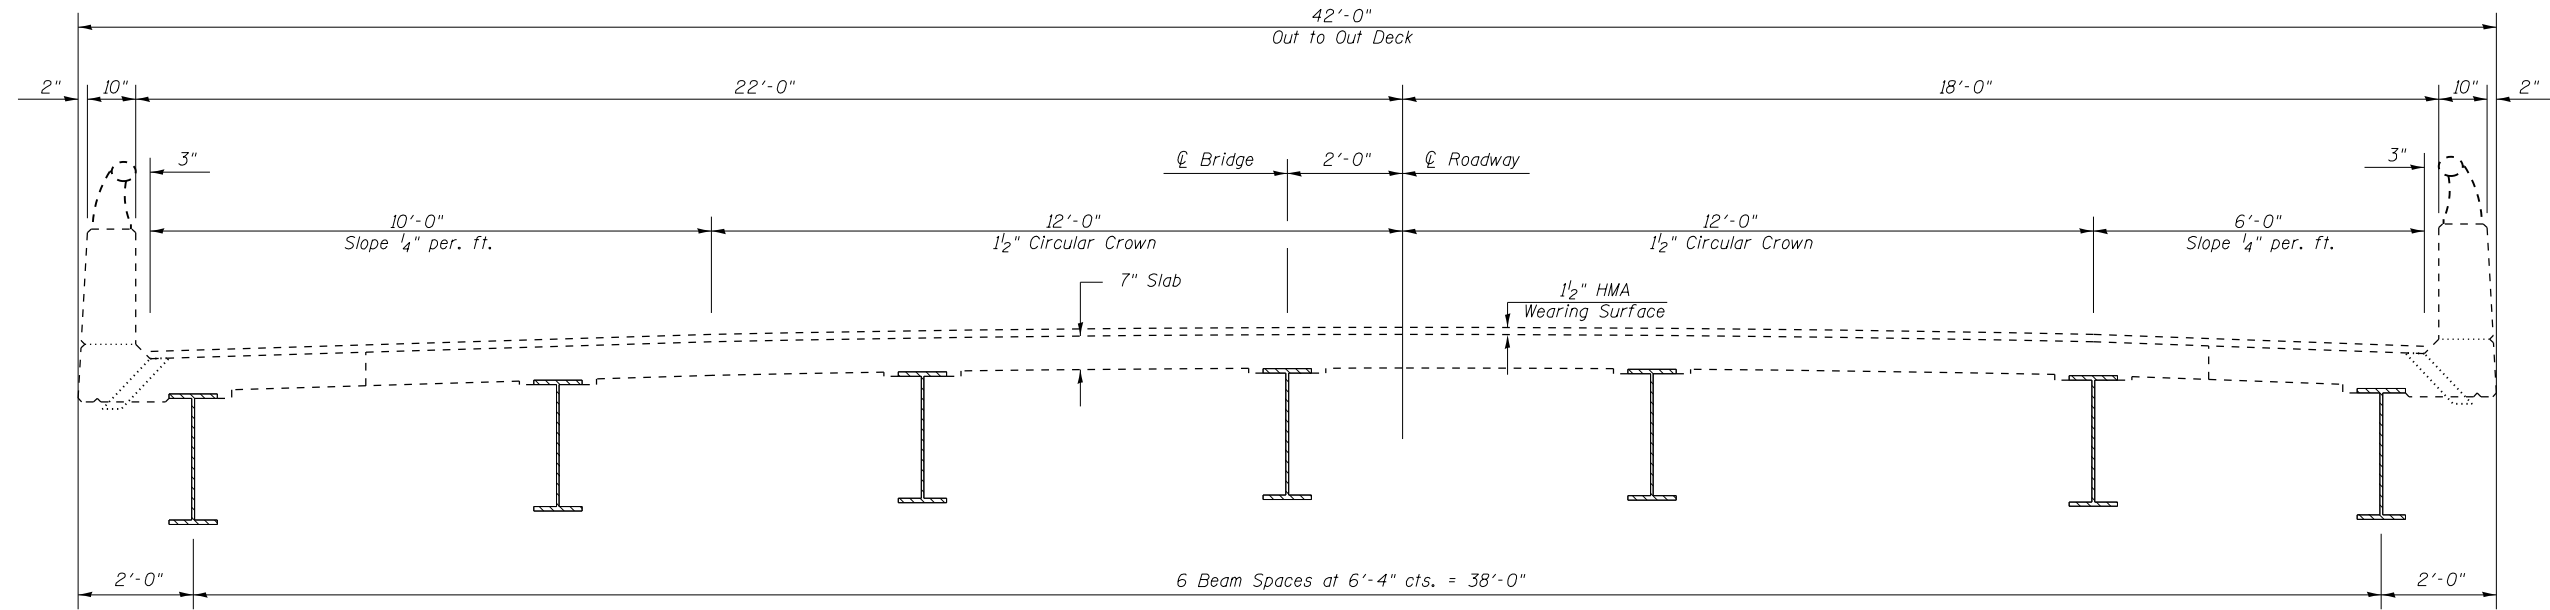

Looking East Str. 010-0014  
Looking West Str. 010-0015

## PROPOSED DECK CROSS SECTION

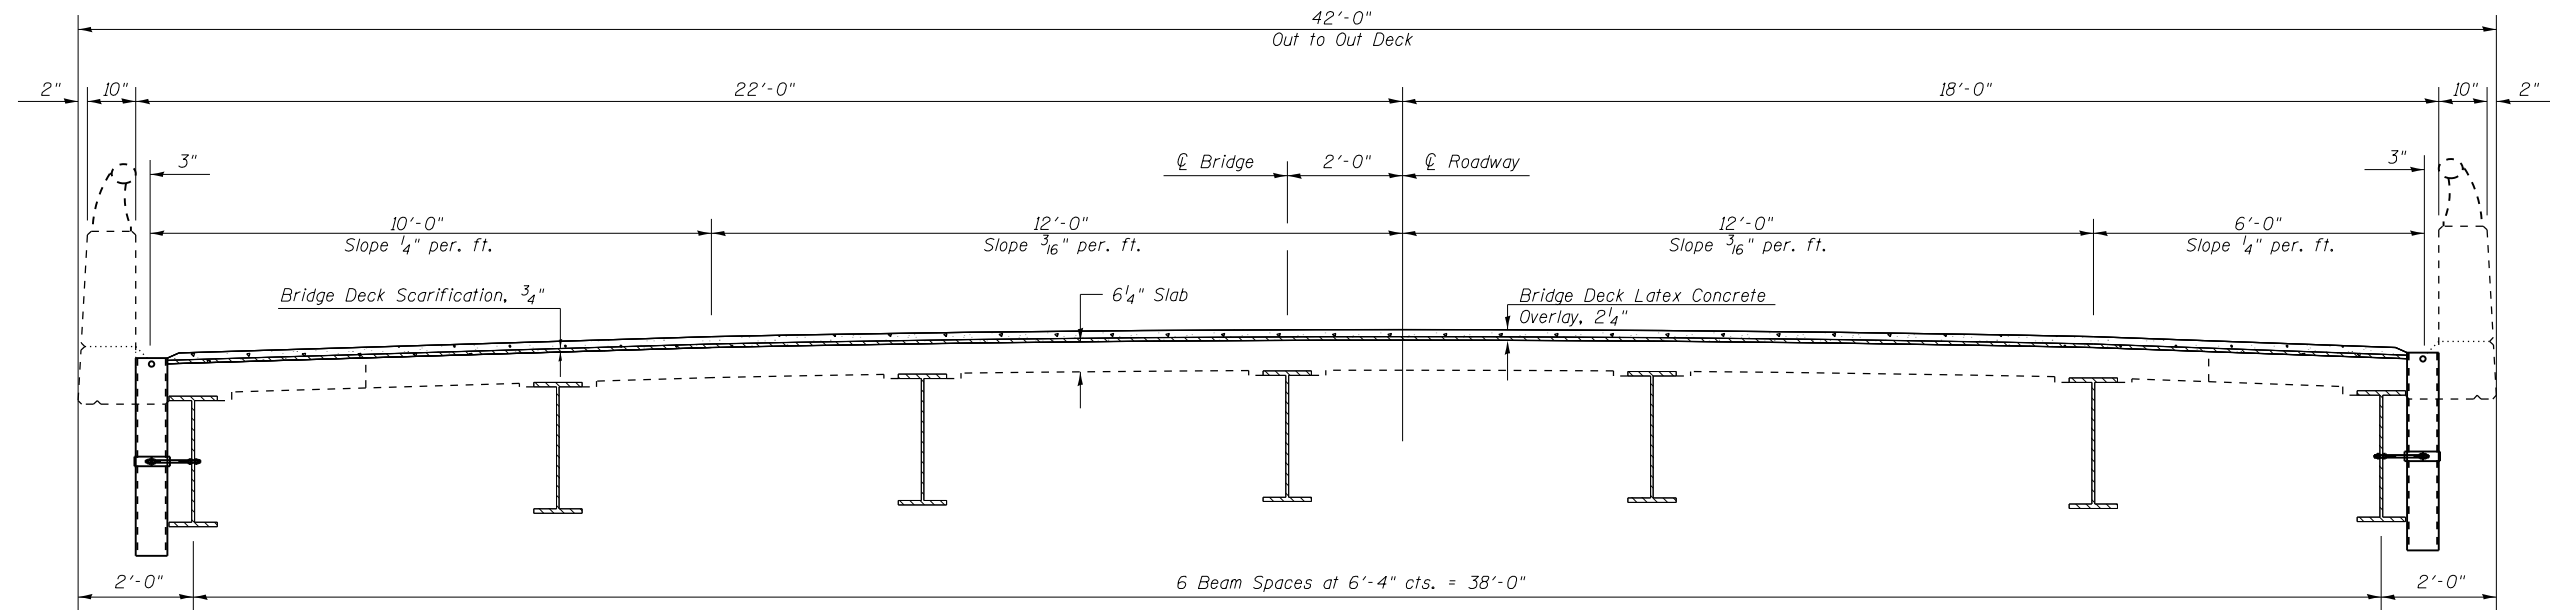


Looking East Str. 010-0014  
Looking West Str. 010-0015

FIBER IS REQUIRED FOR BRIDGE DECK LATEX CONCRETE OVERLAY, 2 1/2"


FILE NAME =	USER NAME = shererjm	DESIGNED - ESS	REVISED -	<b>STATE OF ILLINOIS DEPARTMENT OF TRANSPORTATION</b>	<b>TYPICAL DECK CROSS SECTION S.N. 010-0014 (WB) &amp; 010-0015 (EB)</b>	F.A.I. RTE. =	SECTION	COUNTY	TOTAL SHEETS	SHEET NO.
						74	(10-4,10-5)I	CHAMPAIGN	74	9
						CONTRACT NO. 70B15				
Default	PLOT SCALE = 40.0000' / in.	CHECKED -	REVISOR -			SCALE:	SHEET 3	OF 33 SHEETS	STA.	TO STA.
	PLOT DATE = 8/8/2016	DATE - 11/12/2013	REVISOR -			ILLINOIS FED. AID PROJECT				

## EXISTING APPROACH CROSS SECTION

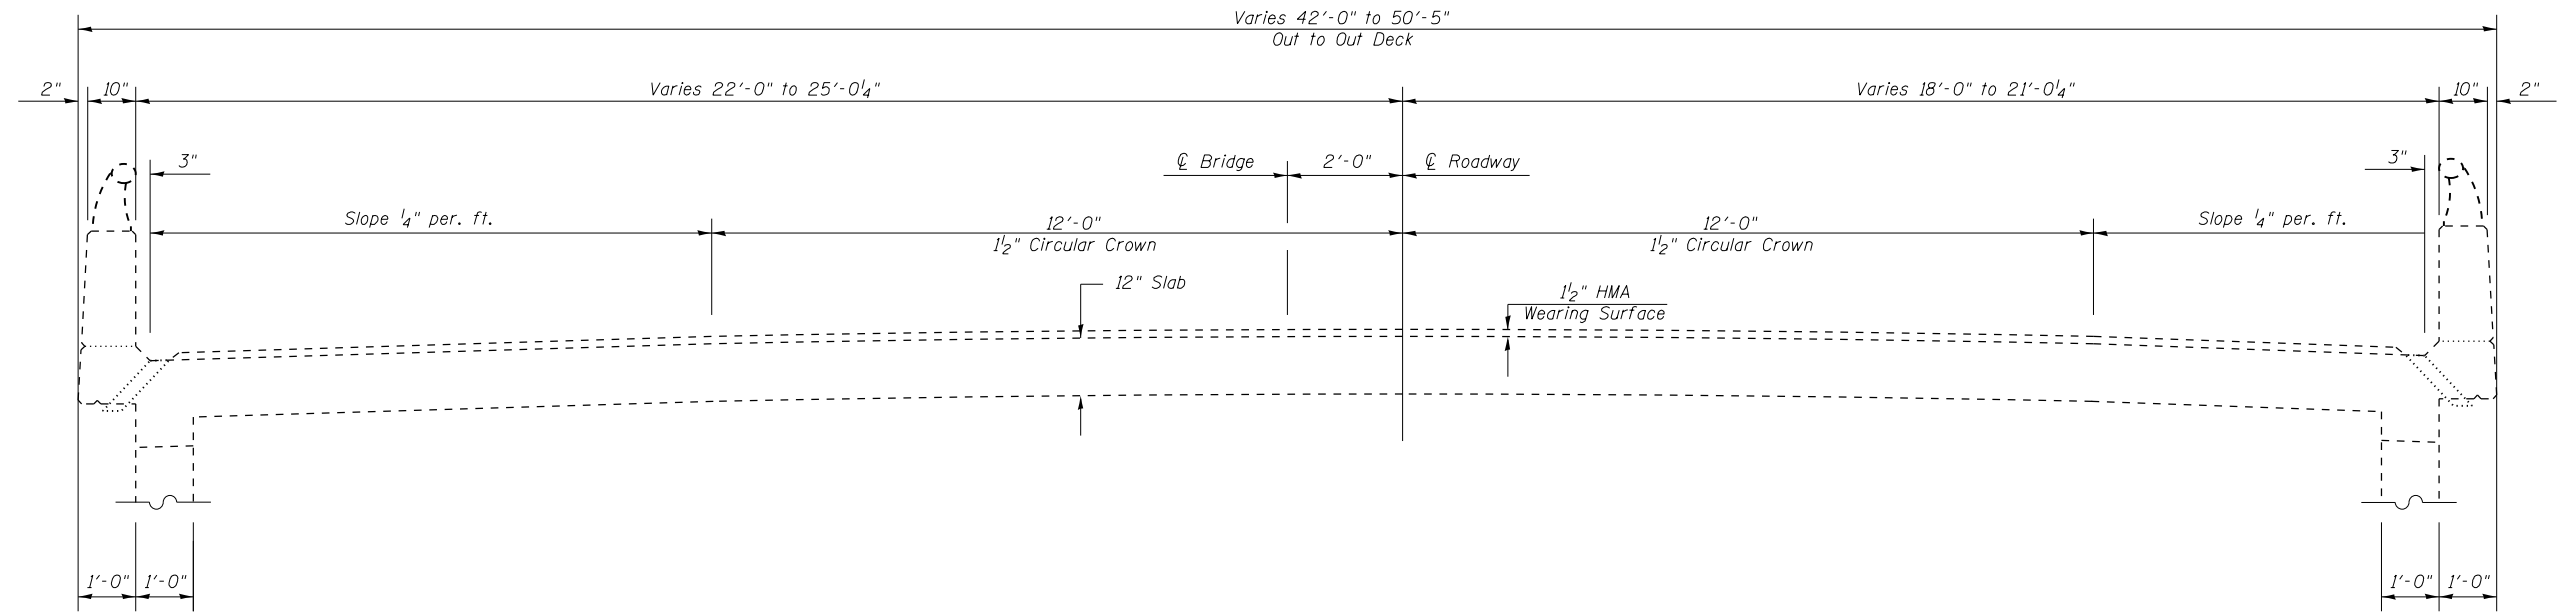

Looking East Str. 010-0014  
Looking West Str. 010-0015


## PROPOSED APPROACH CROSS SECTION

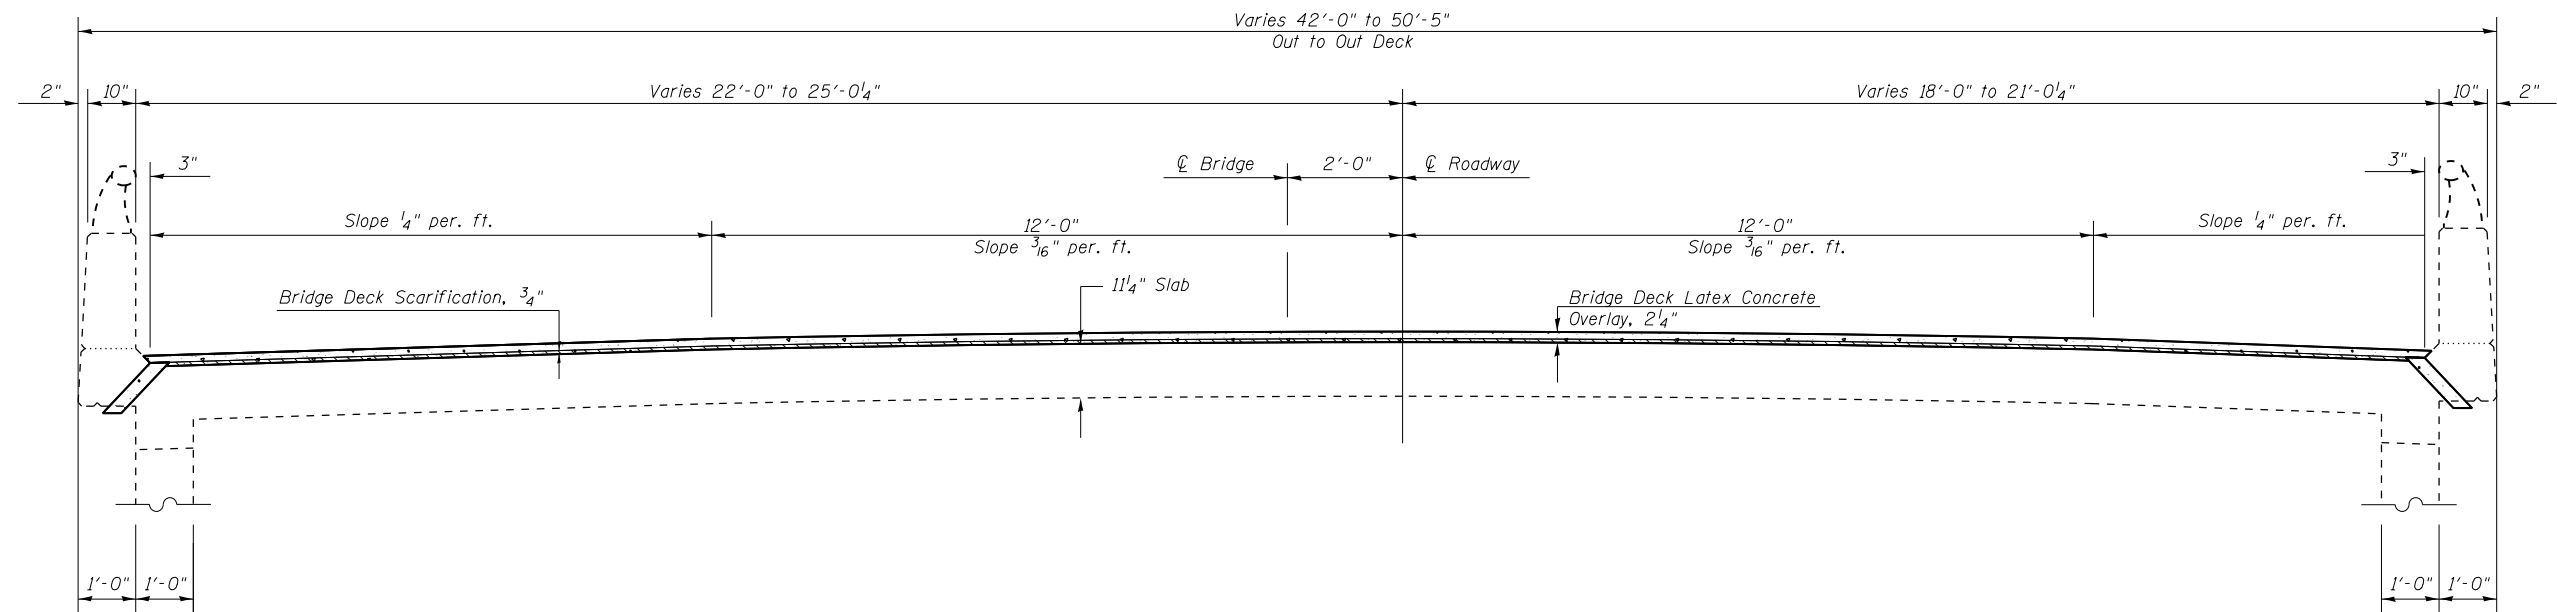

Looking East (Departure End) Str. 010-0014  
Looking West (Departure End) Str. 010-0015

FILE NAME =	USER NAME = shererjm	DESIGNED - ESS	REVISED -	<b>STATE OF ILLINOIS DEPARTMENT OF TRANSPORTATION</b>	<b>TYPICAL APPROACH CROSS SECTION S.N. 010-0014 (WB) &amp; 010-0015 (EB)</b>	F.A.I. RTE.	SECTION	COUNTY	TOTAL SHEETS	SHEET NO.
Default						74	(10-4,10-5)I	CHAMPAIGN	74	10
						CONTRACT NO. 70B15				
	PLOT SCALE = 40.0000' / in.	CHECKED -	REVISED -	SCALE:		SHEET 4 OF 33 SHEETS		STA. TO STA.		ILLINOIS FED. AID PROJECT
	PLOT DATE = 8/8/2016	DATE - 11/12/2013	REVISED -							

# PROPOSED APPROACH CROSS SECTION

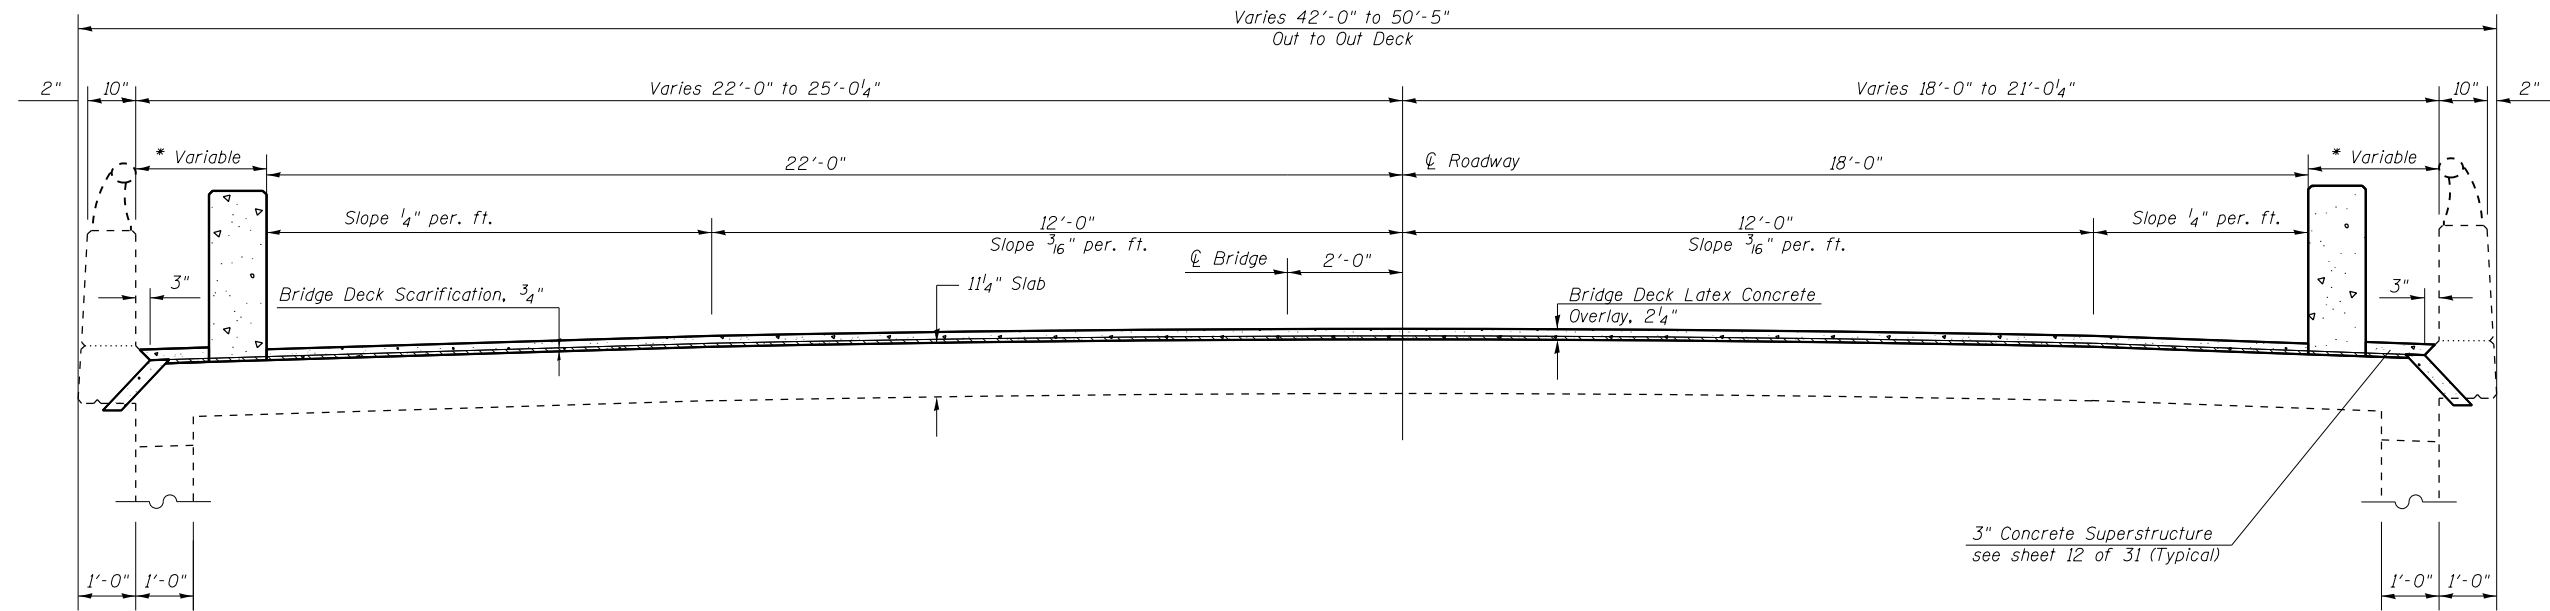


Looking East (Approach End) Str. 010-0014  
Looking West (Approach End) Str. 010-0015

**NOTE:**

- SEE APPROACH PARAPET EXTENSION SHEET 13.

FILE NAME =	USER NAME = shererjm	DESIGNED - ESS	REVISED -	<b>STATE OF ILLINOIS DEPARTMENT OF TRANSPORTATION</b>	<b>TYPICAL APPROACH CROSS SECTION S.N. 010-0014 (WB) &amp; S.N. 010-0015 (EB)</b>	F.A.I. RTE. 74	SECTION (10-4,10-5)I	COUNTY CHAMPAIGN	TOTAL SHEETS 74	SHEET NO. 11
Default	PLOT SCALE = 40.0000' / in.	CHECKED -	REVISED -		SCALE: SHEET 5 OF 33 SHEETS STA. TO STA.	CONTRACT NO. 70B15		ILLINOIS FED. AID PROJECT		
	PLOT DATE = 8/8/2016	DATE - 12/27/2013	REVISED -							

## STAGE I CONSTRUCTION DETAILS S.N. 010-0014 (WB) & S.N. 010-0015 (EB)

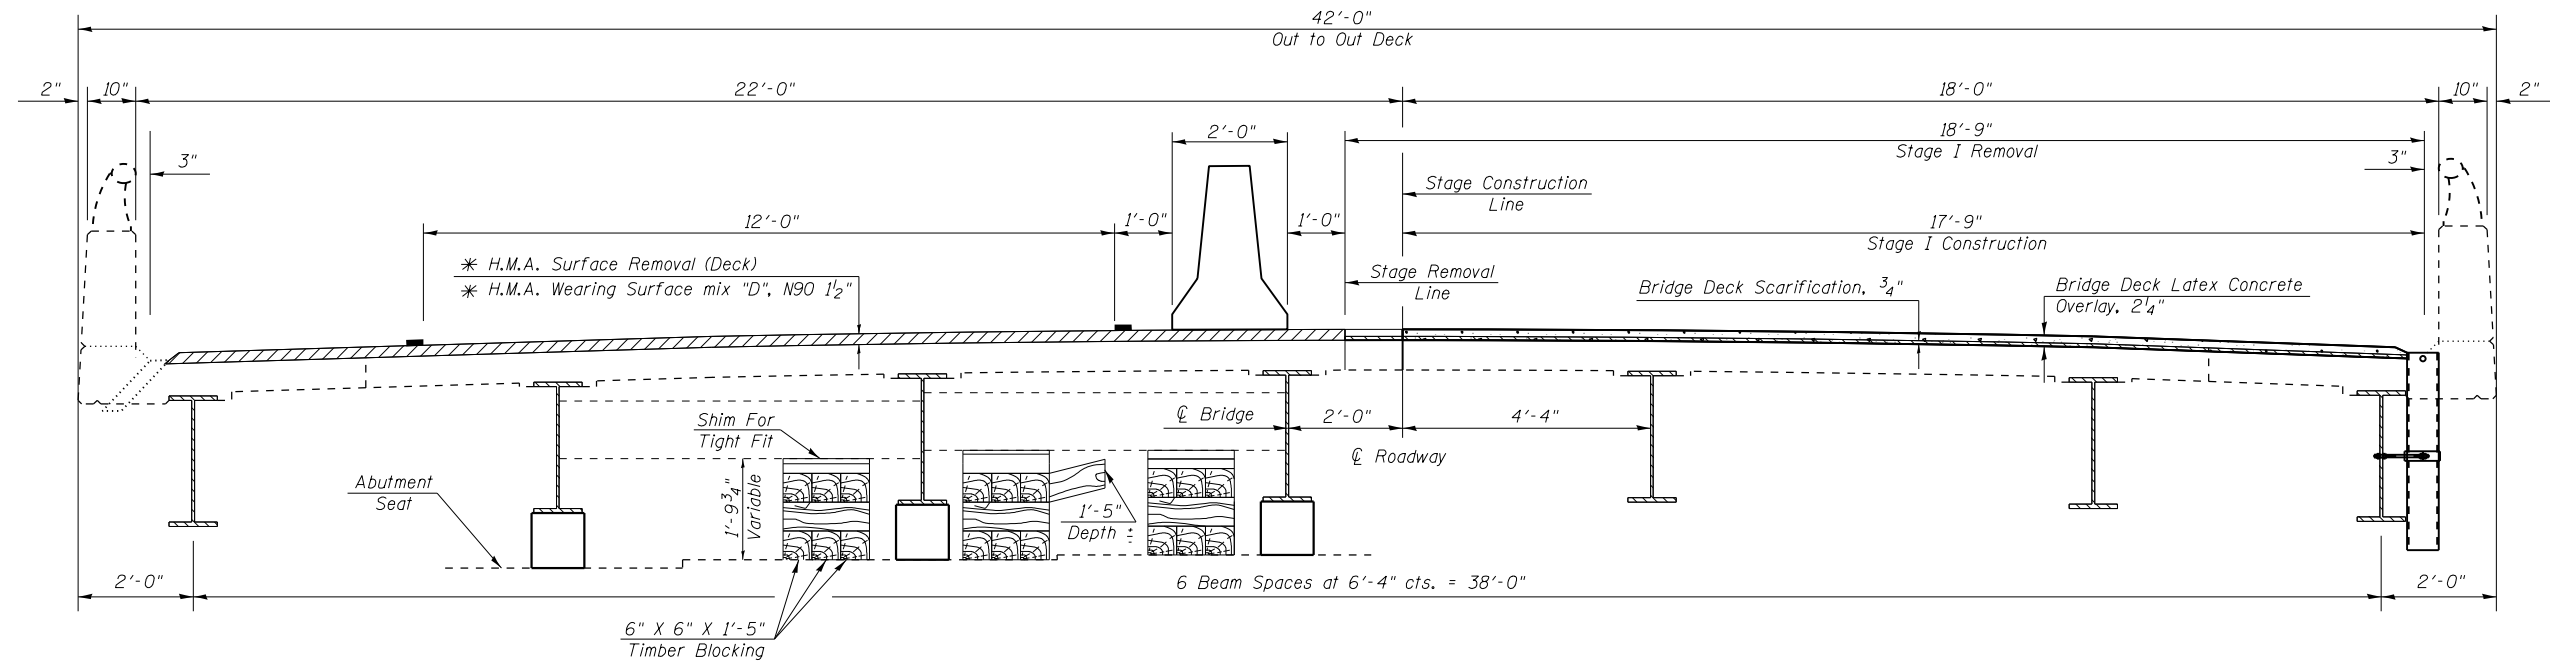


**NOTES:**

Complete Timber Blocking Prior To Stage I Traffic;  
S.N. 010-0015 At West Abutment Only Included With  
The Cost Of Furnishing And Erecting Structural Steel.

\* H.M.A. Wearing Surface Shall Be Inlayed Prior  
To Stage I Traffic.

Looking East Str. 010-0014  
Looking West Str. 010-0015


## STAGE II CONSTRUCTION DETAILS S.N. 010-0014 (WB) & S.N. 010-0015 (EB)

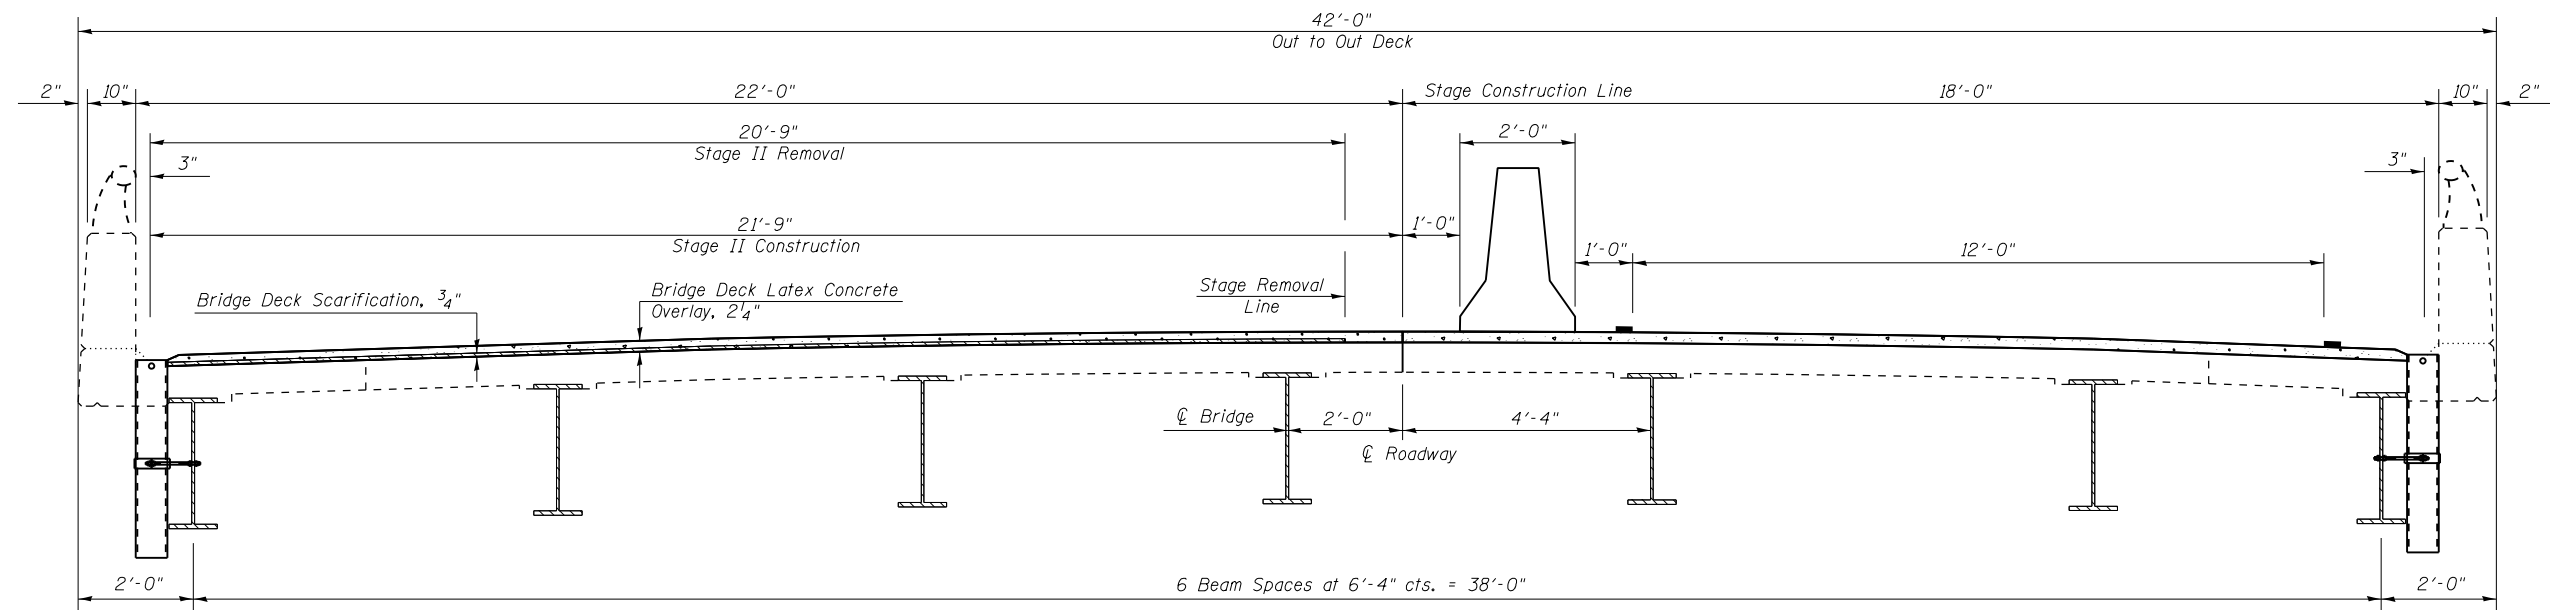

Looking East Str. 010-0014  
Looking West Str. 010-0015

FILE NAME =	USER NAME = shererjm	DESIGNED - ESS	REVISED -	<b>STATE OF ILLINOIS DEPARTMENT OF TRANSPORTATION</b>	<b>STAGE CONSTRUCTION DETAIL S.N. 010-0014 (WB) &amp; S.N. 010-0015 (EB)</b>	F.A.I. RTE.	SECTION	COUNTY	TOTAL SHEETS	SHEET NO.
Default						74	(10-4,10-5)I	CHAMPAIGN	74	12
						CONTRACT NO. 70B15				
				SCALE:		SHEET 6 OF 33 SHEETS		STA. TO STA.		ILLINOIS FED. AID PROJECT

**TEMPORARY CONCRETE  
BARRIER LAYOUT-STAGE I  
S.N. 010-0014 (WB) & S.N. 010-0015 (EB)**

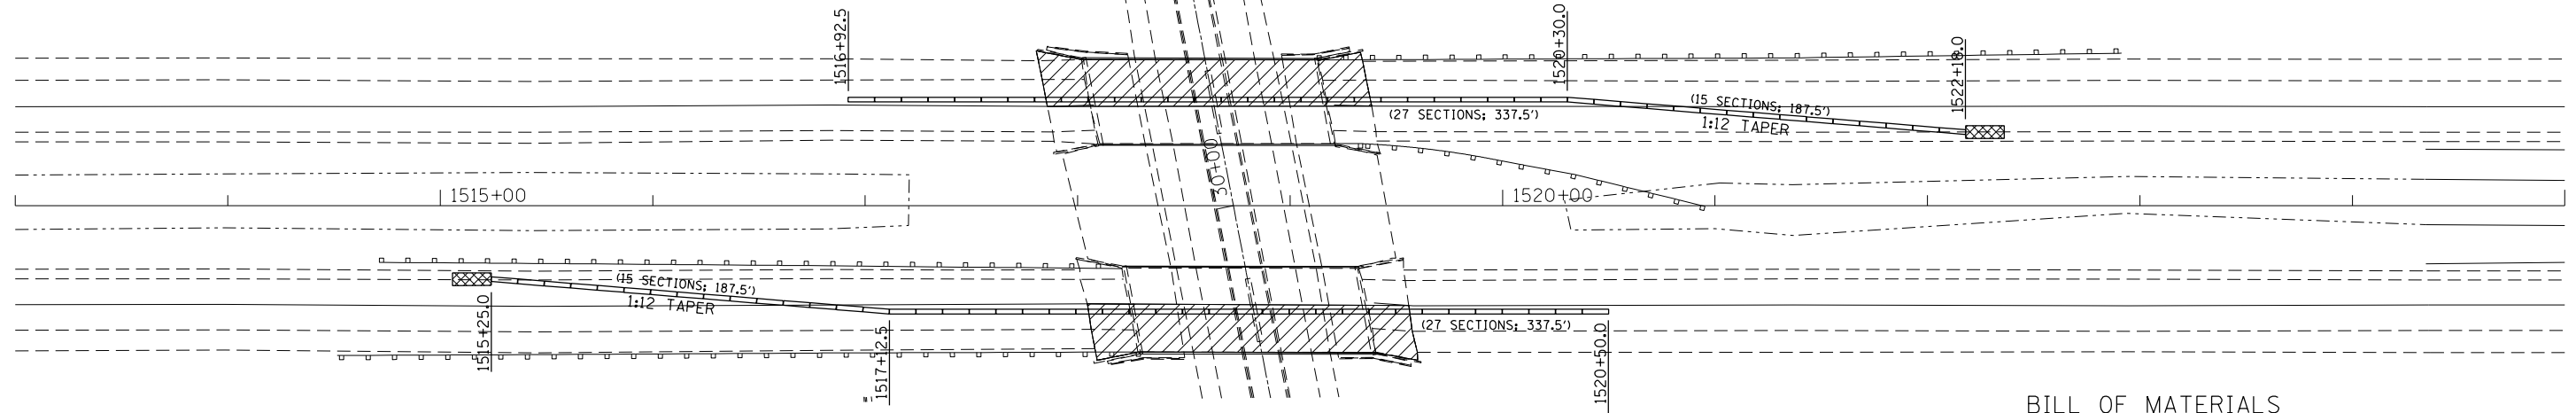

**BILL OF MATERIALS**

ITEM	UNIT	TOTAL
H.M.A. SURFACE REMOVAL (DECK)	SO YD	729.0
BITUMINOUS MATERIAL (TACK COAT)	POUND	329.0
HOT-MIX ASPHALT SURFACE COURSE MIX "D", N90	TON	62.0

**PLAN NOTES:**

ALL STAGING DETAILS SHALL BE IN ACCORDANCE WITH TRAFFIC CONTROL AND PROTECTION STANDARDS 701400 AND 701402 AND PAID FOR AT THE CONTRACT UNIT PRICE PER EACH LOCATION.

ALL WORK WITHOUT TEMPORARY CONCRETE BARRIER IN PLACE SHALL BE IN ACCORDANCE WITH TRAFFIC CONTROL AND PROTECTION STANDARDS 701400 AND 701401.


FOR ADDITIONAL DETAILS ASSOCIATED WITH TEMPORARY CONCRETE BARRIER, SEE TRAFFIC CONTROL AND PROTECTION STANDARD 704001.

VERTICAL PANELS WITH LIGHTS AND REFLECTORS SHALL BE ATTACHED AT 25 FOOT CENTERS TO THE BARRIER WALL AND GUARDRAIL. COST INCLUDED WITH TRAFFIC CONTROL AND PROTECTION STANDARD 701402.

REFLECTORIZED TEMPORARY MARKING TAPE SHALL BE PLACED THROUGHOUT THE TAPER, AND ALONGSIDE BOTH SIDES OF THE WORK AREA. EXISTING MARKINGS THAT CONFLICT WITH THE STAGED TRAFFIC MARKINGS SHALL BE REMOVED. COST TO REMOVE EXISTING MARKINGS AND FOR THE PLACEMENT AND REMOVAL OF TEMPORARY MARKINGS SHALL BE INCLUDED WITH TRAFFIC CONTROL AND PROTECTION STANDARD 701402.



PRIOR TO ROUTING TRAFFIC ONTO THE SHOULDERS, THE CONTRACTOR SHALL SECURE ANY GRATES ON SHOULDER INLETS AS DIRECTED BY THE ENGINEER. THIS WORK SHALL BE PAID FOR ACCORDING TO ARTICLE 109.04 OF THE STANDARD SPECIFICATIONS.


PORTABLE CHANGEABLE MESSAGE SIGNS ARE REQUIRED TWO WEEKS PRIOR TO CONSTRUCTION. THE RESIDENT ENGINEER OR TRAFFIC CONTROL SUPERVISOR SHALL PROVIDE AN APPROPRIATE MESSAGE.

 COMPLETE PRIOR TO STAGE ONE H.M.A. SURFACE REMOVAL (DECK) & H.M.A. SURFACE COURSE MIX "D", N90 1/2"

**TEMPORARY CONCRETE  
BARRIER LAYOUT-STAGE II  
S.N. 010-0014 (WB) & S.N. 010-0015 (EB)**

**SYMBOLS**

-  TEMPORARY CONCRETE BARRIER
-  IMPACT ATTENUATOR

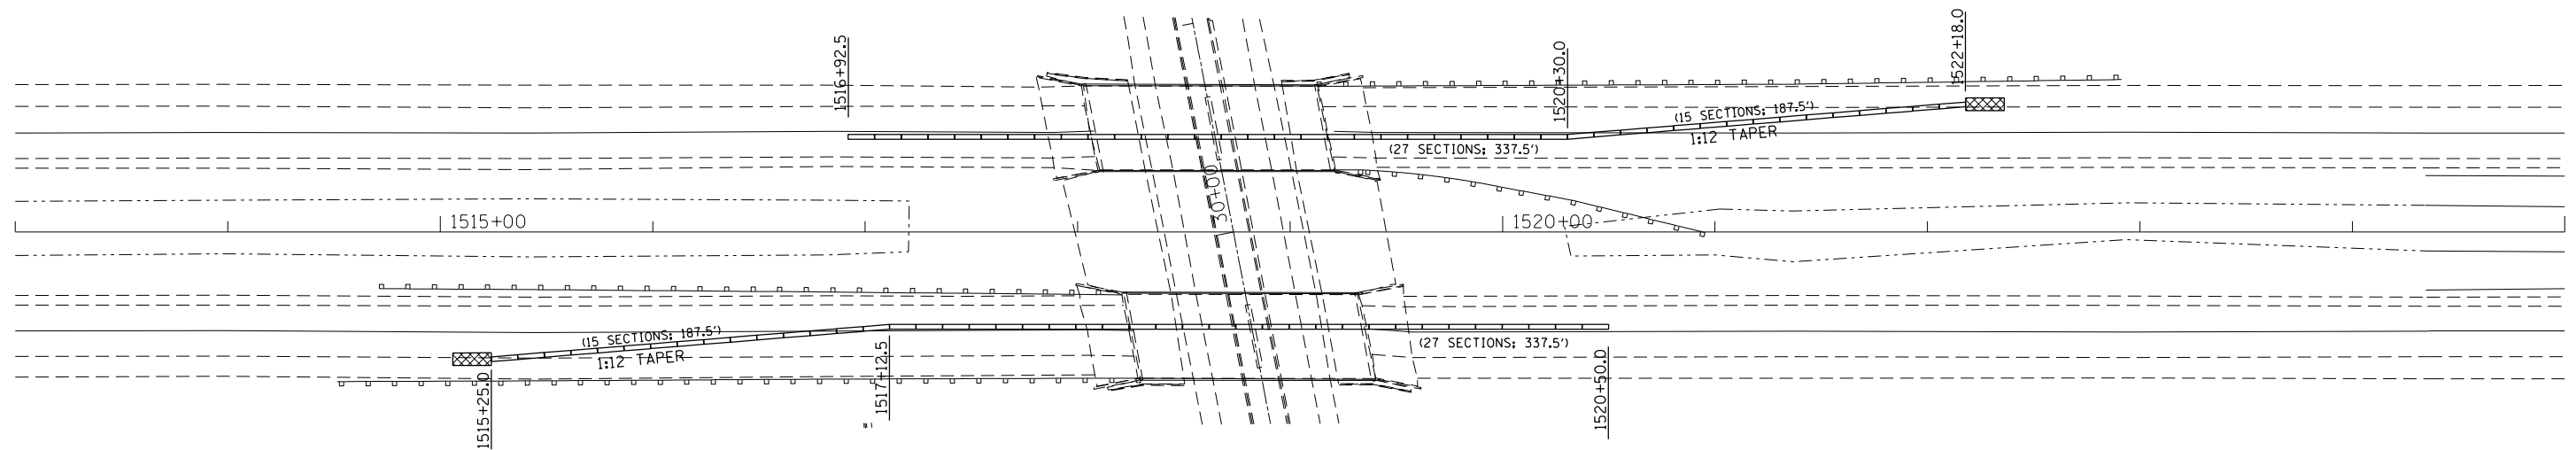

FILE NAME =	USER NAME = shererjm	DESIGNED - ESS	REVISED -
Default		CHECKED -	REVISED -
	PLOT DATE = 8/8/2016	DATE - 8-12-2014	REVISED -


**STATE OF ILLINOIS  
DEPARTMENT OF TRANSPORTATION**

**TEMPORARY CONCRETE BARRIER  
S.N. 010-0014 & S.N. 010-0015**

SCALE: SHEET 7 OF 33 SHEETS STA. TO STA.


F.A.I. RTE.	SECTION	COUNTY	TOTAL SHEETS	SHEET NO.
74	(10-4,10-5)I	CHAMPAIGN	74	13
CONTRACT NO. 70B15			ILLINOIS FED. AID PROJECT	

# WEARING SURFACE PLAN S.N. 010-0014 & S.N. 010-0015

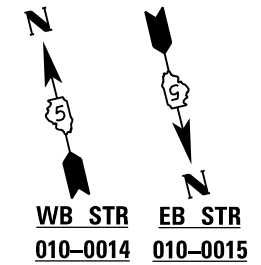

West End of App. (WB Str.)  
East End of App. (EB Str.)

Stage Removal Line  
Stage Construction Line

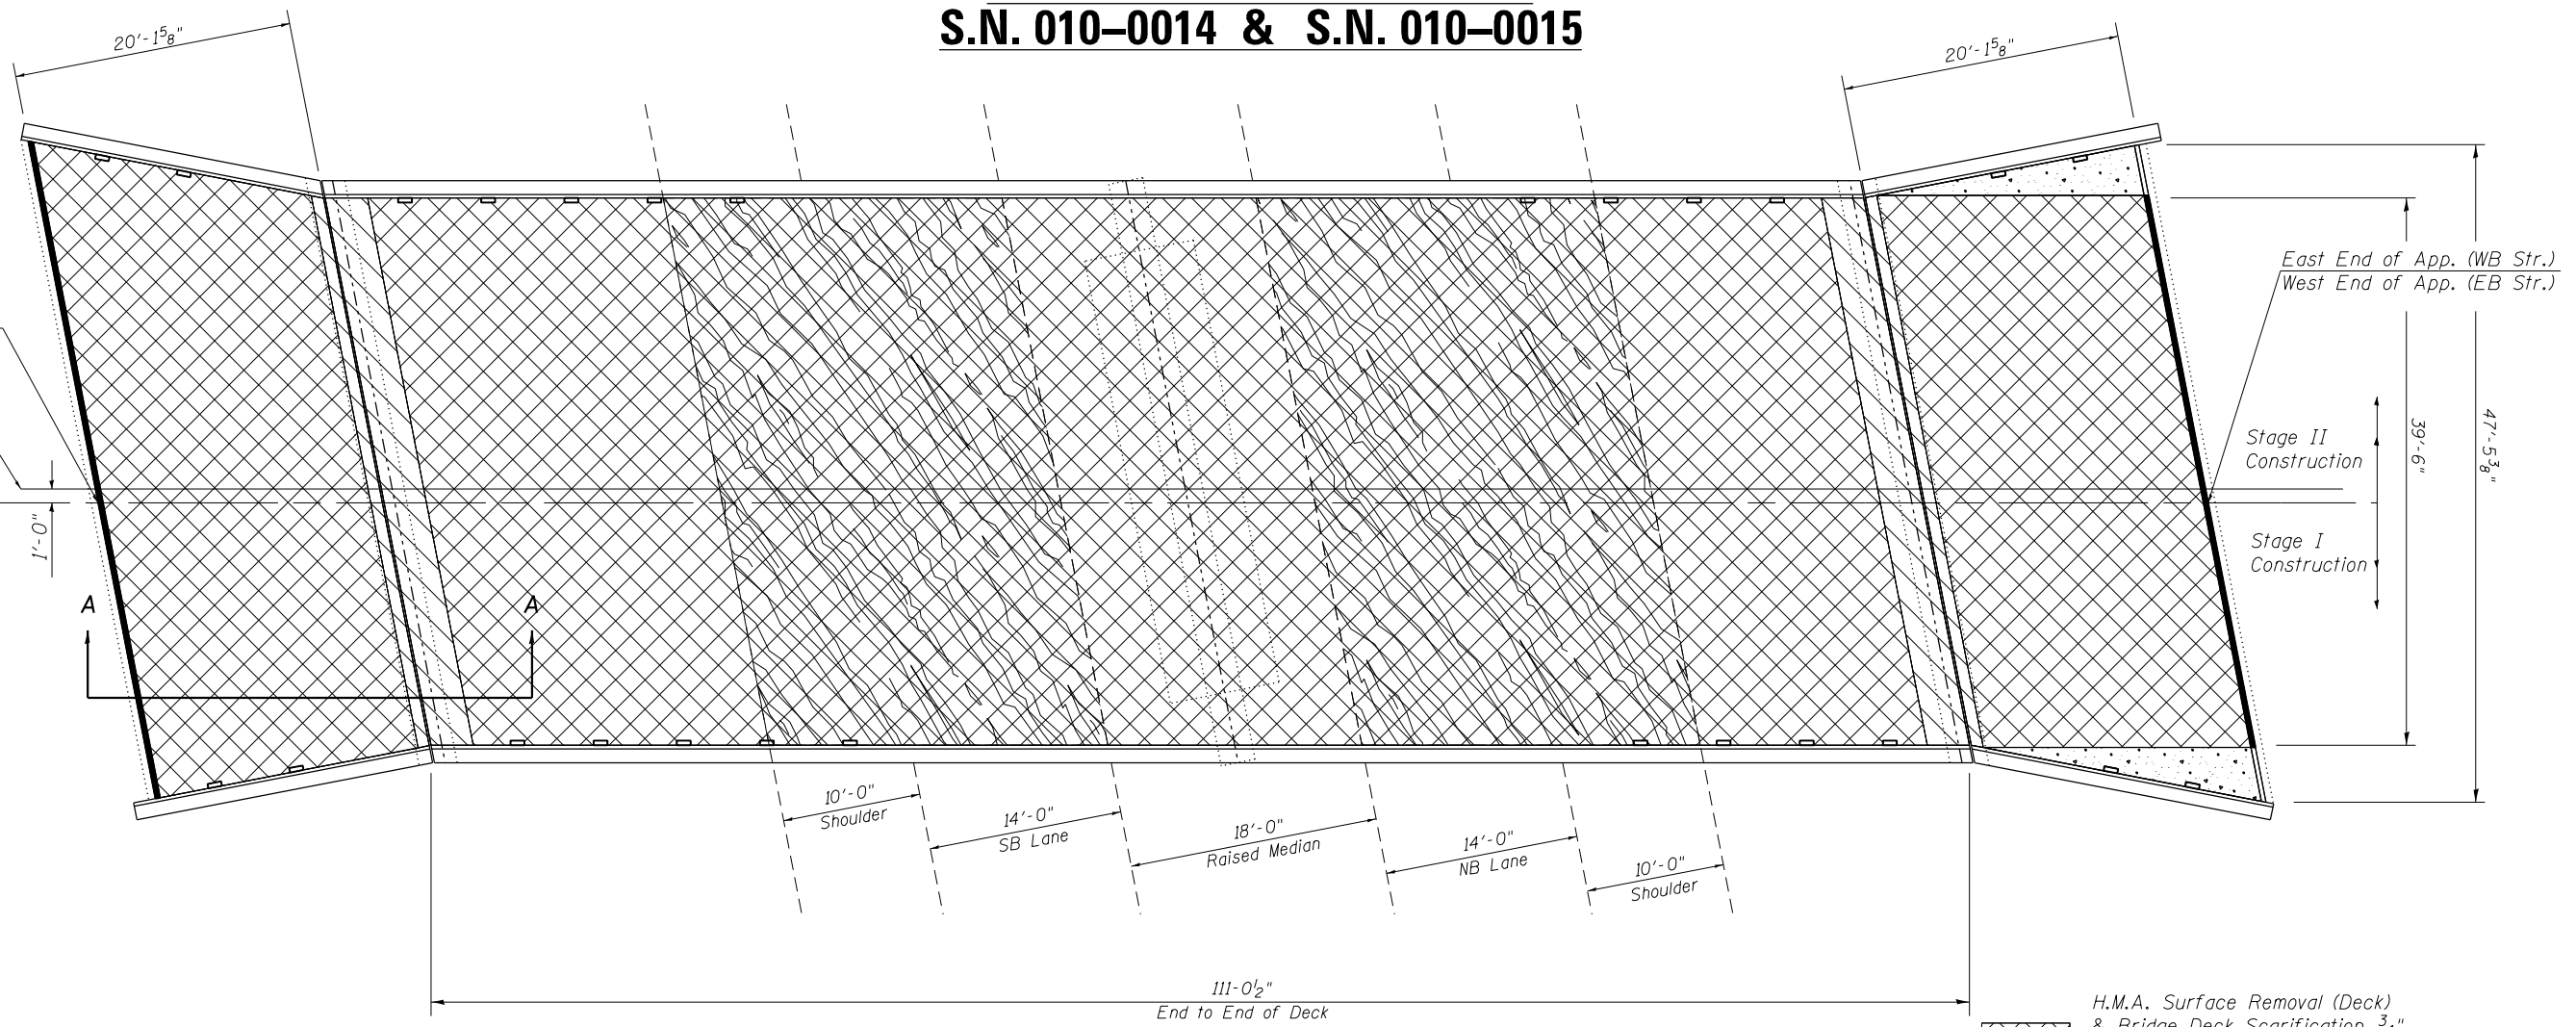

- H.M.A. Surface Removal (Deck) & Bridge Deck Scarification 3/4" & Bridge Deck Latex Concrete Overlay
- H.M.A. Surface Removal (Deck) & Concrete Superstructure
- H.M.A. Surface Removal (Deck) Bridge Deck Scarification 3/4" & Concrete Superstructure
- Protective Shield
- Polymer Concrete


**BILL OF MATERIALS**

ITEM	UNIT	TOTAL
PROTECTIVE SHIELD	SQ YD	410.0
H.M.A. SURFACE REMOVAL (DECK)	SQ YD	1371.0
BRIDGE DECK GROOVING	SQ YD	1286.0
BRIDGE DECK LATEX CONCRETE OVERLAY, 2 1/2"	SQ YD	1279.0
BRIDGE DECK SCARIFICATION 3/4"	SQ YD	1302.0
POLYMER CONCRETE	CU FT	6.6

**NOTE:**

FIBER IS REQUIRED FOR BRIDGE DECK LATEX CONCRETE OVERLAY, 2 1/2"

BRIDGE DECK GROOVING SHALL BE DISCONTINUED AT 1'-0" FROM EACH PARAPET. SEE STANDARD SPECIFICATIONS SECTION 503.16 (a)(3)b.

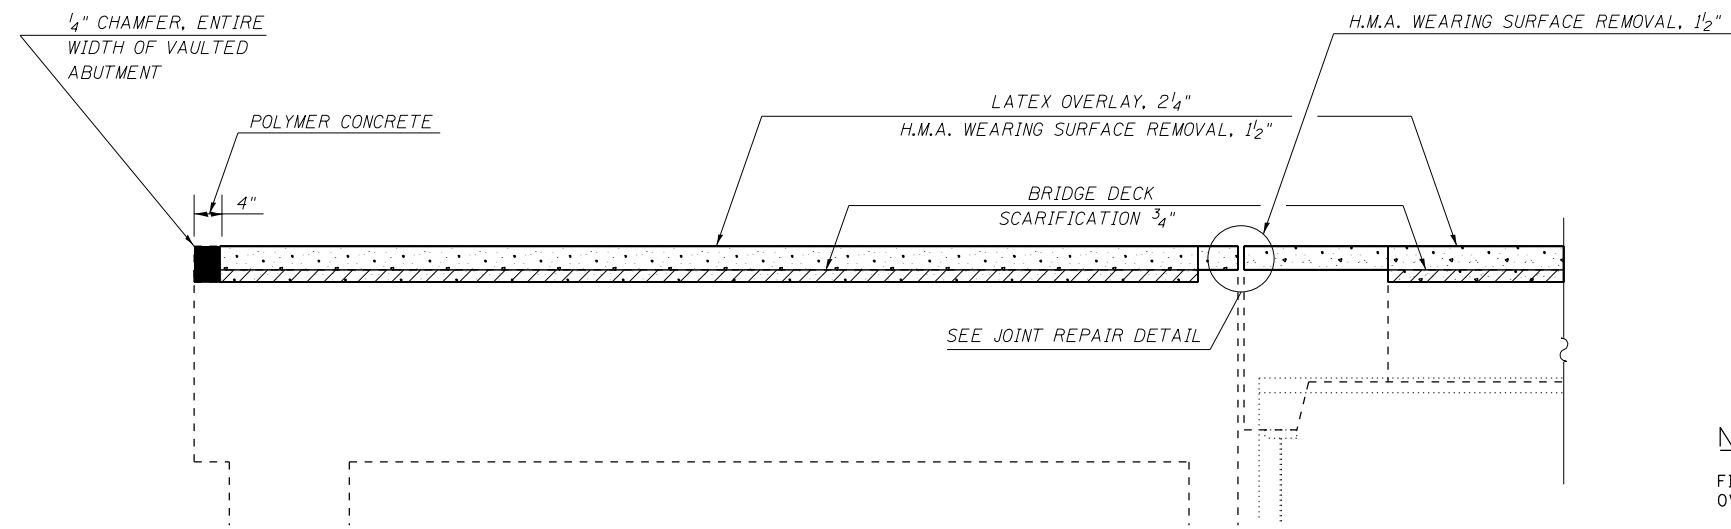

**SECTION A-A**

FILE NAME =	USER NAME = sherer,jm	DESIGNED - ESS	REVISED -
Default	PLOT SCALE = 40.0000' / in.	CHECKED -	REVISED -
	PLOT DATE = 8/8/2016	DATE = 11/14/2013	REVISED -


**STATE OF ILLINOIS  
DEPARTMENT OF TRANSPORTATION**

<b>WEARING SURFACE DETAILS</b>			
<b>S.N. 010-0014 (WB) &amp; S.N. 010-0015 (EB)</b>			
SCALE:	SHEET 8	OF 33 SHEETS	STA. TO STA.

F.A.I. RTE.	SECTION	COUNTY	TOTAL SHEETS	SHEET NO.
74	(10-4,10-5)I	CHAMPAIGN	74	14
CONTRACT NO. 70B15				
ILLINOIS FED. AID PROJECT				

# CONCRETE REMOVAL PLAN

## S.N. 010-0014 & 010-0015

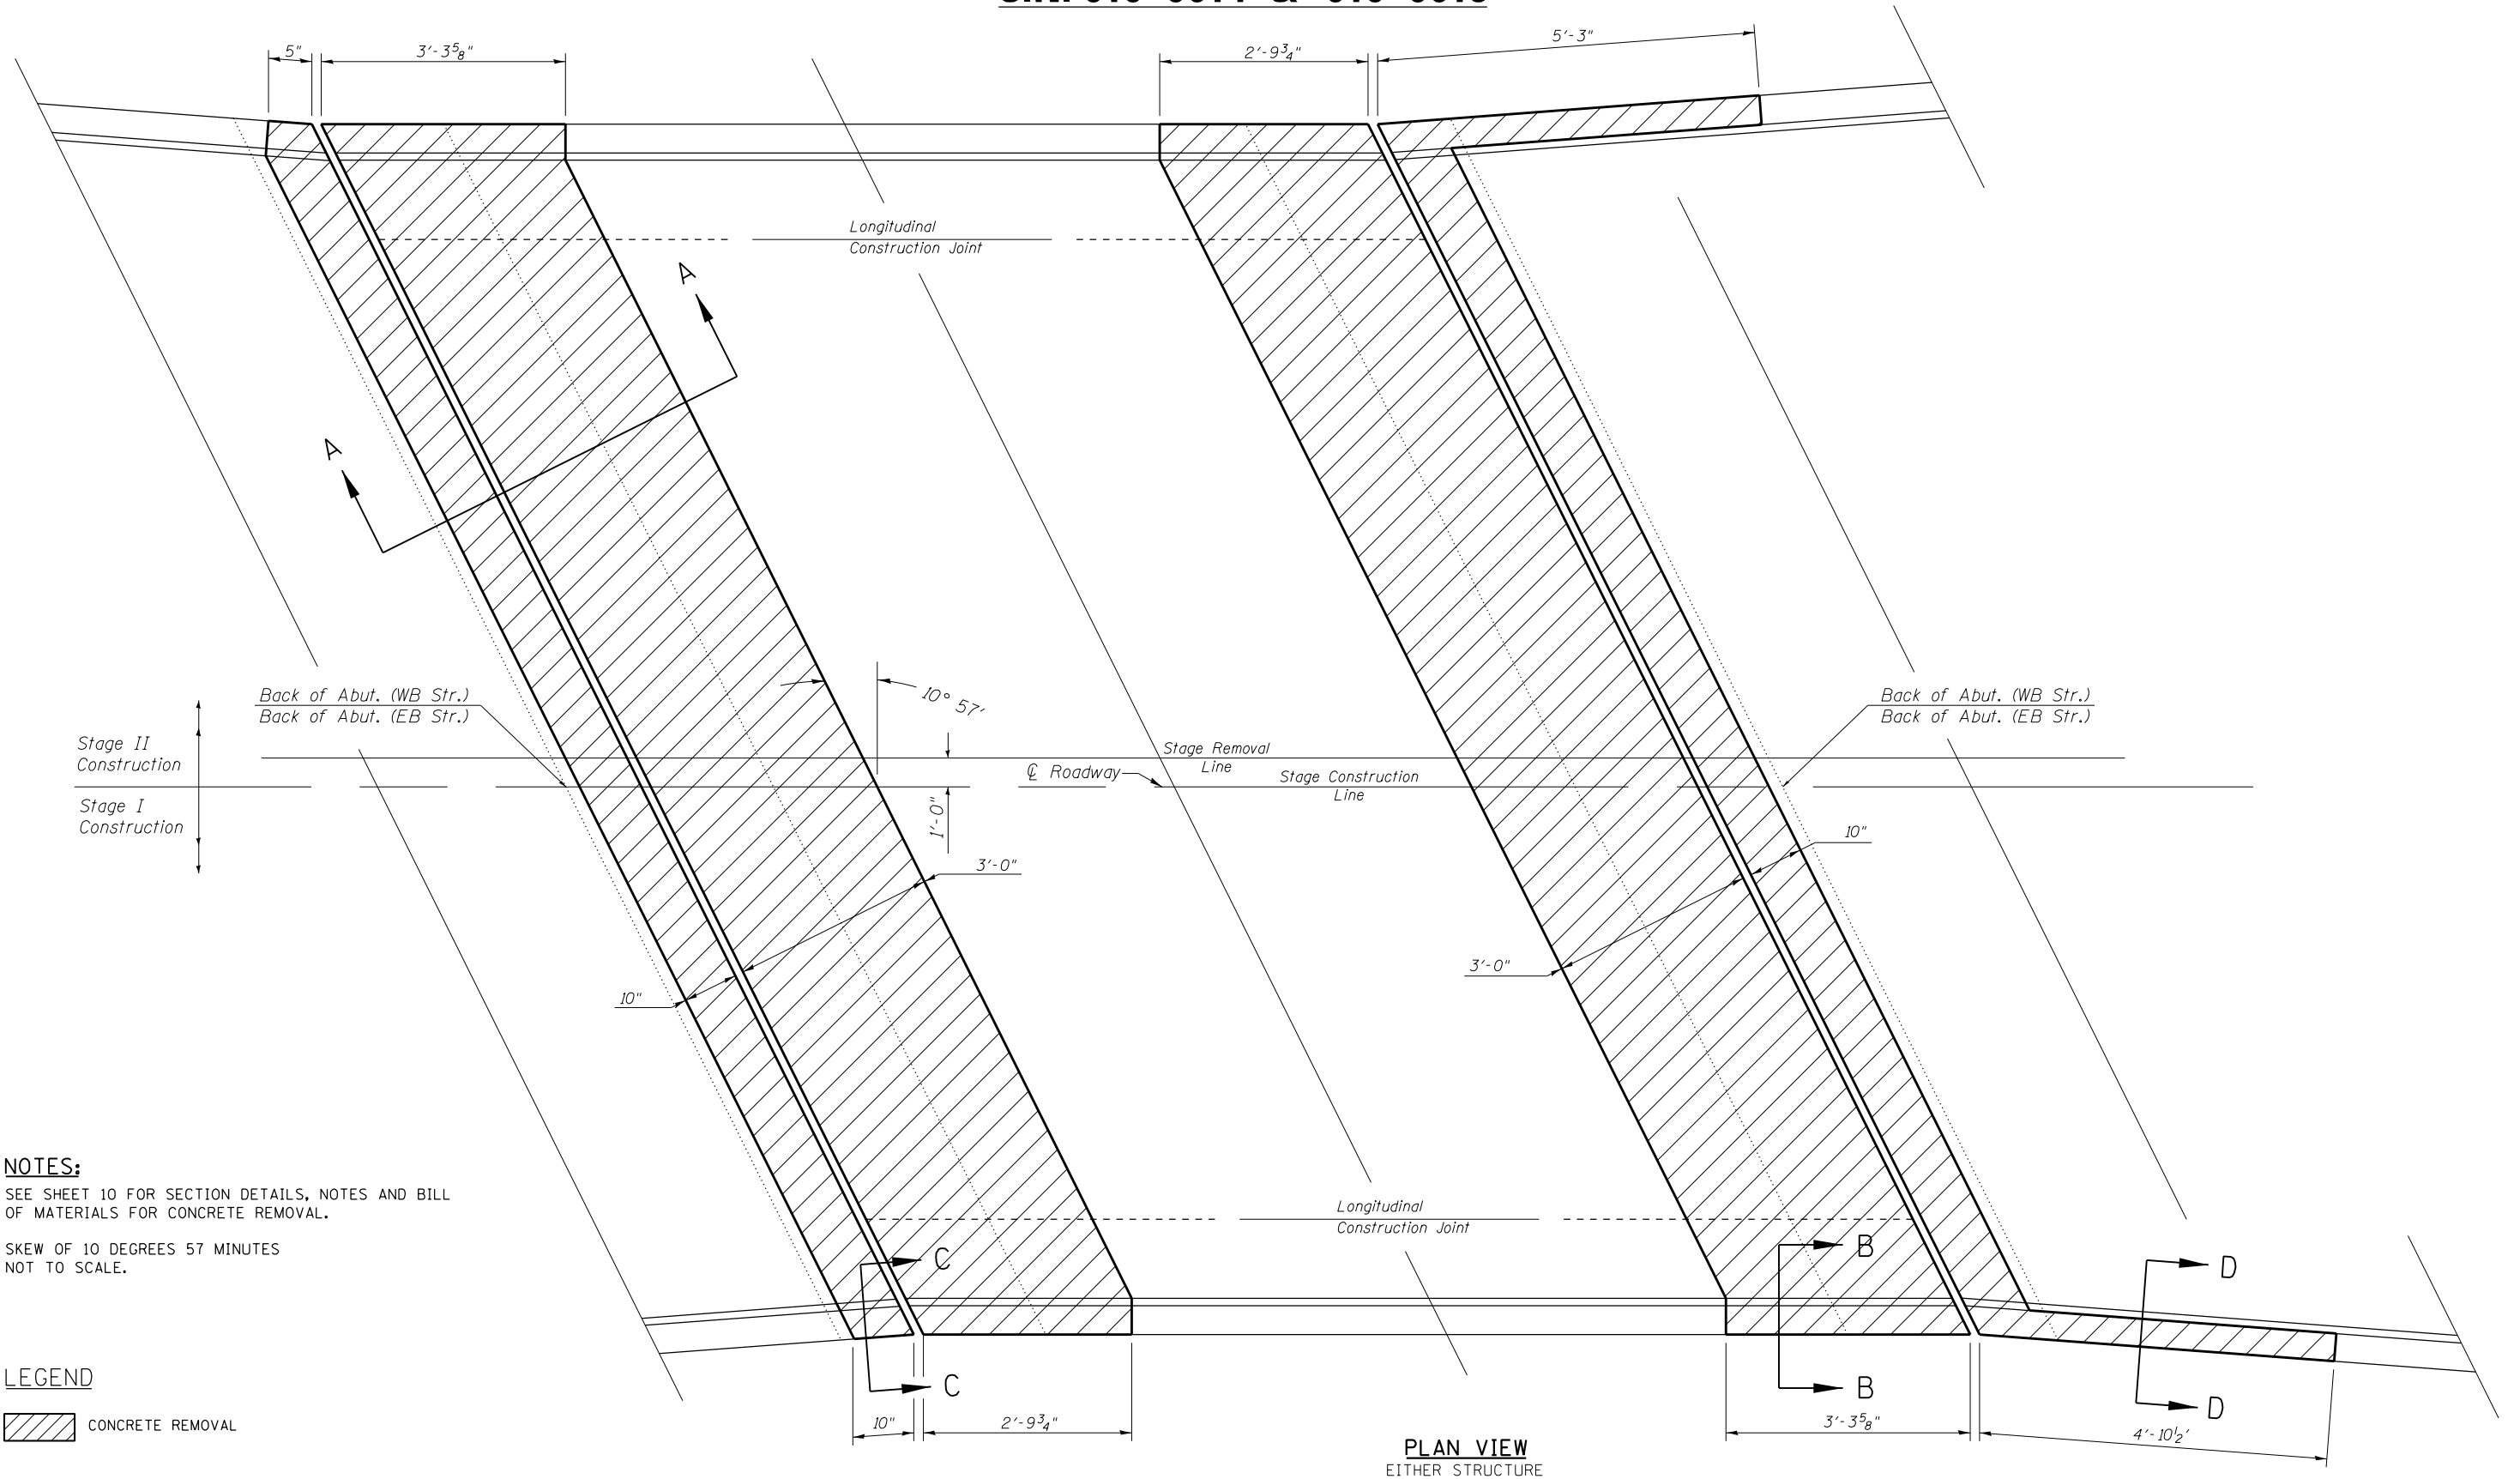

**NOTES:**  
 SEE SHEET 10 FOR SECTION DETAILS, NOTES AND BILL OF MATERIALS FOR CONCRETE REMOVAL.  
 SKEW OF 10 DEGREES 57 MINUTES  
 NOT TO SCALE.

**LEGEND**

CONCRETE REMOVAL


**PLAN VIEW**  
 EITHER STRUCTURE

FILE NAME =	USER NAME = sherer,jm	DESIGNED - ESS	REVISED -	<b>STATE OF ILLINOIS DEPARTMENT OF TRANSPORTATION</b>	<b>SUPERSTRUCTURE PLAN - CONCRETE REMOVAL S.N. 010-0014 (WB) &amp; S.N. 010-0015 (EB)</b>	F.A.I. RTE. =	SECTION	COUNTY	TOTAL SHEETS	SHEET NO.
Default	Documents\DOT Offices\District 5\Projects\057015\Drawings\Struct\057015-sht-Rep\057015-sht-Rep.dwg	CHECKED -	REVISED -			74	(10-4,10-5)I	CHAMPAIGN	74	15
	PLOT SCALE = 40.0000' / in.	DATE - 12/4/2013	REVISED -			CONTRACT NO. 70B15		ILLINOIS FED. AID PROJECT		

SCALE: SHEET 9 OF 33 SHEETS STA. TO STA.

# CONCRETE REMOVAL DETAILS


## S.N. 010-0014 & S.N. 010-0015

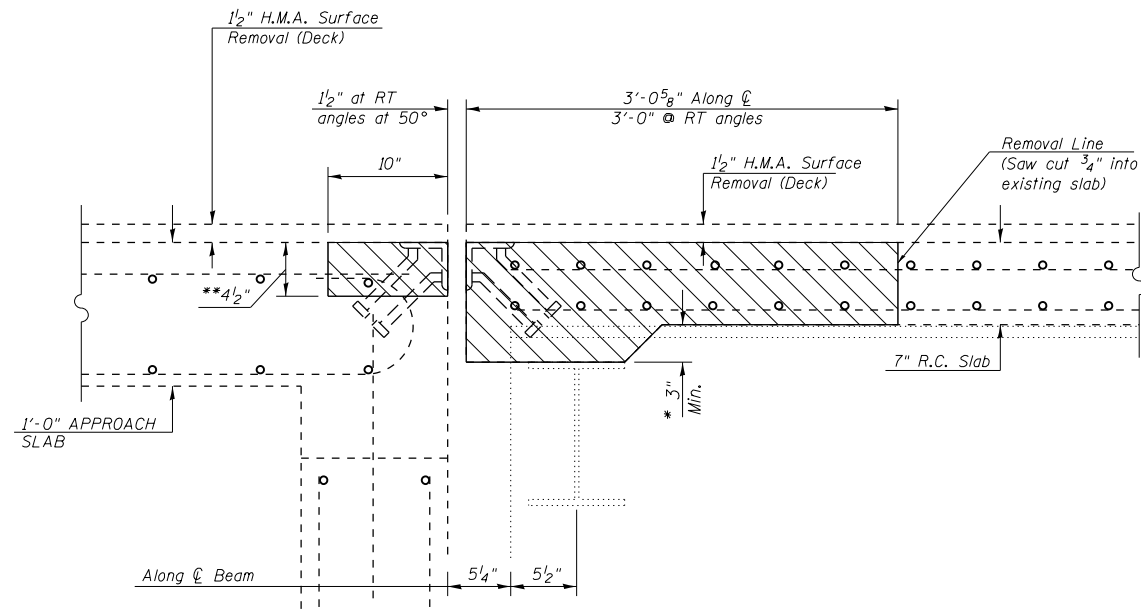

• MINIMUM AT EDGE OF DECK/SLAB  
(INCREASES WITH CROSS SLOPE TOWARDS  $\text{CL}$  BRIDGE)  
\*\* EXISTING STEEL  $\frac{3}{4}$ "  $\phi$  x 8" @ 1'-0" CTS. STUDS  
SHALL BE CUT OFF AT THE CONCRETE REMOVAL LINE.


### SECTION A-A

SHOWING CONCRETE REMOVAL LIMITS  
AT ABUTMENT / DECK END

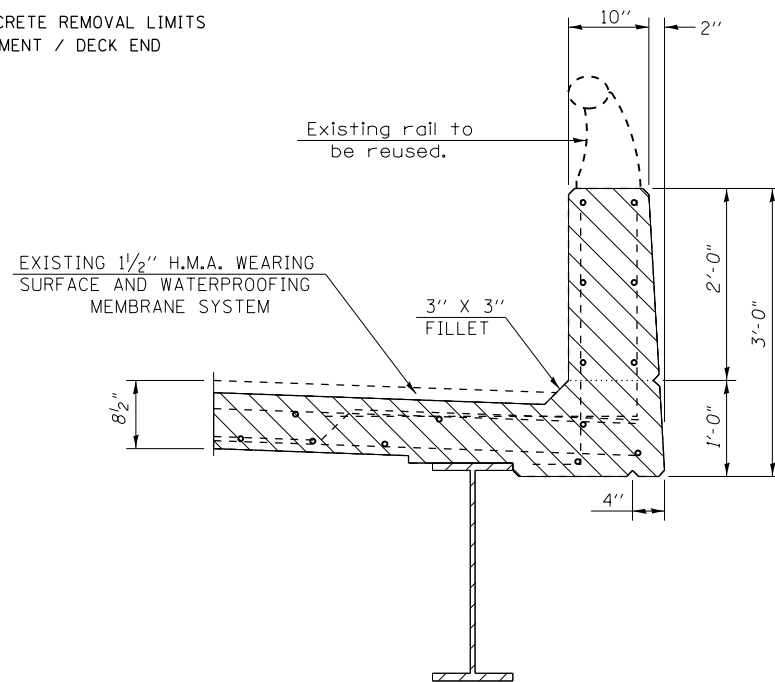


### SECTION B-B

DECK CONCRETE REMOVAL  
LIMITS AT PARAPET

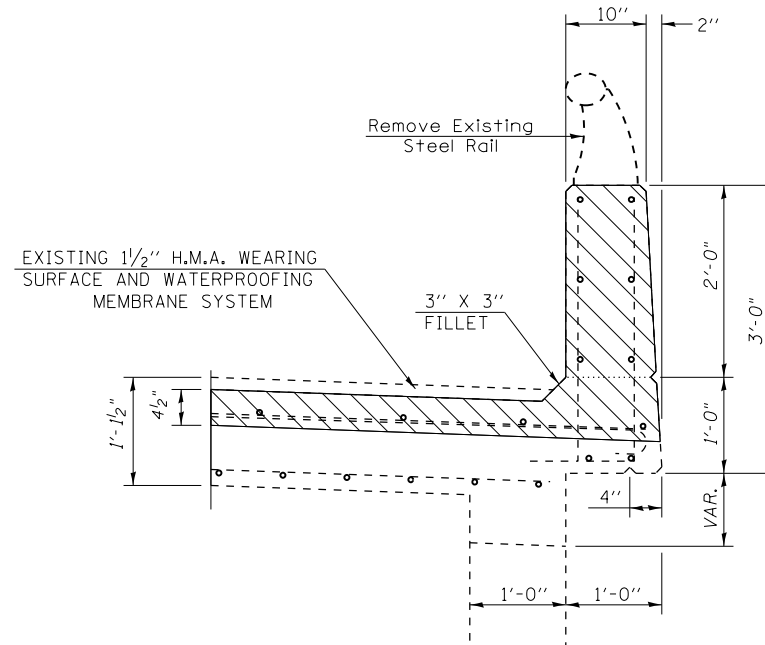

### SECTION C-C

APPROACH CONCRETE REMOVAL  
LIMITS AT PARAPET

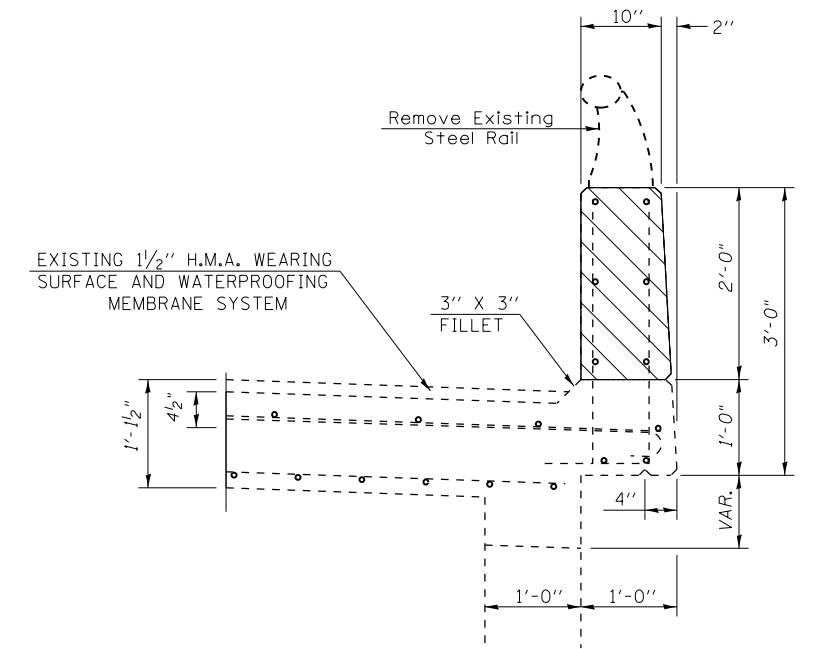

### SECTION D-D

APPROACH CONCRETE REMOVAL  
LIMITS AT PARAPET

### NOTES:

EXISTING REINFORCEMENT BARS EXTENDING INTO THE REMOVAL AREA SHALL BE CLEANED, STRAIGHTENED AND INCORPORATED INTO THE NEW CONSTRUCTION. ANY REINFORCEMENT BARS THAT ARE DAMAGED DURING CONCRETE REMOVAL SHALL BE REPLACED WITH AN APPROVED BAR SPLICER OR ANCHORAGE SYSTEM. COST INCLUDED WITH CONCRETE REMOVAL.

THE EXISTING EXPANSION JOINT SYSTEMS SHALL BE REMOVED COMPLETELY, AS WELL AS ANY FOREIGN MATERIAL THAT HAS ACCUMULATED OR BEEN PLACED IN THE JOINT OPENINGS. THE COST FOR THIS WORK IS INCLUDED IN CONCRETE REMOVAL AND NO ADDITIONAL COMPENSATION WILL BE ALLOWED.

THE COST OF CUTTING THE EXISTING STEEL  $\frac{3}{4}$ "  $\phi$  x 8" STUDS AT THE CONCRETE REMOVAL LINE SHALL BE INCLUDED IN THE COST OF CONCRETE REMOVAL AND NO ADDITIONAL COMPENSATION WILL BE ALLOWED.

THE RAIL POSTS WITHIN THE PARAPET REPAIR AND REMOVAL AND REPLACEMENT LIMITS SHALL BE REMOVED TO ALLOW FOR THE REPAIR WORK TO BE COMPLETED. FOLLOWING COMPLETION OF THE PARAPET ENDS, THE CONTRACTOR TO EITHER SAVE AND REUSE THE EXISTING CAST-IN-PLACE ANCHOR SYSTEM OR USE EPOXY-GROUTED THREADED RODS. THE COST OF THIS WORK SHALL BE INCLUDED IN CONCRETE SUPERSTRUCTURES. SEE AS-BUILT PLANS FOR ALUMINUM RAILING DETAIL.

### BILL OF MATERIALS

ITEM	UNIT	TOTAL
CONCRETE REMOVAL	CU YD	19.7



FILE NAME =	USER NAME = shererjm	DESIGNED - ESS	REVISED -

**STATE OF ILLINOIS**  
**DEPARTMENT OF TRANSPORTATION**


**CONCRETE REMOVAL DETAILS**  
**S.N. 010-0014 (WB) & S.N. 010-0015 (EB)**

SCALE: SHEET 10 OF 33 SHEETS STA. TO STA.


F.A.I. RE.	SECTION	COUNTY	TOTAL SHEETS	SHEET NO.
74	(10-4,10-5)I	CHAMPAIGN	74	16
CONTRACT NO. 70B15				
ILLINOIS FED. AID PROJECT				




# SUPERSTRUCTURE REPAIR PLAN S.N. 010-0014 & 010-0015

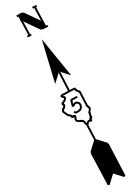

**WB STR**  
**010-0014**

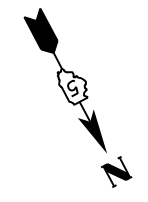

**EB STR**  
**010-0015**

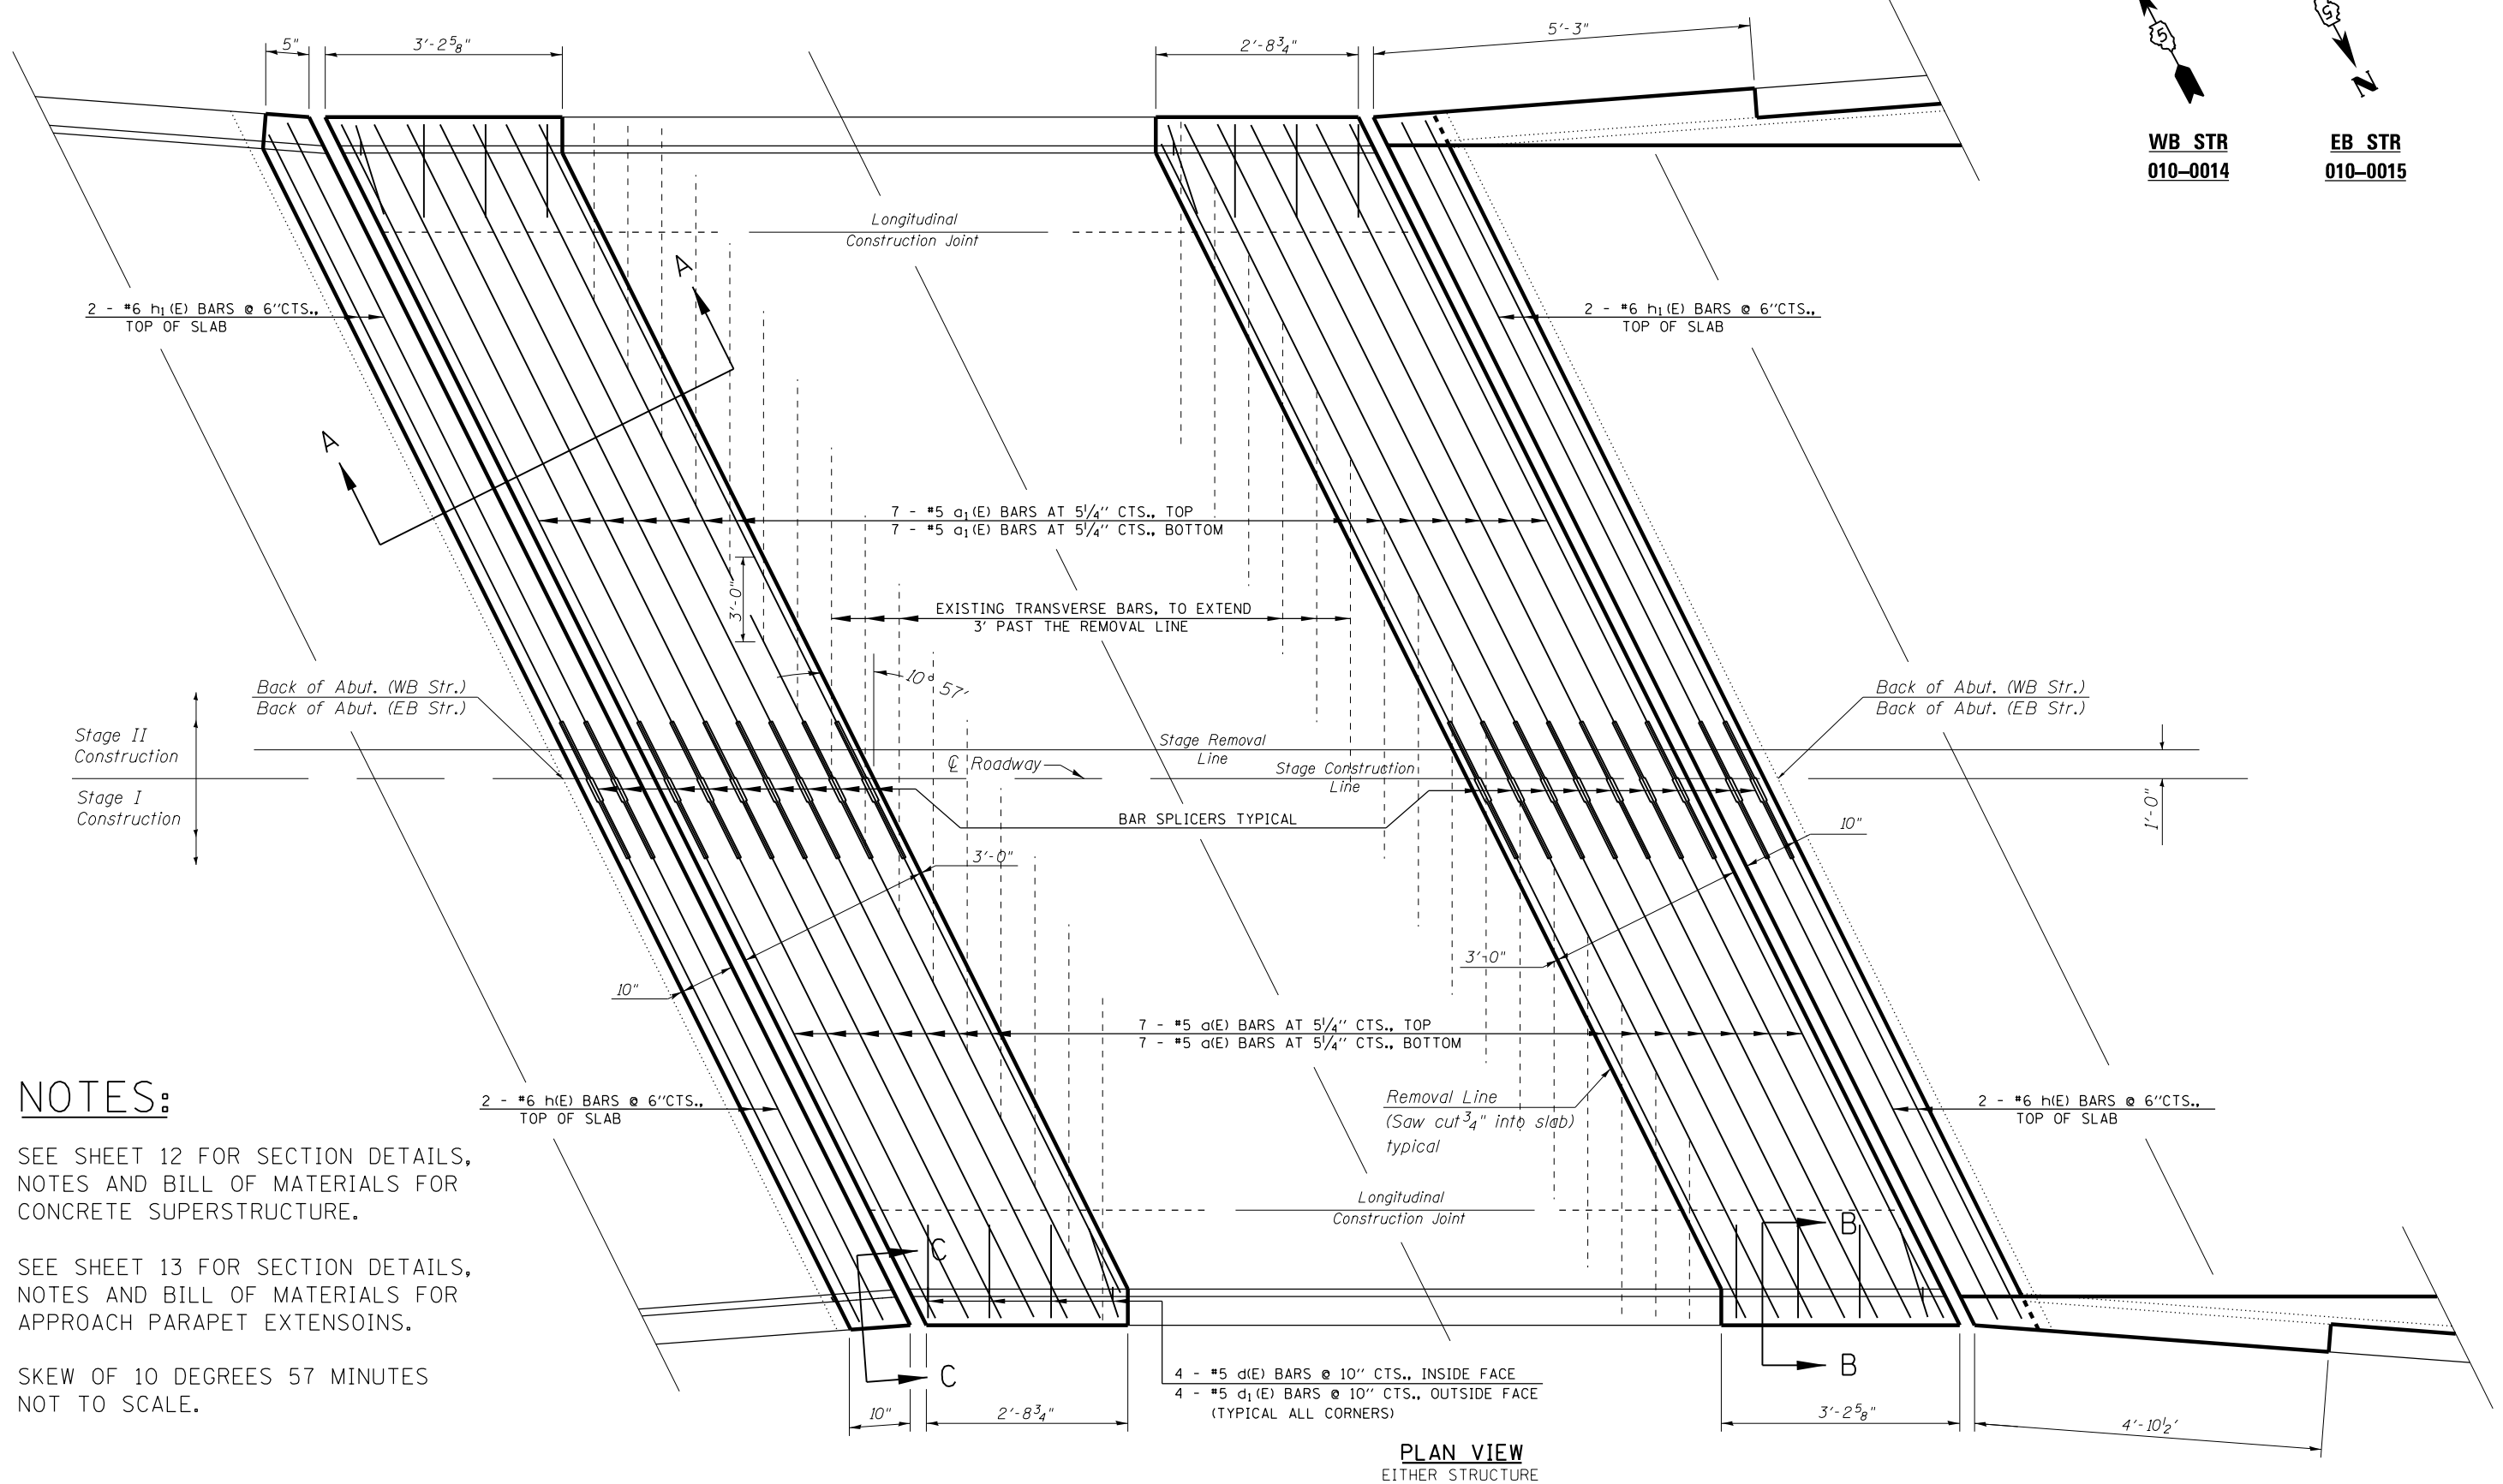

## NOTES:

SEE SHEET 12 FOR SECTION DETAILS, NOTES AND BILL OF MATERIALS FOR CONCRETE SUPERSTRUCTURE.

SEE SHEET 13 FOR SECTION DETAILS, NOTES AND BILL OF MATERIALS FOR APPROACH PARAPET EXTENSIOINS.


SKIEW OF 10 DEGREES 57 MINUTES  
NOT TO SCALE.

**PLAN VIEW**  
EITHER STRUCTURE

FILE NAME =	USER NAME = shererjm	DESIGNED - ESS	REVISED -	<b>STATE OF ILLINOIS DEPARTMENT OF TRANSPORTATION</b>	<b>SUPERSTRUCTURE REPAIR PLAN S.N. 010-0014 &amp; S.N. 010-0015</b>	F.A.I. R.T.E.	SECTION	COUNTY	TOTAL SHEETS	SHEET NO.
Default	Documents\DOT Offices\District 5\Projects\0570\0570-055\0570B15-sht-Repairs	DATE - 12/6/2013	REVISED -			74	(10-4,10-5)I	CHAMPAIGN	74	17
	PLOT SCALE = 40.0000' / in.	CHECKED -	REVISED -			CONTRACT NO. 70B15		ILLINOIS FED. AID PROJECT		

# SUPERSTRUCTURE REPAIR DETAILS


## S.N. 010-0014 & S.N. 010-0015

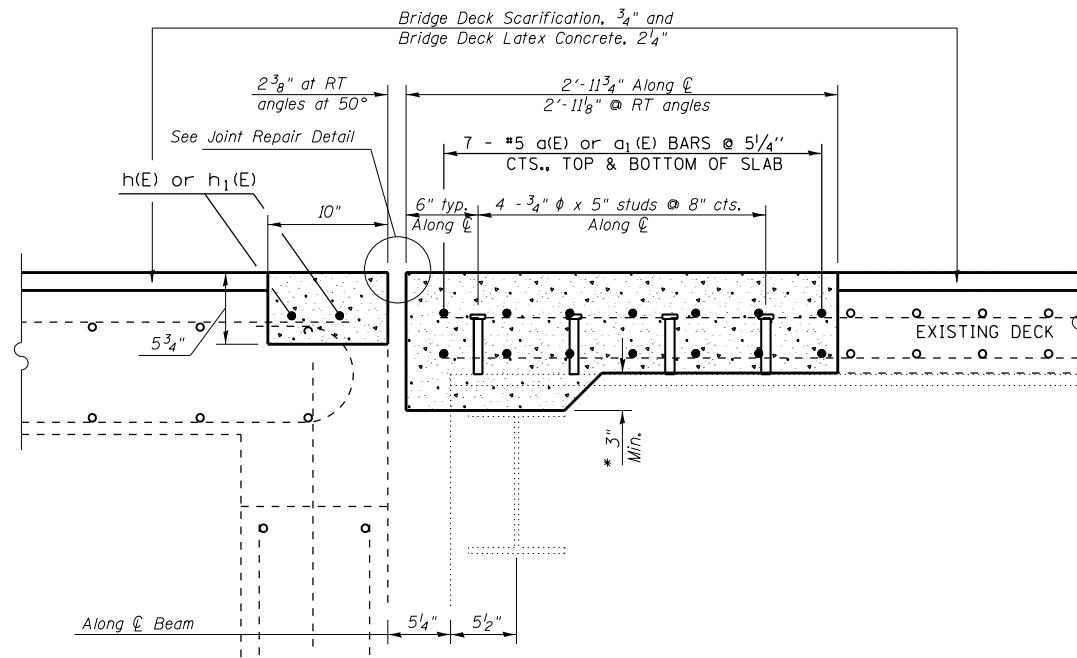

• MINIMUM AT EDGE OF DECK/SLAB  
(INCREASES WITH CROSS SLOPE TOWARDS  $\bar{C}$  BRIDGE)


### SECTION A-A

SHOWING CONCRETE REMOVAL LIMITS  
AT ABUTMENT / DECK END

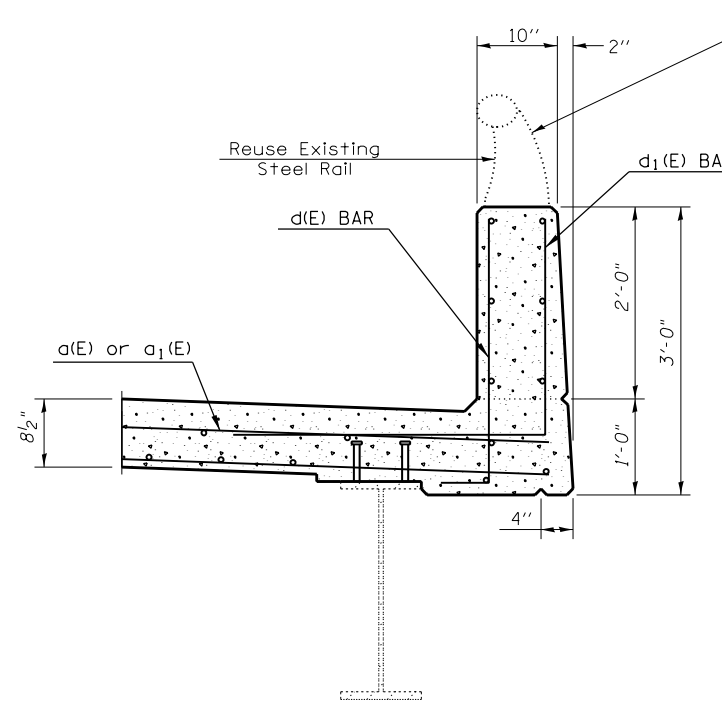


### SECTION B-B

DECK CONCRETE REMOVAL  
LIMITS AT PARAPET

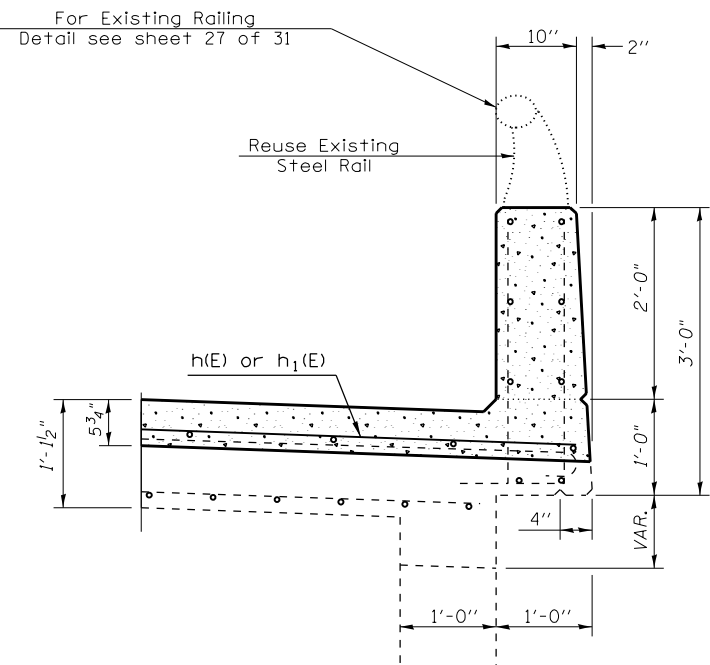


### SECTION C-C

APPROACH CONCRETE REMOVAL  
LIMITS AT PARAPET

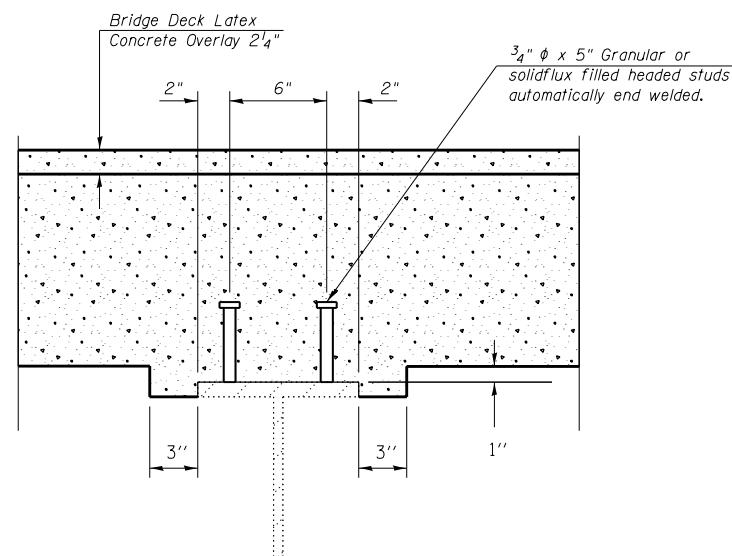


### SECTION AT BEAM END

(ALL BEAMS 27WF-114)

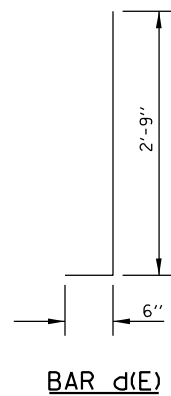

BAR d(E)

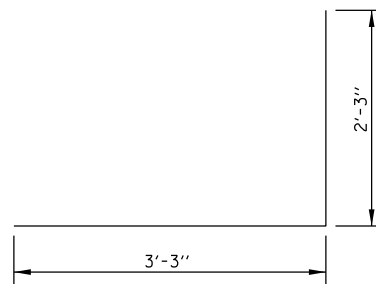

BAR d<sub>1</sub>(E)

### NOTES

EXISTING REINFORCEMENT BARS EXTENDING INTO THE REMOVAL AREA SHALL BE CLEANED, STRAIGHTENED AND INCORPORATED INTO THE NEW CONSTRUCTION. ANY REINFORCEMENT BARS THAT ARE DAMAGED DURING CONCRETE REMOVAL SHALL BE REPLACED WITH AN APPROVED BAR SPLICER OR ANCHORAGE SYSTEM. COST INCLUDED WITH CONCRETE REMOVAL.

COST OF RE-ATTACHMENT OF EXISTING RAIL INCLUDED WITH CONCRETE SUPERSTRUCTURE.

REINFORCEMENT BARS DESIGNATED (E) SHALL BE EPOXY COATED.

### BILL OF MATERIAL

BAR	NO.	SIZE	LENGTH	SHAPE
a(E)	56	#5	19'-2"	—
a <sub>1</sub> (E)	56	#5	23'-3"	—
h(E)	8	#6	19'-2"	—
h <sub>1</sub> (E)	8	#6	23'-3"	—
d(E)	32	#5	3'-3"	J
d <sub>1</sub> (E)	32	#5	5'-6"	J
REINFORCEMENT BARS (EPOXY COATED)			POUND	3280.0
CONCRETE SUPERSTRUCTURE			CU YD	19.7
PROTECTIVE COAT			SQ YD	76.0
BAR SPLICERS			EACH	64.0


FILE NAME =	USER NAME = shererjm	DESIGNED - ESS	REVISED -
Default	PLOT SCALE = 40.0000' / in.	CHECKED -	REVISED -
	PLOT DATE = 8/8/2016	DATE - 12/6/2013	REVISED -

**STATE OF ILLINOIS  
DEPARTMENT OF TRANSPORTATION**

**SUPERSTRUCTURE REPAIR DETAILS  
S.N. 010-0014 & S.N. 010-0015**


SCALE: SHEET 12 OF 33 SHEETS STA. TO STA.

F.A.I. RTÉ.	SECTION	COUNTY	TOTAL SHEETS	SHEET NO.
74	(10-4,10-5)I	CHAMPAIGN	74	18
CONTRACT NO. 70B15				
ILLINOIS FED. AID PROJECT				

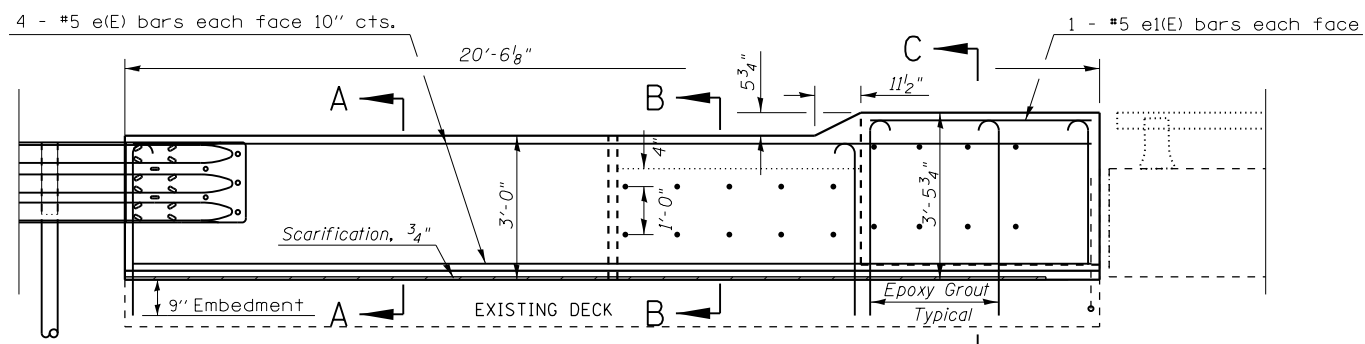


**ELEVATION VIEW**

STR. 0014 EAST ABUT. SOUTH WING  
STR. 0015 WEST ABUT. NORTH WING

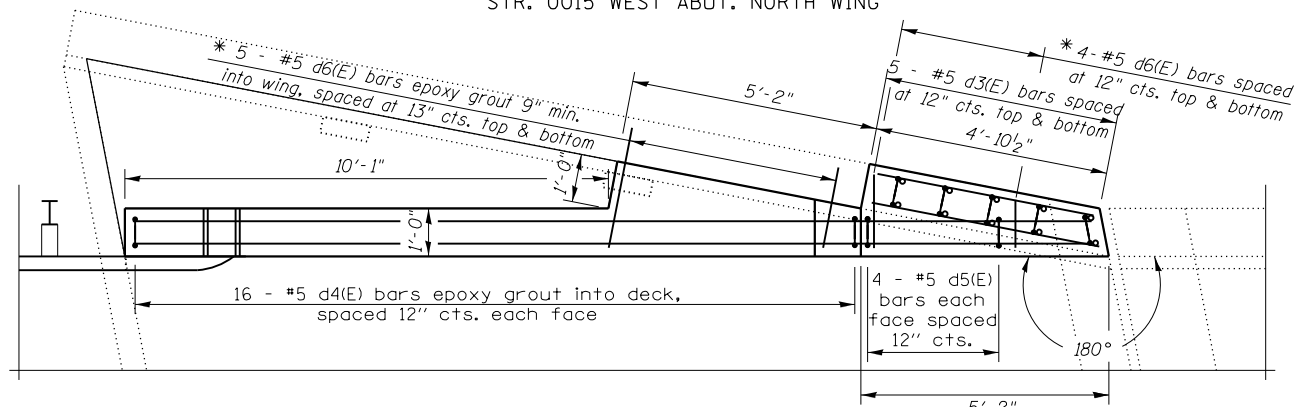


**PLAN VIEW**

STR. 0014 EAST ABUT. SOUTH WING  
STR. 0015 WEST ABUT. NORTH WING

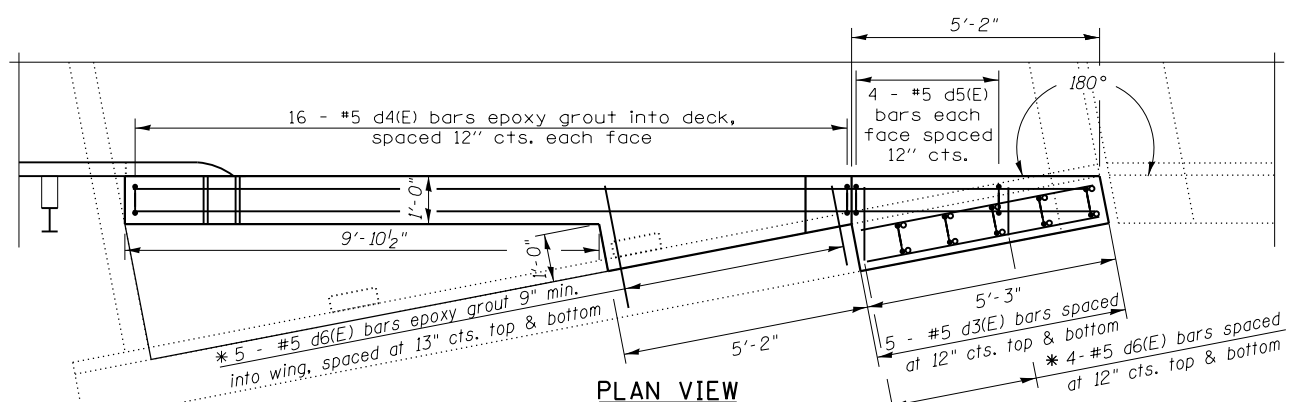


**PLAN VIEW**

STR. 0014 EAST ABUT. NORTH WING  
STR. 0015 WEST ABUT. SOUTH WING

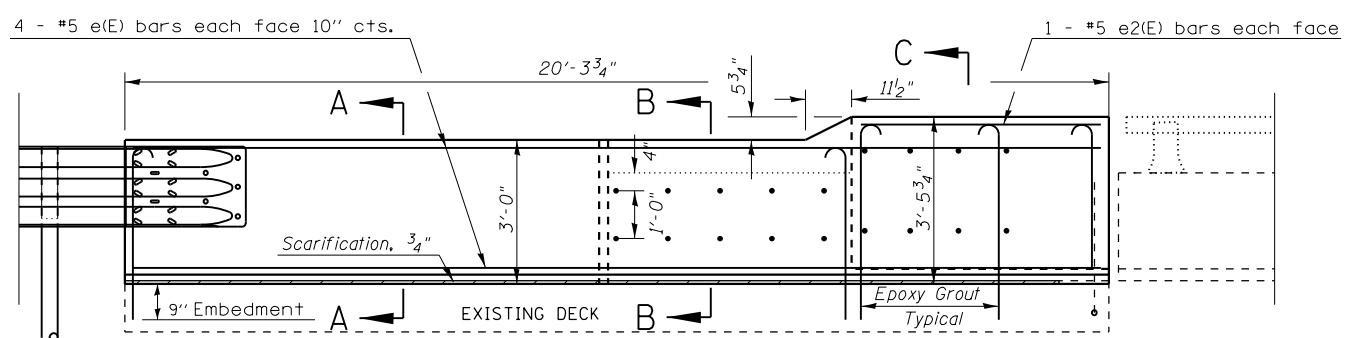


**ELEVATION VIEW**


STR. 0014 EAST ABUT. NORTH WING  
STR. 0015 WEST ABUT. SOUTH WING

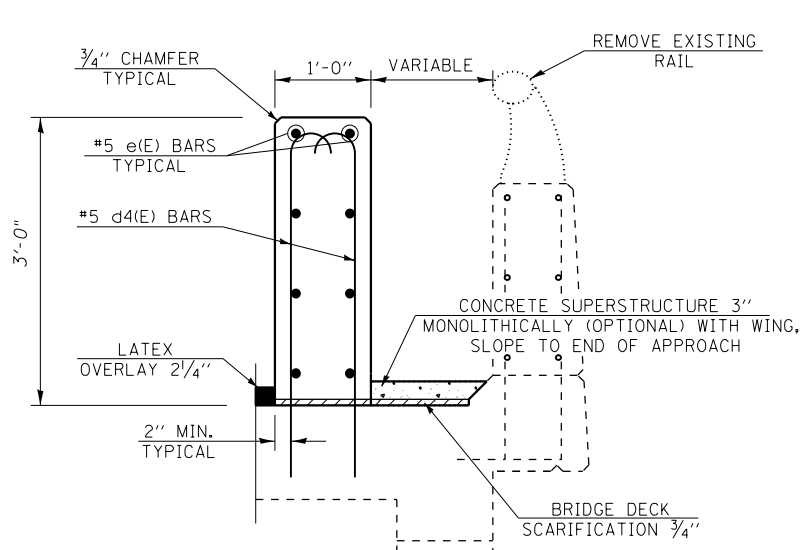

**SECTION A-A**

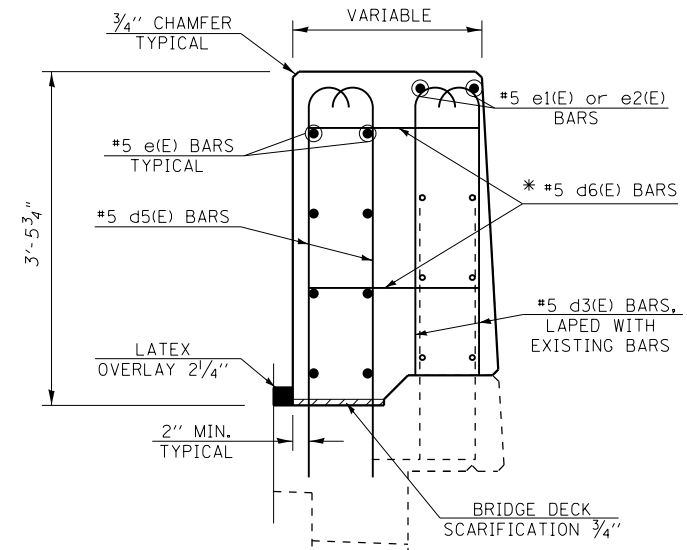

**SECTION C-C**

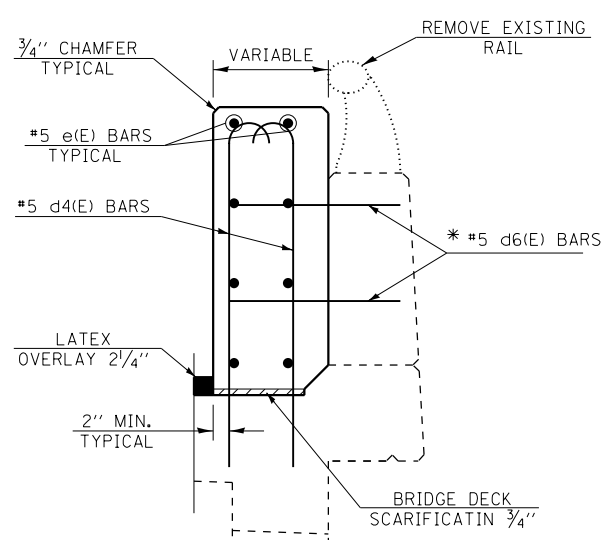

**SECTION B-B**

**NOTES**


PLAN DIMENSIONS AND DETAILS RELATIVE TO EXISTING PLANS ARE SUBJECT TO NOMINAL CONSTRUCTION VARIATIONS. THE CONTRACTOR SHALL FIELD VERIFY EXISTING DIMENSIONS AND DETAILS AFFECTING NEW CONSTRUCTION AND MAKE NECESSARY APPROVED ADJUSTMENTS PRIOR TO CONSTRUCTION OR ORDERING OF MATERIALS. SUCH VARIATIONS SHALL NOT BE CAUSE FOR ADDITIONAL COMPENSATION FOR A CHANGE IN SCOPE OF WORK, HOWEVER, THE CONTRACTOR WILL BE PAID FOR THE QUANTITY ACTUALLY FURNISHED AT THE UNIT PRICE BID FOR THE WORK.

EXISTING REINFORCEMENT BARS EXTENDING INTO THE REMOVAL AREA SHALL BE CLEANED, STRAIGHTENED AND INCORPORATED INTO THE NEW CONSTRUCTION. ANY REINFORCEMENT BARS THAT ARE DAMAGED DURING CONCRETE REMOVAL SHALL BE REPLACED WITH AN APPROVED BAR SPLICER OR ANCHORAGE SYSTEM. COST INCLUDED WITH CONCRETE REMOVAL.

d4(E), d5(E) and d6(E) BARS TO BE DRILLED AND EPOXY GROUTED PER ARTICLE 584 OF THE STANDARD SPECIFICATIONS IF REQUIRED. COST INCLUDED WITH REINFORCEMENT BARS, EPOXY COATED.

\* ORDER d6(E) BARS IN THIS AREA 3'-7". USE CUT DIAGRAM TO ESTABLISH BOTH ROWS OF BARS.


REINFORCEMENT BARS DESIGNATED (E) SHALL BE EPOXY COATED.

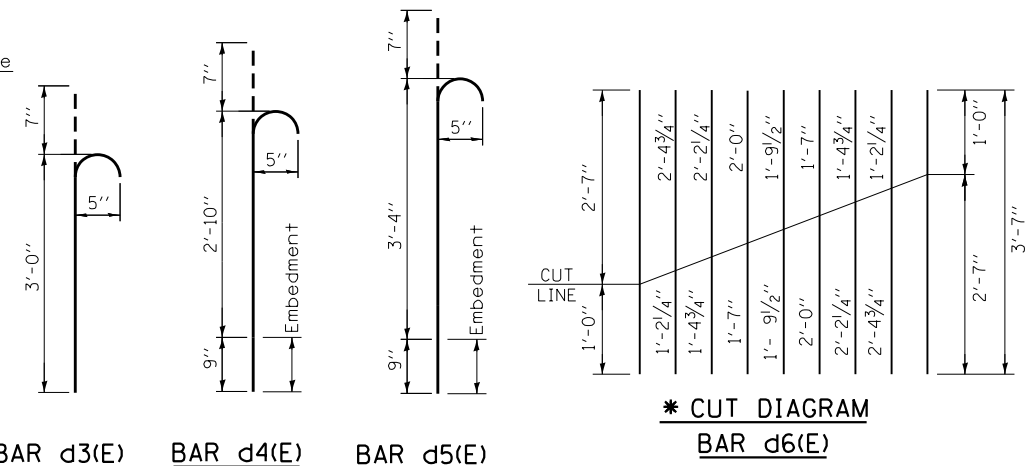


**\* CUT DIAGRAM**

**BILL OF MATERIAL**



BAR	NO.	SIZE	LENGTH	SHAPE
e(E)	32	#5	20'-0"	—
e1(E)	4	#5	4'-6"	—
e2(E)	4	#5	4'-11"	—
d3(E)	40	#5	3'-7"	U
d4(E)	128	#5	4'-2"	U
d5(E)	16	#5	4'-8"	U
d6(E)	36	#5	3'-7"	U
REINFORCEMENT BARS (EPOXY COATED)			POUND	1630.0
CONCRETE SUPERSTRUCTURE			CU YD	12.1
PROTECTIVE COAT			SQ YD	48.0

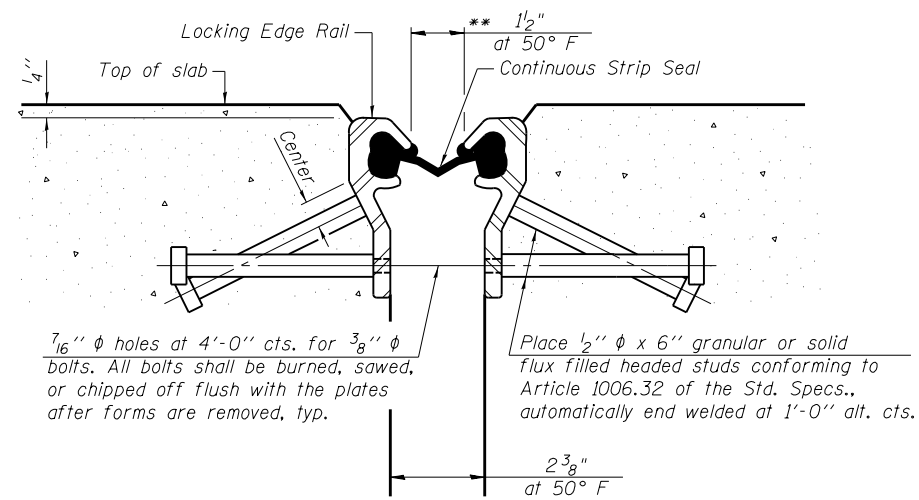


SECTION THRU EXPANSION STRIP SEAL JOINT

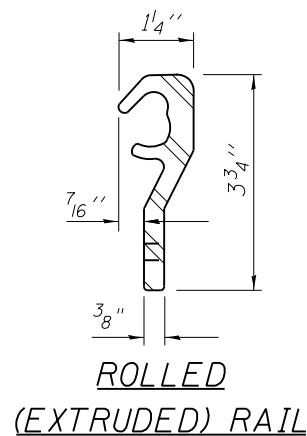

- \* OMIT WELD AT SEAL OPENING.
- \*\* THE MINIMUM DIMENSION SHALL BE  $1/2''$  FOR INSTALLATION PURPOSES.

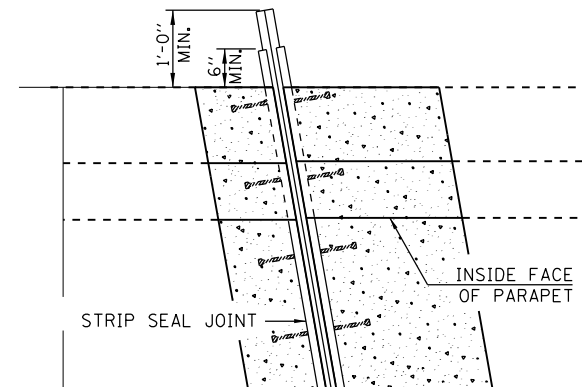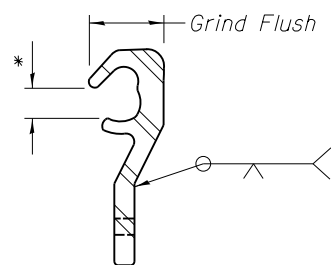

PLAN VIEW AT PARAPET

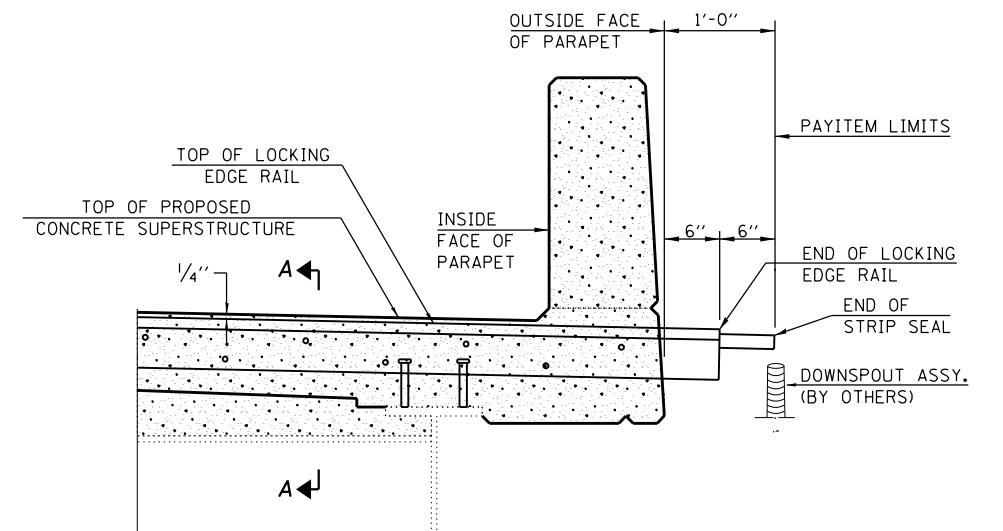

SECTION THRU PARAPET

**NOTES:**

THE STRIP SEAL SHALL BE MADE CONTINUOUS AND SHALL HAVE A MINIMUM THICKNESS OF  $1/4''$ . THE CONFIGURATION OF THE STRIP SEAL SHALL MATCH THE CONFIGURATION OF THE LOCKING EDGE RAILS.

THE LOCKING EDGE RAILS DEPICTED ARE CONCEPTUAL ONLY, EXCEPT FOR THE MINIMUM DIMENSIONS SHOWN. THE ACTUAL CONFIGURATION OF THE LOCKING EDGE RAILS AND MATCHING STRIP SEAL MAY VARY FROM MANUFACTURER TO MANUFACTURER. FLANGED EDGE RAILS WILL NOT BE ALLOWED. LOCKING EDGE RAILS MAY BE SPLICED AT SLOPE DISCONTINUITIES AND STAGE CONSTRUCTION JOINTS. THE INSIDE OF THE LOCKING EDGE RAIL GROVE SHALL BE FREE OF WELD RESIDUE.


THE MANUFACTURER'S RECOMMENDED INSTALLATION METHODS SHALL BE FOLLOWED.

ALL STEEL COMPONENTS SHALL BE GALVANIZED AFTER FABRICATION ACCORDING TO ARTICLE 520.03 OF THE STANDARD SPECIFICATIONS.

MAXIMUM SPACE BETWEEN RAIL SEGMENTS AT STAGE LINES SHALL BE  $3/6''$ , SEALED WITH A SUITABLE SEALANT. JOINTS IN RAILS WITHIN 10 FT. OF CURBS SHALL BE WELDED.

LOCKING EDGE RAILS ARE TO BE PLACED  $1/4''$  BELOW THE DECK ELEVATION THROUGH THE MEDIAN. STOP RAISED MEDIAN 3" SHORT OF DECK ENDS AND 3" SHORT OF FACE OF ABUTMENTS.

SEE SUPERSTRUCTURE REPAIR DETAILS FOR REINFORCEMENT REQUIRED.


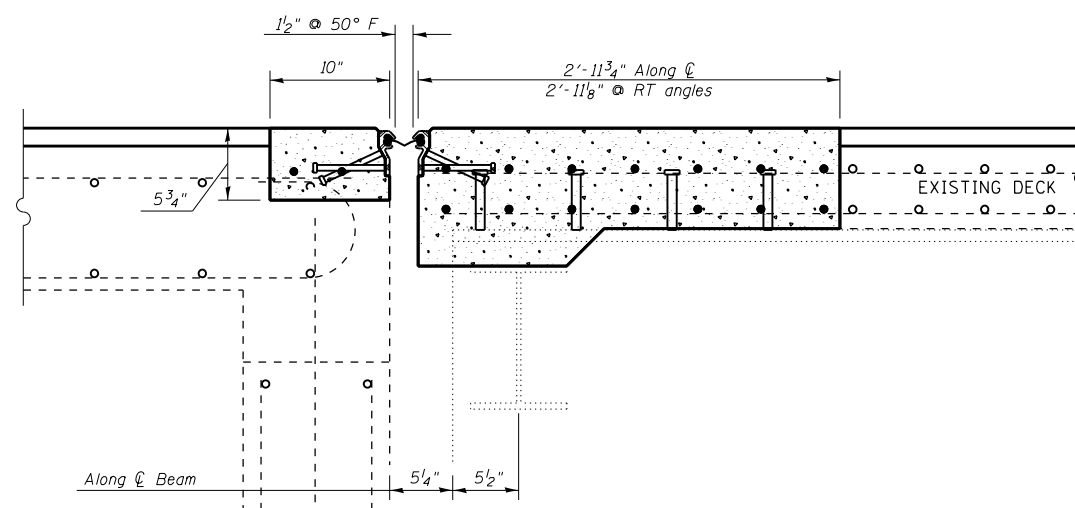


SECTION A-A

**BILL OF MATERIALS**

ITEM	UNIT	TOTAL
PREFORMED JOINT STRIP SEAL	FOOT	180.0

# BRIDGE DECK PATCHING S.N. 010-0014

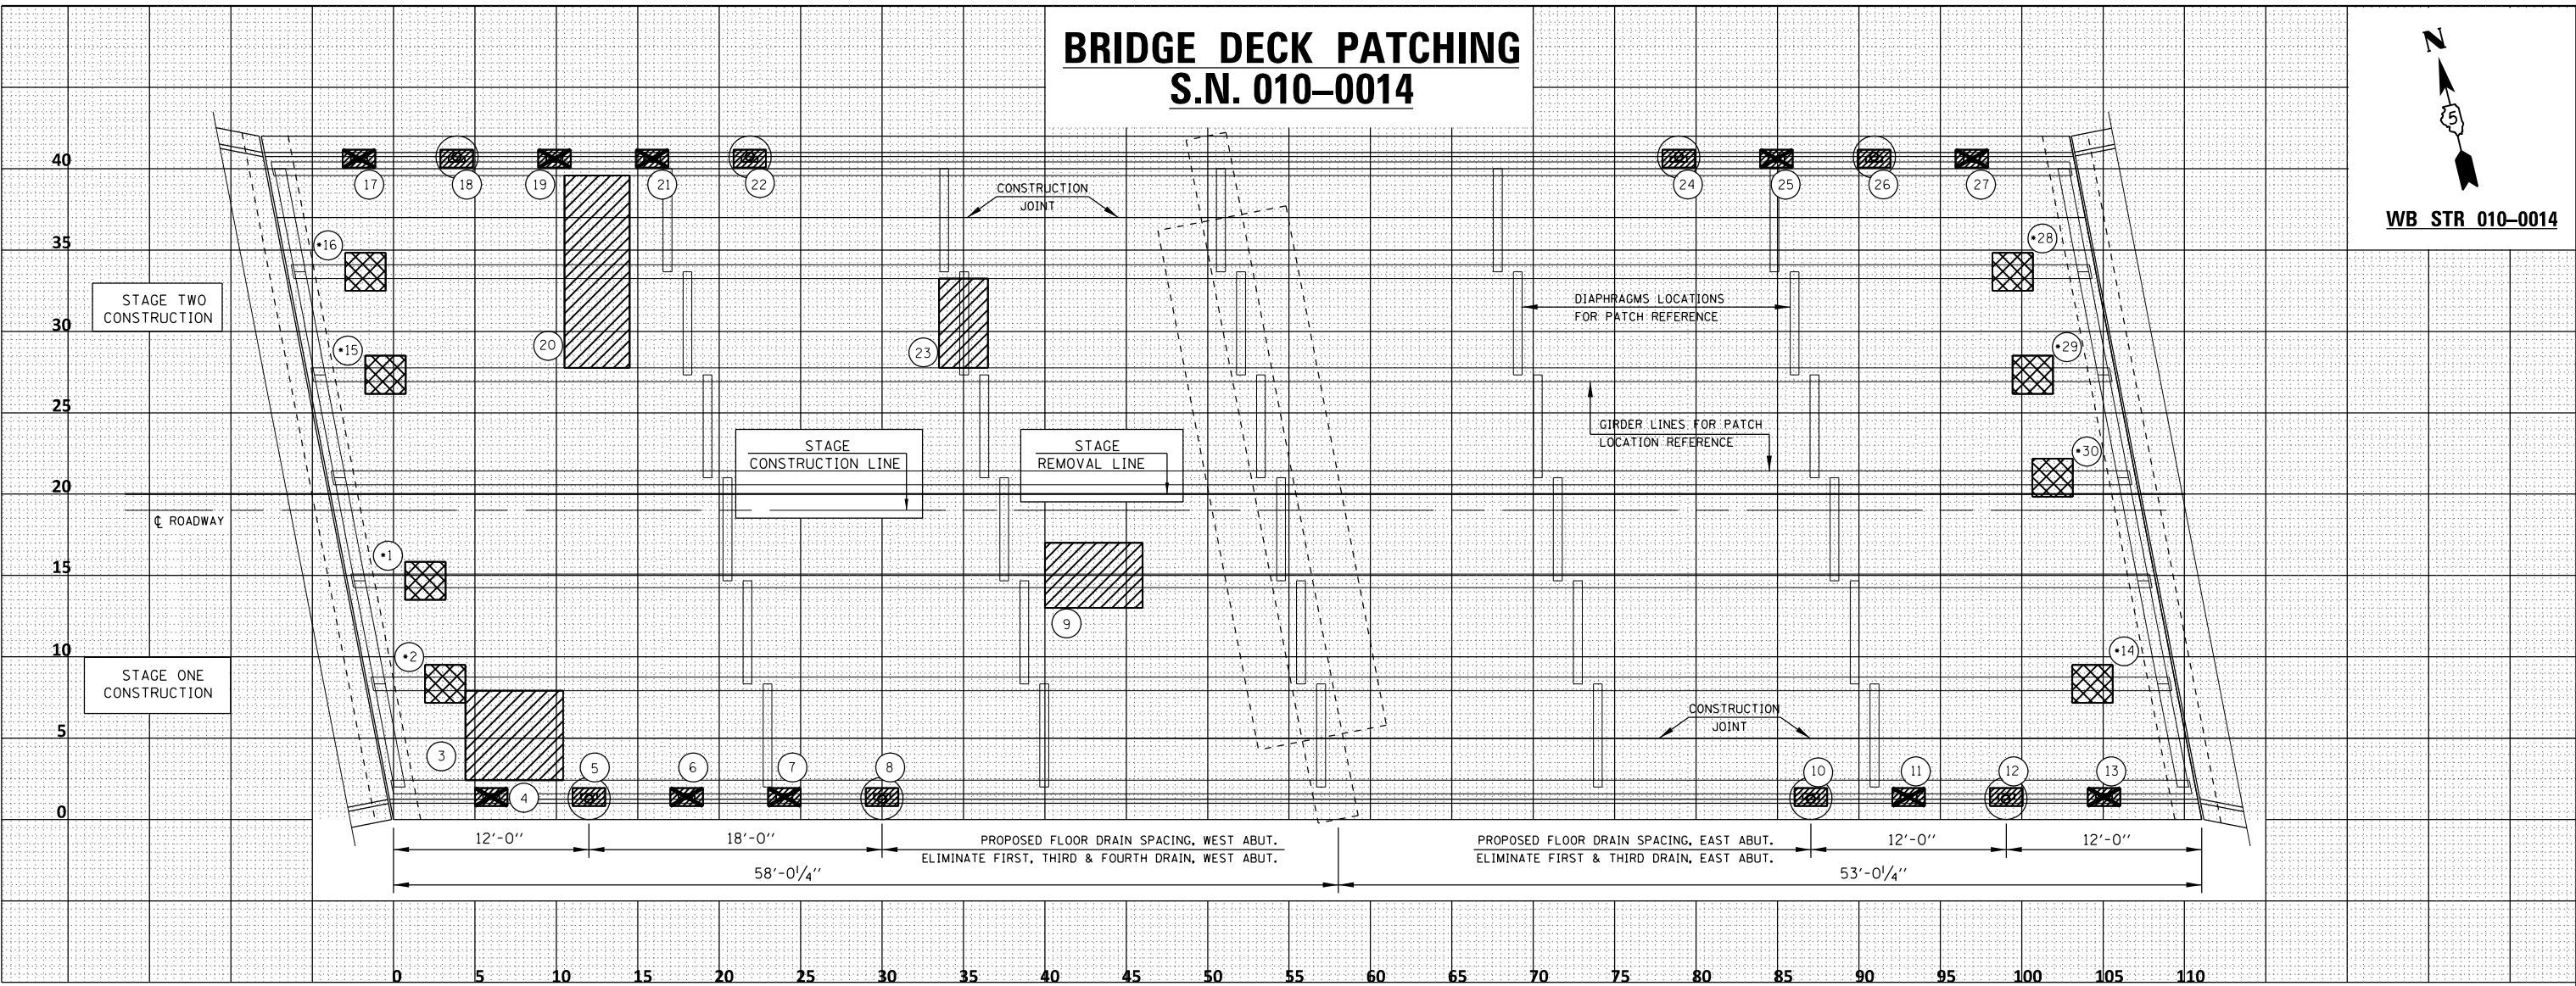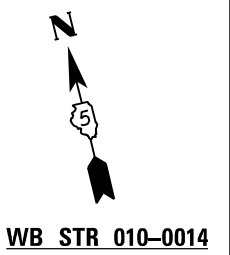

PATCH NO.	SIZE		DECK SLAB REPAIR		
	LENGTH (FT)	WIDTH (FT)	(PARTIAL DEPTH)	(FULL DEPTH I)	(FULL DEPTH II)
			SO YD	SO YD	SO YD
*1	2.50	2.33			0.6
*2	2.50	2.33			0.6
3	6.00	5.50			3.7
4	2.00	1.20		0.3	
5	2.00	1.20		0.3	
6	2.00	1.20		0.3	
7	2.00	1.20		0.3	
8	2.00	1.20		0.3	
9	6.00	6.00			4.0
10	2.00	1.20		0.3	
11	2.00	1.20		0.3	
12	2.00	1.20		0.3	
13	2.00	1.20		0.3	
*14	2.50	2.33			0.6

PATCH NO.	SIZE		DECK SLAB REPAIR		
	LENGTH (FT)	WIDTH (FT)	(PARTIAL DEPTH)	(FULL DEPTH I)	(FULL DEPTH II)
			SO YD	SO YD	SO YD
*15	2.50	2.33			0.6
*16	2.50	2.33			0.6
17	2.00	1.20		0.3	
18	2.00	1.20		0.3	
19	2.00	1.20		0.3	
20	4.00	11.80			5.2
21	2.00	1.20		0.3	
22	2.00	1.20		0.3	
23	3.00	5.50			1.8
24	2.00	1.20		0.3	
25	2.00	1.20		0.3	
26	2.00	1.20		0.3	
27	2.00	1.20		0.3	
*28	2.50	2.33			0.6
*29	2.50	2.33			0.6
*30	2.50	2.33			0.6

**NOTES:**

- \* PATCH SIZE TO REMOVE TIE DOWNS TO BE DETERMINED BY FIELD CONDITIONS.

**BILL OF MATERIALS**

ITEM	UNIT	TOTAL
DECK SLAB REPAIR (FULL DEPTH, TY I)	SO YD	5.4
DECK SLAB REPAIR (FULL DEPTH, TY II)	SO YD	19.5

**LEGEND**

- DECK SLAB REPAIR (FULL-DEPTH)
- REMOVE DECK TIE DOWNS; DECK SLAB REPAIR (FULL-DEPTH)
- EXISTING DECK DRAINS (TO BE ELIMINATED)
- EXISTING DECK DRAINS (TO BE REPLACED WITH FLOOR DRAINS)

DECK SURVEY PERFORMED ON NOVEMBER 21, 2013. IF MORE THAN ONE WINTER FREEZE-THAW CYCLE OCCURS BETWEEN THE INITIAL INSPECTION AND THE COMMENCEMENT OF WORK, THE FINAL PLAN QUANTITIES FOR DECK REPAIRS MUST BE BASED ON A NEW INSPECTION OF THE DECK.



THE LOCATIONS AND SIZES SHOWN GRAPHICALLY ABOVE ARE APPROXIMATE. SEE THIS TABLE FOR ACTUAL SIZES.

METHOD OF SURVEY: VISUAL

BRIDGE DECK PATCHING  
CHAMPAIGN COUNTY  
FAI 74  
OVER IL 47  
WESTBOUND LANE

S.N. 010-0014

# BRIDGE DECK PATCHING S.N. 010-0015

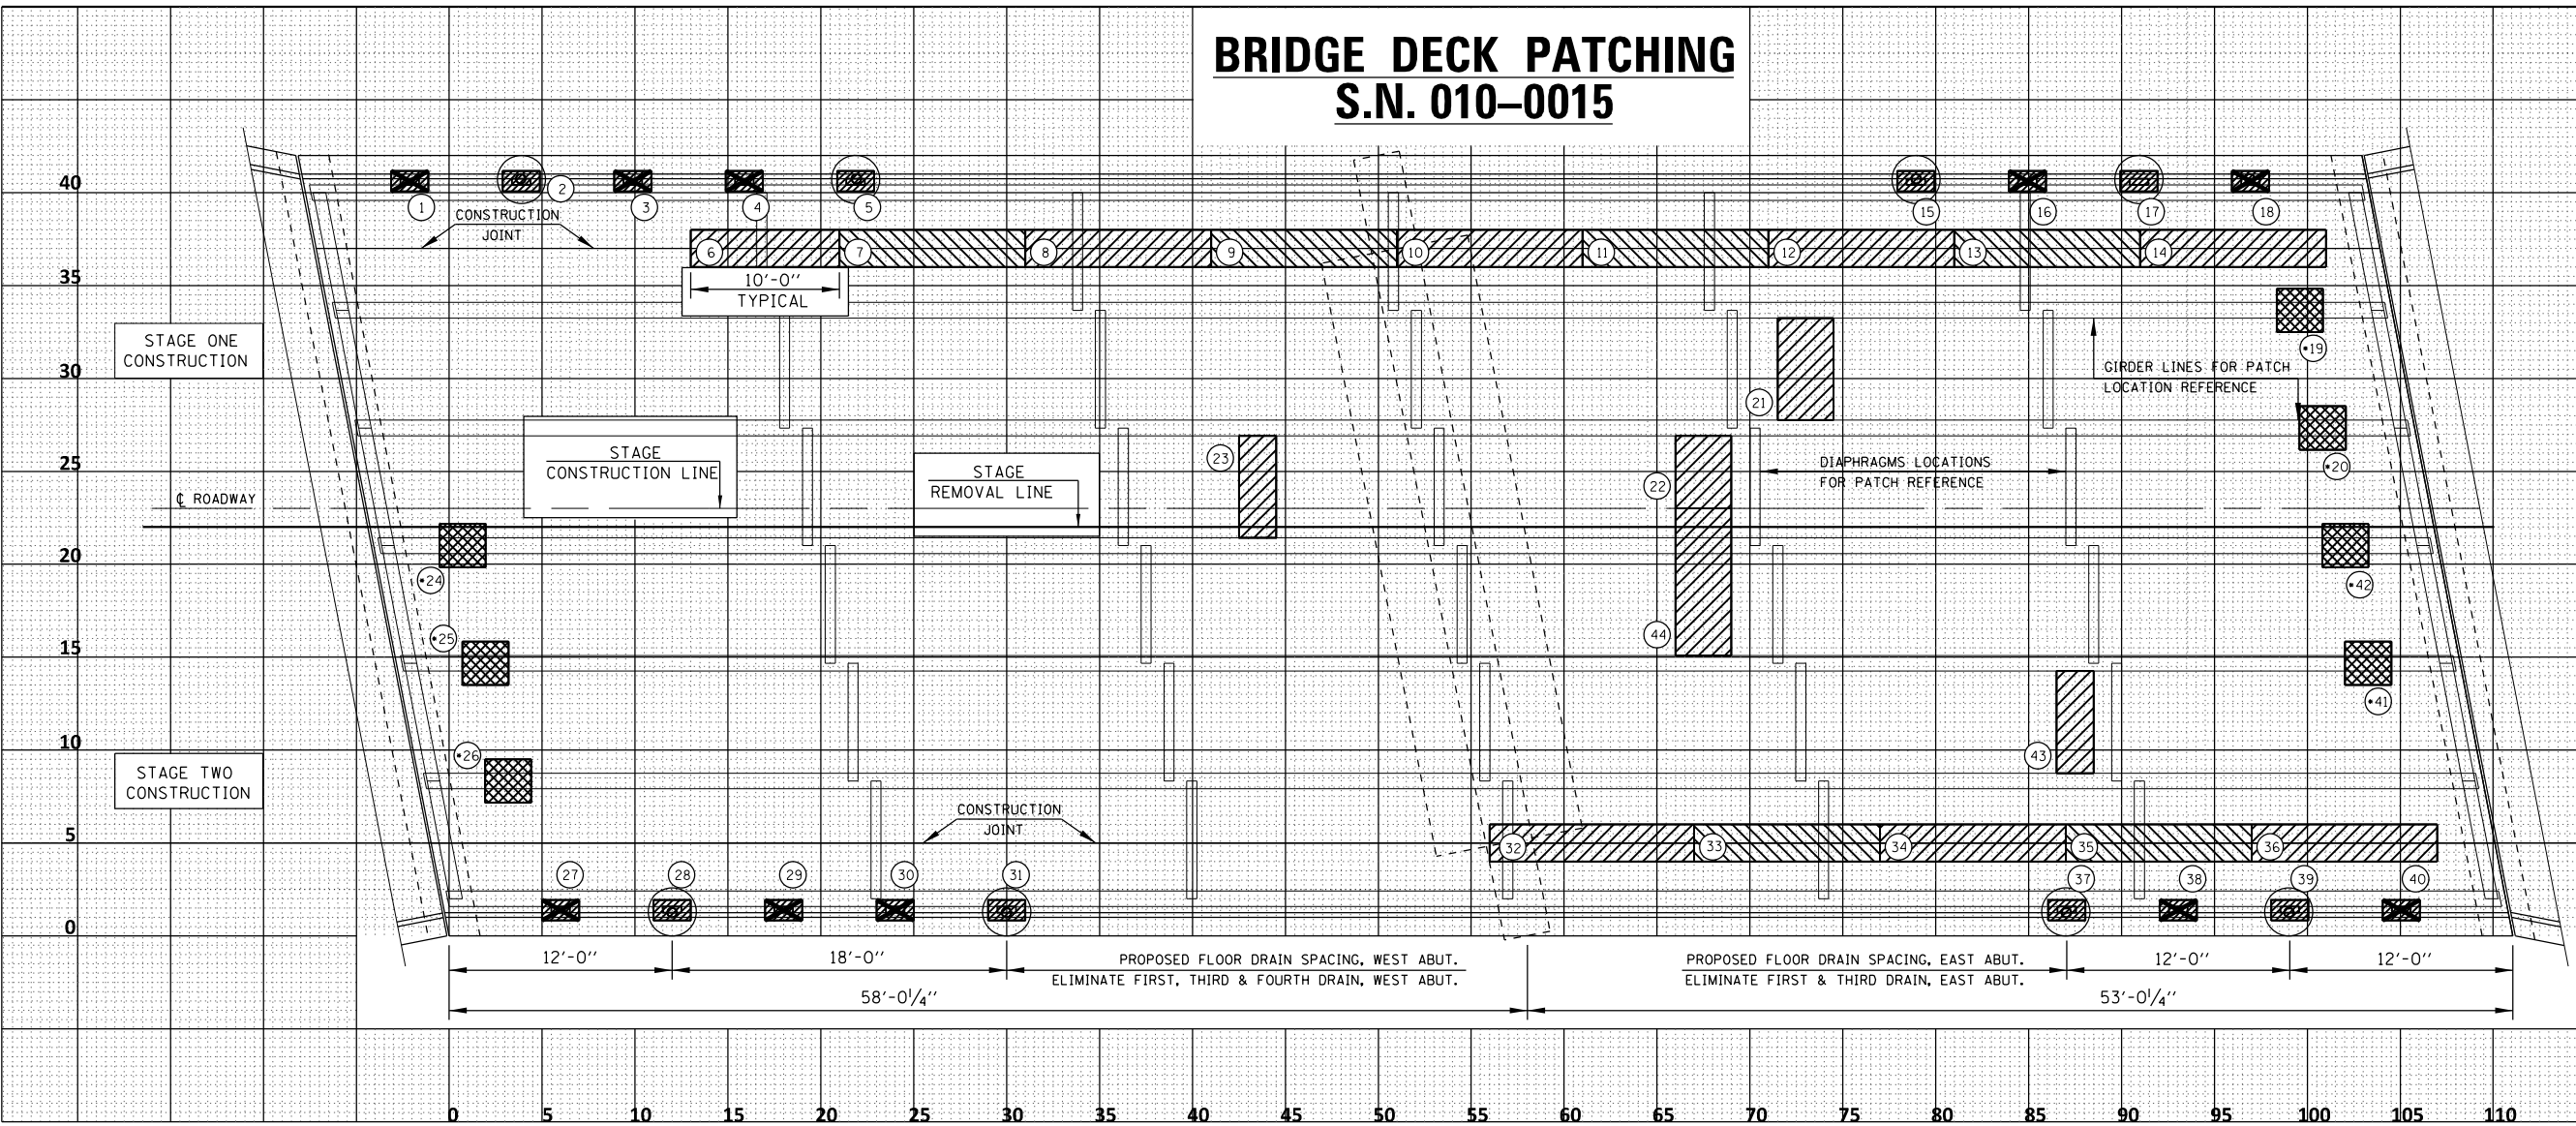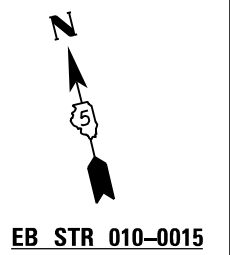

PATCH NO.	SIZE		DECK SLAB REPAIR (PARTIAL DEPTH)			DECK SLAB REPAIR (FULL DEPTH T1)			DECK SLAB REPAIR (FULL DEPTH T2)			
	LENGTH (FT)	WIDTH (FT)	SO	YD	SO	YD	SO	YD	SO	YD	SO	YD
1	2.00	1.20			0.3							
2	2.00	1.20			0.3							
3	2.00	1.20			0.3							
4	2.00	1.20			0.3							
5	2.00	1.20			0.3							
6	10.00	2.00						2.2				
7	10.00	2.00						2.2				
8	10.00	2.00						2.2				
9	10.00	2.00						2.2				
10	10.00	2.00						2.2				
11	10.00	2.00						2.2				
12	10.00	2.00						2.2				
13	10.00	2.00						2.2				
14	10.00	2.00						2.2				
15	2.00	1.20			0.3							
16	2.00	1.20			0.3							
17	2.00	1.20			0.3							

PATCH NO.	SIZE		DECK SLAB REPAIR (PARTIAL DEPTH)			DECK SLAB REPAIR (FULL DEPTH T1)			DECK SLAB REPAIR (FULL DEPTH T2)			
	LENGTH (FT)	WIDTH (FT)	SO	YD	SO	YD	SO	YD	SO	YD	SO	YD
18	2.00	1.20			0.3							
*19	2.50	2.33						0.6				
*20	2.50	2.33						0.6				
21	3.00	5.50						1.8				
22	3.00	4.00						1.3				
23	2.00	5.50						1.2				

PATCH NO.	SIZE		DECK SLAB REPAIR (PARTIAL DEPTH)			DECK SLAB REPAIR (FULL DEPTH T1)			DECK SLAB REPAIR (FULL DEPTH T2)			
	LENGTH (FT)	WIDTH (FT)	SO	YD	SO	YD	SO	YD	SO	YD	SO	YD
*24	2.50	2.33						0.6				
*25	2.50	2.33						0.6				
*26	2.50	2.33						0.6				
27	2.00	1.20			0.3							
28	2.00	1.20			0.3							
29	2.00	1.20			0.3							
30	2.00	1.20			0.3							
31	2.00	1.20			0.3							
32	10.00	2.00						2.2				
33	10.00	2.00						2.2				
34	10.00	2.00						2.2				
35	10.00	2.00						2.2				
36	10.00	2.00						2.2				
37	2.00	1.20			0.3							
38	2.00	1.20			0.3							
39	2.00	1.20			0.3							
40	2.00	1.20			0.3							

PATCH NO.	SIZE		DECK SLAB REPAIR (PARTIAL DEPTH)			DECK SLAB REPAIR (FULL DEPTH T1)			DECK SLAB REPAIR (FULL DEPTH T2)			
	LENGTH (FT)	WIDTH (FT)	SO	YD	SO	YD	SO	YD	SO	YD	SO	YD
*41	2.50	2.33						0.6				
*42	2.50	2.33						0.6				
43	2.00	5.50						1.2				
44	3.00	7.00						2.3				

**NOTES:**

- PATCH SIZE TO REMOVE TIE DOWNS TO BE DETERMINED BY FIELD CONDITIONS.
- LONGITUDINAL REMOVAL FOR DECK SLAB REPAIR ALONG THE CONSTRUCTION JOINT MUST BE DONE IN ALTERNATING SECTIONS OF NO MORE THAN 10 FEET. ADJACENT SECTIONS MUST NOT BE REMOVED UNTIL BOTH OF THE FOLLOWING REQUIREMENTS ARE MET:
  1. AT LEAST 72 HOURS SHALL HAVE ELAPSED FROM THE END OF THE PREVIOUS POUR, AND
  2. THE CONCRETE SHALL HAVE ATTAINED A MINIMUM MODULUS OF RUPTURE OF 650 PSI OR A MINIMUM COMPRESSIVE STRENGTH OF 3500 PSI.

**BILL OF MATERIALS**

ITEM	UNIT	TOTAL
DECK SLAB REPAIR (FULL DEPTH, TY I)	SO YD	5.4
DECK SLAB REPAIR (FULL DEPTH, TY II)	SO YD	42.8

**LEGEND**

- DECK SLAB REPAIR (FULL-DEPTH) PHASE I
- DECK SLAB REPAIR (FULL-DEPTH) PHASE II
- REMOVE DECK TIE DOWNS; DECK SLAB REPAIR (FULL-DEPTH)
- EXISTING DECK DRAINS (TO BE ELIMINATED)
- EXISTING DECK DRAINS (TO BE REPLACED WITH FLOOR DRAINS)

THE LOCATIONS AND SIZES SHOWN GRAPHICALLY ABOVE ARE APPROXIMATE. SEE THIS TABLE FOR ACTUAL SIZES.

METHOD OF SURVEY: VISUAL



BRIDGE DECK PATCHING  
CHAMPAIGN COUNTY  
FAI 74  
OVER IL 47  
EASTBOUND LANE

S.N. 010-0015


# SUPERSTRUCTURE PLAN – DRAIN DETAIL

## S.N. 010-0014 & S.N. 010-0015

**WB STR**    **EB STR**  
**010-0014**   **010-0015**

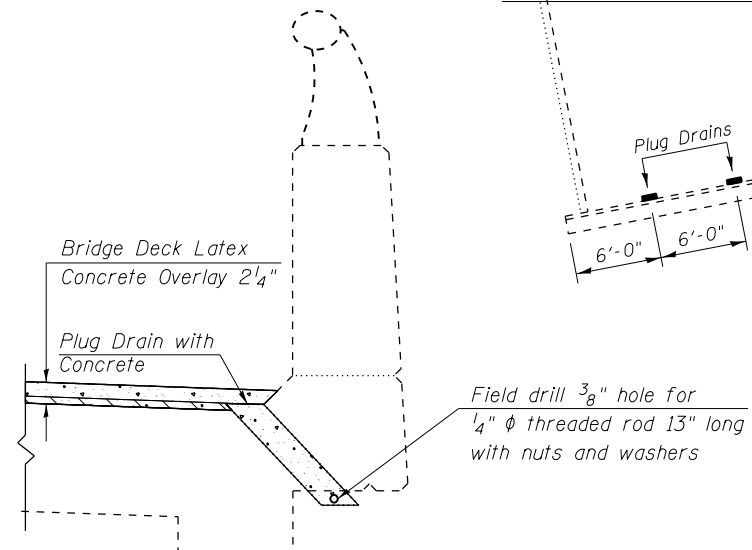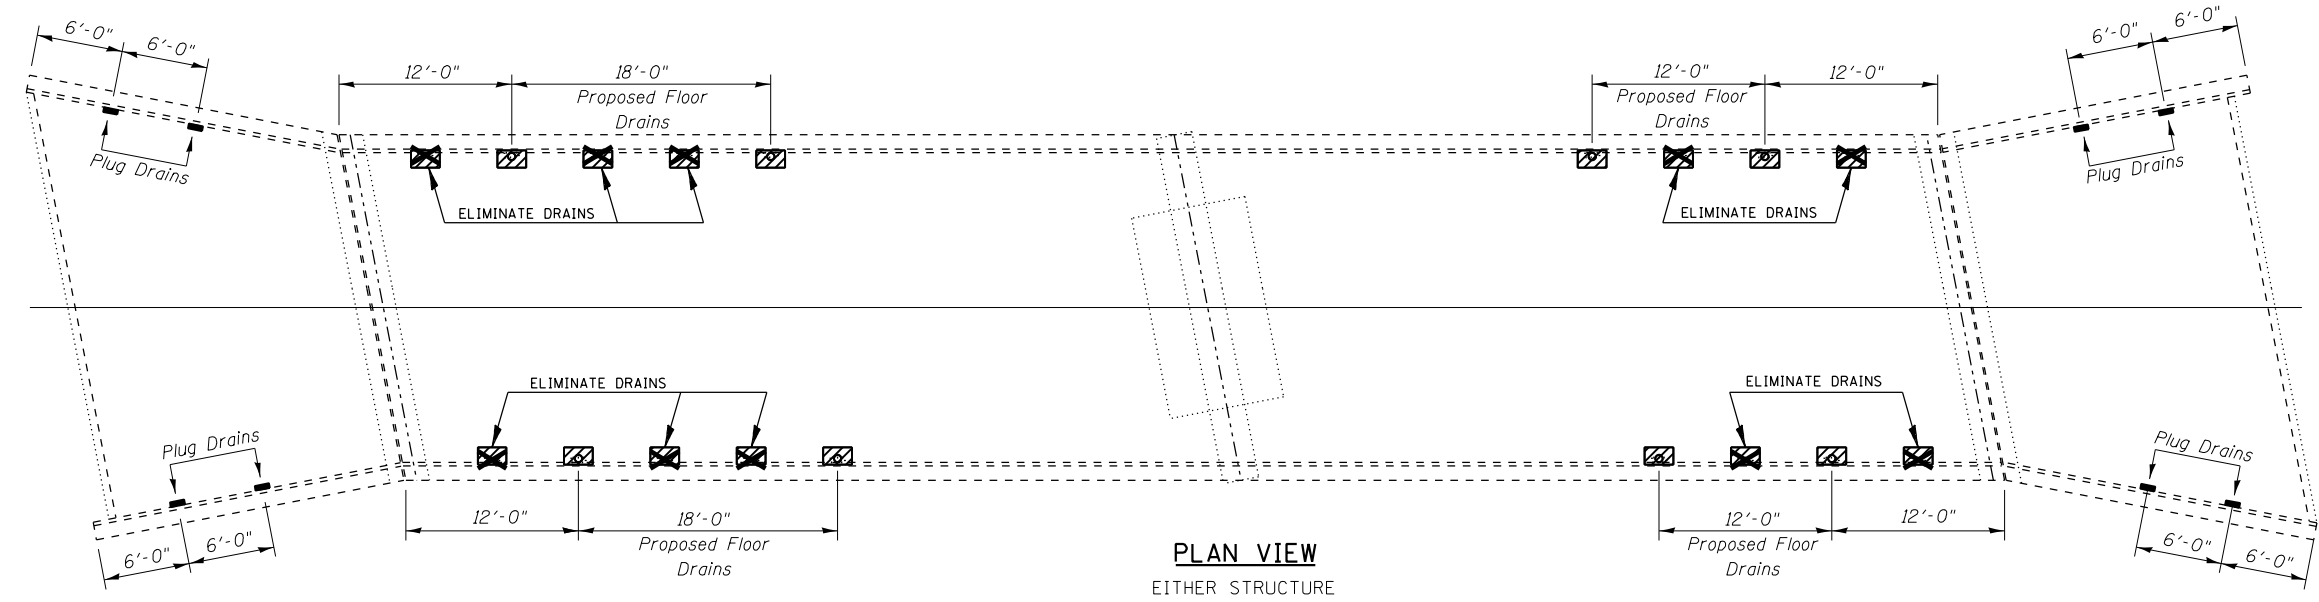


**PROPOSED SECTION APPROACH**

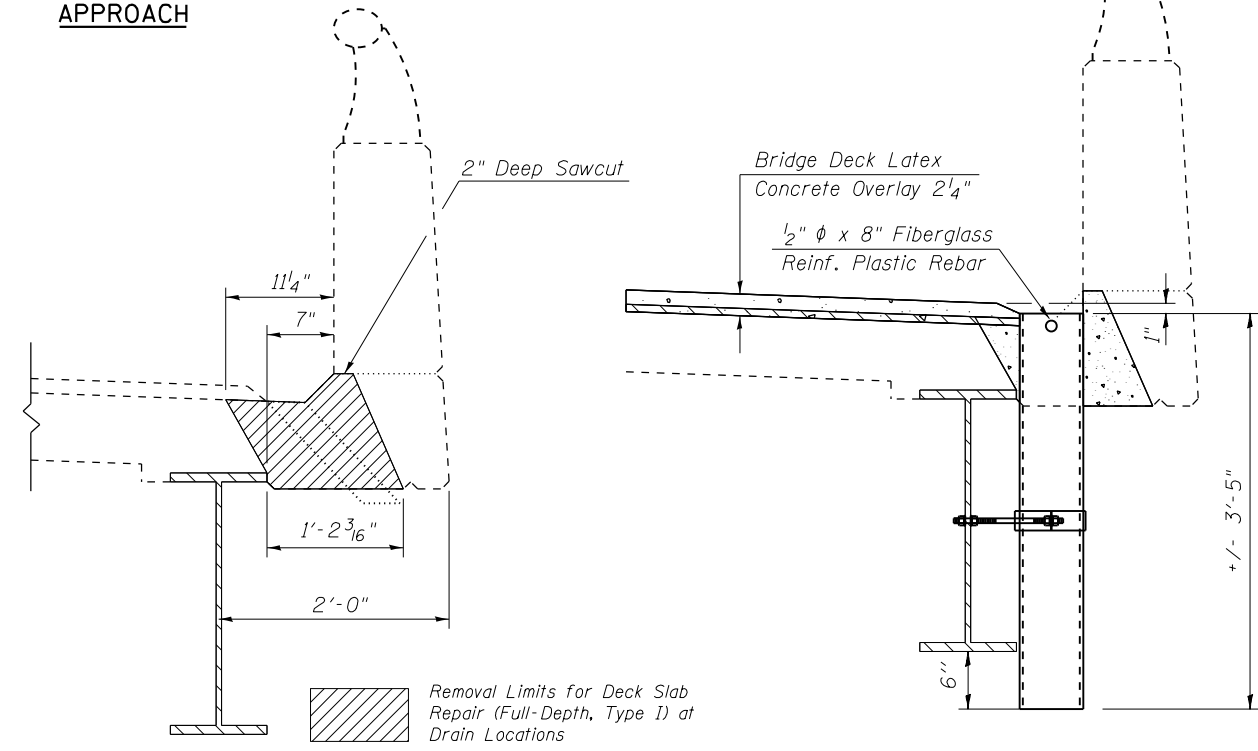


**EXISTING SECTION DECK**


**PROPOSED SECTION DECK**

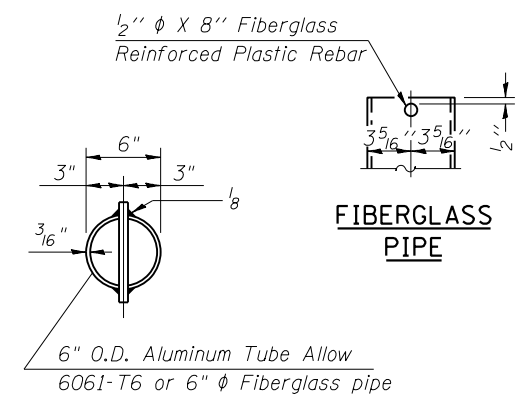

**TOP PLAN (Aluminum Tube Shown)**

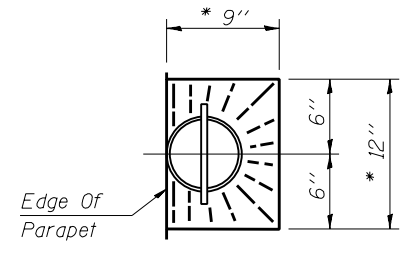

**TOP PLAN**  
• SLOPE TO DRAIN

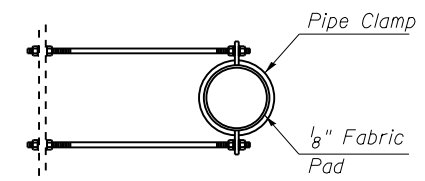

**TOP PLAN Drain Clamp**

**LEGEND**

- Plug drain with concrete
- Eliminate floor drain
- Proposed floor drain location

**NOTES:**

Patch sizes shown represent conditions at the time the plans were completed. The actual sizes and locations of patching shall be determined by the engineer. The Engineer shall show the actual locations of the deck repairs on this sheet.

The existing drains shall be removed. Cost included with "Deck Slab Repair (Full Depth, Type I)".

Extreme care must be used when removing concrete near the top flange of the beams. The contractor is responsible for any damage to the beams.

The exterior surfaces of the floor drains shall be painted with the finish coat as specified in the special provisions for Cleaning and Painting New Metal Structures. The exterior surfaces of the drains shall be cleaned according to Society of Protective Coatings' Spec. SSPC-SP1 prior to painting.

Fiberglass Pipe Shall Conform to ASTM D 2996, with Short-Time Rupture Strength Hoop Tensile Stress of 30,000 P.S.I. Minimum.


Galvanized Clamping Device and All Stud Bolts, Washers and Nuts According to AASHTO M232. Cost of clamping device and galvanizing included with floor drain.

All Dimensions Shall be Field Verified by the Contractor Prior to Ordering of Materials.


**BILL OF MATERIAL**

ITEM	UNIT	TOTAL
FLOOR DRAINS	EACH	16.0
DECK SLAB REPAIR (FULL DEPTH, TYPE I)	SQ YD	10.8
PLUG EXISTING DECK DRAINS	EACH	16.0

# PLAN FOR STRUCTURAL REPAIR OF CONCRETE ON ABUTMENTS S.N. 010-0014 (WB)

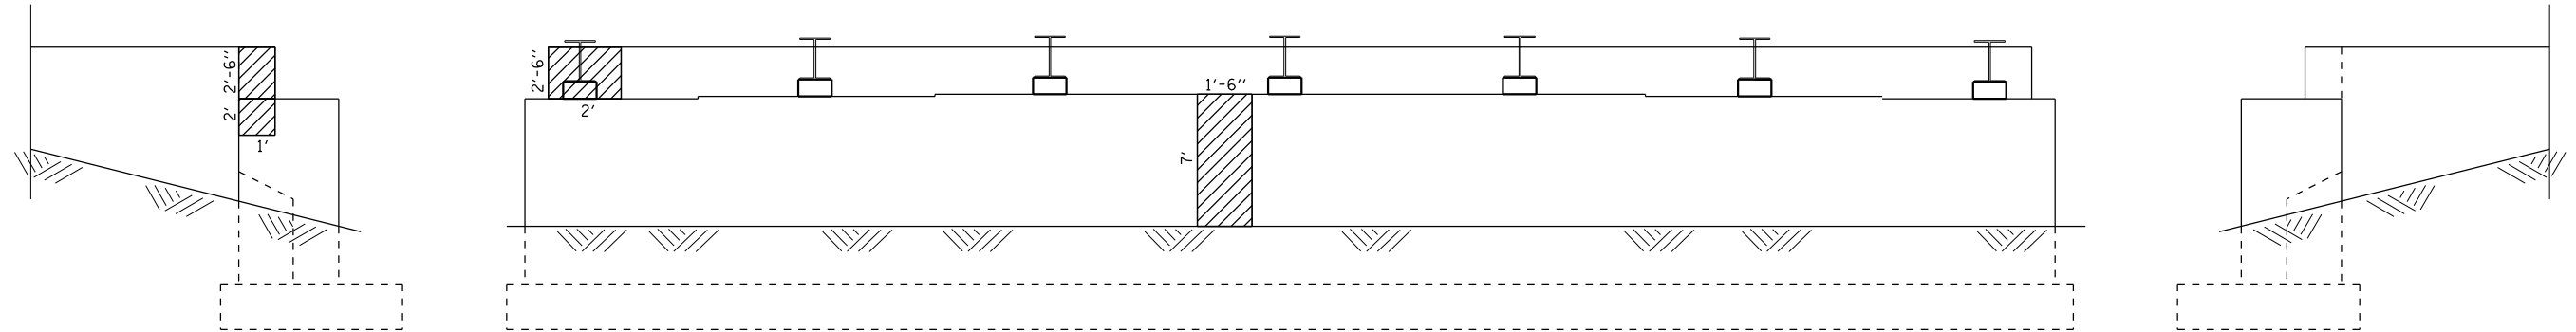

**ELEVATION - WEST ABUTMENT**

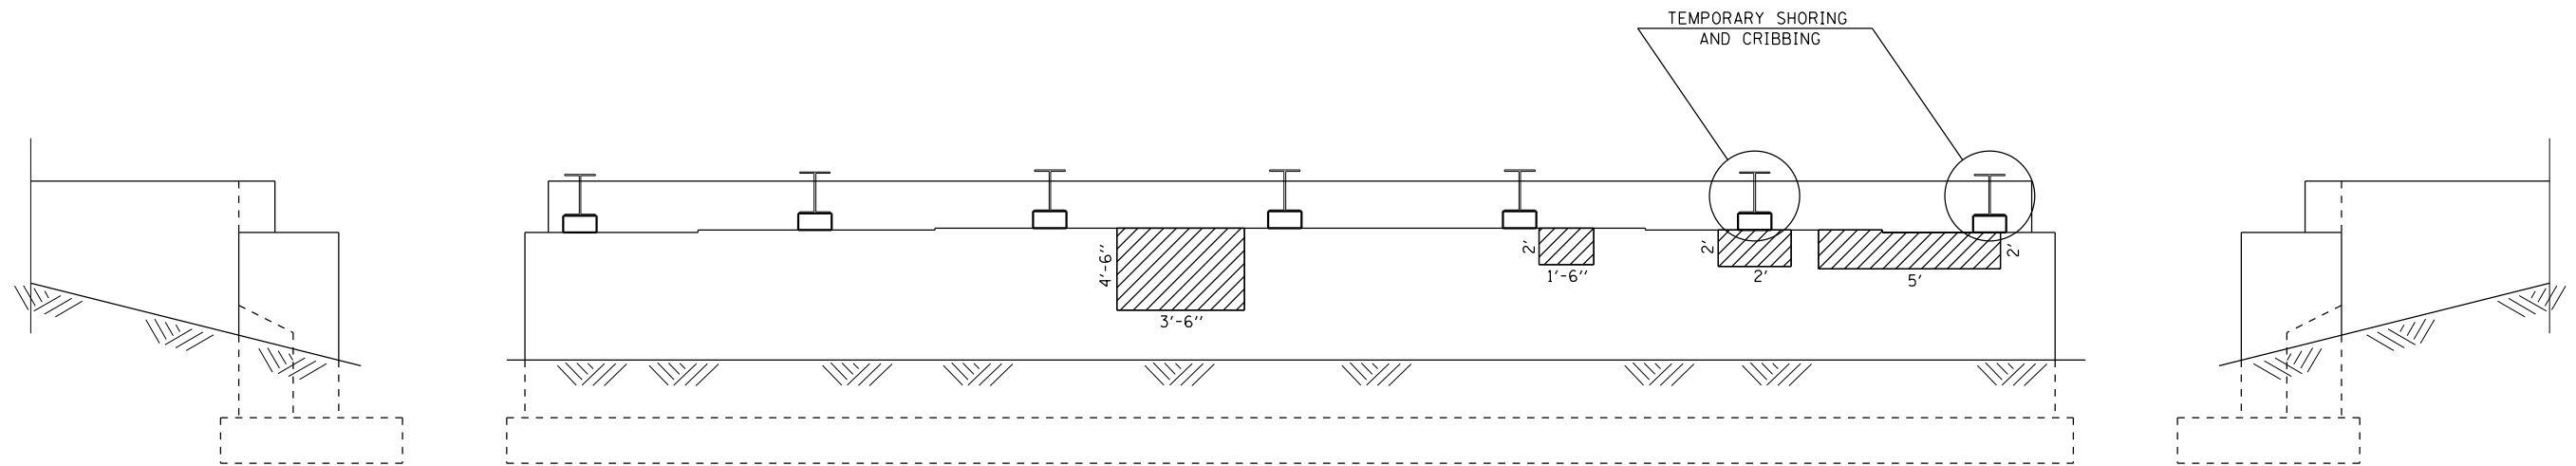

**ELEVATION - EAST ABUTMENT**

**STRESS TABLE**

INTERIOR BEAMS		
REACTIONS = KIPS		
	ABUTMENT	PIER
R <sub>DL</sub> (K)	19.76	61.09
R <sub>LL</sub> (K)	42.69	51.33
R <sub>TOTAL</sub> (K)	62.45	112.42

**NOTE:**

SEE SPECIAL PROVISION FOR STRUCTURAL REPAIR OF CONCRETE.  
SEE SPECIAL PROVISION FOR TEMPORARY SHORING AND CRIBBING.  
STRUCTURE REPAIR OF CONCRETE TO BE COMPLETED WITH JACK AND REMOVE EXISTING BEARINGS. TEMPORARY SHORING AND CRIBBING IF NECESSARY TO BE DETERMINED BY THE ENGINEER.

**LEGEND**


STRUCTURAL REPAIR OF CONCRETE, DEPTH EQUAL TO OR LESS THAN 5"

**BILL OF MATERIALS**


ITEM	UNIT	TOTAL
STRUCTURAL REPAIR OF CONCRETE (DEPTH LESS THAN OR EQUAL TO 5")	SQ FT	52.8
PROTECTIVE COAT	SQ YD	6.0
TEMPORARY SHORING AND CRIBBING	EACH	2.0



# PLAN FOR STRUCTURAL REPAIR OF CONCRETE ON ABUTMENTS S.N. 010-0015 (EB)

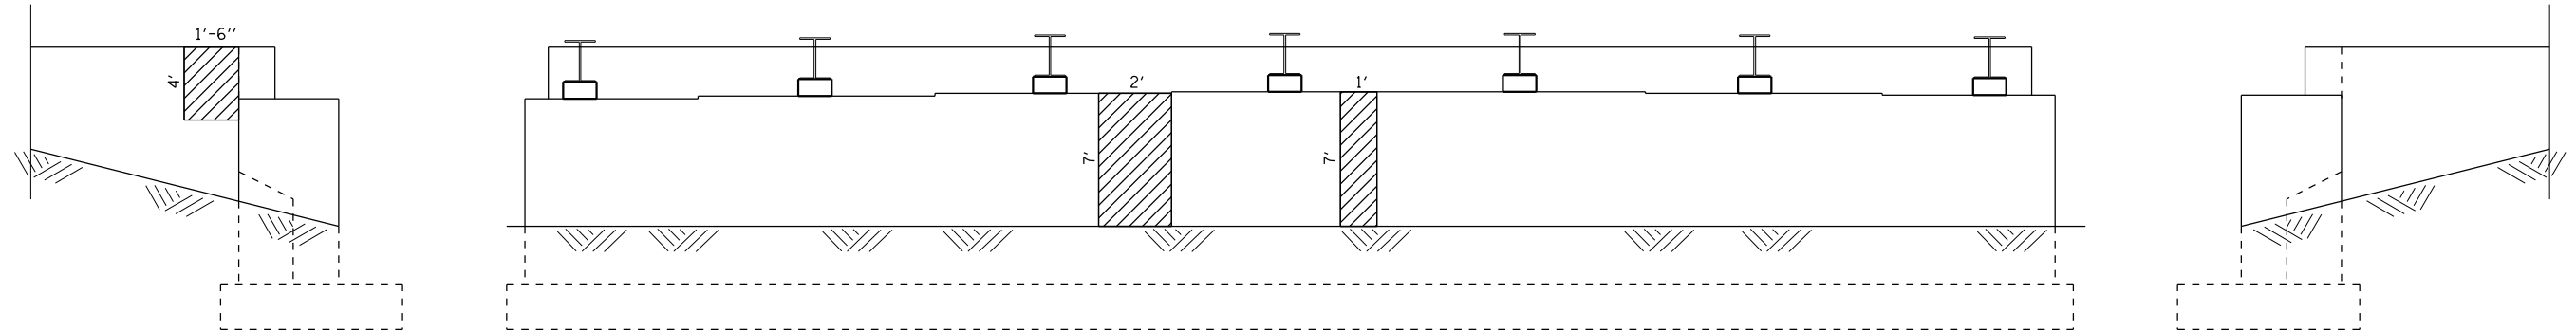

**ELEVATION - WEST ABUTMENT**

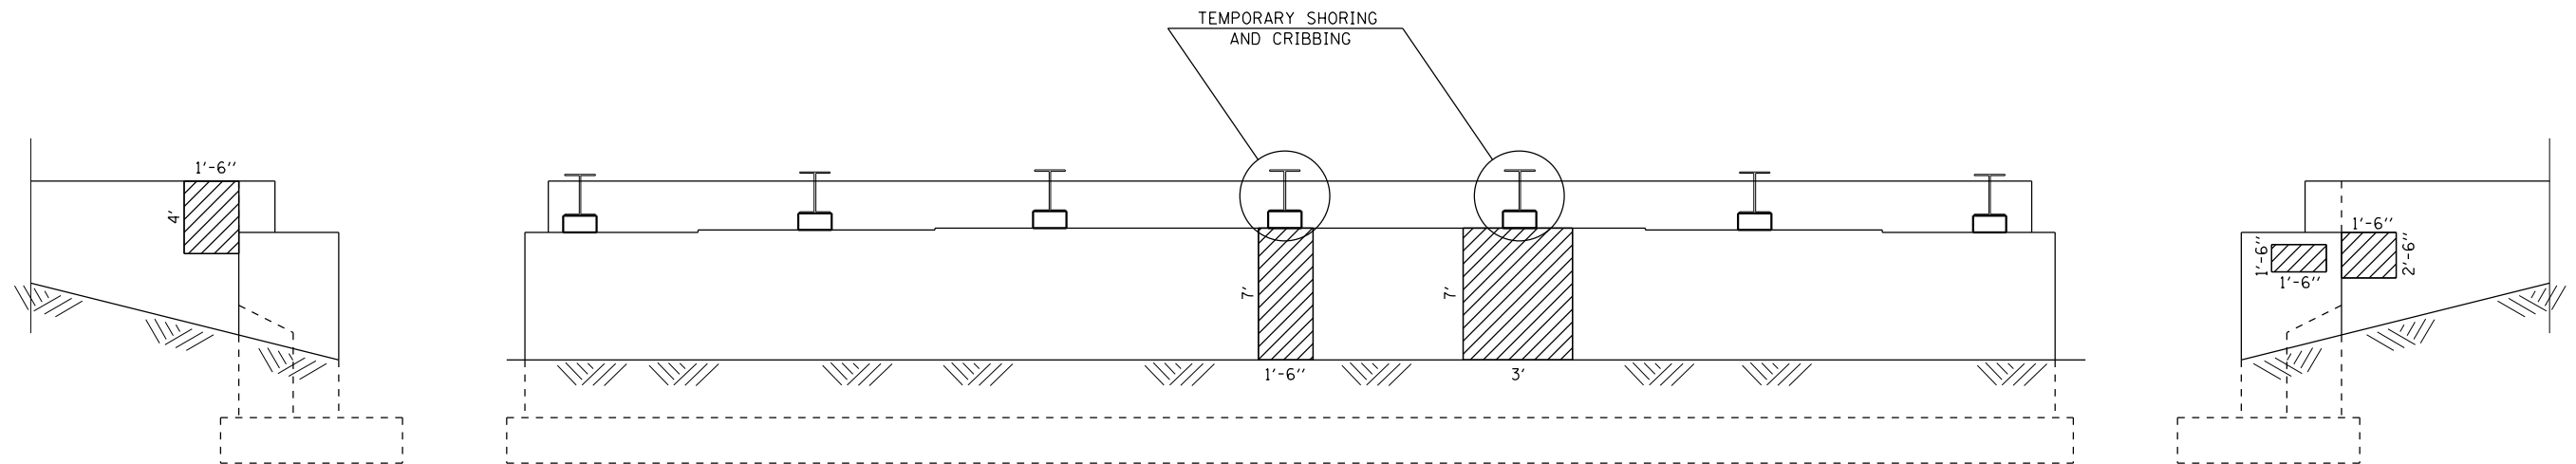

**ELEVATION - EAST ABUTMENT**

**STRESS TABLE**

INTERIOR BEAMS		
REACTIONS = KIPS		
	ABUTMENT	PIER
R <sub>DL</sub> (K)	19.76	61.09
R <sub>LL</sub> (K)	42.69	51.33
R <sub>TOTAL</sub> (K)	62.45	112.42

**NOTE:**

SEE SPECIAL PROVISION FOR STRUCTURAL REPAIR OF CONCRETE.  
SEE SPECIAL PROVISION FOR TEMPORARY SHORING AND CRIBBING.  
STRUCTURE REPAIR OF CONCRETE TO BE COMPLETED WITH JACK AND REMOVE EXISTING BEARINGS. TEMPORARY SHORING AND CRIBBING IF NECESSARY TO BE DETERMINED BY THE ENGINEER.


**LEGEND**

STRUCTURAL REPAIR OF CONCRETE, DEPTH EQUAL TO OR LESS THAN 5"


**BILL OF MATERIALS**

ITEM	UNIT	TOTAL
STRUCTURAL REPAIR OF CONCRETE (DEPTH LESS THAN OR EQUAL TO 5")	SQ FT	70.5
PROTECTIVE COAT	SQ YD	8.0
TEMPORARY SHORING AND CRIBBING	EACH	2.0


# PLAN FOR STRUCTURAL REPAIR OF CONCRETE ON PARAPETS S.N. 010-0014 (WB)

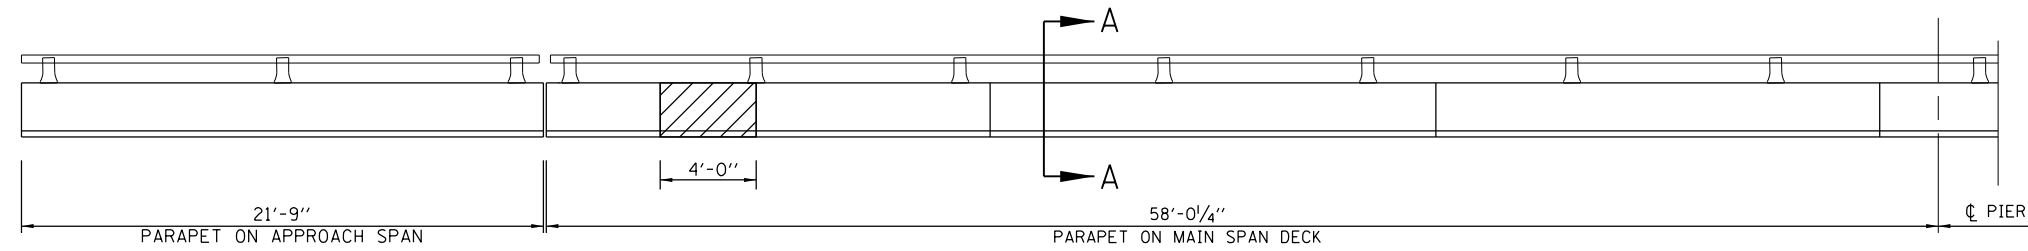


**ELEVATION: WEST HALF OF NORTH PARAPET**

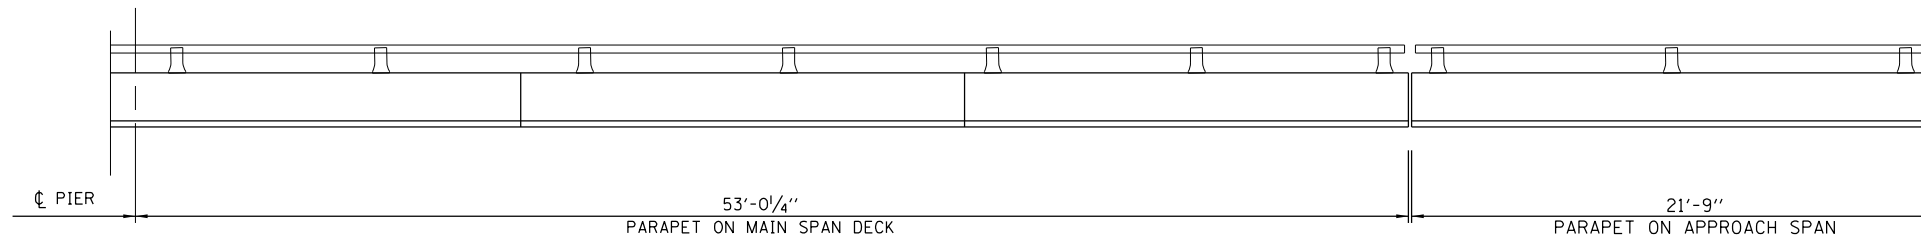


**ELEVATION: EAST HALF OF NORTH PARAPET**

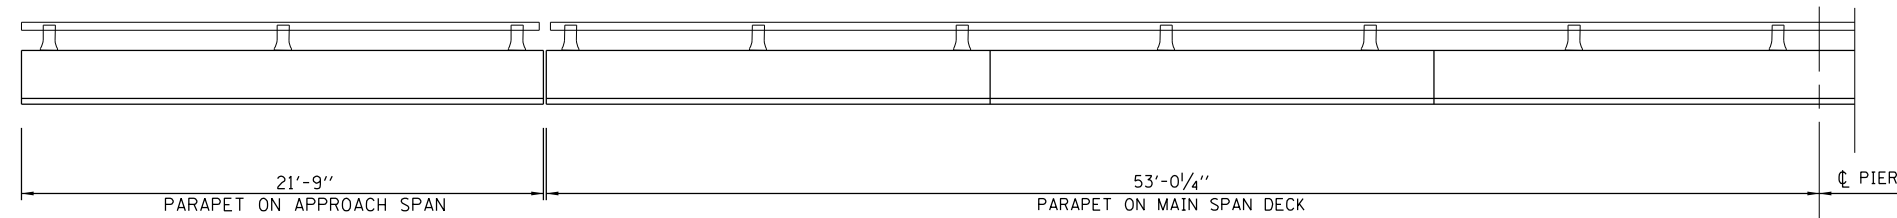

**ELEVATION: EAST HALF OF SOUTH PARAPET**

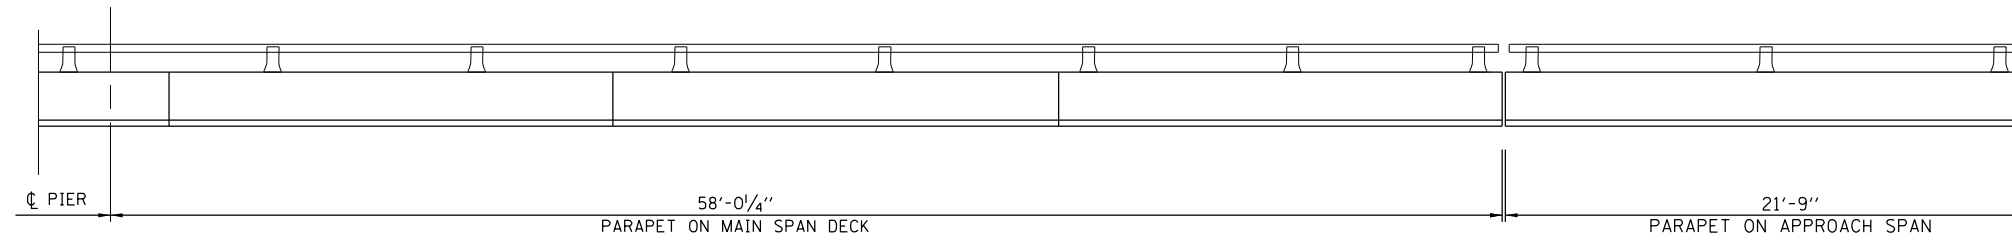


**ELEVATION: WEST HALF OF SOUTH PARAPET**

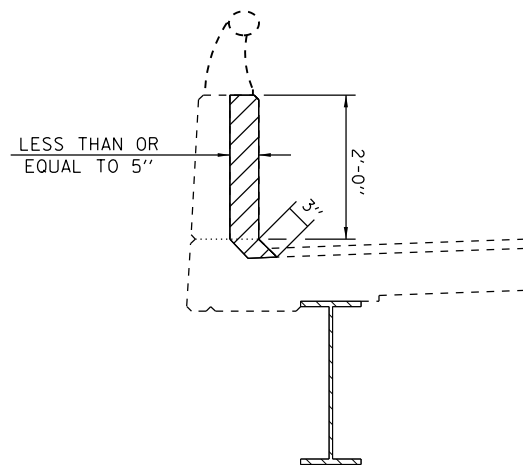

**SECTION A-A**

SHOWING TYPICAL REMOVAL LIMITS FOR  
STRUCTURAL REPAIR OF CONCRETE ON PARAPETS

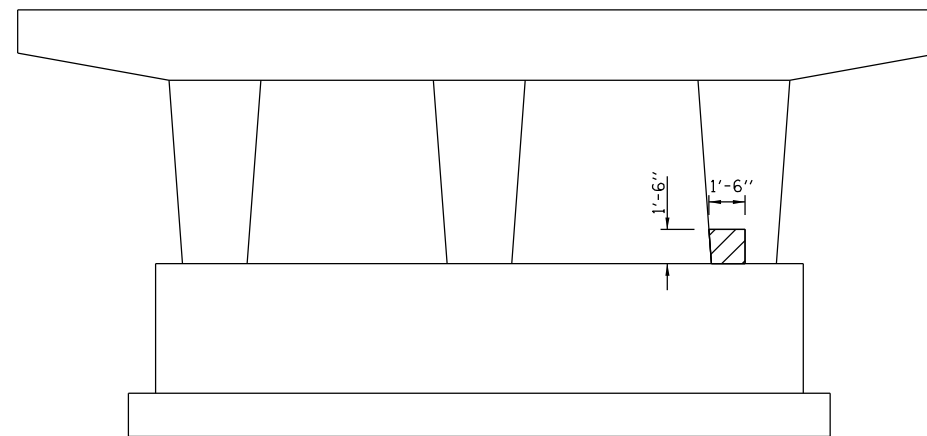

**ELEVATION: EAST SIDE OF PIER**


**NOTE:**  
SEE SPECIAL PROVISION FOR STRUCTURAL REPAIR OF CONCRETE.

**LEGEND**  
 STRUCTURAL REPAIR OF CONCRETE, DEPTH EQUAL TO OR LESS THAN 5"


**BILL OF MATERIALS**

ITEM	UNIT	TOTAL
STRUCTURAL REPAIR OF CONCRETE (DEPTH LESS THAN OR EQUAL TO 5")	SQ FT	9.0
PROTECTIVE COAT	SQ YD	1.0


# PLAN FOR STRUCTURAL REPAIR OF CONCRETE ON PARAPETS S.N. 010-0015 (EB)

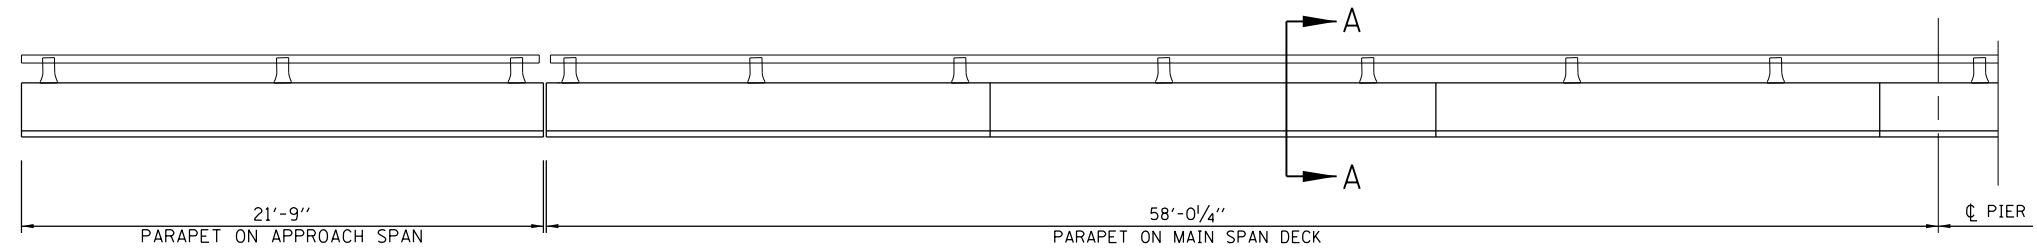


**ELEVATION: NORTH PARAPET WEST SPANS**

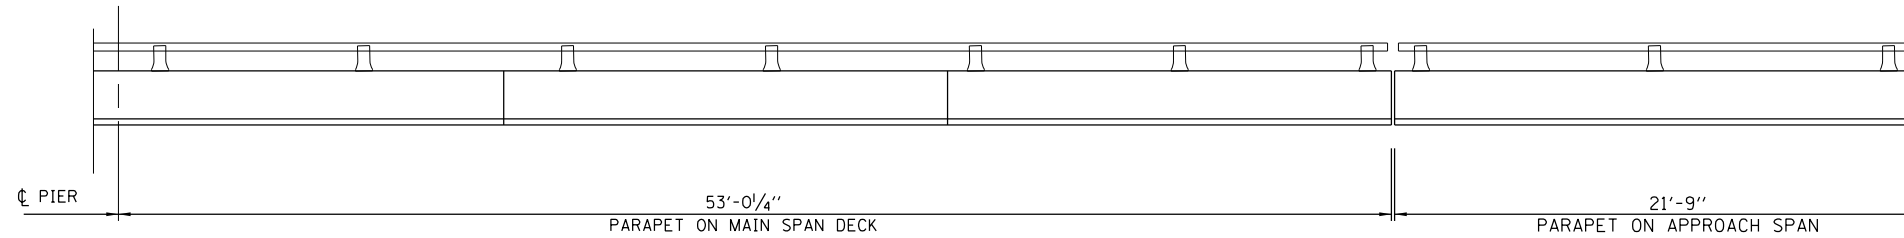


**ELEVATION: NORTH PARAPET EAST SPANS**

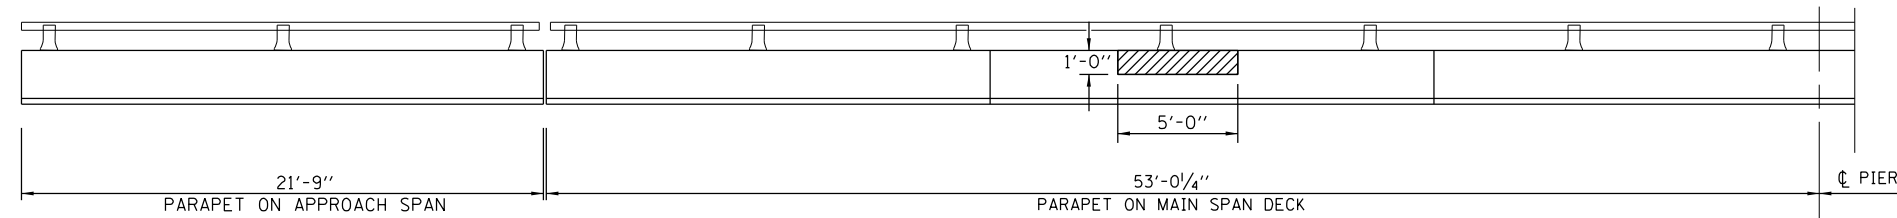

**ELEVATION: EAST HALF OF SOUTH PARAPET**

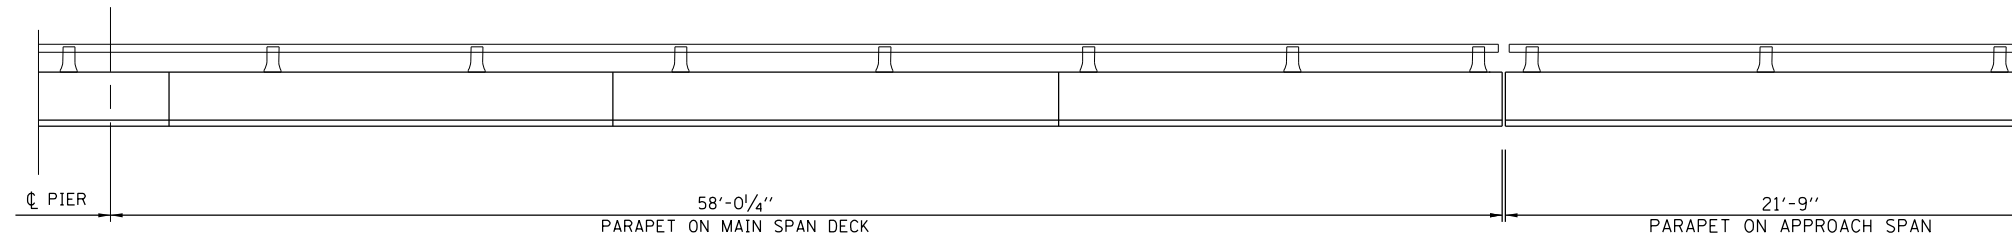

**ELEVATION: WEST HALF OF SOUTH PARAPET**

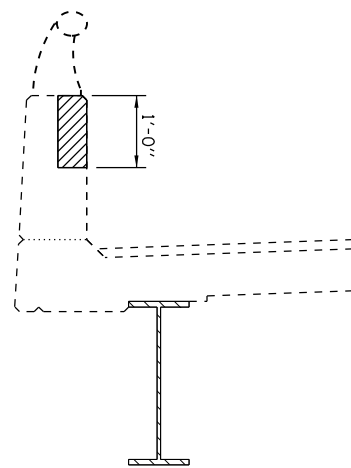


**SECTION A-A**  
SHOWING TYPICAL REMOVAL LIMITS FOR  
STRUCTURAL REPAIR OF CONCRETE ON PARAPETS

**NOTE:**  
SEE SPECIAL PROVISION FOR STRUCTURAL REPAIR OF CONCRETE.

**LEGEND**  
 STRUCTURAL REPAIR OF CONCRETE,  
DEPTH EQUAL TO OR LESS THAN 5"


**BILL OF MATERIALS**

ITEM	UNIT	TOTAL
STRUCTURAL REPAIR OF CONCRETE (DEPTH LESS THAN OR EQUAL TO 5")	SQ FT	5.0
PROTECTIVE COAT	SQ YD	1.0

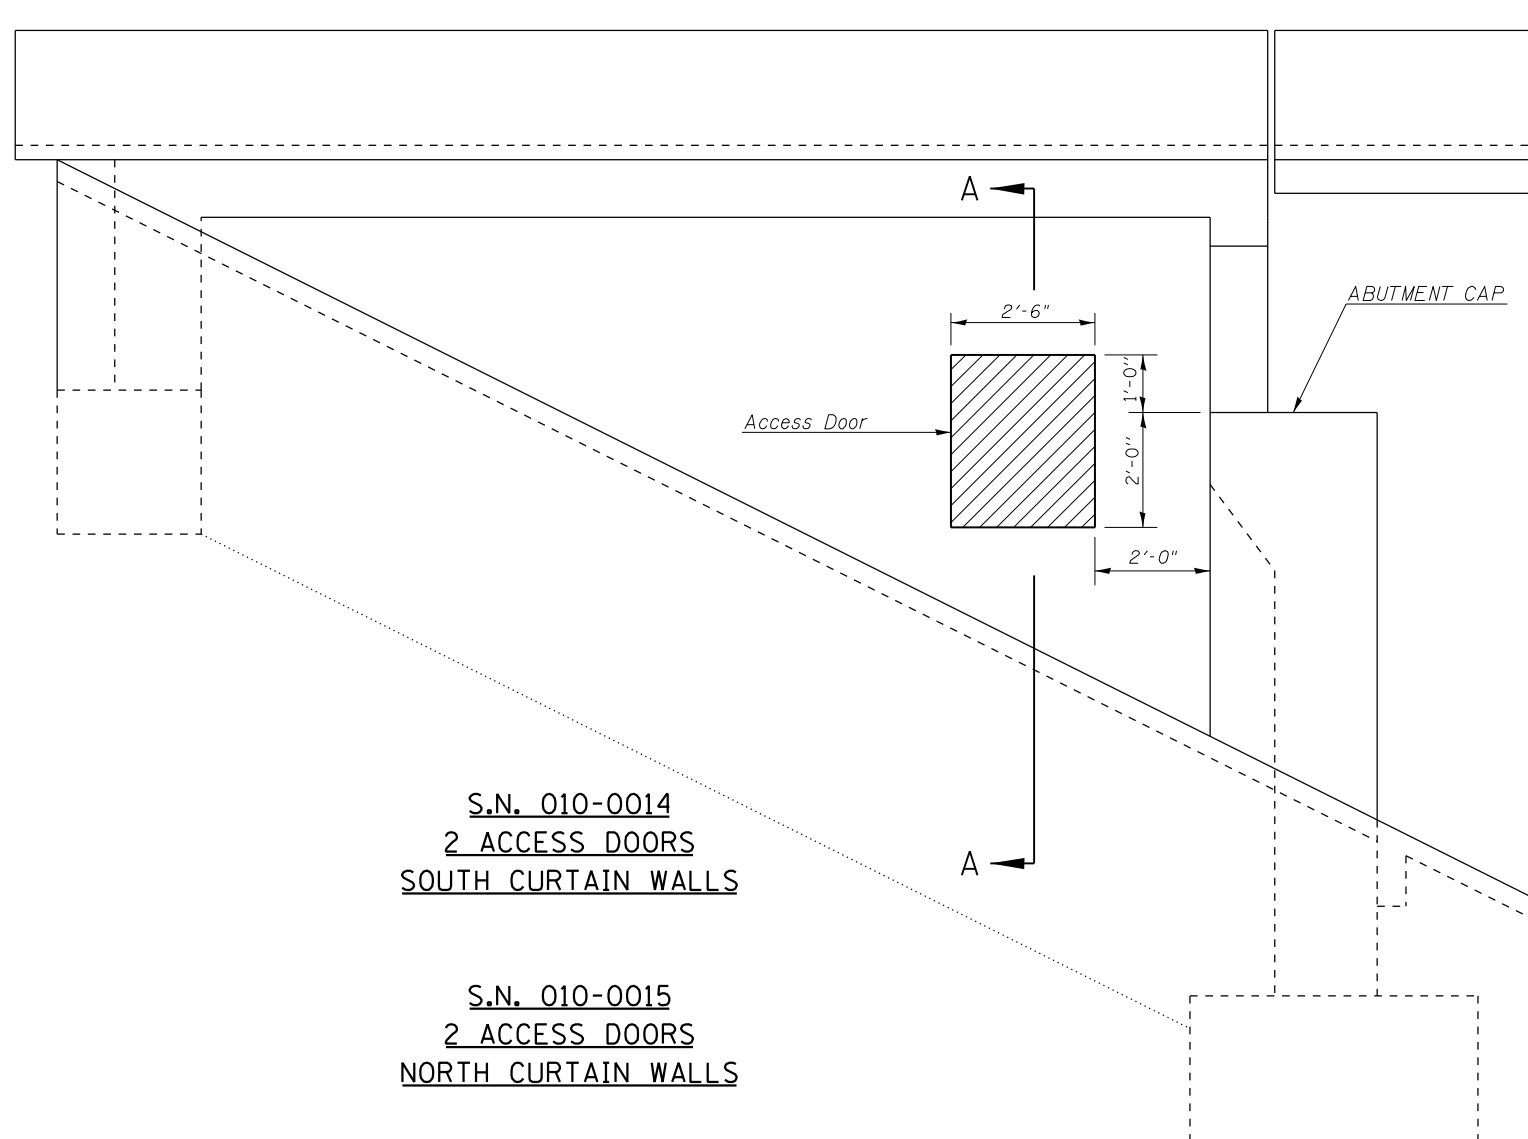


S.N. 010-0014  
2 ACCESS DOORS  
SOUTH CURTAIN WALLS

S.N. 010-0015  
2 ACCESS DOORS  
NORTH CURTAIN WALLS

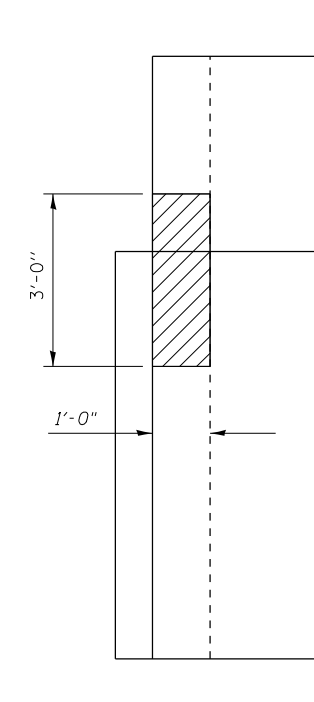


SECTION A-A

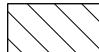 Concrete Removal

**NOTES**

EXPANSION BOLTS SHALL CONSIST OF SELF DRILLING EXPANSION SHIELDS  $\phi$  1/2" DIA. BOLTS. BOLTS SHALL EXTEND A MINIMUM OF 6" INTO EXISTING CONCRETE.

COST OF DOOR AND FRAME ARE INCLUDED WITH FURNISHING & ERECTING STRUCTURAL STEEL.

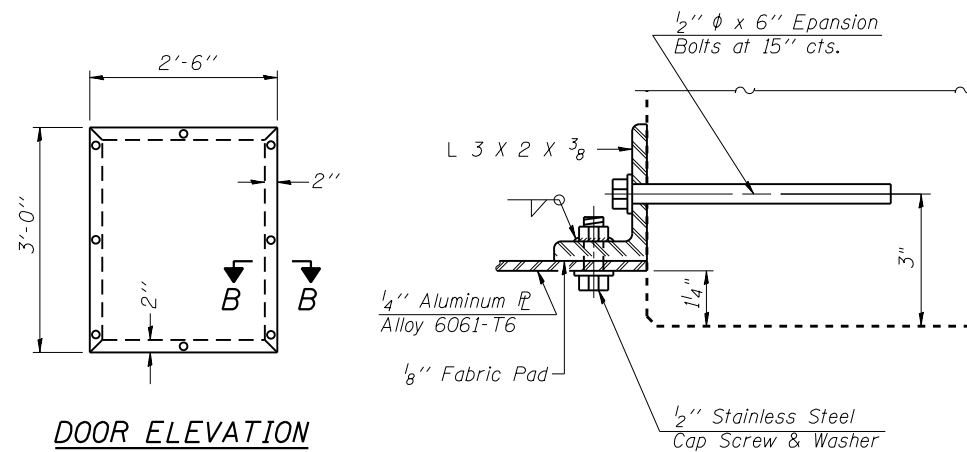

DOOR ELEVATION

SECTION B-B

**BILL OF MATERIALS**


ITEM	UNIT	TOTAL
CONCRETE REMOVAL	CU YD	1.2
FURNISHING AND ERECTING STRUCTURAL STEEL	POUND	400.0

FILE NAME =	USER NAME = shererjm	DESIGNED - ESS	REVISED -
Default	PLOT DATE = 8/8/2016	CHECKED -	REVISED -
		DATE - 12/18/2013	REVISED -

**STATE OF ILLINOIS  
DEPARTMENT OF TRANSPORTATION**

<b>ACCESS DOORS</b>			
<b>S.N. 010-0014 &amp; S.N. 010-0015</b>			
SCALE:	SHEET 22	OF 33 SHEETS	STA. TO STA.

F.A.I. RTE.	SECTION	COUNTY	TOTAL SHEETS	SHEET NO.
74	(10-4,10-5)I	CHAMPAIGN	74	28
CONTRACT NO. 70B15				
ILLINOIS FED. AID PROJECT				

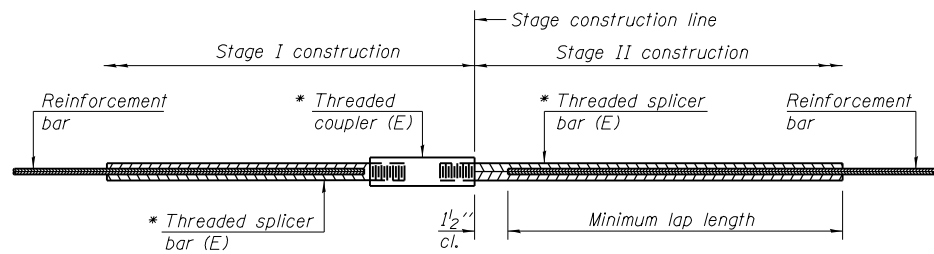

**STANDARD BAR SPLICER ASSEMBLY**


Bar size to be spliced	Minimum Lap Lengths					
	Table 1	Table 2	Table 3	Table 4	Table 5	Table 6
3, 4	1'-5"	1'-11"	2'-1"	2'-4"	2'-7"	2'-11"
5	1'-9"	2'-5"	2'-7"	2'-11"	3'-3"	3'-8"
6	2'-1"	2'-11"	3'-1"	3'-6"	3'-10"	4'-5"
7	2'-9"	3'-10"	4'-2"	4'-8"	5'-2"	5'-10"
8	3'-8"	5'-1"	5'-5"	6'-2"	6'-9"	7'-8"
9	4'-7"	6'-5"	6'-10"	7'-9"	8'-7"	9'-8"

- Table 1: Black bar, 0.8 Class C
- Table 2: Black bar, Top bar lap, 0.8 Class C
- Table 3: Epoxy bar, 0.8 Class C
- Table 4: Epoxy bar, Top bar lap, 0.8 Class C
- Table 5: Epoxy bar, Class C
- Table 6: Epoxy bar, Top bar top, Class C

Threaded splicer bar length = min. lap length + 1/2" + thread length


\* Epoxy not required on Bar Splicer Assembly components used in conjunction with black bars.

Structure No.	Location	Bar size	No. assemblies required	Table for minimum lap length
010-0014	HATCH BLOCK	6	4	3
	DECK END	5	28	3
010-0015	HATCH BLOCK	6	4	3
	DECK END	5	28	3

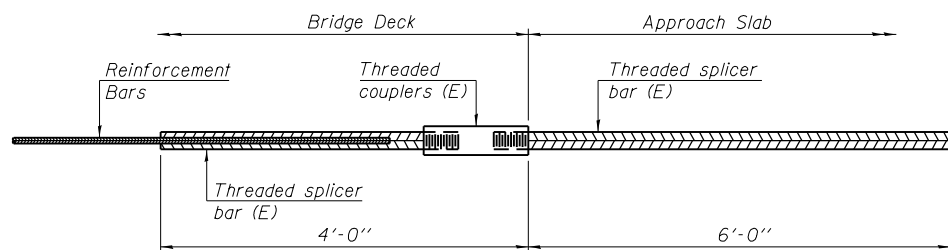


**BAR SPLICER ASSEMBLY FOR #5 BAR ON INTEGRAL OR SEMI-INTEGRAL ABUTMENTS**

No. required =

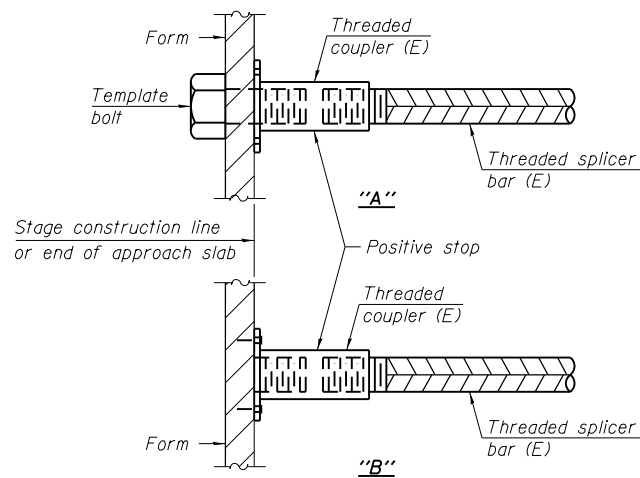


**INSTALLATION AND SETTING METHODS**

"A" : Set bar splicer assembly by means of a template bolt.  
 "B" : Set bar splicer assembly by nailing to wood forms or cementing to steel forms.  
 (E) : Indicates epoxy coating.

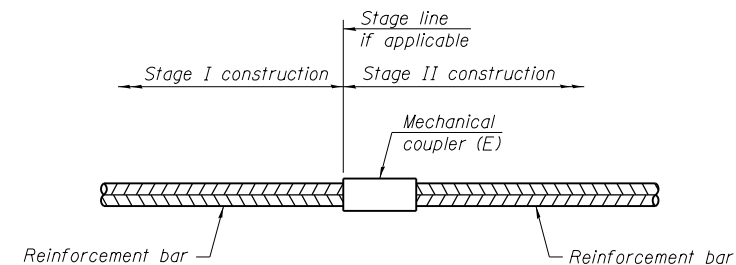

**STANDARD MECHANICAL SPLICER**

Location	Bar size	No. assemblies required

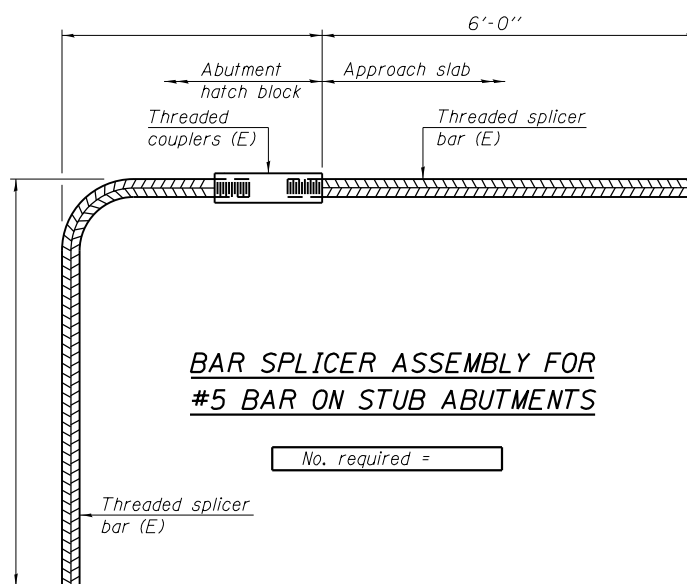


**BAR SPLICER ASSEMBLY FOR #5 BAR ON STUB ABUTMENTS**

No. required =

**NOTES**

Splicer bars shall be deformed with threaded ends and have a minimum 60 ksi yield strength.  
 All reinforcement shall be lapped and tied to the splicer bars.  
 Bar splicer assemblies shall be epoxy coated according to the requirements for reinforcement bars. See Section 508 of the Standard Specifications.  
 See approved list of bar splicer assemblies and mechanical splicers for alternatives.

BSD-1 1-27-12

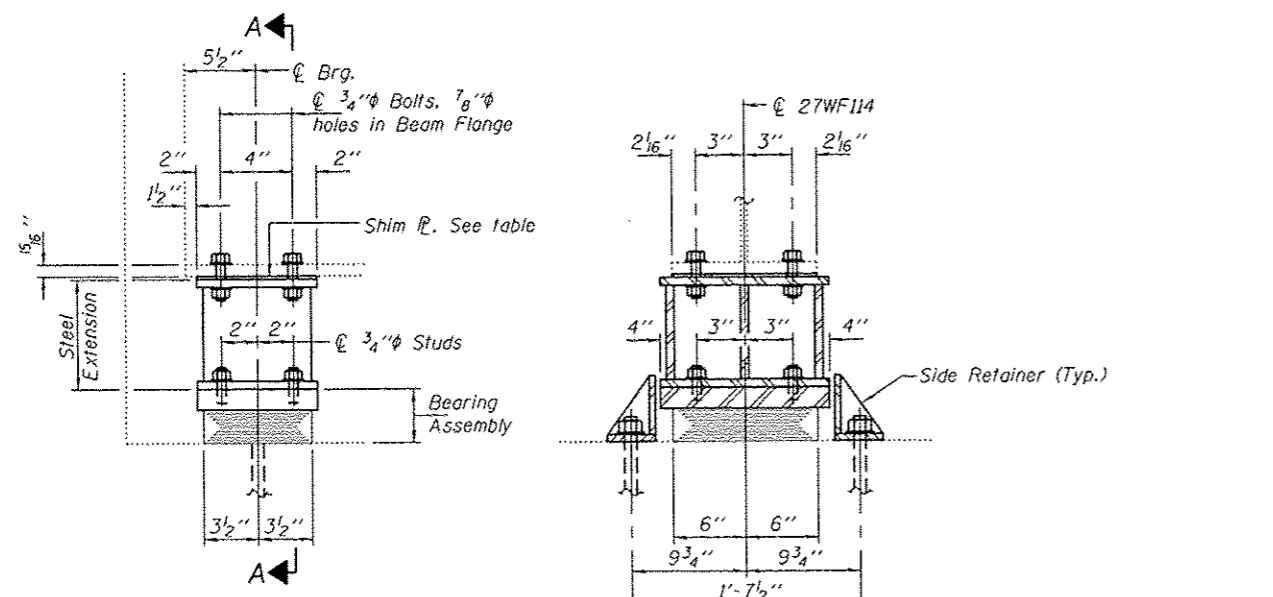

ELEVATION AT ABUTMENTS


SECTION A-A

TYPE I ELASTOMERIC EXP. BRG.


BEAM REACTIONS

R <sub>P</sub>	(K)	19.8
R <sub>L</sub>	(K)	33.5
Imp.	(K)	9.2
R (Total)	(K)	62.5

Notes:  
 Diaphragm removal and installation may be required to facilitate drilling holes. Cost included with Furnishing and Erecting Structural Steel.  
 New steel extensions, shim plates and connection bolts are included with Furnishing and Erecting Structural Steel.  
 Prior to ordering any material, the Contractor shall verify in the field all bearing height and shim thickness dimensions. Adjustment must account for deck heave due to pack rust (if present).  
 Min. jack capacity = 35 Tons.  
 Anchor bolts shall be ASTM F1554 all-thread (or an Engineer-approved alternate material) of the grade(s) and diameter(s) specified. ASTM A307 Grade C anchor bolts may be used in lieu of ASTM F1554 Grade 36 (F<sub>y</sub>=36ksi).  
 The corresponding specified grade of AASHTO M314 anchor bolts may be used in lieu of ASTM F1554.  
 Drilled and set anchor bolts shall be installed according to Article 521.06 of the Standard Specifications.  
 Side retainers shall be included in the cost of Elastomeric Bearing Assembly, Type I.

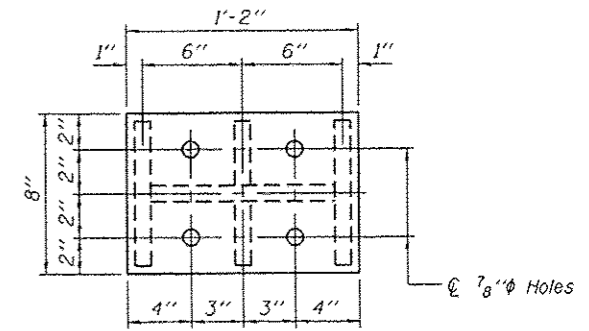

PLAN TOP AND BOTTOM PLATE

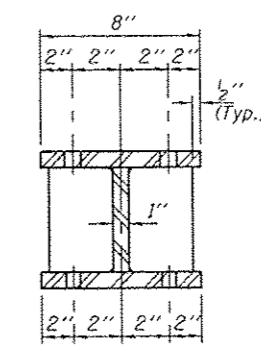

SECTION B-B

STEEL EXTENSION DETAIL


\* 9/4" E. Abut. Beam 7 SN 010-0015  
 \*\* 7/4" E. Abut. Beam 7 SN 010-0015

SHIM TABLE 010-0014

	Beam 1	Beam 2	Beam 3	Beam 4	Beam 5	Beam 6	Beam 7
W. Abut.	3/8"	-	-	1/2"	1/2"	3/8"	-
E. Abut.	3/8"	-	-	1/2"	1/2"	3/8"	-


SHIM TABLE 010-0015

	Beam 1	Beam 2	Beam 3	Beam 4	Beam 5	Beam 6	Beam 7
W. Abut.	-	1/4"	1/8"	-	-	-	-
E. Abut.	-	1/4"	1/8"	-	-	-	-

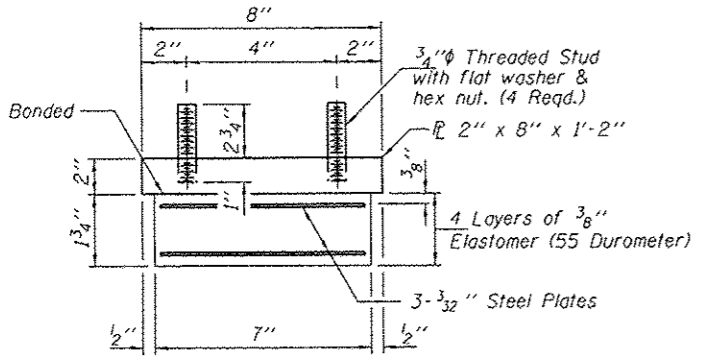


BEARING ASSEMBLY

Note:  
 Shim plates shall not be placed under Bearing Assembly.

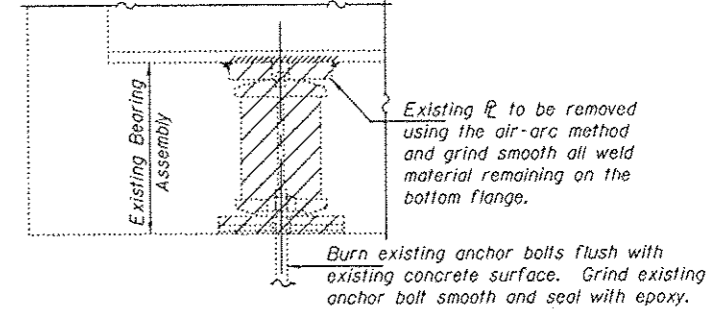


EXISTING BEARING REMOVAL DETAIL

Cost included with Jack and Remove Existing Bearings.

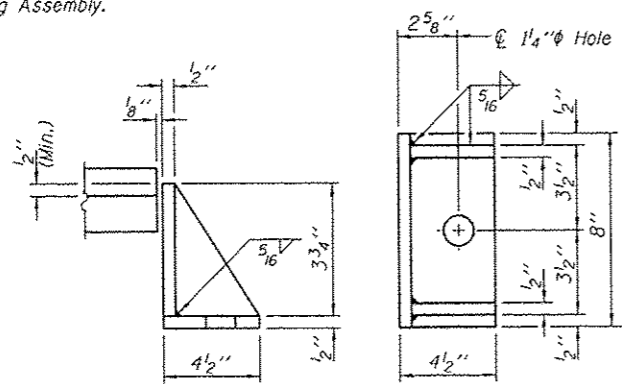

SIDE RETAINER

Equivalent rolled angle with stiffeners will be allowed in lieu of welded plates.

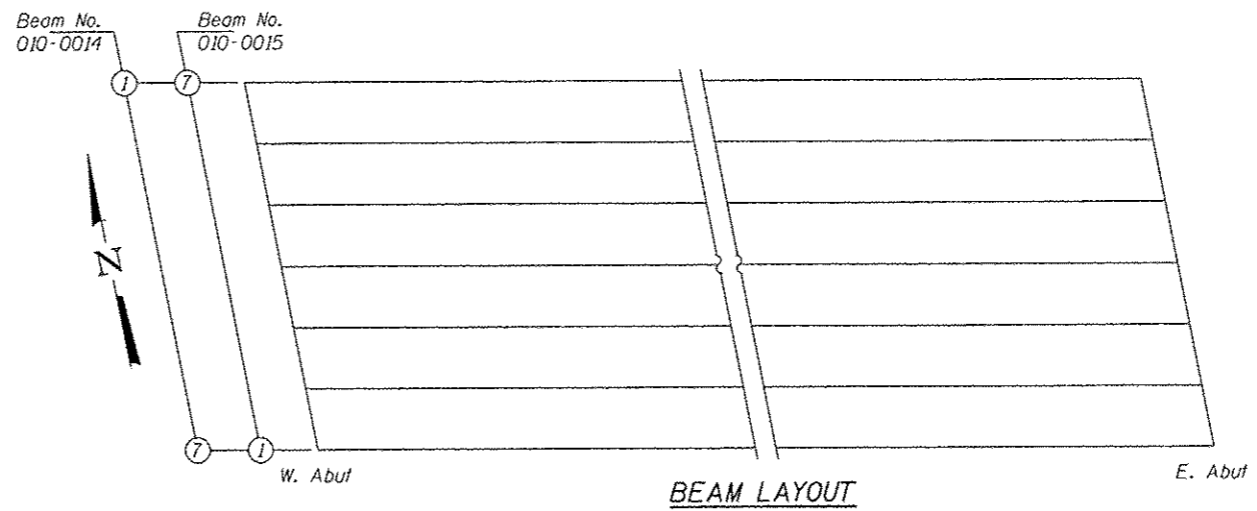

BEAM LAYOUT

BILL OF MATERIAL 010-0014

Item	Unit	Total
Elastomeric Bearing Assembly, Type I	Each	14
Jack and Remove Existing Bearings	Each	14
Furnishing and Erecting Structural Steel	Pound	1920
Anchor Bolts 1"φ	Each	28

BILL OF MATERIAL 010-0015

Item	Unit	Total
Elastomeric Bearing Assembly, Type I	Each	14
Jack and Remove Existing Bearings	Each	14
Furnishing and Erecting Structural Steel	Pound	1890
Anchor Bolts 1"φ	Each	28

TYI/REPS 12-03-2008


DESIGNED SMR  
 CHECKED DAB  
 DRAWN baliva  
 CHECKED SMR DAB

DATE SEPTEMBER 23, 2016  
 PASSED  
 ACTING ENGINEER OF BRIDGES AND STRUCTURES


STATE OF ILLINOIS  
 DEPARTMENT OF TRANSPORTATION

ABUTMENT BEARING REPLACEMENT DETAILS  
 SN 010-0014 (WB) & 0015 (EB)


F.A.I. RTE. 74  
 SECTION (10-4,10-5)  
 COUNTY CHAMPAIGN  
 TOTAL SHEETS 74  
 SHEET NO. 30  
 CONTRACT NO. 70B15  
 ILLINOIS FED. AID PROJECT

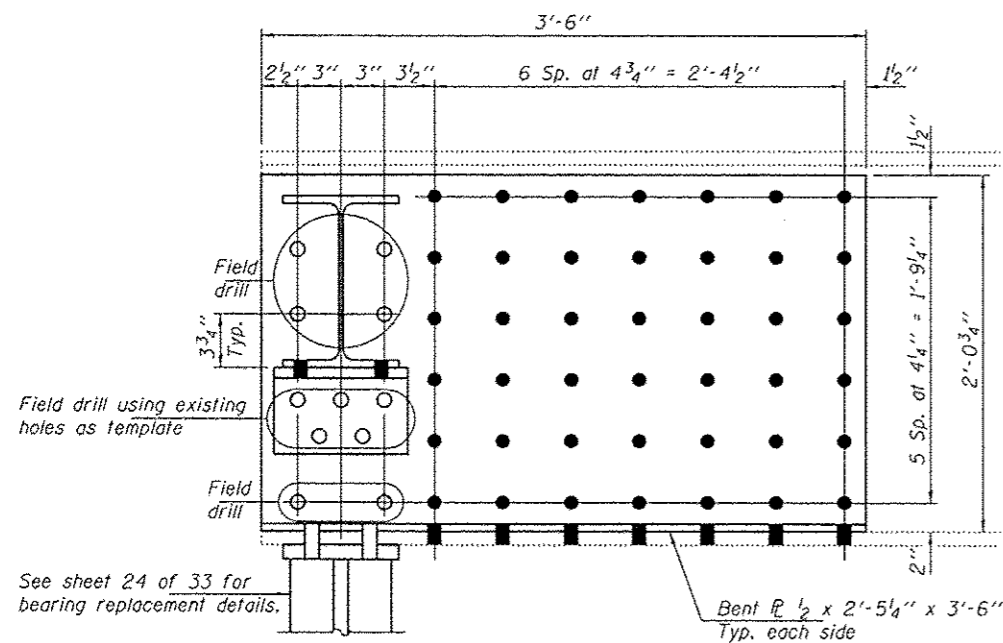

REPAIR A

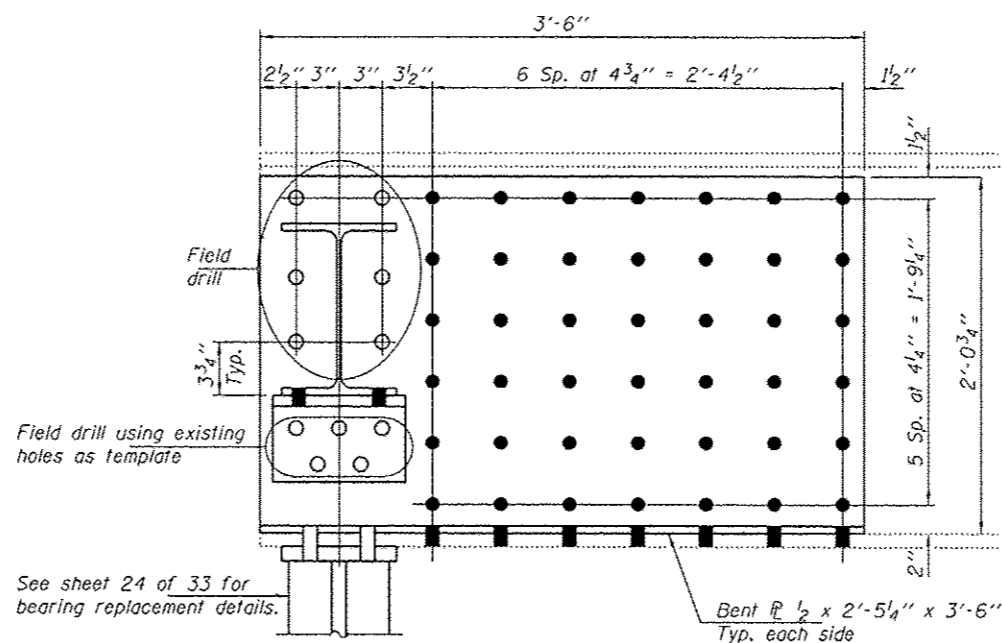


REPAIR B

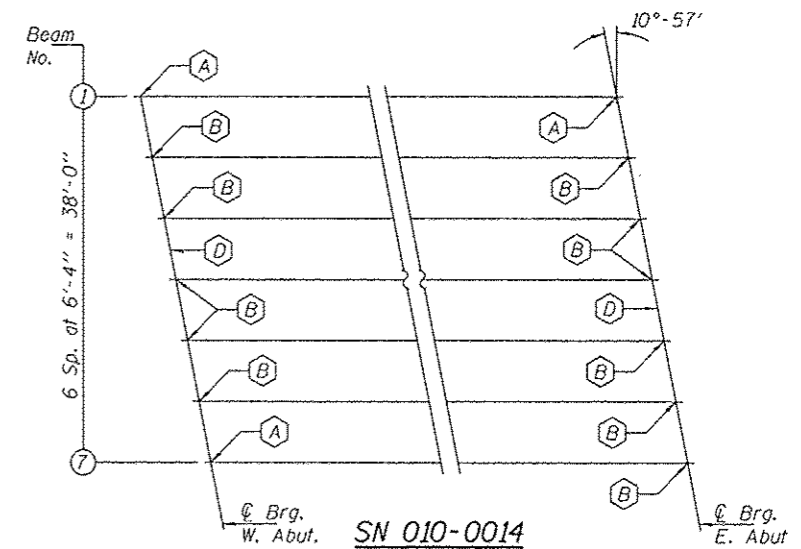


SN 010-0014


● Field drill holes in existing steel using new steel as template.

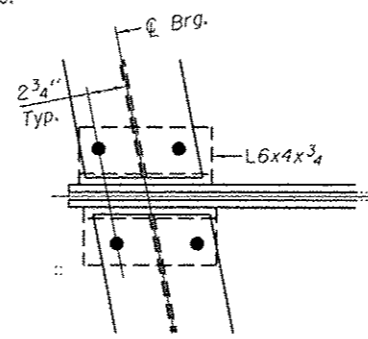


PLAN REPAIR D

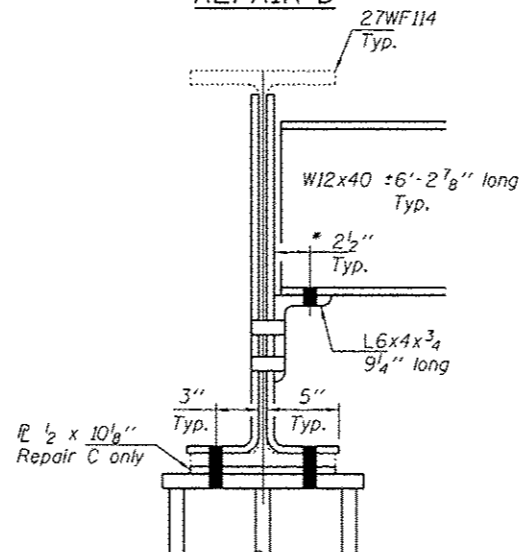


ELEVATION REPAIR D

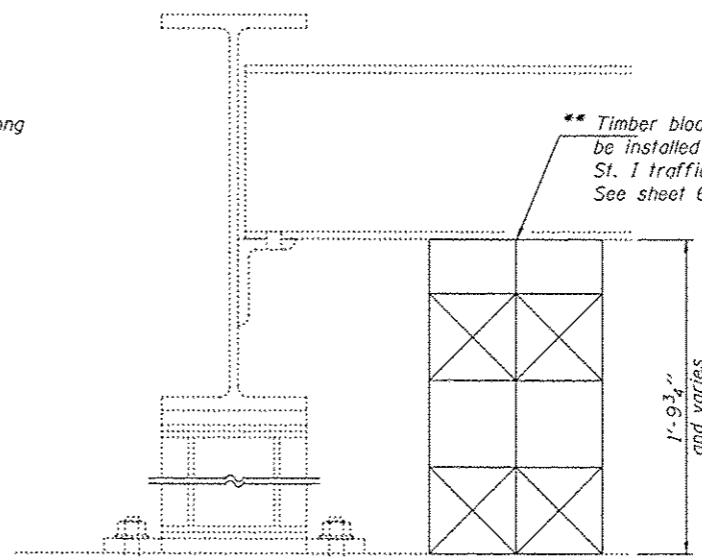

ELEVATION REPAIR E

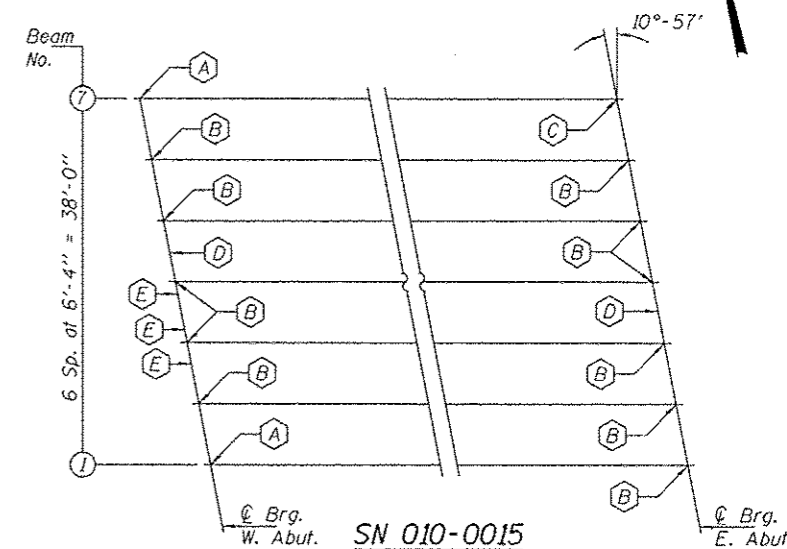

SN 010-0015

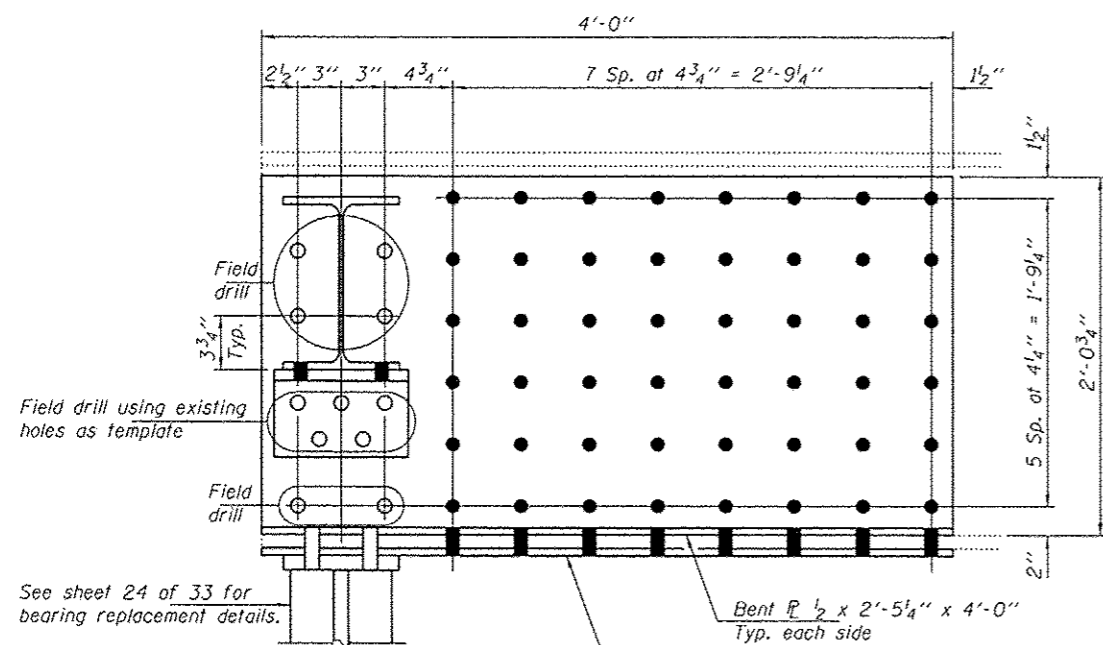

REPAIR C

REPAIR LOCATION PLAN

- Ⓐ - Beam end repair
- Ⓑ - Beam end repair
- Ⓒ - Beam end repair
- Ⓓ - Diaphragm & clip angle replacement, Typ. all
- Ⓔ - Timber blocking

BILL OF MATERIAL 010-0014

Item	Unit	Total
Structural Steel Removal	Pound	3560
Furnishing and Erecting Structural Steel	Pound	9130

BILL OF MATERIAL 010-0015

Item	Unit	Total
Structural Steel Removal	Pound	3560
Furnishing and Erecting Structural Steel	Pound	9270

Cleaning & painting of all connections on this sheet shall meet the requirements for Primary Connections as specified in the special provision for "Cleaning and Painting Contact Surface Areas of Existing Steel Structures".  
Fasteners shall be high strength bolts. Bolts 7/8"φ, open holes 15/16"φ, unless otherwise noted.  
Diaphragm connection holes shall be 15/16"φ for 3/4"φ bolts. Two hardened washers shall be required at diaphragm connections.

STATE OF ILLINOIS  
DEPARTMENT OF TRANSPORTATION

REPAIR DETAILS  
SN 010-0014 (WB) & 0015 (EB)

F.A.I. RTE.	SECTION	COUNTY	TOTAL SHEETS	SHEET NO.
74	(10-4,10-51)	CHAMPAIGN	74	30A

DESIGNED DAB  
CHECKED ATH  
DRAWN baliva  
CHECKED DAB ATH

PASSED


*Carl Perry*  
ACTING ENGINEER OF BRIDGES AND STRUCTURES

DATE SEPTEMBER 23, 2016  
REVISED  
REVISED

SHEET NO. 24A OF 33 SHEETS

ILLINOIS FED. AID PROJECT

When "A" is 3'-6" or less, the temporary concrete barrier shall be anchored to the new slab according to Detail I or Detail II. No anchorage is required when "A" is greater than 3'-6".

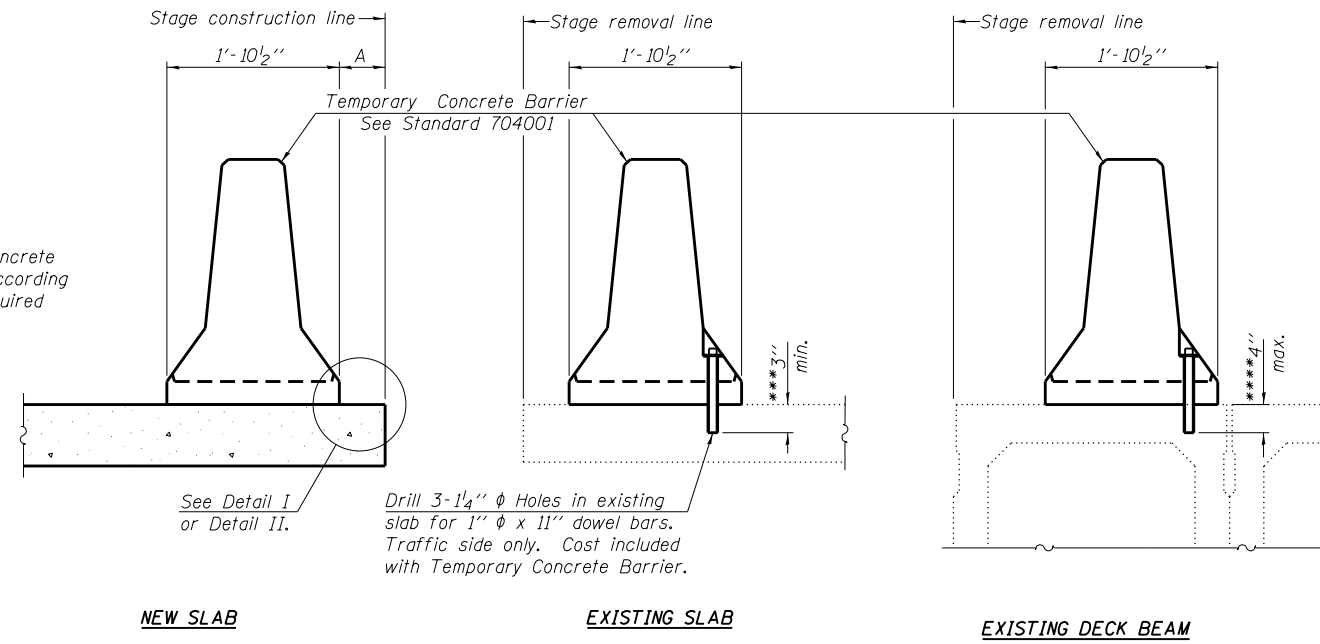

**SECTIONS THRU SLAB OR DECK BEAM**

**NOTES**


Detail I - With Bar Splicer or Couplers:  
Connect one (1) 1" x 7" x "W" steel  $\bar{L}$  to the top layer of couplers with 2-5/8"  $\phi$  bolts screwed to coupler at approximate  $\bar{C}$  of each barrier panel.

Detail II - With Extended Reinforcement Bars:  
Connect one (1) 1" x 7" x "W" steel  $\bar{L}$  to the concrete slab or concrete wearing surface with 2-5/8"  $\phi$  Expansion Anchors or cast in place inserts spaced between the top layer of reinforcement at approximate  $\bar{C}$  of each barrier panel.


Cost of anchorage is included with Temporary Concrete Barrier. The 1" x 7" x "W" plate shall not be removed until stage II construction forms and all reinforcement bars are in place and the concrete is ready to be placed.

\*\*\* Dimension shown is minimum required embedment into concrete. If hot-mix asphalt wearing surface is present, minimum embedment shall be in addition to wearing surface depth.


\*\*\*\* If existing deck beam is to remain in place after stage construction, embedment shall only be into wearing surface and not into existing deck beam concrete.

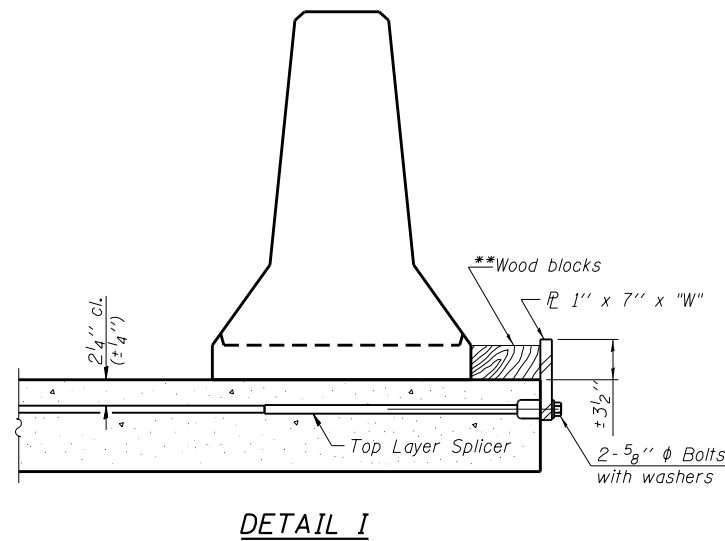

**DETAIL I**

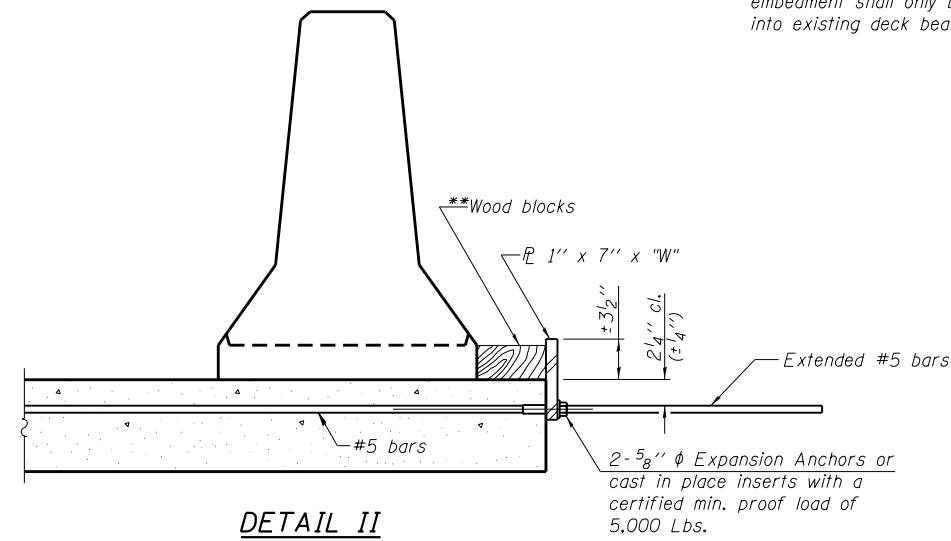

**DETAIL II**

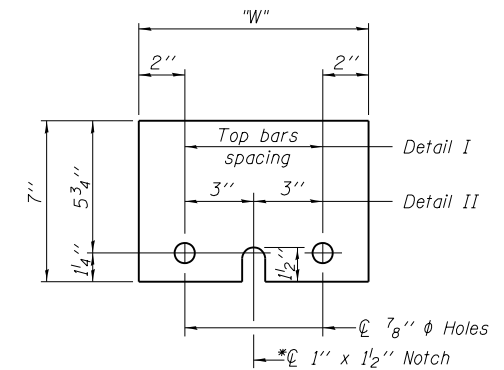

**STEEL RETAINER  $\bar{L}$  1" x 7" x "W"**

\* Required only with Detail II

\*\* Wood blocks may be omitted when required to provide minimum stage traffic lane width. When the wood blocks are omitted, the concrete barrier shall be in direct contact with the steel retainer plate.

"W" = Top bars spacing + 4"





R-27

7-1-10

FILE NAME =	USER NAME = sherer,jm	DESIGNED -	REVISED -	<b>STATE OF ILLINOIS DEPARTMENT OF TRANSPORTATION</b>	<b>SUPERSTRUCTURE REPAIR DETAIL S.N. 010-0014 &amp; 010-0015</b>	F.A.I. R.T.E.	SECTION	COUNTY	TOTAL SHEETS	SHEET NO.
p:\11\084EBIDINTEG.illinois.gov\PIWIDOT\Documents\DOT Offices\District 5\Projects\0577\Drawings\Structures\05770B15-sht-Repairs	DRAWN	CHECKED -	REVISED -			74	(10-4,10-5)I	CHAMPAIGN	74	31
PLOT SCALE = 40.0000' / in.	CHECKED -	REVISED -	REVISED -			CONTRACT NO. 70B15				
PLOT DATE = 8/8/2016	DATE -	REVISED -	REVISED -			ILLINOIS FED. AID PROJECT				
				SCALE:	SHEET 25 OF 33 SHEETS	STA.	TO STA.			




# AS-BUILT PLANS FOR INFORMATION ONLY

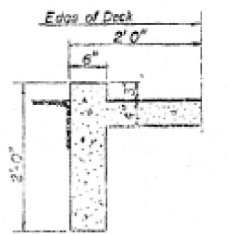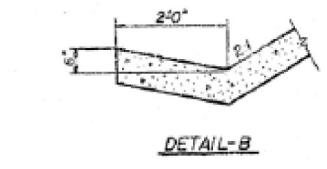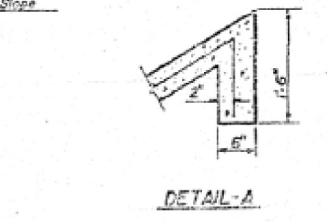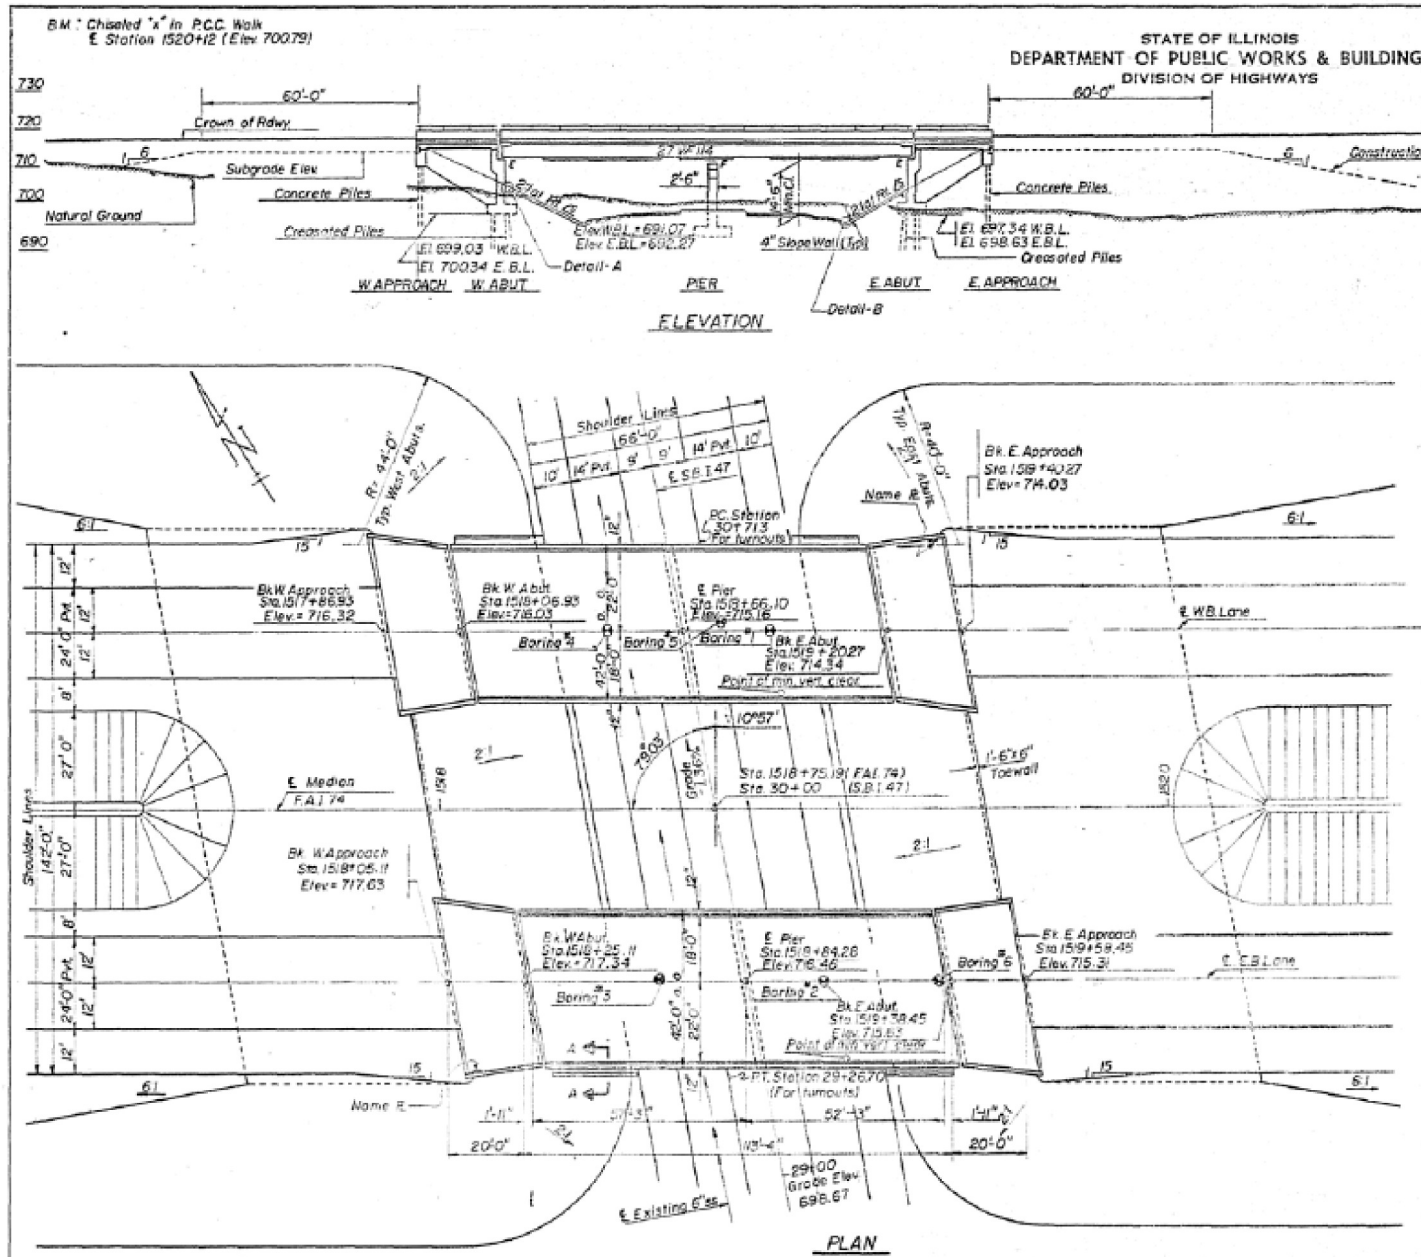

STATION 1518+75.19  
BALT 196 BY  
STATE OF ILLINOIS  
FAI RT. 74 SECTION 10-4HB  
FAI PROJECT 1-74-5 (38)  
LOADING HS 20 BALT.

NAME PLATE  
See Sid. 213-1

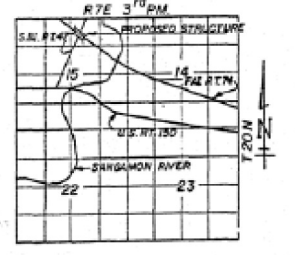


**DESIGN STRESSES**  
 $f_c = 1400$  psi Super & Sub.  
 $f_s = 20,000$  psi Reinf.  
 $f_s = 20,000$  psi Struct. (A36)  
 $n = 10$   
 $\Delta$  Deflection =  $\frac{Span}{1000}$   
**LOADING HS: 20-44B ALTERNATE.**

DESIGNED: *[Signature]*  
 CHECKED: *[Signature]*  
 DRAWN: *[Signature]*  
 CHECKED: *[Signature]*

EXAMINED: *[Signature]*  
 PASSED: *[Signature]*  
 APPROVED: *[Signature]*

July 28 1965

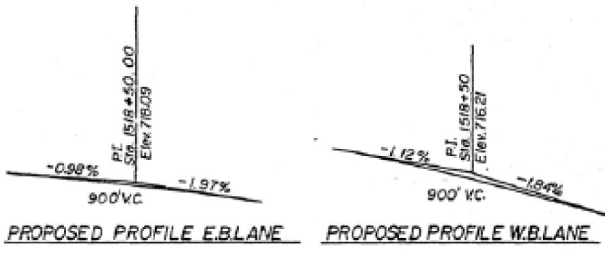

PROJECT NO.	SECTION	TOTAL SHEETS	SHEET NO.
1-74-5	CHAMPAIGN	42	13
12 SHEETS			

**GENERAL NOTES**

Coarse aggregate to be used in parapet handrails and wingwalls must be absolutely free of chert, flint, limestone, lignite and soft sandstone.

The concrete floor slabs shall be finished in accordance with Article 51.19 of the Standard Specifications.

Slope Wall shall be reinforced with welded wire fabric 6"x6" mesh, weighing 58 lbs. per 100 sq. ft.

All reinforcement bars shall be lapped 20 diameters unless otherwise shown.

All Structural Steel shall conform to ASTM specifications for Structural Steel designation A-36.

Rivets 3/8" open holes 1/2" unless otherwise noted.

Anchor bolts shall be set before riveting diaphragms over supports.

All rockers, bolsters, bearing plates, lead plates, pintles and anchor bolts shall be fabricated and set in accordance with Article 51.15 of the Standard Specifications and are included in quantity of Structural Steel. Estimated weight 9770 lbs.

The exposed surfaces of the expansion guard shall be given two shop coats of red lead paint, the contact surfaces shall be given one coat of red lead paint. Anchor studs shall not be painted.

Expansion guards are included in the quantity of Structural Steel. Estimated weight 4530 lbs.

Except as otherwise provided, all Structural Steel shall receive one shop coat of red lead paint and two field coats of aluminum paint. See Article 56.1 to 56.5 inclusive of Standard Specifications.

The Contractor shall drive two concrete test piles, one at the West Approach, West Bound Lanes and another at the East Approach, East Bound Lanes; two timber test piles one in the vicinity of the West Abutment, West Bound Lanes and another in the vicinity of the East Abutment, East Bound Lanes. All test piles shall be driven as directed by the Engineer and before creating the remainder of piles.

Excavations for portions of structures in the embankments shall not be classified.

Permanent forms will not be permitted in forming the concrete deck.

**STRESS TABLE (Int. Bm.)**

D.L.	MOMENTS - Ft. kips.		REACTIONS - kips.	
	Span	Pier	Abut	Pier
L.L. + Imp.	447.12	313.65	42.69	51.33
Total	665.44	646.90	62.45	112.42

Total 27 WF14s = 4080.5 lbs.  
Cover Plates 9"x9" Top & Bottom of Midspans & Pier


**TOTAL BILL OF MATERIAL**

Item	Unit	Super	Sub	Total
Class A Excavation for Structures	Cu. Yds.		830	830
Structural Steel	Lbs.	260650		260650
Class "x" Concrete	Cu. Yds.	4088	410.3	8991
Aluminum Handrail	Lin. Ft.	619		619
Reinforcement Bars	Lbs.	102730	36020	138750
Crossed Piles	Lin. Ft.	1992	1992	
Test Piles Timber	Each	2	2	
Concrete Piles	Lin. Ft.	93	93	
Test Piles Concrete	Each	2	2	
Name Plates	Each	2		2
Slope Wall	Sq. Yds.		1150	1150
Protective Coat	Sq. Yds.	1620		1620
Bridge Seat Sealant	lump/sum	L.S.		L.S.

\* Includes excavation for Slope walls.  
+ Bridge seat sealant applied at Abutments only.

**GENERAL PLAN & ELEVATION**  
 PROJECT 1-74-5(38)174  
 FAI RT. 74 - SECTION 10-4HB  
 CHAMPAIGN COUNTY  
 STATION 1518+75.19 (FAI 74)  
 STATION 30+00 (S.B.I. 47)


# AS-BUILT PLANS FOR INFORMATION ONLY

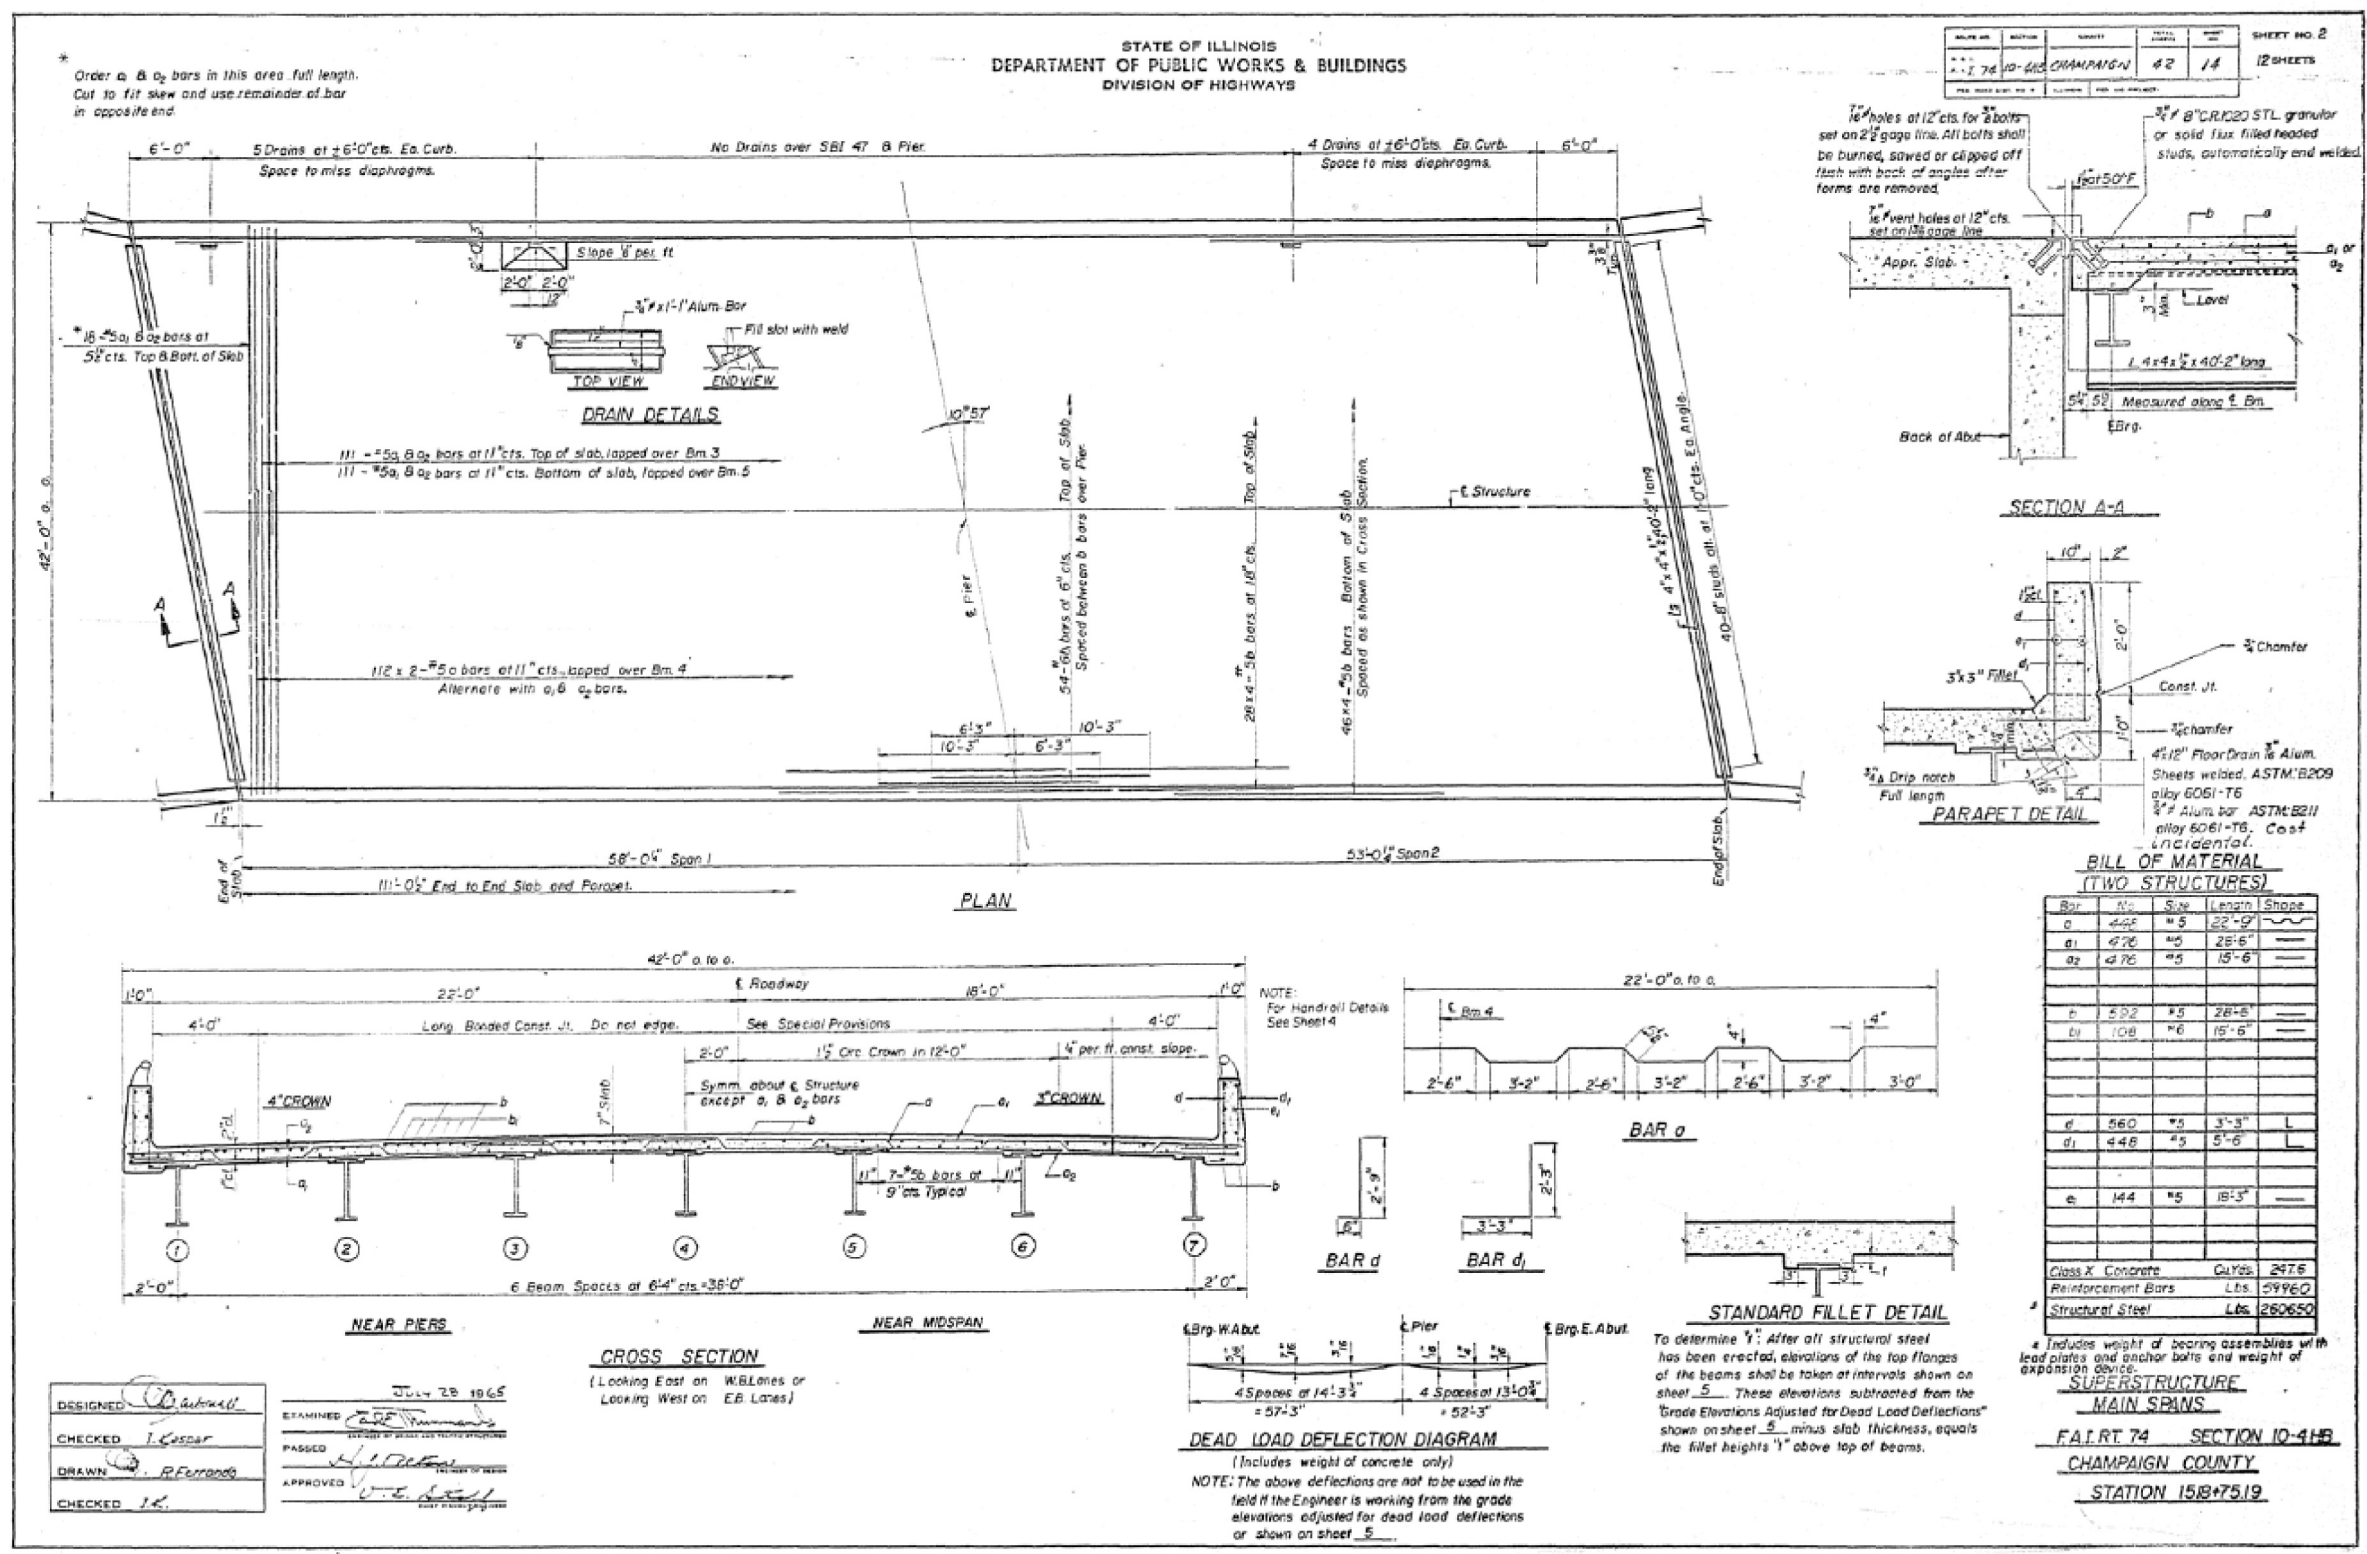


# AS-BUILT PLANS FOR INFORMATION ONLY

STATE OF ILLINOIS  
DEPARTMENT OF PUBLIC WORKS & BUILDINGS  
DIVISION OF HIGHWAYS

SHEET NO. 3	TOTAL SHEETS
74	15
CONTRACT NO. 70B15	

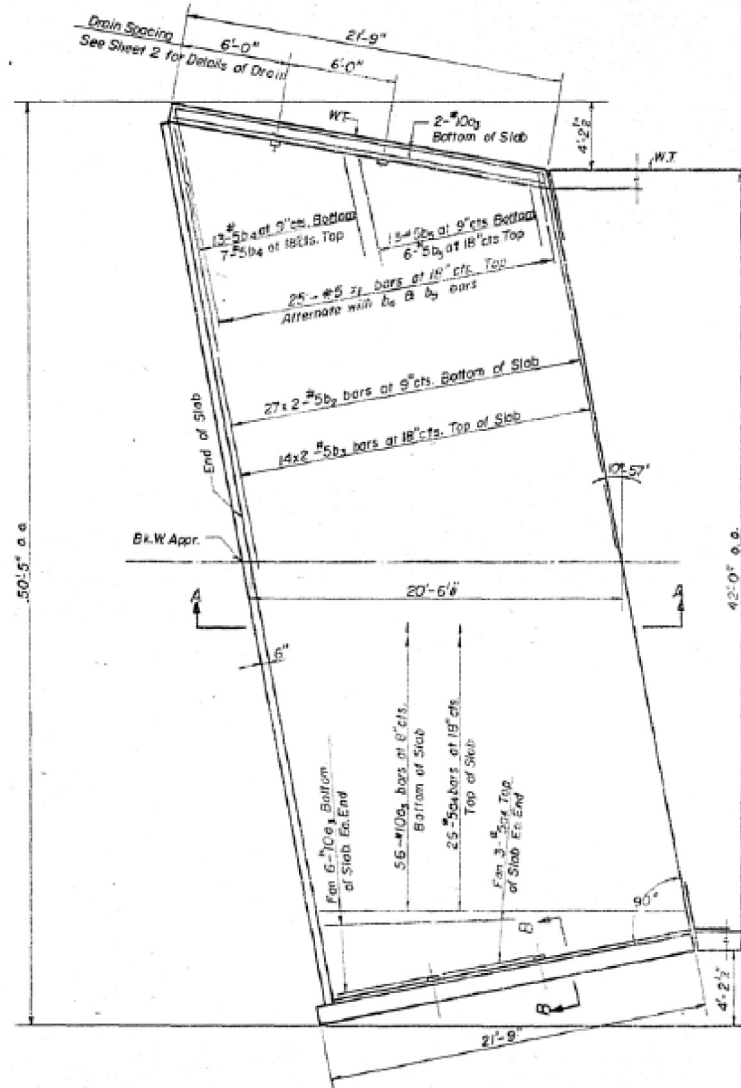


**PLAN**

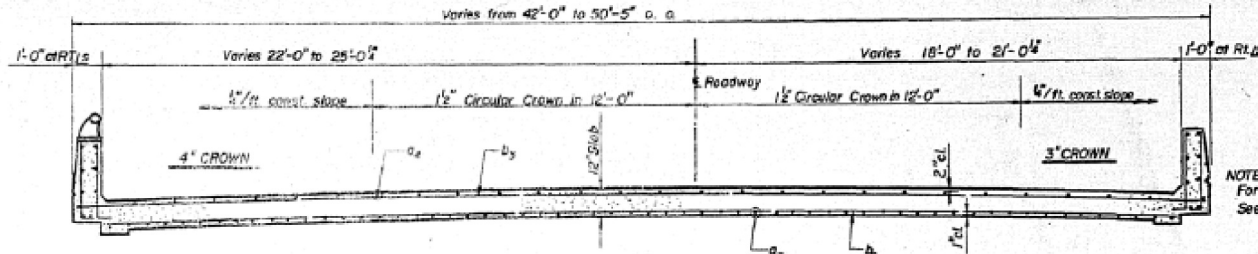


**CROSS SECTION**  
(Looking East on W.B.Lanes or  
Looking West on E.B.Lanes)

NOTE:  
For Handrail Details  
See Sheet 4

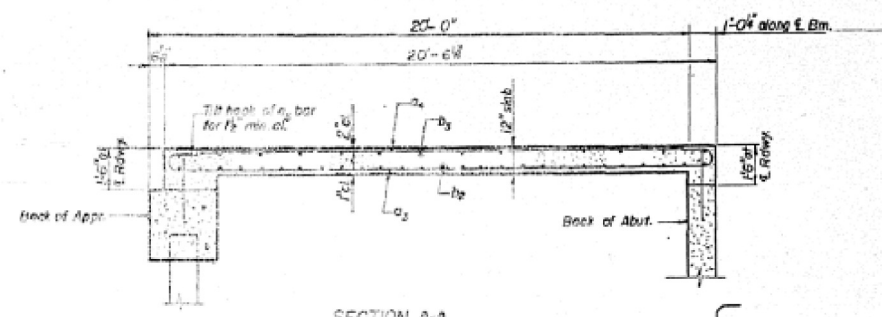


**SECTION A-A**

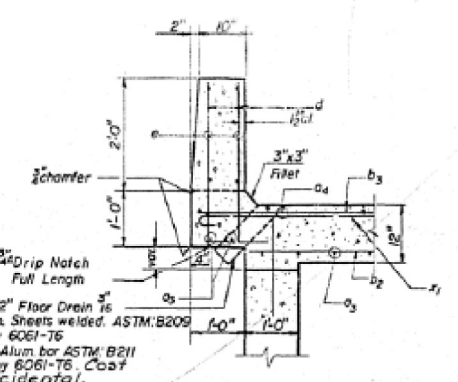


**SECTION B-B**

**BILL OF MATERIALS**

4- APPROACH SPANS				
BAR	NO.	SIZE	LENGTH	SHAPE
a1	288	#10	23'-0"	C
a2	128	#5	20'-3"	C
b1	216	#5	21'-0"	C
b2	112	#5	22'-0"	C
b3	80	#5	9'-6"	C
b4	76	#5	5'-6"	C
d	400	#5	3'-3"	L
e	48	#5	2'-6"	C
x1	100	#3	5'-3"	C
Class X Concrete			Cu Yds.	161.2
Reinforcement Bars			Lbs.	42770

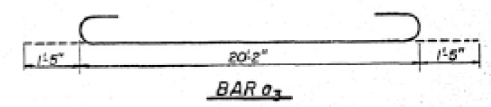

NOTE: For details of bar d see sheet 2

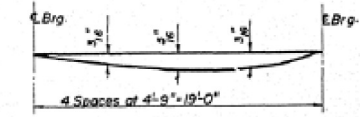

**DEAD LOAD DEFLECTION DIAGRAM**

(Includes weight of concrete only)  
NOTE: The above deflections are not to be used in the field if the Engineer is working from the grade elevations adjusted for dead load deflections as shown on sheet 5.


**SUPERSTRUCTURE**  
**APPROACH SPANS**  
**FA I RT 74 SECTION 10-4-B**  
**CHAMPAIGN COUNTY**  
**STATION 1518+75.19**

DESIGNED: <i>[Signature]</i>	EXAMINED: <i>[Signature]</i>
CHECKED: <i>[Signature]</i>	PASSED: <i>[Signature]</i>
DRAWN: <i>[Signature]</i>	APPROVED: <i>[Signature]</i>
CHECKED: <i>[Signature]</i>	

# AS-BUILT PLANS FOR INFORMATION ONLY


STATE OF ILLINOIS  
DEPARTMENT OF PUBLIC WORKS & BUILDINGS  
DIVISION OF HIGHWAYS

SHEET NO.	PROJECT	COUNTY	SECTION	SHEET NO.	TOTAL SHEETS
42	FAI RT 74	CHAMPAIGN	42	16	12 SHEETS

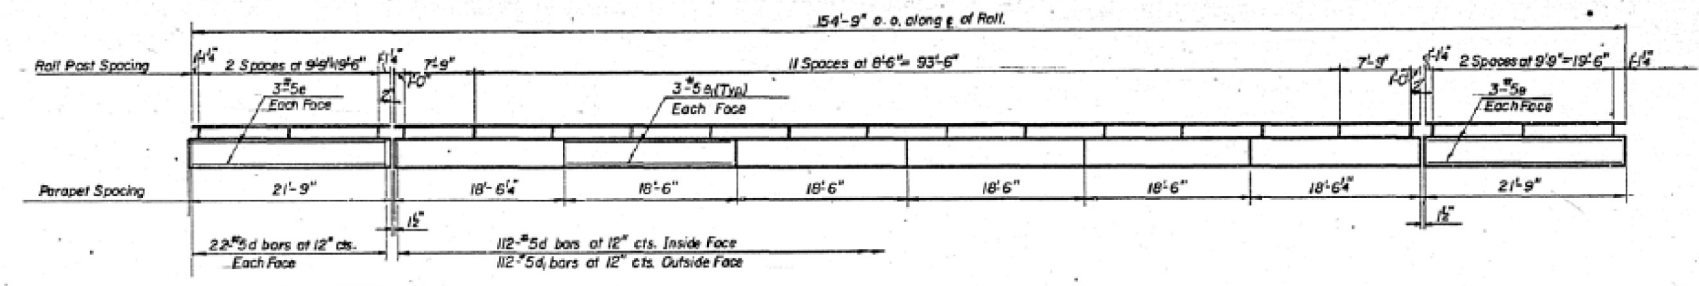


**NOTE:**  
Place 2 additional #5d bars at each rail post, inside face.  
d, d, e & e, bars are billed with Superstructure

**ELEVATION**

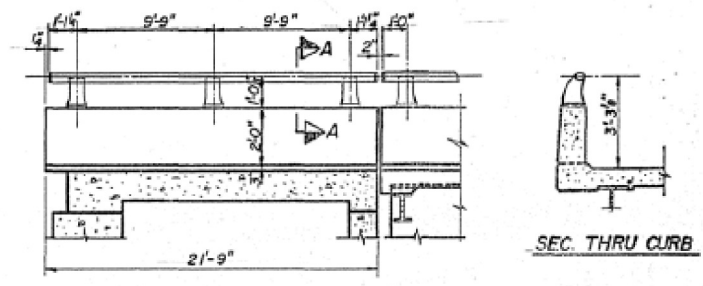

**INSIDE ELEVATION  
APPROACH RAIL**

**SEC. THRU CURB**

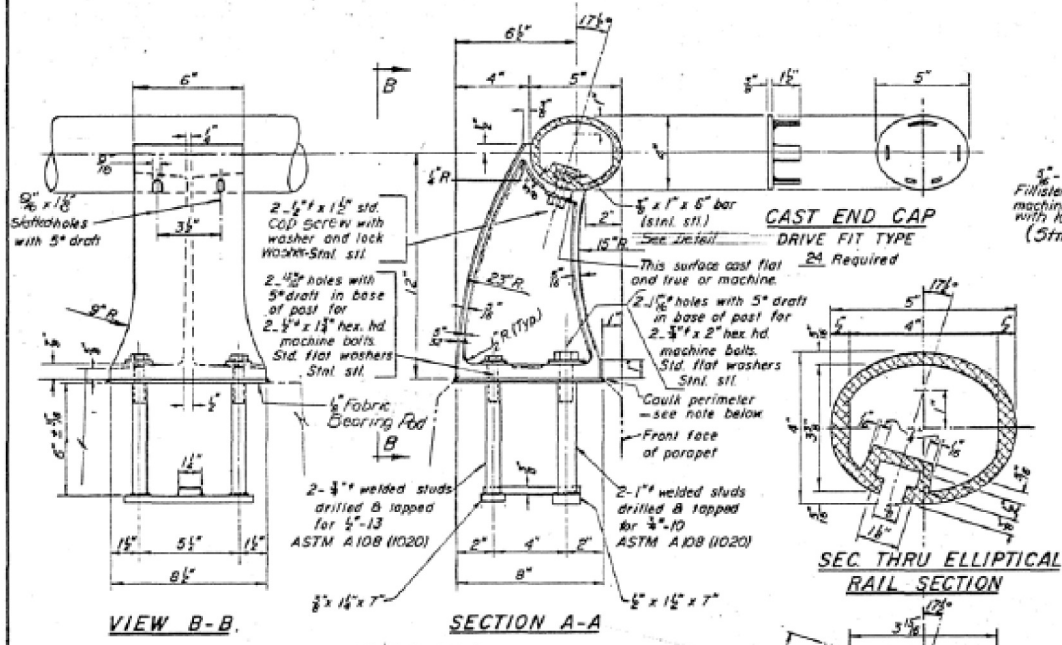


**VIEW B-B  
SECTION A-A  
RAIL POST DETAILS**

DESIGNED	EXAMINED
CHECKED	PASSED
DRAWN	APPROVED
CHECKED	


**NOTE:**  
Seal perimeter of base of post to parapet with two component non-staining gray seating compound with polysulfide liquid polymers - gun grade with primer.

**SEC THRU ELLIPTICAL  
RAIL SECTION**


**SEC THRU SPLICE**

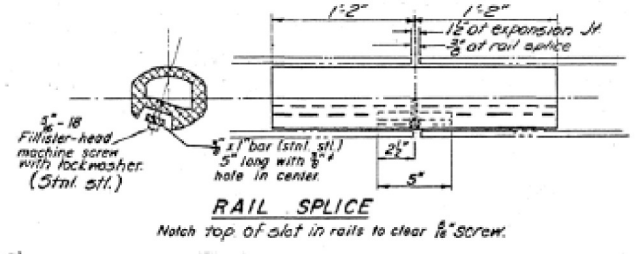

**RAIL SPLICE**

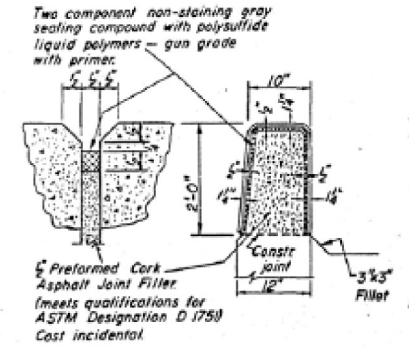

**PARAPET JOINT DETAIL**

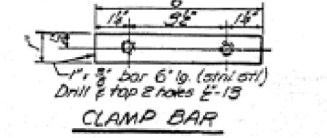

**CLAMP BAR**

**NOTES:**  
All Posts shall be normal to parapet.  
All Aluminum Alloy Extruded Rail shall conform to ASTM specification B-221 alloy 6061-T6, and shall extend a minimum of 2 panel lengths (attached to minimum of 3 posts) except at ends or at open joints where a minimum of 1 panel length is required. All joints in railing must be spliced per detail.  
See Special Provisions for following Material Specifications:  
Cast Aluminum Alloy Bridge Post - Alloy 344-T4  
Stainless Steel Welded Stud Bolts, Washers, and Locknuts  
Fabric bearing Pad


**METHOD OF MEASUREMENT:** Aluminum handrail shall be measured in lineal feet. The length paid for shall be the over all length along the top longitudinal railing member thru all posts and gaps.  
**BASIS OF PAYMENT:** Aluminum handrail shall be paid for at the contract unit price per lineal foot for ALUMINUM HANDRAIL, measured as specified, which price shall be payment in full for all materials, fabrication, transportation, and erection.  
Cast of rail splice, end caps, and hardware to be incidental to item ALUMINUM HANDRAIL.  
Provide 1-1/8" and 2-1/8" Aluminum Shimms for 25% of the Posts. Rail element shall be parallel to Grade - high spots shall be ground, and low spots shimmed.

**BILL OF MATERIAL**

Item	Unit	Quantity
ALUMINUM HANDRAIL	Lin. Ft.	619.

**ALUMINUM HANDRAIL  
FAI RT 74 SECTION 10AHS  
CHAMPAIGN COUNTY  
STATION 15B+75.19**


# AS-BUILT PLANS FOR INFORMATION ONLY

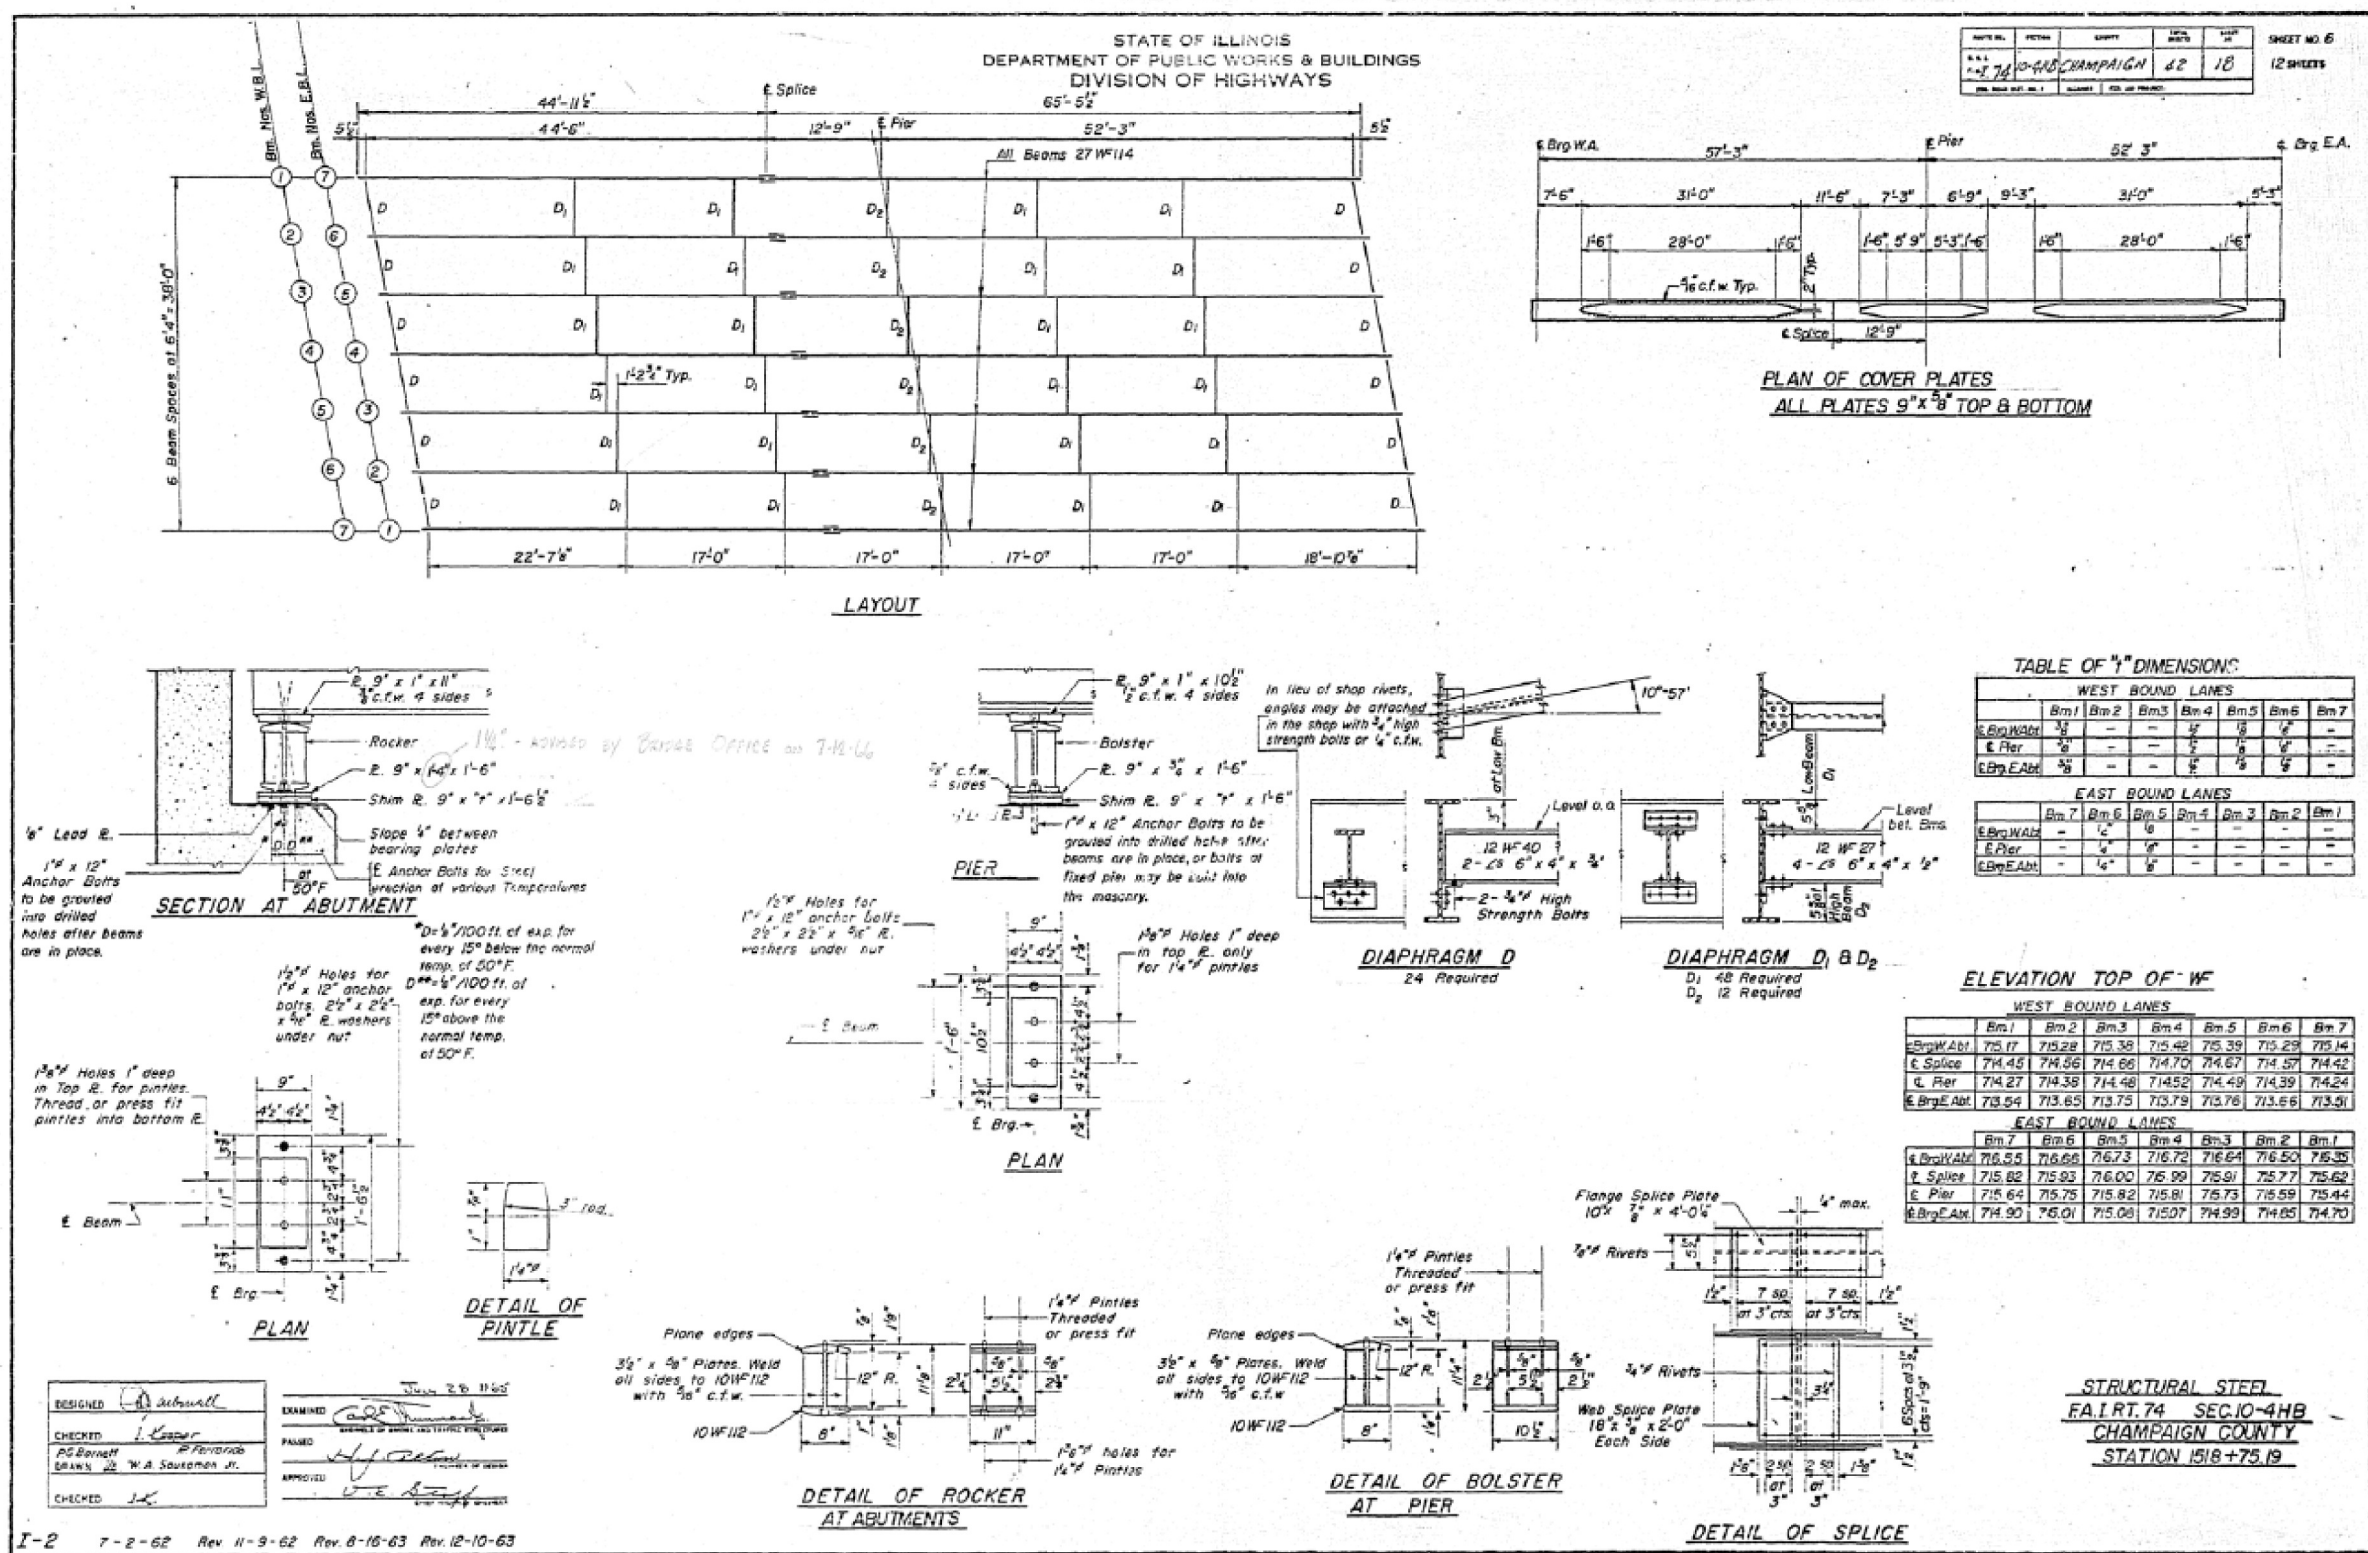


DESIGNED: *[Signature]*  
 CHECKED: *[Signature]*  
 DRAWN: *[Signature]*  
 DATE: 8/8/2016

I-2 7-2-62 Rev 11-9-62 Rev 8-16-63 Rev 12-10-63


# AS-BUILT PLANS FOR INFORMATION ONLY

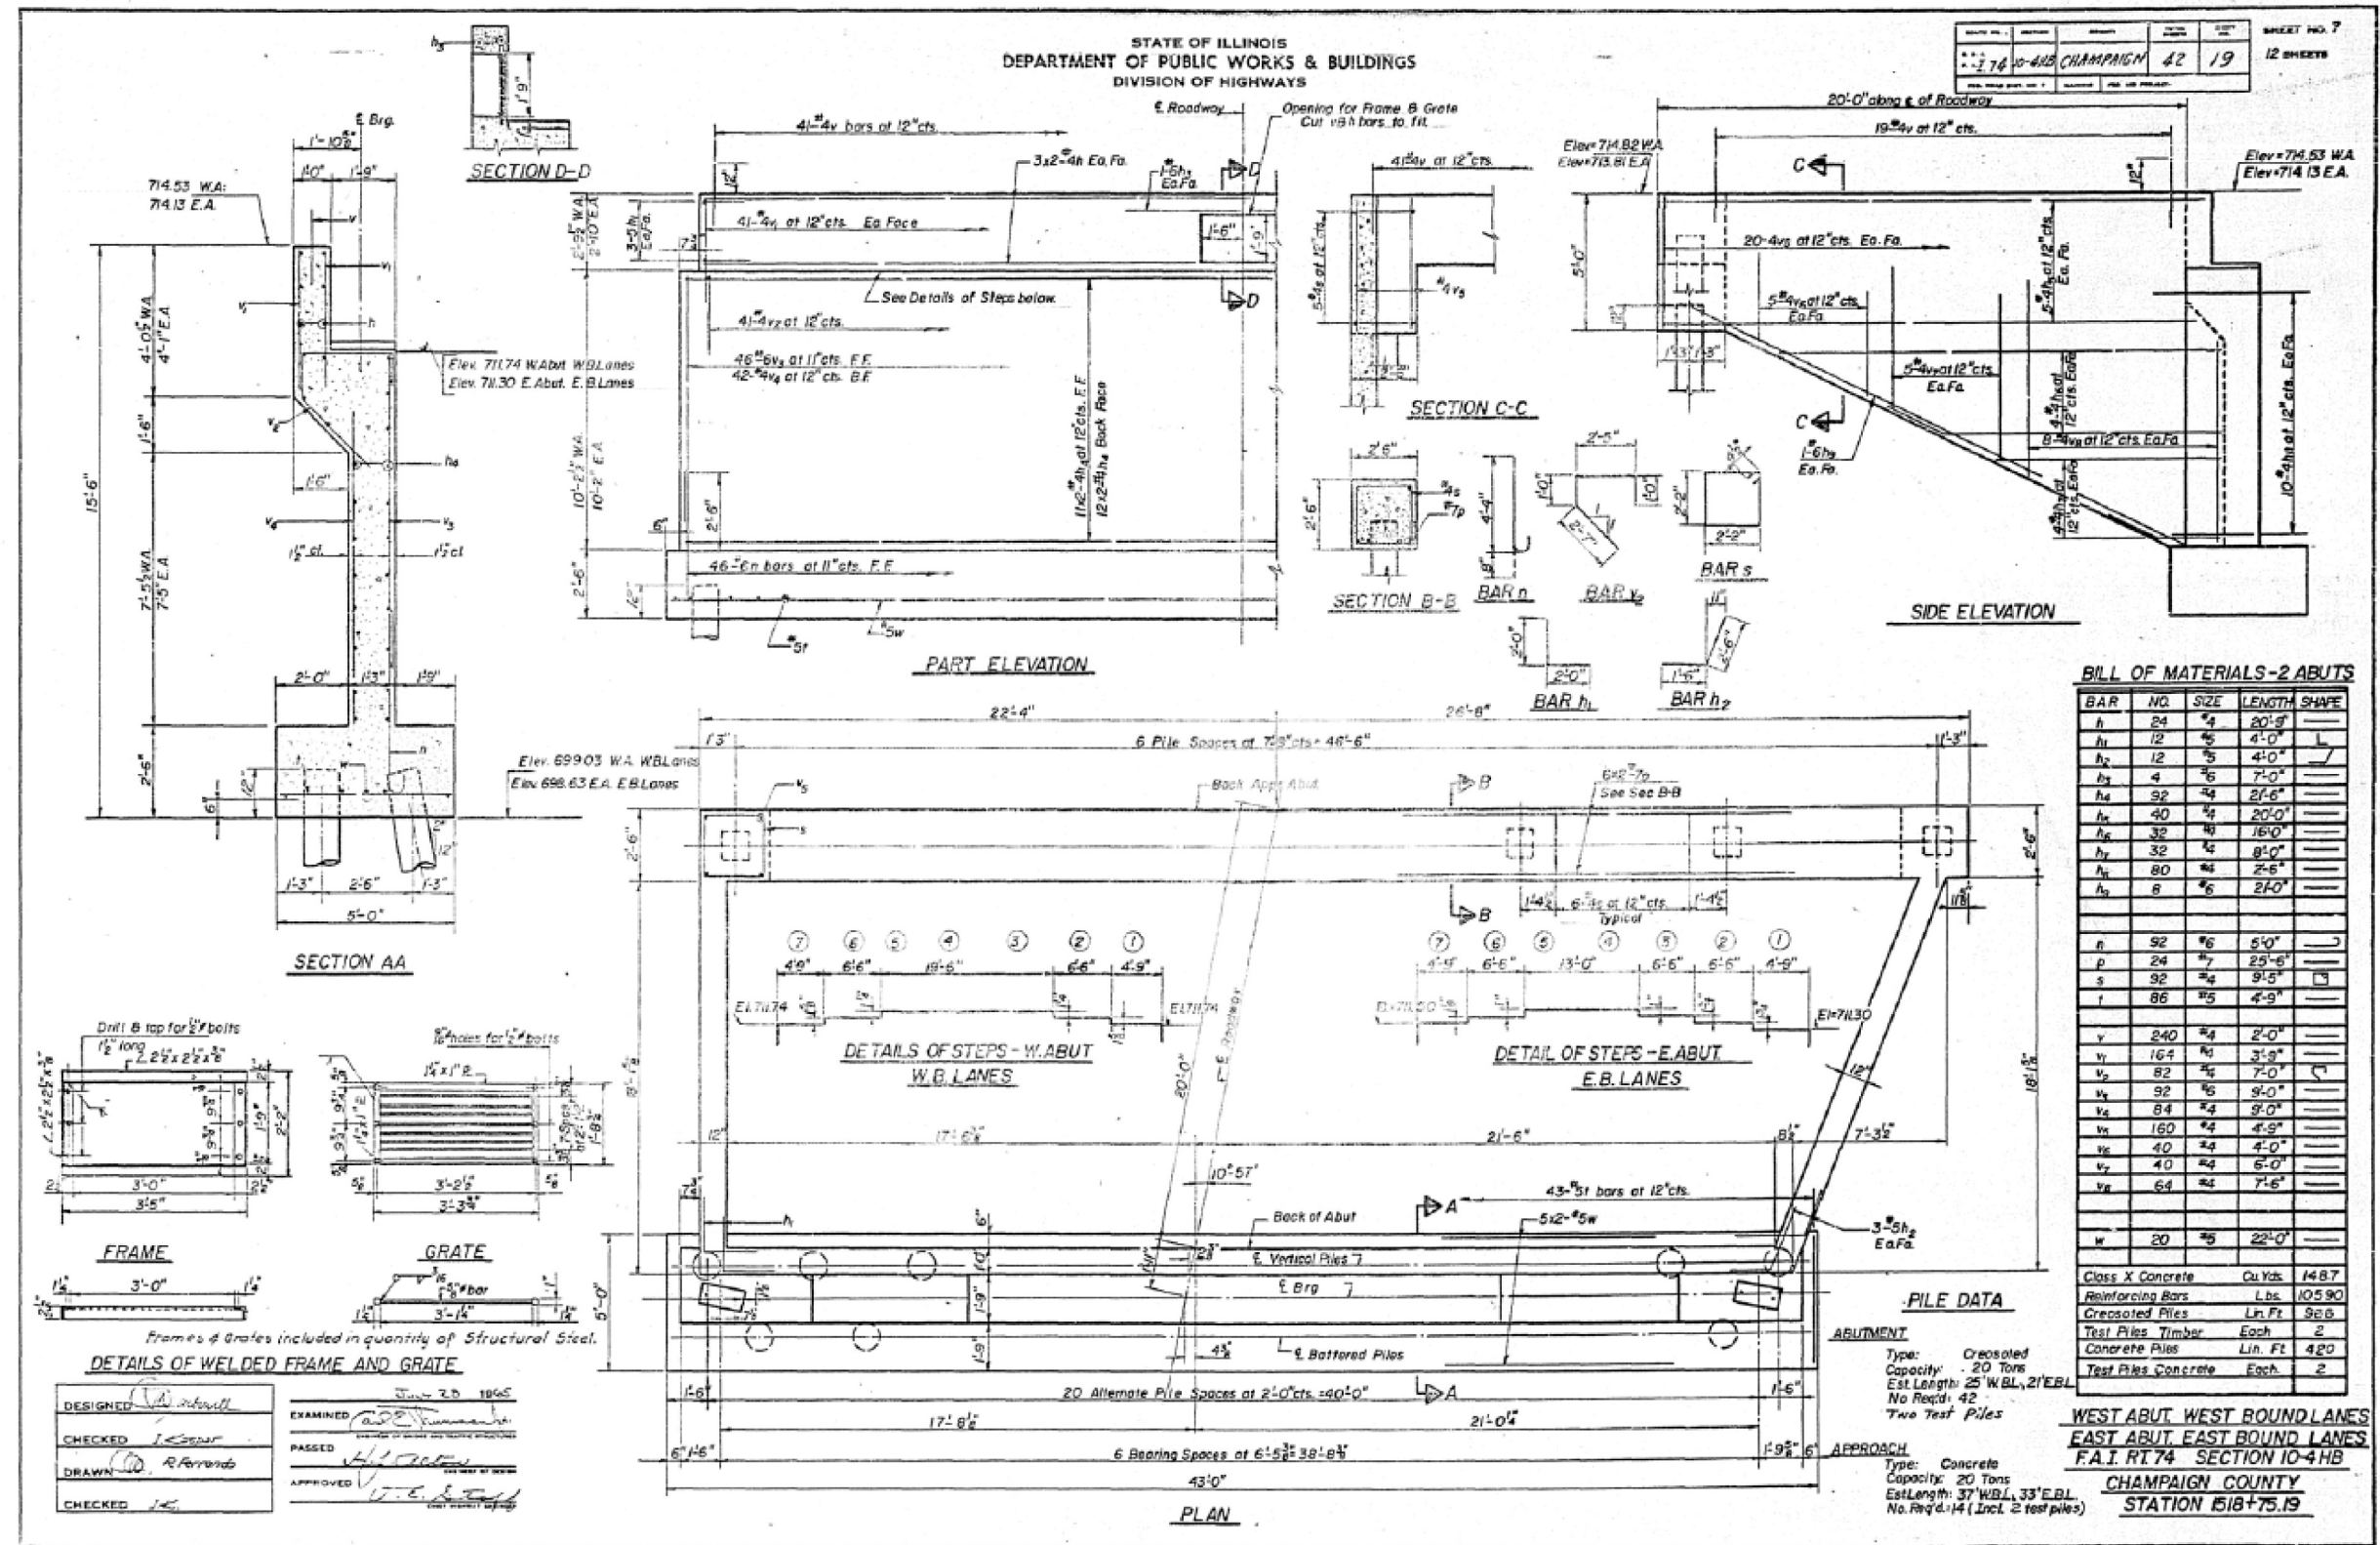


# AS-BUILT PLANS FOR INFORMATION ONLY

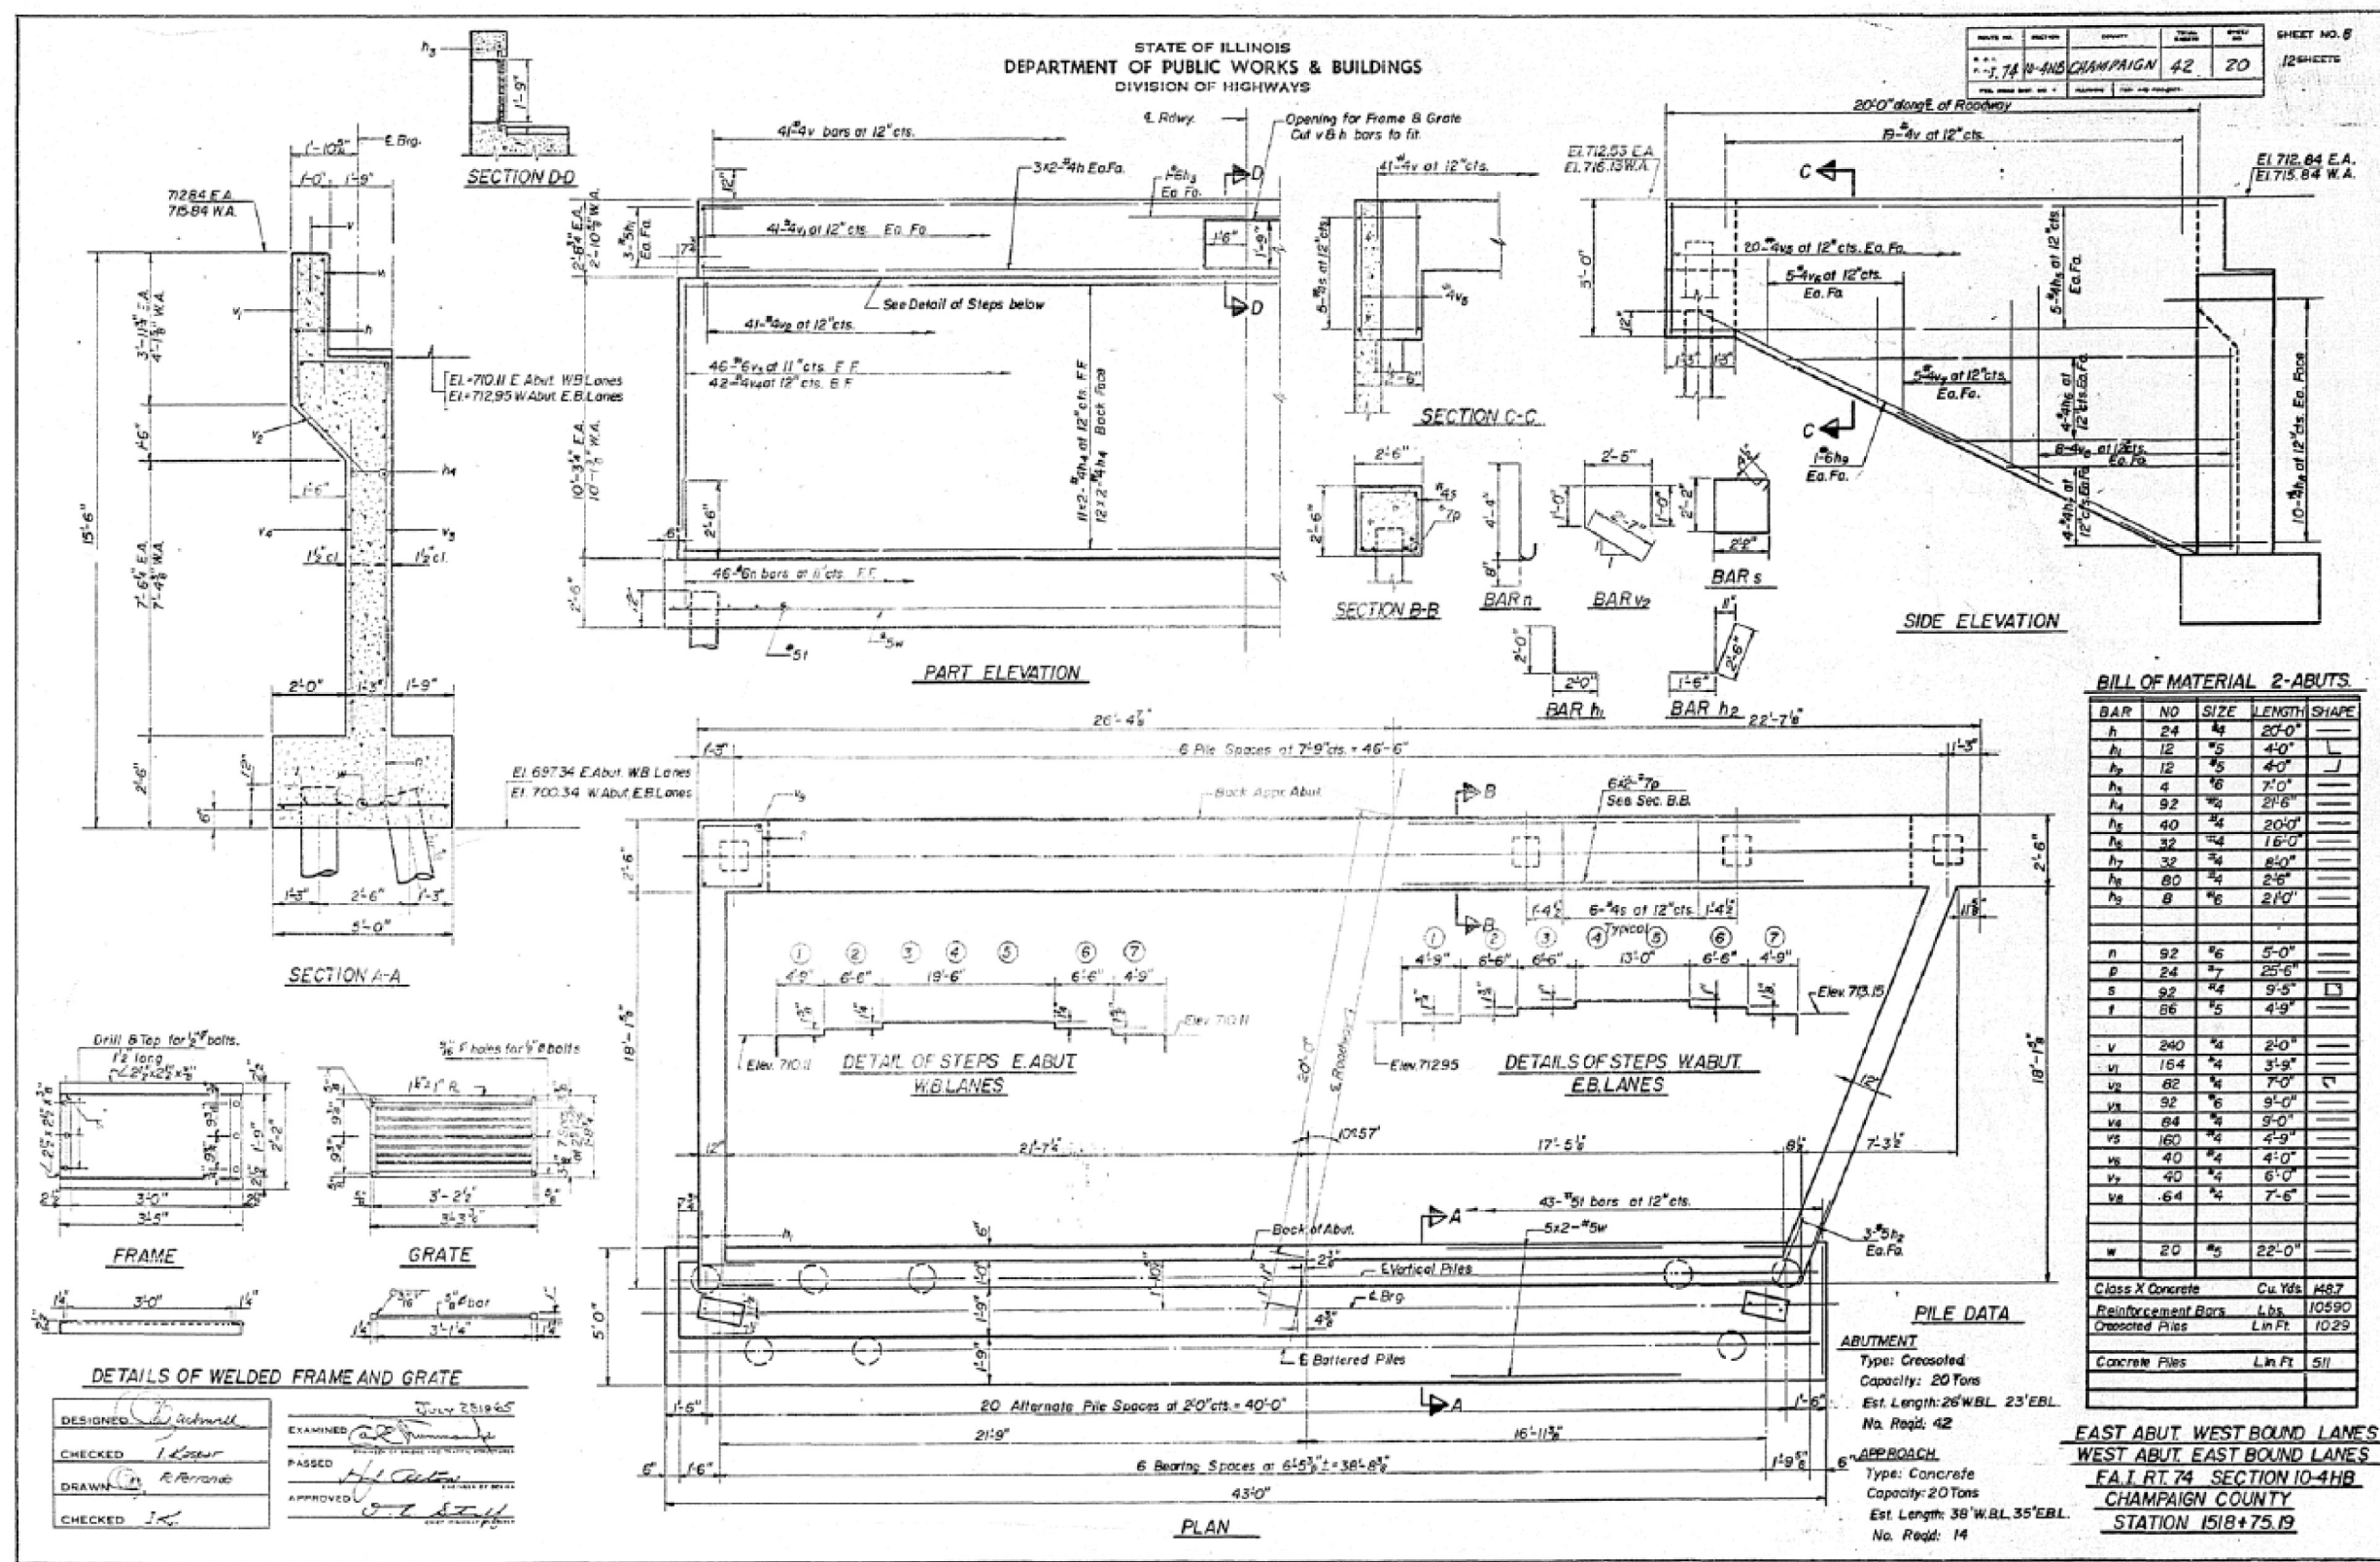


# AS-BUILT PLANS FOR INFORMATION ONLY

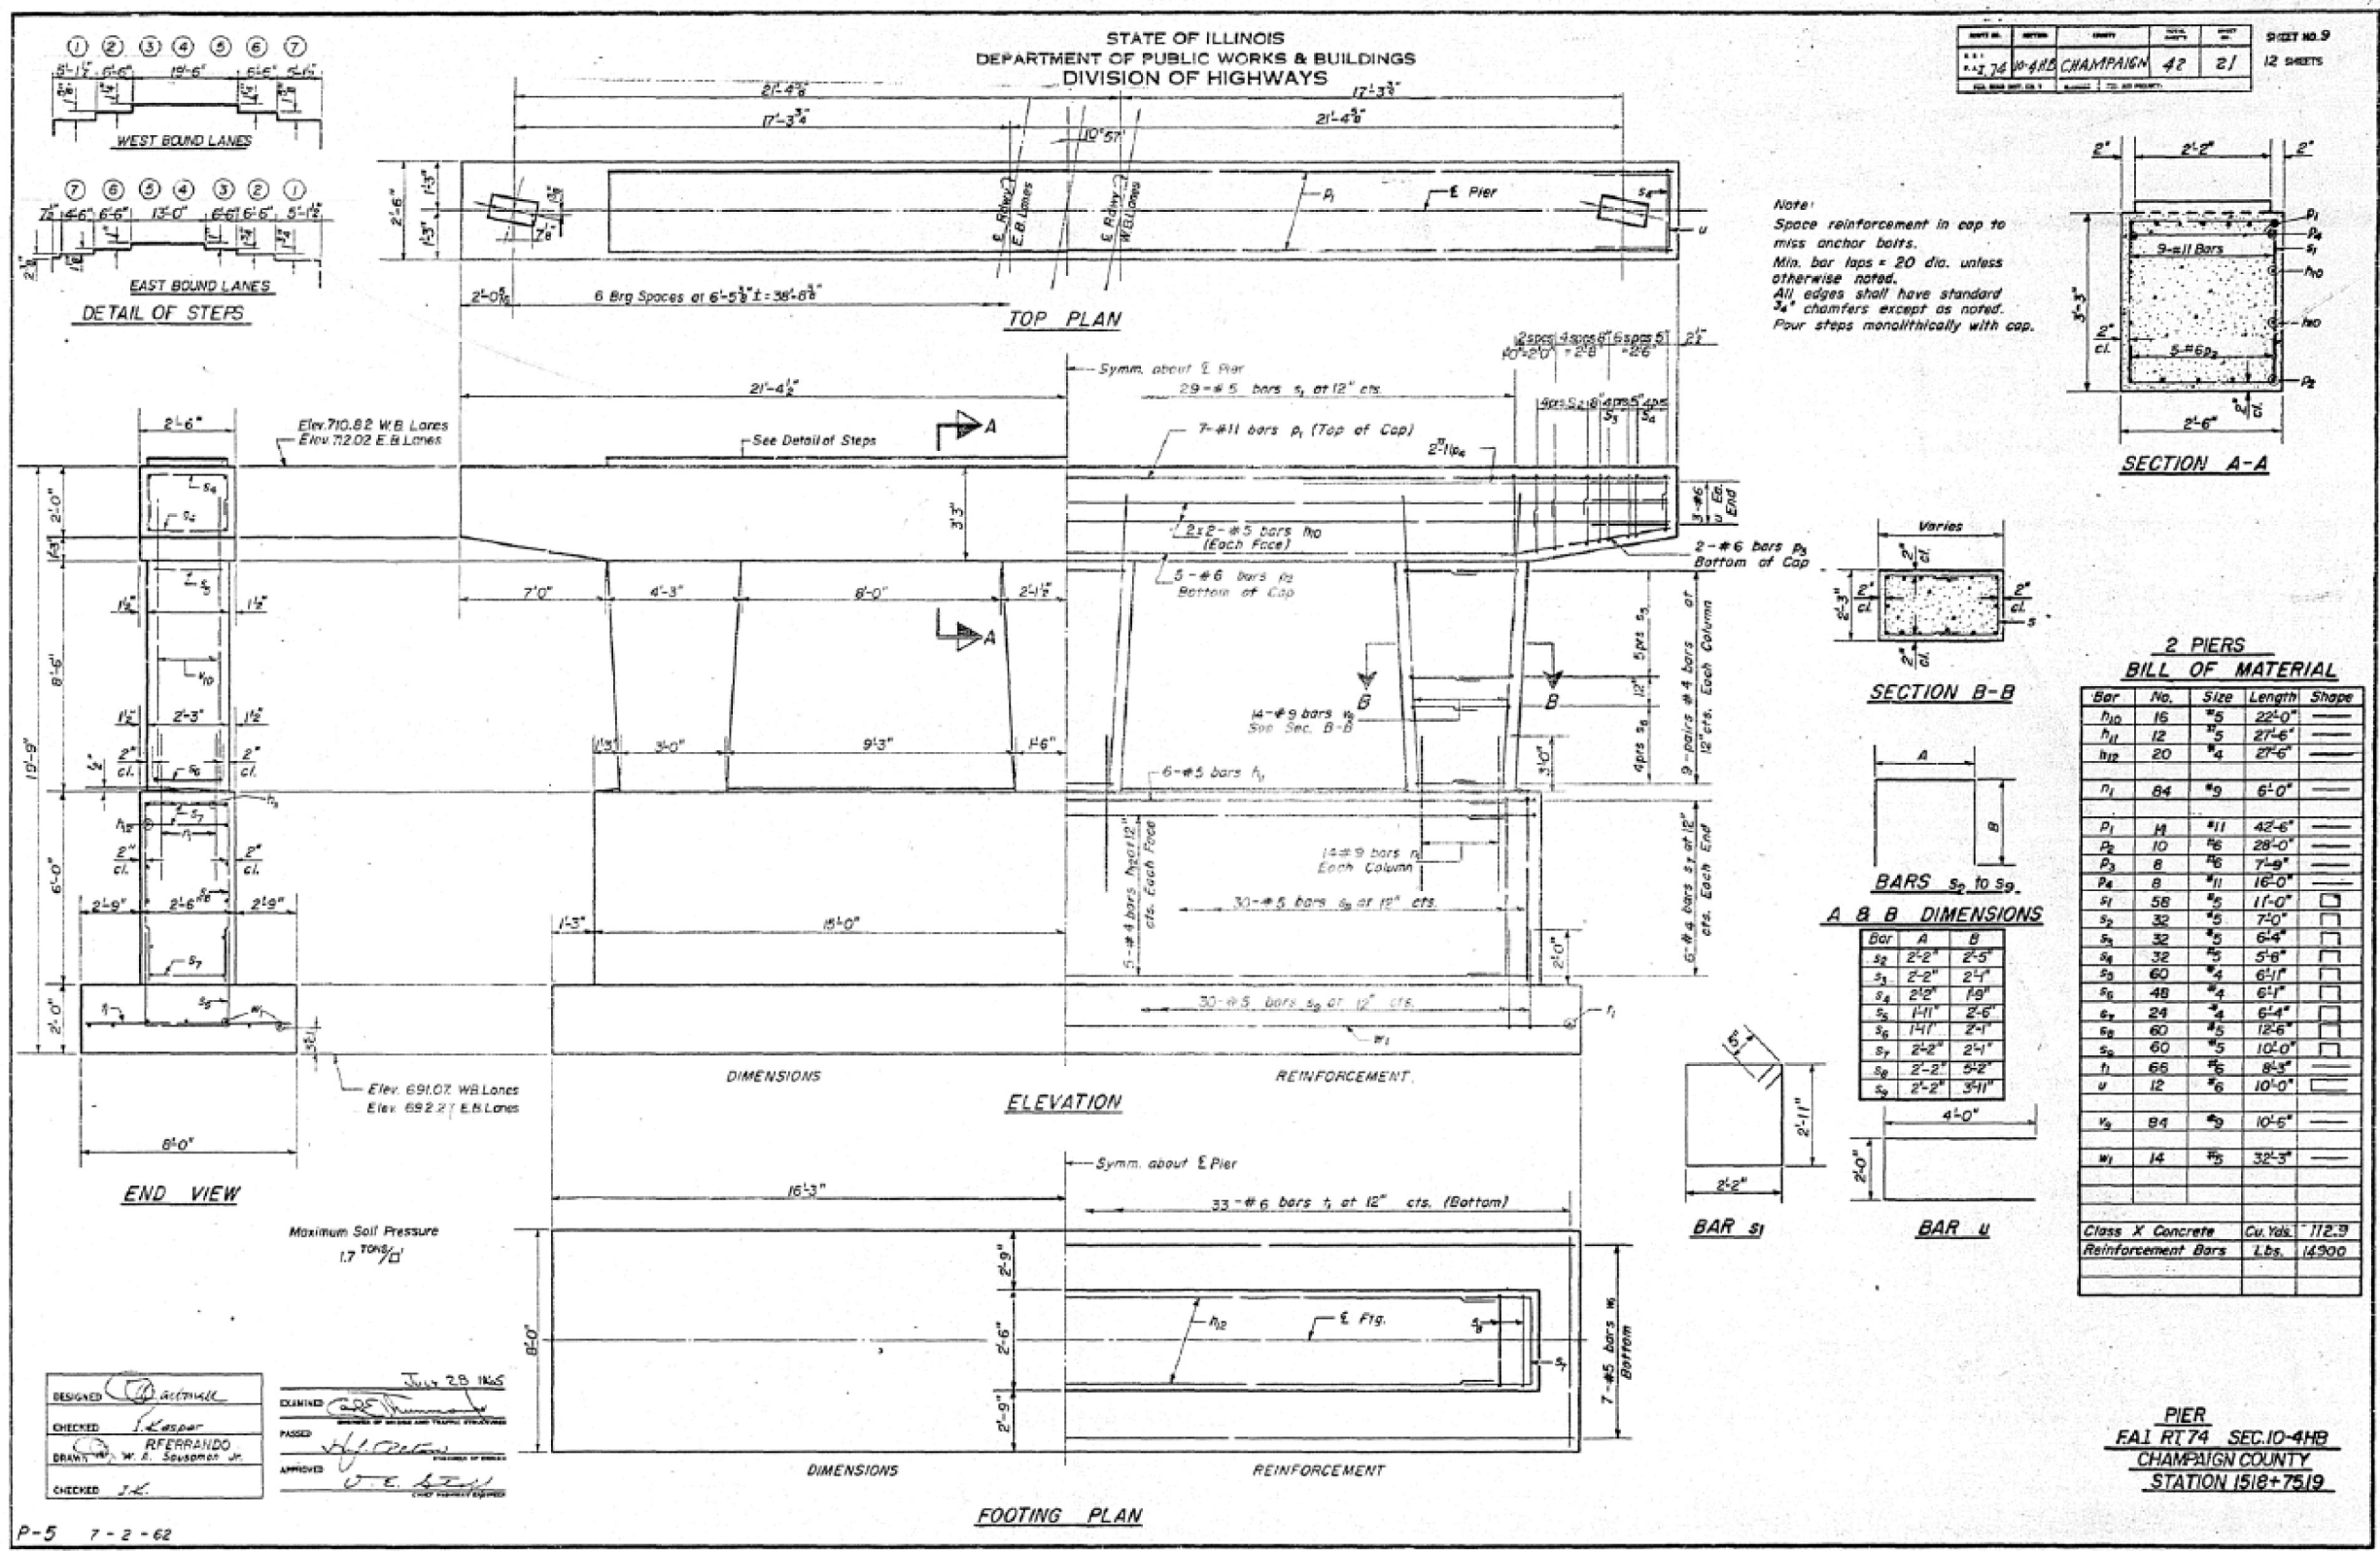




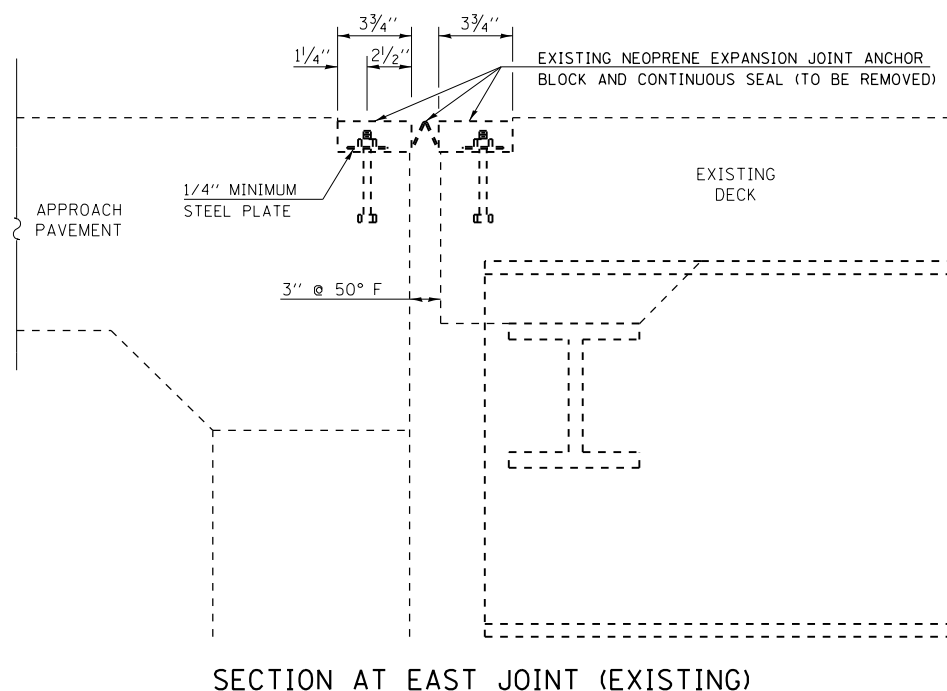


SECTION AT EAST JOINT (EXISTING)

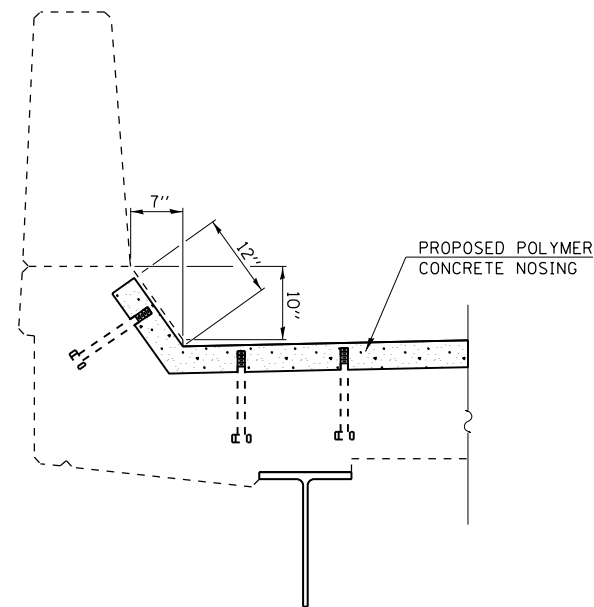

SECTION AT PARAPET POLYMER CONCRETE NOSING

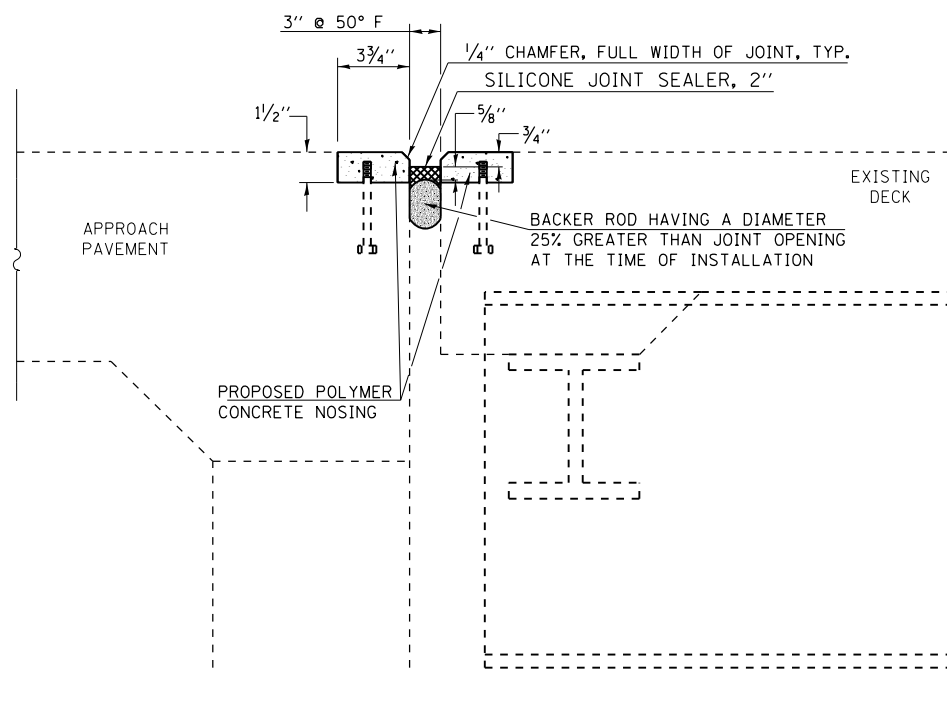

SECTION AT EAST JOINT (PROPOSED)

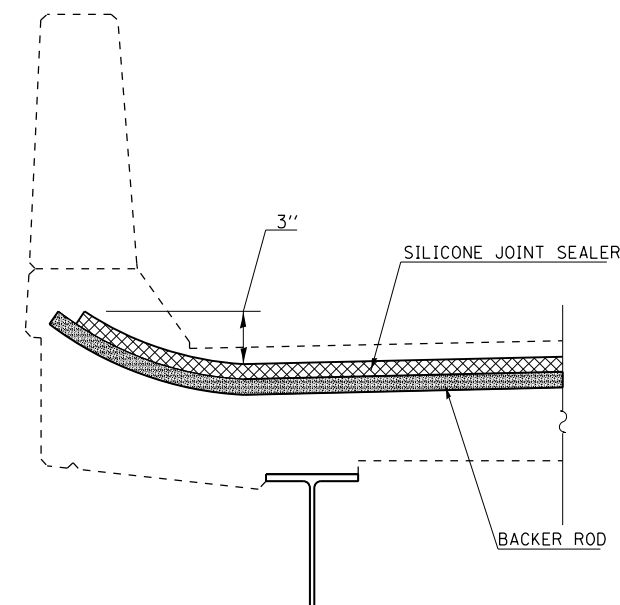

SECTION AT PARAPET SILICONE JOINT SEALER

**General Notes**

Plan dimensions and details relative to existing plans are subject to nominal construction variations. The Contractor shall field verify existing dimensions and details affecting new construction and make necessary approved adjustments prior to construction or ordering of materials. Such variations shall not be cause for additional compensation for a change in scope of the work, however, the Contractor will be paid for the quantity actually furnished at the unit bid price for the work.

Removal of the existing Neoprene Expansion Joint shall be included with the cost of SILICONE JOINT SEALER and POLYMER CONCRETE.

**Proposed Improvements**

1. Remove existing Neoprene Expansion Joint
2. Place Polymer Concrete Nosing
3. Place Backer Rod
4. Place Silicone Joint Sealer

**TOTAL BILL OF MATERIALS  
S.N. 010-0016 & S.N. 010-0017**

Item	Unit	Total
Silicone Joint Sealer, 3"	Foot	89.0
Polymer Concrete	Cu. Ft.	8.0


FILE NAME =	USER NAME = shererjm	DESIGNED - R. CARROLL	REVISED - JMS 081314
PROJECT =	PROJECT =	CHECKED -	REVISED -
PLOT SCALE = 40.0000' / in.	DATE = 8/8/2016	DATE =	REVISED =


**STATE OF ILLINOIS  
DEPARTMENT OF TRANSPORTATION**

**EAST JOINT REPAIR DETAILS  
S.N. 010-0016 & 010-0017**

SCALE: SHEET NO. 1 OF 7 SHEETS STA. TO STA.

F.A.I. RTE.	SECTION	COUNTY	TOTAL SHEETS	SHEET NO.
74	(10-4,10-5)	CHAMPAIGN	74	40
CONTRACT NO. 70B15				
ILLINOIS FED. AID PROJECT				

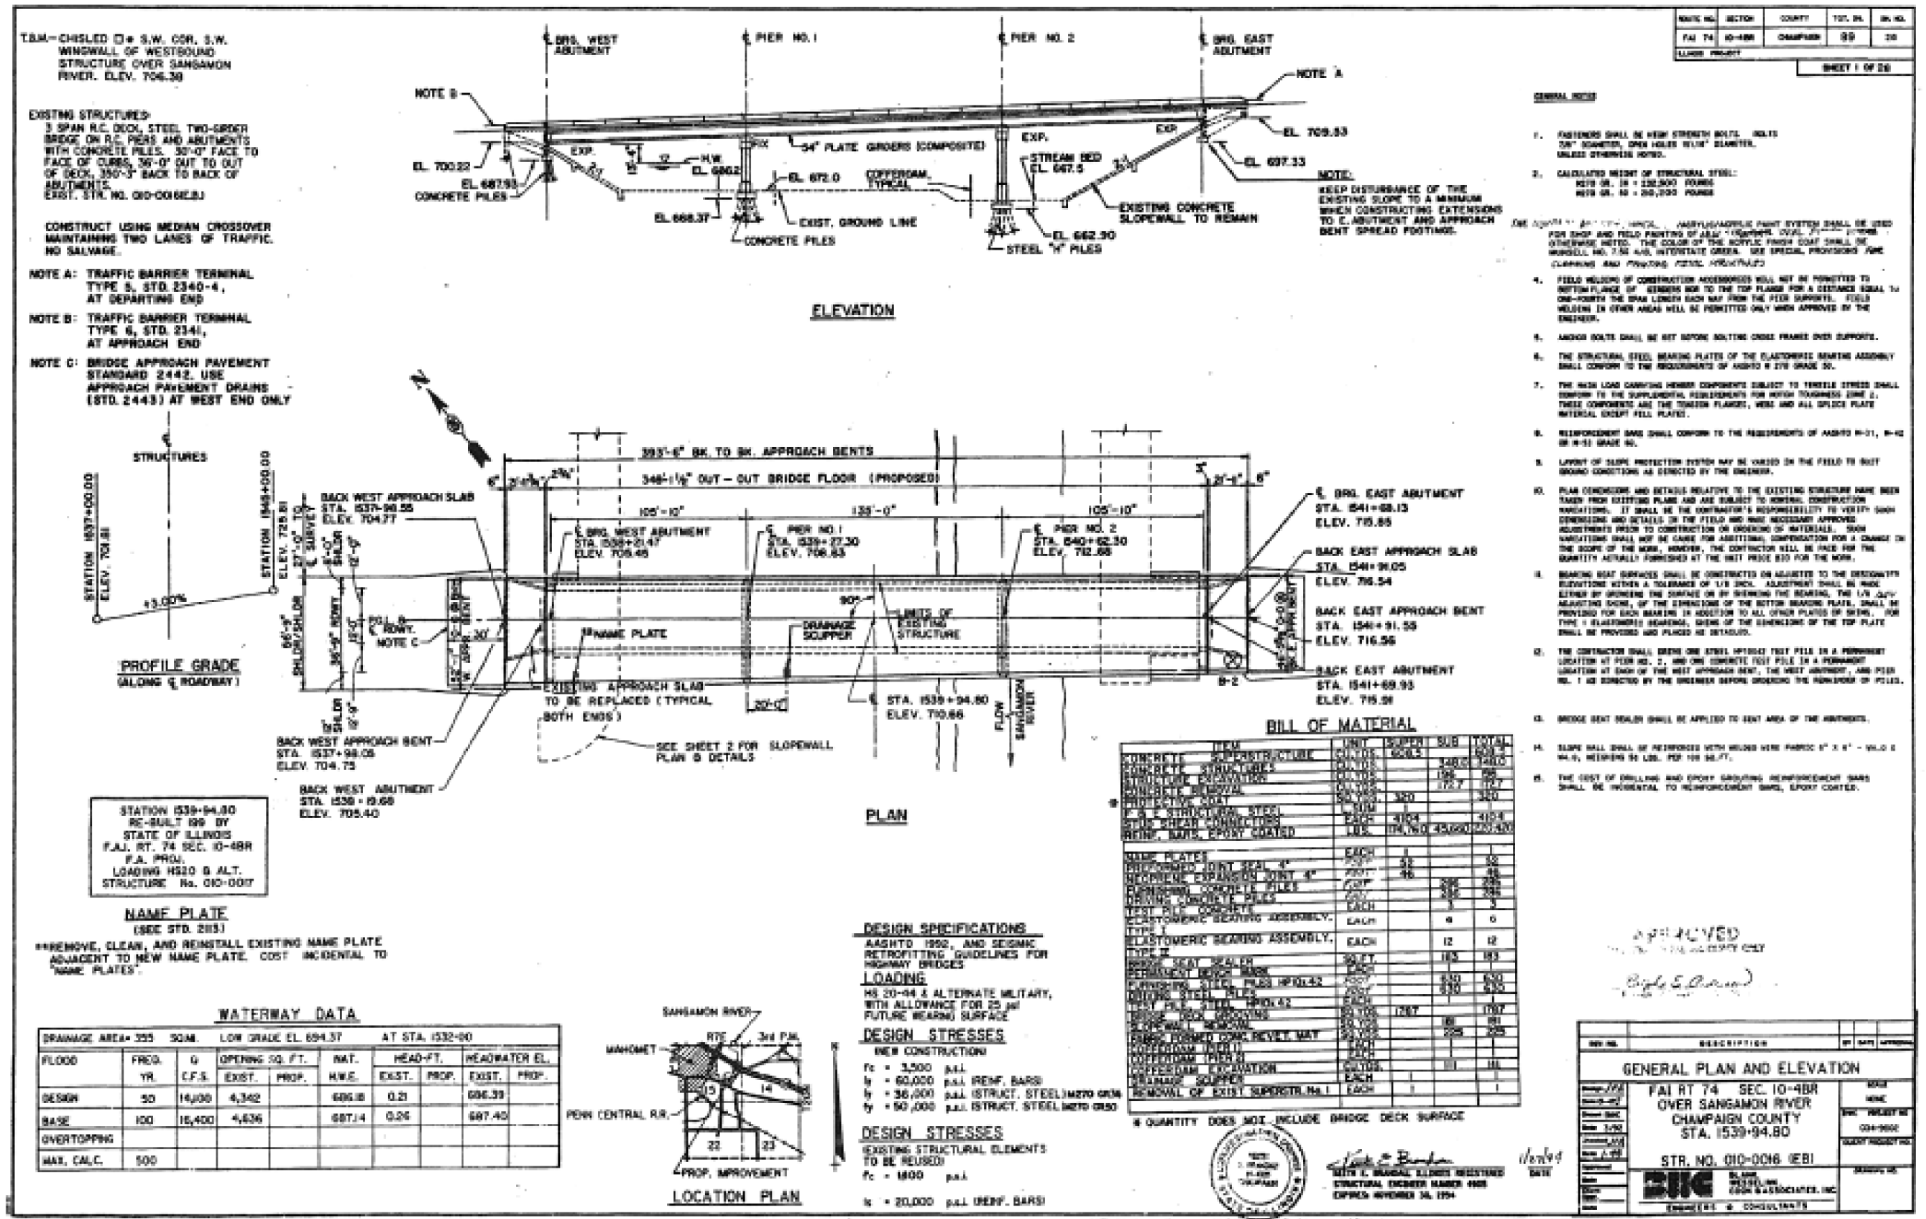

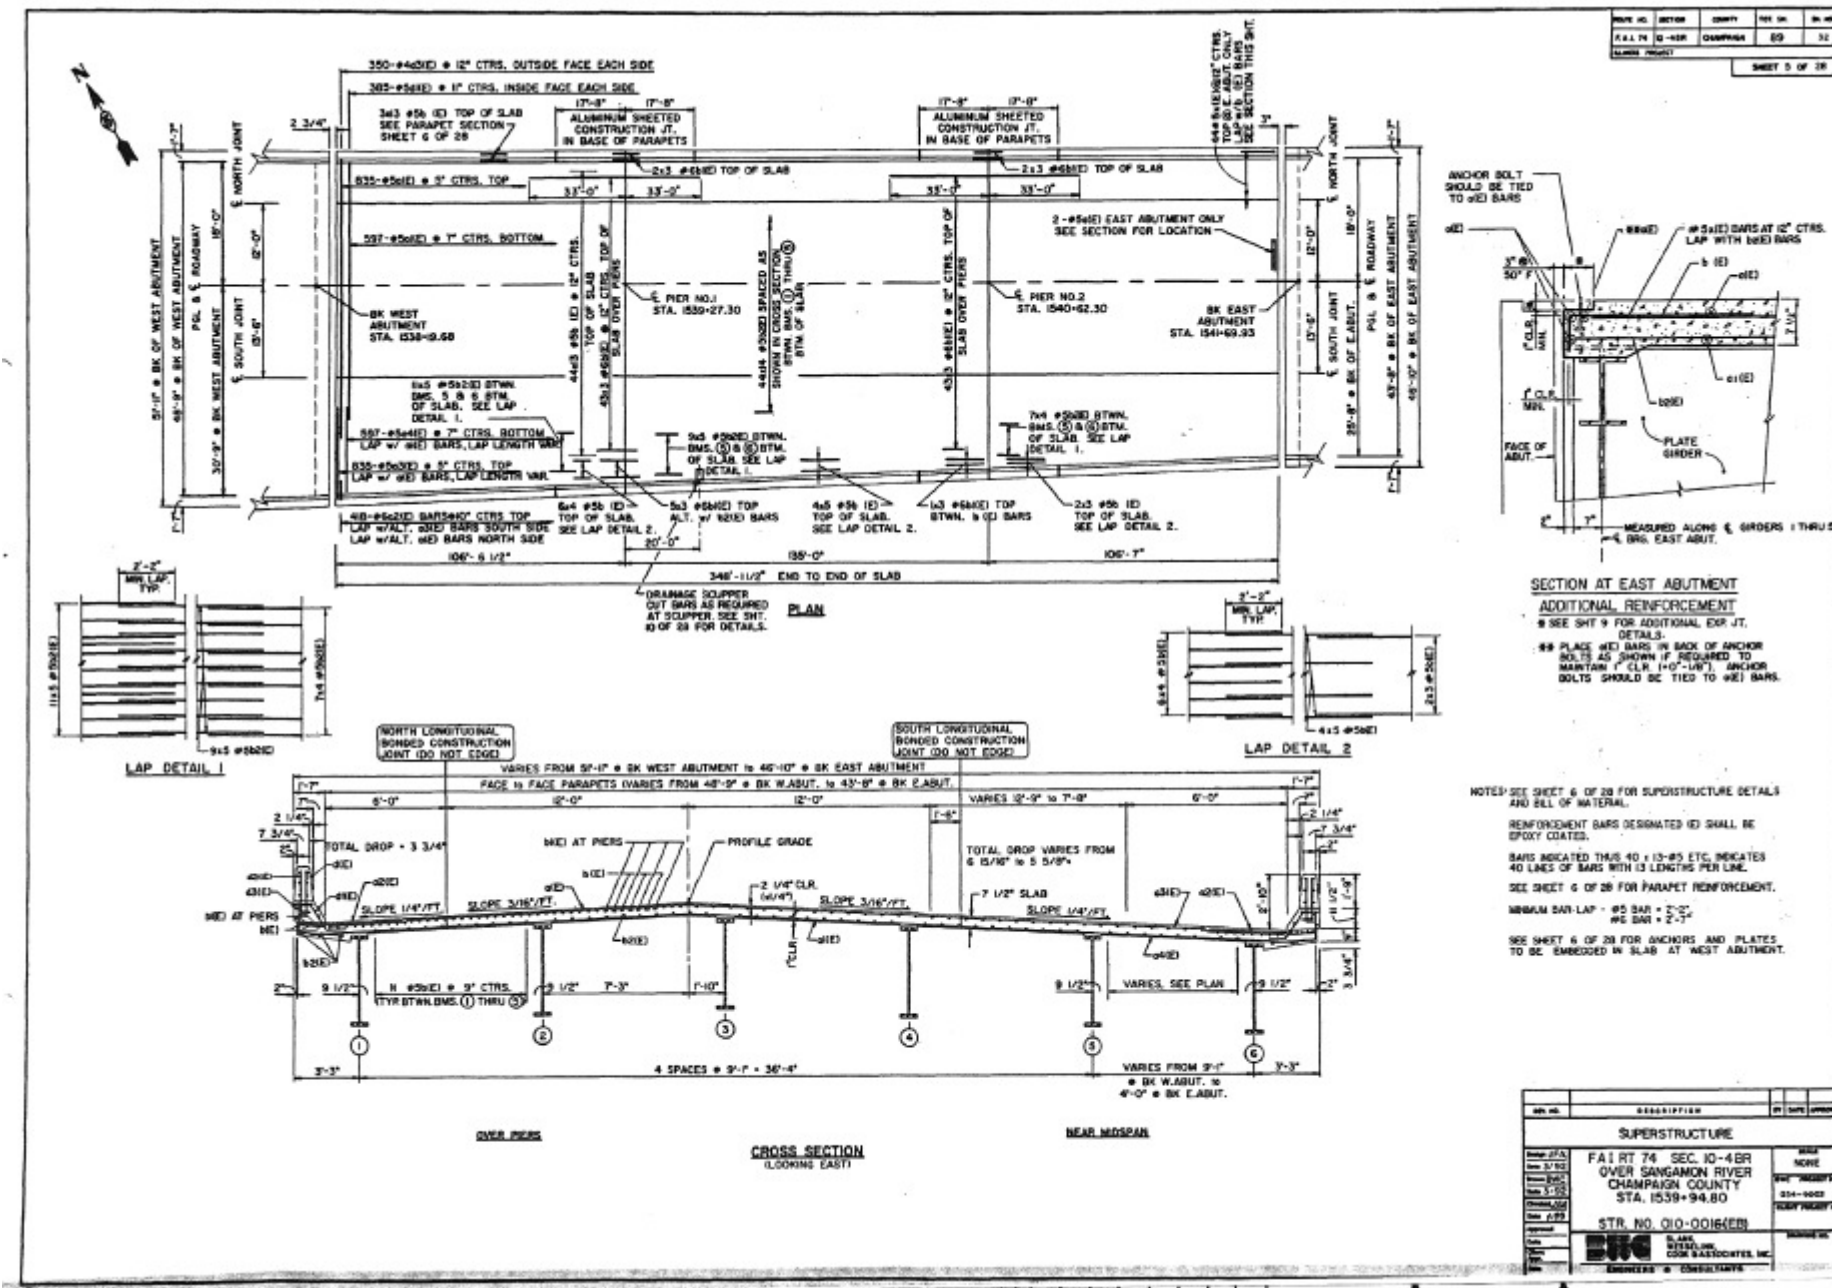

FILE NAME =	USER NAME = shererjm	DESIGNED - R. CARROLL	REVISED - JMS 081314
pw:\11084EBID\INTEG.1\illinois.gov\PI\DOT\Documents\DOT Offices\District 5\Projects\0574\Drawings\Struct\0574-AR\0574-sht-Rep\0574-AR-0016-01.dwg		CHECKED -	REVISED -
		DATE -	REVISED -

**STATE OF ILLINOIS  
DEPARTMENT OF TRANSPORTATION**

**AS-BUILTS  
S.N. 010-0016 & 010-0017**

SCALE: SHEET NO. 3 OF 7 SHEETS STA. TO STA.

F.A.I. RTE.	SECTION	COUNTY	TOTAL SHEETS	SHEET NO.
74	(10-4,10-5)I	CHAMPAIGN	74	42
				CONTRACT NO. 70B15
ILLINOIS FED. AID PROJECT				

Joint Size	1" or 50"	10" or 50"	
	4"	3"	2 1/2" Min.

**INSTALLATION NOTES**


1. Install sponge mastic into positions shown to form flap convolution.
2. Install parapet or sidewalk plate (if in roadway flap to fit before applying epoxy).
3. Install continuous seal in roadway.
4. Install anchor blocks as indicated.

NOTE: A. Maximum spacing of anchor bolts shall be 12" centers.


**SKREW LIMITATIONS**

The details of the anchor blocks and the elastomeric membrane in the parapet, or sidewalk, are for up to 50° skew. For skews greater than 50°, the anchor blocks and the elastomeric membrane, installed in accordance with dimension "D", might require modifications to insure a minimum clearance of 1/2" from centerline of anchor studs to edge of parapet opening. The anchor blocks and the elastomeric membrane shall also be installed to the top of the parapet with the anchor studs spaced of 12" cts.

**FORMING BLOCKOUT SKETCH**

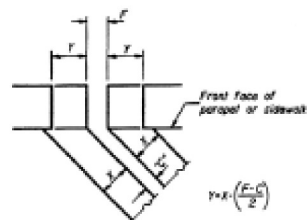

STATE OF ILLINOIS  
DEPARTMENT OF TRANSPORTATION

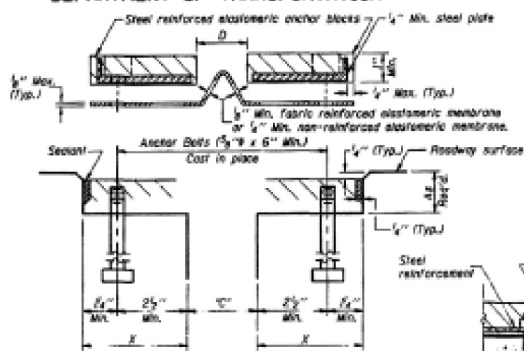


CROSS SECTION


ANCHOR BLOCK REINFORCEMENT WITH ASPHALT SURFACE

**GENERAL NOTES**


Continuous Seal Neoprene Expansion Joint shall consist of nested anchor blocks of elastomer and steel, field assembled over continuous lengths of elastomeric membrane.  
The elastomeric membrane shall be prestressed with a single or a double upward convolution that will have a "memory" to return to its nested position upon joint closure.  
The steel reinforcement must extend up the back face of anchor blocks when asphalt surfaces are used but is omitted in concrete blockout.  
The convolution length shall be such that the extended length will not be greater than the manufactured length when the joint is fully expanded in its design range and will not protrude above the anchor blocks when the joint is fully compressed.  
Joint openings shall be adjusted in accordance with Article 503.03(c) of the Standard Specifications when the deck is poured at an ambient temperature other than 50° F.  
The parapet and sidewalk flaps may be furnished factory vulcanized to the roadway membrane provided the centerline of the convolution is maintained and the process and method meet the approval of the Engineer.

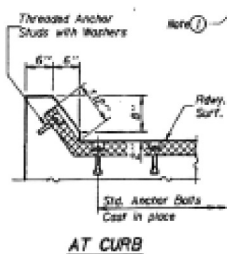


AT CURB

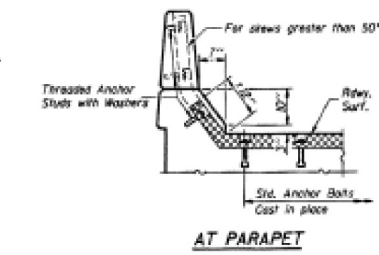

AT PARAPET

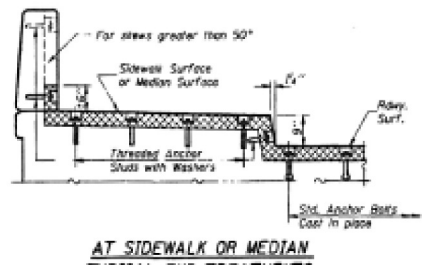

AT SIDEWALK OR MEDIAN  
TYPICAL END TREATMENTS

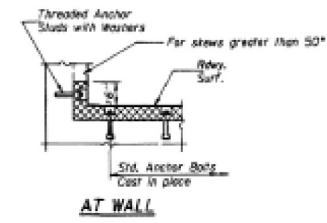

AT WALL

DESIGNED	
CHECKED	
DRAWN	
CHECKED	

EJ-CS 2-26-93

REV. NO.	DESCRIPTION	BY DATE	APPROVAL
1	EAST ABUTMENT NEOPRENE EXPANSION JOINT DETAILS		
2	FAL RT 74 SEC. 10-4BR OVER SANGAMON RIVER CHAMPAIGN COUNTY STA. 1539+94.80 STR. NO. 010-0016 (EB)		

BHC  
 BUREAU OF HIGHWAY CONSTRUCTION & ASSOCIATES, INC.  
 ENGINEERS & CONSULTANTS


FILE NAME =	USER NAME = shererjm	DESIGNED - R. CARROLL	REVISED - JMS 081314
pw:\11084EBID\INTEG.illinois.gov\PI\DOT\Documents\DOT Offices\District 5\Projects\0575\Drawings\Struct\06-CARROLL-5-shr-Rep\		CHECKED -	REVISED -
		DRAWN -	REVISED -
		CHECKED -	REVISED -
		DATE -	REVISED -

STATE OF ILLINOIS  
DEPARTMENT OF TRANSPORTATION

AS-BUILTS  
S.N. 010-0016 & 010-0017


SCALE: SHEET NO. 4 OF 7 SHEETS STA. TO STA.

F.A.I. RTE.	SECTION	COUNTY	TOTAL SHEETS	SHEET NO.
74	(10-4,10-5I)	CHAMPAIGN	74	43
				CONTRACT NO. 70B15
ILLINOIS FED. AID PROJECT				

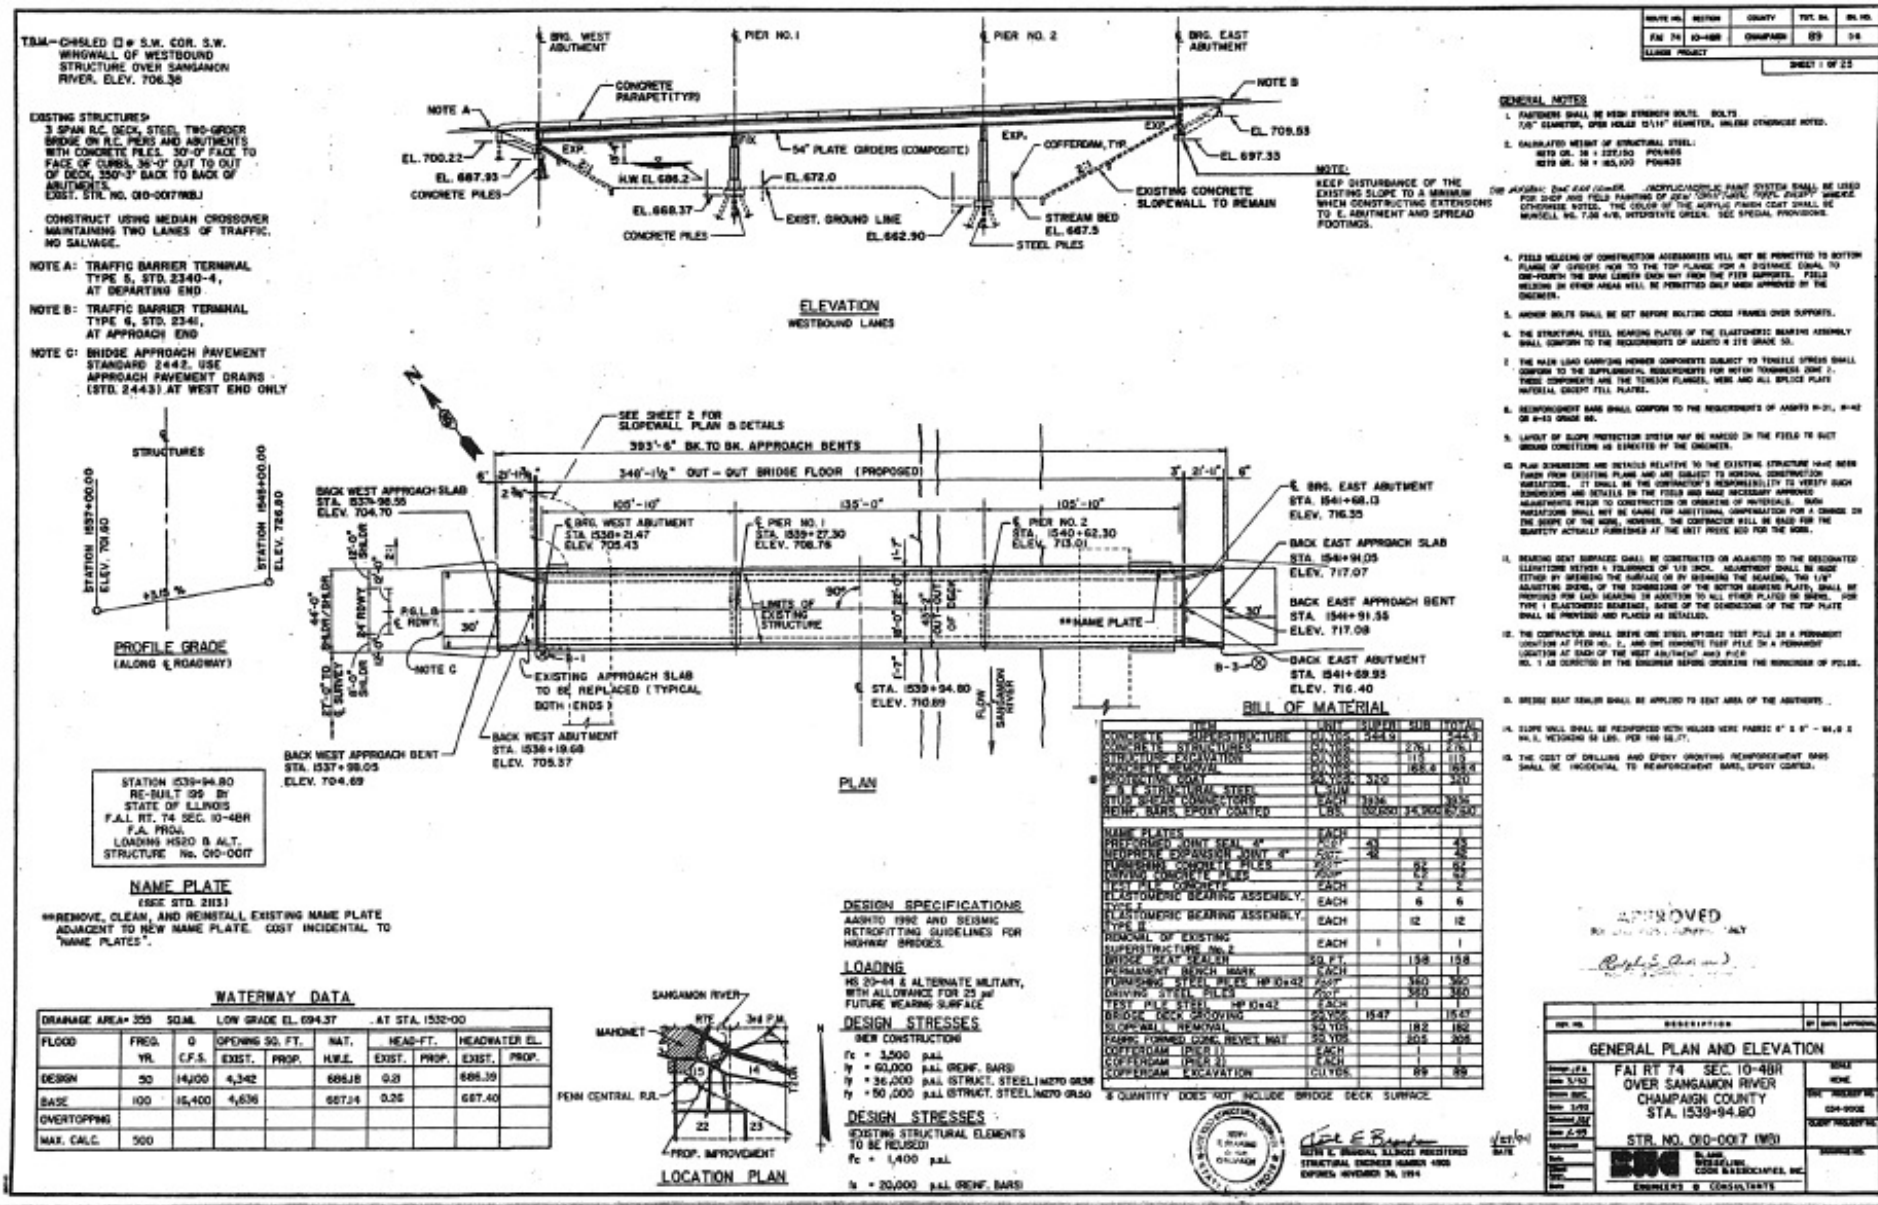

NO.	DESCRIPTION	QUANTITY	UNIT	APPROVAL
1	CONCRETE	154.0	CY	
2	STEEL	27.1	TON	
3	STEEL PILES	113	LINEAL FT.	
4	CONCRETE PILES	165.6	CY	
5	STEEL PILES	300	LINEAL FT.	
6	CONCRETE PILES	1236	CY	
7	STEEL PILES	14,000	LINEAL FT.	
8	STEEL BEAMS	42	LINEAL FT.	
9	STEEL BEAMS	32	LINEAL FT.	
10	STEEL BEAMS	25	LINEAL FT.	
11	STEEL BEAMS	2	LINEAL FT.	
12	STEEL BEAMS	6	LINEAL FT.	
13	STEEL BEAMS	12	LINEAL FT.	
14	STEEL BEAMS	1	LINEAL FT.	
15	STEEL BEAMS	158	LINEAL FT.	
16	STEEL BEAMS	1	LINEAL FT.	
17	STEEL BEAMS	100	LINEAL FT.	
18	STEEL BEAMS	300	LINEAL FT.	
19	STEEL BEAMS	1	LINEAL FT.	
20	STEEL BEAMS	182	LINEAL FT.	
21	STEEL BEAMS	205	LINEAL FT.	
22	STEEL BEAMS	1	LINEAL FT.	
23	STEEL BEAMS	89	LINEAL FT.	

FILE NAME =	USER NAME = shererjm	DESIGNED - R. CARROLL	REVISED - JMS 081314	STATE OF ILLINOIS DEPARTMENT OF TRANSPORTATION	AS-BUILTS S.N. 010-0016 & 010-0017	F.A.I. RTE. 74	SECTION (10-4,10-5)I	COUNTY CHAMPAIGN	TOTAL SHEETS 74	SHEET NO. 44
SCALE:	SHEET NO. 5 OF 7 SHEETS		STA.	TO STA.		ILLINOIS FED. AID PROJECT		CONTRACT NO. 70B15		

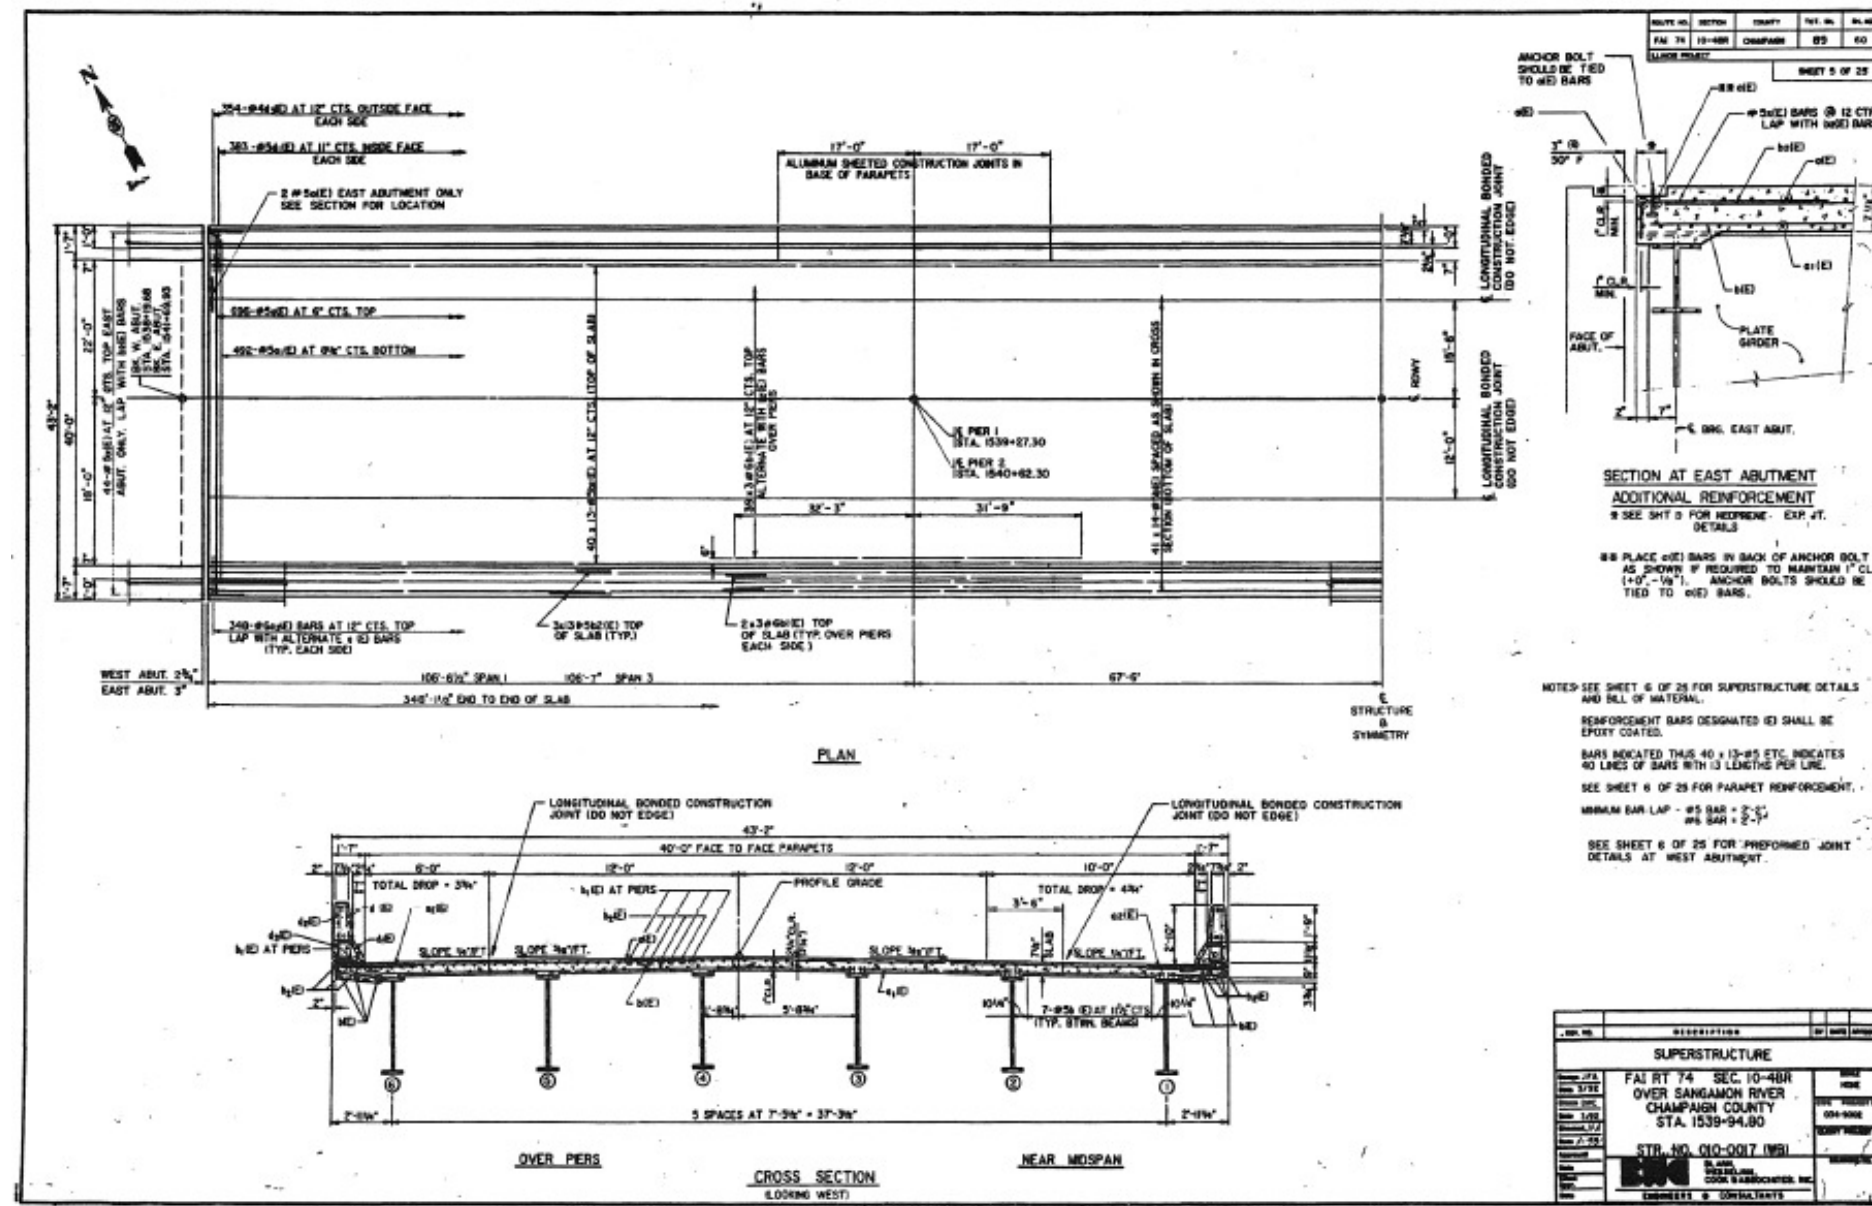

FILE NAME =	USER NAME = shererjm	DESIGNED - R. CARROLL	REVISED - JMS 081314
pw:\1\084EBID\INTEG.illinois.gov\PIWIDOT\Documents\DOT Offices\District 5\Projects\057\DRAWING\Struct\R-CARROLL-5-shr-Rep		CHECKED -	REVISED -
		DATE -	REVISED -

**STATE OF ILLINOIS  
DEPARTMENT OF TRANSPORTATION**

<b>AS-BUILTS</b>	
<b>S.N. 010-0016 &amp; 010-0017</b>	
SCALE:	TO STA.
SHEET NO. 6 OF 7 SHEETS	STA. TO STA.

F.A.I. RTE.	SECTION	COUNTY	TOTAL SHEETS	SHEET NO.
74	(10-4,10-5)I	CHAMPAIGN	74	45
CONTRACT NO. 70B15				
ILLINOIS FED. AID PROJECT				

Joint Size	1" or 50"	10" or 50"
	4"	2 1/2" Min.

**INSTALLATION NOTES**


1. Install sponge mastic into positions shown to form flap convolution.
2. Install parapet or sidewalk piece (true roadway flap to fit) before applying epoxy.
3. Install continuous seal in roadway.
4. Install anchor blocks as indicated.

NOTE: Maximum spacing of anchor bolts shall be 12" centers.


**SKIEW LIMITATIONS**

The details of the anchor bolts and the elastomeric membrane in the parapet, as shown, are for up to 50° skew. For skews greater than 50°, the anchor bolts and the elastomeric membrane, installed in accordance with dimension D<sup>1</sup>, might require modifications to insure a minimum clearance of 1/2" from centerline of anchor studs to edge of parapet skewing. The anchor bolts and the elastomeric membrane shall also be installed to the top of the parapet with the anchor studs spaced at 12" cts.

**FORMING BLOCKOUT SKETCH**

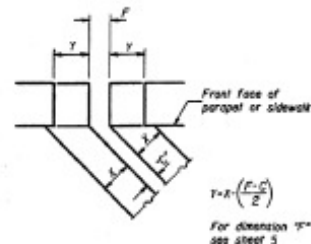


**STATE OF ILLINOIS DEPARTMENT OF TRANSPORTATION**

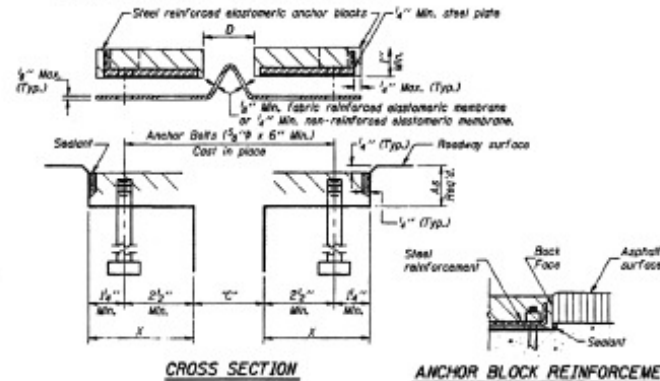


**GENERAL NOTES**


Continuous Seal Neoprene Expansion Joint shall consist of welded anchor blocks of elastomer and steel, field assembled over continuous lengths of elastomeric membrane.  
 The elastomeric membrane shall be provided with a single or a double upward convolution that will have a "memory" to return to its welded position upon joint closure.  
 The steel reinforcement must extend up the back face of anchor blocks when asphalt surfaces are used but is optional in concrete deckout.  
 The convolution length shall be such that the extended length will not be greater than the manufactured length when the joint is fully expanded in its design range and will not protrude above the anchor blocks when the joint is fully compressed.  
 Joint openings shall be adjusted in accordance with Article 503.01(c) of the Standard Specifications when the steel is poured at an ambient temperature other than 50° F.  
 The parapet and sidewalk flaps may be furnished factory vulcanized to the roadway membrane provided the centerline of the convolution is maintained and the process and method meet the approval of the Engineer.

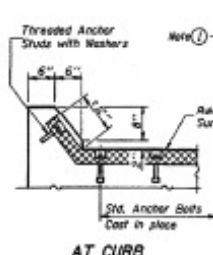


**AT CURB**

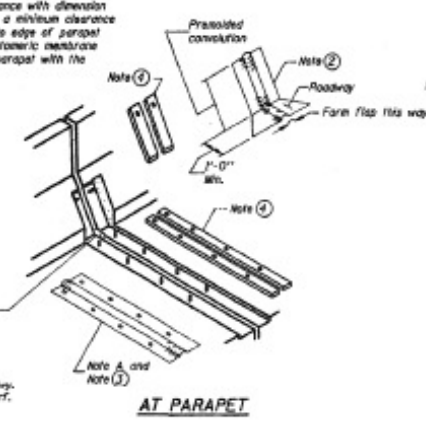

**AT PARAPET**

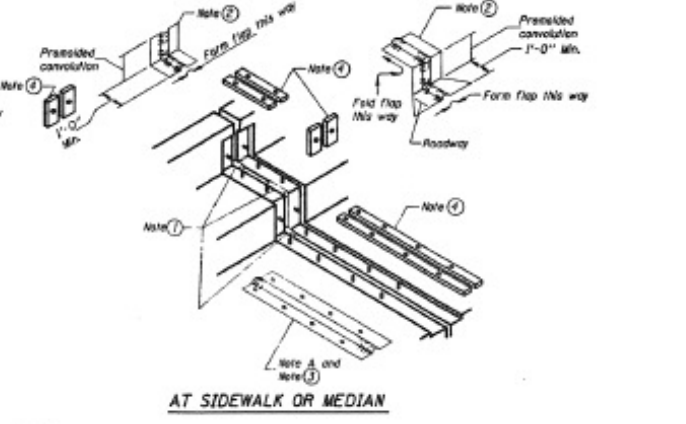

**AT SIDEWALK OR MEDIAN**

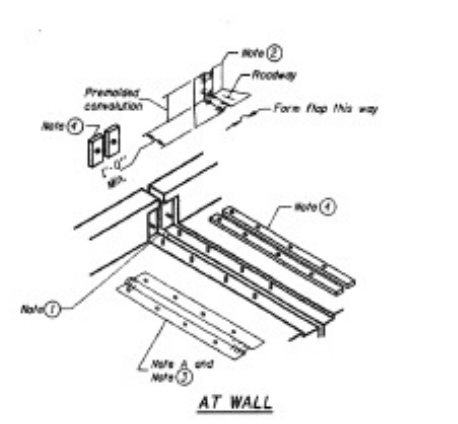

**AT WALL**

DESIGNED	
CHECKED	
DRAWN	
CHECKED	
EJ-CS	2-26-93

REV. NO.	DESCRIPTION	BY	DATE
EAST ABUTMENT NEOPRENE EXPANSION JOINT DETAILS			
1	FAI RT 74 SEC. 10-4BR OVER SANGAMON RIVER CHAMPAIGN COUNTY STA. 1539+94.80 STR. NO. 010-0017 (WB)		

STRUCTURE 010-0167 WAS ORIGINALLY BUILT IN 1966 AS FAI ROUTE 74, SECTION 10-5HB AT STATION 1742+74.26 BY THE STATE OF ILLINOIS.

THE EXISTING STRUCTURE IS A FOUR SPAN STRUCTURE WITH A BACK-TO-BACK OF ABUTMENT LENGTH OF 248'-3". THE STRUCTURE MEASURES 24'-0" FROM FACE-TO-FACE OF SAFETY WALK AND HAS AN OUT-TO-OUT WIDTH OF 30'-0". THE STRUCTURE WAS BUILT ON A 23° 28' LEFT-FORWARD SKEW. THE SUPERSTRUCTURE CONSISTS OF FIVE STEEL GIRDERS SUPPORTING A 6 1/2" REINFORCED CONCRETE DECK. THE SUPERSTRUCTURE IS SUPPORTED BY PILE ABUTMENTS AND PIERS. THE SLOPES ARE PROTECTED WITH CONCRETE SLOPE WALLS.

METHOD OF CONSTRUCTION: ROAD CLOSURE

**GENERAL NOTES**

Plan dimensions and details relative to existing plans are subject to nominal construction variations. The Contractor shall field verify existing dimensions and details affecting new construction and make necessary approved adjustments prior to construction or ordering of materials. Such variations shall not be cause for additional compensation for a change in scope of work. However, the Contractor will be paid for the quantity actually furnished at the unit price for the work.

Reinforcement bars designated (E) shall be epoxy coated.

The existing structural steel coating contains lead. The Contractor shall take appropriate precautions to deal with the presence of lead on this project.


All structural steel shall conform to AASHTO Classification M-270 Grade 36, unless otherwise noted.

Existing structural steel that will be in contact with new structural steel shall be cleaned and painted prior to erection as required by the Special Provision "Cleaning and Painting Contact Surface Areas of Existing Steel Structures".

Existing reinforcement bars extending into the removal area shall be cleaned, straightened and incorporated into the new construction. Any reinforcement bars that are damaged during concrete removal shall be replaced with an approved bar splicer or anchorage system. Cost included with Concrete Removal.

See Special Provision "Deck Slab Repair" for additional requirements pertaining to Deck Slab Repair.


Areas of Deck Slab Repairs shown are estimated. The Engineer shall show actual locations of the deck repairs on As-Built plans.

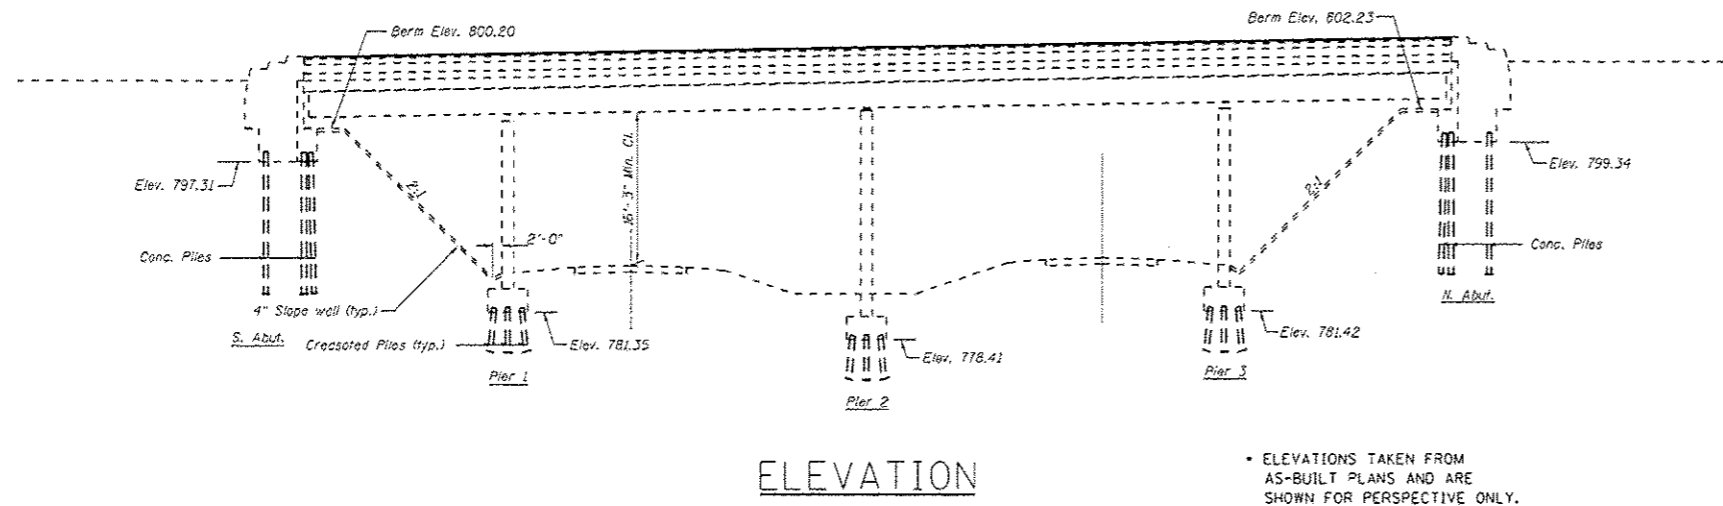

ELEVATIONS TAKEN FROM AS-BUILT PLANS AND ARE SHOWN FOR PERSPECTIVE ONLY.

**PROPOSED WORK**

1. Remove and replace select deck drains.
2. Partial depth patching on existing deck.
3. Place Steel Railing, Type 2399
4. Remove and replace existing guardrail and terminals.

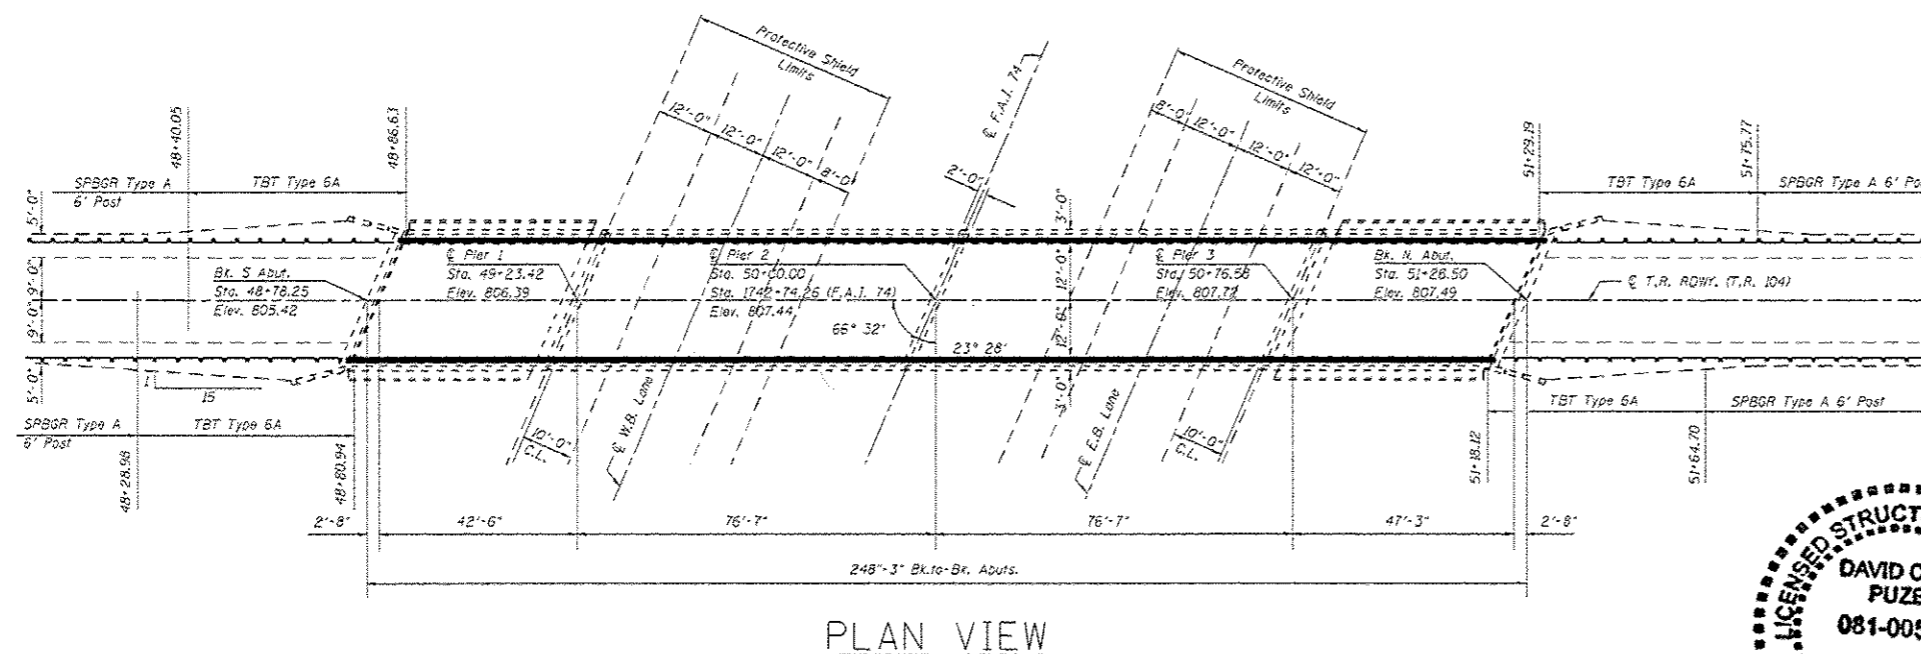

**TOTAL BILL OF MATERIAL S.N. 010-0167**

ITEM	UNIT	TOTAL
Protective Shield	Sq Yd.	175.0
Deck Slab Repair Partial Depth	Sq Yd	15.0
Deck Slab Repair (Full-Depth, Type I)	Sq Yd.	4.0
Deck Slab Repair (Full-Depth, Type II)	Sq. Yd.	18.0
Floor Drains	Each	10.0
Steel Rail Type 2399	Foot	491.0
Guardrail Removal	Foot	1217.0
Steel Plate Beam guardrail, T.A. 6' Posts	Foot	887.5
Traffic Barrier Terminal Type 6A	Each	4.0
Traffic Barrier Terminal T1 Sp (Tangent)	Each	4.0
Terminal Marker Direct Applied	Each	4.0
Guardrail Marker, Type A	Each	12.0




*David Carl Puzey 9/26/16 Expires 11/30/18*


FILE NAME	USER NAME	DESIGNED - JMS	REVISED -	STATE OF ILLINOIS DEPARTMENT OF TRANSPORTATION	GENERAL PLAN & ELEVATION S.N. 010-0167	F.A.I. RTE.	SECTION	COUNTY	TOTAL SHEET NO.	
pw\11884EB10\INTE\illinois.gov\p1007\Documents\DOT Offices\District 5\Projects\007\Drawings\Struct\0072815-snt-Repai		DRAWN	REVISED			74	(10-4,10-5)H	CHAMPAIGN	74	47
PLOT SCALE = 48.0000 1" = 10'	CHECKED -	DATE	REVISED			SCALE: 1" = 20'		SHEET NO. 1 OF 10 SHEETS		TO STA.
PLOT DATE = 8/8/2016	DATE	REVISED	ILLINOIS FED. AID PROJECT			CONTRACT NO. 70B15				



## EXISTING TYPICAL CROSS SECTION S.N. 010-0167

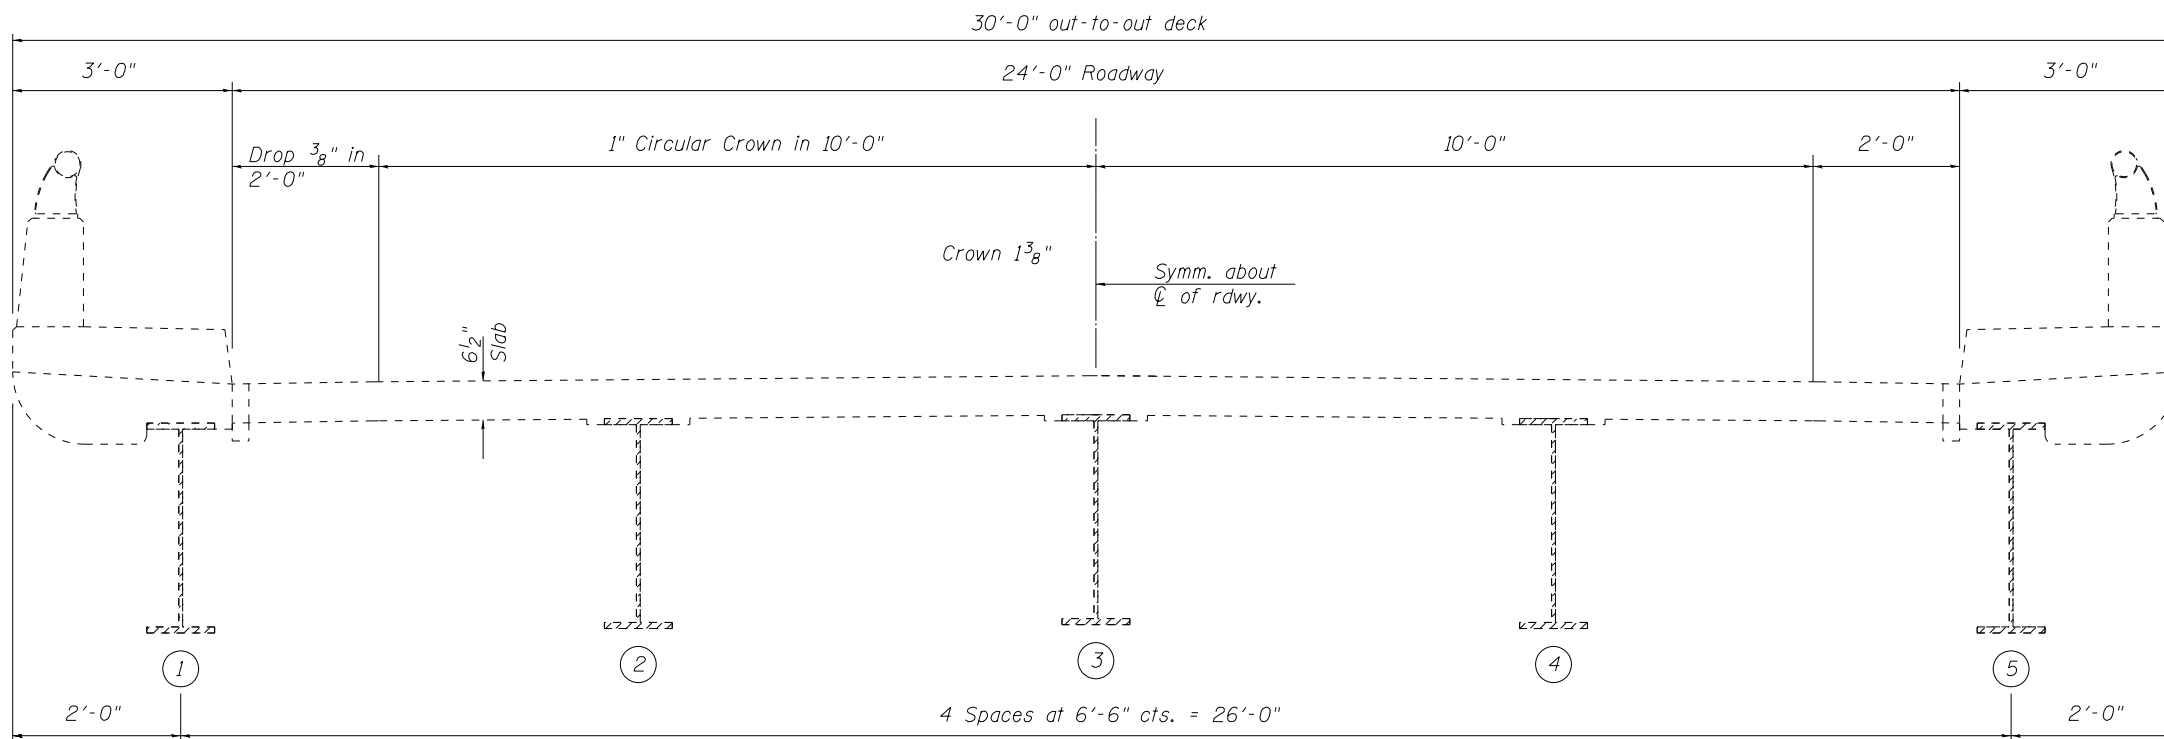


## PROPOSED TYPICAL CROSS SECTION S.N. 010-0167

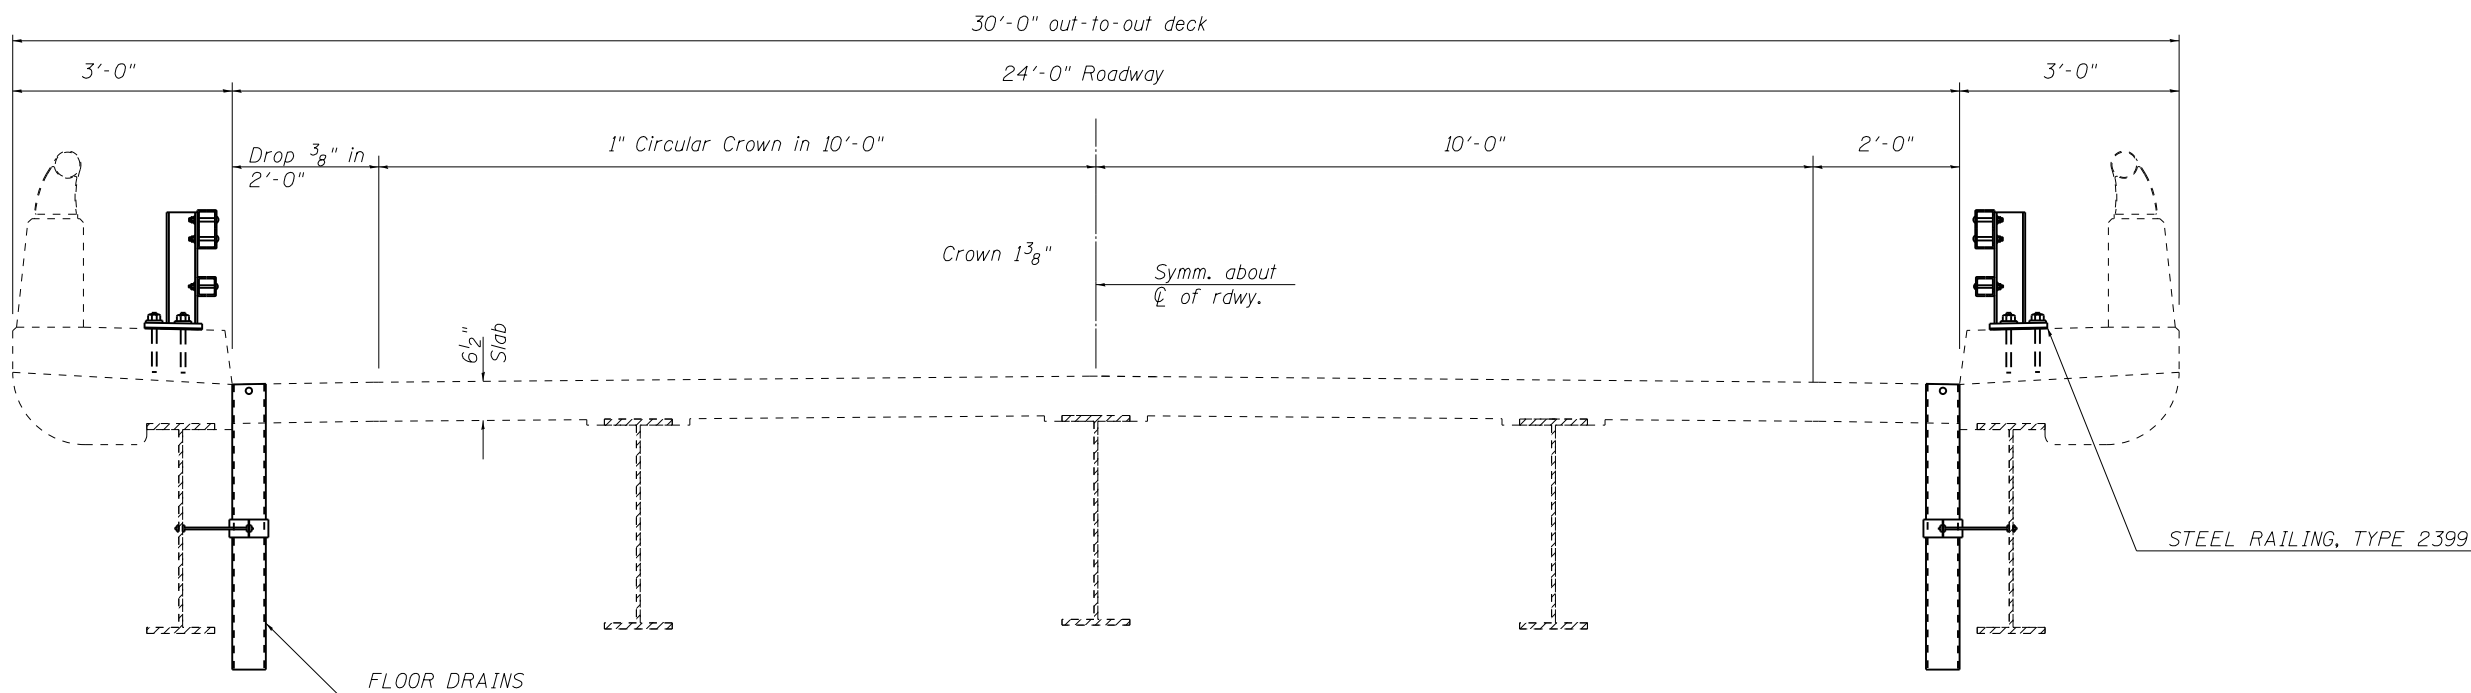


FILE NAME =	USER NAME = shererjm	DESIGNED - JMS	REVISED -	<b>STATE OF ILLINOIS DEPARTMENT OF TRANSPORTATION</b>	<b>TYPICAL CROSS-SECTIONS S.N. 010-0167</b>			F.A.I. RTE.	SECTION	COUNTY	TOTAL SHEETS	SHEET NO.
pw:\11\084EBIDINTEG.illinois.gov\PIWIDOT\Documents\DOT Offices\District 5\Projects\0577\Drawings\Struct\MS\0570B15-sht-Repov\REVISED -	DESIGNED - JMS	REVISED -	REVISED -		74	(10-4,10-5)I	CHAMPAIGN	74	48			
PLOT SCALE = 40.0000' / in.	CHECKED -	REVISED -	REVISED -		CONTRACT NO. 70B15			ILLINOIS FED. AID PROJECT				
PLOT DATE = 8/8/2016	DATE -	REVISED -	REVISED -	SCALE:	SHEET NO. 2 OF 10 SHEETS	STA.	TO STA.					

# S.N. 010-0167 SPANS 1 & 2

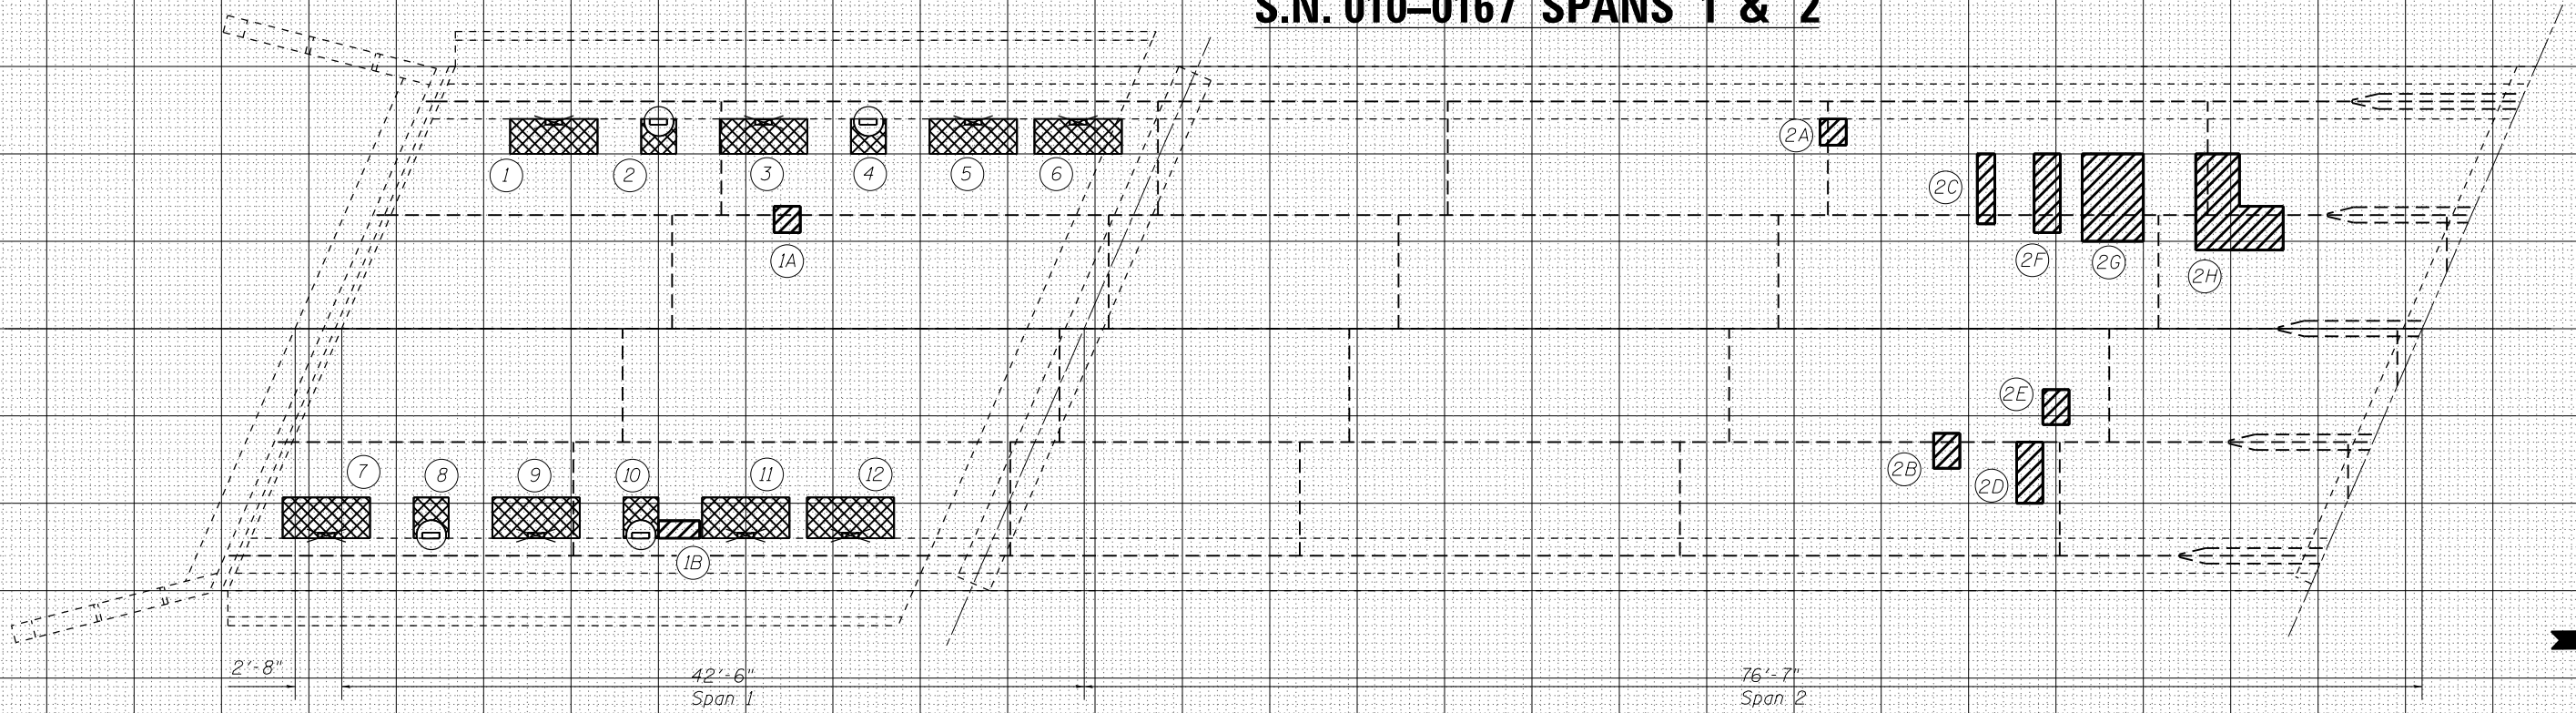

# S.N. 010-0167 SPANS 3 & 4

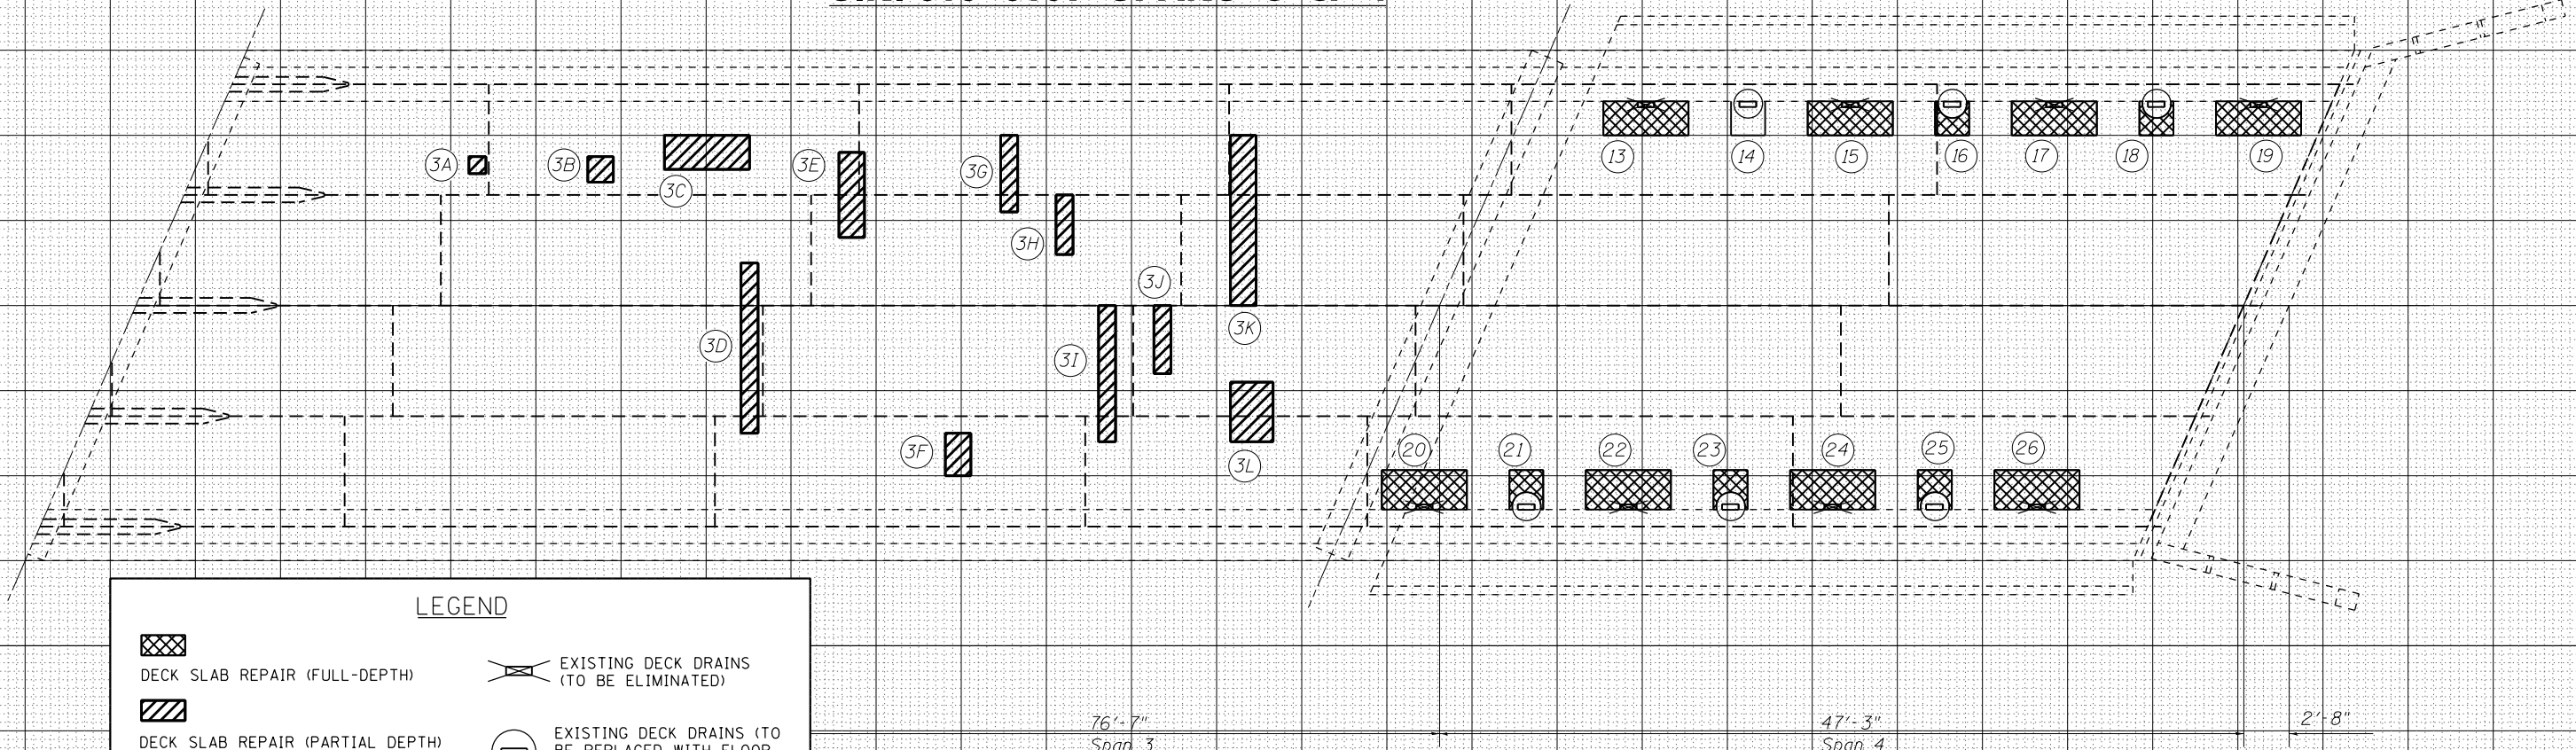

**LEGEND**

- DECK SLAB REPAIR (FULL-DEPTH)
- DECK SLAB REPAIR (PARTIAL DEPTH)
- EXISTING DECK DRAINS (TO BE ELIMINATED)
- EXISTING DECK DRAINS (TO BE REPLACED WITH FLOOR DRAINS)

DATE	
BY	
FINAL SURVEY	
PLOTTED	
TEMPLATE	
NOTE BOOK	
AREAS CHECKED	
NO.	

DATE	
BY	
ORIGINAL SURVEY	
PLOTTED	
TEMPLATE	
NOTE BOOK	
AREAS CHECKED	
NO.	

FILE NAME =	USER NAME = shererjm	DESIGNED - JMS	REVISED -
Default		CHECKED -	REVISED -
		DATE - 8/8/2016	REVISED -

**STATE OF ILLINOIS  
DEPARTMENT OF TRANSPORTATION**

<b>PLAN OF BRIDGE DECK PATCHING</b>			
<b>S.N. 010-0167</b>			
SCALE: 1" = 5'	SHEET 3	OF 10 SHEETS	STA. TO STA.

F.A.I. RTE.	SECTION	COUNTY	TOTAL SHEETS	SHEET NO.
74	(10-4,10-5)I	CHAMPAIGN	74	49
CONTRACT NO. 70B15				

ILLINOIS FED. AID PROJECT

PATCH NO.	SIZE		DECK SLAB REPAIR (PARTIAL DEPTH) SQ YD
	LENGTH (FT)	WIDTH (FT)	
1A	1.5	1.5	0.3
1B	2.5	1	0.3
2A	1.5	1.5	0.3
2B	1.5	2	0.3
2C	1	4	0.4
2D	1.5	3.5	0.6
2E	1.5	2	0.3
2F	1.5	4.5	0.8
2G	2.5	3	0.8
2G	2.5	5	1.4
3A	1	1	0.1
3B	1.5	1.5	0.3
3C	5	2	1.1
3D	1	10	1.1
3E	1.5	5	0.8
3G	1	4.5	0.5
3F	1.5	2.5	0.4
SUB-TOTAL =			9.8

PATCH NO.	SIZE		DECK SLAB REPAIR (PARTIAL DEPTH) SQ YD
	LENGTH (FT)	WIDTH (FT)	
3H	1	3.5	0.4
3I	1	8	0.9
3J	1	4	0.4
3K	1.5	10	1.7
3L	2.5	3.5	1.0
SUB-TOTAL =			4.4
TOTAL =			14.2
USE =			15.0

PATCH NO.	SIZE		DECK SLAB REPAIR (FULL DEPTH T1) SQ YD	DECK SLAB REPAIR (FULL DEPTH T2) SQ YD
	LENGTH (FT)	WIDTH (FT)		
1	5	2		1.1
2	2	2	0.4	
3	5	2		1.1
4	2	2	0.4	
5	5	2		1.1
6	5	2		1.1
7	5	2		1.1
8	2	2	0.4	
9	5	2		1.1
10	2	2	0.4	
11	5	2		1.1
12	5	2		1.1
13	5	2		1.1
14	2	2	0.4	
15	5	2		1.1
16	2	2	0.4	
17	5	2		1.1
SUB-TOTAL =			2.4	12.1


PATCH NO.	SIZE		DECK SLAB REPAIR (FULL DEPTH T1) SQ YD	DECK SLAB REPAIR (FULL DEPTH T2) SQ YD
	LENGTH (FT)	WIDTH (FT)		
18	2	2	0.4	
19	5	2		1.1
20	5	2		1.1
21	2	2	0.4	
22	5	2		1.1
23	2	2	0.4	
24	5	2		1.1
25	2	2	0.4	
26	5	2		1.1
SUB-TOTAL =			1.6	5.5
TOTAL =			4.0	17.6
USE =			4.0	18.0

SCHEDULE NOTE:


DECK SURVEY PERFORMED ON AUGUST 6, 2013. IF MORE THAN ONE WITHIN FREEZE-THAW CYCLE OCCURS BETWEEN THE INITIAL INSPECTION AND THE COMMENCEMENT OF WORK, THE FINAL PLAN QUANTITIES FOR DECK REPAIRS MUST BE BASED ON NEW INSPECTION OF THE DECK.

BILL OF MATERIALS


ITEM	UNIT	TOTAL
DECK SLAB REPAIR (PARTIAL)	SQ YD	15.0
DECK SLAB REPAIR (FULL DEPTH, TYPE I)	SQ YD	4.0
DECK SLAB REPAIR (FULL DEPTH, TYPE II)	SQ YD	18.0

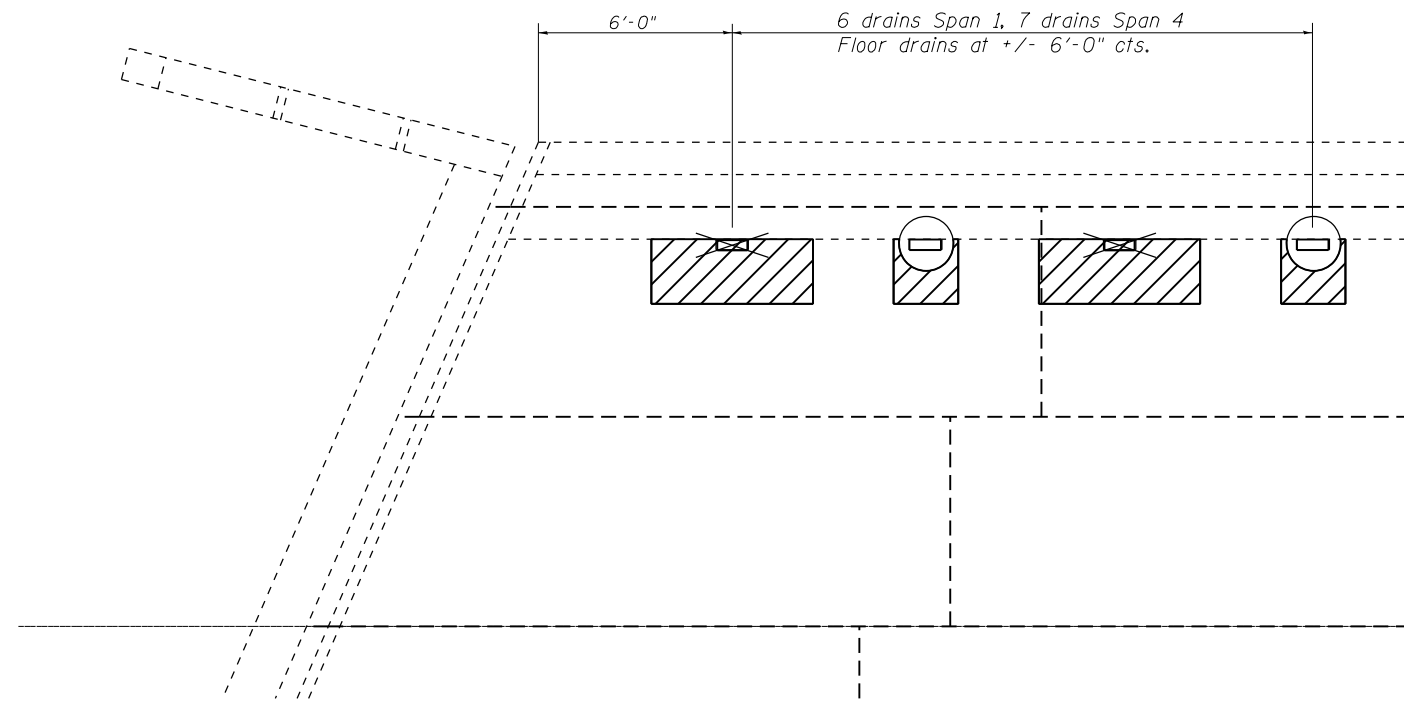


PLAN VIEW OF DRAINS  
TYPICAL

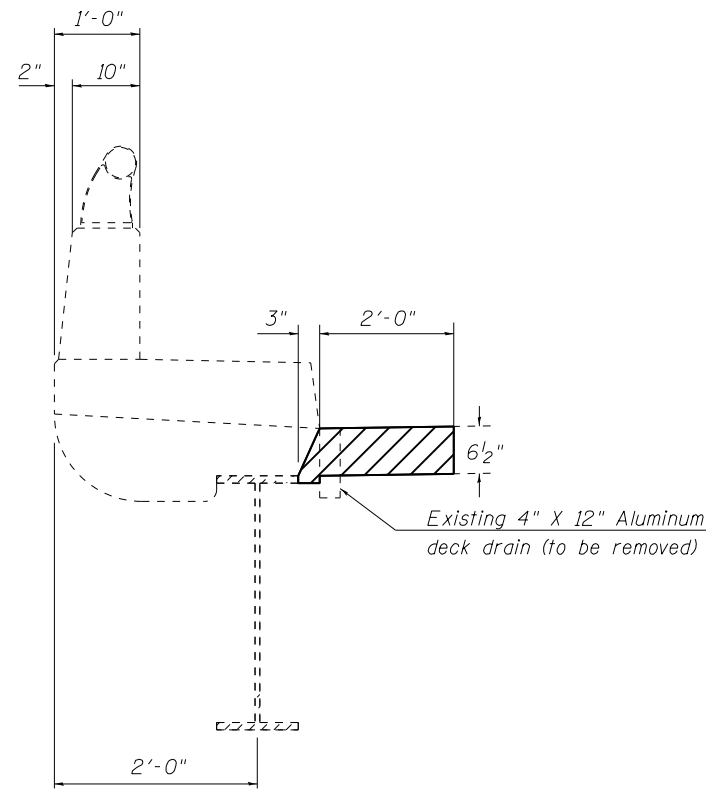


SECTION AT  
EXISTING DRAIN

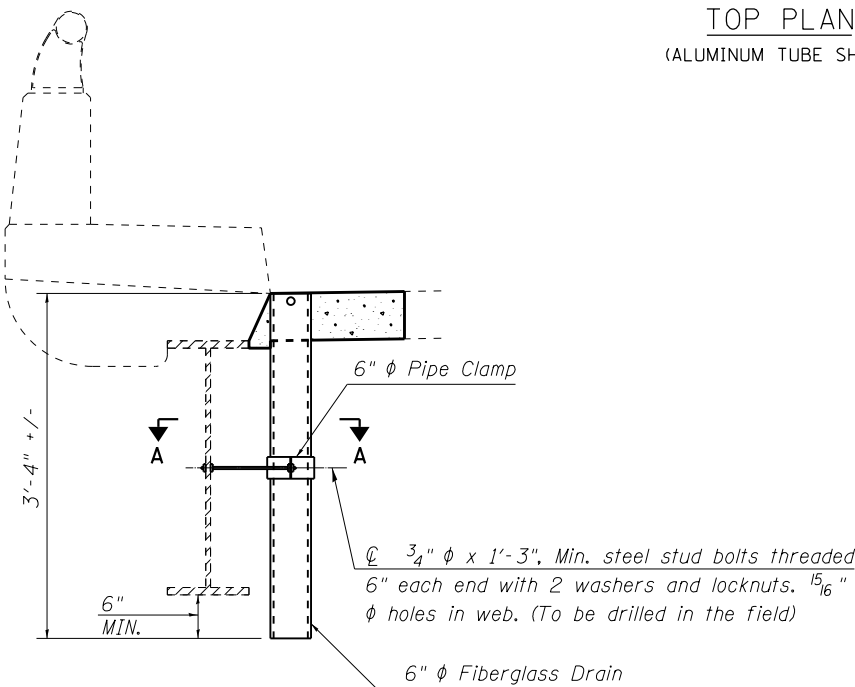

SECTION AT  
PROPOSED DRAIN

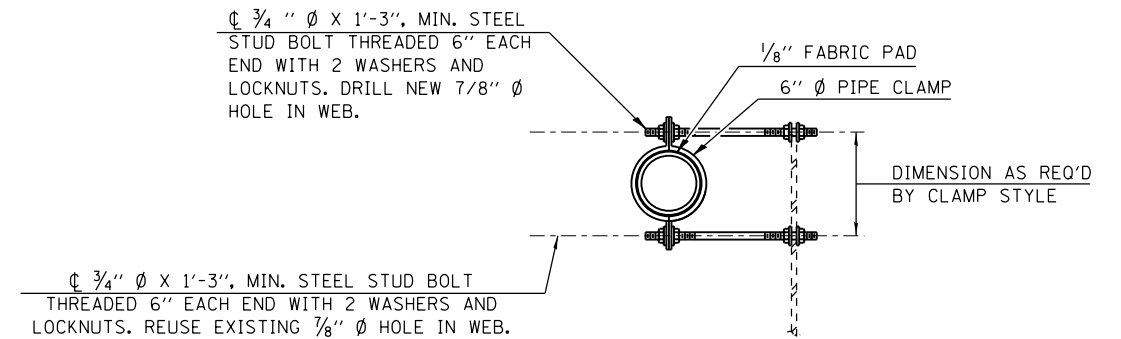


SECTION A-A  
SHOWING PIPE CLAMP  
ANCHORAGE STYLE

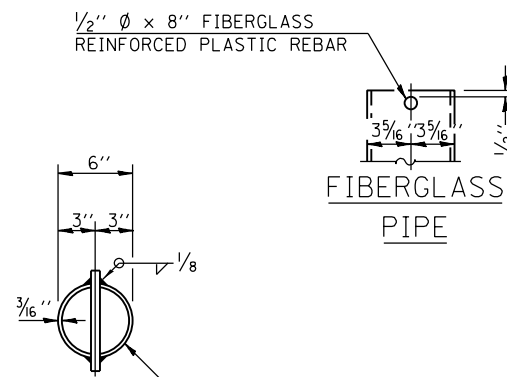

6" O.D. ALUMINUM TUBE ALLOY  
6061-T6 OR 6" Ø FIBERGLASS PIPE

TOP PLAN  
(ALUMINUM TUBE SHOWN)

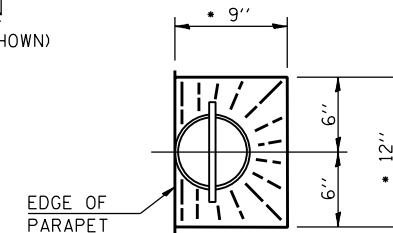

TOP PLAN  
• SLOPE TO DRAIN

LEGEND

- EXISTING DECK DRAINS (TO BE REPLACED WITH FLOOR DRAINS)
- EXISTING DECK DRAINS (TO BE ELIMINATED)
- DECK SLAB REPAIR (FULL DEPTH, TYPE I)

NOTES:


- FLOOR DRAINS NEED NOT BE PAINTED.
- FIBERGLASS PIPE SHALL CONFORM TO ASTM D 2996, WITH SHORT-TIME RUPTURE STRENGTH HOOP TENSILE STRESS OF 30,000 P.S.I. MINIMUM.
- GALVANIZE CLAMPING DEVICE AND ALL STUD BOLTS, WASHERS AND NUTS ACCORDING TO AASHTO M232.
- ALL DIMENSIONS SHALL BE FIELD VERIFIED BY THE CONTRACTOR PRIOR TO ORDERING OF MATERIALS.

BILL OF MATERIALS


ITEM	UNIT	TOTAL
FLOOR DRAINS	EACH	10.0

COST OF REMOVAL OF EXISTING DRAINS IS INCLUDED IN DECK SLAB REPAIR.


\* Cut bottom end of post to curb slope.

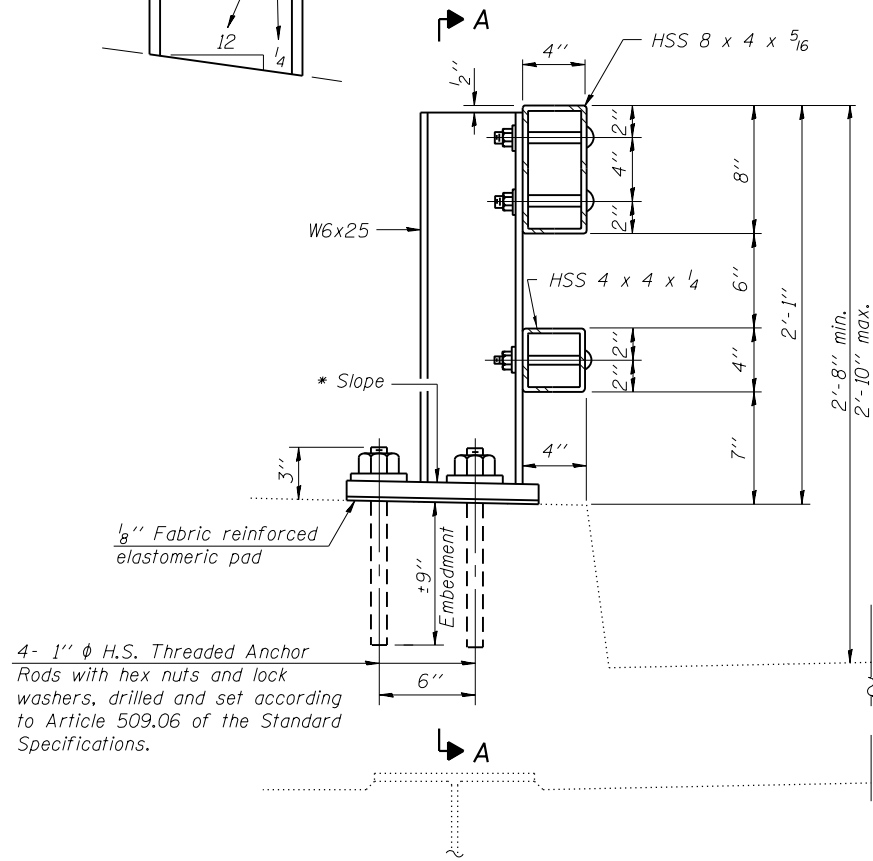


**SECTION AT RAIL POST**

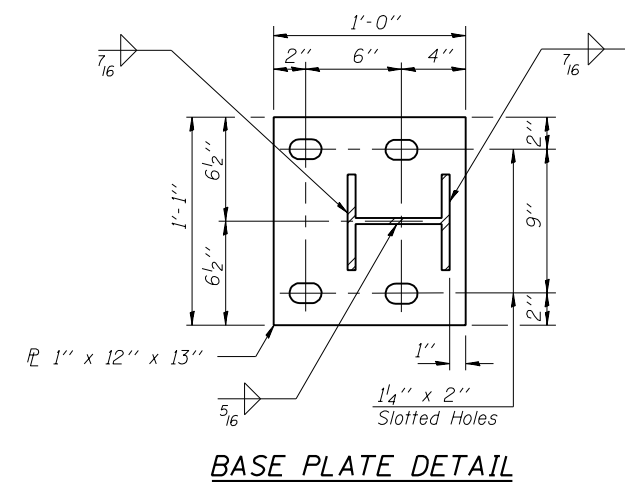


**BASE PLATE DETAIL**

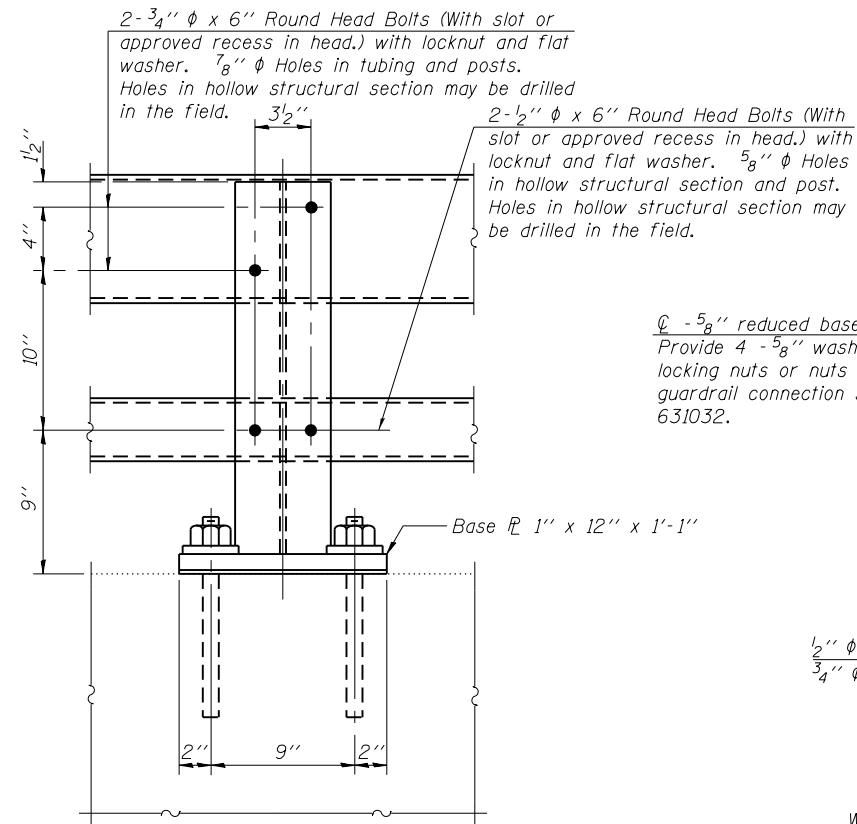


**SECTION A-A**

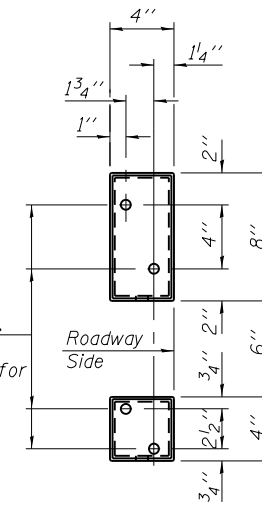


**VIEW B-B**

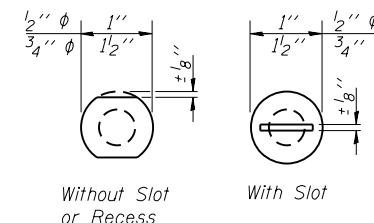


**VIEW C-C**

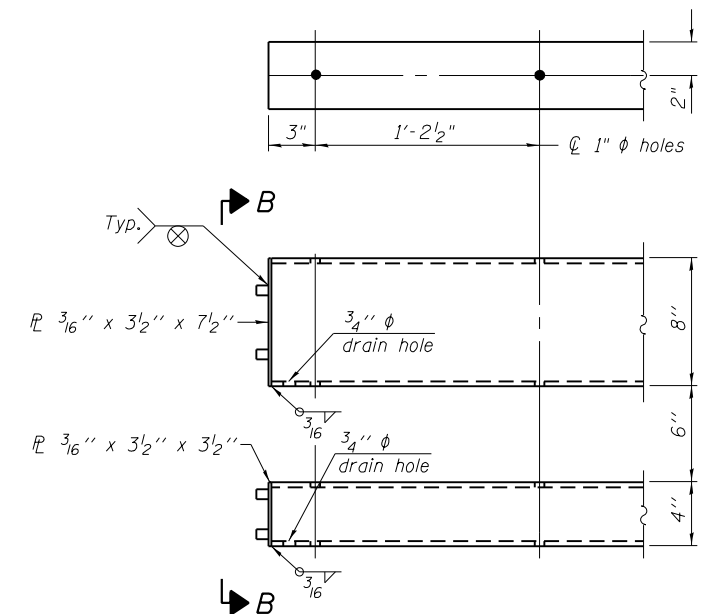


**END OF RAIL DETAILS**

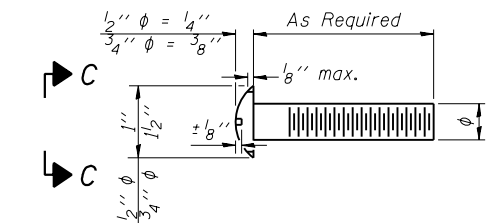


**DETAIL OF 1/2" & 3/4" ROUND HEAD BOLTS**

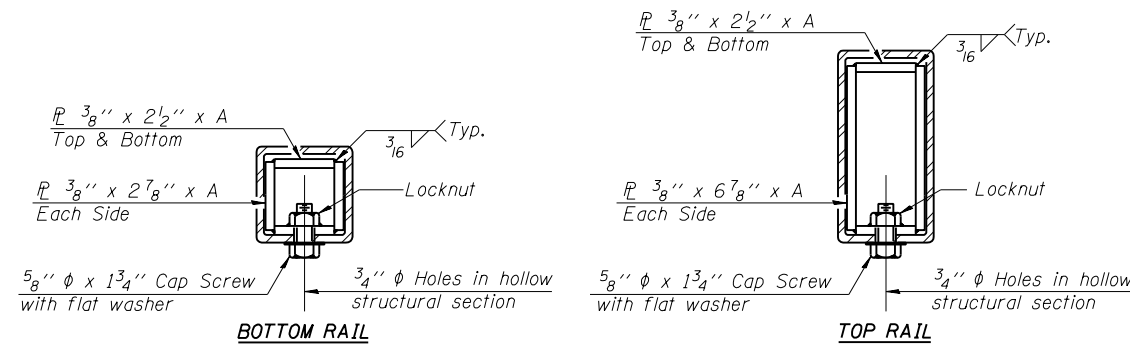

**SECTIONS AT RAIL SPLICE**

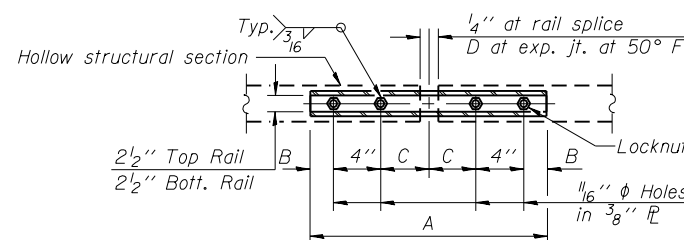

**PLAN-BOTT. SPLICE R TYPICAL**

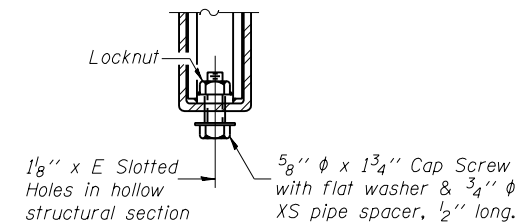

**RAIL SPLICE CONNECTION AT EXPANSION JT.**

**Notes:**

All field drilled holes shall be coated with an approved zinc rich paint before erection.  
 Posts shall not be located closer than 1'-3" to an existing bridge expansion joint or end of bridge.  
 Steel Bridge Rail expansion joint shall be provided between any two (2) posts which span a bridge expansion joint. Bolts located at expansion joint shall be provided with locknuts and shall be tightened only to a point that will allow railing movement.  
 Provide one 1/8" and two 1/16" steel shims for 25% of the posts. Shims shall be similar to base plates in size and holes.  
 All steel rail elements shall be galvanized according to Article 509.05 of the Standard Specifications.

**SPLICE DIMENSIONS**

T	D	A	B	C	E
≤ 4"	2 1/2"	1'-8"	2"	4"	2 1/2"
> 4" ≤ 6 1/2"	3 3/4"	2'-0"	2 1/2"	5 1/2"	3 1/2"
> 6 1/2" ≤ 9"	5"	2'-4"	3 1/2"	6 1/2"	9"
> 9" ≤ 13"	7"	2'-10"	4 1/2"	8 1/2"	11"
Rail Splice	1/4"	1'-8"	2"	4"	—

T = Total movement at expansion joint as shown on the design plans.

**BILL OF MATERIAL**

Item	Unit	Quantity
Steel Railing, Type 2399	Foot	491.0

R-31

7-1-10

(6'-3" Maximum Post Spacing)

FILE NAME =	USER NAME = shererjm	DESIGNED - JMS	REVISED -
pw:\11084EBIDINTEG.illinois.gov\PI\DOT\Documents\DOT Offices\District 5\Projects\0577\Drawings\Struct\MS\0570B15-sht-Rep\REVISED		CHECKED -	REVISED -
PLOT SCALE = 40.0000' / in.		DATE -	REVISED -
PLOT DATE = 8/8/2016			

**STATE OF ILLINOIS  
DEPARTMENT OF TRANSPORTATION**

**STEEL RAILING, TYPE 2399  
S.N. 010-0167**


SCALE: SHEET NO. 6 OF 10 SHEETS STA. TO STA.

F.A.I. RE.	SECTION	COUNTY	TOTAL SHEETS	SHEET NO.
54	(10-4,10-5)I	Champaign	74	52
			CONTRACT NO. 70B15	
ILLINOIS FED. AID PROJECT				

D.M. U.S.C. & G.S. "T-104" On South End of West  
 Bank of Culvert Sta. 48+250 Elev. = 784.41.

STATE OF ILLINOIS  
 DEPARTMENT OF PUBLIC WORKS & BUILDINGS  
 DIVISION OF HIGHWAYS

NO. OF SHEETS	NO. OF SHEETS	NO. OF SHEETS	NO. OF SHEETS	SHEET NO.
10	5	25	6	10
SHEET NO. 1				10 SHEETS

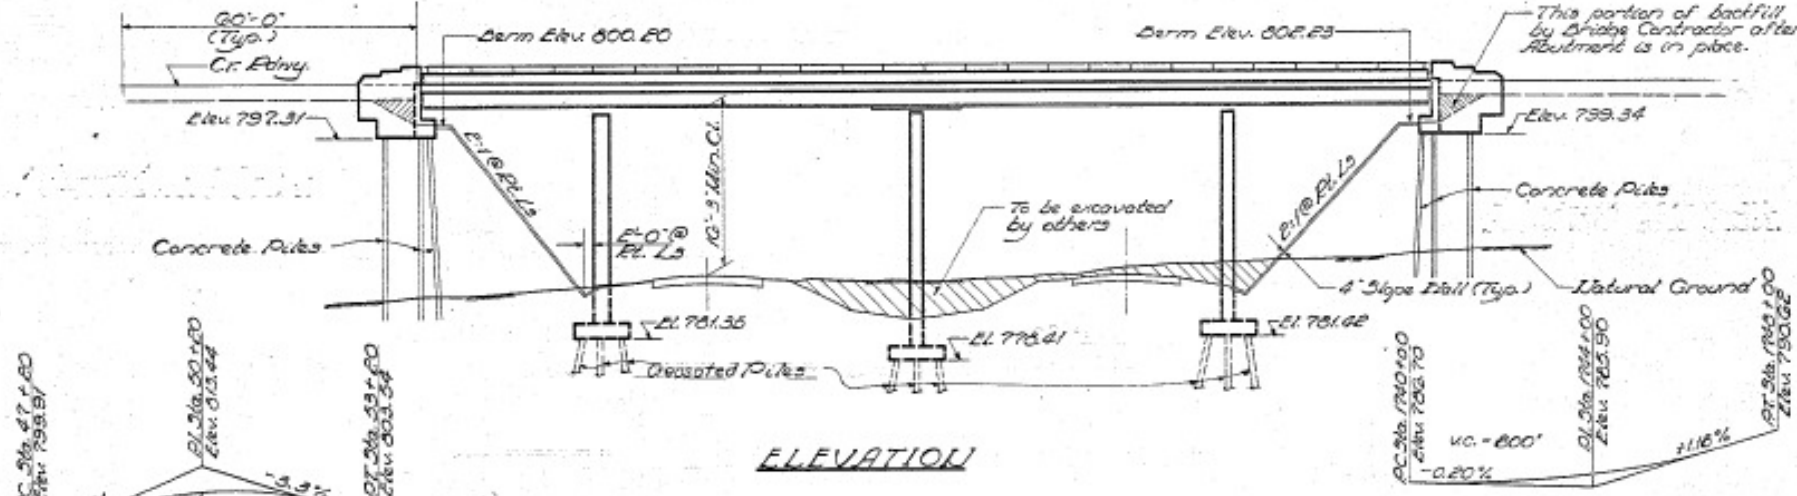

**GENERAL NOTES**

Coarse aggregate to be used in parapet handrails and end posts must be free of dirt, flint, iron ore, lignite and soft sandstone.

The concrete floor slab shall be finished in accordance with Article 5119 of the Standard Specifications.

Slope Wall shall be reinforced with welded wire fabric G<sup>2</sup> x G<sup>2</sup> mesh, weighing 58# per 100 sq. ft.

All reinforcement bars shall be lapped 40 diameters unless otherwise shown.

Piles to be driven 4' unless otherwise noted.

Anchor bolts shall be set before riveting diagonals over supports.

All Structural Steel shall conform to A.S.T.M. A-36 Specifications.

The exposed surfaces of the expansion guard shall be given two shop coats of red lead paint, the contact surfaces shall be given one shop coat of red lead paint. Anchor studs shall not be painted.

Expansion guards are included in the quantity of Structural Steel. Estimated Weight = 750 lbs.



Except as otherwise provided, all Structural Steel shall receive one shop coat of red lead paint and two field coats of aluminum paint. See Articles 56.1 to 56.5 inclusive of the Std. Specifications.

The Contractor shall drive one concrete test pile and one timber test pile, for locations see Sheets # 9 & # 2, as directed by the Engineer before ordering the remainder of piles.

Embankments to be constructed prior to driving piles at Piers # 1 & # 3.

Concrete piles at abutments shall be driven in holes precored through the embankment in accordance with Article 60.9 (c) of the Standard Specifications.

Permanent Metal forms will not be permitted for forming the slab.

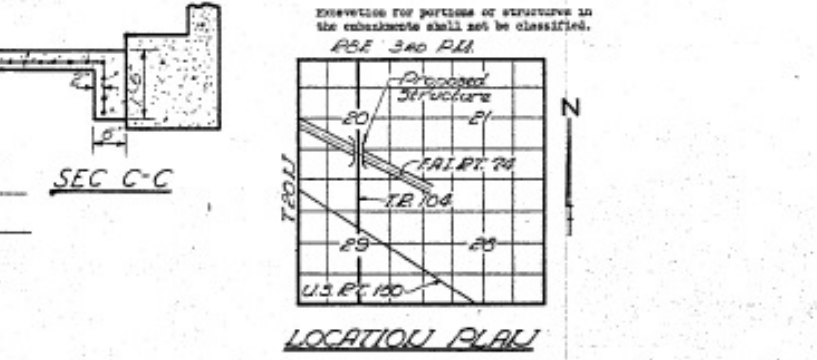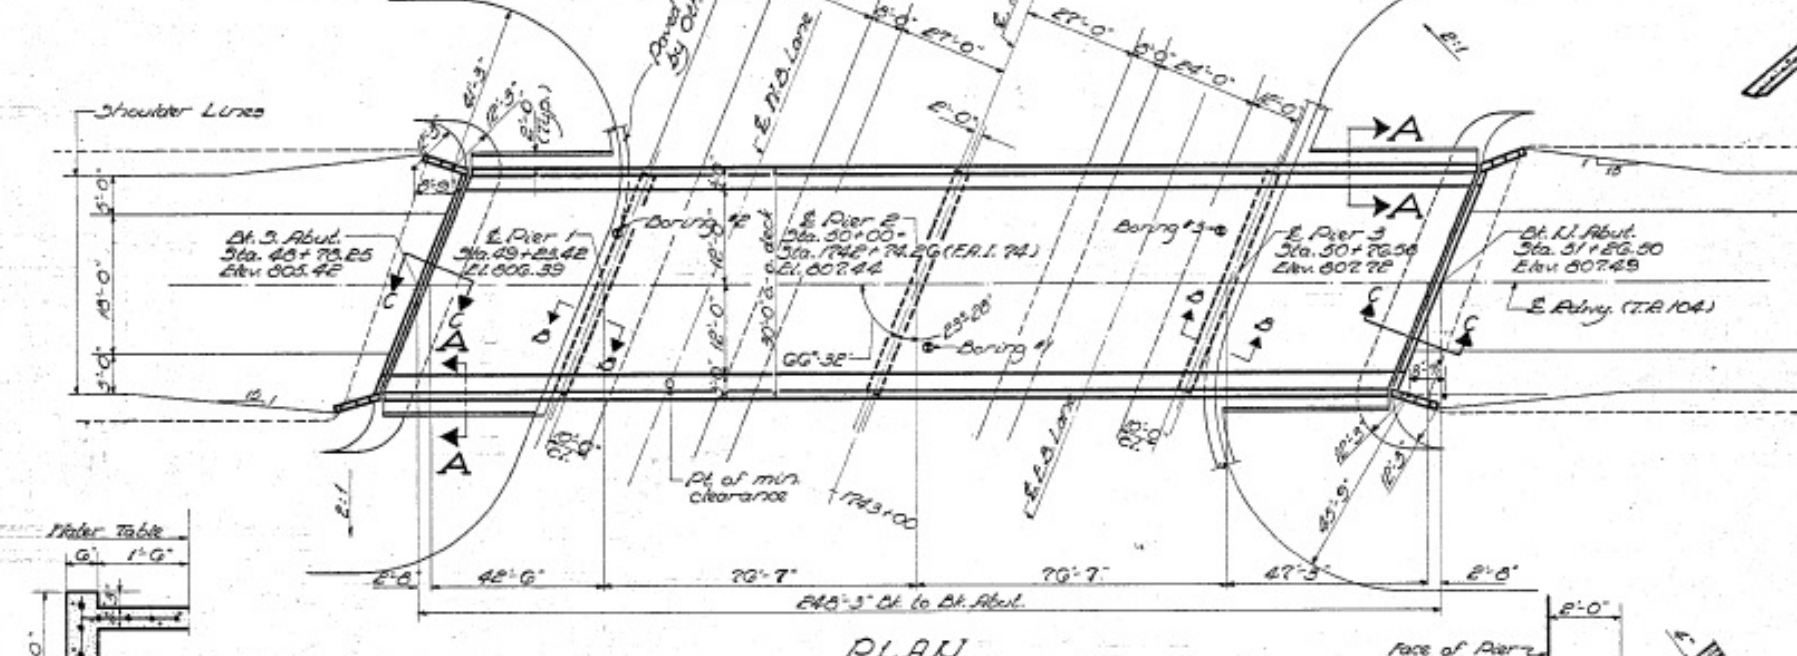

**TOTAL BILL OF MATERIAL**

Item	Unit	Super	Sub	Total
* Class A Excav. for Structures	Cu. Yds.		150	150
Class A Concrete	Cu. Yds.	229.7	216.1	445.8
Structural Steel	Lbs.	180,180		180,180
Aluminum Handrail	Lin. Ft.	490		490
Reinforcement Bars	Lbs.	47,560	17,670	65,230
Crested Piles (20'-1 to 38')	Lin. Ft.		1,910	1,910
Test Piles (Timber)	Each		1	1
Concrete Piles	Lin. Ft.		1,080	1,080
Test Piles (Conc.)	Each		1	1
Wave Plates	Each		2	2
Slope Wall (4')	Sq. Yds.			370
Protective Coat	Sq. Yds.	910		910

\*Includes excavation for Slope Wall

DESIGNED	John W. Clark	EXAMINED	W. E. [Signature]
CHECKED	[Signature]	PASSED	[Signature]
DRAWN	[Signature]	APPROVED	U. E. [Signature]
CHECKED	[Signature]		

STATOLI 1742+74.26  
 BUILT 196 BY  
 STATE OF ILLINOIS  
 F.A.I. RT. 74-SEC. 10-5115  
 LOADING H315  
 NAME PLATE  
 See Std. 2113-1




**DESIGN STRESSES**

Pc = 1,400 p.s.i. Super & Sub.  
 Pp = 20,000 p.s.i. Reinft.  
 Ps = 20,000 p.s.i. Struct. (A-36)  
 Vc = 75 p.s.i. Fldgs.  
 P = 10  
 LOADING: H315-44

PROJ. I-74-5(33)177  
 GENERAL PLAN & ELEVATION  
 T.R. 104 OVER F.A.I. RT. 74  
 F.A.I. RT. 74-SEC. 10-5115  
 CHAMPAIGN COUNTY  
 STA. 1742+74.26

STATE OF ILLINOIS  
DEPARTMENT OF PUBLIC WORKS & BUILDINGS  
DIVISION OF HIGHWAYS

DATE	SECTION	COUNTY	SCALE	SHEET NO.
7-10-62	I-5-L	Champaign	25	8
				10 SHEETS

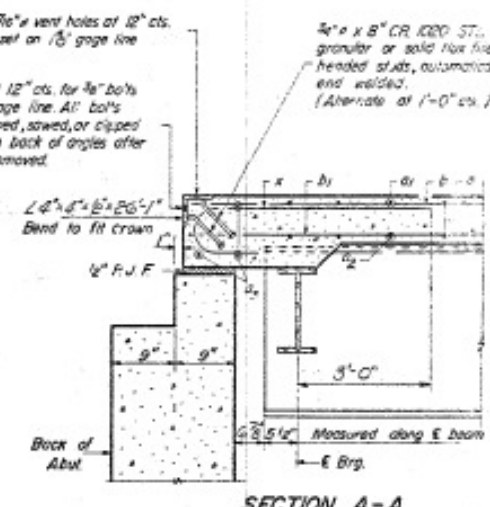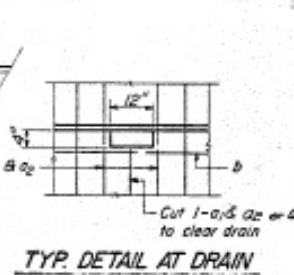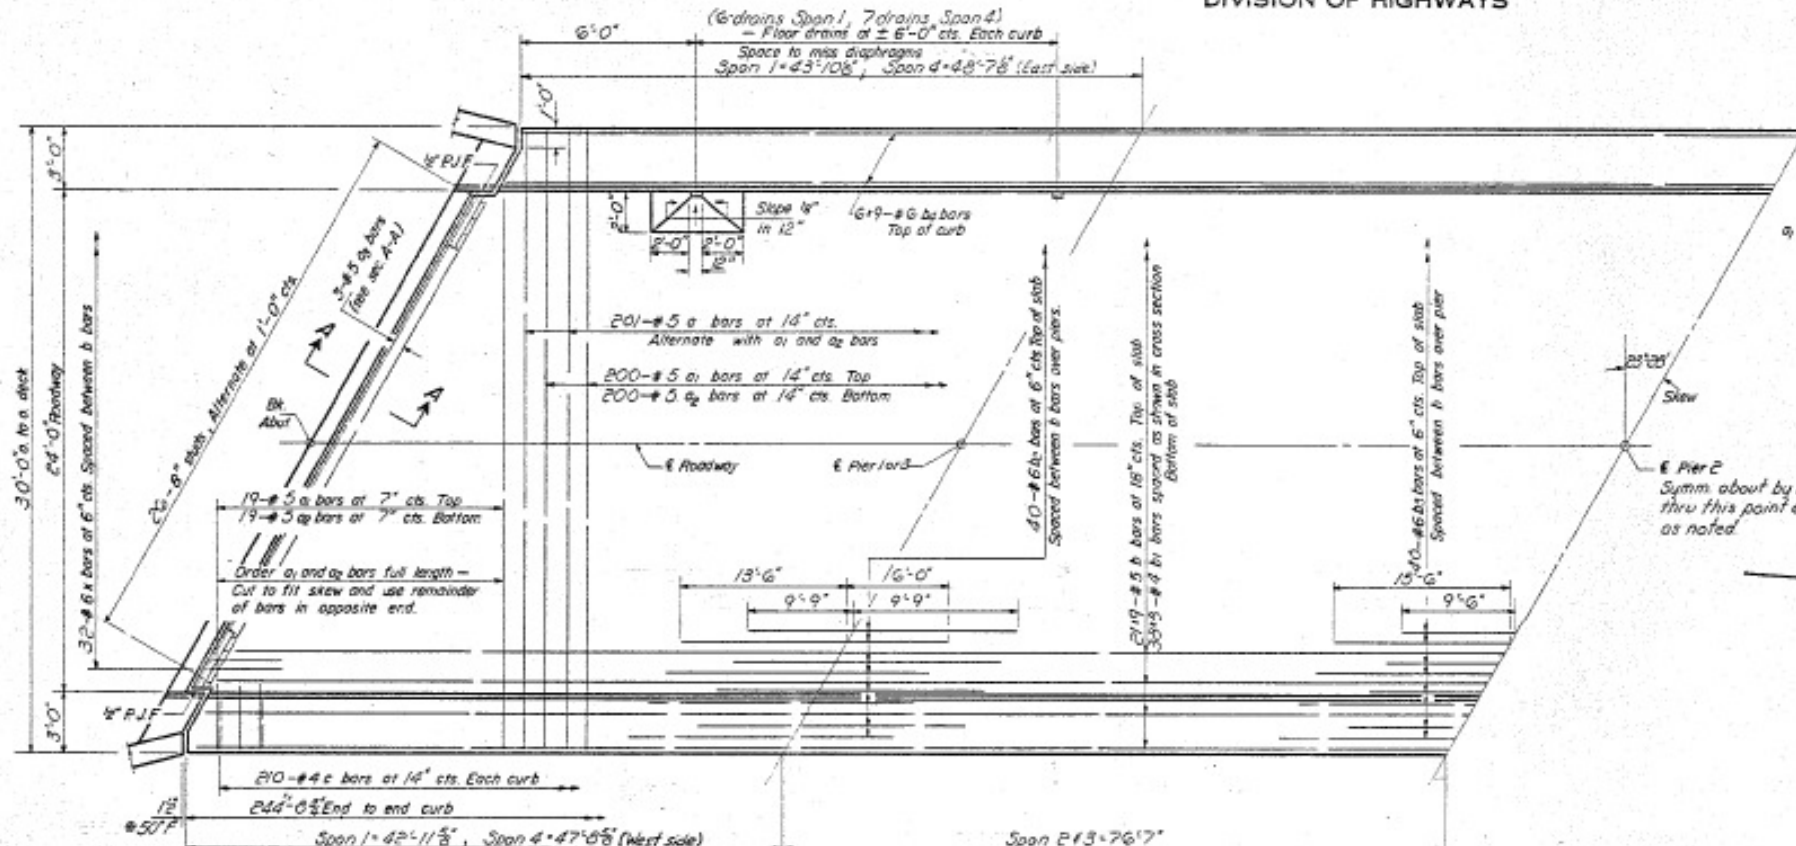

**BILL OF MATERIAL**


Bar No	Size	Length	Shape
a	#5	30'-6"	—
a1	#5	29'-6"	—
a2	#5	28'-6"	—
a3	#5	25'-9"	—
b	#5	28'-6"	—
b1	#4	31'-6"	—
b2	#6	19'-6"	—
b3	#6	25'-0"	—
b4	#6	28'-6"	—
c	#4	5'-9"	—
x	#6	5'-3"	—




Reinforcement Bars	Lbs.	42410
Structural Steel	Lbs.	150120
Class X Concrete	Cu Yd	2047

\* Weight of bearing assemblies with lead plates, and anchor bolts are included as structural steel. Est Wt = 6570/lbs.

Note:  
Bars indicated thus 20 x 3 - #5 etc. indicates 20 lines of bars with 3 lengths per line.  
Min bar laps = 20 dia.

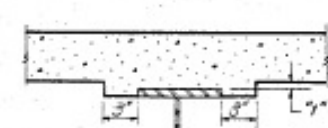

To determine "Y": After all structural steel has been erected, elevations of the top flanges of the beams shall be taken at intervals shown on sheet 2. These elevations subtracted from the "Grade Elevations Adjusted for Dead Load Deflections" shown on sheet 2, minus slab thickness, equals the fillet height "Y" above top of beams.

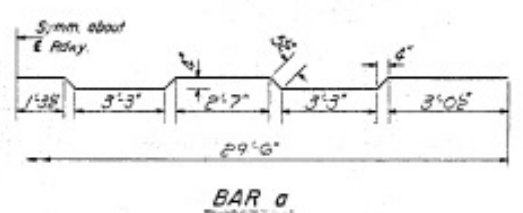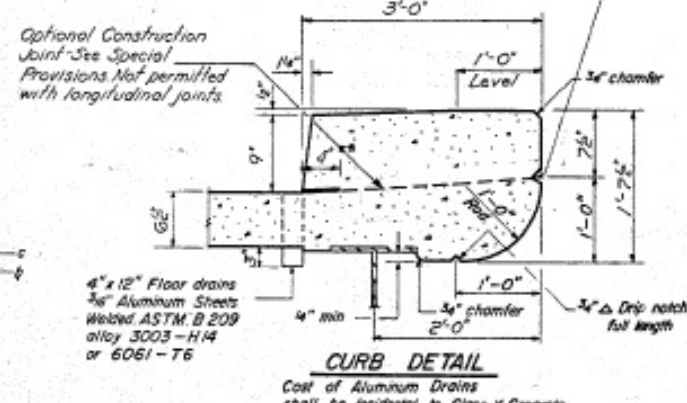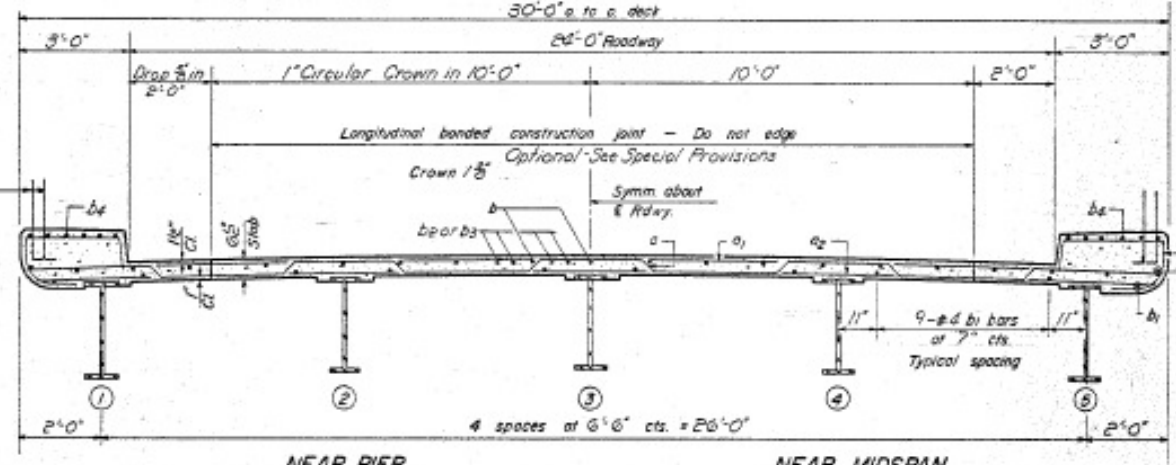

DESIGNED: N.E. Johnson  
CHECKED: John W. Clark Jr.  
W.H. H.E. Dickerson  
DRAWN: D.L. Bremer  
CHECKED: John W. Clark Jr.

EXAMINED: N.E. Johnson  
NOTED: C. Bremer  
APPROVED: U.E. Bluff



Aug 12 1962

I-5-L (>15°) 10-10-62


**SUPERSTRUCTURE**  
FAIR. 74 SEC. 10-5HB  
CHAMPAIGN COUNTY  
STA. 1742+74.26

STATE OF ILLINOIS  
DEPARTMENT OF PUBLIC WORKS & BUILDINGS  
DIVISION OF HIGHWAYS

NO. 74	SECTION 10-5H8	COUNTY CHAMPAIGN	25	9	10 SHEETS
--------	----------------	------------------	----	---	-----------

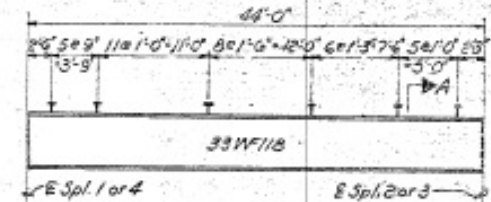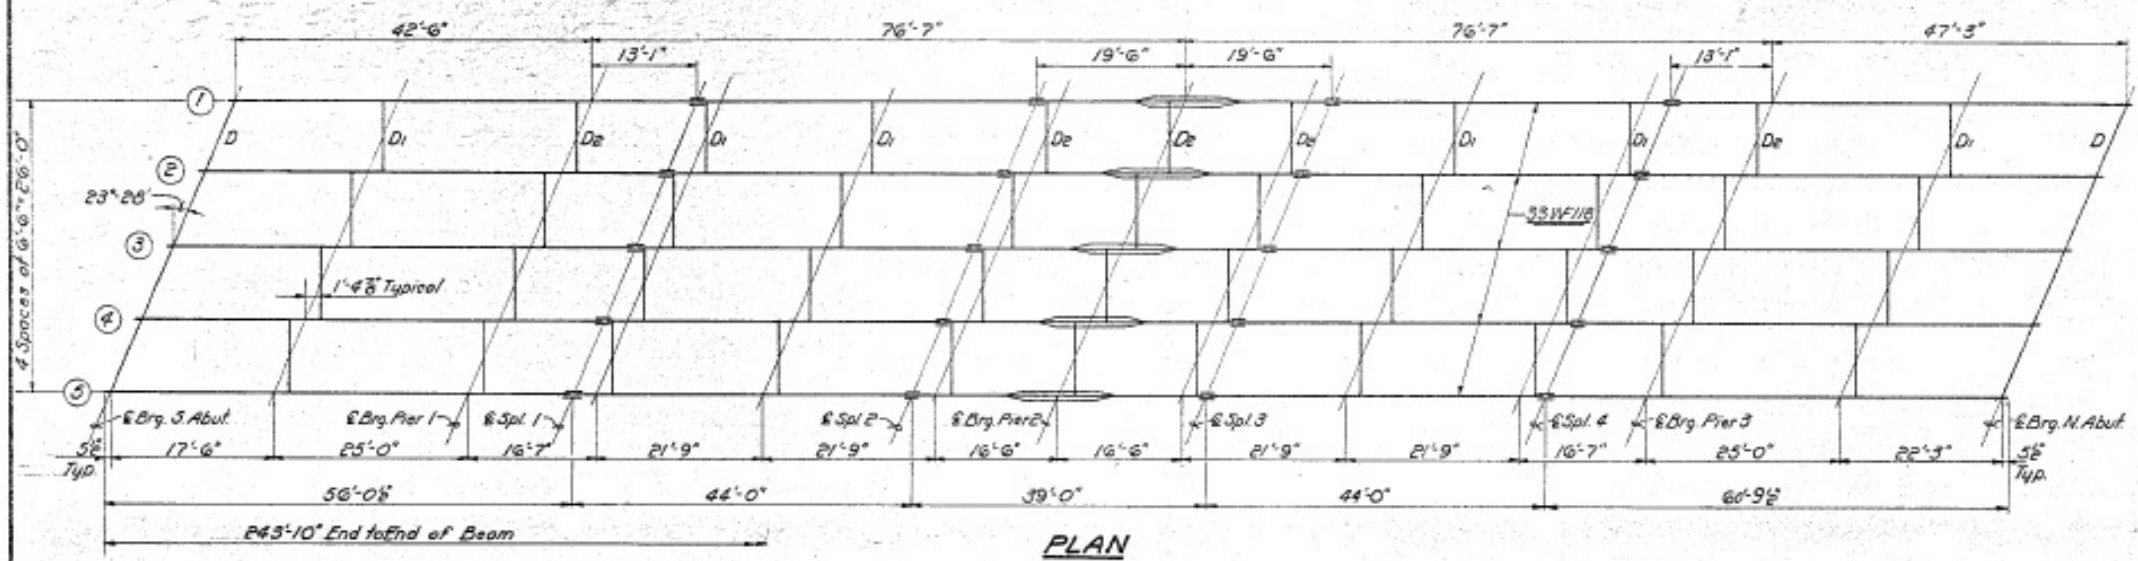


PARTIAL ELEVATION

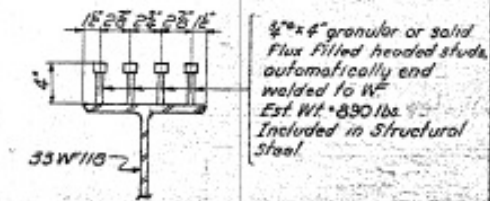


SECTION A-A

NOTE - Run all diaphragms level

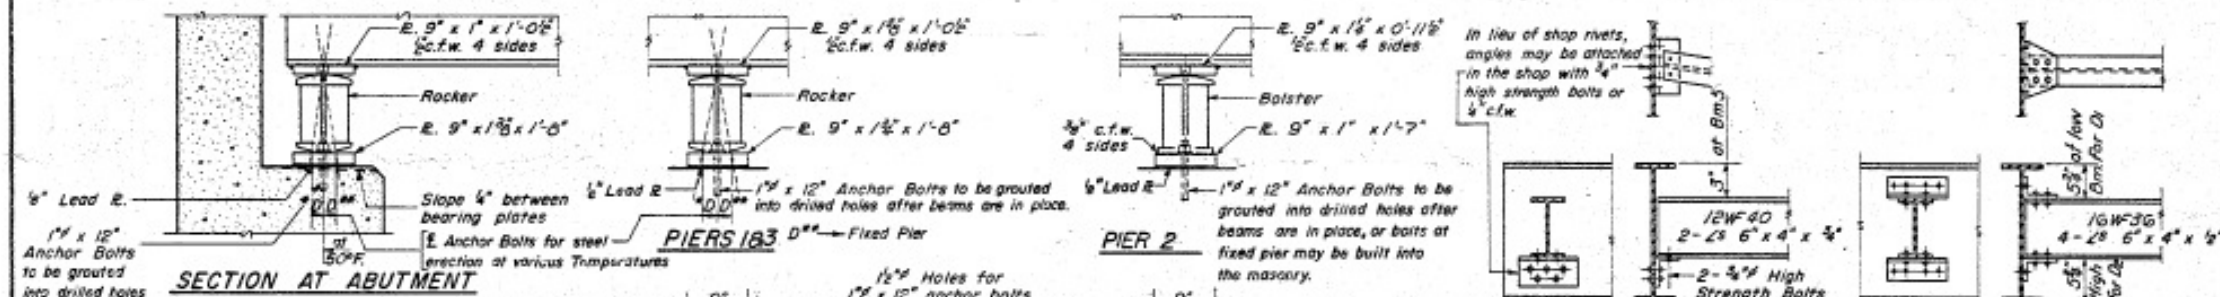

ELEVATION TOP OF W

	Bm 1	Bm 2	Bm 3	Bm 4	Bm 5
6 Brg. S. Abut.	804.78	804.90	804.96	804.86	804.69
6 Brg. Pier 1	805.63	805.75	805.81	805.71	805.54
6 Splice 1	805.89	806.01	806.07	805.97	805.80
6 Splice 2	806.50	806.62	806.68	806.58	806.41
6 Brg. Pier 2	806.67	806.79	806.85	806.75	806.58
6 Splice 3	806.84	806.96	807.02	806.92	806.75
6 Splice 4	806.99	807.11	807.17	807.07	806.90
6 Brg. Pier 3	806.95	807.07	807.13	807.03	806.86
6 Brg. N. Abut.	806.81	806.93	806.99	806.89	806.72

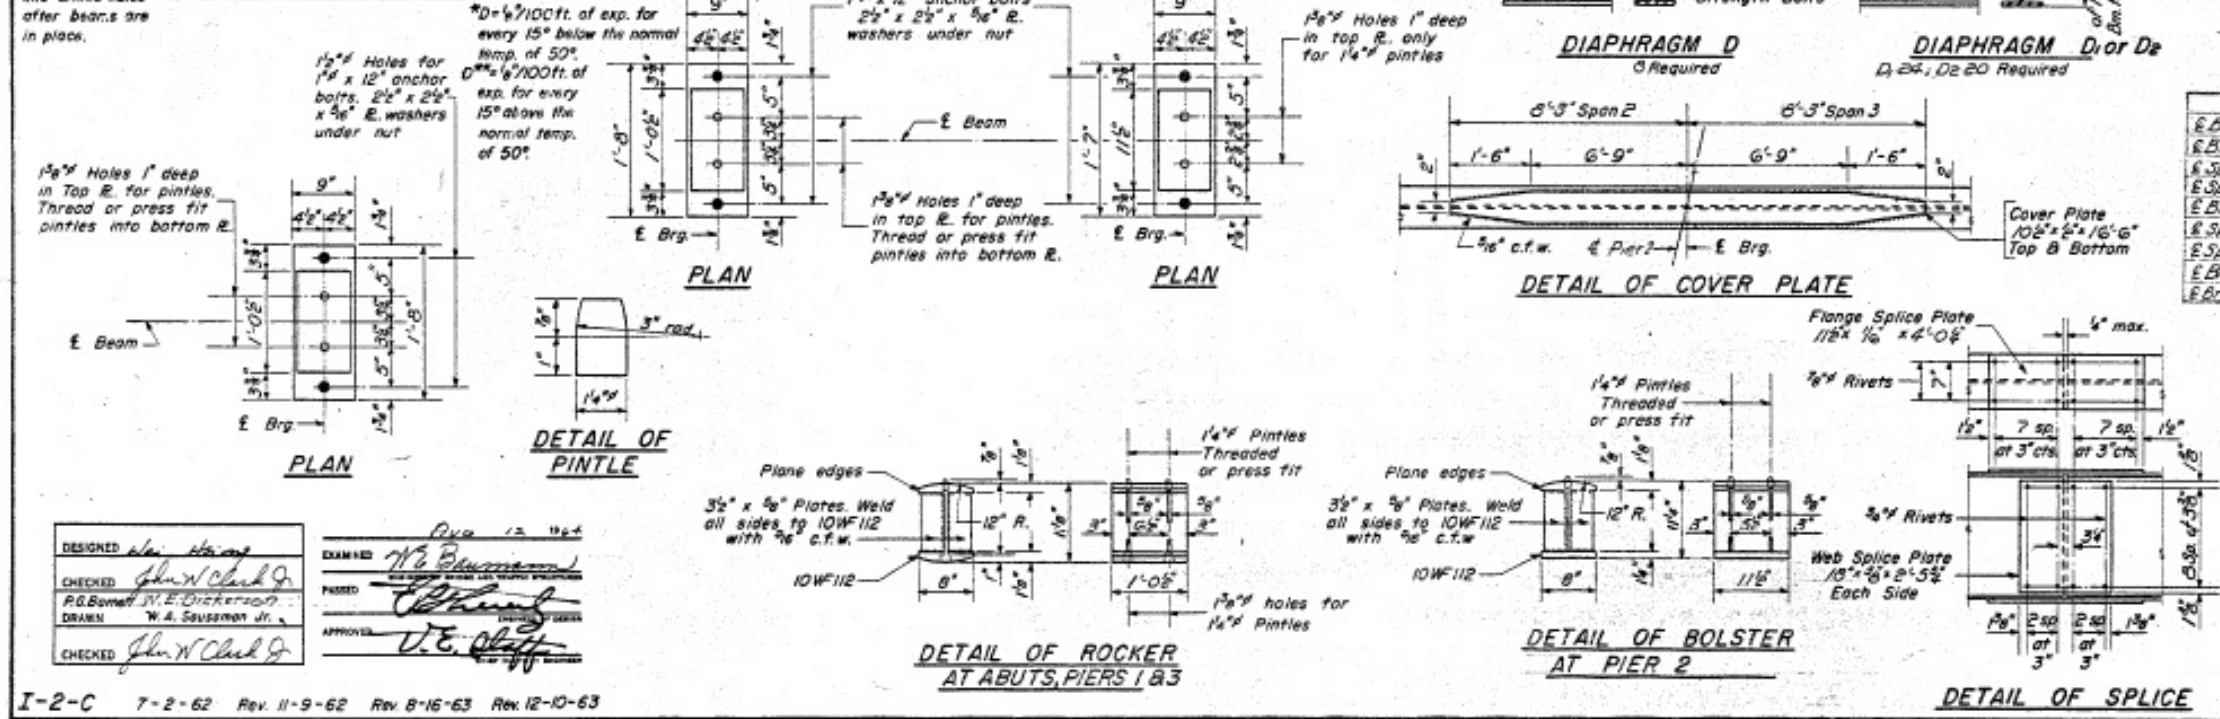

STRUCTURAL STEEL  
F.A.I.R.T. 74 SEC. 10-5H8  
CHAMPAIGN COUNTY  
STA. 1742+74.26






DESIGNED: JMS  
CHECKED: J.W. Clark Jr.  
DRAWN: W.A. Saussman Jr.  
APPROVED: V.E. Cliff

I-2-C 7-2-62 Rev. 11-9-62 Rev. 8-16-63 Rev. 12-10-63



STATE OF ILLINOIS  
DEPARTMENT OF PUBLIC WORKS & BUILDINGS  
DIVISION OF HIGHWAYS

NOTE NO.	DATE	COUNTY	STA.	SP.	SHEET NO.
1	7/10/62	Champaign	25	13	10 SHEETS

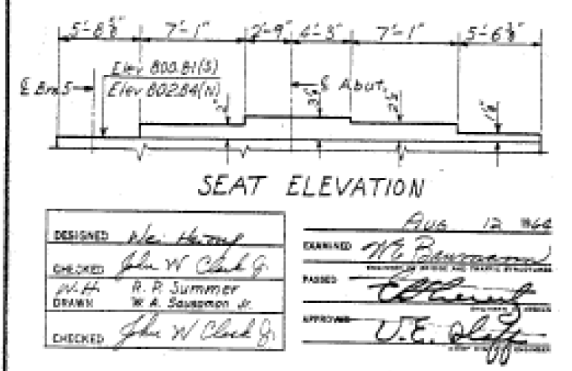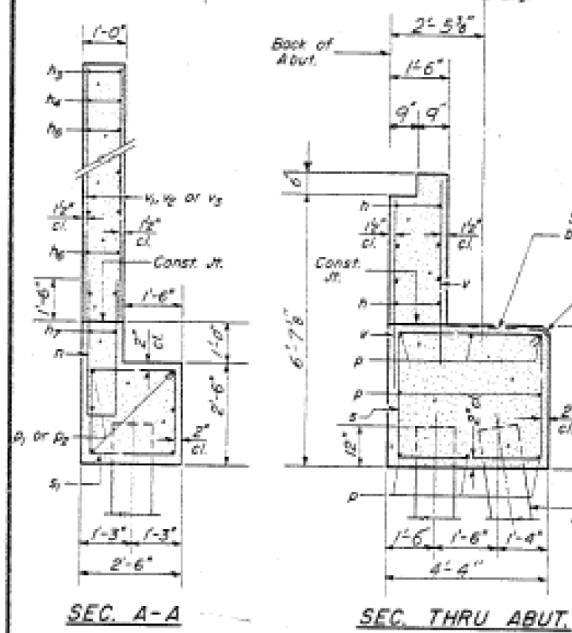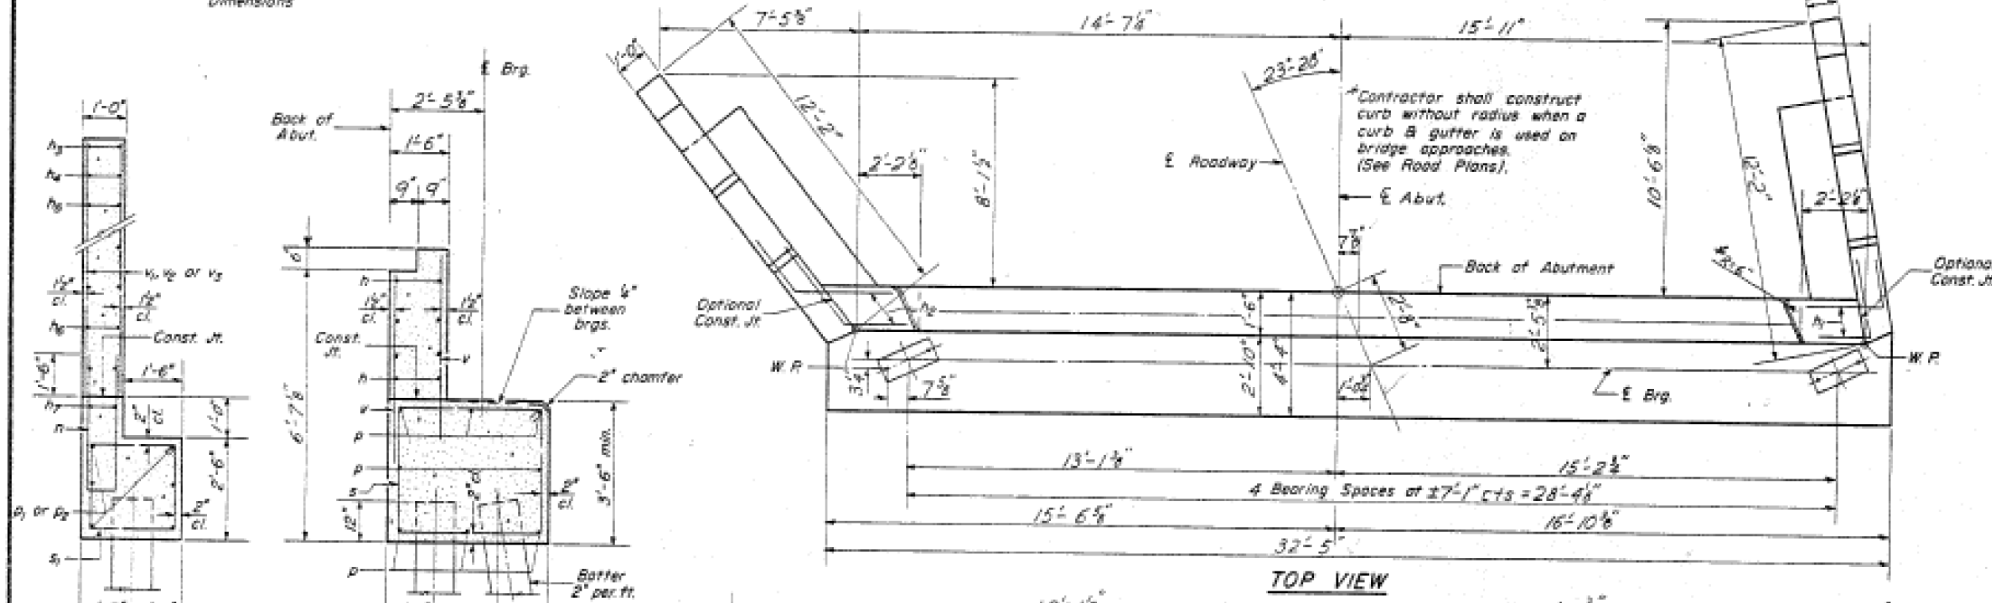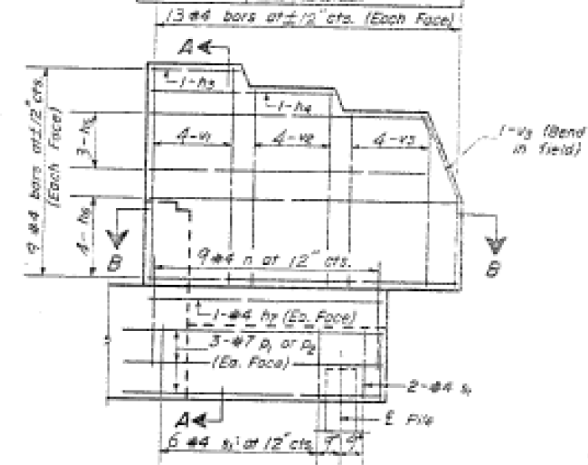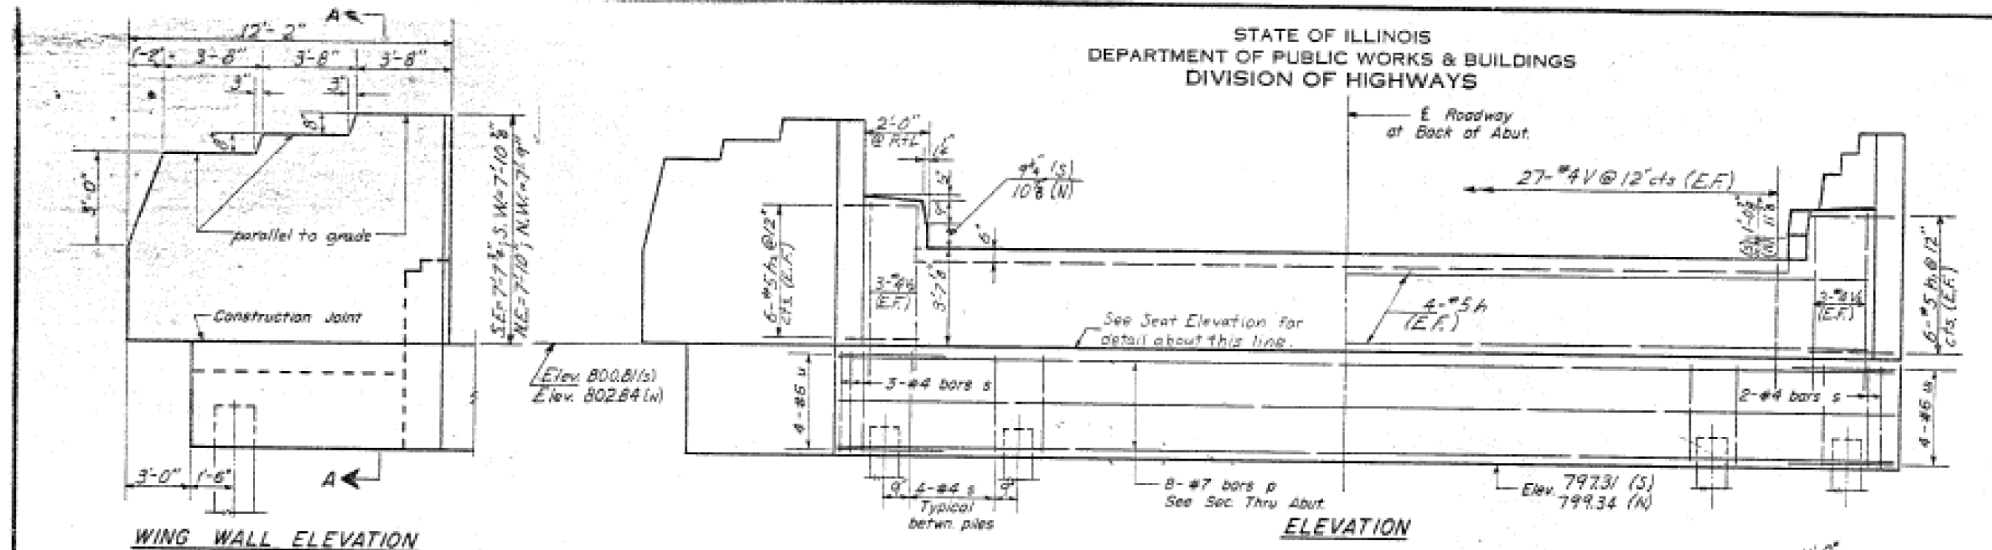

**PILE DATA**  
Type Concrete  
Capacity 30 Tons  
Est. Length 60'-0"  
No. Reqd. 17+1 Test Piles @ N Abut.

**TWO ABUTMENTS**  
**BILL OF MATERIAL**

Bar	No.	Size	Length	Shape
n	16	#5	30'-3"	—
n <sub>1</sub>	24	#5	5'-3"	L
n <sub>2</sub>	24	#5	5'-6"	L
n <sub>3</sub>	8	#4	3'-3"	—
n <sub>4</sub>	8	#4	6'-0"	—
n <sub>5</sub>	24	#4	10'-7"	—
n <sub>6</sub>	32	#4	11'-9"	—
n <sub>7</sub>	8	#4	8'-9"	—
u	36	#4	7'-9"	U
p	16	#7	32'-2"	—
p <sub>1</sub>	12	#7	8'-9"	—
p <sub>2</sub>	12	#7	9'-0"	—
s	58	#4	15'-1"	—
s <sub>1</sub>	32	#4	9'-5"	D
u	8	#6	9'-11"	U
u <sub>1</sub>	8	#6	9'-0"	U
v	108	#4	5'-0"	—
v <sub>1</sub>	32	#4	7'-6"	—
v <sub>2</sub>	56	#4	6'-9"	—
v <sub>3</sub>	40	#4	6'-0"	—
Class X Concrete				Cu. Yds. 71.5
Reinforcement Bars				Lbs. 4930
Concrete Piles				Lin. Ft. 1020
Test Piles (Concrete)				Ea. 1

**ABUTMENTS**  
F. A. I. RT. 74 SEC. 10-5HB  
CHAMPAIGN COUNTY  
STA. 1742+74.26

DESIGNED: *W. H. Thomas*  
CHECKED: *J. W. Clark Jr.*  
DRAWN: *R. P. Summer*  
CHECKED: *J. W. Clark Jr.*

DATE: AUG 12 1962  
EXAMINED: *W. E. Blumenthal*  
APPROVED: *U. E. Slaff*

A-B-L (15° - 35°) 7-18-62 Rev. 11-27-62




Structure 010-0169 was originally built in 1966 as FAI Route 74, Section 10-5HB-1 at station 1837+30.89 by the State of Illinois in Champaign County.

The existing structure is a four span structure with a back-to-back of abutment length of 211'-0". The structure measures 24'-0" from face-to-face of safety walk and has an out-to-out width of 30'-0". The structure was built on a 15° left-forward skew. The superstructure consists of five steel girders supporting a 6 1/2" reinforced concrete deck. The superstructure is supported by pile bent abutments and piers. The slopes are protected with concrete slope walls.

Method of Construction: Road Closure

**PROPOSED WORK**

1. Perform Bridge Deck Scarification 3/4"
2. Remove select deck drains, replace select deck drains.
3. Deck Slab Repair (Full depth)
4. Place Polymer Concrete.
5. Place Bridge Deck Latex Concrete 2 1/4" overlay on Bridge Deck.
6. Install Bridge Rail and Type 6A End Terminals.
7. Place Hot-Mix Asphalt Run-Downs.

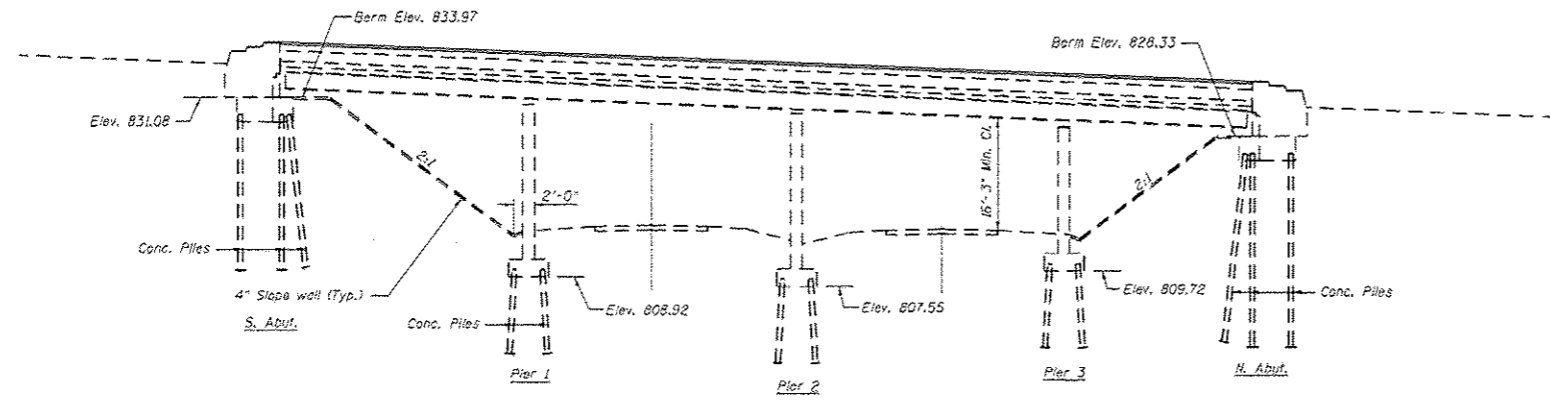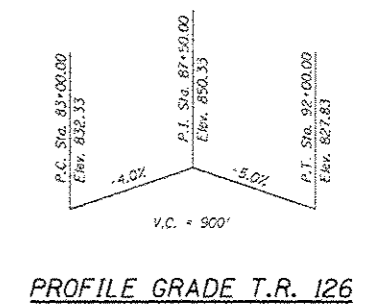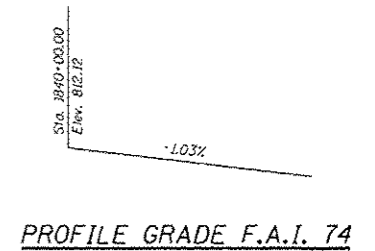

**ELEVATION**


ELEVATIONS TAKEN FROM AS-BUILT PLANS AND ARE SHOWN FOR PERSPECTIVE ONLY.

**GENERAL NOTES**

Plan dimensions and details relative to existing plans are subject to nominal construction variations. The Contractor shall field verify existing dimensions and details affecting new construction and make necessary approved adjustments prior to construction or ordering of materials. Such variations shall not be cause for additional compensation for a change in scope of the work, however, the Contractor will be paid for the quantity actually furnished at the unit price bid for the work.

The existing structural steel coating contains lead. The Contractor shall take appropriate precautions to deal with the presence of lead on this project.

Fibers are included in Bridge Deck Latex Concrete overlays.

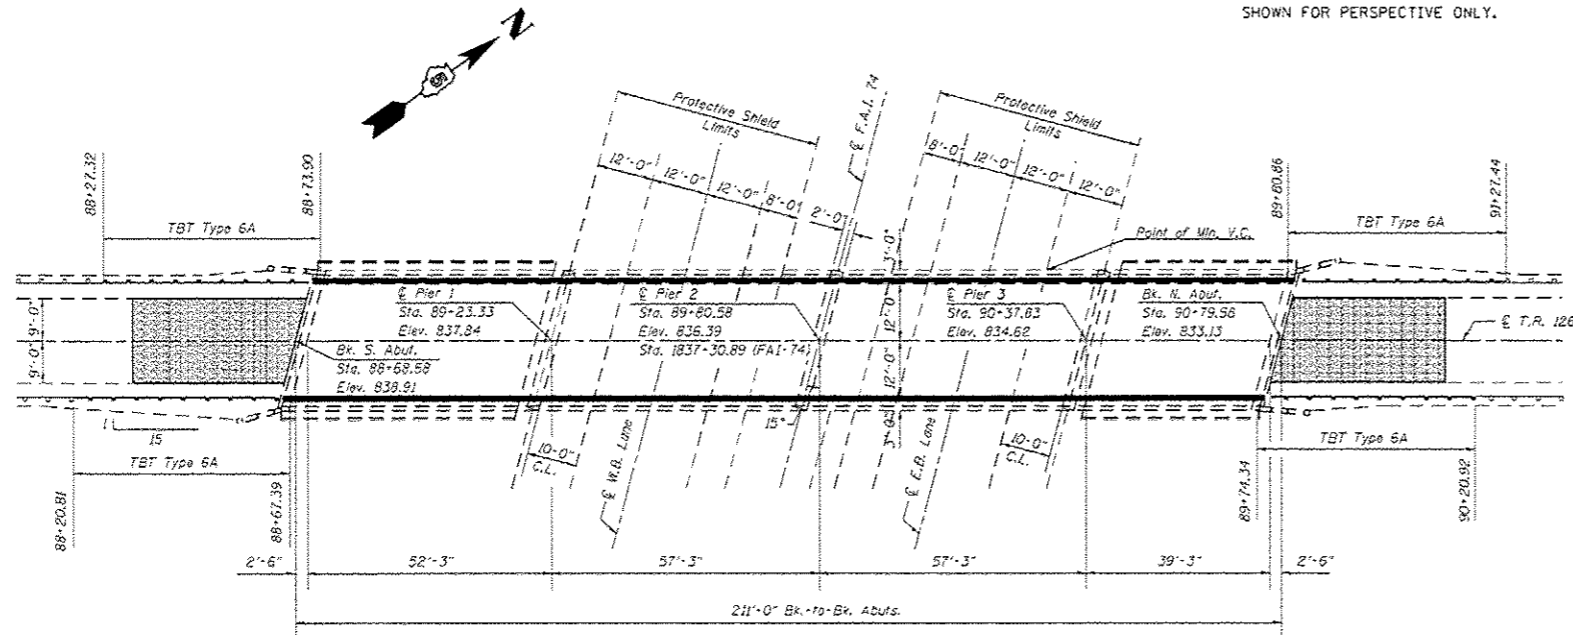

**PLAN VIEW**




*David Carl Puzey* 9/26/16  
Expires 11/30/18

**TOTAL BILL OF MATERIAL S.N. 010-0169**


ITEM	UNIT	TOTAL
Bituminous Materials Tack Coat	Pounds	45.0
HMA Surface Course, Mix "C", N50	Ton	10.0
Protective Shield	Sq Yd	264.0
Floor Drains	Each	10.0
Bridge Deck Grooving	Sq. Yd.	505.0
Steel Rail Type 2399	Foot	420.0
Traffic Barrier Terminal, 6A	Each	4.0
Guardrail Removal	Foot	256.0
Rem & Re-Erect SPBGR, Type A	Foot	50.0
Bridge Deck Scarification 3/4"	Sq. Yd.	551.0
Bridge Deck Latex Conc. Overlay 2 1/4"	Sq. Yd.	551.0
Deck Slab Repair Full Depth Type 1	Sq. Yd.	10.0
Polymer Concrete	Cu. Ft.	2.1

FILE NAME =	USER NAME = shorer_jm	DESIGNED - JMS	REVISED -	STATE OF ILLINOIS DEPARTMENT OF TRANSPORTATION	GENERAL PLAN AND ELEVATION S.N. 010-0169		F.A.I. SECTION COUNTY TOTAL SHEETS SHEET NO.	
PROJECT =	PROJECT =	CHECKED - ATH	REVISED -		74	10-4,10-5H	CHAMPAIGN	74 57
PLOT SCALE = 48,000' / 1"	DATE = 12/17/14	DATE = 12/17/14	REVISED -		SCALE: SHEET NO. 1 OF 6 SHEETS STA. TO STA.		CONTRACT NO. T0B15	
PLOT DATE = 8/8/2016					ILLINOIS FED. AID PROJECT			

## EXISTING TYPICAL DECK CROSS-SECTION

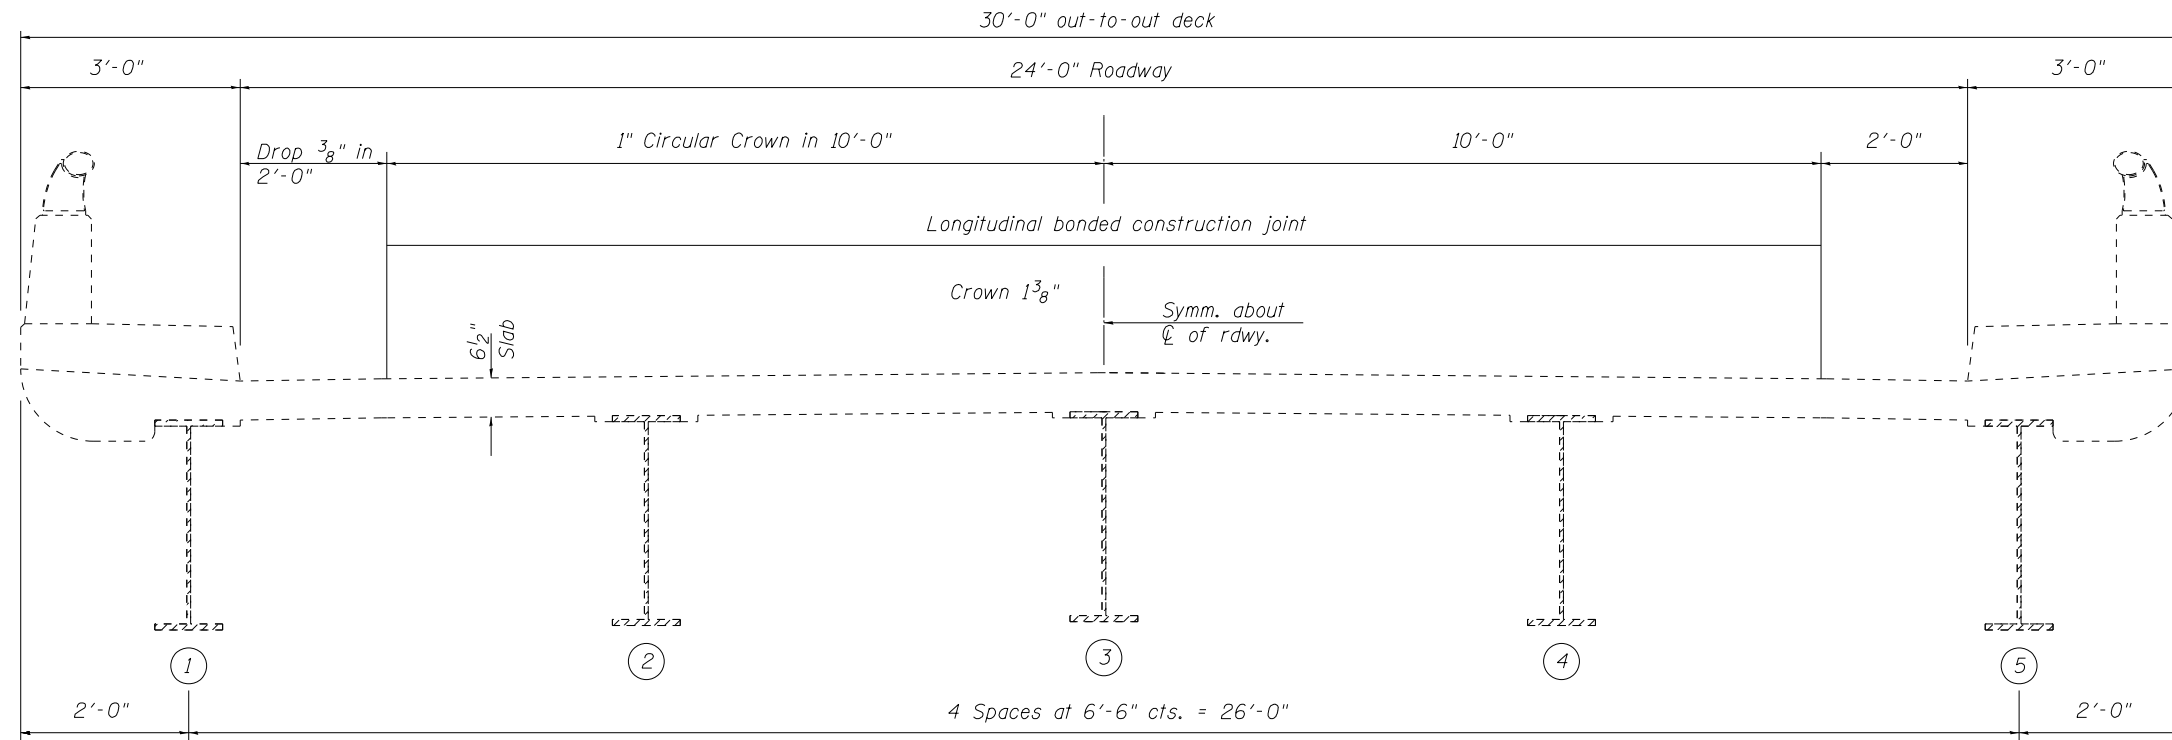




## PROPOSED TYPICAL DECK CROSS-SECTION

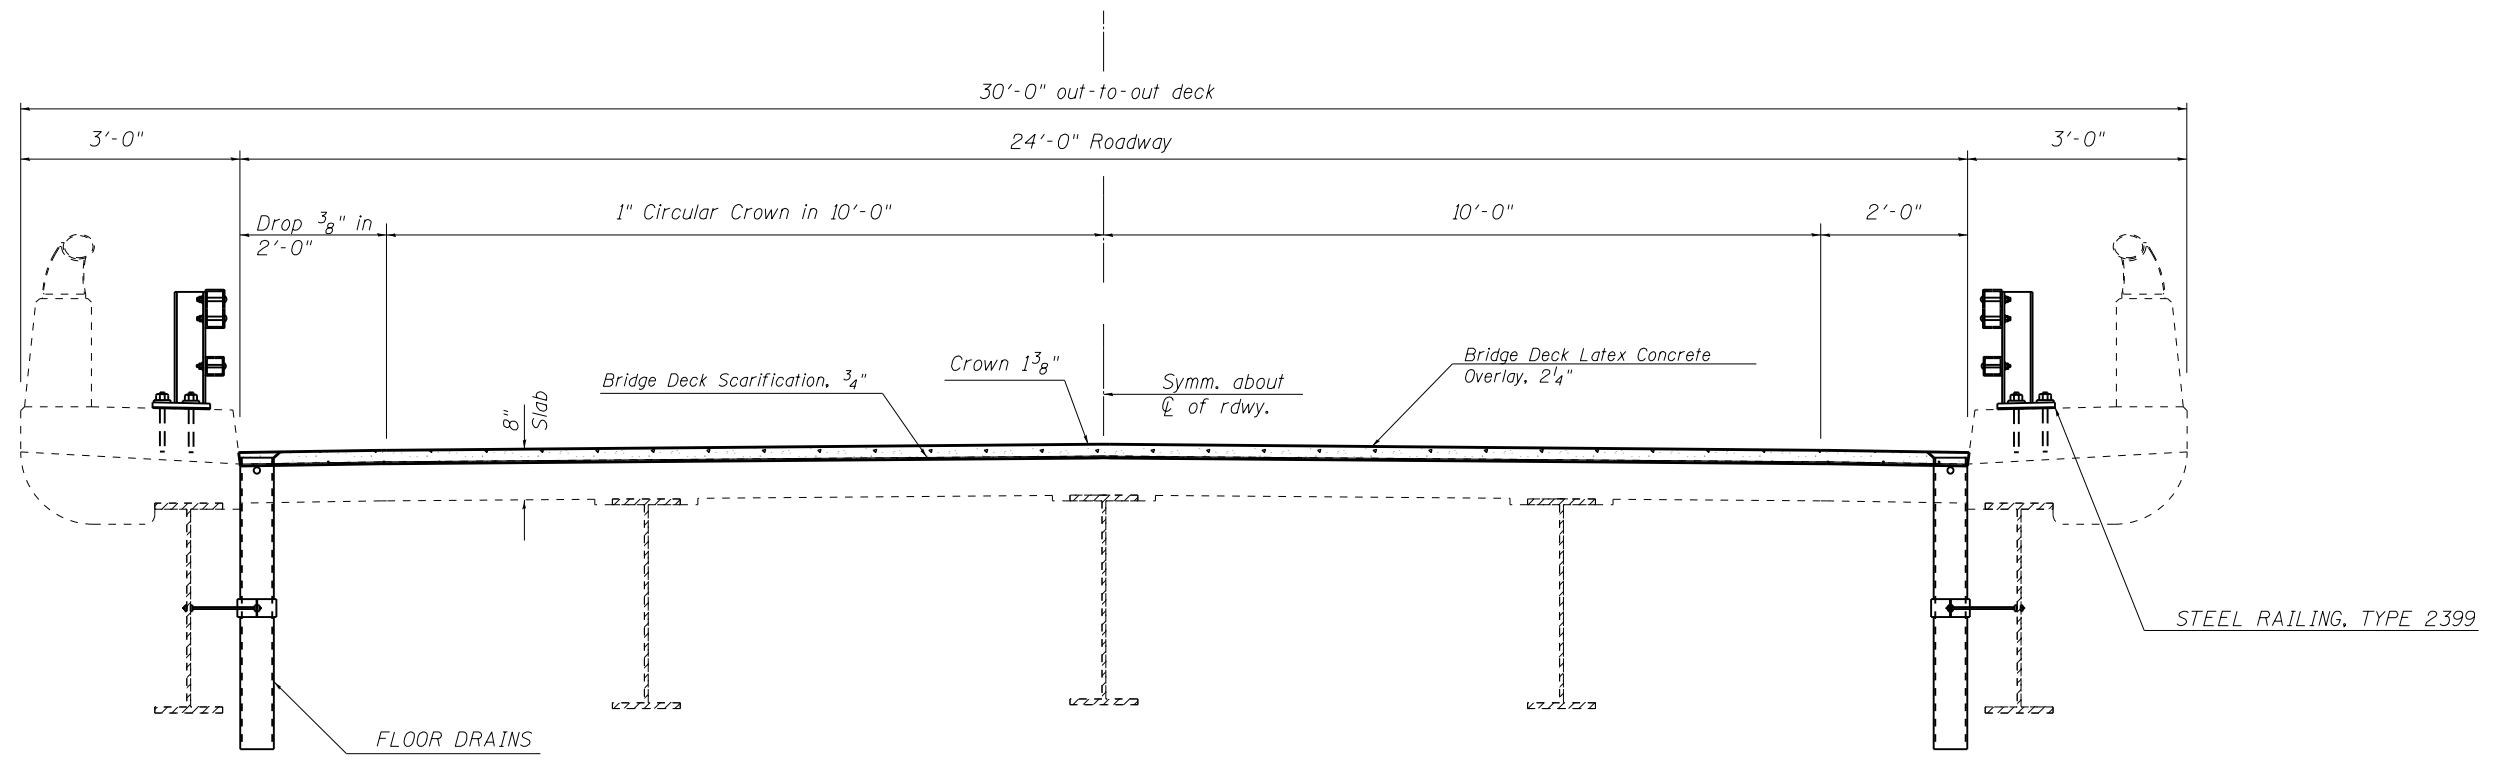

FIBER IS REQUIRED FOR BRIDGE DECK LATEX CONCRETE OVERLAY, 2 1/4"

FILE NAME =	USER NAME = shererjm	DESIGNED - GMS	REVISED -	<b>STATE OF ILLINOIS DEPARTMENT OF TRANSPORTATION</b>	<b>TYPICAL DECK CROSS-SECTIONS</b>			F.A.I. RTE.	SECTION	COUNTY	TOTAL SHEETS	SHEET NO.
pw:\IL\084EBIDINTEG.illinois.gov\PIWIDOT\Documents\DOT Offices\District 5\Projects\0577\Drawings\Struct\GMS\0570B15-sht-Repov\REVISED					<b>S.N. 010-0169</b>			74	(10-4,10-5)I	CHAMPAIGN	74	58
PLOT SCALE = 40.0000' / in.	CHECKED -	REVISIED -	REVISED -		SCALE:      SHEET NO. 2 OF 6 SHEETS      STA.      TO STA.			CONTRACT NO. 70B15				
PLOT DATE = 8/8/2016	DATE -	REVISED -	REVISED -		ILLINOIS FED. AID PROJECT							

Note: Fibers are included in Bridge Deck Latex Concrete overlays.

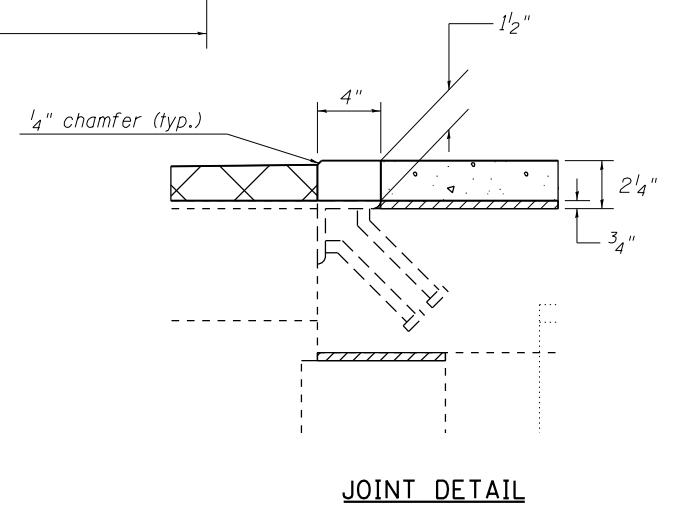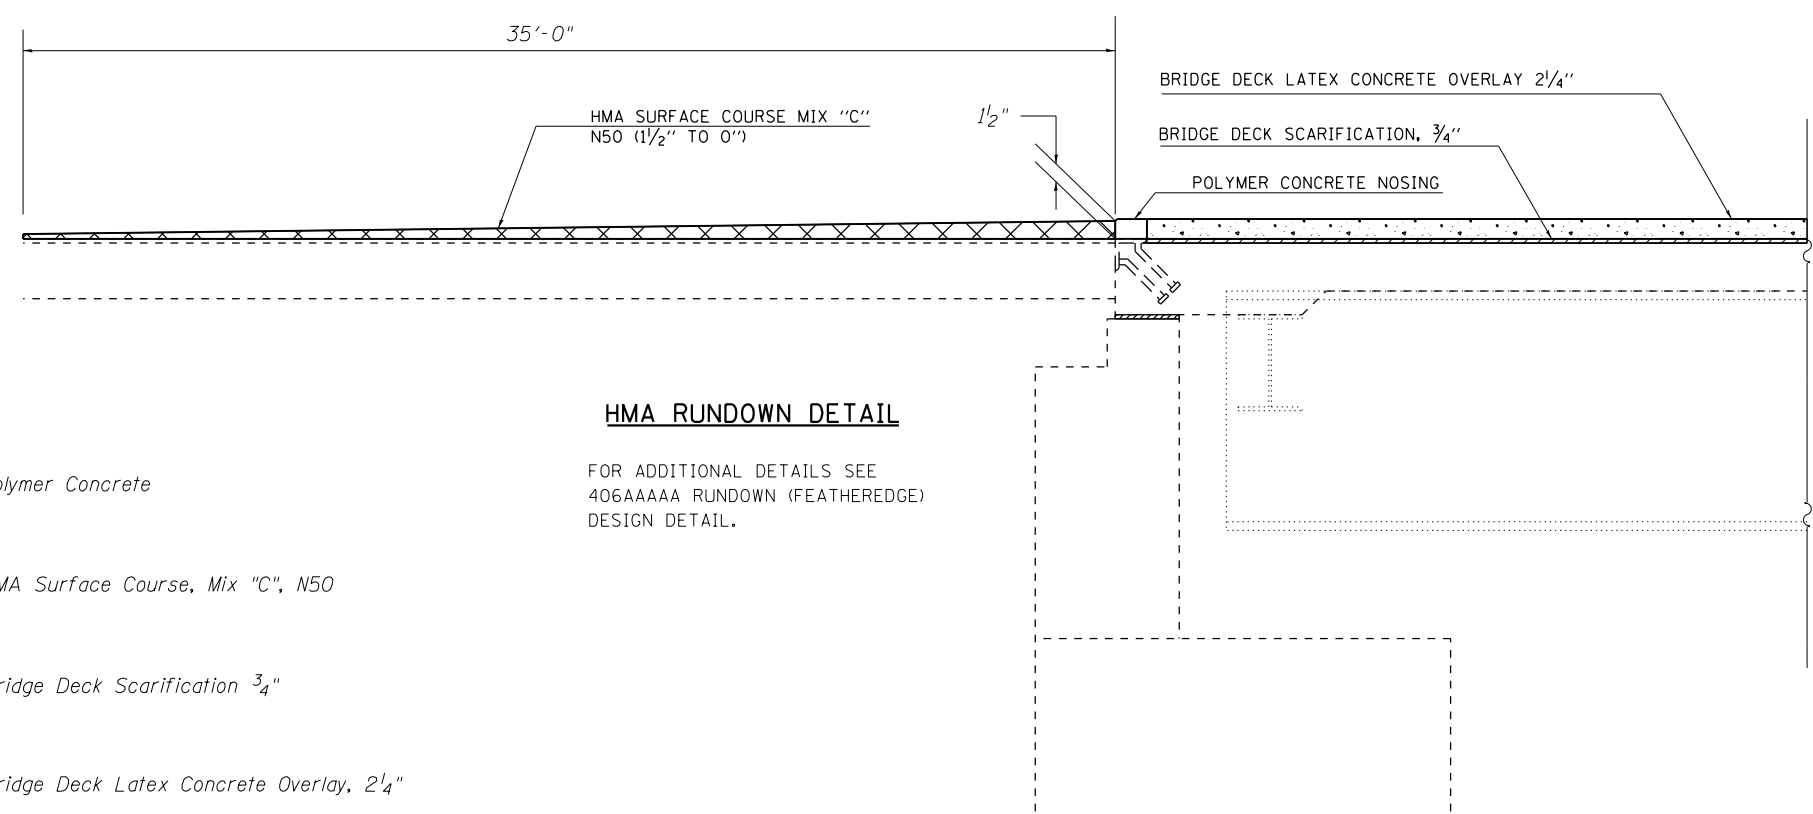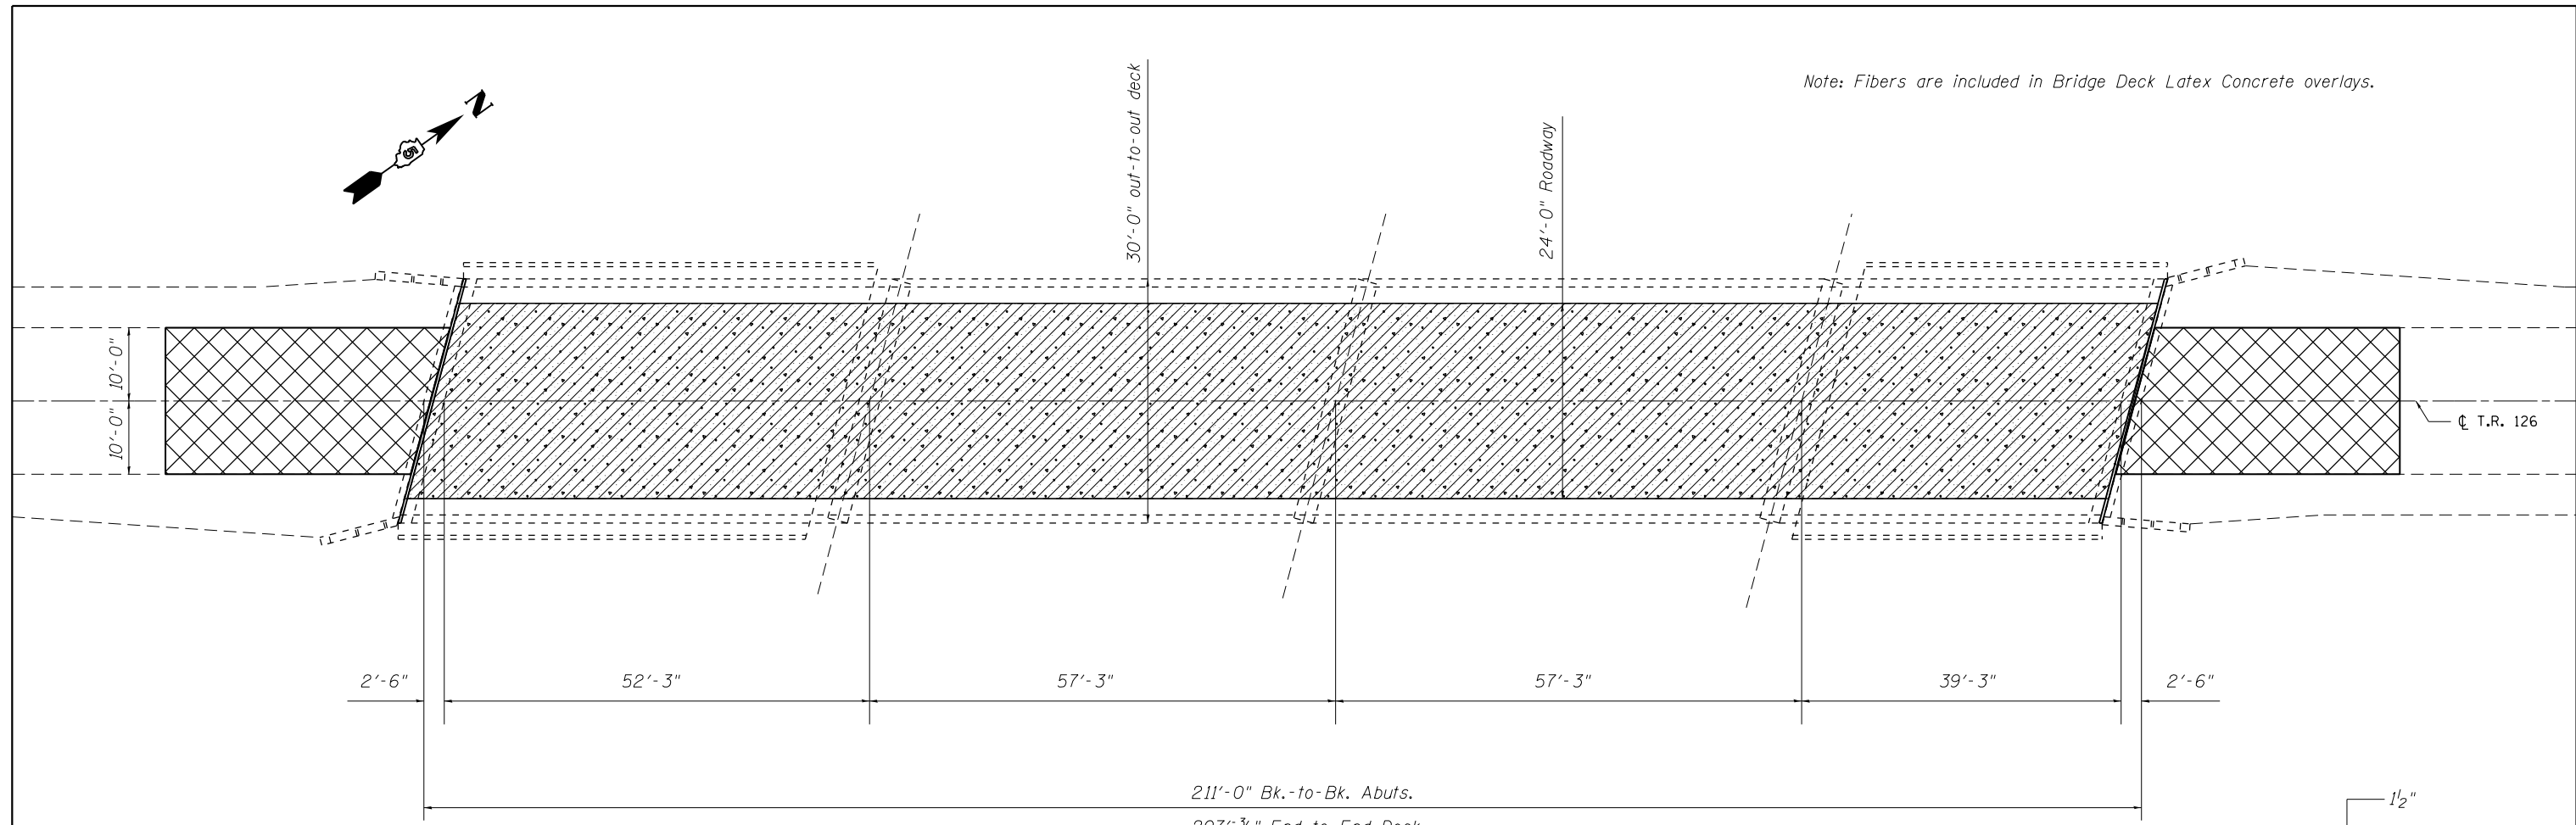

- Polymer Concrete
- HMA Surface Course, Mix "C", N50
- Bridge Deck Scarification 3/4"
- Bridge Deck Latex Concrete Overlay, 2 1/4"

**HMA RUNDOWN DETAIL**  
 FOR ADDITIONAL DETAILS SEE  
 406AAAAA RUNDOWN (FEATHEREDGE)  
 DESIGN DETAIL.

**BILL OF MATERIALS**

ITEM	UNIT	TOTAL
BRIDGE DECK GROOVING	SO YD	505.0
BRIDGE DECK SCARIFICATION 3/4"	SO YD	551.0
BRIDGE DECK LATEX CONCRETE OVERLAY, 2 1/4"	SO YD	551.0
POLYMER CONCRETE	CU FT	2.1

FILE NAME =	USER NAME = shererjm	DESIGNED - GMS	REVISED -

**STATE OF ILLINOIS  
 DEPARTMENT OF TRANSPORTATION**


**WEARING SURFACE PLAN  
 S.N. 010-0169**

SCALE:      SHEET NO. 3 OF 6 SHEETS      STA.      TO STA.

F.A.I. RE.	SECTION	COUNTY	TOTAL SHEETS	SHEET NO.
74	(10-4,10-5)I	CHAMPAIGN	74	59
CONTRACT NO. 70B15			ILLINOIS FED. AID PROJECT	



**PLAN VIEW OF DRAINS (SPAN 1)**

**PLAN VIEW OF DRAINS (SPAN 4)**



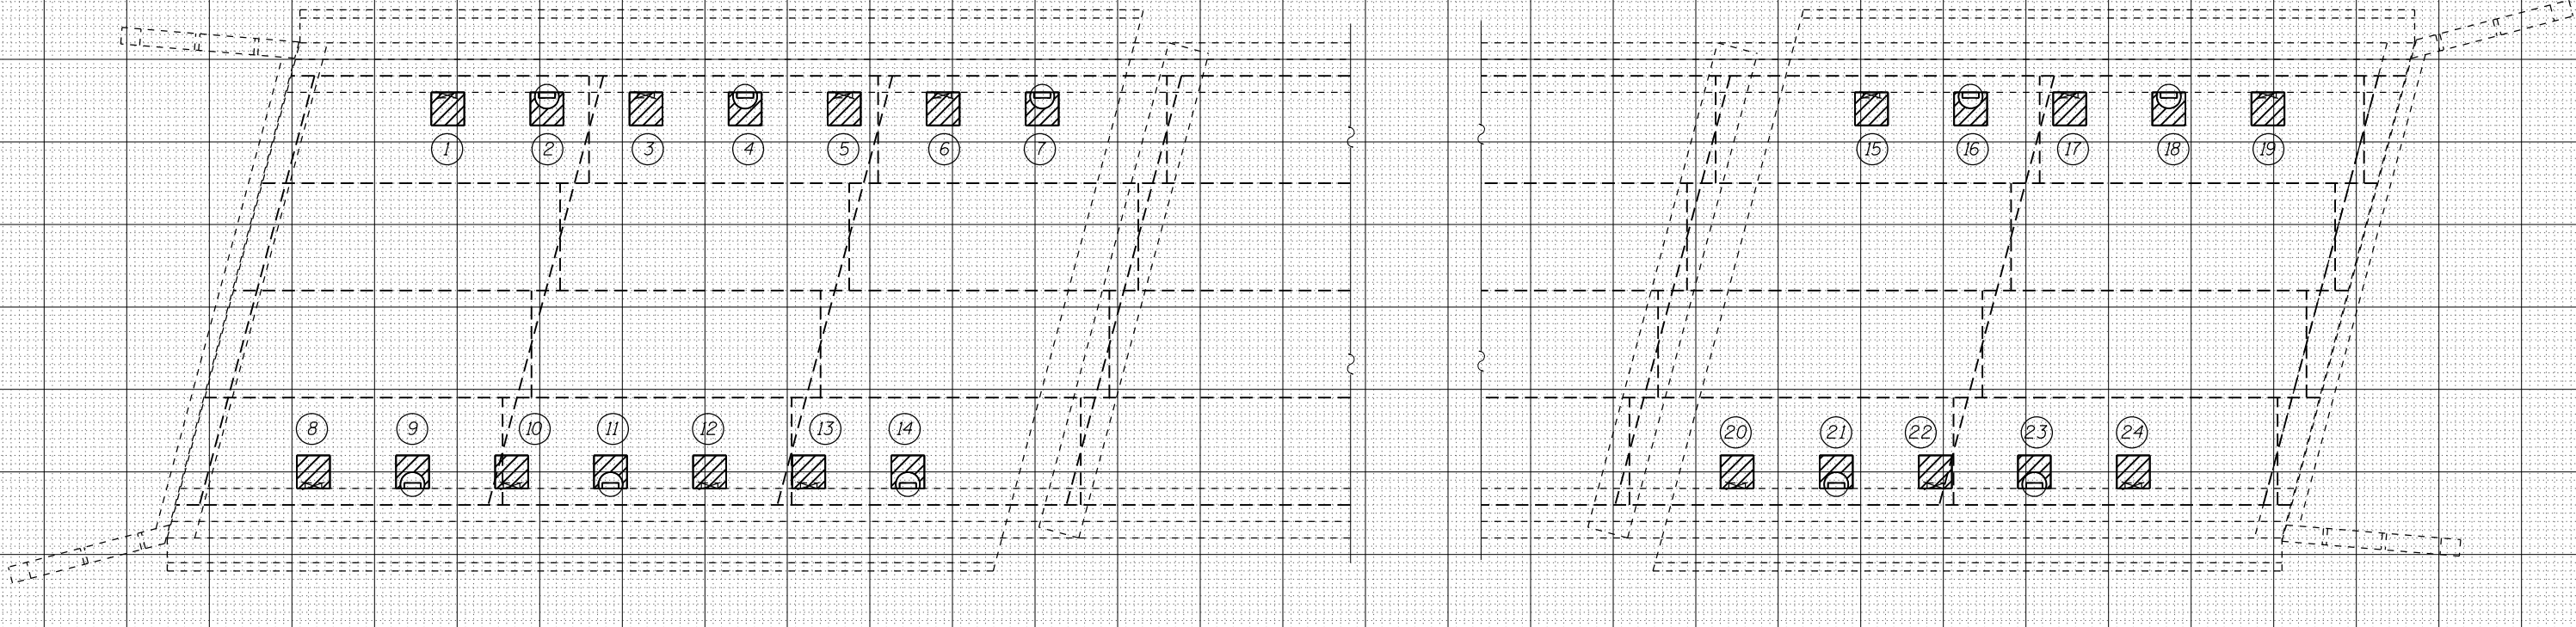


DATE	
BY	
FINAL SURVEY	
NOTE BOOK	
NO.	
SURVEYED	
PLOTTED	
TEMPLATE	
AREAS CHECKED	

DATE	
BY	
ORIGINAL SURVEY	
NOTE BOOK	
NO.	
SURVEYED	
PLOTTED	
TEMPLATE	
AREAS CHECKED	

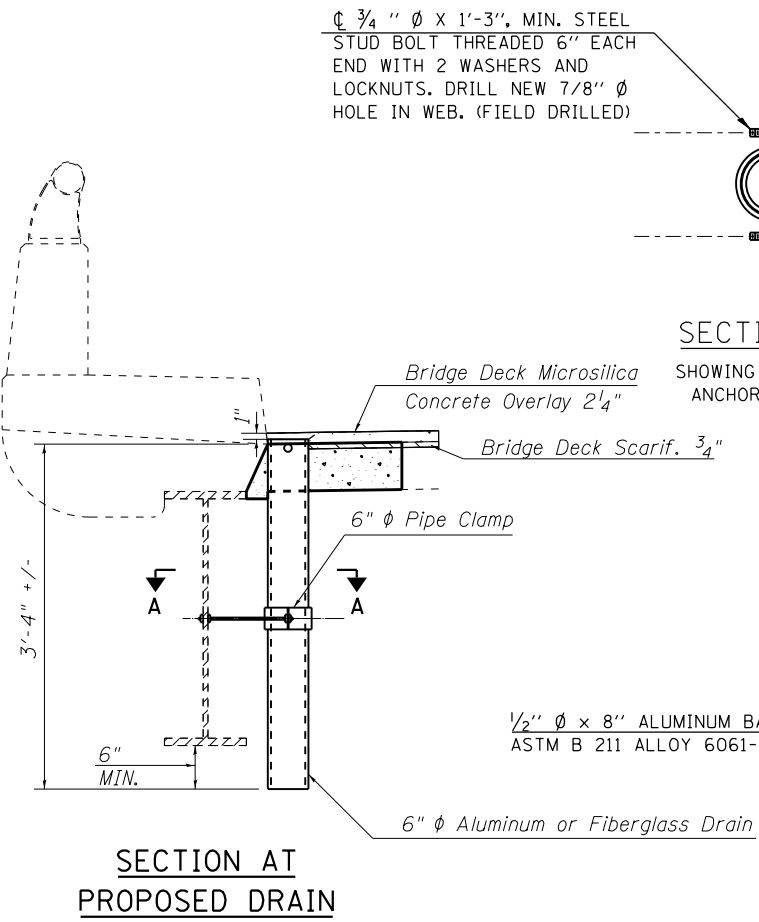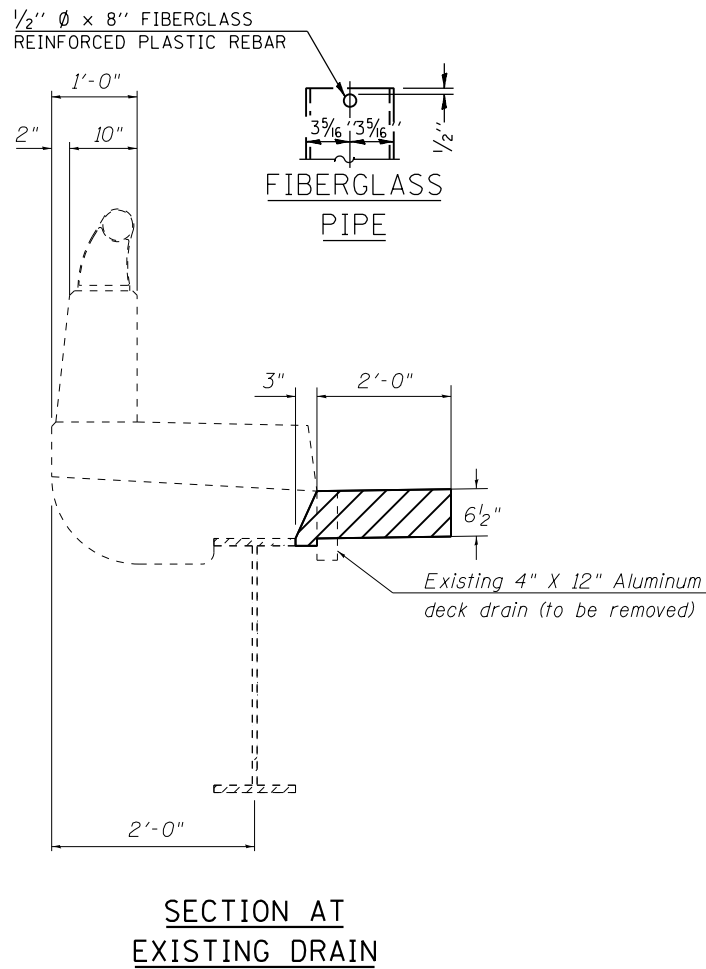

3/4" Ø X 1'-3", MIN. STEEL STUD BOLT THREADED 6" EACH END WITH 2 WASHERS AND LOCKNUTS. DRILL NEW 7/8" Ø HOLE IN WEB. (FIELD DRILLED)

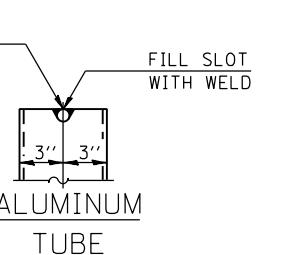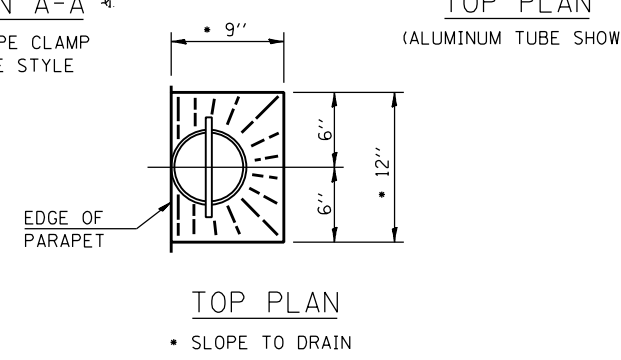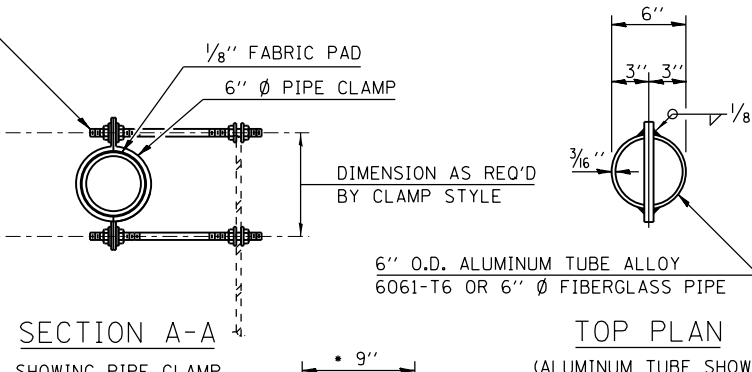

- LEGEND**
- EXISTING DECK DRAINS (TO BE REPLACED WITH FLOOR DRAINS)
  - EXISTING DECK DRAINS (TO BE ELIMINATED)
  - DECK SLAB REPAIR (FULL DEPTH, TYPE I)

**NOTES:**

- Patch sizes shown represent conditions at the time the plans were completed. The actual sizes and locations of patching shall be determined by the engineer. The Engineer shall show the actual locations of the deck repairs on this sheet.
- The existing drains shall be removed. Cost included with "Deck Slab Repair (Full Depth, Type I)".
- Extreme care must be used when removing concrete near the top flange of the beams. The contractor is responsible for any damage to the beams.
- The exterior surfaces of the floor drains shall be painted with the finish coat as specified in the special provisions for Cleaning and Painting New Metal Structures. The exterior surfaces of the drains shall be cleaned according to Society of Protective Coatings' Spec. SSPC-SP1 prior to painting.
- Fiberglass Pipe Shall Conform to ASTM D 2996, with Short-Time Rupture Strength Hoop Tensile Stress of 30,000 P.S.I. Minimum.
- Galvanized Clamping Device and All Stud Bolts, Washers and Nuts According to AASHTO M232. Cost of clamping device and galvanizing included with floor drain.
- All Dimensions Shall be Field Verified by the Contractor Prior to Ordering of Materials.

**BILL OF MATERIALS**

ITEM	UNIT	TOTAL
FLOOR DRAINS	EACH	10.0

COST OF REMOVAL OF EXISTING DRAINS IS INCLUDED IN DECK SLAB REPAIR.

FILE NAME =	USER NAME = shererjm	DESIGNED -	REVISED -
		CHECKED -	REVISED -
		DATE -	REVISED -

**STATE OF ILLINOIS  
DEPARTMENT OF TRANSPORTATION**

**BRIDGE DECK PATCHING & DRAIN DETAIL  
S.N. 010-0169**

SCALE: SHEET 4 OF 6 SHEETS STA. TO STA.

F.A.I. RTE.	SECTION	COUNTY	TOTAL SHEETS	SHEET NO.
74	(10-4,10-5)I	CHAMPAIGN	74	60
CONTRACT NO. 70B15			ILLINOIS FED. AID PROJECT	

PATCH NO.	SIZE		DECK SLAB REPAIR (FULL DEPTH T1)	DECK SLAB REPAIR (FULL DEPTH T2)
	LENGTH (FT)	WIDTH (FT)	SQ YD	SQ YD
1	2	2	0.4	
2	2	2	0.4	
3	2	2	0.4	
SUB-TOTAL =			6.8	


PATCH NO.	SIZE		DECK SLAB REPAIR (FULL DEPTH T1)	DECK SLAB REPAIR (FULL DEPTH T2)
	LENGTH (FT)	WIDTH (FT)	SQ YD	SQ YD
18	2	2	0.4	
19	2	2	0.4	
20	2	2	0.4	
21	2	2	0.4	
22	2	2	0.4	
23	2	2	0.4	
24	2	2	0.4	
SUB-TOTAL =			2.8	
TOTAL =			9.6	
USE =			10.0	

DECK SURVEY PERFORMED ON AUGUST 6, 2013. IF MORE THAN ONE WINTER FREEZE-THAW CYCLE OCCURS BETWEEN THE INITIAL INSPECTION AND THE COMMENCEMENT OF WORK, THE FINAL PLAN QUANTITIES FOR DECK REPAIRS MUST BE BASED ON A NEW INSPECTION OF THE DECK.


**BILL OF MATERIALS**

ITEM	UNIT	TOTAL
DECK SLAB REPAIR (FULL DEPTH, TYPE I)	SQ YD	10.0


\* Cut bottom end of post to curb slope.

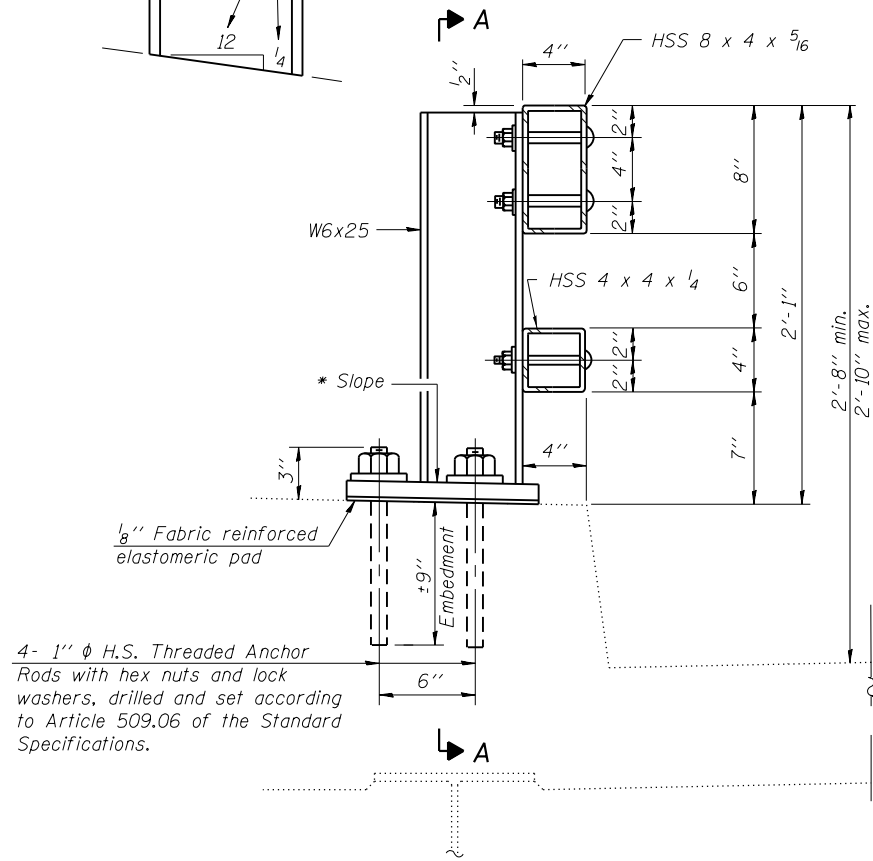


**SECTION AT RAIL POST**

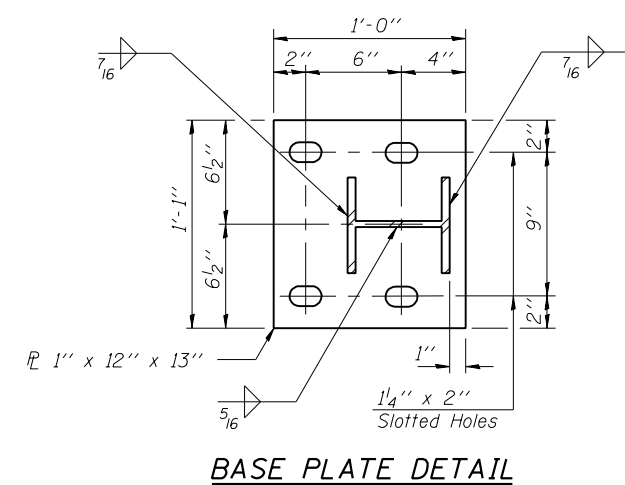


**BASE PLATE DETAIL**

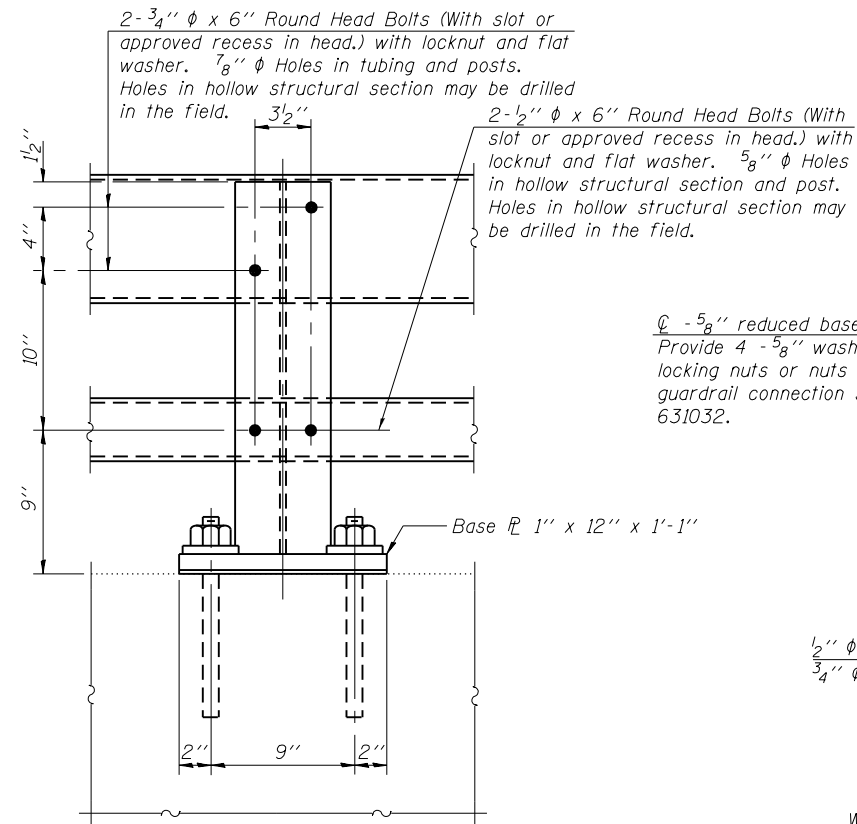


**SECTION A-A**

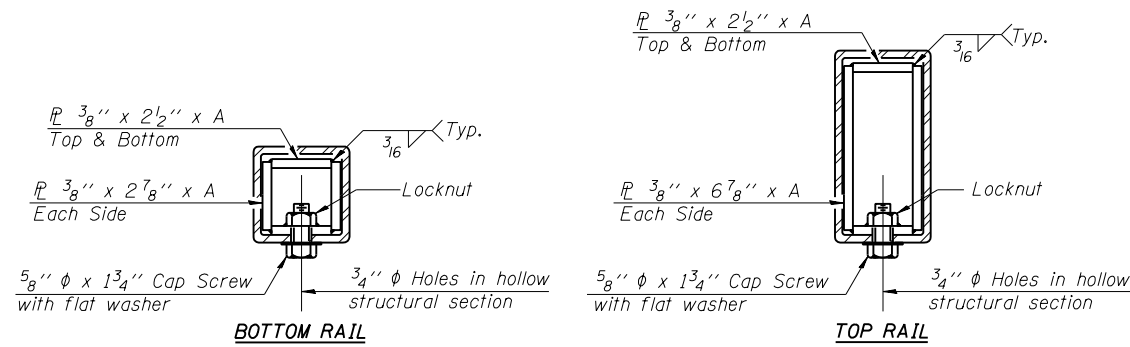


**SECTIONS AT RAIL SPLICE**

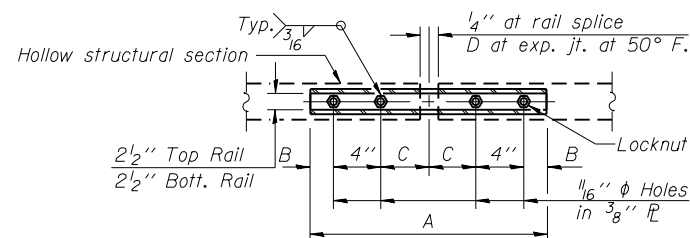


**PLAN-BOTT. SPLICE R TYPICAL**

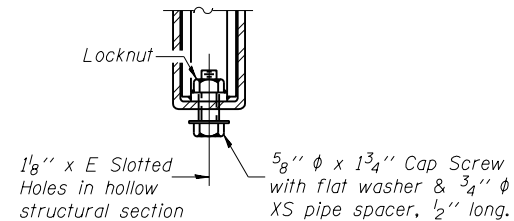


**RAIL SPLICE CONNECTION AT EXPANSION JT.**

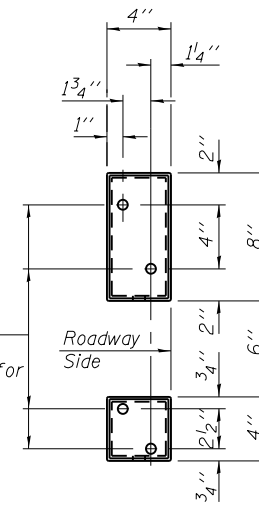


**VIEW B-B**

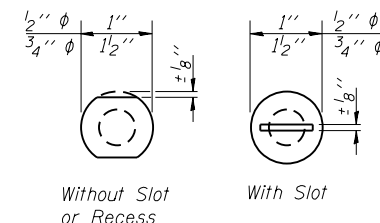

**VIEW C-C**

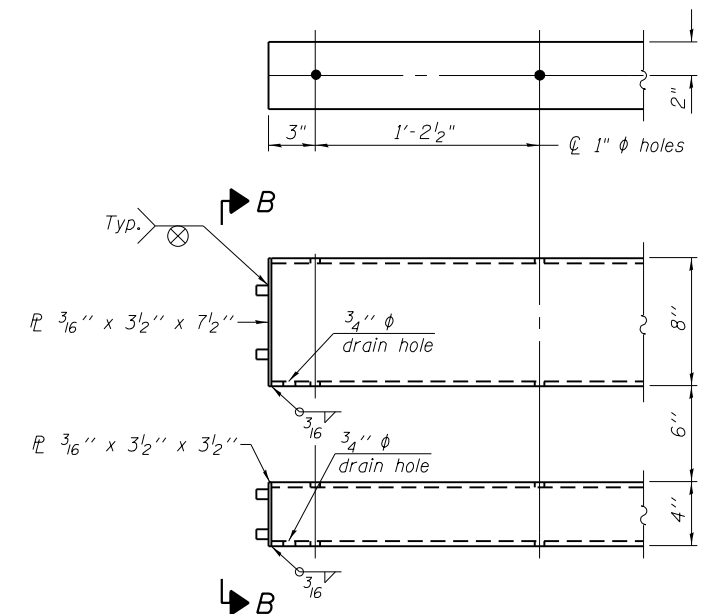

**END OF RAIL DETAILS**

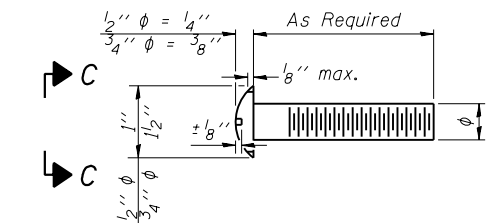

**DETAIL OF 1/2" & 3/4" ROUND HEAD BOLTS**

**Notes:**

All field drilled holes shall be coated with an approved zinc rich paint before erection.  
 Posts shall not be located closer than 1'-3" to an existing bridge expansion joint or end of bridge.  
 Steel Bridge Rail expansion joint shall be provided between any two (2) posts which span a bridge expansion joint. Bolts located at expansion joint shall be provided with locknuts and shall be tightened only to a point that will allow railing movement.  
 Provide one 1/8" and two 1/16" steel shims for 25% of the posts. Shims shall be similar to base plates in size and holes.  
 All steel rail elements shall be galvanized according to Article 509.05 of the Standard Specifications.

**SPLICE DIMENSIONS**

T	D	A	B	C	E
≤ 4"	2 1/2"	1'-8"	2"	4"	2 1/2"
> 4" ≤ 6 1/2"	3 3/4"	2'-0"	2 1/2"	5 1/2"	3 1/2"
> 6 1/2" ≤ 9"	5"	2'-4"	3 1/2"	6 1/2"	9"
> 9" ≤ 13"	7"	2'-10"	4 1/2"	8 1/2"	11"
Rail Splice	1/4"	1'-8"	2"	4"	—

T = Total movement at expansion joint as shown on the design plans.

**BILL OF MATERIAL**

Item	Unit	Quantity
Steel Railing, Type 2399	Foot	420.0

R-31

7-1-10

(6'-3" Maximum Post Spacing)

FILE NAME =	USER NAME = shererjm	DESIGNED - JMS	REVISED -
pw:\11\084EBIDINTEG.illinois.gov\PI\DOT\Documents\DOT Offices\District 5\Projects\057\Drawings\Struct\MS\0570B15-sht-Rep\REVISED		CHECKED -	REVISED -
PLOT SCALE = 40.0000' / in.		DATE -	REVISED -
PLOT DATE = 8/8/2016			

**STATE OF ILLINOIS  
DEPARTMENT OF TRANSPORTATION**

**STEEL RAILING, TYPE 2399  
S.N. 010-0169**


SCALE: SHEET NO. 6 OF 6 SHEETS STA. TO STA.

F.A.I. RTE.	SECTION	COUNTY	TOTAL SHEETS	SHEET NO.
54	(10-4,10-5)I	Champaign	74	62
			CONTRACT NO. 70B15	
ILLINOIS FED. AID PROJECT				

B.M.: U.S.C. (G.S. Marked "W-204" 360' LT.  
Sta. 1842+30 (Elev. 810.22)

STATE OF ILLINOIS  
DEPARTMENT OF PUBLIC WORKS & BUILDINGS  
DIVISION OF HIGHWAYS

DATE	BY	REVISION	SHEET NO.	TOTAL SHEETS
10-17-74	W.D.	CHAMPAGNE	24	6

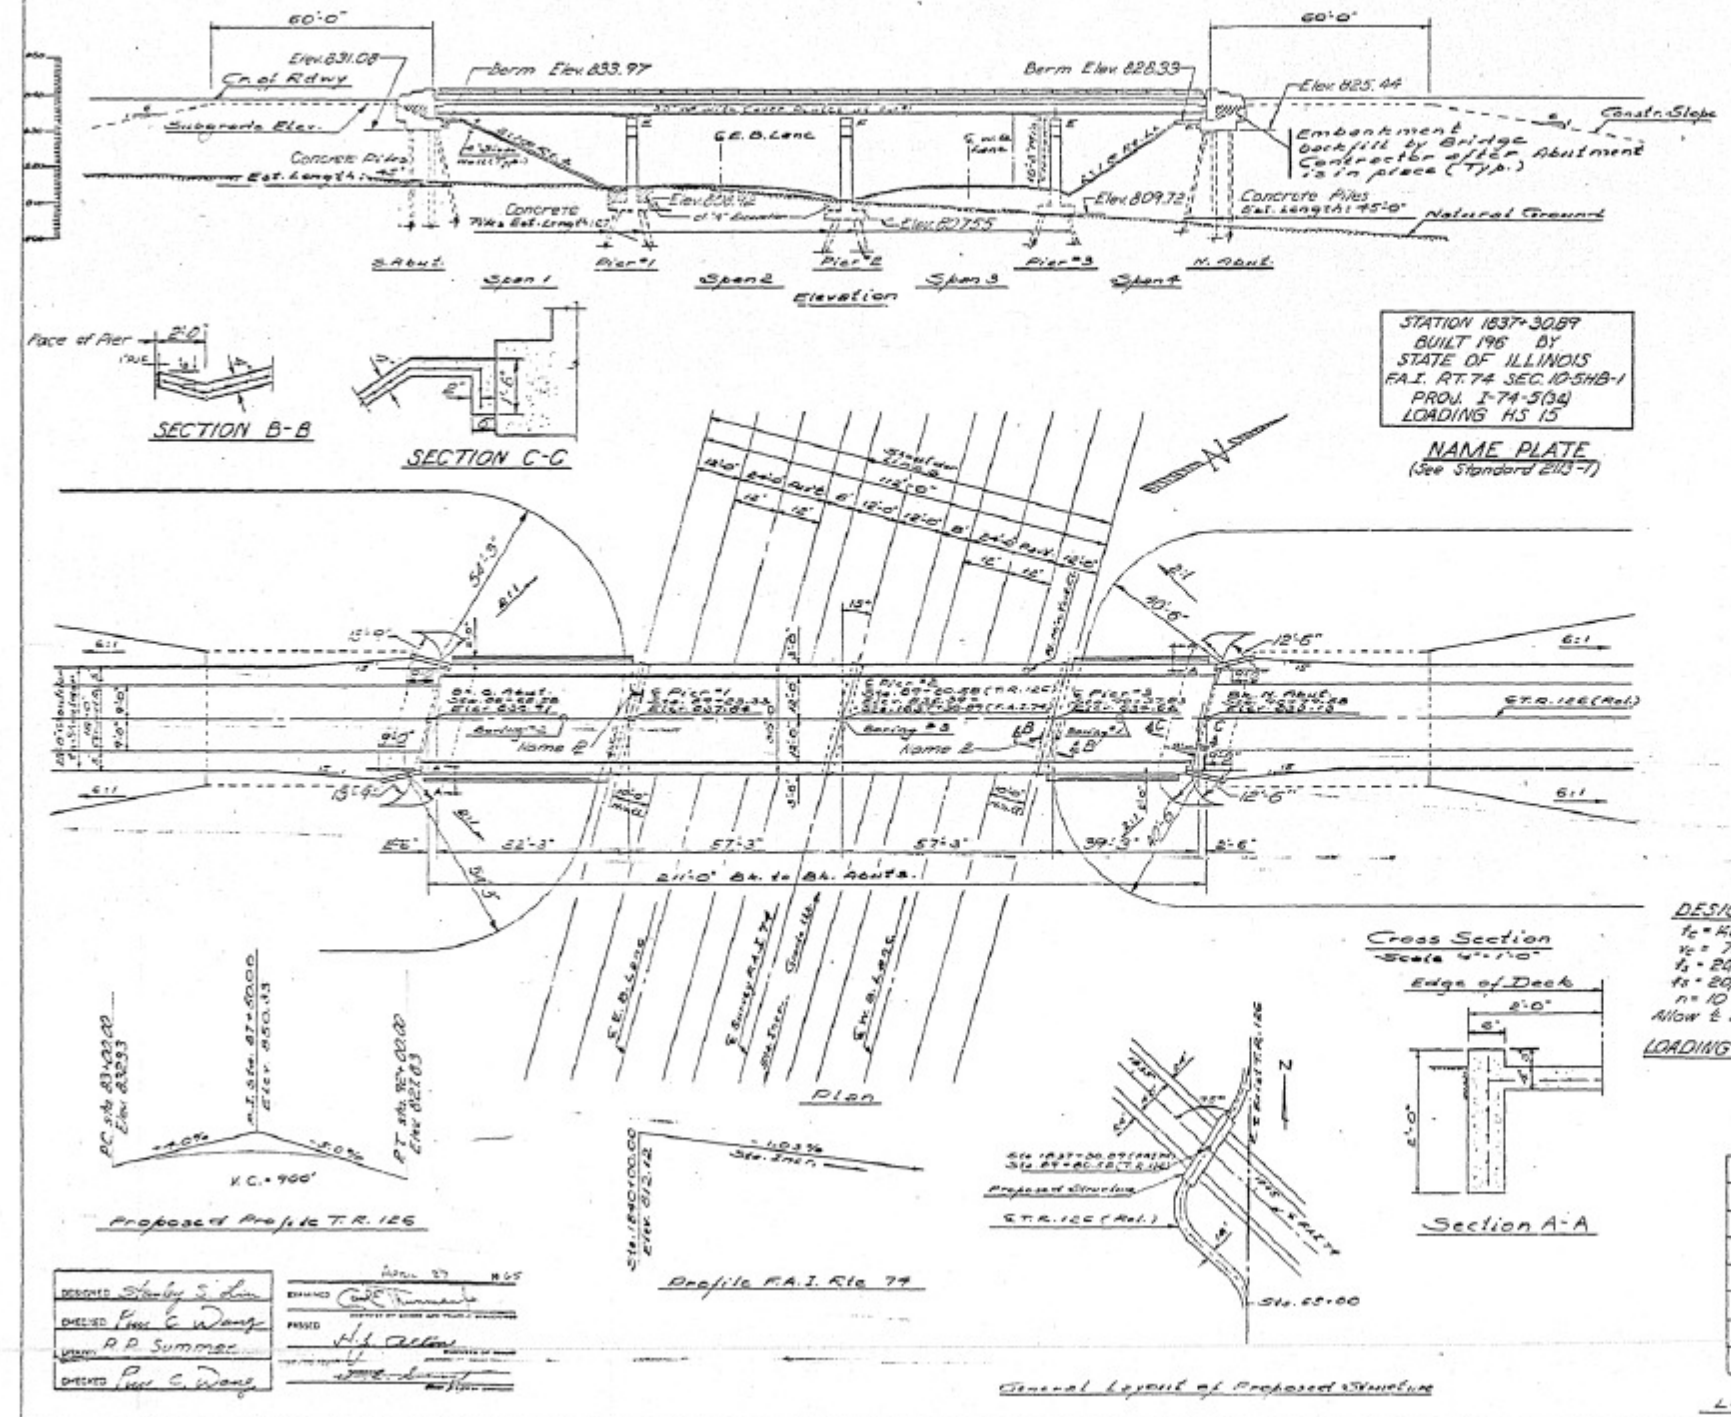

**GENERAL NOTES**

Course aggregate to be used in parapet kerbs and end post must be free of chert, flint, limestone, lignite and soft sandstone. The concrete floor slab shall be finished in accordance with Art 519 of the Standard Specifications.

Slope Wall shall be reinforced with welded wire fabric 6"x6" mesh, weighing 58# per 100 Sq. Ft.

All reinforcement bars shall be spaced 20 diameters unless otherwise shown.

All structural steel shall conform to ASTM Designation A-36. Rivets 1/2" Open Holes 1 1/2", unless otherwise noted. Anchor bolts shall be set before fastening diaphragms over supports.

Exposed surfaces of the expansion devices, inaccessible after erection, shall receive two shop coats of red lead paint. All other surfaces shall be given one shop coat of red lead paint. Anchor studs shall not be painted.

Expansion devices are included in the quantity of structural steel. Est. weight 690 Lbs.

Except as otherwise provided, all structural steel shall receive one shop coat of red lead paint and two field coats of aluminum paint. See Article 561 to 565 inclusive of the Standard Specifications.

Concrete piles of abutments shall be driven in holes prepared thru the embankment in accordance with Article 60.9 (c) of the Standard Specifications.

The contractor shall drive two concrete test piles, one of North Abutment and one at Pier 2. All in permanent locations as directed by the Engineer before ordering the remainder of piles.

STATION 1837+30.89  
BUILT 196 BY  
STATE OF ILLINOIS  
F.A.I. RT. 74 SEC. 10-SHB-1  
PROJ. I-74-5(34)  
LOADING HS 15



NAME PLATE  
(See Standard 2113-7)

**TOTAL BILL OF MATERIALS**

Item	Unit	Super	Sub	Total
C/W Equip for Structure	Sq Yds	80		80
C/W Equip for	Sq Yds	198	198	396
Protective Coat	Sq Yds	774		774
Structural Steel	Lbs	161,040		161,040
Aluminum Handrail	Lbs	415		415
Reinforcement Bars	Lbs	39,120	16,120	55,240
Concrete Piles	Lin Ft		1710	1710
Test Piles (Concrete)	Each		2	2
Name Plates	Each		2	2
Slope Wall 4"	Sq Yds		370	370

**DESIGN STRESSES**

f<sub>c</sub> = 4000 psi. Super & Sub.  
f<sub>c</sub> = 75 psi. Footings  
f<sub>s</sub> = 24,000 psi. Reinf.  
f<sub>s</sub> = 24,000 psi. Struct. (A36)  
n = 10  
Allow & Deflect: 1/8 in  
LOADING: HS 15-44

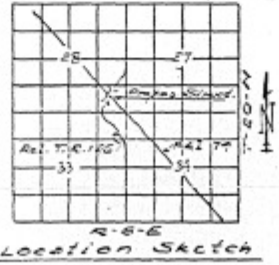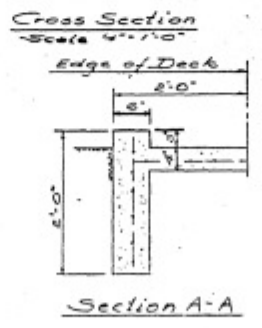

**GENERAL PLAN & ELEVATION**  
TR 126 OVER F.A.I. RT 74  
PROJ. I-74-5(34)179  
F.A.I. RT. 74 - SECTION 10-SHB-1  
CHAMPAIGN COUNTY  
STA. 1837+30.89


DESIGNED: Stanley S. Lin  
CHECKED: Paul E. Wang  
SUPERVISOR: R. P. Sumner  
APPROVED: Paul E. Wang

DATE: 8/8/2016



STATE OF ILLINOIS  
DEPARTMENT OF PUBLIC WORKS & BUILDINGS  
DIVISION OF HIGHWAYS

PROJECT NO.	SECTION	COUNTY	TOTAL SHEETS	SHEET NO.
74	10-511	Champaign	24	9

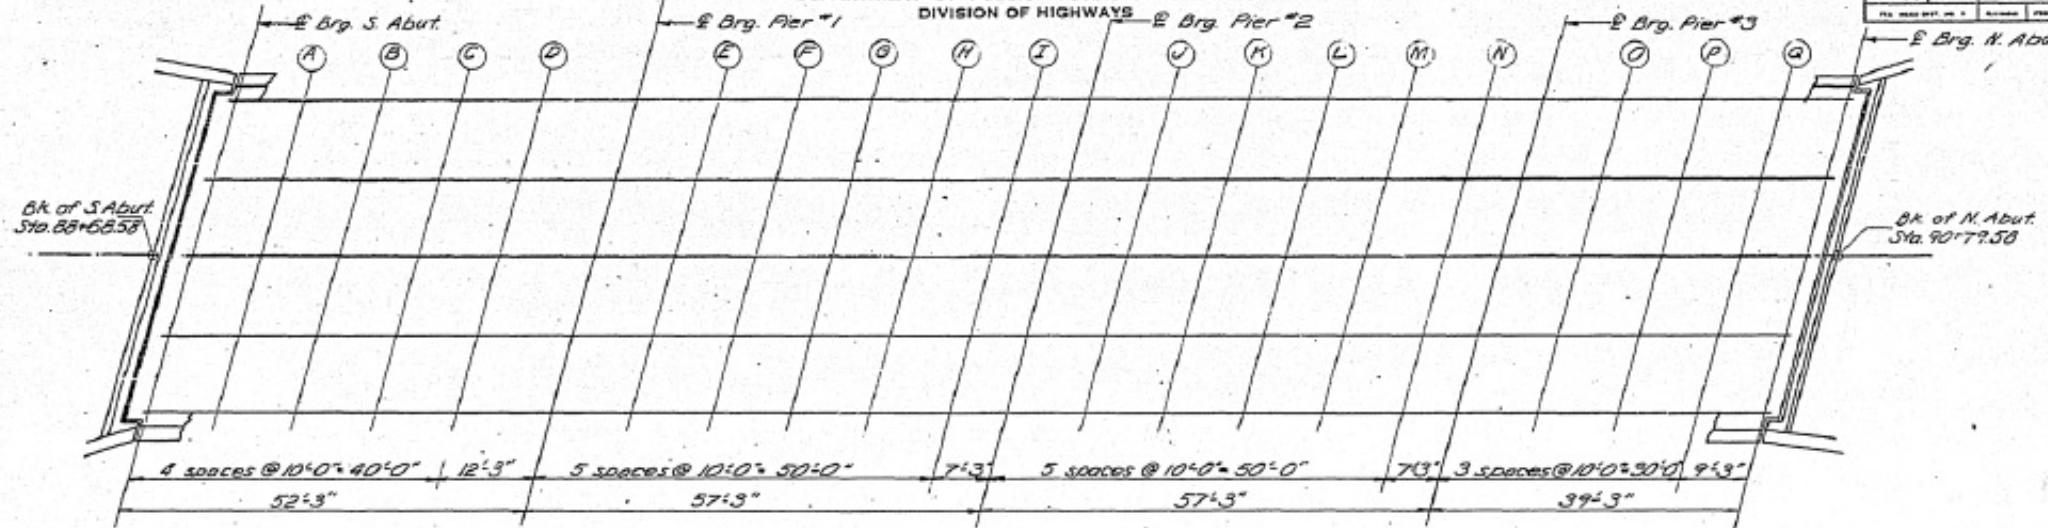

PLAN

Beam	Station	Offset	Theoretical Grade Elevations	Theoretical Grade Elevations Adjusted For Dead Load Deflection
<i>Sk of S Abut.</i>				
4	68+65.58	6.500	838.034	838.034
3	68+65.58	0.000	838.909	838.909
2	68+65.58	6.500	838.882	838.882
<i>E Brg S Abut</i>				
888	68+65.58	6.500	838.034	838.034
889	68+65.58	0.000	838.909	838.909
890	68+65.58	6.500	838.882	838.882
<i>E Brg Pier #1</i>				
891	69+00.00	6.500	838.722	838.742
892	69+00.00	0.000	838.651	838.739
893	69+00.00	6.500	838.659	838.729
<i>E Brg Pier #2</i>				
894	69+35.00	6.500	838.538	838.586
895	69+35.00	0.000	838.504	838.537
896	69+35.00	6.500	838.471	838.500
<i>E Brg Pier #3</i>				
897	69+70.00	6.500	838.348	838.399
898	69+70.00	0.000	838.308	838.336
899	69+70.00	6.500	838.272	838.300
<i>Sk of N Abut</i>				
900	90+77.58	6.500	838.139	838.154
901	90+77.58	0.000	838.112	838.111
902	90+77.58	6.500	838.082	838.090

Beam	Station	Offset	Theoretical Grade Elevations	Theoretical Grade Elevations Adjusted For Dead Load Deflection
<i>Sk of S Abut</i>				
903	90+77.58	6.500	838.034	838.034
904	90+77.58	0.000	838.909	838.909
905	90+77.58	6.500	838.882	838.882
<i>E Brg Pier #1</i>				
906	91+12.58	6.500	838.642	838.676
907	91+12.58	0.000	838.526	838.587
908	91+12.58	6.500	838.547	838.548
<i>E Brg Pier #2</i>				
909	91+47.58	6.500	838.412	838.472
910	91+47.58	0.000	838.394	838.394
911	91+47.58	6.500	838.368	838.368
<i>E Brg Pier #3</i>				
912	91+82.58	6.500	838.238	838.270
913	91+82.58	0.000	838.222	838.222
914	91+82.58	6.500	838.196	838.196
<i>Sk of N Abut</i>				
915	92+17.58	6.500	838.068	838.082
916	92+17.58	0.000	838.052	838.052
917	92+17.58	6.500	838.026	838.026

Beam	Station	Offset	Theoretical Grade Elevations	Theoretical Grade Elevations Adjusted For Dead Load Deflection
<i>Sk of S Abut</i>				
918	92+52.58	6.500	837.898	837.927
919	92+52.58	0.000	837.882	837.882
920	92+52.58	6.500	837.856	837.856
<i>E Brg Pier #1</i>				
921	92+87.58	6.500	837.762	837.781
922	92+87.58	0.000	837.746	837.746
923	92+87.58	6.500	837.720	837.720
<i>E Brg Pier #2</i>				
924	93+22.58	6.500	837.638	837.672
925	93+22.58	0.000	837.622	837.622
926	93+22.58	6.500	837.596	837.596
<i>E Brg Pier #3</i>				
927	93+57.58	6.500	837.504	837.544
928	93+57.58	0.000	837.488	837.488
929	93+57.58	6.500	837.462	837.462
<i>Sk of N Abut</i>				
930	93+92.58	6.500	837.372	837.402
931	93+92.58	0.000	837.356	837.356
932	93+92.58	6.500	837.330	837.330





Beam	Station	Offset	Theoretical Grade Elevations	Theoretical Grade Elevations Adjusted For Dead Load Deflection
<i>E Brg Pier #3</i>				
933	94+27.58	6.500	837.242	837.282
934	94+27.58	0.000	837.226	837.226
935	94+27.58	6.500	837.200	837.200
<i>Sk of N Abut</i>				
936	94+62.58	6.500	837.112	837.152
937	94+62.58	0.000	837.096	837.096
938	94+62.58	6.500	837.070	837.070

DESIGNED: JMS  
CHECKED: PWC  
DRAWN: RPS  
APPROVED: PWC  
DATE: APRIL 27 1965

TOP SLAB ELEVATION  
F.A.I. RT 74 SEC. 10-51B-1  
CHAMPAIGN COUNTY  
STA. 1837+30.89

STATE OF ILLINOIS  
DEPARTMENT OF PUBLIC WORKS & BUILDINGS  
DIVISION OF HIGHWAYS

SHEET NO.	SECTION	DATE	BY	CHECKED	DATE	SCALE
10	74	10-26-62	Champaign	24	10	10 SHEETS

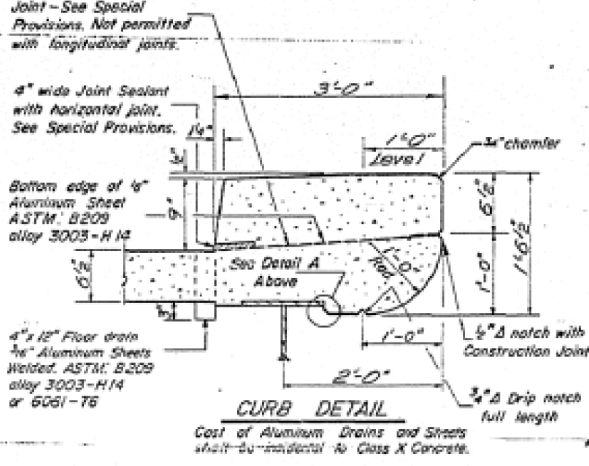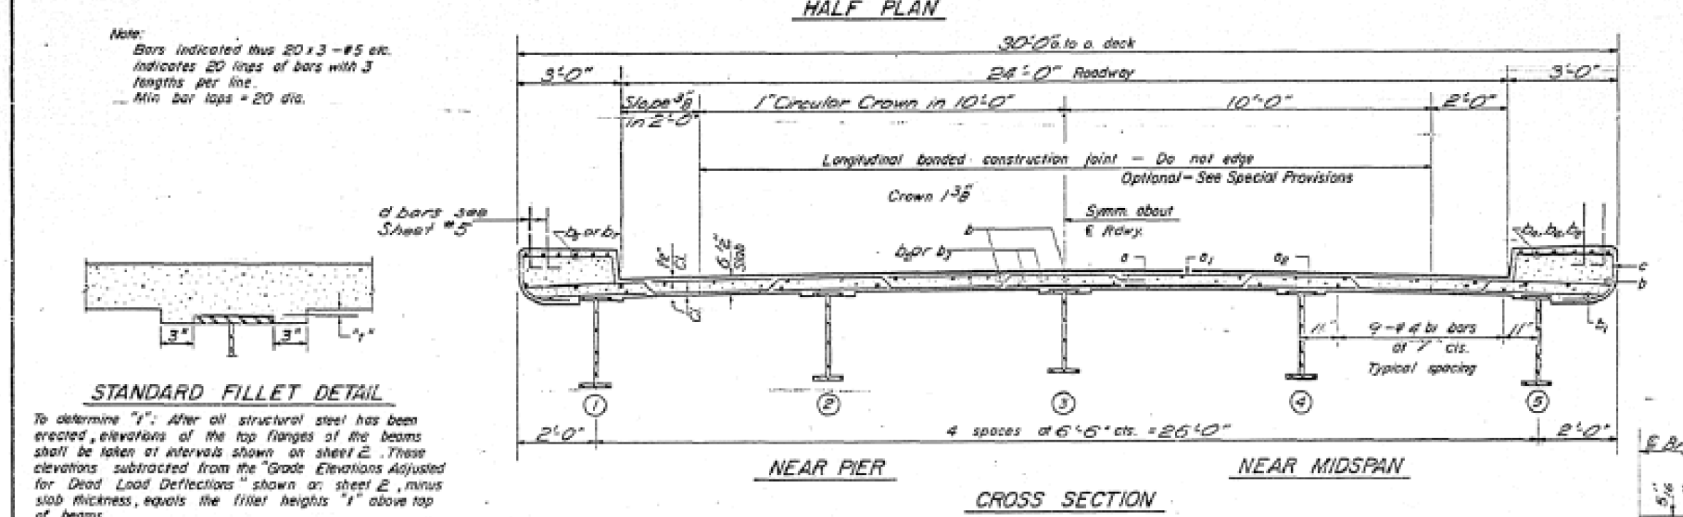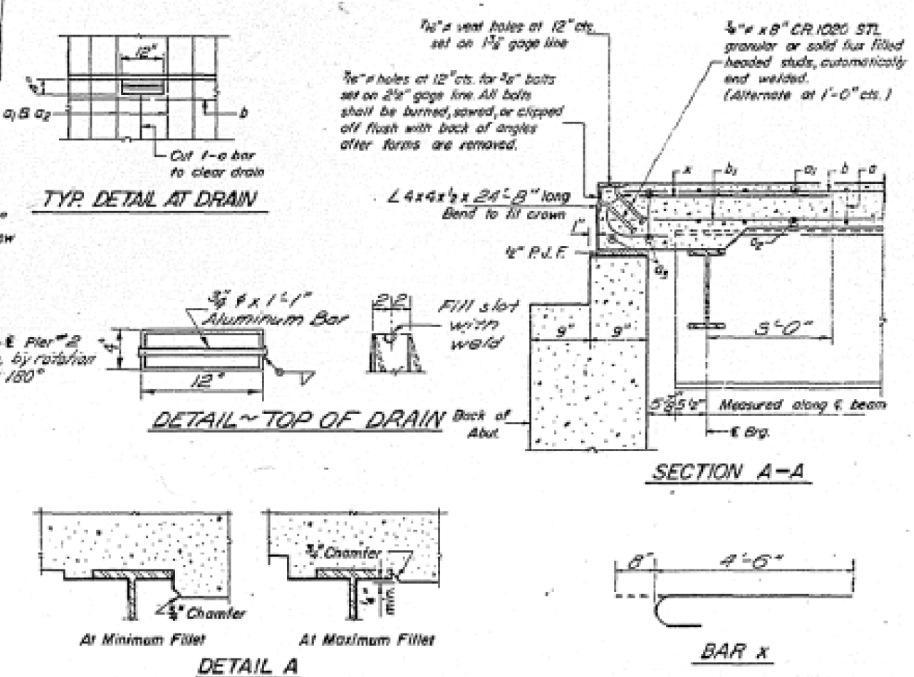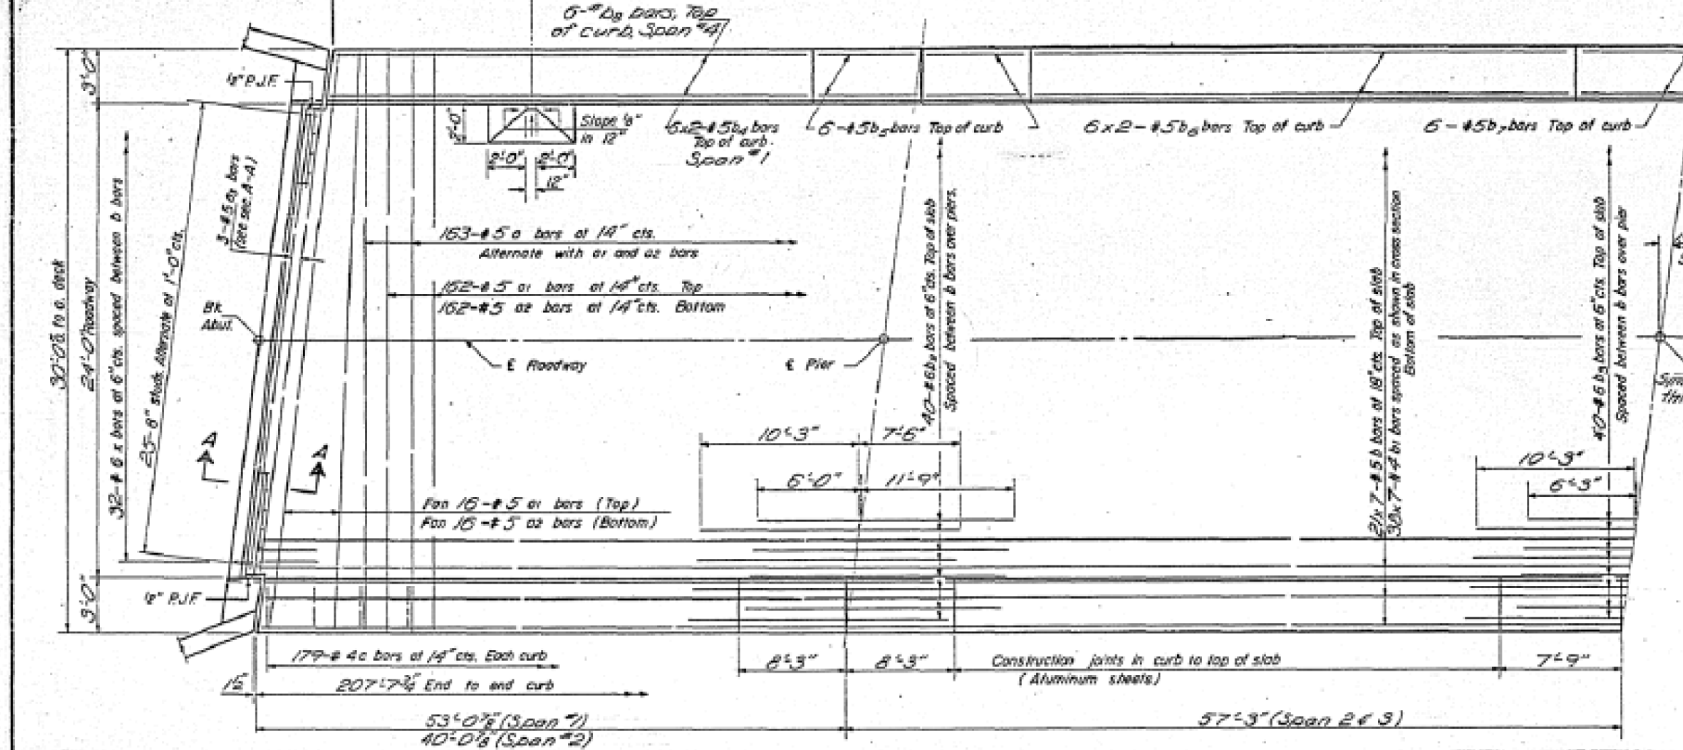

**STANDARD FILLET DETAIL**


To determine "f", after all structural steel has been erected, elevations of the top flanges of the beams shall be taken at intervals shown on sheet 2. These elevations subtracted from the "Grade Elevations Adjusted for Dead Load Deflections" shown on sheet 2, minus slab thickness, equals the fillet height "f" above top of beams.

**BILL OF MATERIAL**

Bar	No.	Size	Length	Stage
a	163	#5	31'-0"	~
a1	194	#5	29'-0"	~
a2	194	#5	26'-9"	~
a3	6	#5	24'-0"	~
b	147	#5	30'-0"	~
b1	200	#4	30'-0"	~
b2	80	#6	17'-9"	~
b3	40	#6	18'-5"	~
b4	24	#5	23'-0"	~
b5	48	#5	8'-0"	~
b6	48	#5	2'-5"	~
c1	24	#5	7'-6"	~
c2	12	#5	3'-6"	~
c	358	#4	5'-9"	~

Reinforcement Bars	Lbs	35000
Structural Steel	Lbs	11000
Class X Concrete	Cu Yd	1672

Weight of bearing assemblies with lead plates and anchor bolts are included as structural steel.  
Est. Wt = 6320 Lbs.

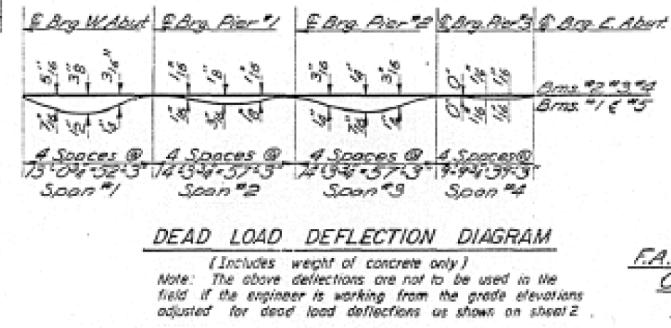

DESIGNED: Stanley S. Liu  
CHECKED: Paul C. Wang  
P.C. Barnett  
BRINK: DL Beemer  
CHECKED: Paul C. Wang

APPROVED: [Signature]

I-5-L (E 15°) 10-10-62 Rev. 11-1-63 5-1-64

**SUPERSTRUCTURE**  
F.A.I. RT. 74 SEC. 10-5HB-1  
CHAMPAIGN COUNTY  
STA. 1837+30.89

STATE OF ILLINOIS  
DEPARTMENT OF TRANSPORTATION

AS-BUILT PLANS  
(FOR INFORMATION ONLY)

FILE NAME:	USER NAME: shererjm	DESIGNED: JMS	REVISED:
PLLOT SCALE: 40.0000' / in.	CHECKED:	REVISOR:	REVISOR:
PLLOT DATE: 8/8/2016	DATE:	REVISOR:	REVISOR:


SCALE: SHEET NO. 3 OF 6 SHEETS STA. TO STA.

F.A.I. RTE.	SECTION	COUNTY	TOTAL SHEETS	SHEET NO.
74	(10-410-5)I	CHAMPAIGN	74	65
CONTRACT NO. 70B15				


ILLINOIS FED. AID PROJECT

STATE OF ILLINOIS  
DEPARTMENT OF PUBLIC WORKS & BUILDINGS  
DIVISION OF HIGHWAYS

DATE	SECTION	SHEET NO.	TOTAL SHEETS
11-1-74	Champaign	24	11

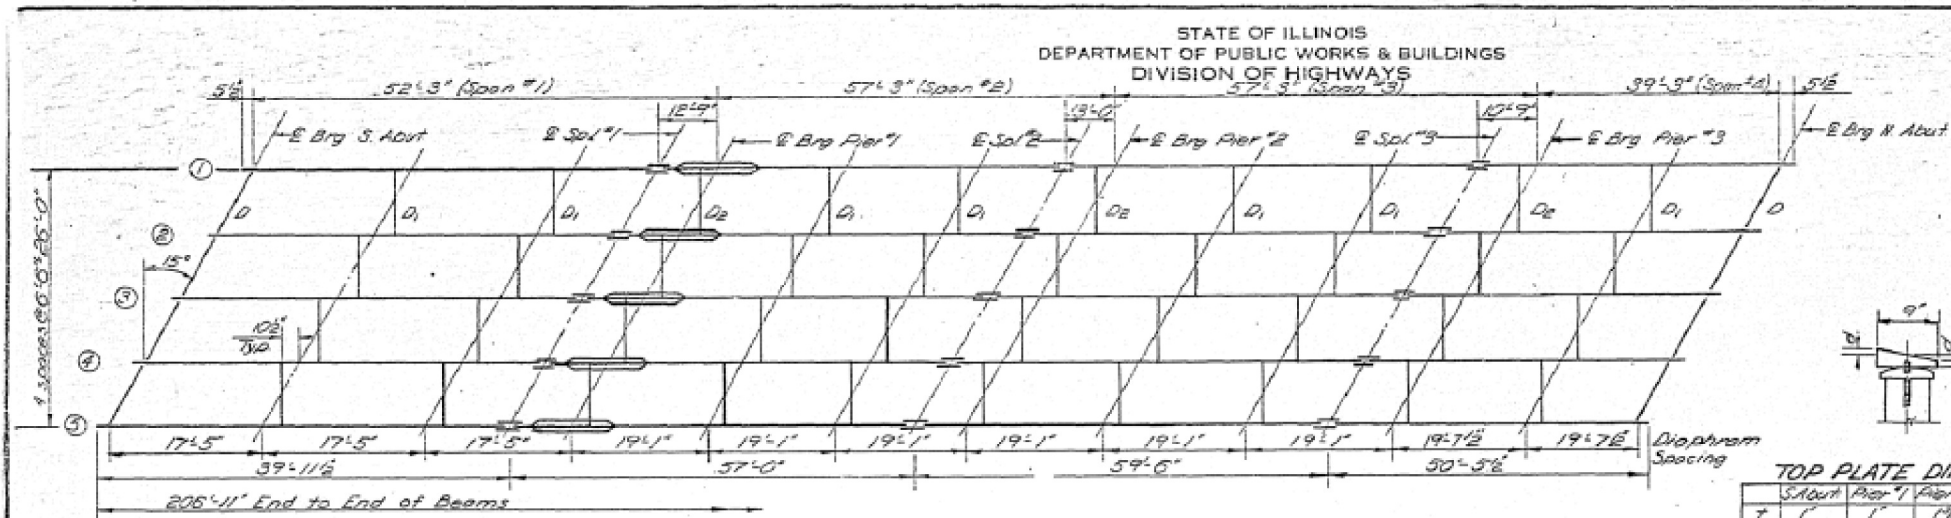

PLAN  
All Beams are 30 W F 105

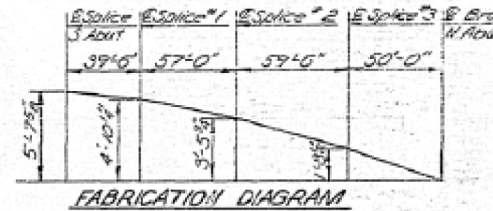

FABRICATION DIAGRAM

TOP PLATE DIMENSION

Span	Pier #1	Pier #2	Pier #3	Abut
7	1	1	1	1
d	8	8	8	8

TABLE OF MAX. MOMENTS  
(INTERIOR BEAM)


Beam	Pier #1	Pier #2	Pier #3	Abut
D.L.	155	282	97	239
L.L.	230	194	205	160
T.M.R.	64	54	58	50
TOTAL	450	530	363	450

Moments are in Ft.-Kips


TABLE OF MAX. REACTIONS  
(INTERIOR BEAM)

Beam	Pier #1	Pier #2	Pier #3	Abut
D.L.	10.8	53.0	49.0	46.2
L.L.	24.8	30.6	30.1	30.2
T.M.R.	6.9	8.6	8.4	8.7
TOTAL	42.5	92.2	87.5	85.1

Reaction are in Kips

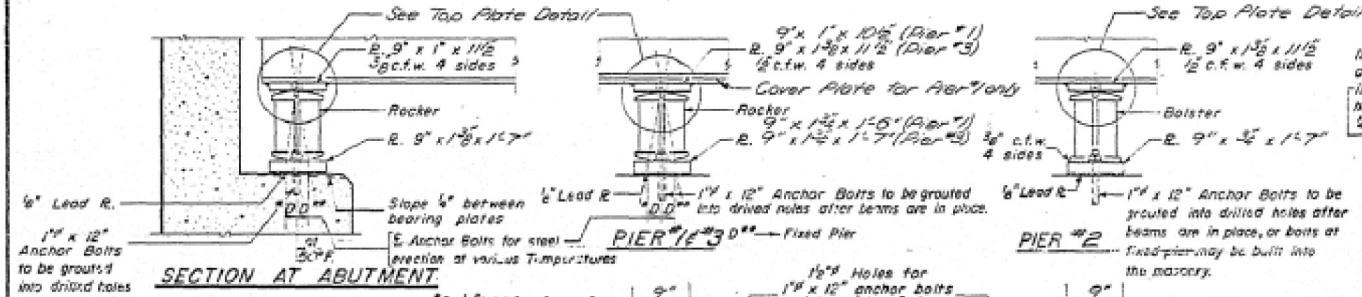


SECTION AT ABUTMENT

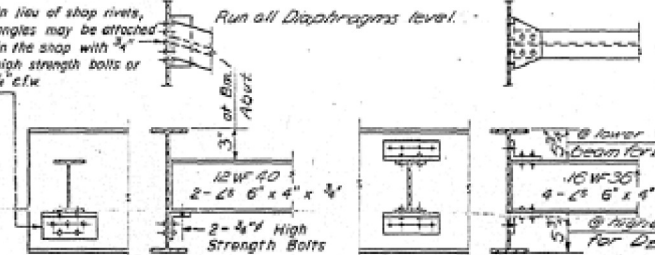

DIAPHRAGM D

DIAPHRAGM D1, D2

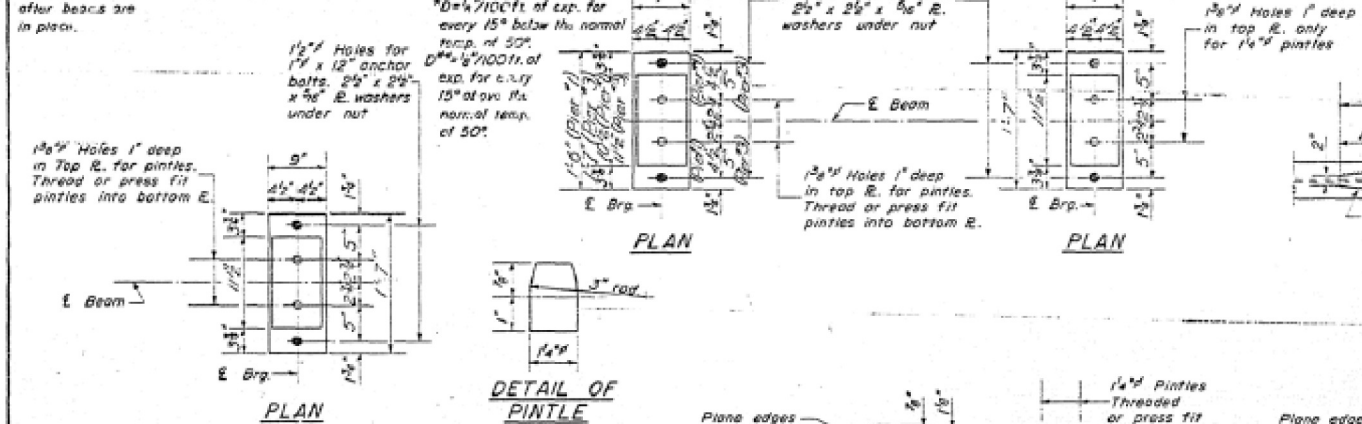

PLAN

PLAN


DETAIL OF COVER PLATE

ELEVATION TOP OF WF


Beam	Bm #1	Bm #2	Bm #3	Bm #4	Bm #5
Location	33821	33827	33834	33837	33841
E. Splice #1	83742	83748	83755	83758	83762
E. Splice #2	83771	83777	83784	83787	83791
E. Splice #3	83805	83811	83818	83821	83825
E. Splice #4	83835	83841	83848	83851	83855
E. Splice #5	83865	83871	83878	83881	83885
E. Splice #6	83895	83901	83908	83911	83915
E. Splice #7	83925	83931	83938	83941	83945

DESIGNED: Stanley S. Lee  
CHECKED: Paul E. Wandy  
DRAWN: W. A. Severson Jr.  
APPROVED: [Signature]


APRIL 27 1945  
EXAMINED: Carl [Signature]  
CHECKED: [Signature]  
APPROVED: [Signature]

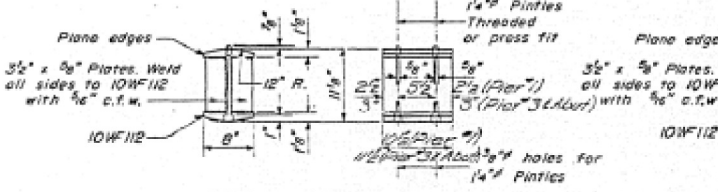

DETAIL OF ROCKER AT PIER #1 & #3

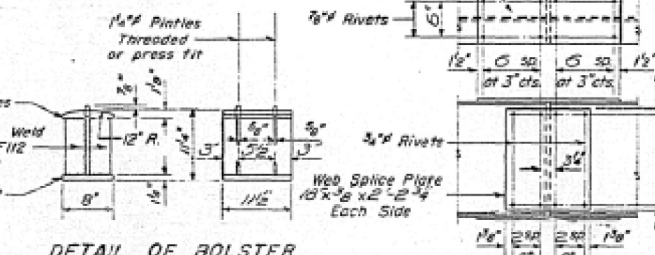

DETAIL OF BOLSTER AT PIER #2

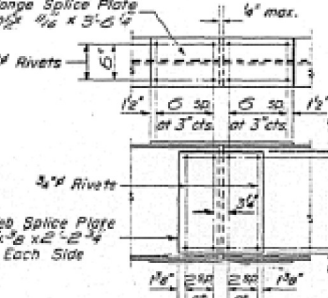


DETAIL OF SPLICE

STRUCTURAL STEEL  
F.A.I. R174 SEC. 10-5HB-1  
CHAMPAIGN COUNTY  
STA. 1837+30.89

I-2-C 7-2-62 Rev. 11-9-62 Rev. 8-16-63 Rev. 12-10-63

STATE OF ILLINOIS  
DEPARTMENT OF PUBLIC WORKS & BUILDINGS  
DIVISION OF HIGHWAYS

PROJECT NO.	SECTION	SHEET NO.	TOTAL SHEETS
11-174	Champaign	24	13

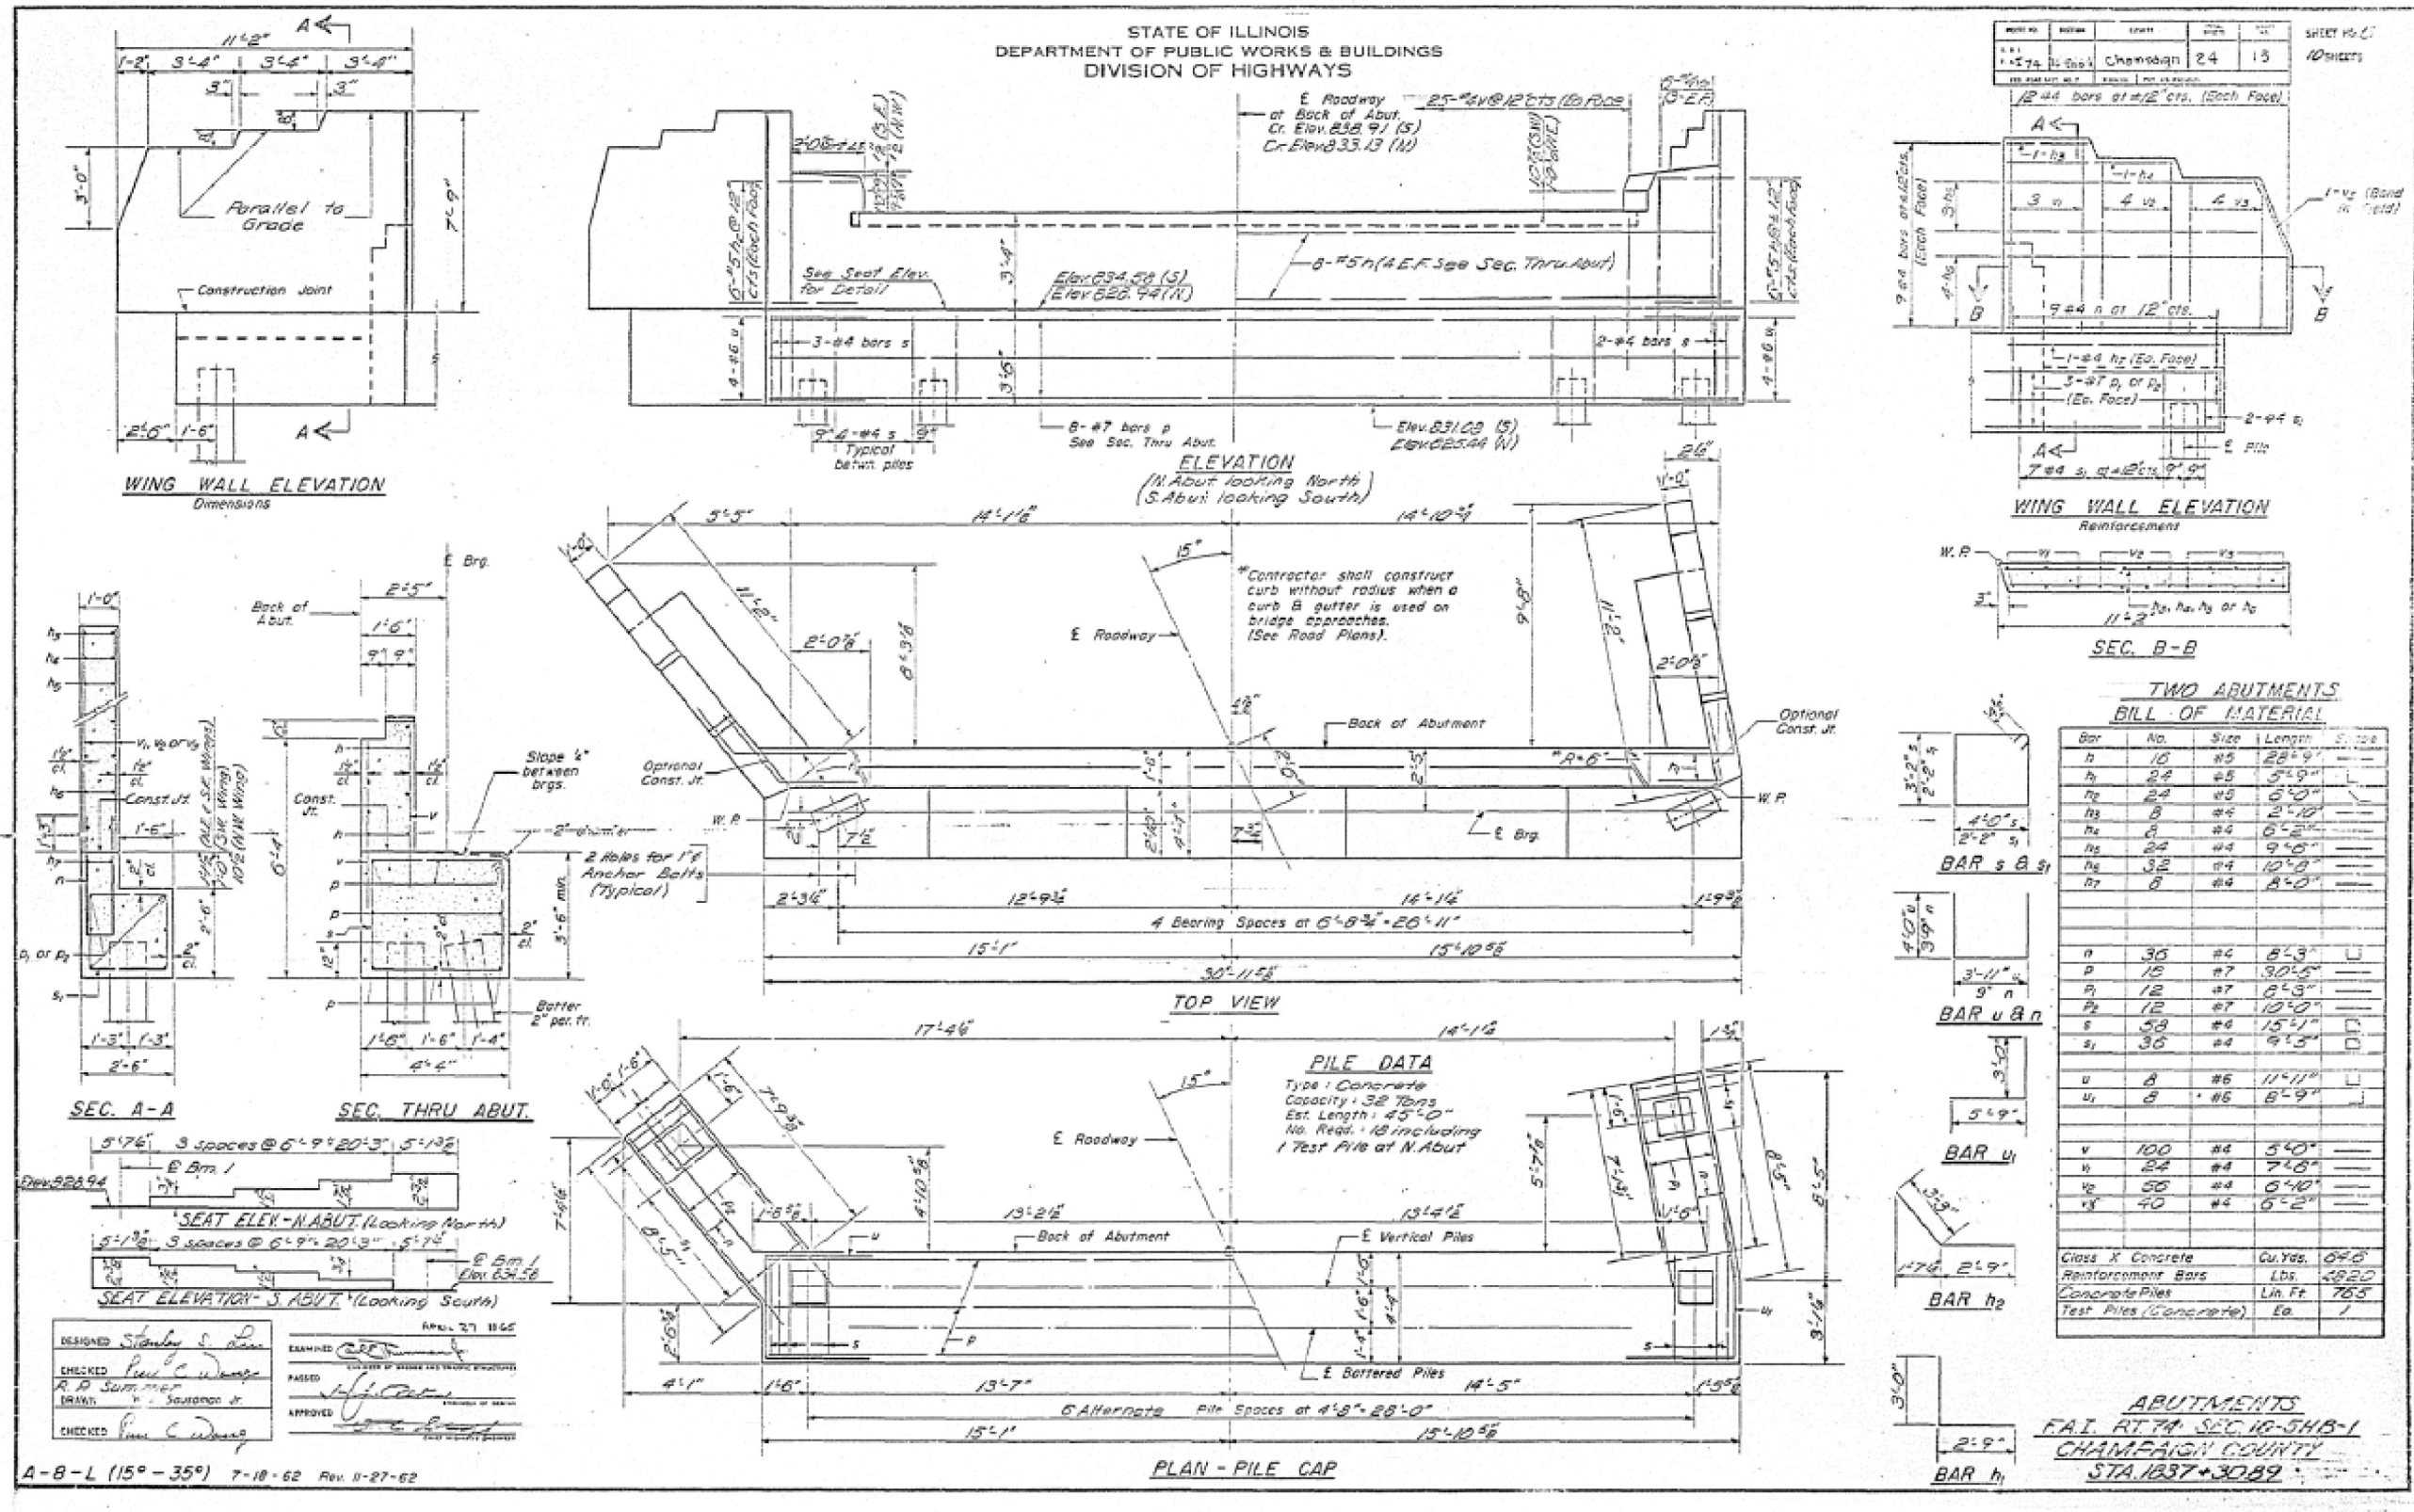

DESIGNED: Stanley S. Dean  
CHECKED: Paul C. Winters  
R. P. Sommer  
DRAWN: J. S. Sautman Jr.  
APPROVED: [Signature]  
DATE: APRIL 27 1962

A-B-L (15°-35°) 7-18-62 Rev. 11-27-62


STATE OF ILLINOIS  
DEPARTMENT OF PUBLIC WORKS & BUILDINGS  
DIVISION OF HIGHWAYS

NO.	DATE	BY	REVISION
1	10-10-59	CHAMBERLAIN	24
2	11-10-59		14


**PILE DATA**

Type: Concrete  
Capacity: 30 Tons  
Est. Length: 27'-0"  
No. Piles: 25 Piles (12 for Pier #1, 14 for Pier #2, includes 1 Test Pile)

2 Piles for 14  
Anchor Bolts  
(Torsion)

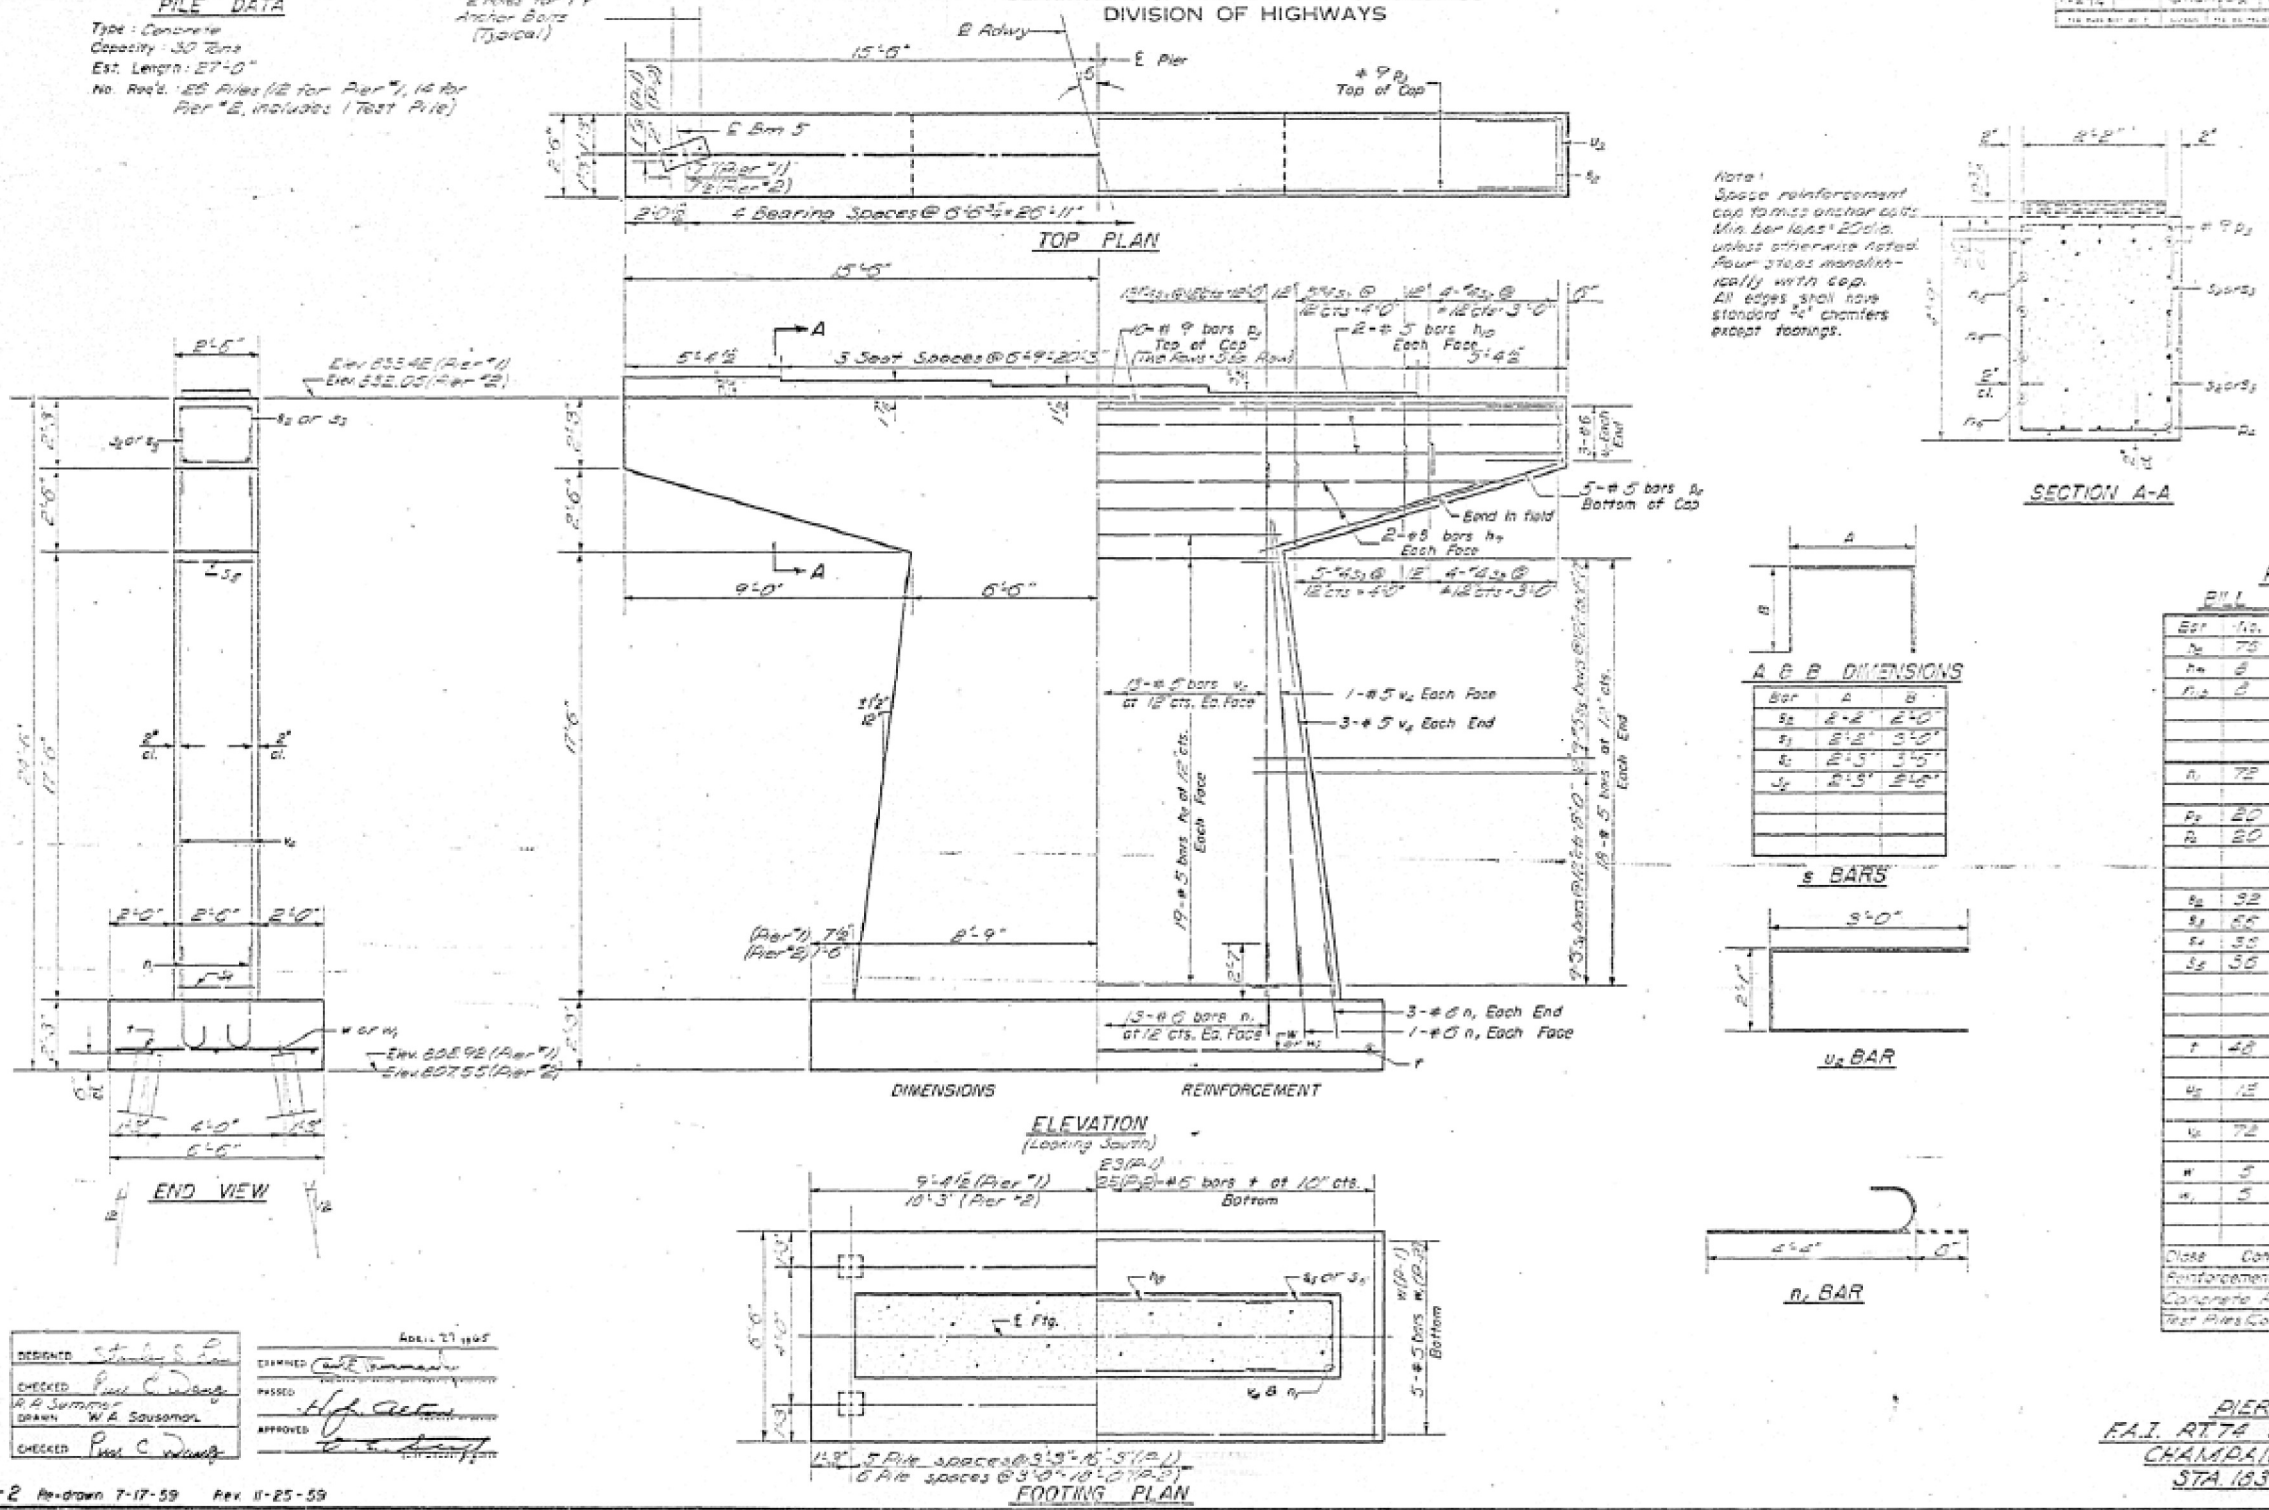

Note:  
Space reinforcement  
cap forms anchor bolts.  
Min. bar 10#5 @ 20 dia.  
unless otherwise noted.  
Four steel mandrels  
install with cap.  
All edges shall have  
standard 1/4" chamfers  
except footings.

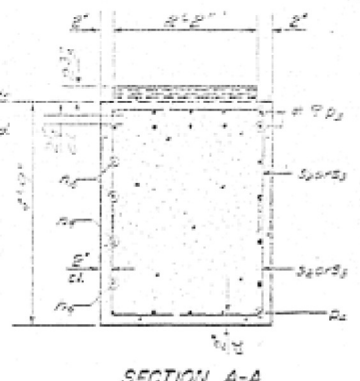

**A & B DIMENSIONS**

Bar	A	B
1	2'-2"	2'-0"
2	2'-2"	3'-5"
3	2'-3"	3'-5"
4	2'-3"	2'-6"

**PIER #1 & #2  
BILL OF MATERIAL**

Est.	No.	Size	Length	Shape
1	75	#5	12'-0"	—
2	6	#5	27'-0"	—
3	3	#5	30'-0"	—
4	72	#5	5'-0"	—
5	20	#5	30'-0"	—
6	20	#5	10'-5"	—
7	32	#4	0'-2"	□
8	60	#4	8'-2"	□
9	30	#5	9'-3"	□
10	30	#5	7'-3"	□
11	40	#5	6'-3"	—
12	12	#5	8'-1"	□
13	72	#5	25'-6"	—
14	5	#5	8'-6"	—
15	5	#5	20'-3"	—

Class Concrete Cu Yds 25.8  
Reinforcement Bars Lbs. 7500  
Concrete Piles Un Ft. 675  
Test Piles (Concrete) Each 1


DESIGNED: *Shirley S. Lee*  
CHECKED: *Paul C. Winters*  
DRAWN: *W.A. Sauson*  
APPROVED: *W.A. Sauson*

EXAMINED: *Carl E. ...*  
PASSED: *H.P. ...*  
APPROVED: *...*

Apr. 27 1965

P-2 Re-drawn 7-17-59 Rev. 11-25-59

PIER #1 & #2  
F.A.I. RT 74 SEC. 10-54B-1  
CHAMPAIGN COUNTY  
STA. 1637+30.89

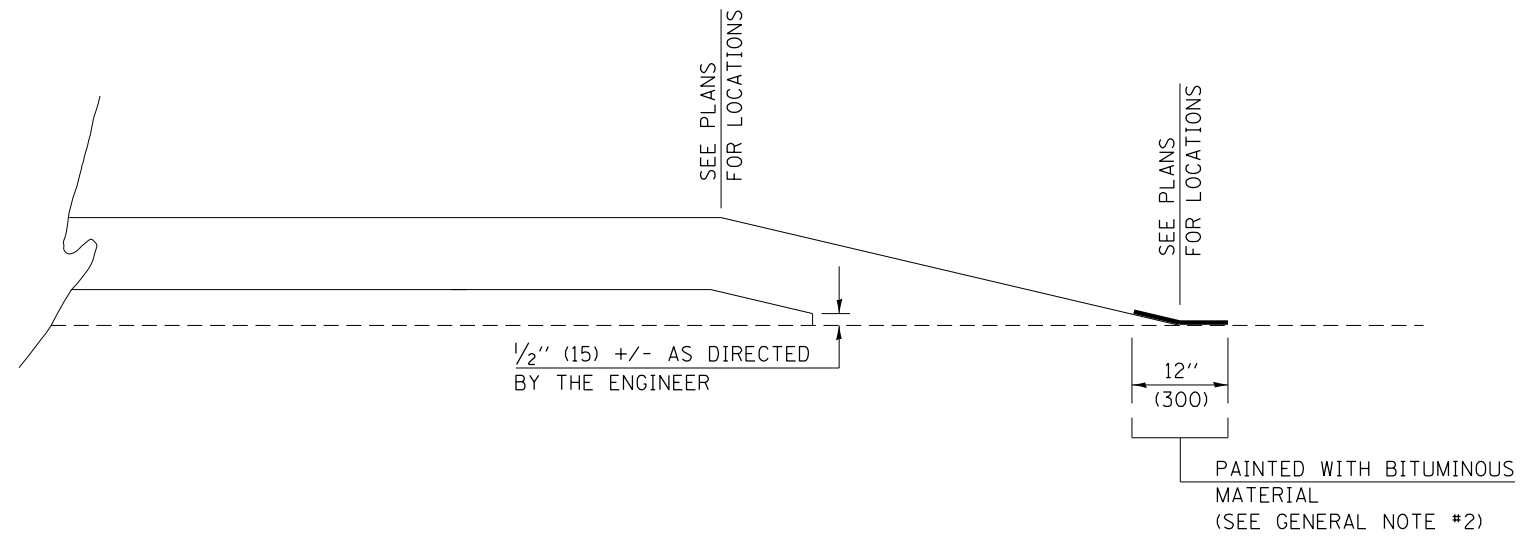

**GENERAL NOTES**

1. ALL PROPOSED RUNDOWNS SHALL BE UNIFORMLY CONSTRUCTED AS FOLLOWS:  
 1: 240 (20 FEET PER INCH) OF THICKNESS FOR NON-INTERSTATE IMPROVEMENTS (SEE ARTICLE 406.09)  
 1: 360 (30 FEET PER INCH) OF THICKNESS FOR INTERSTATE IMPROVEMENTS
2. ON RESURFACING RUNDOWNS THAT ARE TO REMAIN IN PLACE AFTER COMPLETION OF THE SECTION, THE END OF THE FEATHEREDGE SHALL BE PAINTED WITH A UNIFORM COATING OF AC OR HFE BITUMINOUS MATERIAL APPROVED BY THE ENGINEER AFTER THE RUNDOWN IS COMPLETED. THE BITUMINOUS MATERIAL SHALL BE PAINTED ACROSS THE END OF THE RUNDOWN APPROXIMATELY 12 INCHES (300 mm) WIDE, 6 INCHES (150 mm) ON THE RUNDOWN AND 6 INCHES (150 mm) ON THE PAVEMENT. THE PAINTED STRIP SHALL BE COVERED WITH SAND. THIS WORK WILL NOT BE PAID FOR SEPARATELY, BUT SHALL BE CONSIDERED INCIDENTAL TO THE CONTRACT AND NO ADDITIONAL COMPENSATION WILL BE ALLOWED.

Note: All dimensions are in INCHES (millimeters) unless otherwise shown.


**DISTRICT 5 DETAIL NO. 406AAAAA**

FILE NAME =	USER NAME = shererjm	DESIGNED -	REVISED - 12/06	<b>STATE OF ILLINOIS DEPARTMENT OF TRANSPORTATION</b>	<b>FEATHEREDGE RUNDOWN</b>			F.A.I. RTE.	SECTION	COUNTY	TOTAL SHEETS	SHEET NO.
p:\11\084EBIDINTEG.illinois.gov\PI\DOT\Documents\DOT Offices\District 5\Projects\0579\Drawings\Structures\0579B15-sht-Design\0579B15-sht-Design.dwg		CHECKED -	REVISED -		74	(10-4,10-5)I	Champaign	74	69			
		PLOT SCALE = 40.0000' / in.	REVISOR -		SCALE:      SHEET NO. 1 OF 1 SHEETS      STA.      TO STA.			CONTRACT NO. 70B15				
		PLOT DATE = 8/8/2016	DATE -		FED. ROAD DIST. NO.		ILLINOIS FED. AID PROJECT					

# ROAD CLOSURE

# SIDEROAD / STREET CLOSURE


SYMBOLS	
	TYPE III BARRICADE (SEE NOTE 1)
	FLASHING AMBER LIGHT (TYPE A)

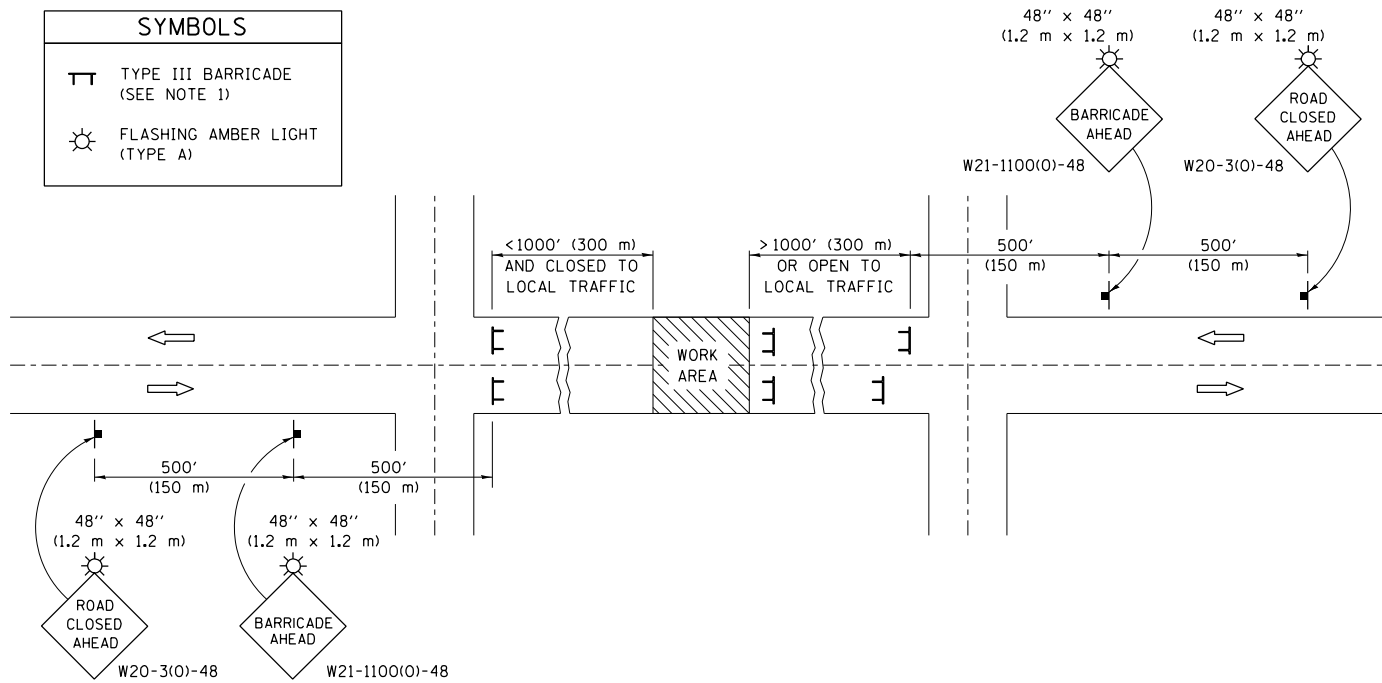

### GENERAL NOTES

- TYPE III BARRICADES SHALL BE AS SHOWN ON STANDARD 701901 "TYPICAL APPLICATIONS OF TYPE III BARRICADES CLOSING A ROAD". EACH TYPE III BARRICADE SHALL HAVE TWO FLASHING AMBER LIGHTS MOUNTED ABOVE IT.
- IF THE ROAD IS OPEN TO LOCAL TRAFFIC OR EXCEEDS 1000' (300 m), ANOTHER SET OF TYPE III BARRICADES, EQUIPPED AS IN NOTE 1 ABOVE, SHALL BE PLACED AT EACH END OF THE WORK AREA.
- WHEN A STOP CONDITION EXISTS, NO SIGNS ARE REQUIRED IN ADVANCE OF THE "STOP" SIGN WHEN THE ROAD IS CLOSED WITHIN 100' (30 m) OF THE INTERSECTION.
- STANDARD 701901 SHALL APPLY FOR THE PLACEMENT & DESIGN OF TYPE III BARRICADES.
- IF A TYPE III BARRICADE WITH AN ATTACHED SIGN PANEL WHICH MEETS NCHRP 350 IS NOT AVAILABLE, THE SIGNS MAY BE MOUNTED ON AN NCHRP 350 TEMPORARY SIGN SUPPORT DIRECTLY IN FRONT OF THE BARRICADE.
- REFLECTORIZED STRIPING SHALL APPEAR ON BOTH SIDES OF THE TYPE III BARRICADES IF ROAD IS OPEN TO LOCAL TRAFFIC.
- ALL SIGNS SHALL BE POST MOUNTED IF THE CLOSURE TIME EXCEEDS FOUR DAYS.
- A MINIMUM OF TWO FLASHING LIGHTS SHALL BE USED AT NIGHT ON EACH APPROACH IN ADVANCE OF THE WORK AREA. FLASHING LIGHTS SHALL BE INSTALLED ABOVE THE FIRST TWO SIGNS IN THE SERIES.
- LONGITUDINAL DIMENSIONS MAY BE ADJUSTED SLIGHTLY TO FIT FIELD CONDITIONS.
- FORMS BT. 725 AND BT. 726 ARE REQUIRED.
- WHEN A SIDEROAD INTERSECTS THE HIGHWAY ON WHICH WORK IS BEING PERFORMED, ADDITIONAL TRAFFIC DEVICES SHALL BE ERECTED AND PROVIDED AS DIRECTED BY THE ENGINEER.
- AN ADDITIONAL SIGN MAY BE REQUIRED AT A MAJOR INTERSECTING ROAD IN ADVANCE OF THE CLOSURE. THE ADDITIONAL SIGN SHALL GIVE THE DISTANCE TO THE BARRICADE IN MILES OR FRACTIONS OF A MILE.

SYMBOLS	
	TYPE III BARRICADE (SEE NOTE)
	FLASHING LIGHT
	FLAGGER WITH TRAFFIC CONTROL SIGN (WHILE WORK IS BEING PERFORMED)
	CONE (DAYLIGHT HOURS ONLY), DRUM, TYPE I OR TYPE II BARRICADE
	WORK AREA
	TRAFFIC FLOW

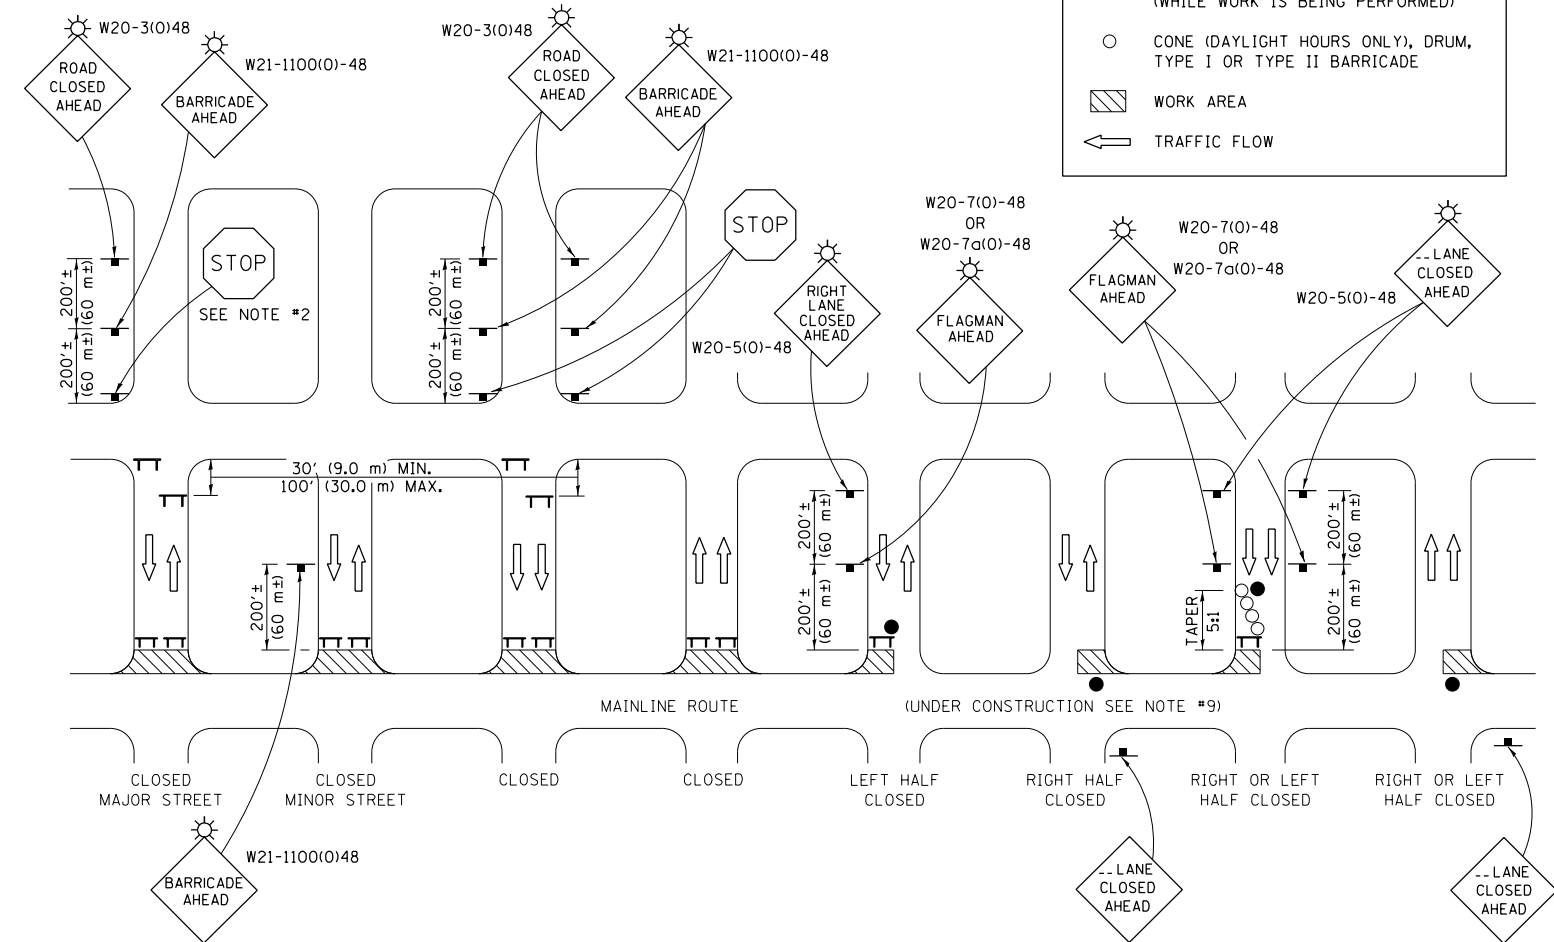

### GENERAL NOTES

- TYPE III BARRICADES SHALL BE AS SHOWN ON "TYPICAL APPLICATIONS OF TYPE III BARRICADES CLOSING A ROAD". EACH TYPE III BARRICADE SHALL HAVE TWO FLASHING AMBER LIGHTS MOUNTED ABOVE IT.
- WHERE A STOP CONDITION EXISTS, AS SHOWN ABOVE, WARNING SIGNS MAY BE OMITTED IN ADVANCE OF THE "STOP" SIGN.
- STANDARD 701901 SHALL APPLY FOR THE PLACEMENT & MANUFACTURE OF TYPE III BARRICADES.
- ALL SIGNS SHALL BE POST MOUNTED IF THE CLOSURE TIME EXCEEDS FOUR DAYS.
- ONE FLASHING LIGHT IS REQUIRED ABOVE EACH ADVANCE WARNING SIGN DURING HOURS OF DARKNESS.
- LONGITUDINAL DIMENSIONS MAY BE ADJUSTED SLIGHTLY TO FIT FIELD CONDITIONS.
- FORMS BT 725 AND BT 726 ARE REQUIRED.
- THE MAINLINE ROUTE TEMPORARY TRAFFIC CONTROL SHALL BE IN ACCORDANCE WITH THE PLANS, SPECIAL PROVISIONS AND STANDARD SPECIFICATIONS.
- ALL FLAGGERS REQUIRED AT SIDE ROADS AND ENTRANCES REMAINING OPEN TO TRAFFIC AND/OR ADDITIONAL BARRICADES REQUIRED BY THE ENGINEER TO CLOSE SIDE ROADS AND ENTRANCES WILL BE PAID FOR ACCORDING TO ARTICLE 109.04.

Note: All dimensions are in INCHES (millimeters) unless otherwise shown.

FILE NAME =	USER NAME = shererjm	DESIGNED -	REVISED - 11/06
pw:\11\084EBID\INTEG.illinois.gov\PIWID\Documents\100T Offices\District 5\Projects\0577\DRAWING\Structures\0570B15-sht-Design\REVISED.dwg		CHECKED -	REVISED - 12/07
		PLOT SCALE = 40.0000' / in.	REVISED - 09/09 - KJT
		PLOT DATE = 8/8/2016	REVISED -

STATE OF ILLINOIS  
DEPARTMENT OF TRANSPORTATION


TRAFFIC CONTROL & PROTECTION DEVICES  
(ROAD & SIDEROAD/STREET CLOSURES)

SCALE: SHEET NO. 1 OF 1 SHEETS STA. TO STA.

DISTRICT 5 DETAIL NO. 7020000

F.A.I. RTE.	SECTION	COUNTY	TOTAL SHEETS	SHEET NO.
74	(10-4,10-5)I	Champaign	74	70
CONTRACT NO. 70B15				
FED. ROAD DIST. NO. ILLINOIS FED. AID PROJECT				

**CENTERLINE INTERSTATE OR MULTI-LANE TWO WAY DIVIDED HIGHWAY**

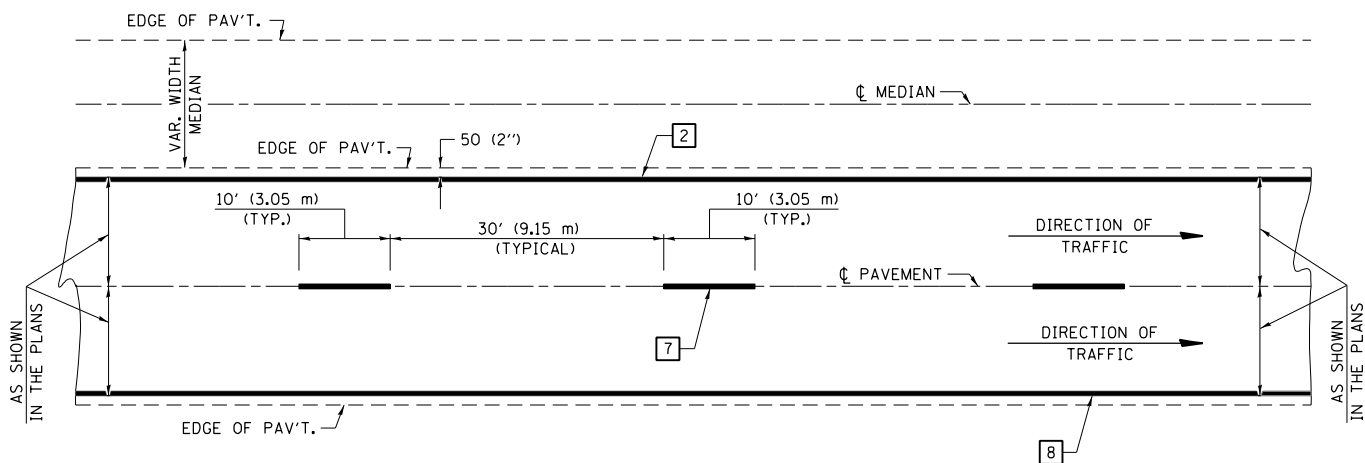


NOTE: PAVEMENT MARKINGS ARE TO BE EXTENDED THROUGH OMISSIONS WHEN APPLICABLE.


NOTE: SEE ARTICLES 780.04 & 781.03 FOR LOCATION OF STRIPES AND MARKERS RELATIVE TO EDGES OR JOINTS.

FOR RAISED REFLECTIVE PAVEMENT MARKERS, REFER TO STANDARD 781001.


**TYPICAL EXIT RAMP TERMINAL**

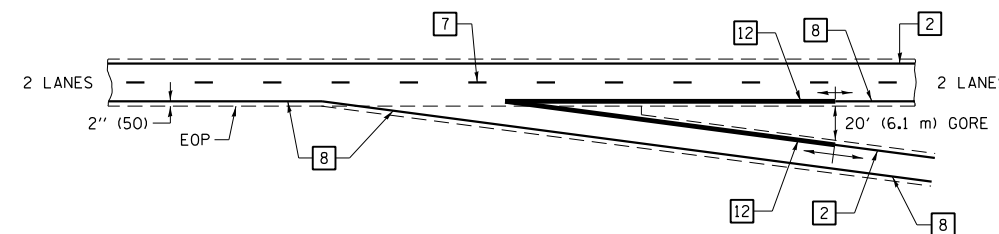


**EXIT RAMP TERMINAL with EXCLUSIVE (auxiliary) LANE**

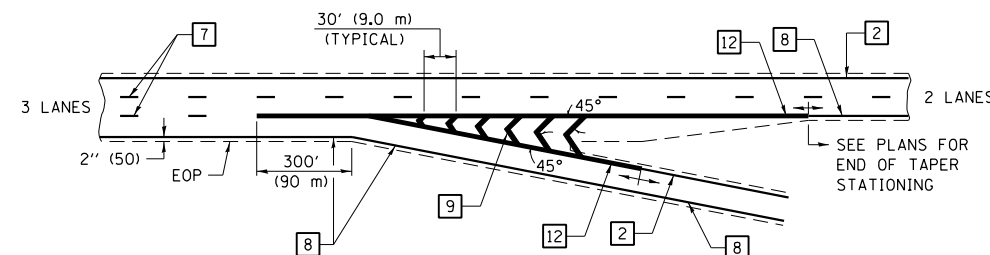


**TYPICAL PAVEMENT MARKING LEGEND**

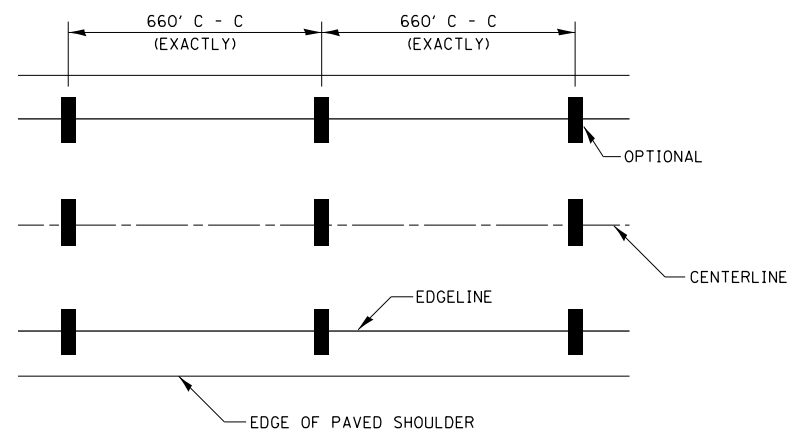


- 1 4" (100) SKIP-DASH (YELLOW)
- 2 4" (100) SOLID (YELLOW)
- 3 12" (300) DIAGONAL (YELLOW)
- 4 4" (100) DOUBLE YELLOW (NARROW)
- 5 RESERVED
- 6 RESERVED
- 7 4" (100) SKIP-DASH (WHITE)
- 8 4" (100) SOLID (WHITE)
- 9 12" (300) DIAGONAL (WHITE)
- 10 6" (150) SOLID (WHITE)
- 11 24" (600) STOP BAR (WHITE)
- 12 8" (200) SOLID (WHITE)
- 13 4" (100) LANE LINE EXTENSIONS (WHITE)

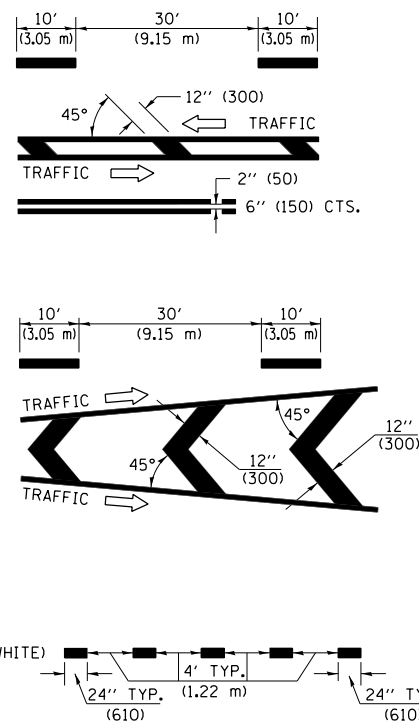


**TYPICAL ENTRANCE RAMP TERMINAL**

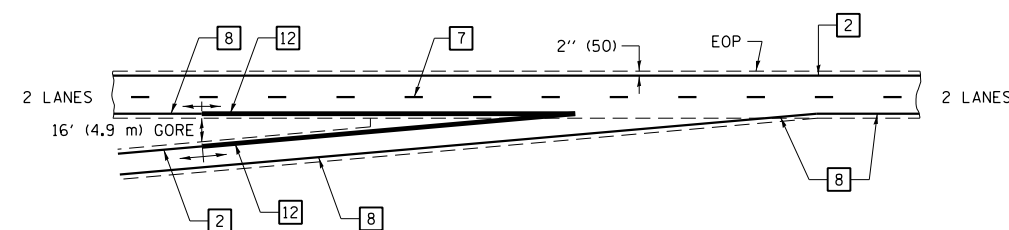


**ENTRANCE RAMP TERMINAL with EXCLUSIVE LANE**

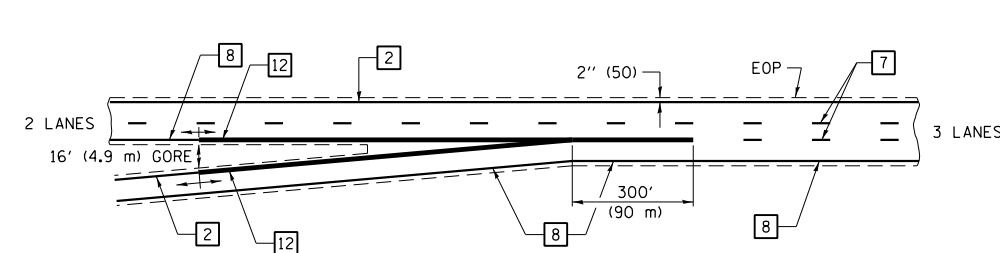

IT WILL BE NECESSARY TO HAVE A REPRESENTATIVE OF THE STATE POLICE PRESENT SO THAT THE ACCURACY OF MEASUREMENT CAN BE ATTESTED TO IN COURT.

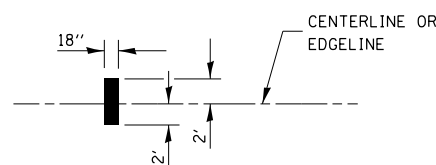

**AERIAL SPEED CHECK ZONES**

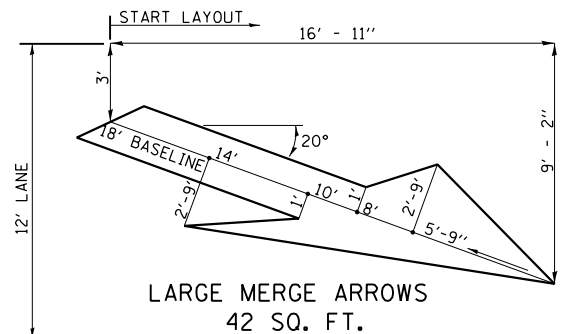

Note: All dimensions are in INCHES (millimeters) unless otherwise shown.

FILE NAME =	USER NAME = shererjm	DESIGNED -	REVISED - 11/06
PROJECT =	PROJECT =	CHECKED -	REVISED -
PLOT SCALE = 40.0000' / in.	DATE = 8/8/2016	DATE -	REVISED -

**STATE OF ILLINOIS  
DEPARTMENT OF TRANSPORTATION**


**PAVEMENT MARKING (INTERSTATE & MULTI-LANE APPLICATIONS)**

SCALE: SHEET NO. 1 OF 1 SHEETS STA. TO STA.

**DISTRICT 5 DETAIL NO. 7800BBBB**


F.A.I. RTE.	SECTION	COUNTY	TOTAL SHEETS	SHEET NO.
74	(10-4,10-5)I	Champaign	74	71
CONTRACT NO. 70B15				
FED. ROAD DIST. NO. ILLINOIS FED. AID PROJECT				



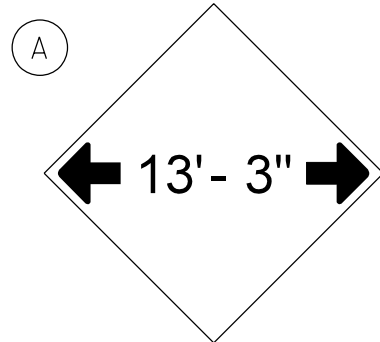


W12-2(0)-48"x48"(1200x1200)

SIGN (A) 2 SIGNS - W12-2(0)-48"x48"(1200x1200) ARE TO BE PLACED AS SHOWN IN THE PLANS OR AS DIRECTED BY THE ENGINEER.

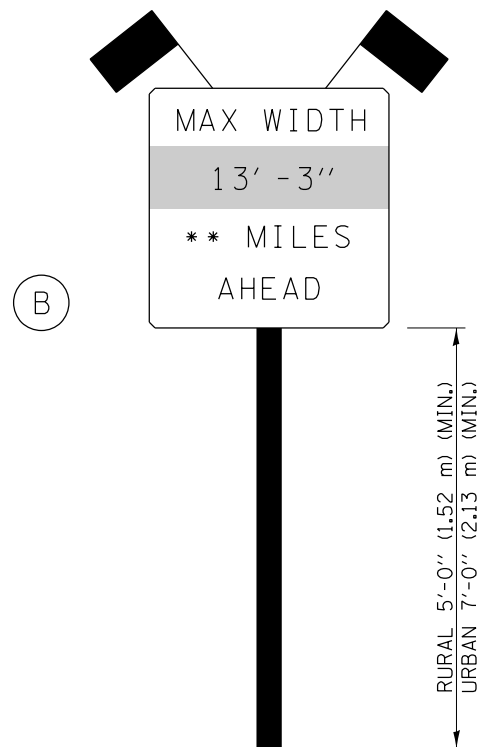

SIGN PANEL, TYPE II

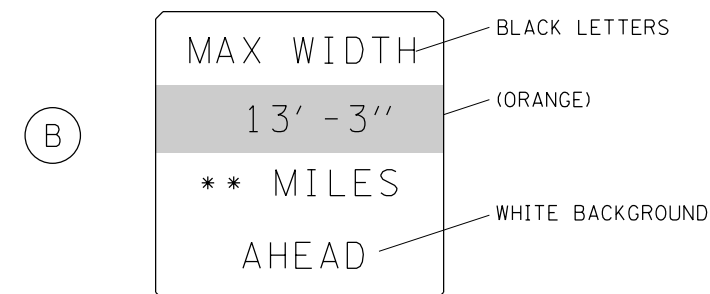

W12-I103(0)-48"x48"(1200x1200)  
"D" LETTERS/NUMBERS

SIGN (B) 2 SIGNS - (SIGN PANEL, TYPE II) AS SHOWN ARE TO BE PLACED AS SHOWN IN THE PLANS OR AS DIRECTED BY THE ENGINEER.

\*\* SEE DETAILS AND DESCRIPTIONS ON NEXT 2 SHEETS

STAGE WIDTHS:

STAGE 1 WIDTH = 17' - 9" actual; 16' - 3" posted; REQUIRED

STAGE 2 WIDTH = 14' - 9" actual; 13' - 3" posted; REQUIRED

GENERAL NOTES

1. ALL TRAFFIC CONTROL DEVICES SHALL BE FURNISHED, ERECTED AND MAINTAINED BY THE CONTRACTOR.
2. ALL (B) SIGNS SHALL HAVE FLAGS INSTALLED UNLESS OTHERWISE DIRECTED.
3. LOCATIONS OF TRAFFIC CONTROL DEVICES MAY BE ADJUSTED BY THE ENGINEER.
4. ALL TRAFFIC CONTROL SHOWN ON THIS SHEET SHALL BE PAID FOR AT THE CONTRACT LUMP SUM PRICE FOR WIDTH RESTRICTION SIGNING.
5. ALL SIGNS SHALL BE POST MOUNTED UNLESS OTHERWISE DIRECTED.
6. ALL SIGNS SHOWN ORANGE (O) SHALL BE FLUORESCENT ORANGE.
7. ALL SIGNS SHOWN SHALL CONSIST OF THE CURRENT RETROREFLECTIVE SHEETING REQUIREMENTS AS OUTLINED IN SECTION 1106.01 OF THE STANDARD SPECIFICATIONS.

FILE NAME =	USER NAME = shererjm	DESIGNED -	REVISED - 03/11 -KJT	<b>STATE OF ILLINOIS DEPARTMENT OF TRANSPORTATION</b>	<b>WIDTH RESTRICTION SIGNING</b>			F.A.I. RTE.	SECTION	COUNTY	TOTAL SHEETS	SHEET NO.
p:\11\084EBIDINTEG.illinois.gov\PI\DOT\Documents\DOT Offices\District 5\Projects\057\DRAWING\Structures\0570815-sht-Design\0570815-01.dwg	DATE = 05/08	CHECKED -	REVISED - 10/08 - KJT					74	(10-4,10-5)I	Champaign	74	72
PLOT SCALE = 40.0000' / in.	DATE -	REVISOR -	REVISED - 7/09 - KJT		CONTRACT NO. 70B15							
PLOT DATE = 8/8/2016	DATE -	REVISOR -	REVISED -		SCALE:	SHEET NO. 1 OF 3 SHEETS	STA.	TO STA.	FED. ROAD DIST. NO.	ILLINOIS FED. AID PROJECT		

WIDTH RESTRICTION SIGNING FOR FAI 74 WESTBOUND TRAFFIC

AT FAI 57 INTERCHANGE

**B1** NORTHWEST OF FAI 57 INTERCHANGE FOR FAI-74 WB  
ERECT BY THE 70 MPH SIGN  
DUAL DISPLAY; INCLUDE 7 MILES AHEAD

7 MILE


AT PRAIRIEVIEW ROAD INTERCHANGE

**B2** EAST OF PRAIRIEVIEW INTERCHANGE FOR FAI-74 WB  
ERECT BY LAKE OF THE WOODS BROWN BOARD SIGN  
DUAL DISPLAY; INCLUDE 2 MILES AHEAD


2 MILE

**A1** PRAIRIEVIEW ROAD INTERCHANGE FOR WB I-74 RAMP  
ERECT BESIDE USE PROHIBITED BY SIGN

AT FAI 57 INTERCHANGE

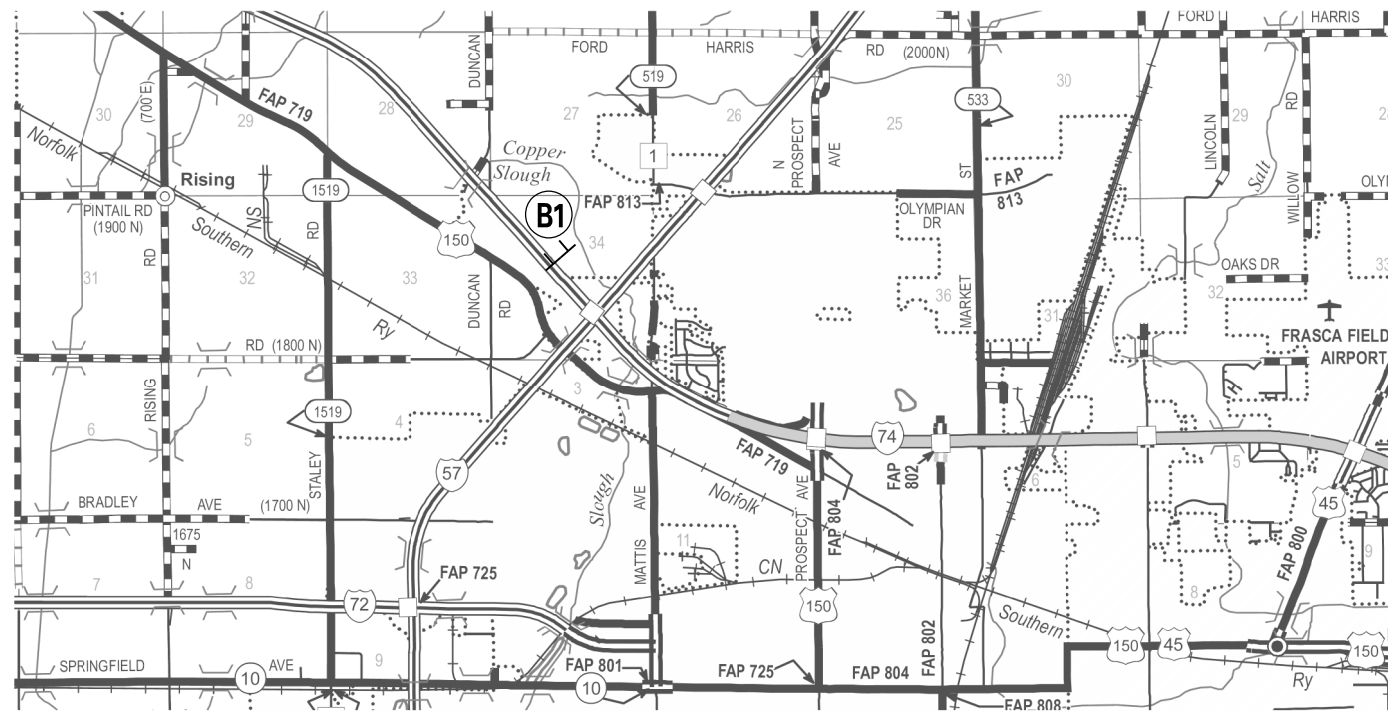

AT PRAIRIEVIEW ROAD INTERCHANGE

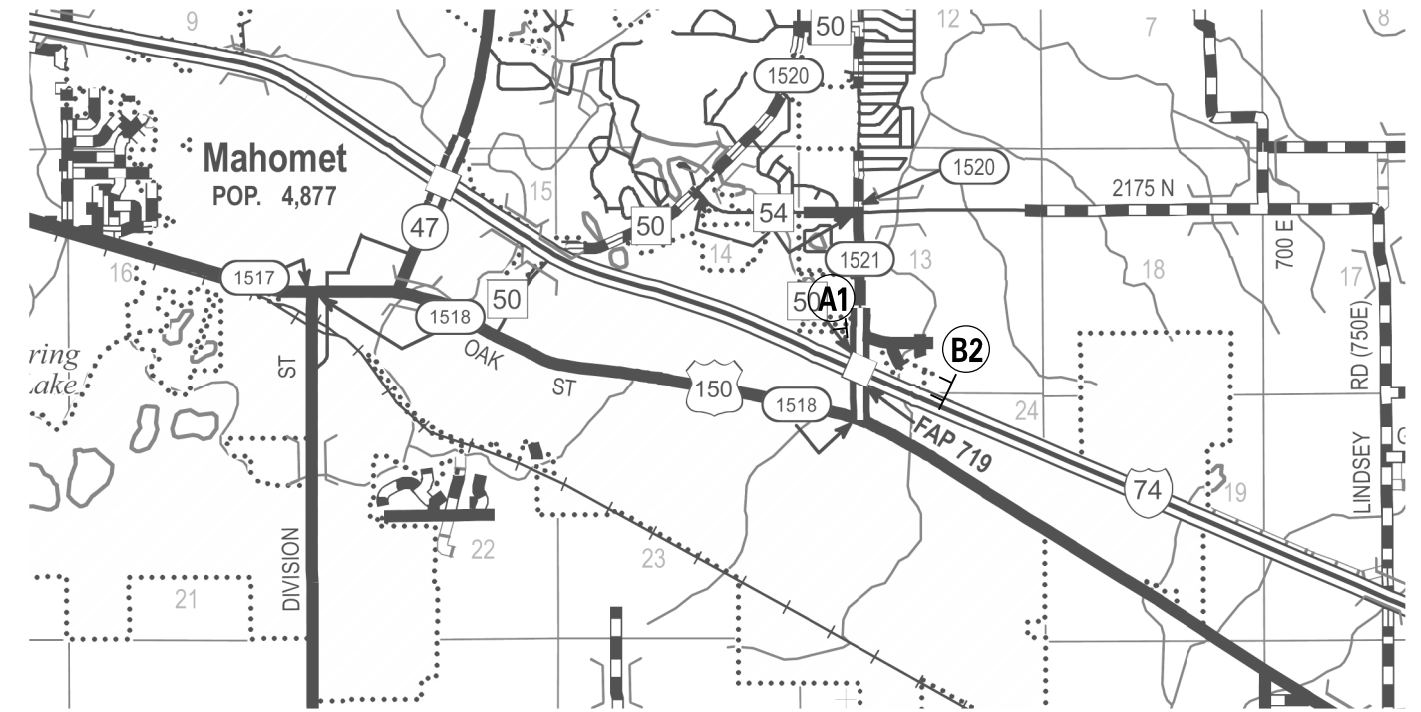


FILE NAME =	USER NAME = shererjm	DESIGNED -	REVISED - 03/11 - KJT	<b>STATE OF ILLINOIS DEPARTMENT OF TRANSPORTATION</b>	<b>WIDTH RESTRICTION SIGNING</b>		F.A.I. RTE.	SECTION	COUNTY	TOTAL SHEETS	SHEET NO.
pw:\IL\084EBIDINTEG.illinois.gov\PI\DOT\Documents\DOT Offices\District 5\Projects\0579\Drawings\Structures\0570B15-sht-Design\0570B15-sht-Design.dwg	DESIGNED -	REVISED - 05/08	74				(10-4,10-5)I	Champaign	74	73	
PLOT SCALE = 40.0000' / in.	CHECKED -	REVISED - 10/08 - KJT	CONTRACT NO. 70B15								
PLOT DATE = 8/8/2016	DATE -	REVISED - 7/09 - KJT	SCALE:		SHEET NO. 2 OF 3 SHEETS	STA.	TO STA.	FED. ROAD DIST. NO.	ILLINOIS FED. AID PROJECT		

WIDTH RESTRICTION SIGNING FOR FAI 74 EASTBOUND TRAFFIC  
AT MANSFIELD INTERCHANGE

**A2** MANSFIELD INTERCHANGE FOR EB I-74 RAMP  
ERECT ACROSS RAMP FROM USE PROHIBITED BY SIGN

**B3** SOUTHEAST OF MANSFIELD INTERCHANGE FOR FAI-74 EB  
ERECT BY MILE POST 165  
DUAL DISPLAY; INCLUDE 6 MILES AHEAD

6 MILE

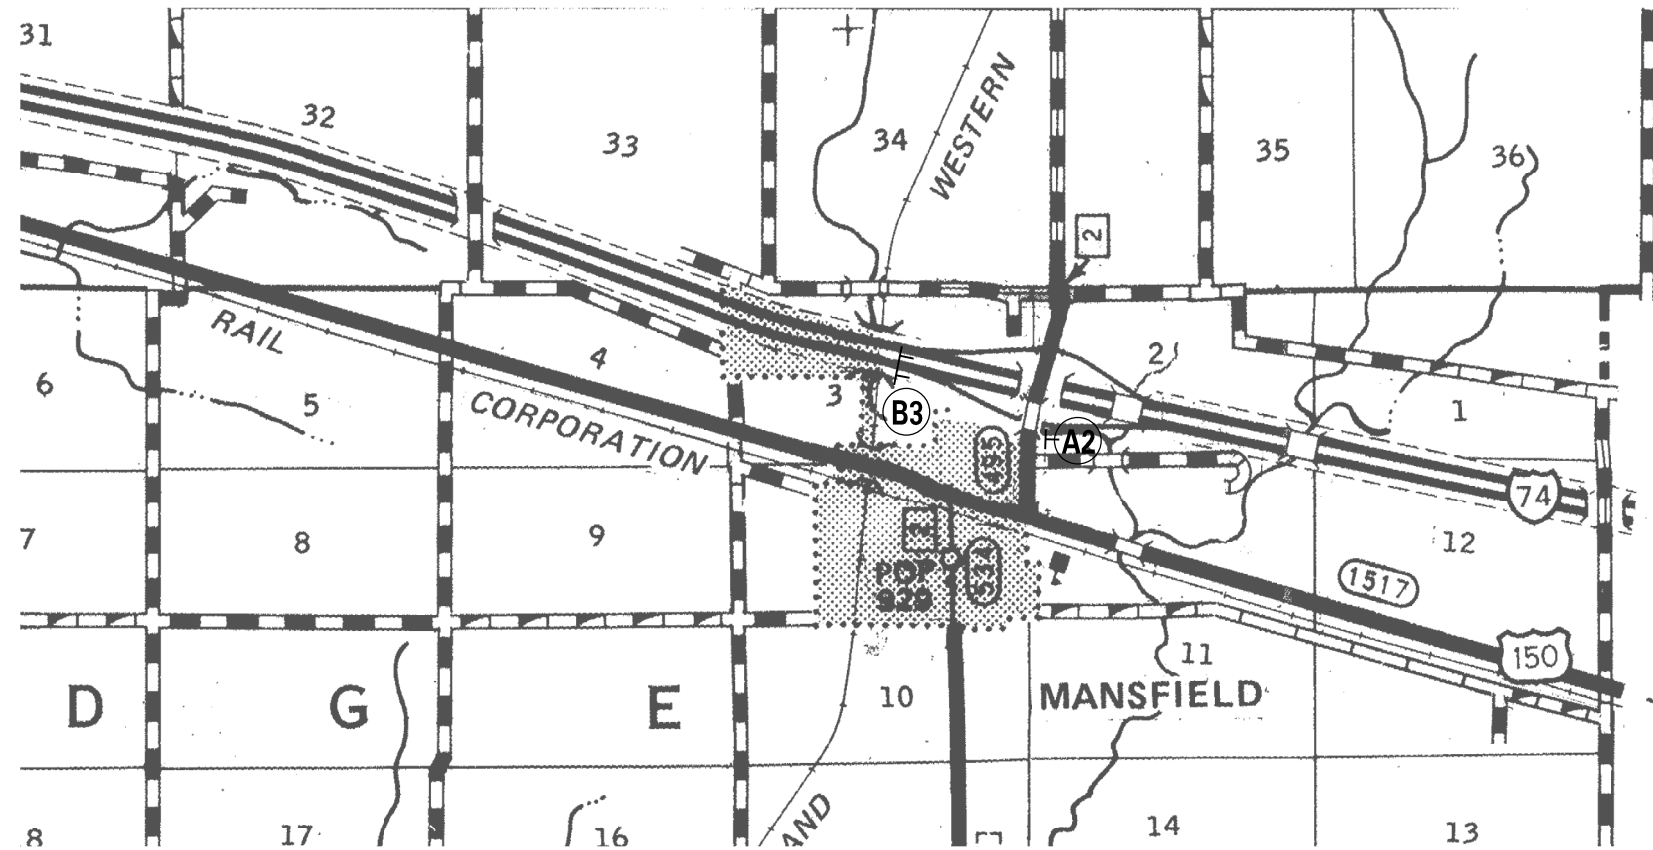

FILE NAME =	USER NAME = shererjm	DESIGNED -	REVISED - 03/11 - KJT
p:\11\084EBID\INTEG.illinois.gov\PIWIDOT\Documents\IDOT Offices\District 5\Projects\057\DRAWING\Structures\0570815-sht-Design\0570815-sht-Design.dwg		DRAWN -	REVISED - 05/08
	PLOT SCALE = 40.0000' / in.	CHECKED -	REVISED - 10/08 - KJT
	PLOT DATE = 8/8/2016	DATE -	REVISED - 7/09 - KJT

**STATE OF ILLINOIS  
DEPARTMENT OF TRANSPORTATION**

**WIDTH RESTRICTION SIGNING**

SCALE: SHEET NO. 3 OF 3 SHEETS STA. TO STA.

F.A.I. RTE.	SECTION	COUNTY	TOTAL SHEETS	SHEET NO.
74	(10-4,10-5)I	Champaign	74	74
CONTRACT NO. 70B15				
FED. ROAD DIST. NO. ILLINOIS FED. AID PROJECT				