## SUMMARY OF QUANTITIES CONSTRUCTION TYPE CODE: 0028

ITEM NUMBER	PAY CODE	DESCRIPTION	UNIT	QUANTITY 0028
<b>△</b> 1	20101700	SUPPLEMENTAL WATERING	UNIT	12
2	21001000	GEOTECHNICAL FABRIC FOR GROUND STABILIZATION	SQ YD	1270
3	21101625	TOPSOIL FURNISH AND PLACE, 6"	SQ YD	1439
4	21101645	TOPSOIL FURNISH AND PLACE, 12"	SQ YD	358
5	21101685	TOPSOIL FURNISH AND PLACE, 24"	SQ YD	112
<b>∆</b> 6	25200110	SODDING, SALT TOLERANT	SQ YD	1439
7	28000305	TEMPORARY DITCH CHECK	FOOT	25
8	28000510	INLET FILTERS	EACH	12
9	28200200	FILTER FABRIC	SQ YD	298
10	31101100	SUBBASE GRANULAR MATERIAL, TYPE B	CU YD	225
11	35102400	AGGREGATE BASE COURSE, TYPE B 12"	SQ YD	2234
12	40600275	BITUMINOUS MATERIALS (PRIME COAT)	POUND	5,025
13	40600290	BITUMINOUS MATERIALS (TACK COAT)	POUND	1085
14	40602978	HOT-MIX ASPHALT BINDER COURSE, IL-9.5, NSO	TON	76
15	40603080	HOT-MIX ASPHALT BINDER COURSE, IL-19.0, N50	TON	295
16	40604060	HOT-MIX ASPHALT SURFACE COURSE, IL-9.5, MIX "D", N50	TON	255
17	42400200	PORTLAND CEMENT CONCRETE SIDEWALK 5 INCH	SQ FT	15753
18	42400800	DETECTABLE WARNINGS	SQ FT	335
19	44000100	PAVEMENT REMOVAL	SY YD	3971
20	44000157	HOT-MIX ASPHALT SURFACE REMOVAL, 2"	SQ YD	642
21	44000500	COMBINATION CURB AND GUTTER REMOVAL	FOOT	962
22	44000600	SIDEWALK REMOVAL	SQ FT	10536
23	50104400	CONCRETE HEADWALL REMOVAL	EACH	1
24	50300225	CONCRETE STRUCTURES	CU YD	193.5
25	50900805	PEDESTRIAN RAILING	FOOT	608
26	54214719	PRECAST REINFORCED CONCRETE FLARED END SECTIONS - ELLIPTICAL, EQUIVALENT ROUND-SIZE 24"	EACH	1
27	55100500	STORM SEWER REMOVAL 12"	FOOT	180
28	55100900	STORM SEWER REMOVAL 18"	FOOT	52
29	55106015	STORM SEWERS INSTALLATION, 8"	FOOT	267
30	56400500	FIRE HYDRANT TO BE REMOVED	EACH	1
31	60218300	MANHOLES, TYPE A, 4'-DIAMETER, TYPE 1 FRAME, OPEN LID	EACH	2
32	60218400	MANHOLES, TYPE A, 4'-DIAMETER, TYPE 1 FRAME, CLOSED LID	EACH	2
33	60236200	INLETS, TYPE A, TYPE 8 GRATE	EACH	1
34	60500040	REMOVING MANHOLES	EACH	1
35	60500060	REMOVING INLETS	EACH	1
36	60604400	COMBINATION CONCRETE CURB AND GUTTER, TYPE B-6.18	FOOT	2368
<b>△</b> 37	66900105	UNDERGROUND STORAGE TANK REMOVAL	EACH	1
△ 38	66900200	NON-SPECIAL WASTE DISPOSAL	CU YD	1340
△ 39	66900530	SOIL DISPOSAL ANALYSIS	EACH	12
<b>△</b> 40	66901001	REGULATED SUBSTANCES PRE-CONSTRUCTION PLAN	L SUM	1
△ 41	66901006	REGULATED SUBSTANCES MONITORING	CAL DA	20
<b>△</b> 42	66901003	REGULATED SUBSTANCES FINAL CONSTRUCTION REPORT	LSUM	1
43	67100100	MOBILIZATION	L SUM	1
<b>△</b> 44	72000100	SIGN PANEL - TYPE 1	SQ FT	55
<u>⊿</u> 45	72400100	REMOVE SIGN PANEL ASSEMBLY - TYPE A	EACH	11
<b>△</b> 46	72800100	TELESCOPING STEEL SIGN SUPPORT	FOOT	247
△ 47	78005100	EPOXY PAVEMENT MARKING - LETTERS AND SYMBOLS	SQ FT	61.5
<u> </u>	78005110	EPOXY PAVEMENT MARKING - LINE 4"	FOOT	3286
∆ 49	78005130	EPOXY PAVEMENT MARKING - LINE 6"	FOOT	545.5
∆ 50	78005180	EPOXY PAVEMENT MARKING - LINE 24"	FOOT	
<del>-51</del>	550A0040	STORM SEWERS, CLASS A B, TYPE 1 10"	FOOT	26
52	550A0050	STOPM SEWERS, CLASS A B, TYPE 1 12"	FOOT	242
53	550A0070	STORM SEWERS, CLASS A.B., TYPE 115"	гоот	277
54	550A0090	STOPH SEWERS, CLASS A B, TYPE 1 18"	гоот	93
55	550A4100	STORM SEWERS, CLASS A, THE 1 EQUIVACENT ROUND SIZE 24	FOOT	45
<b>∆</b> 56	C2C078G3	SHRUB, ROSA X KNOCK OUT (KNOCK OUT ROSE), CONTAINER GROWN, 3-GALLON	EACH	10
<u>A</u> 57	C2C09818	SHRUB, SPIREA X BUMALDA ANTHONY WATERER (ANTHONY WATERER SPIREA), 18' HEIGHT, CONTAINER	EACH	21
△ 58	C2C11736	SHRUB, VIBURNUM DENTATUM (ARROWWOOD VIBURNUM), 3' HEIGHT, CONTAINER	EACH	6
<b>A</b> 59	D2000724	EVERGREEN, JUNIPERUS CHINENSIS VAR. SARGENTII VIVIDIS (GREEN SARGENT JUNIPER), 2' WIDTH, BALLED AND BURLAPPED	EACH	19
△ 60	D2C02524	EVERGREEN, PINUS MUGO (MUGO PINE), 2' HEIGHT, CONTAINER	EACH	3
<b>~~</b>		~~~~~~~~~~~~~~~~~~~~~~~~~~~~~~~~~~~~~~	<b>\</b>	~~~
51	550B0040	STORM SEWERS, CLASS B, TYPE 1 10"	FOOT	26
52	55080050	STORM SEWERS, CLASS B, TYPE 1 12"	FOOT	242
53	550B0070	STORM SEWERS, CLASS B, TYPE 1 15"	FOOT	277
54	55080090	STORM SEWERS, CLASS B, TYPE 1 18"	FOOT	93

## SUMMARY OF QUANTITIES CONSTRUCTION TYPE CODE: 0028

ITEN NUM		CODE	DESCRIPTION	UNIT	QUANTITY 0028
△ 61	K00-	12990	PERENNIAL PLANTS, ORNAMENTAL TYPE, GALLON POT	UNIT	4.59
<b>△</b> 62	K00	12993	PERENNIAL PLANTS, ORNAMENTAL TYPE, 3-GALLON POT	UNIT	0.96
△ 63	K10	05481	SHREDDED BARK MULCH 3"	SQ YD	459
△ 64	X030	01115	LANDSCAPE EDGING	FOOT	373
<b>△</b> 65	X032	20060	GATEWAY MONUMENT SIGN COMPLETE	EACH	2
66	X032	20067	BENCH REMOVAL	EACH	4
67	X032	22936	REMOVE EXISTING FLARED END SECTION	EACH	1
68	X032	23859	DOWNSPOUT CONNECTION	EACH	6
69	X032	26519	STEEL RAILING REMOVAL	FOOT	95
70	X032	26694	PLUG EXISTING STORM SEWERS	CU YD	0.06
71	X032	26806	WASHOUT BASIN	L SUM	1
72	X032	27727	PLANTER REMOVAL	L SUM	1
73	X032	27979	PAVEMENT MARKING REMOVAL - GRINDING	SQ FT	590
74	X03	27989	REMOVE EXISTING BRICK PAVERS	SQ FT	124
75	X20°	10510	CLEARING AND GRUBBING	L SUM	1
76	X424	40430	PORTLAND CEMENT CONCRETE SIDEWALK 5 INCH, SPECIAL	SQ FT	979
<u>△</u> 77	X561	19210	WATER VALVES TO BE ADJUSTED, SPECIAL	EACH	1
<b>△</b> 78	X564	40175	FIRE HYDRANTS, COMPLETE	EACH	1
79	X602	24240	INLETS, SPECIAL	EACH	7
80	X602	24246	INLETS, SPECIAL, NO. 3	EACH	1
81	X70°	10216	TRAFFIC CONTROL AND PROTECTION, SPECIAL	L SUM	1
<b>△</b> 82	X814	40115	HANDHOLE TO BE ADJUSTED	EACH	2
83	XXO	00959	TRASH RECEPTACLES	EACH	4
<b>△</b> 84	XXO	05877	REMOVE EXISTING WOOD UTILITY POLES	EACH	4
85	XX19	97300	SLOTTED DRAIN	FOOT	561
86	XXO	08219	INSTALL FURNISHED BENCH	EACH	10
<u></u> 87	XXXX	08639	SHRUBS (SPECIAL)	EACH	11
88	Z000	03855	BICYCLE RACKS	EACH	1
89	Z000	04002	BOLLARDS	EACH	3
90	Z001	12450	CONCRETE STEPS	CU YD	18.86
<u>△</u> 91	Z007	77805	WOOD POST SPECIAL	EACH	4

## SUMMARY OF QUANTITIES LIGHTING CODE: 0031

ITEM NUMBER	PAY CODE	DESCRIPTION	UNIT	QUANTITY 0031
<b>△</b> 92	80400100	ELECTRIC SERVICE INSTALLATION	EACH	1
△ 93	81028770	UNDERGROUND CONDUIT, COILABLE NONMETALLIC CONDUIT, 3" DIA.	FOOT	834
▲ 94	81300550	JUNCTION BOX, STAINLESS STEEL, ATTACHED TO STRUCTURE, 12"X12"x6"	EACH	1
△ 95	81400730	HANDHOLE, COMPOSITE CONCRETE	EACH	3
△ 96	81603037	UNIT DUCT, 600V, 2-1C NO.6, 1/C NO.6 GROUND, (XLP TYPE USE). 1 1/4" DIA. POLYETHYLENE	FOOT	2462
△ 97	83600200	LIGHT POLE FOUNDATION, 24" DIAMETER	FOOT	162
△ 98	84200600	REMOVAL OF LIGHTING UNIT, NO SALVAGE	EACH	8
△ 99	84200804	REMOVAL OF POLE FOUNDATION	EACH	8
△ 100	87300901	ELECTRIC CABLE IN CONDUIT, TRACER, NO. 12 1 C	FOOT	45
△ 101	X8250505	LIGHTING CONTROLLER, SPECIAL	EACH	1
△ 102	XX007450	ORNAMENTAL LIGHT POLE, INSTALL ONLY	EACH	18
△ 103	Z0033028	MAINTENANCE OF LIGHTING SYSTEM	CAL MO	5

## SUMMARY OF QUANTITIES NON-PARTICIPATING CODE: 0028

ITEM NUMBER	PAY CODE	DESCRIPTION	UNIT	QUANTITY 0028
104	XX009374	FLAGPOLE SOCKET	EACH	16
105	XX009375	ASH URN	EACH	4

A SPECIALTY ITEMS

# FEHR GRAHAM

ENGINEERING & ENVIRONMENTAL

ILLINOIS IOWA WISCONSIN VILLAGE OF DURAND 308 WEST MAIN STREET DURAND, ILLINOIS 61024 PROJECT AND LOCATION:
DOWNTOWN SQUARE
DURAND, ILLINOIS

DRAWN BY: BF
APPROVED BY: VL
DATE: 4/10/20
SCALE: AS NOTED

REV. NO.	DESCRIPTION	DATE
2	CONTRACTOR QUESTIONS	10/18/21

SUMMARY OF QUANTITIES


SET TYPE: FOR BIDDING C\CD0\15\16-19\Pinn\16

16-199 SHEET NUMBER: 2 of 87


JOB NUMBER:

2

2

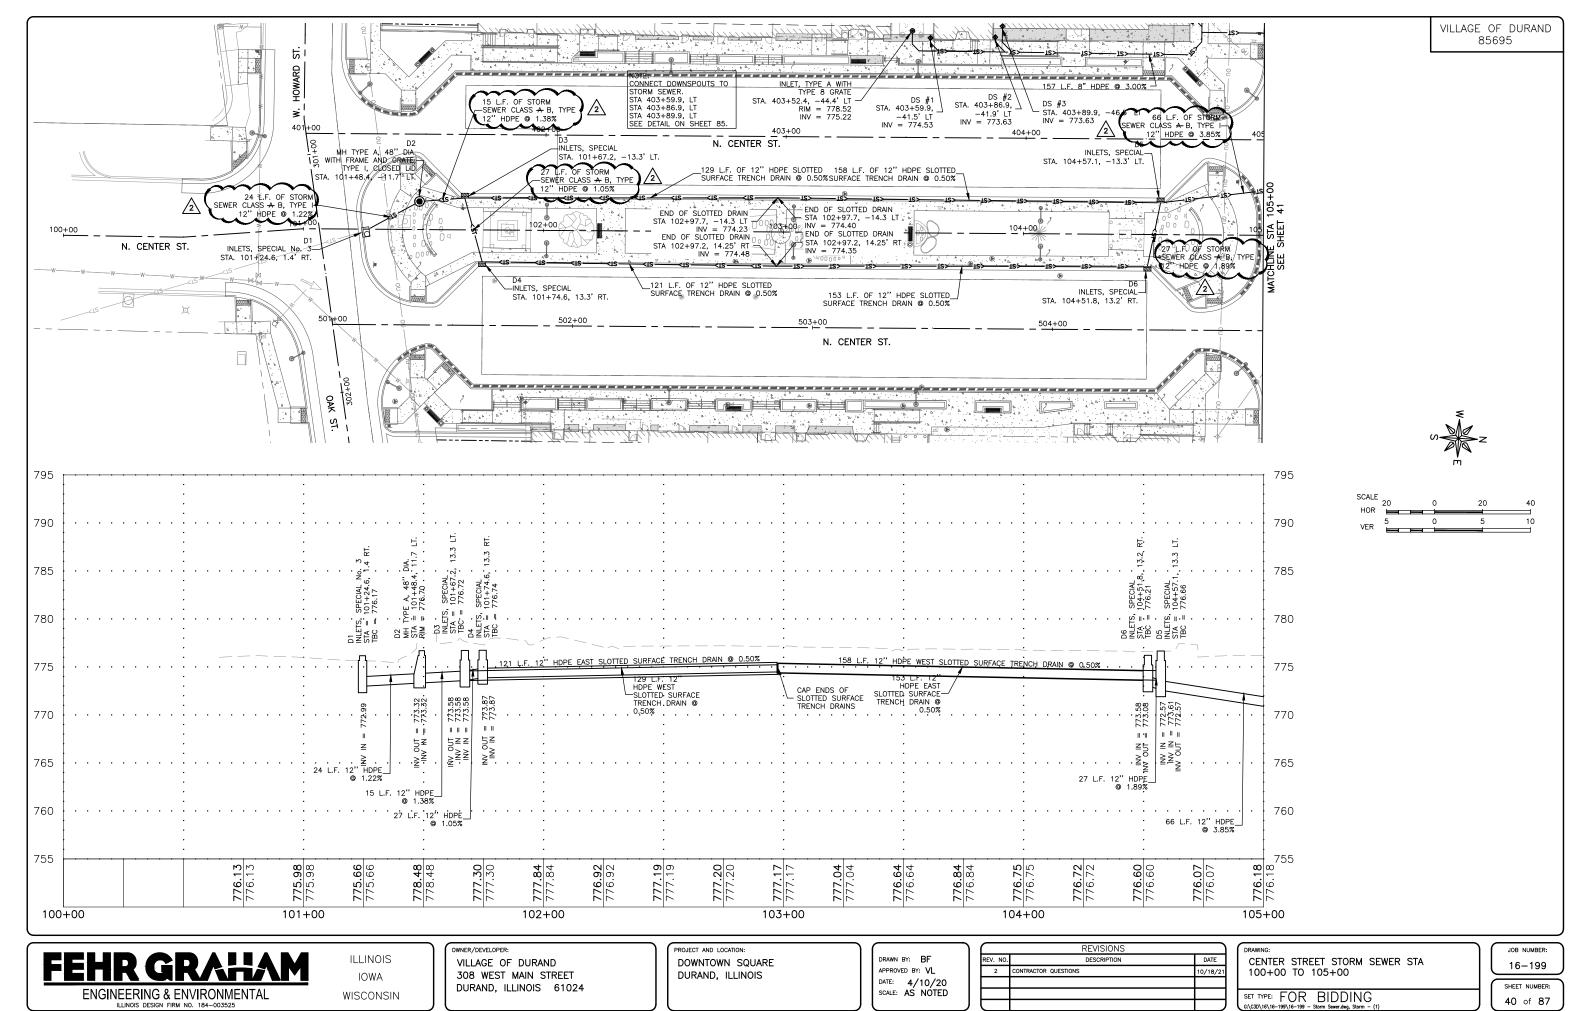

PLOT DATE: 10/18/21 © 2021 FEHR GRAHAM

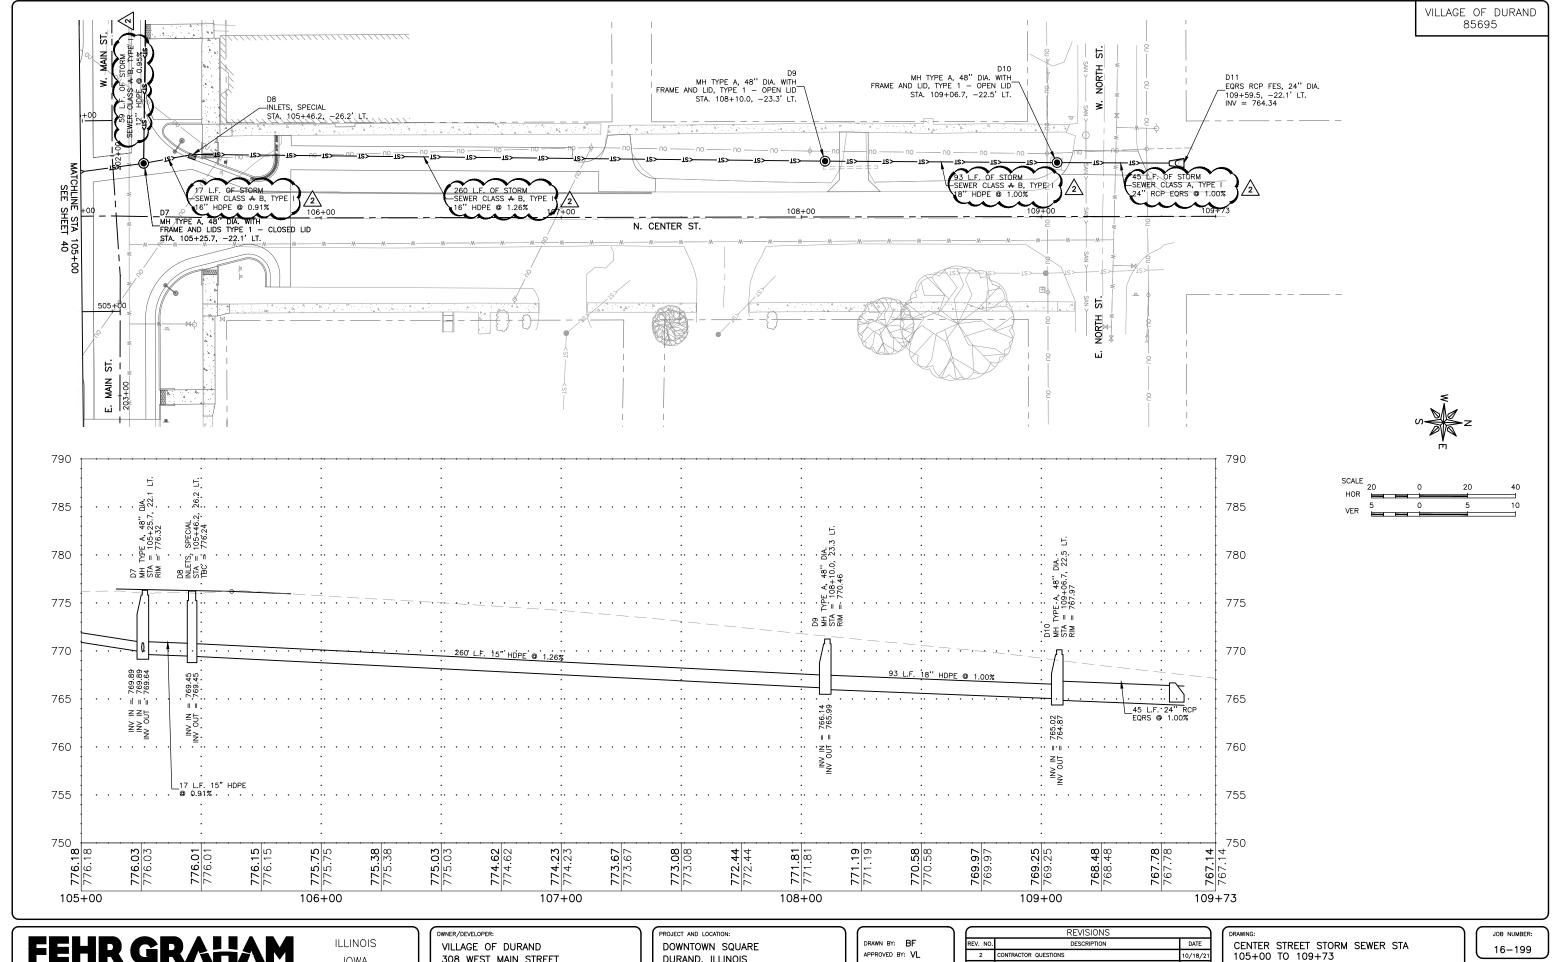

IOWA WISCONSIN 308 WEST MAIN STREET DURAND, ILLINOIS 61024 DURAND, ILLINOIS


DATE: 4/10/20 SCALE: AS NOTED

	REVISIONS	
EV. NO.	DESCRIPTION	DATE
2	CONTRACTOR QUESTIONS	10/18/21

SET TYPE: FOR BIDDING

**41** of **87** 

ENGINEERING & ENVIRONMENTAL ILLINOIS DESIGN FIRM NO. 184-003525 PLOT DATE: 10/18/21 © 2021 FEHR GRAHAM

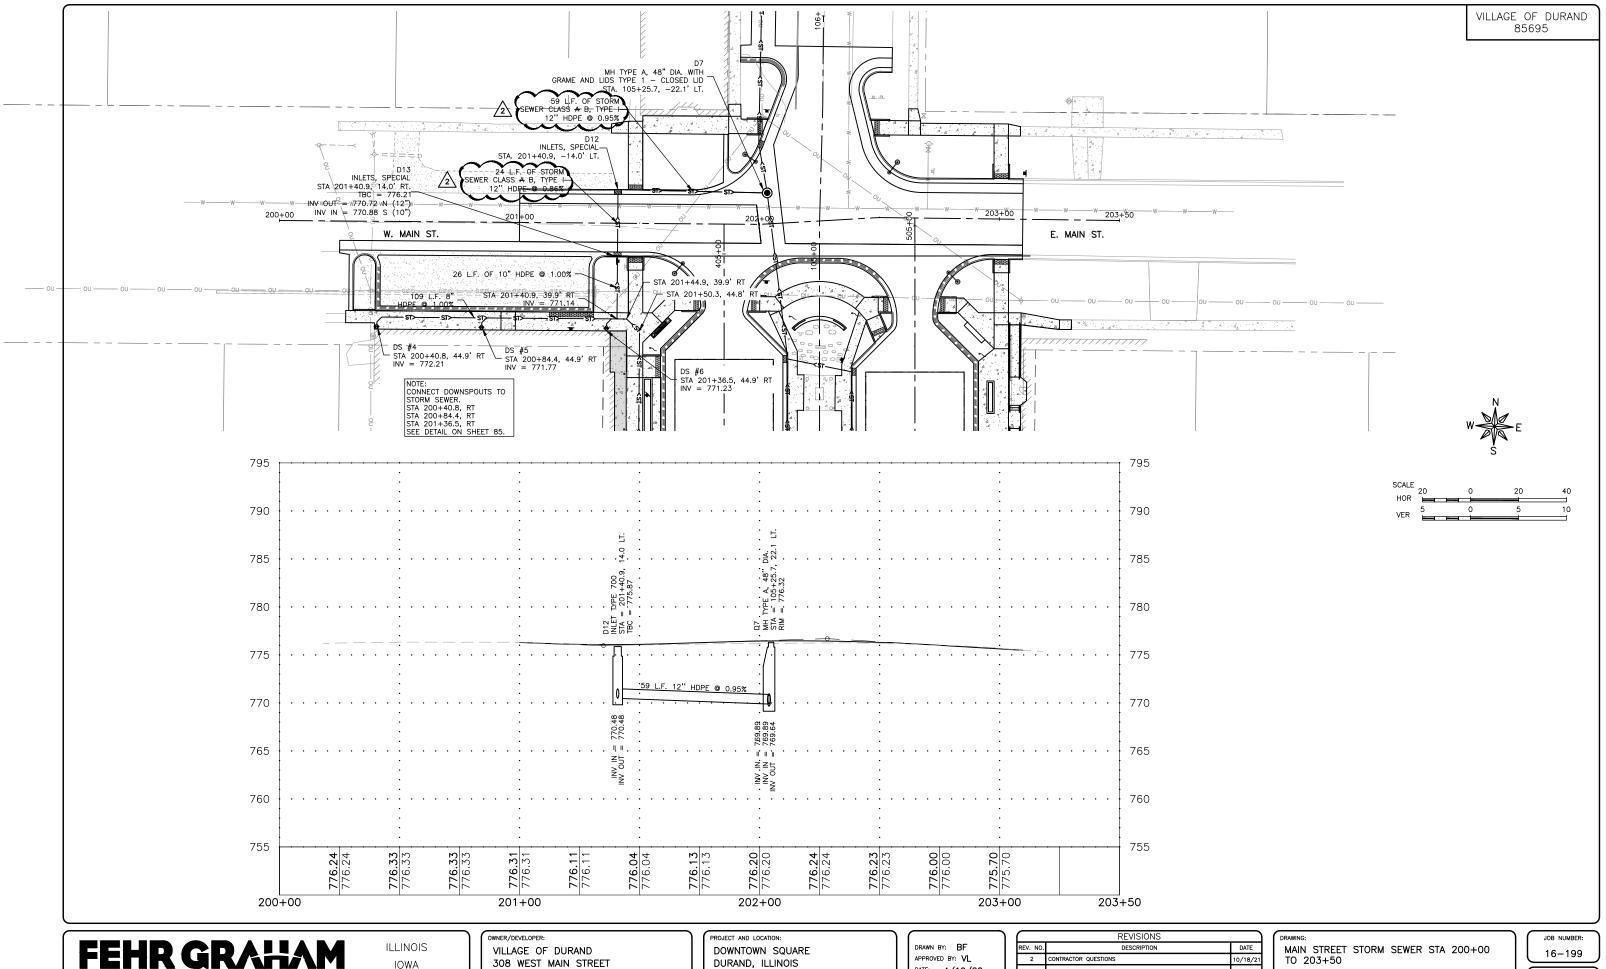

IOWA WISCONSIN DURAND, ILLINOIS 61024

DATE: 4/10/20 SCALE: AS NOTED

REVISIONS				
EV. NO.	DESCRIPTION	DATE		
2	CONTRACTOR QUESTIONS	10/18/21		

SET TYPE: FOR BIDDING

SHEET NUMBER:

**42** of **87**