


FOR INFORMATION ONLY

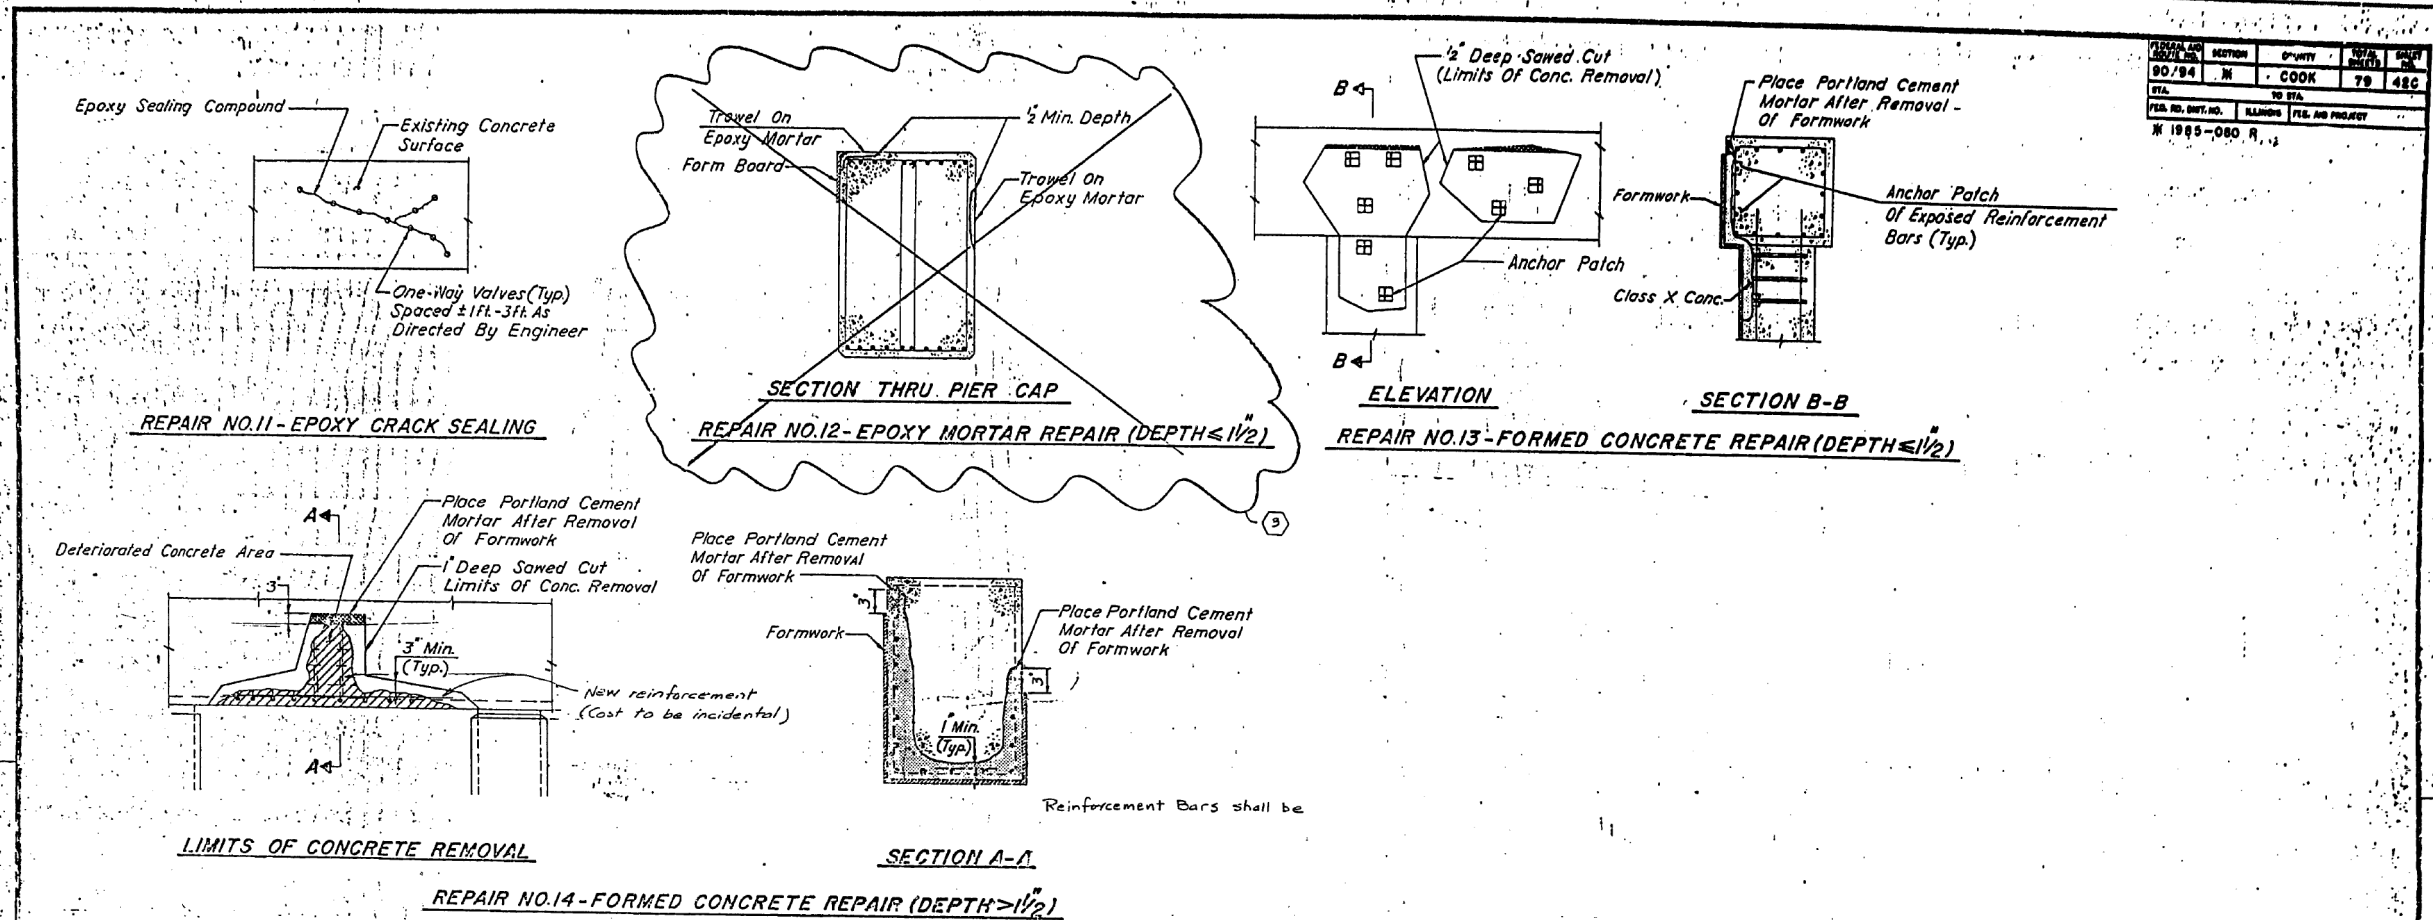

SECTION NO.	SECTION	COUNTY	TOTAL SHEETS	SHEET NO.
90/94	M	COOK	79	48C
F.I.L. TO STA.				
ILLINOIS FED. AID PROJECT				
M 1985-080 R				

SHEET HAR-500F 6

STATE OF ILLINOIS
 DEPARTMENT OF TRANSPORTATION
 F.A.I. ROUTE 90/94 'CAM RYAN EXPRESSWAY'
 SECTION 1985-080 R. - COOK COUNTY
 ROADWAY GRADING AND PAVING
 HARRISON ST. BRIDGE OVER S.B. DAN RYAN EXPY.
 PIER REPAIR DETAILS
 Scale: NONE
 Date: AUGUST 14, 1987
 Drawn By: R.A.S.
 Checked By: C.O.B.
 ENVIRONMENTAL ENGINEERS INC.
 Chicago, Illinois

REVISIONS	
Name	Date
(4) New Sheet	6-22-86

FILE PATH = C:\Project\ase\19-0820 - Circle 60W26 As-Built\Final\0160W26-sht-AS-BUILT-10.dgn

DI60W26-sht-AS-BUILT-10.dgn	DESIGNED -	REVISED -
USER NAME = auyeungh	DRAWN -	REVISED -
PLOT SCALE = 1.0000' / in.	CHECKED -	REVISED -
PLOT DATE = 8/16/2013	DATE - 07/15/13	REVISED -

STATE OF ILLINOIS
 DEPARTMENT OF TRANSPORTATION

EXISTING AS-BUILTS SN 016-1087	
SCALE: NTS	SHEET AS-10 OF AS-62 SHEETS
STA.	TO STA.

F.A.I. RTE.	SECTION	COUNTY	TOTAL SHEETS	SHEET NO.
90/94/290	2013-008R	COOK	559	308
CONTRACT NO. 60W26				
ILLINOIS FED. AID PROJECT				