


FOR INFORMATION ONLY

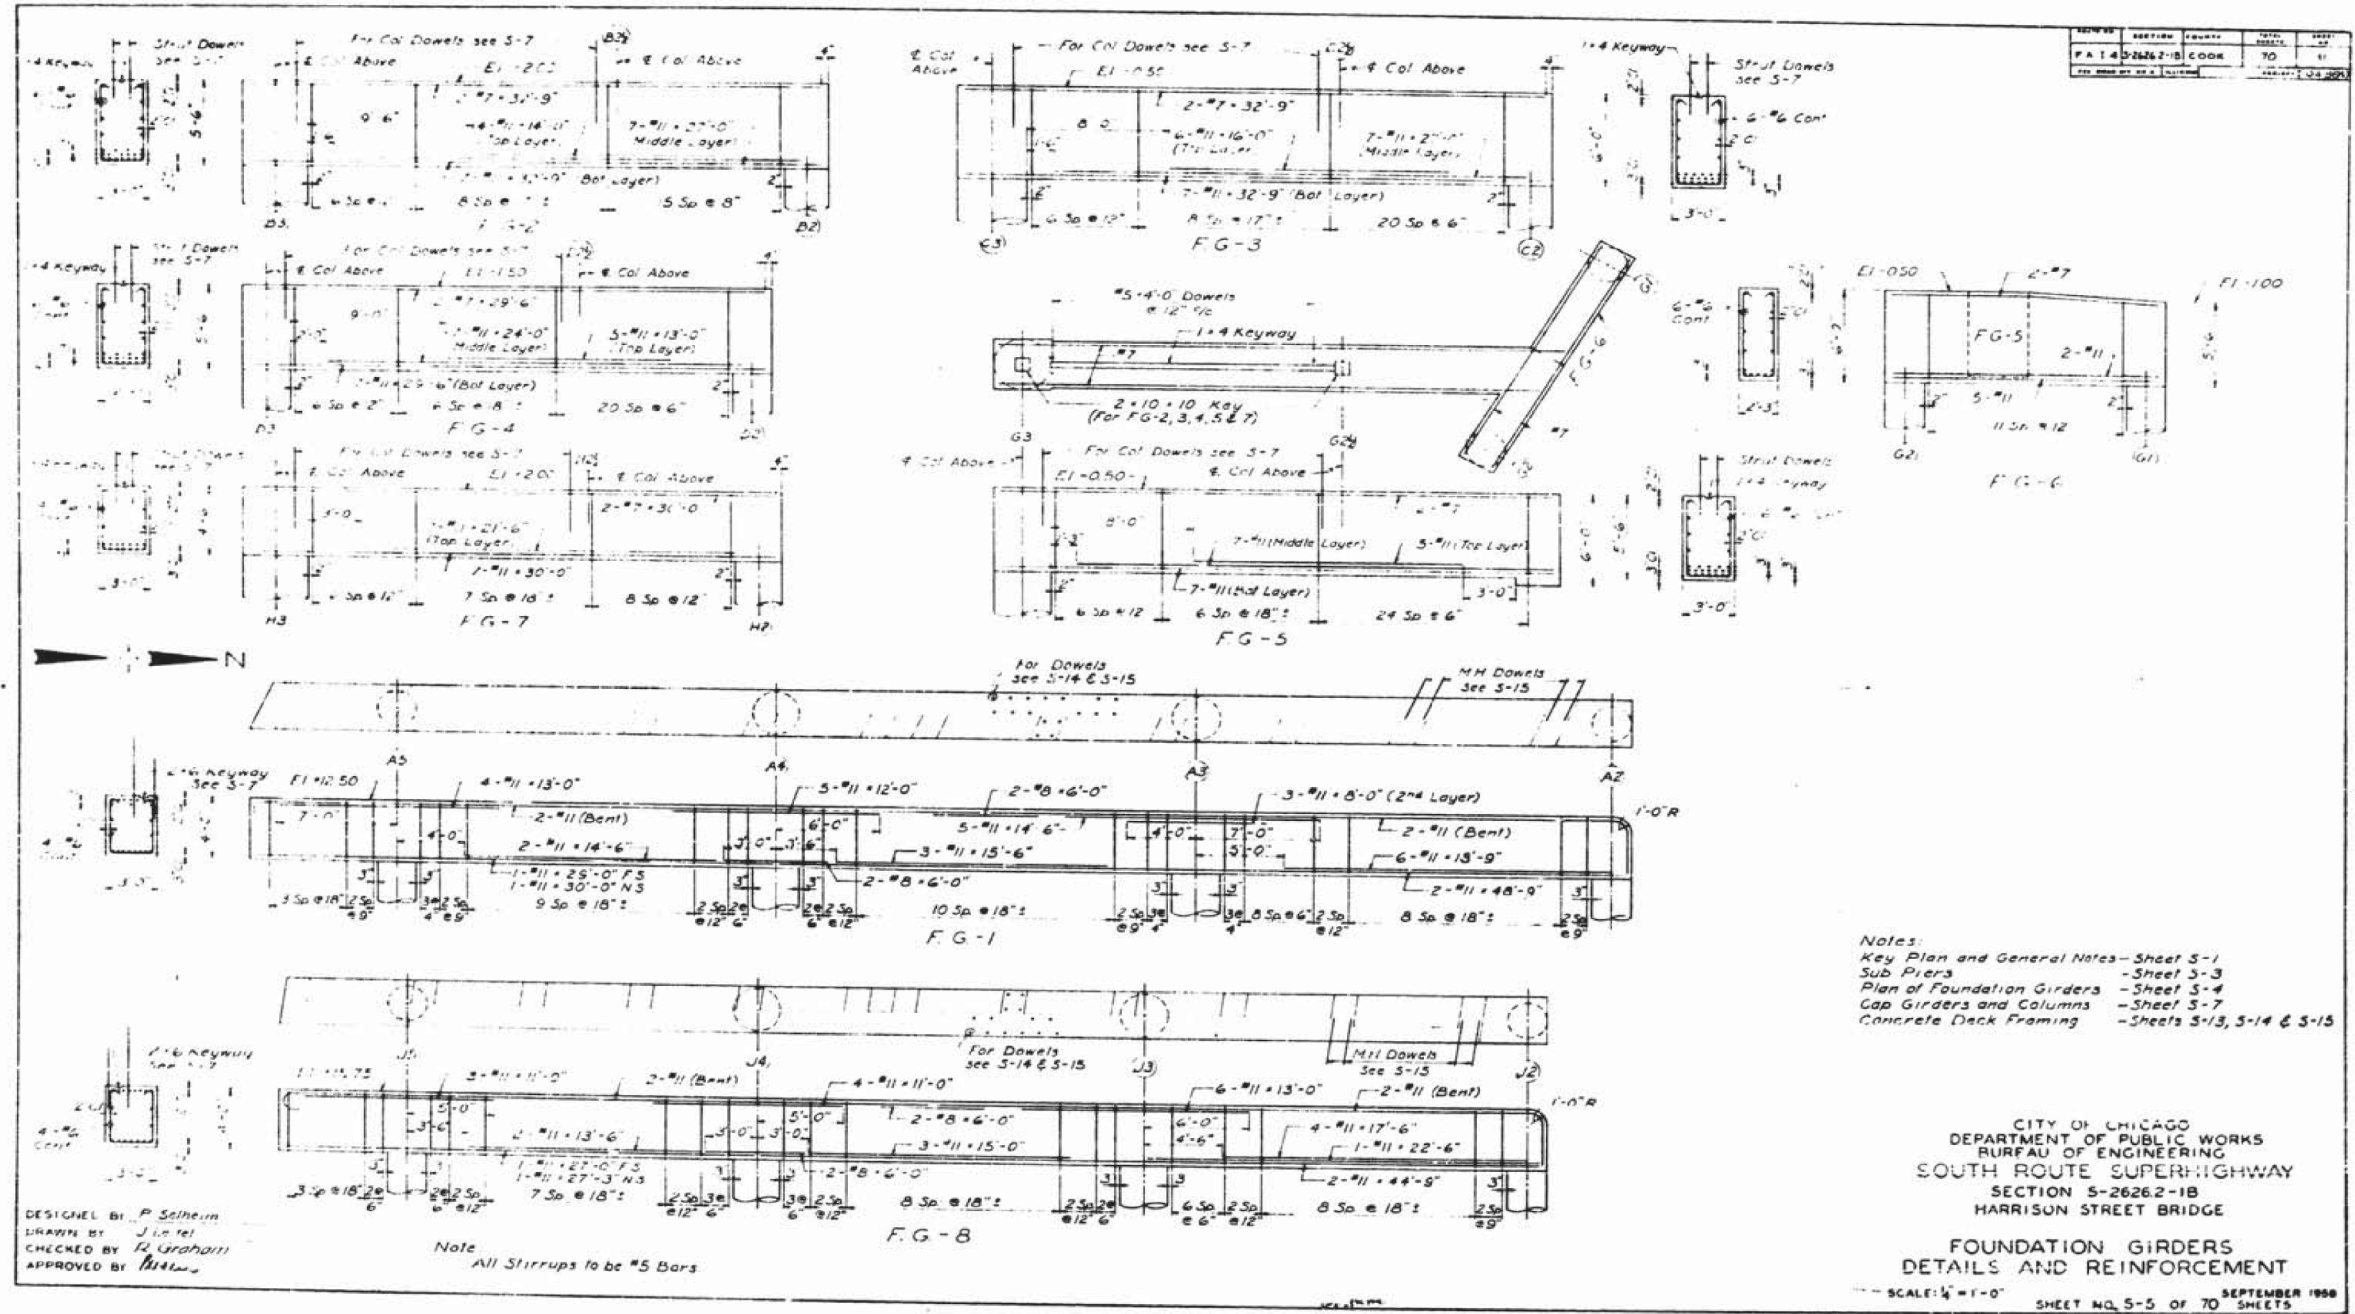

Notes:
 Key Plan and General Notes - Sheet S-1
 Sub Props - Sheet S-3
 Plan of Foundation Girders - Sheet S-4
 Cap Girders and Columns - Sheet S-7
 Concrete Deck Framing - Sheets S-13, S-14 & S-15

DESIGNED BY P. Seim
 DRAWN BY J. Lee
 CHECKED BY T. Graham
 APPROVED BY [Signature]

Note
 All Stirrups to be #5 Bars

STATE OF ILLINOIS
 DEPARTMENT OF TRANSPORTATION

EXISTING AS-BUILTS SN 016-1087

F.A.I. R.E.	SECTION	COUNTY	TOTAL SHEETS	SHEET NO.
90/94/290	2013-008R	COOK	559	322
CONTRACT NO. 60W26				

SCALE: NTS SHEET AS-24 OF AS-62 SHEETS STA. TO STA.

ILLINOIS FED. AID PROJECT

FILE PATH = C:\Projects\15-0820 - Circle 60W26 AS-BUILTS - Circle 60W26 AS-BUILTS - Circle 60W26 AS-BUILTS - BUILT-24.dgn