


FOR INFORMATION ONLY

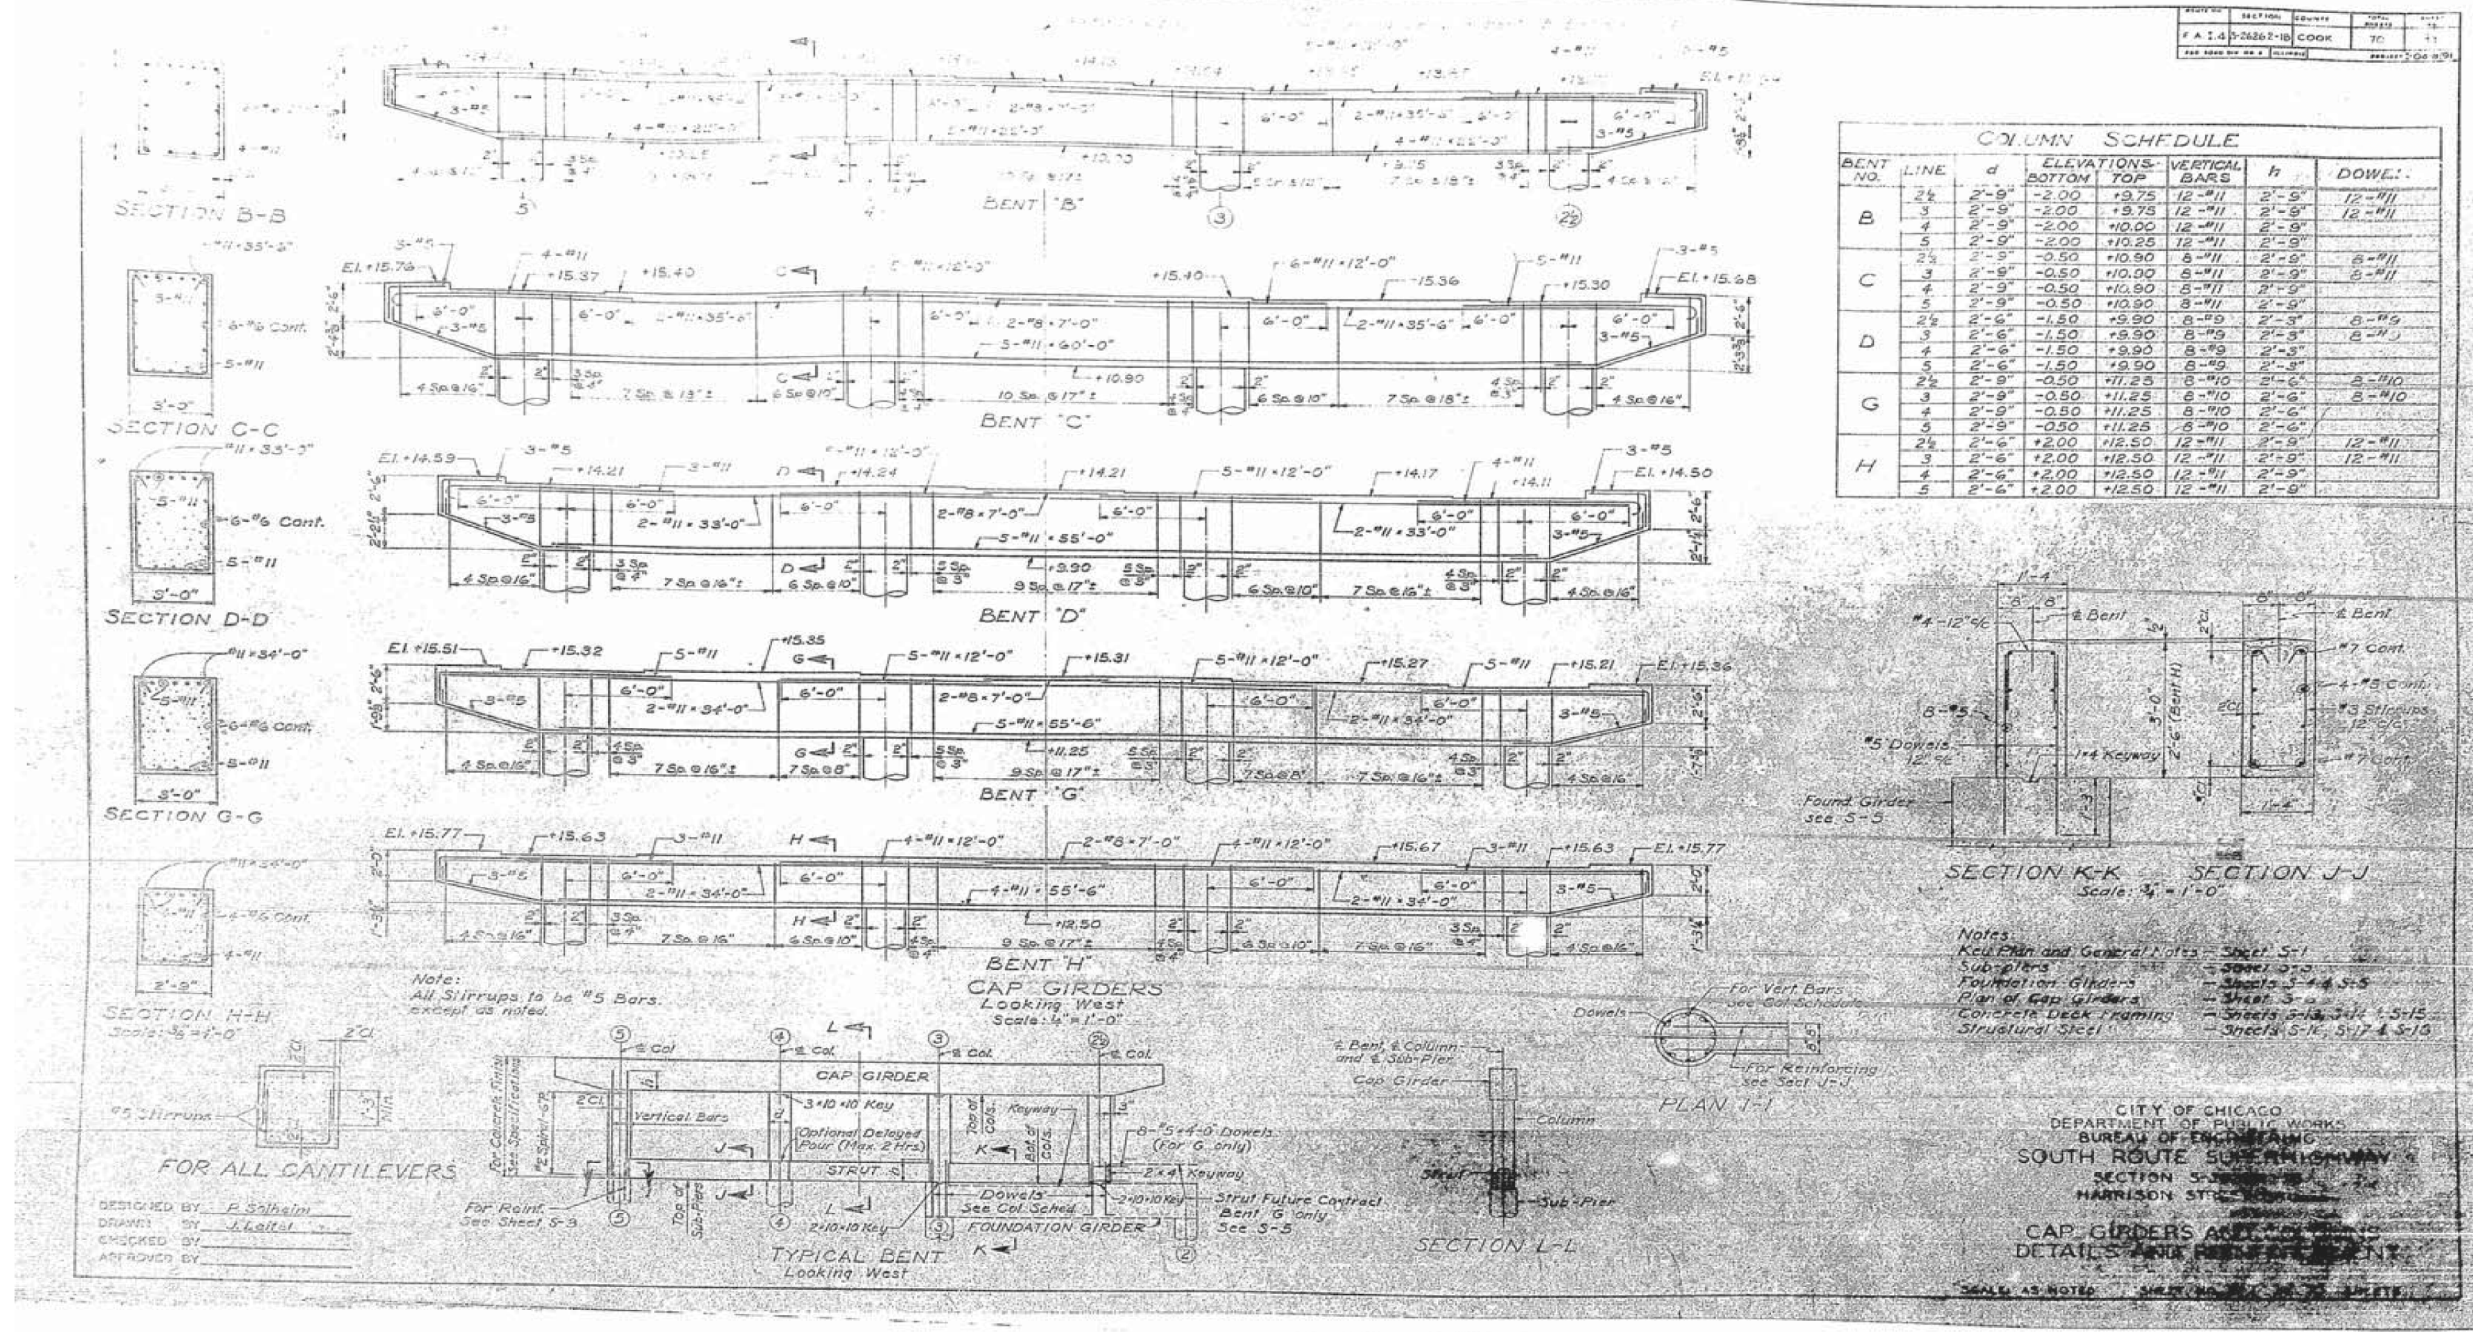

Notes:
 Key Plan and General Notes - Sheet S-1
 Sub-piers - Sheet S-2
 Foundation Girders - Sheets S-3 & S-5
 Plan of Cap Girders - Sheet S-4
 Concrete Deck Framing - Sheets S-6, S-7, S-15
 Structural Steel - Sheets S-16, S-17 & S-18

DESIGNED BY: F. Salheim
 DRAWN BY: J. Kaitel
 CHECKED BY:
 APPROVED BY:

CITY OF CHICAGO
 DEPARTMENT OF PUBLIC WORKS
 BUREAU OF ENGINEERING
 SOUTH ROUTE 58 NORTH AVENUE
 SECTION 5-3
 HARRISON STREET

STATE OF ILLINOIS
 DEPARTMENT OF TRANSPORTATION

EXISTING AS-BUILTS SN 016-1087

F.A.I. RTE.	SECTION	COUNTY	TOTAL SHEETS	SHEET NO.
90/94/290	2013-008R	COOK	559	324
CONTRACT NO. 60W26				

SCALE: NTS SHEET AS-26 OF AS-62 SHEETS STA. TO STA.

ILLINOIS FED. AID PROJECT

FILE PATH = C:\Projects\13-0820 - Circle 60W26 As-Built - Circle 60W26 As-Built - sht-AS-BUILT-26.dgn