


FOR INFORMATION ONLY

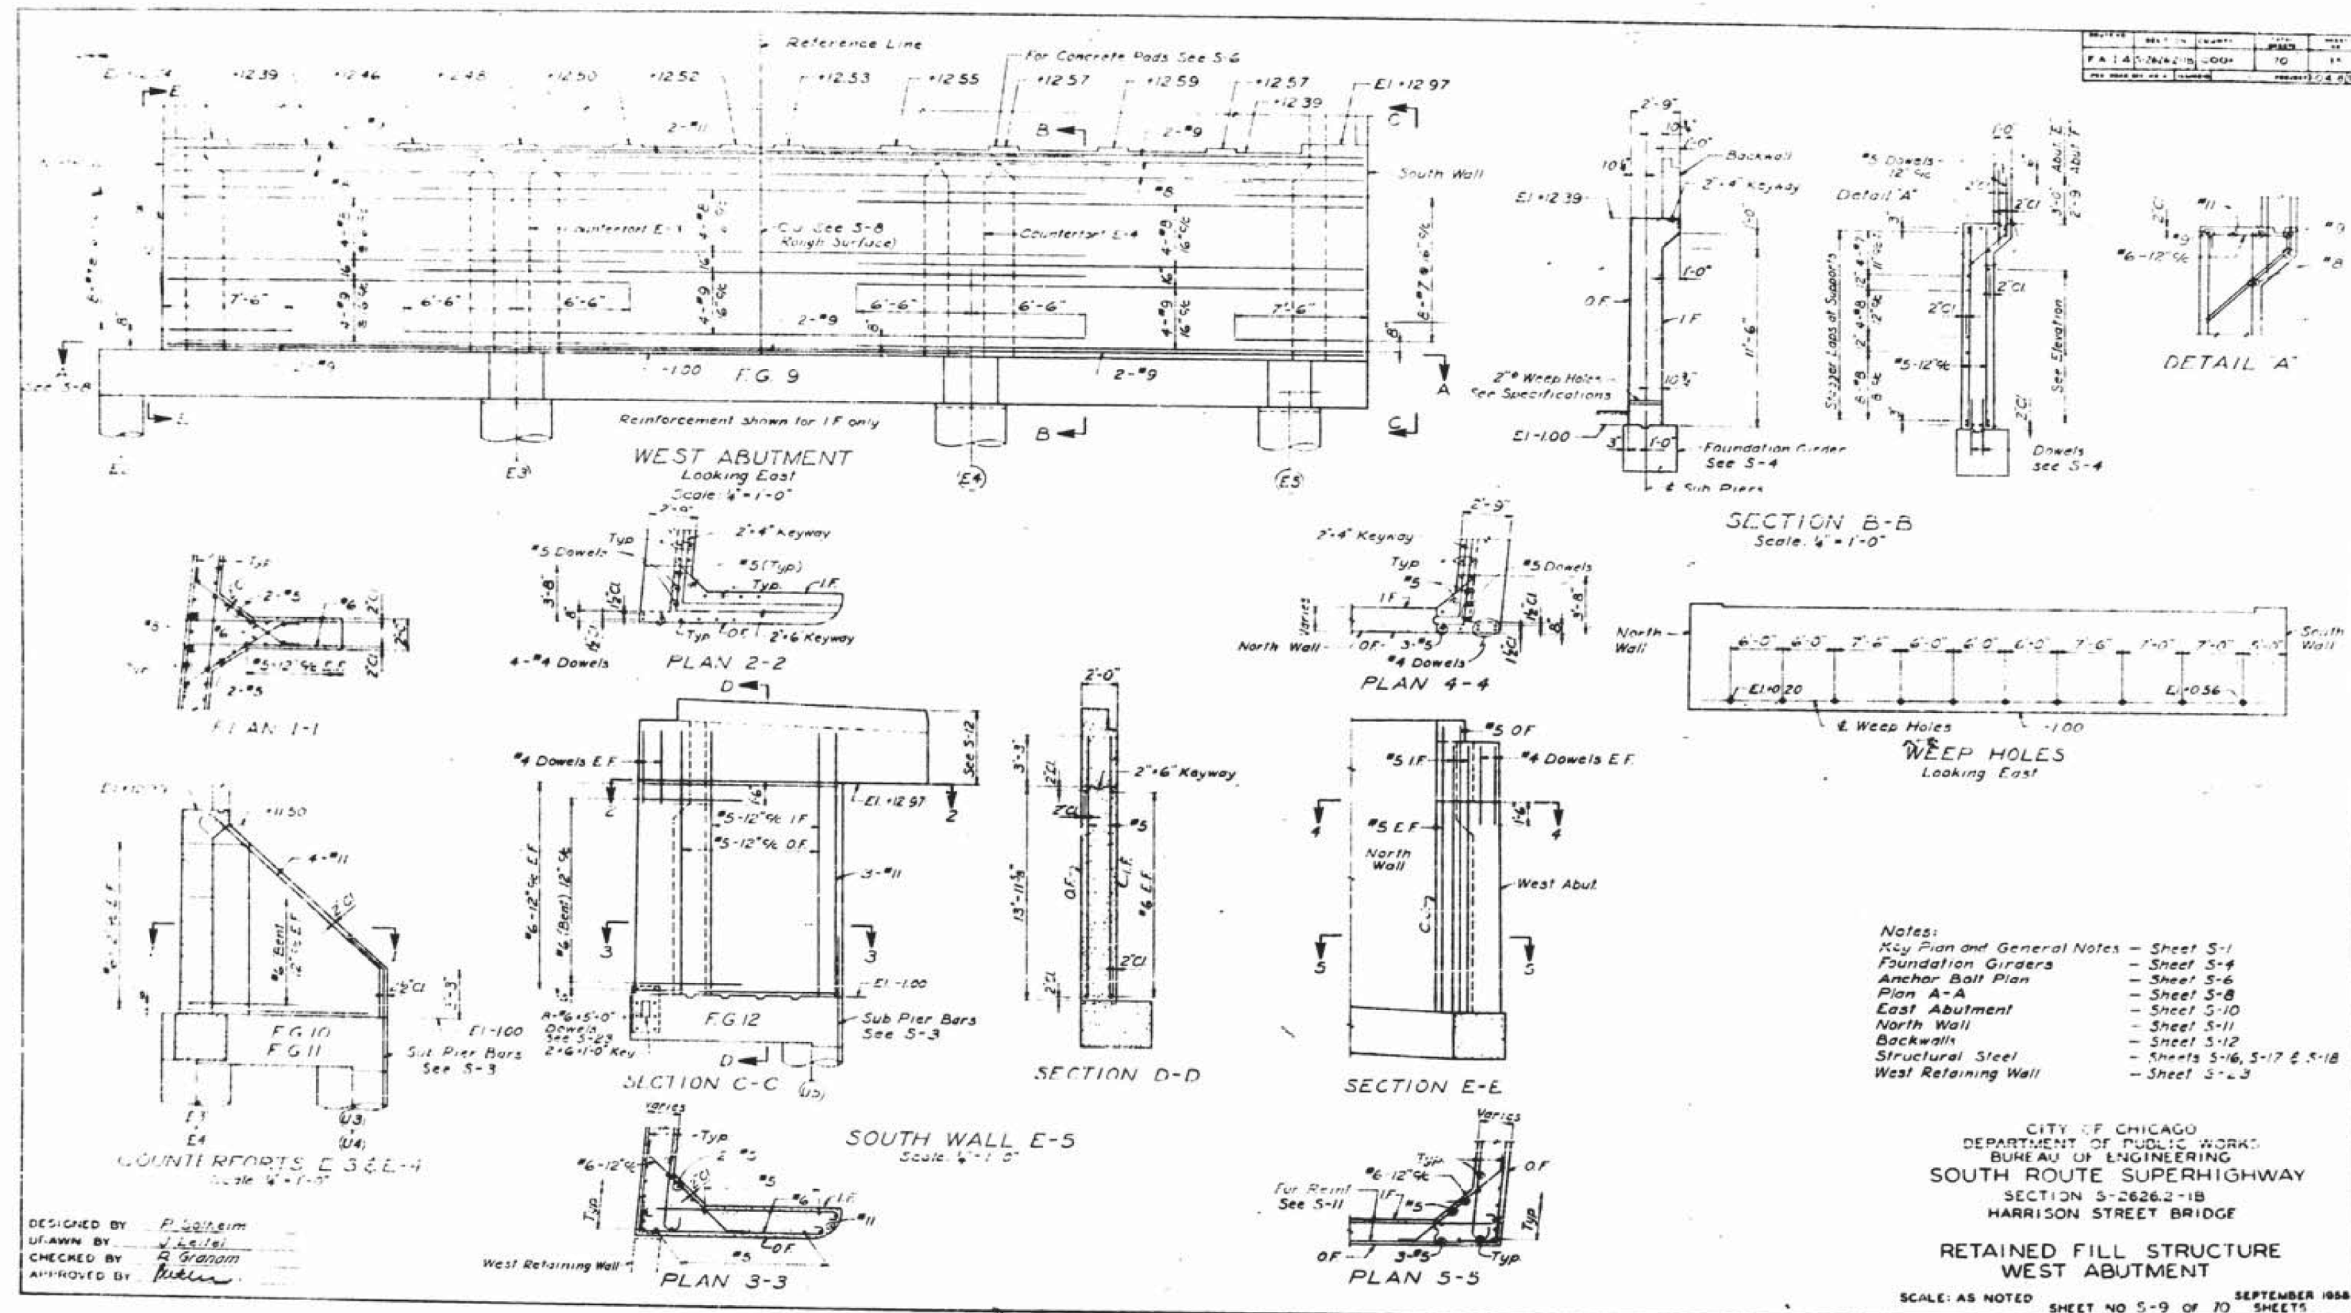

FILE PATH = C:\Projects\15-0820 - Circle 60W26 As-Built - Final\0160W26-sht-AS-BUILT-28.dgn

DESIGNED BY - P. G. G. G.	DESIGNED -	REVISED -
DRAWN BY - J. G. G.	DRAWN -	REVISED -
CHECKED BY - R. G. G.	CHECKED -	REVISED -
APPROVED BY -	DATE - 07/15/13	REVISED -

STATE OF ILLINOIS
 DEPARTMENT OF TRANSPORTATION

EXISTING AS-BUILTS SN 016-1087			
SCALE: NTS	SHEET AS-28 OF AS-62 SHEETS	STA.	TO STA.

F.A.I. RTE.	SECTION	COUNTY	TOTAL SHEETS	SHEET NO.
90/94/290	2013-008R	COOK	559	326
CONTRACT NO. 60W26				
ILLINOIS FED. AID PROJECT				