


FOR INFORMATION ONLY

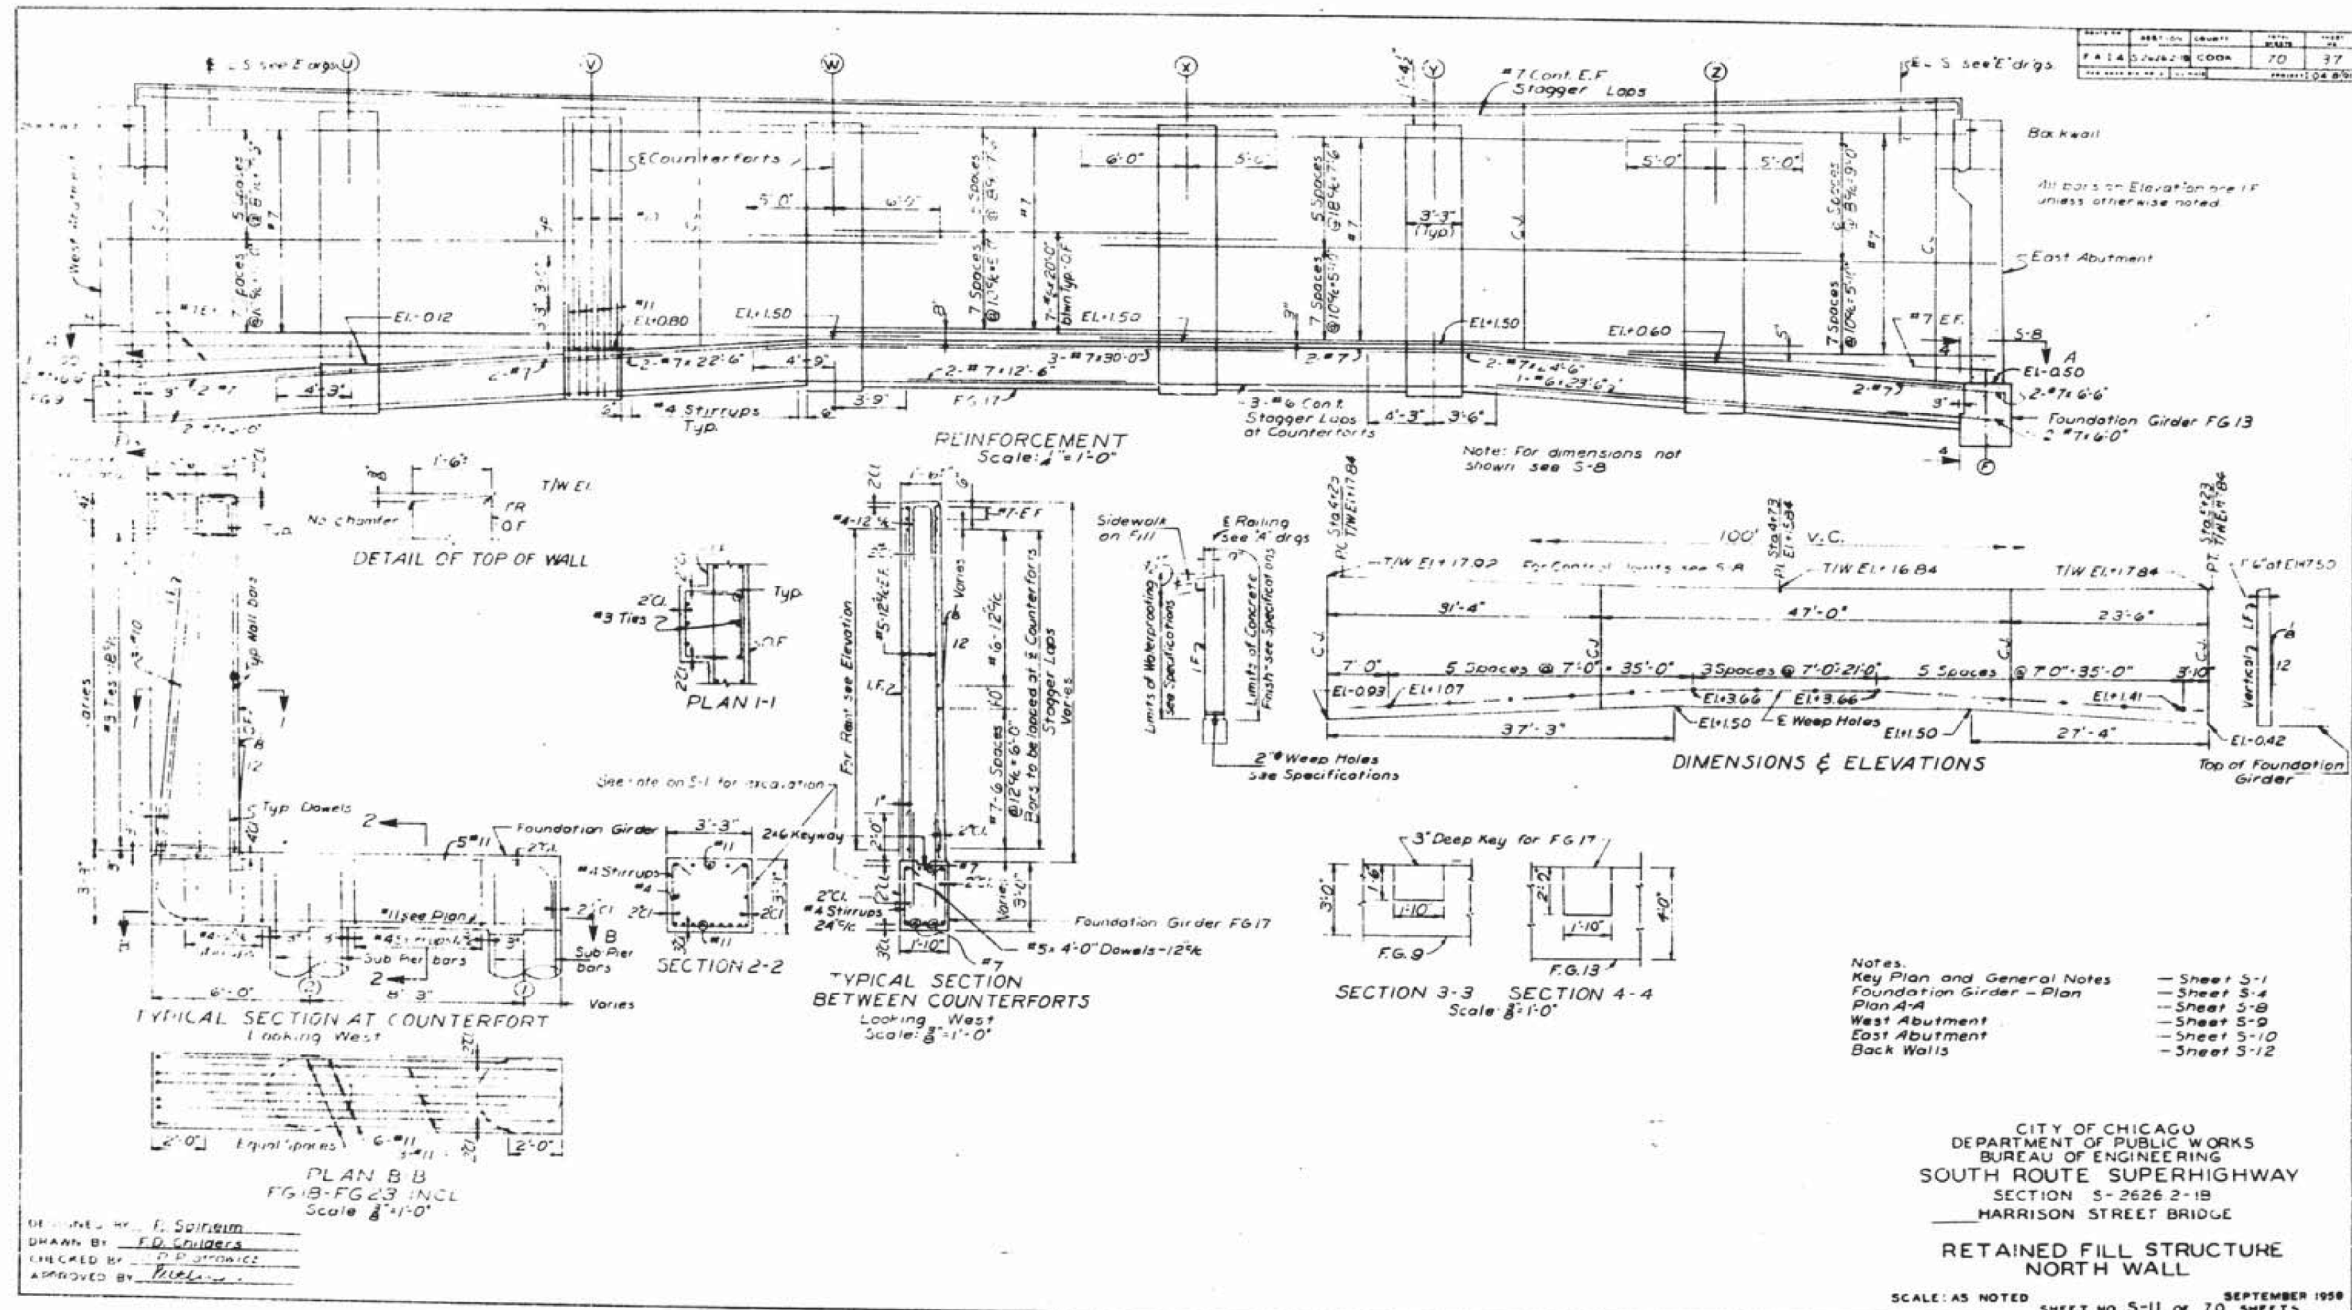

FILE PATH = C:\Projects\15-0820 - Circle 60W26 AS-Built\15-0820-AS-BUILT-31.dgn

DESIGNED BY: F. Spillman
DRAWN BY: F. Spillman
CHECKED BY: P. F. ...
APPROVED BY: ...

DESIGNED -	REVISED -
DRAWN -	REVISED -
CHECKED -	REVISED -
DATE - 07/15/13	REVISED -

STATE OF ILLINOIS
DEPARTMENT OF TRANSPORTATION

EXISTING AS-BUILTS SN 016-1087

SCALE: NTS SHEET AS-31 OF AS-62 SHEETS STA. TO STA.

F.A.I. R.T.E.	SECTION	COUNTY	TOTAL SHEETS	SHEET NO.
90/94/290	2013-008R	COOK	559	329
CONTRACT NO. 60W26				
ILLINOIS FED. AID PROJECT				