


FOR INFORMATION ONLY

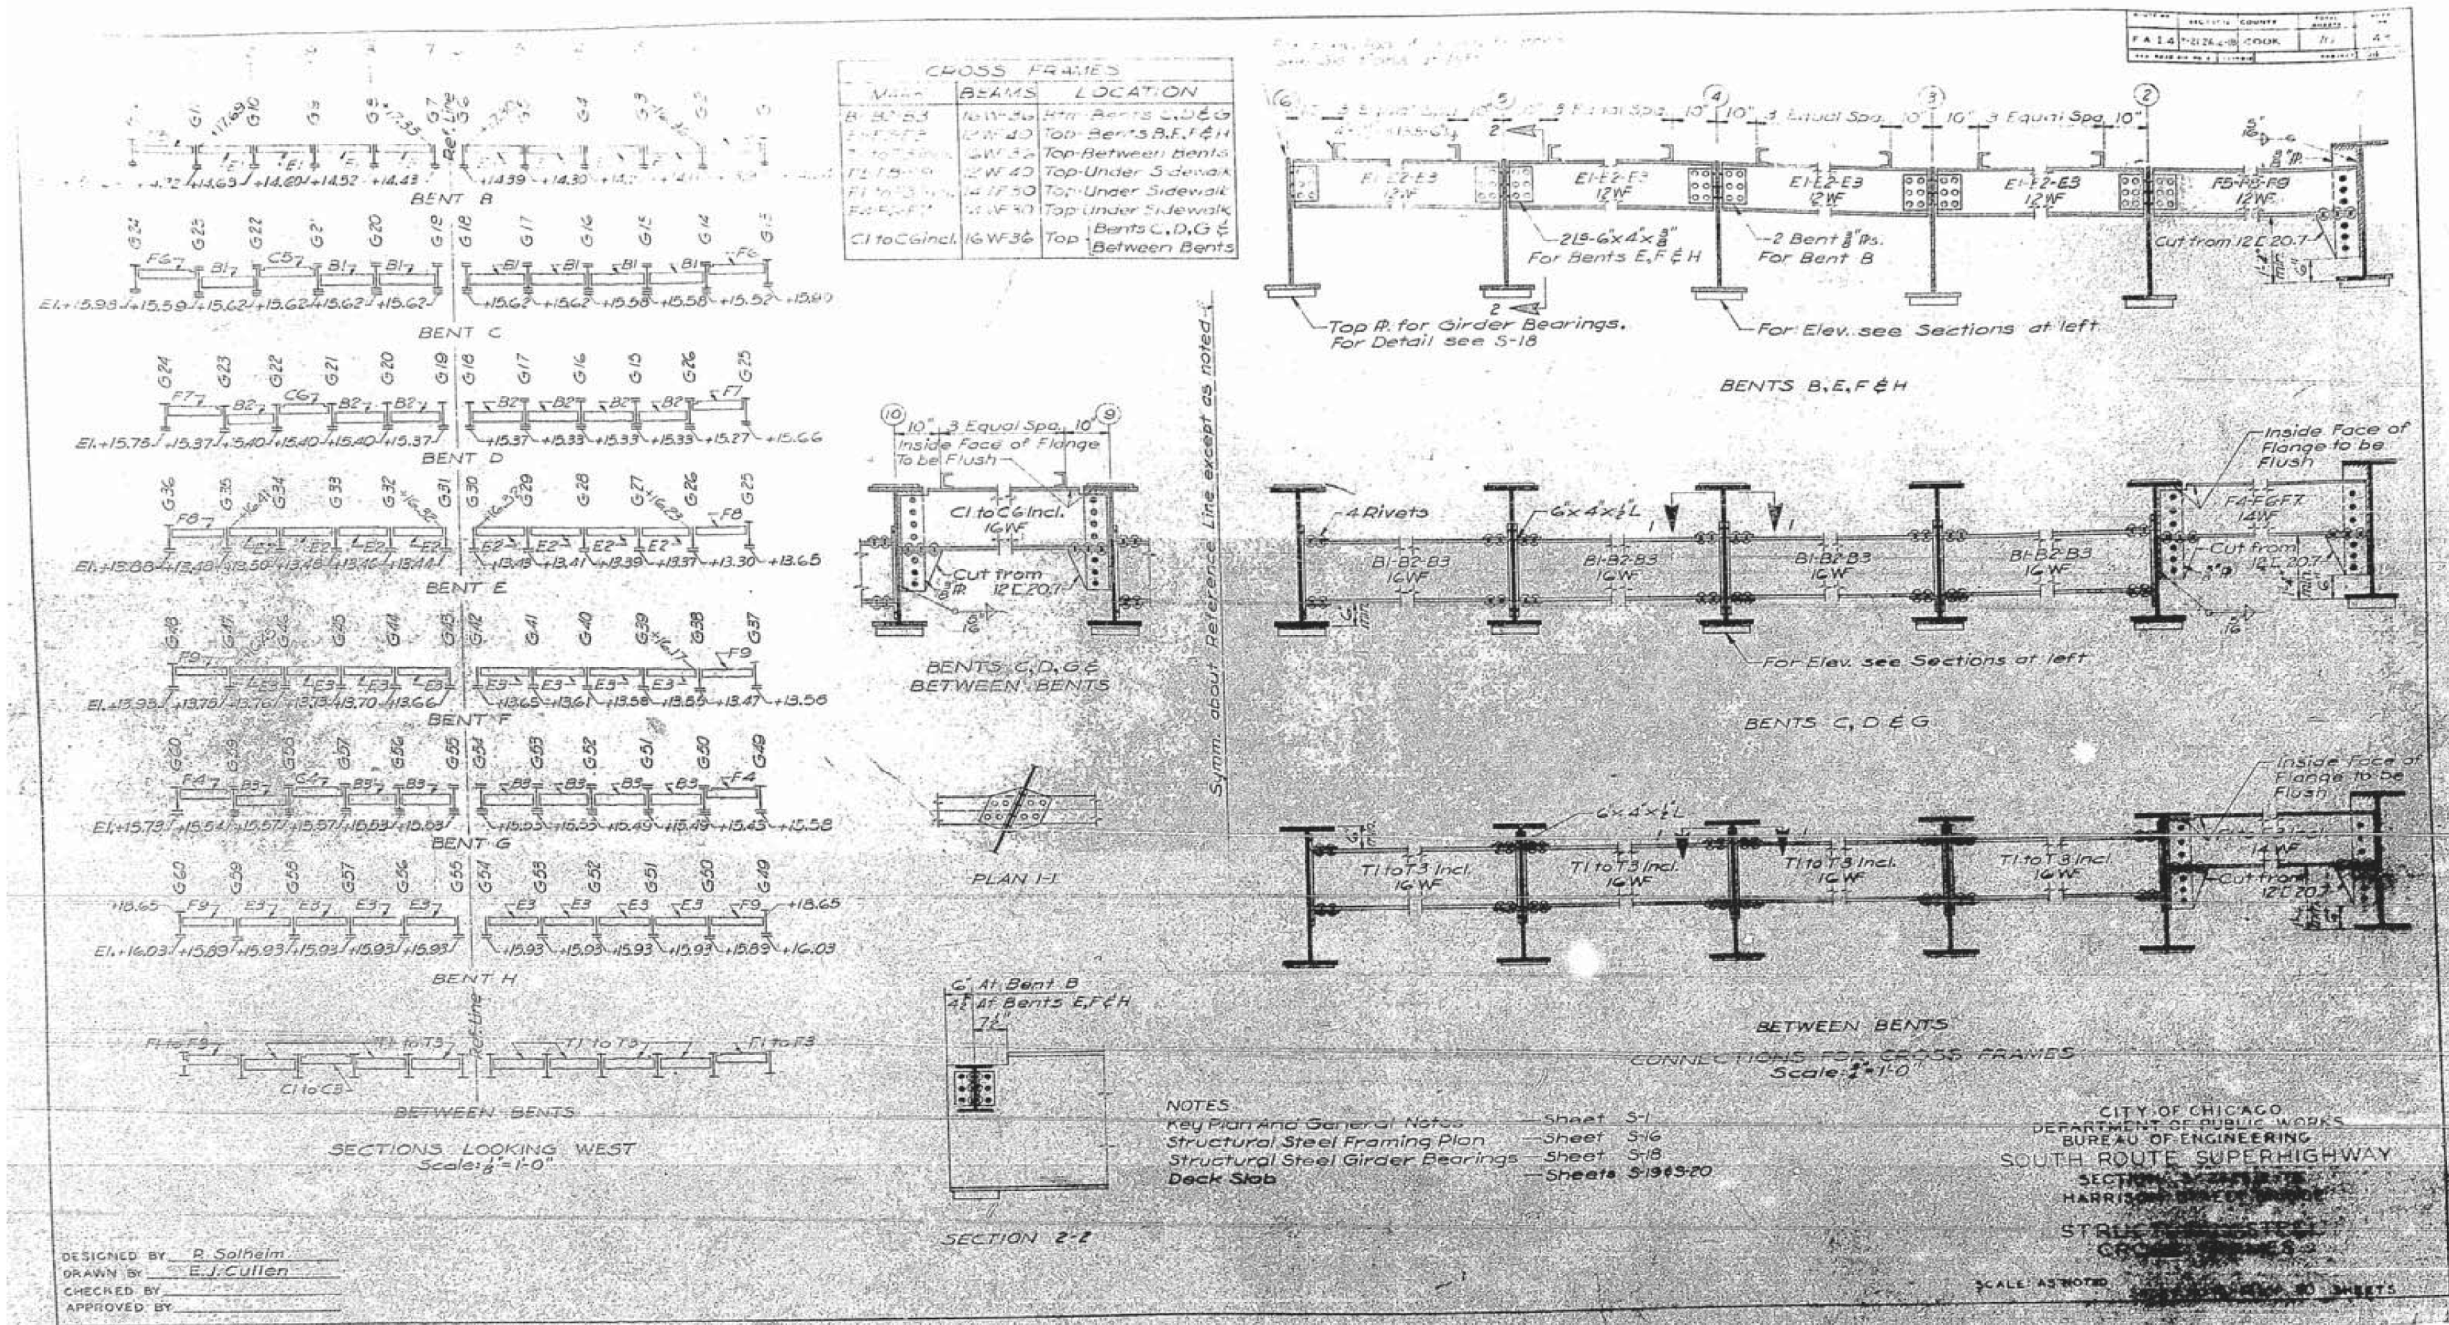

FILE PATH = C:\Projects\15-0820 - Circle 60W26 AS-Built - Final\0160W26-sht-AS-BUILT-37.dgn

DESIGNED BY - R. Solheim	DESIGNED -	REVISED -
DRAWN BY - E. J. Cullen	DRAWN -	REVISED -
CHECKED BY -	CHECKED -	REVISED -
APPROVED BY -	DATE - 07/15/13	REVISED -

STATE OF ILLINOIS  
DEPARTMENT OF TRANSPORTATION

EXISTING AS-BUILT SN 016-1087	
SCALE: NTS	SHEET AS-37 OF AS-62 SHEETS
STA.	TO STA.

F.A.I. R.E. 90/94/290	SECTION 2013-008R	COUNTY COOK	TOTAL SHEETS 559	SHEET NO. 335
CONTRACT NO. 60W26				
ILLINOIS FED. AID PROJECT				