


FOR INFORMATION ONLY

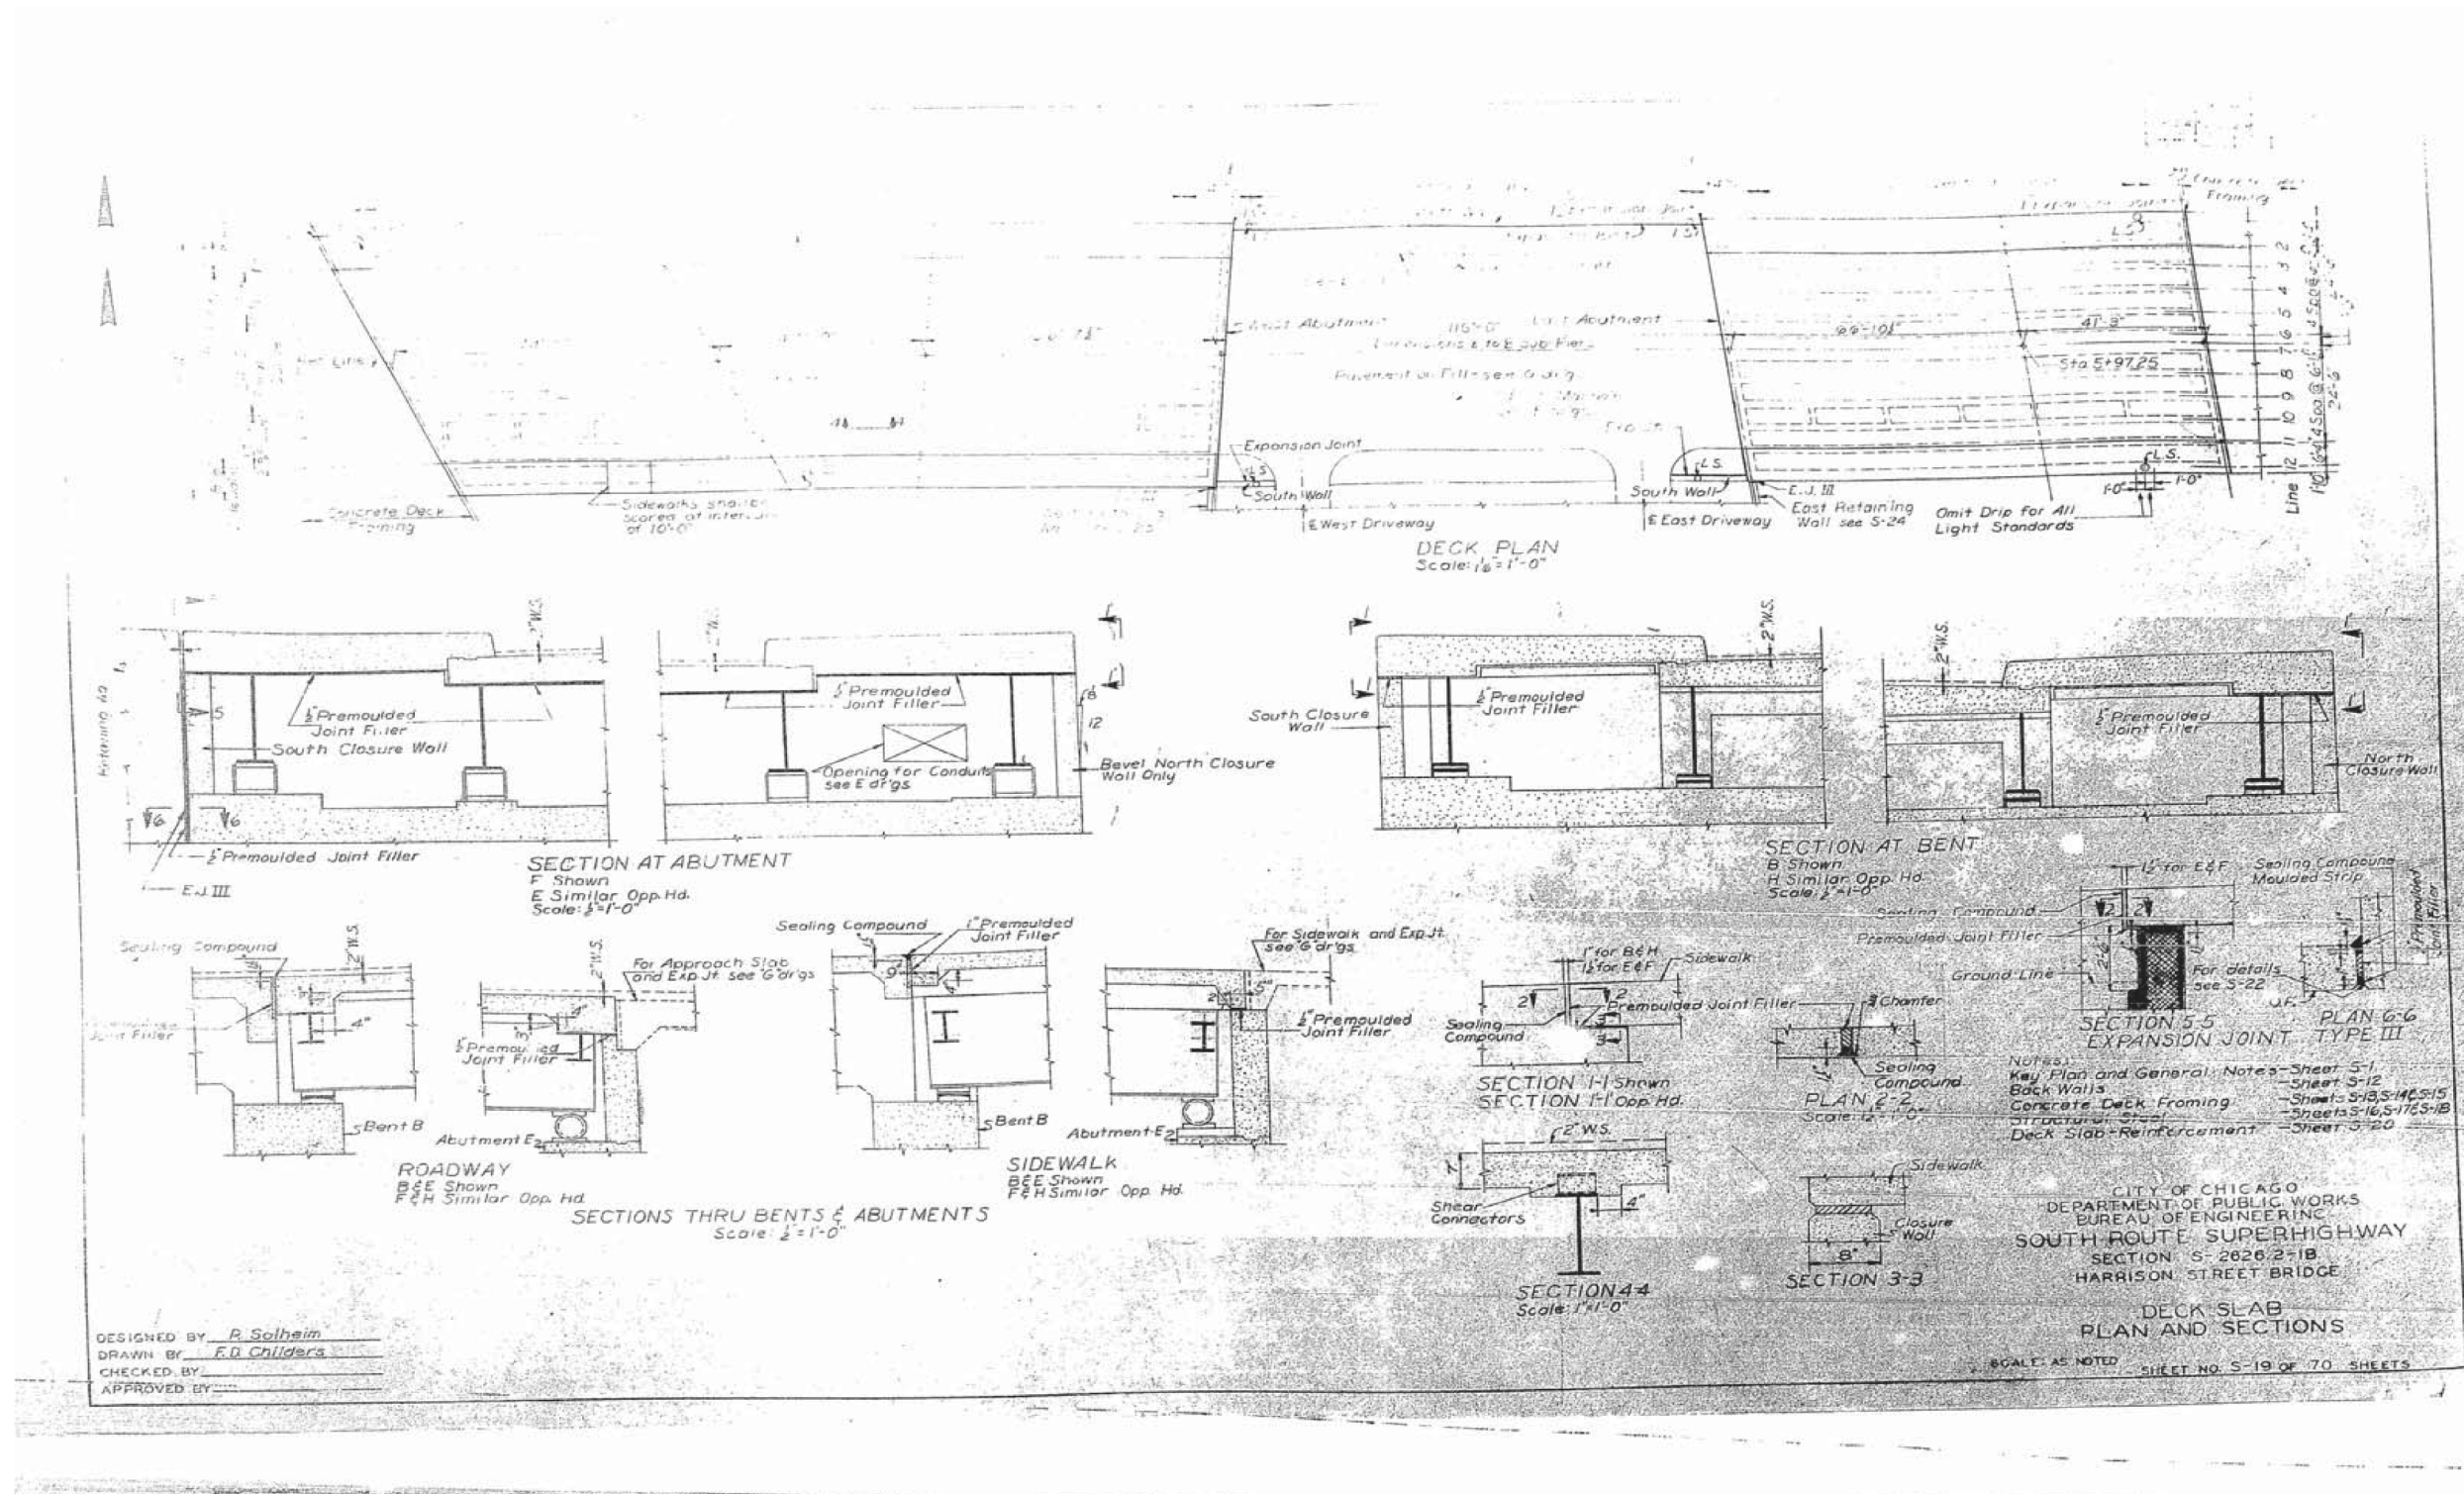

DESIGNED BY R. Solheim
DRAWN BY F.D. Childers
CHECKED BY _____
APPROVED BY _____

STATE OF ILLINOIS
DEPARTMENT OF TRANSPORTATION

EXISTING AS-BUILTS SN 016-1087

SCALE: NTS SHEET AS-39 OF AS-62 SHEETS STA. TO STA.

F.A.I. R.E.	SECTION	COUNTY	TOTAL SHEETS	SHEET NO.
90/94/290	2013-008R	COOK	559	337
CONTRACT NO. 60W26				
ILLINOIS FED. AID PROJECT				