


FOR INFORMATION ONLY

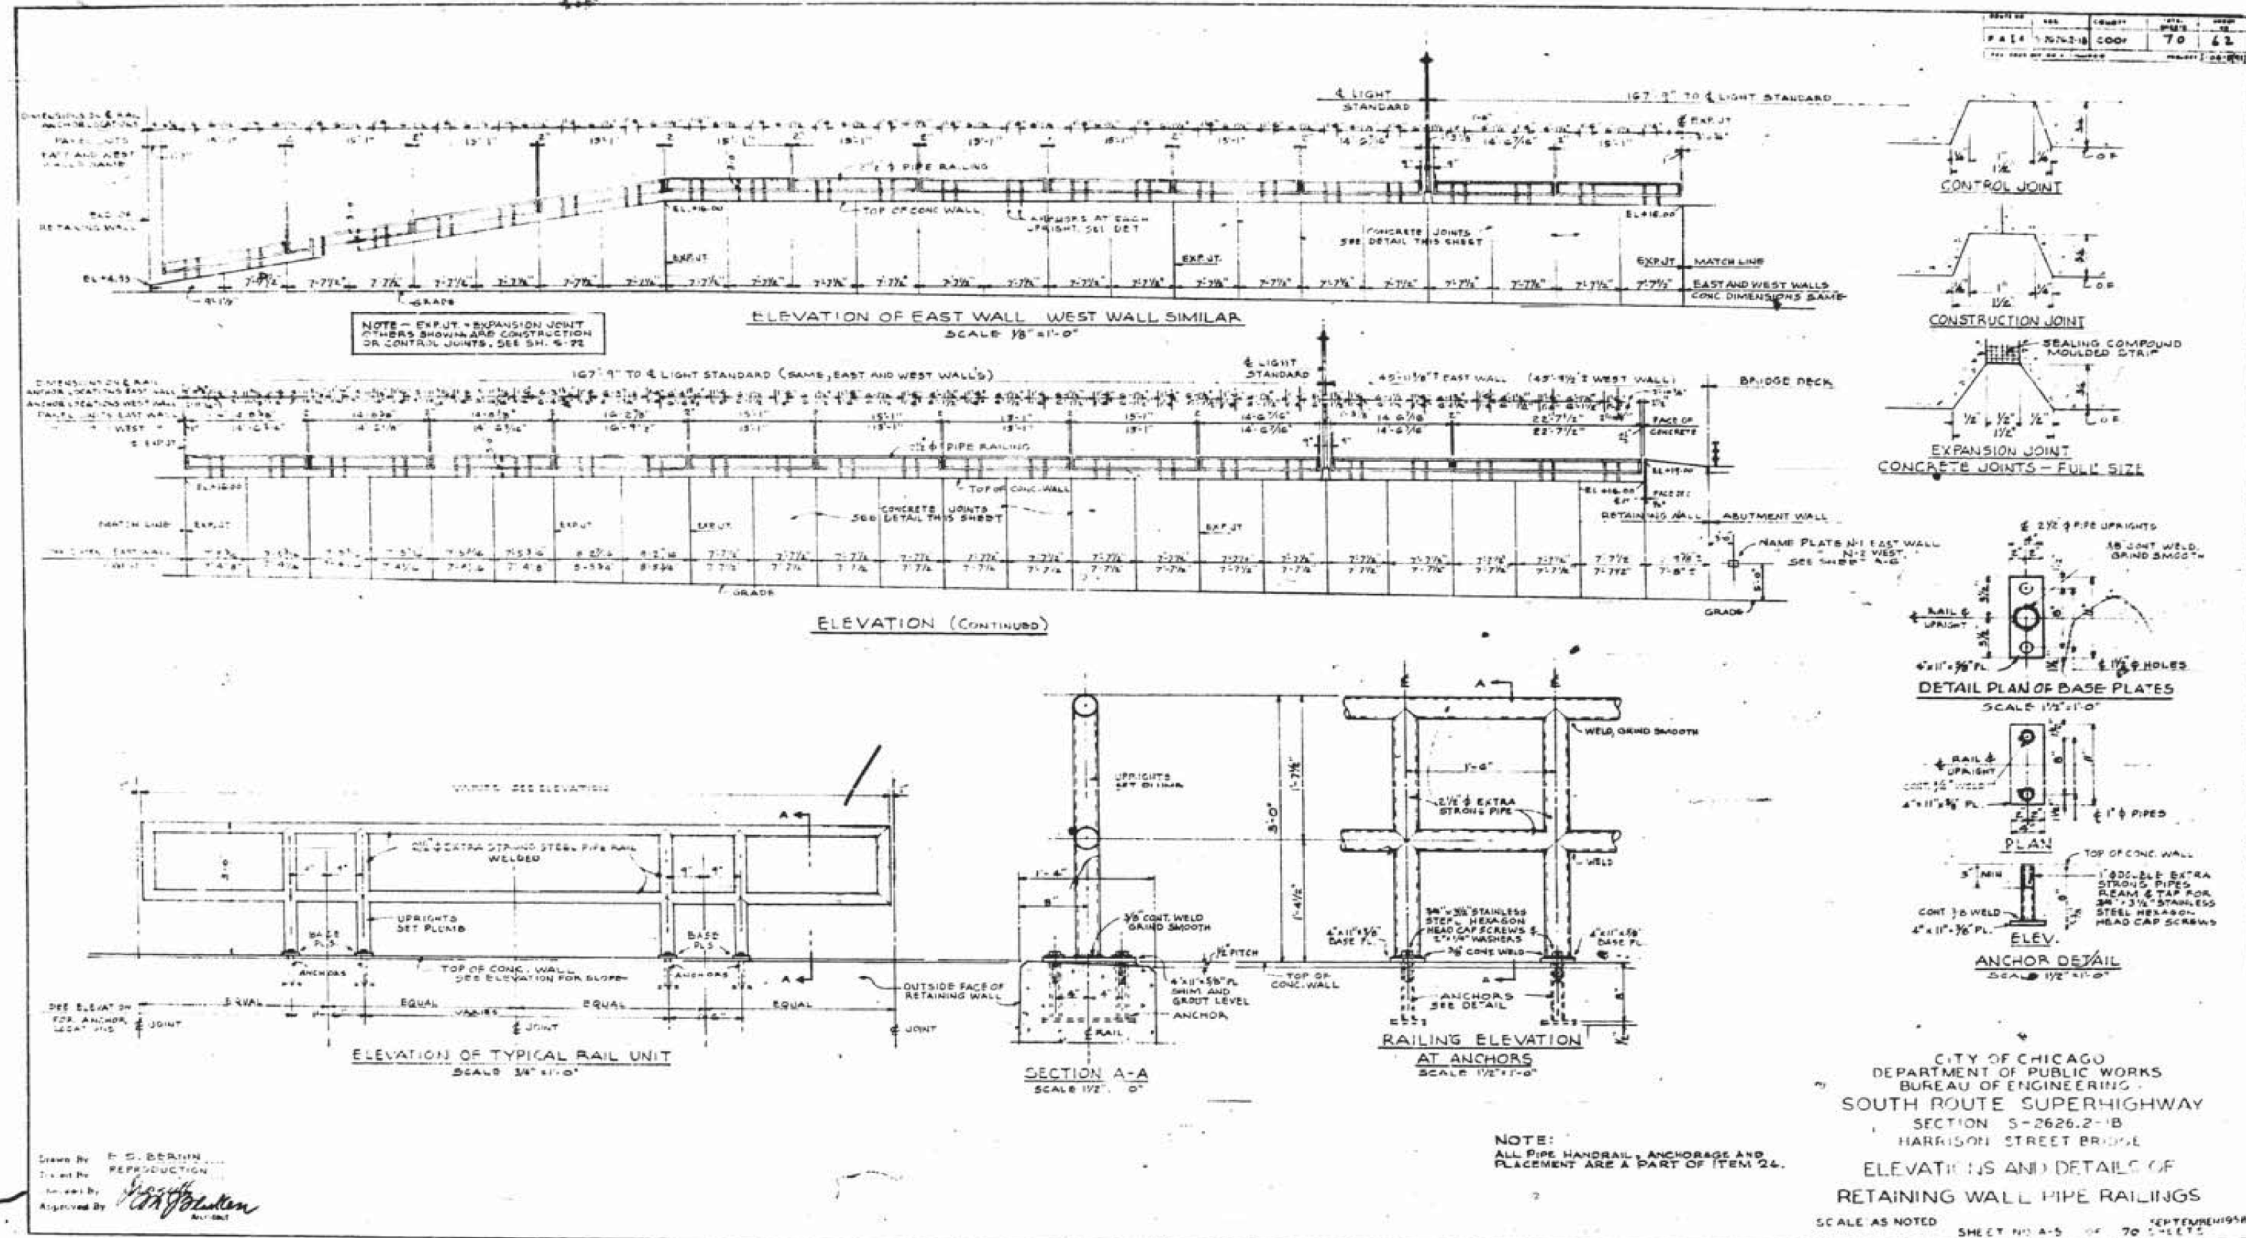

FILE PATH = C:\Projects\13-0820 - Circle 60W26 As-Built\Final\0160W26-sht-AS-BUILT-55.dgn

D160W26-sht-AS-BUILT-55.dgn	DESIGNED -	REVISED -
USER NAME = ayeuengh	DRAWN -	REVISED -
PLOT SCALE = 1,0000' / 1"	CHECKED -	REVISED -
PLOT DATE = 8/16/2013	DATE - 07/15/13	REVISED -

DESIGNED -	REVISED -
DRAWN -	REVISED -
CHECKED -	REVISED -
DATE - 07/15/13	REVISED -

STATE OF ILLINOIS
DEPARTMENT OF TRANSPORTATION

EXISTING AS-BUILTS SN 016-1087			
SCALE: NTS	SHEET AS-55 OF AS-62 SHEETS	STA.	TO STA.

F.A.I. R.T.E.	SECTION	COUNTY	TOTAL SHEETS	SHEET NO.
90/94/290	2013-008R	COOK	559	353
CONTRACT NO. 60W26				
ILLINOIS FED. AID PROJECT				