


# LOCATION

KENT CREEK BRIDGE  
SPRINGFIELD AVENUE



CITY OF  
ROCKFORD

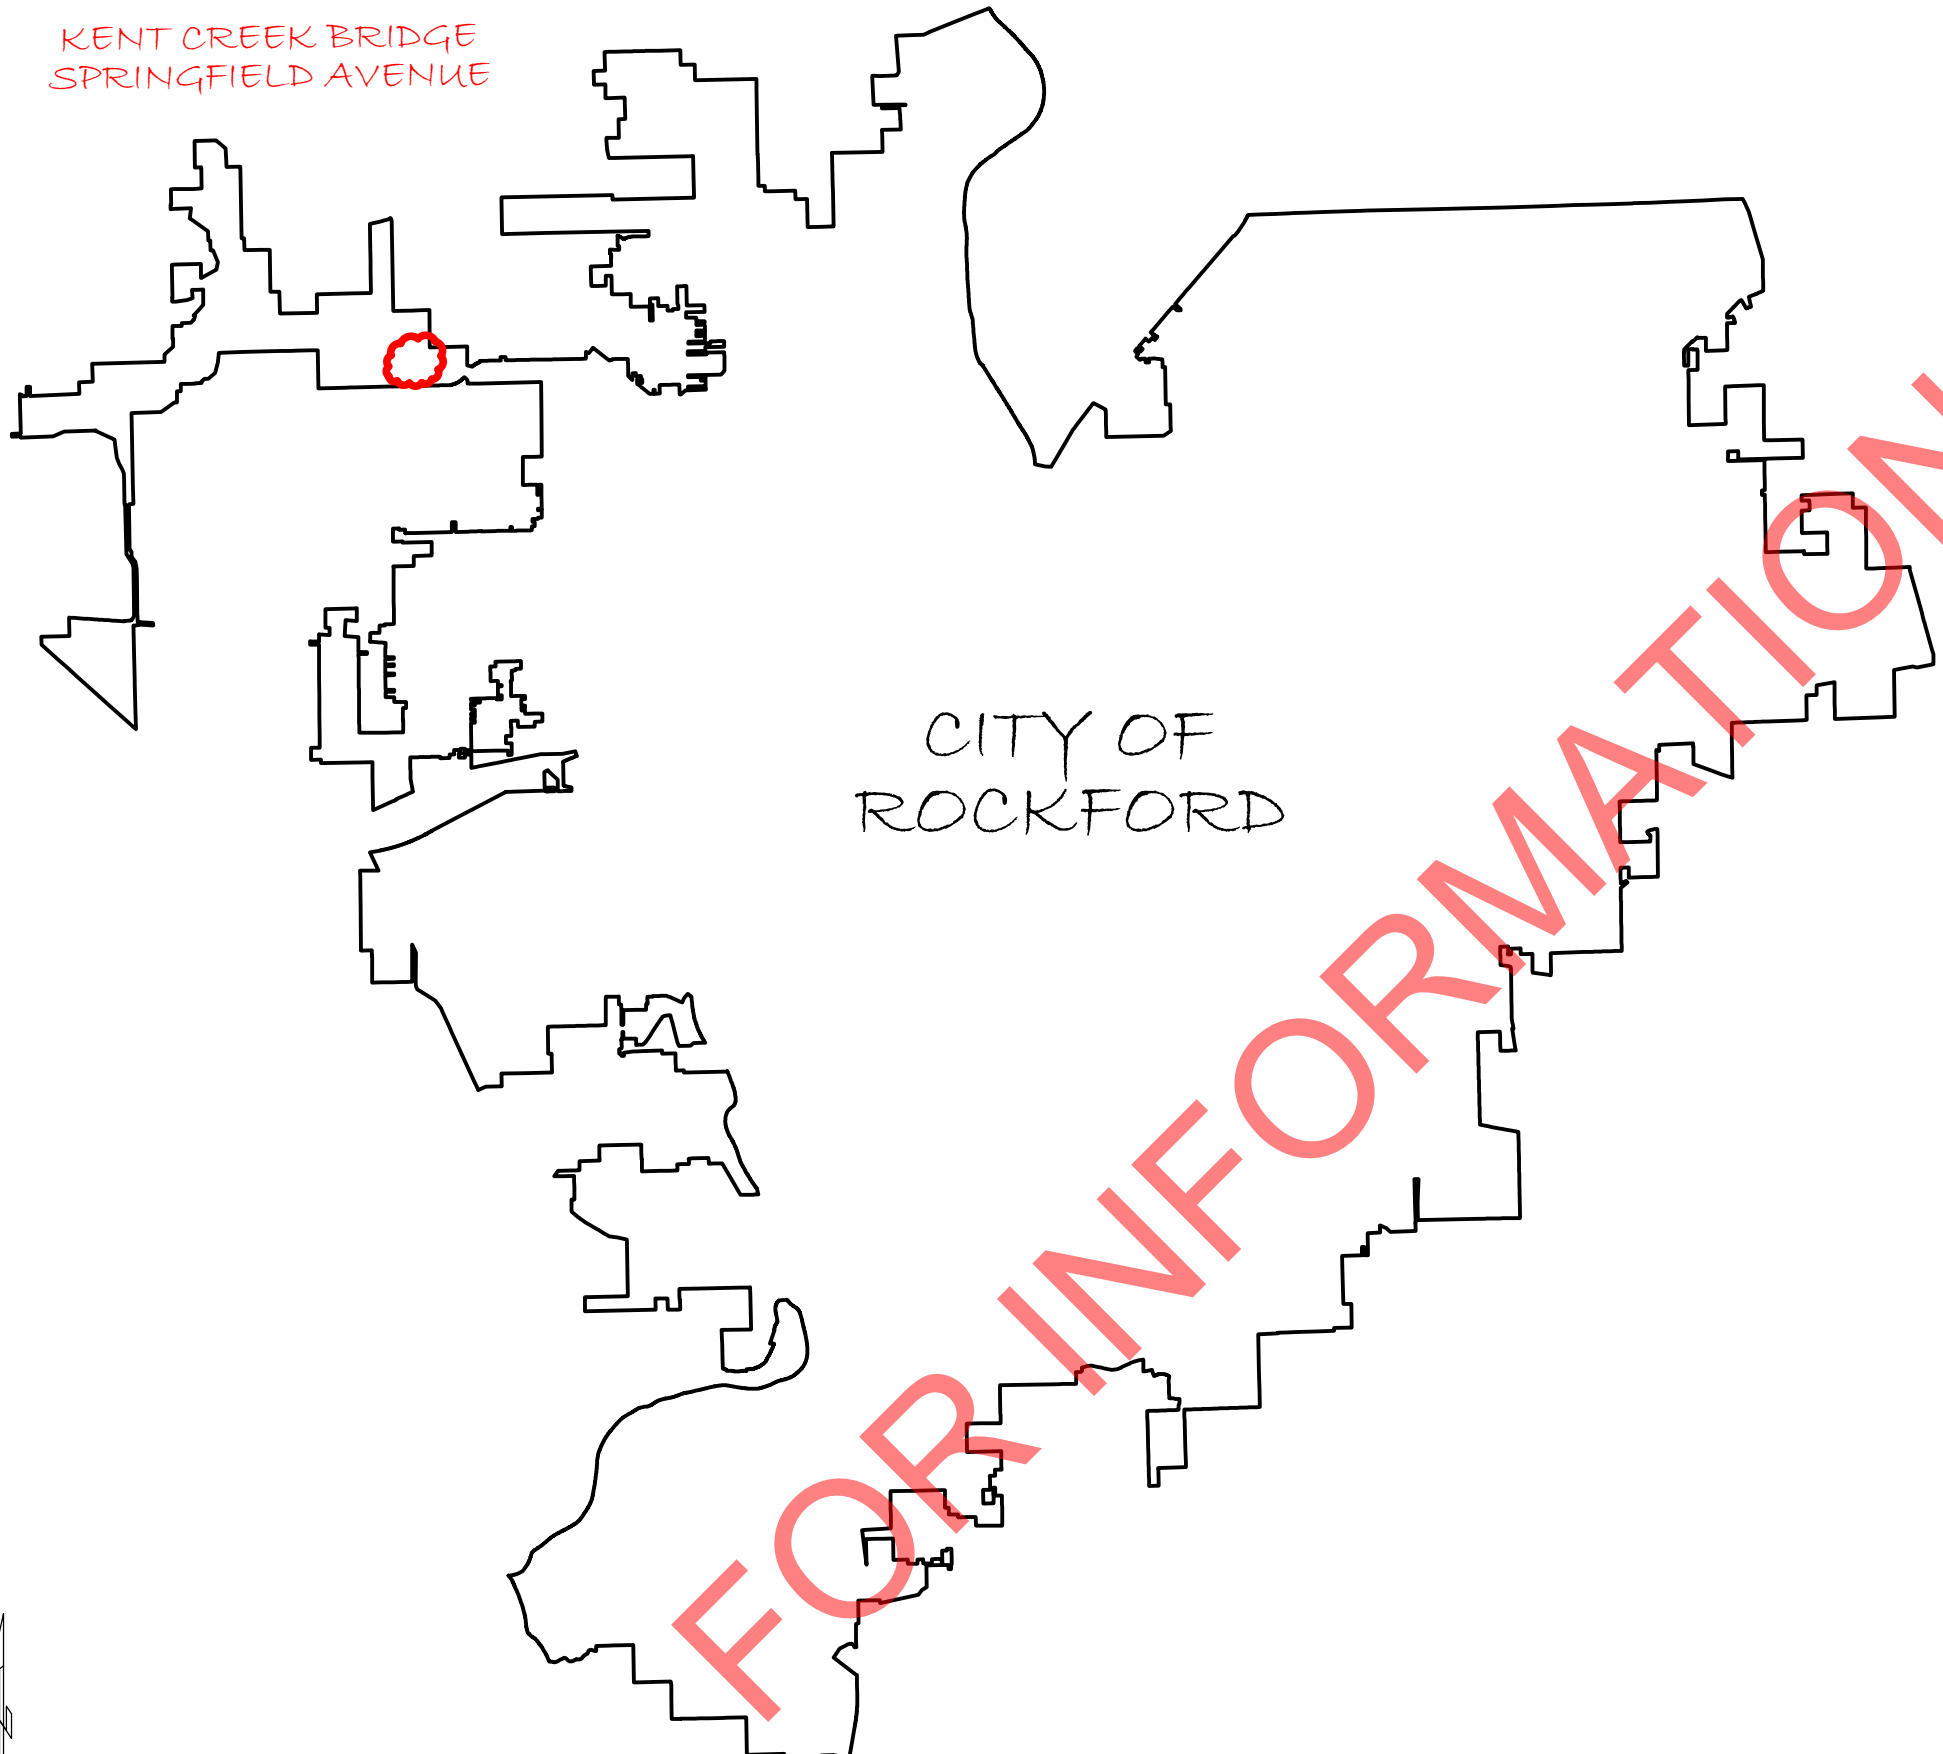

STATE PROJECT ID #: C-92-104-23

PROJECT NAME: FAP ROUTE 525 (SPRINGFIELD AVENUE) OVER  
NORTH FORK KENT CREEK BRIDGE REPLACEMENT - ROCKFORD - IL  
- WINNEBAGO COUNTY

## NARRATIVE

ILLINOIS DEPARTMENT OF TRANSPORTATION PROJECT C-92-104-23 WILL IMPROVE ROUTE 525 AND REPLACE THE BRIDGE OVER NORTH FORK KENT CREEK IN WINNEBAGO COUNTY.

WIN TECHNOLOGY HAS UNDERGROUND FIBER FACILITIES WITHIN THE EAST RIGHT-OF-WAY CORRIDOR IN THE CONSTRUCTION POLYGON. FACILITIES HAVE BEEN LOCATED AND PLOTTED FOR CONFLICT REVIEWS. NO WIN CONFLICTS ARE ANTICIPATED.

WIN UNDERGROUND UTILITY LOCATIONS SHOWN HEREON ARE APPROXIMATE. INFORMATION FROM LOCATES OF UTILITIES WAS USED TO DEVELOP A VIEW OF UNDERGROUND UTILITIES; AS SUCH, THE EXACT LOCATION OF UNDERGROUND FEATURES CANNOT BE ACCURATELY, COMPLETELY, OR RELIABLY DEPICTED VIA LOCATES. CONSTRUCTION CONTRACTOR IS RESPONSIBLE FOR THE EXACT LOCATION OF UTILITIES; CONTRACTOR MUST PROTECT FIBER ASSETS AT ALL TIMES. REPAIR OF ANY AND ALL DAMAGES INCURRED SHALL BE AT THE EXPENSE OF THE CONTRACTOR.



### WIN PROJECT CONTACTS


EMERGENCY	NMC	866-206-2027	support@wintechnology.com
PROJECT ENGINEER	KEN WHITING	920-376-2996	ken.whiting@wintechnology.com
CONST COORDINATOR	MIKE FERM	515-493-6014	mike.ferm@wintechnology.com

### TIMELINES

AS-STAKED	NOVEMBER 2023
REVISION 1	1 MARCH 2024
REVISION 2	
REDLINES	
AS-BUILT	


MEMBER  
WISCONSIN STATUTE 182.0175 (1974) REQUIRES CONTRACTORS TO NOTIFY DIGGERS HOTLINE A MINIMUM OF THREE BUSINESS DAYS PRIOR TO EXCAVATION AT 811 OR (800) 242-8511 OR (262) 432-7910. EMAIL-A-LOCATE IS AVAILABLE AT: WWW.DIGGERSHOTLINE.COM  
ONE-CALL


**NOTICE**  
Information contained in this document is proprietary and shall not be used, copied, reproduced, or disclosed, in whole or in part, without written consent of WIN, LLC.

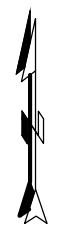

KENT CREEK NORTH FORK BRIDGE REPLACEMENT - IDOT - FACILITY LOCATE DOCUMENTATION

Ftr ID	Locator Depth (in)	Locator Depth (ft)	GPS Latitude	GPS Longitude	GPS Uncertainty	Station	Off-Set (ft)
2	40	3.33	42.3059011	-89.1446669	1.05ft	194+00	11.627
3	40	3.33	42.3060107	-89.1446322	0.58ft		
4	43	3.58	42.3060976	-89.1446023	0.47ft	193+50	10.8954
5	41	3.42	42.3061808	-89.1445726	0.35ft		
6	38	3.17	42.3062598	-89.1445431	0.41ft	193+00	10.6223
7	40	3.33	42.3063407	-89.1445126	0.60ft	192+50	10.2116
8	41	3.42	42.3064219	-89.1444819	0.45ft		
9	45	3.75	42.3065185	-89.1444395	0.48ft	192+00	10.7666
10	45	3.75	42.3066079	-89.1443937	0.64ft	191+50	13.5028
11	44	3.67	42.3067076	-89.144341	0.48ft	191+00	16.7742
12	44	3.67	42.3068042	-89.1442874	0.69ft		
13	42	3.50	42.3068678	-89.1442507	0.42ft	190+50	20.4107
14	40	3.33	42.3069359	-89.1442119	0.46ft		
15	39	3.25	42.3070142	-89.1441678	1.42ft	190+00	23.2302
16	40	3.33	42.3070856	-89.1441248	0.39ft		
17	37	3.08	42.3071446	-89.1440897	1.43ft	189+50	26.225
18	35	2.92	42.3072101	-89.1440498	0.73ft		
19	35	2.92	42.3072665	-89.1440144	0.47ft	189+00	29.2337
20	34	2.83	42.3073173	-89.1439819	0.58ft		
21	33	2.75	42.3073572	-89.1439533	0.60ft	188+50	33.0075
22	35	2.92	42.3074431	-89.1438984	0.60ft		
23	33	2.75	42.3074919	-89.1438685	0.71ft	188+00	34.8074
24	39	3.25	42.3075114	-89.1438579	1.21ft		
25	38	3.17	42.3075616	-89.1438341	0.88ft		
26	42	3.50	42.3076101	-89.1437986	0.79ft	187+50	34.9694
27	38	3.17	42.3076794	-89.1437595	0.83ft		
31	32	2.67	42.3077402	-89.1437184	1.75ft	187+00	34.5437
32	30	2.50	42.3077829	-89.1436931	1.17ft		
33	52	4.33	42.3078441	-89.1436113	1.03ft		
34	73	6.08	42.3078639	-89.1435947	0.62ft	186+50	46.4345
35	64	5.33	42.3079657	-89.1435215	1.94ft		
36	46	3.83	42.3079965	-89.1435002	1.03ft	186+00	48.5747
37	29	2.42	42.3082024	-89.1433723	0.75ft	185+00	42.6579
38	36	3.00	42.3082921	-89.1433379	0.50ft		
39	37	3.08	42.3083852	-89.1432749	1.02ft	184+50	37.6529
40	41	3.42	42.3084721	-89.1432183	1.20ft	184+00	34.8192
41	50	4.17	42.3085199	-89.1431899	1.37ft		
42	39	3.25	42.3086003	-89.1431251	0.96ft	183+50	33.8165
43	41	3.42	42.308654	-89.143086	1.30ft		
44	35	2.92	42.3087693	-89.1430034	0.96ft	183+00	31.976
45	32	2.67	42.3088606	-89.1429445	1.16ft	182+50	27.5467
46	30	2.50	42.3089461	-89.1428851	2.40ft		
47	36	3.00	42.3090023	-89.142847	1.15ft	182+00	23.3524
48	34	2.83	42.3090619	-89.1428017	0.74ft	181+50	19.9744
49	39	3.25	42.3091294	-89.1427509	1.56ft		
50	46	3.83	42.3091897	-89.142708	0.85ft	181+00	16.8353
51	52	4.33	42.3092453	-89.1426563	1.31ft		
52	57	4.75	42.3093012	-89.1426008	2.40ft		
53	59	4.92	42.3093612	-89.1425511	1.14ft	180+50	17.1032
54	59	4.92	42.3094189	-89.1424893	1.42ft	180+00	18.7295
55	57	4.75	42.3094722	-89.142431	1.07ft		
56	58	4.83	42.3095252	-89.1423754	1.34ft	179+50	20.8928
57	56	4.67	42.3095829	-89.1423203	1.30ft		
59	58	4.83	42.3096352	-89.1422598	1.96ft	179+00	20.9557
60	58	4.83	42.3097013	-89.1421992	1.34ft		
61	59	4.92	42.3097614	-89.1421341	1.64ft	178+50	24.3788
62	57	4.75	42.3098154	-89.1420636	2.76ft		
63	59	4.92	42.3098867	-89.1419947	2.96ft	178+00	23.6317
64	59	4.92	42.3099569	-89.1419174	1.85ft		
65	64	5.33	42.3100192	-89.1418432	4.07ft	177+50	25.1311
66	59	4.92	42.3100841	-89.1417718	1.40ft	177+00	24.675
67	53	4.42	42.3101561	-89.1416914	1.62ft		
68	51	4.25	42.3102199	-89.1416124	0.79ft	176+50	26.7937
69	50	4.17	42.3102842	-89.141531	0.87ft	176+00	27.6887
70	48	4.00	42.3103489	-89.1414542	0.76ft		
71	48	4.00	42.310412	-89.141374	0.65ft	175+50	29.111
72	49	4.08	42.3104735	-89.1412923	0.64ft		
73	49	4.08	42.3105318	-89.1412116	0.99ft	175+00	30.5191
74	44	3.67	42.3105914	-89.1411346	1.03ft	174+50	31.1217

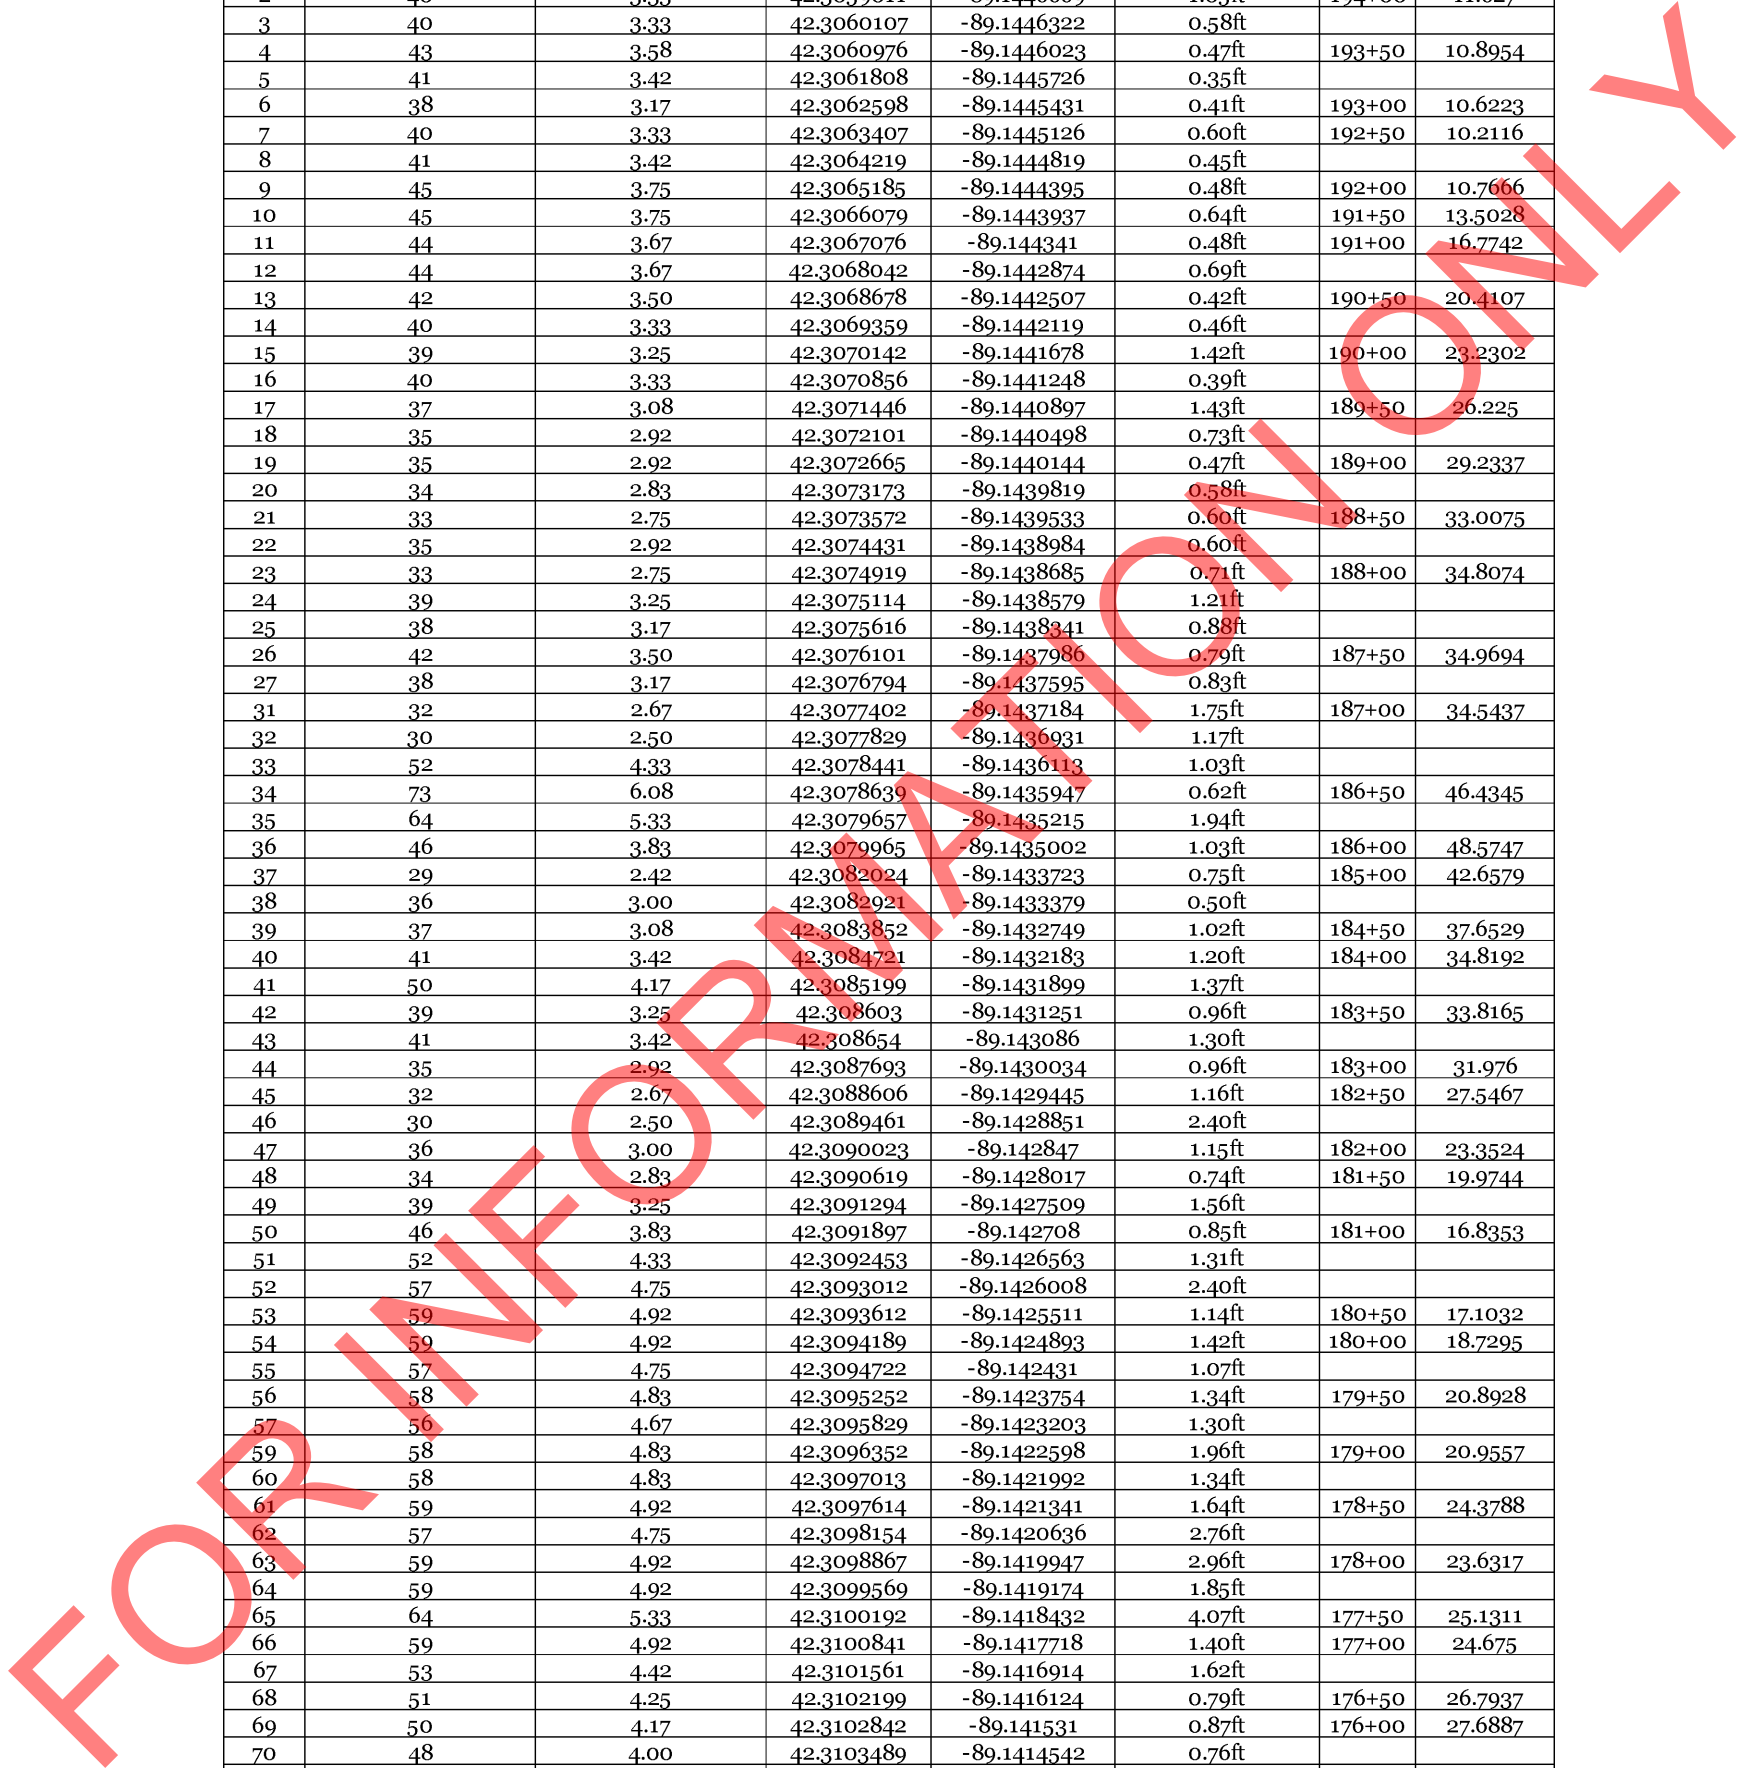

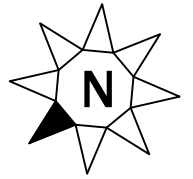

COUNTY:  
WINNEBAGO

MUNICIPALITY:  
CITY OF ROCKFORD

TOWN:  
44N

RANGE:  
1E

SECTION:  
5 & 8

ROAD NAME:  
SPRINGFIELD AVENUE




IDOT PROJECT ID #: C-92-104-23

PROJECT NAME:  
CONFLICT REVIEW - KENT  
CREEK NORTH FORK BRIDGE  
REPLACEMENT


REVIEW DATE: 7/2024

WIN PROJECT ENGINEER  
KEN WHITING  
920-376-2996  
ken.whiting@wintechology.com

WIN CONST COORDINATOR  
MIKE FERM  
515-493-6014  
mike.ferm@wintechology.com

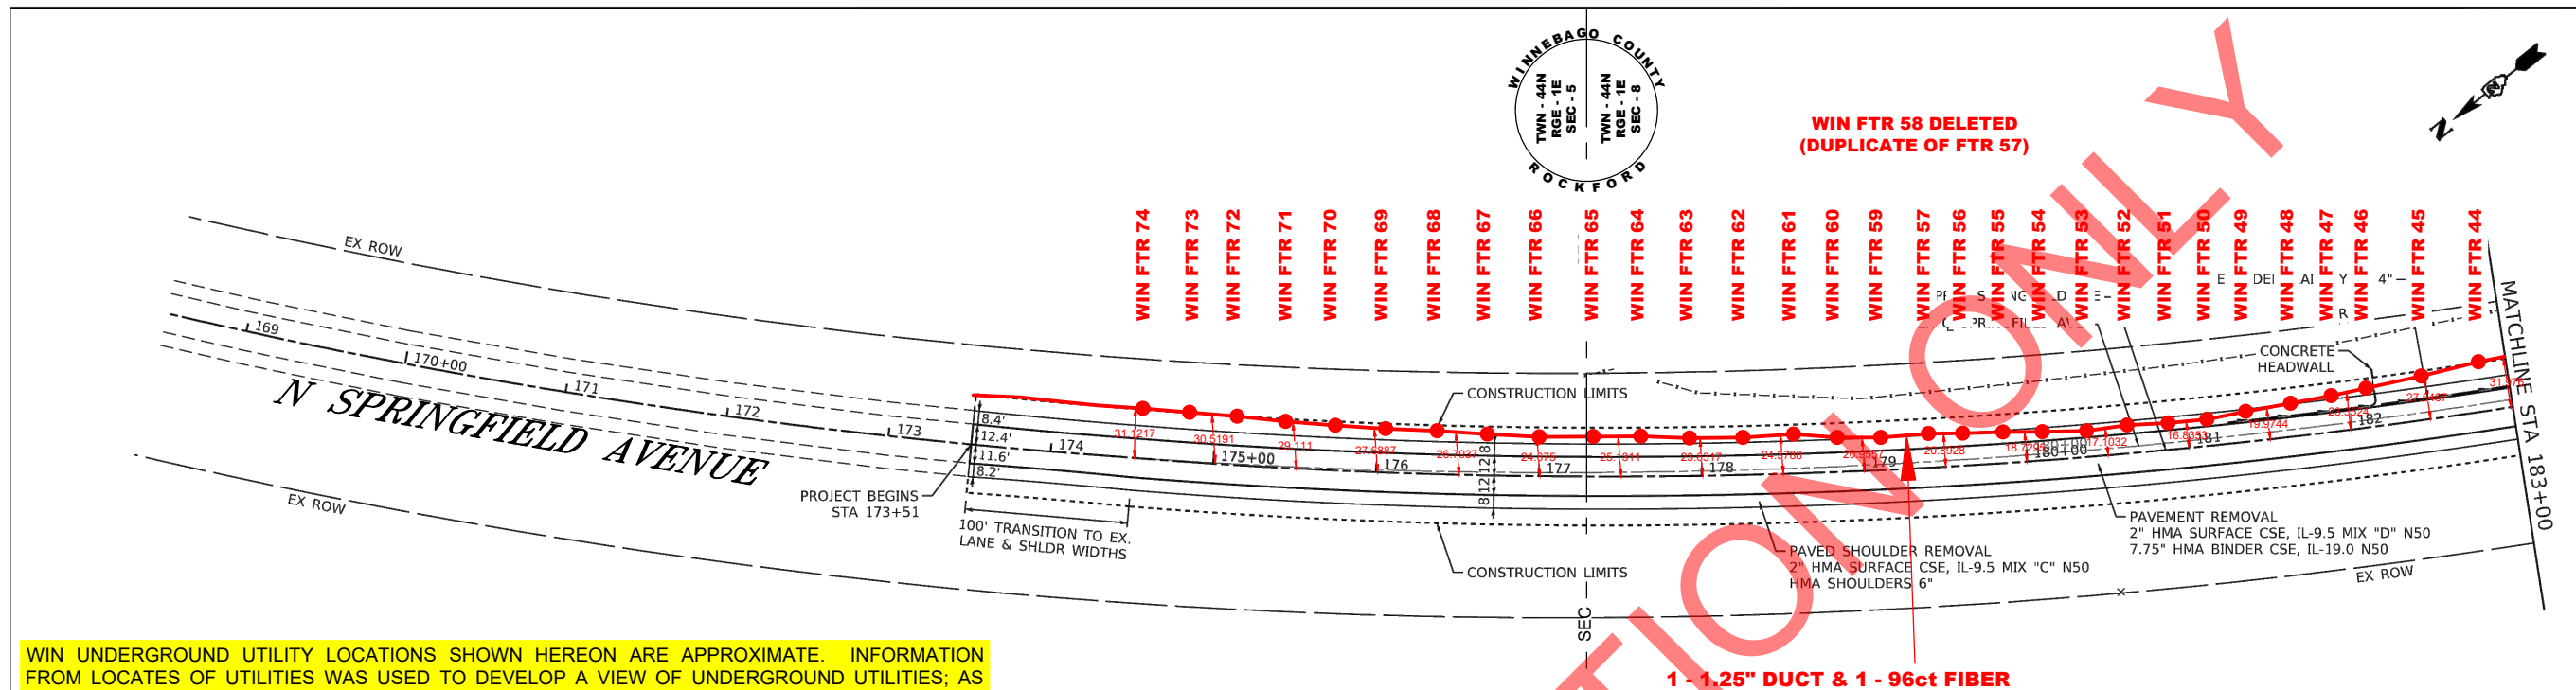

WIN UNDERGROUND UTILITY LOCATIONS SHOWN HEREON ARE APPROXIMATE. INFORMATION FROM LOCATES OF UTILITIES WAS USED TO DEVELOP A VIEW OF UNDERGROUND UTILITIES; AS SUCH, THE EXACT LOCATION OF UNDERGROUND FEATURES CANNOT BE ACCURATELY, COMPLETELY, OR RELIABLY DEPICTED VIA LOCATES. CONSTRUCTION CONTRACTOR IS RESPONSIBLE FOR THE EXACT LOCATION OF UTILITIES; COMPLETE REPAIR OF ANY AND ALL DAMAGES INCURRED SHALL BE AT THE EXPENSE OF THE CONTRACTOR.

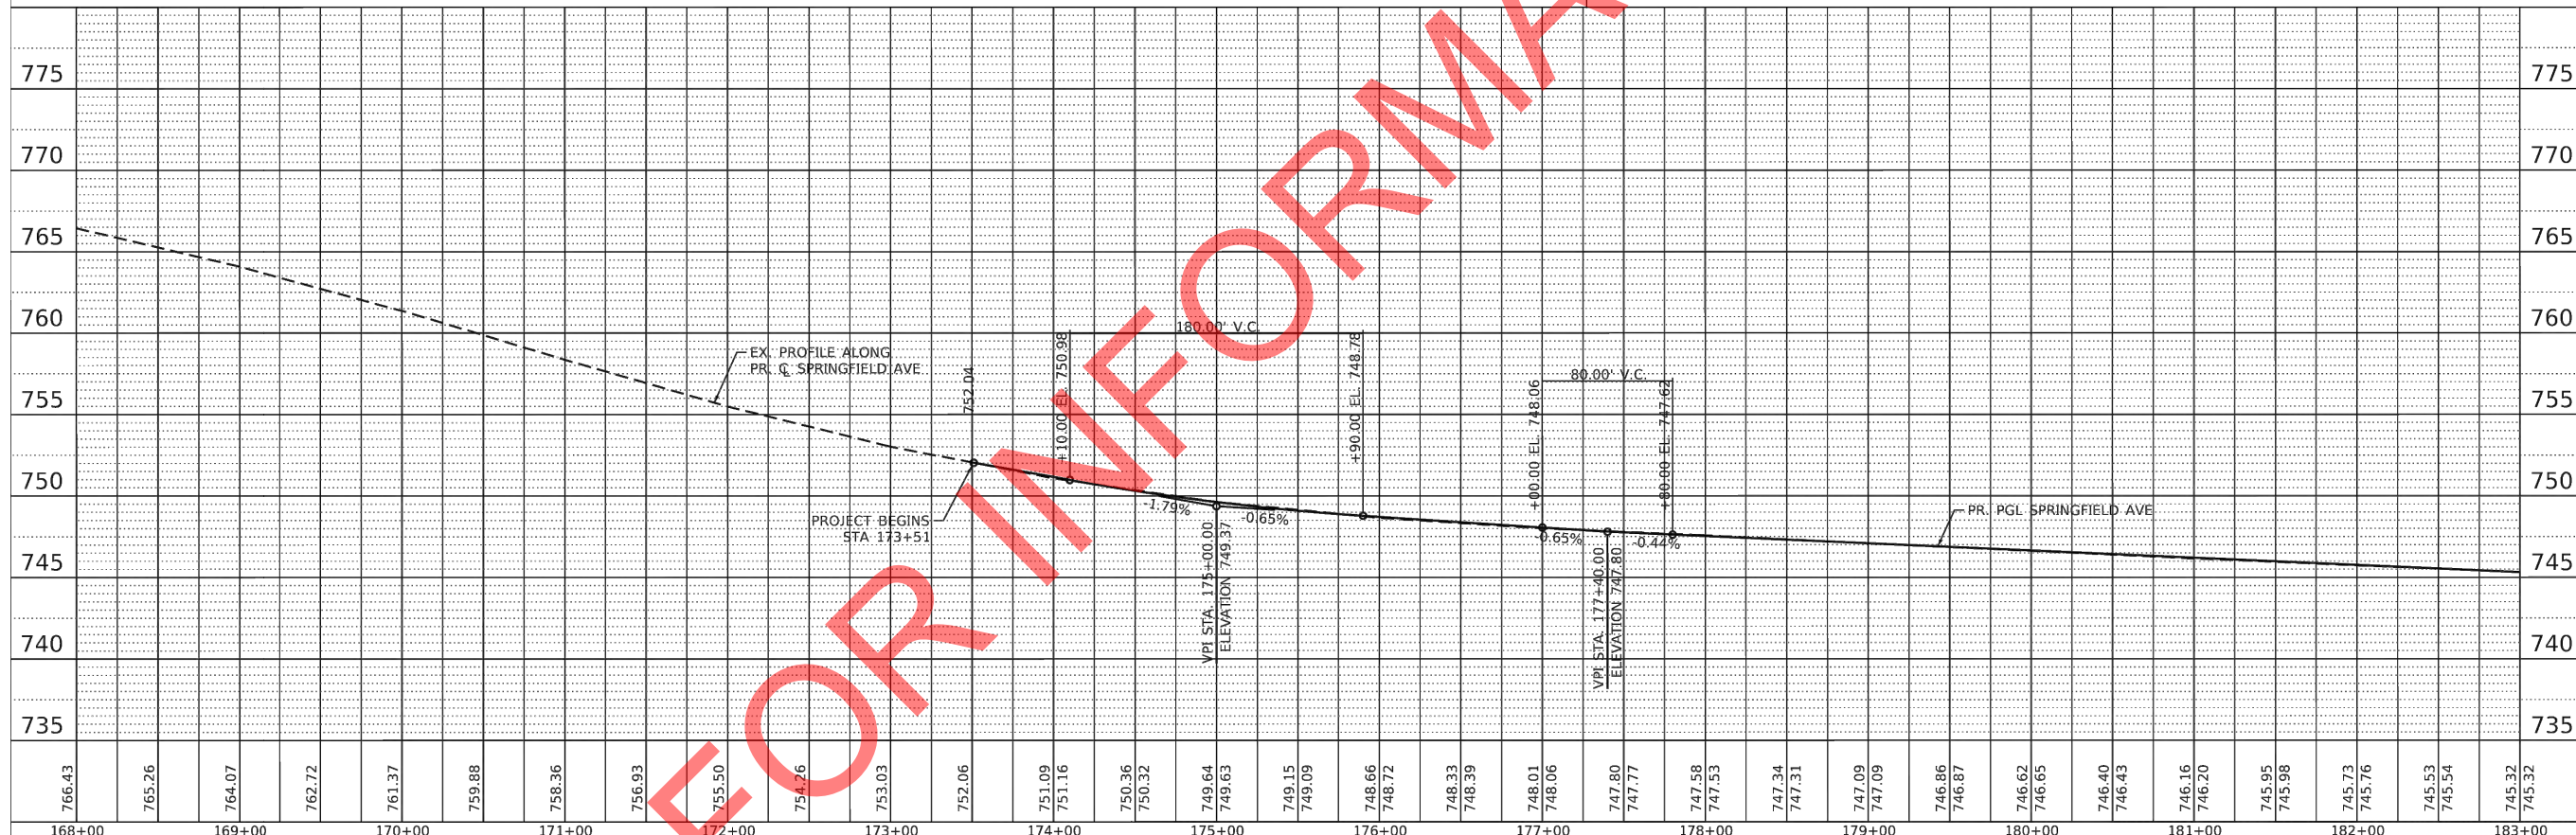


766.43	765.26	764.07	762.72	761.37	759.88	758.36	756.93	755.50	754.26	753.03	752.06	751.09	751.16	750.36	750.32	749.64	749.63	749.15	749.09	748.66	748.72	748.33	748.39	748.01	748.06	747.80	747.77	747.58	747.53	747.34	747.31	747.09	747.09	746.86	746.87	746.62	746.65	746.40	746.43	746.16	746.20	745.95	745.98	745.73	745.76	745.53	745.54	745.32	745.32
168+00	169+00	170+00	171+00	172+00	173+00	174+00	175+00	176+00	177+00	178+00	179+00	180+00	181+00	182+00	183+00																																		

<p>BLA, Inc. ITASCA, ILLINOIS</p>	USER NAME = WTeng	DESIGNED - WT	REVISED -	<p>STATE OF ILLINOIS DEPARTMENT OF TRANSPORTATION</p>	<p>PLAN AND PROFILE SPRINGFIELD AVENUE</p>	F.A.P. RTE. = 525	SECTION = 111BR	COUNTY = WINNEBAGO	TOTAL SHEETS = 76	SHEET NO. = 14
	PLOT SCALE = 100.0000' / in.	CHECKED - JPO	REVISED -			SCALE: 1" = 50'	SHEET 1 OF 2 SHEETS	STA. 168+50 TO STA. 183+00	ILLINOIS FED. AID PROJECT	
PLOT DATE = 1/13/2024	DATE = 7/31/2023	REVISED -	REVISED -			CONTRACT NO. 64P06				

CONFLICT REVIEW PLAN SET



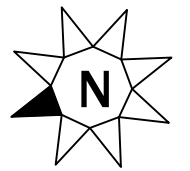

COUNTY:  
WINNEBAGO

MUNICIPALITY:  
CITY OF ROCKFORD

TOWN:  
44N

RANGE:  
1E

SECTION:  
8

ROAD NAME:  
SPRINGFIELD AVENUE





IDOT PROJECT ID #: C-92-104-23

PROJECT NAME:  
CONFLICT REVIEW - KENT  
CREEK NORTH FORK BRIDGE  
REPLACEMENT

REVIEW DATE: 7/2024

WIN PROJECT ENGINEER  
KEN WHITING  
920-376-2996  
ken.whiting@wintechology.com

WIN CONST COORDINATOR  
MIKE FERM  
515-493-6014  
mike.ferm@wintechology.com

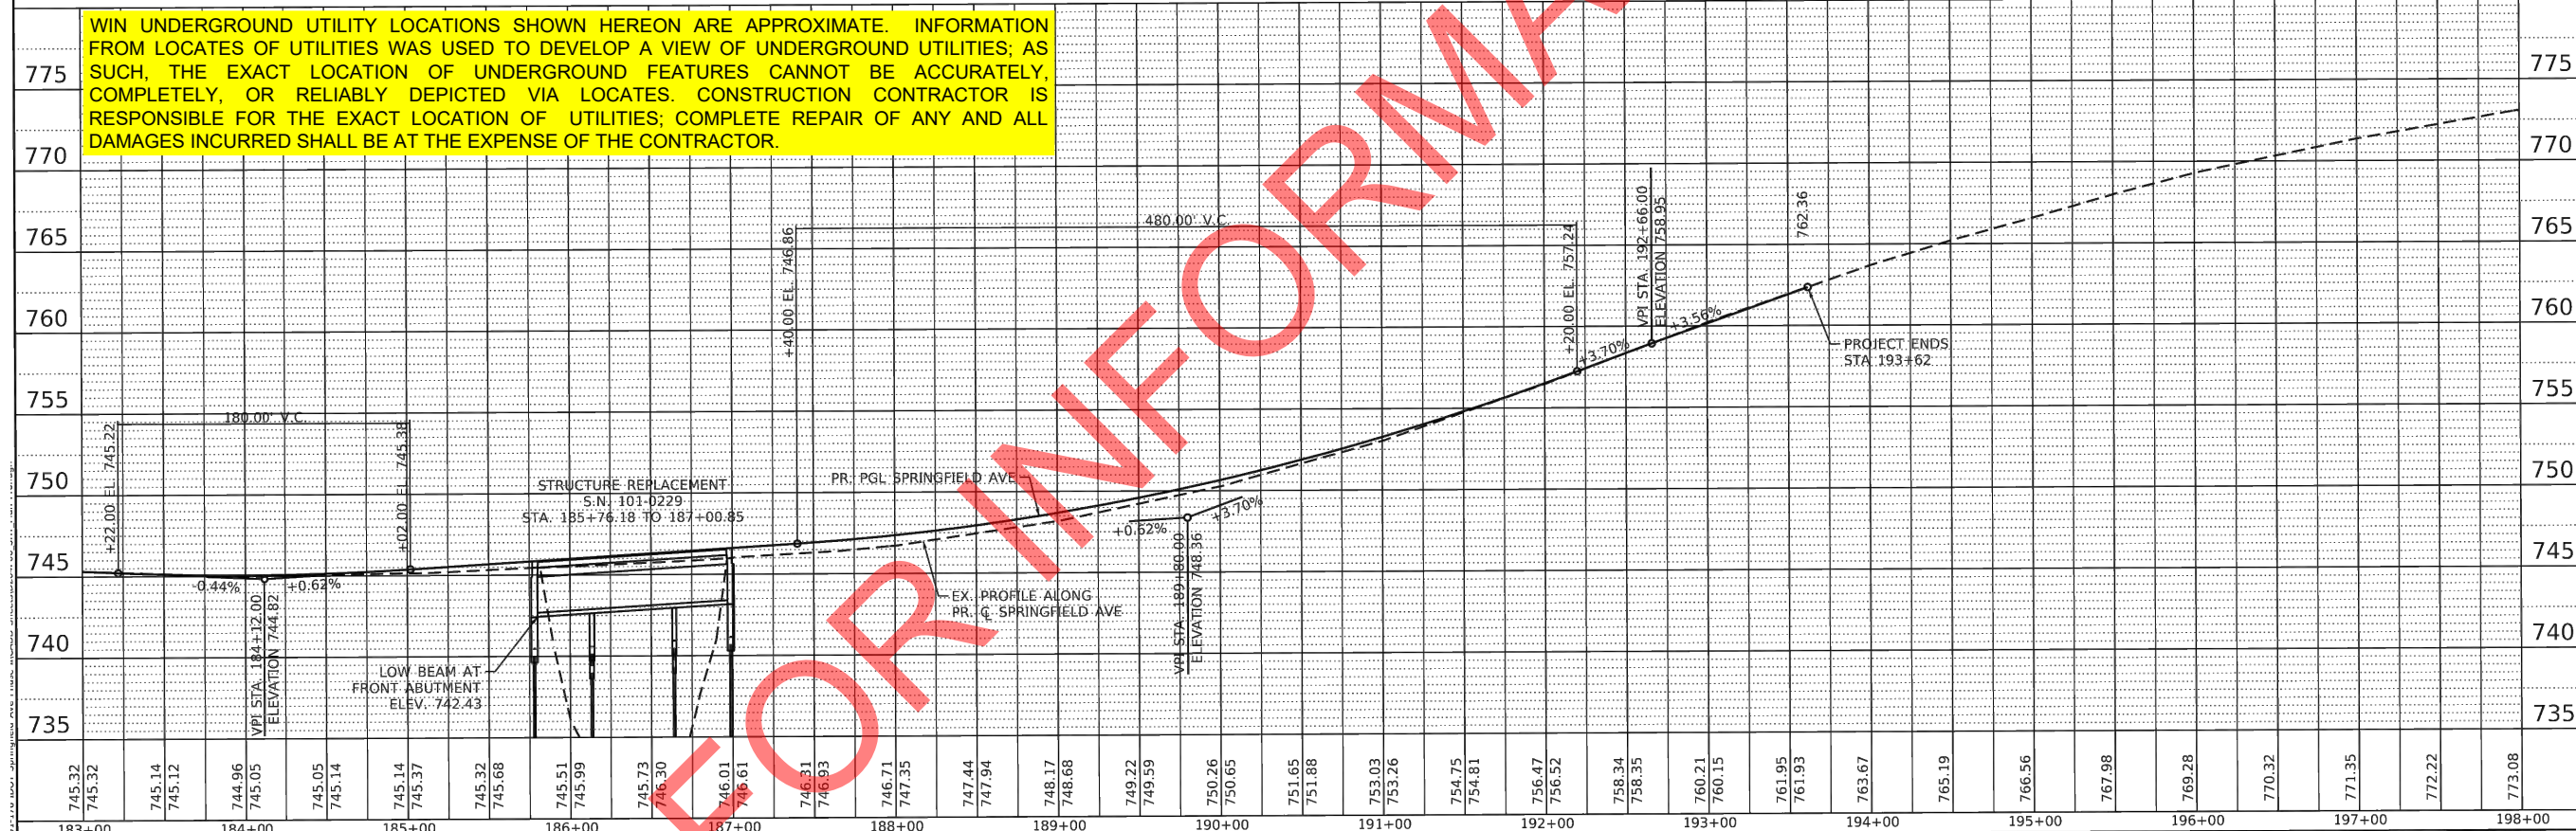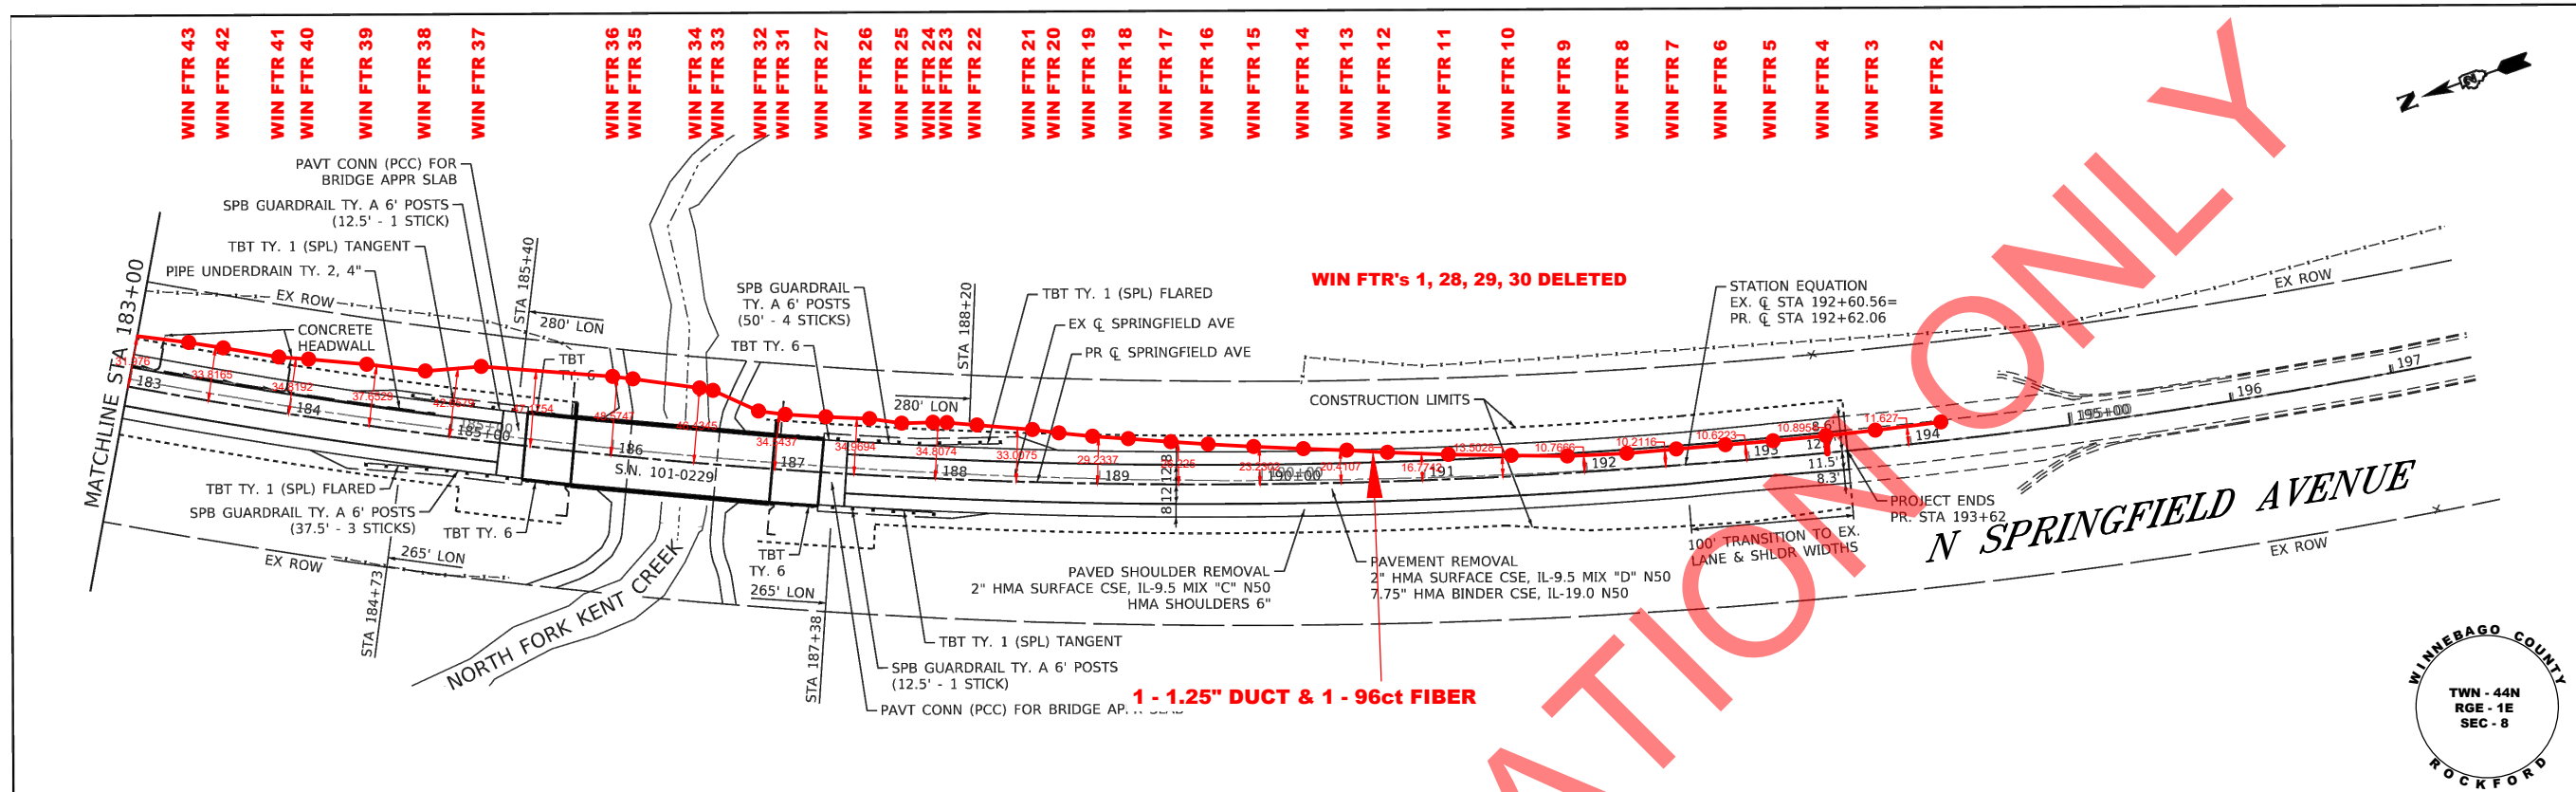


745.32	745.32	745.14	745.12	744.96	745.05	745.05	745.14	745.14	745.37	745.32	745.68	745.51	745.99	745.73	746.30	746.01	746.61	746.31	746.93	746.71	747.35	747.44	747.94	748.17	748.68	749.22	749.59	750.26	750.65	751.65	751.88	753.03	753.26	754.75	754.81	756.47	756.52	758.34	758.35	760.21	760.15	761.95	761.93	763.67	765.19	766.56	767.98	769.28	770.32	771.35	772.22	773.08
183+00	184+00	185+00	186+00	187+00	188+00	189+00	190+00	191+00	192+00	193+00	194+00	195+00	196+00	197+00	198+00																																					

<p>BLA, Inc. ITASCA, ILLINOIS</p>	USER NAME = WTeng	DESIGNED - WT	REVISED -	<p><b>STATE OF ILLINOIS</b> <b>DEPARTMENT OF TRANSPORTATION</b></p> <p><b>PLAN AND PROFILE</b> <b>SPRINGFIELD AVENUE</b></p>	F.A.P. RTE. = 525	SECTION = 111BR	COUNTY = WINNEBAGO	TOTAL SHEETS = 76	SHEET NO. = 15
	PLOT SCALE = 100.0000' / in.	CHECKED - JPO	REVISED -		SCALE: 1" = 50'	SHEET 2 OF 2 SHEETS	STA. 183+00 TO STA. 197+50	ILLINOIS FED. AID PROJECT	CONTRACT NO. 64P06
	PLOT DATE = 1/15/2024	DATE = 7/31/2023	REVISED -						

CONFLICT REVIEW PLAN SET



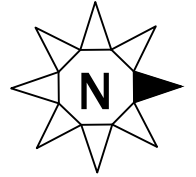

COUNTY:  
WINNEBAGO  
MUNICIPALITY:  
CITY OF ROCKFORD

TOWN:  
44N

RANGE:  
1E

SECTION:  
8

ROAD NAME:  
SPRINGFIELD AVENUE




IDOT PROJECT ID #: C-92-104-23

PROJECT NAME:  
CONFLICT REVIEW - KENT  
CREEK NORTH FORK BRIDGE  
REPLACEMENT

REVIEW DATE: 7/2024

WIN PROJECT ENGINEER  
KEN WHITING  
920-376-2996  
ken.whiting@wintechology.com

WIN CONST COORDINATOR  
MIKE FERM  
515-493-6014  
mike.ferm@wintechology.com

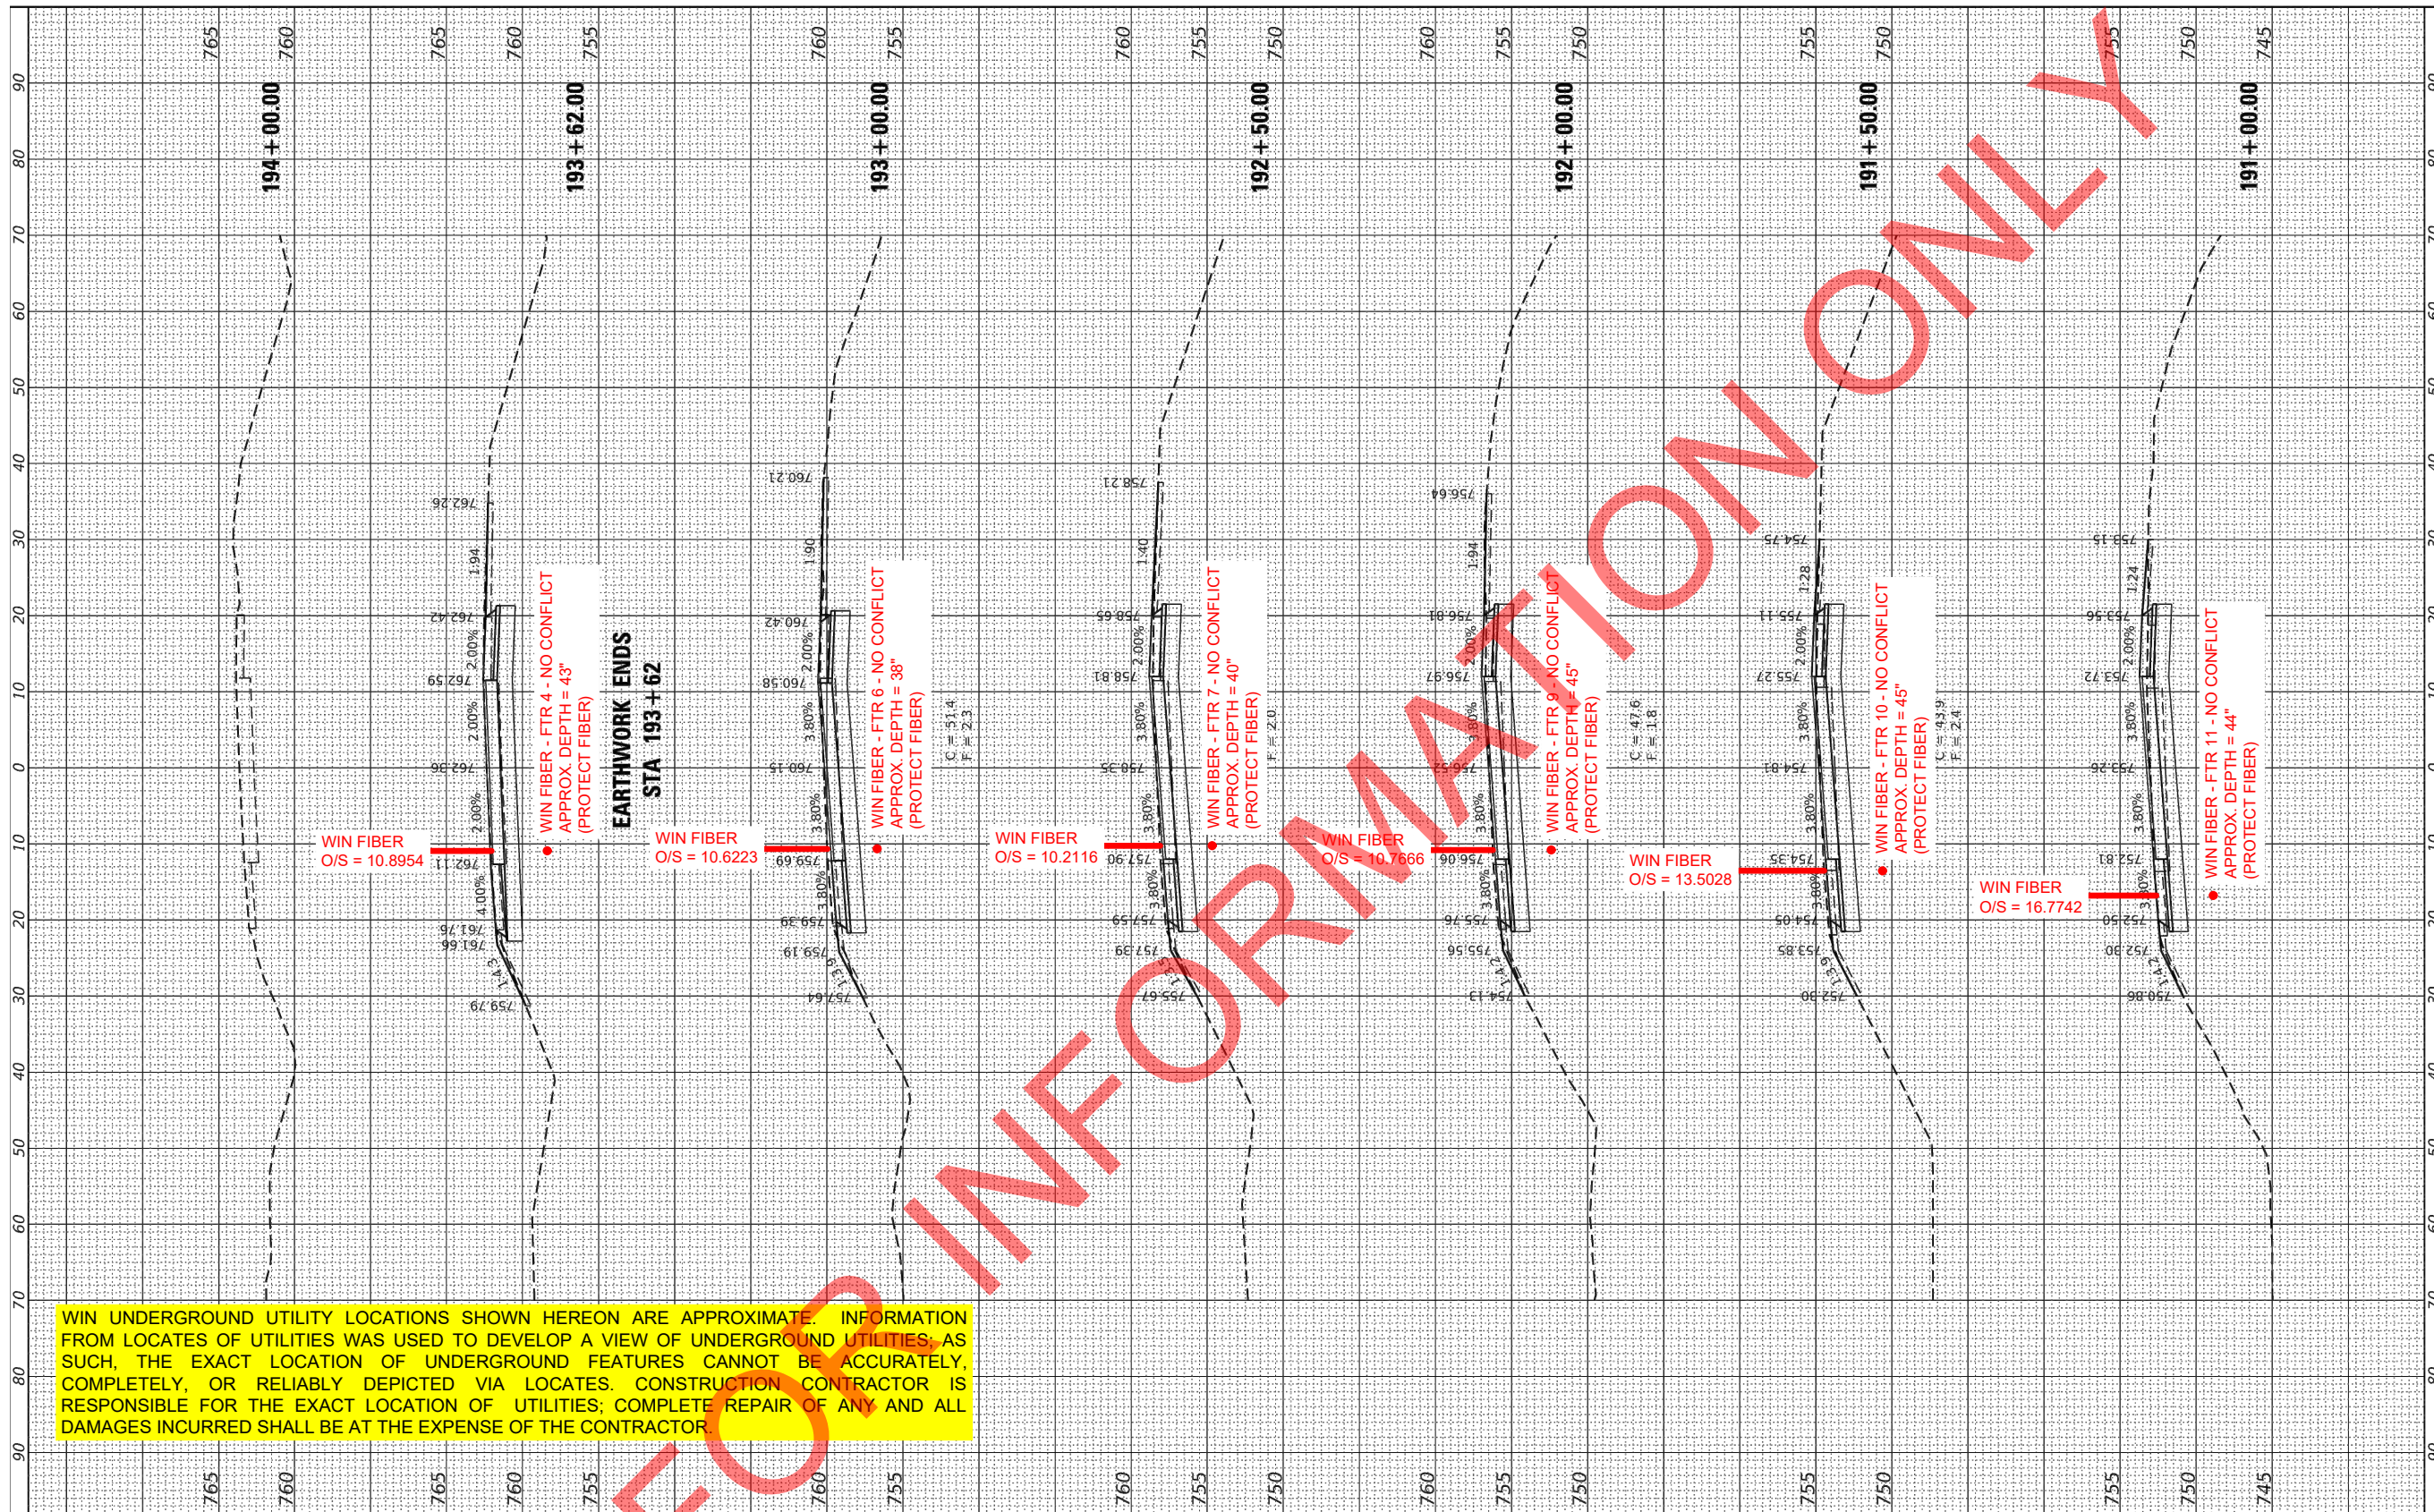

WIN UNDERGROUND UTILITY LOCATIONS SHOWN HEREON ARE APPROXIMATE. INFORMATION FROM LOCATES OF UTILITIES WAS USED TO DEVELOP A VIEW OF UNDERGROUND UTILITIES; AS SUCH, THE EXACT LOCATION OF UNDERGROUND FEATURES CANNOT BE ACCURATELY, COMPLETELY, OR RELIABLY DEPICTED VIA LOCATES. CONSTRUCTION CONTRACTOR IS RESPONSIBLE FOR THE EXACT LOCATION OF UTILITIES; COMPLETE REPAIR OF ANY AND ALL DAMAGES INCURRED SHALL BE AT THE EXPENSE OF THE CONTRACTOR.




USER NAME = WTeng	DESIGNED - WT	REVISED -
	DRAWN - WT	REVISED -
PLOT SCALE = 20.0000' / in.	CHECKED - JPO	REVISED -
PLOT DATE = 1/15/2024	DATE = 7/31/2023	REVISED -

STATE OF ILLINOIS  
DEPARTMENT OF TRANSPORTATION

CROSS SECTIONS SPRINGFIELD AVENUE		F.A.P RTE. 525	SECTION 111BR	COUNTY WINNEBAGO	TOTAL SHEETS 76	SHEET NO. 76
SCALE: 1:10H, 1:5V		SHEET 7 OF 7 SHEETS		CONTRACT NO. 64P06		
TO STA.		ILLINOIS FED. AID PROJECT				

CONFLICT REVIEW PLAN SET



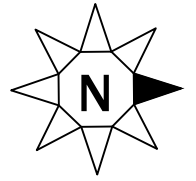

COUNTY:  
WINNEBAGO  
MUNICIPALITY:  
CITY OF ROCKFORD

TOWN:  
44N

RANGE:  
1E

SECTION:  
8

ROAD NAME:  
SPRINGFIELD AVENUE




IDOT PROJECT ID #: C-92-104-23

PROJECT NAME:  
CONFLICT REVIEW - KENT  
CREEK NORTH FORK BRIDGE  
REPLACEMENT

REVIEW DATE: 7/2024

WIN PROJECT ENGINEER  
KEN WHITING  
920-376-2996  
ken.whiting@wintechnology.com

WIN CONST COORDINATOR  
MIKE FERM  
515-493-6014  
mike.ferm@wintechnology.com

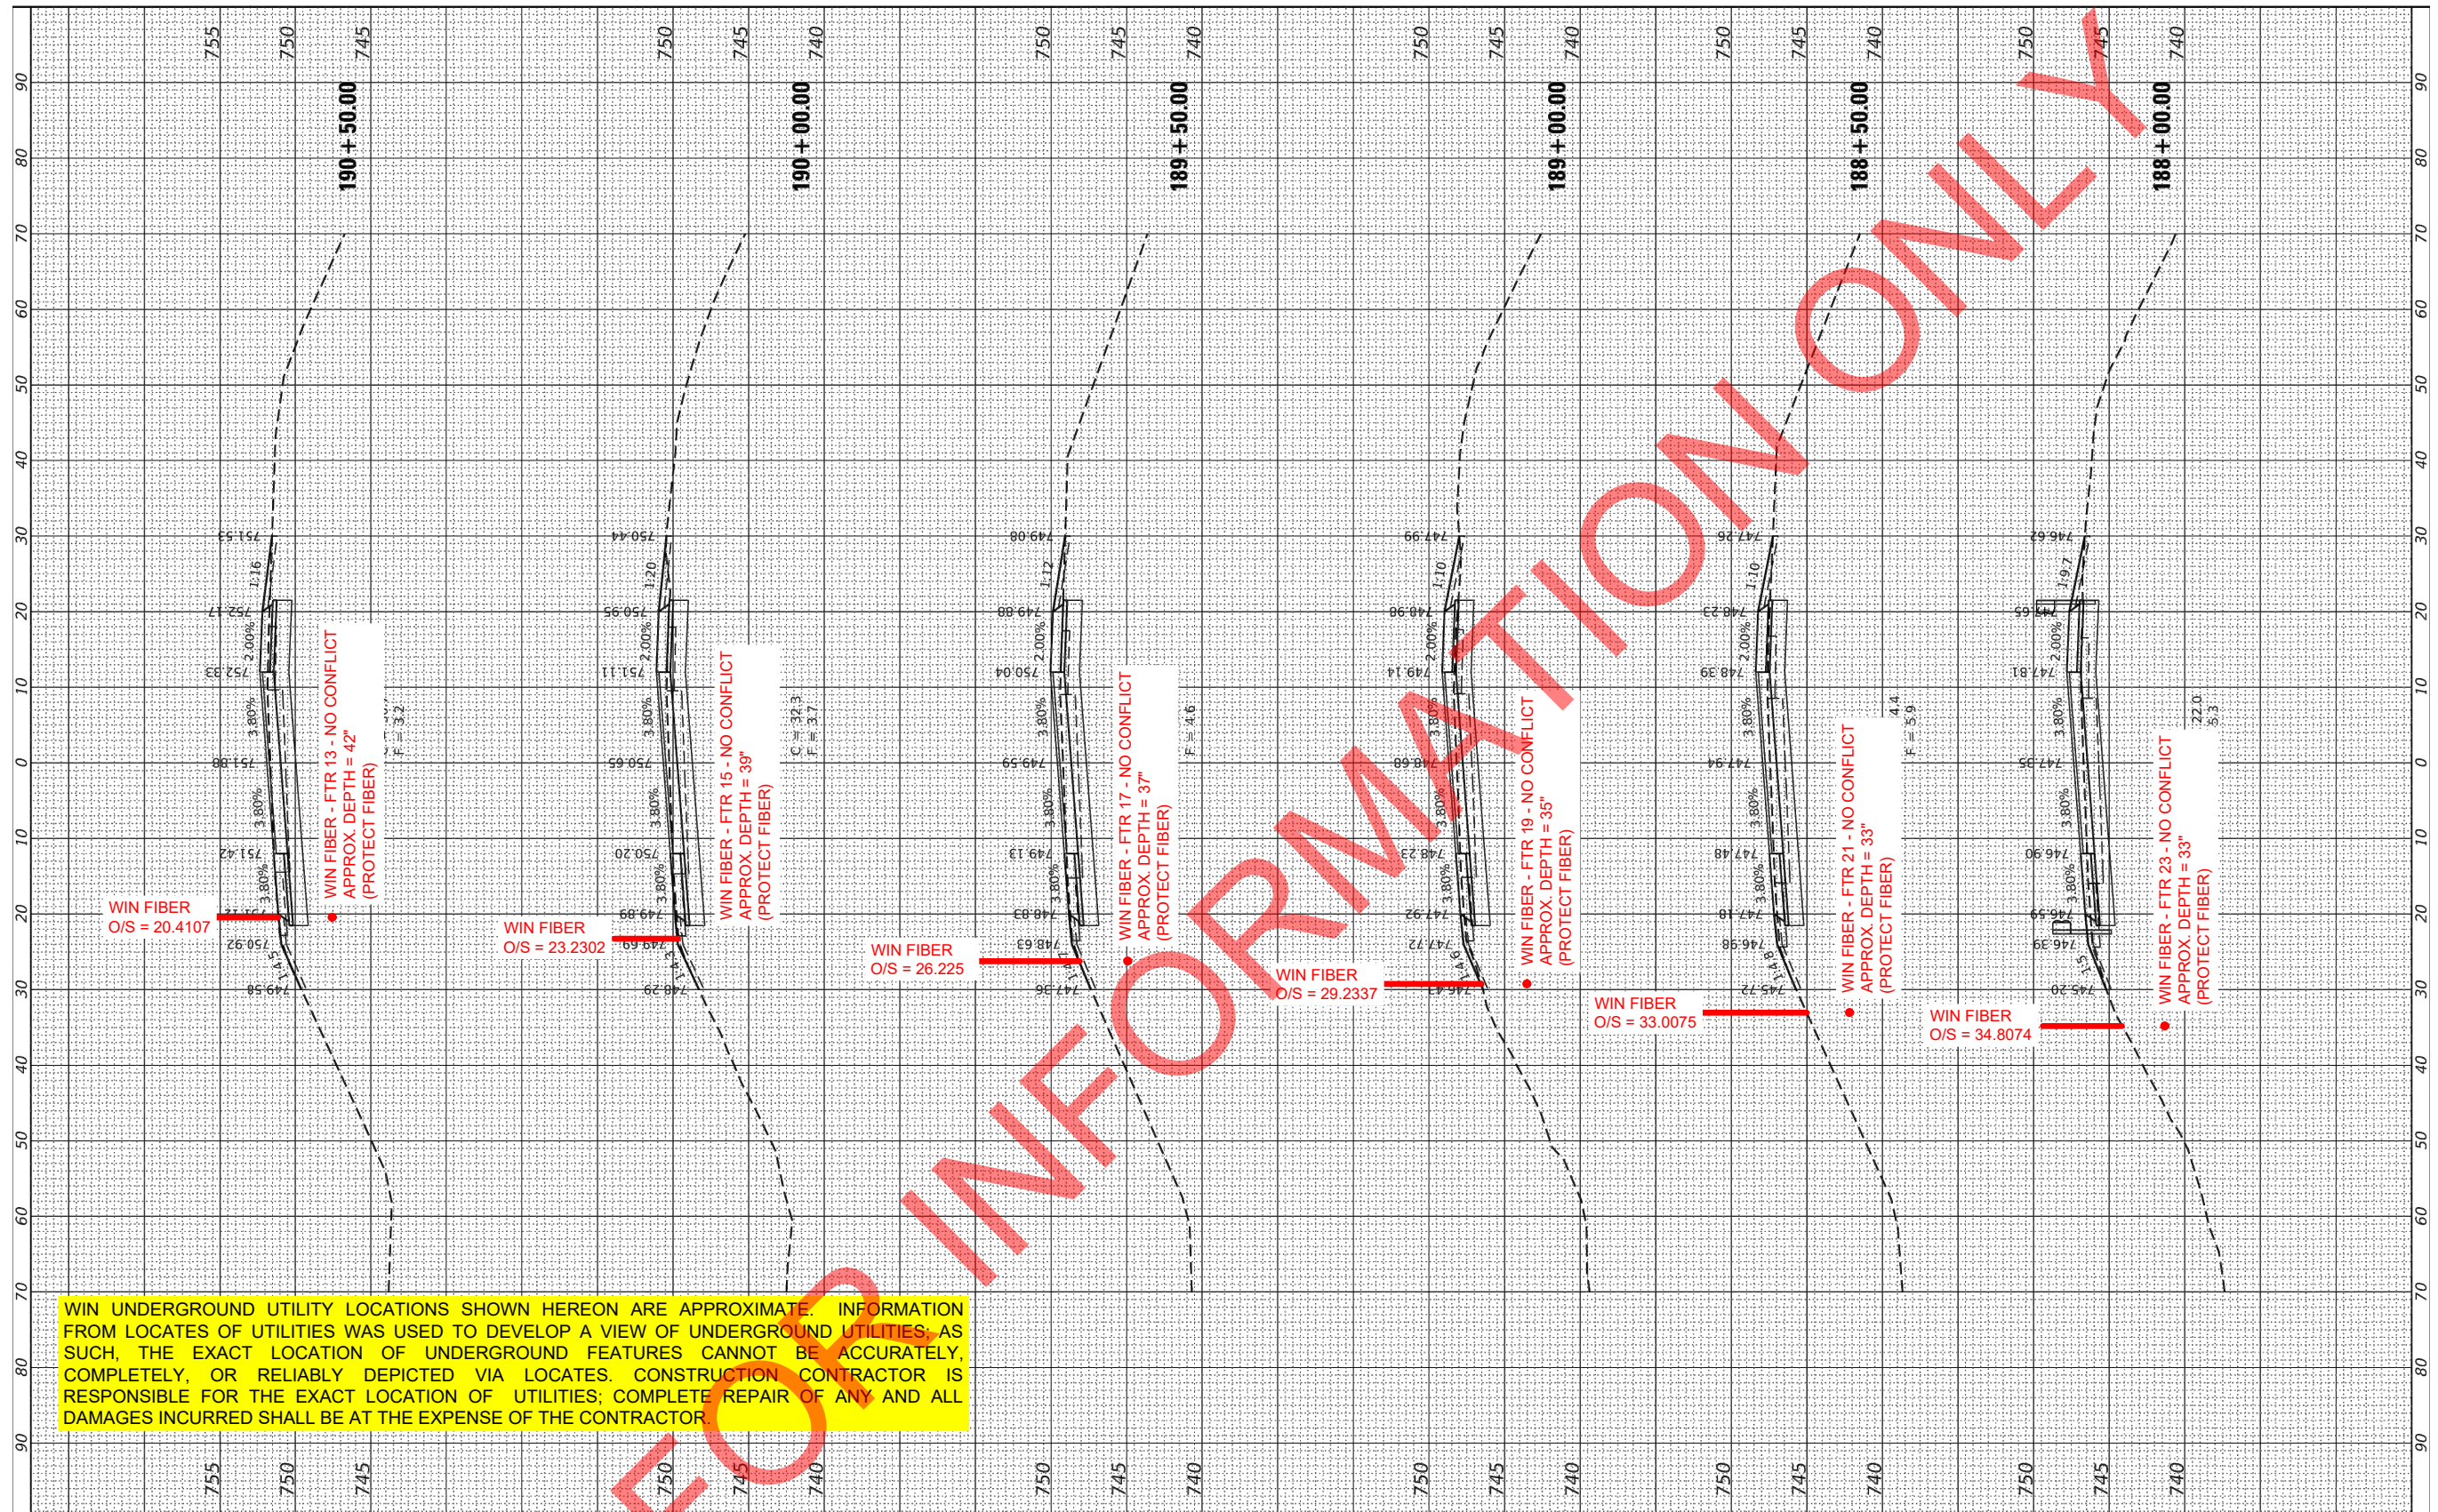

WIN UNDERGROUND UTILITY LOCATIONS SHOWN HEREON ARE APPROXIMATE. INFORMATION FROM LOCATES OF UTILITIES WAS USED TO DEVELOP A VIEW OF UNDERGROUND UTILITIES; AS SUCH, THE EXACT LOCATION OF UNDERGROUND FEATURES CANNOT BE ACCURATELY, COMPLETELY, OR RELIABLY DEPICTED VIA LOCATES. CONSTRUCTION CONTRACTOR IS RESPONSIBLE FOR THE EXACT LOCATION OF UTILITIES; COMPLETE REPAIR OF ANY AND ALL DAMAGES INCURRED SHALL BE AT THE EXPENSE OF THE CONTRACTOR.



USER NAME = WTeng	DESIGNED - WT	REVISED -
	DRAWN - WT	REVISED -
PLOT SCALE = 20.0000' / in.	CHECKED - JPO	REVISED -
PLOT DATE = 1/15/2024	DATE = 7/31/2023	REVISED -


STATE OF ILLINOIS  
DEPARTMENT OF TRANSPORTATION

CROSS SECTIONS  
SPRINGFIELD AVENUE  
SCALE: 1:10H, 1:5V SHEET 6 OF 7 SHEETS STA. TO STA.

F.A.P. RTE.	SECTION	COUNTY	TOTAL SHEETS	SHEET NO.
525	111BR	WINNEBAGO	76	75
			CONTRACT NO. 64P06	
ILLINOIS FED. AID PROJECT				

CONFLICT REVIEW PLAN SET



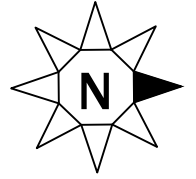

COUNTY:  
WINNEBAGO

MUNICIPALITY:  
CITY OF ROCKFORD

TOWN:  
44N

RANGE:  
1E

SECTION:  
8

ROAD NAME:  
SPRINGFIELD AVENUE




IDOT PROJECT ID #: C-92-104-23

PROJECT NAME:  
CONFLICT REVIEW - KENT  
CREEK NORTH FORK BRIDGE  
REPLACEMENT

REVIEW DATE: 7/2024

WIN PROJECT ENGINEER  
KEN WHITING  
920-376-2996  
ken.whiting@wintechnology.com

WIN CONST COORDINATOR  
MIKE FERM  
515-493-6014  
mike.ferm@wintechnology.com

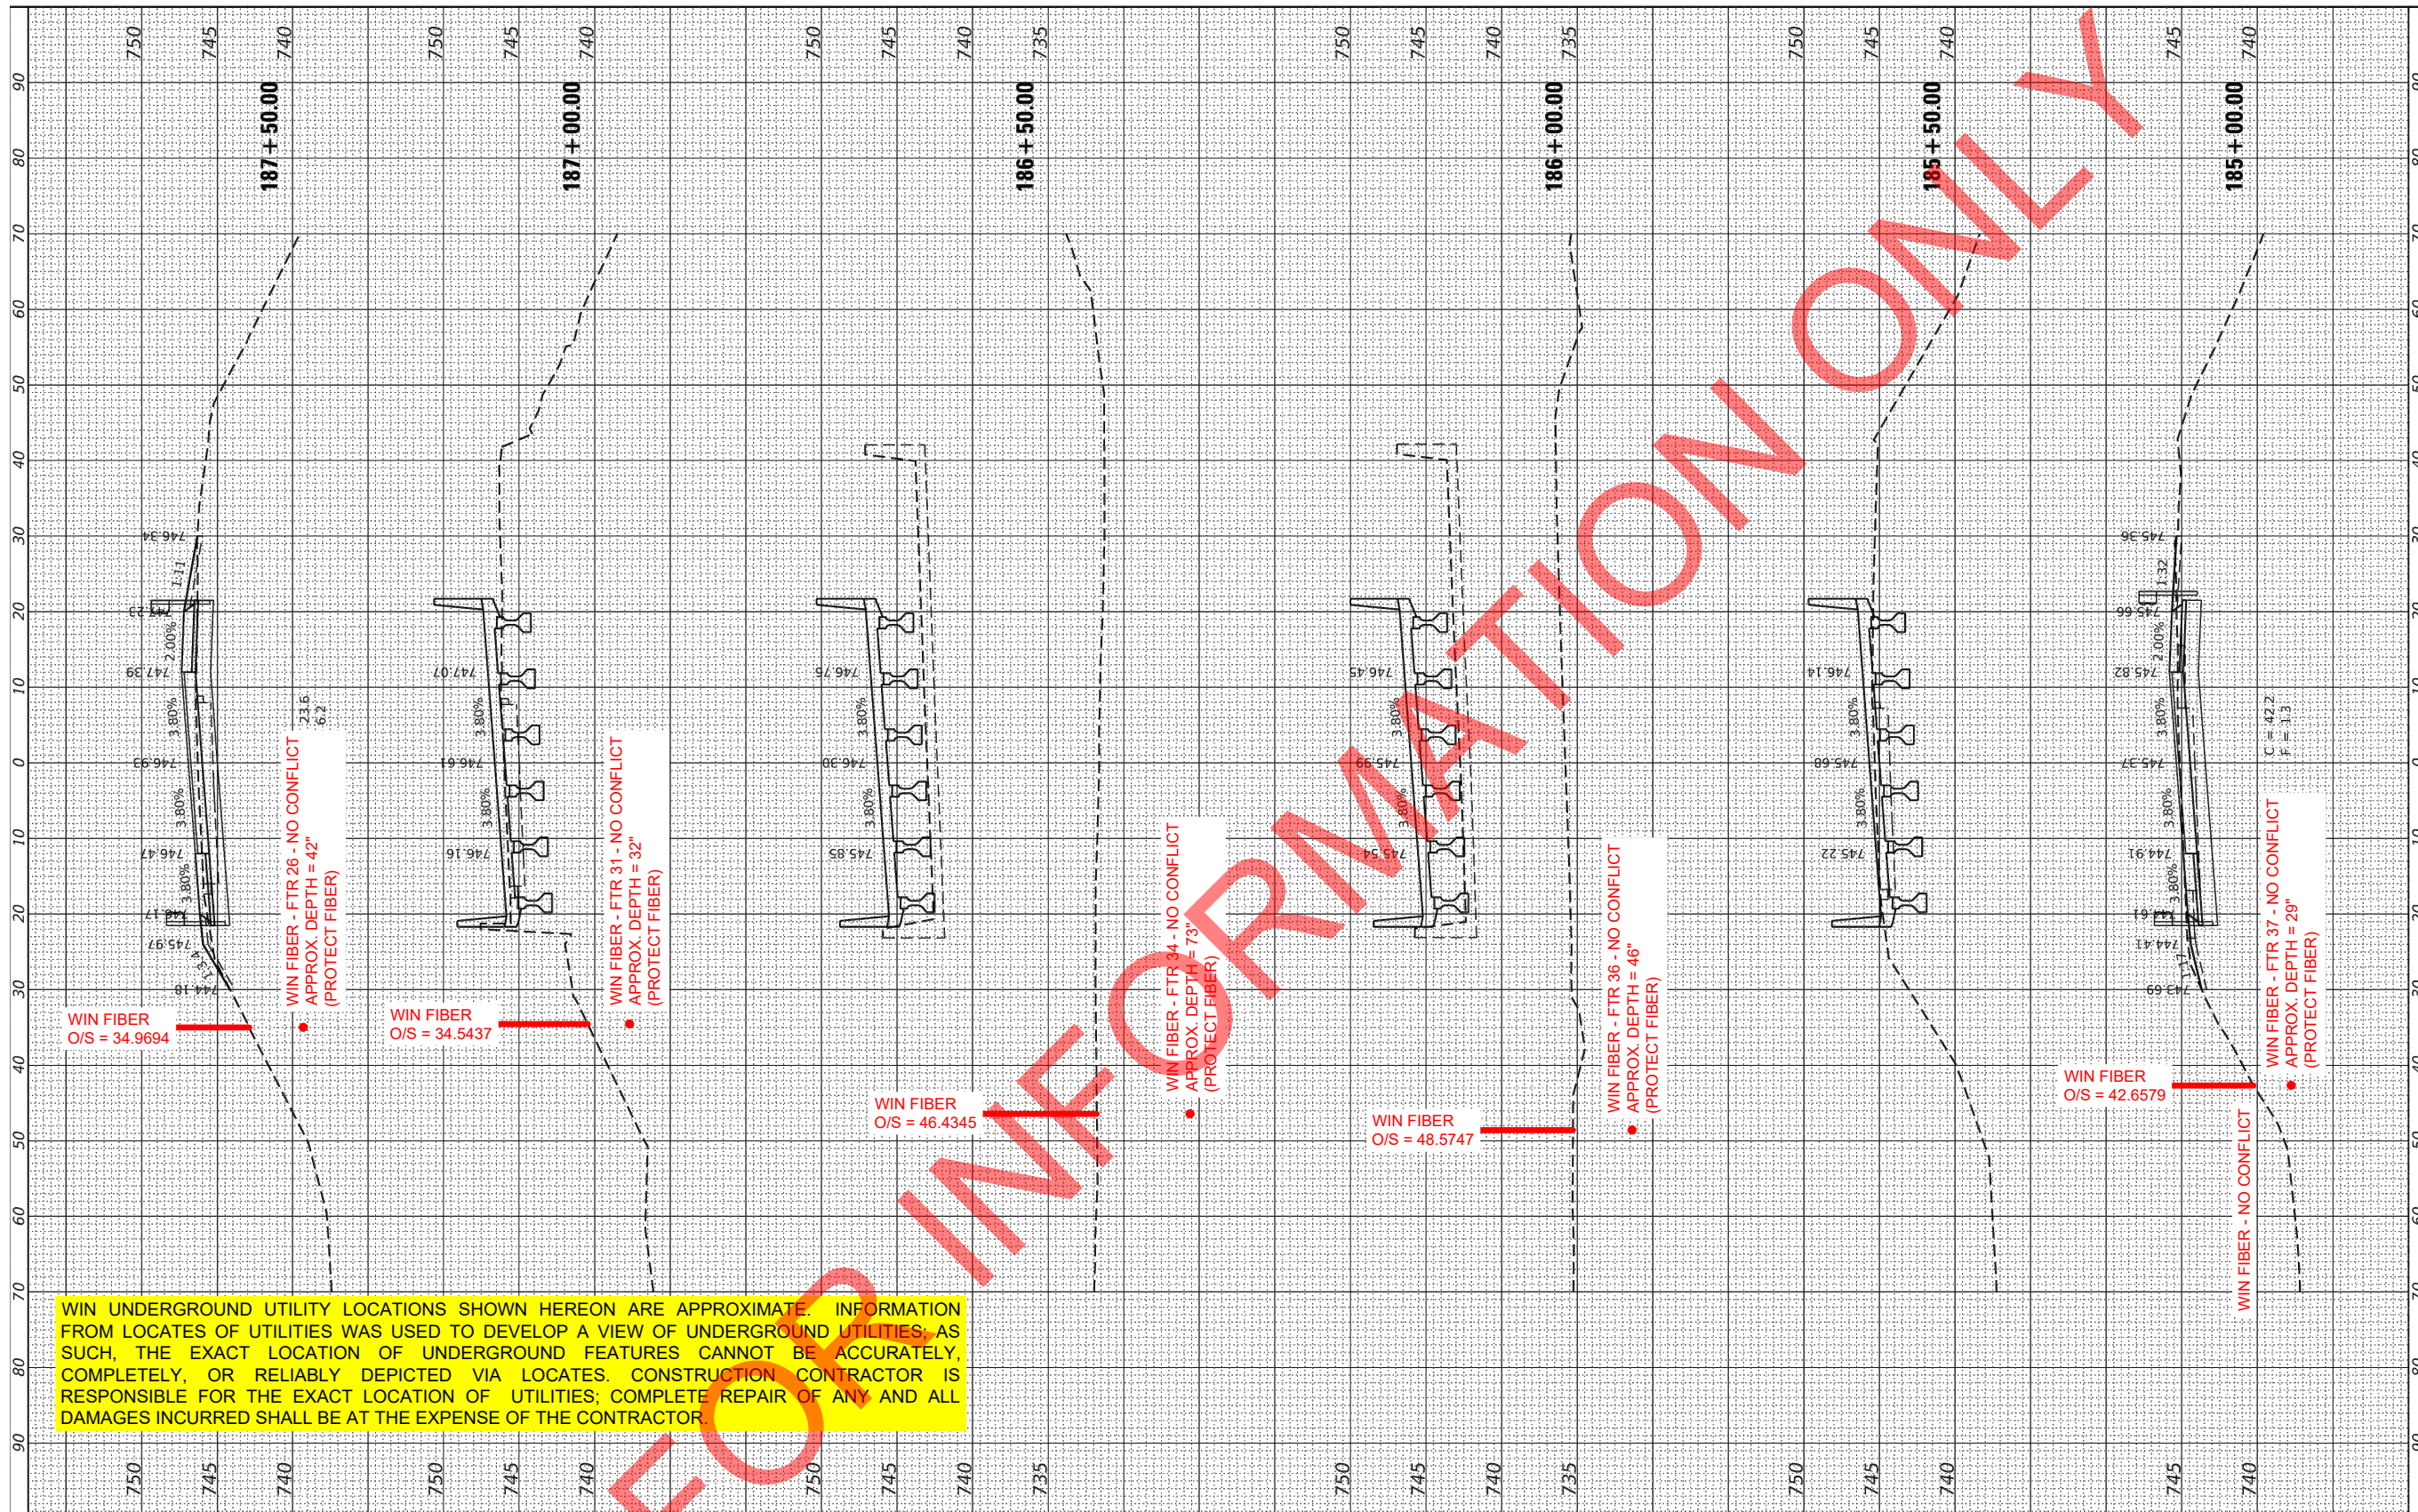

WIN UNDERGROUND UTILITY LOCATIONS SHOWN HEREON ARE APPROXIMATE. INFORMATION FROM LOCATES OF UTILITIES WAS USED TO DEVELOP A VIEW OF UNDERGROUND UTILITIES; AS SUCH, THE EXACT LOCATION OF UNDERGROUND FEATURES CANNOT BE ACCURATELY, COMPLETELY, OR RELIABLY DEPICTED VIA LOCATES. CONSTRUCTION CONTRACTOR IS RESPONSIBLE FOR THE EXACT LOCATION OF UTILITIES; COMPLETE REPAIR OF ANY AND ALL DAMAGES INCURRED SHALL BE AT THE EXPENSE OF THE CONTRACTOR.



USER NAME = WTeng	DESIGNED - WT	REVISED -
	DRAWN - WT	REVISED -
PLOT SCALE = 20.0000' / in.	CHECKED - JPO	REVISED -
PLOT DATE = 1/15/2024	DATE = 7/31/2023	REVISED -


STATE OF ILLINOIS  
DEPARTMENT OF TRANSPORTATION

CROSS SECTIONS SPRINGFIELD AVENUE	
SCALE: 1:10H, 1:5V	SHEET 5 OF 7 SHEETS STA. TO STA.

F.A.P. RTE. 525	SECTION 111BR	COUNTY WINNEBAGO	TOTAL SHEETS 76	SHEET NO. 74
ILLINOIS FED. AID PROJECT			CONTRACT NO. 64P06	

CONFLICT REVIEW PLAN SET



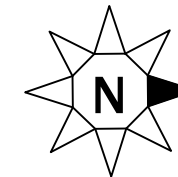

COUNTY:  
WINNEBAGO

MUNICIPALITY:  
CITY OF ROCKFORD

TOWN:  
44N

RANGE:  
1E

SECTION:  
8

ROAD NAME:  
SPRINGFIELD AVENUE




IDOT PROJECT ID #: C-92-104-23

PROJECT NAME:  
CONFLICT REVIEW - KENT  
CREEK NORTH FORK BRIDGE  
REPLACEMENT

REVIEW DATE: 7/2024

WIN PROJECT ENGINEER  
KEN WHITING  
920-376-2996  
ken.whiting@wintechology.com

WIN CONST COORDINATOR  
MIKE FERM  
515-493-6014  
mike.ferm@wintechology.com

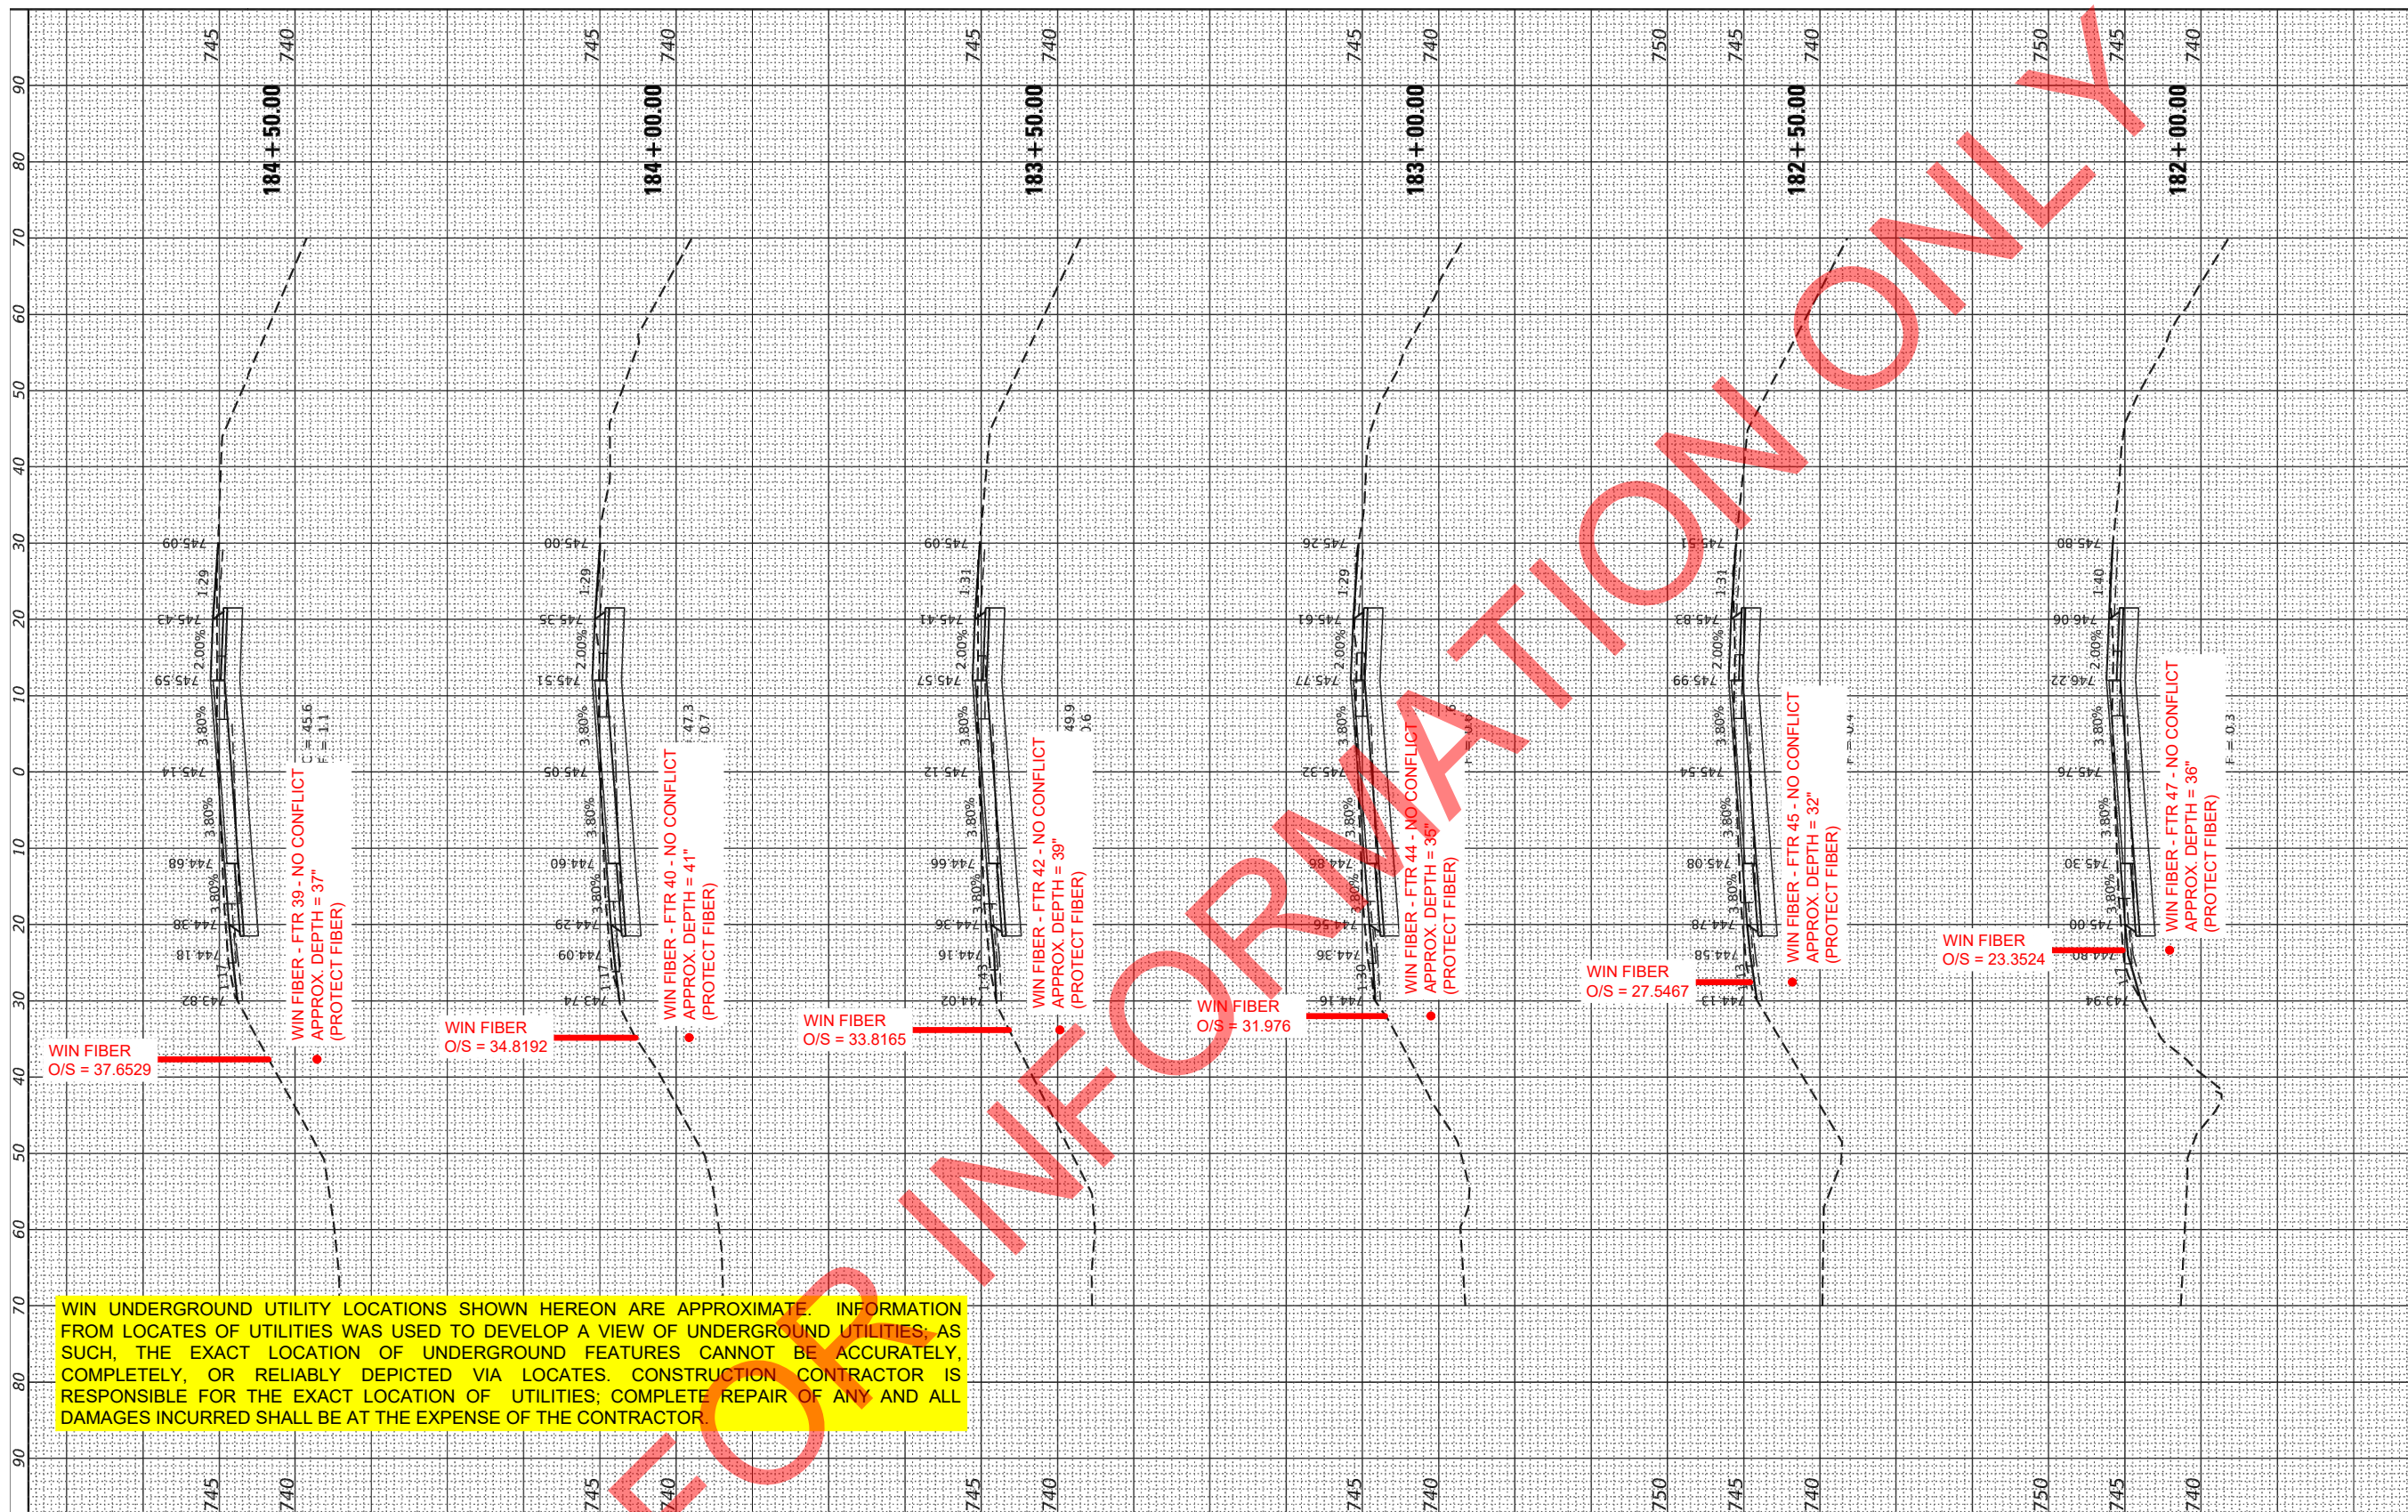

WIN UNDERGROUND UTILITY LOCATIONS SHOWN HEREON ARE APPROXIMATE. INFORMATION FROM LOCATES OF UTILITIES WAS USED TO DEVELOP A VIEW OF UNDERGROUND UTILITIES; AS SUCH, THE EXACT LOCATION OF UNDERGROUND FEATURES CANNOT BE ACCURATELY, COMPLETELY, OR RELIABLY DEPICTED VIA LOCATES. CONSTRUCTION CONTRACTOR IS RESPONSIBLE FOR THE EXACT LOCATION OF UTILITIES; COMPLETE REPAIR OF ANY AND ALL DAMAGES INCURRED SHALL BE AT THE EXPENSE OF THE CONTRACTOR.

<p>BLA, Inc. ITASCA, ILLINOIS</p>	USER NAME = Wfeng	DESIGNED - WT	REVISED -
	PLOT SCALE = 20.0000' / in.	DRAWN - WT	REVISED -
	PLOT DATE = 1/15/2024	CHECKED - JPO	REVISED -
		DATE - 7/31/2023	REVISED -

STATE OF ILLINOIS  
DEPARTMENT OF TRANSPORTATION


CROSS SECTIONS  
SPRINGFIELD AVENUE

SCALE: 1:10H, 1:5V SHEET 4 OF 7 SHEETS STA. TO STA.

F.A.P. RTE.	SECTION	COUNTY	TOTAL SHEETS	SHEETS NC
525	111BR	WINNEBAGO	76	7
CONTRACT NO. 64P06				
ILLINOIS FED. AID PROJECT				

CONFLICT REVIEW PLAN SET



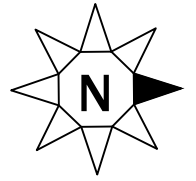

COUNTY:  
WINNEBAGO

MUNICIPALITY:  
CITY OF ROCKFORD

TOWN:  
44N

RANGE:  
1E

SECTION:  
8

ROAD NAME:  
SPRINGFIELD AVENUE




IDOT PROJECT ID #: C-92-104-23

PROJECT NAME:  
CONFLICT REVIEW - KENT  
CREEK NORTH FORK BRIDGE  
REPLACEMENT

REVIEW DATE: 7/2024

WIN PROJECT ENGINEER  
KEN WHITING  
920-376-2996  
ken.whiting@wintechnology.com

WIN CONST COORDINATOR  
MIKE FERM  
515-493-6014  
mike.ferm@wintechnology.com

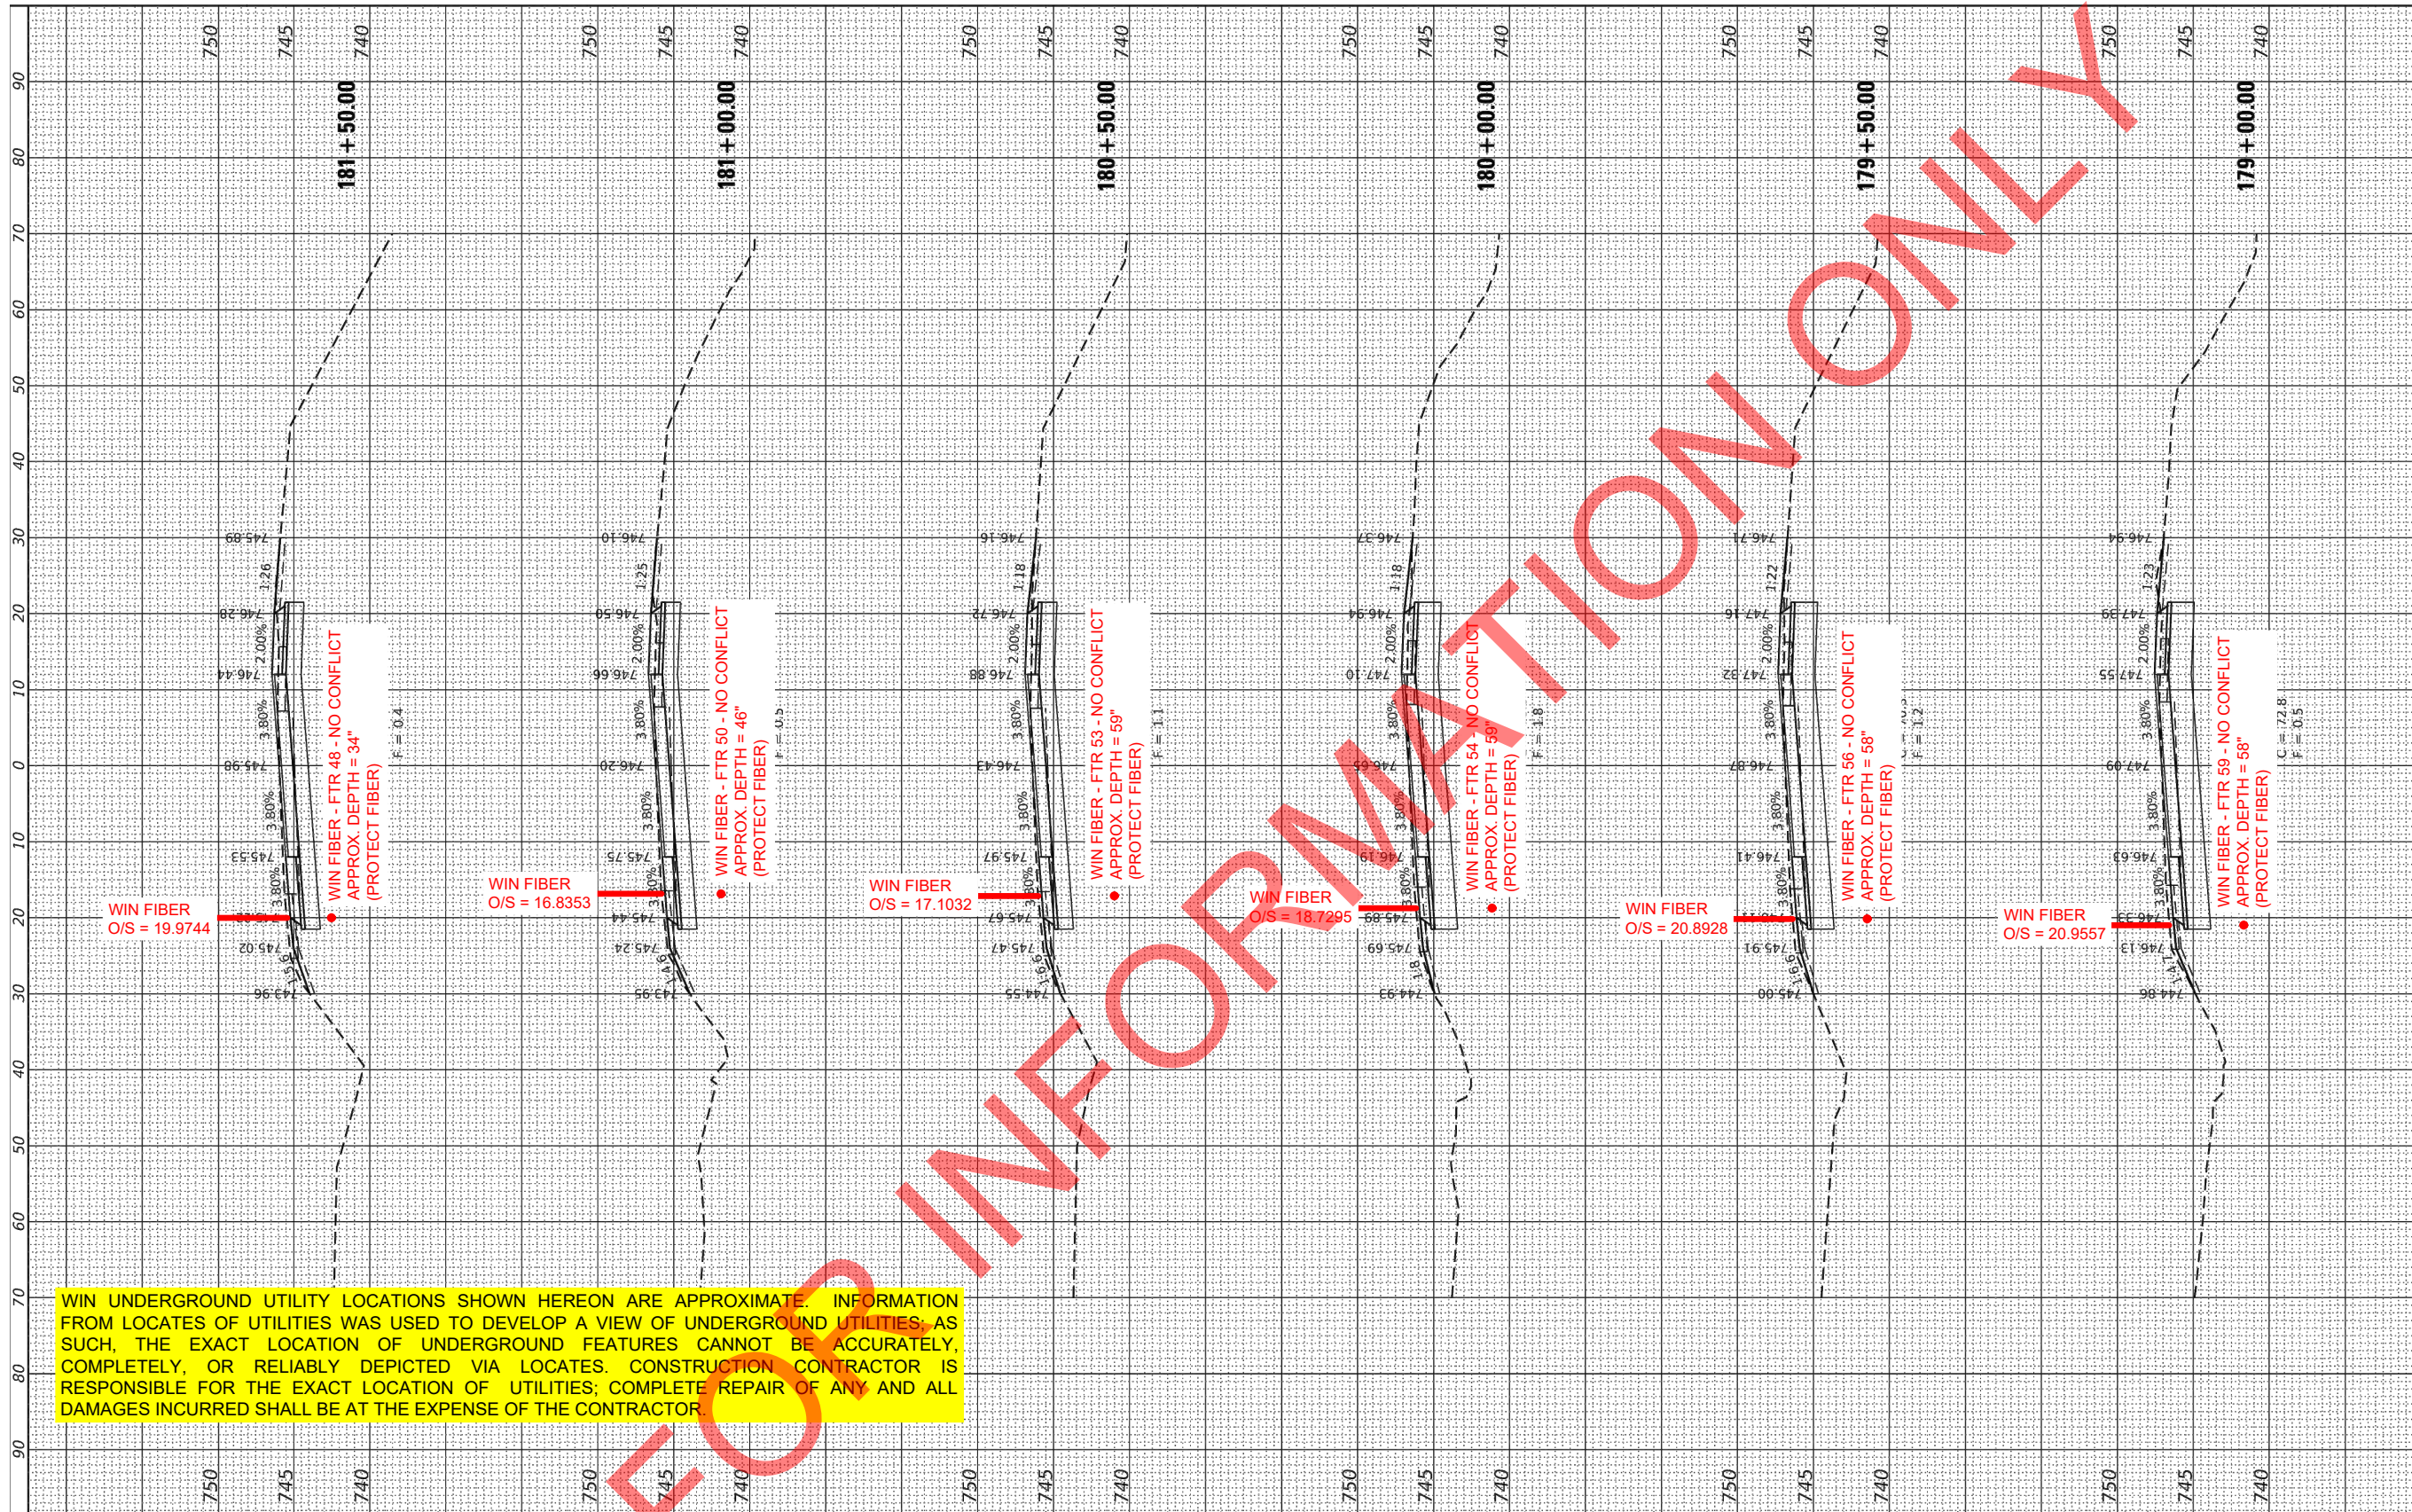

WIN UNDERGROUND UTILITY LOCATIONS SHOWN HEREON ARE APPROXIMATE. INFORMATION FROM LOCATES OF UTILITIES WAS USED TO DEVELOP A VIEW OF UNDERGROUND UTILITIES; AS SUCH, THE EXACT LOCATION OF UNDERGROUND FEATURES CANNOT BE ACCURATELY, COMPLETELY, OR RELIABLY DEPICTED VIA LOCATES. CONSTRUCTION CONTRACTOR IS RESPONSIBLE FOR THE EXACT LOCATION OF UTILITIES; COMPLETE REPAIR OF ANY AND ALL DAMAGES INCURRED SHALL BE AT THE EXPENSE OF THE CONTRACTOR.

**BLA, Inc.**  
ITASCA, ILLINOIS

USER NAME = WTeng	DESIGNED - WT	REVISED -
PLOT SCALE = 20.0000' / in.	DRAWN - JPO	REVISED -
PLOT DATE = 1/15/2024	CHECKED -	REVISED -
	DATE - 7/31/2023	REVISED -

**STATE OF ILLINOIS**  
**DEPARTMENT OF TRANSPORTATION**


**CROSS SECTIONS**  
**SPRINGFIELD AVENUE**

SCALE: 1:10H, 1:5V SHEET 3 OF 7 SHEETS STA. TO STA.

F.A.P. RTE.	SECTION	COUNTY	TOTAL SHEETS	SHEETS NC
525	111BR	WINNEBAGO	76	7
CONTRACT NO. 64P06				
ILLINOIS FED. AID PROJECT				

CONFLICT REVIEW PLAN SET



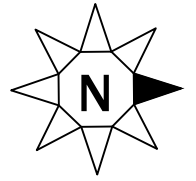

COUNTY:  
WINNEBAGO

MUNICIPALITY:  
CITY OF ROCKFORD

TOWN:  
44N

RANGE:  
1E

SECTION:  
5 & 8

ROAD NAME:  
SPRINGFIELD AVENUE




IDOT PROJECT ID #: C-92-104-23

PROJECT NAME:  
CONFLICT REVIEW - KENT  
CREEK NORTH FORK BRIDGE  
REPLACEMENT

REVIEW DATE: 7/2024

WIN PROJECT ENGINEER  
KEN WHITING  
920-376-2996  
ken.whiting@wintechnology.com

WIN CONST COORDINATOR  
MIKE FERM  
515-493-6014  
mike.ferm@wintechnology.com

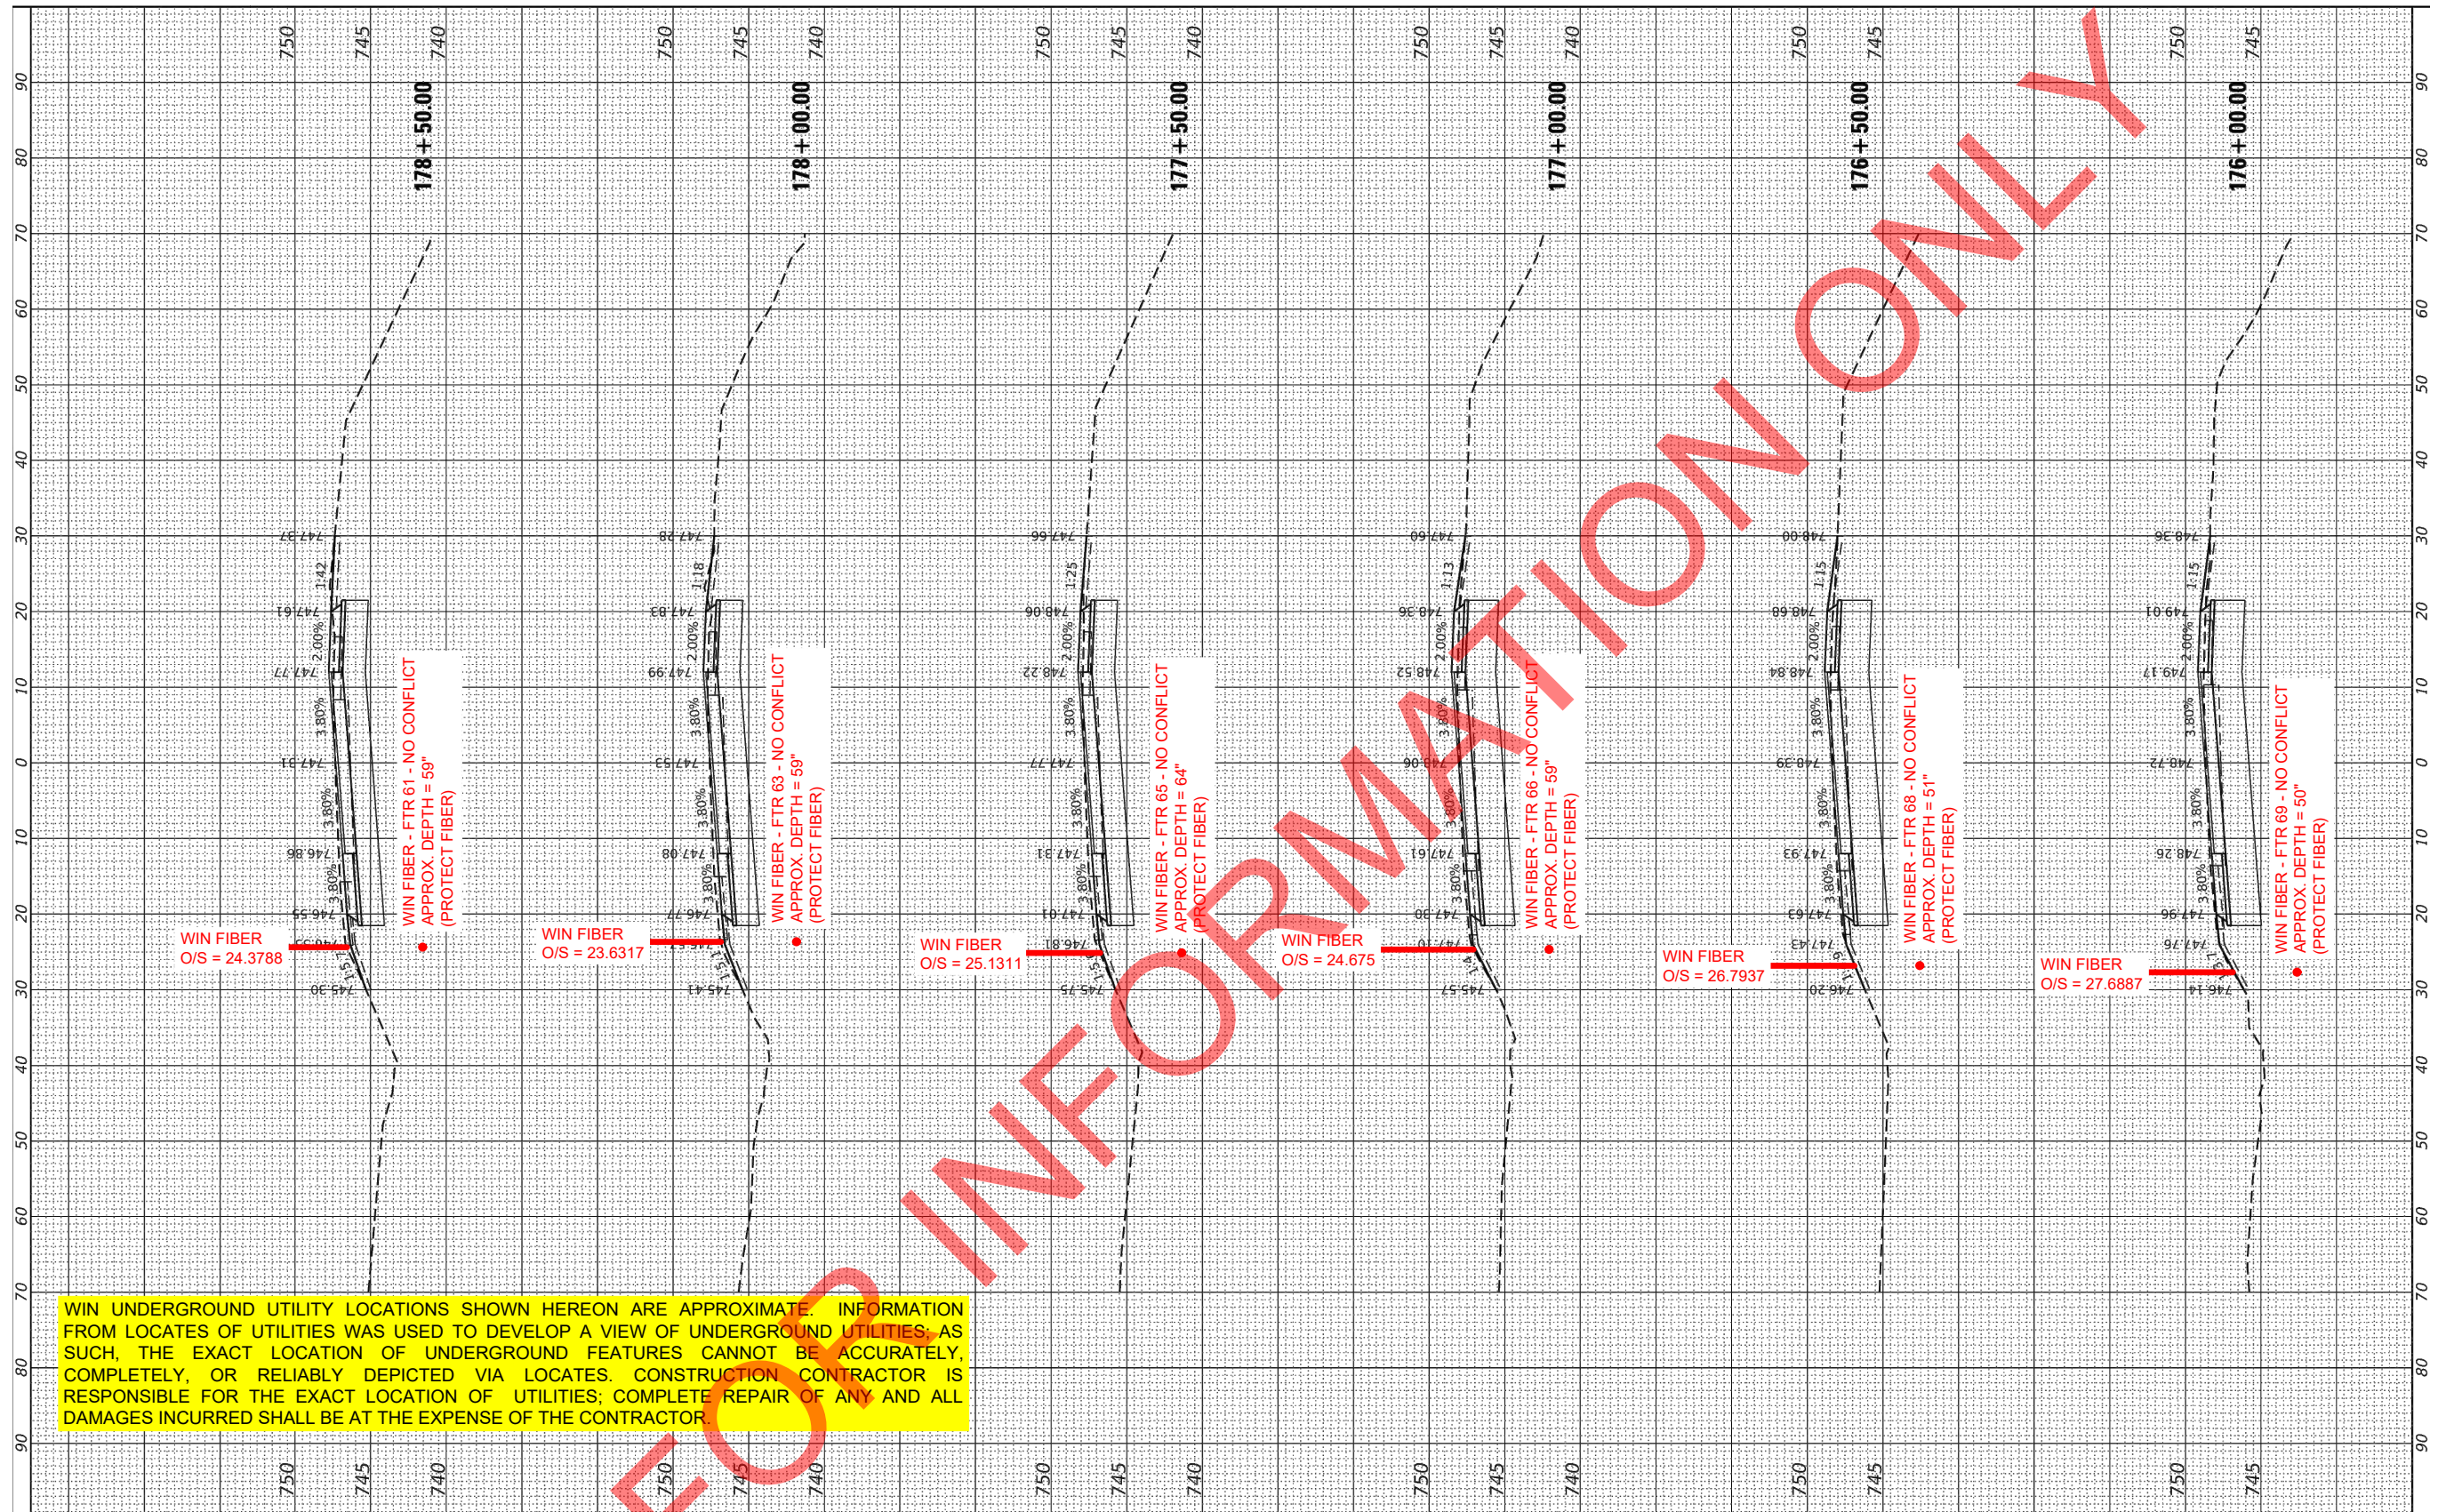

WIN UNDERGROUND UTILITY LOCATIONS SHOWN HEREON ARE APPROXIMATE. INFORMATION FROM LOCATES OF UTILITIES WAS USED TO DEVELOP A VIEW OF UNDERGROUND UTILITIES; AS SUCH, THE EXACT LOCATION OF UNDERGROUND FEATURES CANNOT BE ACCURATELY, COMPLETELY, OR RELIABLY DEPICTED VIA LOCATES. CONSTRUCTION CONTRACTOR IS RESPONSIBLE FOR THE EXACT LOCATION OF UTILITIES; COMPLETE REPAIR OF ANY AND ALL DAMAGES INCURRED SHALL BE AT THE EXPENSE OF THE CONTRACTOR.



USER NAME = Wteng	DESIGNED - WT	REVISED -
	DRAWN - WT	REVISED -
PLOT SCALE = 20.0000' / in.	CHECKED - JPO	REVISED -
PLOT DATE = 1/15/2024	DATE = 7/31/2023	REVISED -


STATE OF ILLINOIS  
DEPARTMENT OF TRANSPORTATION

CROSS SECTIONS SPRINGFIELD AVENUE	
F.A.P. RTE. 525	SECTION 111BR
SCALE: 1:10H, 1:5V SHEET 2 OF 7 SHEETS STA. TO STA.	

COUNTY	TOTAL SHEETS	SHEET NO.
WINNEBAGO	76	71
CONTRACT NO. 64P06		
ILLINOIS FED. AID PROJECT		

CONFLICT REVIEW PLAN SET



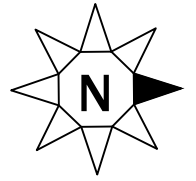

COUNTY:  
WINNEBAGO

MUNICIPALITY:  
CITY OF ROCKFORD

TOWN:  
44N

RANGE:  
1E

SECTION:  
5

ROAD NAME:  
SPRINGFIELD AVENUE




IDOT PROJECT ID #: C-92-104-23

PROJECT NAME:  
CONFLICT REVIEW - KENT  
CREEK NORTH FORK BRIDGE  
REPLACEMENT

REVIEW DATE: 7/2024

WIN PROJECT ENGINEER  
KEN WHITING  
920-376-2996  
ken.whiting@wintechnology.com

WIN CONST COORDINATOR  
MIKE FERM  
515-493-6014  
mike.ferm@wintechnology.com

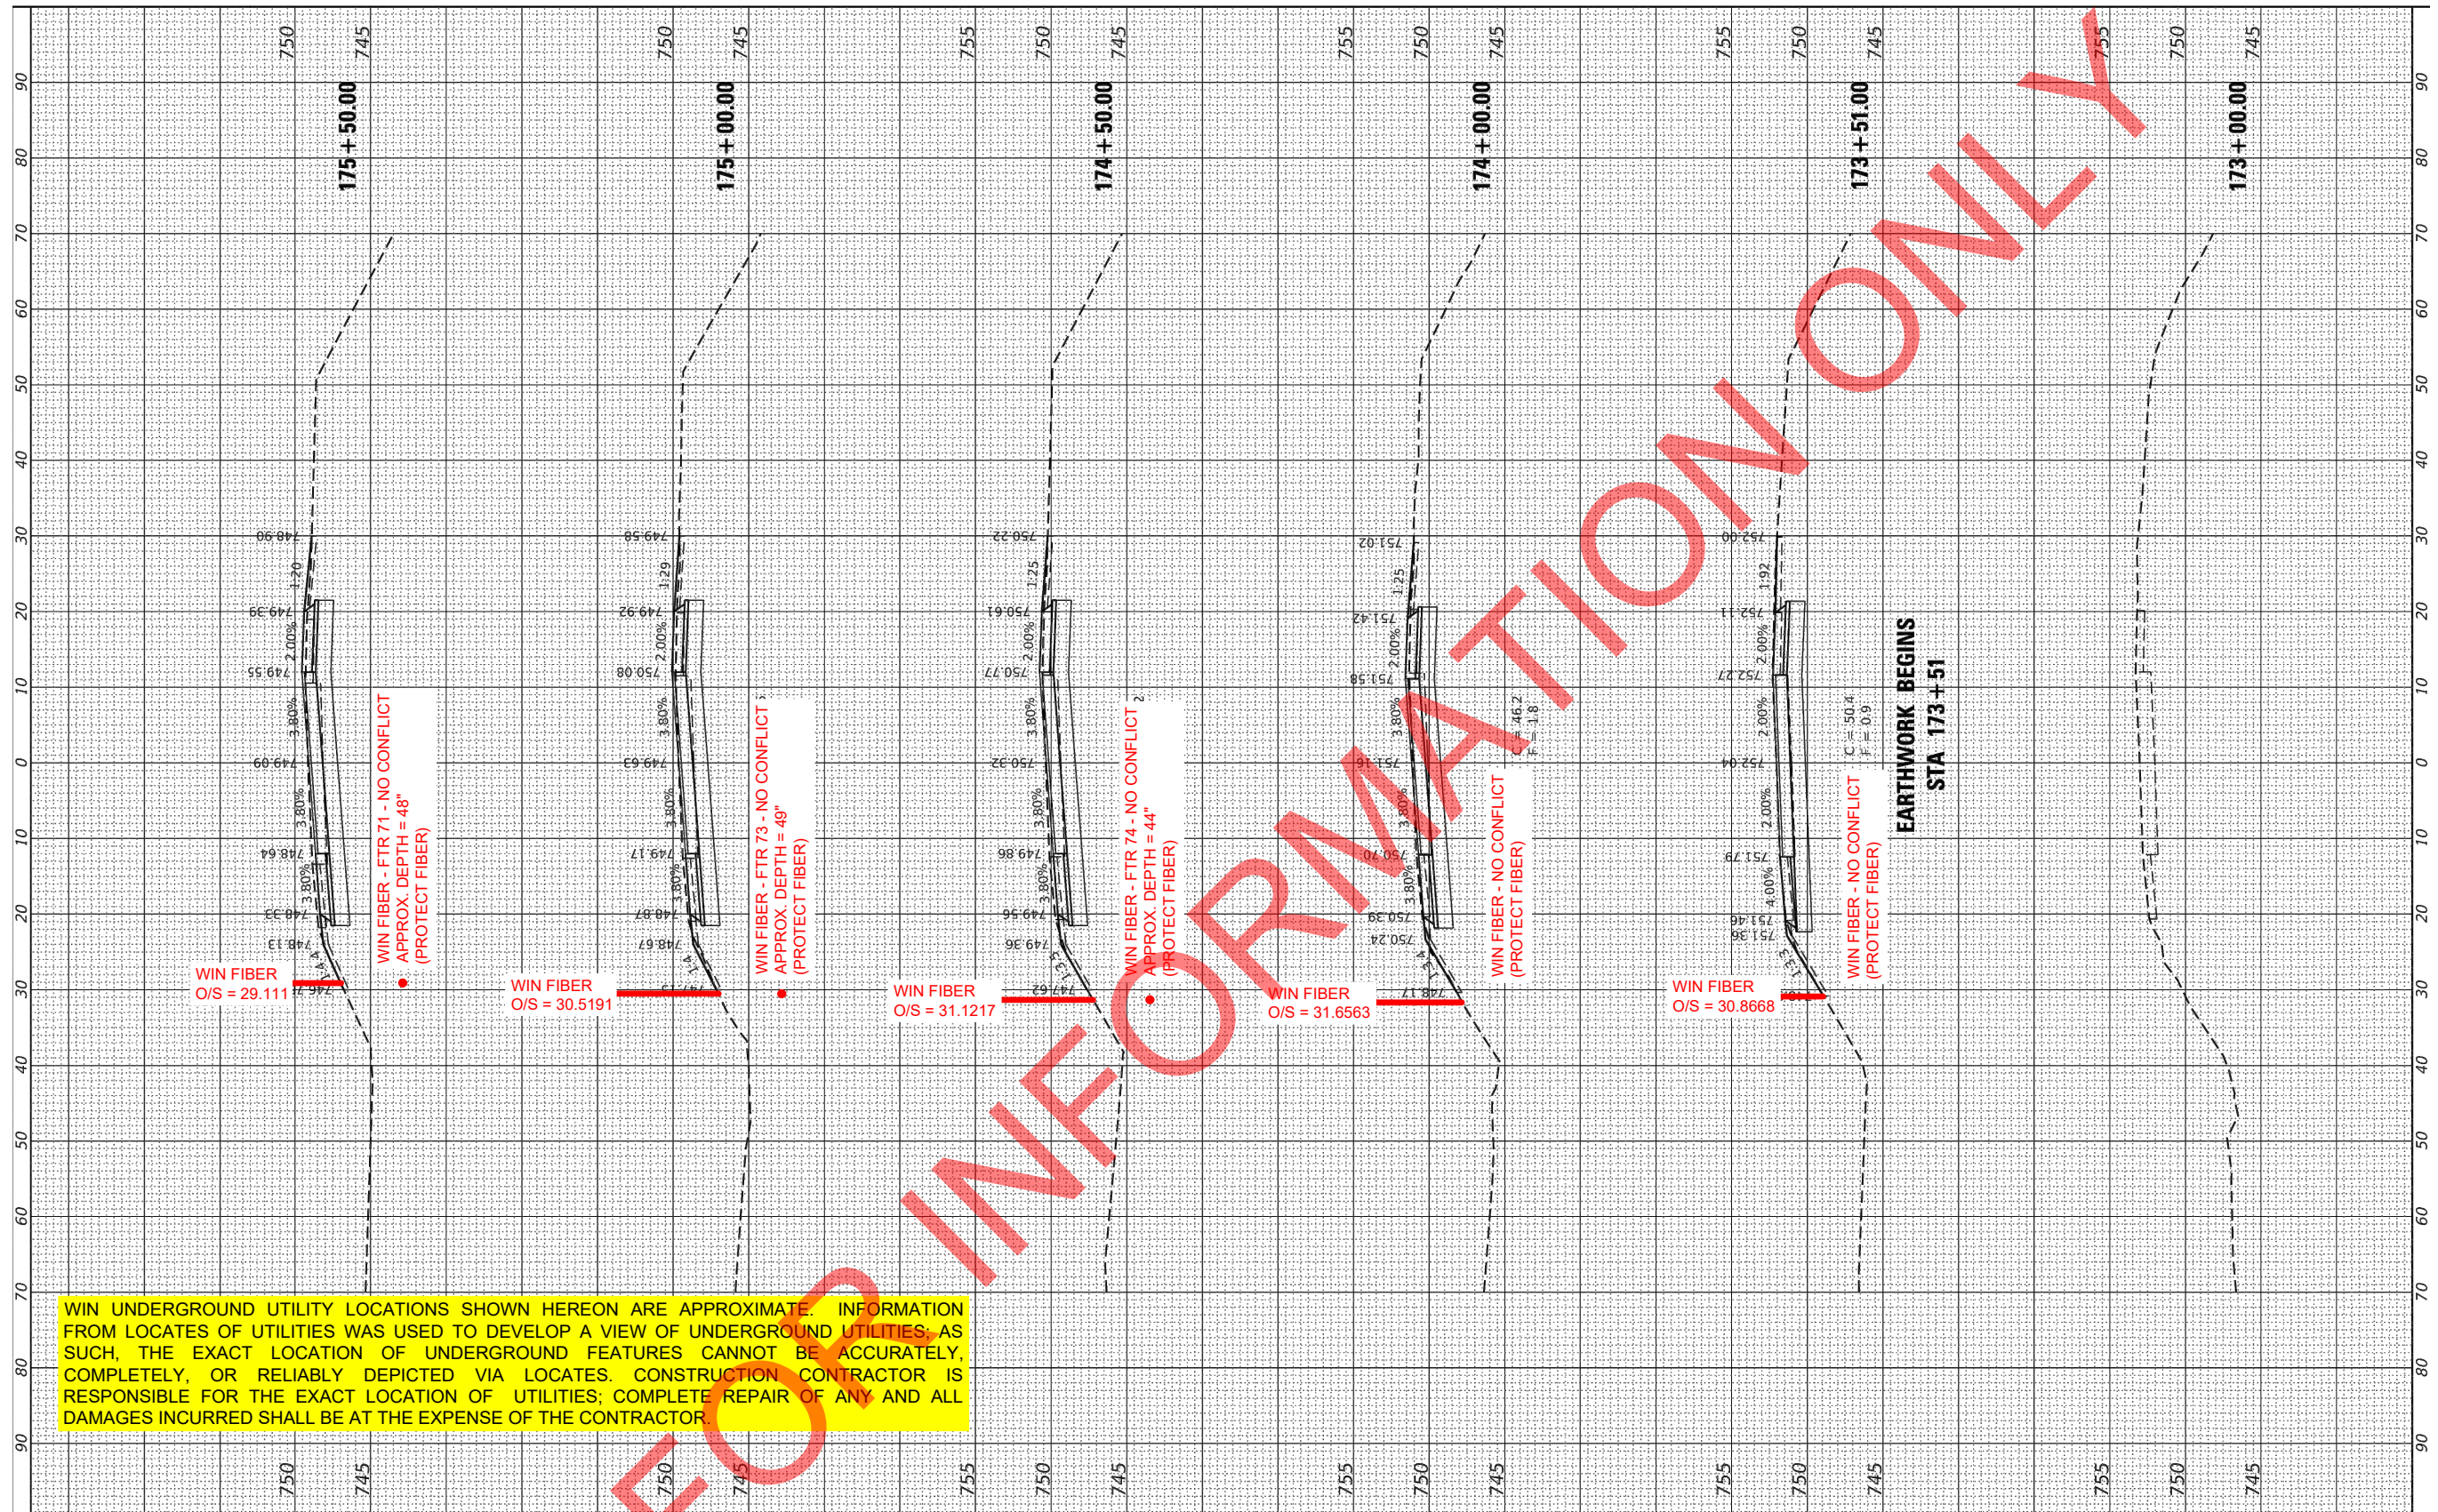

WIN UNDERGROUND UTILITY LOCATIONS SHOWN HEREON ARE APPROXIMATE. INFORMATION FROM LOCATES OF UTILITIES WAS USED TO DEVELOP A VIEW OF UNDERGROUND UTILITIES; AS SUCH, THE EXACT LOCATION OF UNDERGROUND FEATURES CANNOT BE ACCURATELY, COMPLETELY, OR RELIABLY DEPICTED VIA LOCATES. CONSTRUCTION CONTRACTOR IS RESPONSIBLE FOR THE EXACT LOCATION OF UTILITIES; COMPLETE REPAIR OF ANY AND ALL DAMAGES INCURRED SHALL BE AT THE EXPENSE OF THE CONTRACTOR.

<p>BLA, Inc. ITASCA, ILLINOIS</p>	USER NAME = Wteng	DESIGNED - WT	REVISED -	<p align="center"><b>STATE OF ILLINOIS</b> <b>DEPARTMENT OF TRANSPORTATION</b></p>	<p align="center"><b>CROSS SECTIONS</b> <b>SPRINGFIELD AVENUE</b></p>	F.A.P. RTE. = 525	SECTION = 111BR	COUNTY = WINNEBAGO	TOTAL SHEETS = 76	SHEET NO. = 70
	PLOT SCALE = 20.0000' / in.	DRAWN - WT	REVISED -			SCALE: 1:10H, 1:5V	SHEET 1 OF 7 SHEETS	CONTRACT NO. 64P06	ILLINOIS FED. AID PROJECT	
	PLOT DATE = 3/15/2024	CHECKED - JPO	REVISED -			DATE = 7/31/2023	TO STA.			

CONFLICT REVIEW PLAN SET