


F.A. RTE.	SECTION	COUNTY	TOTAL SHEETS	SHEET NO.
338/IL 59	2011-030	DUPAGE	0	3

STA.	TO STA.
FED. ROAD DIST. NO.	ILLINOIS CONTRACT 60P42

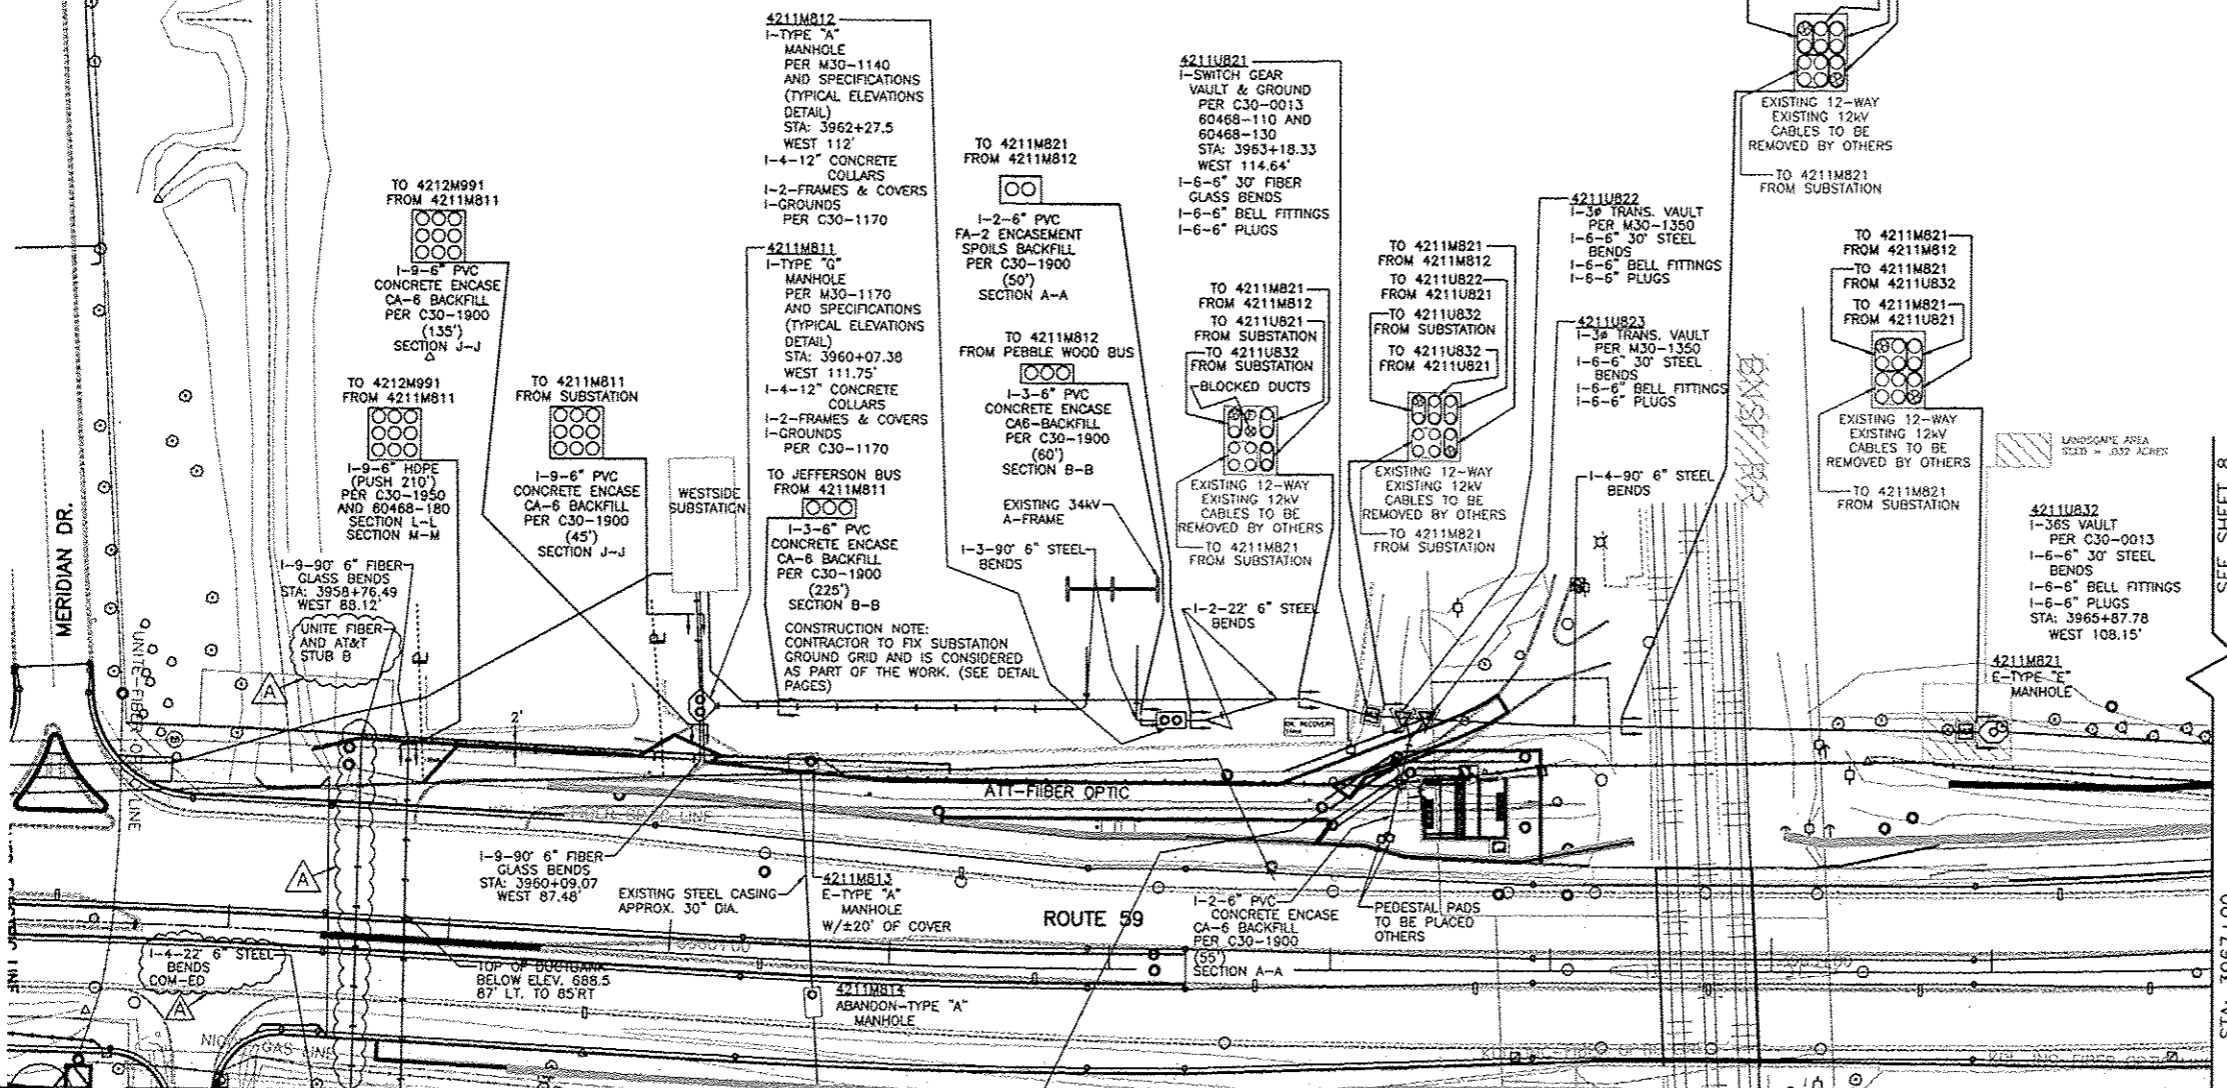

LEGEND

EXISTING UNDERGROUND	
⊙	E-SW. VAULT
⊙	E-SW. MOD.
⊙	E-TRANSFORMER
⊙	E-TYPE "A" MANHOLE
⊙	E-TYPE "C" MANHOLE
⊙	E-TYPE "C" DOUBLE OPENING MANHOLE
⊙	E-TYPE "D" MANHOLE
⊙	E-TYPE "E" MANHOLE
⊙	E-CONDUIT
ABANDON UNDERGROUND	
—	E-DISTRIBUTION/TRANSMISSION POLE
INSTALL UNDERGROUND	
⊙	I-SW. VAULT
⊙	I-TRANSFORMER VAULT
⊙	I-TYPE "A" MANHOLE
⊙	I-TYPE "E" DOUBLE OPENING MANHOLE
⊙	I-TYPE "G" DOUBLE OPENING MANHOLE
⊙	I-TYPE "G" SINGLE OPENING MANHOLE
—	I-CONDUIT
ABANDON UNDERGROUND	
—	A-CONDUIT

SEE SHEET 8
SEE SHEET 8
SEE SHEET 8

CONSTRUCTION NOTE:
CONTRACTOR IS TO BE AWARE OF 36" AND 30" PROPOSED STORM SEWERS. PRIOR TO CROSSING WITH 2-6" CONDUITS.

CALL JULIE 48 HRS. PRIOR TO CONSTRUCTION 1-800-892-0123 OR CALL 811		
NOTES: 1. THE PROJECT ENGINEER FOR THIS JOB IS BRIAN CHAMBERLAIN AT (630)420-6653. 2. THE PROJECT COORDINATOR FOR THIS PROJECT IS PAUL MICHALOWSKI AT (630)305-5227. 3. CONTRACTOR IS RESPONSIBLE FOR MANHOLE PHOTOS TAKEN OF ALL CLEARLY MARKED CABLE AND ALL WALLS OF MANHOLES. PHOTOS WILL BE GIVEN TO THE GIS GROUP WITH THE AS-BUILTS.		
LOCATION MAP	DESIGN REVISION DATES	ADDENDUM A 7-16-12

ROUTE 59 ROAD IMPROVEMENTS			
PROJECT DESCRIPTION TO RELOCATE AND INSTALL NEW DUCTBANK AND 34KV FEEDERS			
ENGINEER	DRAWN DATE	APP #	SCALE
BCC	5-11-12	4211.4212.4223	1 = 40
DESIGNED BY	DESIGNED DATE	APP. JOINT AGREEMENT #	PROJECT #
DL	PSM	N/A	EU-12
REVISIONS BY	APPROVED BY	CAD FILE	SHEET #
		0060468001C3.DWG	3 OF 63
Naperville Department of Public Utilities Electric Division			
CONTRACT 60P42 SHEET 135 OF 234			

